



- LEGEND**
- Existing concrete (to remain)
 - Existing concrete or curb (to be removed & rebuilt)
 - Existing granite (to remain)
 - Existing concrete (to be removed)


I-95 SOUTHBOUND OVER PISCATAQUIS RIVER (6069)

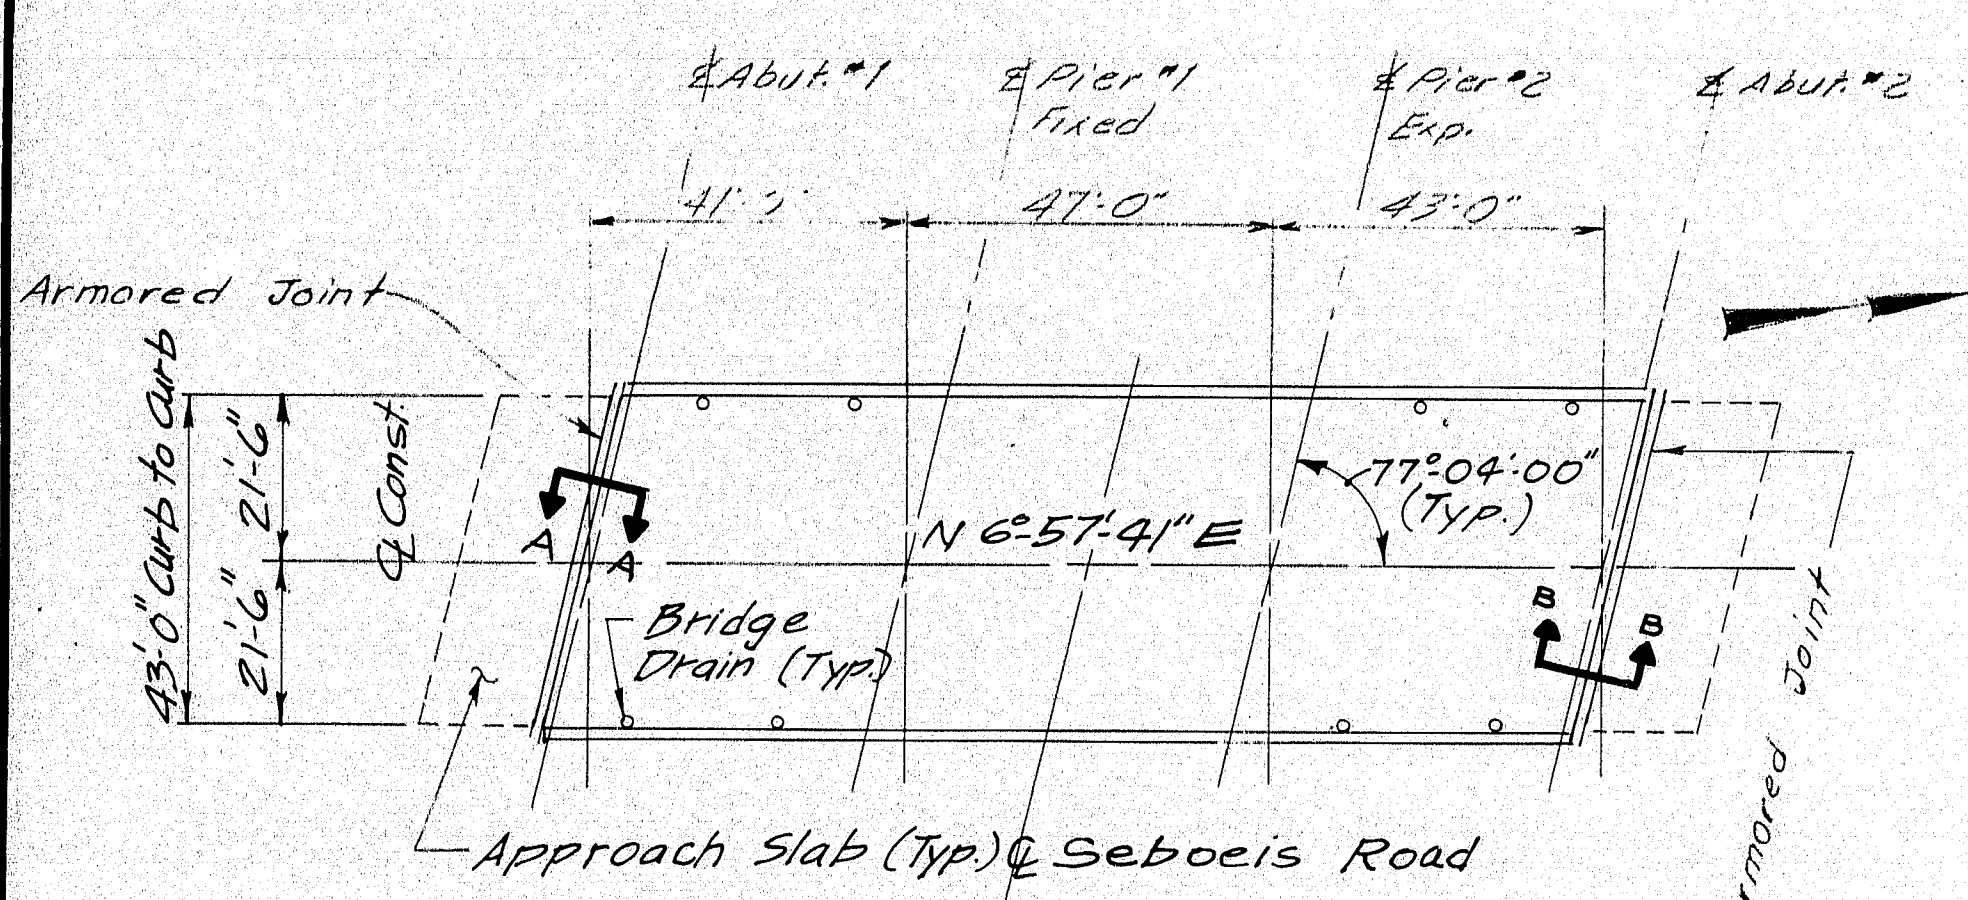


I-95 SOUTHBOUND OVER SEBOEIS ROAD (6070)

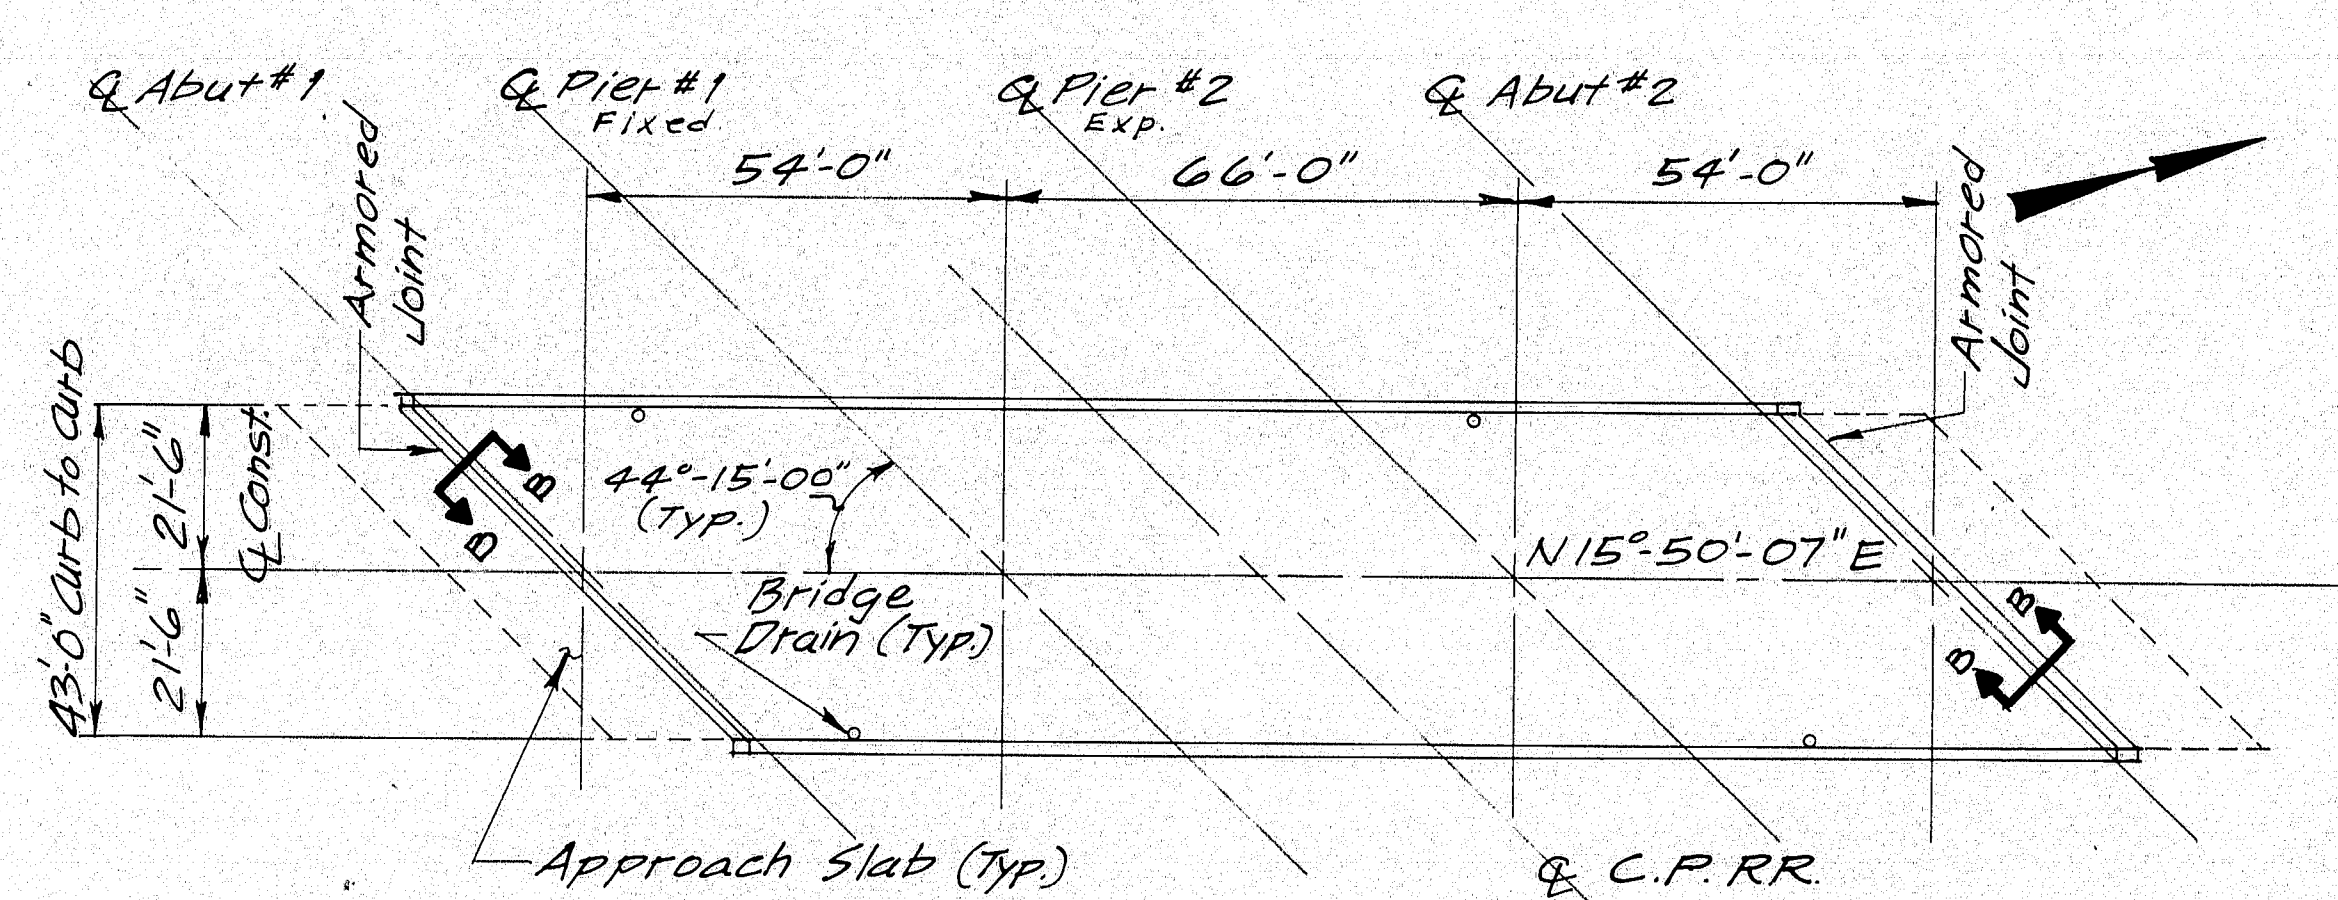


I-95 SOUTHBOUND OVER CANADIAN PACIFIC RR (6075)

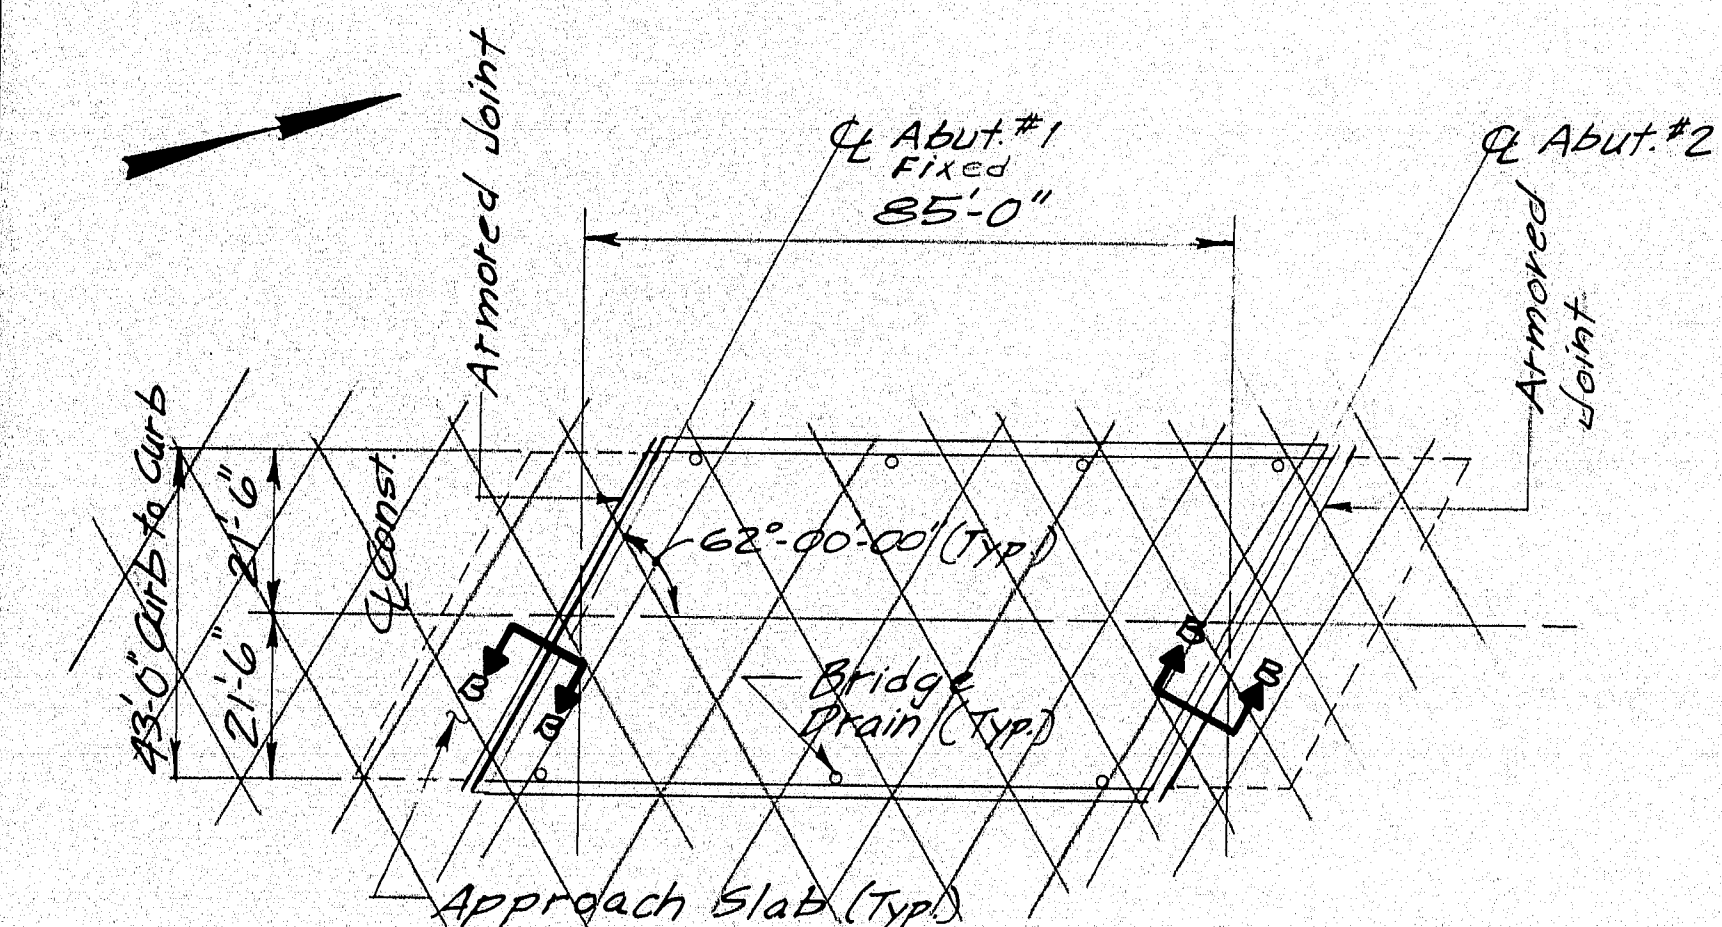


I-95 NORTHBOUND OVER SALMON STREAM (6164)

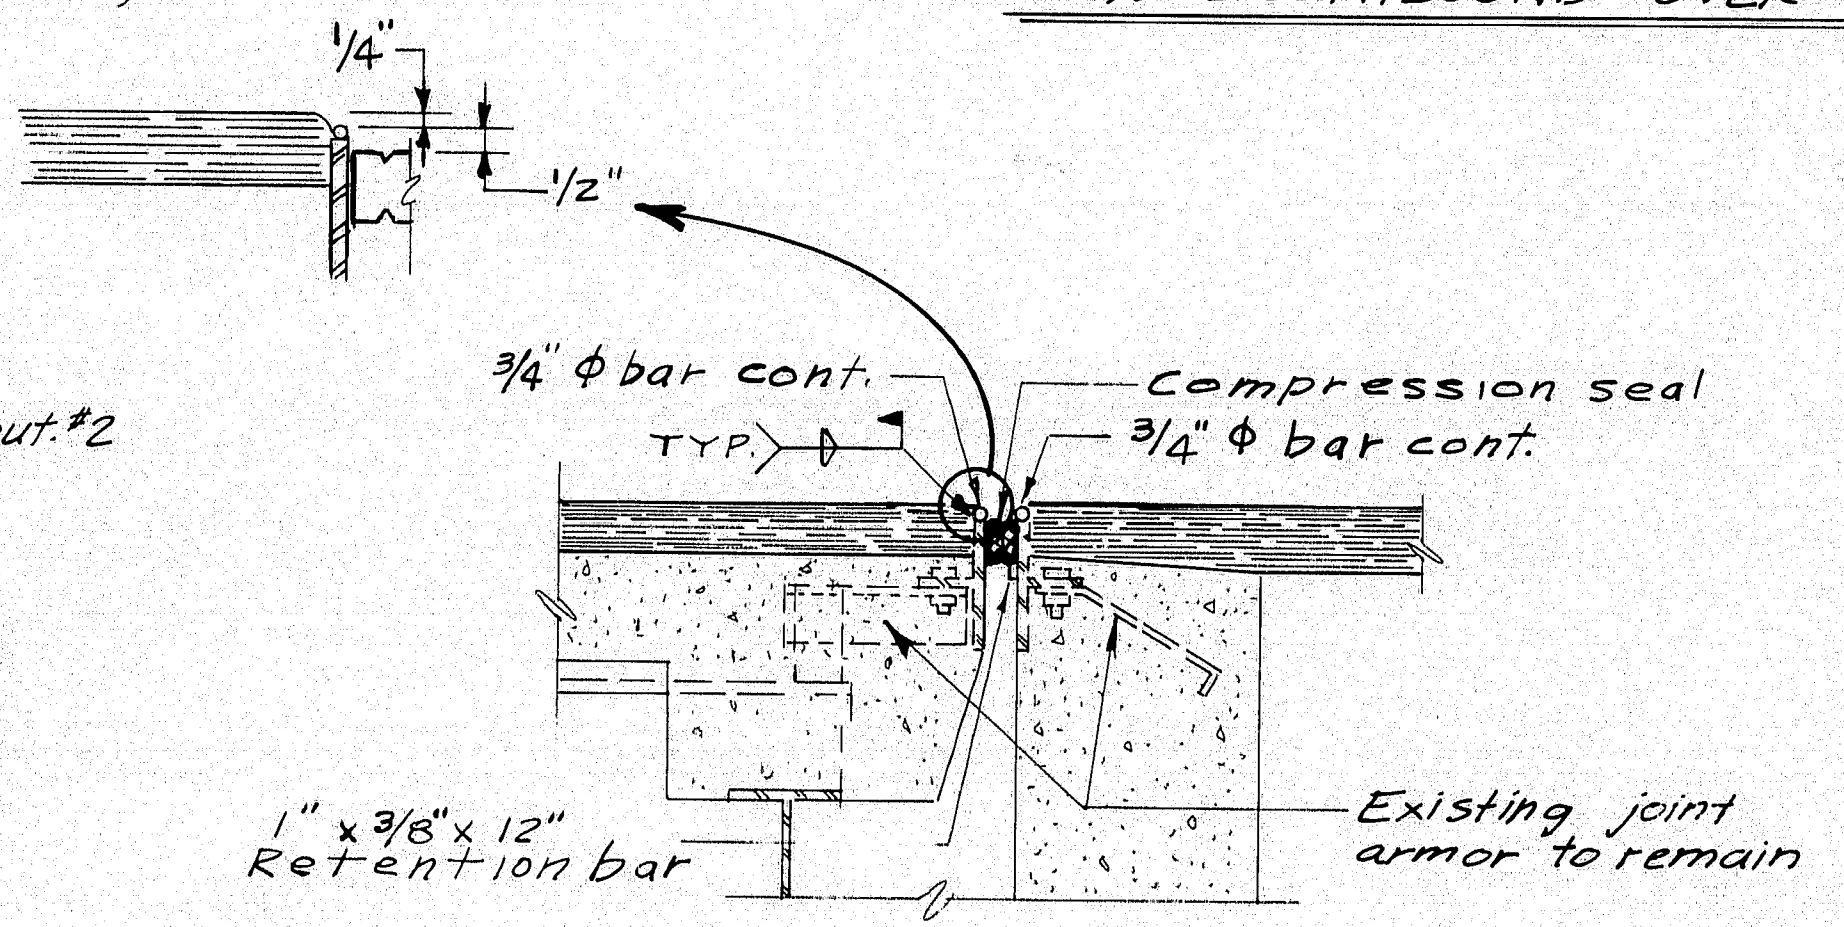

SECTION A-A

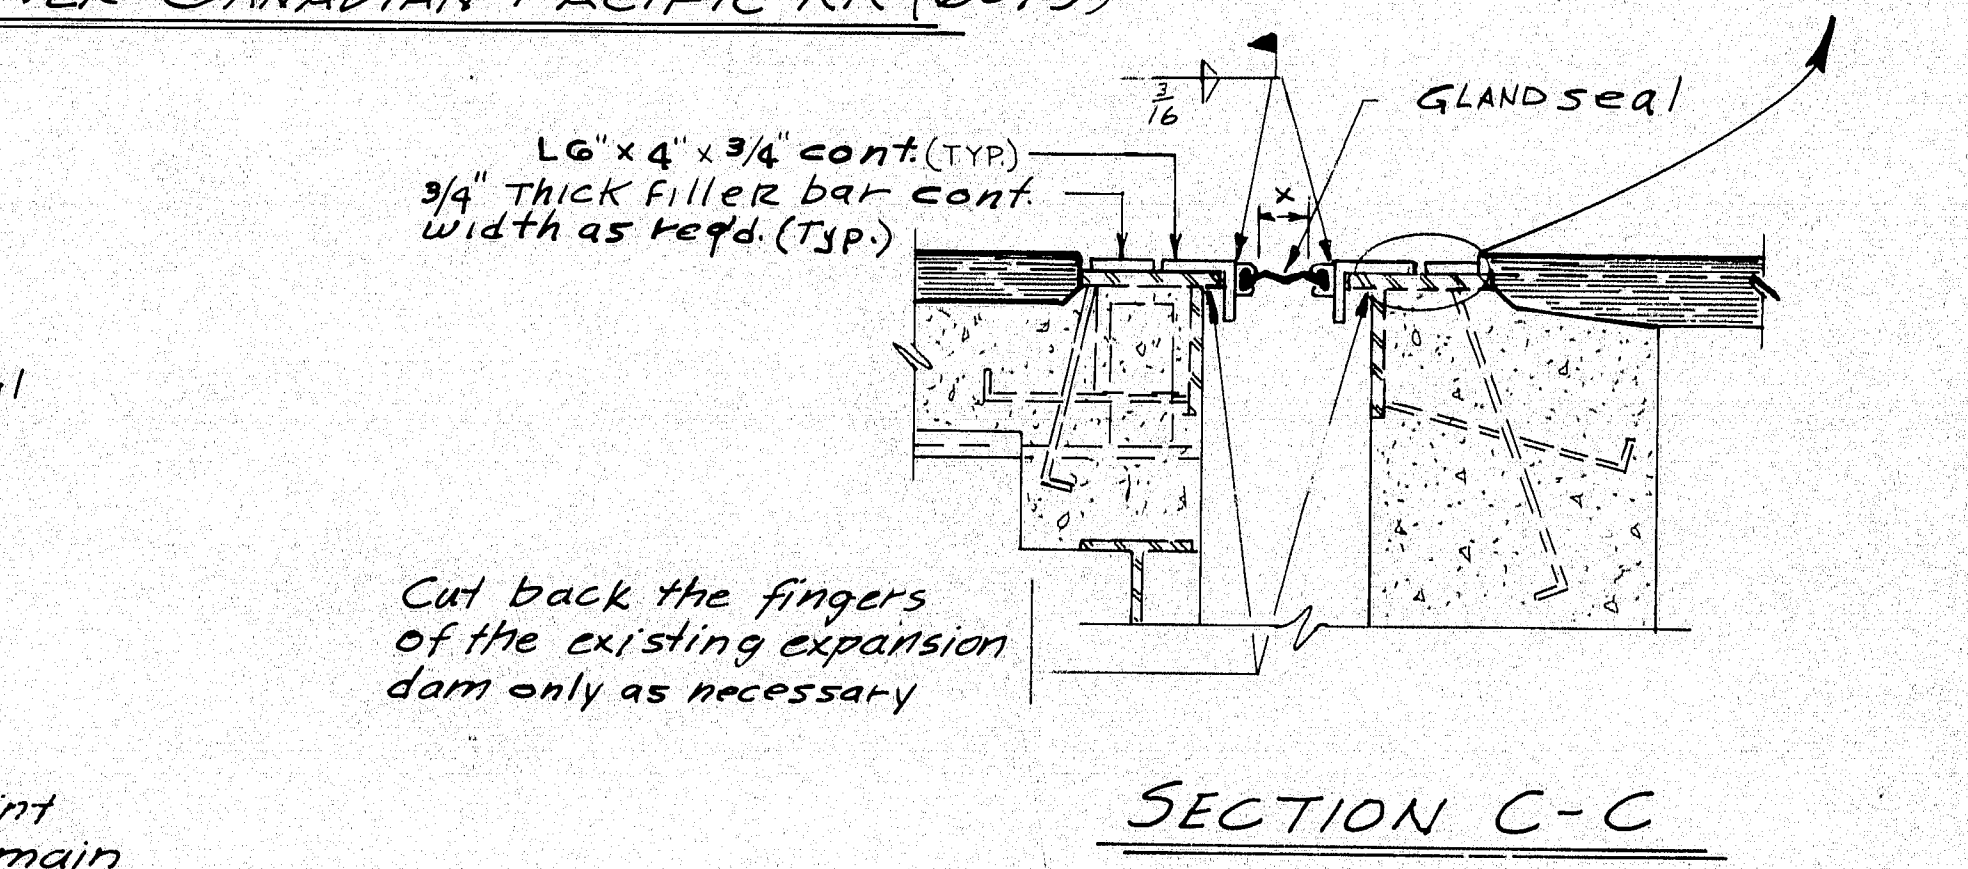

SECTION C-C

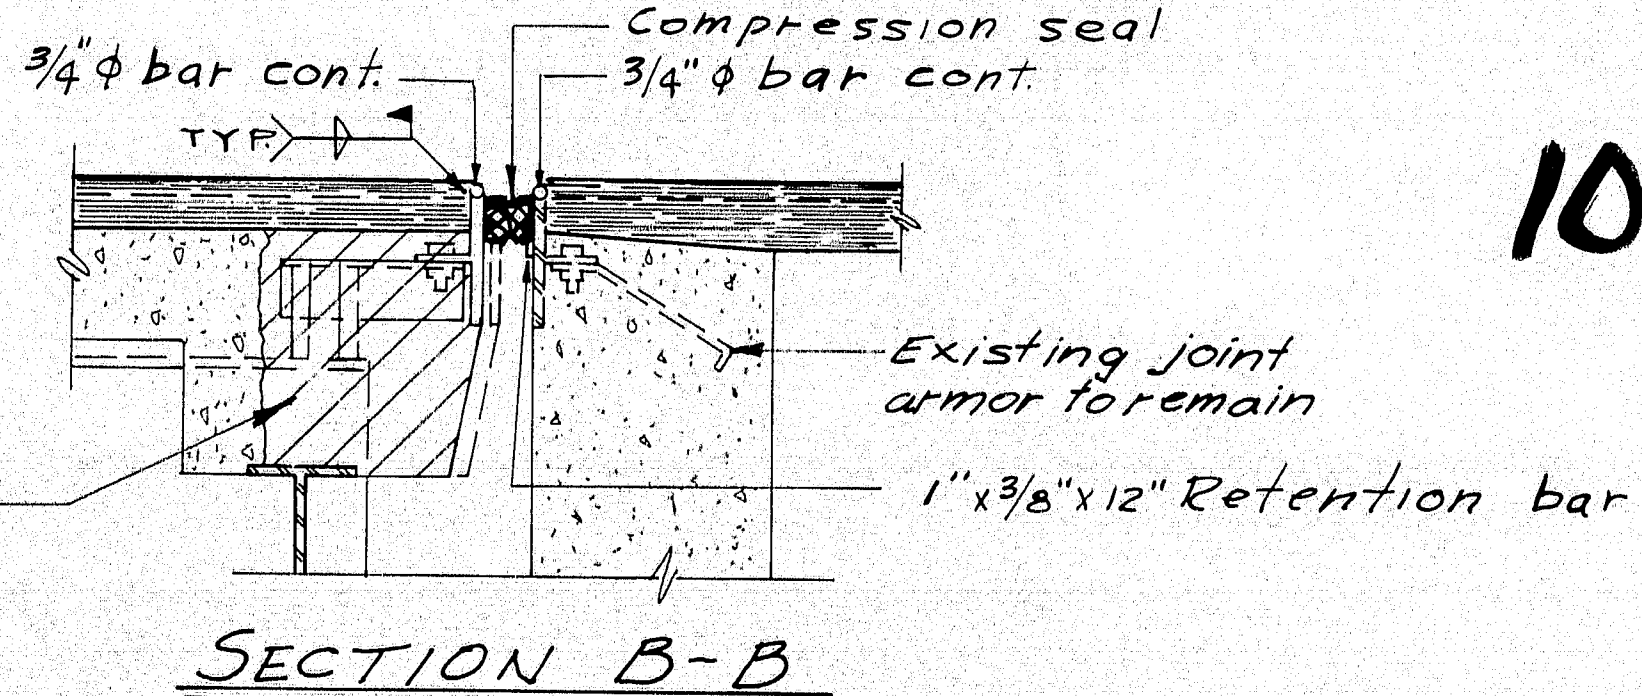

SECTION B-B

PROJECT NO.	STATE	PROJECT NUMBER	SHEET NO.	TOTAL SHEETS
1	MAINE	IRG-95-8(133)	24	34
		IRG-95-8(134)		

SPECIFICATIONS

DESIGN: LOAD FACTOR DESIGN PER AASHTO STANDARD SPECIFICATIONS FOR HIGHWAY BRIDGES 1983, AND INTERIM SPECIFICATIONS THROUGH 1985.

CONTRACT: STATE OF MAINE, DEPARTMENT OF TRANSPORTATION, STANDARD SPECIFICATIONS HIGHWAYS AND BRIDGES, REVISION OF JAN. 1984.

MATERIALS: CONCRETE--CLASS A4
REINFORCING STEEL--ASTM A615, GRADE 60.

BASIC DESIGN STRESSES: CONCRETE--f'c = 3,000 PSI;
REINFORCING STEEL--fy = 60,000 PSI.


PLANS OF THE EXISTING BRIDGES ARE AVAILABLE FOR THE CONTRACTOR'S REFERENCE AT THE BRIDGE DESIGN OFFICE IN AUGUSTA. THE PLANS ARE REPRODUCTIONS OF ORIGINAL DRAWINGS AS PREPARED FOR THE CONSTRUCTION OF THE BRIDGES AND IT IS VERY UNLIKELY THAT THE PLANS WILL SHOW ANY CONSTRUCTION FIELD CHANGES OR ANY ALTERATIONS WHICH MAY HAVE BEEN MADE TO THE BRIDGES DURING THEIR LIFE SPAN.

- INDEX OF SHEETS**
- General Plan & Sections
 - Scope Notes & Sections
 - Half Sections & Joint Details
 - End Post & Guard Rail Connection (Piscataquis River Bridge)
 - Rail Connection & Joint Modifications (Canadian Pacific RR)
 - General Plan & Details (Route 116 & Vaughn Duggett Bridges)
 - End Post & Guard Rail Connection
 - Reinforcing Steel Schedule

- STANDARDS**
- BD 114-81 Aluminum Bridge Railing
 - BD 125-82 Compression & Gland Seal
 - BD 127-81 Temporary Concrete Barrier

AS BUILT
Revised & Issued
3-2-92

CARROLL E. TAYLOR & ASSOCIATES
CONSULTING ENGINEERS
410 SUMMER STREET
AUBURN MAINE

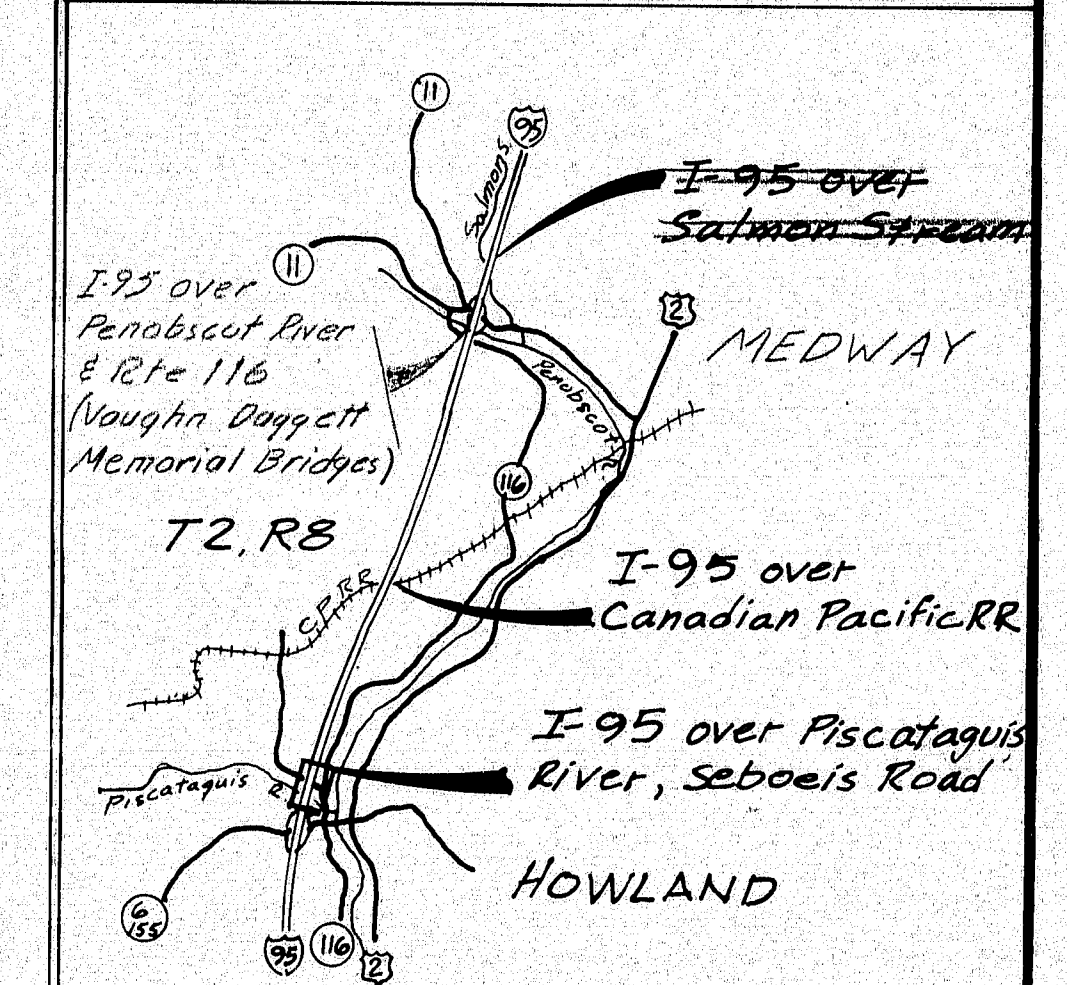

LOCATION MAP

0 5 10 15 20
Scale in Miles

STATE OF MAINE
DEPARTMENT OF TRANSPORTATION

INTERSTATE 95 SOUTHBOUND OVER
Piscataquis River, Seboeis Road,
Canadian Pacific RR


INTERSTATE 95 NORTHBOUND OVER
Salmon Stream

HOWLAND - T2, R8 - MEDWAY
GENERAL PLAN & SECTIONS

SHEET 1 OF 11 AUGUSTA, MAINE

HOWLAND - T2, R8 - MEDWAY 95-8(133)/95-8(134)

104-144

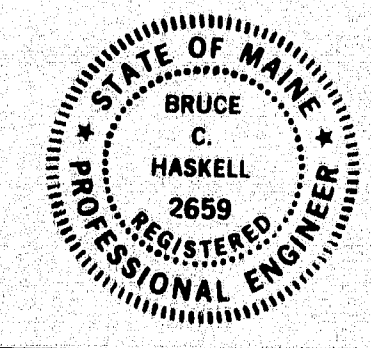

PROJECT DESIGN ENGINEER	BY	DATE
PLANS	BY	DATE
DESIGN - DETAILED	BY	DATE
CHECKED	BY	DATE
REVISIONS		
FIELD CHANGES		

BRIDGE 4413 497101


CONSTRUCTION NOTES

1. Maintain 12' of unobstructed traffic at all times.
2. All work shall be done within the existing concrete barriers.
3. The top surface of the existing concrete slabs shall be repaired as directed.
4. Depress the bituminous wearing surface around the existing bridge drains as directed.
5. Because of staged construction some expansion joints may require construction joints. These shall be as approved by the Engineer as to type and locations.
6. Payment for drilling & grouting associated with modifications of the joints will be considered incidental to the bridge joint modification items.
7. All grout shall contain a non-shrink additive.
8. Payment for removing and re-installing or modifying existing bridge rail, cutting - removing granite bridge curb and replacing with concrete, as directed, will be considered incidental to the bridge joint modification items unless otherwise noted.
9. Reinforcing steel shall have a cover of 2 inches unless otherwise noted.
10. Where granite curb is called for to be removed to modify a joint or to install a seal, only the smallest amount necessary to accomplish the work shall be removed. It is preferable to remove curb to an existing joint, but if a joint is more than 3 feet away the curb shall be cut in the field. The decision about whether to cut or not, and where, shall be the Engineer's.
11. Payment for all materials, labor and incidentals required to adjust beam guard rail and anchors at the trailing end of all bridges shall be considered incidental to guard rail items.

SCOPE OF WORK


- ALL BRIDGES:
- *Remove 2 1/2 inch bituminous wearing surface and remove existing membrane waterproofing.
 - *Repair deck as necessary.
 - *Modify and seal expansion joints.
 - *Install membrane waterproofing and 3 inch bituminous wearing surface.
 - *Clean and paint all structural steel.
 - Modify approach pavement for new grades where required.
 - Modify end posts and attach terminal connectors at leading ends of all bridges plus trailing end of Piscataquis River Bridge.
 - At trailing end adjust beam guardrail as shown.

*Except Vaughn Dapgett & Route 116 Bridges

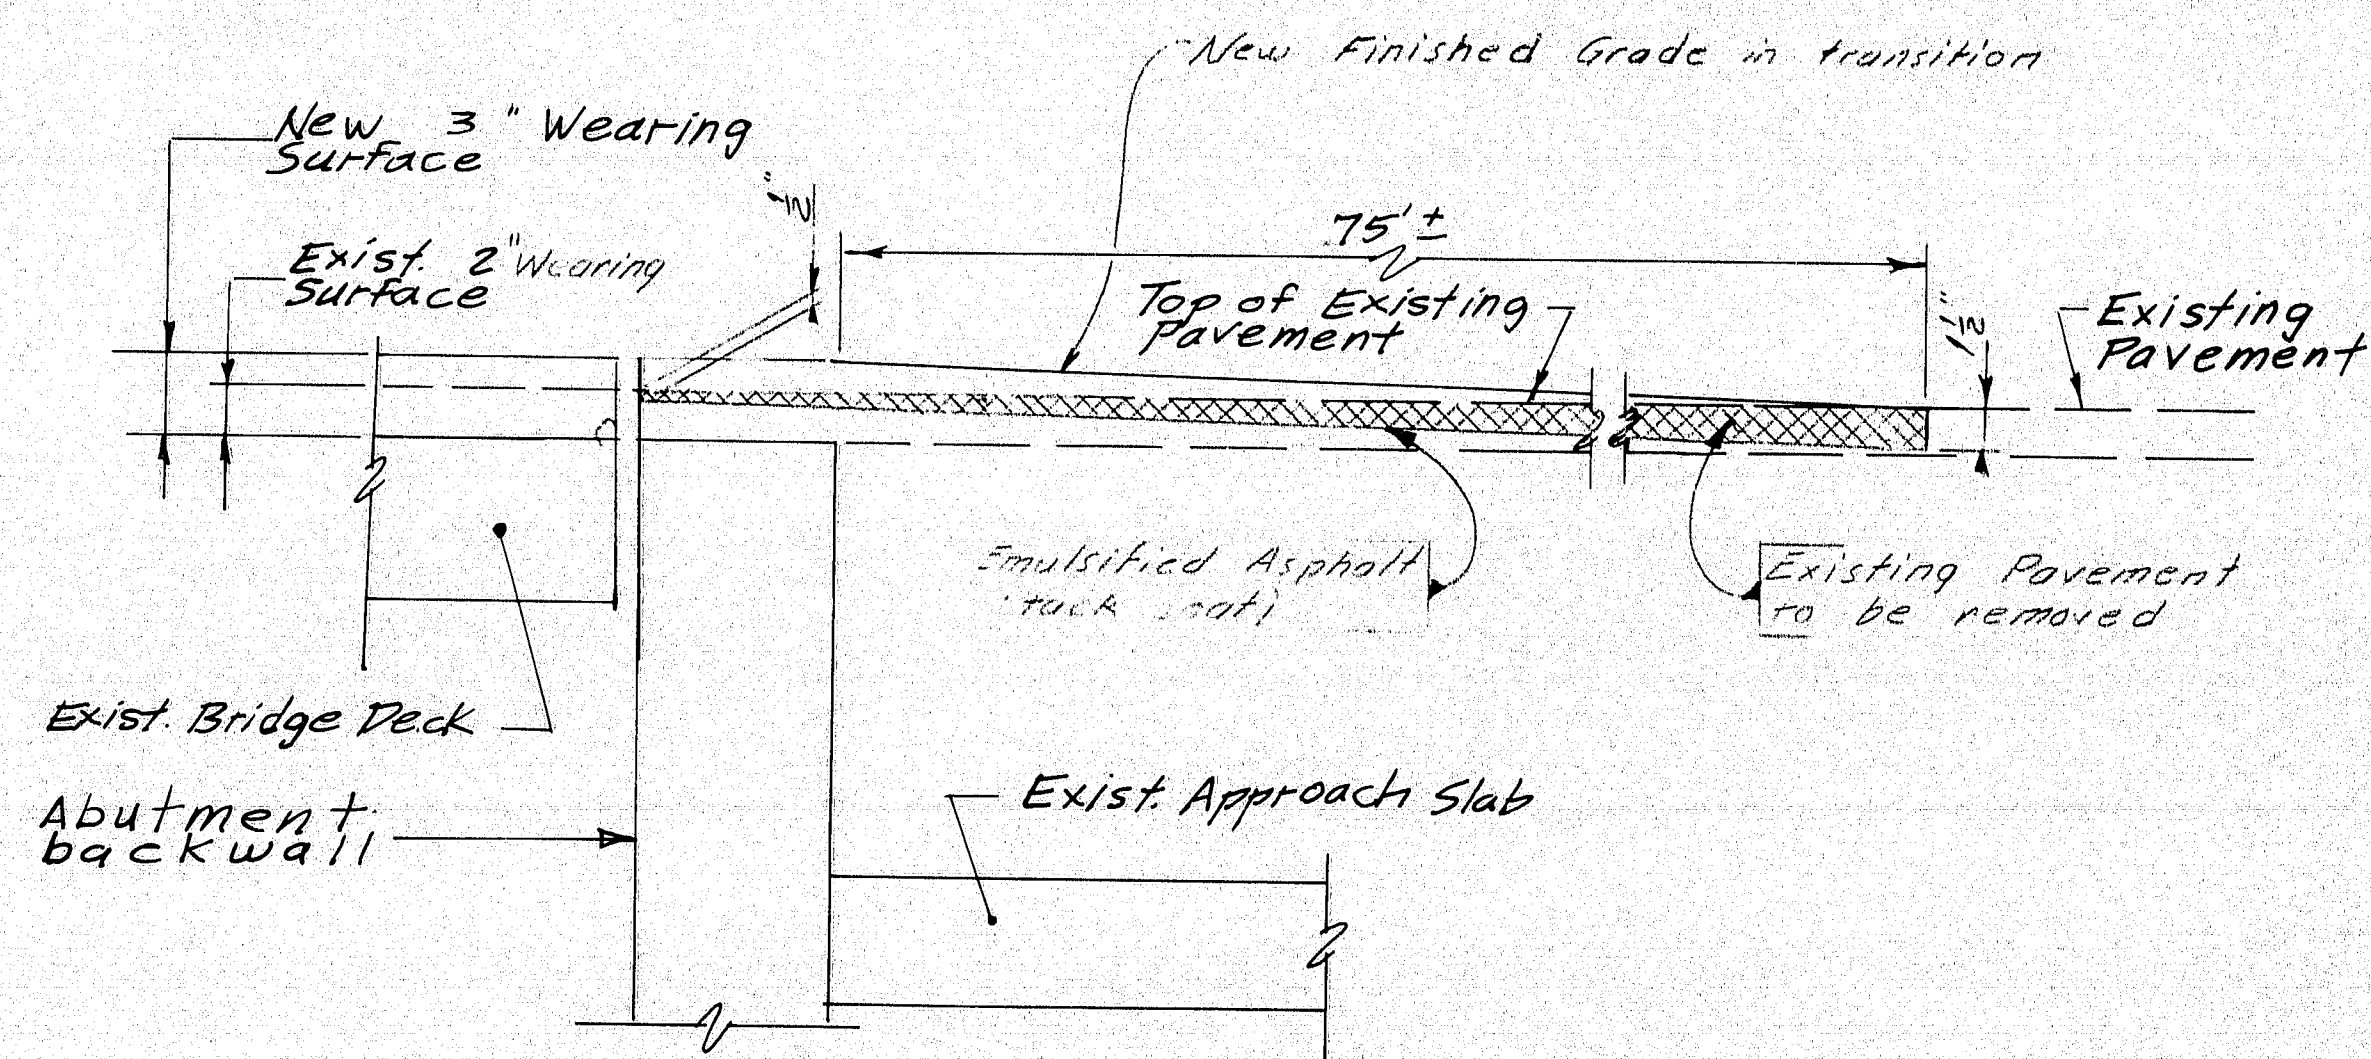

APPROACH PAVEMENT TRANSITION


- Both ends of Piscataquis River Bridge
- Both ends of Sebobeis Road
- South end only Canadian Pacific R.R.

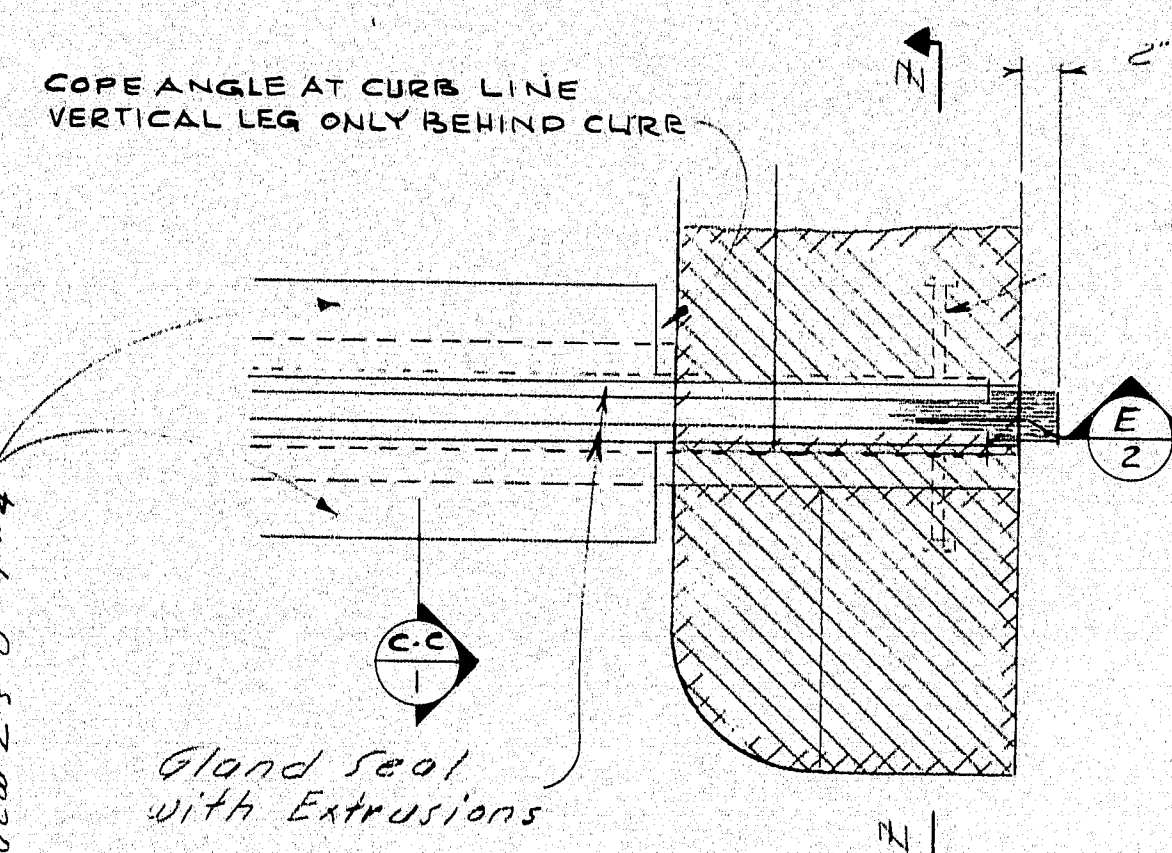


PARTIAL PLAN - GLAND SEAL

SEE RD 125-B2
NOTE: Any granite curb removed shall be replaced with concrete.


1. SEALS TO BE FURNISHED SHALL HAVE A MOVEMENT RATING OF:
3 3/8" - PISCATAQUIS R. (BOTH)
1 1/2" - CPRR (#2)
1 1/8" - SEBOEIS RD. (#2) AND SALMON STREAM (#2)
3/4" - CPRR (#1)
5/8" - SEBOEIS RD. (#1)
5/8" - SALMON STREAM (#1)
2. SEALS SHALL BE APPROVED BY THE ENGINEER PRIOR TO FABRICATION OF THE JOINT ARMOR.
3. COMPRESSION SEAL JOINT OPENINGS WILL VARY DEPENDING ON THE DIMENSIONS OF THE SEAL SELECTED BY THE CONTRACTOR. THE JOINT OPENING SHALL BE SET ACCORDING TO THE OPENING SHOWN ON THE APPROVED SHOP DETAIL DRAWINGS.
4. THE COMPRESSION SEAL ADJUSTMENT CHART SHOWS THE ADJUSTMENT NECESSARY TO ADJUST THE JOINT OPENING SHOWN ON THE SHOP DETAIL DRAWINGS (FOR COMPRESSION SEALS) OR OTHER THAN 45°F. ADJUSTMENT IS TO BE MEASURED PARALLEL TO THE CENTERLINE OF CONSTRUCTION.

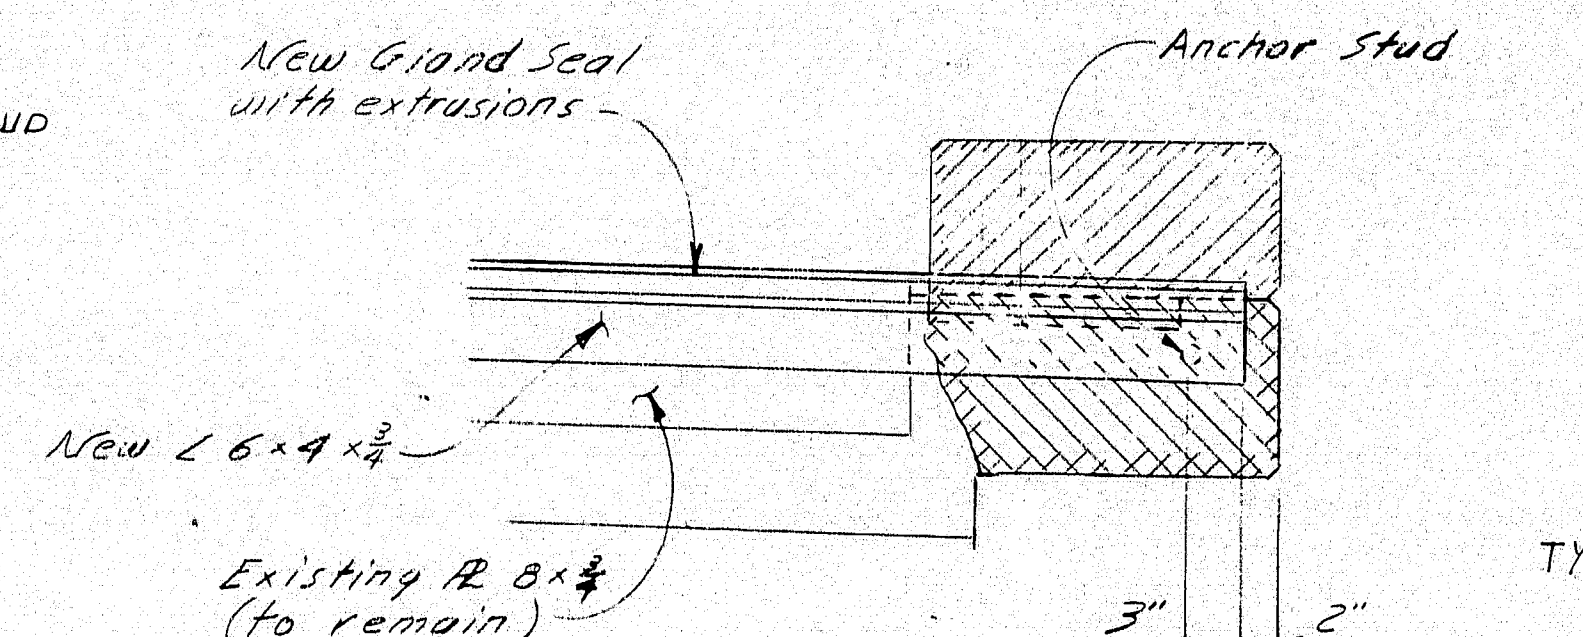

SECTION E

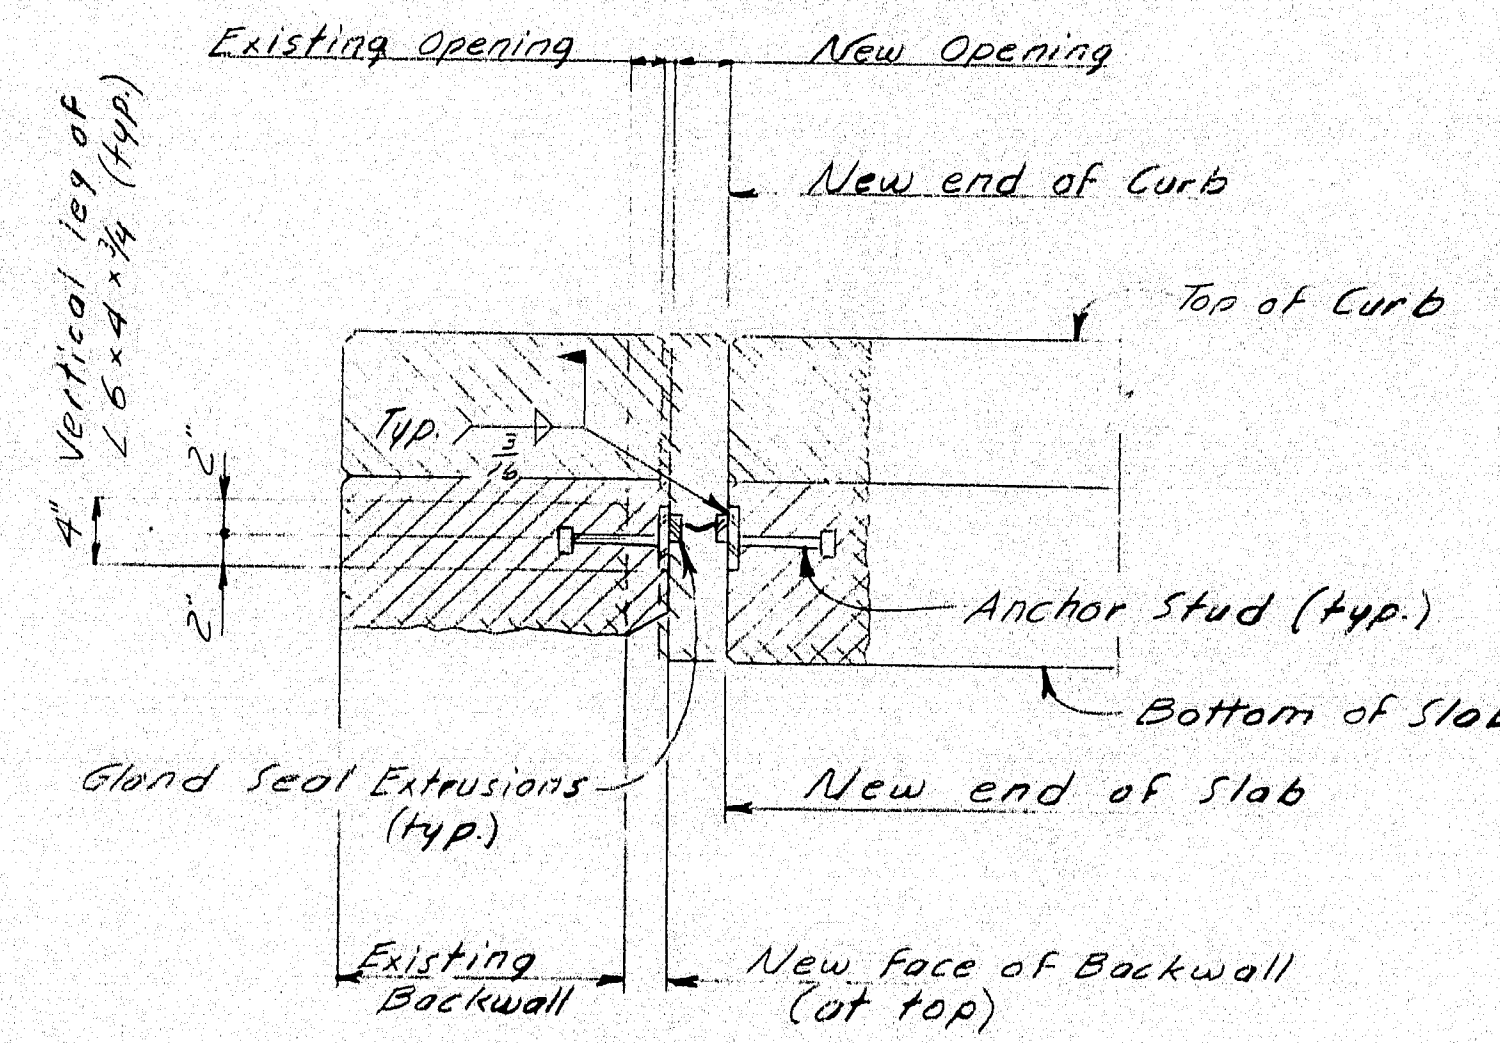


SECTION Z-Z

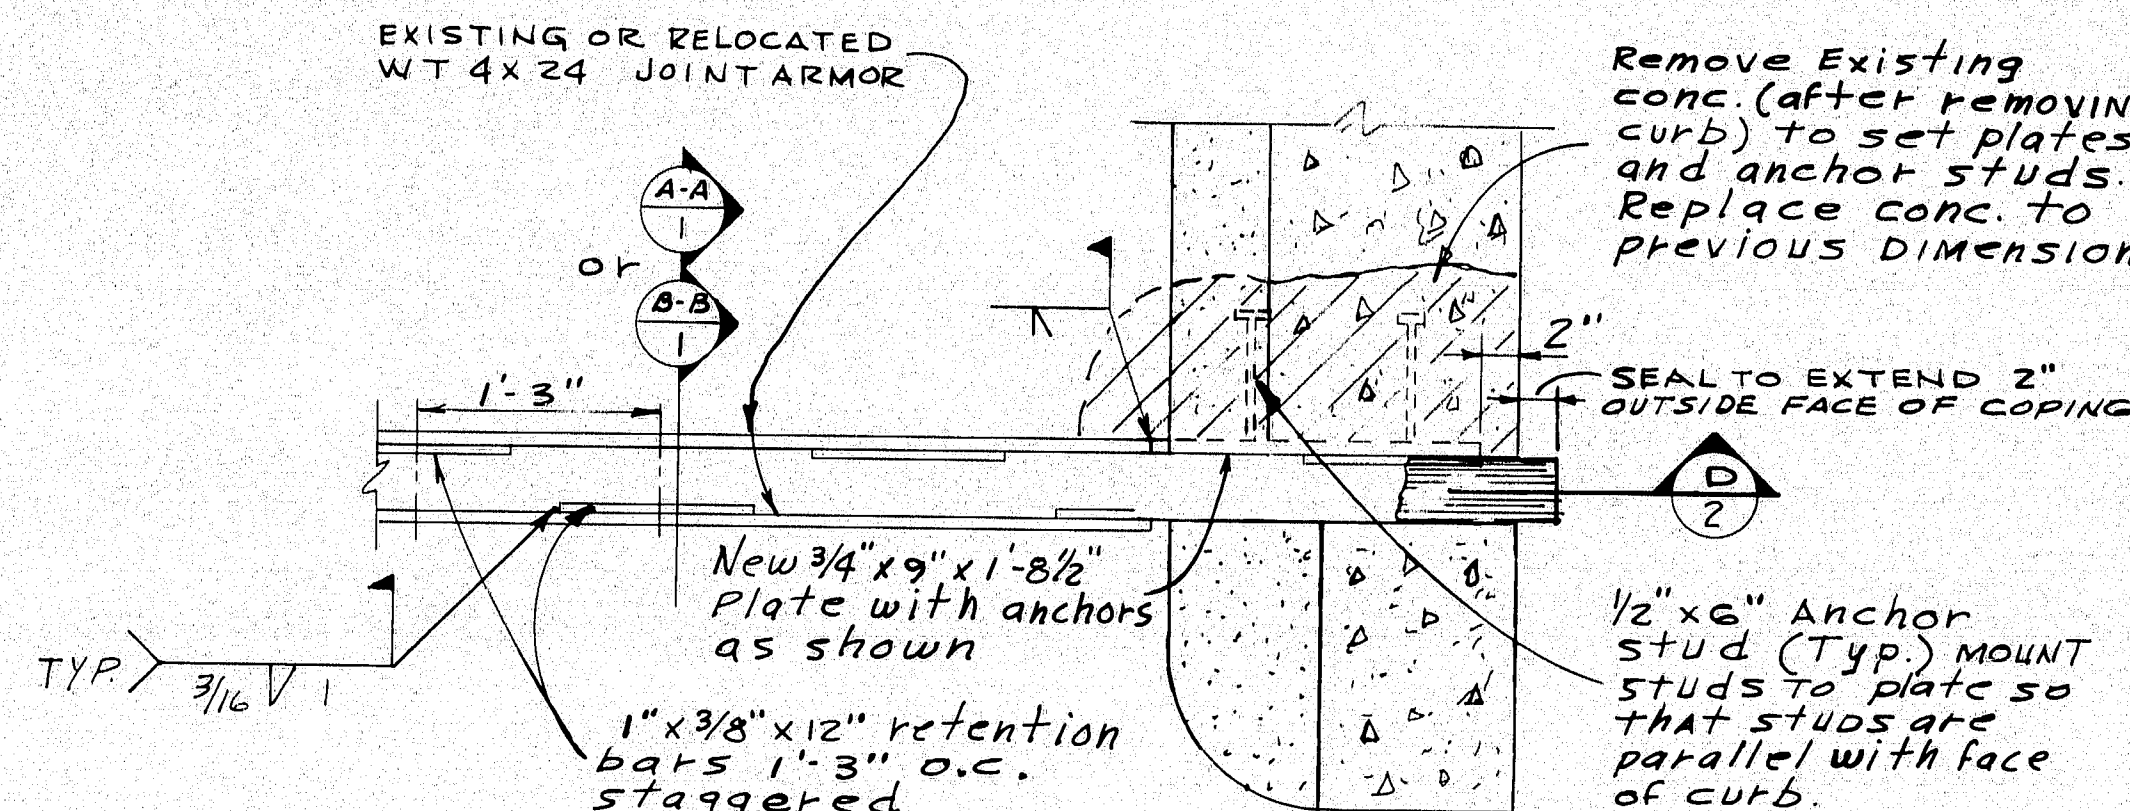


PARTIAL PLAN - COMPRESSION SEAL

SEE RD 125-B2
NOTE: Any granite curb removed shall be replaced with concrete.

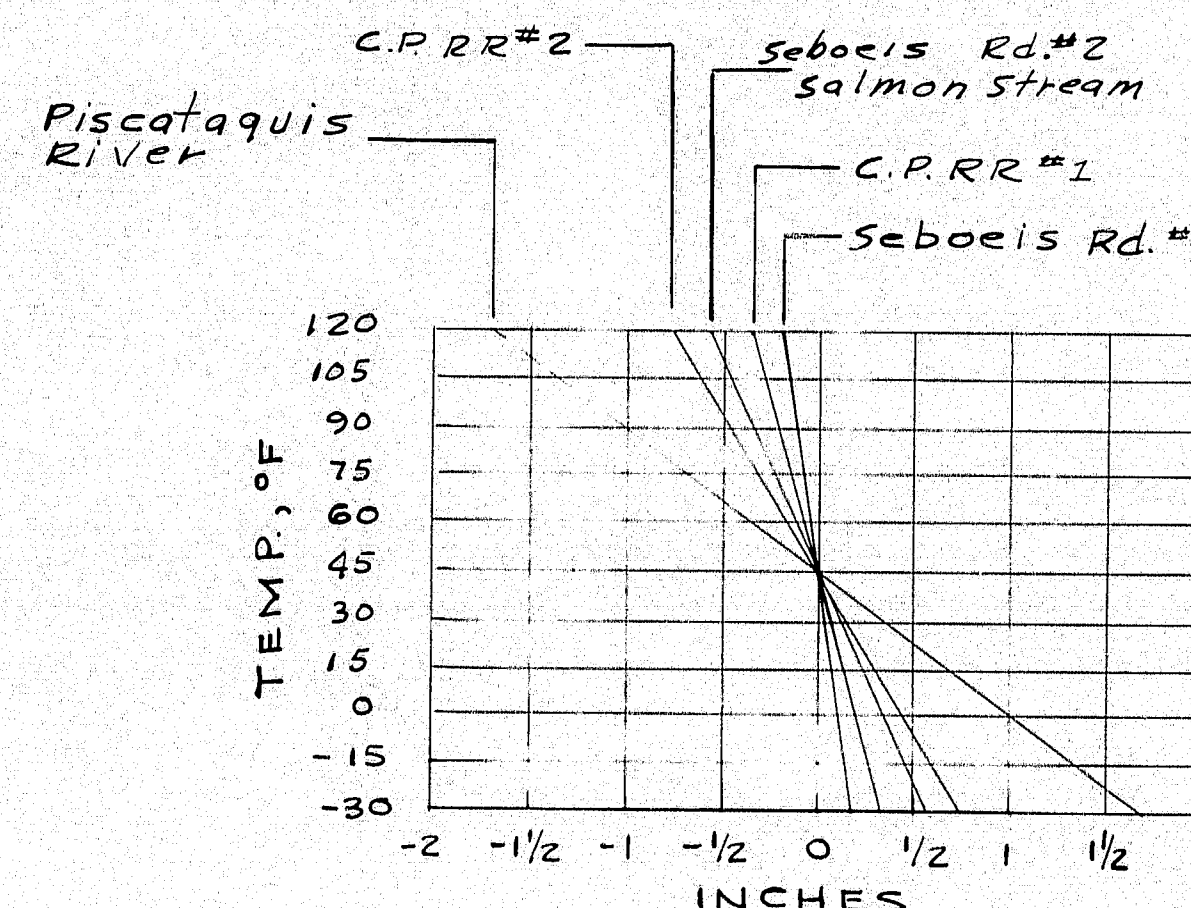

SETTING

104-145

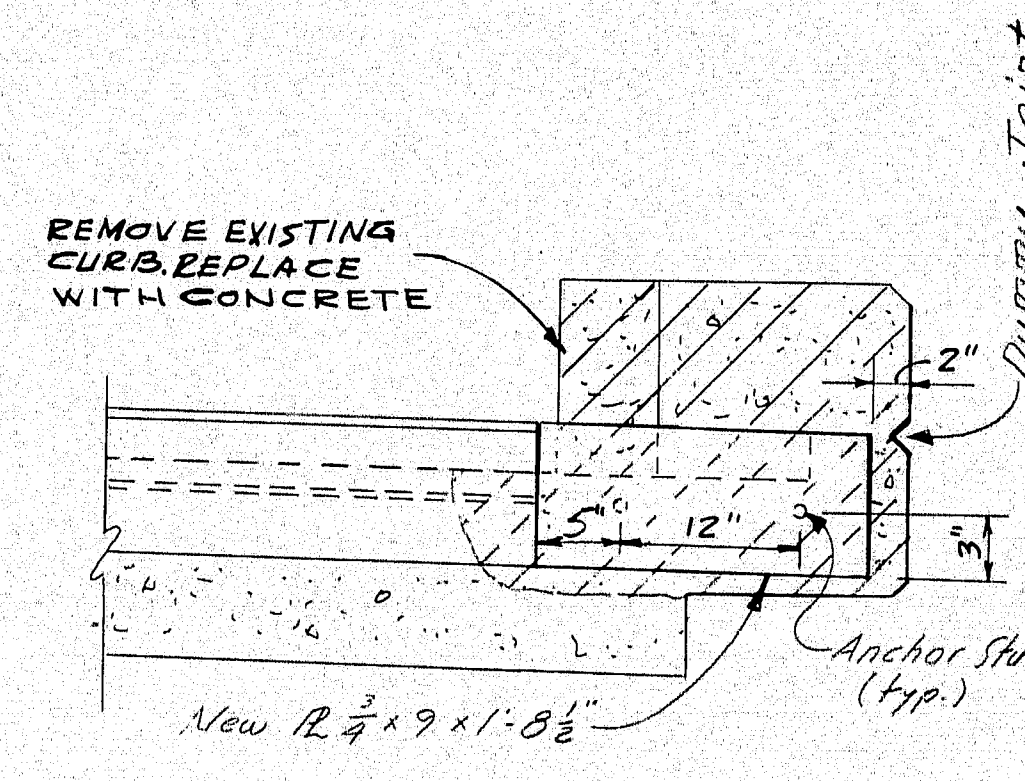

SECTION D


AS BUILT
Richard J. Arnold
3-2-92

CARROLL E. TAYLOR & ASSOCIATES
CONSULTING ENGINEERS
410 SUMMER STREET
AUBURN MAINE


STATE OF MAINE
DEPARTMENT OF TRANSPORTATION
INTERSTATE 95 SOUTHBOUND
OVER
Piscataquis River, Sebobeis Road,
Canadian Pacific RR.
INTERSTATE 95 NORTHBOUND
OVER
Salmon Stream
HOWLAND - T2R8 - T2R9 - MEDWAY
SCOPE, NOTES & SECTIONS
SHEET 2 OF 11 AUGUSTA, MAINE

HOWLAND - T2R8 - T2R9 - MEDWAY 95-8(133)/95-8(134)


IRG 95-B(134)			
F.P.W.A. REQ. NO.	STATE	PROJECT NUMBER	SHEET NO. TOTAL SHEETS
1	MAINE	IR 95-4(133)	26 34

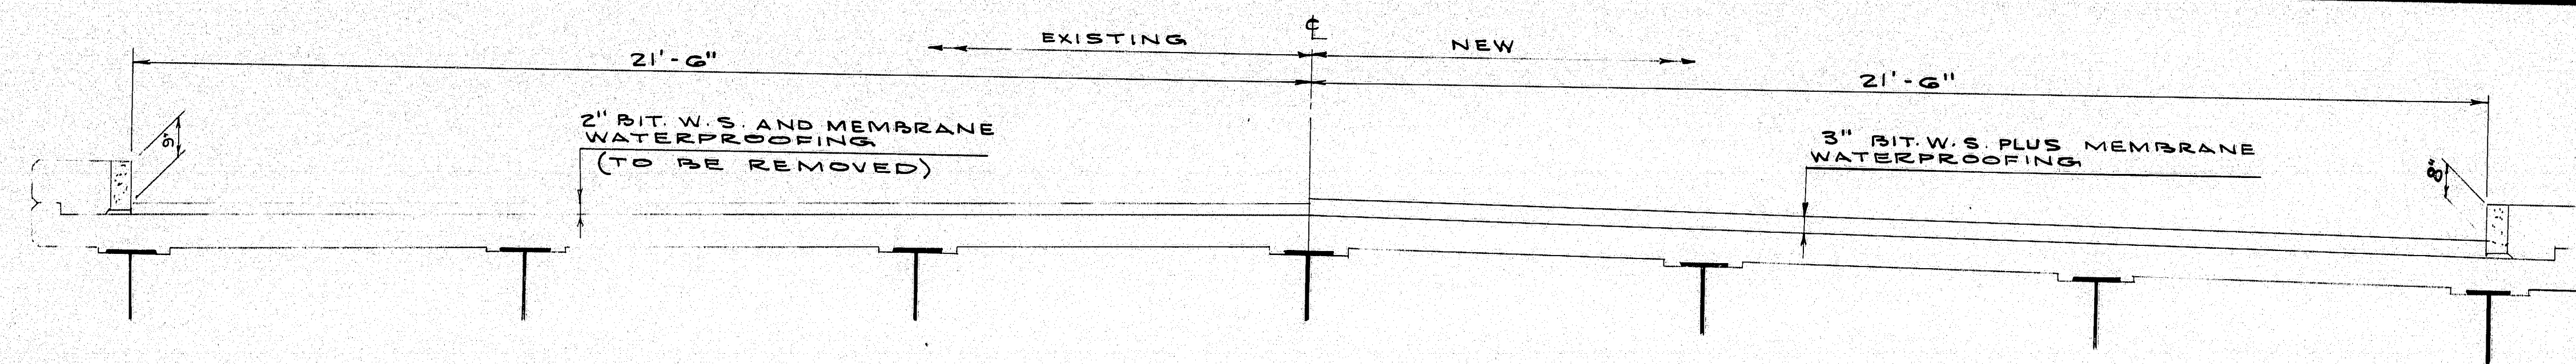



I-95 SOUTHBOUND OVER SEBOEIS ROAD AND CANADIAN PACIFIC RR

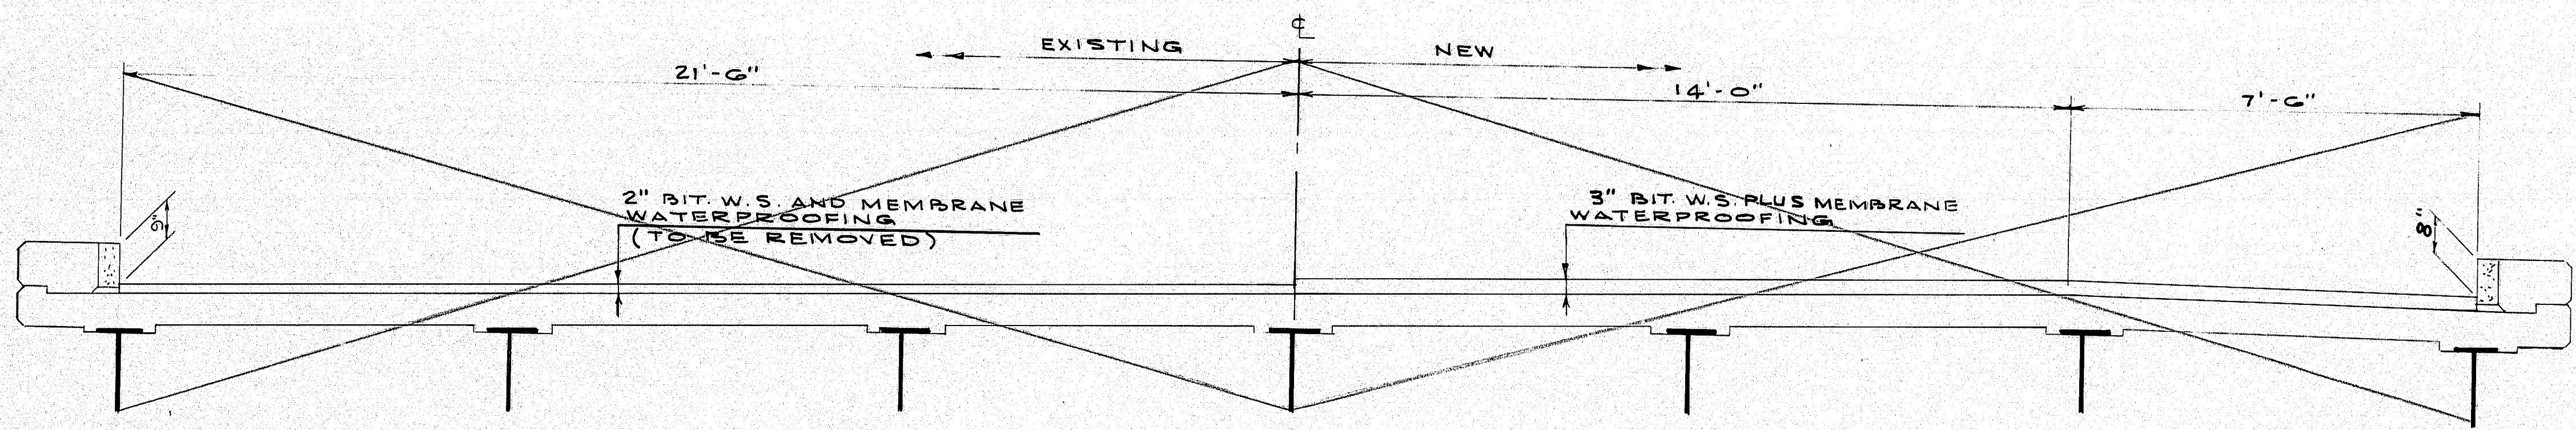

I-95 NORTHBOUND OVER SALMON STREAM

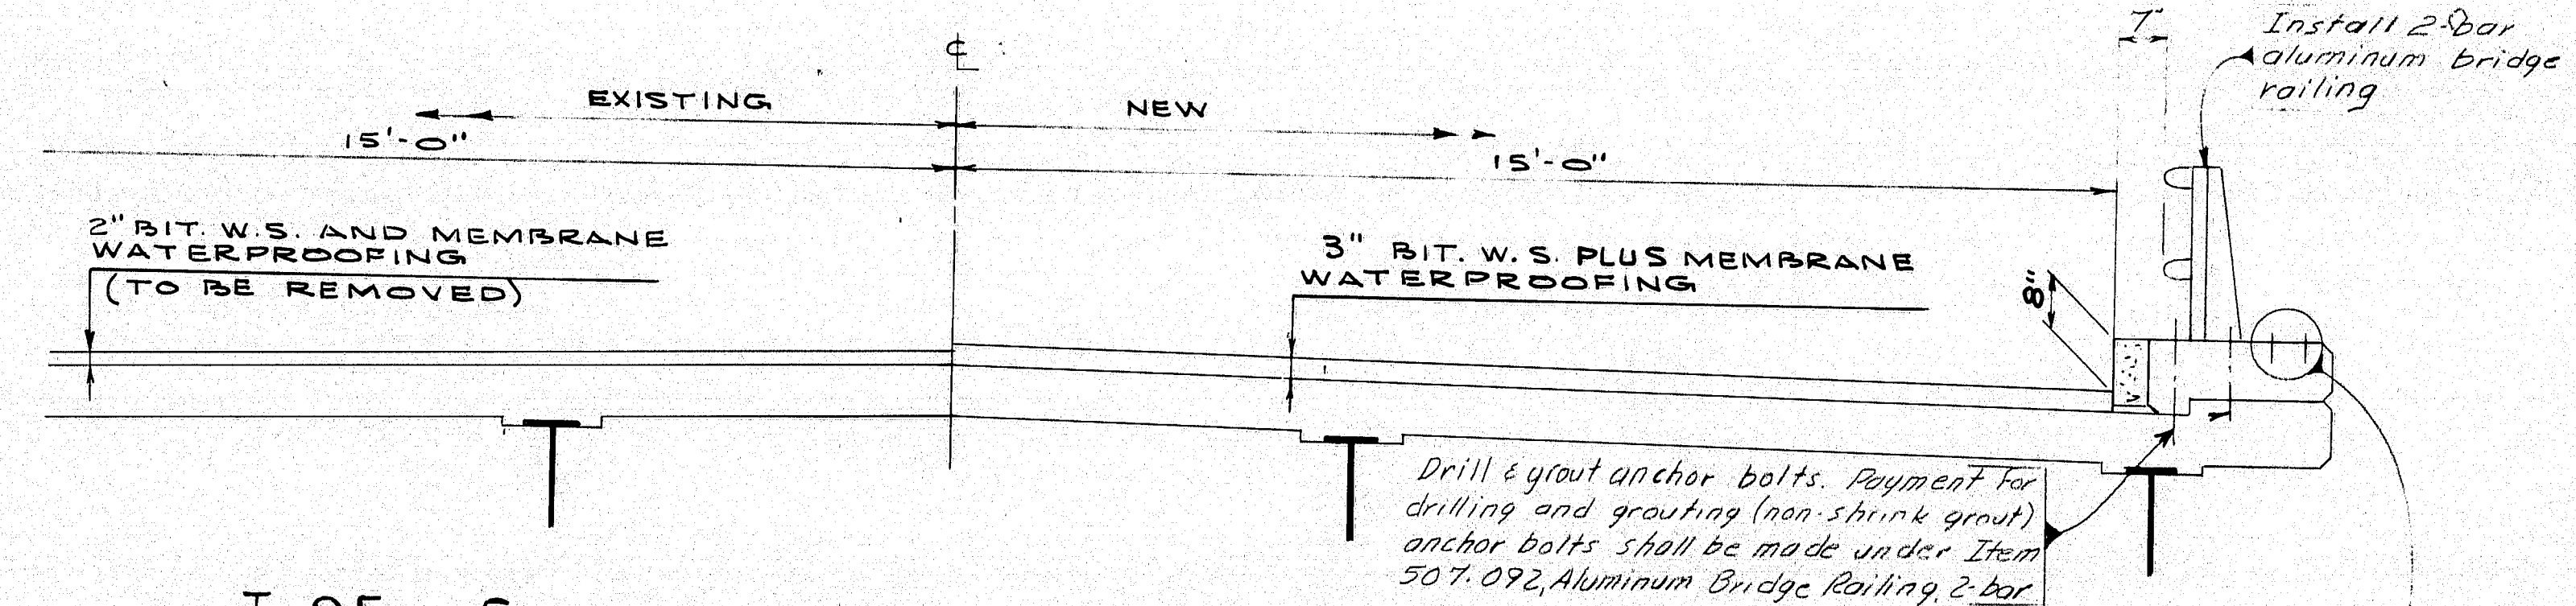

I-95 SOUTHBOUND OVER PISCATAQUIS RIVER

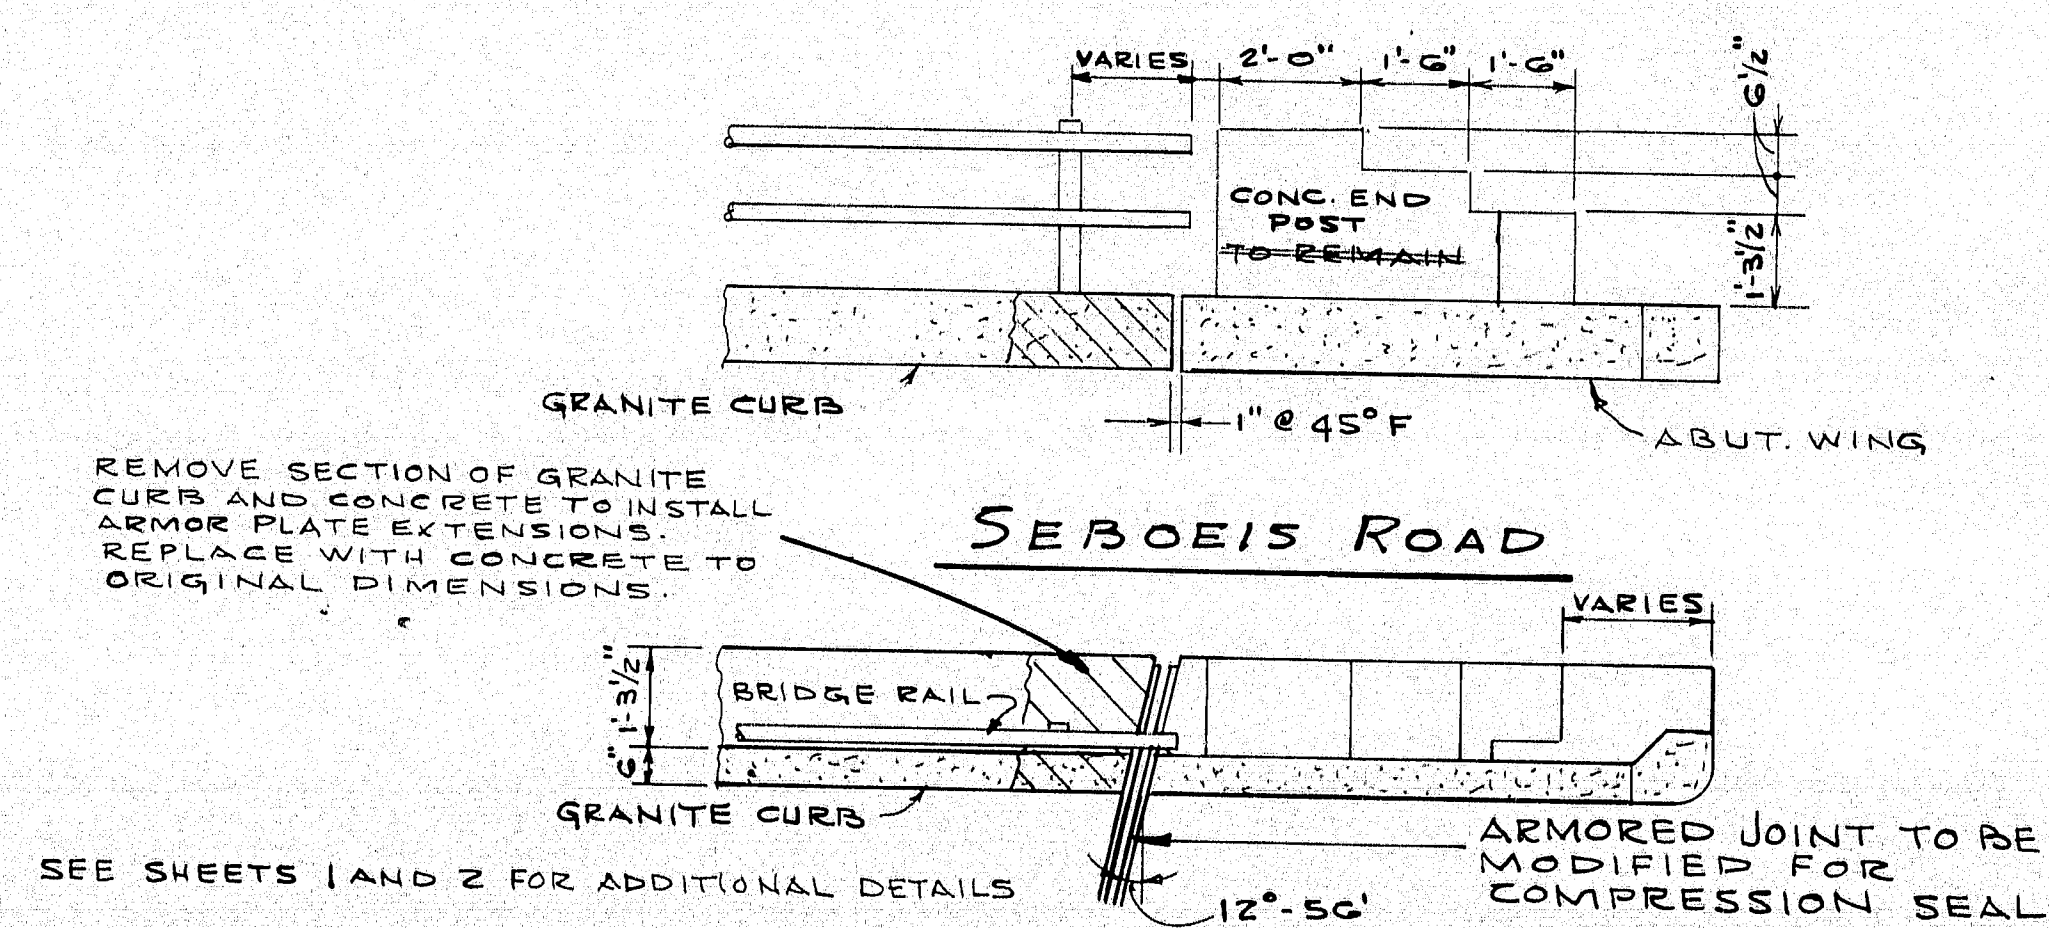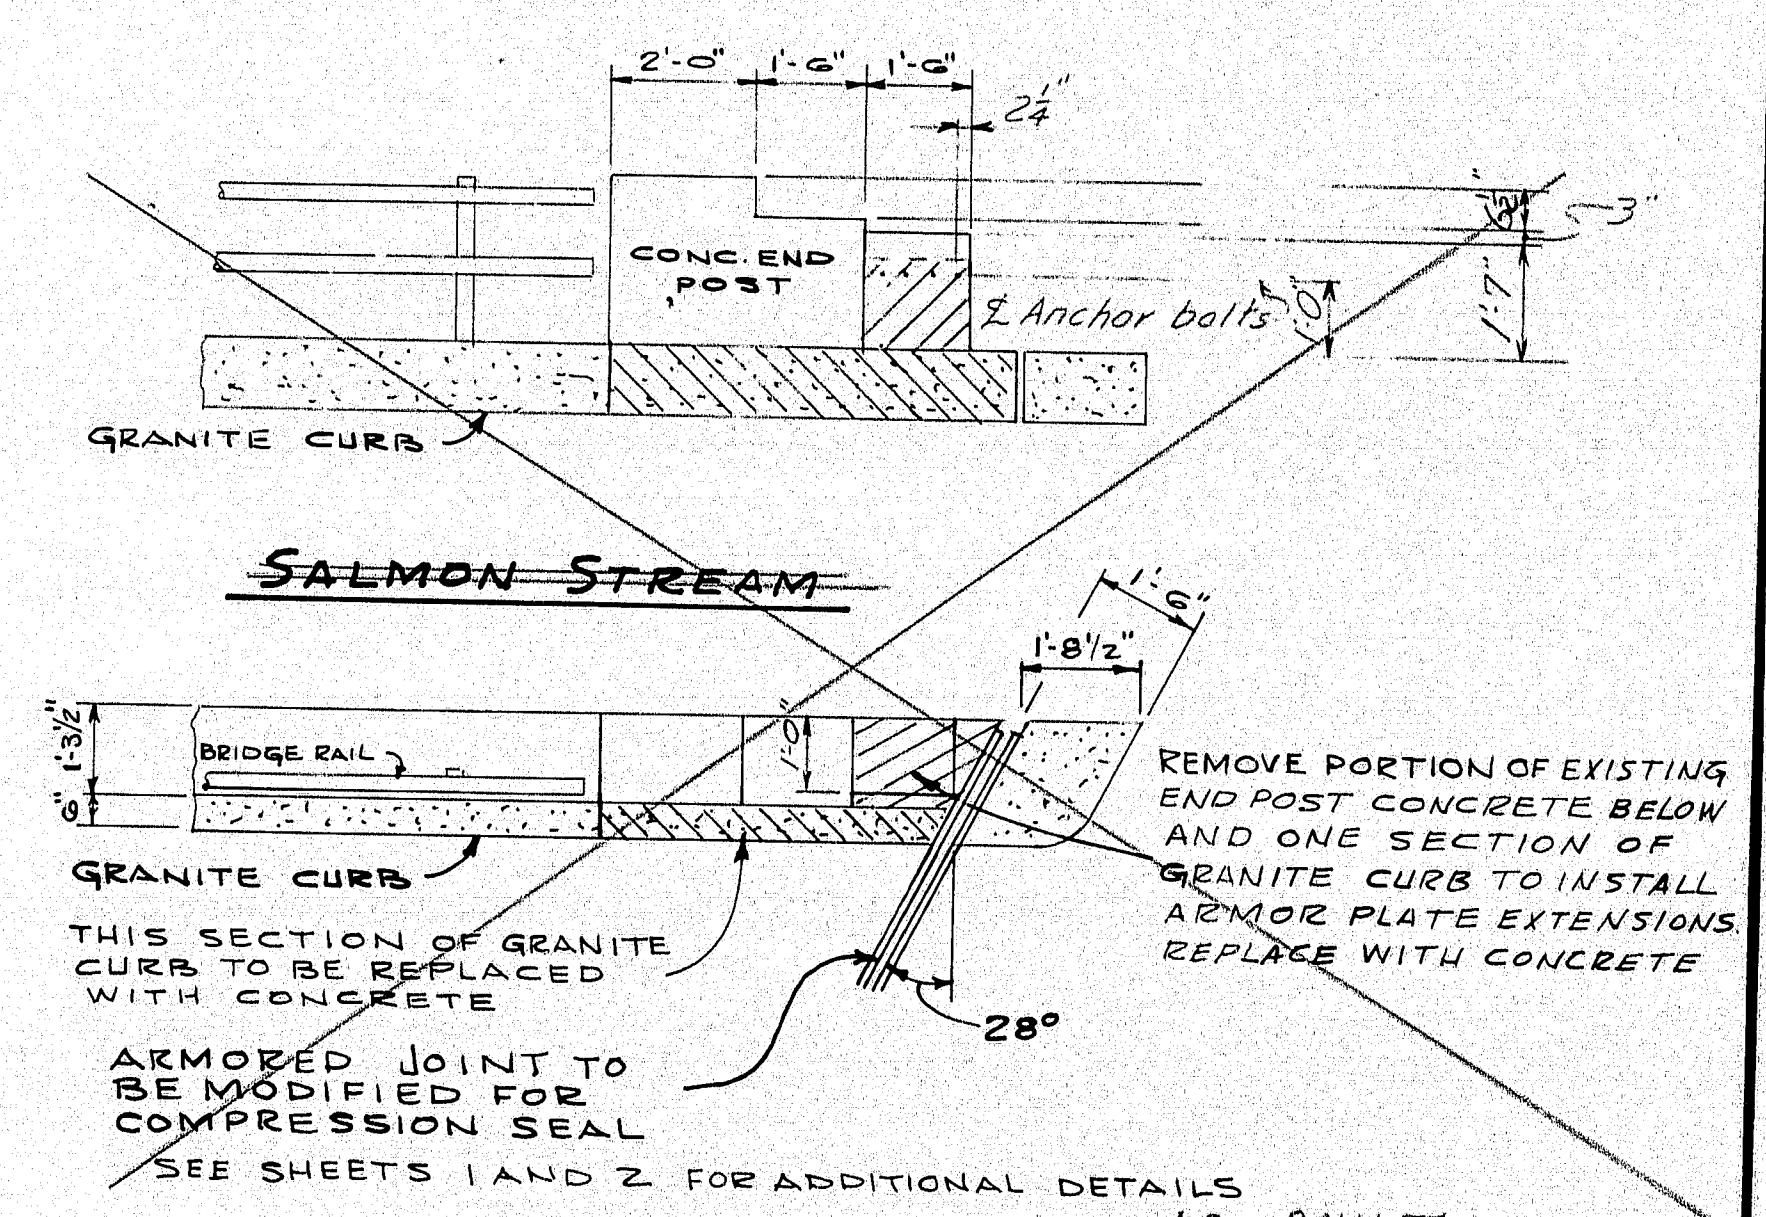

BRIDGE JOINT ARRANGEMENTS (PLAN & ELEVATIONS) WEST END ABUTMENT #2
OTHER LOCATIONS SIMILAR

Fill holes with mortar containing a non-shrink additive as directed by the Engineer

Payment for removing a portion of existing bridge rail anchorage and end post reinforcing steel shall be considered incidental to the Bridge Rail Items.

104-146

AS BUILT
Richard G. Smith
3-2-92

CARROLL E. TAYLOR & ASSOCIATES
CONSULTING ENGINEERS
410 SUMMER STREET
AUBURN MAINE




STATE OF MAINE
DEPARTMENT OF TRANSPORTATION
INTERSTATE 95 SOUTHBOUND
OVER
Piscataquis River, Sebouis Road,
Canadian Pacific RR
INTERSTATE 95 NORTHBOUND
OVER
Salmon Stream
HOWLAND-T2R8-MEDWAY
HALF SECTIONS & JOINT DETAILS
SHEET 3 OF 11 AUGUSTA, MAINE
95-B(133)/95-B(134)

HOWLAND-T2R8-T2R9-MEDWAY





PROJECT DESIGN ENGINEER	BY	DATE
DESIGN - DETAILED	BCW	2-9-85
CHECKED		
REVISIONS		
FIELD CHANGES		

BRUNING 44-132-457(10-1)

STATE	PROJECT NUMBER	SHEET NO.	TOTAL SHEETS
MAINE	1R-95-B(134)	27	34

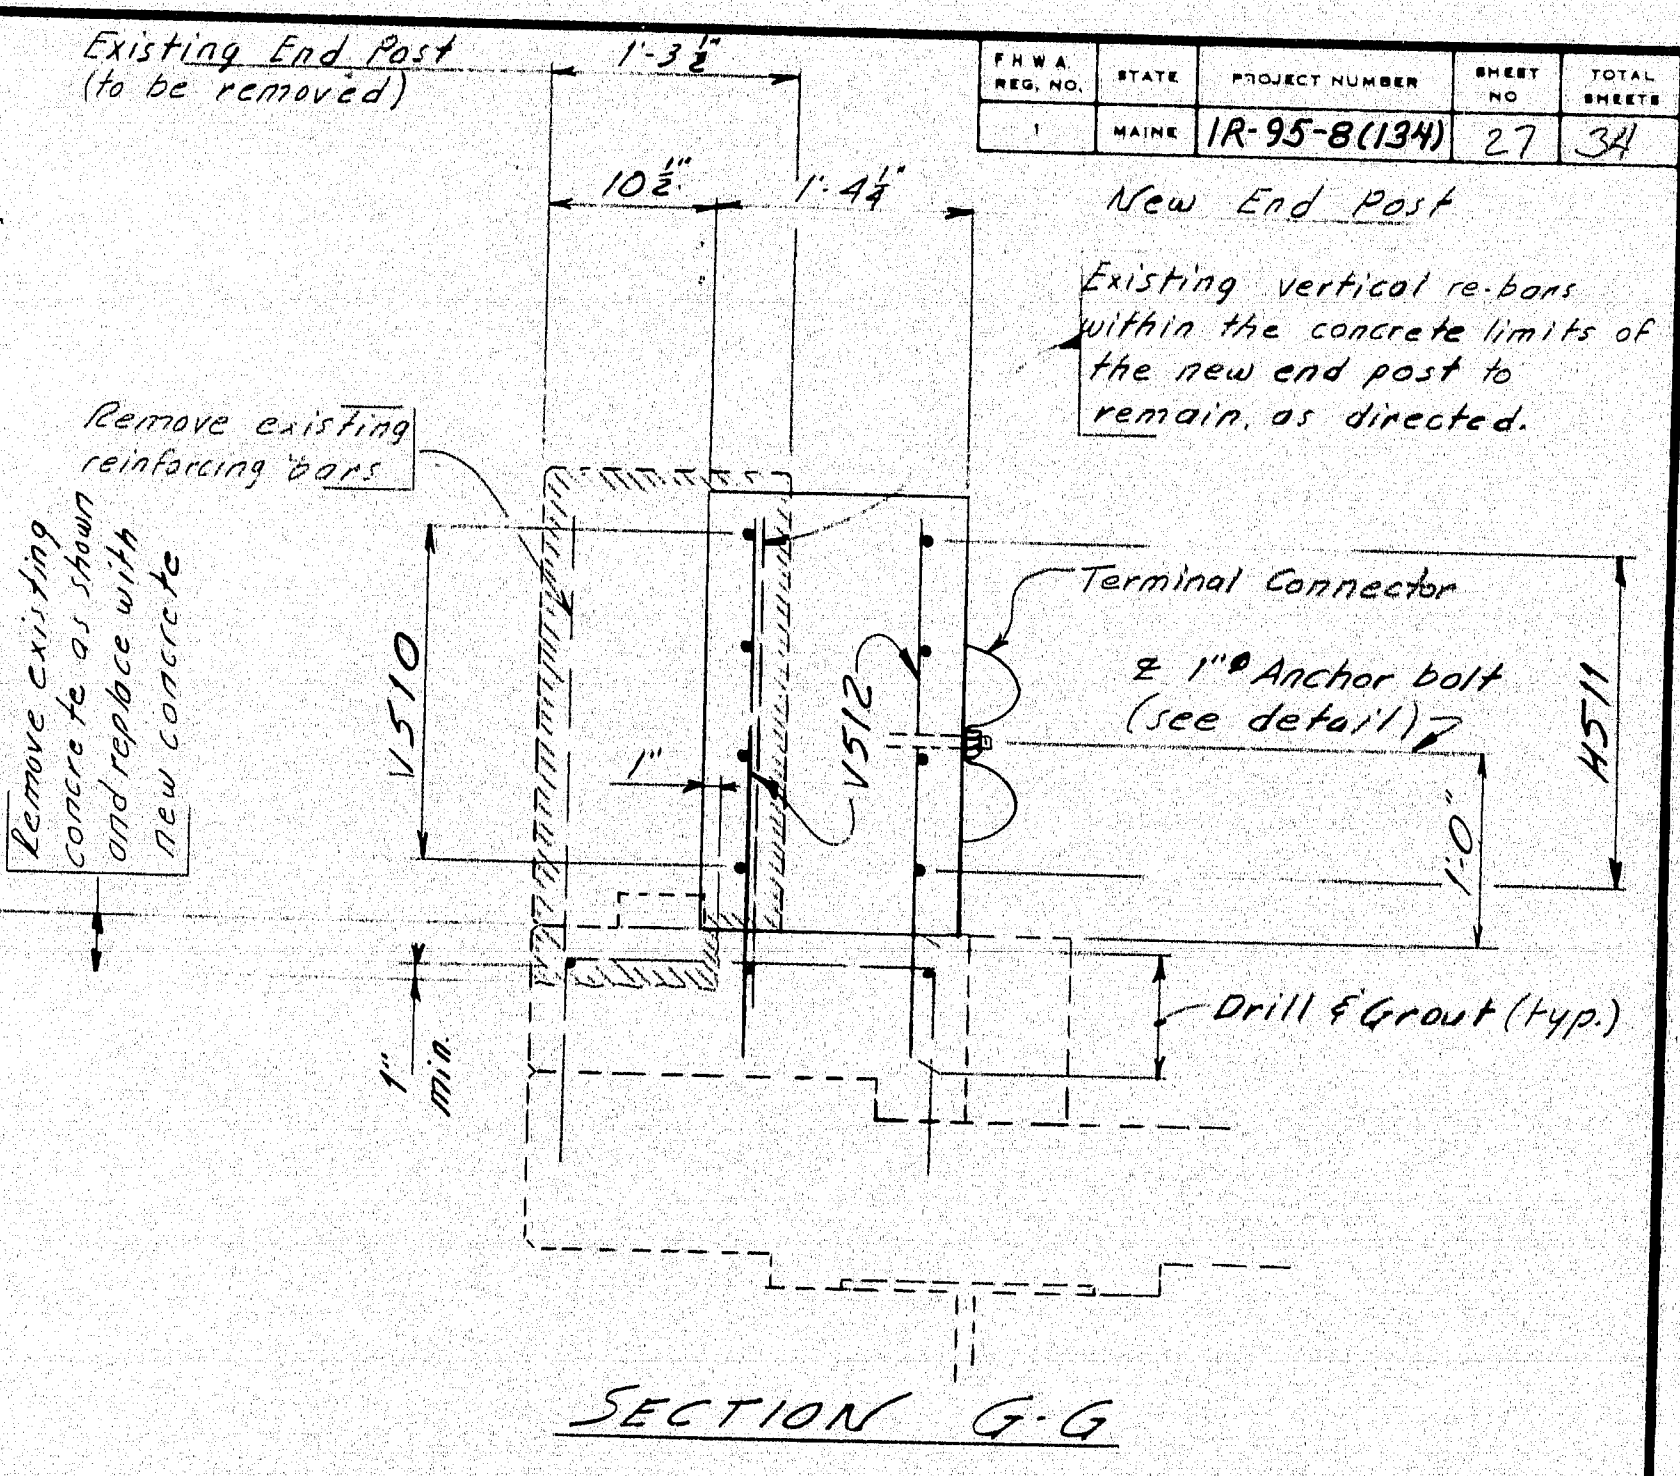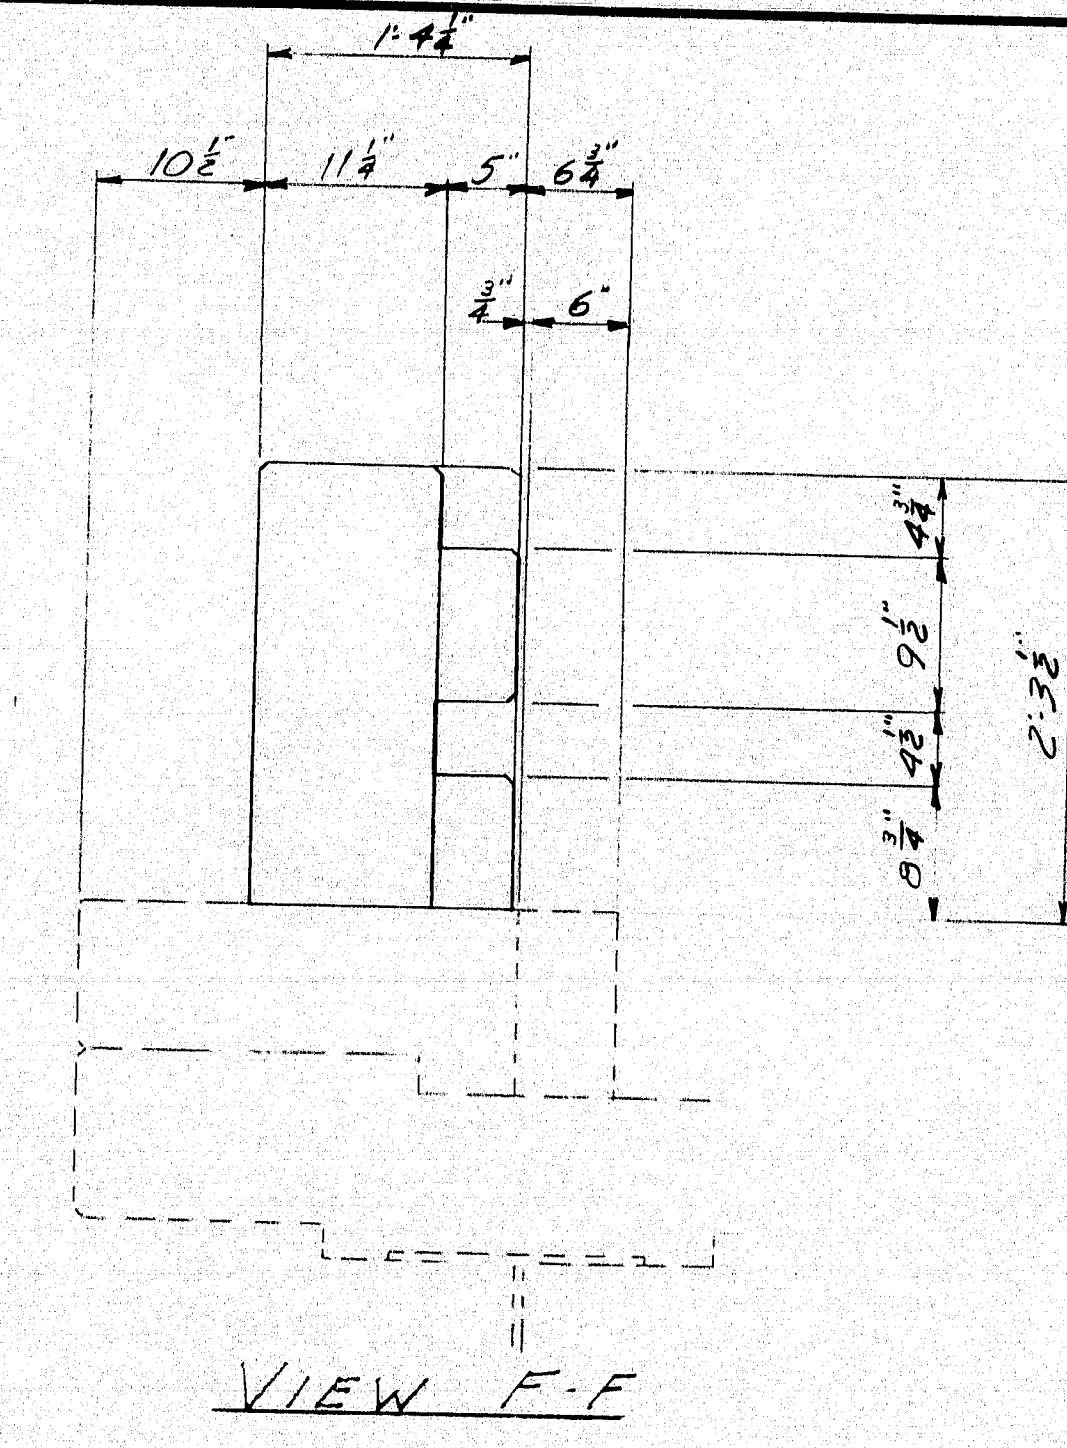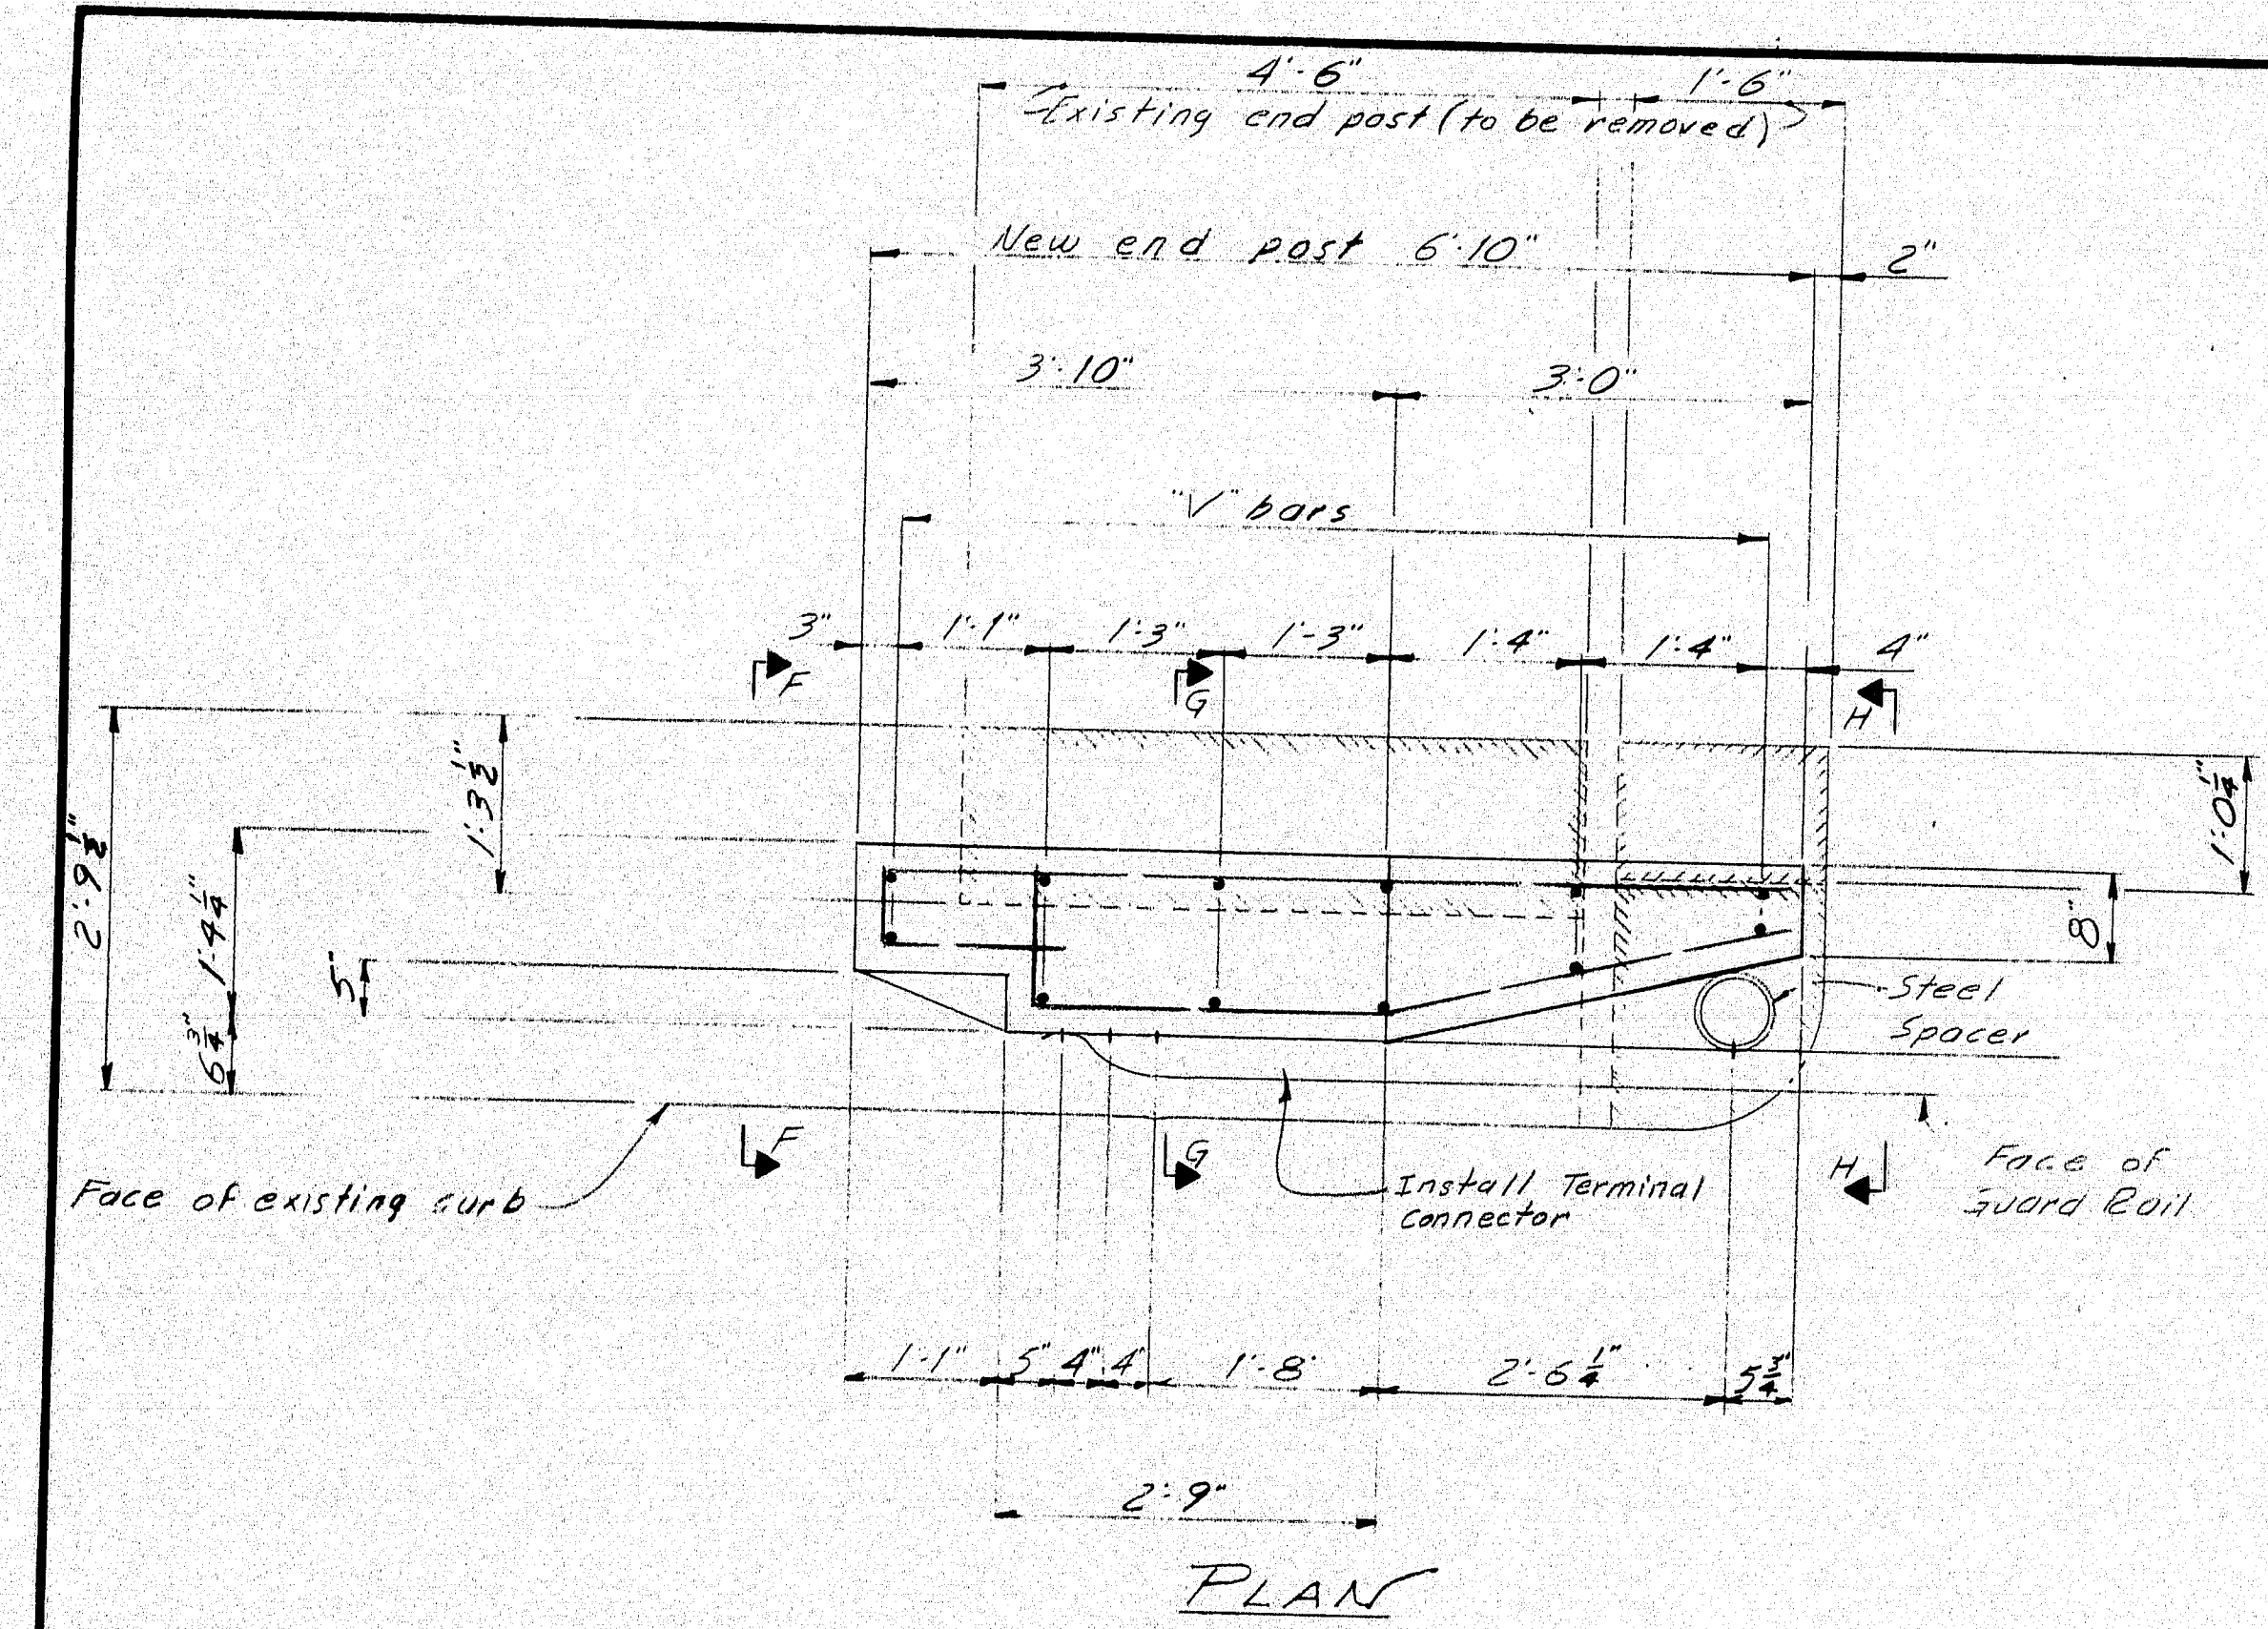

- NOTES**
- Reinforcing steel shall have a minimum cover of 2 inches unless otherwise indicated.
 - Existing reinforcing steel to remain shall be cleaned as directed prior to placing new concrete.
 - Mortar for grouting dowels shall contain an approved non shrink additive. Payment for drilling and grouting of dowels shall be considered incidental to Item 608.173, Bridge Connections.
 - Additional holes required in Guard Rail Panels "B" and "C" may be made by drilling, punching, or any other method that produces a neat, clean hole of the required size. Burning of holes will not be allowed.
 - After installation of guard rail is complete upset the thread on the anchor bolts in three places around each bolt at the junction of the nut and the exposed thread, with a center punch or similar tool.

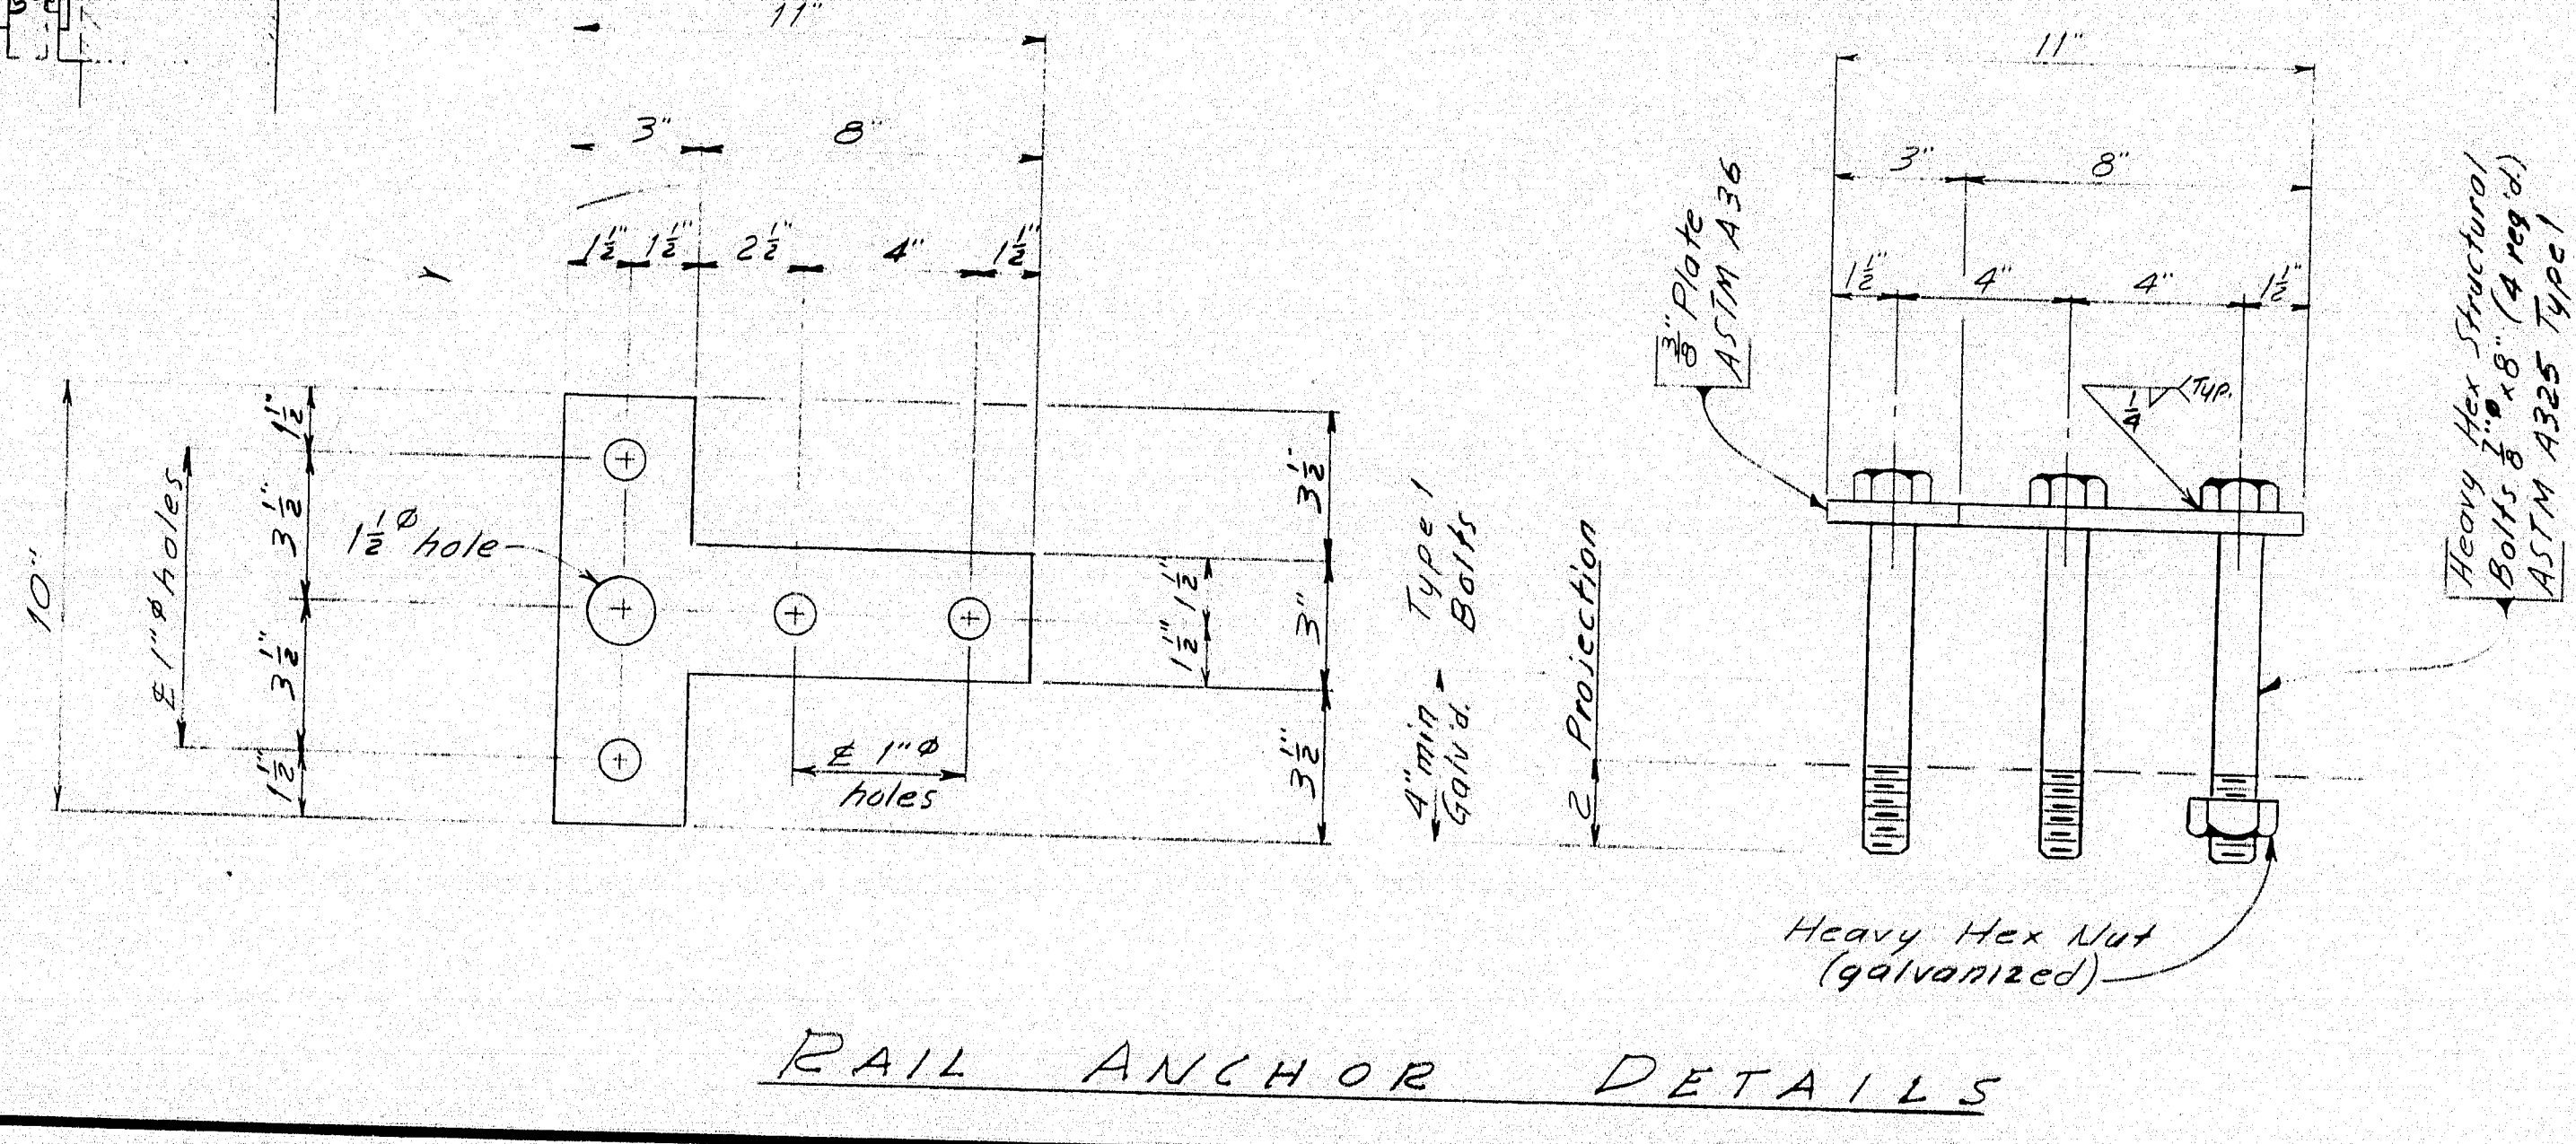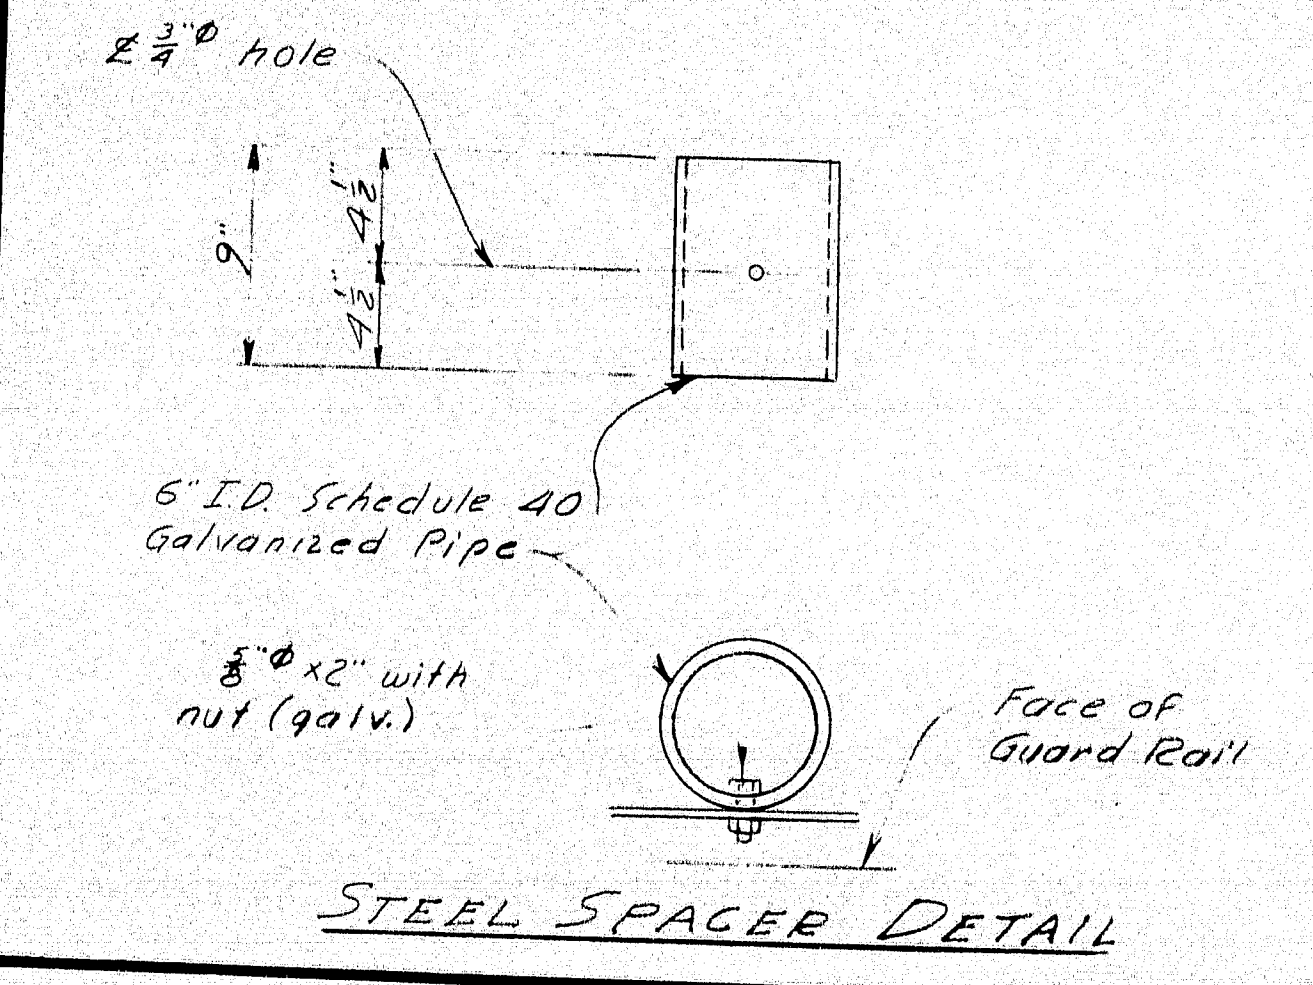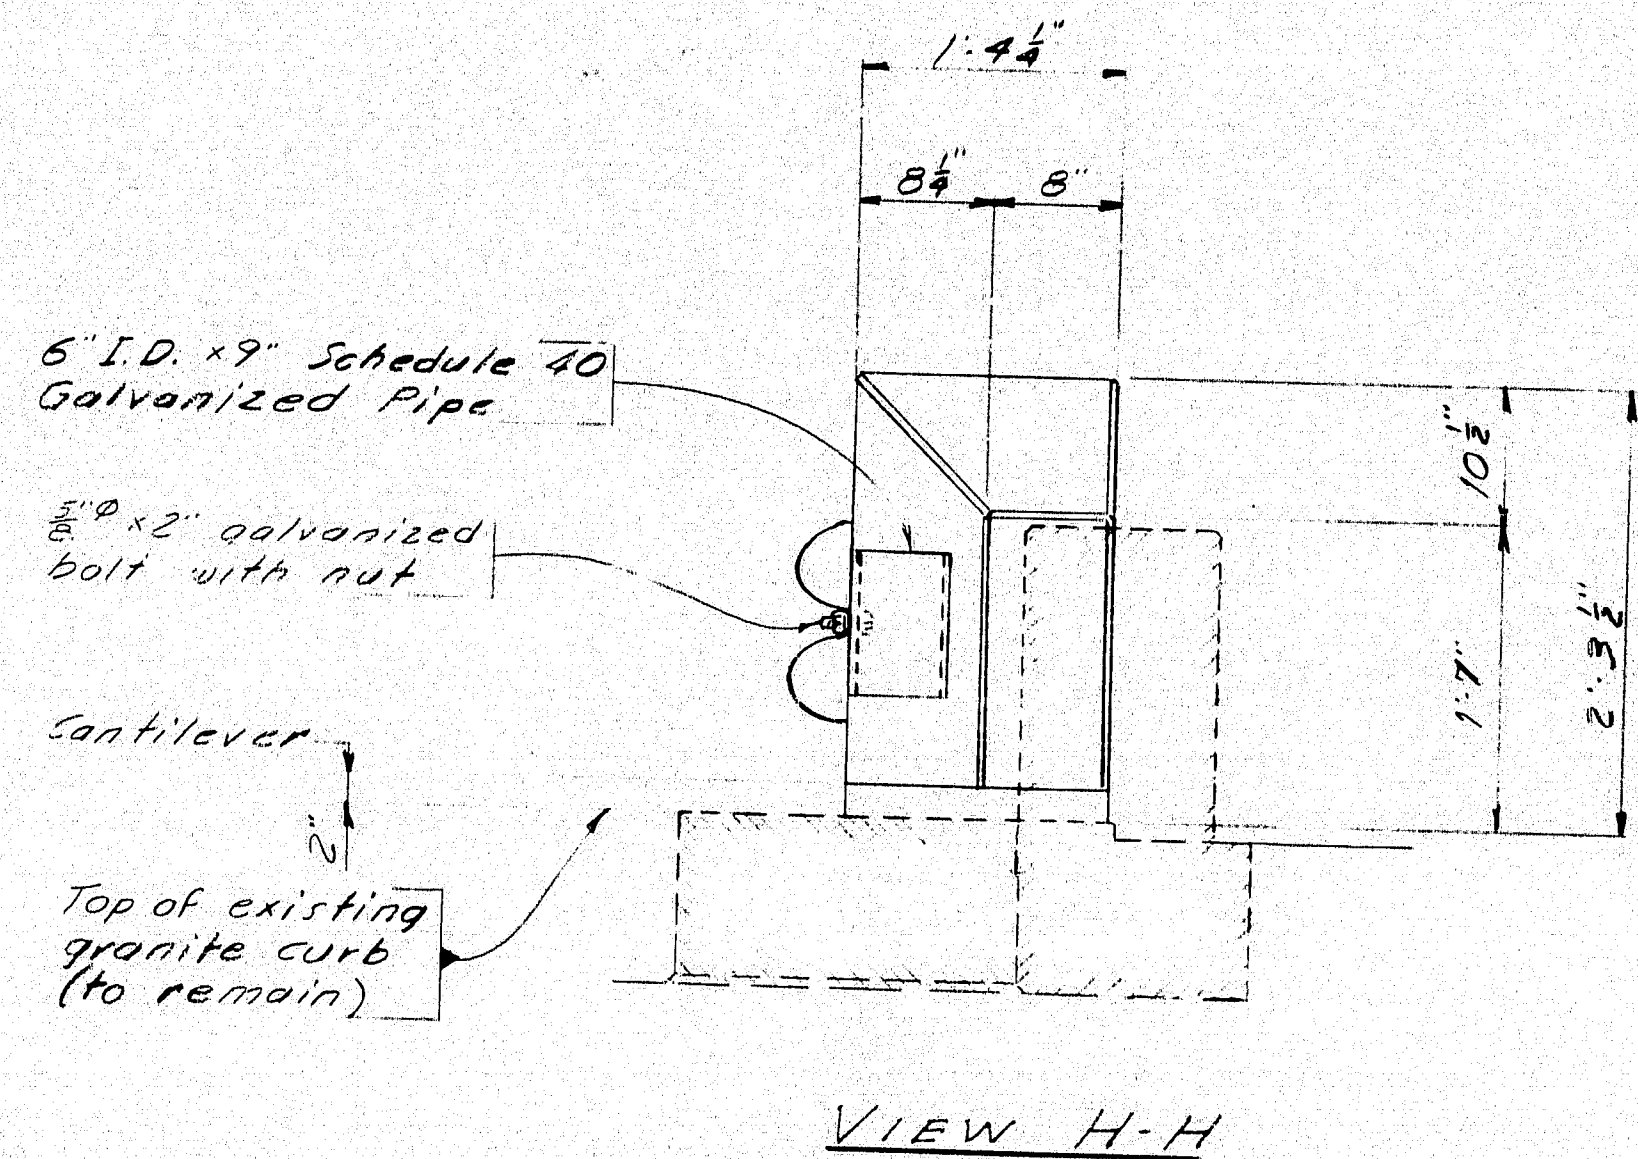
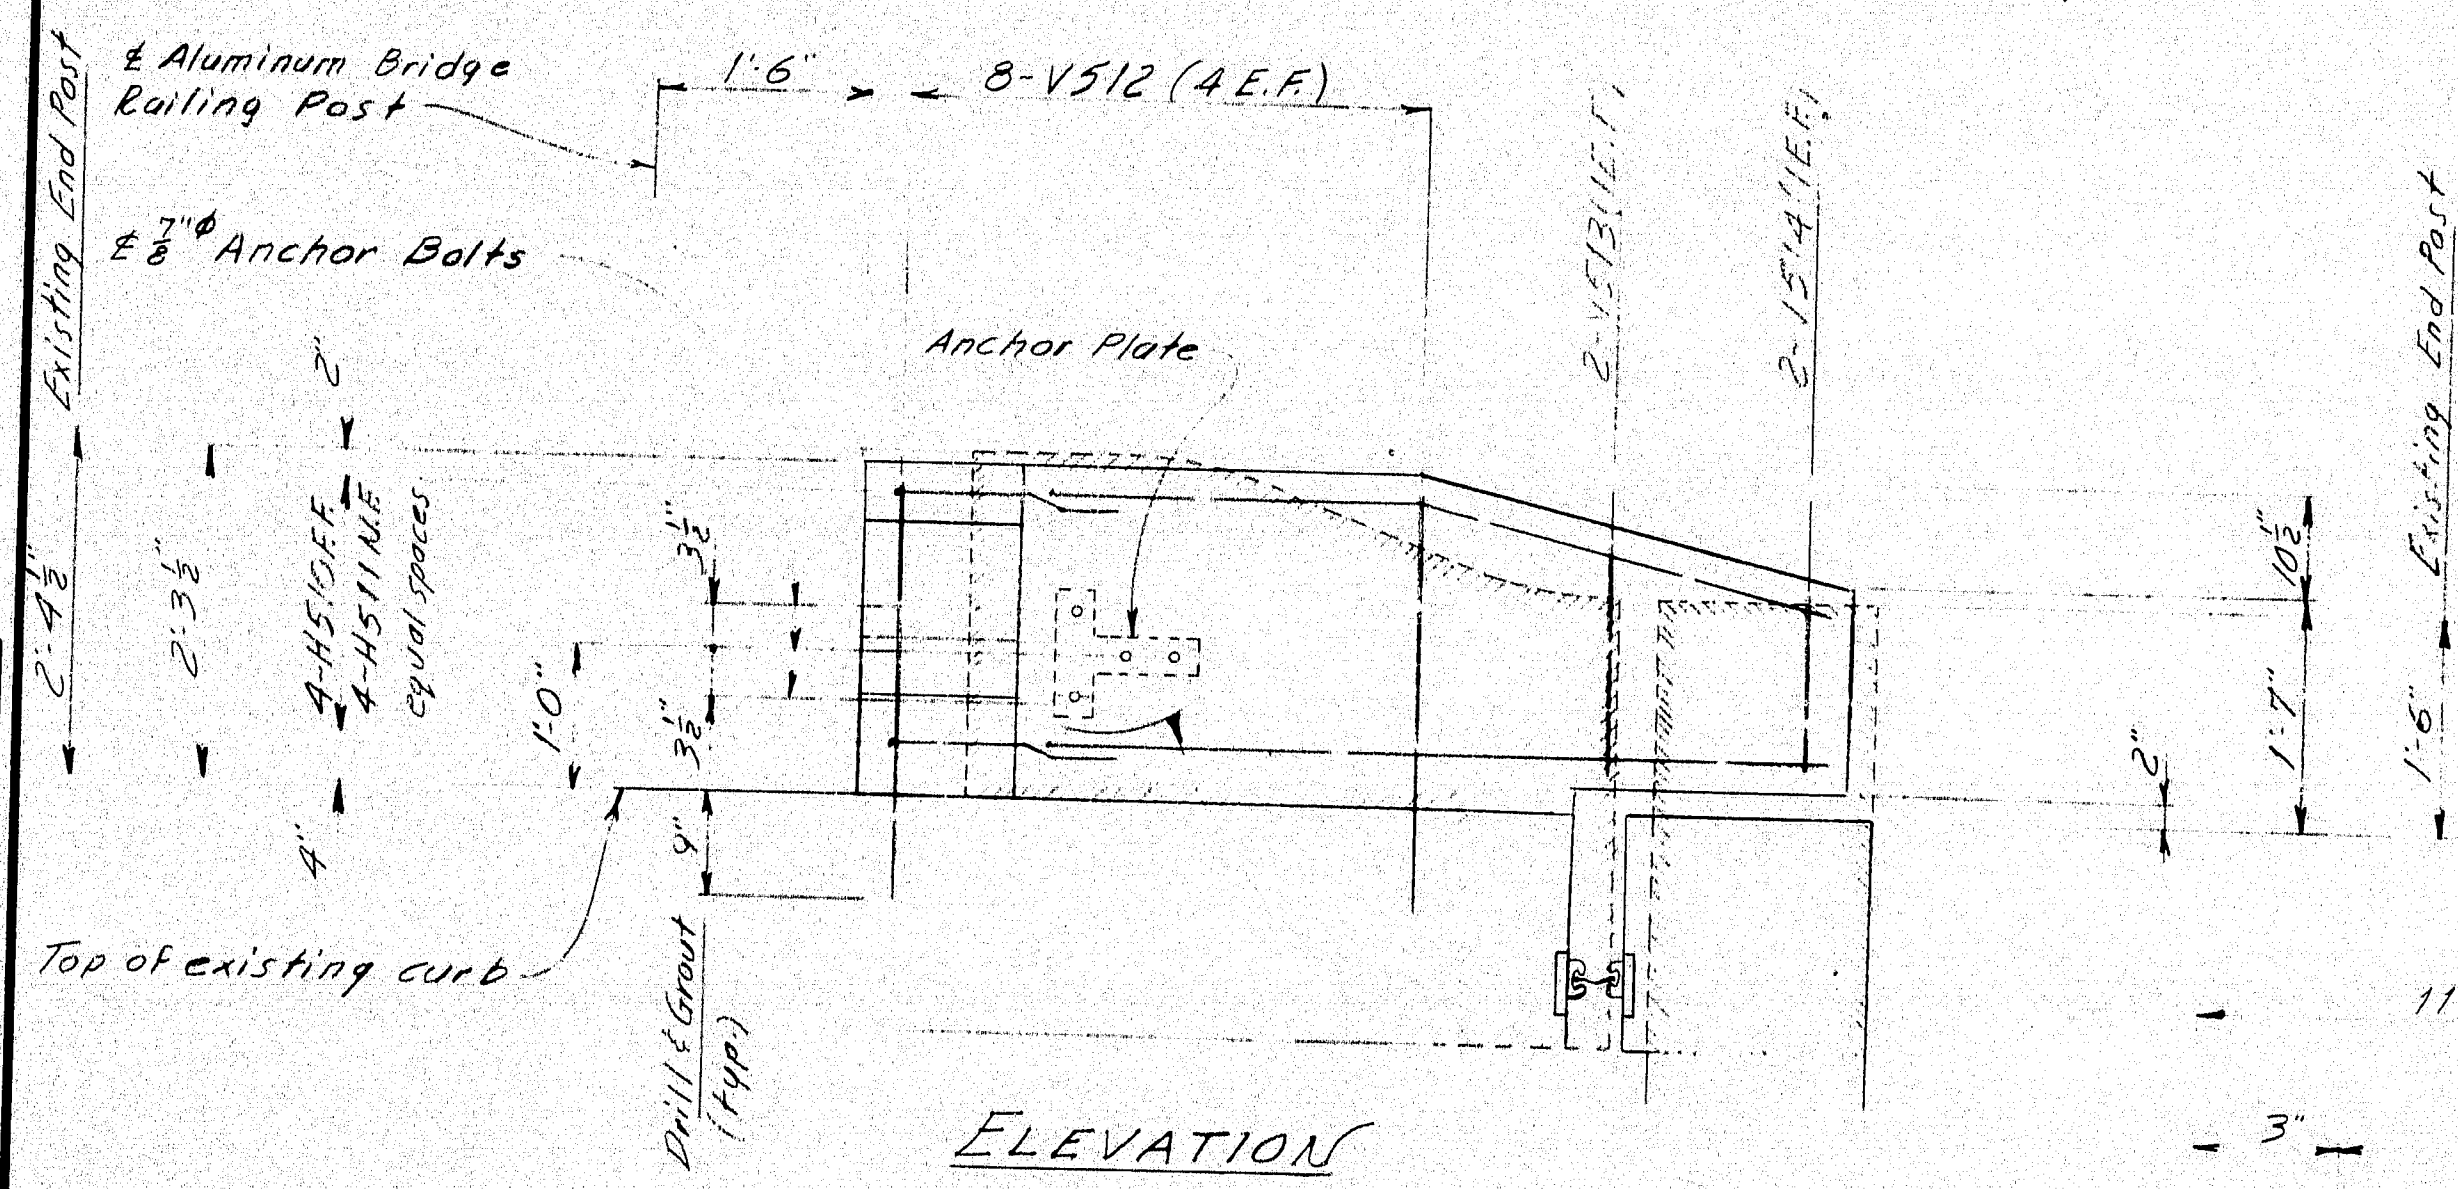


104-147

"AS BUILT"
Furnished & revised
3-2-92

For Guard Rail Layout see sheet #7


STATE OF MAINE DEPARTMENT OF TRANSPORTATION
END POST & GUARD RAIL CONNECTION DETAIL
SB PISCATAQUIS RIVER BRIDGE
SHEET 4 OF 11 AUGUSTA, MAINE

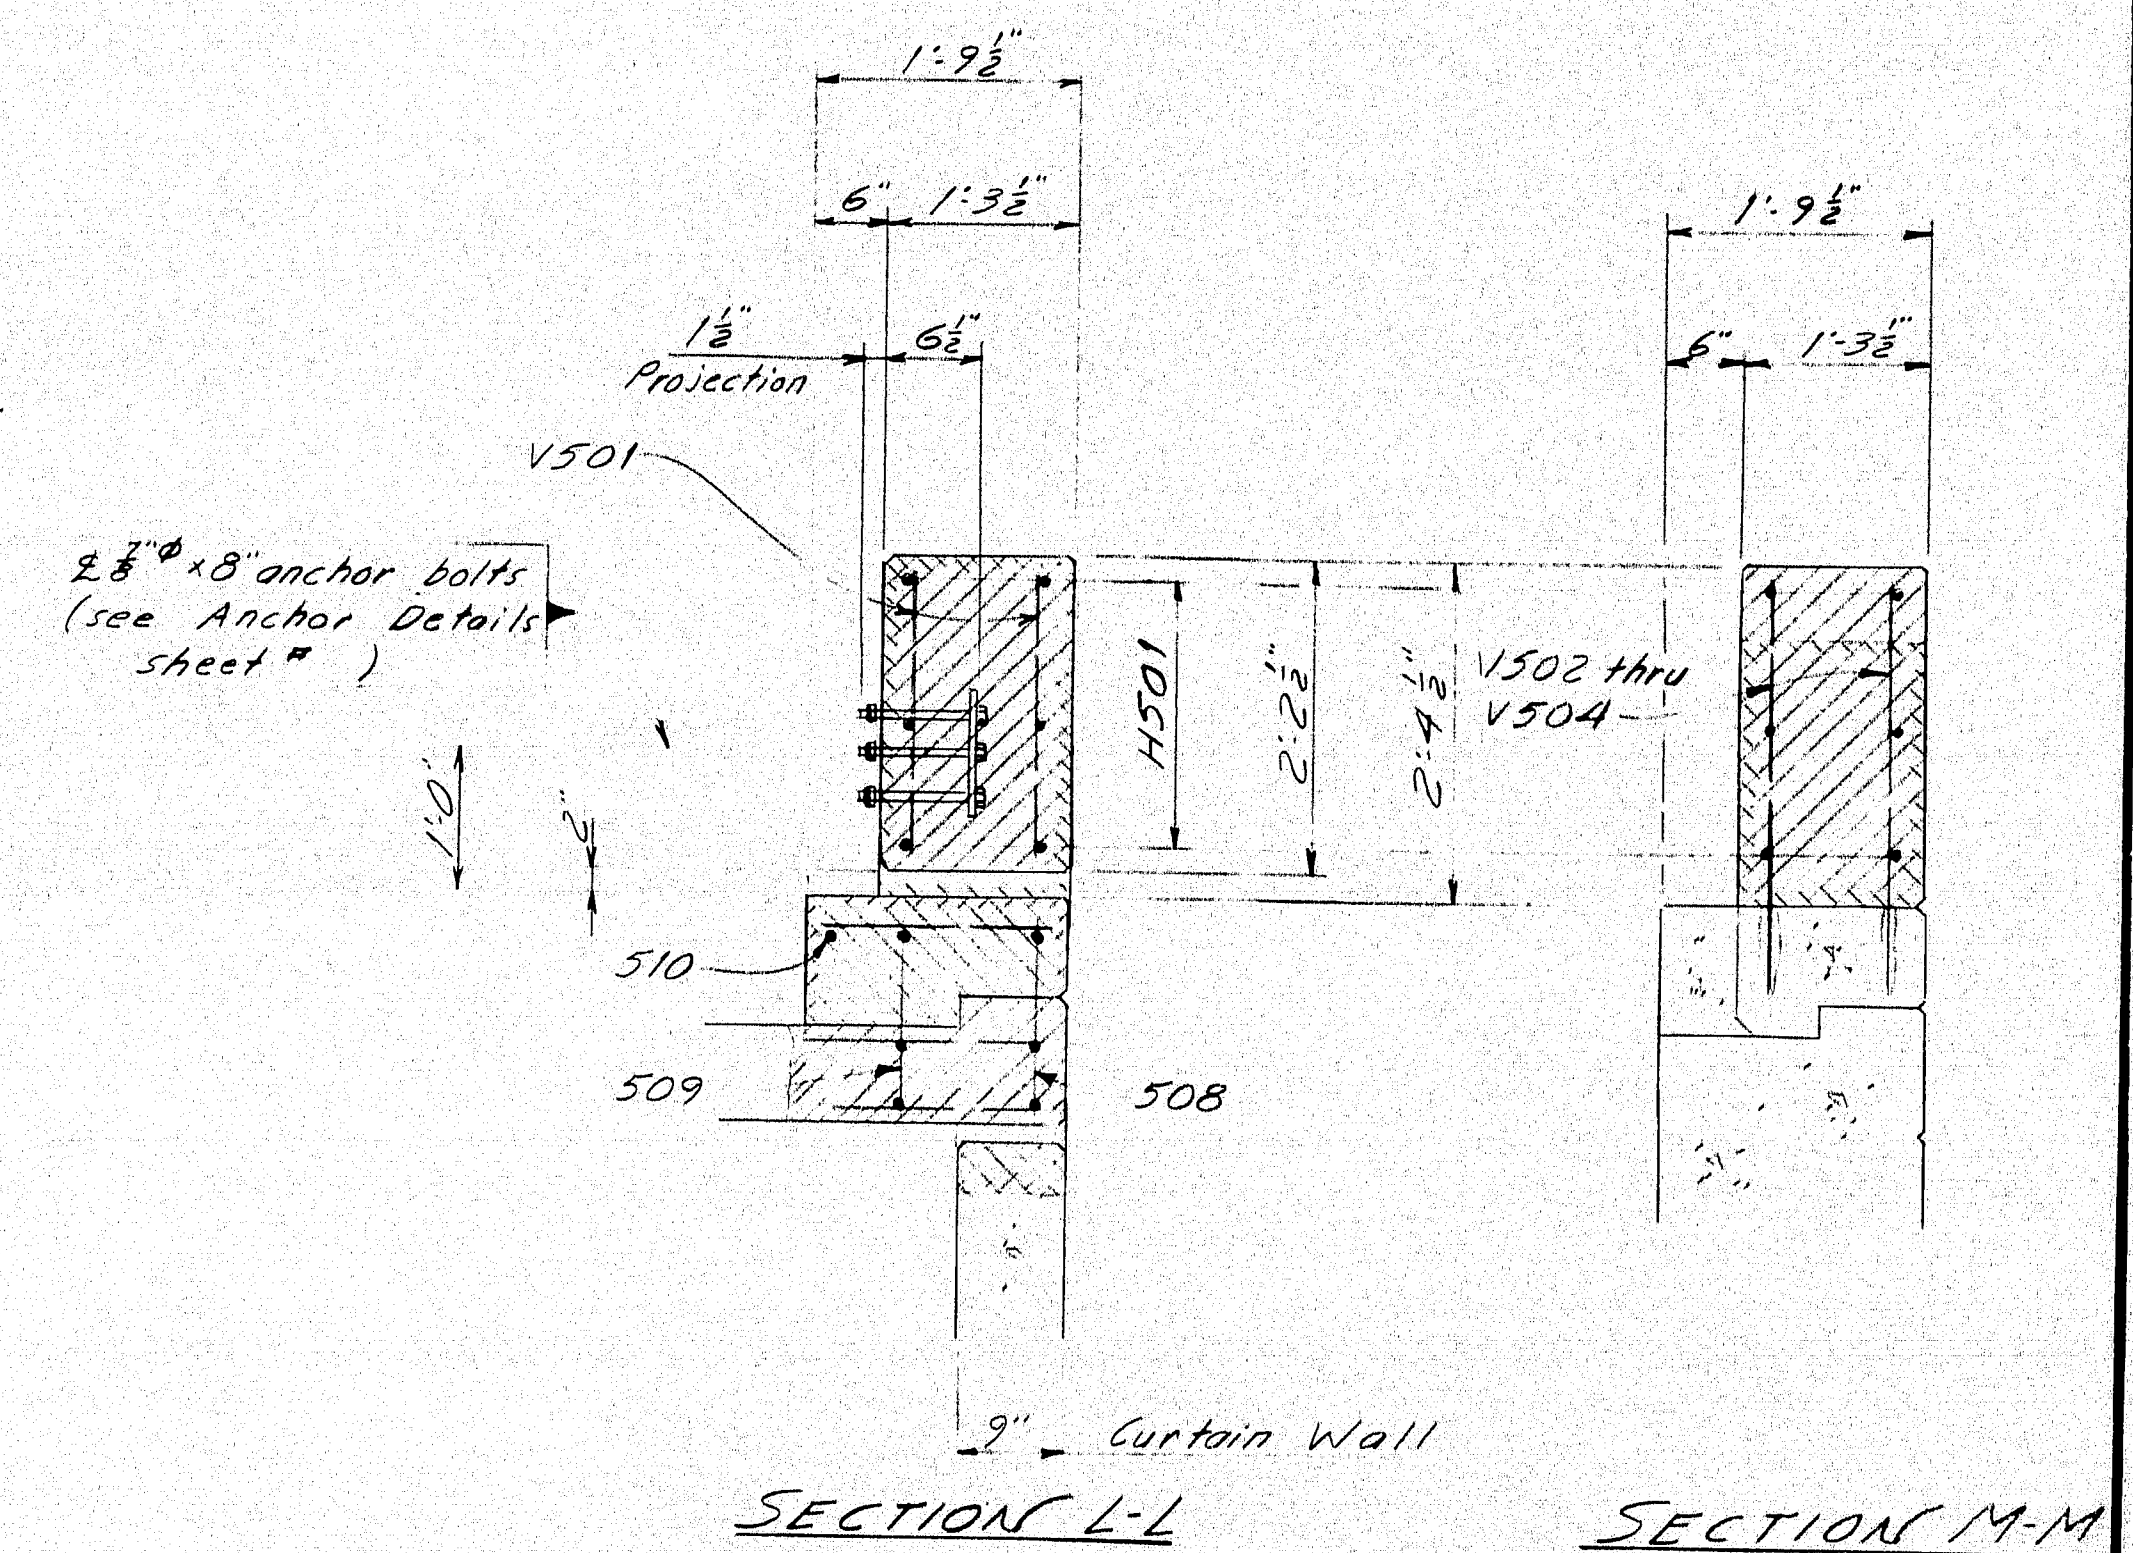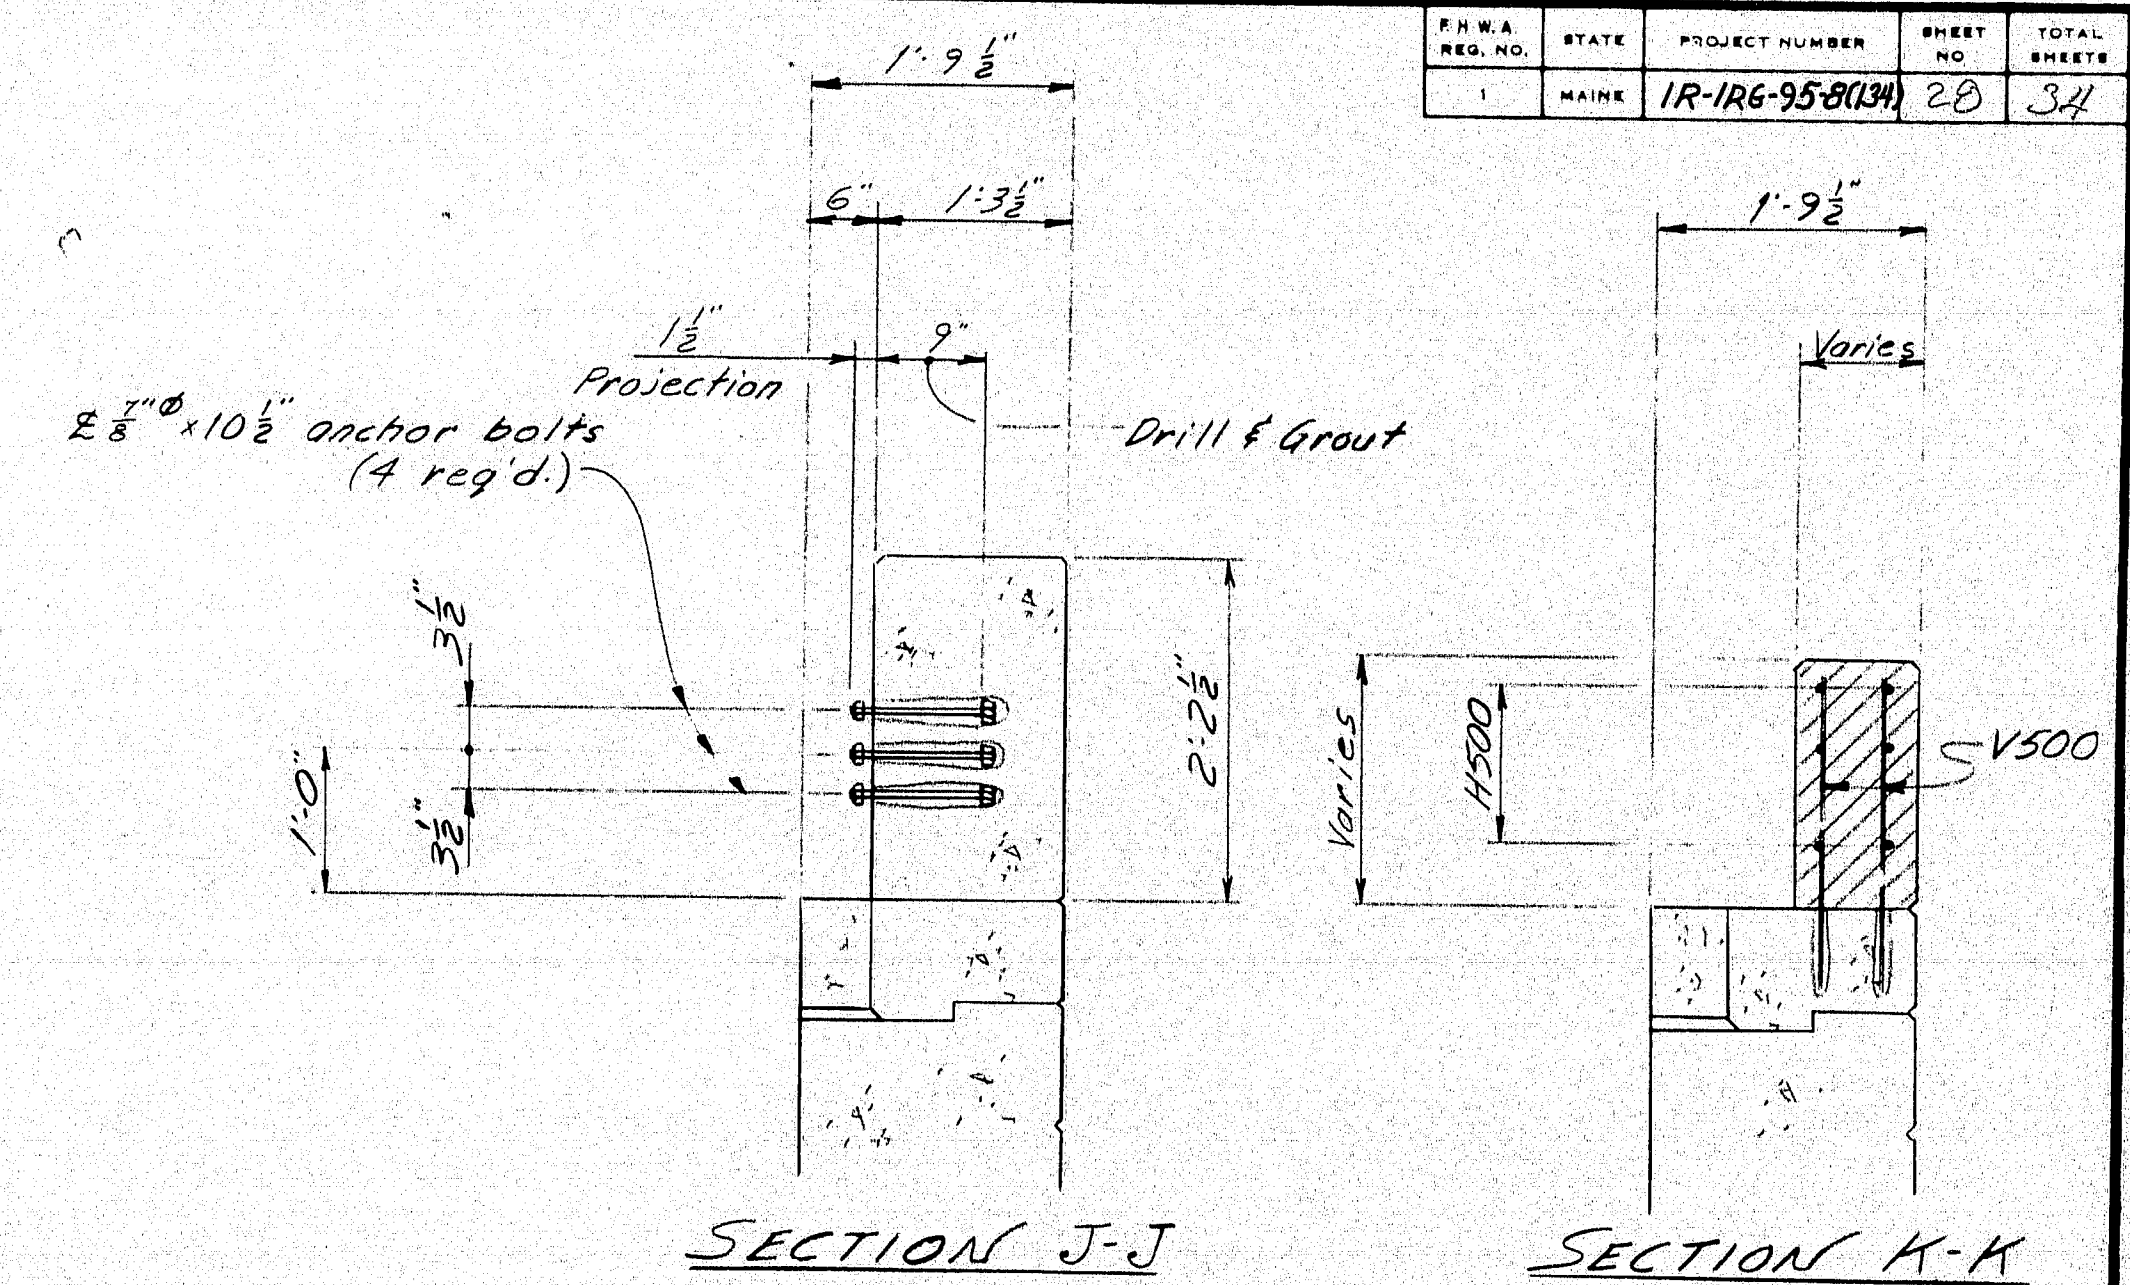


ELEVATION
The removing or cutting of the existing reinforcing steel to accommodate the new compression steel and rebuilding of the end posts shall be kept at a minimum. The exposed reinforcing steel to remain shall be cleaned as directed.

SHEET 5 OF 11 AUGUSTA, MAINE

F.R.A. REG. NO.	STATE	PROJECT NUMBER	SHEET NO.	TOTAL SHEETS
1	MAINE	IR-95-9(12.1)	29	34

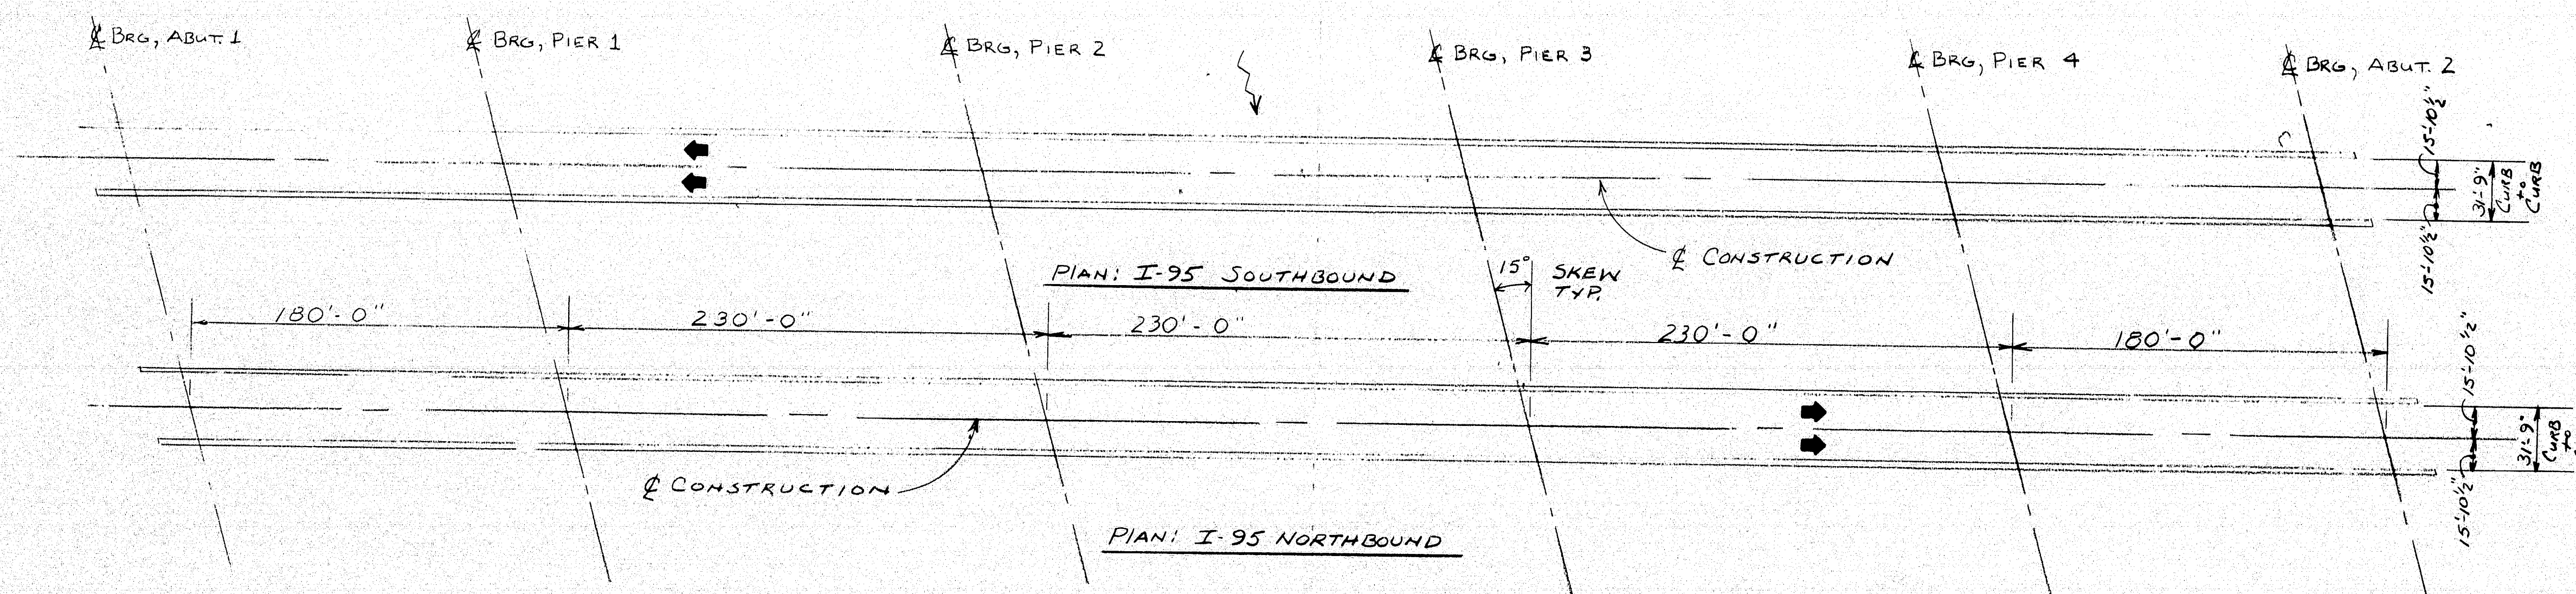


- CONSTRUCTION NOTES**
- 1— Maintain a minimum of one 12 foot travel lane at all times.
 - 2— Grind and replace 1 1/2 inches of bituminous pavement on the Vaughn Daggett bridges and 1 1/2 inches on the I-95 over Route 116 bridges.
 - 3— Grinding and paving shall be from curb to curb on both bridges northbound and southbound.
 - 4— Exposed asphalt after grinding shall be cleaned and have a tack coat of emulsified asphalt applied.

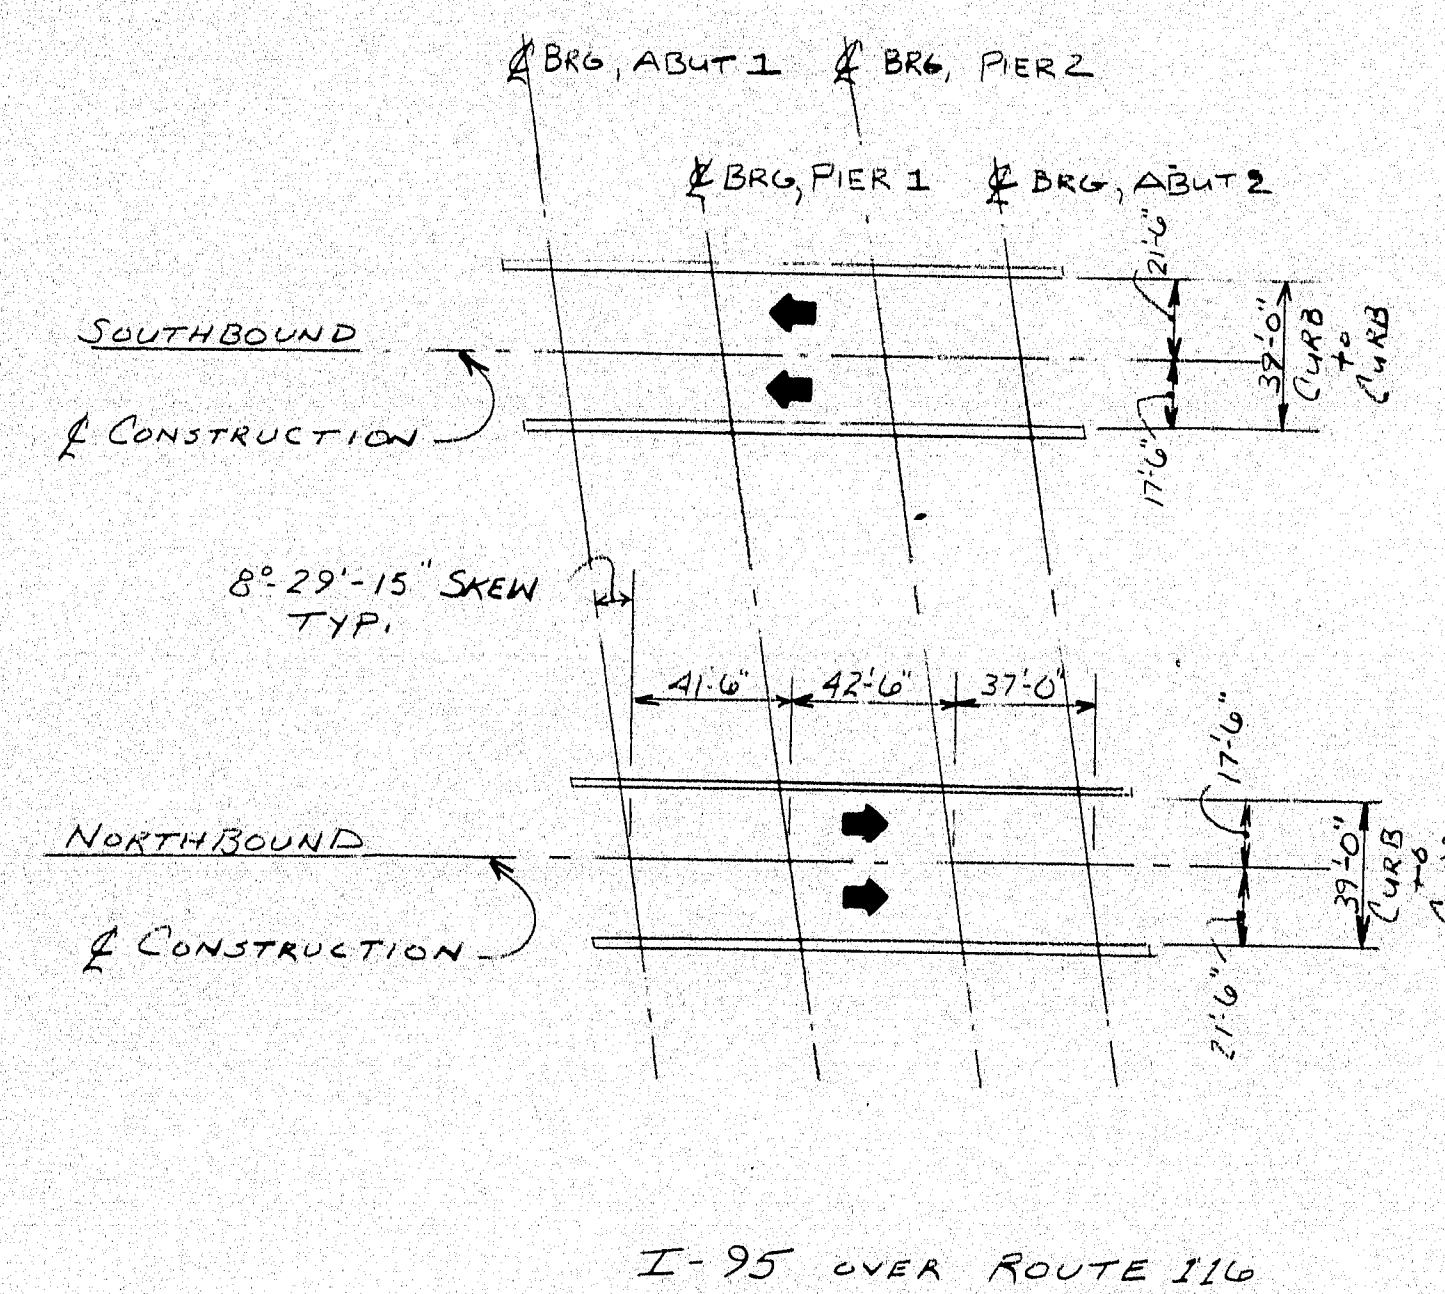


I-95 OVER ROUTE 116

VAUGHN DAGGETT

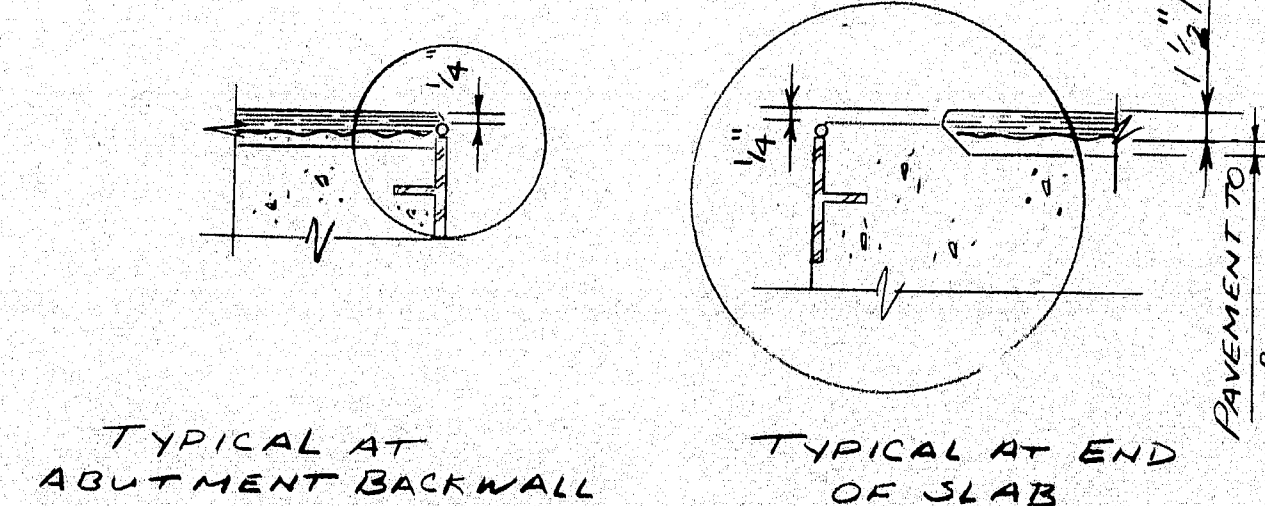

I-95 OVER ROUTE 116 NB & SB

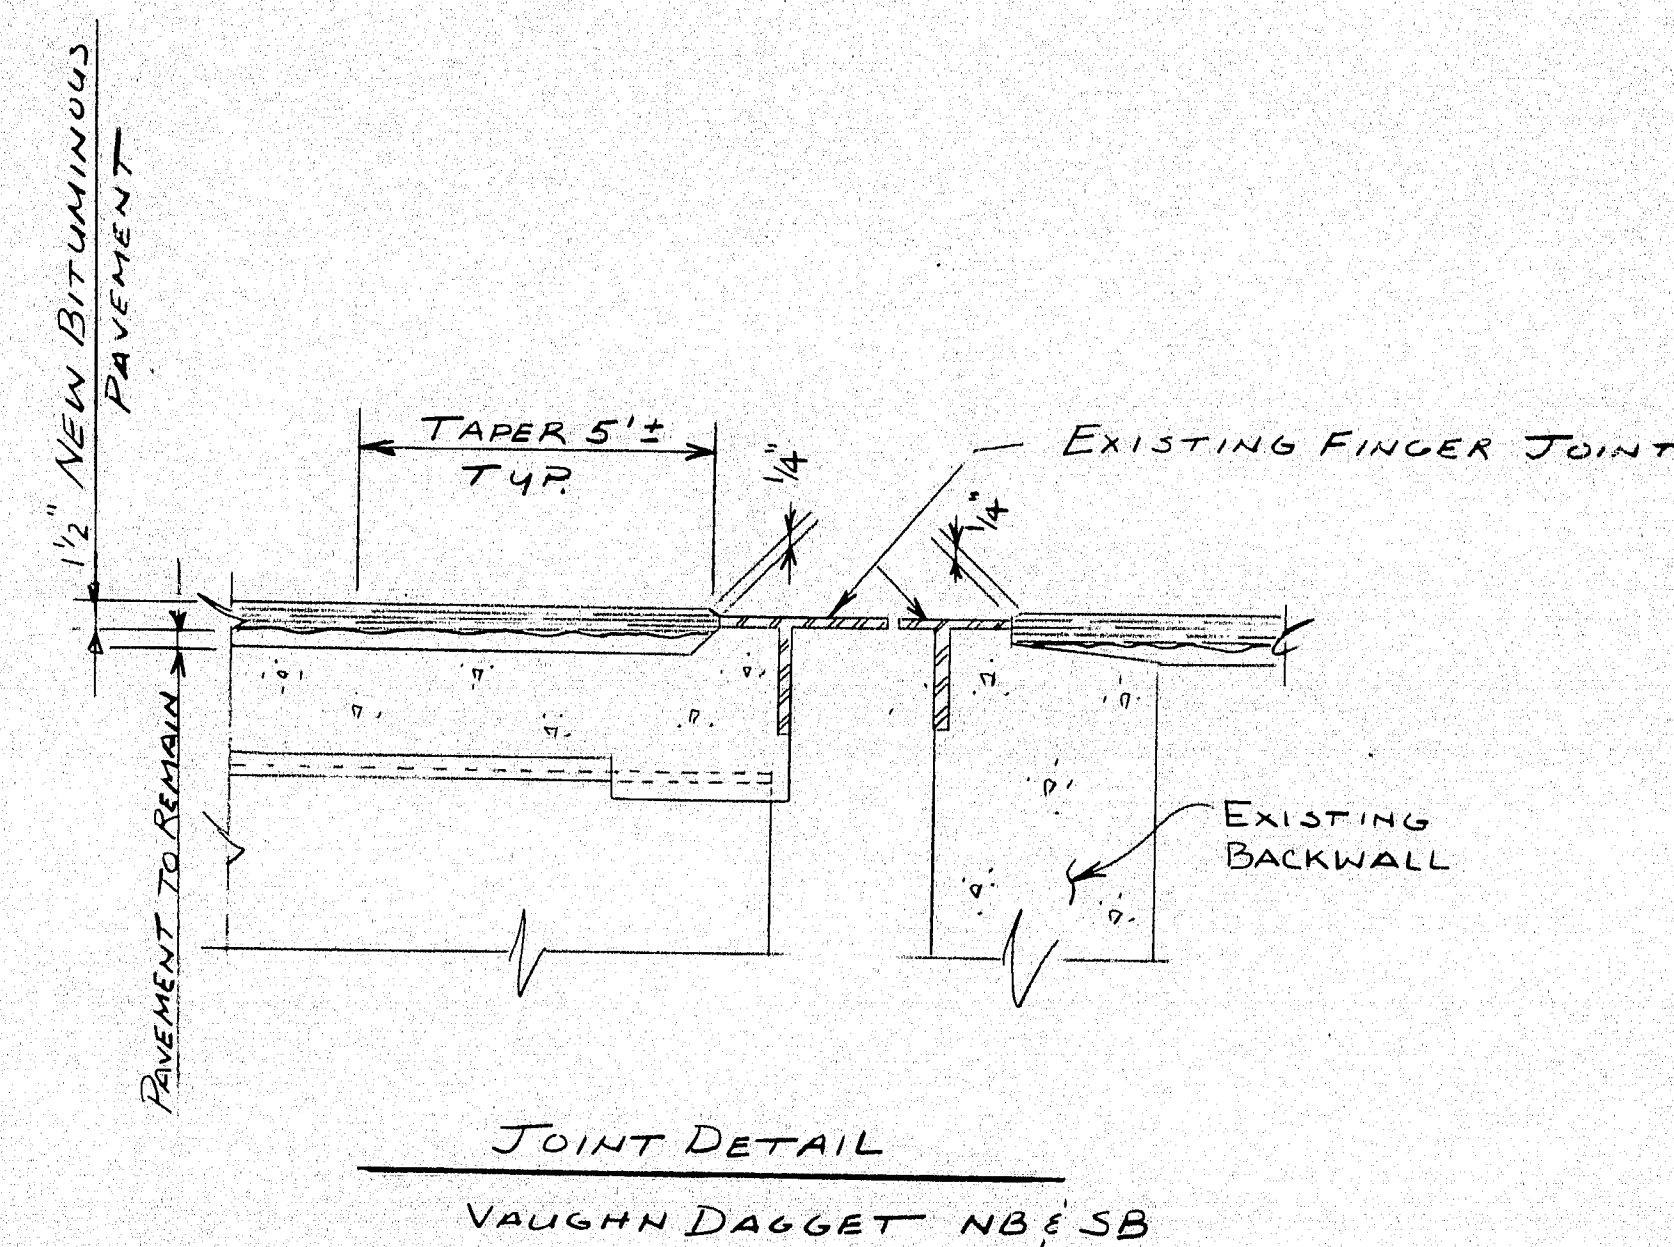

104-149





AS BUILT
Perkins & Associates
3-2-92

STATE OF MAINE
DEPARTMENT OF TRANSPORTATION
VAUGHN DAGGETT MEMORIAL
BRIDGE OVER PENOBSCOT RIVER
INTERSTATE 95 OVER
ROUTE 116
IN THE TOWN OF
MEDWAY
PENOBSCOT COUNTY
GENERAL PLAN & DETAILS
SHEET 6 OF 11 AUGUSTA, MAINE

MEDWAY


95-9(12.1)

F.H.W.A. REG. NO.	STATE	PROJECT NUMBER	SHEET NO.	TOTAL SHEETS
1	MAINE	1R-95-9(121)	30	34

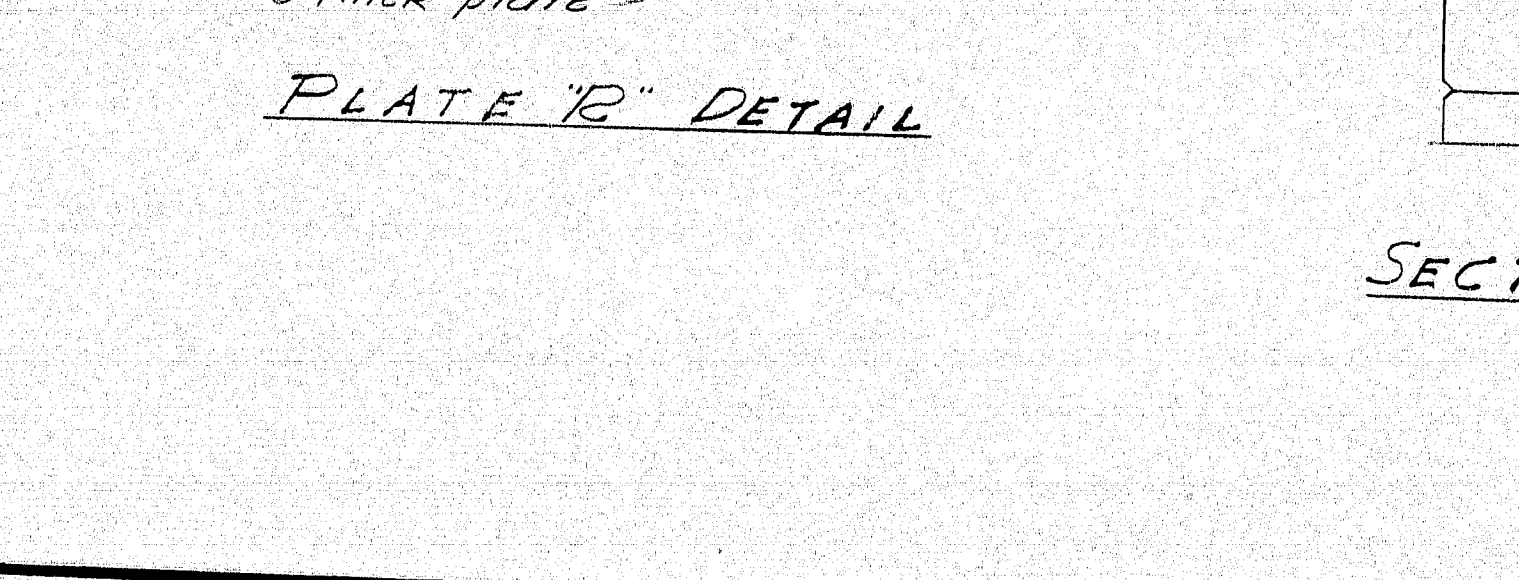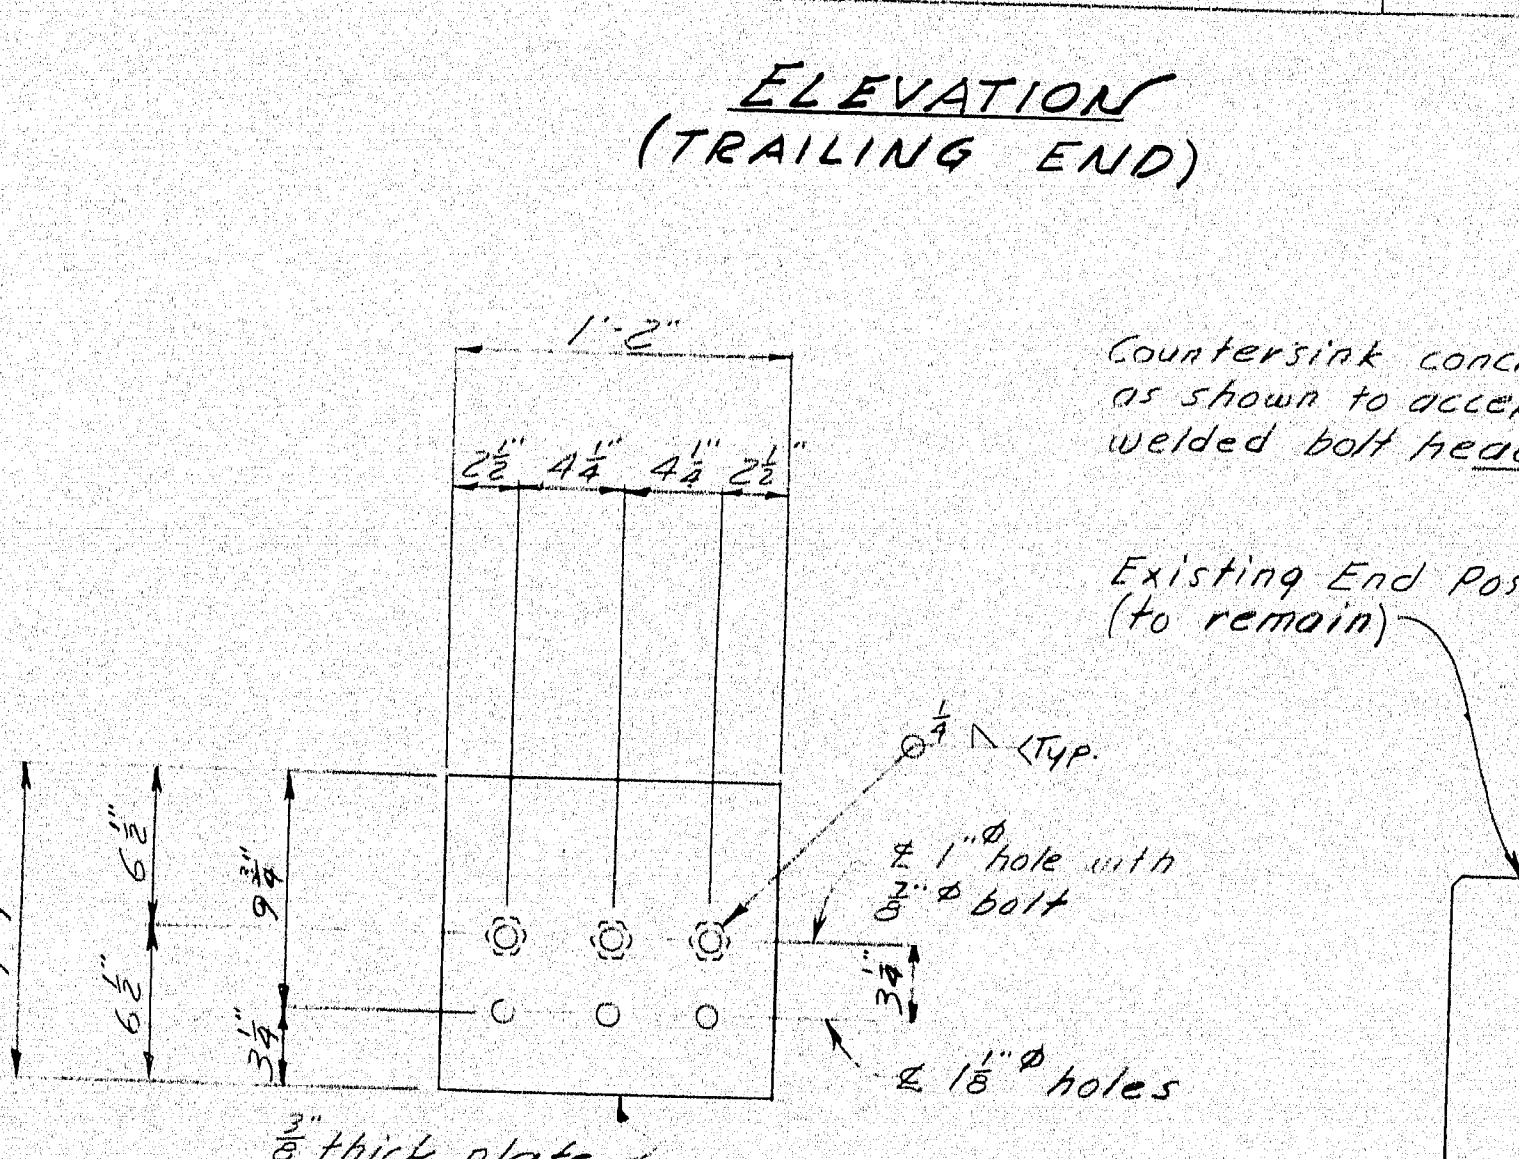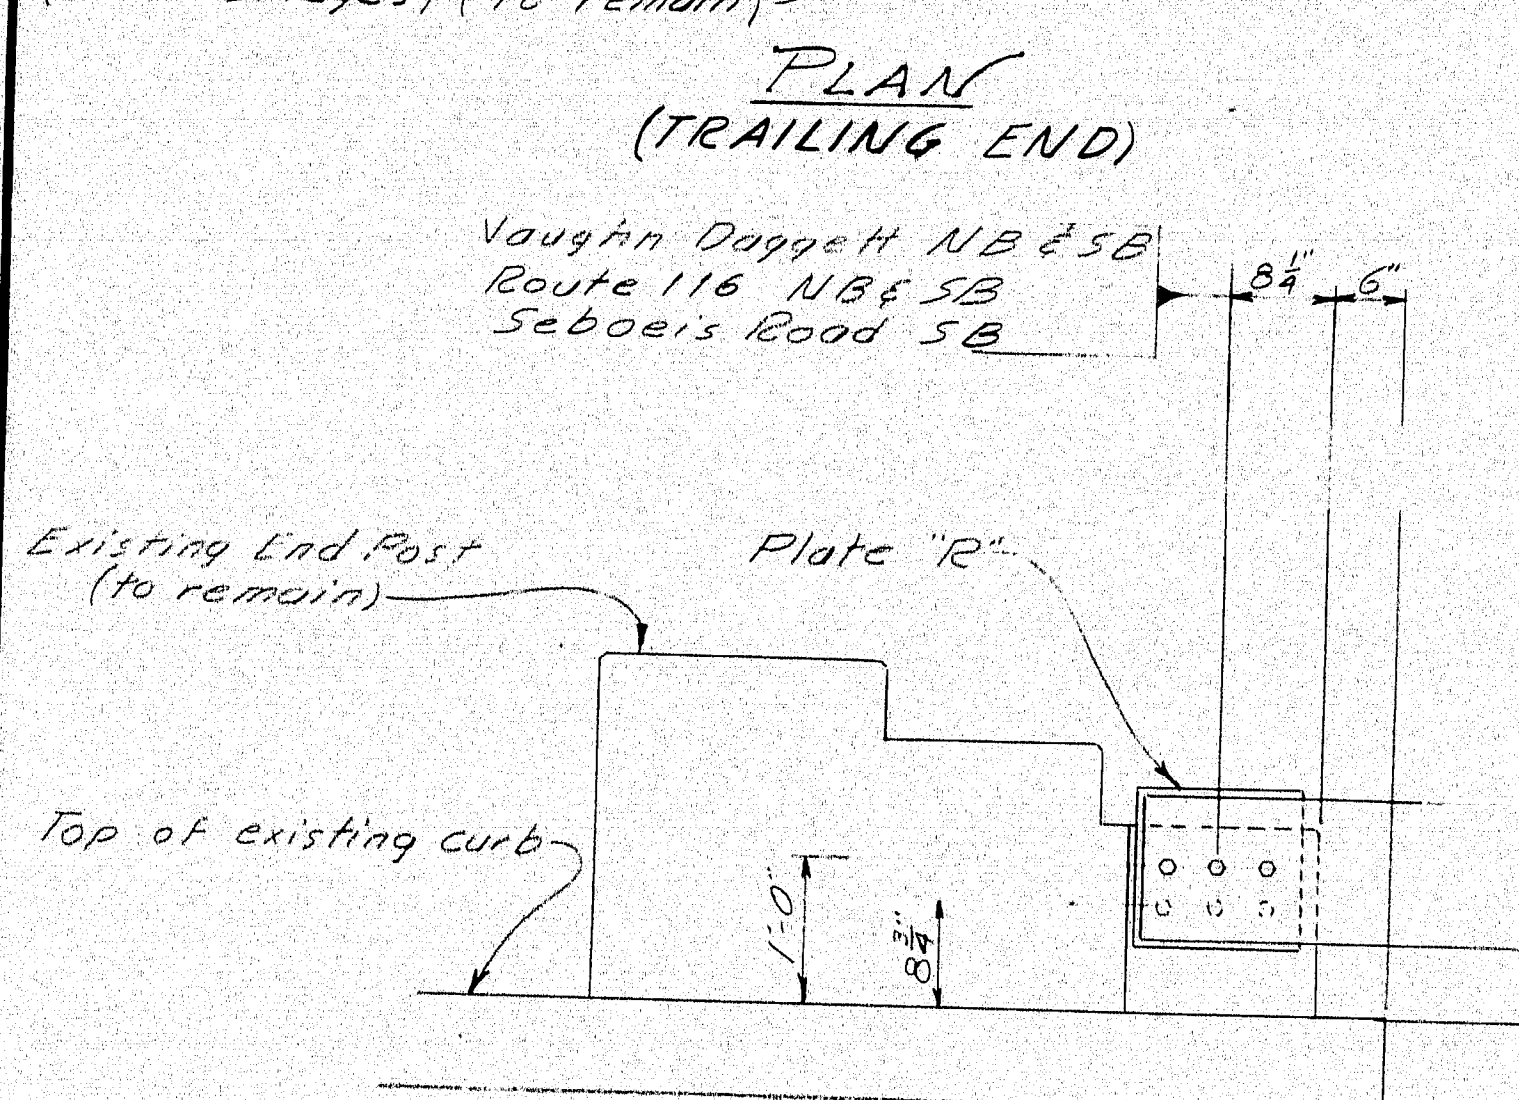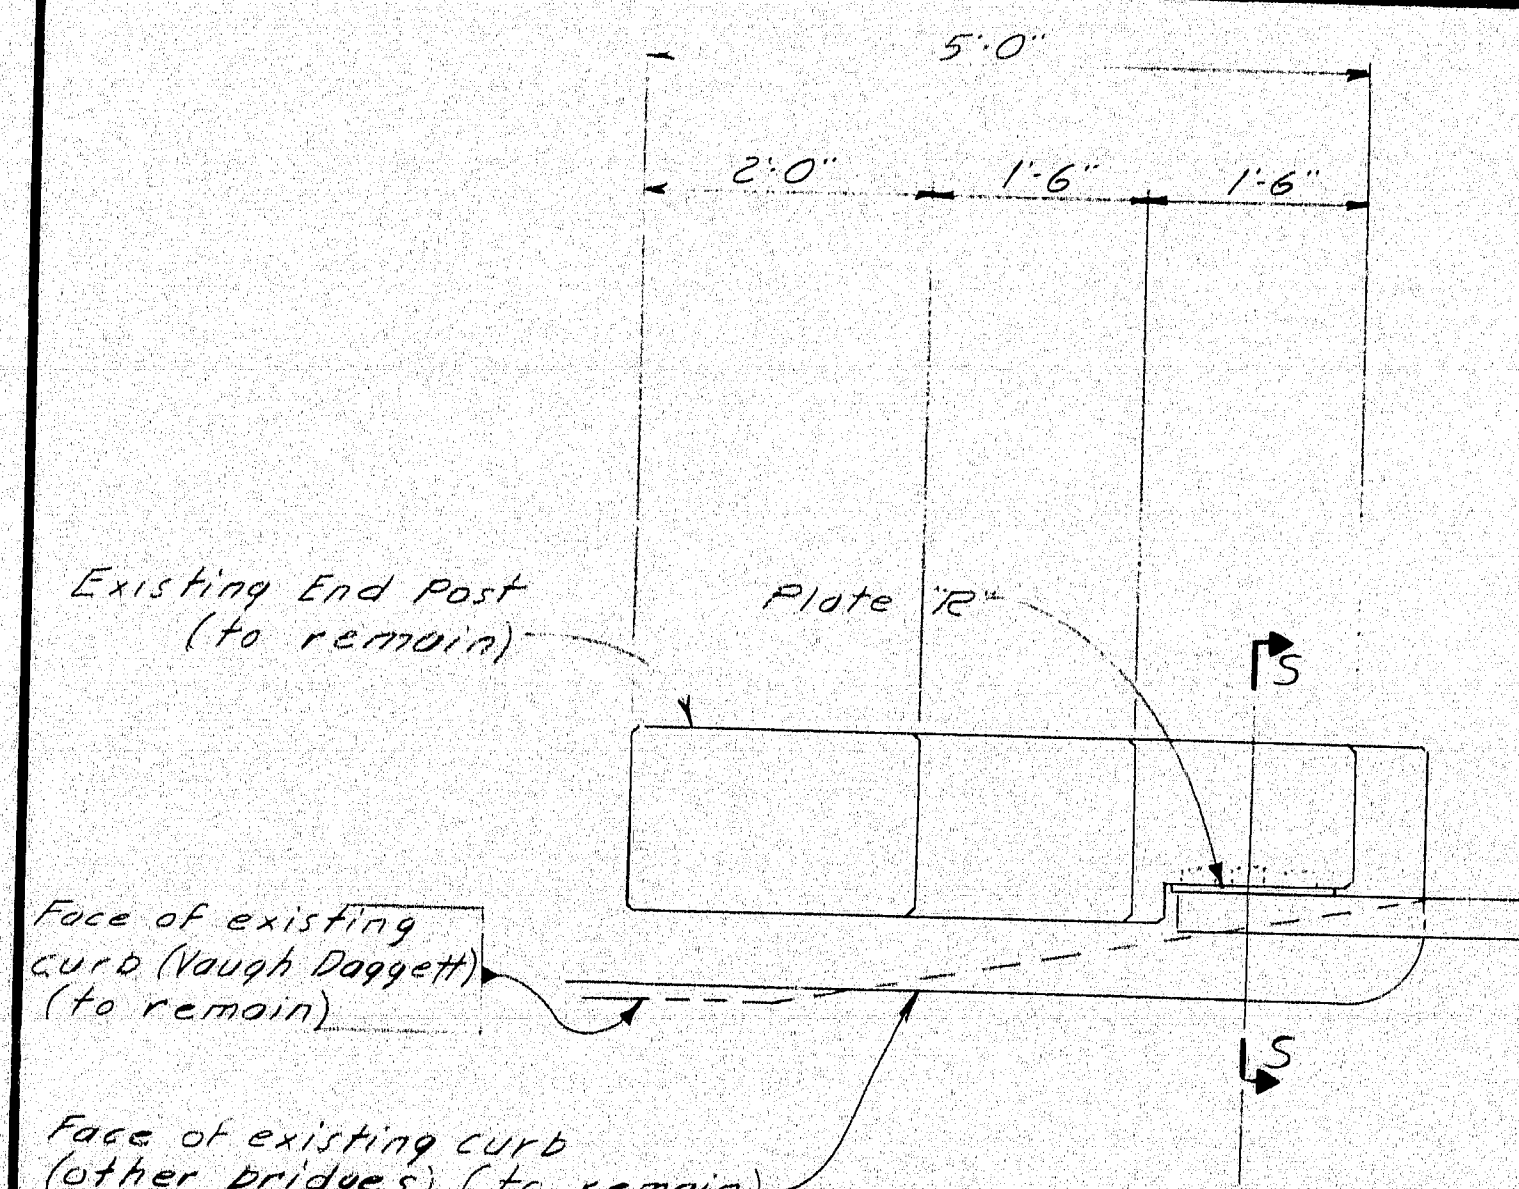


Rail Post Spacing 6'-3"
Typical all bridges except
SB Piscataquis River Bridge and
Canadian Pacific Railway SB





GUARD RAIL LAYOUT (TRAILING END)
(all panels single rail)

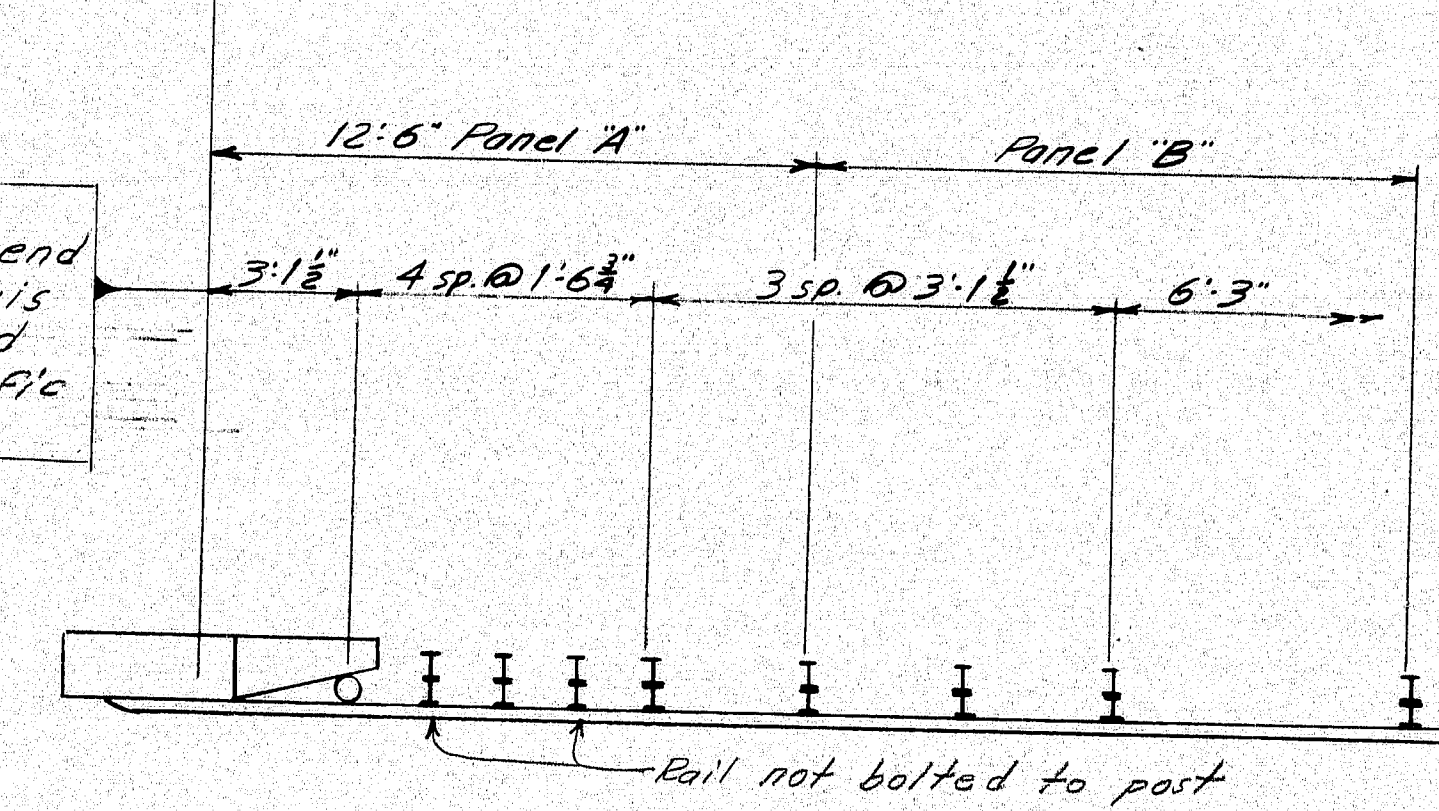

GUARD RAIL LAYOUT (LEADING END)
(Panel 'A' double rail)

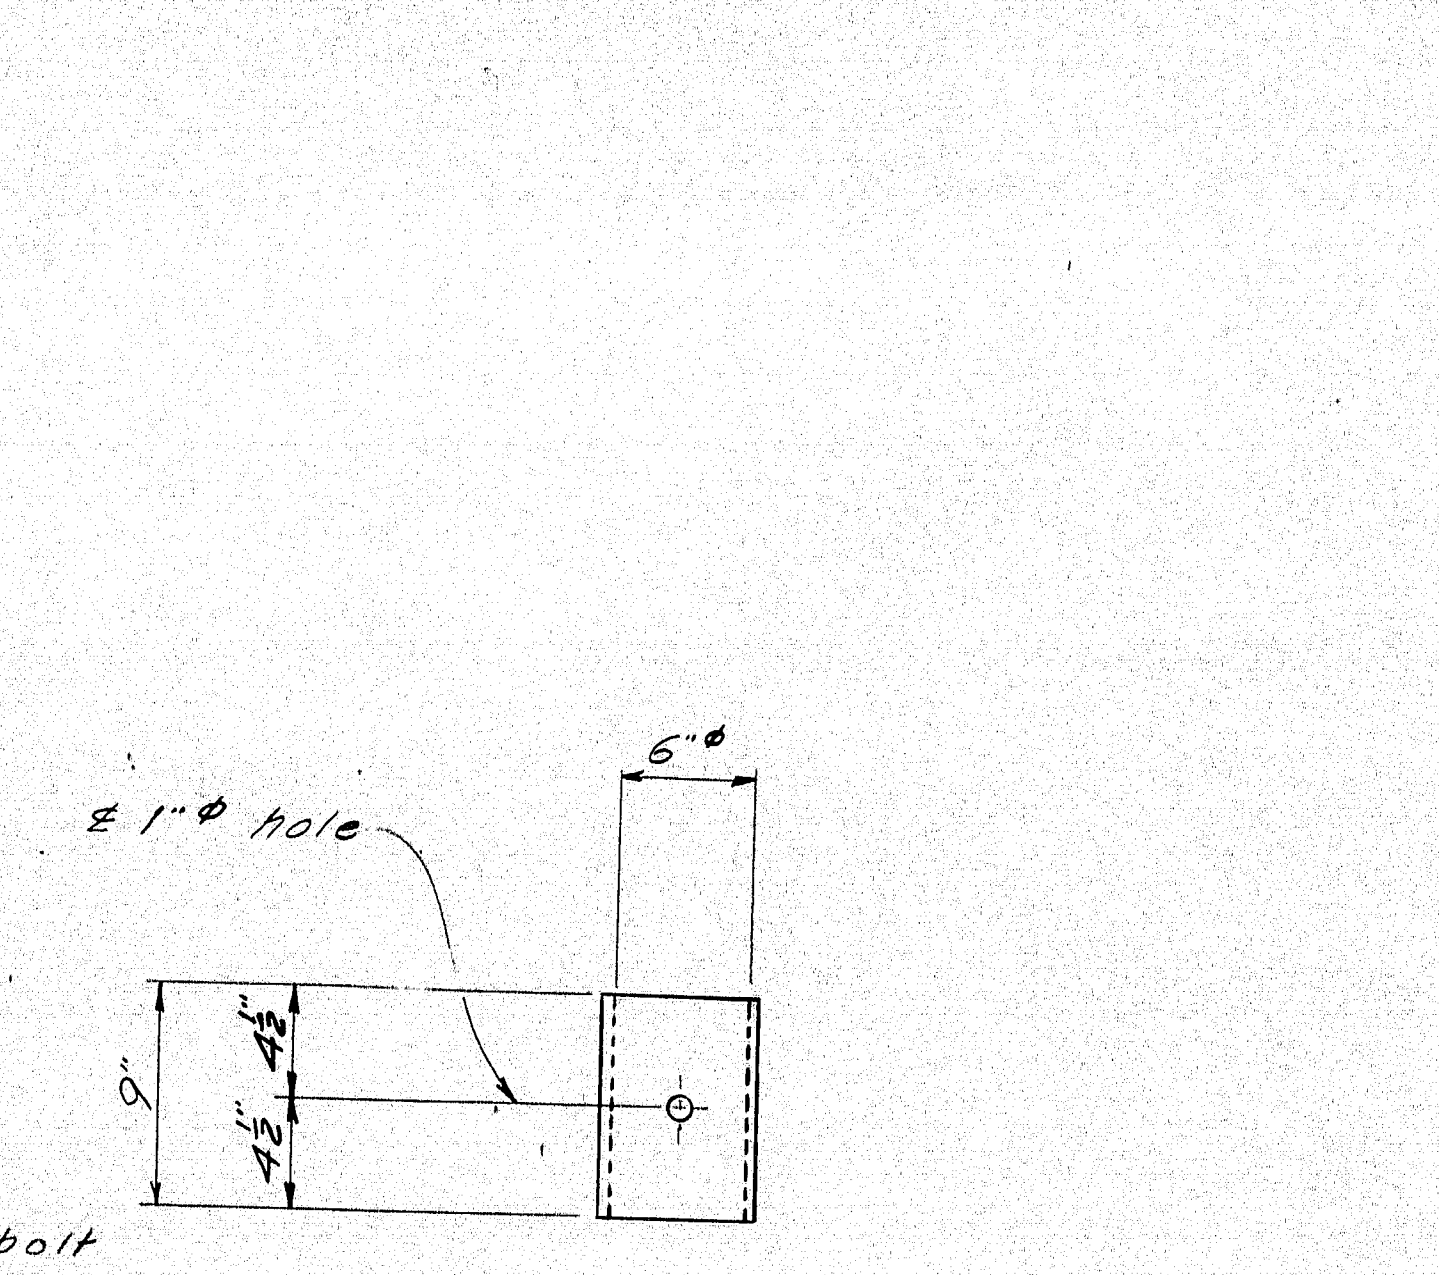

SECTION S-S

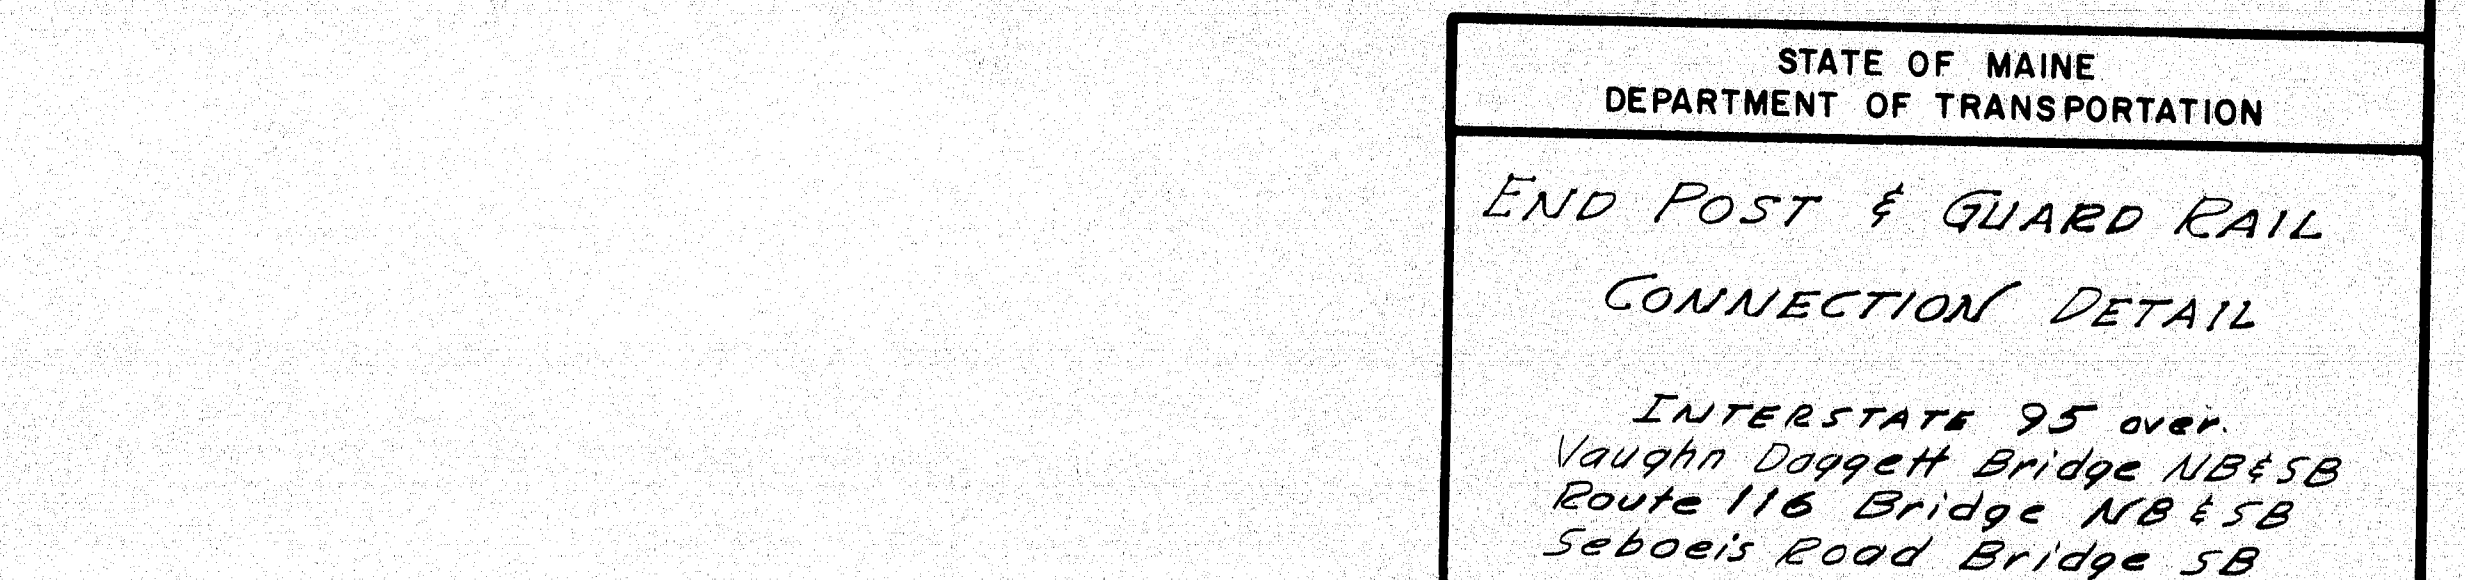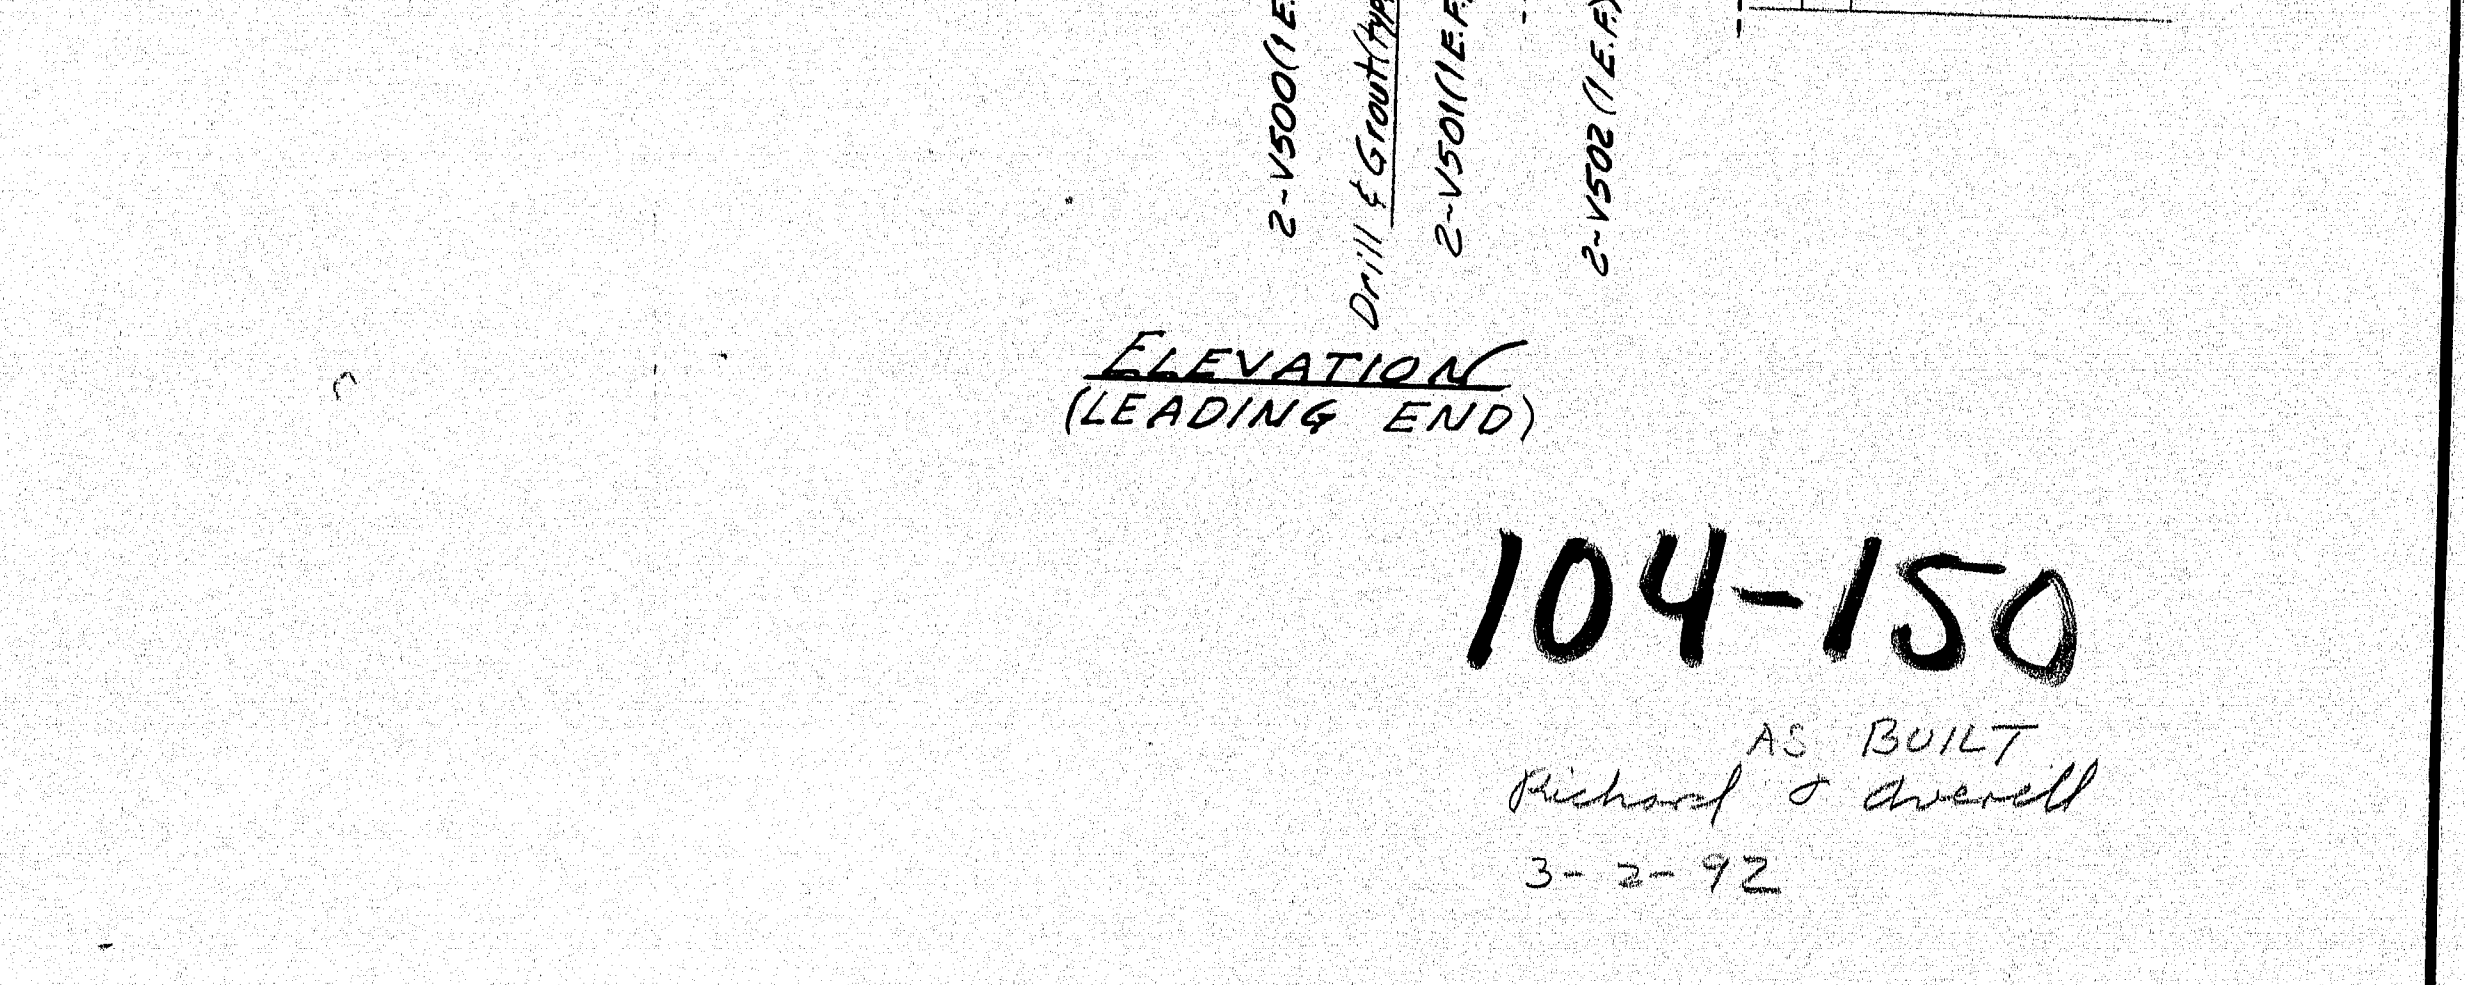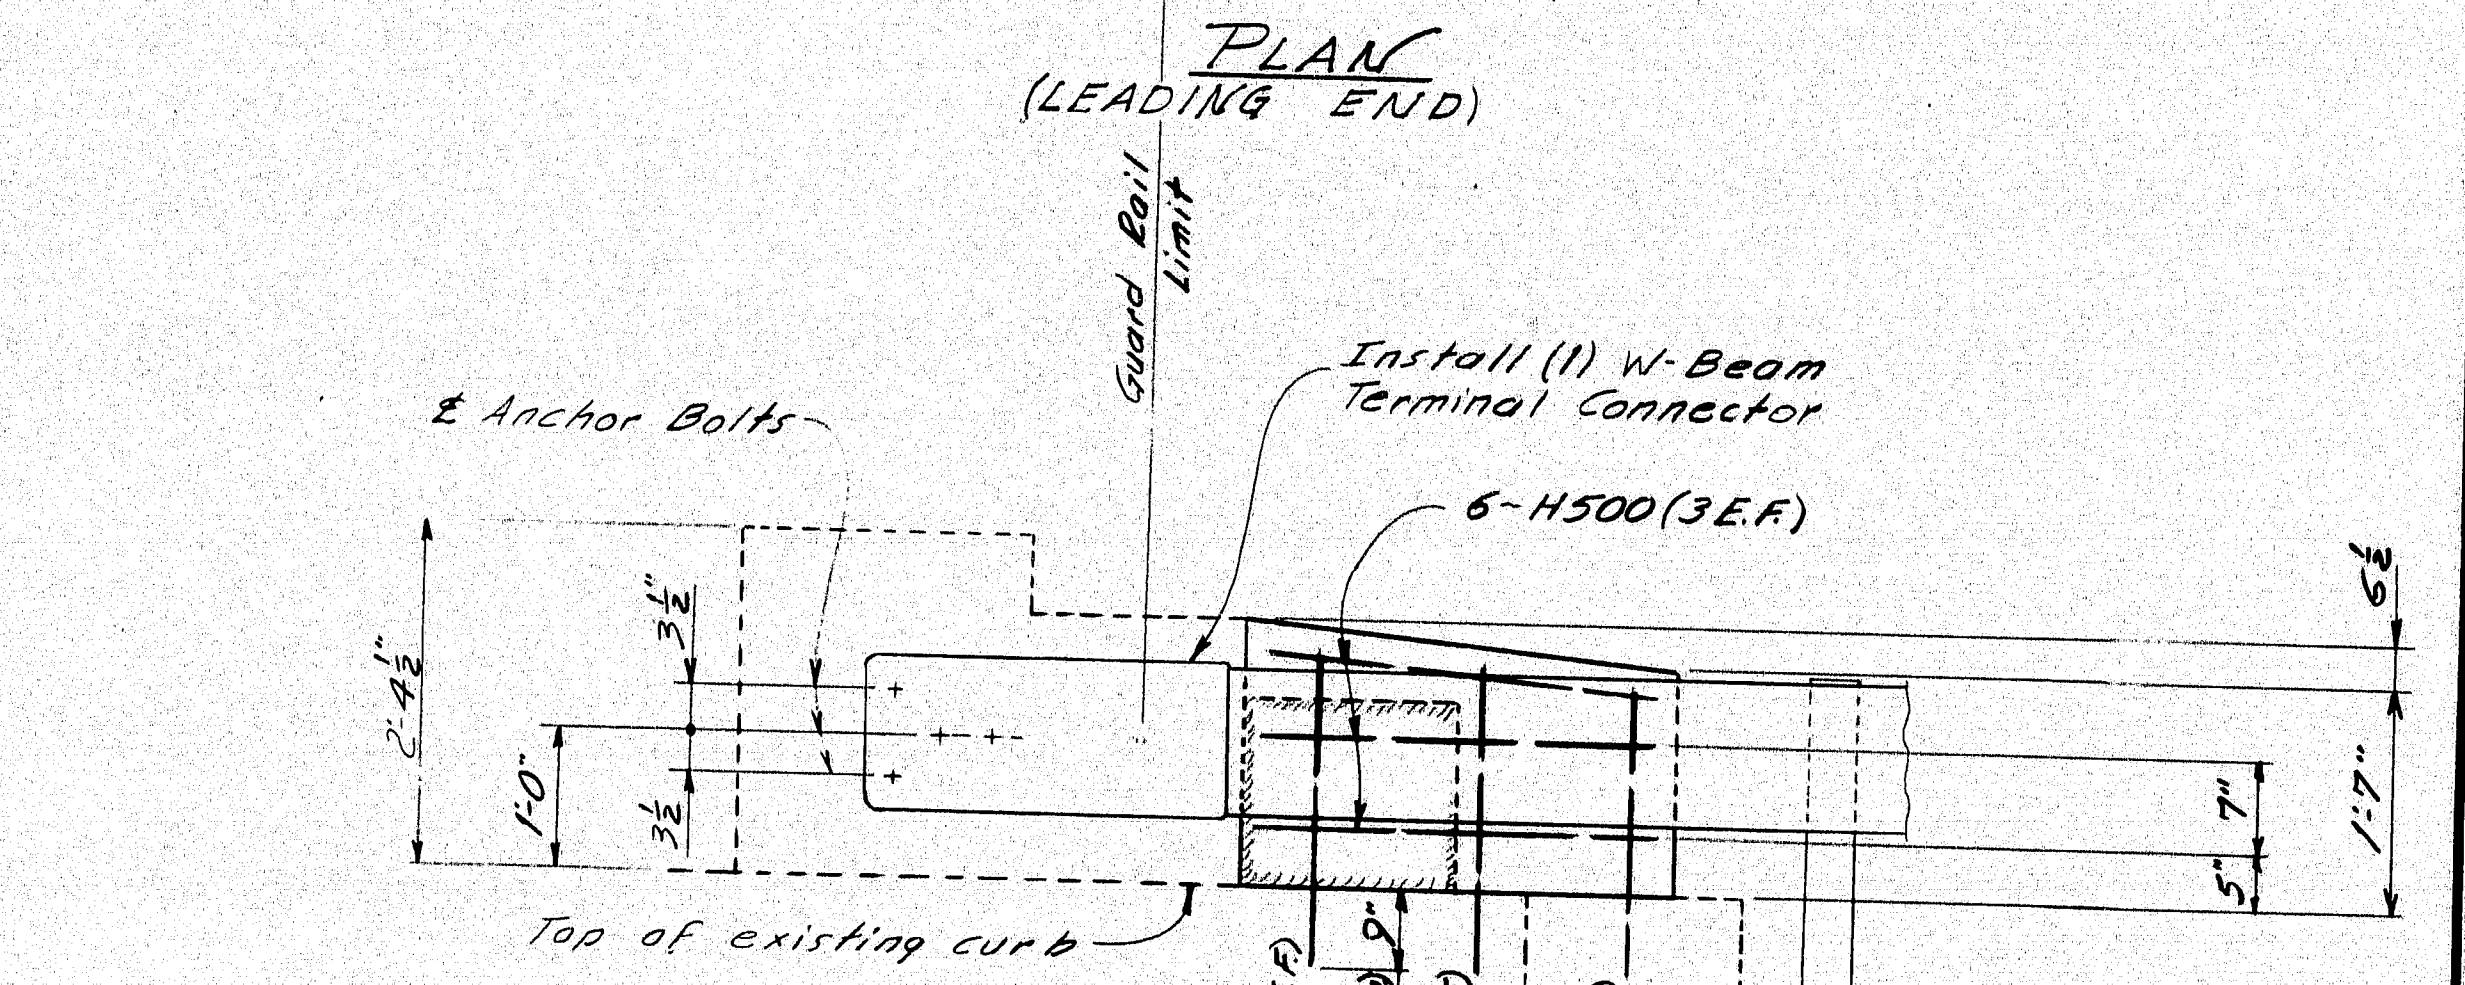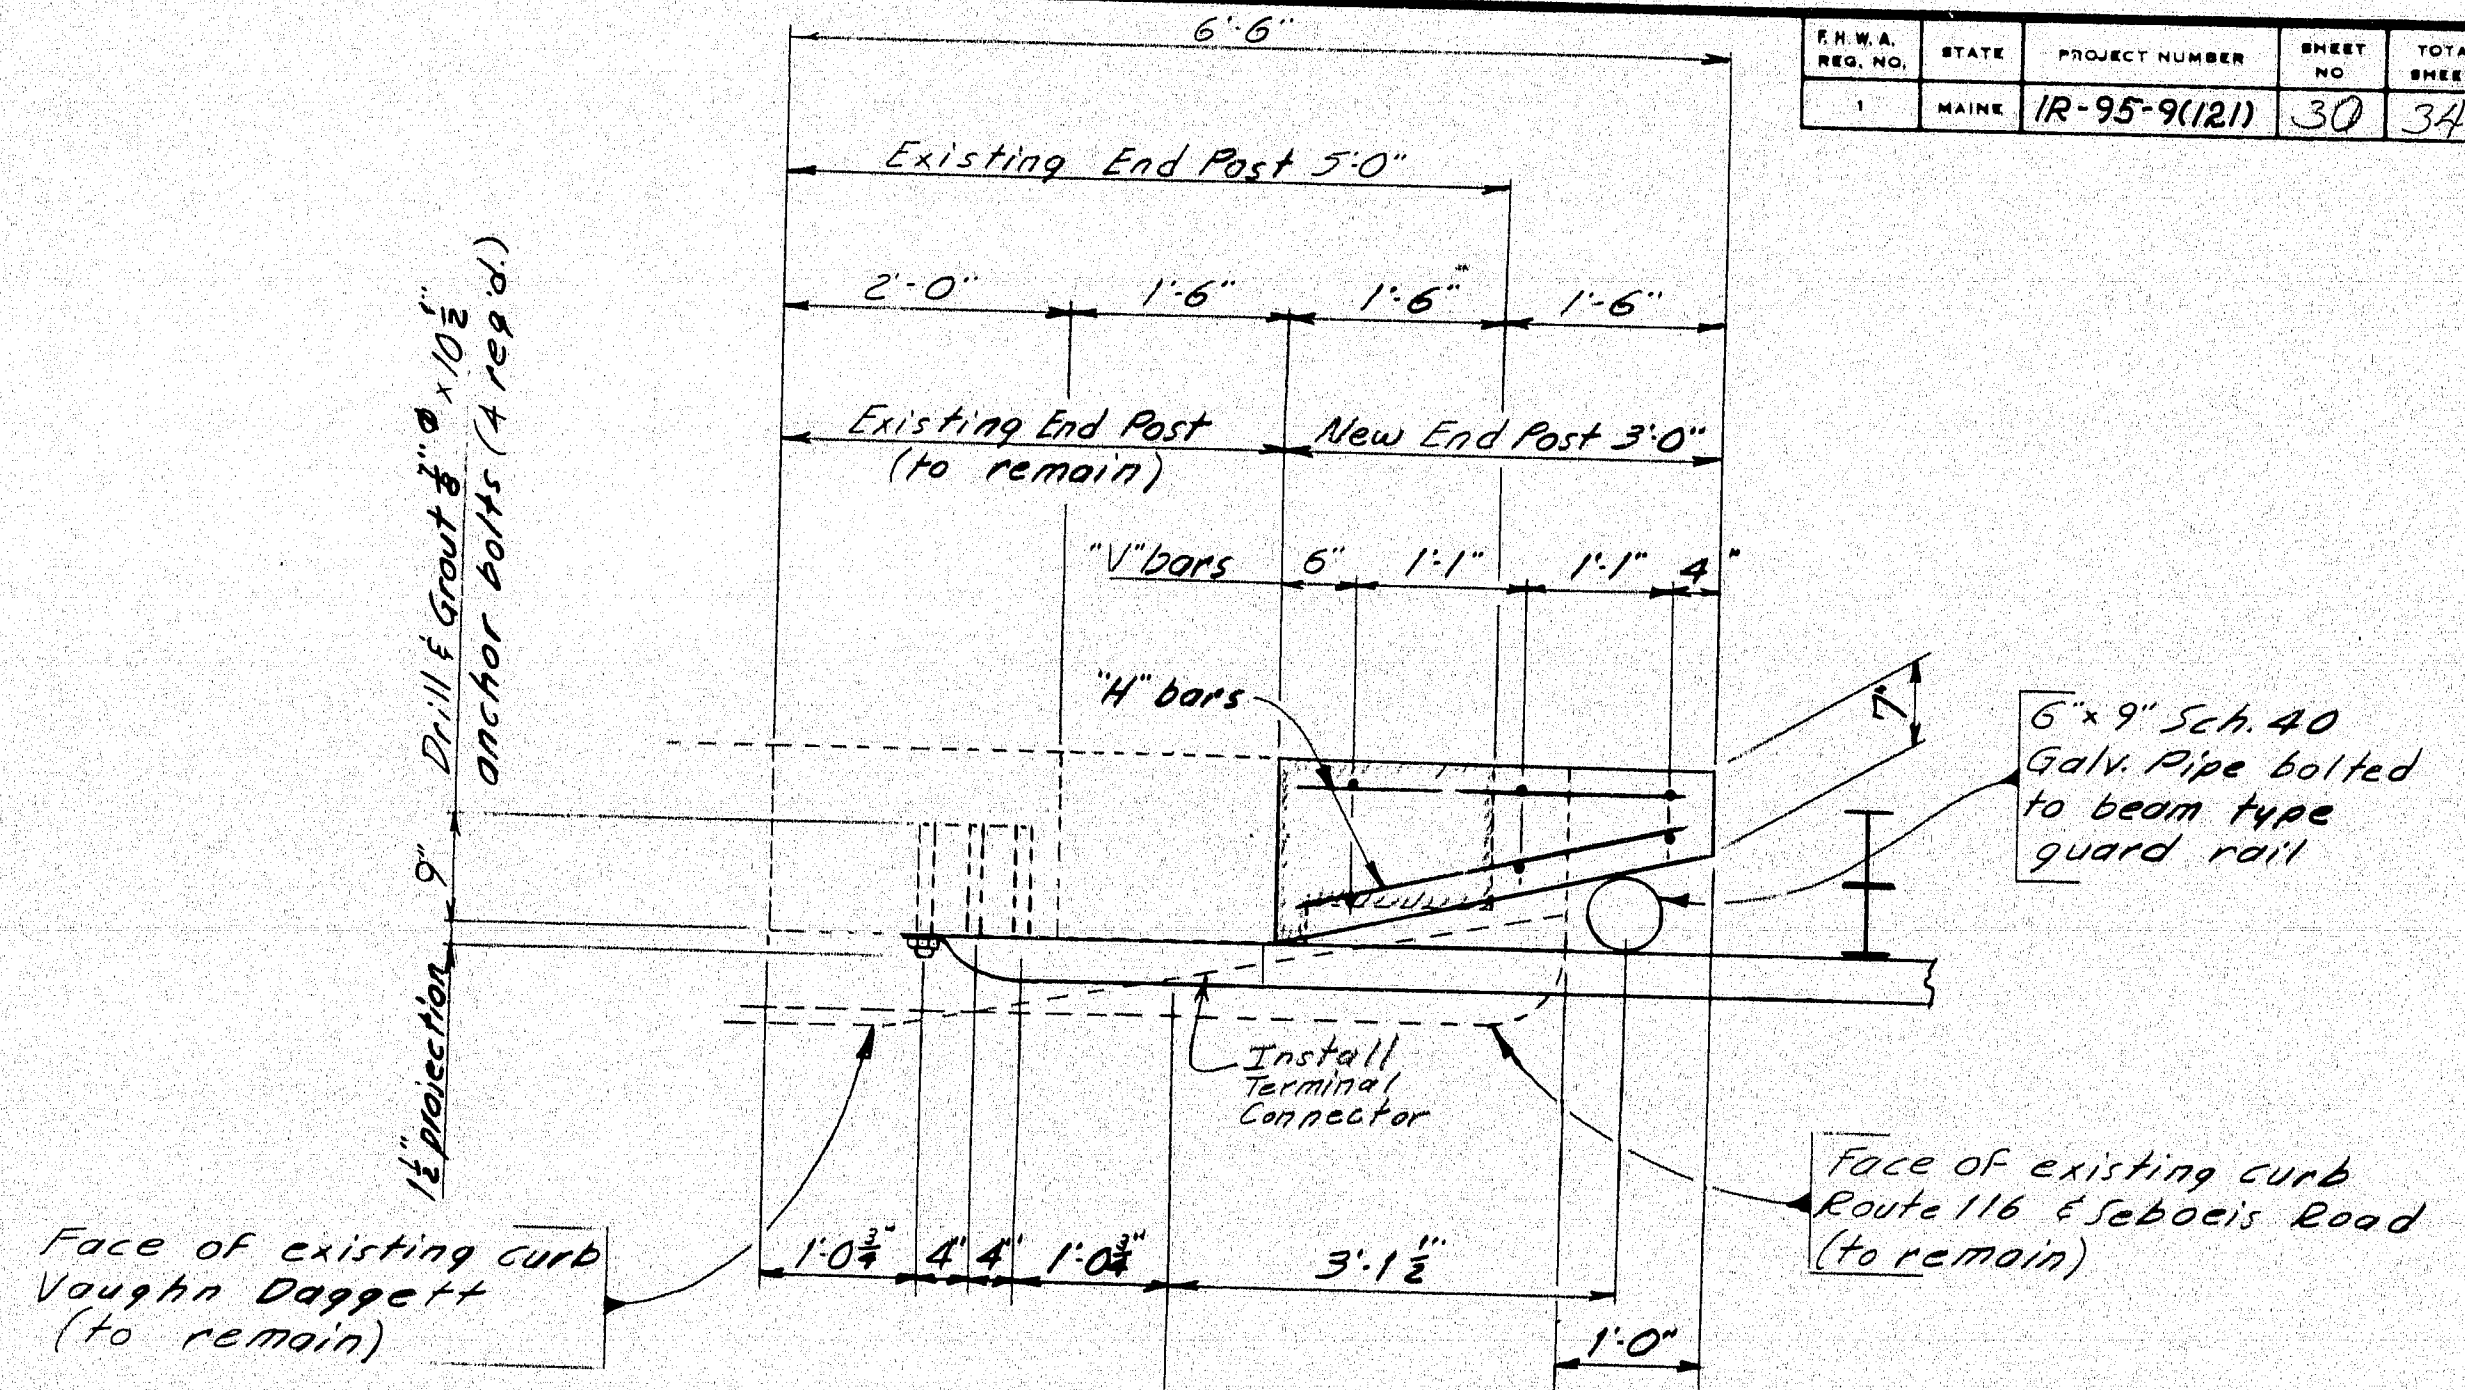

104-150

AS BUILT
Richard O. Dorell
3-2-92

STATE OF MAINE
DEPARTMENT OF TRANSPORTATION
END POST & GUARD RAIL
CONNECTION DETAIL
INTERSTATE 95 over
Vaughn Daggett Bridge NB&SB
Route 116 Bridge NB&SB
Seboeis Road Bridge SB

SHEET 7 OF 11 AUGUSTA, MAINE

MEDWAY 95-9(121)

REINFORCING STEEL SCHEDULE																										
STRAIGHT BARS								BENT BARS																		
MARK	NO.	LENGTH	LOCATION	MARK	NO.	LENGTH	LOCATION	MARK	NO.	LENGTH	LOCATION	MARK	NO.	LENGTH	TYPE	A	B	C	D	E	F	G	H	O	R	LOCATION
PISCATAQUIS RIVER BRIDGE SB				ROUTE 116 NB & SB																						
V512	32	2'-10"	Dowel	V500	8	2'-4"	Dowel																			
V513	8	1'-6"	End Post	V501	8	2'-3"	Dowel																			
V514	8	1'-2"	End Post	V502	8	1'-3"	Dowel																			

PLANS	DESIGN - DETAIL	BY	DATE
	CHECKED		5-28
	REVISIONS		
	FIELD CHANGES		