


F.H.W.A. REG. NO.	STATE	PROJECT NUMBER	SHEET NO.	TOTAL SHEETS
1	MAINE	I-95-5(42)	1	37

STATE OF MAINE DEPARTMENT OF TRANSPORTATION

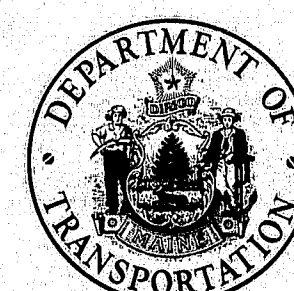

BUREAU OF HIGHWAYS

INTERSTATE 95

OVER

ROUTE 138

IN THE TOWN OF

BOWDOINHAM

SAGADAHOC COUNTY

MAINE FEDERAL AID INTERSTATE
PROJECT NO. I-95-5(42)81
LENGTH OF PROJECT 0.018 MILES

CONVENTIONAL SIGNS

COUNTY LINES	---	TRAVELLED WAY - PROPOSED	=====
TOWN LINES	----	UNDERGROUND UTILITIES - EXISTING	----
PROPERTY LINES	-----	UNDERGROUND UTILITIES - PROPOSED	----
R/W LINES - EXISTING	=====	RAILROAD - SINGLE TRACK	=====
R/W LINES - NEW - ACCESS CONTROL	=====	RAILROAD - DOUBLE TRACK	=====
R/W LINES - NEW - NO ACCESS CONTROL	=====	UTILITY POLE - EXISTING	+
CULVERT - EXISTING	=====	UTILITY POLE - JOINT OCCUPANCY	+
CULVERT - PROPOSED	=====	PROPOSED UTILITY POLE - TEMPORARY	X
CURBING - EXISTING	=====	PROPOSED UTILITY POLE - PERMANENT	*
CURBING - PROPOSED	=====	TREES	
TRAVELLED WAY - EXISTING	=====	WOODS	

SPECIFICATIONS

DESIGN - AASHTO Standard Specifications for Highway Bridges 1973, and
Interim Specifications 1974

CONTRACT - State of Maine, State Highway Commission, Standard
Specifications, Highways and Bridges, Revision of June 1968

DESIGN LOADING

LIVE LOAD = HS 20-44 (as modified for Interstate Highways)

MATERIALS

CONCRETE - Class A Except as noted


REINFORCING STEEL - ASTM A615, Grade 60

STRUCTURAL STEEL - ASTM A588


HIGH STRENGTH BOLTS ASTM A325 Type 3

BASIC ALLOWABLE STRESSES

CONCRETE	$f_c = 1200 \text{ psi}$	$n = 10$
REINFORCING STEEL	$f_s = 24,000 \text{ psi}$	
STRUCTURAL STEEL	ASTM A588	$f_s = 27,000 \text{ psi}$
	ASTM A325, Type 3	$f_v = 13,500 \text{ psi}$

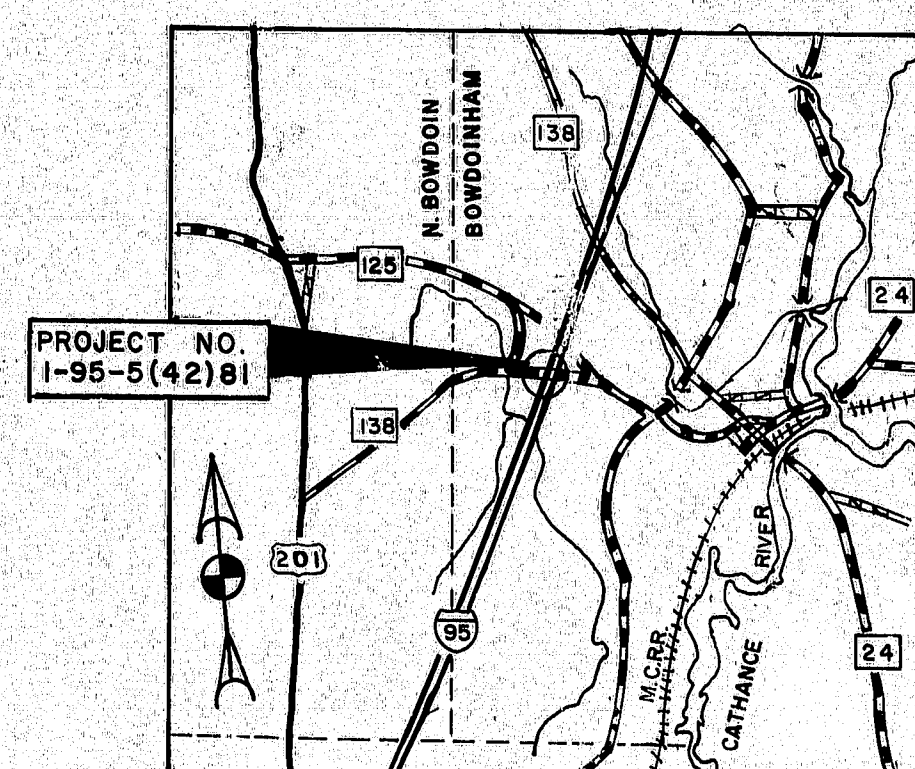

LOCATION MAP

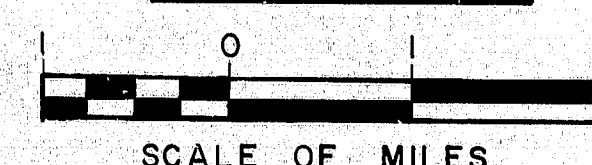

TRAFFIC DATA


INTERSTATE 95		ROUTE 138
12,240	A.D.T. 1976	1570
21,678	A.D.T. 1996	2266
2,818	D.H.V.	295
11	T. (%)	11
60	D. (%)	60
70	V.	50
	P.S.D. (%)	
	18 KIPS	

INDEX OF SHEETS

1	TITLE SHEET
2	ESTIMATE OF QUANTITIES
3	GENERAL PLAN
4	EMBANKMENT PROFILE SOUTHBOUND
5	EMBANKMENT PROFILE NORTHBOUND
6	FOUNDATION SURVEY SOUTHBOUND
7	FOUNDATION SURVEY NORTHBOUND
8	ABUTMENT NO. 1 SOUTHBOUND
9	ABUTMENT NO. 2 SOUTHBOUND
10	FOOTING DETAILS NORTHBOUND
11	DOWEL LAYOUT FOOTINGS NORTHBOUND
12	ABUTMENT NO. 1 NORTHBOUND
13	ABUTMENT NO. 2 NORTHBOUND
14	ARCHITECTURAL TREATMENT SOUTHBOUND
15	ARCHITECTURAL TREATMENT NORTHBOUND
16	STRUCTURAL STEEL SOUTHBOUND
17	STRUCTURAL STEEL NORTHBOUND
18	SUPERSTRUCTURE SOUTHBOUND
19	SUPERSTRUCTURE NORTHBOUND
20	SLOPE PROTECTION SOUTHBOUND
21	SLOPE PROTECTION NORTHBOUND
22	REINFORCING STEEL SCHEDULE SOUTHBOUND
23	REINFORCING STEEL SCHEDULE NORTHBOUND
24	RIGHT OF WAY MAP

STANDARD DETAILS

25	BD 101-74 BEARING PEDESTALS
26	BD 104-73 ARMORED JOINT, DRAIN, SHEAR
27	BD 113-72 DIAPHRAGMS AND CROSSFRAMES
28	BD 114-73 ALUMINUM RAILING
29	AUG. 1969 (4)
30	AUG. 1969 (11)
31	AUG. 1969 (12)

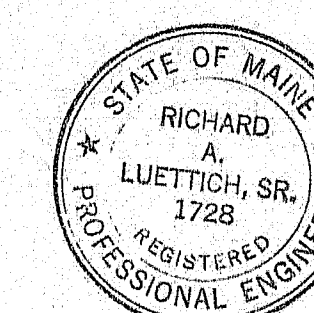

APPROVED:

STATE OF MAINE
DEPARTMENT OF TRANSPORTATION
COMMISSIONER

DATE

MARCH 24, 1975

BUREAU DIRECTOR AND CHIEF ENGINEER

MARCH 24, 1975

As built 1975 H&E






UNITED STATES
DEPARTMENT OF TRANSPORTATION
FEDERAL HIGHWAY ADMINISTRATION
REGION 1

APPROVED:

DIVISION ENGINEER DATE

172-73

F.H.W.A. REG. NO.	STATE	PROJECT NUMBER	SHEET NO.	TOTAL SHEETS
1	MAINE	95-142	3	31

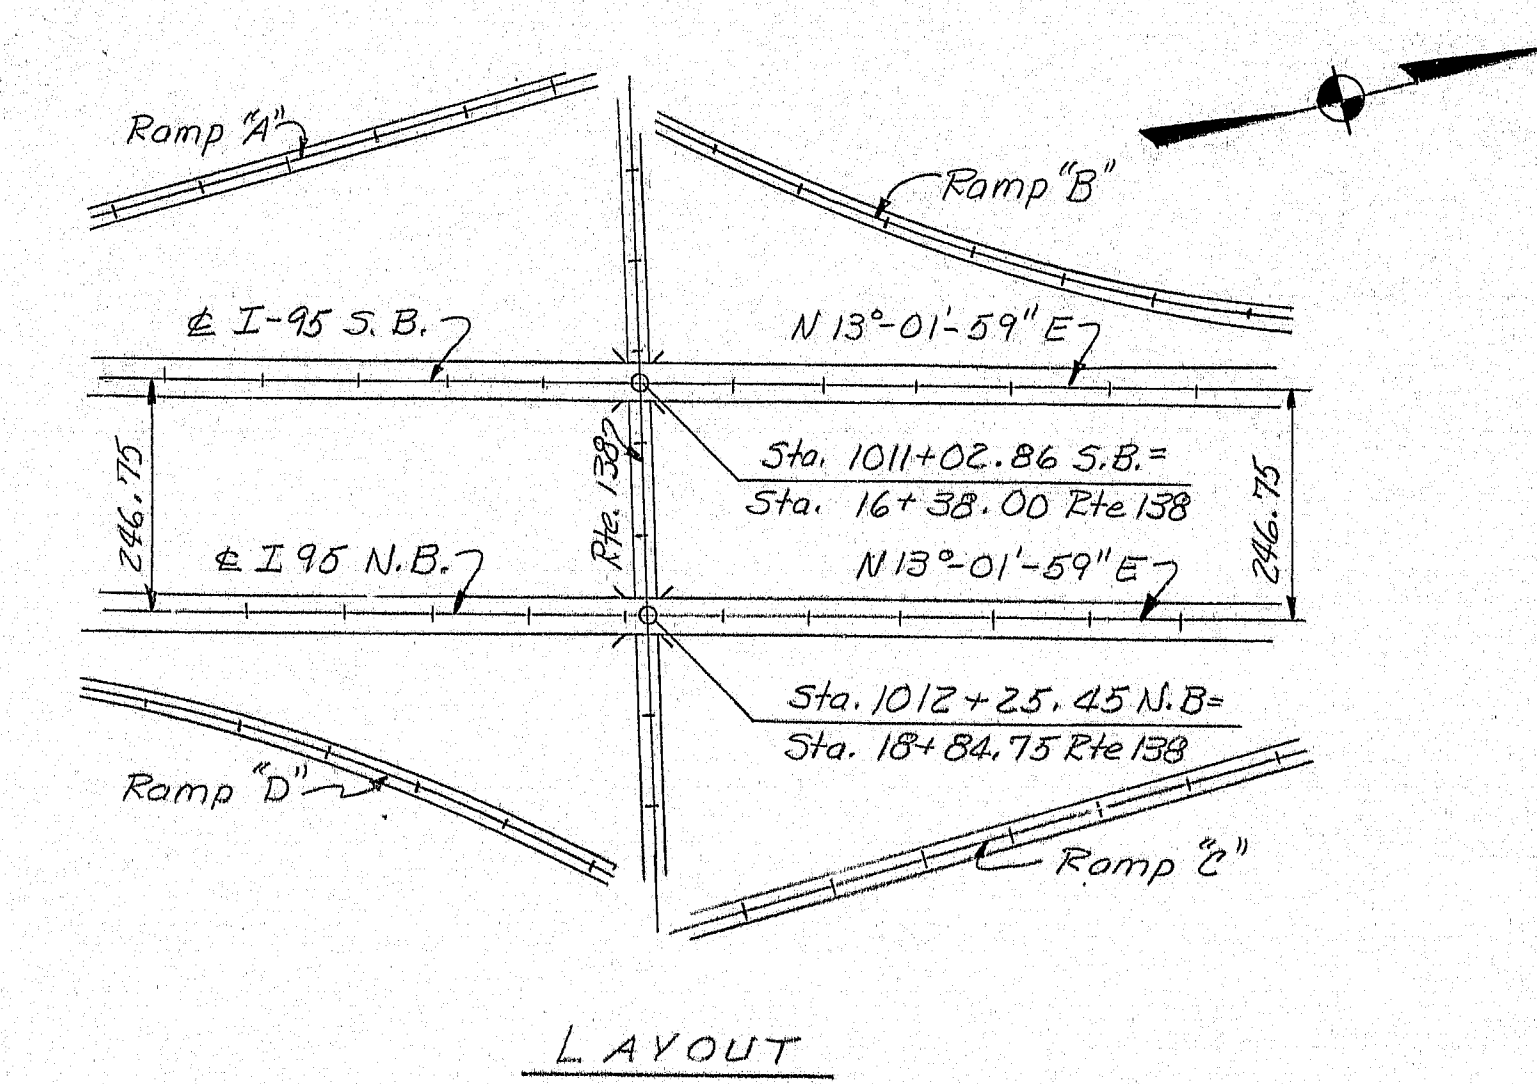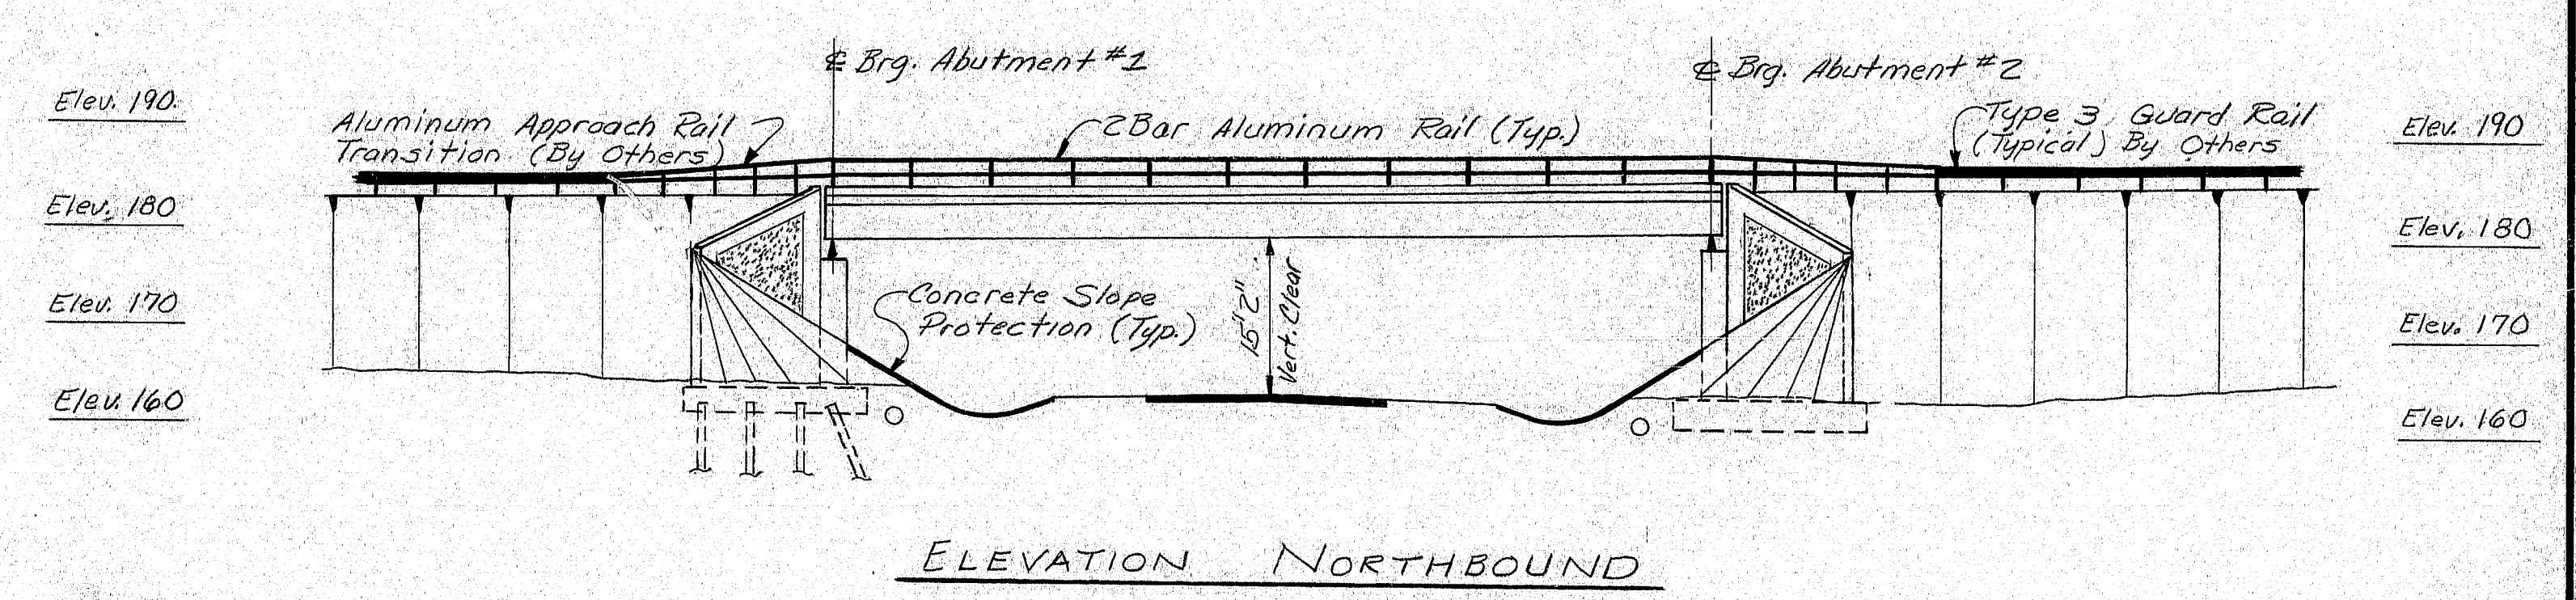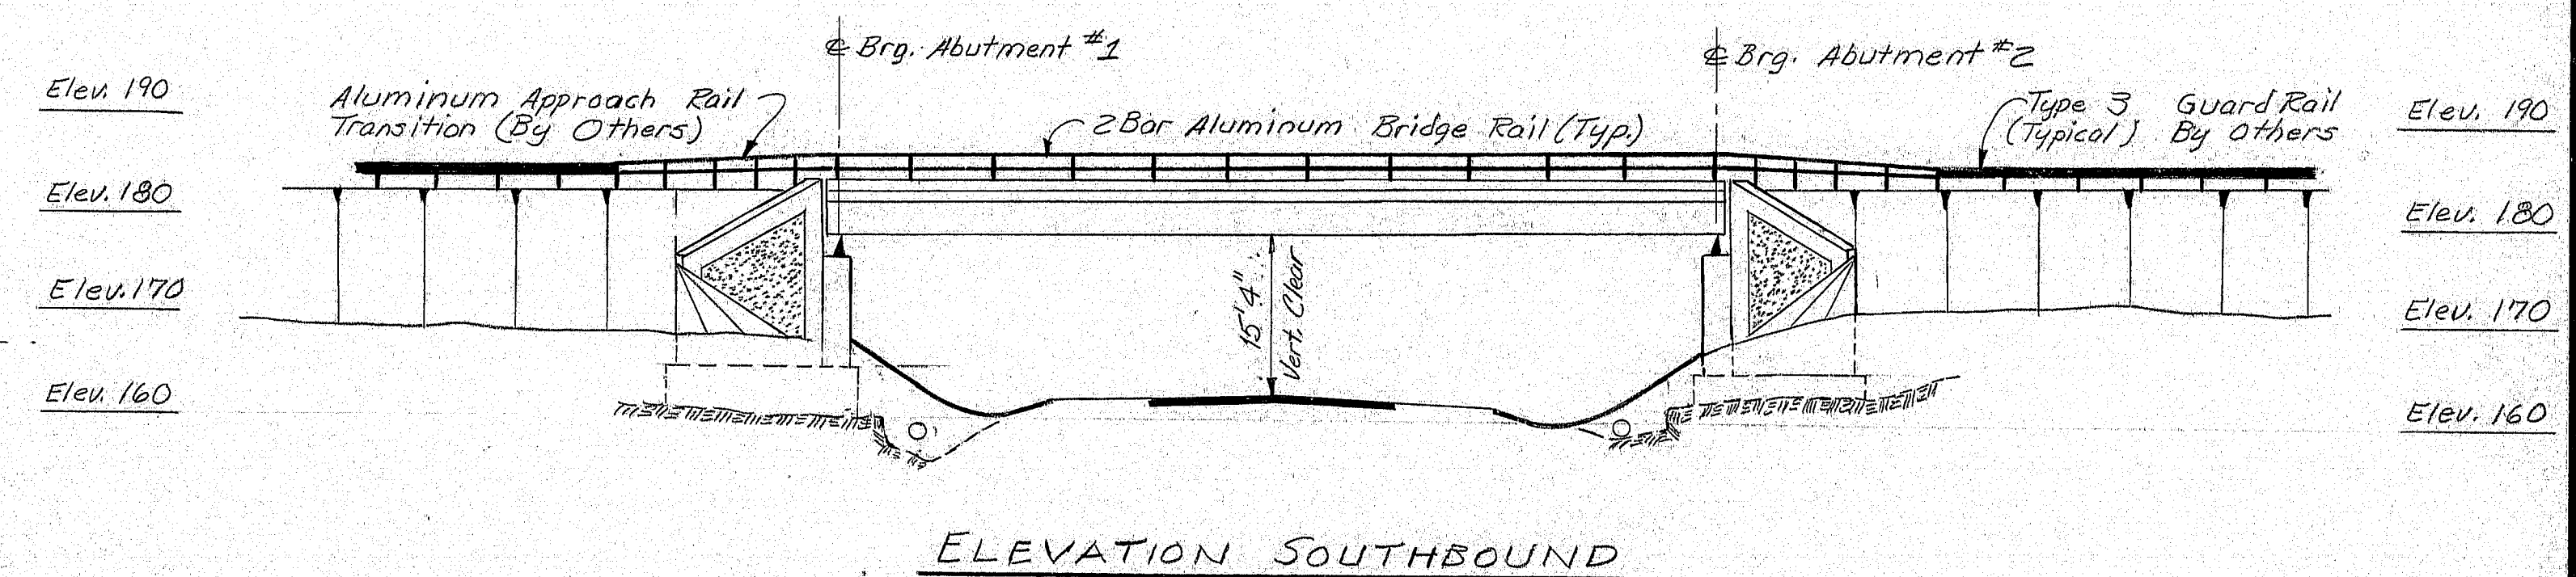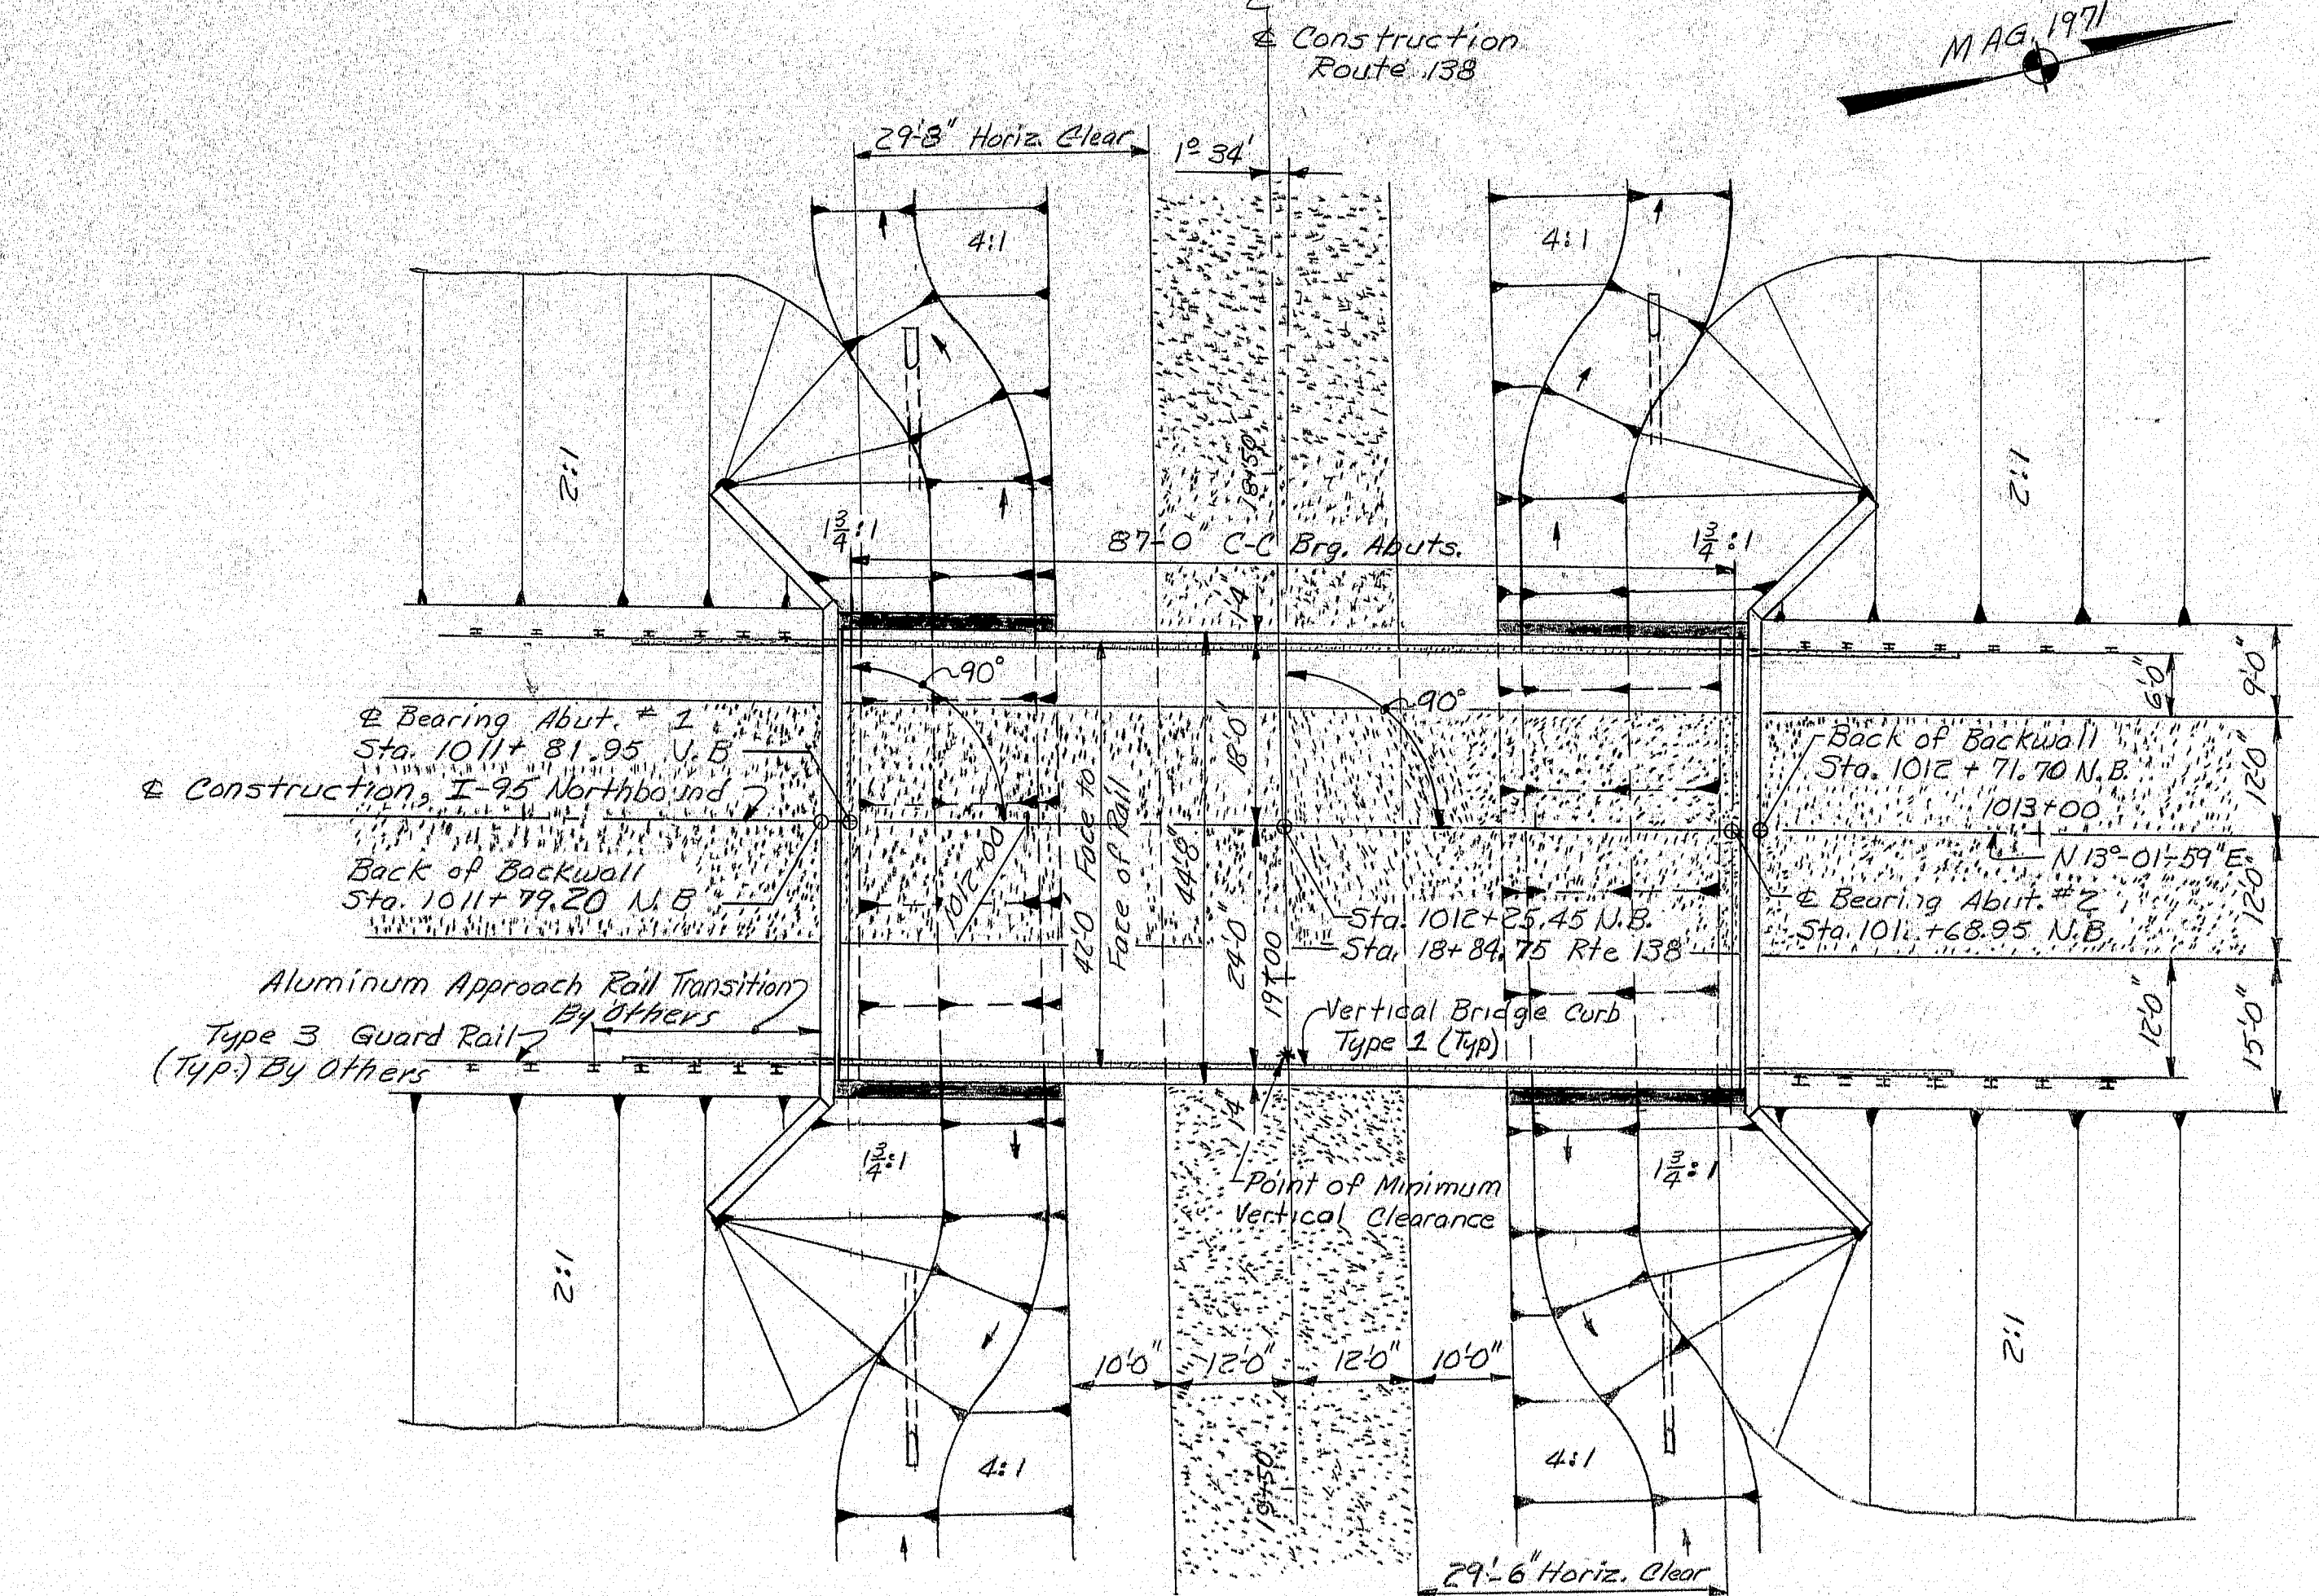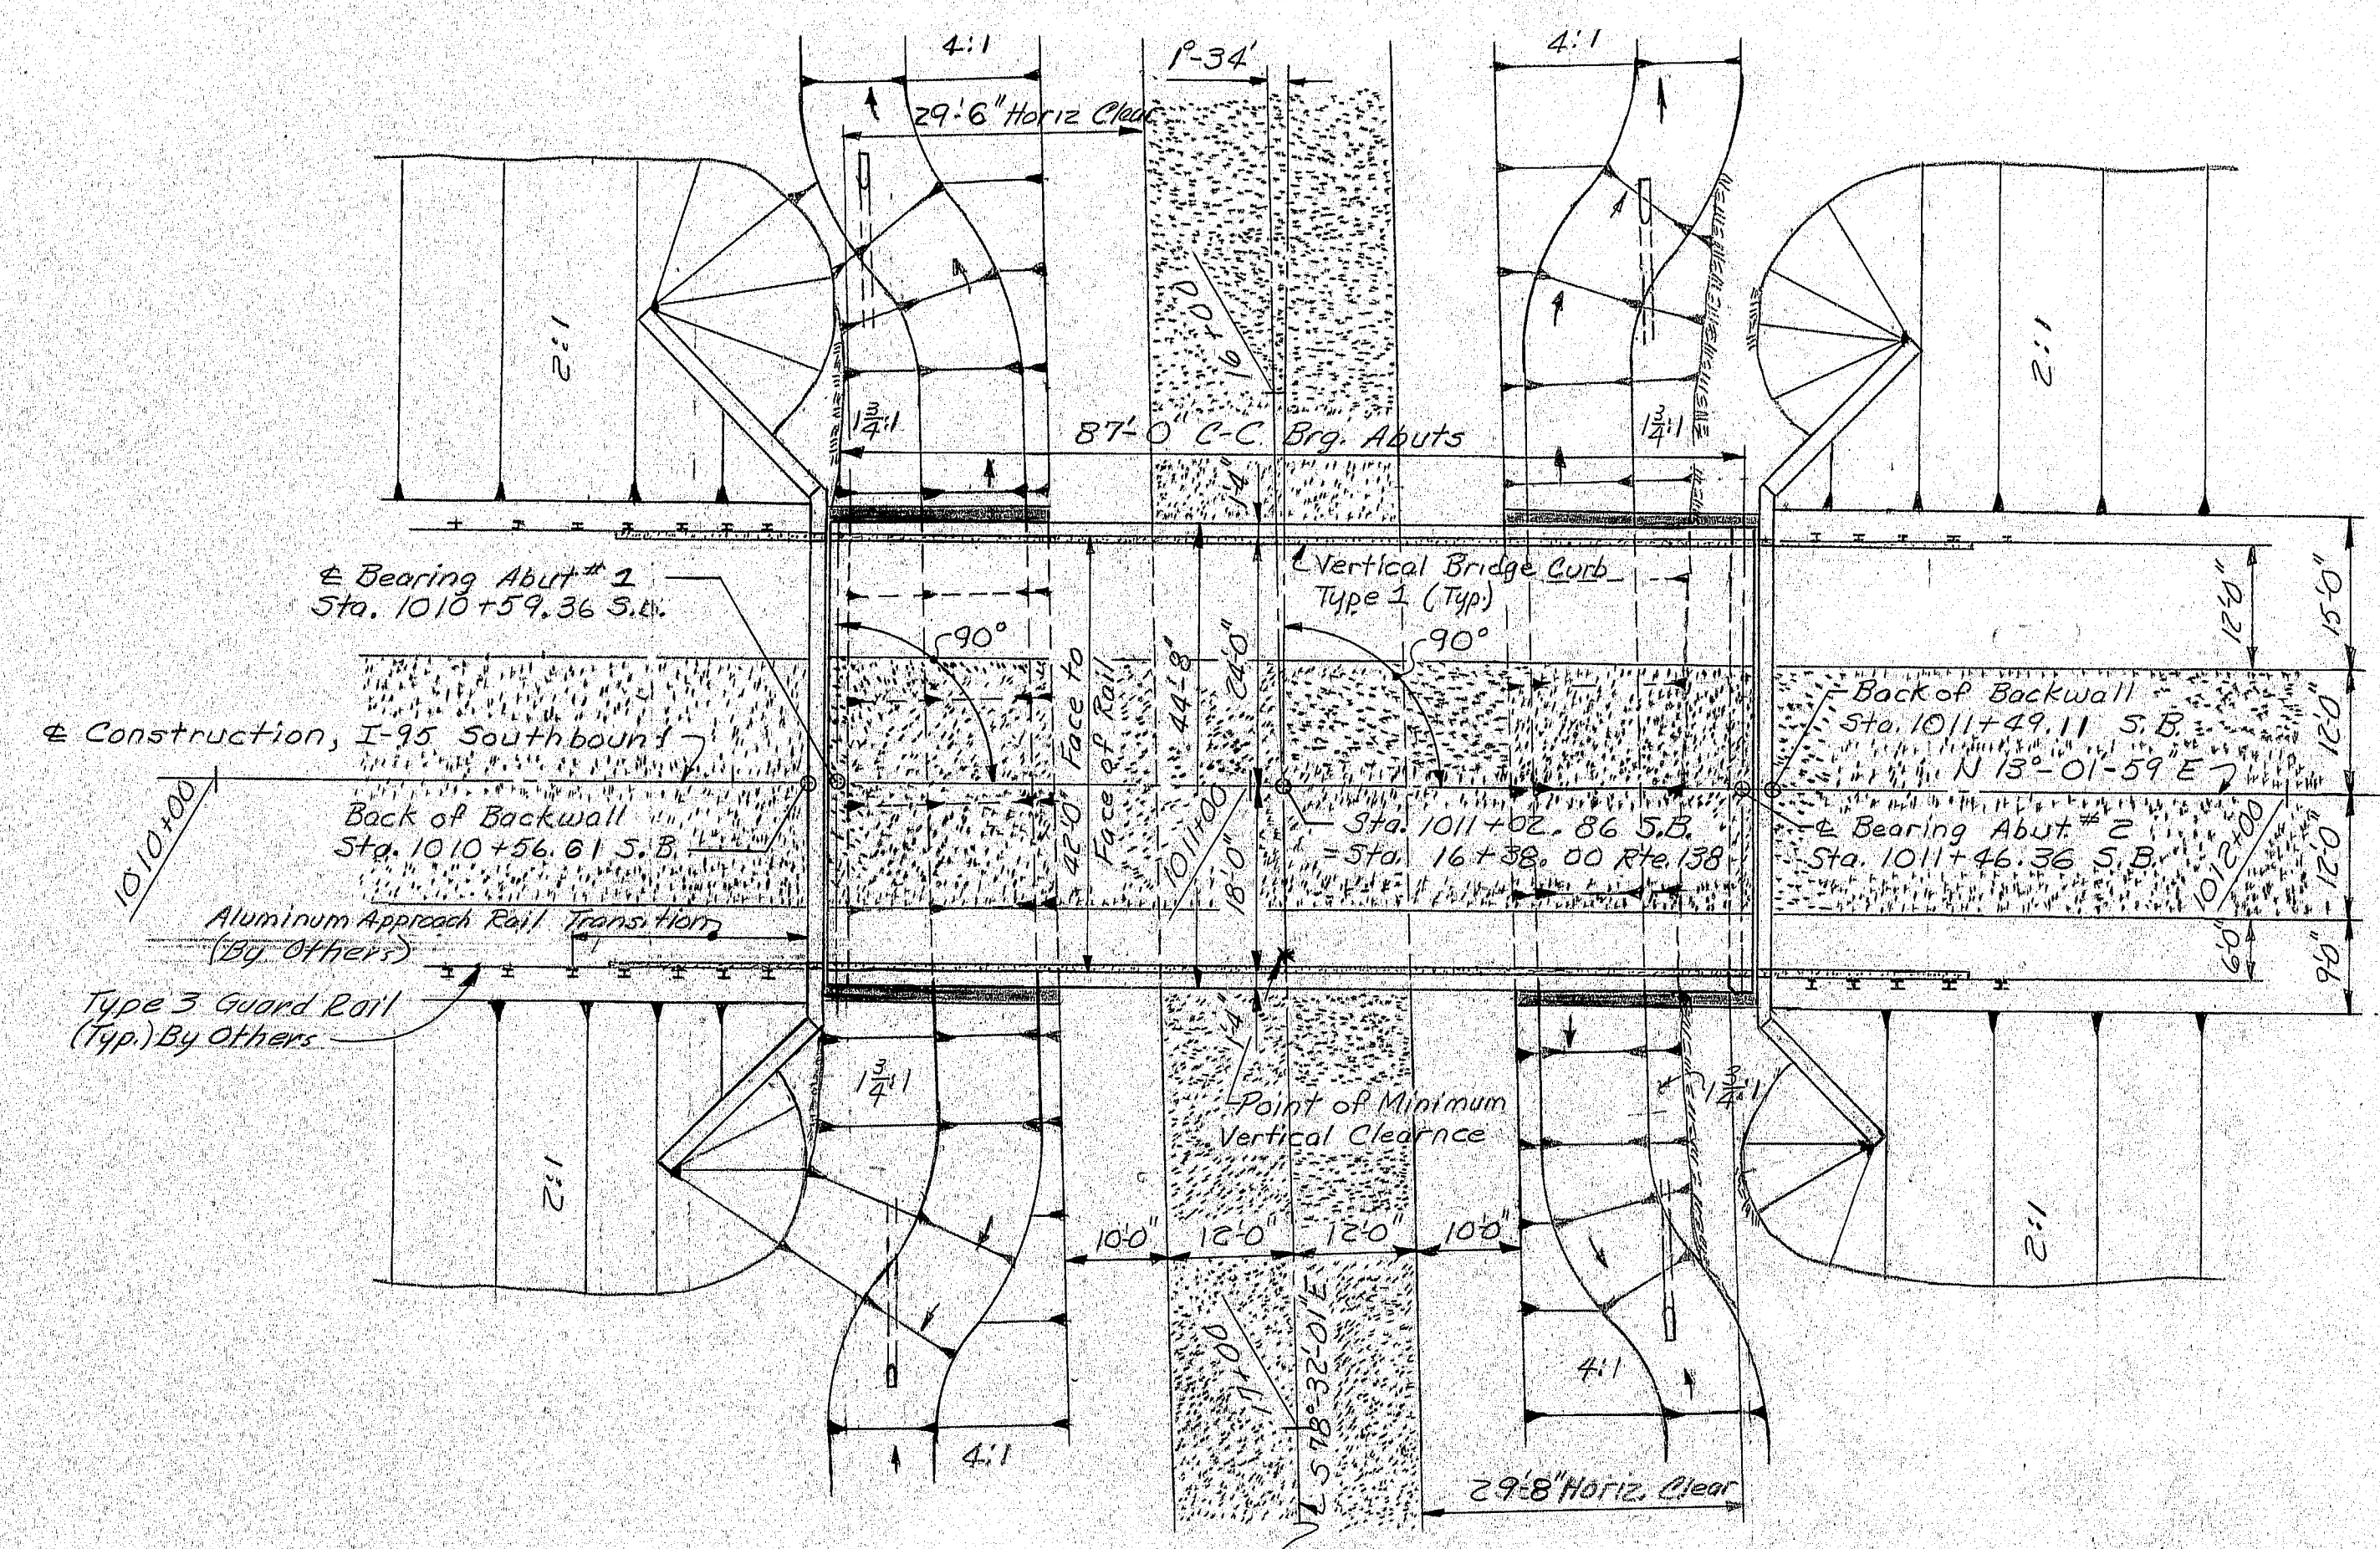

As built 1975 H&B.





STATE OF MAINE
DEPARTMENT OF TRANSPORTATION

INTERSTATE 95
OVER
ROUTE 138
IN THE TOWN OF
BOWDOINHAM
SAGadahoc COUNTY
GENERAL PLAN

SHEET 3 OF 31 AUGUSTA, MAINE March 1991

172-75

F.H.A. REG. NO.	STATE	PROJECT NUMBER	SHEET NO.	TOTAL SHEETS
1	MAINE	95-442	3	31

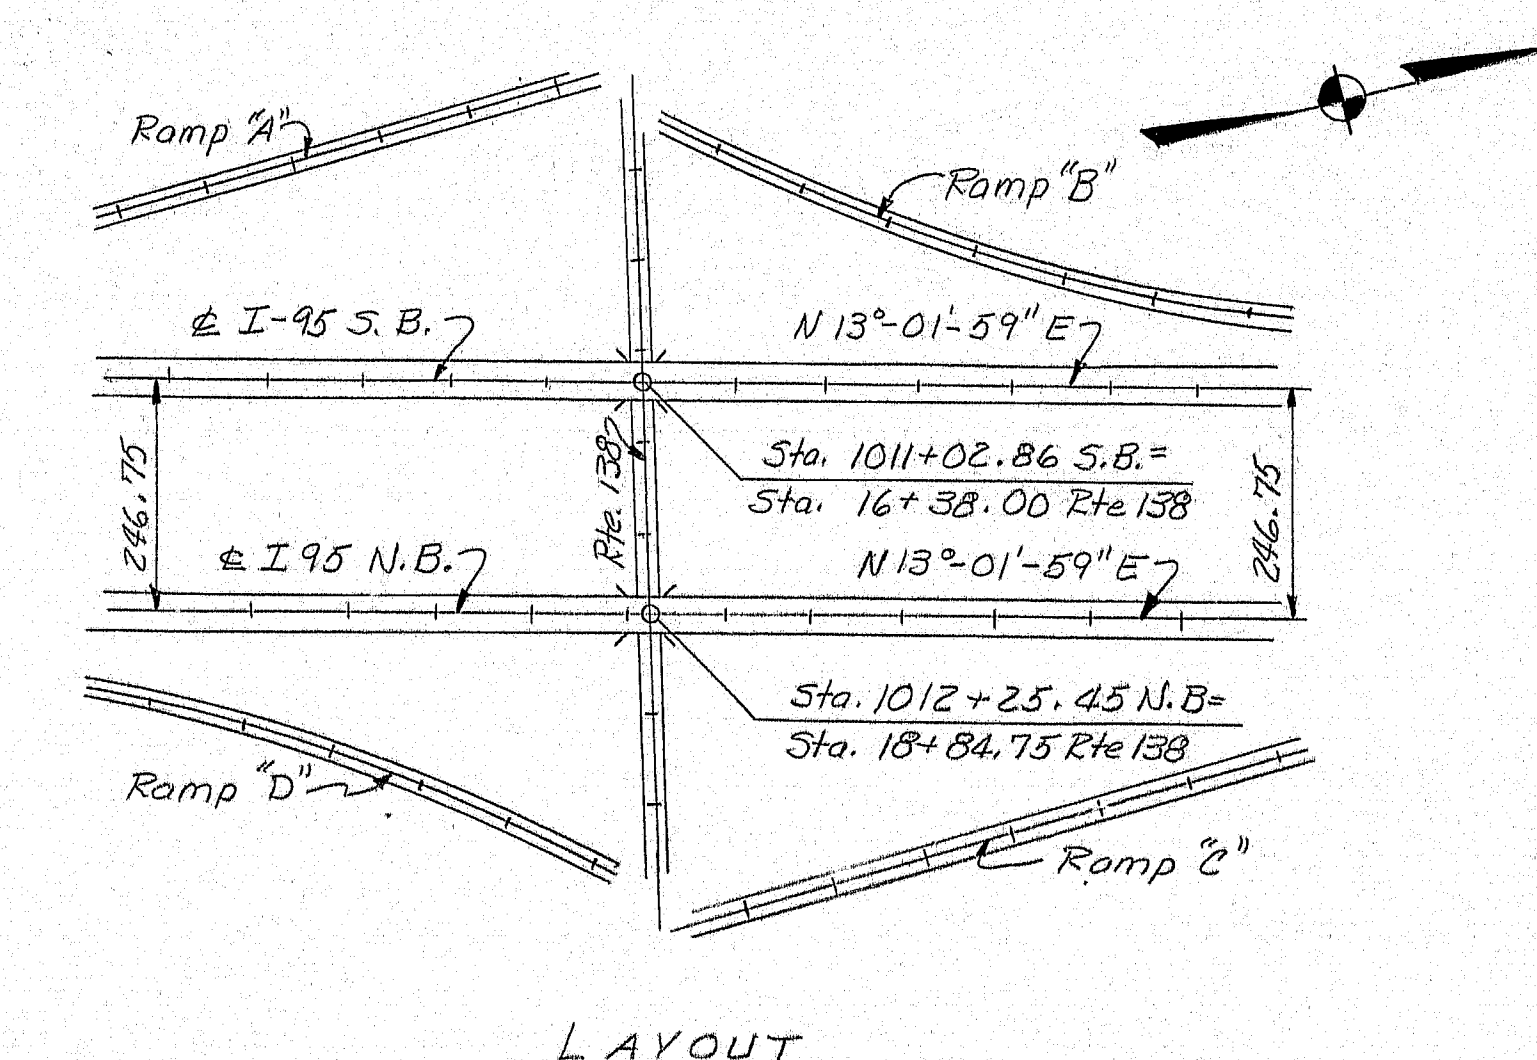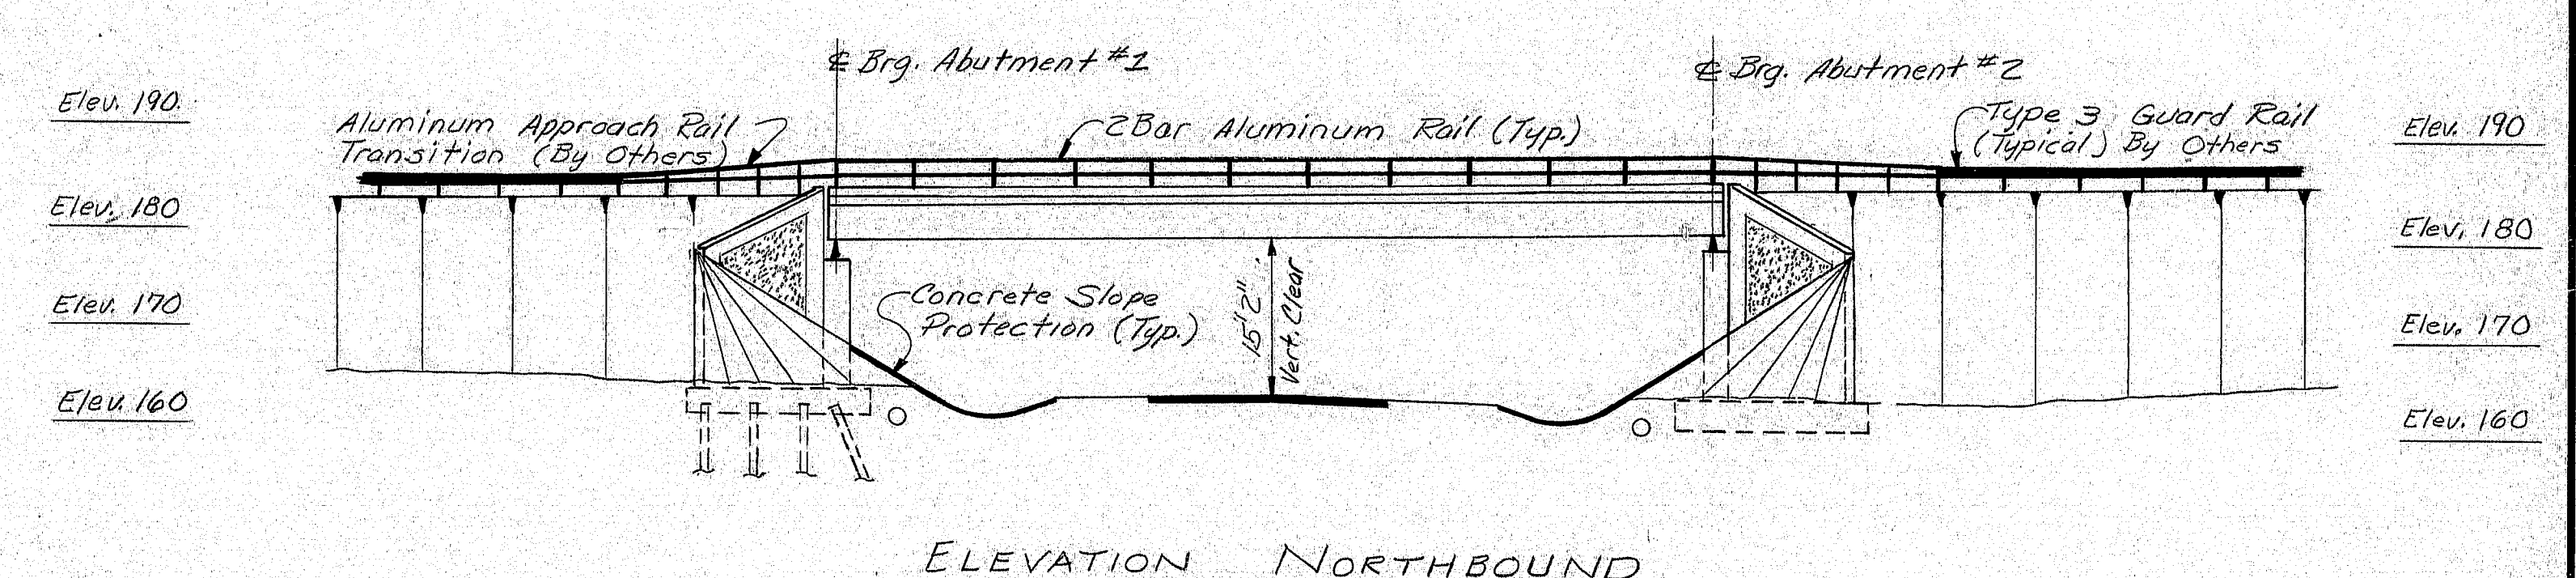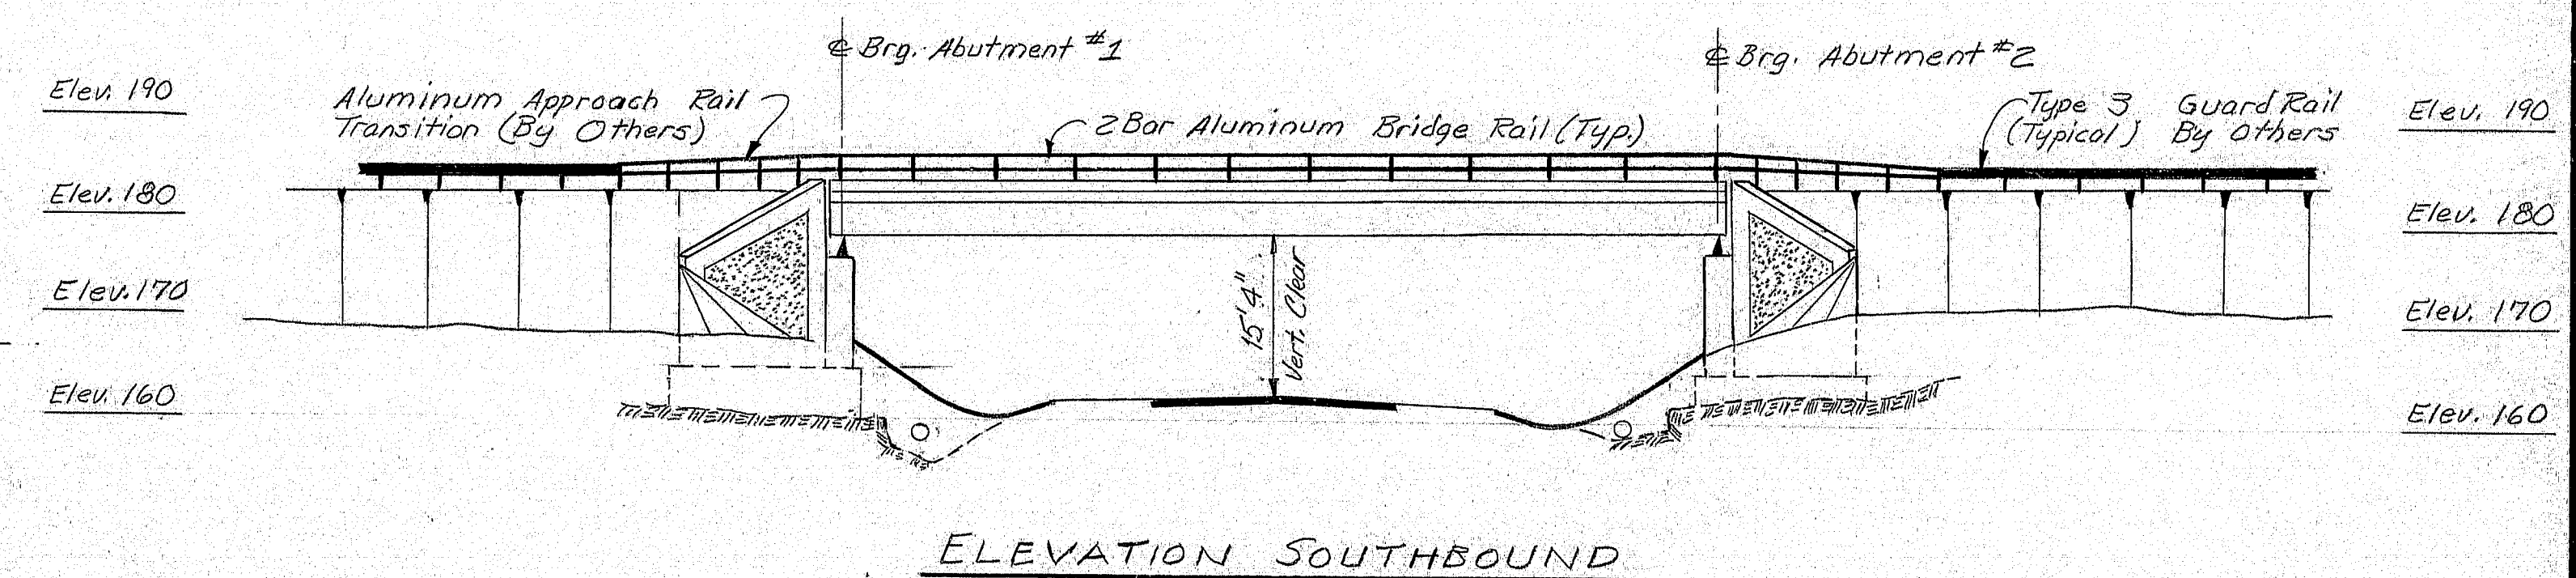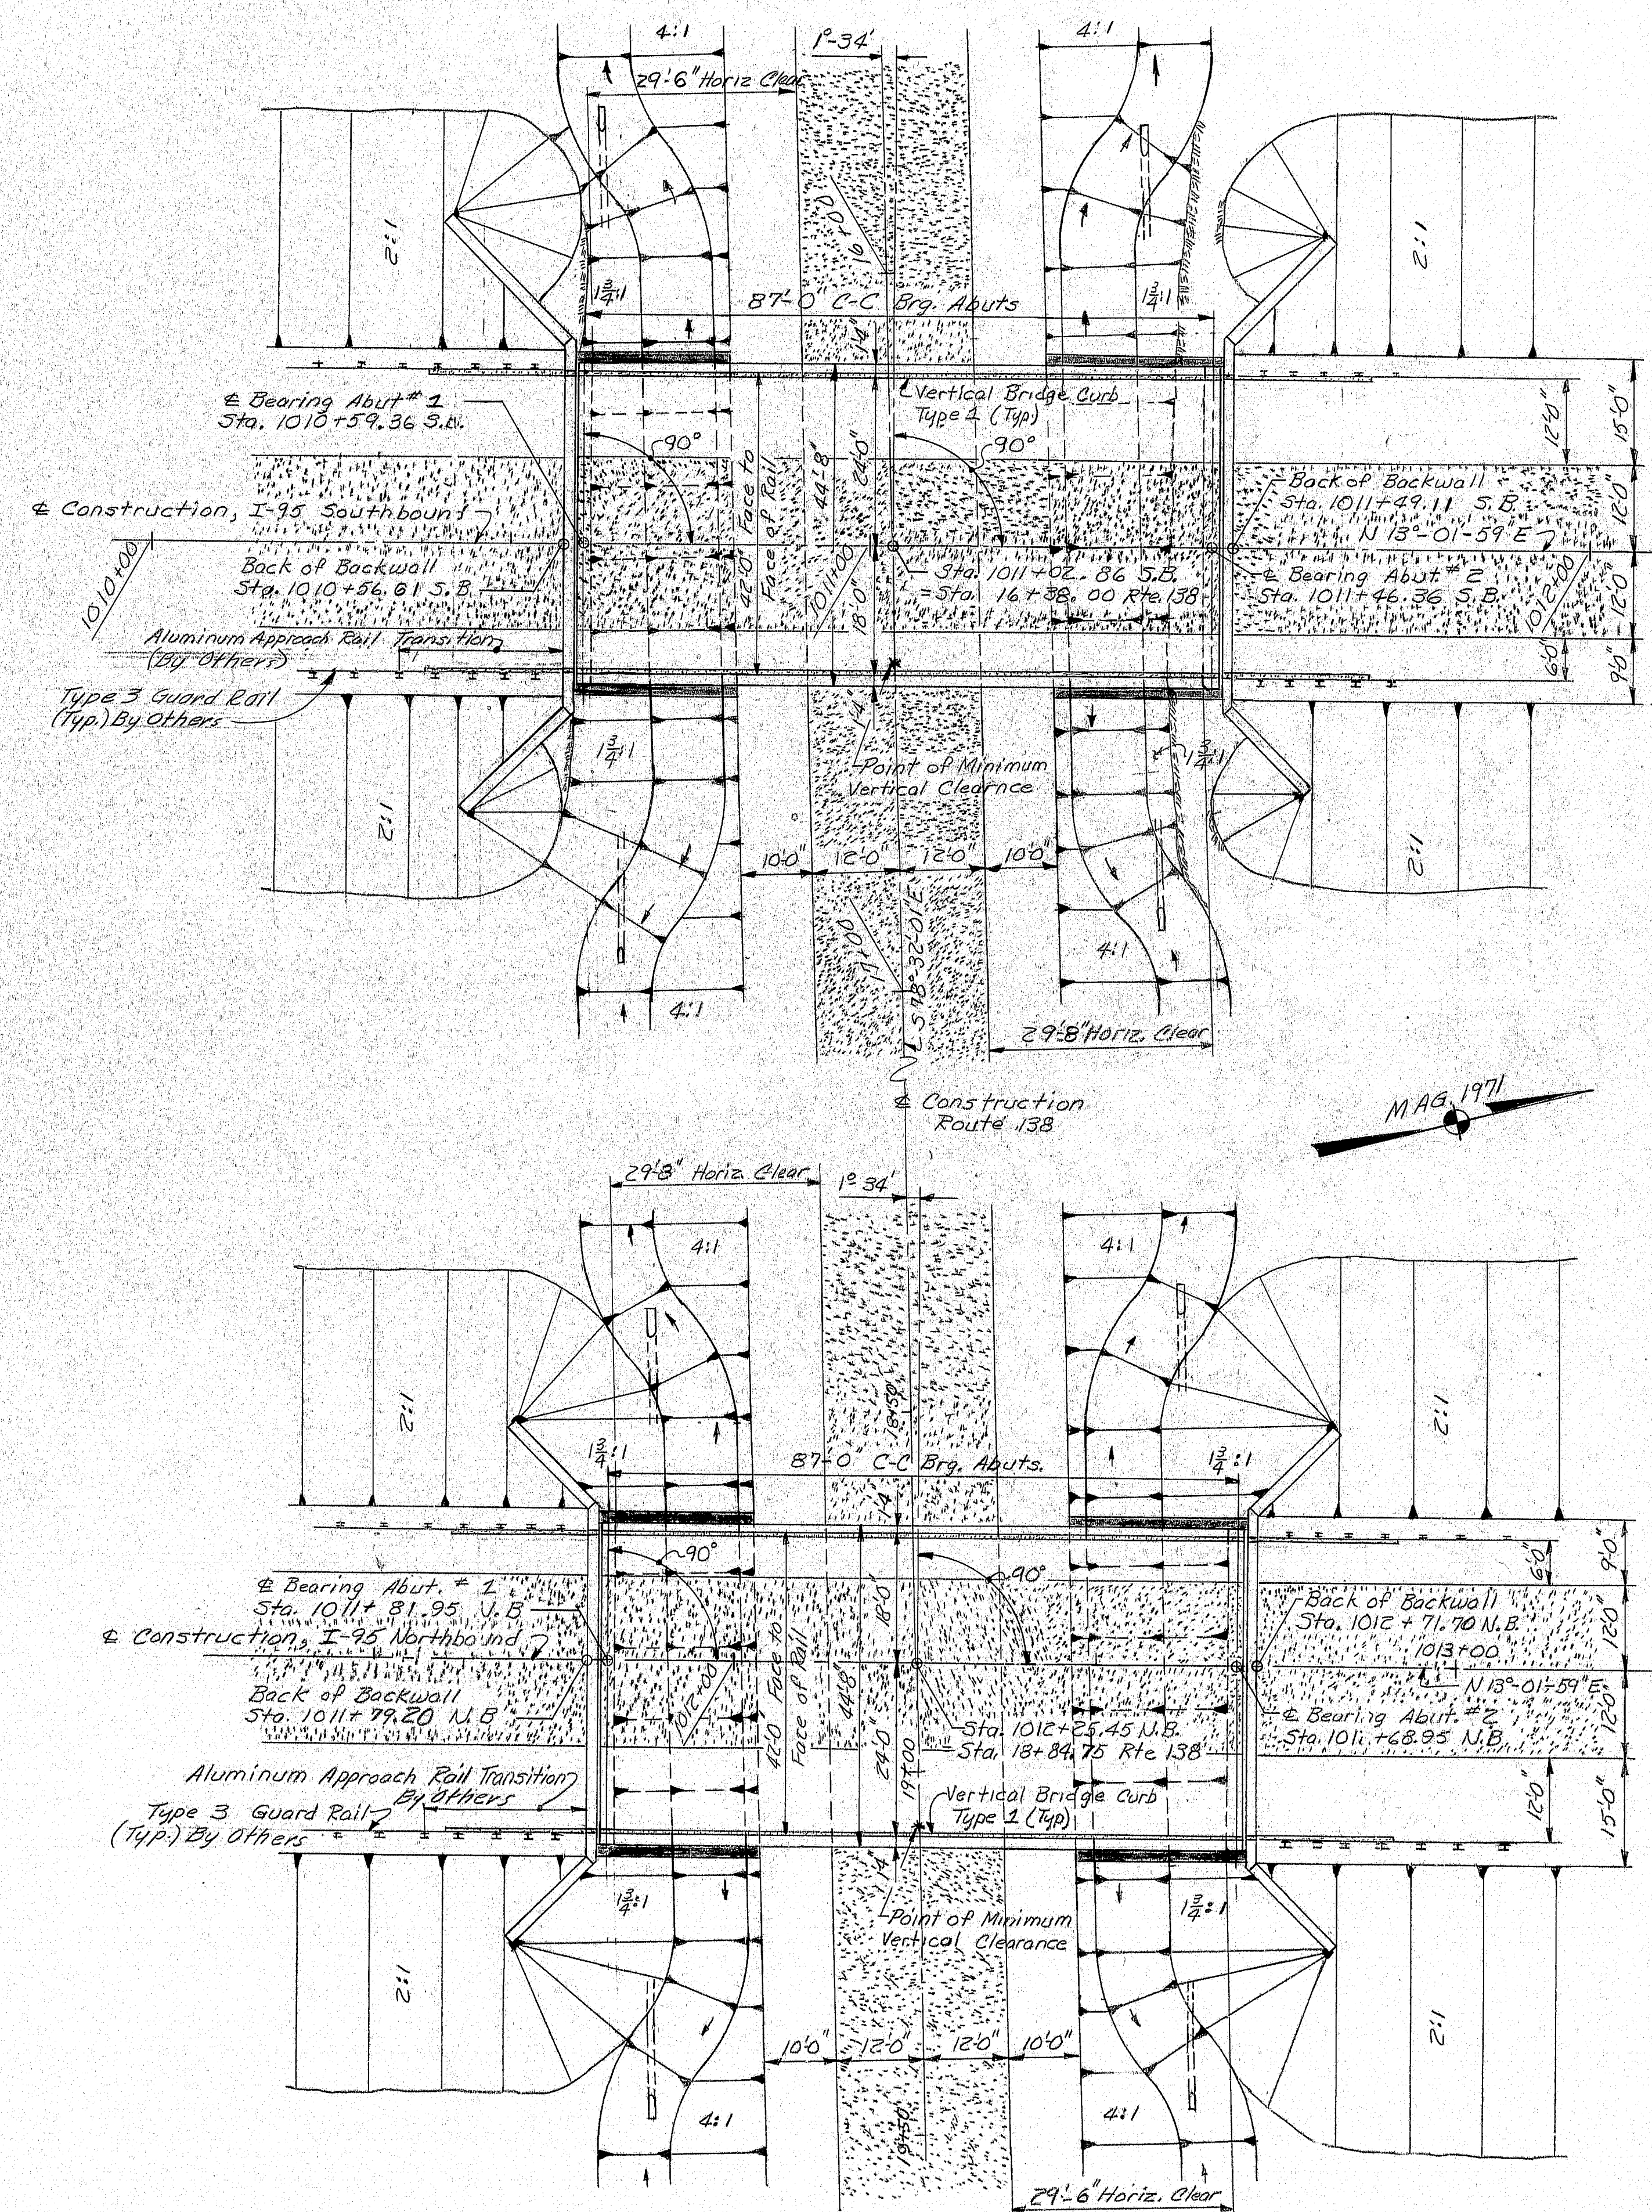

PROJECT DESIGN ENGINEER	DATE
BY	3-75
DESIGN - CHECKED	REVISIONS
PLANS	FIELD CHANGES

As built 1975 H&S.


STATE OF MAINE
DEPARTMENT OF TRANSPORTATION

INTERSTATE 95
OVER
ROUTE 138
IN THE TOWN OF
BOWDOINHAM
SAGADAHOC COUNTY
GENERAL PLAN


SHEET 3 OF 31 AUGUSTA, MAINE March 1975

172-75

F.H.W.A. RES. NO.	STATE	PROJECT NUMBER	SHEET NO.	TOTAL SHEETS
1	MAINE	95-5 (42)	4	32

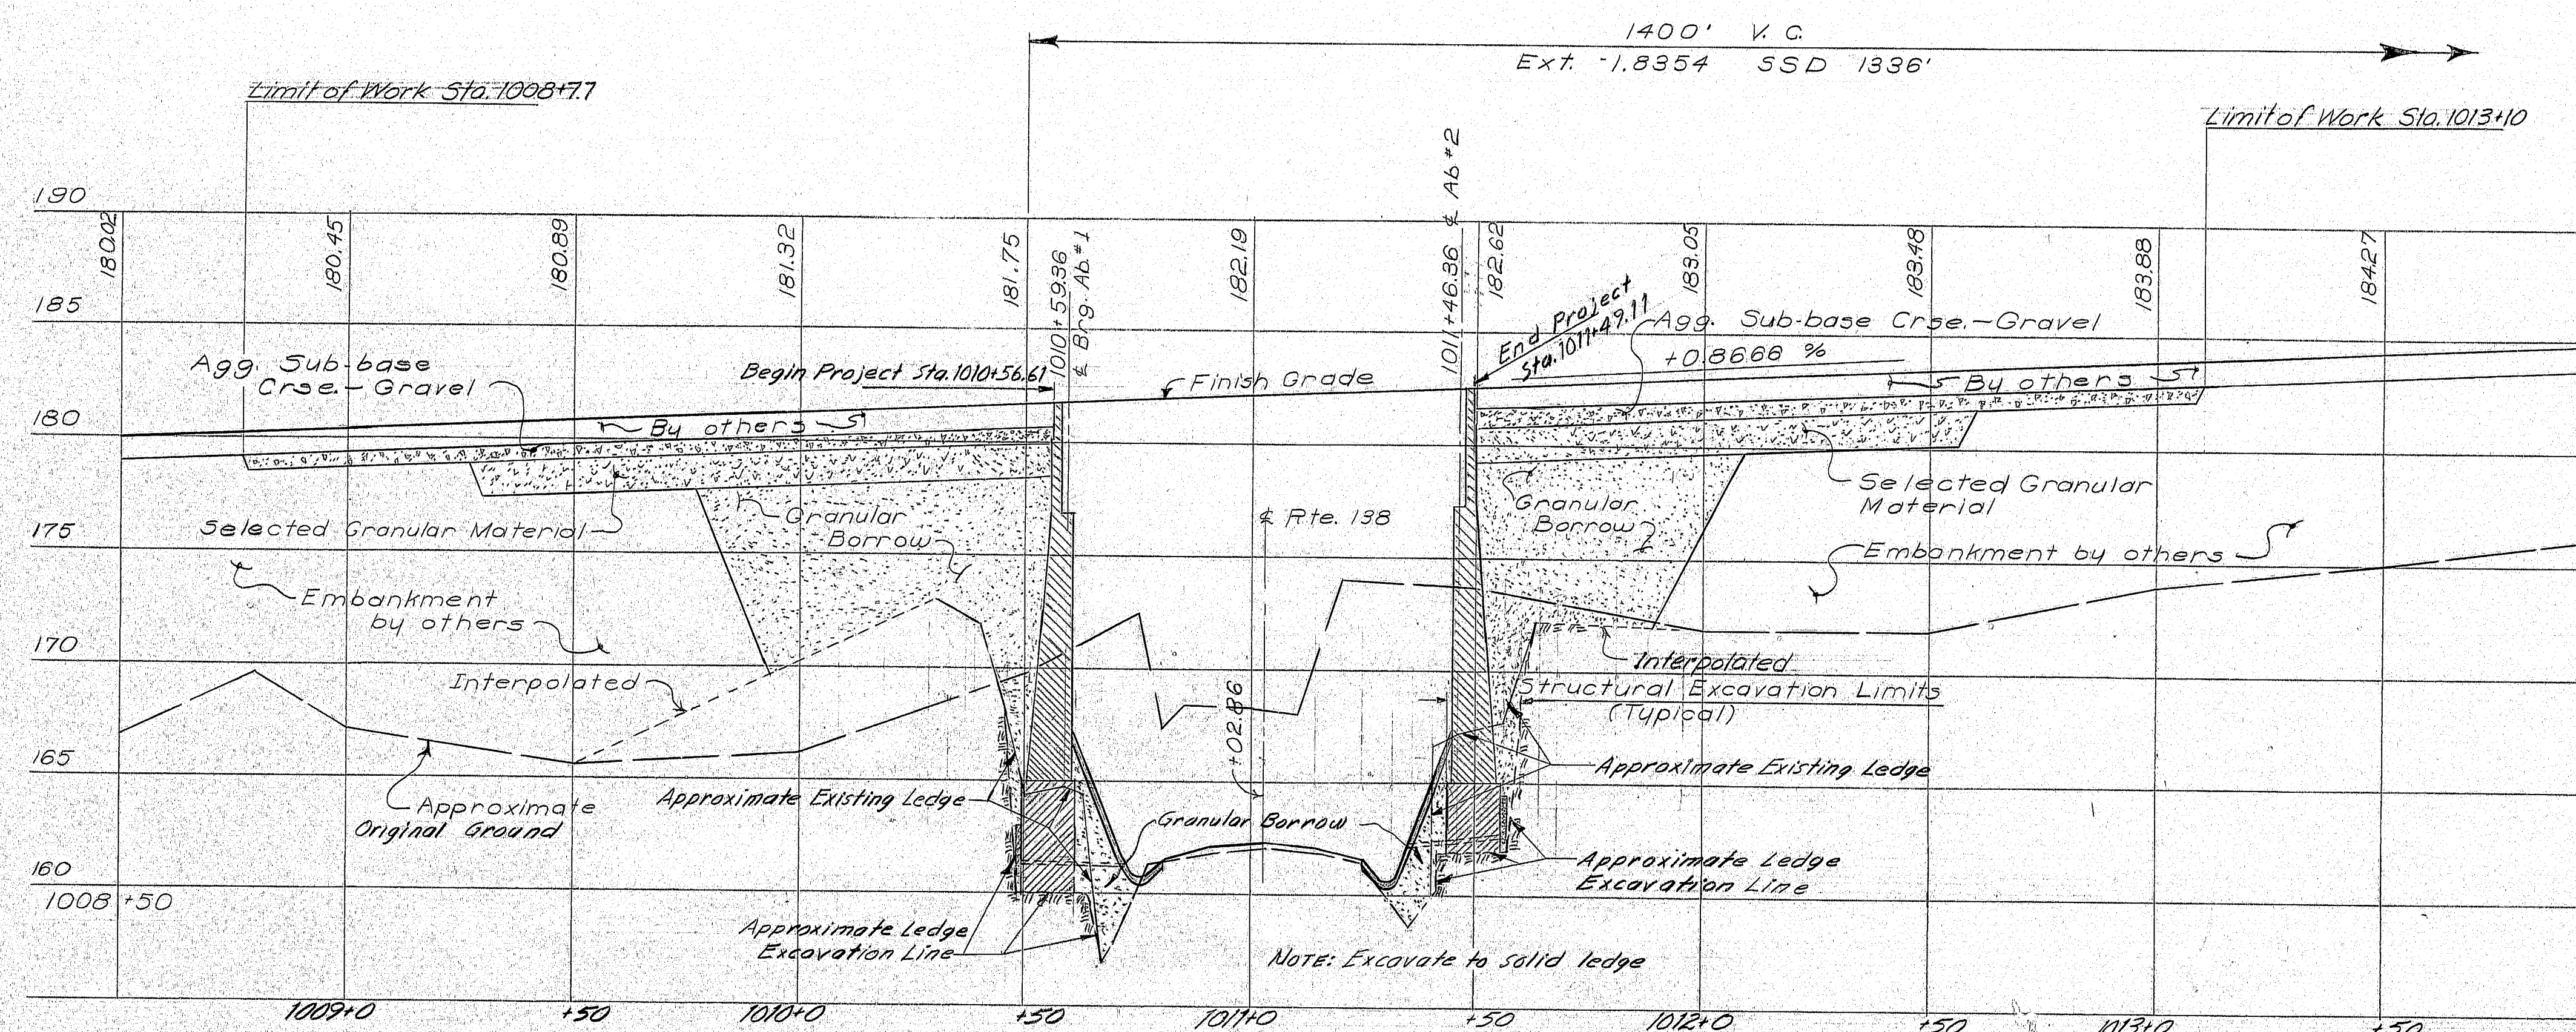

EMBANKMENT PROFILE
I-95 SB

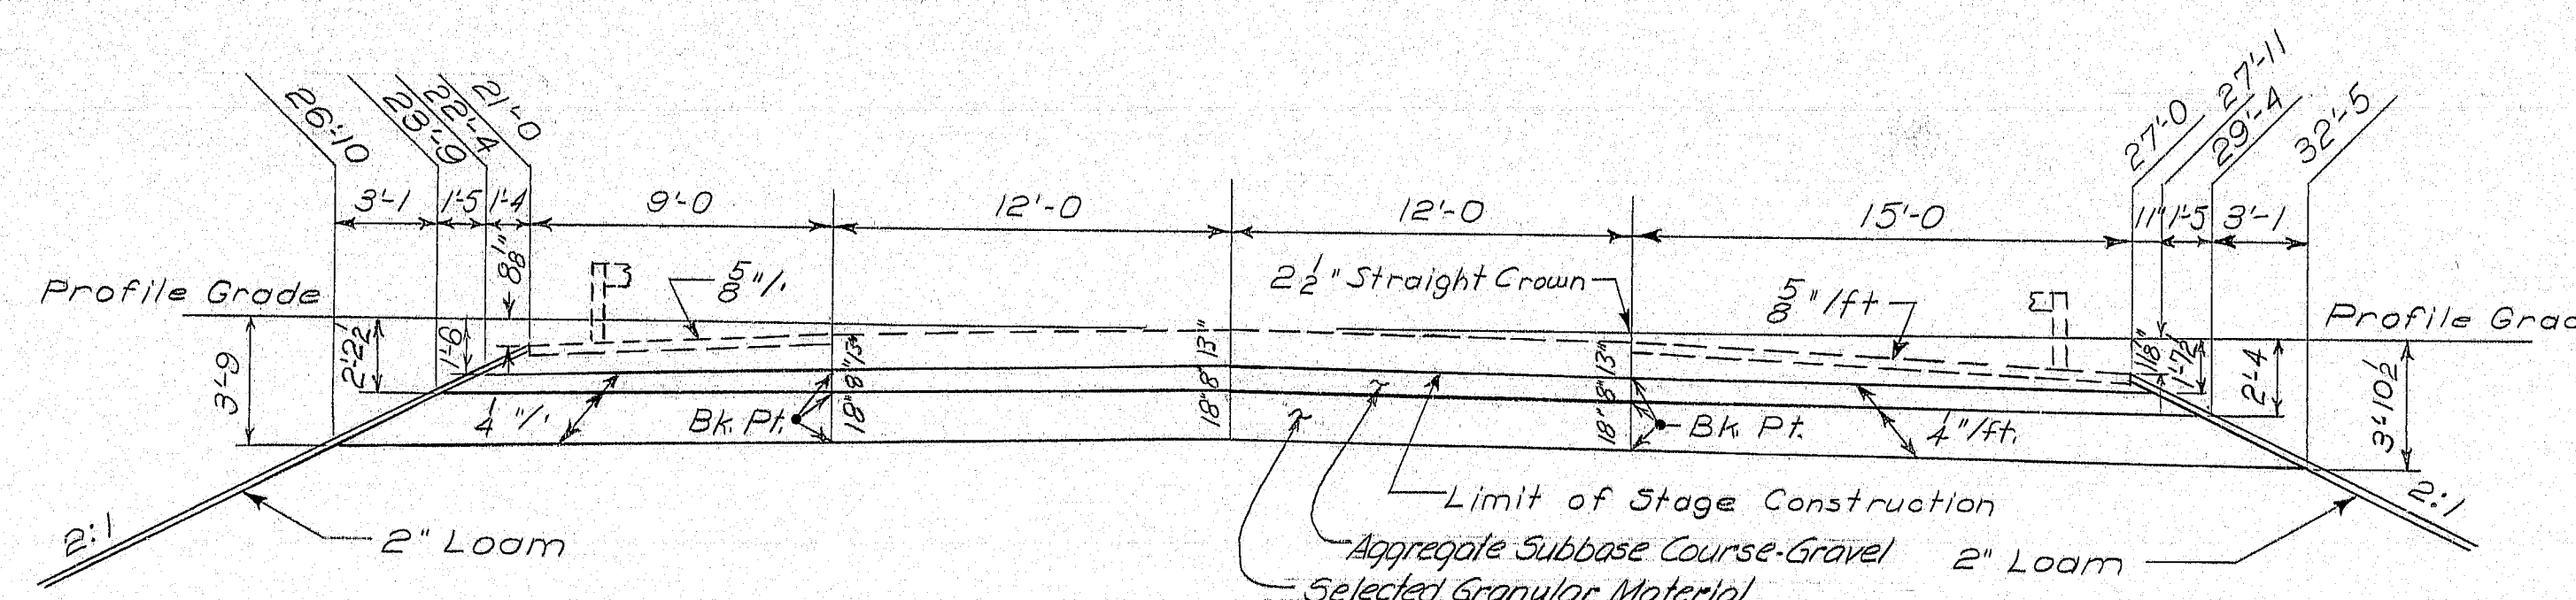

TYPICAL APPROACH SECTION I-95

PROJECT DESIGN ENGINEER	DATE
BY: [Signature]	3-75
DESIGN - CHECKED	3-75
REVISIONS	
FIELD CHANGES	


STATE OF MAINE
DEPARTMENT OF TRANSPORTATION

INTERSTATE 95
OVER
ROUTE 138
IN THE TOWN OF
BOWDOINHAM
SAGadahoc COUNTY
EMBANKMENT PROFILE SOUTHBOUND

SHEET 4 OF 31 AUGUSTA, MAINE March 17

172-76

F.H.W.A. REG. NO.	STATE	PROJECT NUMBER	SHEET NO.	TOTAL SHEETS
1	MAINE	95-5(42)	5	37

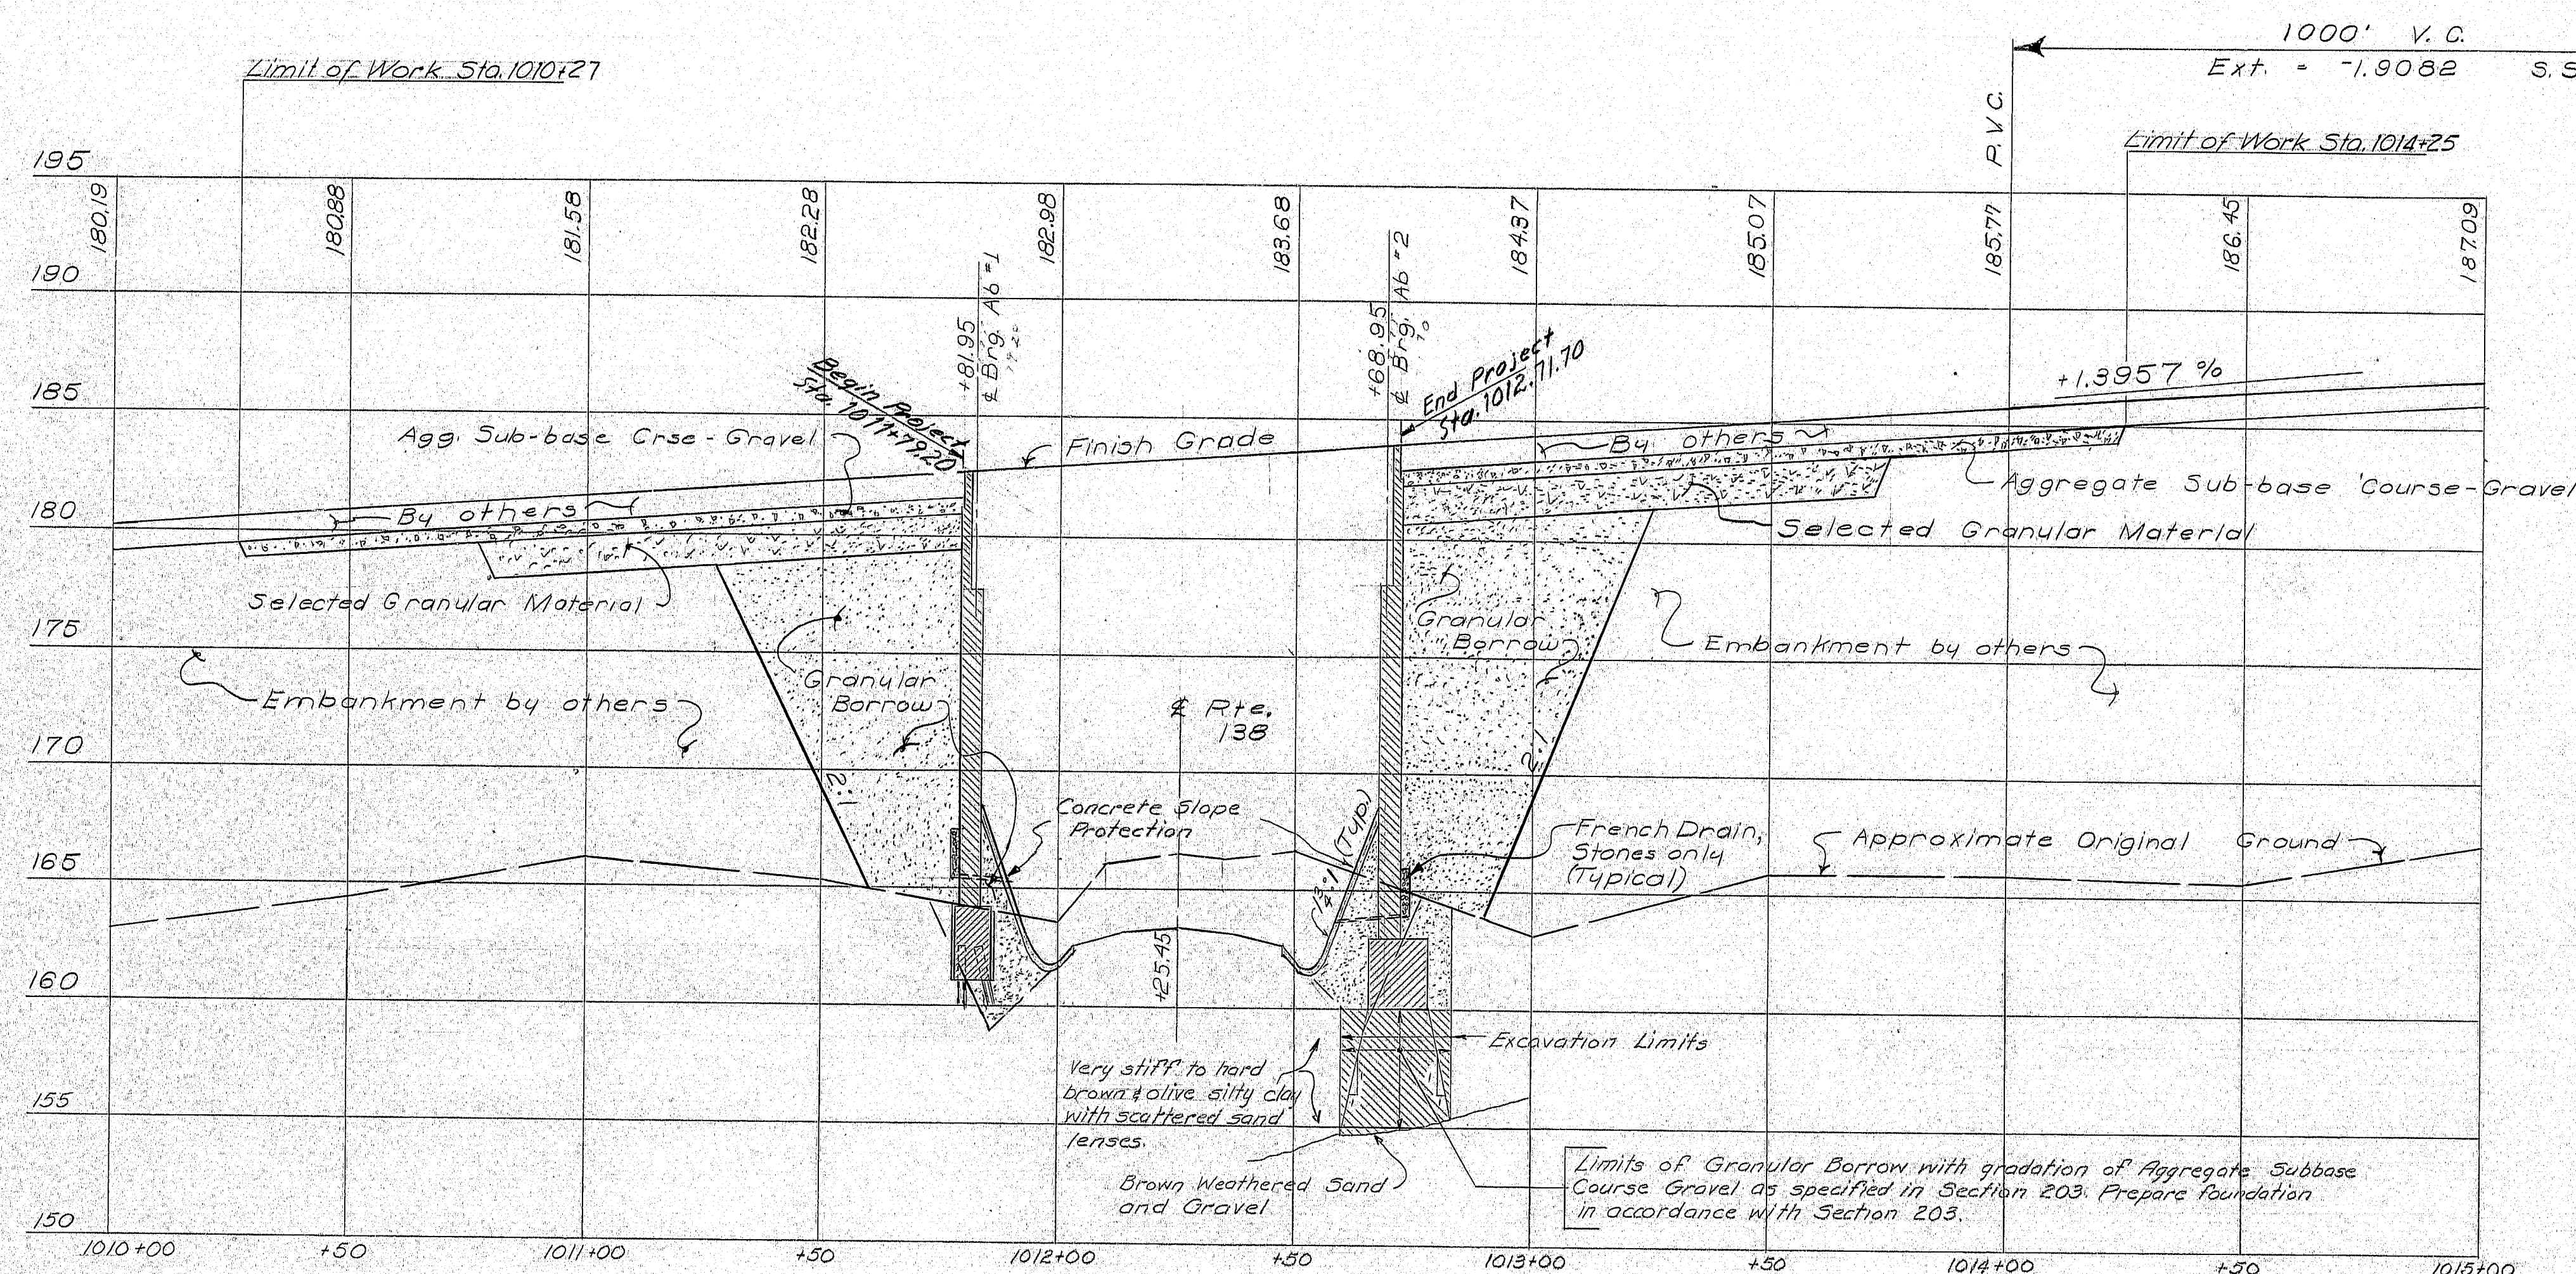

NOTES:

1. The shaded area of Abutment #2 shall be prepared and the embankments constructed in accordance with Section 203. (Preparation of Foundation and Construction of Embankments in Abutment and Pier Areas)
2. Excavate - Very Stiff to Hard Brown and Olive Silty Clay with Scattered Sand Lenses (Cross hatched area) Abutment #2, down to Limits of the Brown Weathered Sand and Gravel.



EMBANKMENT PROFILE 1-95 NB

For Typical Section 1-95 see sheet #4

PROJECT DESIGN ENGINEER	BY	DATE
DESIGN - DETAILED	1/1/75	1/1/75
CHECKED	P/L	3-75
FIELD CHANGES		


STATE OF MAINE DEPARTMENT OF TRANSPORTATION
INTERSTATE 95 OVER ROUTE 138 IN THE TOWN OF BOWDOINHAM SAGadahoc COUNTY EMBANKMENT PROFILE NORTHBOUND
SHEET 5 OF 31 AUGUSTA, MAINE March 1975

172-77

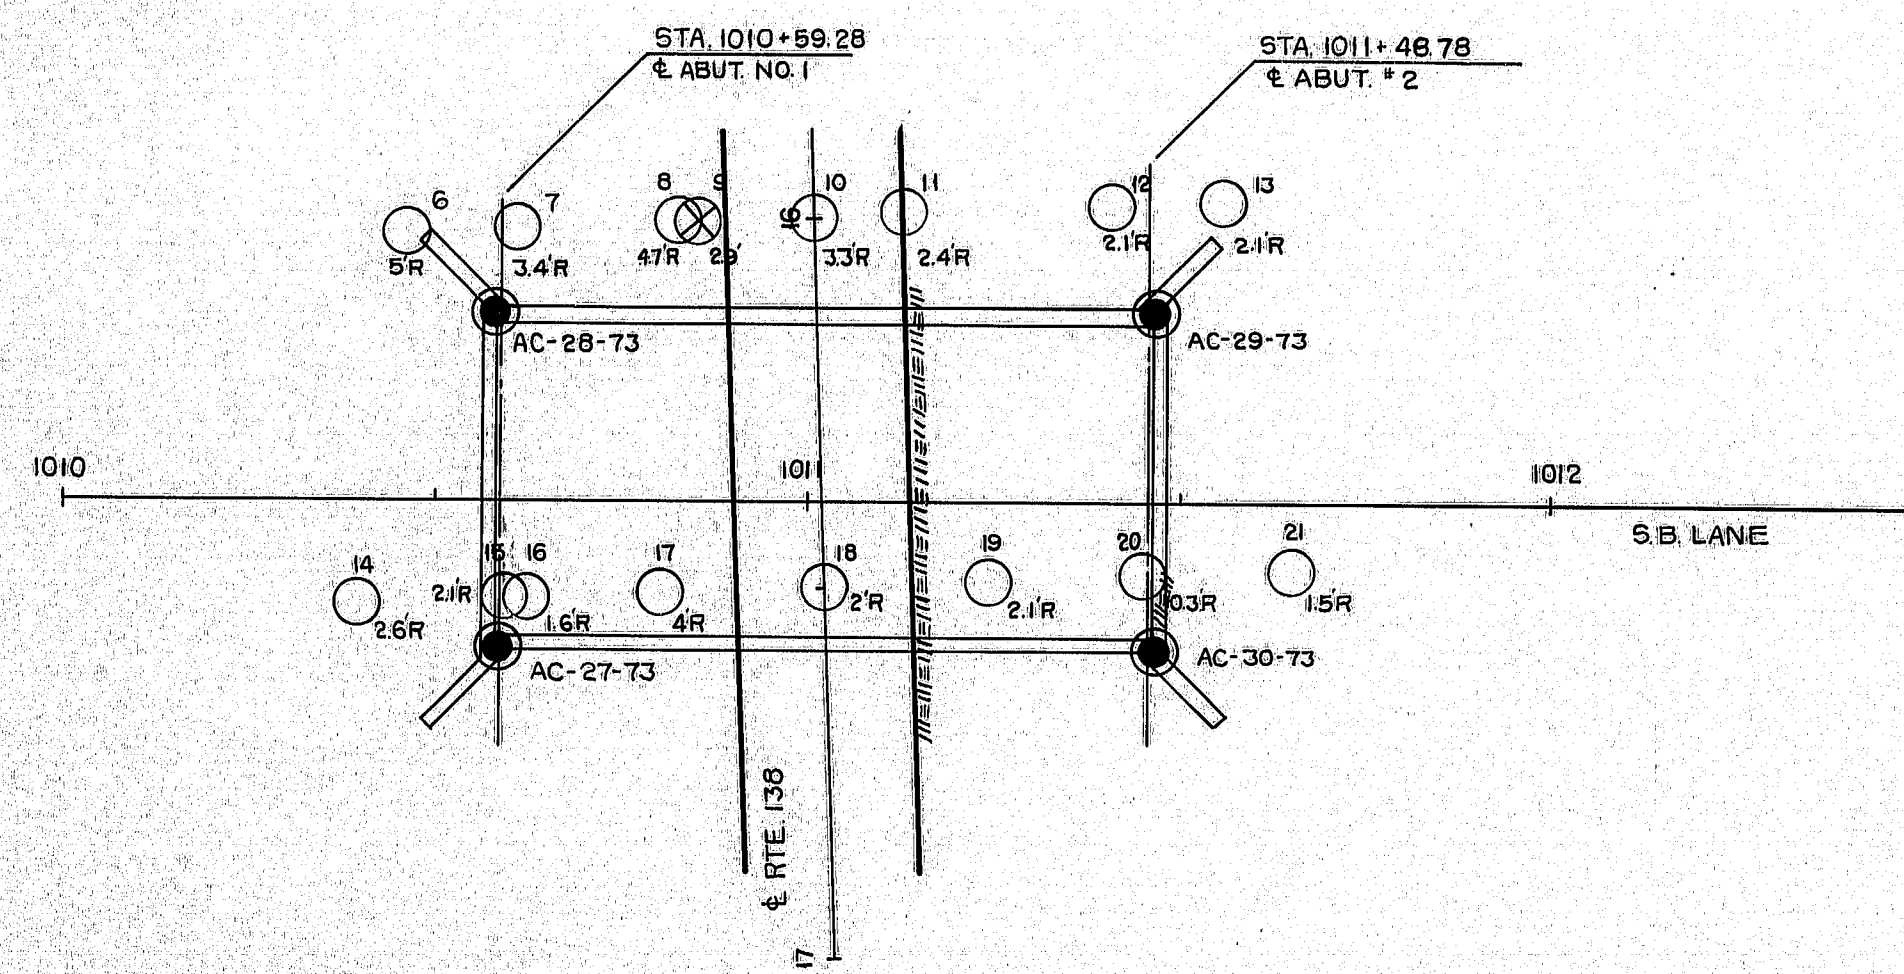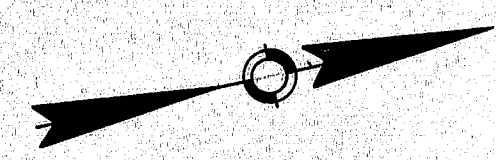

PLAN


SCALE: 1" = 25'

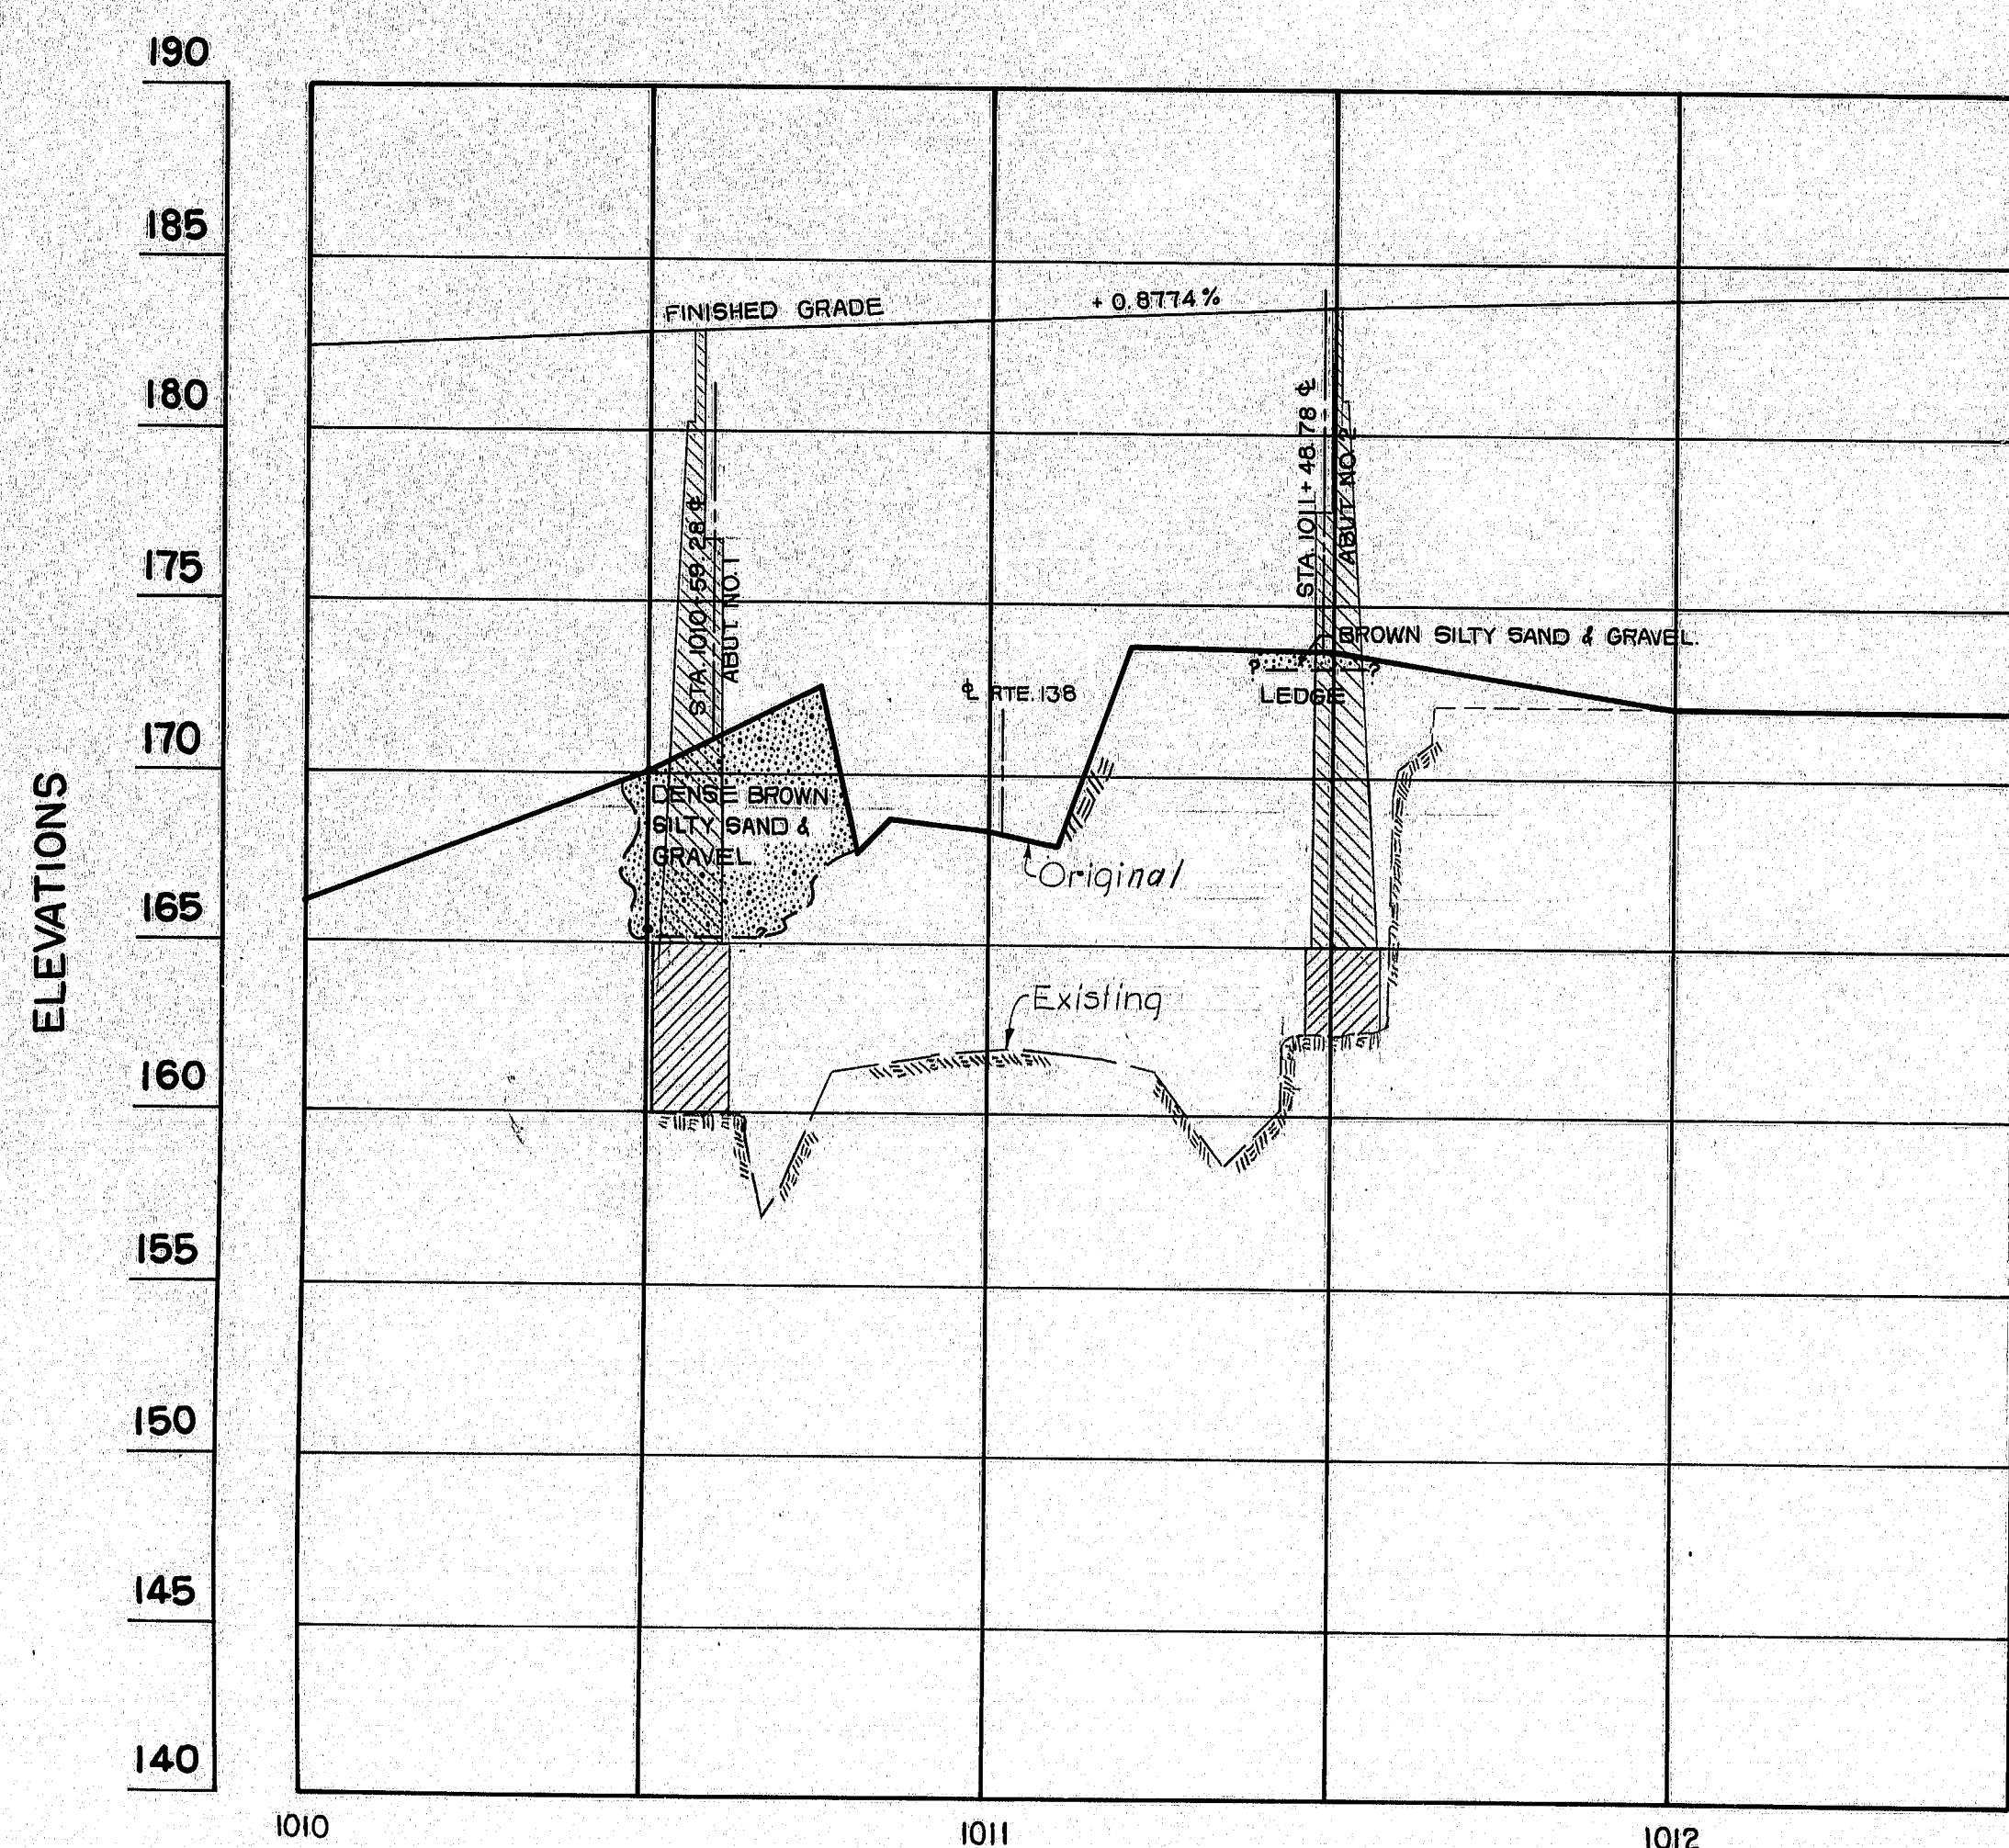


PROFILE

SCALE: 1" = 25'

ROD SOUNDING RESULTS		
SOUNDING NUMBER	GROUND ELEVATION	REFUSAL ELEVATION
6	165.3	160.3
7	166.1	162.7
8	166.0	161.3
9	167.0	164.1
10	167.2	163.9
11	167.6	165.2
12	168.8	166.7
13	168.6	166.5
14	170.6	168.0
15	172.4	170.3
16	170.0	171.0
17	170.0	166.0
18	168.7	166.7
19	174.1	172.0
20	174.5	174.2
21	174.0	172.5

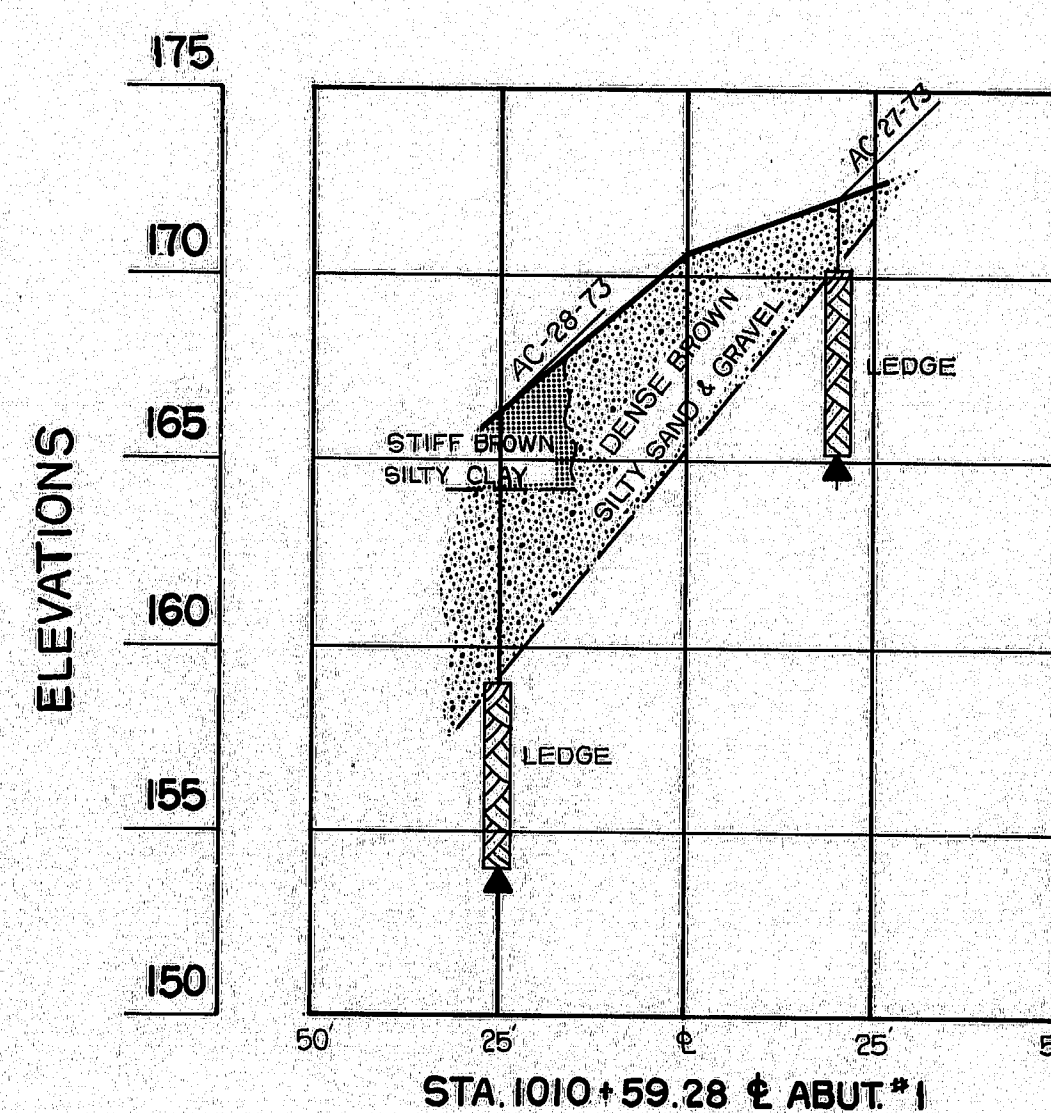





STA. 1010+59.28 & ABUT. #1

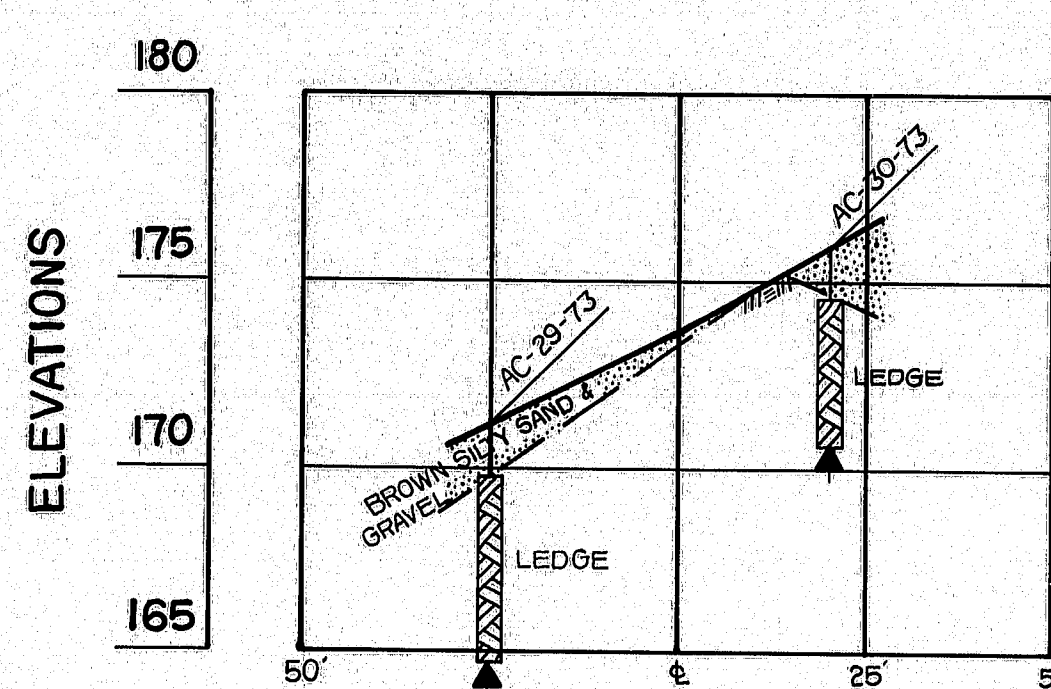

STA. 1011+48.78 & ABUT. #2

TRANSVERSE SECTIONS

SCALE: 1" = 25'

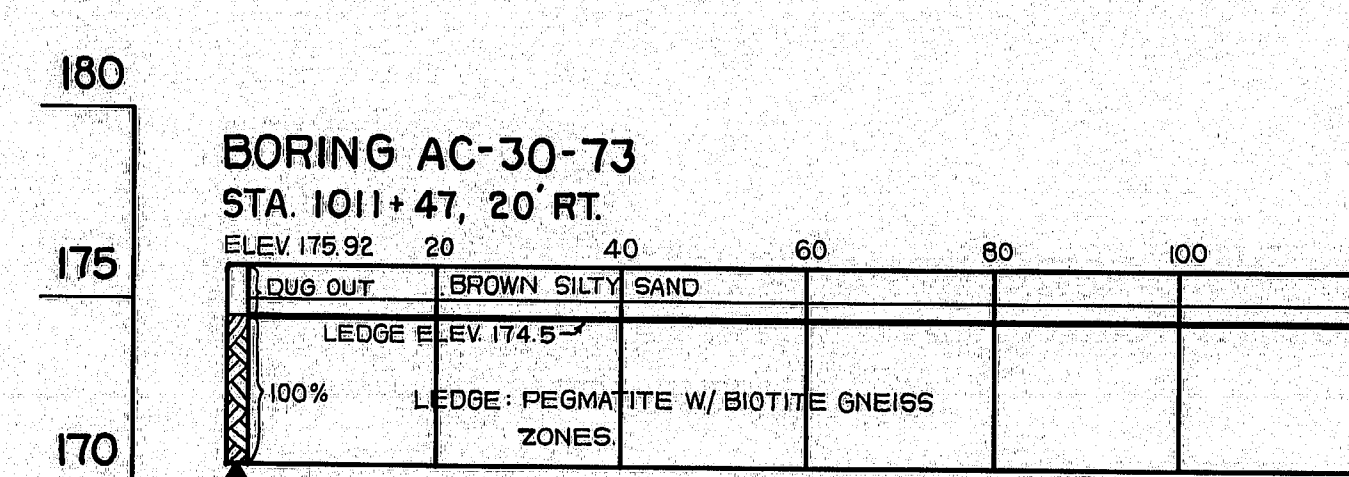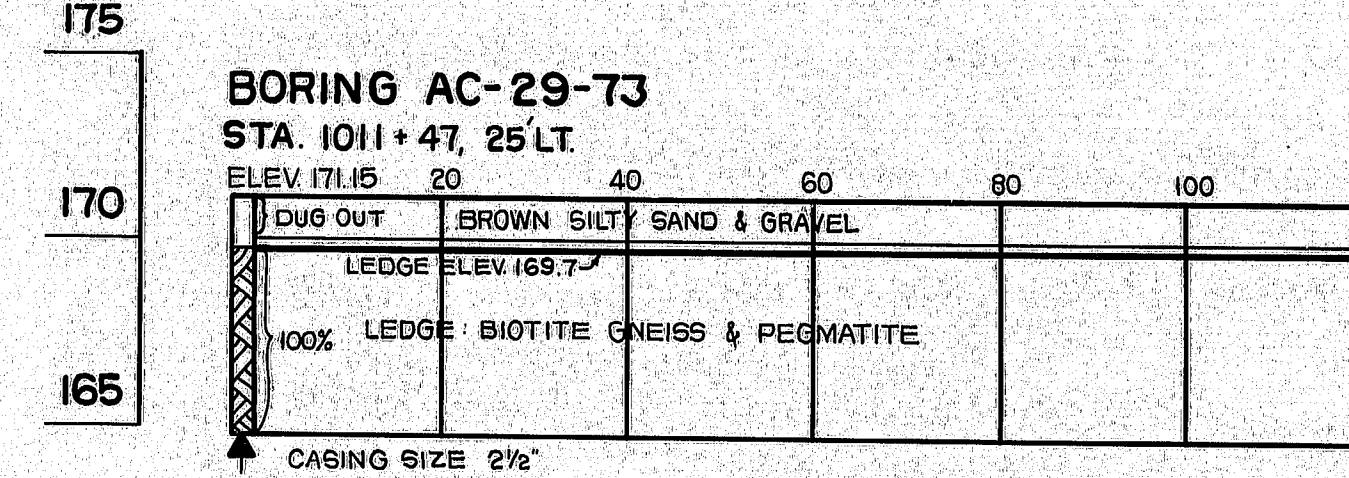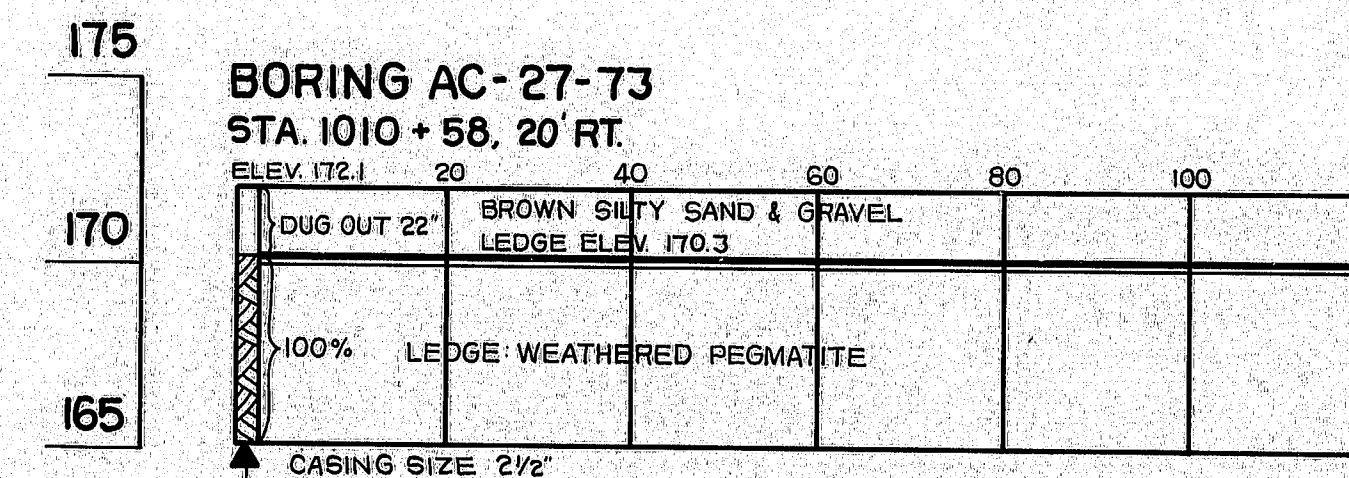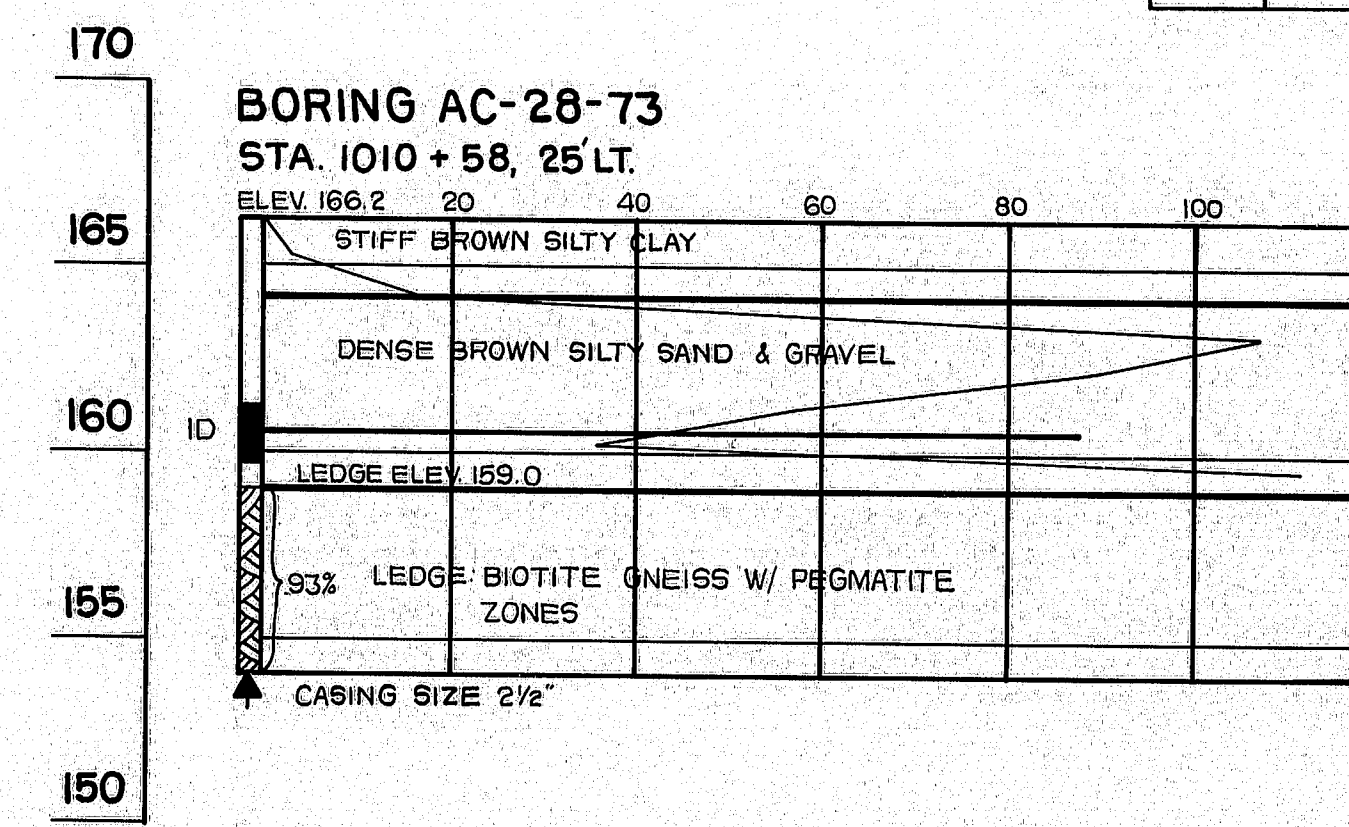

F.H.W.A. REG. NO.	STATE	PROJECT NUMBER	SHEET NO.	TOTAL SHEETS
1	MAINE	95-5(42)	6	31

DESIGN - DETAILED	CHECKED	REVISIONS	FIELD CHANGES
BY	DATE		
AL	3-23		

PLANS


STATE OF MAINE
DEPARTMENT OF TRANSPORTATION

INTERSTATE 95
OVER
ROUTE 138
IN THE TOWN OF
BOWDOINHAM
SAGadahoc COUNTY
FOUNDATION SURVEY S.B.


SHEET 6 OF 31, AUGUSTA, MAINE March 1975

172-78


F.R.W. REG. NO.	STATE	PROJECT NUMBER	SHEET NO.	TOTAL SHEETS
1	MAINE	95-5(42)	9	37

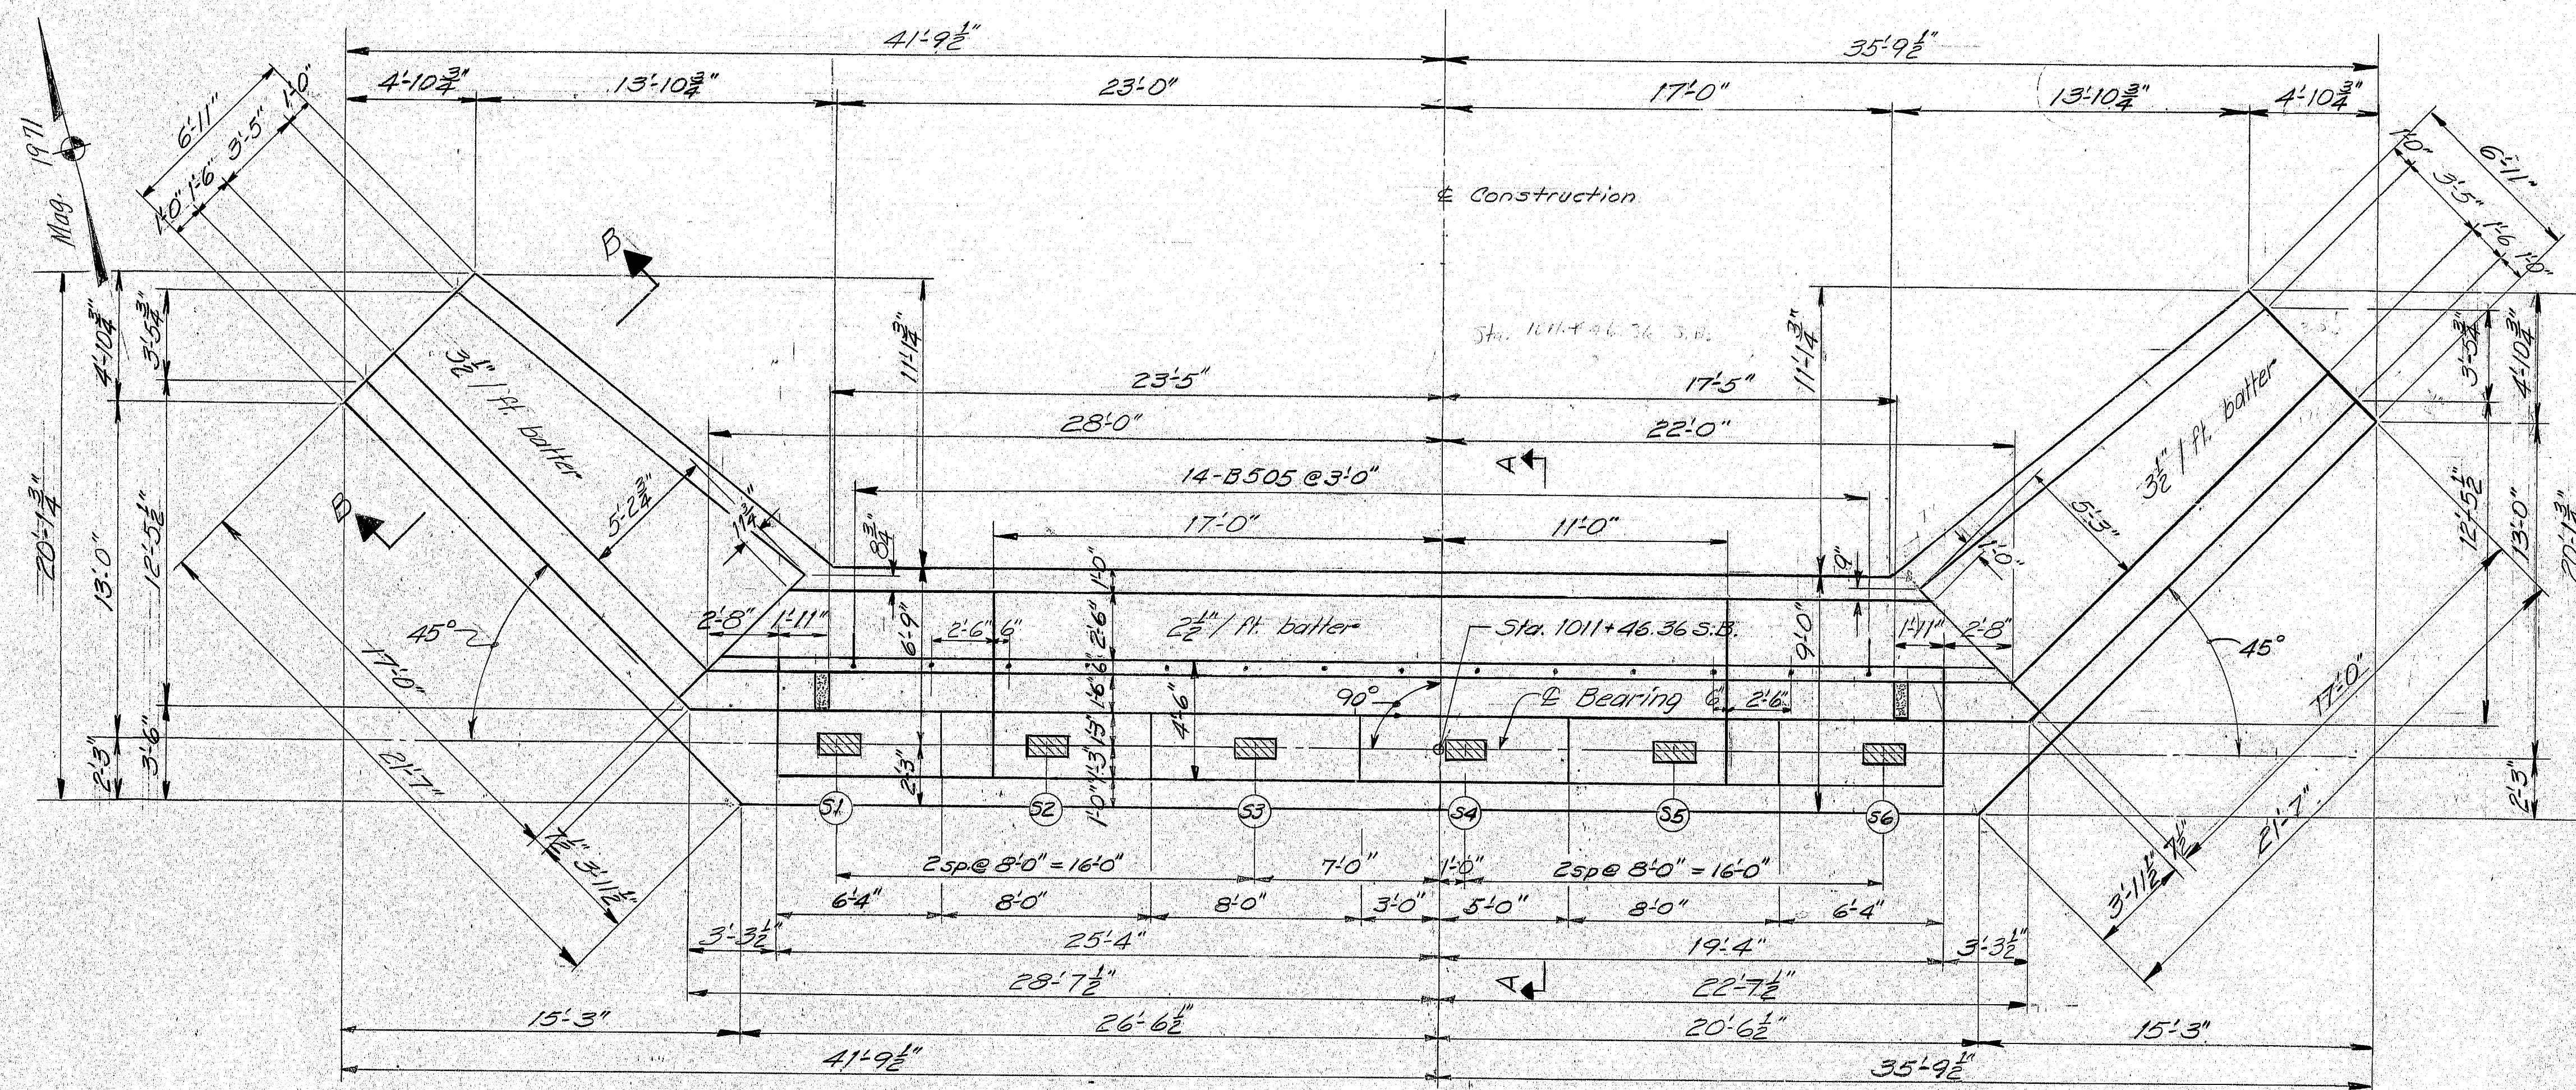


PLAN - ABUT. NO. 2 S.B.

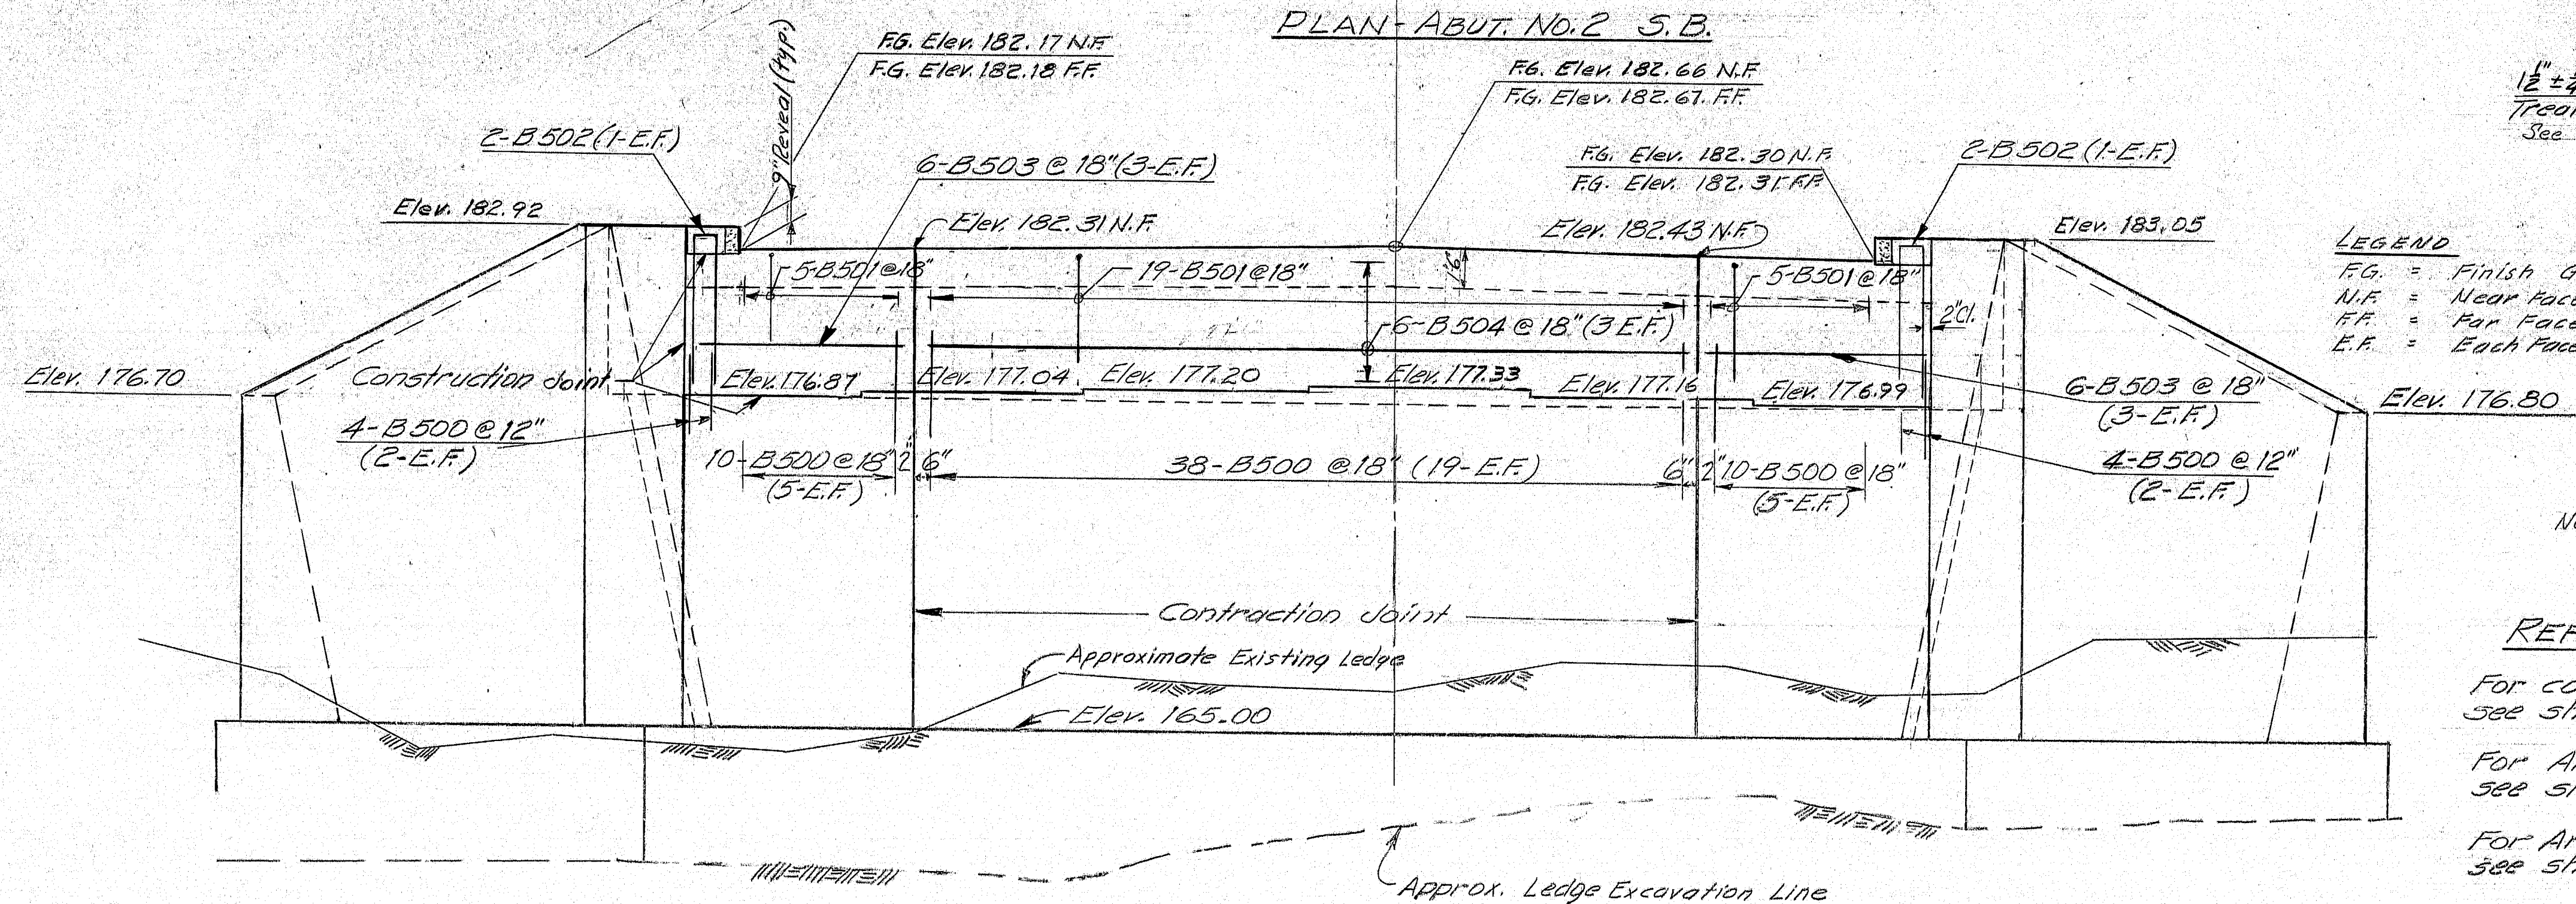

ELEVATION - ABUT. NO. 2 S.B.

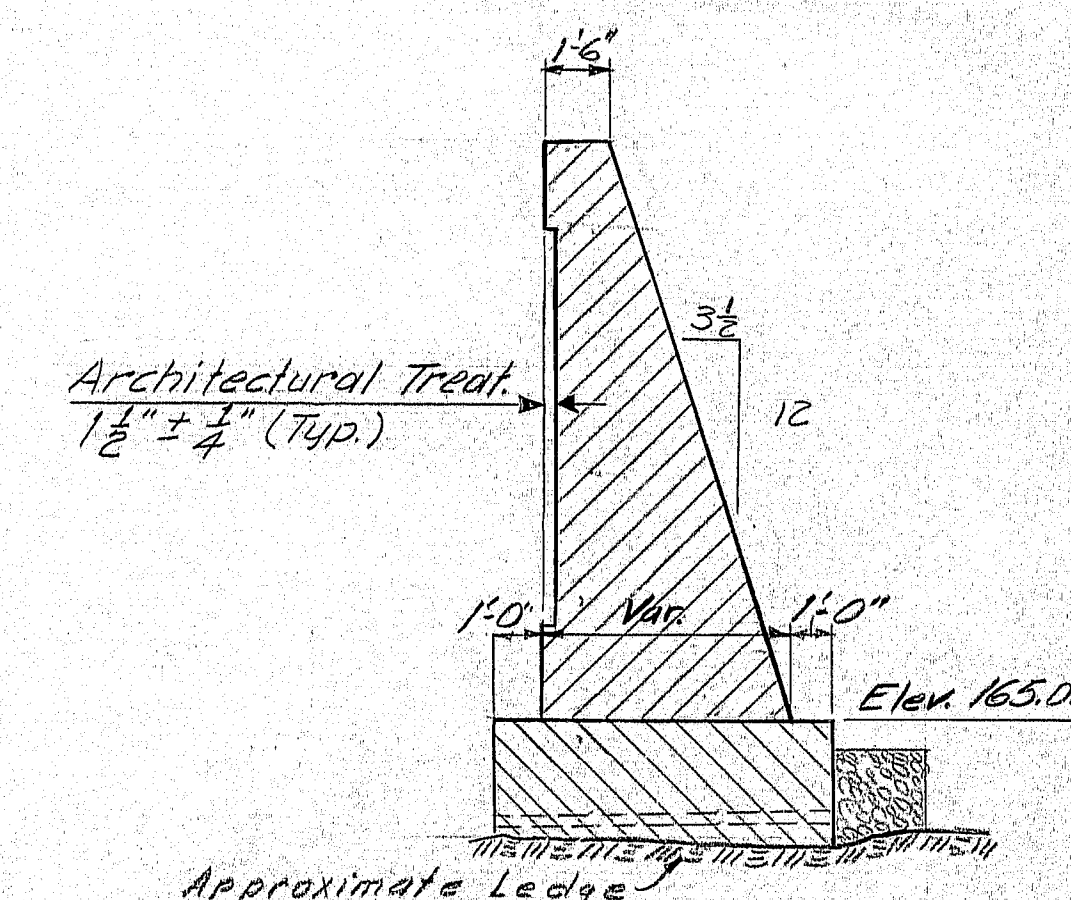

SECTION B-B

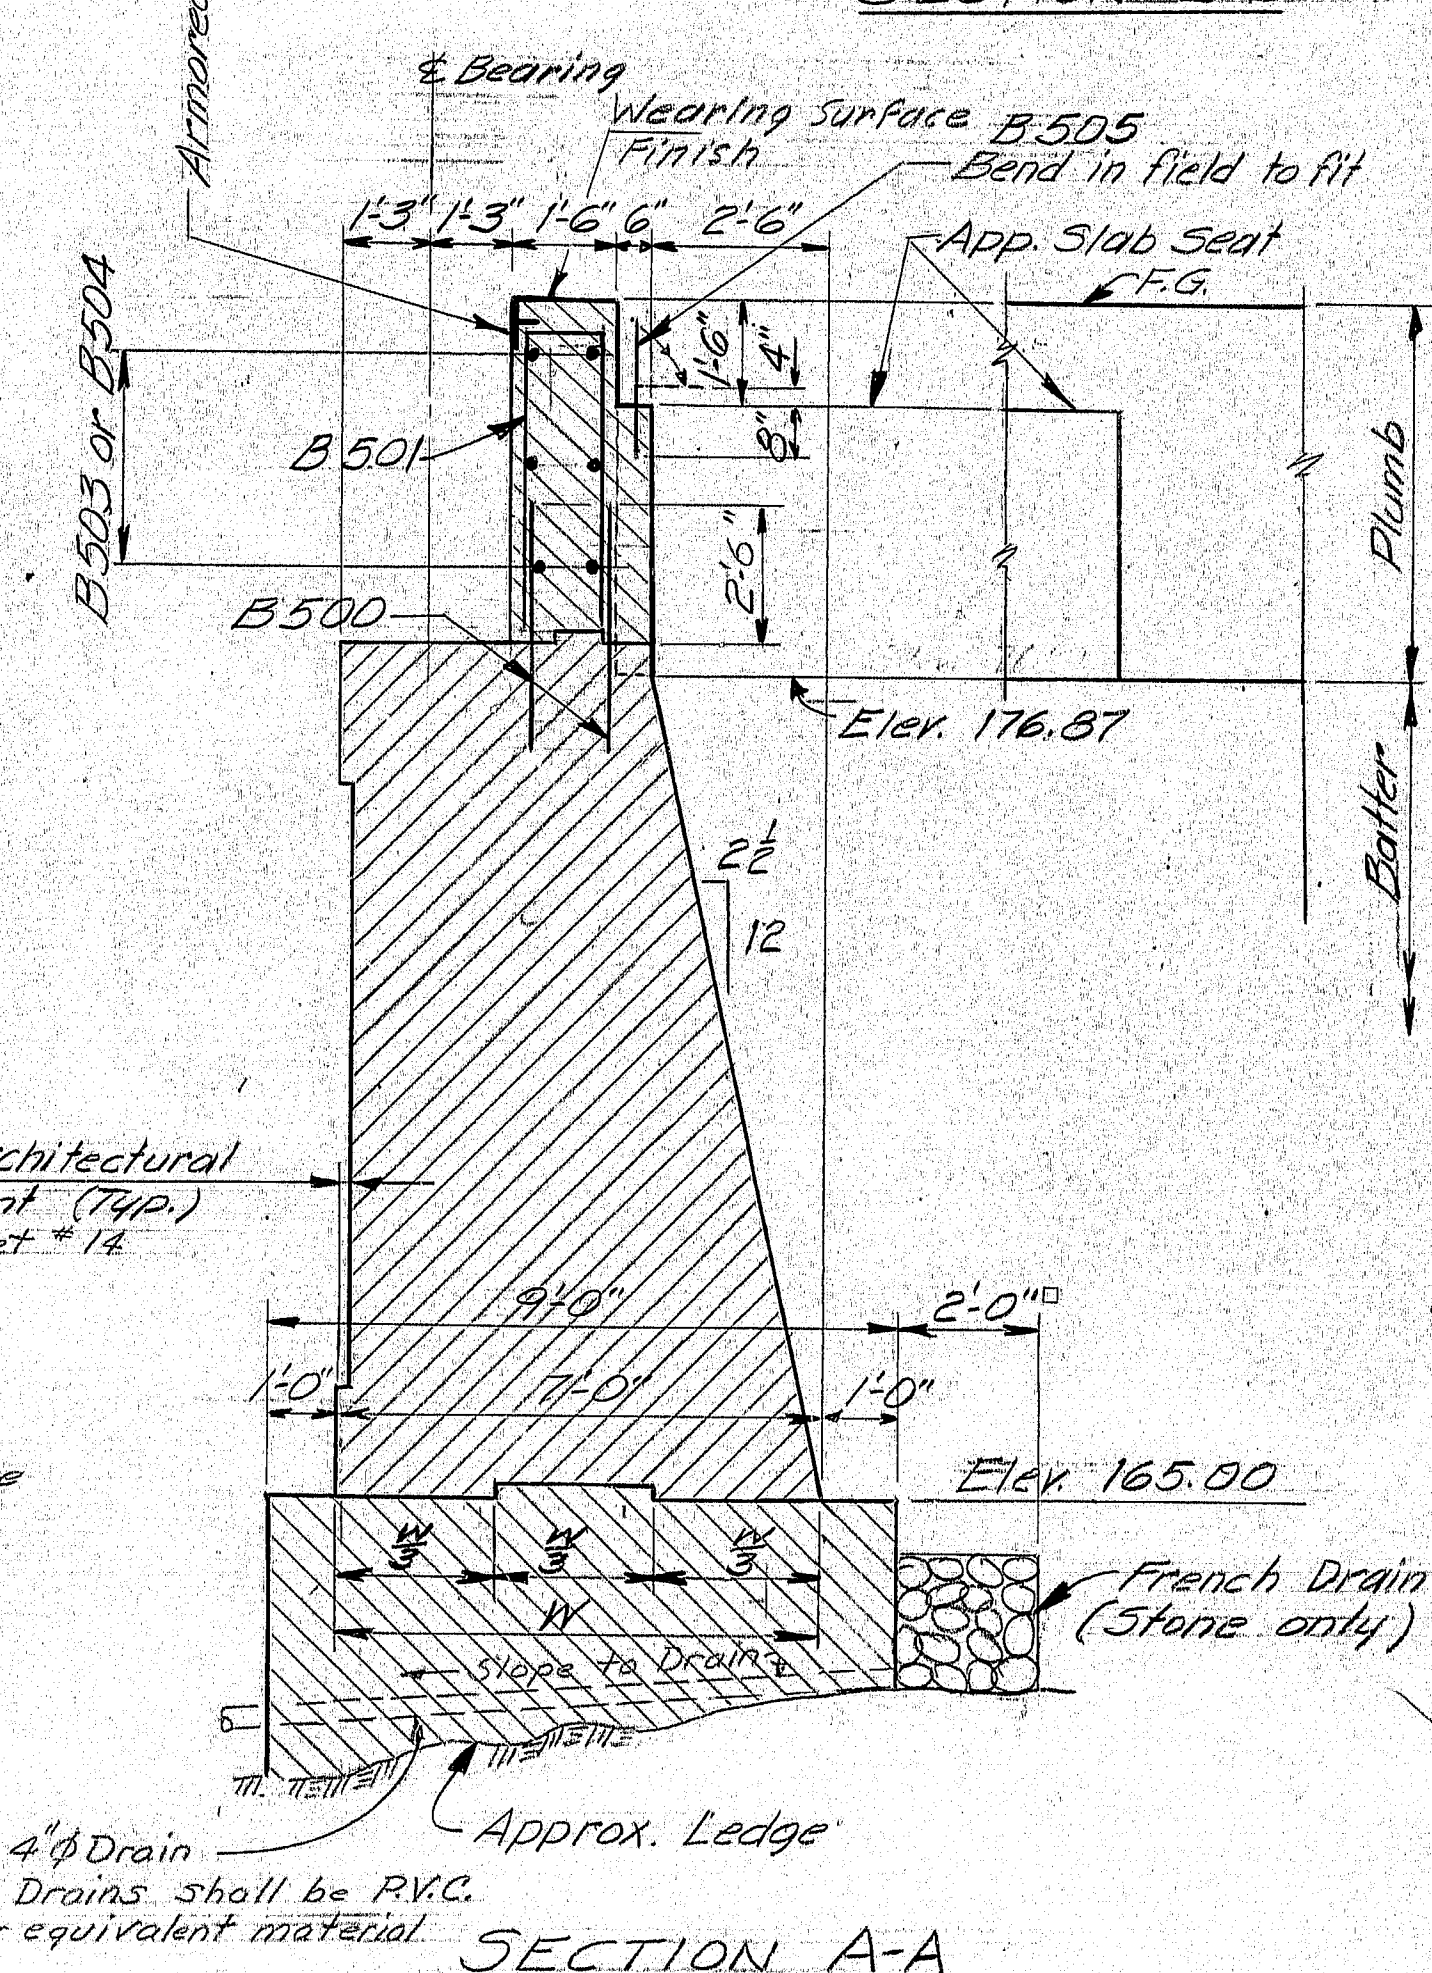

SECTION A-A

LEGEND
 F.G. = Finish Grade
 N.F. = Near Face
 F.F. = Far Face
 E.F. = Each Face

REFERENCES

For concrete slope protection
 see sh. # 20
 For Architectural Treatment
 see sh. # 14
 For Armored Joint details
 see sh. # 26 (BD 104-73)
 For General Notes see sh. # 12
 For Abut. Protection Note
 see sh. # 8


STATE OF MAINE
 DEPARTMENT OF TRANSPORTATION
 INTERSTATE 95
 OVER
 ROUTE 138
 IN THE TOWN OF
 BOWDOINHAM
 SAGadahoc COUNTY
 ABUTMENT NO. 2 SOUTHBOUND

SHEET 9 OF 37 AUGUSTA, MAINE March 1975


172-81

PROJECT DESIGN ENGINEER	DATE
GOI R.M.	3-7-75
DESIGN - DETAIL	CHECKED
15-11	3-7-75
PLANS	FIELD CHANGES


PROJECT DESIGN ENGINEER	DATE
GOI	2/20/22
CHECKED	3-75
REVISIONS	
FIELD CHANGES	

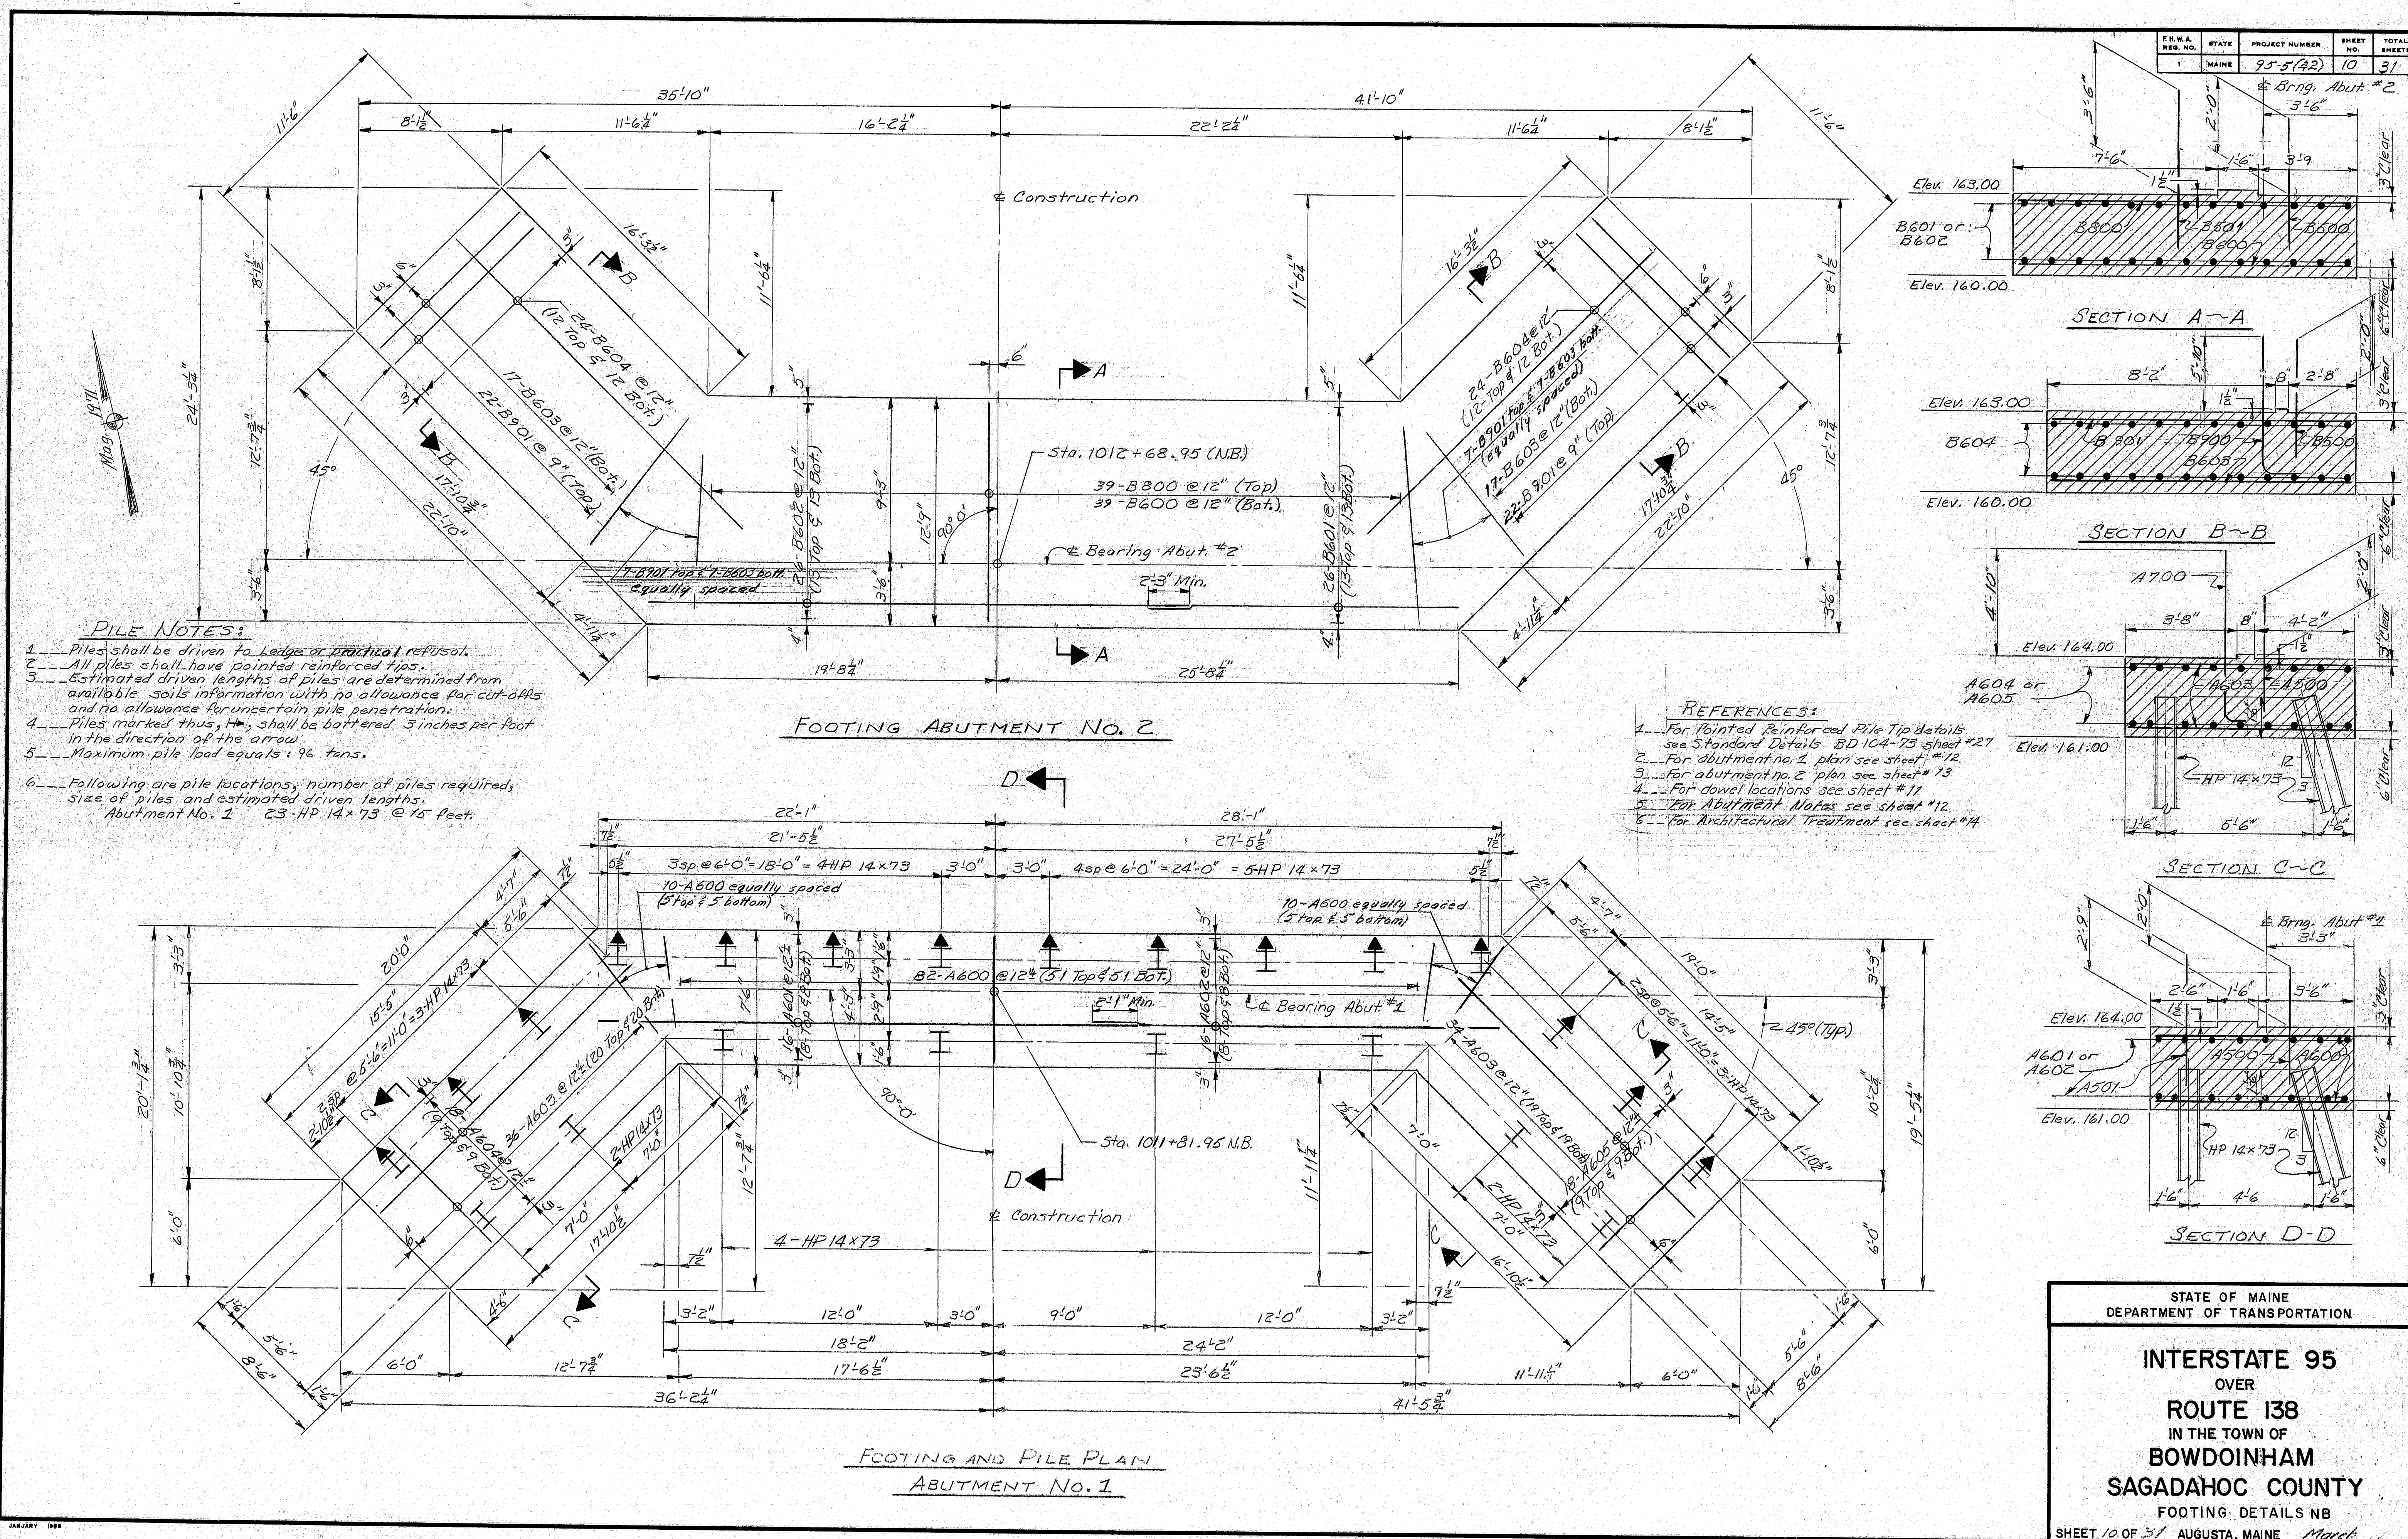


PROJECT DESIGN ENGINEER	BY	DATE
DESIGN - DETAILED	G.O.T. R.C.B.	220775
CHECKED	PUL	3-35
REVISIONS		
FIELD CHANGES		

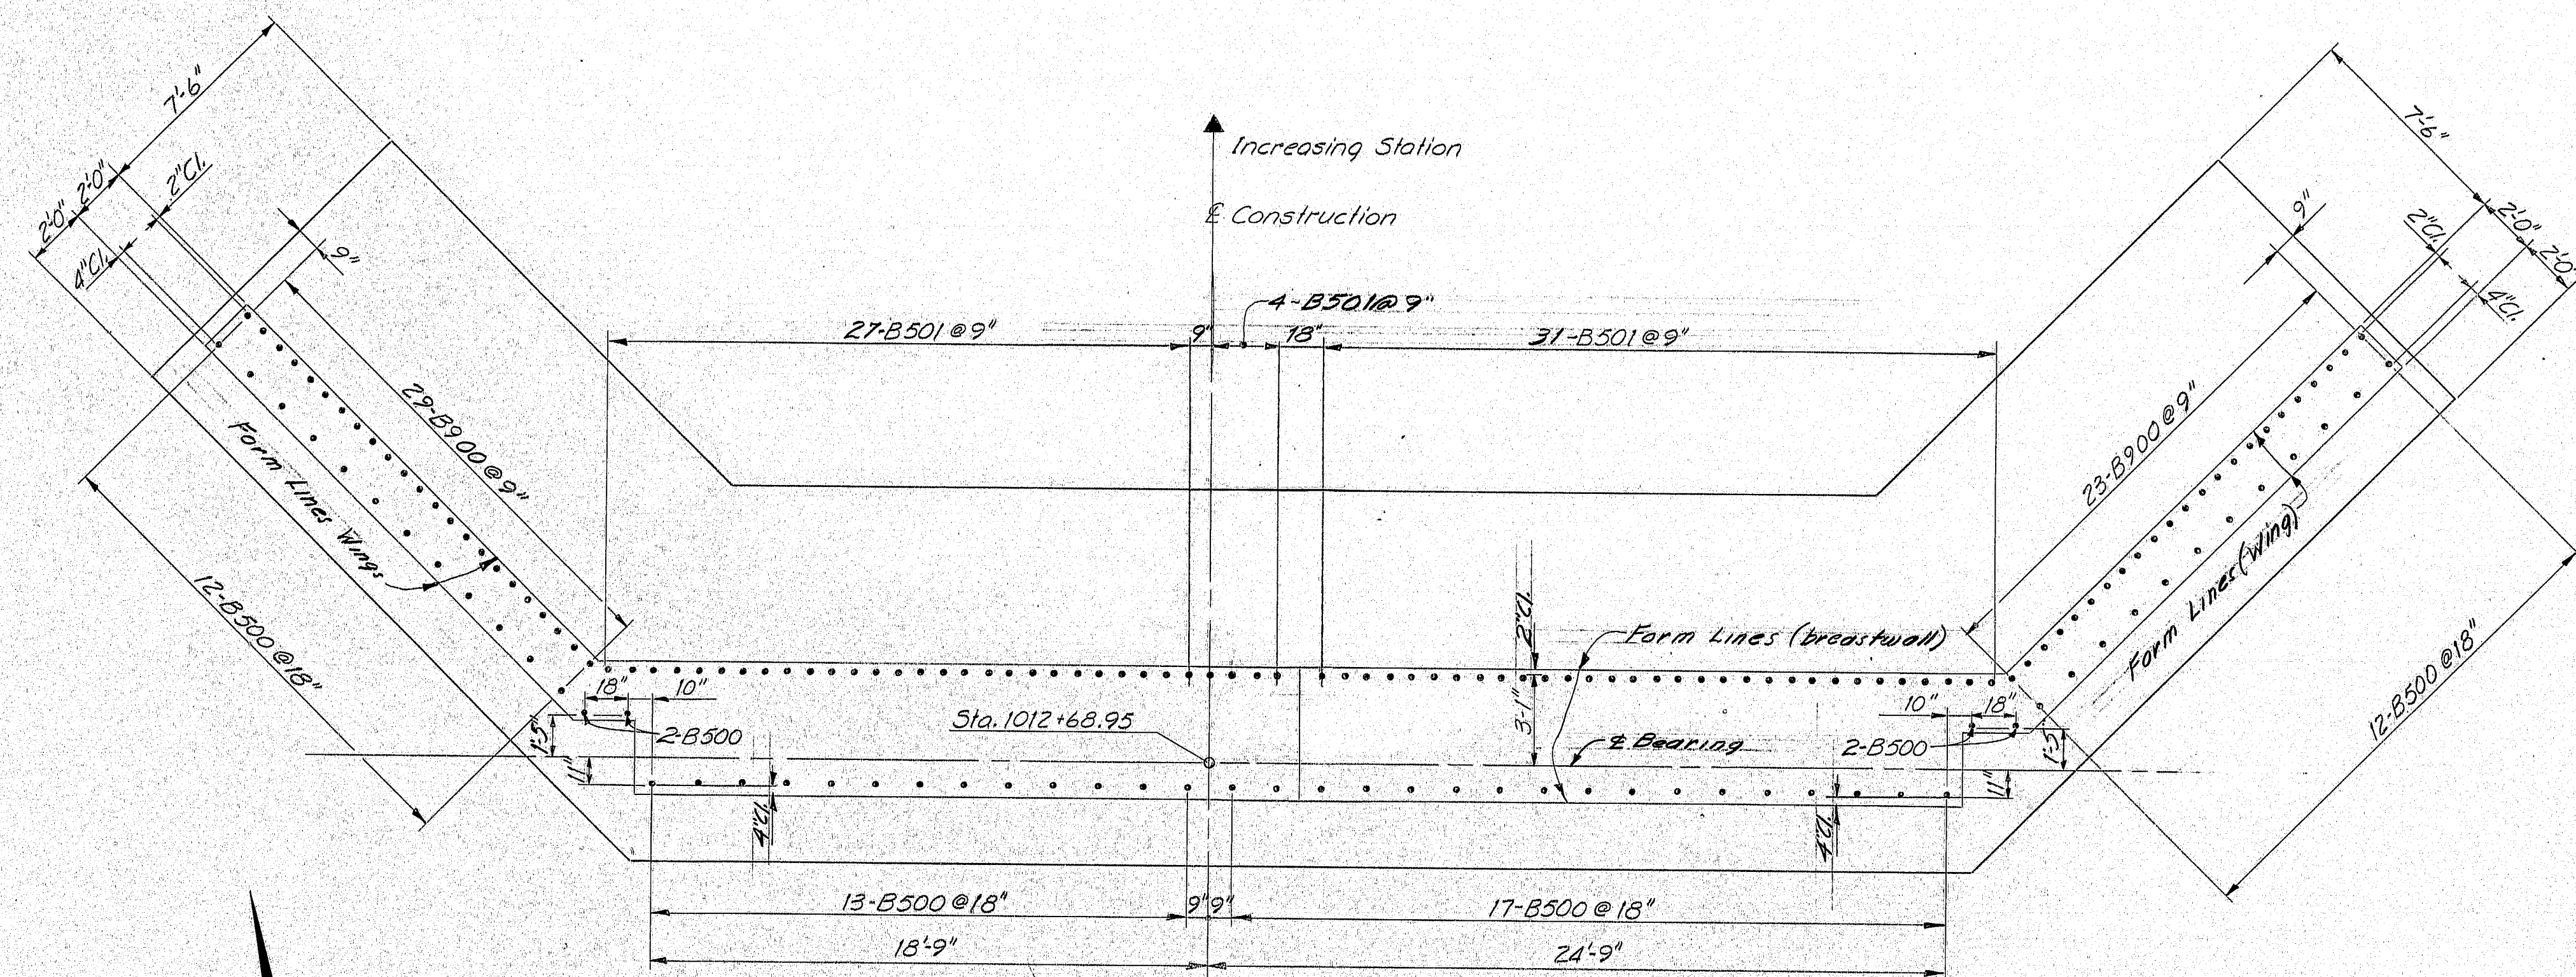

DOWEL LAYOUT-ABUTMENT #2 FOOTING
"NORTHBOUND"

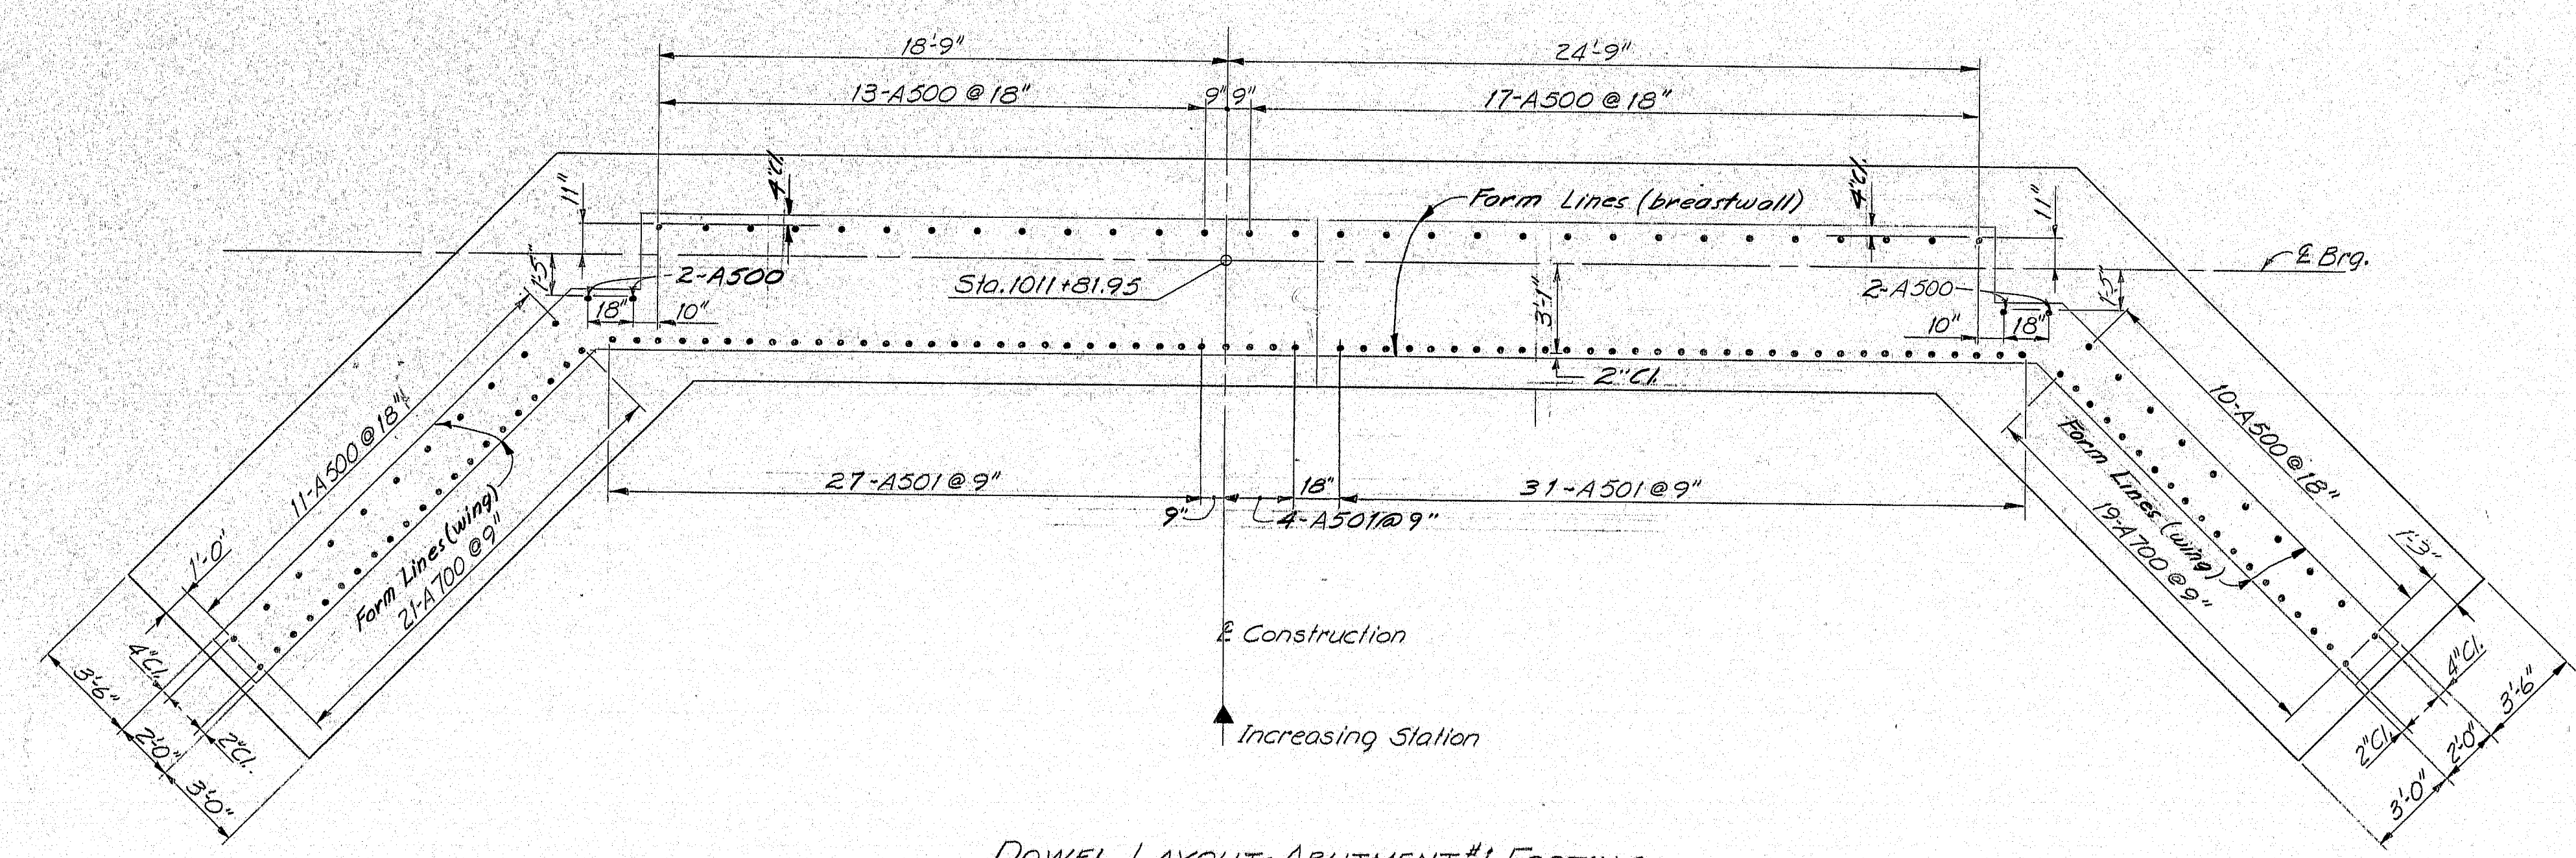

DOWEL LAYOUT-ABUTMENT #1 FOOTING
"NORTHBOUND"

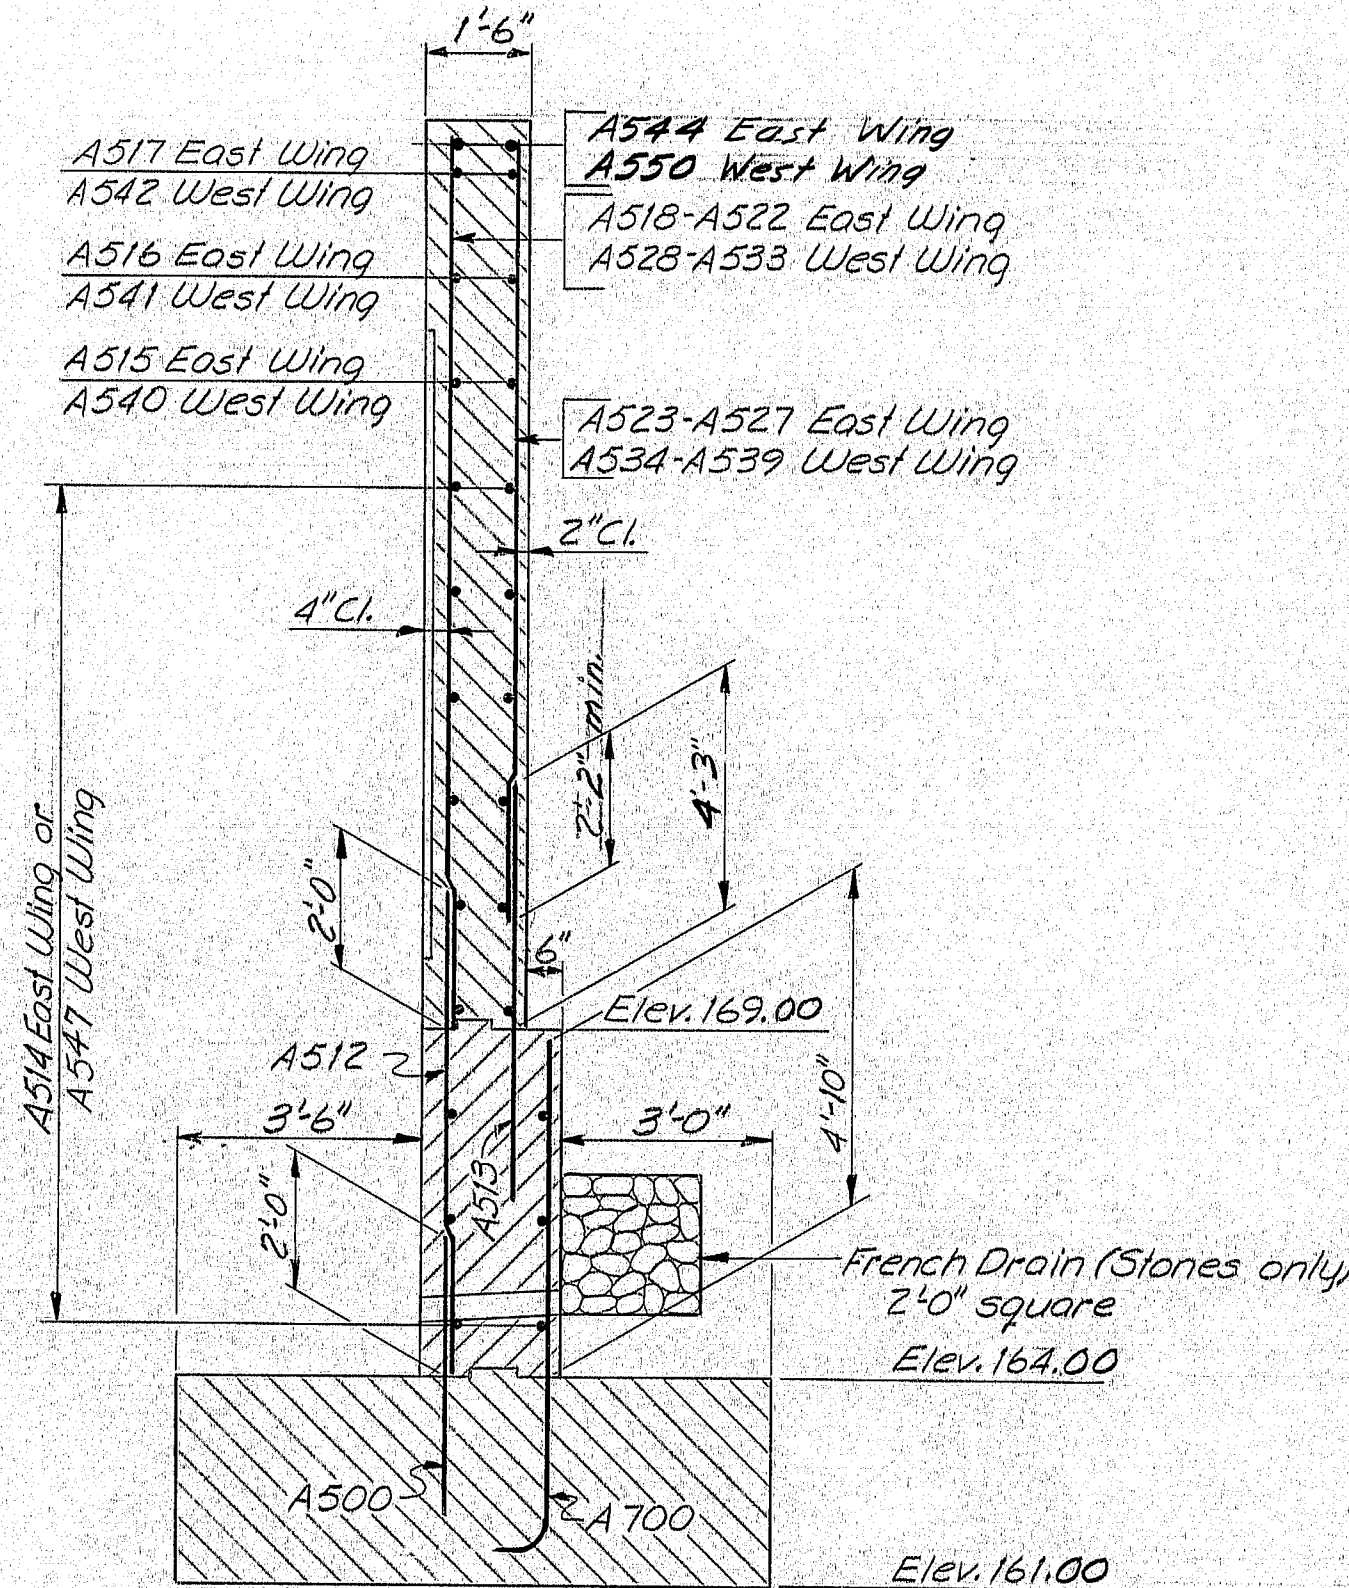

SECTION B-B
ABUTMENT #1
Sheet 12

REFERENCES
For Abutment Notes see sheet #12

LEGEND
Cl. = Clear


STATE OF MAINE
DEPARTMENT OF TRANSPORTATION

INTERSTATE 95
OVER
ROUTE 138
IN THE TOWN OF
BOWDOINHAM
SAGADAHOC COUNTY
DOWEL LAYOUT FOOTINGS NE


SHEET 11 OF 31 AUGUSTA, MAINE March 18th

172-83

E. P. 14144

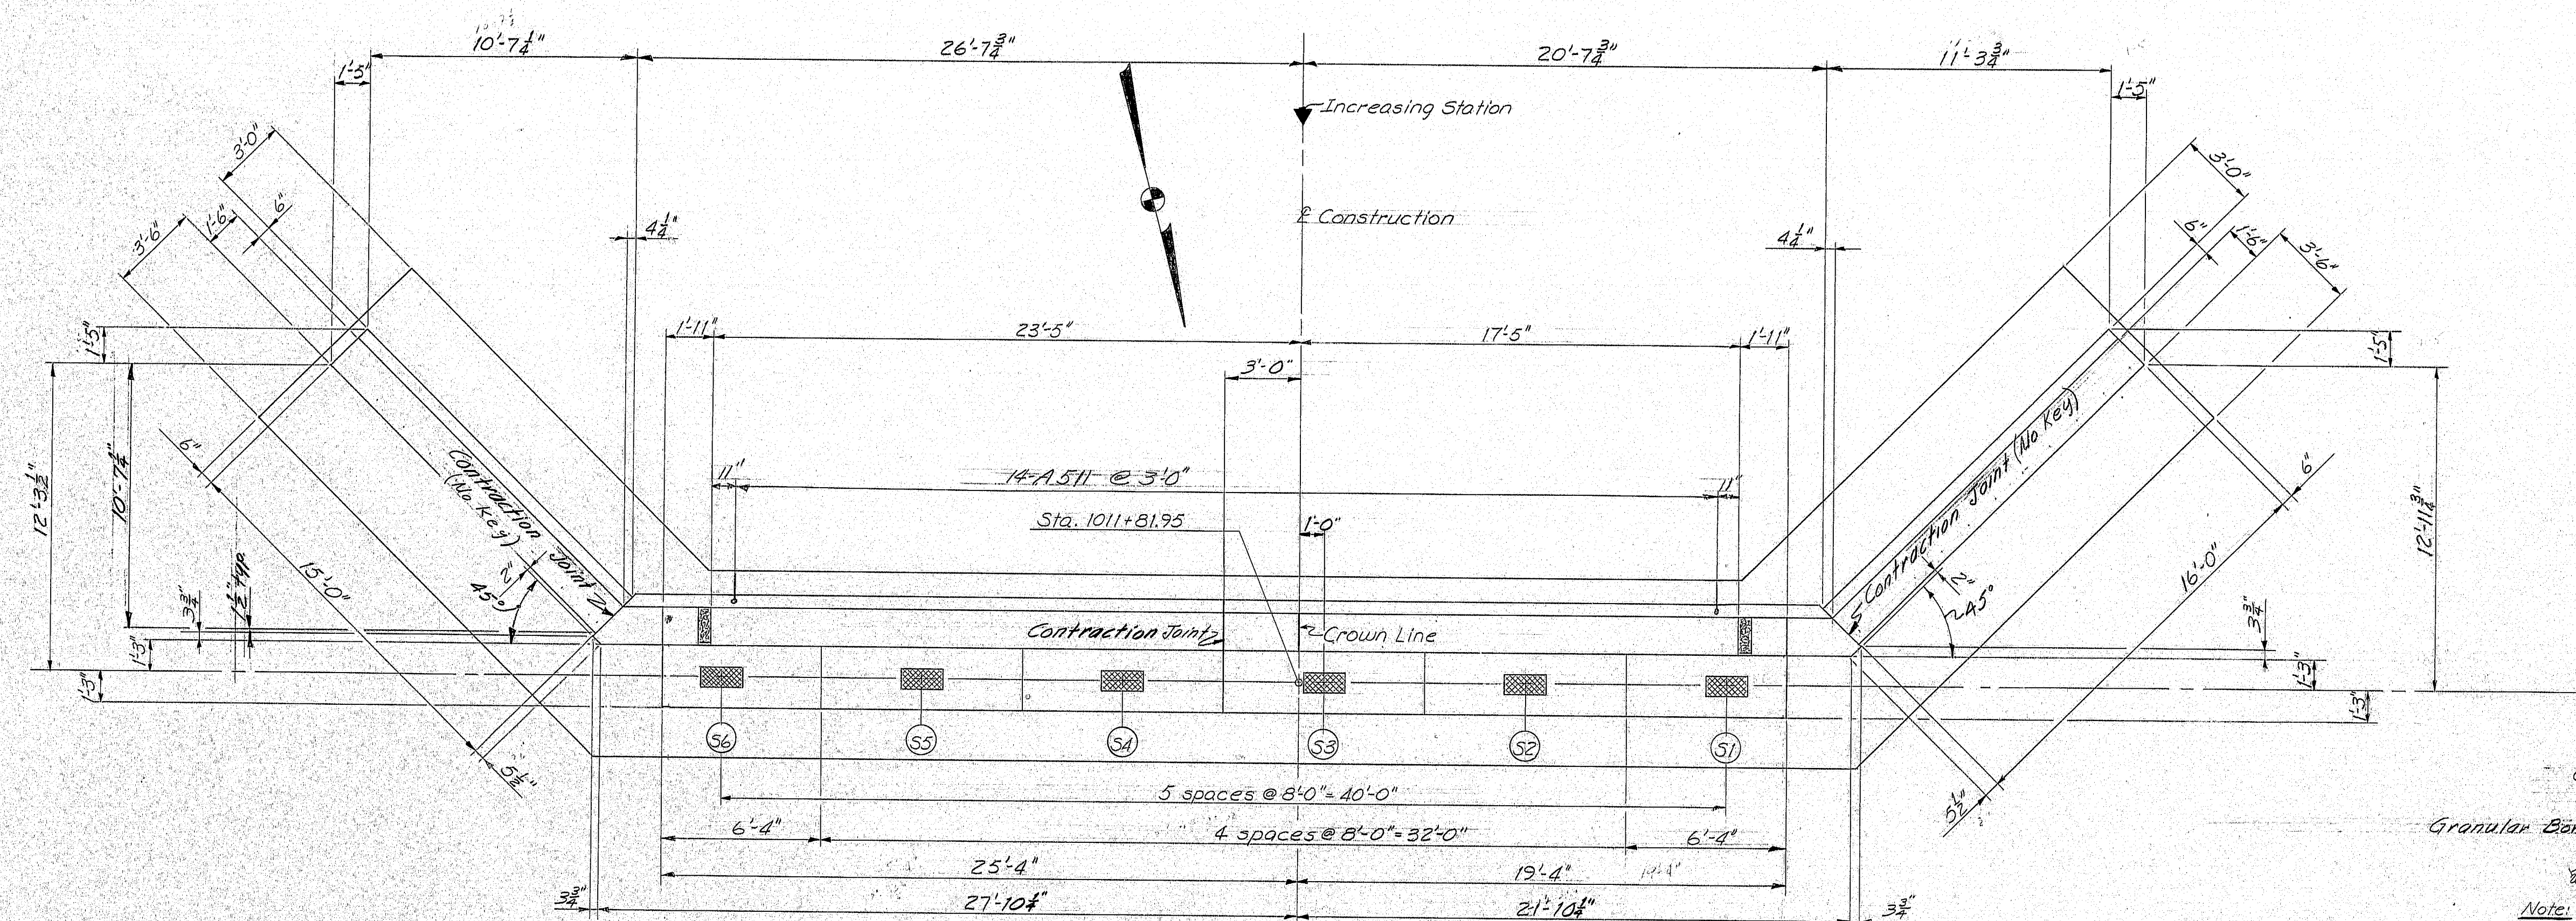

PLAN-ABUTMENT #1 NORTHBOUND

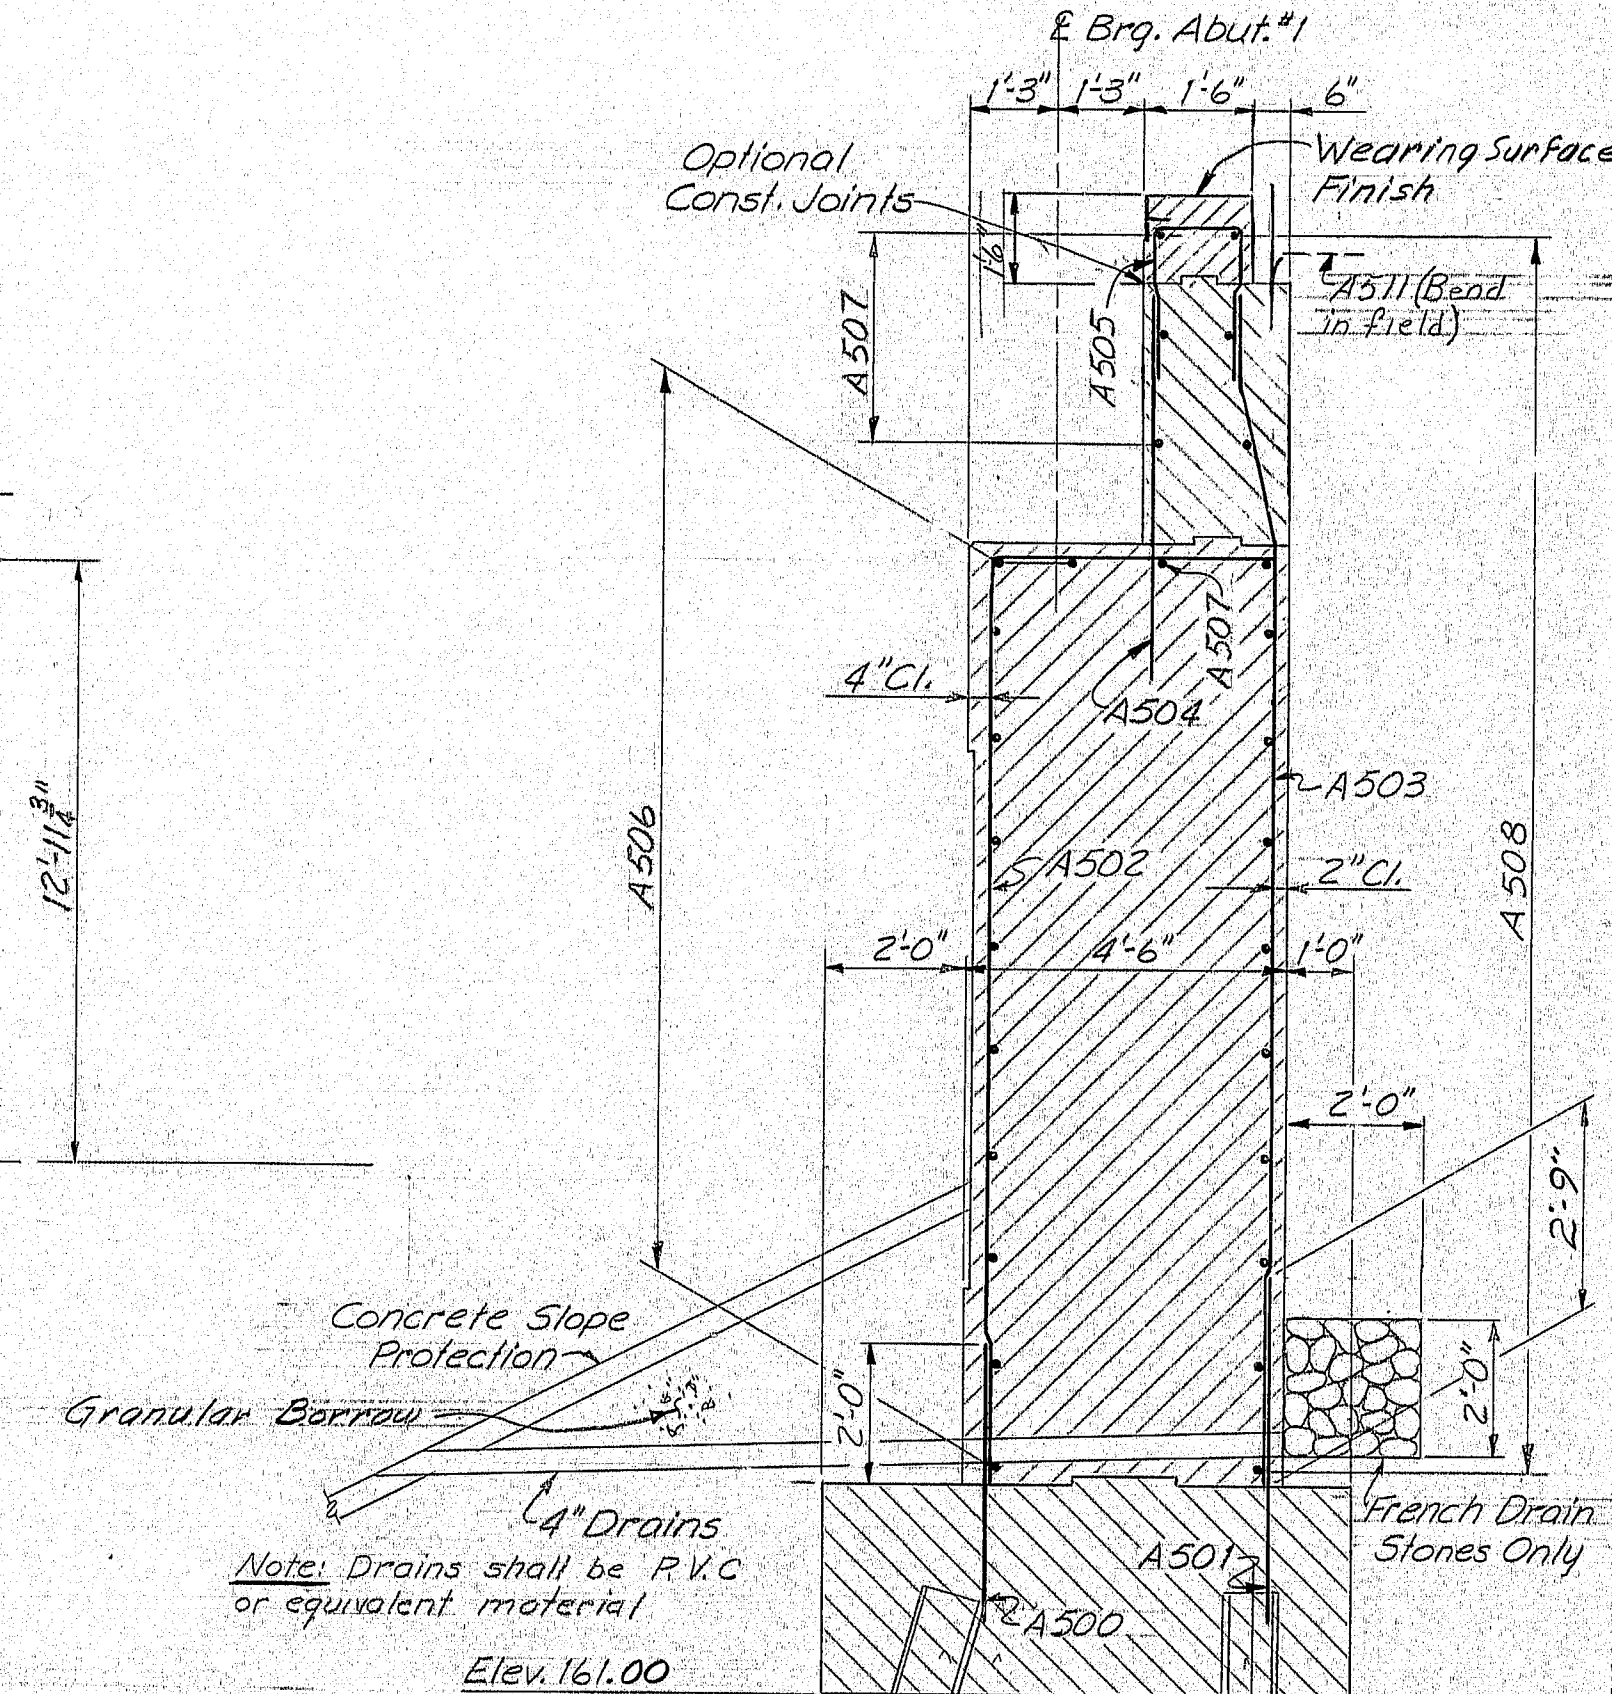


SECTION A-A

- REFERENCES
 For File Plan & Notes see sheet # 10
 For Footing Plan & Sections see sheet # 10
 For Footing Dowel Layout see sheet # 11
 For Architectural Treatment see sheet # 15
 For Armored Joint see BD 104-73 sheet # 26
 For Slope Protection see sheet # 21

- For Section B-B see sheet # 11
For Abutment Protection Note see sheet # 12

- ## ABUTMENT NOTES
1. Chamfer all exposed edges of concrete $\frac{1}{2}$ inch unless otherwise indicated.
 2. Reinforcing steel shall have 2 inches cover unless otherwise indicated.
 3. Place reinforcing steel in bridge seats to clear anchor bolts.
 4. Break bond at vertical contraction joints by a method approved by the Engineer.
 5. Polyvinylchloride waterstops shall be placed in all vertical contraction and expansion joints.
 6. Waterstops are not required in horizontal construction joints.
 7. Protective Coating for Concrete Surfaces shall be applied to top of backwall and Top of parapets.
 8. Maximum footing toe pressure is 3.6 tons per square foot Abutment No. 2.
 9. Place 4 inch diameter drains in breastwall and wings at 20 foot maximum spacing and at all low points in ledge. Exact location to be determined by the Engineer in the field. Extend drains through Slope Protection.
 10. For details of Construction & Contraction Joints see Standard Sheet 80104-73.

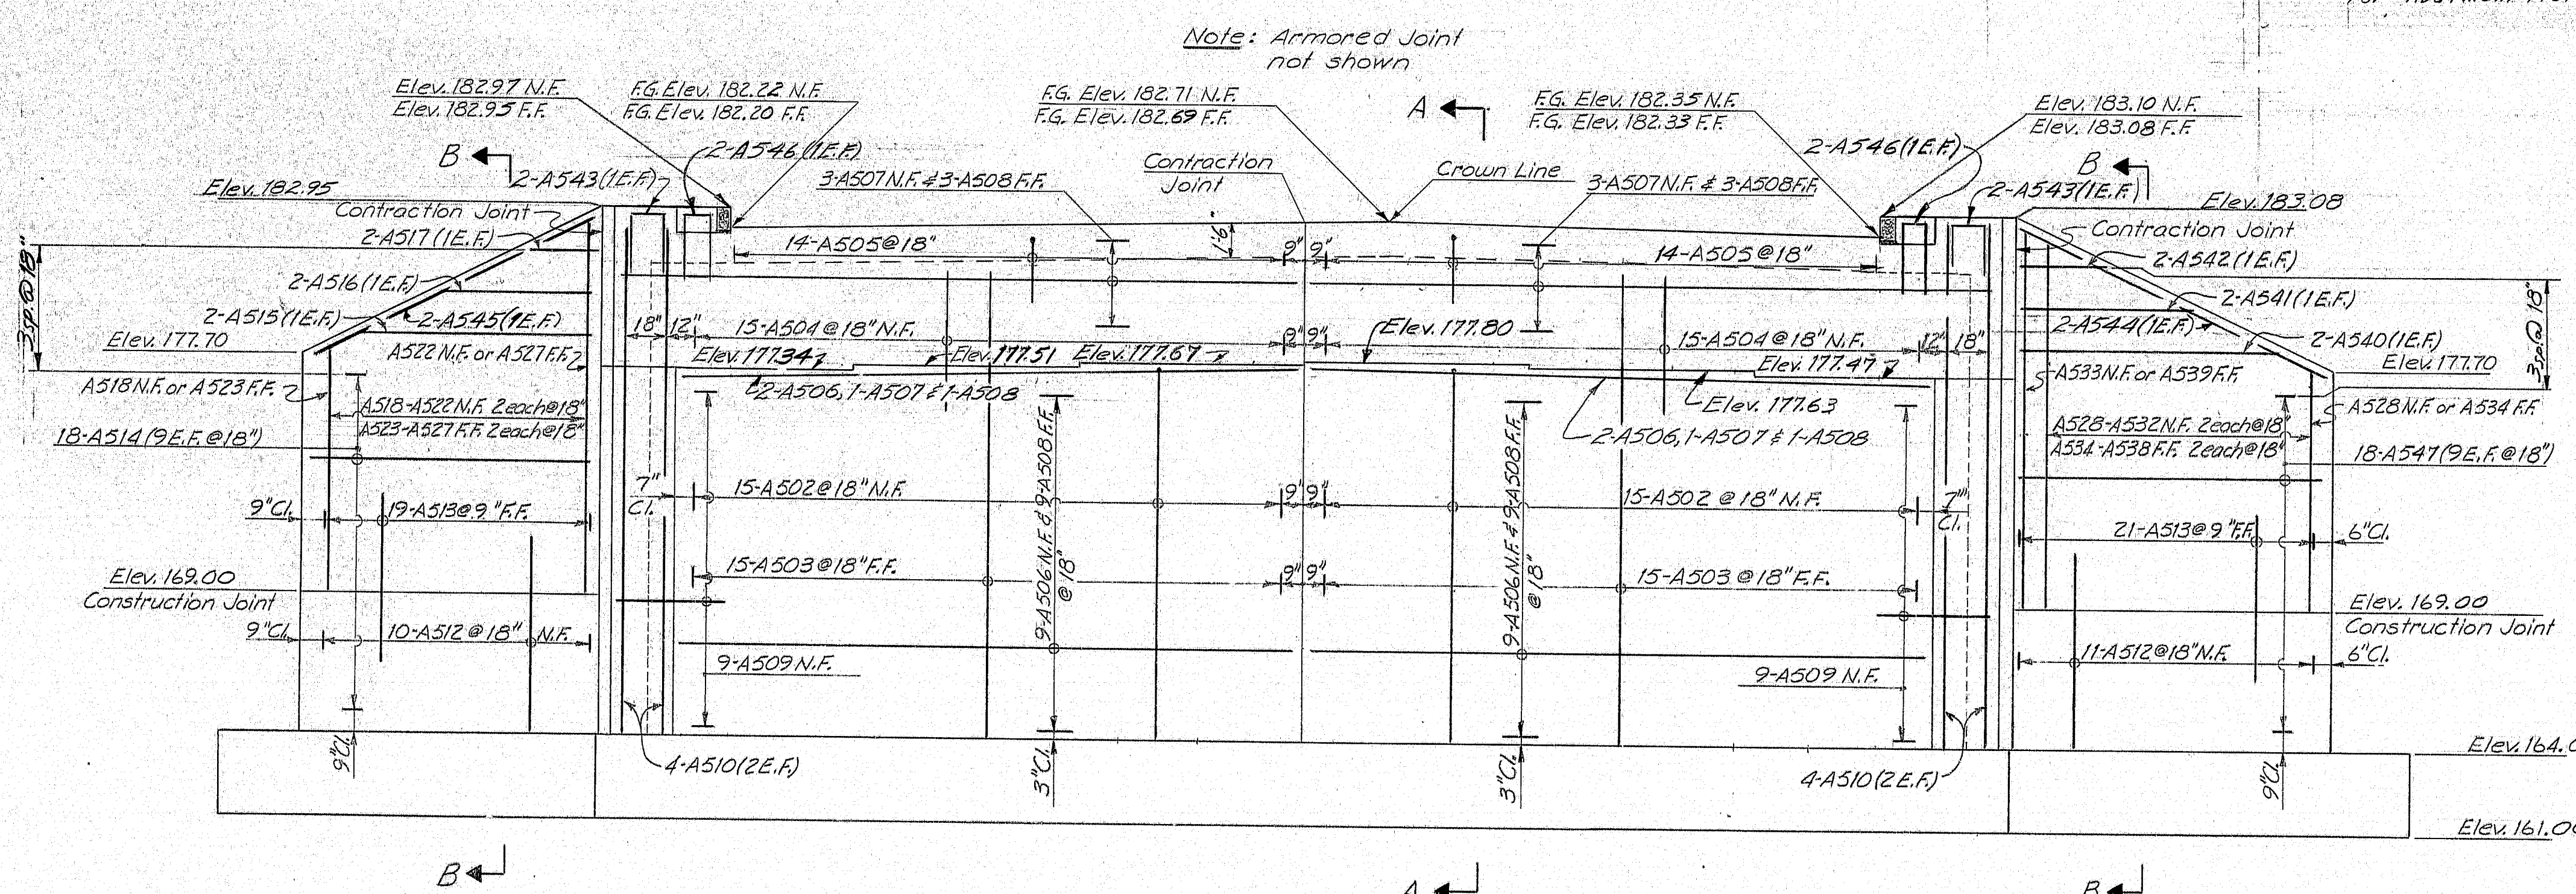

ELEVATION-ABUTMENT #1 NORTHBOUND

PLANS	PROJECT DESIGN ENGINEER	BY	DATE
	DESIGN - DETAILED	G.O.T.	P.C.B. 2-20-73
	CHECKED		
	REVISIONS	P.L.	3-7-72
	FIELD CHANGES		

LEGEND

F.G.	=	Finished Grade
N.F.	=	Near Face
F.F.	=	Far Face
E.F.	=	Each Face

STATE OF MAINE
DEPARTMENT OF TRANSPORTATION


INTERSTATE 95
OVER
ROUTE 138
IN THE TOWN OF
BOWDOINHAM
SAGadahoc COUNT

ABUTMENT NO. 1 NORTHBOUND
ET 12 OF 31 AUGUSTA, MAINE *Mars*


172-84

[illegible]

PLAN ABUTMENT NO. 2 NORTHBOUND

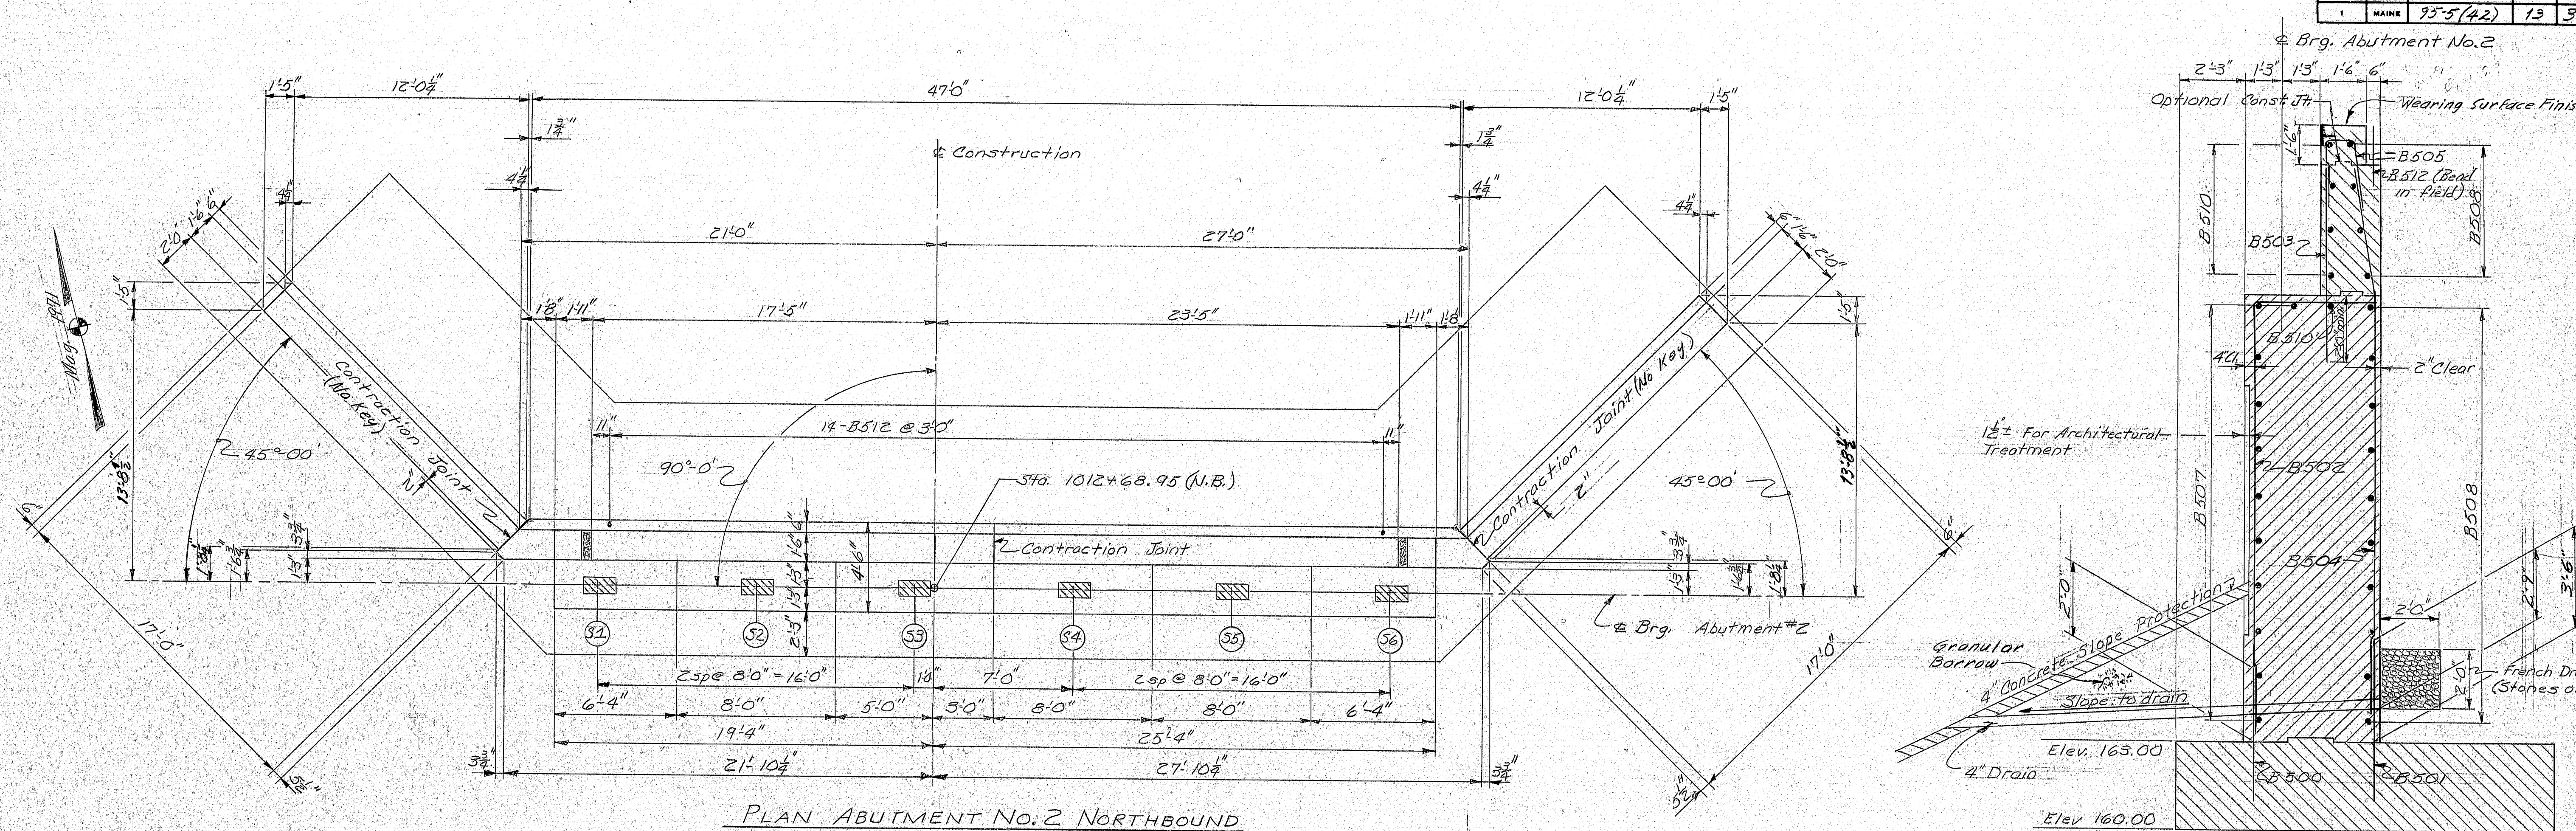

PLAN ABUTMENT NO. 2 NORTHBOUND

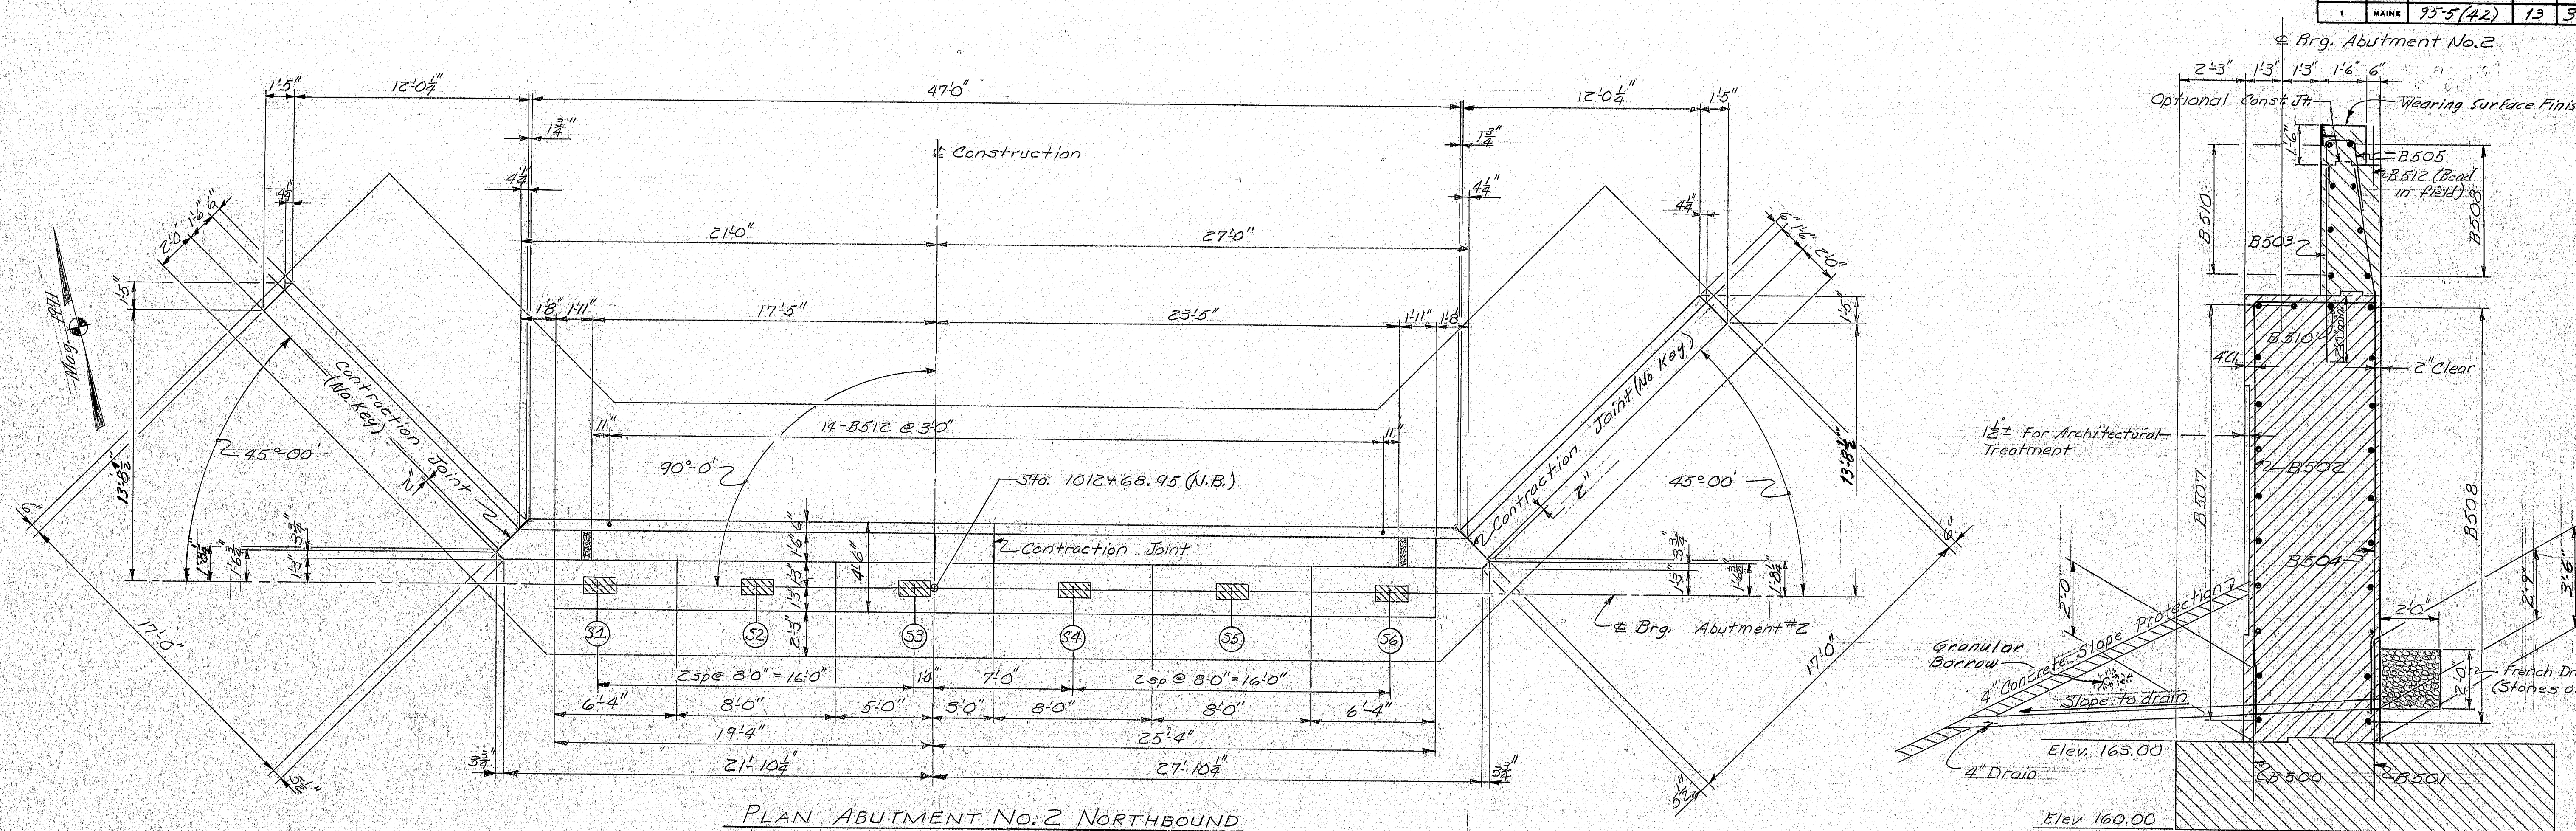

PLAN ABUTMENT No. 2 NORTHBOUND

PLAN ABUTMENT No. 2 NORTHBOUND

PLAN ABUTMENT NO. 2 NORTHBOUND


[illegible]

PLAN ABUTMENT NO. 2 NORTHBOUND


[illegible]

PLAN ABUTMENT NO. 2 NORTHBOUND


F.H.W.A. REG. NO.	STATE	PROJECT NUMBER	SHEET NO.	TOTAL SHEETS
1	MAINE	95-5(42)	14	31

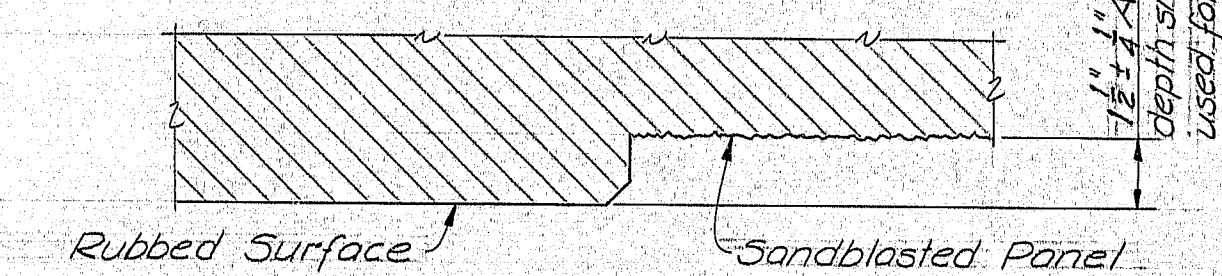

TYPICAL PLAN SECTION

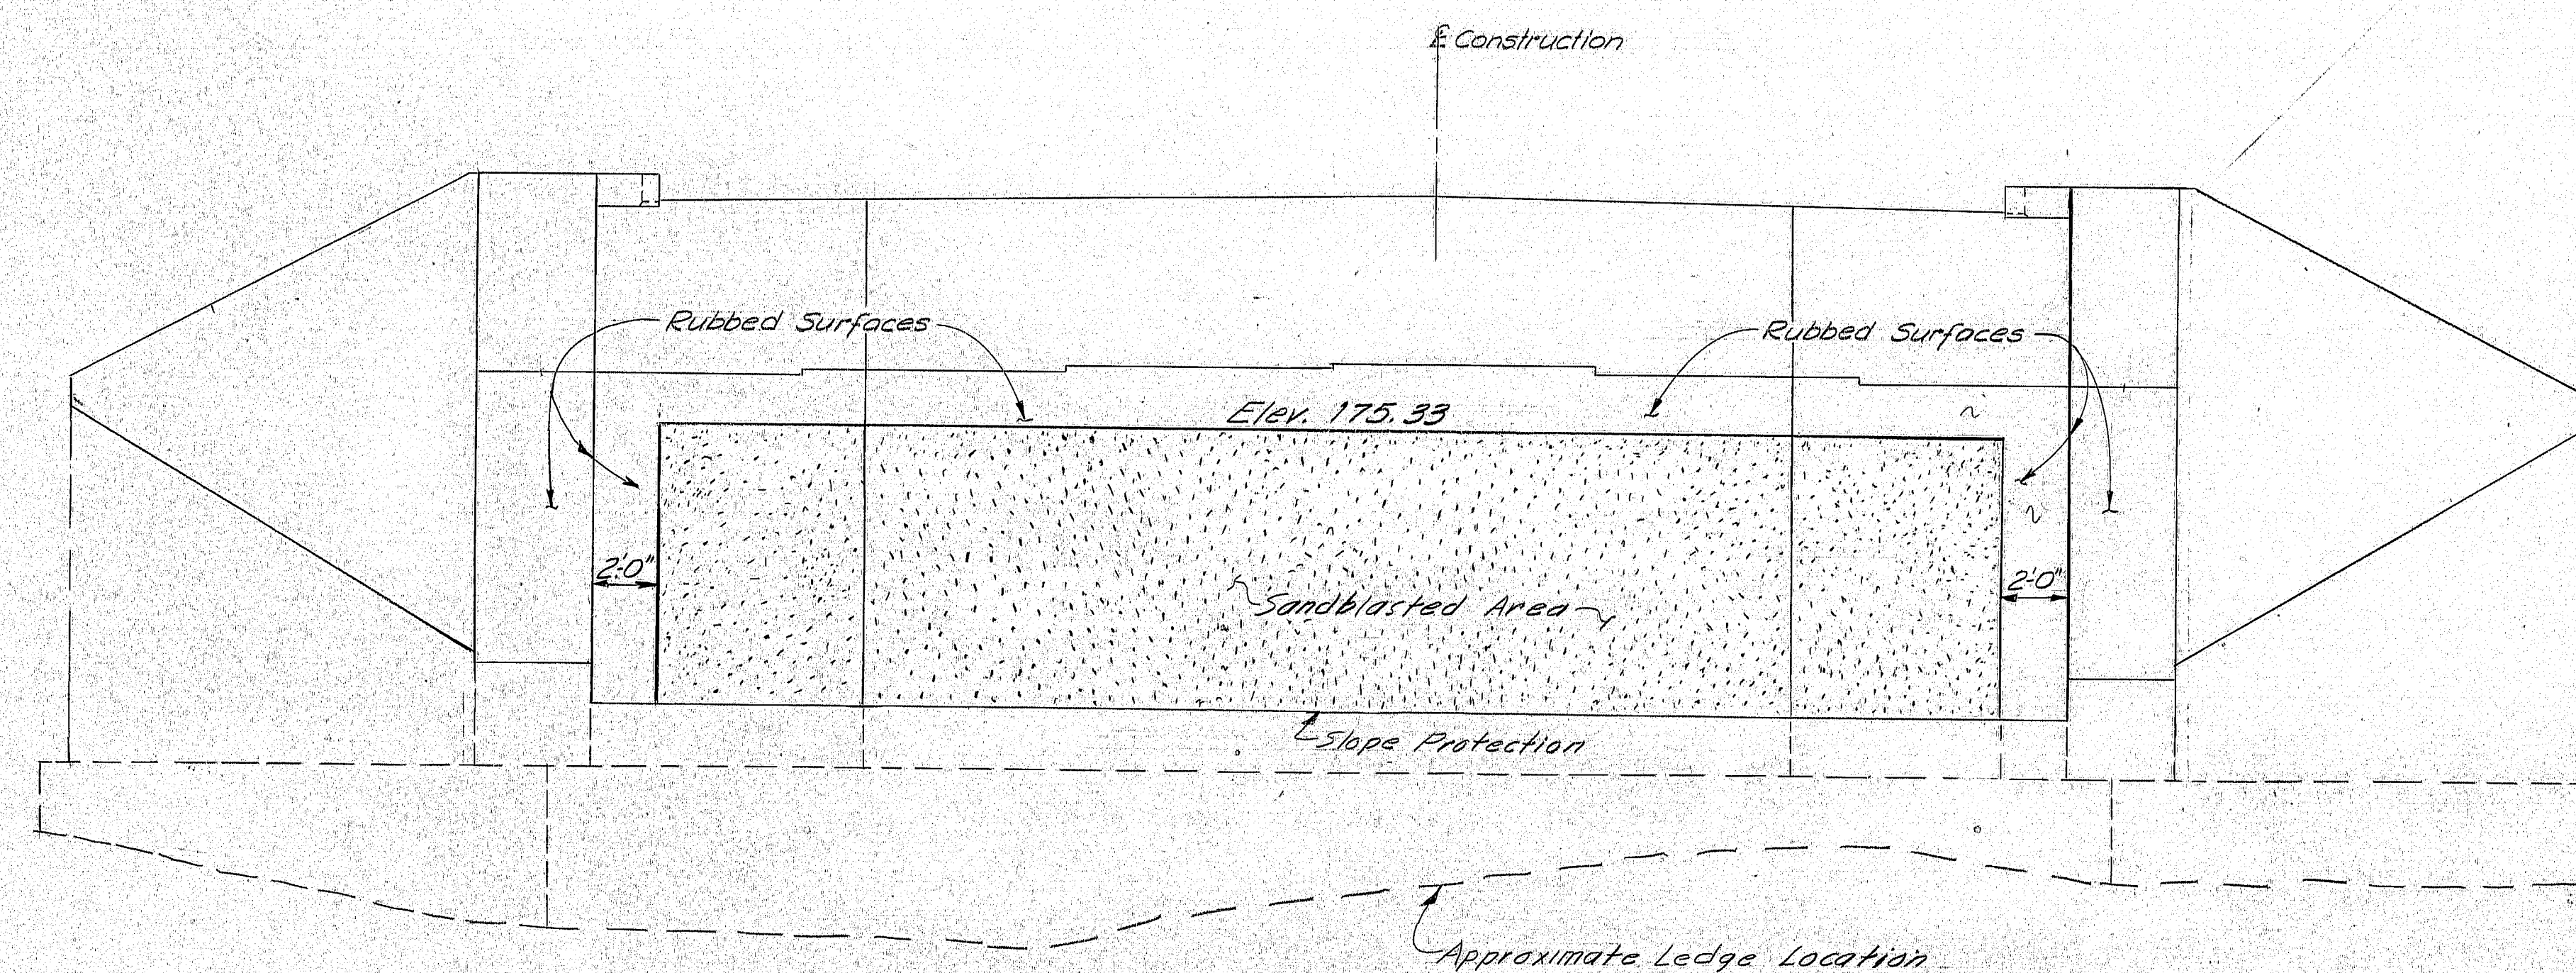

ABUTMENT #2 SOUTHBOUND

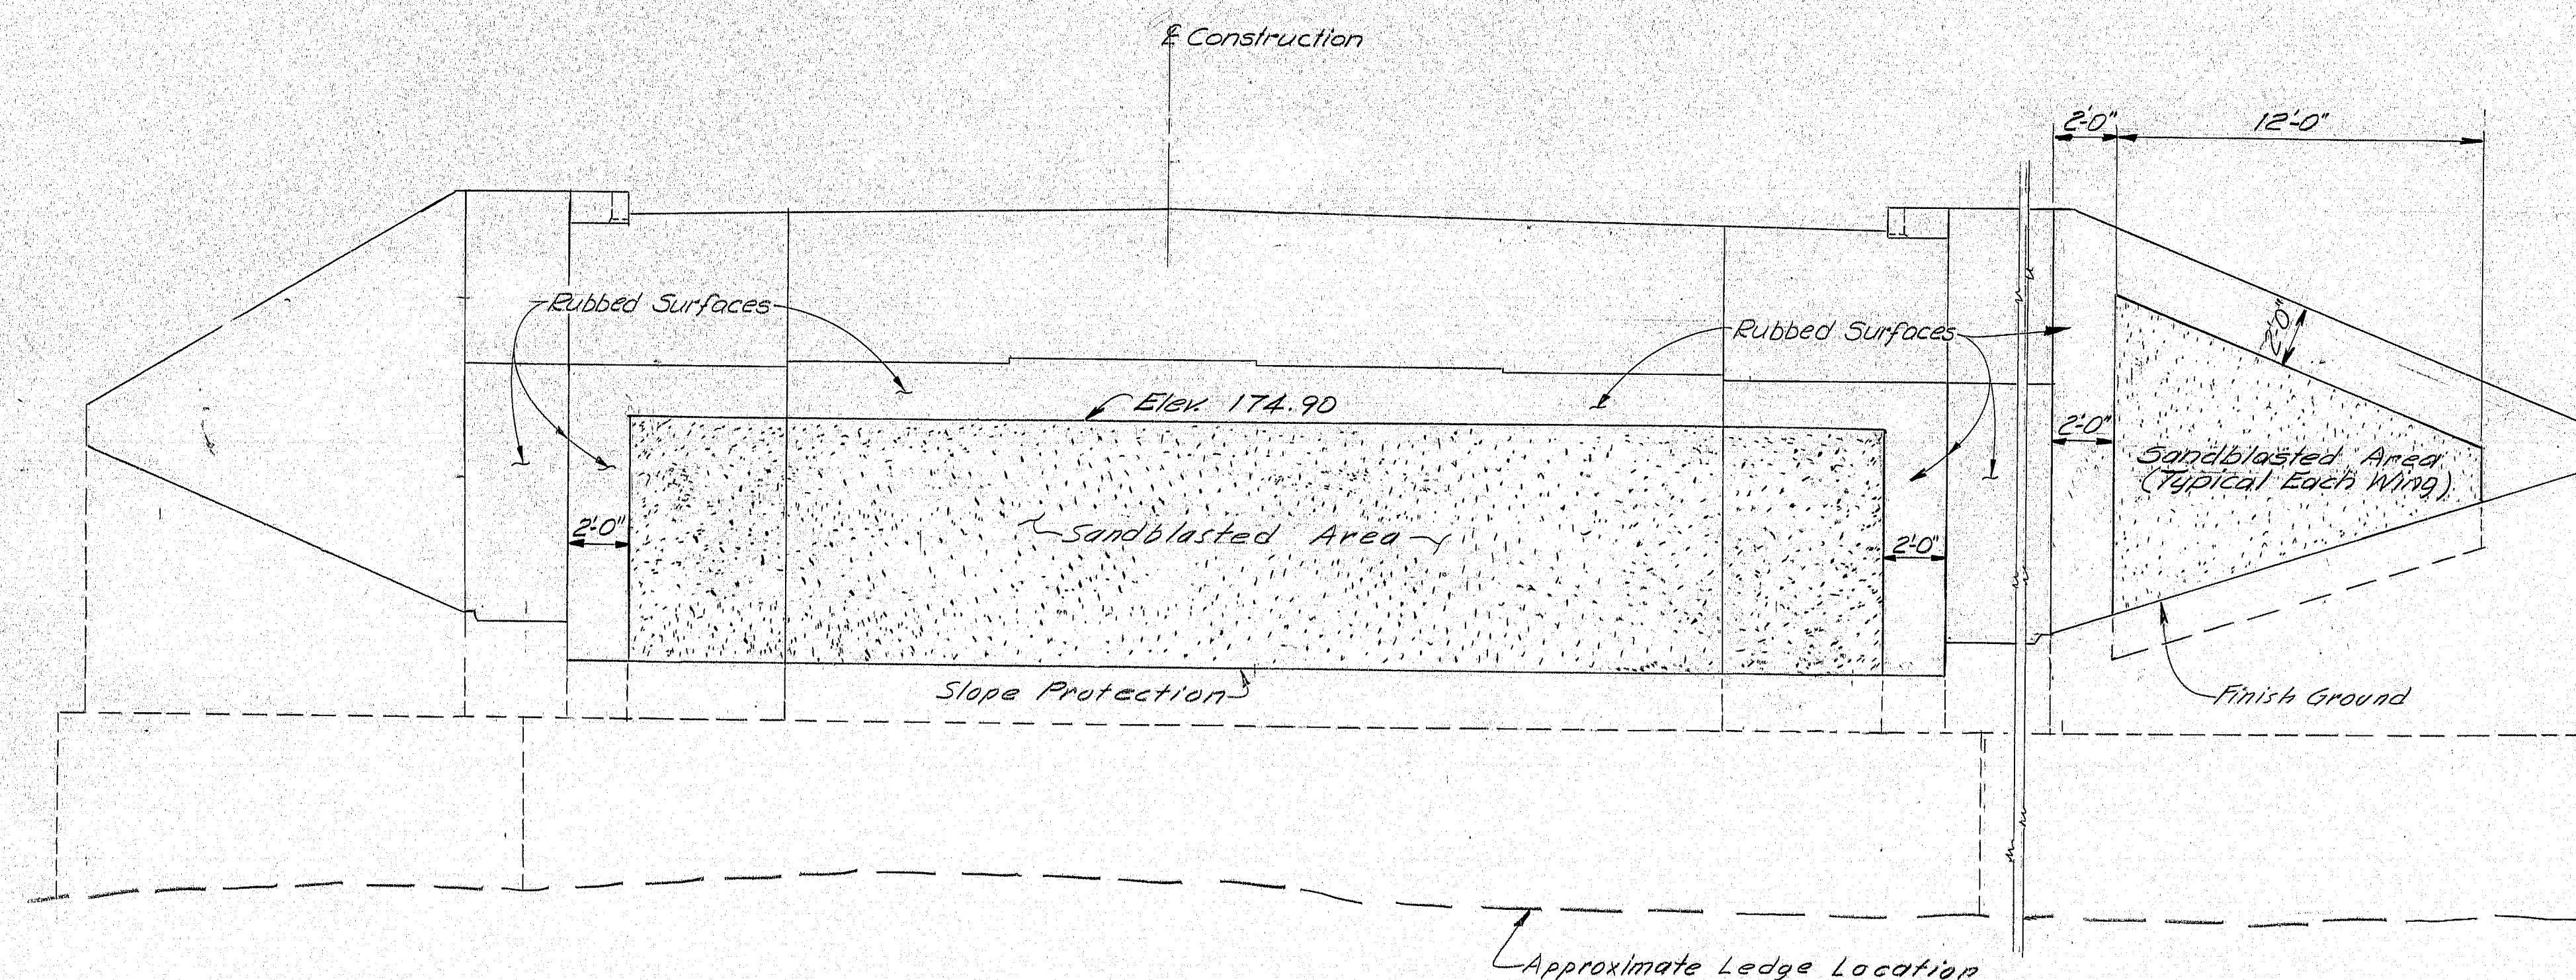

ABUTMENT #1 SOUTHBOUND

GENERAL NOTES

All surfaces so designated on the plans shall be sandblasted. These surfaces shall be carried to a minimum depth of 18 inches below finished ground unless otherwise specified.

Special care shall be exercised so that form joints at the exposed face of concrete shall be tight.

Before sandblasting, all fins and projections in the concrete shall be removed and all holes patched to create a surface of uniform texture.

In order to insure a consistent surface texture for the areas to be architecturally treated, concrete aggregate shall be from the same source and portland cement shall be from the same manufacturer throughout the entire placement of the abutment wings and breast walls.

At the time the concrete is placed, the contractor shall cast 3 sample slabs (2' x 2' x 4').

Prior to sandblasting, the samples shall be sandblasted, each to a different degree of penetration with a maximum depth of 1/8 inch approximately, and under the direction of the Engineer. The most desirable sample will be chosen by the Engineer, and the designated areas shall be sandblasted to match this sample.

Concrete shall not be sandblasted for at least 28 days after placement.

The contractor shall take the necessary steps to protect nearby materials and equipment from damage by the sandblasting operation. Personnel shall be properly equipped: sandblast hood for the operator, and respirator and goggles for all other personnel exposed to dust.

The contractor shall conform to any applicable safety specifications, such as O.S.H.A. in the sandblasting operation.

Payment for sandblasting will be included in the contract unit price for Item 502.21, "Structural Concrete Abutments and Retaining Walls."

No deduction in the concrete pay volume will be made for the recess in the architectural treatment.

PROJECT DESIGN ENGINEER	BY	DATE
DESIGN - DETAIL	607	3-5-72
CHECKED	10/1	3-72
REVISIONS		
FIELD CHANGES		

PLANS

STATE OF MAINE
DEPARTMENT OF TRANSPORTATION

INTERSTATE 95
OVER

ROUTE 138
IN THE TOWN OF

BOWDOINHAM
SAGadahoc COUNTY

ARCHITECTURAL TREATMENT SB

SHEET 14 OF 31 AUGUSTA, MAINE March 1975

172-86

F.H.W.A. REG. NO.	STATE	PROJECT NUMBER	SHEET NO.	TOTAL SHEETS
1	MAINE	95-5(42)	15	31

GENERAL NOTES

All surfaces so designated on the plans shall be sandblasted. These surfaces shall be carried to a minimum depth of 18 inches below finished ground.

Special care shall be exercised so that form joints at the exposed face of concrete shall be tight.

Before sandblasting, all fins and projections in the concrete shall be removed and all holes patched to create a surface of uniform texture.

In order to insure a consistent surface texture for the areas to be architecturally treated, concrete aggregate shall be from the same source and portland cement shall be from the same manufacturer throughout the entire placement of the abutment wings and breastwalls.

At the time the concrete is placed, the contractor shall cast 3 sample slabs (2' x 2' x 4').

Prior to sandblasting, the samples shall be sandblasted, each to a different degree of penetration with a maximum depth of 1/8 inch approximately, and under the direction of the Engineer. The most desirable sample will be chosen by the Engineer, and the designated areas shall be sandblasted to match this sample.


Concrete shall not be sandblasted for at least 28 days after placement.

The contractor shall take the necessary steps to protect nearby materials and equipment from damage by the sandblasting operation. Personnel shall be properly equipped with sandblast hood, respirator and goggles for all other personnel exposed to dust.


The contractor shall conform to any applicable safety specifications, such as O.S.H.A. in the sandblasting operation.

Payment for sandblasting will be included in the contract unit price for Item 502.26, Structural Concrete Abutments and Retaining Walls.


No deduction in the concrete pay volume will be made for the recess in the architectural treatment.

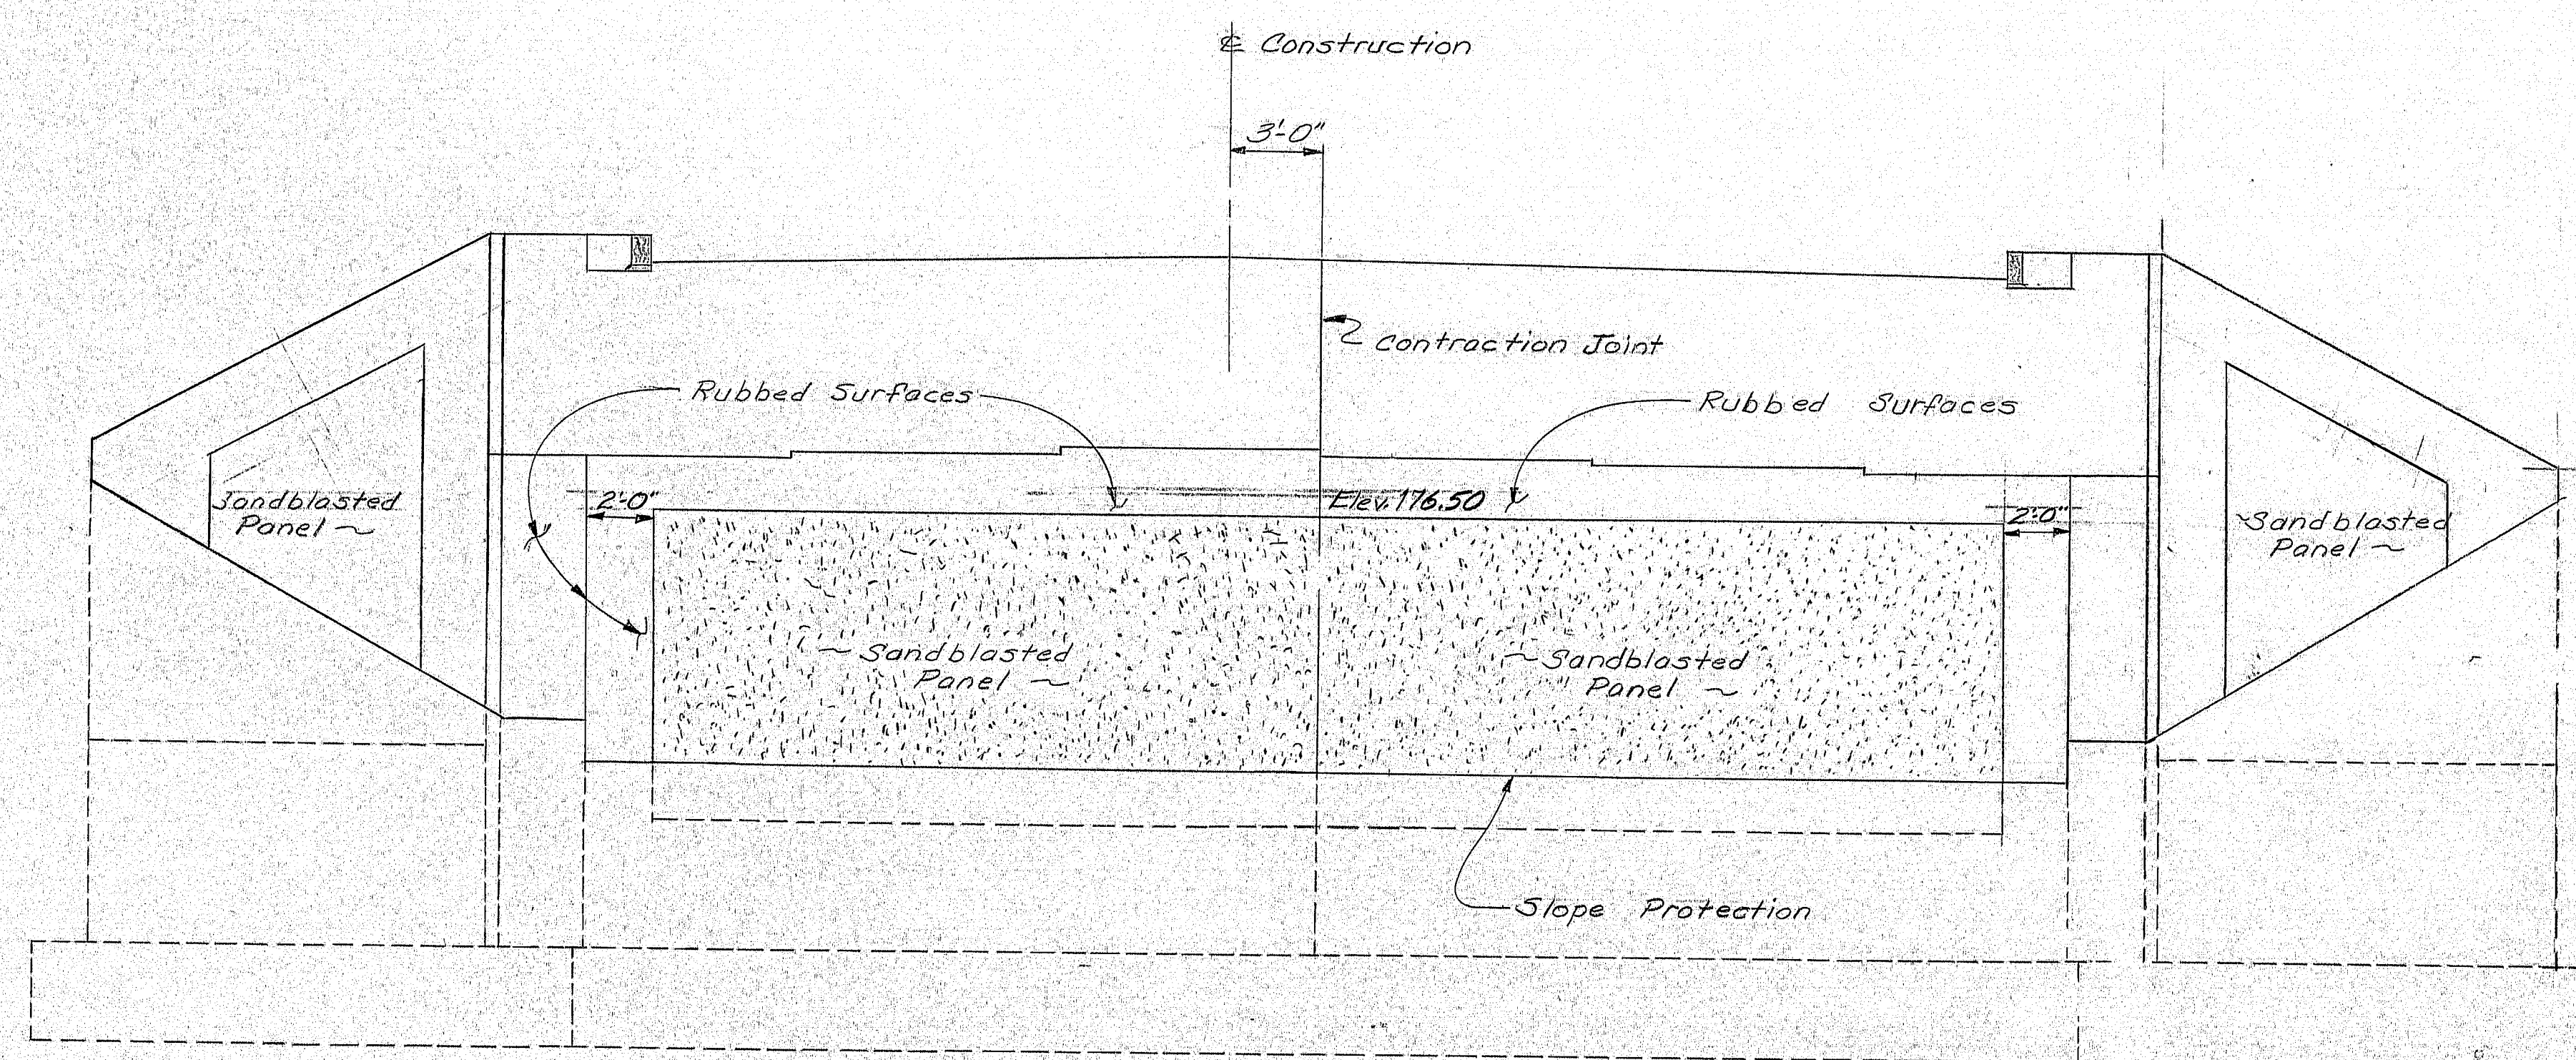

ELEVATION ABUTMENT No. 2 N.B.

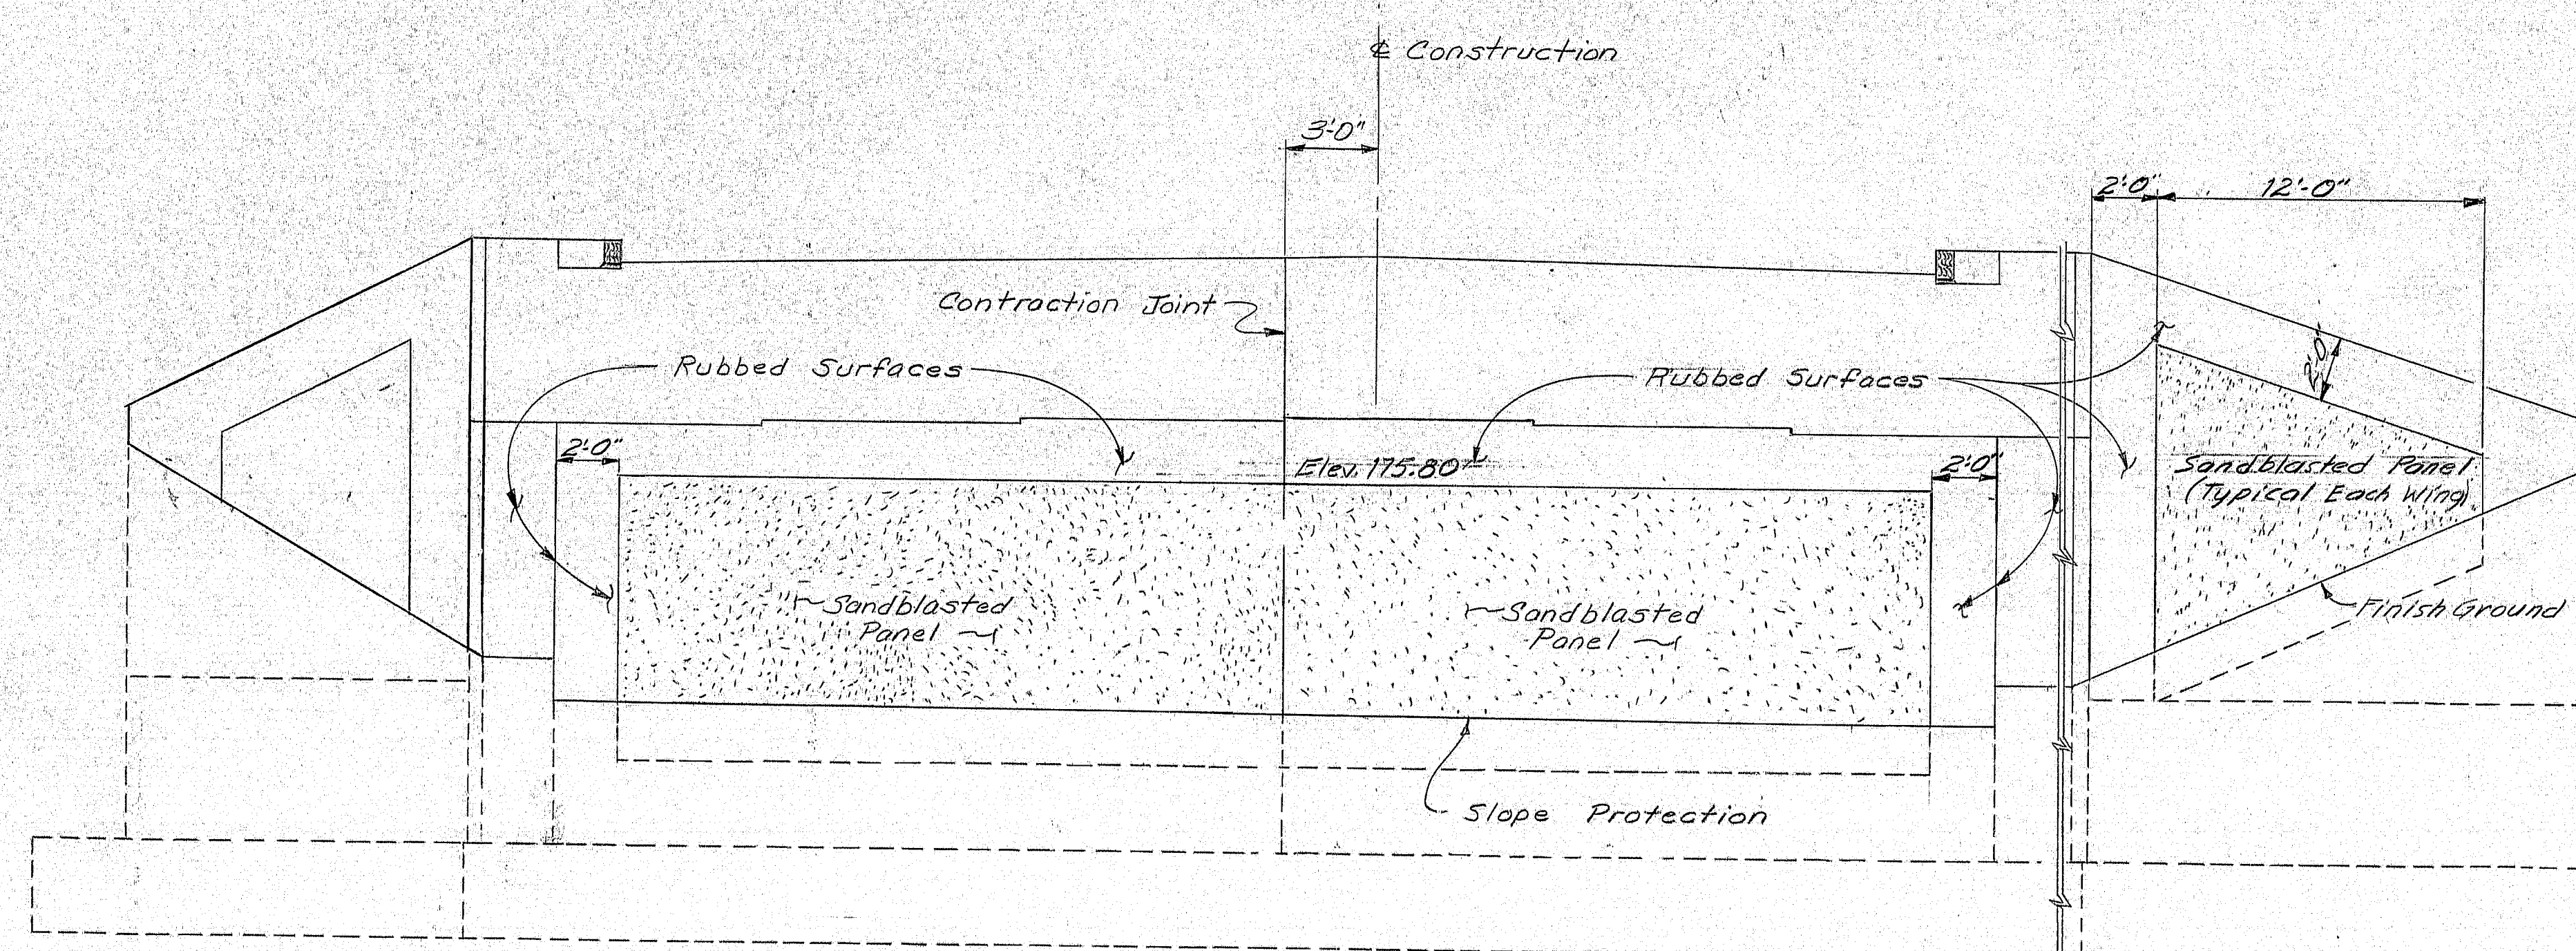

ELEVATION ABUTMENT No. 1 N.B.

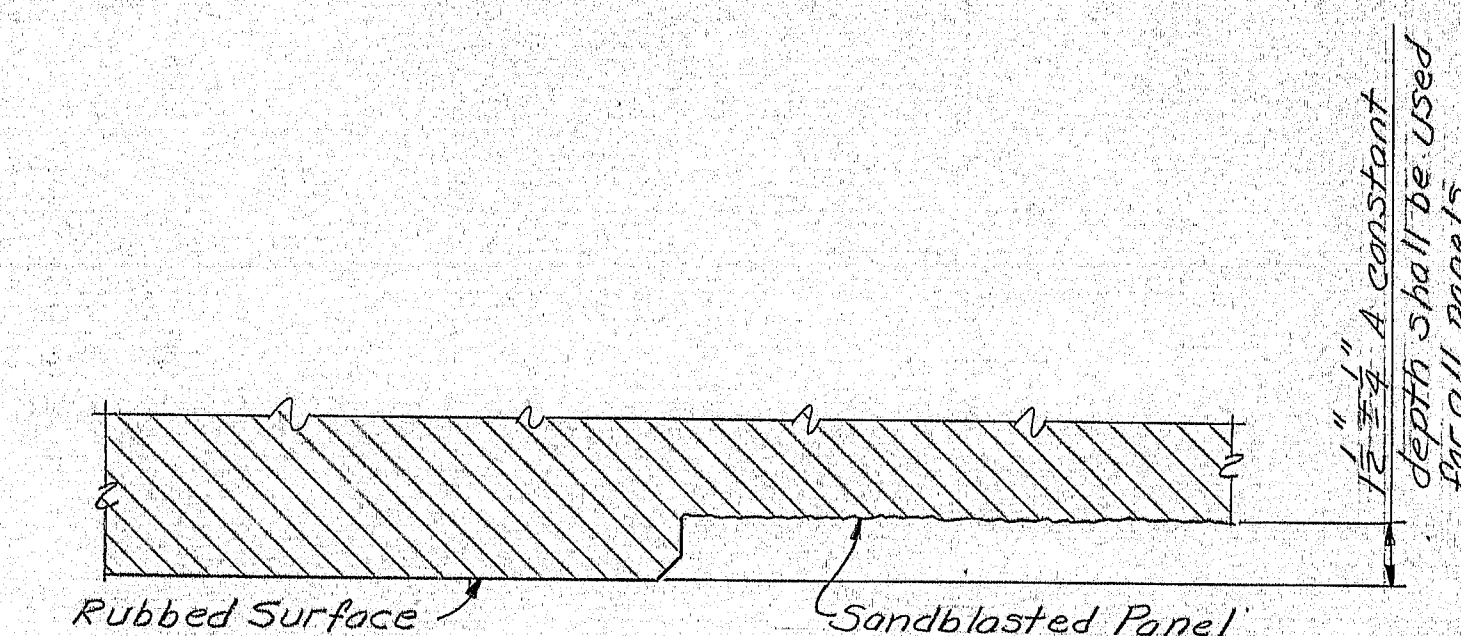


TYPICAL PLAN SECTION

PROJECT DESIGN ENGINEER	BY	DATE
DESIGN - DETAIL	GO. F. F. F.	2-28-78
CHECKED	FOR	3-7-78
FIELD CHANGES		

STATE OF MAINE DEPARTMENT OF TRANSPORTATION
INTERSTATE 95 OVER ROUTE 138 IN THE TOWN OF BOWDOINHAM SAGadahoc COUNTY ARCHITECTURAL TREATMENT NB
SHEET 15 OF 31 AUGUSTA, MAINE March 1978

172-87

F.R.W.A. RES. NO.	STATE	PROJECT NUMBER	SHEET NO.	TOTAL SHEETS
1	MAINE	95-5(42)	16	31

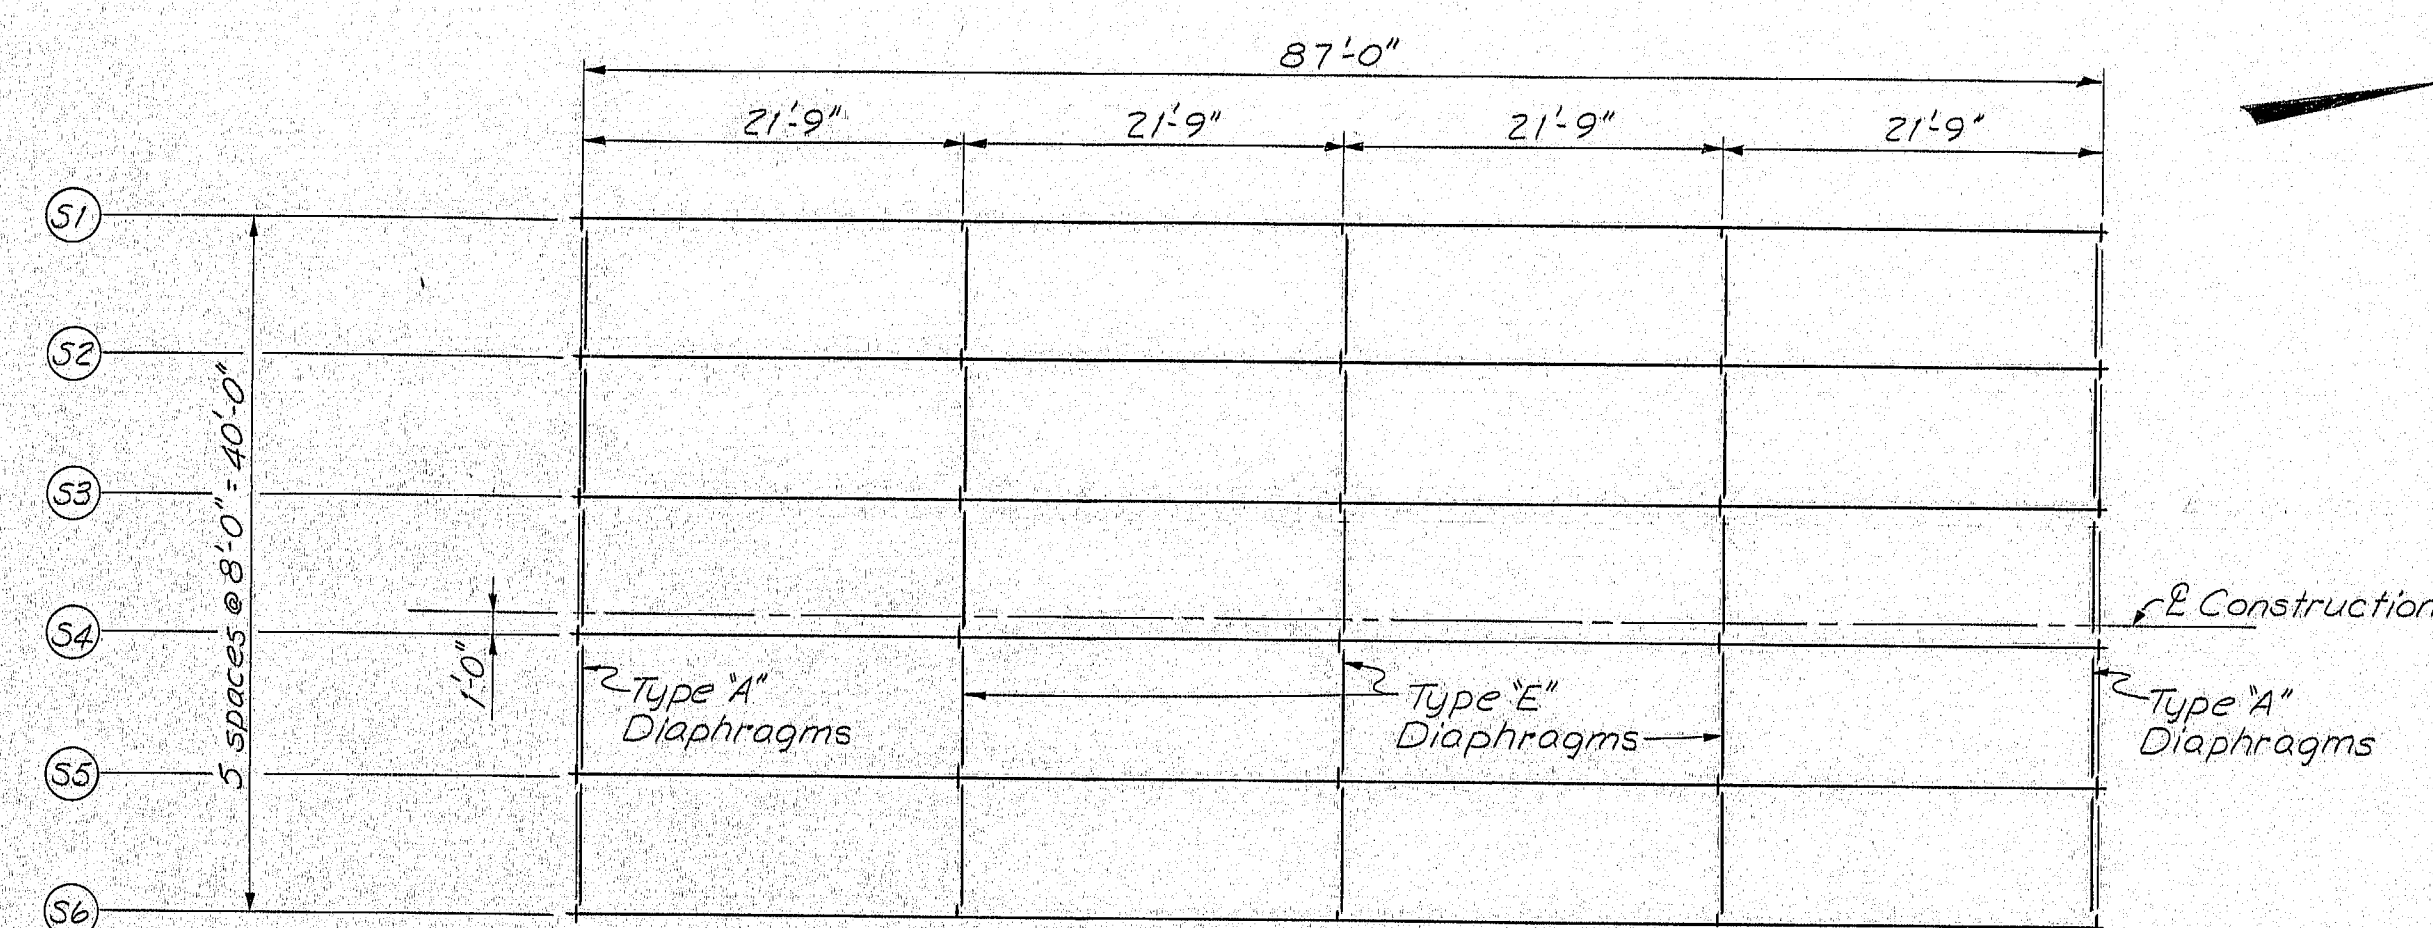


E Brg. Abut. #1 - Sta. 1010+59.28

Abut. #1 - EPC-2 (Fixed) (Modified)*
For Bearing Pedestal Details see
Standard Detail Sheet BD 101-74 sheet #25


E Brg. Abut. #2 - Sta. 1011+46.28

Abut. #2 - EPC-3 (Expansion)
For Bearing Pedestal Details see
Standard Detail Sheet BD 101-74 sheet #25


FRAMING PLAN
(all dimensions are horizontal)

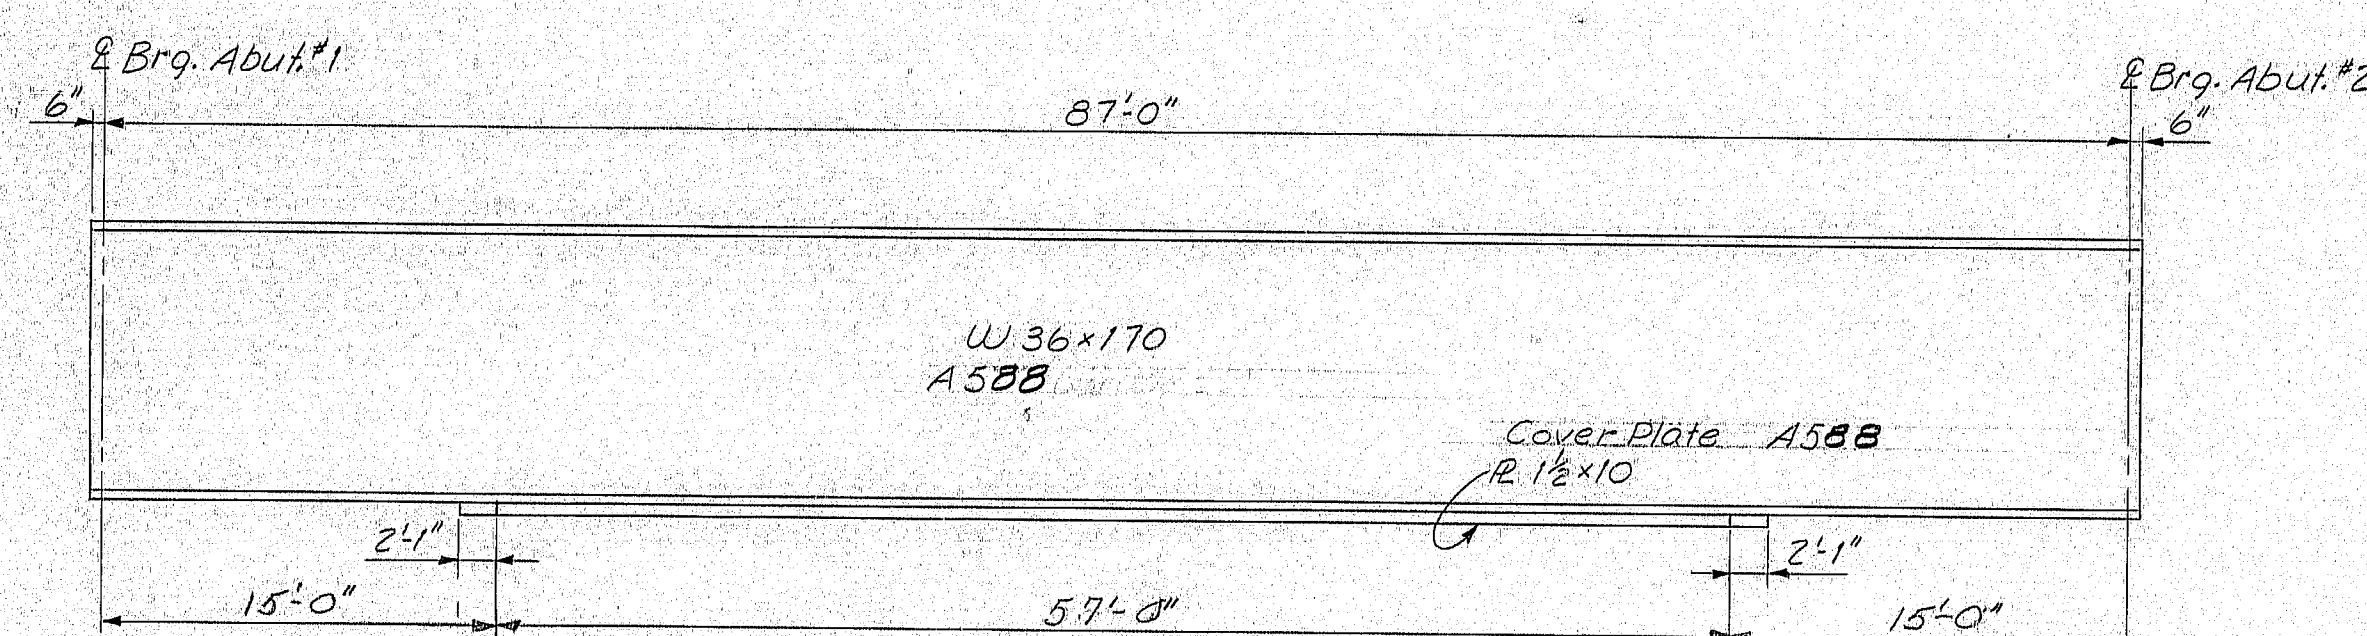


TYPICAL BEAM DETAIL
Note: Camber all beams

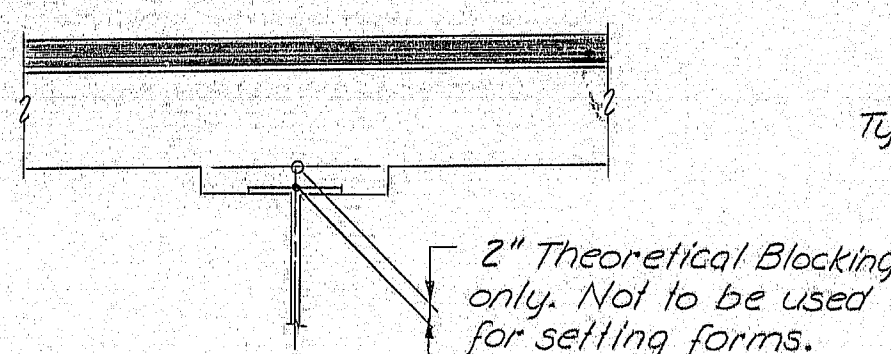


BLOCKING DIAGRAM

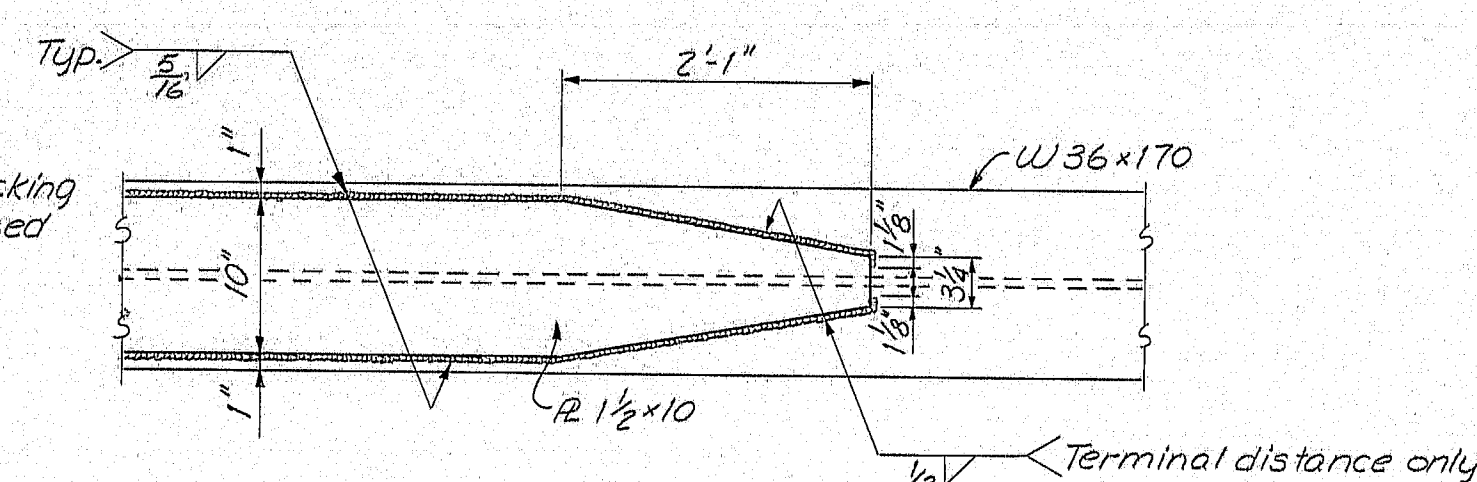


COVER PLATE DETAIL

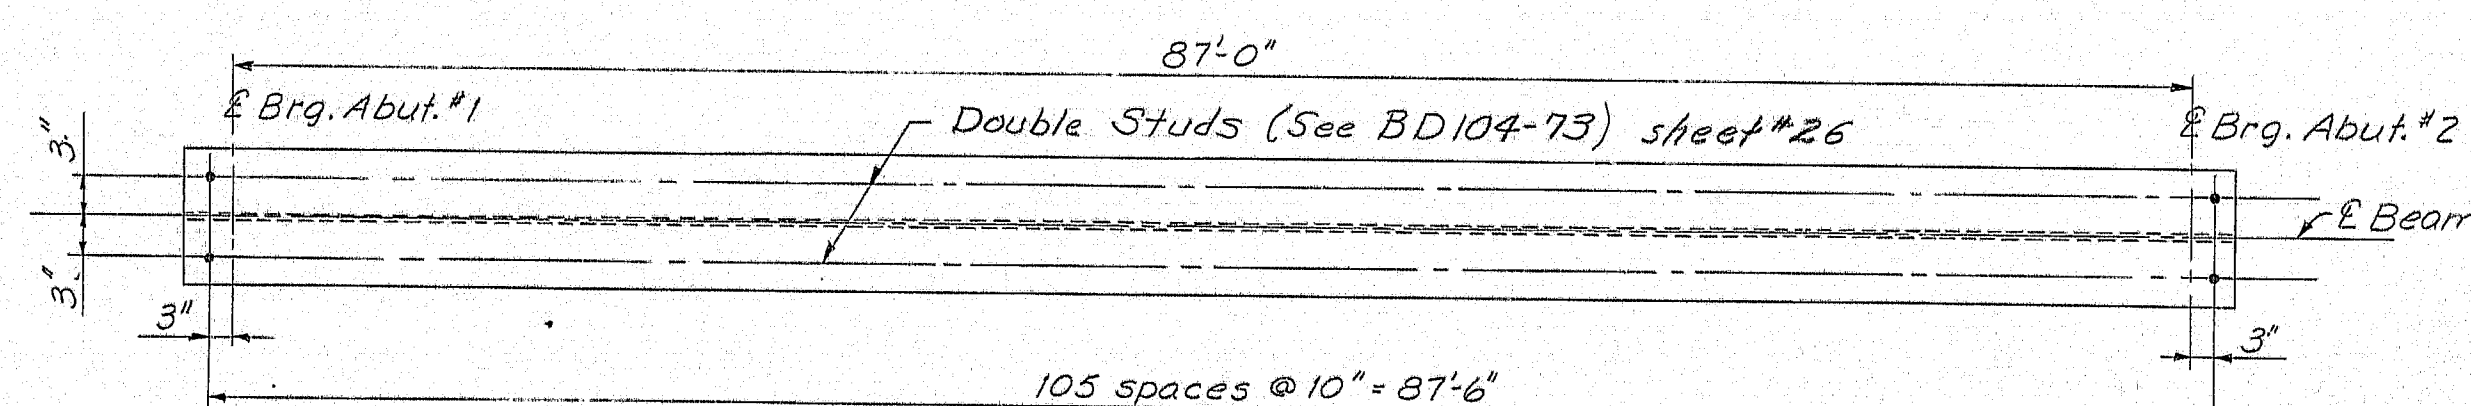


SHEAR CONNECTOR LAYOUT
212 studs per beam - 1272 studs total

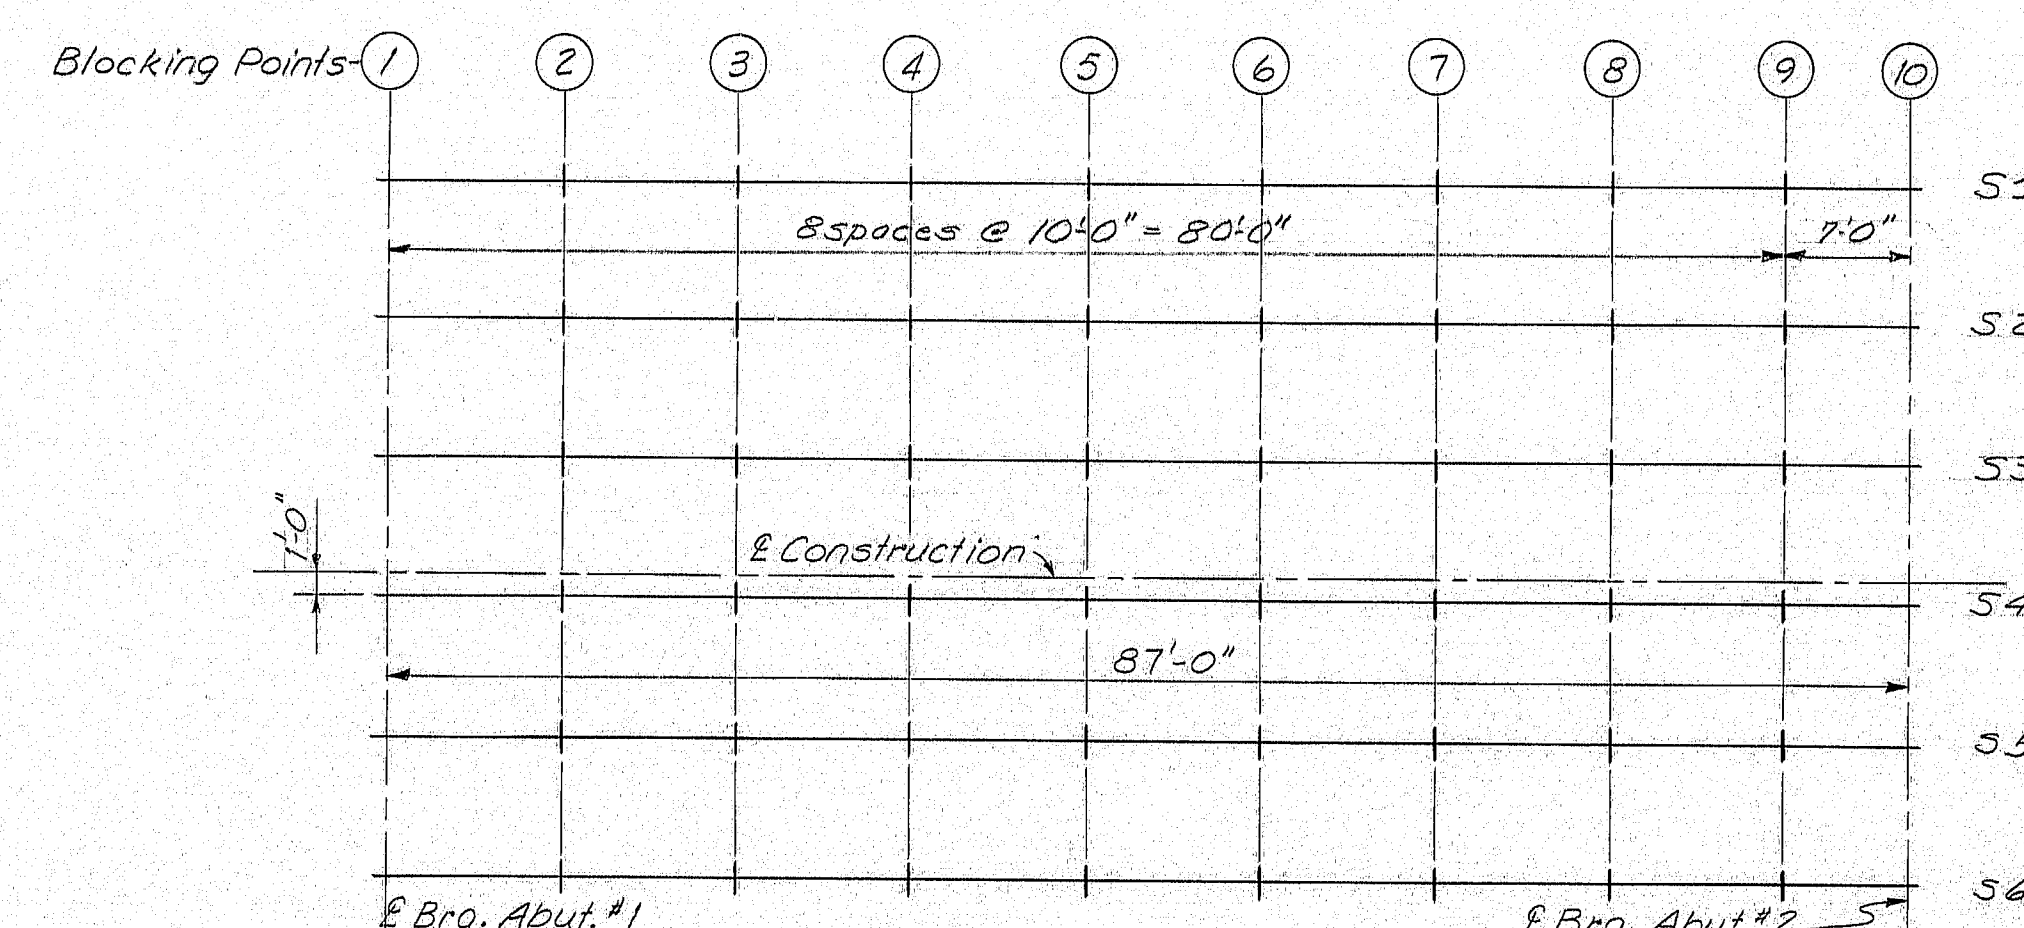

BLOCKING LAYOUT
(all dimensions are horizontal)

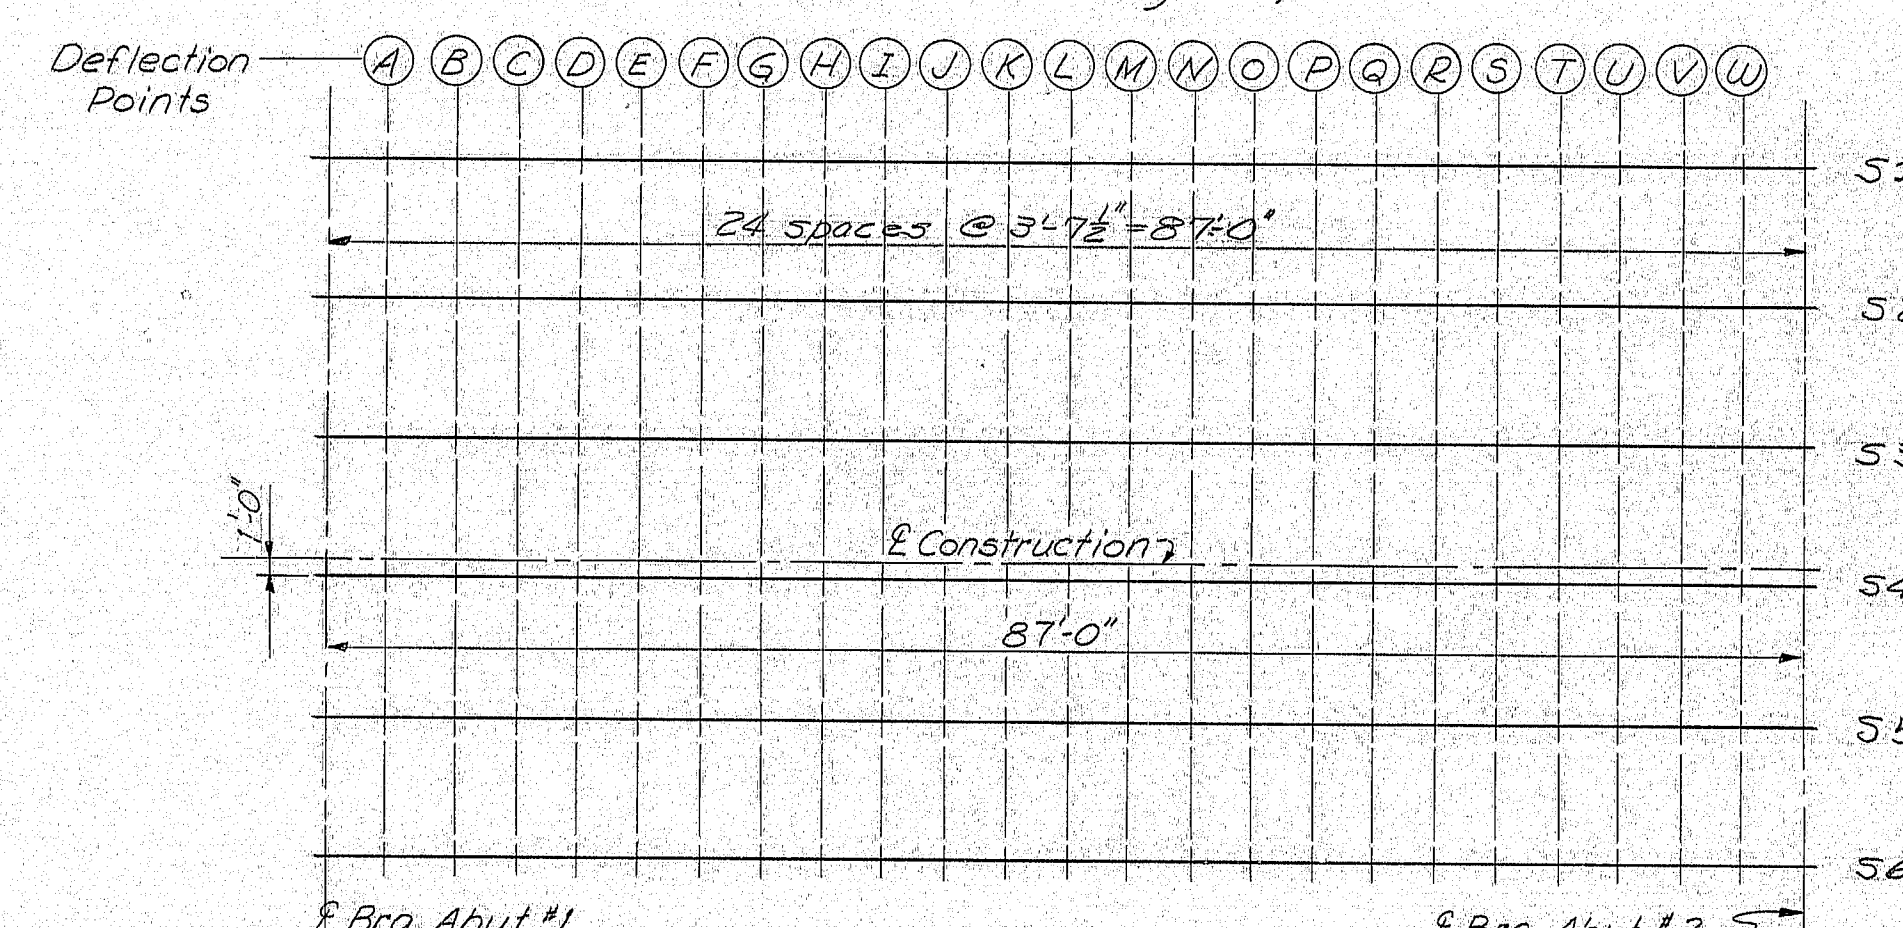

DEAD LOAD DEFLECTION LAYOUT
(all dimensions are horizontal)

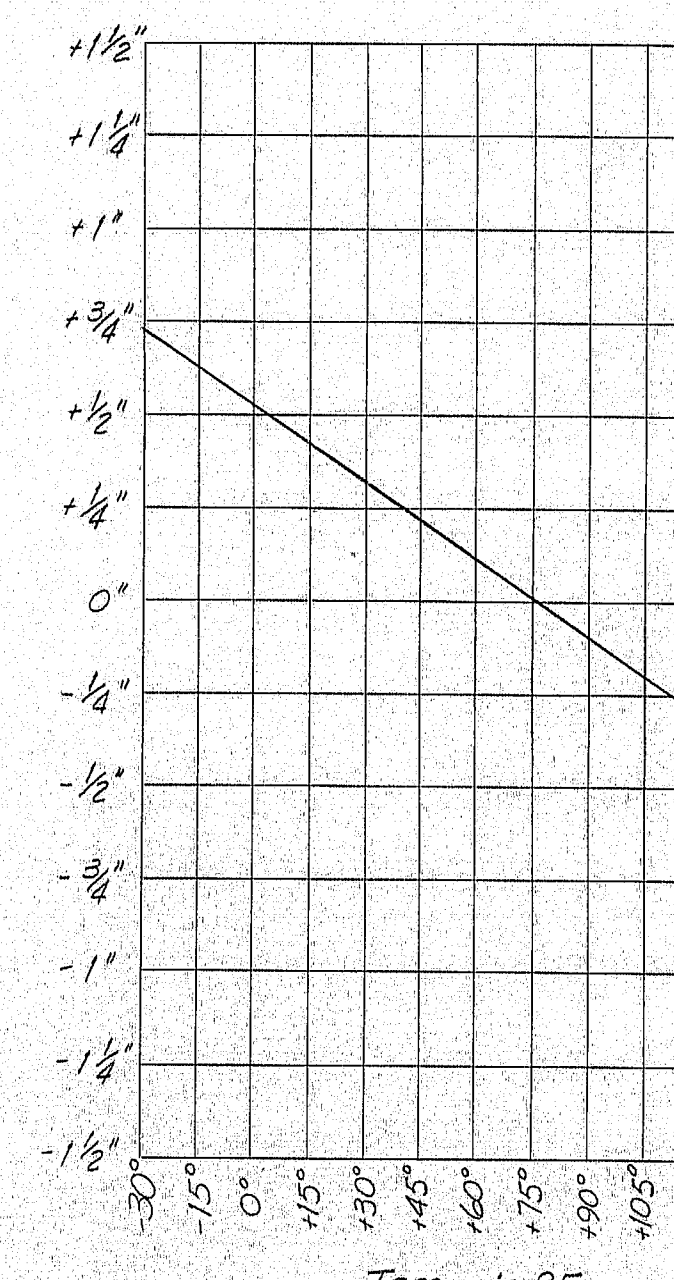

ROCKER BEARING SETTING GRAPH
This table of bearing settings compensates for longitudinal movement due to temperature change and dead load deflection, due to slab and wearing surface.

DEAD LOAD DEFLECTIONS IN FEET																									
Points	Abut. #1	A	B	C	D	E	F	G	H	I	J	K	L	M	N	O	P	Q	R	S	T	U	V	W	Abut. #2
Superimp.	0.000	0.001	0.014	0.020	0.026	0.031	0.036	0.040	0.044	0.046	0.048	0.050	0.050	0.050	0.048	0.046	0.044	0.040	0.036	0.031	0.026	0.020	0.014	0.007	0.000
Steel	0.000	0.008	0.016	0.024	0.031	0.037	0.043	0.047	0.052	0.055	0.057	0.059	0.059	0.059	0.057	0.055	0.052	0.047	0.043	0.037	0.031	0.024	0.016	0.008	0.000
Fluid	0.000	0.033	0.065	0.096	0.124	0.150	0.172	0.192	0.209	0.222	0.231	0.237	0.239	0.237	0.231	0.222	0.209	0.192	0.172	0.150	0.124	0.097	0.065	0.033	0.000


BOTTOM OF SLAB ELEVATIONS											
Span Points	1	2	3	4	5	6	7	8	9	10	Abut. #2
S1	180.46	180.65	180.83	180.97	181.09	181.17	181.22	181.23	181.23	181.21	
S2	180.62	180.82	180.99	181.14	181.26	181.34	181.38	181.40	181.39	181.38	
S3	180.79	180.98	181.16	181.31	181.42	181.50	181.55	181.57	181.56	181.54	
S4	180.91	181.11	181.28	181.43	181.55	181.63	181.68	181.69	181.68	181.67	
S5	180.75	180.94	181.12	181.27	181.38	181.46	181.51	181.53	181.52	181.50	
S6	180.53	180.78	180.95	181.10	181.21	181.30	181.34	181.36	181.35	181.33	

NOTE:
Before taking elevations on the tops of the beams for purposes of setting bottom of slab elevations, the welding of shear connectors to the beams and the diaphragm and cross frame connections to the beams shall have been completed.

NOTE:
Rocker setting data as shown shall be used as a guide only. No extra payment will be made for resetting of the rocker bearings, subsequent to the original setting, made by the contractor as required by the Engineer to make the rocker settings conform with paragraph four (4) of Subsection 304.5B.

NOTES
Bottom of slab elevations are adjusted to compensate for the dead load deflections.

Diaphragm connection plates may be either plumb or normal to the top flange.

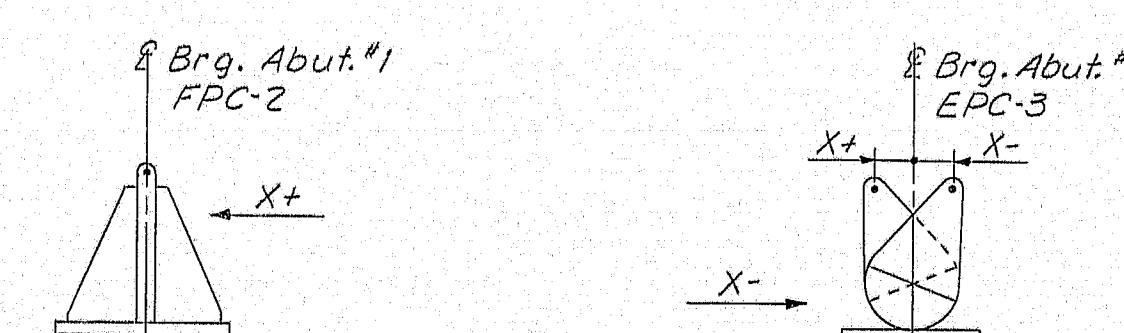

ROCKER BEARING SETTING DIAGRAM


STATE OF MAINE
DEPARTMENT OF TRANSPORTATION

INTERSTATE 95
OVER
ROUTE 138
IN THE TOWN OF
BOWDOINHAM
SAGadahoc COUNTY
STRUCTURAL STEEL SOUTHBOUND

SHEET 16 OF 31 AUGUSTA, MAINE March 1995

172-88


F.H.W.A. REG. NO.	STATE	PROJECT NUMBER	SHEET NO.	TOTAL SHEETS
1	MAINE	95-5(42)	17	31

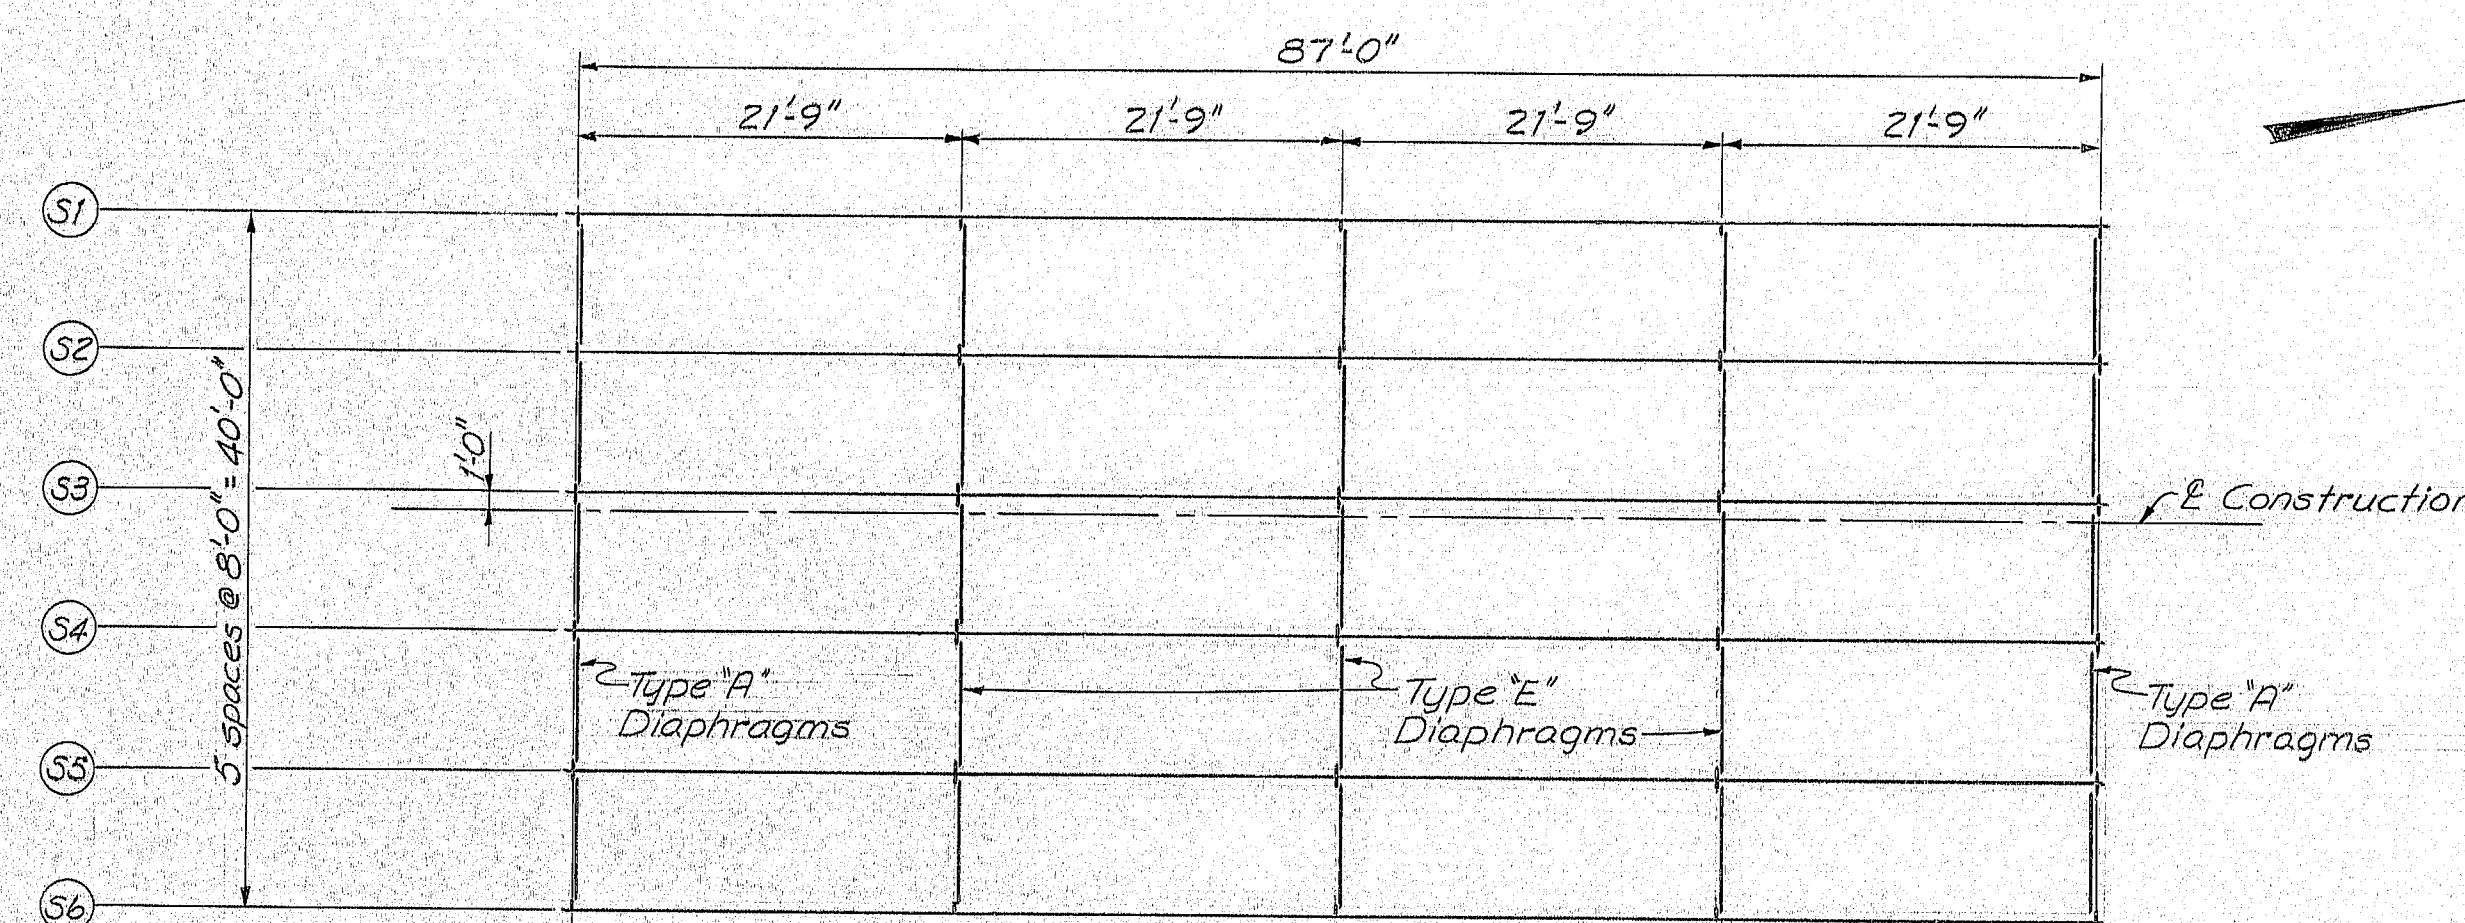


Brig. Abut. #1 - Sta. 1011+81.95
Abut. #1 - FPC-2 (Fixed)
For Bearing Pedestal Details see
Standard Detail Sheet (SD 101-74) sheet #25
* See Note this sheet

FRAMING PLAN
(all dimensions are horizontal)


Brig. Abut. #2 - Sta. 1012+68.95
Abut. #2 - EPC-3 (Expansion)
For Bearing Pedestal Details see
Standard Detail Sheet (SD 101-74) sheet #25
* See Note this sheet

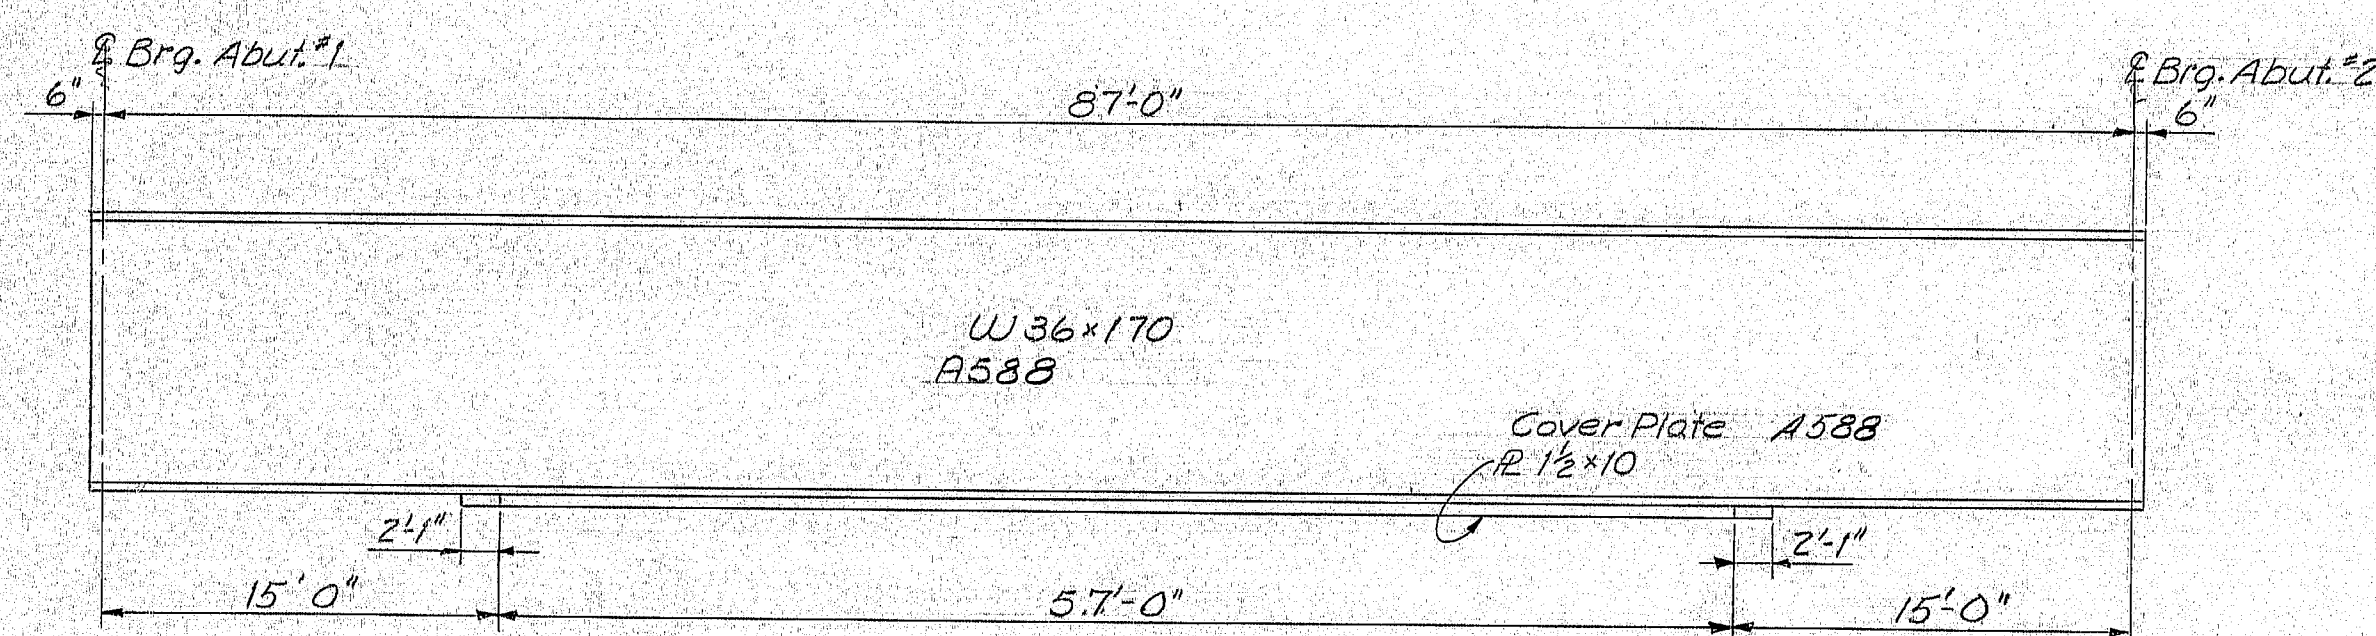


TYPICAL BEAM DETAIL
Note: Camber all beams

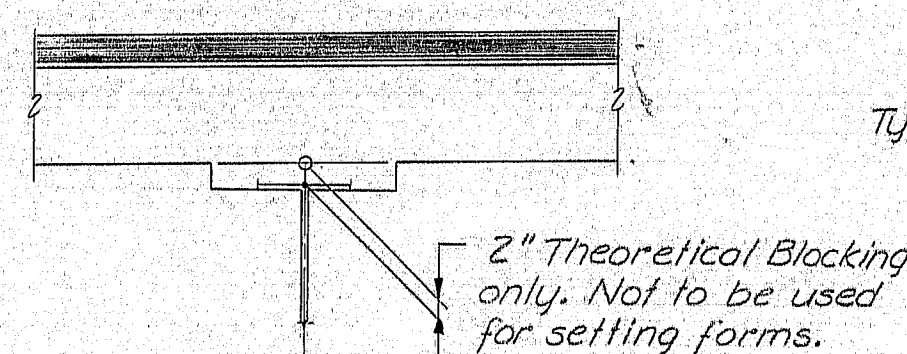



BLOCKING DIAGRAM

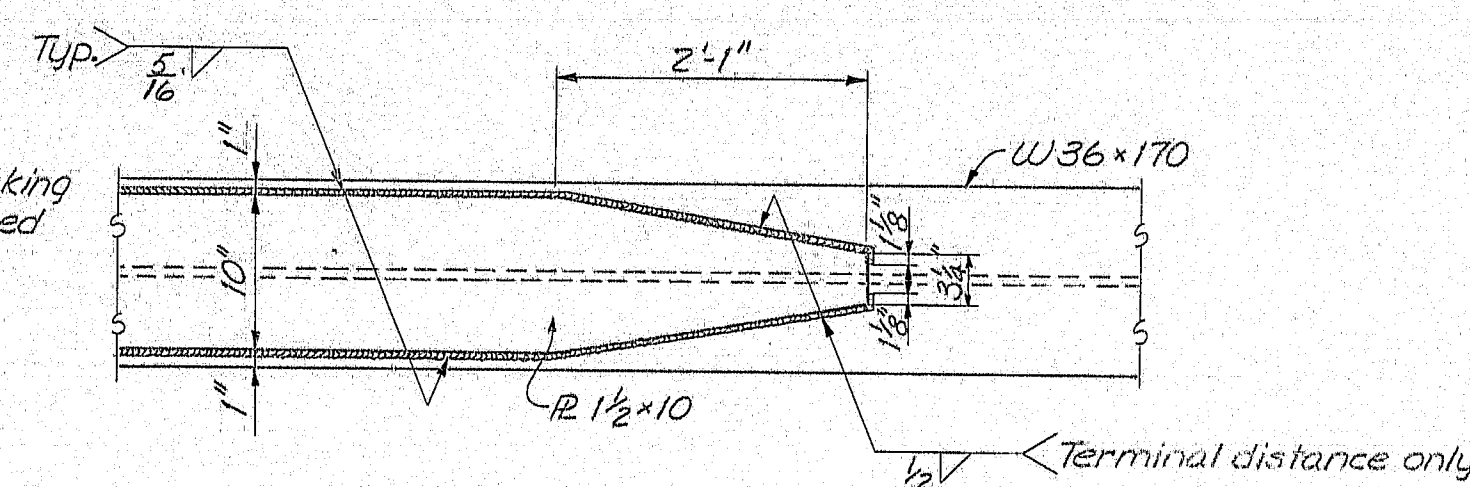

COVER PLATE DETAIL

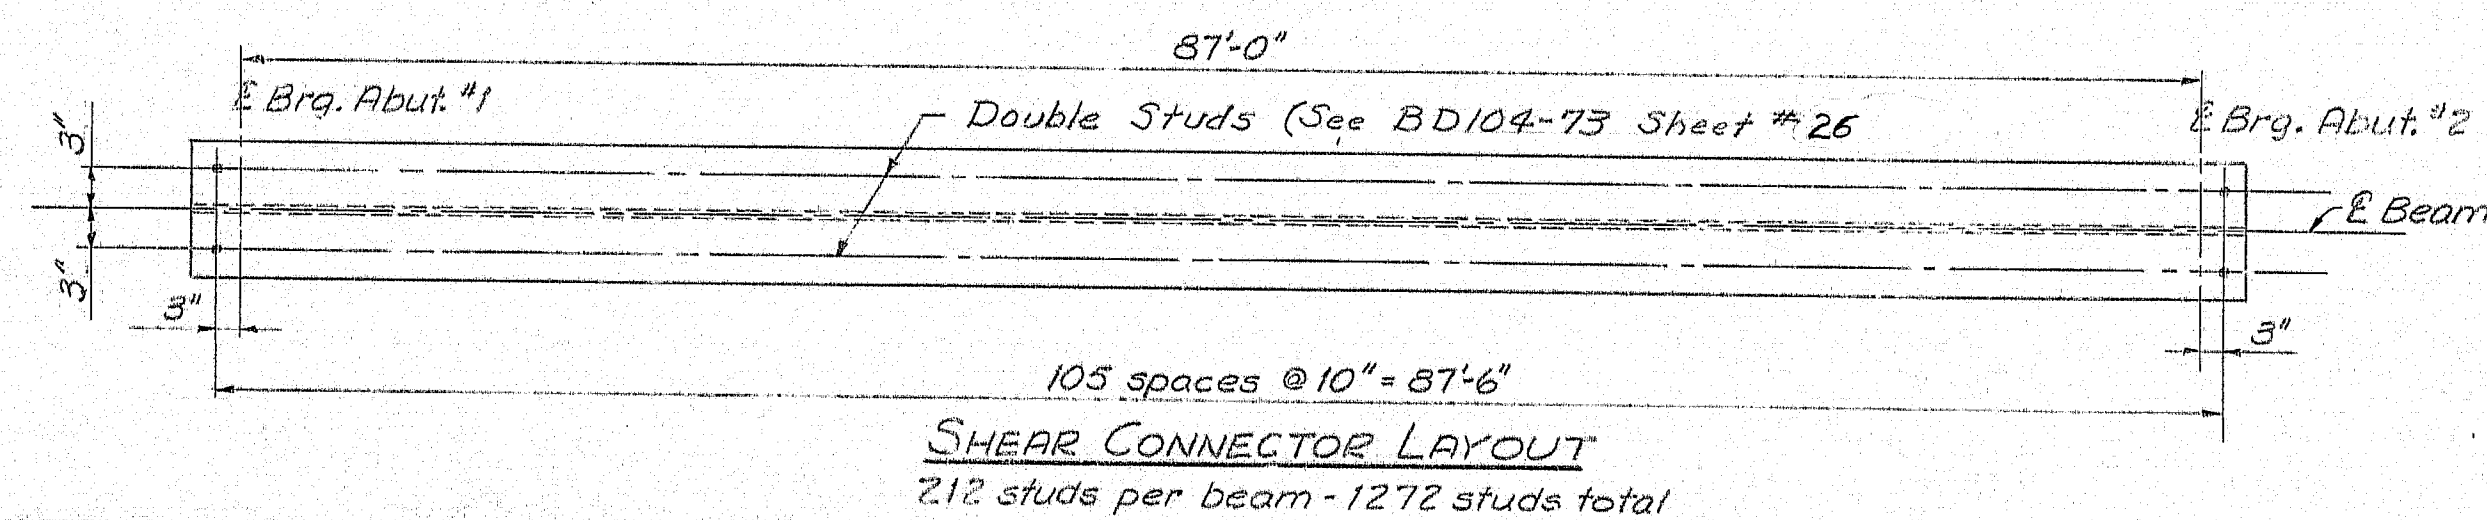


SHEAR CONNECTOR LAYOUT
212 studs per beam - 1272 studs total

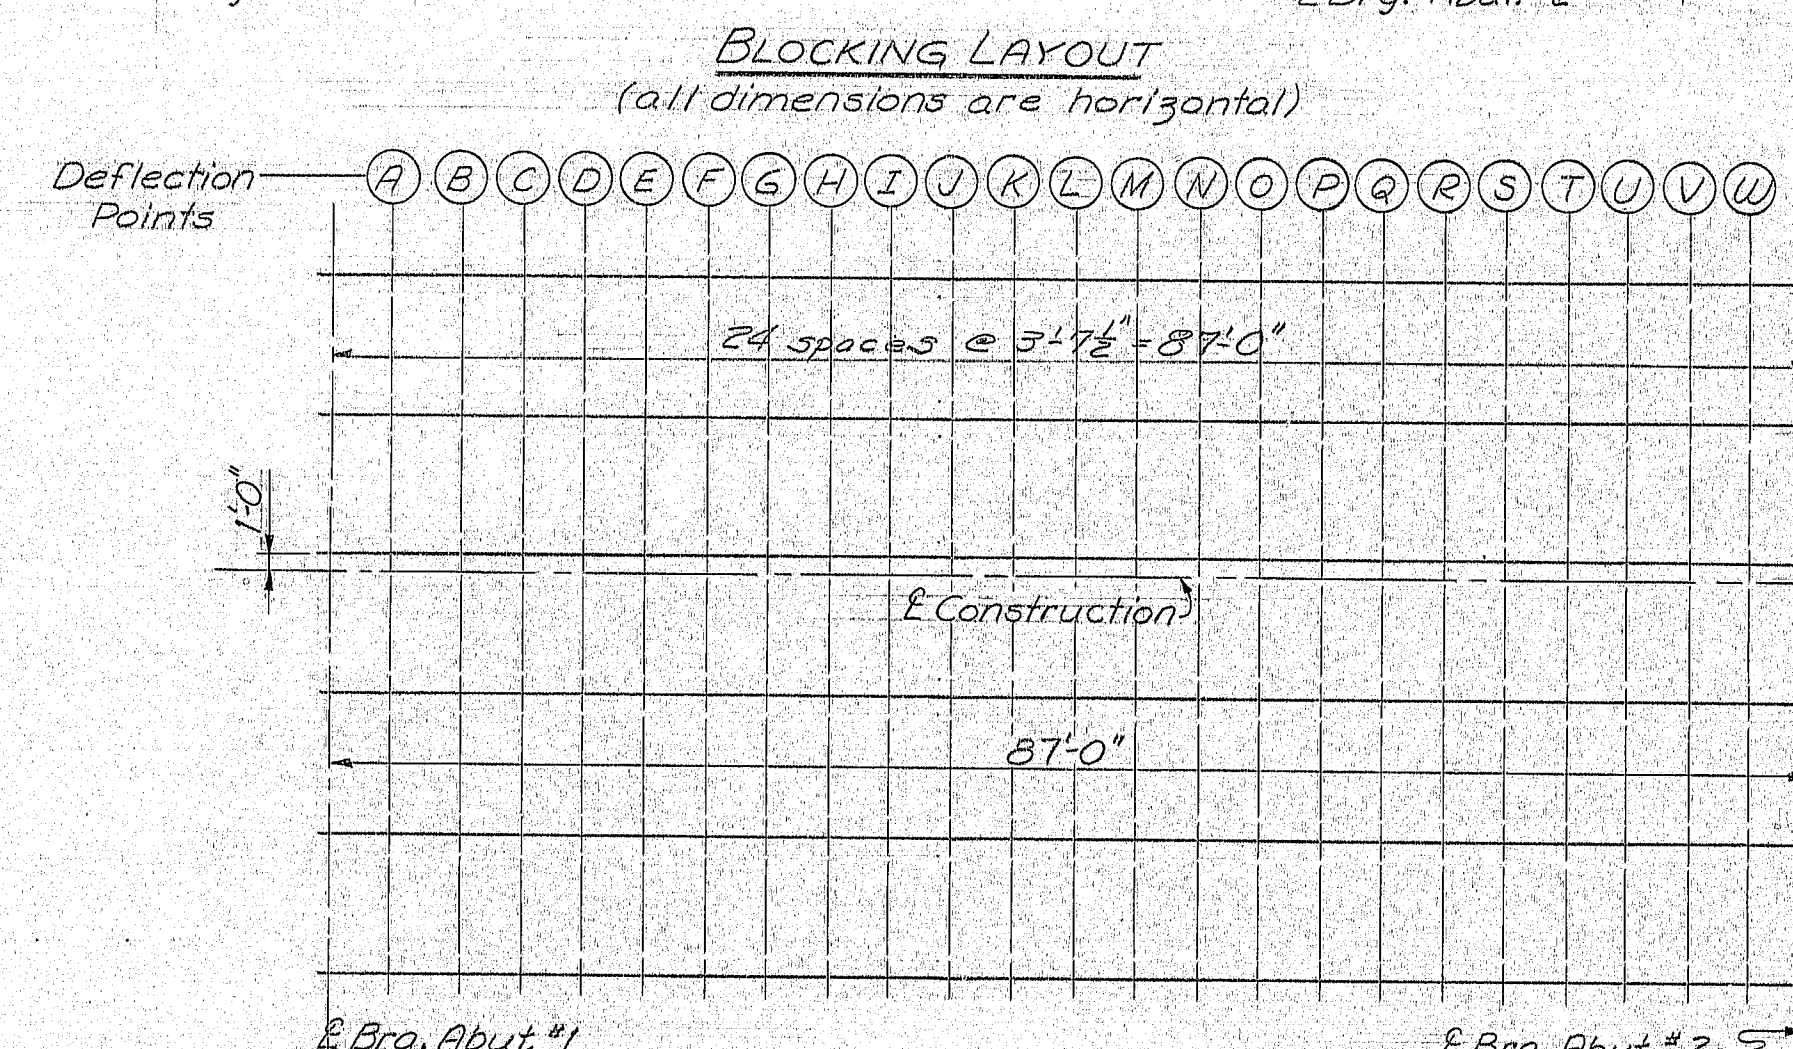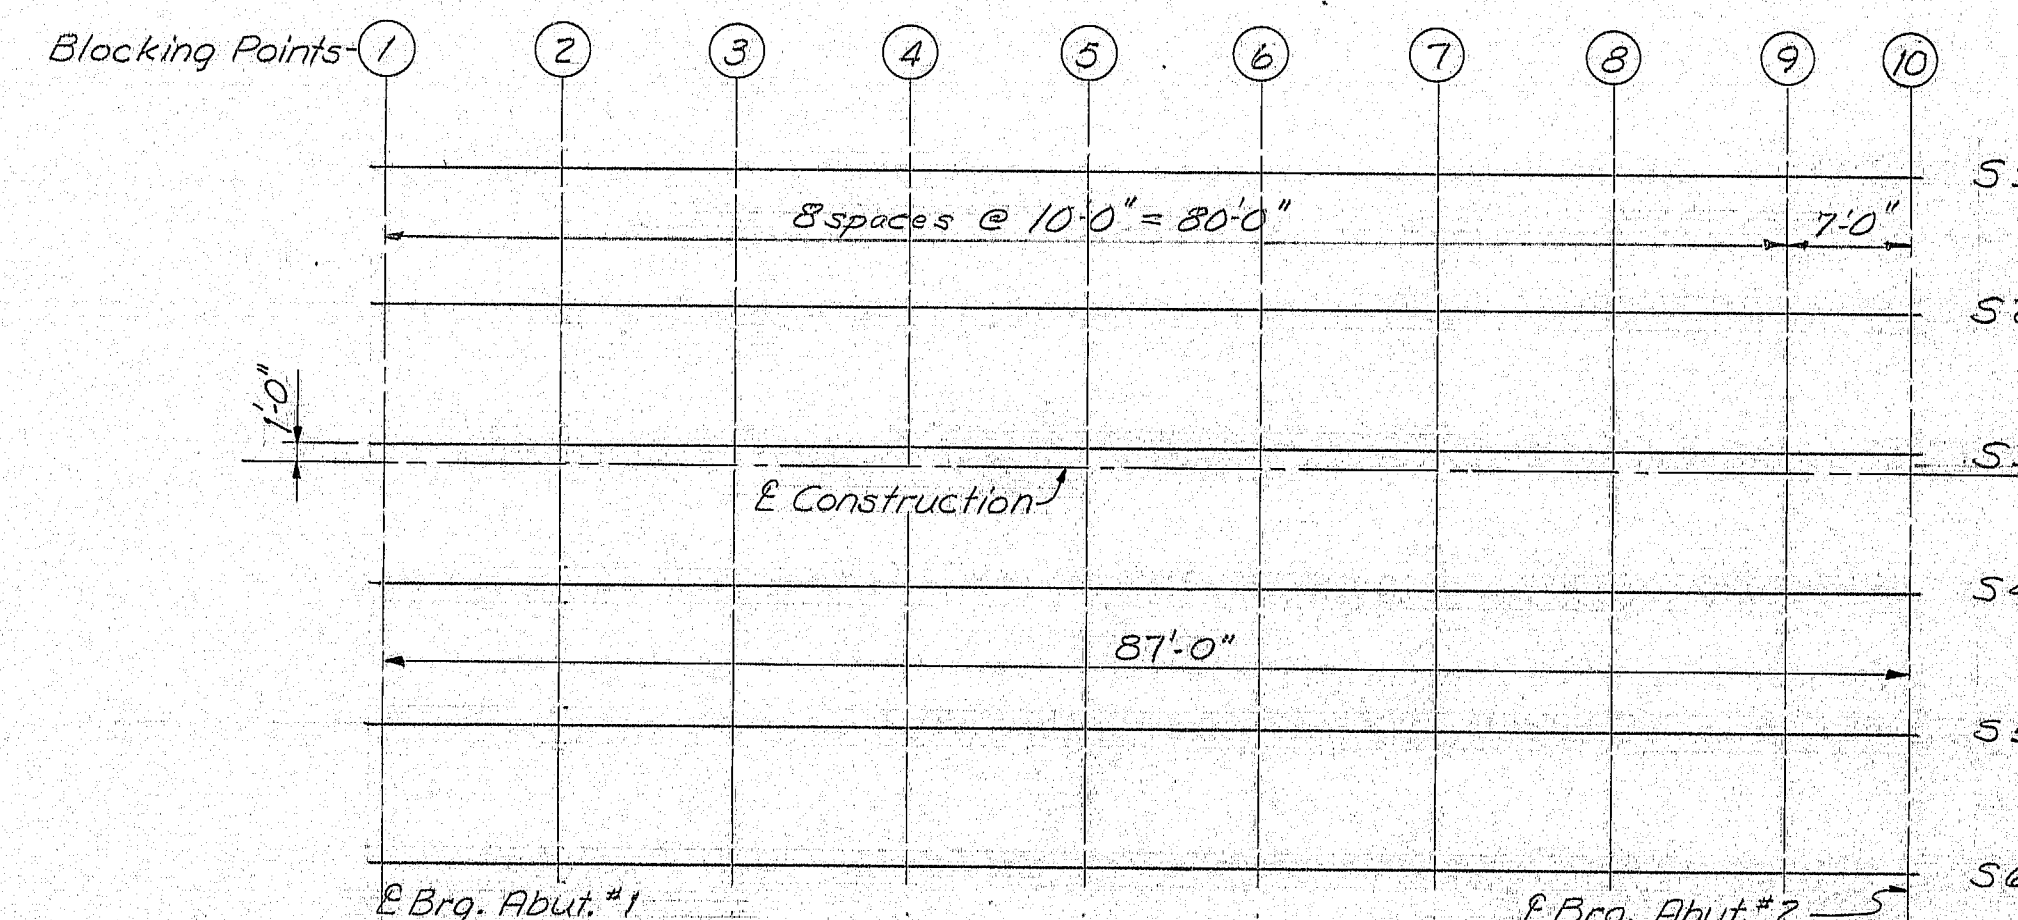


DEAD LOAD DEFLECTIONS IN FEET																									
Points	Abt. ⁴	A	B	C	D	E	F	G	H	I	J	K	L	M	N	O	P	Q	R	S	T	U	V	W	Abt.
Superimp.	0.000	0.007	0.014	0.020	0.026	0.031	0.036	0.040	0.044	0.046	0.048	0.050	0.050	0.050	0.048	0.046	0.044	0.040	0.036	0.031	0.026	0.020	0.014	0.007	0.000
Steel	0.000	0.008	0.016	0.024	0.031	0.037	0.043	0.047	0.052	0.055	0.057	0.059	0.059	0.059	0.057	0.055	0.052	0.047	0.043	0.037	0.031	0.024	0.016	0.008	0.000
Fluid	0.000	0.033	0.065	0.096	0.124	0.150	0.172	0.192	0.209	0.222	0.231	0.237	0.239	0.237	0.231	0.222	0.209	0.192	0.172	0.150	0.124	0.097	0.065	0.033	0.000

Span	Brig. #1	+10'	+20'	+30'	+40'	+50'	+60'	+70'	+80'	Brig. #2
Points	1	2	3	4	5	6	7	8	9	10
S1	181.48	181.72	181.95	182.15	182.32	182.46	182.56	182.63	182.67	182.69
S2	181.64	181.89	182.12	182.32	182.49	182.62	182.72	182.79	182.84	182.86
S3	181.81	182.06	182.28	182.49	182.65	182.79	182.89	182.96	183.00	183.02
S4	181.68	181.93	182.16	182.36	182.53	182.66	182.76	182.83	182.88	182.90
S5	181.52	181.76	181.99	182.19	182.36	182.50	182.60	182.67	182.71	182.73
S6	181.35	181.60	181.83	182.03	182.20	182.33	182.43	182.50	182.54	182.57

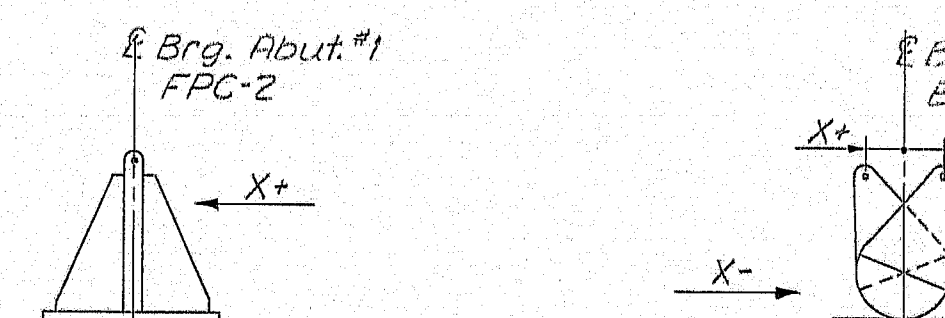

ROCKER BEARING SETTING DIAGRAM

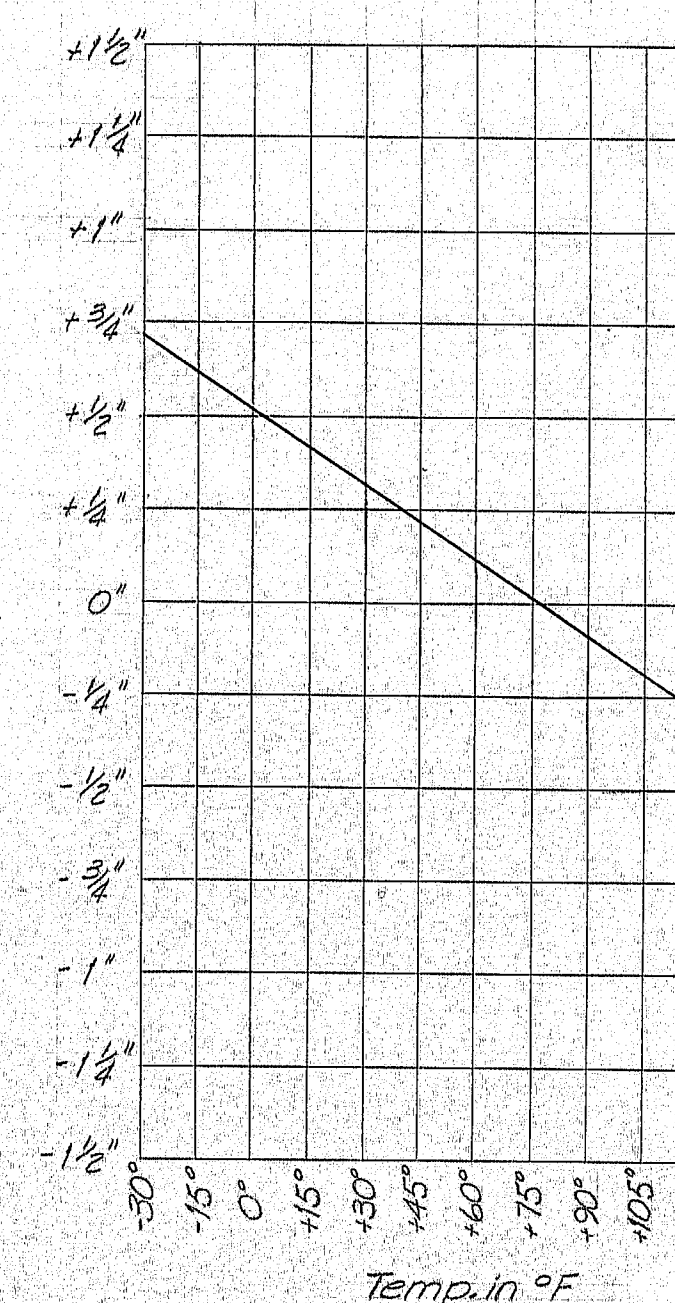

ROCKER BEARING SETTING GRAPH
This table of bearing settings compensates for longitudinal movement due to temperature change and dead load deflection, due to slab and wearing surface.

NOTE:
Before taking elevations on the tops of the beams for purposes of setting bottom of slab elevations, the welding of shear connectors to the beams and the diaphragm connections to the beams shall have been completed.

NOTE:
Rocker setting data as shown shall be used as a guide only. No extra payment will be made for resetting of the rocker bearings, subsequent to the original setting, made by the contractor as required by the Engineer to make the rocker settings conform with paragraph four (4) of Subsection 504.58.

NOTES
Bottom of slab elevations are adjusted to compensate for the dead load deflections.

Diaphragm connection plates may be either plumb or normal to the top flange.





STATE OF MAINE
DEPARTMENT OF TRANSPORTATION

INTERSTATE 95
OVER
ROUTE 138
IN THE TOWN OF
BOWDOINHAM
SAGADAHOC COUNTY
STRUCTURAL STEEL NORTHBOUND.

SHEET 17 OF 31 AUGUSTA, MAINE March 1971

172-89

PLANS	DESIGN - DETAILED	BY G.O.T.	R.C.B.	DATE 11-7-74
	CHECKED		P.J.L.	3-75
	REVISIONS			
	FIELD CHANGES			

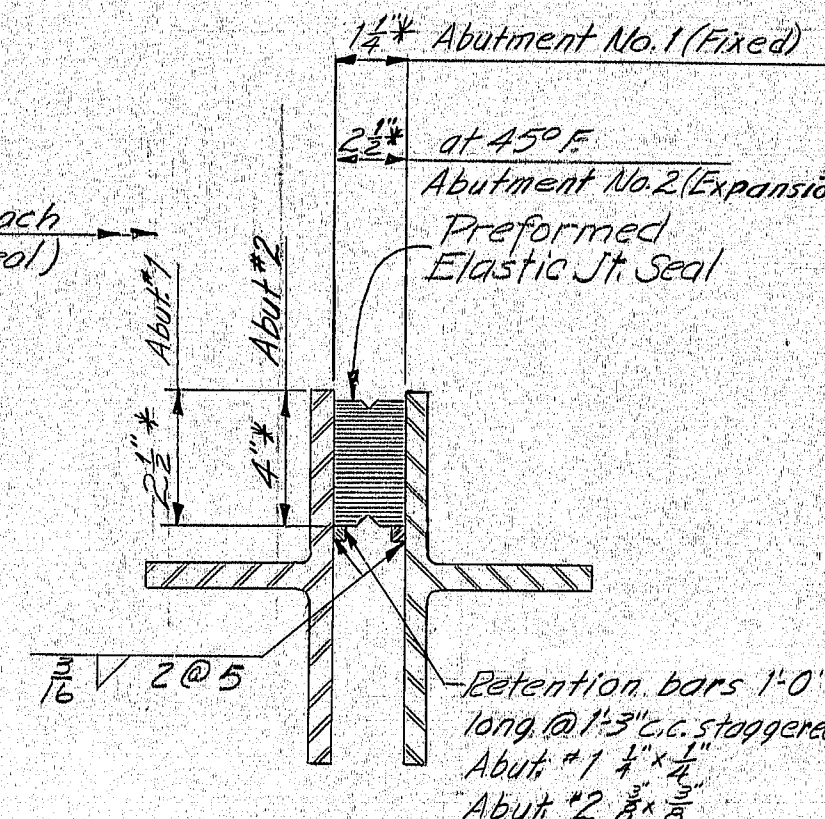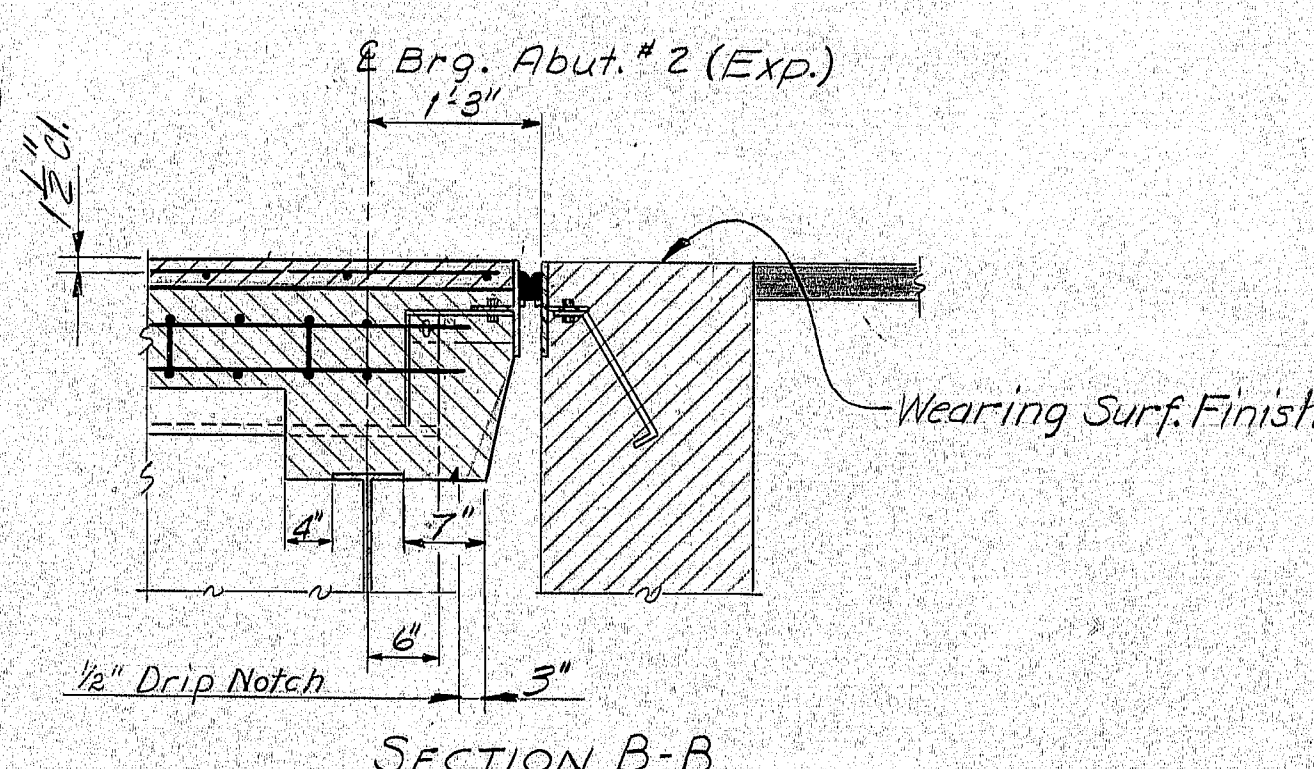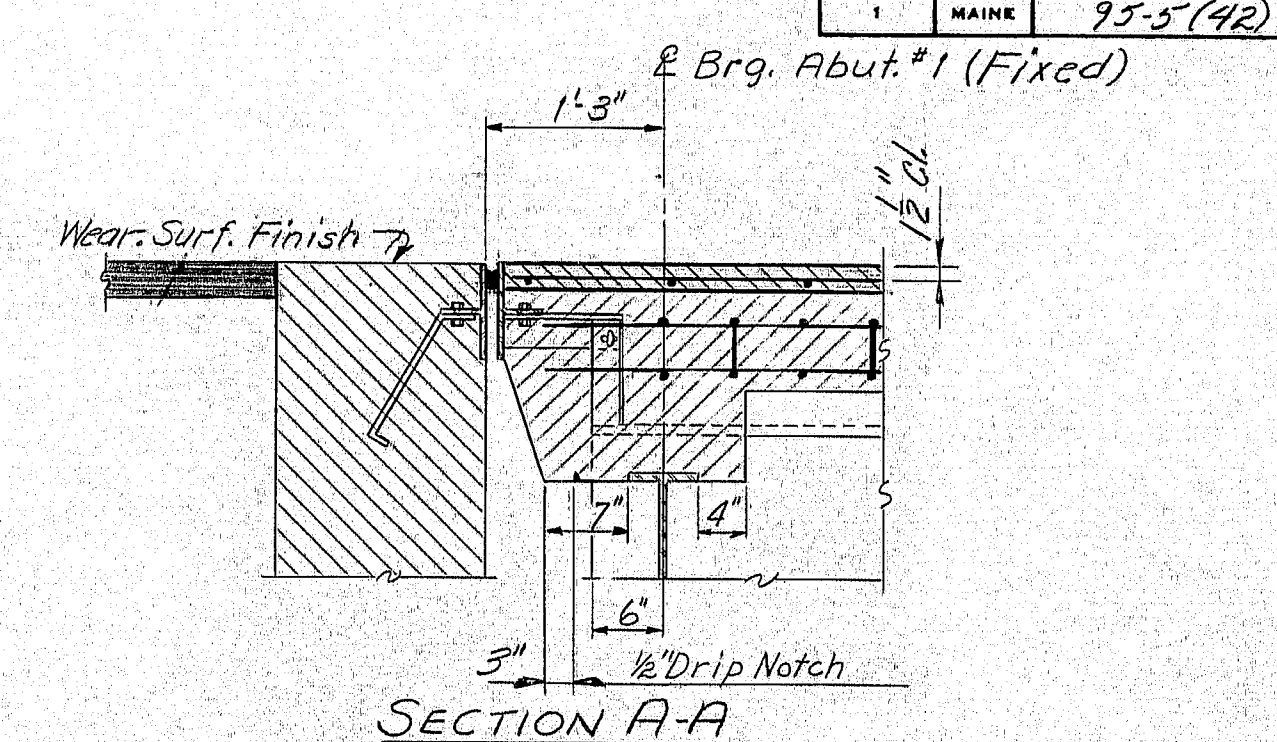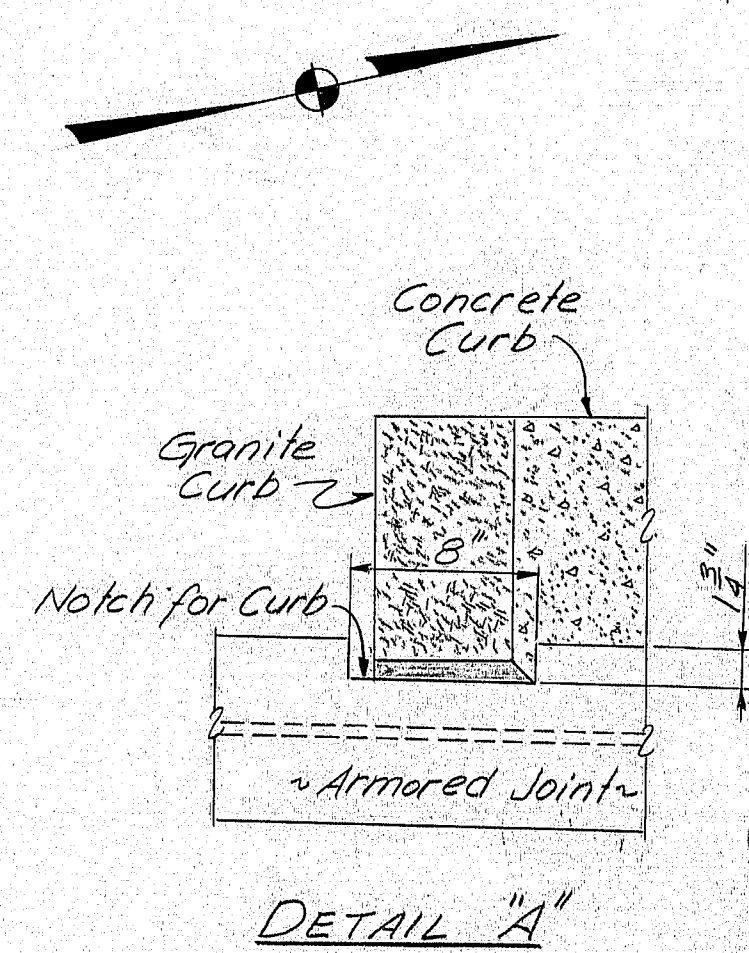

Chamfer all exposed edges of concrete inch unless otherwise indicated.

Form a 1 inch V-groove on the outside faces of each contraction joint in the curbs and at the joint between the curb and slab.

Break the bond in contraction joints in the concrete curbs by a method approved by the Engineer.

Provide joints in the Vertical Bridge Curb, Type 1 at each contraction joint in the concrete curb.

Reinforcing steel shall have a minimum cover of 2 inches unless otherwise indicated.

Protective Coating for Concrete Surfaces shall be applied to the following areas:

- Concrete curb and fascia down to the drip notch, and including Struct. Conc. Wear Surfs.

Mortar for bedding and for joints in the granite curb shall contain a non-shrink additive.

For Armored Joint detail see BD104-73 Sheet #26.

For Aluminum Bridge Rail see BD 114-73 sheet #23.



p.) SEAL DETAIL

The seals furnished shall be as follows

Location	Movement Rating
Abutment No.1	0.50 inches
Abutment No.2	1.00 inches

NOTES:

1. The seals furnished shall have a movement rating of $\frac{1}{8}$ " for Abutment No.1 and $\frac{1}{4}$ " for Abutment No.2.
2. The dimensions* shown are for design only and are subject to change due to differences in seals as supplied by various manufacturers. Do not use for fabrication or setting of the joint opening during construction.
3. The seal characteristics shall be submitted to the Engineer for approval, prior to the fabrication of the Armored Joint.
4. A movement of $\frac{3}{8}$ inch due to dead loads (slab, curb, and wearing surface) shall be taken into account when setting the Armored Joint. Abutment No.1 The gap of Abutment No.2 shall be field adjusted for temperature.

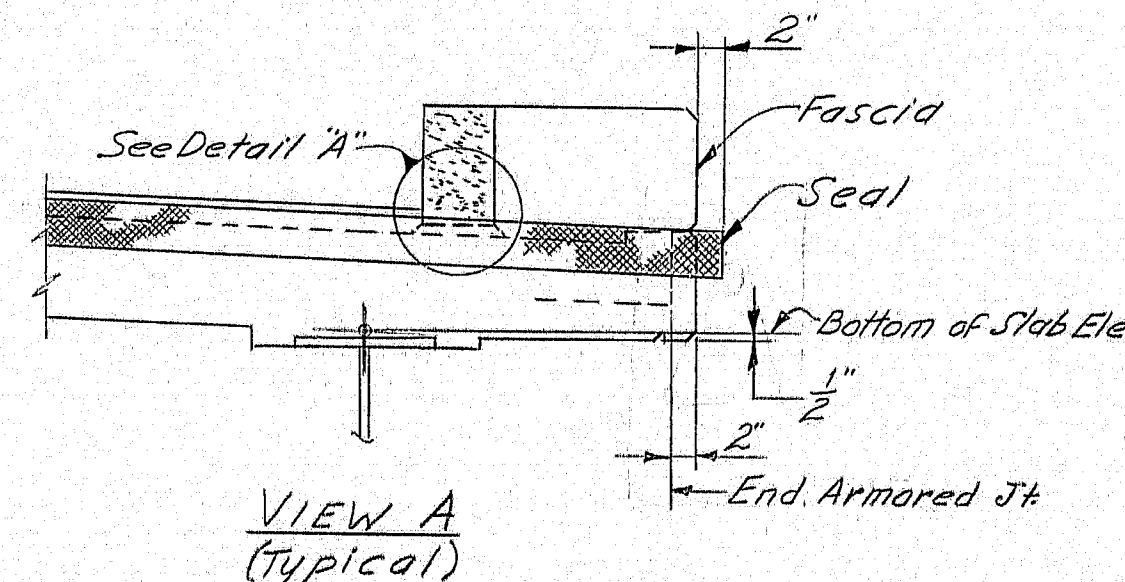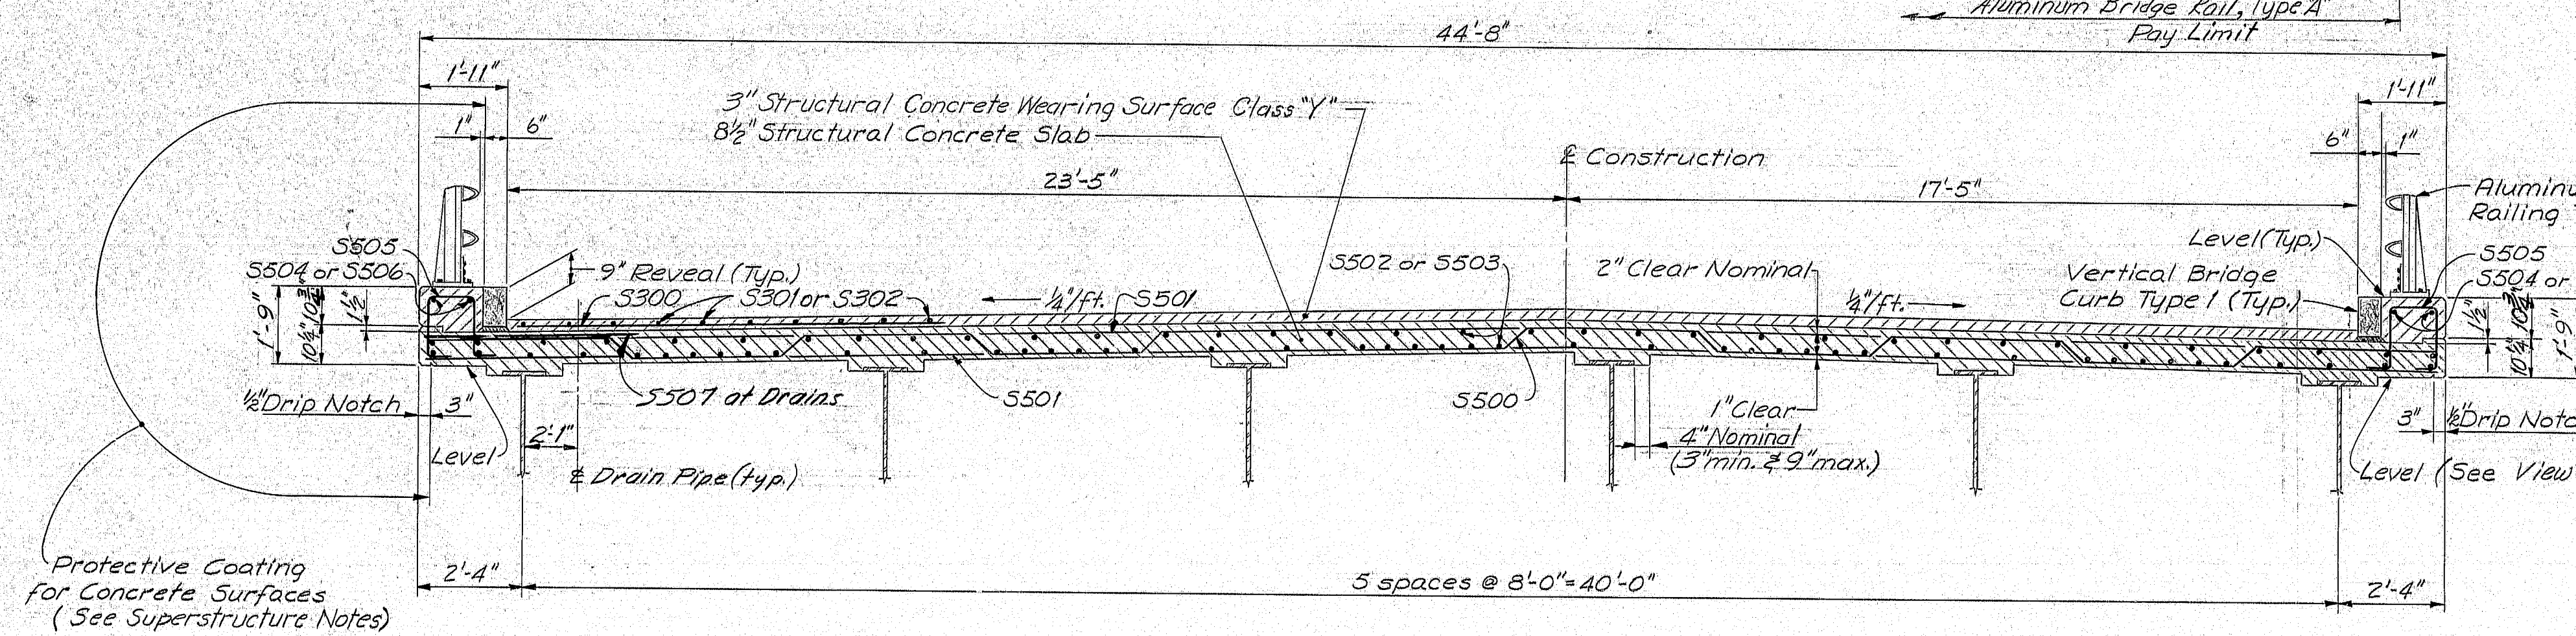


INTERSTATE 95
OVER
ROUTE 138
IN THE TOWN OF
BOWDOINHAM
SAGadahoc COUNTY
SUPERSTRUCTURE SOUTHBOUND


SHEET 18 OF 31 AUGUSTA, MAINE March 1975

172-90



F.H.W.A. REG. NO.	STATE	PROJECT NUMBER	SHEET NO.	TOTAL SHEETS
1	MAINE	95-5(42)	17	31

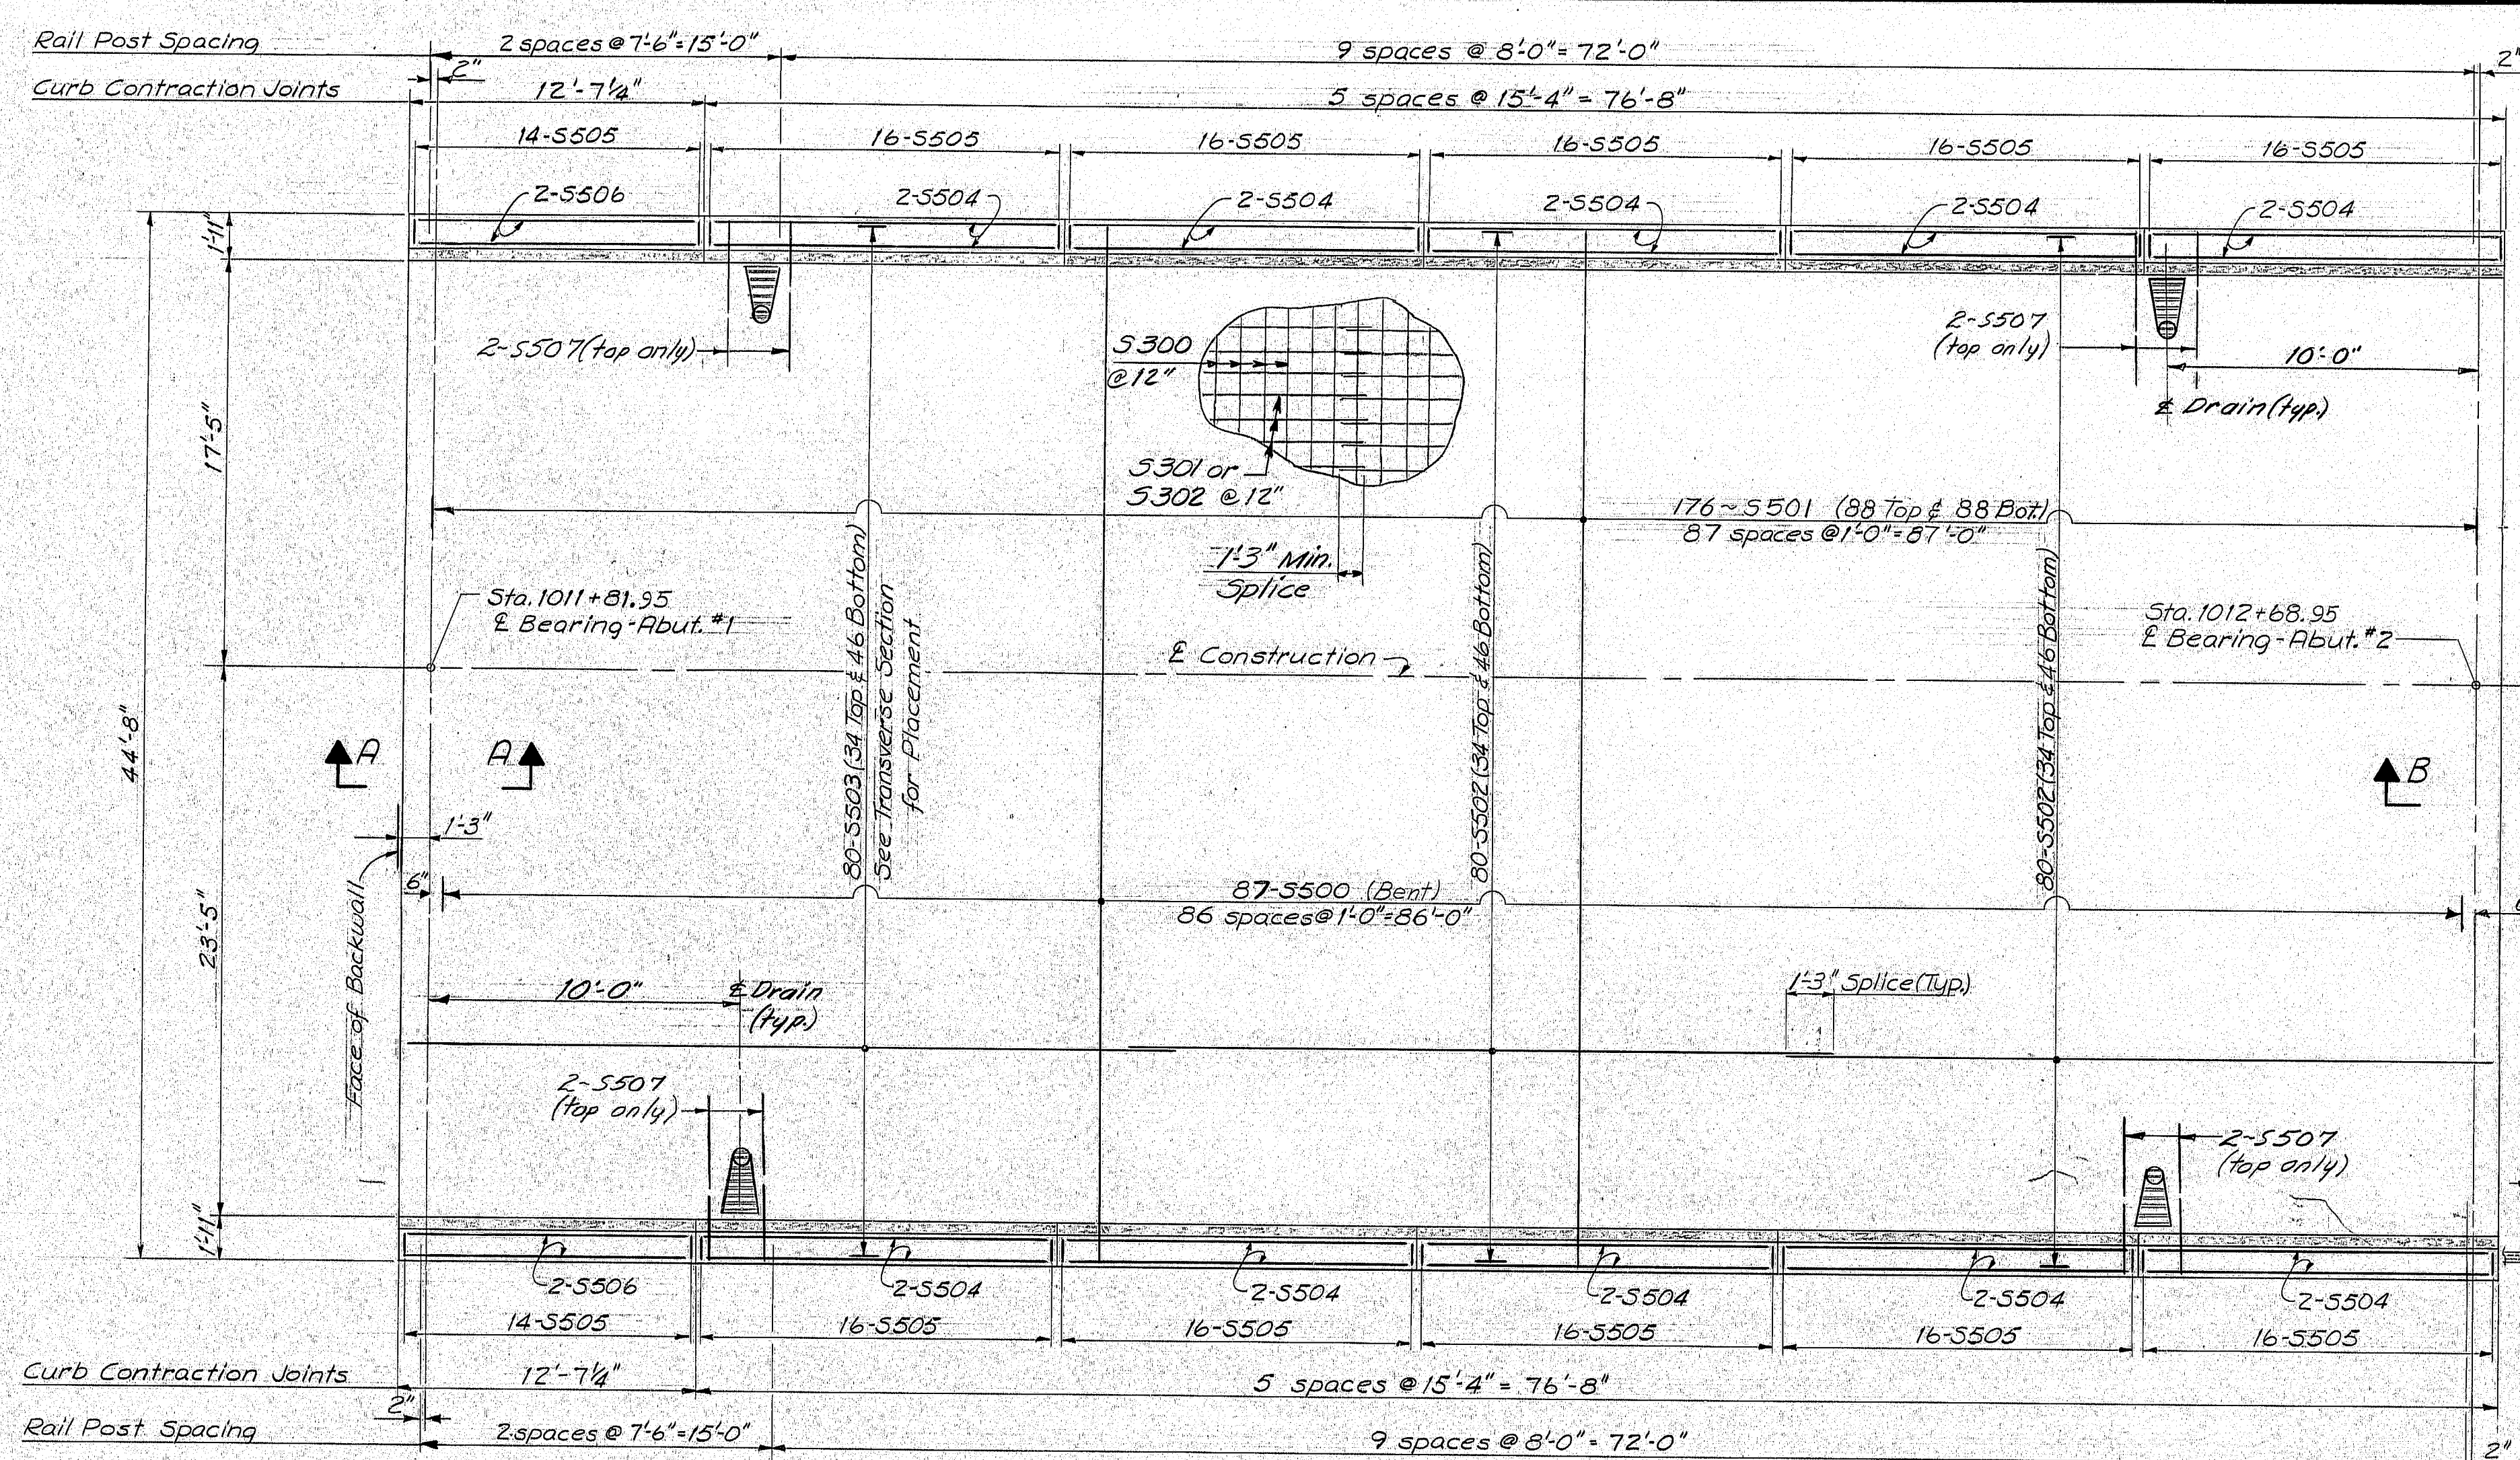


PLAN-NORTHBOUND

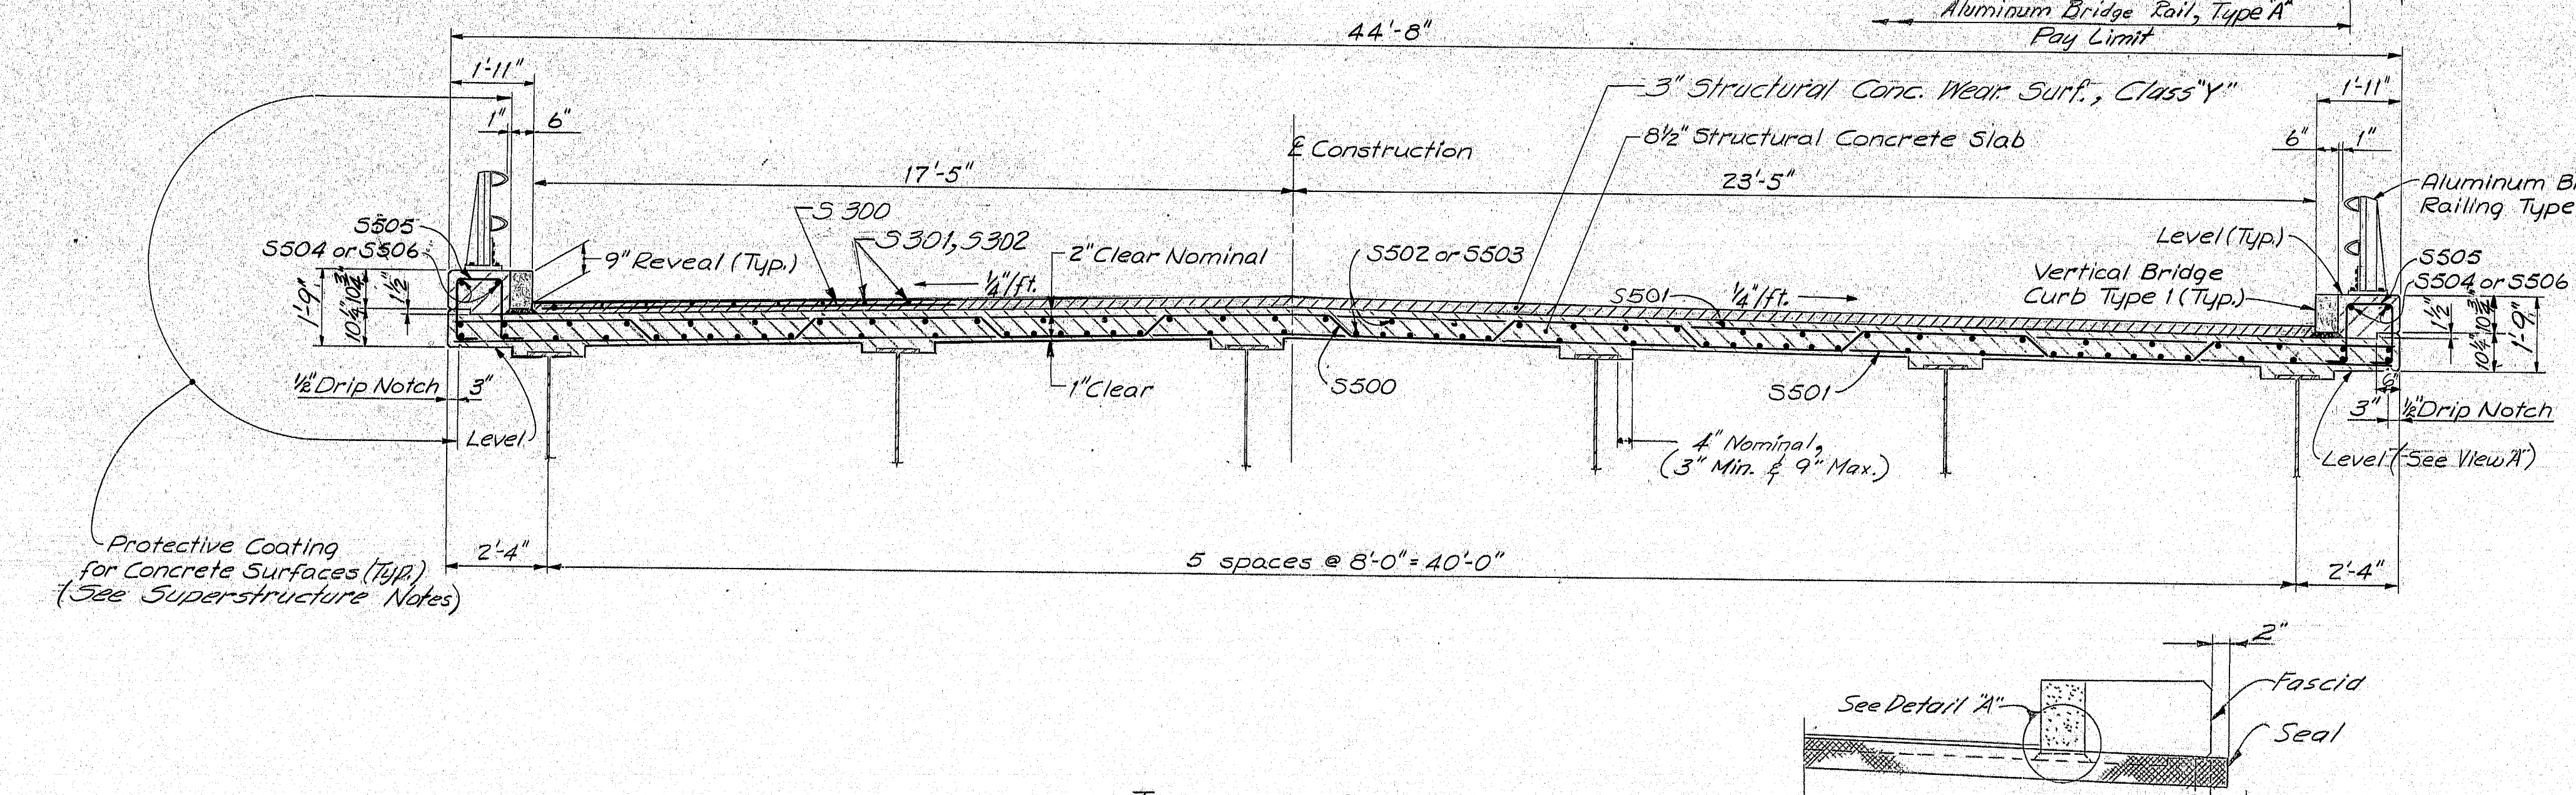


TRANSVERSE SECTION - NORTHBOUND

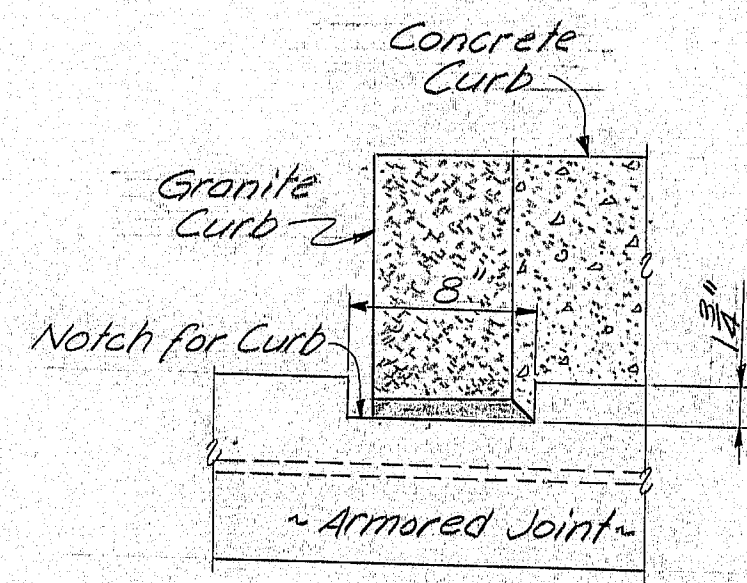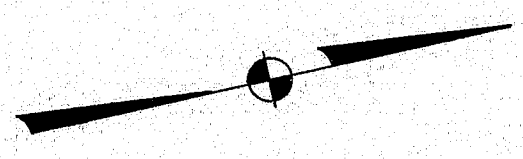


DETAIL 'A'

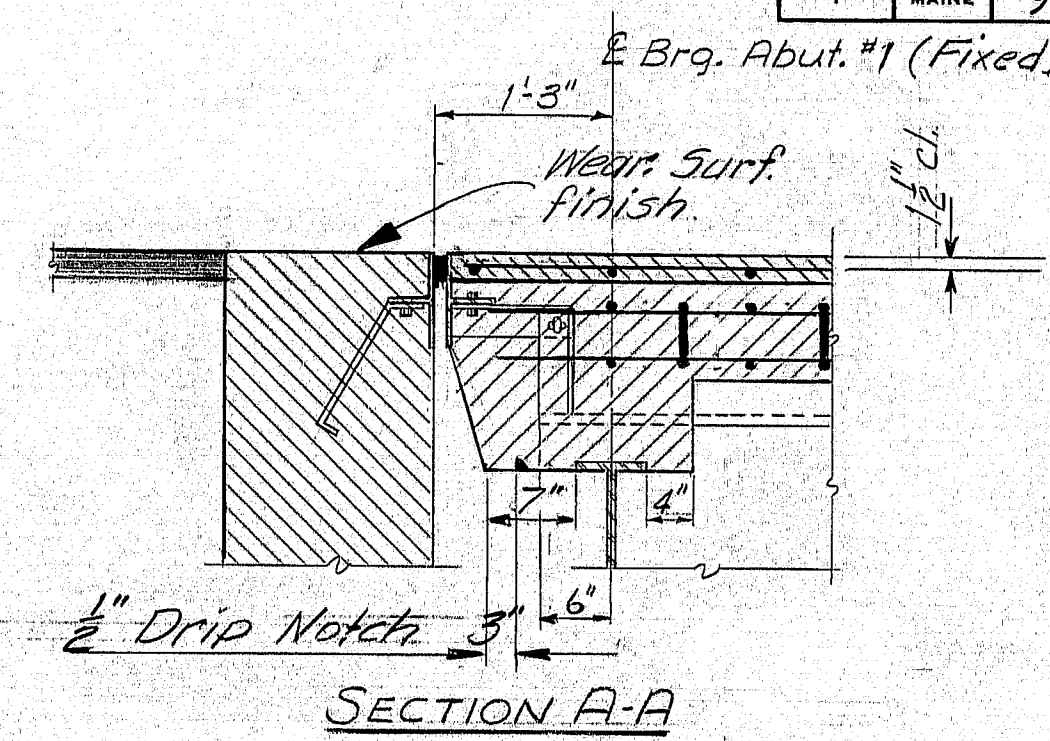

SECTION A-A

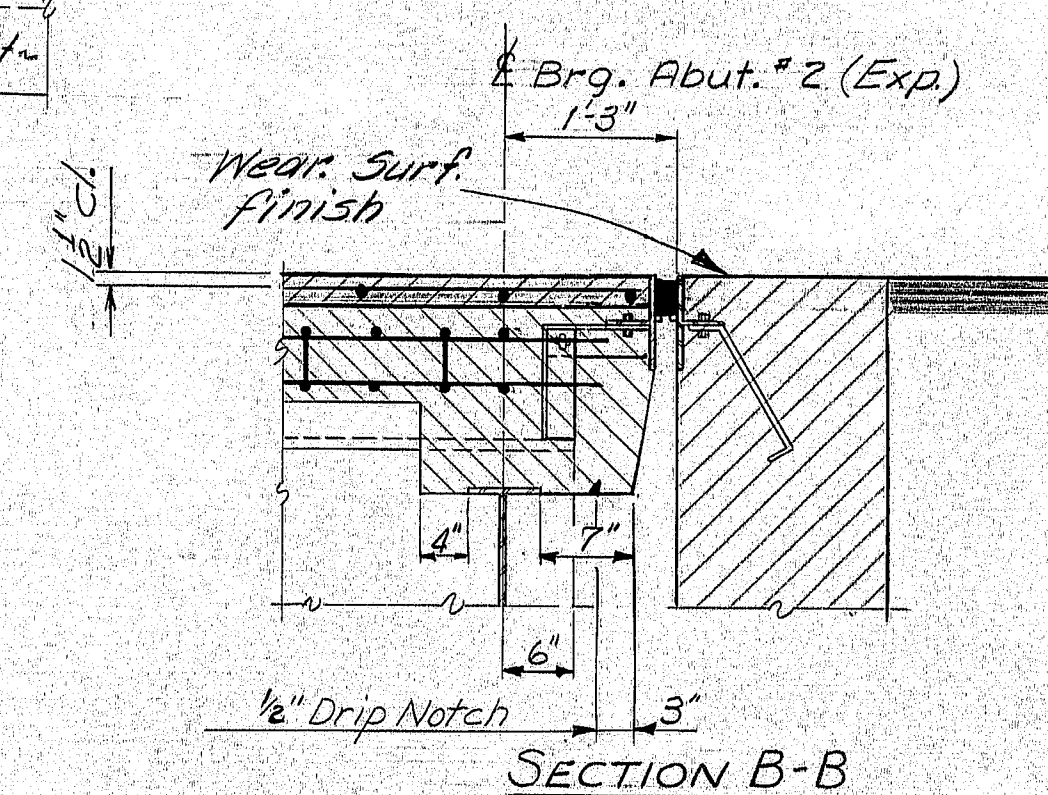

SECTION B-B

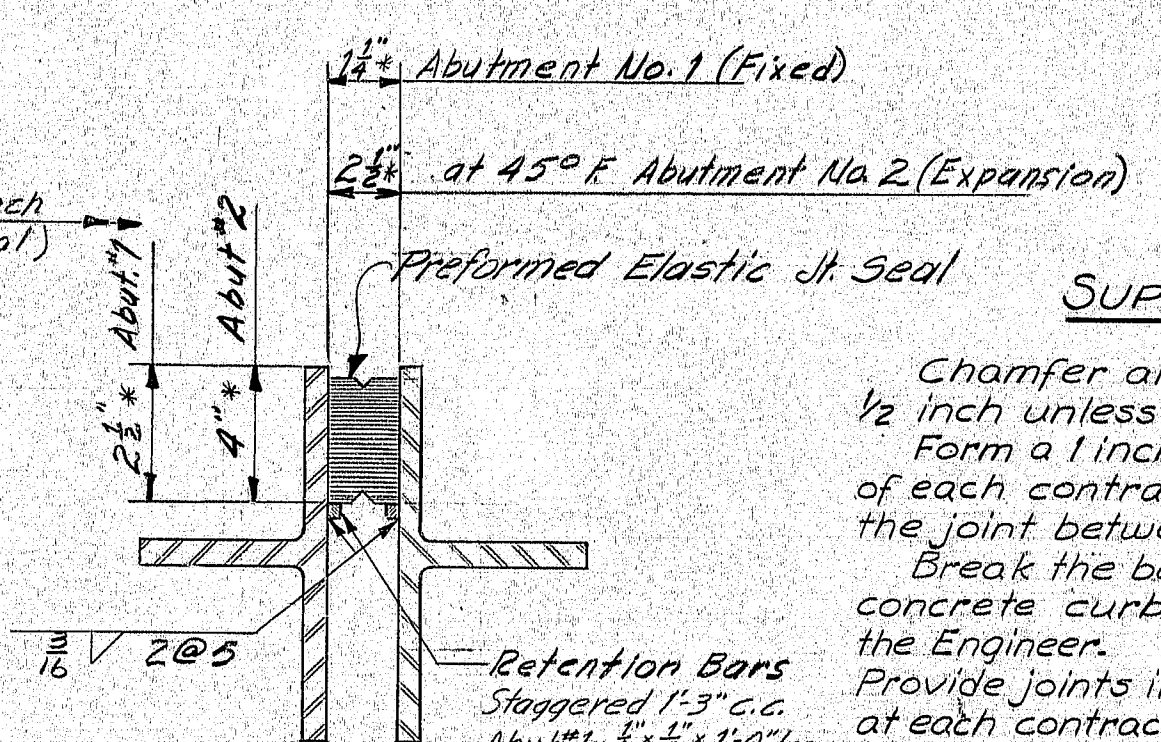

SEAL DETAIL

SUPERSTRUCTURE NOTES

Chamfer all exposed edges of concrete 1/2 inch unless otherwise indicated.
Form a 1 inch V-groove on the outside faces of each contraction joint in the curbs and at the joint between the curb and slab.
Break the bond in contraction joints in the concrete curbs by a method approved by the Engineer.
Provide joints in the Vertical Bridge Curb, Type 1 at each contraction joint in the concrete curb.
Reinforcing steel shall have a minimum cover of 2 inches unless otherwise indicated.
Mortar for bedding and for joints in the granite curb shall contain a non-shrink additive.

Protective Coating for Concrete Surfaces shall be applied to the following areas:
Concrete curb and fascia down to the drip notch, and concrete wearing surface.

For Armored Joint detail see BD104-73 sheet #26.
For Aluminum Bridge Rail see BD114-73 sheet #28.

- NOTES:**
- The seals furnished shall have a movement rating of 3/8" for Abutment No. 1 and 1" for Abutment No. 2.
 - The dimensions shown are for design only, and are subject to change due to differences in seals as supplied by various manufacturers. Do not use for fabrication or setting of the joint opening during construction.
 - The seal characteristics shall be submitted to the Engineer for approval, prior to the fabrication of the Armored Joint.
 - A movement of 3/8 inch due to dead loads (slab, curb and wearing surface) shall be taken into account when setting the Armored Joint at Abutment No. 1. The gap at Abutment No. 2 shall be field adjusted for temperature.

Location	Movement Rating
Abutment No. 1	0.50 inches
Abutment No. 2	1.00 inches

STATE OF MAINE
DEPARTMENT OF TRANSPORTATION

INTERSTATE 95
OVER
ROUTE 138
IN THE TOWN OF
BOWDOINHAM
SAGadahoc COUNTY
SUPERSTRUCTURE NORTHBOUND


SHEET 17 OF 31 AUGUSTA, MAINE March 1975

172-91



DATE	BY	DESIGN - DETAILED	CHECKED	REVISIONS	FIELD CHANGES
3-7-75	P.J.L.				

PLANS


PLANS	DESIGN - DETAILED	BY	DATE
	CHECKED		3/75
	REVISIONS	PJL	3-76
	FIELD CHANGES		

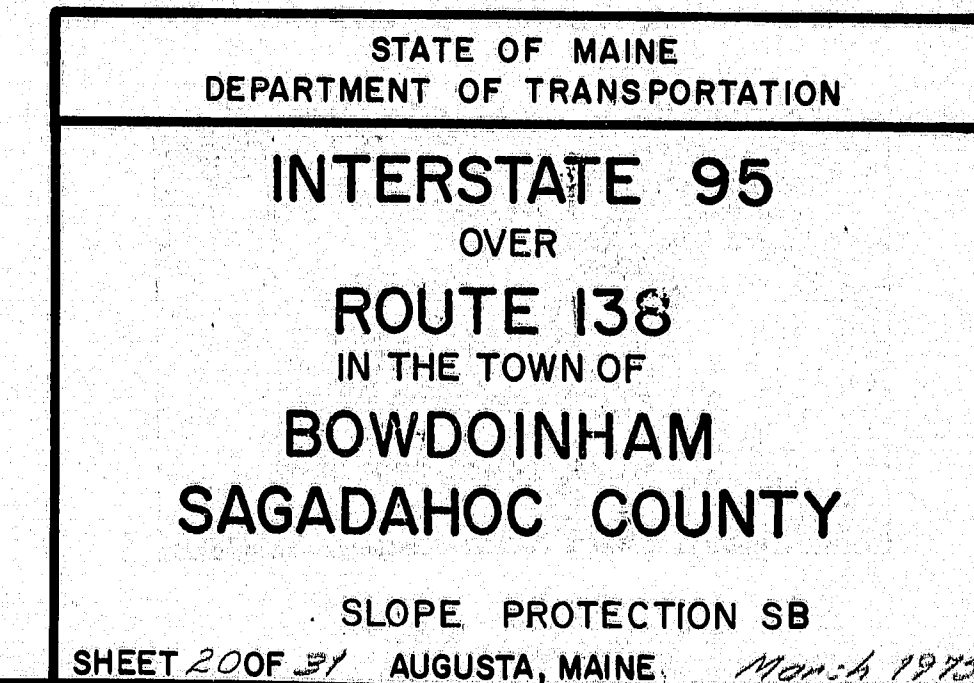


F.R.A. REG. NO.	STATE	PROJECT NUMBER	SHEET NO.	TOTAL SHEETS
1	MAINE	95-5(42)	21	31

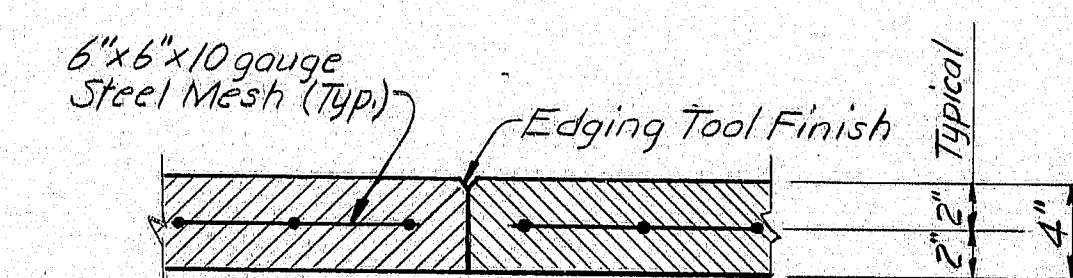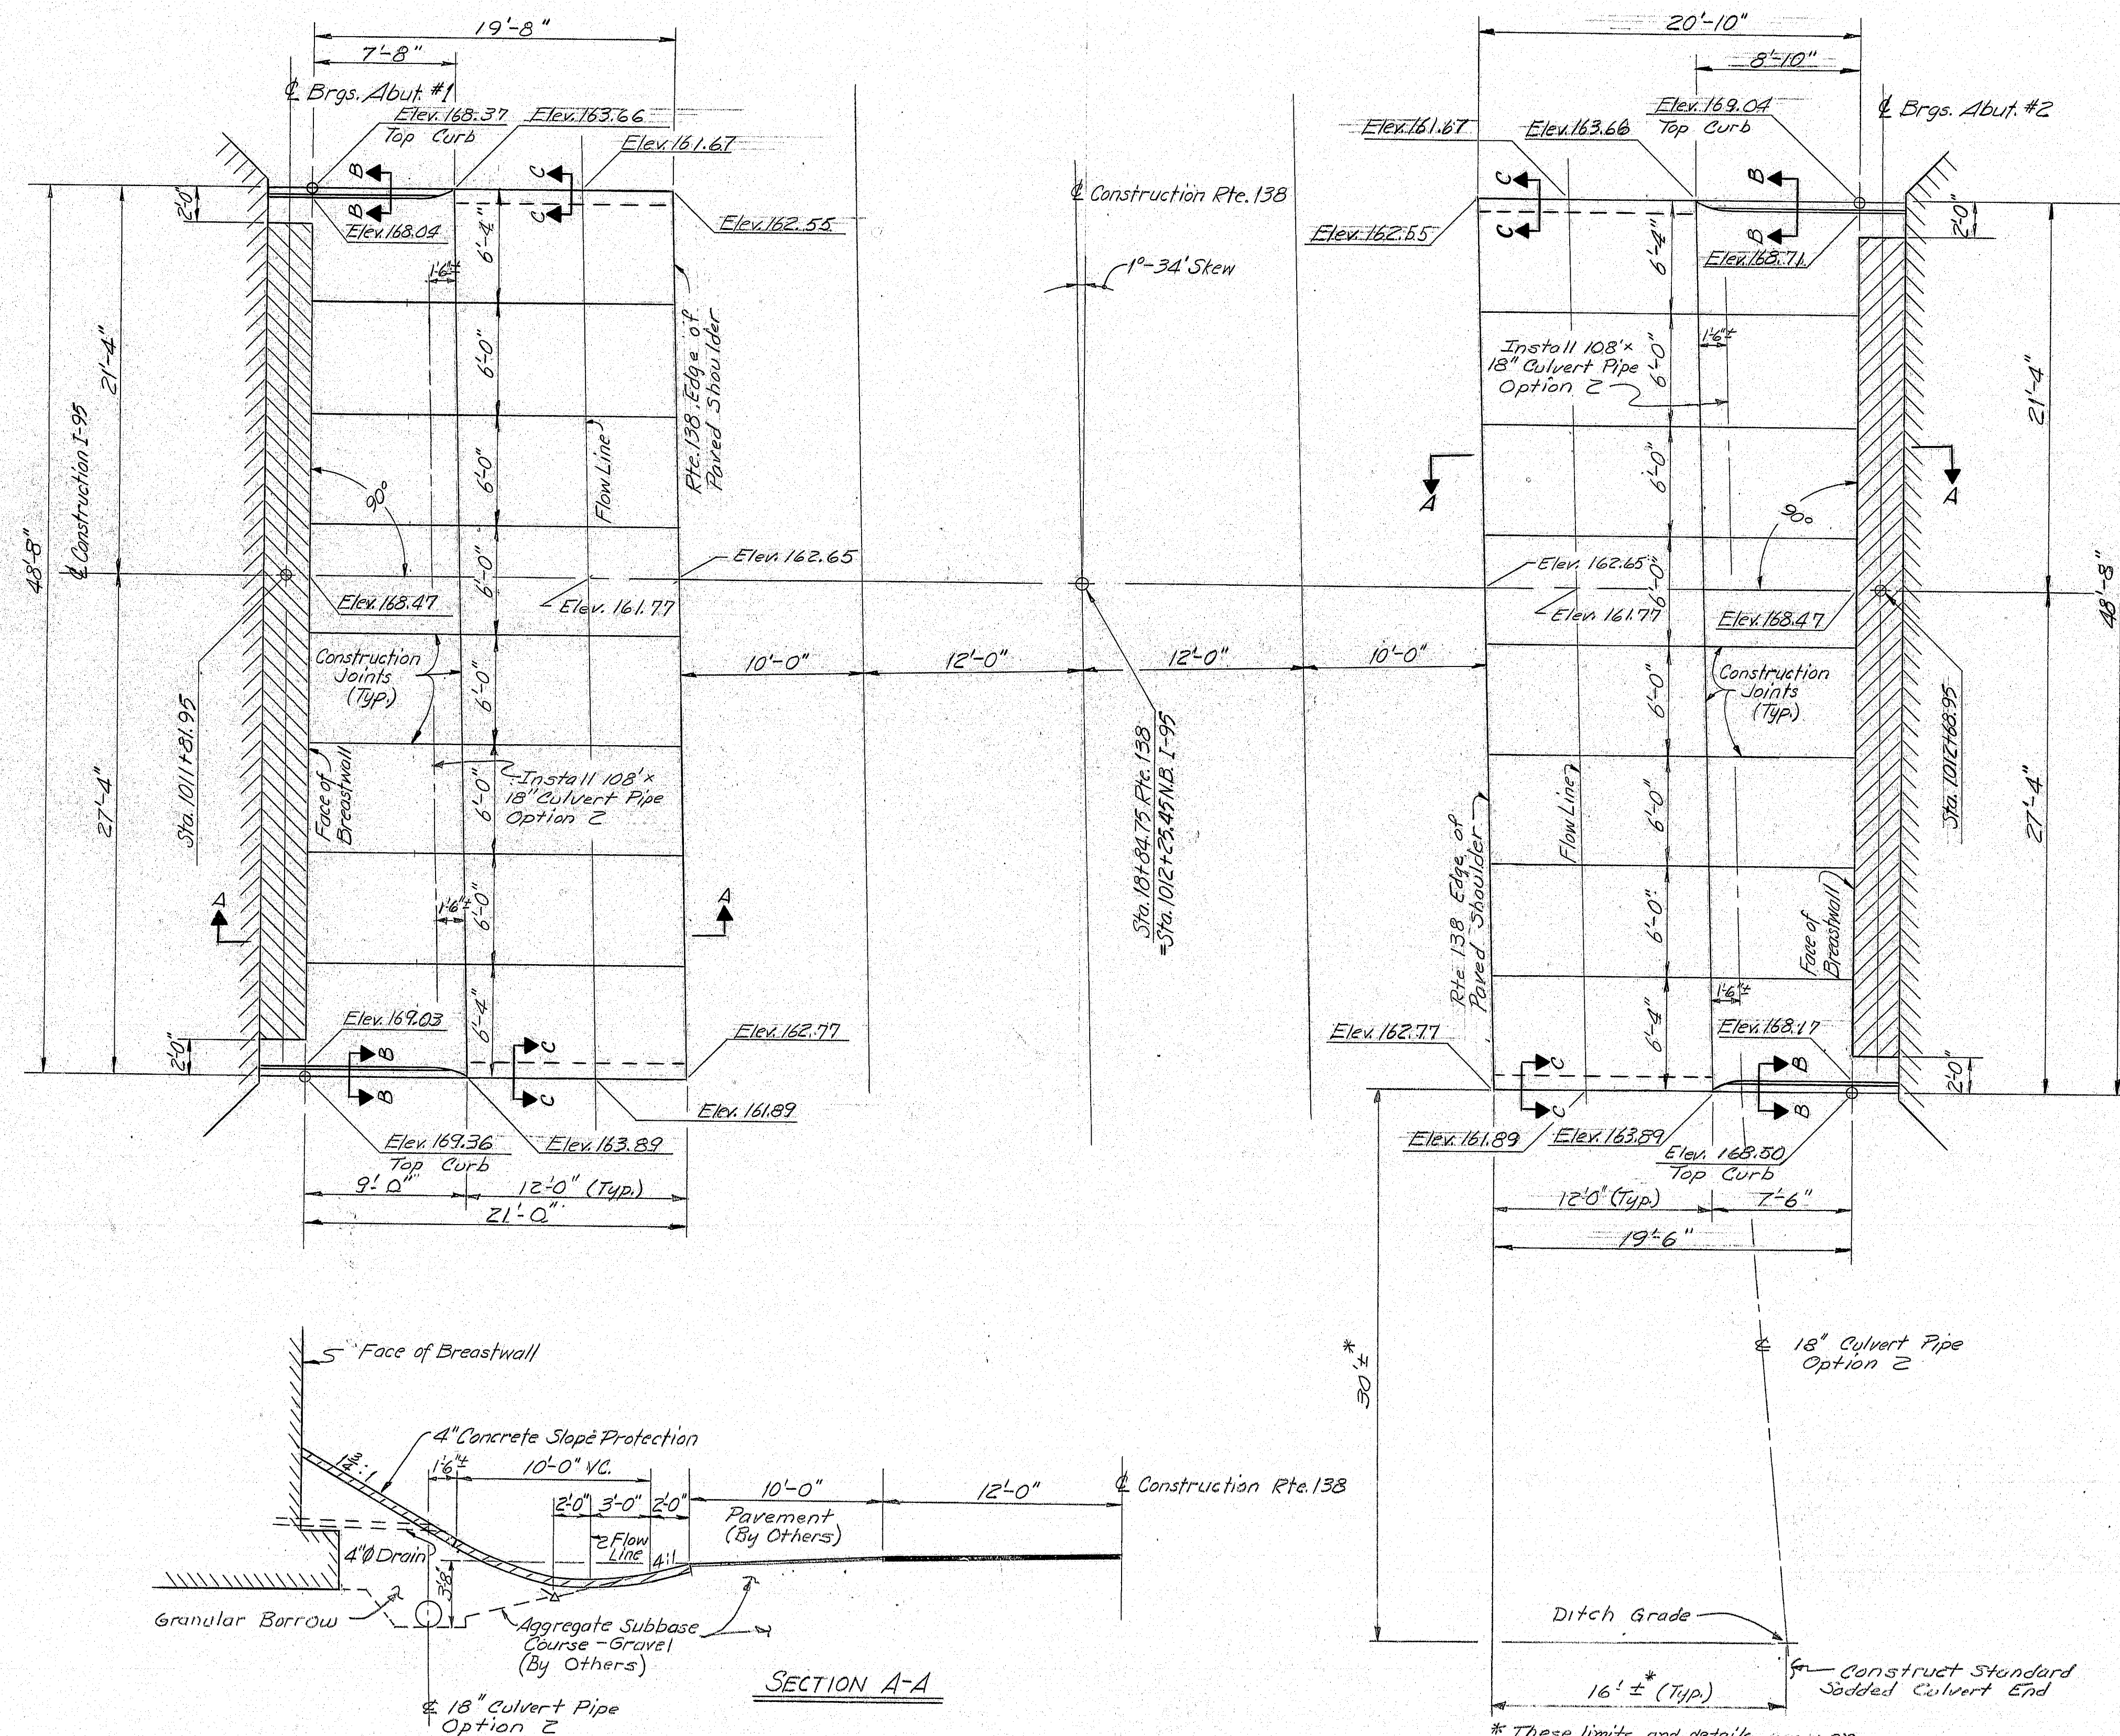

CONSTRUCTION JOINT

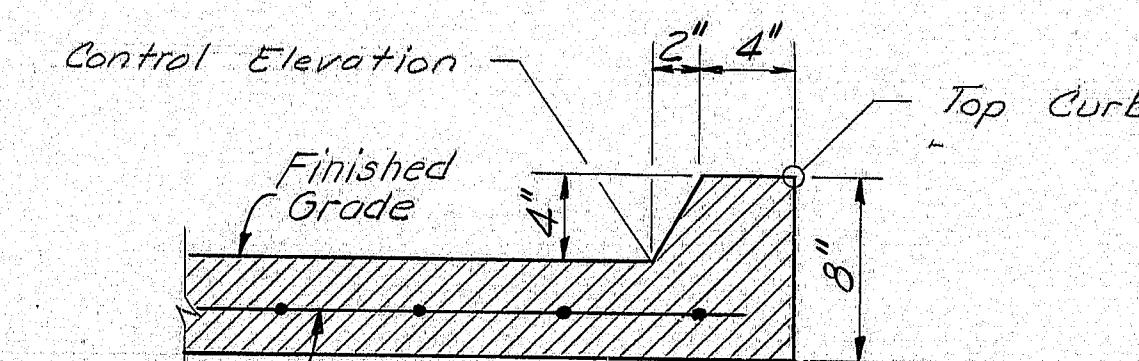

SECTION B-B

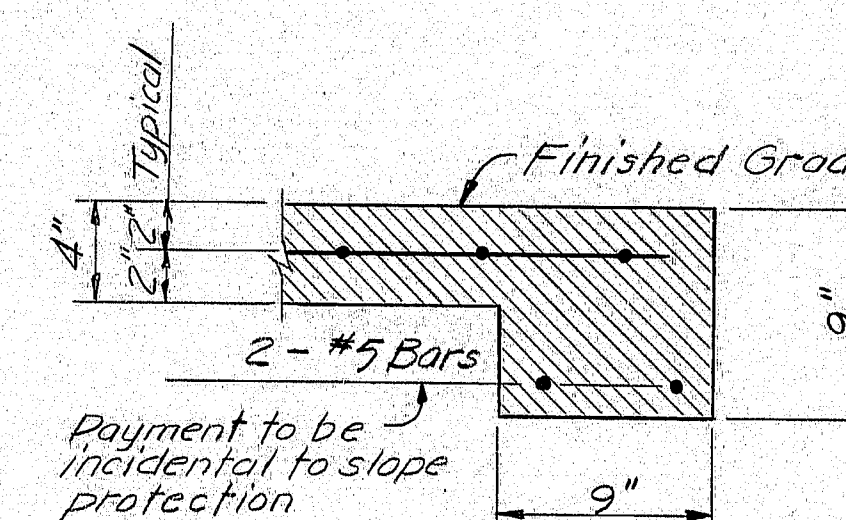


SECTION C-C

NOTE:

1. Steel Mesh shall not pass thru any Construction Joints.
2. Break the band in Construction Joints by a method approved by the Engineer.
3. Portland Cement Concrete for Slope Protection to be class "A".
4. Payment for Excavation of shoulder and for Pipe will be paid for under Item 206.06 Structural Earth Excavation, Drainage and minor structures.

PROJECT DESIGN ENGINEER	DATE
BY: G.R.W.	2/78
DESIGN - CHECKED	3/78
REVISIONS	
FIELD CHANGES	

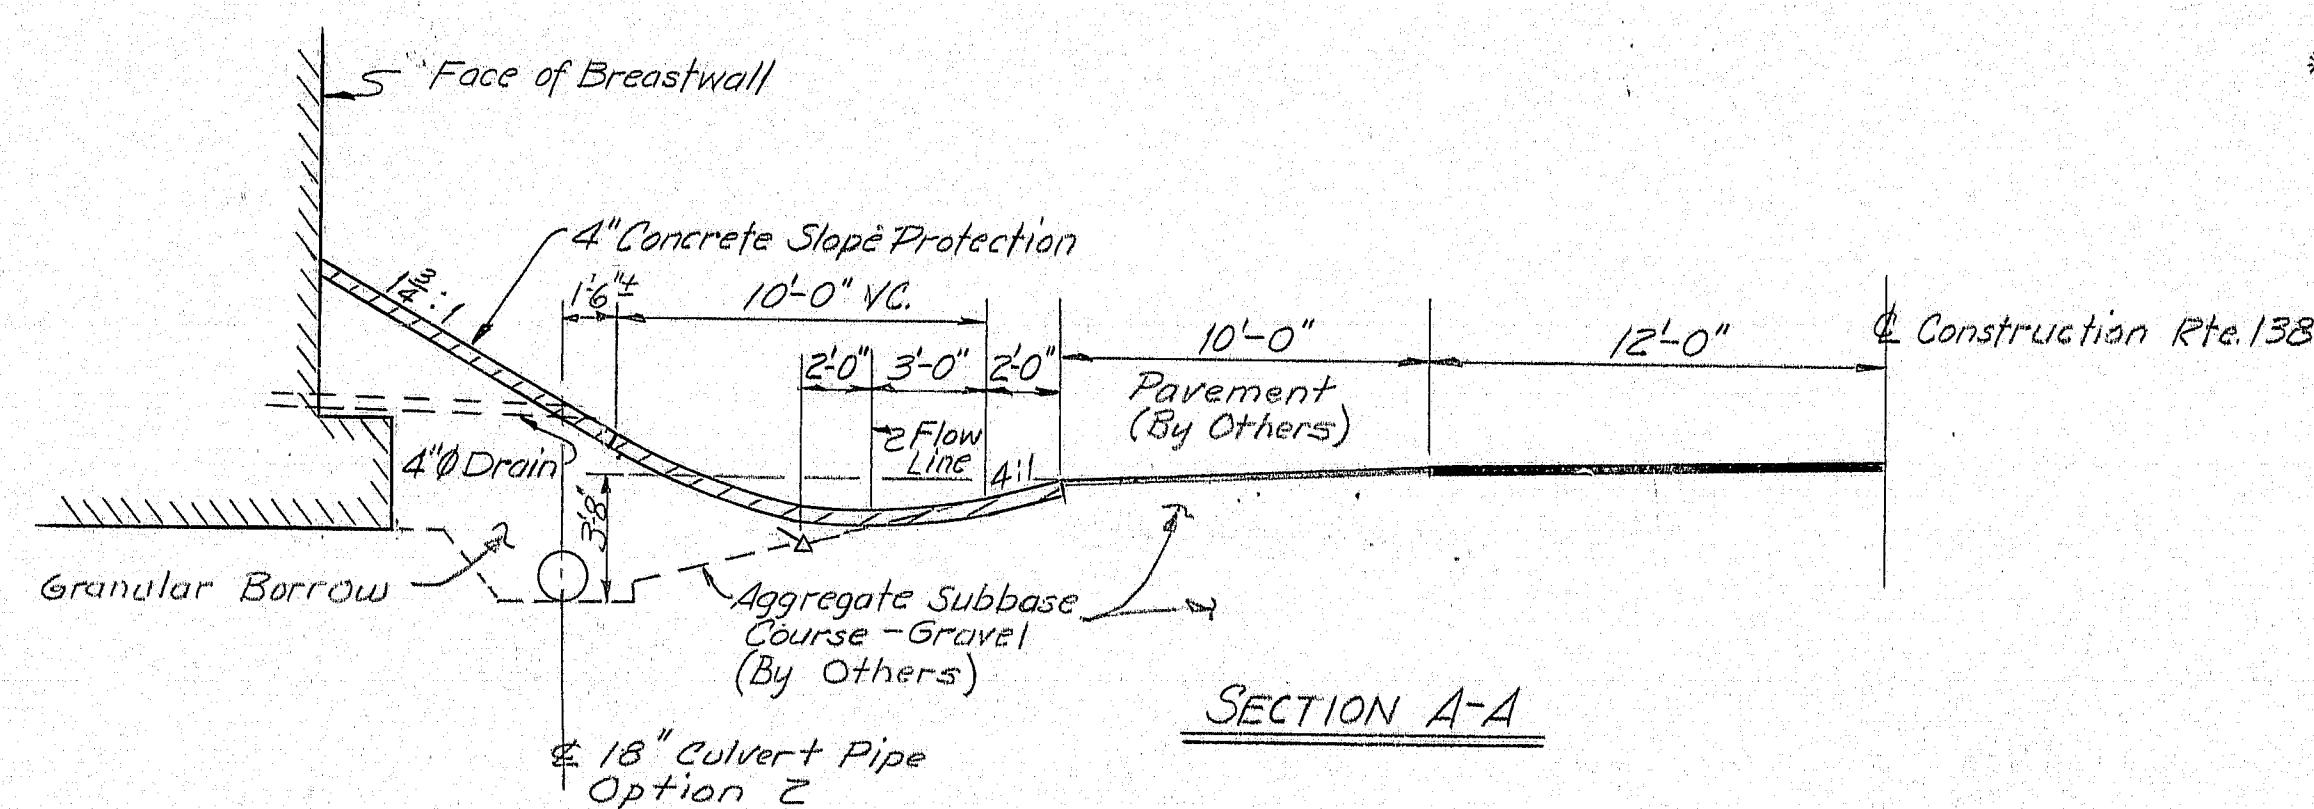

SECTION A-A

* These limits and details apply on each side of both abutments

STATE OF MAINE DEPARTMENT OF TRANSPORTATION
INTERSTATE 95 OVER ROUTE 138 IN THE TOWN OF BOWDOINHAM SAGadahoc COUNTY
SLOPE PROTECTION NB
SHEET 21 OF 31 AUGUSTA, MAINE March, 1975

172-93

[illegible]

FHWA REG. NO.	STATE	PROJECT NUMBER	SHEET NO.	TO SHEET
1	MAINE	95-5(42)	22	3

Figure 1 consists of 18 diagrams, labeled A through R, illustrating various types of structural joints and connections. The diagrams are arranged in a grid-like fashion, with some diagrams showing multiple views or details of a joint.

- A:** A simple beam-column joint.
- B:** A beam-column joint with a horizontal beam and a vertical column.
- C:** A beam-column joint with a horizontal beam and a vertical column, showing a different detail.
- D:** A beam-column joint with a horizontal beam and a vertical column.
- E:** A beam-column joint with a horizontal beam and a vertical column.
All dimensions are out to out of reinf. bar

Bending details and hooks shall conform to the recommendations of ACI Standard 315-65.

Reinforcing Bar: ASTM A615 Grade 60

GENERAL NOTES

1. First digit(s) following the letter of the Mark indicates size of reinf. bar.
Mark (A 502) bar size - #5
Mark (P 1001) bar size - #10
Mark (S 603) bar size - #6
2. Letter of Marks A, P & S locates bars of Abutments, Piers, and Superstructure parts respectively.
3. Each truss bar (3500) may be replaced by two straight bars (one top and one bottom) of the same bar size, as the truss bar. Payment, in either case, shall be based on truss bars as scheduled on the plans.

STATE OF MAINE
DEPARTMENT OF TRANSPORTATION

INTERSTATE 95
OVER
ROUTE 138
IN THE TOWN OF
BOWDOINHAM
SAGADAHOC COUNTY
REINFORCING STEEL SCHEDULE SOUTH

SHEET 22 OF 31 AUGUSTA, MAINE March 1972


172-94

PLANS	DESIGN - DETAIL	BY	DATE
	CHECKED	PUL	3-25
	REVISIONS		
	FIELD CHANGES		

REINFORCING STEEL SCHEDULE

FHWA REV. NO.	STATE	PROJECT NUMBER	SHEET NO.	TOTAL SHEETS
1	MAINE	95-5 (42)	23	31

TYPE-BENDING DIAGRAMS

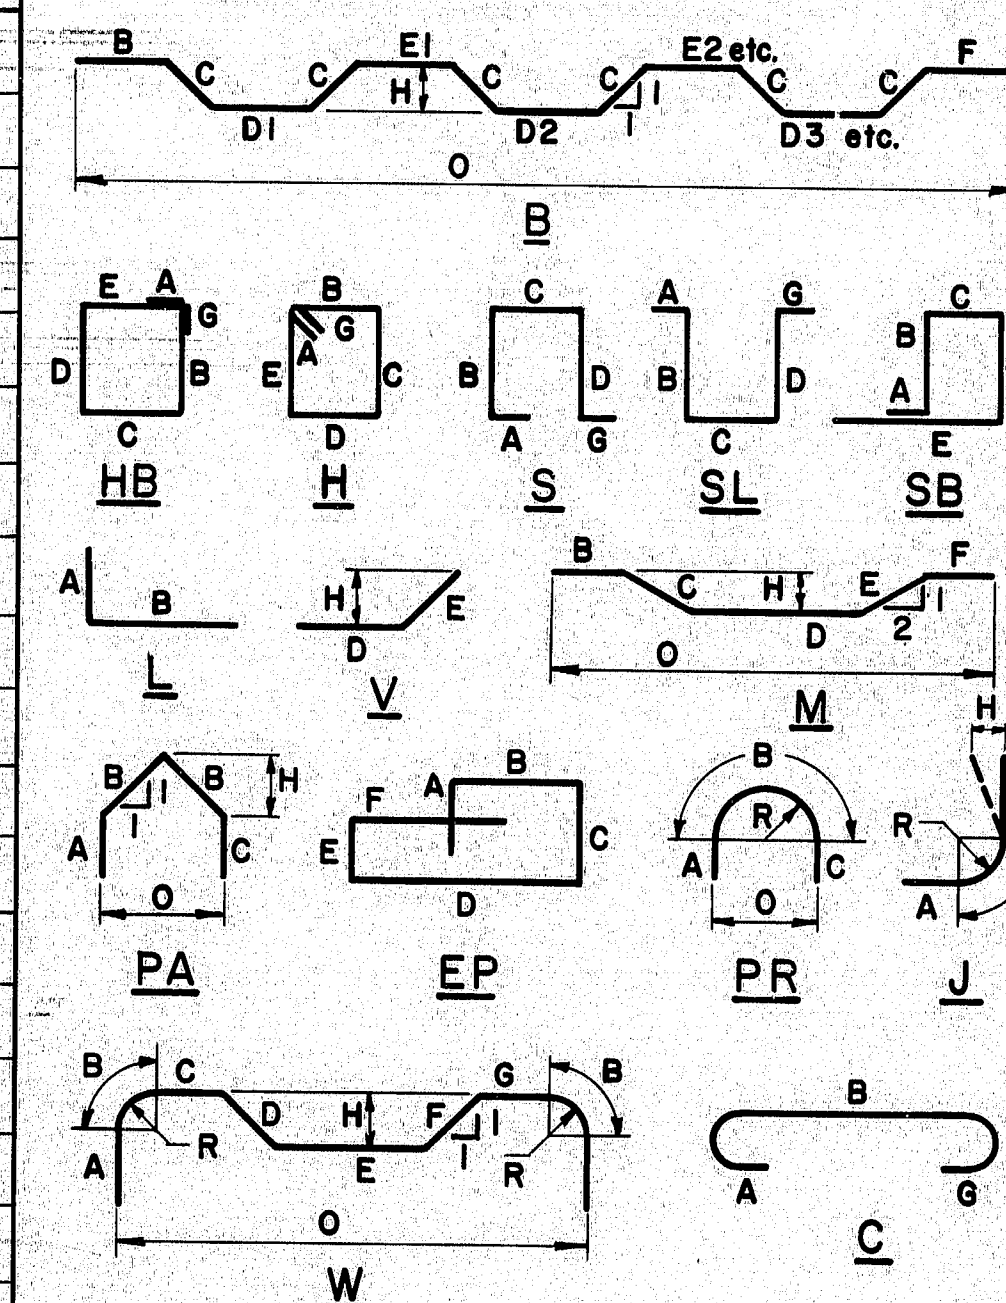

All dimensions are out to out of reinf. bar.
 Bending details and hooks shall conform to the recommendations of ACI Standard 315-65.
 Reinforcing Bar: ASTM A615 Grade 60

GENERAL NOTES

- First digit(s) following the letter of the Mark indicates size of reinf. bar.
 Mark (A 502) bar size - #5
 Mark (P 100) bar size - #10
 Mark (S 603) bar size - #6
- Each truss bar (S500) may be replaced by two straight bars (one top & one bottom) of the same bar size as the truss bar. Payment, in either case, shall be based on truss bars as scheduled on the plans.


STATE OF MAINE
 DEPARTMENT OF TRANSPORTATION

INTERSTATE 95
 OVER
 ROUTE 138
 IN THE TOWN OF
 BOWDOINHAM
 SAGadahoc COUNTY
 REINFORCING STEEL SCHEDULE NORTHBOUND
 SHEET 23 OF 31 AUGUSTA, MAINE March 1975

172-95

REINFORCING STEEL SCHEDULE																											
STRAIGHT BARS														BENT BARS													
MARK	NO.	LENGTH	LOCATION	MARK	NO.	LENGTH	LOCATION	MARK	NO.	LENGTH	LOCATION	MARK	NO.	LENGTH	TYPE	A	B	C	D	E	F	G	H	O	R	LOCATION	
ABUTMENT No. 1				ABUTMENT No. 1				ABUTMENT No. 2				ABUTMENT No. 1															
A500	55	4'-0"	Footing	A600	102	7'-0"	Footing	B537	2	13'-5"	West Wing	A502	30	17'-0"	L	4'-0"	13'-0"										Breastwall
A501	63	6'-3"	Footing	A601	16	30'-0"		B538	1	14'-6"		A505	28	5'-6"	S	0	2'-2"	1'-2"	2'-2"			0					Backwall
A503	30	16'-9"	Breastwall	A602	16	22'-4"		B539		5'-6"		A543	4	6'-0"	S	0	2'-4"	1'-4"	2'-4"			0					Parapet
A504	30	5'-8"	Breastwall	A603	70	8'-0"		B540		6'-6"		A546	4	5'-8"	S	0	2'-4"	1'-0"	2'-4"			0					Curb
A506	22	22'-0"	Breastwall	A604	18	19'-9"		B541		7'-6"																	
A507	3	24'-6"	Backwall	A605	13	18'-9"	Footing	B542		8'-7"																	
A508	26	23'-4"	Breastwall & Backwall					B543	1	9'-7"		A100	40	8'-8"	J	0'-9"	1'-7"	6'-4"					0		12"	Footing	
A509	18	4'-6"	Breastwall					B544	2	10'-8"	West Wing																
A510	8	18'-8"	Breastwall																								
A511	14	2'-0"	Approach Slab Seat																								
A512	21	7'-0"	Wings																								
A513	40	6'-6"	Wings																								
A514	18	14'-8"	East Wing	ABUTMENT No. 2				B600	46	12'-3"	Footing	ABUTMENT No. 2															
A515	2	12'-3"		B500	58	4'-0"	Dowel Breastwall	B601	26	17'-8"		B502	30	19'-0"	L	15'-0"	4'-0"										Breastwall
A516	1	8'-0"		B501	63	6'-3"	Dowel Breastwall	B602	26	30'-0"		B505	28	5'-8"	S	0	2'-3"	1'-2"	2'-3"			0					Backwall
A517		3'-8"		B503	30	6'-0"	Breastwall	B603	48	11'-0"		B506	4	6'-0"	S	0	2'-4"	1'-4"	2'-4"			0					Parapet
A518		8'-9"		B504	38	19'-0"	Backwall	B604	48	22'-8"	Footing	B545	4	5'-8"	S	0	2'-4"	1'-0"	2'-4"			0					Curb
A519		9'-10"		B506	8	3'-3"	Backwall	B605	46	8'-3"	Wings																
A520		10'-11"		B507	22	21'-9"	Breastwall					B900	52	12'-5"	J	3'-2"	1'-7"	7'-6"						12"	Footing		
A521		11'-11"		B508	22	23'-0"	Backwall																				
A522		13'-0"		B509	22	4'-6"	Breastwall	B800	39	17'-3"	Footing																
A523		6'-9"		B510	10	24'-3"	Backwall																				
A524		7'-10"																									
A525		8'-11"		B512	14	2'-0"	Approach Slab Seat																				
A526		9'-11"		B513	2	9'-6"	East Wing																				
A527		11'-0"	East Wing	B514	1	10'-6"																					
A528		8'-6"	West Wing	B515		11'-6"																					
A529		9'-7"		B516		12'-6"		SUPERSTRUCTURE																			
A530		10'-7"		B517	1	13'-8"		S501	176	44'-4"	Slab Transverse	S500	89	46'-3"	B		4'-0"	1'-6"	3'-3"	3'-9"	4'-0"		5'-6"	44'-4"			Slab Transverse
A531		11'-7"		B518	2	14'-6"	East Wing	S502	160	30'-0"	Slab Longitudinal	S505	188	5'-0"	S	6"	1'-6"	1'-0"	1'-6"			6"					Curb
A532		12'-7"		B519	4	2'-4"	Wings	S503	80	32'-0"	Slab Longitudinal																
A533		13'-8"		B520	1	7'-0"		S504	20	15'-0"	Curb																
A534		6'-6"		B521	1	11'-8"		S506	4	12'-3"	Curb																
A535		7'-7"		B522	4	16'-4"		S507	8	5'-0"	Slab at Drains																
A536		8'-7"		B523	40	16'-8"		S300	90	40'-6"	Wearing Surface																
A537		9'-7"		B524	24	8'-0"	Wings	S301	82	30'-0"	Wearing Surface																
A538		10'-7"						S302	41	31'-6"	Wearing Surface																
A539		11'-8"		B526	2	5'-8"	East Wing																				
A540		13'-0"		B527	1	6'-8"																					
A541	1	8'-8"		B528		7'-8"																					
A542	2	4'-0"	West Wing	B529		8'-8"																					
				B530	1	9'-8"																					
A544	2	16'-6"	West Wing	B531	2	10'-8"	East Wing																				
A545	2	15'-6"	East Wing	B532	4	17'-6"	Wings																				
A547	18	15'-8"	West Wing	B533	2	9'-4"	West Wing																				
				B534	1	10'-4"																					
				B535	1	11'-4"																					
				B536	2	12'-5"	West Wing																				
MARK	NO.	LENGTH	TYPE	A	B	C	D	E	F	G	H	O	R	LOCATION													

DESIGN - DETAIL
 CHECKED
 PLANS
 DATE
 BY
 P/L
 FIELD CHANGES

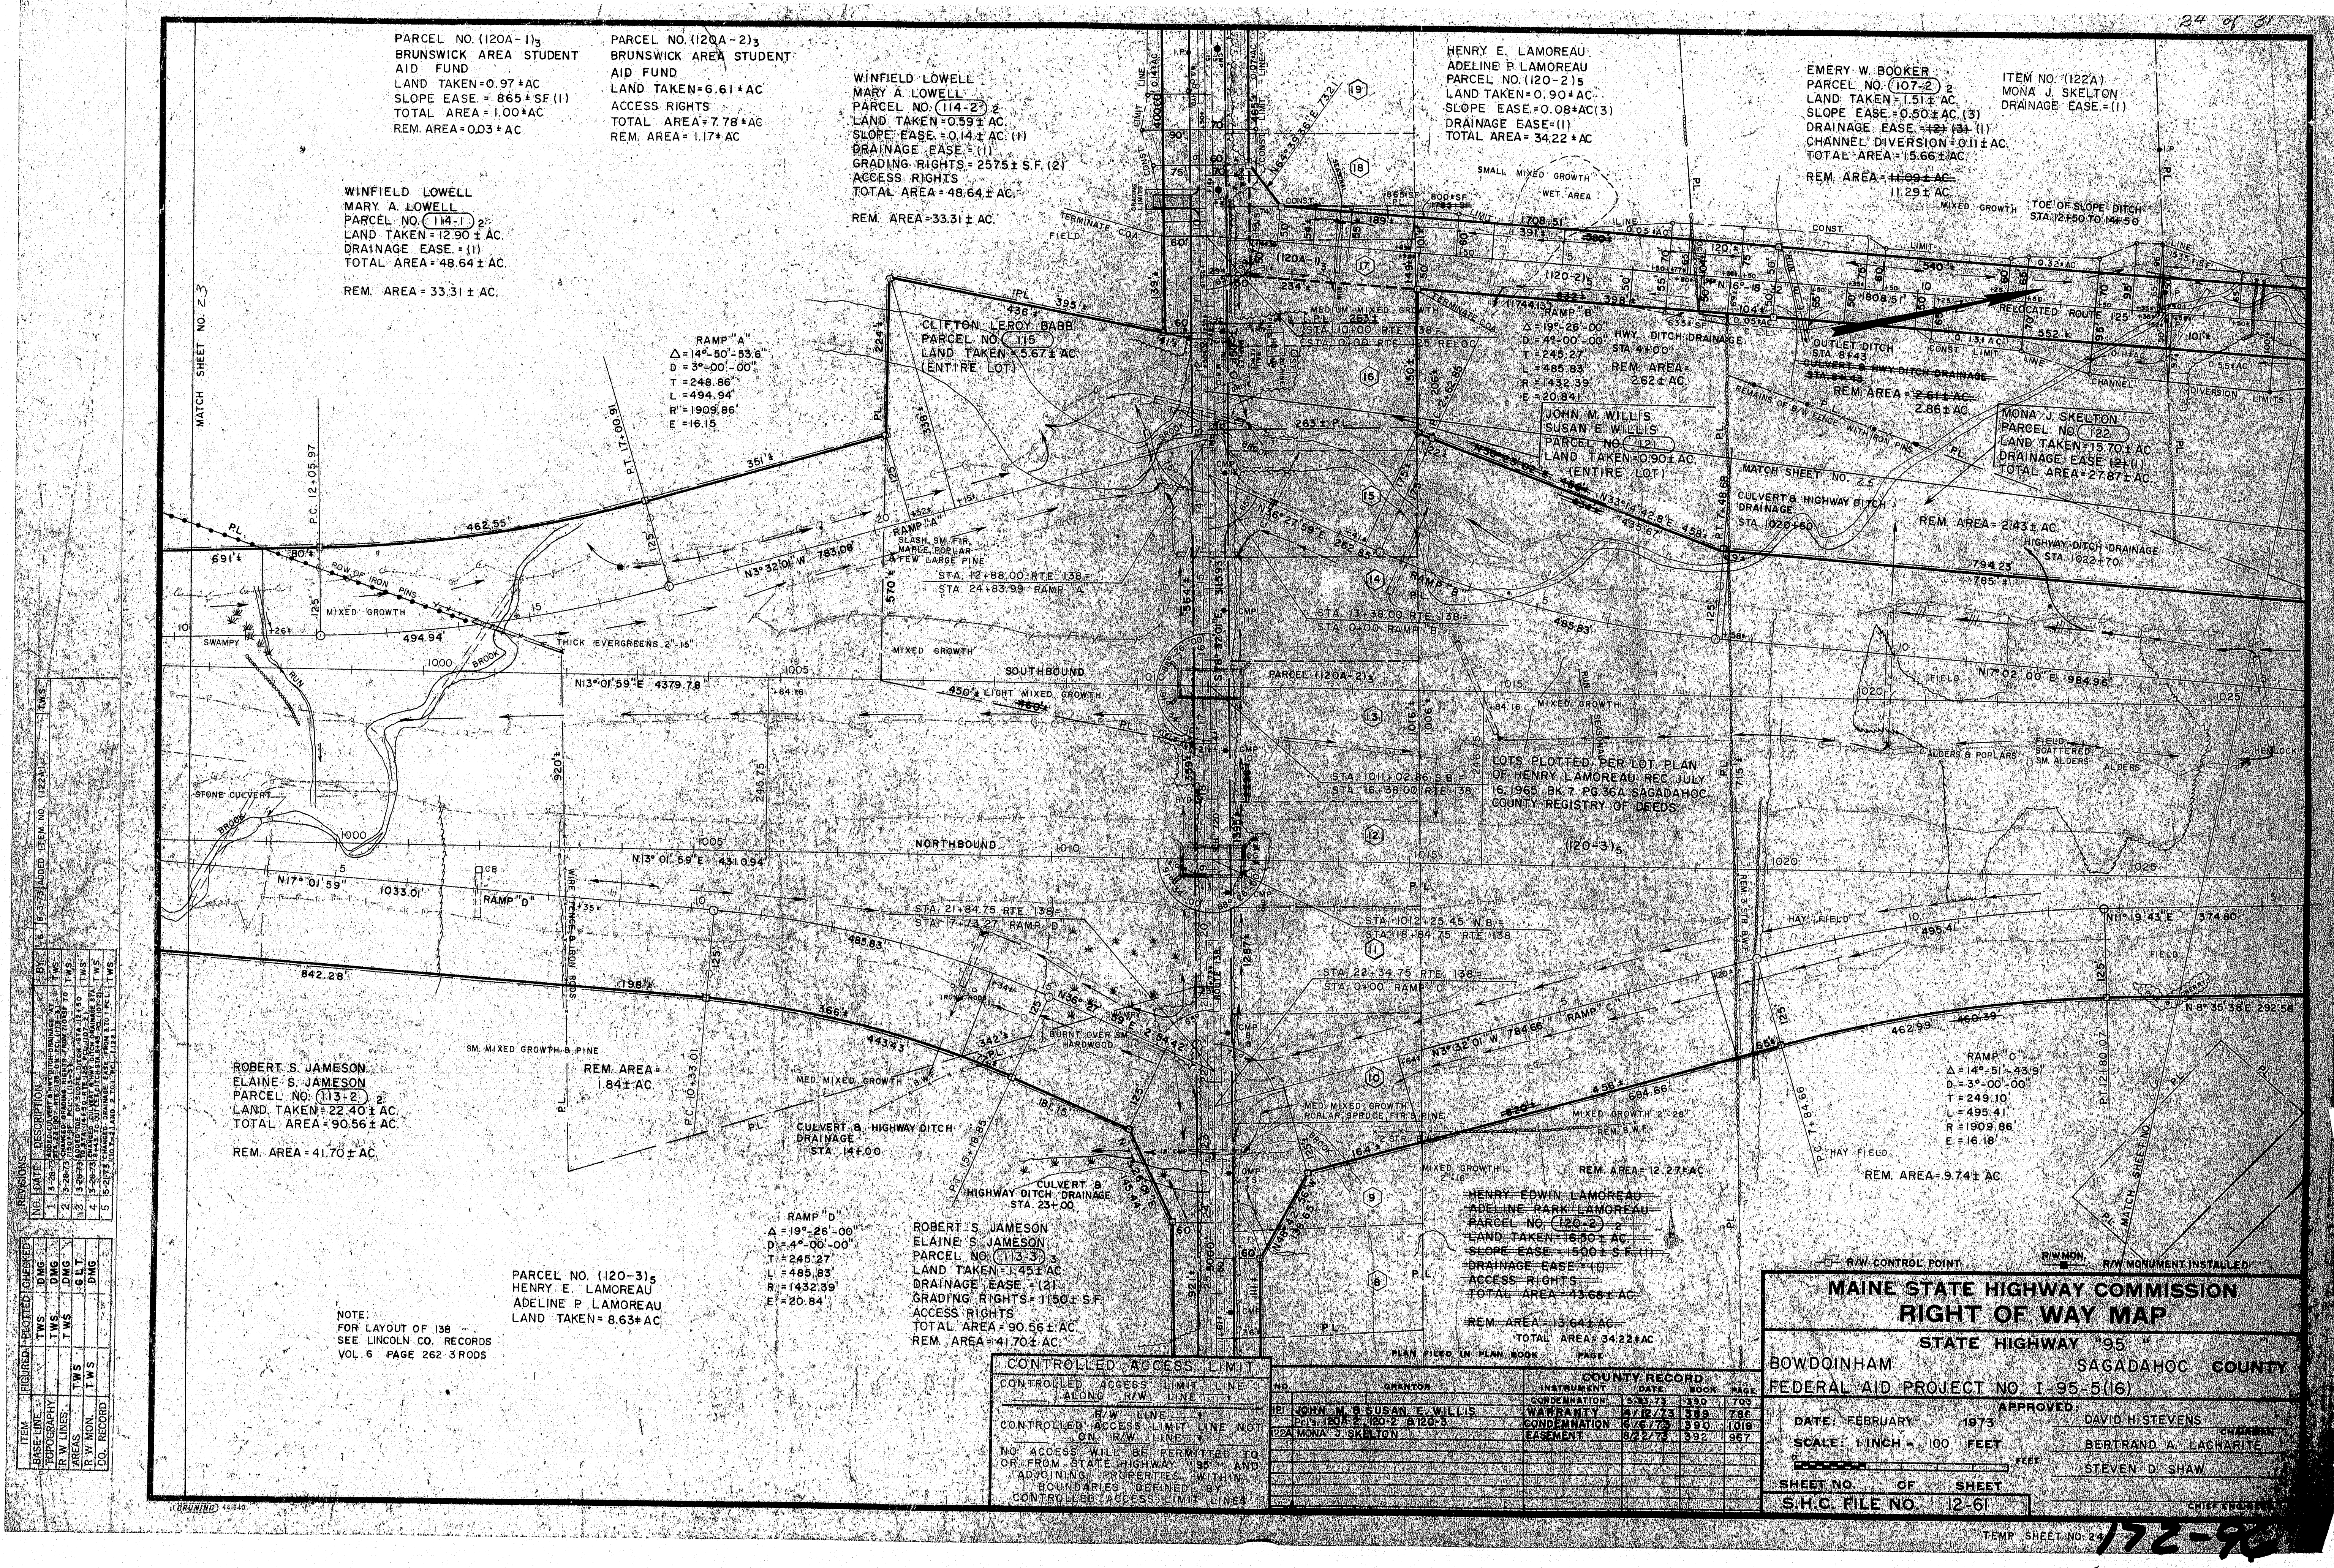

NO.	DATE	DESCRIPTION	BY	REVISED	ITEM NO.	ITEM
1	12-27-73	REVISION	TWS	1	12-27-73	12-27-73
2	12-27-73	REVISION	TWS	2	12-27-73	12-27-73
3	12-27-73	REVISION	TWS	3	12-27-73	12-27-73
4	12-27-73	REVISION	TWS	4	12-27-73	12-27-73
5	12-27-73	REVISION	TWS	5	12-27-73	12-27-73


ITEM	REVISION	DATE	BY	REVISED	ITEM NO.	ITEM
1	12-27-73	REVISION	TWS	1	12-27-73	12-27-73
2	12-27-73	REVISION	TWS	2	12-27-73	12-27-73
3	12-27-73	REVISION	TWS	3	12-27-73	12-27-73
4	12-27-73	REVISION	TWS	4	12-27-73	12-27-73
5	12-27-73	REVISION	TWS	5	12-27-73	12-27-73

CONTROLLED ACCESS LIMIT
NO ACCESS WILL BE PERMITTED TO OR FROM STATE HIGHWAY 139 AND ADJOINING PROPERTIES WITHIN BOUNDARIES DEFINED BY CONTROLLED ACCESS LIMIT LINES


NO.	GRANTOR	INSTRUMENT	DATE	BOOK	PAGE
1	JOHN W. SUSAN E. WILLIS	WARRANTY	4/12/73	138	78
2	MONA J. SKELTON	WARRANTY	6/27/73	139	101
3		EASEMENT	8/22/73	139	97

MAINE STATE HIGHWAY COMMISSION	
RIGHT OF WAY MAP	
STATE HIGHWAY 139	
BOWDOINHAM	SAGADAHOC COUNTY
FEDERAL AID PROJECT NO. 1-95-5(16)	
DATE: FEBRUARY 1973	APPROVED: DAVID H. STEVENS
SCALE: 1 INCH = 100 FEET	BERTRAND A. LACHARITE
SHEET NO. 12-61	STEVEN D. SHAW
S.H.C. FILE NO. 12-61	


TEMP SHEET NO. 172-96

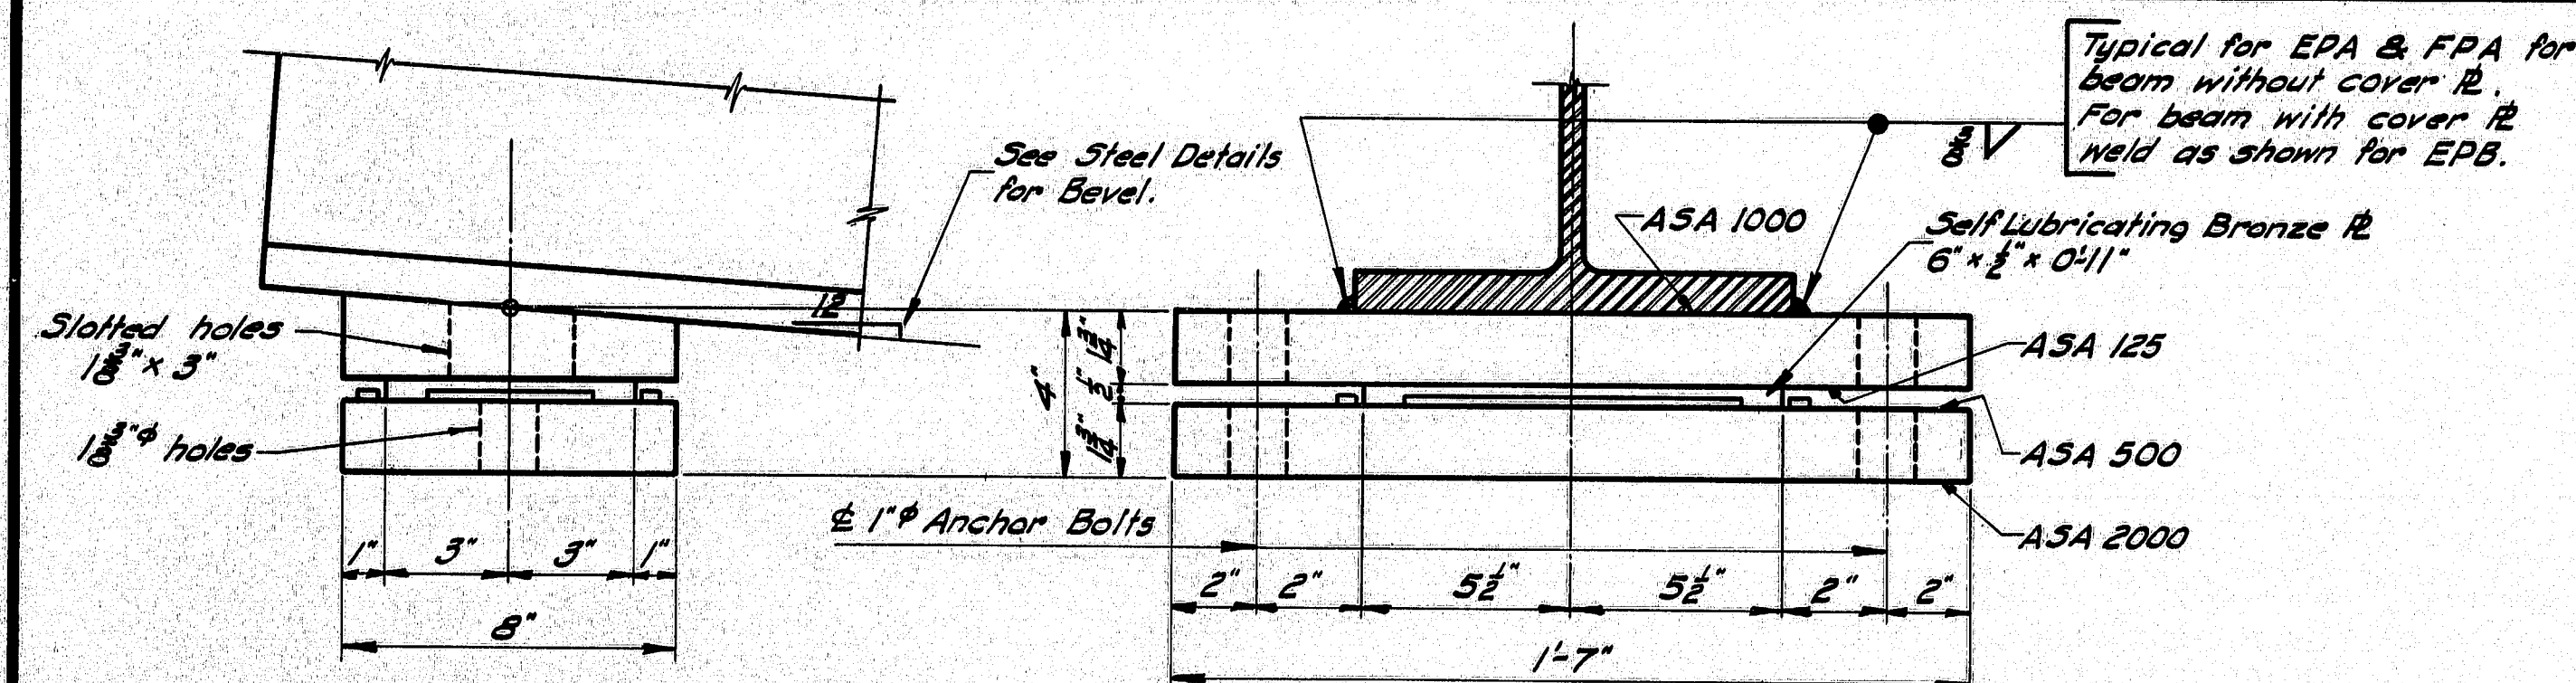


EXPANSION PEDESTAL - EPA

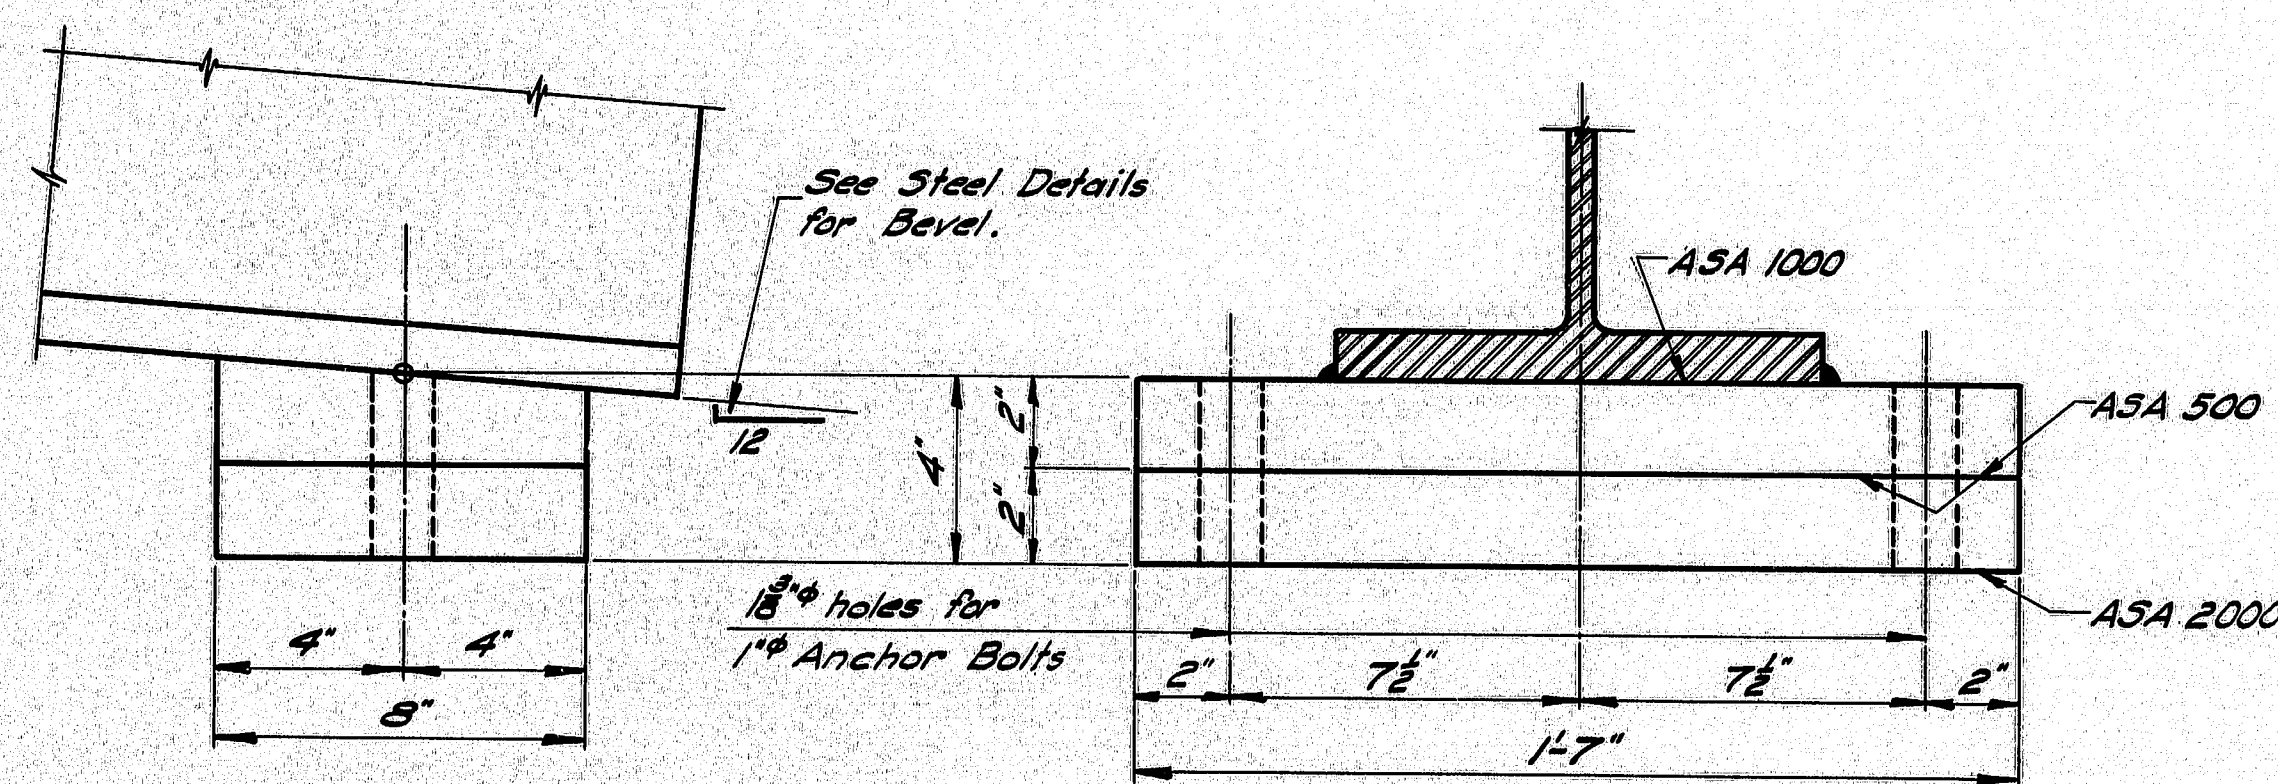


FIXED PEDESTAL - FPA

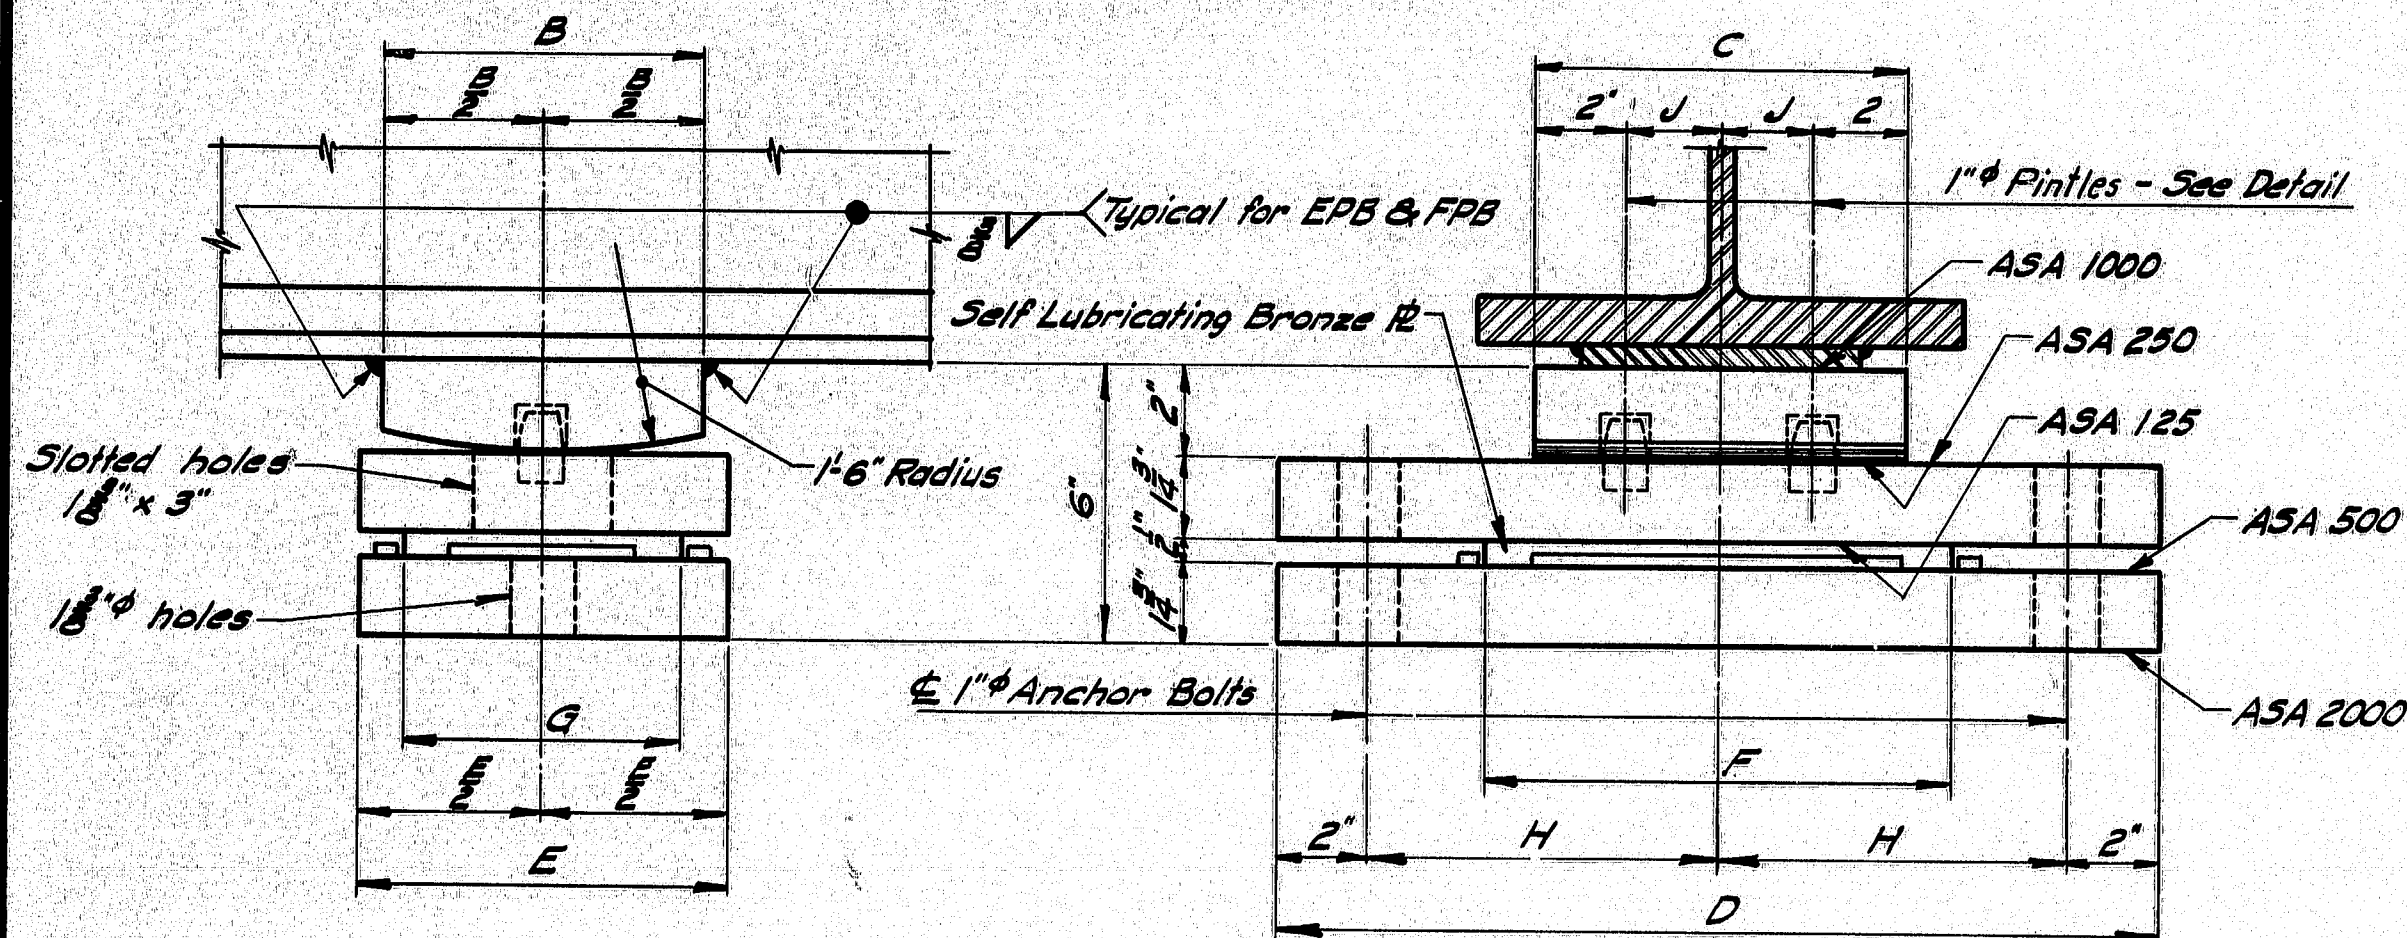


EXPANSION PEDESTAL - EPB

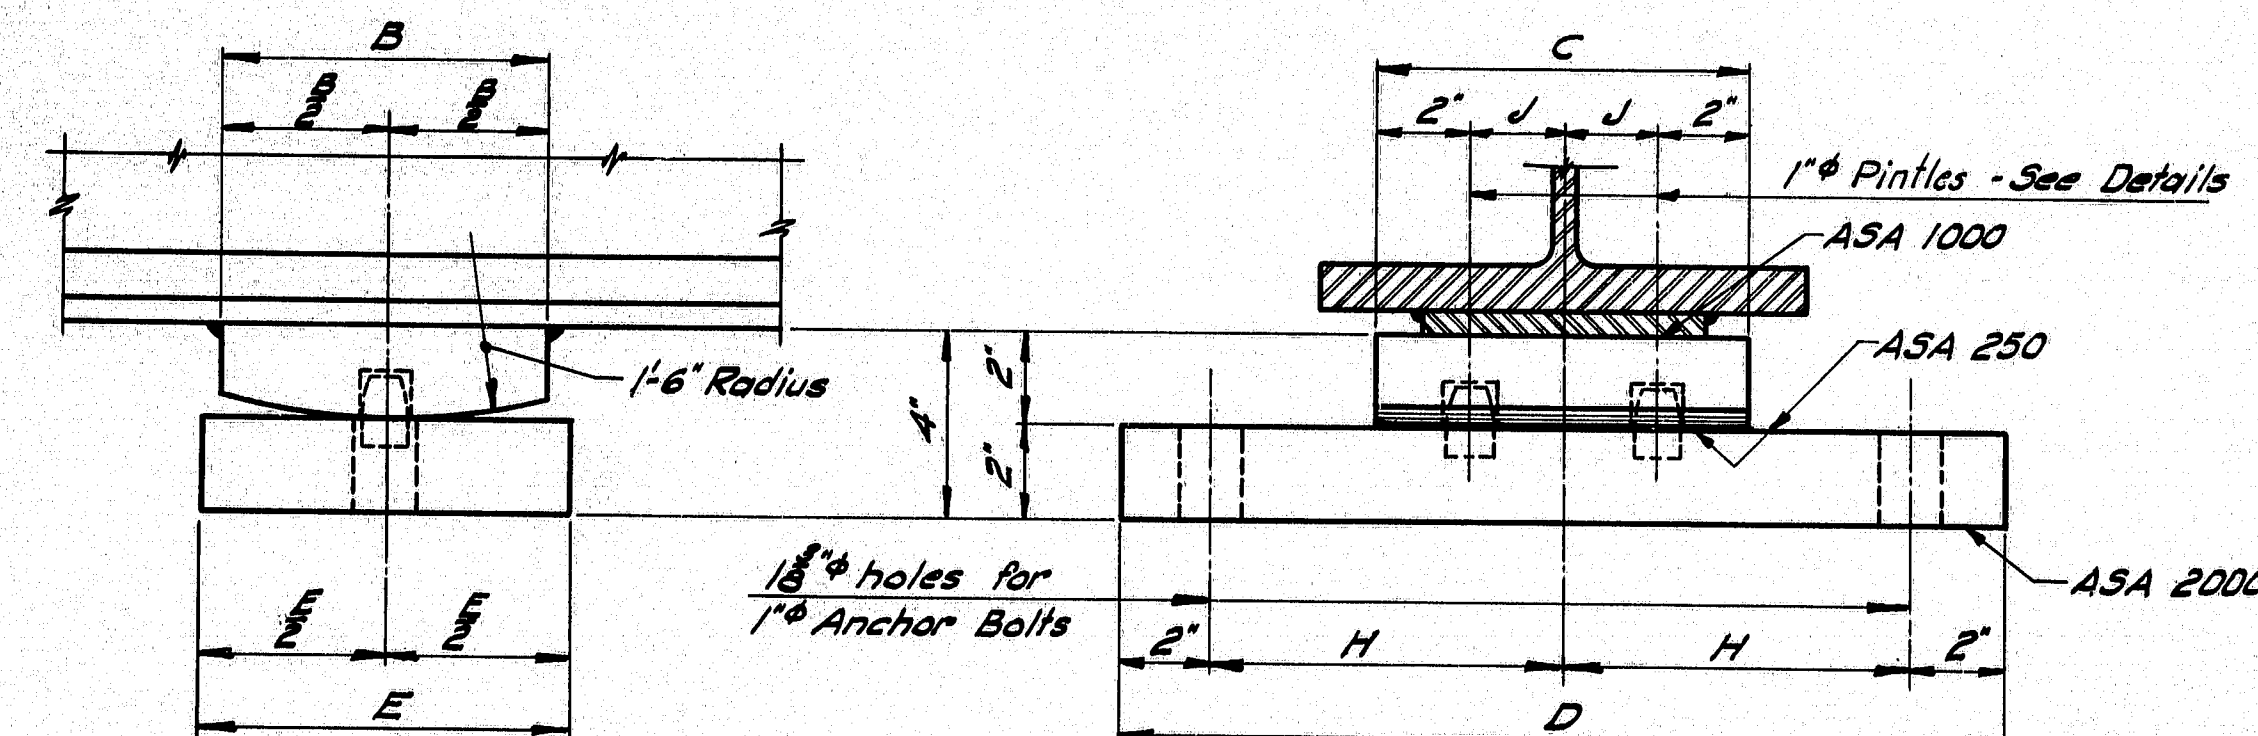


FIXED PEDESTAL - FPB

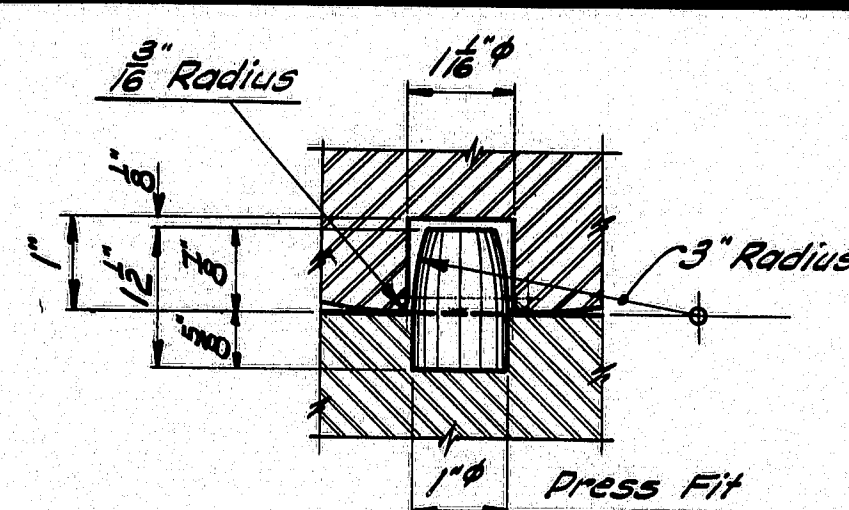

PINTLE DETAIL

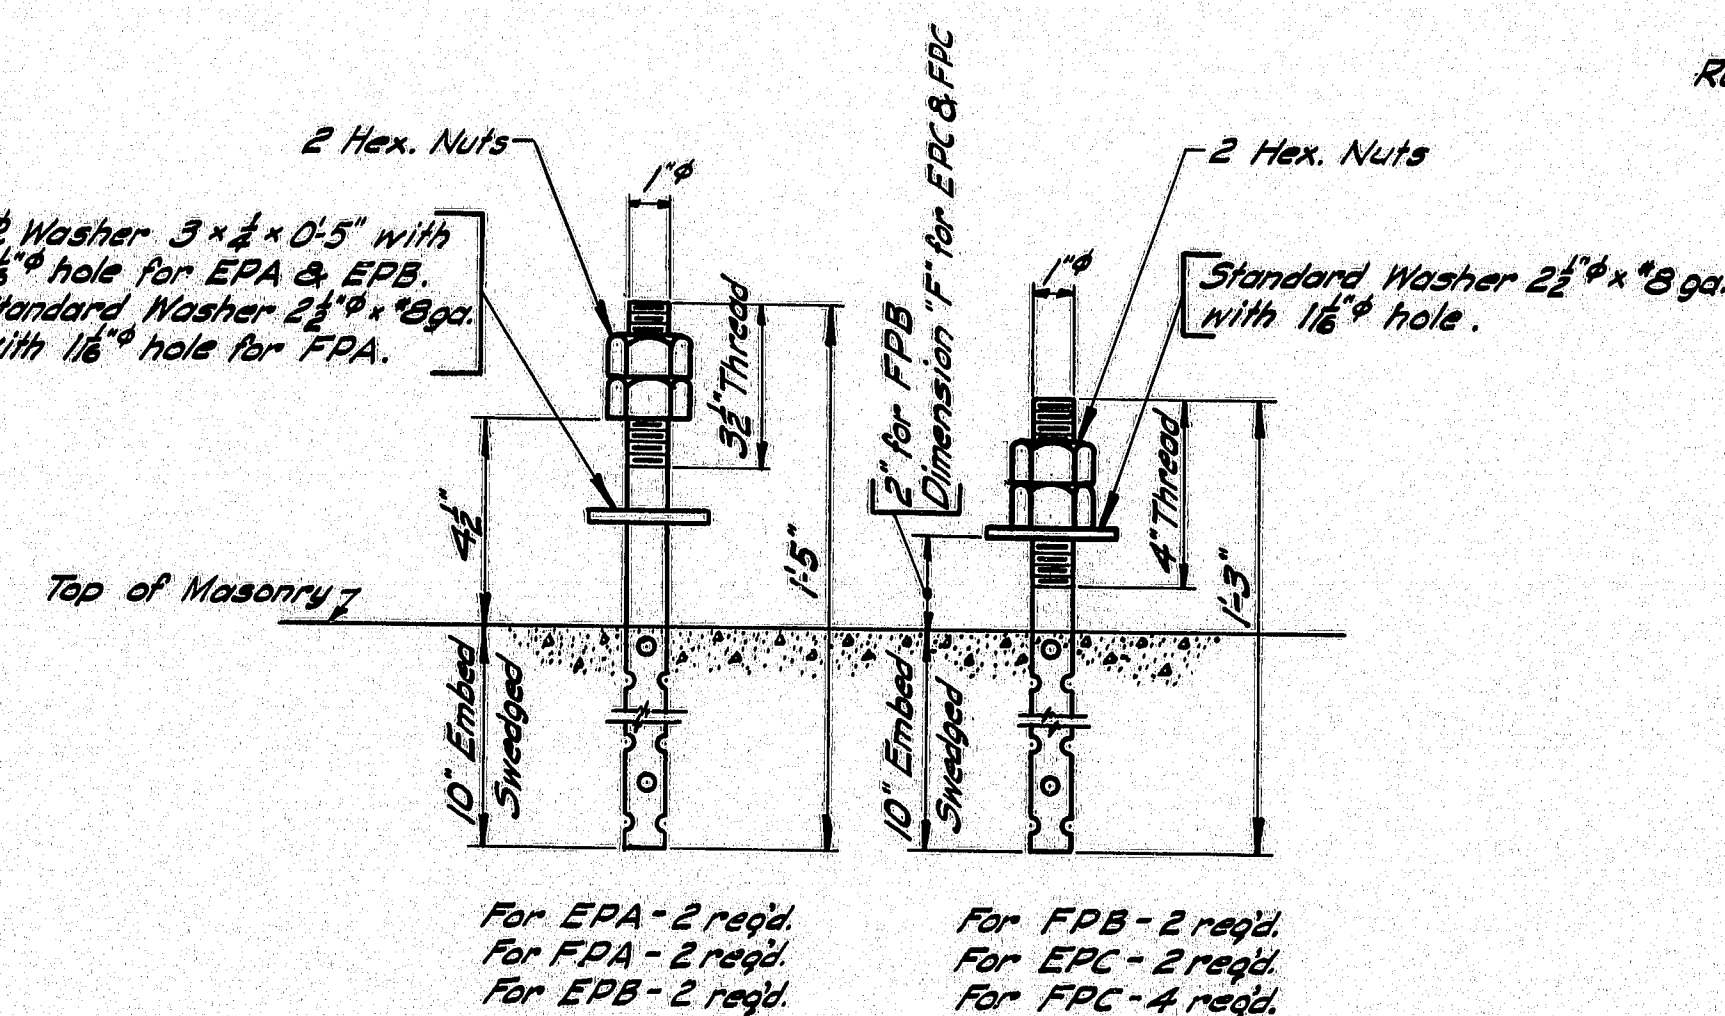

ANCHOR BOLT DETAIL

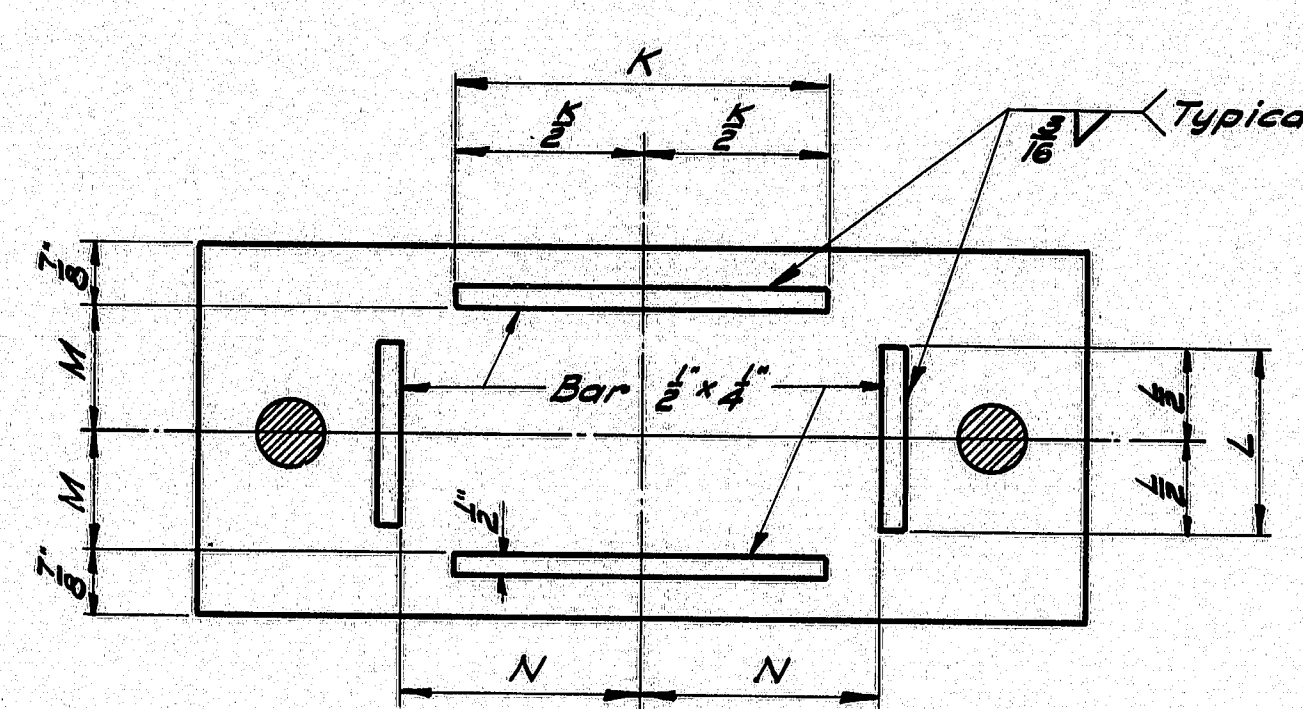

FOR EPA & EPB
MASONRY PLATE

PEDESTALS - ALLOWABLE LOADS & DIMENSIONS													
Pedestal	Load	A	B	C	D	E	F	G	H	J	K	L	M
EPA	132K	-	-	-	-	-	-	-	-	-	8"	4"	3 1/2"
FPA	130K	-	-	-	-	-	-	-	-	-	-	-	-
EPB-1	120K	-	6"	8"	14 7/8"	8"	10"	6"	7 1/2"	2"	8"	4"	3 1/2"
EPB-2	165K	-	7"	10"	14 7/8"	9"	14 0"	7"	8"	3"	10"	5"	3 1/2"
EPB-3	224K	-	8"	11"	24 0"	10"	14 1/2"	8"	10"	4 1/2"	11 1/2"	5"	4 1/2"
FPB-1	120K	-	6"	8"	14 7/8"	8"	-	-	7 1/2"	2"	-	-	-
FPB-2	165K	-	7"	10"	14 7/8"	9"	-	-	8"	3"	-	-	-
FPB-3	224K	-	8"	11 1/2"	24 0"	10"	-	-	10"	5"	-	-	-
EPC-1	70K	9 1/2"	6"	8"	14 7/8"	8"	14 1/2"	3 1/2"	3"	3"	4 1/2"	-	6"
EPC-2	100K	11 1/2"	8"	8"	14 7/8"	8"	14 1/2"	3 1/2"	3"	3"	6 1/2"	-	6"
EPC-3	130K	14 1/2"	10"	8"	14 7/8"	9"	14 1/2"	4"	3"	3"	8 1/2"	-	7"
EPC-4	160K	17 1/2"	10"	8"	14 7/8"	9"	14 1/2"	4"	3"	3"	8 1/2"	-	7"
EPC-5	190K	20 1/2"	10"	9"	24 0"	10"	24 0"	5"	3"	3"	8 1/2"	-	8"
EPC-6	220K	23 1/2"	14 1/2"	10"	24 0"	14 0"	24 0"	5"	3"	3"	10 1/2"	-	8"
EPC-7	250K	26 1/2"	14 1/2"	14 0"	24 0"	14 0"	24 0"	5"	3"	3"	10 1/2"	-	8"
FPC-1	100K	-	-	8"	14 7/8"	9"	14 1/2"	3 1/2"	8"	-	6 1/2"	-	6"
FPC-2	160K	-	-	8"	14 7/8"	10"	14 1/2"	3 1/2"	8"	-	6 1/2"	-	7"
FPC-3	190K	-	-	9"	24 0"	10"	14 1/2"	3"	10"	-	6 1/2"	-	8"
FPC-4	220K	-	-	10"	24 0"	14 0"	14 1/2"	4"	10"	-	6 1/2"	-	8"
FPC-5	250K	-	-	14 0"	24 0"	14 0"	24 0"	4"	10"	-	6"	-	8"

NOTE: At the location of bearing pedestals the concrete bridge seats shall be dressed one inch larger all around than size of masonry plates and to exact elevations shown on the plans. If dressed areas are below the surface of the surrounding bridge seat a small channel shall be cut to the edge of the bridge seat for drainage where required by the Engineer. Channels shall have a min. width of 2" and min. slope of 1/8" inch per foot. No separate payment for this work will be made as it shall be considered incidental to contract items.

DESIGN SPECIFICATIONS

A.A.S.H.O., Standard Specifications for Highway Bridges, 1973

A.S.T.M. STEEL CLASSIFICATION

Anchor Bolts - A36
All other - A36.


STANDARD DETAILS
(BD 101-74)

BEARING PEDESTALS

A Charpy V Notch tests are not required

REVISIONS

DATE

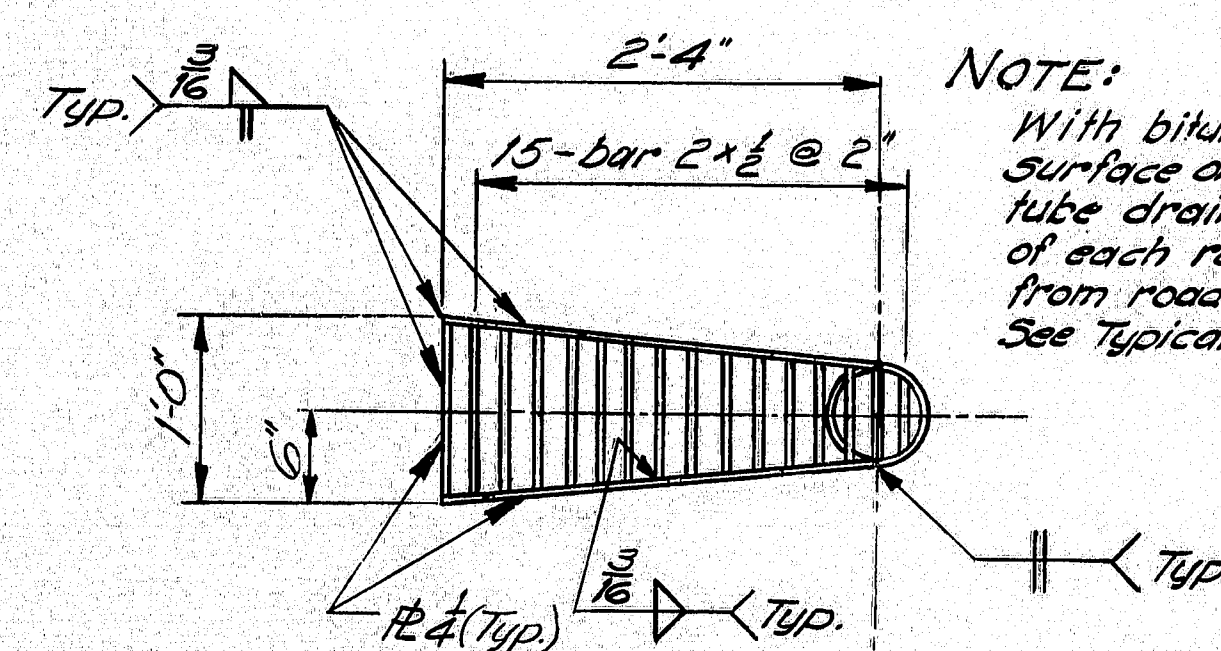


NOTE:

With bituminous wearing surface only, place 1" plastic tube drain on upgrade side of each roadway drain, 3' from roadway drain. See Typical Curb Section.

NOTE:


Alternate pointed reinforced pile tips may be used if they have at least the cross-sectional area of the pile tip shown, and are approved by the Engineer.

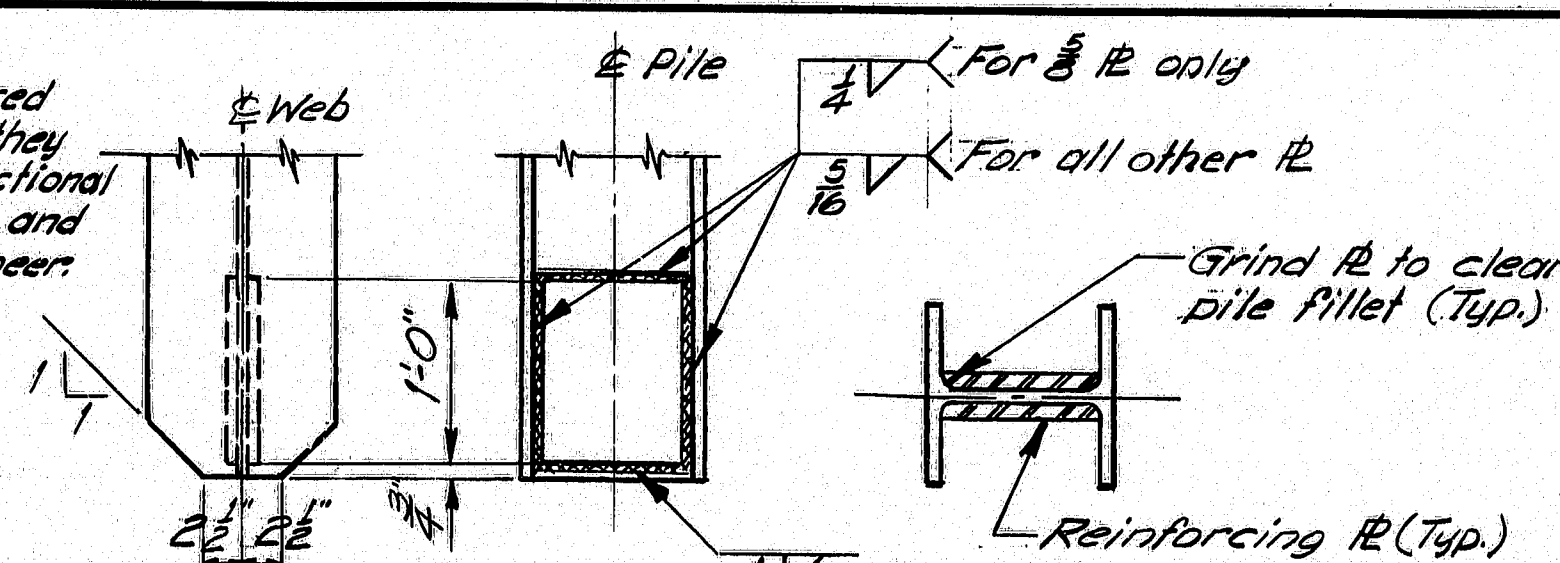


POINTED REINFORCED PILE TIP

Note: Plates may be shop or field welded


PILE SIZE	REINF. R. SIZE
HP 10 x 42	8# x 3/8 x 1'-0"
HP 10 x 57	8# x 3/8 x 1'-0"
HP 12 x 53	10# x 3/8 x 1'-0"
HP 12 x 74	10# x 3/8 x 1'-0"
HP 14 x 73	12# x 3/8 x 1'-0"
HP 14 x 89	12# x 1 x 1'-0"

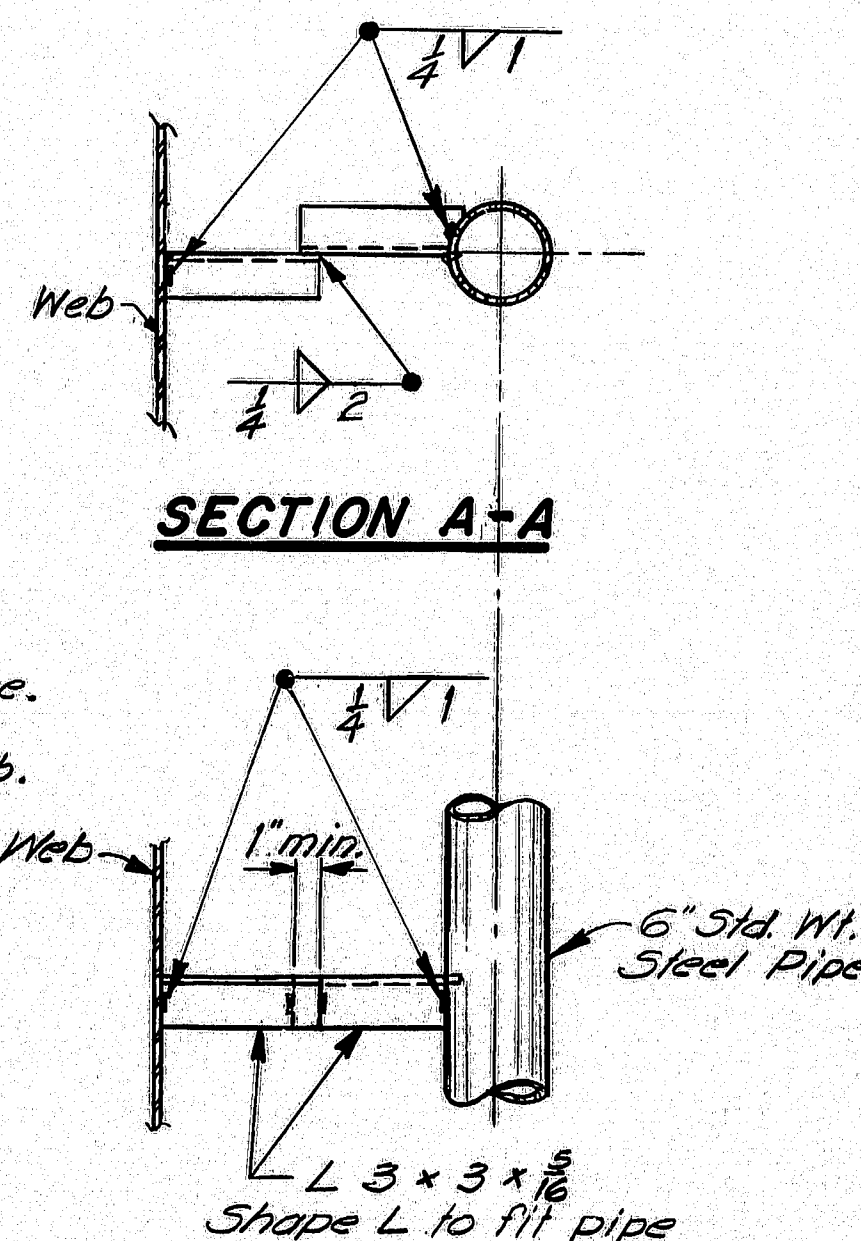

SECTION A-A

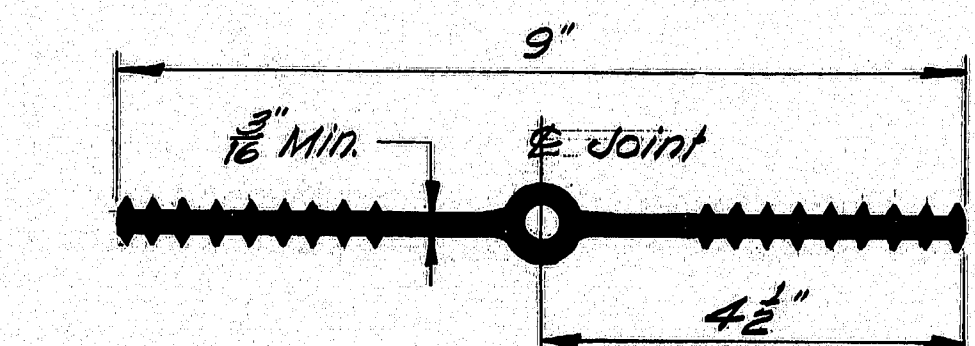


POLYVINYLCHLORIDE WATERSTOP

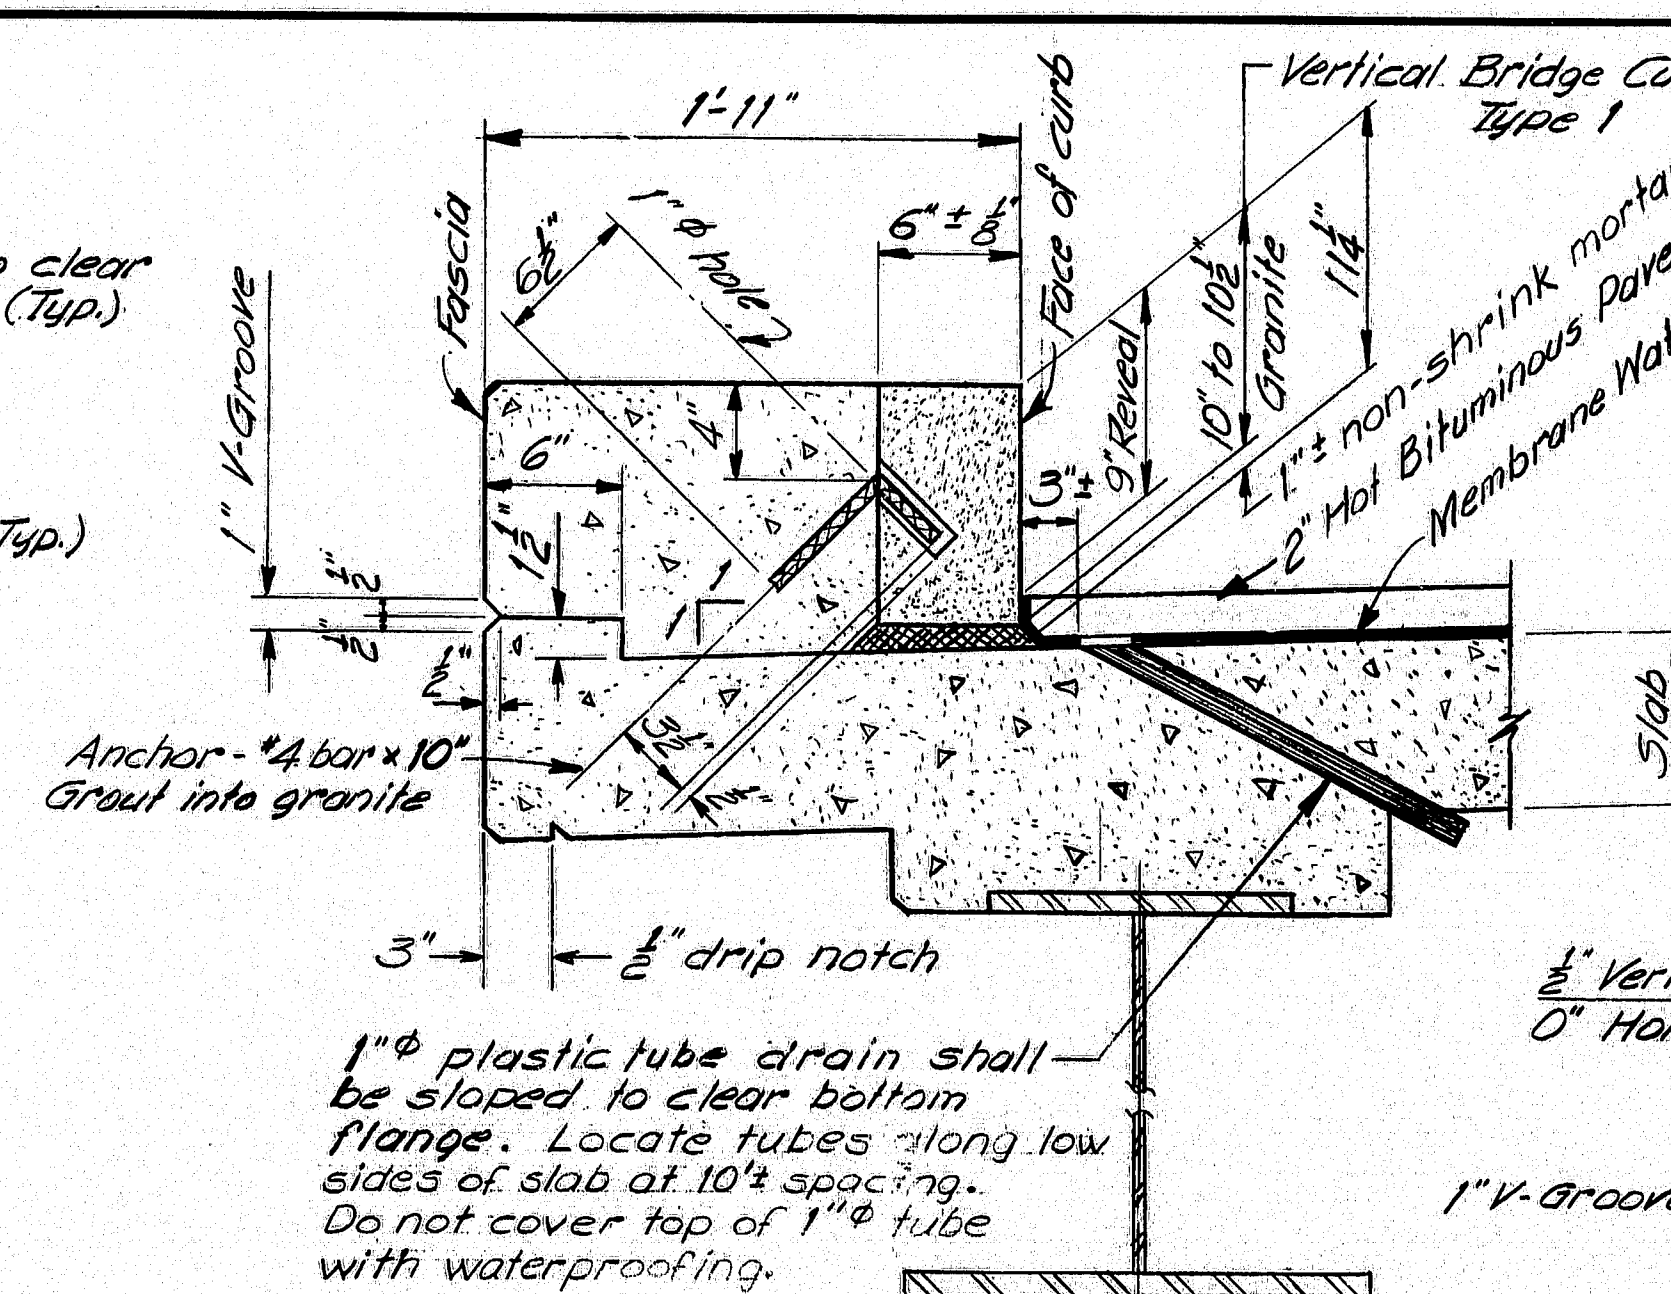

CURB SECTION

(Hot Bituminous Pavement only)

CONSTRUCTION & CONTRACTION JOINTS

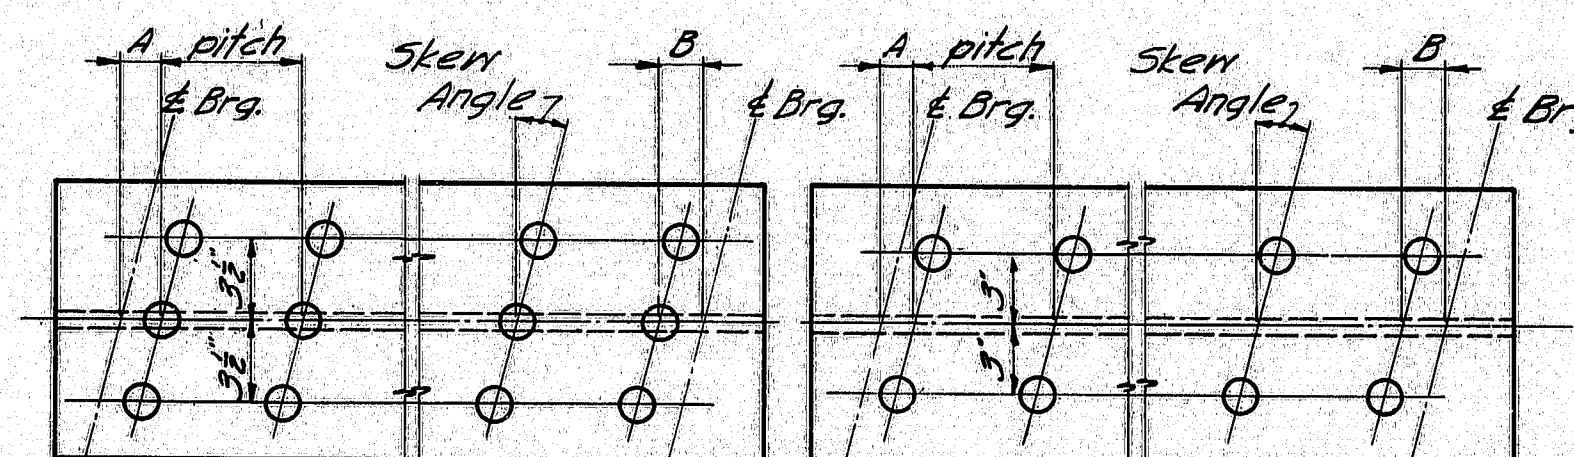

TRIPLE STUDS

DOUBLE STUDS

STUD DETAIL


NOTE

1. Studs shall be granular or solid flux filled and automatically welded to top flange in the shop or field.
2. See the design details for Dimensions 'A' & 'B', stud pitch and skew angle for studs.


SHEAR CONNECTORS

NOTE

Use only those items called for on design details. In case of conflict between these Standard Details and design details, the requirements of the design details shall be followed. Drains to be incidental, see sub-section 502.20

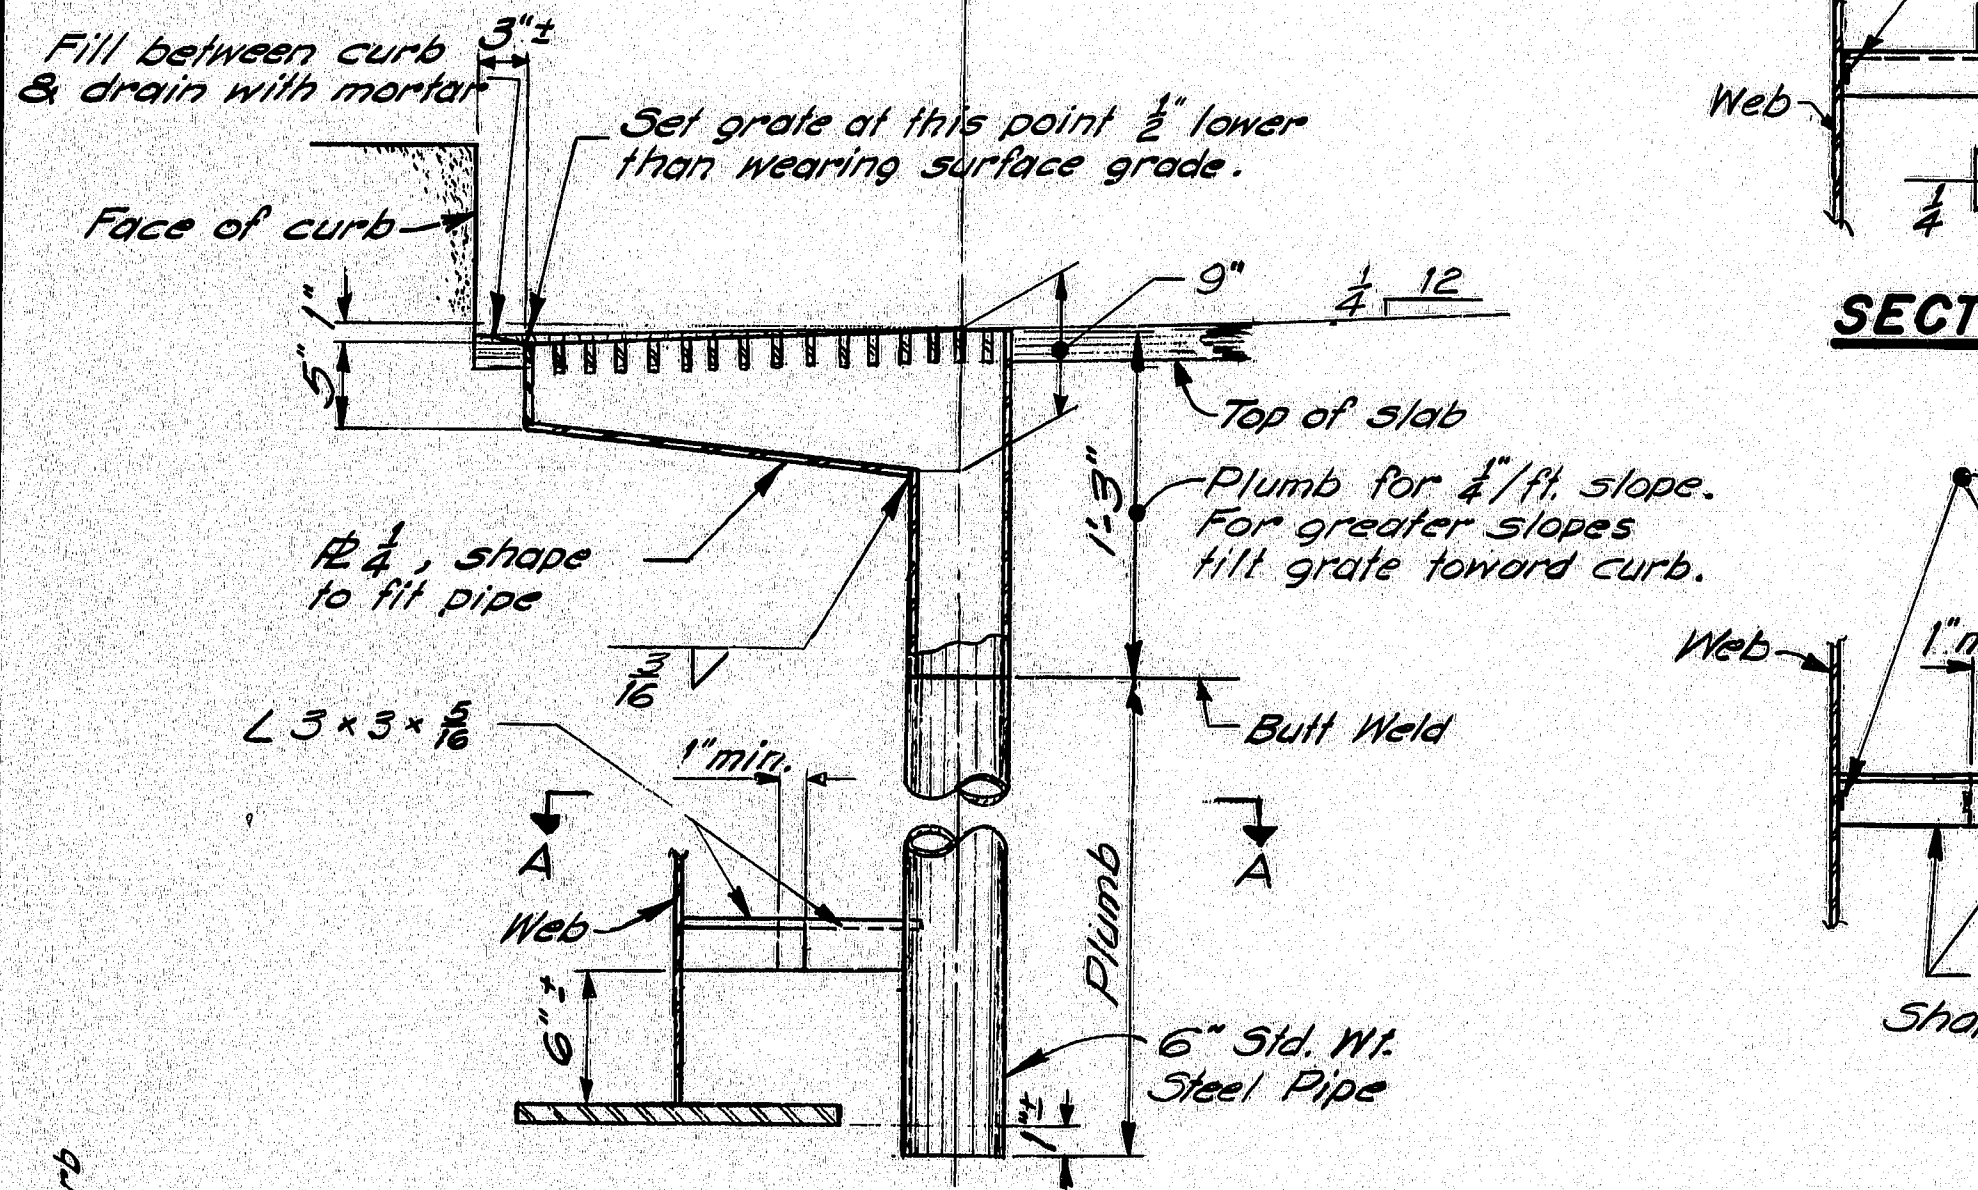


DRAIN

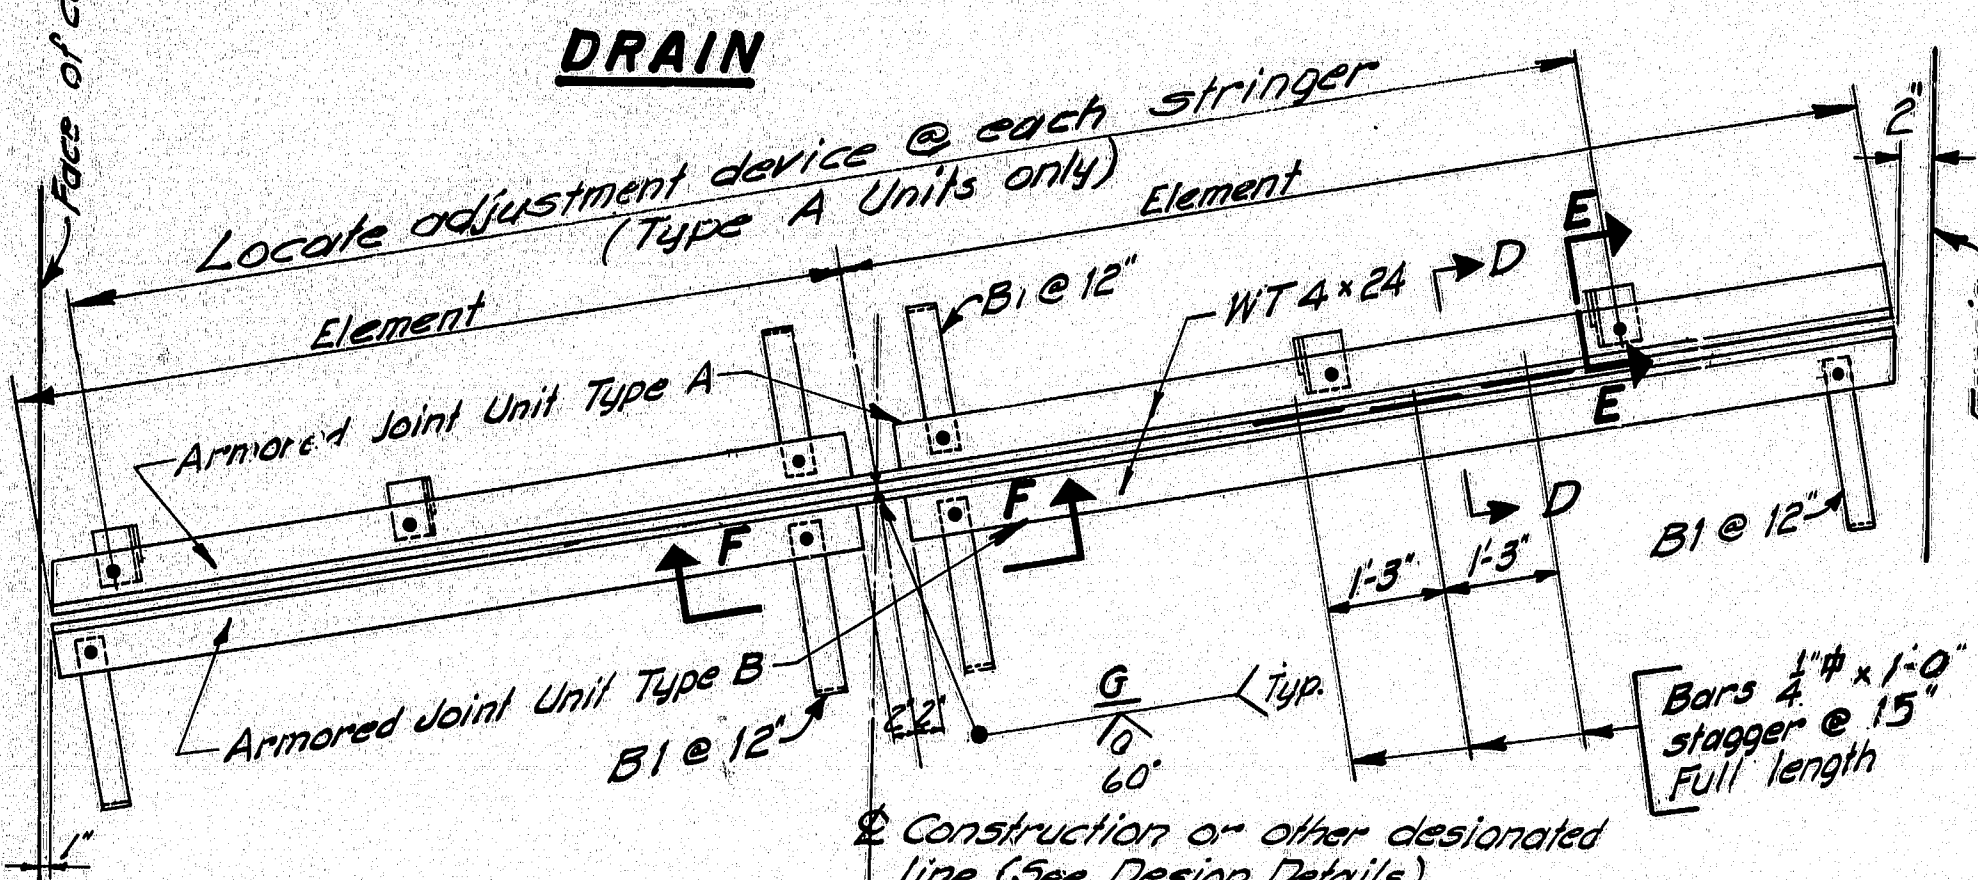

HALF PLAN

Curb to curb

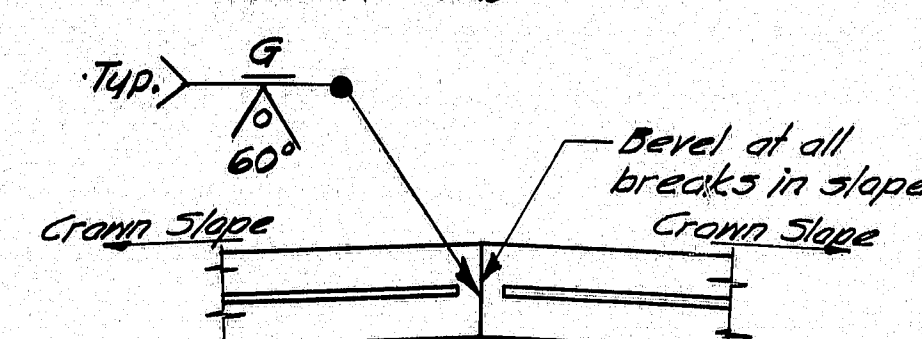

SECTION F-F

Note: See design details for construction of curb dimensions, skew, crown slope, slab thickness, other dimensions necessary to complete the fabrication details, and location.

HALF PLAN


Fascia to fascia

NOTE

1. Type A Armored Joint Units are intended to be used for attachment to superstructures. Type B Armored Joint Units are intended to be used for attachment to abutments. At armored joints over piers, two (2) Type A Armored Joint Units shall be used.
2. When more elements than two (2) are required by the design details, the elements of both units shall be field welded together in the same manner as shown in Section F-F.
3. Armored Joints to be paid for as Structural Steel.

ARMORED JOINT


An armored joint consists of two armored joint units. See note 1.

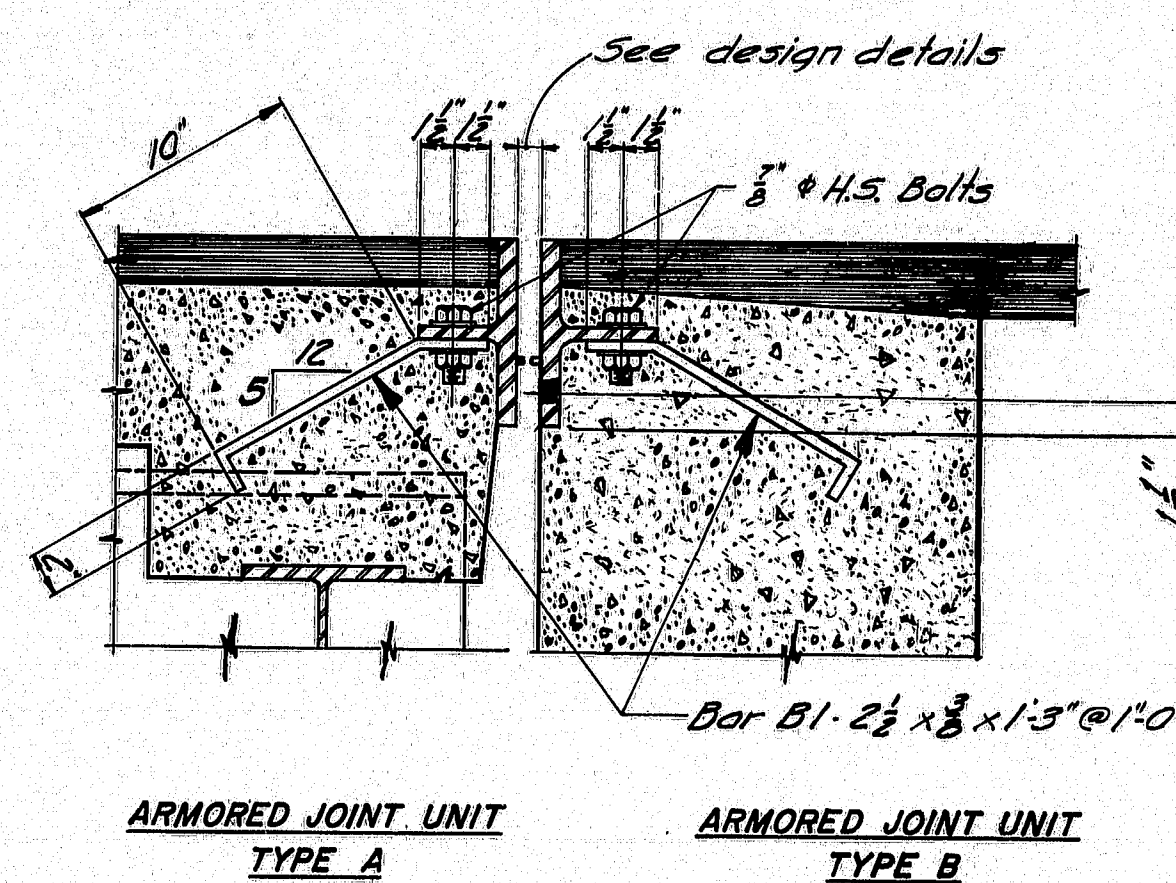

ARMORED JOINT UNIT TYPE A


ARMORED JOINT UNIT TYPE B

SECTION D-D

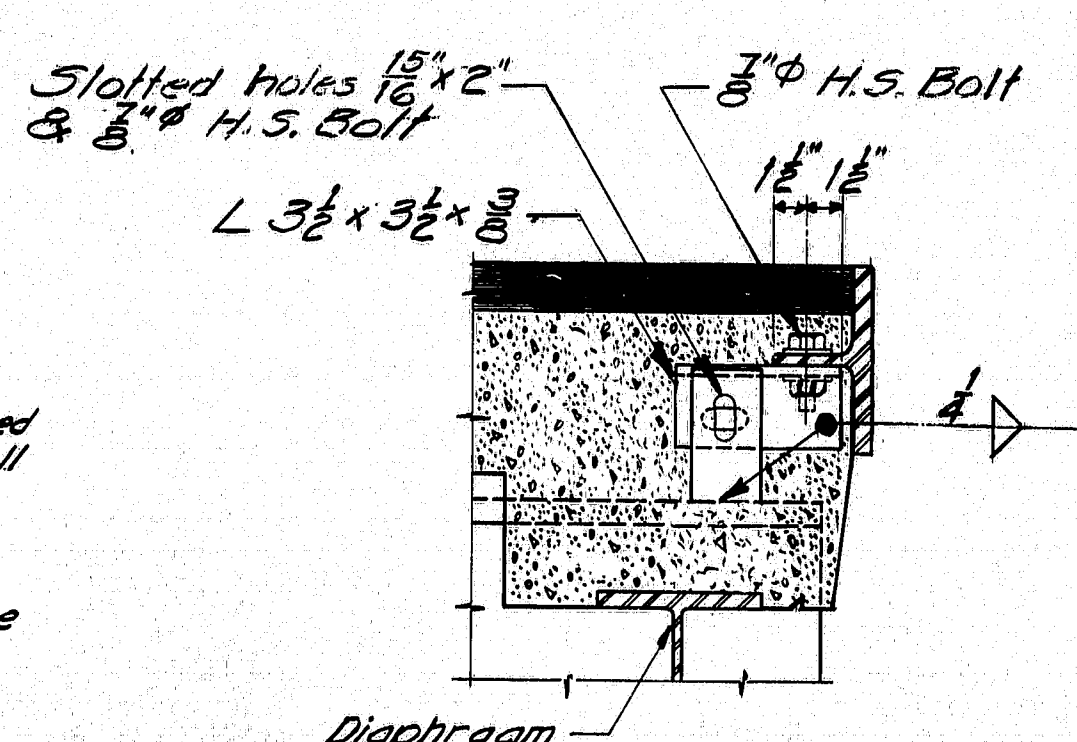


SECTION E-E

Showing Adjustment Device Armored Joint Unit Type A only. After unit is in final position weld bar to angle with 1/8" fillet.

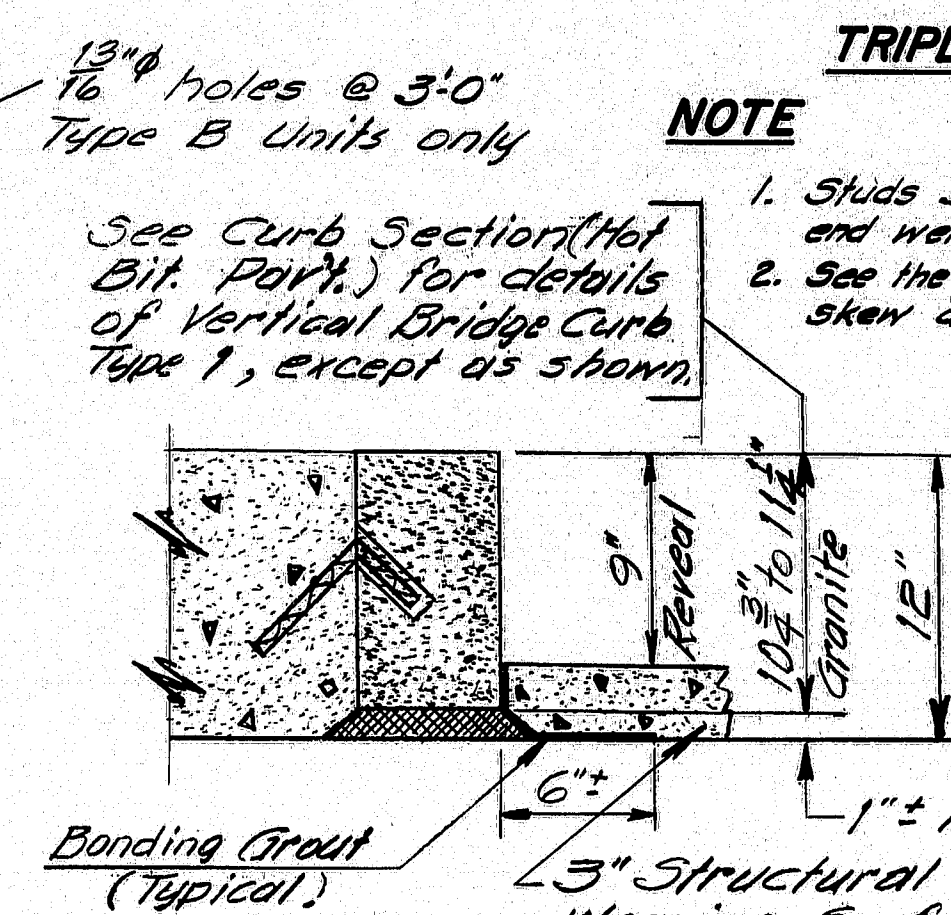

CURB SECTION

(Structural Concrete Wearing Surface)

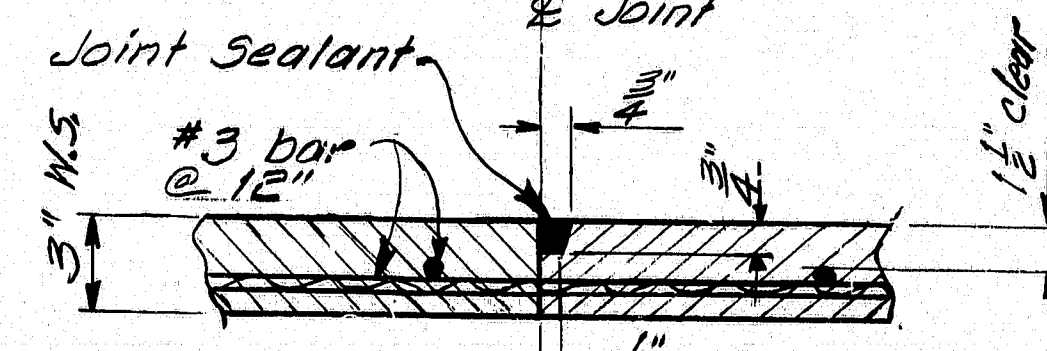

CONSTRUCTION JOINT

(Typical for concrete wear. surf.)

STATE OF MAINE
DEPARTMENT OF TRANSPORTATION

STANDARD DETAILS

(BD 104-73)

ARMORED JOINT, DRAIN

SHEAR CONNECTORS

MISC. STRUCTURAL DETAILS

F.H.A. NO.	STATE	PROJECT NUMBER	SHEET NO.	TOTAL SHEETS
1	MAINE	95-5 (42)	27	31

FABRICATION NOTES

1. For location and type of diaphragm or crossframe see design details.
2. Holes for $\frac{3}{8}$ " diameter bolts shall be $\frac{1}{8}$ " dia. and edge distances shall be $\frac{1}{2}$ " minimum unless otherwise shown.
3. Connection plates and gusset plates shall have a minimum thickness of $\frac{3}{8}$ " and shall have sufficient width to provide erection clearances. When bearing stiffeners or intermediate stiffeners are used as connection plates, the plate size will be given on the design details.
4. Connection plates shall be fastened to beam and girder webs as follows:
 0° to 30° skew... fillet weld both sides.
 Over 30° skew... full penetration groove weld (see Detail B) except as indicated in Note 5
 Over 45° skew... weld prequalification will be required.

The skew angle is the angle between the connection plate and a line normal to the beam.


5. Bearing stiffeners shall be used as connection plates when the skew is not over 30°. When the skew is over 30° a bent connection plate shall be attached to the web adjacent to the bearing stiffener as shown in Detail A.
6. All fillet weld sizes shall be the minimum for the thickness of metal being joined according to AWS Specifications for Welded Highway & Railway Bridges.
7. Connection plates on welded beams and girders shall extend to the top flange in areas where the top flange is always in compression or when used as a bearing stiffener or intermediate stiffener.
8. Connection plates shall extend to the bottom flange when used as a bearing stiffener, at points where lateral bracing is attached & on welded beams and girders in areas where the bottom flange is always in compression.
9. When a conn. plate is extended to a flange it shall be a paint tight fit except as otherwise indicated on design details.
10. Conn. plates shall be 2" clear from flanges, except as indicated by Notes 7 & 8.
11. Use only those items called for on the design details. In case of conflict between these standard details and the design details, the design details shall be followed.

STATE OF MAINE
DEPARTMENT OF TRANSPORTATION


STANDARD DETAILS (BD 113 - 72) **DIAPHRAGMS & CROSSFRAMES**

SHEET 27 OF 31 AUGUSTA, MAINE SEPT. 1972


NOTE A This dimension may be varied ($\pm 1"$) to allow a series of diagonals to have the same slope.

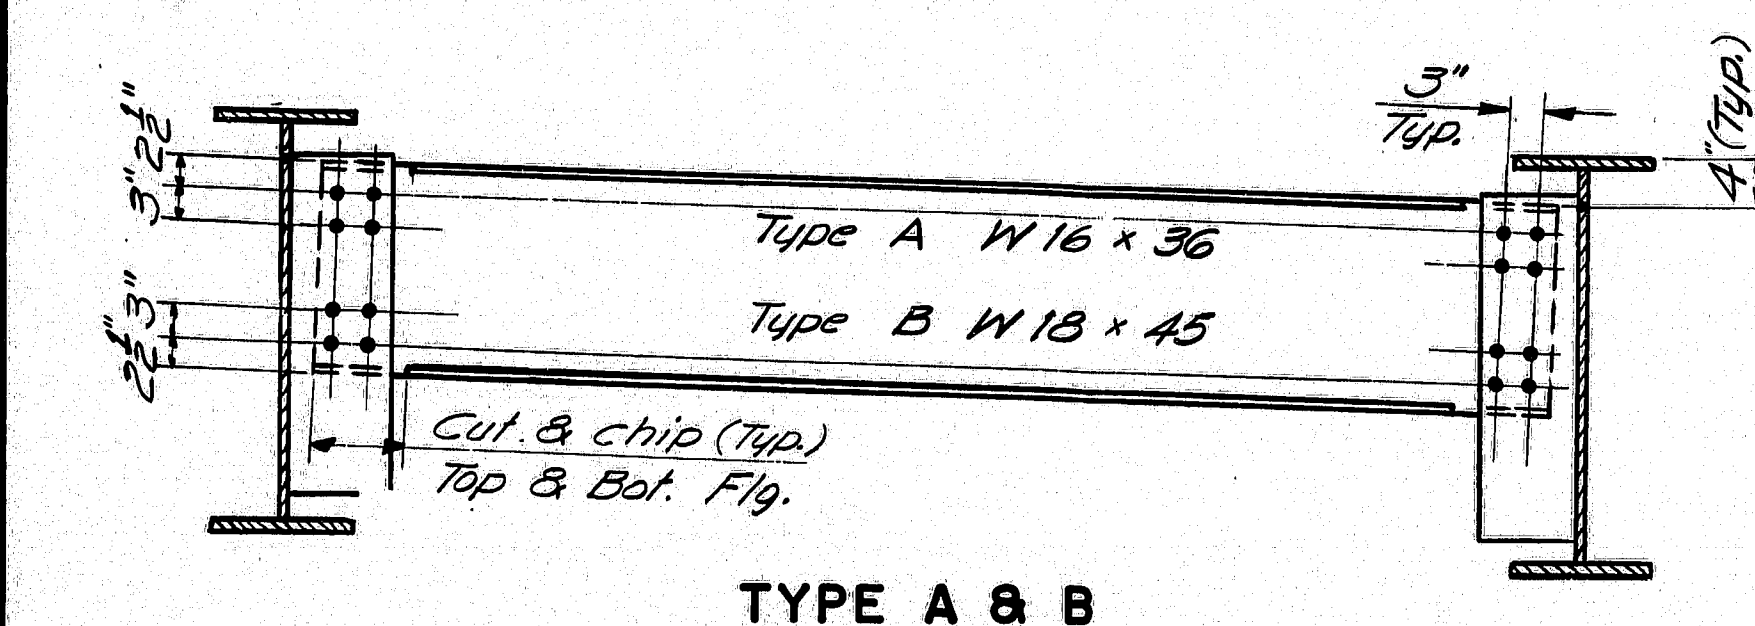


TYPE A & B

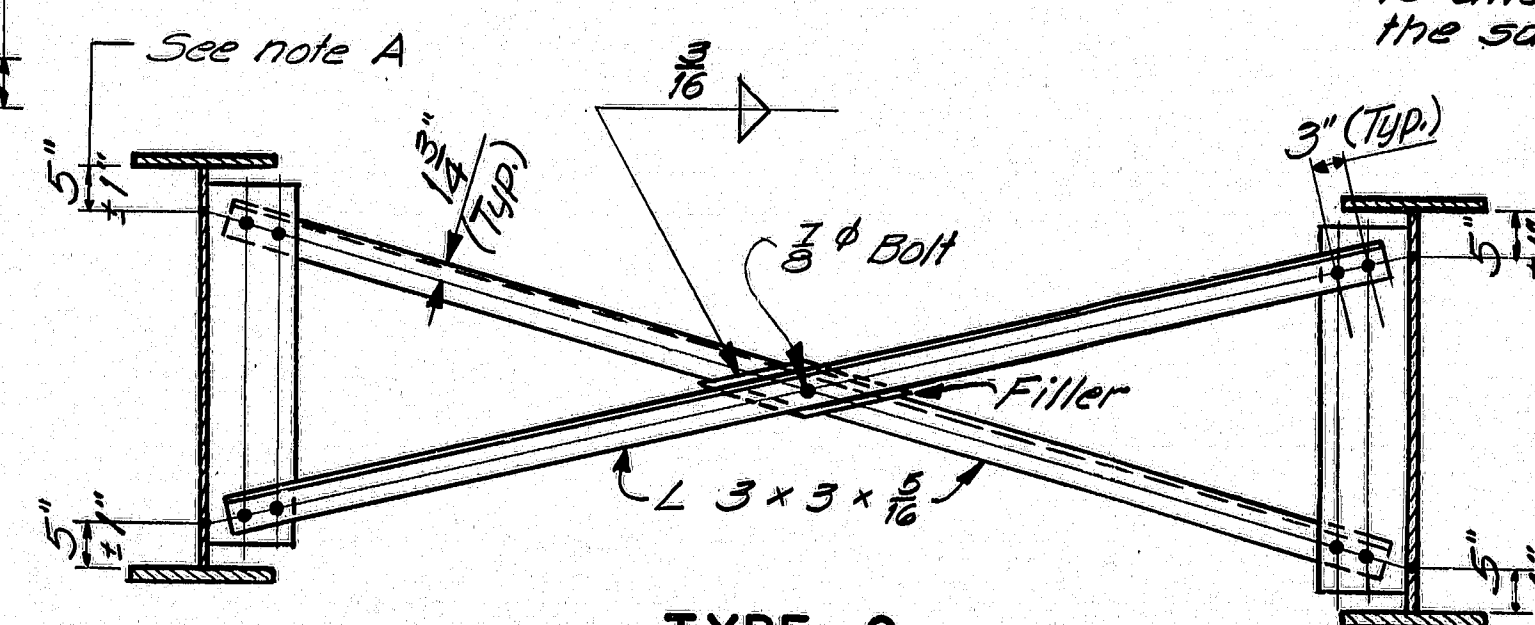


TYPE G

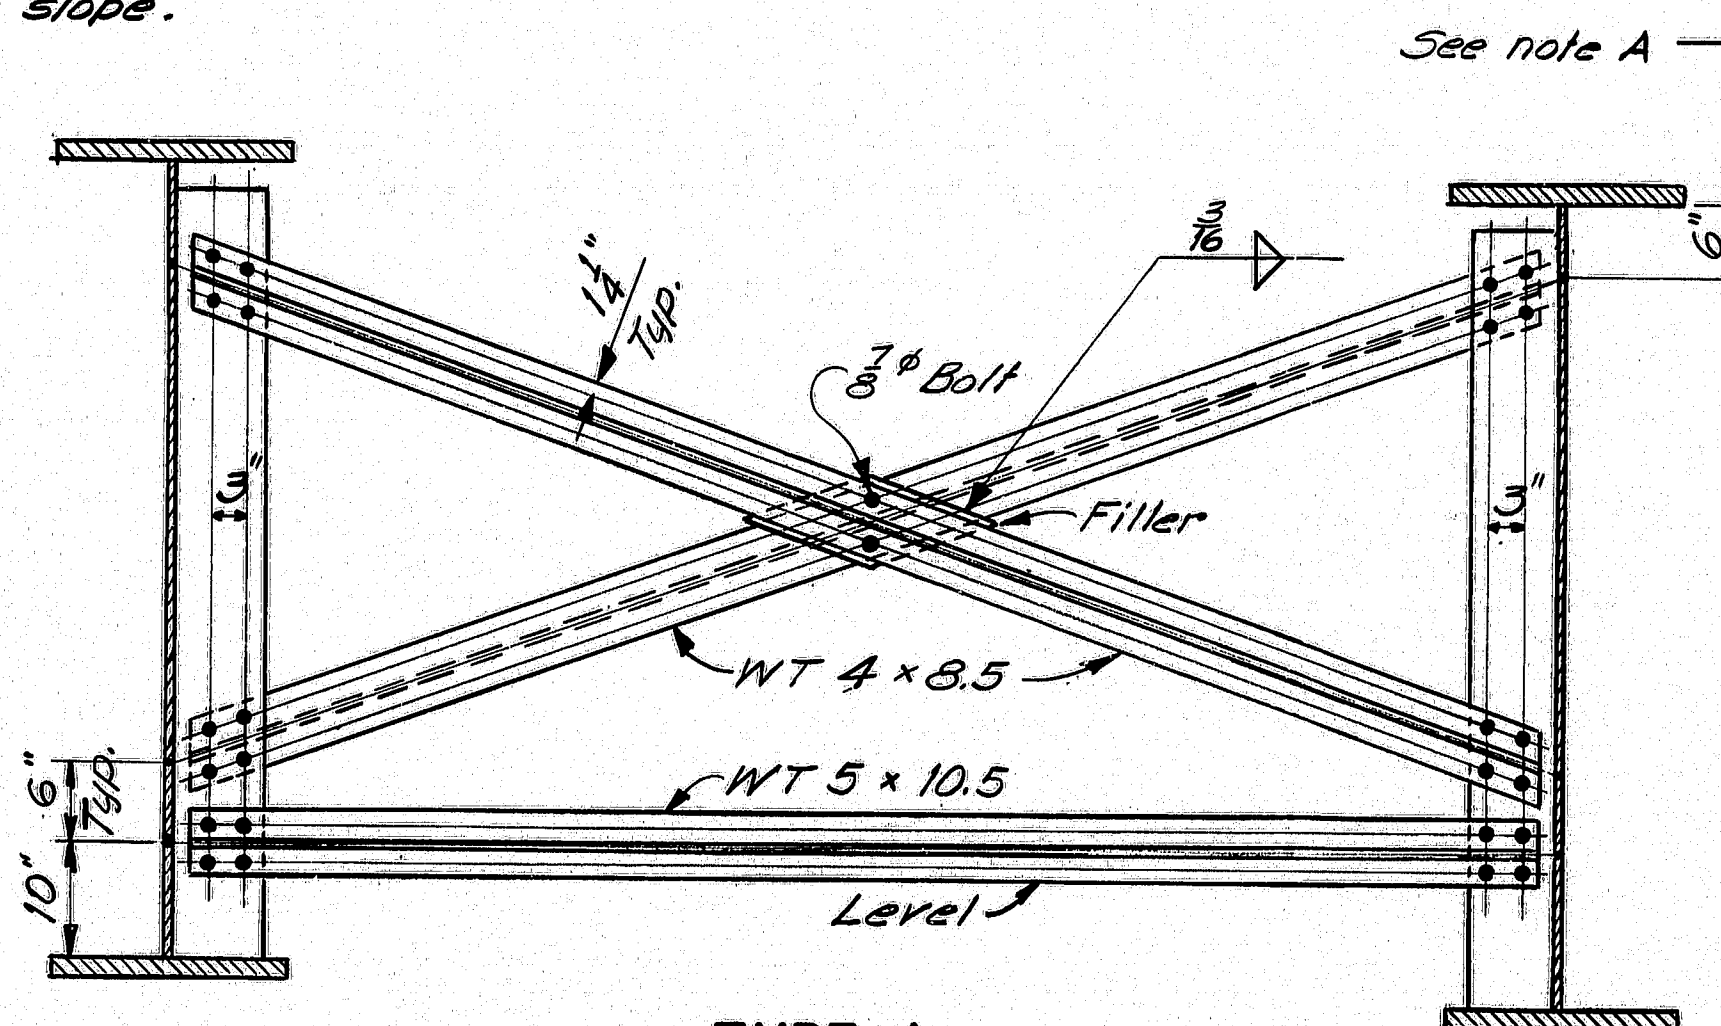


TYPE L

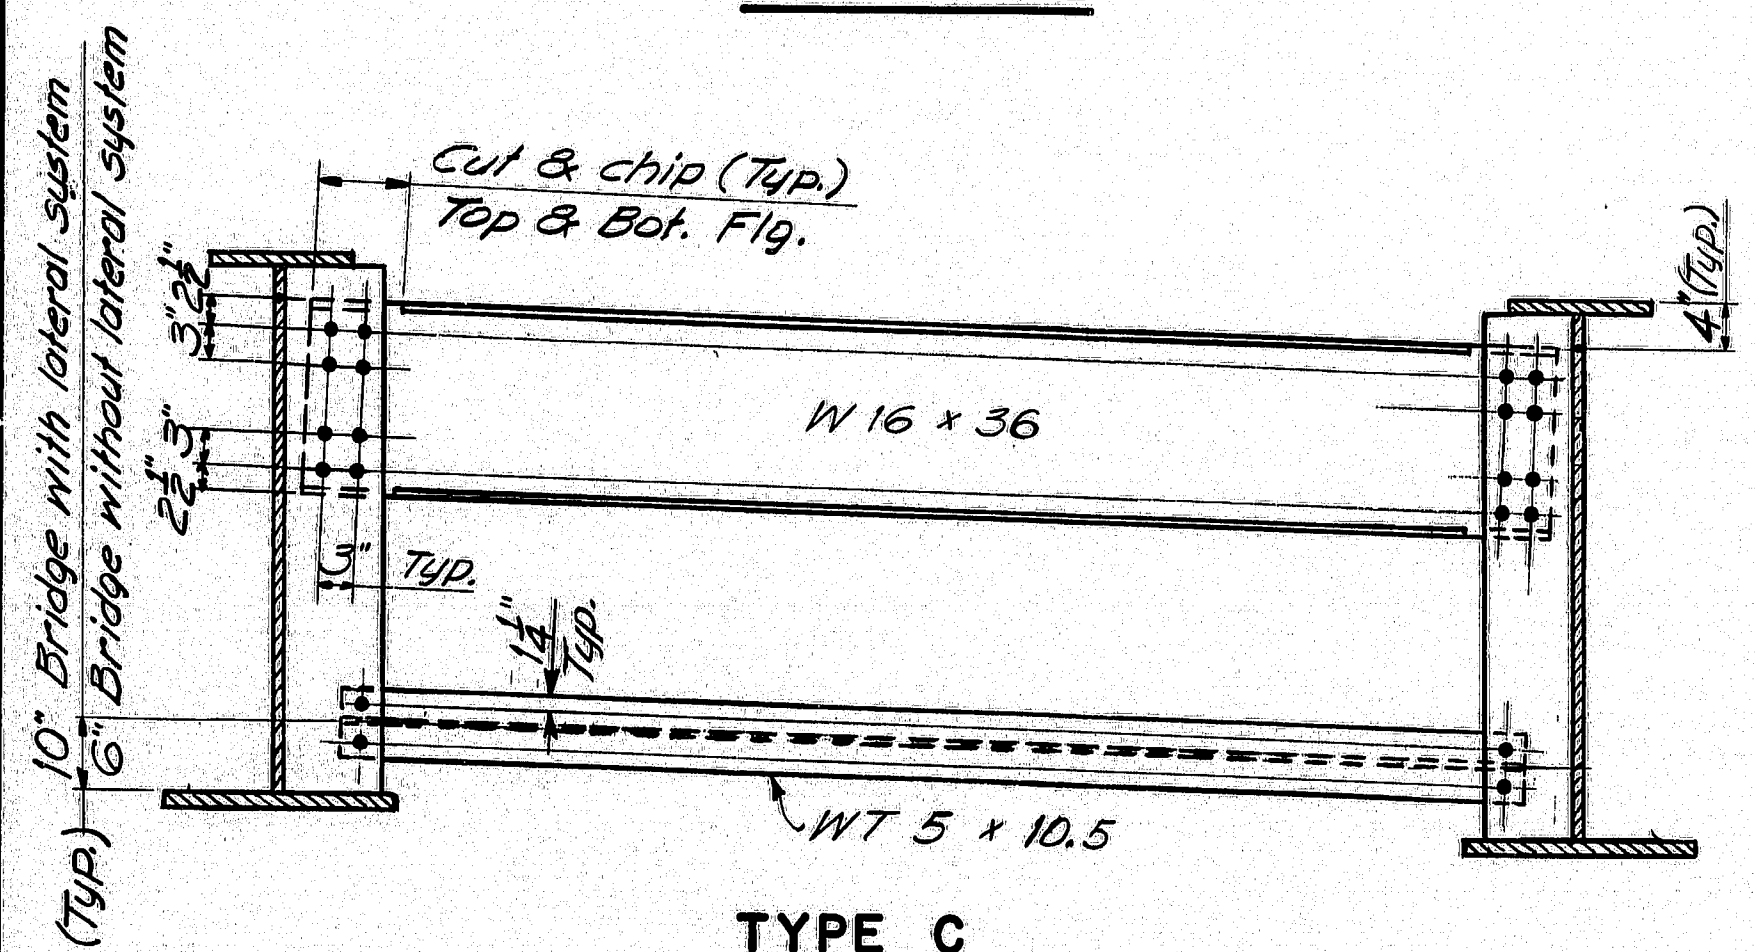


TYPE C

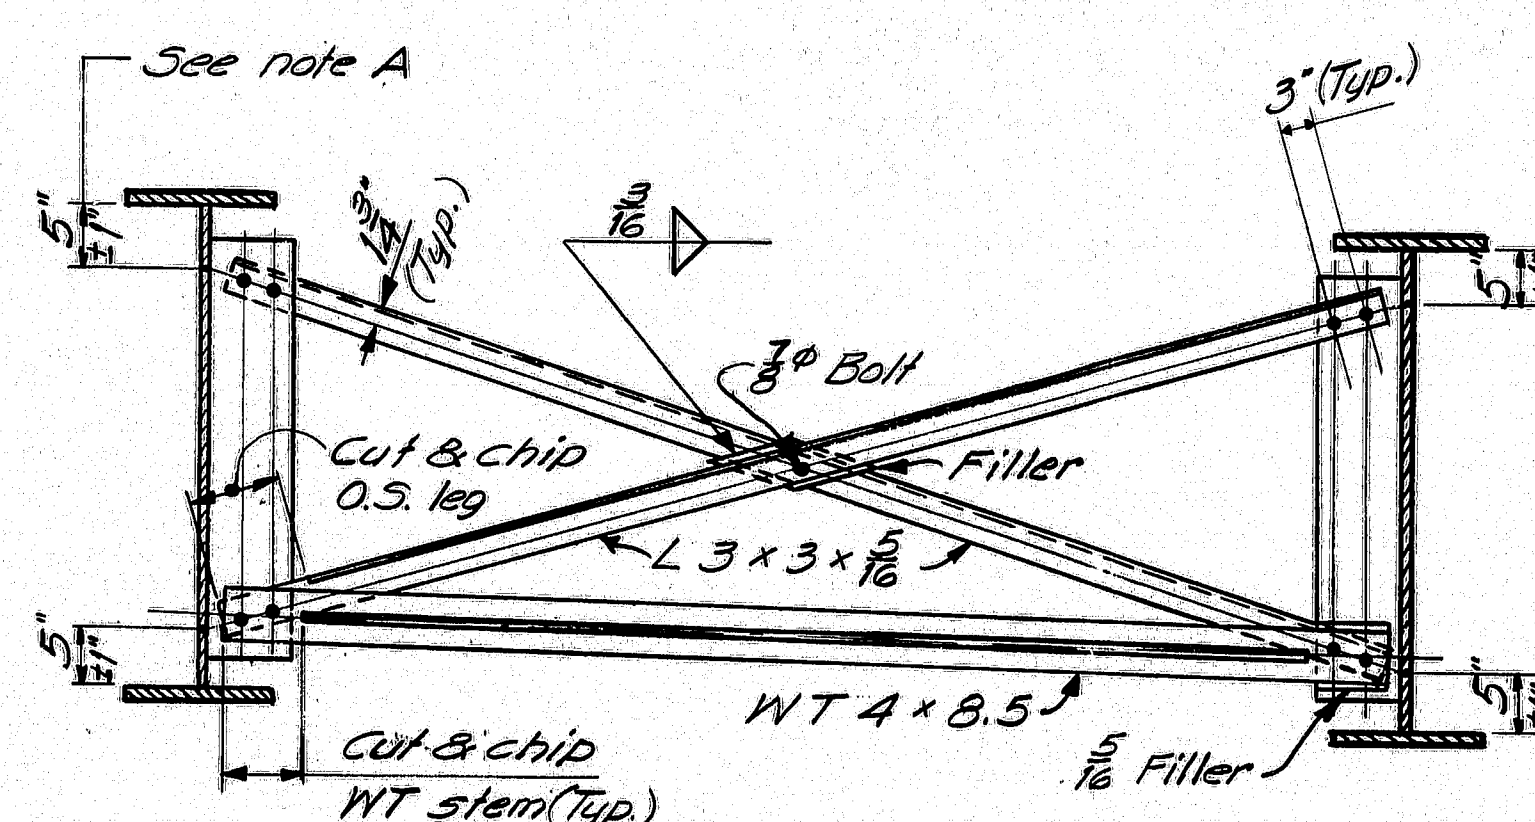


TYPE H

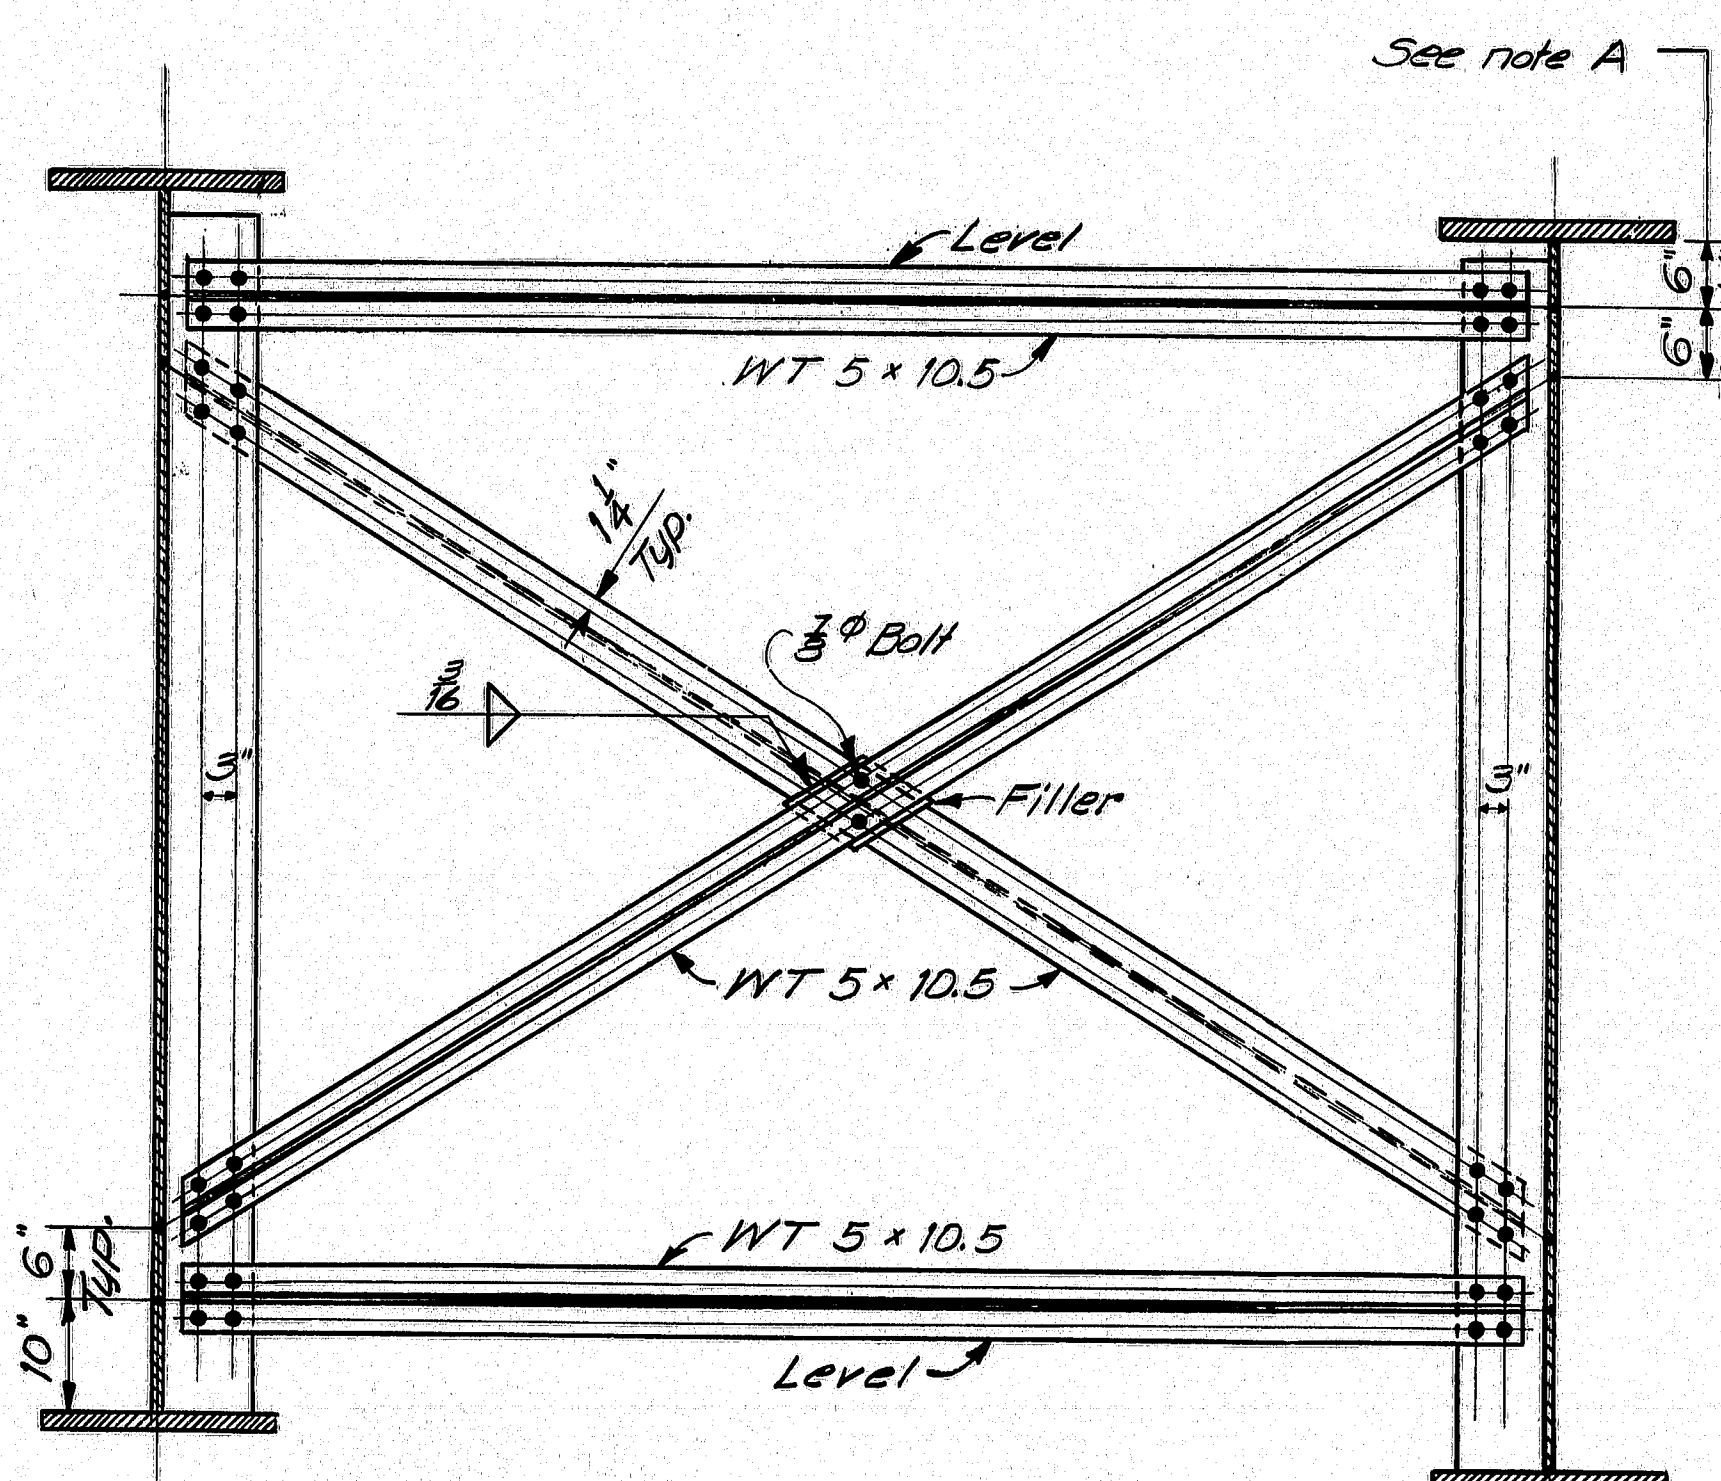


TYPE M

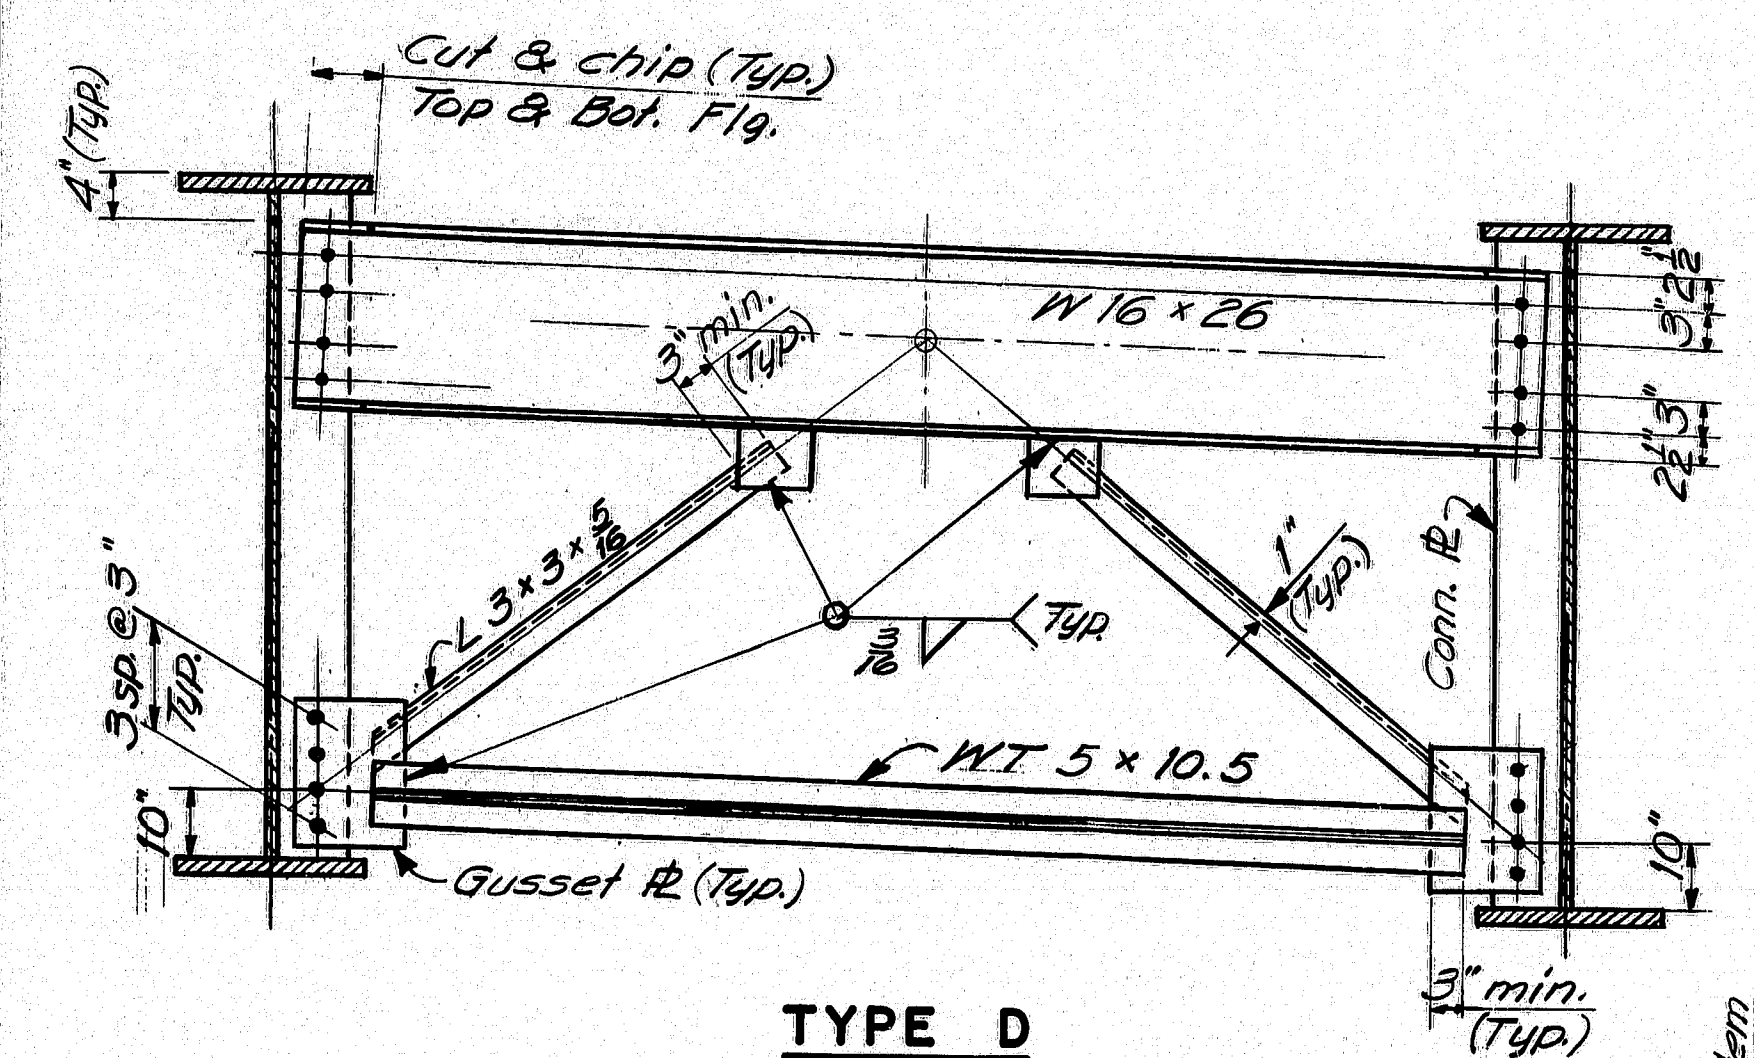


TYPE D

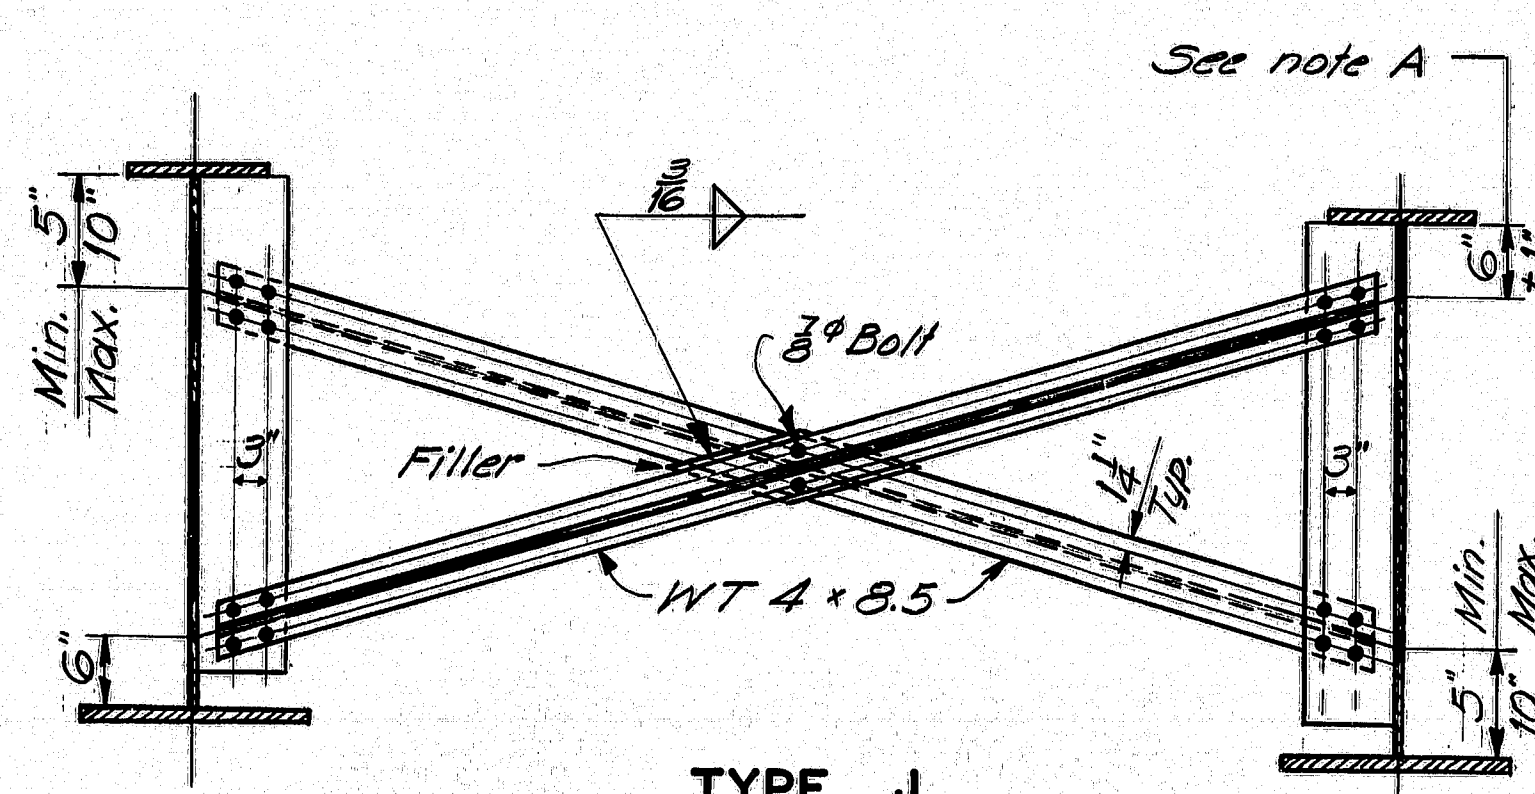


TYPE J

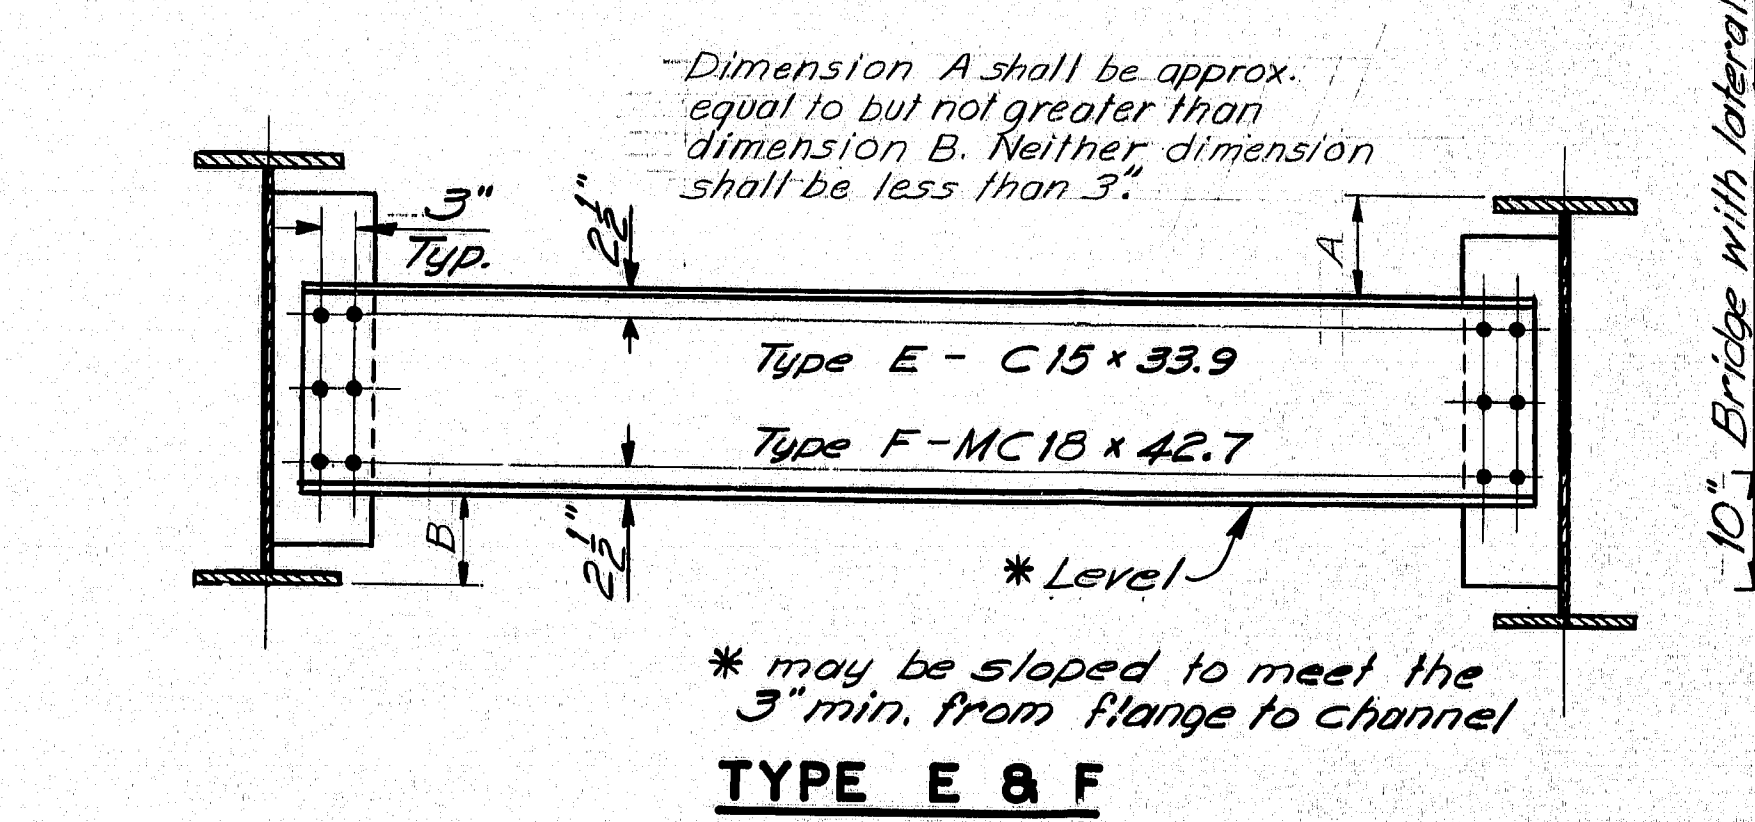

TYPE E & F

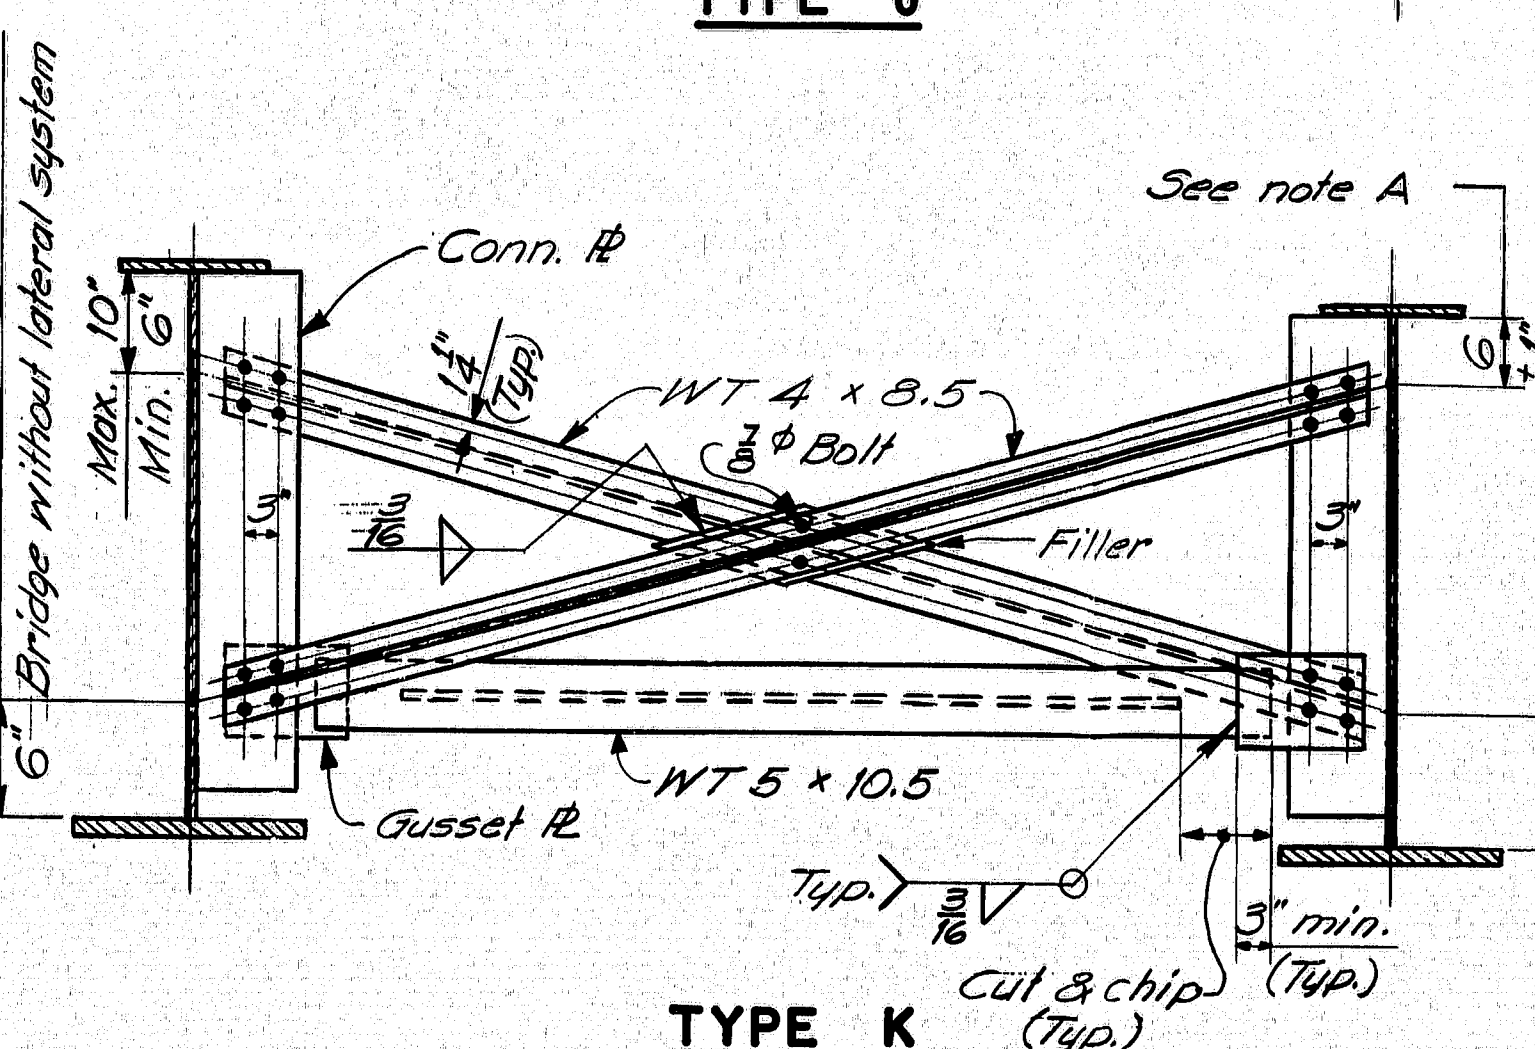

TYPE K

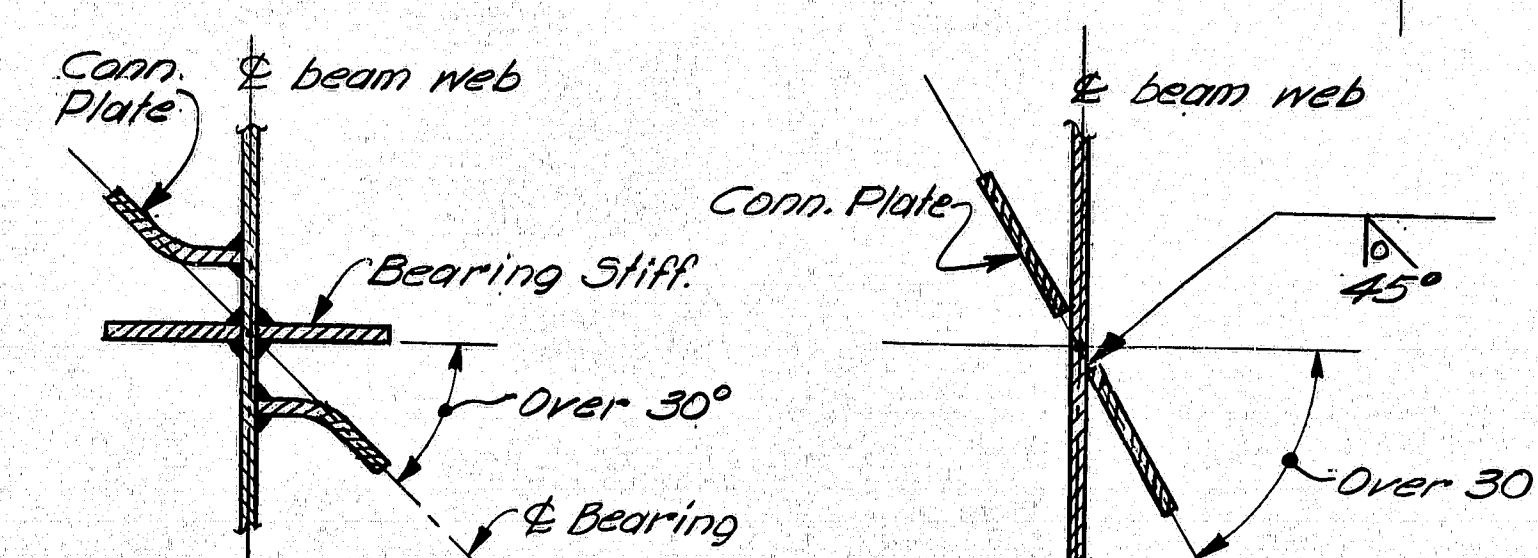

DETAIL A

Referenced from Note 5

DETAIL B

Referenced from Note 4

MATERIALS

Diaphragms, Crossframes and All Plates (Filler, gusset, and connection) ASTM A36
High Strength Bolts $\frac{3}{8}$ " diameter — ASTM A325

PLANS	DESIGN - DETAILED	CHECKED	REVISIONS	FIELD CHANGES
BY				
DATE				

172-99

DESIGN SPECIFICATIONS
A.A.S.H.O. Standard Specifications for
Highway Bridges 1969 and
Interim Specifications.



Lengths of rail shall be attached to a minimum of four (4) rail posts wherever possible, and in any case never less than two (2). Rail posts are to be set normal to grade unless otherwise shown on the Bridge Plans.



NOTE - An alternate to the dimple system for holding the splice bar in position may be used if approved by the Engineer.



See "Rail Detail"




(Assembly)

* Preferable minimum dimensions. For actual dimensions see Bridge Plan.	\$ Anchor Bolts	\$ Anchor Bolts
---	-----------------	-----------------



If cut threads are used, body diameter shall be not less than nominal diameter.
If rolled threads are used, body diameter shall be not less than root diameter of the threads.

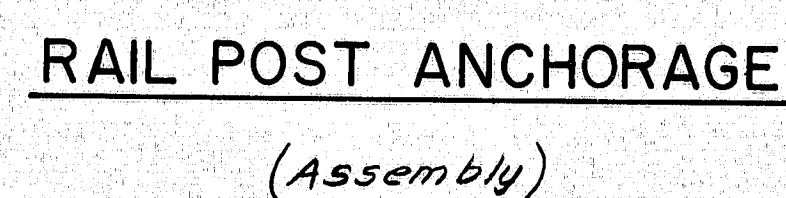


STATE OF MAINE
DEPARTMENT OF TRANSPORTATION
STANDARD DETAILS
(BD 114 - 73)
ALUMINUM RAILING
2 - BAR (SEMI-ELLIPSE)
EXTRUDED POST

SHEET 28 OF 31 AUGUSTA, MAINE FEBRUARY 1973

172-100

NOTES:

1. CROSSTIES THROUGH CROSSING.
2. RAIL JOINTS IN CROSSING TO BE WELDED.
3. STONE BALLAST TO EXTEND ALONG TRACK BEYOND EACH SIDE OF THE CROSSING FOR A DISTANCE OF APPROXIMATELY 40' AT SAME MINIMUM DEPTH AS THRU CROSSING - THEN TAPER TO A MIN. DEPTH UNDER TIES OF 6" IN THE NEXT 40'.
4. WORK TO BE DONE BY RAILROAD
5. PAVING ALONG TRACK TO BE OUT TO OUT OF SHOULDER TAPERED TO NORMAL PAVING WIDTH IN ABOUT 25 FEET.
6. STYRA FOAM IS OPTIONAL UNDER HIGHWAY APPROACHES TO THE CROSSING AREA.
7. NOT TO SCALE.

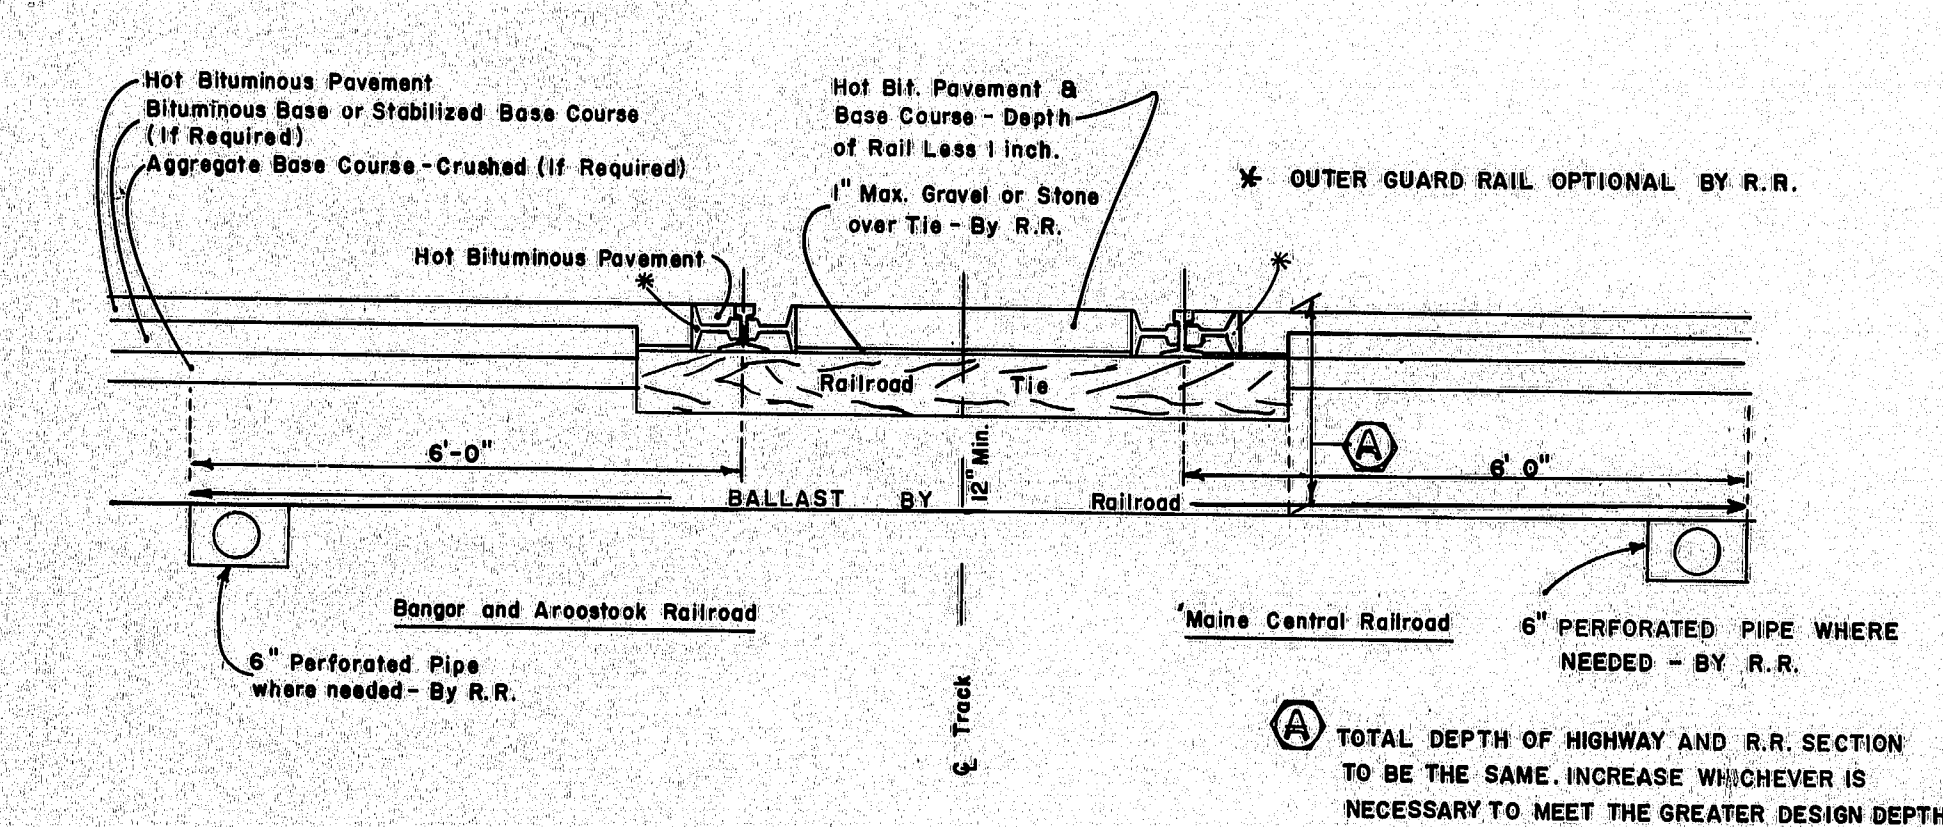

RAILROAD GRADE CROSSING DETAIL



ROADWAY CULVERT END SLOPE TREATMENT FOR METAL AND CONCRETE CULVERTS

TABLE B

Culvert Diameter	4:1 Slope	6:1 Slope
18"	0'-0"	13'-0"
21"	0'-0"	15'-0"
24"	1'-0"	18'-0"
30"	1'-0"	20'-0"
36"	1'-0"	25'-0"
42"	1'-0"	28'-0"
48"	1'-0"	29'-0"
54"	2'-0"	32'-0"
60"	2'-0"	35'-0"
66"	2'-0"	39'-0"
72"	2'-0"	42'-0"
84"	3'-0"	48'-0"

NOTES:


1. The dimensions shown are approximate and may be modified by the resident engineer.
2. Culverts installed under 2:1 slopes shall have riprap laid on 2:1 slopes around the inlet and outlet; and no ditch transitions.
3. Riprap will be required on the portions of the culvert end treatment 1:1 and steeper. The remaining portion shall be sodded or seeded and mowed as directed by the engineer.
4. 24" diameter culverts and under may be sodded around ends of culvert.

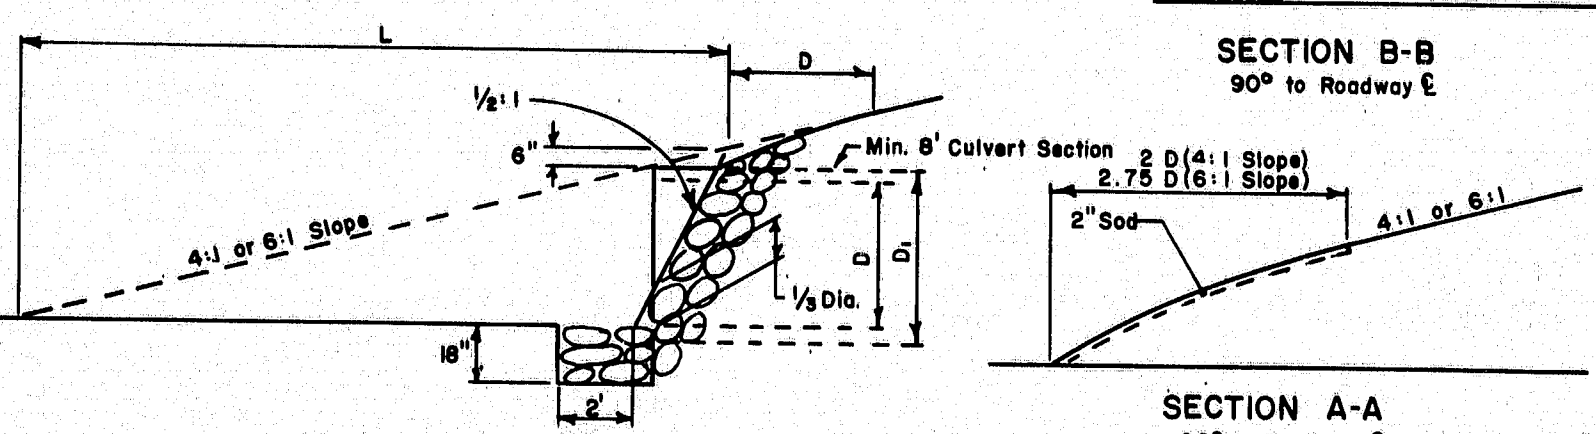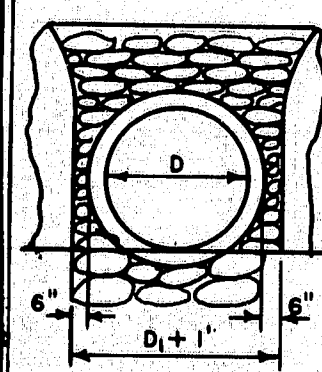

SECTION B-B 90° to Roadway E

SECTION A-A 90° to Roadway E

CONCRETE INLET ENDWALL

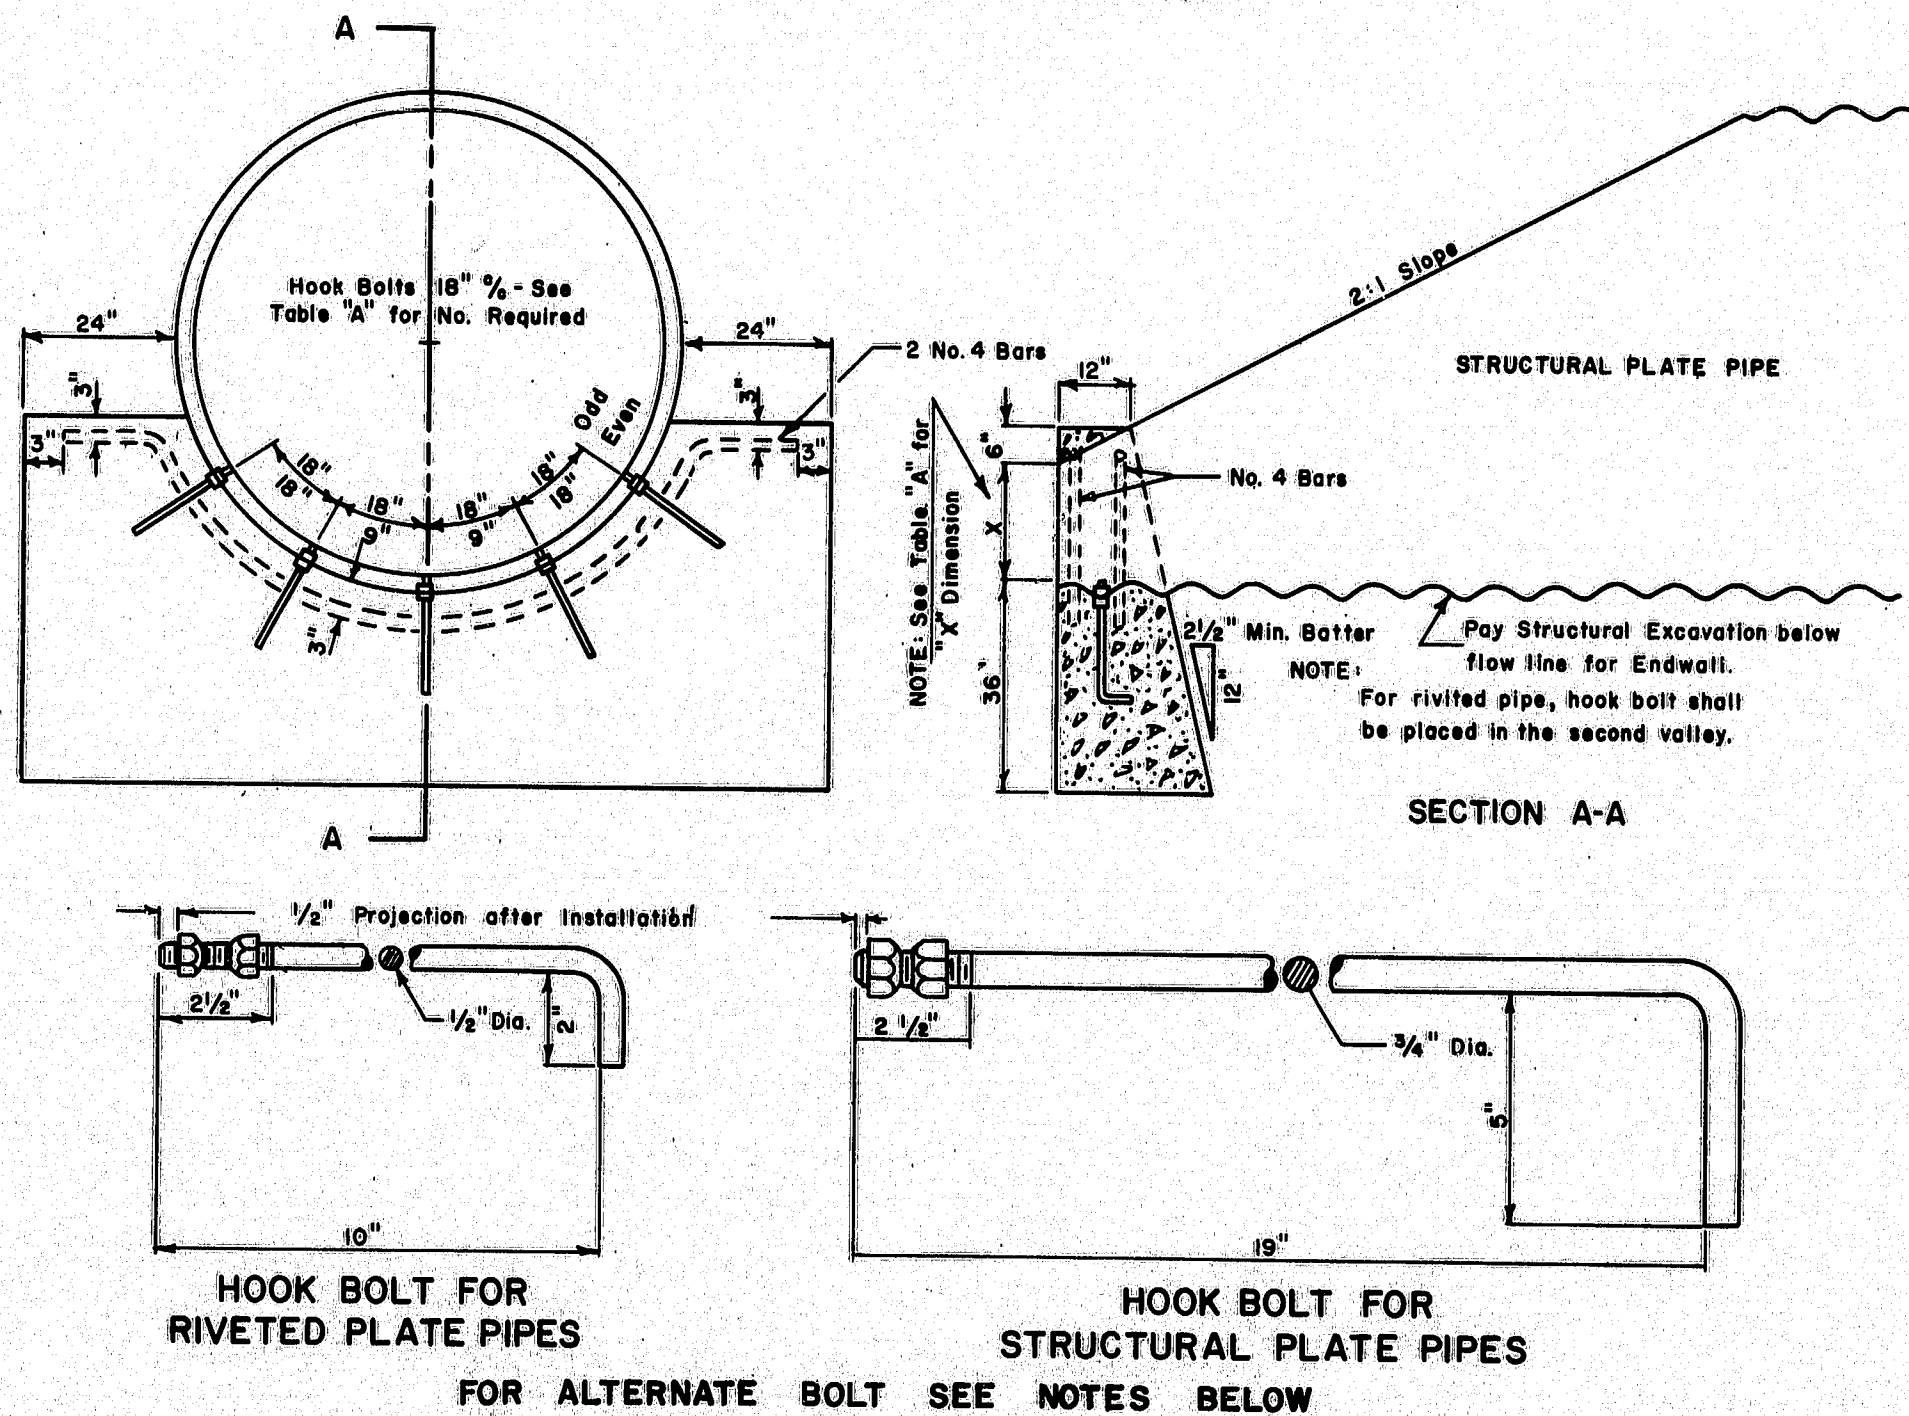

CONCRETE INLET ENDWALL

TABLE A


RIVETED PIPES			
SIZE	NO. BOLTS REQUIRED	"X" DIMENSION	"Y" DIMENSION
60"	4	1.5	1.5
66"	4	1.5	1.5
72"	4	1.5	1.5
78"	5	1.5	1.5
84"	5	1.5	1.5

STRUCTURAL PLATE PIPE			
SIZE	NO. BOLTS REQUIRED	"X" DIMENSION	"Y" DIMENSION
72"	4	1.5	1.5
78"	5	1.625	1.75
84"	5	1.75	1.875
90"	5	1.875	2.0
96"	6	2.0	2.125
102"	6	2.125	2.25
108"	6	2.25	2.375
114"	7	2.375	2.5
120"	7	2.5	2.625
126"	7	2.625	2.75
132"	8	2.75	2.875
138"	8	2.875	3.0
144"	9	3.0	3.125
150"	9	3.125	3.25
156"	9	3.25	3.375
162"	10	3.375	3.5
168"	10	3.5	3.625
174"	10	3.625	3.75
180"	11	3.75	3.875


NOTES

1. Culverts installed under 2:1 slopes shall have riprap laid on 2:1 slope and no ditch transitions. All riprap as shown shall be hand laid.
2. Excavation required to grade culvert inlets and outlets as shown will not be paid separately, but will be incidental to the culvert.
3. Bolts are required in metal pipes only and will be incidental to concrete items.
4. Concrete endwalls shall be structural concrete class "A" and shall be paid for as Item 502.32 structural concrete culvert endwalls. Reinforcing steel will not be paid for separately but will be considered incidental to Item 502.32.
5. Standard galvanized carriage or machine bolts 1/2" x 8" long or 3/4" x 12" long with minimum of 2" thread, may be furnished in place of hook bolts. Washers shall be furnished at the head of each bolt.
6. Bolt material shall conform to ASTM A307. Nuts shall conform to ASTM A563. Bolts, nuts, and washers shall be hot dip galvanized after fabrication to meet ASTM A153.

CONCRETE INLET ENDWALLS FOR RIVETED AND STRUCTURAL PLATE PIPES 60" TO 180" IN 2:1 SLOPES

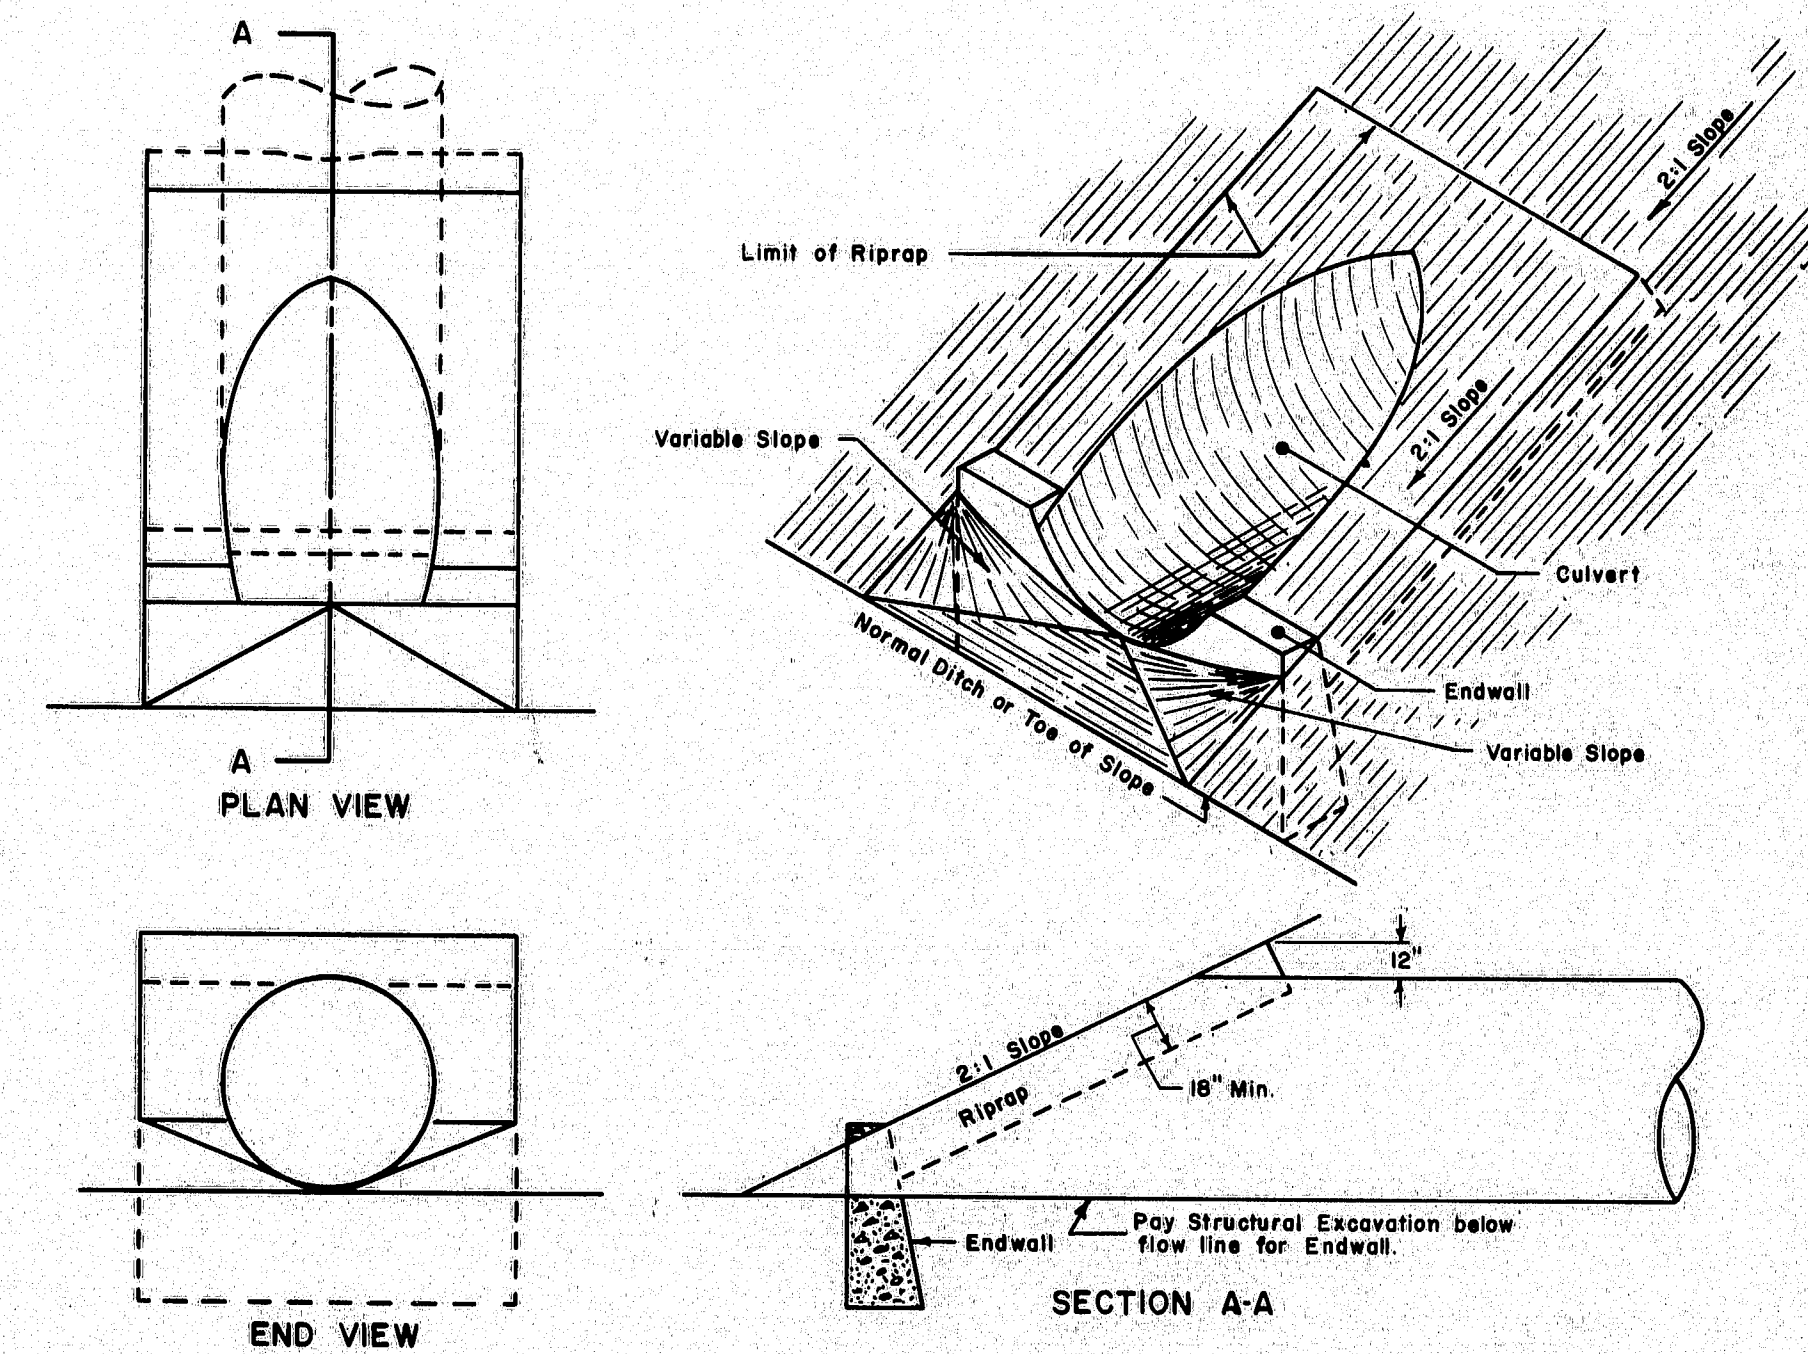

CONCRETE INLET ENDWALLS FOR RIVETED AND STRUCTURAL PLATE PIPES 60" TO 180" IN 4:1 SLOPES

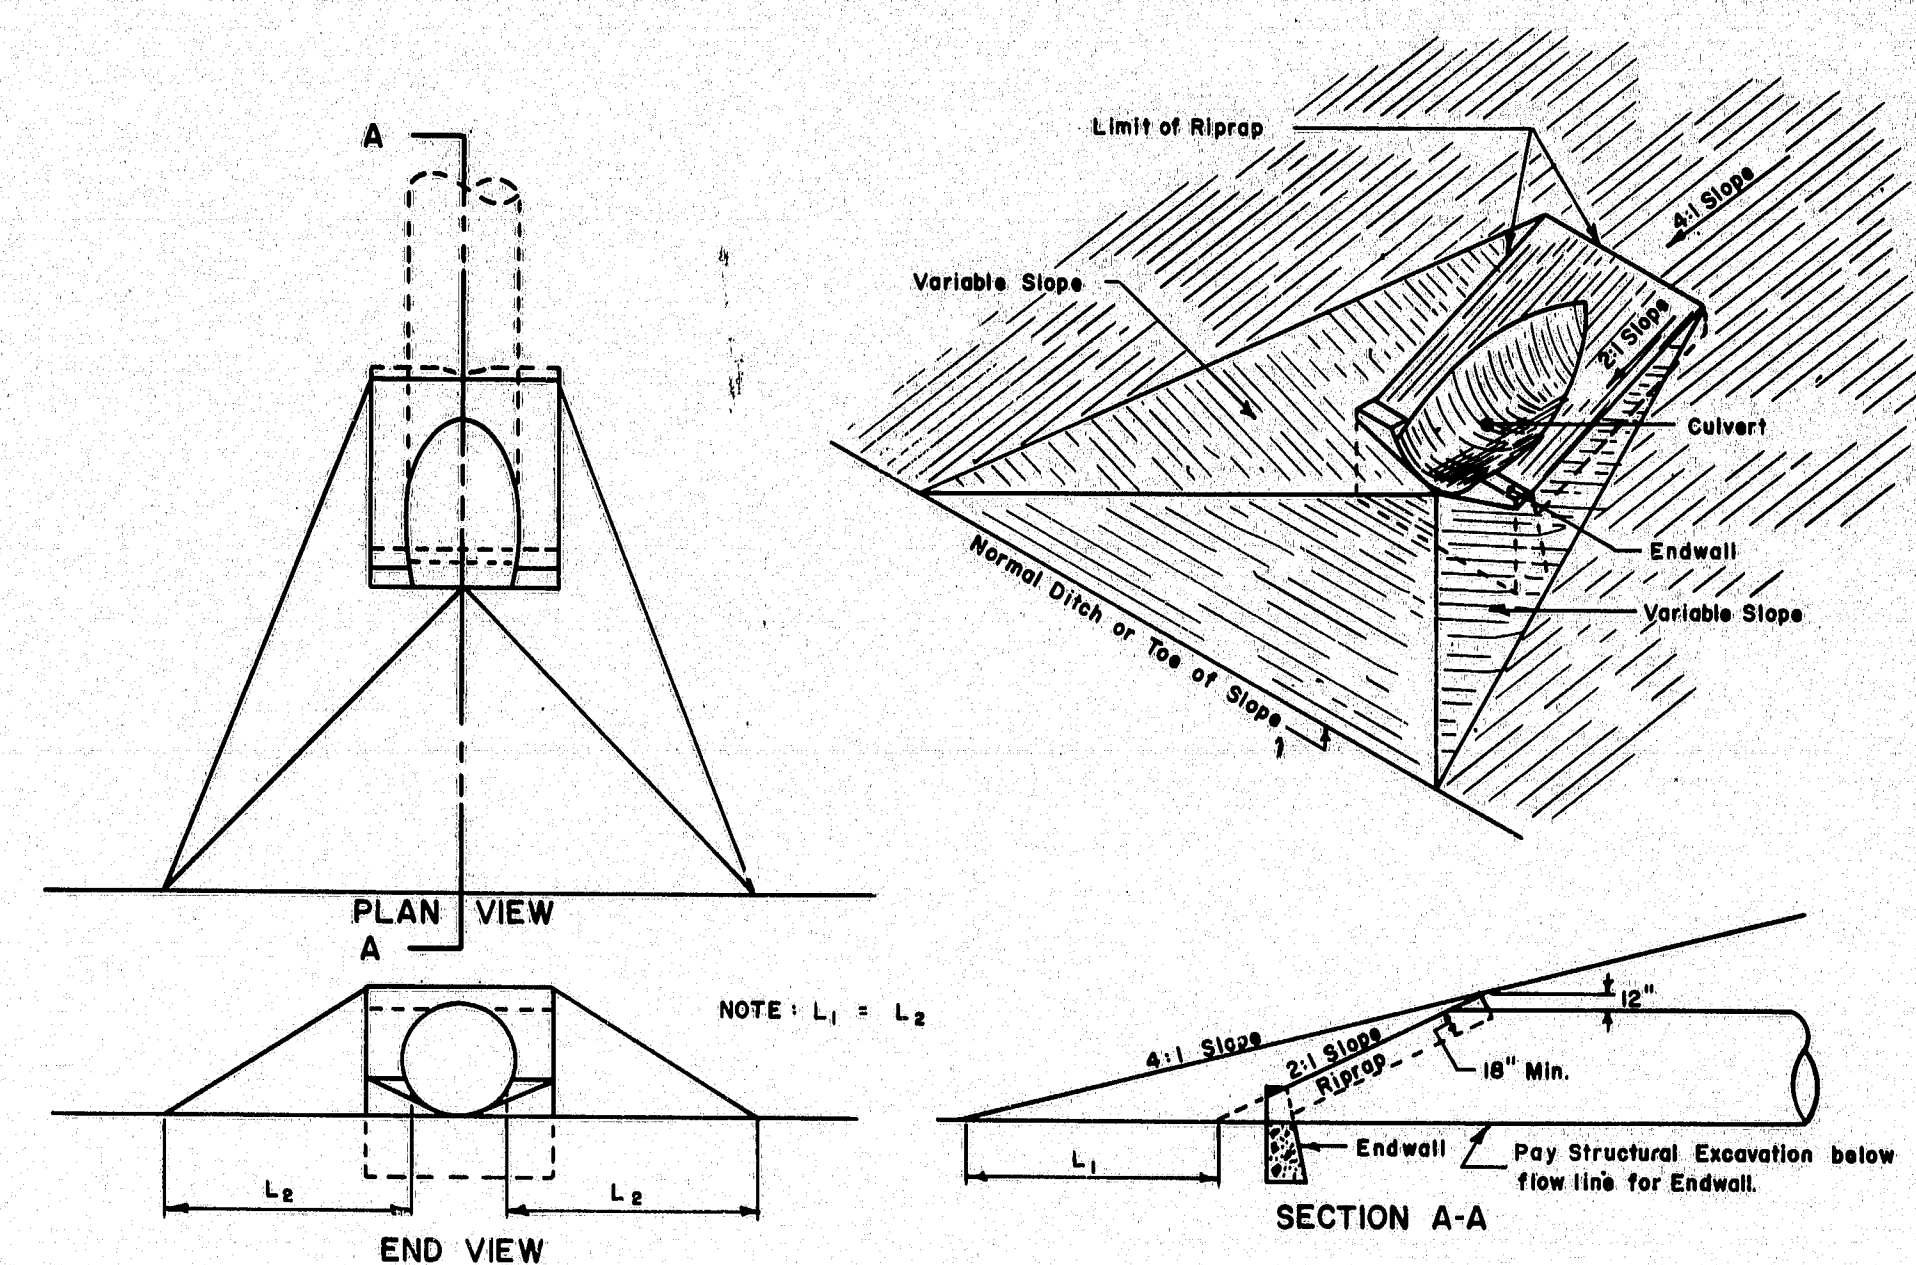

REVISIONS

Plate	Revised	By	Date
Plate 4-D	12-23-69		
PLATE A,B,C	2-15-72		
PLATE A	6-18-74		

STATE OF MAINE
DEPARTMENT OF TRANSPORTATION
AUGUSTA, MAINE


STANDARD DETAILS

CULVERT INLETS & OUTLETS


AUG. 1969

172-101


F.H.W.A. REG. NO.	STATE	PROJECT NUMBER	SHEET NO.	TOTAL SHEETS
1	MAINE	95-5(42)	31	31

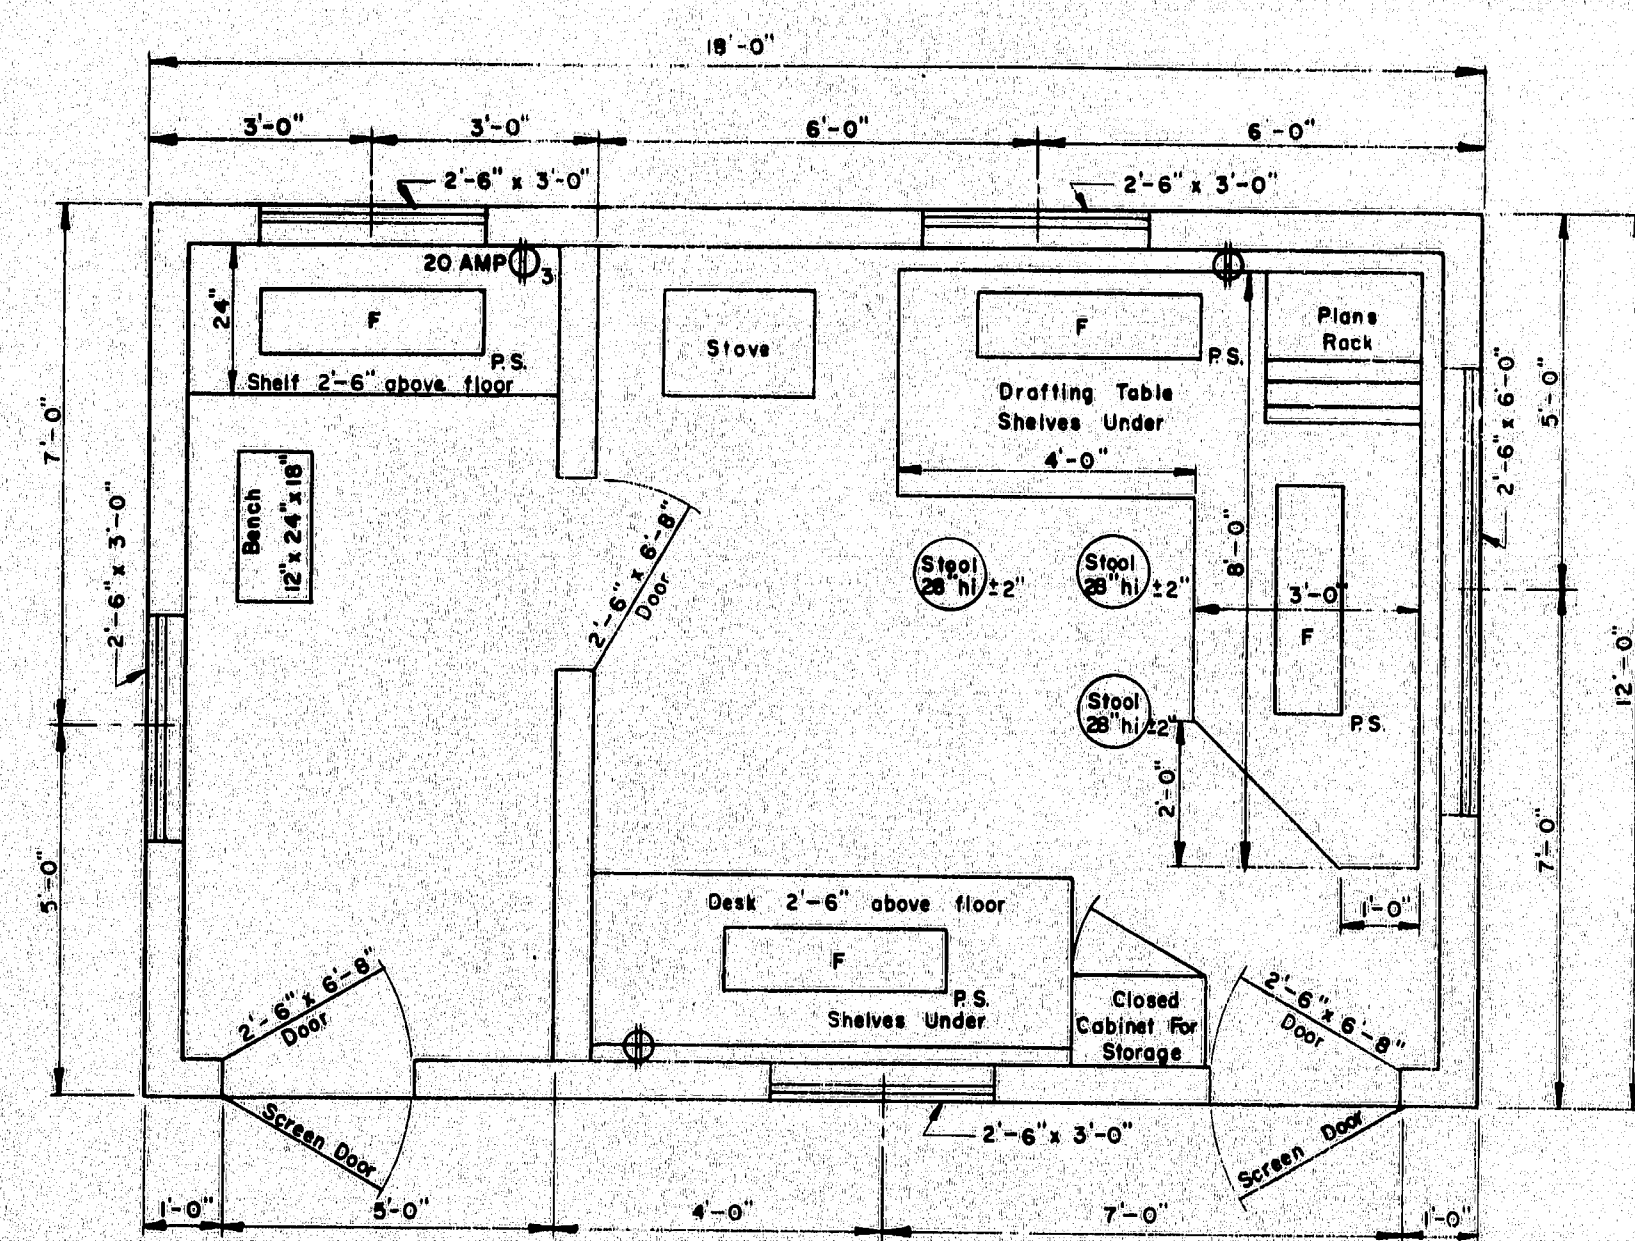

FLOOR PLAN
TYPE "A"

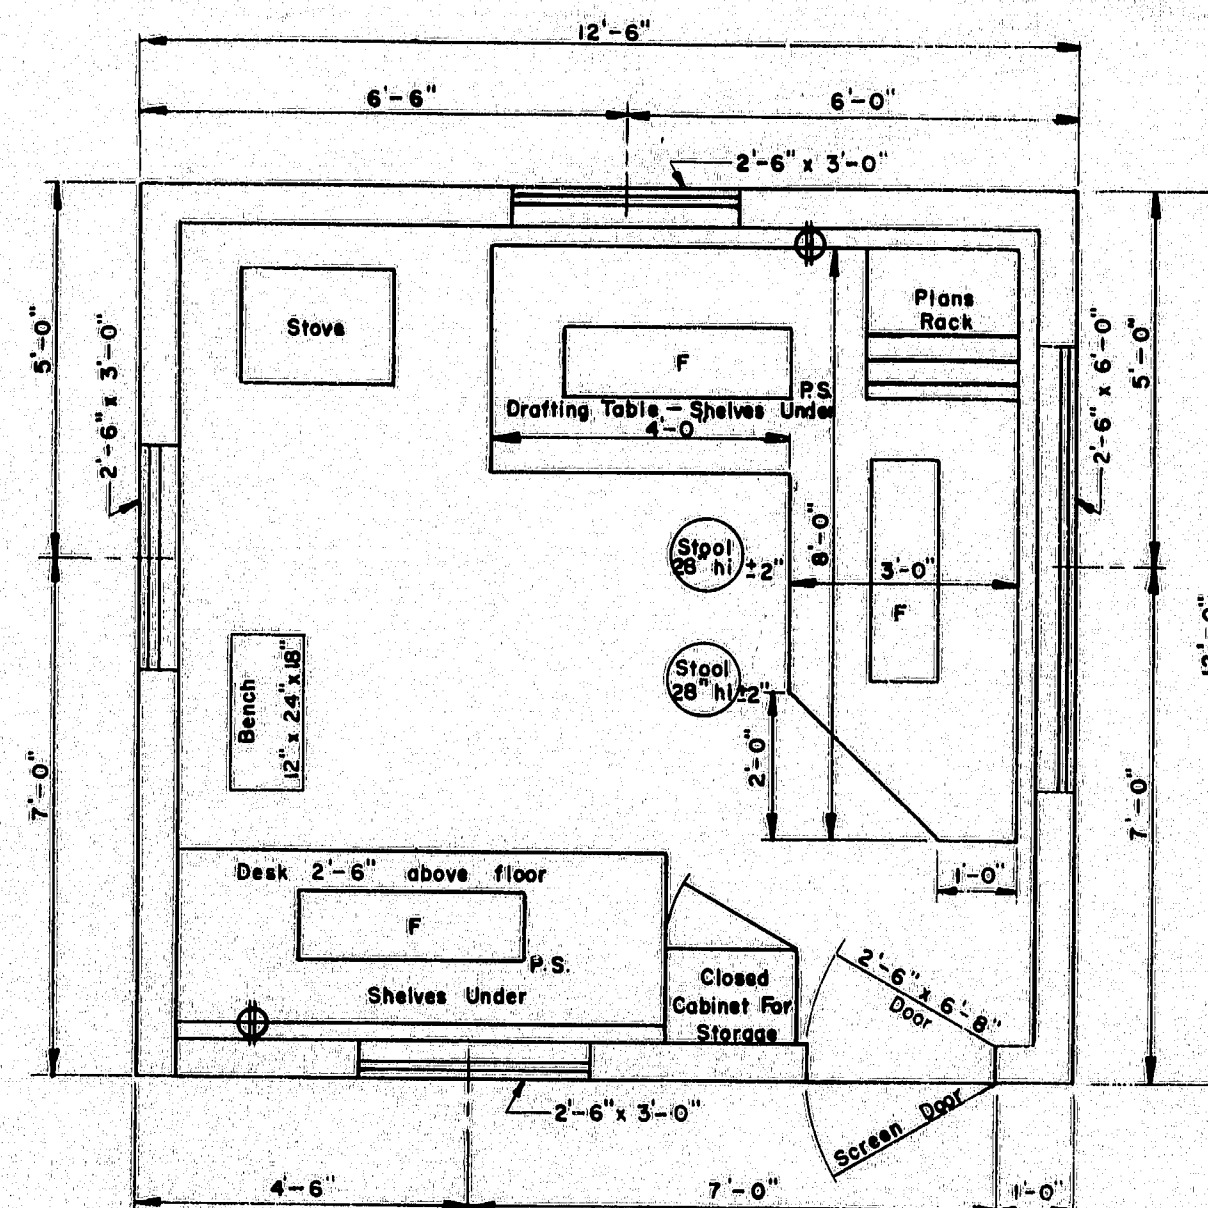


FLOOR PLAN
TYPE "B"

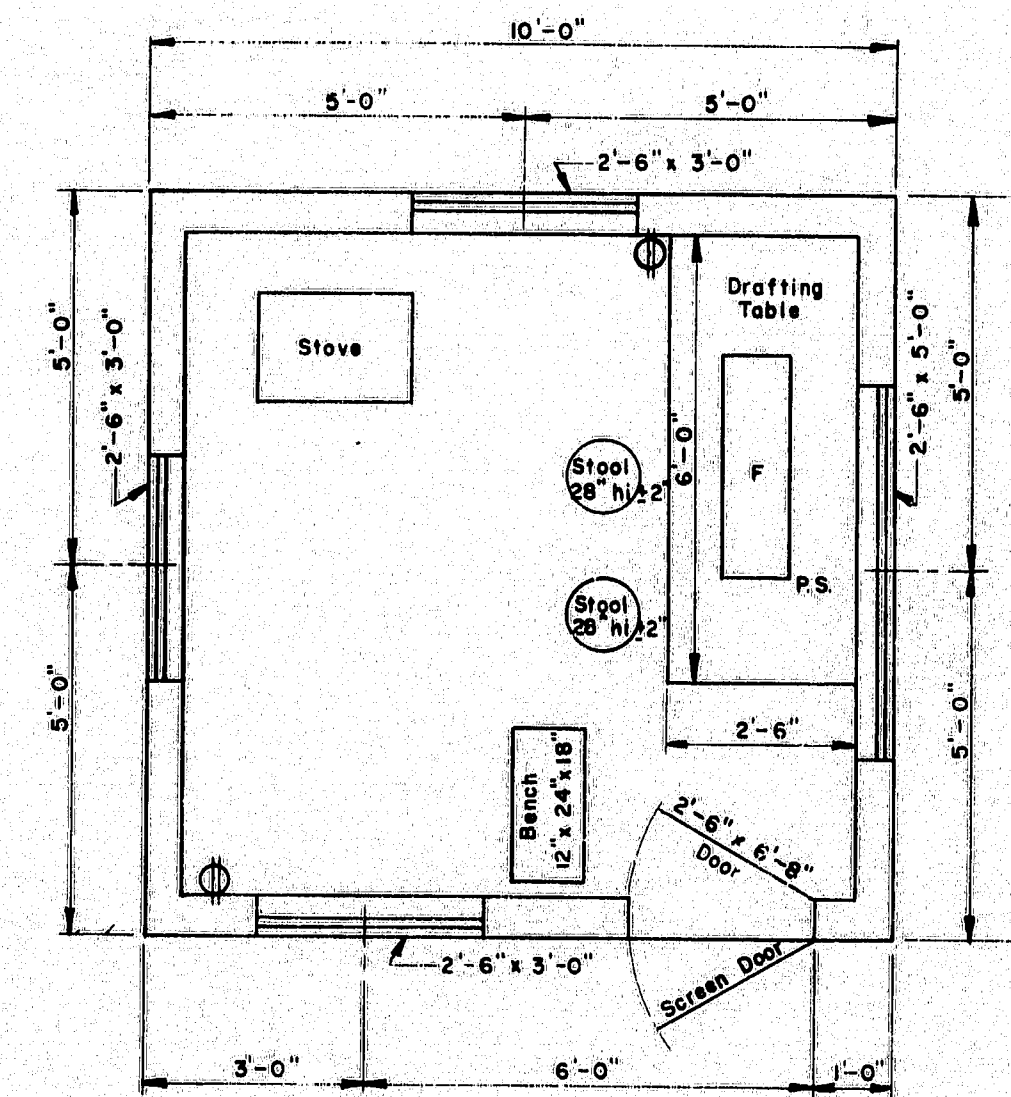


FLOOR PLAN
TYPE "C"

- GENERAL NOTES**
- Drafting table shall be 3'-4" high at front edge and placed 2" from studs to allow prints to hang down behind table when in use.
 - Shelves under desk shall be constructed to receive 11 1/2" x 14" x 25" transfiles.
 - Windows shall be double hung.
 - Slopepipe shall not be in direct contact with combustible material; the pipe shall be surrounded with at least 6" of fireproof material.
 - Continuous 110 volt 60 cycle electric service shall be supplied.
 - The engineer may rearrange the items shown on the plan views during construction of the field office.
 - FURNISHINGS TO BE SUPPLIED:**
 - 2 Straight back chairs for types A and B
 - 1 Bench for types A, B & C
 - 3 Stools for type A
 - 2 Stools for types B & C
 - SYMBOLS:**
 - F: Fluorescent lights (2 light, rapid start 48" strips and 40 watt bulbs.)
 - P.S.: Pull switch
 - ⊕: Duplex wall outlet—15 amp unless otherwise noted.
 - ⊕: Triplex Wall Outlet
 - For the Type "A" Field Office one clean 55 gal. drum shall be supplied, installed on a suitable rack and equipped with a spigot suitable for drawing off water. The drum shall be furnished with water at all times.

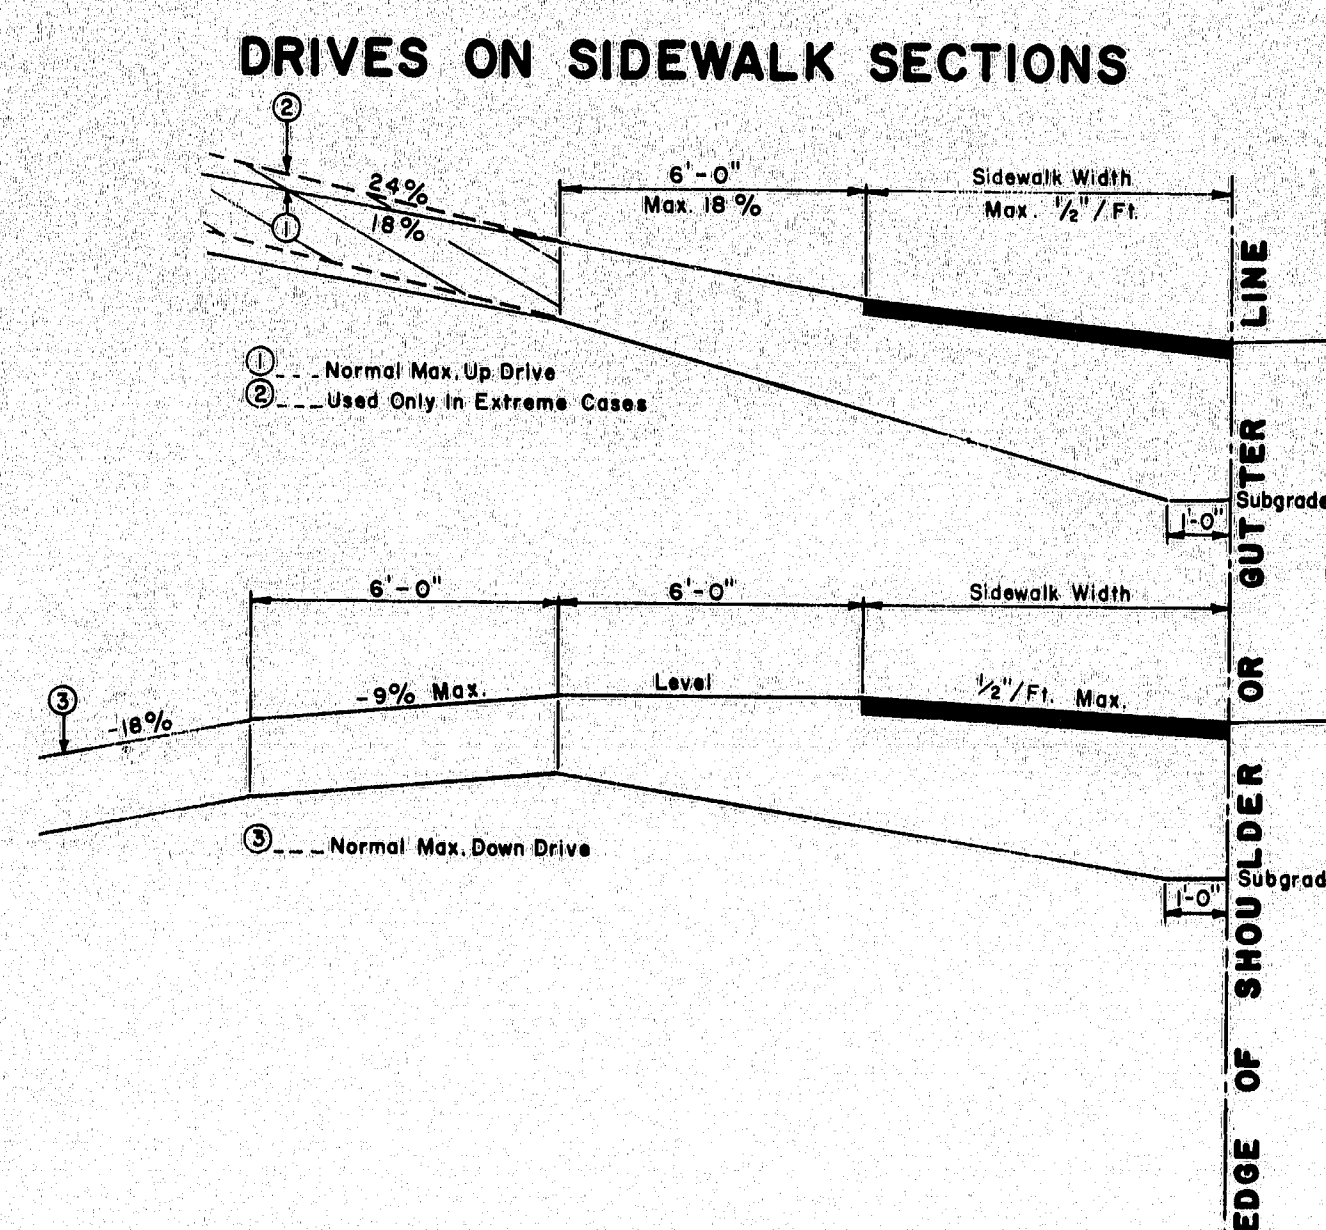


- GENERAL NOTES**
- The sidewalk width shall be paved in all cases.
 - All residential or commercial drives 10% and over shall be paved.

- NOTES ON MAXIMUM DRIVEWAY PROFILES**
- These profiles are a guide for the majority of cases, but should be field checked when the main line grade is steep (4% to 6% or greater) or the angle of approach to the drive is unusual.
 - Generally the majority of drives on a project will be built with flatter profiles than these maximum cases.
 - When grading drives which are flatter than the maximum profiles the following rule of thumb should be used, do not exceed a grade % change of more than 9% in a 6 foot increment of driveway length. This applies to both up and down profiles.

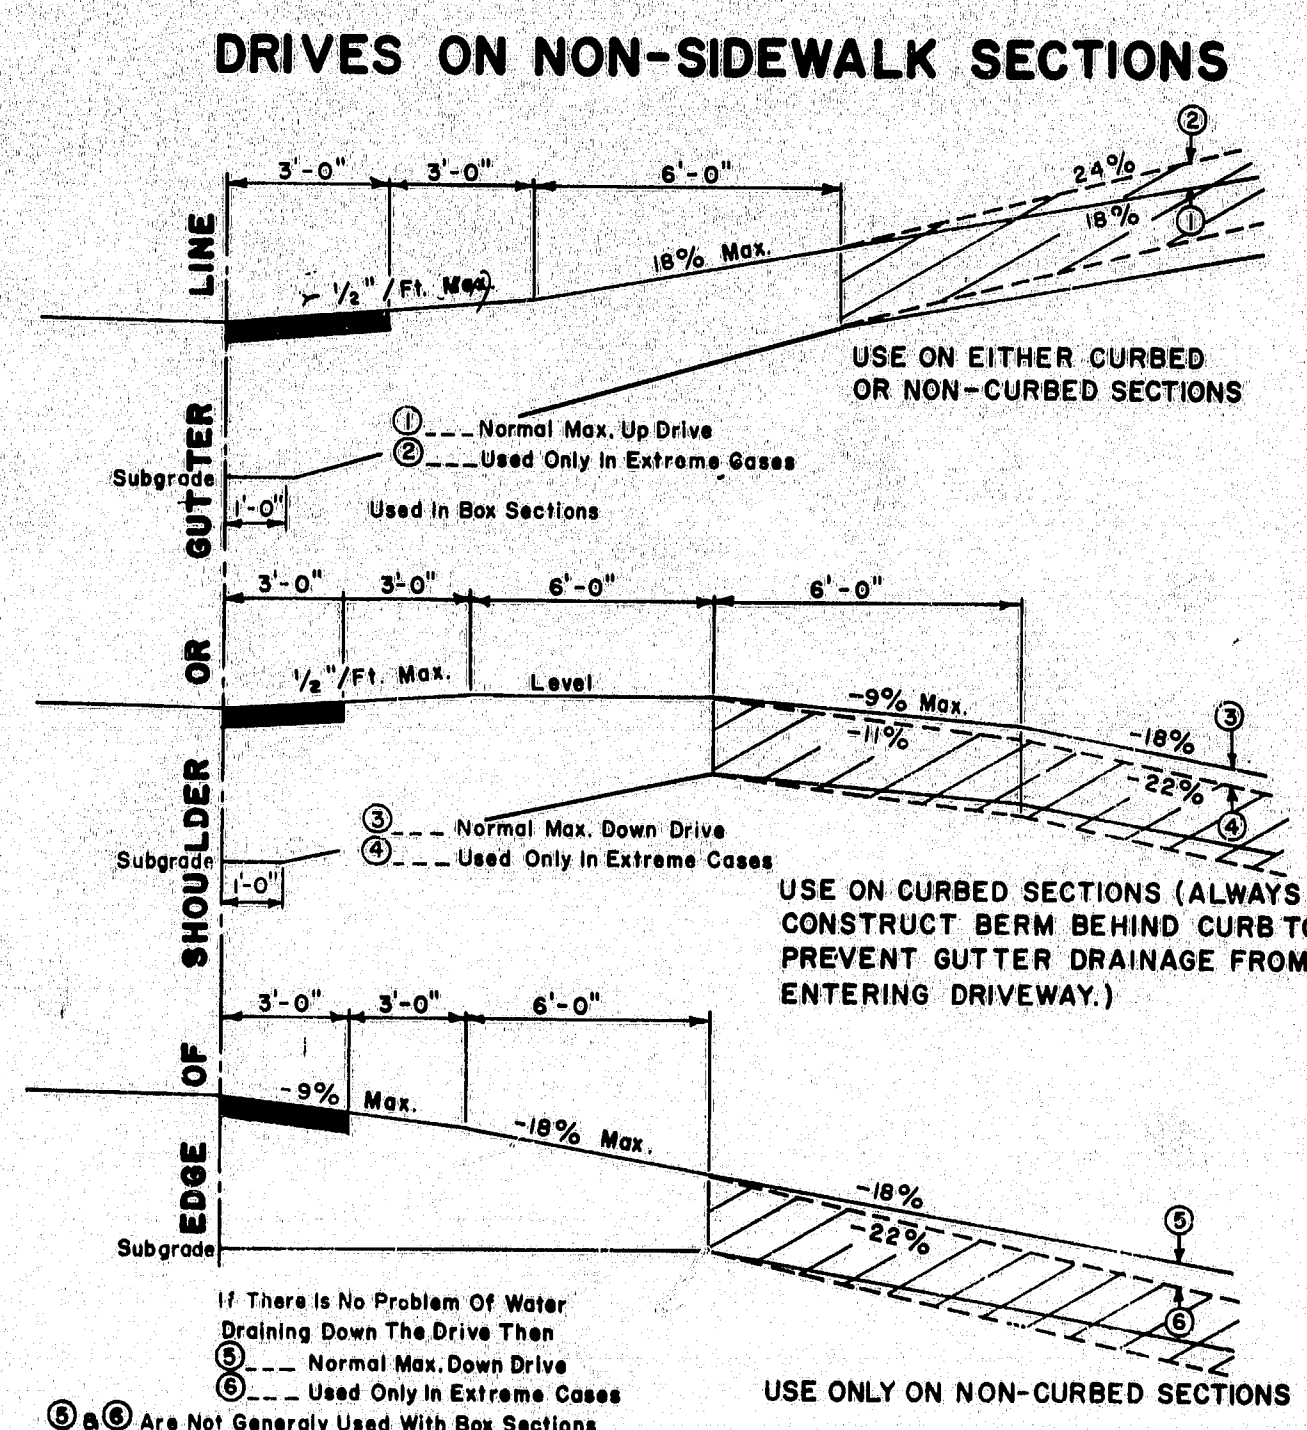


- GENERAL NOTES**
- The first 3' shown as pavement shall be paved only when abutting a paved area.
 - All residential or commercial drives 10% and over shall be paved.


- NOTES ON MAXIMUM DRIVEWAY PROFILES**
- These profiles are a guide for the majority of cases, but should be field checked when the main line grade is steep (4% to 6% or greater) or the angle of approach to the drive is unusual.
 - Generally the majority of drives on a project will be built with flatter profiles than these maximum cases.
 - When grading drives which are flatter than the maximum profiles the following rule of thumb should be used, do not exceed a grade % change of more than 9% in a 6 foot increment of driveway length. This applies to both up and down profiles.

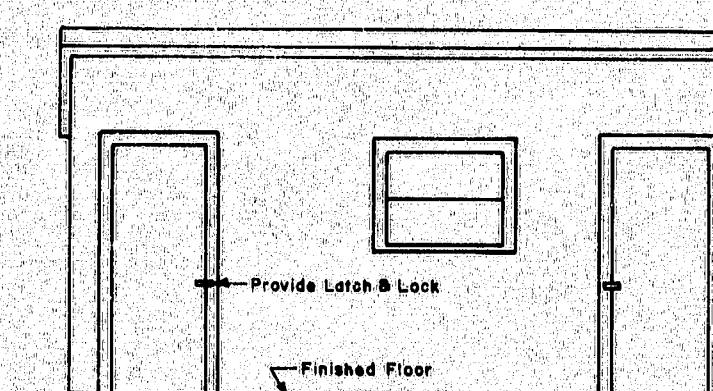


FRONT ELEVATION
TYPE "A"

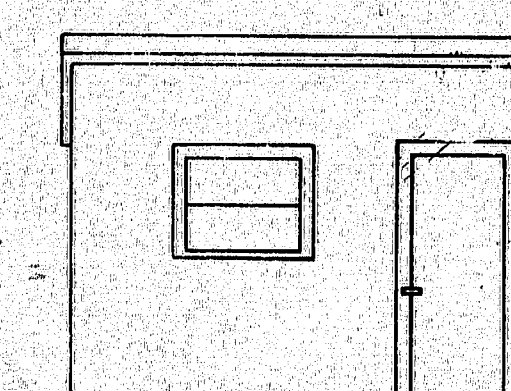

FRONT ELEVATION
TYPE "B"

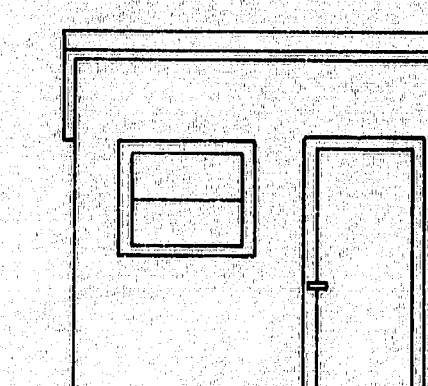

FRONT ELEVATION
TYPE "C"

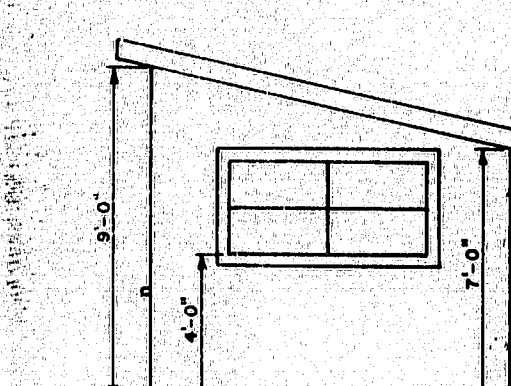

SIDE ELEVATION
TYPES "A" "B" & "C"

REVISIONS	
PLATE	D'E 3-16-73

STATE OF MAINE
DEPARTMENT OF TRANSPORTATION
AUGUSTA, MAINE

STANDARD DETAILS

DRIVEWAY DETAILS
FIELD OFFICES
TESTING LABORATORY

AUG. 1969

172-103