

Date: 2/21/2011

Username: COMMON

Division: HIGHWAY

Filename:

FOR CONTINUATION
SEE SHEET NO. 254

SR8	40'
III	22,500
CKT A	TENON
STA	306+00

FOR CONTINUATION
SEE SHEET NO. 255

SR10	30'
III	17,000
CKT A	TENON
STA	307+77

SR11	30'
III	17,000
CKT A	TENON
STA	309+37

SR12	30'
III	17,000
CKT A	TENON
STA	310+55

SR13	40'
II	22,500
CKT A	TENON
STA	312+22

NR6	40'
II	22,500
CKT A	TENON
STA	215+62

NR7	40'
III	22,500
CKT A	TENON
STA	217+26

NR8	30'
III	17,000
CKT A	TENON
STA	218+85

NR9	30'
III	17,000
CKT A	TENON
STA	220+42

NR10	30'
III	17,000
CKT A	TENON
STA	221+89

NR11	40'
II	22,500
CKT A	TENON
STA	223+34

NR12	40'
II	22,500
CKT A	TENON
STA	225+66

NR13	40'
II	22,500
CKT A	TENON
STA	227+90

NOTES:

1. FOR THE LEGEND, ABBREVIATIONS AND GENERAL NOTES, SEE DRAWING 251.
2. FOR LIGHT DETAILS, SEE DRAWING 257.

STATE OF MAINE
DEPARTMENT OF TRANSPORTATION
IM-1108(600) EXIT 15
CM-1749(000)X PARK & RIDE LOT
WIN 11086.00 EXIT 15 HIGHWAY PLANS
WIN 17490.00 PARK & RIDE LOT


PROJ. MANAGER	DATE	BY	SIGNATURE
DESIGN-DETAILED			
CHECKED-REVIEWED			
DESIGN-DETAILED2			
DESIGN-DETAILED3			
REVISIONS 1			
REVISIONS 2			
REVISIONS 3			
REVISIONS 4			
FIELD CHANGES			

YARMOUTH
I-295 EXIT 15
LIGHTING PLANS

SHEET NUMBER


256

OF 283

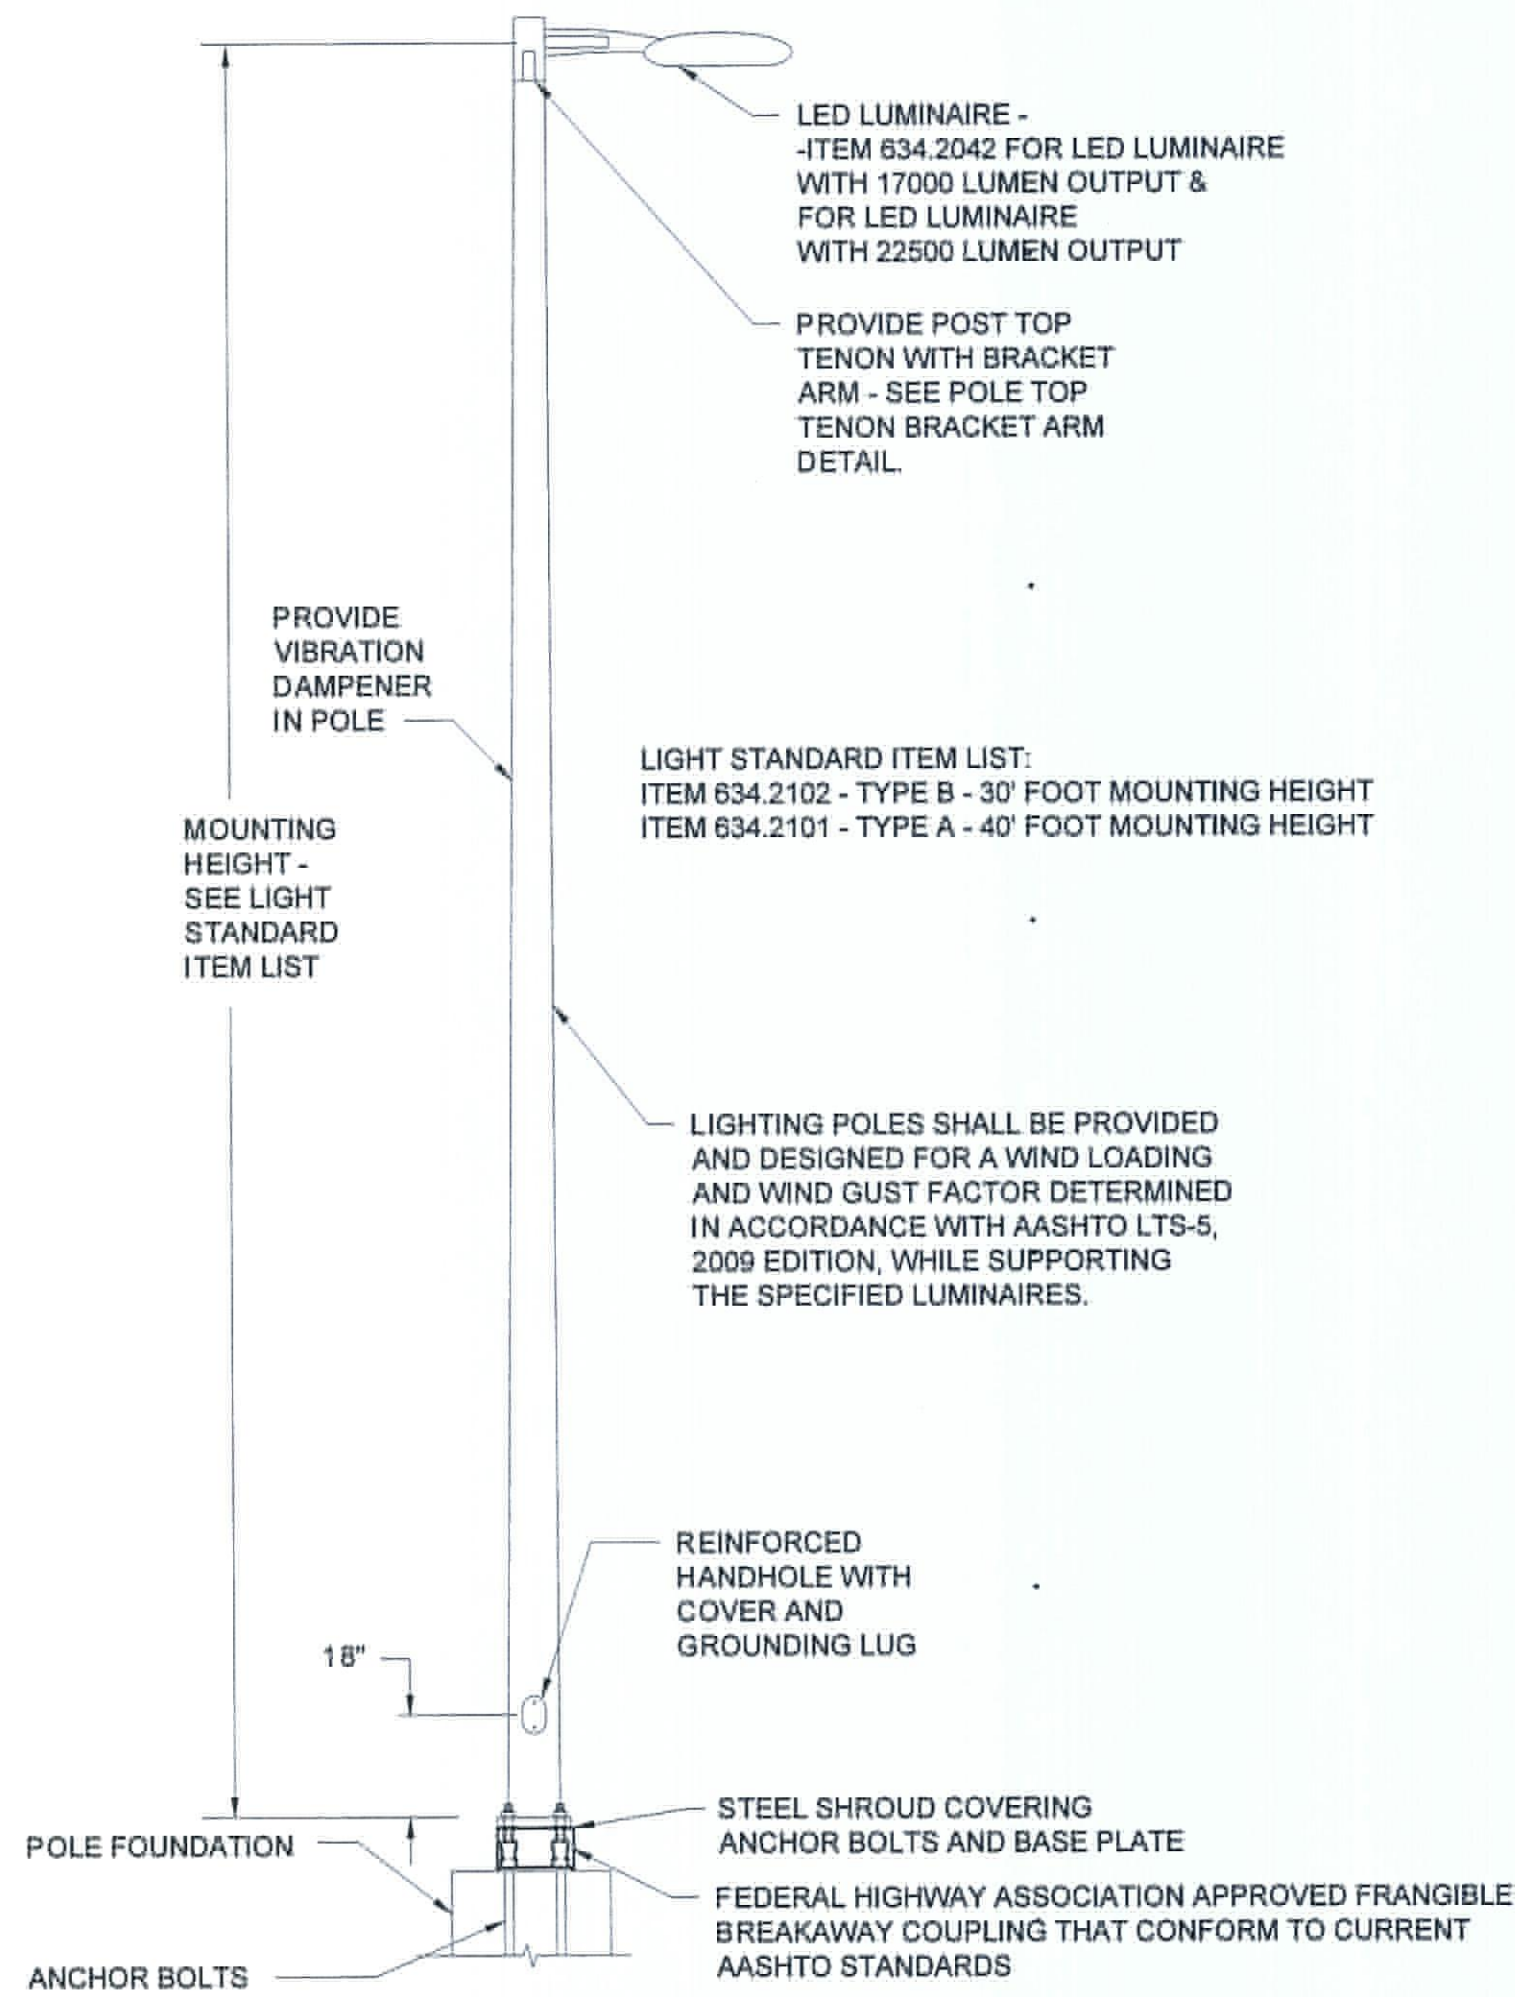


LIGHT POLE DETAIL

LIGHT POLE DETAIL - NEW INSTALLATION
NOT TO SCALE

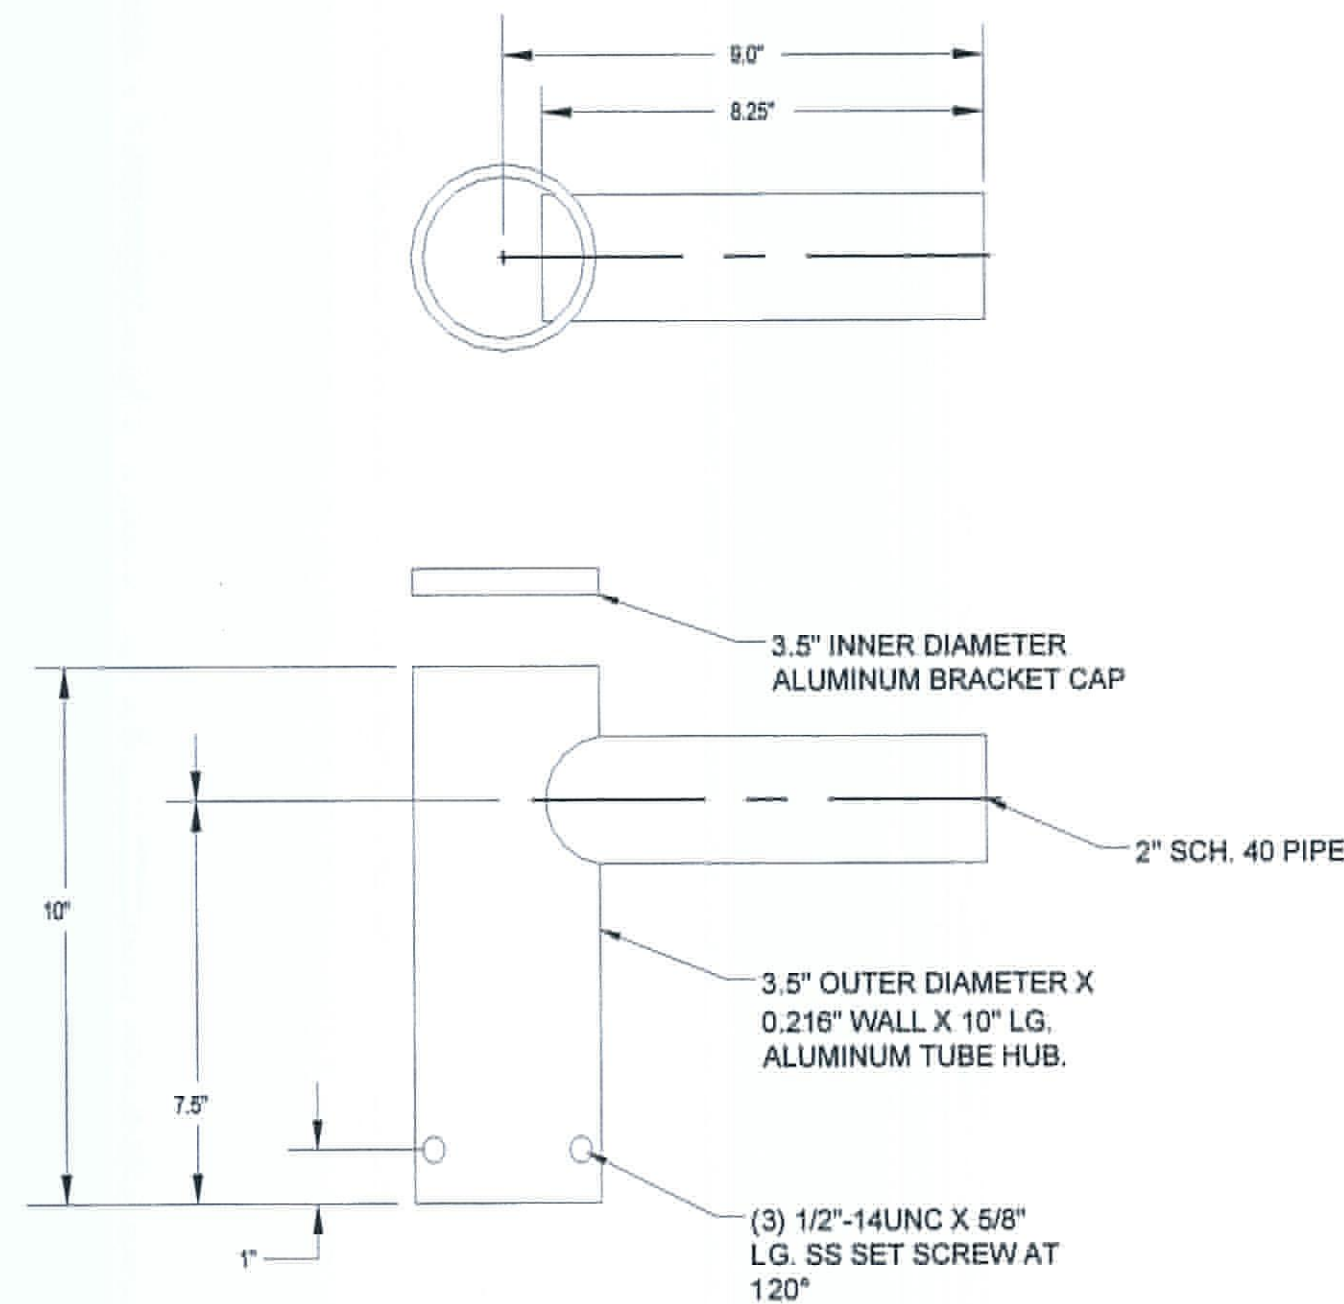


POLE TOP TENON BRACKET ARM DETAIL

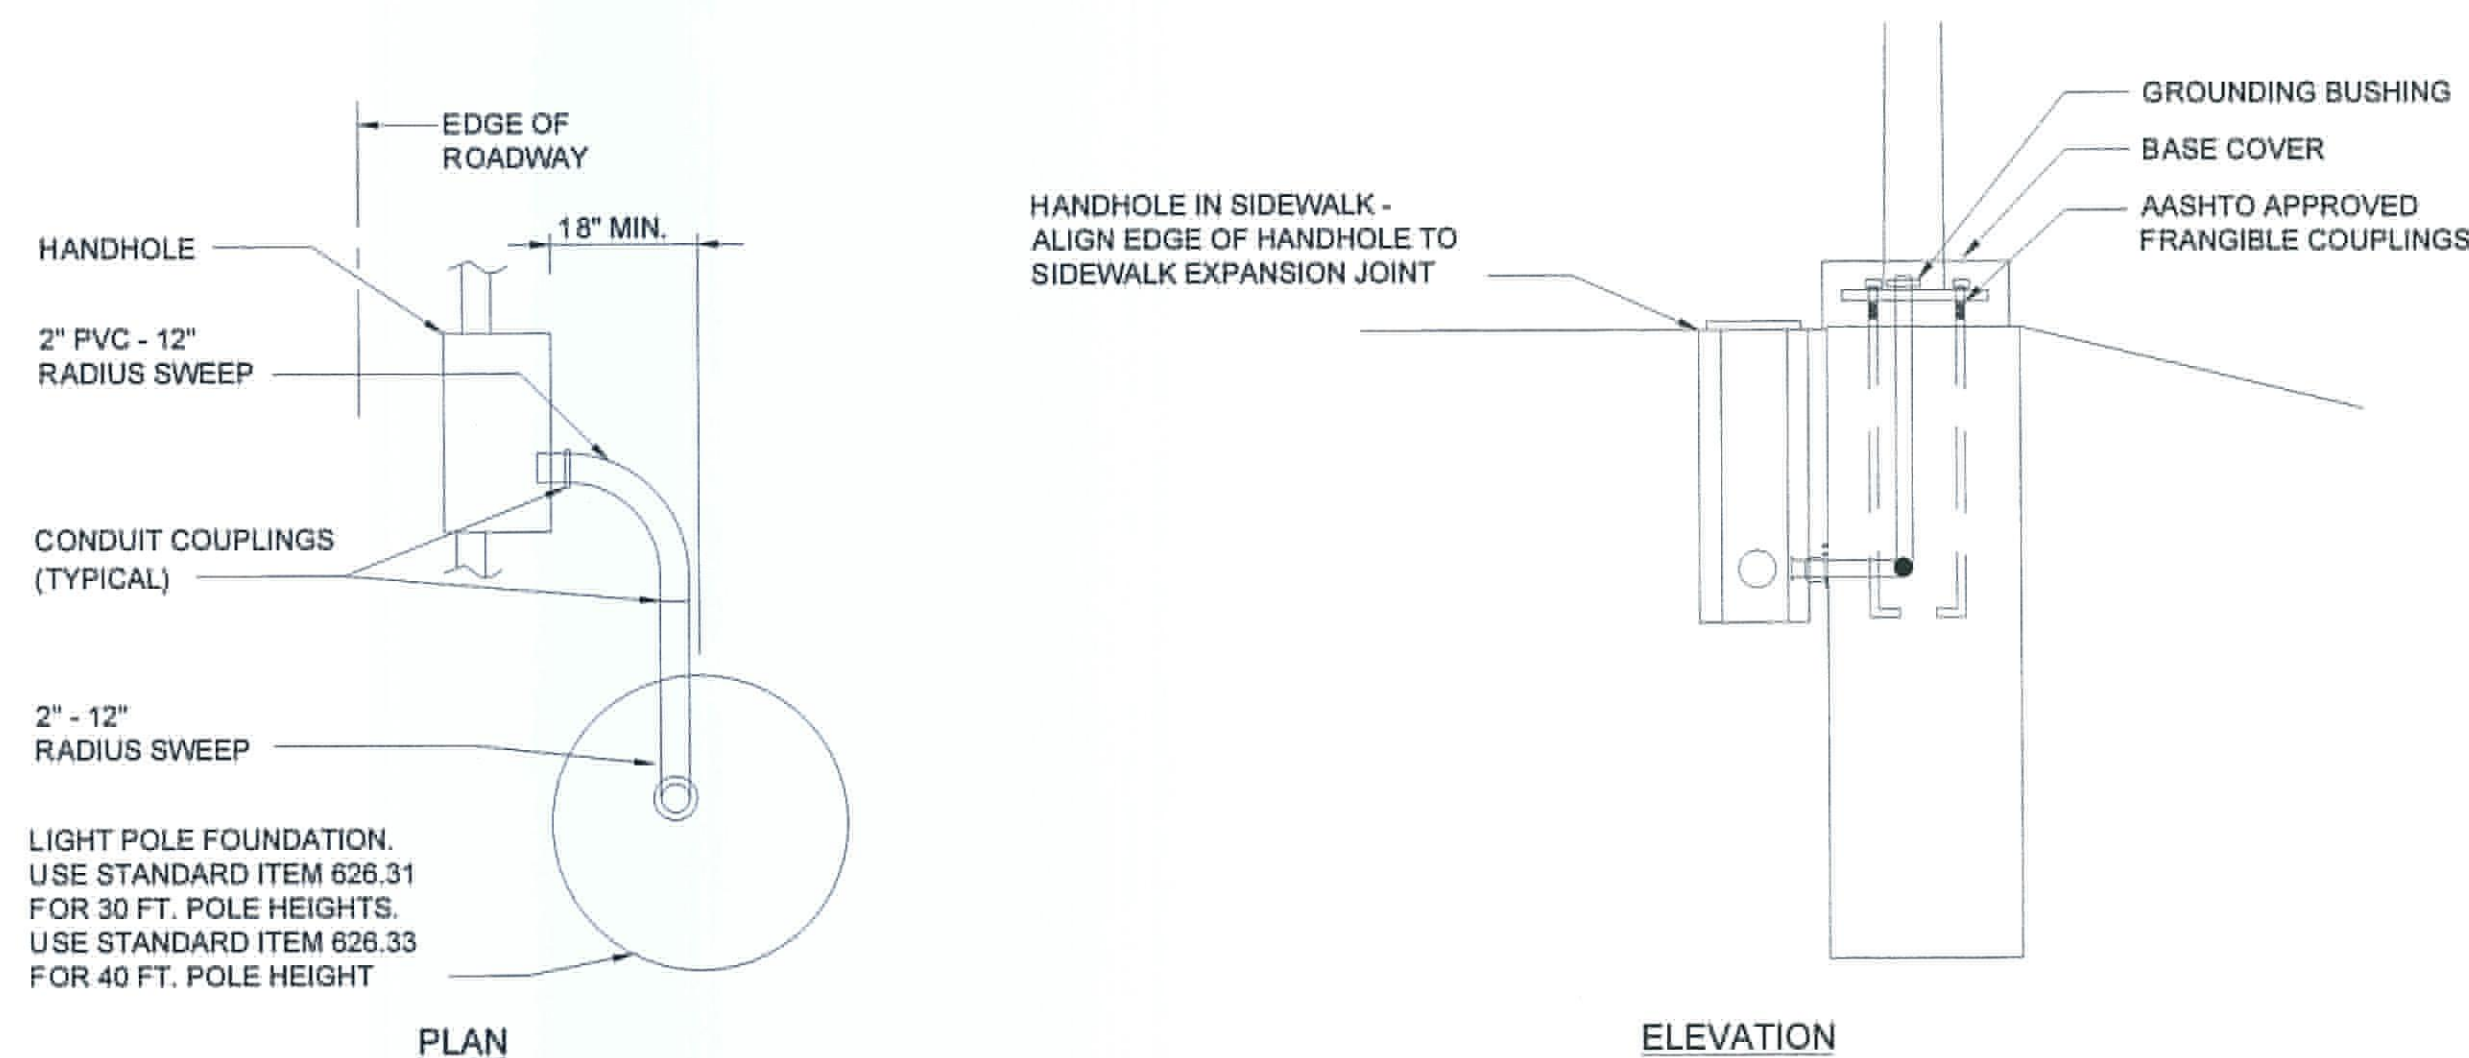


HIGHWAY LIGHTING HANDHOLE AND POLE BASE LAYOUT

NOT TO SCALE

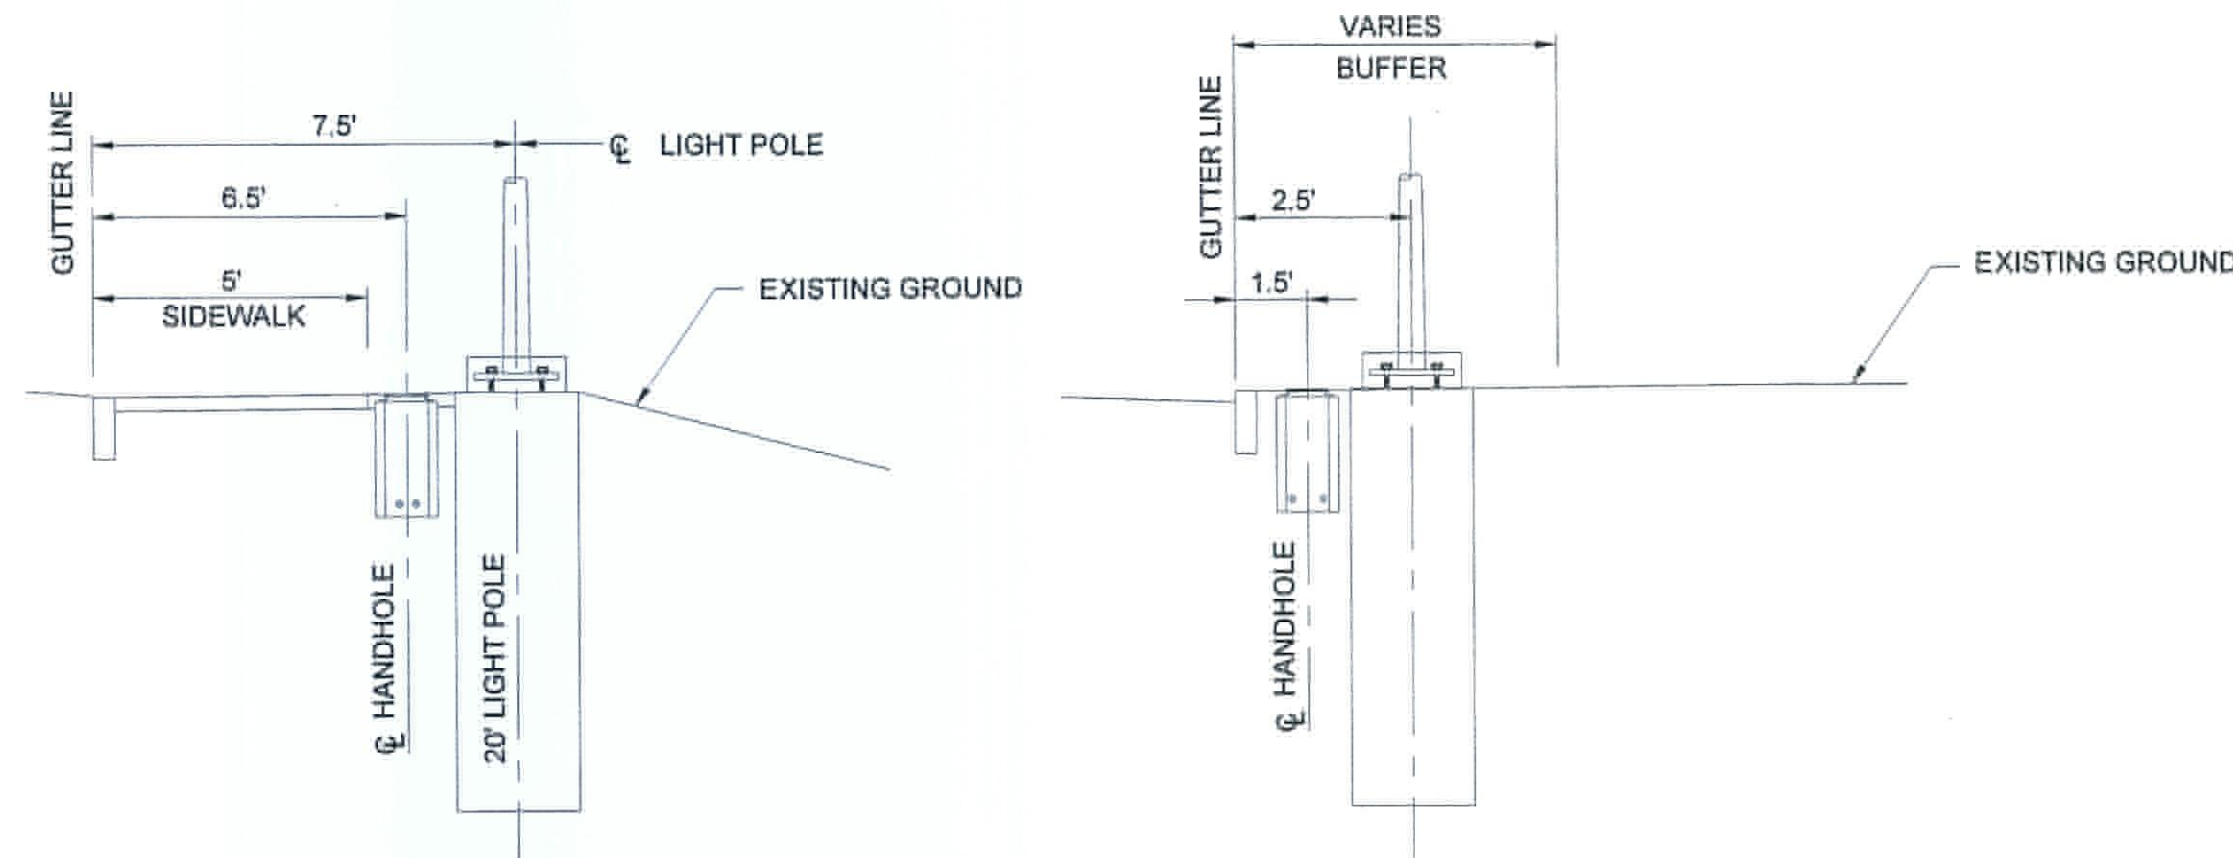

TYPE A
BEHIND SIDEWALK - PARK AND RIDE CONCOURSE

TYPE B
ALONG ROADWAY WITH CURB

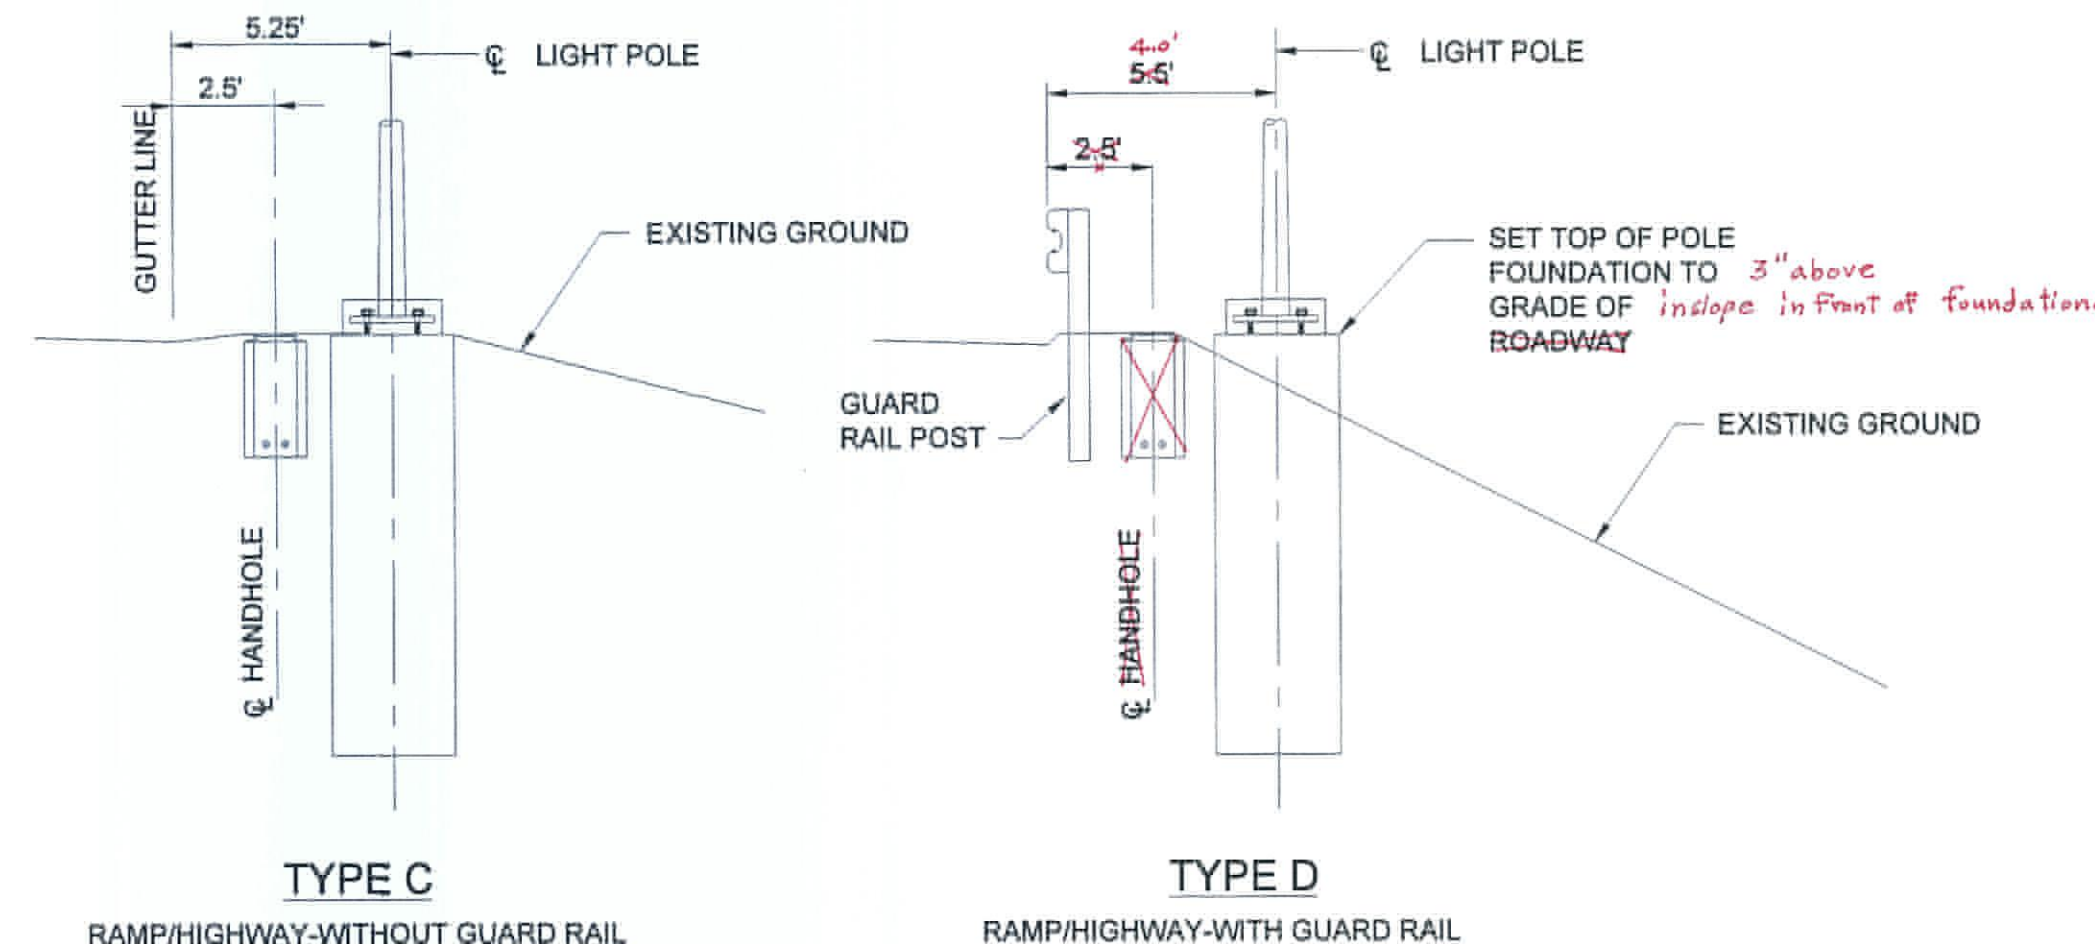


TYPICAL LIGHT POLE AND HANDHOLE LAYOUT DETAILS AT SIDEWALKS OR RAMPS


NOT TO SCALE

PROJ. MANAGER	DATE	BY	SIGNATURE	P.E. NUMBER	DATE
DESIGN DETAIL					
CHECKED REVIEWED					
DESIGN DETAIL					
DESIGN DETAIL					
REVISIONS 1					
REVISIONS 2					
REVISIONS 3					
REVISIONS 4					
FIELD CHANGES					

As-Built by T.P. Dwyer, Dec. 2013

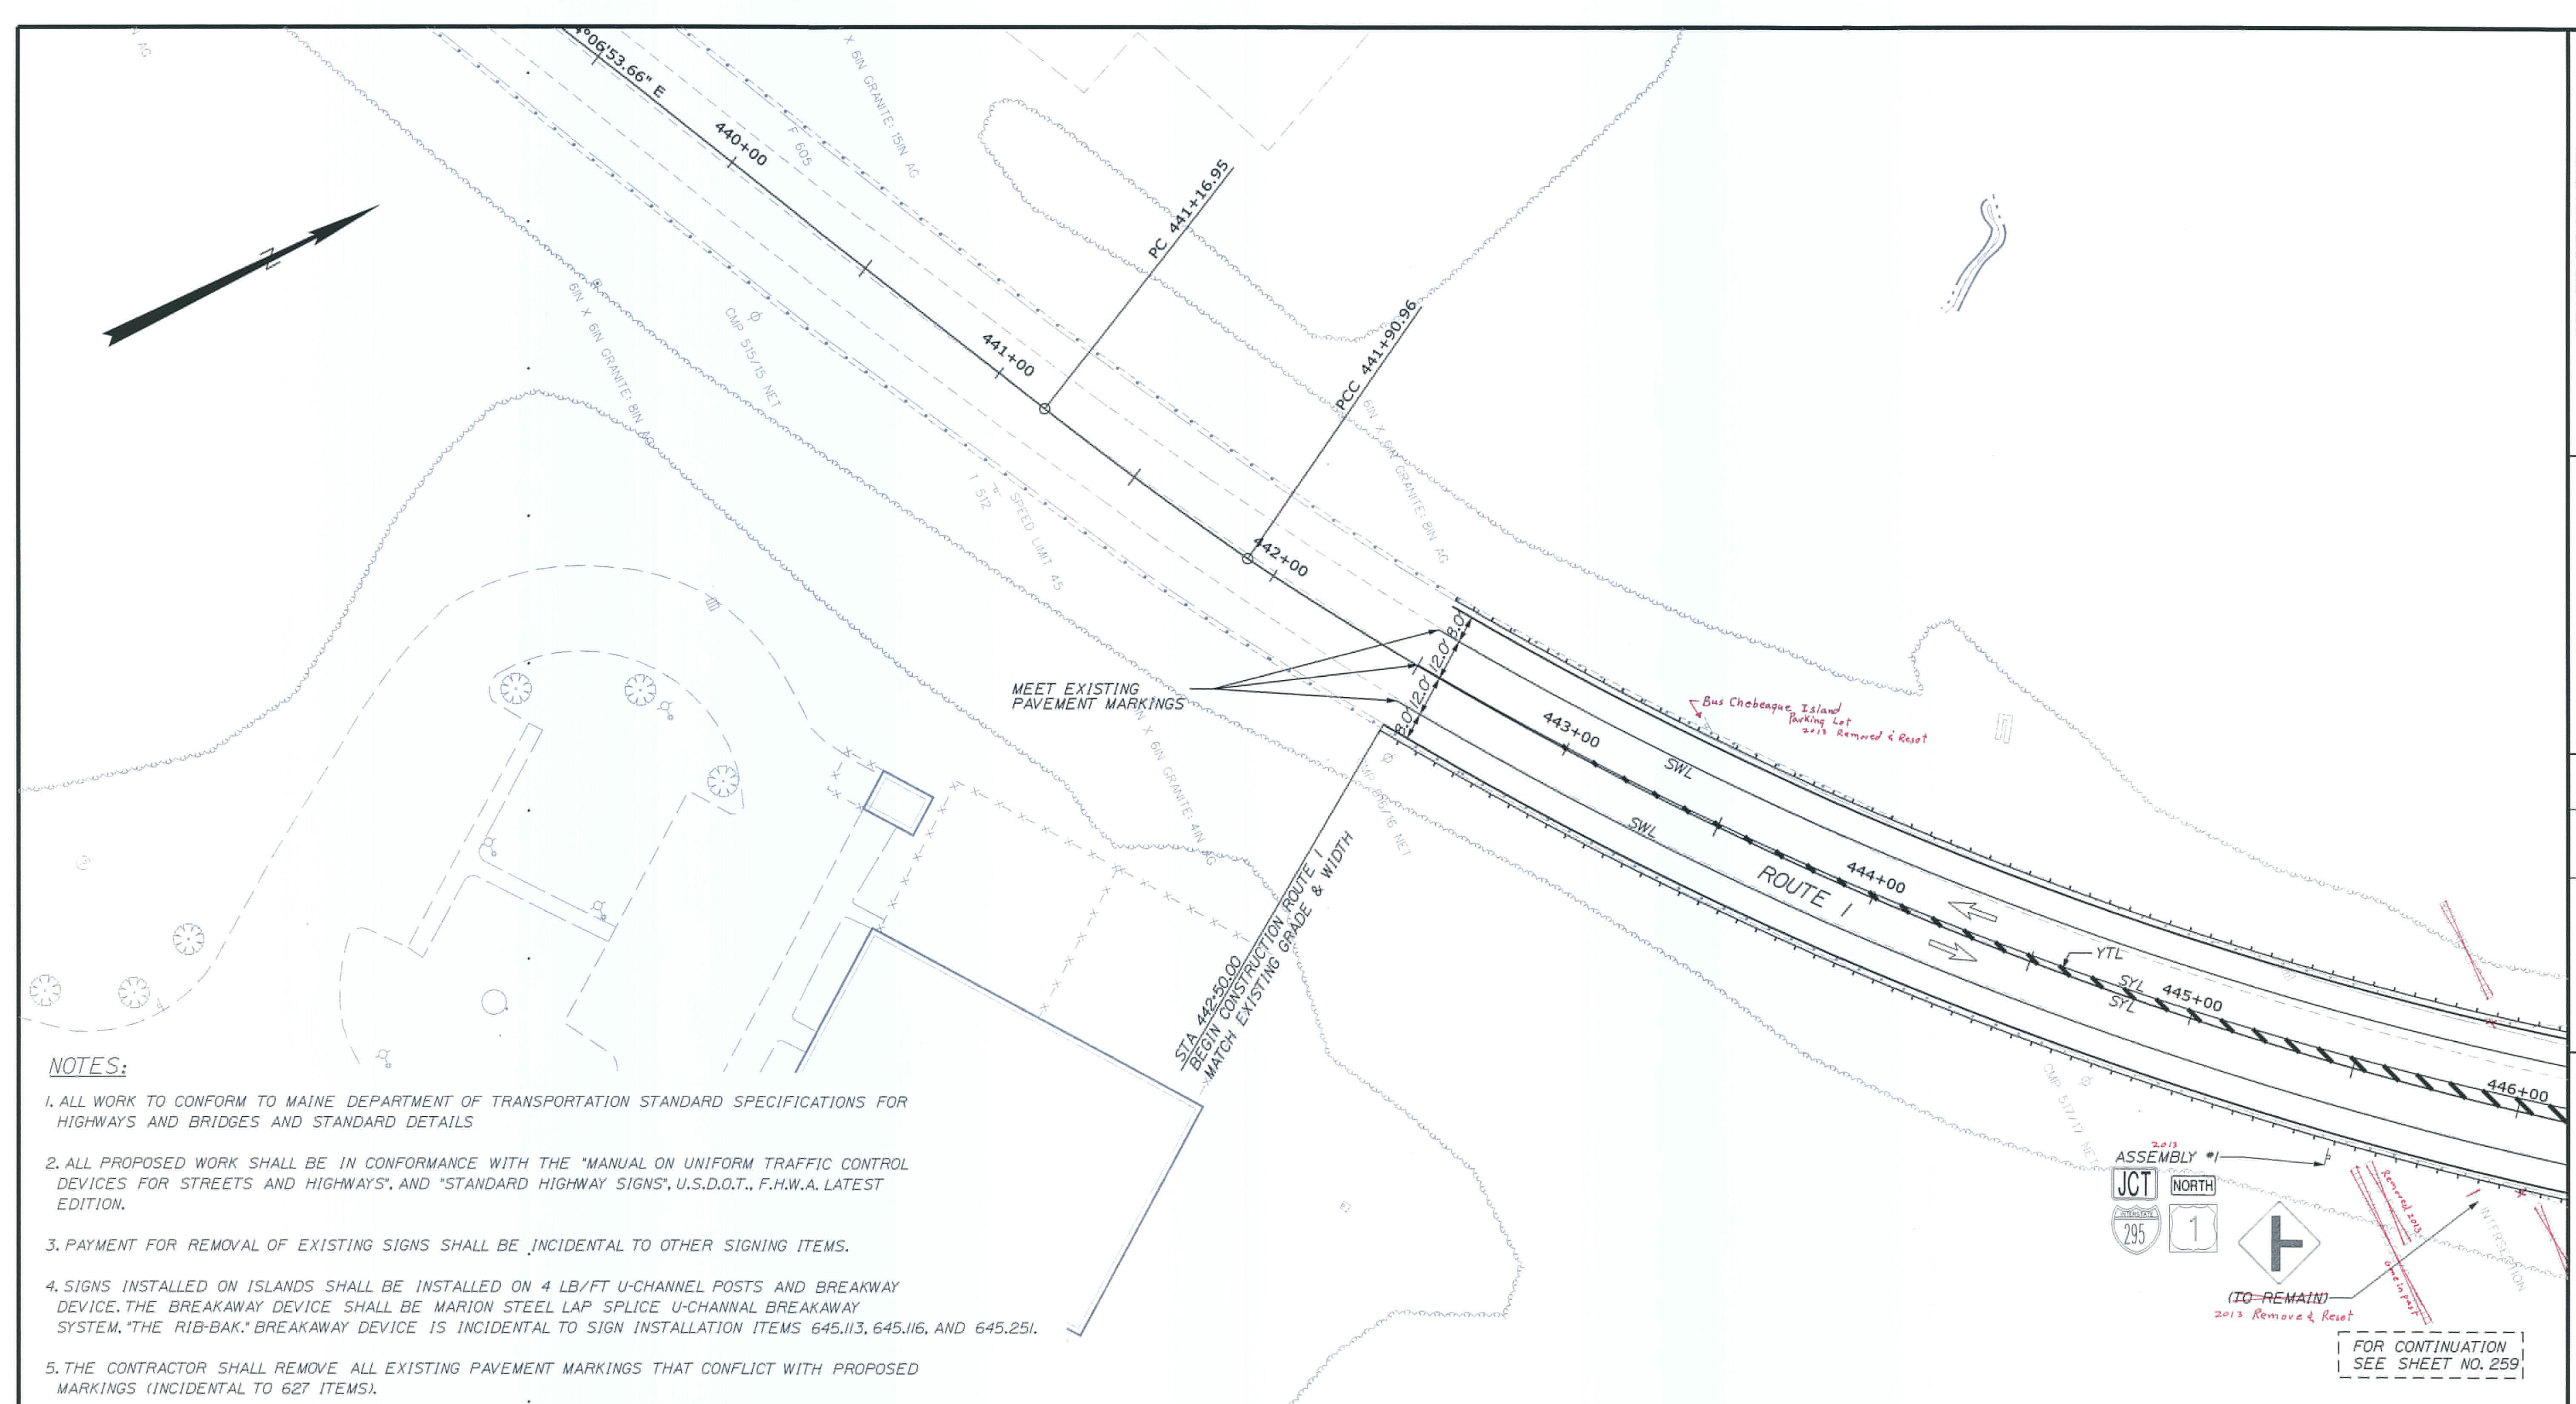

LEGEND			
SWL	SOLID WHITE LINE (6")		STRAIGHT ARROW PAVEMENT MARKING
SYL	SOLID YELLOW LINE (6")		LEFT ARROW PAVEMENT MARKING
DYL	DOUBLE YELLOW LINE (6")		RIGHT ARROW PAVEMENT MARKING
BWL	BROKEN WHITE LINE (6")		"ONLY" PAVEMENT MARKING
DL	6" DOTTED WHITE LINE (2' LINE & 6" GAP)		HANDICAP PAVEMENT MARKING
WGL	WHITE GORE LINES (12" @ 45° TO TRAFFIC)		DIRECTIONAL FLOW ARROW
CWL	CHANNELIZING WHITE LINE		
YTL	YELLOW TRANSVERSE LINE (12" LINE @ 45° TO TRAFFIC - 10' O.C.)		
SL	STOP LINE (24")		
	SINGLE SIGN POST		
	DOUBLE SIGN POST		

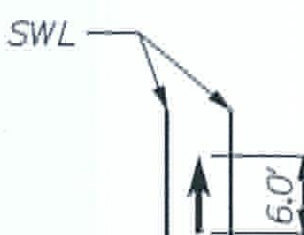


SWL

BIKE LANE
MARKINGS
NOT TO SCALE




SHARED LANE
MARKING
NOT TO SCALE

YARMOUTH I-295 EXIT 15 SIGNS & PVMT. MARKINGS	SHEET NUMBER		258		OF 283	
	PROJ. MANAGER		BY	DATE	STATE OF MAINE	
	DESIGN-DETAILED				DEPARTMENT OF TRANSPORTATION	
	CHECKED-REVIEWED				IM-1108(600) EXIT 15	
	DESIGN2-RETAILED2				CM-1749(000)X PARK & RIDE LOT	
DESIGN3-RETAILED3					WIN 11086.00 EXIT 15 HIGHWAY PLANS	
REVISIONS 1					WIN 17490.00 PARK & RIDE LOT	
REVISIONS 2						
REVISIONS 3						
REVISIONS 4						
FIELD CHANGES						

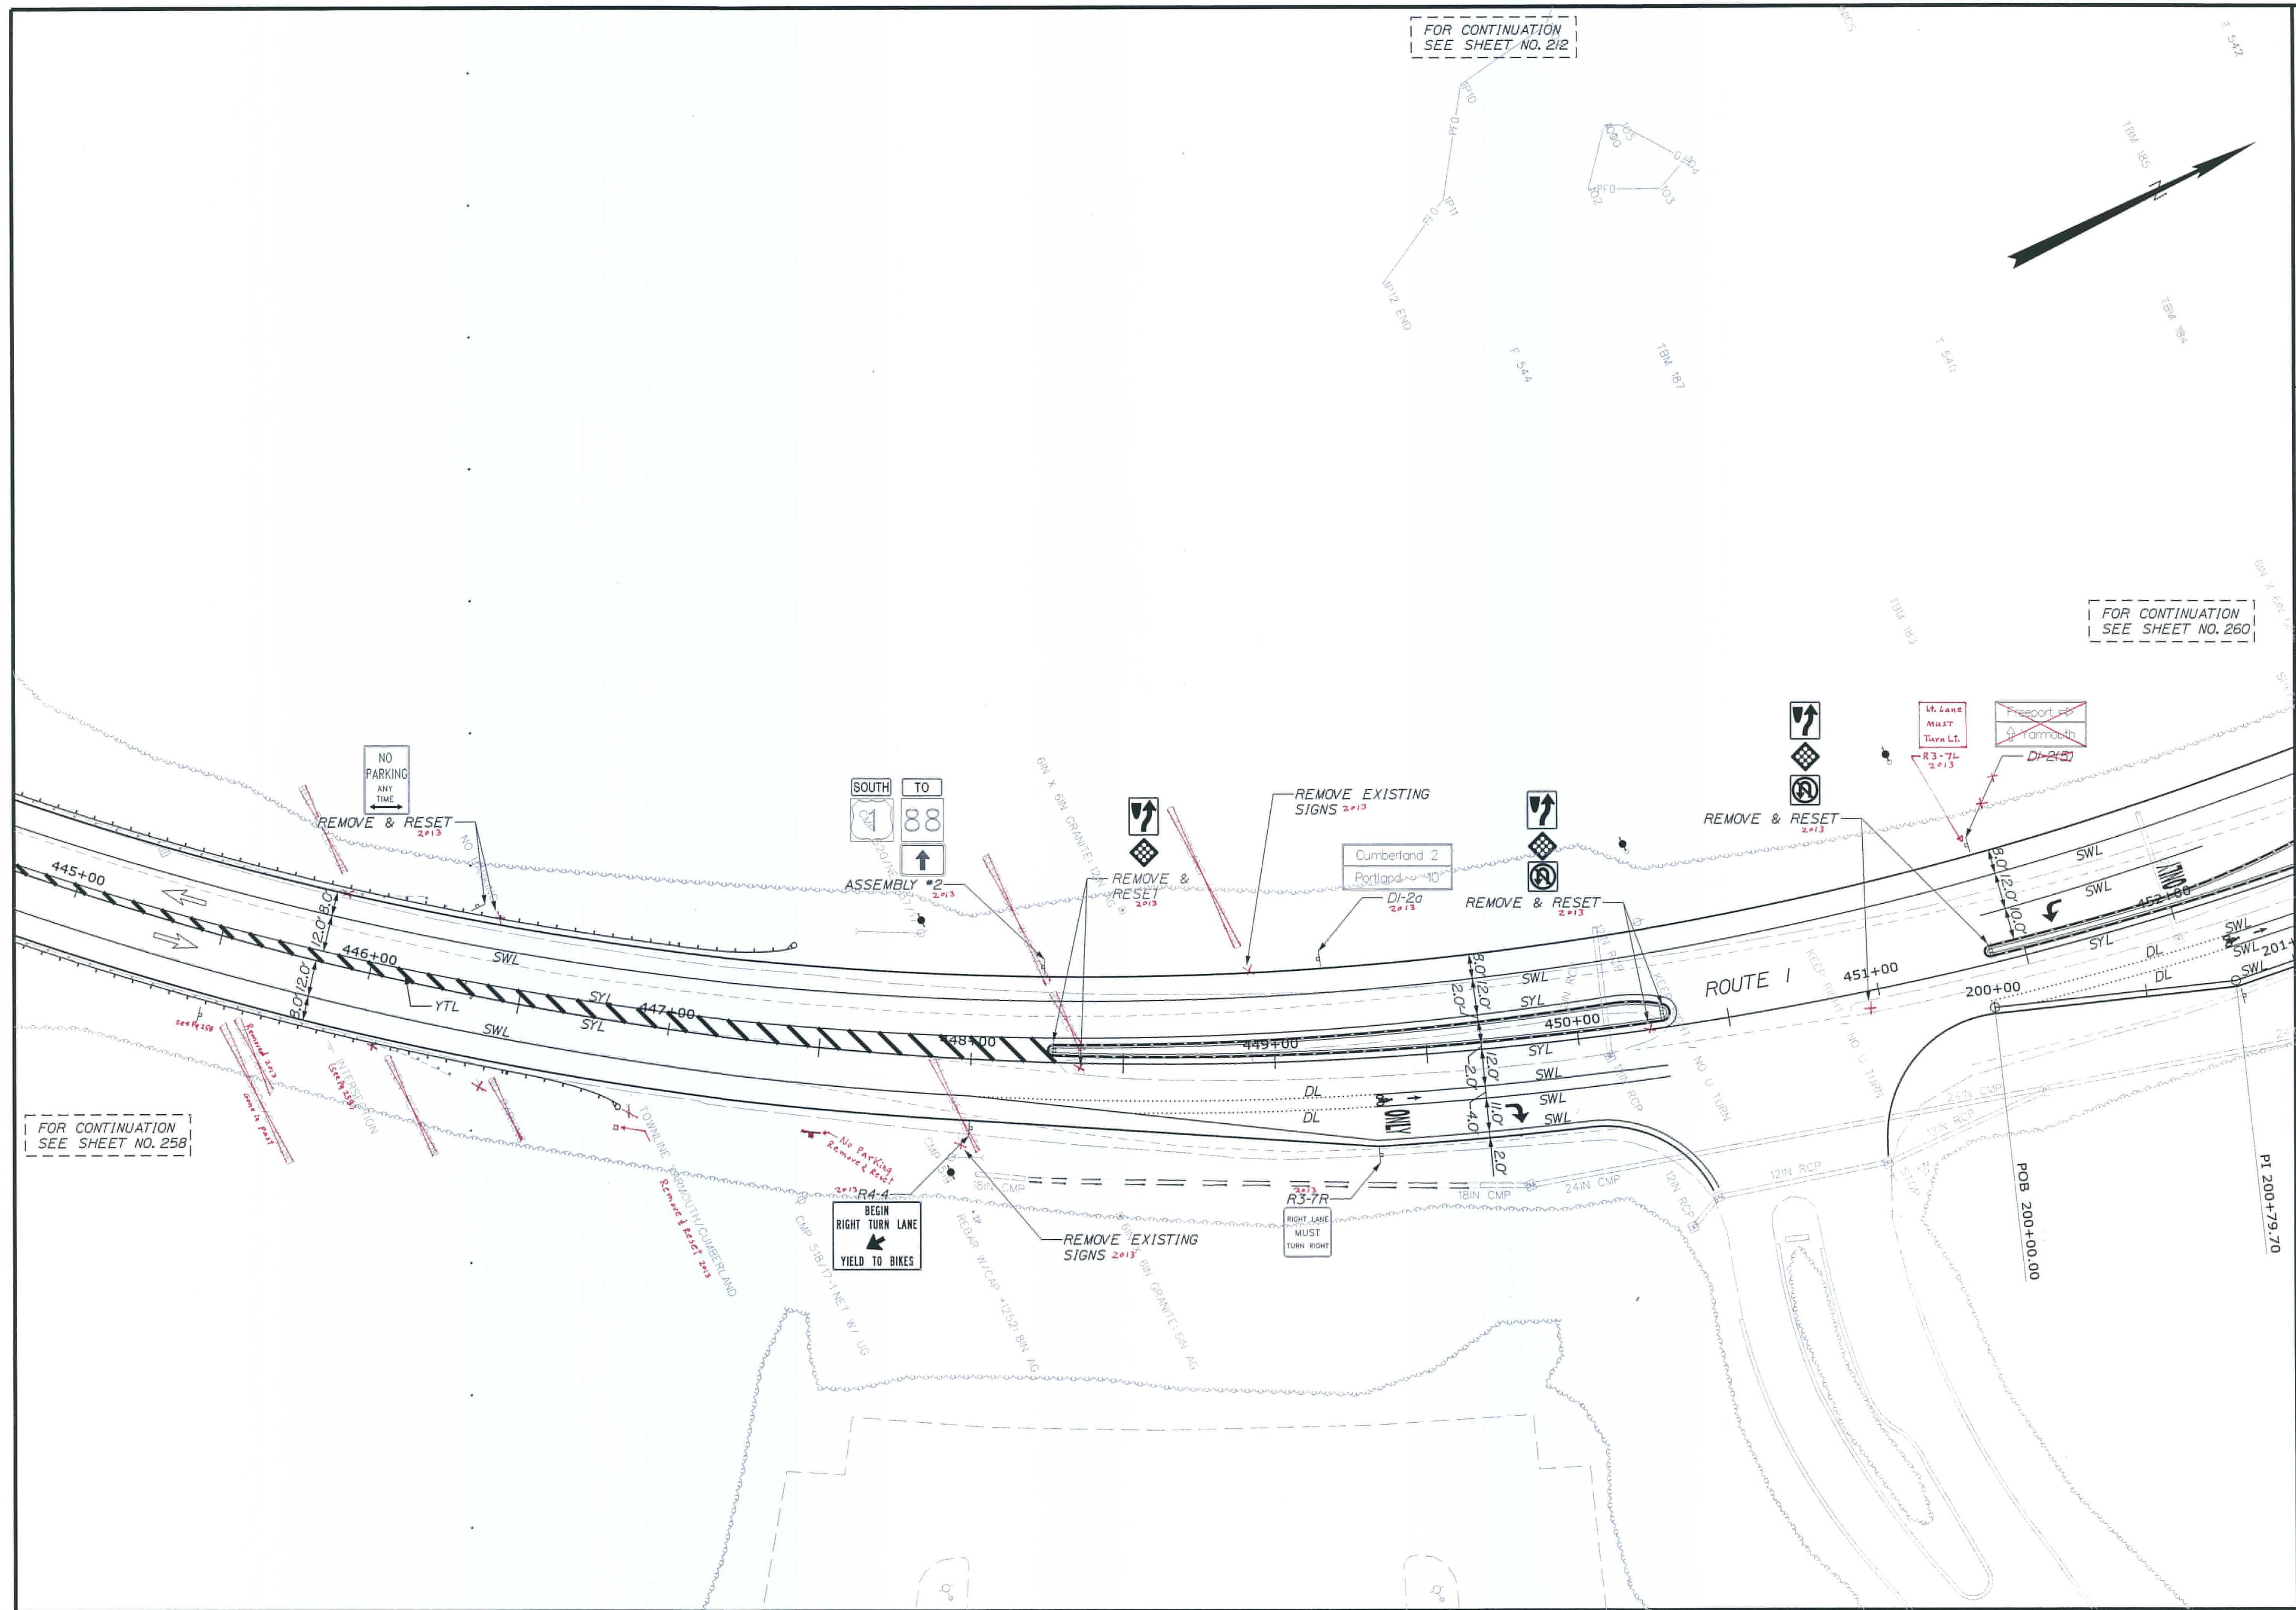

STATE OF MAINE DEPARTMENT OF TRANSPORTATION IM-1108(600) EXIT 15 CM-1749(000)X PARK & RIDE LOT WIN 11086.00 EXIT 15 HIGHWAY PLANS WIN 17490.00 PARK & RIDE LOT	YARMOUTH I-295 EXIT 15 SIGNS & PVMT. MARKINGS		PROJ. MANAGER DESIGN-DETAILED DESIGNED-REVIEWED DESIGN-DET. AL. E02 DESIGN-DET. AL. E03 REVISIONS 1 REVISIONS 2 REVISIONS 3 REVISIONS 4 FIELD CHANGES		BY DATE SIGNATURE P.E. NUMBER DATE	
	SHEET NUMBER 259 OF 283					

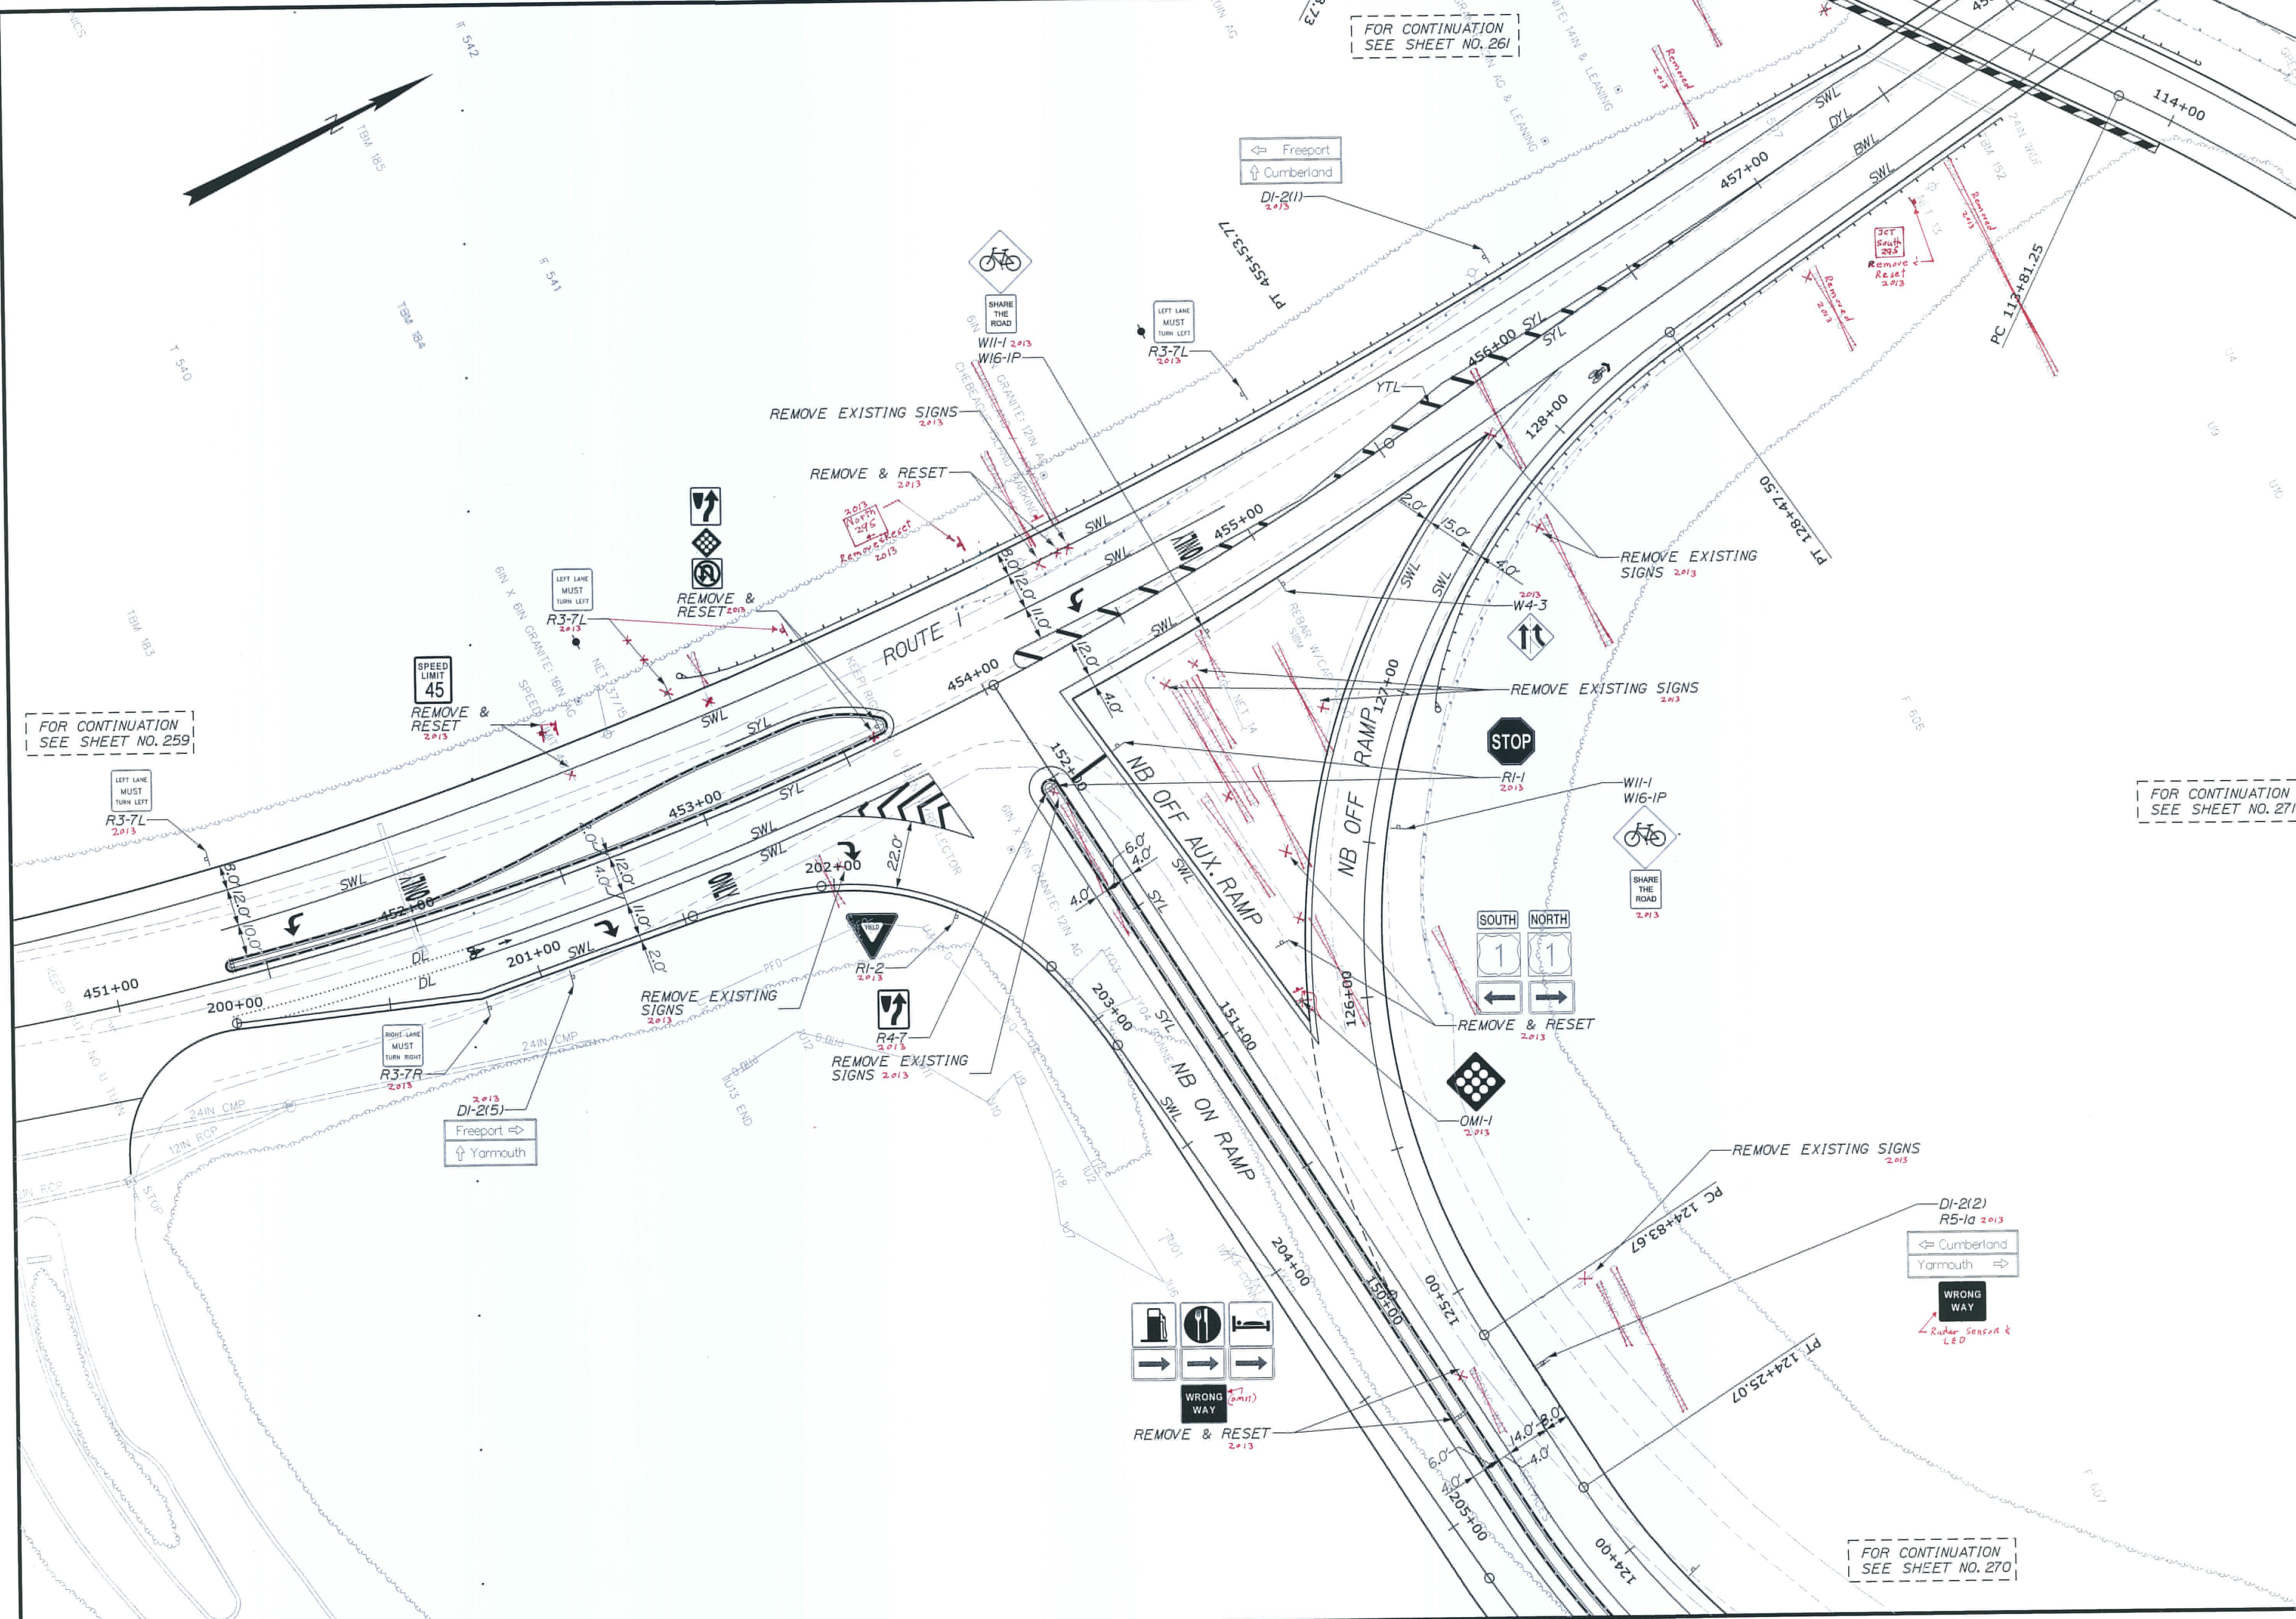


STATE OF MAINE
DEPARTMENT OF TRANSPORTATION
IM-1108(600) EXIT 15
CM-1749(000)X PARK & RIDE LOT
WIN 11086.00 EXIT 15 HIGHWAY PLANS
WIN 17490.00 PARK & RIDE LOT

PROJ. MANAGER	BY	DATE	SIGNATURE
DESIGN-DETAILED			
CHECKED-REVIEWED			
DESIGN-DETAILED2			
DESIGN-DETAILED3			
REVISIONS 1			
REVISIONS 2			
REVISIONS 3			
REVISIONS 4			
FIELD CHANGES			

YARMOUTH
I-295 EXIT 15
SIGNS & PVMT. MARKINGS

SHEET NUMBER
260
OF 283

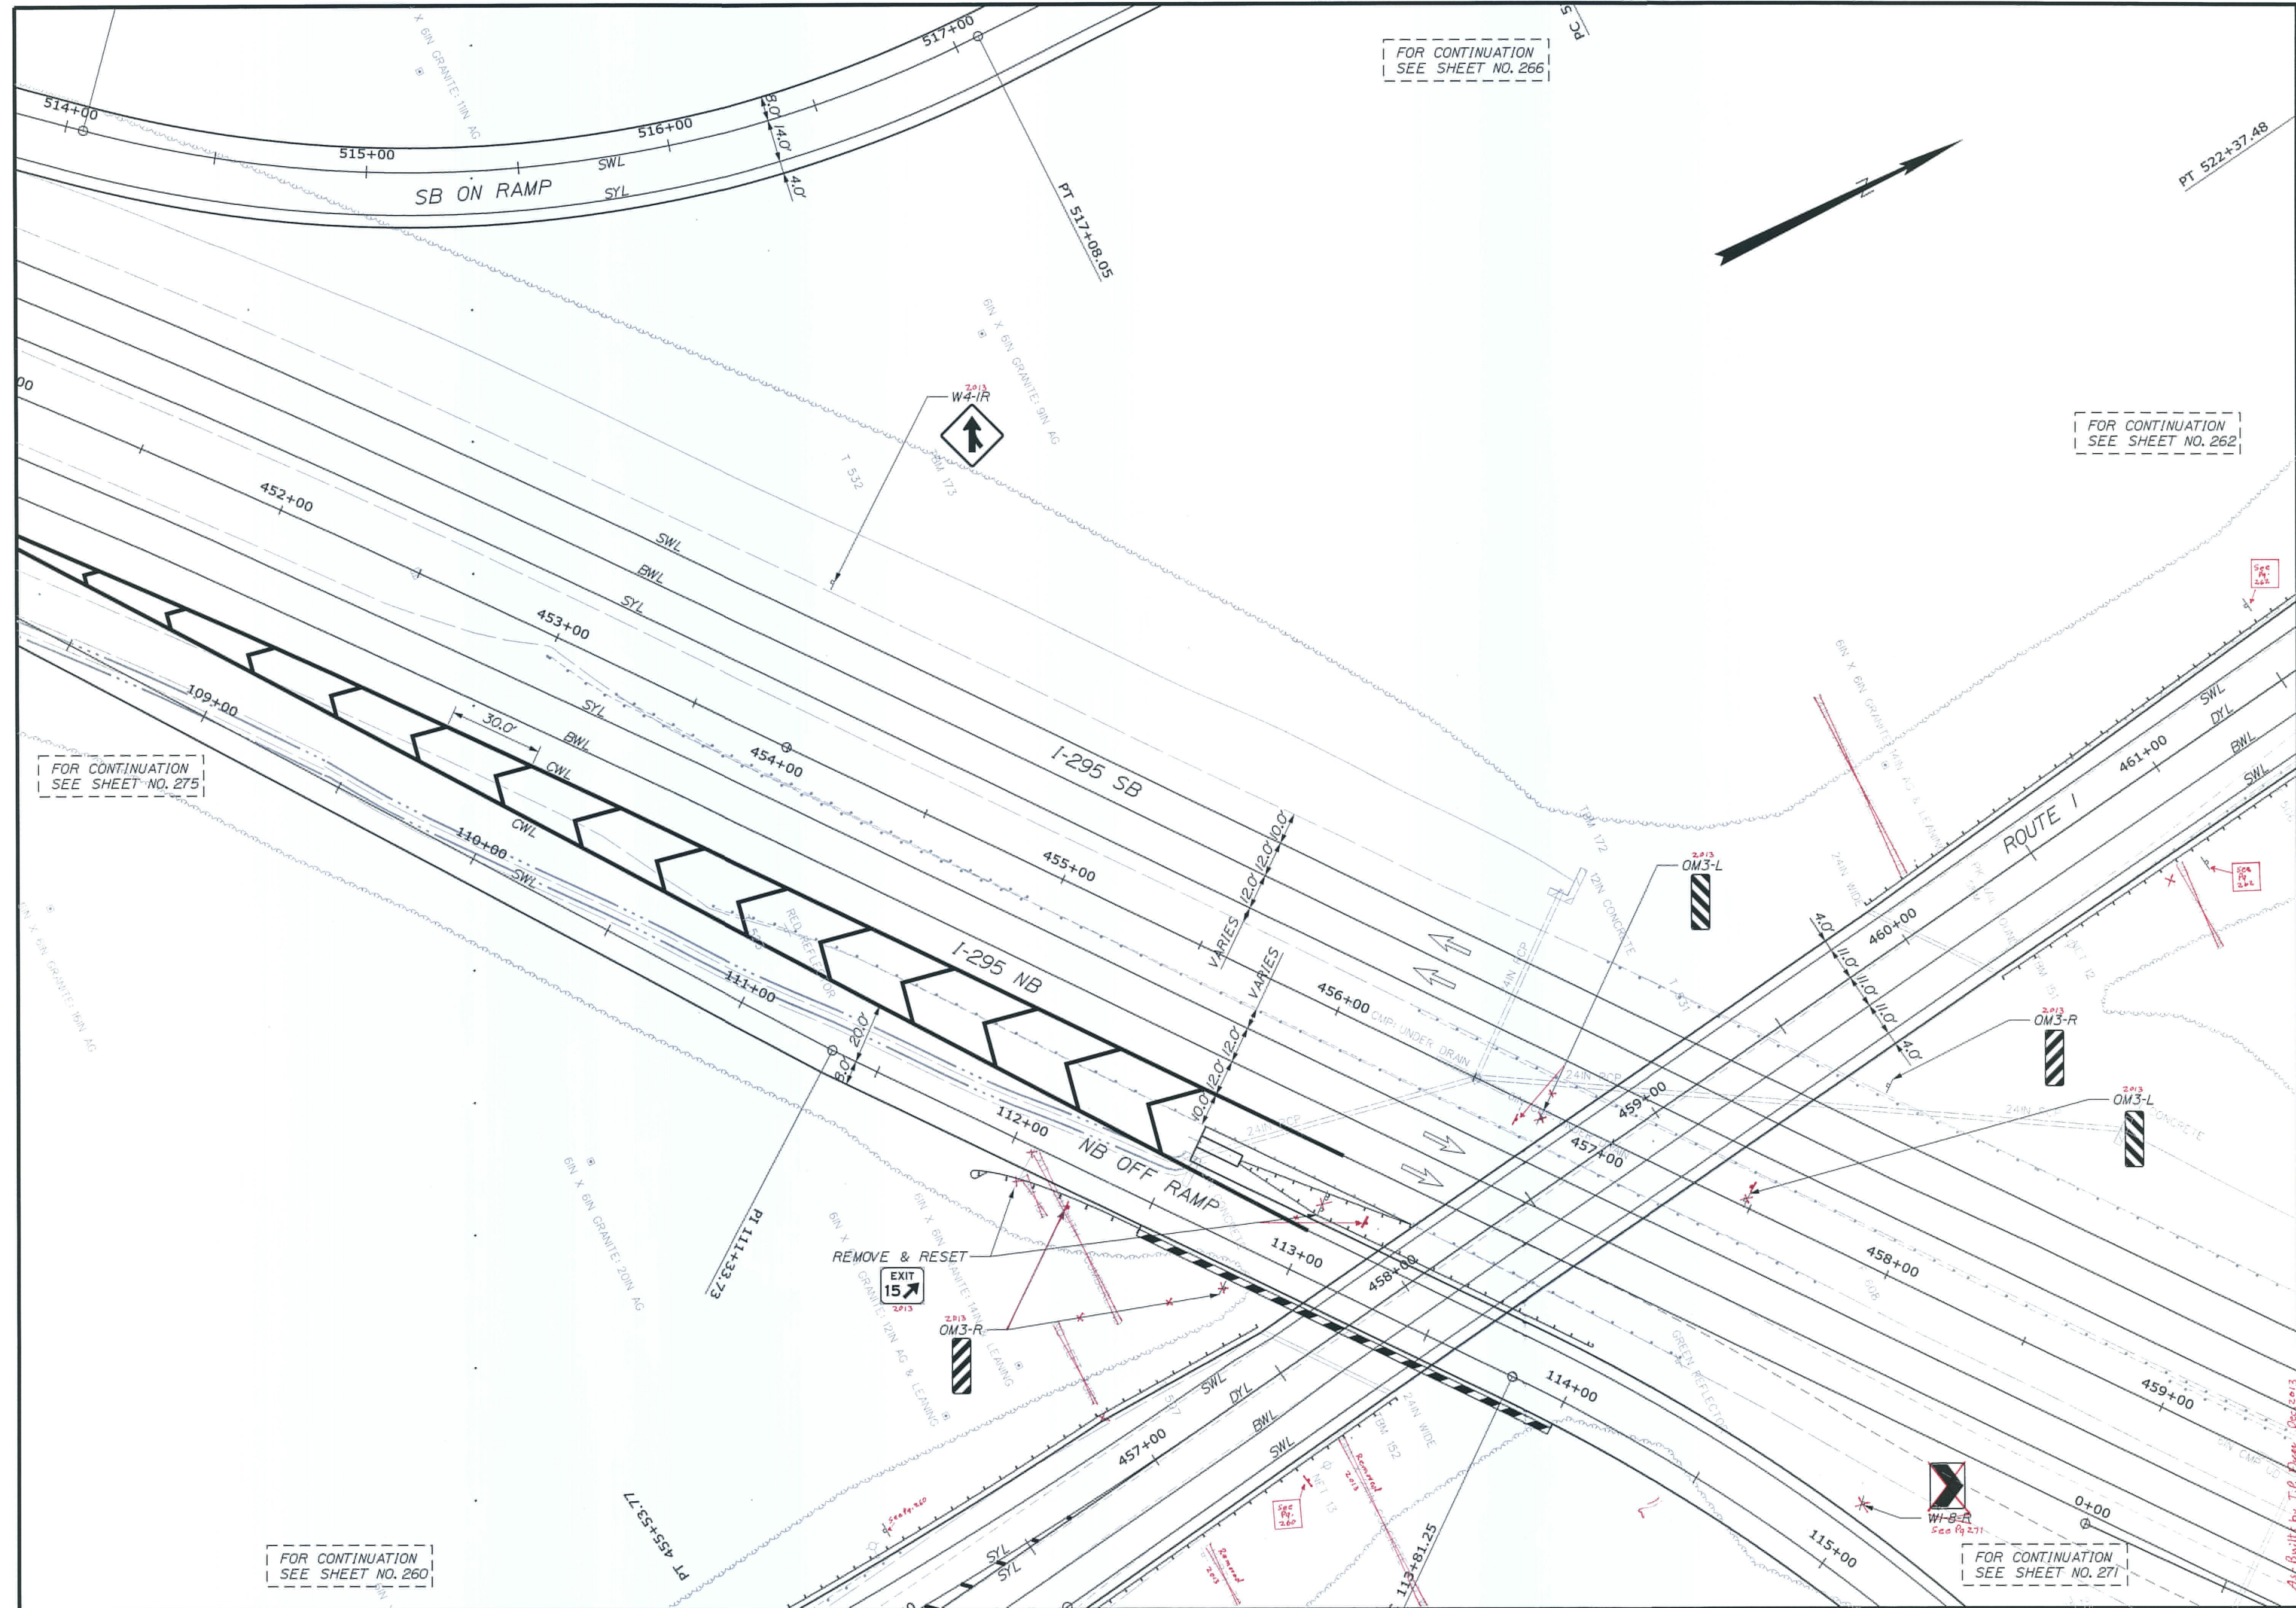
[illegible]

Filename:

Division: HIGHWAY

Username: COMMON

Date: 2/21/2011

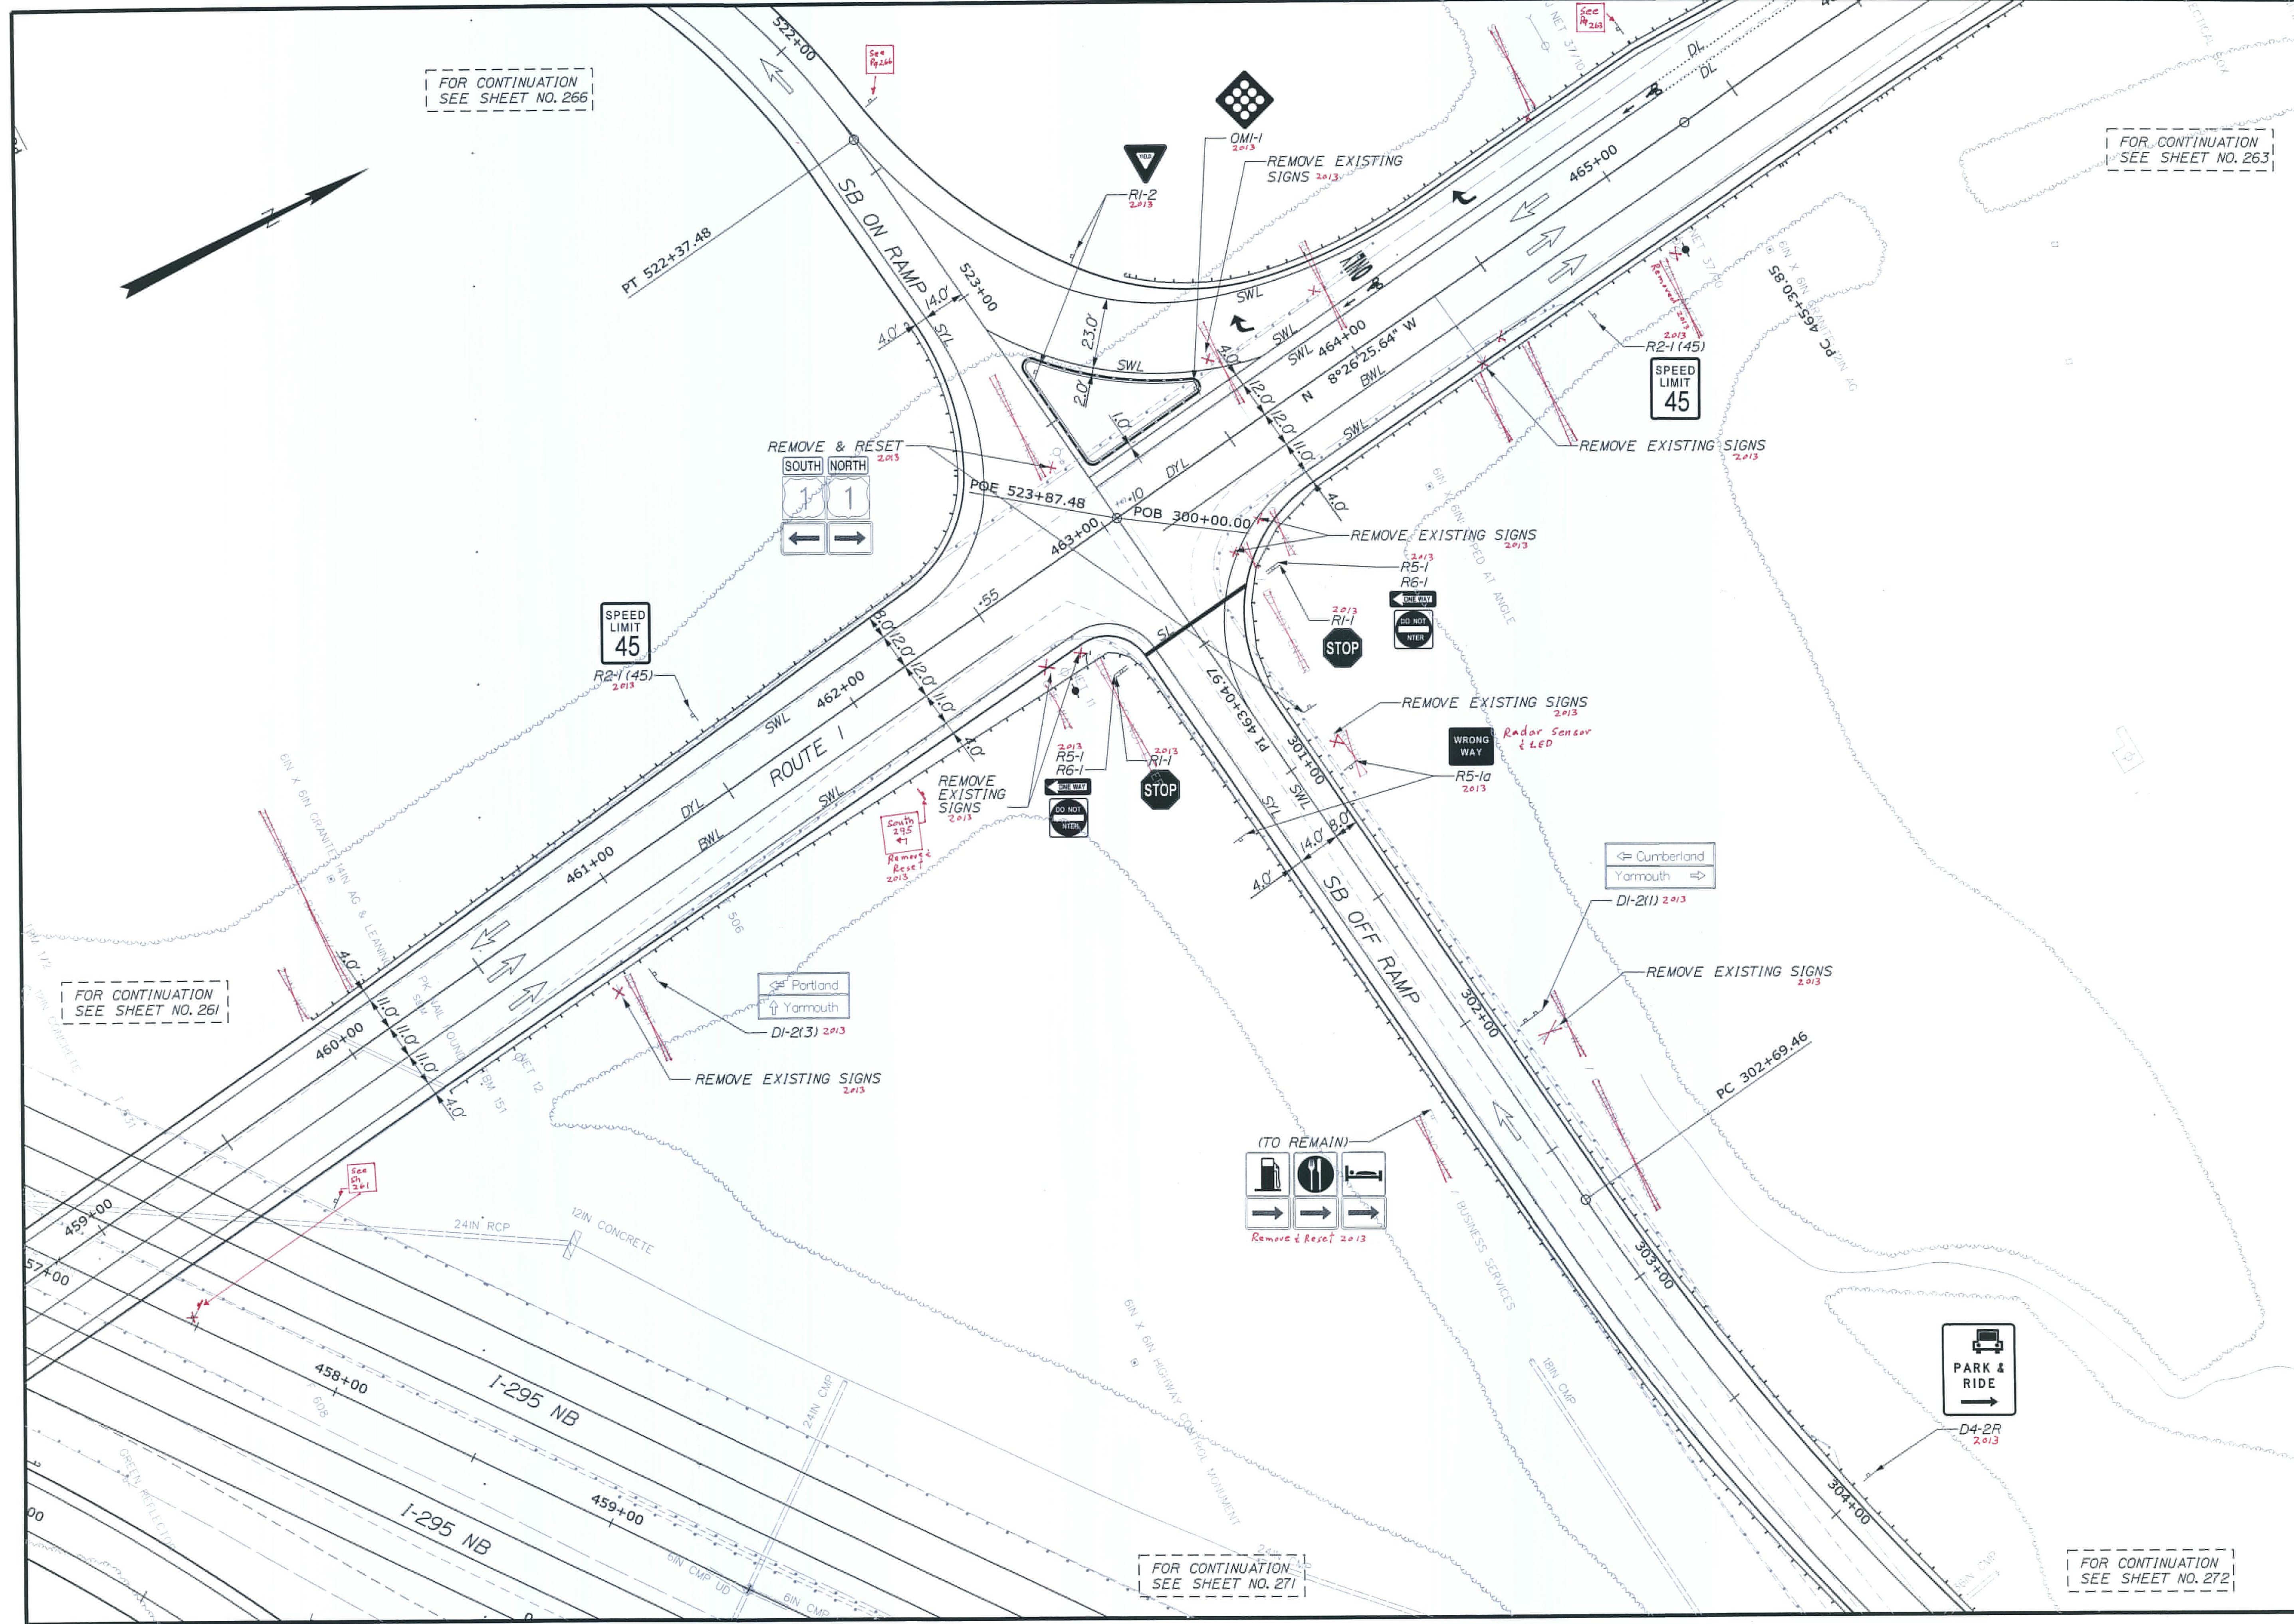

FOR CONTINUATION
SEE SHEET NO. 266


FOR CONTINUATION
SEE SHEET NO. 263

FOR CONTINUATION
SEE SHEET NO. 261

FOR CONTINUATION
SEE SHEET NO. 271

FOR CONTINUATION
SEE SHEET NO. 272

STATE OF MAINE		DEPARTMENT OF TRANSPORTATION	
IM-1108(600) EXIT 15		CM-1749(000)X PARK & RIDE LOT	
WIN 11086.00 EXIT 15 HIGHWAY PLANS		WIN 17490.00 PARK & RIDE LOT	
YARMOUTH I-295 EXIT 15		SIGNALS & PVMT. MARKINGS	
SHEET NUMBER		262	
OF 283			
PROJ. MANAGER	DATE	SIGNATURE	DATE
DESIGN-DETAILED			
CHECKED-REVISED			
DESIGN-DETAILED			
DESIGN-DETAILED			
REVISIONS 1			
REVISIONS 2			
REVISIONS 3			
REVISIONS 4			
FIELD CHANGES			

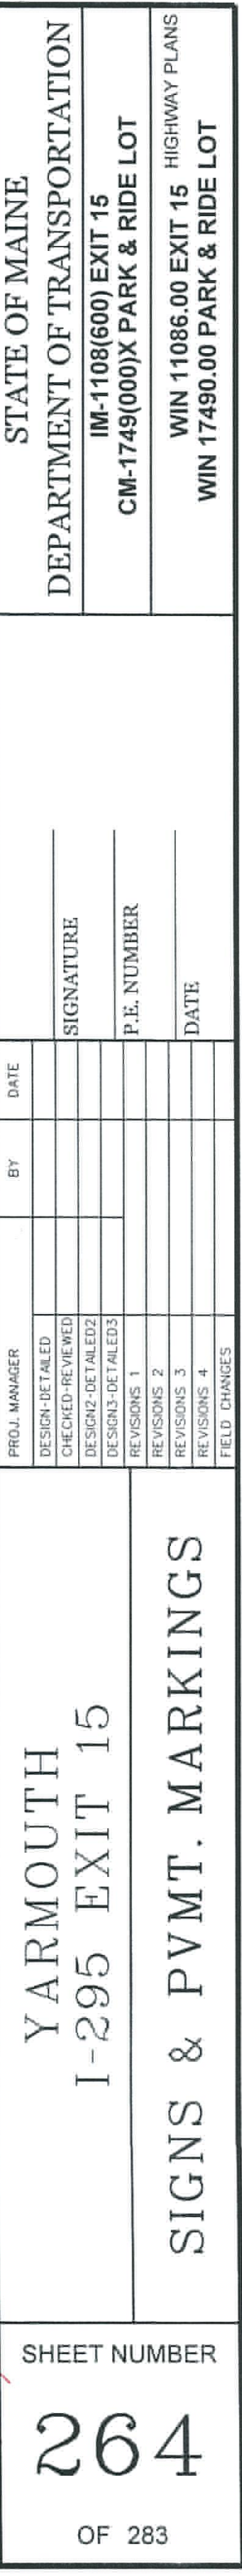


Filename:

Division: HIGHWAY

Username: COMMON

Date: 2/21/2011

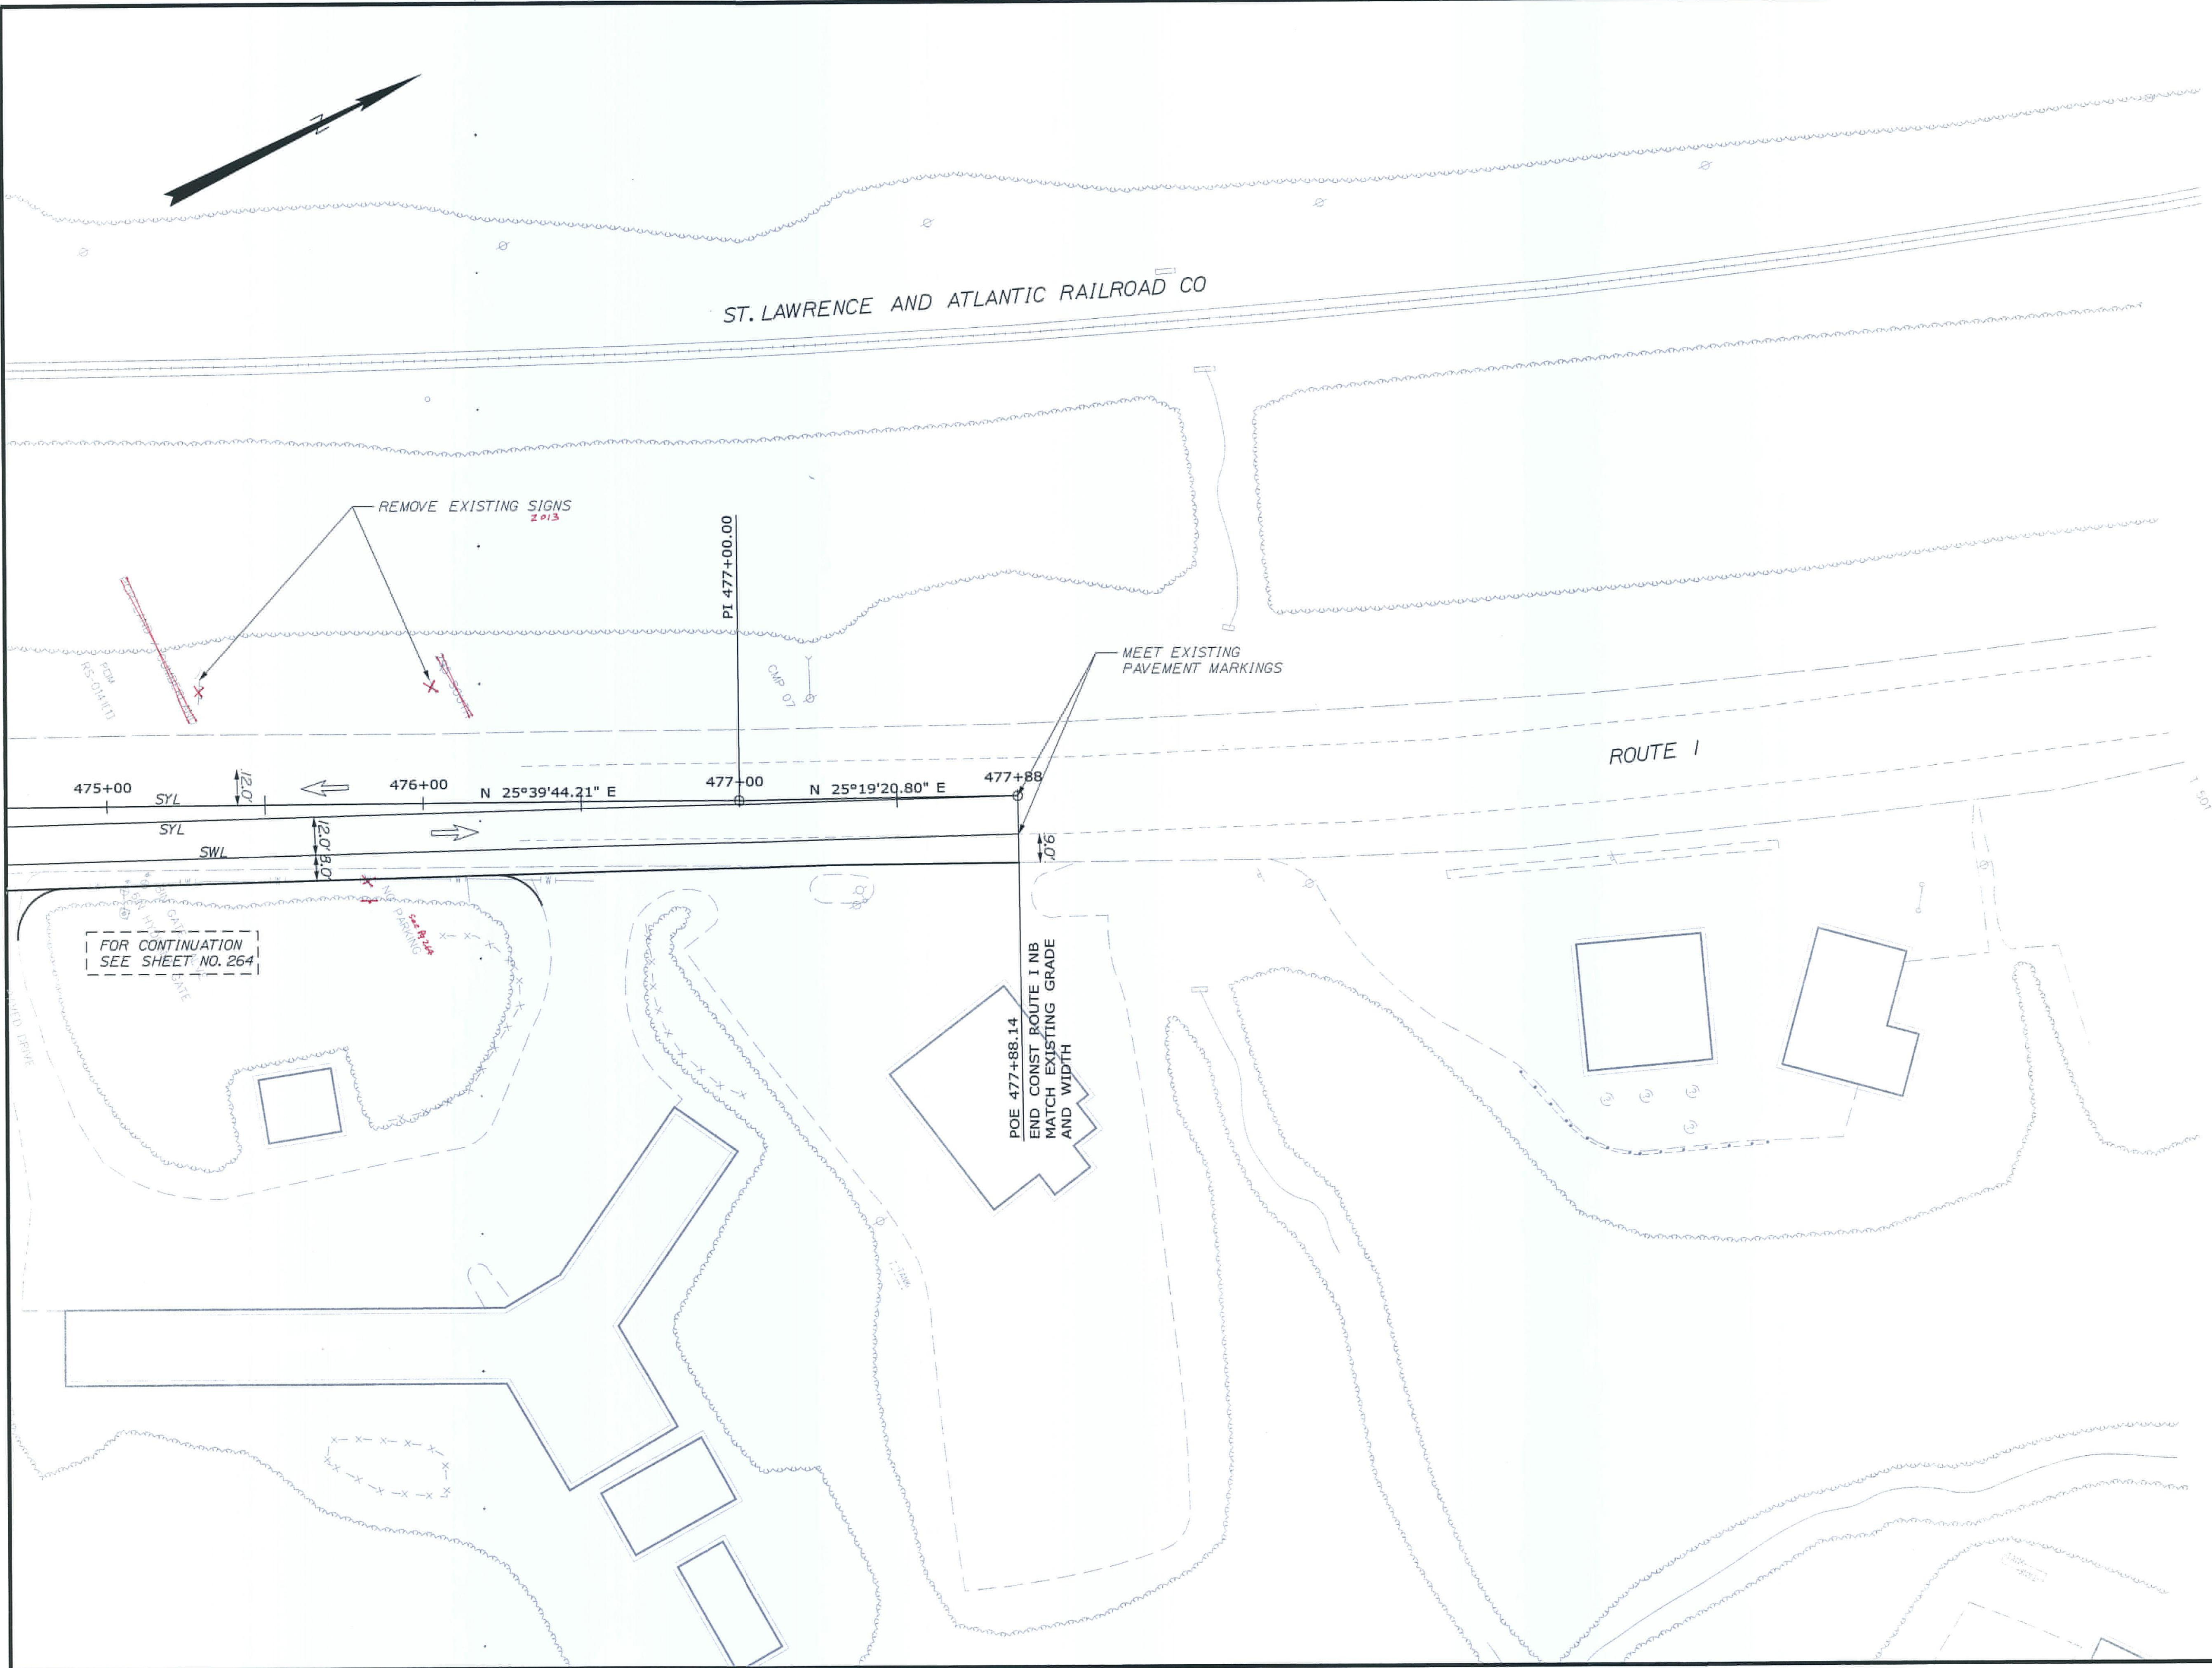

STATE OF MAINE
DEPARTMENT OF TRANSPORTATION
IM-1108(600) EXIT 15
CM-1749(000)X PARK & RIDE LOT
WIN 11086.00 EXIT 15 HIGHWAY PLANS
WIN 17490.00 PARK & RIDE LOT


YARMOUTH
I-295 EXIT 15
SIGNS & PVMT. MARKINGS

PROJECT MANAGER
DESIGN DET AILED
CHECKED-REVIEWED
DESIGN DET AILED 2
DESIGN DET AILED 3
REVISIONS 1
REVISIONS 2
REVISIONS 3
REVISIONS 4
FIELD CHANGES

BY
DATE
SIGNATURE
P.E. NUMBER
DATE

DATE

SHEET NUMBER
265
OF 283

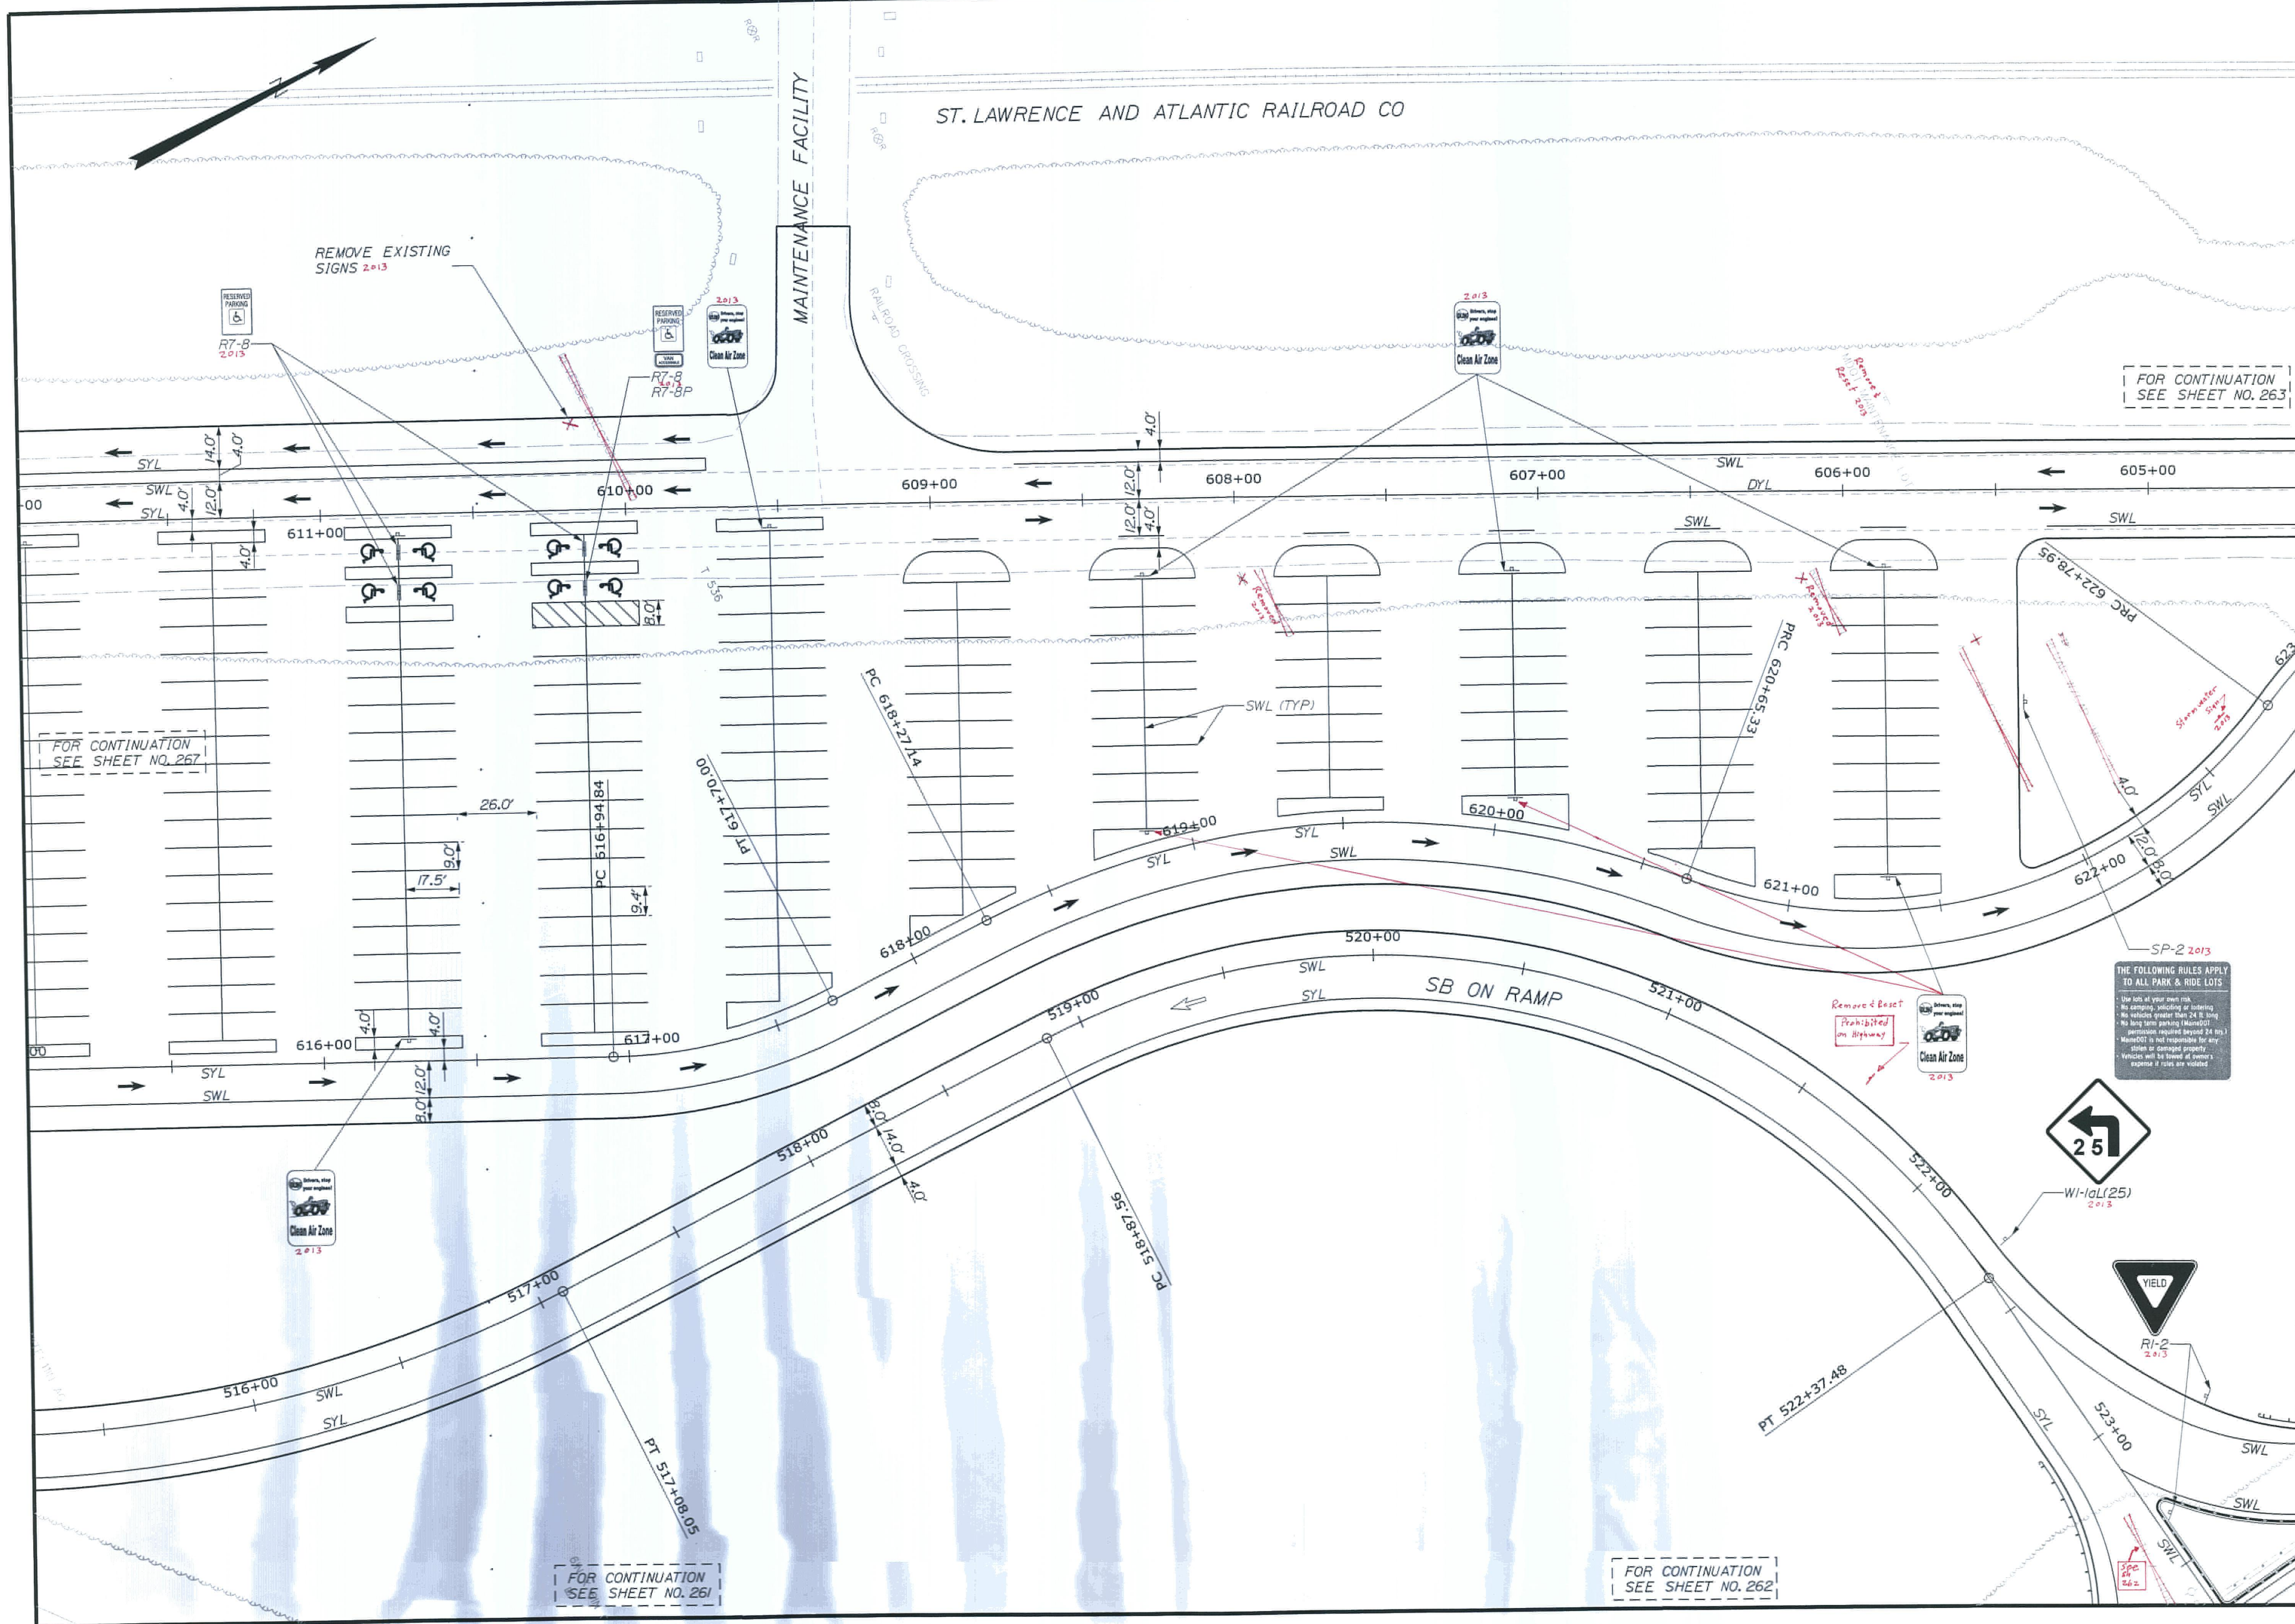


STATE OF MAINE
DEPARTMENT OF TRANSPORTATION
IM-1108(600) EXIT 15
CM-1749(000)X PARK & RIDE LOT
WIN 11086.00 EXIT 15 HIGHWAY PLANS
WIN 17490.00 PARK & RIDE LOT

PROJ. MGR.	DATE	BY	SIGNATURE	P.E. NUMBER	DATE
DESIGN-DETAILED					
CHECKED-REVIEWED					
DESIGN-DETAILED					
REVISIONS 1					
REVISIONS 2					
REVISIONS 3					
REVISIONS 4					
FIELD CHANGES					

YARMOUTH
I-295 EXIT 15
SIGNS & PVMT. MARKINGS

SHEET NUMBER
266
OF 283

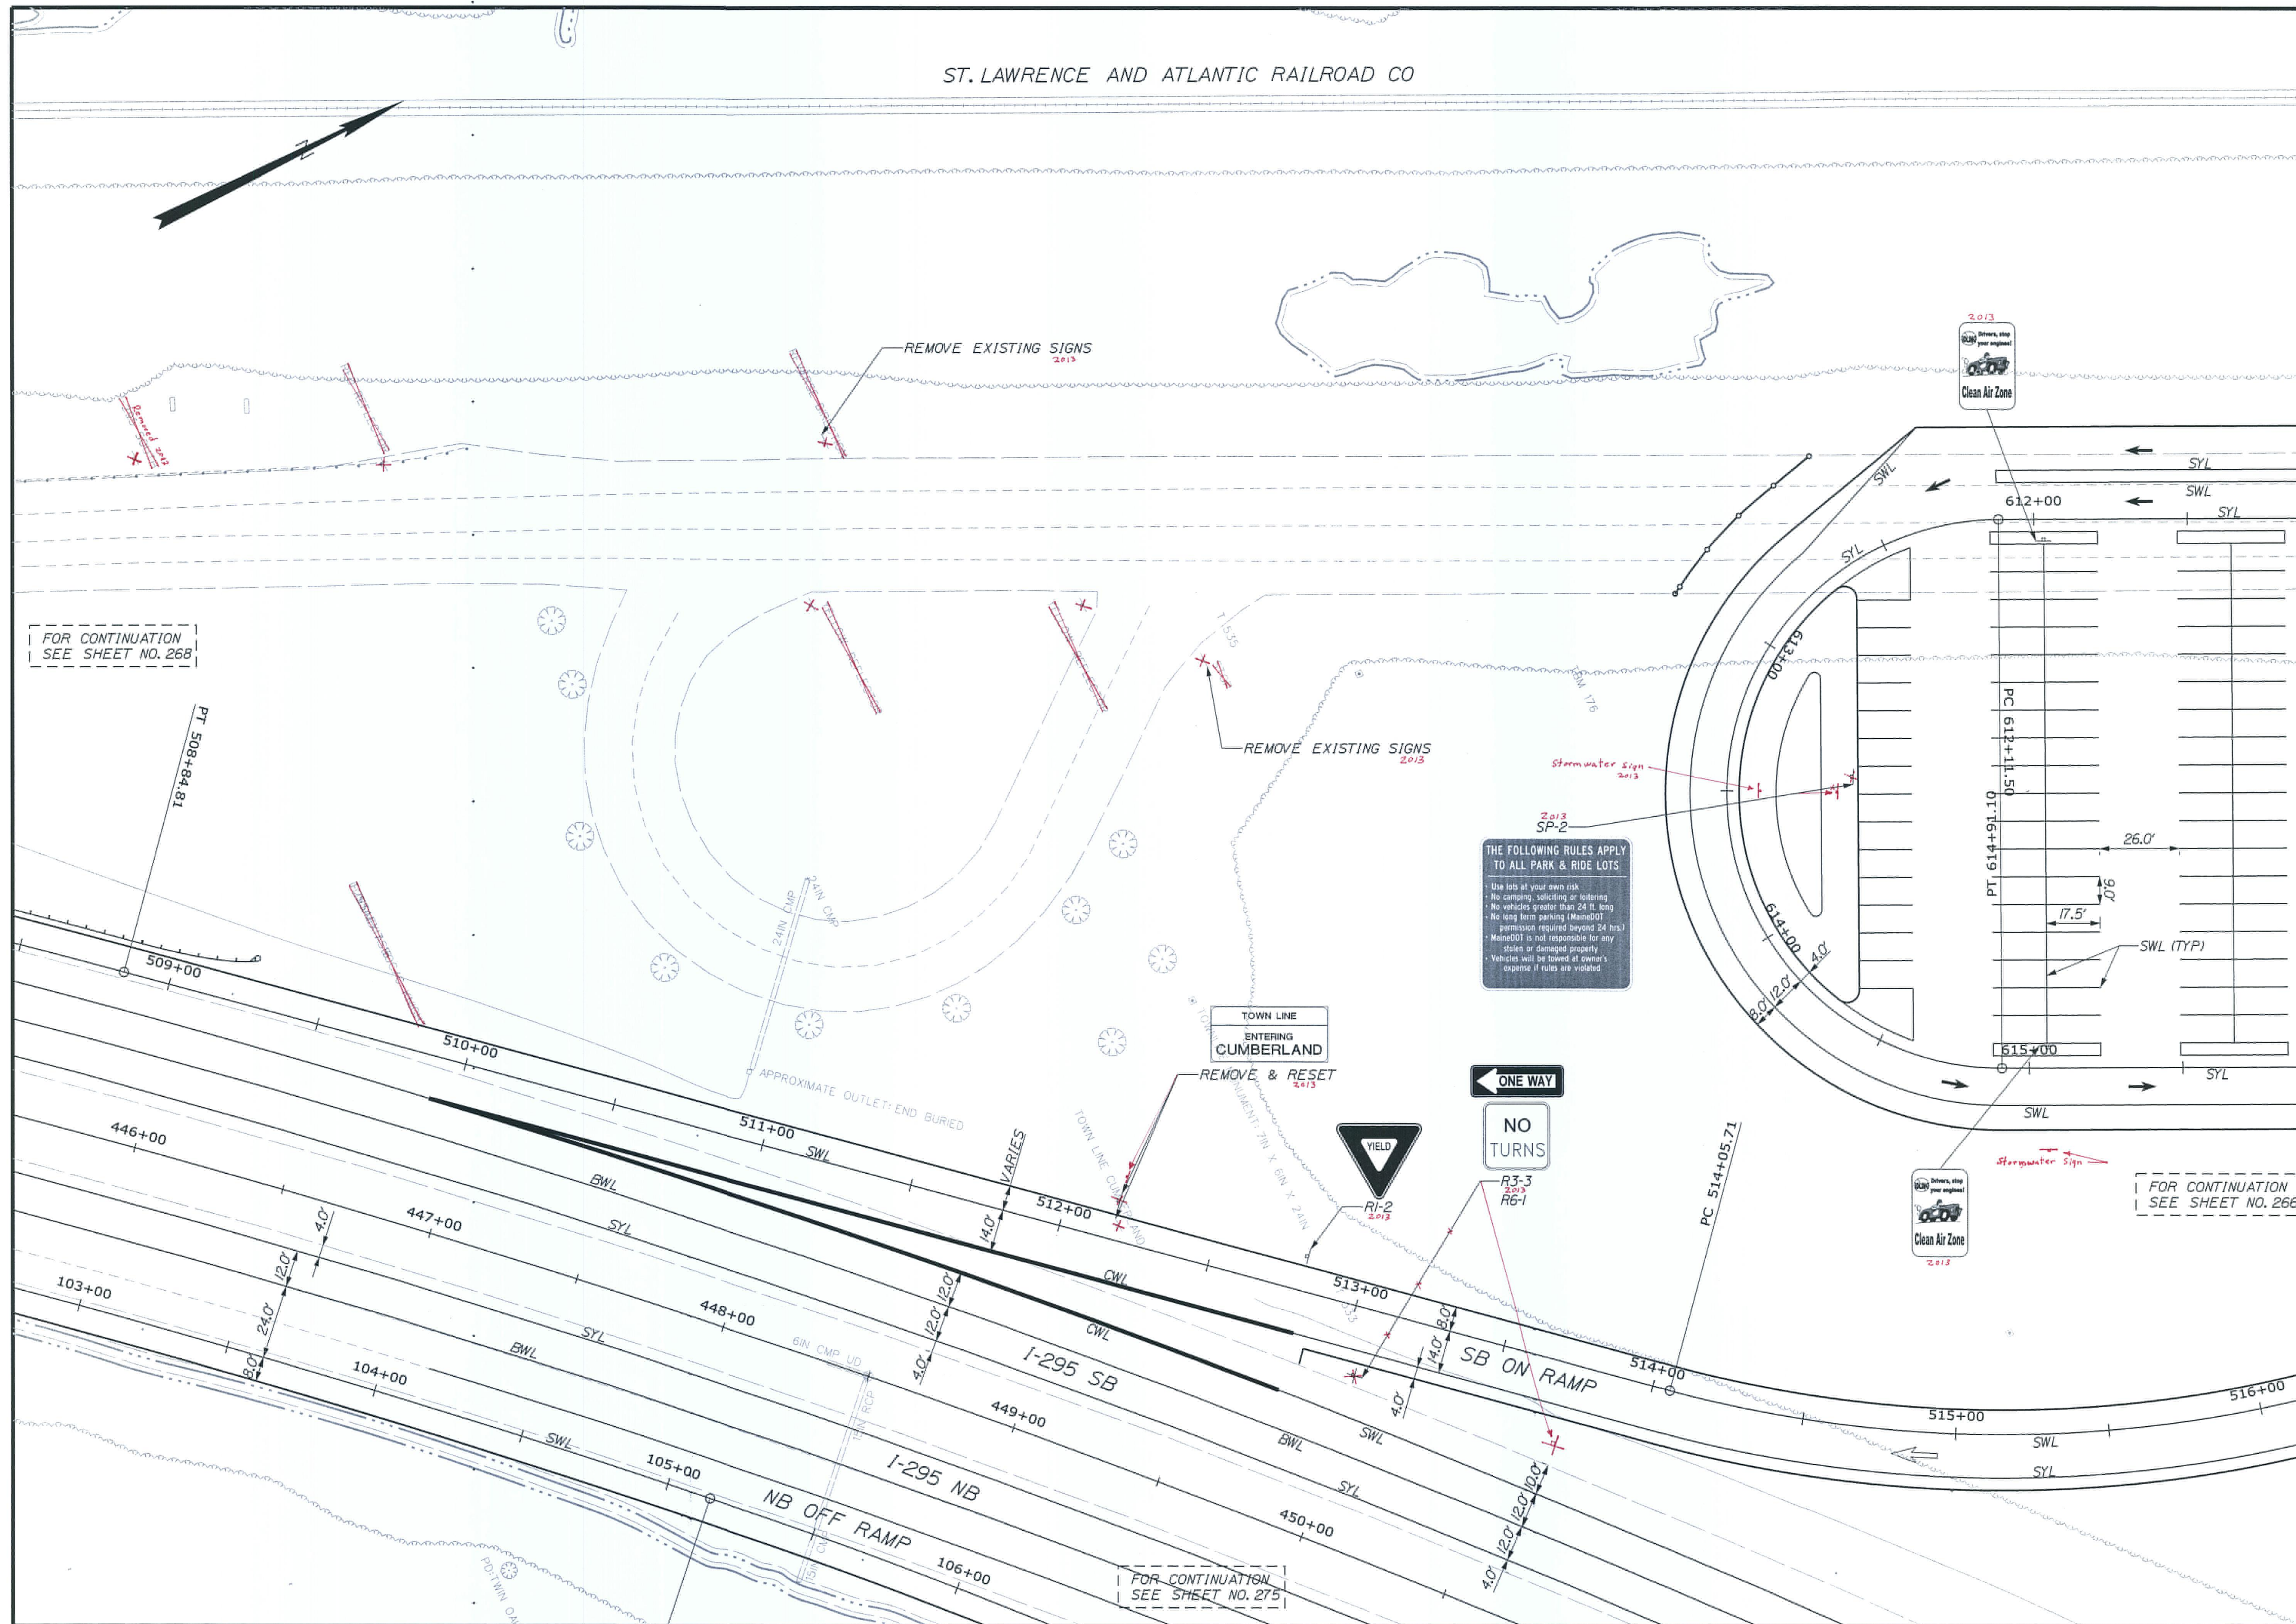
[illegible]

Filename:

Division: HIGHWAY

Username: COMMON

Date: 2/21/2011

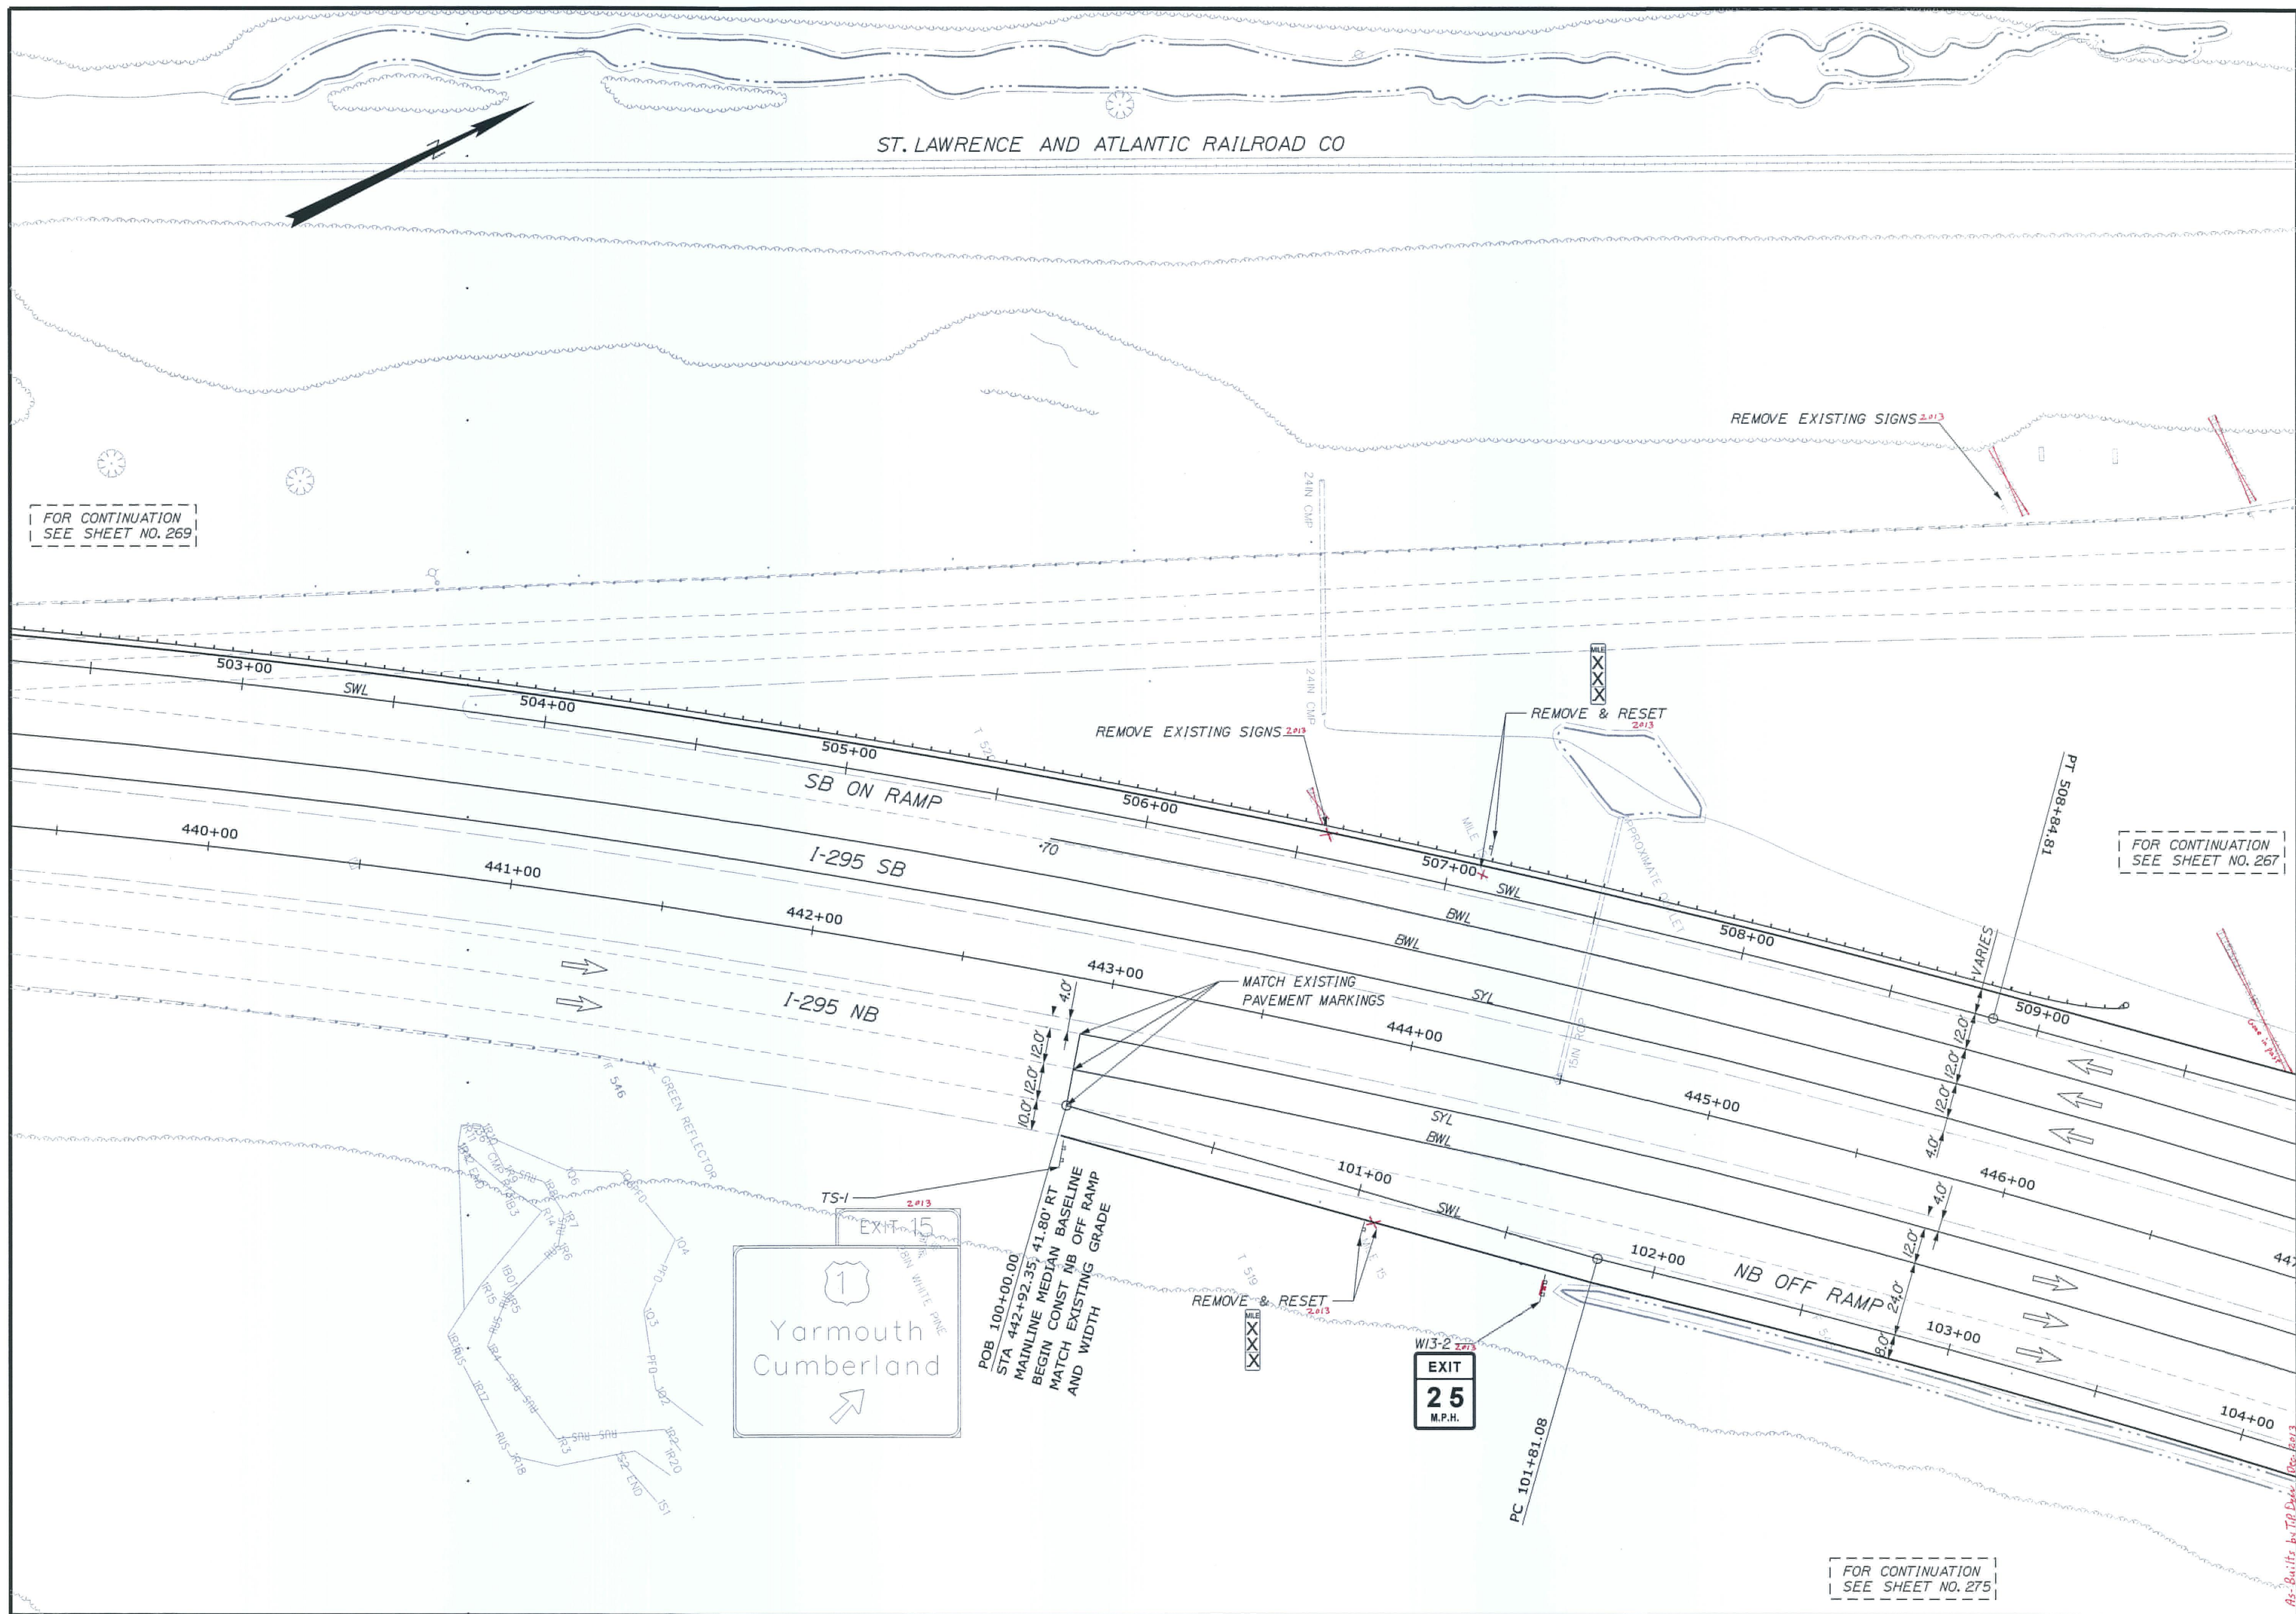

STATE OF MAINE	
DEPARTMENT OF TRANSPORTATION	
IM-1108(600) EXIT 15	
CM-1749(000)X PARK & RIDE LOT	
WIN 11086.00 EXIT 15 HIGHWAY PLANS	
WIN 17490.00 PARK & RIDE LOT	

PROJ. MANAGER	DATE	BY	DATE
DESIGN-DETAILED			
CHECKED-REVIEWED			
DESIGN-DETAILED			
DESIGN-DETAILED			
REVISIONS 1			
REVISIONS 2			
REVISIONS 3			
REVISIONS 4			
FIELD CHANGES			

YARMOUTH	
I-295 EXIT 15	
SIGNS & PVMT. MARKINGS	


SHEET NUMBER
268
OF 283

Filename:

Division: HIGHWAY

Username: COMMON

Date: 2/21/2011

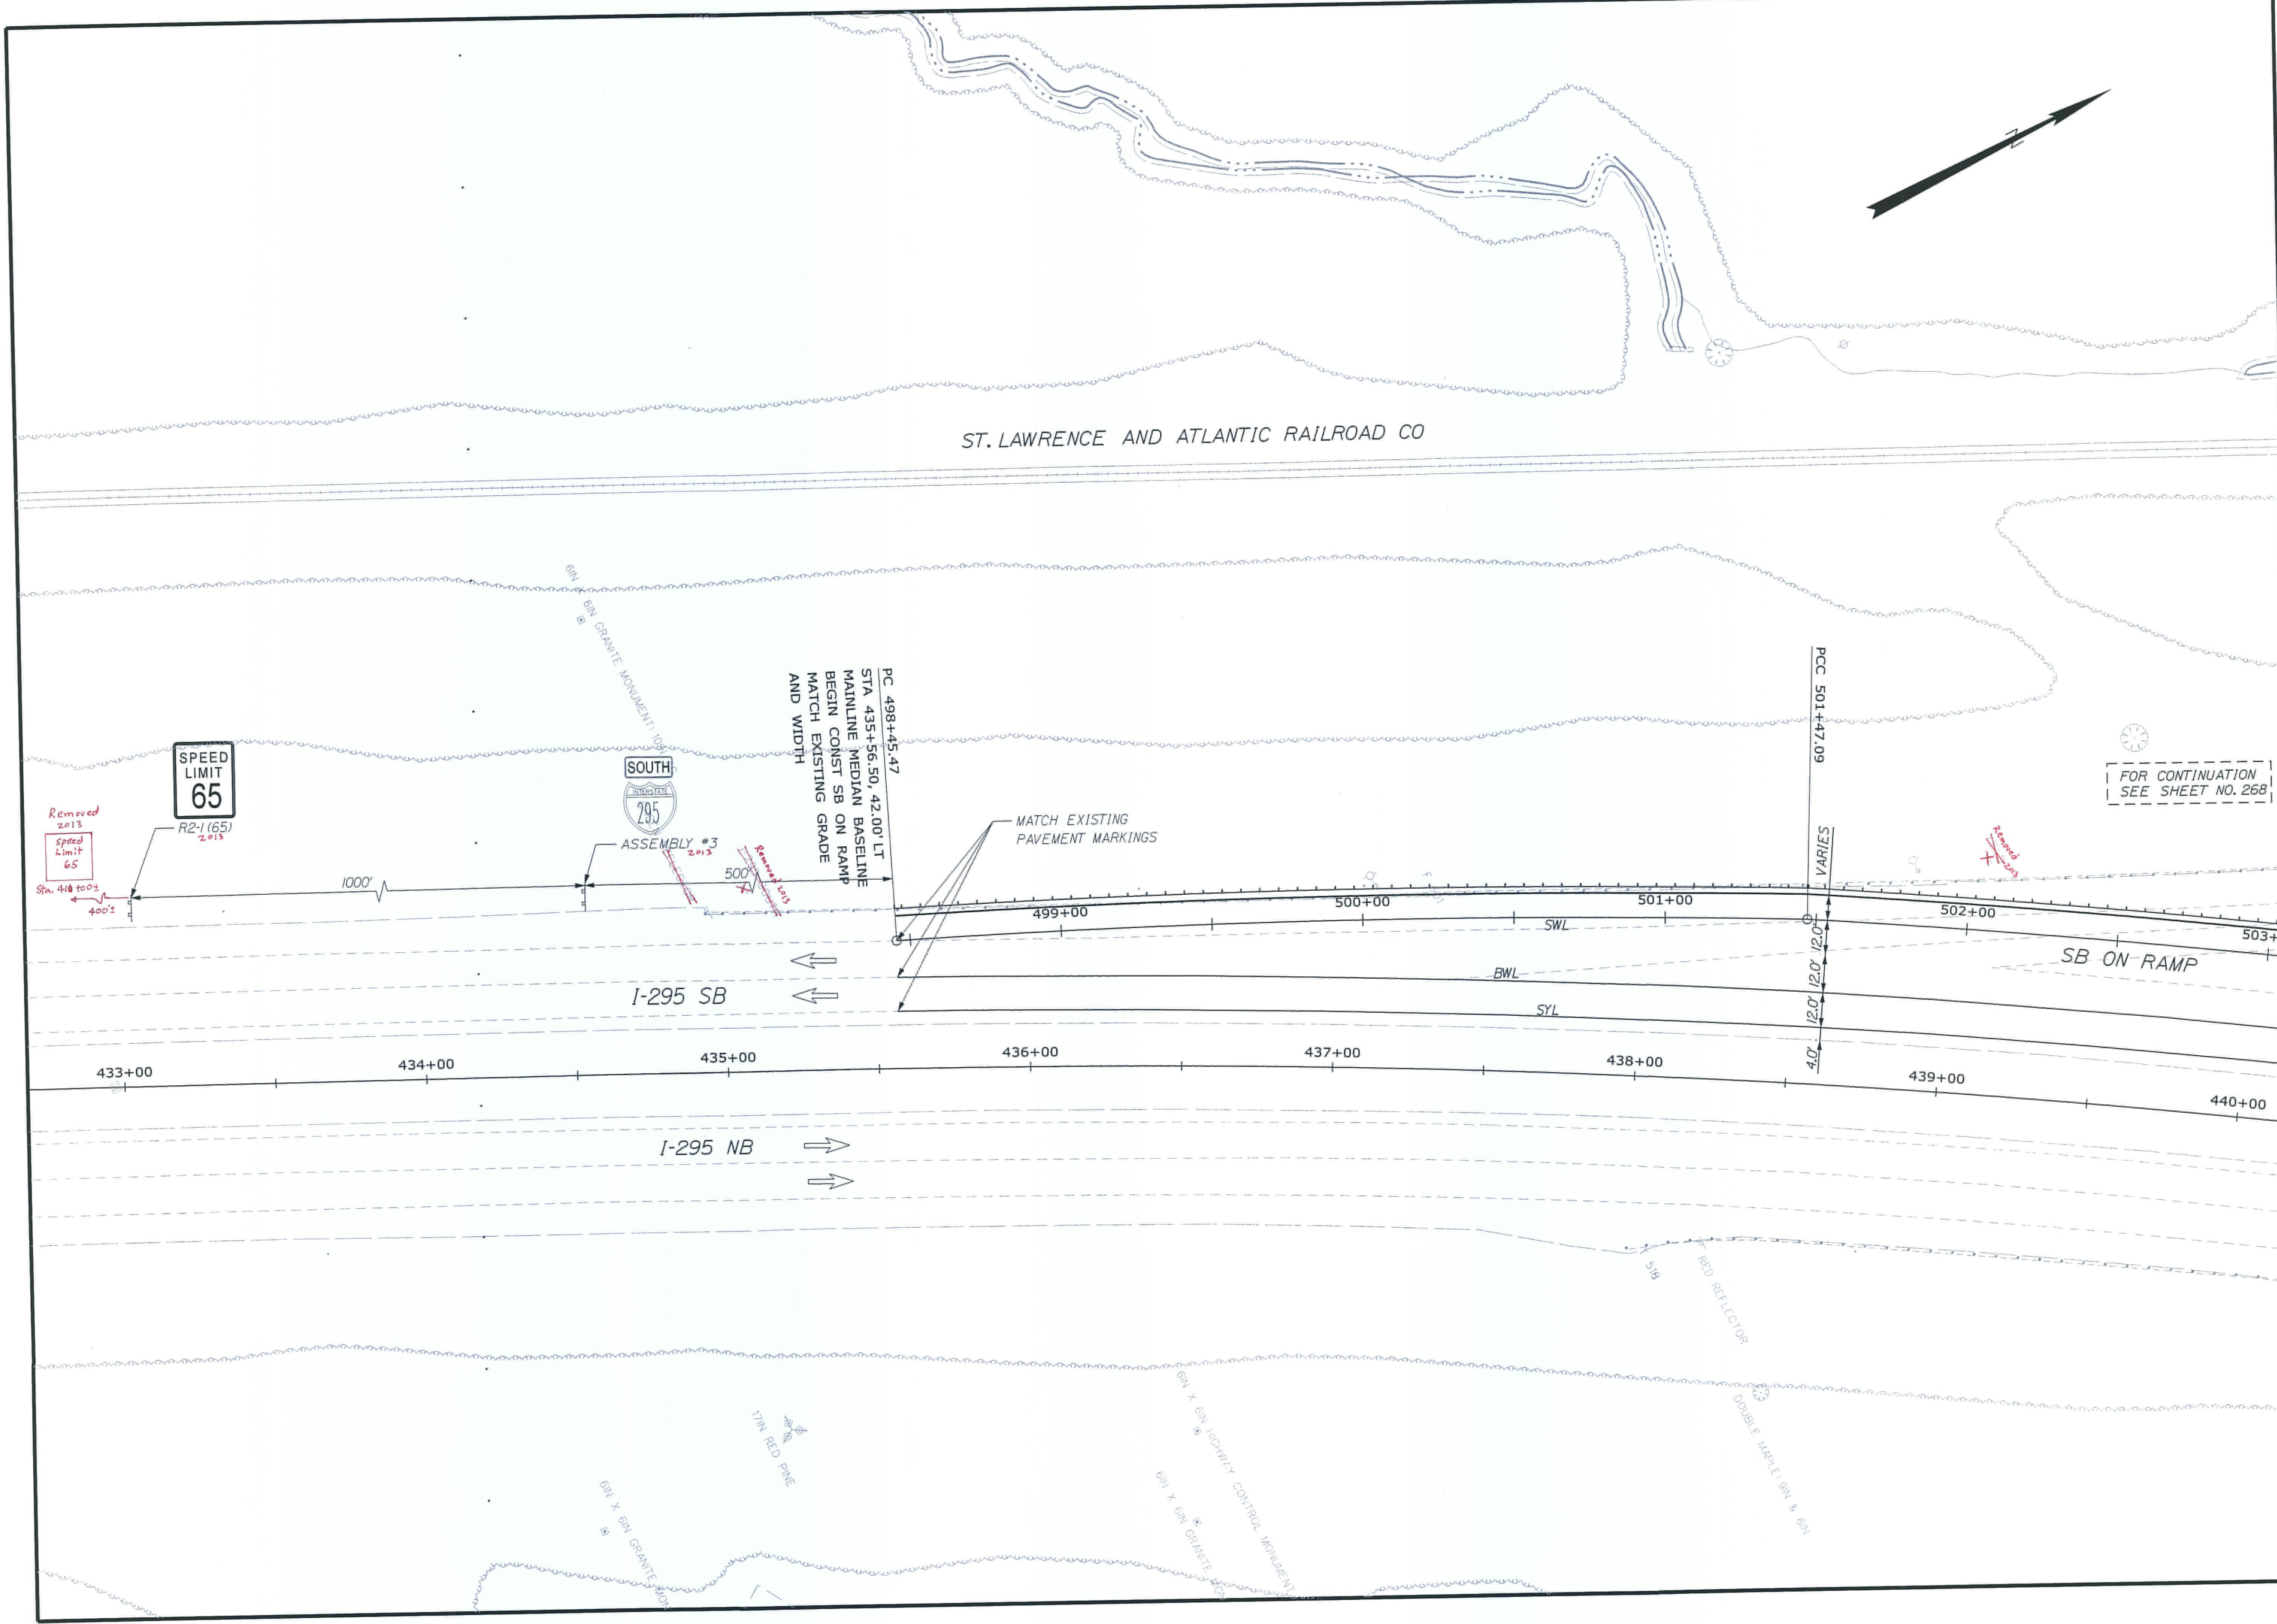

FOR CONTINUATION
SEE SHEET NO. 268

STATE OF MAINE
DEPARTMENT OF TRANSPORTATION
IM-1108(600) EXIT 15
CM-1749(000)X PARK & RIDE LOT
WIN 11086.00 EXIT 15 HIGHWAY PLAN
WIN 17490.00 PARK & RIDE LOT

PROJ. MANAGER	BY	DATE	SIGNATURE
CHECKED-DETAILED			
CHECKED-REVIEWED			
DESIGN-DETAILED			
DESIGN-REVIEWED			
REVISIONS 1			
REVISIONS 2			
REVISIONS 3			
REVISIONS 4			
FIELD CHANGES			

YARMOUTH
I-295 EXIT 15
SIGNS & PVMT. MARKINGS


SHEET NUMBER
269
OF 283

Filename:

Division: HIGHWAY

Username: COMMON

Date: 2/21/2011

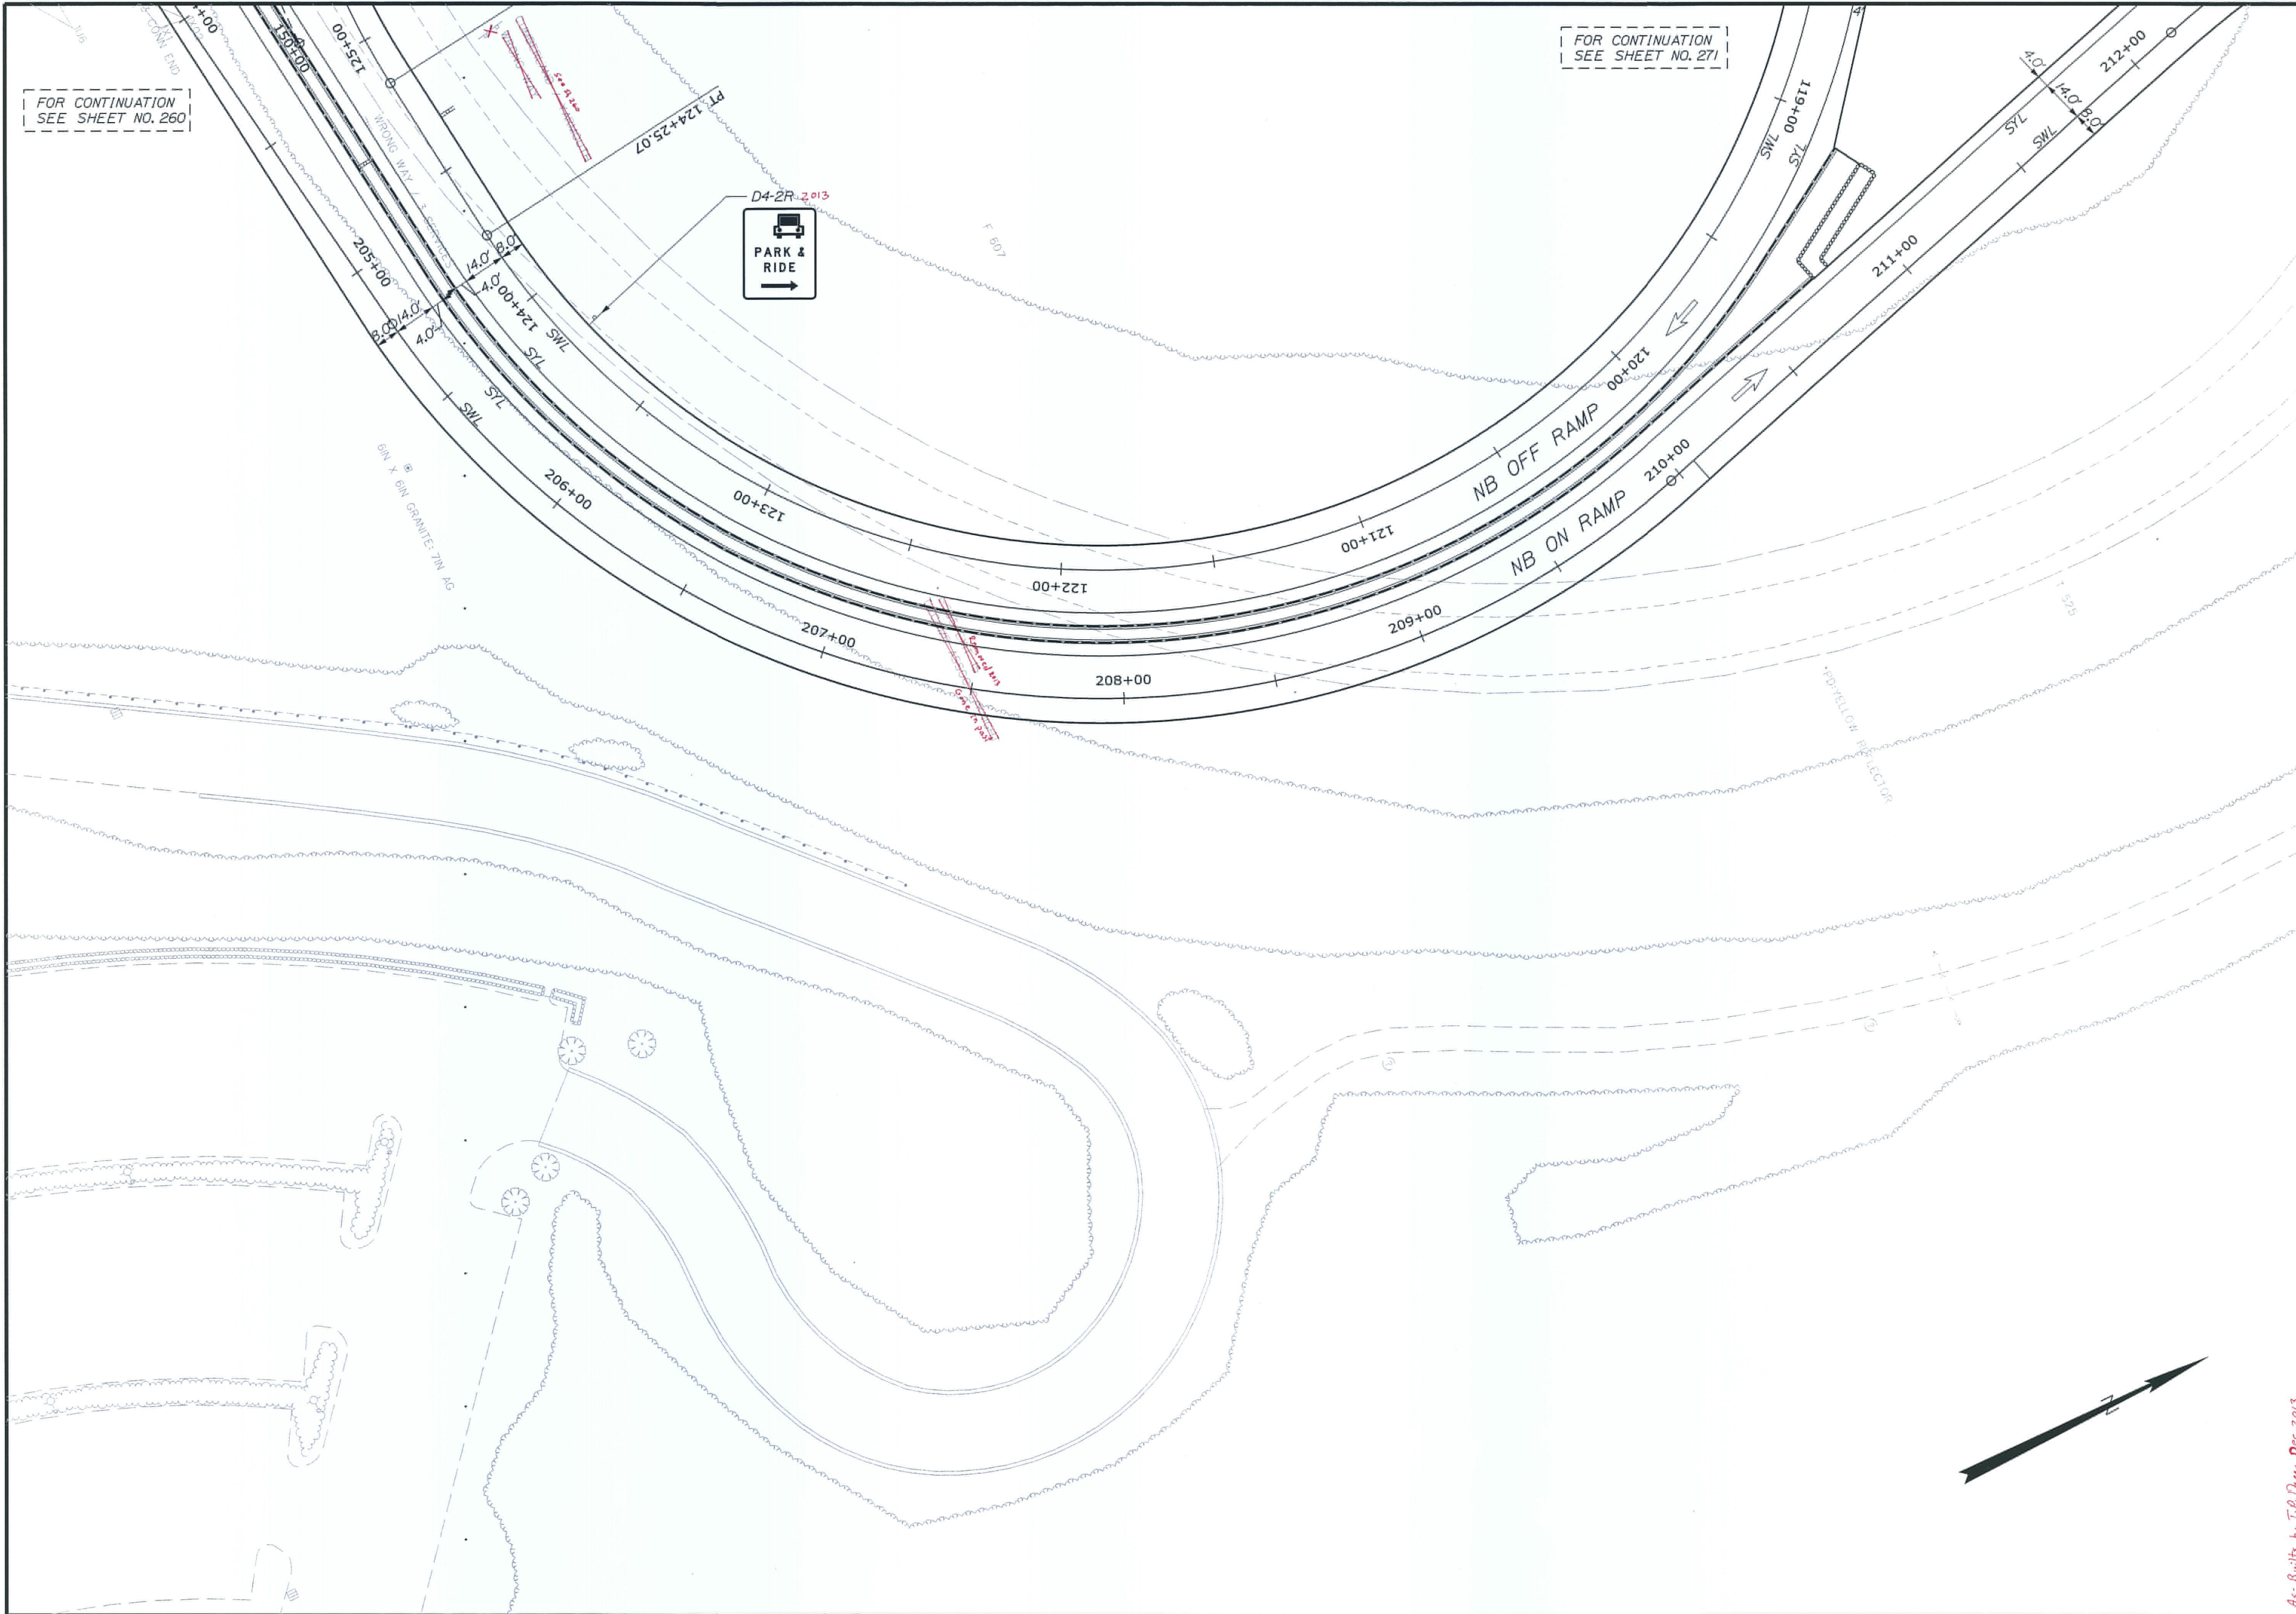


STATE OF MAINE DEPARTMENT OF TRANSPORTATION IM-1108(600) EXIT 15 CM-1749(000)X PARK & RIDE LOT WIN 11086.00 EXIT 15 HIGHWAY PLANS WIN 17490.00 PARK & RIDE LOT	
SIGNATURE P.E. NUMBER DATE	
BY DATE	
PROJ. MANAGER DESIGN-DETAILED CHECKED-REVIEWED DESIGN2-DETAILED2 DESIGN3-DETAILED3 REVISIONS 1 REVISIONS 2 REVISIONS 3 REVISIONS 4 FIELD CHANGES	
YARMOUTH I-295 EXIT 15 SIGNS & PVMT. MARKINGS	
SHEET NUMBER 270 OF 283	

Filename:

Division: HIGHWAY

Username: COMMON

Date: 2/21/2011

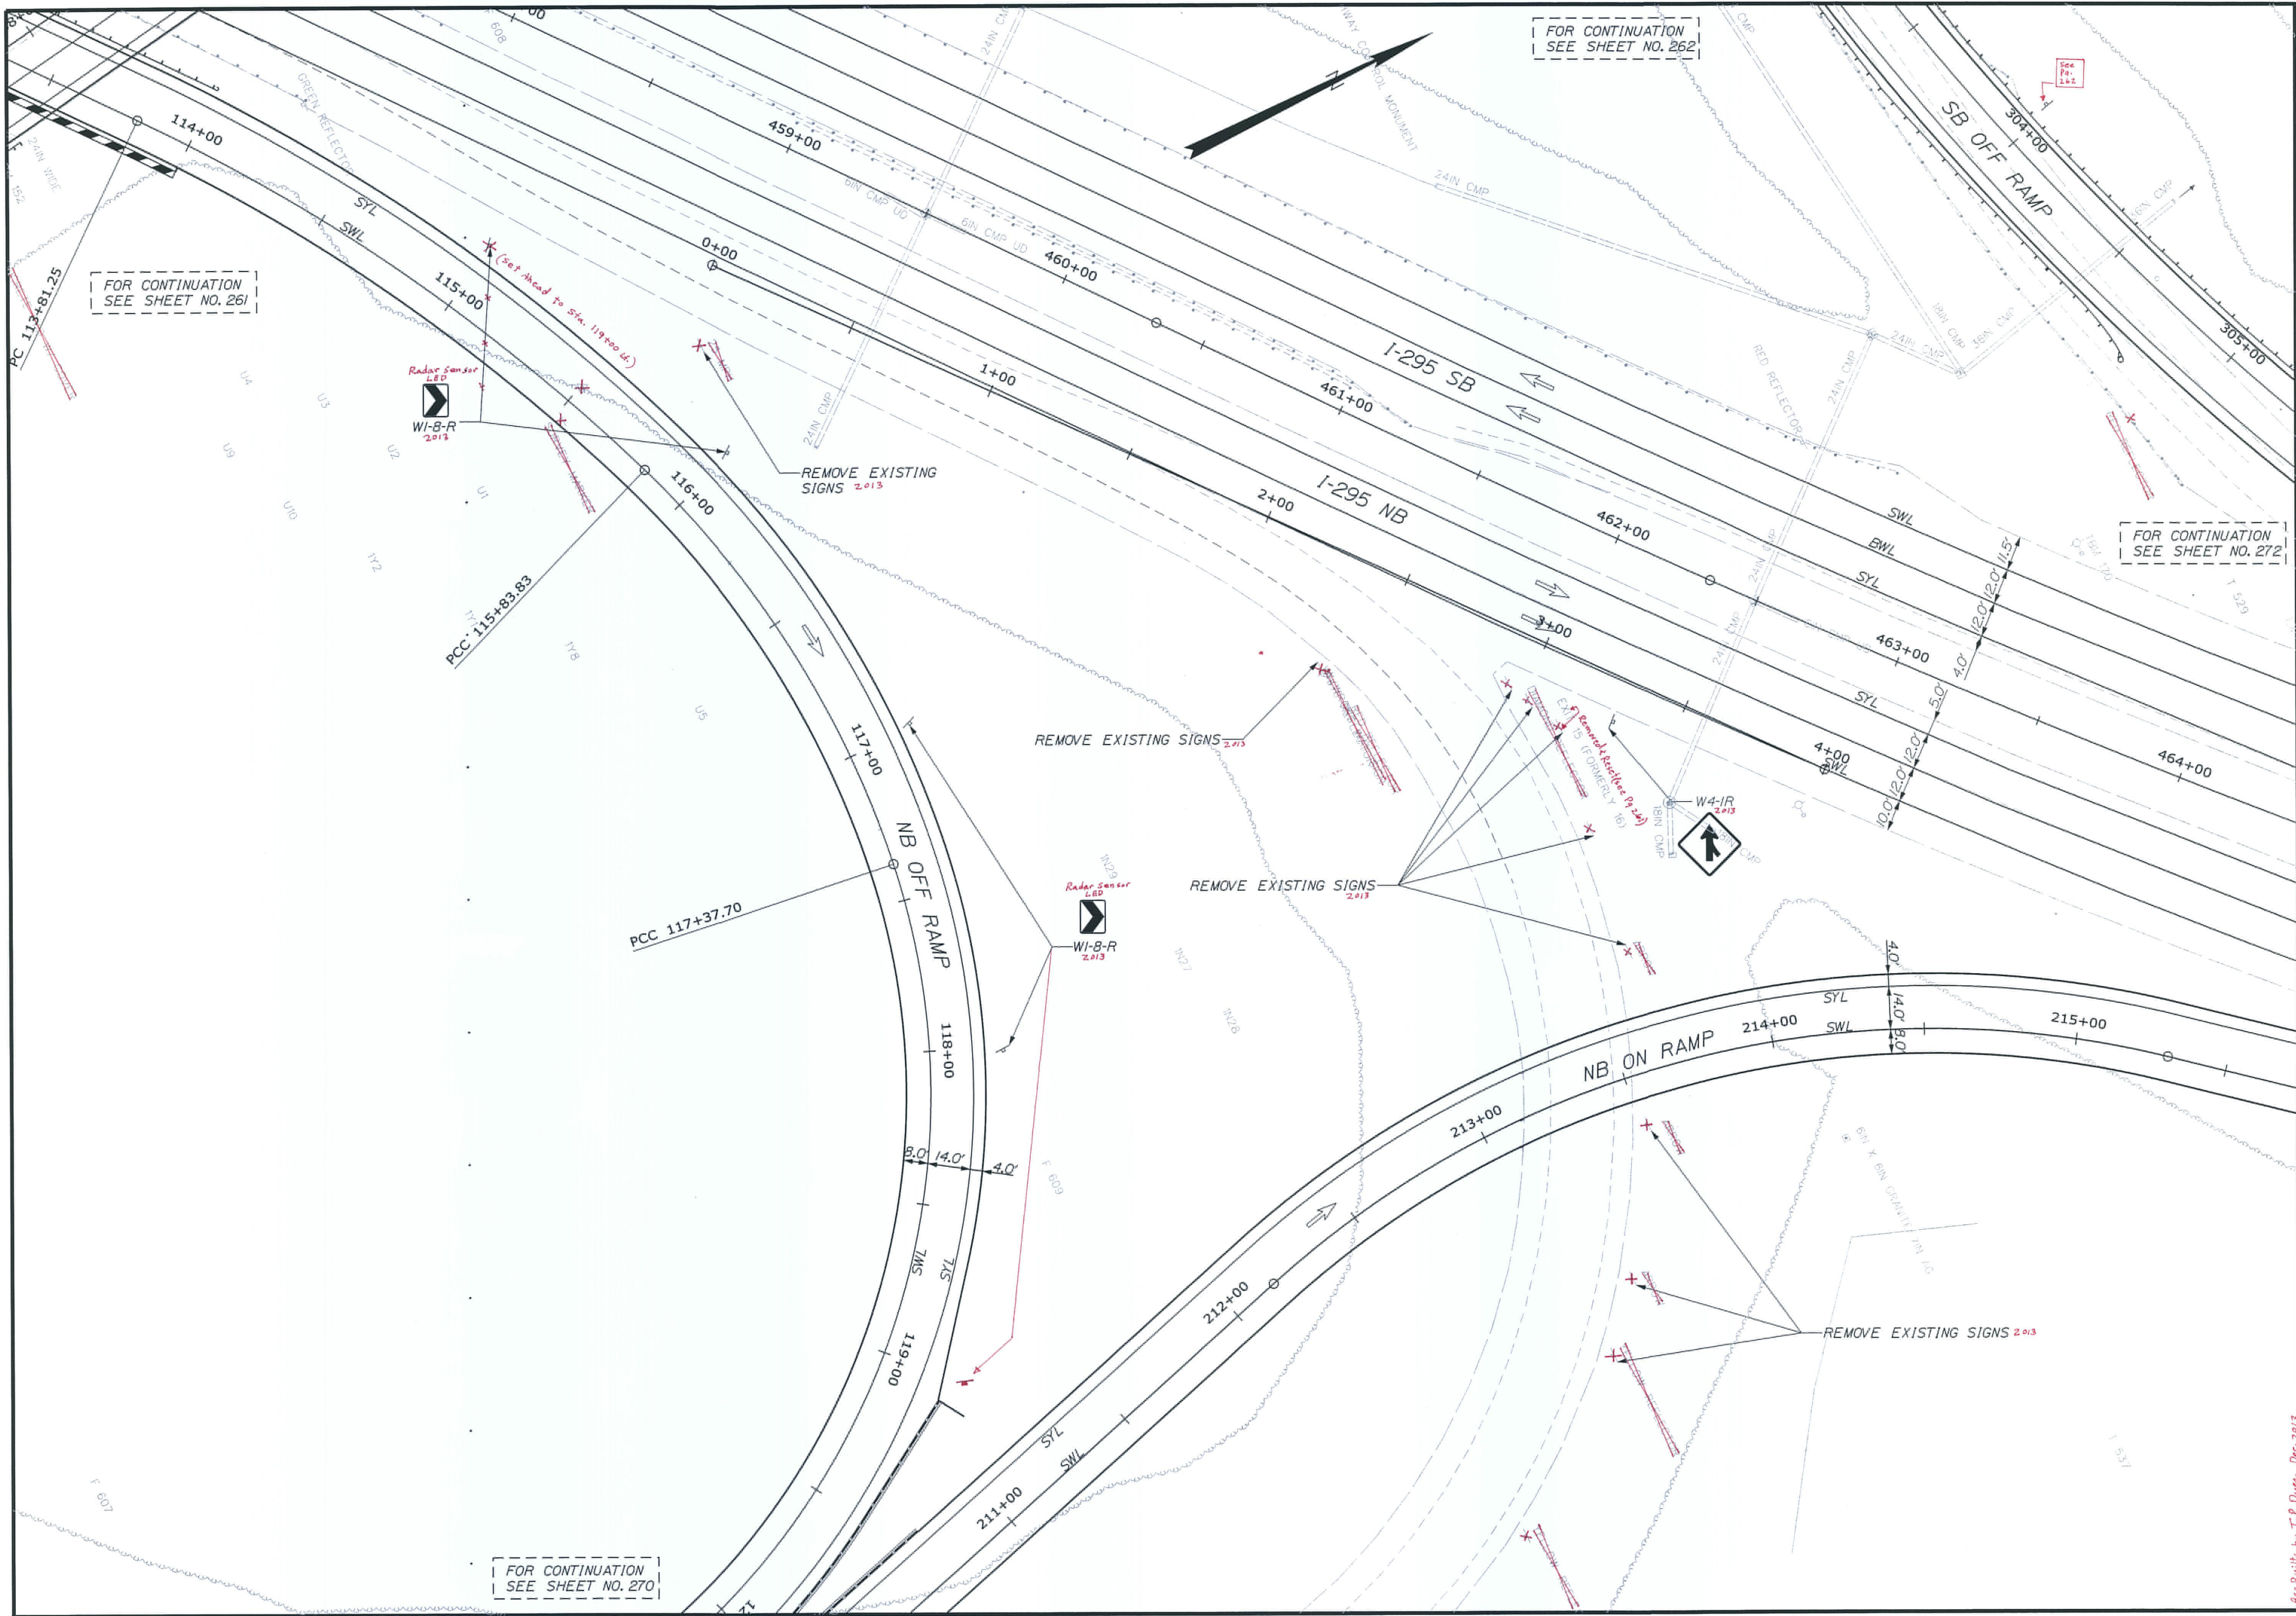


STATE OF MAINE		DEPARTMENT OF TRANSPORTATION	
IM-1108(600) EXIT 15		CM-1749(000)X PARK & RIDE LOT	
WIN 11086.00 EXIT 15 HIGHWAY PLANS		WIN 17490.00 PARK & RIDE LOT	
SIGNATURE		P.E. NUMBER	
DATE		DATE	
PROJ. MANAGER		DESIGN DETAIL	
CHECKED/REVIEWED		DESIGN DETAIL	
DESIGN DETAIL		DESIGN DETAIL	
REVISIONS 1		REVISIONS 1	
REVISIONS 2		REVISIONS 2	
REVISIONS 3		REVISIONS 3	
REVISIONS 4		REVISIONS 4	
FIELD CHANGES		FIELD CHANGES	
YARMOUTH		I-295 EXIT 15	
SHEETS & PVMT. MARKINGS		SHEET NUMBER	
271		OF 283	

Filename:

Division: HIGHWAY

Username: COMMON

Date: 2/21/2011

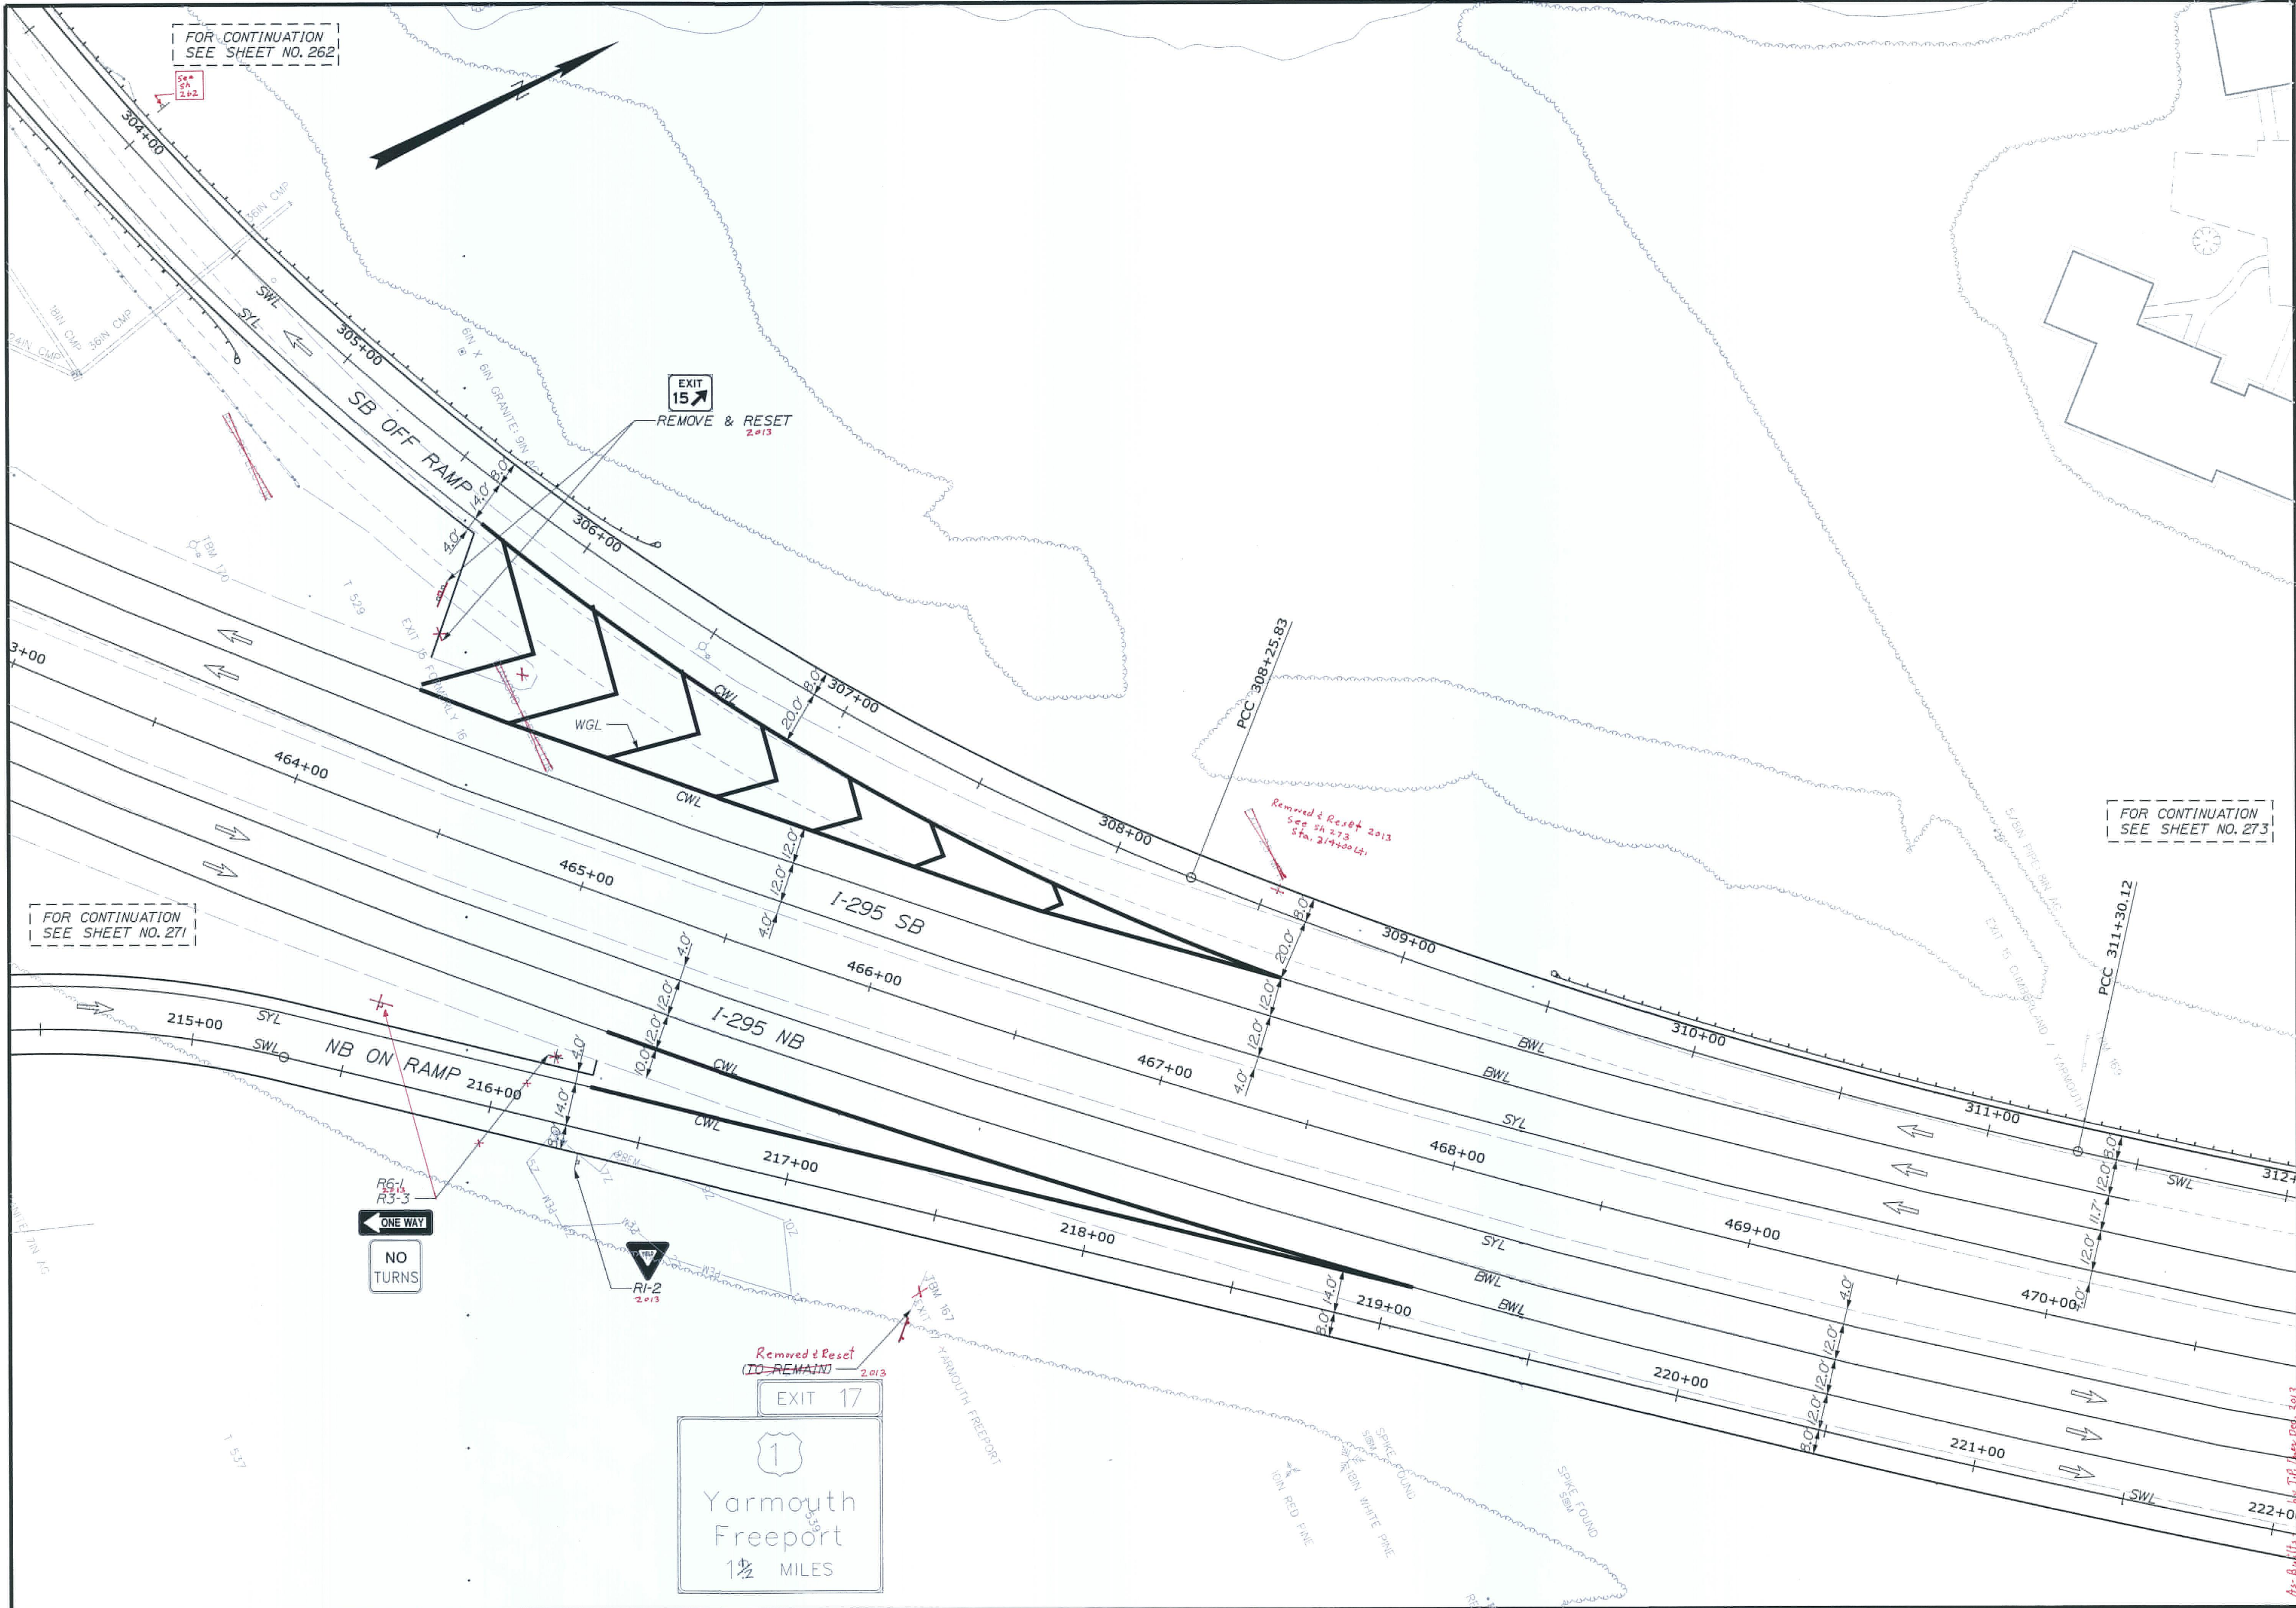


STATE OF MAINE		DEPARTMENT OF TRANSPORTATION	
IM-1108(600) EXIT 15		CM-1749(000)X PARK & RIDE LOT	
WIN 11086.00 EXIT 15 HIGHWAY PLANS		WIN 17490.00 PARK & RIDE LOT	
SIGNATURE		P.E. NUMBER	
DATE		DATE	
PROJ. MANAGER		BY	
DESIGN-DETAILED		CHECKED	
DESIGN-REVIEWED		DESIGN-DETAILED	
REVISIONS 1		REVISIONS 2	
REVISIONS 3		REVISIONS 4	
FIELD CHANGES		FIELD CHANGES	
YARMOUTH I-295 EXIT 15		SIGNS & PVMT. MARKINGS	
SHEET NUMBER		272	
OF 283			

Filename:

Division: HIGHWAY

Username: COMMON

Date: 2/21/2011

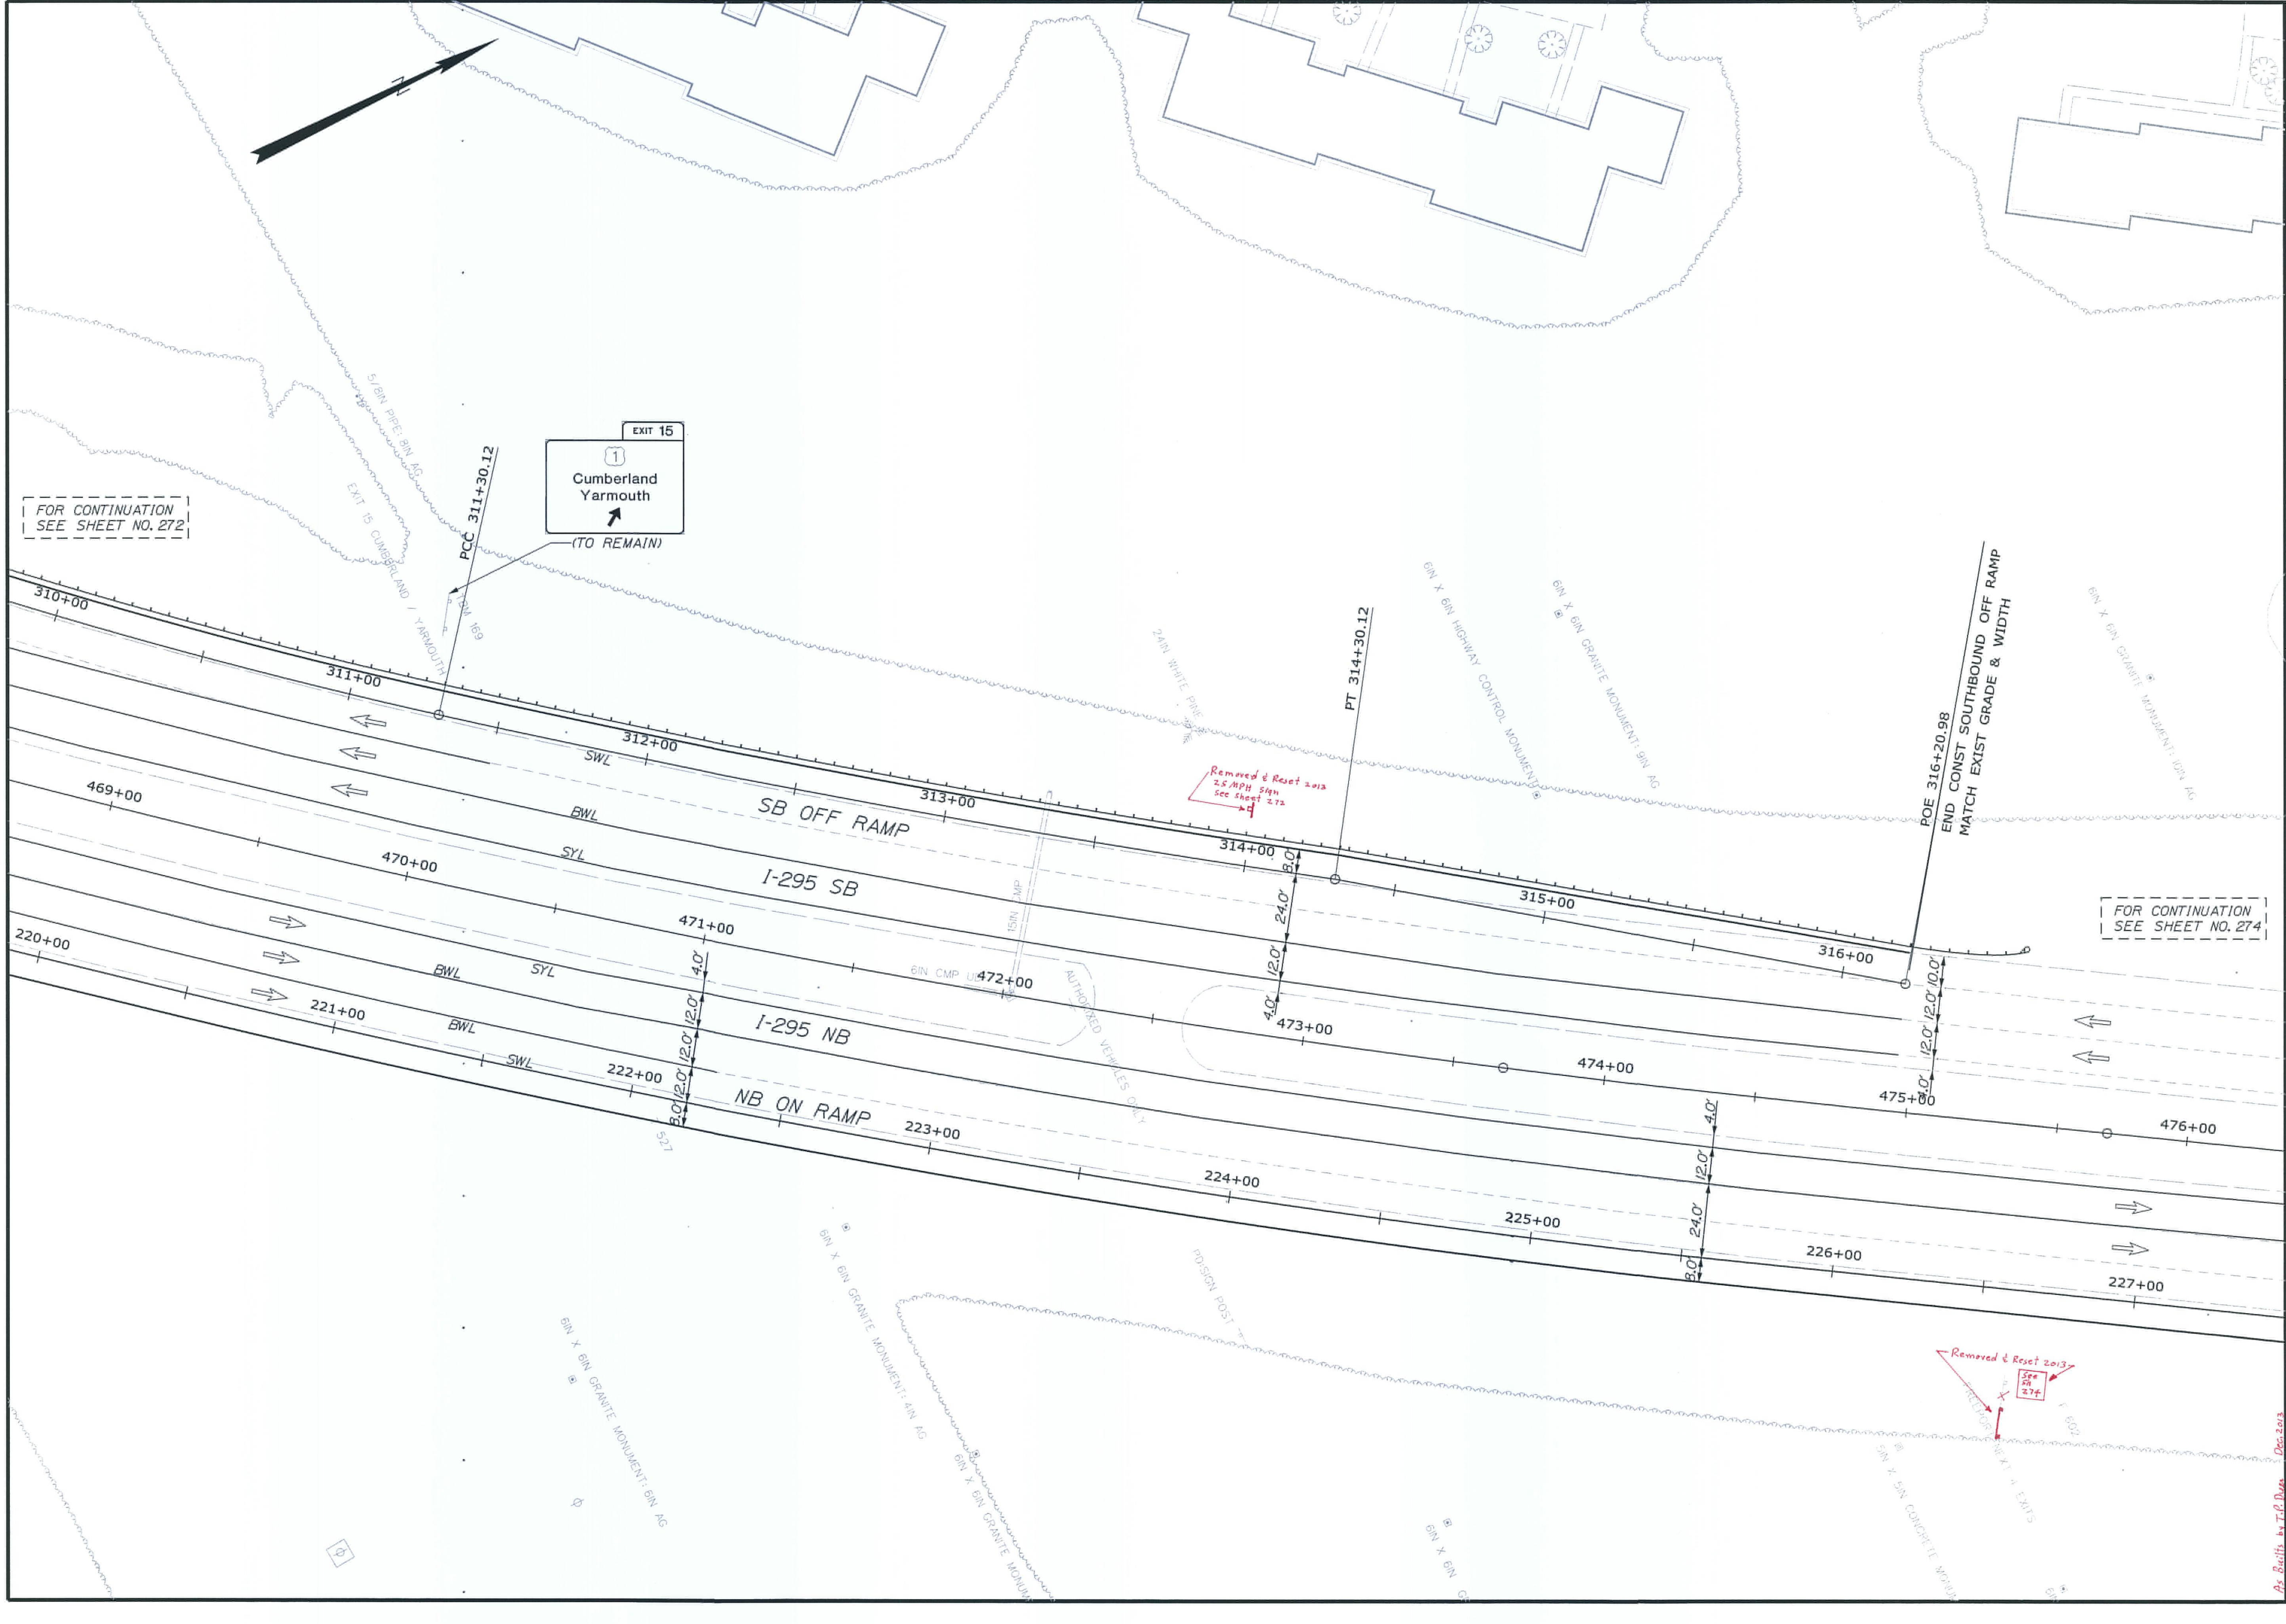

STATE OF MAINE		DEPARTMENT OF TRANSPORTATION	
IM-1108(600) EXIT 15		CM-1749(000)X PARK & RIDE LOT	
WIN 11086.00 EXIT 15		WIN 17490.00 PARK & RIDE LOT	
SIGNATURE		P.E. NUMBER	
DATE		DATE	
PROJ. MANAGER		FIELD CHANGES	
DESIGN-DETAILED		REVISIONS 1	
CHECKED-REVIEWED		REVISIONS 2	
DESIGN-DETAILED2		REVISIONS 3	
DESIGN-DETAILED3		REVISIONS 4	
SIGNATURE		DATE	
BY		DATE	
DATE		DATE	

YARMOUTH
I-295 EXIT 15
SIGNS & PVMT. MARKINGS


SHEET NUMBER
273
OF 283

Filename:

Division: HIGHWAY

Userame: COMMON

Date: 2/21/2011

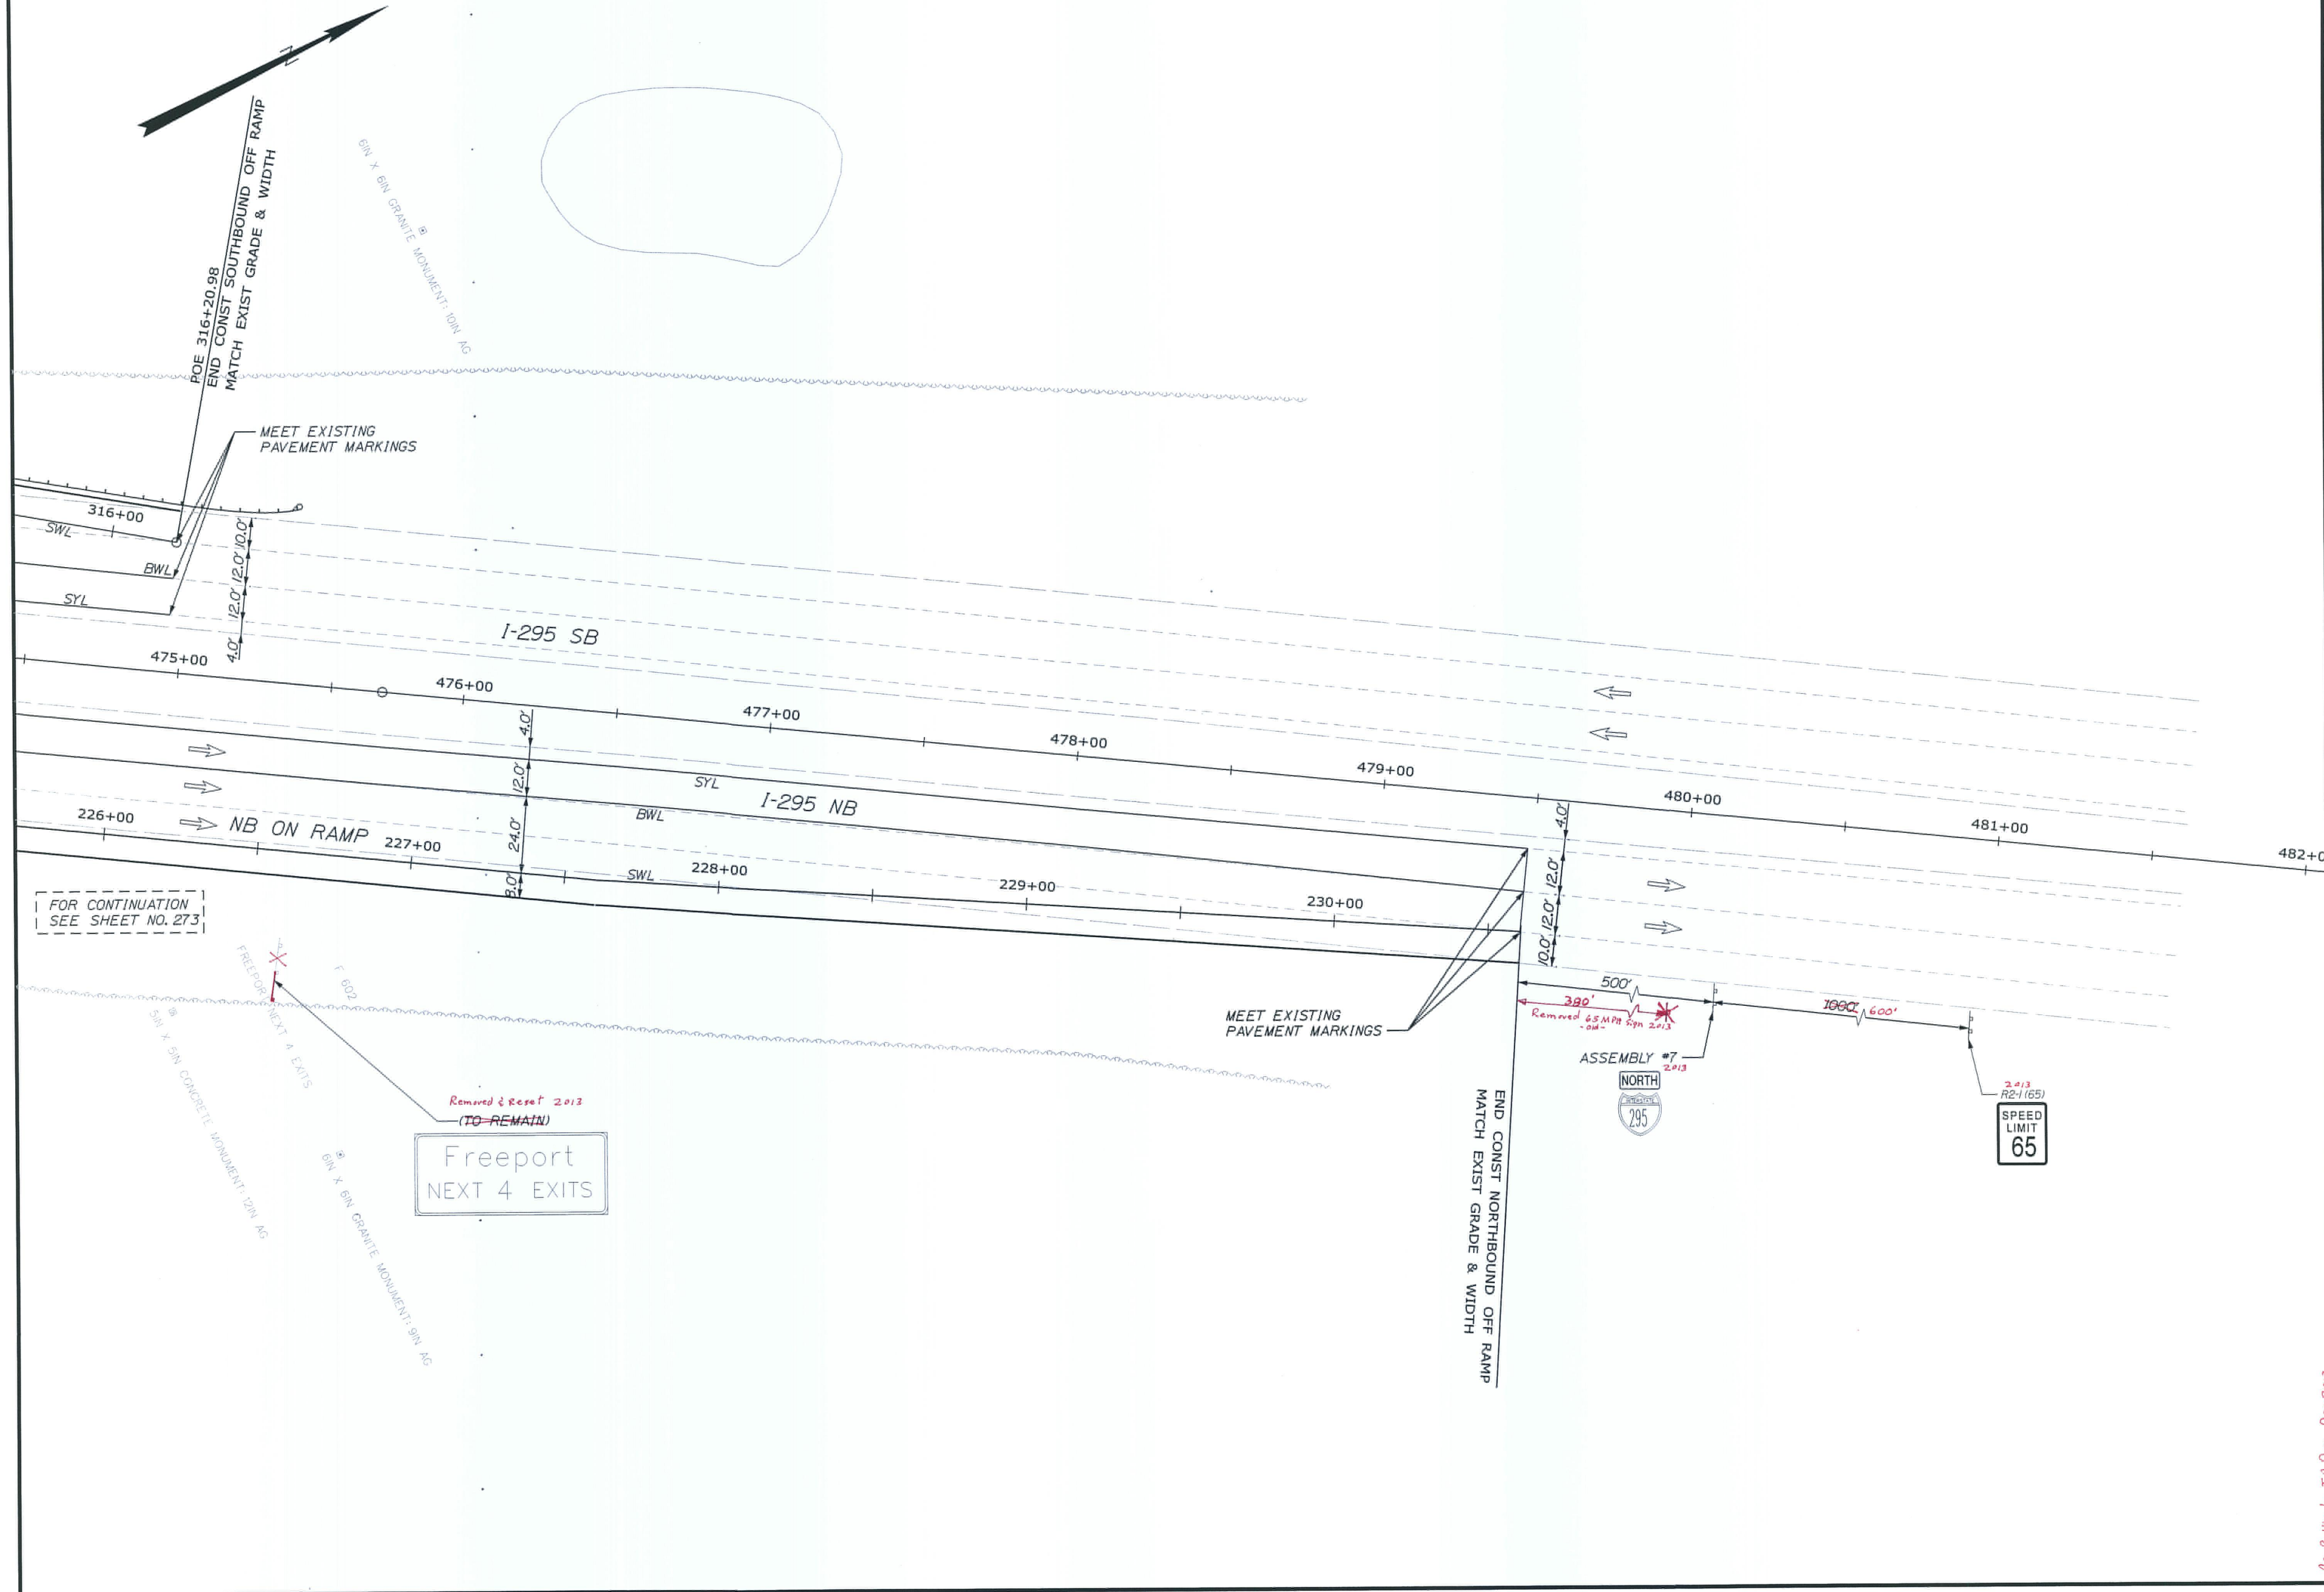

1715-Exits by I-295

12-20-2013

STATE OF MAINE
DEPARTMENT OF TRANSPORTATION

IM-1108(600) EXIT 15
CM-1749(000)X PARK & RIDE LOT

WIN 11086.00 EXIT 15 HIGHWAY PLANS
WIN 17490.00 PARK & RIDE LOT

YARMOUTH
I-295 EXIT 15

SIGNS & PVMT. MARKINGS

SHEET NUMBER

274


OF 283

PROJ. MANAGER
BY
DATE






DESIGN-DETAILED
CHECKED-REVIEWED
DESIGN-DETAILED2
DESIGN-DETAILED3
REVISIONS 1
REVISIONS 2
REVISIONS 3
REVISIONS 4
FIELD CHANGES


SIGNATURE
P.E. NUMBER
DATE

As-Built by T.P. Dyer Dec 2013

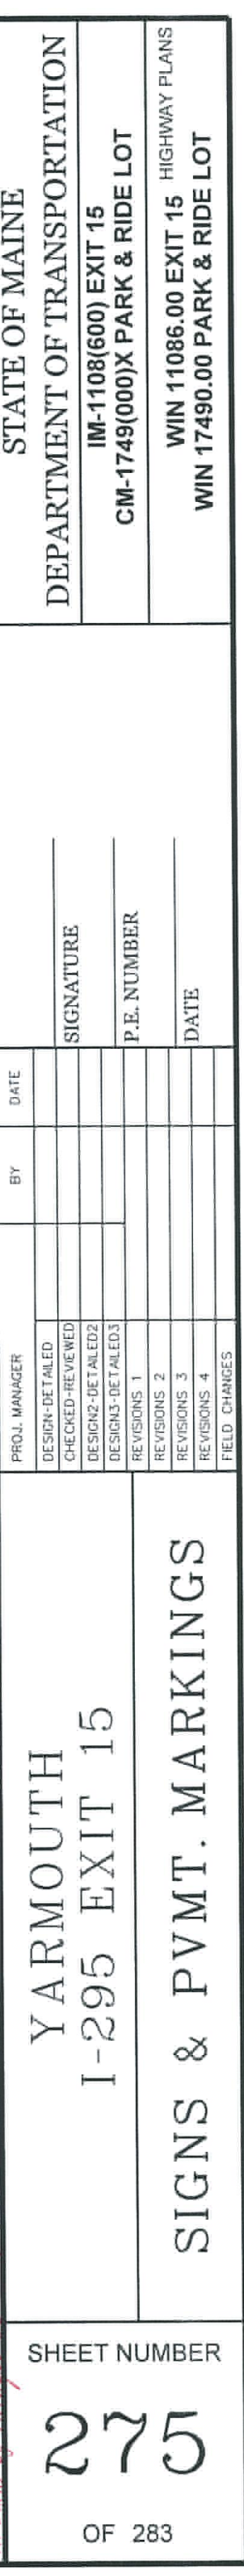

PROPOSED SIGN SUMMARY

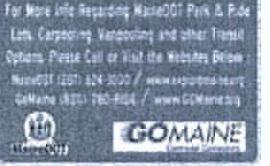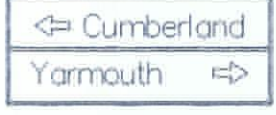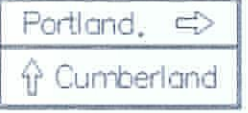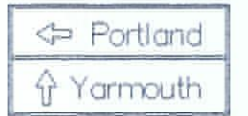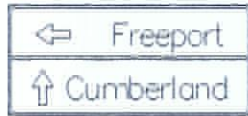
ITEM NUMBER	IDENTIFICATION NUMBER	SIZE OF SIGN		TEXT	TEXT DIMENSIONS			NUMBER OF SIGNS REQUIRED	SIGN AREA (SQ. FT.)		REMARKS
		WIDTH	HEIGHT		LETTER HEIGHT	VERTICAL SPACING	SHIELD/ARROW		NOM. AREA	TOTAL AREA	
645.292	OMI-1	24"	24"	 <i>All Signs installed in 2013</i>				4 4	4.00	16.00 16.00	
645.292	OM3-L	12"	36"					2	3.00	6.00	
645.292	OM3-L	12"	36"					2	3.00	6.00	
645.292	D4-2L	36"	48"					1	12.00	6.00	
645.292	D4-2R	36"	48"					3 3	12.00	36.00 36.00	
645.292	SP-1	12"	18"					11	1.50	16.5	
645.292	SP-2	48"	48"		2.75 CAPS 2" UPPER			3	16.00	48.00	
645.292	SP-3	24"	36"		1.75 UPPER			1	6.00	6.00	
645.292	SP-4	30"	48"		5" CAPS 3" UPPER 3" CAPS			1	10.00	10.00	
645.292	SP-5	36"	36"					2	9.00	18.00	
645.251	DI-2(1)	72"	30"		6"D 6"D	4.75" 3.875" 3.875" 4.75"	6" ARROW 0.75" HOR. LINE 6" ARROW	2	15	30	
645.251	DI-2(2)	66"	30"		6"D 6"D	4.75" 3.875" 3.875" 4.75"	6" ARROW 0.75" HOR. LINE 6" ARROW	1	13.75	13.75	
645.251	DI-2(3)	60"	30"		6"D 6"D	4.75" 3.875" 3.875" 4.75"	6" ARROW 0.75" HOR. LINE 6" ARROW	1	12.50	12.50	
645.251	DI-2(4)	66"	30"		6"D 6"D	4.75" 3.875" 3.875" 4.75"	6" ARROW 0.75" HOR. LINE 6" ARROW	1	13.75	13.75	
645.251	DI-2(5)	60"	30"		6"D 6"D	4.75" 3.875" 3.875" 4.75"	6" ARROW 0.75" HOR. LINE 6" ARROW	1	12.50	12.50	
645.251	DI-2a	72"	30"		6"D 6"D	4.75" 3.875" 3.875" 4.75"	0.75" HOR. LINE	1	15	15	

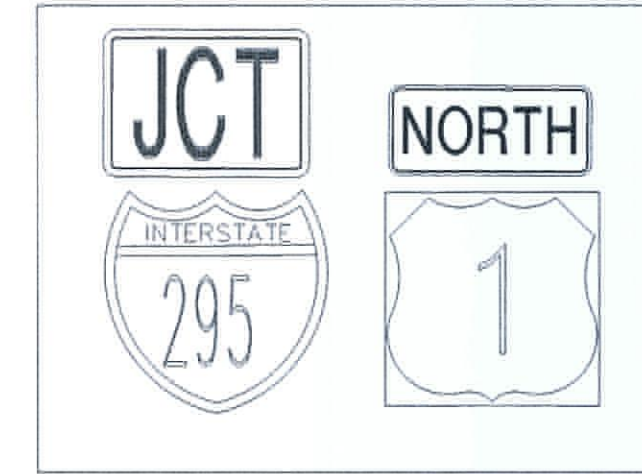

ASSEMBLY #1 2013




ASSEMBLY #3
2013

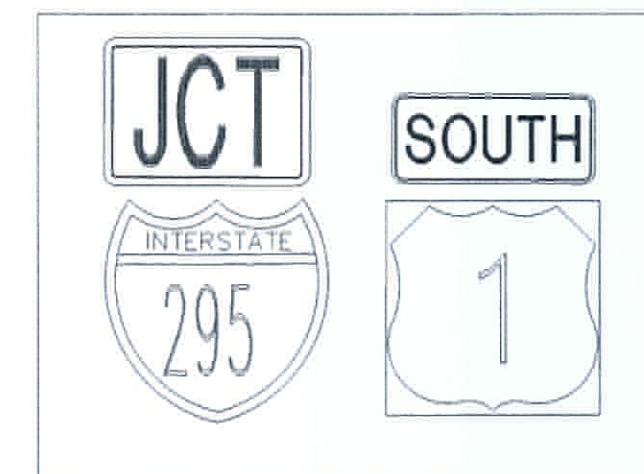


ASSEMBLY #5 2013




ASSEMBLY #7
2013

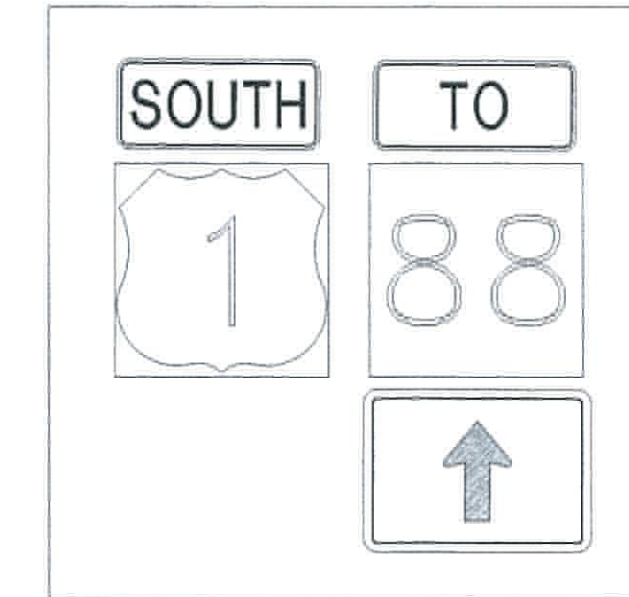

ASSEMBLY #2 2013

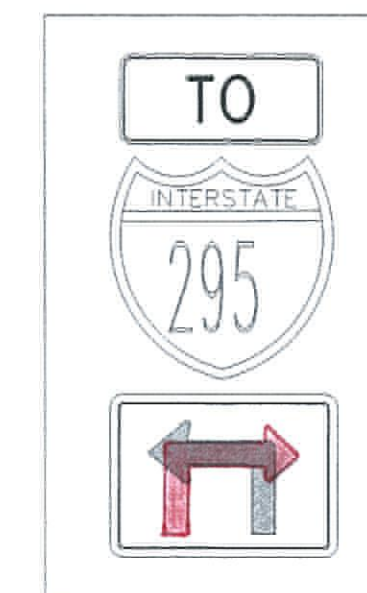

ASSEMBLY #4
Rt. Turn Arrow 2013

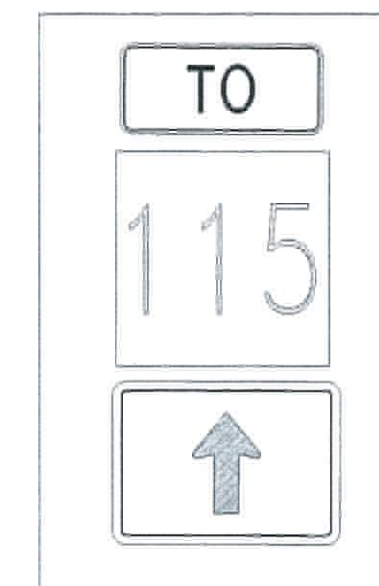

ASSEMBLY #6
2013

SIGN SUMMARY NOTES:

1. REFER TO STANDARD SPECIFICATIONS SECTION TO DETERMINE SIZE OF POSTS.
2. SIGN TEXT SHALL CONFORM TO MUTCD.
3. SIGN TYPE AND LOCATIONS SHALL BE IN ACCORDANCE WITH MUTCD.
4. SIGN LOCATIONS ARE APPROXIMATE AND TO BE VERIFIED IN THE FIELD.

As-Built by T.P. Dyer Dec. 2013

STATE OF MAINE
DEPARTMENT OF TRANSPORTATION
IM-1108(600) EXIT 15 HIGHWAY PLANS
CM-1749(000)X PARK & RIDE LOT
WIN 11086.00 EXIT 15
WIN 17490.00 PARK & RIDE LOT

PROJ. MANAGER		BY	DATE
DESIGN-DETAILED			
CHECKED-REVIEWED			
DESIGN2-DETAILED2			SIGNATURE
DESIGN3-DETAILED3			
REVISIONS 1			P.E. NUMBER
REVISIONS 2			
REVISIONS 3			DATE
REVISIONS 4			
FIELD CHANGES			

YARMOUTH
 I-295 EXIT 15
 SIGN SUMMARY

SHEET NUMBER

276

OF 283

PROPOSED SIGN SUMMARY

ITEM NUMBER	IDENTIFICATION NUMBER	SIZE OF SIGN		TEXT <i>All Signs installed in 2013</i>	TEXT DIMENSIONS			NUMBER OF SIGNS REQUIRED	SIGN AREA (SQ. FT.)		REMARKS
		WIDTH	HEIGHT		LETTER HEIGHT	VERTICAL SPACING	SHIELD/ARROW		NOM. AREA	TOTAL AREA	
645.292	MI-1	45"	36"		TEXT DIMENSIONS SHALL CONFORM TO "STANDARD HIGHWAY SIGNS"			2	11.25	22.5	
645.292	MI-1	30"	24"					3	5.00	15.00	
645.292	MI-4	24"	24"					3	4.00	12.00	
645.292	MI-5	24"	24"					1	4.00	4.00	
645.292	MI-5	24"	24"					1	4.00	4.00	
645.292	M2-1	21"	15"					2	2.19	4.38	
645.292	M3-1	36"	18"					1	4.5	4.5	
645.292	M3-1	24"	12"					1	2.00	2.00	
645.292	M3-3	36"	18"					1	4.5	4.5	
645.292	M3-3	24"	12"					2	2.00	4.00	
645.292	M4-5	24"	12"					3	2.00	6.00	
645.292	M5-1R	21"	15"					1	2.19	2.19	
645.292	M6-3	21"	15"					1	2.19	4.38	
645.292	RI-1	30"	30"					5	6.25	31.25	
645.292	RI-2	60" X 60" X 60"						2	10.83	21.65	
645.292	RI-2	36" X 36" X 36"						9	3.90	35.1	
645.292	R2-1	48"	60"					2	20.00	40.00	
645.292	R2-1	24"	30"					2	5.00	10.00	
645.292	R3-3	36"	36"					2	9.00	18.00	

ITEM NUMBER	IDENTIFICATION NUMBER	SIZE OF SIGN		TEXT <i>All Signs installed in 2013</i>	TEXT DIMENSIONS			NUMBER OF SIGNS REQUIRED	SIGN AREA (SQ. FT.)		REMARKS
		WIDTH	HEIGHT		LETTER HEIGHT	VERTICAL SPACING	SHIELD/ARROW		NOM. AREA	TOTAL AREA	
645.292	R3-8	30"	30"					1	6.25	6.25	
645.292	R4-4	36"	30"					2	7.50	15.00	
645.292	R3-7L	30"	30"					3	6.25	18.75	
645.292	R3-7R	30"	30"					3	6.25	18.75	
645.292	R4-7	24"	30"					1	5.00	5.00	
645.292	R5-1	30"	30"					2	6.25	12.5	
645.2511	R5-1a	36"	24"					3	6.00	18.00	RADAR SENSOR & LED ILLUMINATED
645.292	R6-1	54"	18"					2	6.75	13.5	
645.292	R6-1	36"	12"					2	3.00	6.00	
645.292	R7-8	12"	18"					8	1.50	12.00	
645.292	R7-8P	18"	9"					2	1.13	2.25	
645.292	WI-1a	36"	36"					1	9.00	9.00	
645.2512	WI-8R	18"	24"					4	3.00	12.00	RADAR SENSOR & LED ILLUMINATED
645.292	W4-1R	48"	48"					2	16.00	32.00	
645.292	W4-3	36"	36"					1	9.00	9.00	
645.292	W11-1	30"	30"					2	6.25	12.5	
645.292	WI6-1P	18"	24"					2	3.00	6.00	
645.292	WI3-2	36"	48"					1	12.00	12.00	


STATE OF MAINE
DEPARTMENT OF TRANSPORTATION
IM-1108(600) EXIT 15
CM-1749(000)X PARK & RIDE LOT
WIN 11086.00 EXIT 15 HIGHWAY PLANS
WIN 17490.00 PARK & RIDE LOT

PROJ. MANAGER
DESIGN-DETAILED
CHECKED-REVIEWED
DESIGN2-DETAILED2
DESIGN3-DETAILED3
REVISIONS 1
REVISIONS 2
REVISIONS 3
REVISIONS 4
FIELD CHANGES
DATE
BY
SIGNATURE
P.E. NUMBER
DATE

YARMOUTH
I-295 EXIT 15
SIGN SUMMARY

SHEET NUMBER
277
OF 283

As-Built by T.R. Dyer Dec 2013

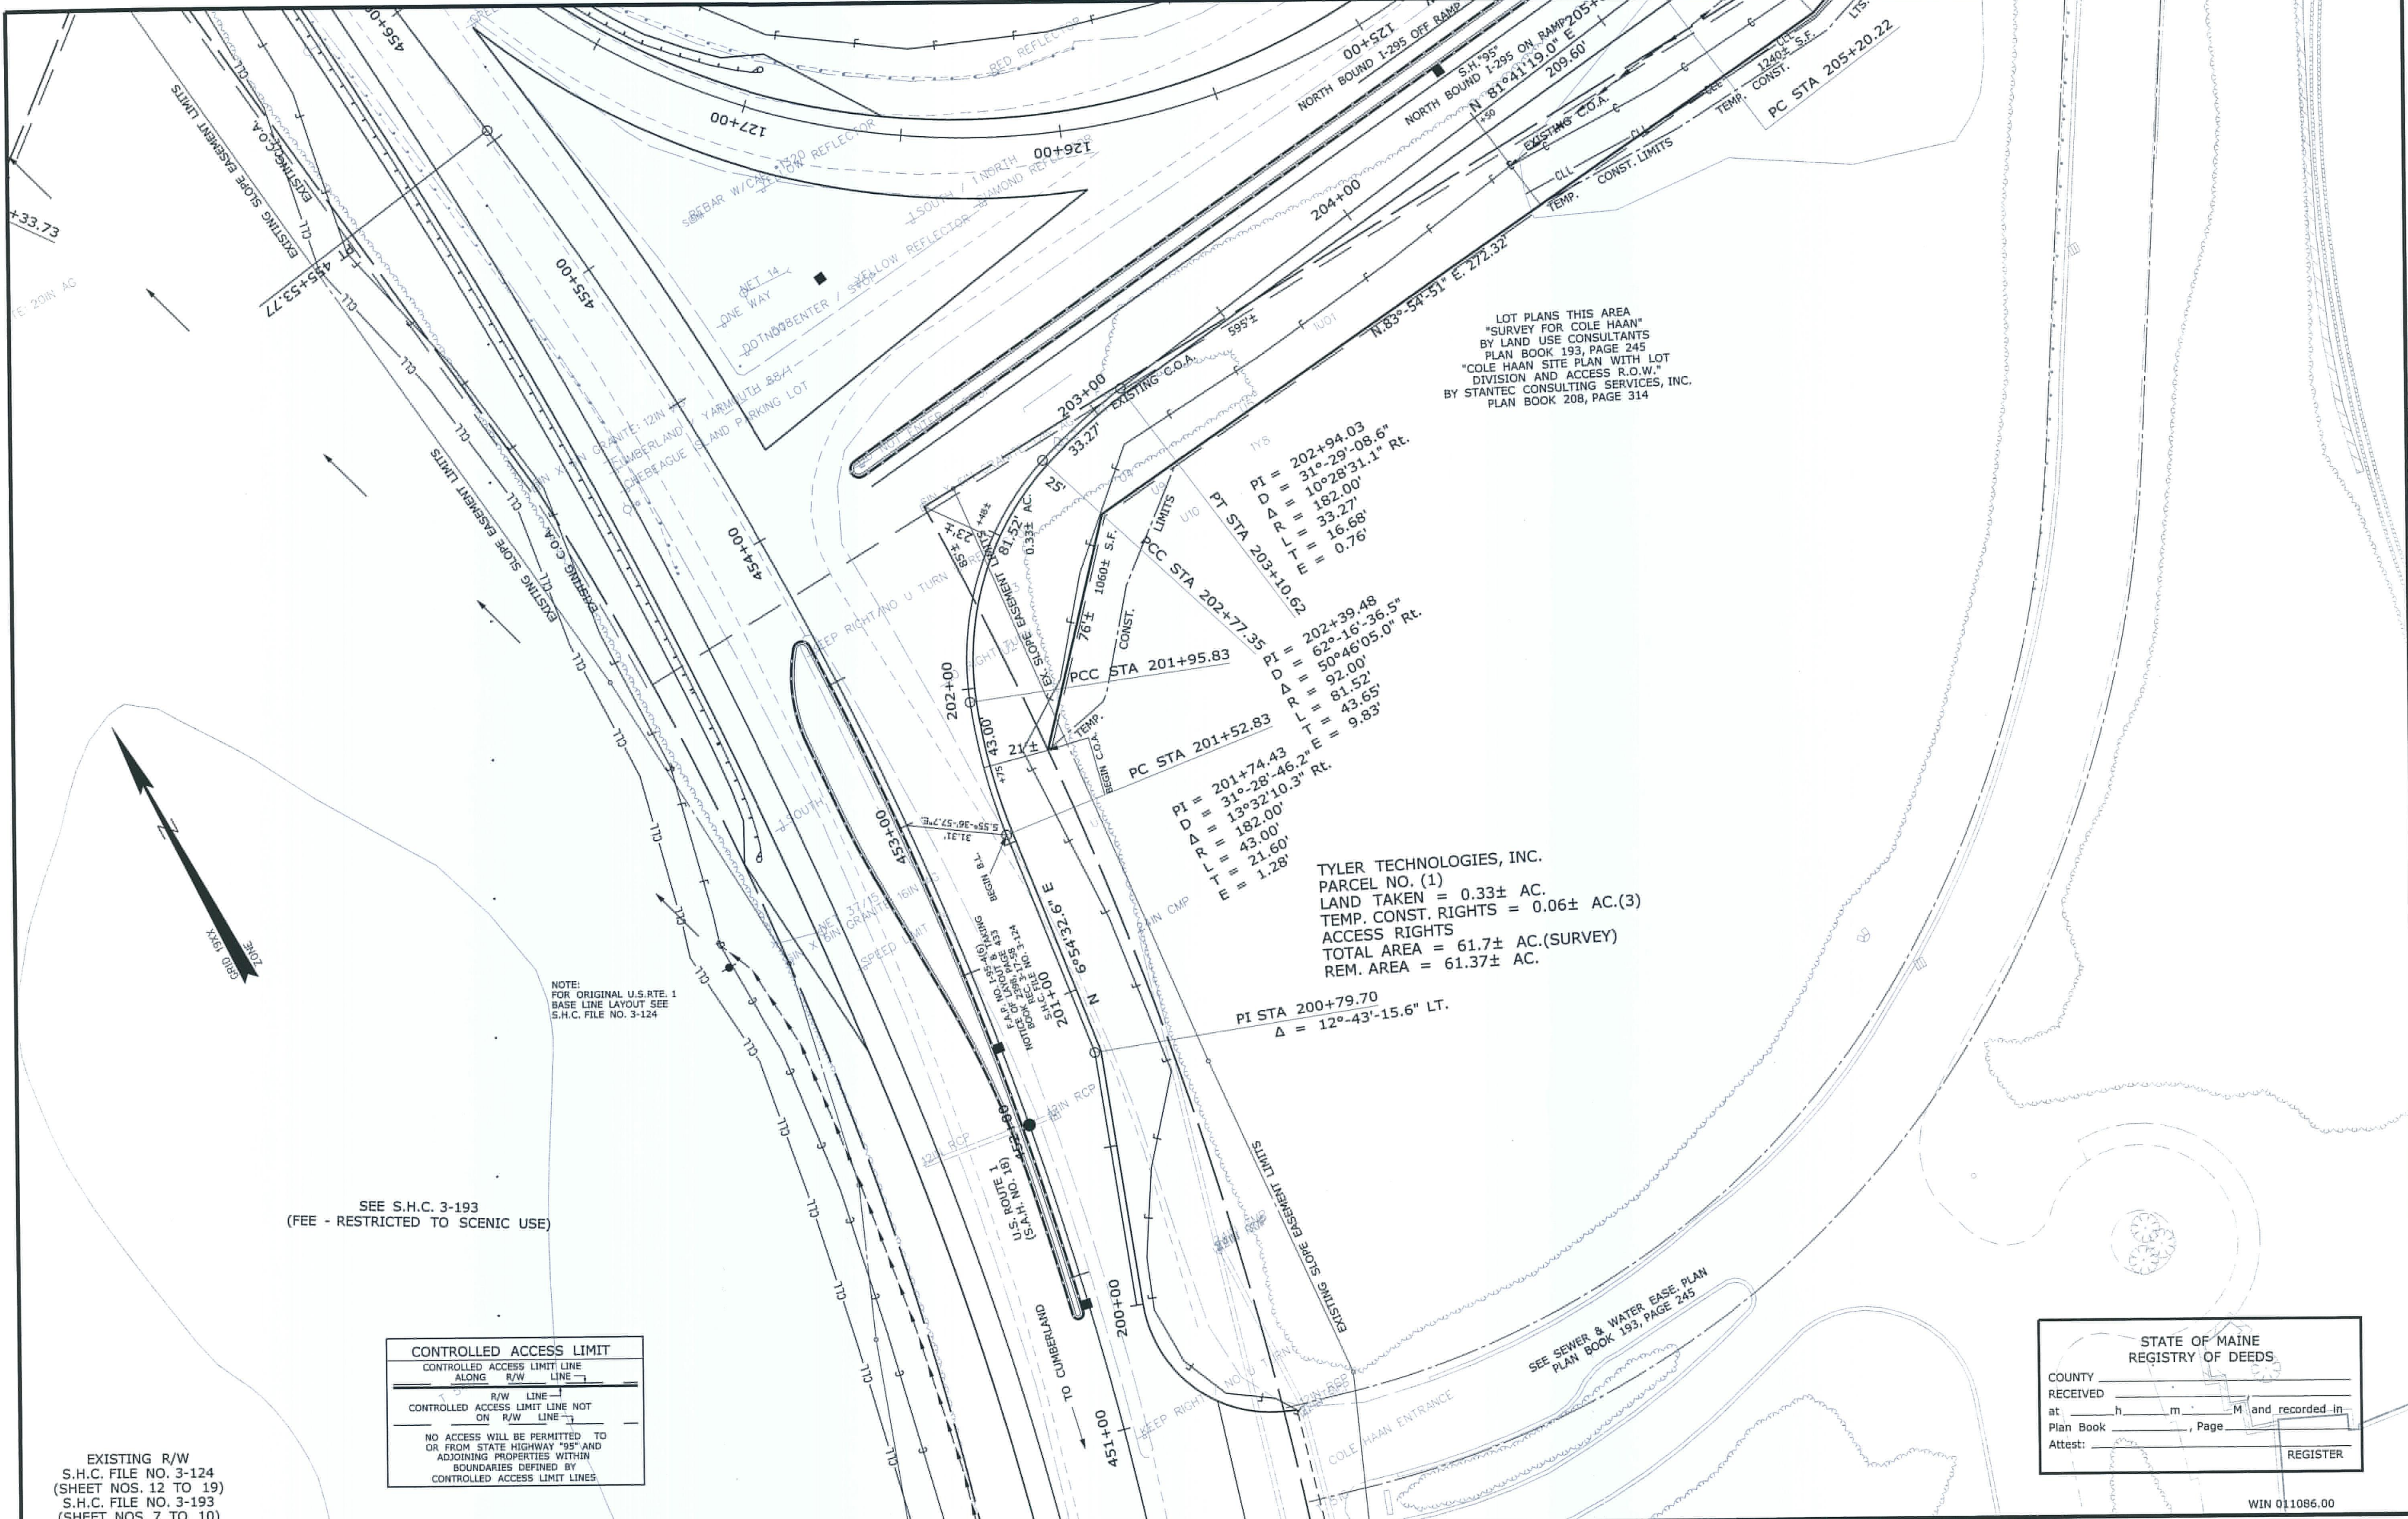

EXISTING R/W
S.H.C. FILE NO. 3-124
(SHEET NOS. 12 TO 19)
S.H.C. FILE NO. 3-193
(SHEET NOS. 7 TO 10)

SEE S.H.C. 3-193
(FEE - RESTRICTED TO SCENIC USE)

CONTROLLED ACCESS LIMIT
CONTROLLED ACCESS LIMIT LINE
ALONG R/W LINE
R/W LINE
CONTROLLED ACCESS LIMIT LINE NOT
ON R/W LINE
NO ACCESS WILL BE PERMITTED TO
OR FROM STATE HIGHWAY "95" AND
ADJOINING PROPERTIES WITHIN
BOUNDARIES DEFINED BY
CONTROLLED ACCESS LIMIT LINES

LOT PLANS THIS AREA
"SURVEY FOR COLE HAAN"
BY LAND USE CONSULTANTS
PLAN BOOK 193, PAGE 245
"COLE HAAN SITE PLAN WITH LOT
DIVISION AND ACCESS R.O.W."
BY STANTEC CONSULTING SERVICES, INC.
PLAN BOOK 208, PAGE 314

PI = 202+94.03
31°-29'-08.6" Rt.
Q = 182.00'
PCC STA 203+10.62
PT STA 203+77.35
Q = 182.00'
PCC STA 201+95.83
PC STA 201+52.83
PT STA 200+79.70
Δ = 12°-43'-15.6" Lt.

PI = 202+39.48
62°-16'-36.5" Rt.
Q = 182.00'
PCC STA 203+10.62
PT STA 203+77.35
Q = 182.00'
PCC STA 201+95.83
PC STA 201+52.83
PT STA 200+79.70
Δ = 12°-43'-15.6" Lt.

TYLER TECHNOLOGIES, INC.
PARCEL NO. (1)
LAND TAKEN = 0.33± AC.
TEMP. CONST. RIGHTS = 0.06± AC.(3)
ACCESS RIGHTS
TOTAL AREA = 61.7± AC.(SURVEY)
REM. AREA = 61.37± AC.

PI STA 200+79.70
Δ = 12°-43'-15.6" Lt.

STATE OF MAINE
REGISTRY OF DEEDS
COUNTY RECEIVED
at h m M and recorded in
Plan Book , Page
Attest: REGISTER

WIN 011086.00

REVISIONS			PLAN FILED IN PLAN BOOK			PAGE			COUNTY RECORD		
NO.	DATE	DESCRIPTION	BY	NO.	GRANTOR	INSTRUMENT	DATE	BOOK	DATE	BOOK	PAGE
						COND.	11/26/12	30152		334	


DAVID BERNHARDT
COMMISSIONER
KENNETH L. SWEENEY
CHIEF ENGINEER
DATE



STATE HIGHWAY "95"
INTERSTATE 295 (EXIT 15)
YARMOUTH CUMBERLAND COUNTY
FEDERAL AID PROJECT NO. IM-1108(600) SECT. I
AUGUST 2012
SCALE 1" = 25'
RIGHT-OF-WAY MAP
SHEET 1 OF 5
D.O.T. FILE NO. 3-585

STATE OF MAINE
DEPARTMENT OF TRANSPORTATION
16 STATE HOUSE STATION - AUGUSTA, ME 04333-0016
YARMOUTH
RIGHT OF WAY MAP

SHEET NUMBER
279
OF 283

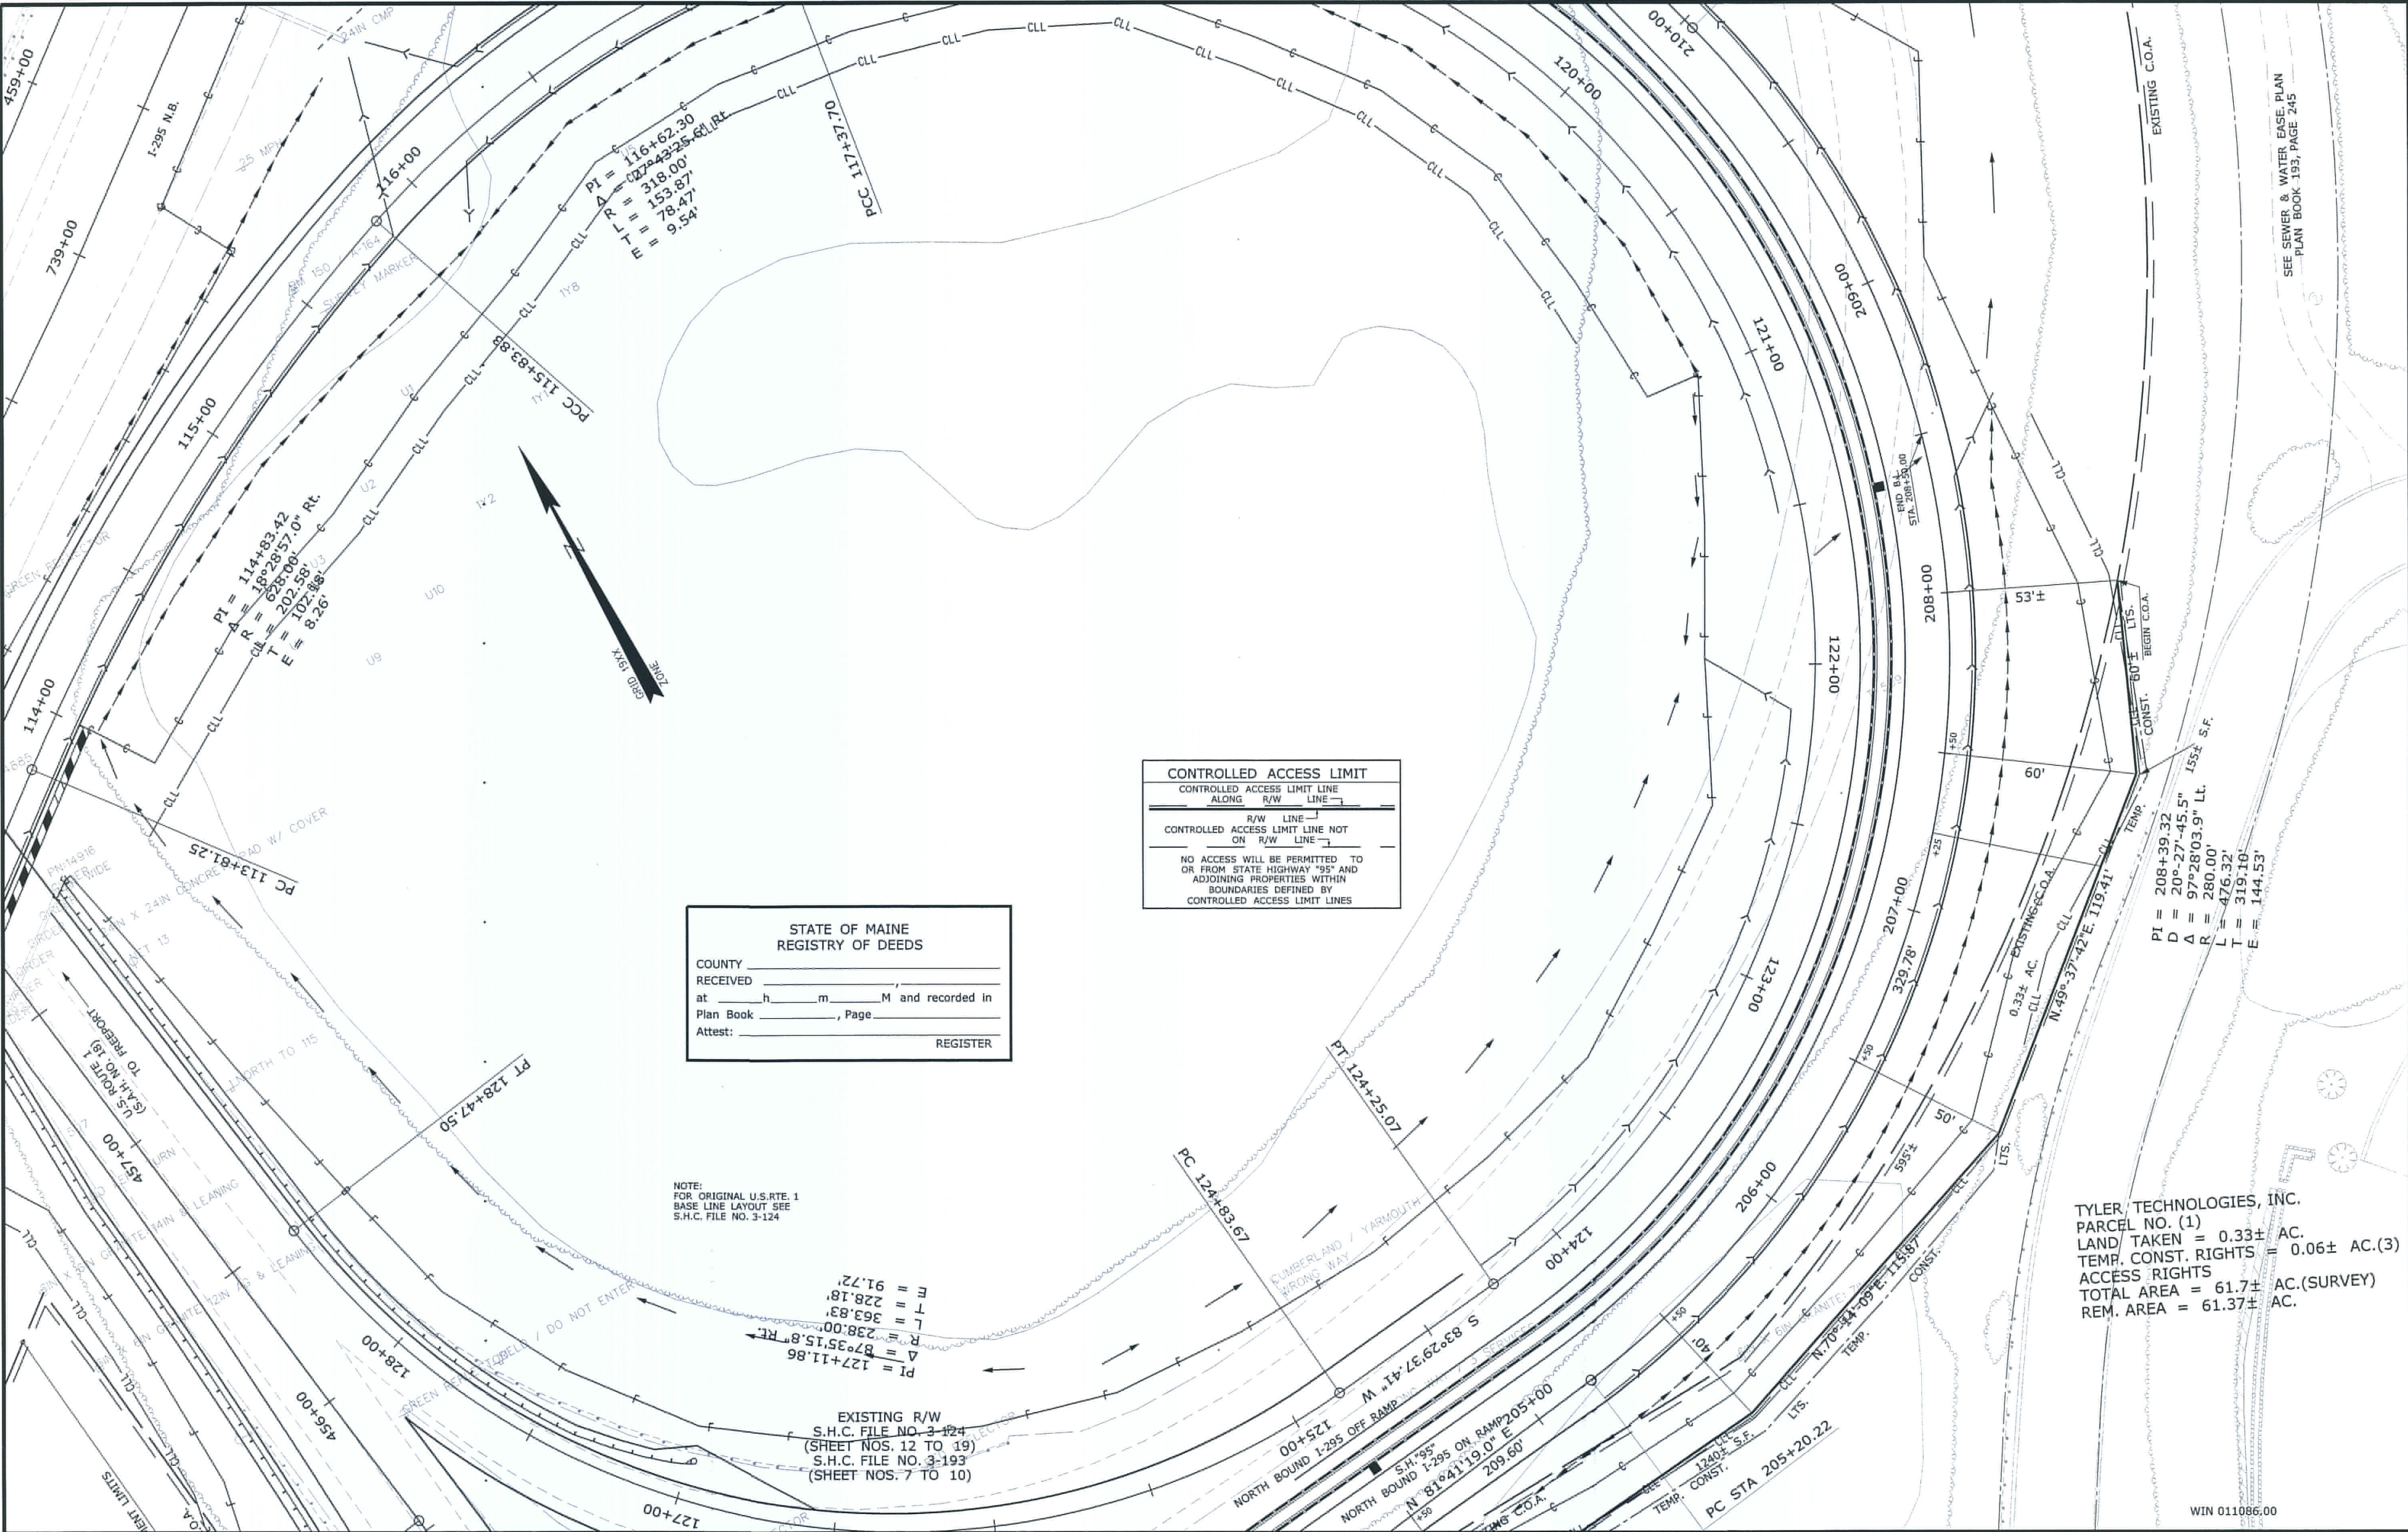

REVISIONS				PLAN FILED IN PLAN BOOK PAGE COUNTY RECORD						DAVID BERNHARDT COMMISSIONER KENNETH L. SWEENEY CHIEF ENGINEER DATE 	
NO.	DATE	DESCRIPTION	BY	NO.	GRANTOR	INSTRUMENT	DATE	BOOK	PAGE		
						COND.	11/26/12	30152	334		
										</	

STATE OF MAINE
DEPARTMENT OF TRANSPORTATION
16 STATE HOUSE STATION - AUGUSTA, ME 04333-0016
YARMOUTH
RIGHT OF WAY MAP

TYLER TECHNOLOGIES, INC.
PARCEL NO. (1)
LAND TAKEN = 0.33± AC.
TEMP. CONST. RIGHTS = 0.06± AC.(3)
ACCESS RIGHTS
TOTAL AREA = 61.7± AC.(SURVEY)
REM. AREA = 61.37± AC.

SYMBOLS
• P or • (IRON PIPE OR PIN FOUND)
□ (SEPTIC TANK)
□ (WATER TANK)
Δ (TRAP POINT)
— (WATER LINE)
— (GAS LINE)
— (ELECTRIC LINE)
— (TELEPHONE LINE)
— (SEWER LINE)
○ (WELL)
— (GRADING LIMIT LINE)
— (CONSTRUCTION LIMIT LINE)
— (PROPERTY LINE)
— (LIMITS OF WRIGHT PORTION (LOW P))
— (EXISTING RIGHT OF WAY)
— (NEW RIGHT OF WAY)
— (NEW RIGHT OF WAY)
— (NEW RIGHT OF WAY)
— (CONTROL OF ACCESS)


WIN 011086.00

Date: 12/12/2012

Username: terry.blairsr

Division: ROW

Filename: ...\\00\\row\\msta\\003_RWPLAN3.dgn

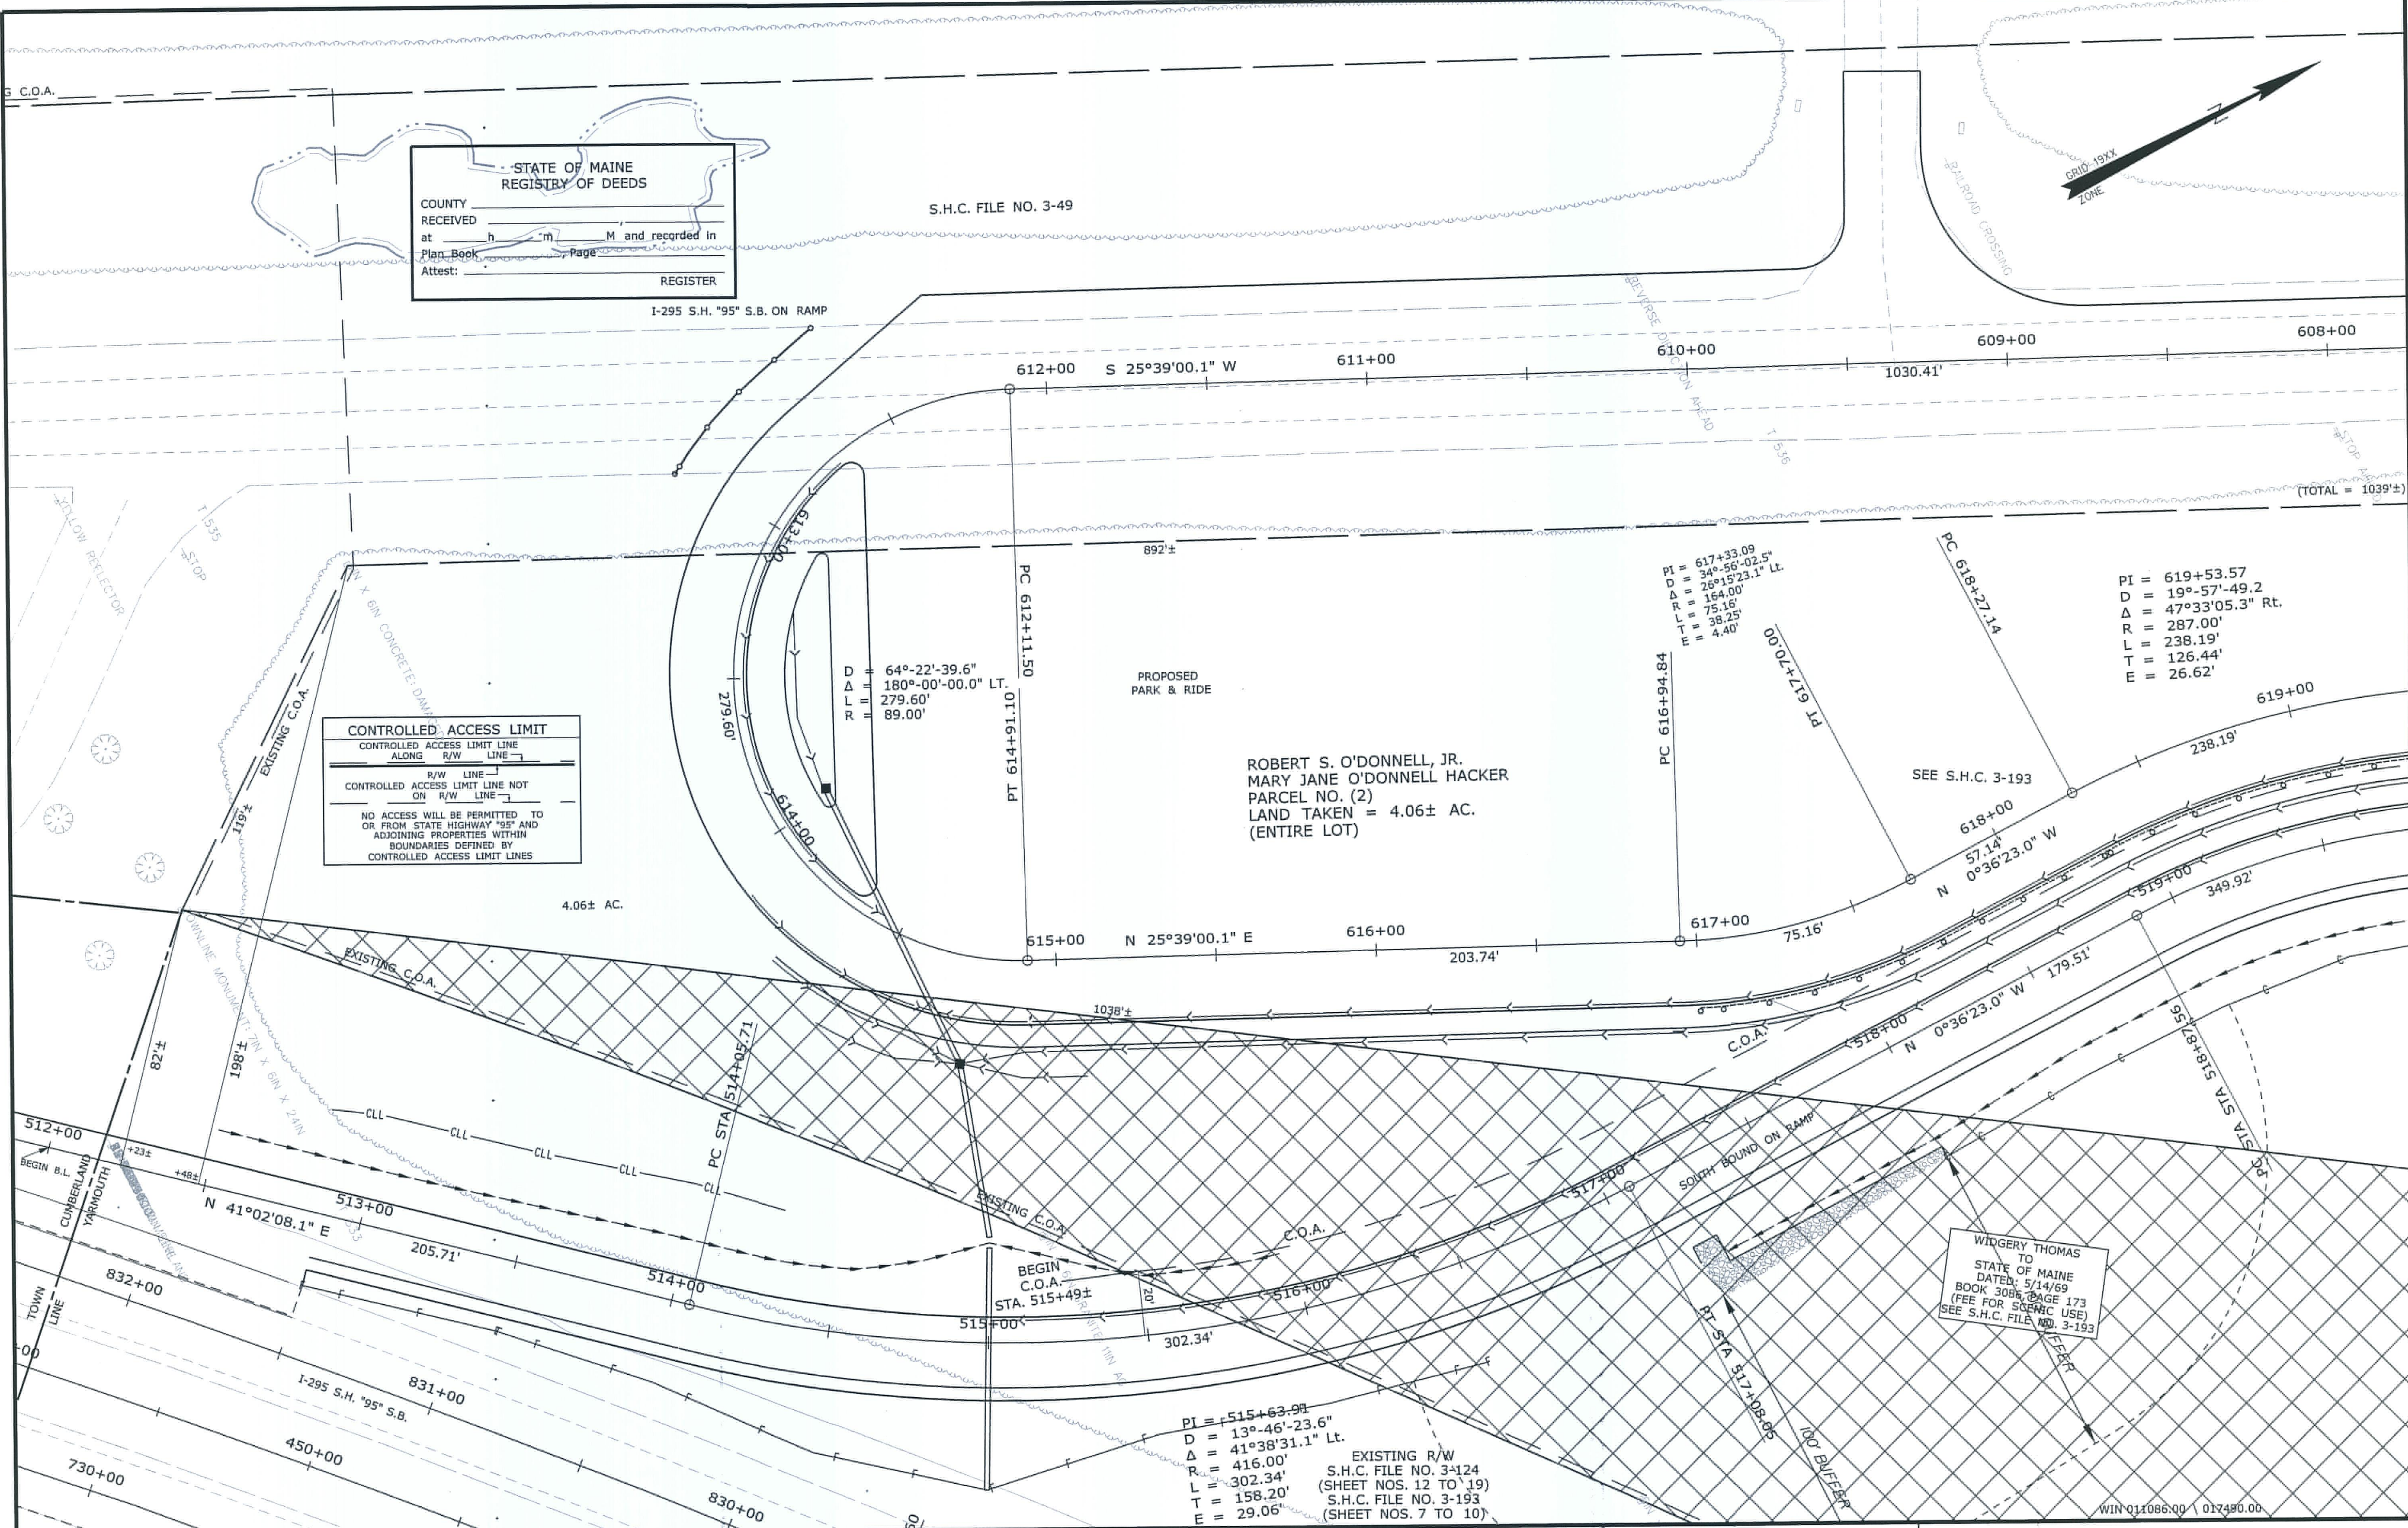

REVISIONS			PLAN FILED IN PLAN BOOK			PAGE			COUNTY RECORD		
NO.	DATE	DESCRIPTION	BY	NO.	GRANTOR	INSTRUMENT	DATE	BOOK	PAGE	DATE	BOOK

DAVID BERNHARDT
COMMISSIONER
KENNETH L. SWEENEY
CHIEF ENGINEER
DATE




STATE HIGHWAY "95"
INTERSTATE 295 (EXIT 15)
YARMOUTH CUMBERLAND COUNTY
FEDERAL AID PROJECT NO. IM-1108(600) SECT. II
FEDERAL AID PROJECT NO. CM-1749(000)X
AUGUST 2012 RIGHT-OF-WAY MAP
SCALE 1" = 25' SHEET 3 OF 5
D.O.T. FILE NO. 3-585

STATE OF MAINE
DEPARTMENT OF TRANSPORTATION
16 STATE HOUSE STATION - AUGUSTA, ME 04333-0016
YARMOUTH
RIGHT OF WAY MAP

ITEM	TECH	CHECKED	SYMBOLS
BASE MAP			(WELL)
EXIST. R/W	T.L.B.		GRADING LIMIT LINE
PROP. LINES	T.L.B.		CONSTRUCTION LIMIT LINE
AREAS	T.L.B.		PROPERTY LINE
			LIMITS OF WISCONSIN PORTION (LOW P)
			EXISTING RIGHT OF WAY
			NEW RIGHT OF WAY
			NEW TOWN WITHIN EXIST. ROW
			CONTROL OF ACCESS

SHEET NUMBER
281
OF 283

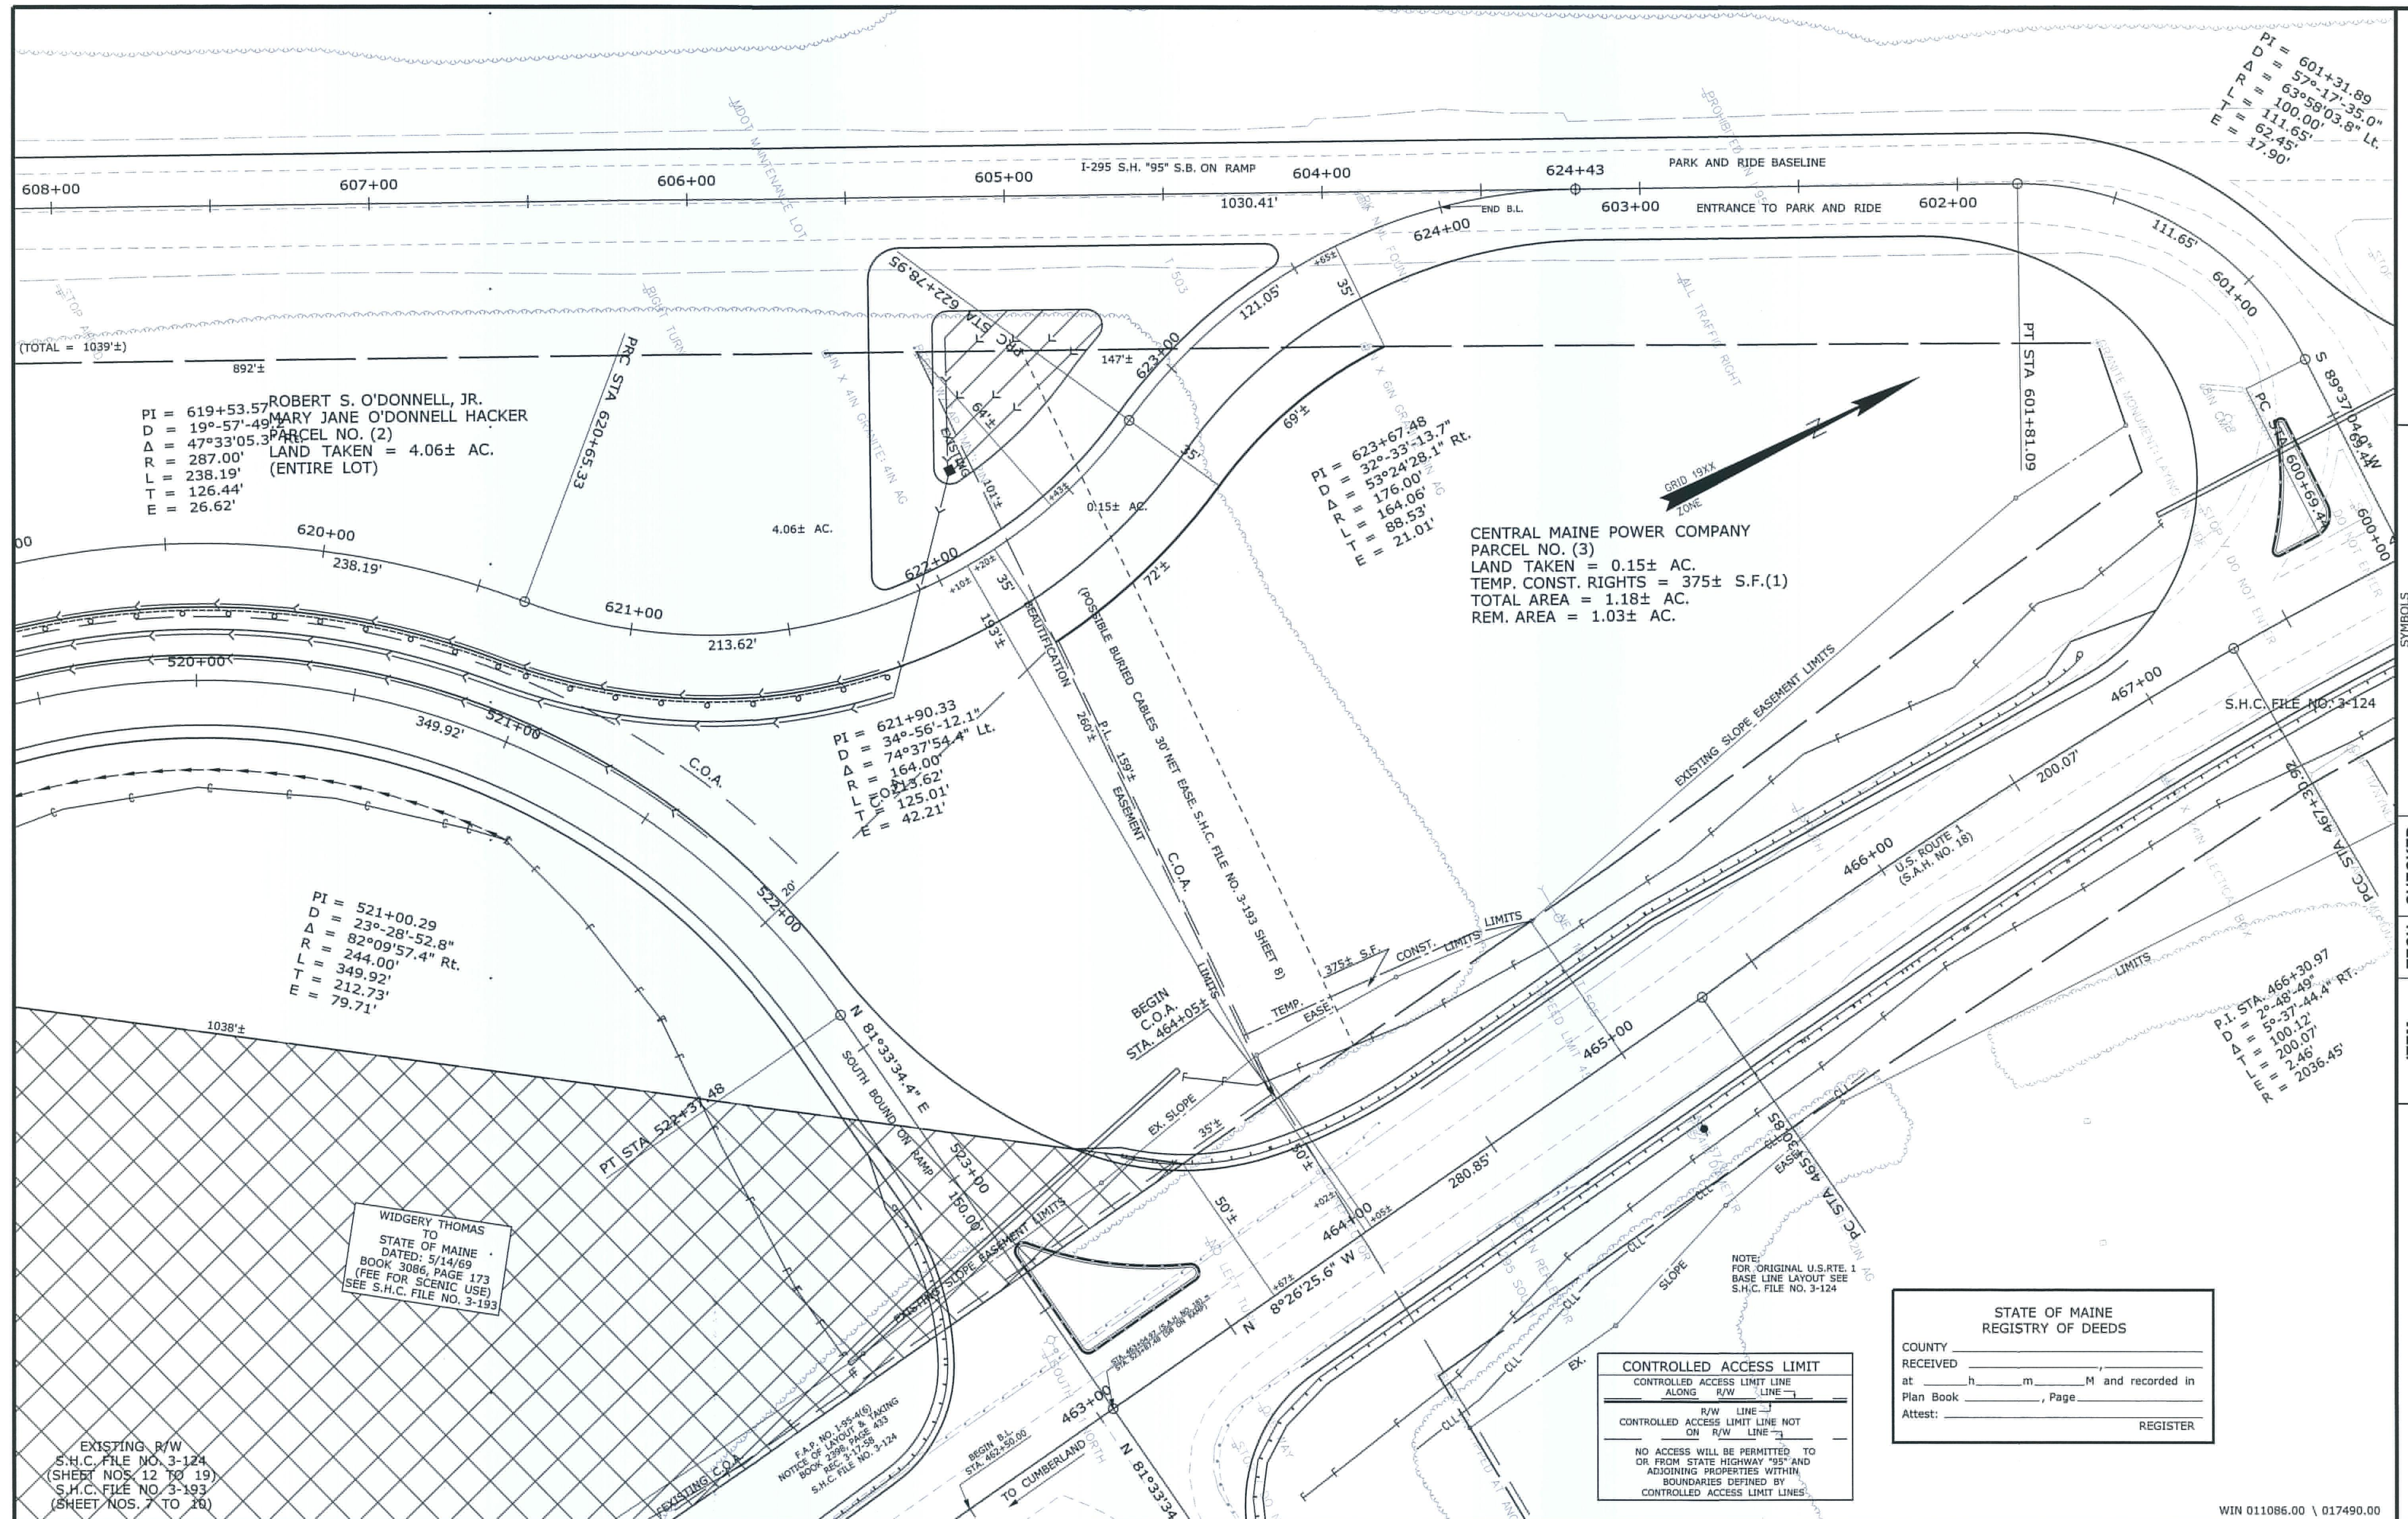[illegible]

DAVID BERNHARDT
COMMISSIONER
KENNETH L. SWEENEY
CHIEF ENGINEER
DATE



STATE HIGHWAY "95"		
INTERSTATE 295 (EXIT 15)		
YARMOUTH		CUMBERLAND COUNTY
FEDERAL AID	PROJECT NO. IM-1108(600)	SECT. II
FEDERAL AID	PROJECT NO. CM-1749(000)	X
AUGUST 2012	RIGHT-OF-WAY MAP	D.O.T. FILE NO. 3-585
SCALE 1" = 25'	SHEET 4 OF 5	

SHEET NUMBER

282


OF 283

Date:12/12/2012

Username: terry blair

Division: ROW

Filenome: ...\\00\\row\\msta\\005_RWPLAN5.dgn

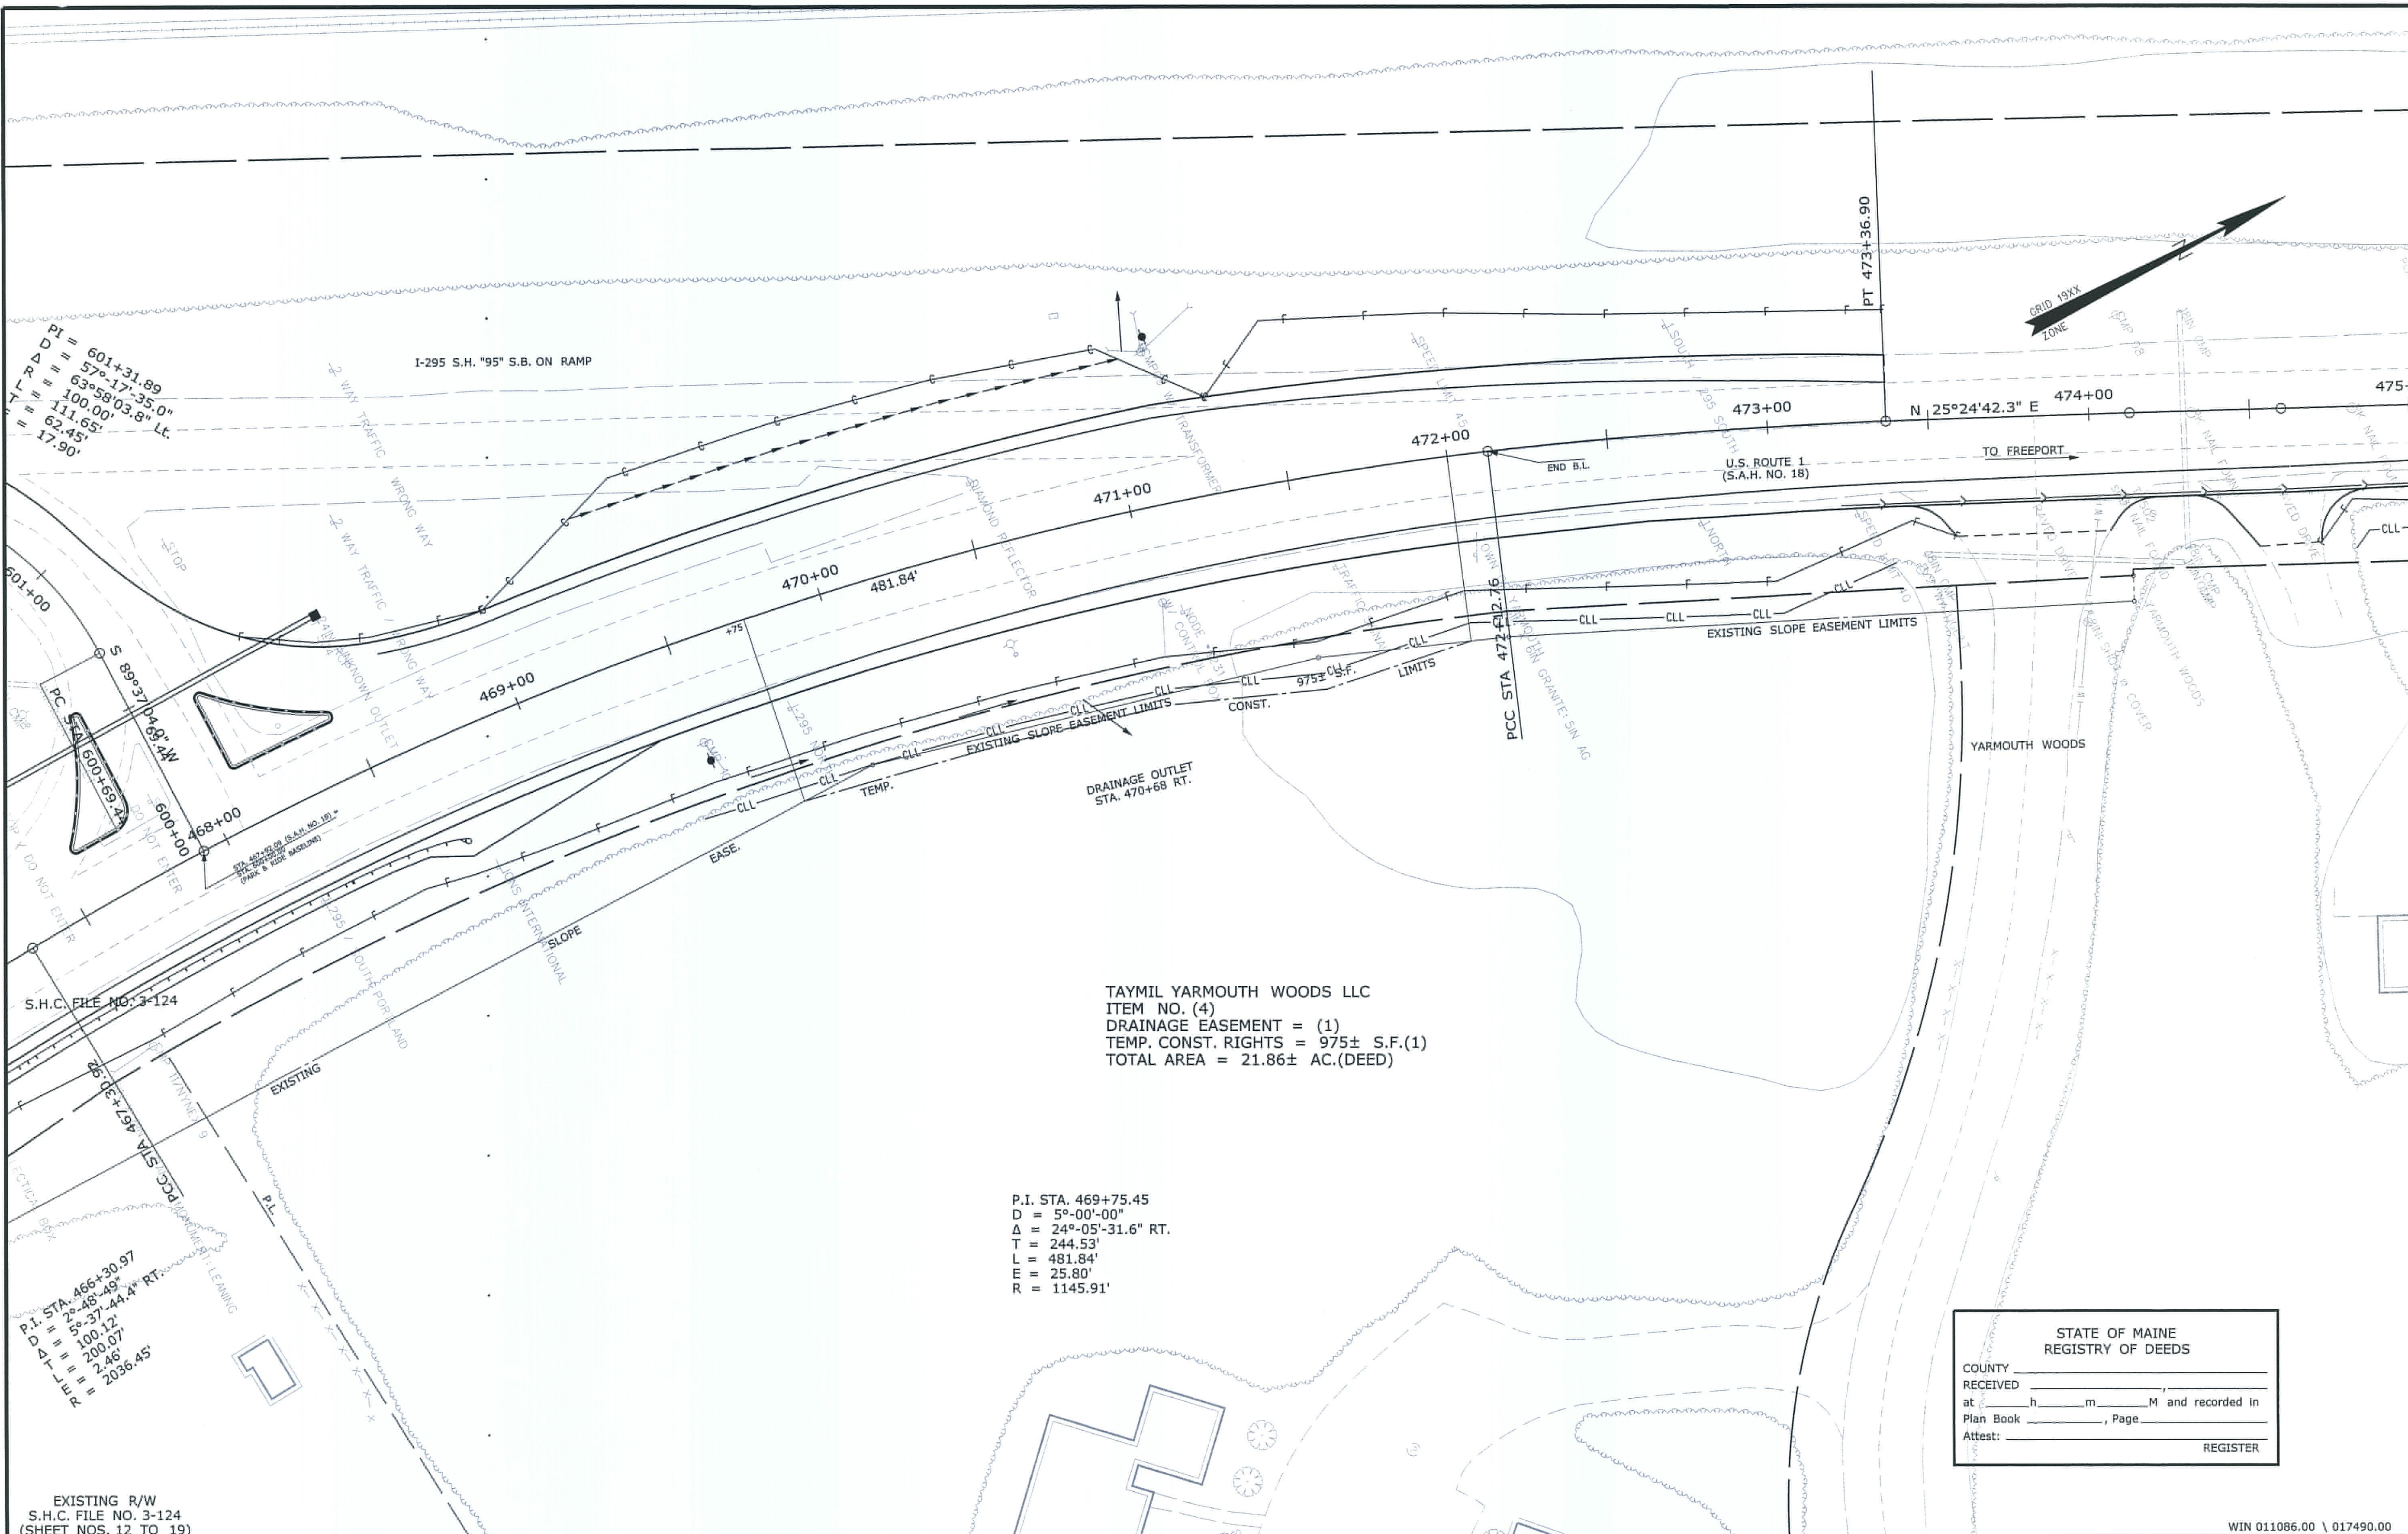

TAYMIL YARMOUTH WOODS LLC
ITEM NO. (4)
DRAINAGE EASEMENT = (1)
TEMP. CONST. RIGHTS = 975± S.F.(1)
TOTAL AREA = 21.86± AC.(DEED)

P.I. STA. 469+75.45
D = 5°-00'-00"
Δ = 24°-05'-31.6" RT.
T = 244.53'
L = 481.84'
E = 25.80'
R = 1145.91'

STATE OF MAINE
REGISTRY OF DEEDS
COUNTY _____
RECEIVED _____
at _____ h _____ m _____ M and recorded in
Plan Book _____, Page _____
Attest: _____ REGISTER

EXISTING R/W
S.H.C. FILE NO. 3-124
(SHEET NOS. 12 TO 19)

REVISIONS			PLAN FILED IN PLAN BOOK		PAGE		COUNTY RECORD		BY
NO.	DATE	DESCRIPTION	NO.	GRANTOR	INSTRUMENT	DATE	BOOK	PAGE	
					COND.	11/26/12	30152	334	

DAVID BERNHARDT
COMMISSIONER
KENNETH L. SWEENEY
CHIEF ENGINEER
DATE _____

STATE OF MAINE
PETER A. DELANGER
1341
PROFESSIONAL
LAND SURVEYOR

STATE HIGHWAY "95"
INTERSTATE 295 (EXIT 15)
YARMOUTH CUMBERLAND COUNTY
FEDERAL AID PROJECT NO. IM-1108(600) SECT. II
FEDERAL AID PROJECT NO. CM-1749(000)X
AUGUST 2012 RIGHT-OF-WAY MAP
SCALE 1" = 25' SHEET 5 OF 5
D.O.T. FILE NO. 3-585

STATE OF MAINE
DEPARTMENT OF TRANSPORTATION
16 STATE HOUSE STATION - AUGUSTA, ME 04333-0016
YARMOUTH
RIGHT OF WAY MAP

ITEM	TECH	CHECKED	SYMBOLS
BASE MAP			GRADING LIMIT LINE CONSTRUCTION LIMIT LINE PROPERTY LINE LIMITS OF WRIGHT PORTION (LOW P) EXISTING RIGHT OF WAY NEW RIGHT OF WAY RELATION WITHIN EXIST. ROW CONTROL OF ACCESS
EXIST. R/W	T.L.B.		WATER LINE GAS LINE ELECTRIC LINE TELEPHONE LINE SEWER LINE
PROP. LINES	T.L.B.		
AREAS	T.L.B.	D.S.G.	