

STATE OF MAINE
DEPARTMENT OF TRANSPORTATION




YARMOUTH
CUMBERLAND COUNTY
I-295 EXIT 15 (ROUTE 1)
IM-1108(600) EXIT 15
CM-1749(000)X PARK & RIDE LOT
WIN 11086.00 & 17490.00
PROJECT LENGTH: 0.670 MILES
INTERCHANGE IMPROVEMENTS AND PARK & RIDE

INDEX OF SHEETS

Description	Sheet No.
Title Sheet	1
Typical Sections	2-12
Estimated Quantities	13
Drainage Summary	14
General Notes	15
Construction Notes	16
Drainage Details	17-19
Park and Ride Grading Details	20
Soil Nail Wall	21-26
Geotechnical Special Detail	27
Boring Logs	28-70
Plans	71-88
Profiles	89-115
Geometric Layout	116-118
Cross Sections	119-250
Lighting	251-257
Signing and Pavement Marking	258-278
Right-of-Way Plans	279-283

PLAN LEGEND


Town, County, State	Centerline-Existing	Centerline-Proposed
Property Lines	Travelway-Existing	Travelway-Proposed
R/W Lines-Existing	Travelway-Proposed	Railroad
R/W Lines-Proposed		
Culvert-Existing	Catch Basins Existing	Proposed
Culvert Proposed	Manholes Existing	Proposed
	Proposed Underdrain	Proposed
Curbing Existing	Proposed Ditch	Existing Ditch
Type 1		
Type 3		
Type 5		
Outline of Bodies of Water	Utility Poles Existing	Proposed
Ledge	Fire Hydrants Existing	Proposed
Buildings	Existing Water Line	Existing San. Sewer
	Existing San. Sewer Manhole	
Trees	Guardrail-Existing	Guardrail-Proposed
Tree Line	Guardrail-Cable, Other	
Clearing Limit Line		
CLL		

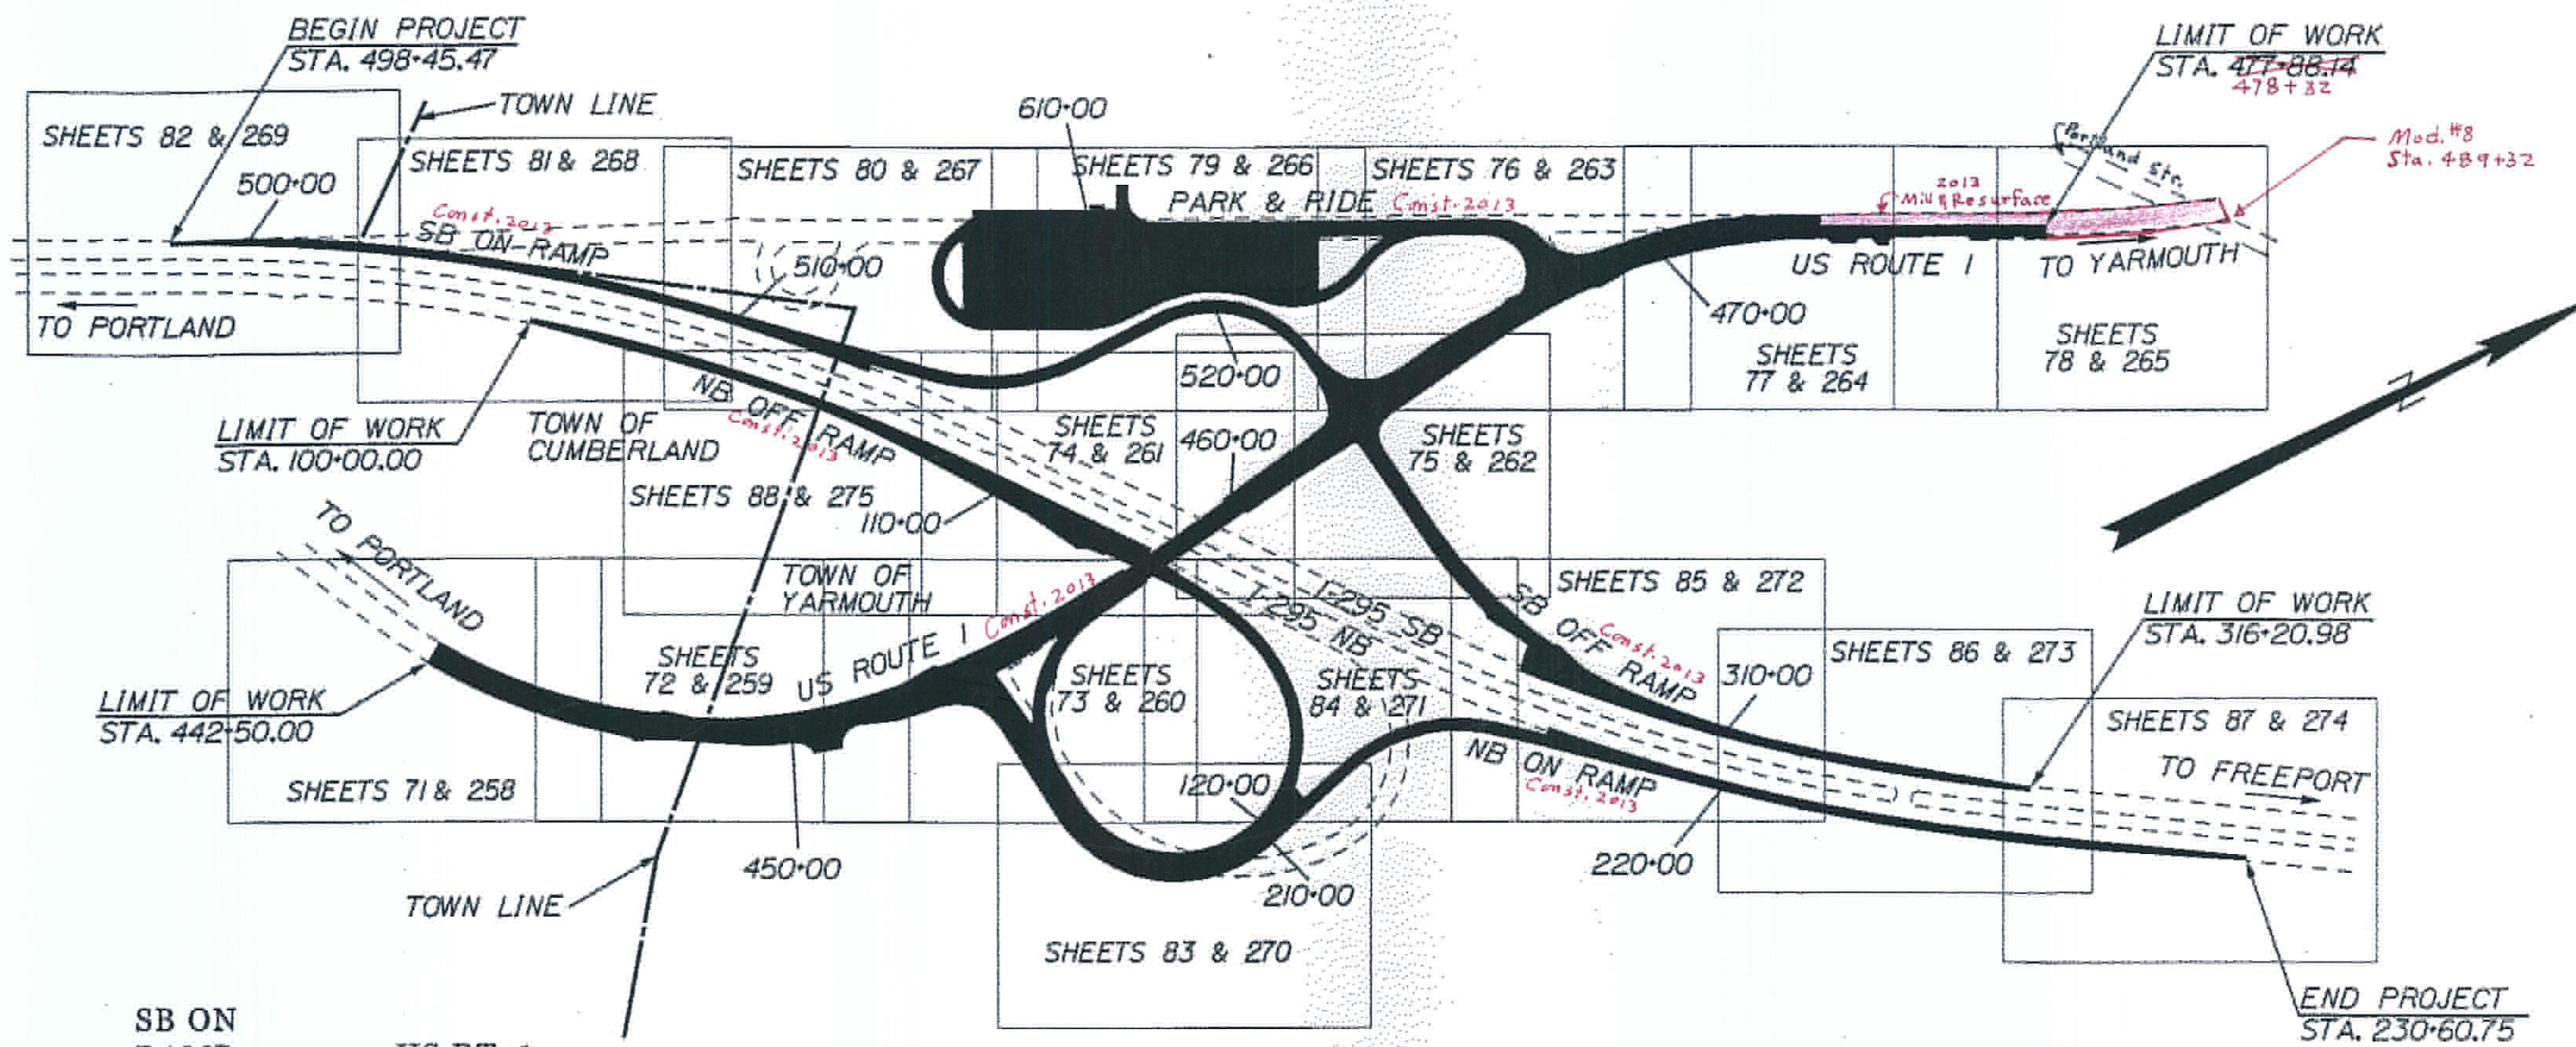

TRAFFIC DATA

	NB OFF RAMP	NB ON RAMP	SB OFF RAMP	SB ON RAMP	US RT. 1
Current (2010) AADT	4000	1120	920	4040	14,870
Future (2030) AADT	4800	1340	1100	4850	17,840
DHV - % of AADT	16%	17%	8%	11%	11%
Design Hour Volume	774	223	89	553	2037
% Heavy Trucks (AADT)	3%	4%	4%	3%	4%
% Heavy Trucks (DHV)	3%	4%	4%	3%	4%
Directional Distribution (DHV)	100%	100%	100%	100%	64%
18 kip Equivalent P 2.0	149	51	38	180	372
18 kip Equivalent P 2.5	142	49	36	172	354
Design Speed (mph)	30	30-35	35	30-35	50
Functional Class:	PRINCIPAL	PRINCIPAL	PRINCIPAL	PRINCIPAL	MAJOR
	ARTERIAL	ARTERIAL	ARTERIAL	ARTERIAL	URBAN
	INERSTATE	INERSTATE	INERSTATE	INERSTATE	COLLECTOR

LAYOUT SCALE

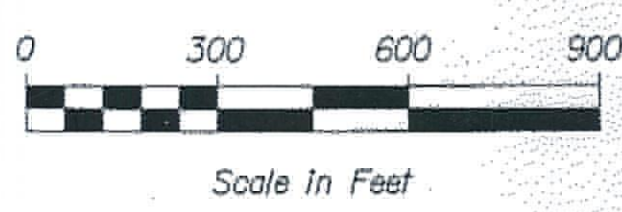

PROJECT LOCATION: HIGHWAY CONSTRUCTION I-295 EXIT 15 TO UPGRADE SOUTHBOUND RAMPS, NORTHBOUND OFF RAMP AND CONSTRUCT A NEW NORTHBOUND ON RAMP. CONSTRUCTION OF A NEW PARK AND RIDE LOT IS ALSO INCLUDED IN THE SCOPE.

PROGRAM AREA: HIGHWAY PROGRAM

SCOPE OF WORK: PAVEMENT RECONSTRUCTION, GRADING, DRAINAGE, LIGHTING, RAMP CONSTRUCTION

WIN 11086.00
WIN 17490.00
WIN 20258.00 Mod. #9
IM-1108(600) EXIT 15
CM-1749(000)X PARK & RIDE LOT
As-Built by T&D Dec. 2013

YARMOUTH
I-295 EXIT 15


TITLE SHEET

SHEET NUMBER
1
OF 283

STATE OF MAINE DEPARTMENT OF TRANSPORTATION	APPROVED	DATE
COMMISSIONER: [Signature]	12/14/12	
CHIEF ENGINEER: [Signature]	12-14-12	



PROJECT INFORMATION	PROGRAM	DESIGNER	CONSULTANT	PROJECT RESIDENT	CONTRACTOR	PROJECT COMPLETION DATE
HIGHWAY PROGRAM	ERHIE MARTIN	MARK DEBOWSKI	PAVE STRONG HOLDING	Beechey Whitcomb	Shaw Brothers	




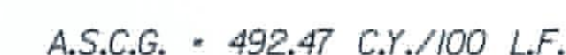


FULL DEPTH PAVEMENT:
1.5" H.M.A. 12.5mm. SURFACE (403.208)
6.5" H.M.A. 12.5mm. BASE (403.213)
22.0" AGGREGATE SUBBASE COURSE GRAVEL (304.10)

NOTE:

1. THE PAVEMENT, BASE, AND SUBBASE DEPTHS AS SHOWN ON THE PLANS ARE INTENDED TO BE NOMINAL.
2. WHEN SUPERELEVATION EXCEEDS THE SLOPE OF THE LOW SIDE SHOULDER, THE LOW SIDE SHOULDERS PAVEMENTS SHALL HAVE THE SAME CROSS SLOPE AS THE TRAVEL WAY.
3. CROWNS FOR BOTH NORMAL AND SUPERELEVATION SECTIONS FOR ALL COURSES OF SUBBASE AND PAVEMENT SHALL BE STRAIGHT.
4. THE GRAVEL QUANTITY CALCULATION IS BASED ON A 2" LOAM OR DIRTY BORROW DEPTH. THE ACTUAL DEPTH MAY VARY, SEE THE GENERAL NOTES.
5. THE ALGEBRAIC DIFFERENCE BETWEEN SHOULDER AND TRAVEL LANE CROSS SLOPES "ROLL-OVER" SHALL NOT EXCEED 8%.
6. THE STATIONING SHOWN UNDER EACH TYPICAL IS APPROXIMATE
7. H.M.A. = HOT MIX ASPHALT
A.S.C.G. = AGGREGATE SUBBASE COURSE GRAVEL
P.G. = PROFILE GRADE
ETW = EXISTING EDGE OF TRAVELWAY
C = CONSTRUCTION CENTER LINE
CL = CONSTRUCTION BASE LINE
8. WHERE HMA SHIMMING IS NEEDED IN AREAS OF MILLING AND RESURFACING, IT SHALL BE PAID FOR UNDER ITEM 403.213, HOT MIX ASPHALT 12.5MM BASE



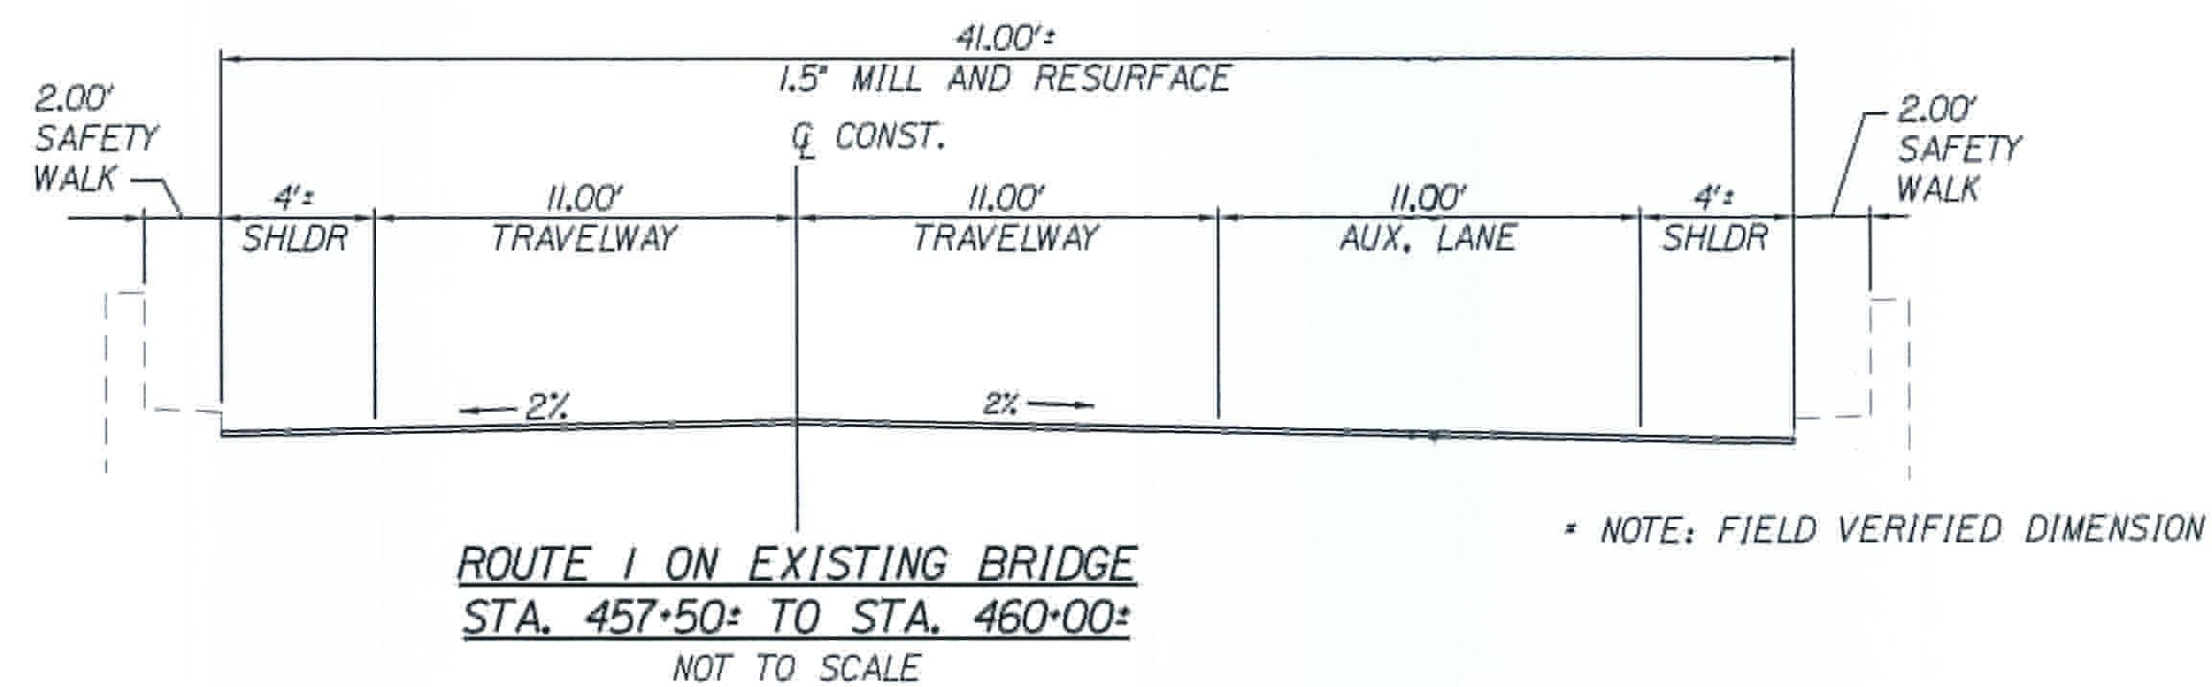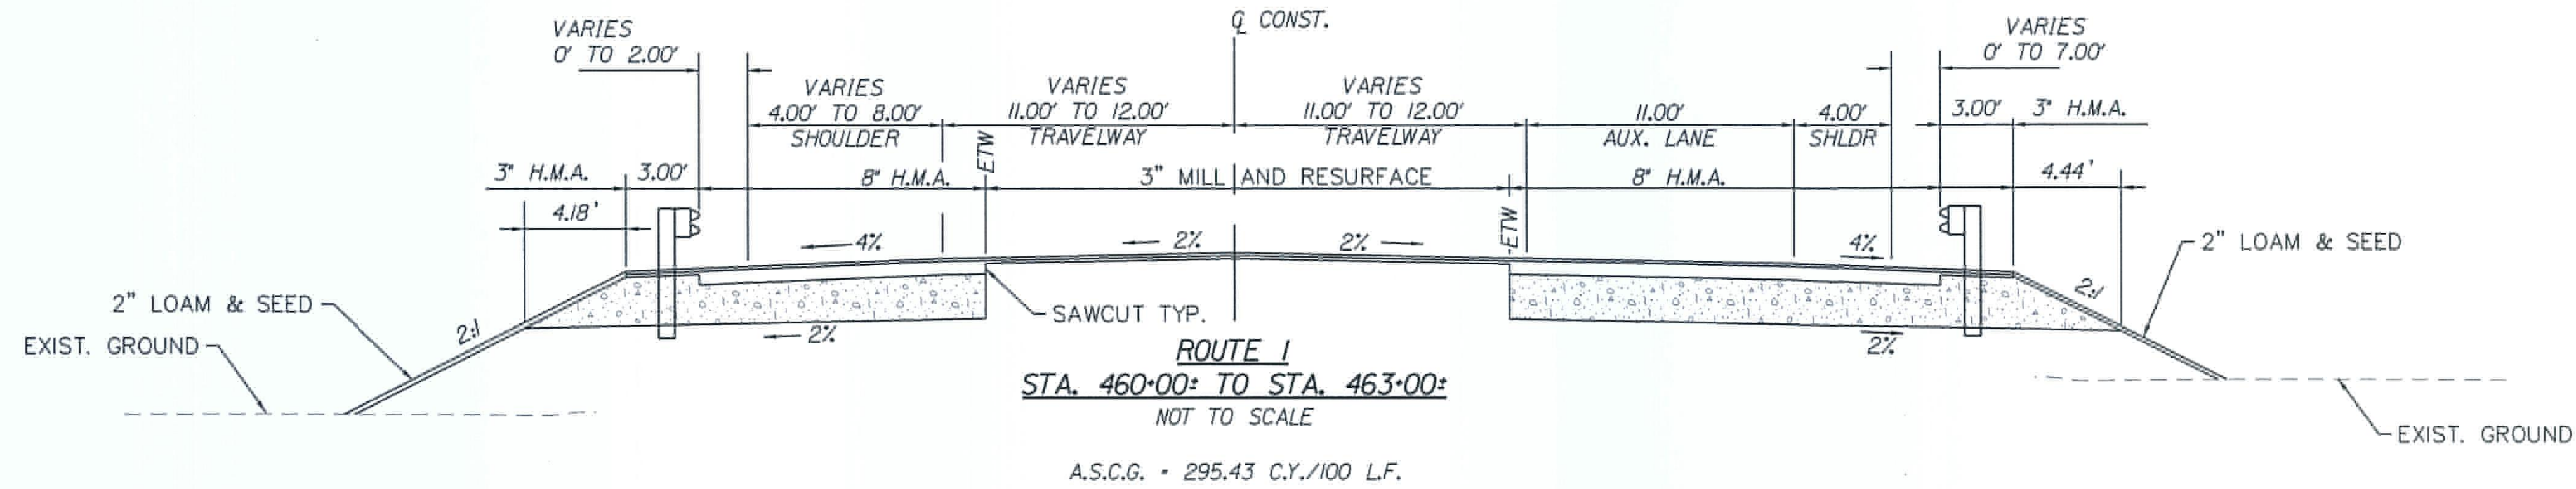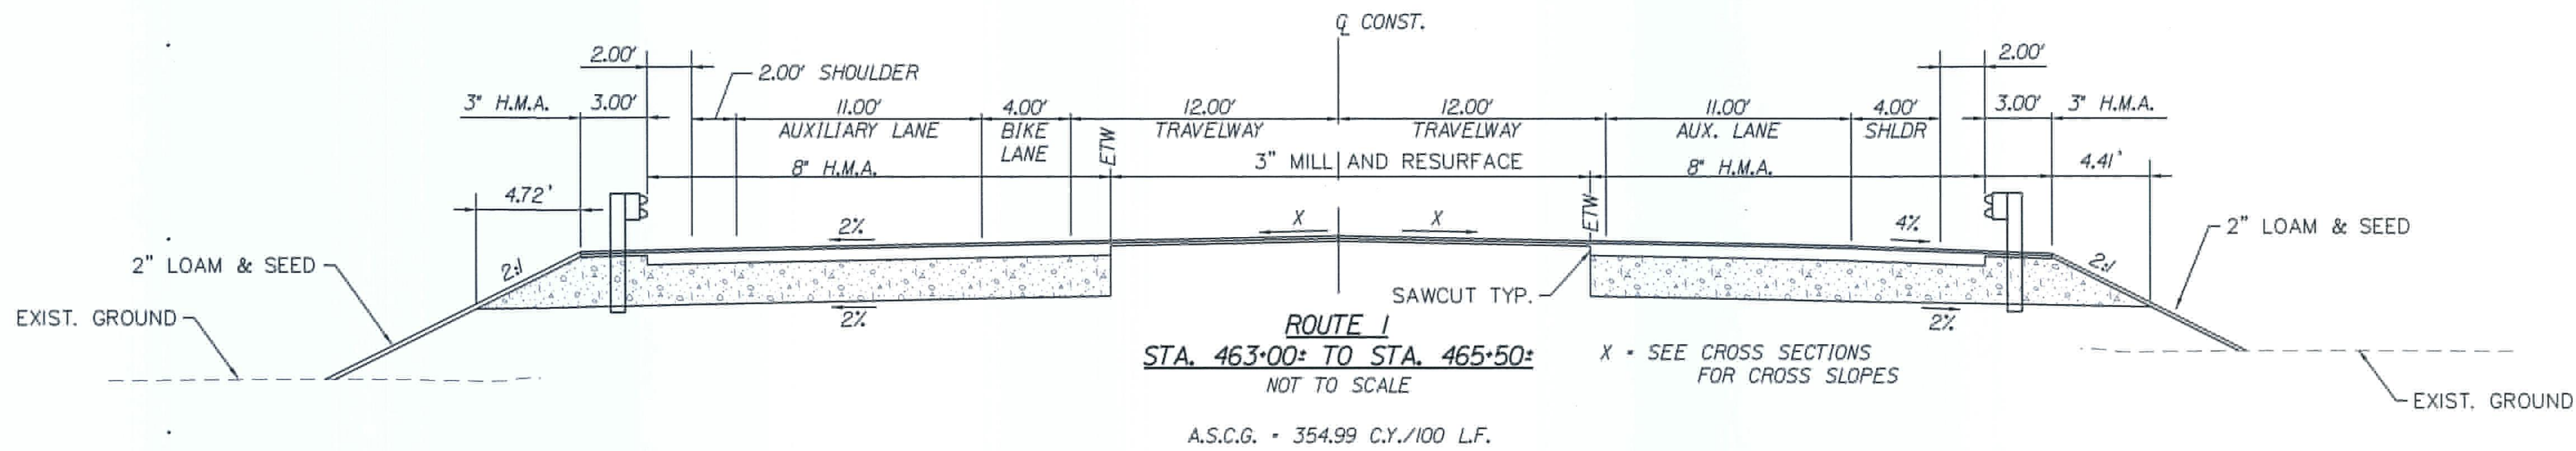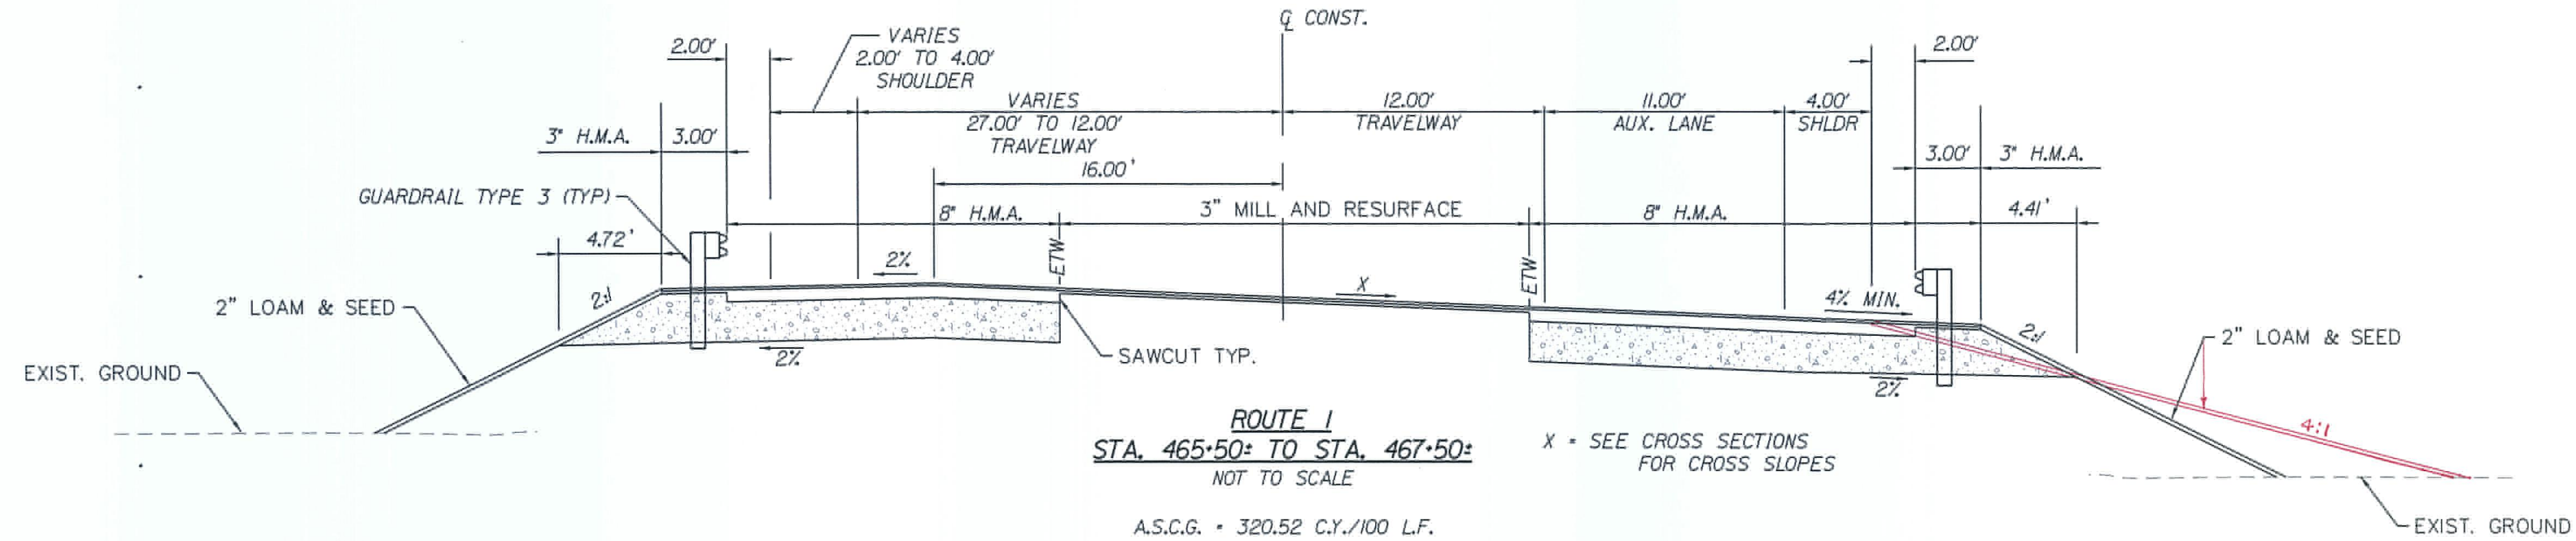

PROJ. MANAGER	BY	DATE	SIGNATURE	P.E. NUMBER	DATE
DESIGN-DETAILED	WAG				
CHECKED-REVIEWED	MJD				
DESIGN-DETAILED					
REVISIONS 1					
REVISIONS 2					
REVISIONS 3					
REVISIONS 4					
FIELD CHANGES					


YARMOUTH
I-295 EXIT 15
TYPICAL SECTIONS

SHEET NUMBER

4

OF 283

NOT TO SCALE

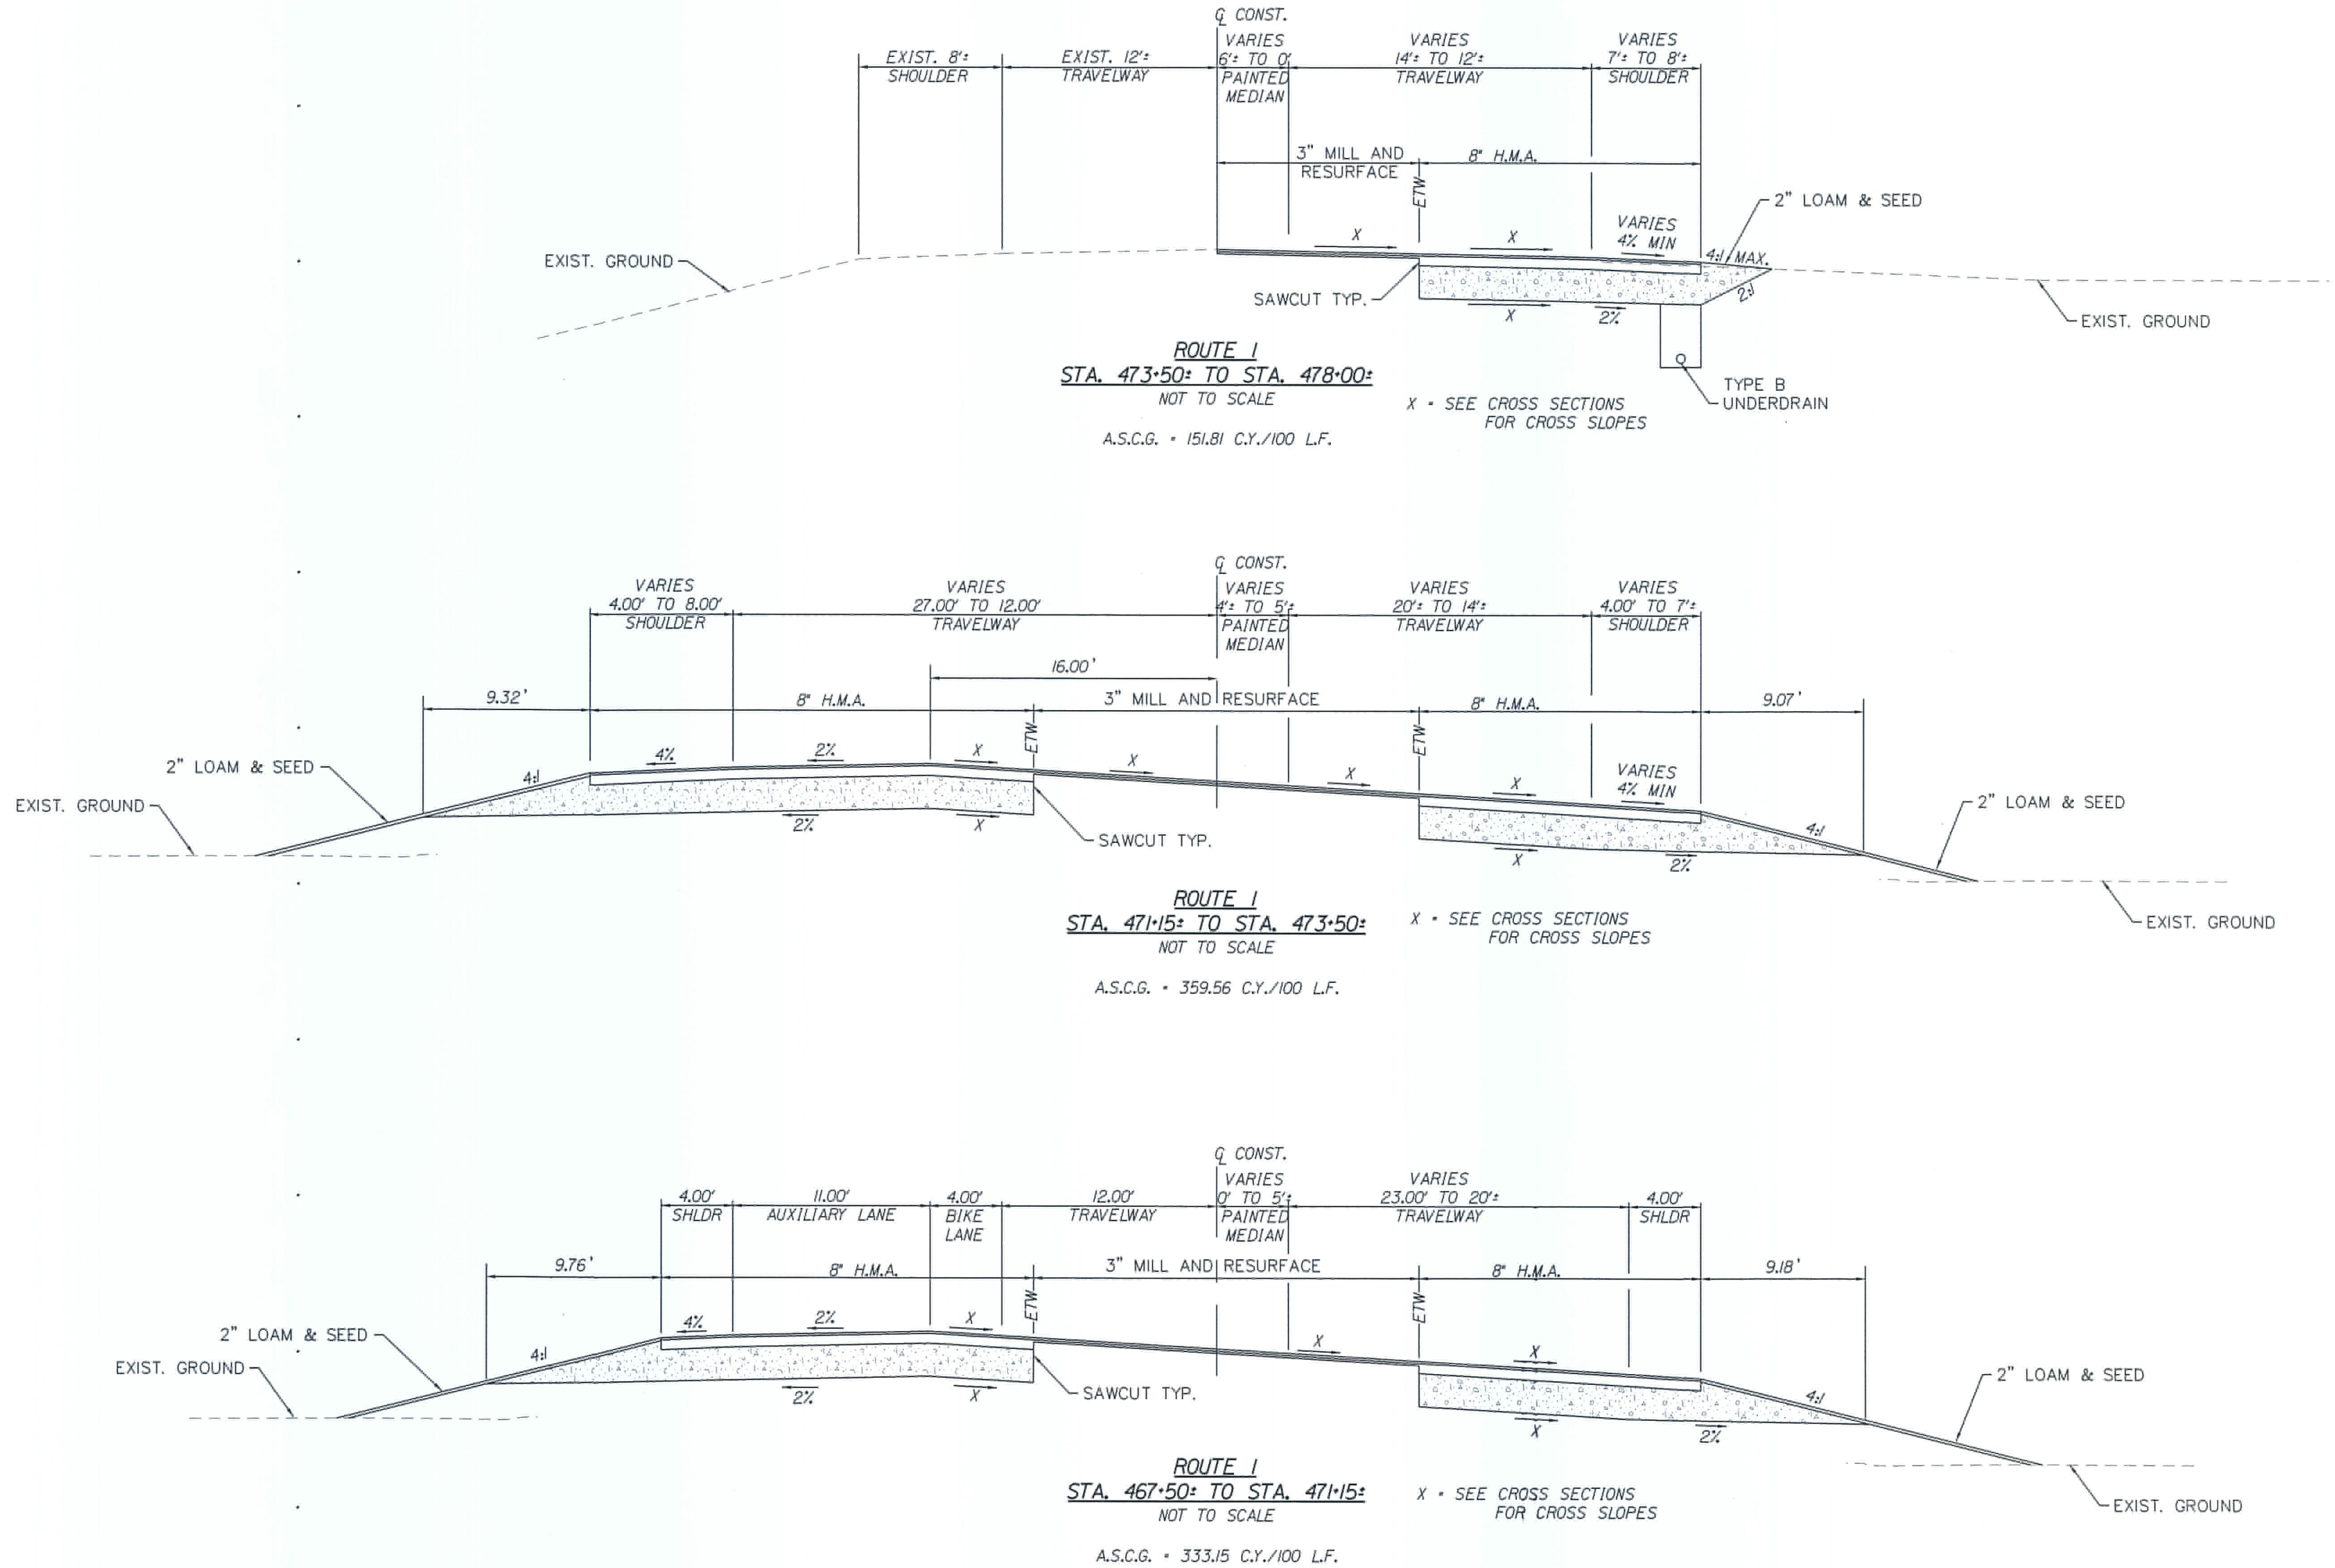

NOT TO SCALE

STATE OF MAINE
DEPARTMENT OF TRANSPORTATION
IM-1108(600) EXIT 15
CM-1749(000)X PARK & RIDE LOT
WIN 11086.00 EXIT 15 HIGHWAY PLANS
WIN 17490.00 PARK & RIDE LOT

PROJ. MANAGER	BY	DATE	SIGNATURE	P.E. NUMBER	DATE
DESIGN-DETAILED	WAG				
CHECKED-REVIEWED	WAG				
DESIGN-DETAILED2					
DESIGN-DETAILED3					
REVISIONS 1					
REVISIONS 2					
REVISIONS 3					
REVISIONS 4					
FIELD CHANGES					

YARMOUTH
I-295 EXIT 15
TYPICAL SECTIONS

SHEET NUMBER

5

OF 283


ROUTE 1 - SUPERELEVATION TABLE						
LT. SHOULDER	AUXILIARY	TRAVELWAY	STATION	TRAVELWAY	AUXILIARY	RT. SHOULDER
-6.7-5.7	-	-6.7-5.7	441+65.95 441+65 443+65	5.7 6.7	-	-2.3
			TO			
-6.7-5.7	-	-6.7-5.7	448+00	5.7 6.7	-	-2.3
-5.7	-	-5.7	448+50	5.7	-2.0 5.7	-2.0 5.7
			TO			
-5.7	-	-5.7	453+50	5.7	-2.0	-2.0
-5.7	-	-5.7	454+00	5.7	-	-
-5.7	-5.7	-5.7	454+50	5.7	-	5.7
-4.2	-4.2	-4.2	455+00	4.2	-	4.2
-4.0	-2.6-4.0	-2.6	455+50	2.6	-	2.6
-4.0	-	-2.0	456+00	1.1	-2.0 -	-4.0 -
-4.0	-	-2.0	456+50	-0.5	-2.0 -3.4	-4.0
-4.0	-	-2.0	457+00	-2.0	-2.0-4.0	-4.0
			overpass TO			
-2.0	-2.0	-2.0	464+00	-2.0	-2.0	-4.0
-2.0	-2.0	-0.4	464+50	-2.0	-	-4.0
-2.0	-2.0	1.2	465+00	-2.0	-	-4.0
-2.0	-2.0	2.7	465+50	-2.7	-	-4.0
-2.0	-2.0	4.3	466+00	-4.3	-	-4.3
			TO			
-2.0	-	4.3	467+00	-4.3	-	-4.3
-	-	7.0 5.7	467+50	-5.7 -7.0	-	-5.7 -7.0
			TO			
-4.0	-2.0	7.0 5.7	468+50	-5.7 -7.0	-	-5.7 -7.0
			TO			
-4.0	-2.0	7.0 5.7	472+00	-5.7 -7.0	-	-5.7 -7.0
-4.0	-2.0	3.6 4.8	472+50	-4.8	-	-4.8
3.4-4.0	-	1.9 4.8	473+00	-4.8	-	-4.8
-	-	-	473+50	-4.1	-	-4.1
-	-	-	474+00	-3.4	-	-4.0
-	-	-	474+50	-2.7	-	-4.0
-	-	-	475+00	-2.0	-	-4.0
			TO			
-	-	-	477+00	-2.0	-	-4.0

Date: 2/21/2011



Username: COMMON

Division: HIGHWAY

Filename:

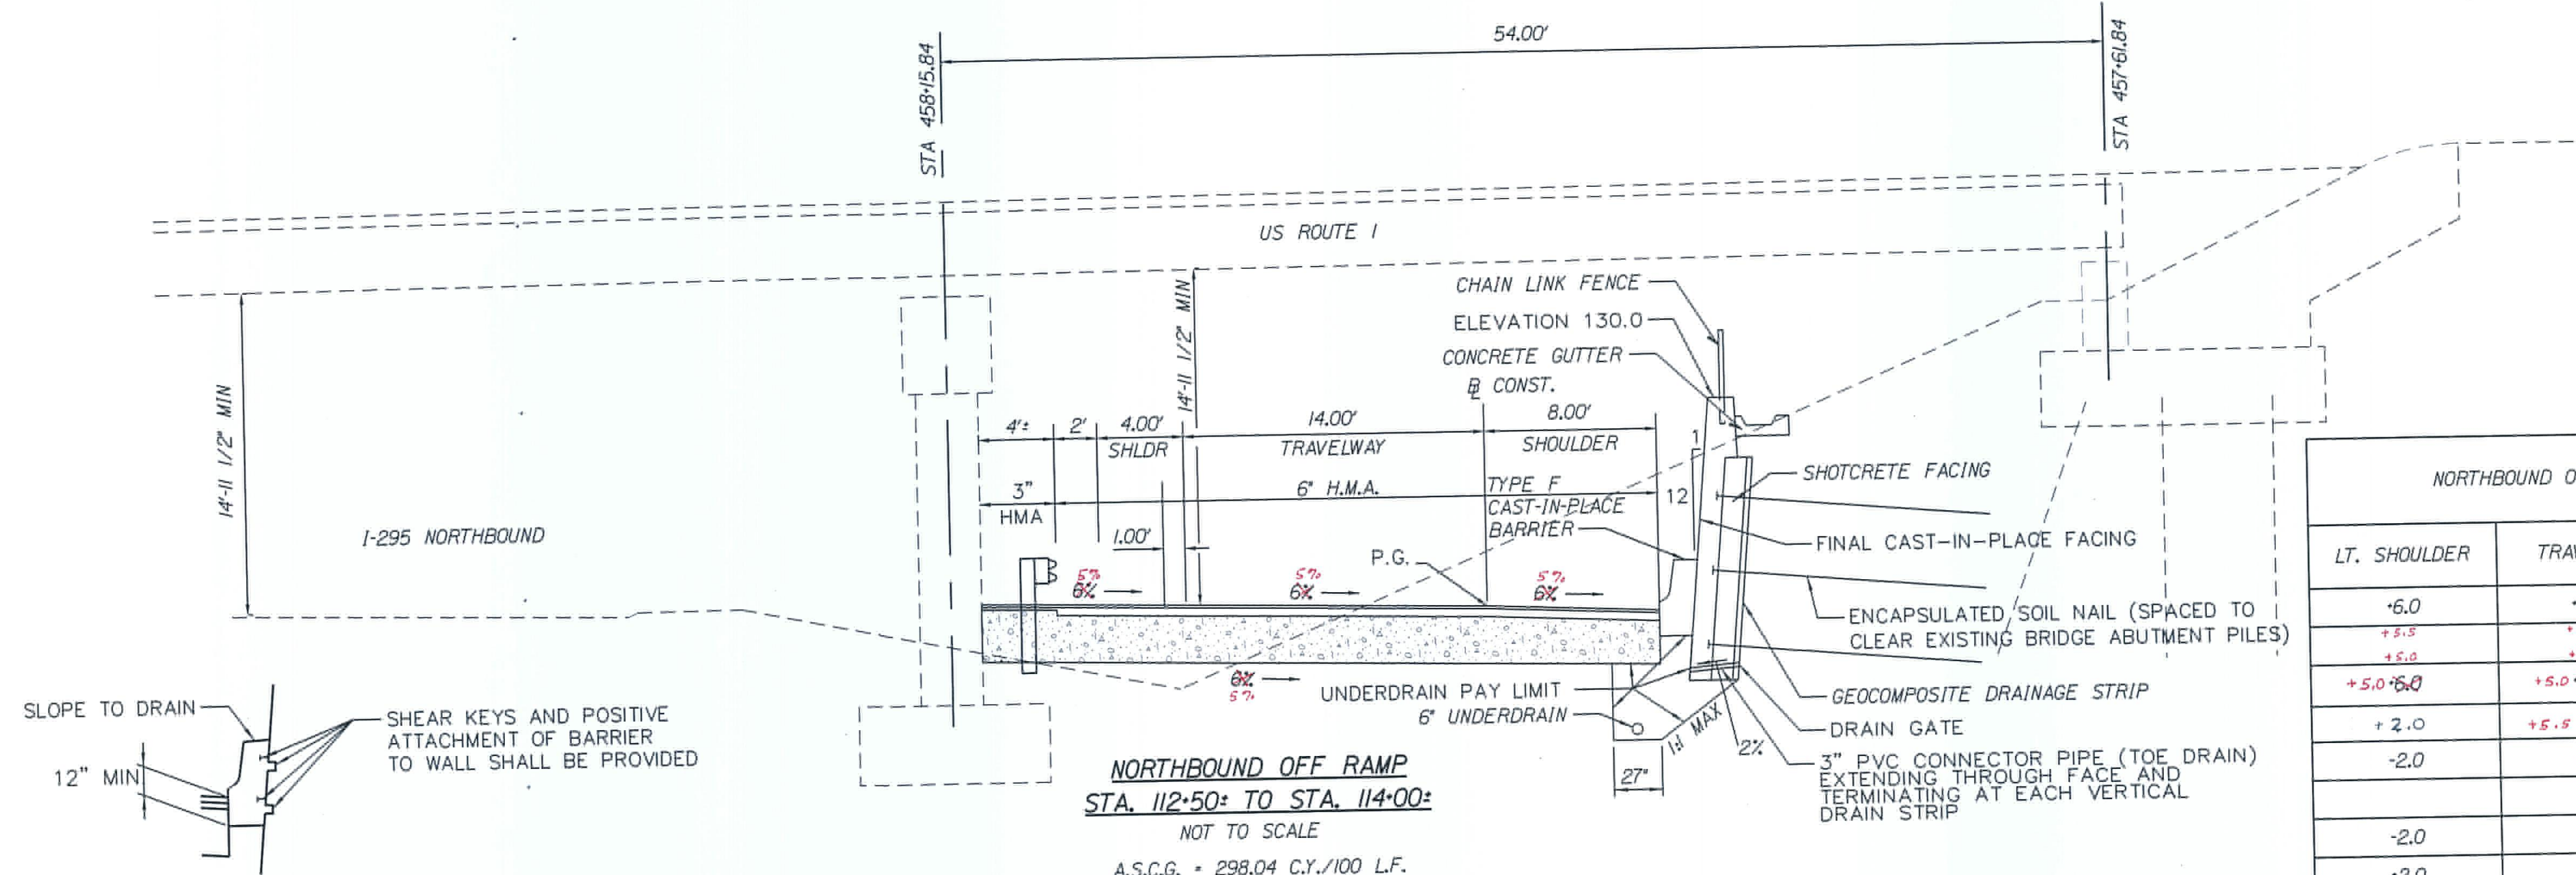

BARRIER DETAIL

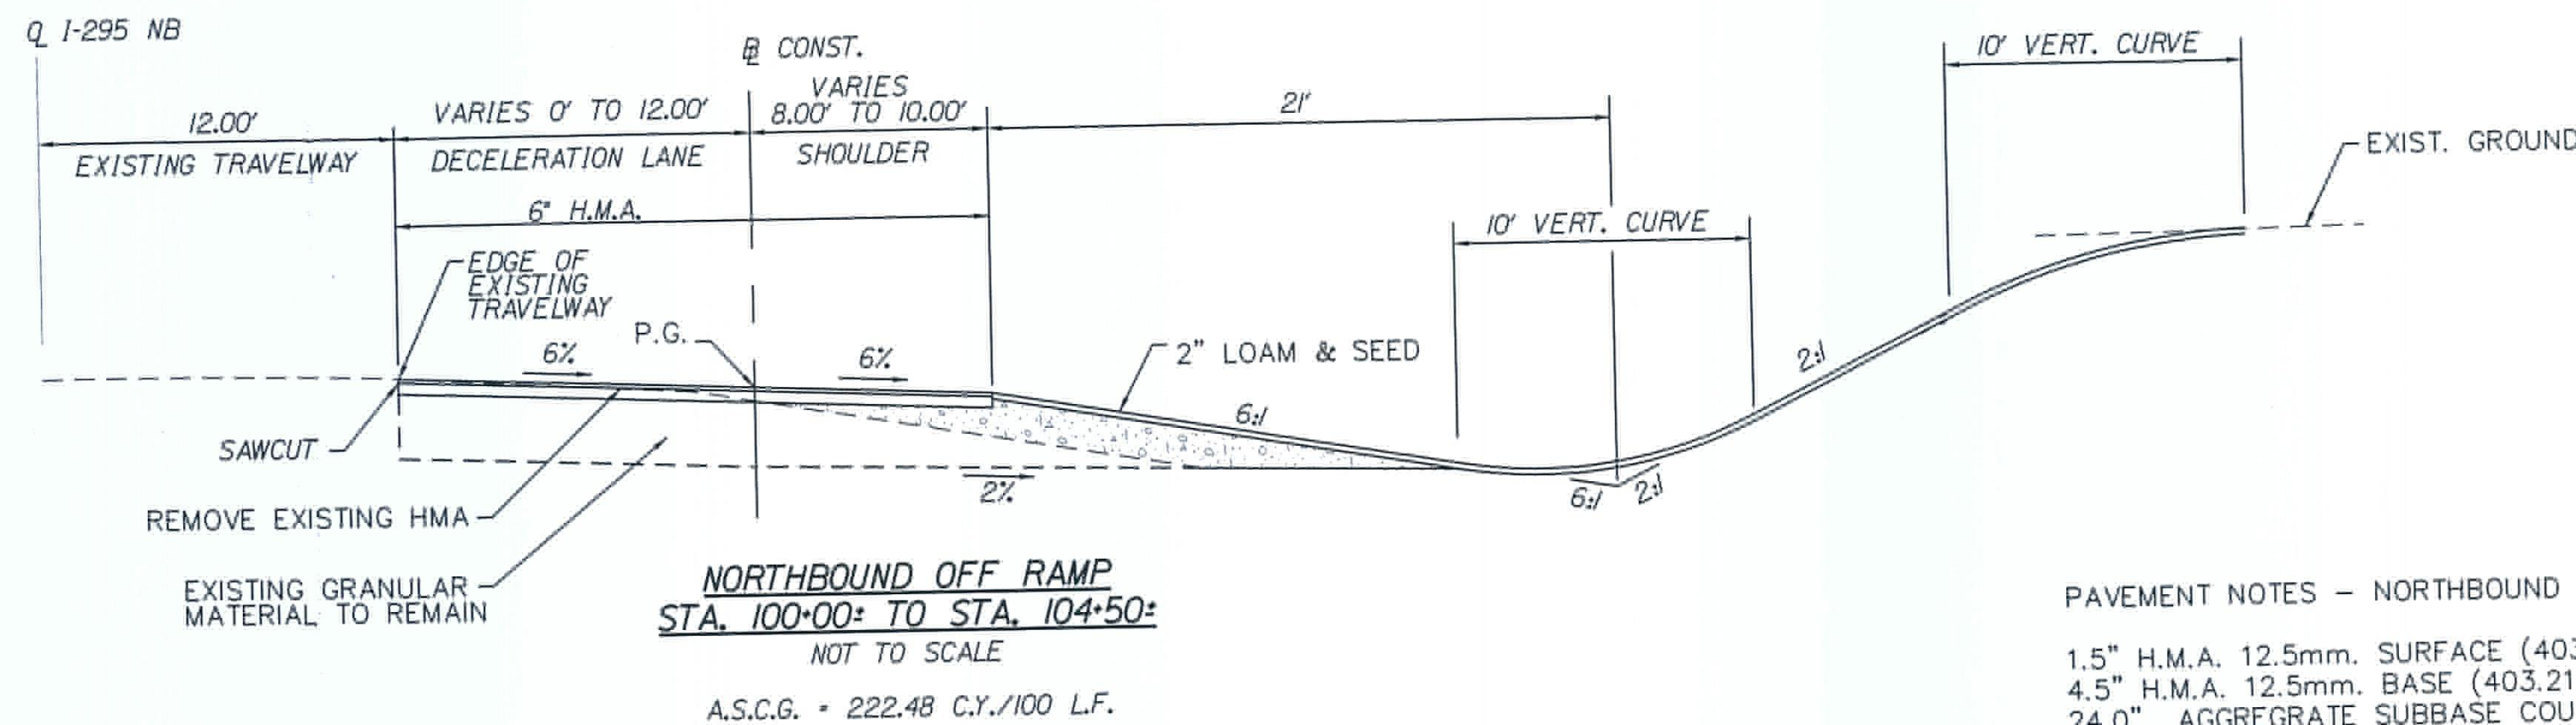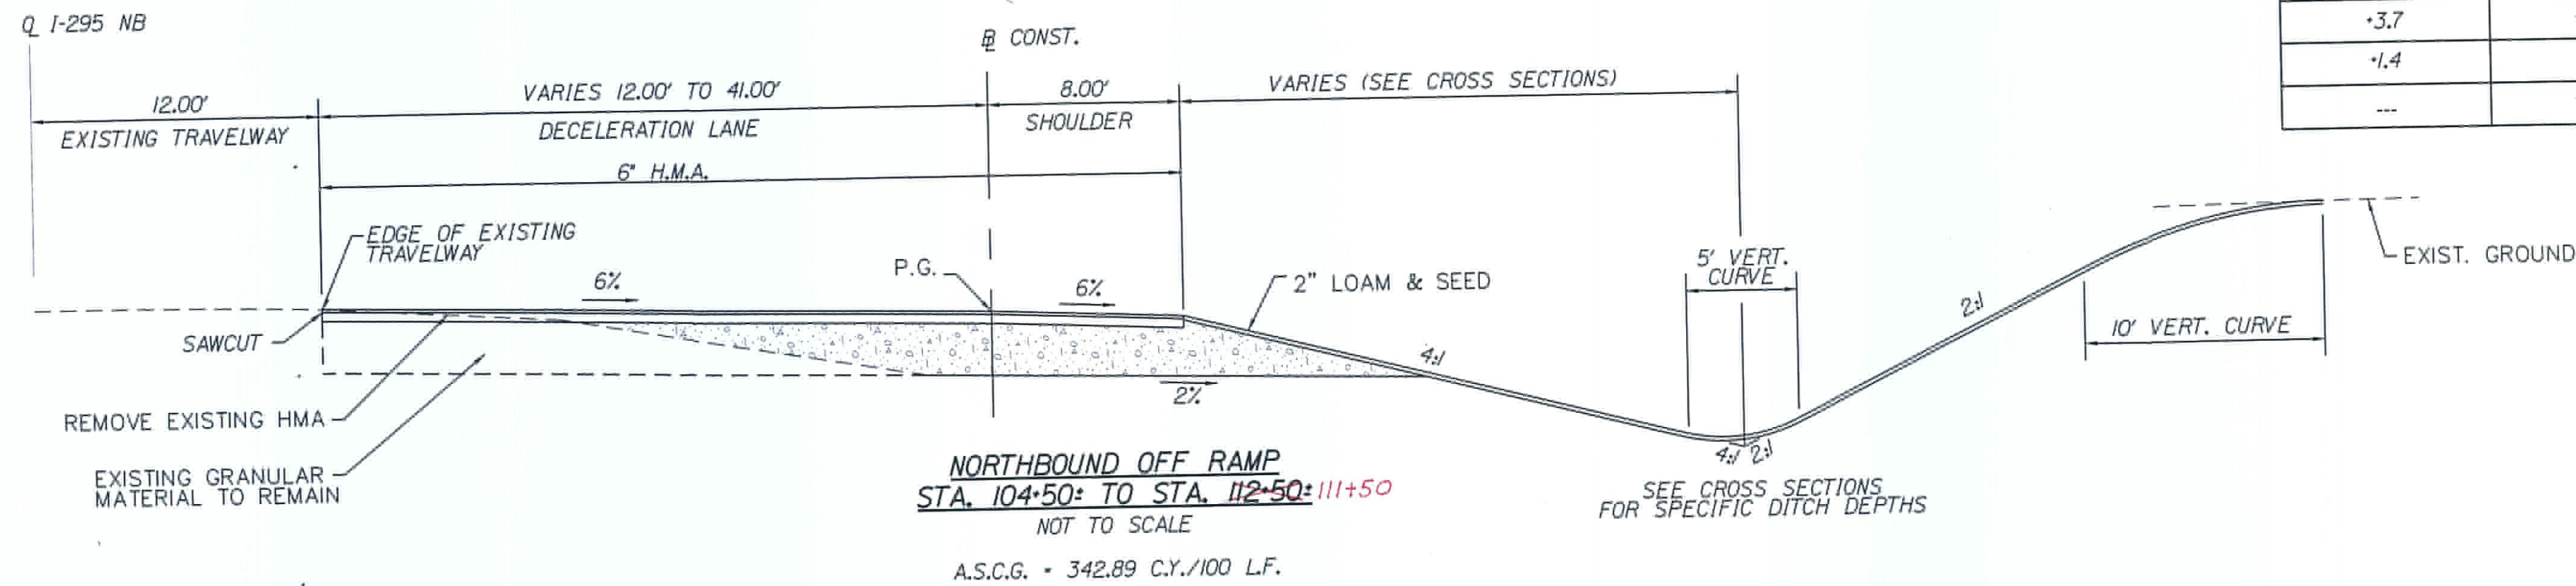

PAVEMENT NOTES - NORTHBOUND OFF RAMP
1.5\" H.M.A. 12.5mm. SURFACE (403.208)
4.5\" H.M.A. 12.5mm. BASE (403.213)
24.0\" AGGREGATE SUBBASE COURSE GRAVEL (304.10)

NORTHBOUND OFF RAMP - SUPERELEVATION TABLE			
LT. SHOULDER	TRAVELWAY	STATION	RT. SHOULDER
-6.0	-6.0	100+00	-6.0
+5.5	+5.5	112+50	-5.5
+5.0	+5.0	113+50	-5.0
+5.0 -6.0	+5.0 -6.0	114+00	-6.0 -5.0
+2.0	+5.5 -6.0	114+50	-6.0 -5.5
-2.0	-6.0	115+00	-6.0
		TO	
-2.0	-6.0	118+00	-6.0
-2.0	-6.0	118+50	-6.0
-6.0	-6.0	119+00	-6.0
		TO	
-6.0	-6.0	127+00	-6.0
-3.7	-3.7	127+50	-4.0
-1.4	-1.4	128+00	-4.0
---	-3.4	128+47.50	-4.0

PROJ. MANAGER	BY	DATE	SIGNATURE	P.E. NUMBER	DATE
DESIGN-DETAILED	WAG				
CHECKED-REVIEWED	MAD				
DESIGN-DETAILED2					
DESIGN-DETAILED3					
REVISIONS 1					
REVISIONS 2					
REVISIONS 3					
REVISIONS 4					
FIELD CHANGES					


YARMOUTH
I-295 EXIT 15
TYPICAL SECTIONS

SHEET NUMBER

7


OF 283

NOT TO SCALE

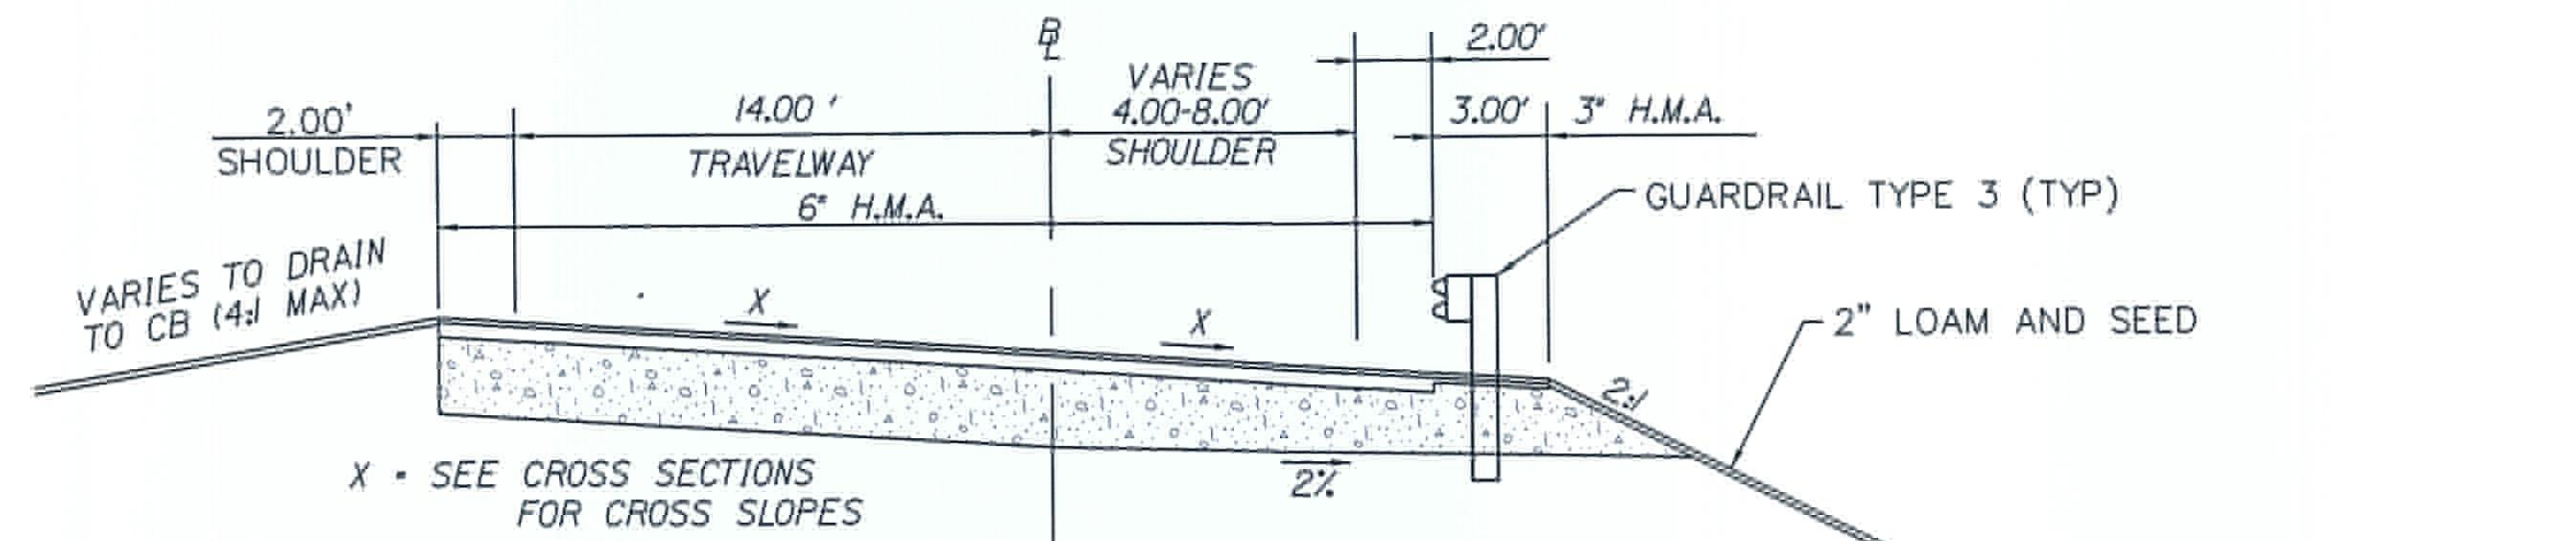


NORTHBOUND OFF RAMP
STA. 125+50 TO STA. 128+00
NOT TO SCALE

A.S.C.G. = 208.81 C.Y./100 L.F.

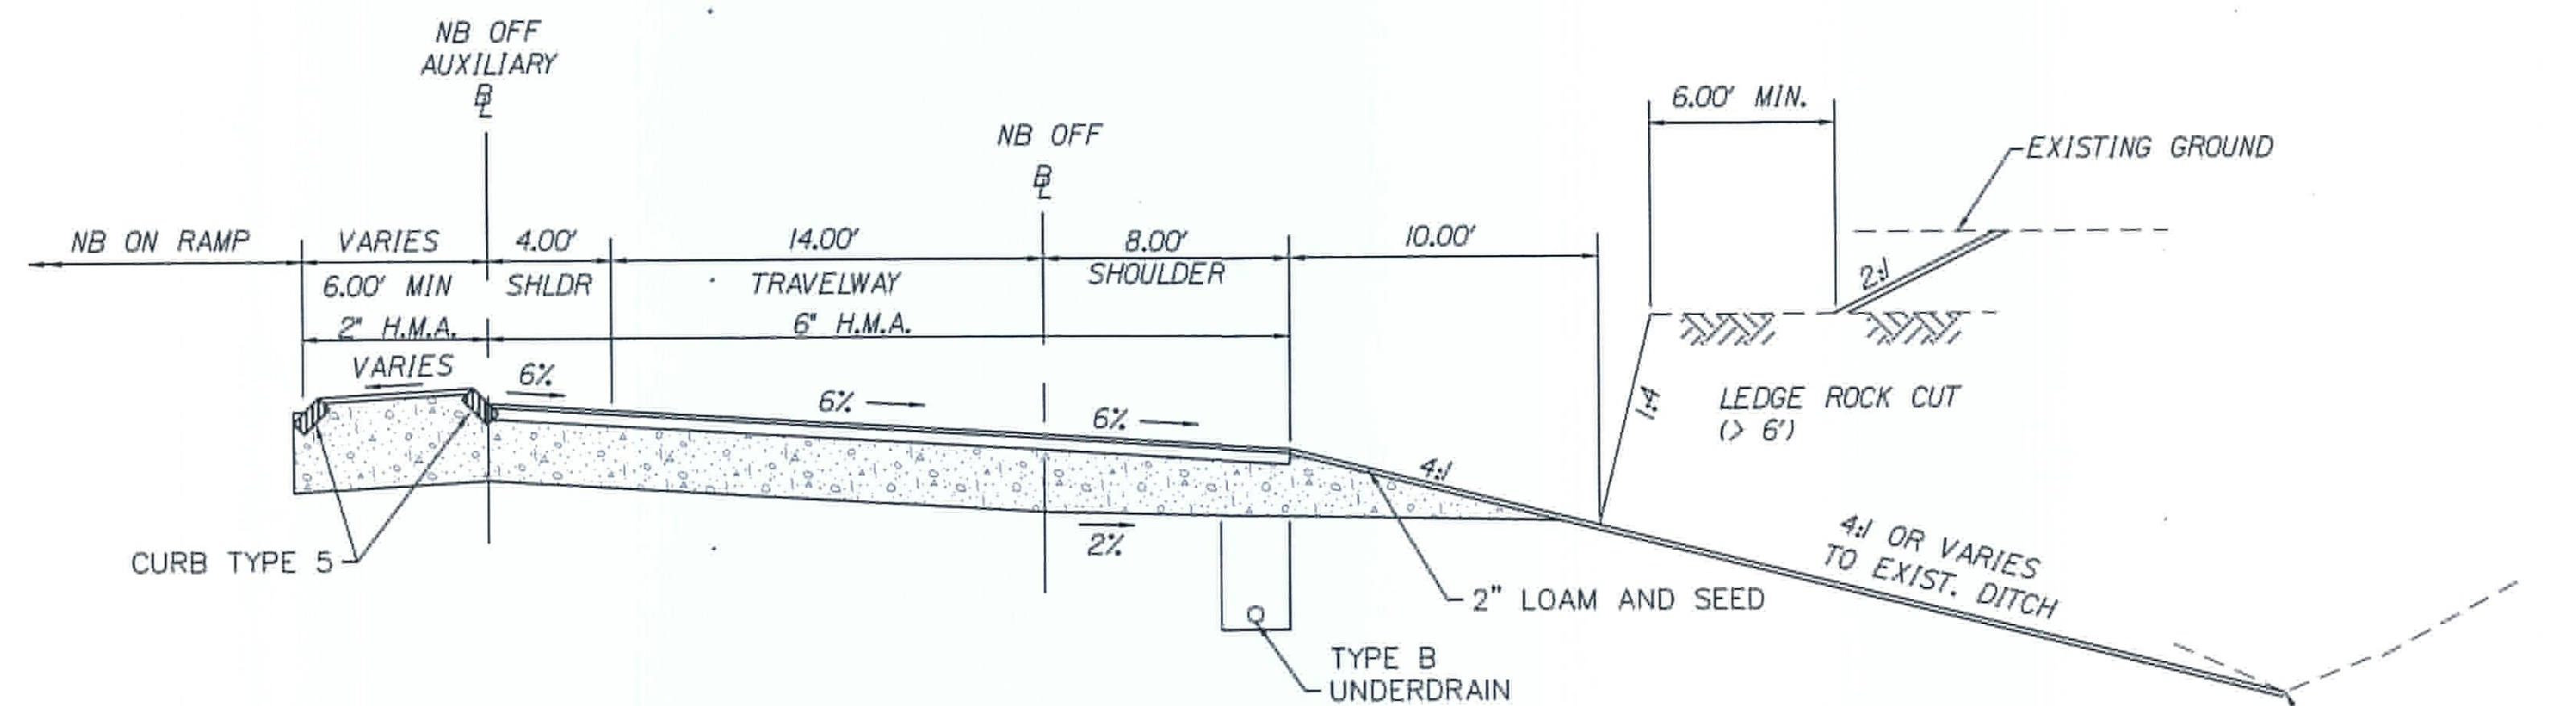

NORTHBOUND OFF RAMP
STA. 119+00 TO STA. 125+50
NOT TO SCALE


A.S.C.G. = 217.74 C.Y./100 L.F.

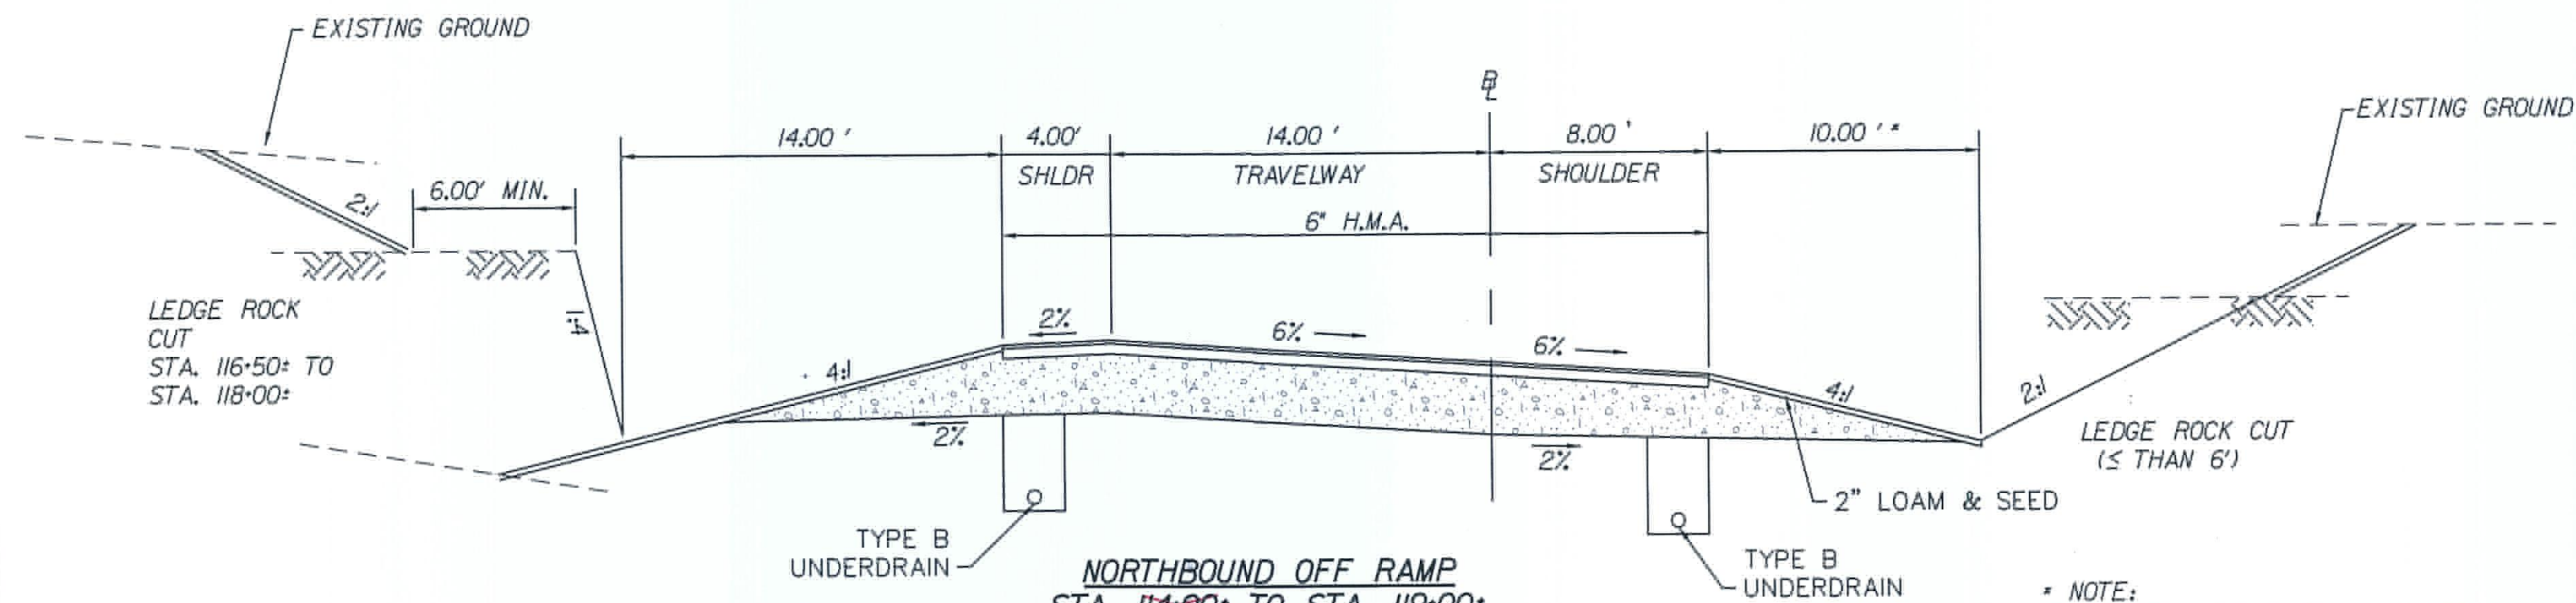

NORTHBOUND OFF RAMP
STA. 114+00 TO STA. 119+00
NOT TO SCALE

A.S.C.G. = 309.02 C.Y./100 L.F.

* NOTE:
STA. 114+00 TO STA. 116+00 DITCH
DIMENSION VARIES TO ACHIEVE SPECIFIC
DITCH DEPTHS (SEE CROSS SECTIONS)

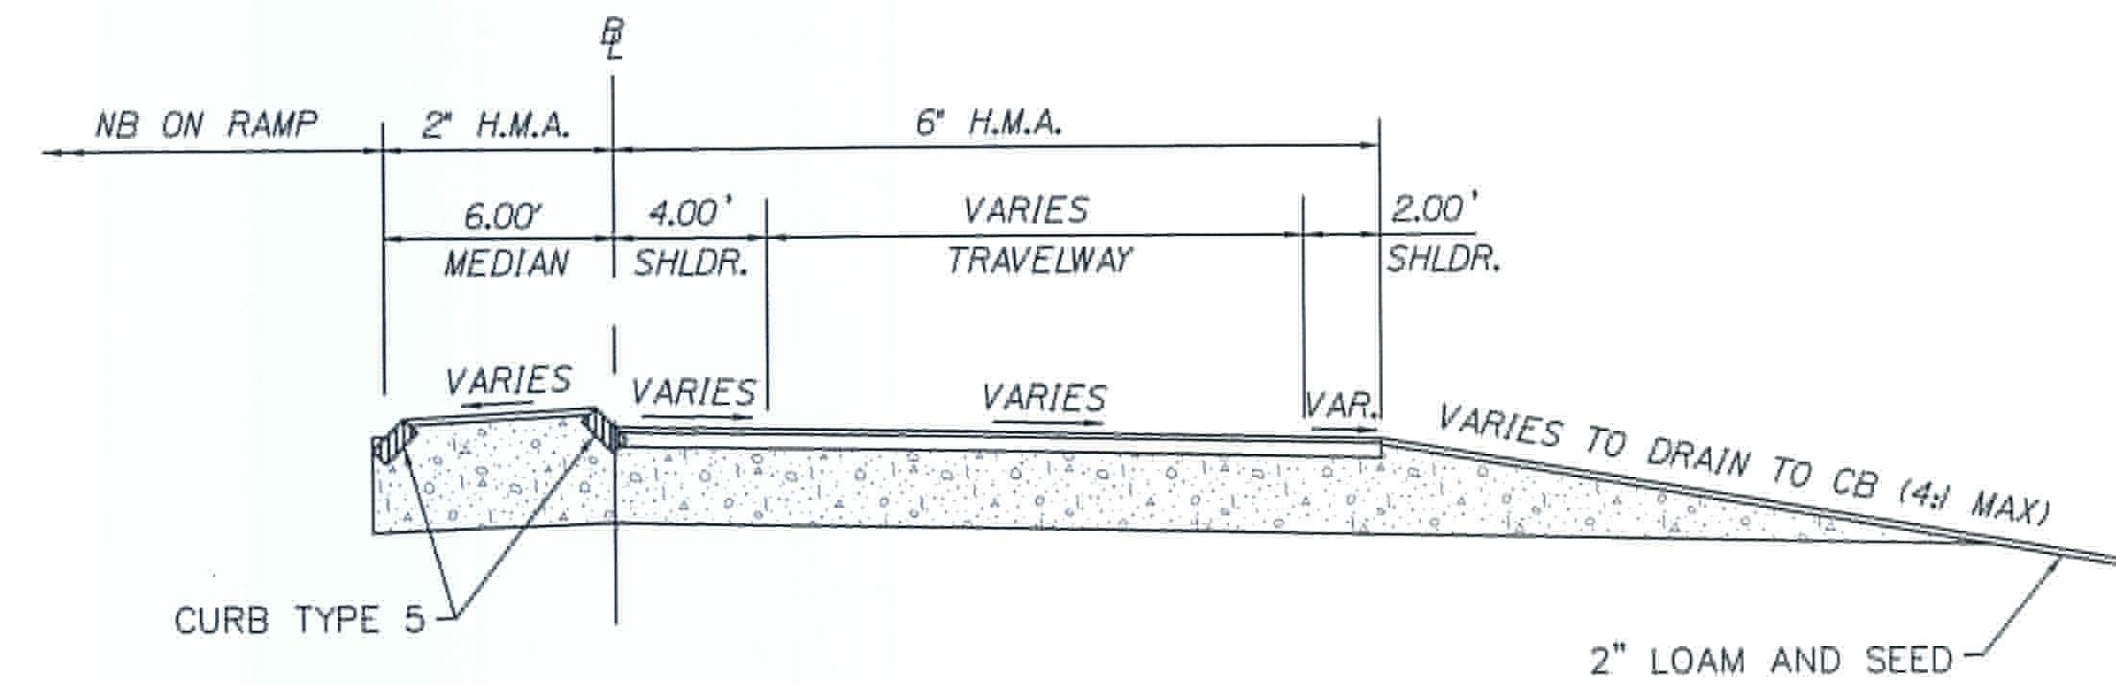

NORTHBOUND OFF AUXILIARY RAMP
STA. 150+00 TO STA. 152+35
NOT TO SCALE

A.S.C.G. = 271.89 C.Y./100 L.F.

NORTHBOUND OFF AUXILIARY RAMP - SUPERELEVATION TABLE				
LT. SHOULDER	STATION	TRAVELWAY	RT. SHOULDER	
-2.0	150+00	-2.0	-2.0	
-2.0	TO			
-2.0	151+00	-2.0	-2.0	
-1.0	151+50	-1.0	-1.0	
0.0	152+00	0.0	0.0	
+0.9 *	152+19.37 *	+0.9 *	+0.9 *	

* MATCHES ROUTE 1 CROSS SECTION AND PROFILE

NOTES: 114+00
1. STA. 113+50 TO STA 124+50: ADD *open Graded Friction* ULTRA THIN BONDED WEARING COURSE TO TOP SURFACE




PROJ. MANAGER	BY	DATE	SIGNATURE	P.E. NUMBER	DATE
DESIGN-DETAILED	WJD				
CHECKED-REVIEWED	MJD				
DESIGN-DETAILED					
DESIGN-DETAILED					
REVISIONS 1					
REVISIONS 2					
REVISIONS 3					
REVISIONS 4					
FIELD CHANGES					

Date: 2/21/2011

Username: COMMON

Division: HIGHWAY

Filename:

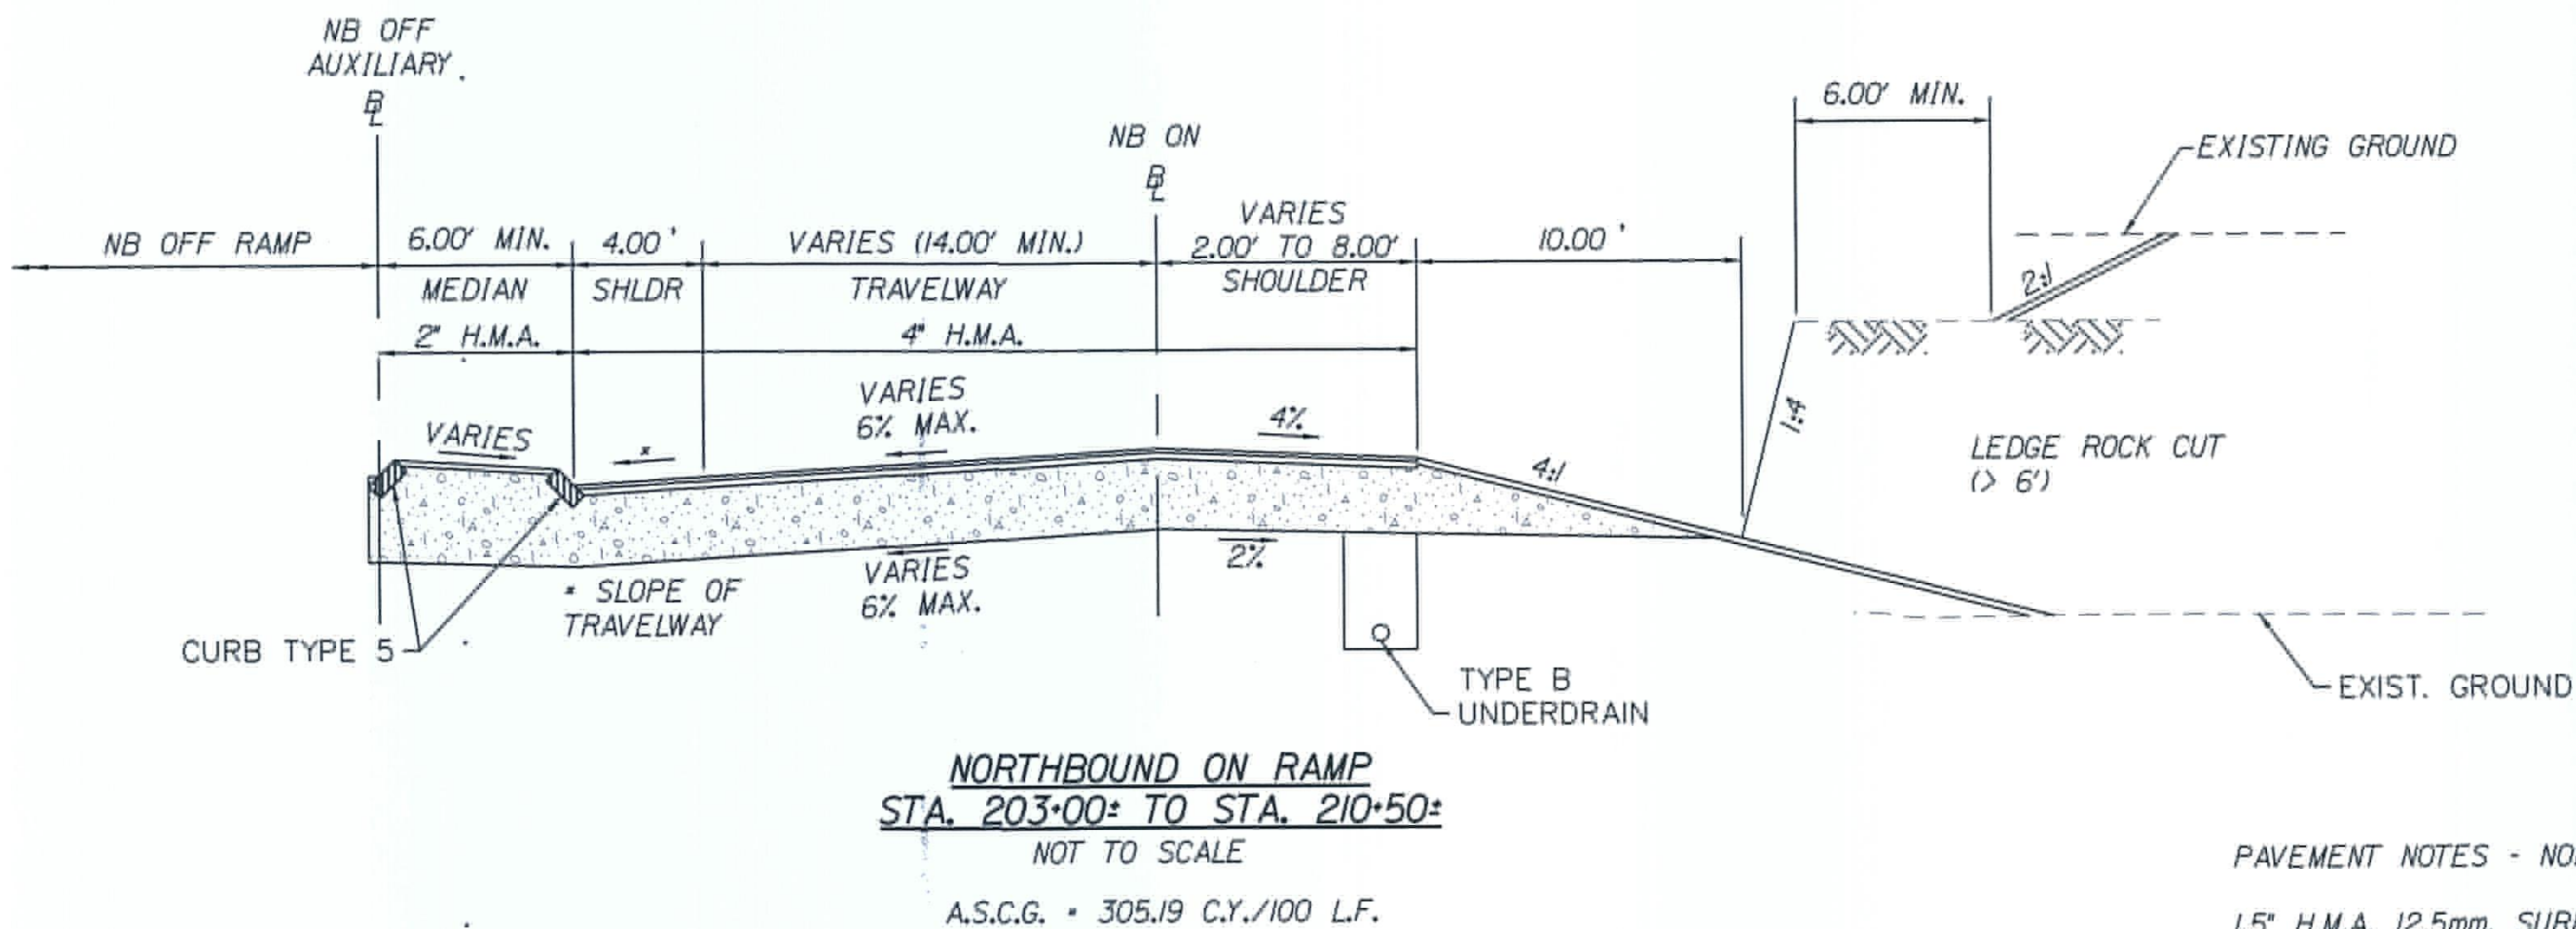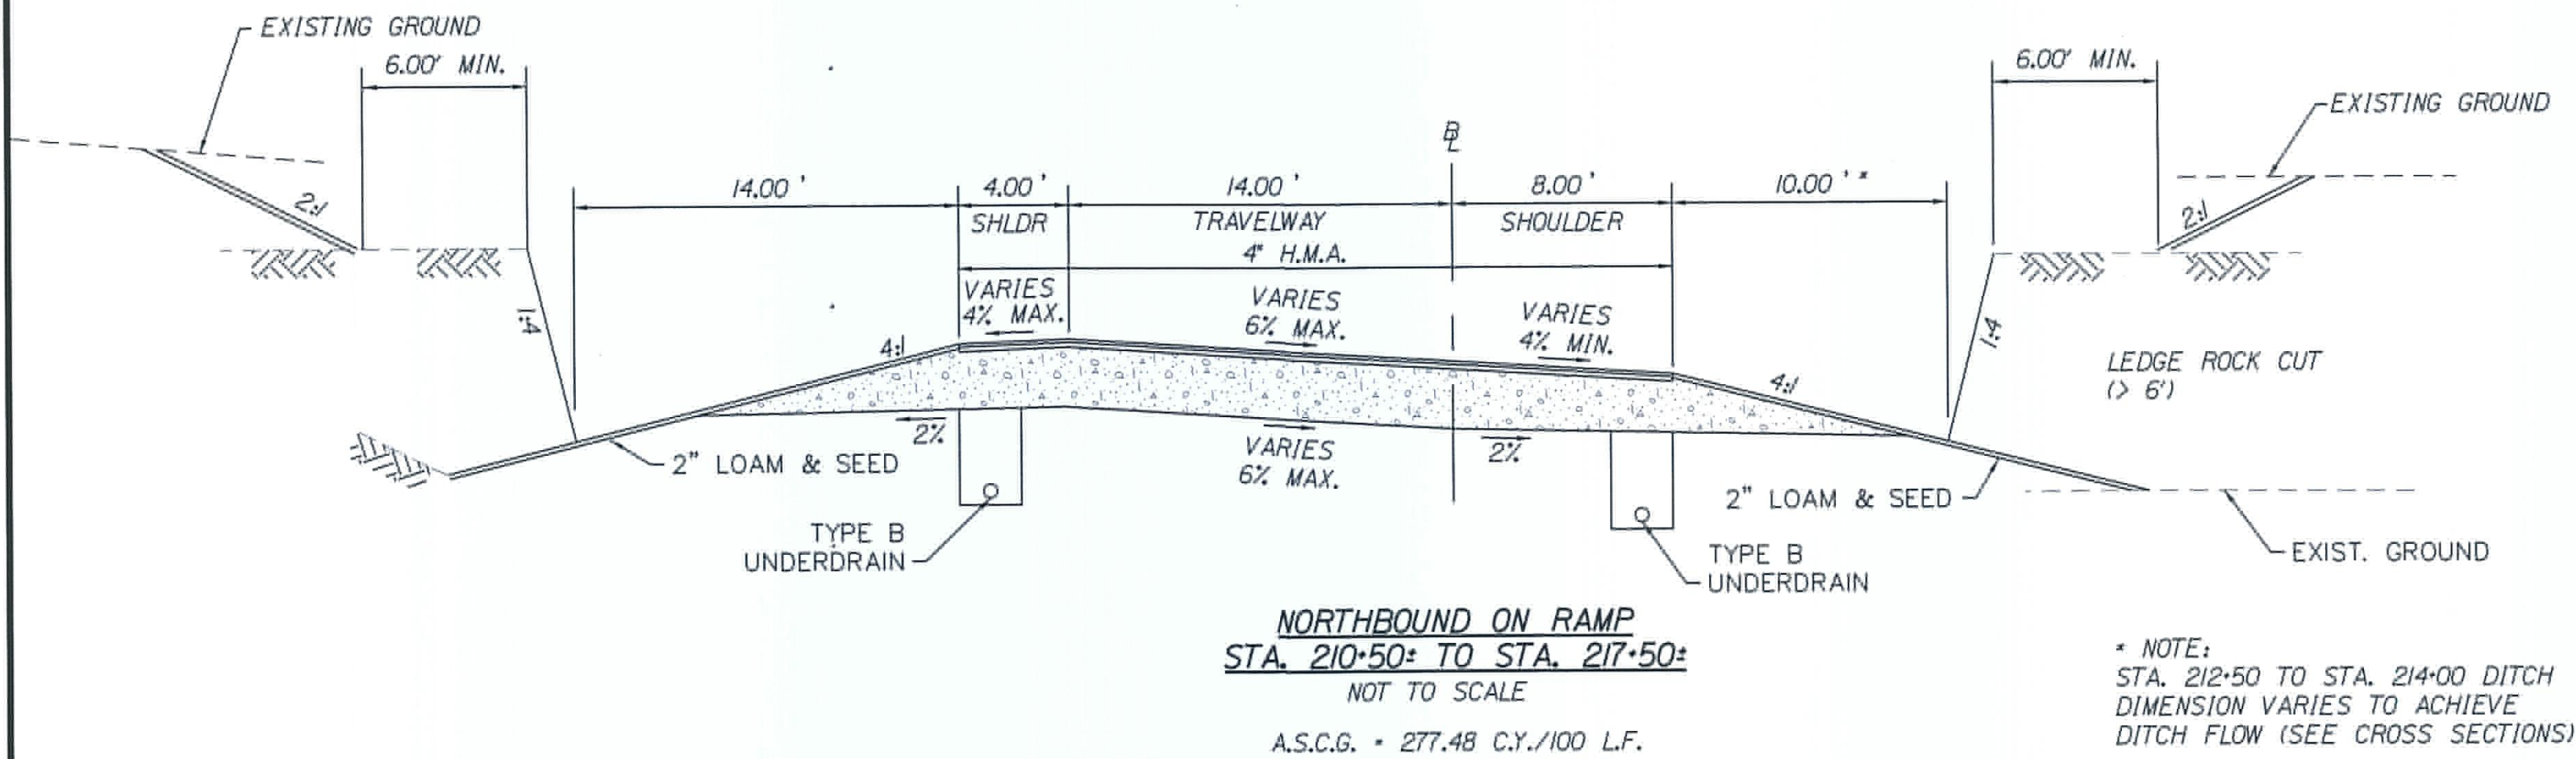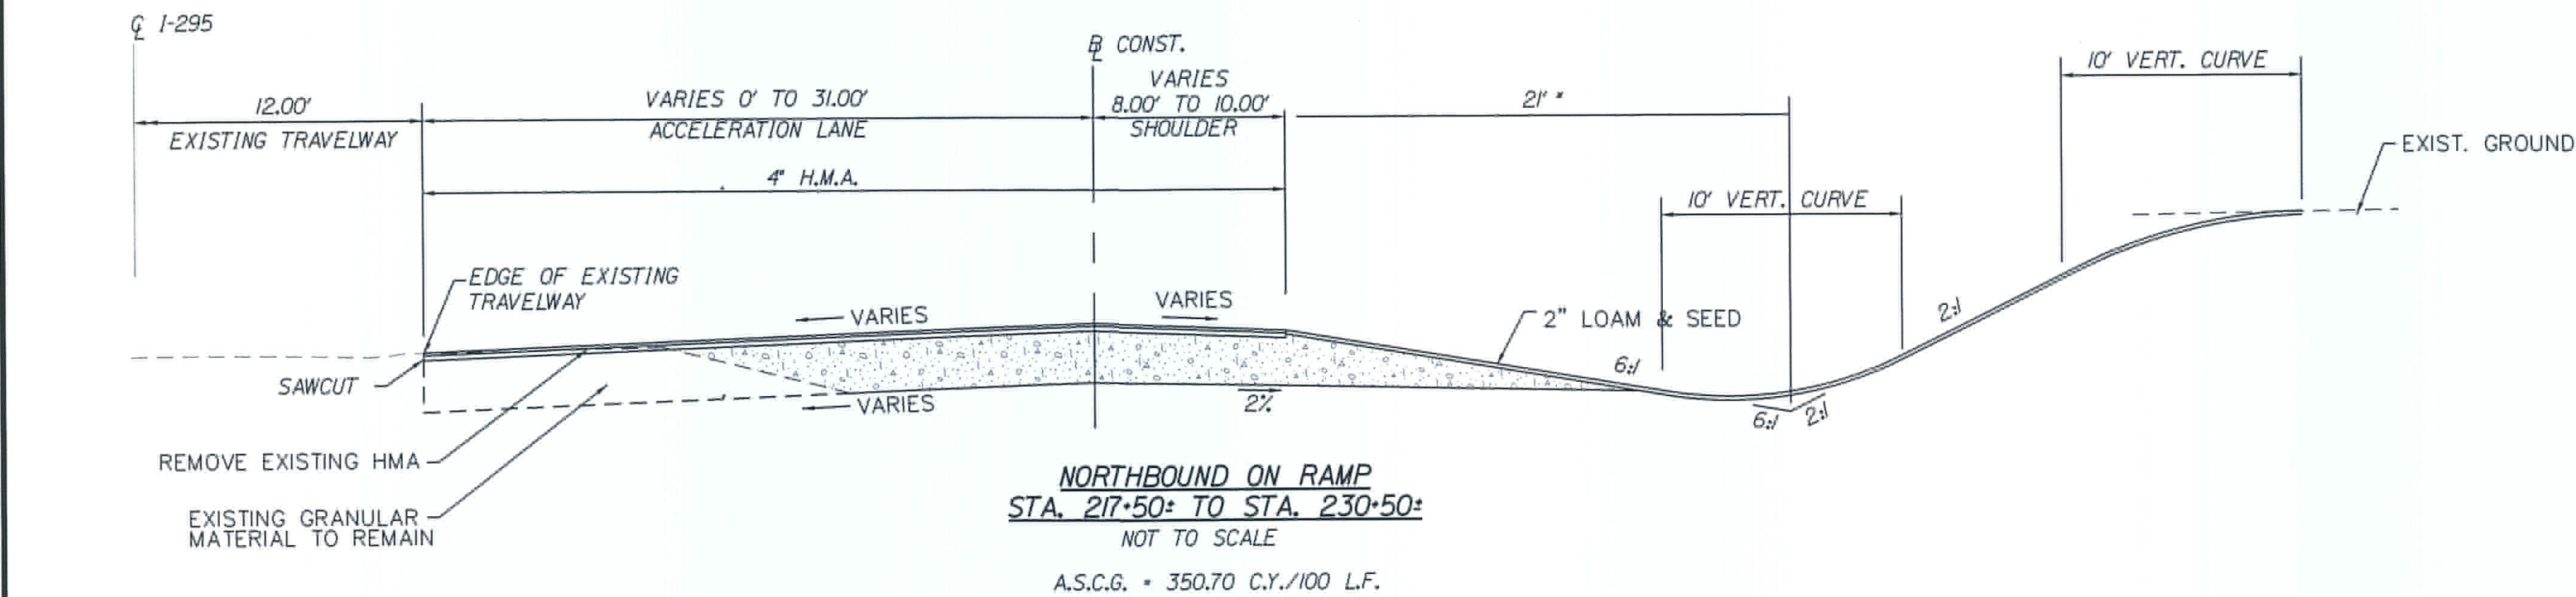

PAVEMENT NOTES - NORTHBOUND ON RAMP
1.5" H.M.A. 12.5mm. SURFACE (403.208)
2.5" H.M.A. 12.5mm. BASE (403.213)
26.0" AGGREGATE SUBBASE COURSE GRAVEL (304.10)


NORTHBOUND ON RAMP - SUPERELEVATION TABLE			
LT. SHOULDER	TRAVELWAY	STATION	RT. SHOULDER
		START	
-	+2.0	200+00	-2.0
-	+2.2	200+50	-2.0
-	+2.4	201+00	-2.0
-	+3.1	201+50	-2.0
-	+3.9	202+00	-3.9
-	+4.8	202+50	-4.8
+6.0	+6.0	203+00	-6.0
+3.6	+3.6	203+50	-4.0
1.2	1.2	204+00	-4.0
-1.2	-1.2	204+50	-4.0
-3.6	-3.6	205+00	-4.0
-6.0	-6.0	205+50	-2.0
		TO	
-6.0	-6.0	209+50	-2.0
-4.0	-4.0	210+00	-4.0
-4.0	-2.0	210+50	-4.0
-4.0	0	211+00	-4.0
-4.0	+2.0	211+50	-4.0
-4.0	+4.0	212+00	-4.0
-2.0	+6.0	212+50	-6.0
		TO	
-2.0	+6.0	214+50	-6.0
-4.0	+4.0	215+00	-4.0
-4.0	+2.0	215+50	-4.0
-4.0	0	216+00	-4.0
-	-1.6	216+50	-4.0
-	-1.8 -2.0	217+00	-4.0
		TO	
-	-1.9 -2.0	219+50	-4.0
-	-2.4	220+00	-4.0
-	-3.6 -3.8	220+50	-3.4
-	-5.6	221+00	-2.0
-	-5.1 -5.4	221+50	-2.0
-	-5.4	222+00	-2.0
-	-5.0 -5.2	222+50	-2.0
-	-5.2	223+00	-2.0
-	-4.8 -5.0	223+50	-2.0
-	-4.9 -5.0	224+00	-2.0
-	-3.9 -4.8	224+50	-2.0
-	-4.6 -4.8	225+00	-2.0
-	-3.6 -4.6	225+50	-3.6
-	-2.7 -2.8	226+00	-4.0
-	-1.3 -1.8	226+50	-4.0
-	-0.9 -0.4	227+00	-4.0
-	+0.8 -2.0	227+50	-4.0
		TO	
-	+4.5 -2.0	230+00	-4.5 -4.0
-	-	230+54.40	-4.5 -4.0

Date: 2/21/2011

Username: COMMON

Division: HIGHWAY

Filename:

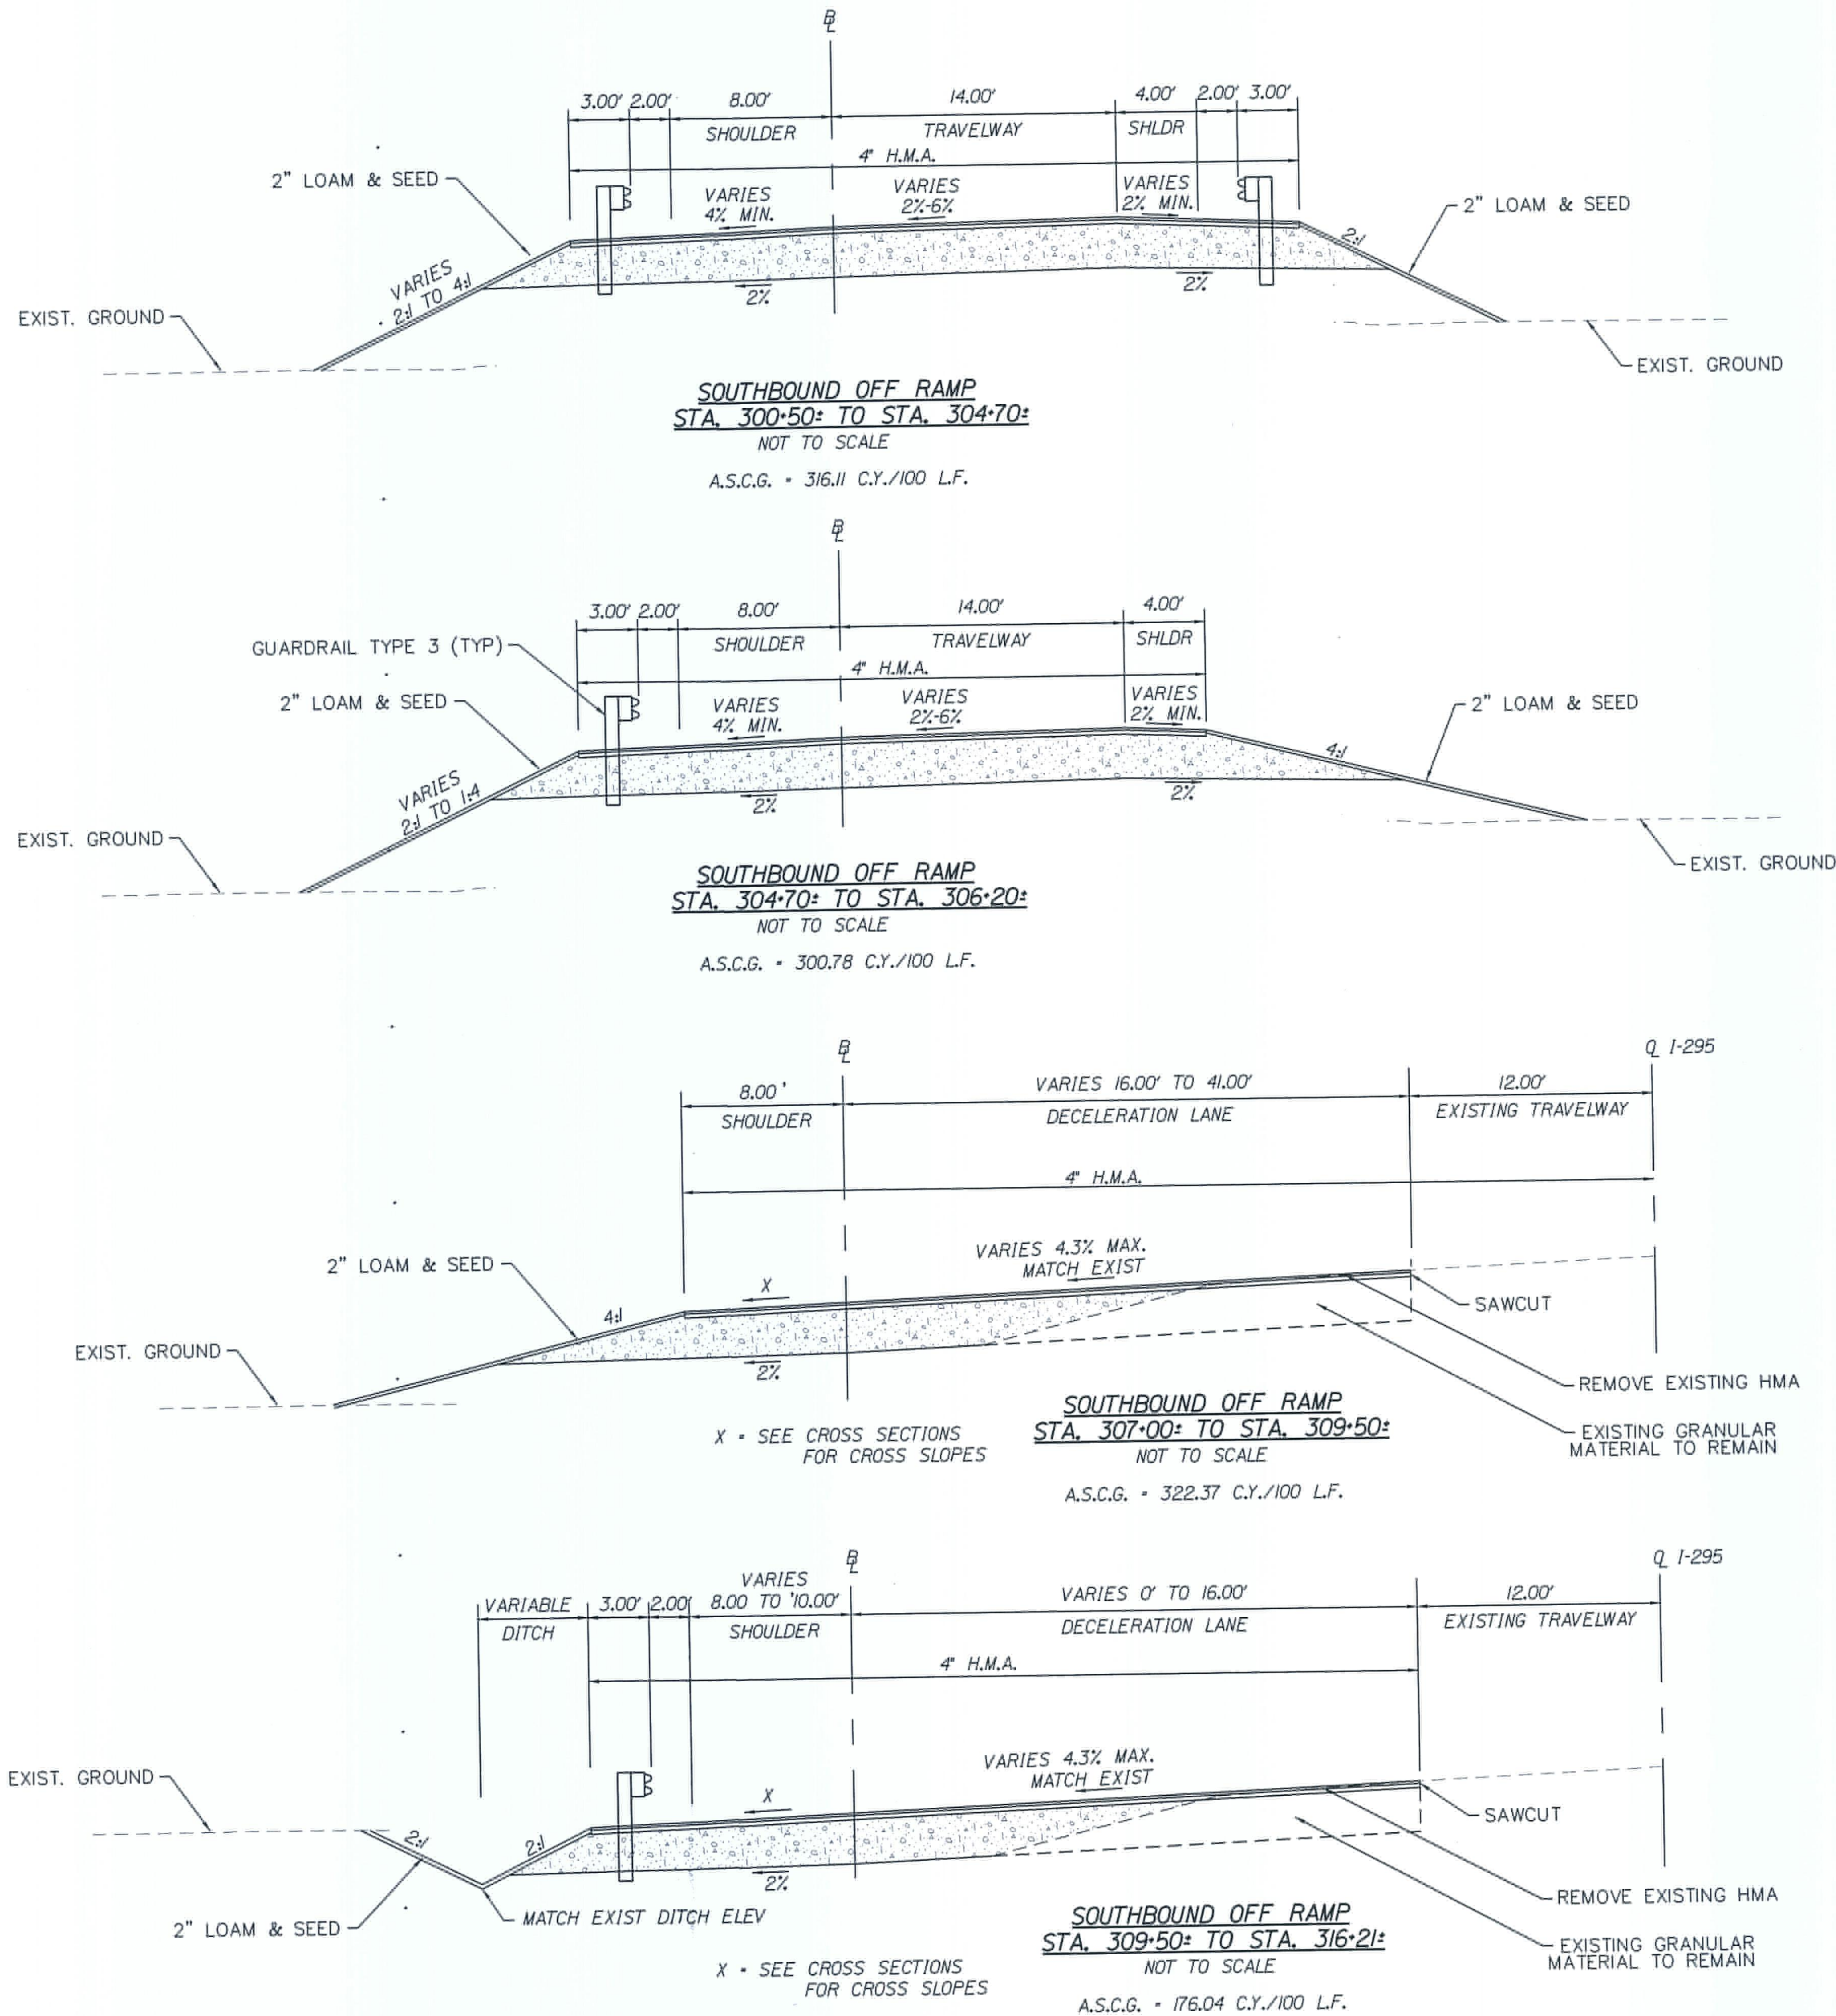

SOUTHBOUND OFF RAMP - SUPERELEVATION TABLE			
LT. SHOULDER	STATION	TRAVELWAY	RT. SHOULDER
	START		
-	300+00	-	-
-4.0	300+50	+2.0	-4.0
	TO		
-4.0	302+00	+2.0	-4.0
-4.0	302+50	+3.2	-4.0
-4.3	303+00	+4.3	-3.7
	TO		
-4.3	305+50	+4.3	-3.7
-4.3	306+00	+4.3	-
-4.3	306+50	+4.3	-
-4.3	307+00	+4.3	-
-4.3	307+50	+4.3	-
-4.3	308+00	+4.3	-
-5.1 -5.6	308+50	+5.6 +5.1	-
-5.6	309+00 TO	+5.6	-
-5.6	311+00 311+50	+5.6	-
-4.7	311+50 312+00	+4.7	-
	TO		
-4.7	313+00 314+00	+4.7	-
-4.0	314+50	+3.4	-
-4.0	315+00	+2.0	-
	TO		
-4.0	316+20.98	+2.0	-

PAVEMENT NOTES - SOUTHBOUND OFF RAMP
1.5" H.M.A. 12.5mm. SURFACE (403.208)
2.5" H.M.A. 12.5mm. BASE (403.213)
26.0" AGGREGATE SUBBASE COURSE GRAVEL (304.10)

STATE OF MAINE
DEPARTMENT OF TRANSPORTATION
IM-1108(600) EXIT 15
CM-1749(000)X PARK & RIDE LOT
WIN 11086.00 EXIT 15 HIGHWAY PLANS
WIN 17490.00 PARK & RIDE LOT

YARMOUTH
I-295 EXIT 15
TYPICAL SECTIONS

As-Built by T.P. Davis, Dec. 2013





PROJ. MANAGER
DESIGN-DETAILED
CHECKED-REVIEWED
DESIGN-DETAILED
DESIGN-DETAILED
REVISIONS 1
REVISIONS 2
REVISIONS 3
REVISIONS 4
FIELD CHANGES

DATE
BY
WIG
JMD

SIGNATURE
P.E. NUMBER
DATE

SHEET NUMBER
10
OF 283

NOT TO SCALE

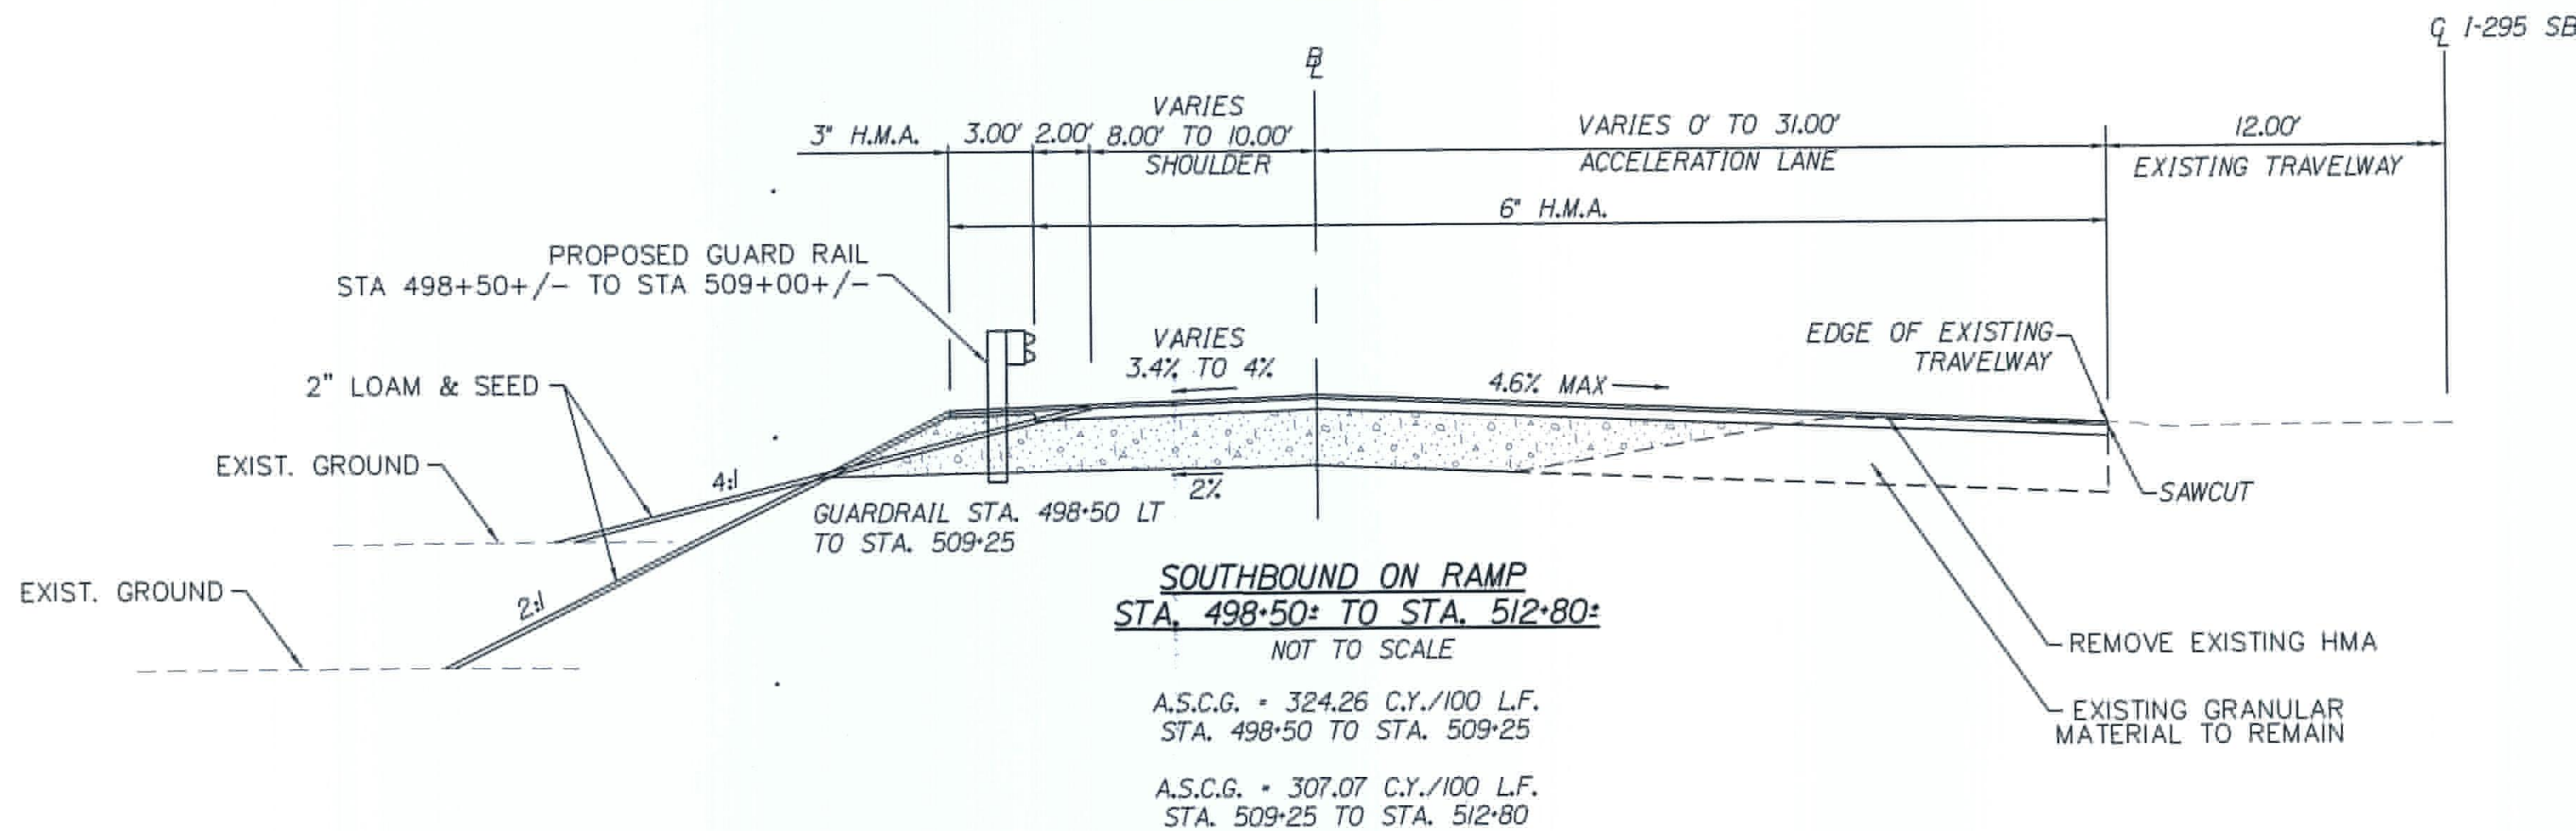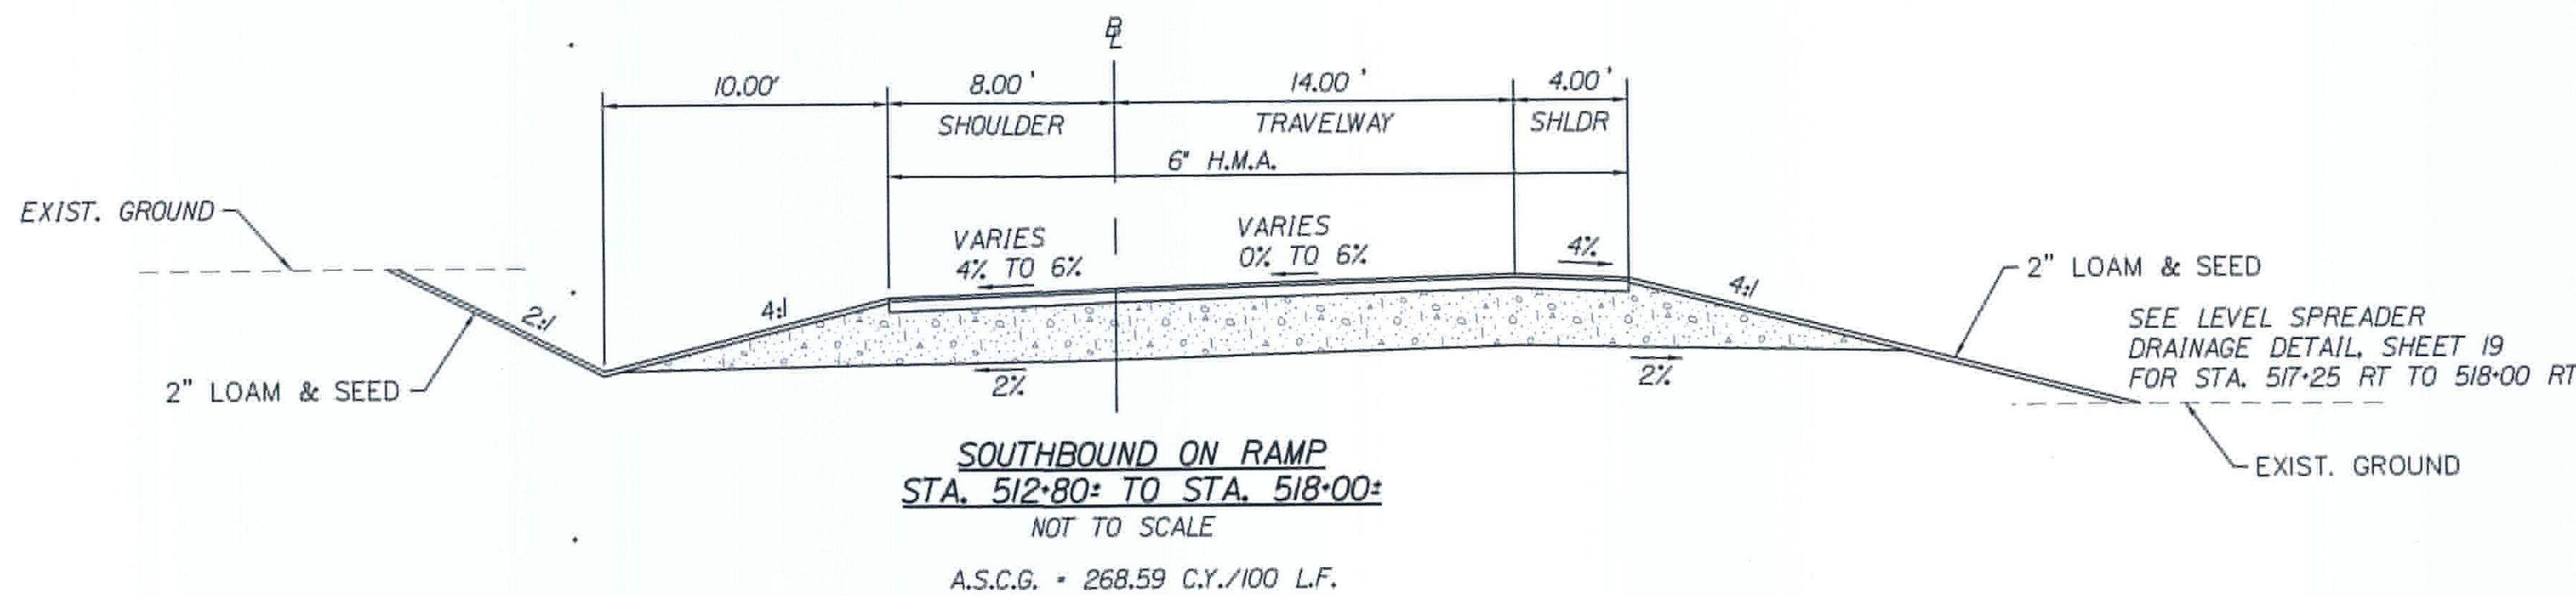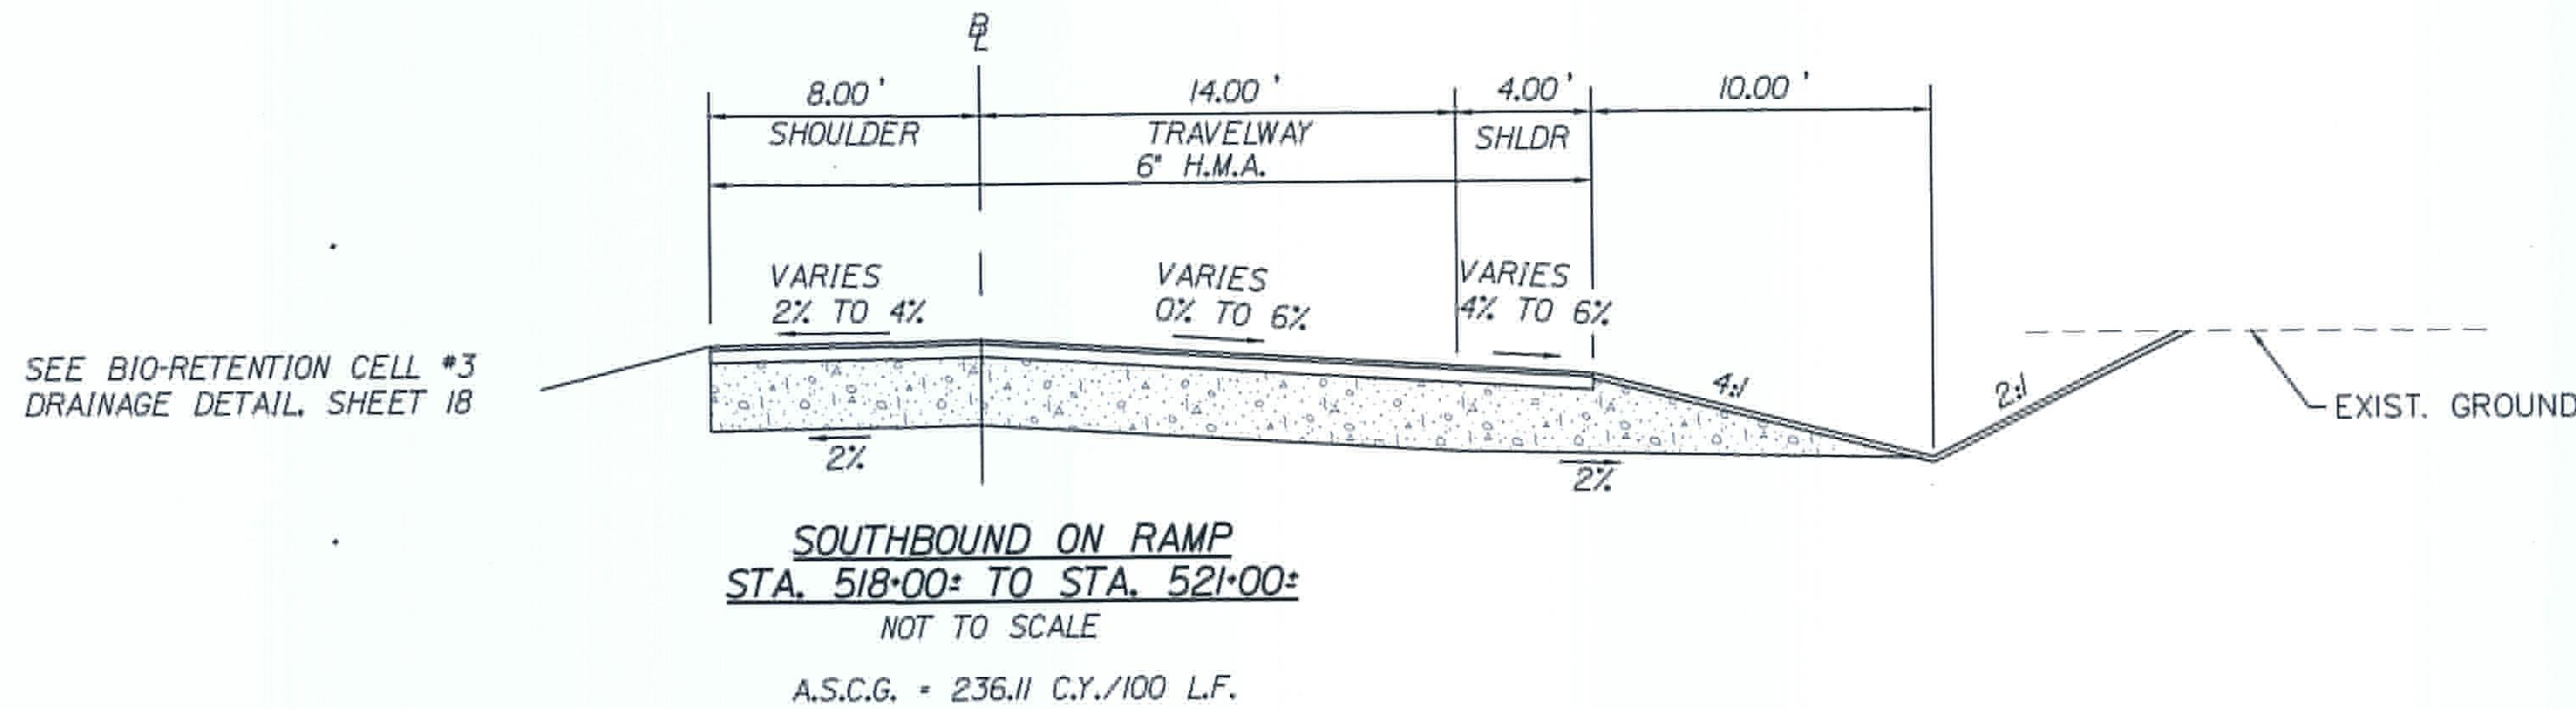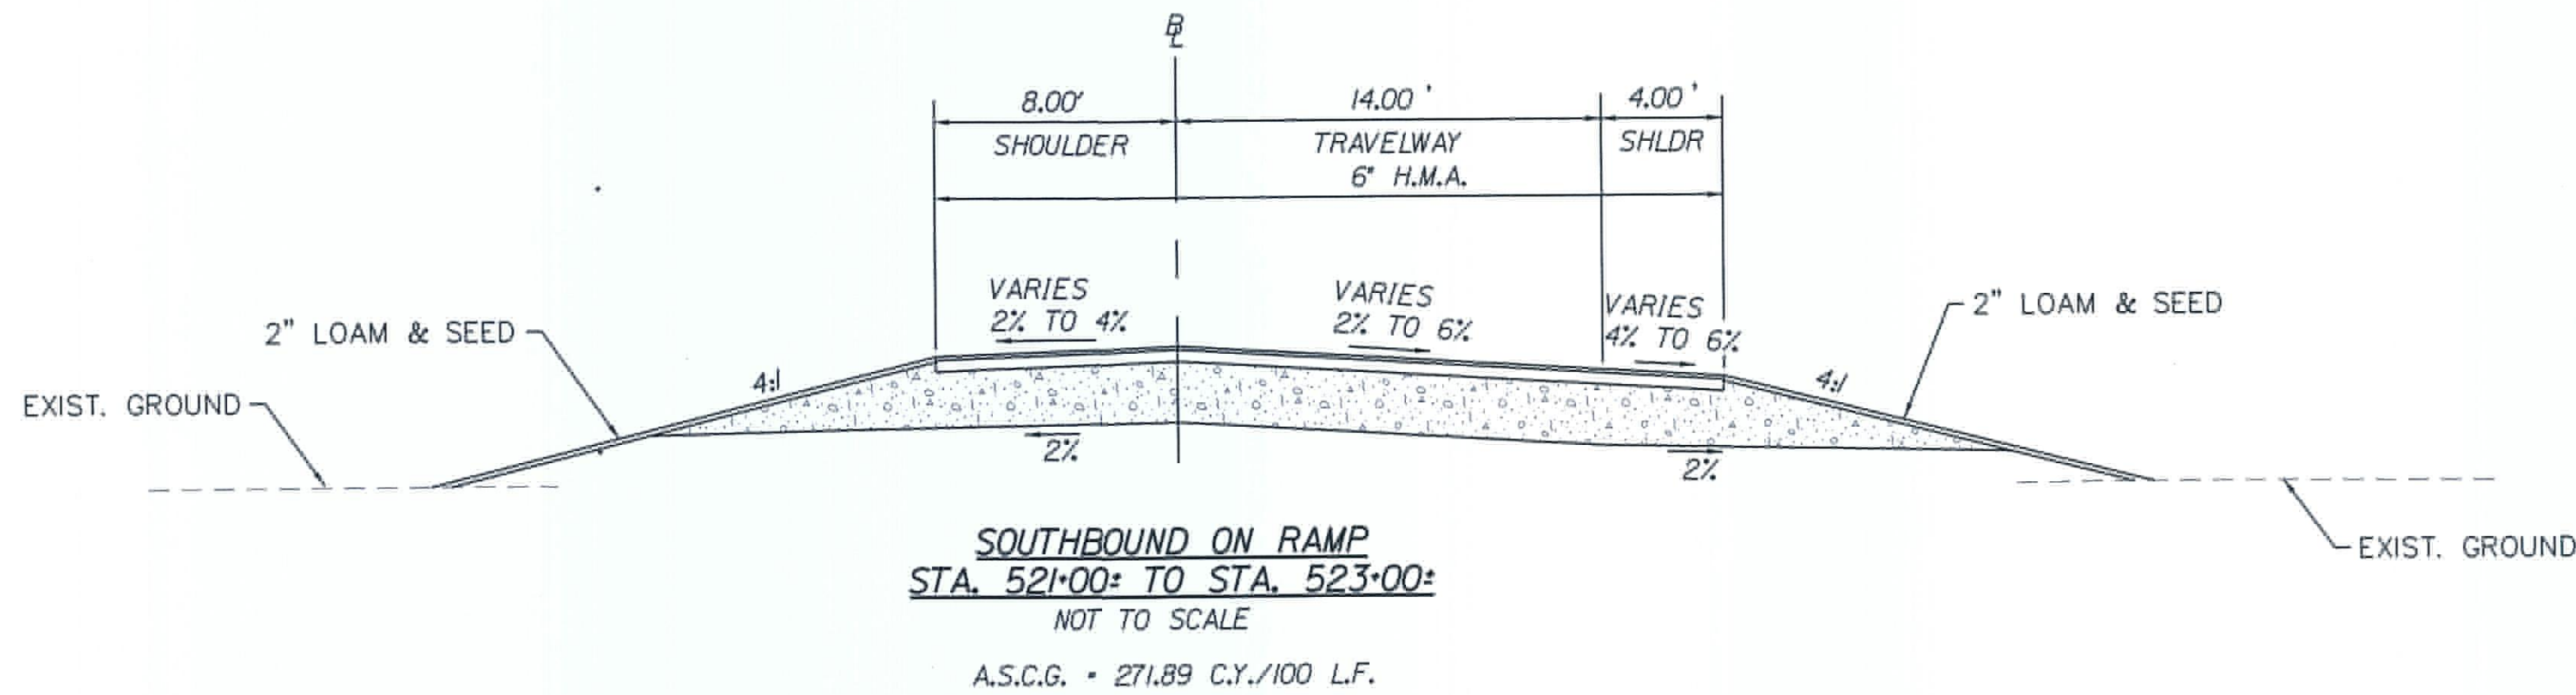

SOUTHBOUND ON RAMP - SUPERELEVATION TABLE			
LT. SHOULDER	STATION	TRAVELWAY	RT. SHOULDER
	START		
-4.3	498+45.47	-	-
-4.3	499+00	-4.3	-
-4.0	499+50	-2.1	-
-4.0	500+00	0	-
-4.0	500+50	-1.5	-
-4.0	501+00	-2.3	-
-4.0	501+50	-3.4	-
-3.4	502+00	-4.6	-
	TO		
-3.4	508+50	-4.6	-
-4.0	509+00	-3.3	-
-4.0	509+50	-2.0	-
	TO		
-4.0	511+50	-1.6	-
-4.0	512+00	-1.3	-
-4.0	512+50	-1.4	-
-4.0	513+00	-0.9	-4.0
-4.0	513+50	-1.4	-4.0
-4.0	514+00	-3.7	-4.0
-6.0	514+50	-6.0	-2.0
	TO		
-6.0	516+50	-6.0	-2.0
-4.0	517+00	-4.0	-4.0
-4.0	517+50	-2.0	-4.0
-4.0	518+00	0	-4.0
-4.0	518+50	-2.0	-4.0
-4.0	519+00	-4.0	-4.0
-2.0	519+50	-6.0	-6.0
	TO		
-2.0	522+00	-6.0	-6.0
-3.8 -4.0	522+50	-3.3	-4.0
-3.9 -4.0	523+00	-0.7	-4.0
-2.3	523+50	+2.0	-2.3
-	524+00	-	-

PAVEMENT NOTES - SOUTHBOUND ON RAMP
1.5" H.M.A. 12.5mm. SURFACE (403.208)
4.5" H.M.A. 12.5mm. BASE (403.213)
24.0" AGGREGATE SUBBASE COURSE GRAVEL (304.10)


Date: 2/21/2011

Username: COMMON

Division: HIGHWAY

Filename:

SEE BIO-RETENTION CELL #3
DRAINAGE DETAIL SHEET 18

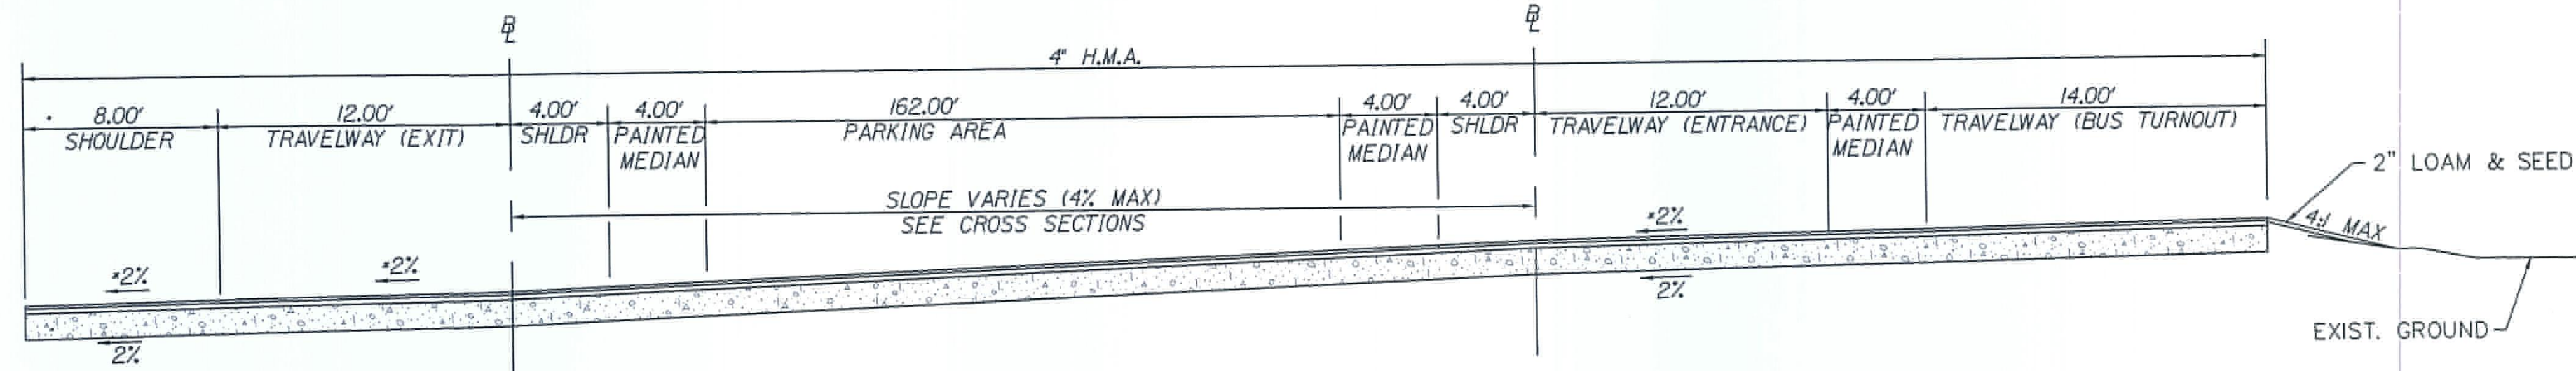


PARK AND RIDE
STA. 609+50 TO STA. 612+50
NOT TO SCALE
A.S.C.G. = 1,199.26 C.Y./100 L.F.

* TRAVELWAY AND SHOULDER CROSS SLOPE (RIGHT OF BASELINE IN DIRECTION OF TRAVEL)	
601+00 TO 607+50:	-2%
608+00:	0%
608+50 TO 613+75:	-2%
614+25:	0%
614+75 TO 624+43:	-2%


SEE BIO-RETENTION CELL #3
DRAINAGE DETAIL SHEET 18

SCREENING FENCE

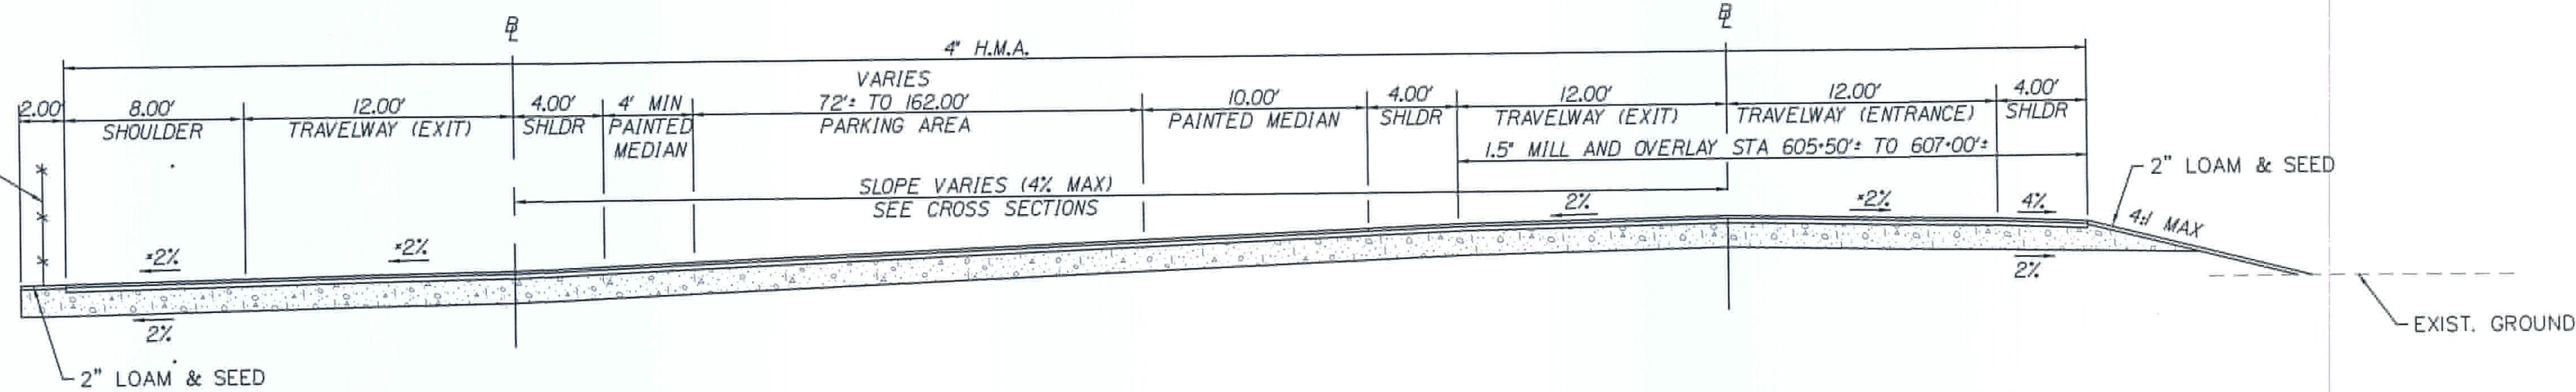

PARK AND RIDE
STA. 605+50 TO STA. 609+50
NOT TO SCALE
A.S.C.G. = 613.89 C.Y./100 L.F.

SEE BIO-RETENTION CELL #1
DRAINAGE DETAIL SHEET 17

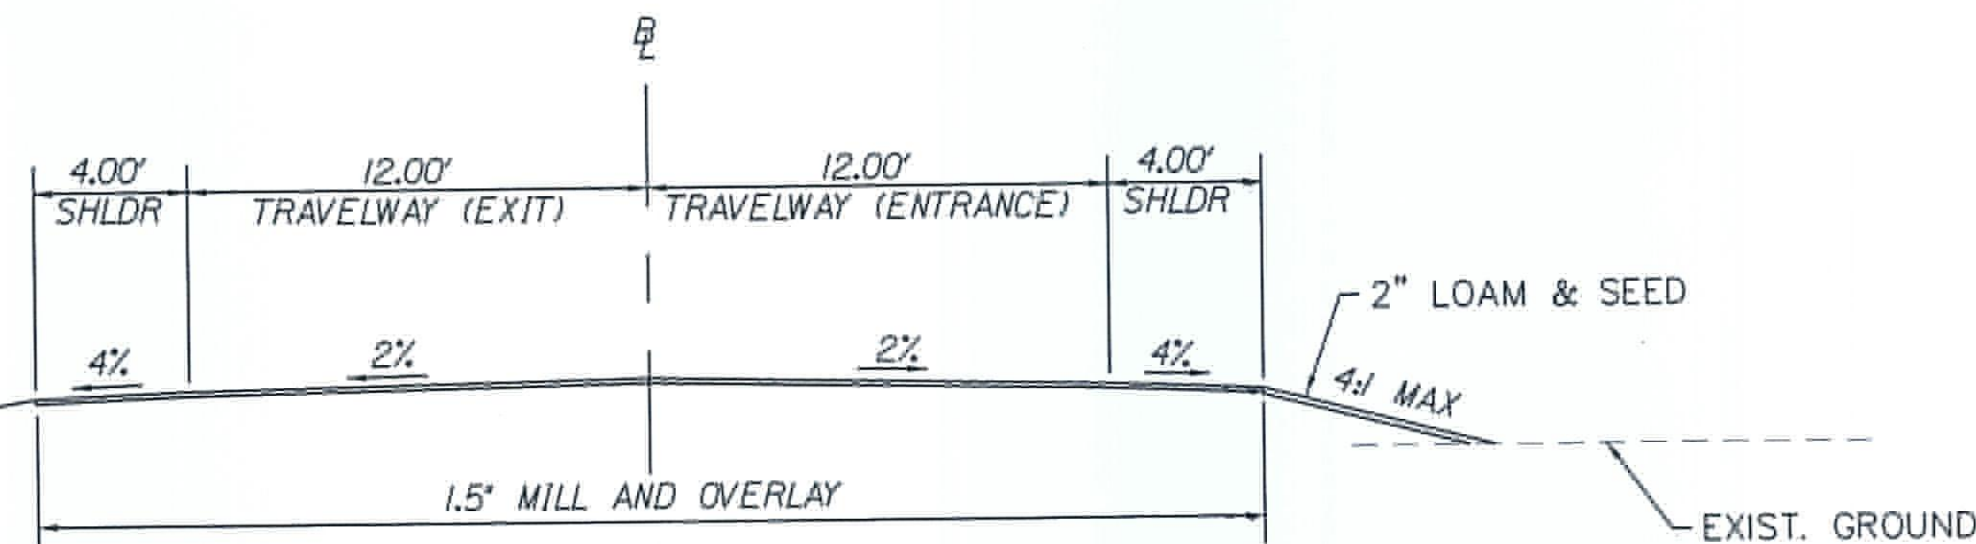

PARK AND RIDE
STA. 602+00 TO STA. 607+00
NOT TO SCALE

PAVEMENT NOTES - PARK AND RIDE LOT & ROAD

OVERLAY:
1.5\" H.M.A. 12.5mm SURFACE (403.208)
AFTER MILLING

FULL DEPTH PAVEMENT:
1.5\" H.M.A. 12.5mm SURFACE (403.208)
2.5\" H.M.A. 12.5mm BASE (403.213)
17.0\" AGGREGATE SUBBASE COURSE GRAVEL (304.10)

NOT TO SCALE

STATE OF MAINE
DEPARTMENT OF TRANSPORTATION
IM-1108(600) EXIT 15
CM-1749(000)X PARK & RIDE LOT
WIN 11086.00 EXIT 15 HIGHWAY PLANS
WIN 17490.00 PARK & RIDE LOT

PROJ. MANAGER	BY	DATE	SIGNATURE	P.E. NUMBER	DATE
DESIGN-DETAILED	W.J.G.				
CHECKED-REVIEWER	M.J.D.				
DESIGN-DET. ALDO					
DESIGN-DET. ALDO					
REVISIONS 1					
REVISIONS 2					
REVISIONS 3					
REVISIONS 4					
FIELD CHANGES					

YARMOUTH
I-295 EXIT 15

TYPICAL SECTIONS

SHEET NUMBER

12

OF 283

Date:12/13/2012

Username: common

Division: HIGHWAY

Filename: ... \MST\013_EST_QUANTITIES.dgn

ESTIMATED QUANTITIES - WIN 11086.00 EXIT 15 & WIN 20258.00 *			
ITEM NO.	DESCRIPTION	QUANTITY	UNIT
201.110	CLEARING	5.0	AC
201.120	SELECTIVE CLEARING AND THINNING	0.54	AC
202.150	REMOVING MANHOLE OR CATCH BASIN	5.0	EA
202.202	REMOVING PAVEMENT SURFACE	14,735.9	SY Incl. *
203.200	COMMON EXCAVATION	43,973	CY
202.203	PAVEMENT BUTT JOINTS	15.7	SY
203.210	ROCK EXCAVATION	38,127	CY
203.212	SPECIAL PERIMETER CONTROL BLASTING	9,084	LF
203.213	SHATTER SOLID ROCK SUBGRADE	5,880	SY
203.270	ROCK BORROW	500	CY
206.061	STR EARTH EXCV-DRAIN & MINOR STRUC. BELOW GRAD	35.2	CY
206.070	STRUCTURAL ROCK EXCV - DRAIN & MINOR STRUC. BELOW GRAD	582.7	CY
304.100	AGGREGATE SUBBASE COURSE - GRAVEL	28,424	CY
403.208	HOT MIX ASPHALT 12.5 MM HMA SURFACE	4944.42	TON Incl. *
403.209	HOT MIX ASPHALT 9.5 MM (SIDEWALKS, DRIVES, INCIDENTALS)	171.61	TON
403.213	HOT MIX ASPHALT 12.5 MM BASE	11,695.13	TON
409.150	BITUMINOUS TACK COAT - APPLIED	3,582	G Incl. *
462.300	ULTRA THIN BONDED WEARING COURSE Open Graded Friction Crse.	3,076.22	SY (Mod.13) *
526.301	TEMPORARY CONCRETE BARRIER TYPE I	1	LS
527.305	QUADGUARD CRASH CUSHION	1	UN
527.340	WORKZONE TRAFFIC CUSHION	3	UN
603.155	12" RCP CLASS III	11.9	LF
603.159	12" CULVERT PIPE OPTION III	0	LF
603.161	15" CORRUGATED METAL PIPE	10	LF
603.169	15" CULVERT PIPE OPTION III	0	LF
603.179	18" CULVERT PIPE OPTION III	128	LF
603.191	24" CORRUGATED METAL PIPE	10	LF
603.195	24" RCP CLASS III	390	LF
603.199	24" CULVERT PIPE OPTION III	0	LF
604.090	CATCH BASIN TYPE BI (Part of 615.25 - Bioretention Cells Park & Ride)	0	EA
604.092	CATCH BASIN TYPE BI-C	7,125	EA
604.150	MANHOLE	1	EA
604.182	CLEAN EXISTING CB AND MANHOLE	0	EA
605.090	6 INCH UNDERDRAIN TYPE B	3,762	LF
605.100	6 INCH UNDERDRAIN OUTLET	321	LF
606.1721	BRIDGE TRANSITION - TYPE I	5	EA
606.230	GUARDRAIL TYPE 3C - SINGLE RAIL	5208.25	LF
606.265	TERMINAL END - SGL RAIL - GALV STEEL	5	EA
606.353	REFLECTORIZED FLEXIBLE GUARDRAIL MARKER	30	EA
606.356	UNDERDRAIN DELINEATOR POST	12	EA
606.790	GUARDRAIL 350 FLARED TERMINAL	11	EA
609.340	CURB TYPE 5	2,674.1	LF
609.350	CURB TYPE 5 - CIRCULAR	59.8	LF
610.080	PLAIN RIPRAP	208.1	CY
613.319	EROSION CONTROL BLANKET	32.48	SY
615.070	LOAM	2889.34	CY
618.1401	SEEDING, METHOD NUMBER 2 - PLAN QUANTITY	617.07	UN
618.1411	SEEDING, METHOD NUMBER 3 - PLAN QUANTITY	0	UN
619.1201	MULCH - PLAN QUANTITY	578.79	UN
619.130	BARK MULCH	1.7	UN
620.540	STABILIZATION GEOTEXTILE	4630.5	SY
621.025	EVERGREEN TREES (3 FOOT - 4 FOOT) GROUP A	20	EA
621.031	EVERGREEN TREES (4 FOOT - 5 FOOT) GROUP A	10	EA
621.037	EVERGREEN TREES (5 FOOT - 6 FOOT) GROUP A	15	EA
621.044	EVERGREEN TREES (6 FOOT - 8 FOOT) GROUP B	10	EA
621.045	EVERGREEN TREES (6 FOOT - 8 FOOT) GROUP C	5	EA
621.180	MEDIUM DECIDUOUS TREES (6 FOOT - 8 FOOT) GROUP C	15	EA
621.202	MEDIUM DECIDUOUS TREES (2 IN - 2.50 IN CALIPER) GROUP B	8	EA
621.245	LG DECIDUOUS TREES (2 FOOT - 3 FOOT) GROUP A	20	EA
621.255	LG DECIDUOUS TREES (8 FOOT - 10 FOOT) GROUP A	10	EA
621.273	LG DECIDUOUS TREES (2 IN - 2.50 IN CALIPER) GROUP A	18	EA
621.546	DECIDUOUS SHRUBS (2 FOOT - 3 FOOT) GROUP A	100	EA
621.552	DECIDUOUS SHRUBS (3 FOOT - 4 FOOT) GROUP A	40	EA
621.711	HERBACEOUS PERENNIALS GROUP B	650	EA
621.800	ESTABLISHMENT PERIOD	1	LS
626.110	PRECAST JUNCTION BOX	4	EA * (Mod.5)
626.22	NON-METALLIC CONDUIT	8,155.5	LF
626.31	18" FOUNDATION	0	EA * (Mod.5)
626.33	30" FOUNDATION	2	EA * (Mod.5)
627.180	12" SOLID WHITE PAVEMENT MARKING	2,795	LF
627.733	4" WHITE OR YELLOW PAINTED PAVE MRK LINE	14,158.4	LF Incl. *
627.744	6" WHITE OR YELLOW PAINTED PAVE MRK LINE	17,530.2	LF
627.750	WHITE OR YELLOW PAVEMENT AND CURB MARKING	2,015.2	SF Incl. *
627.760	TEMPORARY PVMT. MARK LINE, W OR YELLOW	1	LS
629.050	HAND LABOR - STRAIGHT TIME	30.25	HR
631.120	ALL-PURPOSE EXC (INC OPERATOR)	25.25	HR
631.172	TRUCK-LARGE (INC OPERATOR)	2.0	HR
631.32	CULVERT CLEANER (INCLUDING OPERATOR)	0	HR
634.180	RGS CONDUIT	0	LF
634.2042	LED LUMINAIRES	38	EA
634.2082	REMOVE EXISTING LIGHT STANDARD	11	EA
634.2101	TYPE A LIGHT STANDARD	32	EA
634.2102	TYPE B LIGHT STANDARD	6	EA
504.07	Concrete Pipe Ties	16	G.P. (Mod.4) *
603.165	15" RCP Class III	105.7	LF (Mod.1) *
603.175	18" RCP Class III	488.6	LF (Mod.1) *
626.32	24" Foundation	38	EA (Mod.5) *

ESTIMATED QUANTITIES WIN 11086.00 EXIT 15			
ITEM NO.	DESCRIPTION	QUANTITY	UNIT
634.25	SERVICE POLE COMPLETE WITH CABINET AND CONTROLS	2	EA * (Mod.5)
634.313	*4 AWG COPPER WIRING	29,706	LF
634.316	*10 AWG COPPER WIRING	0	LF
636.400	SOIL NAIL WALL DESIGN	1	LS
636.411	SOIL NAIL WALL	1450	SF
639.180	FIELD OFFICE TYPE A	1	EA
643.72	TEMPORARY TRAFFIC SIGNAL EXIT 10 NB OFF RAMP	1	LS
643.72	TEMPORARY TRAFFIC SIGNAL EXIT 17 NB RAMP	1	LS
643.970	WOOD POLES WITH GUYS AND SPAN WIRE	1	EA
645.103	DEMOUNT GUIDE SIGN	14	EA
645.106	DEMOUNT REG. WRNG. CONF & RTE MARKER ASSY SGN	71	EA
645.113	REINSTALL GUIDE SIGNS	6	EA
645.116	REINST. REG. WRNG. CONF & RTE MARKER ASSY SGN	29	EA
645.251	ROADSIDE GUIDE SIGNS	320.25	SF
645.292	REG. WRNG. CONF & RTE MARKER SGN TYPE II	596.37	SF
645.511	FLASHING WARNING SIGN RIGHT CHEVRON SIGN	4	EA
645.511	FLASHING WARNING SIGN WRONG WAY SIGN	3	EA
652.300	FLASHING ARROW BOARD	1	EA
652.310	TYPE I BARRICADE	0	EA
652.312	TYPE III BARRICADE	7	EA
652.330	DRUM	210	EA
652.340	CONE	104	EA
652.350	CONSTRUCTION SIGNS	1,374.7	SF
652.361	MAINTENANCE OF TRAFFIC CONTROL DEVICES	1	LS
652.380	FLAGGER	5438	HR
652.381	TRAFFIC OFFICER	445.5	HR
652.410	PORTABLE CHANGEABLE MESSAGE SIGN	2	EA
656.750	TEMPORARY SOIL EROSION & W.P. CONTROL	1	LS
658.20	ACRYLIC LATEX COLOR FINISH, GREEN	874.5	SY
659.100	MOBILIZATION	1	LS
ESTIMATED QUANTITIES - WIN 17490.00 PARK & RIDE LOT			
201.110	CLEARING	3.0	AC
203.200	COMMON EXCAVATION	10,470	CY
206.061	STR EARTH EXCV-DRAIN & MINOR STRUC. BELOW GRAD	0	CY
304.100	AGGREGATE SUBBASE COURSE - GRAVEL	8,210	CY
403.208	HOT MIX ASPHALT 12.5 MM HMA SURFACE	1877.44	TON
403.213	HOT MIX ASPHALT 12.5 MM BASE	2,048.2	TON
409.150	BITUMINOUS TACK COAT - APPLIED	420	G
603.179	18" CULVERT PIPE OPTION III	150.9	LF
605.090	6 INCH UNDERDRAIN TYPE B	953	LF
607.220	CEDAR RAIL FENCE	48	LF
607.421	SCREENING FENCE	972	LF
609.340	CURB TYPE 5	176.1	LF
609.350	CURB TYPE 5 - CIRCULAR	34.4	LF
610.080	PLAIN RIPRAP	4.1	CY
615.070	LOAM	132.72	CY
615.250	BIORETENTION CELL	1	LS
618.1401	SEEDING METHOD NUMBER 2 - PLAN QUANTITY	34.43	UN
619.1201	MULCH - PLAN QUANTITY	33.60	UN
626.11	PRECAST JUNCTION BOX	1	EA * (Mod.5)
626.22	NON-METALLIC CONDUIT	22.79	LF
626.32	30" FOUNDATION 24"	15	EA * (Mod.5)
627.180	12" SOLID WHITE PAVEMENT MARKING	0	LF
627.733	4" WHITE OR YELLOW PAINTED PAVE MRK LINE	14,744.7	LF
627.750	WHITE OR YELLOW PAVEMENT AND CURB MARKING	348.6	SF
634.2042	LED LUMINAIRES	15	EA
634.2082	REMOVE EXISTING LIGHT STANDARD	1	EA
634.2101	TYPE A LIGHT STANDARD	15	EA
634.313	*4 AWG COPPER WIRE	6,953	LF
634.316	*10 AWG COPPER WIRE	0	LF
645.292	REG. WRNG. CONF & RTE MARKER SGN TYPE II	147.84	SF
652.312	TYPE III BARRICADE	0	EA
652.330	DRUM	23	EA
652.350	CONSTRUCTION SIGNS	128	SF
656.750	TEMPORARY SOIL EROSION & W.P. CONTROL	1	LS
658.20	ACRYLIC LATEX COLOR FINISH, GREEN	91.5	SY
659.10	MOBILIZATION	1	LS
1	Change metal opt. III pipes to RCP Class III pipes 15" & 18"	See *	
2	Swap Traffic deflection devices & to add preemption at Temporary signals	No Change	
3	Add GPS & RTIS equipment and Training for all layout & control.	1	UN
4	504.07 Add concrete Pipe Ties for RCP Class III pipes 18" & 24"	See *	
5	omit most of Jct. Boxes and change 18" & 30" Foundations to 24" & add control cabinet.	See *	
6	Change 4" pavement to 6" pavement NB & SB OFF Ramps (omitted Change)		
7	Omitted guardrail going across CMP entrance to major power lines.		
8	Extended mill & resurface beyond Rte 1 to Portland street intersection.	(WIN 20258.00)	See *
9	Eliminate 4 overpass bridge deck drains due to new NB OFF Ramp under bridge.	4	EA
10	606.611 Add wooden guardrail to extend beyond existing due to ledge drop off for NB on Ramp	45	LF
11	603.2014 Extended cross pipe with 33" opt. III pipe SB OFF Ramp Sta. 304+52.5 Lt.	1	LS
12	606.232 Add guardrail Type 3C over 15' Radius	1.75	LF
13	462.31 Add mix design for open Graded Friction Crse pavement.	See *	
14	Maine Drilling & Blasting site conditions		
15	Extra work to open NB OFF & on Ramps by the end of June 2013		

EARTHWORK SUMMARY - WIN 11086.00 EXIT 15 ALL QUANTITIES IN CUBIC YARDS (CY)			
COMMON EXCAVATION FOR ESTIMATE			
COMMON EXCAVATION (FROM CROSS SECTIONS)	39,510		
GRUBBING IN FILL	4,560		
TRIANGULAR AREA FROM SHEET 84	87		
REMOVING EXISTING PAVEMENT	1,069		
TOTAL COMMON EXCAVATION	45,226		
FILL FOR BORROW CALCULATIONS			
COMMON FILL (FROM CROSS SECTIONS)	12,428		
TOTAL FILL	12,428		
ROCK EXCAVATION			
ROCK EXCAVATION (FROM CROSS SECTIONS)	36,782		
STRUCTURAL ROCK EXCAVATION (FOR DRAINAGE)	900		
TOTAL ROCK EXCAVATION	37,682		
AVAILABLE COMMON EXCAVATION FOR BORROW CALCULATIONS			
(1) TOTAL COMMON EXCAVATION	45,226		
DEDUCTIONS:			
GRUBBING IN FILL	4,560		
REMOVING EXISTING PAVEMENT	1,069		
(2) TOTAL DEDUCTIONS	5,629		
TOTAL AVAILABLE COMMON EXCAVATION (1) MINUS (2)	39,597		
TOTAL AVAILABLE STRUCTURAL EXCAVATION (DRAINAGE)	1,104		
TOTAL AVAILABLE NON-ROCK EXCAVATION	40,701		
COMPUTATION OF WASTE MATERIAL			
GRUBBING IN FILL	4,560		
TOTAL WASTE MATERIAL	4,560		
COMPUTATION OF COMMON BORROW FOR ESTIMATE			
(3) TOTAL FILL	12,428		
TOTAL AVAILABLE NON-ROCK EXCAVATION	40,701 x 0.85 = 35,596		
TOTAL AVAILABLE ROCK EXCAVATION	37,682 x 1.33 = 50,117		
(4) TOTAL AVAILABLE EXCAVATION	85,713		
TOTAL SURPLUS MATERIAL = TOTAL AVAILABLE EXCAVATION MINUS TOTAL FILL PLUS TOTAL WASTE MATERIAL		77,845	
EARTHWORK SUMMARY - WIN 17490.00 PARK & RIDE LOT ALL QUANTITIES IN CUBIC YARDS (CY)			
COMMON EXCAVATION FOR ESTIMATE			
COMMON EXCAVATION (FROM CROSS SECTIONS)	7,869		
GRUBBING IN FILL	2,596		
TOTAL COMMON EXCAVATION	10,465		
FILL FOR BORROW CALCULATIONS			
COMMON FILL (FROM CROSS SECTIONS)	1,980		
TOTAL FILL	1,980		
ROCK EXCAVATION			
ROCK EXCAVATION (FROM CROSS SECTIONS)	0		
STRUCTURAL ROCK EXCAVATION (FOR DRAINAGE)	0		
TOTAL ROCK EXCAVATION	0		
AVAILABLE COMMON EXCAVATION FOR BORROW CALCULATIONS			
(1) TOTAL COMMON EXCAVATION	10,465		
DEDUCTIONS:			
GRUBBING IN FILL	2,596		
REMOVING EXISTING PAVEMENT	0		
(2) TOTAL DEDUCTIONS	2,596		
TOTAL AVAILABLE COMMON EXCAVATION (1) MINUS (2)	7,869		
TOTAL AVAILABLE STRUCTURAL EXCAVATION (DRAINAGE)	1,848		
TOTAL AVAILABLE NON-ROCK EXCAVATION	9,717		
COMPUTATION OF WASTE MATERIAL			
GRUBBING IN FILL	2,596		
TOTAL WASTE MATERIAL	2,596		
COMPUTATION OF COMMON BORROW FOR ESTIMATE			
(3) TOTAL FILL	1,980		
TOTAL AVAILABLE NON-ROCK EXCAVATION	9,717 x 0.85 = 8,259		
TOTAL AVAILABLE ROCK EXCAVATION	0 x 1.33 = 0		
(4) TOTAL AVAILABLE EXCAVATION	8,259		
TOTAL SURPLUS MATERIAL = TOTAL AVAILABLE EXCAVATION MINUS TOTAL FILL PLUS TOTAL WASTE MATERIAL		8,875	

YARMOUTH I-295 EXIT 15			SHEET NUMBER			STATE OF MAINE		
ESTIMATED QUANTITIES			13			DEPARTMENT OF TRANSPORTATION		
			OF 283			IM-1108(600) EXIT 15		
						CM-1749(000)X PARK & RIDE LOT		
						WIN 11086.00 EXIT 15		
						WIN 17490.00 PARK & RIDE LOT		

As-Builts by T.P. Dyer Dec. 2013

GENERAL NOTES

1. THE UTILITIES INVOLVED IN THIS CONTRACT ARE AS FOLLOWS:CENTRAL MAINE POWER
2. ALL UTILITY FACILITIES SHALL BE ADJUSTED BY THE RESPECTIVE UTILITIES UNLESS OTHERWISE NOTED.
3. ALL DITCH ELEVATIONS SHOWN ON THE CROSS SECTIONS ARE FOR THE FINISH DITCH FLOW LINE.
4. ALL JOINTS BETWEEN EXISTING AND PROPOSED HOT BITUMINOUS PAVEMENT SHALL BE BUTTED.PAYMENT SHALL BE MADE UNDER ITEM 202.203 PAVEMENT BUTT JOINT.
5. CONSTRUCT BUTT JOINTS AT ALL PAVED DRIVES AND ENTRANCES.
6. GRIND TRANSITION TAPERS AT CATCH BASINS UNDER ITEM 202.203 PAVEMENT BUTT JOINTS,AS DIRECTED BY THE RESIDENT.
7. ALL ROADWAY CULVERT INLETS AND OUTLETS ARE TO RECEIVE SLOPE AND RIPRAP TREATMENT IN ACCORDANCE WITH MAINE DOT STANDARD DETAIL 802(05).
8. CLEARING LIMITS SHALL BE 10' BEYOND AND PARALLEL TO THE CONSTRUCTION SLOPE LINES OR AS SHOWN ON THE PLANS UNLESS OTHERWISE AUTHORIZED BY THE RESIDENT. IN WETLAND AREAS AS DELINEATED ON THE PLANS OR AS DIRECTED BY THE RESIDENT, THE CLEARING LIMIT SHALL BE THE TOE OF SLOPE.
9. REQUIRED DITCH PROTECTION SHOWN ON THE PLANS IS FOR ESTIMATING PURPOSES ONLY. ACTUAL TYPE AND LOCATION FOR EROSION CONTROL BLANKET, STONE DITCH PROTECTION, AND RIPRAP SHALL BE DETERMINED IN THE FIELD BY THE RESIDENT.
10. SHOULDERS ARE TO BE WIDENED AT GUARDRAIL ENDS AS SHOWN IN MAINE DOT STANDARD DETAIL 606(18).
11. GRANULAR BORROW USED TO BACKFILL MUCK EXCAVATION OR IN LOW WET AREAS TO 1FT ABOVE WATER LEVEL OR OLD GROUND SHALL MEET REQUIREMENTS FOR GRANULAR BORROW UNDERWATER BACKFILL.
12. EXISTING INSLOPES STEEPER THAN 2:1 IN PROPOSED FILL AREAS SHALL BE BENCHED AS DIRECTED BY THE RESIDENT.
13. GRUBBING IN FILL AREAS HAS BEEN SHOWN ON THE CROSS SECTIONS AND THE QUANTITIES NOTED.THESE LIMITS ARE APPROXIMATE AND HAVE BEEN USED FOR ESTIMATING PURPOSES ONLY. ACTUAL GRUBBING LIMITS MAY VARY BASED ON FIELD CONDITIONS AS DIRECTED BY THE RESIDENT. ESTIMATED GRUBBING DEPTHS ARE 6 INCHES IN FIELD AREAS AND 12 INCHES IN WOODED AREAS.
14. ALL INSLOPE AND DITCHES IN CUT AREAS SHALL BE GRADED AS SHOWN ON THE TYPICALS OR FLATTER,OR AS DIRECTED BY THE RESIDENT.
15. WHERE NO DITCHING OR INSLOPE EXCAVATION IS NEEDED,THE GRADNG OF EXISTING MATERIAL OR THE ADDITION OF MATERIAL FOR 3 FEET BEYOND SHOULDER BREAK TO MATCH THE EXISTING SLOPE SHALL BE INCIDENTAL TO THE CONTRACT. ANY ADDITIONAL MATERIAL SHALL BE APPROVED BY THE RESIDENT.
16. DRIVEWAY FILL SIDE SLOPES SHALL BE THE SAME AS THE NON-GUARDRAIL FILL SLOPES UNLESS OTHERWISE NOTED ON THE PLANS.
17. IF FOUNDATION MATERIAL IS REQUIRED UNDER CULVERTS, IT SHALL MEET THE REQUIREMENTS FOR GRANULAR BORROW - UNDERWATER BACKFILL AND WILL PAID FOR AS GRANULAR BORROW.
18. RESIDENTIAL PAVED ENTRANCES SHALL BE CONSTRUCTED WITH: 2" HOT MIX ASPHALT AND 12" AGGREGATE SUBBASE COURSE GRAVEL.
19. COMMERCIAL PAVED ENTRANCES SHALL BE CONSTRUCTED WITH: 3" HOT MIX ASPHALT AND 11" AGGREGATE SUBBASE COURSE GRAVEL.
20. EXTENDED USE EROSION CONTROL BLANKET, SEEDED DITCHES, RIPRAP DOWNSPOUTS, AND OTHER DITCHES LINED WITH STONE DITCH PROTECTION SHALL BE CONSTRUCTED AFTER PAVING AND SHOULDER WORK IS COMPLETED.WHERE IT IS APPARENT THAT RUNOFF WILL CAUSE CONTINUAL EROSION,PAYMENT WILL BE MADE UNDER APPROPRIATE CONTRACT ITEMS.

21. ANY NECESSARY CLEANING OF EXISTING PAVEMENT PRIOR TO PAVING SHALL BE INCIDENTAL TO THE RELATED PAVING ITEMS.
22. REMOVAL OF EXISTING CURBING SHALL BE CONSIDERED INCIDENTAL TO ITEM 203.20 COMMON EXCAVATION.
23. WHEN SUPER ELEVATION EXCEEDS THE SLOPE OF THE LOW SIDE SHOULDER, THE SHOULDER PAVEMENT WILL HAVE SAME SLOPE AS TRAVELED WAY.
24. EXISTING CULVERTS AND CATCH BASINS WILL BE CLEANED AS DIRECTED BY THE RESIDENT UNDER THE APPROPRIATE PAY ITEMS.
25. NO EXISTING DRAINAGE SHALL BE ABANDONED, REMOVED OR PLUGGED WITHOUT PRIOR APPROVAL OF THE RESIDENT.
26. THE CULVERT SIZES SHOWN ON THE PLANS AND CROSS SECTIONS ARE FOR SMOOTHLINED PIPES. FOR COMPARABLE CORRUGATED SIZES SEE THE DRAINAGE TABULATION.
27. ANY NECESSARY CUTTING OF EXISTING PIPES TO FIT IN AREAS OF PROPOSED CATCH BASINS WILL NOT BE PAID FOR SEPARATELY AND WILL BE CONSIDERED INCIDENTAL TO ITEM 604.
28. ANY NECESSARY CUTTING OF EXISTING CATCH BASINS TO ALLOW FOR PROPOSED PIPE CONNECTIONS WILL NOT BE PAID FOR SEPARATELY AND WILL BE CONSIDERED INCIDENTAL TO ITEM 603 OR 605.
29. ALL UNDERDRAIN SHOWN ON THE CROSS SECTIONS WILL HAVE A FLOW LINE WITH ELEVATIONS SPECIFIED ON THE CROSS SECTIONS. ALL FLOW LINE ELEVATIONS ARE SUBJECT TO APPROVAL BY THE RESIDENT.
30. ALL CONNECTIONS FOR UNDERDRAIN (U.D.) TO ROADWAY CULVERTS WILL BE INCIDENTAL TO U.D. PIPE ITEMS.
31. A 3 FT. X 3 FT. SQUARE RIPRAP PAD SHALL BE CONSTRUCTED AT U.D.OUTLETS.
32. GUARDRAIL END TREATMENTS SHALL BE INSTALLED CONCURRENTLY WITH THE PLACEMENT OF EACH SECTION OF BEAM GUARDRAIL.
33. HOLES CREATED BY GUARDRAIL REMOVAL WILL BE FILLED AND COMPACTED WITH APPROVED MATERIALS AS DIRECTED BY THE RESIDENT. PAYMENT TO BE CONSIDERED INCIDENTAL TO THE GUARDRAIL ITEMS.
34. ALL EXISTING GUARDRAIL SHALL BE REMOVED AND BECOME THE PROPERTY OF THE CONTRACTOR. REMOVAL AND DISPOSAL SHALL BE CONSIDERED INCIDENTAL TO THE GUARDRAIL ITEMS.
35. TWO REFLECTORIZED FLEXIBLE G.R. MARKERS (ITEM 606.353) WILL BE INSTALLED AT EACH GUARDRAIL END. A DELINEATOR POST (ITEM 606.356) WILL BE INSTALLED AT EACH UNDERDRAIN OUTLET.
36. CONNECTIONS FOR PROPOSED GUARDRAIL TO EXISTING GUARDRAIL WILL BE CONSIDERED INCIDENTAL TO ITEM 606.
37. REMOVAL OF EXISTING DRAIANGE PIPE AS DIRECTED BY THE RESIDENT SHALL BE CONSIDERED INCIDENTAL TO ITEM 203.20 COMMON EXCAVATION.
38. LOAM HAS BEEN ESTIMATED FOR DISTURBED AREAS. ACTUAL PLACEMENT OF THE LOAM SHALL BE AS NOTED ON THE PLANS OR DESIGNATED BY THE RESIDENT.
39. UNLESS OTHERWISE NOTED SEEDING METHOD NO.1 SHALL BE UTILIZED ON ALL LAWNS AND DEVELOPED AREAS; SEEDING METHOD NO. 2 SHALL BE UTILIZED ON ALL NON-GUARDRAIL SLOPES. SEEDING METHOD NO. 3 SHALL BE UTILIZED ON ALL GUARDRAIL FILL SLOPES. ON LONG NON-GUARDRAIL BACKSLOPES, SEEDING METHOD NO. 3 MAY BE USED INSTEAD OF METHOD NO. 2 IF NOTED OR DIRECTED BY THE RESIDENT.
40. LOAM SHALL BE PLACED TO A NOMINAL DEPTH OF 2 INCHES UNLESS OTHERWISE NOTED OR DIRECTED.

41. ACRYLIC LATEX COLOR FINISH GREEN (ITEM 658.20) SHALL BE PLACED ON ALL PAVED ISLANDS.
42. THE CONTRACTOR WILL BE RESPONSIBLE FOR MAINTAINING ALL EXISTING MAILBOXES TO ENSURE THAT THE MAIL WILL BE DELIVERABLE. NO SEPARATE PAYMENT WILL BE MADE FOR THIS WORK; IT SHALL BE CONSIDERED INCIDENTAL TO THE CONTRACT.
43. ANY DAMAGE TO THE SLOPES CAUSED BY THE CONTRACTOR'S EQUIPMENT, PERSONNEL, OR OPERATION SHALL BE REPAIRED TO THE SATISFACTION OF THE RESIDENT. ALL WORK, EQUIPMENT, AND MATERIALS REQUIRED TO MAKE REPAIRS SHALL BE AT THE CONTRACTOR'S EXPENSE.
44. PLANS OF PREVIOUSLY CONSTRUCTED PROJECTS ARE AVAILABLE ON REQUEST. THESE PROJECTS ARE:
- FEDERAL AID PROJECT NO. I-95-4(16)
- FEDERAL AID PROJECT NO. I-95-4(18)58
- FEDERAL AID PROJECT NO. I-95-4(19)
45. IF SOFT AND WET SOIL IS ENCOUNTERED AT THE SUBGRADE LEVEL, UTILIZE ITEM 620.54 STABILIZATION GEOTEXTILE PLACED ON SUBGRADE
46. AREAS REQUIRING FILL ON THE PROJECT WILL COME FROM SUITABLE EXCAVATION FROM EXCAVATION AREAS.
47. ESTIMATED QUANTITIES FOR REQUIRED STRUCTURAL EARTH EXCAVATION, DRAINAGE AND MINOR STRUCTURES ARE INFORMATIONAL ONLY AND REPRESENT THE APPROXIMATE MINIMUM QUANTITY REQUIRED TO INSTALL DRAINAGE STRUCTURES. ADDITIONAL EXCAVATION FOR THE CONTRACTOR'S CONVENIENCE OR TO COMPLY WITH BACKSLOPING REQUIREMENTS WILL NOT BE PAID FOR DIRECTLY BUT WILL BE CONSIDERED INCIDENTAL TO THE RELATED DRAINAGE ITEMS.
48. NO SEPARATE PAYMENT FOR SUPERINTENDENT OR FOREMAN WILL BE MADE FOR THE SUPERVISION OF EQUIPMENT BEING PAID FOR UNDER THE EQUIPMENT RENTAL ITEMS.
49. "UNDETERMINED LOCATIONS" SHALL BE DETERMINED BY THE RESIDENT.
50. STATIONS REFERENCED ARE APPROXIMATE.
51. ALL WORK SHALL BE DONE IN ACCORDANCE WITH THE MAINE DEPARTMENT OF TRANSPORTATION'S BEST MANAGEMENT PRACTICES FOR EROSION CONTROL & SEDIMENT CONTROL, FEBRUARY, 2008.
52. ~~2" MINIMUM DEPTH~~ MULCH SHALL BE APPLIED TO ALL SEEDED AREAS.
53. THE LOCATION OF THE EXISTING UTILITIES AND DRAINAGE SHOWN ON THE PLANS AND CROSS SECTIONS WERE COMPLIED FROM FIELD SURVEY. LOCATIONS ARE APPROXIMATE AND ARE NOT GUARANTEED TO BE ACCURATE, NOR IS IT GUARANTEED THAT ALL UTILITIES ARE SHOWN. NO SEPARATE OR ADDITIONAL COMPENSATION WILL BE ALLOWED TO THE CONTRACTOR DUE TO THE VARIANCE BETWEEN THE DATA SHOWN ON THE PLANS AND THE ACTUAL FIELD CONDITIONS ENCOUNTERED.
54. ANY NECESSARY FINE GRADING OR COMPACTION OF EXISTING GRAVEL SHALL NOT BE PAID FOR SEPARATELY AND SHALL BE INCIDENTAL TO ITEM 304.10.
55. PAVEMENT CUT LINES SHALL BE NEAT, CLEAN, AND STRAIGHT AS DIRECTED BY THE RESIDENT. PAYMENT FOR CUTTING OF EXISTING PAVEMENT SHALL BE INCIDENTAL TO ITEM 403.
56. PAYMENT FOR PAVEMENT REMOVAL WHERE SHOWN ON THE PLANS SHALL BE PAID FOR UNDER ITEM 203.20 COMMON EXCAVATION.
57. PAVEMENT MARKING SHALL BE IN ACCORDANCE WITH THE "MANUAL ON UNIFORM TRAFFIC CONTROL DEVICES FOR STREETS AND HIGHWAYS," U.S.D.O.T., F.H.W.A., LATEST EDITION.
58. FOLLOW STANDARD DETAIL 801(10) FOR PAVEMENT TRANSITION AT BRIDGE.



STATE OF MAINE DEPARTMENT OF TRANSPORTATION	IM-1108(600) EXIT 15		CM-1749(000)X PARK & RIDE LOT		WIN 11086.00 EXIT 15		WIN 17490.00 PARK & RIDE LOT			
YARMOUTH I-295 EXIT 15 GENERAL NOTES	PROJ. MANAGER	DESIGN-DETAILED	CHECKED-REVIEWED	DESIGNED-DETAILED	DESIGNED-DETAILED	REVISIONS 1	REVISIONS 2	REVISIONS 3	REVISIONS 4	FIELD CHANGES
	DATE	BY								
SHEET NUMBER		15								
OF 283										

As-Built by J.P. Dwyer Dec 2013


SB ON 497+75 LT. 1 EA.
SB ON 523+15 LT. 1 EA

~~472~~

As-Builts by T.P. Dyer Dec. 2013

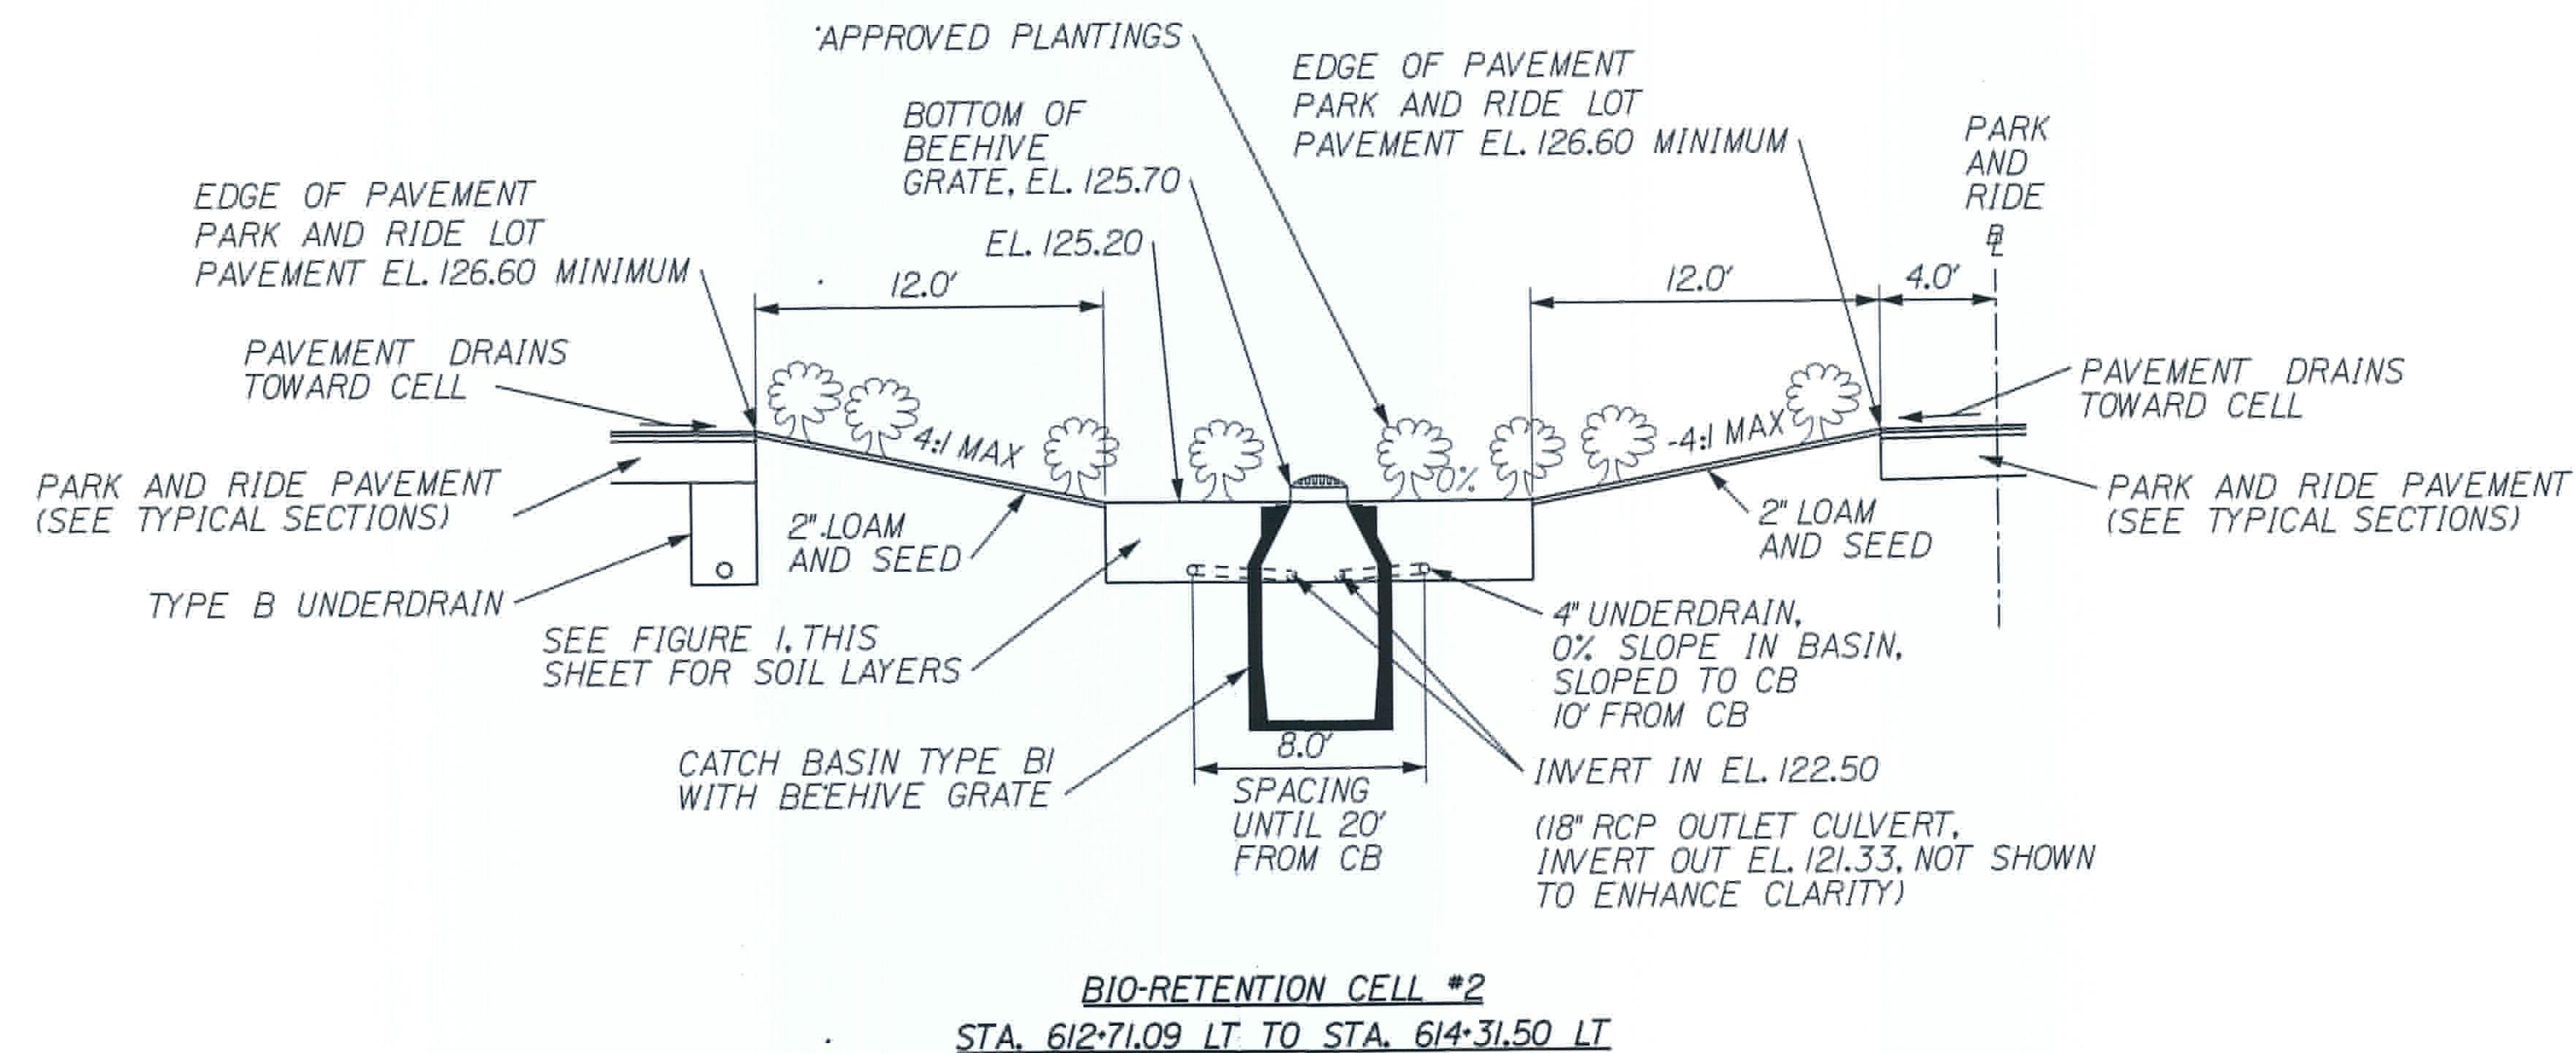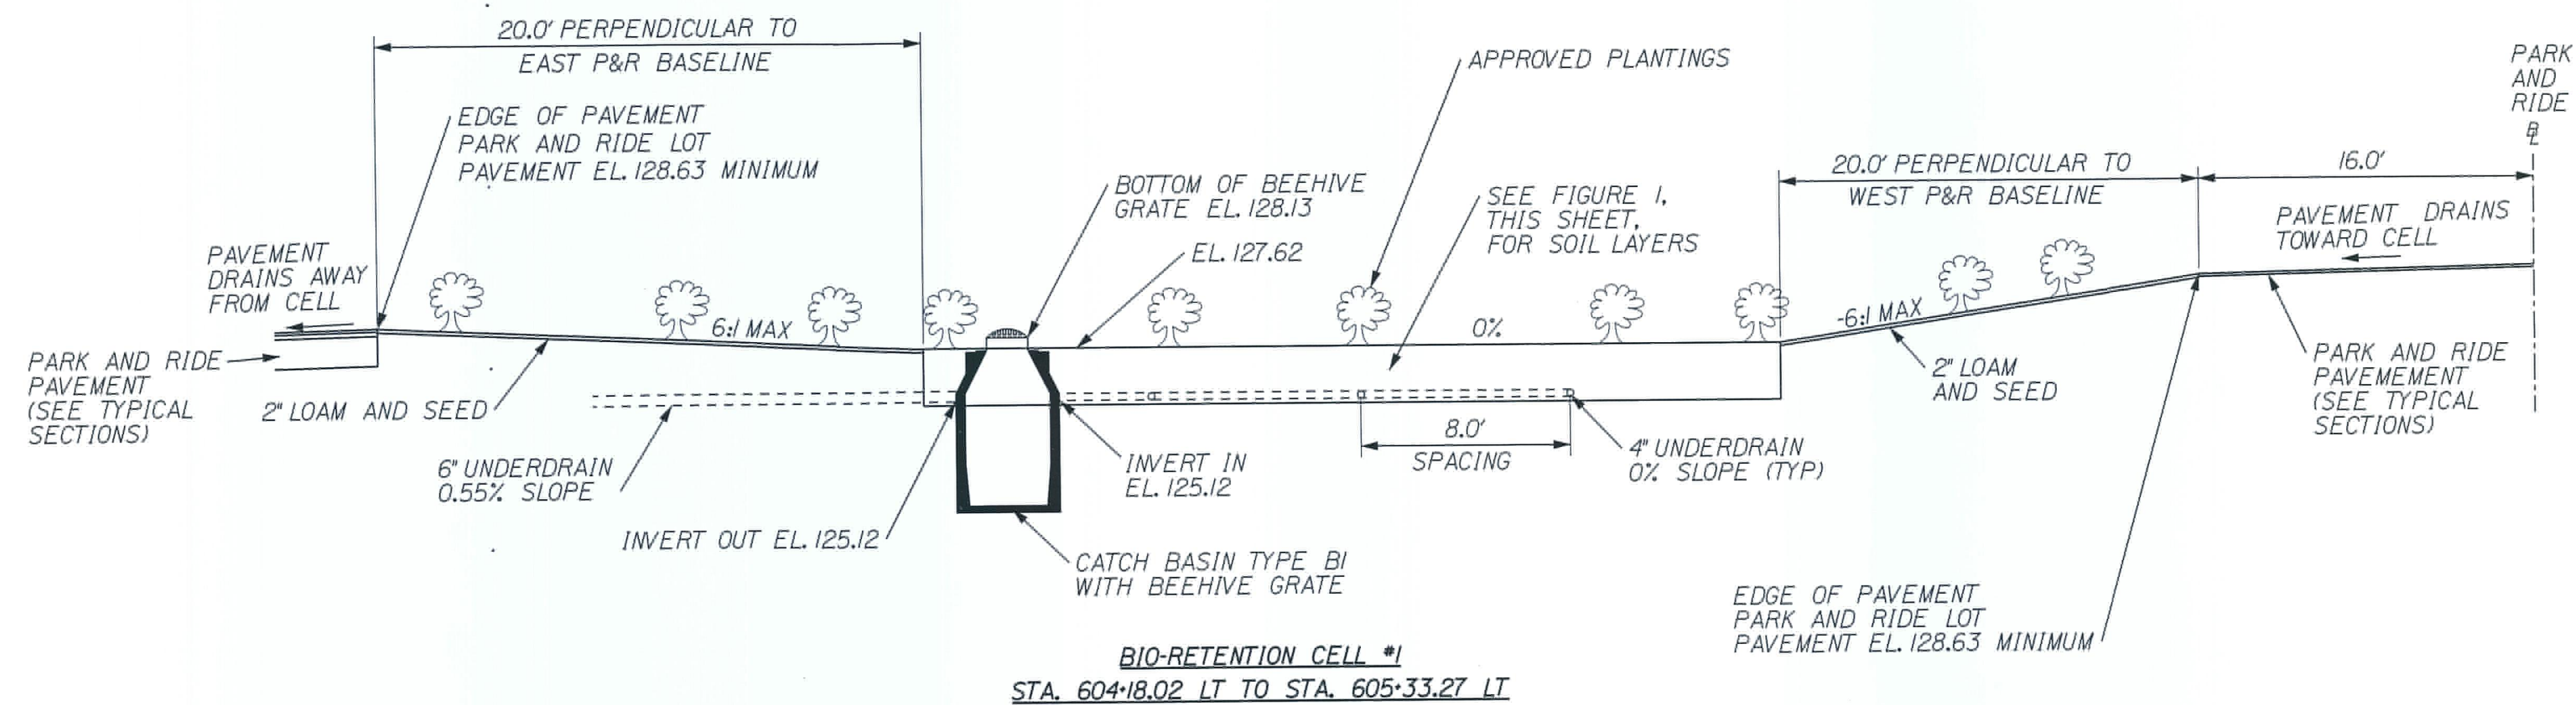

NOTE: IN EACH TREATMENT CELL PROVIDE CLEANOUTS FOR EACH 4" LINE AT THE FARTHEST POINT FROM THE CATCH BASIN

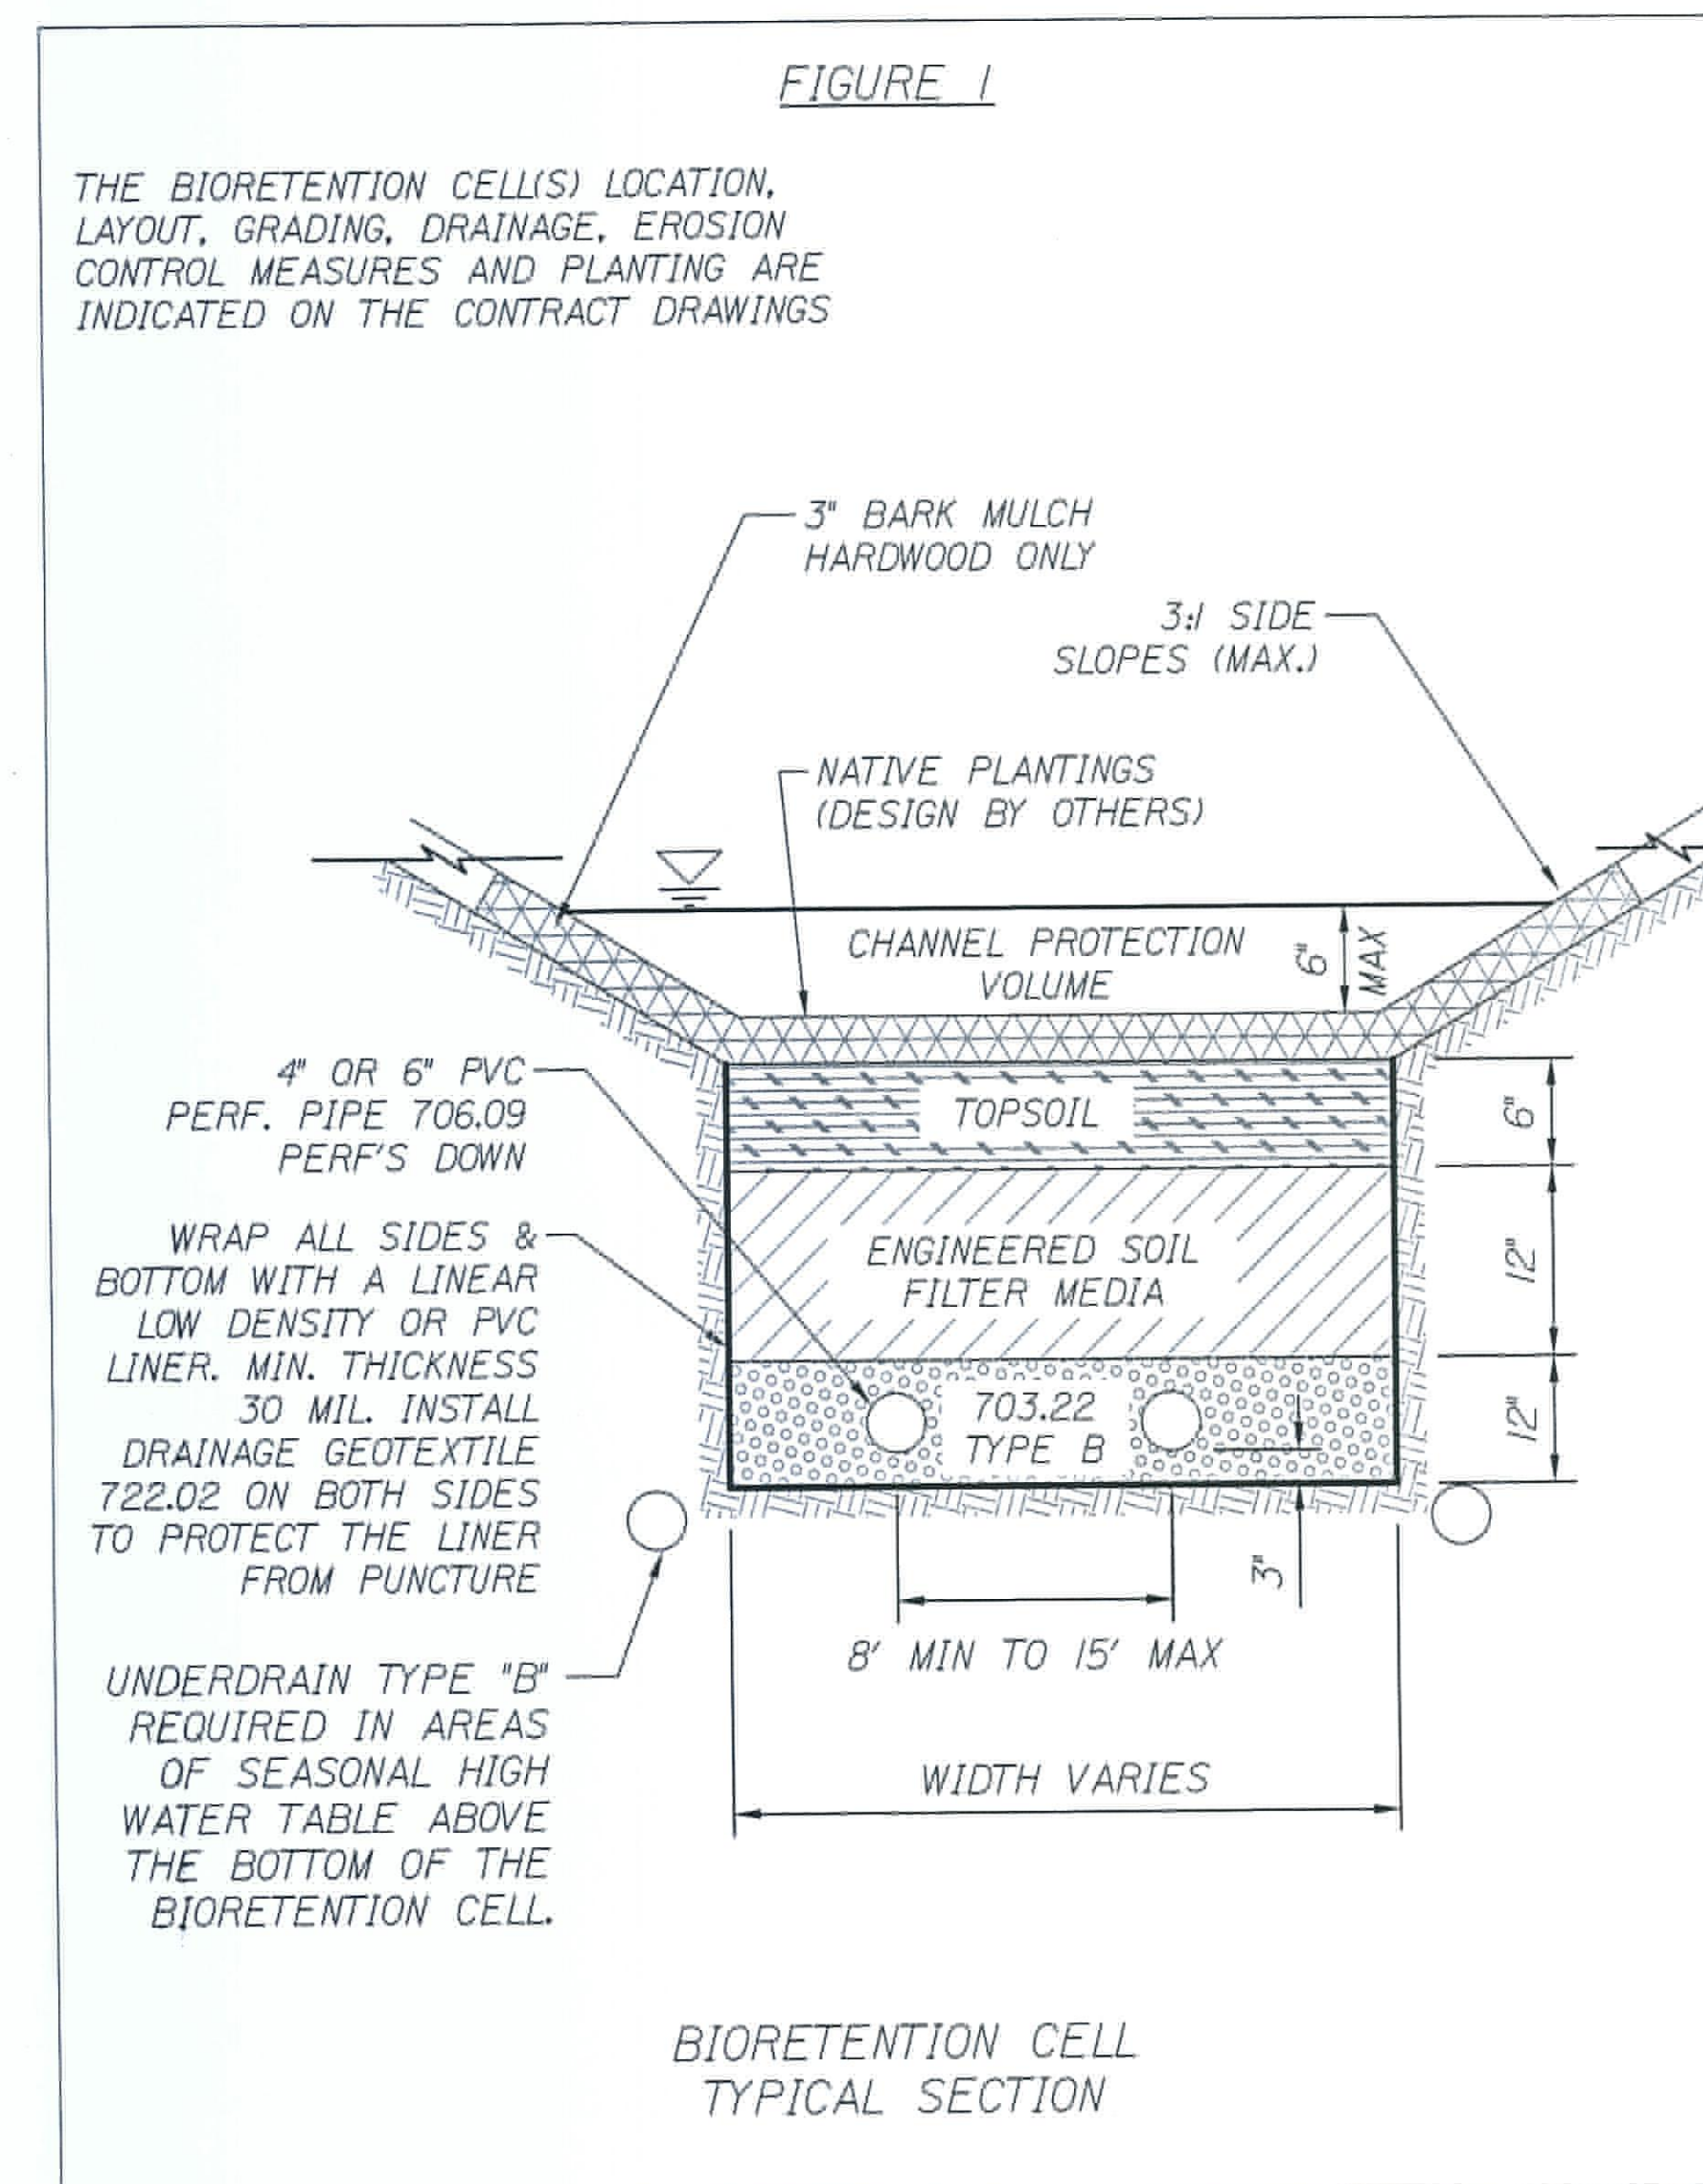

STATE OF MAINE
DEPARTMENT OF TRANSPORTATION
IM-1108(600) EXIT 15
CM-1749(000)X PARK & RIDE LOT
WIN 11086.00 EXIT 15 HIGHWAY PLANS
WIN 17490.00 PARK & RIDE LOT

PROJ. MANAGER	DATE	BY	SIGNATURE	P.E. NUMBER	DATE
DESIGN-DETAILED					
CHECKED-REVIEWED					
DESIGN-DETAILED					
DESIGN-DETAILED					
REVISIONS 1					
REVISIONS 2					
REVISIONS 3					
REVISIONS 4					
FIELD CHANGES					

YARMOUTH
I-295 EXIT 15
DRAINAGE DETAILS

SHEET NUMBER

17


OF 283

Date:2/21/2011

Username: COMMON


Division: HIGHWAY

Filename:


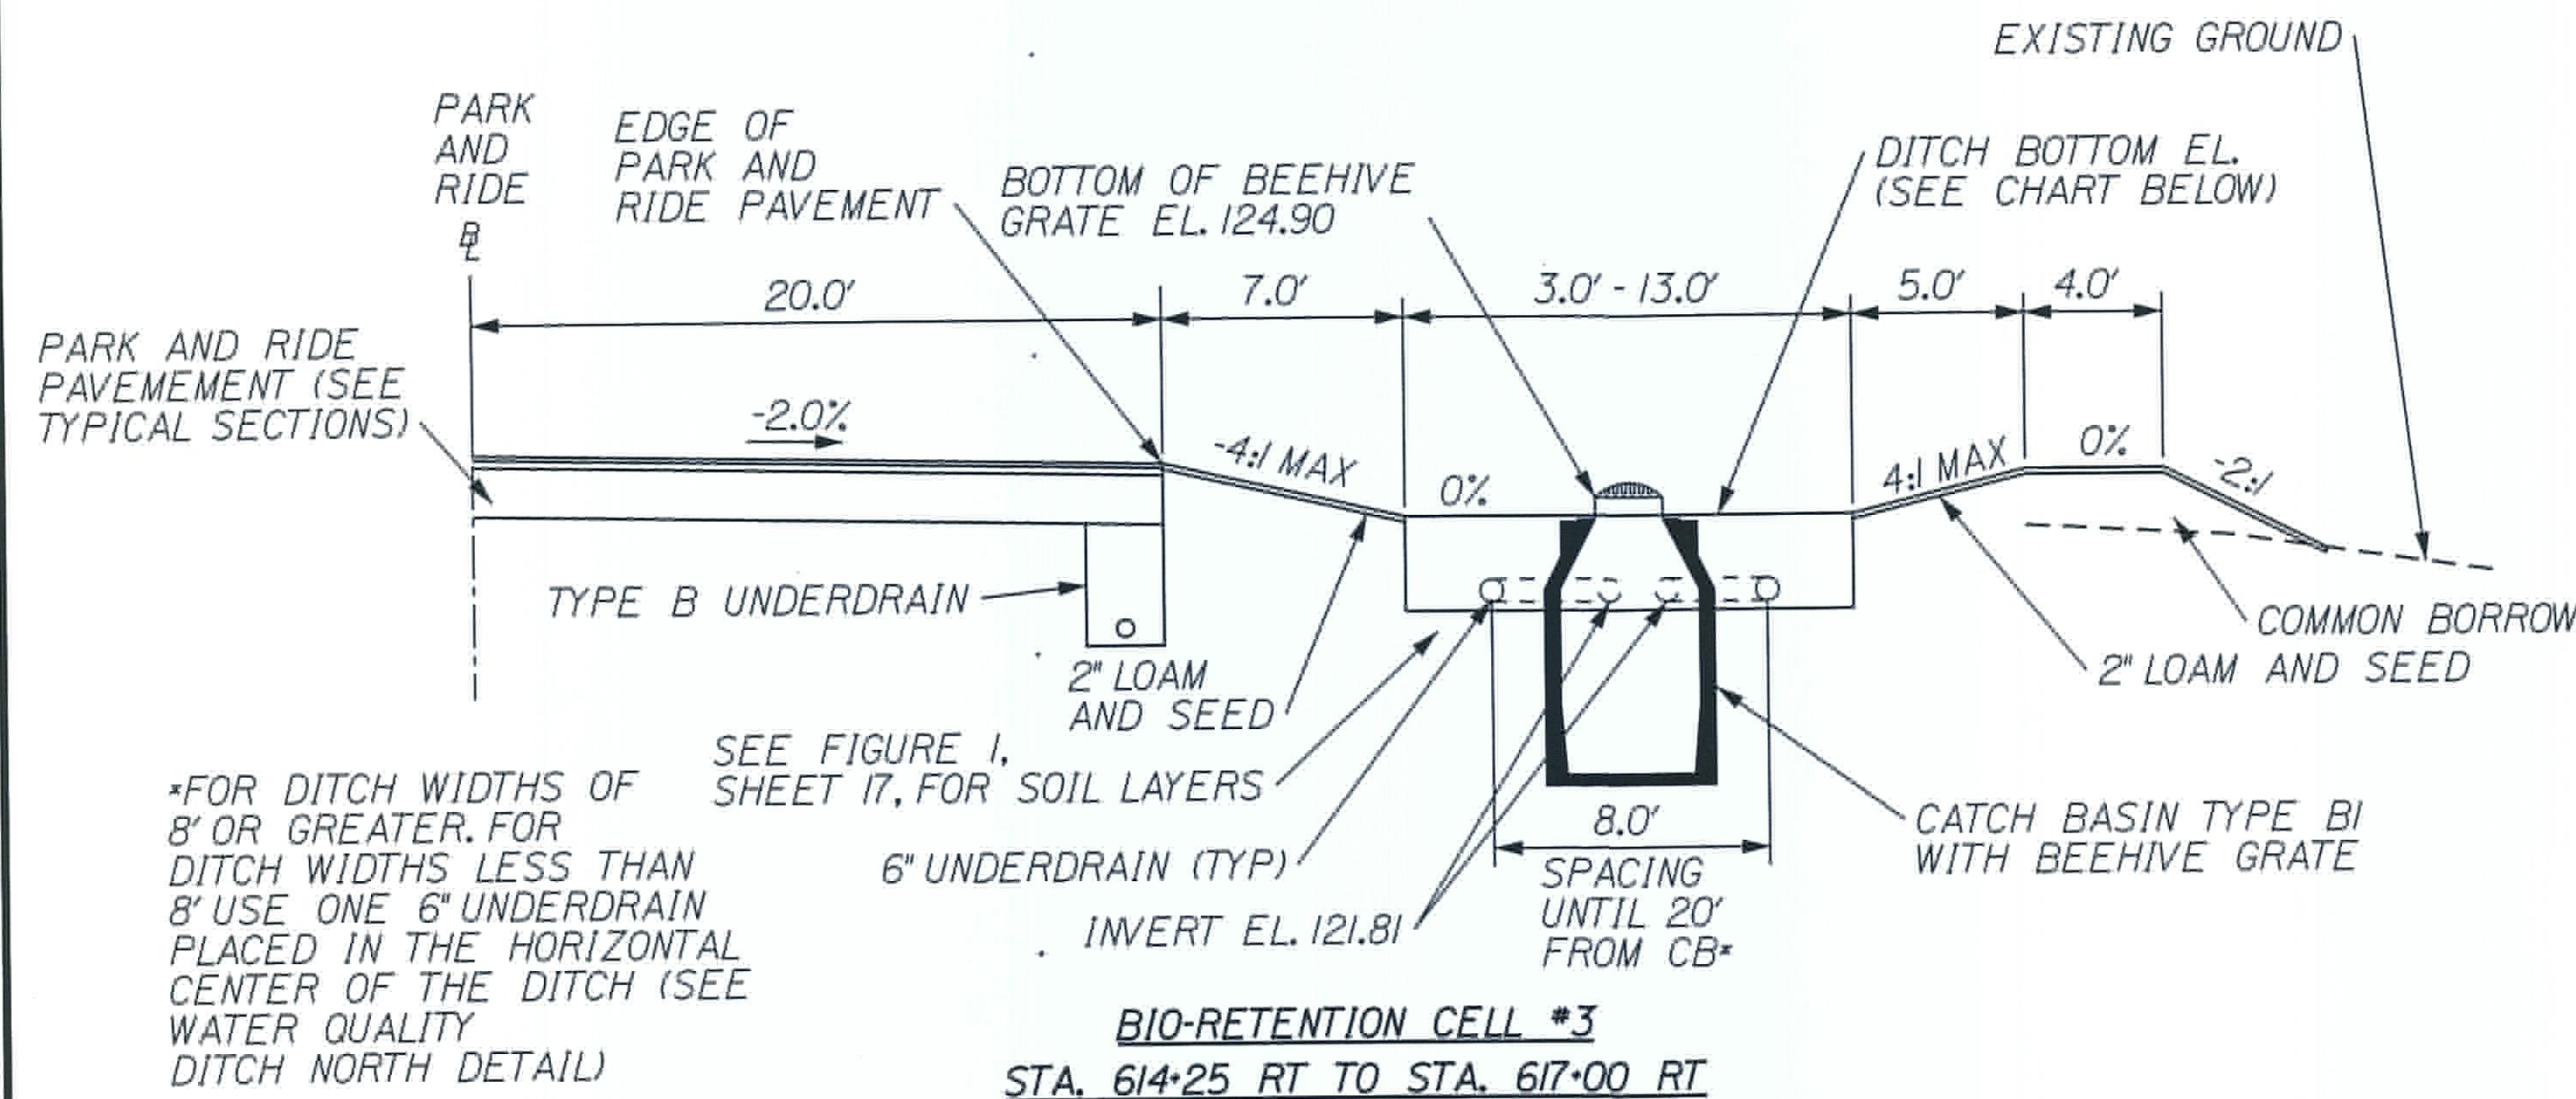


(18" RCP INLET AND OUTLET CULVERTS, INVERTS 120.85, NOT SHOWN TO ENHANCE CLARITY)

WATER QUALITY DITCH BOTTOM ELEVATIONS		
STATION, OFFSET	ELEVATION	SLOPE DOWNSTATION
621+75, 28.5 RT	127.64	-0.24%
621+25, 28.5 RT	127.51	-0.24%
620+75, 28.5 RT	127.37	-0.50%
620+25, 28.5 RT	127.13	-0.50%
619+75, 28.5 RT	126.90	-0.50%
619+25, 28.5 RT	126.68	-0.50%
618+75, 28.5 RT	126.45	-0.50%
618+25, 28.5 RT	126.23	-0.50%
617+75, 28.5 RT	125.98	-0.50%
617+25, 28.5 RT	125.69	-0.50%
616+75, 28.5 RT	125.41	-0.50%
616+25, 28.5 RT	125.16	-0.50%
615+75, 28.5 RT	124.91	-0.50%
615+25, 28.5 RT	124.66	-0.50%
614+75, 28.5 RT	124.39	-0.50%
614+25, 28.5 RT	124.72	

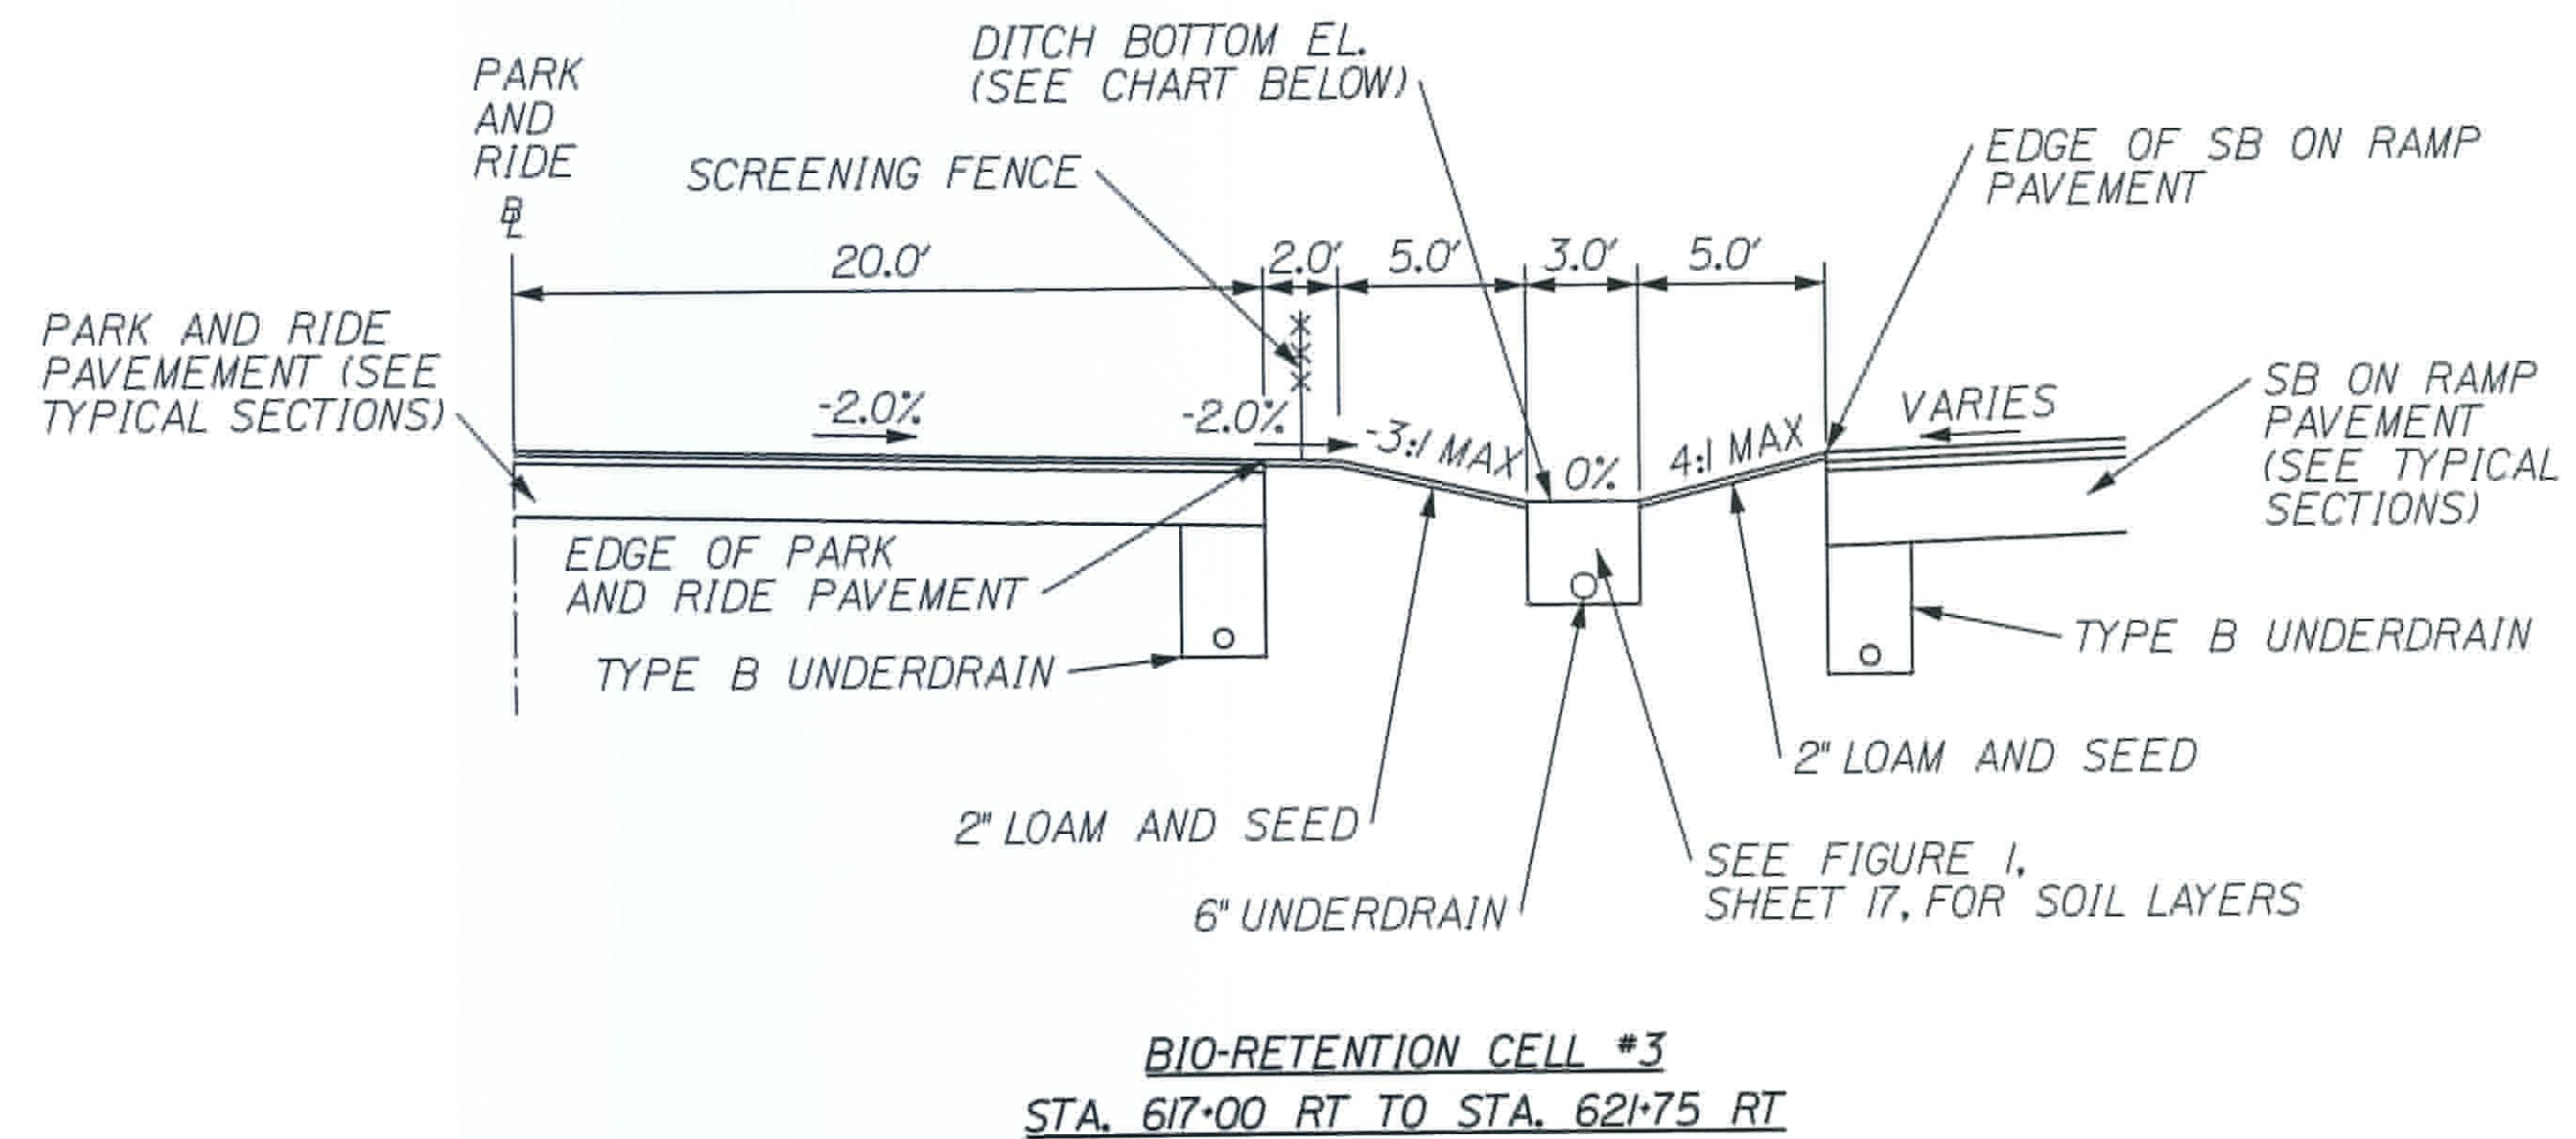


STATE OF MAINE	DEPARTMENT OF TRANSPORTATION	IM-1108(600) EXIT 15	CM-1749(000)X PARK & RIDE LOT	WIN 11086.00 EXIT 15 HIGHWAY PLANS	WIN 17490.00 PARK & RIDE LOT
YARMOUTH I-295 EXIT 15 DRAINAGE DETAILS		PROJECT MANAGER	CHECKED-REVIEWED	DESIGNER-DETAILED	DESIGNER-DETAILED
		BY	DATE	SIGNATURE	P.E. NUMBER
					DATE
		REVISIONS 1			
		REVISIONS 2			
		REVISIONS 3			
		REVISIONS 4			
		FIELD CHANGES			
SHEET NUMBER		18			
		OF 283			

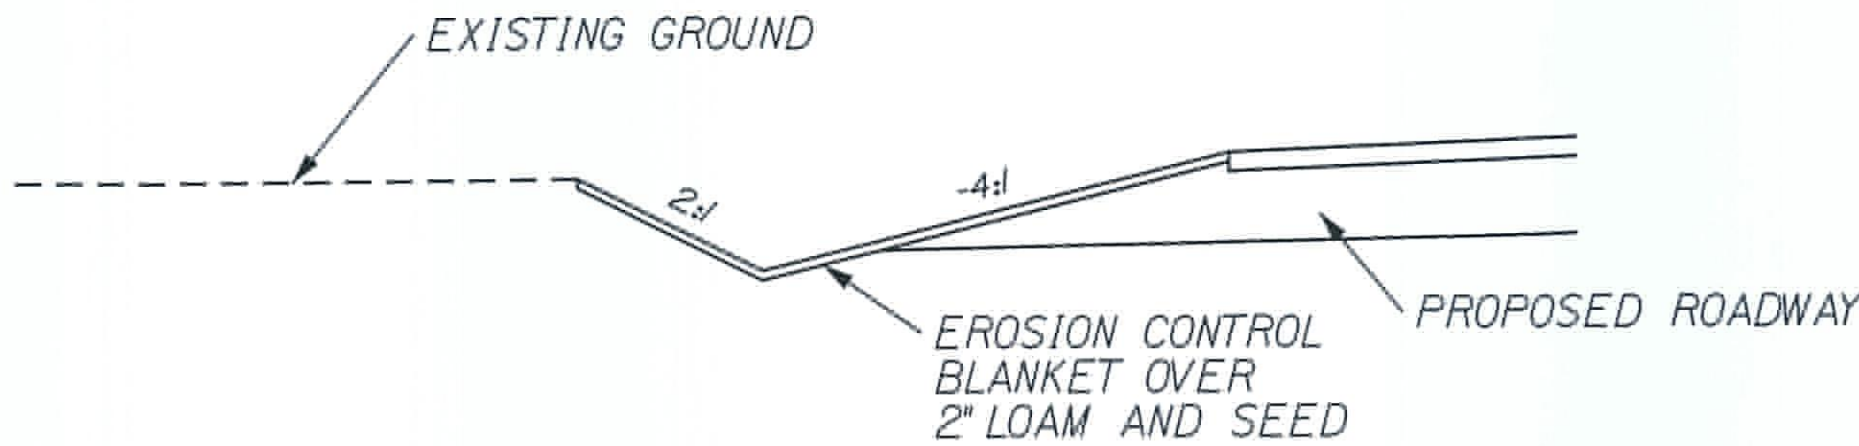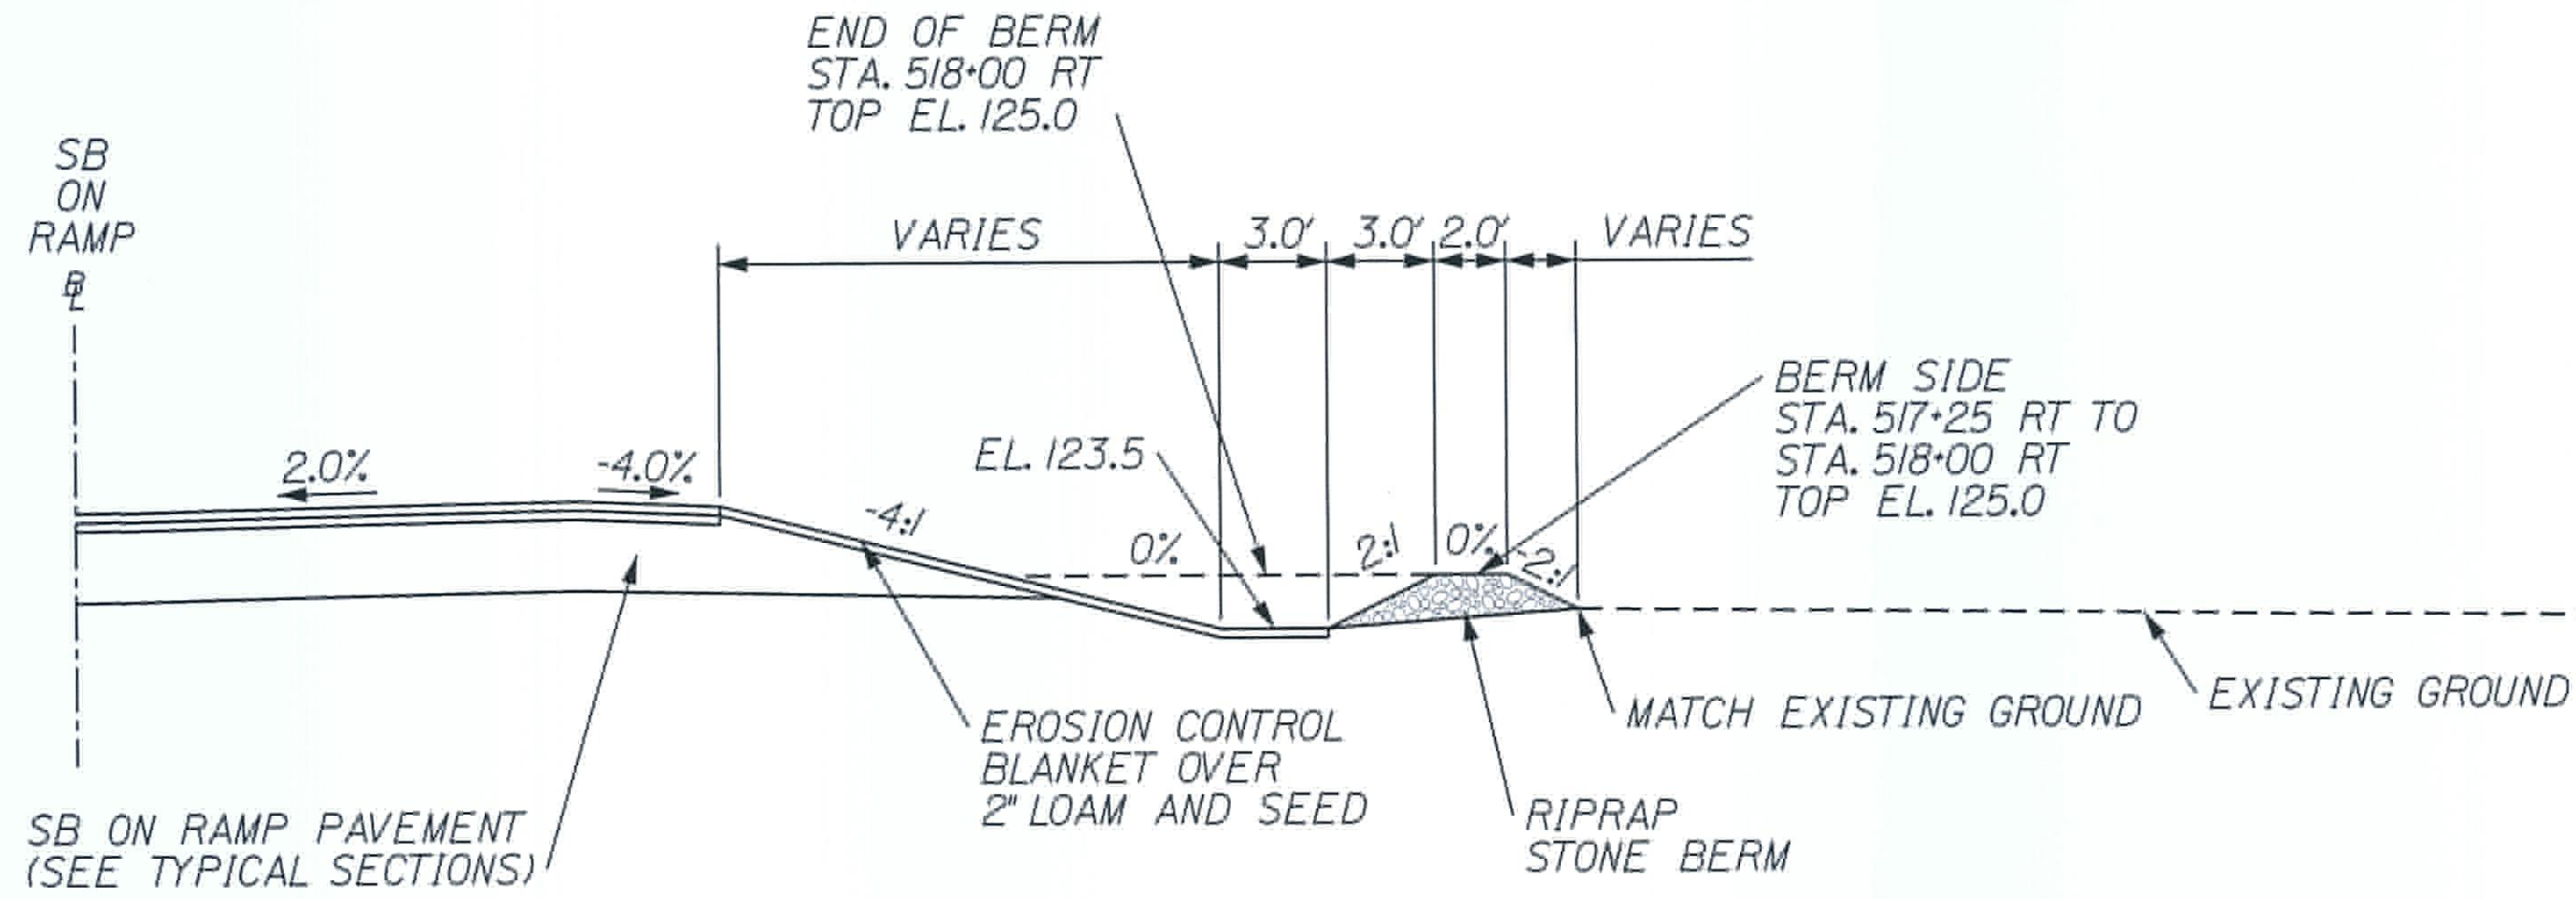


VEGETATIVE DITCH TREATMENT
FOR DITCHES WITH SLOPES
GREATER THAN 5%

STATE OF MAINE DEPARTMENT OF TRANSPORTATION		IM-1108(600) EXIT 15		SIGNATURE	BY	DATE
		CM-1749(000)X PARK & RIDE LOT		P.E. NUMBER		
		WIN 11086.00 EXIT 15 HIGHWAY PLANS		DATE		
YARMOUTH I-295 EXIT 15		DRAINAGE DETAILS				
SHEET NUMBER 19 OF 283						

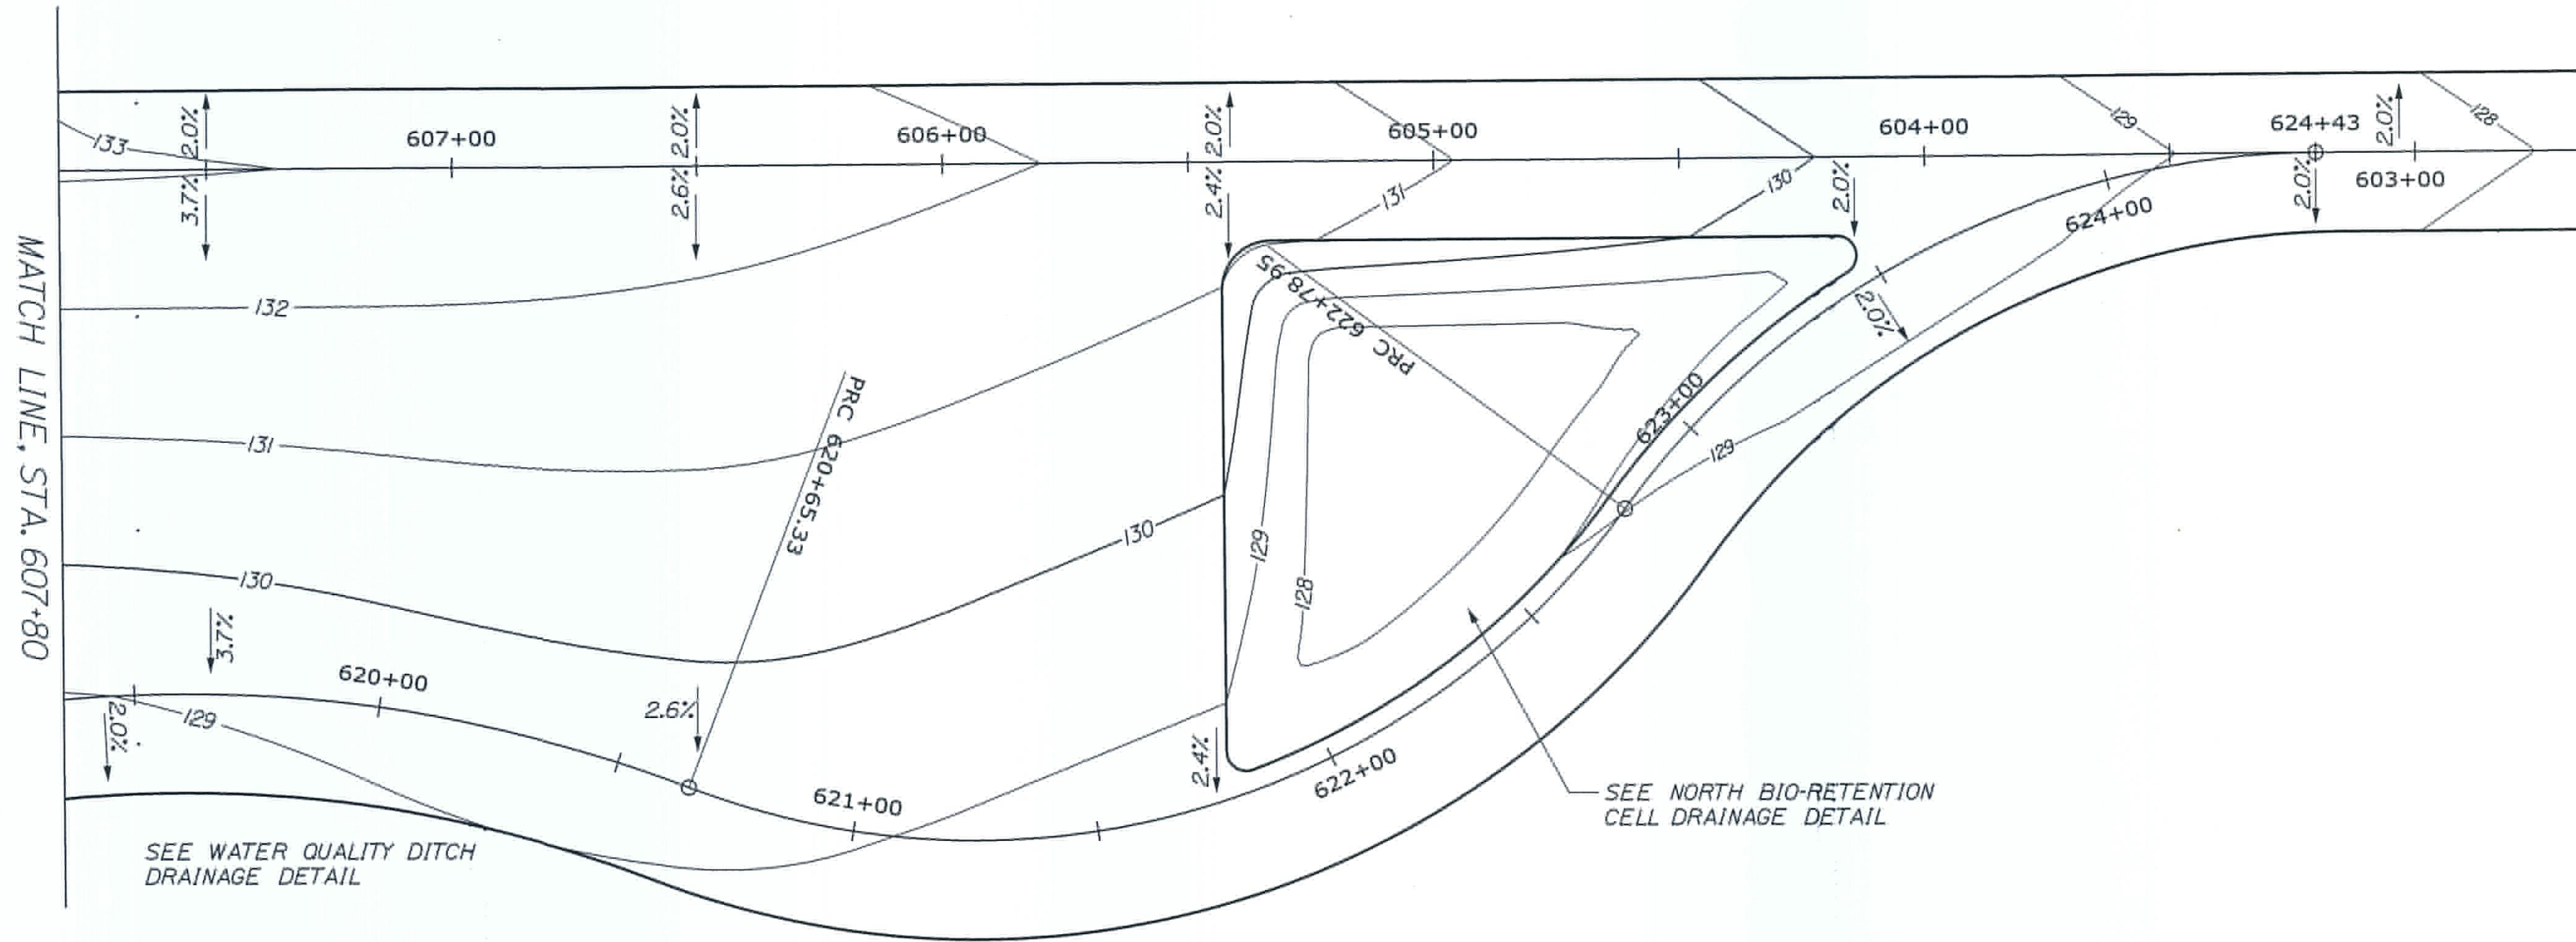

SEE SOUTH BIO-RETENTION
CELL DRAINAGE DETAIL

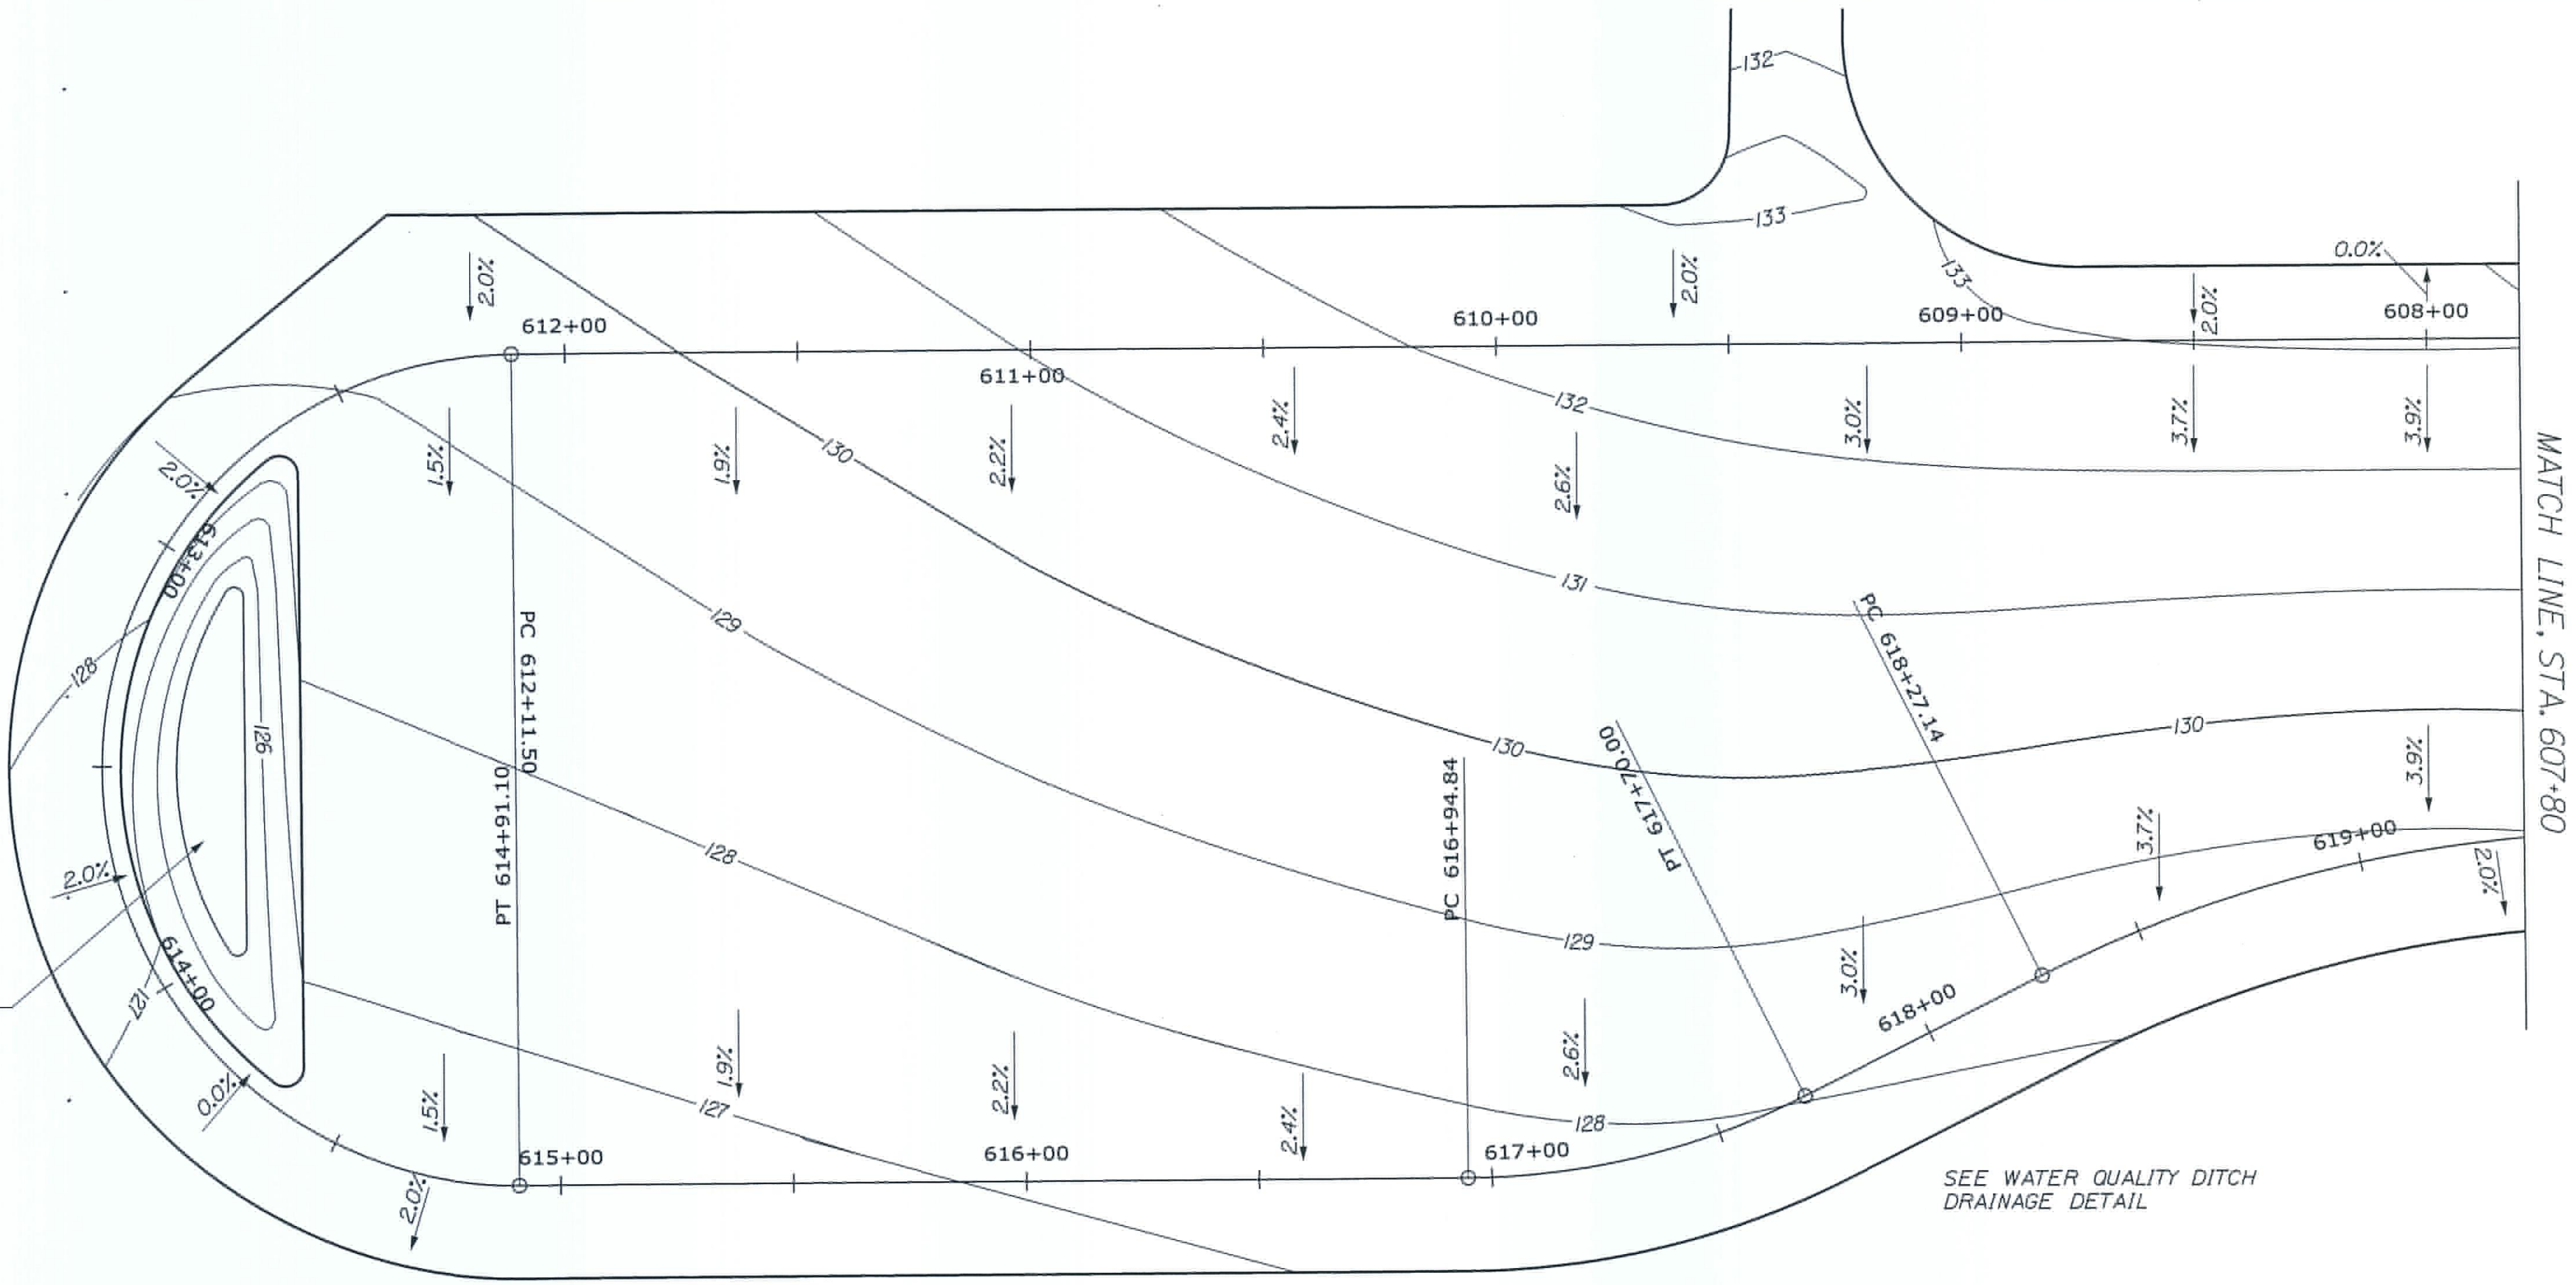

MATCH LINE, STA. 607+80

SHEET NUMBER

20

OF 283

YARMOUTH
I-295 EXIT 15

PARK & RIDE GRADING PLAN

STATE OF MAINE
DEPARTMENT OF TRANSPORTATION
IM-1108(600) EXIT 15
CM-1749(000)X PARK & RIDE LOT
WIN 11806.00 EXIT 15 HIGHWAY PLANS
WIN 17490.00 PARK & RIDE LOT

PRG. MANAGER	DATE	BY	SIGNATURE
DESIGN-DETAILED			
CHECKED-REVIEWED			
DESIGN-DETAILED			
DESIGN-DETAILED			
REVISIONS 1			
REVISIONS 2			
REVISIONS 3			
REVISIONS 4			
FIELD CHANGES			

GENERAL NOTES:

1. THE CRITERIA ON THIS SHEET ARE MINIMUM CRITERIA. THE CONTRACTOR SHALL USE OTHER CRITERIA, AS NECESSARY, TO COMPLETE THE WORK IN ACCORDANCE WITH THE CONTRACT REQUIREMENTS. THE PERMANENT SOIL NAIL RETAINING WALL SHALL BE DESIGNED BY THE CONTRACTOR FOR A DESIGN LIFE OF 75 YEARS.
2. THE LIMITS OF THE PERMANENT SOIL NAIL RETAINING WALL ARE SHOWN ON THE DRAWINGS.
3. UNLESS MODIFIED BY THE CONTRACT DRAWINGS AND SPECIFICATIONS, THE STRUCTURAL DESIGN AND ALLOWABLE UNIT STRESSES SHALL BE GOVERNED BY THE CURRENT EDITIONS OF THE FOLLOWING MANUALS, CODES, OR SPECIFICATIONS, AND SHALL BE CONSIDERED PART OF THE SPECIFICATIONS.

GENERAL:

GEOTECHNICAL ENGINEERING CIRCULAR NO. 7, SOIL NAIL WALLS, REPORT NO. FHWA-IF-03-017.

STEEL:

SPECIFICATIONS FOR THE DESIGN, FABRICATION, AND ERECTIONS OF STRUCTURAL STEEL FOR BUILDINGS AND *THE MANUAL OF STEEL CONSTRUCTION* (ASD EDITION), THE AMERICAN INSTITUTE FOR STEEL CONSTRUCTION.

WELDING:

STRUCTURAL STEEL WELDING CODE STEEL, ANSI/AWS D1.1 OF THE AMERICAN WELDING SOCIETY, INC.

REINFORCED CONCRETE:

BUILDING CODE REQUIREMENTS FOR REINFORCED CONCRETE, ACI 318 OF THE AMERICAN CONCRETE INSTITUTE.

ANALYSIS AND DESIGN:

1. DESIGN OF THE PERMANENT SOIL NAIL RETAINING WALL SHALL BE COMPLETED IN ACCORDANCE WITH SPECIAL PROVISION 636. DESIGN OF SOIL NAIL WALL AND WILL BE PAID FOR UNDER ITEM NO. 636.40.
2. THE PERMANENT SOIL NAIL RETAINING WALL SHALL BE DESIGNED USING THE PROCEDURES CONTAINED IN THE FEDERAL HIGHWAY ADMINISTRATION "GEOTECHNICAL ENGINEERING CIRCULAR NO. 7, SOIL NAIL WALLS," REPORT NO. FHWA-IF-03-017, DATED MARCH 2003, AND THE RECOMMENDATIONS INCLUDED IN THE GEOTECHNICAL DESIGN REPORT PREPARED BY HALEY & ALDRICH, INC. ENTITLED "GEOTECHNICAL DESIGN REPORT, INTERSTATE 295/U.S. ROUTE 1 INTERCHANGE IMPROVEMENTS, MAINE DOT PIN 11086.00, YARMOUTH, MAINE."
3. THE DESIGN OF THE PERMANENT SOIL NAIL RETAINING WALL SYSTEM SHALL SATISFY THE MOST CRITICAL CONDITIONS ANTICIPATED DURING BOTH THE TEMPORARY CONSTRUCTION SEQUENCE AND PERMANENT OPERATION OF THE SYSTEM.
4. THE CONTRACTOR SHALL SUBMIT THE FOLLOWING INFORMATION, STAMPED AND SIGNED BY A LICENSED PROFESSIONAL ENGINEER IN THE STATE OF MAINE: WRITTEN DESCRIPTION OF THE INTENDED SEQUENCE OF CONSTRUCTION, PLAN LIMITS OF THE SYSTEM, CROSS SECTIONS OF EACH DESIGN SECTION, DETAILS OF SOIL NAILS AND ANCHOR HEADS, AND DESIGN CALCULATIONS FOR THE COMPLETE SYSTEM.
5. VARIOUS DESIGN CASES SHALL BE DETERMINED BY COMBINING TOGETHER THE LOADING CONDITIONS FOR SOIL, SURCHARGES, AND SEISMIC LOADINGS.
6. THE FOLLOWING ENGINEERING PROPERTIES SHALL BE ASSUMED FOR SOILS PRESENT AT THE SITE:

SOIL UNIT	TOTAL UNIT WEIGHT (PCF)	INTERNAL ANGLE OF FRICTION (DEGREES)	COHESION (LB/SQFT)
FILL	120	28	NA
MARINE SAND	115	30	NA
MARINE CLAY	115	NA	500


7. THE PERMANENT SOIL NAIL RETAINING WALL SHALL BE ANALYZED/DESIGNED FOR MINIMUM LATERAL PRESSURES DUE TO TRAFFIC AND CONSTRUCTION EQUIPMENT BASED ON AN ASSUMED SURFACE SURCHARGE EQUAL TO 250 POUNDS PER SQUARE FOOT (PSF) ACTING OVER A 20-FT WIDE INFLUENCE AREA. THE CONTRACTOR SHALL DETERMINE IF THE 250 PSF VERTICAL SURCHARGE LOAD IS SUFFICIENT. THE CONTRACTOR SHALL ALSO ACCOUNT FOR CRITICAL SURCHARGE LOADING CONDITIONS NOT DESCRIBED HEREIN, WHICH MAY INCLUDE POINT LOADS OR UNIFORM LINE OR STRIP LOADS RESULTING FROM CRANES OR MATERIAL STOCKPILES. IF ADDITIONAL CONSTRUCTION SURCHARGE LOADS ARE ANTICIPATED EITHER ON TOP OF THE SOIL NAIL RETAINING WALL AND/OR ON TOP OF THE ROUTE 1 EMBANKMENT, THESE SURCHARGE LOADS SHALL ALSO BE INCLUDED IN THE ANALYSIS/DESIGN.
8. THE DESIGN OF THE SOIL NAIL RETAINING WALL SYSTEM SHALL INCLUDE ACCOMMODATIONS FOR THE DESIGN PHREATIC SURFACE.
9. THE DESIGN OF ALL STRUCTURAL COMPONENTS OF THE PERMANENT SOIL NAIL RETAINING WALL SYSTEM SHALL INCLUDE THE SEISMIC LOADING CONDITION.
10. THE EXCAVATION DEPTH SHALL BE DEFINED AS A VERTICAL DISTANCE FROM THE LOWEST EXCAVATION TO THE HIGHEST GROUND SURFACE ELEVATION BEHIND THE PERMANENT SOIL NAIL RETAINING WALL.

SOIL NAILS:

1. NAIL BARS SHALL BE EPOXY COATED.
2. THE FOLLOWING TOLERANCES SHALL BE STRICTLY ADHERED TO:

ELEVATIONS: +/- 0.1 FT
WALL HEIGHT: +/- 0.1 FT

3. EXCAVATION TO THE FINAL WALL EXCAVATION FACE SHALL BE PERFORMED USING PROCEDURES THAT: (1) PREVENT GROUND LOSS, SWELLING, AIR SLAKING, OR LOOSENING; (2) MINIMIZE DEGRADATION OF SOIL BEARING SUPPORT BELOW THE OVERLYING PORTIONS OF THE SOIL NAIL WALL AND BELOW THE SOIL NAILS CURRENTLY BEING INSTALLED; (3) PREVENT PREMATURE LOSS OF SOIL MOISTURE AT THE FACE; (4) PREVENT GROUND FREEZING; (5) PREVENT POTENTIAL FOR SHOTCRETE OVERAGES; (6) MINIMIZE GROUNDWATER SEEPAGE FROM THE EXCAVATED FACE; AND (7) MAINTAIN SATISFACTORY MOISTURE CONTROL OF EXCAVATED FACE TO ALLOW PROPER PLACEMENT OF SHOTCRETE.
4. LOSS OF GROUND AS A RESULT OF SLOUGHING OR RAVELING OF THE EXCAVATED FACE SHALL NOT BE PERMITTED.
5. PROVIDE CONTRACTION AND EXPANSION JOINTS IN ACCORDANCE WITH ACI 506.2-90 (SPECIFICATION OF SHOTCRETE) SECTION 3.6 AND ACI 506R-90 (GUIDE TO SHOTCRETE) SECTION 5.7.
6. PRIOR TO SHOTCRETING THE SOIL SURFACE, CLEAN ALL SURFACES OF LOOSE MATERIAL.
7. PROVIDE 3 IN. (MINIMUM) CLEAR COVER AROUND ALL REBAR.
8. SOIL NAILS SHALL BE INSTALLED USING ROTARY/ROTARY PERCUSSIVE DRILLING. AIR OR WATER SHALL BE USED TO FLUSH CUTTINGS FROM DRILL HOLES AS THE HOLE IS ADVANCE. CASING SHALL BE EMPLOYED FOR FULL SOIL NAIL LENGTH. THE DRILLHOLE DIAMETER SHALL BE SELECTED TO PROVIDE A MINIMUM OF 1.5 INCHES OF GROUT COVER OVER AN EPOXY-COATED SOIL NAIL BAR; AND TO DEVELOP THE REQUIRED SOIL-GROUT BOND STRENGTH. IT IS THE CONTRACTOR'S RESPONSIBILITY TO DETERMINE THE FINAL DRILLHOLE DIAMETER REQUIRED TO PROVIDE THE ULTIMATE SOIL-GROUT BOND STRENGTH VALUE REQUIRED BY THE SOIL NAIL WALL DESIGN. THE DRILLHOLE SHALL BE DRILLED TO THE DEPTHS INDICATED ON THE CONTRACTOR'S PLANS TO ACCOMMODATE THE REQUIRED LENGTH OF SOIL NAIL. UPON REACHING THE DESIGN DEPTH, INSERT THE NAIL BAR AND TREMIE GROUT THE DRILLHOLE FROM THE BOTTOM. A FULL HEAD OF GROUT SHALL BE MAINTAINED DURING WITHDRAWAL OF CASING TO ENSURE COMPLETE FILLING OF THE DRILLHOLE. ALL HOLES DRILLED EACH DAY SHALL BE GROUTED THE SAME DAY.
9. THE EARTH FACE SHALL BE TRIMMED TO THE TOLERANCES SPECIFIED AND ROLLS OF GEOCOMPOSITE DRAIN STRIPS SUFFICIENT IN LENGTH TO BE CONTINUOUS FOR THE WALL HEIGHT AT EACH LOCATION SHALL BE INSTALLED. THE ROLL SHALL BE UNROLLED AND APPLIED TO THE SOIL FACE, AS NEEDED FOR EACH LIFT. THE REMAINDER OF THE ROLL SHALL BE COLLECTED NEATLY AT THE BASE OF THE WALL. A COVER SHALL BE PLACED OVER THE REMAINING ROLL TO PREVENT REBOUND FROM BONDING TO THE MEDIA DURING SHOTCRETE APPLICATION. "U"-SHAPED BENT PINS SHALL BE USED TO AFFIX THE BOARD TO THE SOIL SURFACE. THEY SHALL WRAP ALL EDGES AND RETURN 6 INCHES ON THE BACK OF THE STRIP OF DRAINAGE MEDIA.
10. SHOTCRETING SHALL BE PERFORMED THE SAME DAY AS THE EXCAVATION OF THE LIFT OR TEMPORARY BERM (IF USED). SHOTCRETING SHALL START FROM THE BASE OF THE EXCAVATION LIFT WORKING UPWARDS. WHENEVER POSSIBLE, THE FULL SECTION SHOULD BE GUNNED TO FULL DESIGN THICKNESS IN ONE LAYER. THE SHOTCRETE THICKNESS DURING GUNNING SHALL BE MONITORED AND APPLIED SUCH THAT SAGS AND SLOUGHS DO NOT FORM.
11. ALL EXTERIOR CORNERS AND EDGES SHALL HAVE A *-IN. CHAMFER AND ALL INTERIOR CORNERS SHALL HAVE A *-IN. FILLET.
12. THE CONTRACTOR IS RESPONSIBLE FOR PROVIDING AND MAINTAINING STABLE SLOPES ABOVE AND BELOW THE SOIL NAIL RETAINING WALL AT ALL TIMES.
13. NO OPEN CUTS STEEPER THAN 1H:1V SHALL BE MADE WITHIN 20 FEET IN FRONT OF THE SOIL NAIL RETAINING WALL WITHOUT APPROVAL OF THE GEOTECHNICAL ENGINEER.
14. THE FINAL CAST-IN-PLACE FACING SHALL HAVE CONTRACTION JOINTS AT MAXIMUM 30-FT SPACING.
15. AT A MINIMUM, THE FINAL CAST-IN-PLACE FACING SHALL CONTAIN TEMPERATURE REINFORCEMENT CONSISTING OF #5 EPOXY COATED REBAR IN A GRID PATTERN WITH AND 18 IN. SPACING.


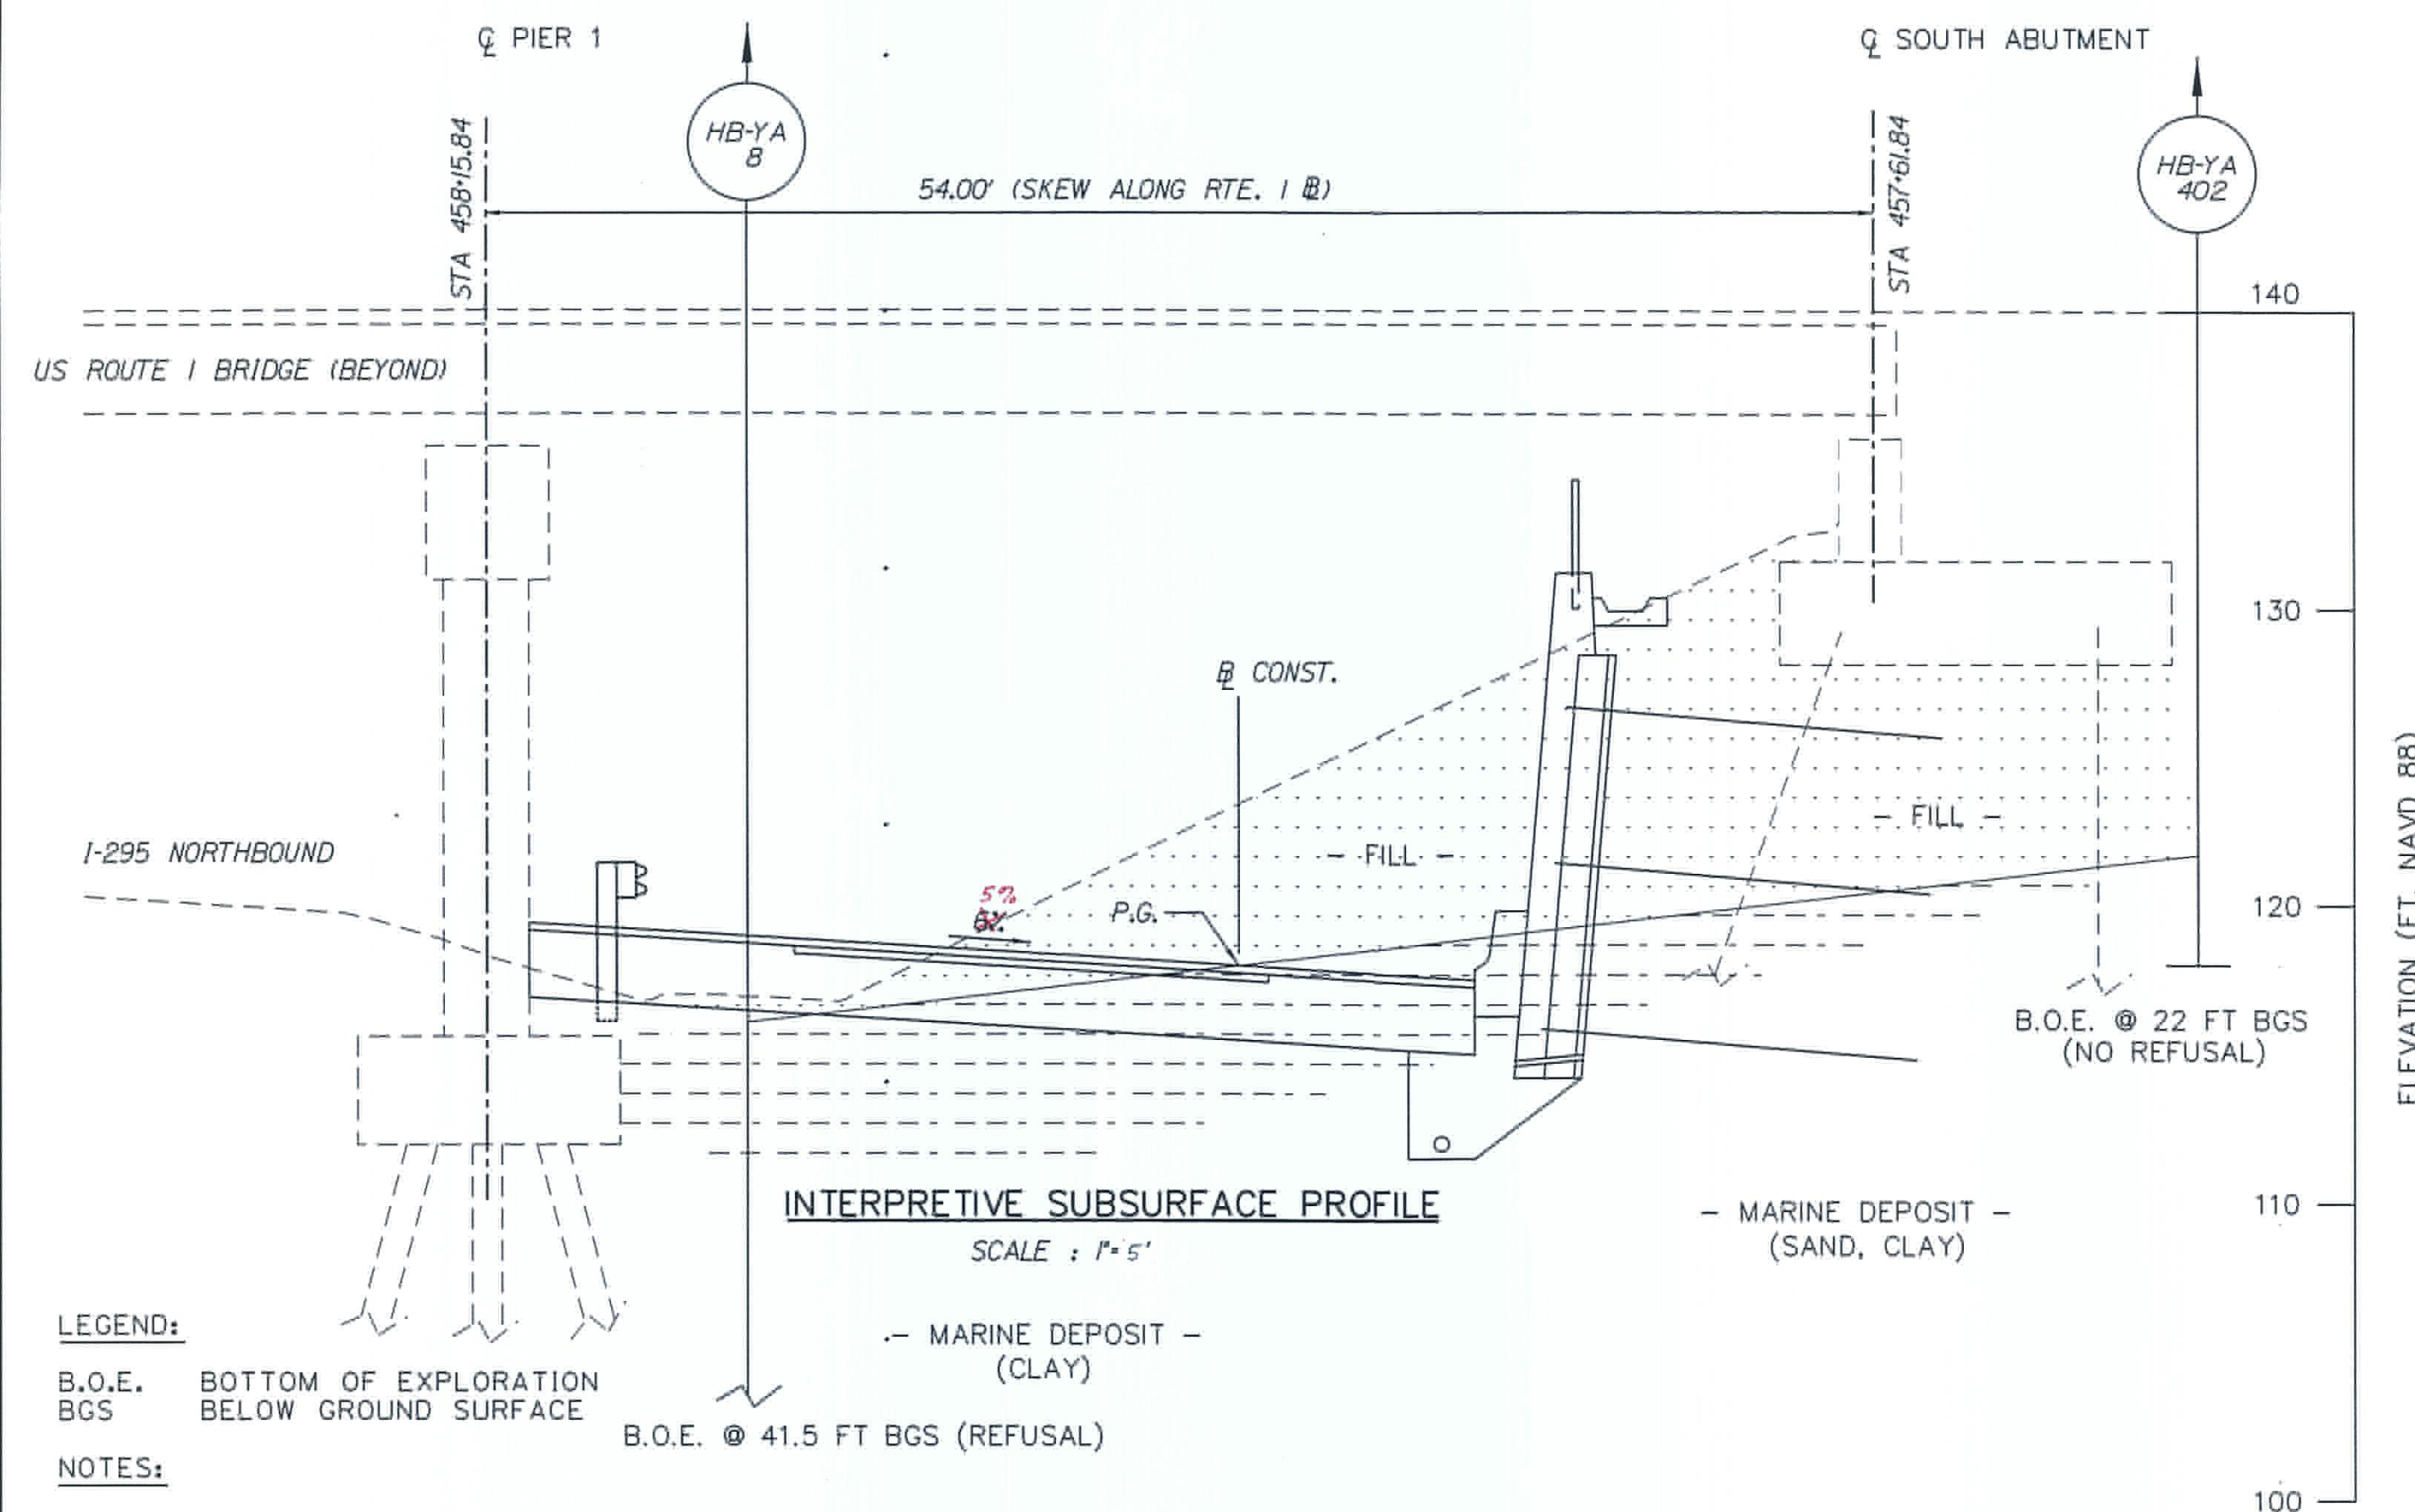


LEGEND:

B.O.E. BOTTOM OF EXPLORATION
BGS BELOW GROUND SURFACE

NOTES:

1. THE PLAN LOCATION AND GROUND SURFACE ELEVATION OF EXPLORATIONS WAS DETERMINED BY MAINEDOT.
2. STRATA LINES ARE APPROXIMATE AND ARE BASED ON LINEAR INTERPOLATION BETWEEN EXPLORATIONS. ACTUAL CONDITIONS WILL VARY.
3. REFER TO THE GEOTECHNICAL DESIGN REPORT PREPARED BY HALEY & ALDRICH, INC. ENTITLED "GEOTECHNICAL DESIGN REPORT, INTERSTATE 295/U.S. ROUTE 1 INTERCHANGE IMPROVEMENTS. MAINEDOT WIN 11086.00, YARMOUTH, MAINE."

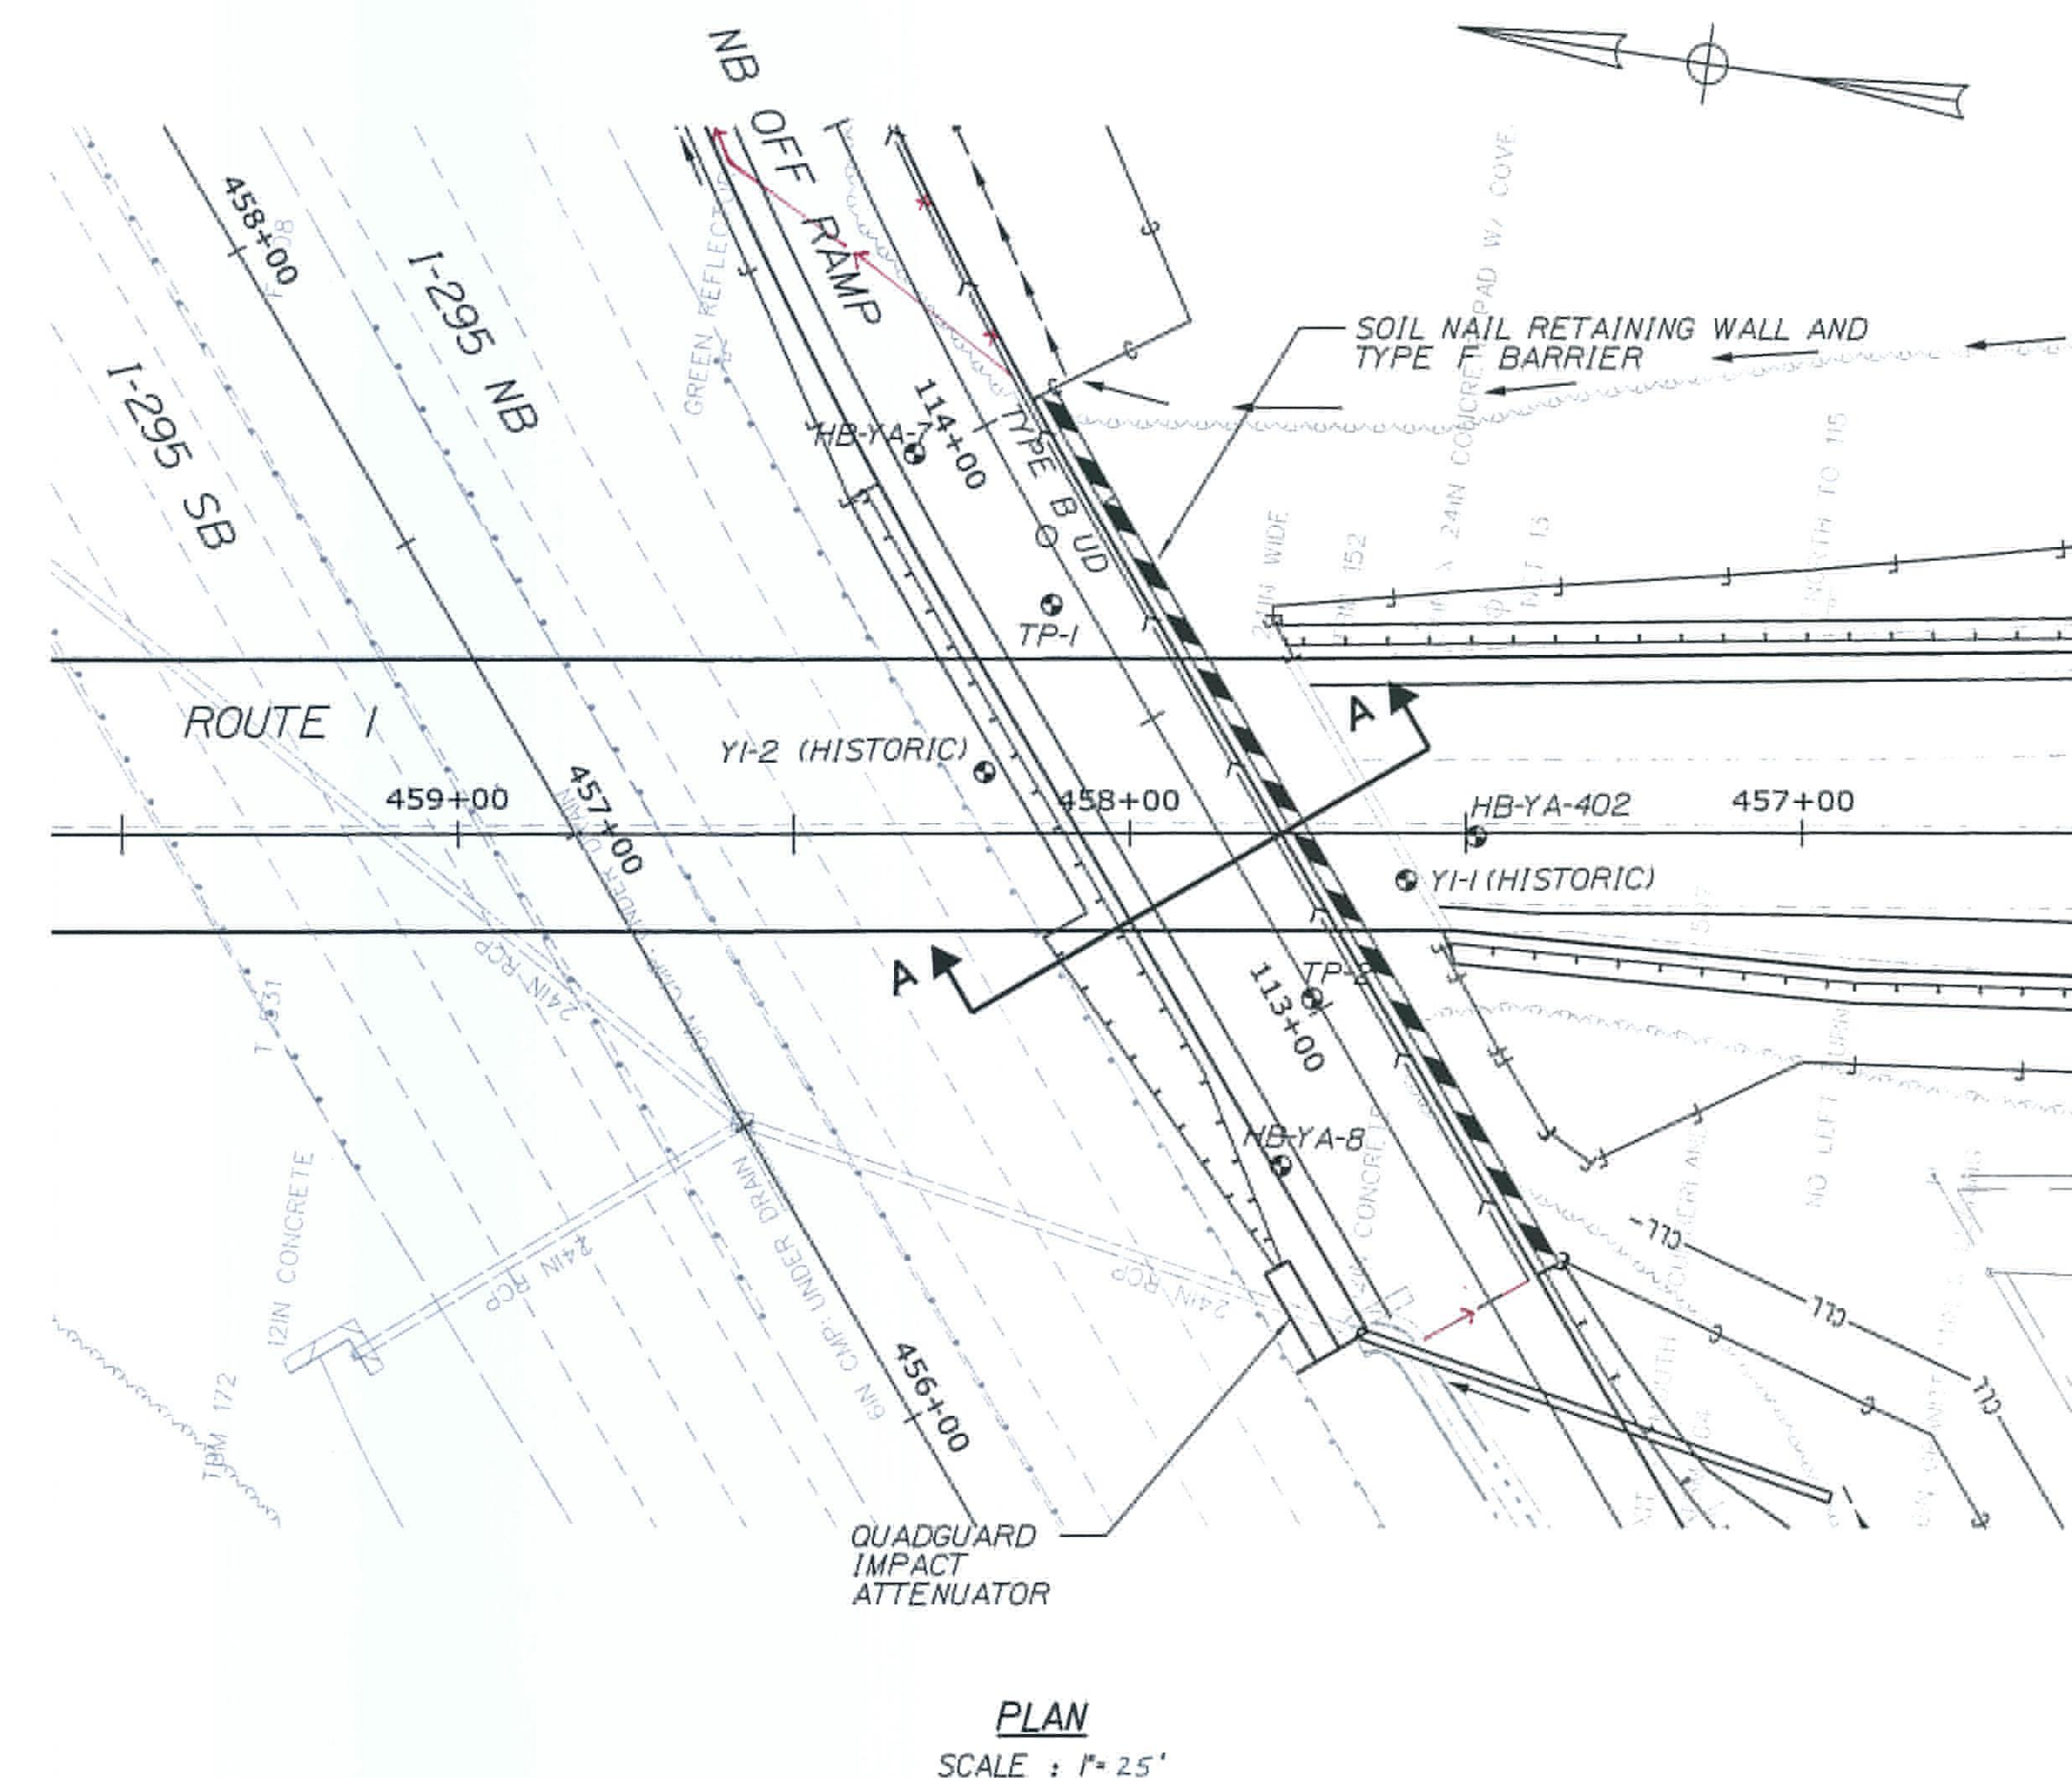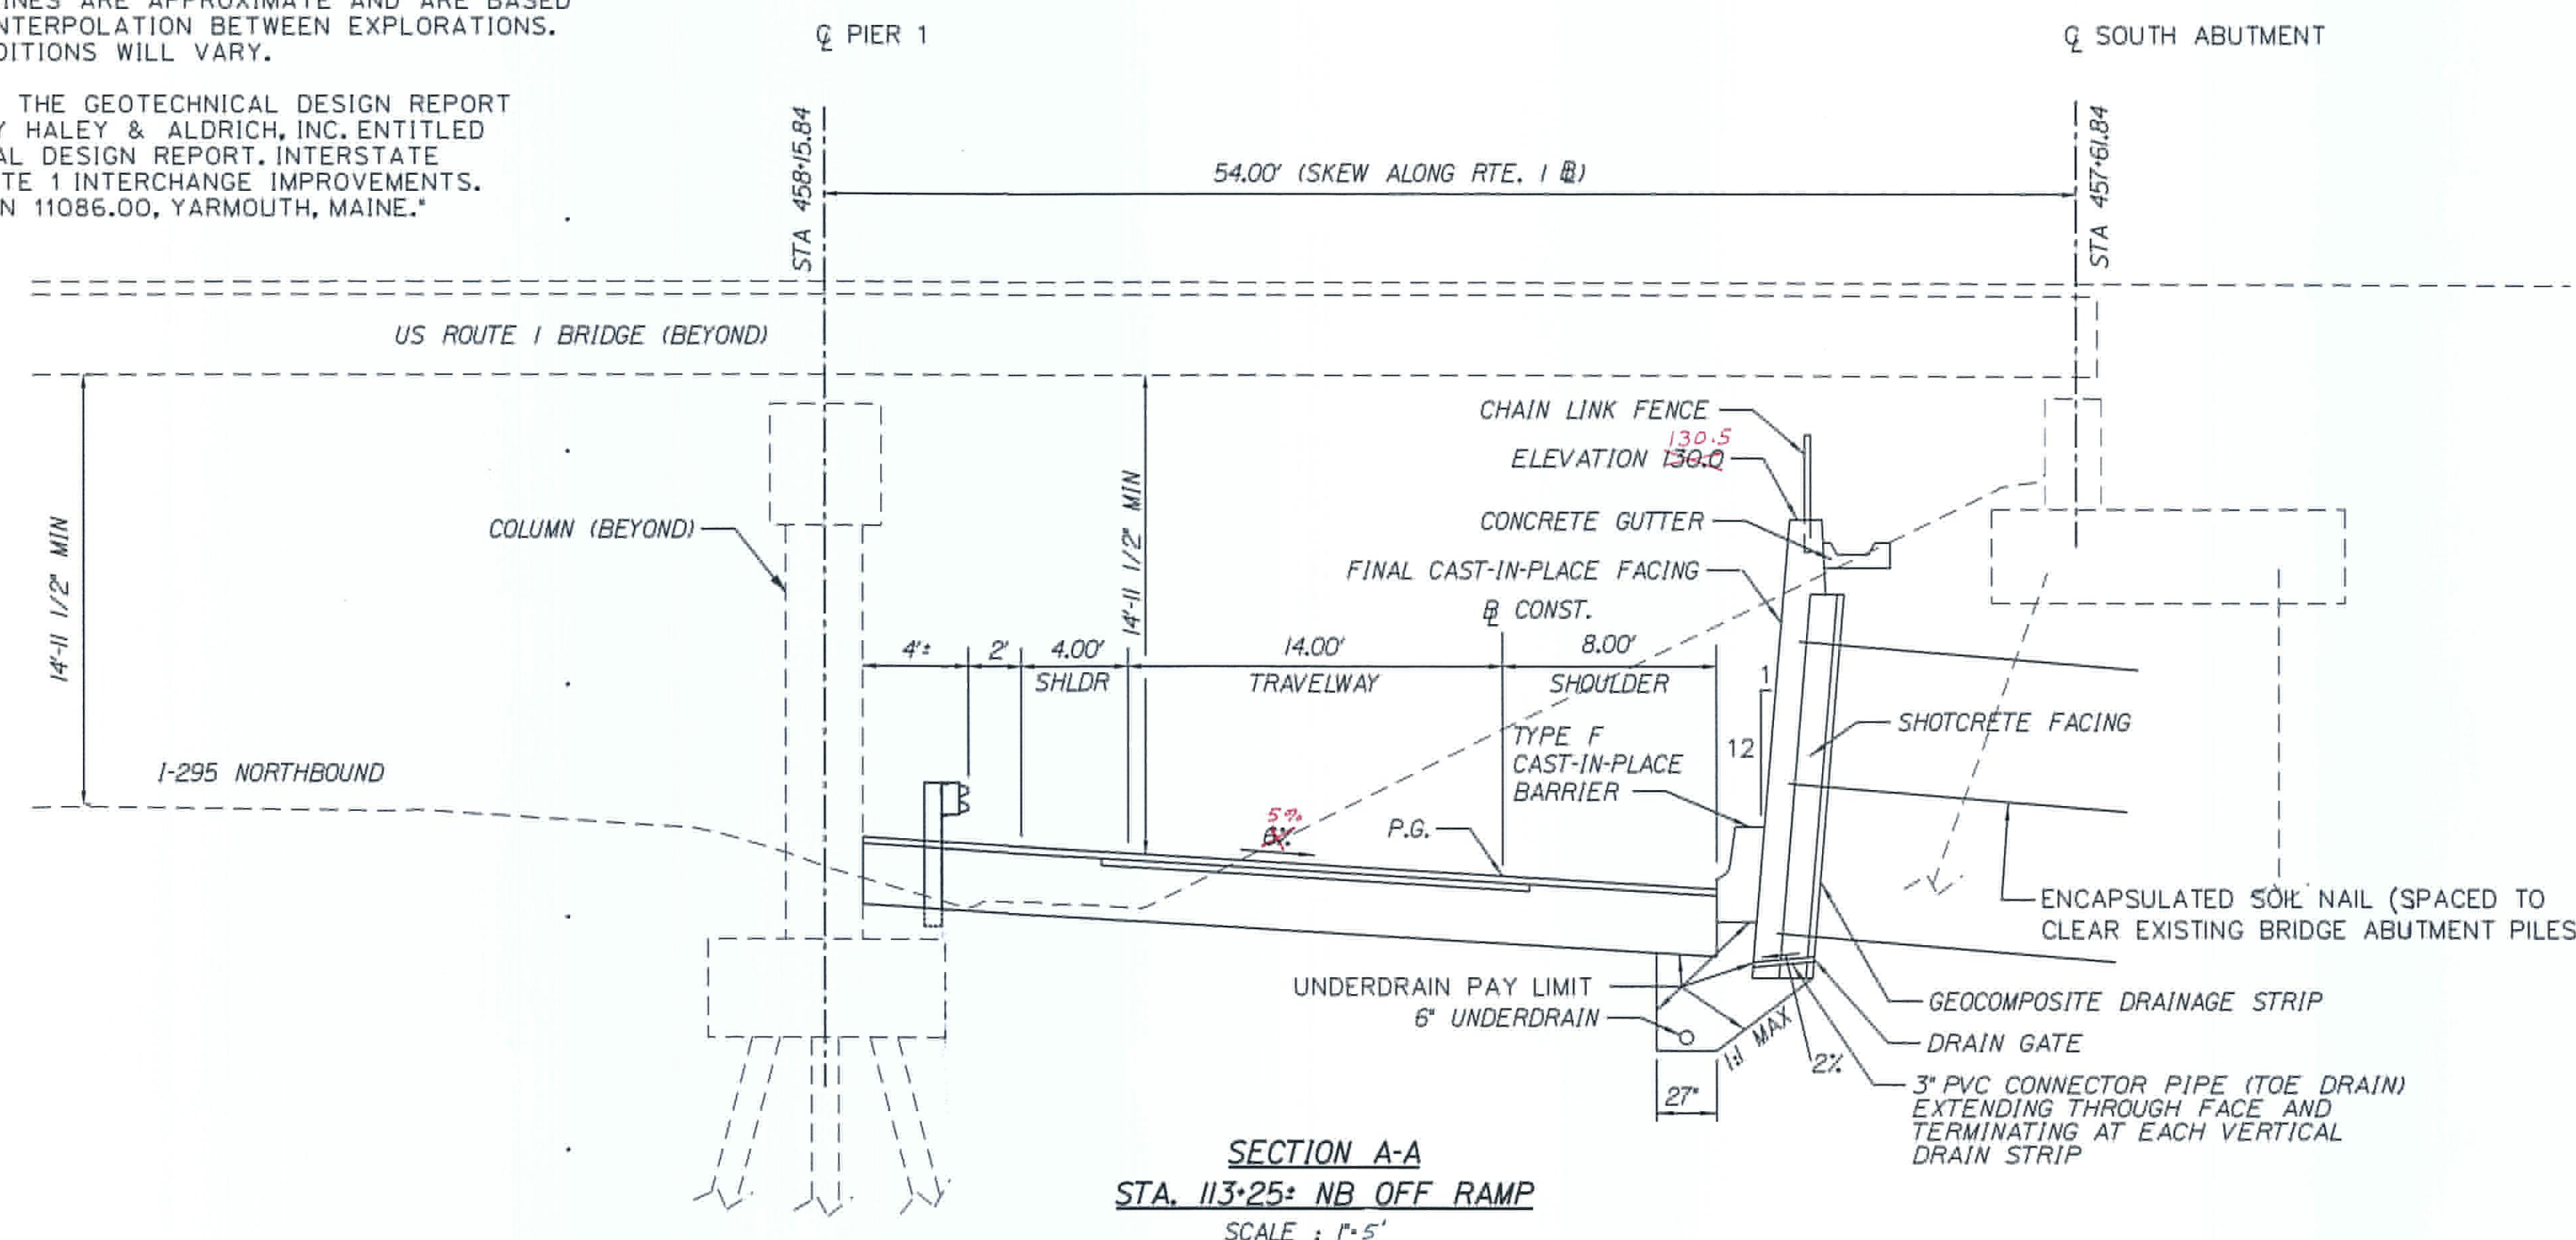

SOIL NAIL RETAINING WALL NOTES:

1. DESIGN OF THE SOIL NAIL RETAINING WALL SHALL BE COMPLETED IN ACCORDANCE WITH SPECIAL PROVISION 636 - DESIGN OF SOIL NAIL WALL AND THE RECOMMENDATIONS OF THE GEOTECHNICAL DESIGN REPORT PREPARED BY HALEY & ALDRICH, INC. ENTITLED "GEOTECHNICAL DESIGN REPORT, INTERSTATE 295/U.S. ROUTE 1 INTERCHANGE IMPROVEMENTS, MAINEDOT PIN 11086.00, YARMOUTH, MAINE." DESIGN OF THE SOIL NAIL RETAINING WALL WILL BE PAID FOR UNDER ITEM NO. 636.400.
2. CONSTRUCTION OF THE SOIL NAIL RETAINING WALL SHALL BE COMPLETED IN ACCORDANCE WITH SPECIAL PROVISION 636 - SOIL NAIL WALL AND WILL BE PAID FOR UNDER ITEM NO. 636.411. ANY WALL PROJECTIONS BEYOND THE LIMITS SHOWN, TO ACCOMMODATE SPACING OF WALL FACING WILL BE CONSIDERED INCIDENTAL TO THIS ITEM.
3. THE CONTRACTOR SHALL TAKE ALL MEASURES NECESSARY TO PROTECT THE EXISTING U.S. ROUTE 1 OVERPASS BRIDGE AND ANY EXISTING UTILITIES FROM DAMAGE THROUGH THE ENTIRE CONSTRUCTION OPERATION. THE CONTRACTOR SHALL COORDINATE THE SPACING OF SOIL NAILS TO AVOID INTERFERENCE WITH THE EXISTING BRIDGE ABUTMENT PILES. ANY AND ALL DAMAGE TO THE EXISTING U.S. ROUTE 1 OVERPASS BRIDGE STRUCTURE OR EXISTING UTILITIES CAUSED BY THE CONTRACTOR'S OPERATIONS SHALL BE REPAIRED AT HIS/HER OWN EXPENSE, AT NO ADDITIONAL COST TO THE DEPARTMENT.
4. FOR BRIDGE LOCATION AND SPACING OF EXISTING U.S. ROUTE 1 OVERPASS BRIDGE ABUTMENT PILES, SEE BRIDGE PLAN, SHEET NO. 32 OF 103 ENTITLED "PORTLAND-YARMOUTH INTERSTATE, RELOCATED ROUTE 1 OVER INTERSTATE, SOUTH ABUTMENT."
5. CHAIN LINK FENCE INCIDENTAL TO SOIL NAIL WALL ITEM 636.411 SOIL NAIL WALL.


PROJ. MANAGER		BY	DATE
DESIGN DETAIL	CHECKED-REVIEWED		SIGNATURE
DESIGN DETAIL D2	DESIGN DETAIL D2		
DESIGN DETAIL D3	DESIGN DETAIL D3		
REVISIONS 1			P.E. NUMBER
REVISIONS 2			
REVISIONS 3			
REVISIONS 4			DATE

YARMOUTH
I-295 EXIT 15
SOIL NAIL WALL PLANS

SHEET NUMBER

22

OF 283

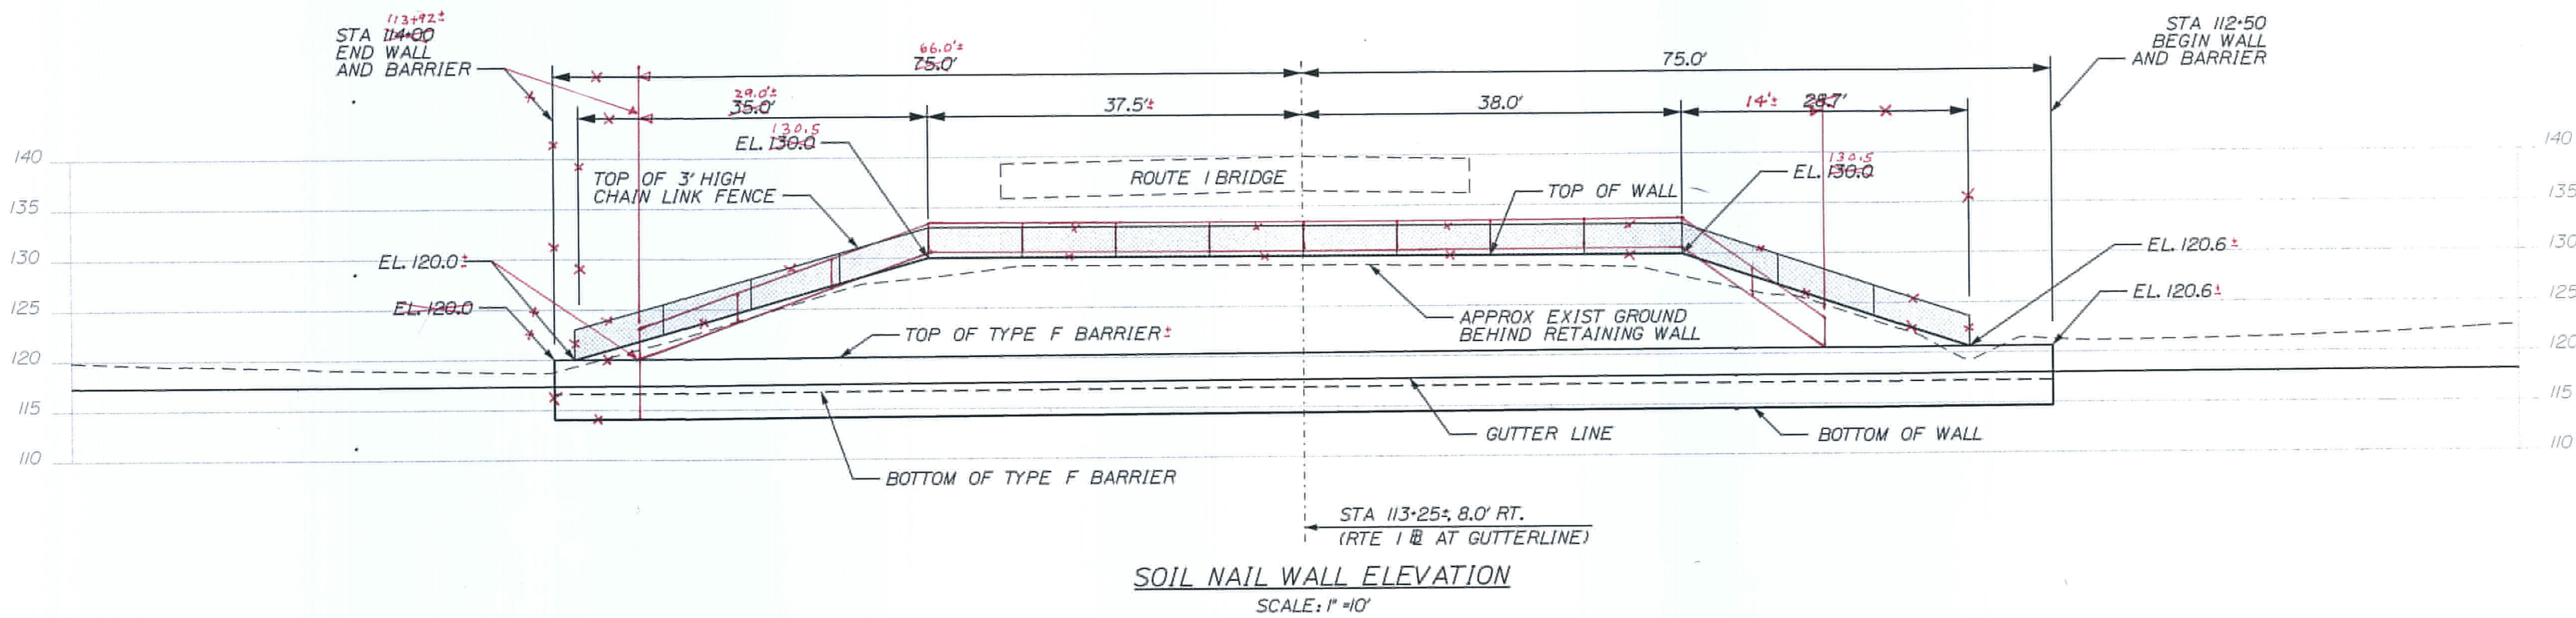

SOIL NAIL WALL ELEVATION
SCALE: 1" = 10'

STATE OF MAINE
DEPARTMENT OF TRANSPORTATION
IM-1108(600) EXIT 15
CM-1749(000)X PARK & RIDE LOT
WIN 11086.00 EXIT 15 HIGHWAY PLANS
WIN 17490.00 PARK & RIDE LOT

YARMOUTH
I-295 EXIT 15
SOIL NAIL WALL PLANS


As-Built by J.P. Dyer, Dec. 2013

SHEET NUMBER
23
OF 283

PROJ. MANAGER	BY	DATE	SIGNATURE
DESIGN-REVIEWED			
CHECKED-REVIEWED			
DESIGN-REVIEWED			
DESIGN-REVIEWED			
REVISIONS 1			
REVISIONS 2			
REVISIONS 3			
REVISIONS 4			
FIELD CHANGES			



VIEW OF I-295 NB DECELERATION LANE BENEATH THE EXISTING ROUTE 1 OVERPASS BRIDGE WITH PIER NO. 1 (LEFT) VISIBLE, LOOKING NORTH.

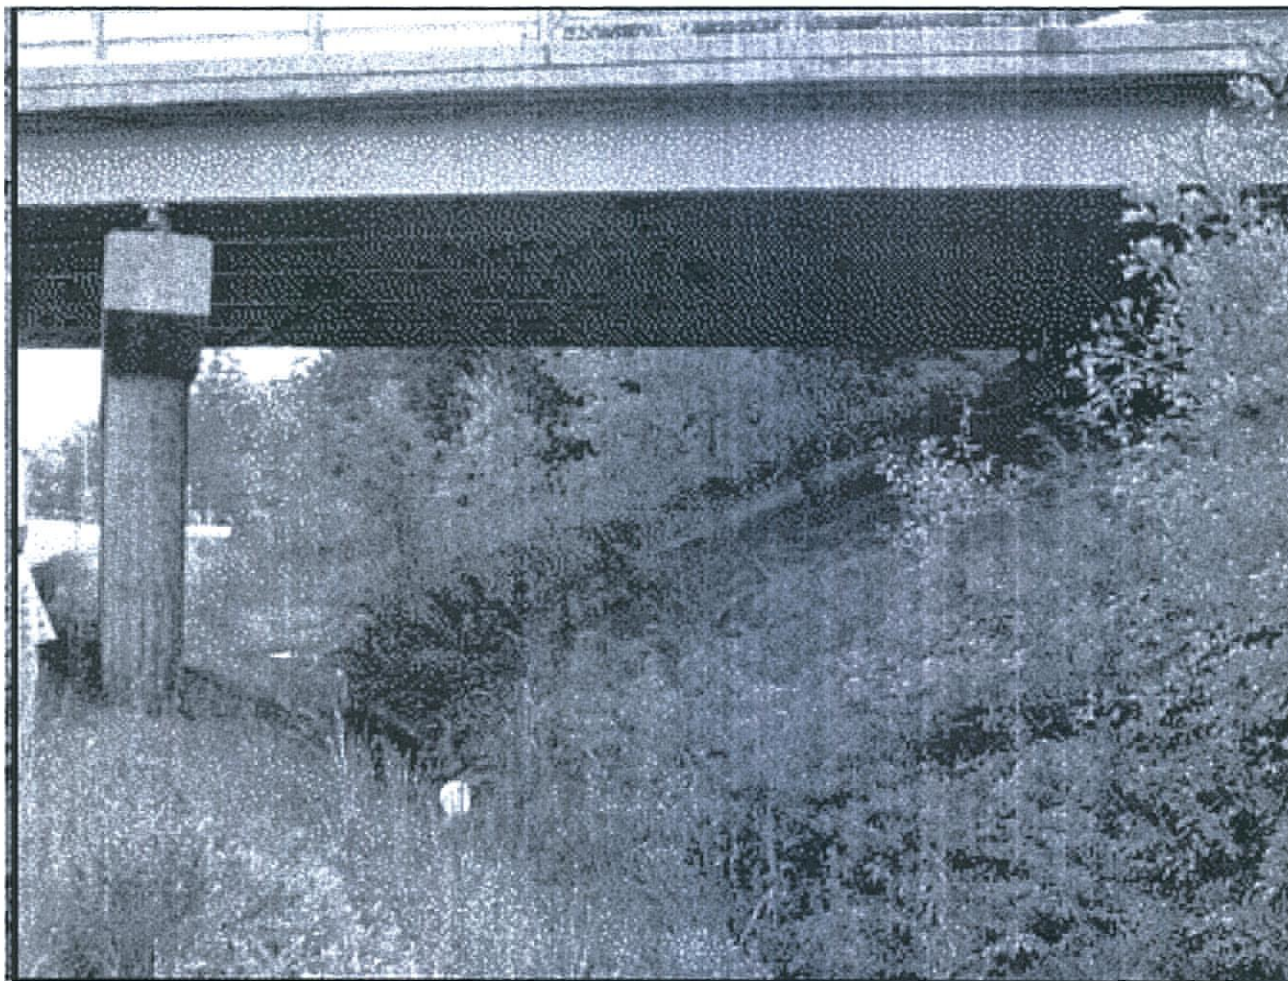


VIEW OF I-295 NB DECELERATION LANE BENEATH THE EXISTING ROUTE 1 OVERPASS BRIDGE WITH PIER NO. 1 (LEFT) VISIBLE, LOOKING NORTH.



VIEW OF CONCRETE PAVER SLOPE PROTECTION BENEATH THE EXISTING ROUTE 1 OVERPASS BRIDGE WITH ABUTMENT A (RIGHT) VISIBLE, LOOKING NORTHEAST.



VIEW OF CONCRETE PAVER SLOPE PROTECTION BENEATH THE EXISTING ROUTE 1 OVERPASS BRIDGE WITH ABUTMENT A (LEFT) AND PIER NO. 1 (RIGHT) VISIBLE, LOOKING SOUTHEAST.

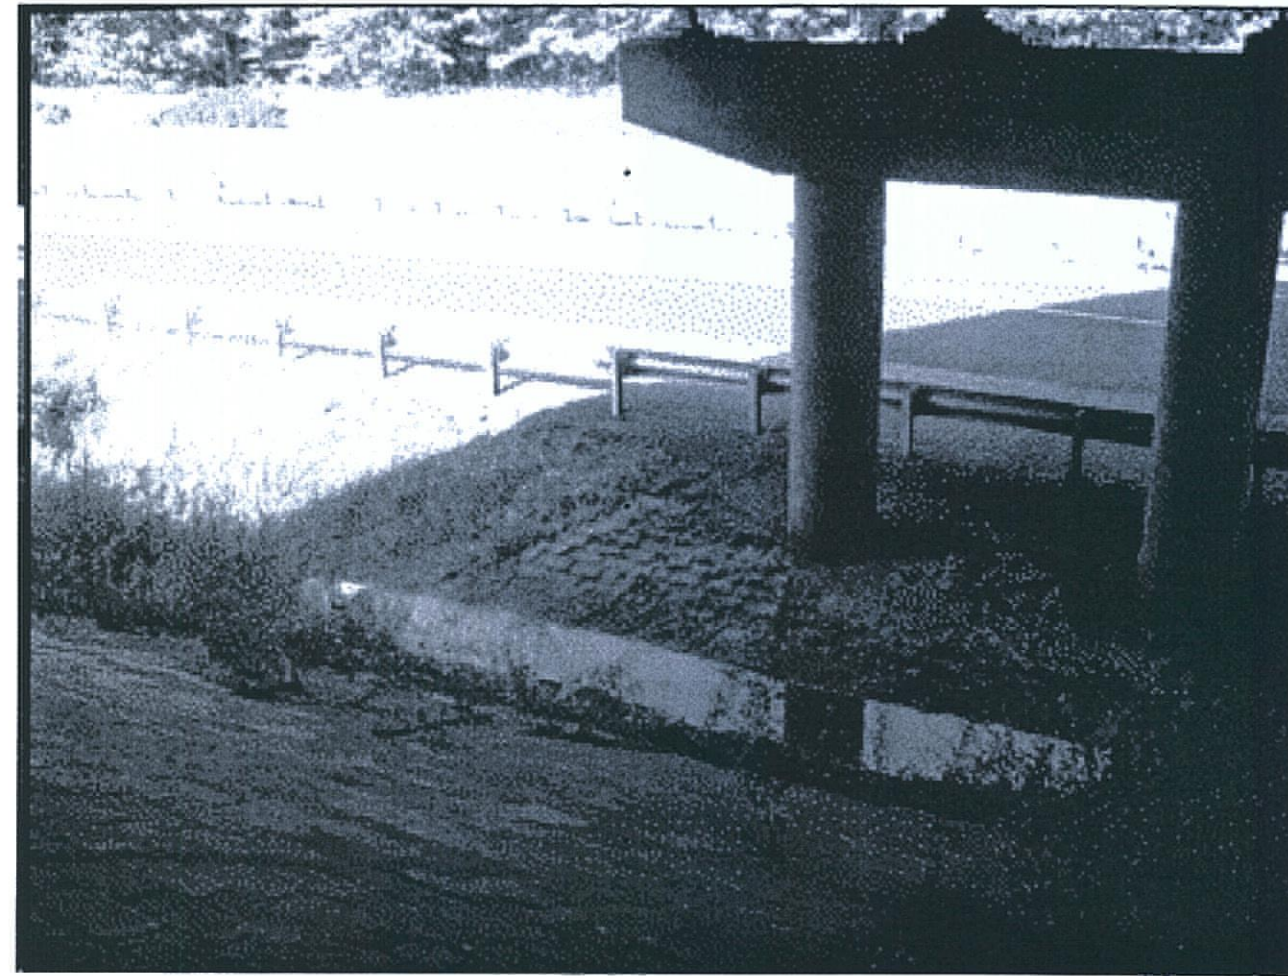

VIEW OF CONCRETE PAVER SLOPE PROTECTION BENEATH THE EXISTING ROUTE 1 OVERPASS BRIDGE WITH PIER NO. 1 VISIBLE, LOOKING SOUTHWEST.


YARMOUTH I-295 EXIT 15 SOIL NAIL WALL EXIST. CONDITIONS	STATE OF MAINE DEPARTMENT OF TRANSPORTATION			
	IM-1108(600) EXIT 15 CM-1749(000)X PARK & RIDE LOT			
	WIN 11086.00 EXIT 15 HIGHWAY PLANS WIN 17490.00 PARK & RIDE LOT			
SHEET NUMBER 24 OF 283	PROJ. MANAGER	BY	DATE	SIGNATURE
	CHECKED-REVIEWED DESIGN-2-DETAILED2 DESIGN-3-DETAILED3 REVISIONS 1 REVISIONS 2 REVISIONS 3 REVISIONS 4 FIELD CHANGES			P.E. NUMBER DATE



VIEW OF I-295 NB DECELERATION LANE BENEATH THE EXISTING ROUTE 1 OVERPASS BRIDGE WITH PIER NO. 1 (LEFT) VISIBLE, LOOKING NORTH.




VIEW OF TEST PIT NO. 1 EXCAVATED ON THE NORTH SIDE OF THE EXISTING ROUTE 1 OVERPASS BRIDGE IMMEDIATELY AFTER EXCAVATION, LOOKING EAST, 20 JUNE 2011. THIN GRANULAR FILL OVERLYING FORMER TOPSOIL/ORGANIC LAYER AND UNDERLYING MARINE SILT/CLAY DEPOSIT.

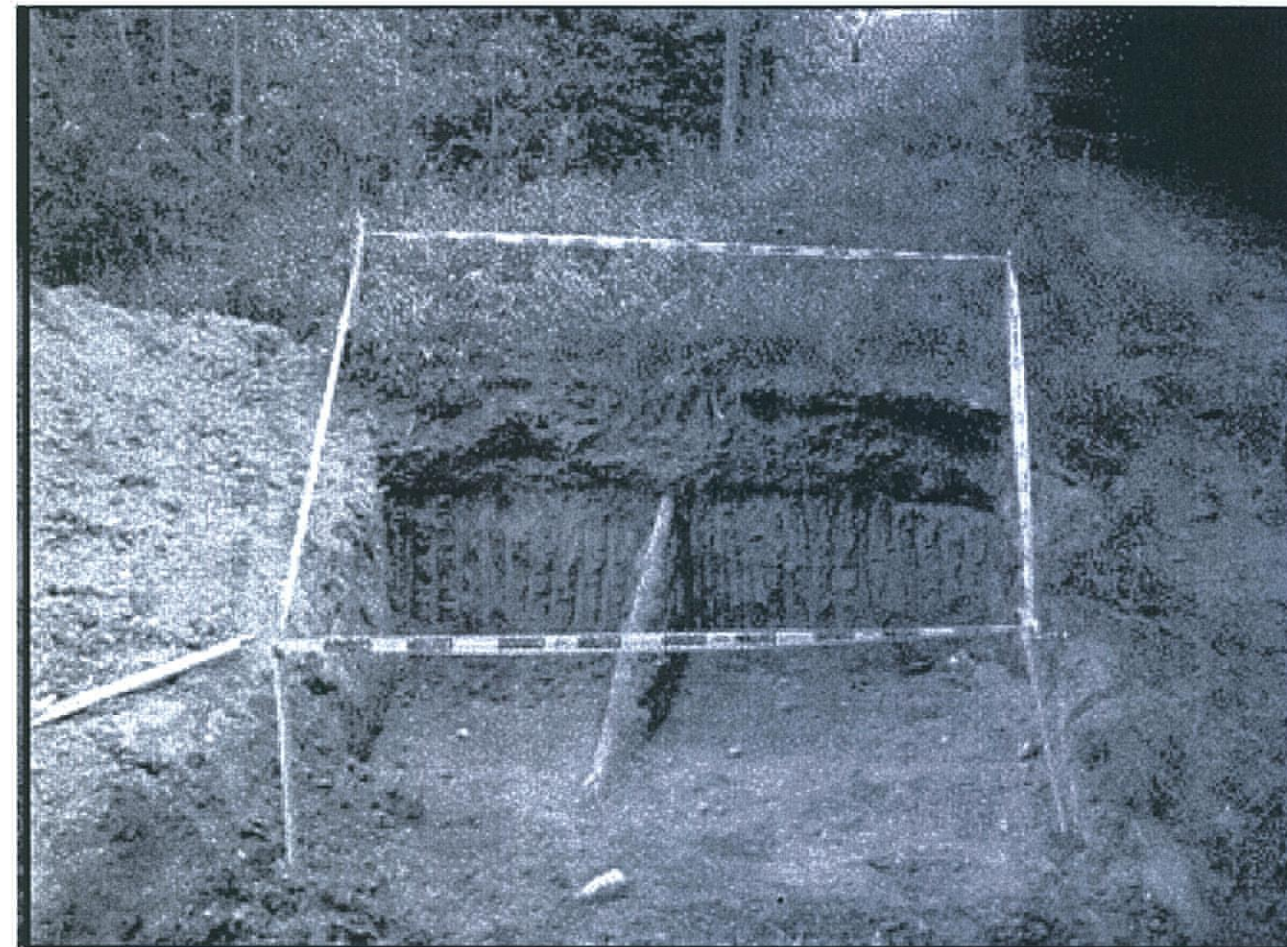

VIEW OF TEST PIT NO. 1 EXCAVATED ON THE NORTH SIDE OF THE EXISTING ROUTE 1 OVERPASS BRIDGE APPROXIMATELY ONE WEEK AFTER EXCAVATION, LOOKING EAST, 30 JUNE 2011. THIN GRANULAR FILL OVERLYING FORMER TOPSOIL/ORGANIC LAYER AND UNDERLYING MARINE SILT/CLAY DEPOSIT.



VIEW OF TEST PIT NO. 1 EXCAVATED ON THE NORTH SIDE OF THE EXISTING ROUTE 1 OVERPASS BRIDGE IMMEDIATELY AFTER EXCAVATION, LOOKING EAST, 20 JUNE 2011. THIN GRANULAR FILL OVERLYING FORMER TOPSOIL/ORGANIC LAYER AND UNDERLYING MARINE SILT/CLAY DEPOSIT.

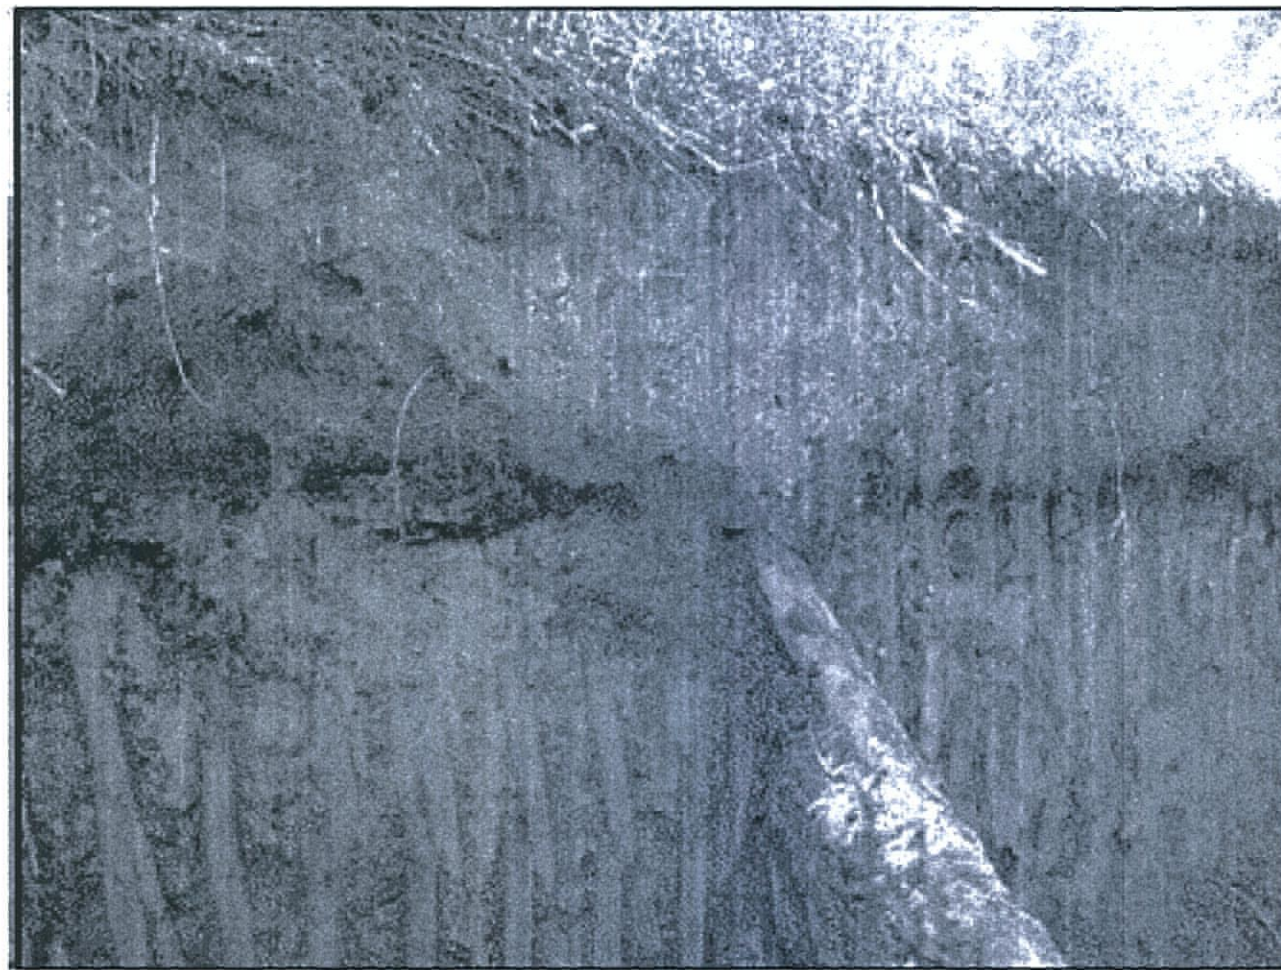

CLOSE-UP VIEW OF TEST PIT NO. 1 EXCAVATED ON THE NORTH SIDE OF THE EXISTING ROUTE 1 OVERPASS BRIDGE IMMEDIATELY AFTER EXCAVATION, LOOKING NORTHEAST, 20 JUNE 2011. THIN GRANULAR FILL OVERLYING FORMER TOPSOIL/ORGANIC LAYER AND UNDERLYING MARINE SILT/CLAY DEPOSIT.

TEST PIT NO.1 DESCRIPTION:


SOIL DESCRIPTIONS PRESENTED IN ORDER OF INCREASING DEPTH BELOW GROUND SURFACE.

1. SURFICIAL LAYER OF TOPSOIL RANGED IN THICKNESS FROM APPROXIMATELY 0.1 TO 0.3 FT.
2. TOPSOIL UNDERLAIN BY VARIABLE THICKNESS OF GRAY, SILTY FINE SAND, TRACE MEDIUM TO COARSE SAND AND FINE TO COARSE GRAVEL. THE THICKNESS RANGED FROM APPROXIMATELY 0.8 TO 2.0 FT IN THE NORTHERN AND SOUTHERN PORTIONS OF THE EXPOSED FACE.
3. VARIABLE THICKNESS OF LIGHT BROWN, WELL-GRADED SAND WITH GRAVEL (NORTHERN HALF OF TEST PIT), TO ORANGE-BROWN POORLY-GRADED SAND, TRACE FINE AND COARSE SAND AND FINE GRAVEL (SOUTHERN HALF OF TEST PIT). THE THICKNESS IN THE NORTHERN HALF OF THE TEST PIT RANGED FROM APPROXIMATELY 0.2 TO 1.3 FT AND THE THICKNESS IN THE SOUTHERN HALF OF THE TEST PIT RANGED FROM APPROXIMATELY 0.1 TO 0.8 FT.
4. VARIABLE THICKNESS OF DARK BROWN SILTY FINE TO BLACK ORGANIC SOIL. THE THICKNESS RANGED FROM APPROXIMATELY 0.1 TO 0.5-FT THICK.
5. VARIABLE THICKNESS OF LIGHT GRAY, FINE SAND. THE THICKNESS RANGED FROM APPROXIMATELY 0.1 TO 0.8 FT.
6. GRAY, MOTTLED, SILTY CLAY EXTENDING TO BOTTOM OF TEST PIT.
7. ENCOUNTERED EXISTING UNKNOWN UTILITY PIPE WITHIN LIMITS OF TEST PIT. PIPE CONSISTS OF 3.5-IN. DIAMETER, BITUMEN COATED METAL PIPE SLOPING DOWN FROM EAST TO WEST, TOWARDS INTERSTATE 295, AT APPROXIMATELY 3H:1V.


STATE OF MAINE DEPARTMENT OF TRANSPORTATION	SIGNATURE		DATE
	IM-1108(600) EXIT 15 CM-1749(000)X PARK & RIDE LOT		P.E. NUMBER
HIGHWAY PLANS WIN 11086.00 EXIT 15 WIN 17490.00 PARK & RIDE LOT		DATE	
YARMOUTH I-295 EXIT 15 SOIL NAIL WALL EXIST. CONDITIONS	PROJ. MANAGER	BY	DATE
	DESIGN-REVIEWED		
	CHECKED-REVIEWED		
	DESIGN-REVIEWED		
	REVISIONS 1		
	REVISIONS 2		
	REVISIONS 3		
	REVISIONS 4		
	FIELD CHANGES		
SHEET NUMBER			
25			
OF 283			




VIEW OF TEST PIT NO. 2 EXCAVATED ON THE SOUTH SIDE OF THE EXISTING ROUTE 1 OVERPASS BRIDGE IMMEDIATELY AFTER EXCAVATION, LOOKING EAST, 20 JUNE 2011.

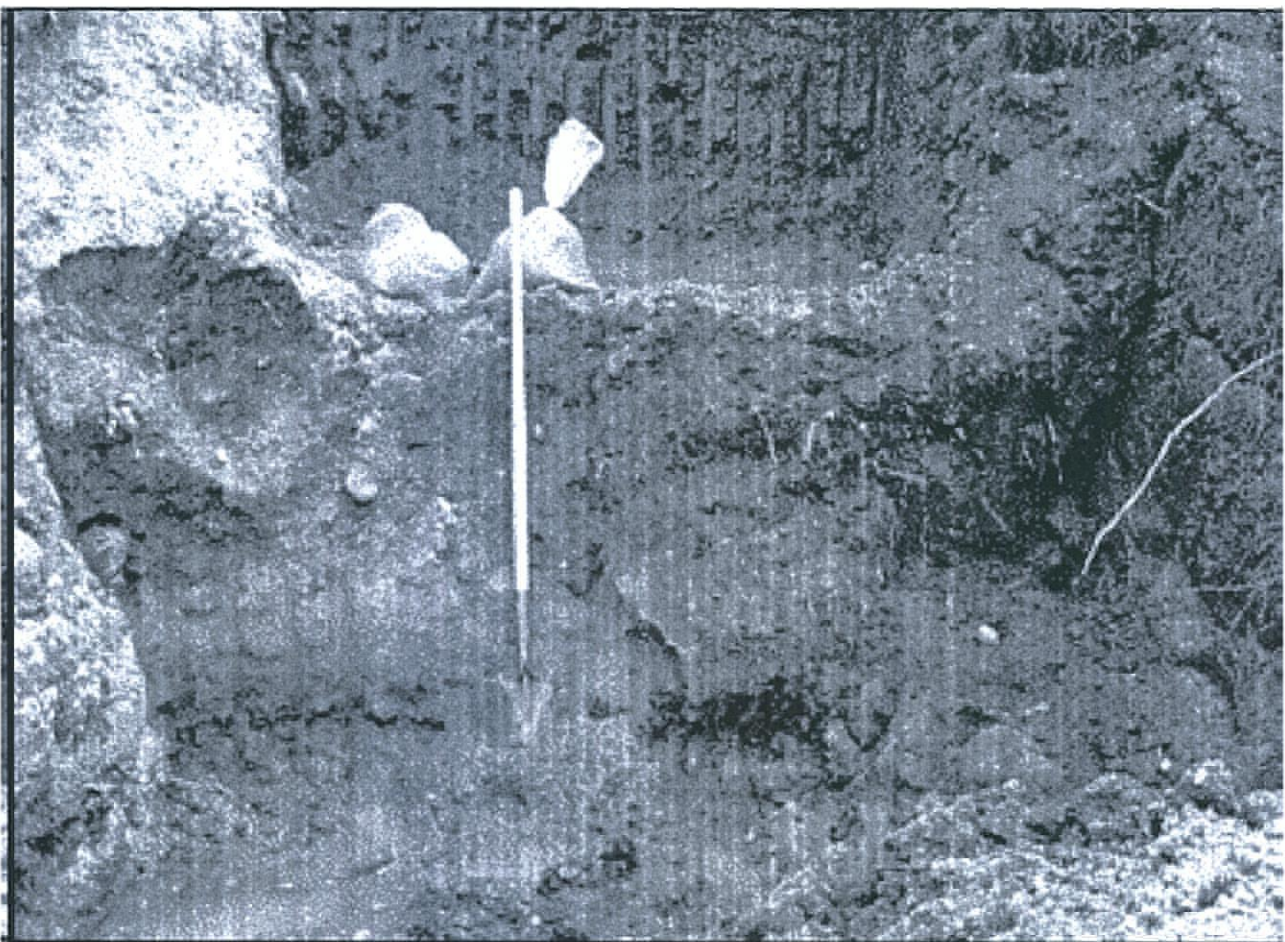

CLOSE-UP VIEW OF THE LOWER PORTION OF TEST PIT NO. 2 IMMEDIATELY AFTER EXCAVATION WITH GRANULAR MATERIAL VISIBLE OVERLYING A FORMER TOPSOIL/ORGANIC LAYER AND MARINE SILT/CLAY DEPOSIT, LOOKING EAST, 20 JUNE 2011.

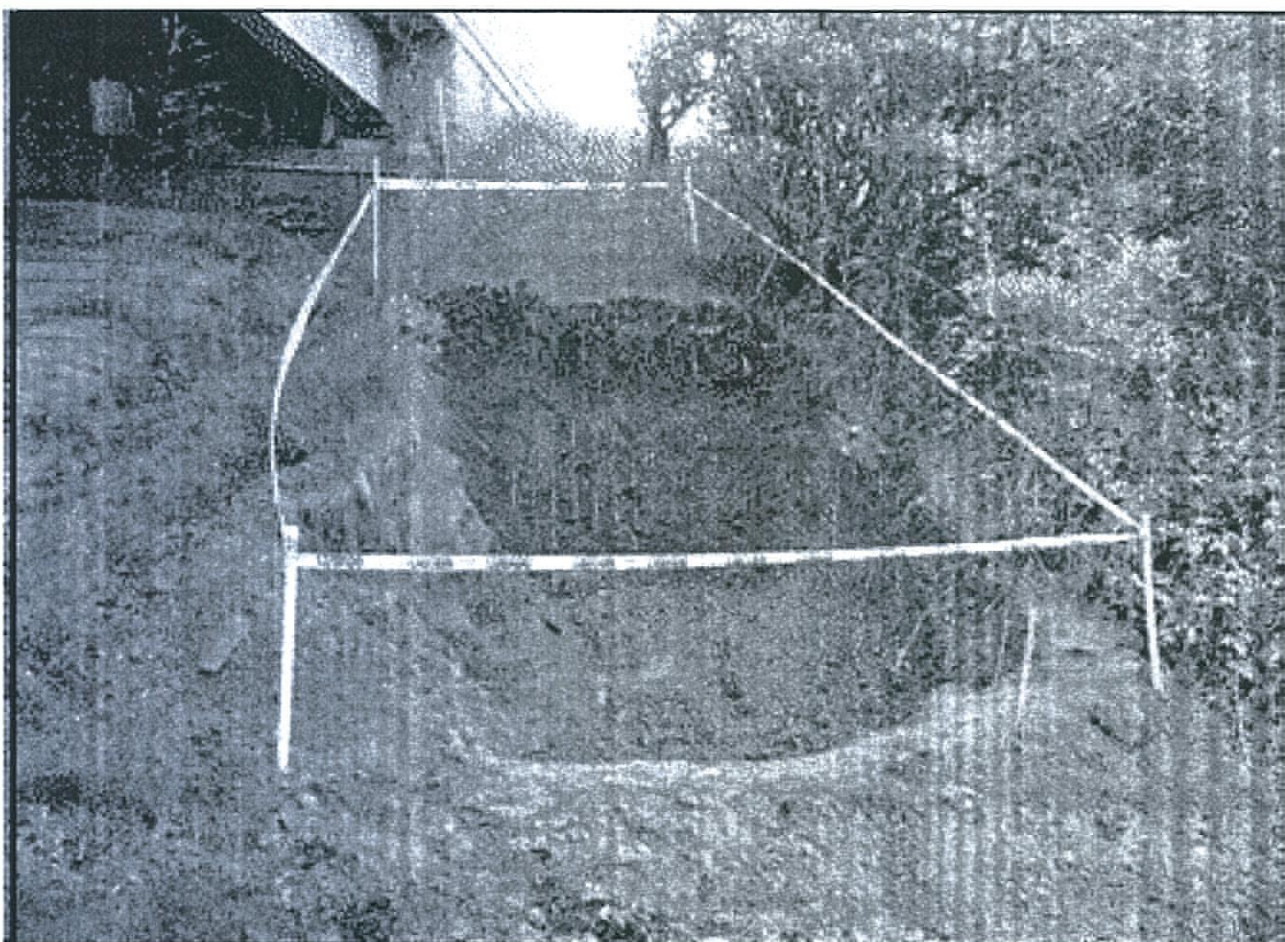

VIEW OF TEST PIT NO. 2 EXCAVATED ON THE NORTH SIDE OF THE EXISTING ROUTE 1 OVERPASS BRIDGE APPROXIMATELY ONE WEEK AFTER EXCAVATION, LOOKING EAST, 30 JUNE 2011.

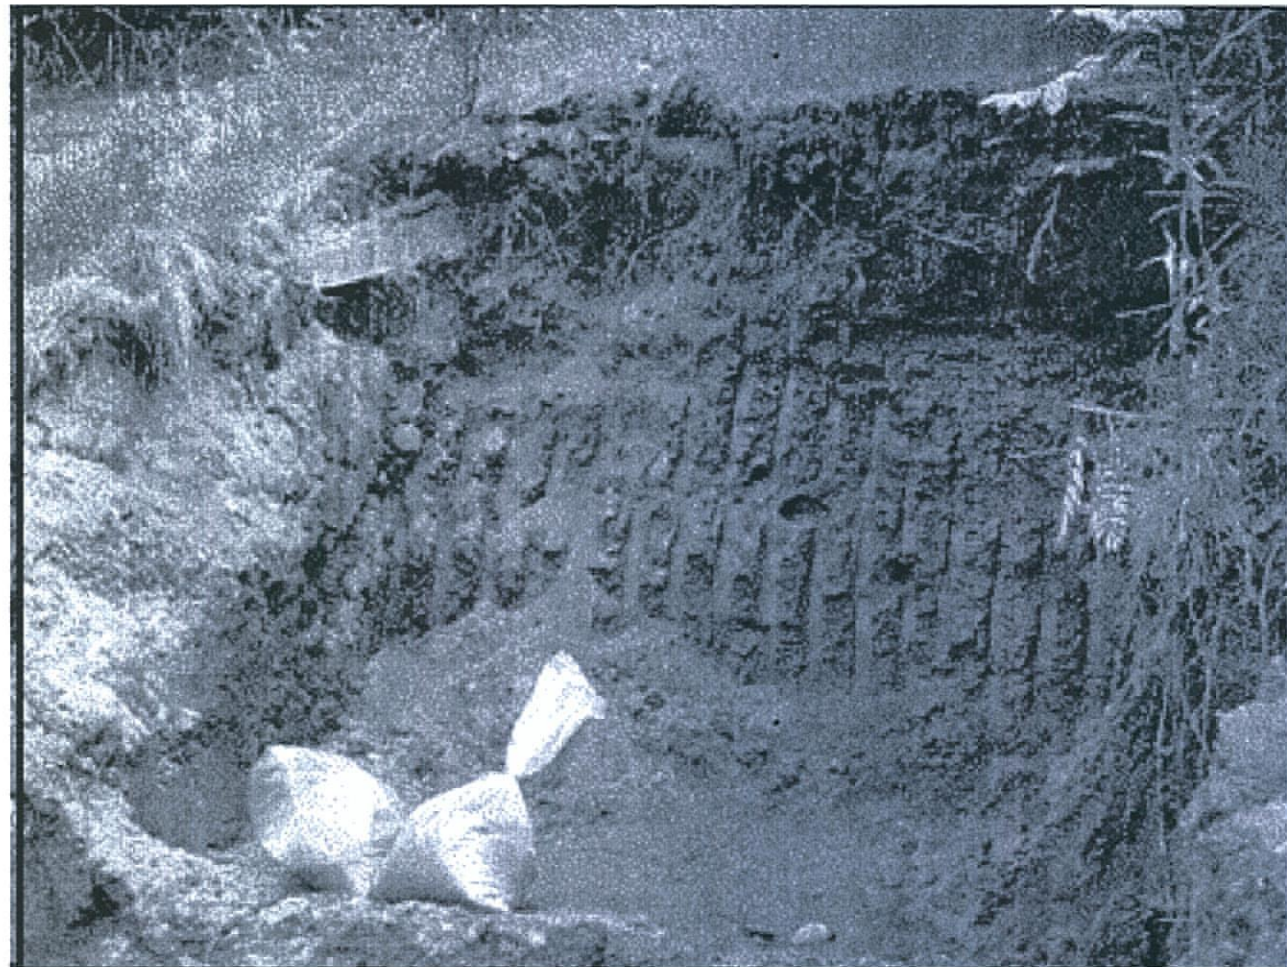

CLOSE-UP VIEW OF THE UPPER PORTION OF TEST PIT NO. 2 IMMEDIATELY AFTER EXCAVATION WITH GRANULAR MATERIAL VISIBLE OVERLYING SILT/CLAY DEPOSIT, LOOKING EAST, 20 JUNE 2011.



CLOSE-UP VIEW OF TEST PIT NO. 2 EXCAVATED ON THE NORTH SIDE OF THE EXISTING ROUTE 1 OVERPASS BRIDGE APPROXIMATELY ONE WEEK AFTER EXCAVATION, LOOKING EAST, 30 JUNE 2011.

TEST PIT NO. 2 DESCRIPTION:

SOIL DESCRIPTIONS PRESENTED IN ORDER OF INCREASING DEPTH BELOW GROUND SURFACE.

UPPER PORTION OF TEST PIT (EAST):

1. SURFICIAL LAYER OF TOPSOIL RANGED IN THICKNESS FROM APPROXIMATELY 0.1 TO 0.3 FT.
2. TOPSOIL UNDERLAIN BY VARIABLE THICKNESS OF GRAY, SILTY FINE SAND, TRACE MEDIUM TO COARSE SAND AND FINE TO COARSE GRAVEL. THE THICKNESS RANGED FROM APPROXIMATELY 0.5 TO 1.2 FT IN THE NORTHERN AND SOUTHERN PORTIONS OF THE EXPOSED FACE.
3. VARIABLE THICKNESS OF GRAY AND BROWN, WELL-GRADED SAND WITH GRAVEL. CONTAINS SOME COBBLES AND SMALL BOULDERS. THE THICKNESS RANGED FROM APPROXIMATELY 0.7 TO 2.1 FT AND THE THICKNESS IN THE SOUTHERN HALF OF THE TEST PIT RANGED FROM APPROXIMATELY 0.1 TO 0.8 FT.
4. VARIABLE THICKNESS OF GRAY, SILTY FINE SAND, TRACE MEDIUM TO COARSE SAND AND FINE GRAVEL. VERY SILTY IN SOME AREAS AND CONTAINS LOCALIZED LENSES OF MEDIUM TO COARSE SAND AND FINE GRAVEL. THE THICKNESS RANGED FROM APPROXIMATELY 0.4 TO 1.2 FT AND TRANSITIONED INTO GRAY, MOTTLED, SILTY CLAY EXTENDING TO THE BOTTOM OF THE TEST PIT.
5. WATER OBSERVED SEEPING FROM EXPOSED FACE AT TOP OF GRAY, SILTY FINE SAND LAYER.

LOWER PORTION OF TEST PIT (WEST):

1. SAND AND GRAVEL ENCOUNTERED FROM GROUND SURFACE TO A DEPTH OF 6 FT AT THE NORTHERN FACE OF TEST PIT. THE TOP 1 TO 2 FT OF THIS MATERIAL CONSISTED OF GRAY, SILTY FINE SAND. THE MIDDLE 1 TO 2 FT CONSISTED OF SILTY FINE SAND WITH GRAVEL. THE LOWEST PORTION OF THIS LAYER CONSISTED OF WELL-GRADED SAND.
2. VARIABLE THICKNESS OF ORGANIC MATERIAL MEASURING APPROXIMATELY 0.1 TO 0.4-FT THICK.
3. GRAY, SILTY FINE SAND AND MOTTLED, SILTY CLAY VISIBLE TO BOTTOM OF TEST PIT.
4. WATER OBSERVED ENTERING LOWER PORTION OF TEST PIT THROUGH ORGANIC MATERIAL AND SILTY FINE SAND OVERLYING THE SILTY CLAY.


STATE OF MAINE	
DEPARTMENT OF TRANSPORTATION	
IM-1108(600) EXIT 15	
CM-1749(000)X PARK & RIDE LOT	
WIN 11086.00 EXIT 15	HIGHWAY PLANS
WIN 17490.00 PARK & RIDE LOT	

PROJ. MANAGER	BY	DATE	SIGNATURE
DESIGN-DETAILED			
CHECKED-REVIEWED			
DESIGNER-DETAILED			
DESIGNER-REVIEWED			
REVISIONS 1			
REVISIONS 2			
REVISIONS 3			
REVISIONS 4			
FIELD CHANGES			

YARMOUTH	
I-295 EXIT 15	
SOIL NAIL WALL EXIST. CONDITIONS	

SHEET NUMBER
26
OF 283

NOTES:

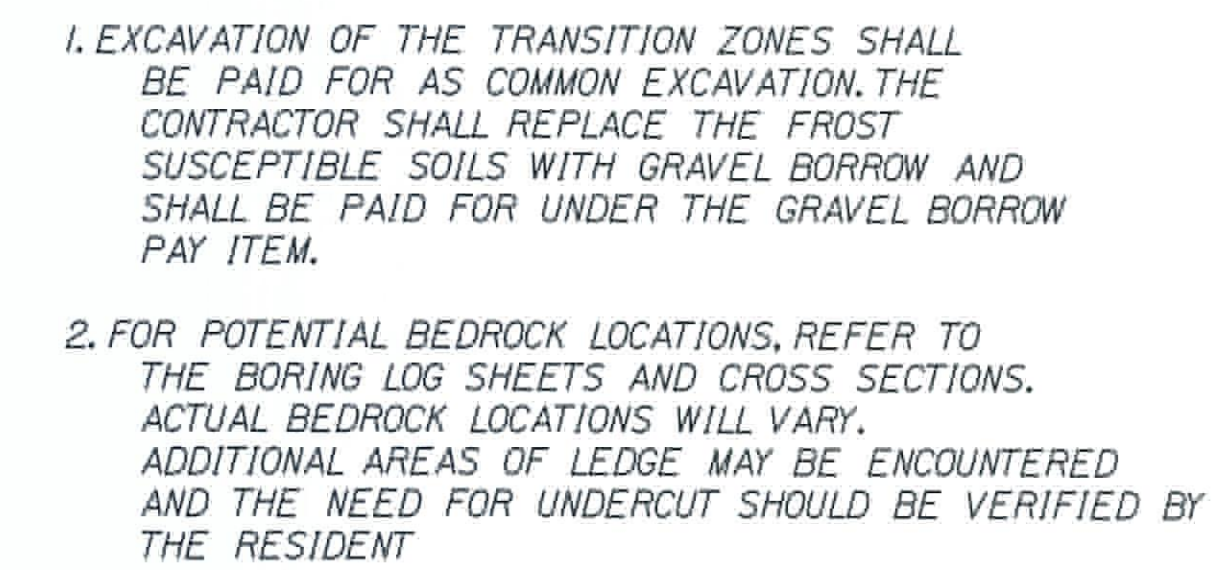


EDGE OF SHOULDER

20:1 TRANSVERSE TRANSITION

UNDERCUT MUST BE DRAINED AND OUTLETTED PERIODICALLY USING LATERAL WEEP DRAINS

TRANSITION SHOULD BE CONSTRUCTED FROM THE BOTTOM OF THE UNDERCUT EXTENDING TO A POINT WHERE A LINE PROJECTED DOWNWARD FROM THE EDGE OF SHOULDER INTERCEPTS SUBGRADE

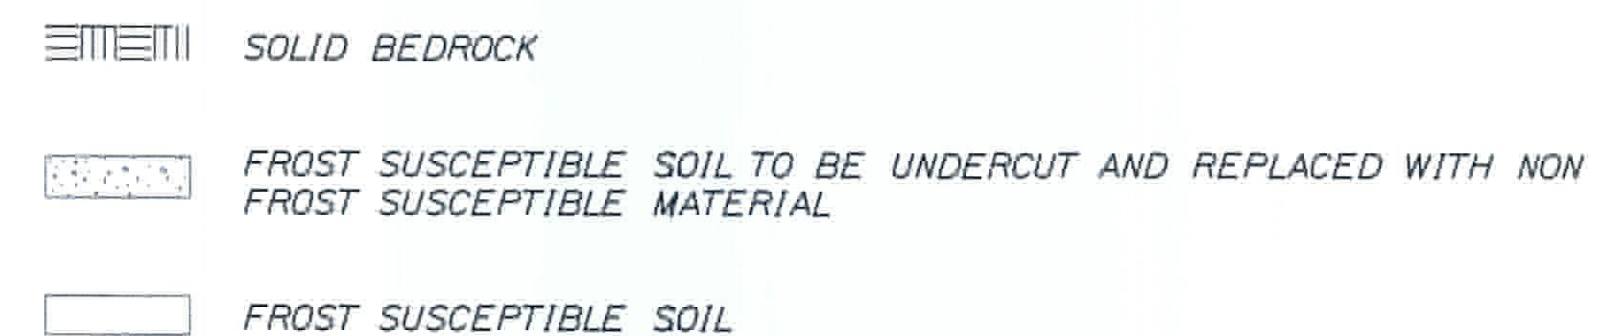

STATE OF MAINE DEPARTMENT OF TRANSPORTATION		HIGHWAY PLANS
IM-1108(600) EXIT 15	CM-1749(000)X PARK & RIDE LOT	
WIN 11086.00 EXIT 15	WIN 17490.00 PARK & RIDE LOT	

PROJ. MANAGER	BY	DATE
DESIGN-DET AILED		
CHECKED-REVIEWED		
DESIGN2-DET AILED2		
DESIGN3-DET AILED3		
REVISIONS 1		
REVISIONS 2		
REVISIONS 3		
REVISIONS 4		
FIELD CHANGES		

YARMOUTH
I-295 EXIT 15
UNDERCUT OF FROST
SUSCEPTIBLE SOILS OVER LEDGE

SHEET NUMBER

27


OF 283

Filename:

Division: HIGHWAY

Username: COMMON

Date: 2/21/2011

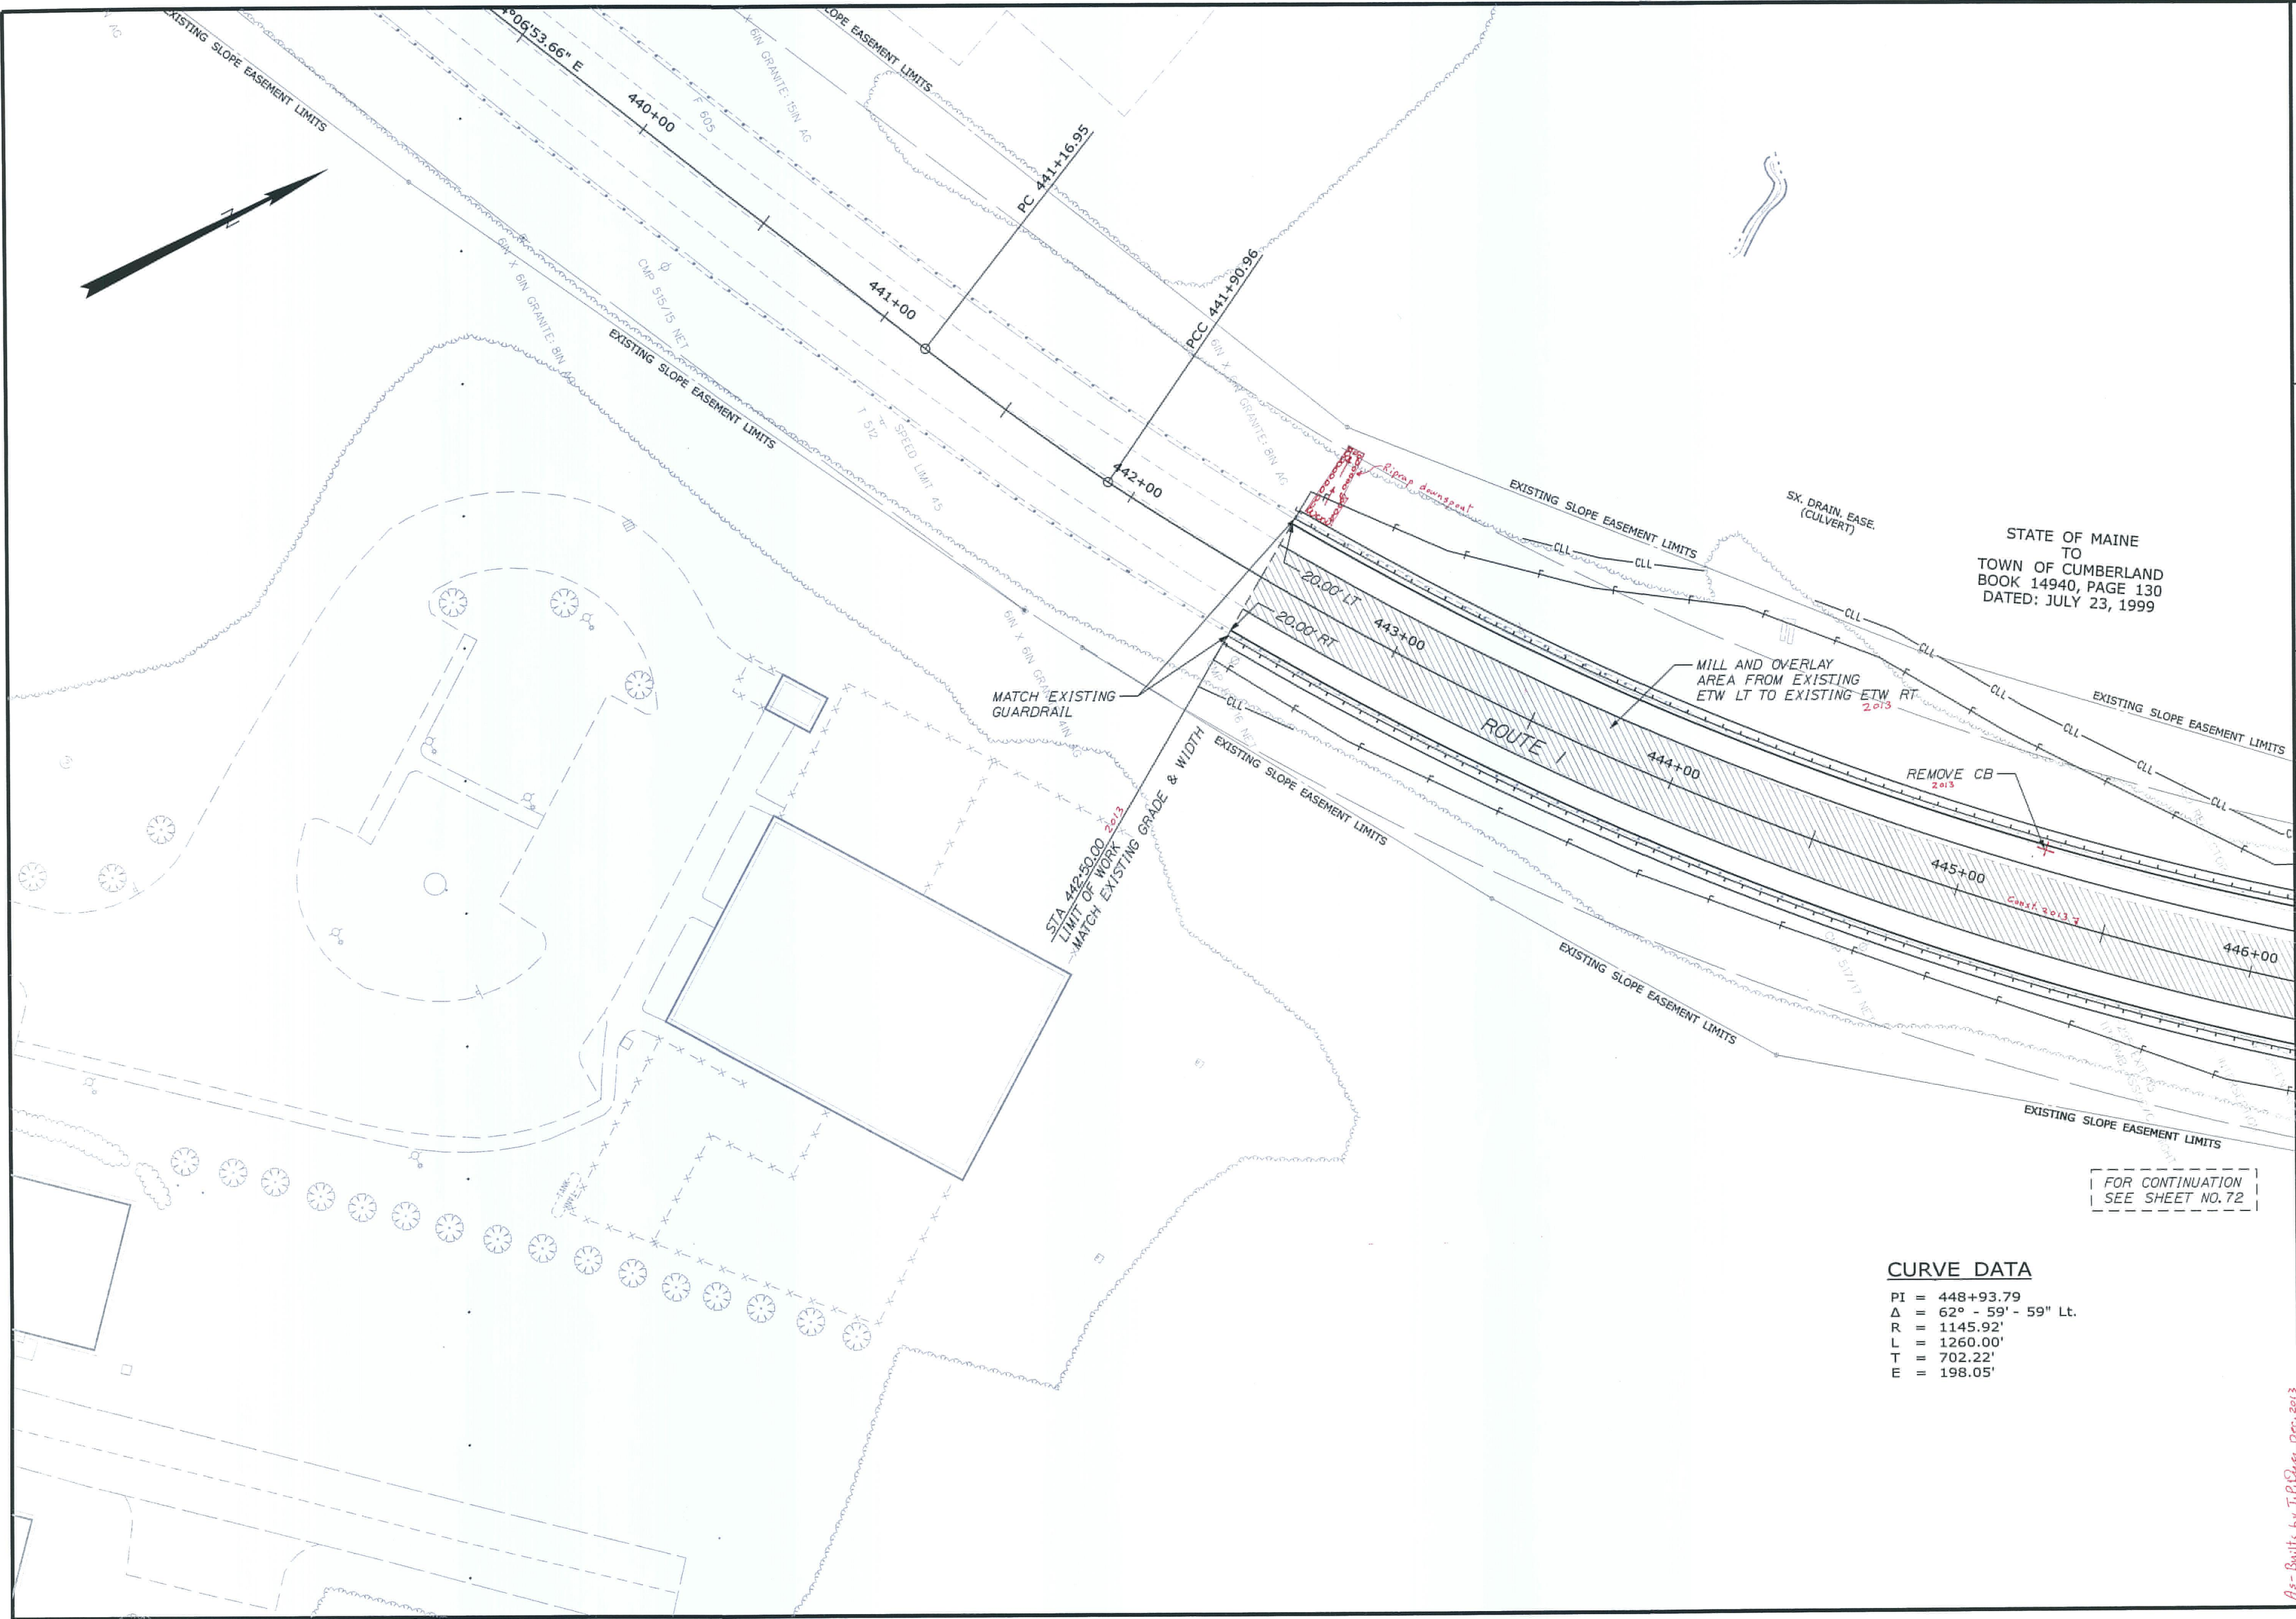

CURVE DATA

PI = 448+93.79
Δ = 62° - 59' - 59" Lt.
R = 1145.92'
L = 1260.00'
T = 702.22'
E = 198.05'


FOR CONTINUATION
SEE SHEET NO. 72

STATE OF MAINE DEPARTMENT OF TRANSPORTATION		SIGNATURE		DATE
IM-1108(600) EXIT 15 CM-1749(000)X PARK & RIDE LOT		P.E. NUMBER		
WIN 11086.00 EXIT 15 HIGHWAY PLANS WIN 17490.00 PARK & RIDE LOT		DATE		
YARMOUTH I-295 EXIT 15		PLANS		
SHEET NUMBER		71 OF 283		

Figure 1

PI = 448+93.79
 Δ = 62° - 59' - 59" Lt.
R = 1145.92'
L = 1260.00'
T = 702.22'
E = 198.05'

OF 283

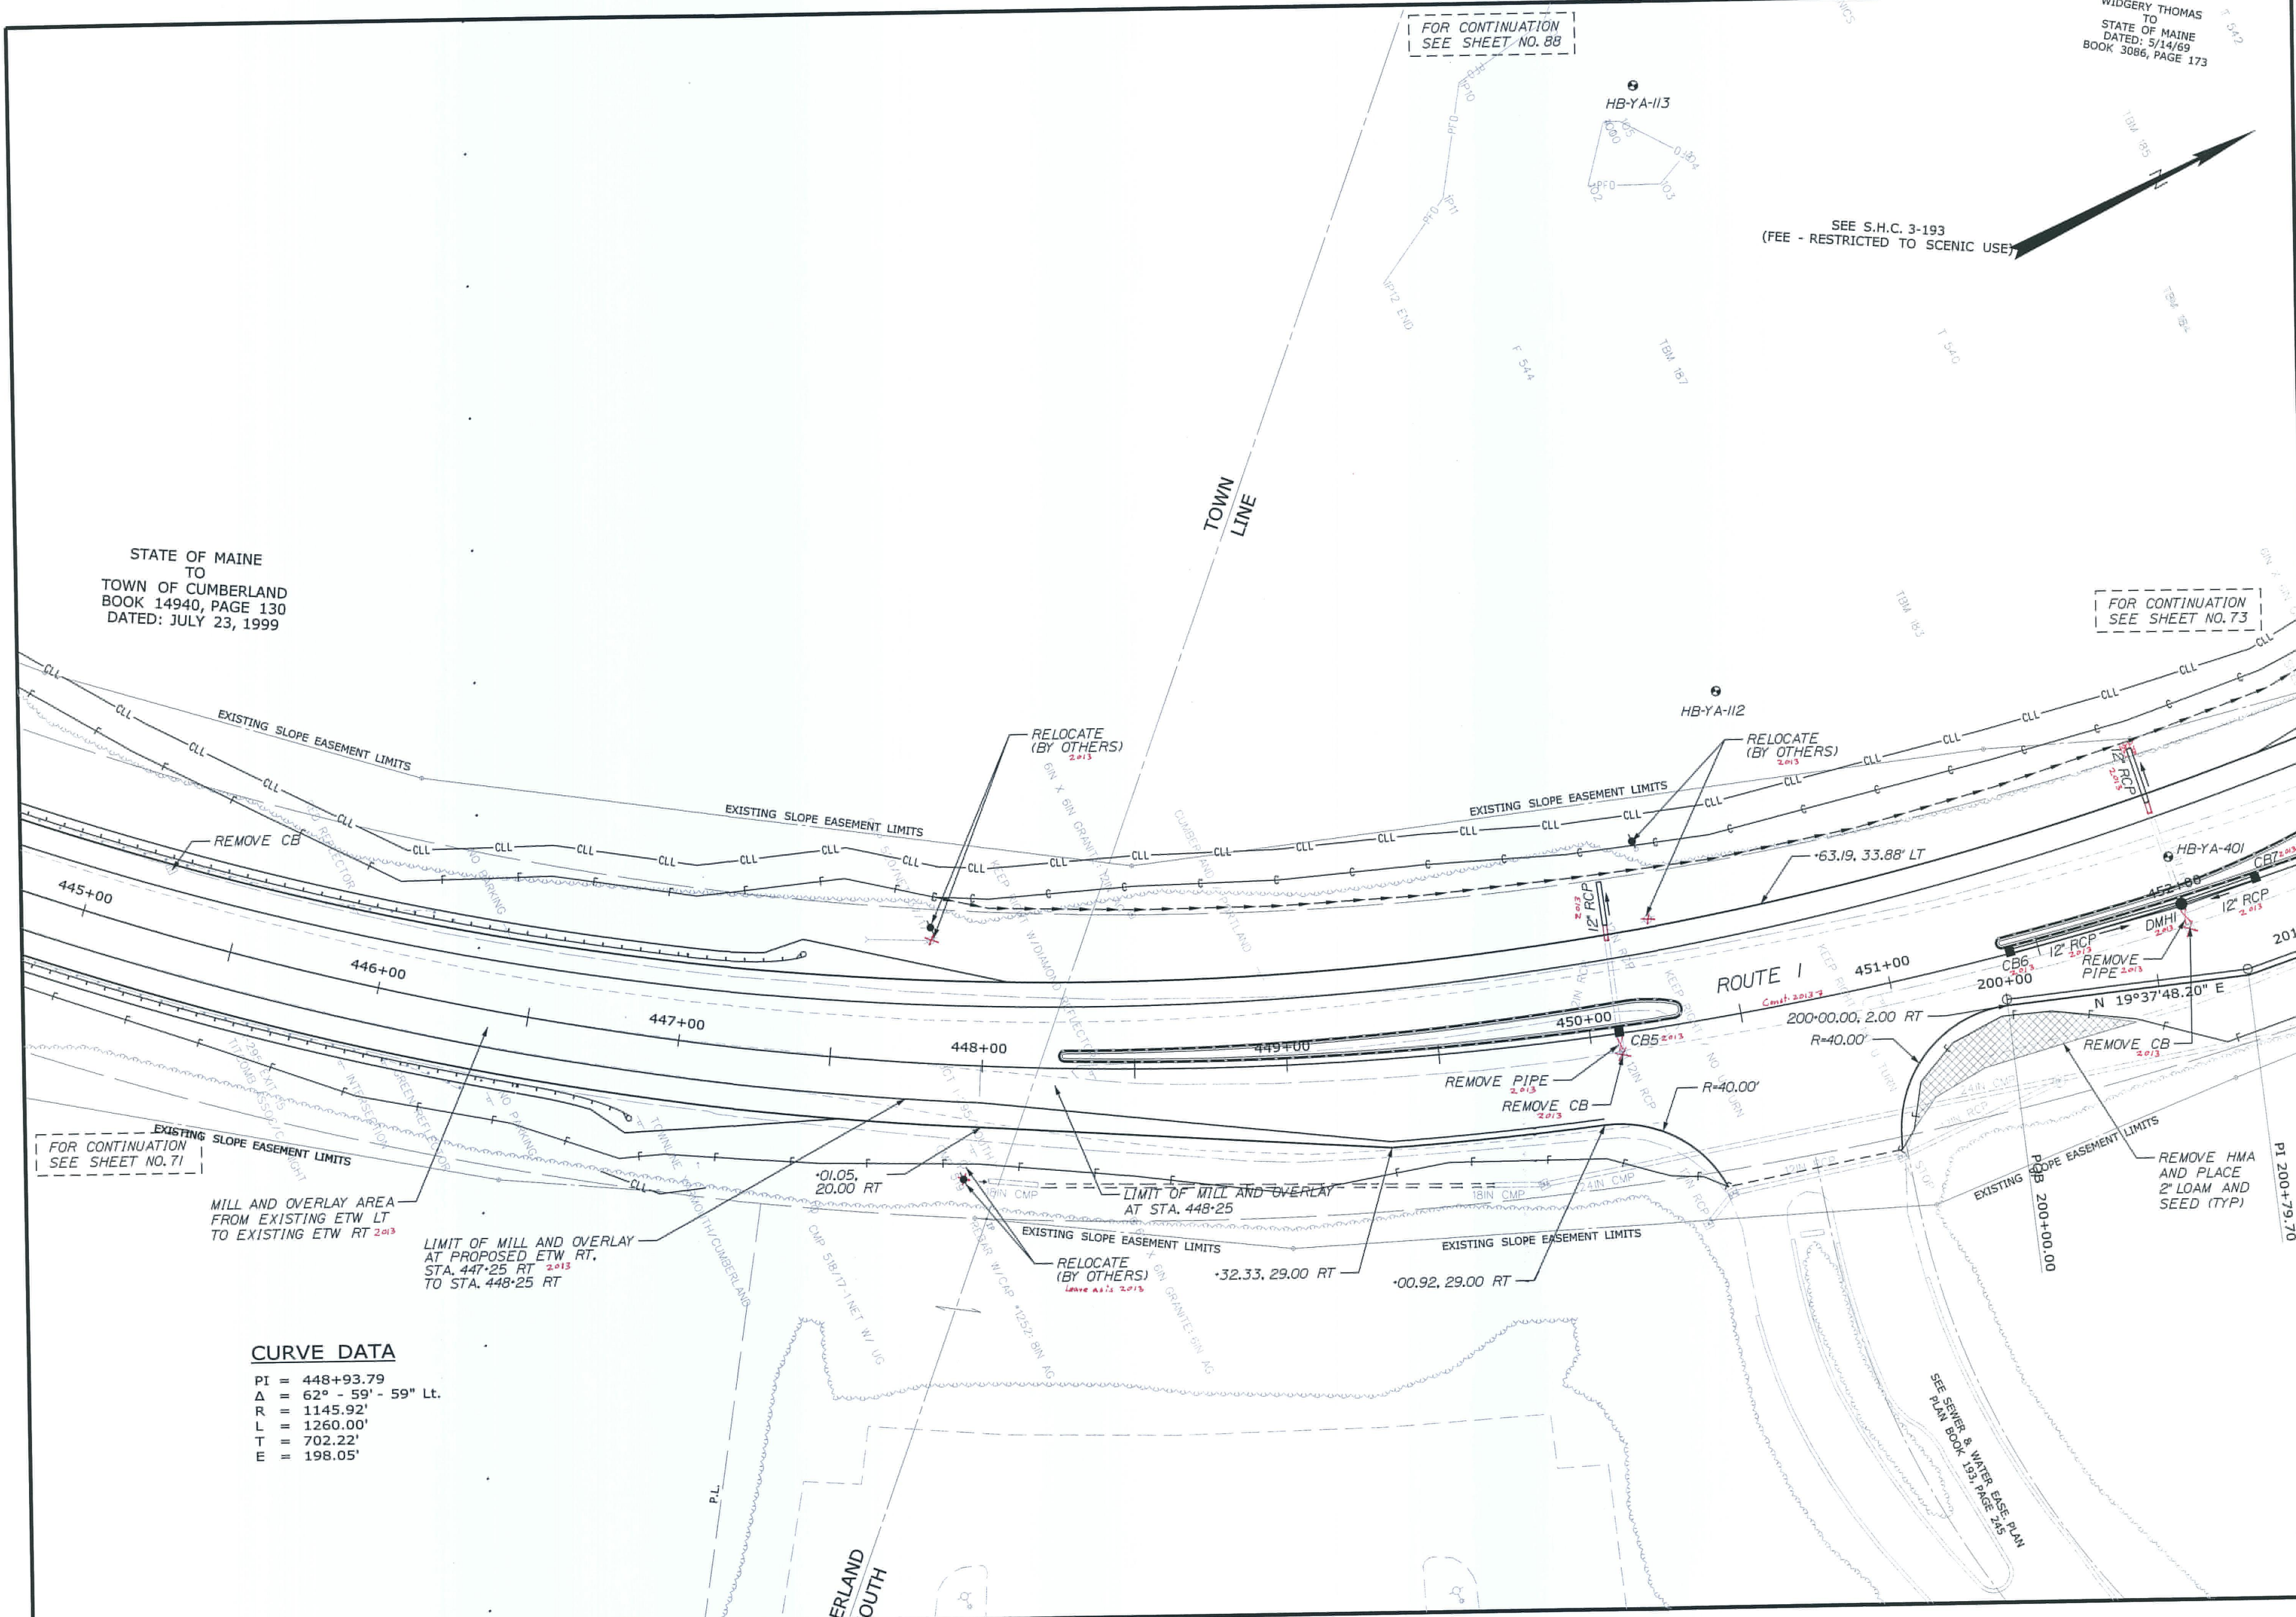

Date: 2/21/2011

Username: COMMON

Division: HIGHWAY

Filename:

SEE S.H.C. 3-193
EE - RESTRICTED TO SCENIC USE)

CURVE DATA

PI = 448+93.79
Δ = 62° - 59' - 59" Lt.
R = 1145.92'
L = 1260.00'
T = 702.22'
E = 198.05'

CURVE DATA

PI = 127+15.40
Δ = 83° - 50' - 21" Rt.
R = 237.00'
L = 346.80'
T = 12.79'
E = 81.51'

CURVE DATA

PI = 201+74.43
Δ = 13°32'10.3" Rt.
R = 182.00'
L = 43.00'
T = 21.60'
E = 1.28'

CURVE DATA

PI = 202+39.48
Δ = 50°46'05.0" Rt.
R = 92.00'
L = 15.52'
T = 43.65'
E = 9.83'

CURVE DATA

PI = 202+94.03
Δ = 10°28'31.1" Rt.
R = 182.00'
L = 33.27'
T = 16.68'
E = 0.76'

TYLER TECHNOLOGIES, INC.
COLE HAAN - LESSEE
TA = 61.7± AC.(SURVEY)
PP 4

LOT PLANS THIS AREA
"SURVEY FOR COLE-HAAN"
BY LAND USE CONSULTANTS
PLAN BOOK 193, PAGE 245
"COLE HAAN SITE PLAN WITH LOT
DIVISION AND ACCESS R.O.W."
PLAN BOOK 208, PAGE 314

FOR CONTINUATION
SEE SHEET NO. 83

FOR CONTINUATION
SEE SHEET NO. 84

YARMOUTH
I-295 EXIT 15

PLANS

SHEET NUMBER

73

OF 283

STATE OF MAINE

DEPARTMENT OF TRANSPORTATION

IM-1108(600) EXIT 15

CM-1749(000)X PARK & RIDE LOT

WIN 11086.00 EXIT 15 HIGHWAY PLANS

WIN 17490.00 PARK & RIDE LOT


PROJ. MANAGER	DATE	BY	SIGNATURE	P.E. NUMBER	DATE
DESIGN-DETAILED					
CHECKED-REVIEWED					
DESIGN-DETAILED					
REVISIONS 1					
REVISIONS 2					
REVISIONS 3					
REVISIONS 4					
FIELD CHANGES					

Date: 2/21/2011

Username: COMMON

Division: HIGHWAY


Filename:

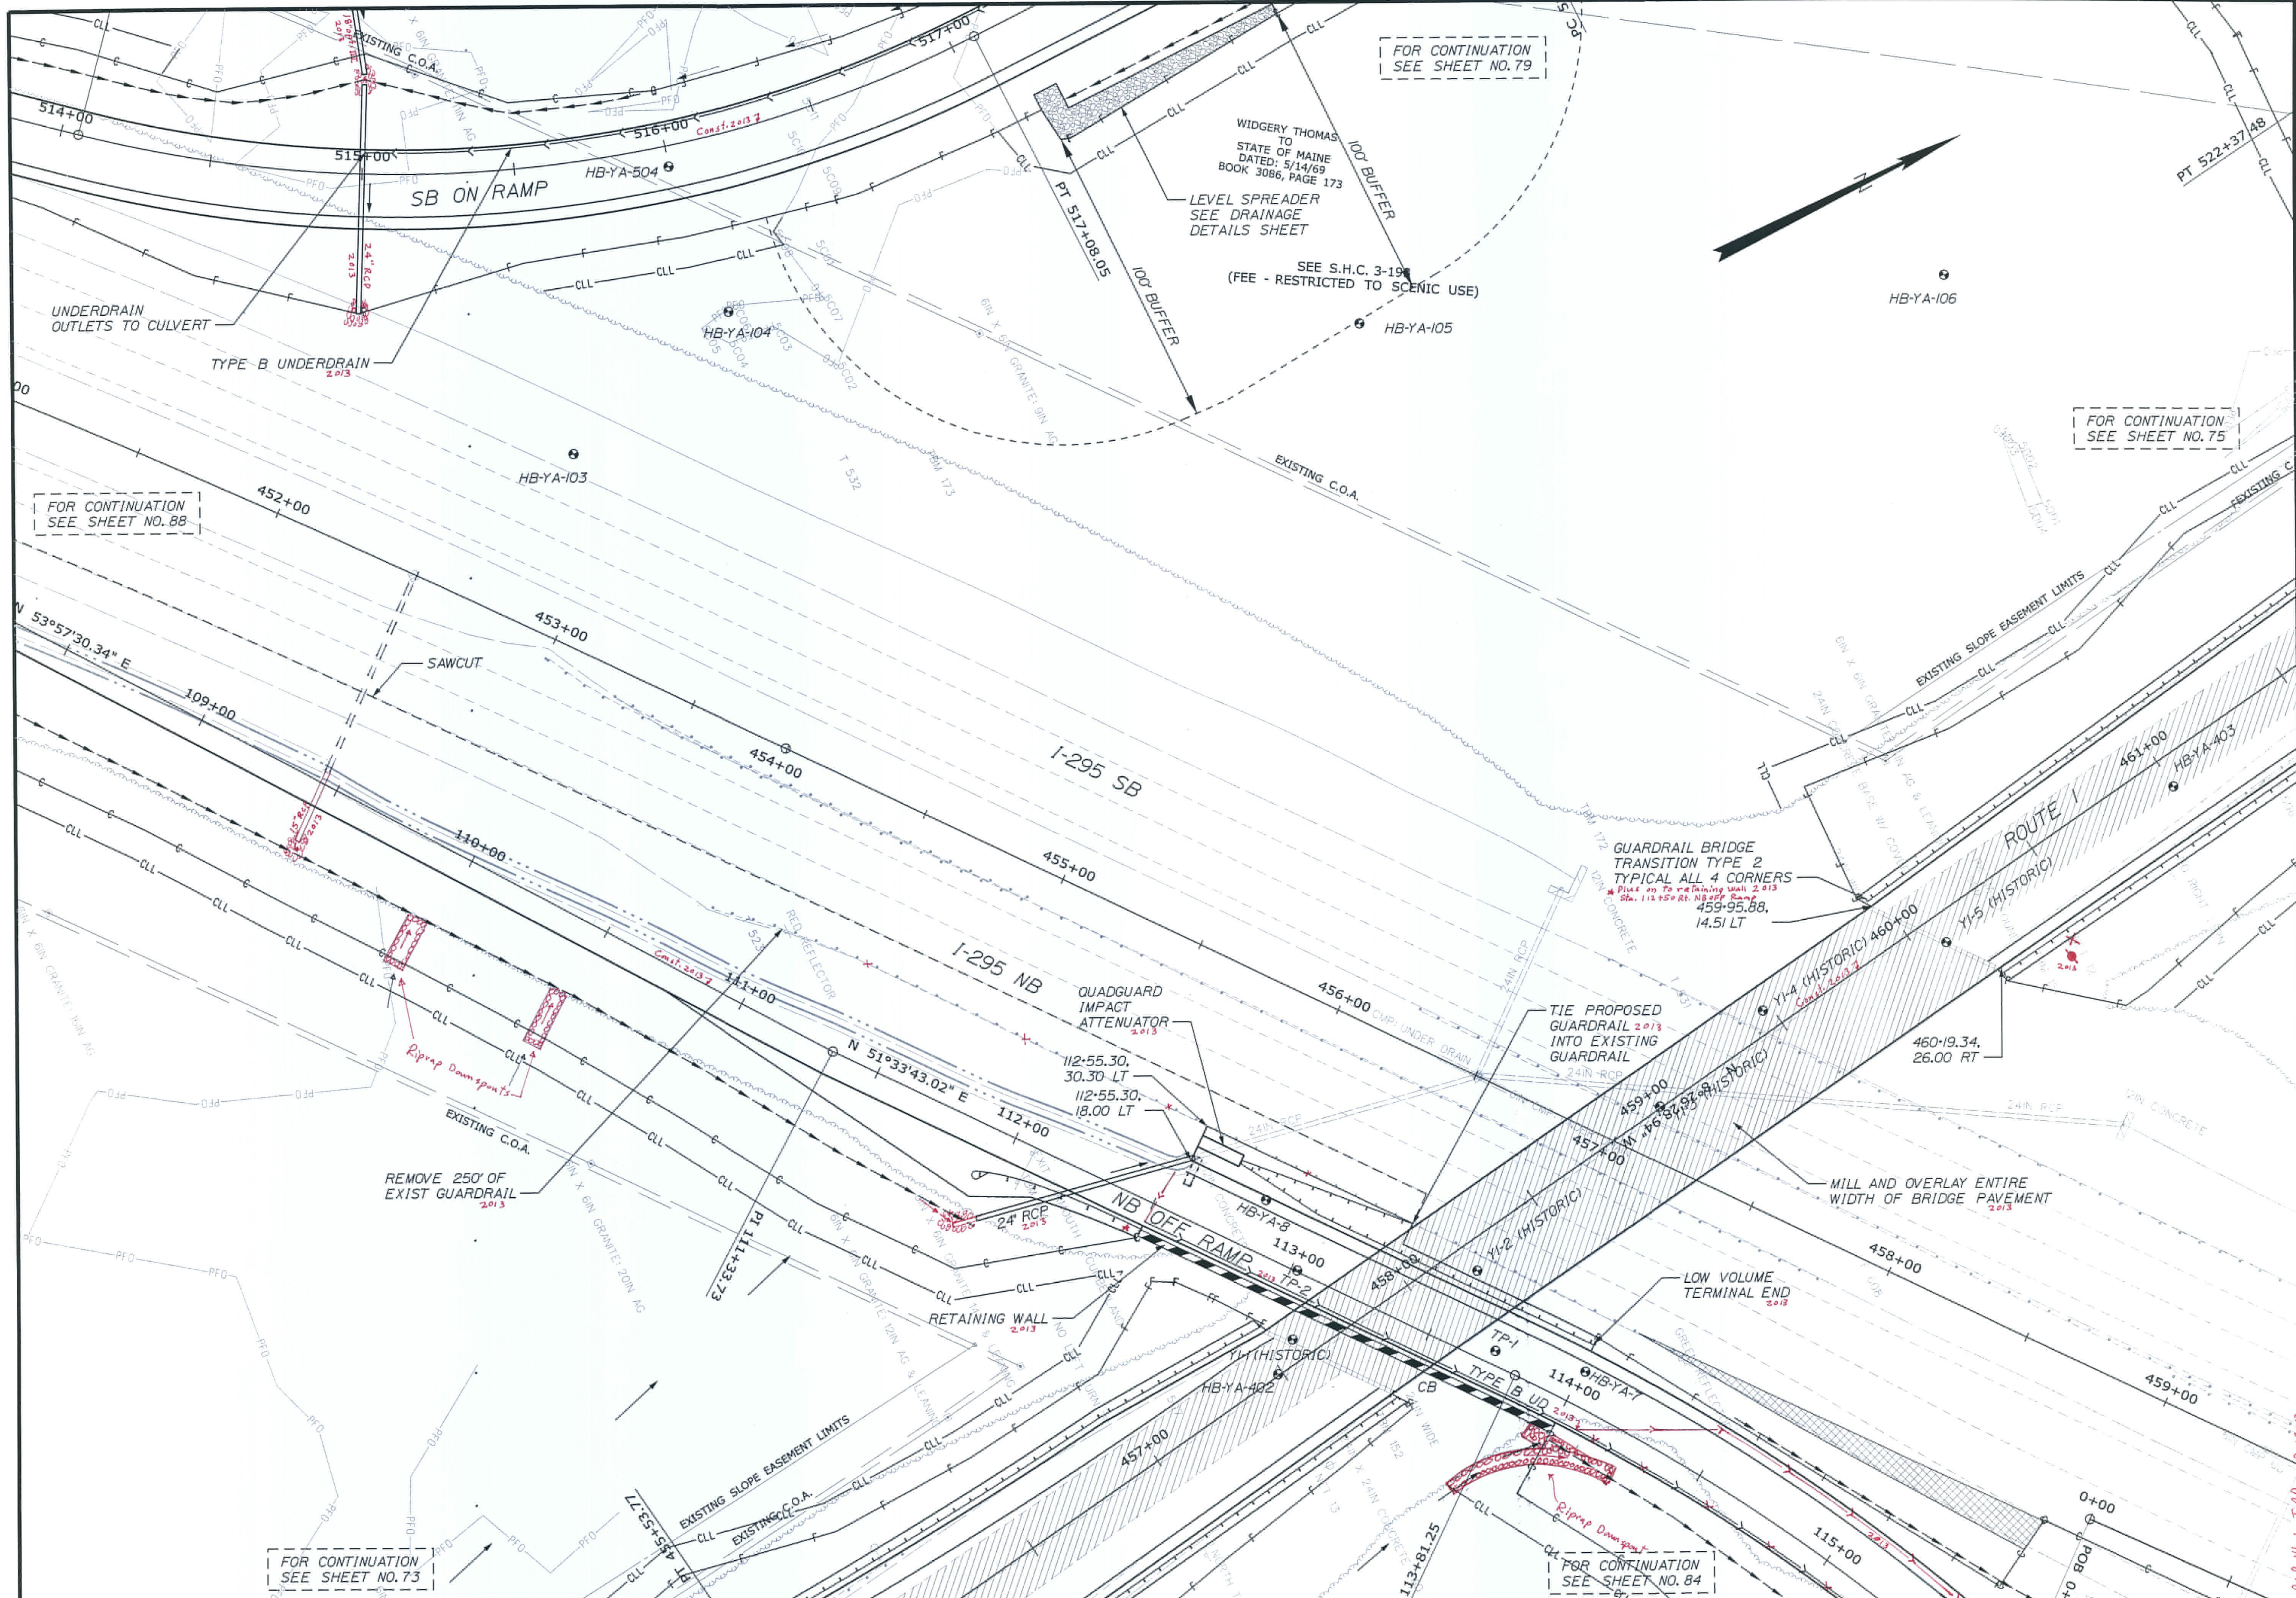

STATE OF MAINE
DEPARTMENT OF TRANSPORTATION
IM-1108(600) EXIT 15
CM-1749(000)X PARK & RIDE LOT
WIN 11086.00 EXIT 15 HIGHWAY PLANS
WIN 17490.00 PARK & RIDE LOT

PROJ. MANAGER	DESIGN-DETAILED	CHECKED-REVIEWED	DESIGN-DETAILED	DESIGN-DETAILED	REVISIONS 1	REVISIONS 2	REVISIONS 3	REVISIONS 4	FIELD CHANGES
BY	DATE	SIGNATURE	P.E. NUMBER	DATE					

YARMOUTH
I-295 EXIT 15
PLANS
SHEET NUMBER
74
OF 283

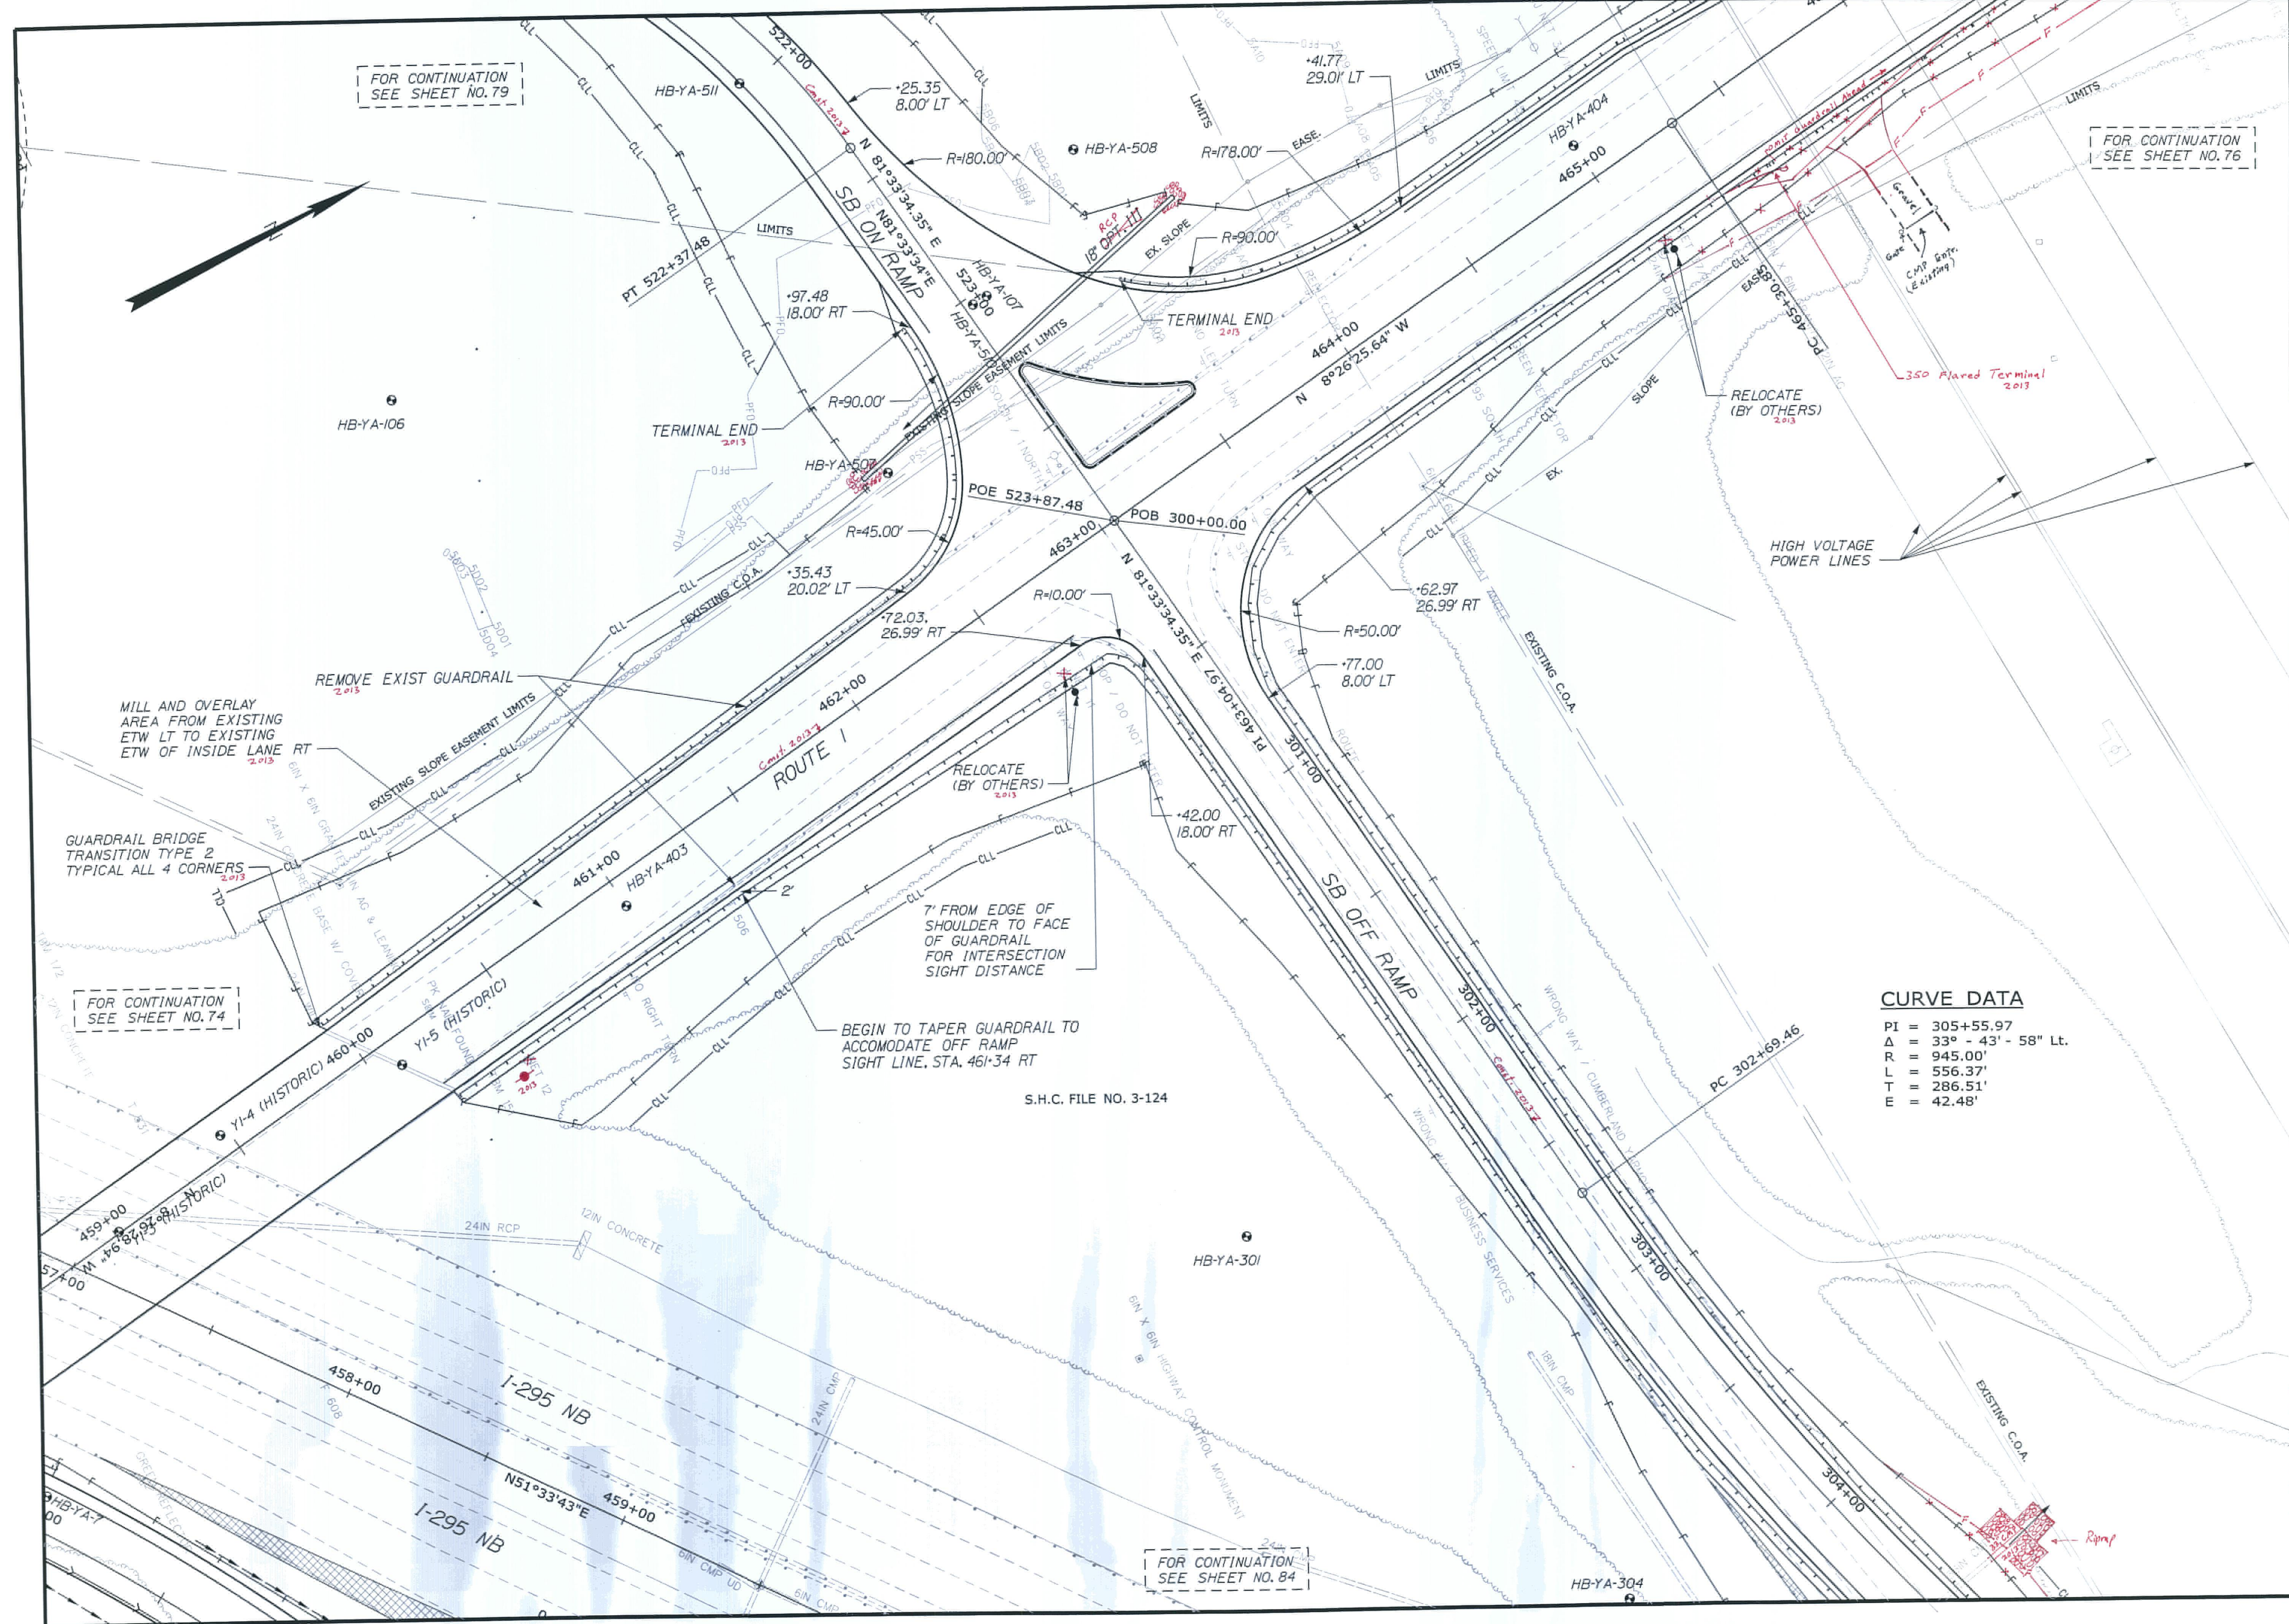

STATE OF MAINE	
DEPARTMENT OF TRANSPORTATION	
IM-1108(600) EXIT 15	HIGHWAY PLANS
CM-1749(000)X PARK & RIDE LOT	
WIN 11086.00 EXIT 15	
WIN 17490.00 PARK & RIDE LOT	

PROJ. MANAGER	BY	DATE
DESIGN DET AILED		
CHECKED-REVIEWED		
DESIGN DET AILED 02		
DESIGN DET AILED 03		
REVISIONS 1		
REVISIONS 2		
REVISIONS 3		
REVISIONS 4		
FIELD CHANGES		

YARMOUTH
 I-295 EXIT 15
 PLANS

SHEET NUMBER

75

OF 283

~~$PI = 621 + 98.58$
 $\Delta = 74^\circ - 37' - 43'' \text{ Lt}$
 $R = 164.00'$
 $L = 213.61'$
 $T = 125.00'$
 $E = 42.21'$~~

$PI = 623 + 75.59$
 $\Delta = 53^\circ - 20' - 09''$ Rt.
 $R = 176.00'$
 $L = 163.84'$
 $T = 88.40'$
 $E = 20.95'$

$$\begin{aligned} \text{PI} &= 601 + 31.64 \\ \Delta &= 64^\circ - 32' - 02'' \text{ Lt.} \\ R &= 100.00' \\ L &= 112.63' \\ T &= 63.14' \\ E &= 18.26' \end{aligned}$$

ENTRANCE/EXIT TO PARK & RIDE

FOR CONTINUATION
SEE SHEET NO. 77

REMOVE HMA AND PLACE
2" LOAM & SEED (TYP)
— Planted Trees in area 2013 —

Filename:

IM-1108(600) EXIT 15
CM-1749(000)X PARK & RIDE LOT

WIN 17490.00 PARK & RIDE LOT

P.E. NUMBER

DATE _____

[illegible]

--	--	--	--

11

FILED 3		
---------	--	--

53		
----	--	--

DESIGN	REVISION	REVISION
--------	----------	----------

REVISION	
REVISION	
FIELD C	

1

1

1	
---	--

1	2	3	466
---	---	---	---	---	---	---	---	---	----	----	-----	-----	
AN

22

P

1	
---	--

1

--	--

76

F 283

113 - DM 113 by 1.1.1994 DEC 2003


Date: 2/21/2011

Username: COMMON

Division: HIGHWAY

Filename:

ST. LAWRENCE AND ATLANTIC RAILROAD CO

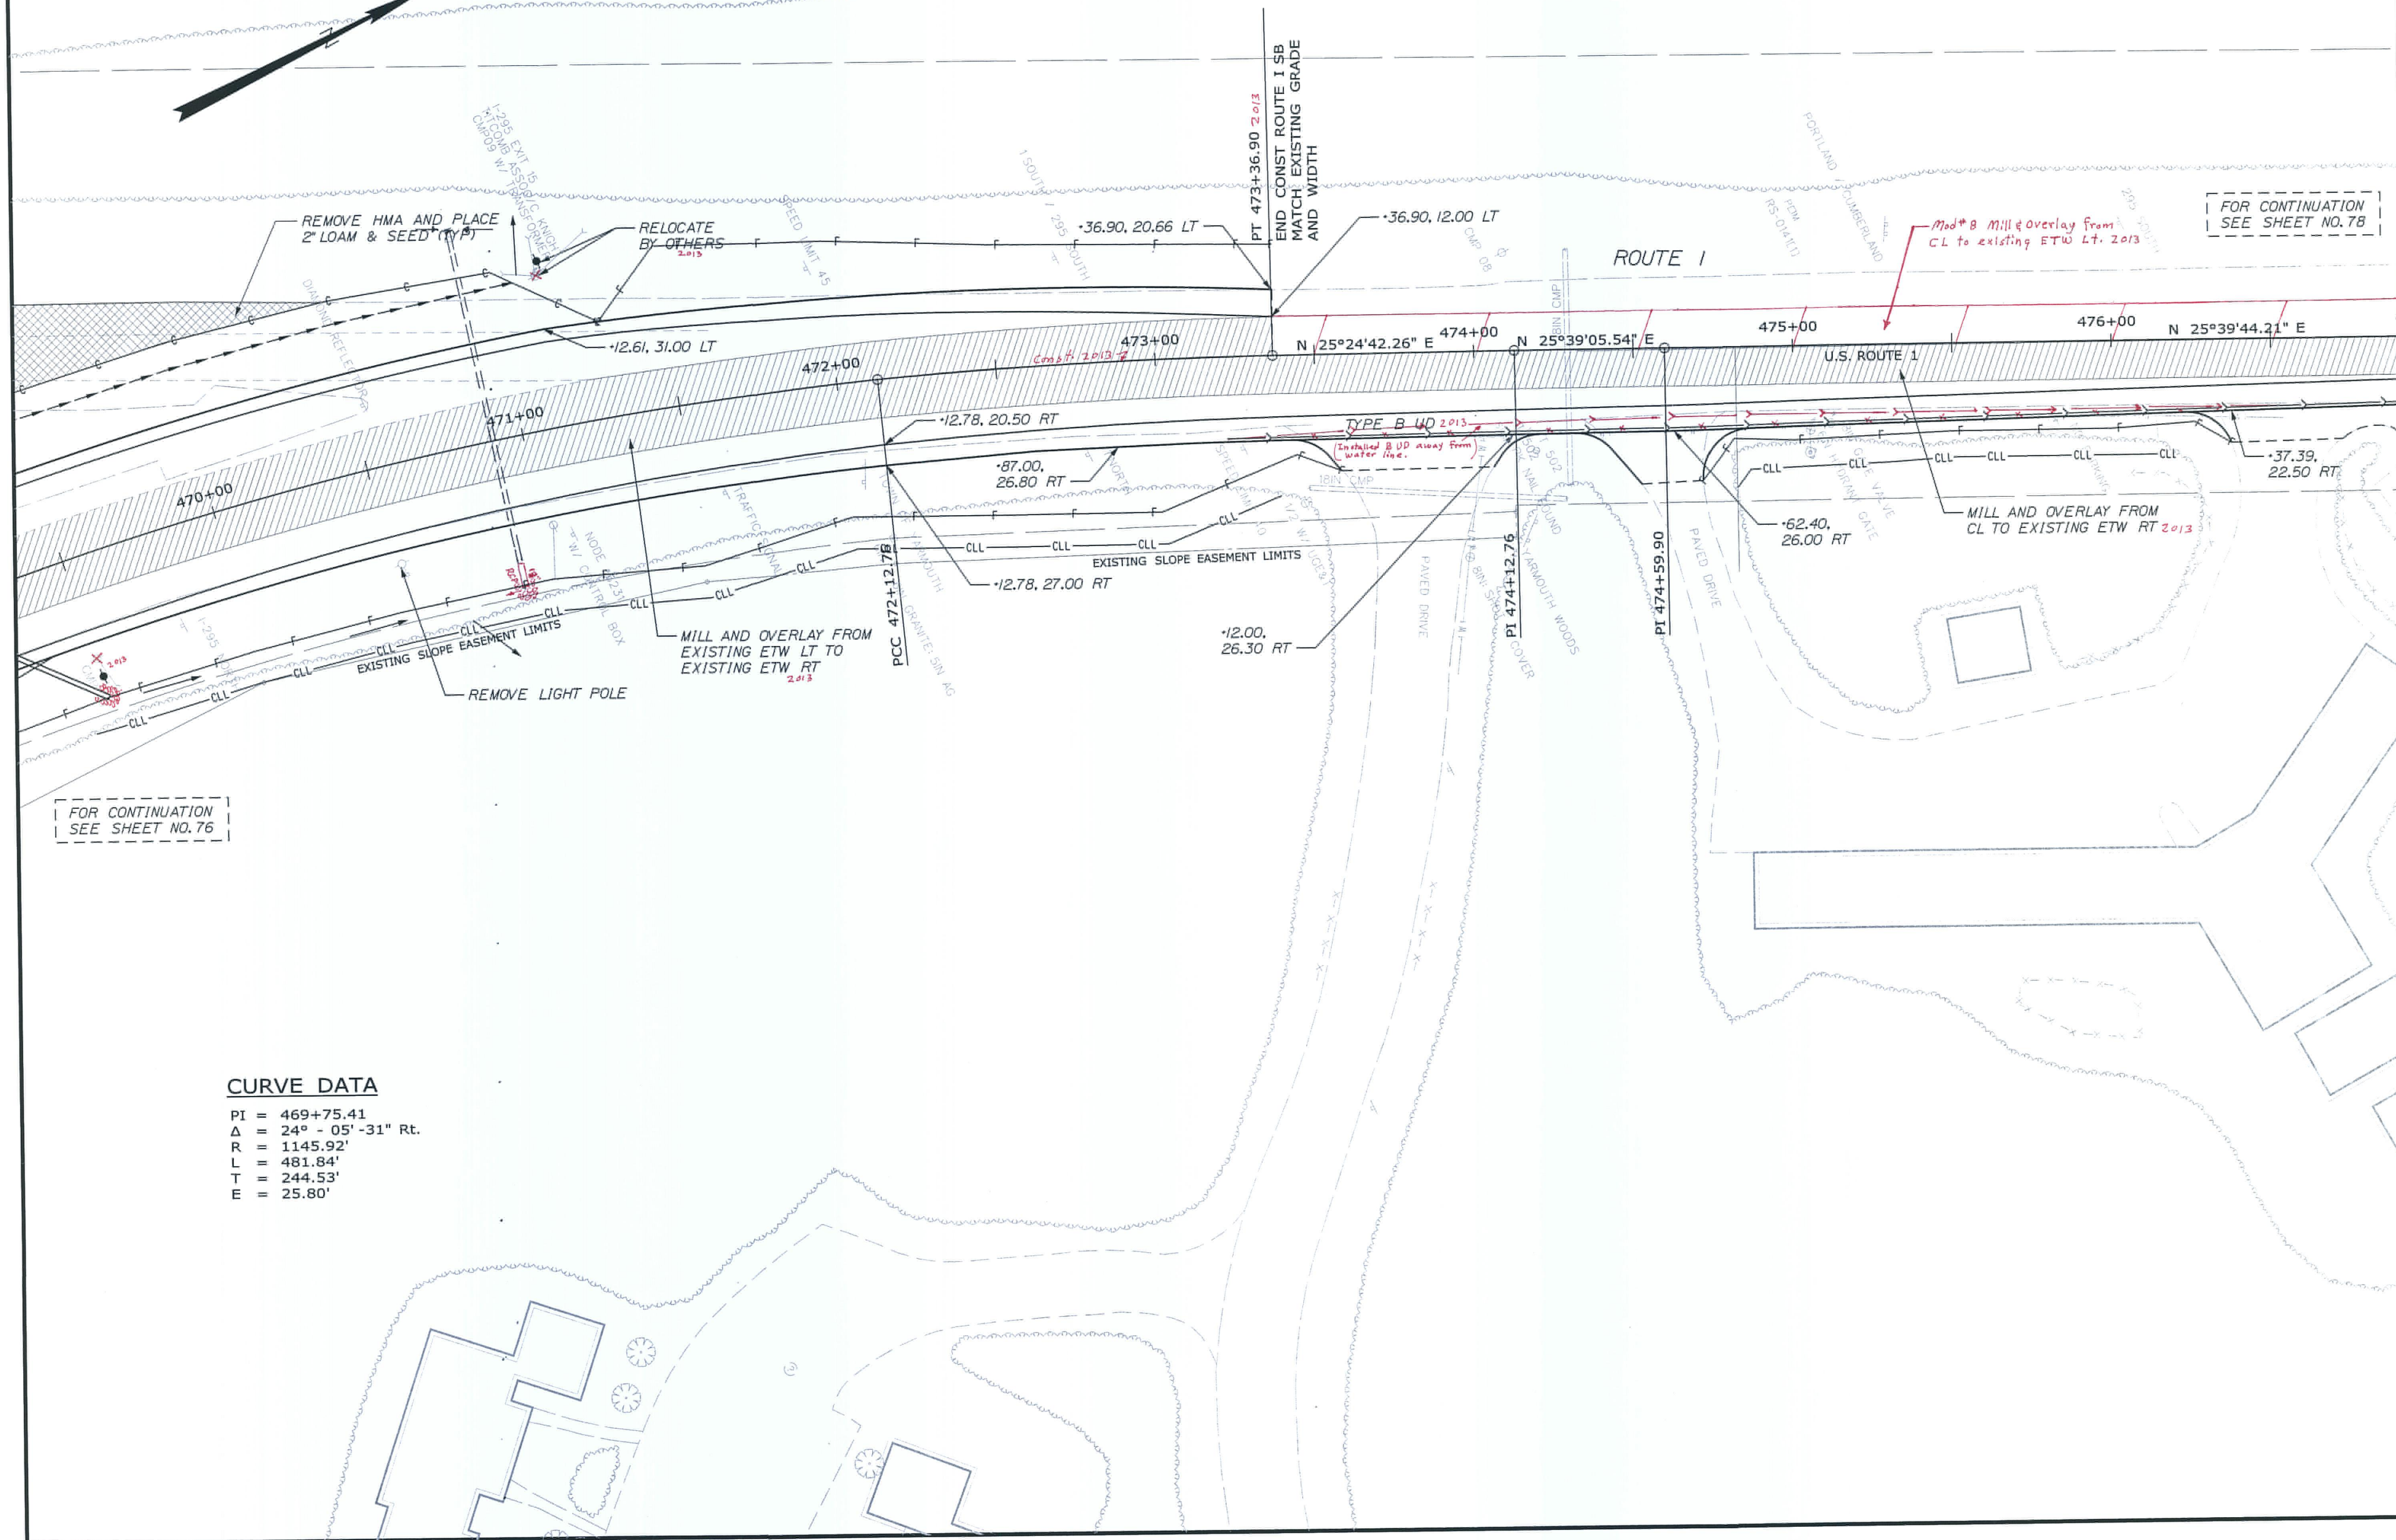

CURVE DATA

PI = 469+75.41
Δ = 24° - 05' - 31" Rt.
R = 1145.92'
L = 481.84'
T = 244.53'
E = 25.80'

STATE OF MAINE
DEPARTMENT OF TRANSPORTATION
IM-1108(600) EXIT 15
CM-1749(000)X PARK & RIDE LOT
WIN 11086.00 EXIT 15
WIN 17490.00 PARK & RIDE LOT

PROJ. MANAGER	DATE	BY	SIGNATURE	P.E. NUMBER	DATE
DESIGN-DETAILED					
CHECKED-REVIEWED					
DESIGN-DETAILED					
DESIGN-DETAILED					
REVISIONS 1					
REVISIONS 2					
REVISIONS 3					
REVISIONS 4					
FIELD CHANGES					

YARMOUTH
I-295 EXIT 15

PLANS

SHEET NUMBER

77


OF 283

Filename:

Division: HIGHWAY

Username: COMMON


Date: 2/21/2011

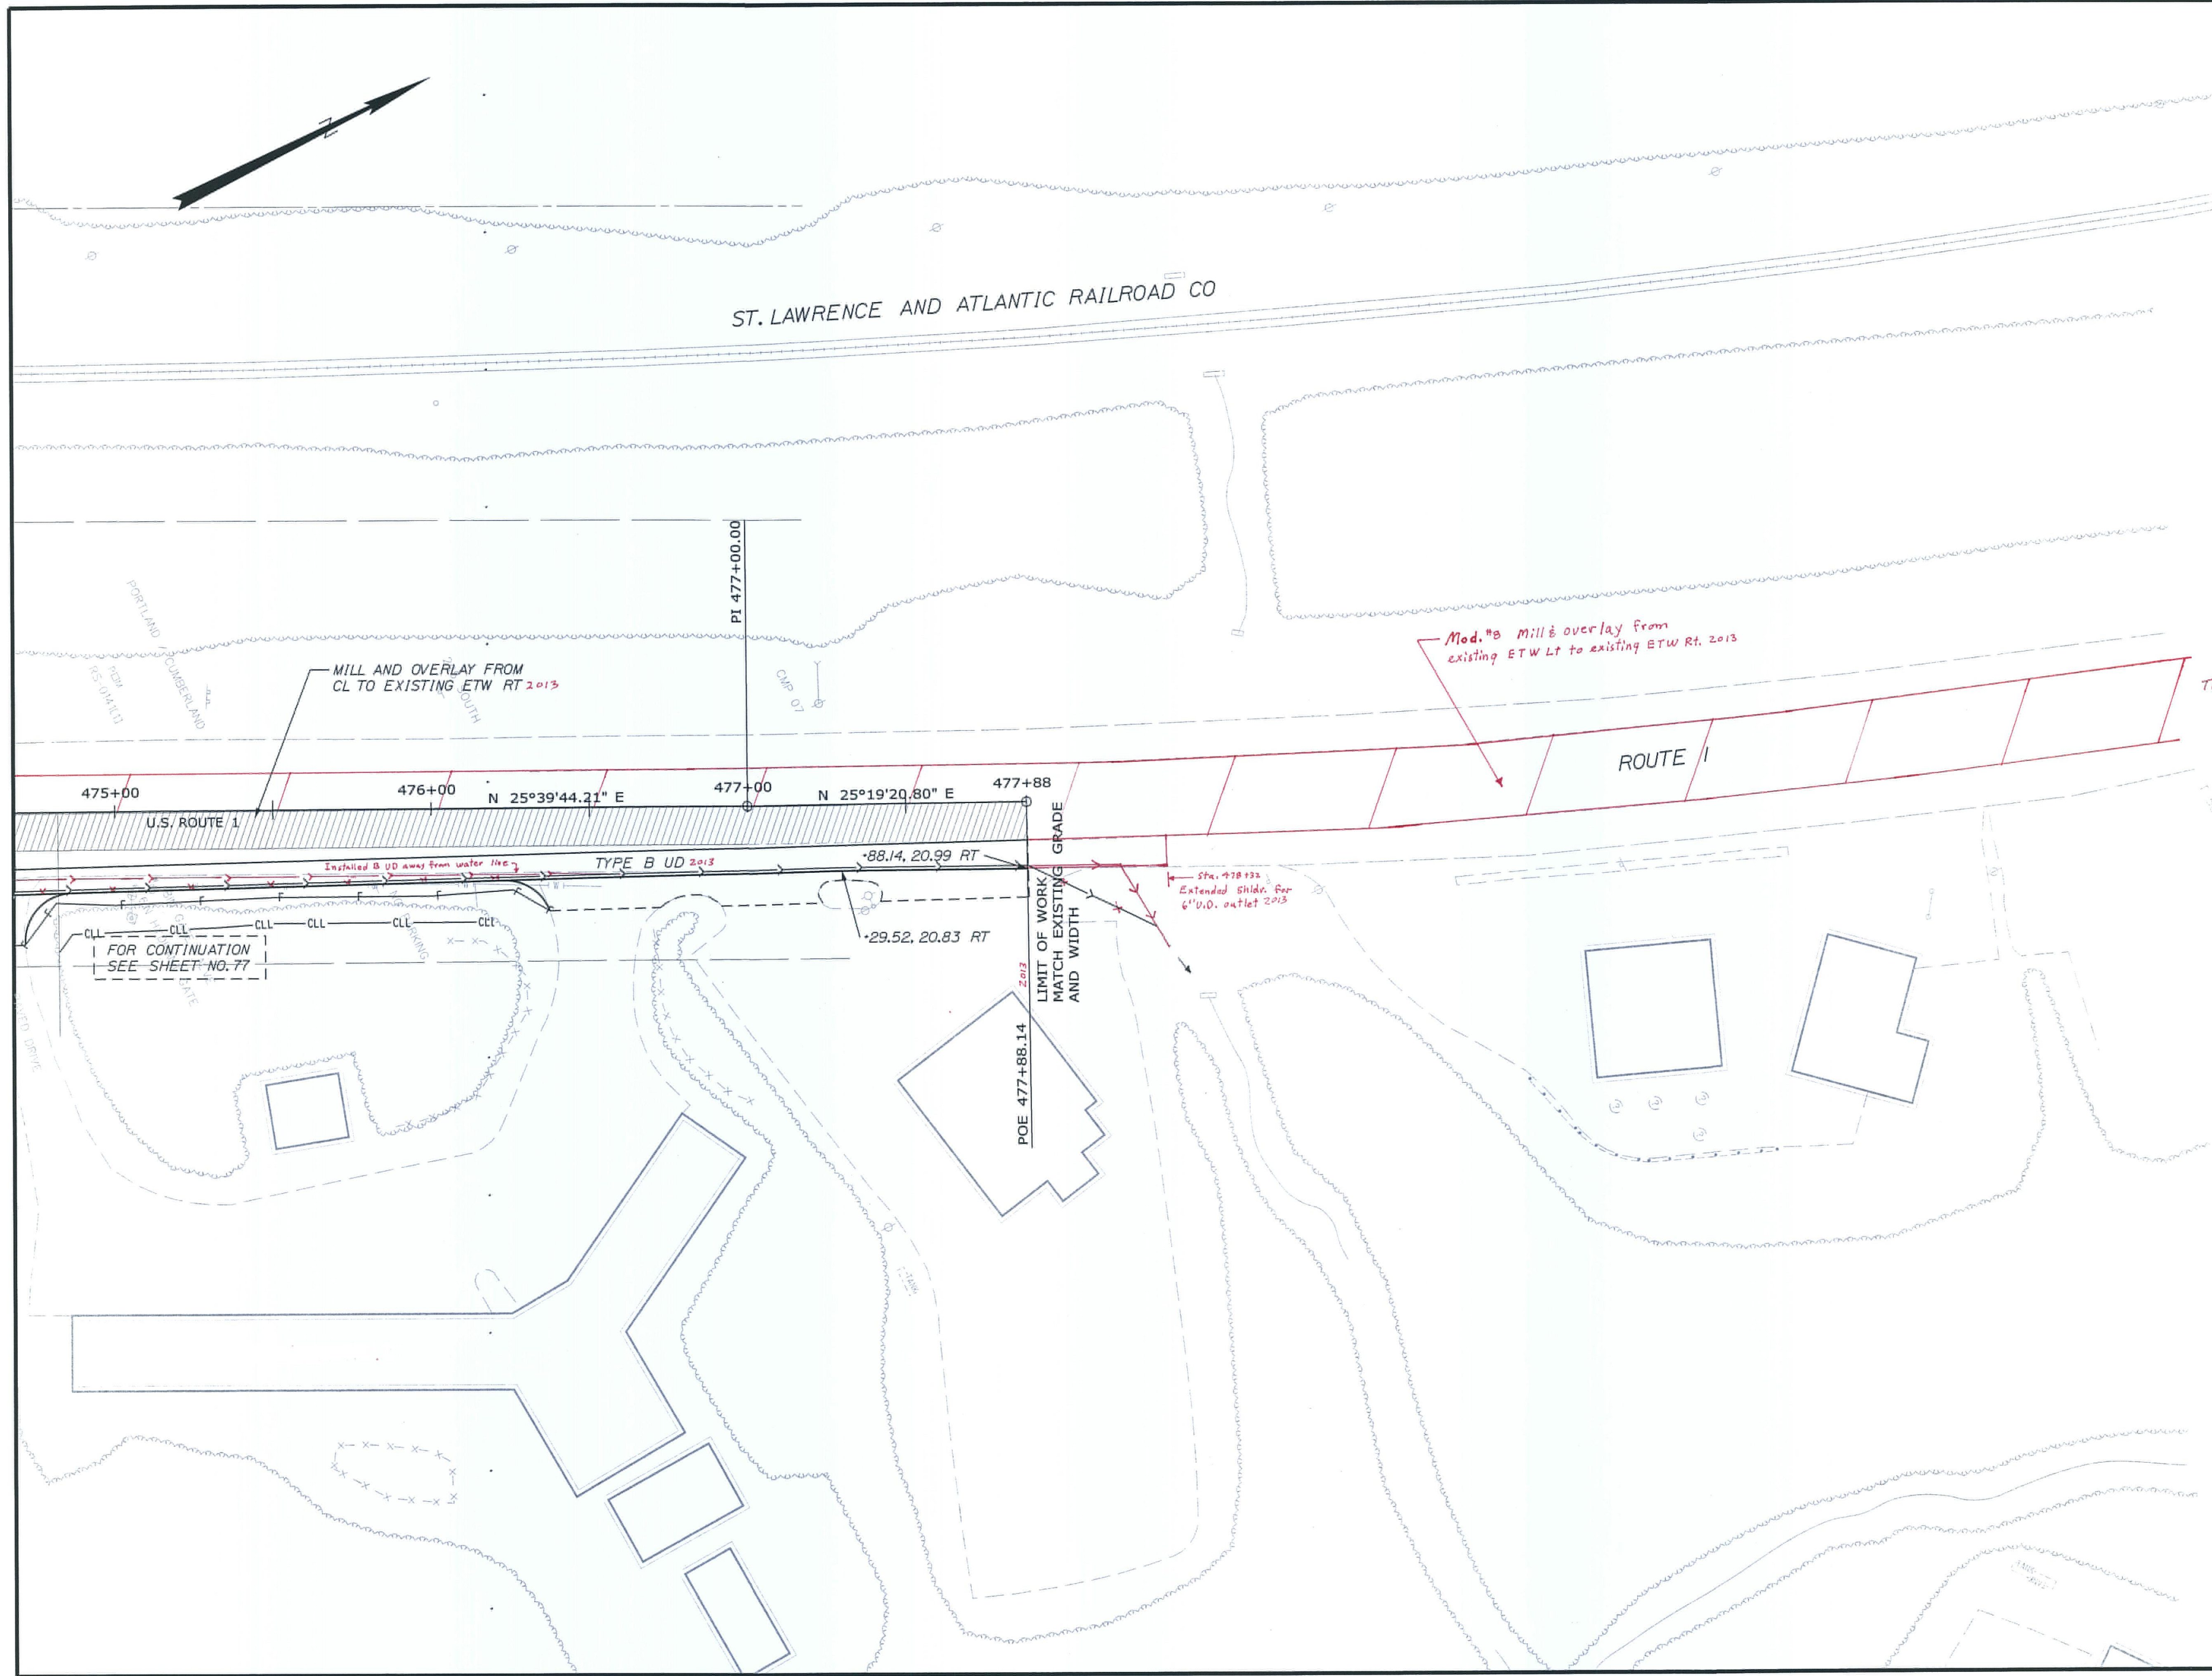

As-Built by T.P.O. Dec. 2013

STATE OF MAINE		DEPARTMENT OF TRANSPORTATION	
YARMOUTH		IM-1108(600) EXIT 15	
I-295 EXIT 15		CM-1749(000)X PARK & RIDE LOT	
PLANS		WIN 11086.00 EXIT 15 HIGHWAY PLANS	
SHEET NUMBER		WIN 17490.00 PARK & RIDE LOT	
78			
OF 283			
		PROJ. MANAGER	SIGNATURE
		CHECKED-REVIEWED	P.E. NUMBER
		DESIGN-DETAILED	DATE
		DESIGN-REVIEWED	
		DESIGN-DETAILED2	
		DESIGN-DETAILED3	
		REVISIONS 1	
		REVISIONS 2	
		REVISIONS 3	
		REVISIONS 4	
		FIELD CHANGES	

Date: 2/21/2011
Username: COMMON
Division: HIGHWAY
Filename:

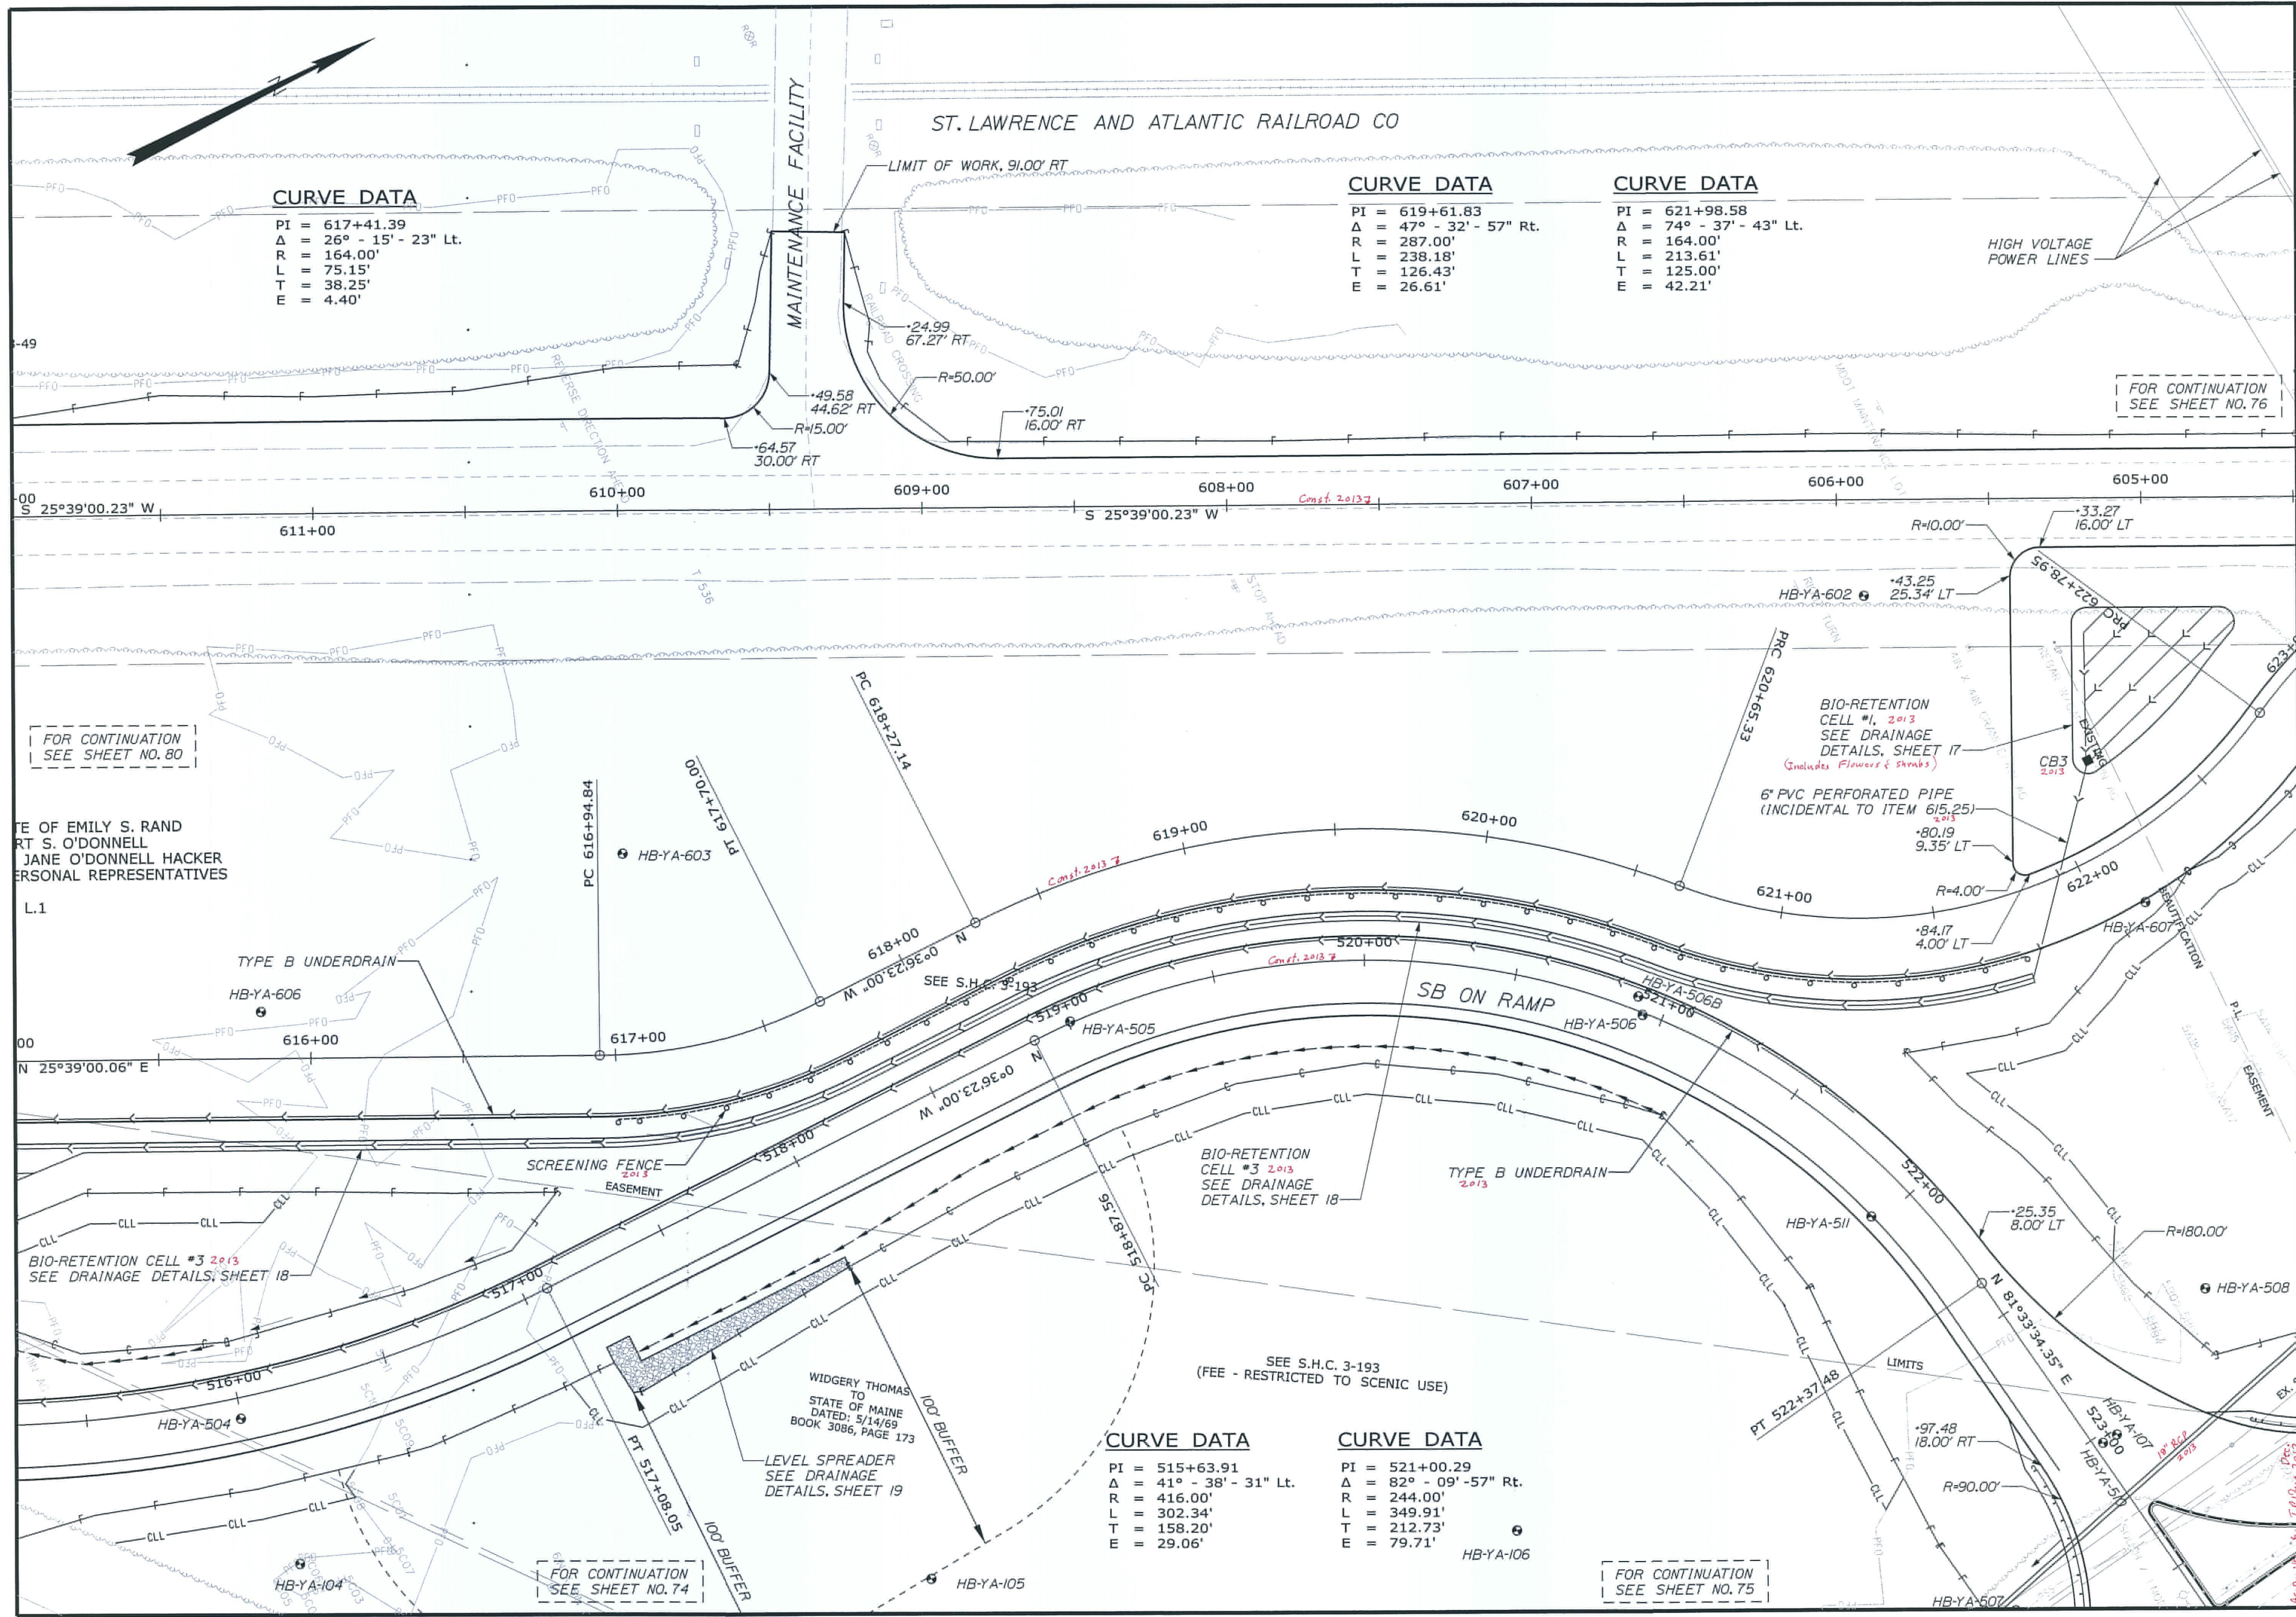

STATE OF MAINE
DEPARTMENT OF TRANSPORTATION
IM-1108(600) EXIT 15
CM-1749(000)X PARK & RIDE LOT
WIN 11086.00 EXIT 15 HIGHWAY PLANS
WIN 17490.00 PARK & RIDE LOT

PROJ. MANAGER	DESIGN-DETAILED	CHECKED-REVIEWED	DESIGN-DETAILED	DESIGN-REVIEWED	REVISIONS 1	REVISIONS 2	REVISIONS 3	REVISIONS 4	FIELD CHANGES

DATE

BY


SIGNATURE

P.E. NUMBER

DATE


YARMOUTH
I-295 EXIT 15
PLANS

SHEET NUMBER
79
OF 283

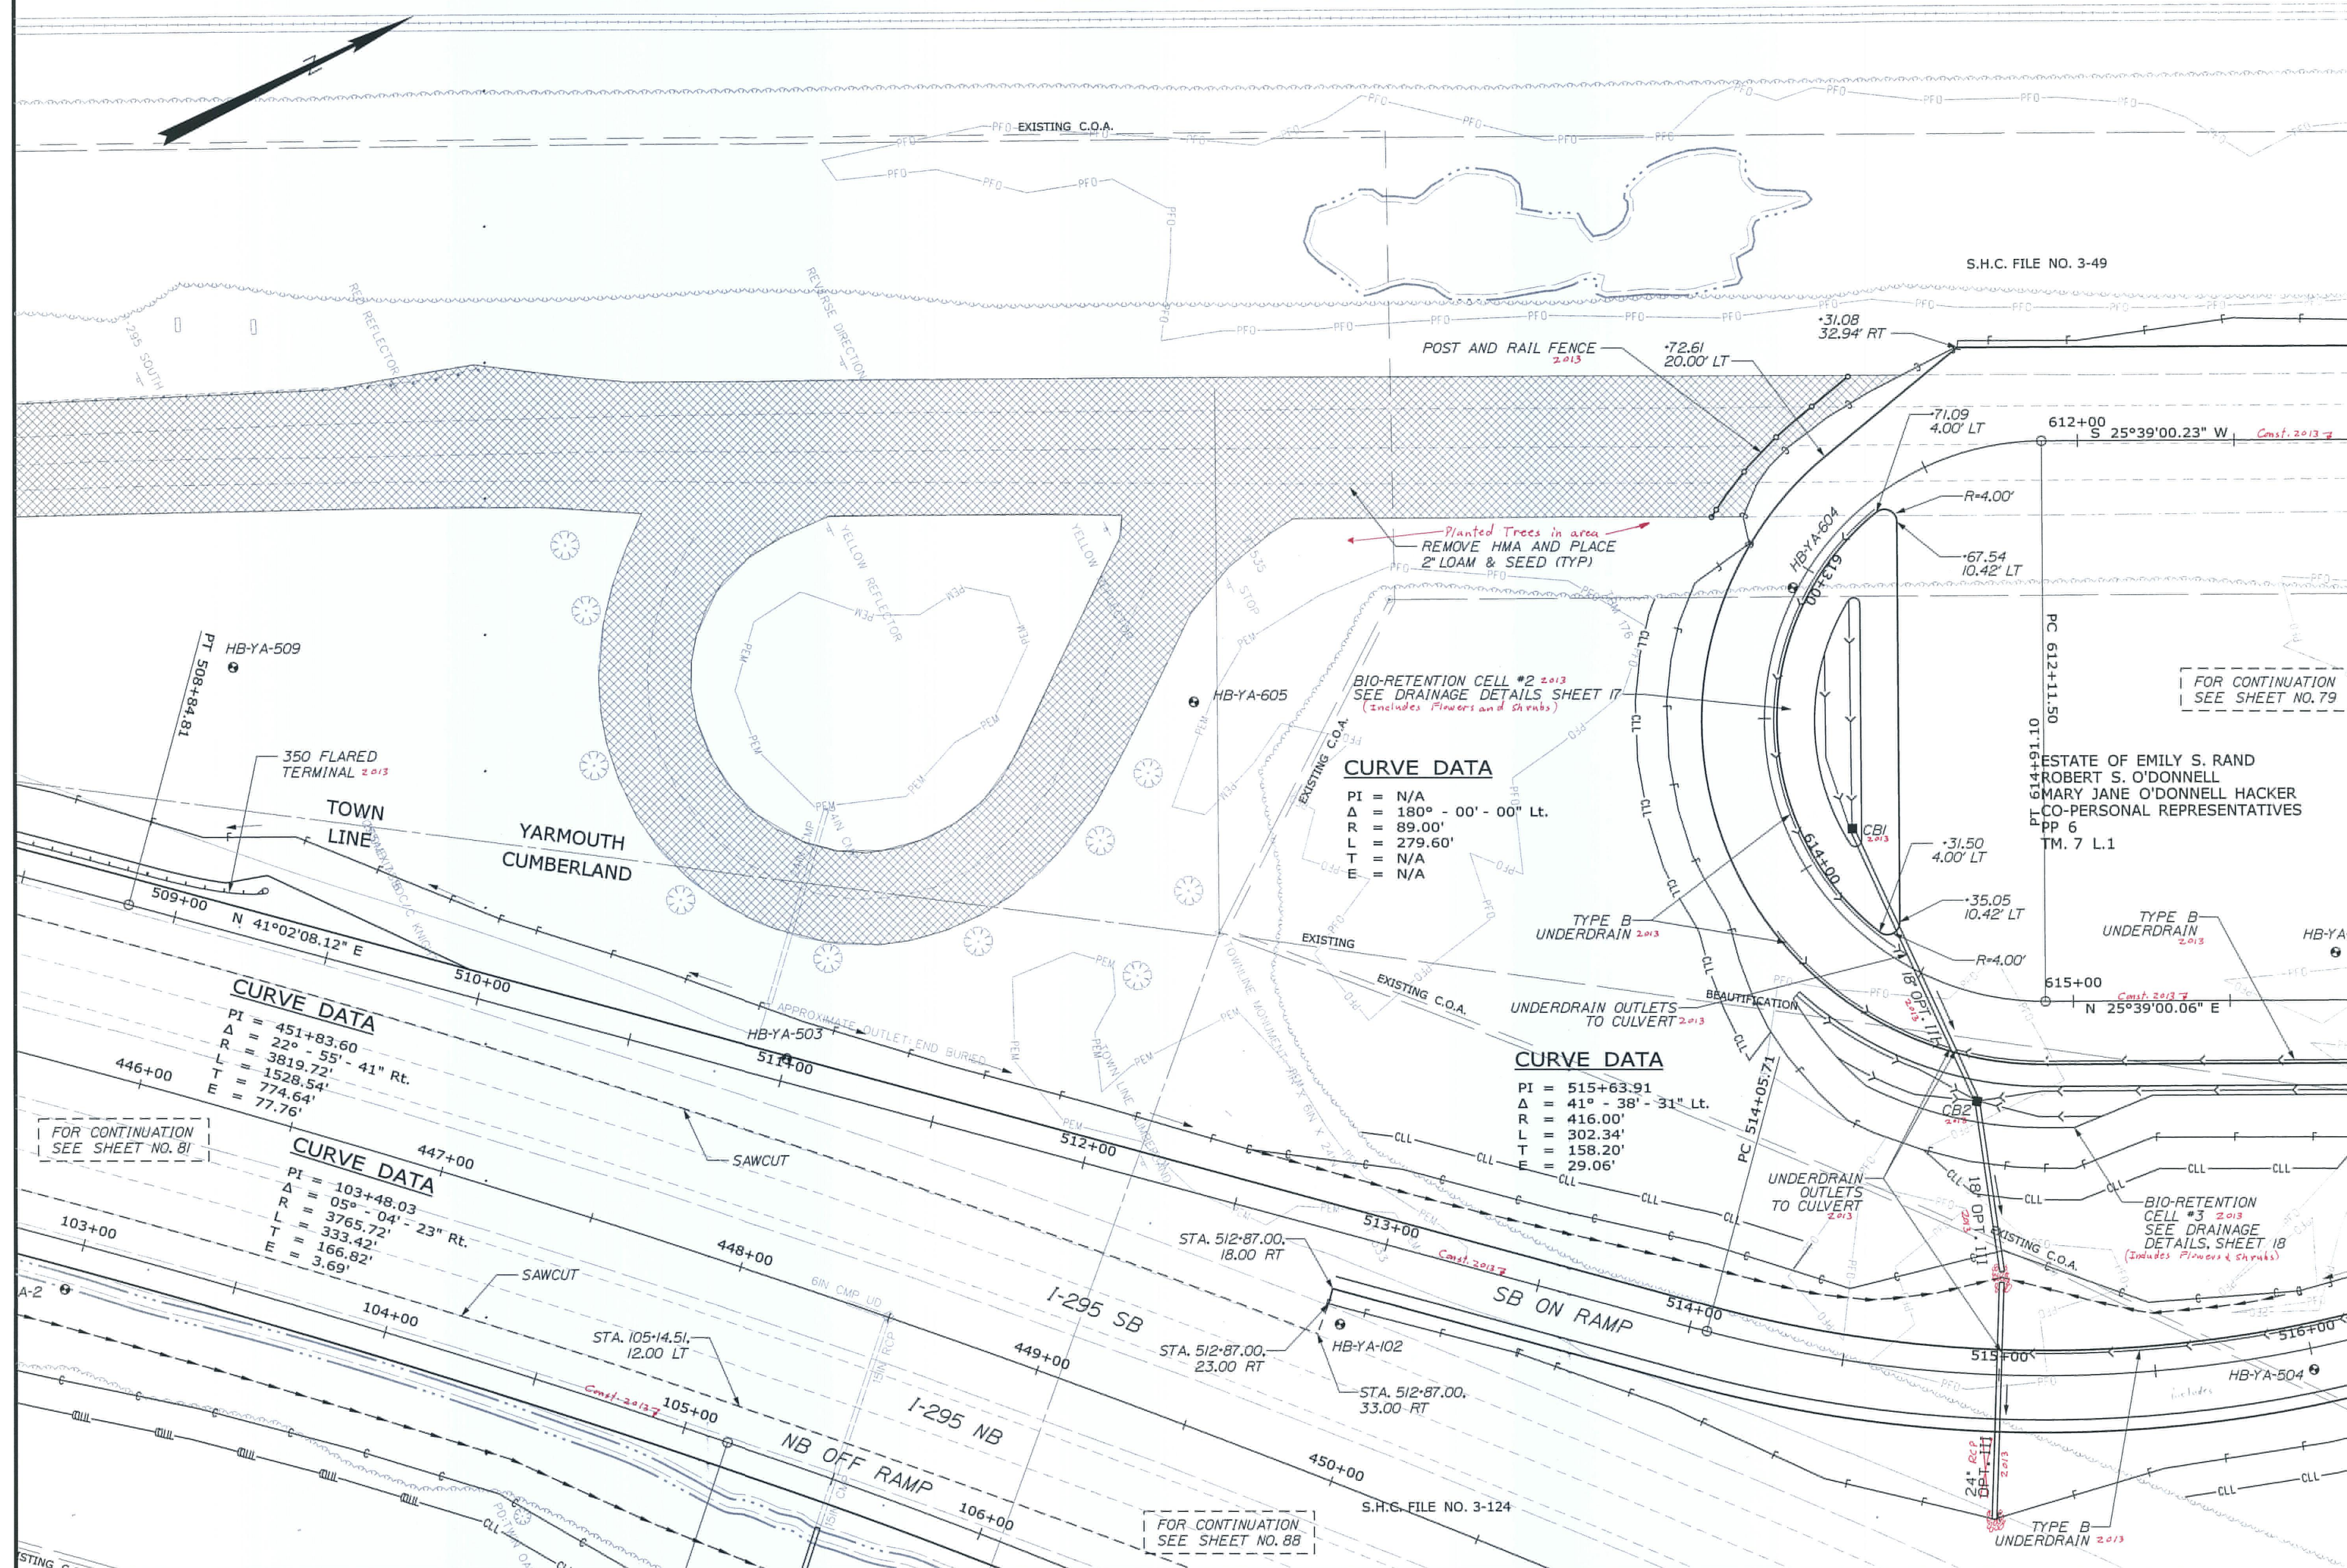

PROJ. MANAGER	BY	DATE
DESIGN-DETAILED		
CHECKED-REVIEWED		
DESIGN2-DETAILED2		
DESIGN3-DETAILED3		
REVISIONS 1		
REVISIONS 2		
REVISIONS 3		
REVISIONS 4		
FIELD CHANGES		

Filename:

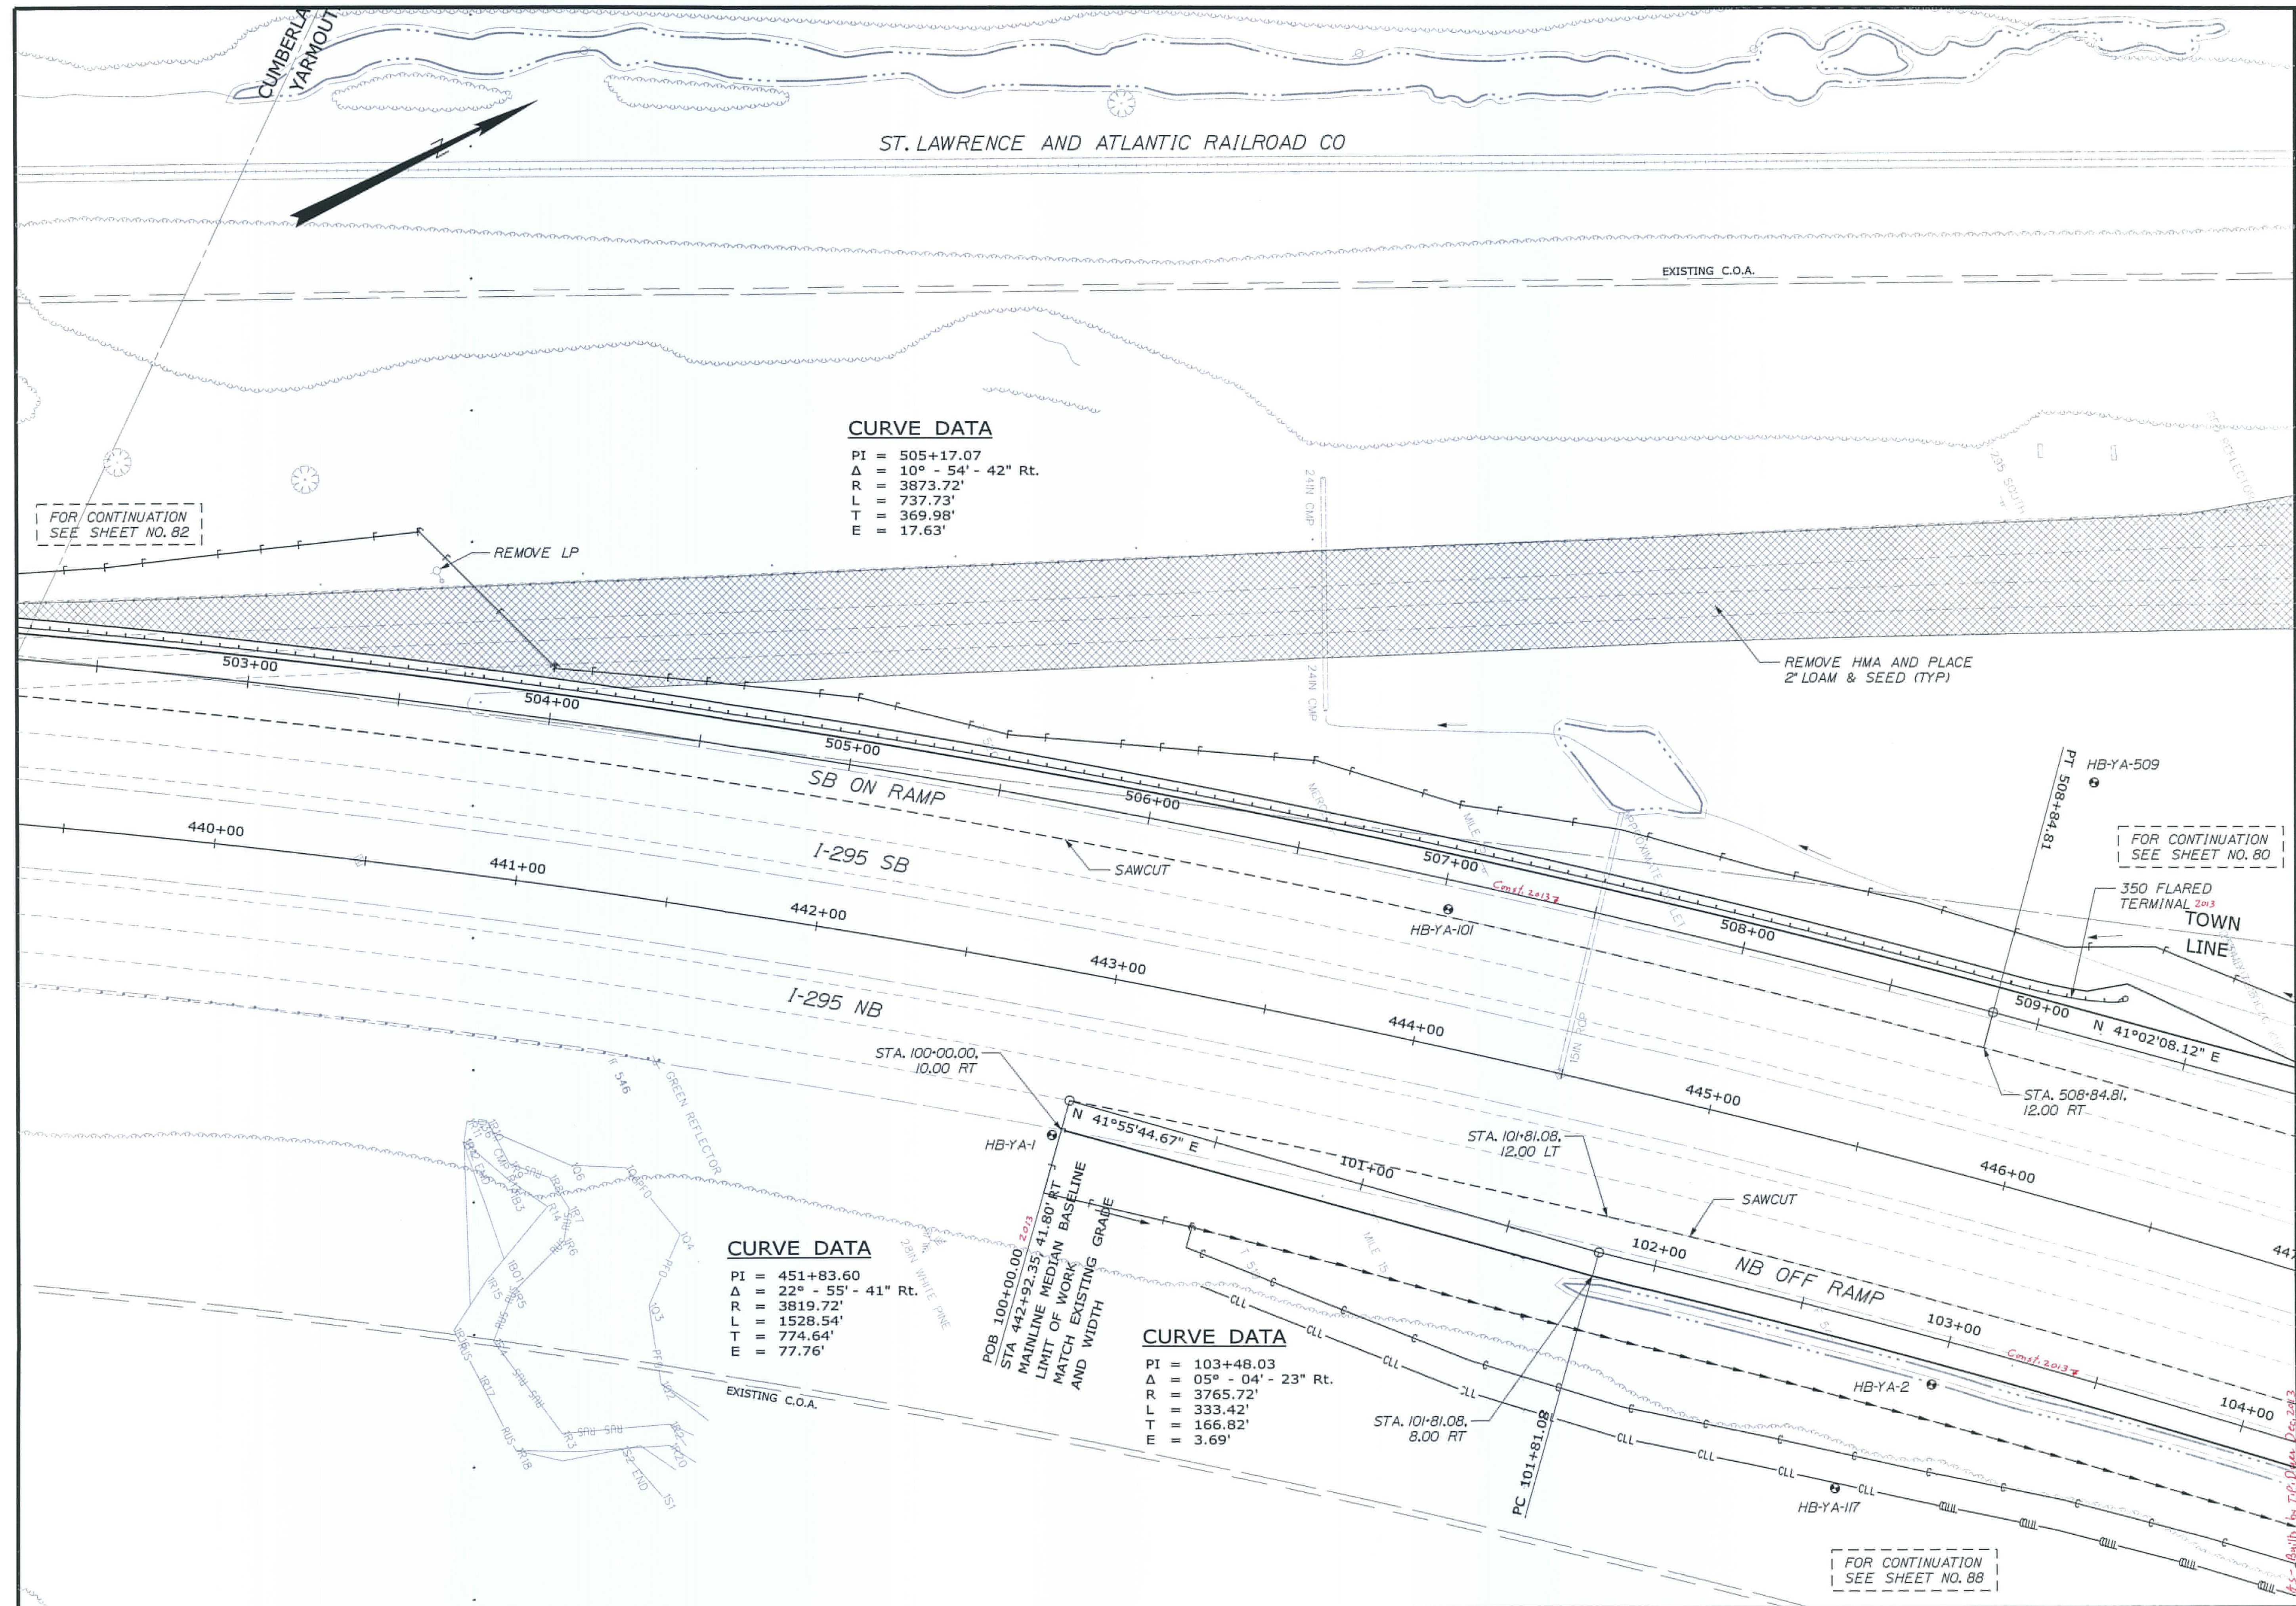

STATE OF MAINE
DEPARTMENT OF TRANSPORTATION

PROJ. MANAGER	BY	DATE
DESIGN-DET. TAILED		
CHECKED-REVIEWED		
DESIGN-DET. TAILED 2		
DESIGN-DET. TAILED 3		
REVISIONS 1		
REVISIONS 2		
REVISIONS 3		
REVISIONS 4		

YARMOUTH
I-295 EXIT 15
PLANS

SHEET NUMBER

81


OF 283

Date: 2/21/2011

Username: COMMON

Division: HIGHWAY

Filename:

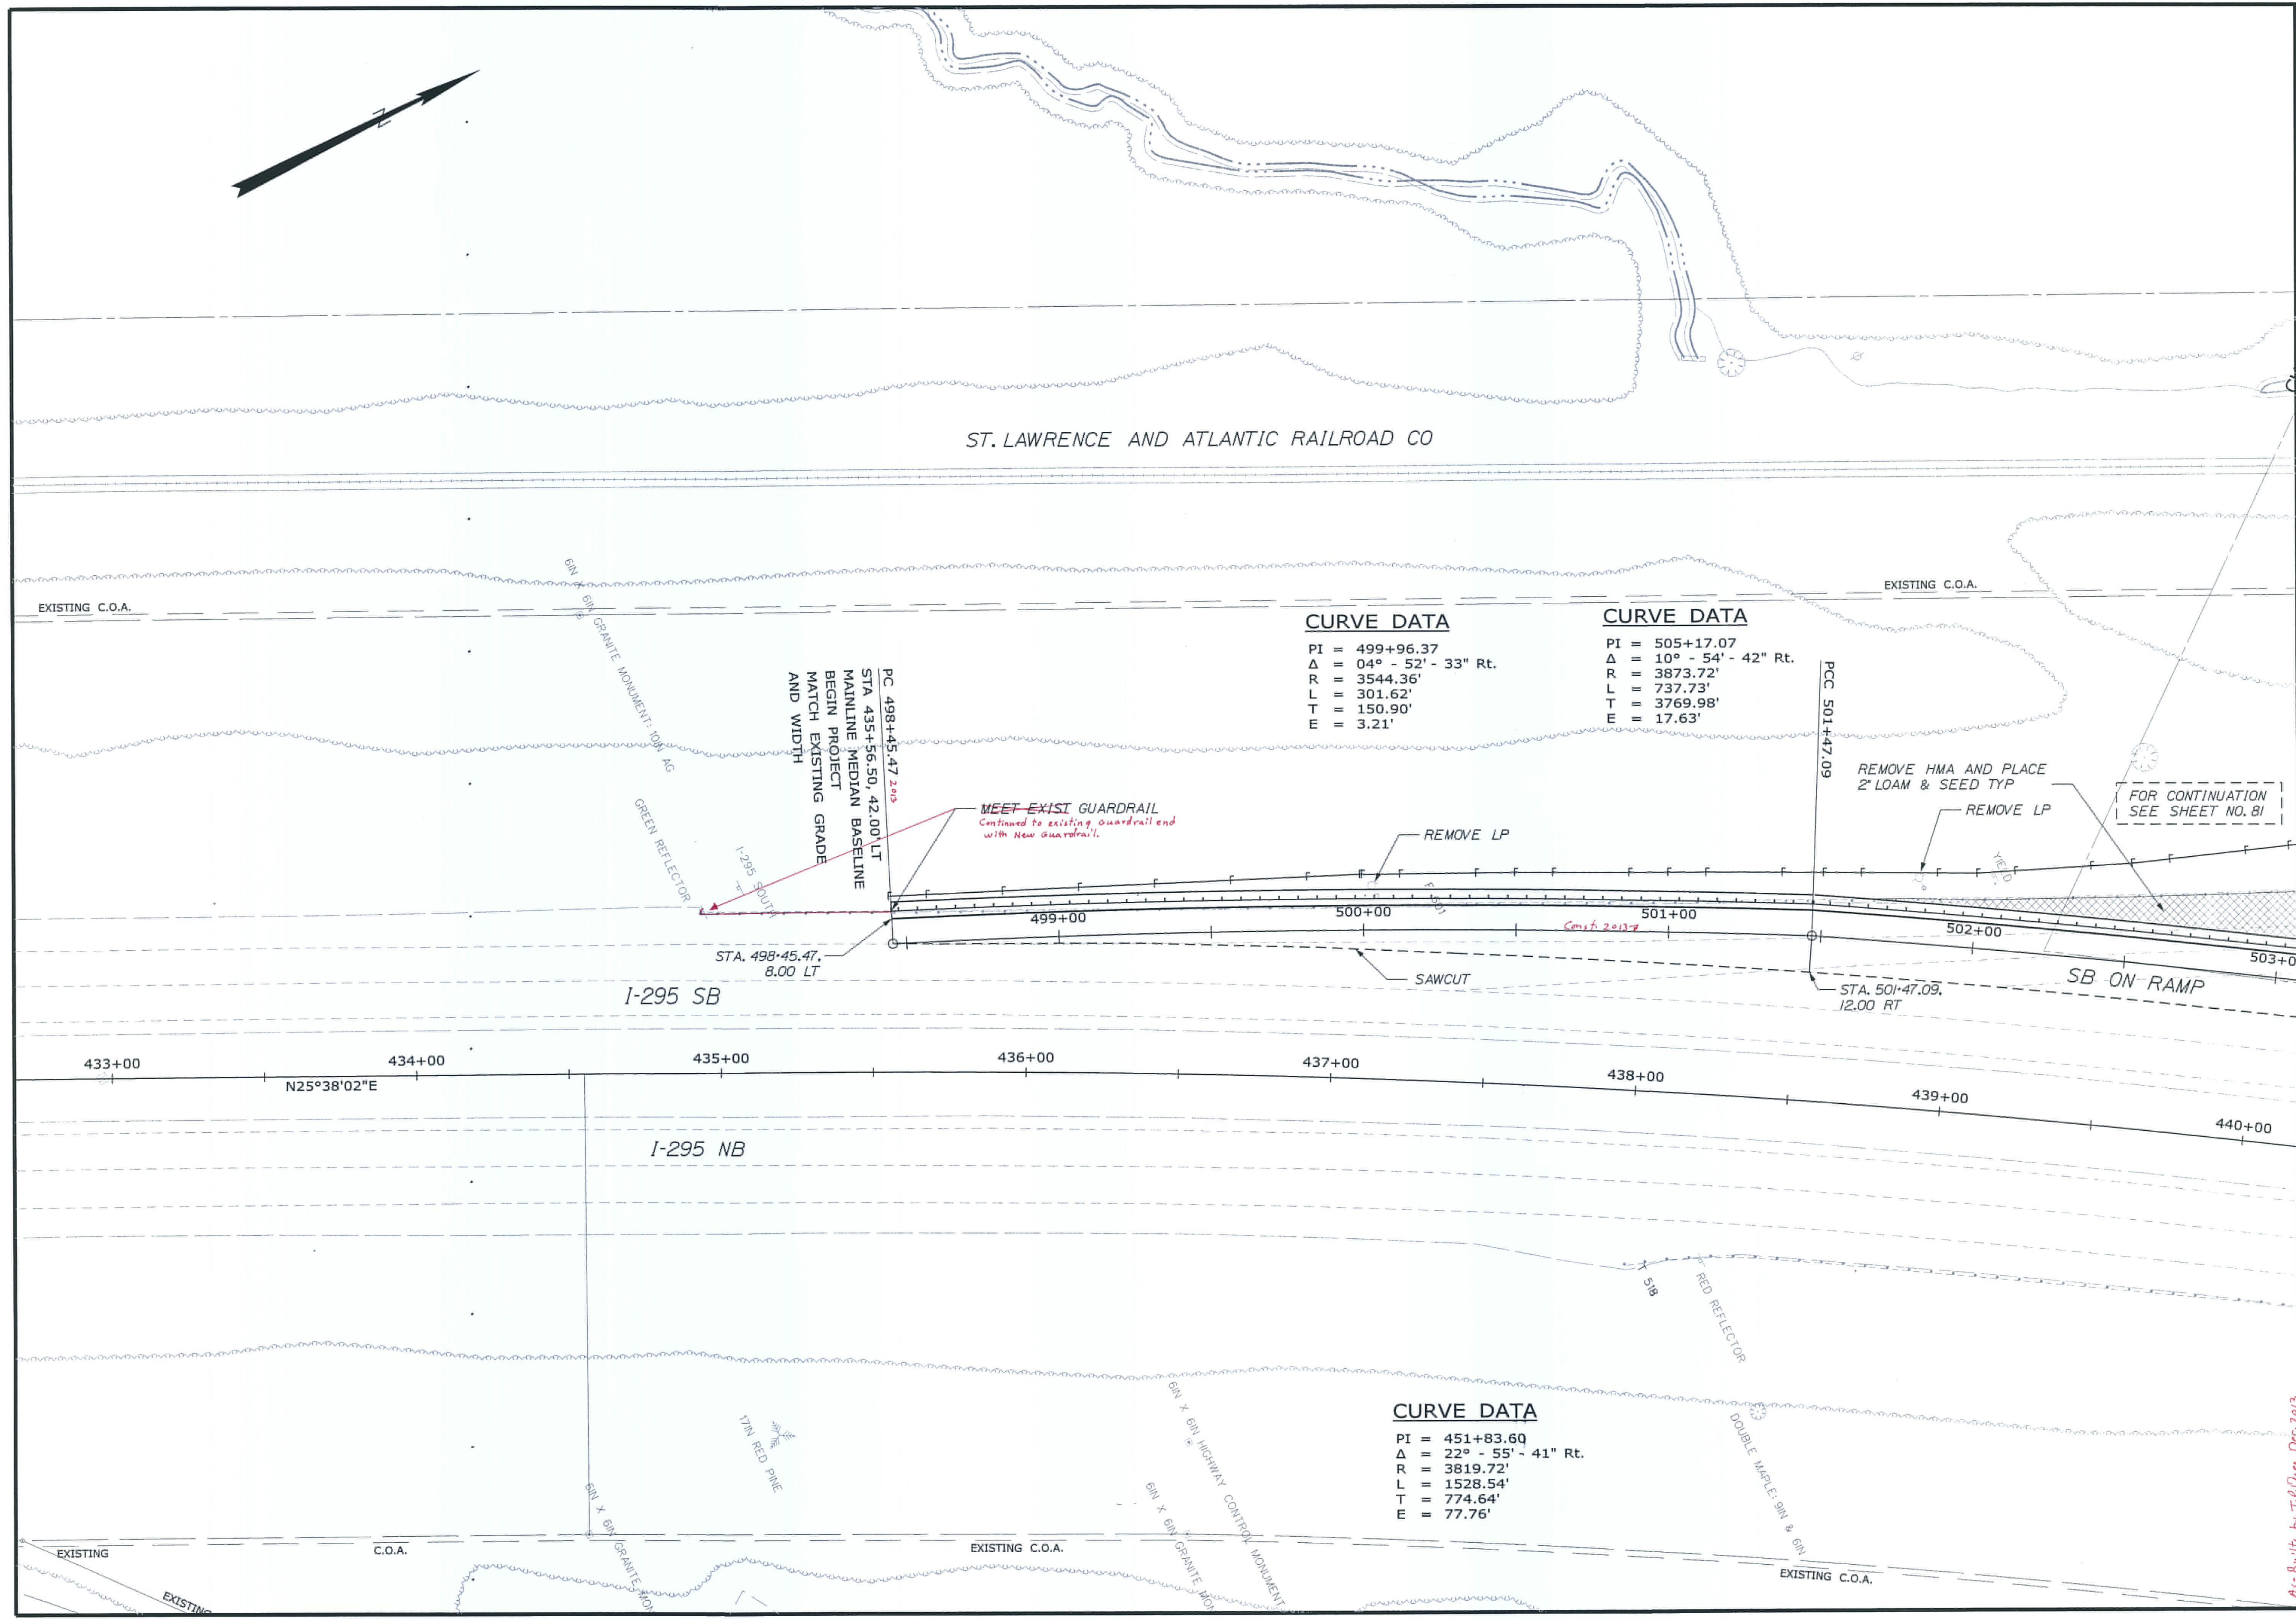


STATE OF MAINE		DEPARTMENT OF TRANSPORTATION	
IM-1108(600) EXIT 15		CM-1749(000)X PARK & RIDE LOT	
WIN 11086.00 EXIT 15 HIGHWAY PLANS		WIN 17490.00 PARK & RIDE LOT	

PROJ. MANAGER	CHECKED-REVIEWED	DESIGN-REVIEWED	DESIGN-REVIEWED	DESIGN-REVIEWED	REVISIONS 1	REVISIONS 2	REVISIONS 3	REVISIONS 4	FIELD CHANGES

SIGNATURE	P.E. NUMBER	DATE

YARMOUTH		I-295 EXIT 15		PLANS	
SHEET NUMBER		82		OF 283	

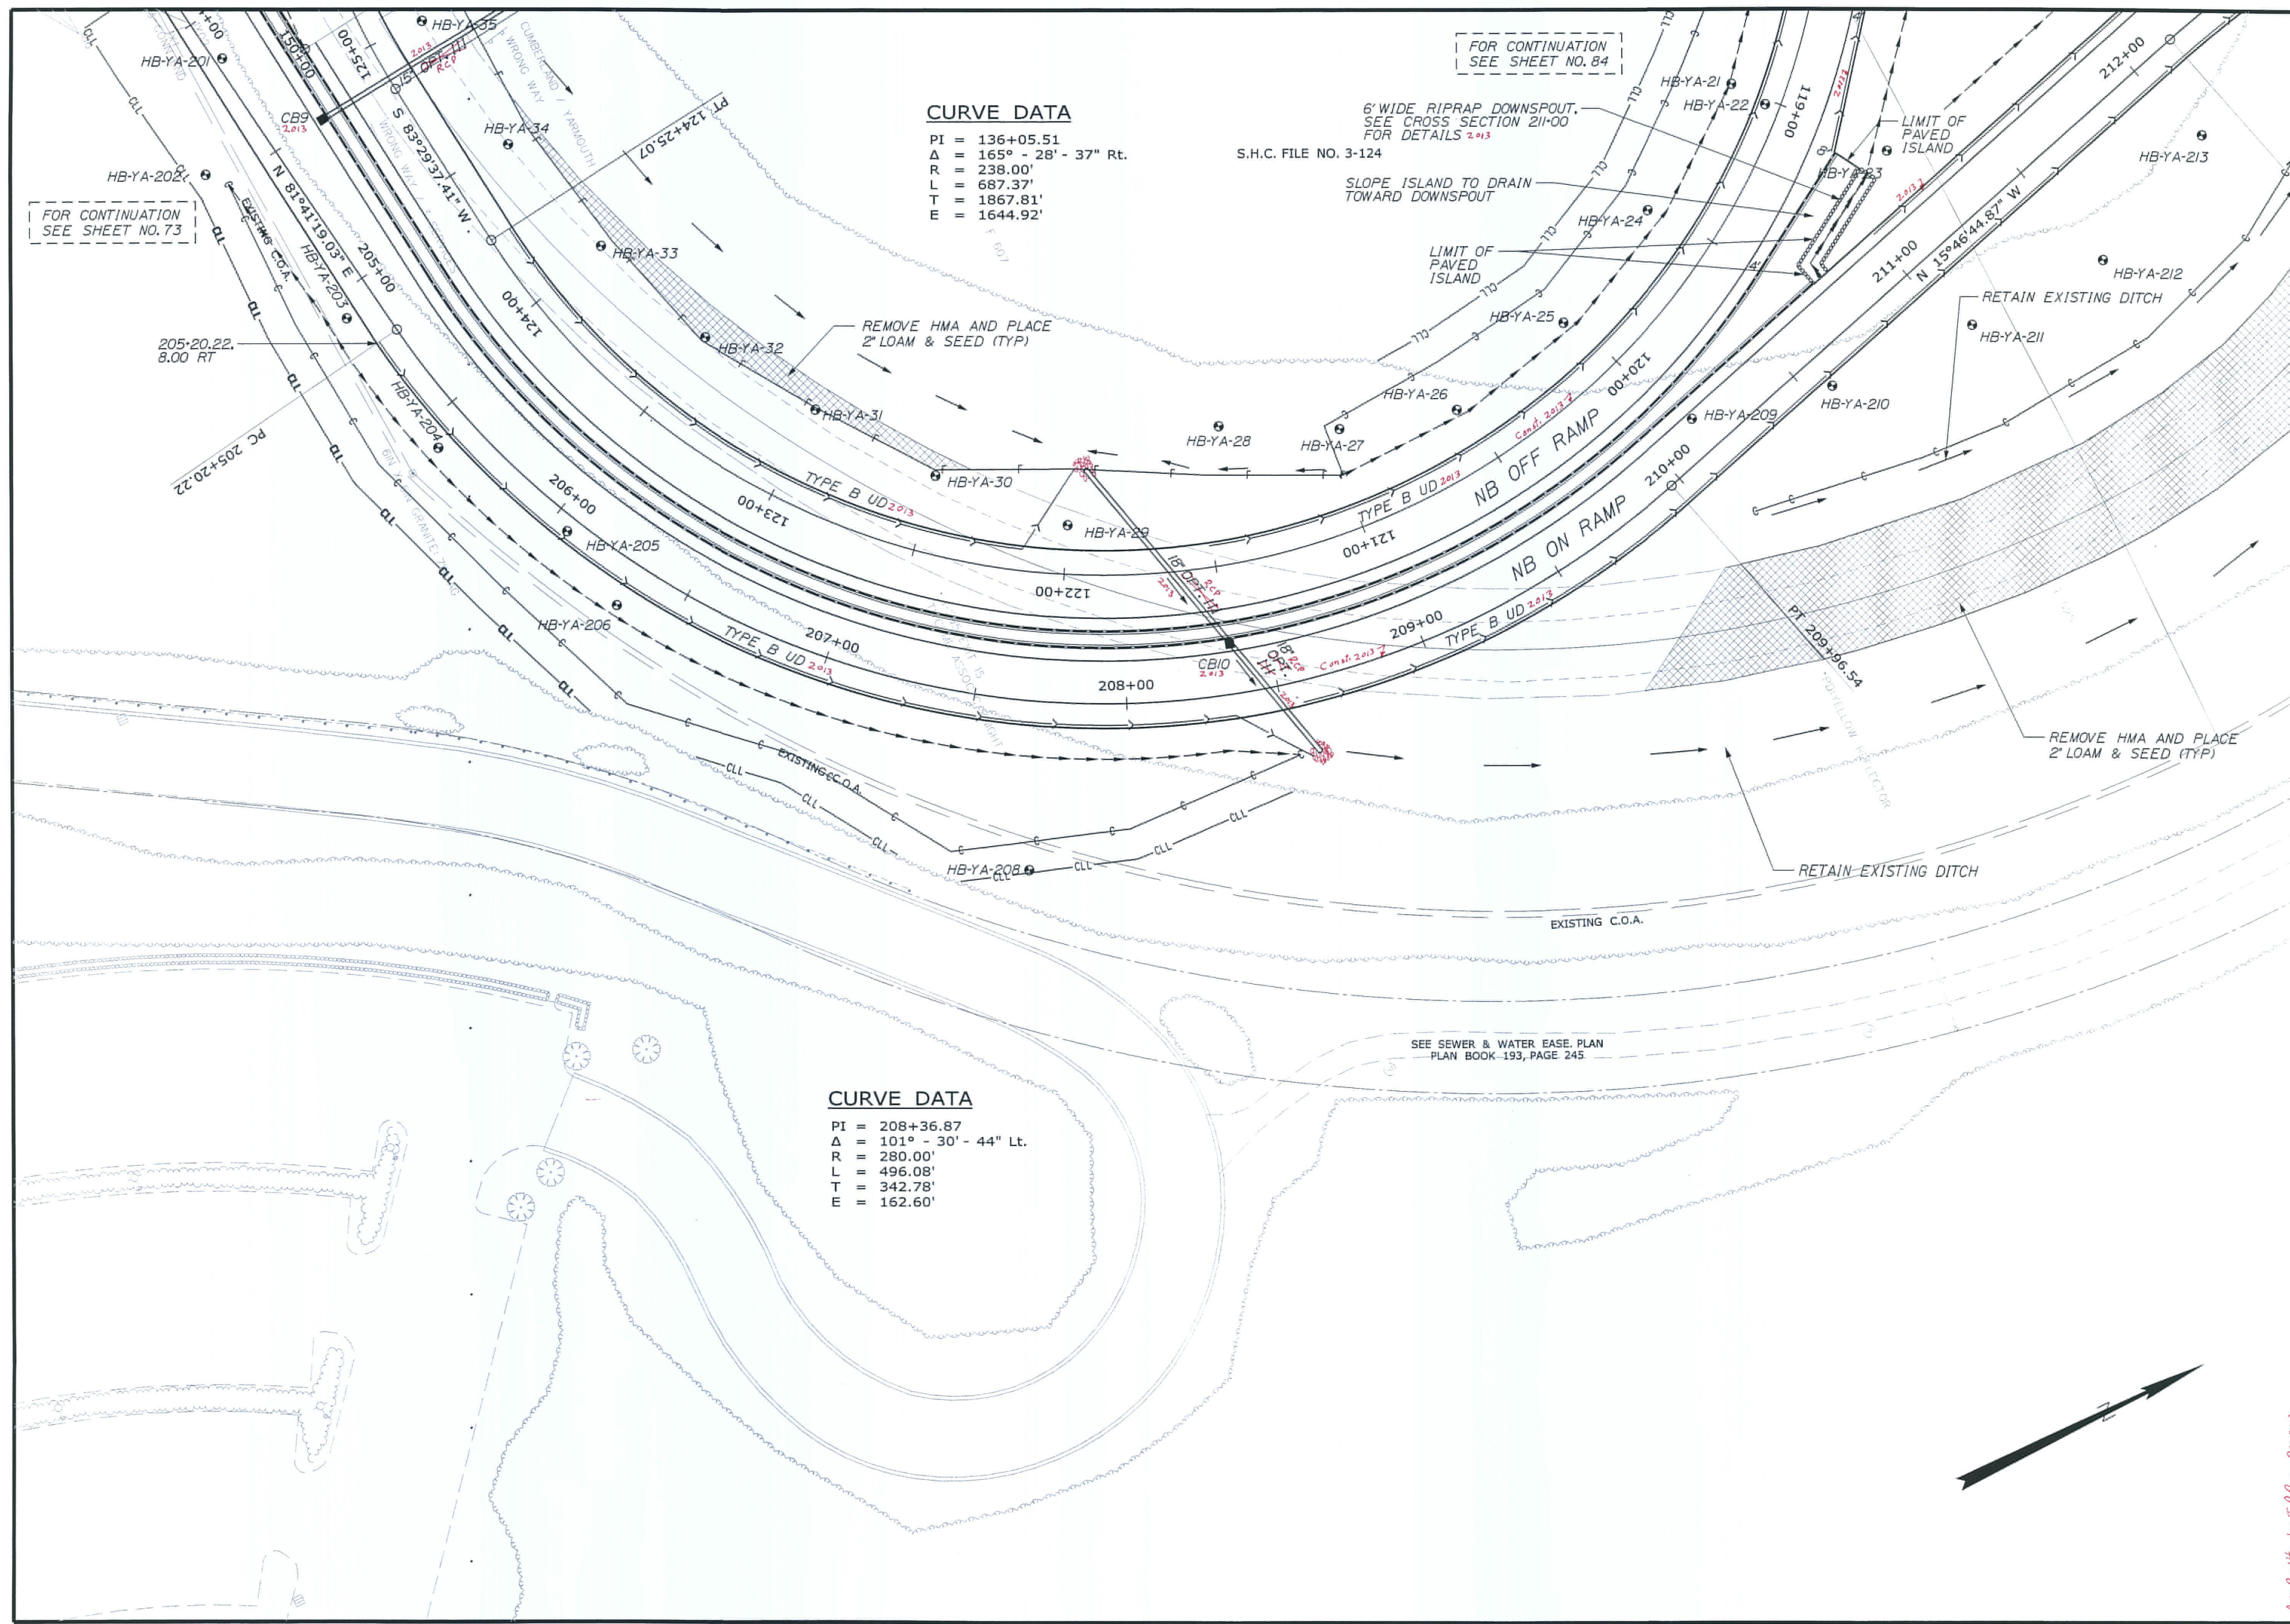

STATE OF MAINE
DEPARTMENT OF TRANSPORTATION
IM-1108(600) EXIT 15
CM-1749(000)X PARK & RIDE LOT
WIN 11086.00 EXIT 15 HIGHWAY PLANS
WIN 17490.00 PARK & RIDE LOT

YARMOUTH
I-295 EXIT 15
PLANS

SHEET NUMBER
83
OF 283

PROJ. MANAGER	BY	DATE	SIGNATURE	P.E. NUMBER	DATE
DESIGN DETAIL					
CHECKED-REVIEWED					
DESIGN DETAIL					
REVISIONS 1					
REVISIONS 2					
REVISIONS 3					
REVISIONS 4					
FIELD CHANGES					