

GENERAL LEGEND

	TP1	TEST PIT
		SOIL BORING OR PROBING
		EXISTING CATCHBASIN
		PROPOSED CATCHBASIN
		EXISTING SEWER MANHOLE
		PROPOSED SEWER/DRAIN MANHOLE
		EXISTING TELEPHONE MANHOLE
		EXISTING WATER GATE VALVE
		PROPOSED WATER GATE VALVE
		EXISTING CURB STOP
		PROPOSED CURB STOP
		EXISTING FIRE HYDRANT
		PROPOSED FIRE HYDRANT
		EXISTING SOFTWOOD TREE
		EXISTING HARDWOOD TREE
		STONE WALL
		EXISTING UTILITY POLE
		PROPOSED UTILITY POLE
	SD	EXISTING STORM DRAIN
	SD	PROPOSED STORM DRAIN
	ES	EXISTING SANITARY SEWER MAIN OR SERVICE
	S	PROPOSED SANITARY SEWER MAIN OR SERVICE
	UD	PROPOSED UNDERDRAIN
	W	EXISTING WATERMAIN OR SERVICE
	W	PROPOSED WATERMAIN OR SERVICE
	UT	EXISTING UNDERGROUND TELEPHONE CABLE
	UE	EXISTING UNDERGROUND ELECTRIC CABLE OR CONDUIT
	OHE	EXISTING OVERHEAD ELECTRIC
	RAIL	EXISTING GUARD RAIL
	X X X	EXISTING FENCE
		EXISTING EDGE OF PAVEMENT
		PROPOSED EDGE OF PAVEMENT
		EXISTING DITCH
		PROPOSED DITCH
	150	EXISTING CONTOUR
	150	PROPOSED CONTOUR
		EXISTING WET AREA
		PROPOSED RIP-RAP OR STONE LINING
		BORING (IN PROFILE)
	Refusal	
	No Refusal	

METRIC	F.H.W.A. REG. NO.	STATE	PROJECT NUMBER	SHEET NO.	TOTAL SHEETS
	1	MAINE	NH-7164(00)	82	110



STATE OF MAINE	
DEPARTMENT OF TRANSPORTATION	
RIGHT OF WAY MAP	
STATE HIGHWAY '25'	
MEXICO	OXFORD COUNTY
FEDERAL AID PROJECT NO.	NH-7164(OO)
DATE: NOVEMBER 1997	
SCALE: 1 = 250	<u>JOHN G. MELROSE</u> COMMISSIONER
SHEET NO. 6 OF 10 SHEETS	
D.O.T. FILE NO. 8 - 205	<u>JOHN E. DORITY</u> CHIEF ENGINEER

METRIC

1. All dimensions are in millimeters unless otherwise noted.
2. All elevations and stations are in meters.


F.H.W.A. REG. NO.	STATE	PROJECT NUMBER	SHEET NO.	TOTAL SHEETS
1	MAINE	NH-7164(00)	92	110

- NOTES:
1. THE TOWN OF MEXICO, THOROUGH A RELATED PROJECT, HAS REPLACED A PORTION OF THE SEWER ON MITCHELL STREET. IN ORDER TO MAINTAIN FLOW, THE NEW SEWER WAS DIVERTED INTO THE EXISTING SEWER THROUGH A TEMPORARY PVC CONNECTION. THE MDOT CONTRACT SHALL CONNECT TO THE NEW MANHOLE AND ELIMINATE THE TEMPORARY CONNECTION WITH ALL ASSOCIATED RETROFIT WORK IN THE CONNECTION MANHOLE. THE CONNECTION MANHOLE IS PROVIDED WITH A PVC STUB FOR CONNECTION. LOCATION OF CONNECTION MANHOLE IS APPROXIMATE BASED ON A PLAN ENTITLED "NORTH GRANITE STREET SEWER REPLACEMENT" DATED JULY 1997 BY MILLETT ASSOCIATES.
 2. PROVIDE CLEAN-OUTS AT THE RIGHT-OF-WAY LINE FOR EACH OF THE NEW SEWER SERVICES ON THIS SHEET. SEE DETAIL SHEET 24.
 3. EXISTING WATERMAINS ON MAIN STREET SHALL BE ABANDONED AFTER CONNECTIONS ARE MADE TO NEW WATERMAINS.
 4. LOCATIONS OF WATER AND SEWER LINES/SERVICES ON SHEETS 6-9 ARE BASED ON FIELD INVESTIGATIONS, PAVEMENT MARKINGS, AND AS-BUILT PLANS OF THE SEWER INTERCEPTOR DATED MARCH 1973. THE LOCATIONS ARE MEANT AS A BEST REPRESENTATION OF THE EXISTING SERVICE LOCATIONS. AS WITH ALL THE SHEETS, THE CONTRACTOR IS RESPONSIBLE FOR LOCATING UTILITIES AND SERVICES IN THE FIELD.

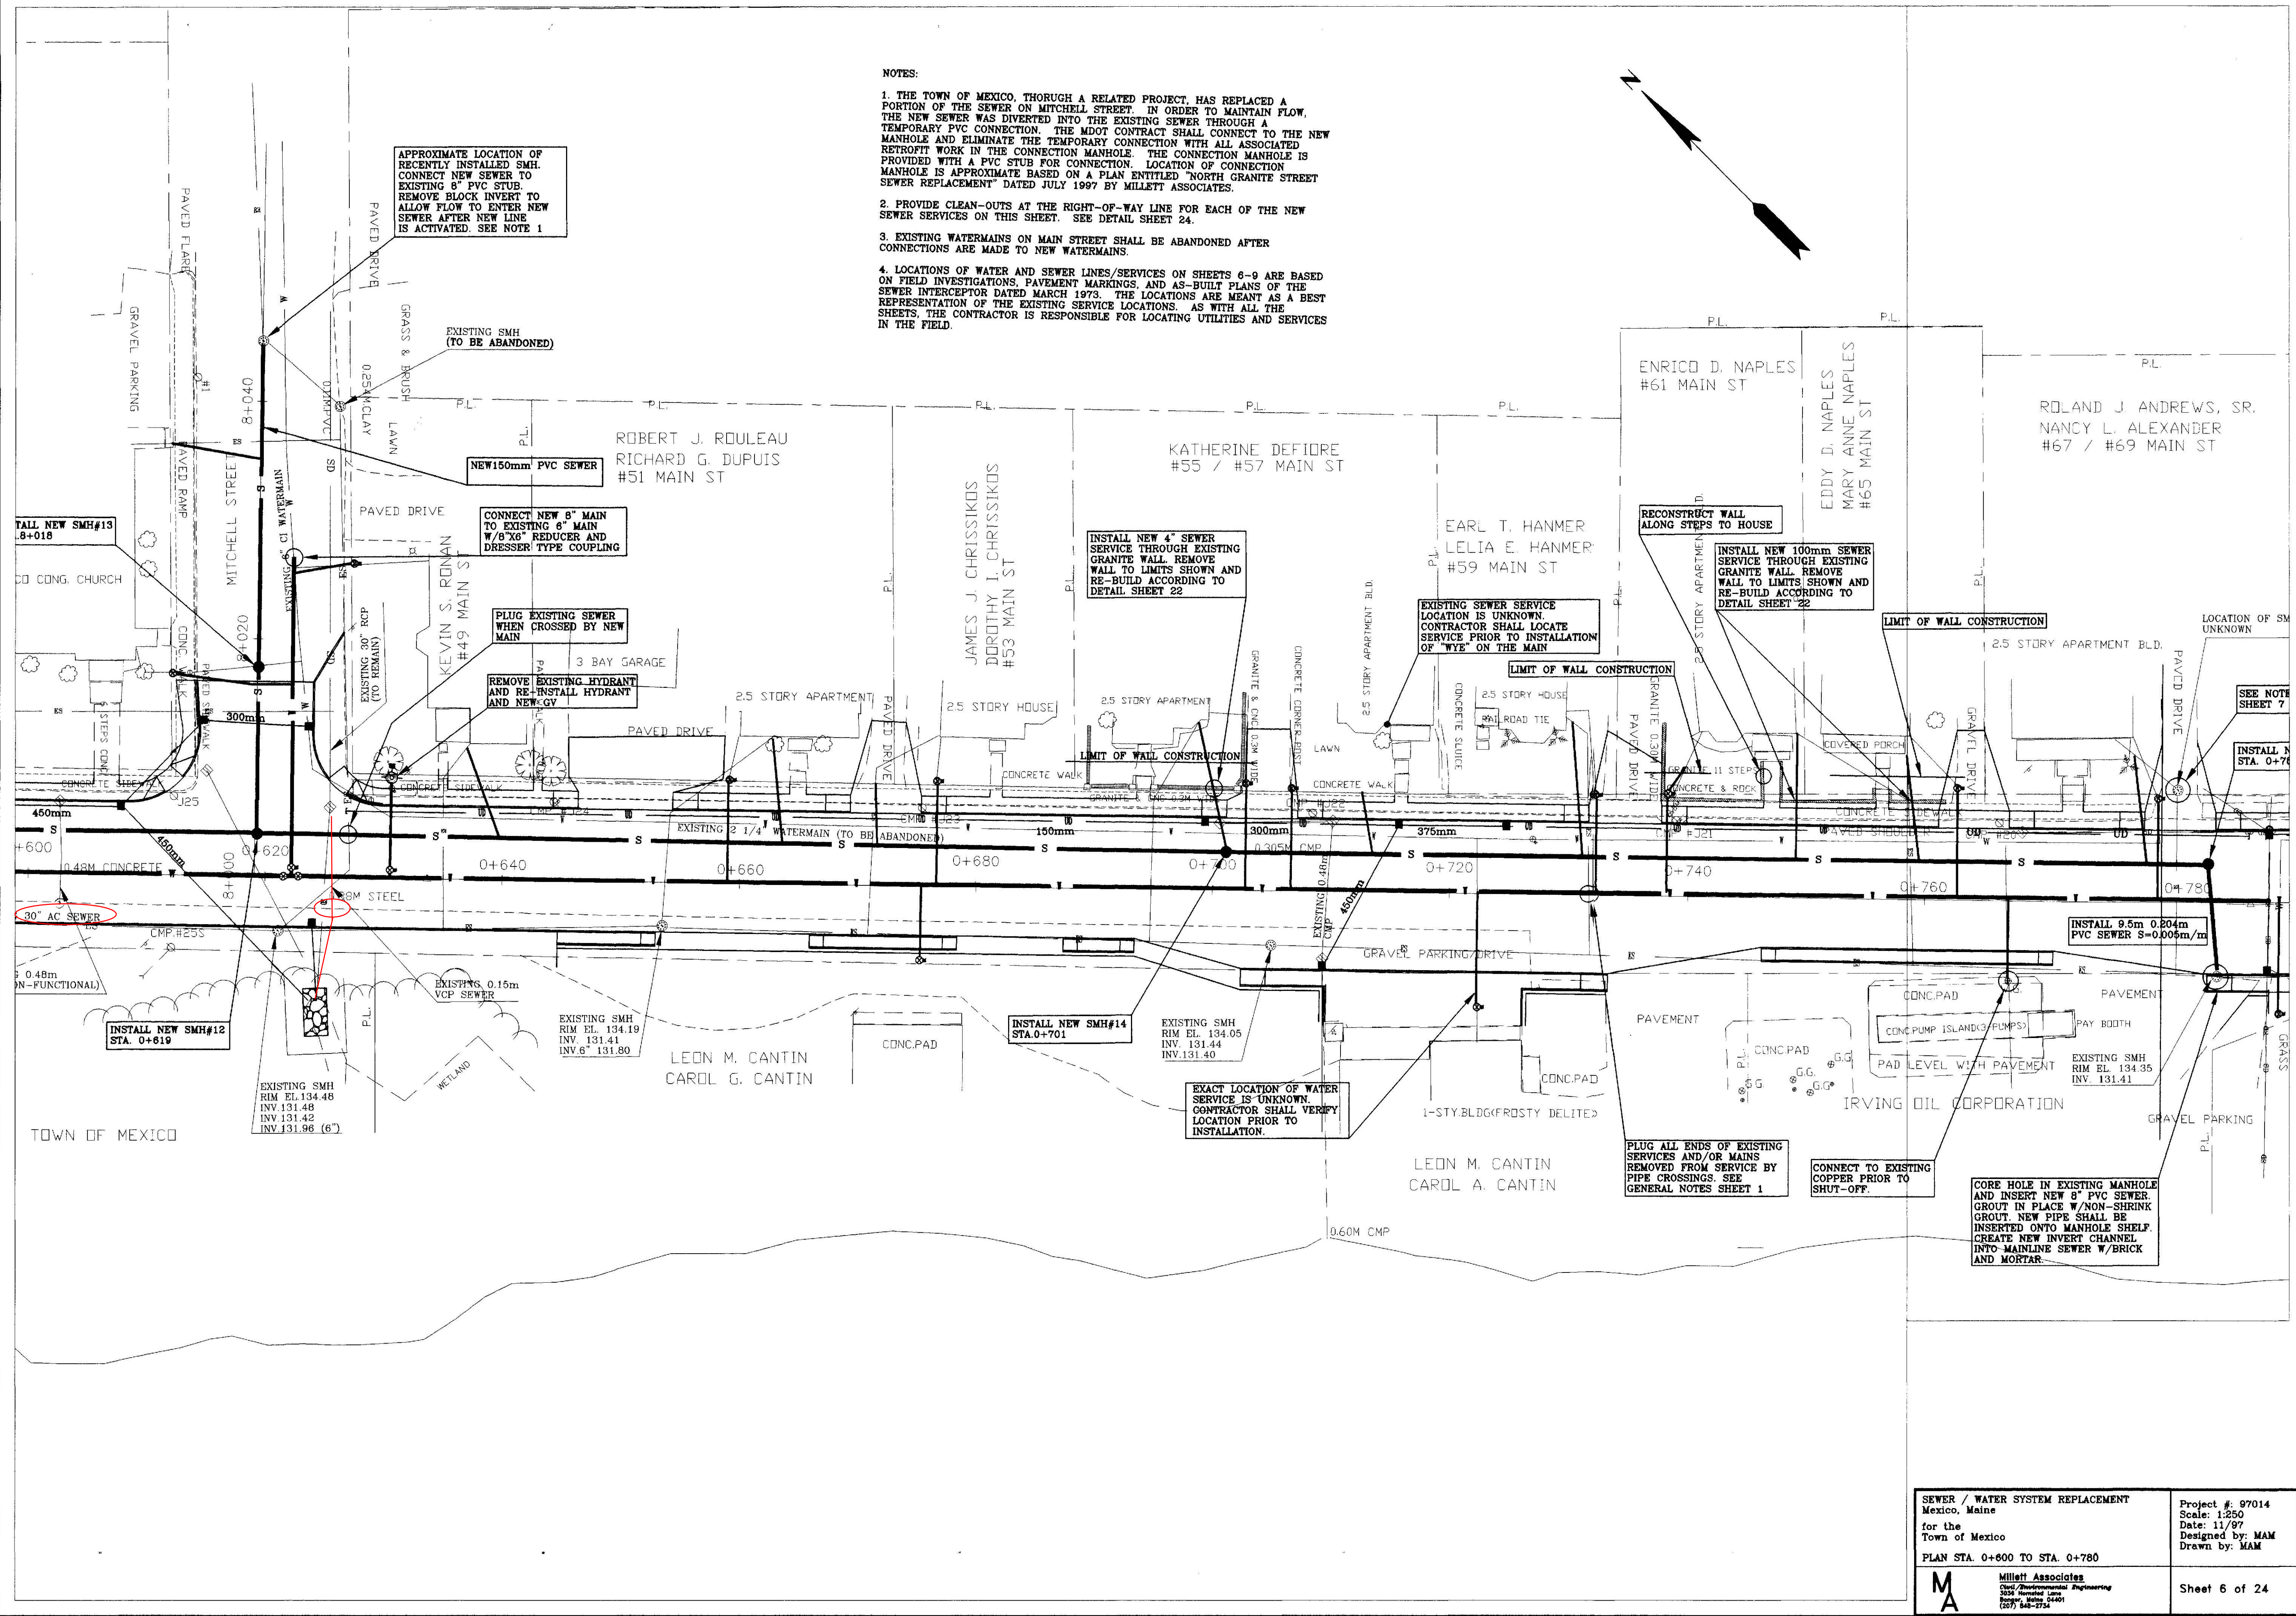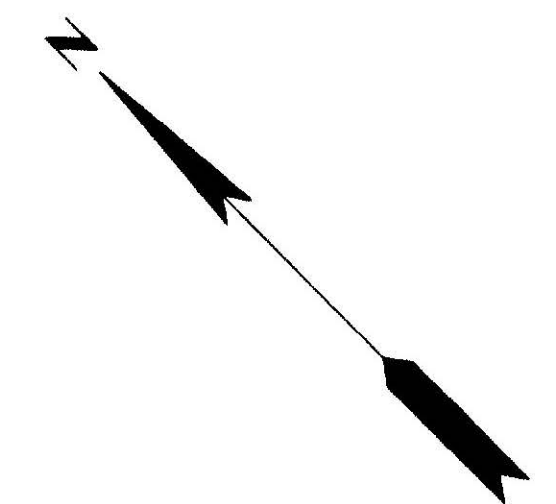


PROJECT DESIGN ENGINEER	DATE
BY	
DESIGN-DETAILED	
CHECKED	
REVISIONS	
FIELD CHANGES	
PLANS	

SEWER / WATER SYSTEM REPLACEMENT Mexico, Maine for the Town of Mexico PLAN STA. 0+600 TO STA. 0+780	Project #: 97014 Scale: 1:250 Date: 11/97 Designed by: MAM Drawn by: MAM
M A Millett Associates Civil/Environmental Engineering 2555 Portland Ave. Beverly, MA 01915 (508) 865-7754	Sheet 6 of 24

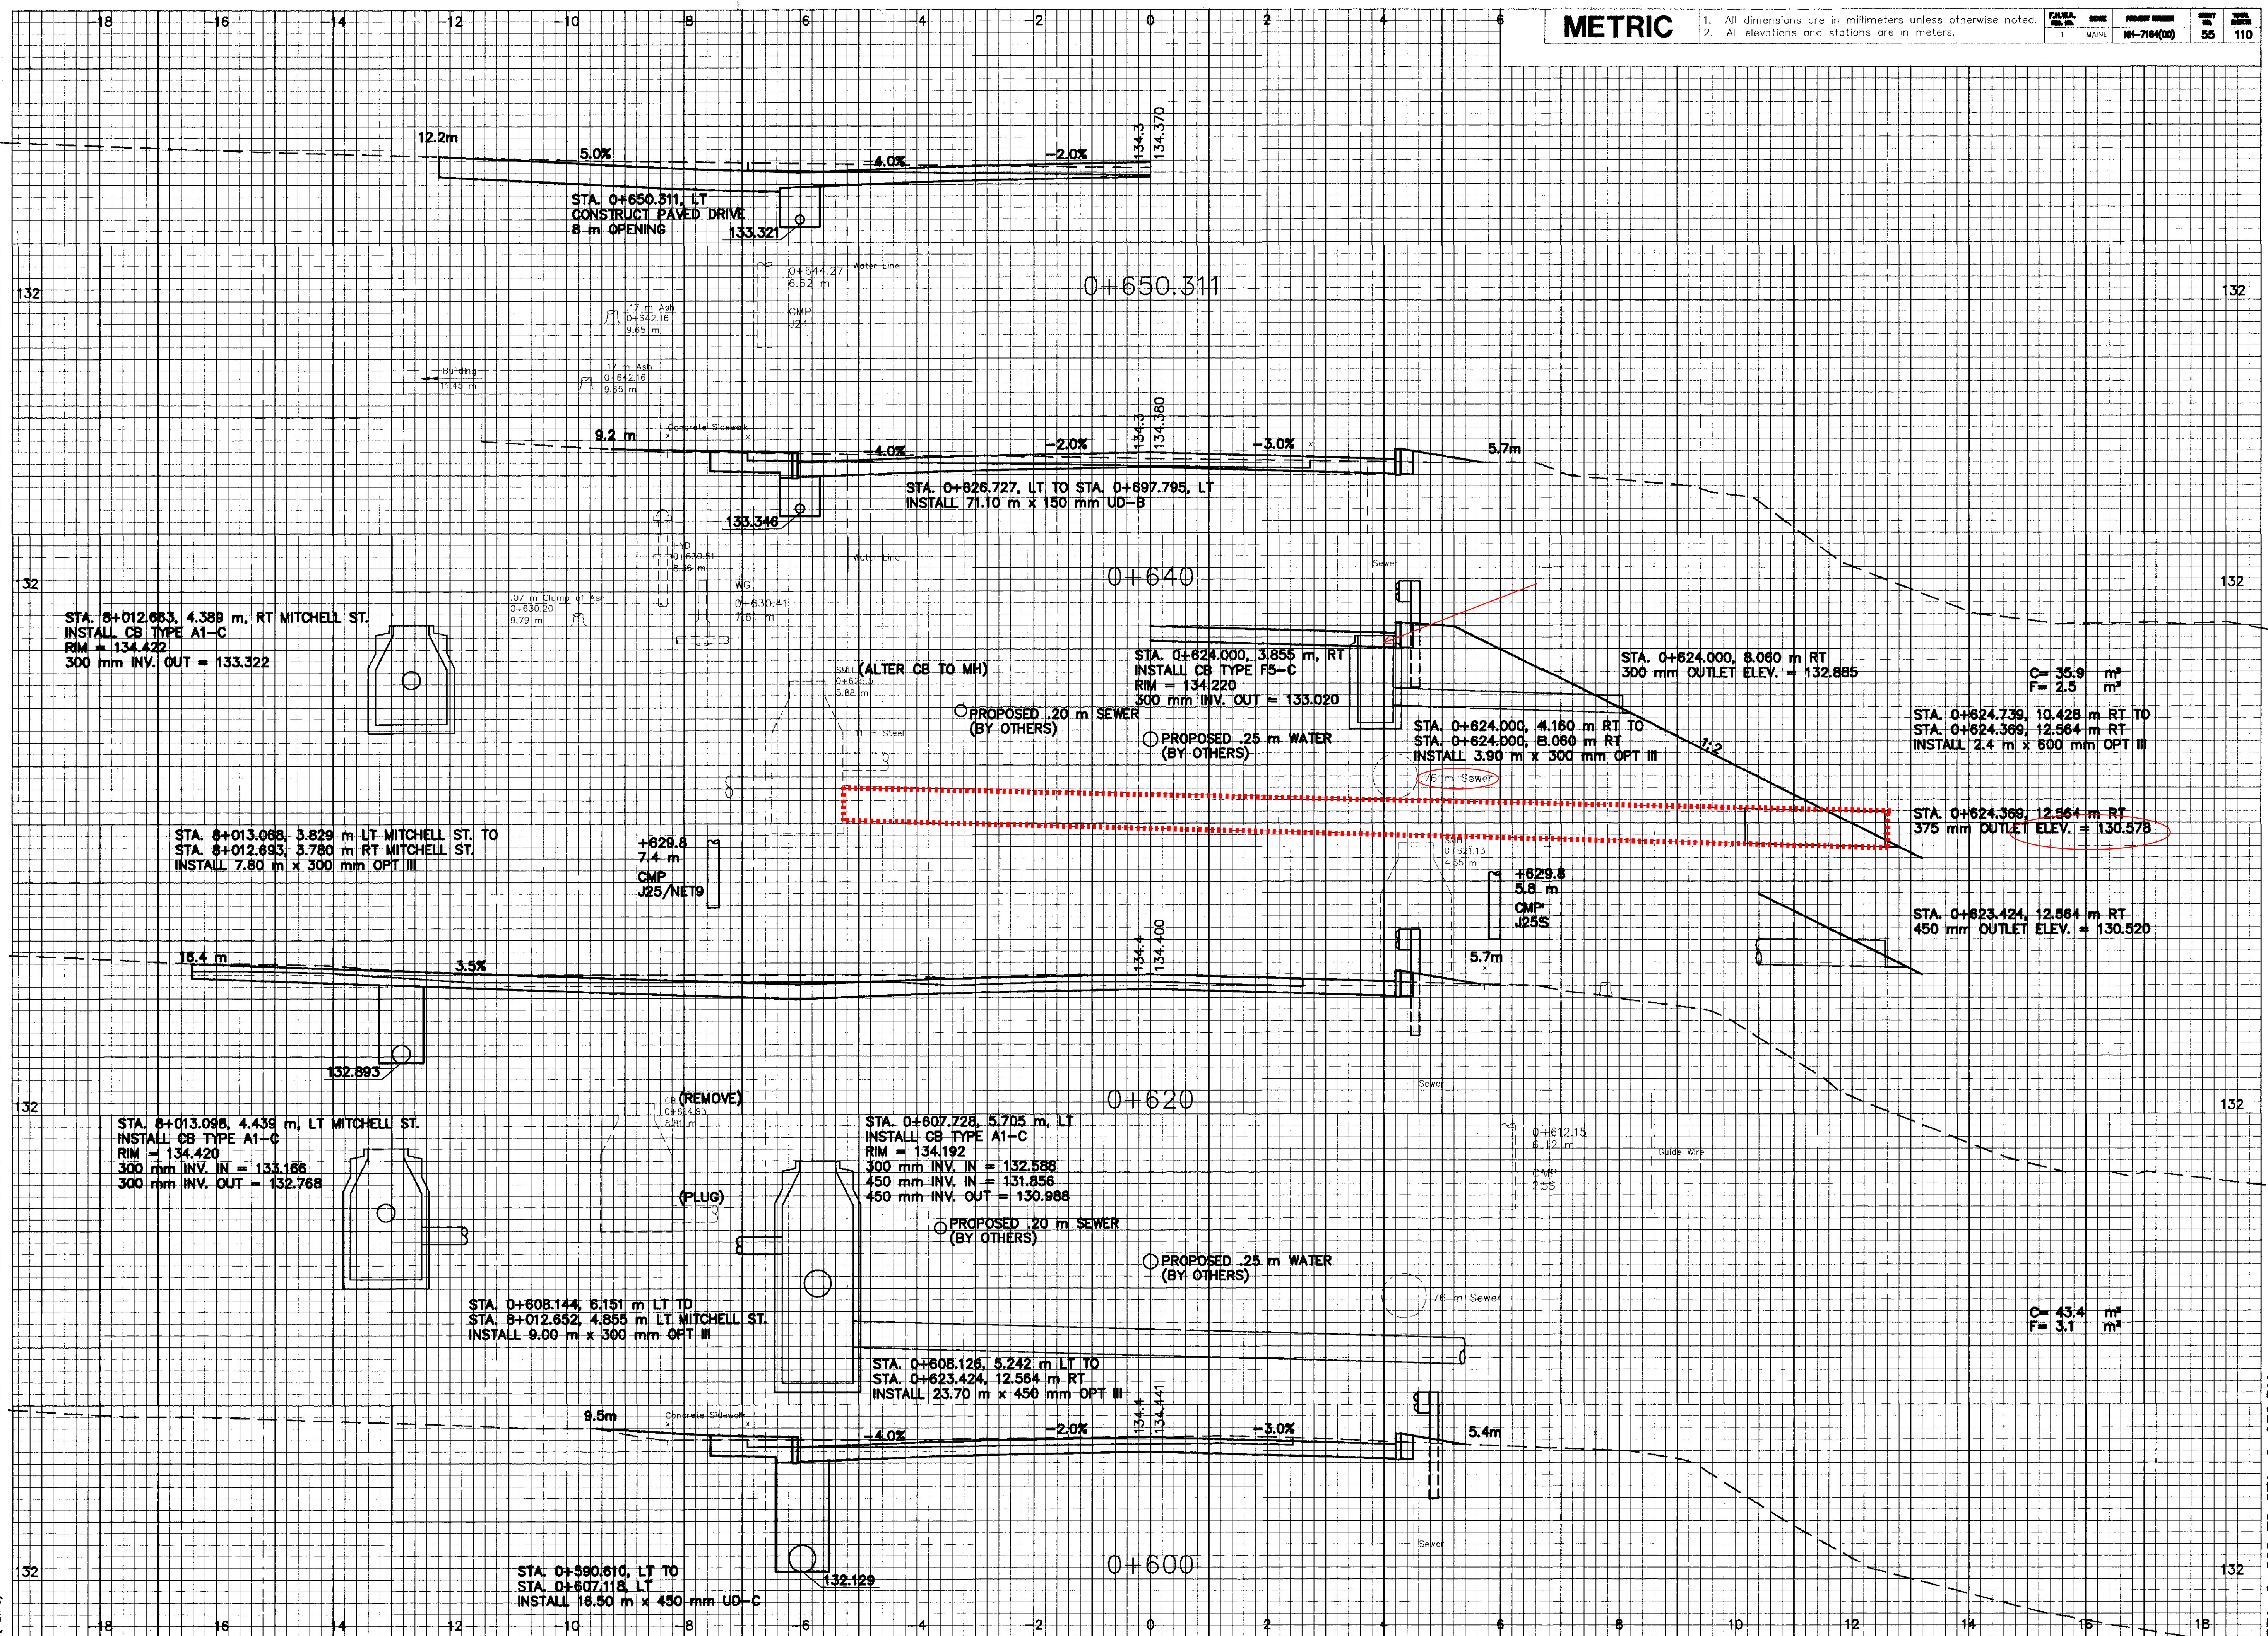

STA. 0+600 TO STA. 0+650.311

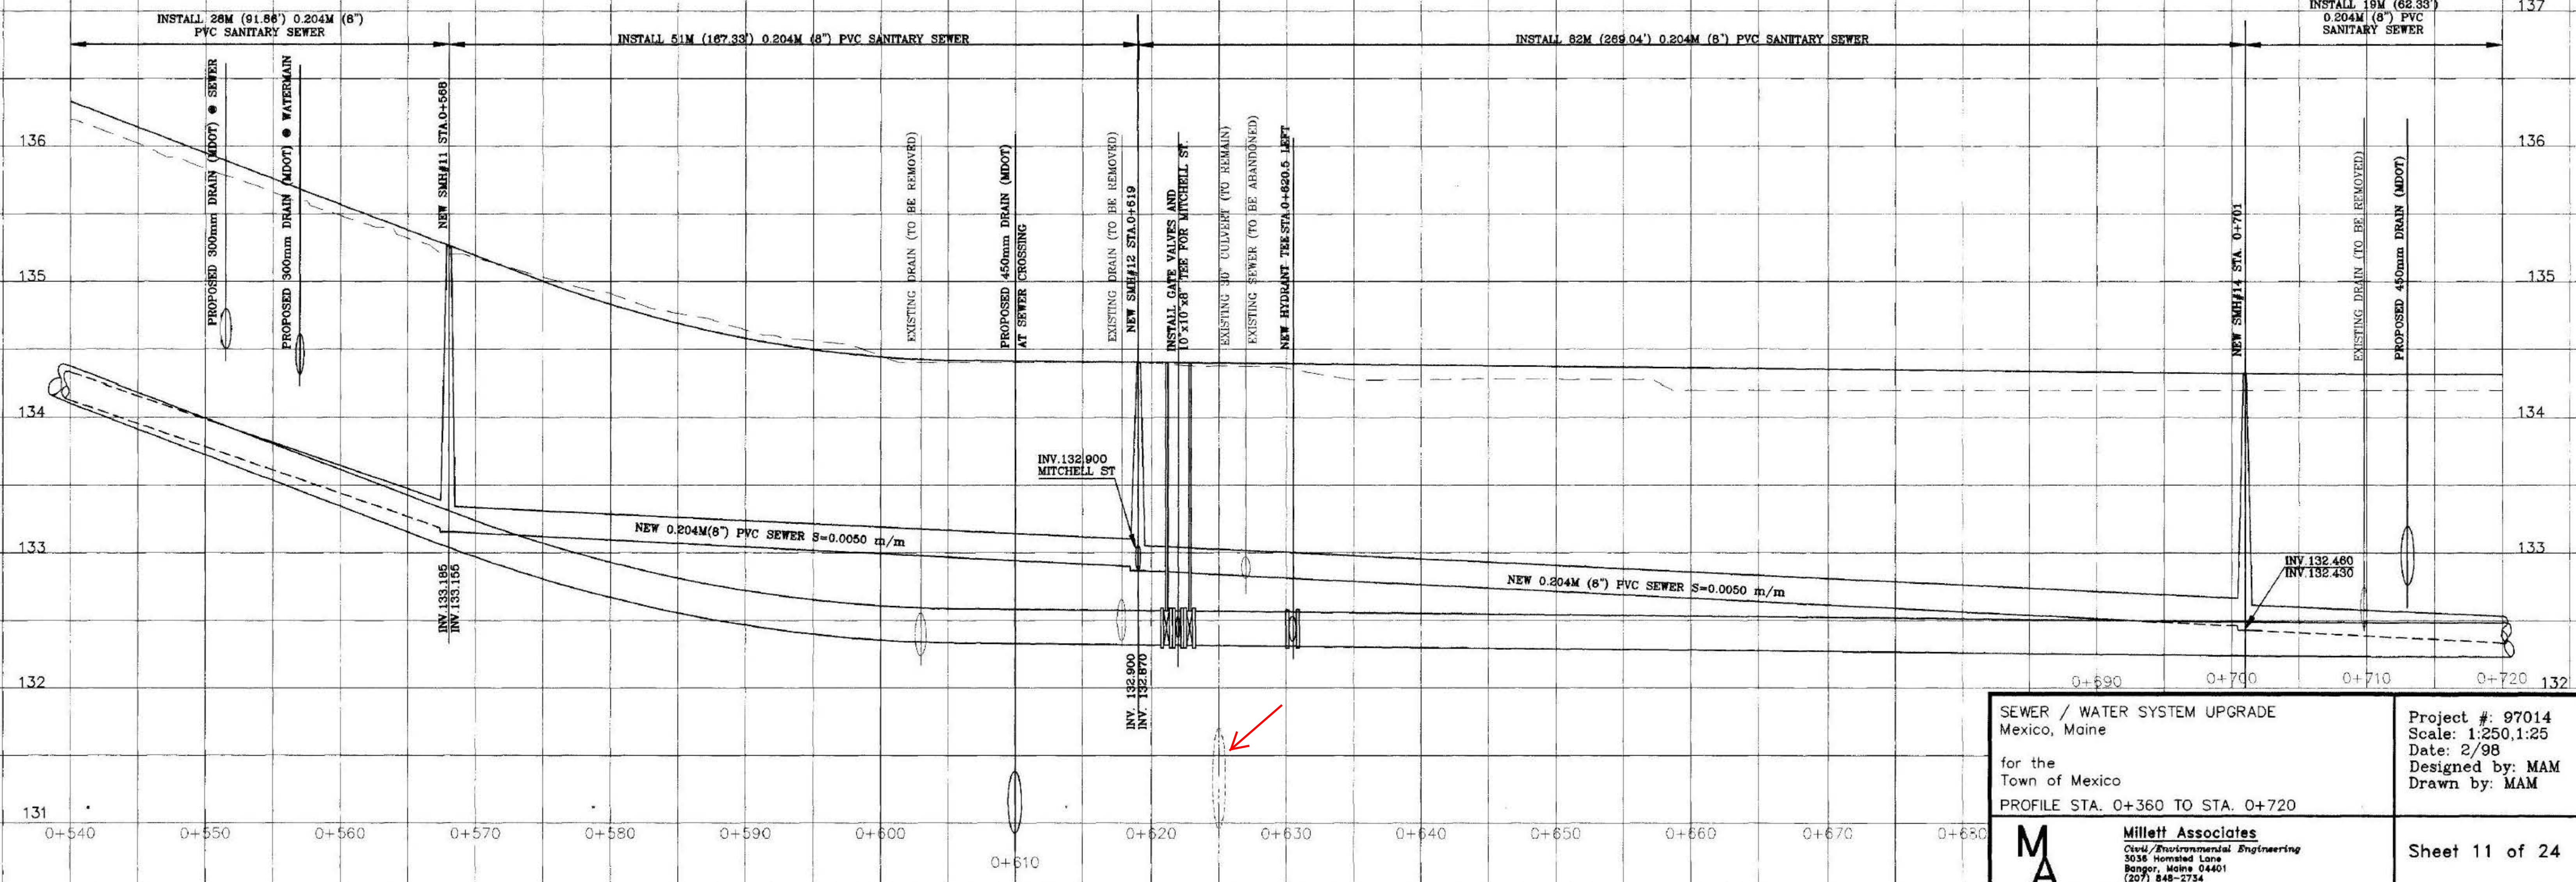



SEWER / WATER SYSTEM UPGRADE Mexico, Maine		Project #: 97014 Scale: 1:250, 1:25 Date: 2/98 Designed by: MAM Drawn by: MAM
for the Town of Mexico		
PROFILE STA. 0+360 TO STA. 0+720		
	Millet Associates Civil/Environmental Engineering 3036 Homestead Lane Bangor, Maine 04401 (207) 848-2734	Sheet 11 of 24

APPROXIMATE LOCATION OF RECENTLY INSTALLED SMH. CONNECT NEW SEWER TO EXISTING 8" PVC STUB. REMOVE BLOCK INVERT TO ALLOW FLOW TO ENTER NEW SEWER AFTER NEW LINE IS ACTIVATED. SEE NOTE 1

REMOVE EXISTING HYDRANT AND INSTALL NEW HYDRANT & GV

PROVIDE 200mmX150mm REDUCER AND 150mm DRESSER COUPLING TO CONNECT TO EXISTING MAIN

SEE SHEET 5 FOR CONTINUATION

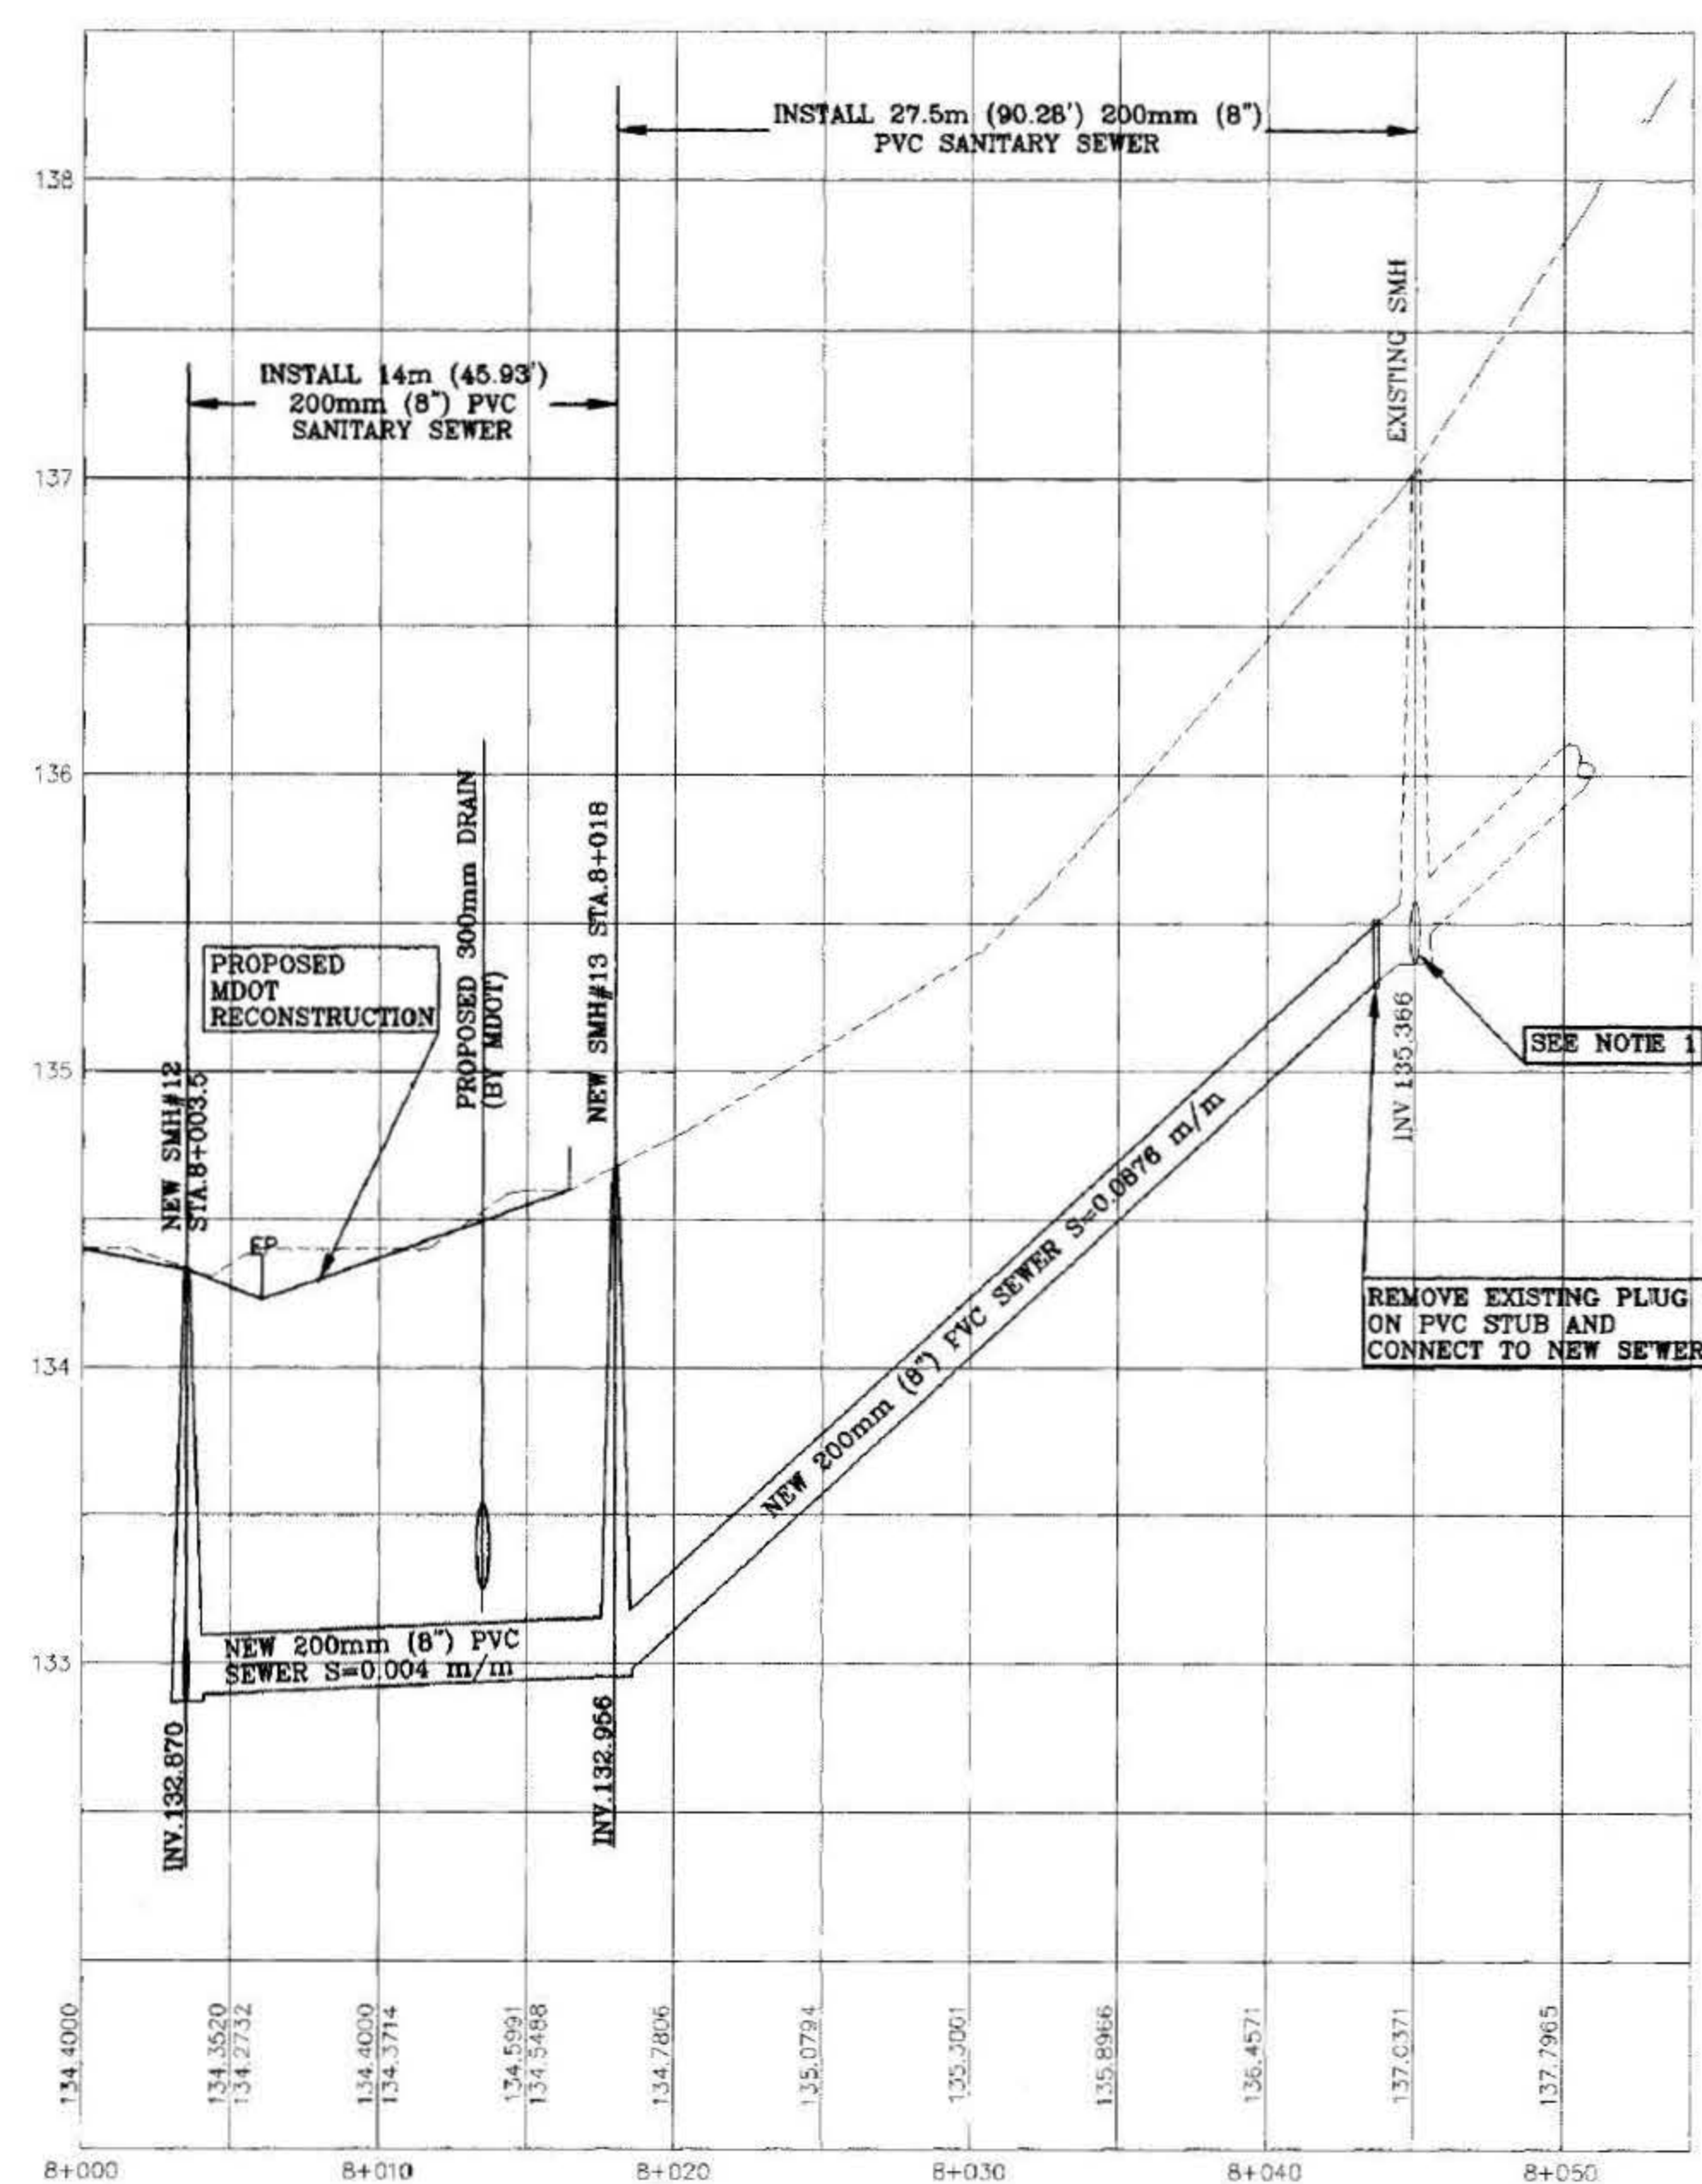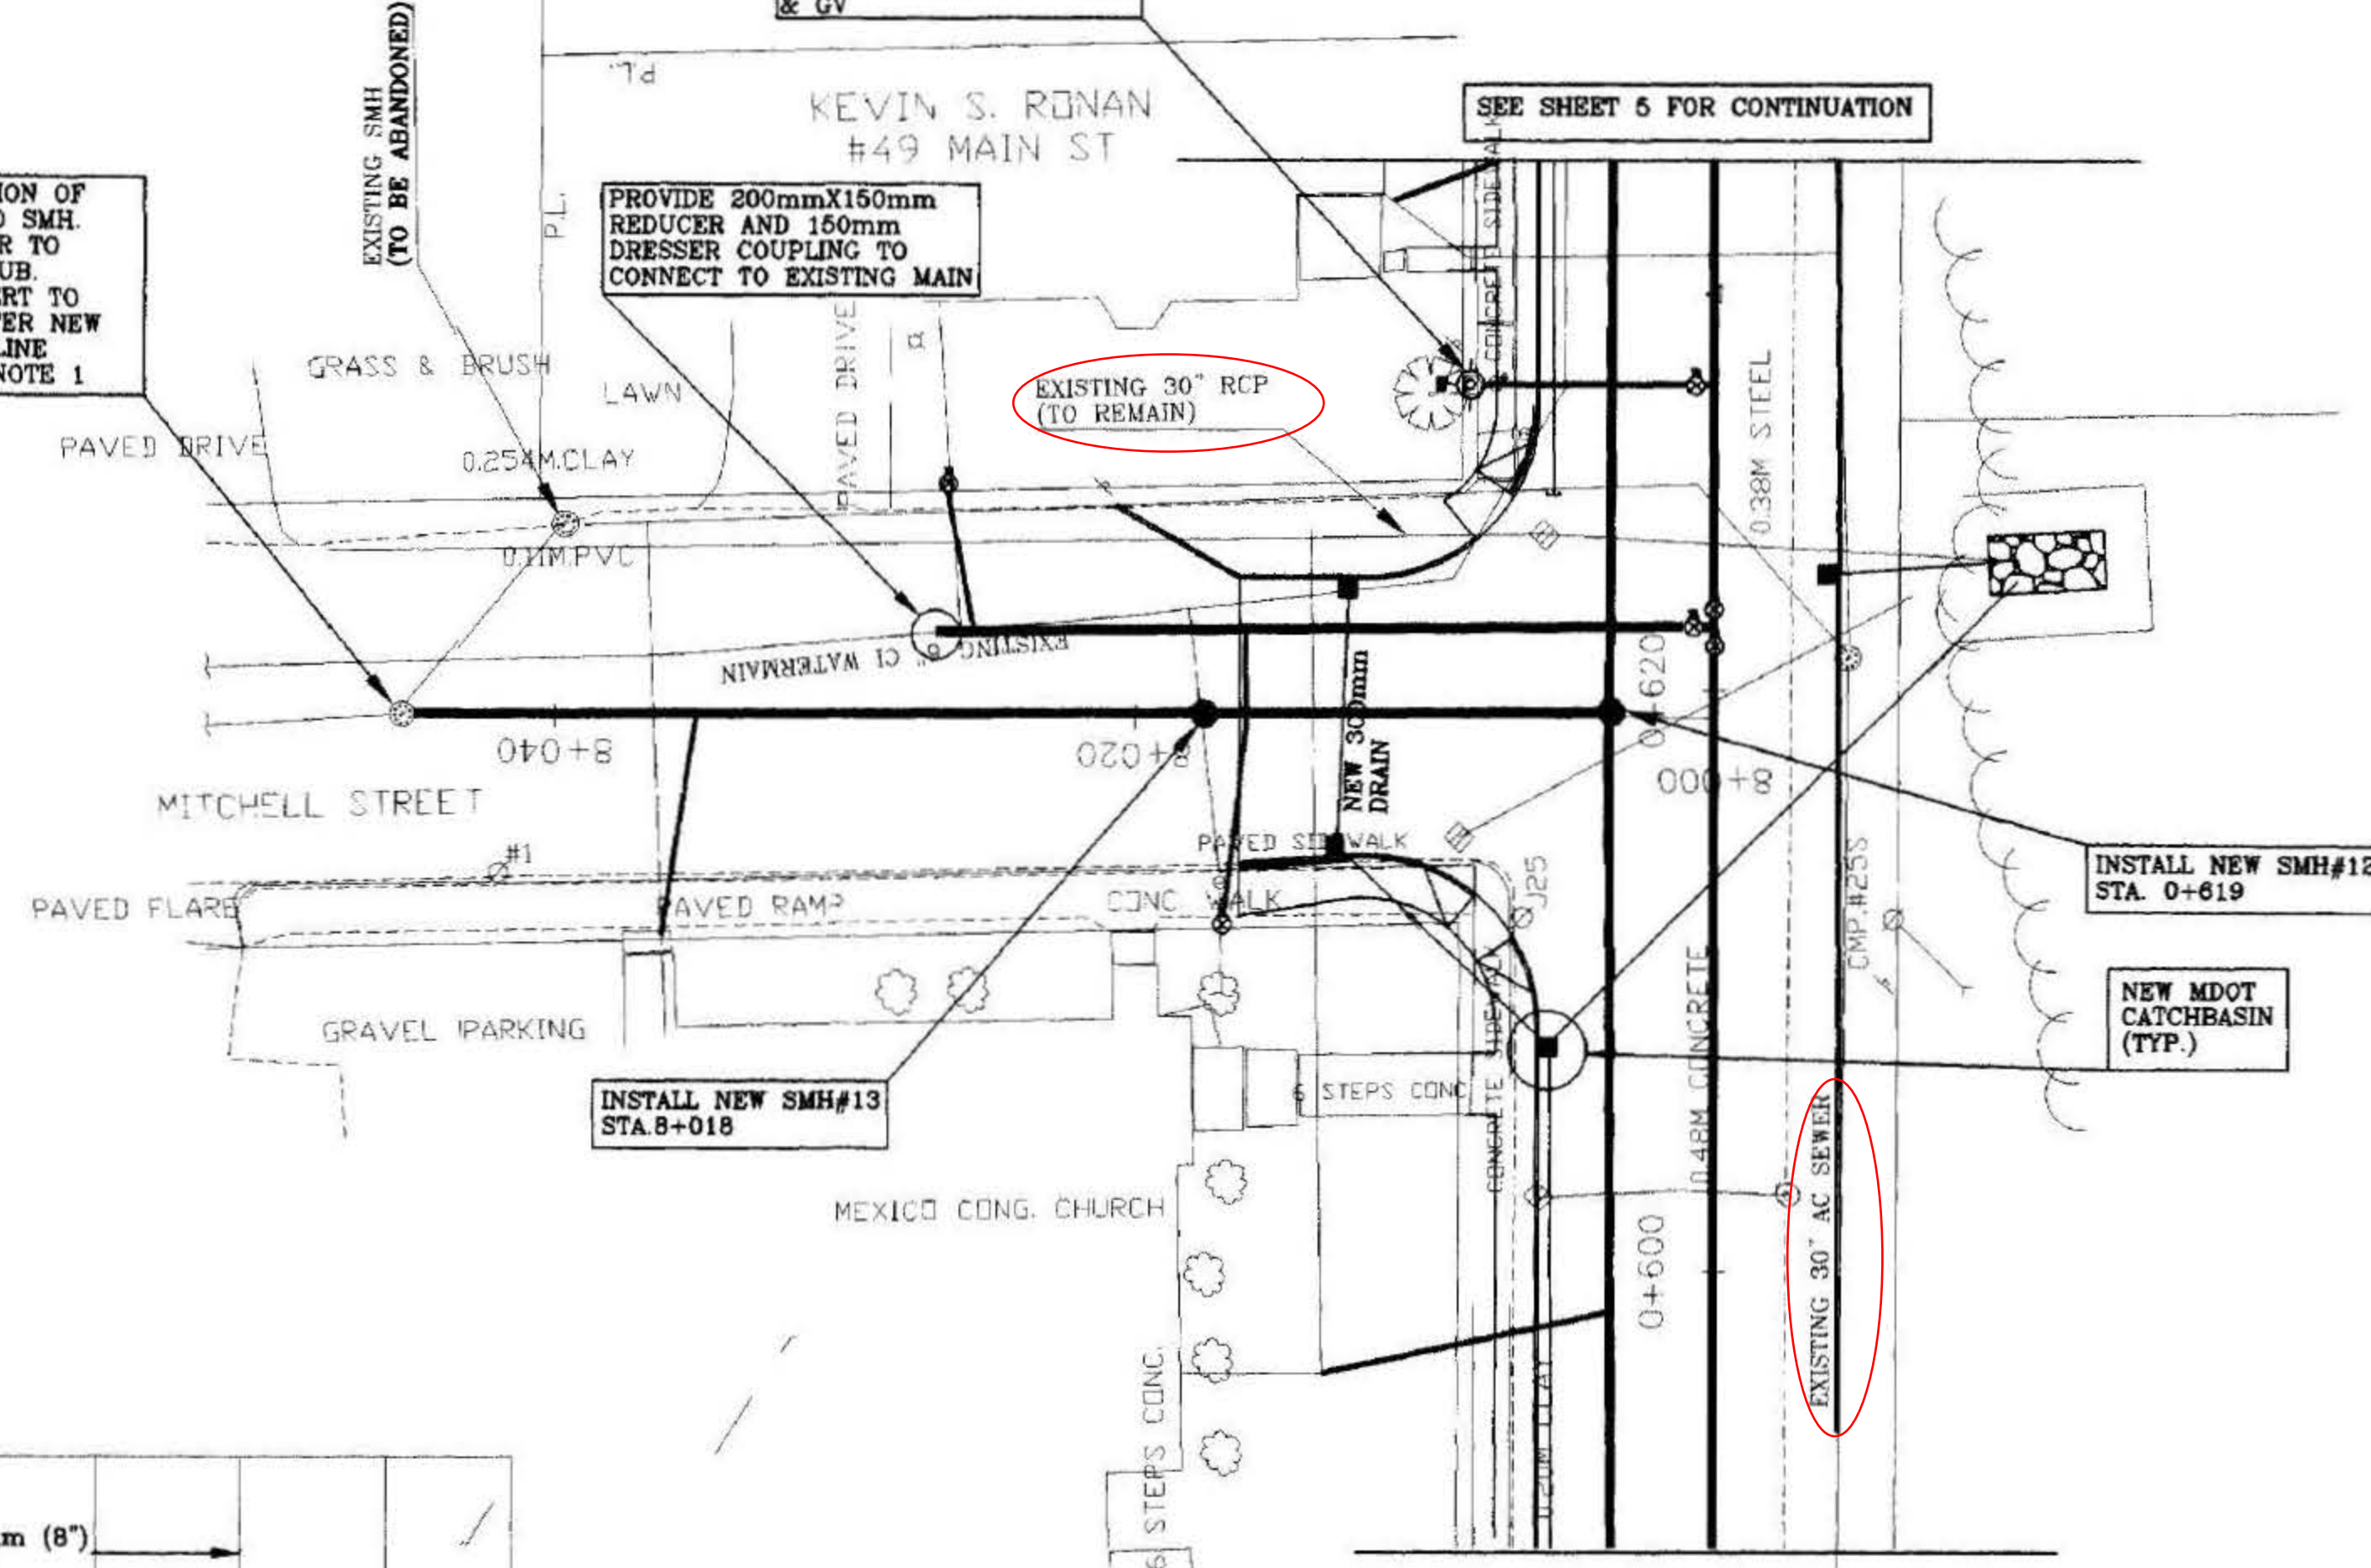

NOTES:

1. THE TOWN OF MEXICO, THROUGH A RELATED PROJECT, HAS REPLACED A PORTION OF THE SEWER ON MITCHELL STREET. IN ORDER TO MAINTAIN FLOW, THE NEW SEWER WAS DIVERTED INTO THE EXISTING SEWER THROUGH A TEMPORARY PVC CONNECTION. THE MDOT CONTRACT SHALL CONNECT TO THE NEW MANHOLE AND ELIMINATE THE TEMPORARY CONNECTION WITH ALL ASSOCIATED RETROFIT WORK IN THE CONNECTION MANHOLE. THE CONNECTION MANHOLE IS PROVIDED WITH A PVC STUB FOR CONNECTION. LOCATION OF CONNECTION MANHOLE IS APPROXIMATE BASED ON A PLAN ENTITLED "NORTH GRANITE STREET SEWER REPLACEMENT" DATED JULY 1997 BY MILLETT ASSOCIATES.
2. LOCATIONS OF WATER AND SEWER LINES/SERVICES ON SHEETS 8-9 ARE BASED ON FIELD INVESTIGATIONS, PAVEMENT MARKINGS, AND AS-BUILT PLANS OF THE SEWER INTERCEPTOR DATED MARCH 1973. THE LOCATIONS ARE MEANT AS A BEST REPRESENTATION OF THE EXISTING SERVICE LOCATIONS. AS WITH ALL THE SHEETS, THE CONTRACTOR IS RESPONSIBLE FOR LOCATING UTILITIES AND SERVICES IN THE FIELD.