

CANTON

STATE OF MAINE STATE HIGHWAY COMMISSION

PLANS

CANTON OXFORD COUNTY

MAINE FEDERAL AID PRIMARY PROJECT NO. F-022-1(7)

TOTAL LENGTH 1.756 MILES


SCALES { PLAN 1 IN. = 25 FT.
 { PROFILE 1 IN. = 50 FT. & 1 IN. = 25 FT.
 { VER. 1 IN. = 5 FT.
 { CROSS SECTIONS 1 IN. = 5 FT.

GRADING, BASE & PAVEMENT "AS BUILT" 1970


INDEX OF SHEETS

SHEET NO.	TITLE PAGE	STA.
SHEET NO. 1	TITLE PAGE	
SHEET NO. 2-4	TYPICAL SECTIONS	
SHEET NO. 5	QUANTITIES	
SHEET NO. 6	DRAINAGE DETAILS	
SHEET NO. 7-16	STANDARD DETAILS	
SHEET NO. 17	BRIDGE STANDARD DETAIL	
SHEET NO. 18-30	BRAGGS BRIDGE AND STATE ROAD BRIDGE	
SHEET NO. 31	GRADING AND GEOMETRICS ROUTE 140 INTERSECTION	
SHEET NO. 32	PROFILE SHOWING VARIABLE EXPOSURE OF CURB FACE	
SHEET NO. 33	SPECIAL DETAILS	
SHEET NO. 34	SIDE ROAD AND RADIUS PROFILES	
SHEET NO. 35-44	PLANS AND PROFILES	
SHEET NO. 45-91	MAIN LINE CROSS SECTIONS	
SHEET NO. 92	HIGH STREET CROSS SECTIONS	
SHEET NO. 93-95	ROUTE 140 WEST CROSS SECTIONS	
SHEET NO. 96-97	ROUTE 140 EAST CROSS SECTIONS	
SHEET NO. 98-99	ROUTE 140 WEST CONNECTOR CROSS SECTIONS	
SHEET NO. 100	CROSS STREET CROSS SECTIONS	
SHEET NO. 101	GRAVEL ROAD CROSS SECTIONS	
SHEET NO. 102	OUTLET DITCH PROFILES	

Sheets 18-30 missing assumed taken by Bridge Maint.

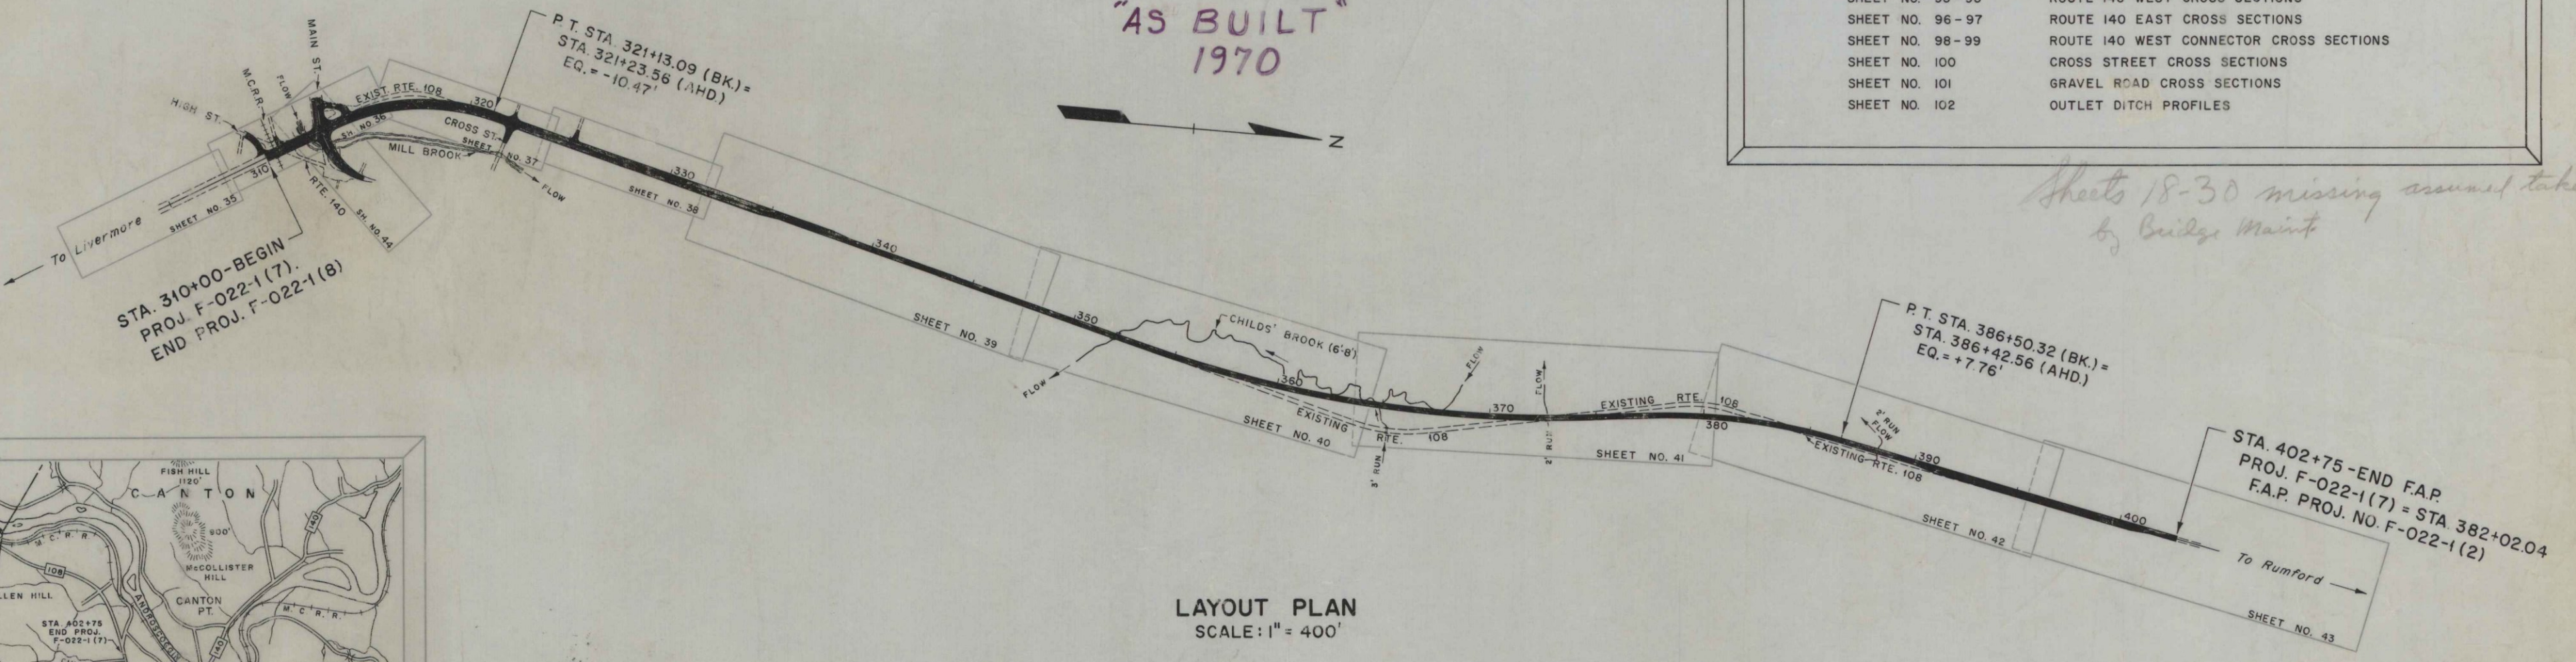

LAYOUT PLAN
SCALE: 1" = 400'

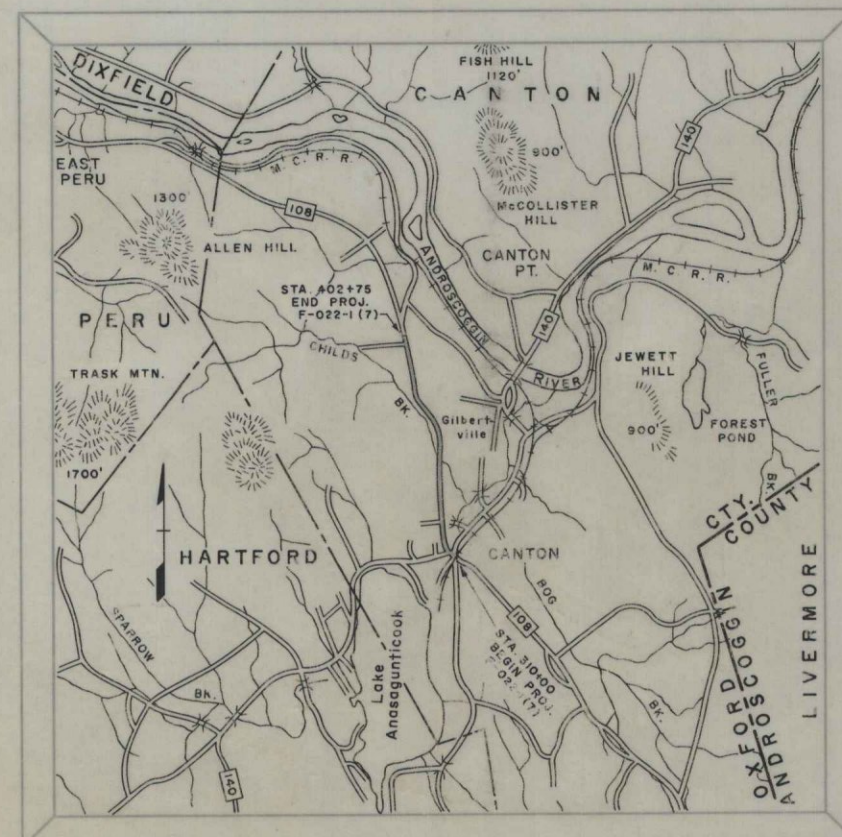

A PORTION OF OXFORD COUNTY
SCALE: 1" = 1 mile

NOTE:
All Work Contemplated Under This Contract To Be Governed By And In Conformity With The Specifications Adopted June 1968 Except As Modified On These Plans And In The Special Provisions And In Any Other Supplemental Specifications.


TRAFFIC DATA		
A.D.T. 1967	1850	
A.D.T. 1987	2960	
D.H.V.	385	
T.	8%	
D.	60%	
V.	40 mph	Sta. 310+00 - 323+00
V.	60 mph	Sta. 323+00 - 402+75

APPROVED:
MAINE STATE HIGHWAY COMMISSION
Dieter Stuever 7 Aug '68
Bernard E. Richards 7 Aug '68
Steven D. Shaw 7 Aug '68
Sylvester L. Poor 7 Aug '68
CHIEF ENGINEER

DEPARTMENT OF TRANSPORTATION
FEDERAL HIGHWAY ADMINISTRATION
BUREAU OF PUBLIC ROADS
REGION 1
APPROVED:
DIVISION ENGINEER DATE

3" HOT BITUMINOUS PAVEMENT *

STAGE I

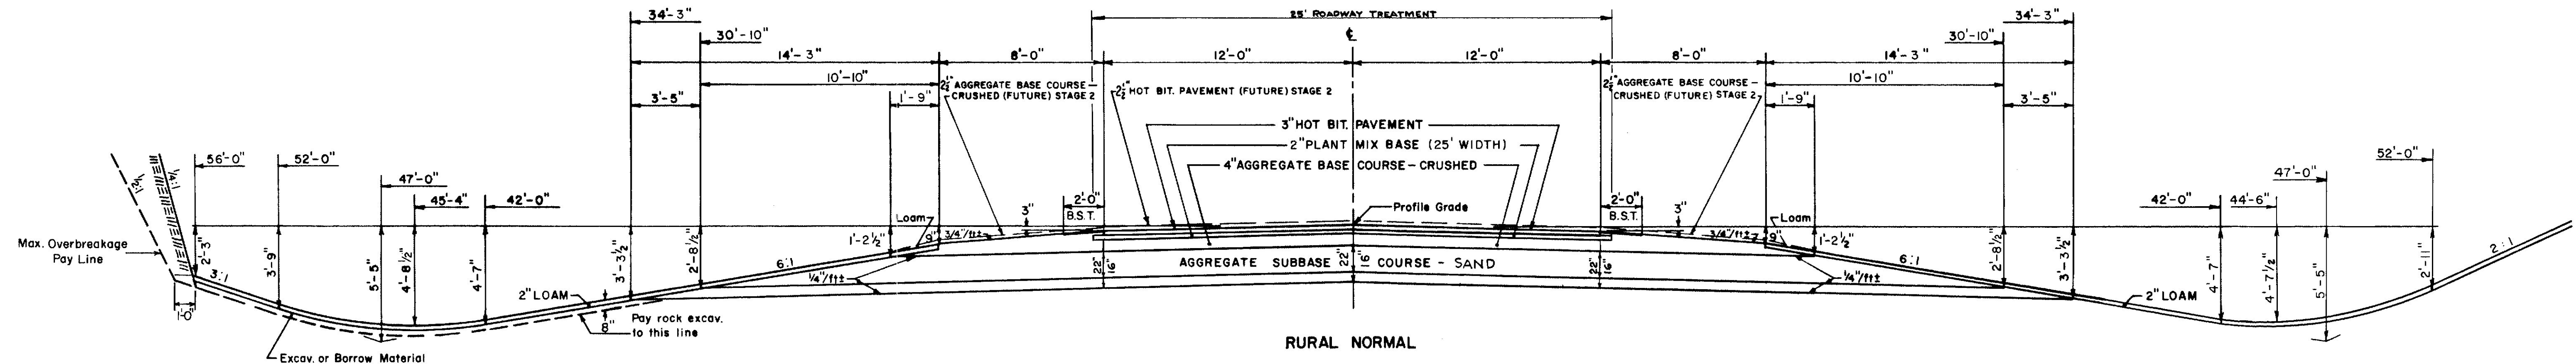


* NOTE:
The pavement and base depths as shown on the plans are intended to be nominal.

Aggregate Base Course-Crushed (on shoulder)= 17.86 cu.yds./100 lin.ft.
16" Aggregate Subbase Course- Sand (under shoulder)= 70.08 cu.yds./100 lin.ft.
22" Aggregate Subbase Course- Sand (under shoulder)= 108.33 cu.yds./100 lin.ft.

4" Aggregate Base Course-Crushed 24' Wide = 29.63 cu.yds./100 lin.ft.
16" Aggregate Subbase Course- Sand 24' Wide = 118.52 cu.yds./100 lin.ft.
22" Aggregate Subbase Course- Sand 24' Wide = 162.96 cu.yds./100 lin.ft.

Aggregate Base Course-Crushed (on shoulder)= 17.86 cu.yds./100 lin.ft.
16" Aggregate Subbase Course- Sand (under shoulder)= 70.08 cu.yds./100 lin.ft.
22" Aggregate Subbase Course- Sand (under shoulder)= 108.33 cu.yds./100 lin.ft.


NOTE:
Crowns for both normal and superelevated sections for all courses of subbase, base, and pavement shall be straight.

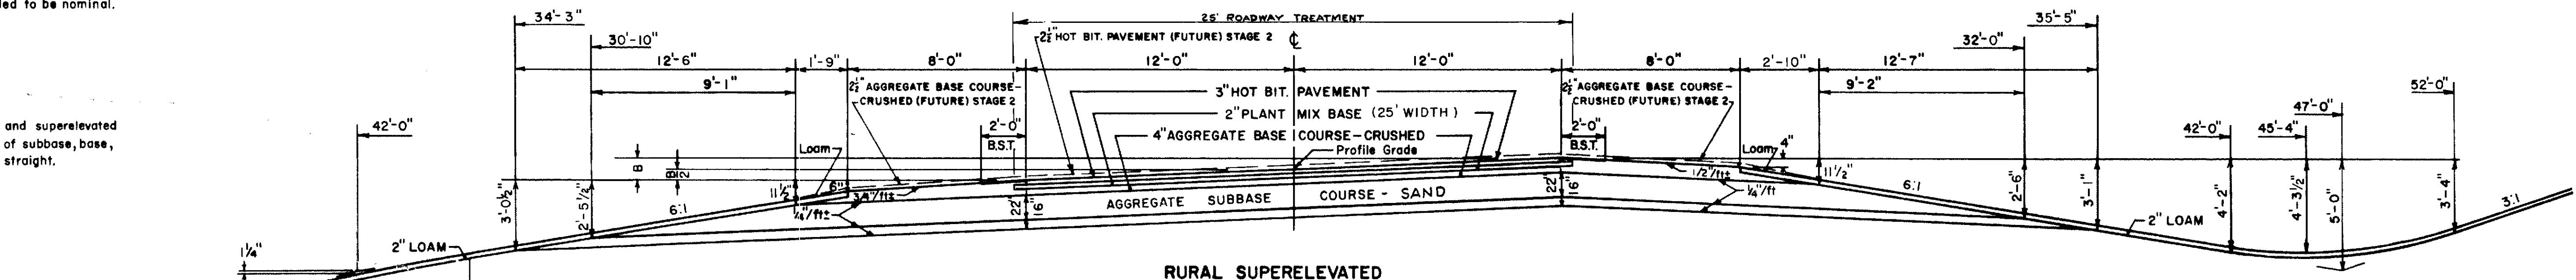

Aggregate Base Course-Crushed (on shoulder)= 17.86 cu.yds./100 lin.ft.
16" Aggregate Subbase Course- Sand (under shoulder)= 70.08 cu.yds./100 lin.ft.
22" Aggregate Subbase Course- Sand (under shoulder)= 108.33 cu.yds./100 lin.ft.


4" Aggregate Base Course-Crushed 24' Wide = 29.63 cu.yds./100 lin.ft.
16" Aggregate Subbase Course- Sand 24' Wide = 118.52 cu.yds./100 lin.ft.
22" Aggregate Subbase Course- Sand 24' Wide = 162.96 cu.yds./100 lin.ft.

Aggregate Base Course-Crushed (on shoulder)= 21.37 cu.yds./100 lin.ft.
16" Aggregate Subbase Course- Sand (under shoulder)= 76.77 cu.yds./100 lin.ft.
22" Aggregate Subbase Course- Sand (under shoulder)= 117.28 cu.yds./100 lin.ft.

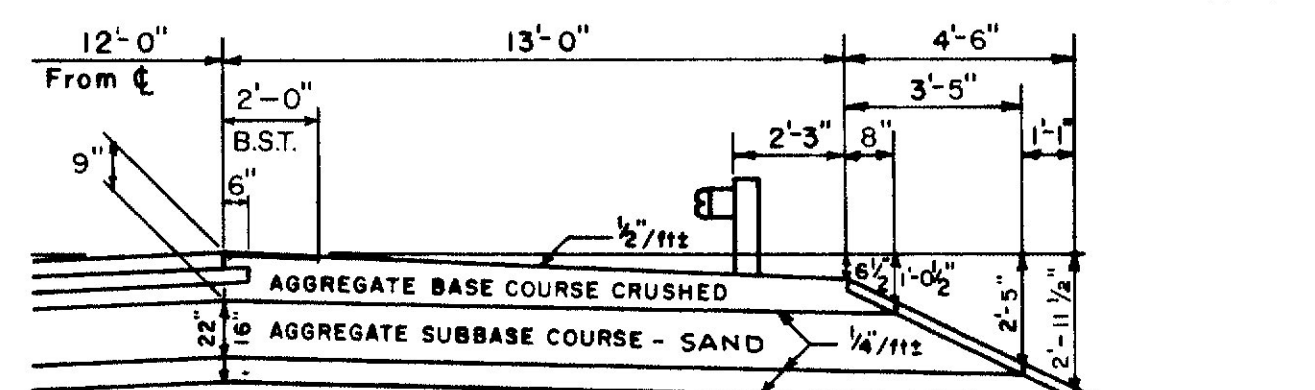

GUARD RAIL SUPERELEVATED

Aggregate Base Course-Crushed (on shoulder)= 29.84 cu.yds./100 lin.ft.
16" Aggregate Subbase Course- Sand (under shoulder)= 73.85 cu.yds./100 lin.ft.
22" Aggregate Subbase Course- Sand (under shoulder)= 105.85 cu.yds./100 lin.ft.

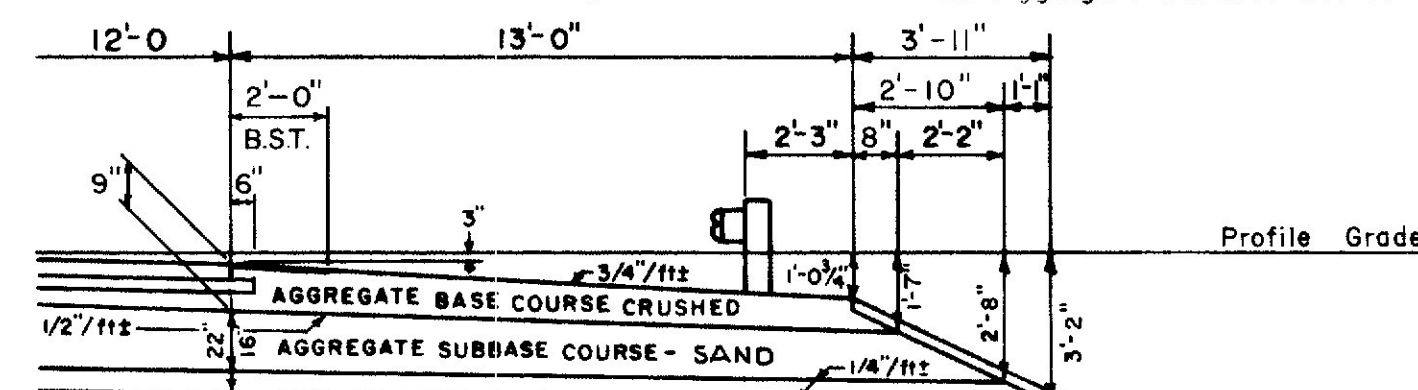

GUARD RAIL NORMAL

Aggregate Base Course-Crushed (on shoulder)= 30.00 cu.yds./100 lin.ft.
16" Aggregate Subbase Course- Sand (under shoulder)= 64.17 cu.yds./100 lin.ft.
22" Aggregate Subbase Course- Sand (under shoulder)= 93.99 cu.yds./100 lin.ft.

(e) The maximum superelevation shall not exceed 0.08' per foot width of pavement. All curves shall have full superelevation at the first 50' station occurring a minimum distance of 50' after the PC and a minimum distance of 50' before the PT. When superelevation exceeds 3/4" per foot, inside shoulder shall have same slope as pavement.

SUPERELEVATED	NORMAL
Sta. 313+50 to Sta. 321+75	Sta. 309+50 to Sta. 313+50
Sta. 353+50 to Sta. 387+00	Sta. 321+75 to Sta. 353+50
	Sta. 387+00 to Sta. 404+50

16" AGG. SUBBASE COURSE - SAND	22" AGG. SUBBASE COURSE - SAND	12" AGG. SUBBASE COURSE - SAND
Sta. 340+25 to Sta. 375+50	Sta. 309+50 to Sta. 340+25	Sta. 375+50 to Sta. 386+00
Sta. 386+00 to Sta. 389+75	Sta. 389+75 to Sta. 402+75	

OTHER BITUMINOUS ITEMS CONT.

ROADWAY TREATMENT
The bituminous treatment of the roadway shall consist of a prime coat of RT-5, item no. 410.18, and cover coat sand, item no. 410.16.

PAVEMENT DESIGN INFORMATION

DESCRIPTION OF COURSE	GRADATION	ITEM NO.	% MIX BITUMEN	THICK - INCHES	NO. of LAYERS	NOTES
Travel Way (Include Truck Lane)						
Wearing	"C"	403.080	7.0	1 1/2"	1	1, 2
Binder	"B"	403.070	6.0	1 1/4"	1	1, 2
Base	"A"	301.08	5.0	2"	1	1, 2
Paved Approaches, Sideroads, & Shoulders						
Wearing	"C"	403.080	7.0	1 1/2"	1	1, 2
Binder	"B"	403.070	6.0	1 1/4"	1	1, 2
Shim Course						
Leveling	"E"	403.121	7.5	Variable	1 or More	1, 2, 3, 4
Paved Drives, Downspouts, Sidewalks & Incidentals						
Wearing & Binder	"E"	403.12	7.5	2"	2	1, 2, 3, 4

NOTES:

- The bituminous binder material for the mixtures shall be Penetration Grade (85-100) Asphalt Cement. The Asphalt Cement shall be paid for Separately.
 - The asphalt contents shown are to serve as a guide only and are not specifications.
 - Mixtures meeting the aggregate gradation of "B" and "C" above may be used for the bottom layer with payment to be made under Item 403.12
 - The density requirements are waived
- * Note: The substitution of gradations "B" and "C" to be used for shimming Bridge Slabs only.

OTHER BITUMINOUS ITEMS

SHOULDER TREATMENT (2" B.S.T.)
Bituminous treatment of the gravel shoulders shall consist of a Prime Coat of RT-5, Item 410.13 and Cover Coat Material-sand (if required) Item 410.16 followed by a Seal Coat of RT-6, Item 410.13 and Cover Coat Material-sand, Item 410.16.

The use of rollers as specified in subsection 405.05 and 410.05 may be substituted by adequate rolling in accordance with subsection 411.04





TACK COAT

In the event paving operations are extended into the following spring, a tack coat of Emulsified Asphalt, AE-90, Item 410.15 shall be applied to the existing course prior to placing a new course if so directed by the Engineer.



3" BITUMINOUS PAVEMENT *

STATE	PROJECT NUMBER	SHEET NO.	TOTAL SHEETS
2	F-022-1(7)	3	102

* NOTE:
The pavement and base depths as shown on the plans are intended to be nominal.

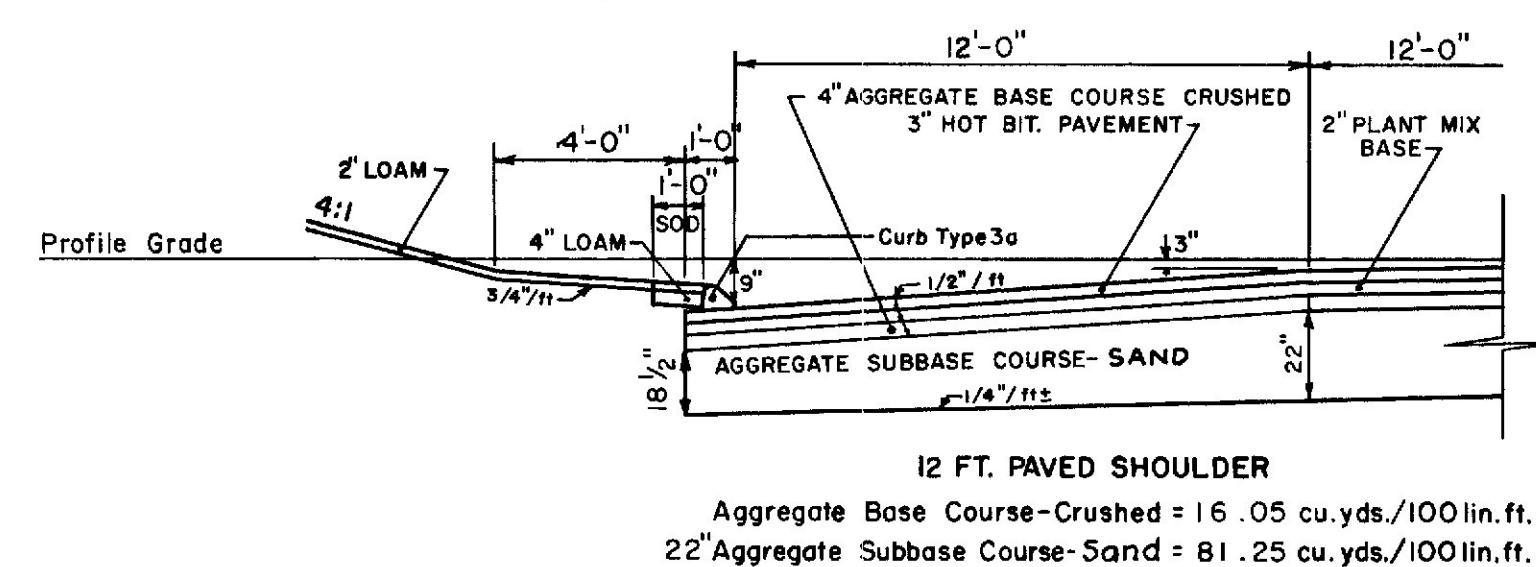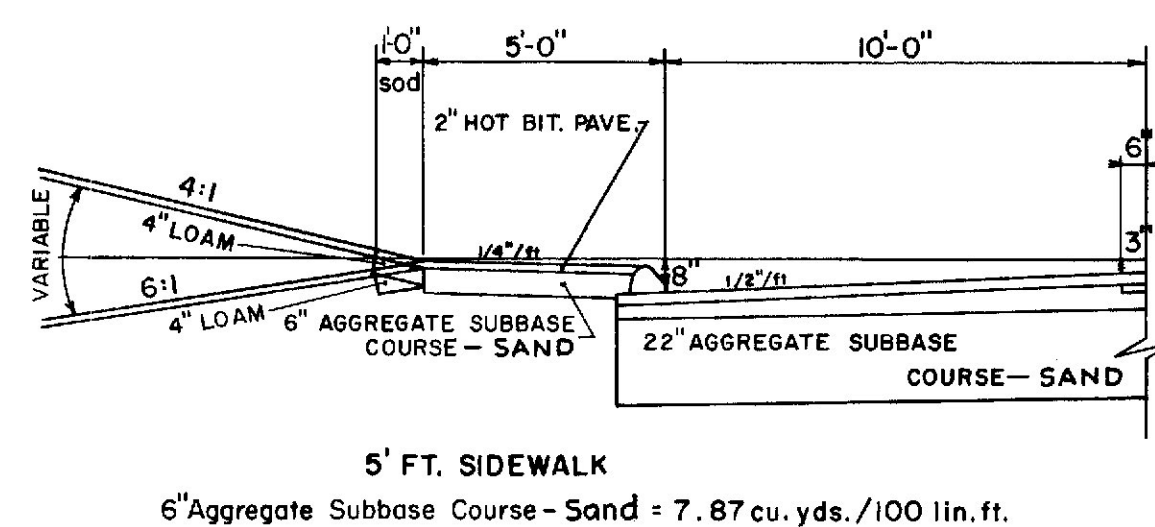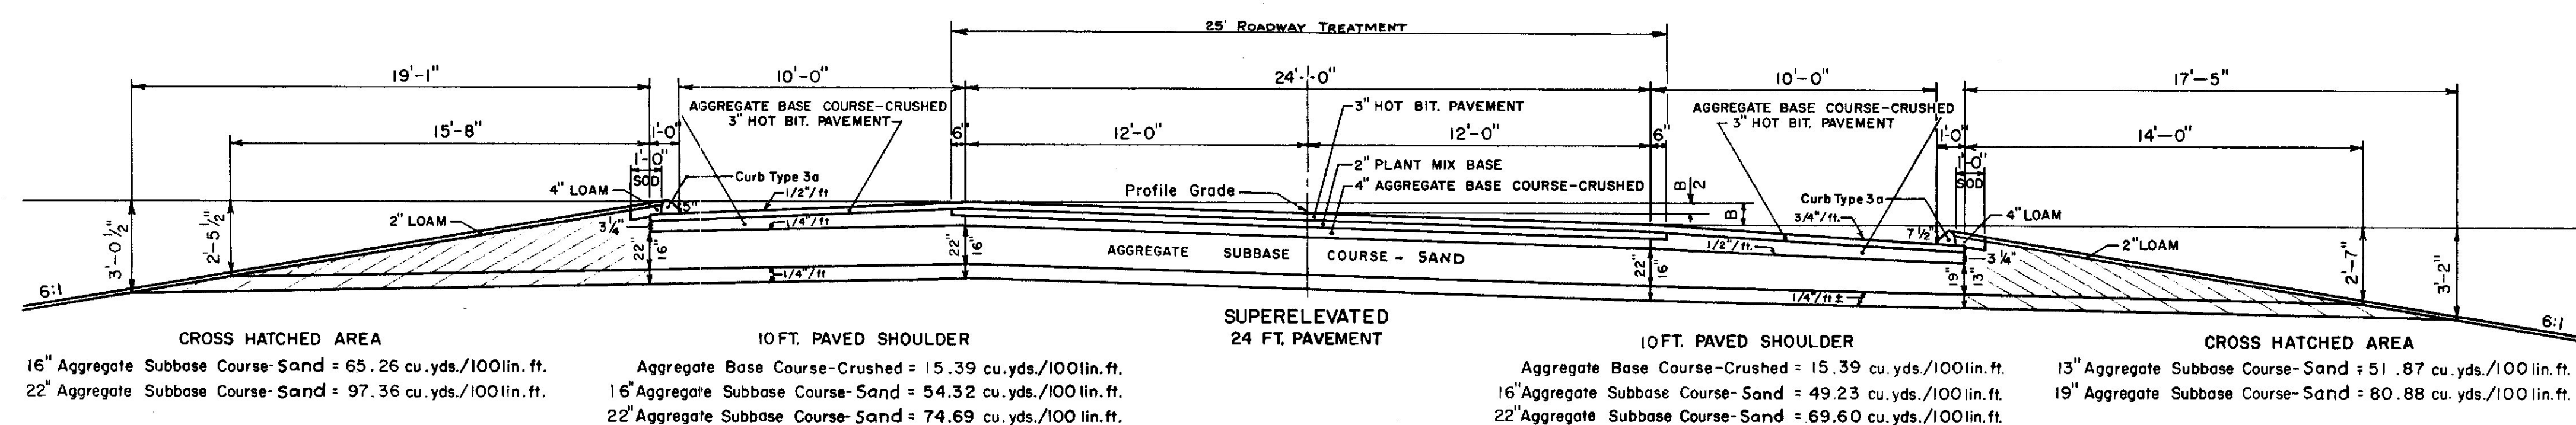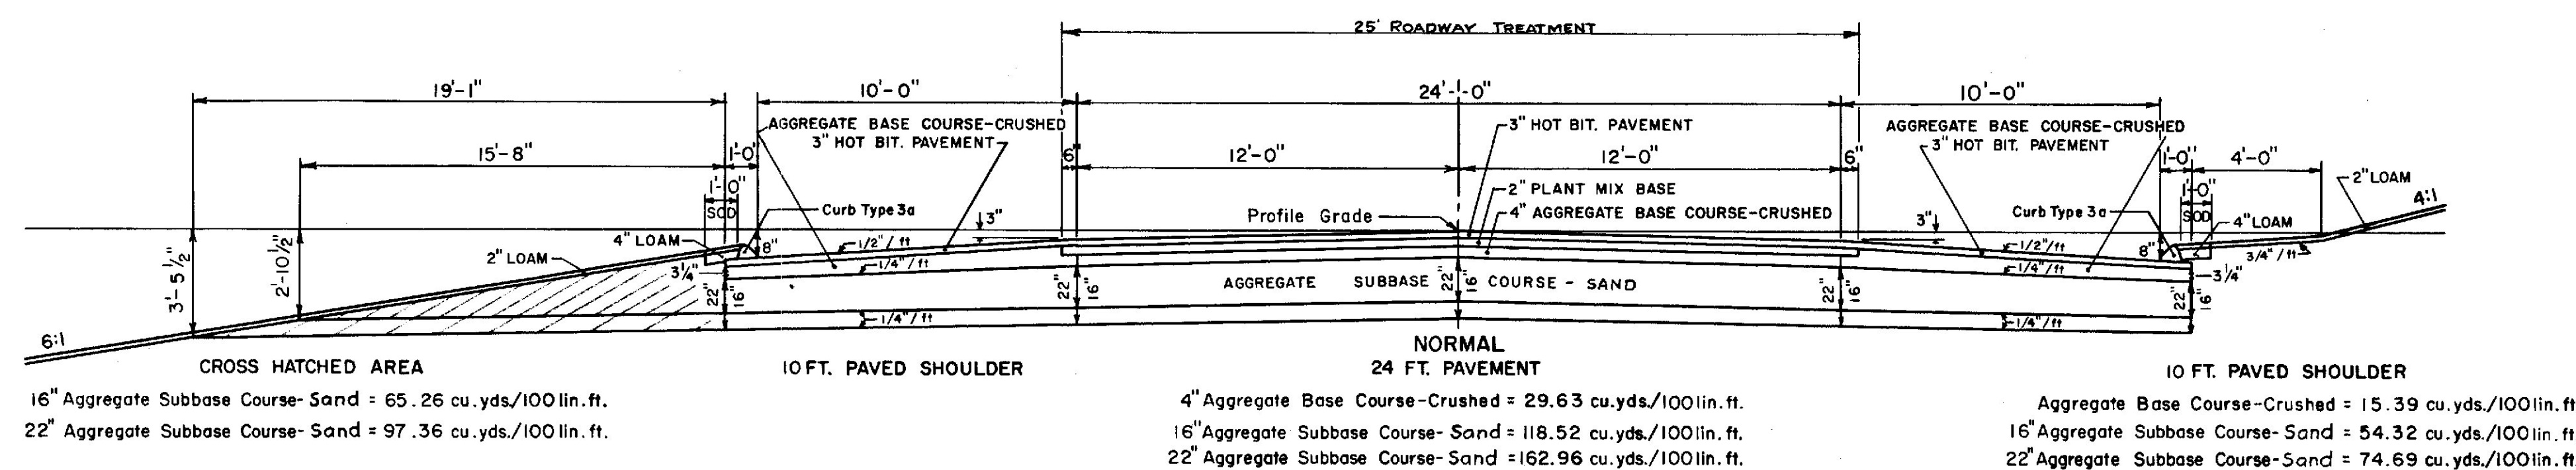



NORMAL

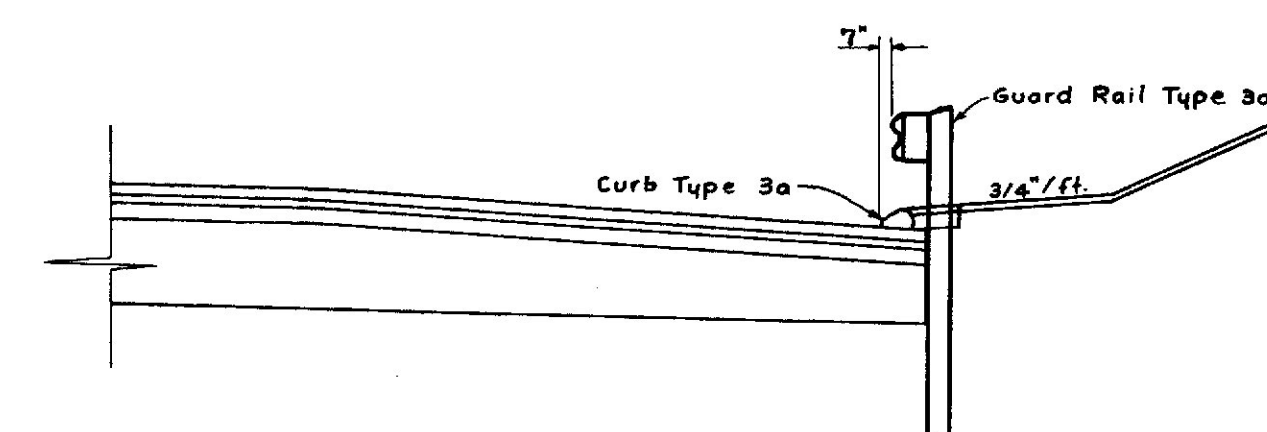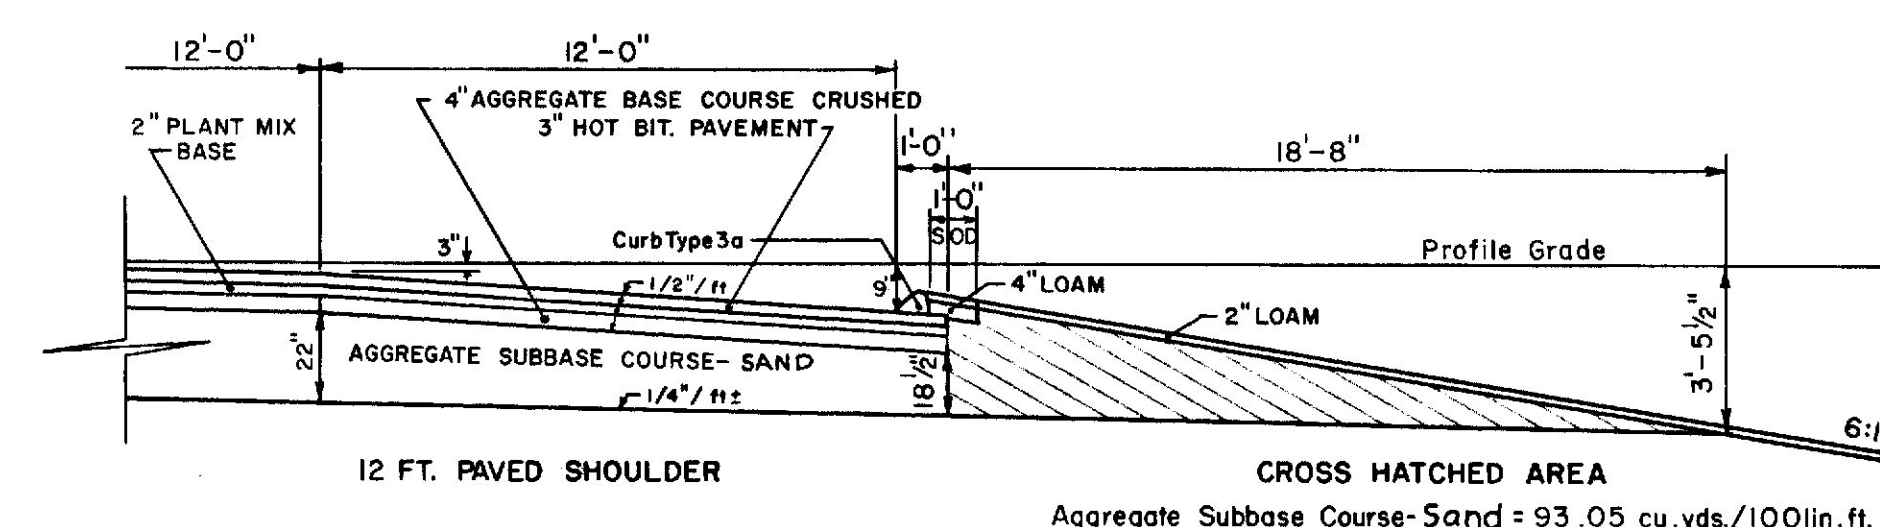

GUARD RAIL LOCATION IN CURB AREAS

3" HOT BITUMINOUS PAVEMENT*

S. P. R. REG. NO.	STATE	PROJECT NUMBER	SHEET NO.	TOTAL SHEETS
1	MAINE	F-022-1 (7)	4	102

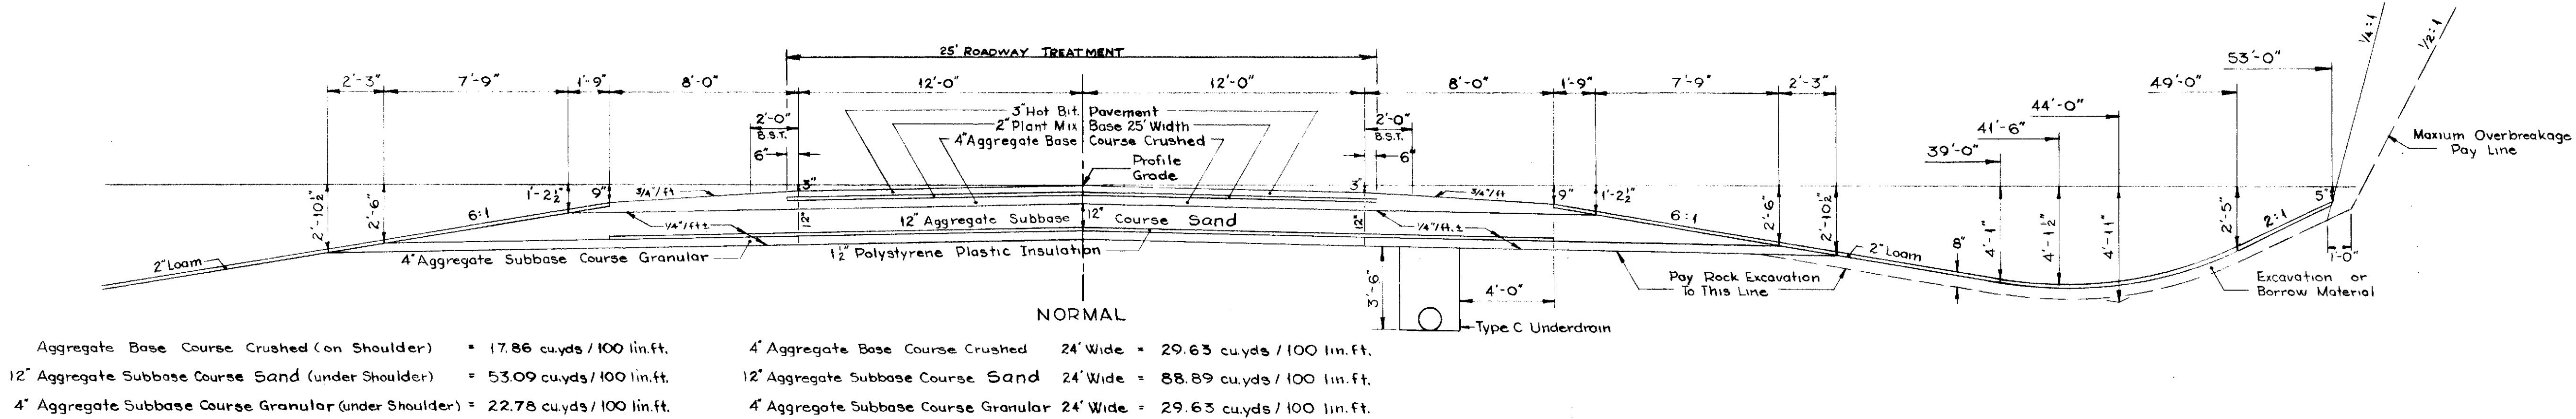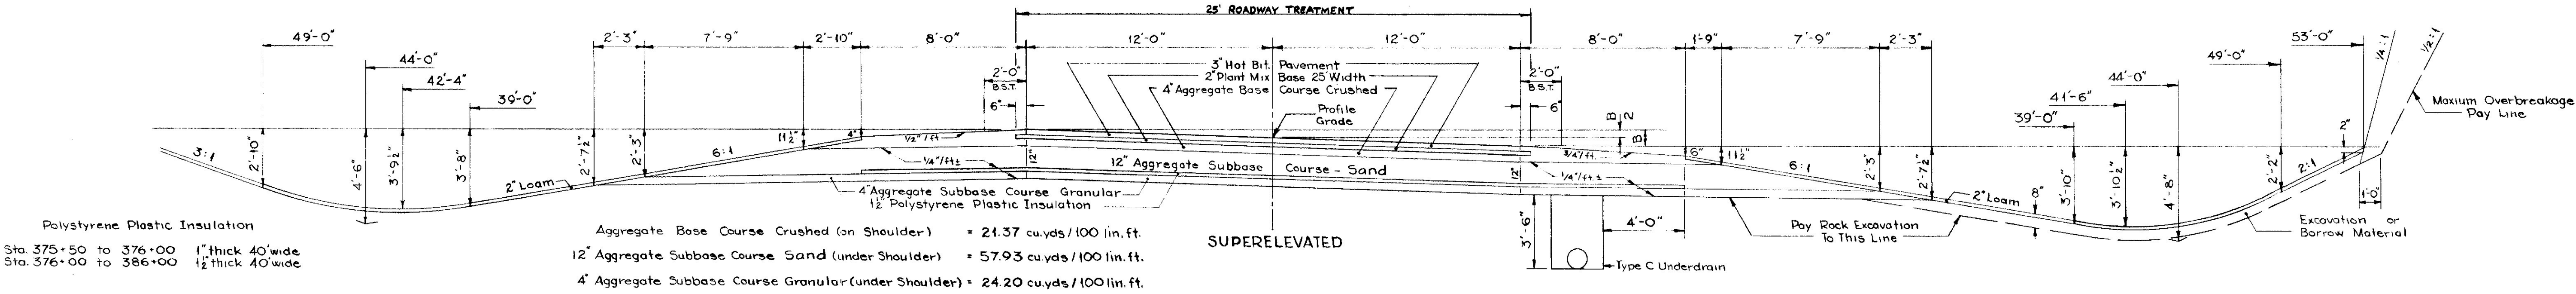


PLANS	DESIGN - DETAILED	CHECKED	REVISIONS	FIELD CHANGES
DATE	BY	RAB	DCI	
8-68				

STATE HIGHWAY COMMISSION

SHEET OF AUGUSTA, MAINE

Main Line Ties, Back Tangent Ties*			Gutter Elevation
Point	Station	Offset	
1	312+31.85	24.00' Lt	395.17
2	312+31.85	64.00' Lt	
17*	313+70.79	21.92' Lt	392.80
19*	313+59.74	20.57' Lt	
21*	314+04.42	25.92' Lt	
22*	314+04.18	20.93' Lt	392.63
24	313+45.99	1.59' Rt	
25*	314+54.39	22.29' Lt	
26*	314+49.51	21.22' Lt	
27*	314+53.90	17.32' Lt	
28	313+43.00	22.00' Lt	392.55
39	312+17.00	24.00' Lt	395.65
Route 140 West Ties			Gutter Elevation
Point	Station	Offset	
2	9+55.42	68.00' Rt	393.32
3	9+55.42	28.00' Rt	
4	9+68.00	3.00' Rt	
5	9+68.00	E	
6	9+68.00	3.00' Lt	
7	9+09.00	3.00' Rt	
8	9+09.00	E	
9	9+09.00	3.00' Lt	
10	8+55.28	25.00' Lt	395.48
11	8+55.28	40.00' Lt	
14	9+16.00	40.00' Lt	
15	9+17.95	25.13' Lt	394.06
Route 140 East Ties			Gutter Elevation
Point	Station	Offset	
29	10+62.00	61.00' Lt	394.25
30	10+62.00	21.00' Lt	
31	10+31.00	3.00' Lt	
32	10+31.00	E	
33	10+31.00	3.00' Rt	
34*	10+99.90	1.01' Lt	
35*	10+99.82	1.99' Rt	
36*	10+99.73	4.99' Rt	
37	10+64.00	25.00' Rt	395.35
38	10+64.00	65.00' Rt	
Connector Ties			Gutter Elevation
Point	Station	Offset	
11	1+80.91	30.09' Rt	394.70
12	1+79.28	15.18' Rt	394.49
13	1+65.73	13.62' Lt	
14	1+65.10	28.53' Lt	
16	1+42.01	18.94' Lt	
18	1+34.09	10.05' Lt	393.71
20	0+90.68	27.22' Lt	392.59
21	0+94.47	30.47' Lt	
23	1+39.29	19.56' Rt	393.24
25	0+50.91	5.71' Lt	
26	0+54.38	9.32' Lt	392.54
27	0+48.56	10.12' Lt	392.63

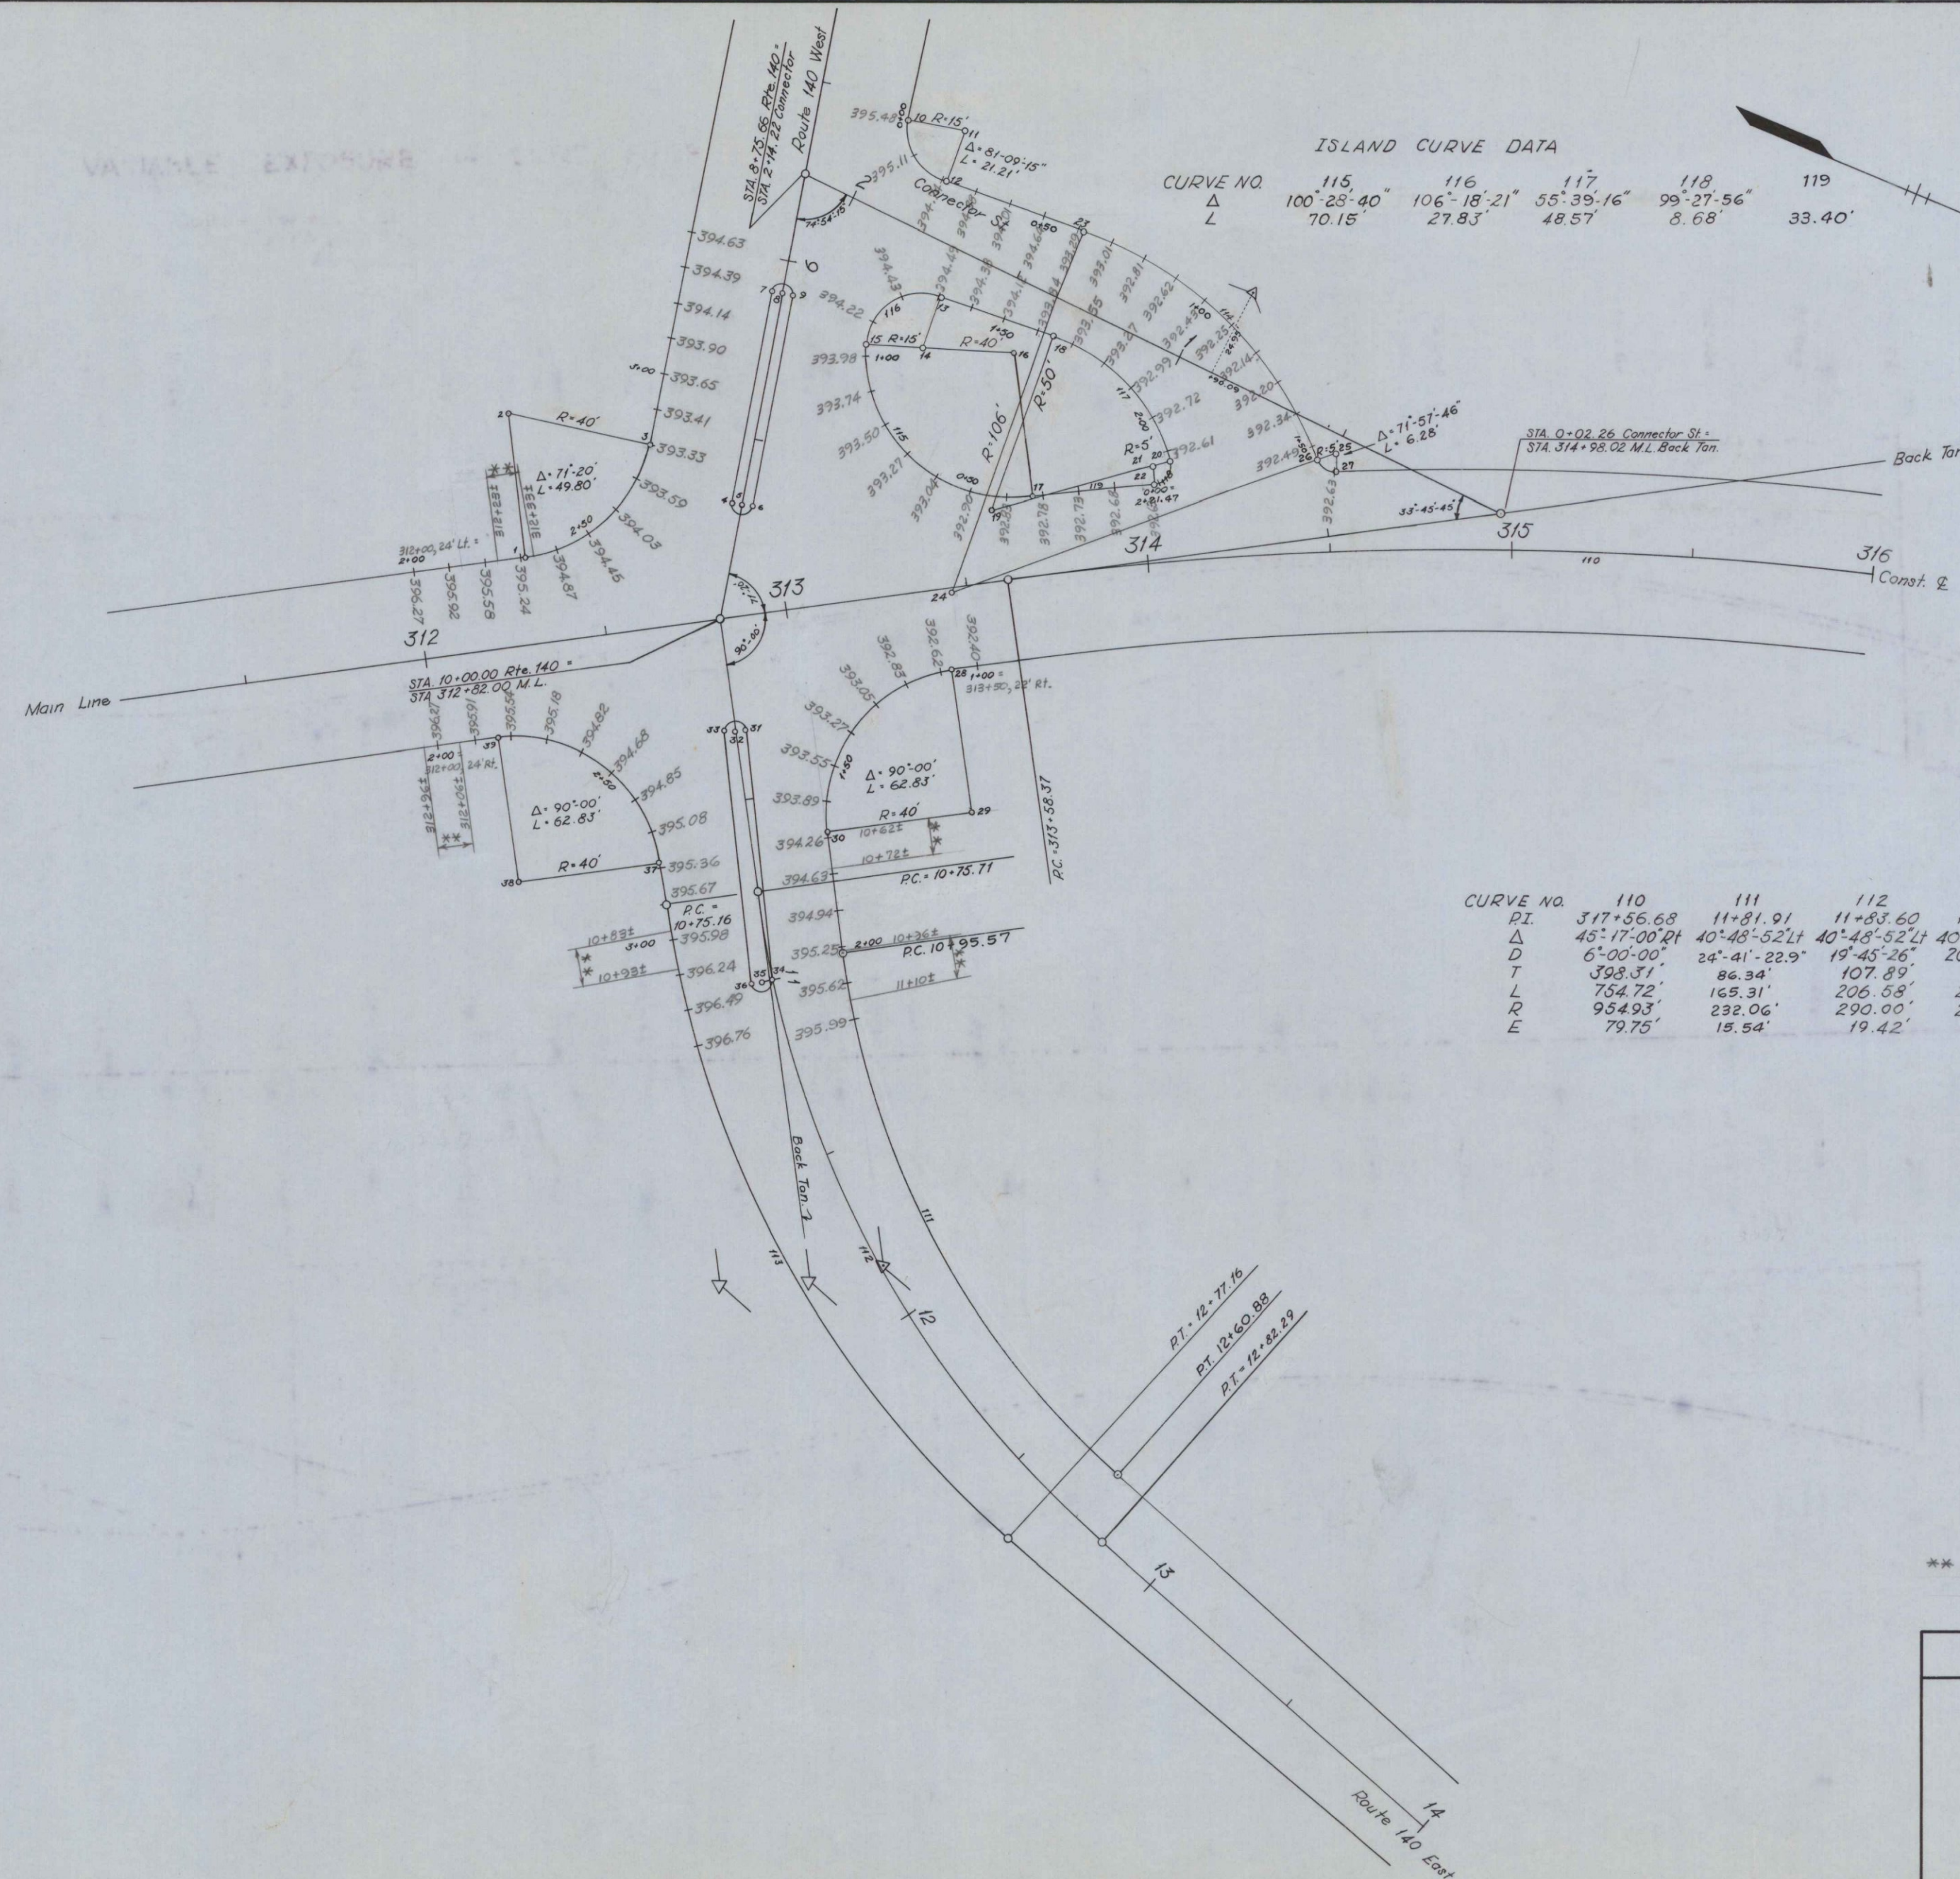

CURVE NO.	110	111	112	113	114
PI	317+56.68	11+81.91	11+83.60	11+80.66	50°03'43"
Δ	45°17'00" Rt	40°48'52" Lt	40°48'52" Lt	40°48'52" Lt	54°03'10"
D	6°00'00"	24°41'22.9"	19°45'26"	20°12'18"	49.50'
T	398.31'	86.34'	107.89'	105.50'	92.62'
L	754.72'	165.31'	206.68'	202.00'	106.00'
R	954.93'	232.06'	290.00'	283.57'	
E	79.75'	15.54'	19.42'	18.99'	

** See General Note No. 17 Sheet No. 35

MAINE STATE HIGHWAY COMMISSION
AUGUSTA, MAINE

GRADING AND GEOMETRICS

SCALE 1"=25'

CANTON (22)


FINAL SURVEY	SURVEYED	DATE
NOTE BOOK	PLOTTED	BY
NO.	AREAS	CHECKED

ORIGINAL SURVEY	SURVEYED	DATE
NOTE BOOK	PLOTTED	BY
NO.	AREAS	CHECKED

R. F. R. REG. NO.	STATE	PROJECT NUMBER	SHEET NO.	TOTAL SHEETS
1	MAINE	F-022-1(7)	32	102



VARIABLE EXPOSURE OF CURB FACE

Scale: horiz. 1" = 50'
vert. 1" = 0.5'

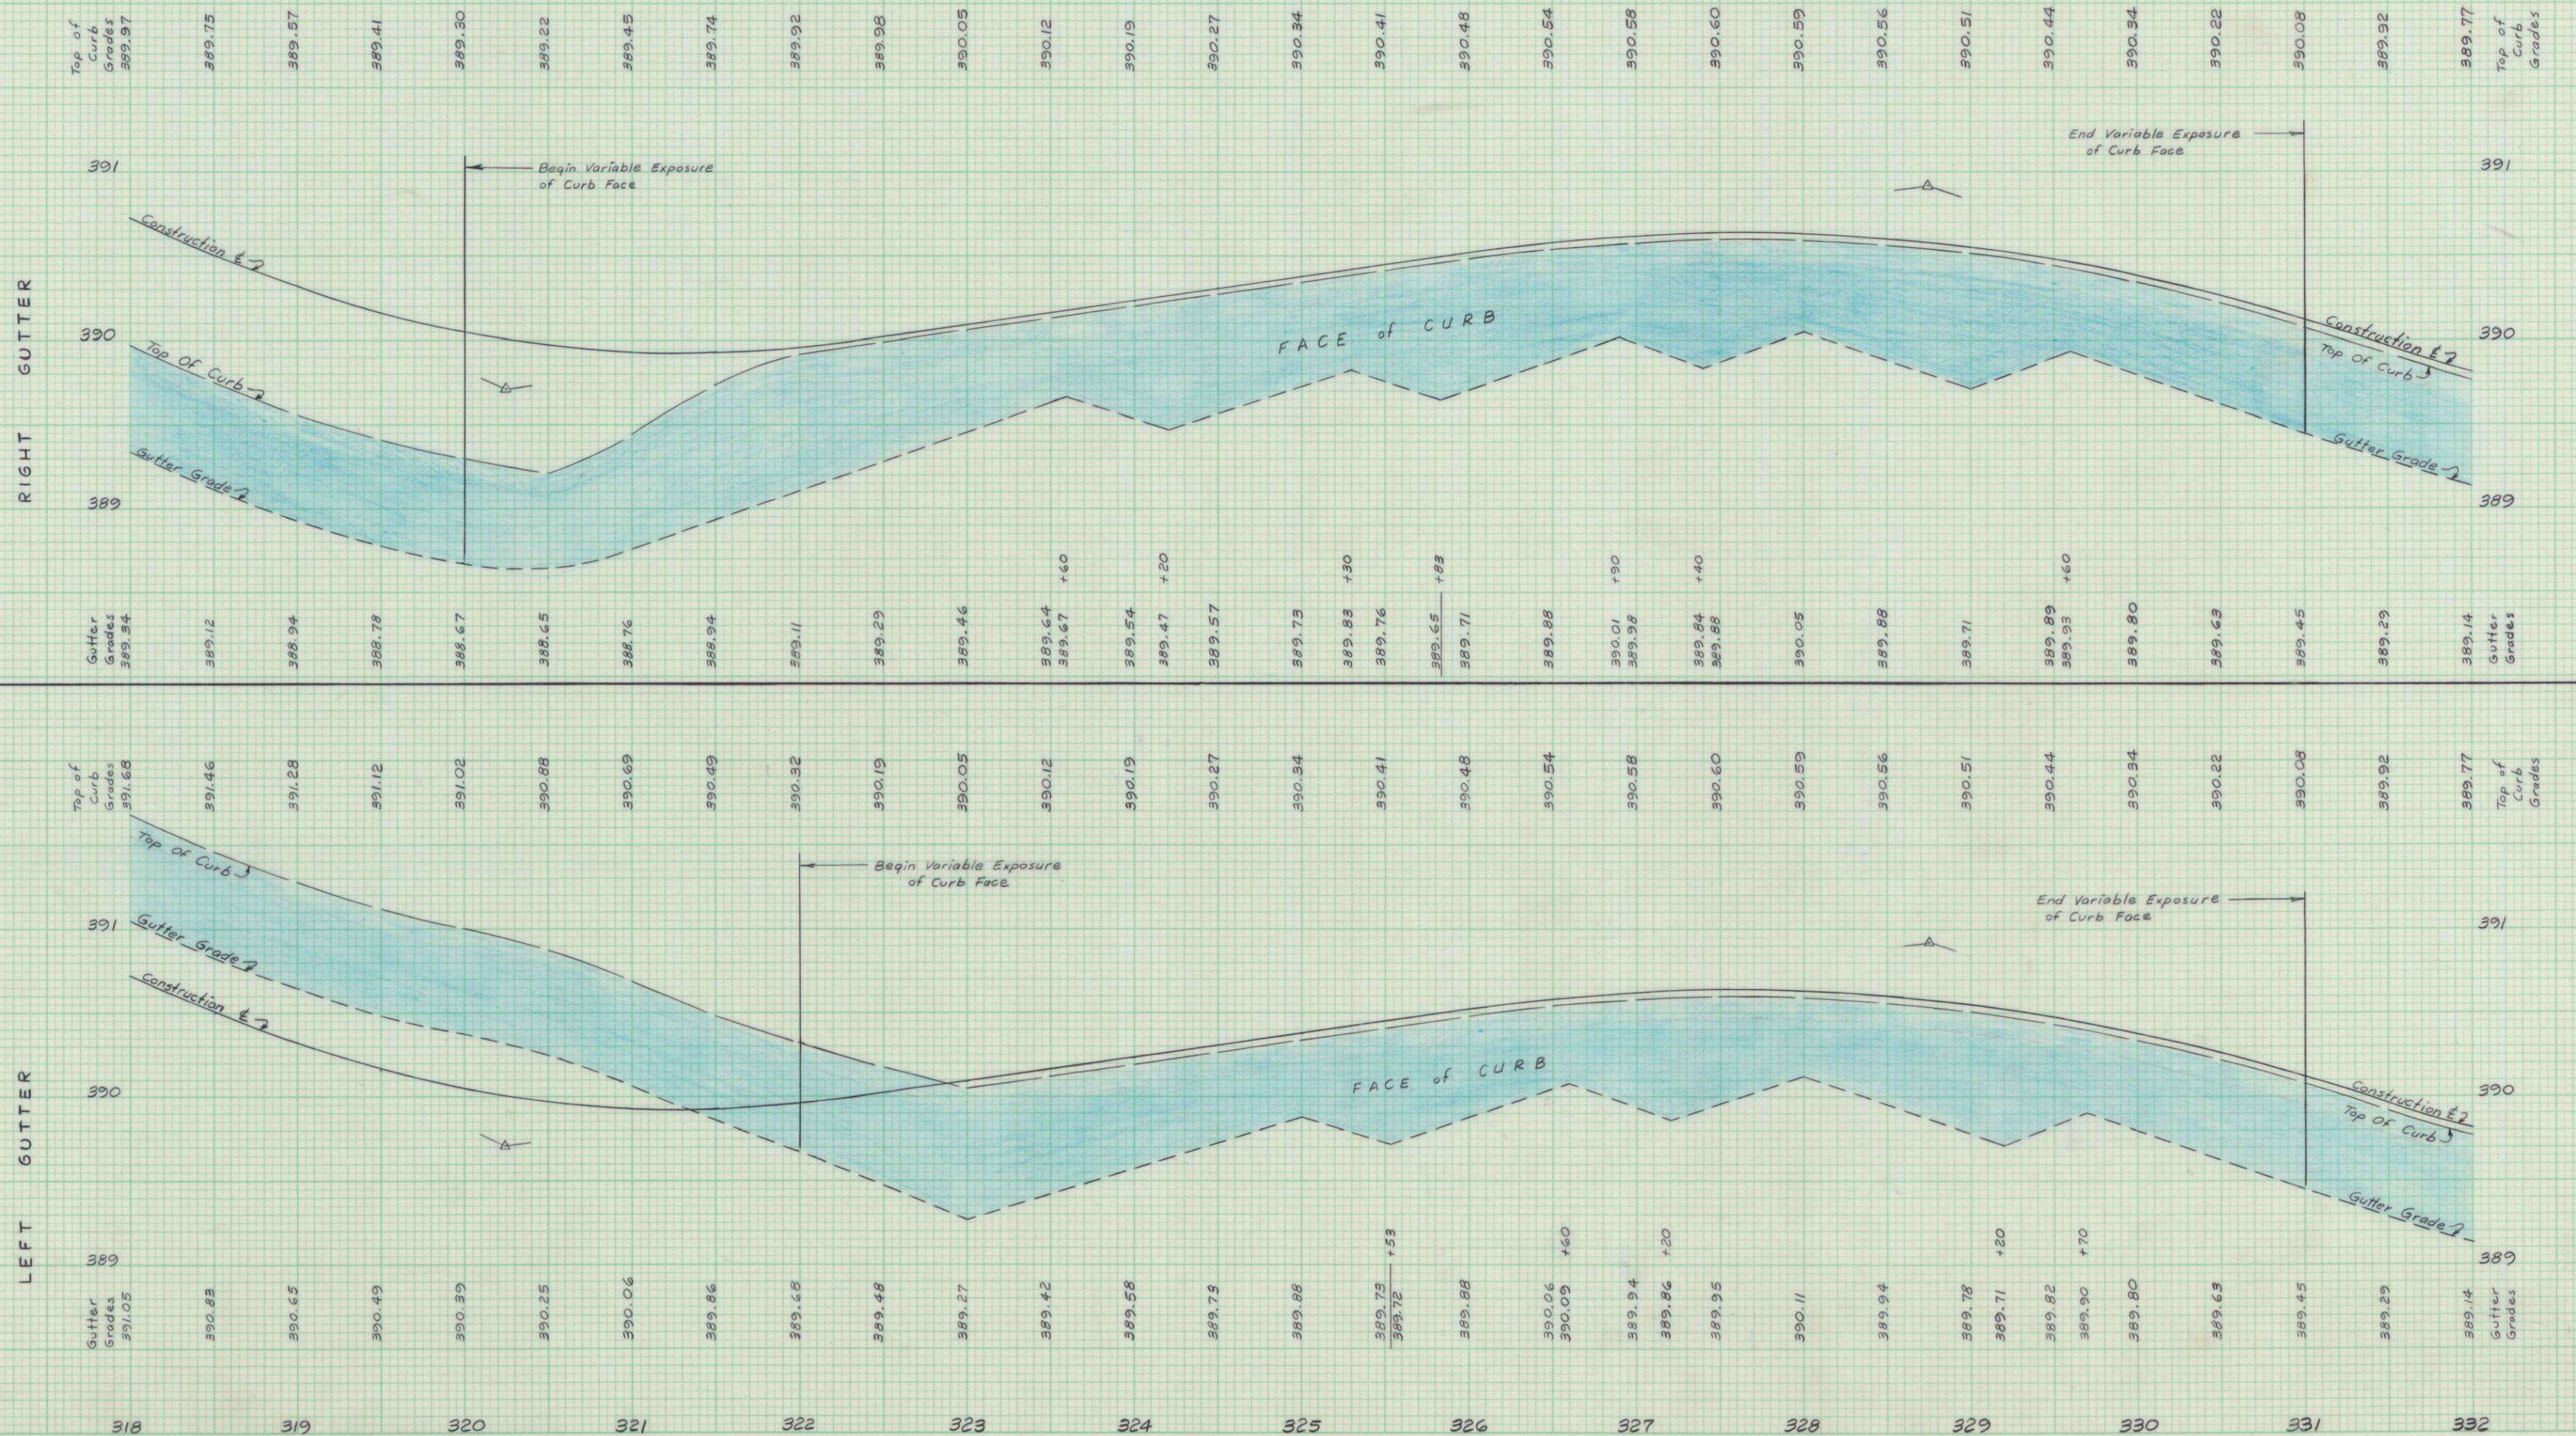




FINAL SURVEY	DATE
NO.	
NOTE BOOK	
PLATTED	
TEMPLATE	
AREAS CHECKED	

ORIGINAL SURVEY	DATE
NO.	
NOTE BOOK	
PLATTED	
TEMPLATE	
AREAS CHECKED	

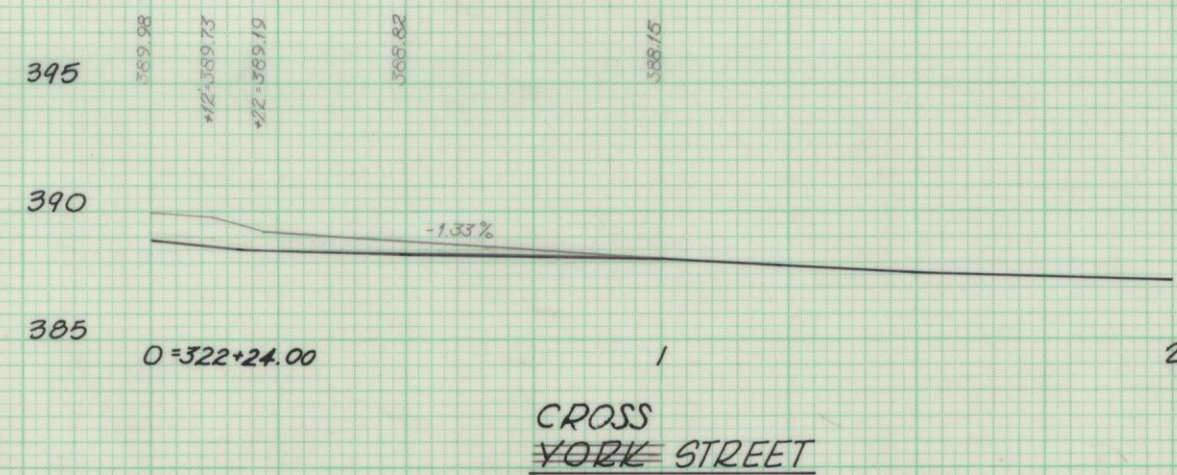
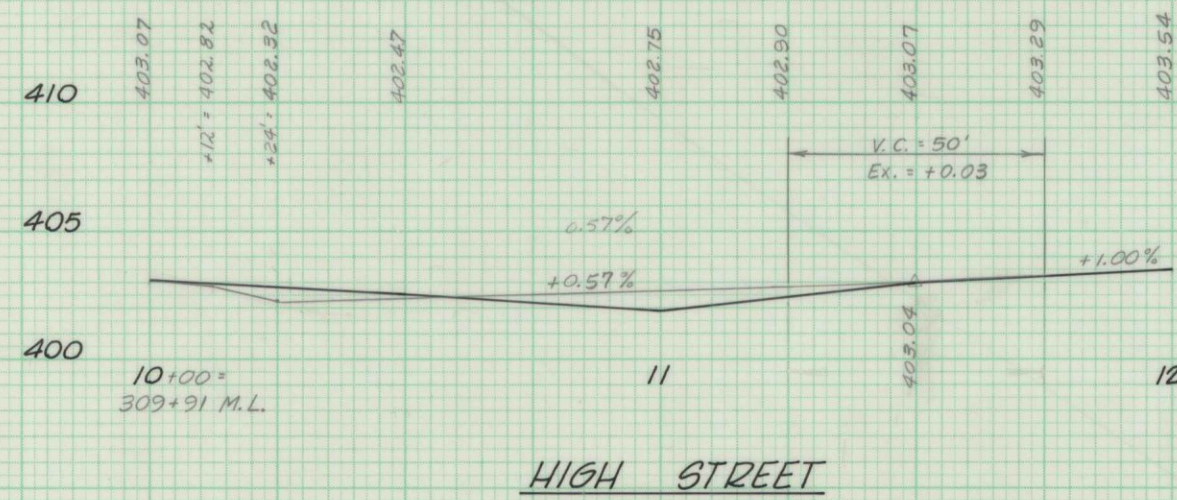


Scale: Vert. 1" = 5'
Horiz. 1" = 25'

SIDE ROAD PROFILES

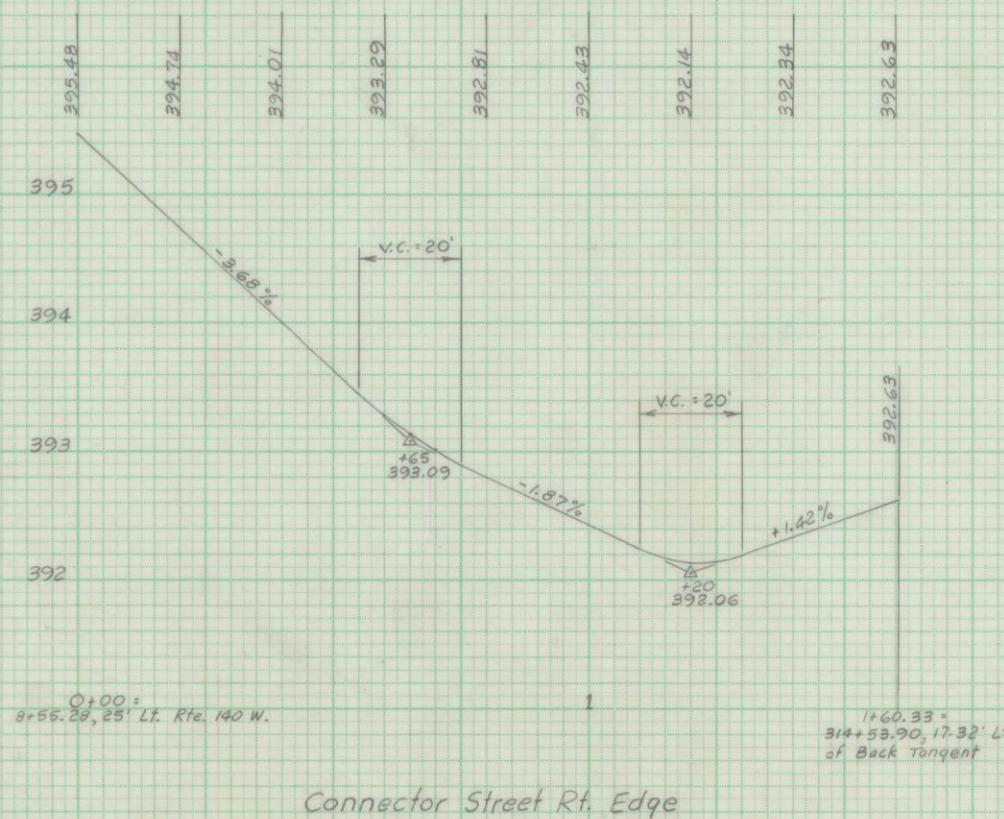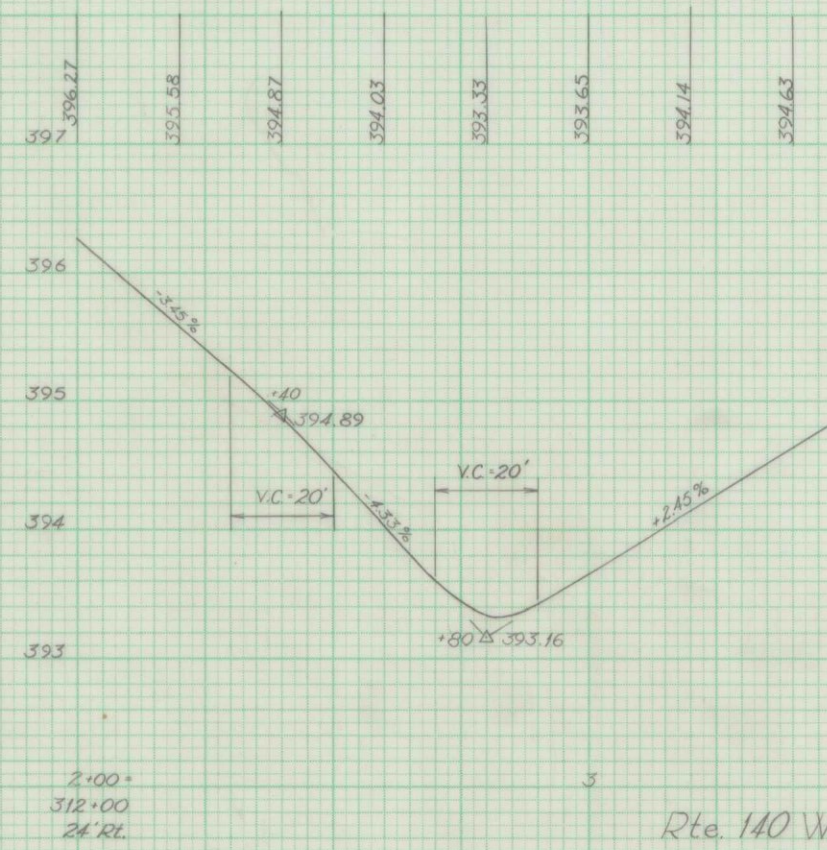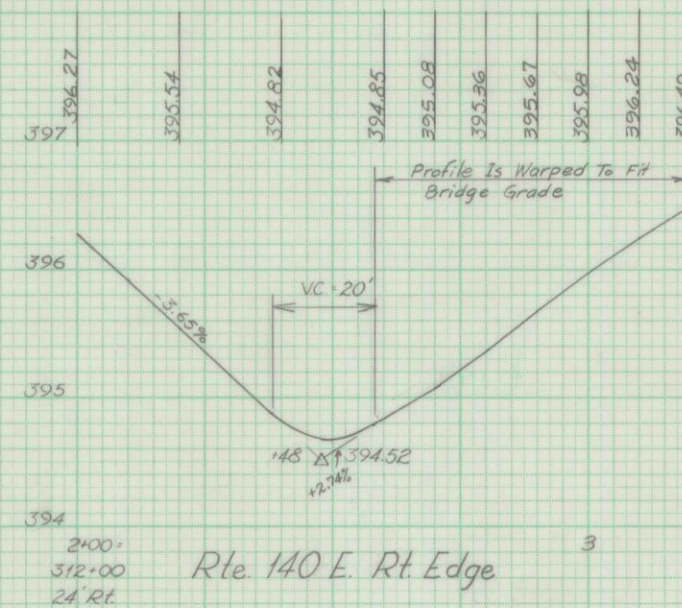

Connector Street Rt. Edge

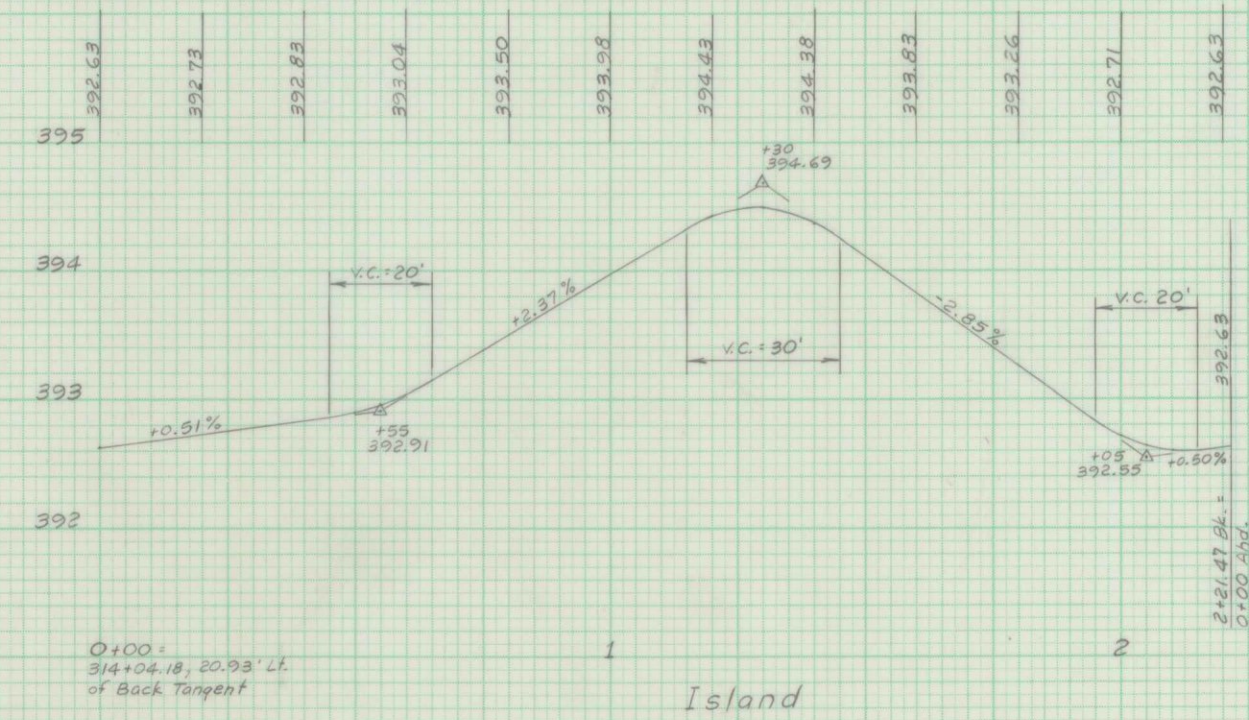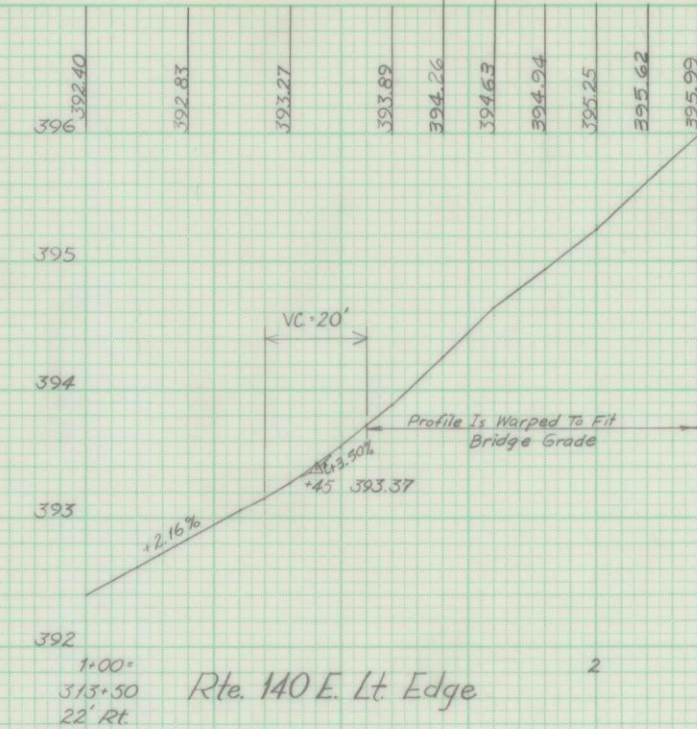


Scale: Vert. 1" = 1'
Horiz. 1" = 25'

RADIUS PROFILES

DATE	BY	APPROVED	PLANNED	ALIGNED	CONCRETE	NO. 22/11
11-67	D.C.L.					

DATE	BY	APPROVED	PLANNED	ALIGNED	CONCRETE	NO. 22/12
11-67	D.C.L.					

S. P. R.	STATE	PROJECT NUMBER	SHEET NO.	TOTAL SHEETS
1	MAINE	F-022-1 (7)	35	102

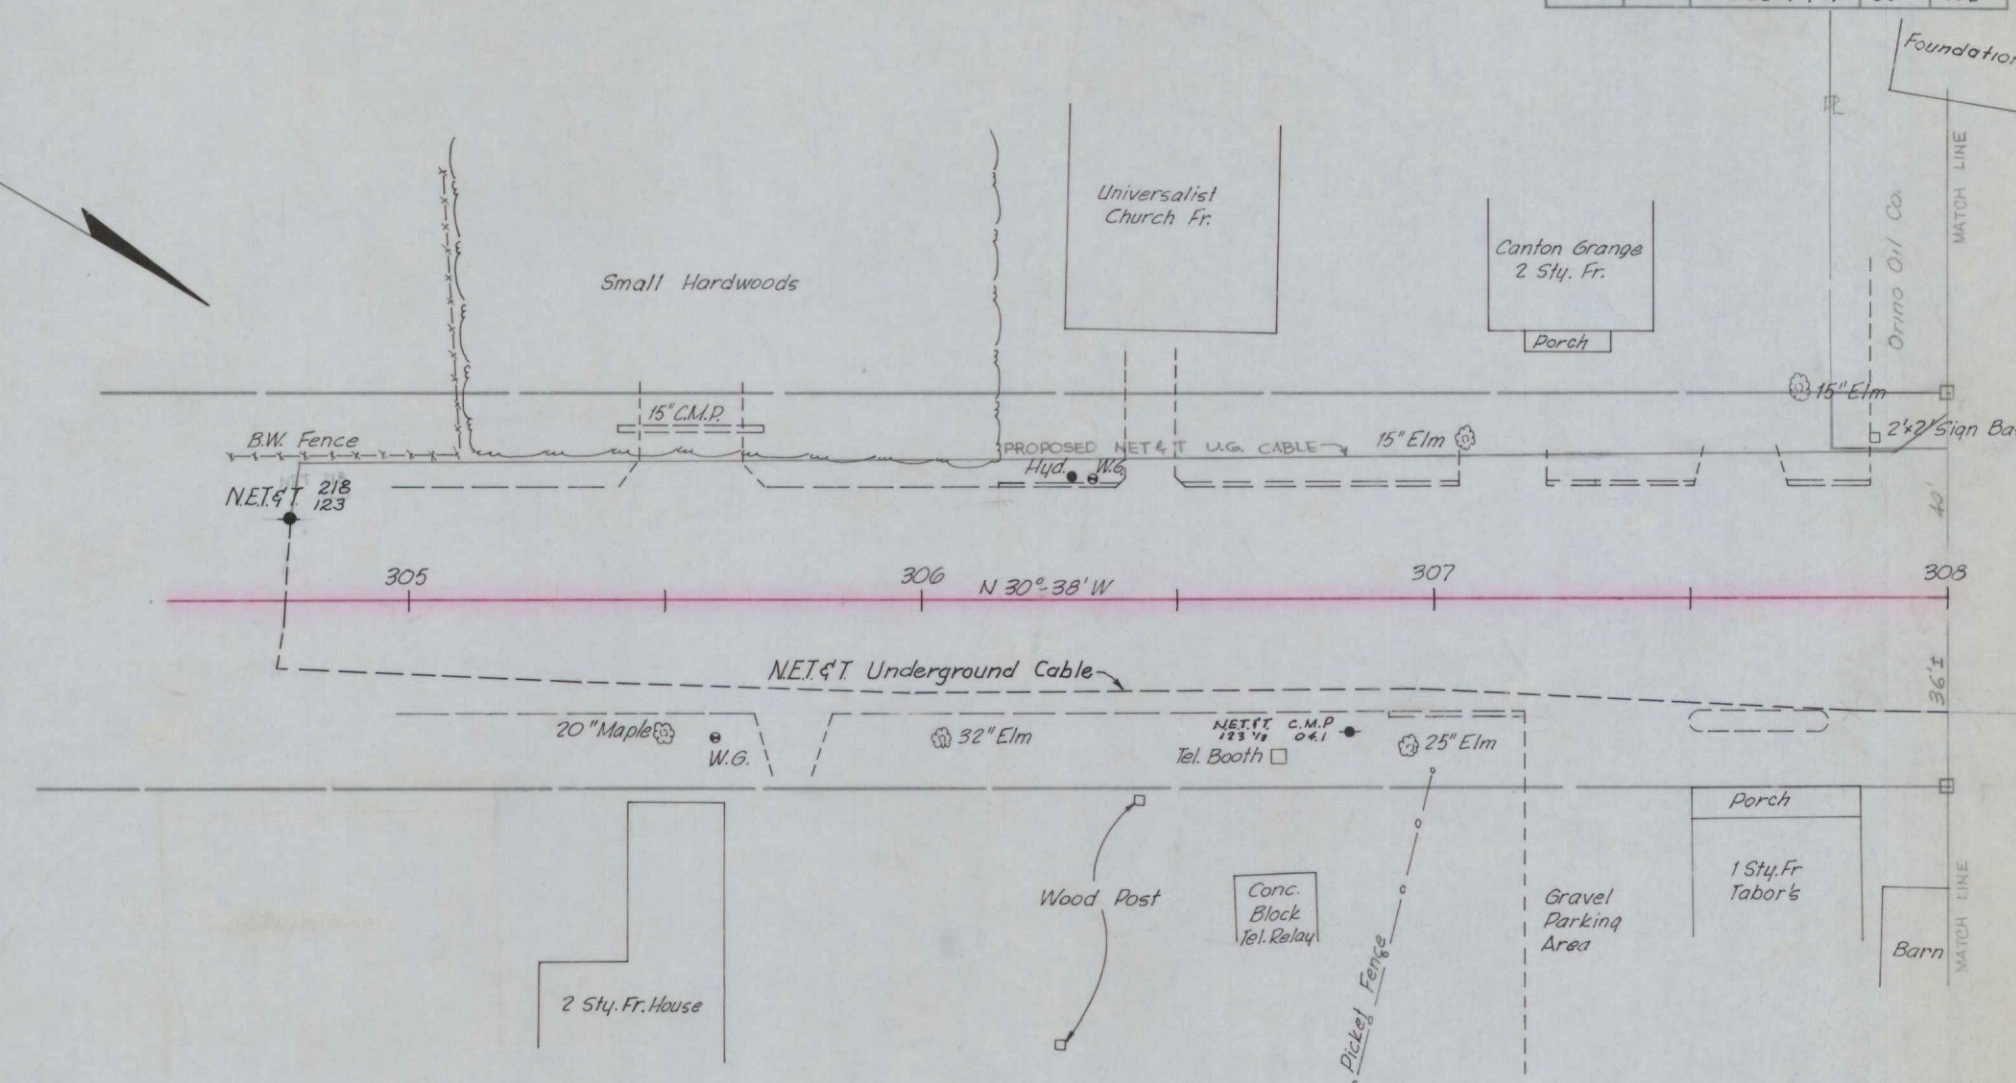

SCALE: 1"=25'


GENERAL NOTES

- All gravel drives and entrances shall be constructed of 2" Aggregate Base Course - Crushed and 12" Aggregate Subbase Course - Sand. Show on plans as
- All paved drives shall be constructed of 2" Hot Bituminous Pavement, 2" Aggre. Base Course - Crushed and 10" Aggre. Subbase Course - Sand. Show on plans as
- All entrances and driveways shall be 20' wide at the shoulder berm or curb line unless otherwise noted or directed by the Engineer.
- Install 1'-0" sod strip behind all curb and sidewalk adjacent to earth slopes unless otherwise shown or directed by the Engineer.
- Sod around inlets and outlets of all roadway pipes unless otherwise noted or directed by the Engineer.
- All slopes from Sta. 300+50 Lt. and Rt. to 334+00 Rt. and 338+00 Lt. shall have 4" Loam and Seeding Method No. 1. All slopes from Sta. 334+00 Rt. and 338+00 Lt. to 404+00 Lt. and Rt. shall have 2" Loam, Seeding Method No. 2, Hay Mulch and Asphalt Mulch Binder, unless otherwise noted or directed by the Engineer.
- All proposed curb (shown) shall be Curb Type 3a unless otherwise noted.
- All Curb Type 3a to be installed with Mold No. 2.
- Reflectorize Curb Type 3a on drive locations as shown on standard details; all other Reflectorization of Curb Type 3a shall be listed on the plans or as directed by the Engineer.
- Apply Bituminous Hand Sealing Black on Curb Type 3a and Paved Islands as directed by the Engineer.
- All Aggregate Subbase for Foundations and Aggregate Subbase for Slope Blanket shall have the gradation for Aggregate Subbase Course - Sand.
- All embankments on this project from subgrade to a depth of 5'-0" below subgrade shall be constructed with Moisture and Density Control (subsection 203.12). Any embankment below a depth of 5'-0" below subgrade shall be constructed by the Layer Method (subsection 203.11).
- Testing Facilities required for this project:
 - Testing Laboratory - Soils
 - Testing Laboratory - Bituminous Mixes
 - Testing Laboratory - Bituminous Liquids and Cements

- Utilities Involved:
 - Central Maine Power Co.
 - New England Tel. and Tel. Co.
 - Maine Central Railroad Co.
 - Oxford County Tel. and Tel. Co.
 - Canton Water District
- All building foundations shall be removed and all foundation holes backfilled as directed by the Engineer.
- All shimming for variable exposure of curb face and transition to bridge curb shall be incidental to Item 603.32, Curb Type 3a.
- Clearing shall be paid to the Right of Way Line or Construction Limit Line or as shown on the plans.
- All utility plant shall be adjusted by the respective utilities unless noted.
- All Reinforced Concrete Pipes shall be Class III unless otherwise noted.
- All areas shown by Reserve Limit Lines may not be available to the Contractor before July 1, 1969, except that the property and building listed under Item no. 202.0804 shall be available to the contractor June 15, 1969.
- UTILITIES LEGEND
 - Proposed Poles
 - Proposed Cable
 NOTE: All work done by others
- Q.M.L. = Quantity Match Line
C.L.L. = Construction Limit Line
C.P.L. = Clearing Payment Line

DATE 11-67
BY R.C.L.
REVISIONS
NO. 21/69
NO. 22/11

DATE 11-67
BY R.C.L.
REVISIONS
NO. 21/69
NO. 22/11

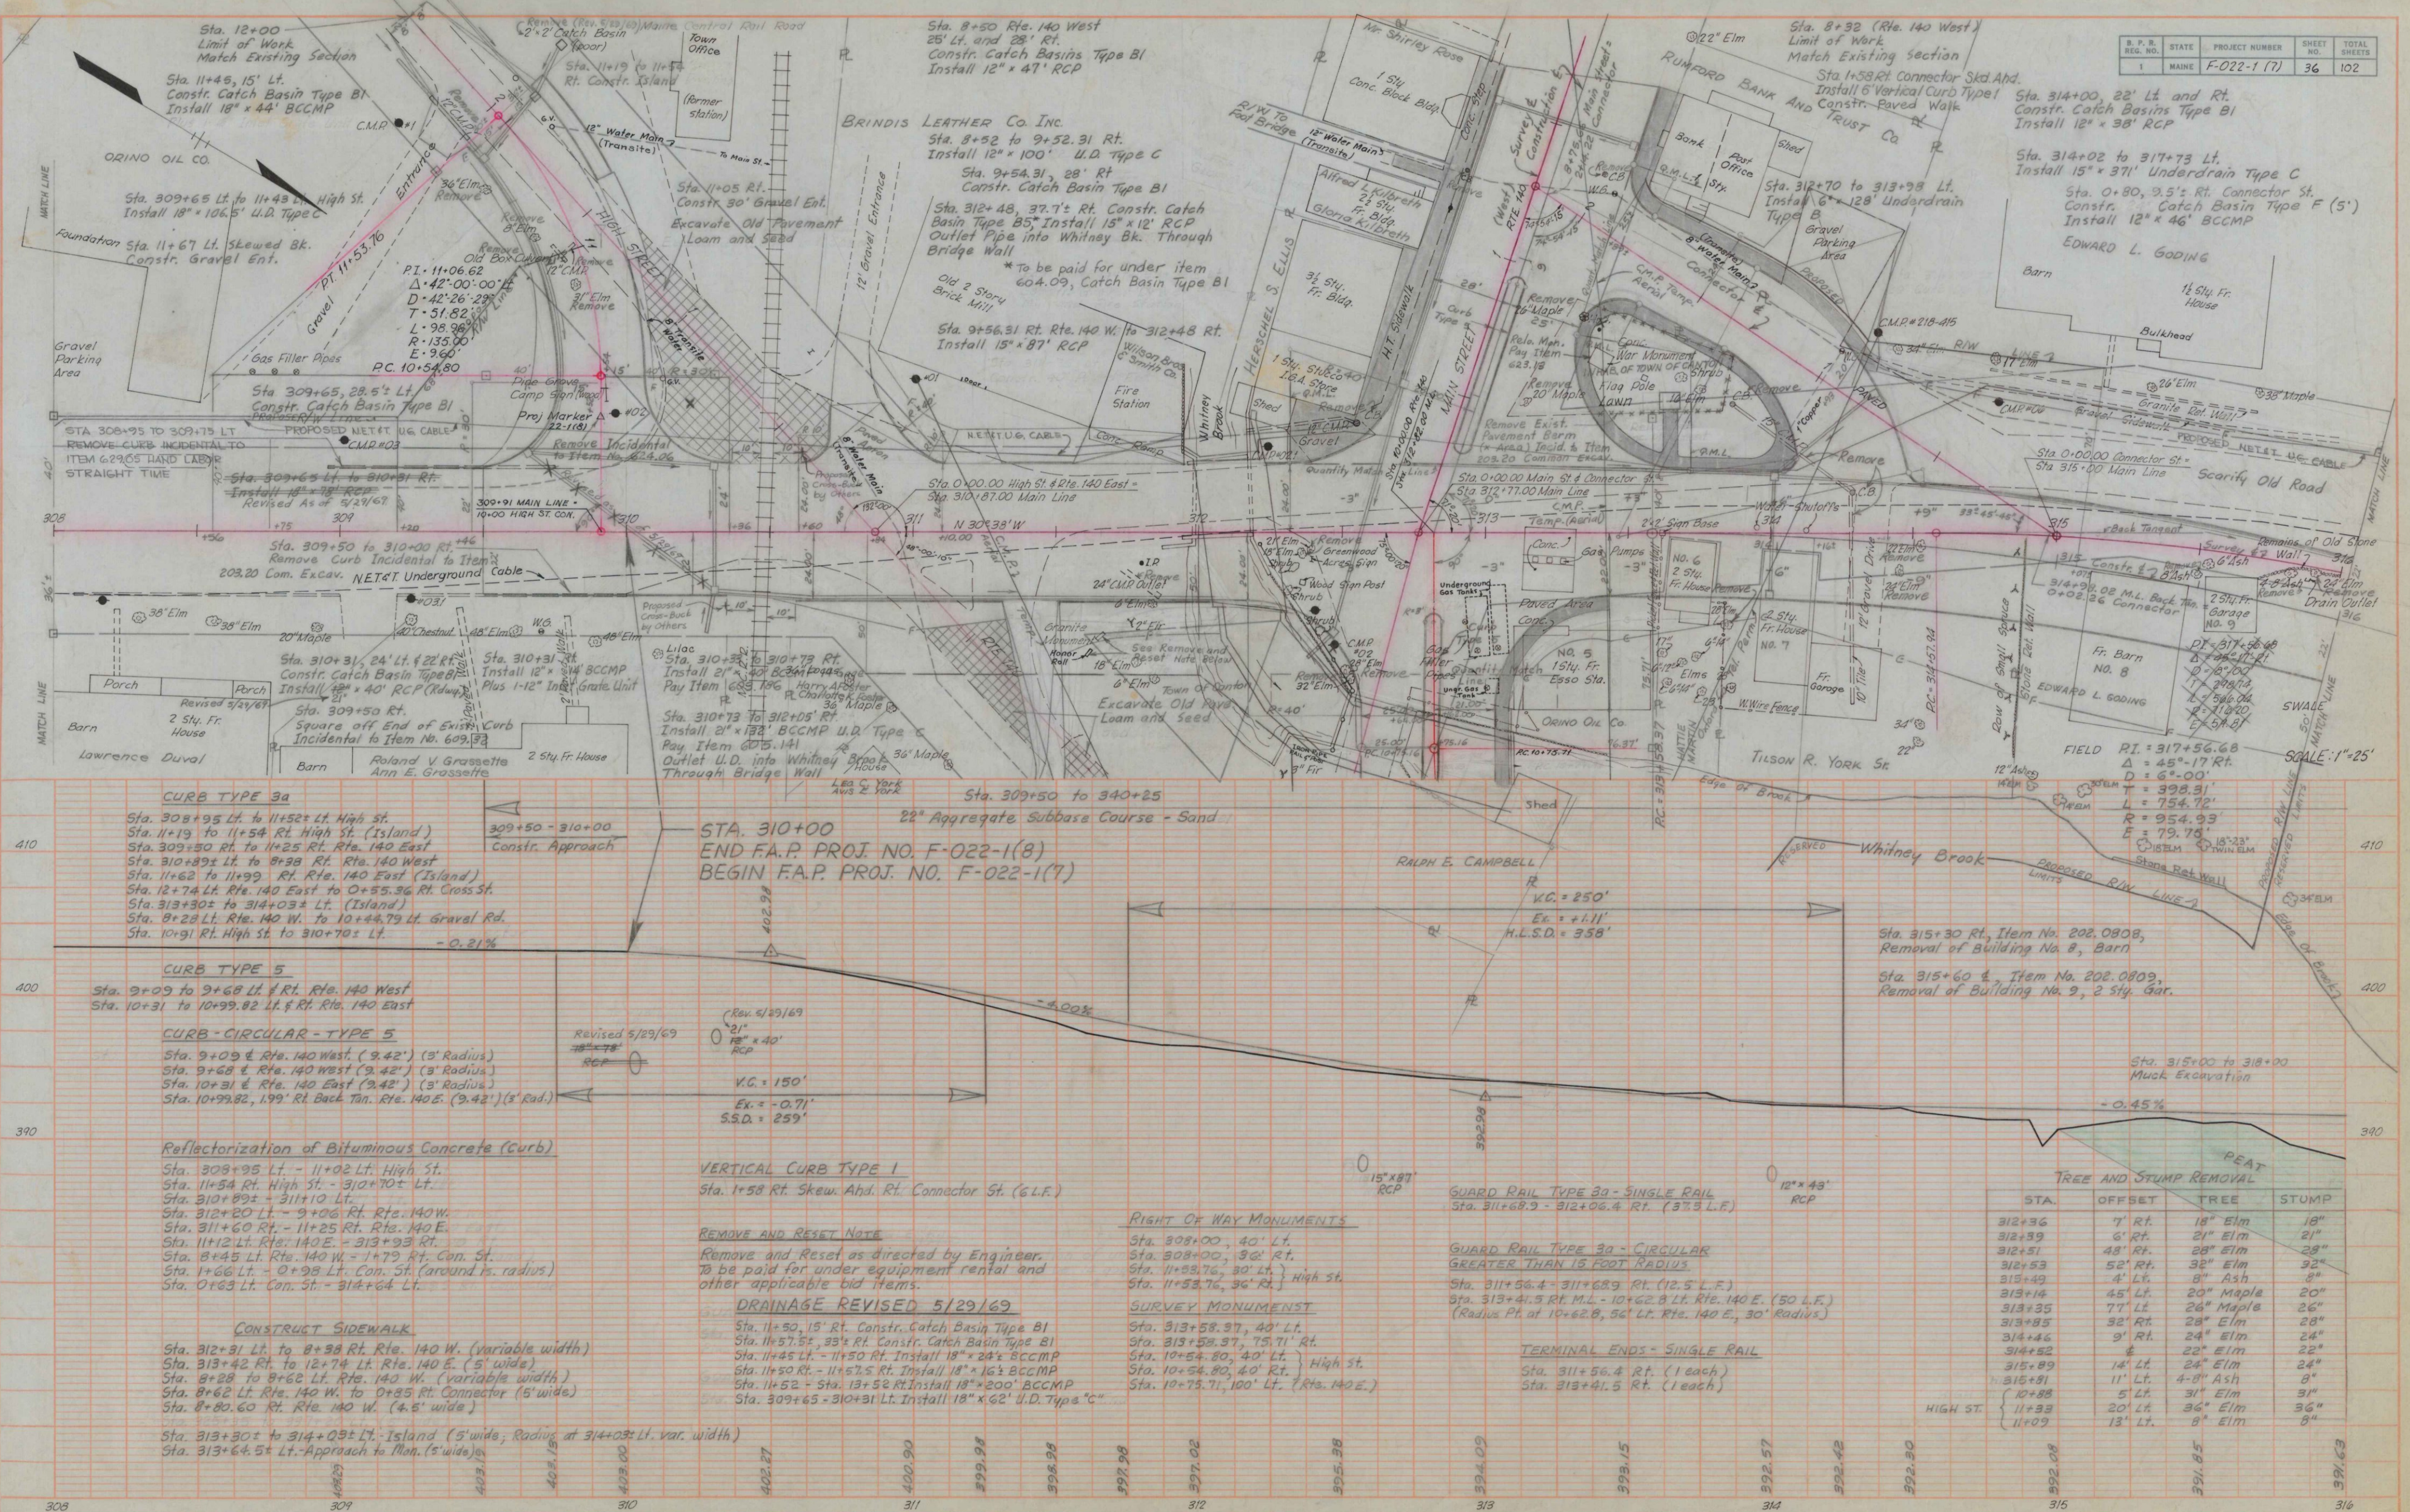

CURB TYPE 3a
Sta. 308+95 Lt. to 11+52+11 Rt. High St.
Sta. 11+19 to 11+54 Rt. High St. (Island)
Sta. 309+50 Rt. to 11+25 Rt. Rte. 140 East
Sta. 310+89 Lt. to 8+28 Rt. Rte. 140 West
Sta. 11+62 to 11+99 Rt. Rte. 140 East (Island)
Sta. 12+74 Lt. Rte. 140 East to 0+55.36 Rt. Cross St.
Sta. 313+30± to 314+03± Lt. (Island)
Sta. 8+28 Lt. Rte. 140 W. to 10+44.79 Lt. Gravel Rd.
Sta. 10+91 Rt. High St. to 310+70± Lt.

CURB TYPE 5
Sta. 9+09 to 9+68 Lt. Rte. 140 West
Sta. 10+31 to 10+99.82 Lt. Rte. 140 East

CURB - CIRCULAR - TYPE 5
Sta. 9+09 & Rte. 140 West (9.42') (3' Radius)
Sta. 9+68 & Rte. 140 West (9.42') (3' Radius)
Sta. 10+31 & Rte. 140 East (9.42') (3' Radius)
Sta. 10+99.82, 199' Rt. Back Tan. Rte. 140 E. (9.42') (3' Rad.)

Reflectorization of Bituminous Concrete (Curb)
Sta. 308+95 Lt. - 11+02 Lt. High St.
Sta. 11+54 Rt. High St. - 310+70± Lt.
Sta. 310+89± - 311+10 Lt.
Sta. 312+20 Lt. - 9+06 Rt. Rte. 140 W.
Sta. 311+60 Rt. - 11+25 Rt. Rte. 140 E.
Sta. 11+12 Lt. Rte. 140 E. - 313+93 Rt.
Sta. 8+45 Lt. Rte. 140 W. - 1+79 Rt. Con. St.
Sta. 1+66 Lt. - 0+98 Lt. Con. St. (around is. radius)
Sta. 0+63 Lt. Con. St. - 314+64 Lt.

CONSTRUCT SIDEWALK
Sta. 312+31 Lt. to 8+38 Rt. Rte. 140 W. (variable width)
Sta. 313+42 Rt. to 12+74 Lt. Rte. 140 E. (5' wide)
Sta. 8+28 to 8+62 Lt. Rte. 140 W. (variable width)
Sta. 8+62 Lt. Rte. 140 W. to 0+85 Rt. Connector (5' wide)
Sta. 8+80.60 Rt. Rte. 140 W. (4.5' wide)
Sta. 313+30± to 314+03± Lt. Island (5' wide; Radius at 314+03± Lt. var. width)
Sta. 313+64.5± Lt. Approach to Mon. (5' wide)

STA. 310+00
END F.A.P. PROJ. NO. F-022-1(8)
BEGIN F.A.P. PROJ. NO. F-022-1(7)

VERTICAL CURB TYPE 1
Sta. 1+58 Rt. Skew. Ahd. Rt. Connector St. (6 L.F.)

REMOVE AND RESET NOTE
Remove and Reset as directed by Engineer.
To be paid for under equipment rental and other applicable bid items.

DRAINAGE REVISED 5/29/69
Sta. 11+50, 15' Rt. Constr. Catch Basin Type B1
Sta. 11+57.5±, 33' Rt. Constr. Catch Basin Type B1
Sta. 11+45 Lt. - 11+50 Rt. Install 18" x 24" BCCMP
Sta. 11+50 Rt. - 11+57.5 Rt. Install 18" x 16" BCCMP
Sta. 11+52 - Sta. 13+52 Rt. Install 18" x 200" BCCMP
Sta. 309+65 - 310+31 Lt. Install 18" x 62" U.D. Type "C"

RIGHT OF WAY MONUMENTS

Sta. 308+00, 40' Lt.
Sta. 308+00, 36' Rt.
Sta. 11+33.76, 30' Lt.
Sta. 11+53.76, 36' Rt. High St.

SURVEY MONUMENT

Sta. 313+58.37, 40' Lt.
Sta. 313+58.37, 75.71' Rt.
Sta. 10+54.80, 40' Lt. High St.
Sta. 10+54.80, 40' Rt.
Sta. 10+75.71, 100' Lt. (Rte. 140 E.)

GUARD RAIL TYPE 3a - SINGLE RAIL
Sta. 311+68.9 - 312+06.4 Rt. (33.5 L.F.)

GUARD RAIL TYPE 3a - CIRCULAR
GREATER THAN 15 FOOT RADIUS

Sta. 311+56.4 - 311+68.9 Rt. (12.5 L.F.)
Sta. 313+41.5 Rt. M.L. - 10+62.8 Lt. Rte. 140 E. (50 L.F.)
(Radius Pl. at 10+62.8, 56' Lt. Rte. 140 E., 30' Radius)

TERMINAL ENDS - SINGLE RAIL



Sta. 311+56.4 Rt. (1 each)
Sta. 313+41.5 Rt. (1 each)

TREE AND STUMP REMOVAL

STA.	OFFSET	TREE	STUMP
312+36	7' Rt.	18' Elm	18"
312+39	6' Rt.	21' Elm	21"
312+31	48' Rt.	28' Elm	28"
312+53	52' Rt.	32' Elm	32"
313+49	4' Lt.	8' Ash	8"
313+14	45' Lt.	20' Maple	20"
313+35	77' Lt.	26' Maple	26"
313+85	32' Rt.	28' Elm	28"
314+46	9' Rt.	24' Elm	24"
314+52	4	22' Elm	22"
315+89	14' Lt.	24' Elm	24"
315+81	11' Lt.	4-8' Ash	8"
10+88	5' Lt.	31' Elm	31"
11+33	20' Lt.	36' Elm	36"
11+09	13' Lt.	8' Elm	8"

PLAN
NOTES:
1. ALL DIMENSIONS IN FEET UNLESS OTHERWISE NOTED.
2. SEE SHEET 38 FOR CONTINUATION OF PLAN.

PROFILE
NOTES:
1. ALL ELEVATIONS IN FEET UNLESS OTHERWISE NOTED.
2. SEE SHEET 38 FOR CONTINUATION OF PROFILE.

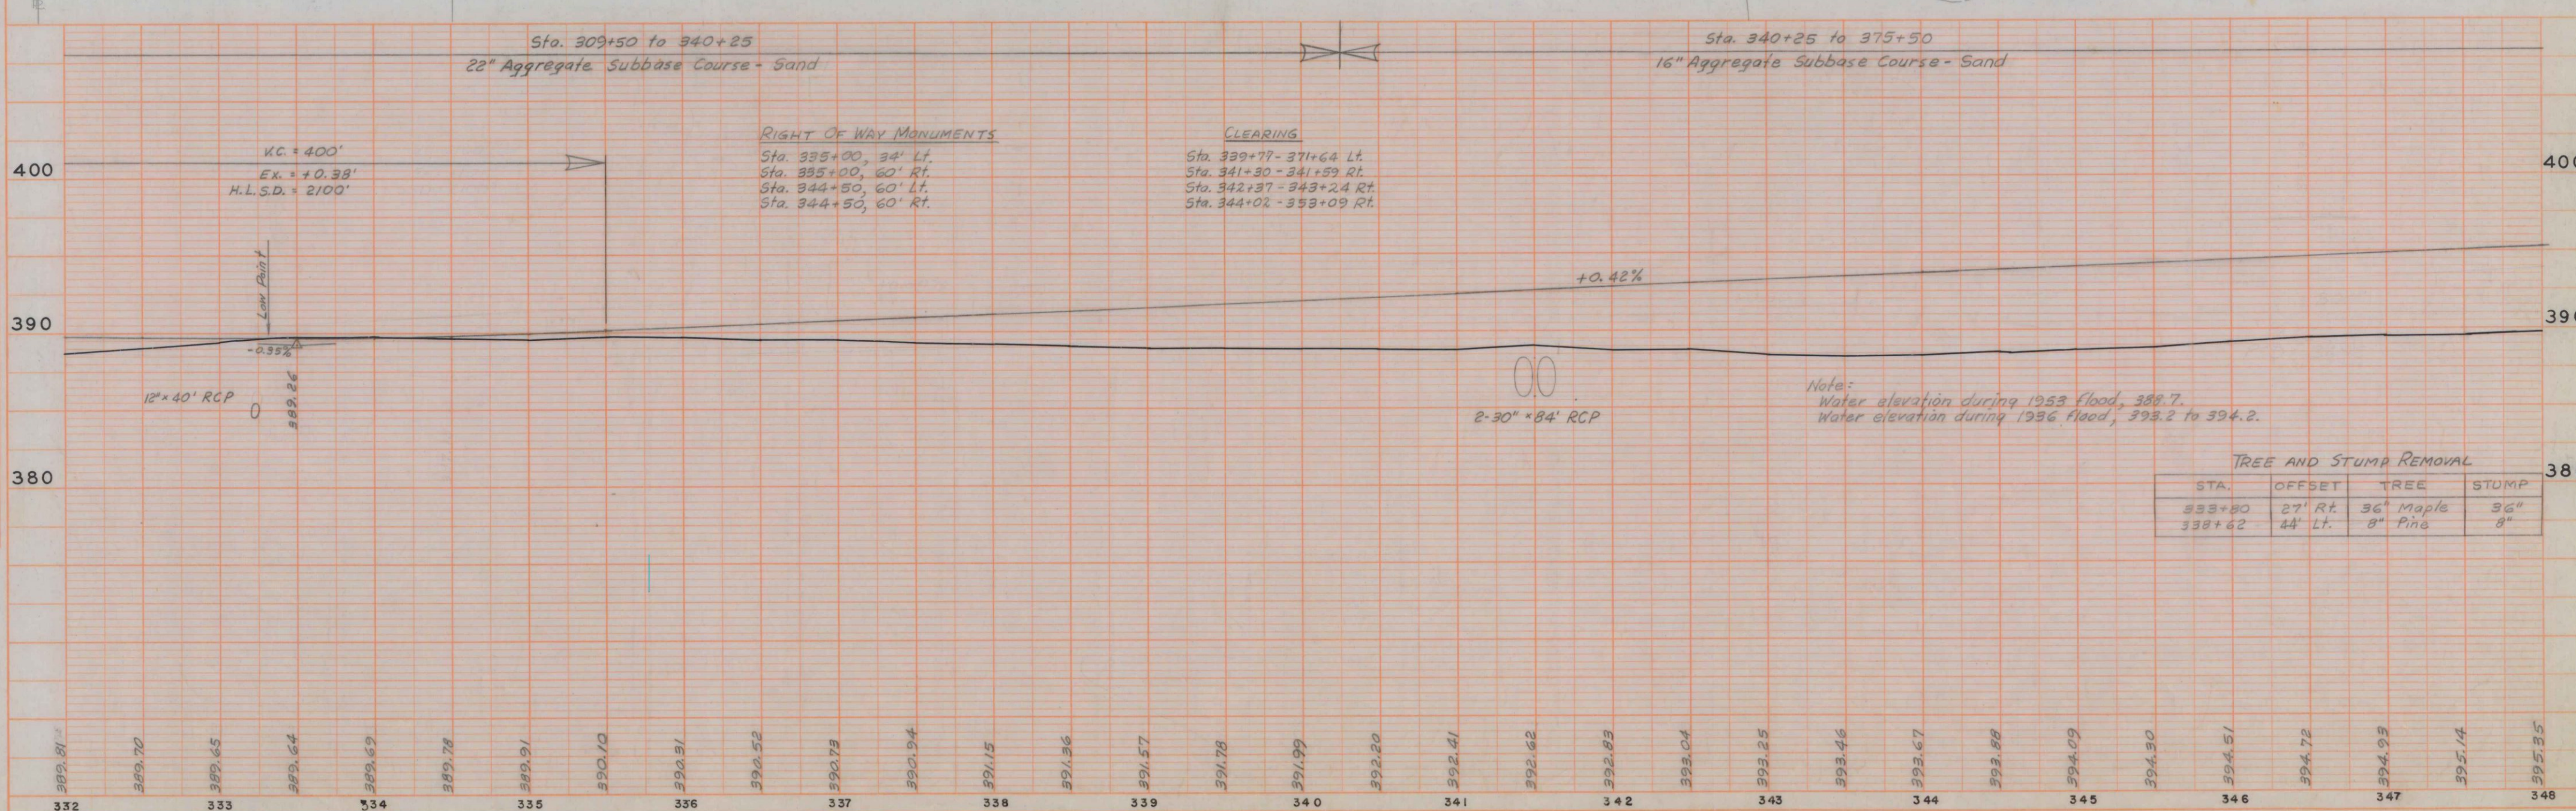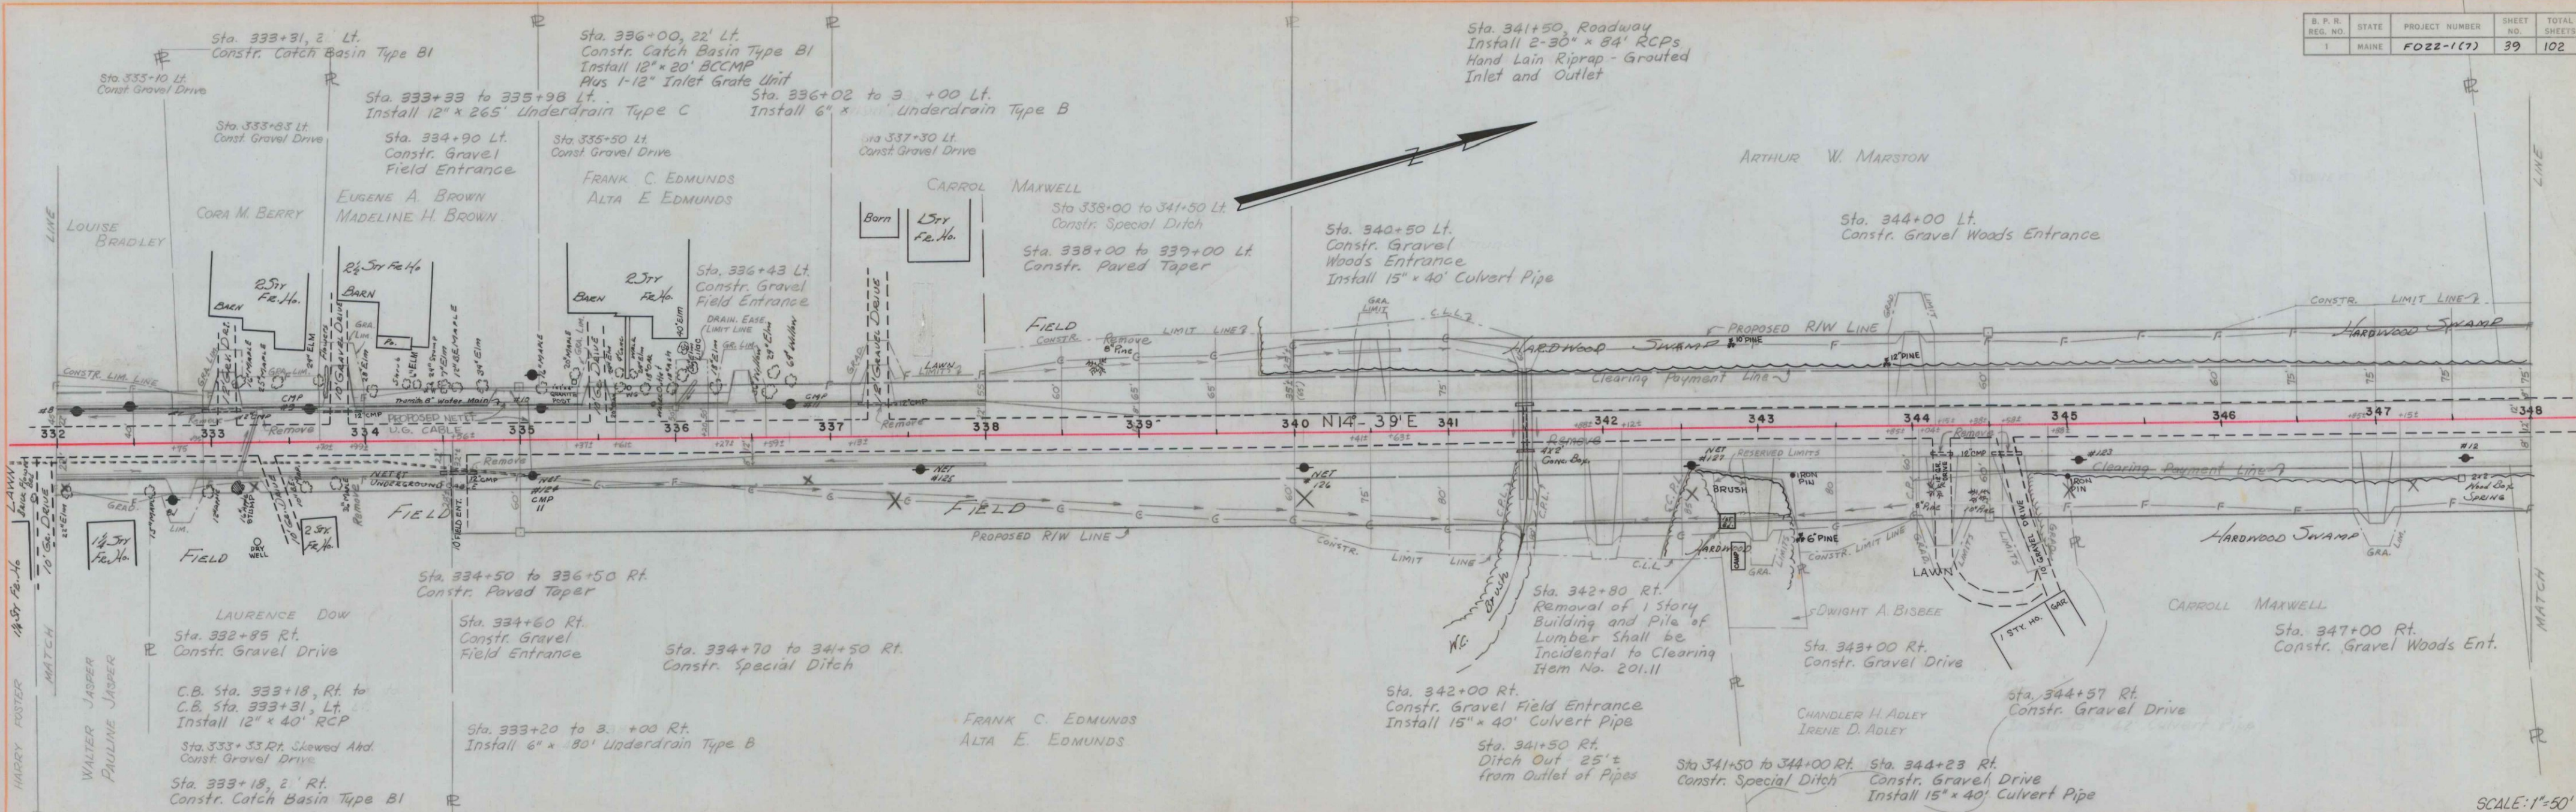

STA.	OFFSET	TREE	STUMP
333+80	27' Rt.	36" Maple	36"
338+62	44' Lt.	8" Pine	8"

S. P. R.	STATE	PROJECT NUMBER	SHEET NO.	TOTAL SHEETS
1	MAINE	FO22-1(7)	40	102

Sta. 352+83, Skew 10° Ahead Lt.
Install 11'-5" Span, 7'-3" Rise, 102' Length (f.l.) Str. Plate Pipe Arch
Inlet (flow line) at Sta. 352+91.59, 48.73' Lt.
Outlet (flow line) at Sta. 352+73.88, 51.72' Rt.
Hand Laid Riprap - Grouted Inlet and Outlet
10 Gage Top; 8 Gage Bottom and Corners

PI = 359+79.31
Δ = 17°-27' Lt.
D = 1°-00'-00"
T = 879.31
L = 1745.00
Ex = 67.08

CONST. CENTERLINE
RI = 364+50.81
Δ = 21°-19'-06" Lt.
D = 1°-00'-00"
T = 1079.11
L = 2133.22
E = 100.73'
R = 5729.58'

Sta. 360+00 to 369+00 Lt.
Constr. Channel Diversion
Pay Item 206.12 Structural
Earth Excavation - Channel

Sta. 361+00 Lt.
Constr. pool approximately
20' wide, 30' long and 1' deep

DONALD C. BONNEY
NINA P. BONNEY

Sta. 350+00 Lt.
Constr. Gravel Woods Ent.

FLORENCE CHILDS
HERMAN CHILDS

Sta. 356+50 Lt.
Constr. Gravel Field Entrance

Sta. 363+50 to 365+00 Rt.
Constr. Special Ditch

Sta. 360+30 to 369+50 Rt.
Remove old pavement, scarify
loam and seed.

Sta. 360+08 Rt.
Constr. Gravel Drive

NINA P. BONNEY & DONALD C. BONNEY

SCALE: 1"=50'

FLORENCE CHILDS
HERMAN CHILDS

Sta. 351+15 to 352+74 Rt.
Constr. Channel Diversion
Pay Item 206.12 Structural
Earth Excavation - Channel

Sta. 350+00 Rt.
Constr. Gravel Woods Ent.

Fill in Existing Brook Bed
Pay Item 203.20 Common
Excavation

Sta. 340+25 to 375+50
16" Aggregate Subbase Course - Sand

GUARD RAIL TYPE 3a - CIRCULAR

Sta. 351+95 to 352+07.5 Rt. (12.5 L.F.)
Sta. 352+07.5 to 352+20 Lt. (12.5 L.F.)
Sta. 353+45 to 353+57.5 Rt. (12.5 L.F.)
Sta. 353+57.5 to 353+70 Lt. (12.5 L.F.)

GUARD RAIL TYPE 3a - SINGLE RAIL

Sta. 352+07.5 to 353+45 Rt. (137.5 L.F.)
Sta. 352+20 to 353+57.5 Lt. (137.5 L.F.)

TERMINAL ENDS - SINGLE RAIL

Sta. 351+95 Rt. 1 Each
Sta. 352+07.5 Lt. 1 Each
Sta. 353+57.5 Rt. 1 Each
Sta. 353+70 Lt. 1 Each

RIGHT OF WAY MONUMENTS

Sta. 353+71.70, 75' Lt.
Sta. 353+71.70, 60' Rt.
Sta. 360+50, 75' Lt.
Sta. 360+50, 74' Rt.

CLEARING

Sta. 356+30 - 356+90 Rt.

11'-5" Span x 7'-3" Rise x 102' Length (f.l.)
Structural Plate Pipe Arch


Sta. 359+70 & Item 202.0811
Removal of Building No. 11, Garage

TREE AND STUMP REMOVAL

STA.	OFFSET	TREE	STUMP
357+02	23' Rt.	13" Appl'd	13"

PLAN
NO. 22.11.1
DATE 11/11/09

PROFILE
NO. 22.11.1
DATE 11/11/09

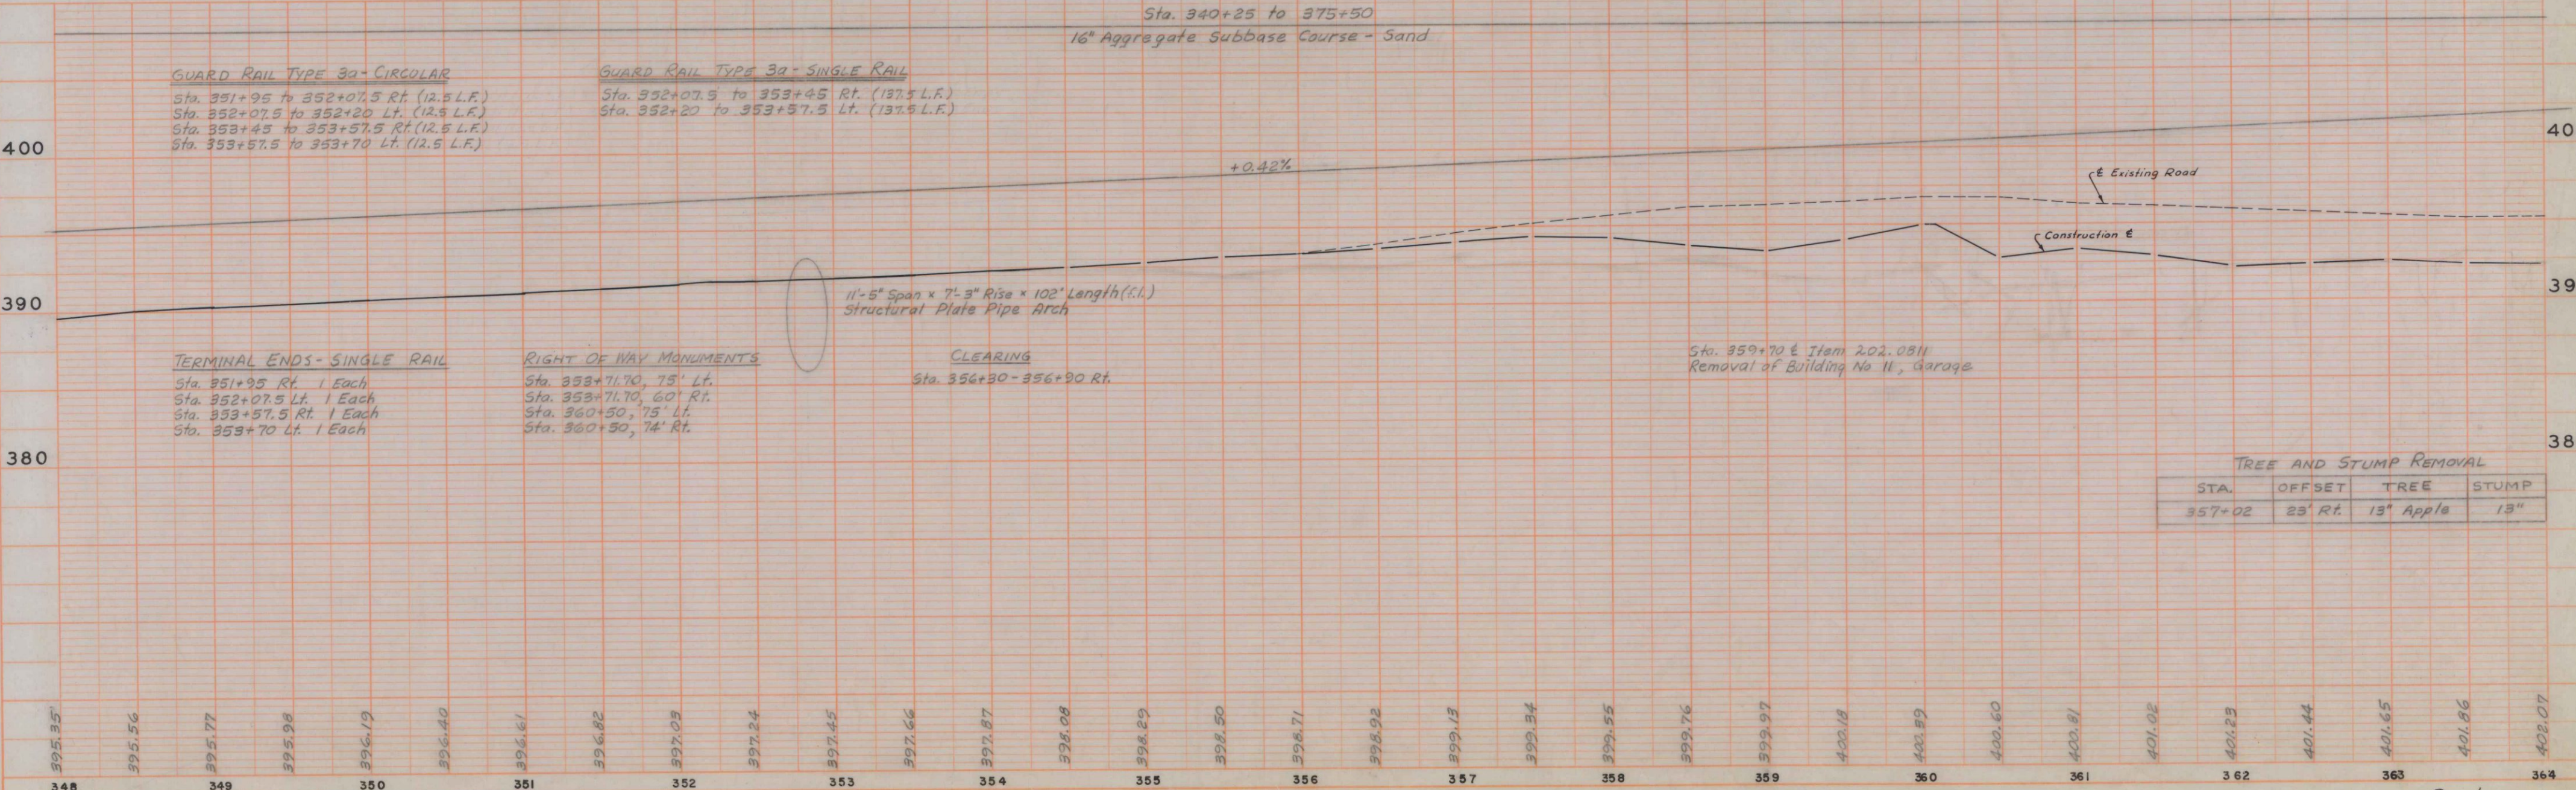

PLAN
 DATE: 5/29/69
 BY: DONALD C. BONNEY
 CHECKED: NINA T. BONNEY
 22/12/69

PROFILE
 DATE: 5/29/69
 BY: DONALD C. BONNEY
 CHECKED: NINA T. BONNEY
 22/12/69



CONST. CENTERLINE
 P.I. = 364+50.81
 $\Delta = 21^\circ-19'-56''$ LT.
 $D = 1^\circ-00'-00''$
 $T = 1079.11'$
 $L = 2133.22'$
 $E = 100.73'$
 $R = 5729.58'$

DONALD C. BONNEY
 NINA T. BONNEY

Sta. 372+69 Skewed 6° Ahead Rt.
 Install 30" x 120' RCP

REVISED 5/29/69
 Sta. 376+50 - 387+50
 Bank on Super. Section
 Shall Be as Shown Below



B. P. R.	STATE	PROJECT NUMBER	SHEET NO.	TOTAL SHEETS
1	MAINE	FO22-1(7)	41	102

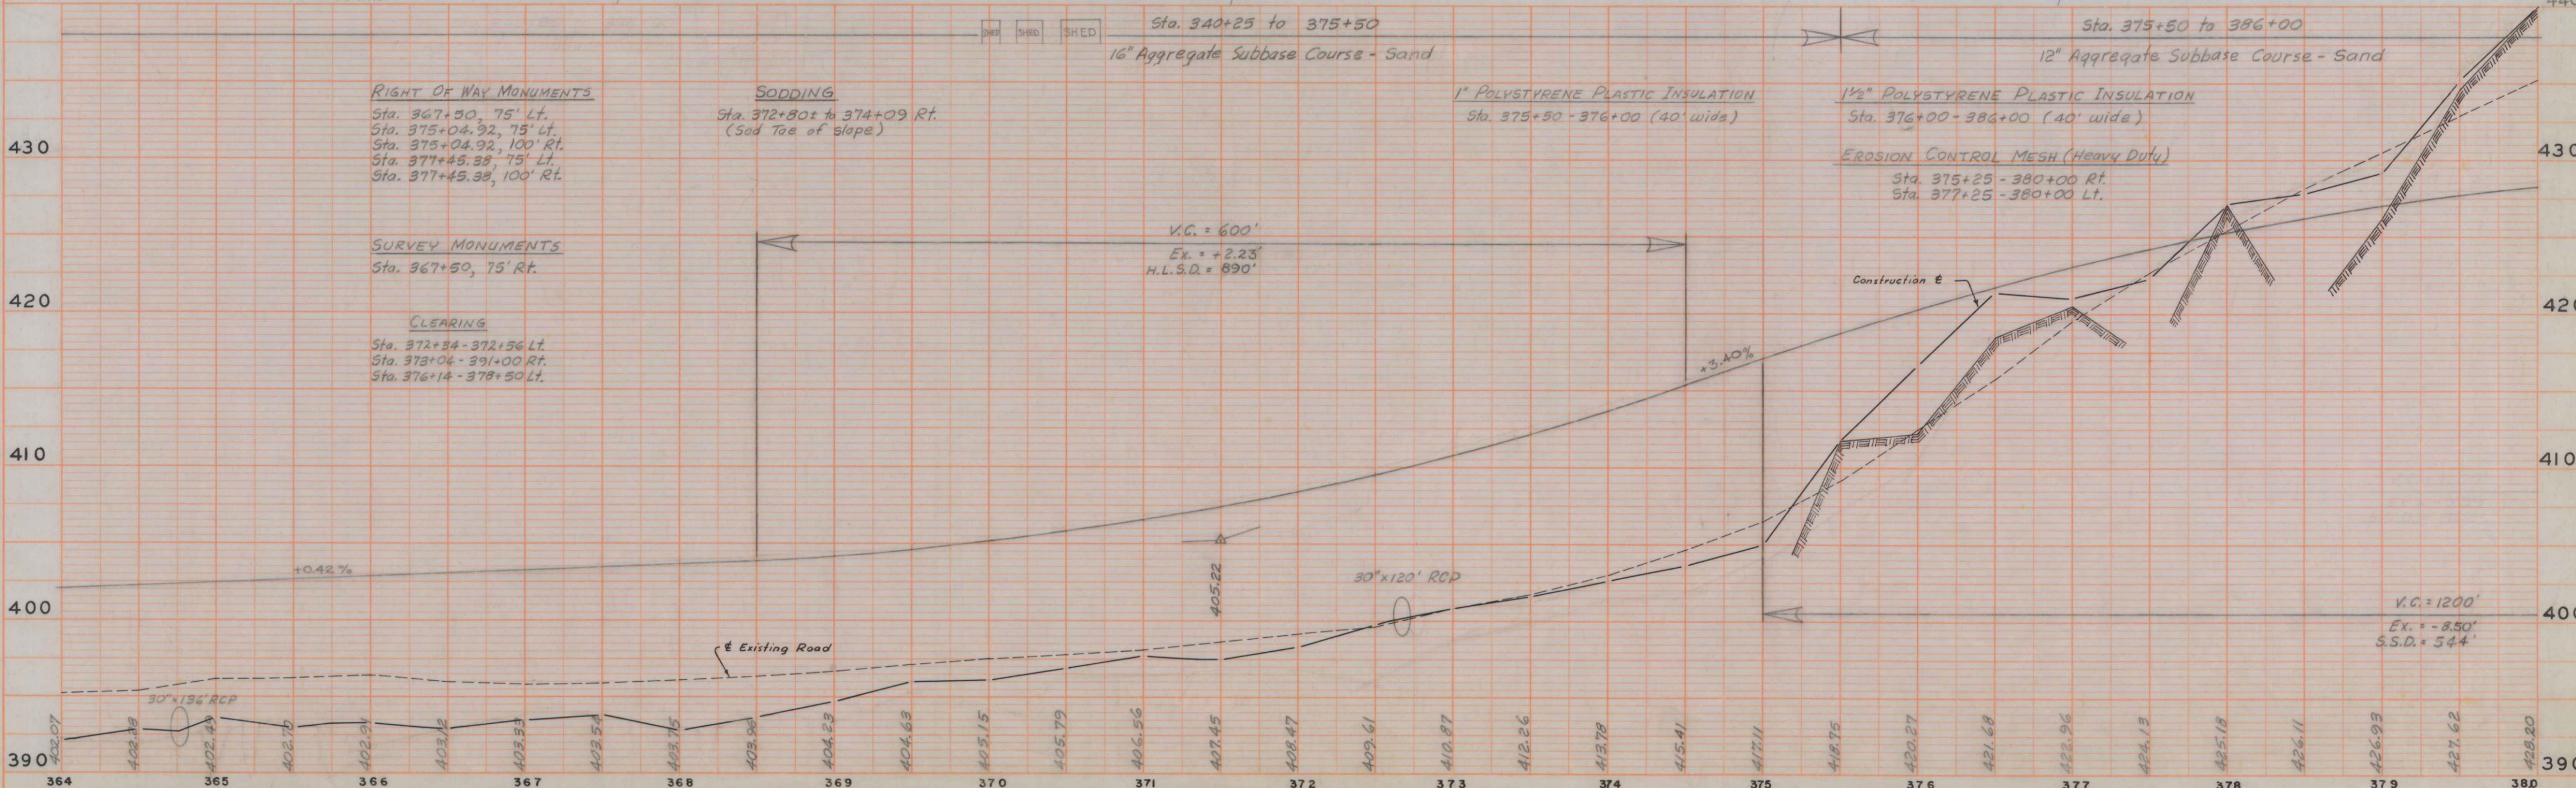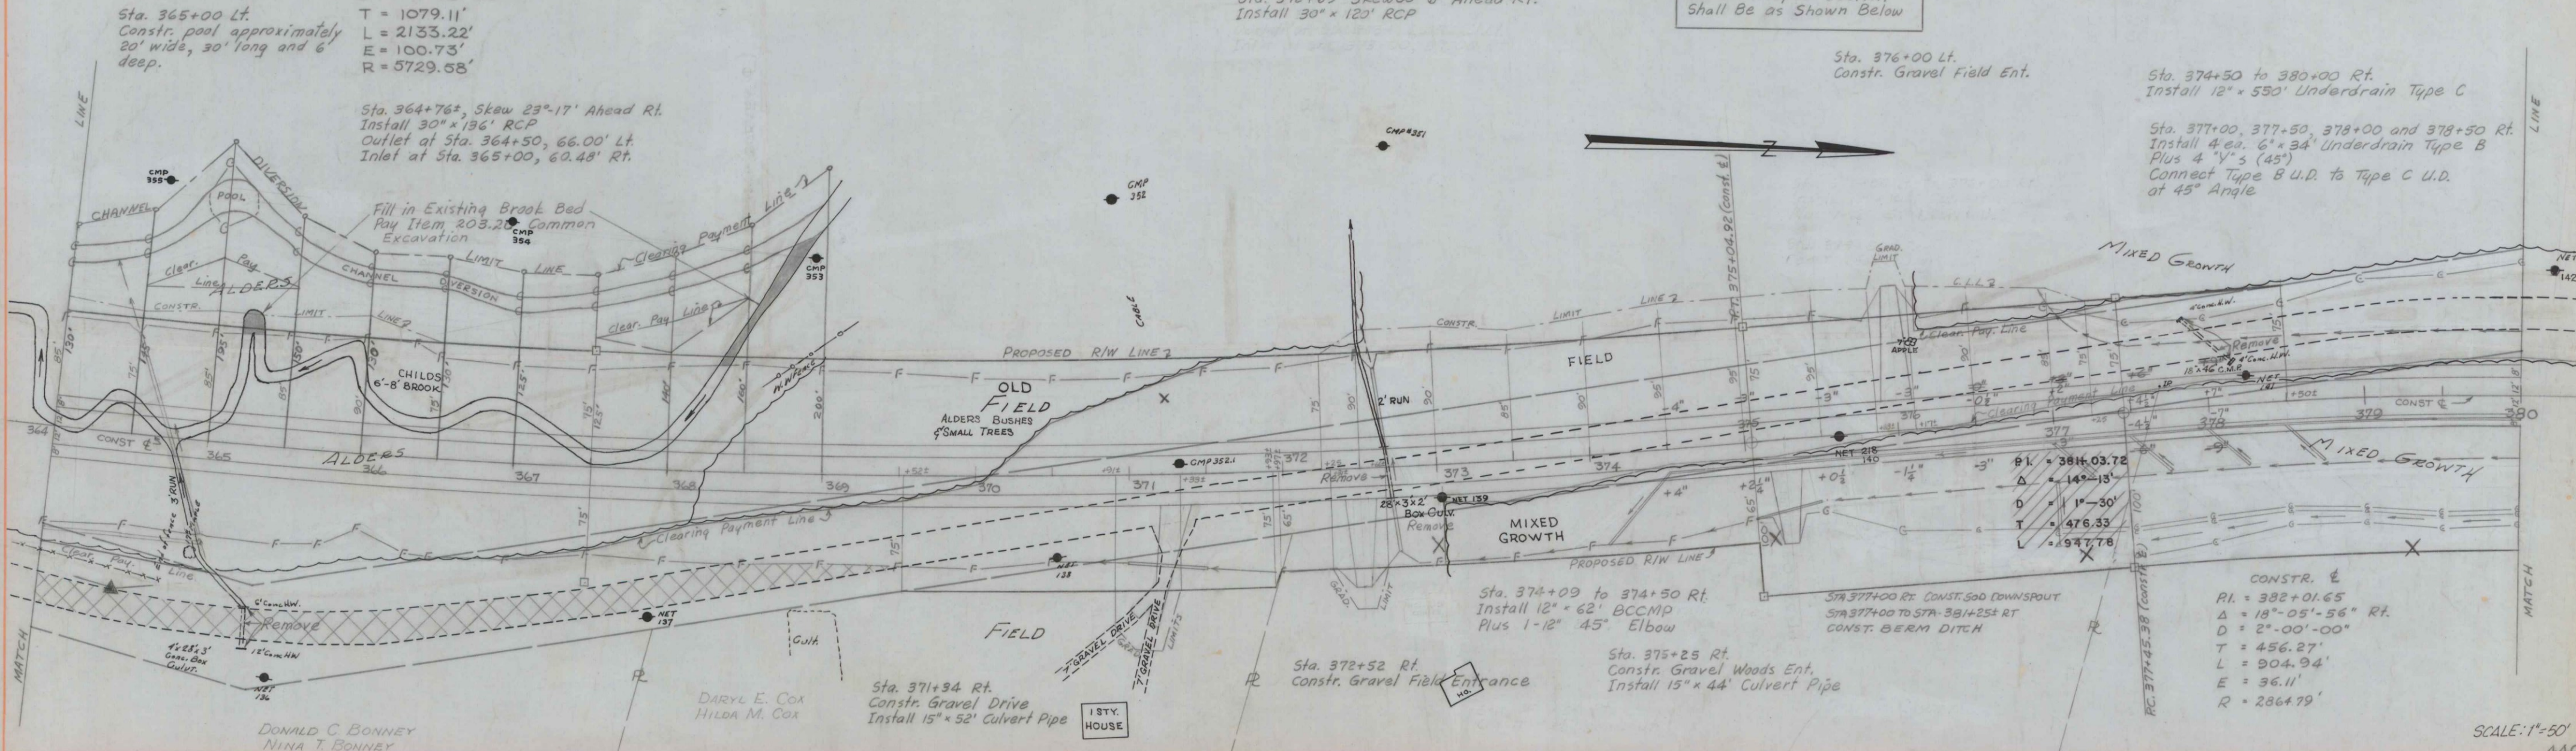

B. P. R. REG. NO.	STATE	PROJECT NUMBER	SHEET NO.	TOTAL SHEETS
1	MAINE	F022-1(7)	43	102

PLAN
NO. 22/11-6
DATE 2/11/6
BY [Signature]
CHECKED [Signature]
APPROVED [Signature]

PROFILE
NO. 22/11-6
DATE 2/11/6
BY [Signature]
CHECKED [Signature]
APPROVED [Signature]

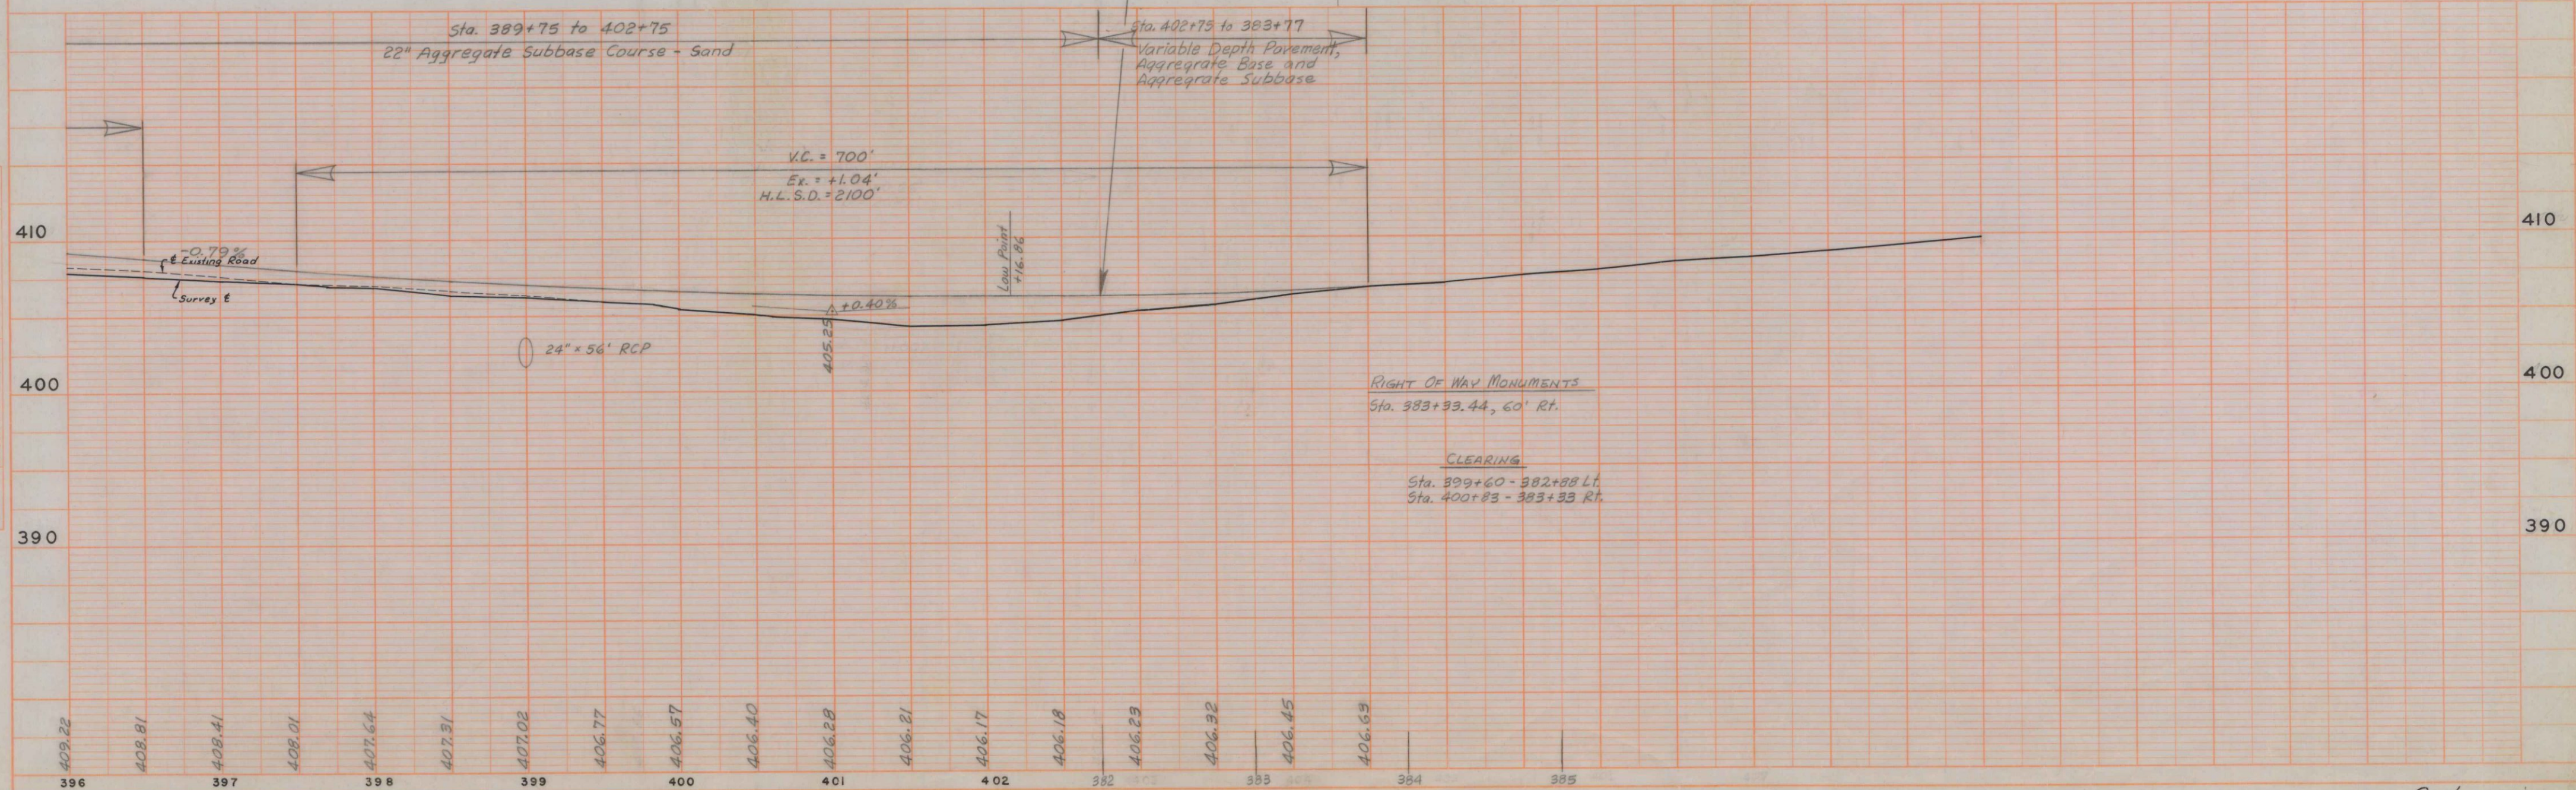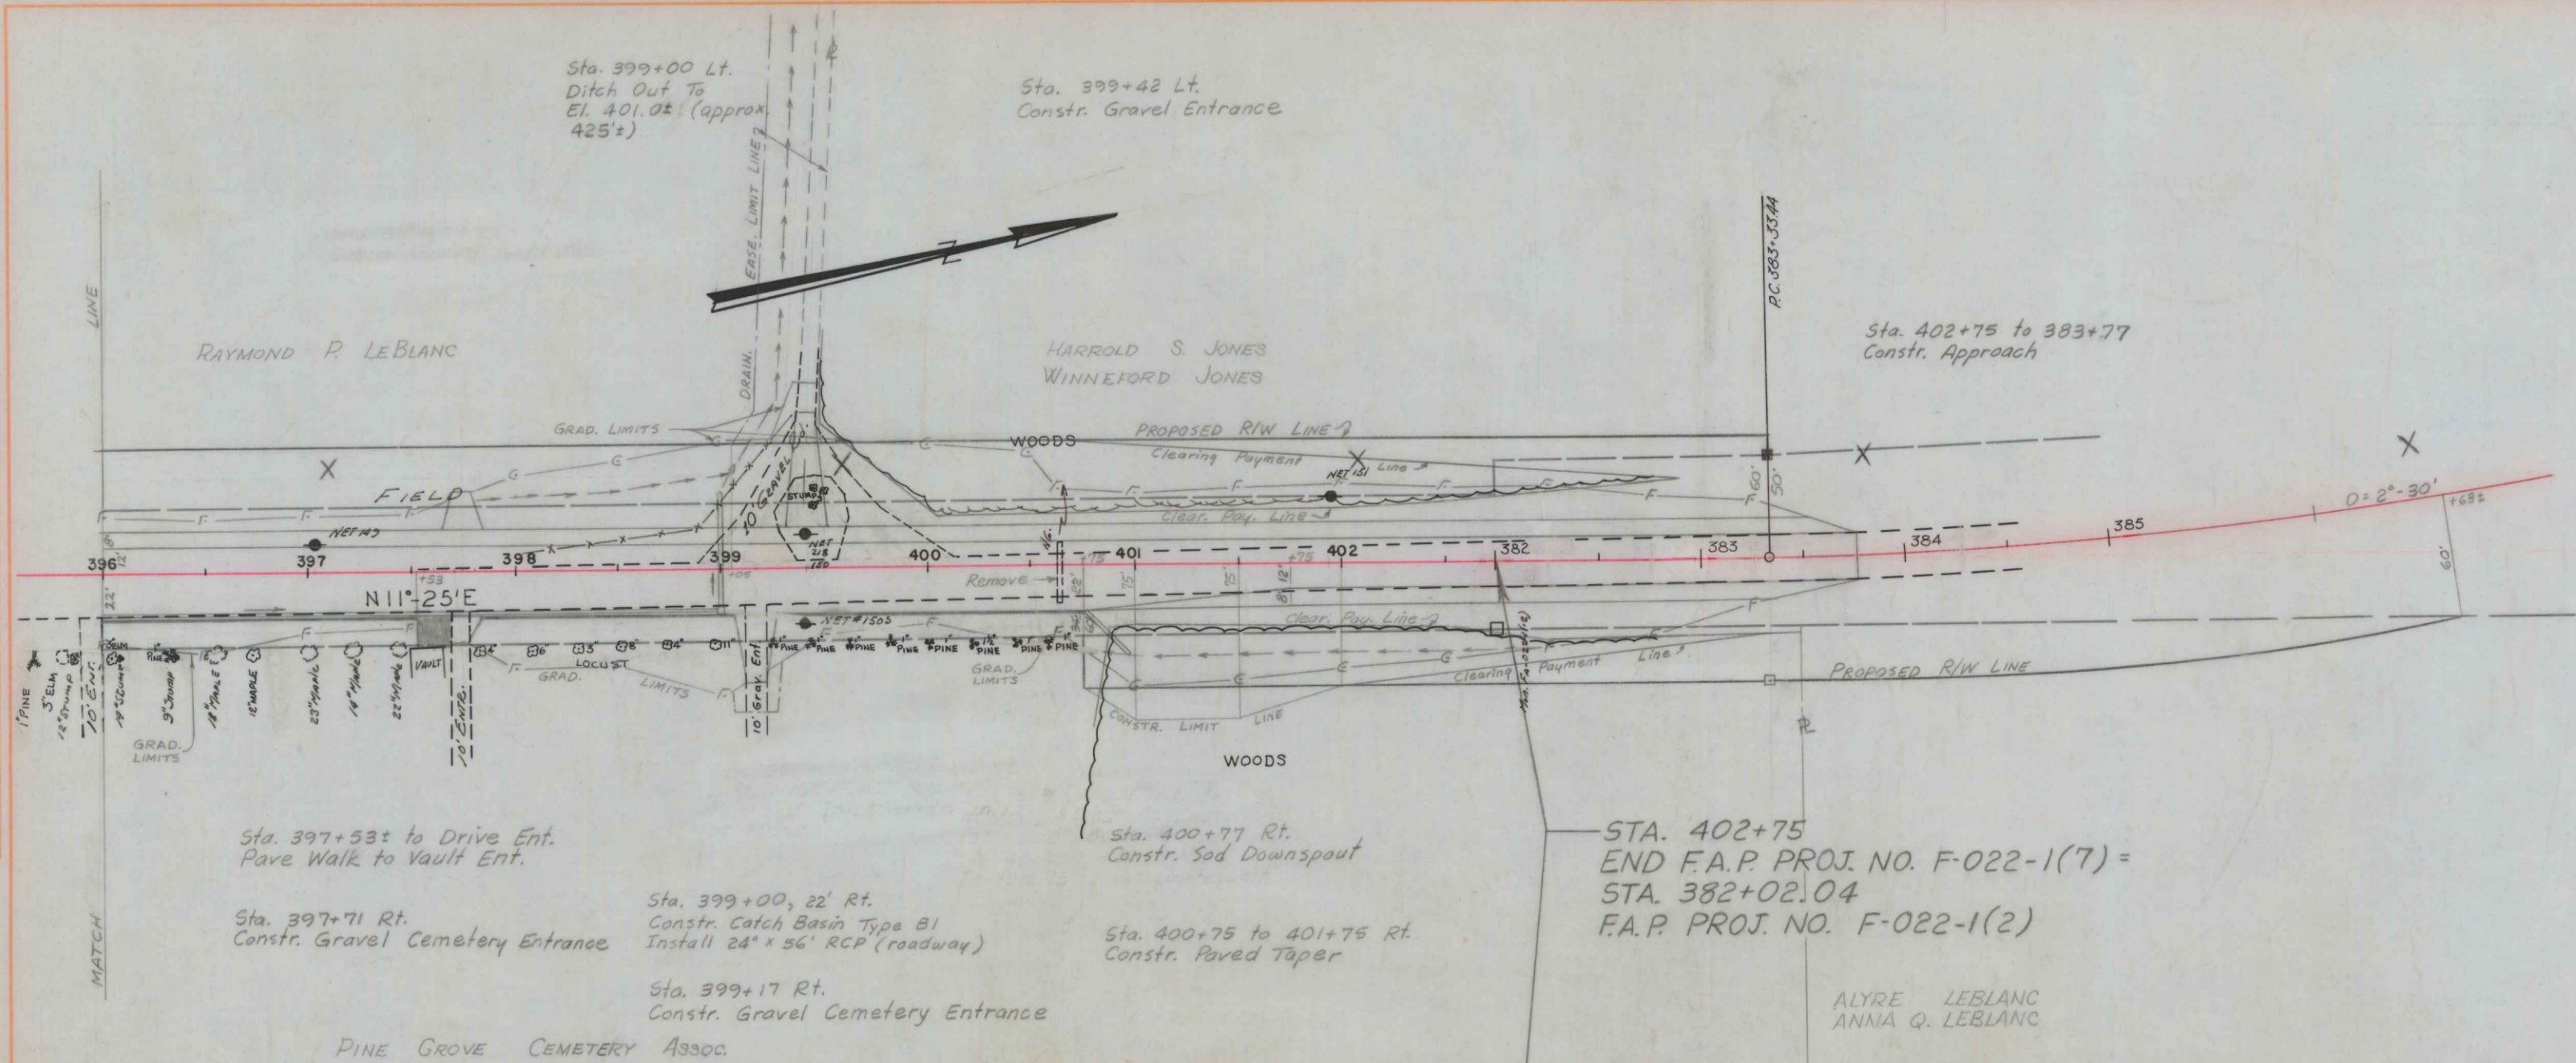

PLAN
DATE 11/67
BY R.C.L.
CHECKED
DATE 11/67
BY R.C.L.

PROFILE
DATE 11/67
BY R.C.L.
CHECKED
DATE 11/67
BY R.C.L.

