
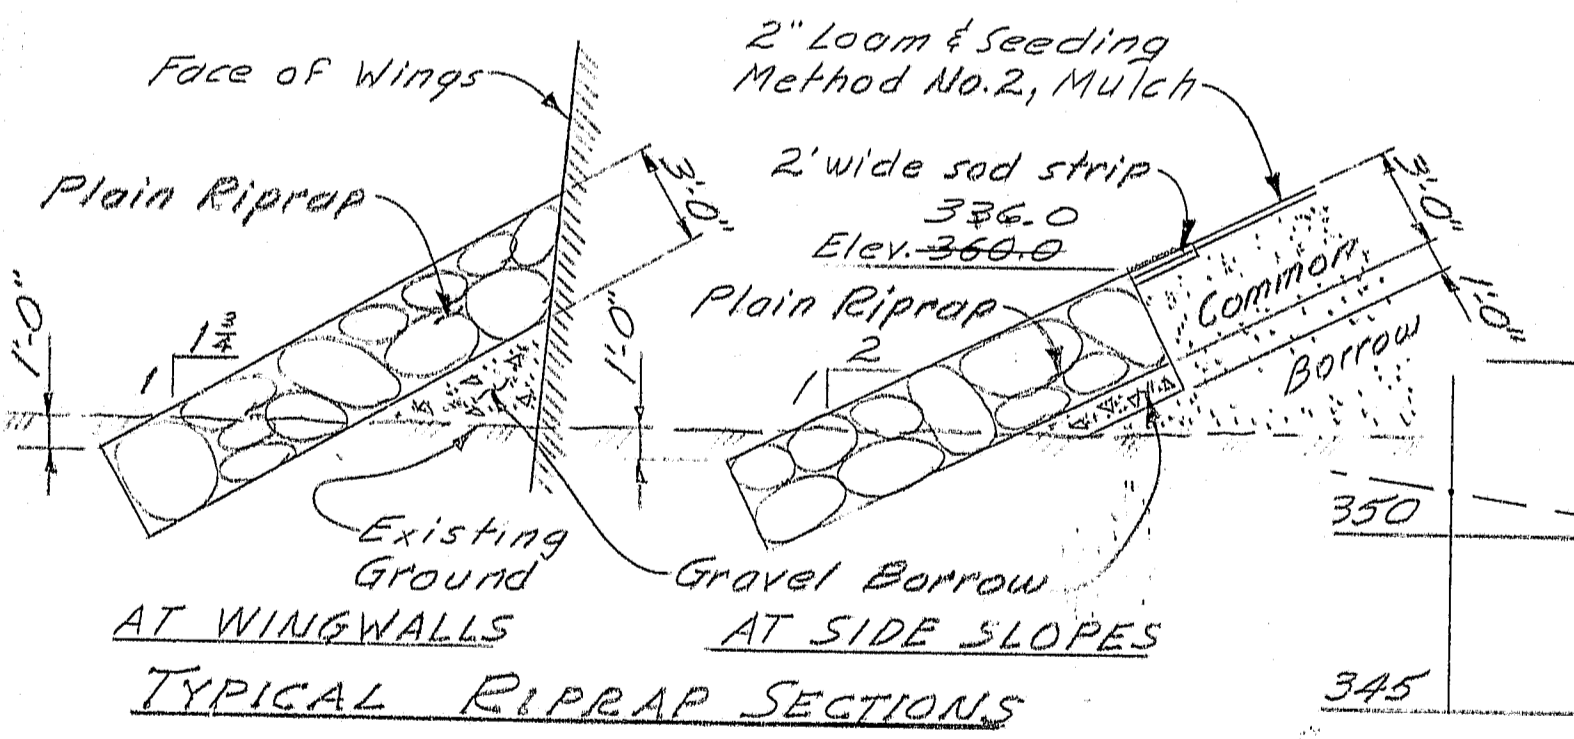


F.R.A. REG. NO.	STATE	PROJECT NUMBER	SHEET NO.	TOTAL SHEETS
1	MAINE	FE-0241(1)	7	19

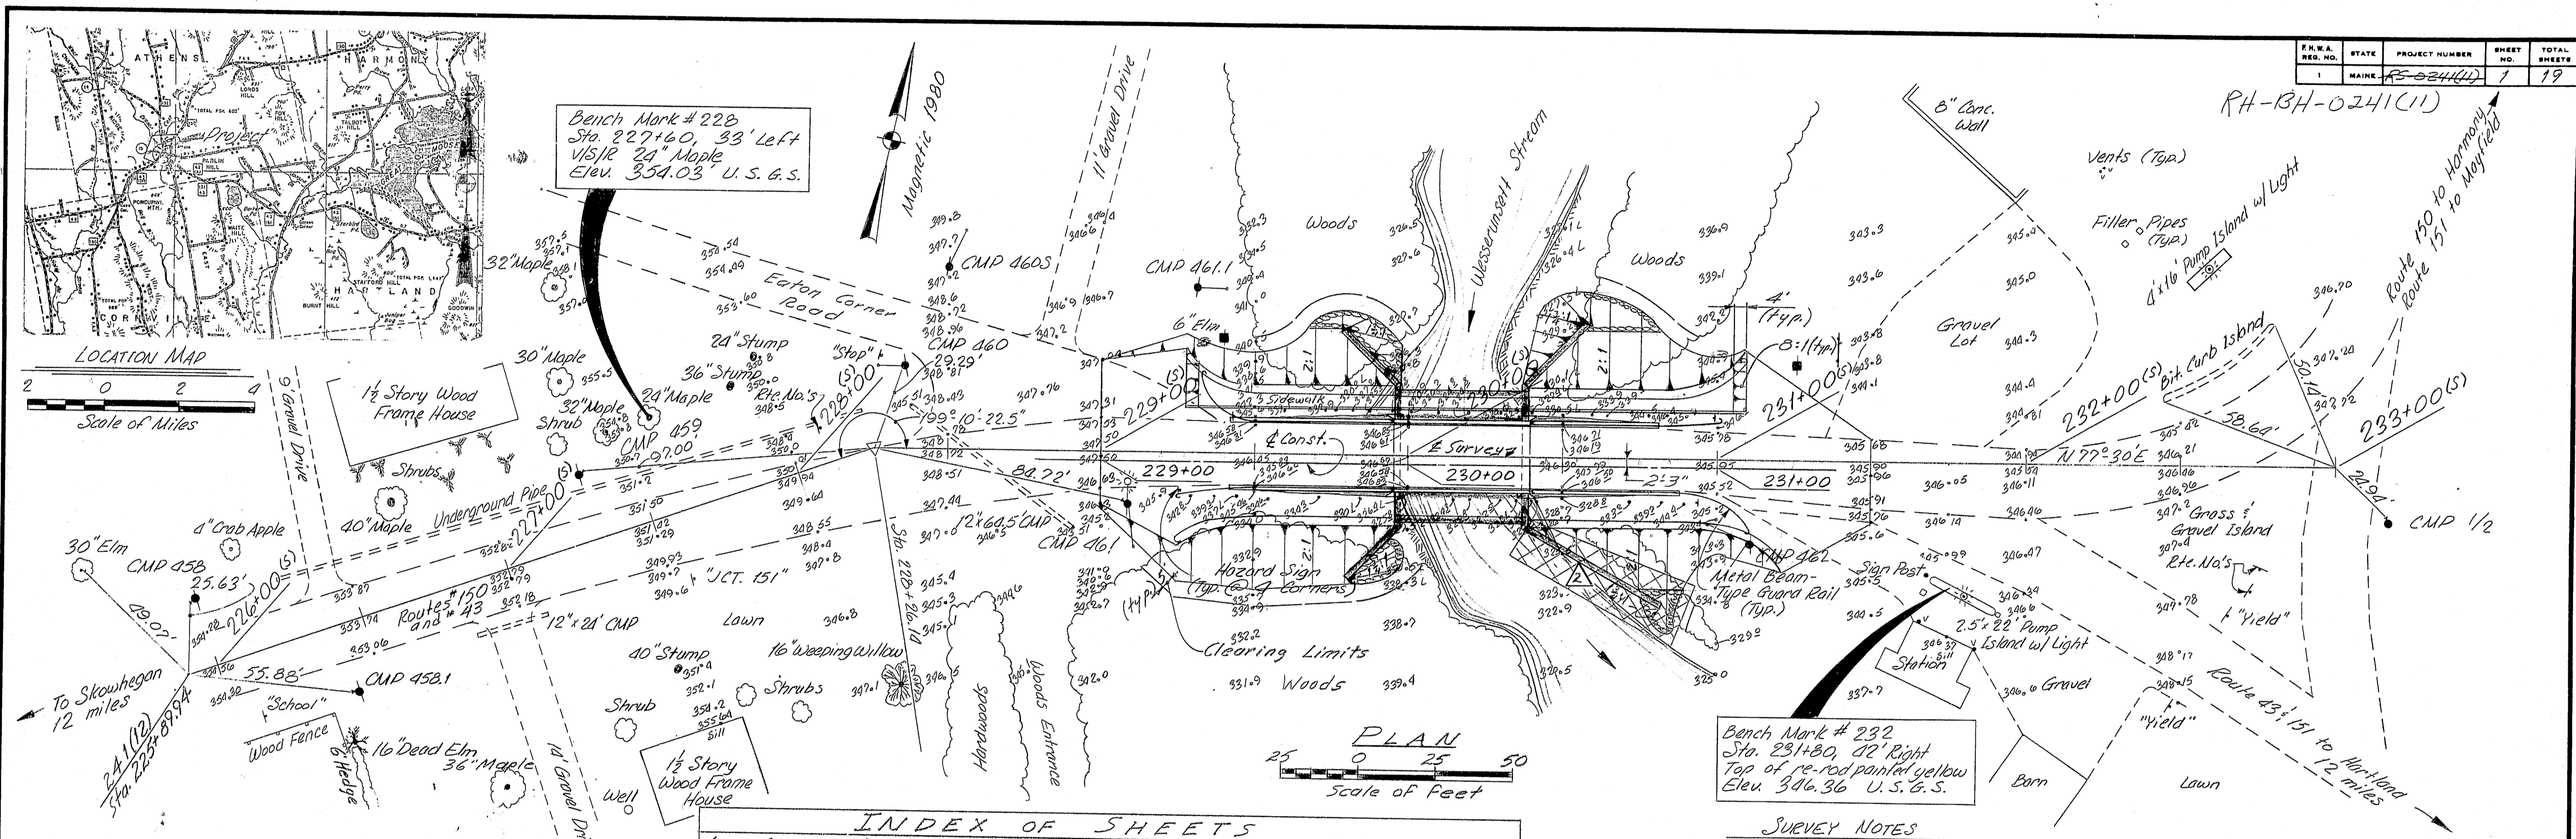

INDEX OF SHEETS

1. General Plan	10. BD114-B1 Aluminum Bridge Railing (2-bar)
2. Estimated Quantities and Construction Notes	11. BD115-B1 Aluminum Bridge Railing (3-bar)
3. Foundation Survey	12. BD116-B1 Aluminum Bridge Railing (pale panel)
4. Cross Sections	13. BD120-B1 Concrete End Posts
5. Abutment No. 1	14. Curb - Type 3
6. Abutment No. 2	15. Guard Rail - Type 3
7. Superstructure Details	16. Traffic Control Plans
8 & 9. Reinforcing Steel Schedule	17. Right of Way Map

SURVEY NOTES

Superstructure: Concrete T-beam deck in good condition with some spalling. 20' curb-to-curb. Substructure: Mass concrete abutments with dry cut granite wings in good condition. Approaches: 22' bituminous roadway in fair to good condition. Travelled heavily by Scott Paper Company log trucks.

Stream: Swift flow. Water elev. on July 29, 1980 = 325.8.

Foundation: Ledger streambed.

Utilities: Central Maine Power Company, Somerset Telephone Company, New England Telephone Co.

▲	Added New T-Beam Details, Sheet #3	8-31-82
▲	Revisions-Gabions & Riprap-See Sh. 6a & 6b.	10/7/82

HYDROLOGIC DATA

Drainage Area	31.84 sq. mi.
Design Discharge (Q ₅₀)	5,000 cfs.
Check Discharge (Q ₁₀₀)	8,000 cfs.
Headwater Elev. at (Q ₅₀)	Elev. 337.3
Headwater Elev. at (Q ₁₀₀)	Elev. 339.0
Discharge Velocity (Q ₅₀)	116.0 Fps
Discharge Velocity (Q ₁₀₀)	17.1 Fps

TRAFFIC DATA

AADT, 1980	1740
AADT, 2000	2550
DHV	281
T%	6.5
V%	30
18 ft	2.0
4' (ME)	

SPECIFICATIONS

DESIGN: AASHTO Standard Specifications for Highway Bridges 1975 and Interim Specifications 1978 thru 1980.

CONTRACT: State of Maine, Department of Transportation, Standard Specifications, Highways and Bridges, Revision of June 1981.

DESIGN LOADING

Live Load: HS20

MATERIALS


STRUCTURAL CONCRETE: Class "A"

REINFORCING STEEL: ASTM A615, Grade 60

BASIC ALLOWABLE STRESSES

STRUCTURAL CONCRETE: f_c = 1200 p.s.i.

REINFORCING STEEL: F_y = 24,000 p.s.i.

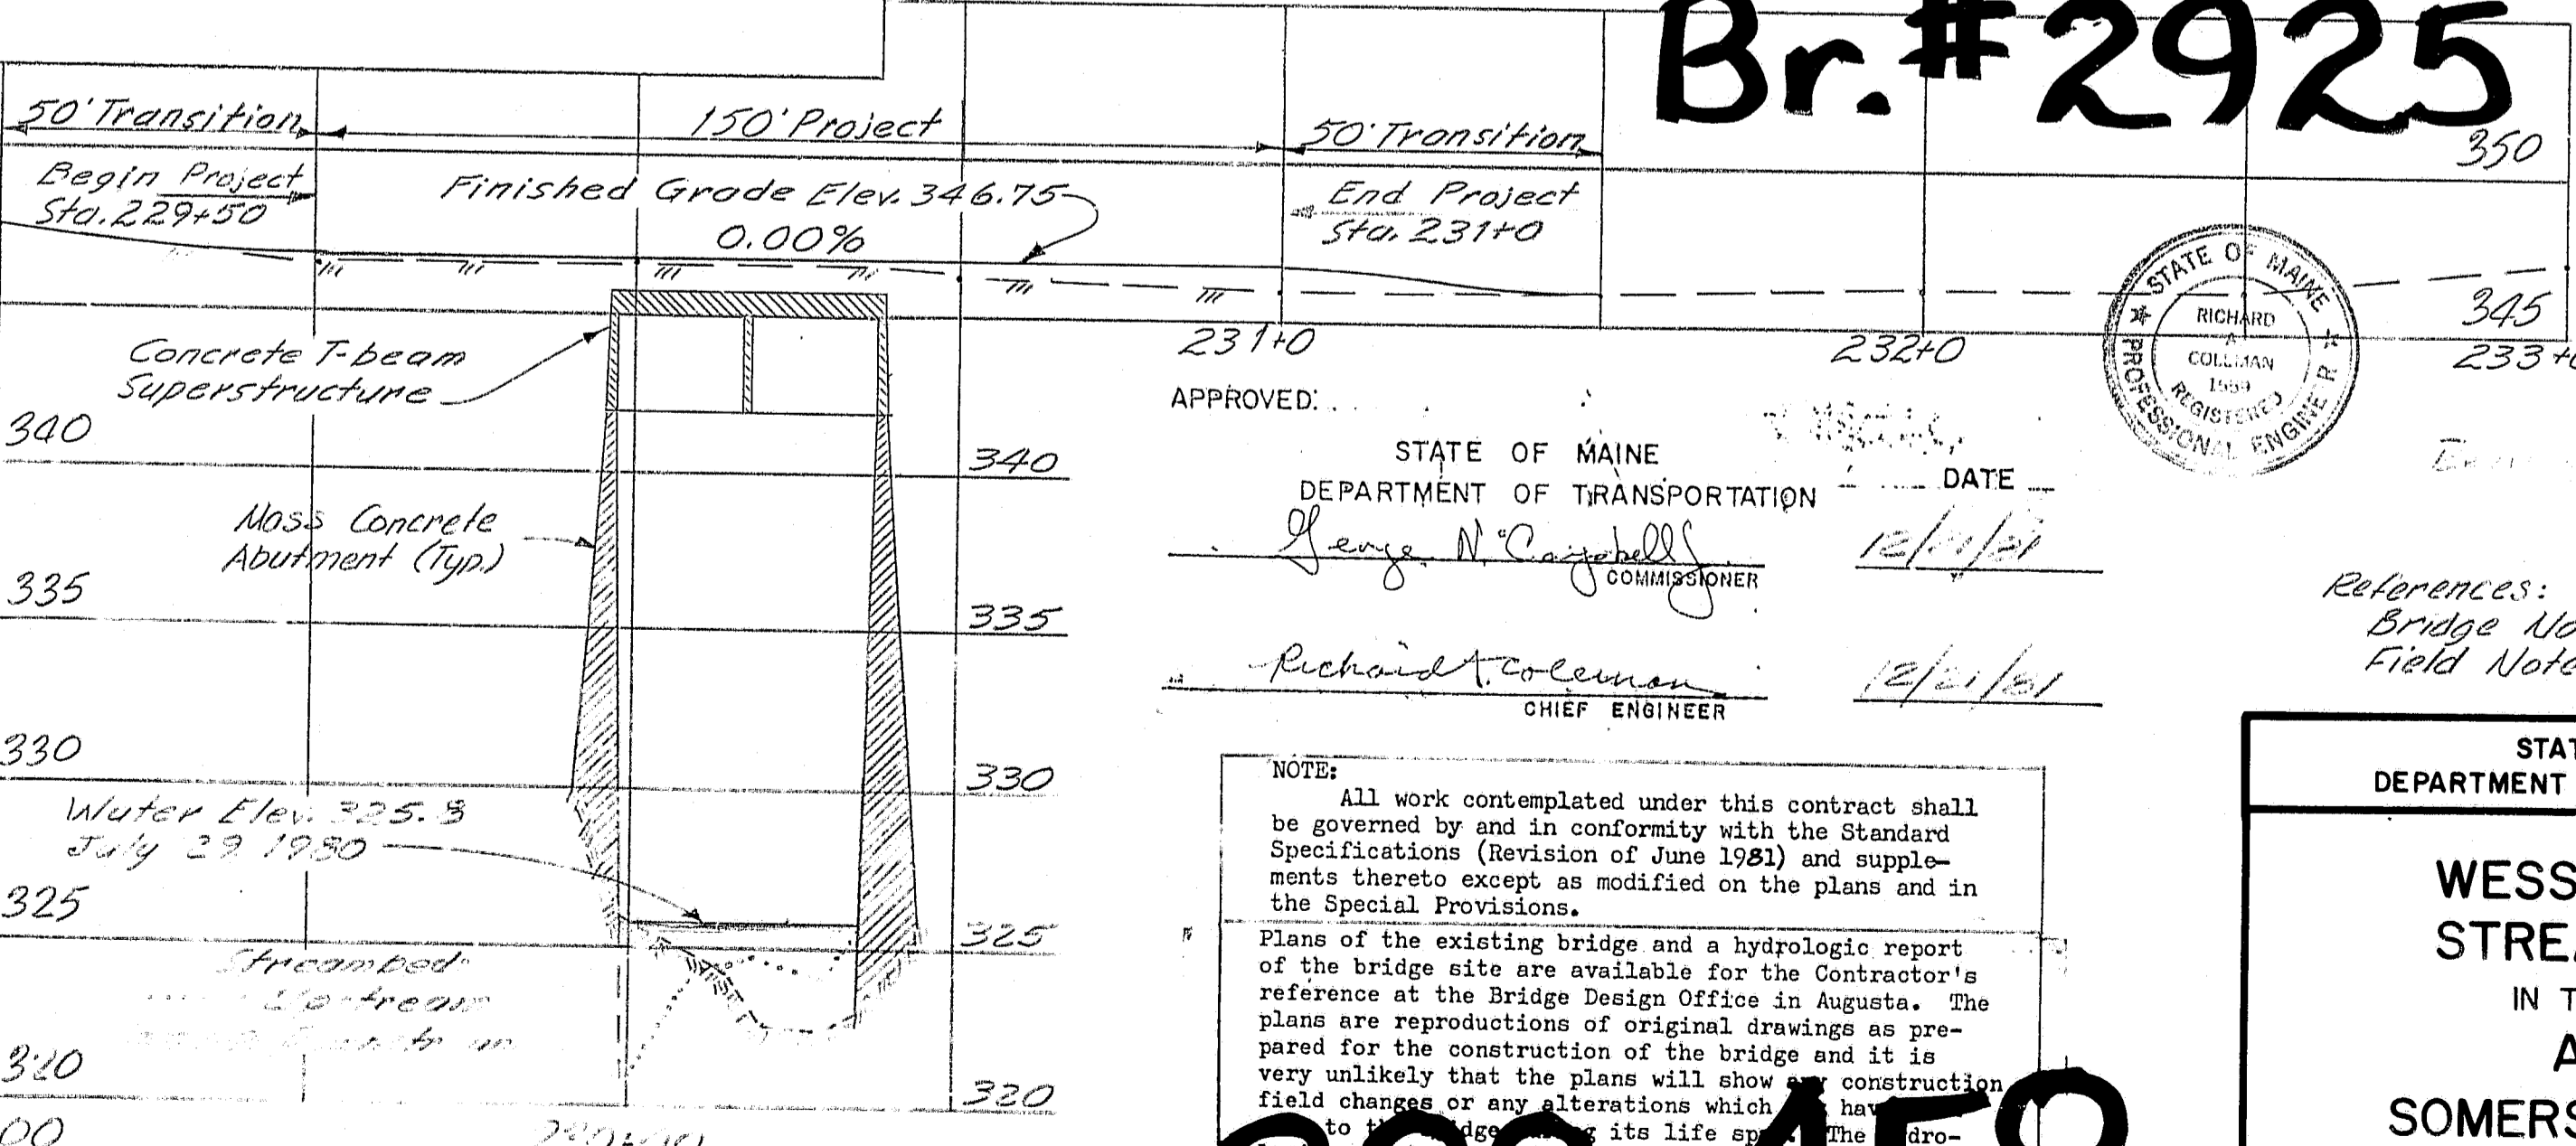

APPROVED: _____ DATE: 12/1/81

STATE OF MAINE
DEPARTMENT OF TRANSPORTATION
George N. Campbell, COMMISSIONER

Richard A. Coleman, CHIEF ENGINEER

NOTE:

All work contemplated under this contract shall be governed by and in conformity with the Standard Specifications (Revision of June 1981) and supplements thereto except as modified on the plans and in the Special Provisions.

Plans of the existing bridge and a hydrologic report of the bridge site are available for the Contractor's reference at the Bridge Design Office in Augusta. The plans are reproductions of original drawings as prepared for the construction of the bridge and it is very unlikely that the plans will show any construction field changes or any alterations which have occurred since the original drawings were prepared. The Contractor shall be responsible for obtaining the correct information or conclusions of the Report will be the responsibility of the Contractor.

STATE OF MAINE
DEPARTMENT OF TRANSPORTATION

WESSERUNSETT STREAM BRIDGE
IN THE TOWN OF ATHENS
SOMERSET COUNTY
GENERAL PLAN

SHEET 7 OF 19 AUGUSTA, MAINE Jan. 1982


Br. #2925

809458

Survey Plotted: DMD 8-2
Survey Checked: _____
PROJECT ENGINEER: _____
DESIGNER: _____
CHECKED: _____
REVISIONS: _____
FIELD CHANGES: _____

ESTIMATED QUANTITIES			
ITEM No.	DESCRIPTION	QUANTITY	UNIT
202.17	Removal of Existing Str. Concrete	1	Lump Sum
203.20	Common Excavation	315	Cu. Yds.
203.24	Common Borrow	800	Cu. Yds.
203.25	Granular Borrow	115	Cu. Yds.
203.26	Gravel Borrow	525	Cu. Yds.
206.081	Structural Earth Excavation-Abutments, Retaining Walls, Box Culverts and Structural Plate Units	200	Cu. Yds.
206.091	Structural Rock Excavation-Abutments, Retaining Walls, Box Culverts and Structural Plate Units	10	Cu. Yds.
304.10	Aggregate Subbase Course-Gravel	800	Cu. Yds.
307.20	Sand Leveling	13	Cu. Yds.
403.07	Hot Bituminous Pavement, Grading B	130	Ton
403.08	Hot Bituminous Pavement, Grading C	80	Ton
403.101	Hot Bituminous Pavement, Grading D (sidewalk)	15	Ton
502.21	Structural concrete, Abutments & Retaining Walls	450	Cu. Yds.
502.27	Structural Concrete Superstructure T-beam Type	1	Lump Sum
503.12	Reinforcing Steel Fabricated & Delivered	16,500	Lbs.
503.13	Reinforcing Steel Piling	16,500	Lbs.
507.092	Aluminum Bridge Railing, 2 Bar	33	Lin. Ft.
507.094	Aluminum Bridge Railing, 3 Bar, with pales	33	Lin. Ft.
511.0701	Cofferdam - Abut. #1	1	Lump Sum
511.0702	Cofferdam - Abut. #2	1	Lump Sum
512.08	French Drains	170	Lin. Ft.
514.06	Curing Box for Concrete Cylinders	1	Each
515.20	Protective Coating for Concrete Surfaces	115	Sq. Yds.
526.30	Temporary Concrete Barrier, Type 1	100	Lin. Ft.
526.40	Resetting Temporary Concrete Barrier, Type 1	100	Lin. Ft.
606.265	Terminal End-Single Rail-Galvanized Steel	4	Each
606.35	Guard Rail Delineator Post	4	Each
606.55	Guard Rail Type 3-Single Rail	213	Lin. Ft.
606.60	Guard Rail Type 3-over 15 Ft. Radius	88	Lin. Ft.
609.13	Vertical Bridge Curb-Type 1	81	Lin. Ft.
609.31	Curb Type 3	130	Lin. Ft.
610.08	Plain Riprap	120	Cu. Yds.
615.07	Loom	26	Cu. Yds.
616.08	Sodding	12	Sq. Yds.
618.14	Seeding Method No. 2	4	Unit
618.15	Temporary Seeding	3	Lbs.
619.12	Mulch	4	Unit
627.63	4 inch Solid Yellow Pavement Marking Line	500	Lin. Ft.
627.67	Removing Pavement Markings	188	Sq. Ft.
629.05	Hand Labor, Straight Time	10	Man Hr.
630.0606	Traffic Officers	25	Man Hr.
631.10	Air Compressor (including operator)	10	Hour
631.11	Air Tool (including operator)	10	Hour
631.12	All Purpose Excavator (including operator)	10	Hour
631.132	Small Bulldozer (including operator)	10	Hour

ESTIMATED QUANTITIES			
ITEM No.	DESCRIPTION	QUANTITY	UNIT
631.171	Truck-small (including operator)	10	Hour
631.22	Front End Loader (including operator)	10	Hour
637.07	Sprinkling	10	M. Gal.
637.08	Calcium Chloride	1	Ton
639.20	Field Office Type C	1	Each
643.72	Temporary Traffic Signal	1	Lump Sum
652.31	Type I Barricades	10	Each
652.34	Cones	10	Each
652.35	Construction Signs	300	Sq. Ft.
652.36	Maintenance of Traffic Control Devices	120	Col. Days
652.37	Warning Lights	2	Group
652.38	Flaggers	100	Man Hr.
659.10	Mobilization	1	Lump Sum
502.27	Structural Concrete Superstructure T-beam Type	78	Cu. Yds.

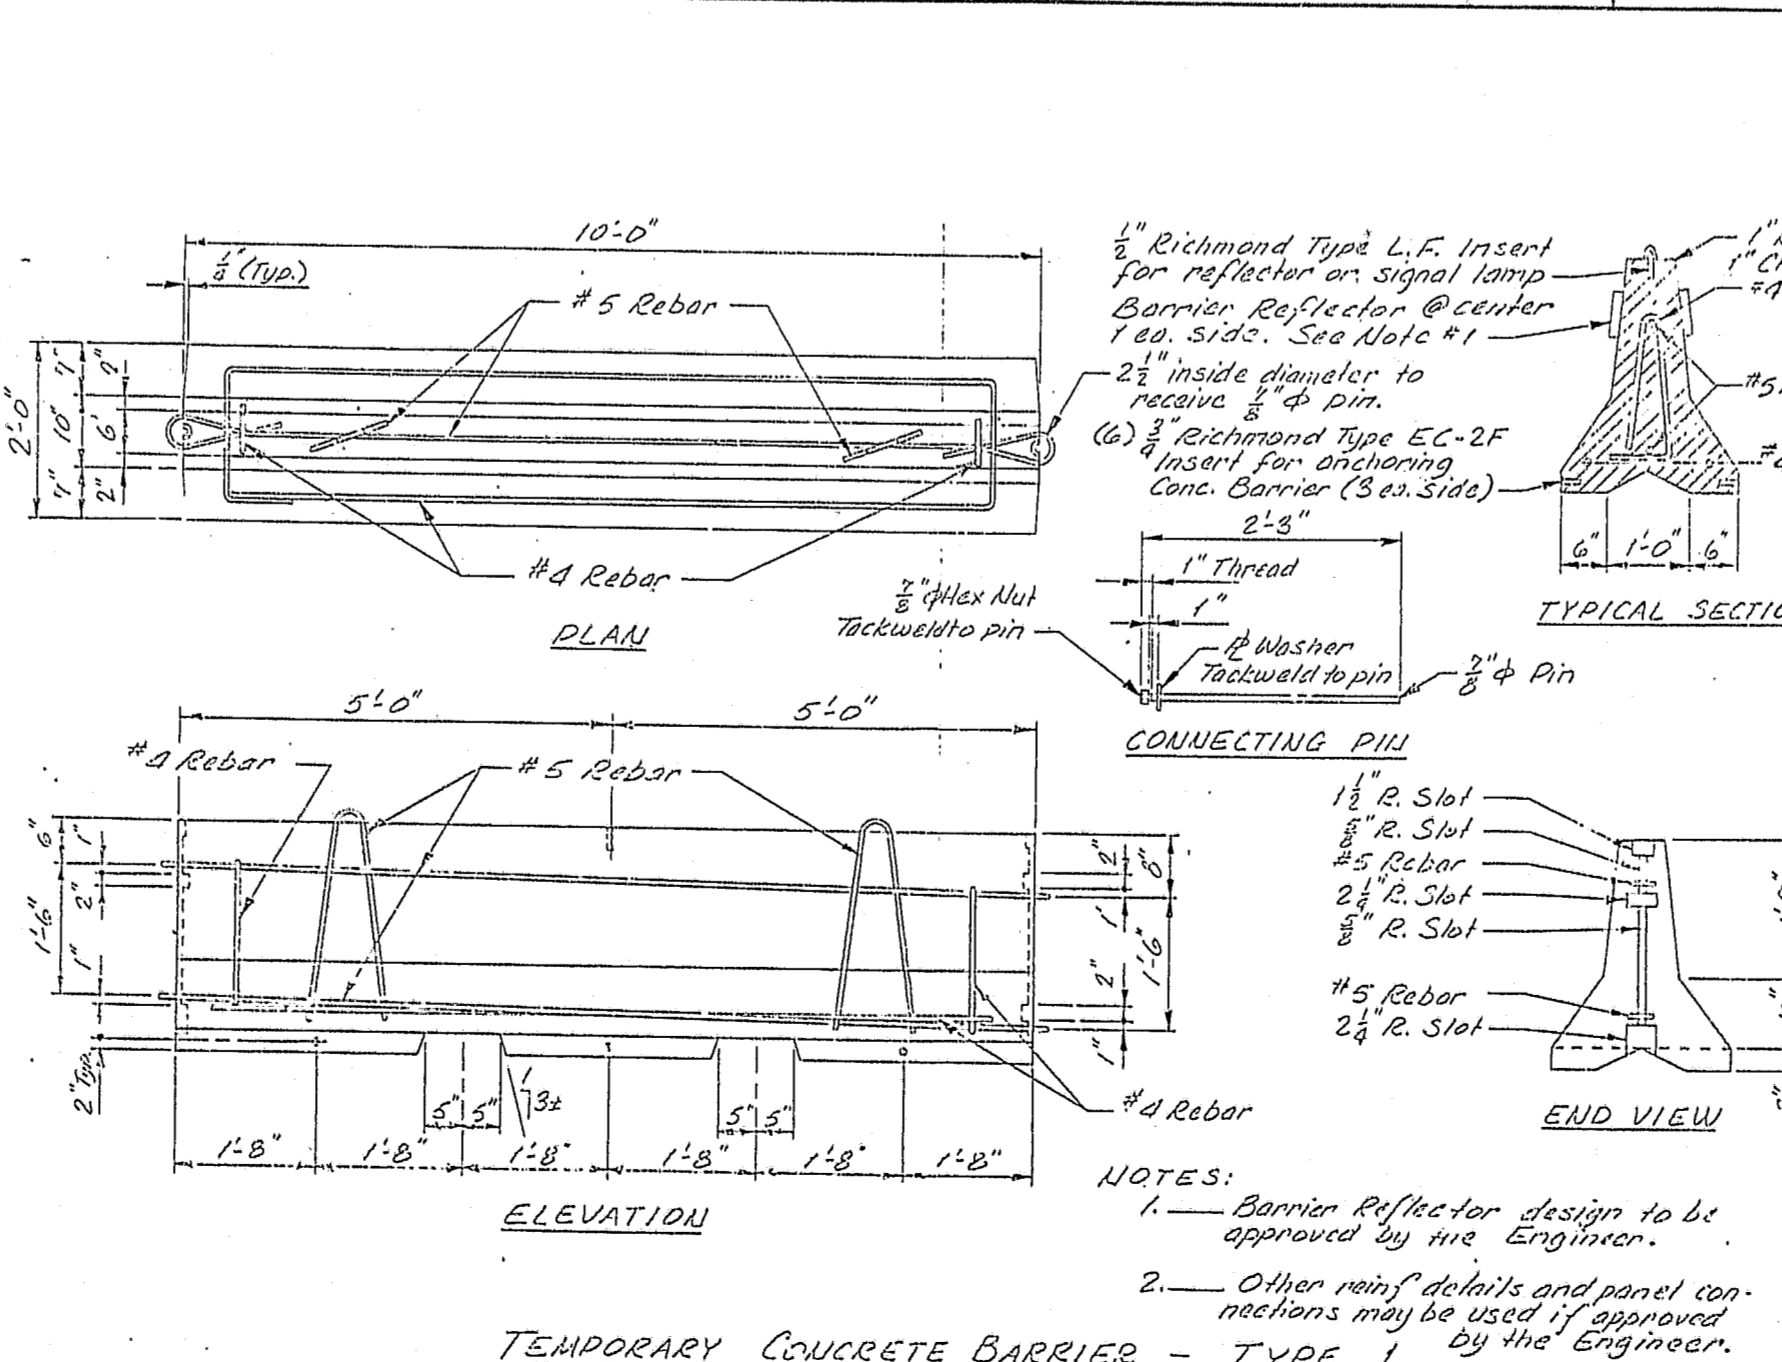

- ### CONSTRUCTION NOTES
- All utility facilities shall be adjusted by the respective utilities unless noted.
 - For easements, construction limits and right-of-way lines refer to Right of Way Map.
 - The Contractor shall maintain a minimum 14 foot roadway at all times.
 - Place a 2 foot wide strip of sod on the side slopes along the top of the riprap.
 - The clearing limits as shown on the plans are approximate. The exact limits shall be established in the field by the Engineer. Payment for clearing shall be incidental to contract items.
 - Place loam, 2 inches deep, on slopes between Station 229+0 and Station 231+50.
 - Do not excavate for Aggregate Subbase Course where existing material is suitable as determined by the Engineer. Shaping and compacting of the existing subbase and layers of new subbase 6 inches or less thick, in areas where the Engineer directs the Contractor not to excavate to the subgrade line shown on the plans, will be paid for with appropriate equipment rental items.
 - One guard rail delineator post and one terminal end shall be installed at each guard rail end.
 - All embankment material, except as otherwise shown, placed below Elevation 328.0, shall be granular borrow meeting the requirements of Subsection 702.19, Material for Underwater Backfill.
 - Payment for removal of the existing concrete curbs and portions of the T-beams, where shown on the plans, shall be paid for under Item 202.17.
 - The Contractor shall remove the 4 granite mill wheels, located in the existing wingwalls, with care and shall store them within the right of way. They are to become the property of the Town of Athens. Payment for removing and storing of the granite mill wheels shall be incidental to contract items.
 - Sodded gutters shall be constructed after paving and shoulder work is completed, where it is apparent that runoff will cause continual erosion.
 - Payment for the removal of the existing beam type guard rail over superstructure curbs to be considered incidental to item 202.17.
 - Chamfer all exposed edges of concrete a consistent dimension between 1/8 inch and 3/8 inch inclusive, unless otherwise indicated.
 - Reinforcing steel shall have 2 inches cover unless otherwise indicated.
 - Break bond at vertical contraction joints by a method approved by the Engineer.
 - Waterstops are not required in horizontal construction joints.
 - Protective coating for concrete surfaces shall be applied to the following areas:
 - Top of concrete sidewalk and curb.
 - Fascias and outside face of exterior T-beams.
 - Ends of sidewalk and curb to 1 foot below finished grade.
 - Top and back face of parapets to 1 foot below finished grade.
 - All exposed surfaces of concrete and posts.
 - Place 4 inch diameter drains in breastwall and wings at 20 foot maximum spacing. Exact location to be determined by the Engineer in the field.
 - Form a 1 inch V-groove on the fascias at the horizontal joint between the curb and the slab.
 - Mortar for bedding and for joints in the granite curb, and for the grout used in setting dowels (5508) shall contain an approved non-shrink additive.
 - Payment for drilling and grouting of dowels shall be considered incidental to contract items.
 - The superstructure slab concrete shall be placed monolithically with the beam section and shall be kept plastic until the entire slab concrete, on at least one side of the bridge, has been placed. Approved set retarding admixtures shall be used when authorized by the Engineer, in accordance with the Standard Specifications.
 - All deteriorated concrete on the exposed faces of the existing T-beams shall be removed and shall be patched with a non-shrink grout as directed by the Engineer. Payment for all materials and labor to be incidental to contract items.
 - The ends of the superstructure 4 inch PVC sections shall be plugged by a method approved by the Engineer.

As Built 1983

STATE OF MAINE
DEPARTMENT OF TRANSPORTATION

WESSERUNSETT
STREAM BRIDGE

ATHENS

ESTIMATED QUANTITIES
and CONSTRUCTION NOTES
SHEET 2 OF 19 AUGUSTA, MAINE JAN 1982

R89-459


PROJECT DESIGN ENGINEER
DESIGN-DETAILED
CHECKED
REVISED
FIELD CHANGES

DATE
BY
DATE
BY
DATE
BY






PLANS

BRUNING 64132 8/70

F.R.M.A. REG. NO.	STATE	PROJECT NUMBER	SHEET NO.	TOTAL SHEETS
1	MAINE	25-0241(1)	3	19

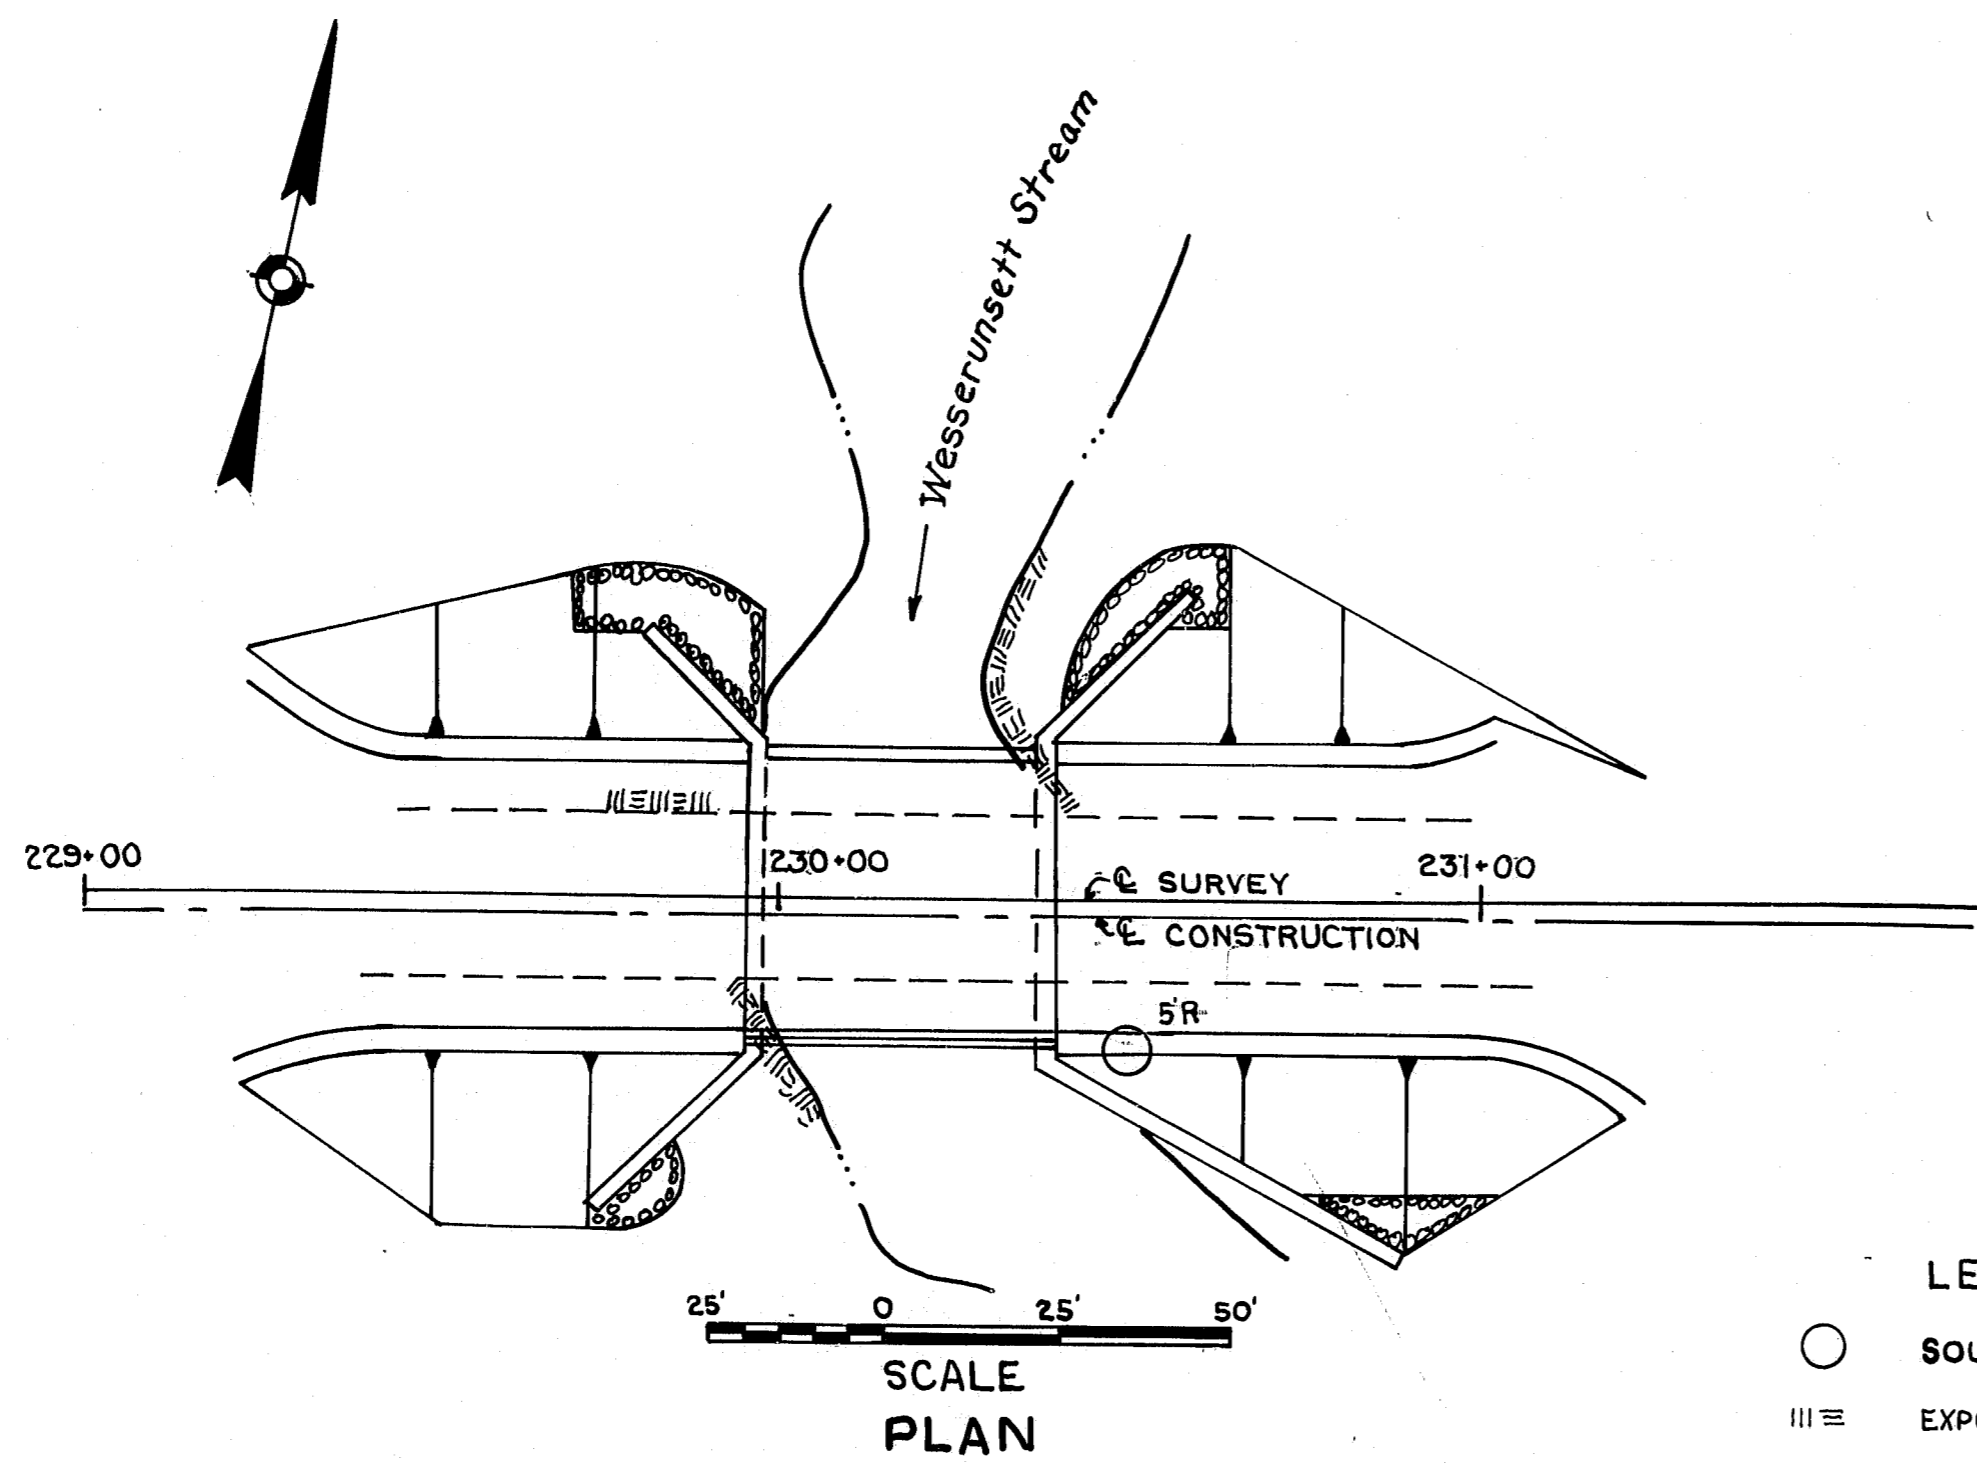

- LEGEND**
- SOUNDING
 - ≡ EXPOSED LEDGE
 - ⊥ BLOWS PER FOOT-ROD SOUNDING
 - ⊥ REFUSAL

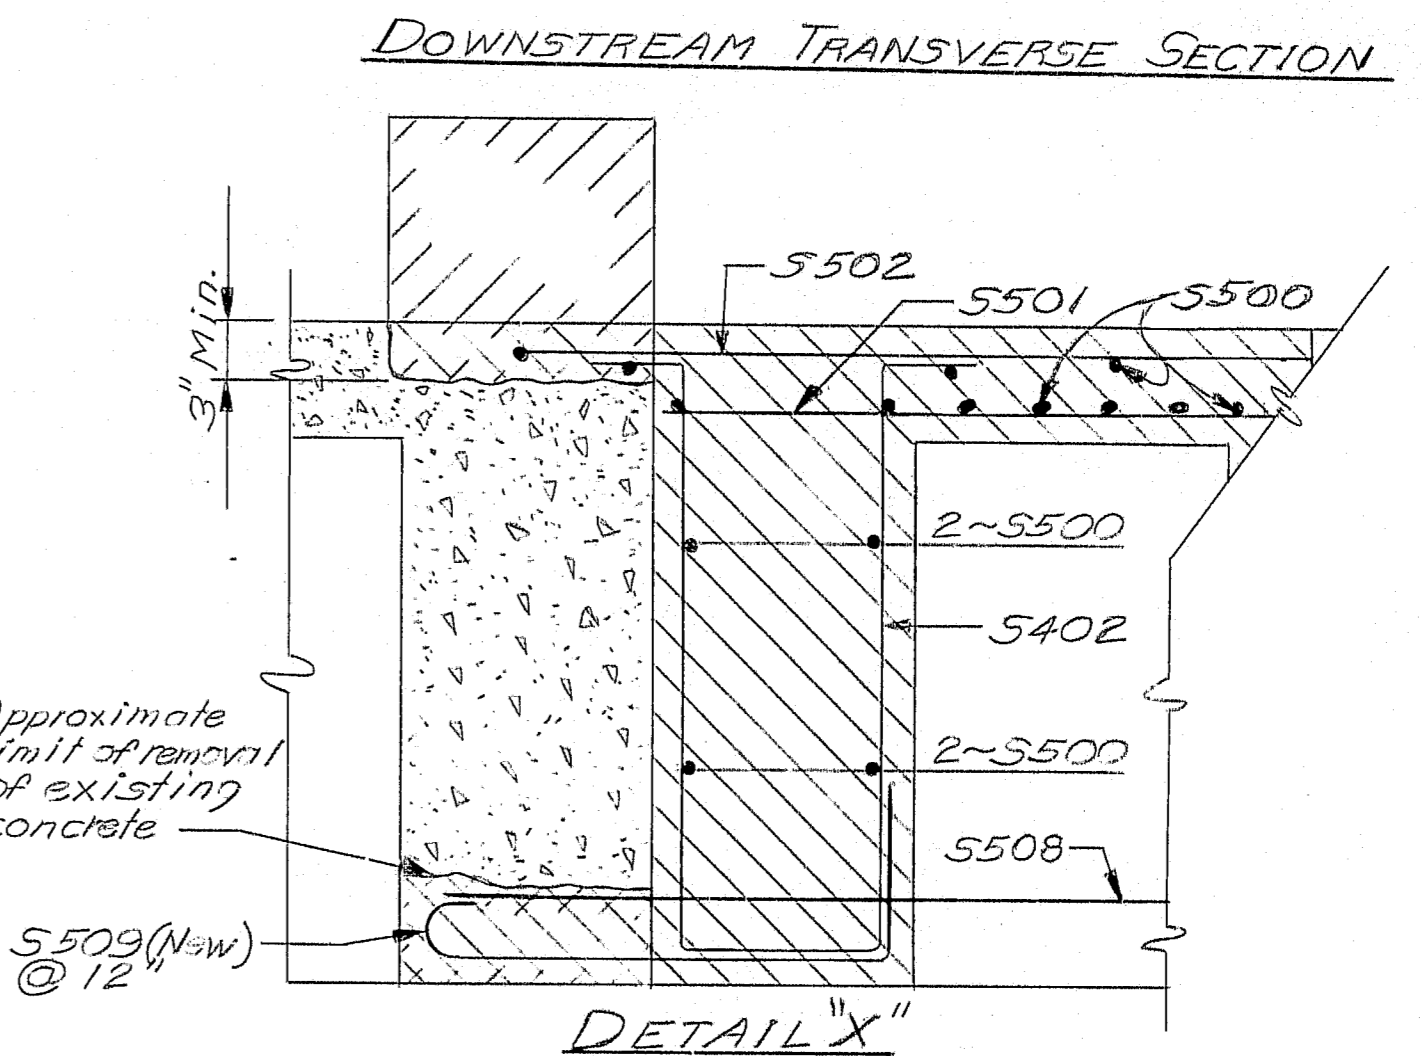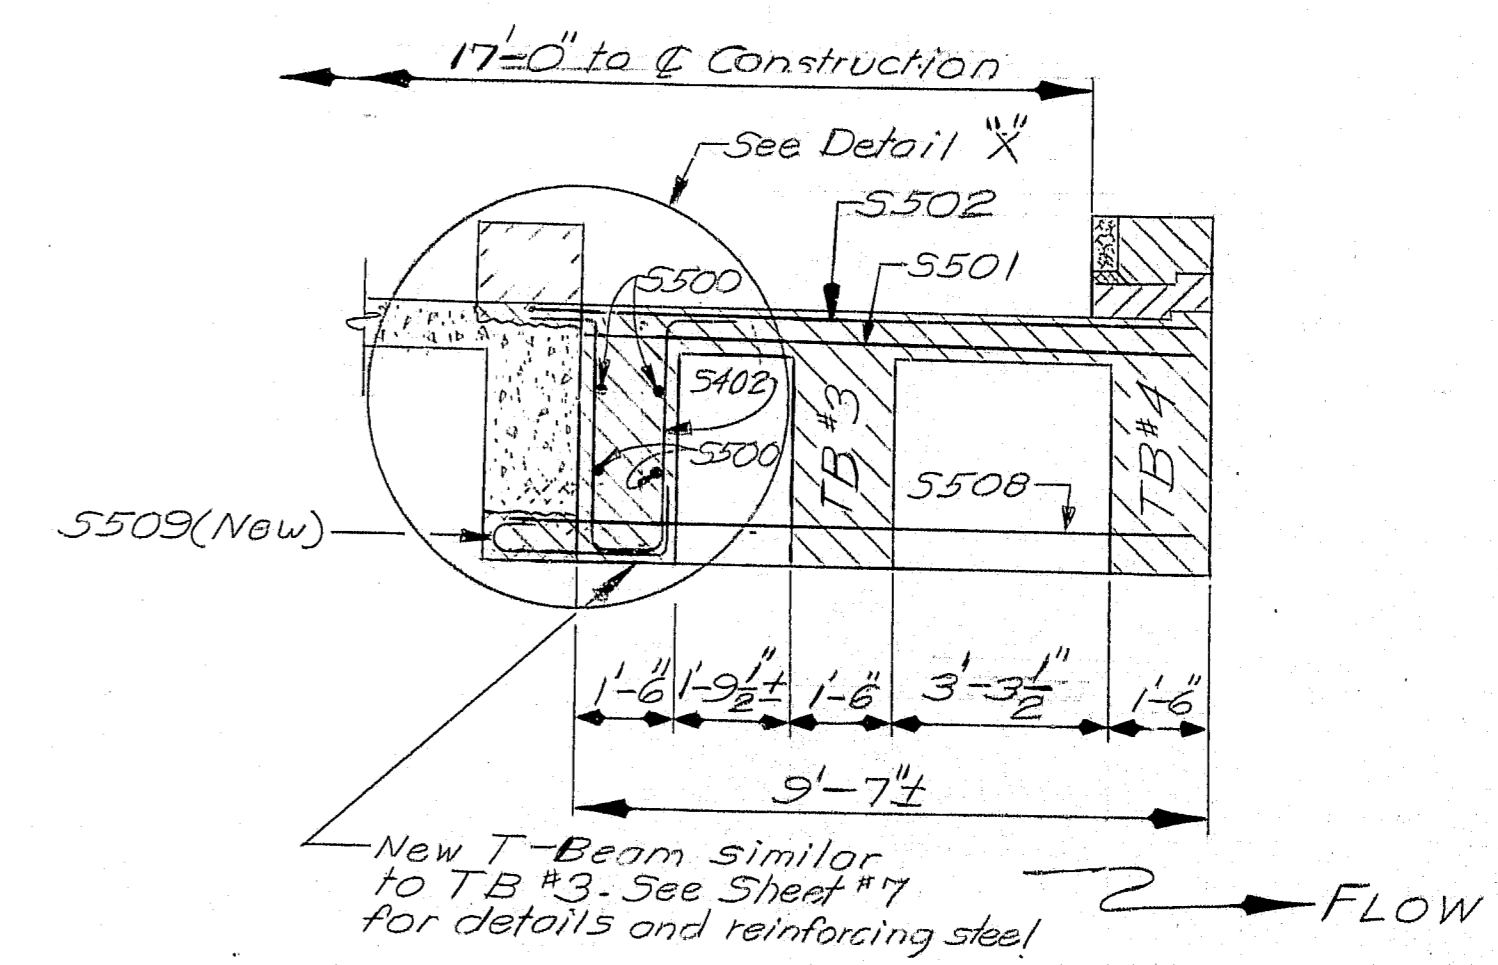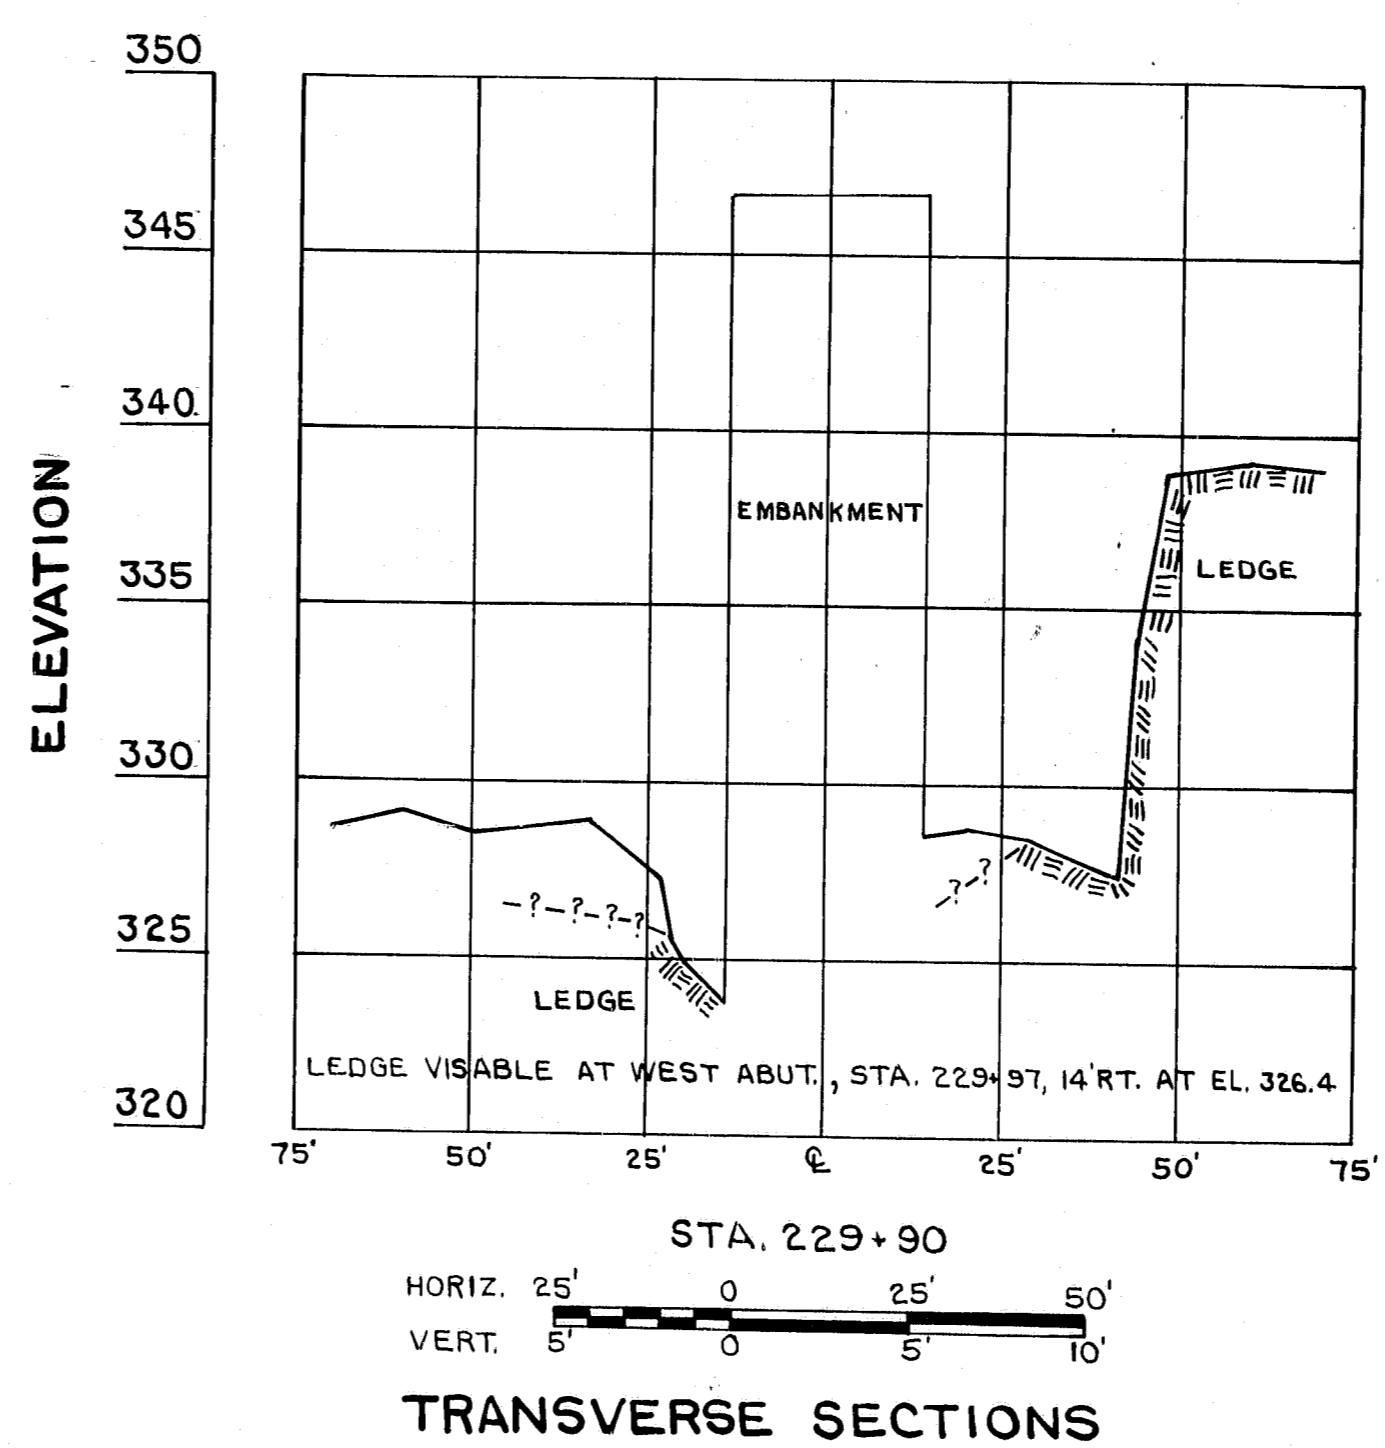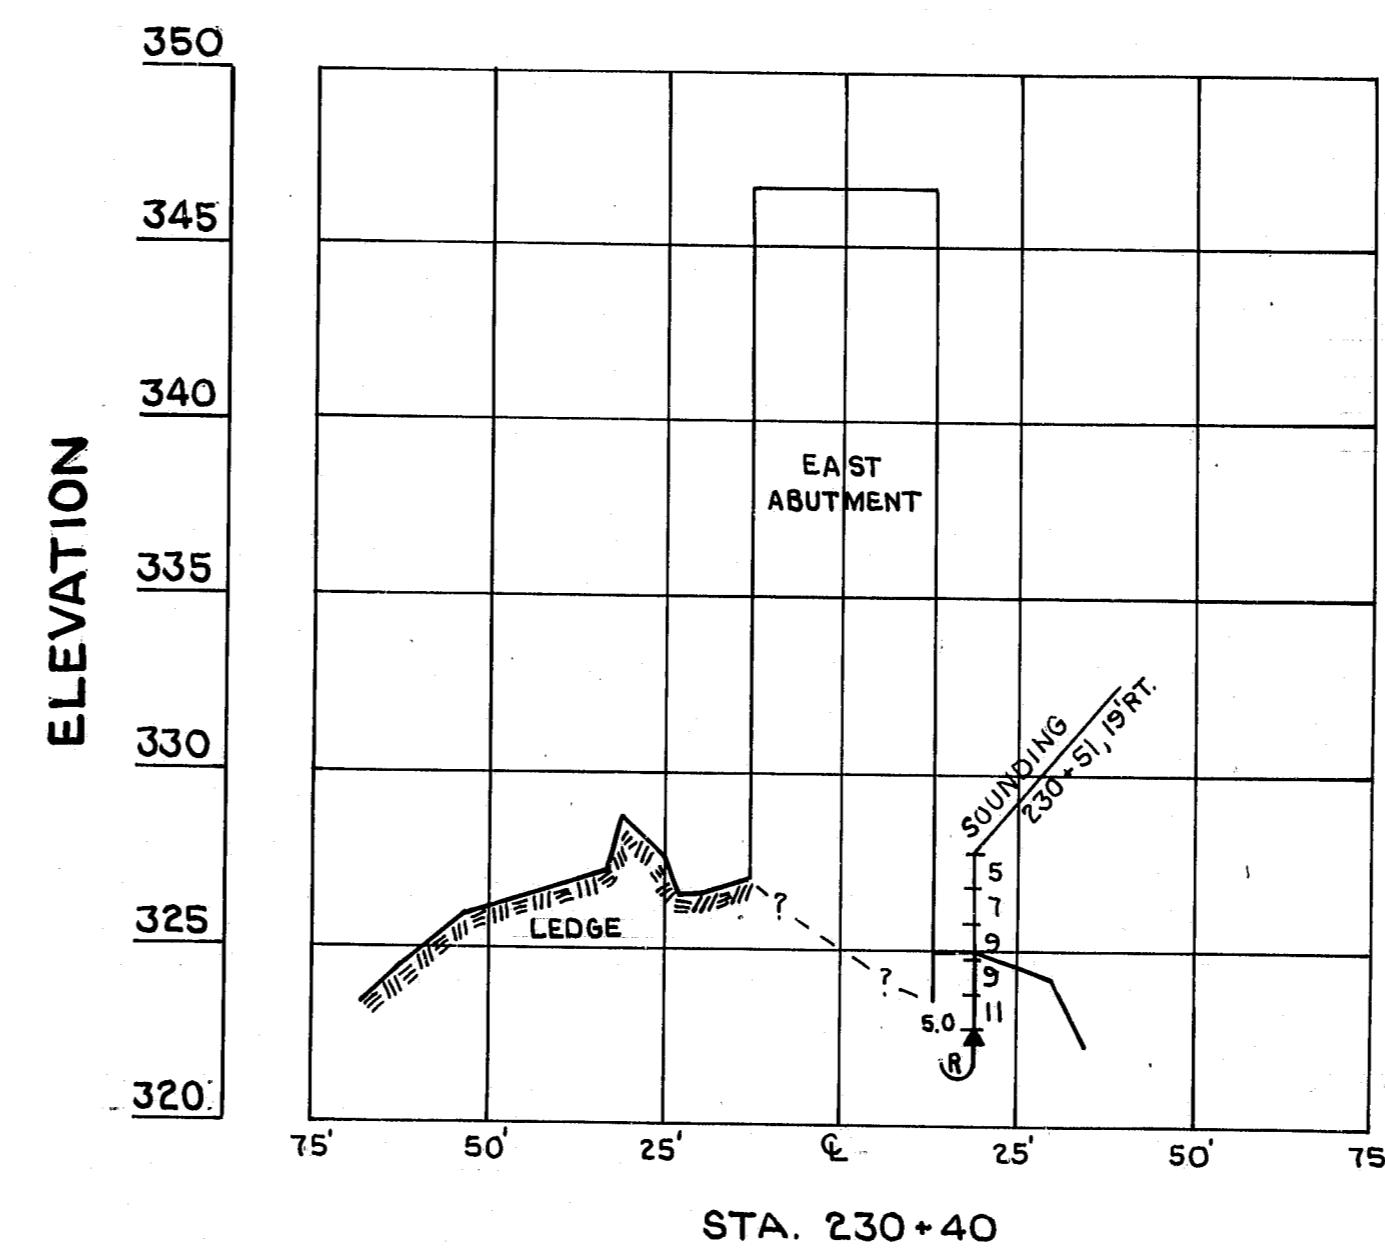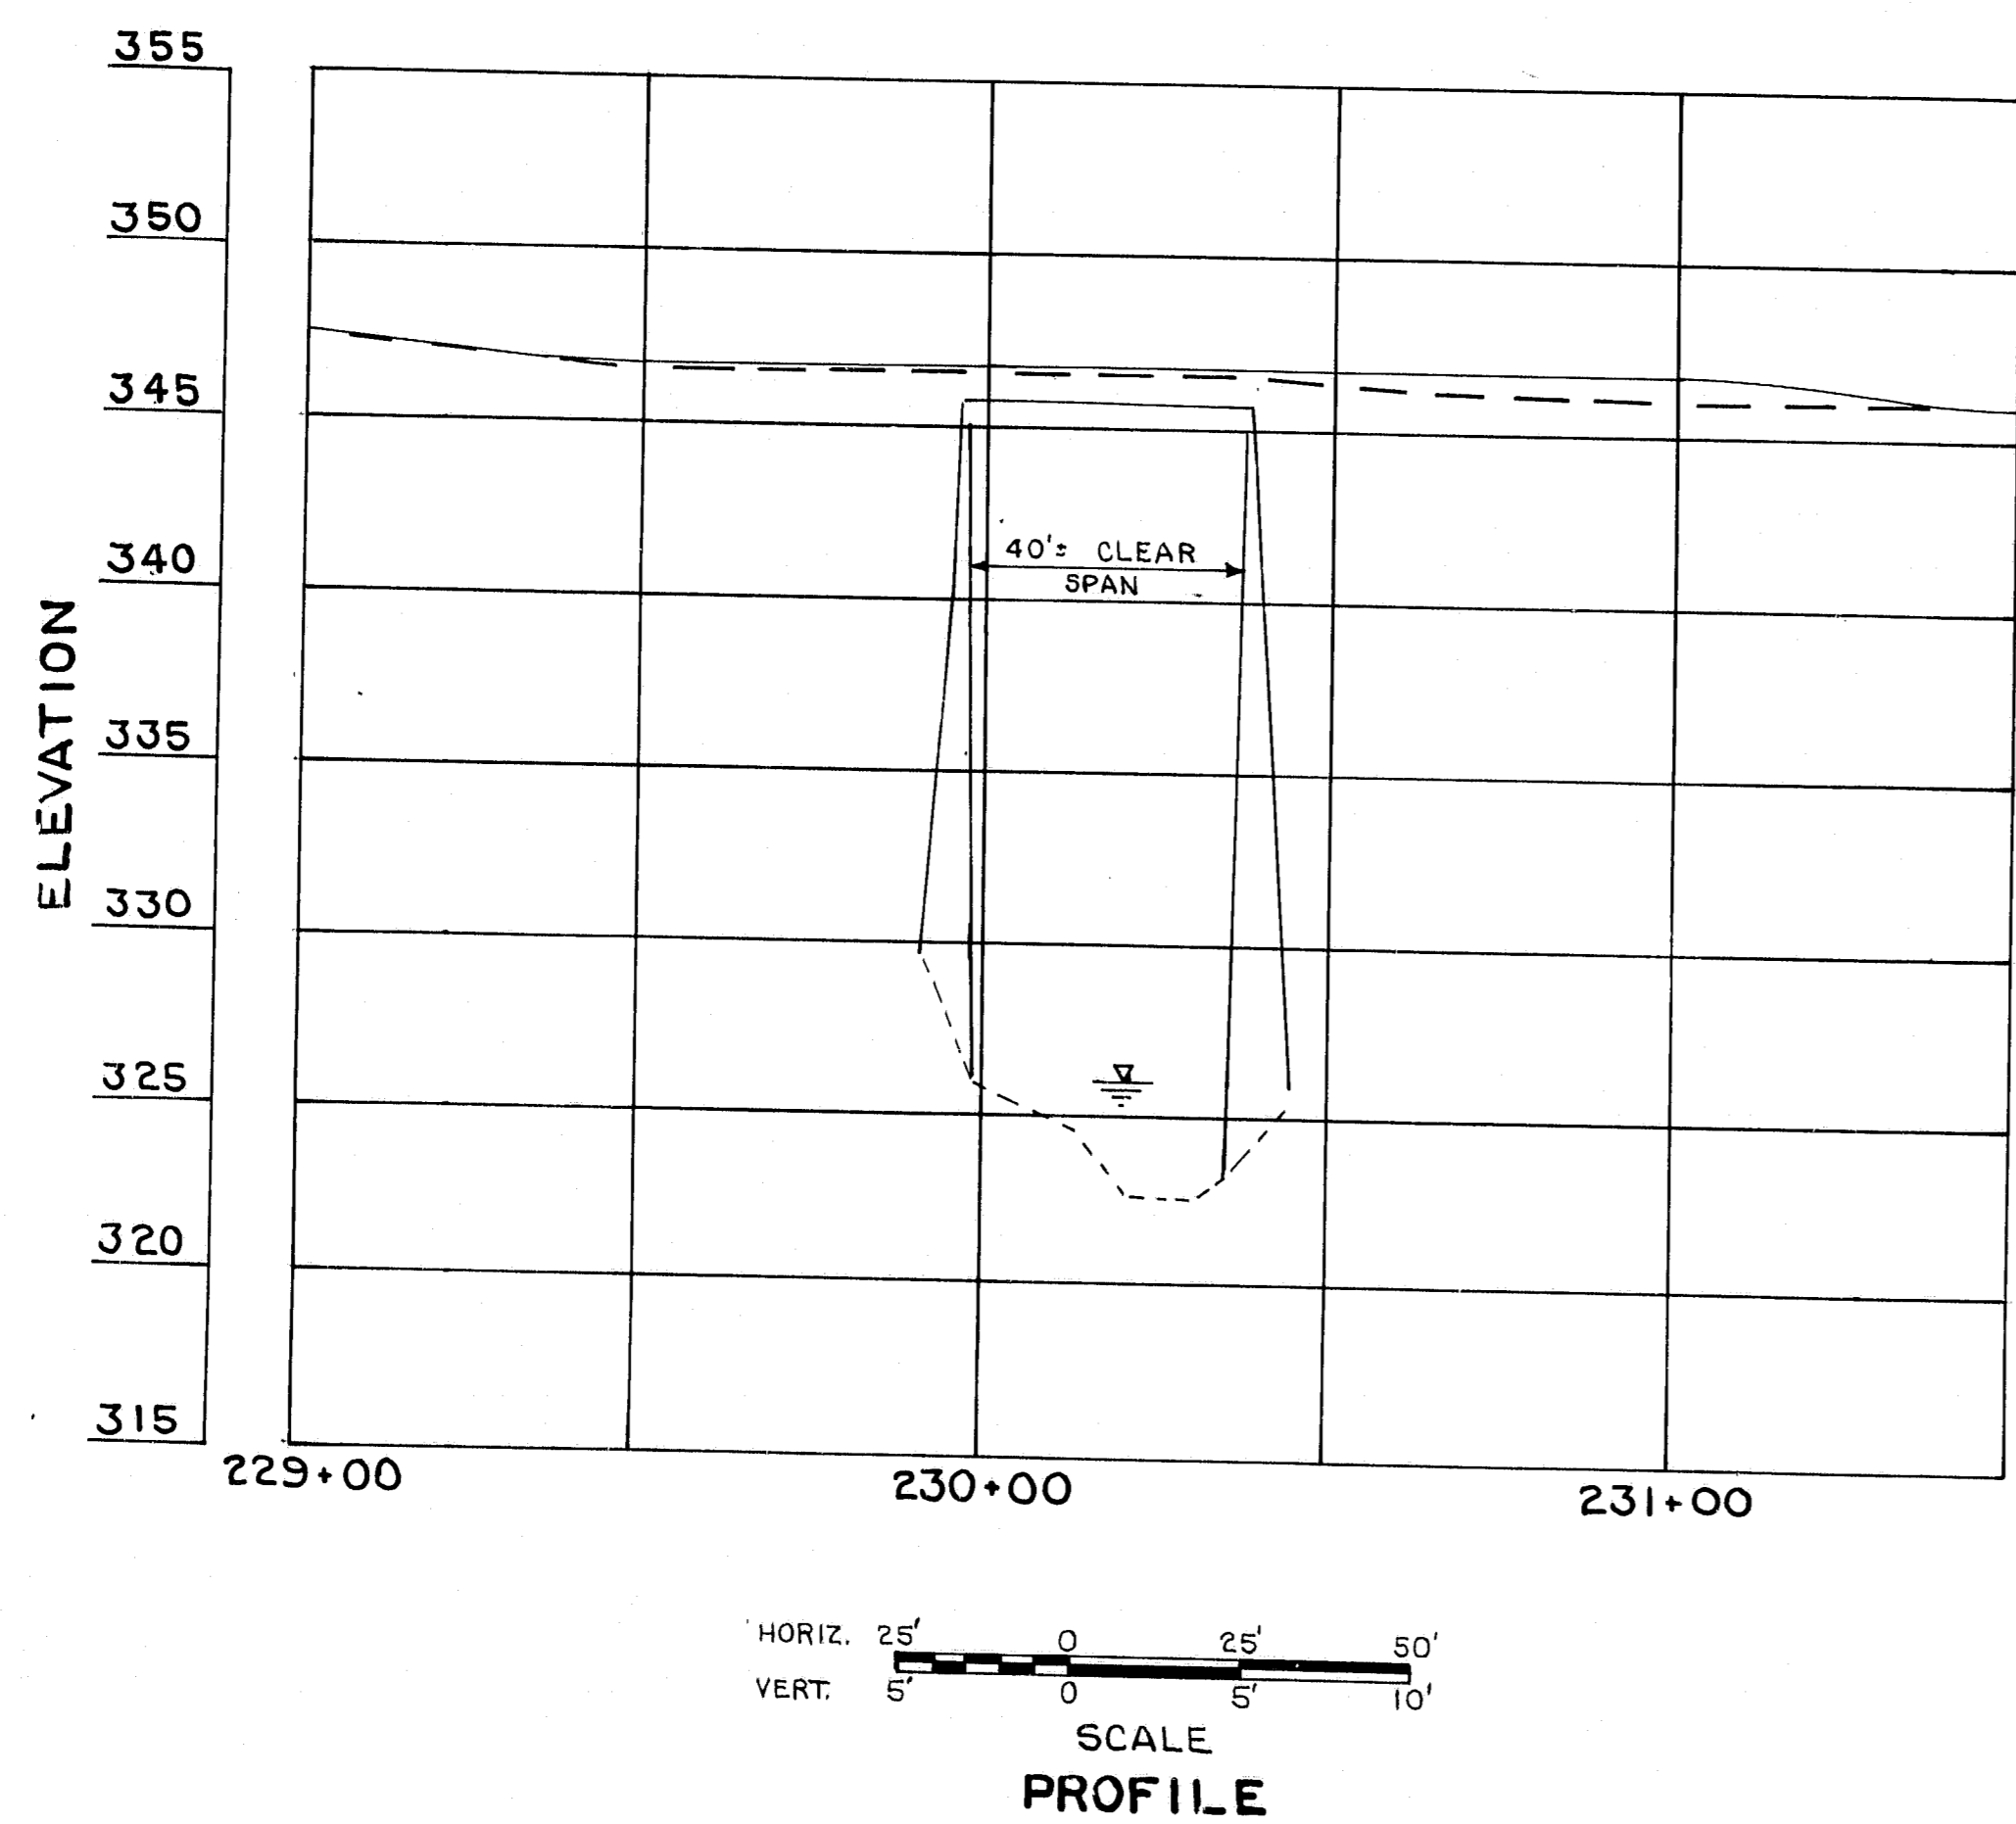


ADDITIONAL REINFORCING STEEL REQUIRED

MARK	NUMBER
S500	17
S501	5
S502	16
S501	16
S502	26
S501	3
S509	40 (maximum, if full length of existing T-Beam concrete removed at bottom)

NOTE: See Sheet #9 for Reinforcing Steel Schedule. Bar S509 is on this sheet. Additional S500 bars are required due to previous omission from the reinforcing steel schedule of bars required in the T-Beams.

Detail of T-Beam revision on downstream side of bridge with additional reinforcing steel required. 10-1-82
As Built 1983 28

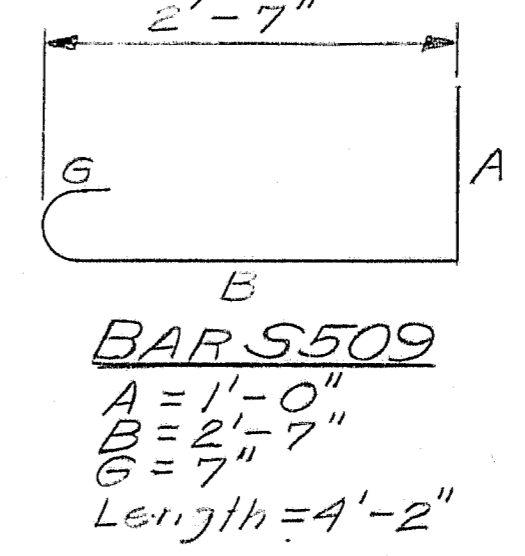

STATE OF MAINE
DEPARTMENT OF TRANSPORTATION

**WESSERUNSETT
STREAM BRIDGE**
IN THE TOWN OF
ATHENS
SOMERSET COUNTY
FOUNDATION SURVEY

R89-455

PROJECT DESIGN ENGINEER	BY	DATE
DESIGN - DETAILED		
REVISIONS		
FIELD CHANGES		
PLANS		

BRIDGE 44132-45710

✓ R89-456
DESIGN: PJM

ORIGINAL SURVEY	DATE
BY: R.P.H.	7-27-81
APPROVED: R.P.H.	
DATE: 7-27-81	

FINAL SURVEY	DATE
BY: R.P.H.	
APPROVED: R.P.H.	
DATE: 7-27-81	





FED. REG. NO.	STATE	PROJECT NUMBER	SHEET NO.	TOTAL SHEETS
1	MAINE	65-0241(1)	4	19

R89-456

ATHENS
WESSERUNSETT STREAM
X-SECTIONS 4 Sheet of 19

F.R.A. NO.	STATE	PROJECT NUMBER	SHEET NO.	TOTAL SHEETS
1	MAINE	RS-027(11)	6a	

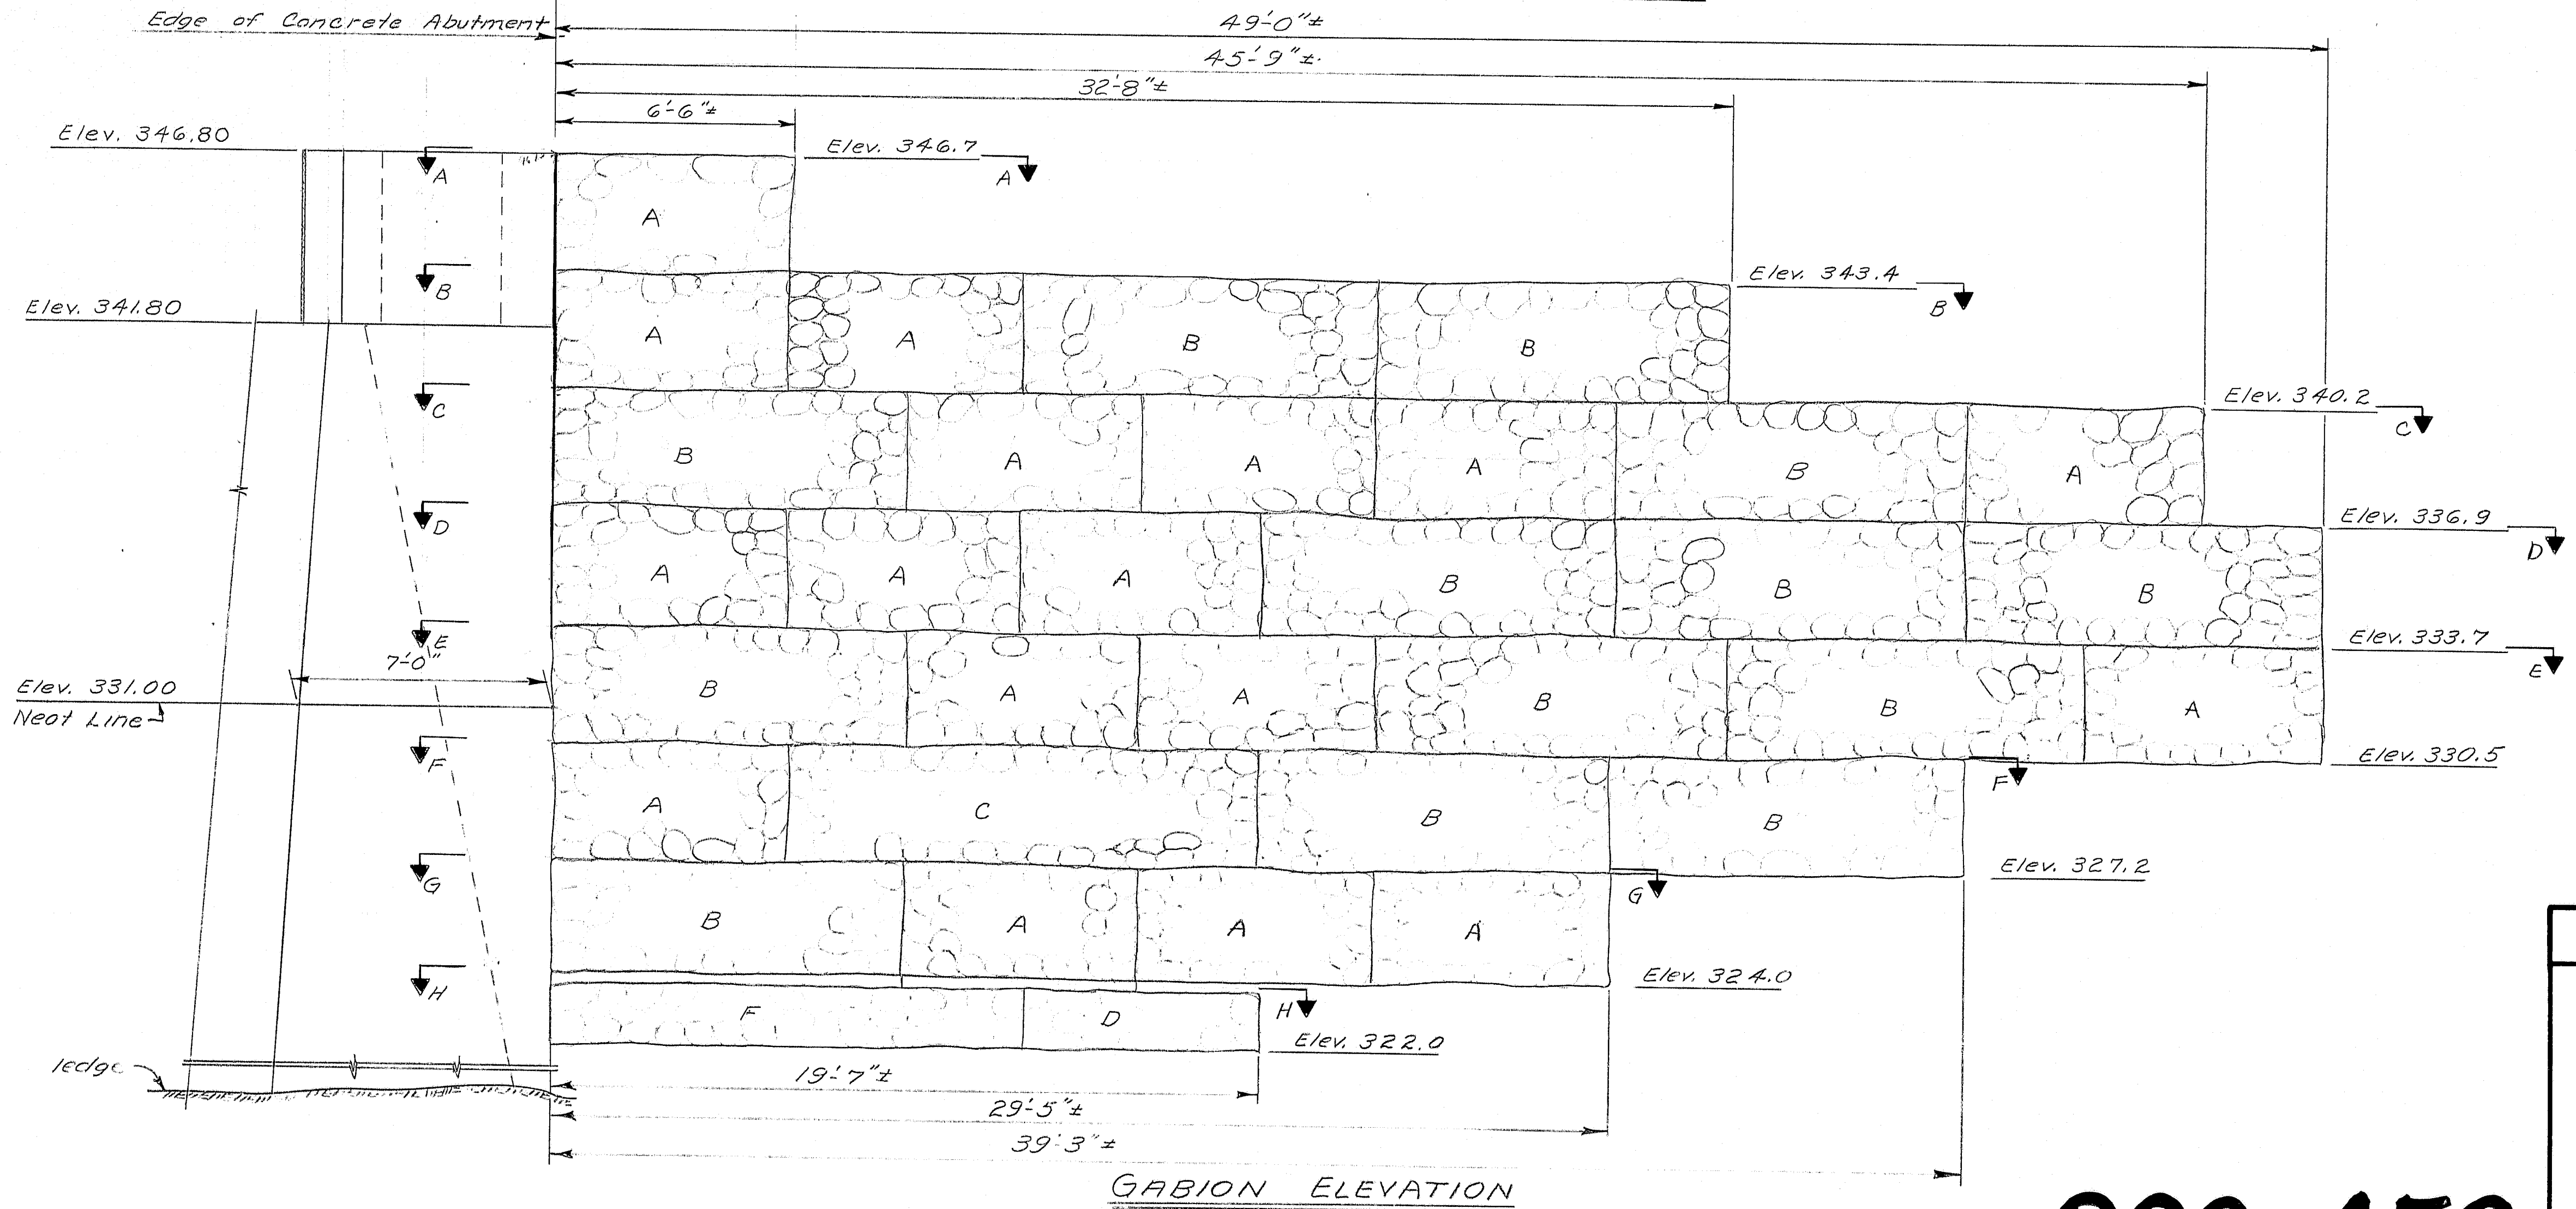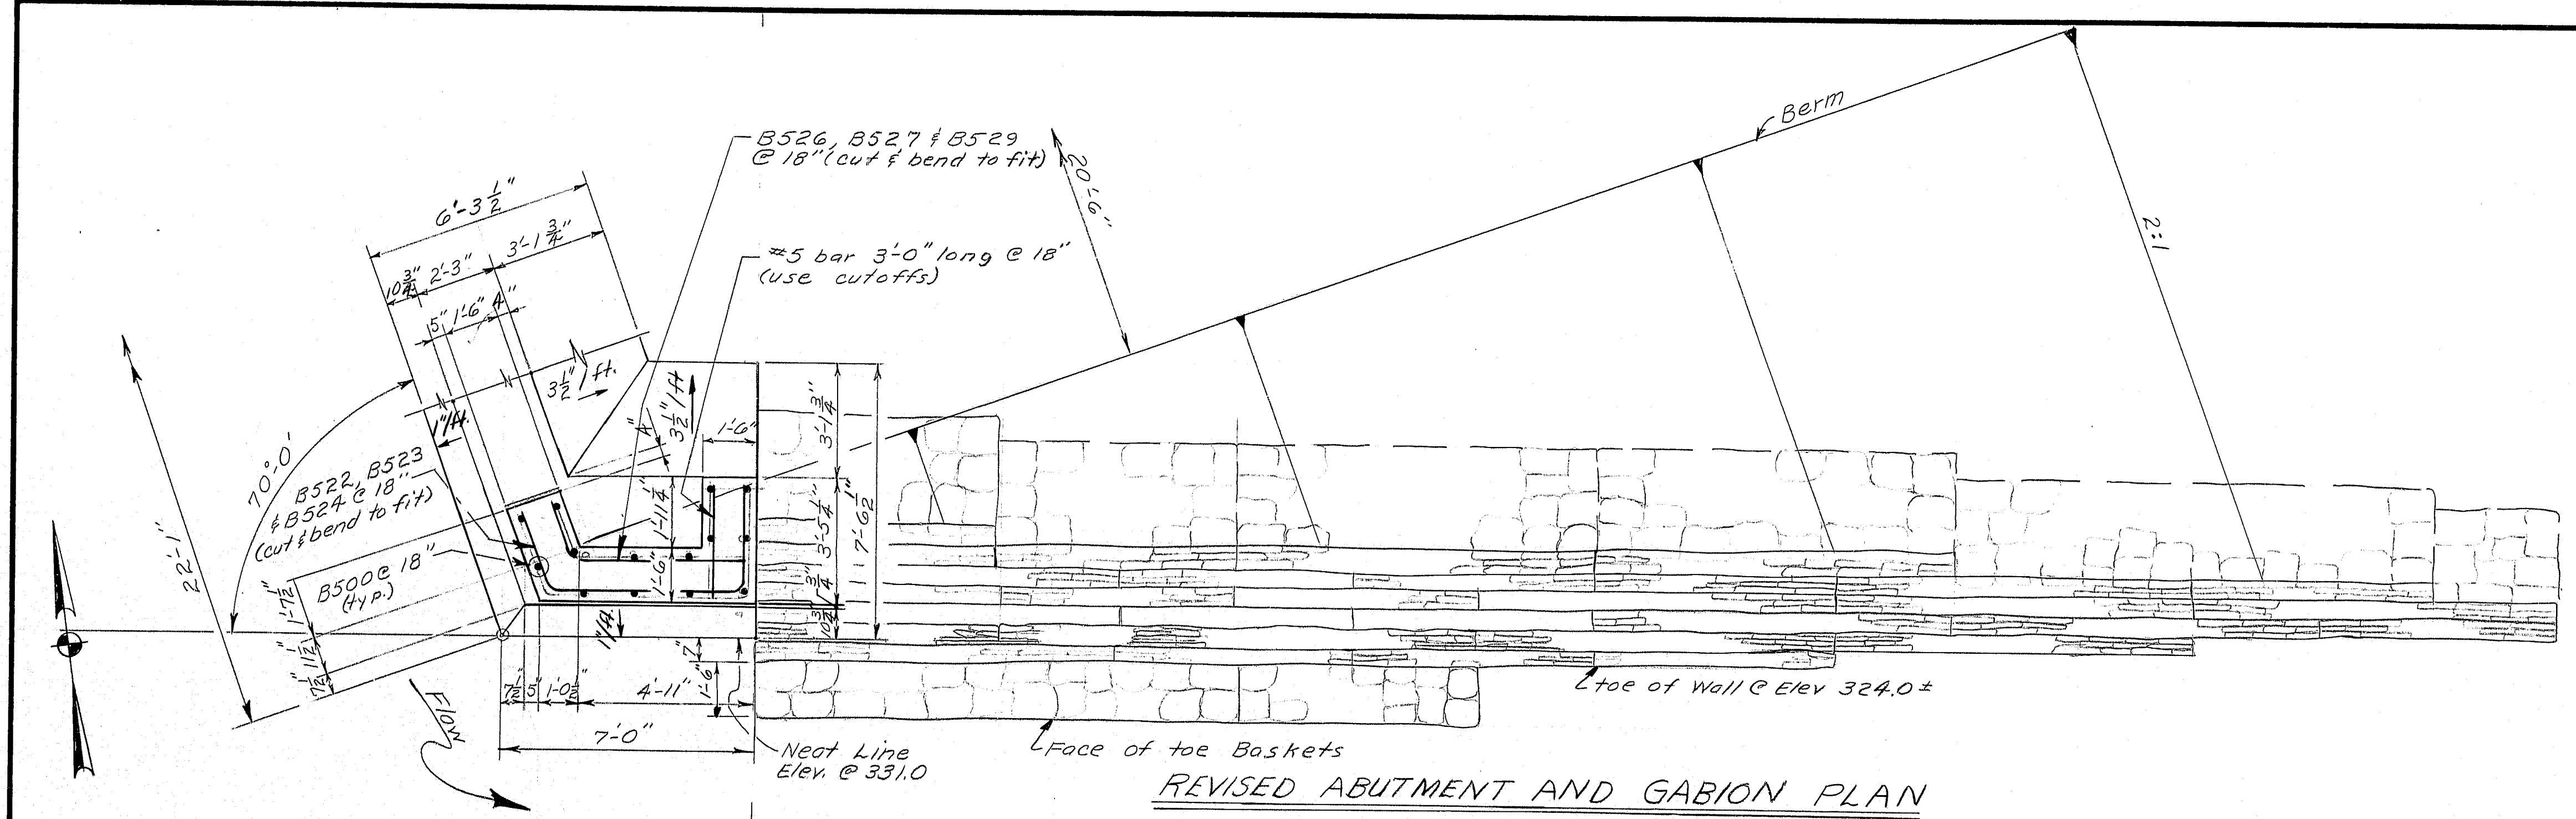

PROJECT DESIGN ENGINEER	BY	DATE
PLANS	W. M. Mousley	10/27/82
DESIGN DETAIL	W. M. Mousley	10/27/82
CHECKED	R. H. H. H.	
REVISIONS		
FIELD CHANGES		

BRUNING 44-152-28710




AS BUILT 1983
 STATE OF MAINE
 DEPARTMENT OF TRANSPORTATION
 WESSERUNSETT
 STREAM BRIDGE
 ATHENS
 ABUTMENT #2 REVISIONS
 & GABIONS
 SHEET 6a OF AUGUSTA, MAINE Oct 17, 1982

R89-459


F.W.A. REG. NO.	STATE	PROJECT NUMBER	SHEET NO.	TOTAL SHEETS
1	MAINE	RS-0241(11)	66	

GABION NOTES

- 1) The Gabions shall be constructed in accordance with the Department of Transportation Standard Specifications for Highways and Bridges Section 601.
- 2) All excavation required to construct the Gabion wall to neat lines 1'-6" out from the face of baskets will be paid for under Item 206.08, Structural Earth Excavation Abuts., Ret. Walls, etc.
- 3) Payment for all materials equipment and labor required to construct the Gabion foundation, as shown on the plans, will be considered incidental to the Gabions.
- 4) Place a 2 foot wide sod strip along the top of the Gabions.

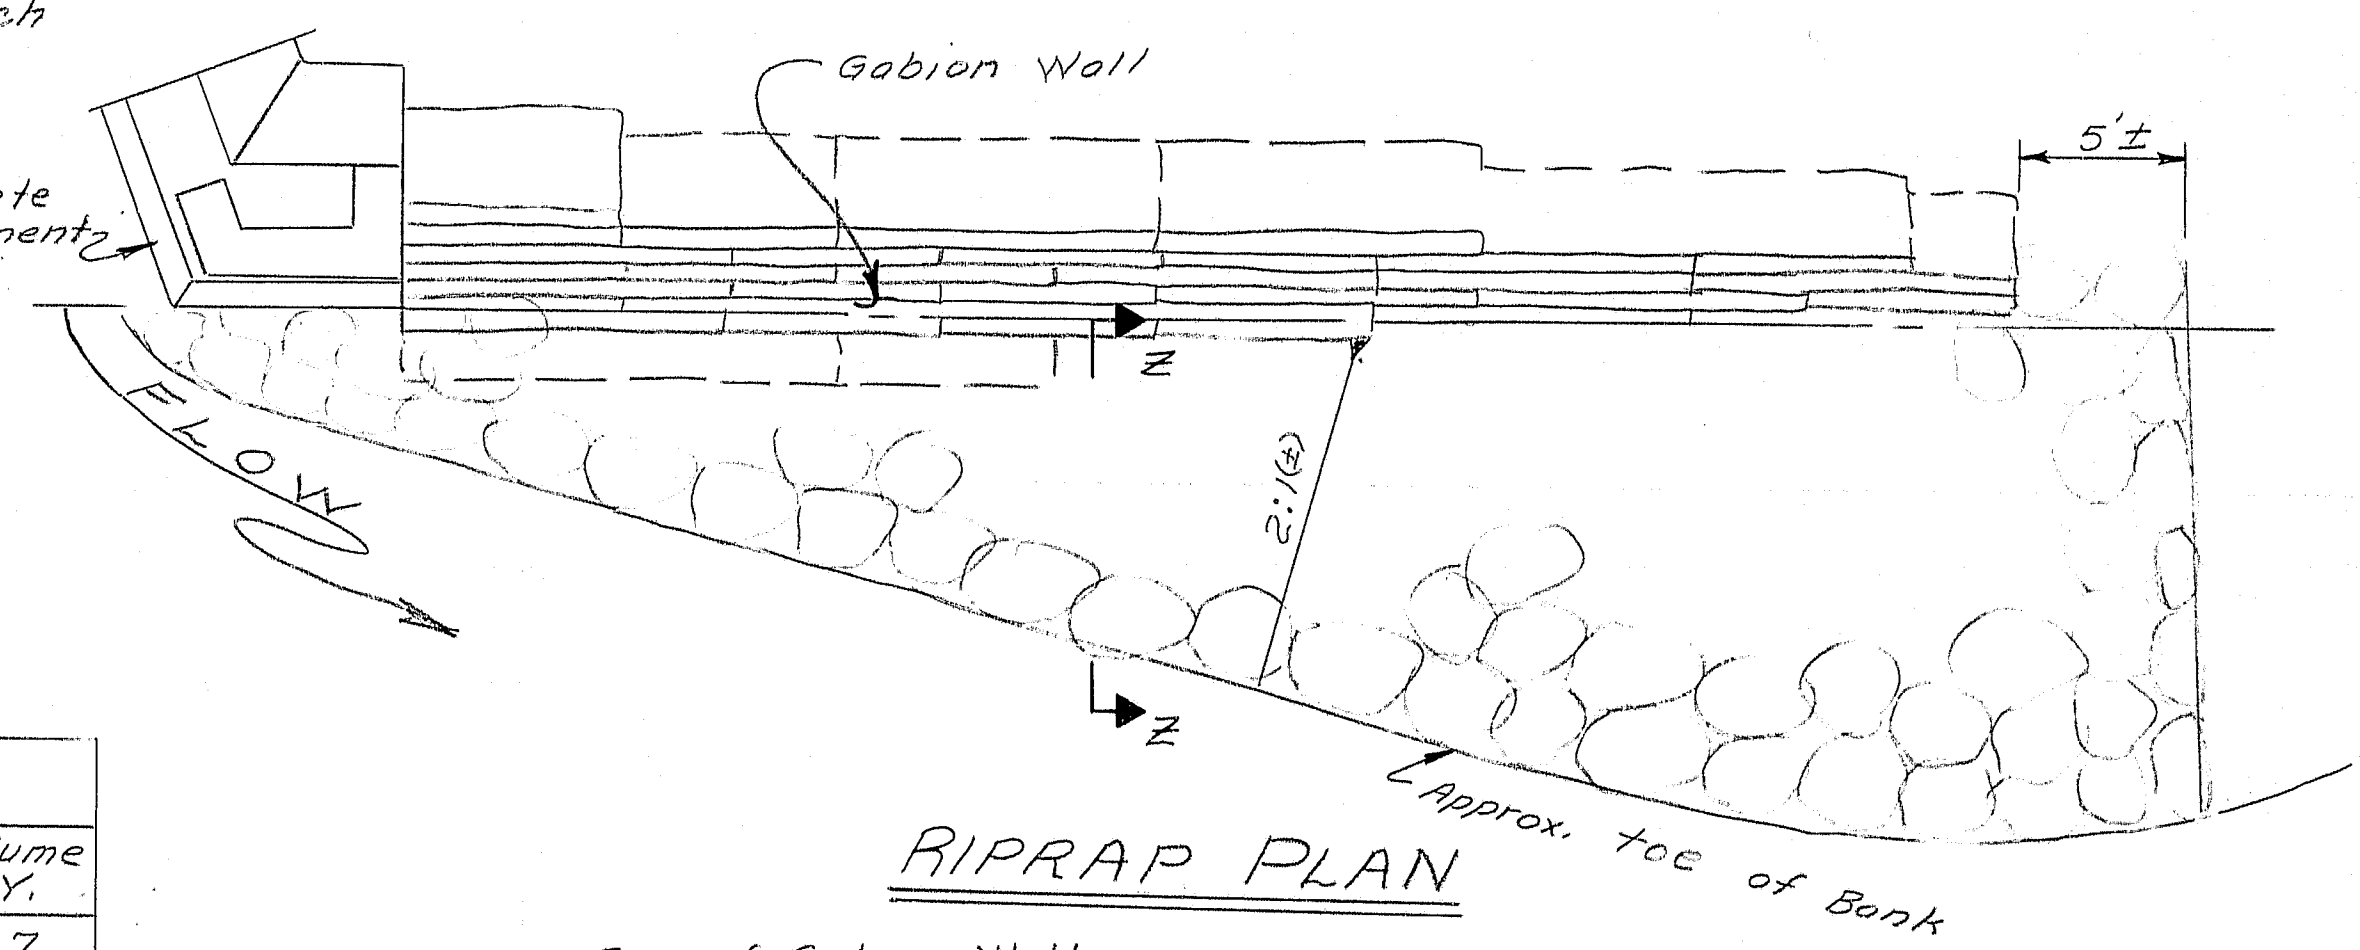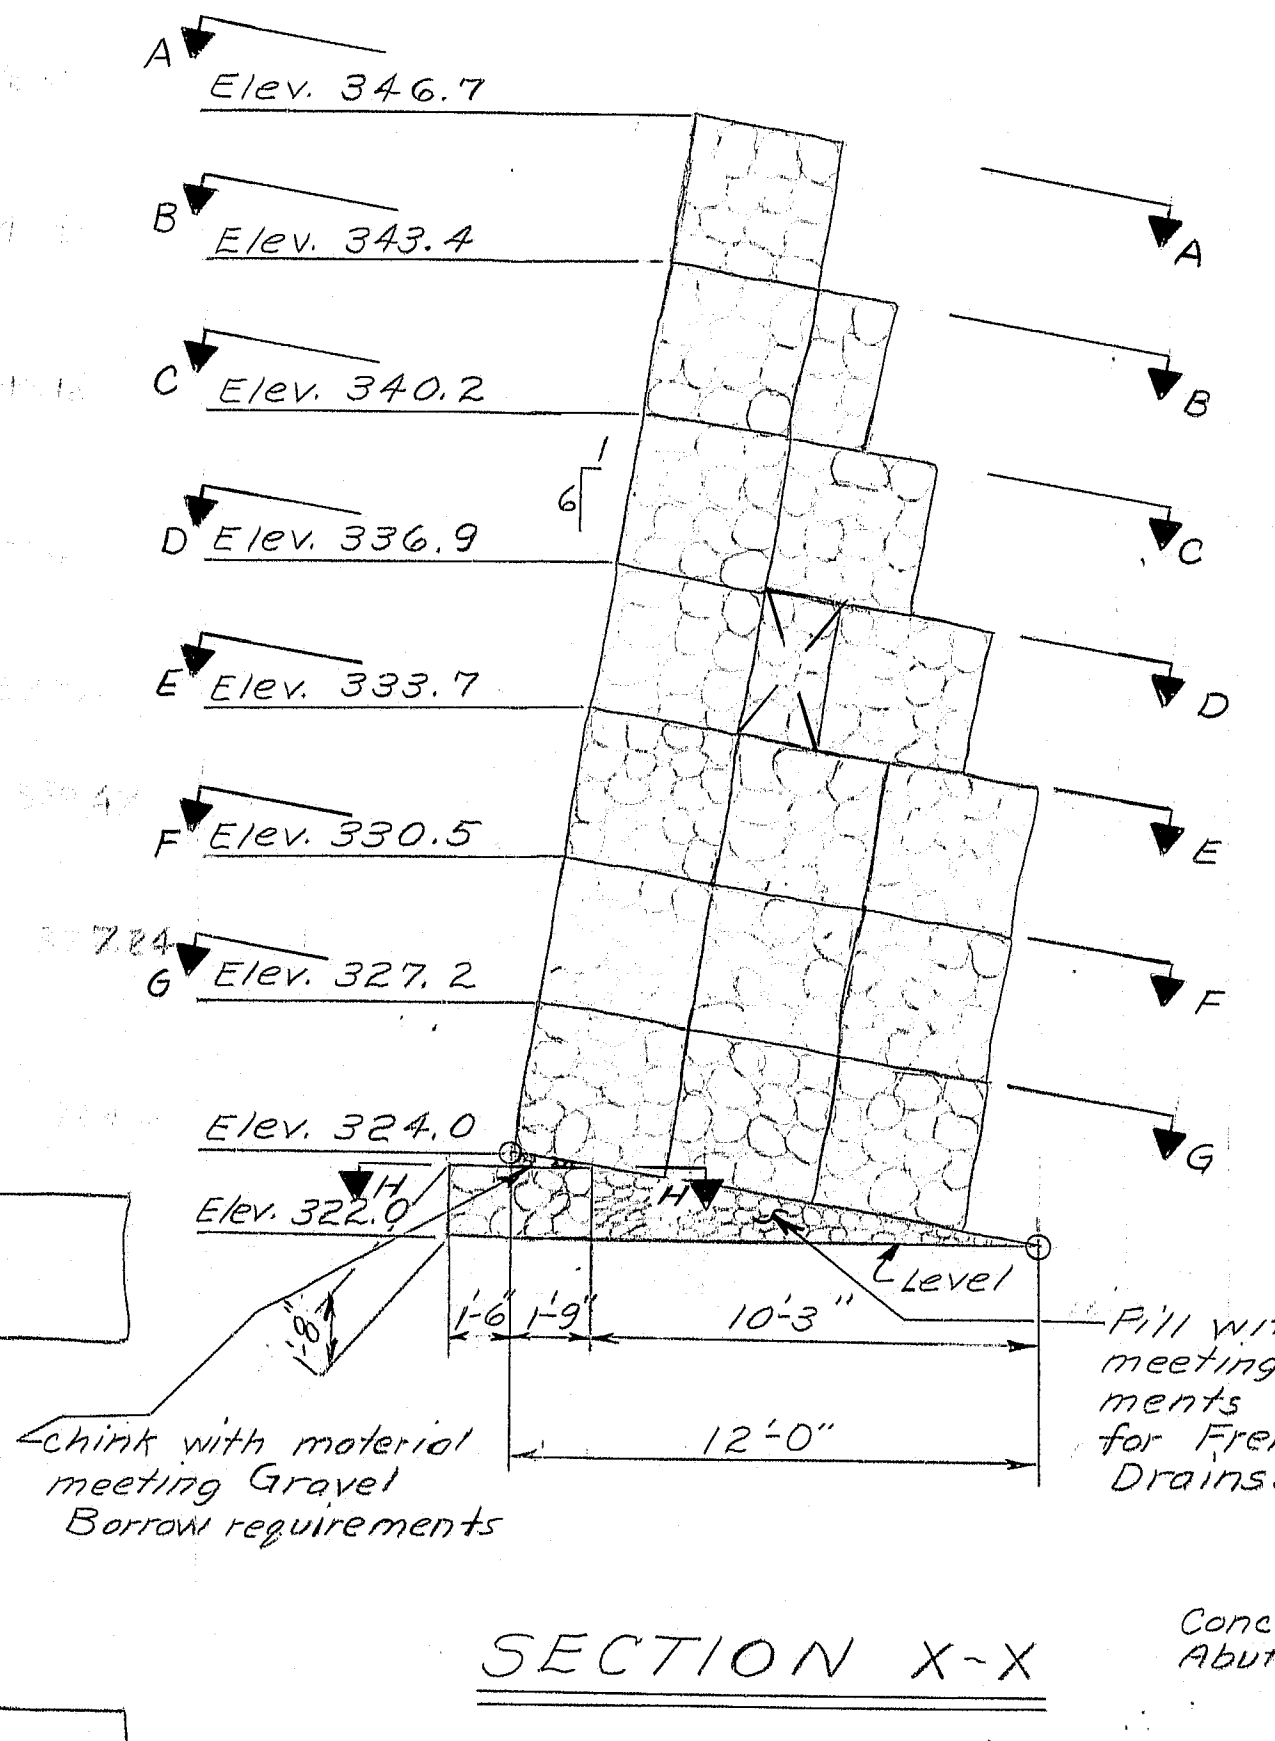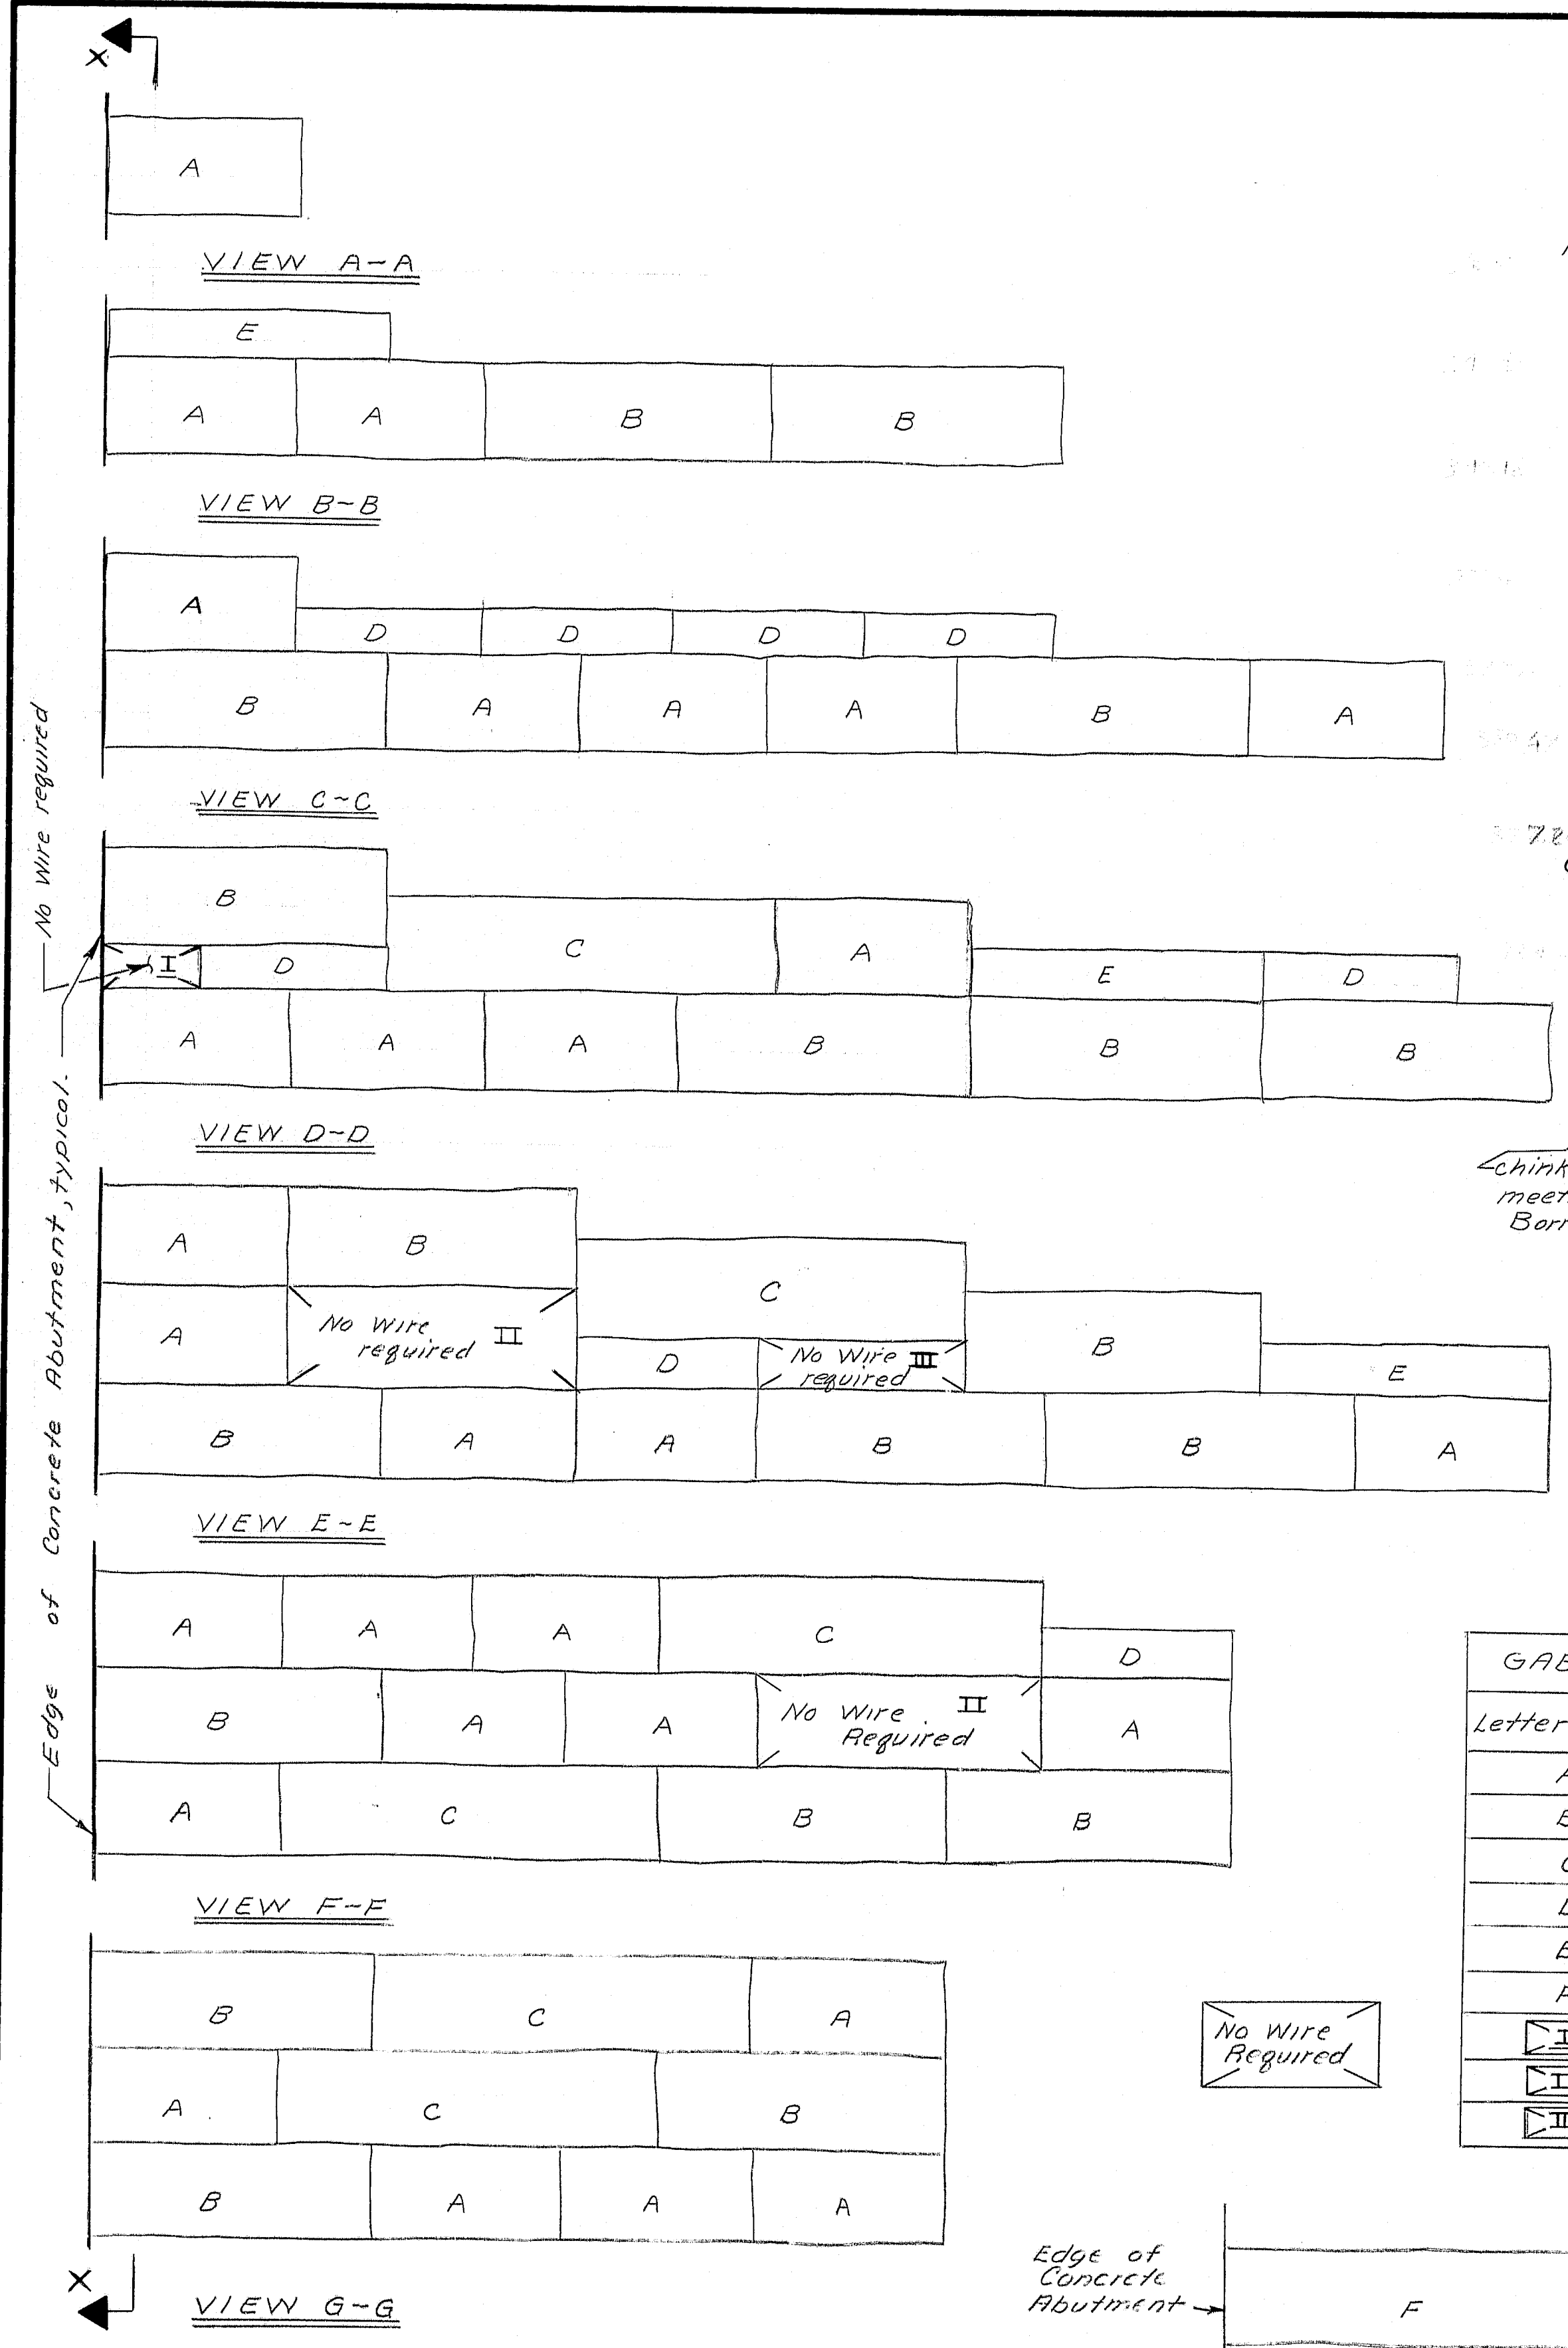

GABION BASKET TABLE				QUANTITIES		
Letter Code	length	width	height	Volume C.Y.	No. of Baskets	Volume C.Y.
A	6'-6"	3'-3"	3'-3"	2.54	29	73.7
B	9'-9"	3'-3"	3'-3"	3.81	19	72.5
C	13'-1"	3'-3"	3'-3"	5.12	6	30.7
D	6'-6"	1'-8"	3'-3"	1.30	9	11.7
E	9'-9"	1'-8"	3'-3"	1.95	3	5.8
F	13'-1"	3'-3"	1'-8"	2.61	1	2.6
I	3'-3"	1'-8"	3'-3"	0.65	1	0.6
II	9'-9"	3'-3"	3'-3"	3.81	2	7.6
III	6'-6"	1'-8"	3'-3"	1.30	1	1.3
TOTAL VOLUME						206.5

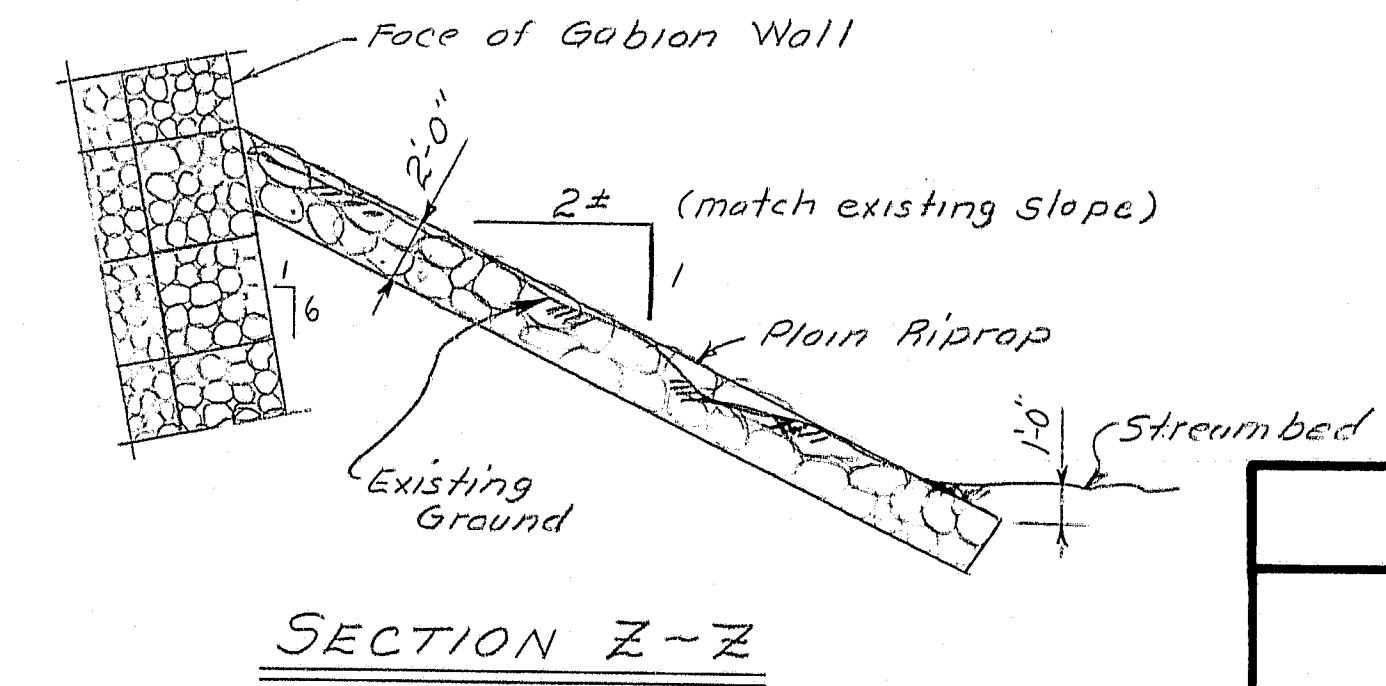

As Built
1983 R.M.J.

STATE OF MAINE
DEPARTMENT OF TRANSPORTATION

WESSERUNSETT
STREAM BRIDGE

ATHENS


GABION DETAILS

SHEET 66 OF AUGUSTA, MAINE Oct. 7, 1982

PROJECT DESIGN ENGINEER	BY	DATE
DESIGN - DETAILED	P.L.M.	8/21/82
CHECKED	R.B.	8/21/82
REVISIONS		
FIELD CHANGES		


R89-460

STATE	PROJECT NUMBER	SHEET NO.	TOTAL SHEETS
MAINE	RS-0241(1)	10	19

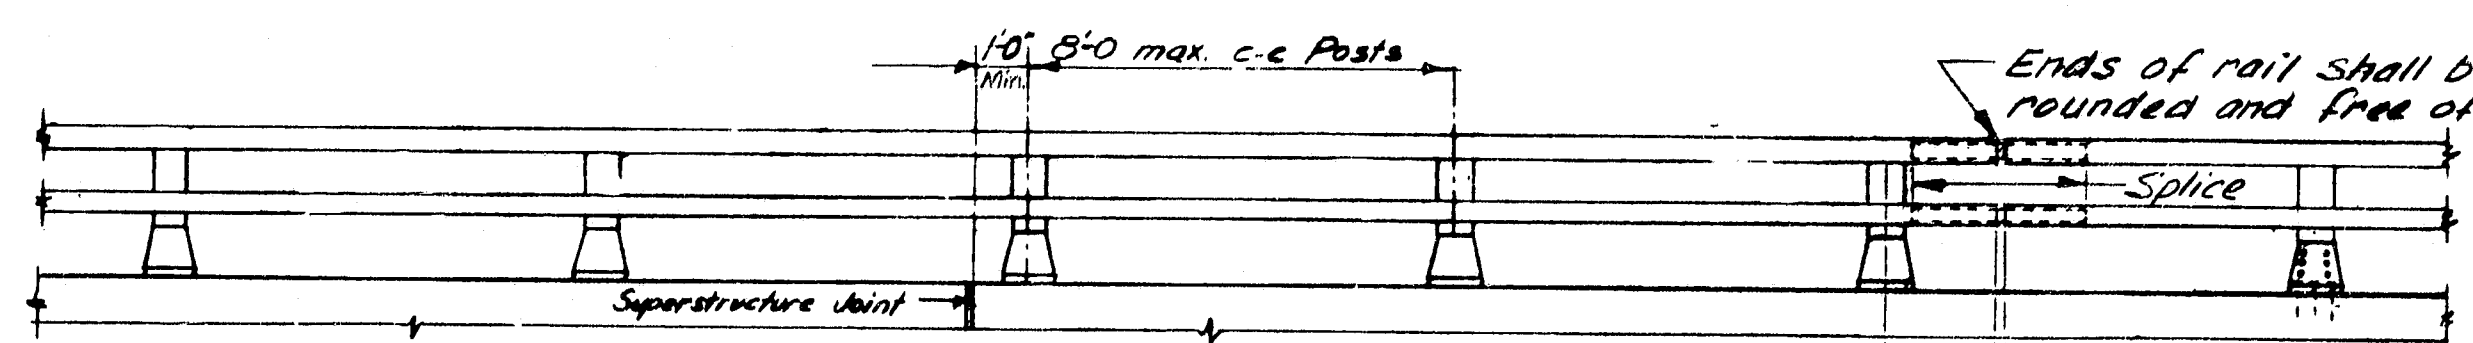

RAILING - ELEVATION


Lengths of rail shall be attached to a minimum of four (4) rail posts wherever possible, and in any case never less than two (2). Rail posts are to be set normal to grade unless otherwise shown on the Bridge Plans.

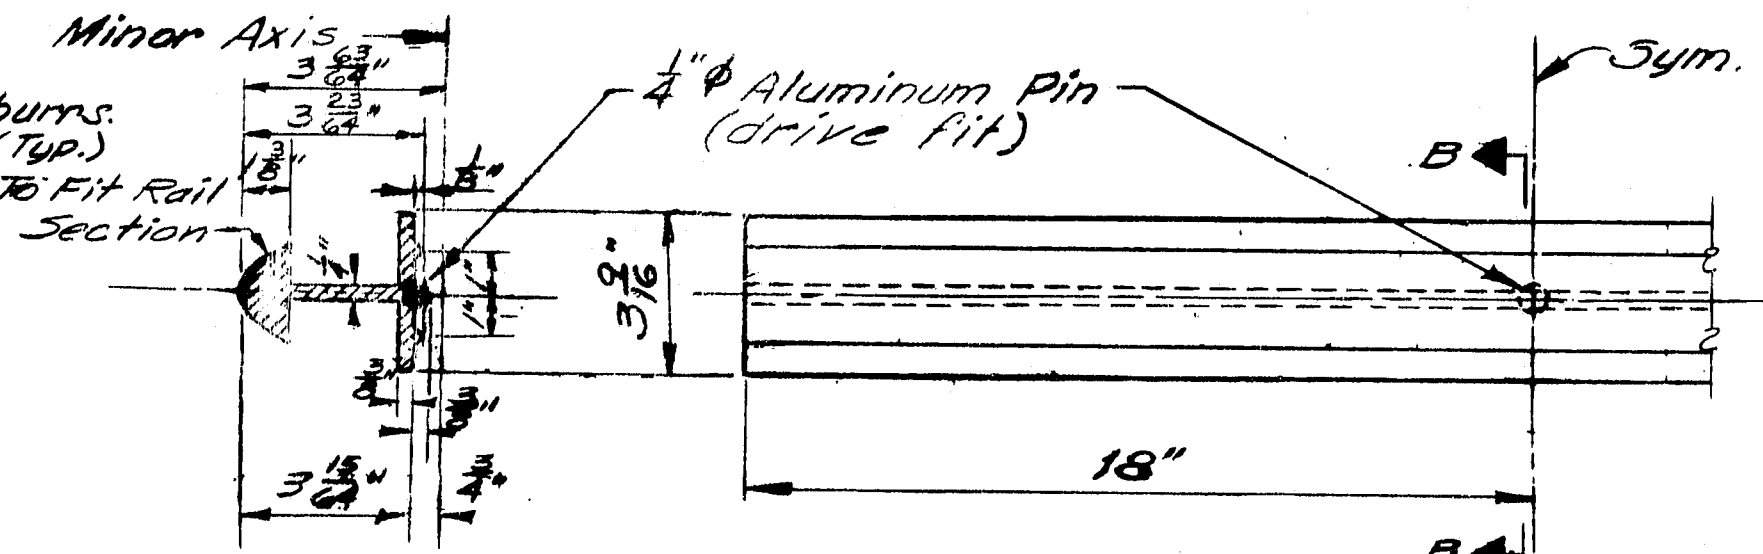


SECTION B-B

SPLICE BAR

Alternate splice bars may be substituted if approved by the Engineer

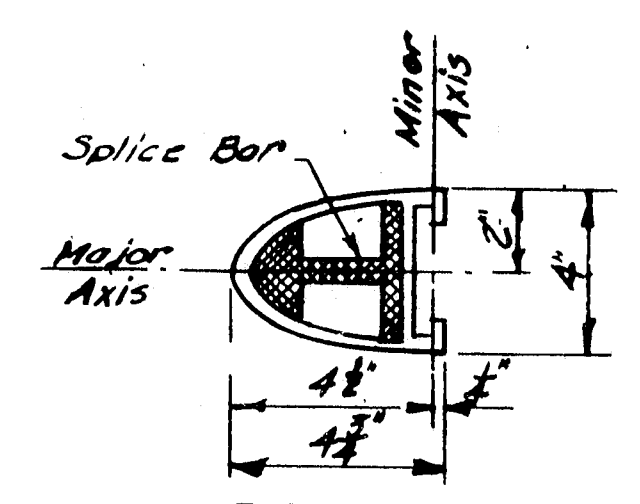


RAIL SECTION

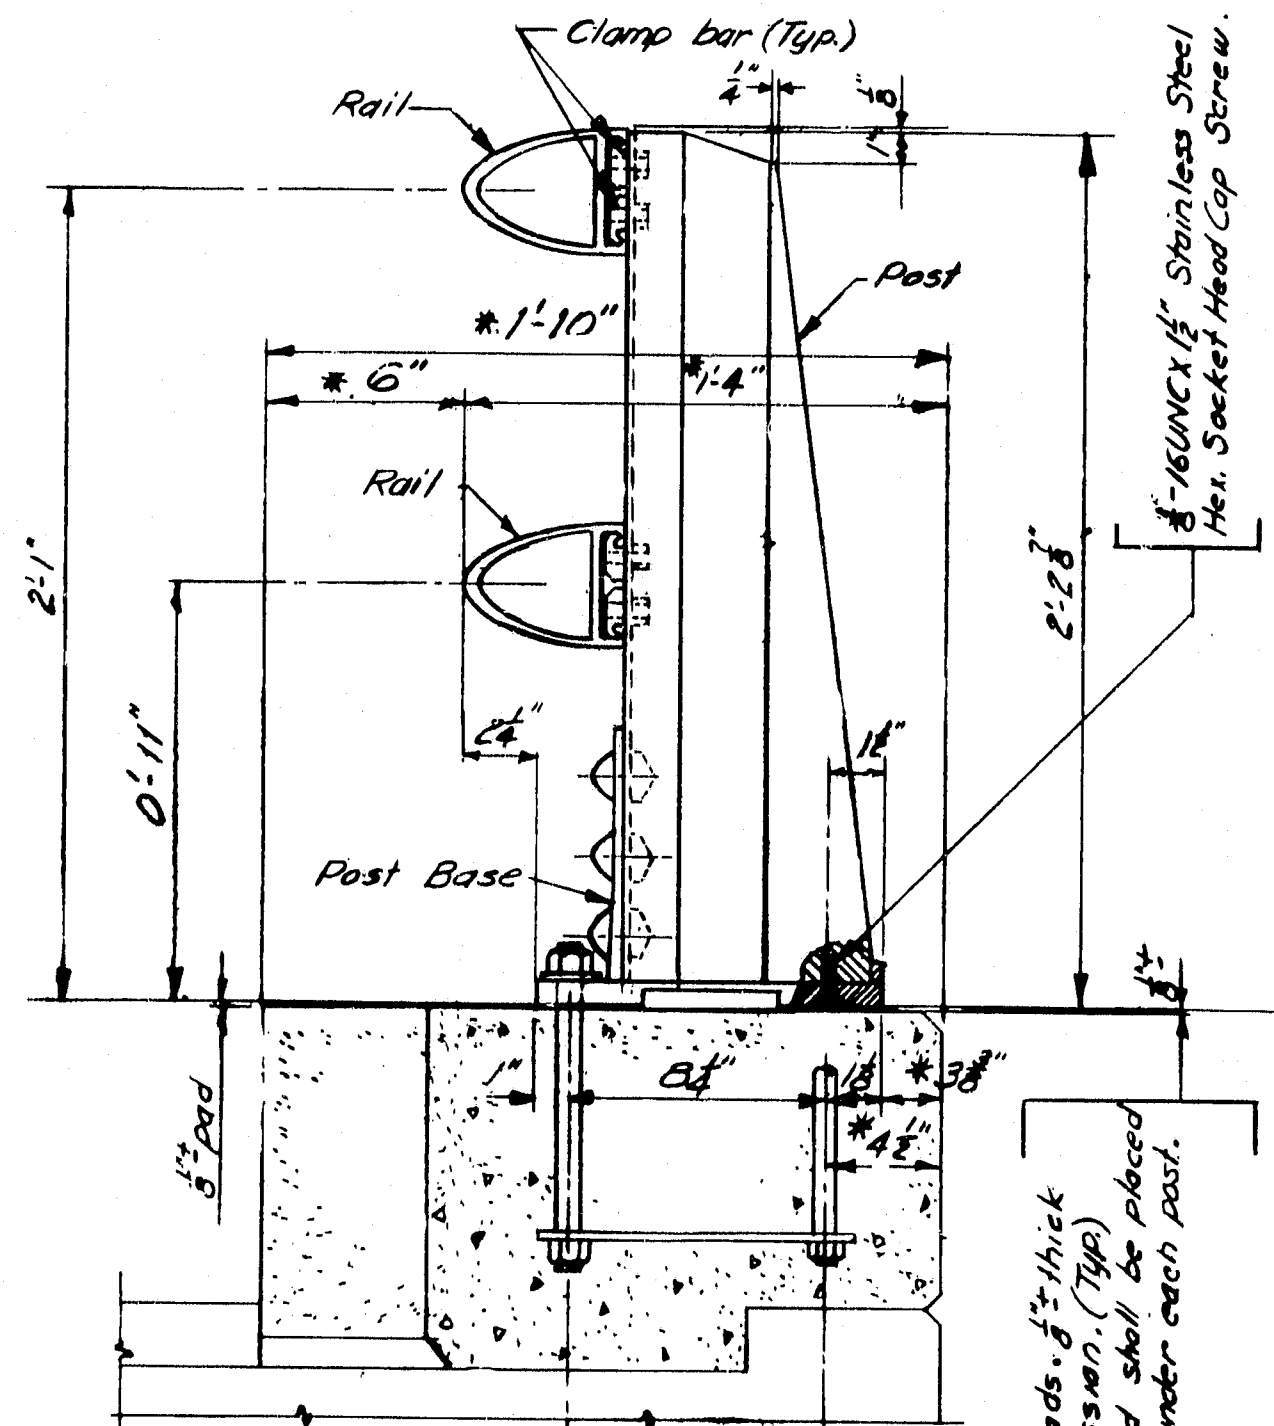


BRIDGE RAILING (Assembly)


* Preferable minimum dimensions. For actual dimensions see Bridge Plan.

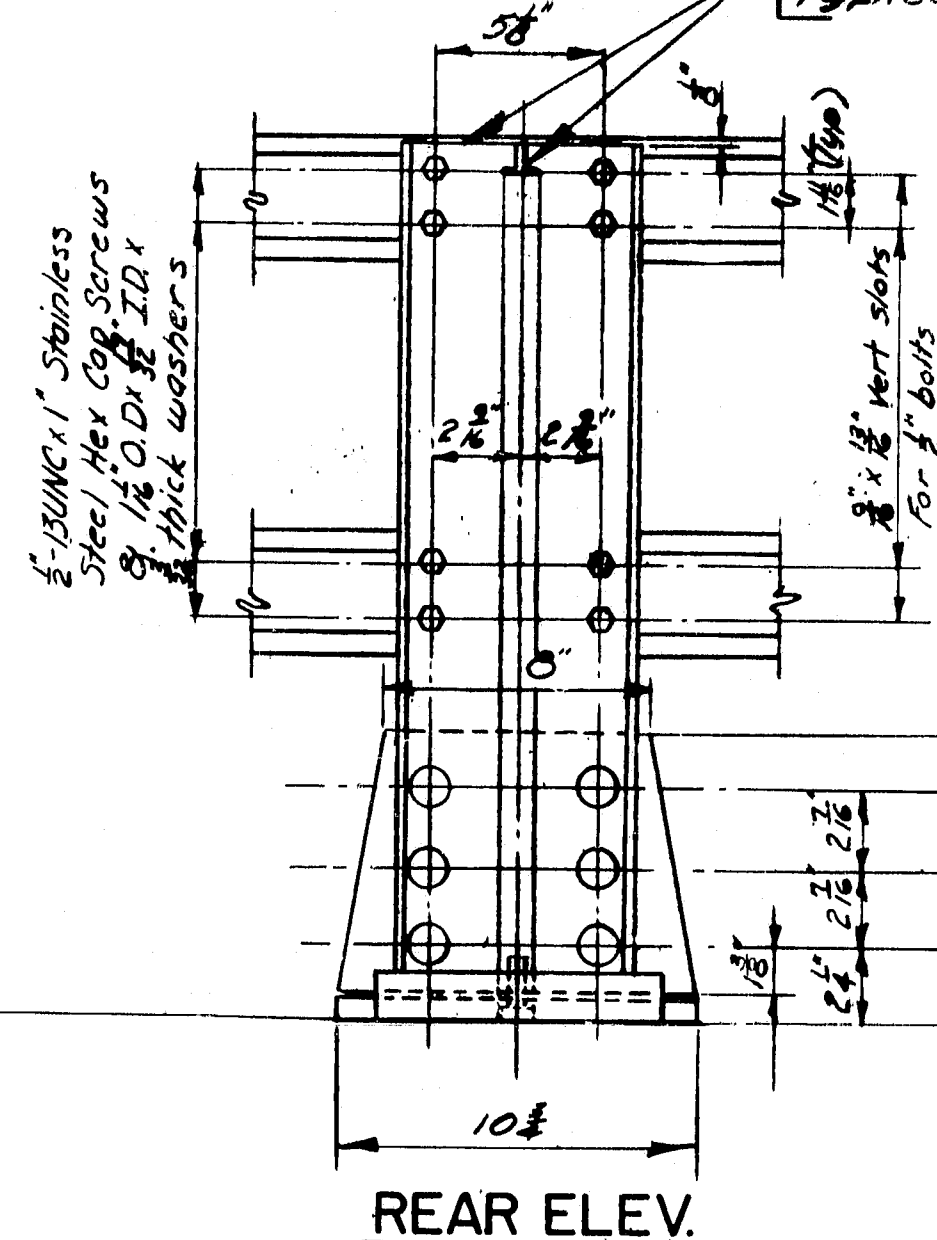


REAR ELEV.

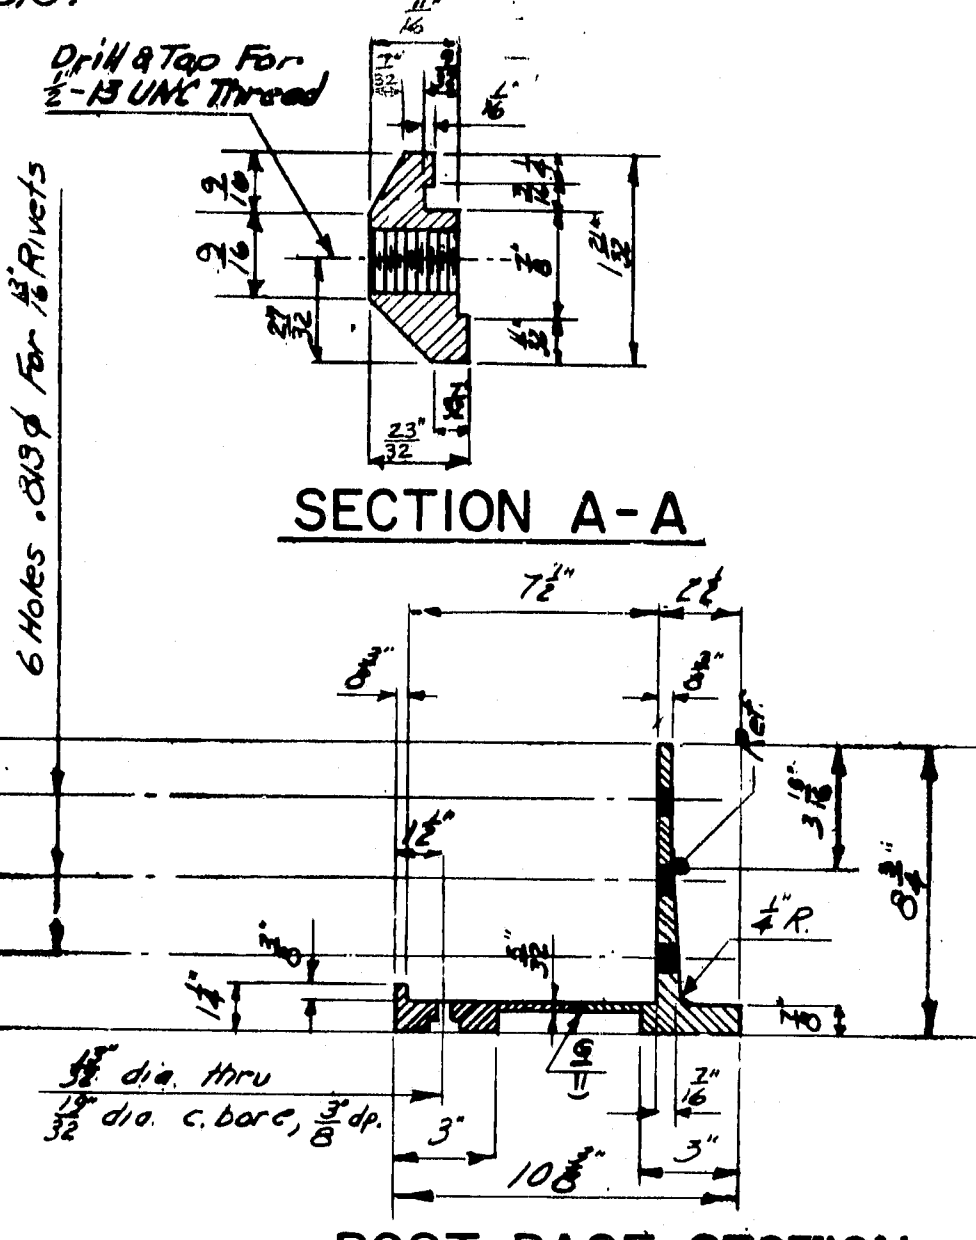


POST BASE SECTION

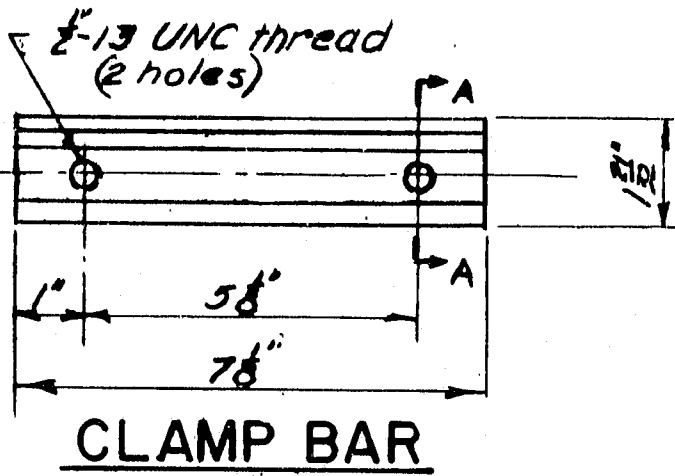


CLAMP BAR

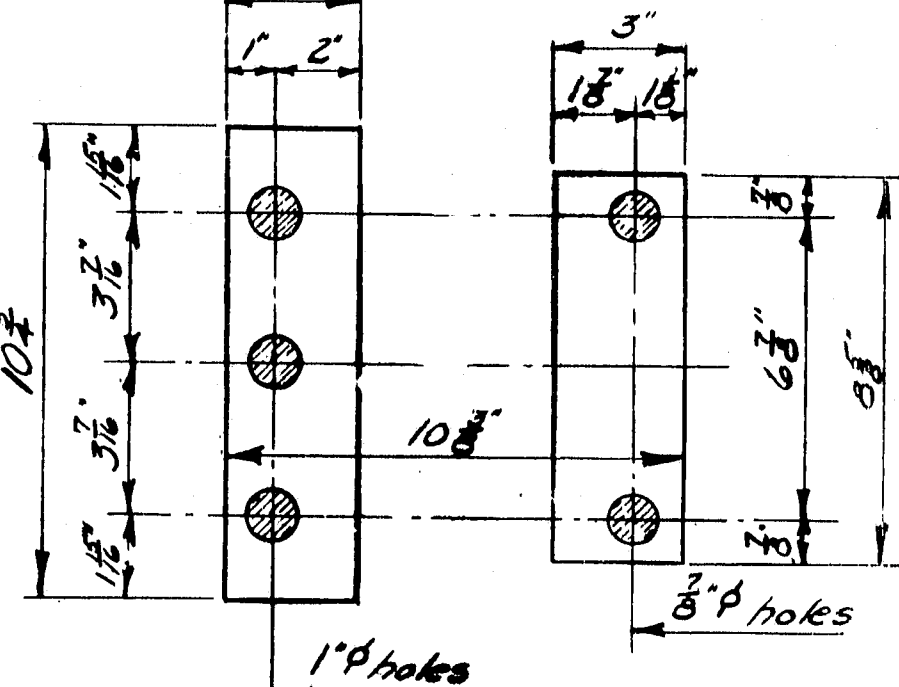


PREFORMED PADS

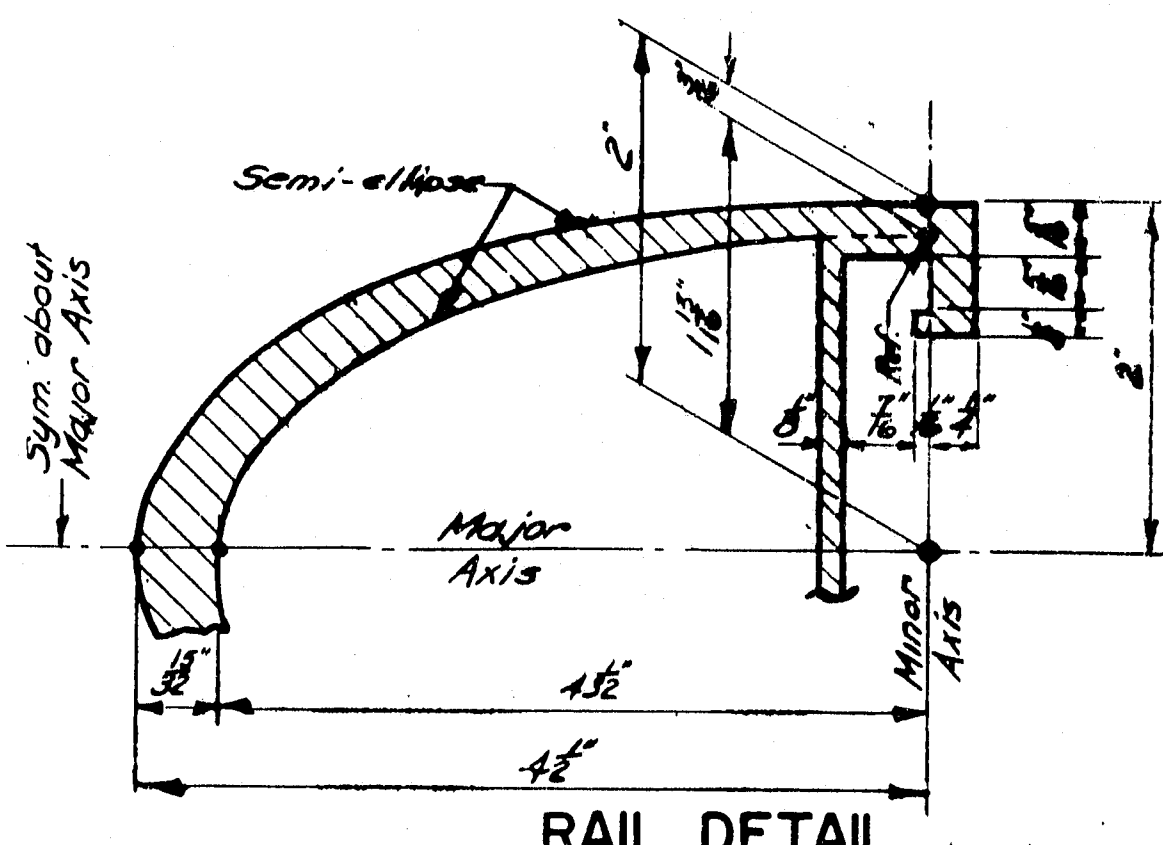

RAIL DETAIL

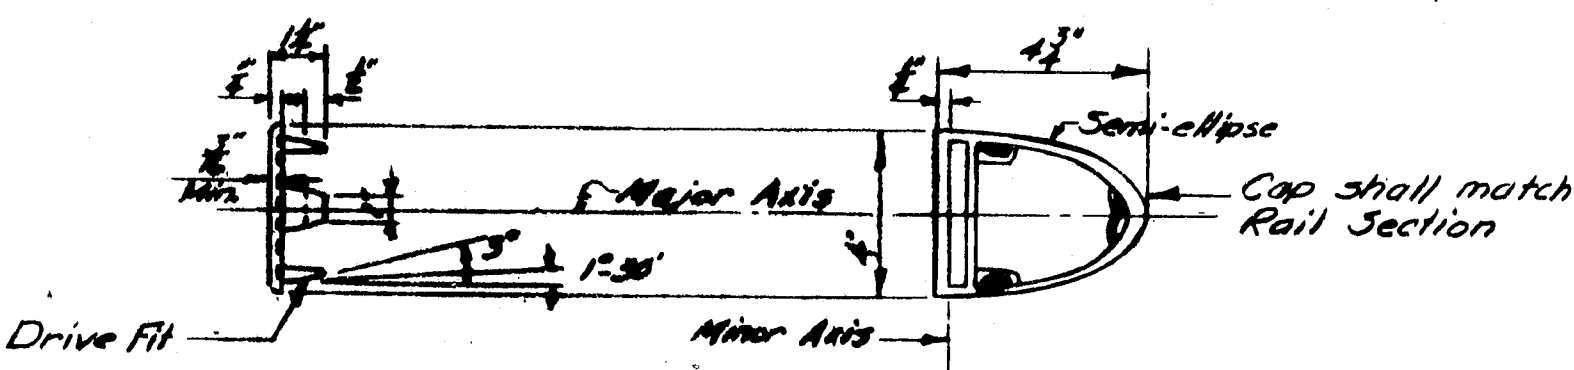


RAIL CAP

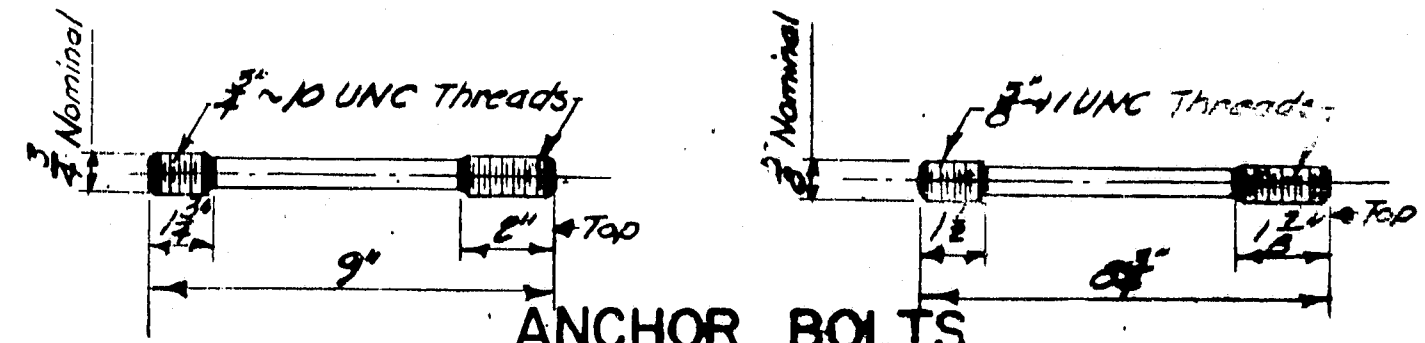


ANCHOR BOLTS


If cut threads are used, body diameter shall be not less than nominal diameter. If rolled threads are used, body diameter shall be not less than pitch diameter of the threads.

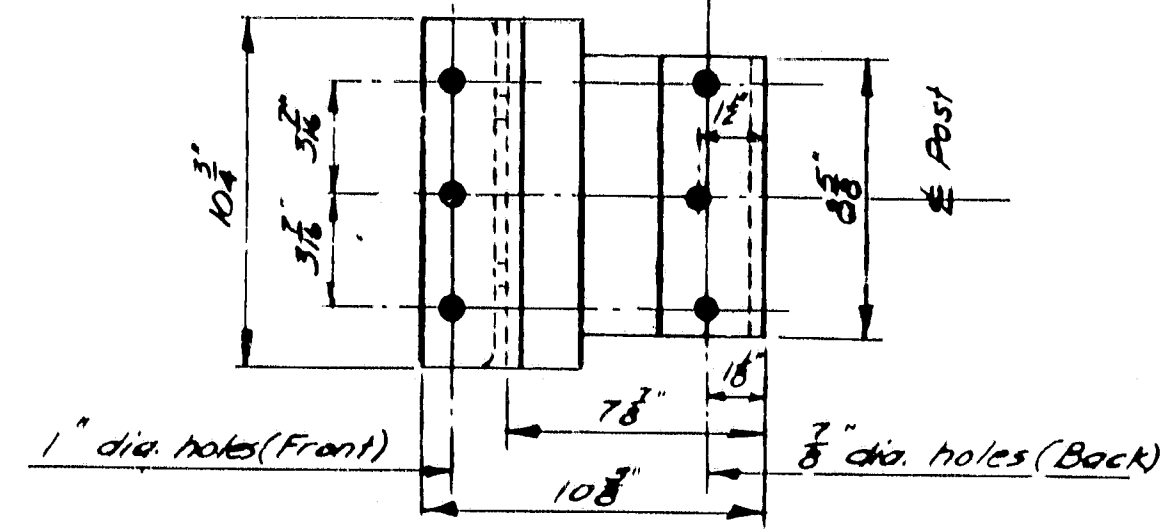


POST BASE (Bottom View)

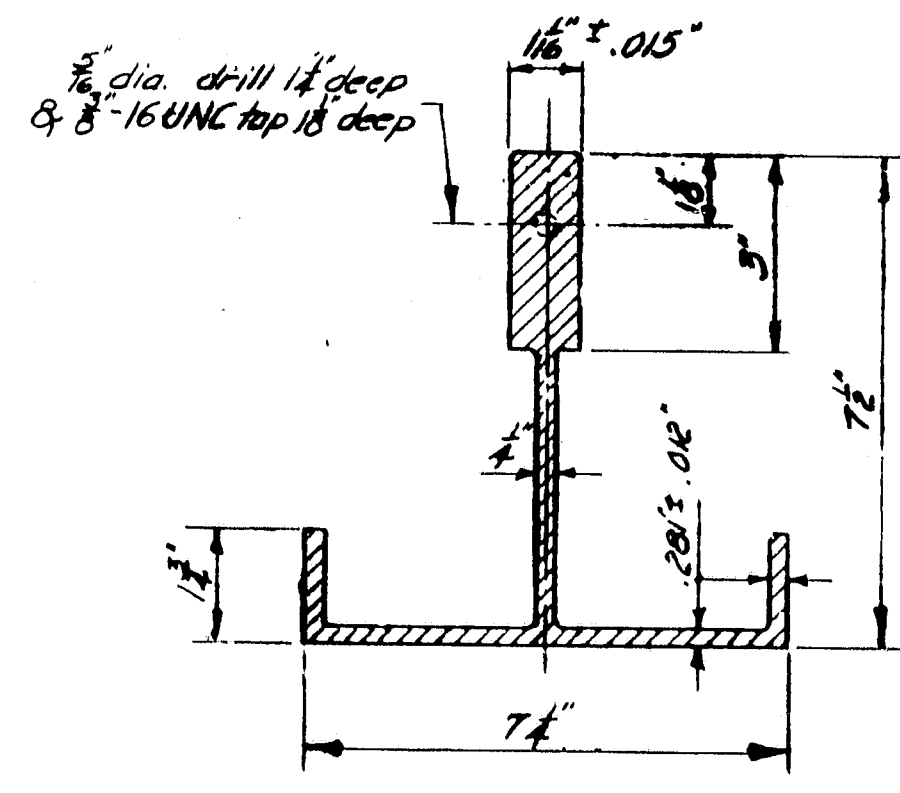

POST SECTION

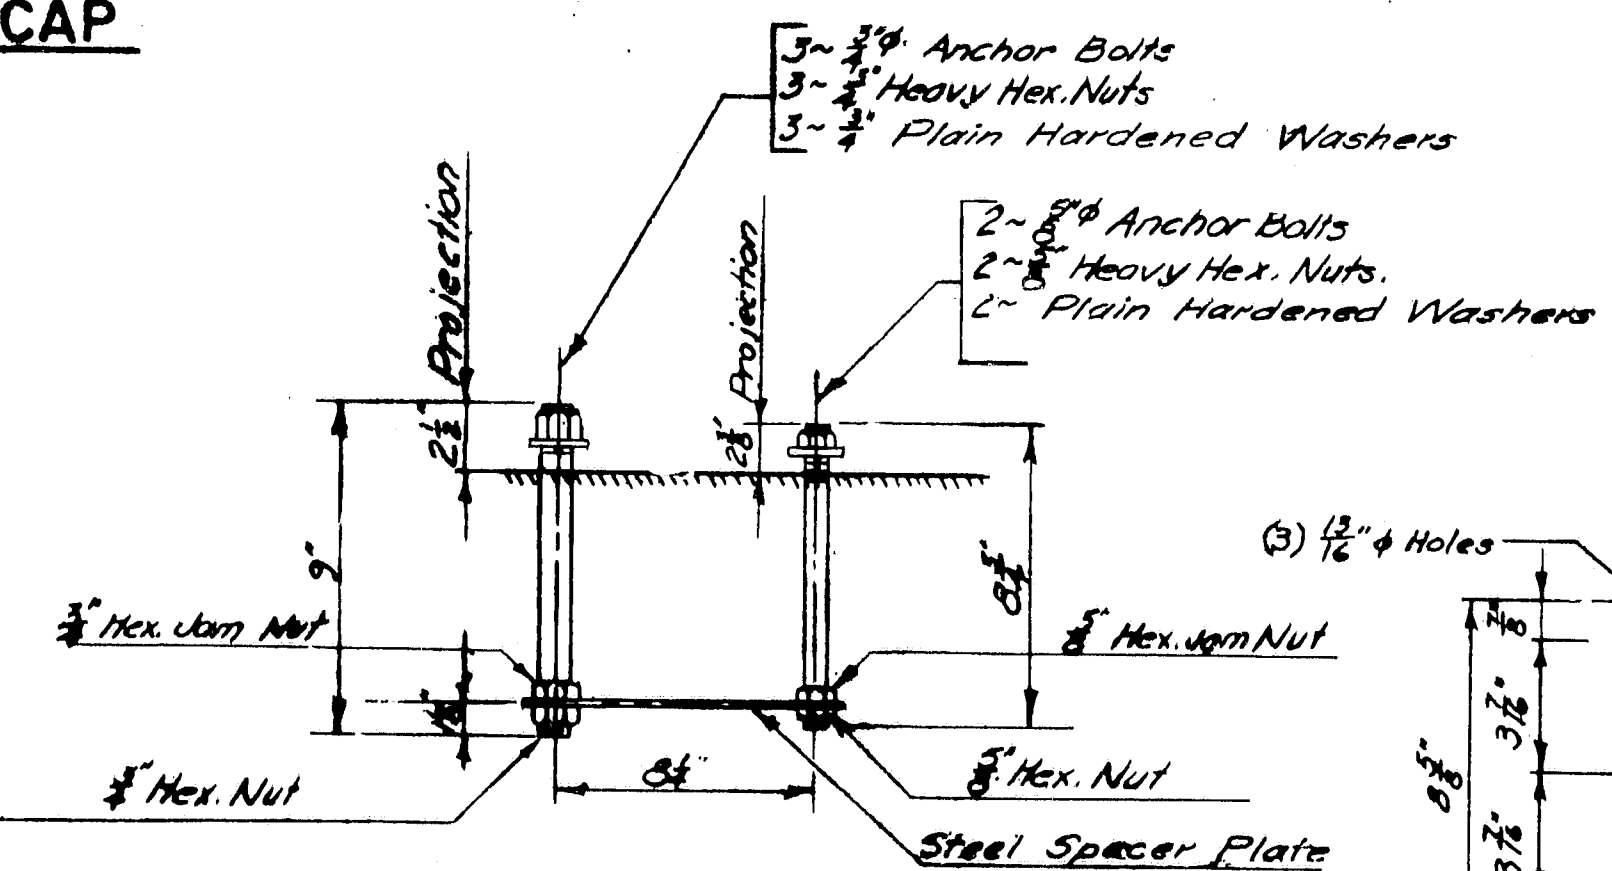

RAIL POST ANCHORAGE (Assembly)

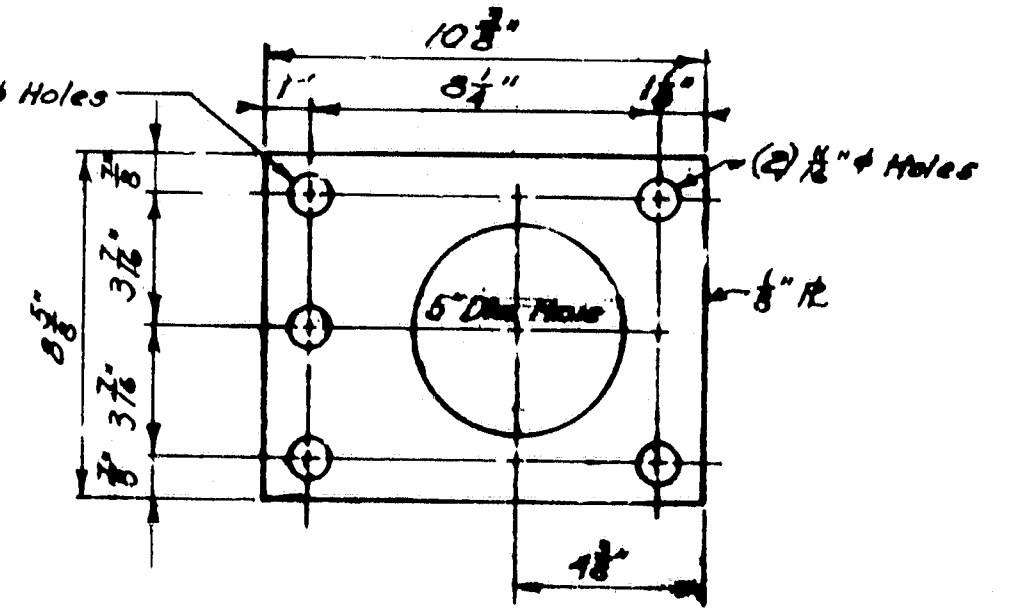

STEEL SPACER PLATE (FOR...)

RS Built 1983
mg


REVISIONS

REVISIONS	DATE
STATE OF MAINE DEPARTMENT OF TRANSPORTATION STANDARD DETAILS (BD 114-01) ALUMINUM BRIDGE RAILING 2-BAR (SEMI-ELLIPTICAL) TYPE "A"SHEET 10 OF 19 AUGUSTA, MAINE JUNE 1981 Athens	


R89-464

DATE	BY	REVISION - DETAILED
		CHECKED
		REVISIONS
		FIELD CHANGES
PLANS		

F.M.A. REG. NO.	STATE	PROJECT NUMBER	SHEET NO.	TOTAL SHEETS
1	MAINE	RS-0241(1)	12	19

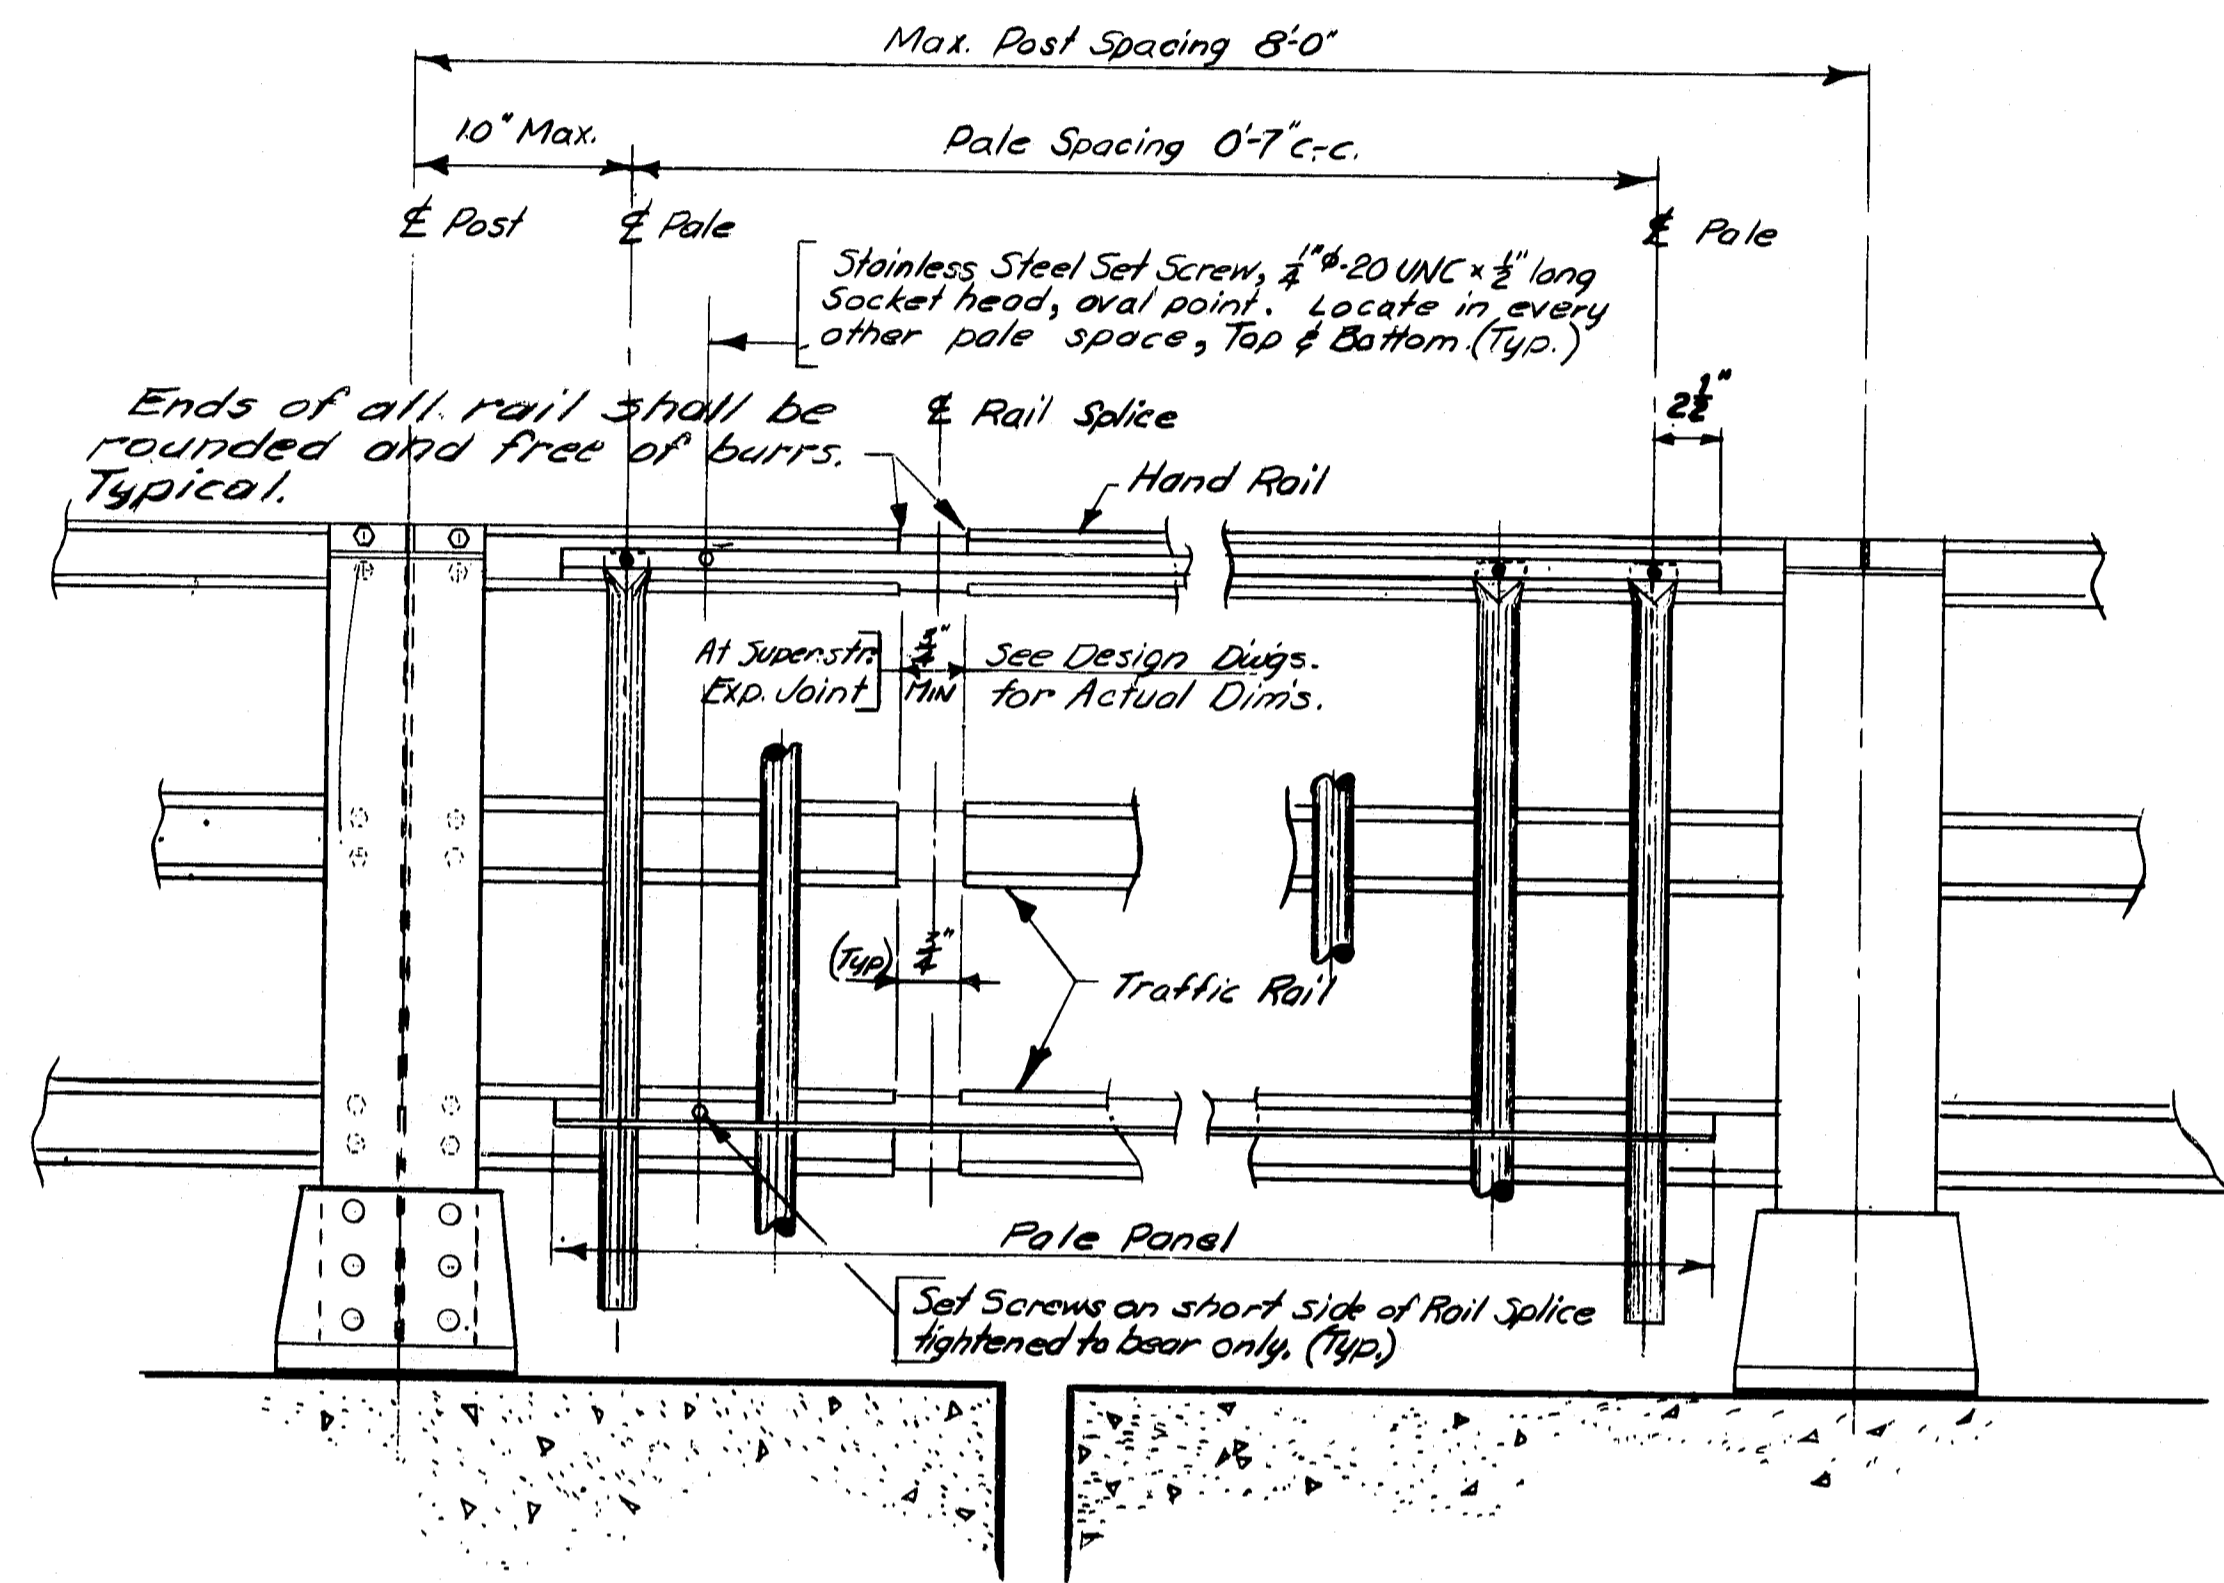

PALE PANEL REAR ELEVATION

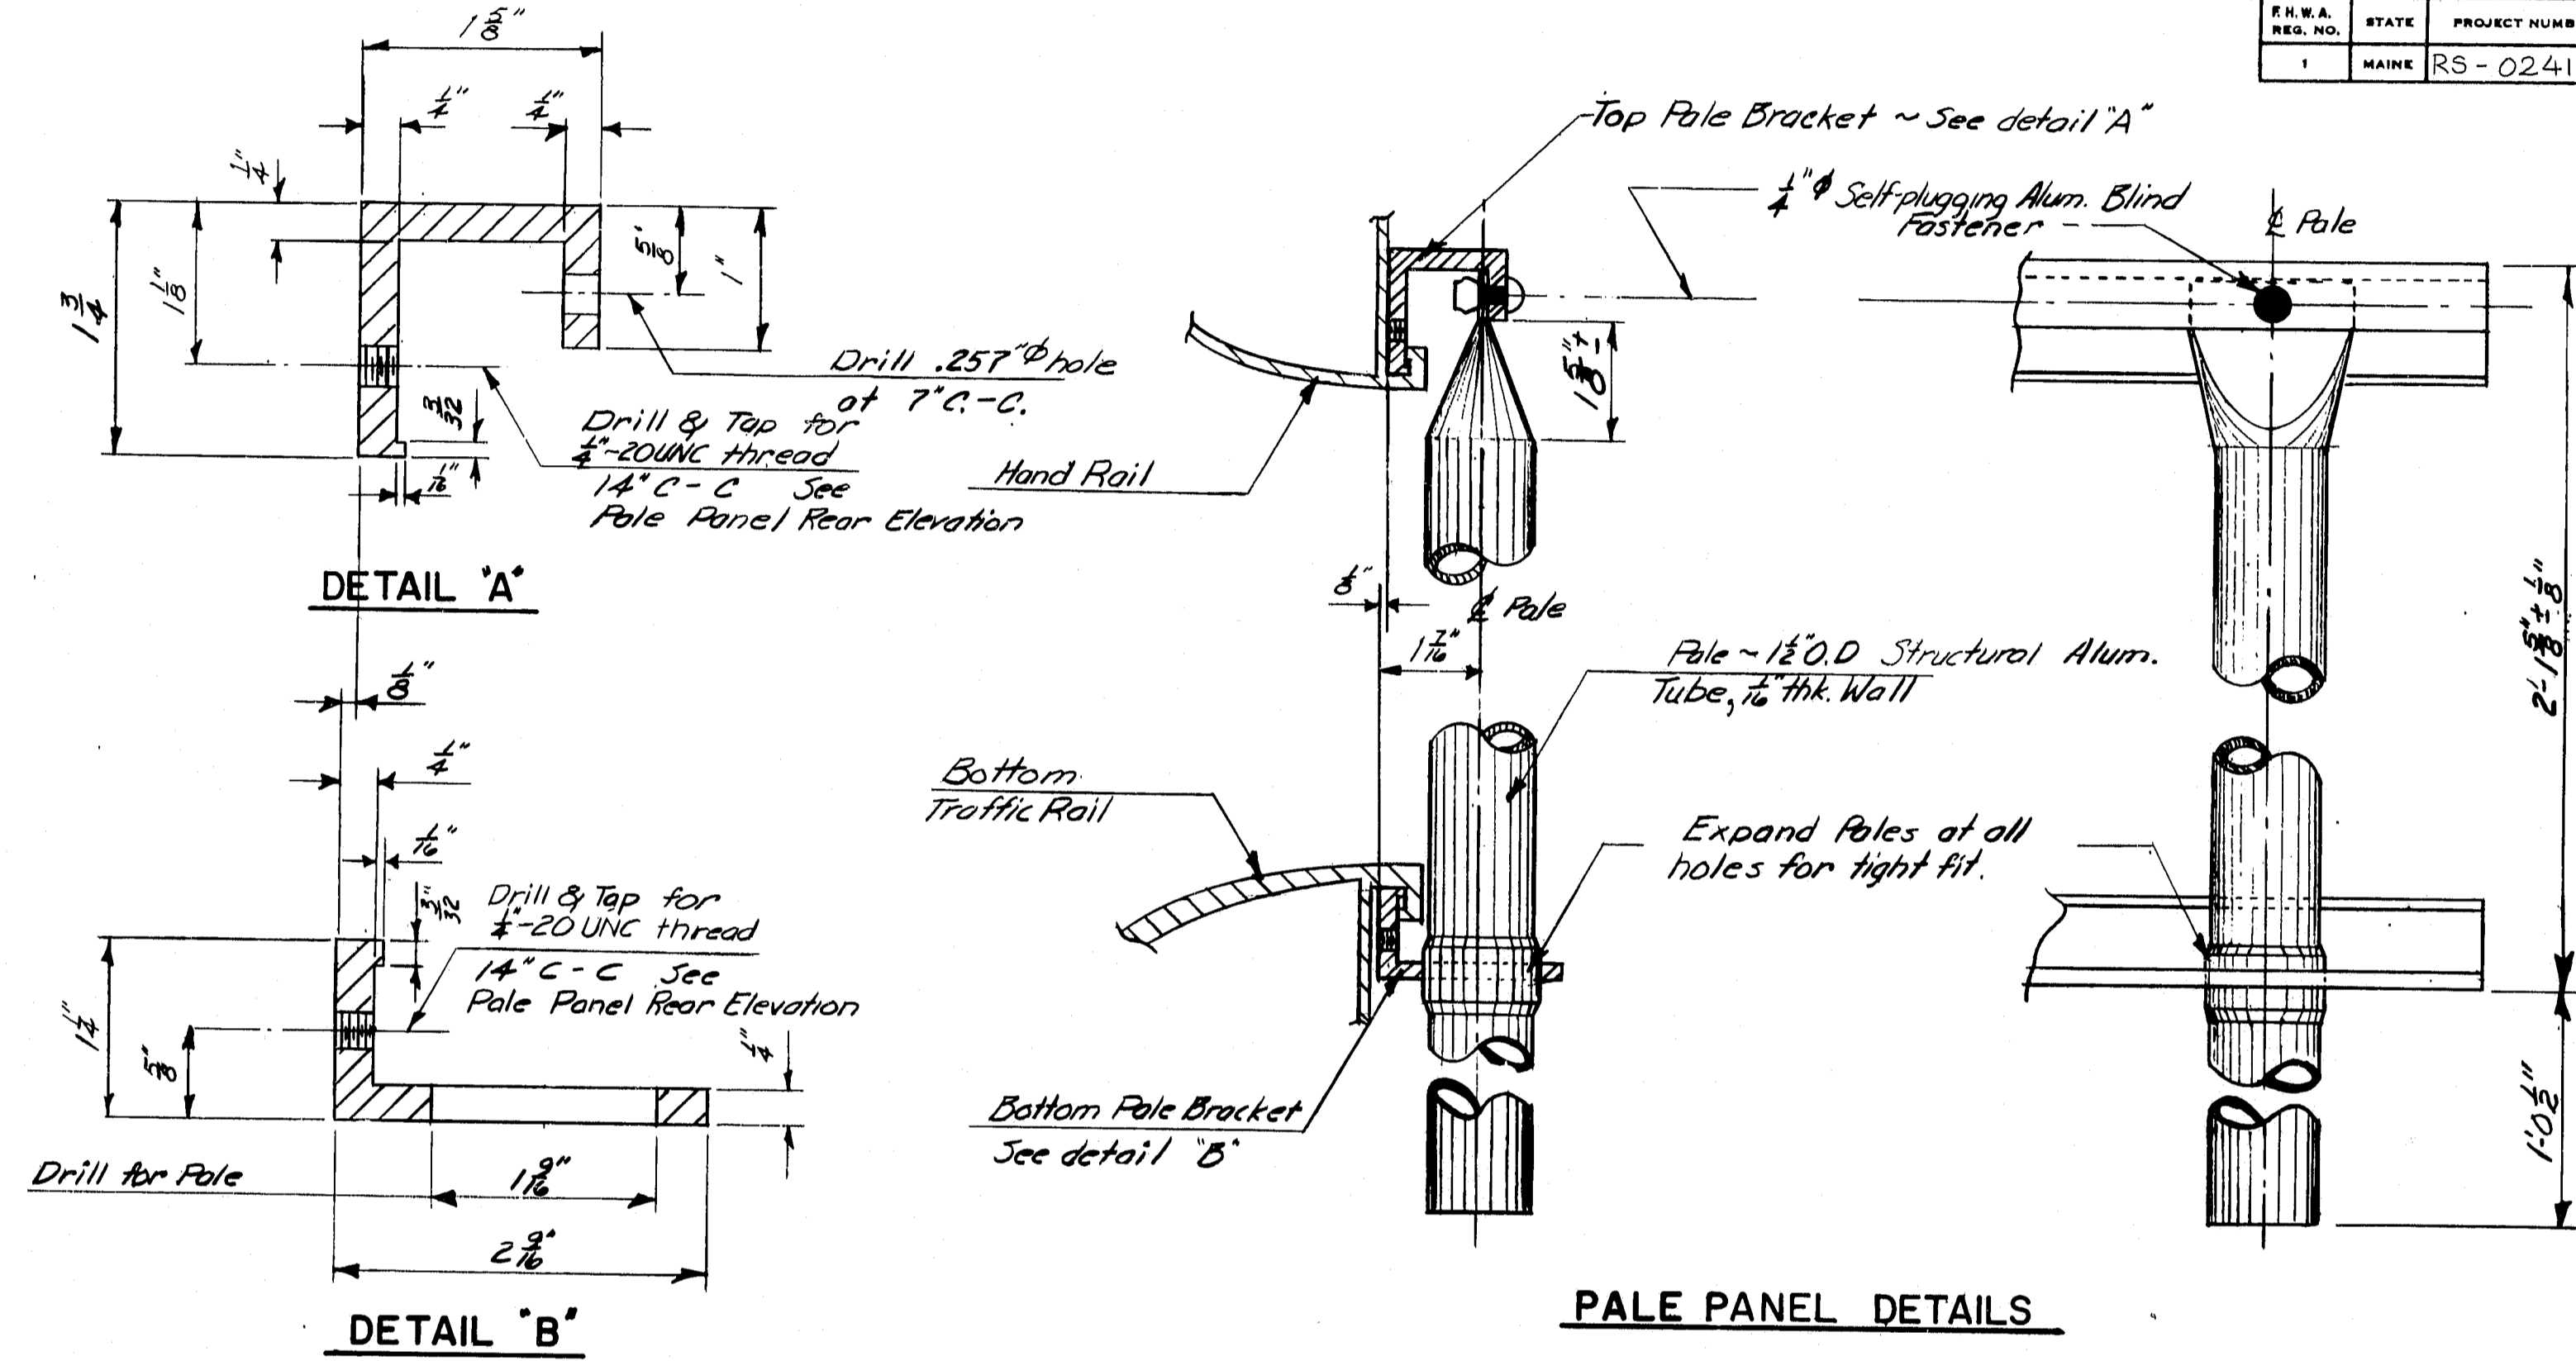


PALE PANEL

PLANS	DESIGN - DETAILED	DATE
	REVISIONS	BY
	FIELD CHANGES	DATE


As Built 1993 rmz	
REVISIONS	DATE
STATE OF MAINE DEPARTMENT OF TRANSPORTATION (SHEET BD 116 - 81 SHALL ACCOMPANY THIS SHEET) STANDARD DETAILS (BD 116 - 81) ALUMINUM BRIDGE RAILING PALE PANEL	
SHEET 12 OF 19 AUGUSTA, MAINE JUNE 1991	
ATKINS	

R89-466


F.W.A. RES. NO.	STATE	PROJECT NUMBER	SHEET NO.	TOTAL SHEETS
1	MAINE	RS-0241 (11)	13	19

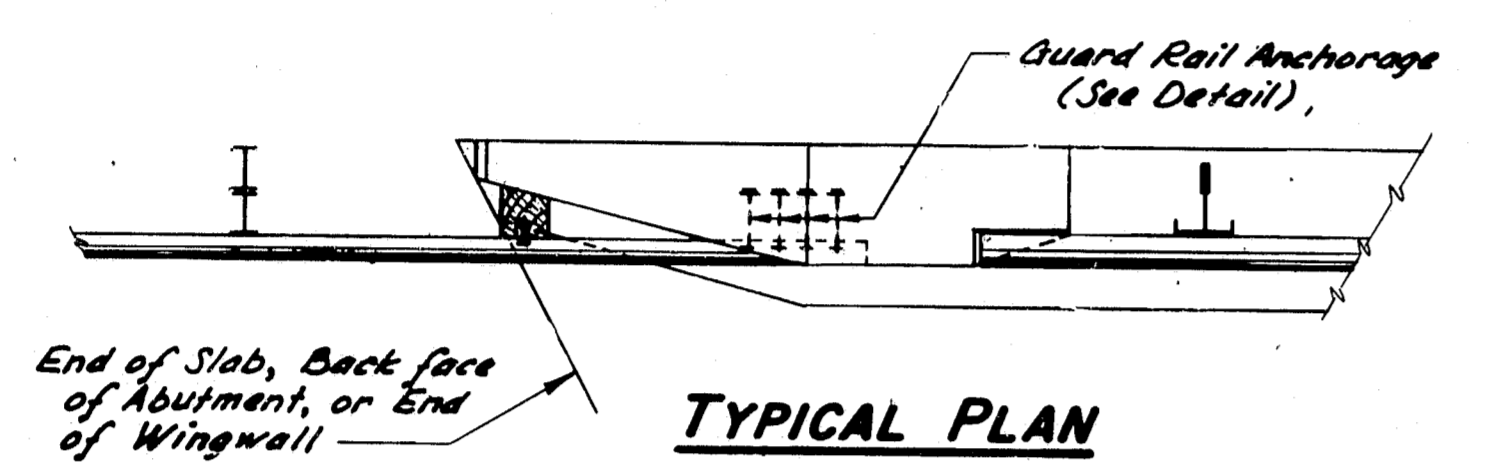


TYPICAL PLAN

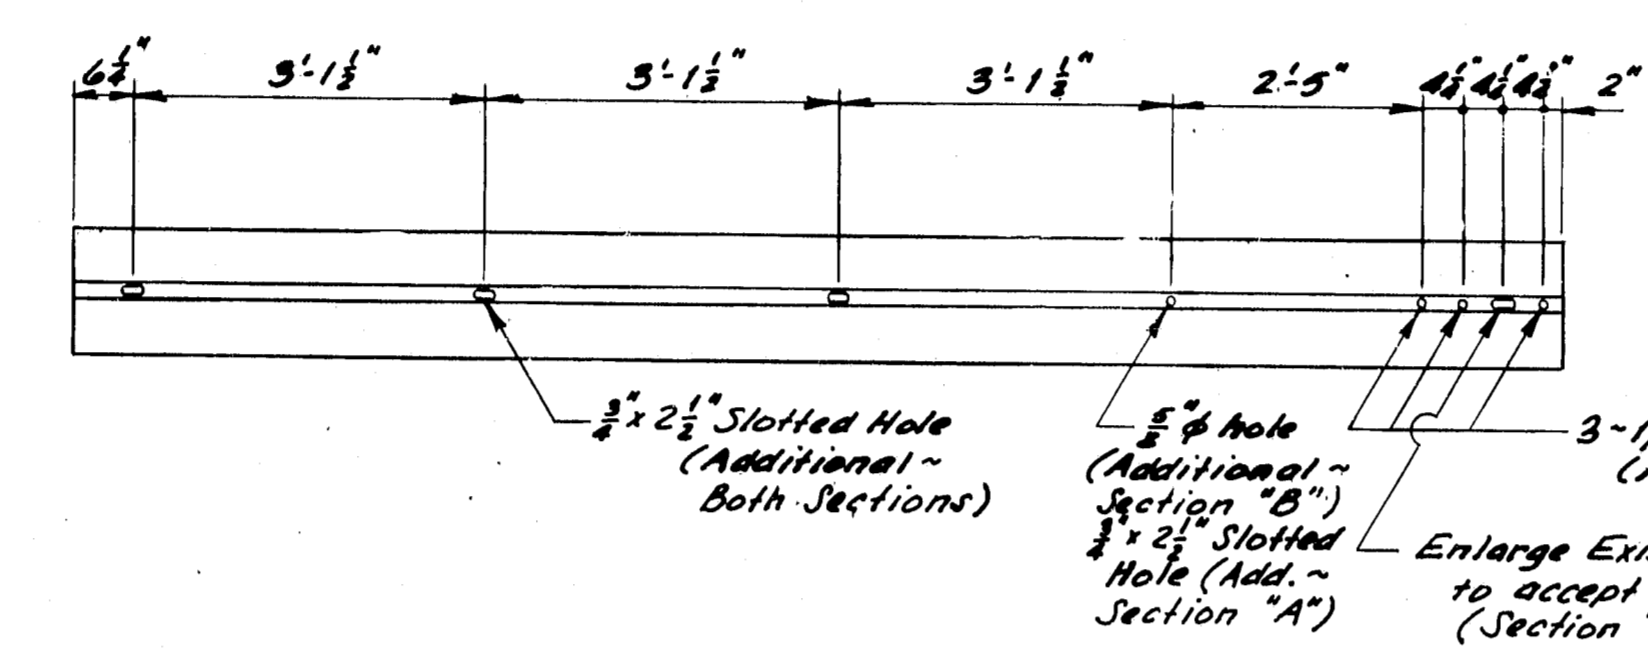

MODIFIED GUARD RAIL SECTIONS
(See Note #6)

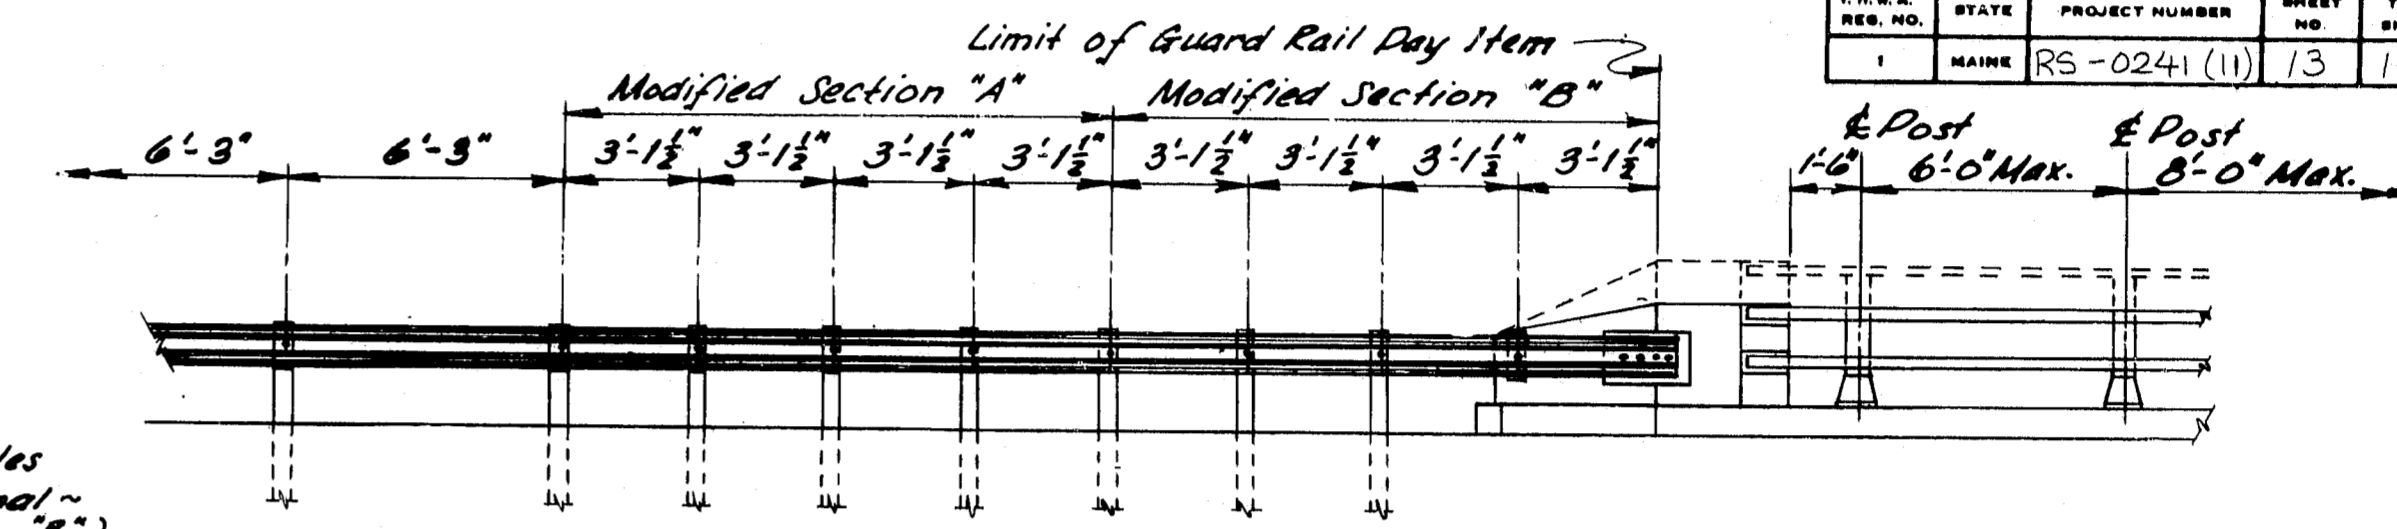


RAILING - ELEVATION

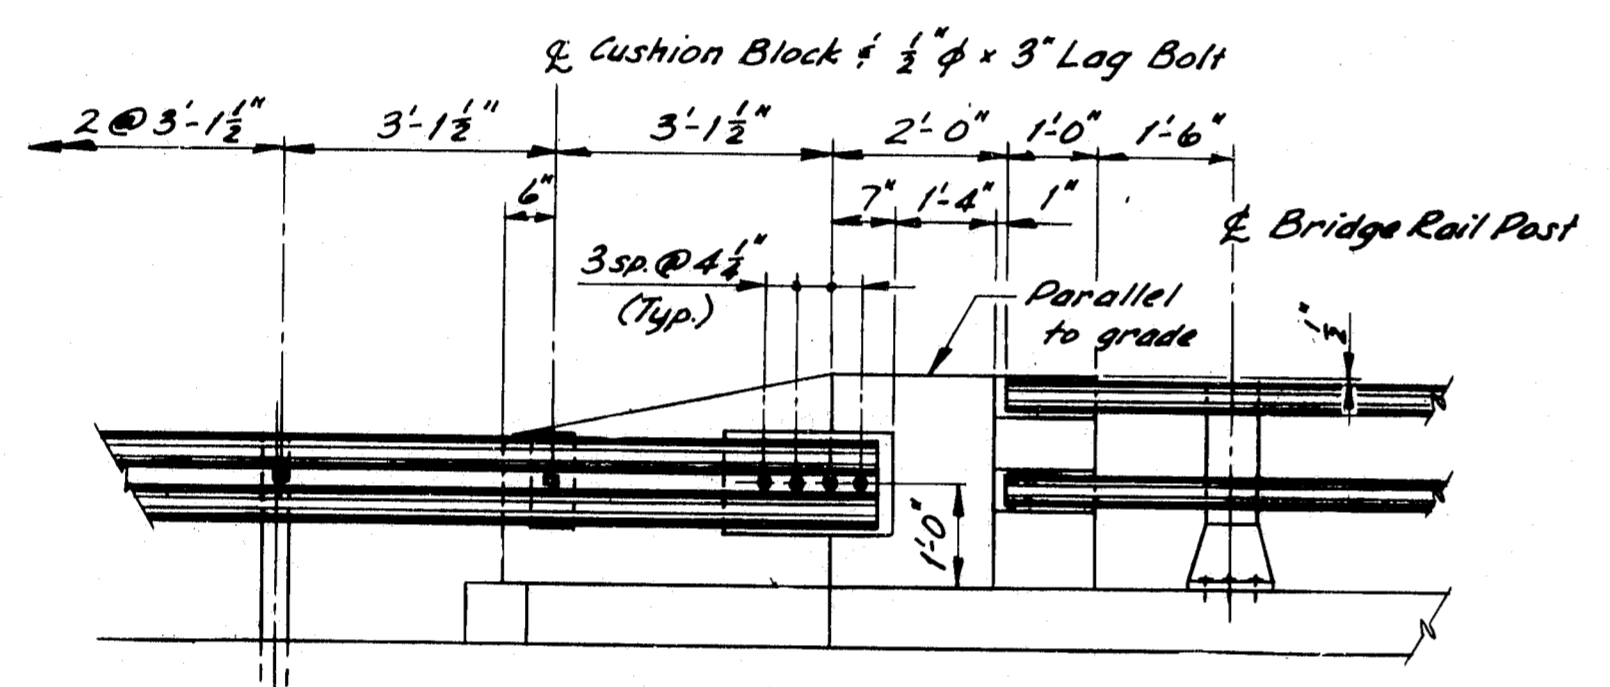


ELEVATION

2-Bar Bridge Rail (Aluminum or Steel)

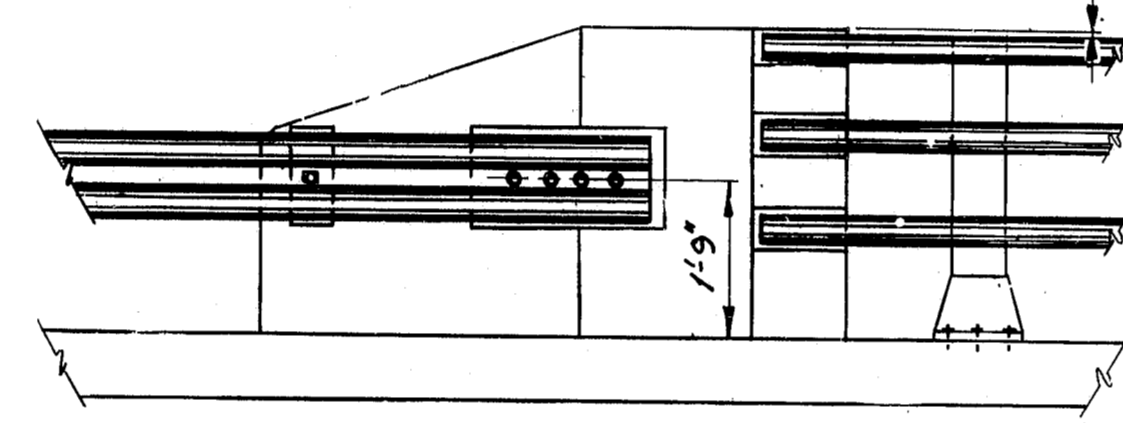


ELEVATION

3-Bar Bridge Rail (Aluminum or Steel)

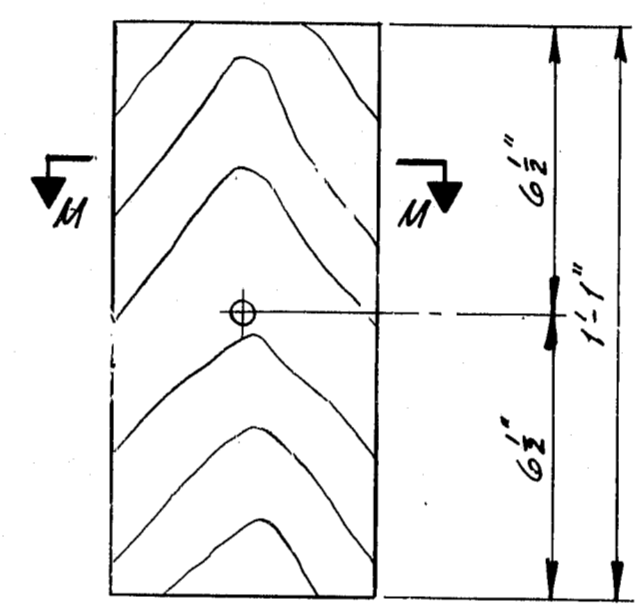


SECTION M-M


CUSHION BLOCK
(See Note #7)

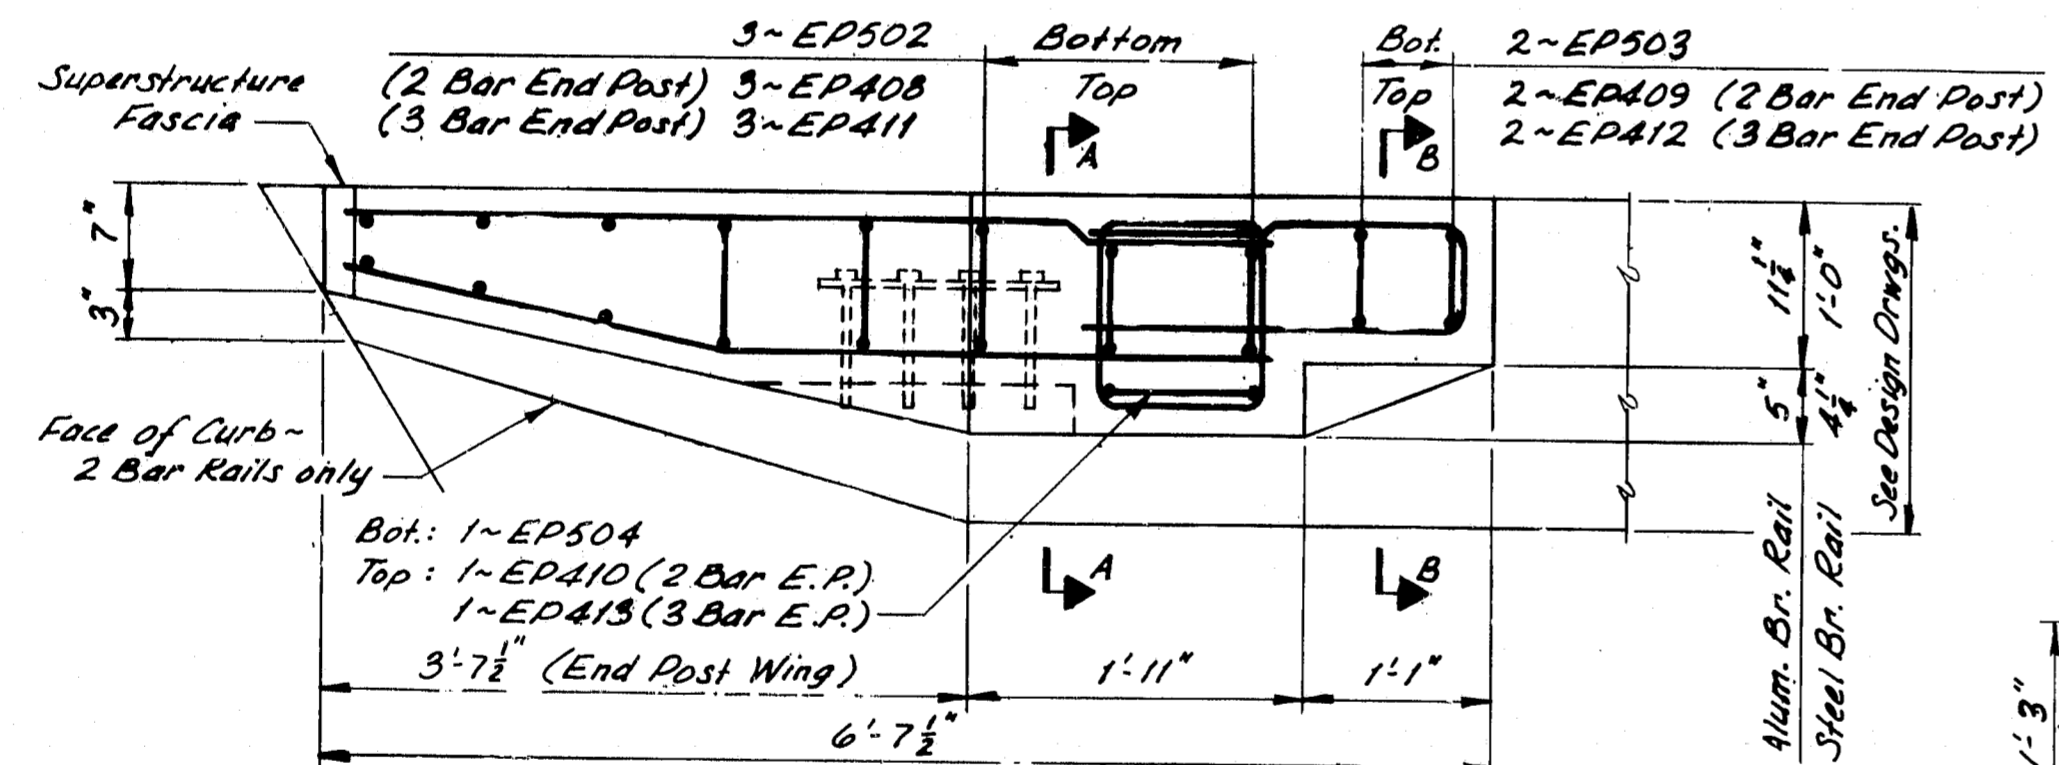

PLAN

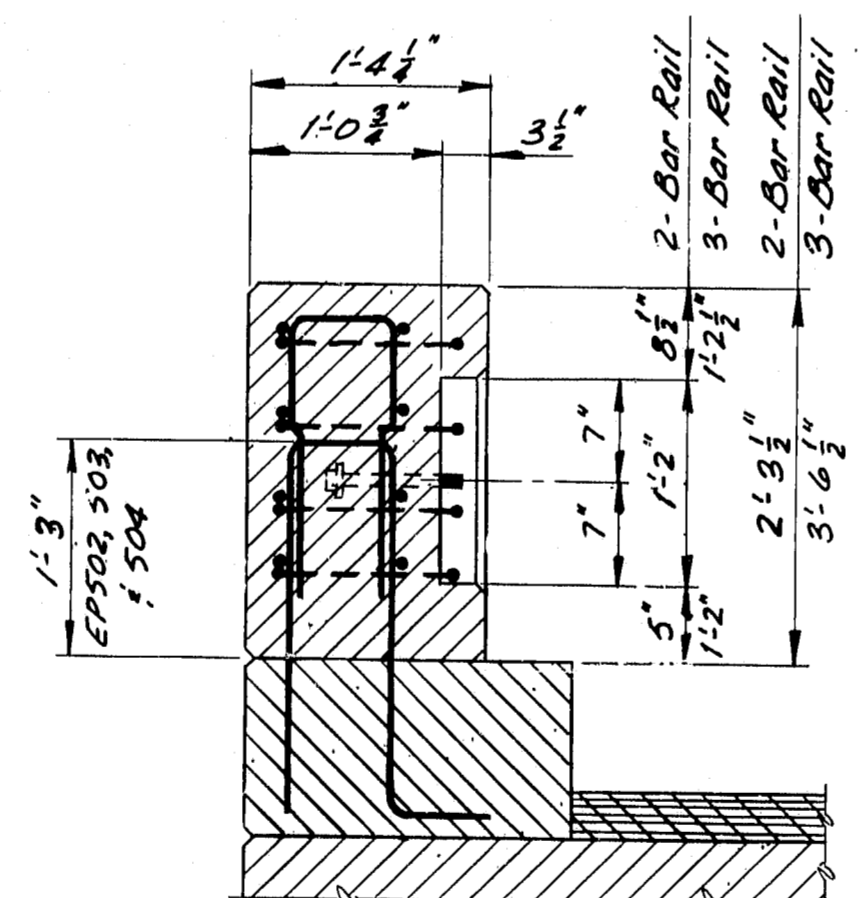


SECTION A-A

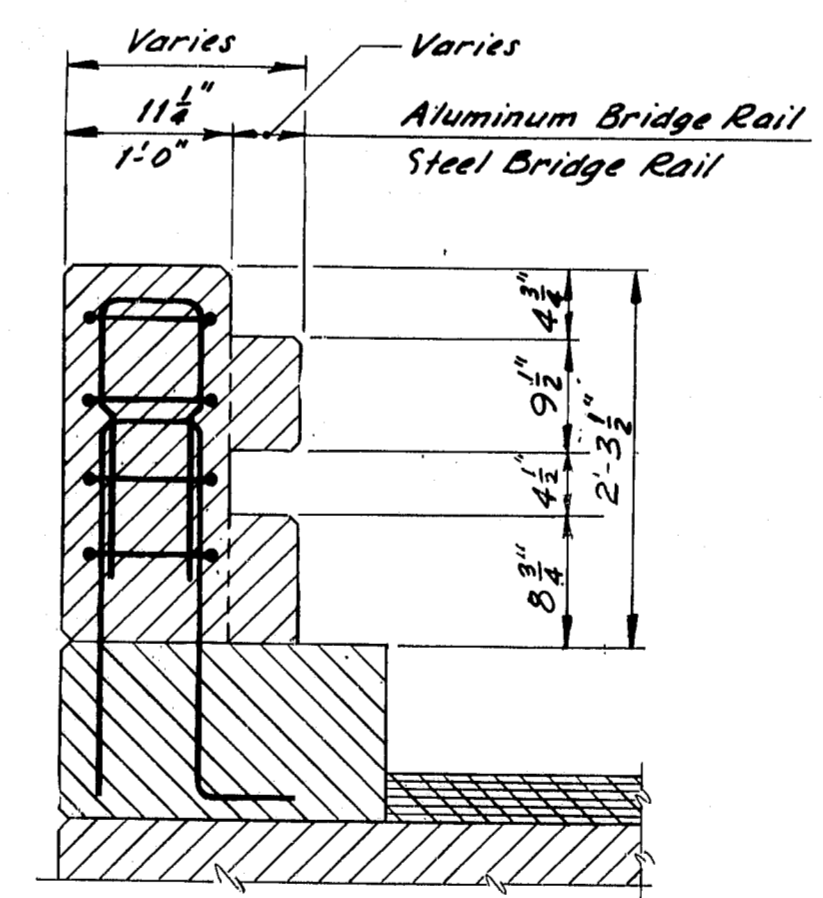


SECTION B-B

2-Bar Bridge Rail (Aluminum or Steel)

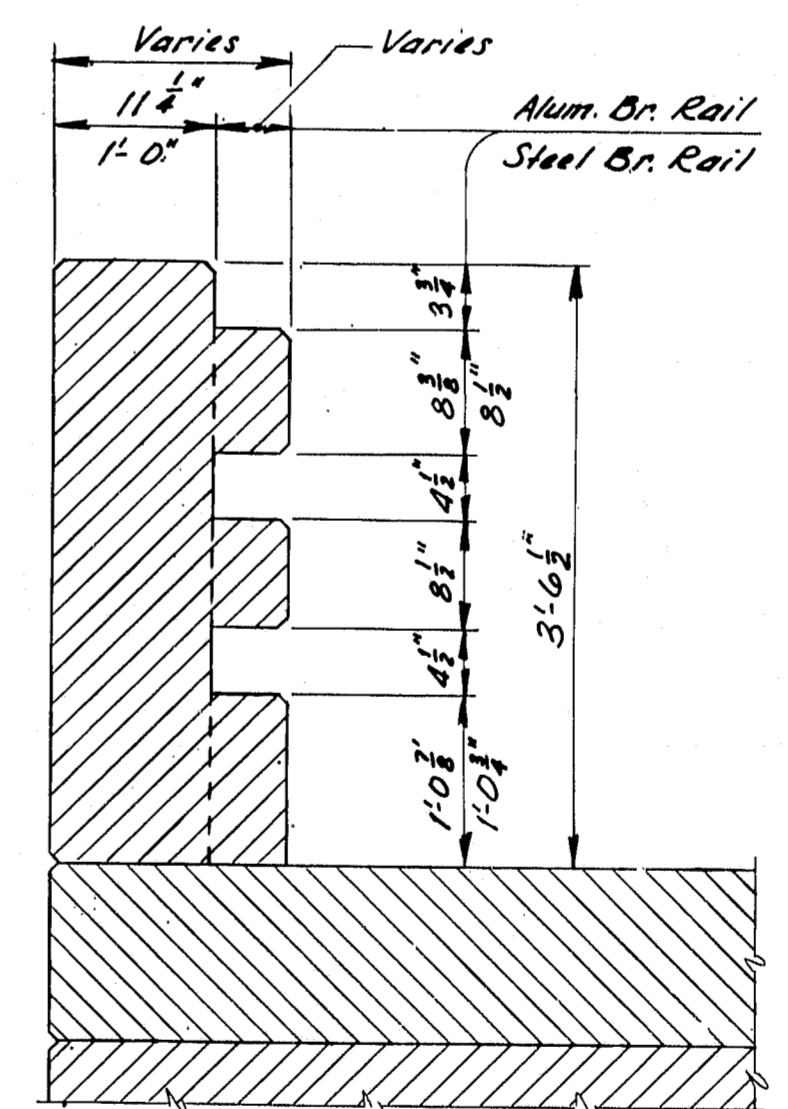


SECTION B-B


3-Bar Bridge Rail (Aluminum or Steel)

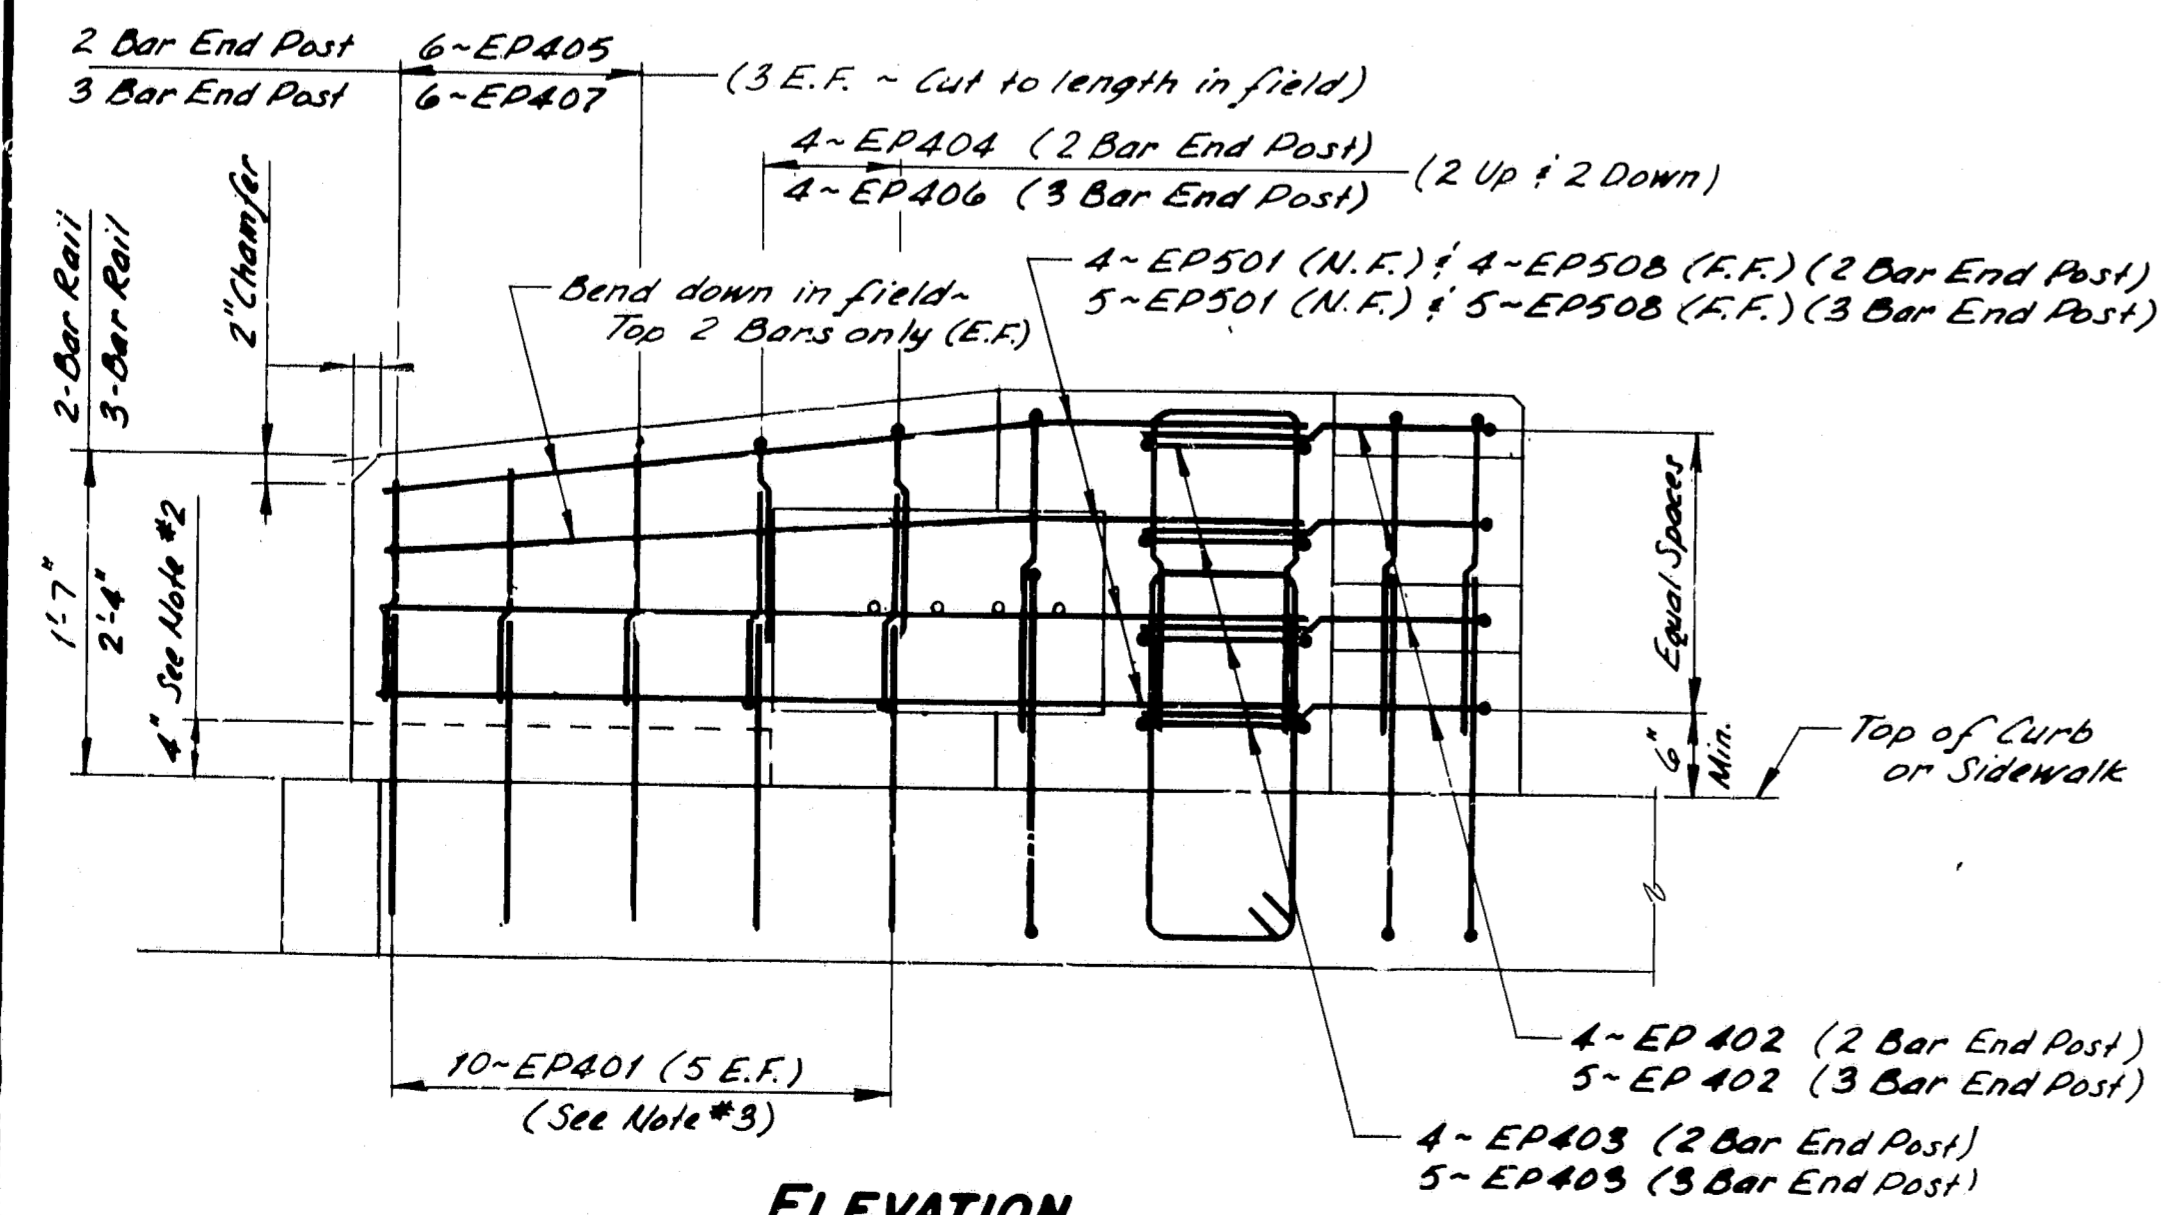

ELEVATION

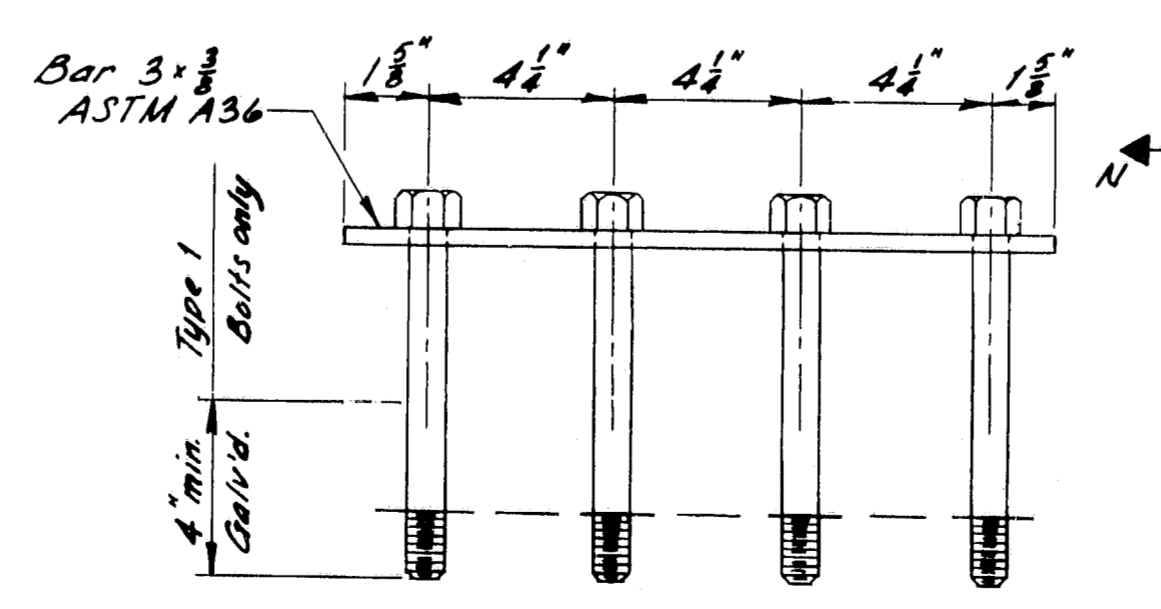

GUARD RAIL ANCHORAGE

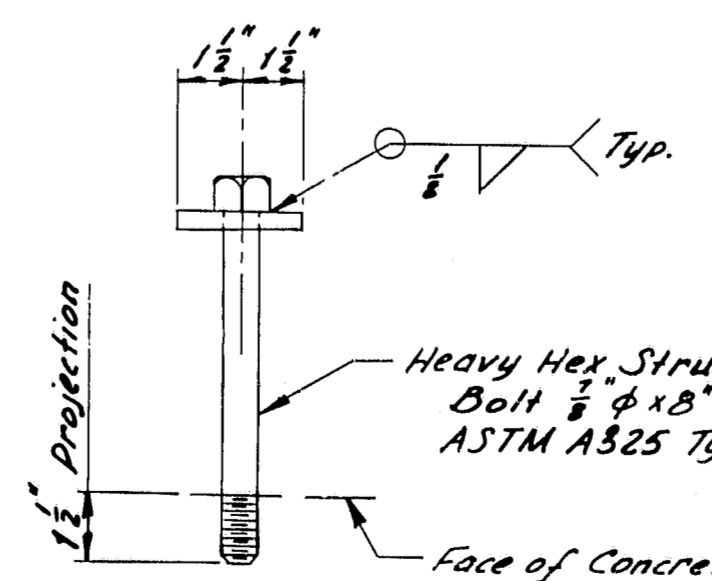

VIEW N-N

- NOTES**
- For locations of End Posts on the structure, see Design Drawings.
 - At times, an End Post Wing may be cantilevered for all or part of its length. For details, see Design Drawings.
 - If an End Post Wing is cantilevered, bars EP401 to be omitted as needed.
 - When End Post Wing is cantilevered more than 2'-0", all #5 bars shall be replaced by #7 bars.
 - Nuts for 3/4" anchor bolts shall be incidental to Guard Rail Pay Items. Nuts shall conform to A.S.T.M. A363, Grade DH, galvanized in accordance with A.S.T.M. A153, or Grade C3, plain.
 - Additional holes in the Modified Guard Rail Sections may be made by drilling, punching, or any other method that produces a neat, clean hole of the required size. Burning of holes will not be allowed.
 - Cushion Block material shall be as specified for Wood Posts in Subsection 710.07 (a). Payment for Cushion Blocks and Lag Bolts shall be incidental to the Guard Rail Pay Items.
 - Reinforcing Steel shall have 2" min. concrete cover.
 - After installation of Guard Rail is complete, upset the thread on the anchor bolts in three places around each bolt, at the junction of the nut and the exposed thread, with a center punch or similar tool.
 - Guard Rail Anchorage shall be incidental to the applicable concrete pay item.
 - End Posts shall be constructed normal to grade unless otherwise shown on Design Drawings.

As Built 1903
R117

STATE OF MAINE
DEPARTMENT OF TRANSPORTATION

STANDARD DETAILS
(BC 120-81)

CONCRETE END POSTS

SHEET 13 OF 19 AUGUSTA, MAINE JUNE 1981
Athens







LEGEND

N.F. = Near Face
F.F. = Far Face
E.F. = Each Face

R89-467

PROJECT DESIGN ENGINEER	DATE
BY: [Signature]	12/20/80
CHECKED	
REVISIONS	
FIELD CHANGES	

F.R.W.A. REG. NO.	STATE	PROJECT NUMBER	SHEET NO.	TOTAL SHEETS
1	MAINE	RS-024(1)	15	19

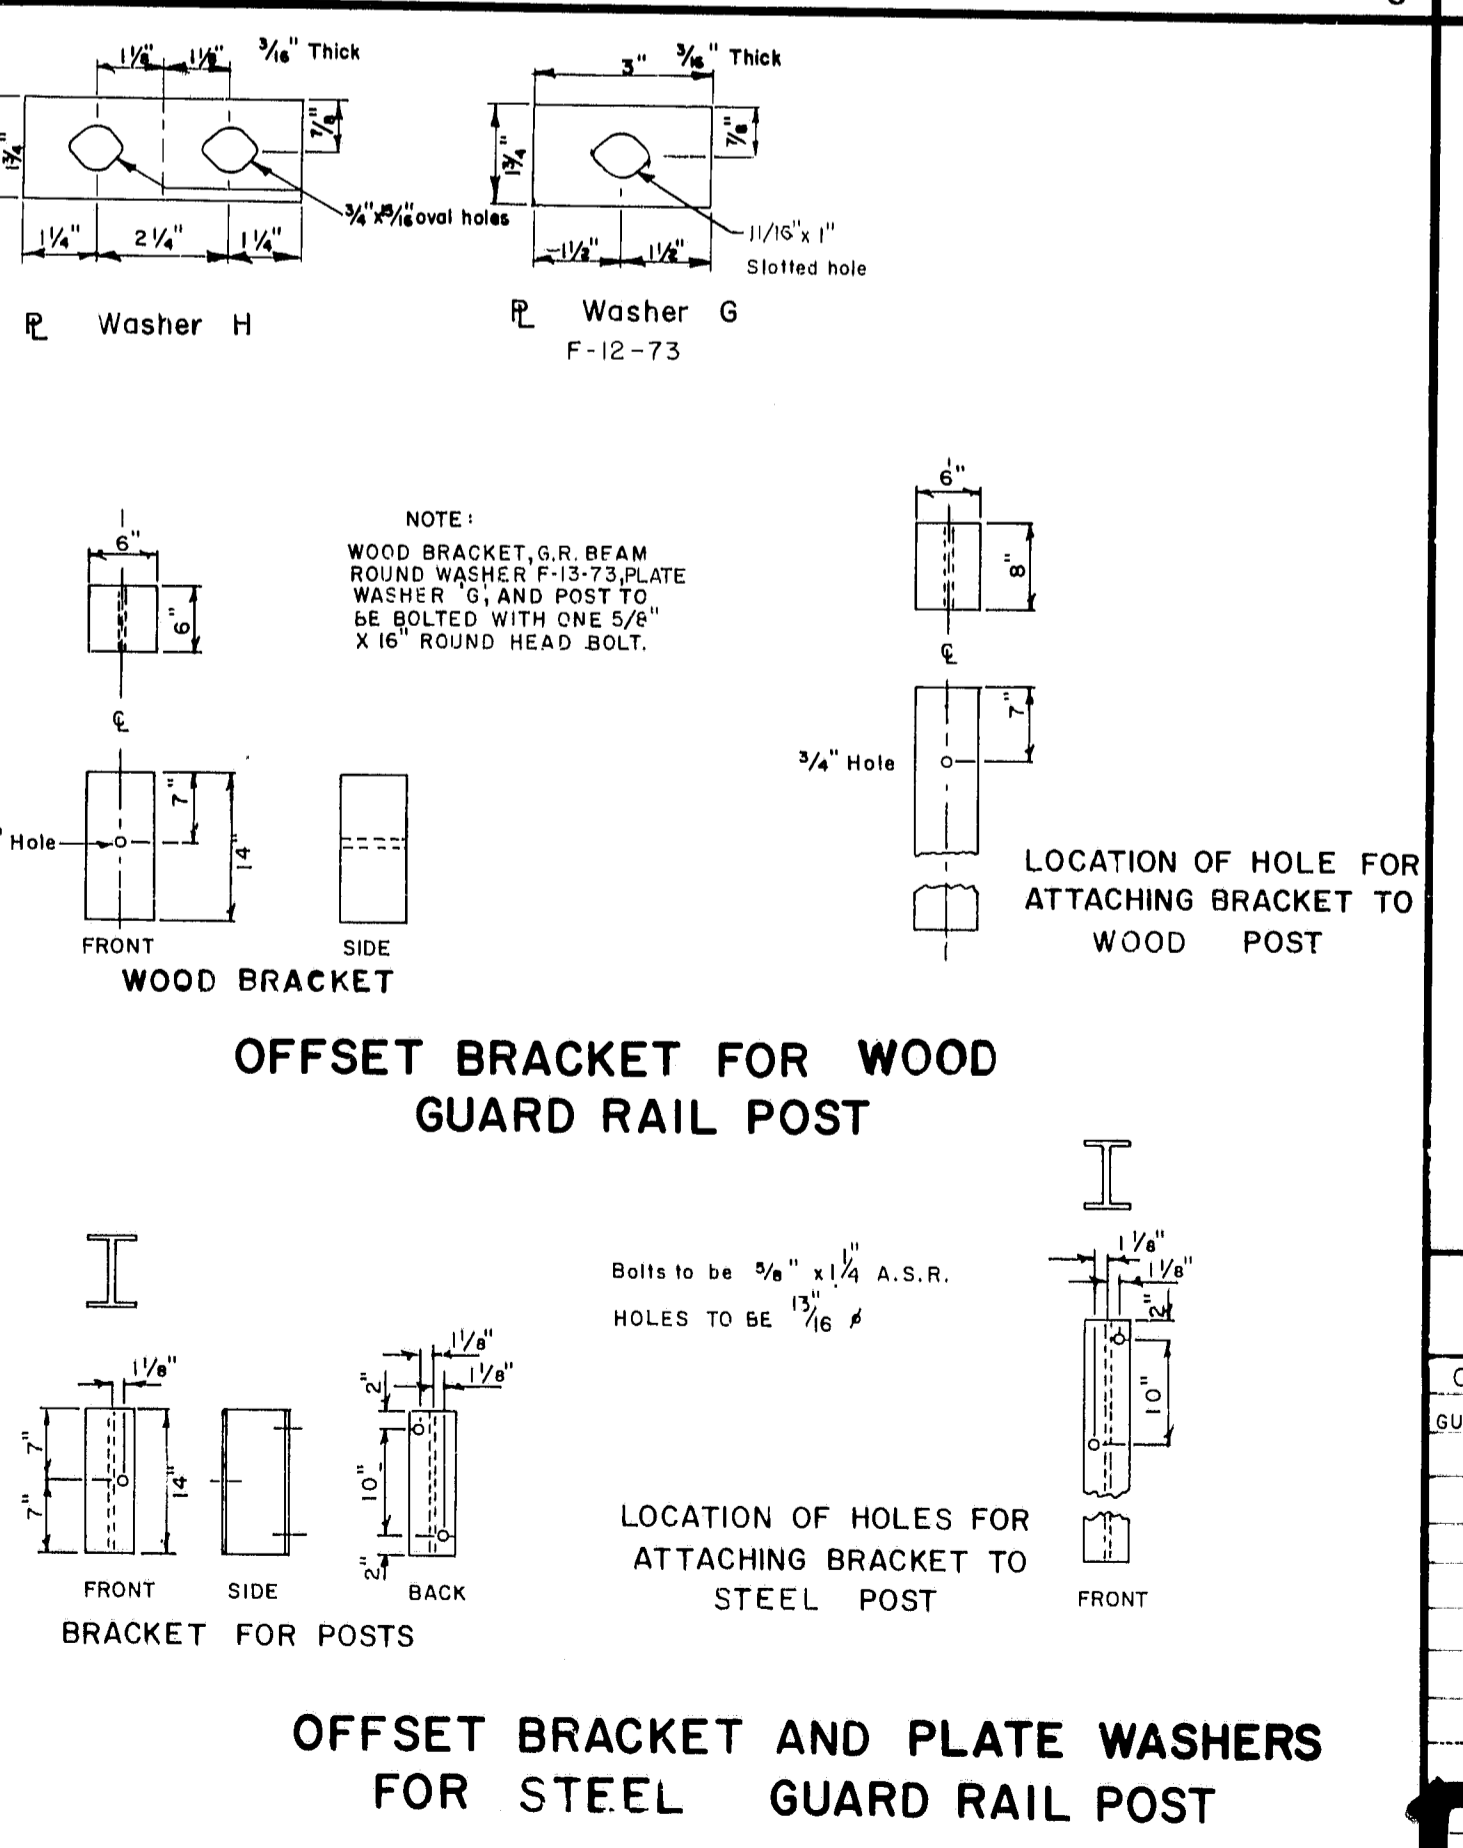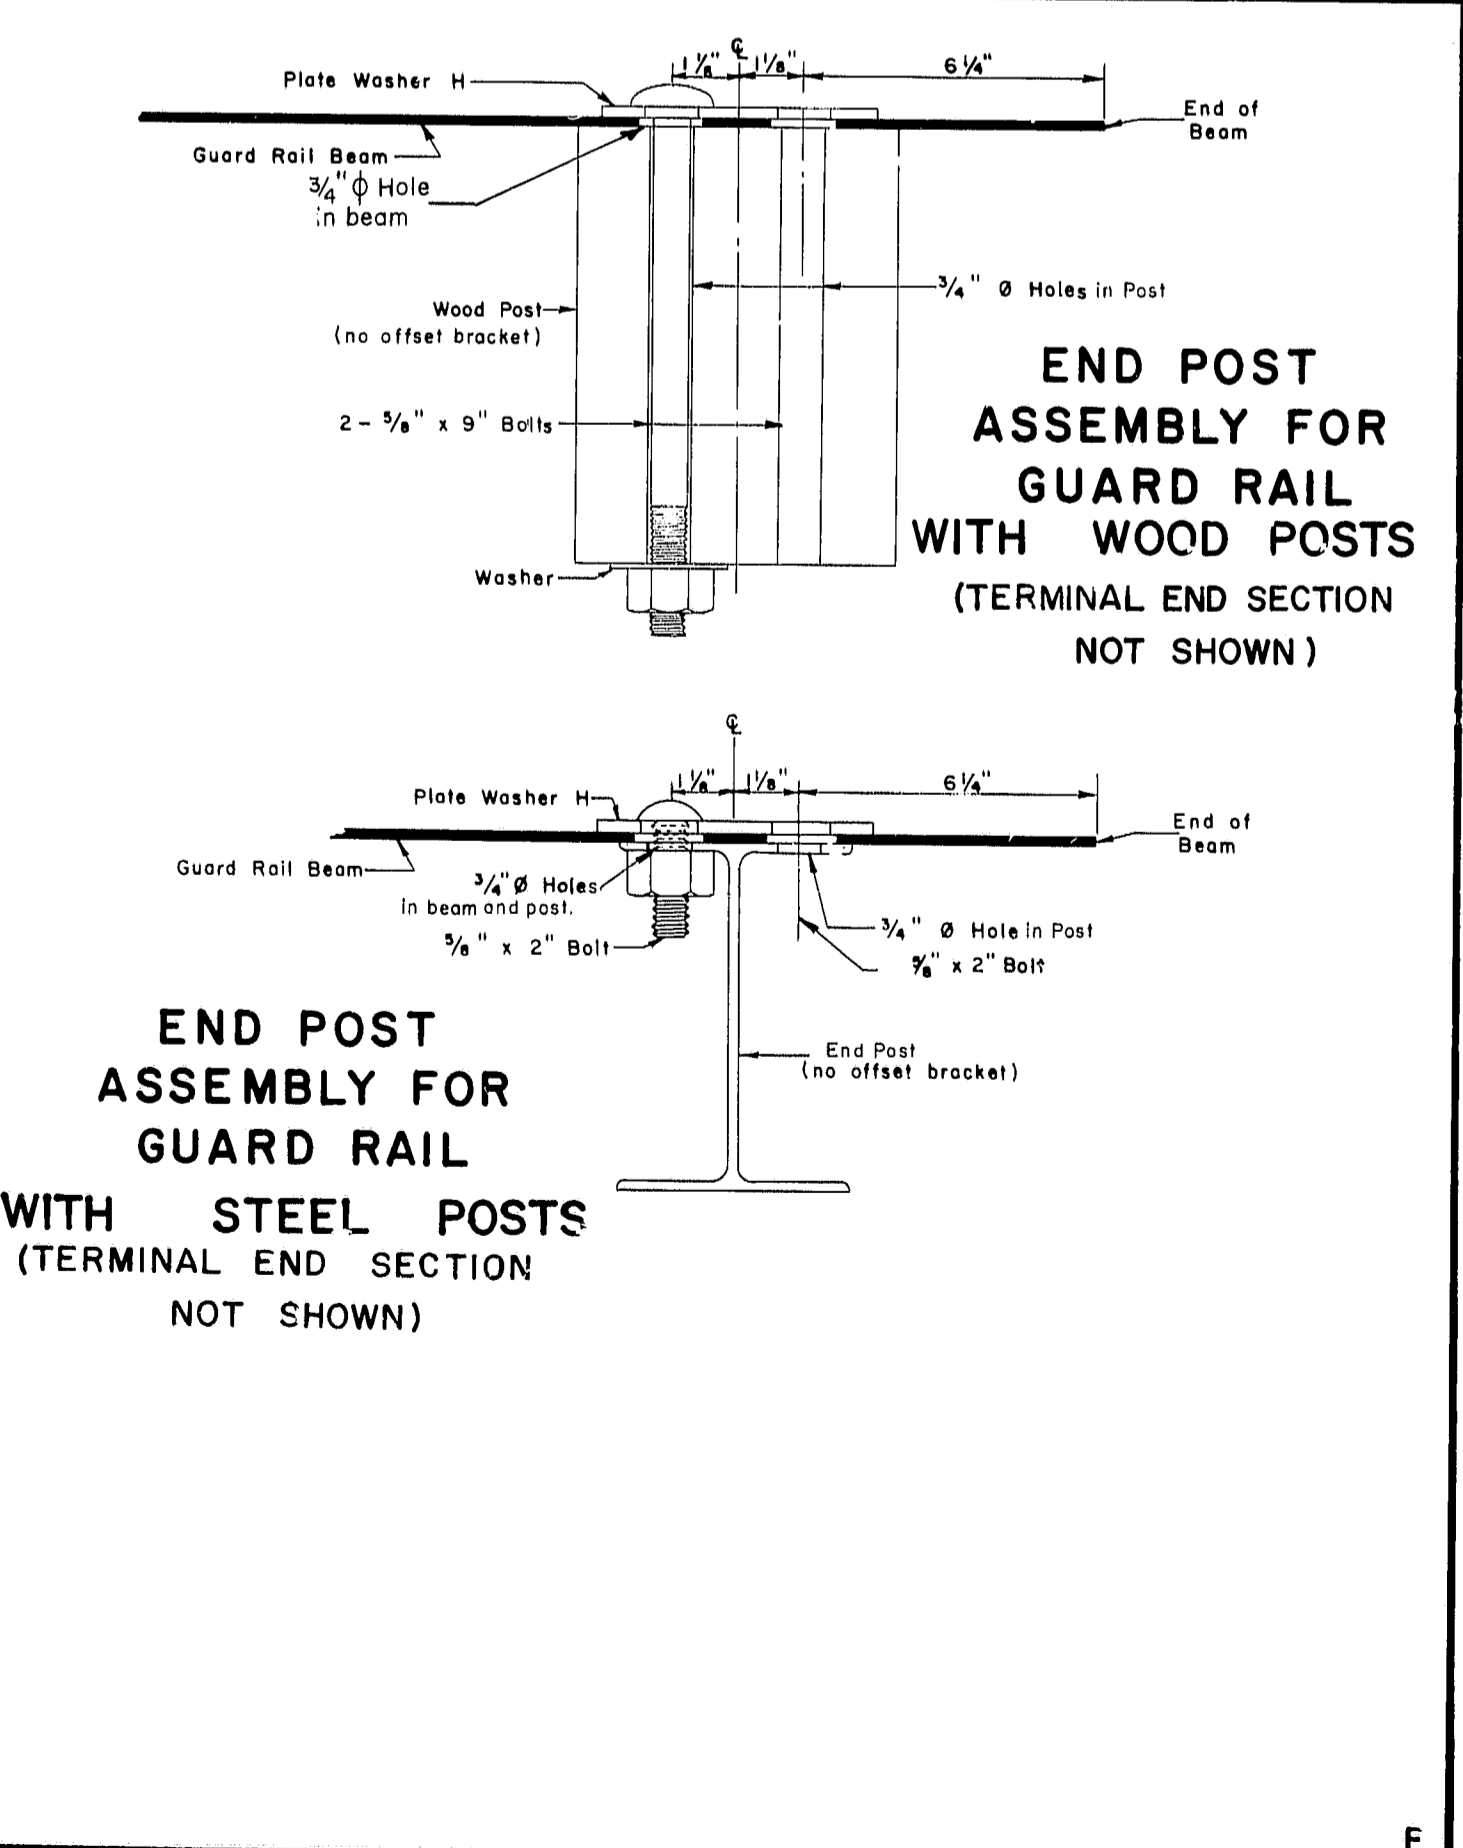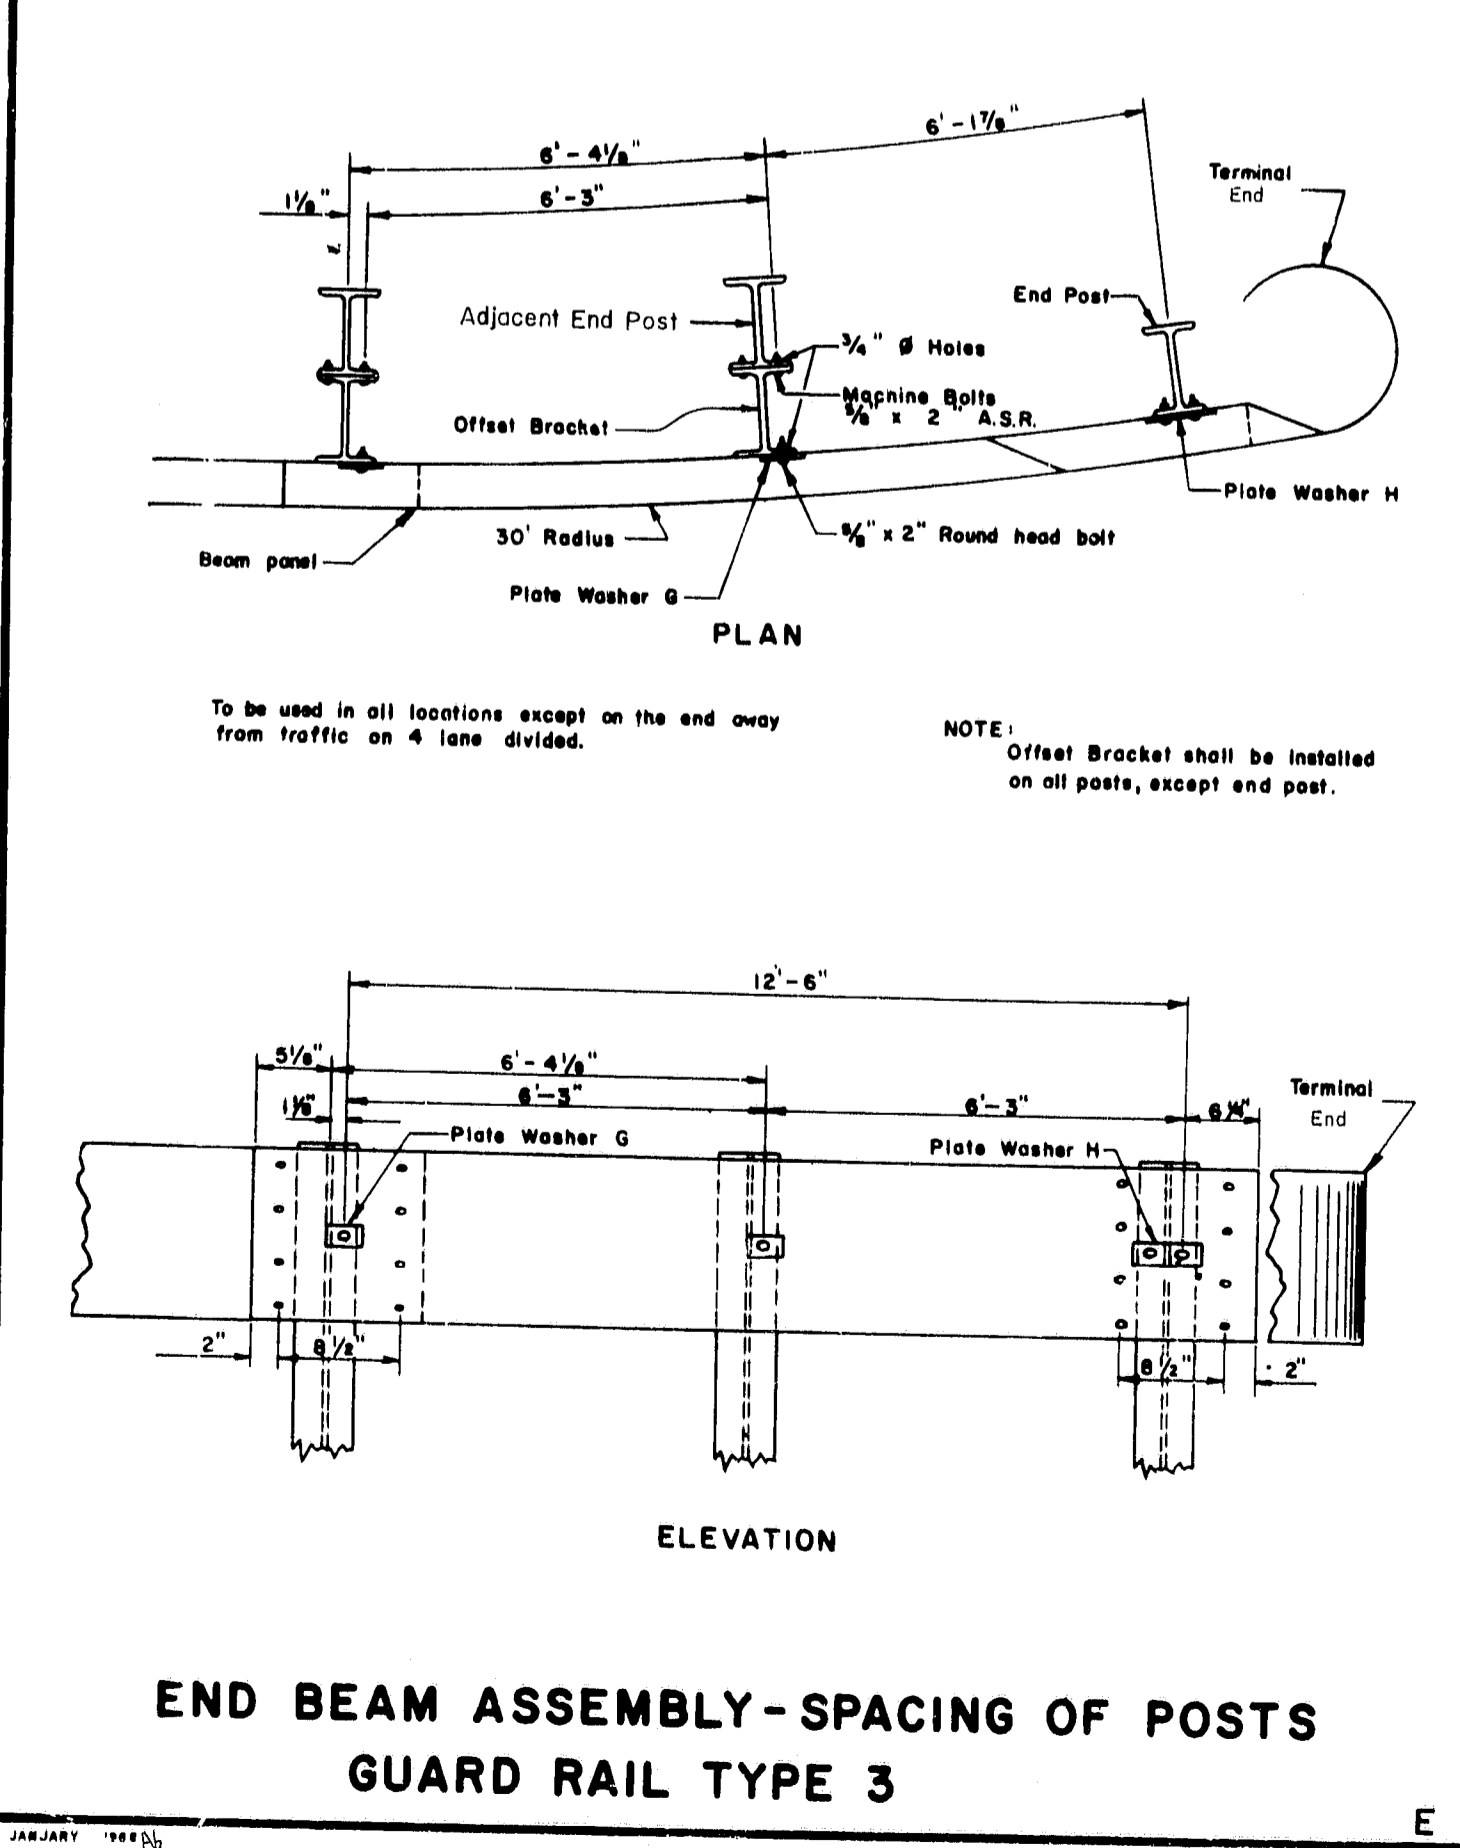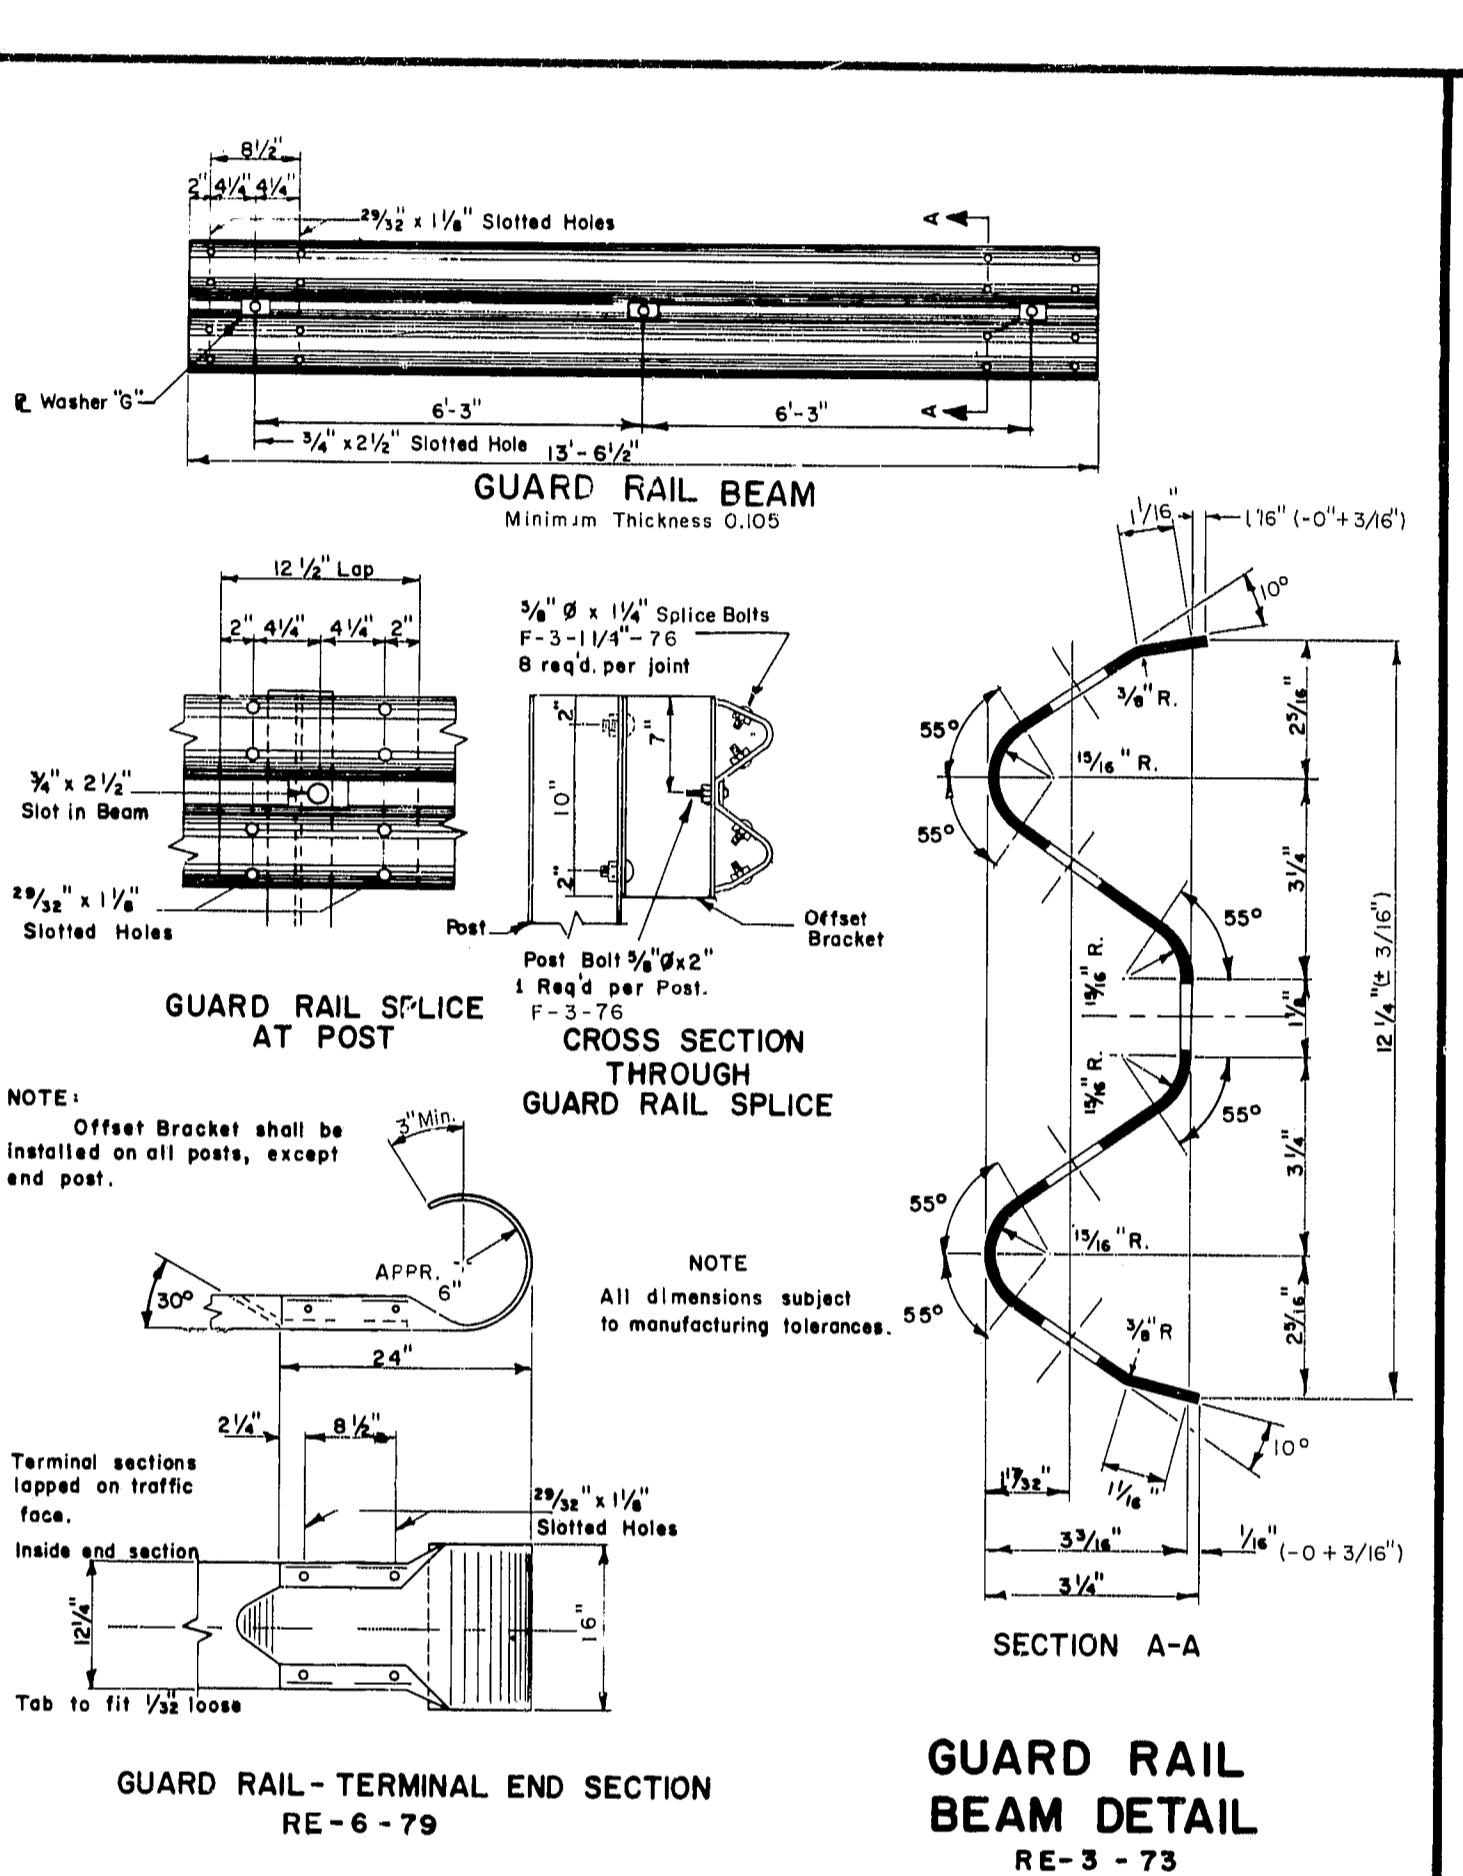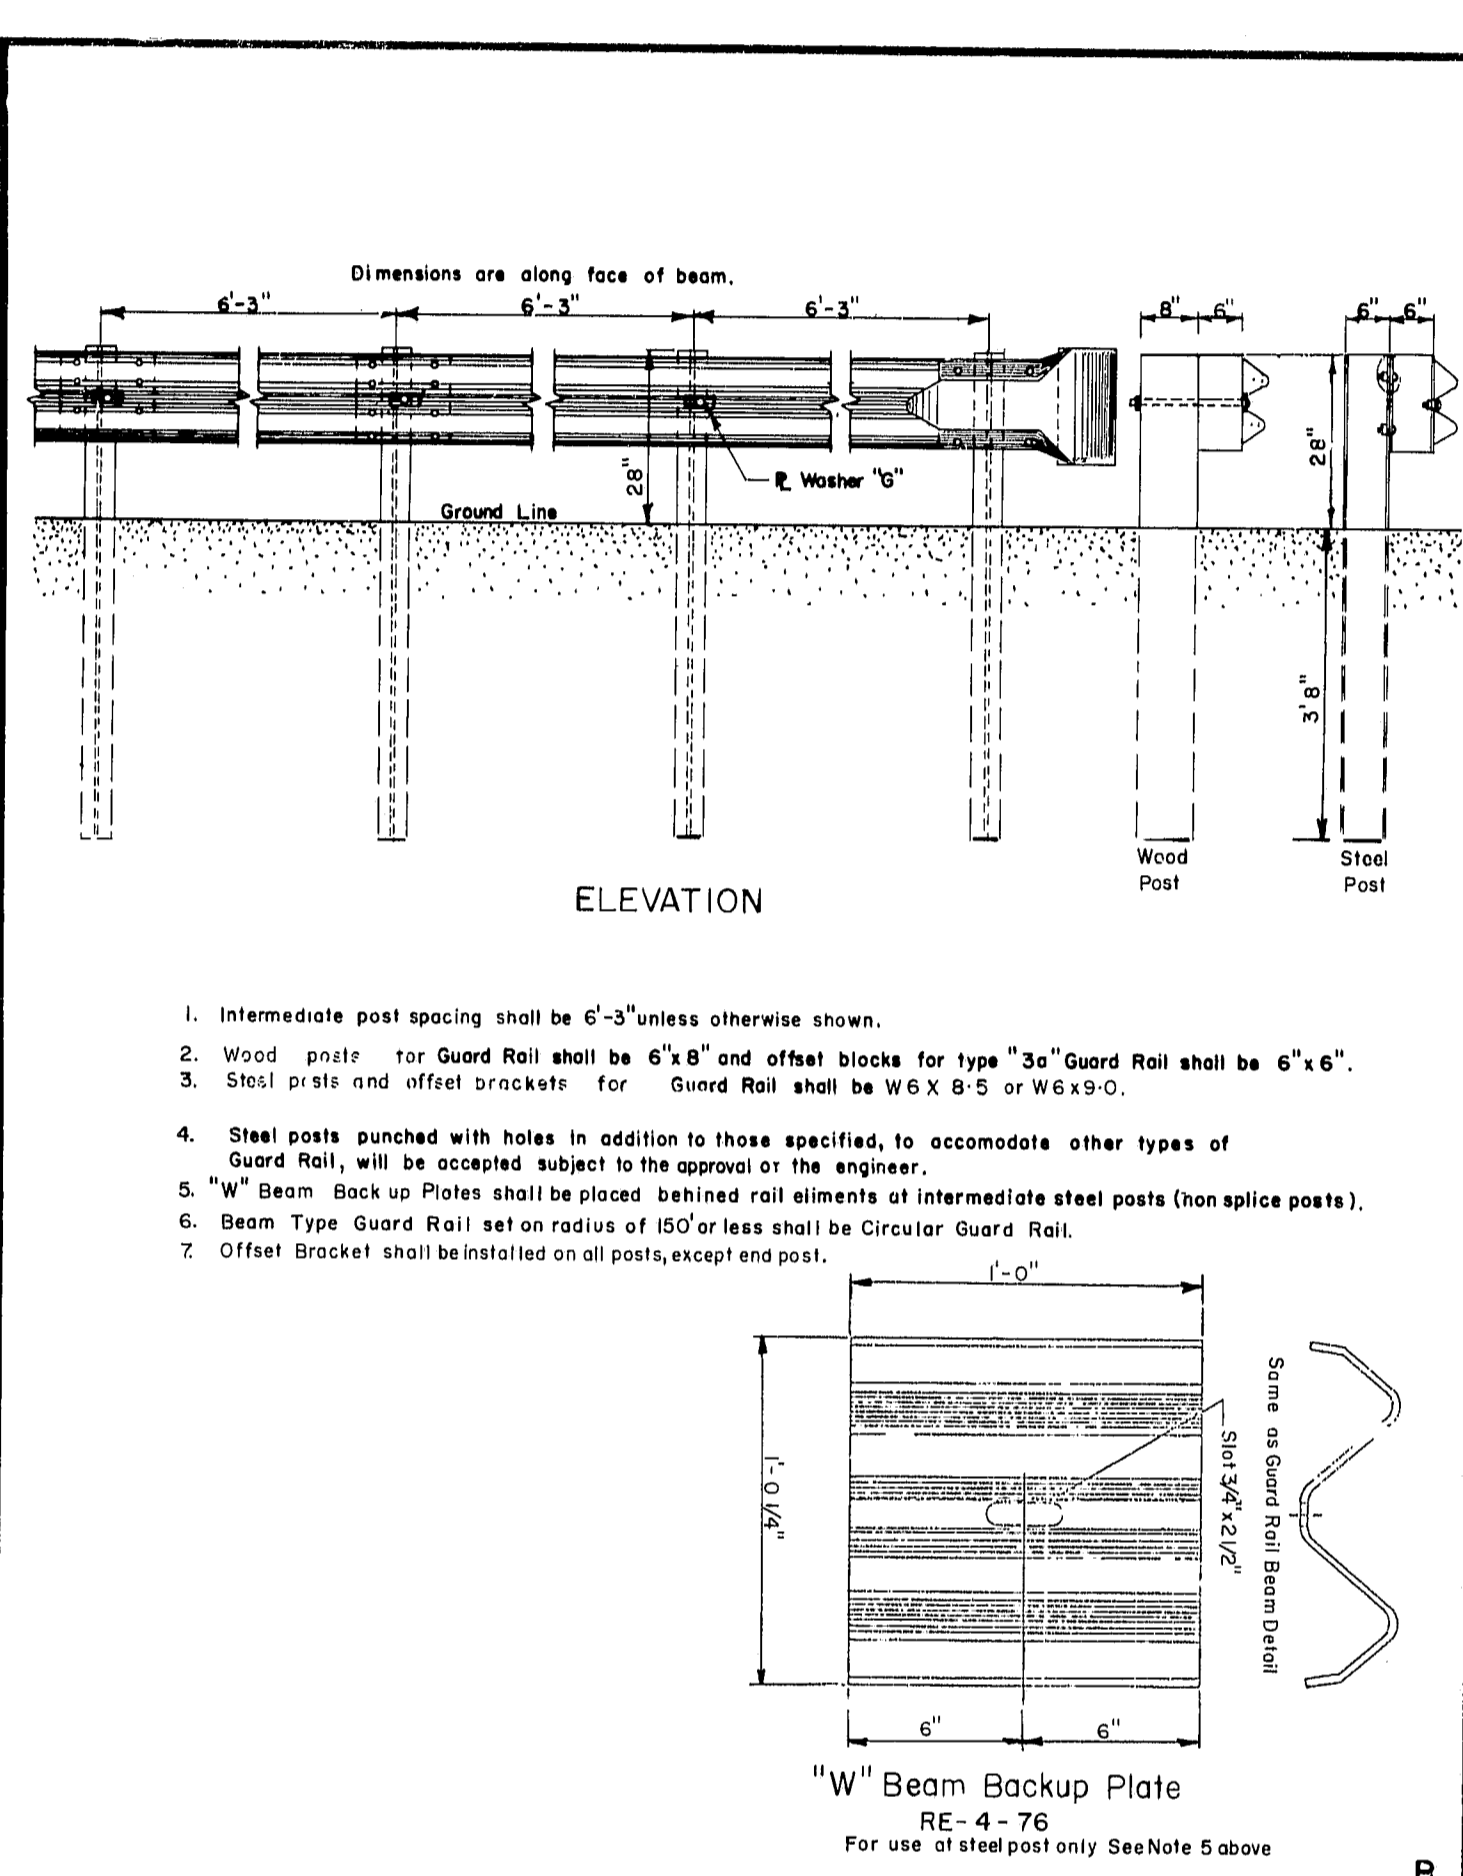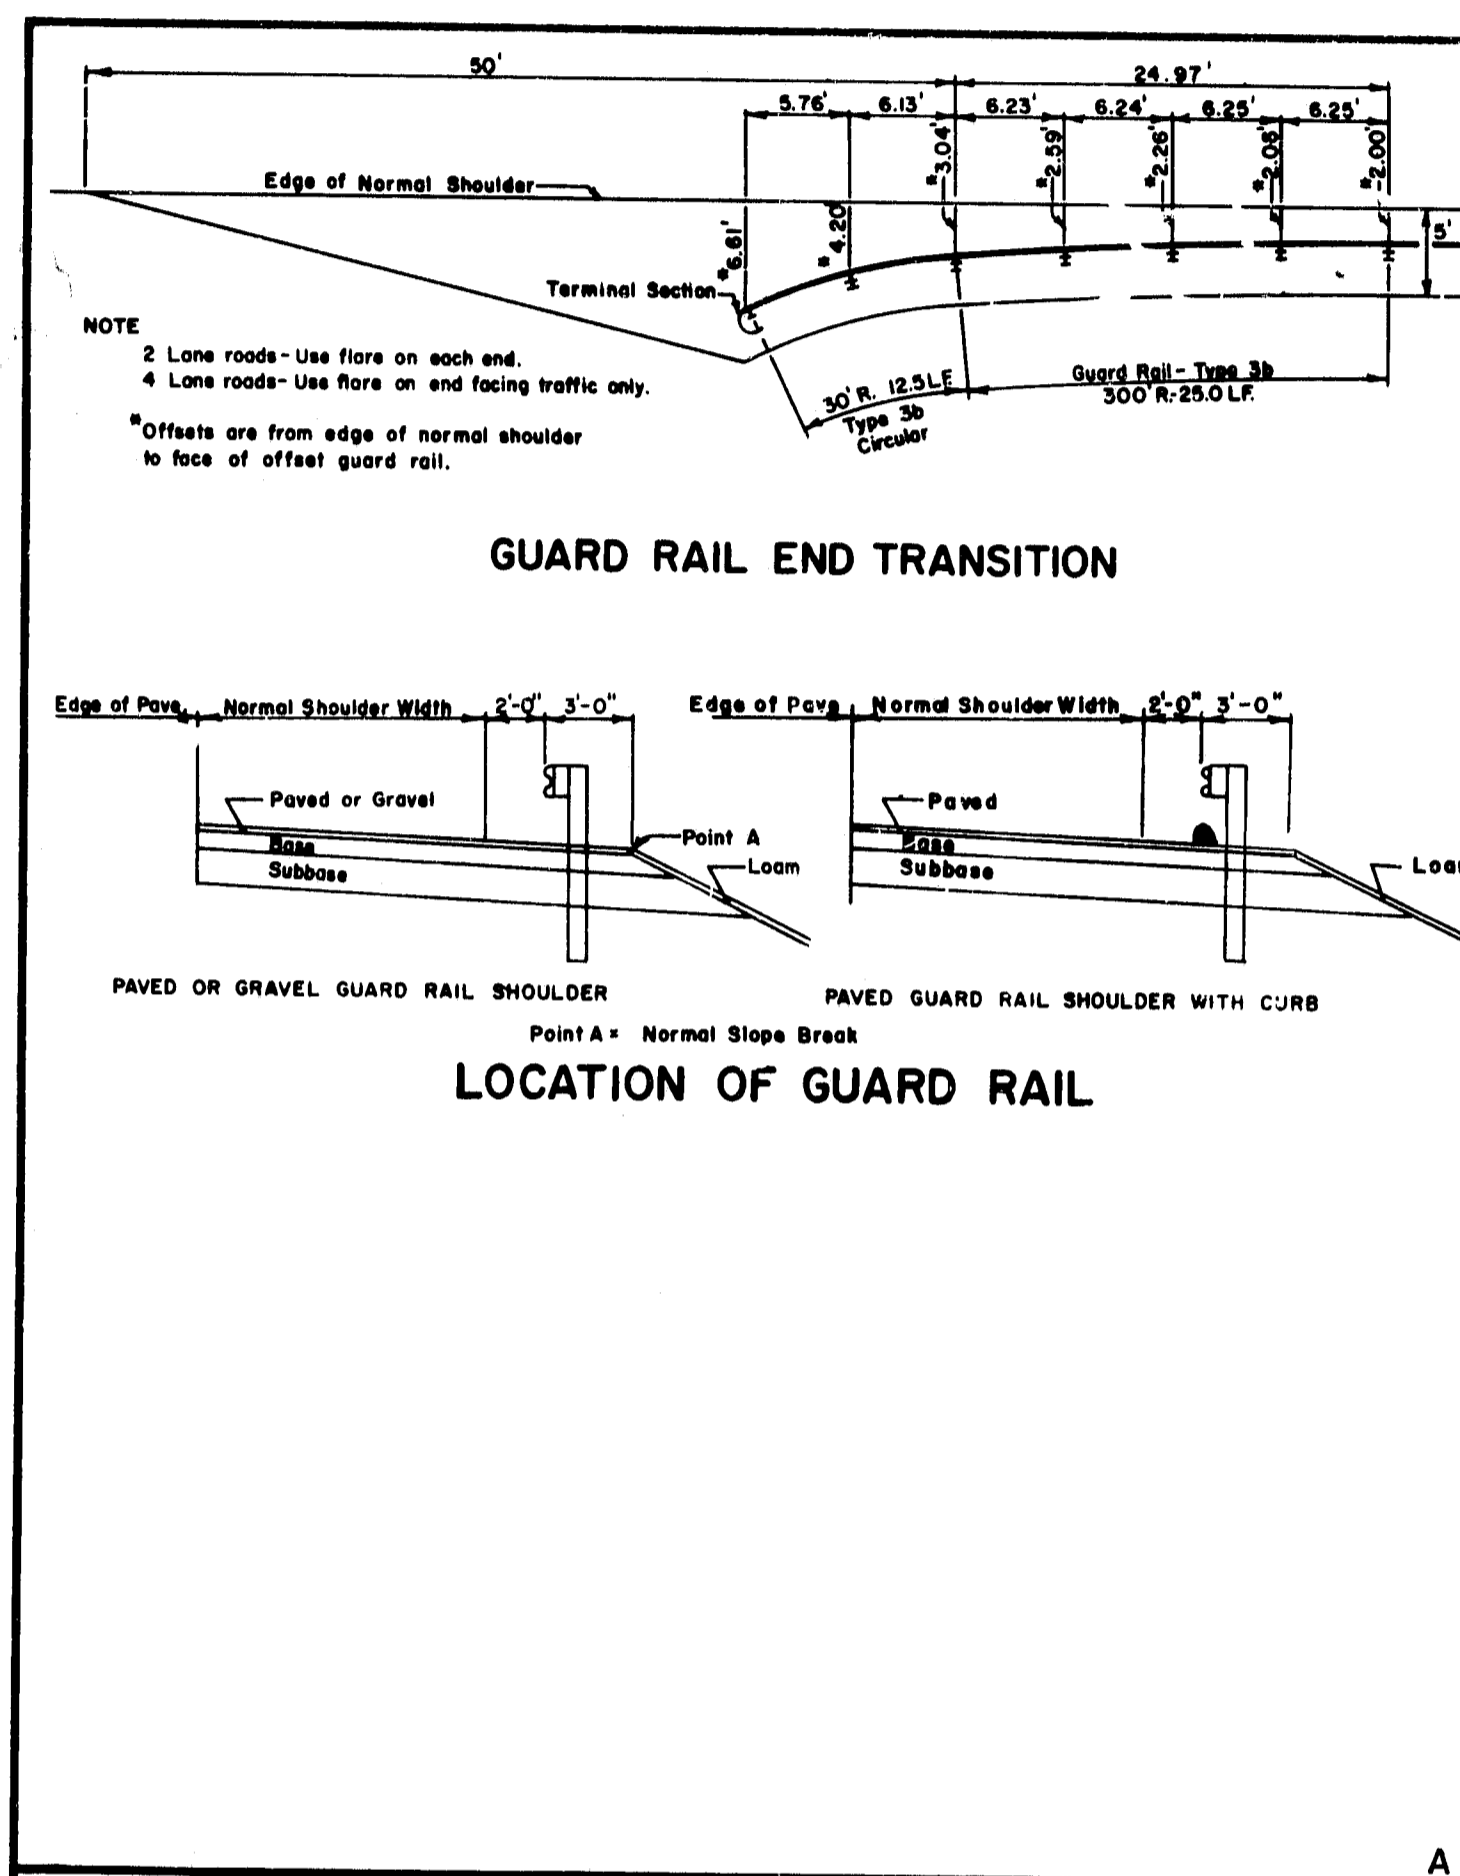

NOTE: Identification letters and numbers on drawings refer to the standard detail drawings shown in "A Guide to Standardized Highway Barrier Rail Hardware" by AASHTO - AGC - ARTBA Joint Cooperative Committee.

REVISIONS	APPROVAL	STATE OF MAINE
Description	Mo. DOT	DEPARTMENT OF TRANSPORTATION
Original Plan	Nov. 1990	AS WITH 1983 R117
GUARD RAIL BEAM DETAIL	JAN. 1981	
		STANDARD DETAILS
		TYPE 3 GUARD RAIL
		REGULATION SECTION 606
		AUGUSTA, MAINE

R89-469
 Veterans of Foreign Wars - Athens