


HALE ELEVATION

HALF SECTION C-C


MAIN TOWER 54221E

Required: Four Main Tower Saddles (Cast Steel annealed)
complete with bolts and covers.

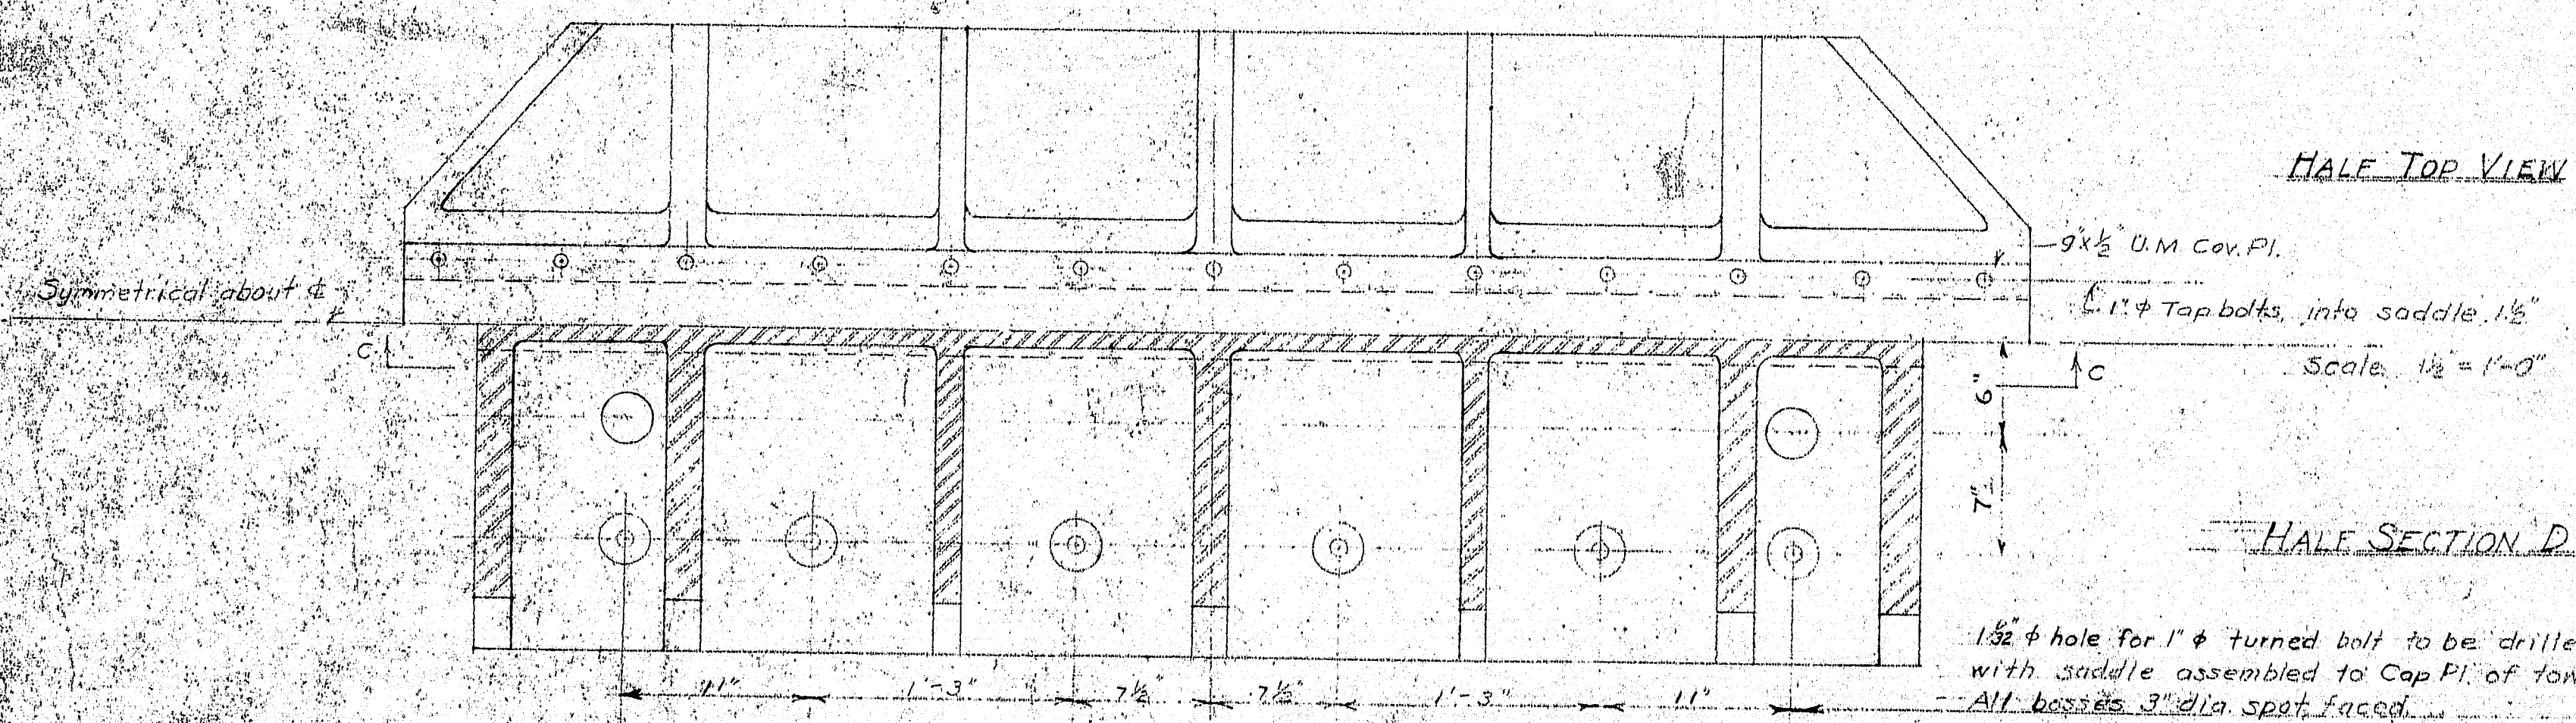

HALF TOP VIEW

HALE SECTION D-D

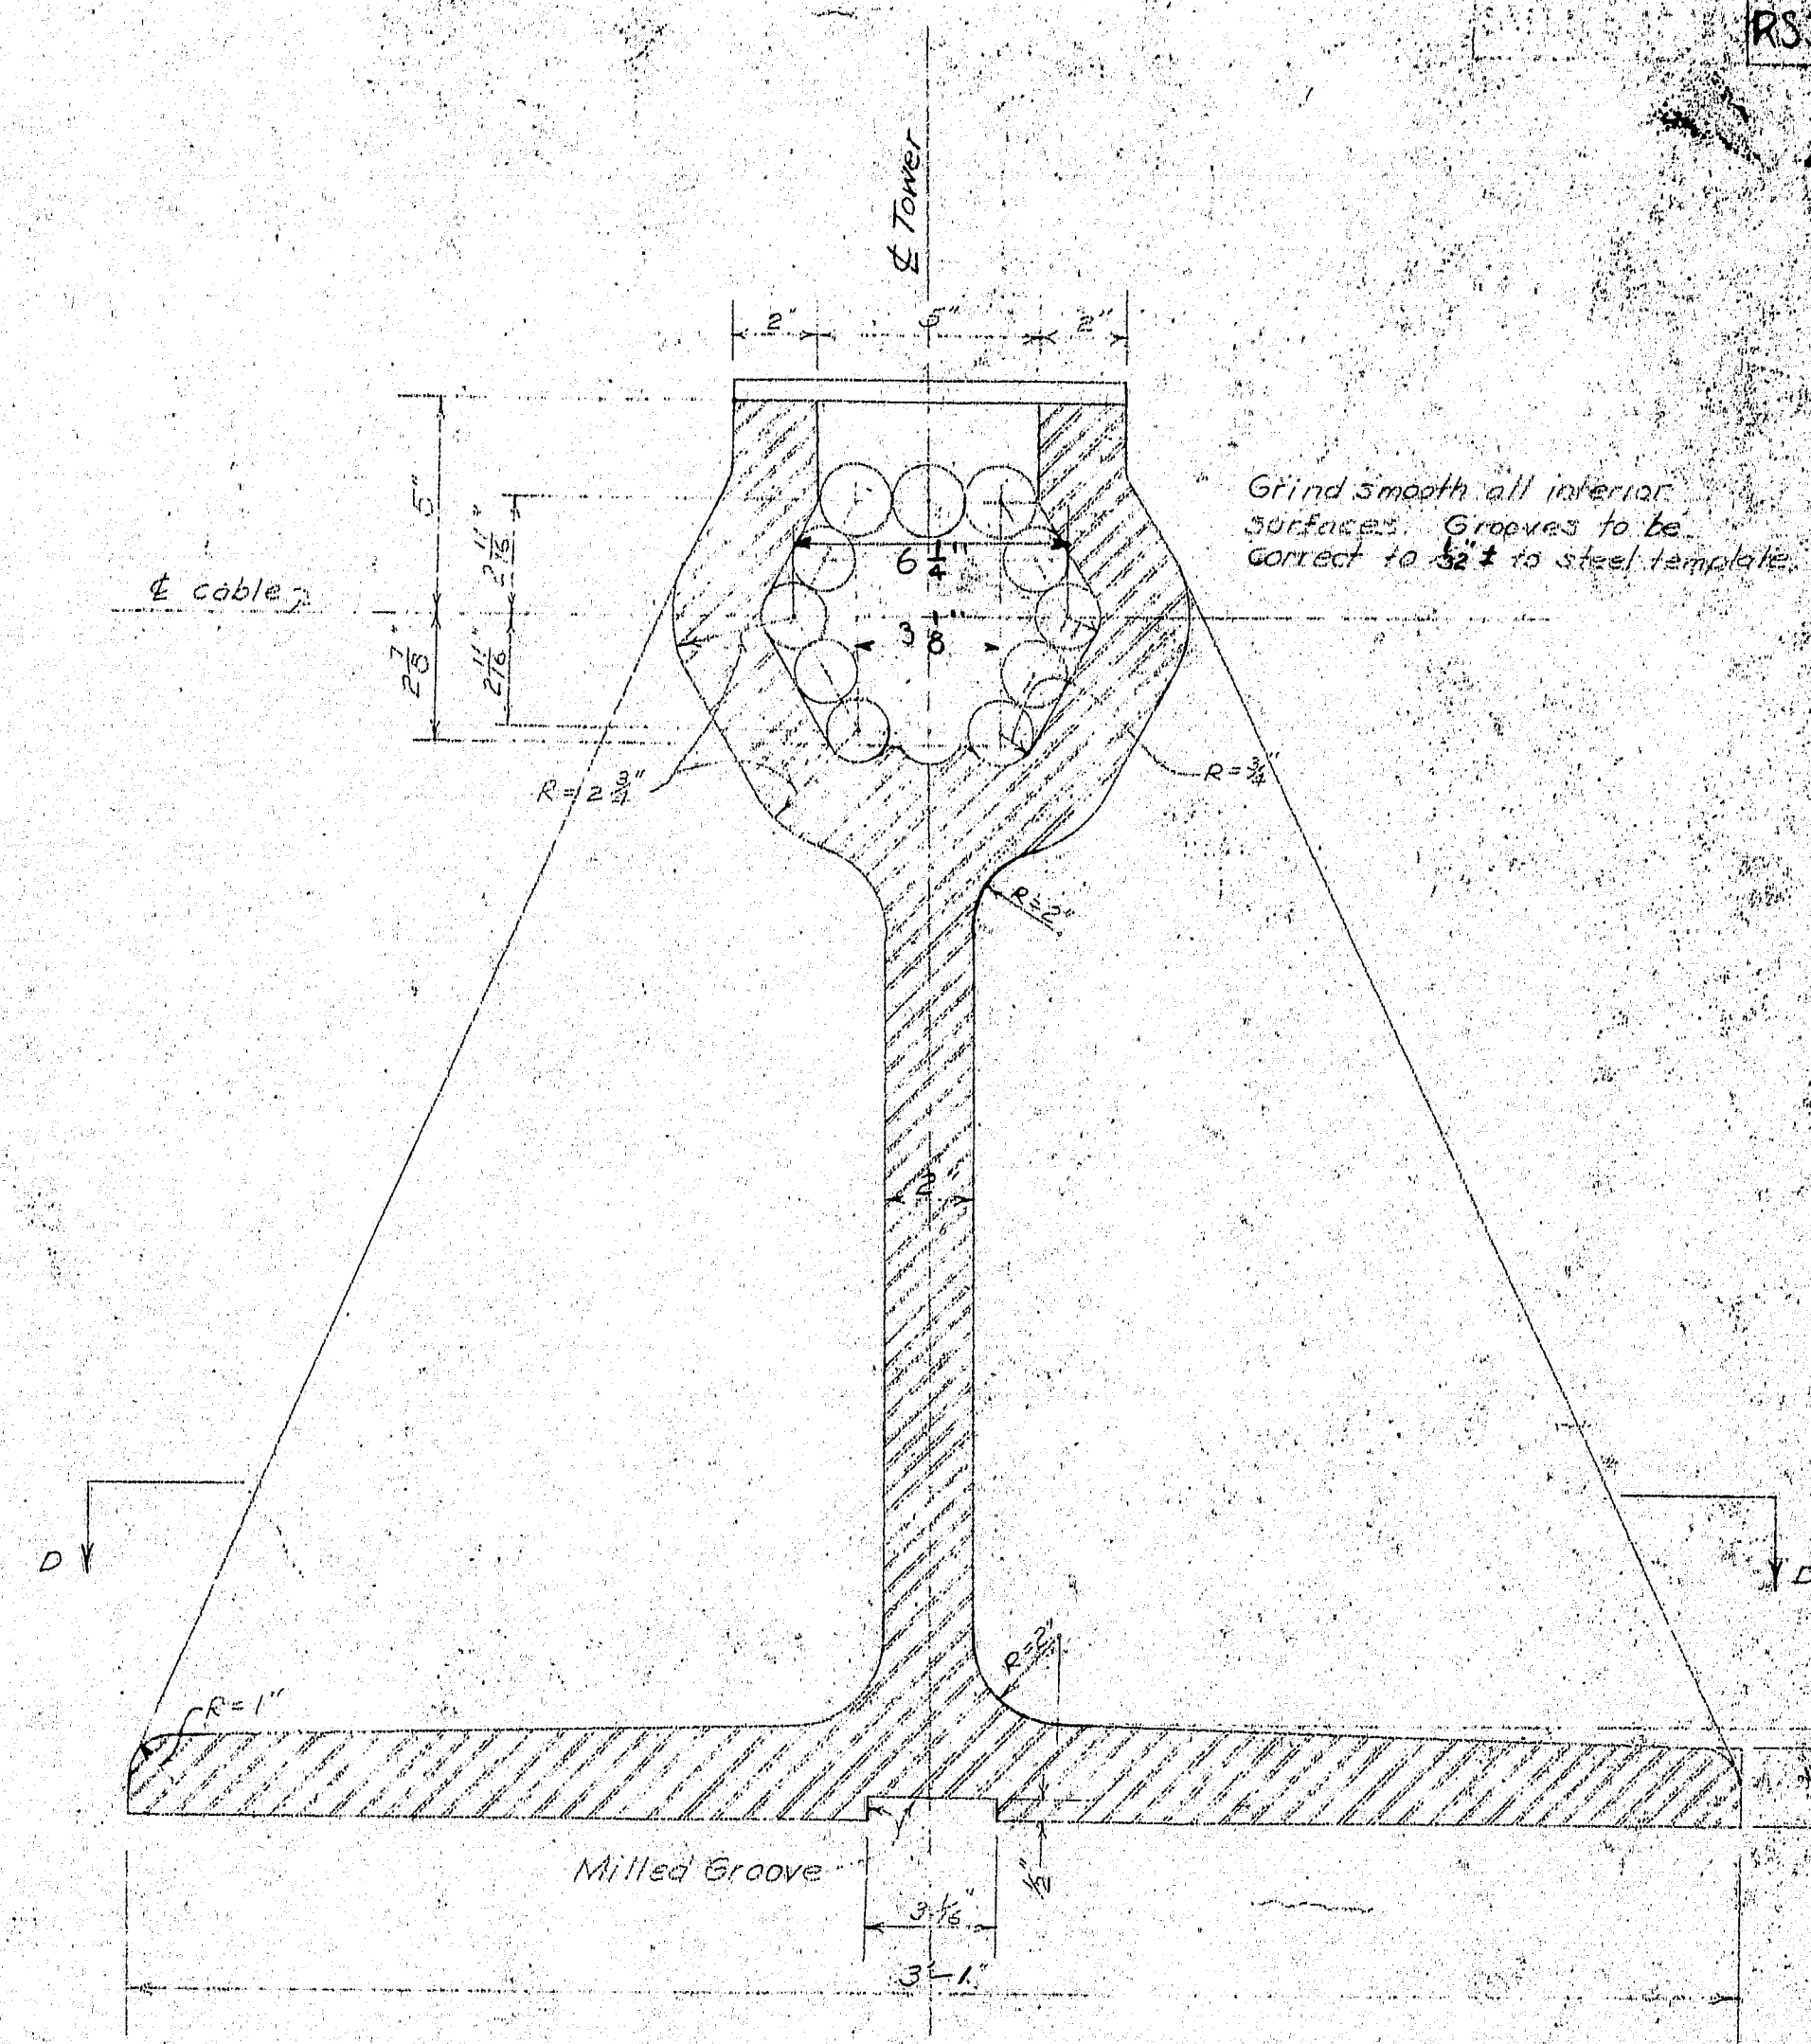

ENLARGED SECTION A-A

Scale 3" = 1'-0"

Estimated Weight of one tower saddle — — — 5700 #
Total for bridge — — — — 22,800 #

SUPERSTRUCTURE

P.W.A. PROJECT NO. ME 1010D

DEER ISLE SEDGWICK BRIDGE DISTRICT
BRIDGE OVER EGGEMOGGIN REACH
FROM LITTLE DEER ISLE TO SEDGWICK
HARCOCK COUNTY MAINE

MAIN TOWER SADDLES

ROBINSON AND STEINMAN
ENGINEERS
NEW YORK CITY

SCALE AS NOTED
DRAWING NUMBER
RS 3310-S

7-26-39 Rebuilt as built.

124-21