


DETAIL OF HIGH TENSION BOLTS  
32 REQUIRED

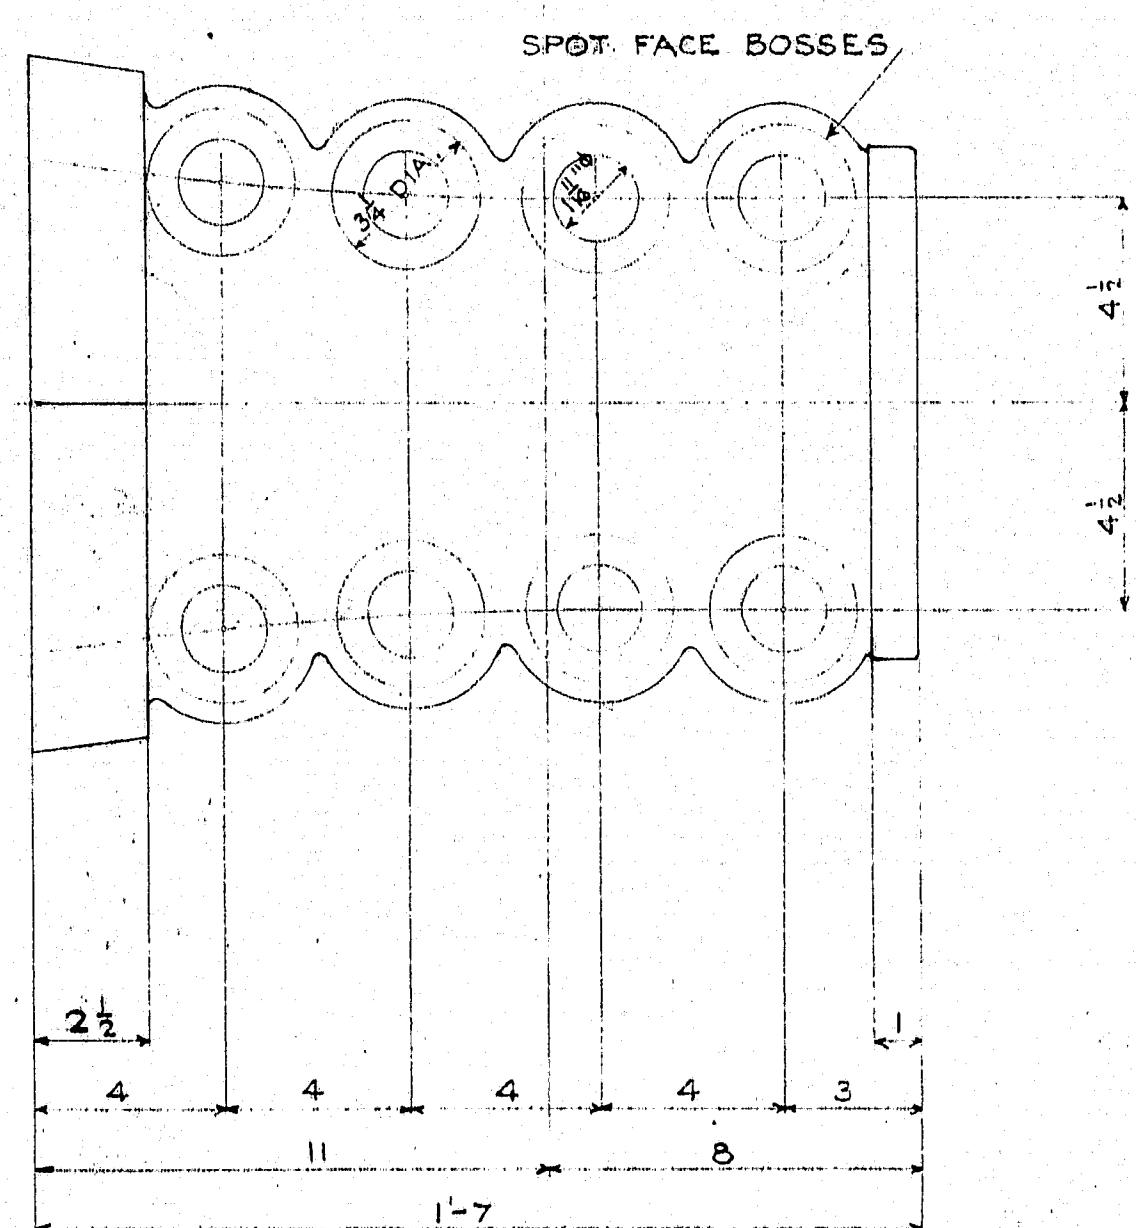

ELEVATION OF SPLAY CASTING  
4 REQUIRED CAST STEEL ANNEALED  
COMPLETE WITH HIGH TENSION BOLTS

WEIGHT OF ONE SPLAY CASTING = 450# TOTAL FOR BRIDGE = 1800#  
WEIGHT OF HIGH TENSION BOLTS FOR ONE CASTING = 90# TOTAL FOR BRIDGE = 360#

SUPERSTRUCTURE	
P.W.A. PROJECT NO. ME 1010-D	
DEER ISLE SEDGWICK BRIDGE DISTRICT BRIDGE OVER EGGEMOGGIN REACH FROM LITTLE DEER ISLE TO SEDGWICK HANCOCK COUNTY, MAINE	
SPLAY CASTINGS	
ROBINSON AND STEINMAN ENGINEERS NEW YORK CITY	SCALE 3" = 1'-0" DRAWING NUMBER RS 3310-3109 SEPTEMBER 1937

7-26-37 Revised as built

