

D:\3\DRAWING\001\0048\DWG\TITLE\001.DWG DATE: 05/04/95

F.H.W.A. REG. NO.	STATE	PROJECT NUMBER	SHEET NO.	TOTAL SHEETS
1	MAINE	0009(002)	1	103

WATERVILLE/WINSLow  
PIN 000566.40

# STATE OF MAINE DEPARTMENT OF TRANSPORTATION




PLANS

**WATERVILLE/WINSLow**  
KENNEBEC COUNTY  
DONALD V. CARTER BRIDGE  
PROJECT NO. DPB-0009(002)  
PROJECT LENGTH = 0.38 MILES  
A BRIDGE PROJECT  
VOLUME 1 - STEEL ALTERNATE

## INDEX OF SHEETS

SEE SHEET NO. 2 FOR INDEX

CONVENTIONAL SIGNS	
COUNTY LINES - - - - -	TRAVELLED WAY - PROPOSED - - - - -
TOWN LINES - - - - -	UNDERGROUND UTILITIES - EXISTING - - - - -
PROPERTY LINES - - - - -	UNDERGROUND UTILITIES - PROPOSED - - - - -
R/W LINES - EXISTING - - - - -	RAILROAD - SINGLE TRACK - - - - -
R/W LINES - NEW - ACCESS CONTROL - - - - -	RAILROAD - DOUBLE TRACK - - - - -
R/W LINES - NEW - NO ACCESS CONTROL - - - - -	UTILITY POLE - EXISTING - - - - -
CULVERT - EXISTING - - - - -	UTILITY POLE - JOINT OCCUPANCY - - - - -
CULVERT - PROPOSED - - - - -	PROPOSED UTILITY POLE - TEMPORARY - - - - -
CURBING - EXISTING - - - - -	PROPOSED UTILITY POLE - PERMANENT - - - - -
CURBING - PROPOSED - - - - -	TREES - - - - -
TRAVELLED WAY - EXISTING - - - - -	WOODS - - - - -

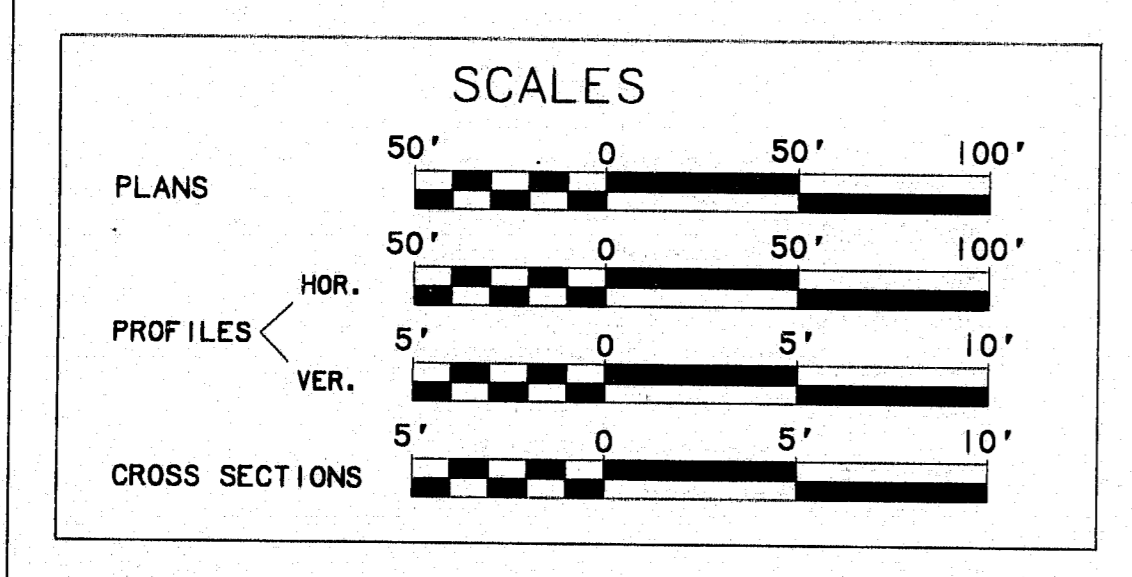


**CONTRACT DESCRIPTION**


VOLUME 1 - STEEL ALTERNATE  
VOLUME 2 - CONCRETE ALTERNATE

**NOTE:**

IT IS THE INTENT TO AWARD ONLY VOLUME 1 OR ONLY VOLUME 2

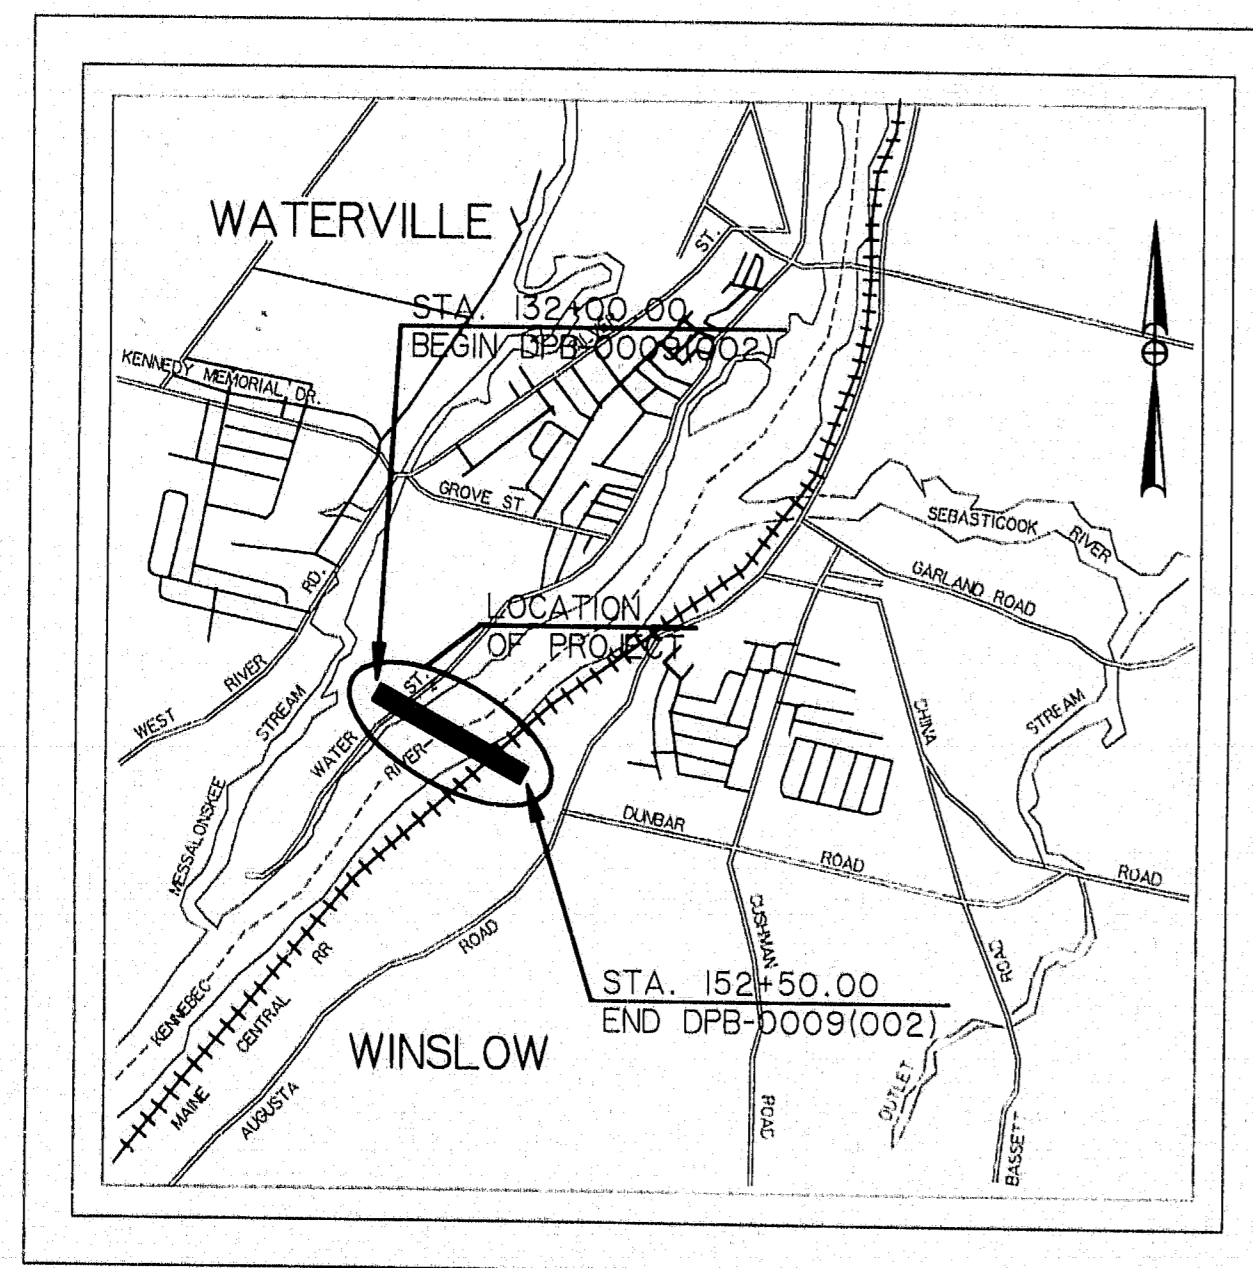

A PORTION OF KENNEBEC COUNTY  
SCALE IN FEET  
0 2500 5000

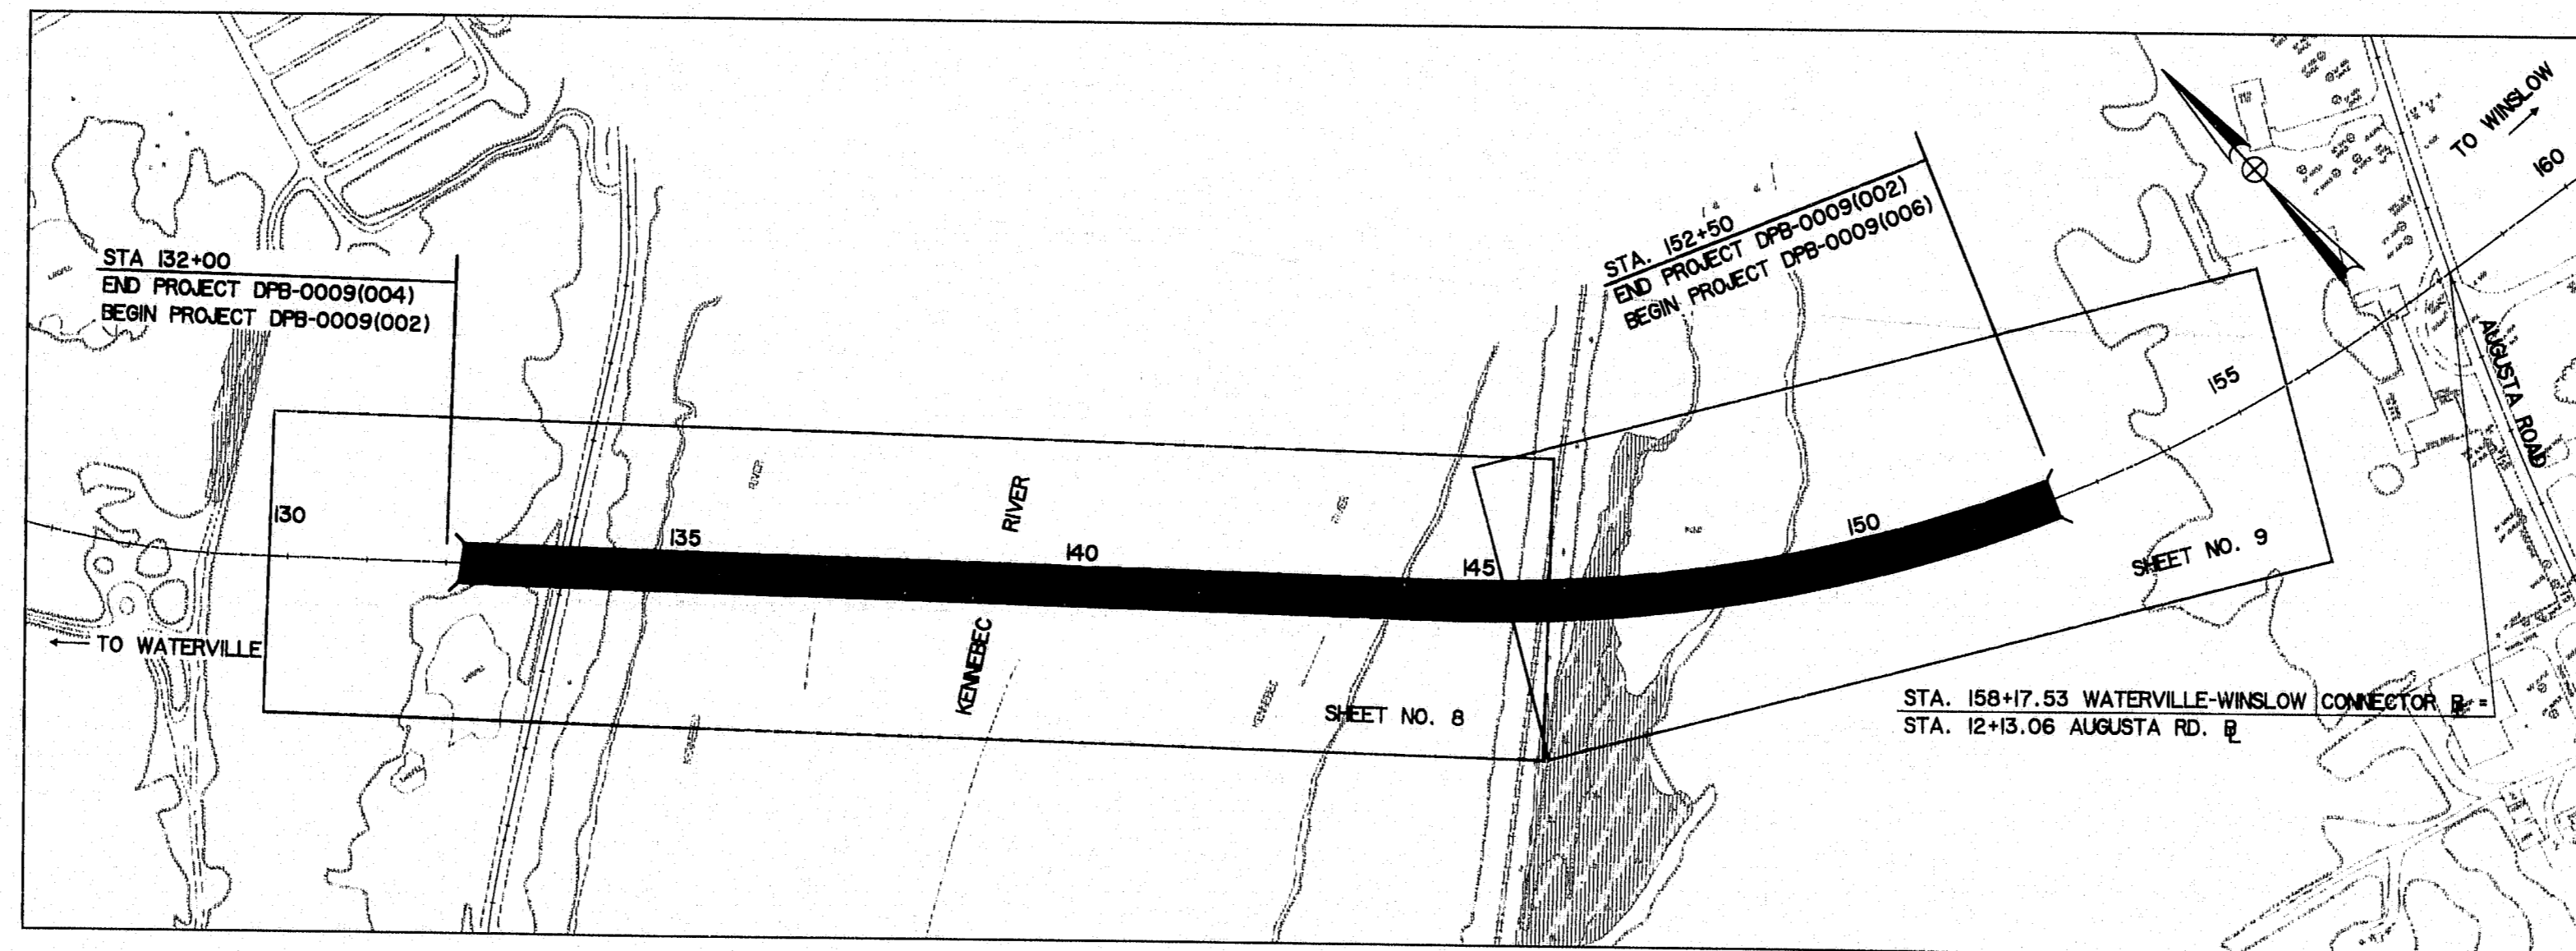


LAYOUT PLAN  
GRAPHIC SCALE 1"=200'

**DONALD V. CARTER BRIDGE  
TRAFFIC DATA**

A.A.D.T. (1994) 12550  
A.A.D.T. (2014) 15110  
D.H.V. 1511  
T. (20-H.V.) 3  
D. (20-H.V.) 55  
V. 50 MPH  
P.S.D. (2) N/A  
18 KIPS P (2.5) 122

NOTE:  
ALL WORK CONTEMPLATED UNDER THIS CONTRACT TO BE GOVERNED BY AND IN CONFORMITY WITH THE STANDARD SPECIFICATIONS (REVISION OF OCTOBER 1990) AND SUPPLEMENTALS THERETO, EXCEPT AS MODIFIED ON THE PLANS AND IN THE SPECIAL PROVISIONS.

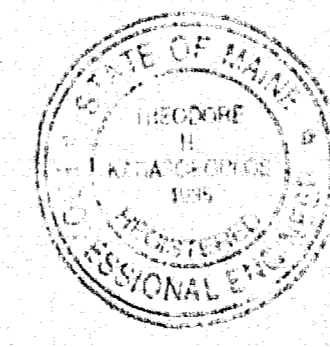


APPROVED:  
STATE OF MAINE  
DEPARTMENT OF TRANSPORTATION

COMMISSIONER  
CHIEF ENGINEER

Prepared by:  
**HNTB** ARCHITECTS ENGINEERS PLANNERS

ENGINEERS SIGNATURE: *Carl Mellica* DATE: 2/20/95

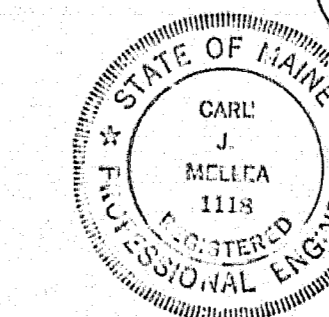

**115-187**

UNITED STATES  
DEPARTMENT OF TRANSPORTATION  
FEDERAL HIGHWAY ADMINISTRATION

REGION

APPROVED: \_\_\_\_\_ DATE: \_\_\_\_\_  
DIVISION ADMINISTRATOR DATE

F.H.W.A. REG. NO.	STATE	PROJECT NUMBER	SHEET NO.	TOTAL SHEETS
1	MAINE	0009(002)	2	103

CONTRACT SHEET NO.	BRIDGE SHEET NO.	DESCRIPTION
--------------------	------------------	-------------

1.		TITLE SHEET
2.		INDEX OF SHEETS
3.		ESTIMATED QUANTITIES AND GENERAL NOTES
4.		HIGHWAY PROFILE
5.-7.		HIGHWAY CROSS SECTIONS
8.-9.	B1 - B2	PLAN AND ELEVATION
10.	B3	GENERAL NOTES
11.	B4	BORING PLAN
12.-26.	B5 - B19	BORING LOGS
27.	B19A	FOUNDATION SURVEY (NORTH SOIL PROFILE)
28.	B19B	FOUNDATION SURVEY (SOUTH SOIL PROFILE)
29.	B20 - B22	FOUNDATION PLAN
32.	B23	COFFERDAM DETAILS
33.	B24	ABUTMENT 1 (CONCRETE)
34.	B25	ABUTMENT 1 (RE-STEEL)
35.	B26	ABUTMENT 2 (CONCRETE)
36.	B27	ABUTMENT 2 (RE-STEEL)
37.	B28	ABUTMENT DETAILS
38.	B29	WINGWALL DETAILS
39.	B30	PIER 1 DETAILS
40.	B31	PIER 1 RE-STEEL
41.	B32	PIER 2 DETAILS
42.	B33	PIER 2 RE-STEEL
43.	B34	PIER 3 DETAILS
44.	B35	PIER 3 RE-STEEL
45.	B36	PIER 4 DETAILS
46.	B37	PIER 4 RE-STEEL
47.	B38	PIER 5 DETAILS
48.	B39	PIER 5 RE-STEEL
49.	B40	PIER 6 DETAILS
50.	B41	PIER 6 RE-STEEL
51.	B42	PIER 7 DETAILS
52.	B43	PIER 7 RE-STEEL
53.	B44	PIER 8 DETAILS
54.	B45	PIER 8 RE-STEEL
55.	B46	PIER 9 DETAILS
56.	B47	PIER 9 RE-STEEL
57.	B48	PIER 10 DETAILS
58.	B49	PIER 10 RE-STEEL
59.	B50	PIER CAP DETAILS
60.-65.	B51 - B56	FRAMING PLAN
66.	B57	CROSSFRAME DETAILS
67.-68.	B58 - B59	DEFLECTION DIAGRAM
69.-70.	B60 - B61	CAMBER DIAGRAM
71.-72.	B62 - B63	BEARING DEVICES
73.	B64	GIRDER SPLICE DETAILS
74.-76.	B65 - B67	CATWALK DETAILS
77.-79.	B68 - B70	BLOCKING ELEVATIONS
80.-84.	B71 - B75	DECK PLAN
85.	B76	DECK SECTIONS
86.	B77	BARRIER DETAILS
87.-88.	B78 - B79	EXPANSION JOINT DETAILS
89.-95.	B80 - B86	REINFORCING STEEL SCHEDULE

REVISED IN AS BUILT

AS BUILT  
C.M. 12/1/76


**BRIDGE STANDARDS**

96.	BD 112-93	DIAPHRAGMS & CROSSFRAMES
97.	BD 304-93	EXPANSION DEVICE - FINGER JOINT
98.	BD 501-93	SUBSTRUCTURE DETAILS
99.	BD 521-93	SUPERSTRUCTURE DETAILS

**HIGHWAY STANDARDS**

100.	HD-7	EROSION CONTROL FOR DITCHES AND SLOPES
101.	HD-10	MAINTENANCE OF TRAFFIC IN CONSTRUCTION ZONES
102.	HD-11	MAINTENANCE OF TRAFFIC IN CONSTRUCTION ZONES
103.	HD-12	MAINTENANCE OF TRAFFIC IN CONSTRUCTION ZONES

NO.	REVISION	BY	DATE	IN CHARGE OF

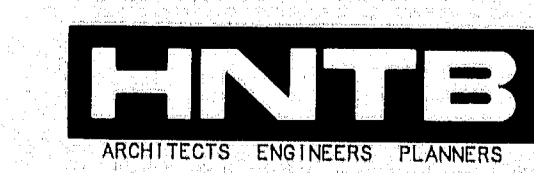

**115-188**

STEEL ALTERNATIVE  
STATE OF MAINE  
DEPARTMENT OF TRANSPORTATION  
WATERVILLE - WINSLOW PROJECT  
DONALD V. CARTER BRIDGE  
OVER  
KENNEBEC RIVER


INDEX OF SHEETS

SHEET OF AUGUSTA, MAINE



D:\3\WORK\009\002\002\DWG\PROFILES\FBI\DWG-00021

F.W.A. REG. NO.	STATE	PROJECT NUMBER	SHEET NO.	TOTAL SHEETS
1	MAINE	0009(002)	4	103

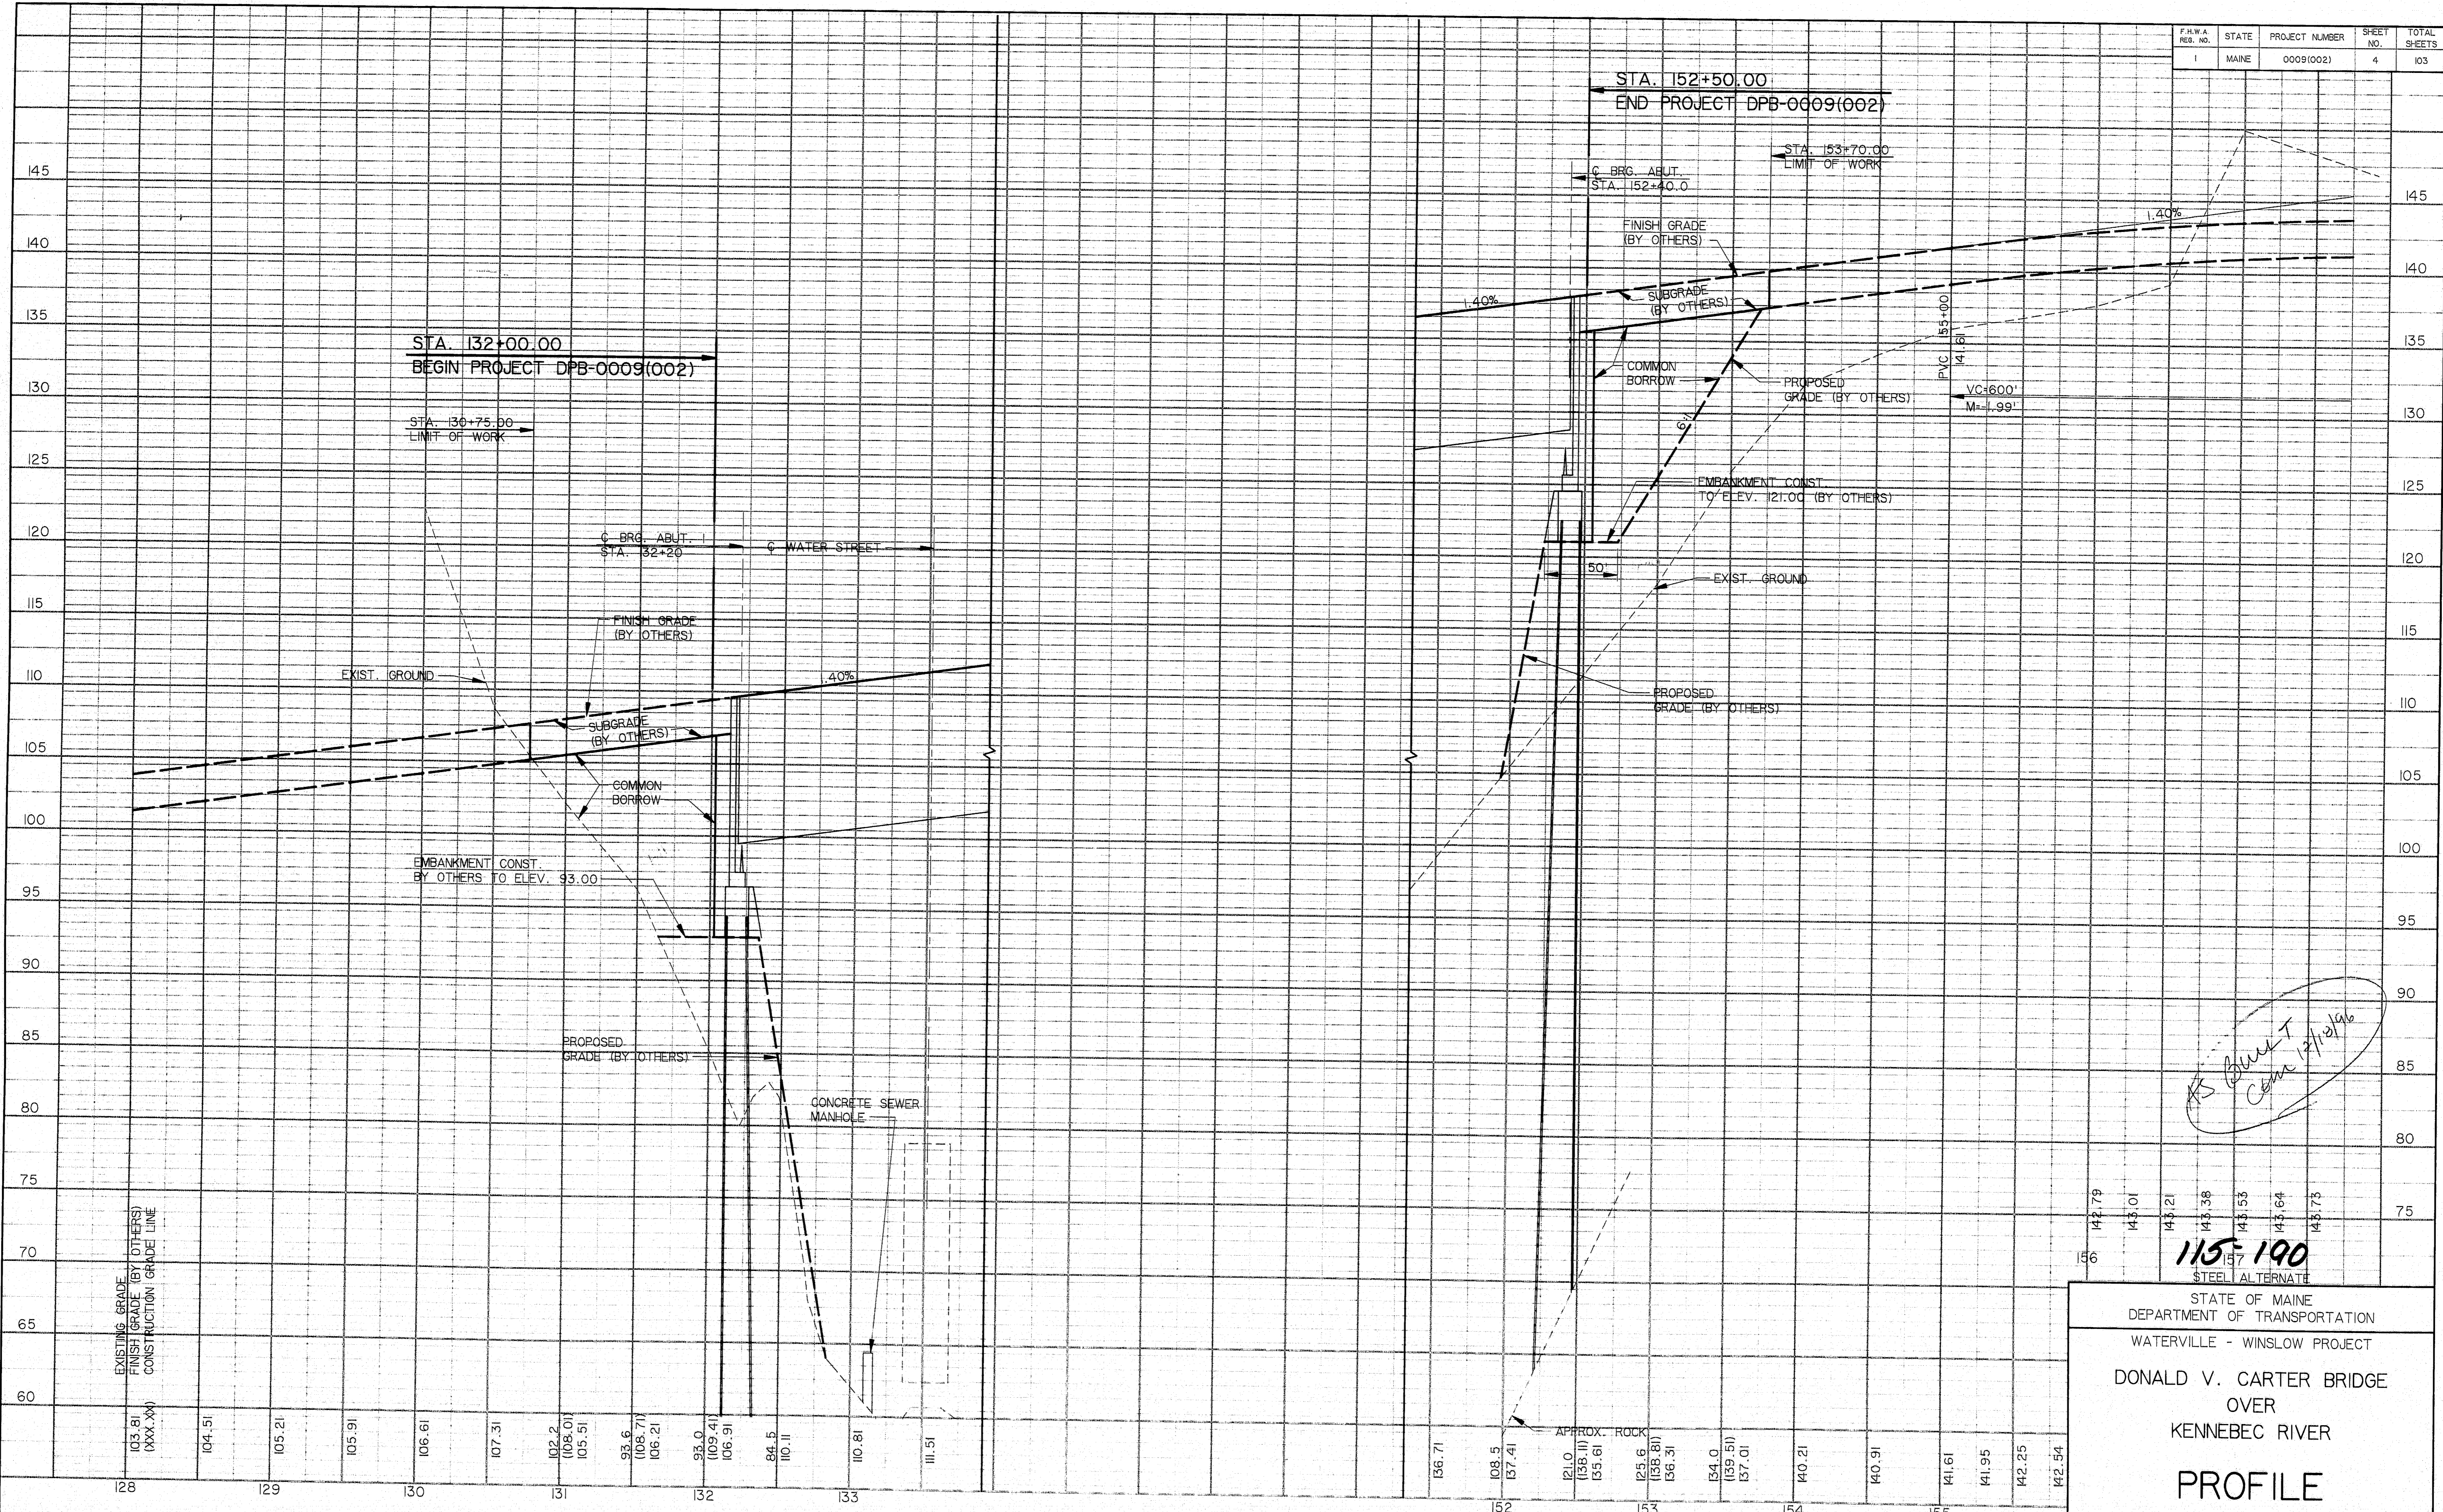

DATE	BY

PROFILE	DATE	BY

DATE	BY

PROFILE	DATE	BY

*KS [Signature]*  
*Carter 12/19/16*

142.79	143.01	143.21	143.38	143.53	143.64	143.75
142.54	142.25	141.95	141.61	140.21	139.31	137.41
136.71	136.5	137.41	121.0	125.6	134.0	137.01


**115-190**  
 STEEL ALTERNATE

STATE OF MAINE  
 DEPARTMENT OF TRANSPORTATION  
 WATERVILLE - WINSLOW PROJECT  
 DONALD V. CARTER BRIDGE  
 OVER  
 KENNEBEC RIVER  
**PROFILE**  
 AUGUSTA, MAINE  
 WATERVILLE-WINSLOW

Generated 17 FEB 95 10:00:00

D:\3\WORK\009\002\002\DWG\PROFILES\FBI\DWG-00021

F.A.W.A. REG. NO.	STATE	PROJECT NUMBER	SHEET NO.	TOTAL SHEETS
1	MAINE	0009(002)	5	103

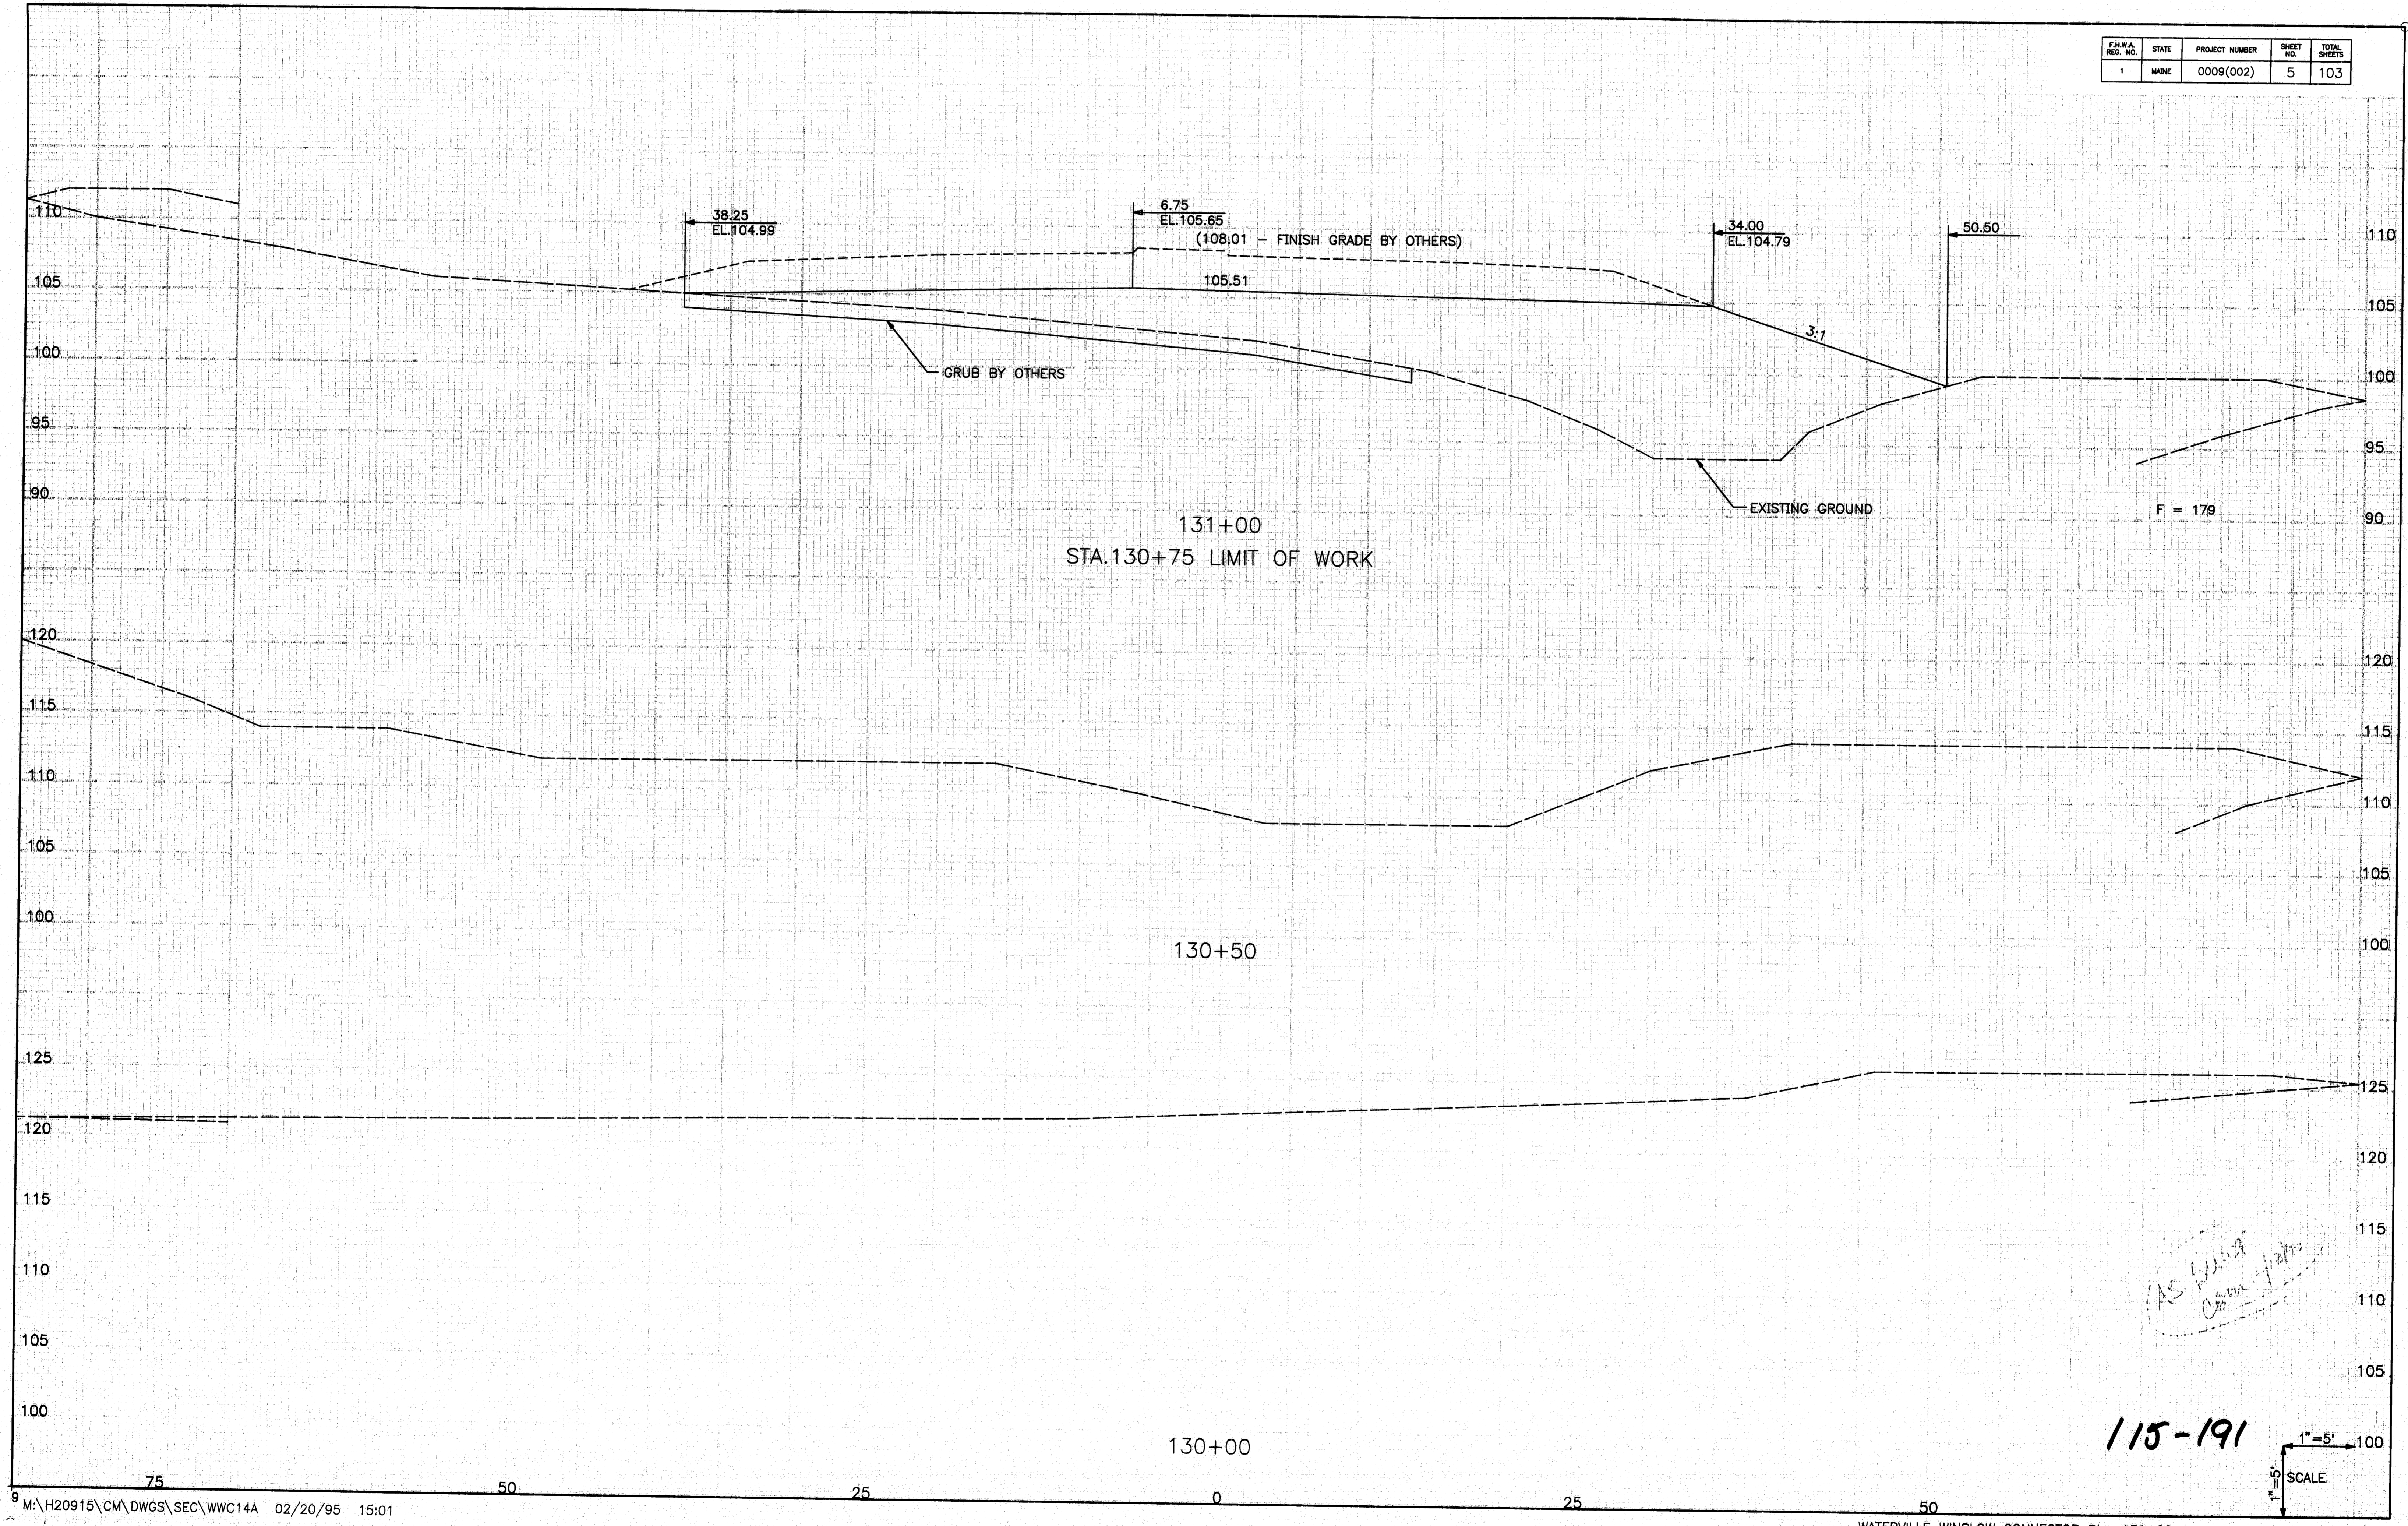


*AS SHOWN  
ON PLAN*


115-191

1" = 5'  
SCALE

F.W.A. REG. NO.	STATE	PROJECT NUMBER	SHEET NO.	TOTAL SHEETS
1	MAINE	0009(002)	6	103

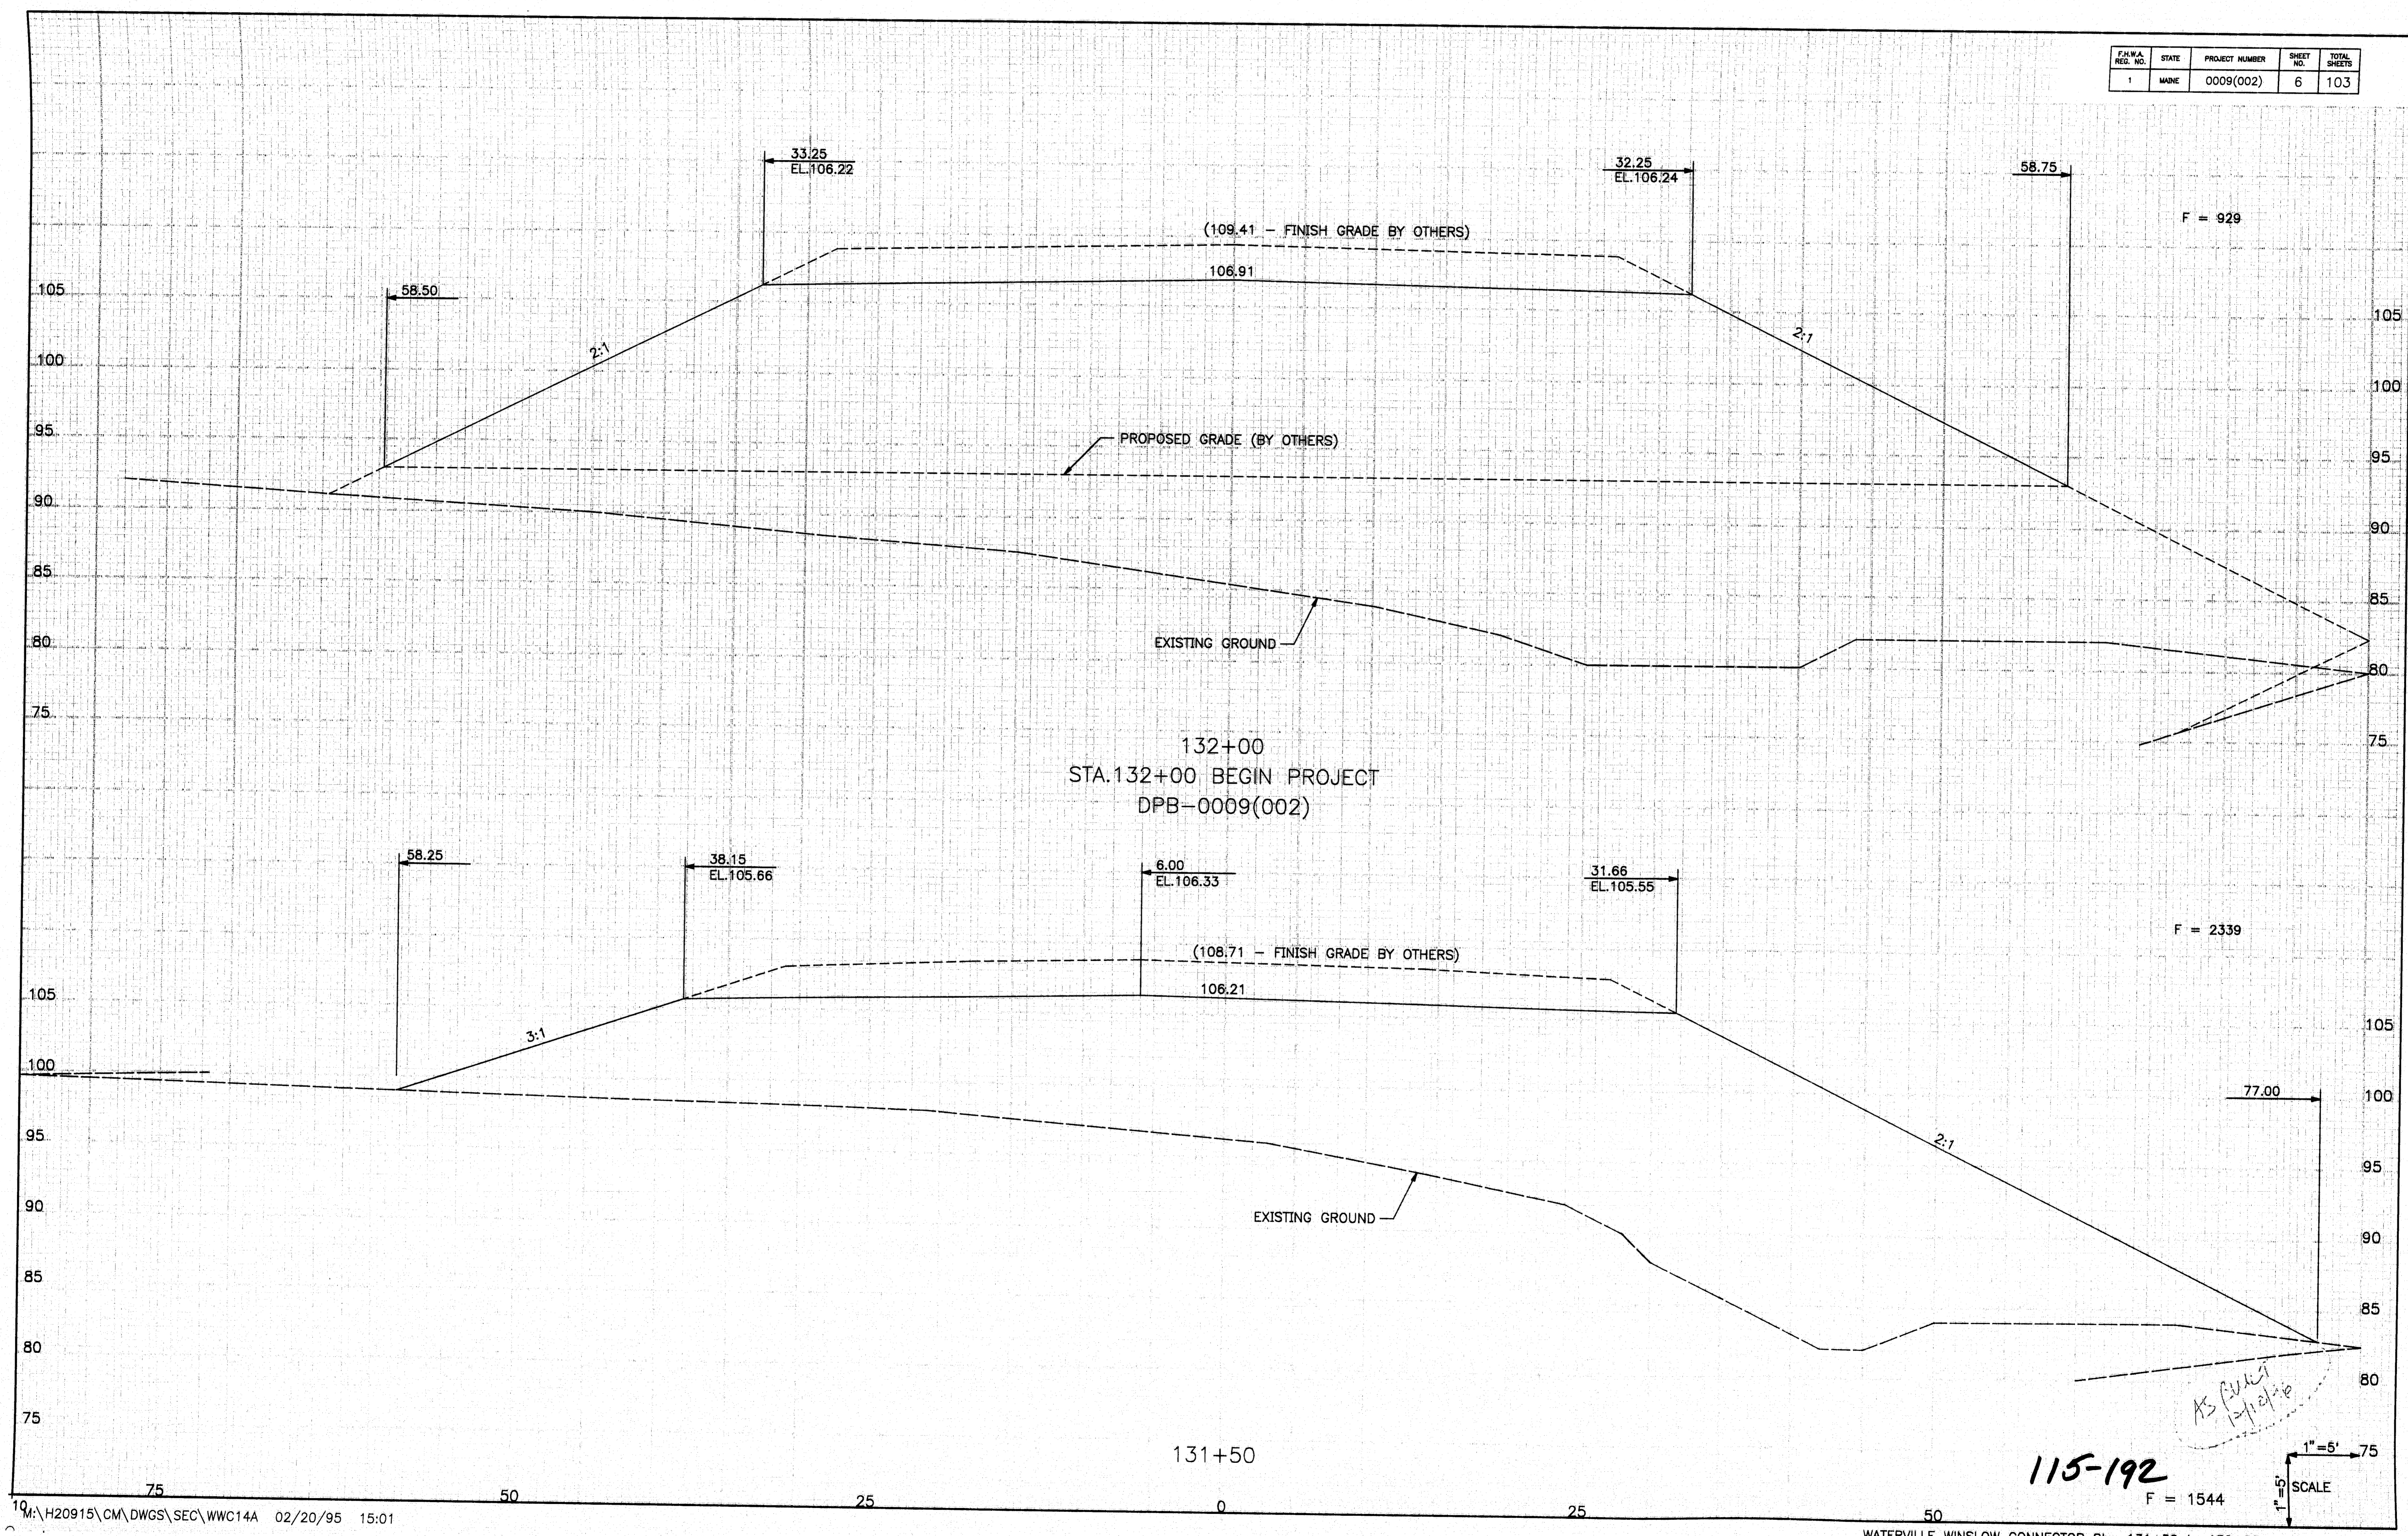


F.A.R.A. REG. NO.	STATE	PROJECT NUMBER	SHEET NO.	TOTAL SHEETS
1	MAINE	0009(002)	7	103


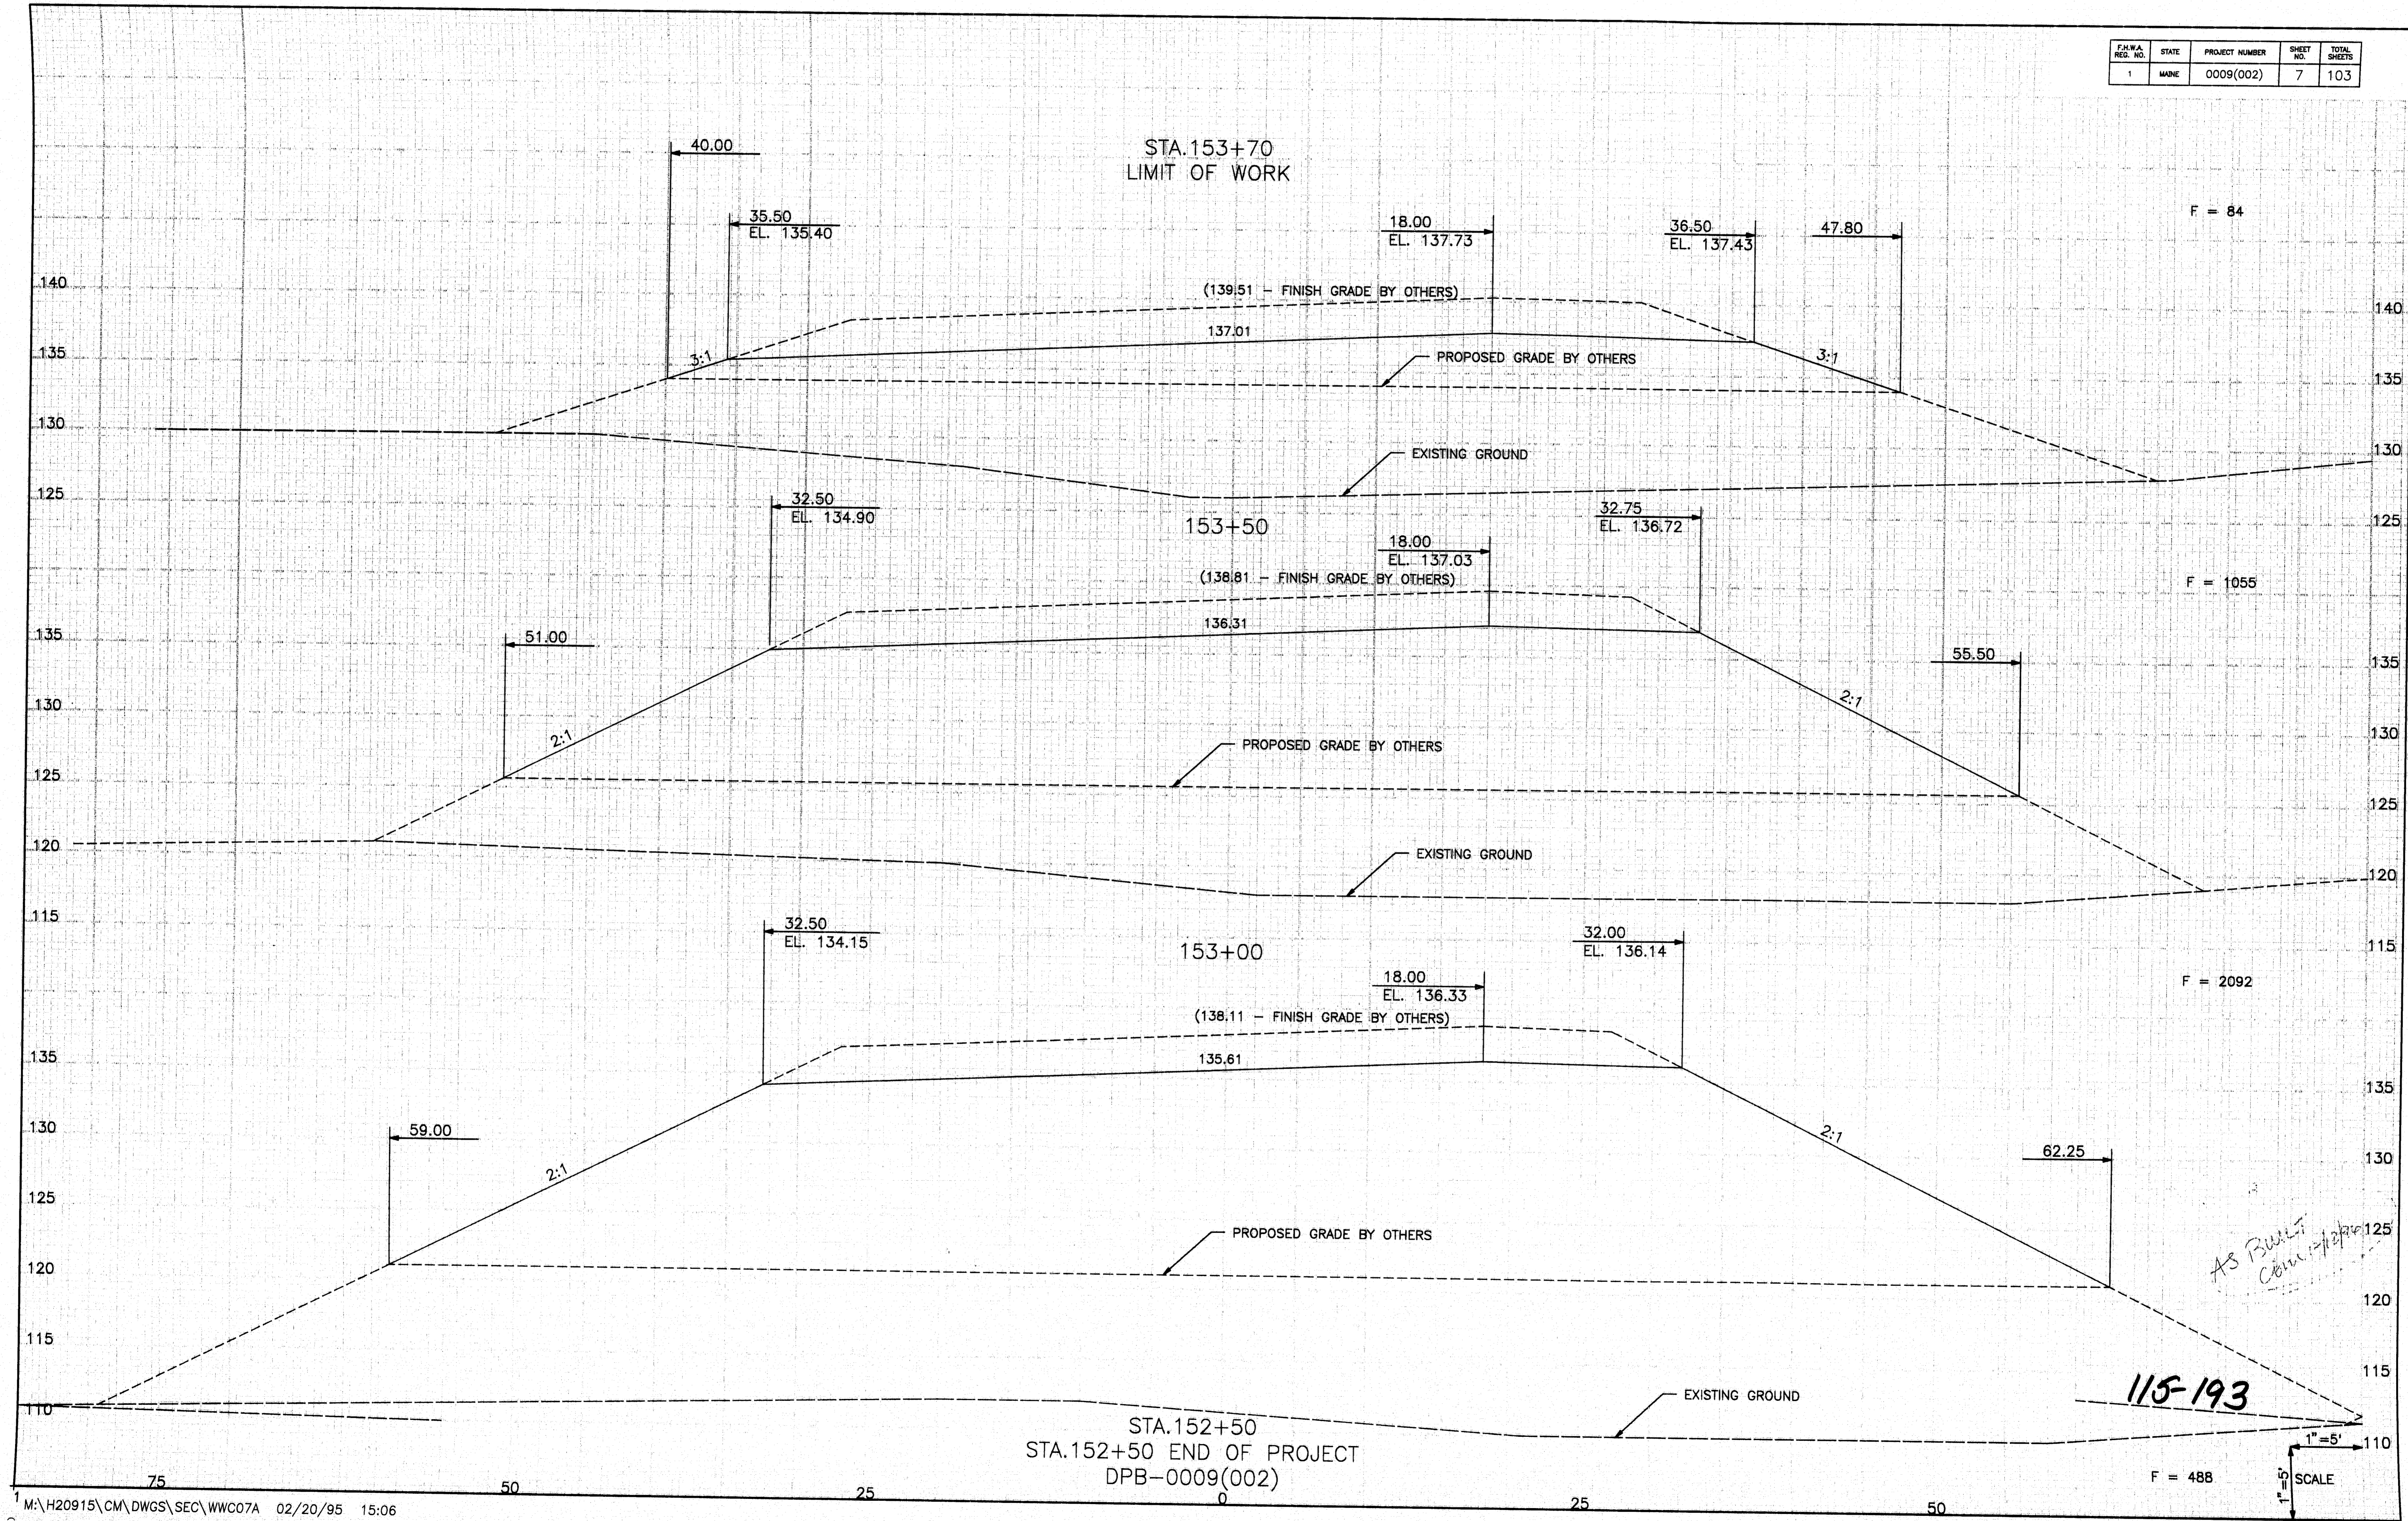




F.H.W.A. RES. NO.	STATE	PROJECT NUMBER	SHEET NO.	TOTAL SHEETS
1	MAINE	00091002	9	103

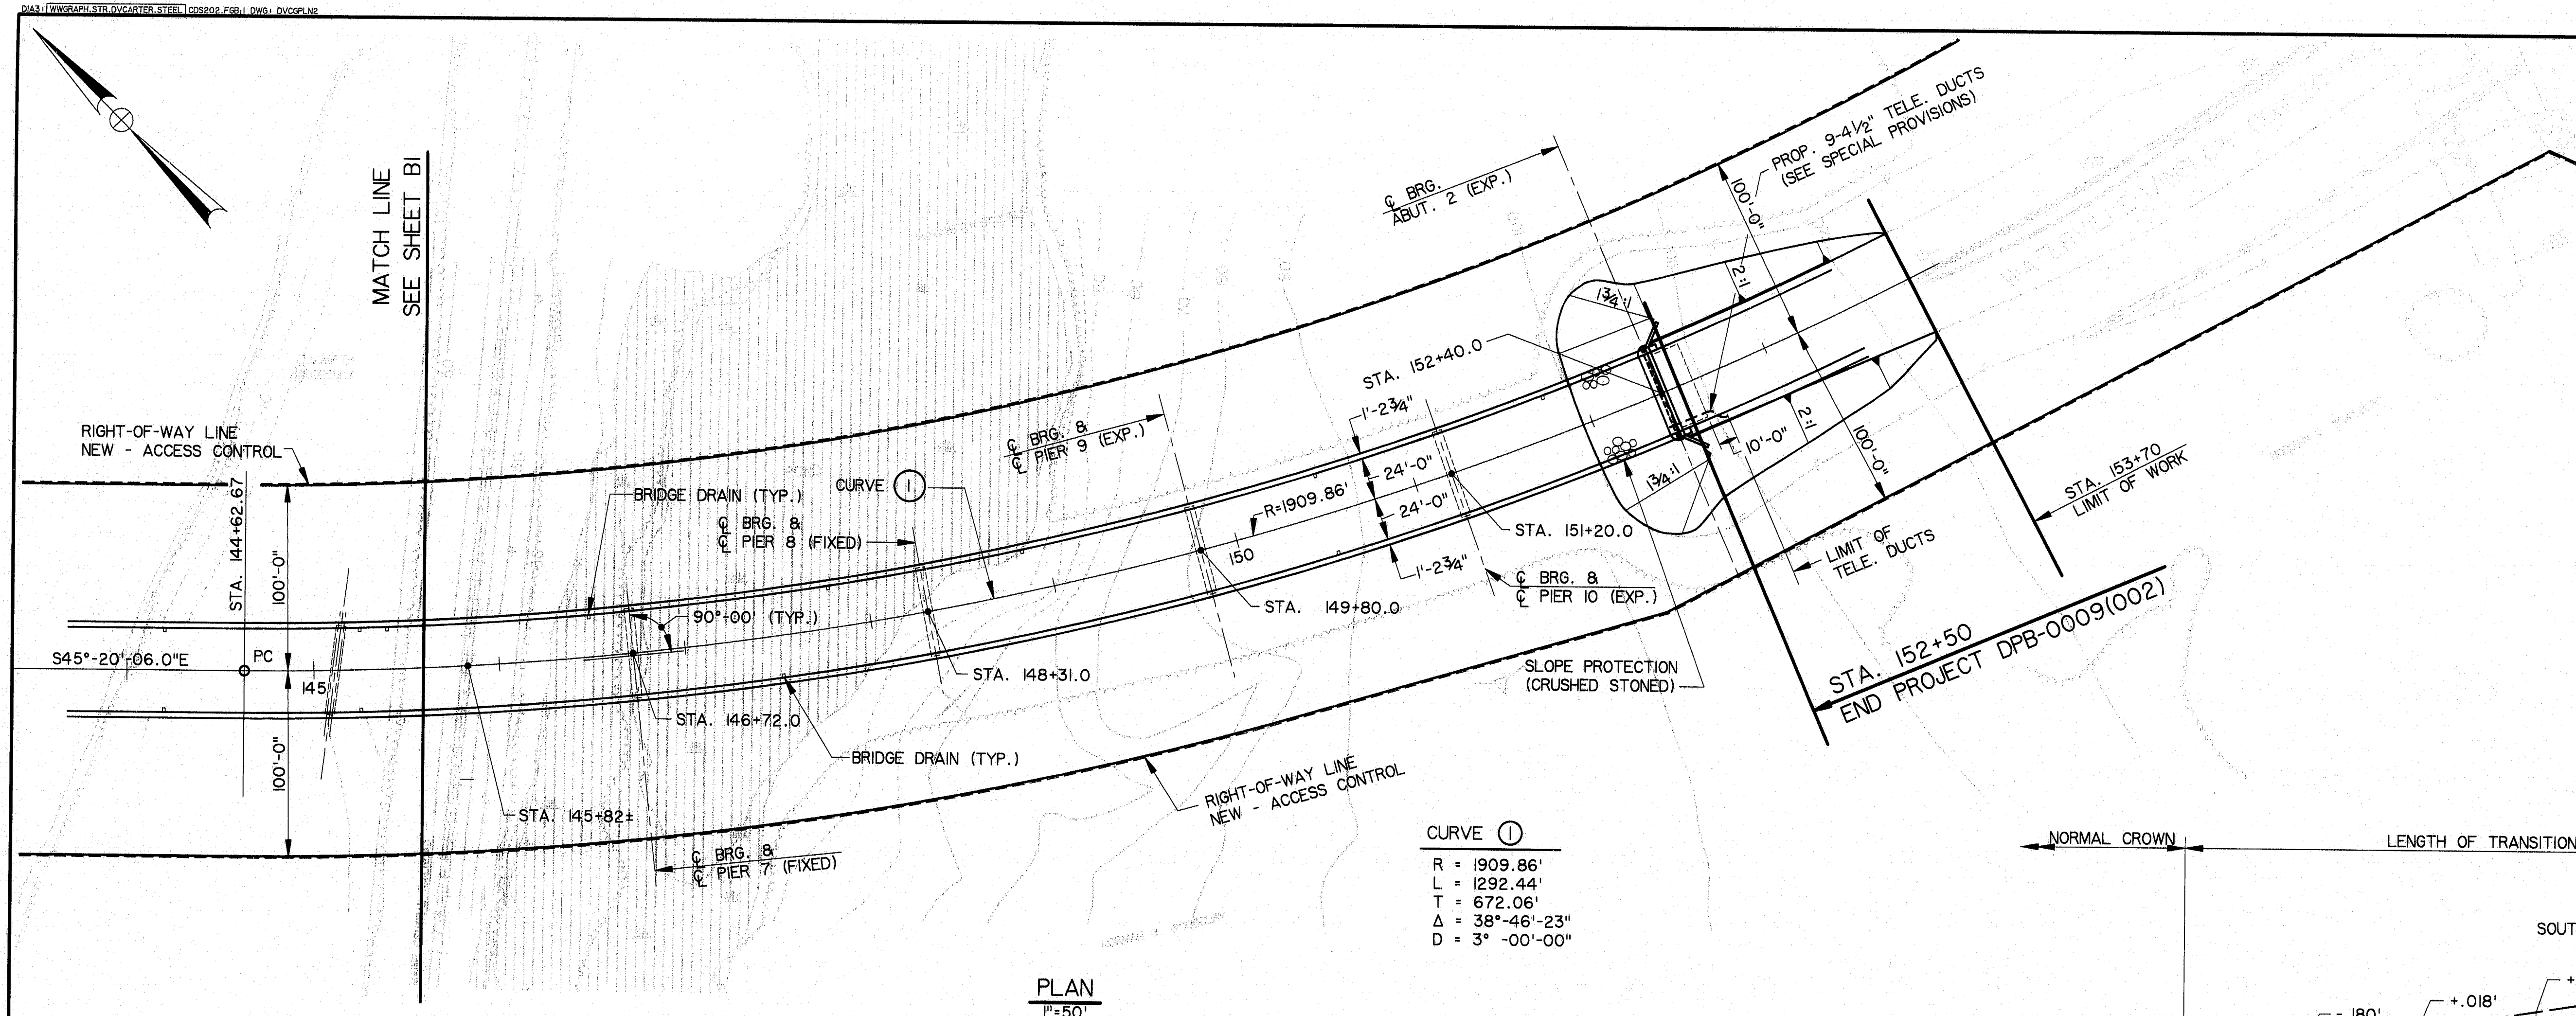

BRIDGE DRAIN		
STATION	24' LEFT	24' RIGHT
132+30		
132+45		
132+75		
135+05		
137+50		
139+90		
142+20		
144+20		
145+25		
145+40		
146+50		
147+50		
148+80		
148+87		
150+50		
151+80		

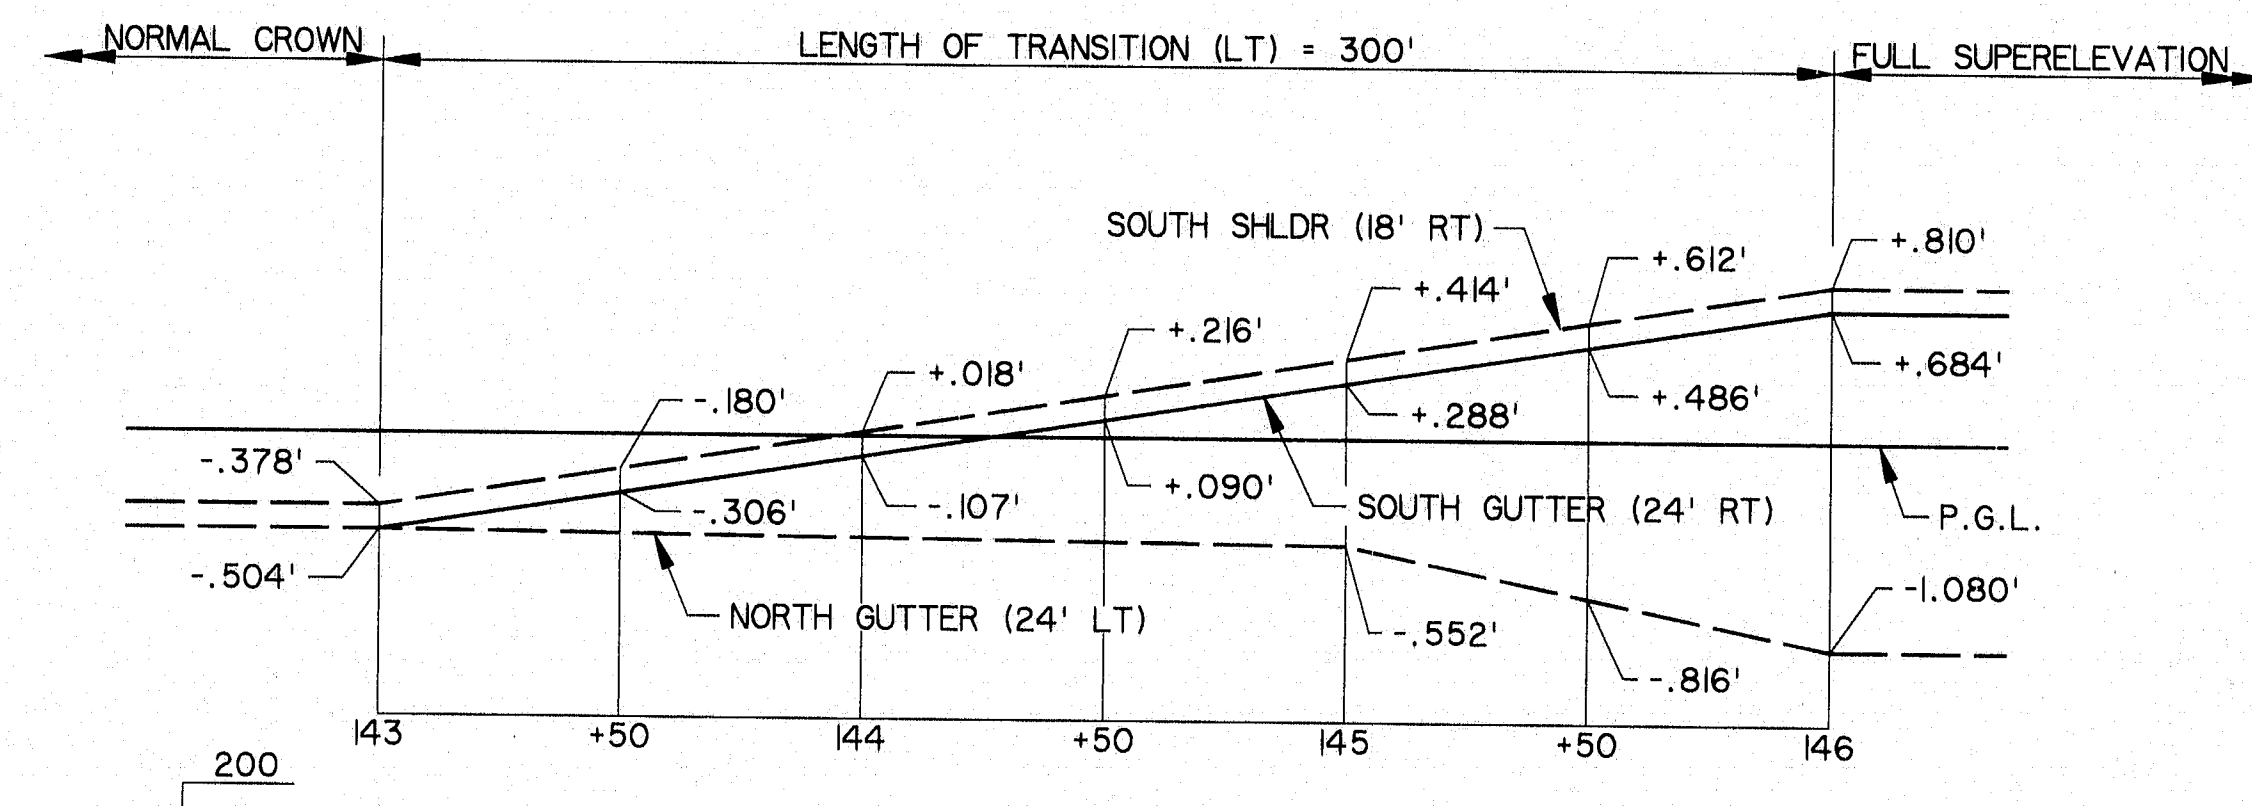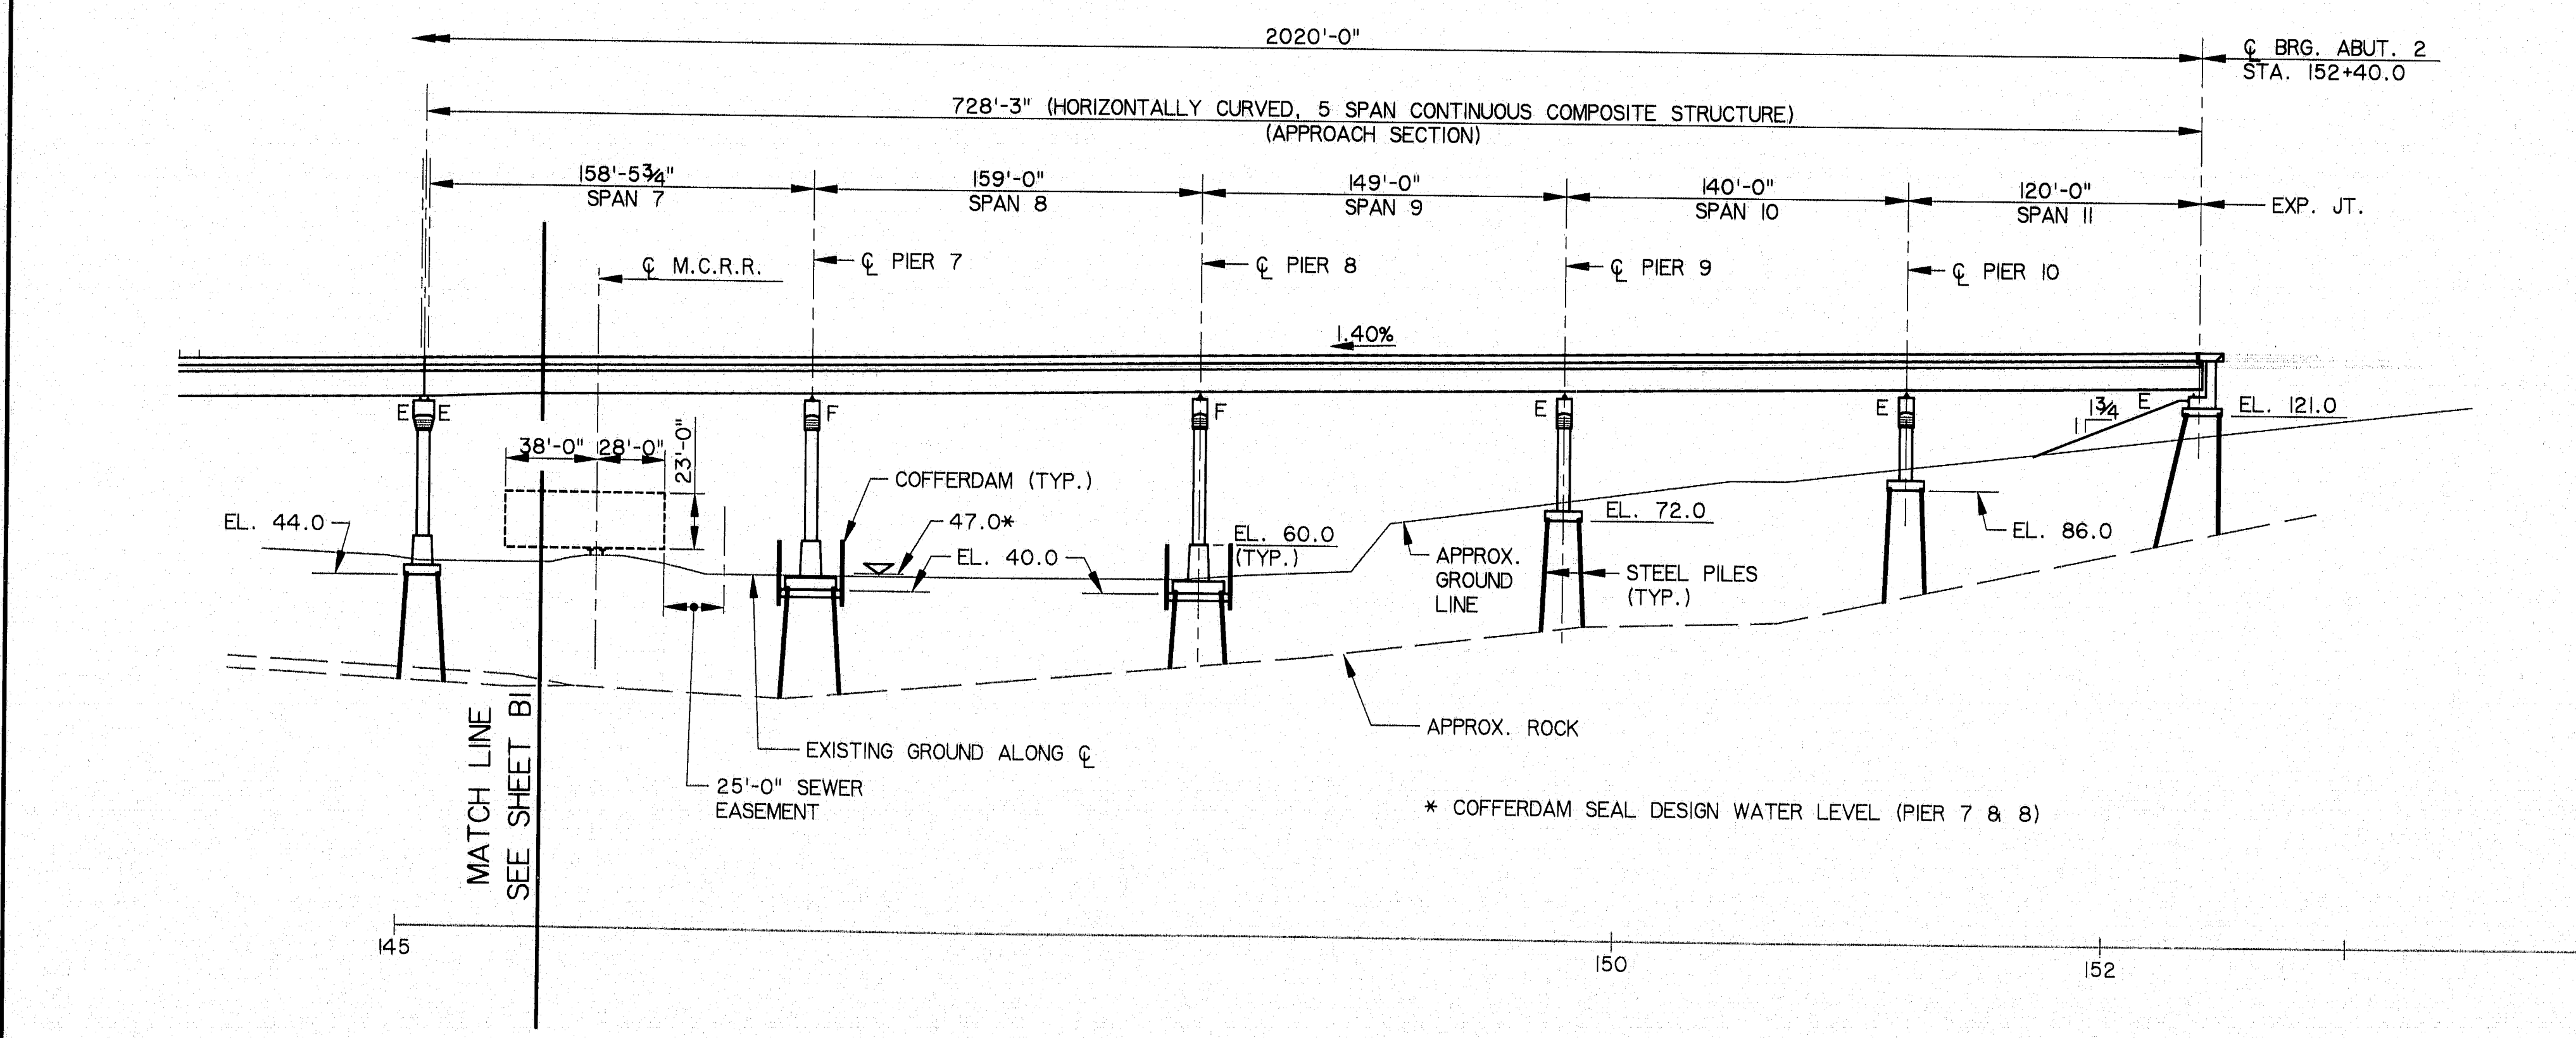

*AS BUILT  
CEN  
10/18/96*

NO.	REVISION	BY	DATE
		DESIGNED: SM	9/94
		DRAWN: RJT	9/94
		CHECKED: DWR	9/94
		IN CHARGE OF: CJM	



**115-195**  
 STEEL ALTERNATIVE  
 STATE OF MAINE  
 DEPARTMENT OF TRANSPORTATION  
 WATERVILLE - WINSLOW PROJECT  
 DONALD V. CARTER BRIDGE  
 OVER  
 KENNEBEC RIVER  
 PLAN AND ELEVATION - II  
 SHEET B2 OF B86 AUGUSTA, MAINE

# GENERAL NOTES

F.R.S.A. REG. NO.	STATE	PROJECT NUMBER	SHEET NO.	TOTAL SHEETS
1	MAINE	000910021	10	103

## SUPERSTRUCTURE

### SPECIFICATIONS

DESIGN: LOAD FACTOR DESIGN  
AASHTO STANDARD SPECIFICATIONS FOR HIGHWAY BRIDGES, 15TH EDITION, 1992.  
AASHTO GUIDE SPECIFICATIONS FOR HORIZONTALLY CURVED HIGHWAY BRIDGES EDITION 1993, AND INTERIM SPECIFICATIONS.

CONTRACT: STATE OF MAINE, DEPARTMENT OF TRANSPORTATION STANDARD SPECIFICATIONS, HIGHWAYS AND BRIDGES, REVISION OF OCTOBER 1990.

### DESIGN LOADING

LIVE LOAD: HS25, ALTERNATE MILITARY LOADING  
FATIGUE 500,000/100,000 CYCLES

### MATERIALS

CONCRETE: DECK SLAB - CLASS A  
BARRIERS - CLASS A WITH SILICA FUME ADDITIVE

REINFORCING STEEL: ASTM DESIGNATION A615, GRADE 60.

STRUCTURAL STEEL: ALL STRUCTURAL STEEL SHALL BE ASTM DESIGNATION A709, GRADE 50W.

HIGH STRENGTH BOLTS: ASTM DESIGNATION A325, TYPE 3.

### BASIC DESIGN STRESSES

CONCRETE: DECK SLAB  $f'_c = 4,000$  PSI  
BARRIERS  $f'_c = 4,000$  PSI

REINFORCING STEEL:  $f_y = 60,000$  PSI

STRUCTURAL STEEL:  $f_y = 50,000$  PSI

### TRAFFIC DATA

AADT 1990 = 12,558  
AADT 2010 = 14,089  
DHV 2010 = 1452  
T(%) (DH) = 2%  
DD (DH) = 56/44%  
V = 50 MPH

NO.	REVISION	BY	DATE	IN CHARGE OF
		BY	DATE	
		DESIGNED: SM	9/94	
		DRAWN: RJT	9/94	
		CHECKED: DWR	9/94	

## SUBSTRUCTURE

### SPECIFICATIONS

DESIGN: LOAD FACTOR DESIGN  
AASHTO STANDARD SPECIFICATIONS FOR HIGHWAY BRIDGES, 15TH EDITION, 1992.  
AND INTERIM SPECIFICATIONS.

CONTRACT: STATE OF MAINE, DEPARTMENT OF TRANSPORTATION STANDARD SPECIFICATIONS, HIGHWAYS AND BRIDGES, REVISION OF OCTOBER 1990.

### DESIGN LOADING

LIVE LOAD: HS25, ALTERNATE MILITARY LOADING

EARTHQUAKE LOAD: ACCORDING TO AASHTO FOR ACCELERATION COEFFICIENT A = 0.10 AND CATEGORY B

### MATERIALS

CONCRETE: ABUTMENTS, APPROACH SLABS - CLASS B  
PIERS (CAP, SHAFT AND FOOTING) - CLASS A  
PIER SEALS - CLASS S  
ALL OTHER CONCRETE SHALL BE CLASS A.

REINFORCING STEEL: ASTM DESIGNATION A615, GRADE 60.

STRUCTURAL STEEL: FOUNDATION PILING SHALL CONFORM TO THE REQUIREMENTS OF AASHTO M270, GRADE 50. (ASTM A709, GRADE 50)

POT BEARING: ALL STRUCTURAL STEEL SHALL BE ASTM DESIGNATION A709, GRADE 50.  
SEE SUPPLEMENTAL SPECIFICATIONS.

### BASIC DESIGN STRESSES

CONCRETE: ABUTMENTS/APPROACH SLABS  $f'_c = 3,000$  PSI  
PIERS  $f'_c = 4,000$  PSI  
PIER SEALS  $f'_c = 3,500$  PSI

REINFORCING STEEL:  $f_y = 60,000$  PSI

### DATUM

BASED ON 1929 N.G.V.D

### HYDROLOGIC DATA

HYDROLOGIC PARAMETERS: DRAINAGE AREA = 5.182 SQUARE MILES  
ORDINARY HIGH WATER (O.H.W.) = 33,000 CFS  
DESIGN DISCHARGE (Q50) = 149,420 CFS  
CHECK DISCHARGE (Q100) = 168,300 CFS  
FLOOD OF RECORD (1987) = 212,770 CFS @ ELEV. 64.2

HYDRAULIC PARAMETERS: HEADWATER EL. @ Q50 = 56.3'  
HEADWATER EL. @ Q100 = 58.9'  
DISCHARGE VELOCITY @ Q50 = 4.8 FPS\*  
DISCHARGE VELOCITY @ Q100 = 5.0 FPS  
ORDINARY HIGH WATER O.H.W. = 36.2'  
VERTICAL CLEARANCE @ Q50 = 43.0'±  
\* OVERBANK VELOCITIES (0.3 FPS TO 0.9 FPS)

A HYDROLOGIC REPORT OF THE BRIDGE SITE IS AVAILABLE FOR THE CONTRACTOR'S REFERENCE AT THE BRIDGE DESIGN OFFICE IN AUGUSTA. THE HYDRAULIC REPORT IS BASED ON THE INTERPRETATION BY THE DEPARTMENT OF INFORMATION OBTAINED FOR THE SUBJECT SITE AND NO ASSURANCE IS GIVEN THAT THE INFORMATION OF THE CONCLUSIONS OF THE REPORT WILL BE REPRESENTATIVE OF ACTUAL CONDITIONS AT THE TIME OF CONSTRUCTION.

### FOUNDATIONS

ABUTMENTS: HP14x73 PILES SHALL BE DRIVEN TO ULTIMATE CAPACITY OF 203 TONS. DESIGN LOAD = 80 TONS AND 10 TONS FOR DRAG DOWN FORCES WITH F.S. = 2.25.

PIERS: SPREAD FOOTING ON ROCK - 10.0 TON/SF ALLOWABLE BEARING PRESSURE WITH COEFFICIENT OF FRICTION = 0.55.  
HP14x73 PILES SHALL BE DRIVEN TO ULTIMATE CAPACITY OF 270 TONS. DESIGN LOAD = 120 TONS AND ALLOWABLE TENSION OF 12 TONS WITH F.S. = 2.25.

CONSTRUCTION CONTROL: WAVE EQUATION ANALYSIS AND PILE DYNAMIC TEST (MEASUREMENT AND ANALYSIS) IS REQUIRED FOR THE ABUTMENT AND PIER PILES INSTALLATION.

POINTED REINFORCED PILE TIPS SHALL BE USED FOR ALL FOUNDATION PILES. PILE LENGTHS SHOWN ON FOUNDATION PLAN ARE FOR ESTIMATING PURPOSES ONLY.

### CONSTRUCTION

FOOTING ELEVATIONS AND SUBSTRUCTURE DETAILS ARE SUBJECT TO CHANGE DEPENDING UPON FOUNDATION MATERIAL ENCOUNTERED. REINFORCING STEEL FOR THE FOOTINGS, COLUMNS AND ABUTMENTS SHALL NOT BE FABRICATED UNTIL FINAL FOOTING ELEVATIONS HAVE BEEN MODIFIED AS REQUIRED.

CONCRETE COVER SHALL BE MEASURED FROM THE FACE OF THE CONCRETE TO THE FACE OF THE REINFORCING STEEL. MINIMUM CONCRETE COVERS ARE SHOWN ON THE REINFORCING DETAILS SHEETS.

### MAINTENANCE

POT BEARINGS: TO ACCOMMODATE REMOVAL, REPLACEMENT OR MAINTENANCE OF THE POT BEARINGS, TEMPORARY JACK POSITIONS ARE INDICATED ON THE DRAWINGS.

*AS BUILT  
CJM  
12/10/96*

**115-196**

STEEL ALTERNATIVE

STATE OF MAINE  
DEPARTMENT OF TRANSPORTATION

WATERVILLE - WINSLOW PROJECT

DONALD V. CARTER BRIDGE

OVER


KENNEBEC RIVER

GENERAL NOTES

**HNTB**  
ARCHITECTS ENGINEERS PLANNERS

SHEET B3 OF B86 AUGUSTA, MAINE

F.H.K.A. REG. NO.	STATE	PROJECT NUMBER	SHEET NO.	TOTAL SHEETS
1	MAINE	000910021	11	103

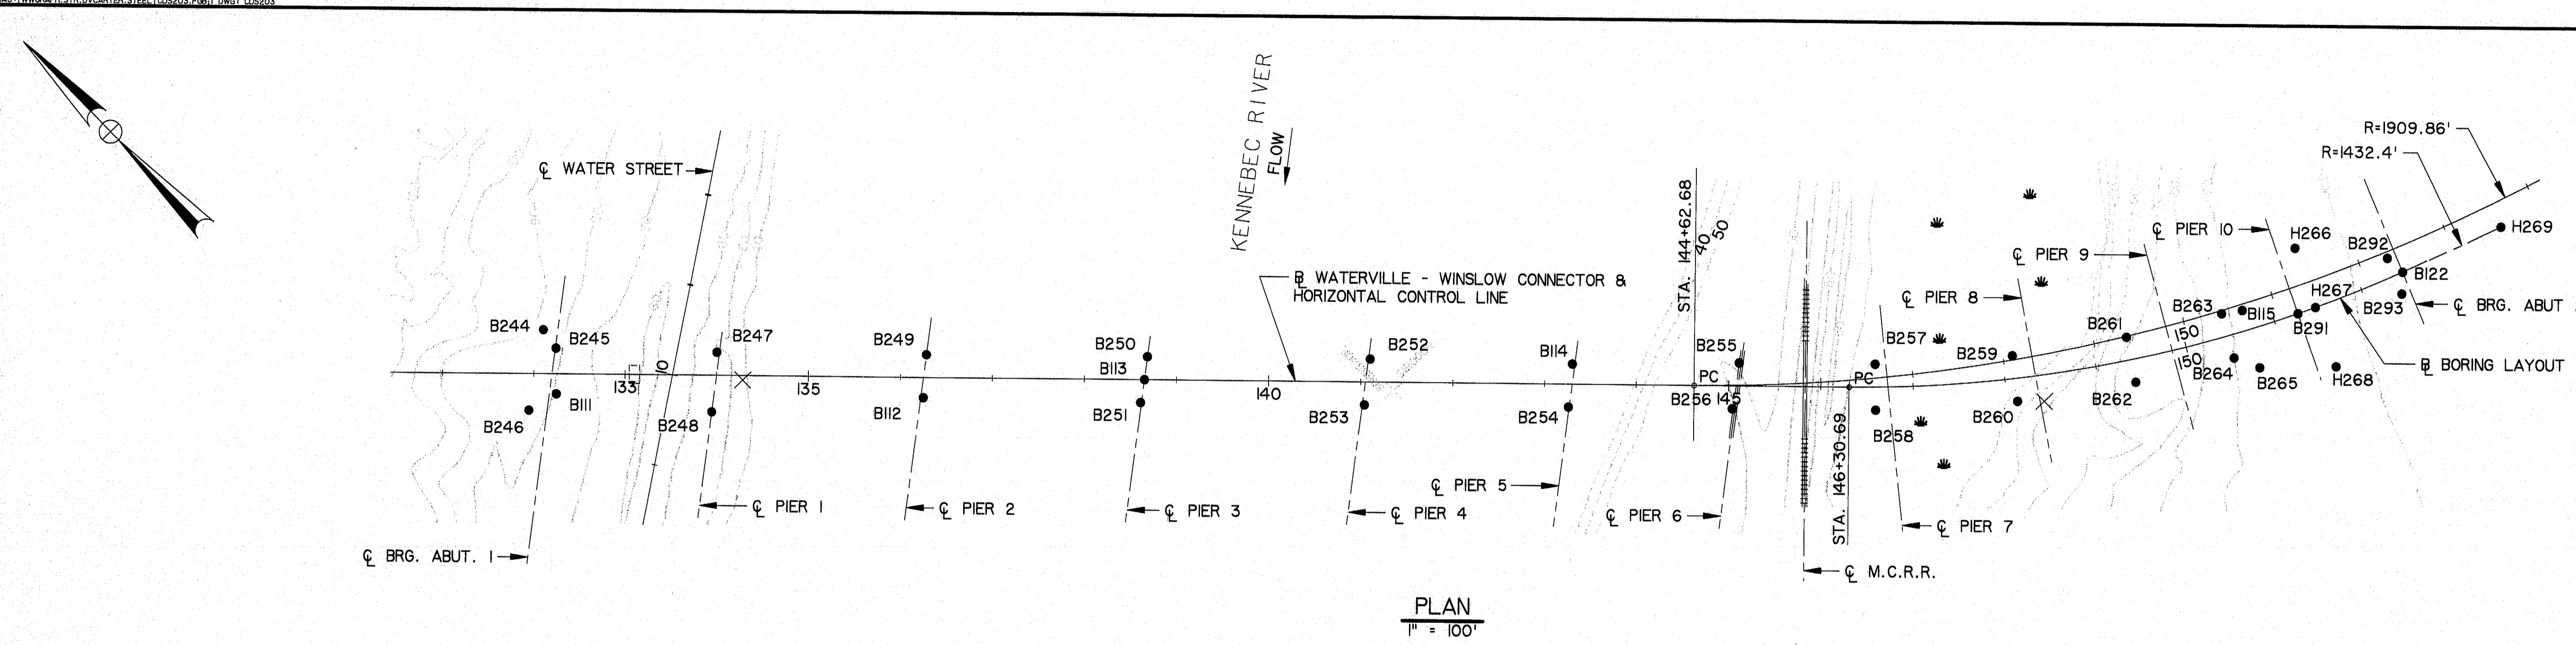

PLAN  
1" = 100'

BORING LOCATIONS *		
BORING	STATION	OFFSET
B244	132+10	48' LT
B245	132+24	28' LT
B111	132+25	22' RT
B246	131+95	40' RT
B247	134+00	25' LT
B248	133+95	40' RT
B249	136+28	25' LT
B112	136+25	22' RT
B250	138+68	25' LT
B113	138+65	CENTER LINE
B251	138+61	25' RT
B252	141+10	25' LT
B253	141+04	25' RT
B114	143+30	22' LT
B254	143+26	25' RT
B255	145+11	25' LT
B256	145+04	25' RT
B257	146+59	25' LT
B258	146+59	25' RT
B259	148+11	25' LT
B260	148+11	25' RT
B261	149+39	25' LT
B262	149+39	25' RT
B263	150+47	25' LT
B264	150+47	25' RT
B115	150+70	22' LT
B265	150+70	43' RT
B291	151+20	CENTER LINE
H266	151+50	65' LT
H267	151+50	CENTER LINE
H268	151+50	65' RT
B292	152+42	27' LT
B293	152+45	27' RT
B122	152+50	CENTER LINE
H269	153+50	CENTER LINE

\* LOCATED FROM BORING LAYOUT

LEGEND

- ▽ - GROUND WATER LEVEL
- SAMPLE IDENTIFICATION:
  - O OPEN END ROD
  - T THIN WALL TUBE
  - U UNDISTURBED SAMPLE
  - S SPLIT SPOON
  - C ROCK CORE

ITEM	CASING	DRIVE SAMPLE	CORE BARREL
TYPE	NW	SS	NX
INSIDE DIA. (IN.)	3.0	1 3/8	2 3/8
HAMMER WEIGHT (LB.)	300	140	-
HAMMER FALL (IN.)	24	30	-

3. DRILLING DESCRIPTION AND PROCEDURE:

GENERAL NOTES

- THE SUBSURFACE EXPLORATIONS SHOWN HEREON WERE MADE BETWEEN JULY, 1990 AND JANUARY, 1992 FOR THE MAINE DEPARTMENT OF TRANSPORTATION.
- SOIL AND ROCK (WHERE ENCOUNTERED) CLASSIFICATION, PROPERTIES AND DESCRIPTIONS ARE BASED ON ENGINEERING INTERPRETATION OF AVAILABLE SUBSURFACE INFORMATION AND MAY NOT NECESSARILY REFLECT ACTUAL VARIATIONS IN SUBSURFACE CONDITIONS THAT MAY BE ENCOUNTERED BETWEEN INDIVIDUAL BORING SAMPLE LOCATIONS.
- OBSERVED WATER LEVELS AND/OR WATER CONDITIONS INDICATED ARE AS RECORDED AT THE TIME OF EXPLORATION AND MAY VARY ACCORDING TO THE PREVAILING RAINFALL, METHODS OF EXPLORATION AND OTHER FACTORS.
- SOUND ENGINEERING JUDGEMENT WAS EXERCISED IN PREPARING THE SUBSURFACE INFORMATION PRESENTED HEREON. ANALYSIS AND INTERPRETATION OF SUBSURFACE DATA WAS PERFORMED AND INTENDED FOR DESIGN AND ESTIMATING PURPOSES ONLY. PRESENTATION OF THE INFORMATION ON THE PLANS OR ELSEWHERE IS FOR THE PURPOSE OF PROVIDING INTENDED USERS WITH ACCESS TO THE SAME DATA AVAILABLE TO THE DEPARTMENT. THE SUBSURFACE INFORMATION IS PRESENTED IN GOOD FAITH AND IS NOT INTENDED AS A SUBSTITUTE FOR PERSONAL INVESTIGATION, INDEPENDENT INTERPRETATIONS, INDEPENDENT ANALYSIS OR JUDGEMENT OF THE CONTRACTOR.


NOTES

- MEAN SEA LEVEL DATUM (NGVD 1929) IS USED THROUGHOUT.
- ALL BORINGS TAKEN BY MAINE TEST BORING, INC. UNDER SUPERVISION OF HALEY & ALDRICH, INC., SCARBOROUGH, MAINE.

*As Built  
Comm. 12/8/96*


115-197

STEEL ALTERNATE  
STATE OF MAINE  
DEPARTMENT OF TRANSPORTATION  
WATERVILLE - WINSLOW PROJECT  
DONALD V. CARTER BRIDGE  
OVER  
KENNEBEC RIVER  
  
BORING PLAN  
SHEET B4 OF B86 AUGUSTA, MAINE

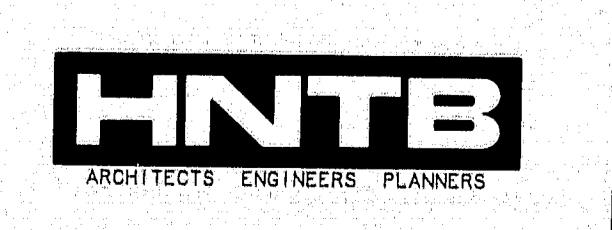


NO.	REVISION	BY	DATE	IN CHARGE OF
		DESIGNED:	SM	9/94
		DRAWN:	RJT	9/94
		CHECKED:	DWR	9/94
				CJM

B-246  
Ground Elev. 78.5


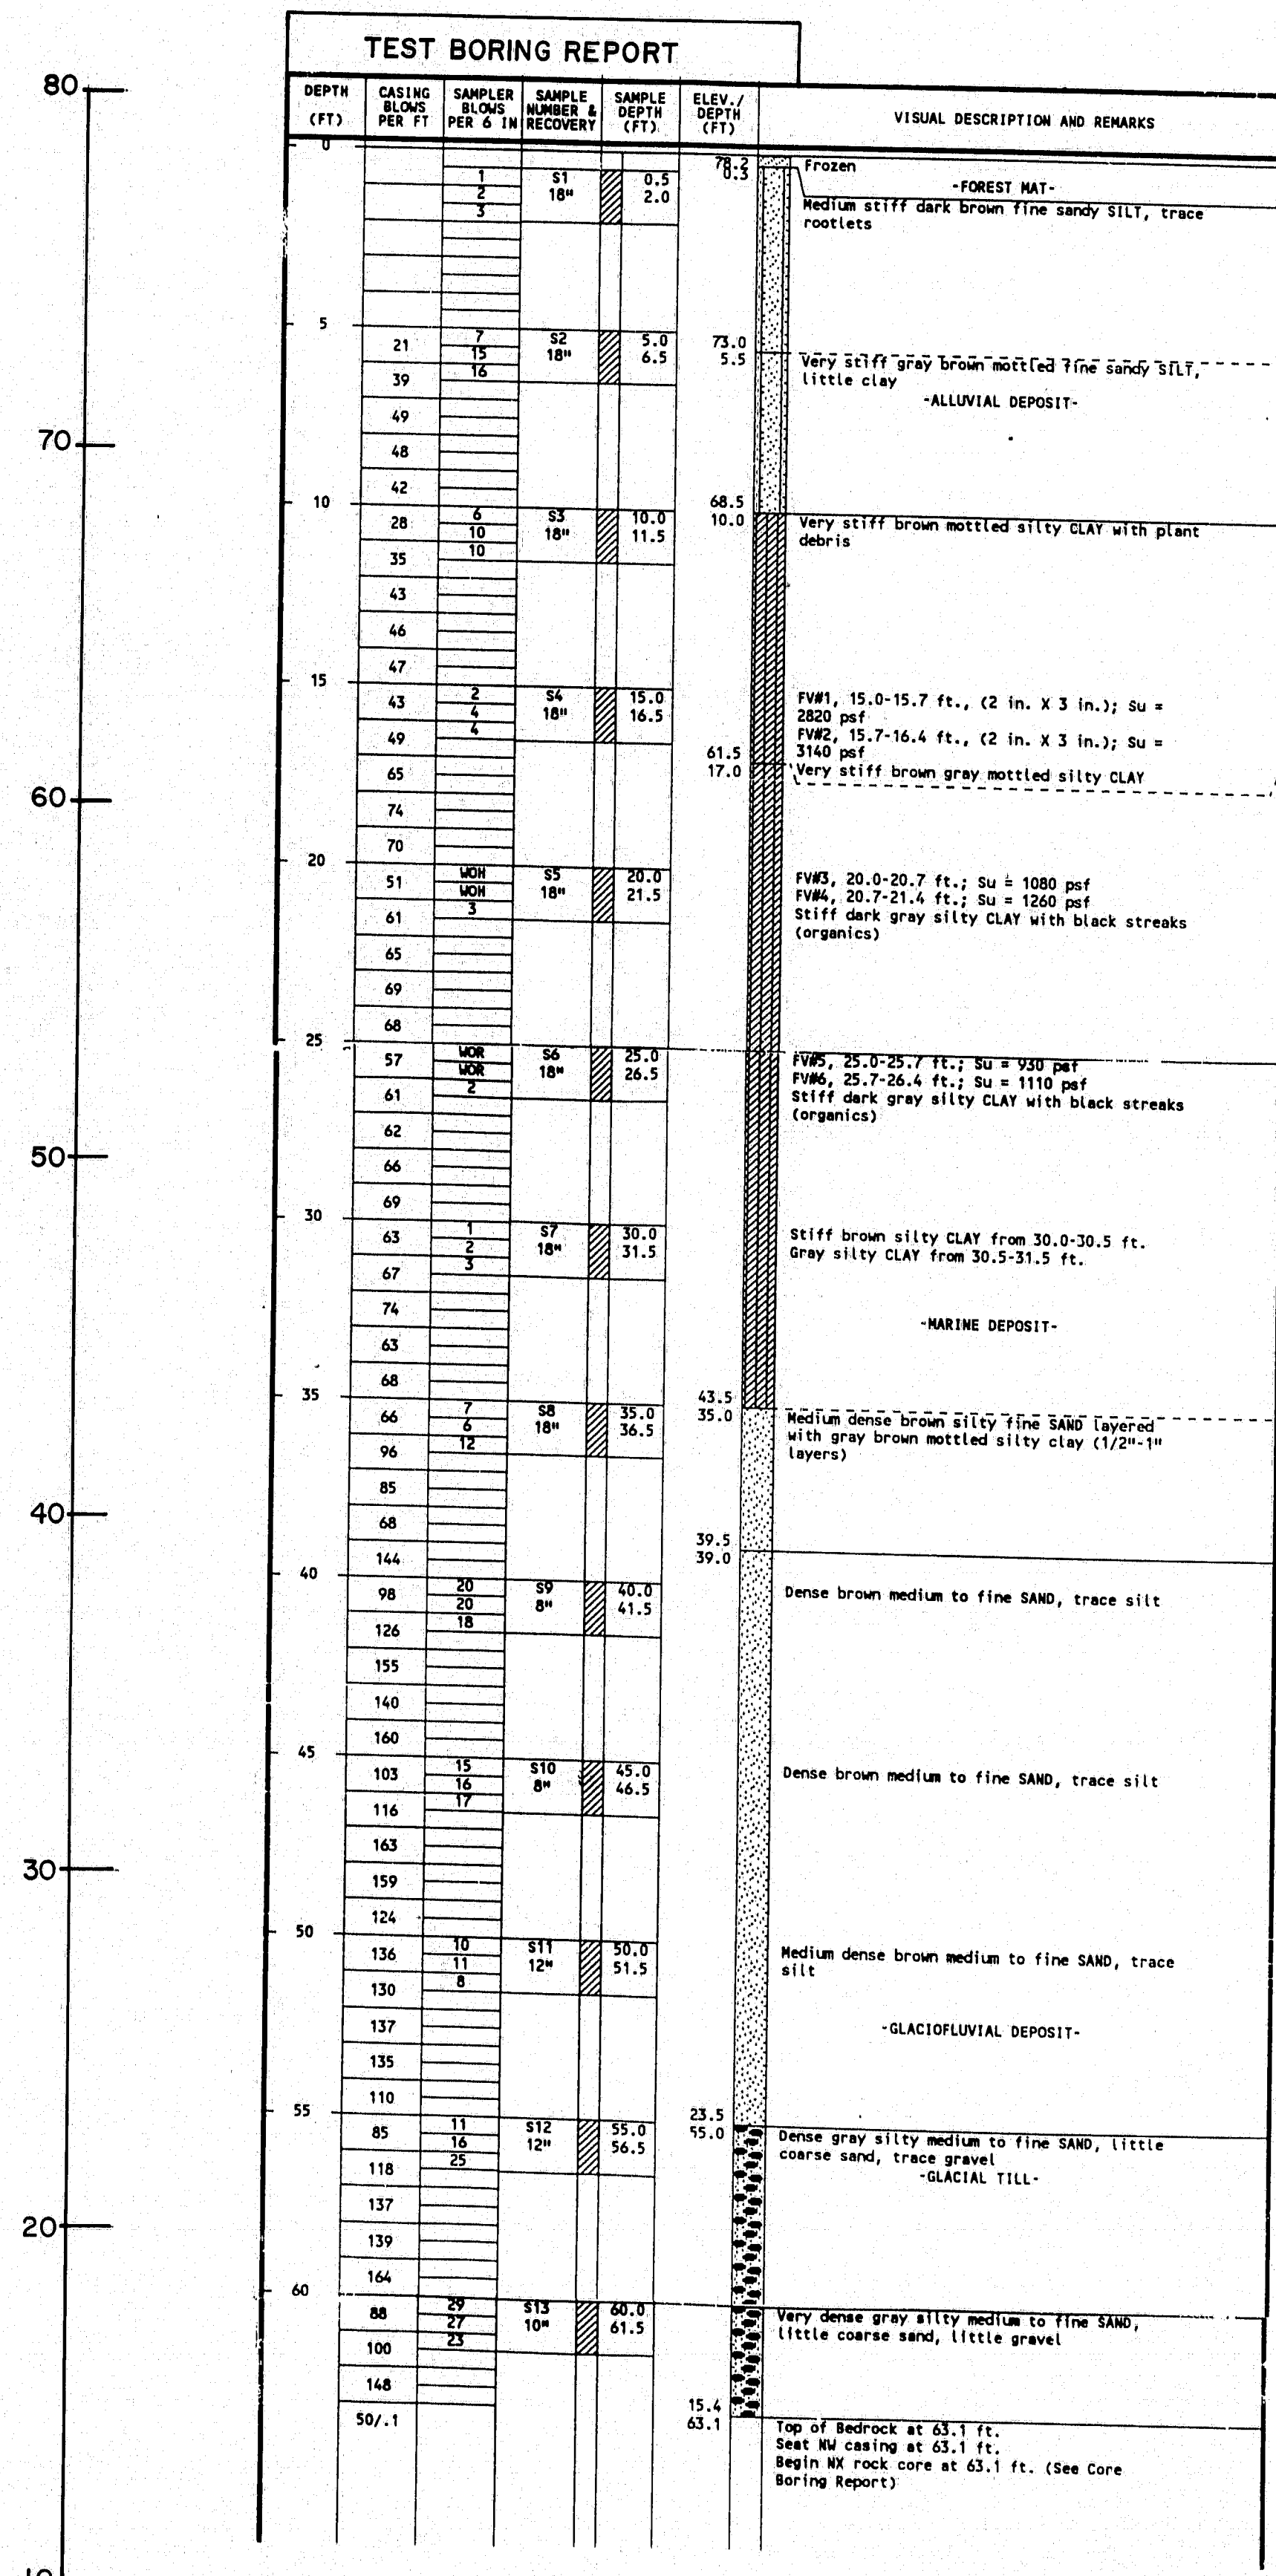


DESIGNED:	SM	7/93
DRAWN:	RJT	7/93
CHECKED:		


B-246 (CONT)

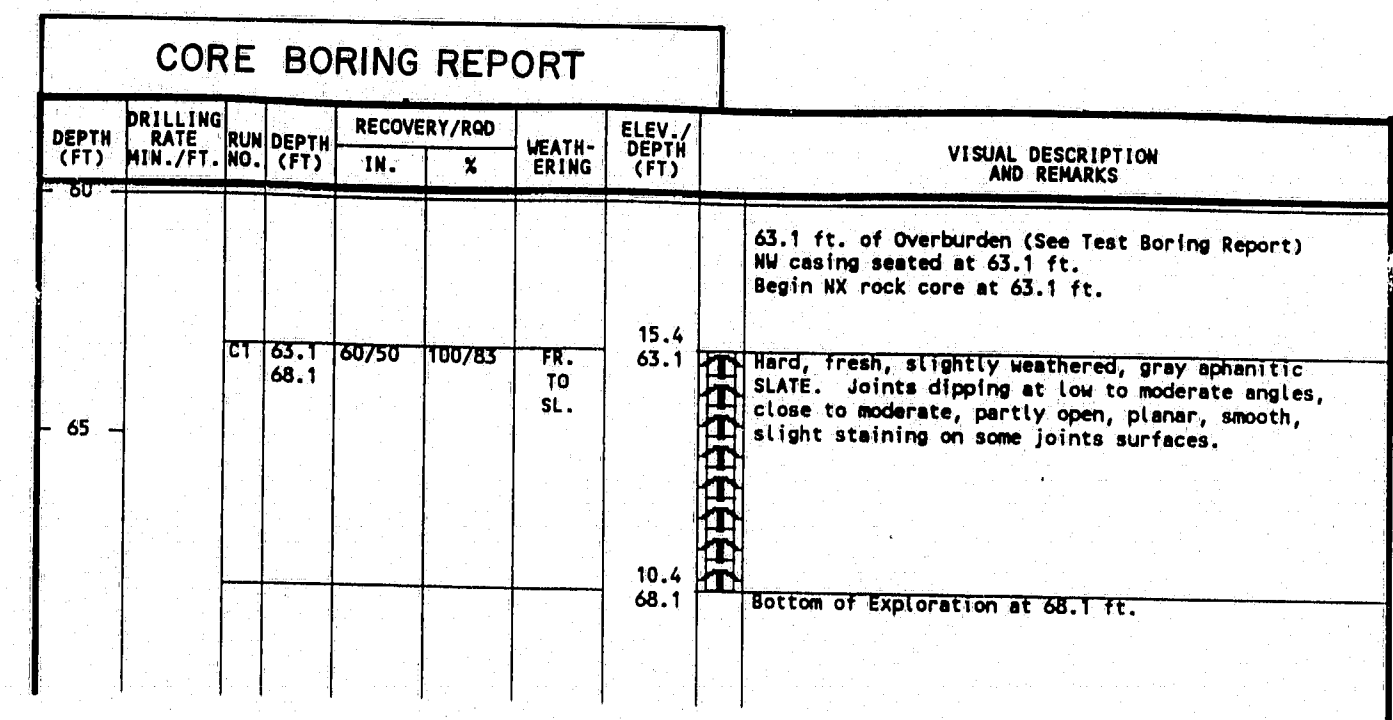

B-III (CONT)

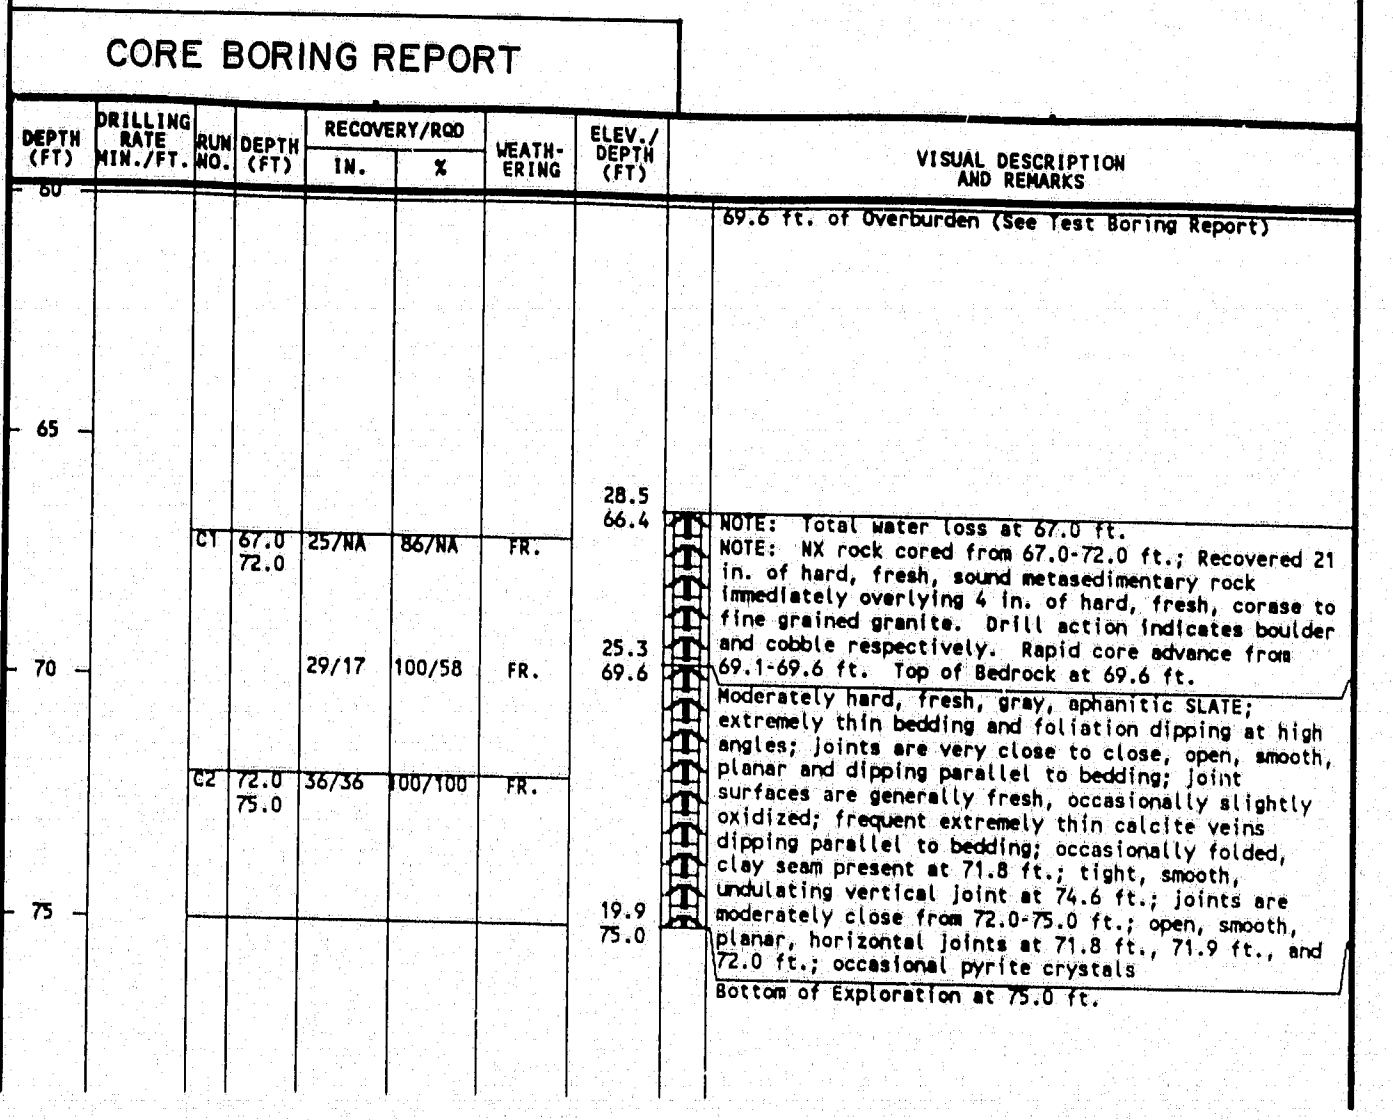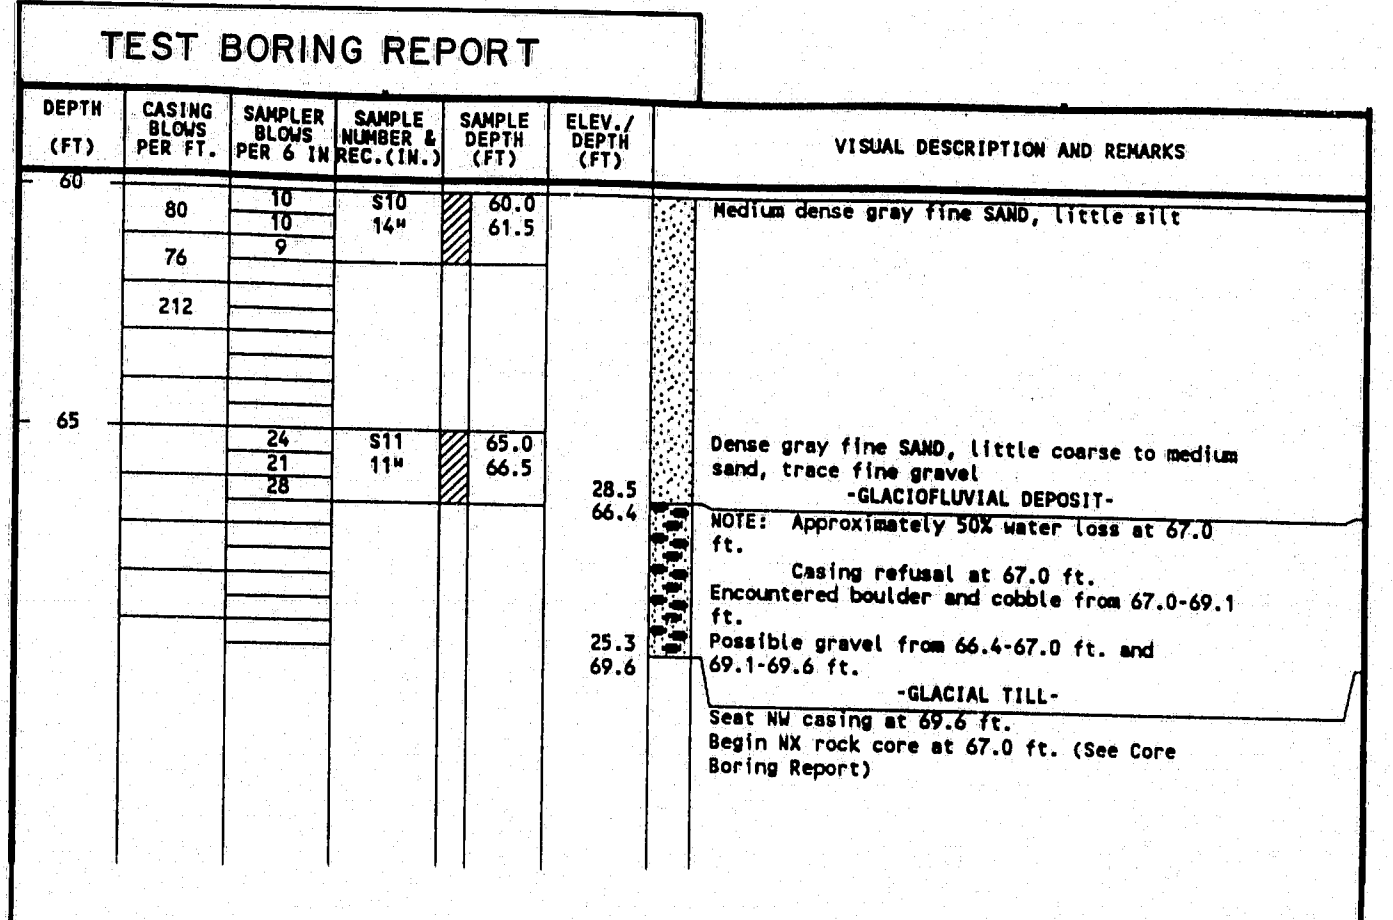


B-III  
Ground Elev. 94.9

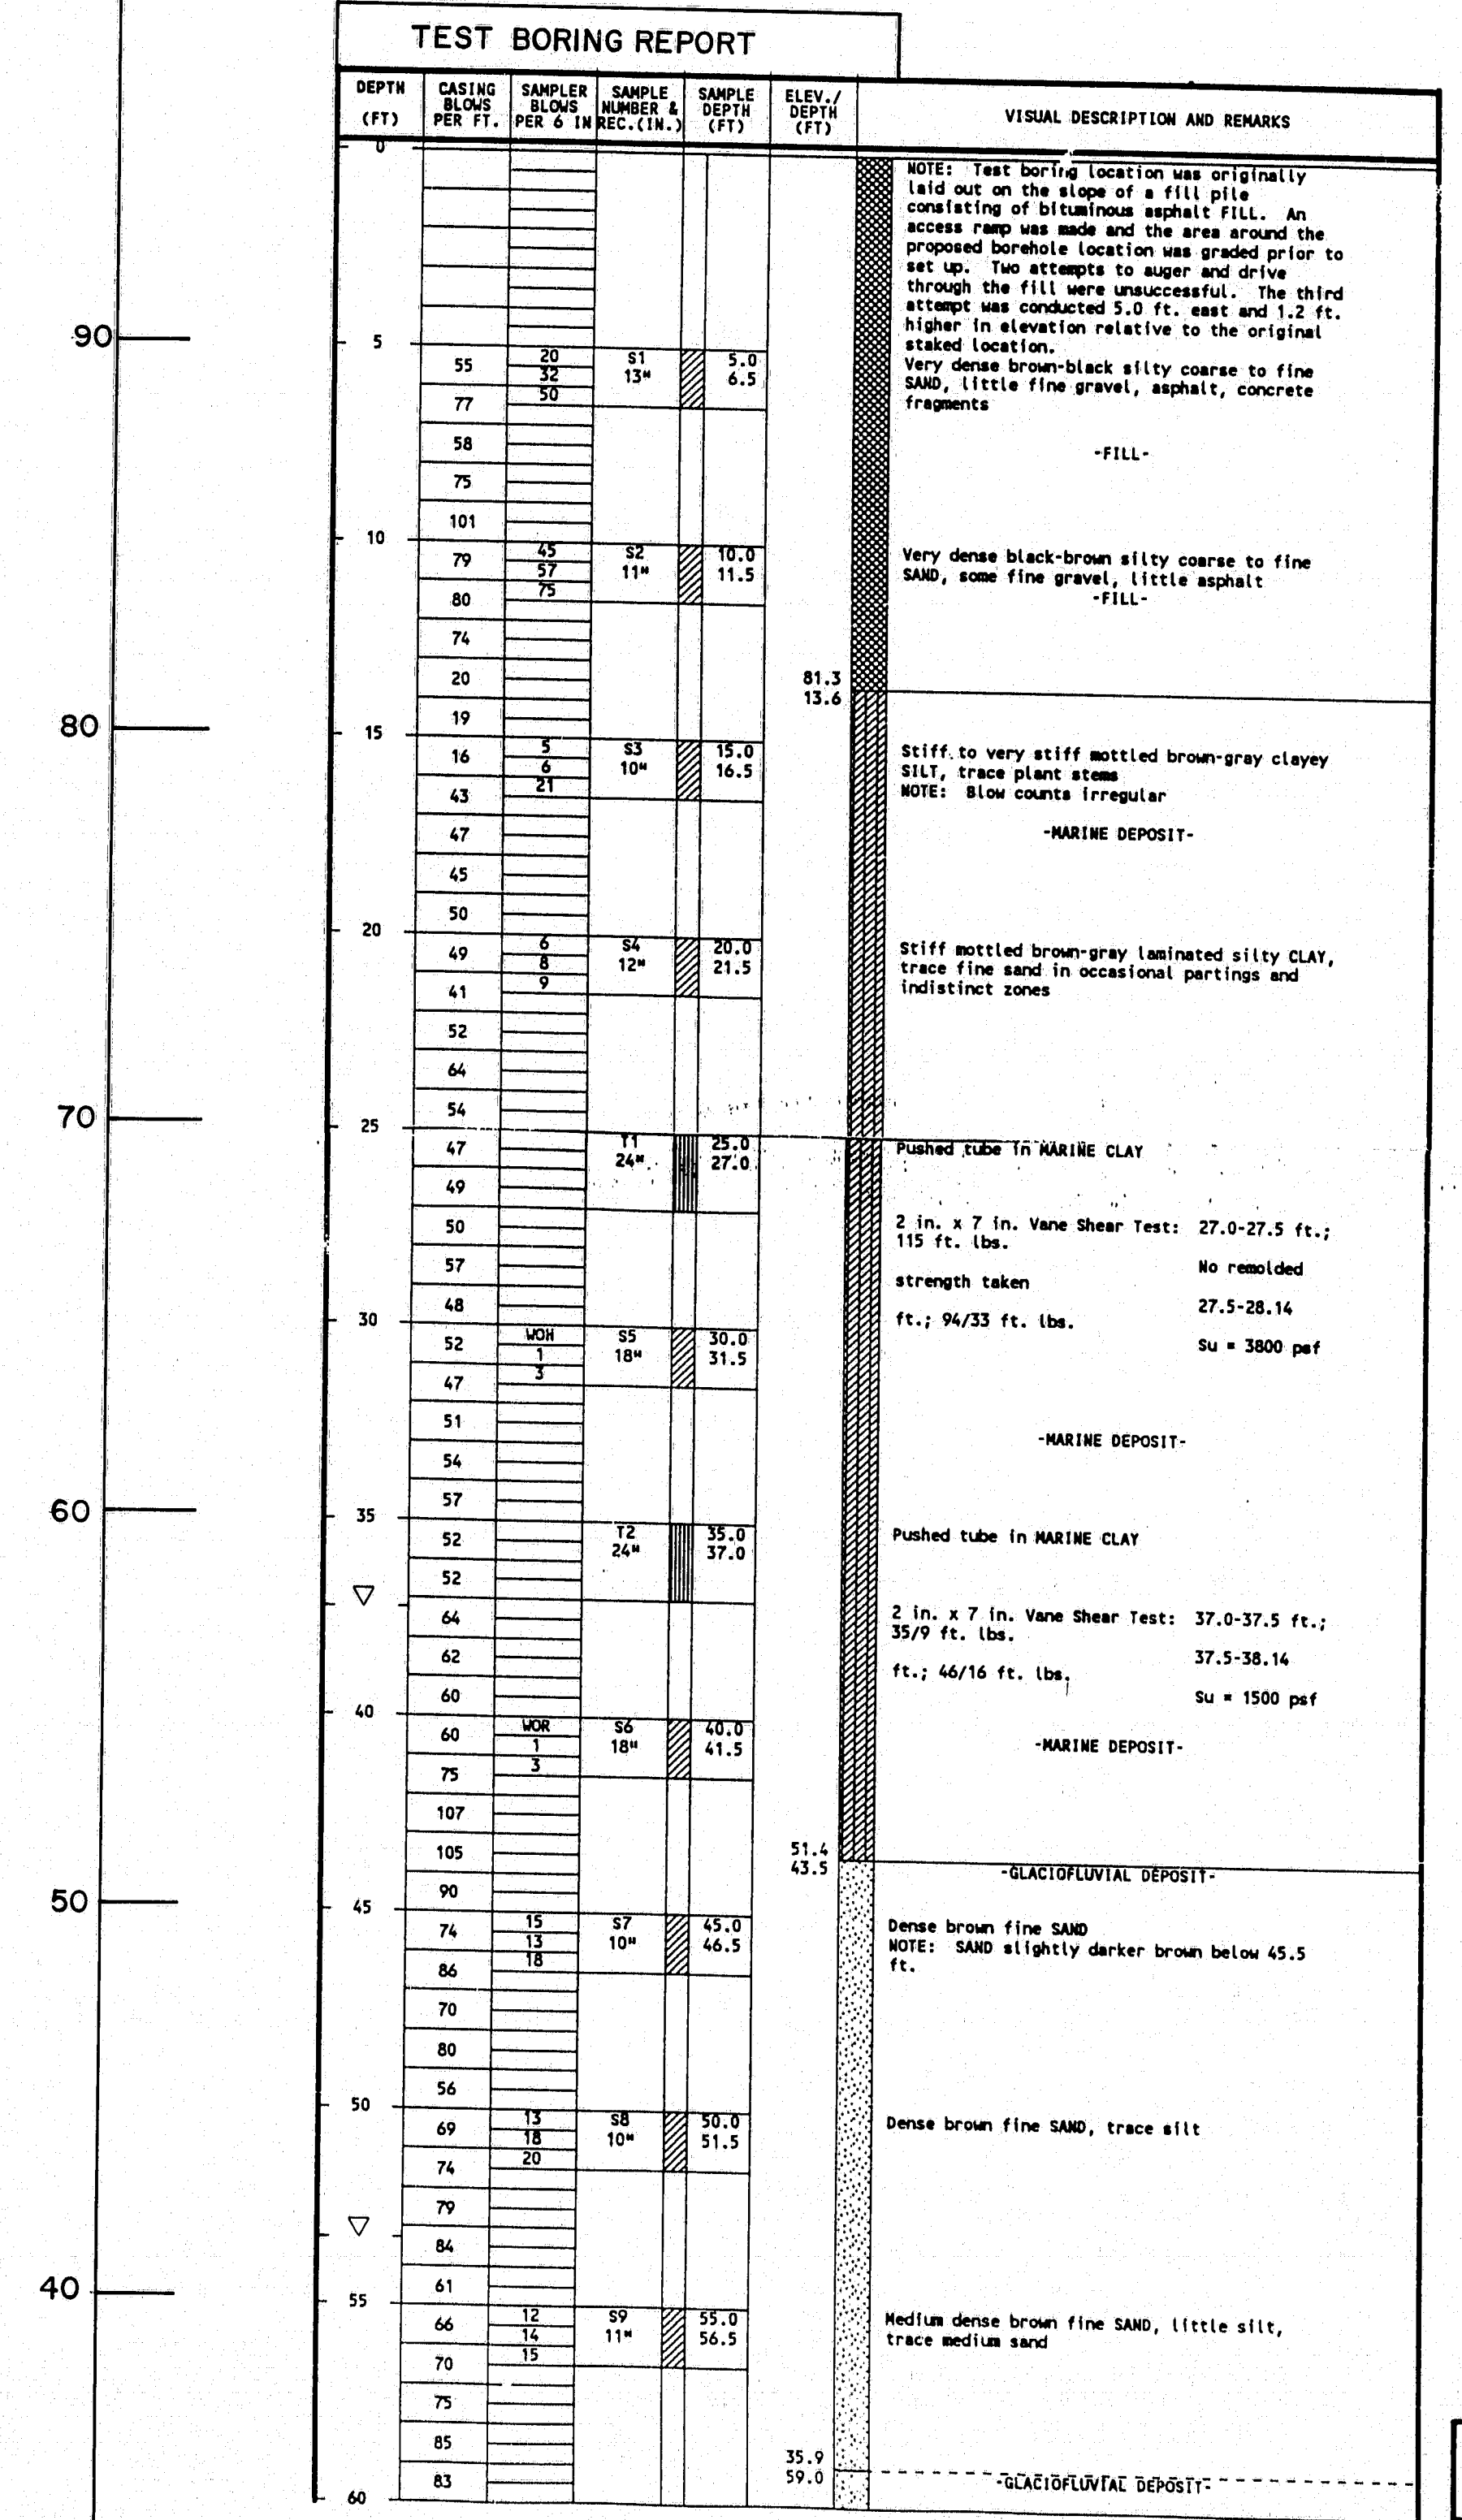

AS BUILT  
Cham  
11/1/96

115-198

STATE OF MAINE  
DEPARTMENT OF TRANSPORTATION  
WATERVILLE - WINSLOW PROJECT  
DONALD V. CARTER BRIDGE  
OVER  
KENNEBEC RIVER  
BORING LOGS  
SHEET B5 OF B86 AUGUSTA, MAINE

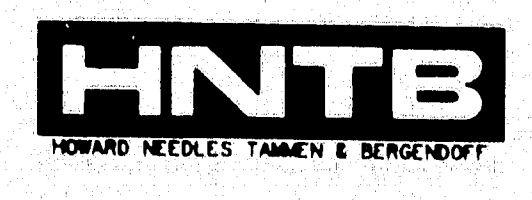

**B-245**  
Ground Elev. 80.8

TEST BORING REPORT					
DEPTH (FT)	CASING BLOCK PER FT	SAMPLER NUMBER	SAMPLE DEPTH (FT)	ELEV./DEPTH (FT)	VISUAL DESCRIPTION AND REMARKS
0	5	51	0.0	80.8	Loose dark brown silty coarse to fine SAND, with roots and gravel
2	2	4*	1.5	80.5	
5	15	52	3.0	80.5	Medium dense dark brown silty coarse to fine SAND -FILL-
14	5	4*	4.5	80.5	
16					Drilled through root at approximately 8.0 ft.
300					
24					
10	33	53	10.0	80.8	Dense gray-brown silty fine SAND, with roots
90	12	6*	11.5	80.8	
108					
127					
15	140	54	15.0	66.8	Very stiff gray-brown silty CLAY (too stiff to press tube) -MARINE DEPOSIT-
72	11	10*	16.5	66.8	
92	9				
112					
108					
122					
20	55	35	20.0	57.3	Very stiff brown silty CLAY, little fine SAND (too stiff to press tube) F <sub>WT</sub> , 20.0-20.5 ft.; S <sub>u</sub> > 5,500 psf
71	5	18*	21.5	57.3	
84					
101					
135					
25	33	56	25.0	52.3	Medium dense brown FINE SAND, trace silt Change to 3 in. I.O. casing at 25.0 ft.
25	10	7*	26.5	52.3	
47					
60					
30	25	57	30.0	47.3	Medium dense brown medium to fine SAND, trace silt
40	13	6*	31.5	47.3	
70					
95					
35	50	58	35.0	42.3	Dense brown medium to fine SAND, trace silt -GLACIOFLUVIAL DEPOSIT-
61	21	6*	36.5	42.3	
100					
105					
40	57	59	40.0	37.3	Very dense brown medium to fine SAND, trace silt, trace coarse sand
78	26	6*	41.5	37.3	
115					
143					
45	57	60	45.0	32.3	Dense brown medium to fine SAND, trace silt
87	25	6*	46.5	32.3	
118					
125					
50	48	61	50.0	27.3	Dense brown medium to fine SAND, trace silt
62	16	8*	51.5	27.3	
82					
81					
55	39	62	55.0	22.3	Dense gray medium to fine SAND, trace silt
47	17	12*	56.5	22.3	
63					
71					
60	15	63	60.0	17.3	Dense gray medium to fine SAND, trace silt, trace fine gravel -GLACIAL TILL-
72	20	12*	61.5	17.3	
115					
58					
30	15	64	65.0	12.3	Very dense gray coarse to fine GRAVEL
65	18	3*	66.4	12.3	

**B-245 (CONT)**

CORE BORING REPORT					
DEPTH (FT)	DRILLING RATE (IN./FT.)	RECOVERY/NO. IN.	RECOVERY/NO. %	WEATH. GRADE	ELEV./DEPTH (FT)
65					66.4
65	01	66.5	22/9	10/22	14.3
		68.4			14.3
3					66.5
3	02	68.4	02/11	100/39	FR.
		70.7			TO
70					SL.
3	03	70.7	02/42	100/70	FR.
		75.7			FR.
4					
3					
4					
3					
4					
75					5.1
4					75.7

66.4 ft. of Overburden (See Test Boring Report)  
Begin at rock core at 66.4 ft.

C1: Moderately hard, gray argillaceous to fine grained "SCHIST". Primary joint set is close, tight to slightly open, slightly to moderately weathered, planar and smooth, dipping at high angles.  
C2: Same lithology as C1, primary joint set same as C1. Secondary joint set is close, open, stepped and set low to horizontal angles, calcite stringers noted.  
C3: Moderately hard, gray argillaceous to fine grained "SCHIST". Primary joint set is fresh, tight to slightly open, close, planar and smooth, to less frequently stepped and smooth, dipping at high angles. Frequent calcite stringers.

Bottom of Exploration at 75.7 ft.

**H-267**  
Ground Elev. 95.9

TEST BORING REPORT					
DEPTH (FT)	CASING BLOCK PER FT.	SAMPLER NUMBER	SAMPLE DEPTH (FT)	ELEV./DEPTH (FT)	VISUAL DESCRIPTION AND REMARKS
0	5	51	0.0	95.9	Dark brown loamy SILT, with frozen leaves -FOREST MAT-
2	2	4*	1.5	95.9	
5	11	52	3.0	95.9	Very loose brown silty FINE SAND, trace coarse sand, with rootlet. -TOPSOIL-
16	7	10*	6.5	95.9	
22					Medium dense brown silty FINE SAND, trace medium sand -ALLUVIAL-
22					
10	27	53	10.0	88.0	Very stiff mottled olive brown clayey SILT
26	6	10*	10.0	88.0	
36	12				
48					
51					
15	23	54	15.0	77.0	F <sub>WT</sub> , 15.0 to 15.6 ft.; S <sub>u</sub> = 1110 psf stiff gray silty CLAY -MARINE DEPOSIT-
24	10*	10*	16.5	77.0	
26					
25					
20	17	55	20.0	61.9	stiff gray silty CLAY
17	10*	10*	21.5	61.9	
20					
19					
22					
25	17	56	25.0	51.9	F <sub>WT</sub> , 25.0 to 25.6 ft.; S <sub>u</sub> = 740 psf Medium stiff gray silty CLAY
17	10*	10*	26.5	51.9	
12					
15					
30	12	57	30.0	41.9	Medium stiff gray silty CLAY -MARINE DEPOSIT-
12	3	10*	31.5	41.9	
17					
18					
35	125	58	35.0	31.9	NOTE: Advanced roller bit through probable cobble from 34.0 to 35.0 ft. Very dense brown silty FINE SAND, little coarse sand, little gravel (well bonded in situ) -GLACIAL TILL-
66	55	35.0	36.0	31.9	
72	12*	36.0			
40	100	59	40.0	21.9	NOTE: Encountered boulder at 38.0 ft. while advancing roller bit. Washed ahead of casing to 40.0 ft. Very dense brown silty FINE SAND, little gravel -GLACIAL TILL-
	1*	40.2			

Bottom of Exploration at 40.2 ft.  
No Refusal.

DESIGNED:	SM	DATE	7/93
DRAWN:	RJT	DATE	7/93
CHECKED:		DATE	
NO.	REVISION	BY	DATE



*AS BUILT 8/24/16*

**115-199**

STATE OF MAINE  
DEPARTMENT OF TRANSPORTATION  
WATERVILLE - WINSLOW PROJECT  
DONALD V. CARTER BRIDGE  
OVER  
KENNEBEC RIVER  
BORING LOGS  
SHEET B6 OF B86 AUGUSTA, MAINE



B-244  
Ground Elev. 87.5

DEPTH (FT)	CASING BLOW PER FT	SAMPLER BLOW PER 6 IN	SAMPLE NUMBER & DEPTH (FT)	ELEV. / DEPTH (FT)	VISUAL DESCRIPTION AND REMARKS
0			1 4" 0.0		Very loose dark brown loamy silt, with leaf fragments and twigs
1			2 4" 1.5		
5			32 4" 3.5		Very loose dark brown medium to fine SAND, little gravel and silt, trace coarse sand with glass, brick and ash fragments, (rust-colored staining)
7			4" 5.0		-FILL-
10			33 6" 10.0		Dense dark brown medium to fine SAND, little silt, trace gravel and coarse sand, with glass and brick fragments (rust-colored staining)
11			6" 11.5		-FILL-
15			34 18" 15.0		Very stiff brown-gray silty CLAY, with mottling
16			15" 16.5		
20			35 15" 20.0		Very stiff brown-gray silty CLAY, with mottling
21			9" 21.5		
25			36 18" 25.0		FV#1: 25.0-26.3 ft.; Su = 4000 psf
26			2" 26.5		Stiff brown-gray silty CLAY, with mottling
27			8" 27.5		-MARINE DEPOSIT-
30			37 15" 30.0		Medium dense grayish-brown medium to fine SAND, trace silt
31			15" 31.5		
35			38 7" 35.0		Dense brown medium to fine SAND, trace coarse sand and silt
36			7" 36.5		
40			39 6" 40.0		Dense brown medium to fine SAND, trace coarse sand and silt
41			6" 41.5		
45			40 6" 45.0		Dense brown medium to fine SAND, trace coarse sand and silt
46			6" 46.5		
50			41 8" 50.0		Dense brown medium to fine SAND, little coarse sand, trace silt
51			8" 51.5		
55			42 7" 55.0		Dense brown medium to fine SAND, little coarse sand, trace silt
56			7" 56.5		
60			43 8" 60.0		Dense brown medium to fine SAND, little coarse sand, trace silt
61			8" 61.0		
65			44 8" 65.0		Dense gray coarse to fine SAND, trace gravel and silt
66			8" 66.0		-GLACIAL TILL-
70			45 20" 70.0		Dense gray coarse to fine SAND, trace gravel and silt
71			20" 71.0		-GLACIAL TILL-
75			46 18" 75.0		Bedrock encountered at 68.7 ft. Roller bit to 68.8 ft. Begin NK rock core at 68.8 ft. (See Core Boring Report)
76			18" 76.0		
80			47 20" 80.0		
81			20" 81.0		
85			48 20" 85.0		
86			20" 86.0		
90			49 20" 90.0		
91			20" 91.0		





DESIGNED:	SM	7/93		
DRAWN:	RJT	7/93		
CHECKED:				
NO.	REVISION	BY	DATE	IN CHARGE OF

B-244 (CONT)

DEPTH (FT)	DRILLING BIT NO.	RECOVERY/ROD IN. X	WEATHERING	ELEV. / DEPTH (FT)	VISUAL DESCRIPTION AND REMARKS
68.7				68.8	68.7 ft. of Overburden (See Test Boring Report) Advanced Roller bit to 68.8 ft. Begin NK rock core at 68.8 ft.
69					
70					
71					
B-247 (CONT)

DEPTH (FT)	DRILLING BIT NO.	RECOVERY/ROD IN. X	WEATHERING	ELEV. / DEPTH (FT)	VISUAL DESCRIPTION AND REMARKS
54.2				54.3	54.2 ft. of Overburden (See Test Boring Report) begin NK rock core at 54.2 ft.
55					
56					
57					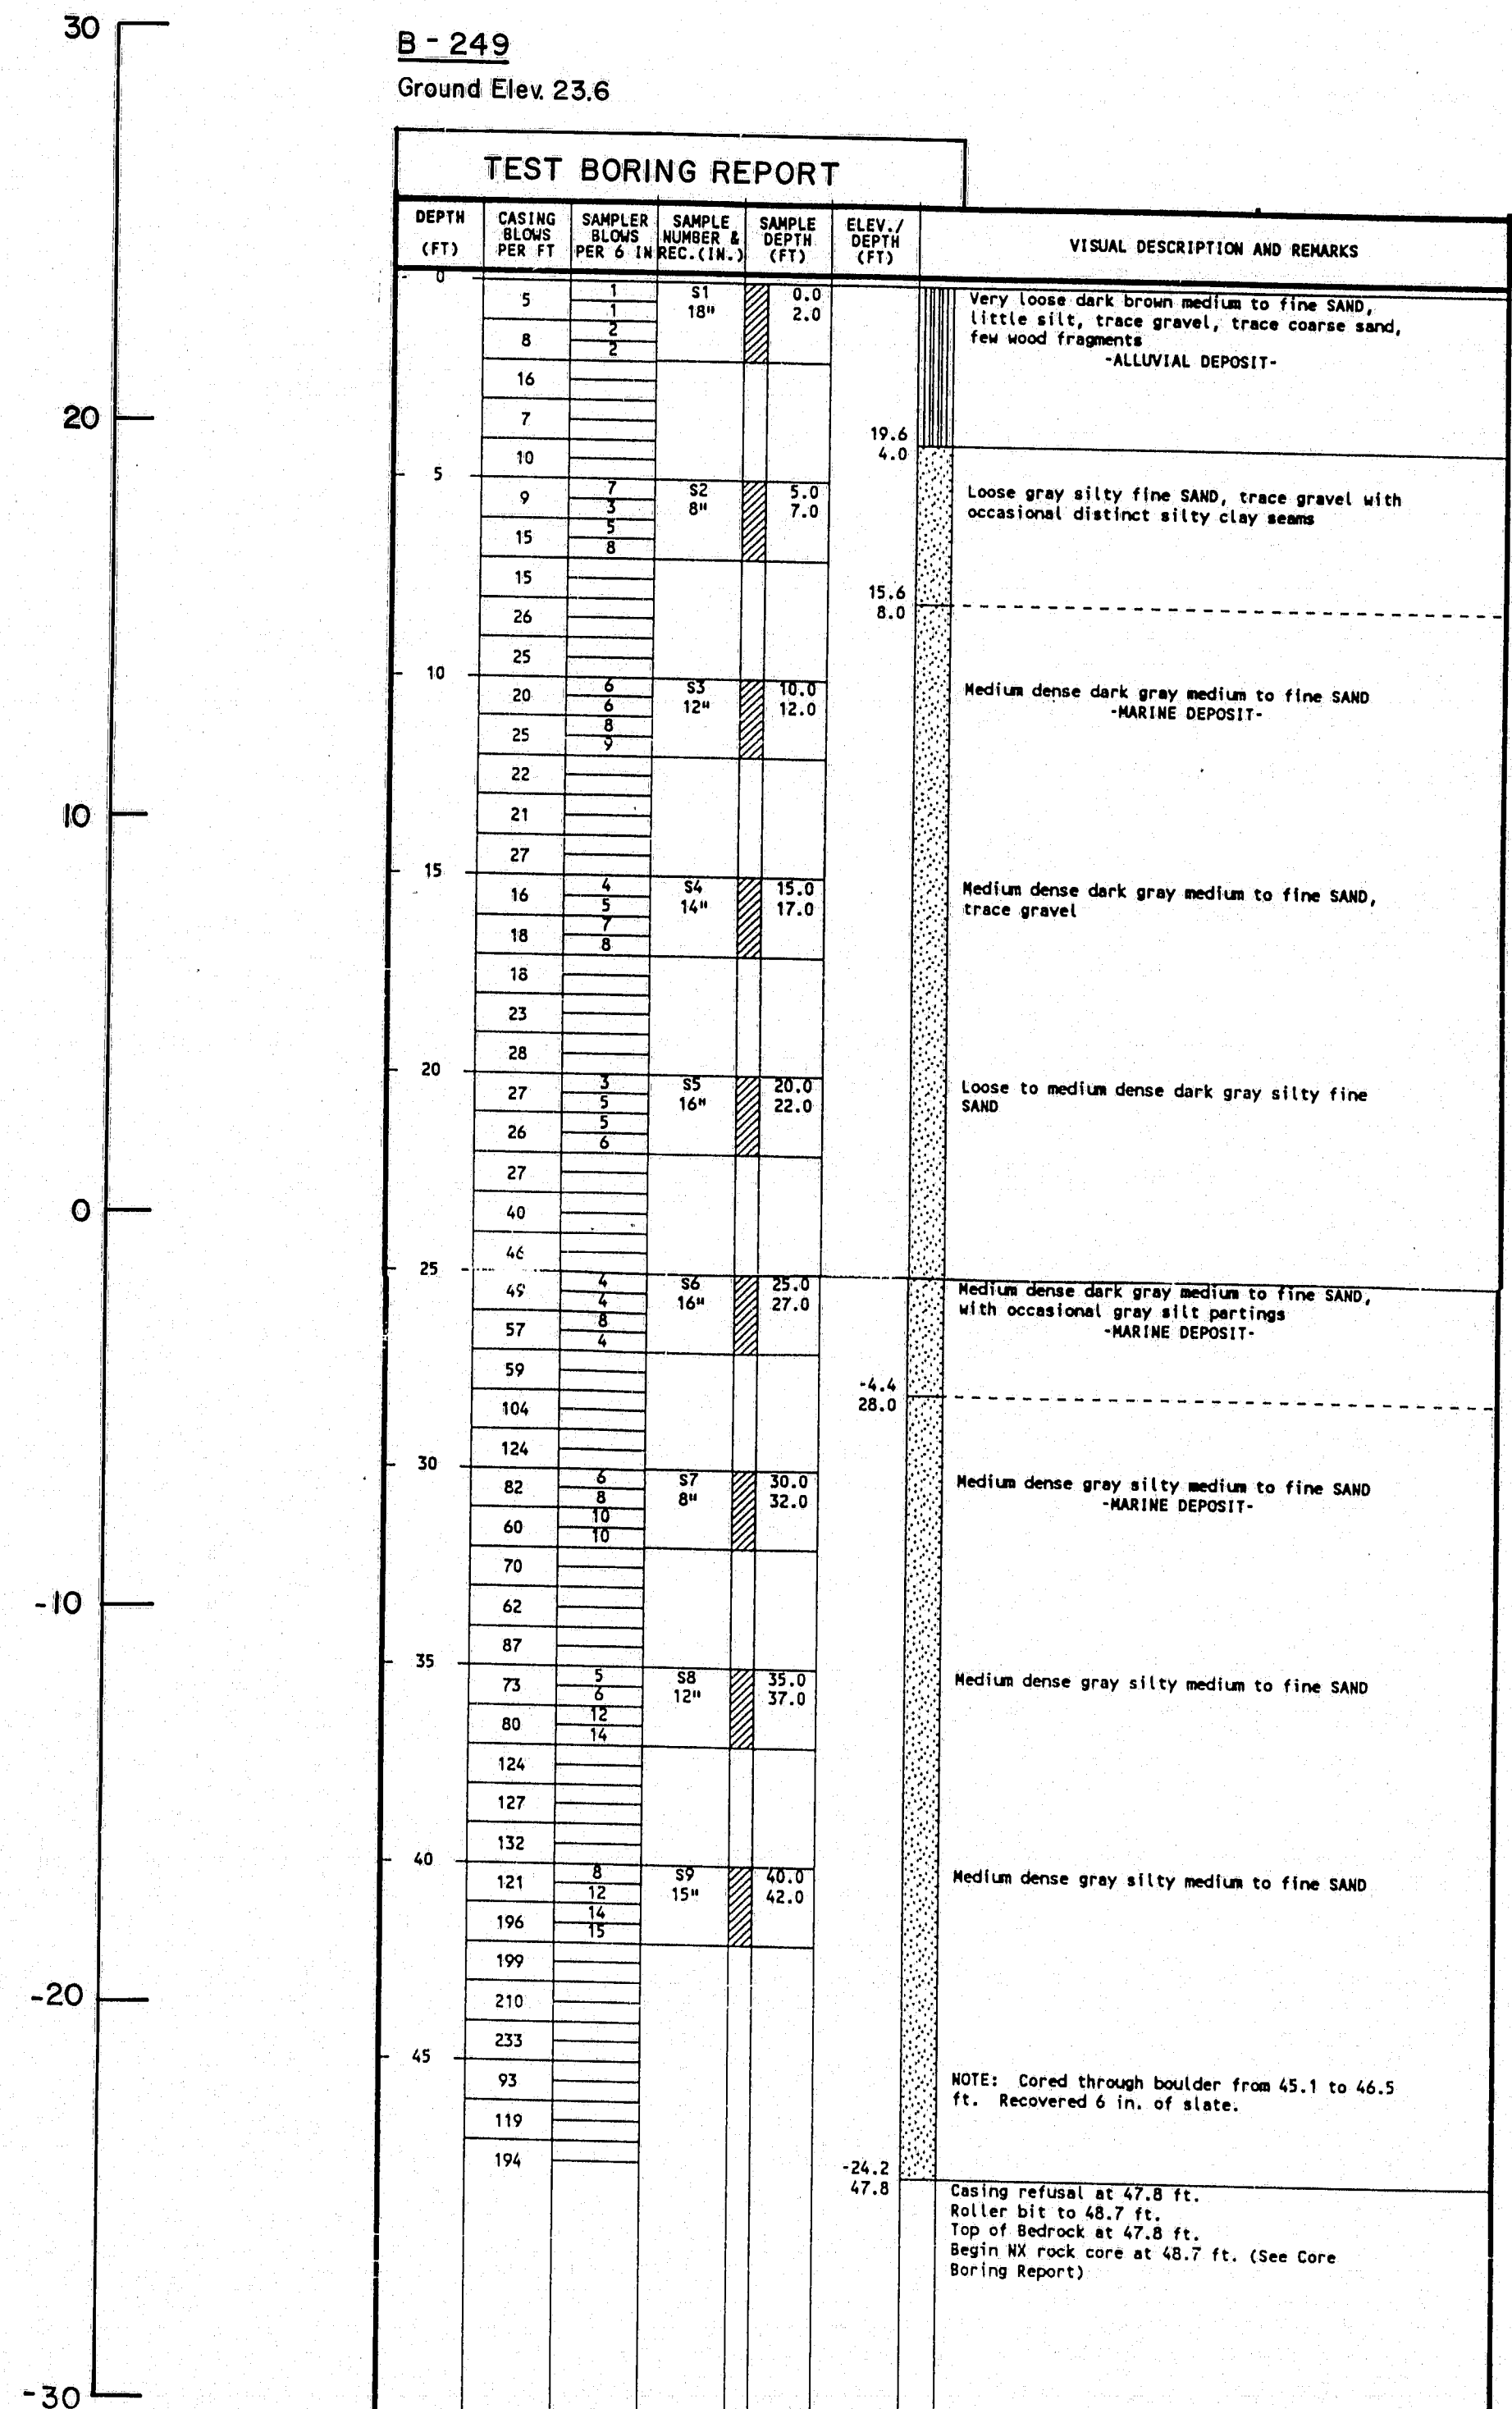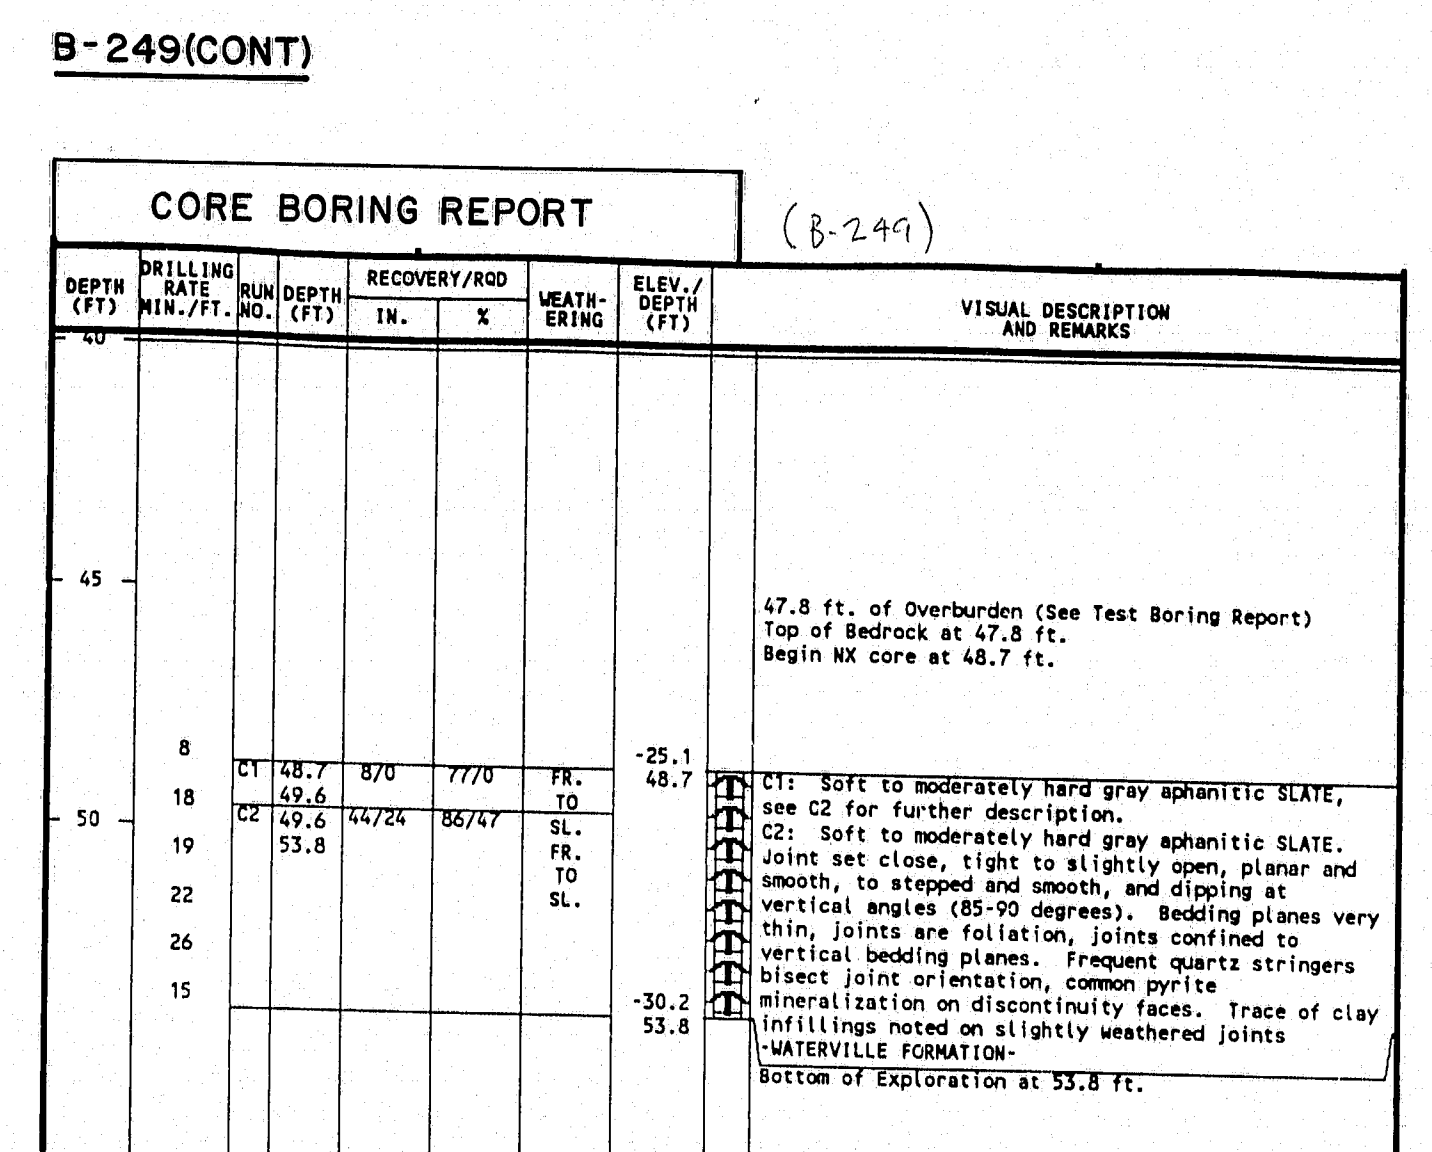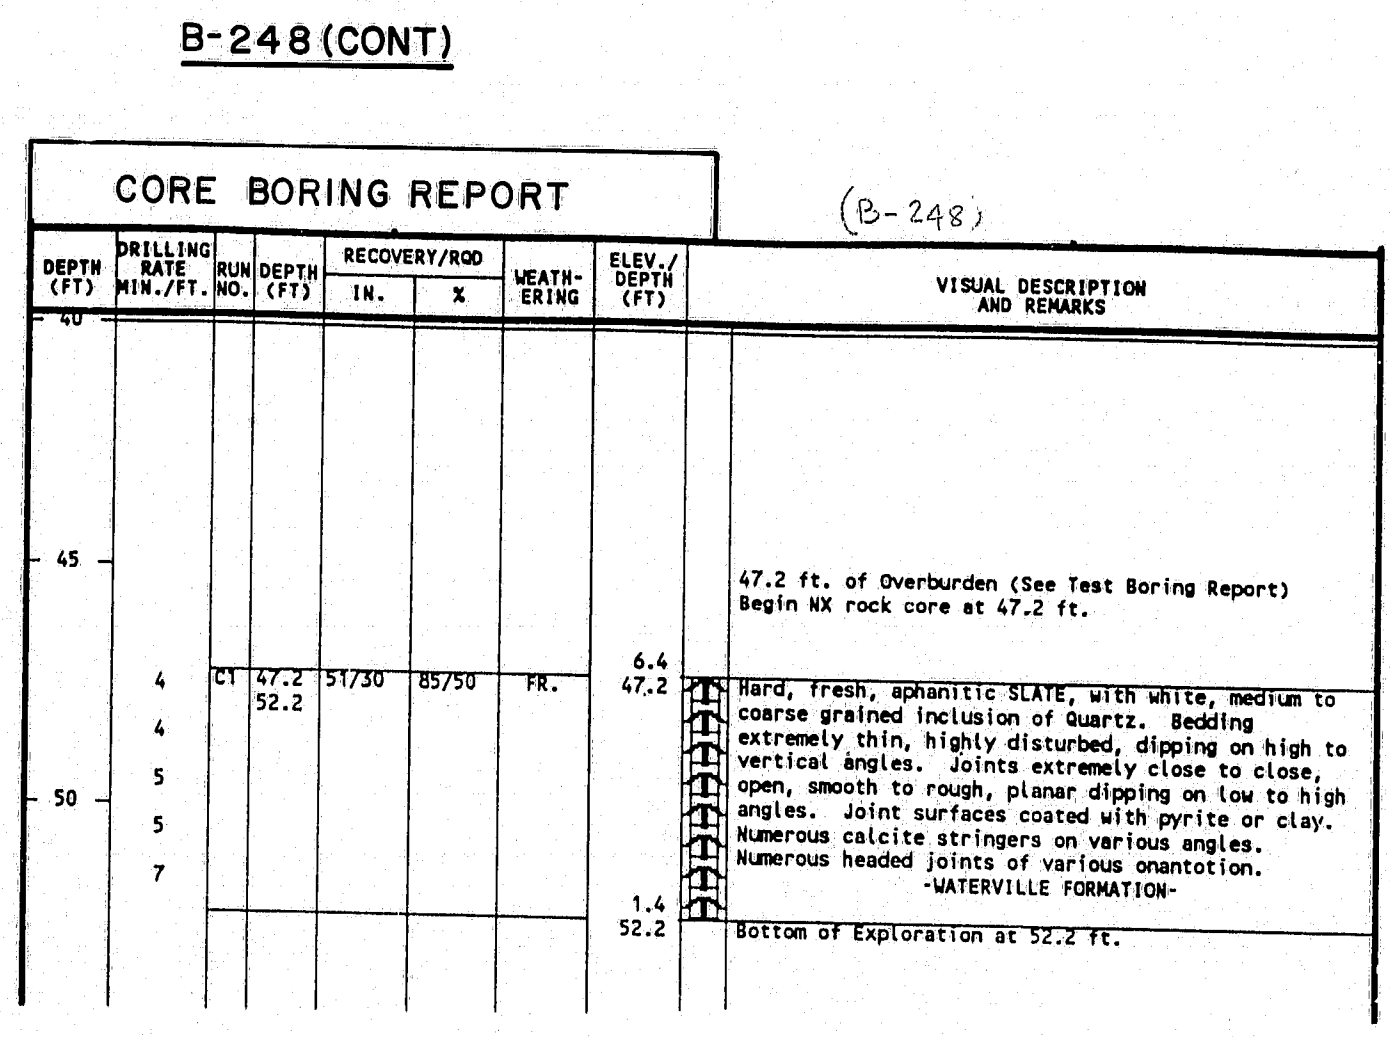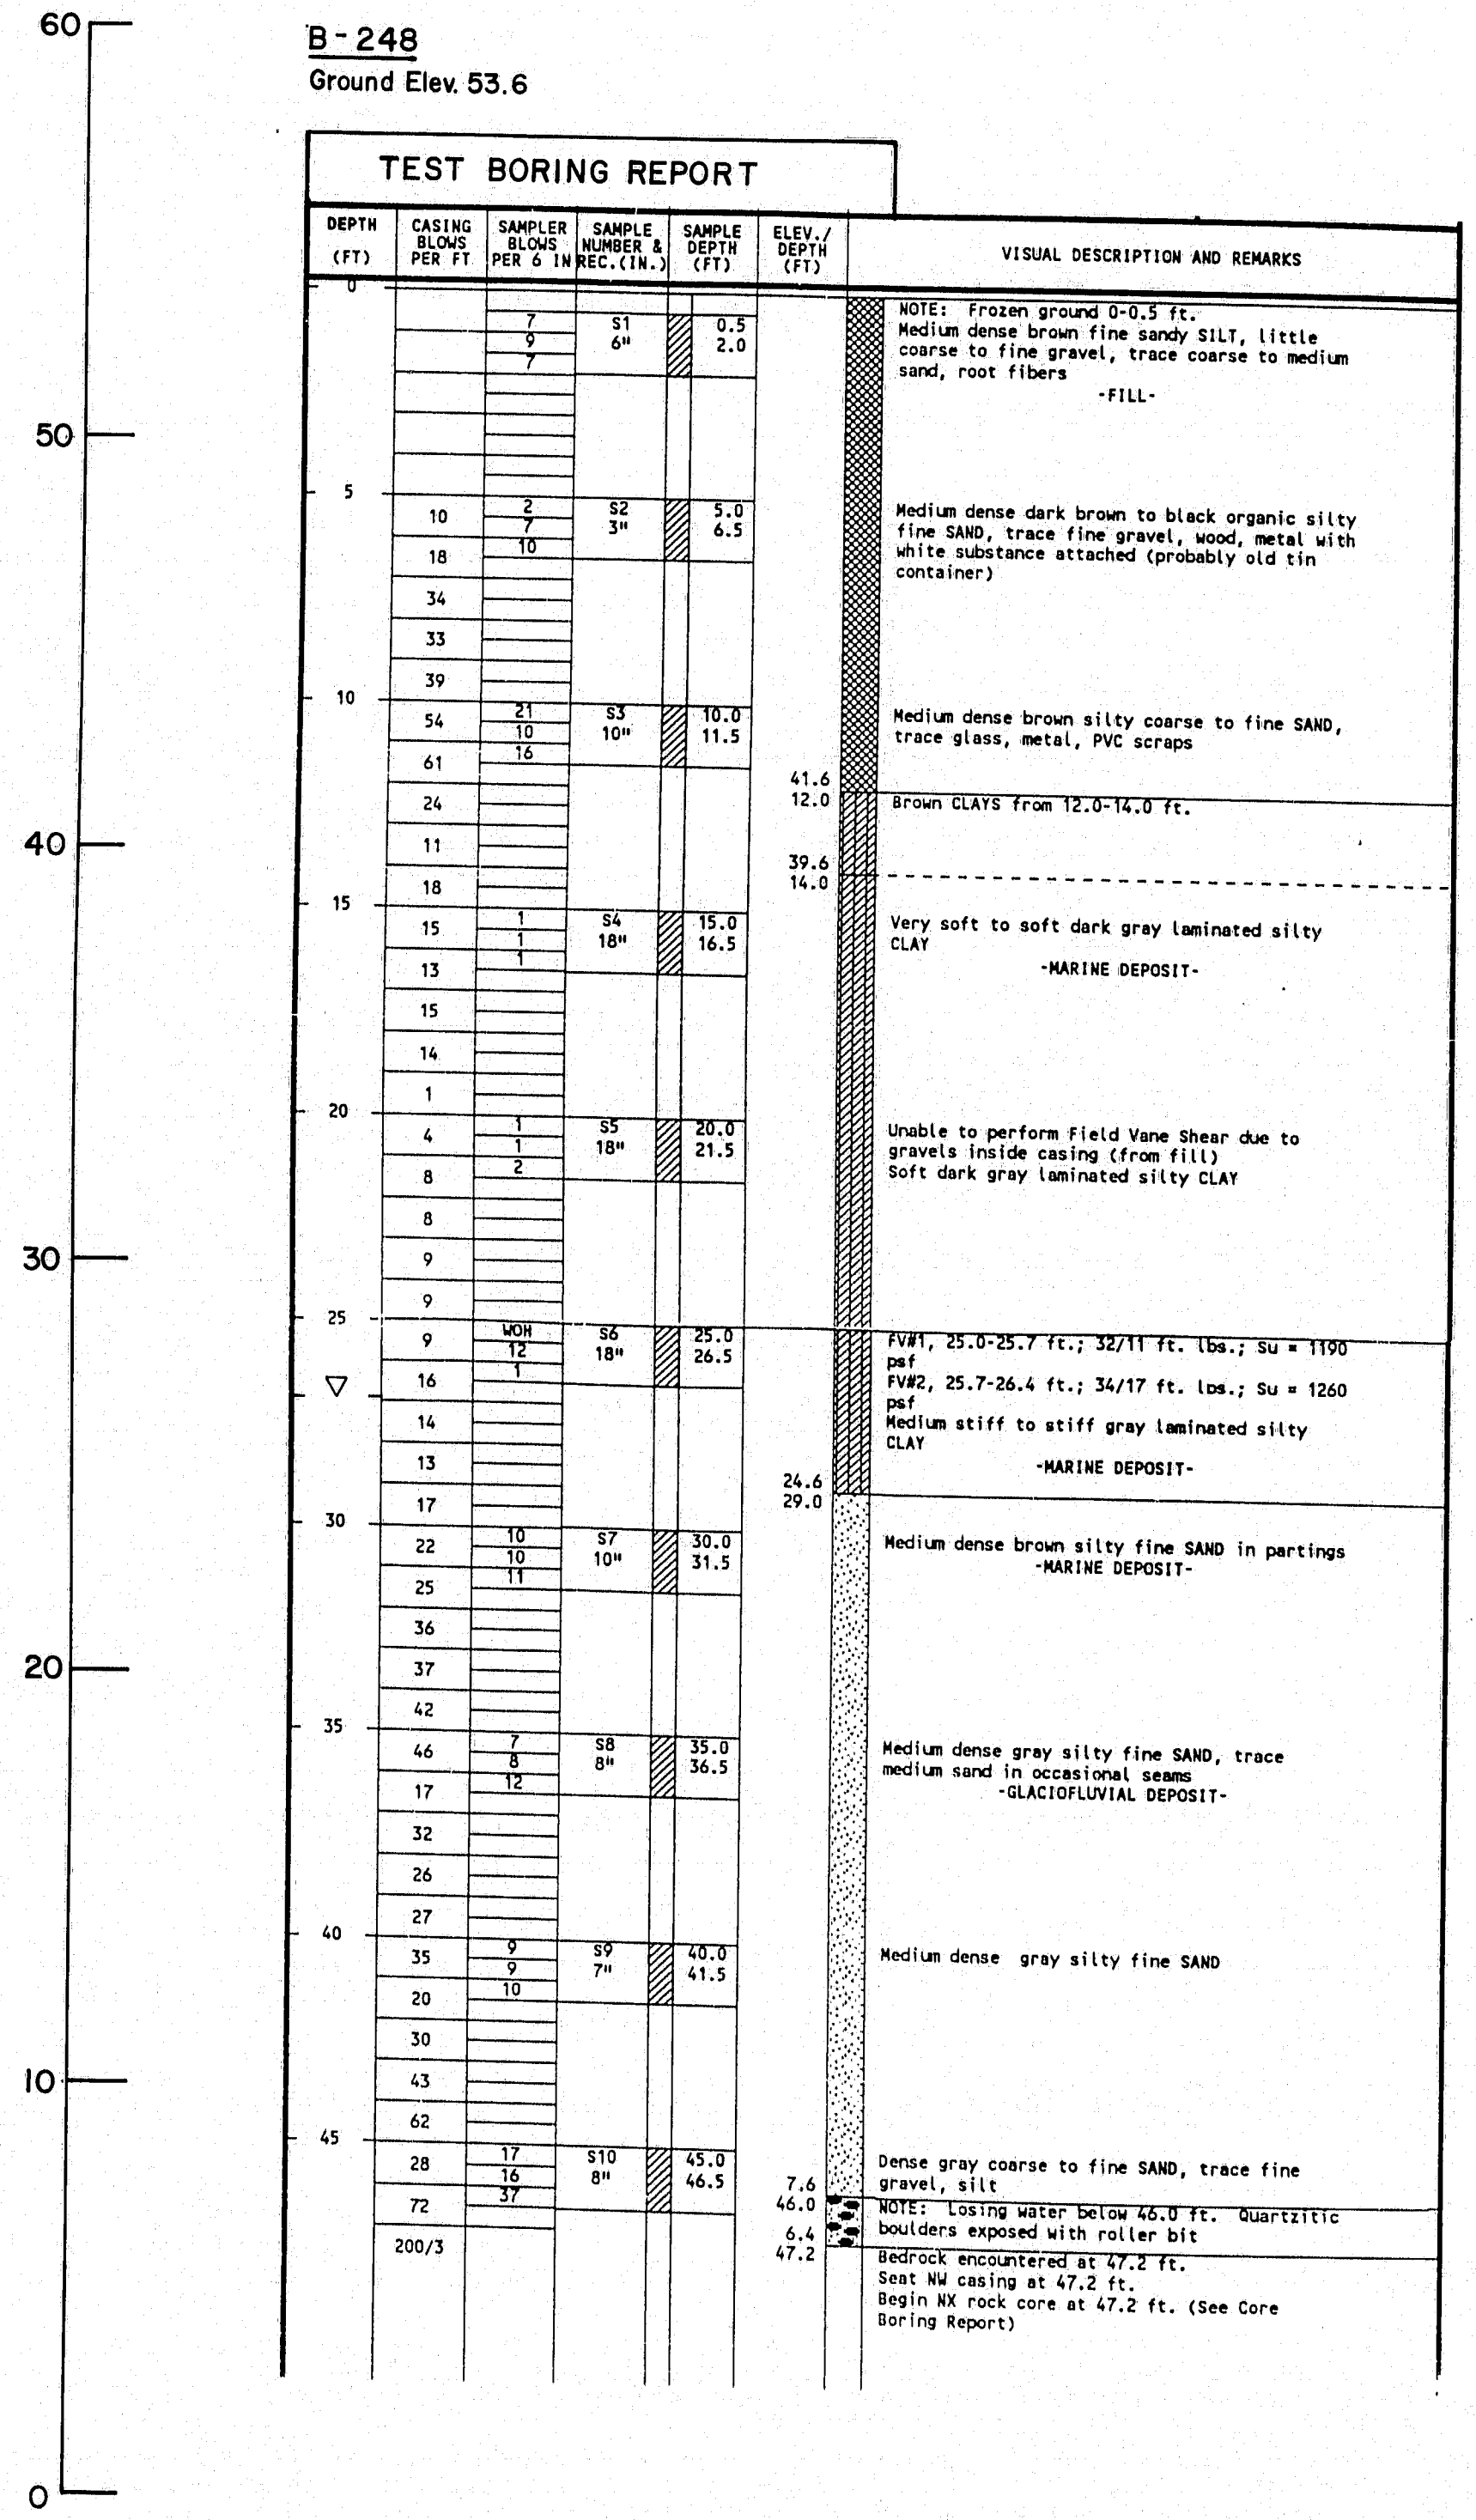
DESIGNED:	SM	7/93
DRAWN:	RJT	7/93
CHECKED:		
NO. REVISION	BY	DATE



115-201

STATE OF MAINE  
DEPARTMENT OF TRANSPORTATION

WATERVILLE - WINSLOW PROJECT

DONALD V. CARTER BRIDGE  
OVER  
KENNEBEC RIVER

BORING LOGS

SHEET 88 OF 886 AUGUSTA, MAINE

*As Built  
5/2/94*

**B-112**  
Ground Elev. 22.9

DEPTH (FT)	CASING BLOSS PER FT.	SAMPLER BLOSS PER FT.	SAMPLE NUMBER	SAMPLE DEPTH (FT)	ELEV./DEPTH (FT)	VISUAL DESCRIPTION AND REMARKS
0						
3	2	21		0.0		Medium dense gray fine gravelly coarse to medium sand
6	2	2*		1.5		-ALLUVIAL DEPOSIT-
7						
19.4		22		3.0	19.4	Loose gray fine GRAVEL, little silt, coarse to fine sand
2	1	14*		4.5	2.0	Very soft gray laminated silty CLAY
7	2	22*		6.5		Medium stiff gray laminated silty CLAY
9	3	24		8.5		-MARINE DEPOSIT-
11	4	6*		8.5		Medium stiff gray silty CLAY
13	4	15		8.3		
14	5	18*		10.5	14.4	Stiff gray silty CLAY, some fine sand in matrix and pockets
15	5	14*		12.5	12.4	-MARINE DEPOSIT-
18	6	36		10.5	10.5	Medium dense gray silty fine SAND, little clay in occasional distinct zones
18	10	14*		12.5	10.4	-MARINE DEPOSIT-
20	9	37		12.5	12.5	Medium dense gray fine SAND, trace silt
16	9	18*		14.5	10.4	
18	6	58		14.5	14.5	Medium dense gray fine SAND
20	10	14*		16.5	16.5	
23	11	39		18.5	18.5	Medium dense gray medium to fine SAND
24	12	12*		18.5	18.5	-MARINE DEPOSIT-
26	11	310		18.5	18.5	Loose gray fine SAND, little medium sand, trace fine gravel
29	9	14*		20.5	20.5	
19	9	311		20.5	20.5	Medium dense gray fine SAND, trace medium sand
23	9	12*		22.5	22.5	
25	9	312		24.5	24.5	Loose gray fine SAND, trace medium sand
16	9	16*		24.5	24.5	
15	9	313		24.5	24.5	Loose gray fine SAND
14	9	15*		26.5	26.5	-MARINE DEPOSIT-
13	9	314		26.5	26.5	Loose gray fine SAND
12	9	14*		28.5	28.5	
11	9	315		28.5	28.5	Loose gray fine SAND, trace silt in occasional distinct zones
10	9	13*		30.5	30.5	NOTE: Sand ran up 18 in. into casing; hole reamed to 30.5 ft.
9	9	316		30.5	30.5	Loose gray fine SAND
8	9	9*		32.5	32.5	-MARINE DEPOSIT-
7	9	317		34.5	34.5	Loose gray fine SAND, little silt in frequent pockets, seams
6	9	15*		34.5	34.5	NOTE: Sand ran up 12 in. into casing; hole reamed to 34.5 ft.
5	9	318		34.5	34.5	Very loose gray fine SAND, trace silt
4	9	2		36.5	36.5	
3	9	319		36.5	36.5	Loose gray fine SAND, little silt in occasional pockets
2	9	13*		38.5	38.5	
1	9	320		38.5	38.5	Dense gray silty fine SAND, little fine gravel lodged in shoe
14	9	12*		40.5	40.5	NOTE: Coarse fraction consists of angular slate fragments
7	9	321		40.5	40.5	Medium dense gray fine SAND, little silt in frequent pockets, seams, trace fine gravel
5	9	11*		42.5	42.5	
10	9	322		42.5	42.5	Dense gray gravelly coarse to fine SAND, trace silt
15	9	11*		44.5	44.5	-GLACIAL TILL-
20	9	323		44.5	44.5	Dense gray gravelly coarse to fine SAND, little silt
19	9	14*		46.5	46.5	Refusal on BEDROCK at 46.0 ft.
23.1				46.0	46.0	Very dense gray gravelly coarse to fine SAND, consisting of very severely weathered slate, vertical foliation distinct
24.0				46.0	46.0	-WEATHERED BEDROCK-
46.9				46.0	46.0	SEE W/C TESTING AT 46.9 FT. Roller bit to 47.2 ft. Begin RK rock core at 47.2 ft. (See Core Boring Report)

**B-112(CONT)**

DEPTH (FT)	DRILLING RATE MIN./FT.	RECOVERY/NO. IN.	WEATH. DRING	ELEV./DEPTH (FT)	VISUAL DESCRIPTION AND REMARKS
47.2				47.2	47.2 ft. of Overburden (See Test Boring Report)
10	01 47.2	5/5	50/50	FR.	26.3
15	02 48.1	5/5	100/100	FR.	47.2
18	50.9				
20	03 50.9	24/12	92/48	FR.	
45	53.1				
45	04 53.1	40/39	96/80	FR.	
18	57.2				
15				54.3	
15				57.2	

**B-250**  
Ground Elev. 25.3

DEPTH (FT)	CASING BLOSS PER FT.	SAMPLER BLOSS PER FT.	SAMPLE NUMBER	SAMPLE DEPTH (FT)	ELEV./DEPTH (FT)	VISUAL DESCRIPTION AND REMARKS
0						
8	3	31		0.0		Loose dense brown coarse to medium SAND, little gravel, trace fine sand
17	4	8*		2.0		-ALLUVIAL DEPOSIT-
13						
20						
25						
5						
24	29	62		5.0		Loose gray silty medium to fine SAND, trace gravel
30	2	8*		7.0		
42						
76					16.8	
178					26.5	
20	100	63		10.0		Very dense gray gravelly coarse to fine SAND, trace silt
29	65	4*		11.0		-GLACIAL TILL-
242						
79						
104						
56						
15						
13		64		15.0		Very stiff gray silty CLAY
10		3*		16.0	9.3	
15					16.0	

DEPTH (FT)	DRILLING RATE MIN./FT.	RECOVERY/NO. IN.	WEATH. DRING	ELEV./DEPTH (FT)	VISUAL DESCRIPTION AND REMARKS
16.0				9.3	16.0 ft. of Overburden (See Test Boring Report) Top of bedrock at 16.0 ft.
12	01 16.0	29/42	95/81	FR.	16.0
9	20.3				
10					
20				5.0	
6				20.3	Bottom of Exploration at 20.3 ft.

**B-113**  
Ground Elev. 24.6

DEPTH (FT)	CASING BLOSS PER FT.	SAMPLER BLOSS PER FT.	SAMPLE NUMBER	SAMPLE DEPTH (FT)	ELEV./DEPTH (FT)	VISUAL DESCRIPTION AND REMARKS
0						
10	4	31		0.0		Loose gray coarse SAND, little medium to fine sand, trace fine gravel
15	4	1*		2.0		-ALLUVIAL DEPOSIT-
16	3	62		2.0		Dense gray medium to fine SAND, trace silt
20	19	1*		4.0		
5						
10	12	33		4.0		Loose gray fine SAND, little coarse to medium sand, trace silt, fine gravel
8	3	4*		6.0		
2	7	NR		6.5		NOTE: Casing sunk to 6.3 ft.; spoon dropped to 6.5 ft. No recovery
2	7	NR		8.5		NOTE: Casing sunk during tightening to 7.0 ft. No recovery
14	9					
20	20	6*		9.0		Medium dense gray coarse to fine sandy fine GRAVEL, trace silt
25	9			11.0		
27	18	25		11.0		Medium dense gray coarse sandy fine GRAVEL, little medium to fine sand, silt in occasional indistinct zones; coarse fraction consists of angular, platy slate fragments
79	36			13.0		NOTE: Total water loss at 13.0 ft. No recovery
13	18	NR		13.0		
30	6			15.0		
15						
9	27	56		15.0		Very dense gray coarse sandy fine GRAVEL, consisting entirely of platy, angular slate fragments
23	17	2*		17.0	8.1	NOTE: Probable wash sample
18	12	37		17.0	16.5	High blue coars due to casing plowing effect
18	12	6*		18.4	6.6	Partial water return from 15.0-17.0 ft.
32/0	17/4	70/1		18.0	18.0	Medium dense gray coarse to fine sandy fine GRAVEL, consisting of angular, platy slate fragments, some laminated clay, little silt in pockets; sample highly disturbed -ALLUVIAL DEPOSIT-

DESIGNED:	SM	BY	DATE
DRAWN:	RJT		7/93
CHECKED:			
NO.	REVISION	BY	DATE



115-202

STATE OF MAINE  
DEPARTMENT OF TRANSPORTATION  
WATERVILLE - WINSLOW PROJECT  
DONALD V. CARTER BRIDGE  
OVER  
KENNEBEC RIVER


BORING LOGS

SHEET B9 OF B86 AUGUSTA, MAINE






**B-256**  
Ground Elev. 49.8

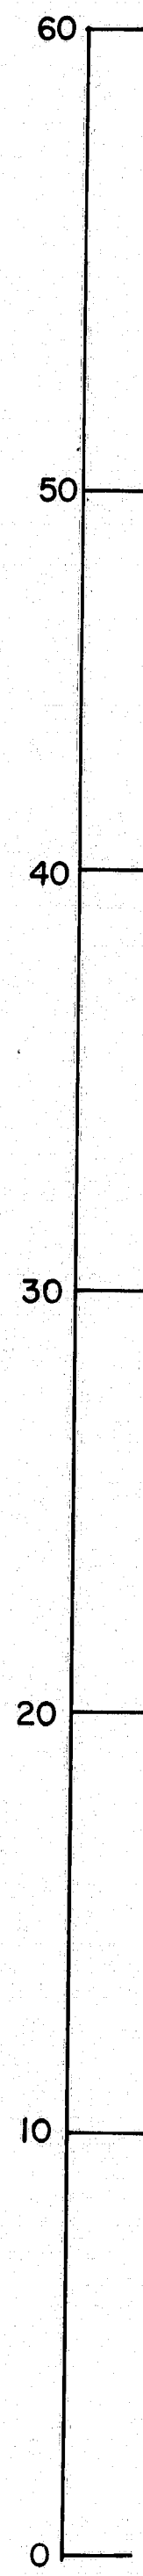

DEPTH (FT)	CASING BLOWS PER FT.	SAMPLER BLOWS PER FT.	SAMPLE NUMBER	SAMPLE DEPTH (FT)	ELEV./DEPTH (FT)	VISUAL DESCRIPTION AND REMARKS
0			31	0.0	49.8	Very loose dark brown silty fine SAND
1			34	1.5		
5			32	5.0		Loose brown silty fine SAND
7			38	6.5		
10			33	10.0		Medium dense brown silty fine SAND
12			39	11.5		
15						NOTE: Spin MW casing from 15.0-16.0 ft.
17			34	15.0		Very dense red-brown sandy coarse to fine GRAVEL
18			41	16.5		ALLUVIAL DEPOSIT
20			35	20.0		Medium dense gray coarse to fine GRAVEL, little coarse sand
22			44	21.5		
25			36	25.0		Medium stiff gray silty CLAY (gravel in bottom of boring, washed ahead of casing to remove)
26			18	26.5		MARINE DEPOSIT
30			37	30.2		Attempted tube, too stiff, could not advance
31			38	31.7		Very stiff gray silty CLAY
32			10	30.8		Gray clayey coarse to fine GRAVEL
33						NOTE: Losing a bit of drill water during clean-out
35			38	35.7		Very dense gray clayey coarse to fine GRAVEL
36			7	36.7		GLACIAL TILL
37			27	35.7		
38			30	36.7		
39						Bedrock encountered at 38.3 ft.
40						Seat MW casing at 38.3 ft.
41						Begin MK rock core at 38.3 ft. (See Core Boring Report)
42						
43						

B-258  
Ground Elev. 46.6

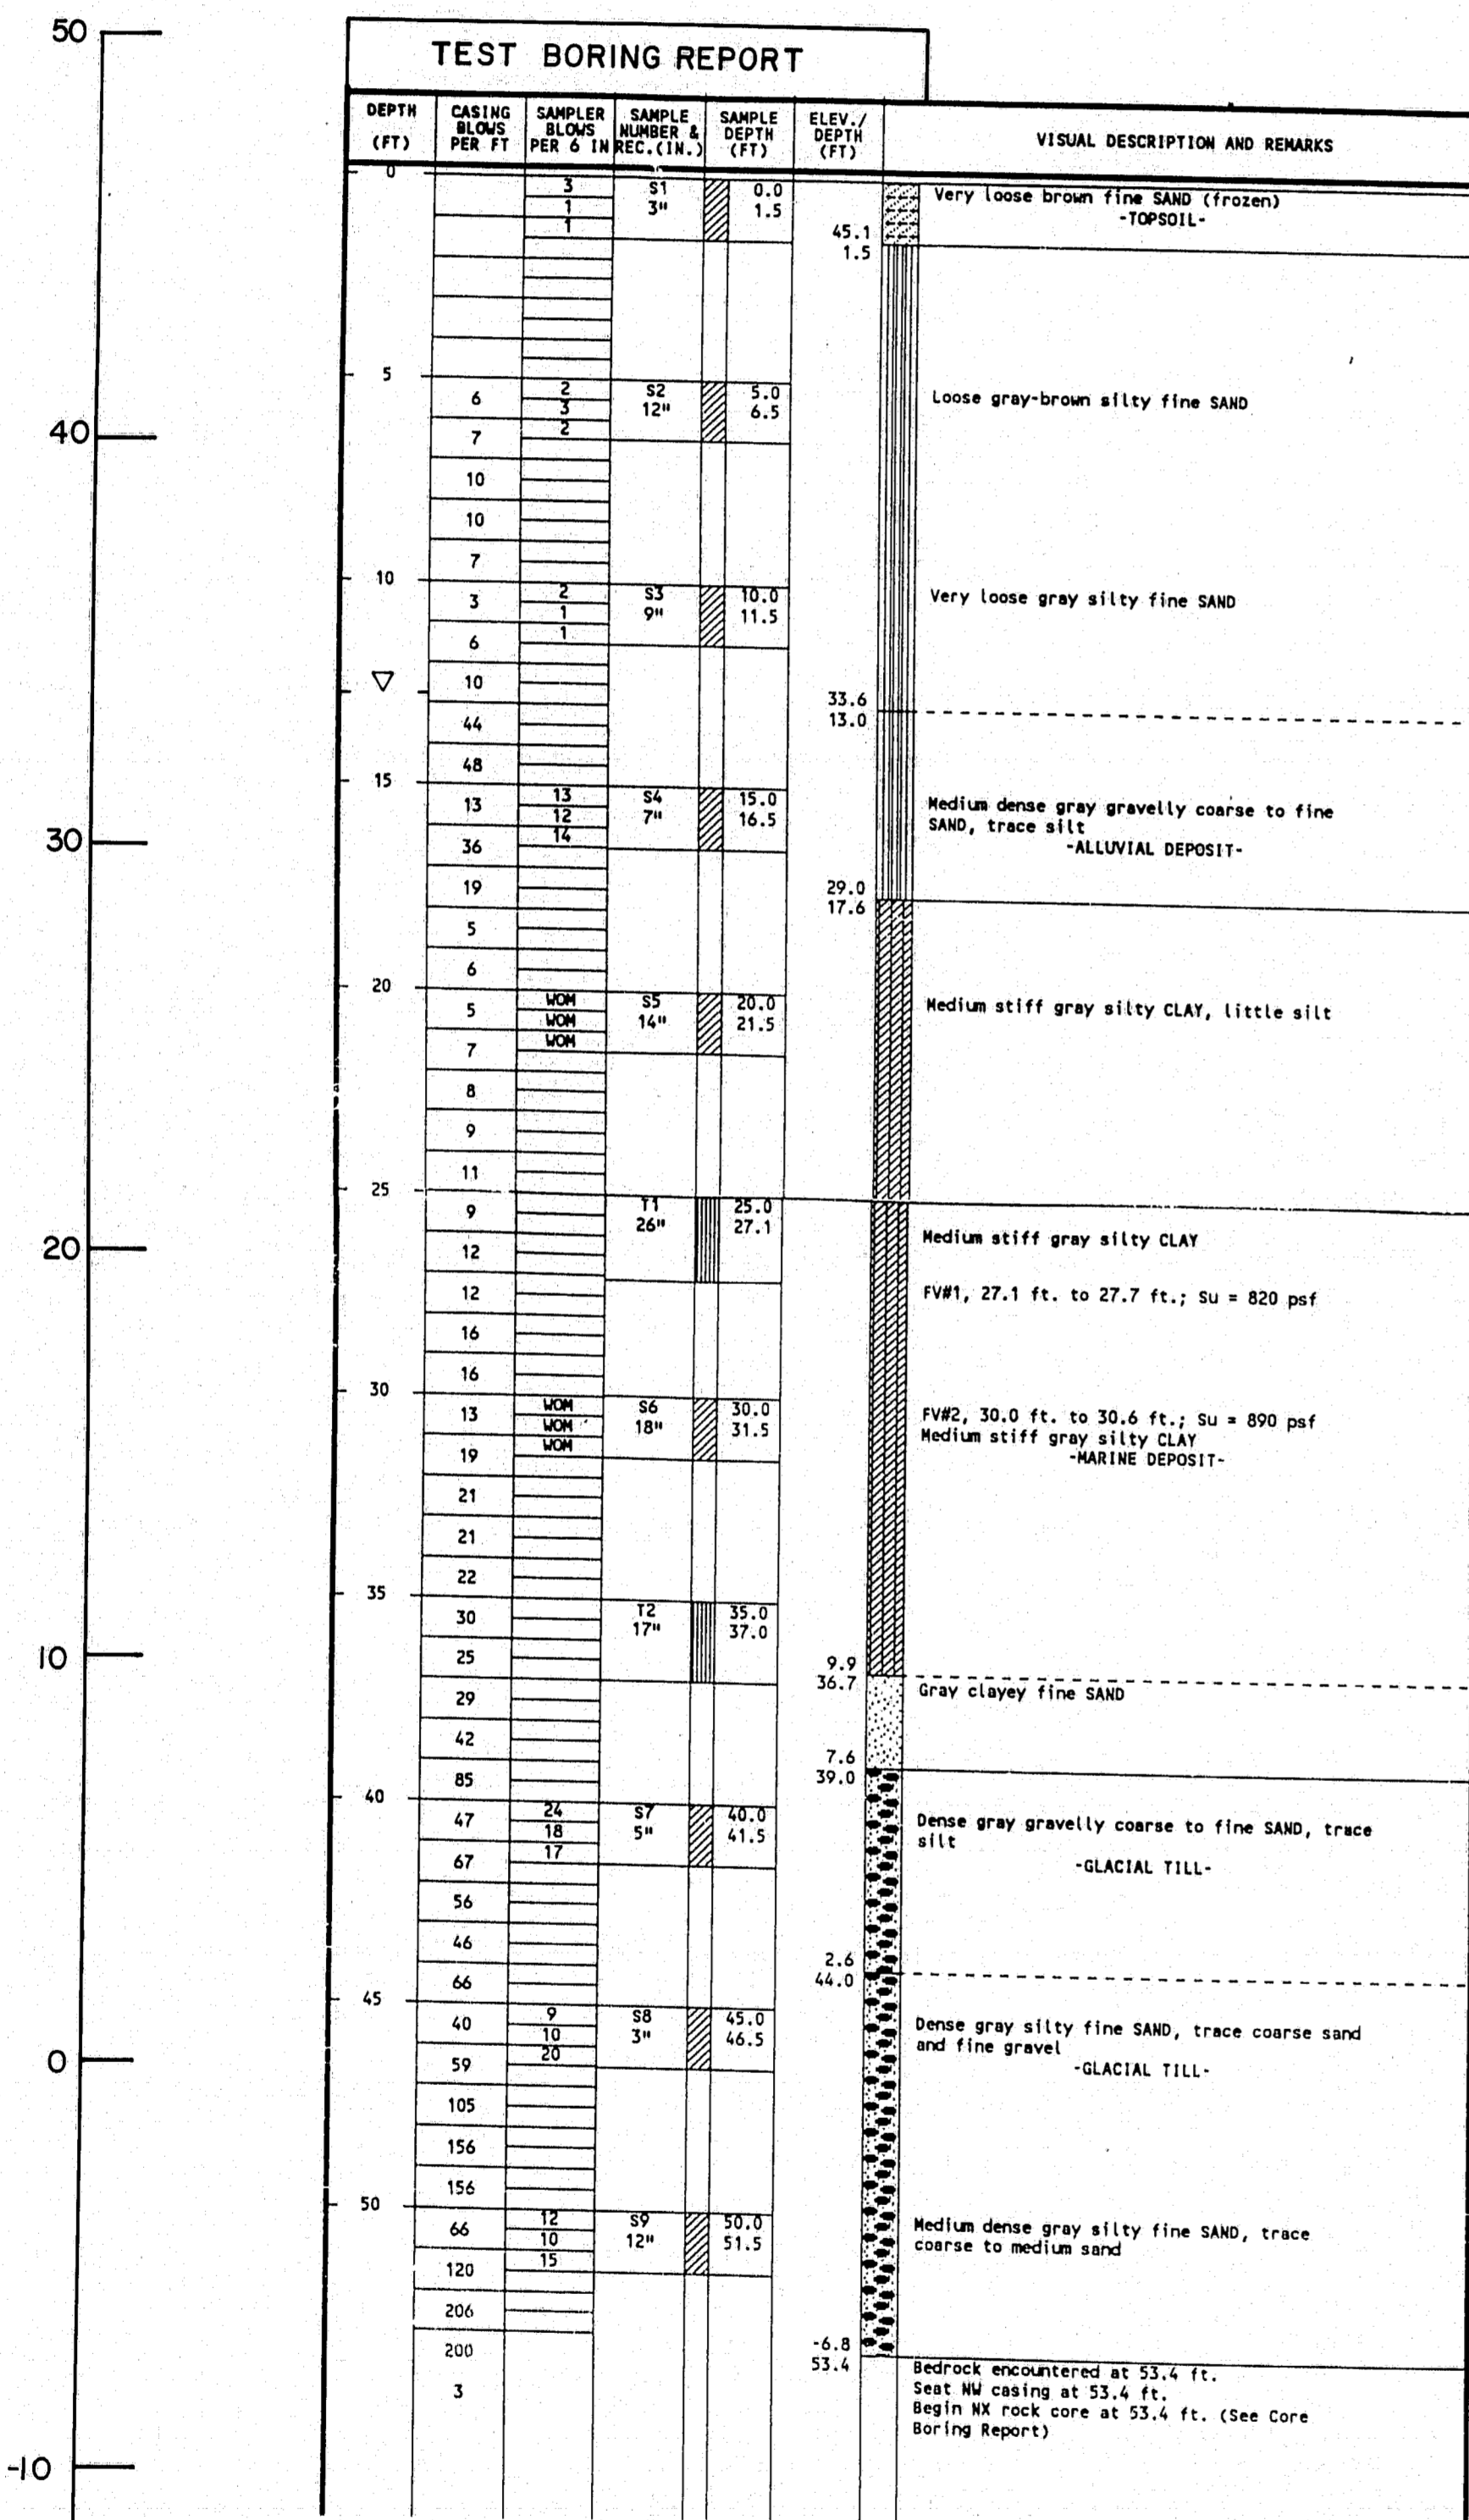

B-258 (CONT)

DEPTH (FT)		DRILLING RATE (FT./MIN.)	RECOVERY/RSD (FT)	WEATHERING	ELEV./DEPTH (FT)	VISUAL DESCRIPTION AND REMARKS
30						33.4 ft. of Overburden (See Test Boring Report) begin MW rock core at 33.4 ft.
3	33.4	29/0	100/0	MOD.	-0.8 53.4	C1: Moderately hard, dark gray sphenitic SLATE. Joints are very close, open, moderately weathered, planar and smooth, to stepped and smooth, and dipping at steep angles. Silty coating noted on joint surfaces. C2: Same as C1.
55	55.8					
60	62.9	35/0	100/0	MOD.		C3: Same as C1.
65	65.4	30/4	100/13	SL.	-18.8 65.4	C4: Moderately hard, gray sphenitic SLATE. Bedding is very thin, and steeply inclined with occasional calcite stringers. Joints are very close, open, moderately weathered, planar and smooth, and dipping at steep angles. Calcite and quartz mineralization present. BOTTOM OF EXPLORATION AT 65.4 FT.

B-259  
Ground Elev. 46.0

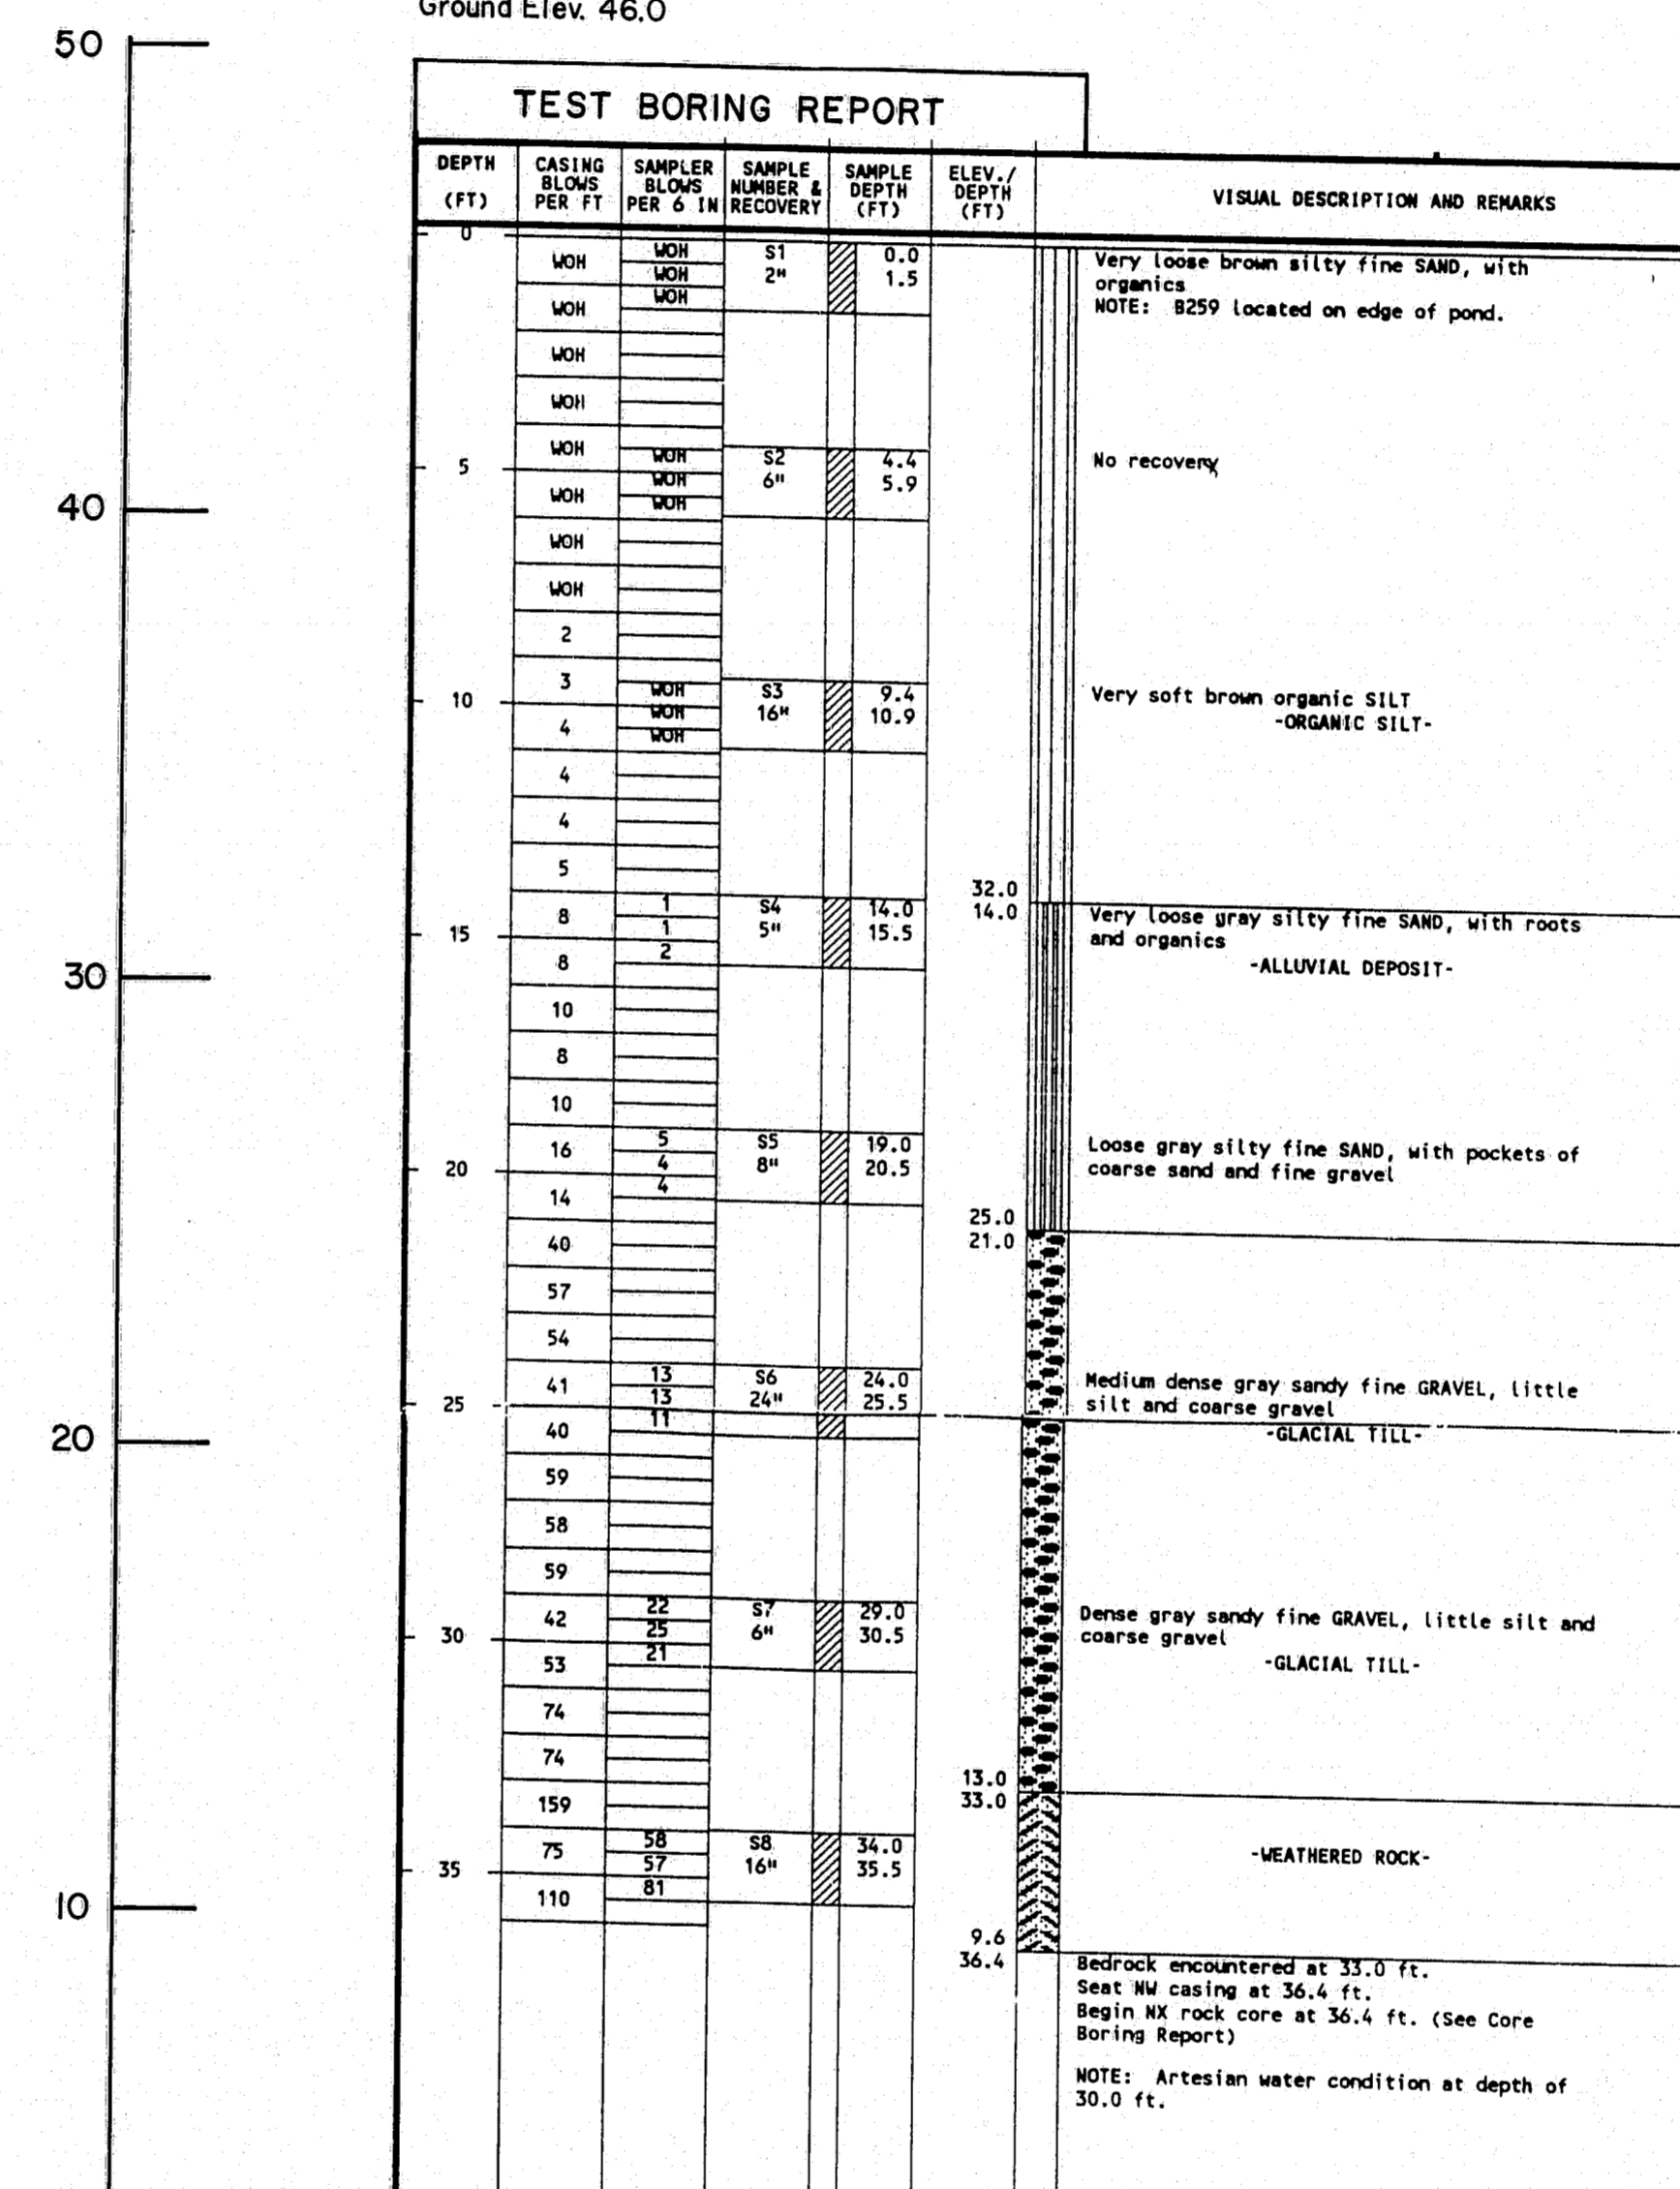

DEPTH (FT)		DRILLING RATE (FT./MIN.)	RECOVERY/RSD (FT)	WEATHERING	ELEV./DEPTH (FT)	VISUAL DESCRIPTION AND REMARKS
30						33.0 ft. of Overburden (See Test Boring Report) Seat MW casing at 36.4 ft. Advanced roller bit to 36.4 ft. Begin MW rock core at 36.4 ft.
4	36.4	14/0	100/0	SL.	9.6 36.4	C1: Moderately hard, gray sphenitic SLATE. Primary joint set is slightly weathered, close, tight, planar and smooth, dipping at high angles. Substance and joint spacing is very close. Frequent calcite stringers. C2: Same as C1 except, joints are coated with silty calcite stringers. C3: Same as C1.
3	37.6	22/0	100/0	SL.		
3	39.4					
3	39.4	30/0	100/30	SL.		
3	41.9					
3	43.9	24/7	100/29	SL.		C4: Same as C1 except, extremely fractured core.
3	45.8	23/0	100/0	SL. TO MOD.		C5: Same as C1 except, core reduced to gravel size fragments. Moderately weathered with silty infillings on joint surfaces.
45	45.8				0.2 45.8	BOTTOM OF EXPLORATION AT 45.8 FT.

AS LOST  
CB LOG 12/2/16

115-206

STATE OF MAINE  
DEPARTMENT OF TRANSPORTATION  
WATERVILLE - WINSLOW PROJECT  
DONALD V. CARTER BRIDGE  
OVER  
KENNEBEC RIVER



BORING LOGS  
SHEET B13 OF B86 AUGUSTA, MAINE

DESIGNED:	SM	7/93
DRAWN:	RJT	7/93
CHECKED:		
NO. REVISION	BY	DATE

**B-260**  
Ground Elev. 48.0

DEPTH (FT)	CASING BLOSS PER FT	SAMPLER NUMBER	SAMPLE DEPTH (FT)	ELEV. / DEPTH (FT)	VISUAL DESCRIPTION AND REMARKS
0		S1	0.0	47.0	No recovery - Frozen soil at ground surface - TOPSOIL -
1		S2	5.0	46.5	Soft brown sandy SILT - ALLUVIAL DEPOSIT -
3		S3	10.0	46.0	Very soft brown sandy SILT, with organics
5		S4	15.0	45.5	Very soft brown sandy SILT, with organics
7		S5	20.0	45.0	Very soft brown sandy SILT, with organics
187		S95	470.0	0.0	Very soft brown sandy SILT, with organics
189		S96	475.0	-0.5	Very soft brown sandy SILT, with organics
191		S97	480.0	-1.0	Very soft brown sandy SILT, with organics
193		S98	485.0	-1.5	Very soft brown sandy SILT, with organics
363		S183	910.0	-44.0	Very soft brown sandy SILT, with organics
365		S1			

B-262  
Ground Elev. 79.1

DEPTH (FT)	CASING BLOCK PER FT	SAMPLER BLOCK PER FT	SAMPLE NUMBER & RECOVERY	SAMPLE DEPTH (FT)	ELEV./DEPTH (FT)	VISUAL DESCRIPTION AND REMARKS
0			S1 8"	0.0	79.1	Loose dark brown loamy silt, trace fine sand, with wood and organic matter. -TOPSOIL-
5			S2 14"	5.0	78.5	Very loose to loose orange brown silty fine sand, trace coarse to medium sand, few rootlets. -ALLUVIAL DEPOSIT-
10			S3 14"	10.0	77.1	Medium dense dark brown coarse to fine sand, trace fine gravel. -ALLUVIAL DEPOSIT-
15			S4 14"	15.0	76.0	Very stiff mottled olive brown clayey silt
20			S5 14"	20.0	74.5	PWS, 15.0-15.25 ft.; Su = 2980 per (2 in. x 3 in.) Very stiff brown gray silty clay -MARINE DEPOSIT-
25			S6 14"	25.0	73.0	PWS, 20.0-20.6 ft.; Su = 1860 per Stiff gray silty clay
30			S7 14"	30.0	71.5	PWS, 25.0-25.6 ft.; Su = 1800 per Stiff gray silty clay, with frequent black oxidized spots
35			S8 14"	35.0	70.0	PWS, 30.0-30.6 ft.; Su = 1450 per Stiff gray silty clay, with frequent black oxidized spots -MARINE DEPOSIT-
40			S9 14"	40.0	68.5	PWS, 35.0-35.6 ft.; Su = 1450 per Stiff gray silty clay
45			S10 14"	45.0	67.0	PWS, 40.0-40.6 ft.; Su = 1370 per Stiff gray silty clay
50			S11 8"	50.0	65.5	Medium stiff gray silty clay, little fine sand
55			S12 8"	55.0	64.0	Very dense gray silty fine sand, little coarse sand, little fine gravel -GLACIAL TILL-
60			S13 8"	60.0	62.5	Very dense black gravel, sample consists of platy slate fragments -WEATHERED BEDROCK-
65			S14 8"	65.0	61.0	Encountered bedrock at 55.2 ft. Set W casing at 56.0 ft. Advanced roller bit to 56.0 ft. Begin RC rock core at 56.0 ft. (see Core Boring Report)

B-262(CONT)




DEPTH (FT)	DRILLING DATE	LOG NO.	RECOVERY/ROD	WEATH. ZONE	ELEV./DEPTH (FT)	VISUAL DESCRIPTION AND REMARKS
55					23.1	55.2 ft. of Overburden (See Test Boring Report) begin RC rock core at 56.0 ft.
60					21.8	C1: Hard, dark gray SPHENITIC SLATE. Primary joint set moderately to steeply dipping, close, tight to slightly open, undulating to planar and smooth, with frequent calcite and quartz veins. C2: Same as C1. -WATERVILLE FORMATION-
65					17.3	Bottom of Exploration at 61.8 ft.

B-263(CONT)

DEPTH (FT)	DRILLING DATE	LOG NO.	RECOVERY/ROD	WEATH. ZONE	ELEV./DEPTH (FT)	VISUAL DESCRIPTION AND REMARKS
55					29.6	59.0 ft. of Overburden (See Test Boring Report) begin RC rock core at 60.0 ft.
60					20.6	C1: Moderately hard, gray SPHENITIC SLATE. Primary joints are very close to close, slightly weathered, tight to slightly open, planar and smooth and dipping at steep angles, parallel to bedding. C2: Same as C1, except joints are close, tight, planar and smooth. C3: Same lithology as C1. Joints are fresh to slightly weathered, close, tight to slightly open, steeply dipping, planar to stepped and smooth. Pyrite, quartz mineralization present. Some oxidation noted. -WATERVILLE FORMATION-
65					25.1	Bottom of Exploration at 65.3 ft.

B-263  
Ground Elev. 89.6

DEPTH (FT)	CASING BLOCK PER FT	SAMPLER BLOCK PER FT	SAMPLE NUMBER & RECOVERY	SAMPLE DEPTH (FT)	ELEV./DEPTH (FT)	VISUAL DESCRIPTION AND REMARKS
0			S1 1"	0.0	89.6	Frozen dark brown loamy silt, leaves -FOREST MAT-
5			S2 12"	5.0	88.1	Dark brown loamy silt -TOPSOIL-
10			S3 8"	10.0	86.5	Medium dense brown fine sand, little silt, trace coarse to medium sand -ALLUVIAL DEPOSIT-
15			S4 8"	15.0	85.0	Medium dense brown medium to fine sand, trace gravel, coarse sand, trace silt
20			S5 10"	20.0	83.5	Soft gray silty clay
25			S6 10"	25.0	82.0	PWS, 17.0-17.6 ft.; Su = 470 per Soft gray silty clay
30			S7 10"	30.0	80.5	Soft gray silty clay -MARINE DEPOSIT-
35			S8 10"	35.0	79.0	Soft gray silty clay
40			S9 10"	40.0	77.5	Soft gray silty clay
45			S10 10"	45.0	76.0	Soft gray silty clay
295			S60 10"	295.0	1.0	Soft gray silty clay
300			S61 10"	300.0	-0.5	Soft gray silty clay
305			S62 10"	305.0	-2.0	Soft gray silty clay
310			S63 10"	310.0	-3.5	Soft gray silty clay
690			S139 10"	690.0	-117.5	Soft gray silty clay
695						

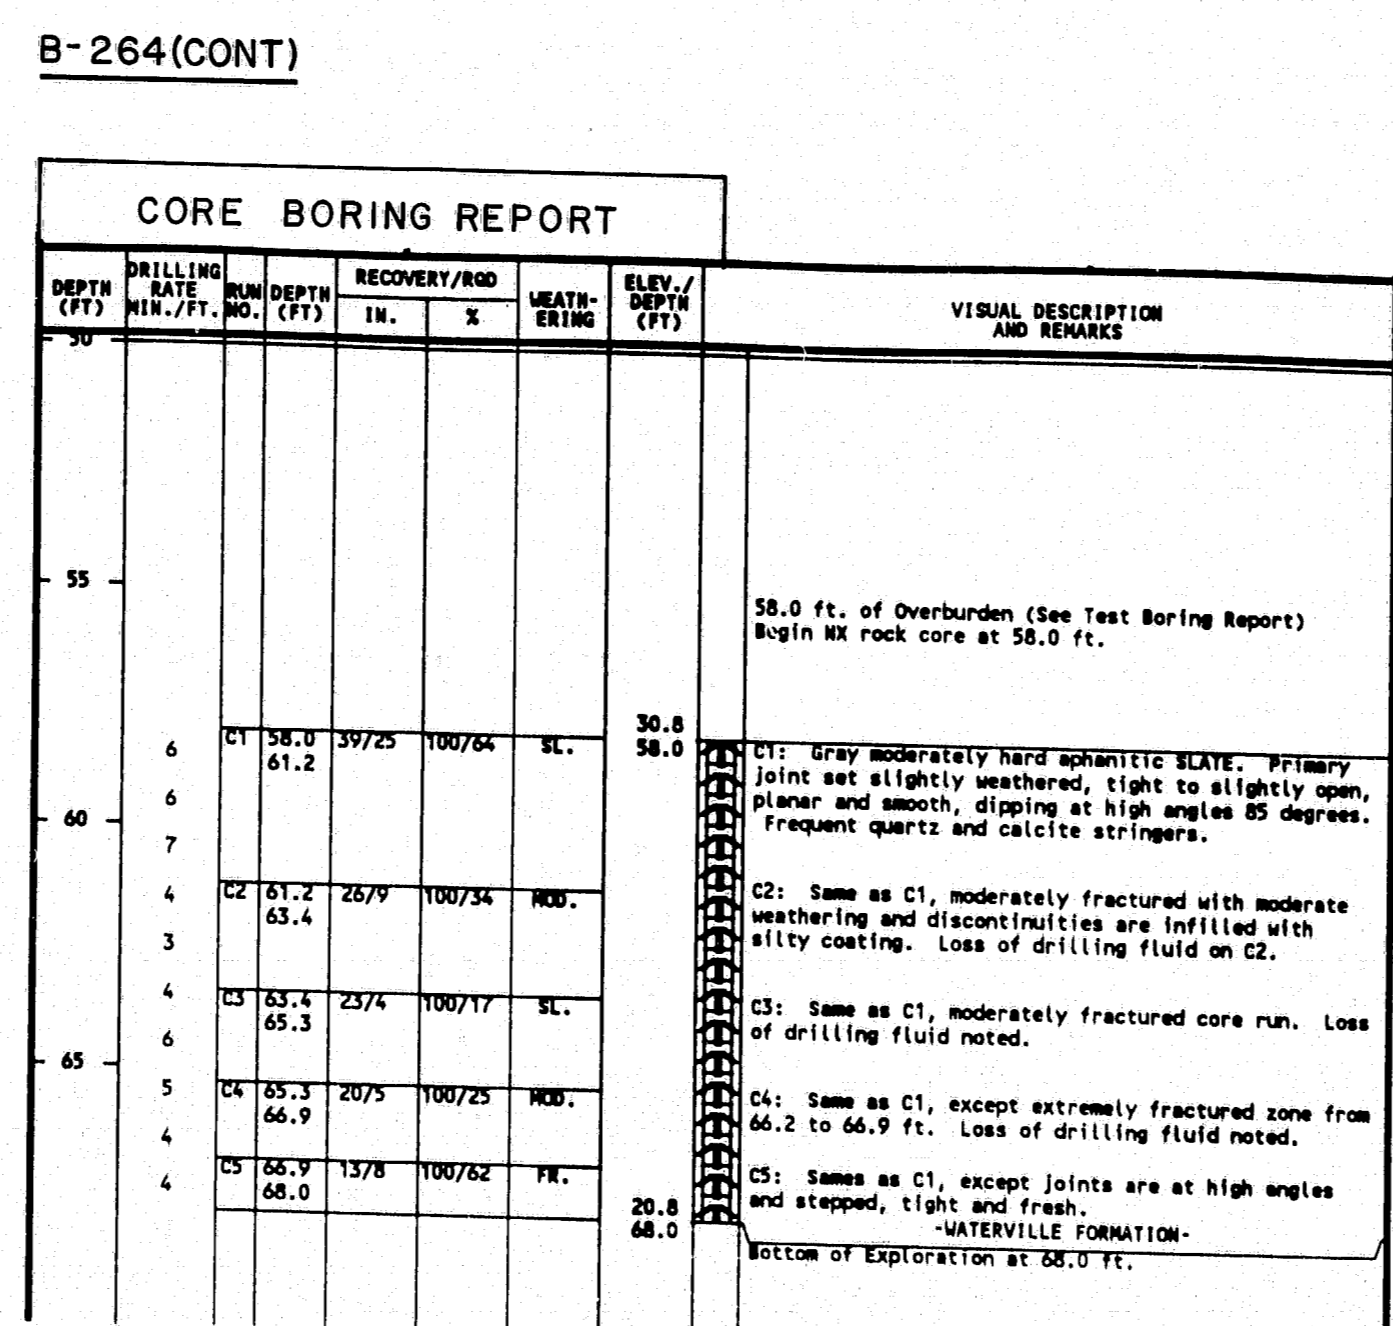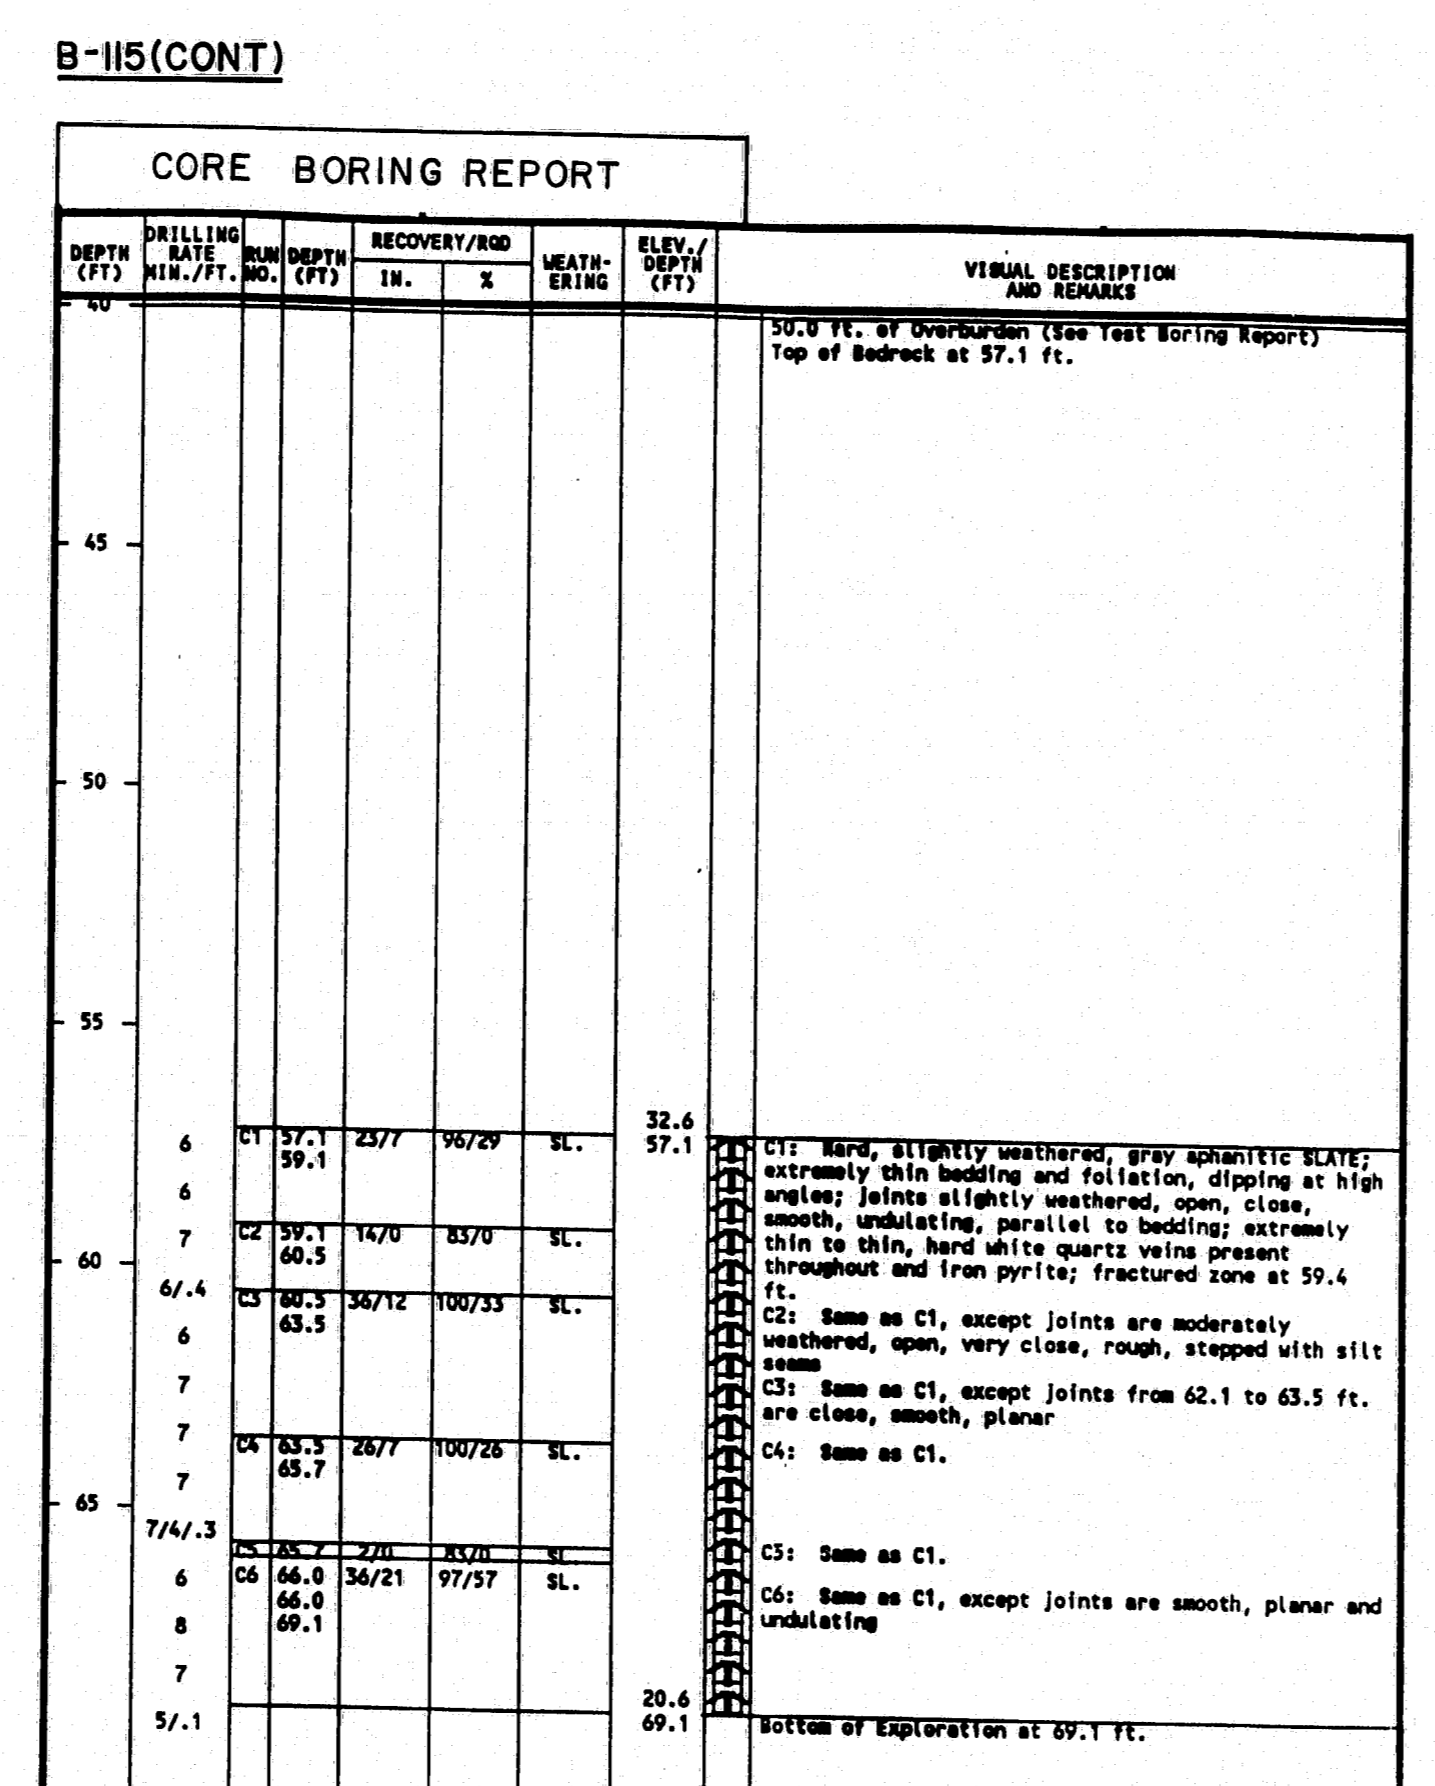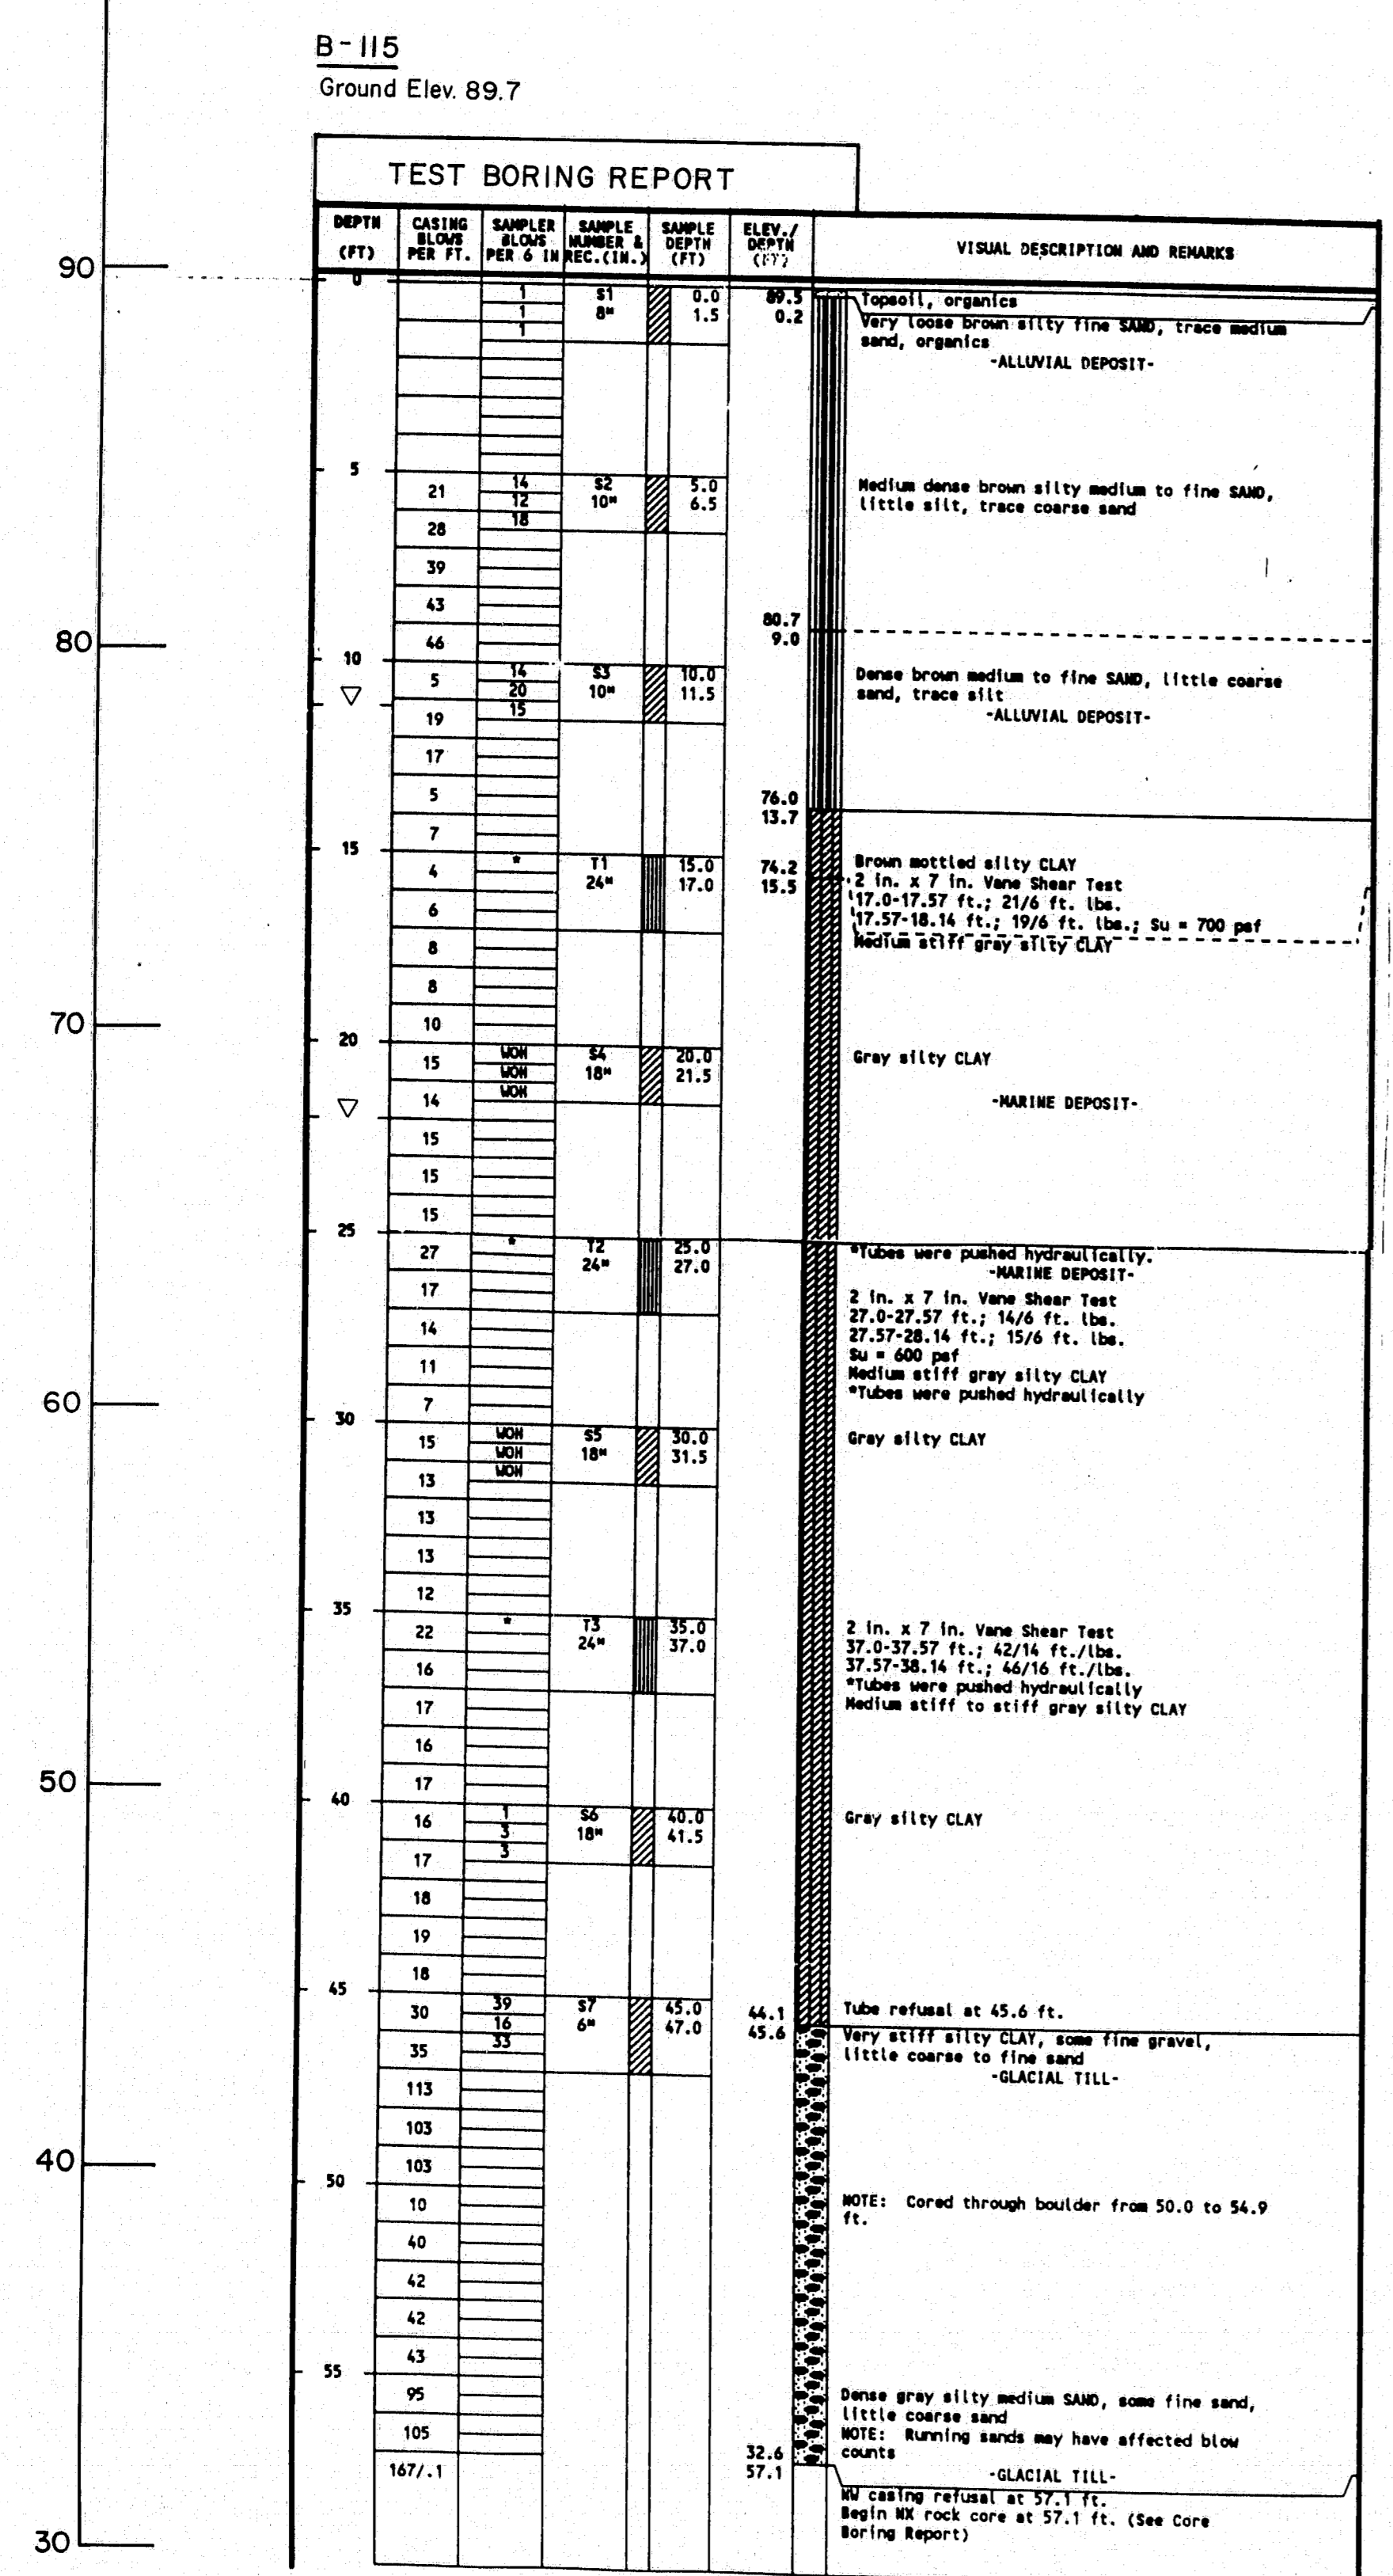

B-265  
Ground Elev. 88.0

TEST BORING REPORT					
DEPTH (FT)	CASING BLOW PER FT.	SAMPLER BLOW PER 6 IN.	SAMPLE DEPTH (FT)	ELEV. / DEPTH (FT)	VISUAL DESCRIPTION AND REMARKS
0				88.0	
1				87.5	
2				86.5	
5				86.5	Soft to medium stiff dark brown loamy silt, little fine sand, trace medium sand with roots, wood fragments. Frozen soils 0-0.5 ft. - TOPSOIL.
10				86.5	Medium dense brown medium to fine sand, little silt. - ALLUVIAL DEPOSIT.
15				86.5	Medium dense brown medium sand, little fine sand, trace coarse sand and silt.
20				86.5	Medium dense brown medium sand, little fine sand, trace coarse sand and silt.
25				86.5	Soft to medium stiff gray silty clay. - MARINE DEPOSIT.
30				86.5	FWP, 20.0-20.6 ft.; Su = 590 psf. Soft to medium stiff gray silty clay.
35				86.5	Soft to medium stiff gray silty clay.
40				86.5	FWP, 30.0-30.6 ft.; Su = 740 psf. Medium stiff gray silty clay with occasional black oxidized specks. - MARINE DEPOSIT.
45				86.5	Medium stiff gray silty clay, with occasional black oxidized specks.
50				86.5	FWP, 40.0-40.6 ft.; Su = 1300 psf. Stiff gray silty clay.
55				86.5	Dense gray silty fine sand, little coarse sand and fine gravel. - GLACIAL TILL.
60				86.5	Brown casing to refusal at 48.0 ft. Advanced roller bit to 49.0 ft. with increased resistance. Coral boulder from 49.0 to 52.0 ft.
65				86.5	Very dense gray silty fine sand, little coarse sand and gravel. - GLACIAL TILL.
70				86.5	Encountered bedrock at 58.8 ft. Test HQ casing at 58.8 ft.

B-265(CONT)

CORE BORING REPORT						
DEPTH (FT)	DRILLING BIT NO.	RECOVERY/FOOT (FT)	IN.	IN.	ELEV. / DEPTH (FT)	VISUAL DESCRIPTION AND REMARKS
58.8	1470	100/0	10	10	29.2	
58.8	1470	100/0	10	10	58.8	58.8 ft. of Overburden (See Test Boring Report) begin HQ rock core at 58.8 ft.
58.8	1470	100/0	10	10	58.8	CT: HIGHLY WEATHERED, FRESH TO SLIGHTLY WEATHERED gray sphenitic SLATE. Primary joint set is steeply dipping, close, tight, fresh, planar and smooth. Infrequently stepped and smooth. Joints parallel to bedding planes. Severely fractured core run. - WATERVILLE FORMATION.
58.8	1470	100/0	10	10	58.8	CT: Hard, fresh, gray sphenitic SLATE. Joints dipping at moderate to high angles, close, tight, planar, smooth, occasional quartz or calcite banding. Fractured zone from approximately 63.0 to 63.3 ft. with mineralization on some joint surfaces. Bottom of Exploration at 63.3 ft.

H-266  
Ground Elev. 93.9

TEST BORING REPORT					
DEPTH (FT)	CASING BLOW PER FT.	SAMPLER BLOW PER 6 IN.	SAMPLE DEPTH (FT)	ELEV. / DEPTH (FT)	VISUAL DESCRIPTION AND REMARKS
0				93.9	
1				93.9	
2				93.9	
5				93.9	Dark brown loamy silt, frozen. - FOREST HAYTOPSOIL.
10				93.9	Medium dense brown mottled silty fine sand, trace medium sand. - ALLUVIAL DEPOSIT.
15				93.9	Medium dense brown mottled medium to fine sand, little silt.
20				93.9	Very stiff olive brown mottled clayey silt.
25				93.9	FWP, 15.0 to 15.6 ft.; Su = 1410 psf. Stiff gray silty clay. - MARINE DEPOSIT.
30				93.9	Stiff gray silty clay, with black specks.
35				93.9	FWP, 25.0 to 25.8 ft.; Su = 500 psf. Medium stiff gray silty clay, with black specks.
40				93.9	Gray silty clay, little fine sand. - MARINE DEPOSIT.
45				93.9	Medium dense brown mottled silty fine sand. - MARINE DEPOSIT.
50				93.9	Probable cobbles and boulders at 33.0 ft. Casing refusal at 33.0 ft. Holed ahead of casing to 35.0 ft.
55				93.9	Very dense gray brown silty fine sand, little coarse to medium sand, little gravel. - GLACIAL TILL.
60				93.9	Very dense gray brown silty fine sand, little coarse to medium sand, little gravel. - GLACIAL TILL.
65				93.9	Bottom of Exploration at 37.5 ft. no refusal.


DESIGNED:	SM	7/93		
DRAWN:	RJT	7/93		
CHECKED:				
NO.	REVISION	BY	DATE	IN CHARGE OF



115-210  
STATE OF MAINE  
DEPARTMENT OF TRANSPORTATION  
WATERVILLE - WINSLOW PROJECT  
DONALD V. CARTER BRIDGE  
OVER  
KENNEBEC RIVER  
BORING LOGS  
SHEET 17 OF 86 AUGUSTA, MAINE

H-268

Ground Elev. 95.0

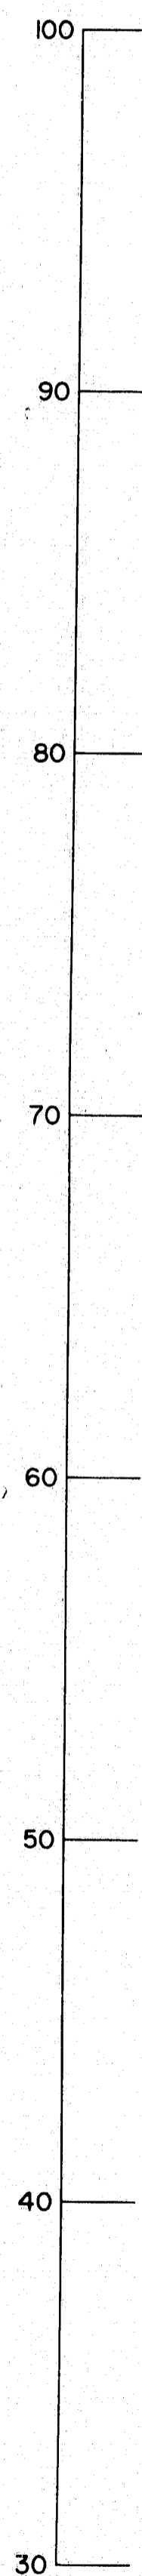

DEPTH (FT)	CASING BLOCS PER FT.	SAMPLER BLOCS PER 6 IN	SAMPLE NUMBER & DEPTH (FT)	SAMPLE DEPTH (FT)	ELEV./DEPTH (FT)	VISUAL DESCRIPTION AND REMARKS
0			51 0.0	0.0	95.0	Loose dark brown loamy silt, trace fine sand, with wood, leaves
1			54 1.5	1.5	93.5	-FOREST MAT/TOPSOIL-
13			32 5.0	5.0	87.5	Medium dense brown silty medium to fine sand
18			18 6.5	6.5	81.5	-ALLUVIAL DEPOSIT-
38					7.5	
41			83 10.0	10.0	85.0	Stiff mottled brown clayey silt
49			18 11.5	11.5	83.5	-MARINE DEPOSIT-
50					11.2	Gray silty clay
57						
39						
28			24 15.0	15.0	80.0	Gray silty clay
26			24 17.0	17.0	78.0	
26			84 18.5	18.5	76.5	FWB1, 17.0 to 17.6 ft., Su = 750 psf
22						Medium stiff gray silty clay
22						
17			85 20.0	20.0	74.0	Medium stiff gray silty clay
15			18 21.5	21.5	72.5	-MARINE DEPOSIT-
16						
16						
14						
17			24 25.0	25.0	69.0	3 in. tube gray silty clay
18					27.0	
25			56 27.0	27.0	62.0	FWB2, 27.0 to 27.6 ft., Su = 770 psf
27					28.6	Medium stiff gray silty clay
28						
23			87 30.0	30.0	61.0	Medium stiff gray silty clay
22			18 31.5	31.5	59.5	-MARINE DEPOSIT-
24						
26						
24						
20						Attempted tube sample at 35.0 ft. - encountered gray silty fine sand
37			88 36.0	36.0	59.0	Loose to medium dense, gray silty fine sand
36			18 37.5	37.5	57.5	Encountered probable boulder at 39.0 ft. Advanced roller bit to 40.0 ft.
24					37.5	
40			82 40.0	40.0	57.0	Very dense gray silty fine sand, little gravel
			1 40.3	40.3	56.7	-GLACIAL TILL-
100/1			510 42.1	42.1	52.9	Split spoon refusal on probable boulder at 42.1 ft.
			NR 42.1	42.1	52.9	Bottom of Exploration at 42.1 ft.

DESIGNED:	SM	6/94
DRAWN:	RJT	6/94
CHECKED:	DWR	6/94
NO. REVISION	BY	DATE

B-291


Ground Elev. 93.2

DEPTH (FT)	CASING BLOCS PER FT.	SAMPLER BLOCS PER 6 IN	SAMPLE NUMBER & DEPTH (FT)	SAMPLE DEPTH (FT)	ELEV./DEPTH (FT)	VISUAL DESCRIPTION AND REMARKS
0			51 0.0	0.0	93.2	Dark brown loamy silt, with organics
1			12 2.0	2.0	91.2	-FOREST MAT-
1			1 2.0	2.0	91.2	Very soft light brown sandy silt, little silty fine sand with rootlets
5					7.0	-TOPSOIL-
16			32 5.0	5.0	88.2	Medium stiff to medium dense laminated brown-gray silty silt and silty fine sand, trace medium sand
25			18 7.0	7.0	81.2	Sample wet at 6.3 ft.
28						
22						
29			83 10.0	10.0	83.2	Medium dense brown silty silt, trace silt, trace fine gravel
15			12 12.0	12.0	81.2	-ALLUVIAL DEPOSIT-
13					11.8	At 11.8 ft. Olive brown clayey silt
23						-MARINE DEPOSIT-
20						
19						
12			11 15.0	15.0	78.2	Gray silty clay
13			24 17.0	17.0	76.2	
13						
12						FWB1, 17.0 to 17.6 ft., Su = 500 psf
12			84 18.2	18.2	75.0	FWB2, 17.6 to 18.2 ft., Su = 500 psf
12					19.7	Medium stiff gray silty clay with black streaks
20						
11			35 20.0	20.0	73.2	Medium stiff gray silty clay, with black streaks
13			24 22.0	22.0	71.2	
13						
13						
12						
13			12 25.0	25.0	68.2	Gray silty clay
13			24 27.0	27.0	66.2	
13						
15			35 28.2	28.2	65.0	FWB3, 27.0 to 27.6 ft., Su = 710 psf
10			1 29.7	29.7	63.5	FWB4, 27.6 to 28.2 ft., Su = 800 psf
19						Medium stiff gray silty clay
17			37 30.0	30.0	63.2	Gray silty clay
14			24 32.0	32.0	61.2	-MARINE DEPOSIT-
15						
18						
20						
18			88 35.0	35.0	58.2	Gray silty clay with black concretions
23					56.3	Olive brown sandy silt, trace fine sand
30					55.3	
99					55.0	Washed ahead from 39.5 to 40.0 ft. through probable cobbles.
150/4						
100			39 40.4	40.4	54.8	Very dense olive brown silty fine sand, little coarse sand, little fine gravel, well bonded matrix
90			3 40.4	40.4	54.8	-GLACIAL TILL-
52						Split spoon refusal at 40.4 ft.
74						Begin M rock core at 40.5 ft.
200/4						Cored boulders, cobbles and glacial till from 40.5 to 44.2 ft.
45						Drive casing to 44.4 ft.
						Begin M rock core at 44.6 ft.
						Cored 4.0 ft. from 44.6 to 48.6 ft. Recovered cobbles and boulders.
						Casing and drive shoe bent from driving to 44.5 ft.
						Removed M driving casing and spun M casing to 50.0 ft.
48			510 50.0	50.0	53.2	Very dense grayish brown silty medium to fine sand, little gravel
50			10 51.5	51.5	51.7	
70						
41.1					52.1	Spun casing to 52.1 ft.
						Refusal on top of Bedrock at 52.1 ft.
						Advanced roller bit to 53.0 ft.
						Begin M rock core at 53.0 ft. (See Test Boring Report)

DEPTH (FT)	DRILLING BIT DIA./FT. NO.	RECOVERY/ROD DEPTH (FT)	WEATH. GRADE	ELEV./DEPTH (FT)	VISUAL DESCRIPTION AND REMARKS
43					52.1 ft. of Overburden (See Test Boring Report)
					Spun M casing to 52.1 ft.
					Advanced roller bit to 53.0 ft.
					Begin M rock core at 53.0 ft.
40.2				53.0	
53.0				53.0	Soft to moderately hard black argillite. Joints are moderately weathered, very close, open and dipping steeply. Core is highly fractured.
35.5				57.7	
					Bottom of Exploration at 57.7 ft.

H-269

Ground Elev. 124.1

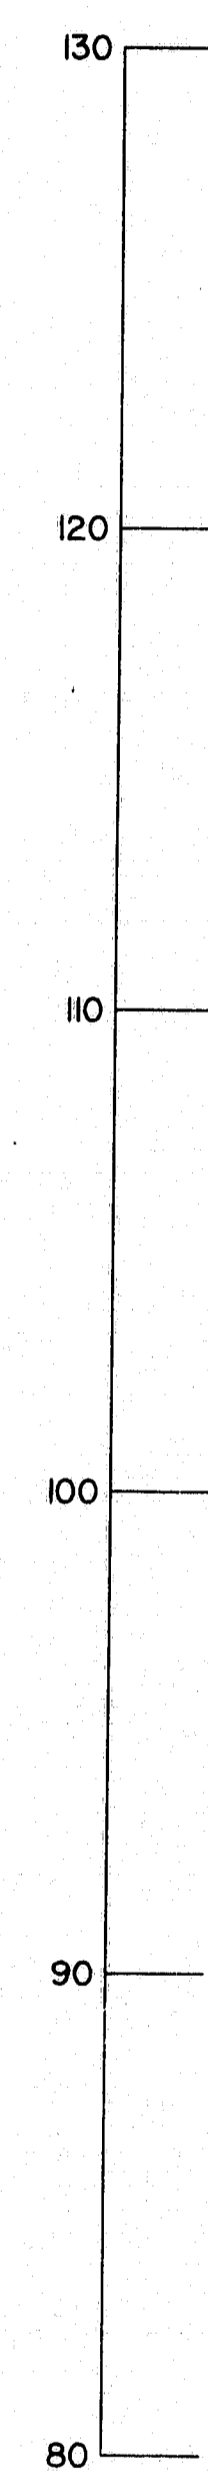



DEPTH (FT)	CASING BLOCS PER FT.	SAMPLER BLOCS PER 6 IN	SAMPLE NUMBER & DEPTH (FT)	SAMPLE DEPTH (FT)	ELEV./DEPTH (FT)	VISUAL DESCRIPTION AND REMARKS
0			81 0.0	0.0	124.1	Loose brown fine sand, little silt, trace medium sand, with rootlets and organics
3			8 1.5	1.5	122.6	-TOPSOIL-
6						
42						Advanced roller bit through probable cobbles and gravel at approximately 4.5 ft.
58						Advanced roller bit to 5.4 ft. washed beyond probable cobbles
27			32 5.4	5.4	118.7	Very stiff olive brown mottled silt, trace clay
5			18 6.9	6.9	117.2	-MARINE DEPOSIT-
63						
69						
75						
46			33 10.0	10.0	114.1	Very stiff olive brown silty clay
60			18 11.5	11.5	112.6	(Pushed cobble ahead of sampler - hence high blow counts)
78						
83						
71					110.1	
39			50 15.5	15.5	108.6	Loose brown silty fine sand, with occasional olive clay partings
45			18 17.0	17.0	107.1	
133						
100/6					105.5	-WEATHERED BEDROCK-
					104.0	
50/1			NR 20.1	20.1	102.1	Advanced casing to 18.6 ft.
						Advanced roller bit to 20.0 ft.
						Split spoon refusal at 20.1 ft.
						Bottom of Exploration at 20.1 ft.

AS BUILT  
CL-11 12/1/16


115-211

STATE OF MAINE  
DEPARTMENT OF TRANSPORTATION  
WATERVILLE - WINSLOW PROJECT  
DONALD V. CARTER BRIDGE  
OVER  
KENNEBEC RIVER  
BORING LOGS  
SHEET B18 OF B86 AUGUSTA, MAINE

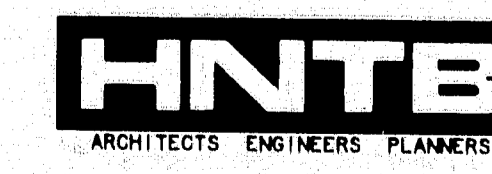


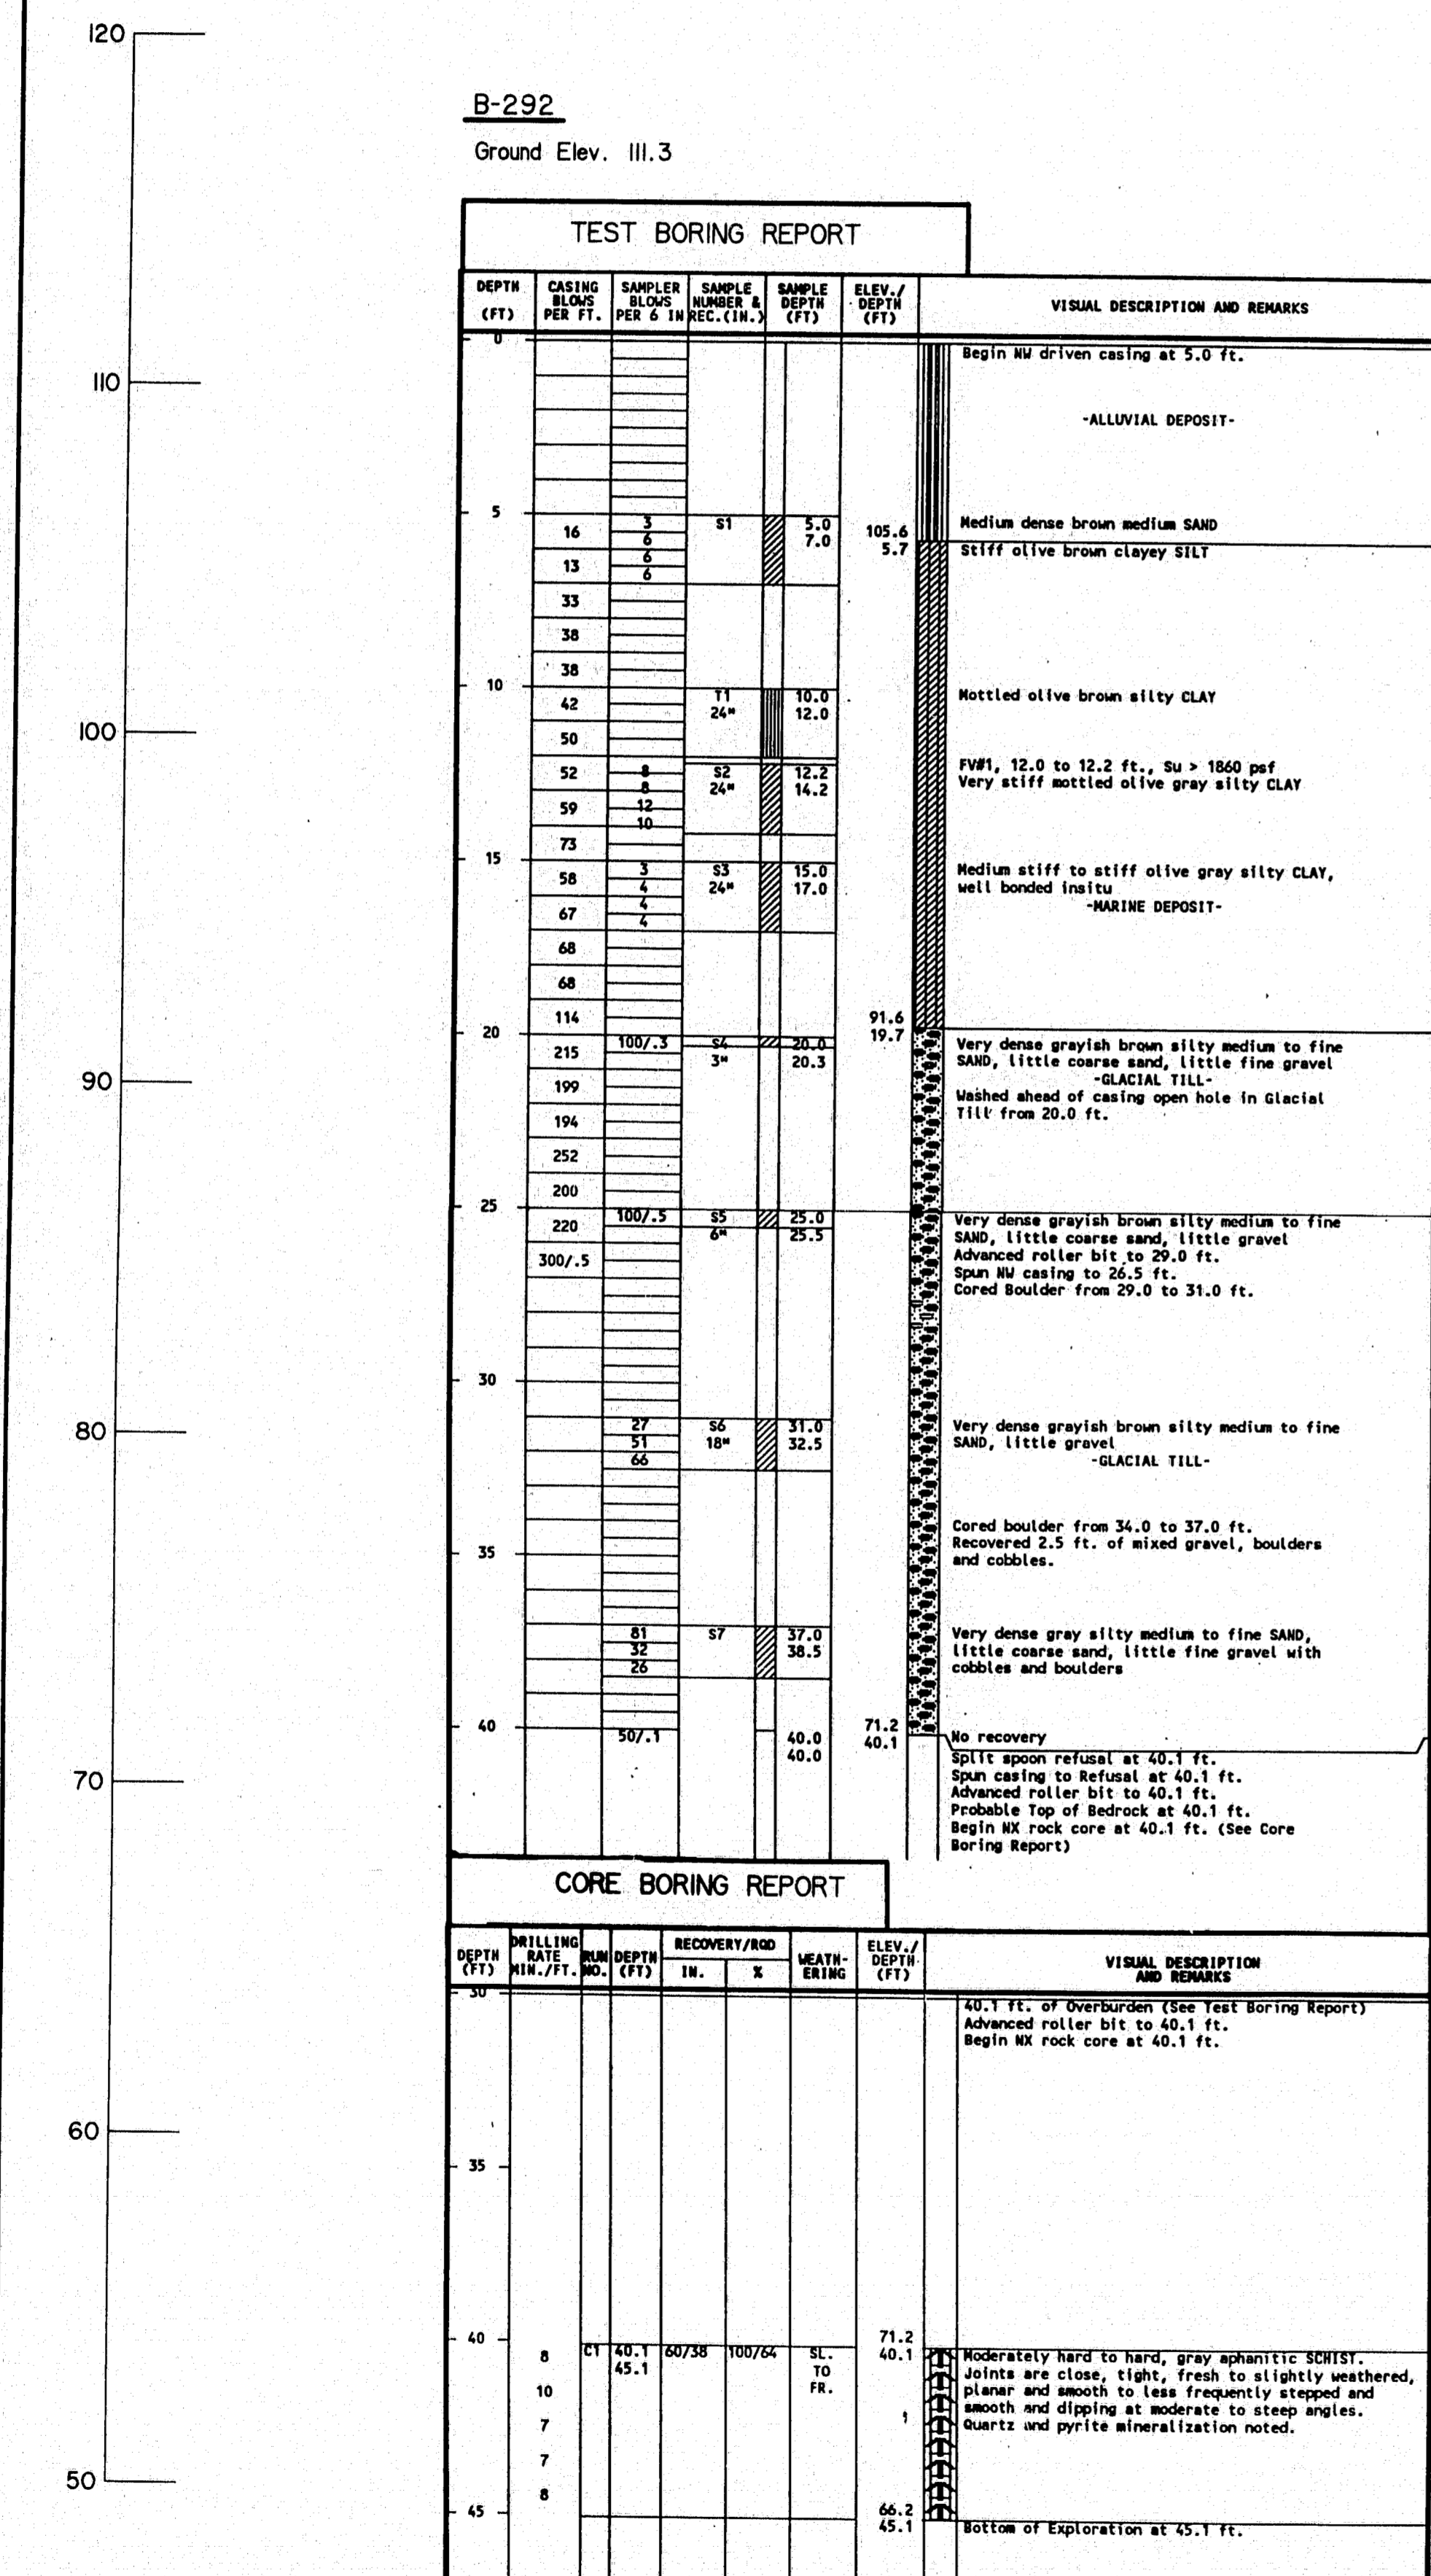

NO.	REVISION	BY	DATE
		SM	6/94
		RJT	6/94
		DWR	6/94

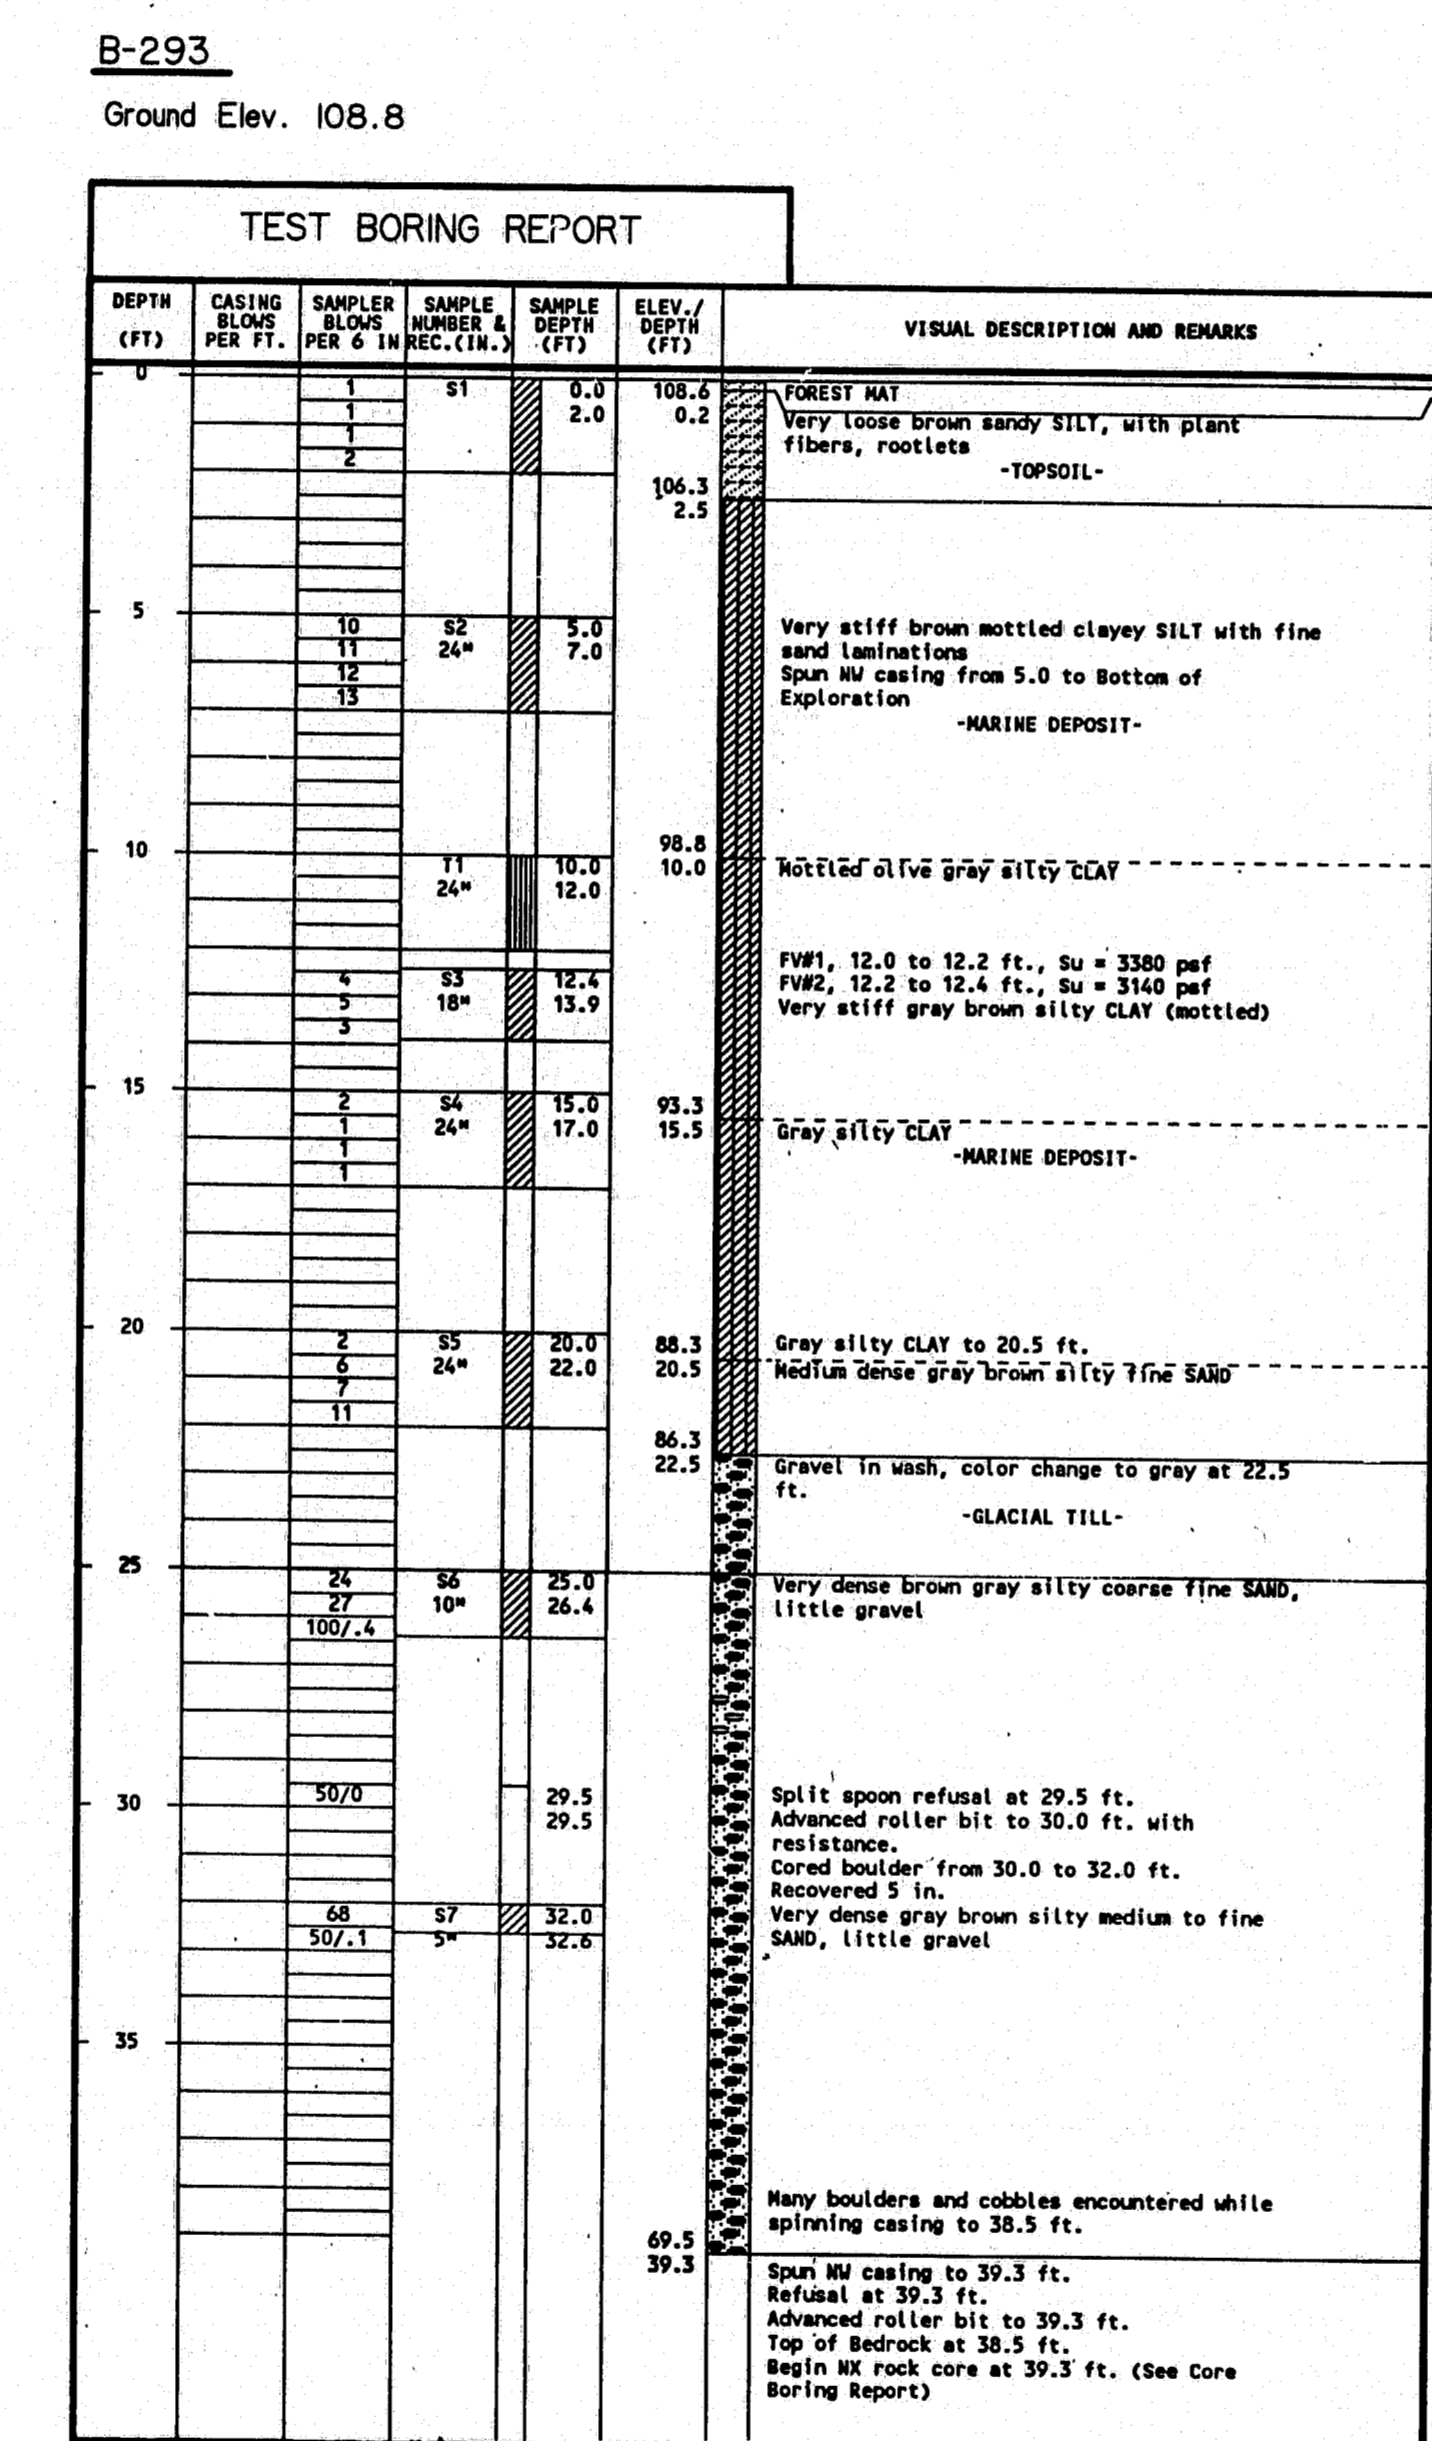

DEPTH (FT)	DRILLING RATE (FT/HR)	RECOVERY/ROD (IN. X)	WEATHERING (SEV.)	ELEV./DEPTH (FT)	VISUAL DESCRIPTION AND REMARKS
30					38.3 ft. of Overburden (See Test Boring Report) Advanced casing and roller bit to 39.5 ft. Begin MK rock core at 39.5 ft.
35					
40	8	CT 39.3 15/0 100/0	NOK.	69.5	Moderately hard dark gray schist. Joints are very close, open, moderately to severely weathered and dipping steeply, planar and smooth. Rock core is reduced to gravel sized fragments and some rock disintegration was noted.
10	12	CT 43.1 30/0 100/0	NOK. TO SEV.	70	
16	16	CT 43.1 14 100	NOK.	64.5	
10	10	CT 44.3 14 100	NOK.	64.5	
				44.5	Bottom of Exploration at 44.5 ft.

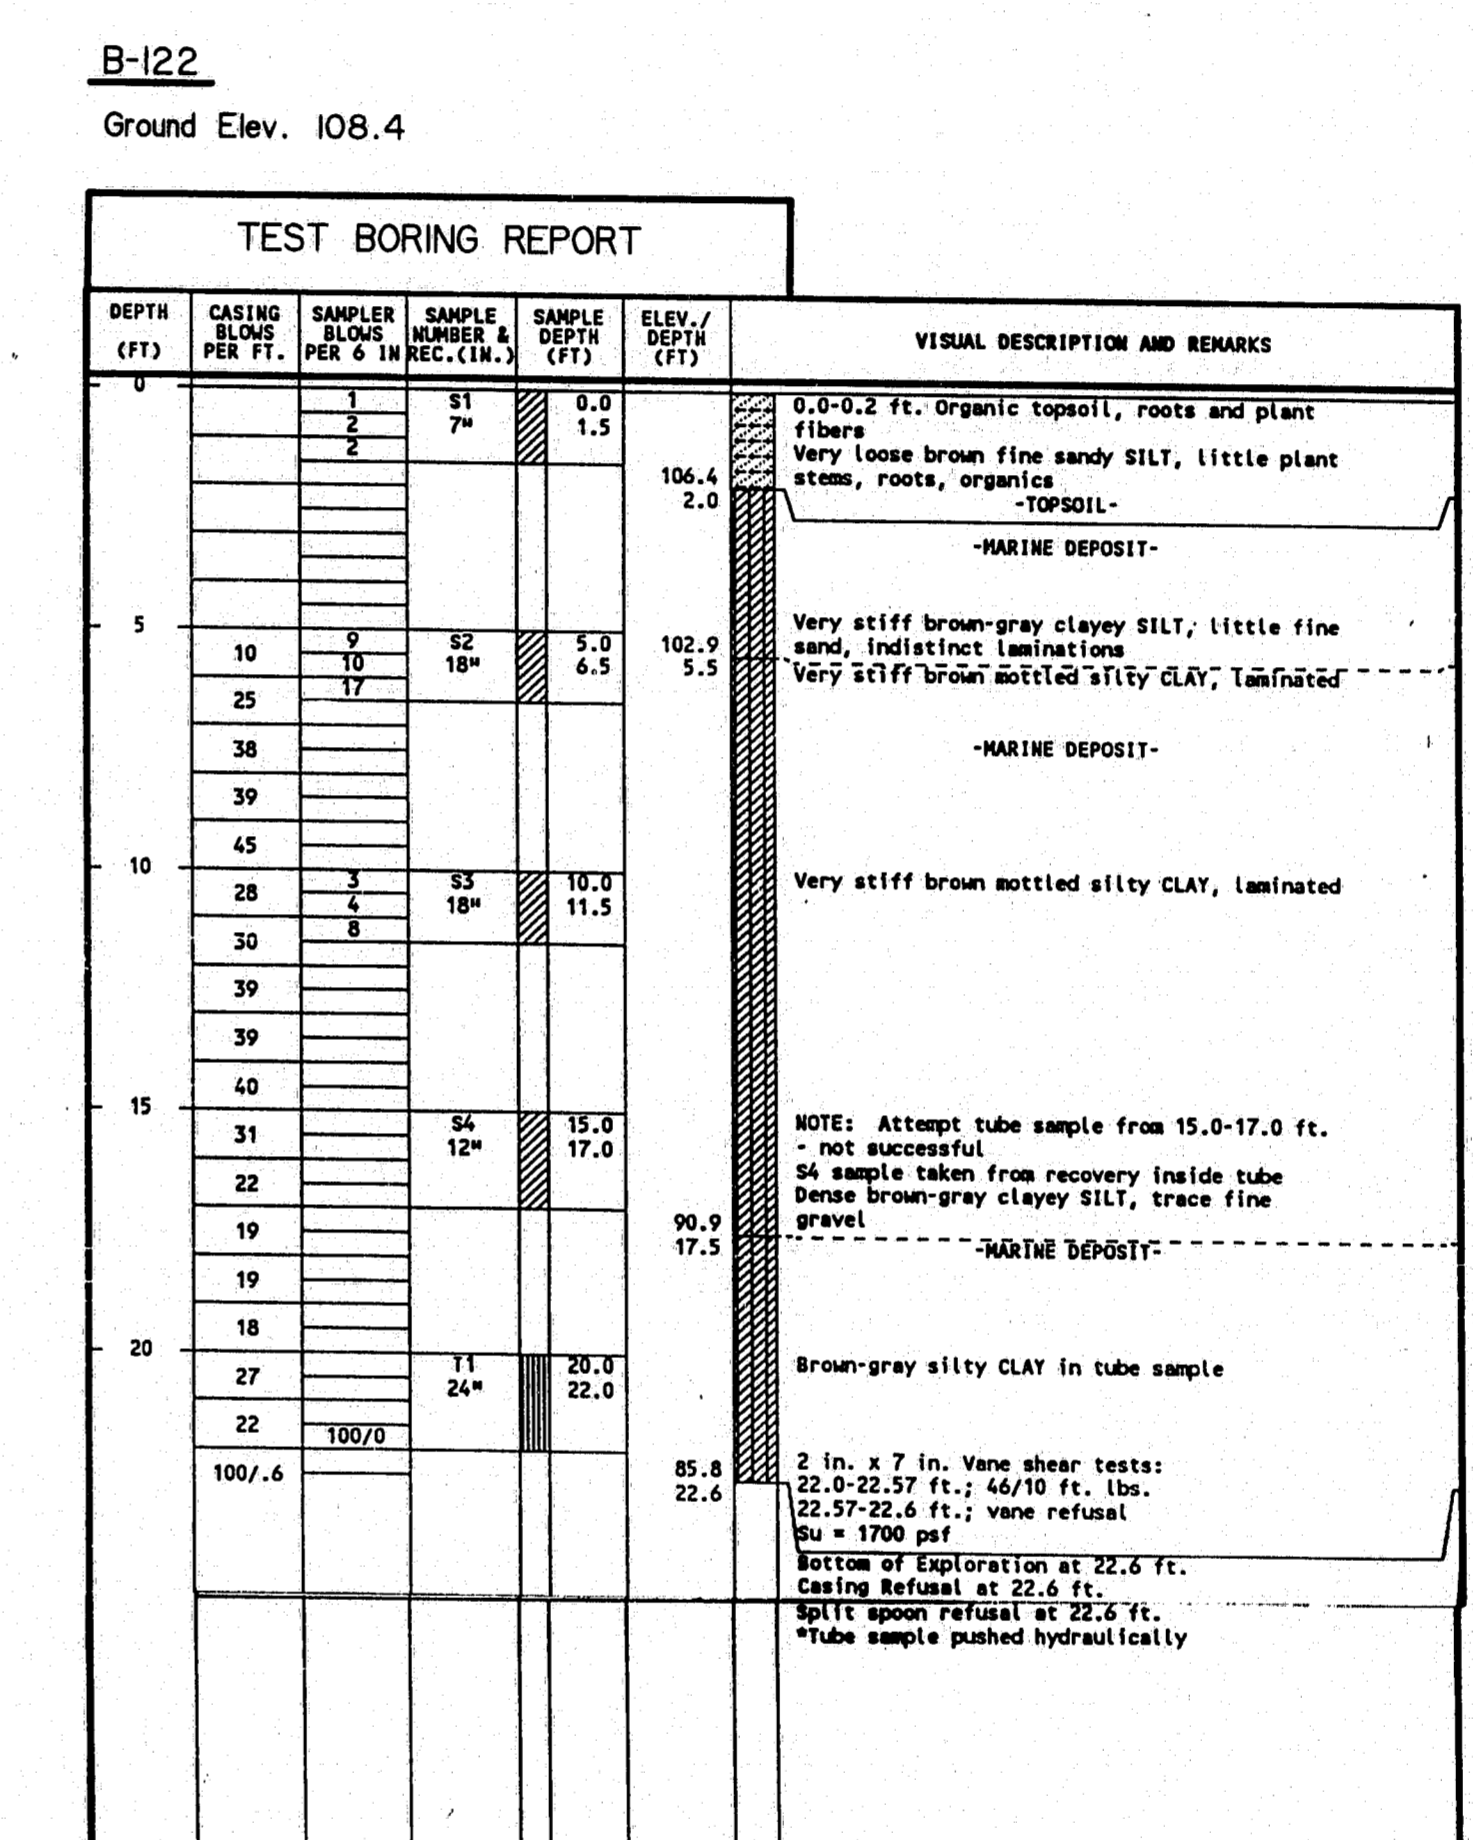


115-212

STATE OF MAINE  
DEPARTMENT OF TRANSPORTATION  
WATERVILLE - WINSLOW PROJECT  
DONALD V. CARTER BRIDGE  
OVER  
KENNEBEC RIVER  
BORING LOGS  
SHEET 19 OF 86 AUGUSTA, MAINE

*AS BUILT  
from 12/10/16*

F.H.K.A. REC. NO.	STATE	PROJECT NUMBER	SHEET NO.	TOTAL SHEETS
1	MAINE	000910021	27	103

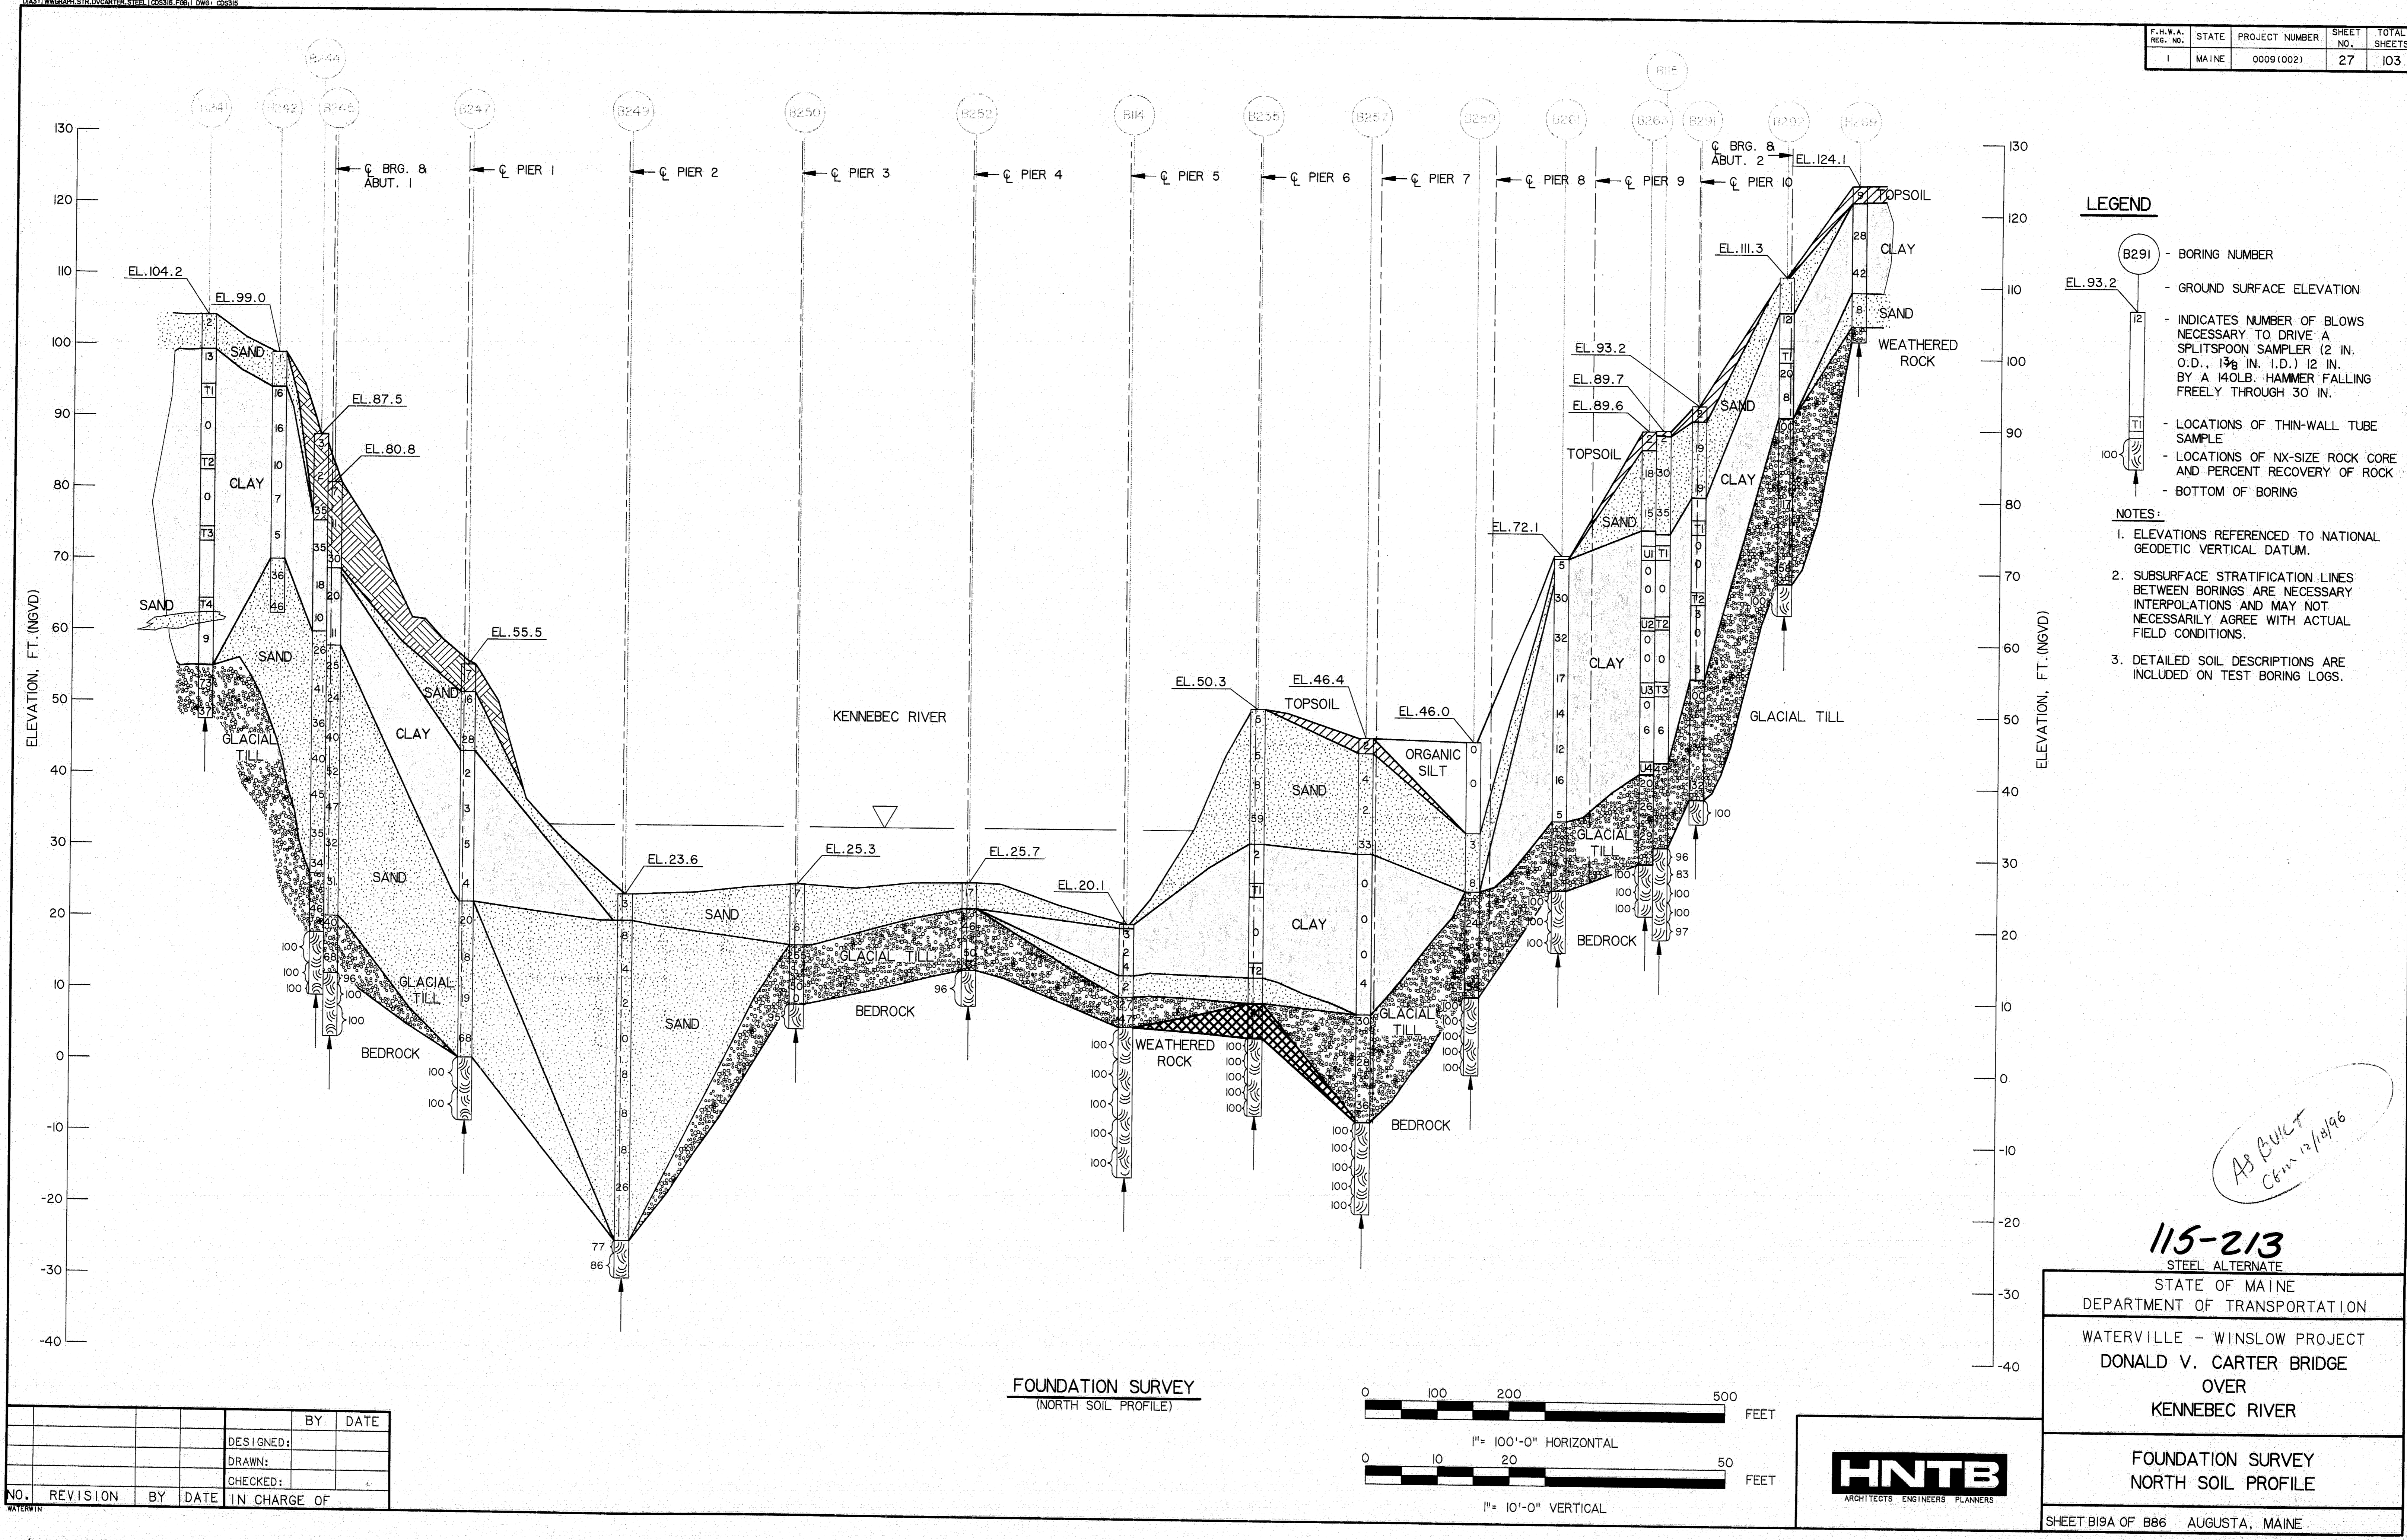

**LEGEND**

- B291 - BORING NUMBER
- EL. 93.2 - GROUND SURFACE ELEVATION
- INDICATES NUMBER OF BLOWS NECESSARY TO DRIVE A SPLITSPOON SAMPLER (2 IN. O.D., 1 1/8 IN. I.D.) 12 IN. BY A 140LB. HAMMER FALLING FREELY THROUGH 30 IN.
- LOCATIONS OF THIN-WALL TUBE SAMPLE
- LOCATIONS OF NX-SIZE ROCK CORE AND PERCENT RECOVERY OF ROCK
- BOTTOM OF BORING

**NOTES:**



1. ELEVATIONS REFERENCED TO NATIONAL GEODETIC VERTICAL DATUM.
2. SUBSURFACE STRATIFICATION LINES BETWEEN BORINGS ARE NECESSARY INTERPOLATIONS AND MAY NOT NECESSARILY AGREE WITH ACTUAL FIELD CONDITIONS.
3. DETAILED SOIL DESCRIPTIONS ARE INCLUDED ON TEST BORING LOGS.

*As Built  
Cems 12/14/96*

**115-213**  
STEEL ALTERNATE


STATE OF MAINE DEPARTMENT OF TRANSPORTATION
WATERVILLE - WINSLOW PROJECT DONALD V. CARTER BRIDGE OVER KENNEBEC RIVER
FOUNDATION SURVEY NORTH SOIL PROFILE
SHEET B19A OF B86 AUGUSTA, MAINE

**FOUNDATION SURVEY**  
(NORTH SOIL PROFILE)

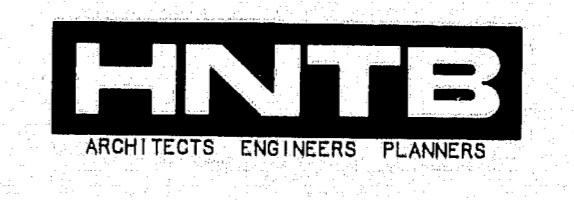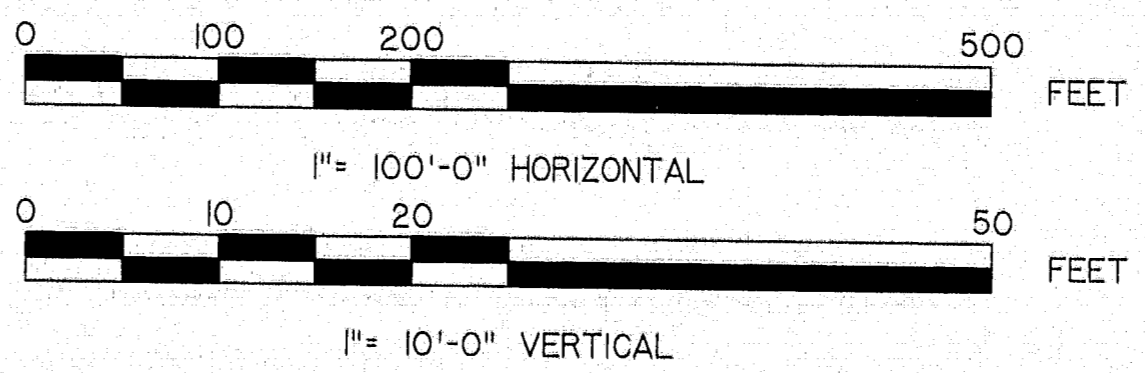

NO.	REVISION	BY	DATE	IN CHARGE OF

F.H.W.A. REG. NO.	STATE	PROJECT NUMBER	SHEET NO.	TOTAL SHEETS
1	MAINE	000910021	28	103

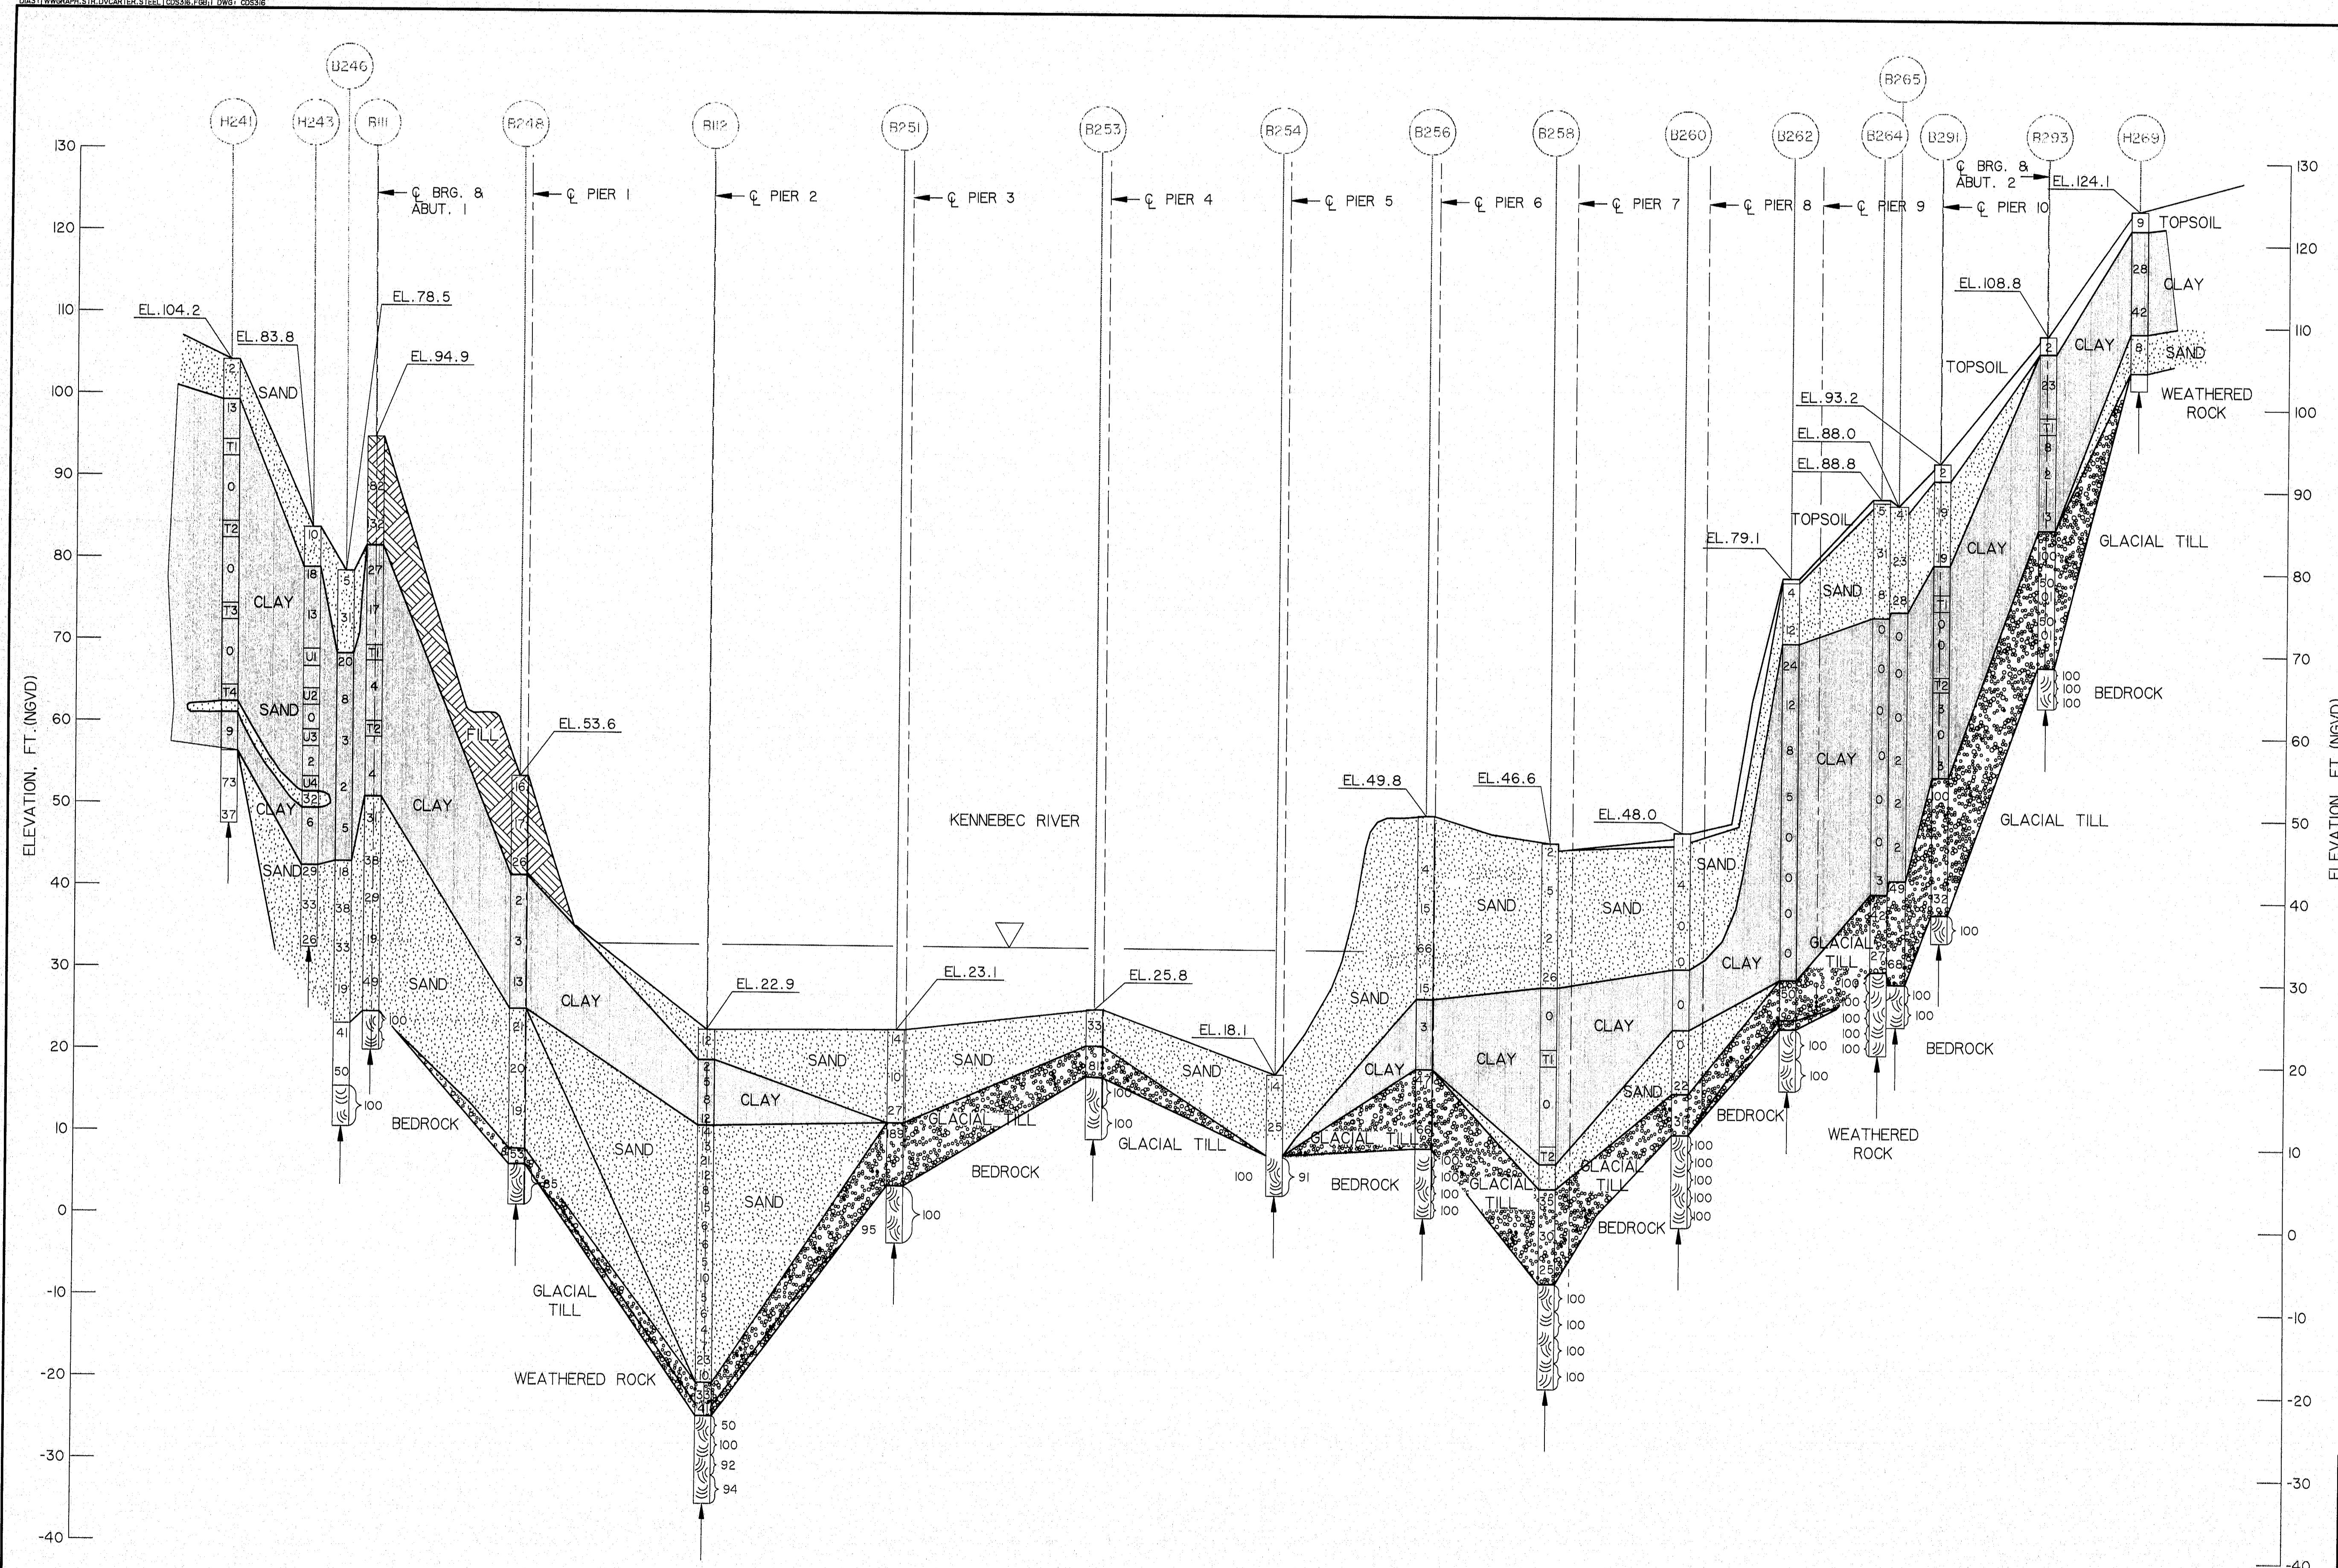

NOTE:  
FOR LEGEND, SEE SHEET B19A



*AS BUILT  
C.E. 12/8/96*

**115-214**


STEEL ALTERNATE
STATE OF MAINE DEPARTMENT OF TRANSPORTATION
WATERVILLE - WINSLOW PROJECT DONALD V. CARTER BRIDGE OVER KENNEBEC RIVER
FOUNDATION SURVEY SOUTH SOIL PROFILE
SHEET B19B OF B86 AUGUSTA, MAINE

NO.	REVISION	BY	DATE	IN CHARGE OF

FOUNDATION SURVEY  
(SOUTH SOIL PROFILE)

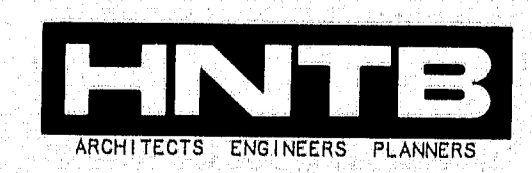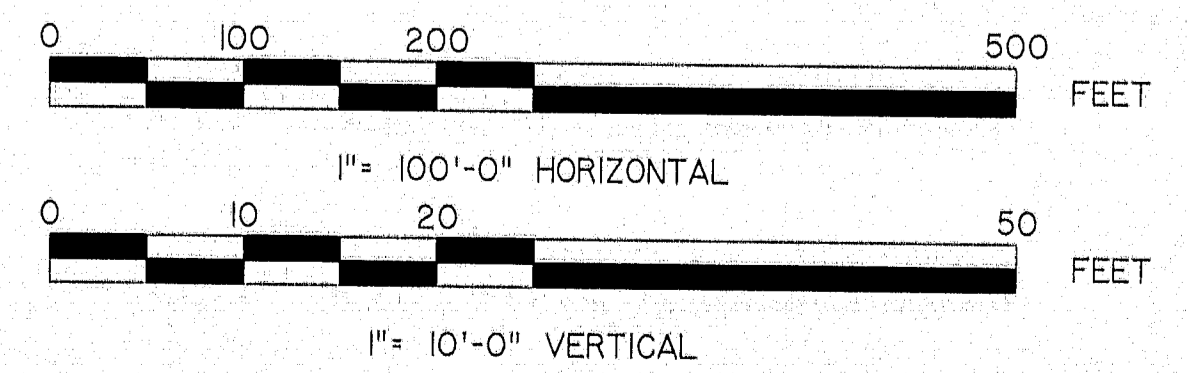

F.H.W.A. REG. NO.	STATE	PROJECT NUMBER	SHEET NO.	TOTAL SHEETS
1	MAINE	0009(1002)	29	103

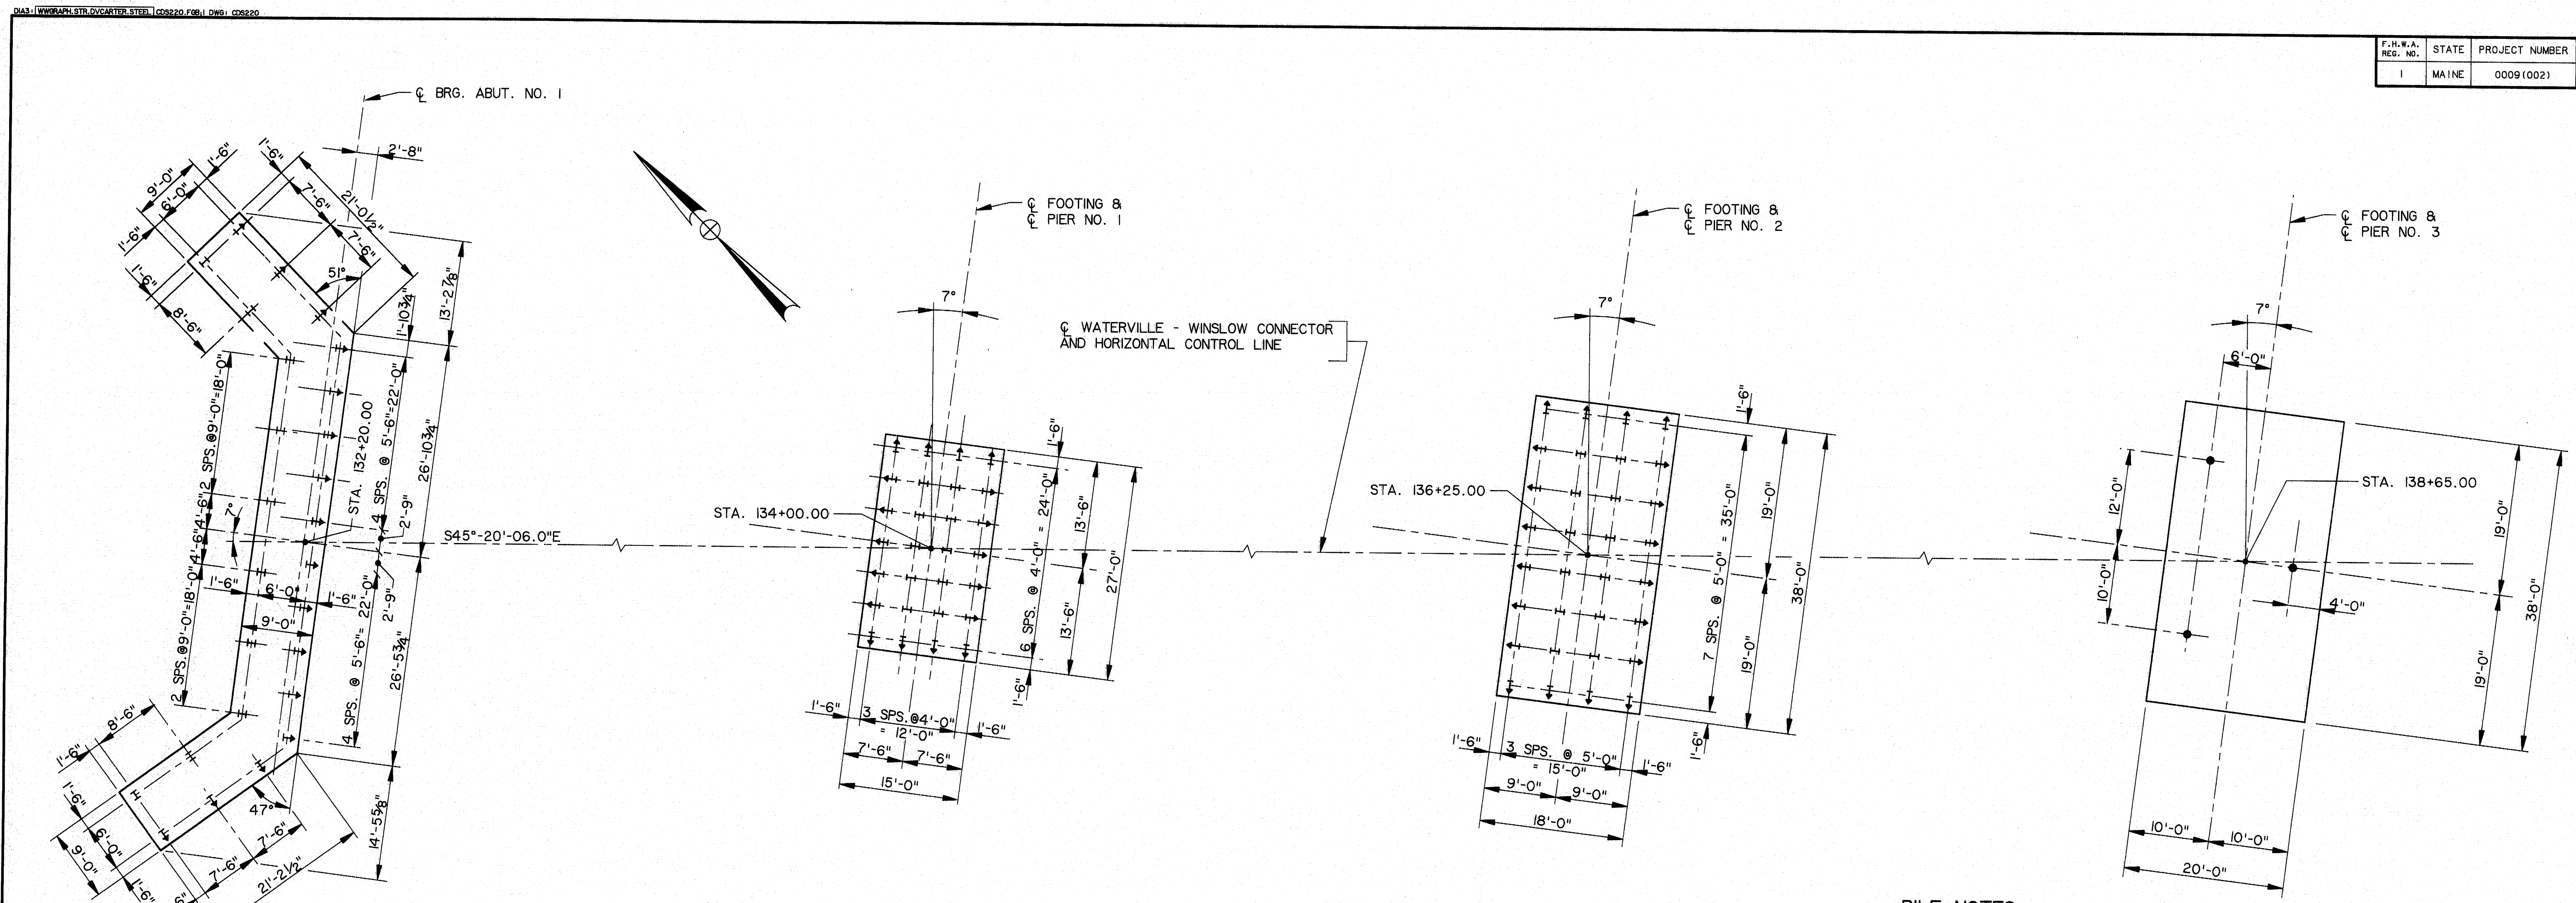

FOUNDATION PLAN

PILE NOTES

- PILES MARKED THIS  $\rightarrow$  SHALL BE BATTER IN THE DIRECTION OF THE ARROW:
  - o ABUTMENTS: 3 INCH PER FOOT
  - o PIERS: 2 INCH PER FOOT
- ESTIMATE OF PILES REQUIRED:
 


ABUTMENT 1	22-HP14x73 @ 78'	= 1716'
PIER 1	28-HP14x73 @ 45'	= 1260'
PIER 2	32-HP14x73 @ 42'	= 1344'
PIER 6	24-HP14x73 @ 40'	= 960'
PIER 7	28-HP14x73 @ 46'	= 1288'
PIER 8	28-HP14x73 @ 34'	= 952'
PIER 9	20-HP14x73 @ 48'	= 960'
PIER 10	20-HP14x73 @ 47'	= 940'
ABUTMENT 2	22-HP14x73 @ 55'	= 1210'
- 13HPx73 BEARING PILES MAY BE SUBSTITUTED FOR 14HPx73 BEARING PILES AT THE OPTION OF THE CONTRACTOR. IN EITHER CASE PAYMENT WILL BE MADE UNDER ITEM 501.216 FOR THE PILES.
- - INDICATES 2 1/8" (NX) CONCRETE SEAL CORE.
- CONCRETE SEAL CORE LOCATIONS MAY BE ADJUSTED IN FIELD BY THE ENGINEER.

*AS BUILT  
COW 12/14/96*

115-215


STEEL ALTERNATIVE

STATE OF MAINE DEPARTMENT OF TRANSPORTATION
WATERVILLE - WINSLOW PROJECT DONALD V. CARTER BRIDGE OVER KENNEBEC RIVER
FOUNDATION PLAN - I
SHEET B20 OF B86 AUGUSTA, MAINE

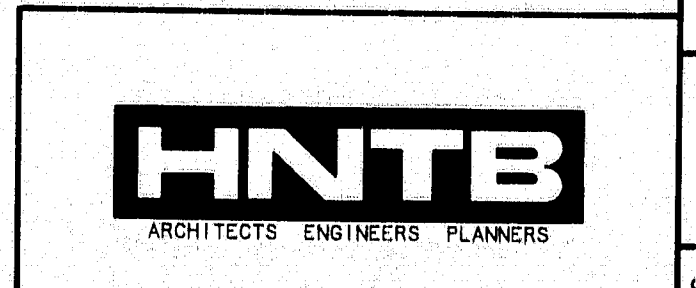

NO.	REVISION	BY	DATE	IN CHARGE OF
		BY	DATE	
		DESIGNED: DWR	9/94	
		DRAWN: RJT	9/94	
		CHECKED: SM	9/94	
				CJM

F.N.R.A. NO.	STATE	PROJECT NUMBER	SHEET NO.	TOTAL SHEETS
1	MAINE	0009 (002)	30	103

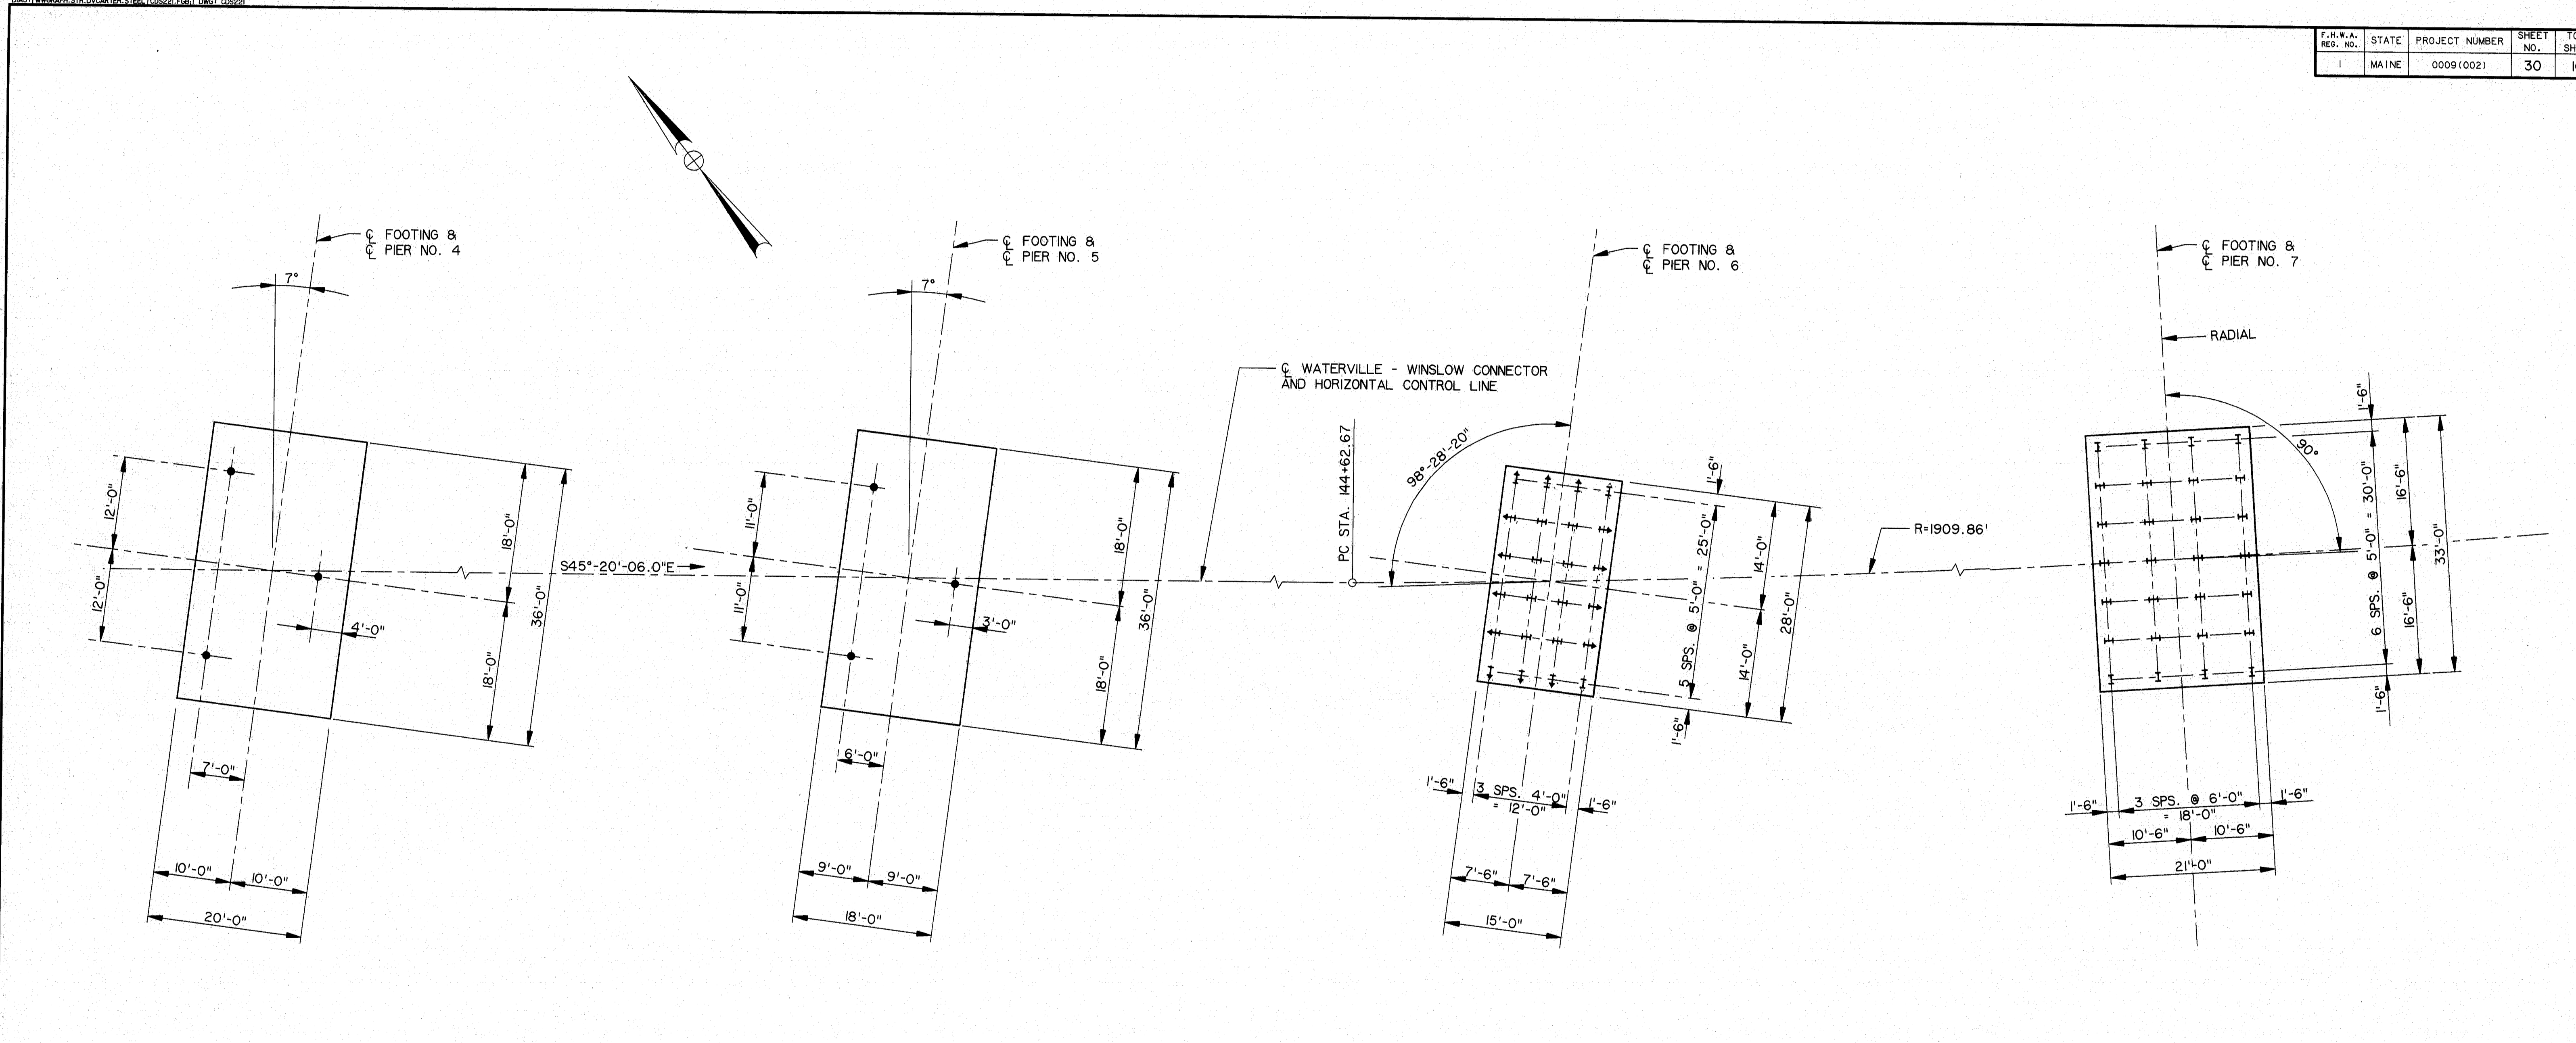

FOUNDATION PLAN

NOTES


- FOR PILE NOTES SEE SHEETS B3 AND B20.
- - INDICATES 2 1/8" (NX) CONCRETE SEAL CORE.

*AS BUILT  
Comm 12/14/96*

115-216


NO.	REVISION	BY	DATE	IN CHARGE OF	CJM

DESIGNED:	SM	9/94
DRAWN:	RJT	9/94
CHECKED:	DWR	9/94

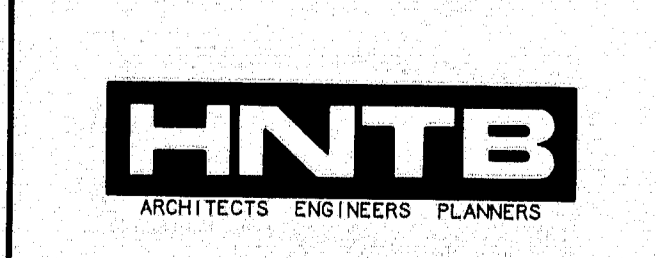


STEEL ALTERNATIVE  
STATE OF MAINE  
DEPARTMENT OF TRANSPORTATION  
WATERVILLE - WINSLOW PROJECT  
DONALD V. CARTER BRIDGE  
OVER  
KENNEBEC RIVER  
FOUNDATION PLAN - II  
SHEET B21 OF B86 AUGUSTA, MAINE

F.M.A. REG. NO.	STATE	PROJECT NUMBER	SHEET NO.	TOTAL SHEETS
1	MAINE	00091002	31	103

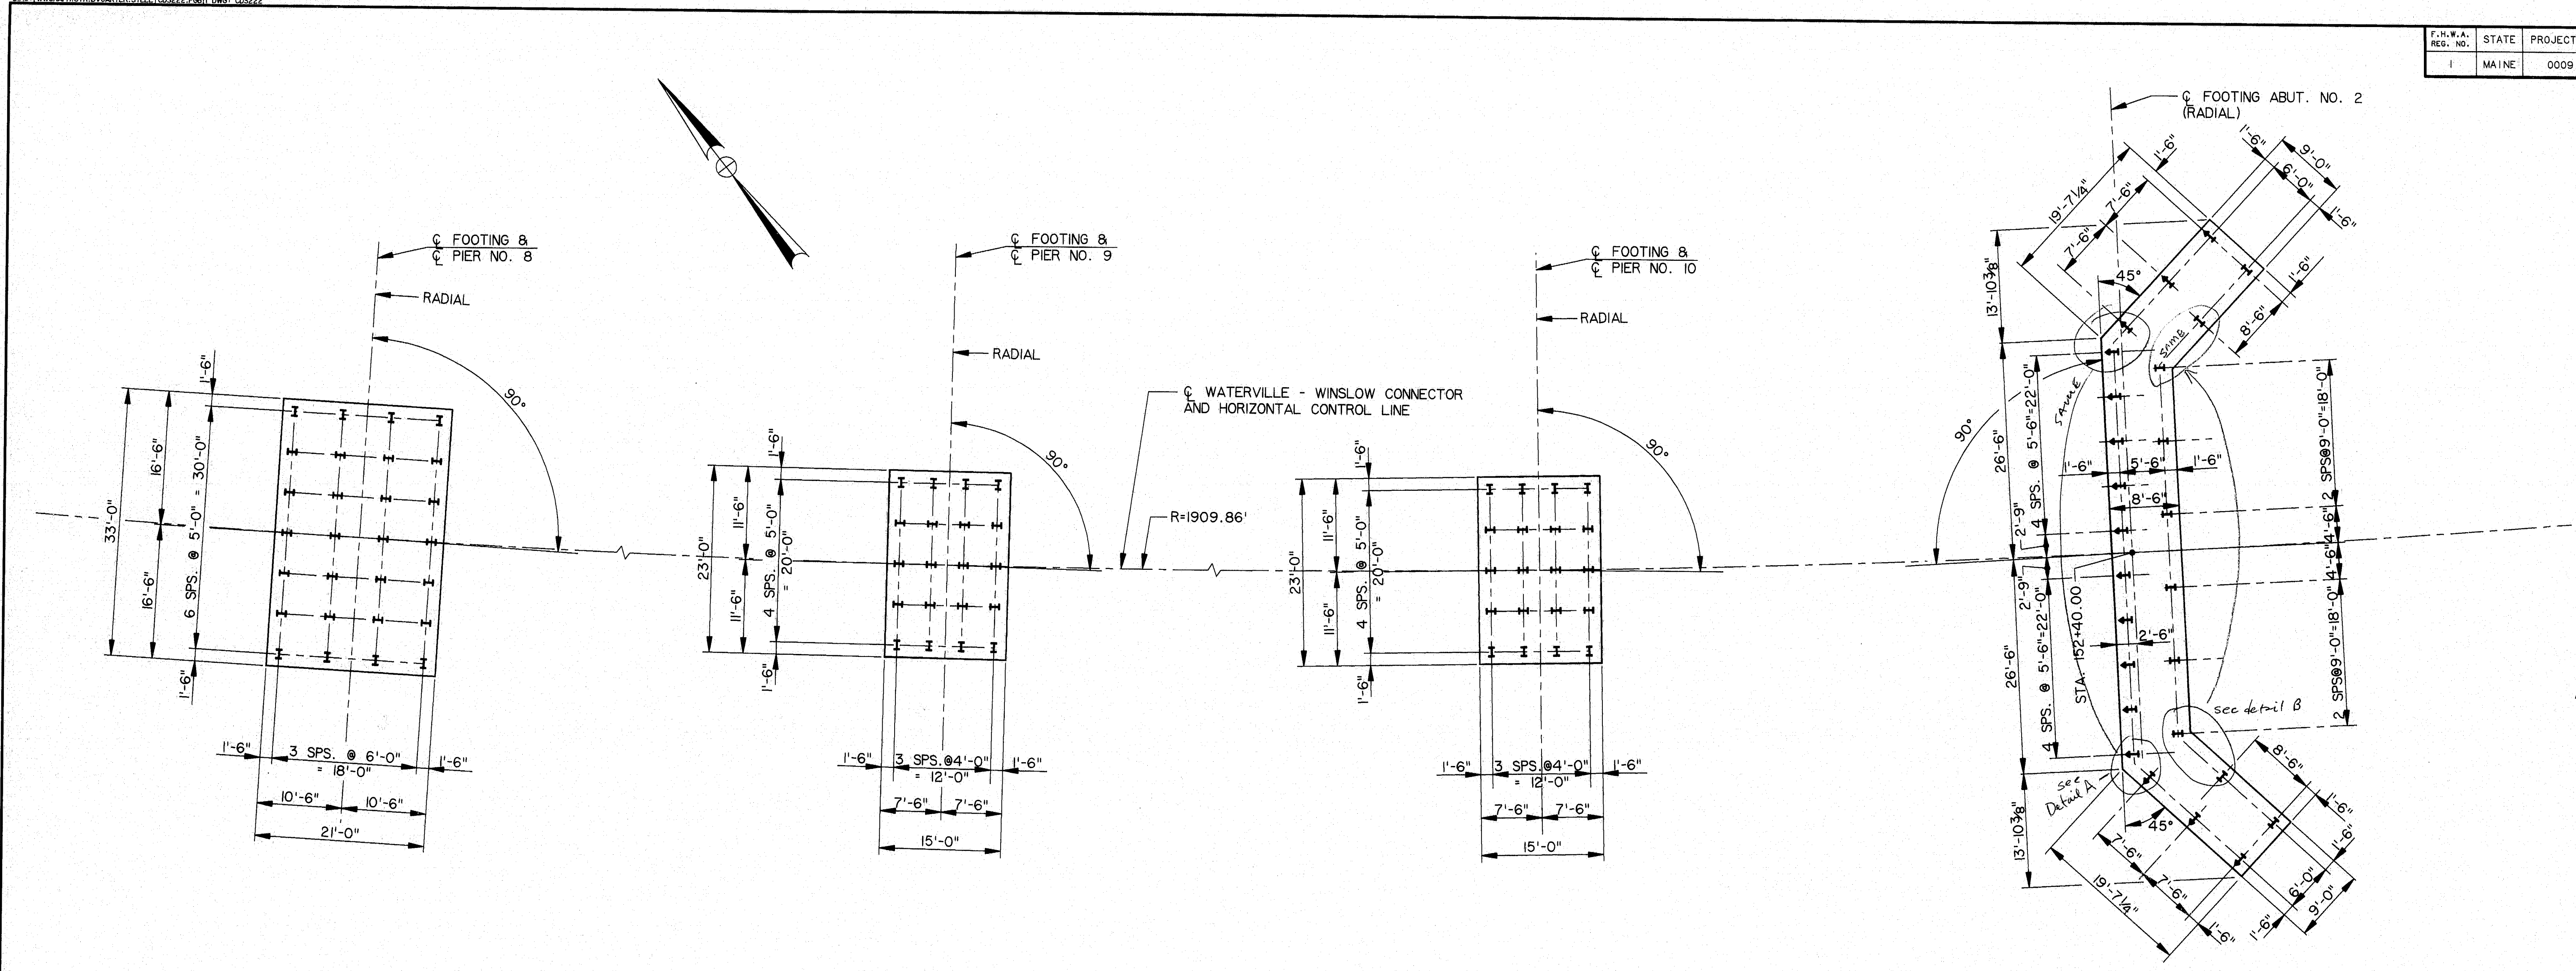

FOUNDATION PLAN  
1" = 10'-0"

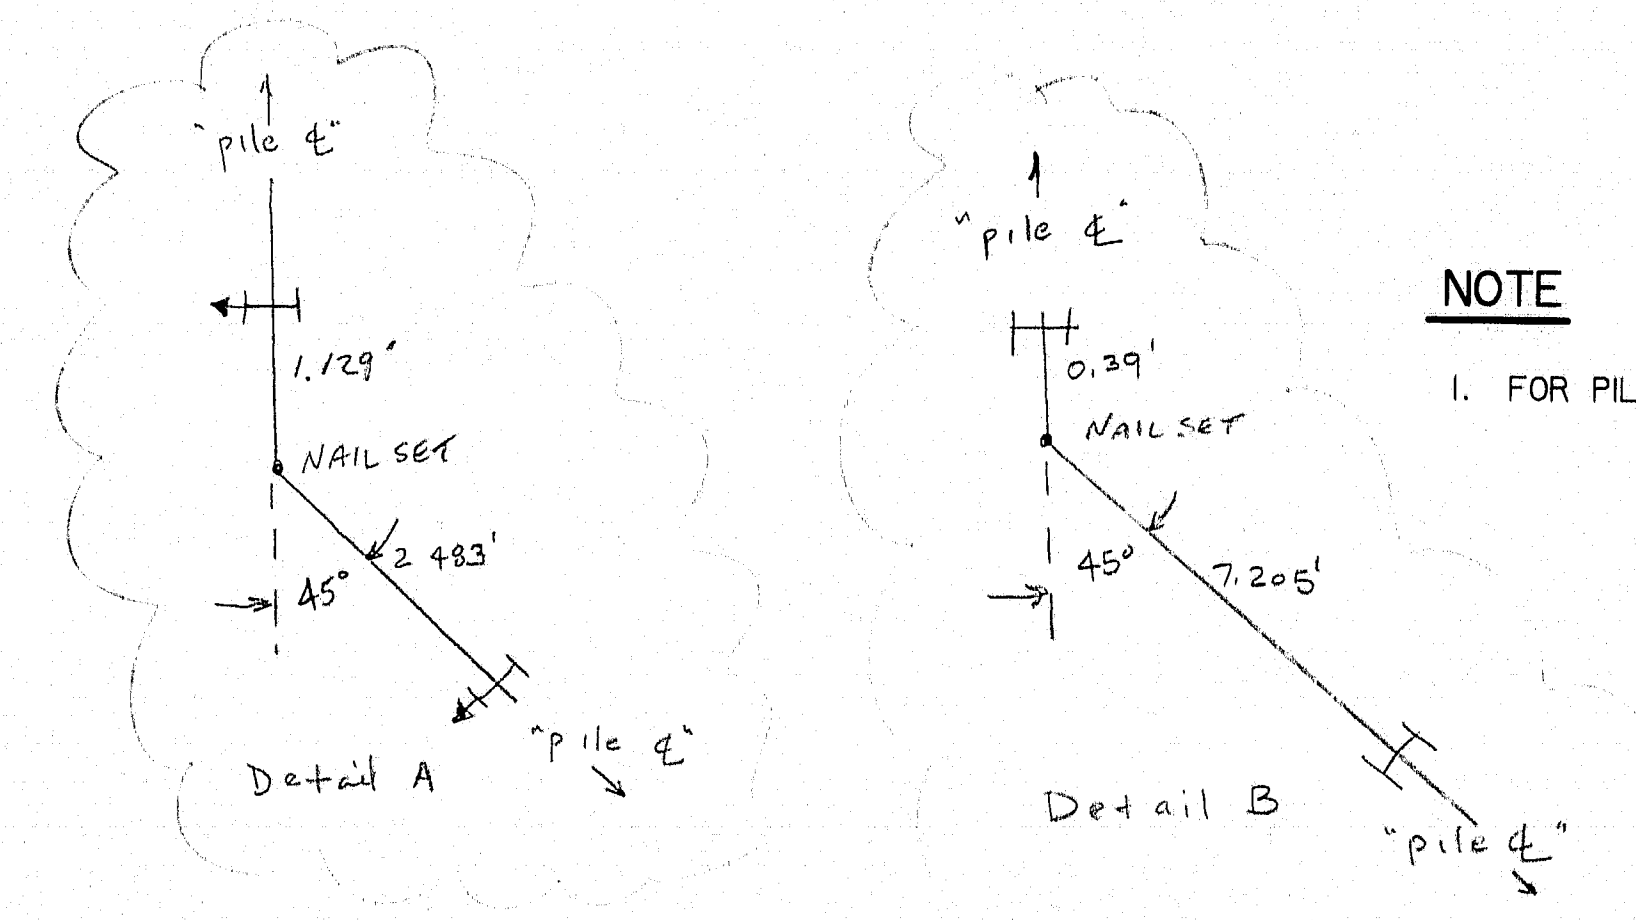

NOTE  
1. FOR PILE NOTES SEE SHEETS B3 AND B20.


REV 115-217

NO.	REVISION	BY	DATE	IN CHARGE OF	CJM
		DESIGNED:	SM	9/94	
		DRAWN:	RJT	9/94	
		CHECKED:	DWR	9/94	



STEEL ALTERNATIVE  
STATE OF MAINE  
DEPARTMENT OF TRANSPORTATION  
WATERVILLE - WINSLOW PROJECT  
DONALD V. CARTER BRIDGE  
OVER  
KENNEBEC RIVER  
FOUNDATION PLAN - III  
SHEET B22 OF B86 AUGUSTA, MAINE

F.S.P.A. PROJ. NO.	STATE	PROJECT NUMBER	SHEET NO.	TOTAL SHEETS
1	MAINE	0009 (002)	32	103

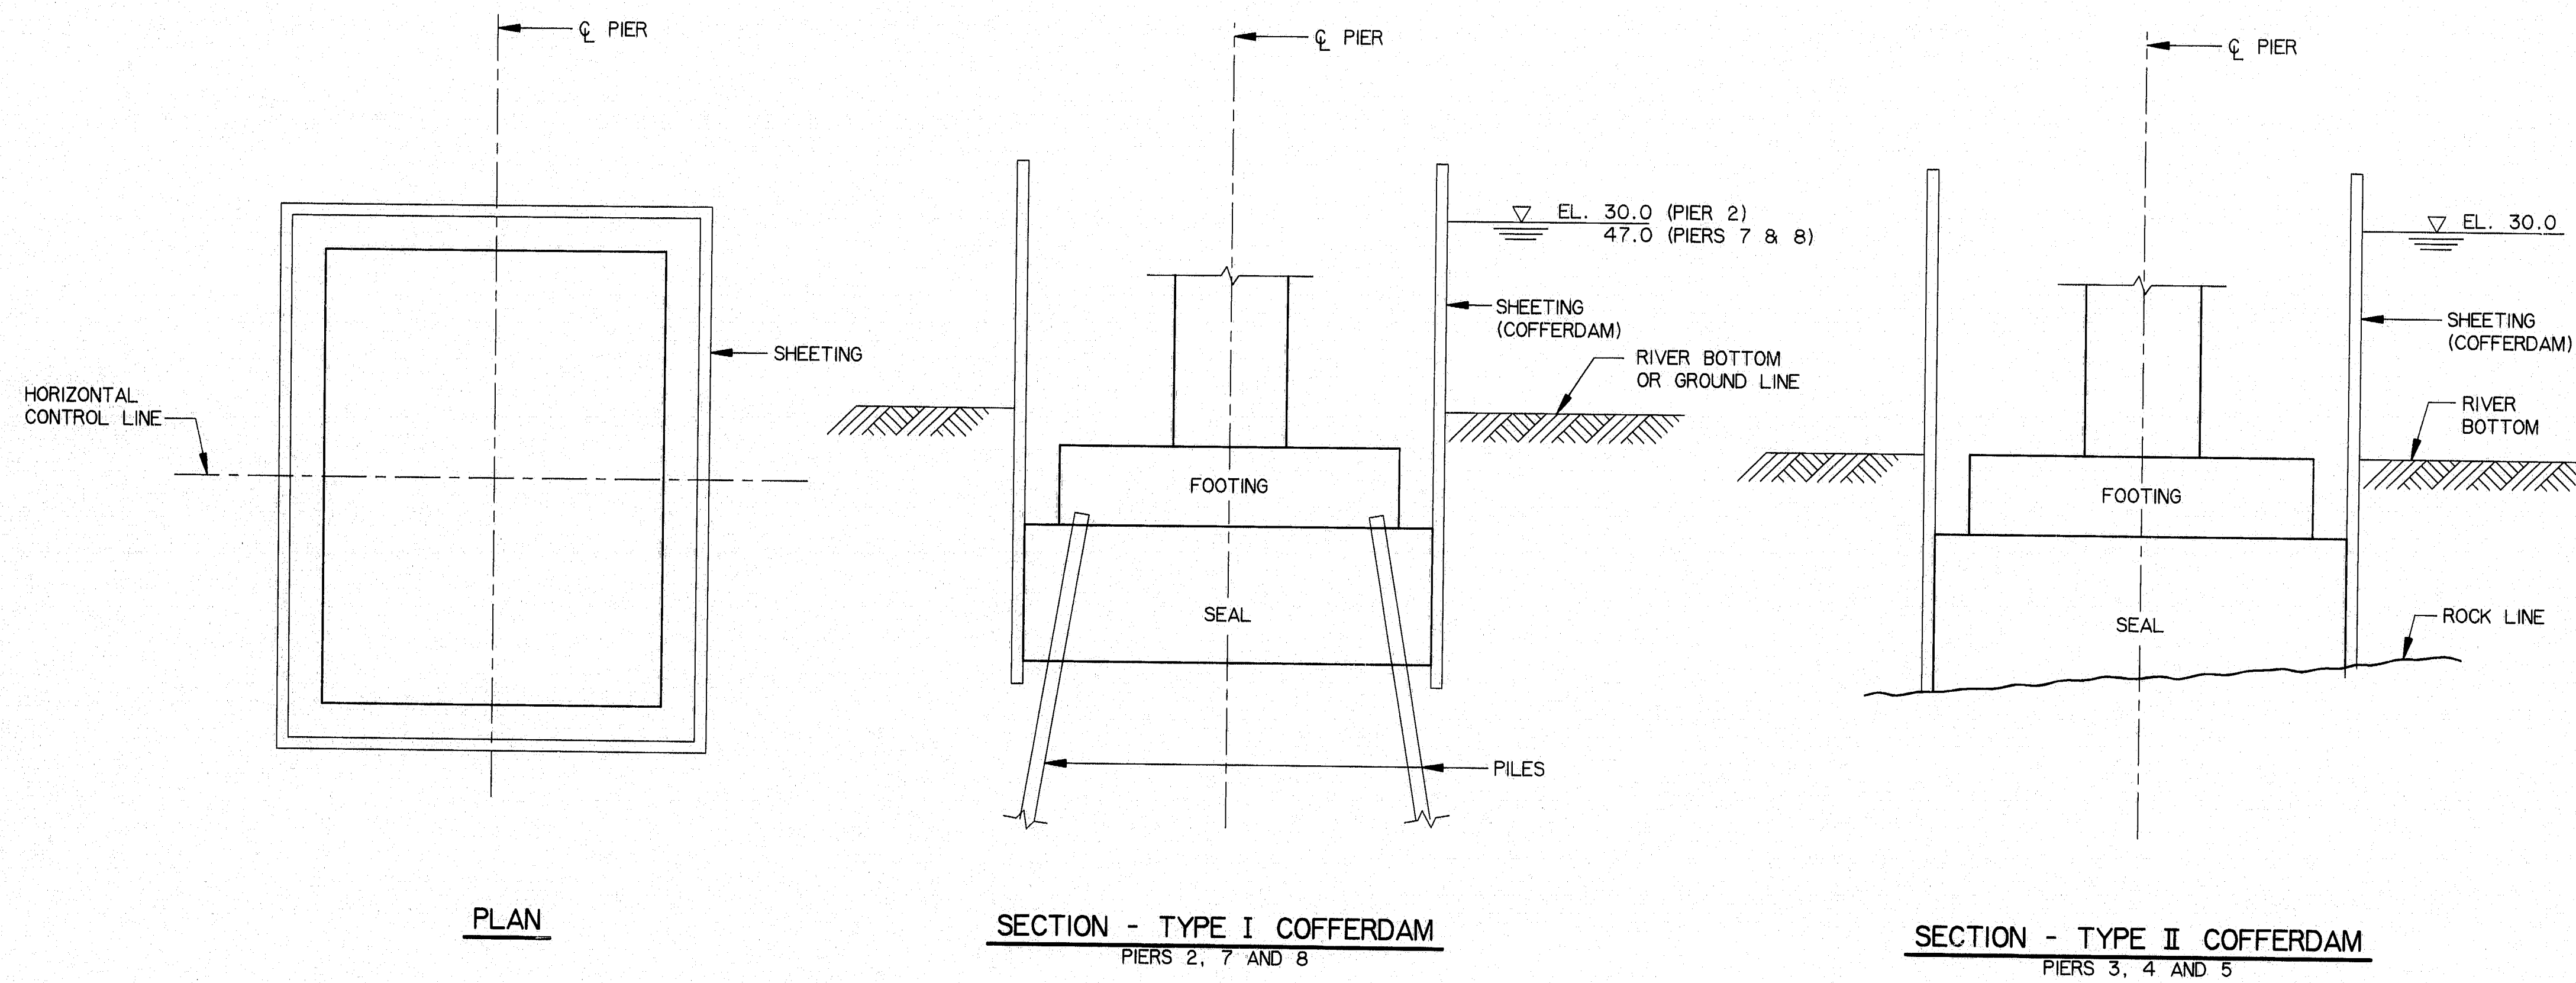

PLAN

SECTION - TYPE I COFFERDAM  
PIERS 2, 7 AND 8

SECTION - TYPE II COFFERDAM  
PIERS 3, 4 AND 5

SCHEMATIC COFFERDAMS

COFFERDAM NOTES:


- IN THE EVENT THAT THE WATER RISES OUTSIDE THE COFFERDAM ABOVE THE ELEVATION 30.0 (EL. 47.0 AT PIERS 7 & 8), THE COFFERDAM SHALL BE FLOODED, AS DIRECTED BY THE ENGINEER.
  - THE CONTRACTOR SHALL CONSIDER THE POSSIBILITY THAT THE BOTTOM OF EXCAVATION MAY BE LOWERED BY A MAXIMUM OF TWO FEET IN HIS SHEETING DESIGN.
  - SKETCHES SHOWN ON THIS SHEET INDICATE THE TYPE OF COFFERDAMS WHICH WILL BE REQUIRED FOR THE CONSTRUCTION OF THE PIERS.
  - FOR CONCRETE SEAL DIMENSIONS SEE FOUNDATION PLAN.
  - SEALS FOUNDED ON ROCK SHALL BE CORED FULL DEPTH, AT THREE LOCATIONS AS INDICATED ON FOUNDATION PLANS. THE CORES SHALL BE INSPECTED BY THE ENGINEER FOR VOIDS OR OTHER DEFECTS. THE CONTRACTOR SHALL CORRECT ANY AND ALL DEFECTS. METHOD(S) FOR CORRECTING DEFECTS SHALL BE APPROVED BY THE ENGINEER. FOR EACH CORE THAT REVEALS VOIDS OR OTHER DEFECTS TWO ADDITIONAL CORES SHALL BE TAKEN. ONE ADDITIONAL CORE SHALL BE MADE IN APPROXIMATELY THE SAME LOCATION AS THE ORIGINAL CORE. THE OTHER ADDITIONAL CORE SHALL BE LOCATED BY THE ENGINEER. ALL COST OF CORING SHALL BE INCLUDED IN LUMP SUM PRICE BID FOR COFFERDAMS.
  - PAY ITEMS:
    - 511.071 - COFFERDAM, PIER 2
    - 511.072 - COFFERDAM, PIER 3
    - 511.073 - COFFERDAM, PIER 4
    - 511.074 - COFFERDAM, PIER 5
    - 511.075 - COFFERDAM, PIER 7
    - 511.076 - COFFERDAM, PIER 8
- SHALL BE FULL COMPENSATION FOR PLACEMENT AND REMOVAL OF CONSTRUCTION MATERIALS, EXCAVATION OF MATERIALS WITHIN THE COFFERDAMS, AND ALL LABOR AND EQUIPMENT TO DO THE NECESSARY WORK.

NO.	REVISION	BY	DATE	IN CHARGE OF	CJM
		DESIGNED:	SM	9/94	
		DRAWN:	RJT	9/94	
		CHECKED:	DWR	9/94	


*AS BUILT  
Cen. 11/21/96*

115-218


STEEL ALTERNATIVE  
STATE OF MAINE  
DEPARTMENT OF TRANSPORTATION  
WATERVILLE - WINSLOW PROJECT  
DONALD V. CARTER  
OVER  
KENNEBEC RIVER  
COFFERDAM DETAILS  
SHEET B23 OF B86 AUGUSTA, MAINE

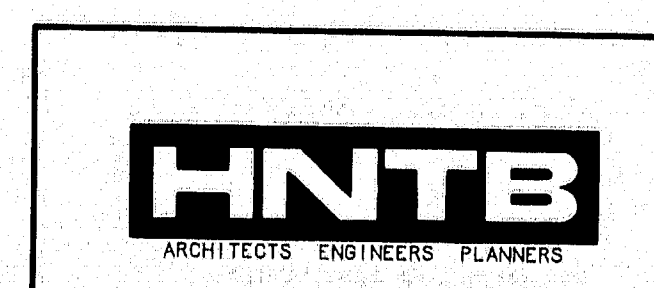


F.C.D. No.	STATE	PROJECT NUMBER	SHEET NO.	TOTAL SHEETS
1	MAINE	000910021	33	103

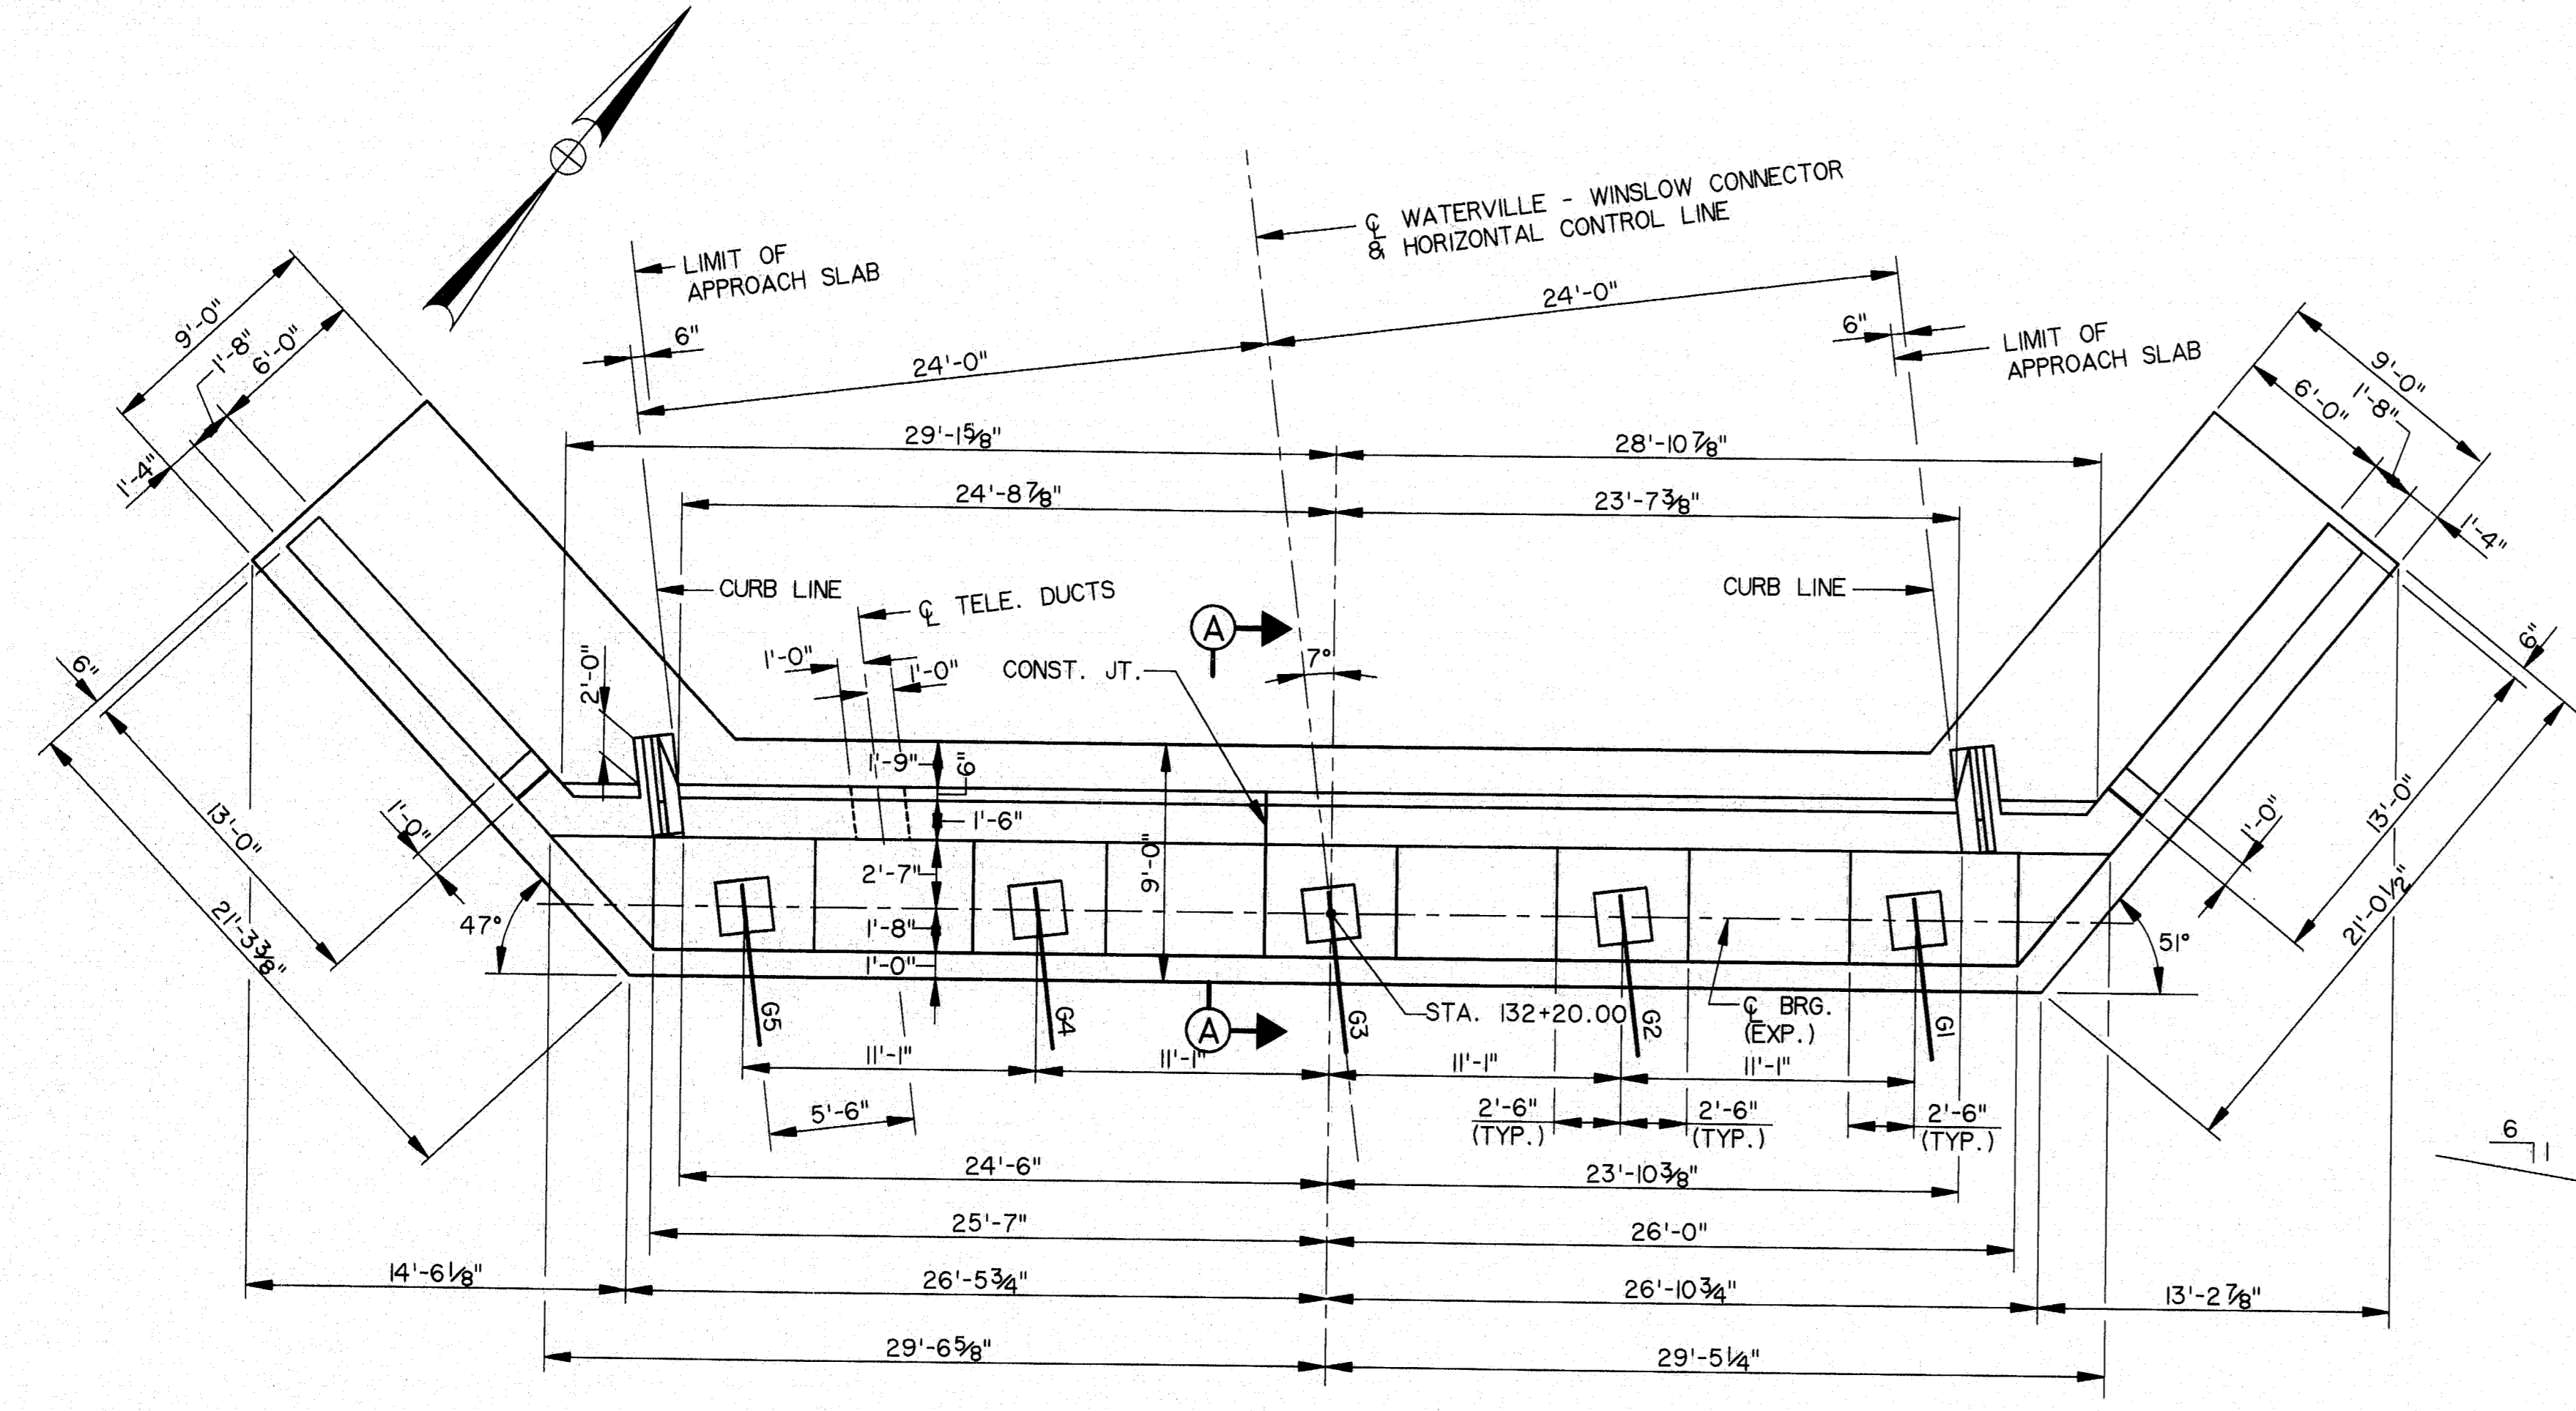

PLAN - ABUTMENT NO. 1

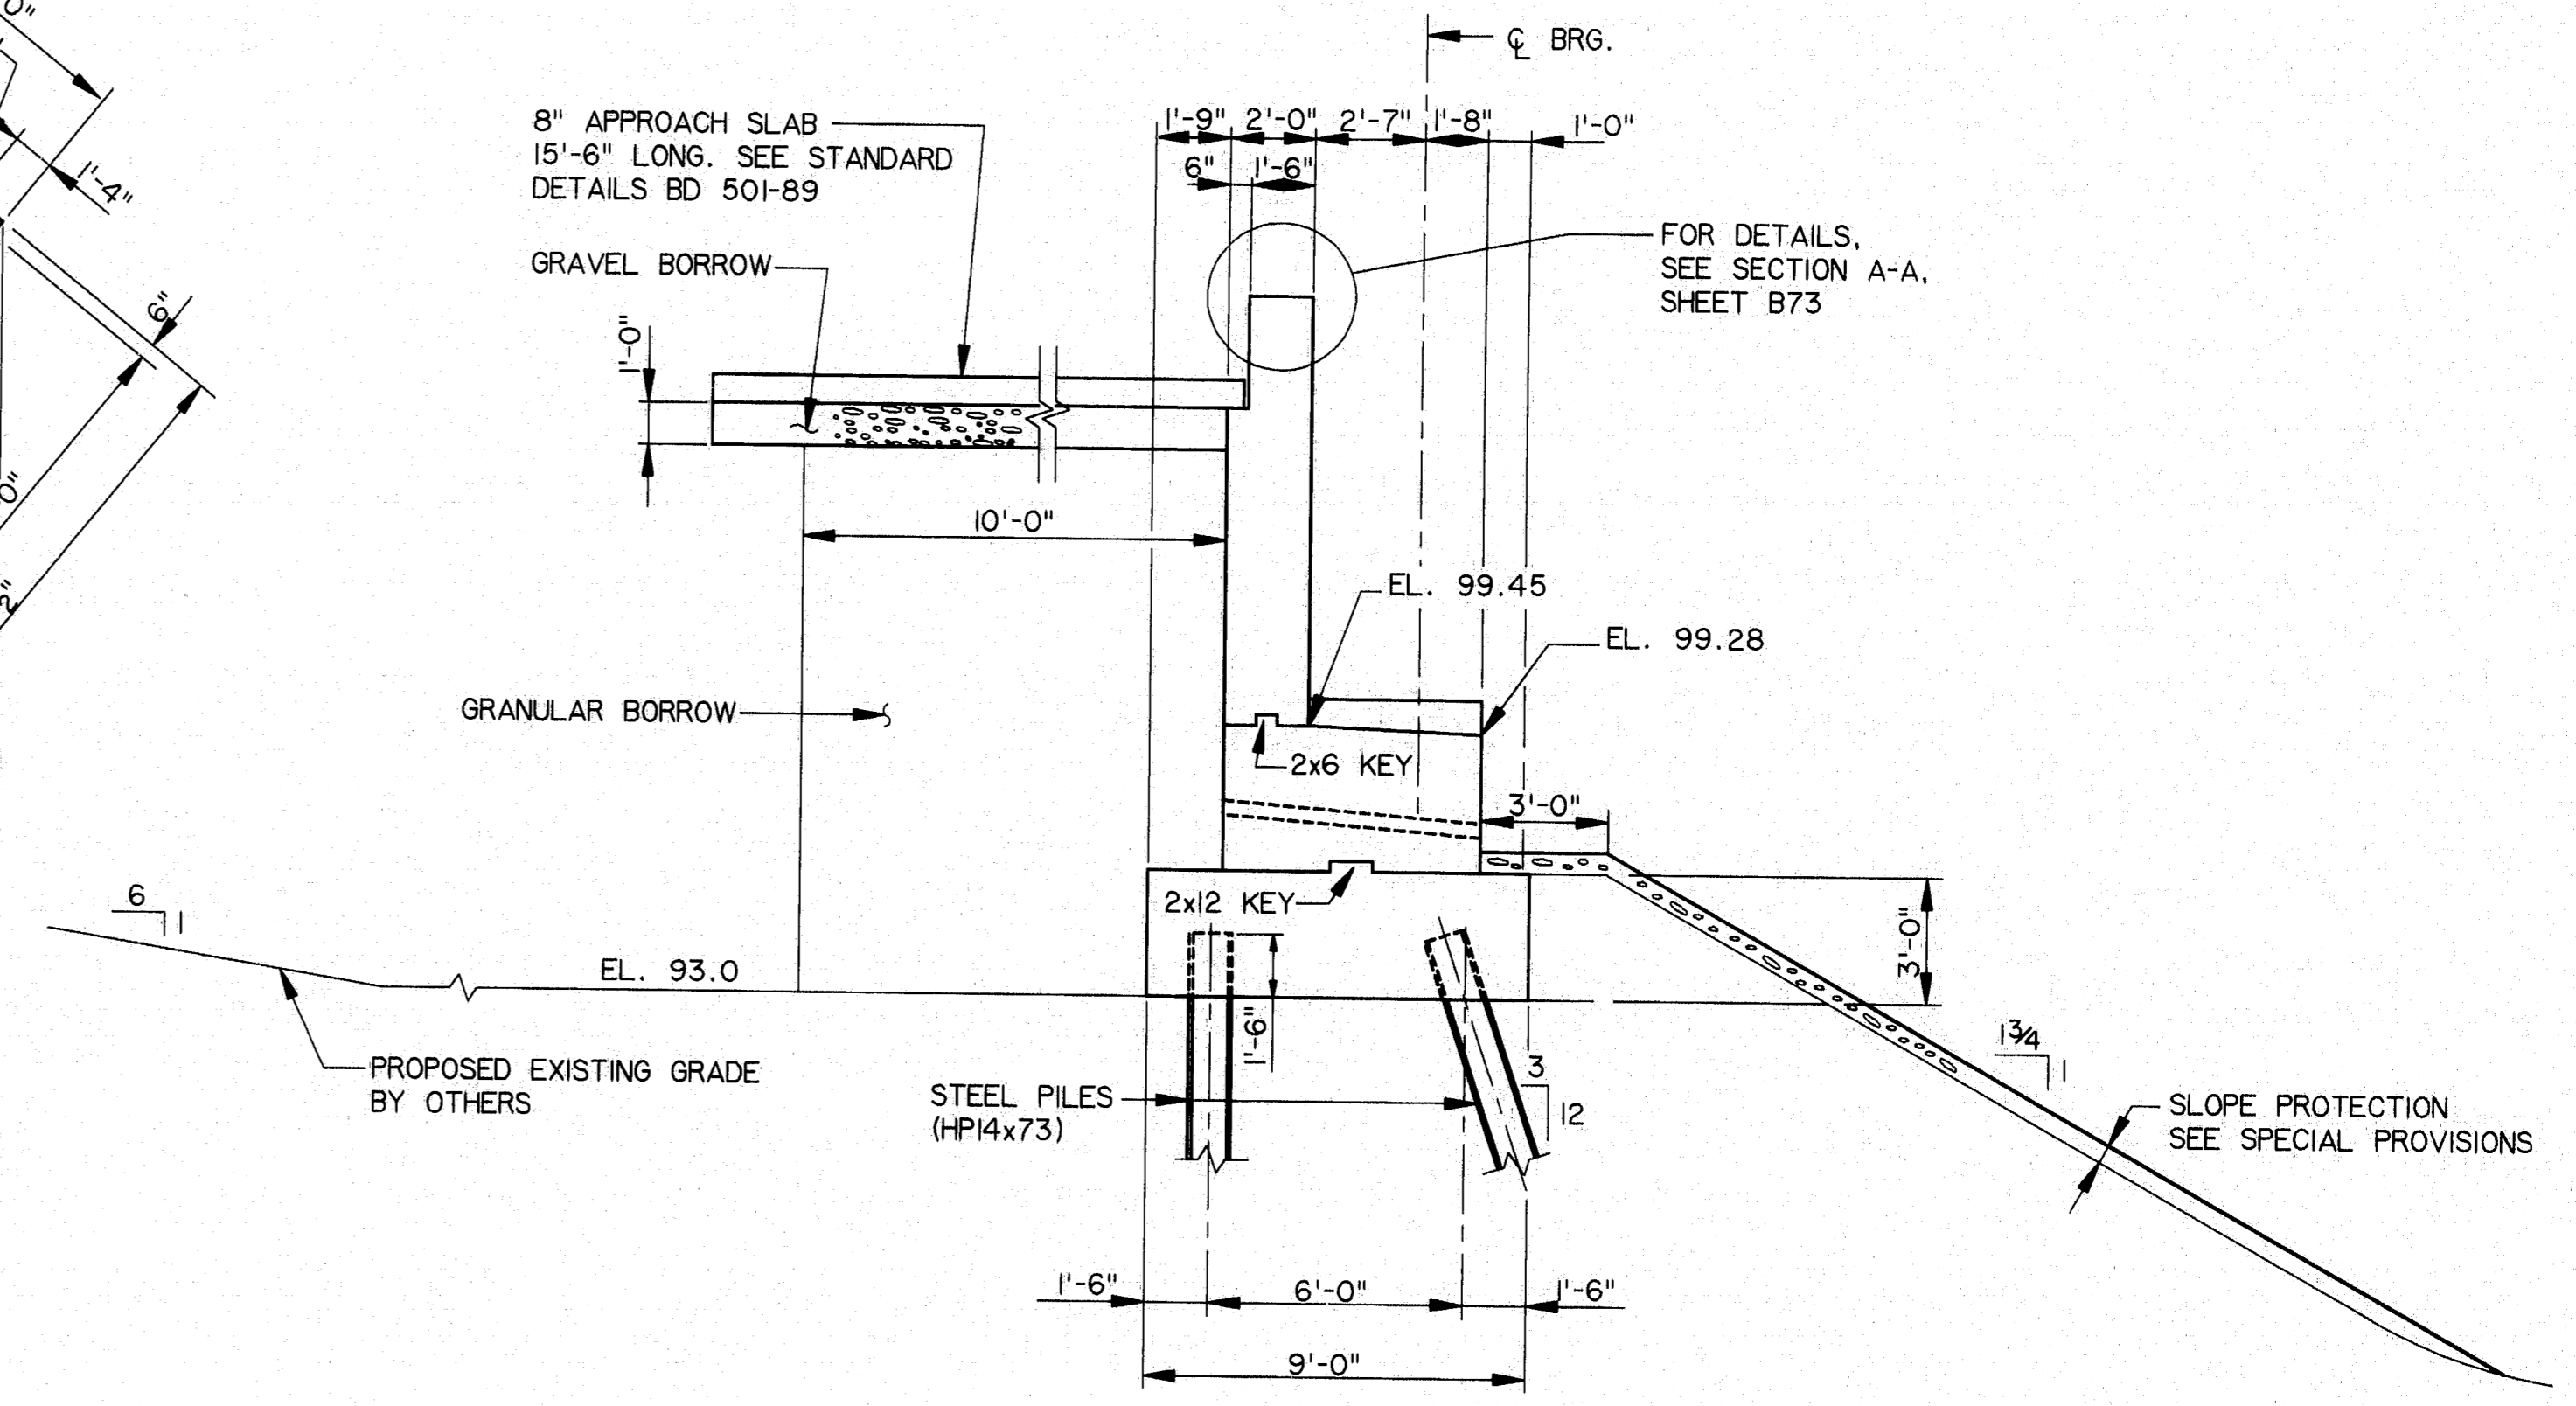

SECTION A-A

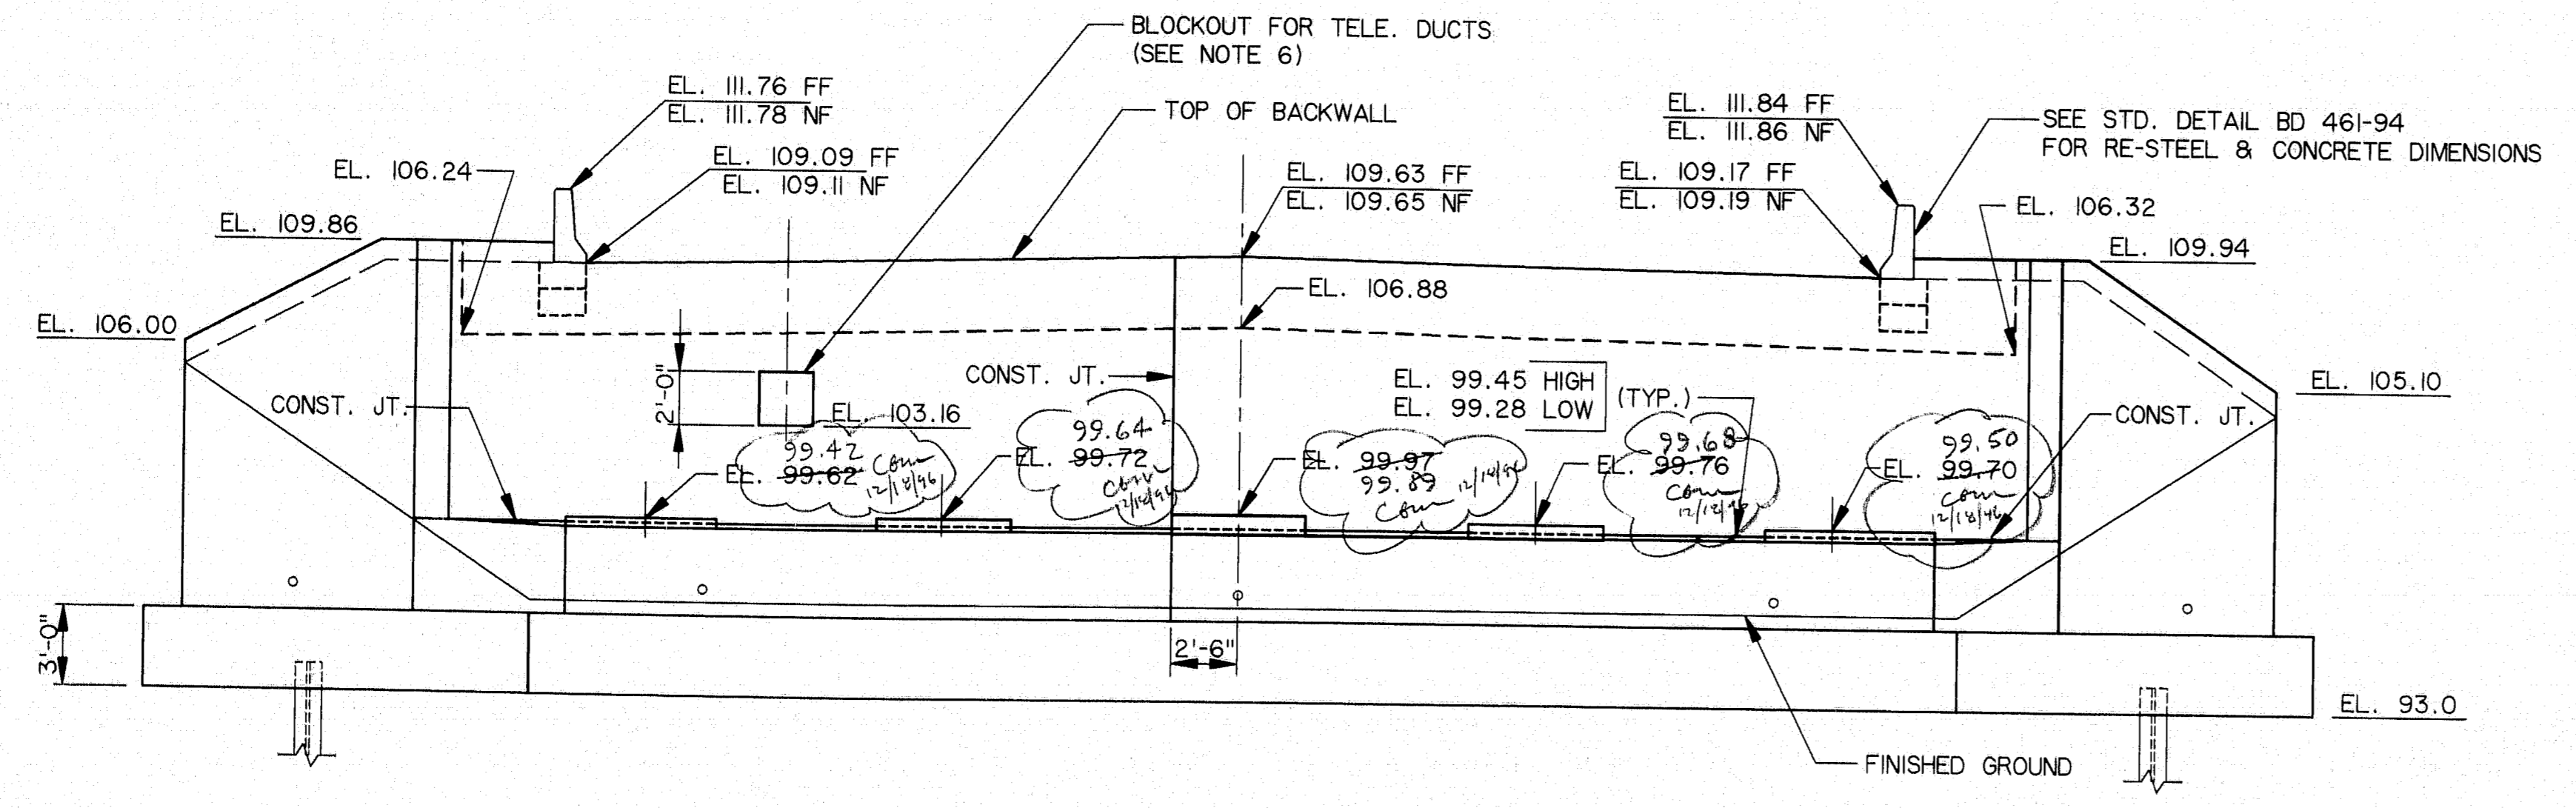


ELEVATION

**ABUTMENT NOTES**

1. REINFORCING STEEL SHALL HAVE 2 INCHES COVER UNLESS OTHERWISE INDICATED.
2. COVER EXPANSION JOINTS ON THE BACK WITH TWO LAYERS OF HEAVY ROOFING FELT, SEE STD. DETAILS BD 501-89.
3. PROTECTIVE COATING FOR CONCRETE SURFACES SHALL BE APPLIED TO THE FOLLOWING AREAS:  
CONCRETE BARRIERS.  
TOP OF ABUTMENT BACKWALLS AND ONE (1) FOOT BELOW TOP OF BACKWALLS ON THE BACK SIDE.  
PAYMENT FOR PROTECTIVE COATING FOR CONCRETE SURFACES WILL BE INCIDENTAL TO THE CONCRETE ITEMS.
4. PLACE 4 INCH DIAMETER DRAINS IN BREASTWALL AND WINGWALLS AT 20 FEET MAXIMUM SPACING.  
EXACT LOCATION TO BE DETERMINED BY THE ENGINEER IN THE FIELD.
5. MAXIMUM PILE LOAD = 77 TONS
6. BLOCKOUT FOR TELEPHONE DUCTS TO BE FILLED WITH BRICK MASONRY.

NO.	REVISION	BY	DATE	IN CHARGE OF
		DESIGNED: SM	9/94	
		DRAWN: RJT	9/94	
		CHECKED: DWR	9/94	
		BY DATE		CJM

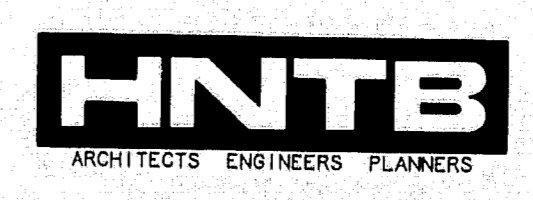


**115-219**

STEEL ALTERNATIVE  
STATE OF MAINE  
DEPARTMENT OF TRANSPORTATION  
WATERVILLE - WINSLOW PROJECT  
DONALD V. CARTER BRIDGE  
OVER  
KENNEBEC RIVER


**ABUTMENT I (CONCRETE)**

SHEET B24 OF B86 AUGUSTA, MAINE


F.H.W.A. REG. NO.	STATE	PROJECT NUMBER	SHEET NO.	TOTAL SHEETS
1	MAINE	0098(002)	34	103

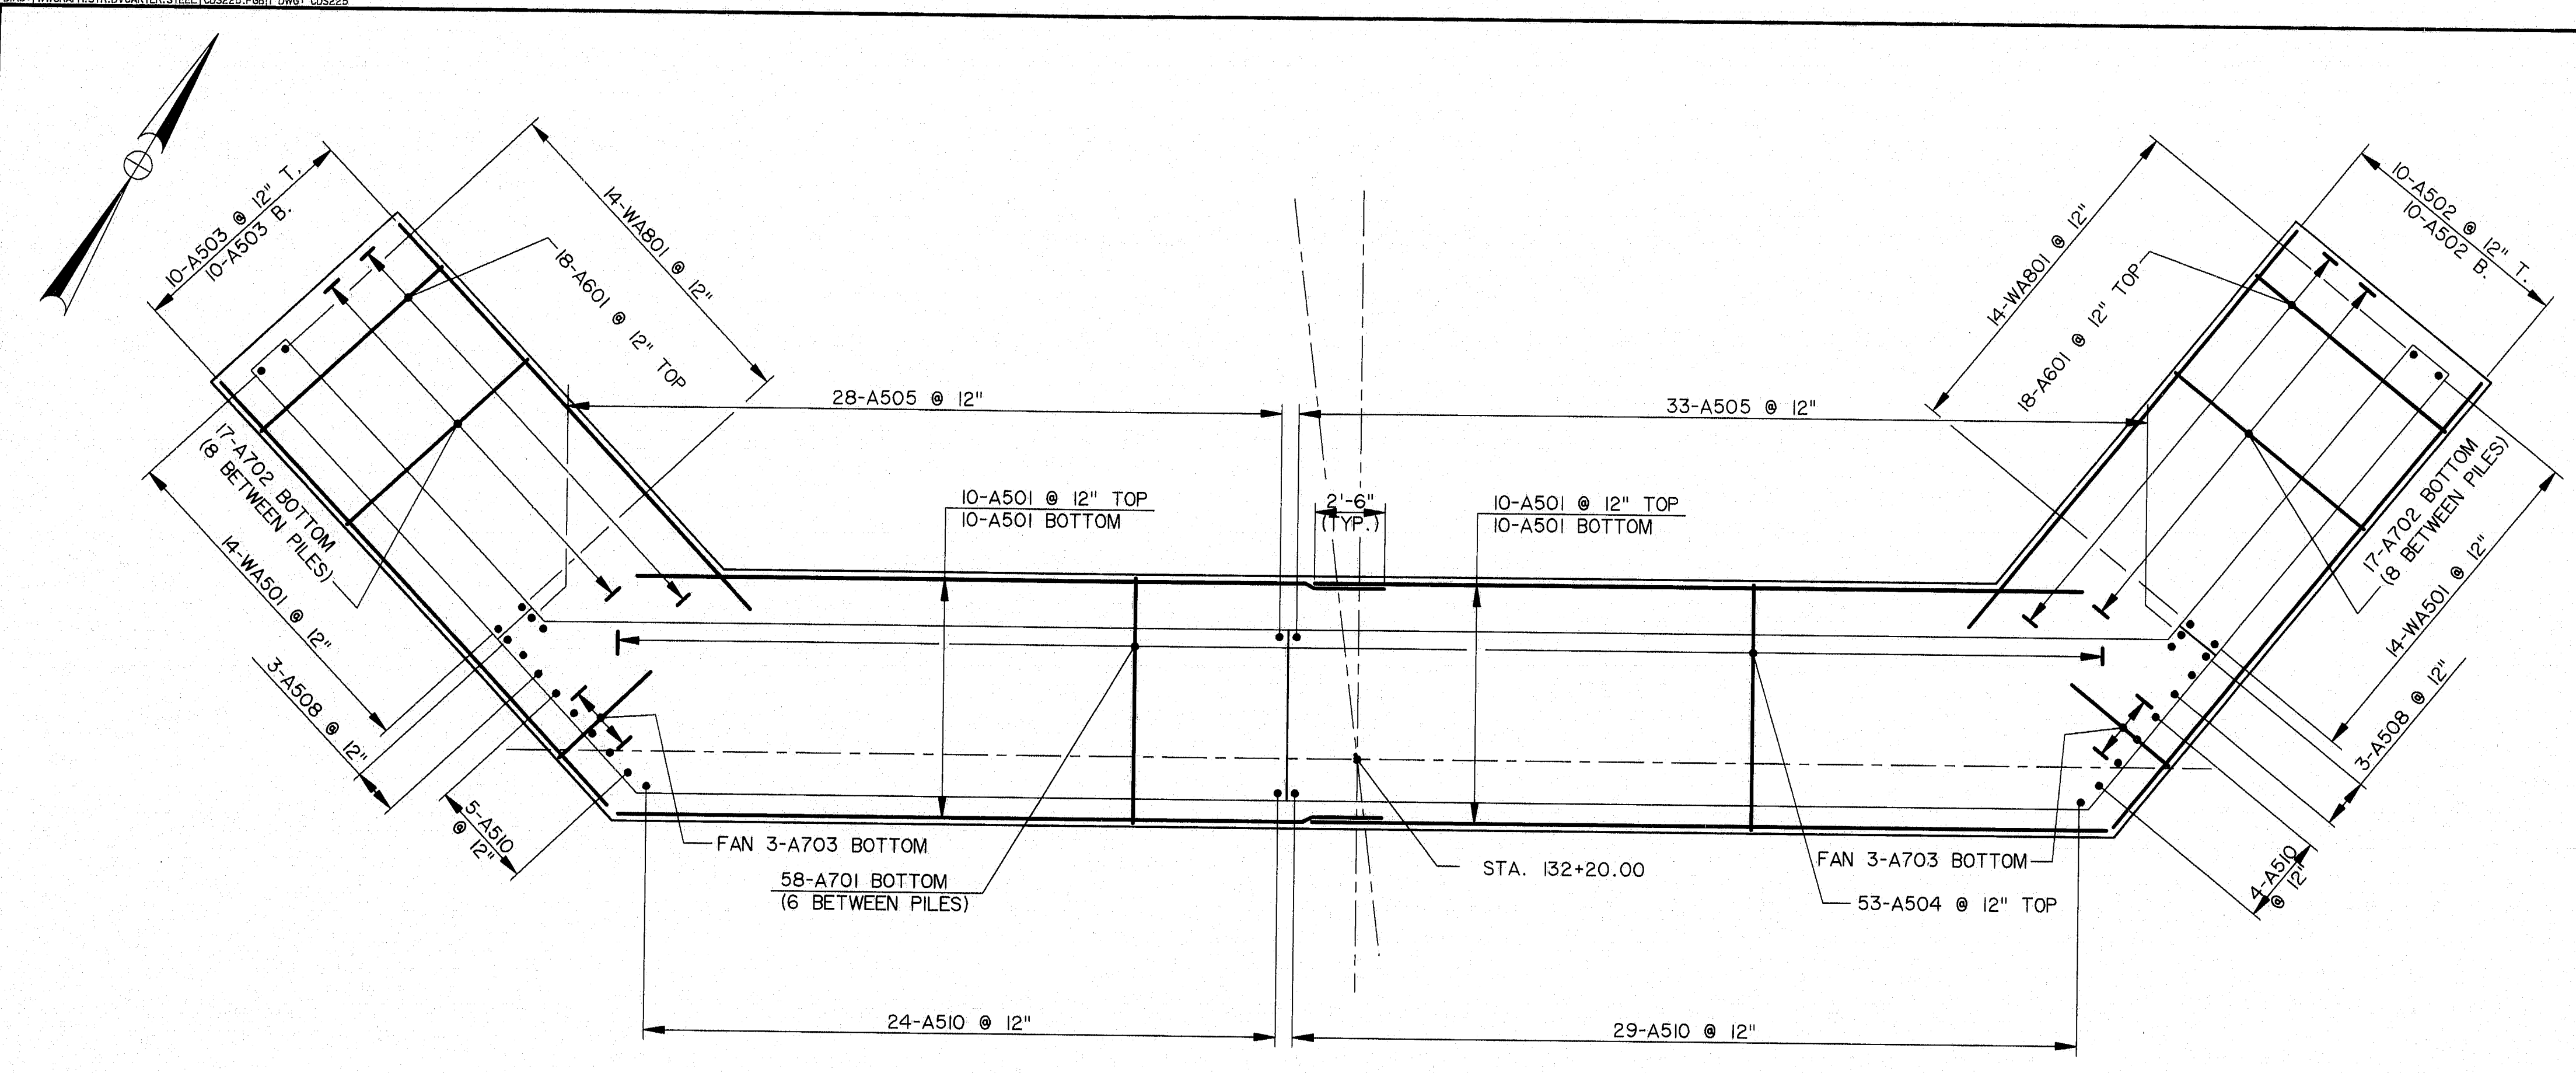

PLAN - ABUTMENT NO. 1

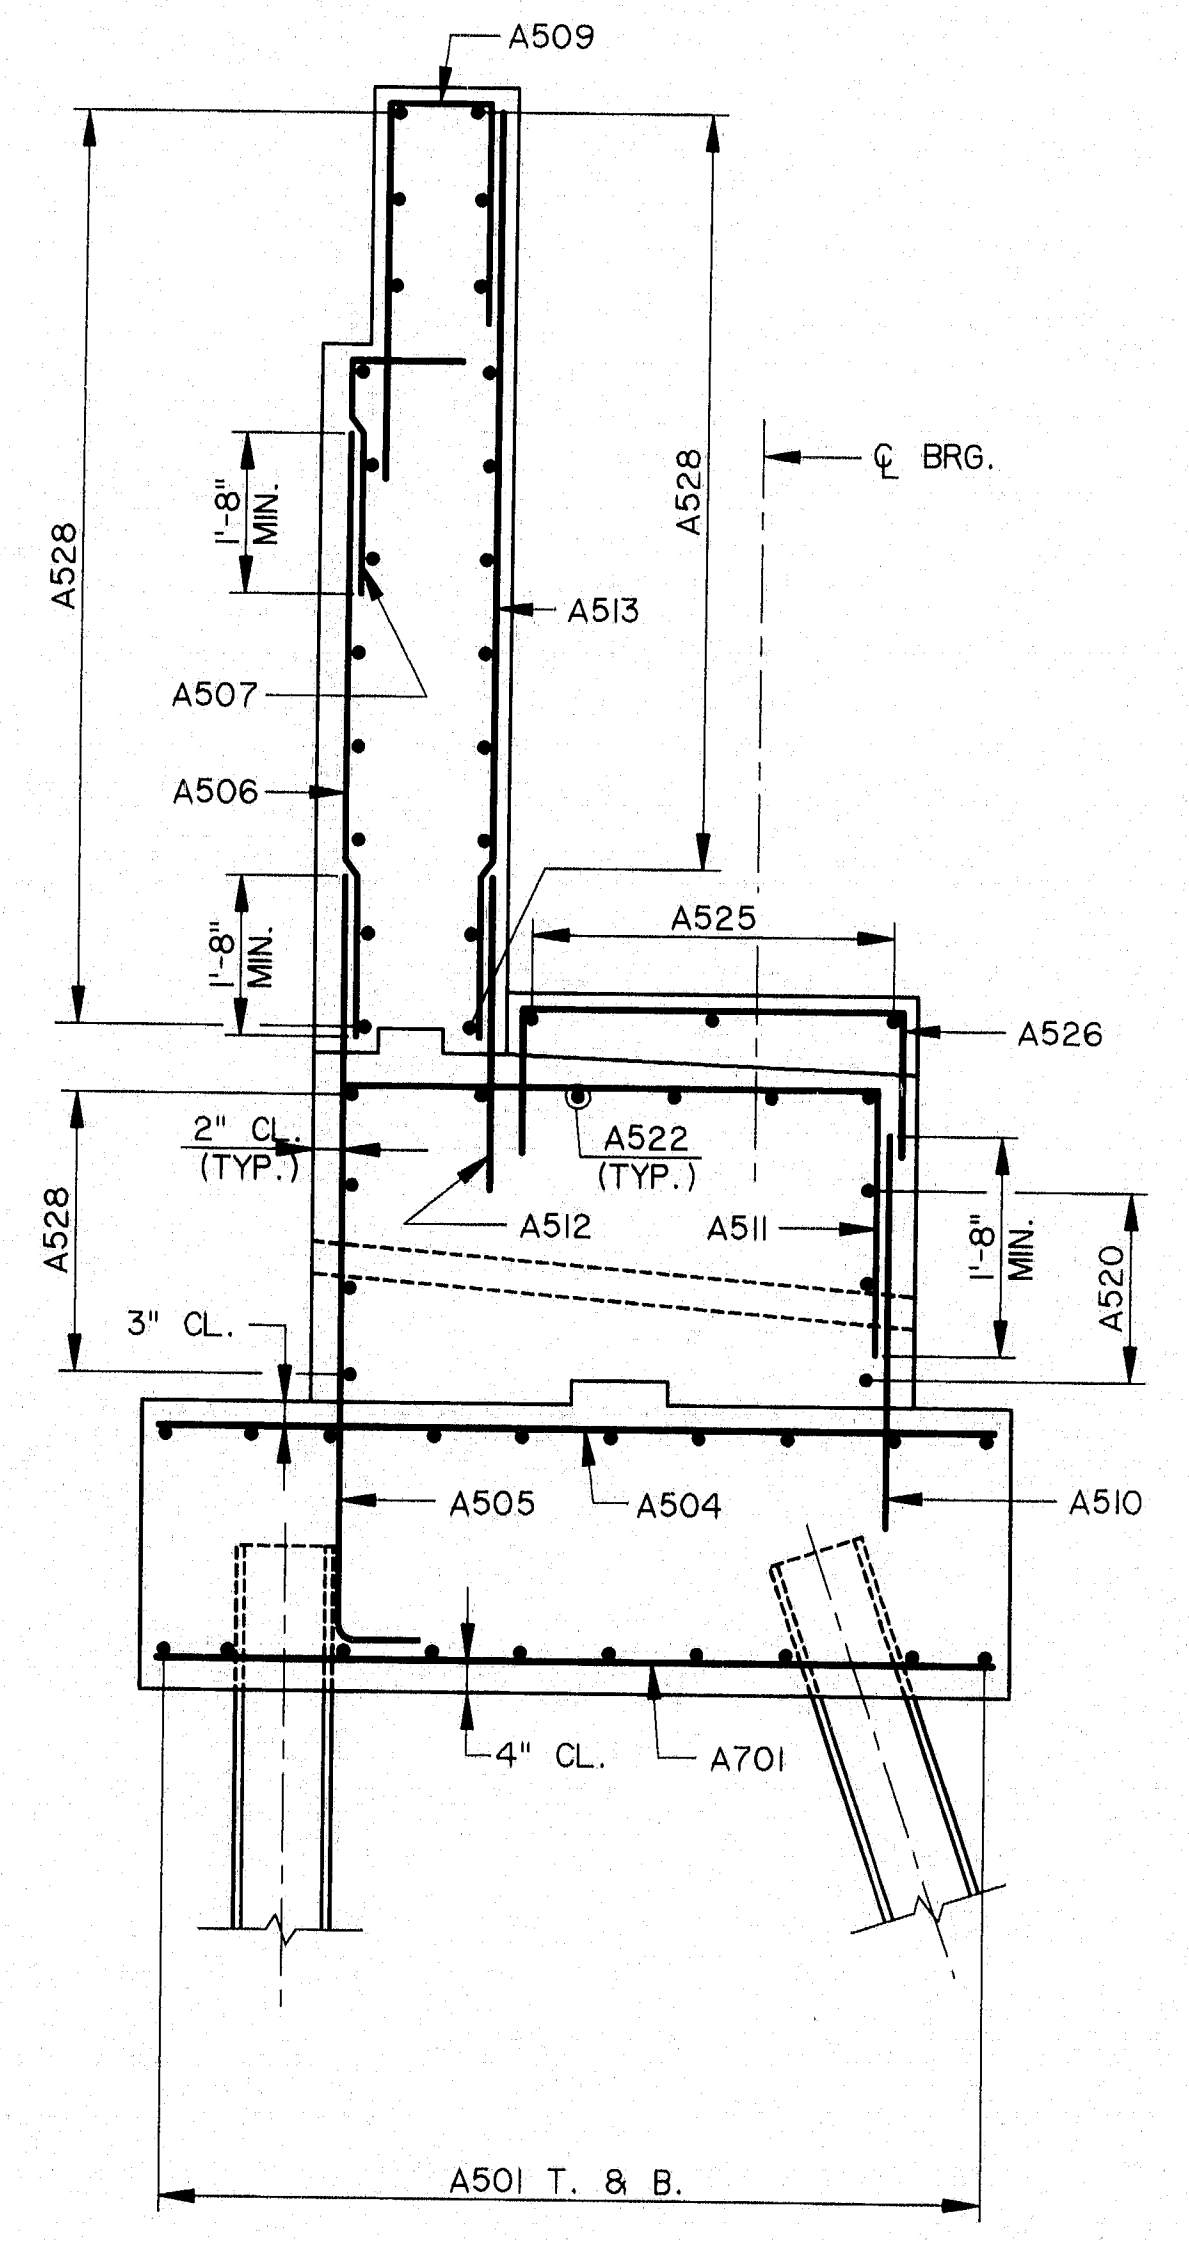

SECTION A-A

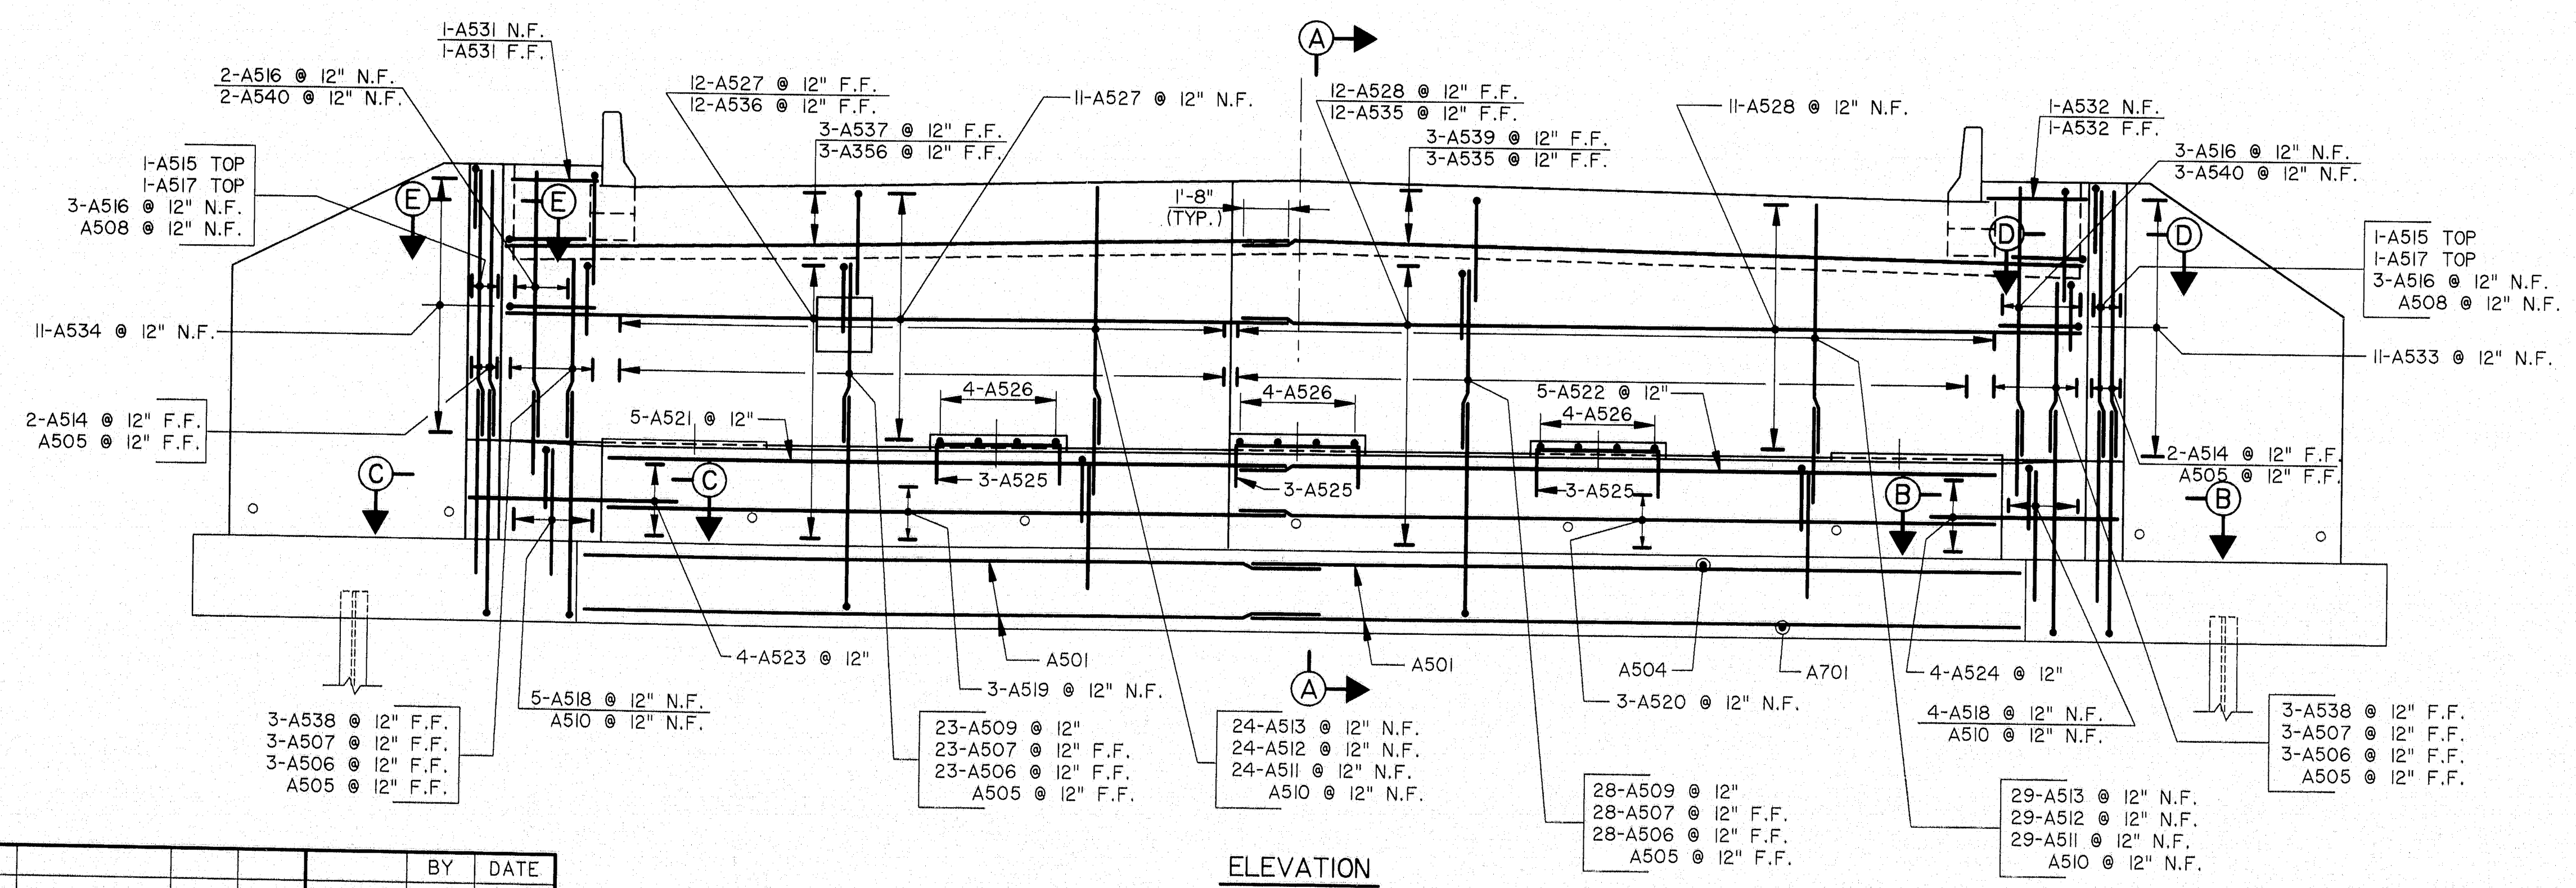

ELEVATION


NOTES

- FOR END BARRIER BRACKET REINFORCEMENT, SEE SHEET B79.
- FOR SECTIONS B-B, C-C, D-D, E-E, SEE SHEET B28.

*AS BUILT*  
*CEM*  
*12/15/16*


115-220

STEEL ALTERNATIVE  
STATE OF MAINE  
DEPARTMENT OF TRANSPORTATION  
WATERVILLE - WINSLOW PROJECT  
DONALD V. CARTER BRIDGE  
OVER  
KENNEBEC RIVER  
ABUTMENT I (RE-STEEL)

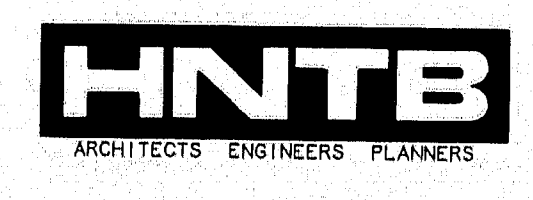


NO.	REVISION	BY	DATE	IN CHARGE OF
		BY	DATE	
		DESIGNED: AD	9/94	
		DRAWN: LS	9/94	
		CHECKED: RJR	9/94	
				CJM


F.M.A. REG. NO.	STATE	PROJECT NUMBER	SHEET NO.	TOTAL SHEETS
1	MAINE	0009(002)	35	103

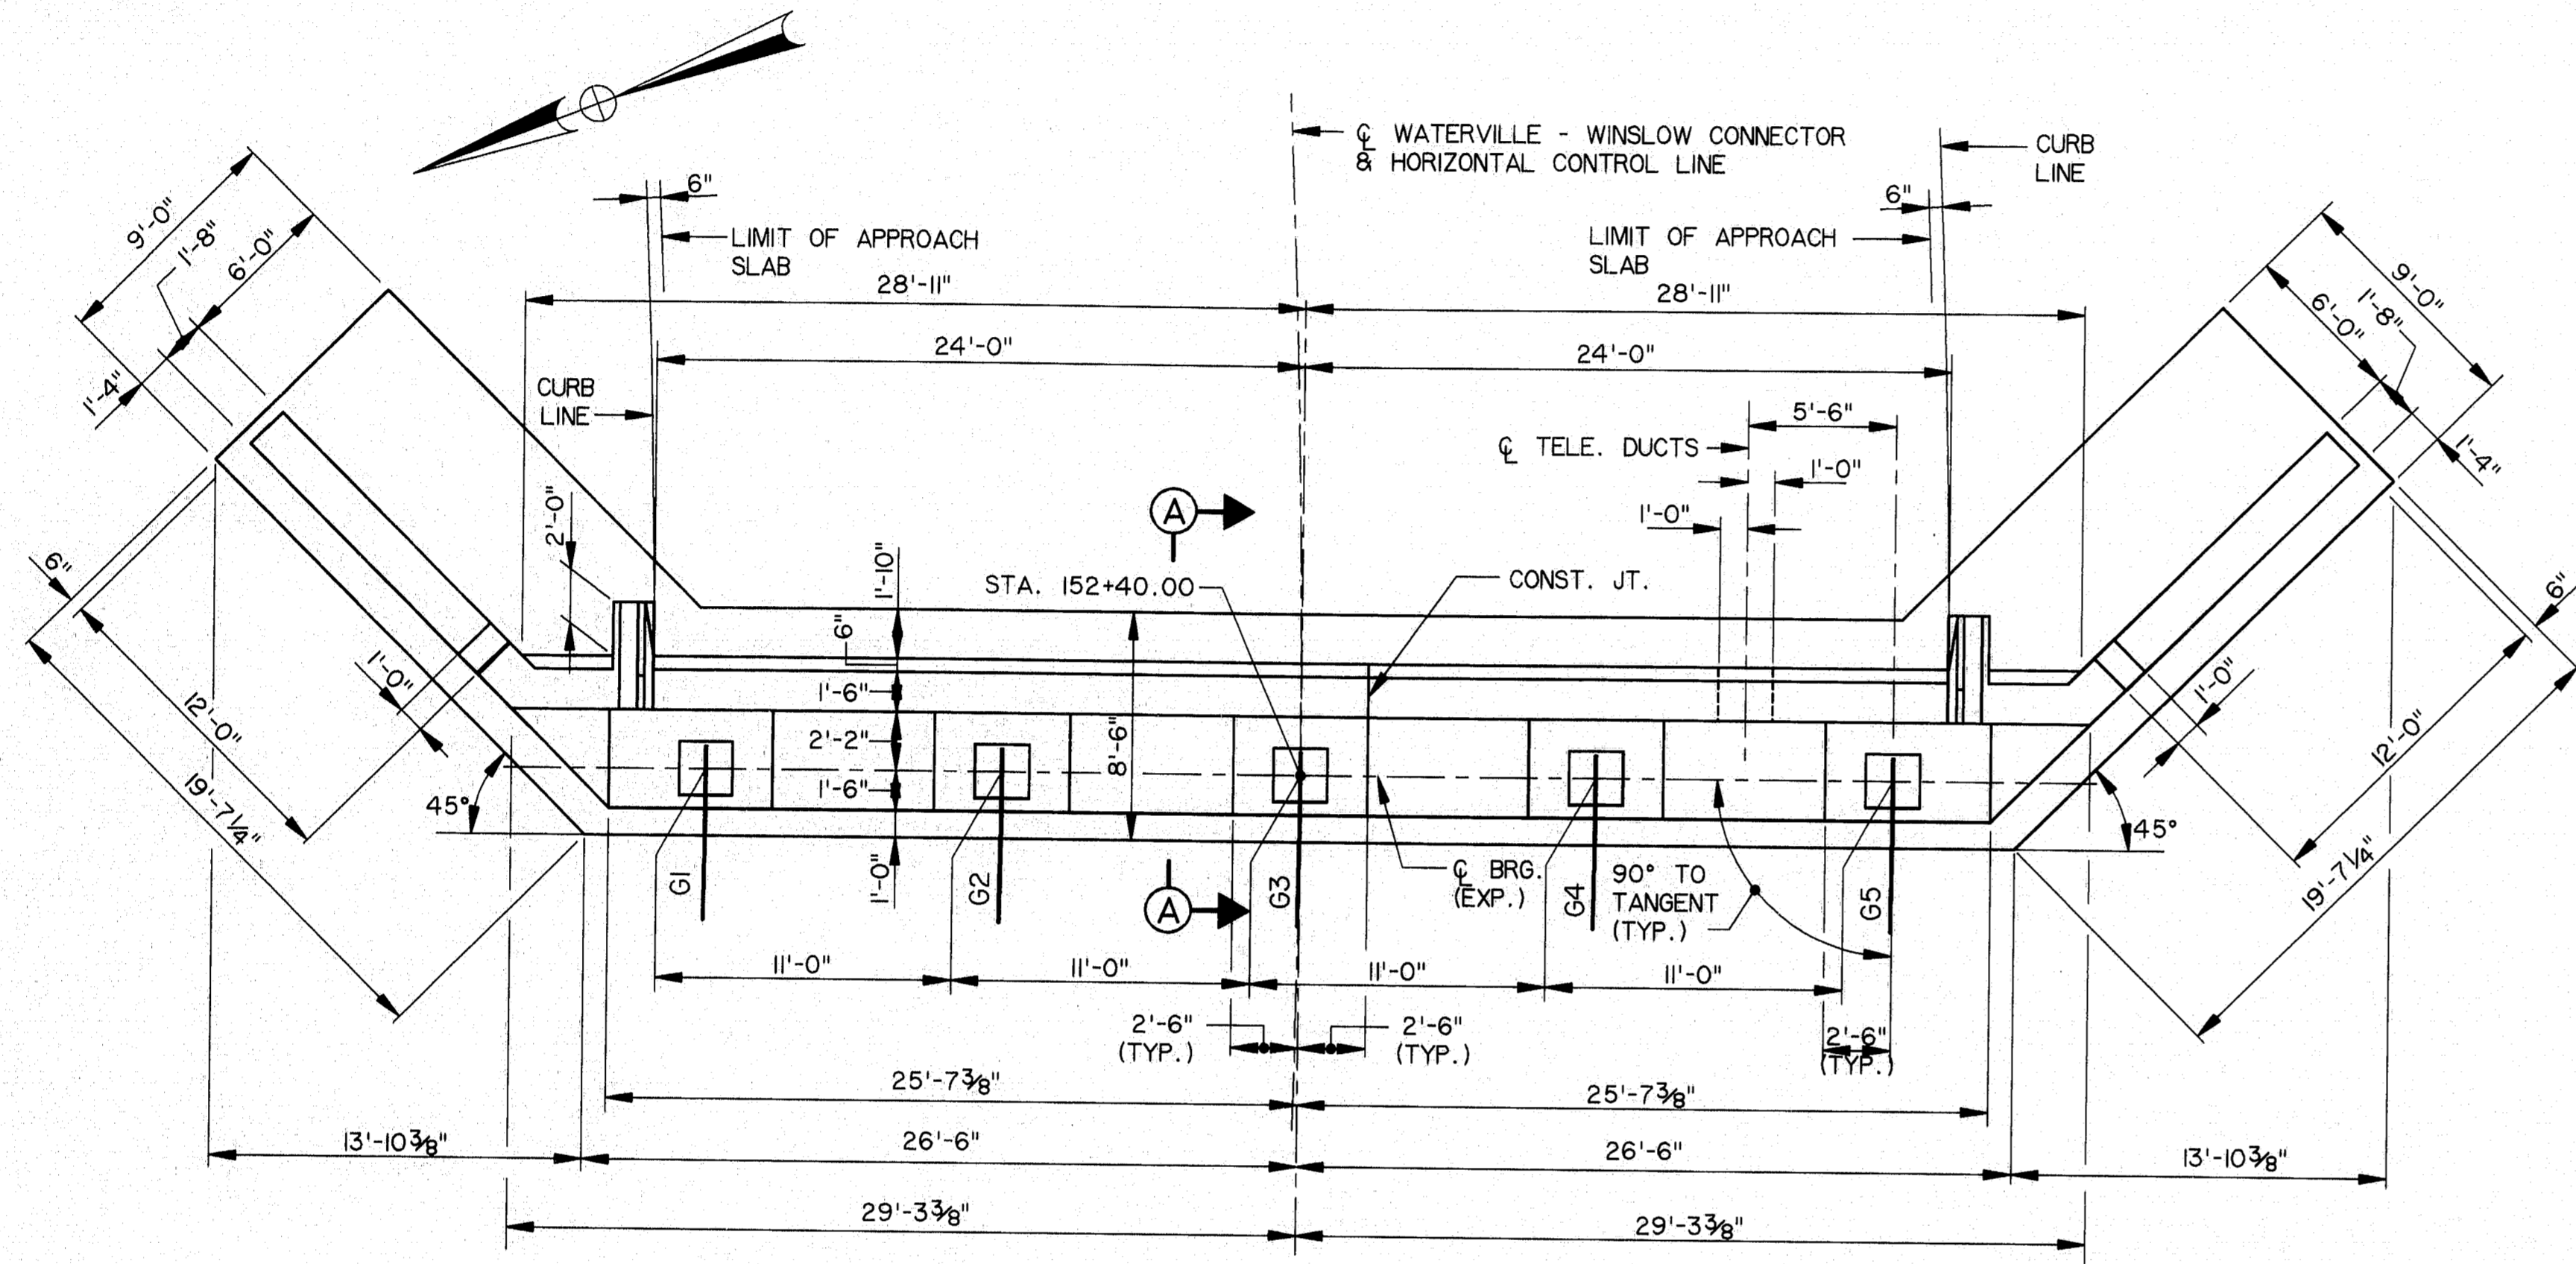

PLAN - ABUTMENT NO. 2

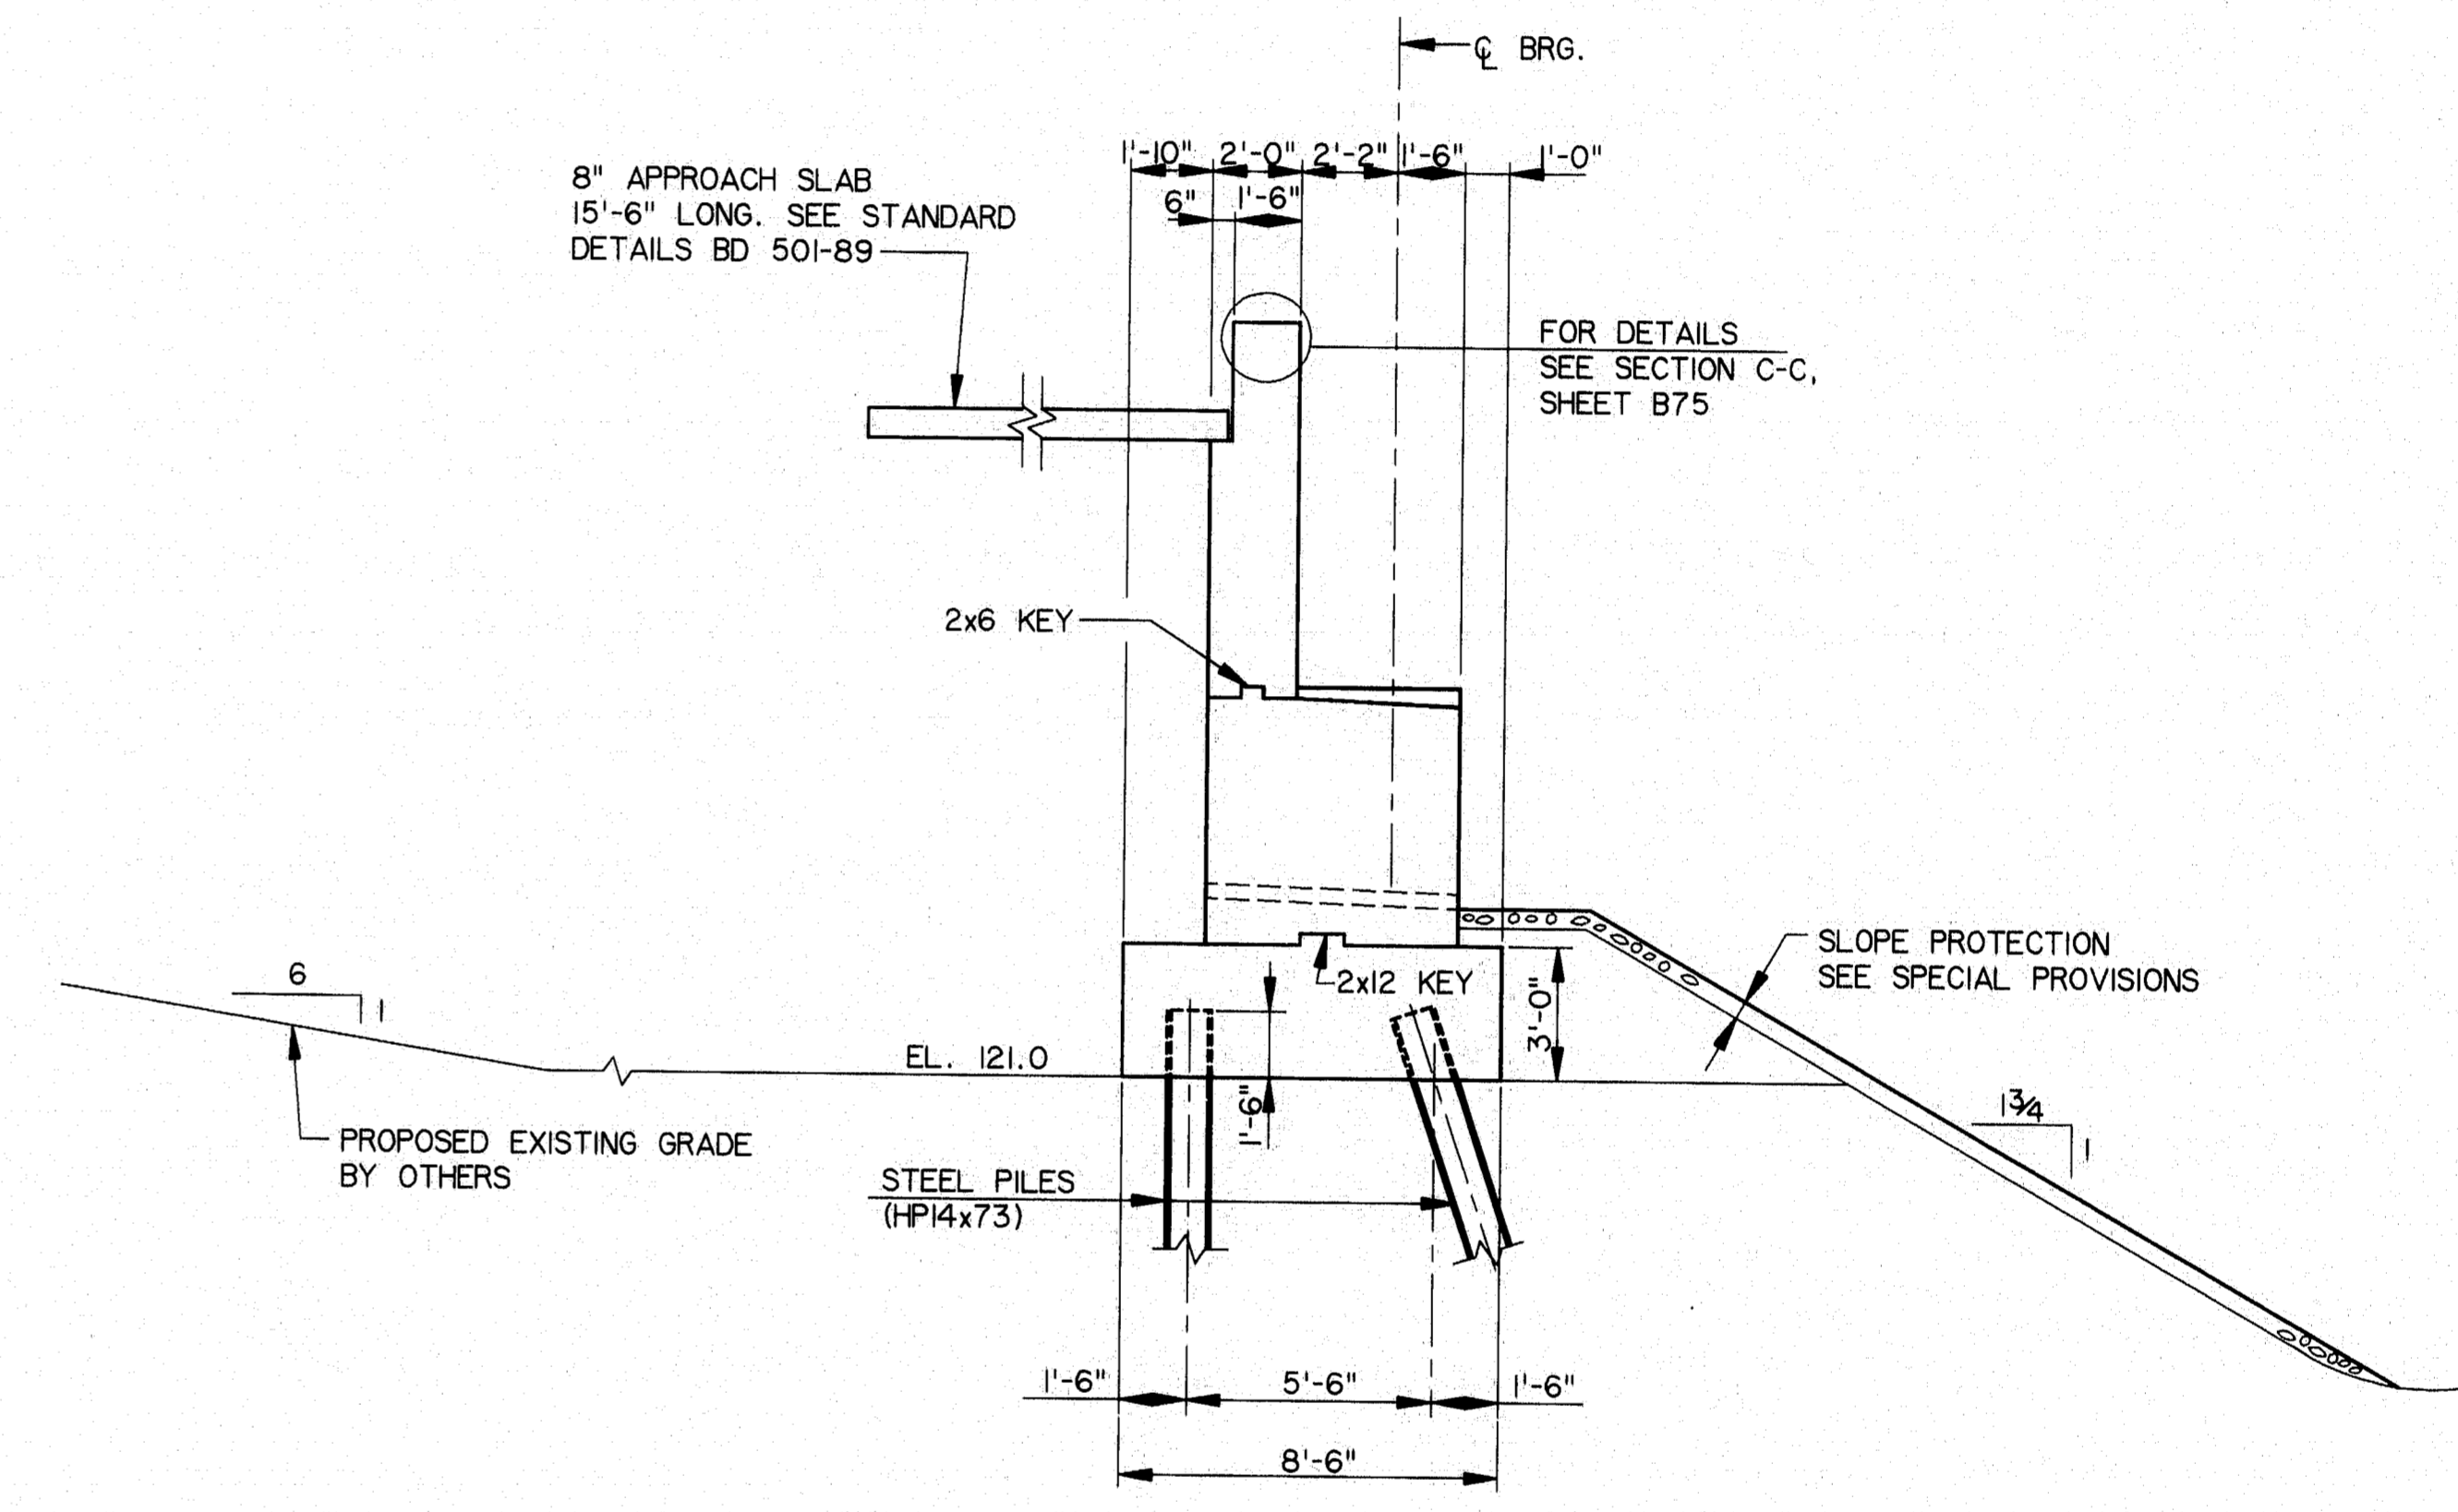

SECTION A-A  
(FOR ADDITIONAL DETAILS, SEE ABUTMENT 1)

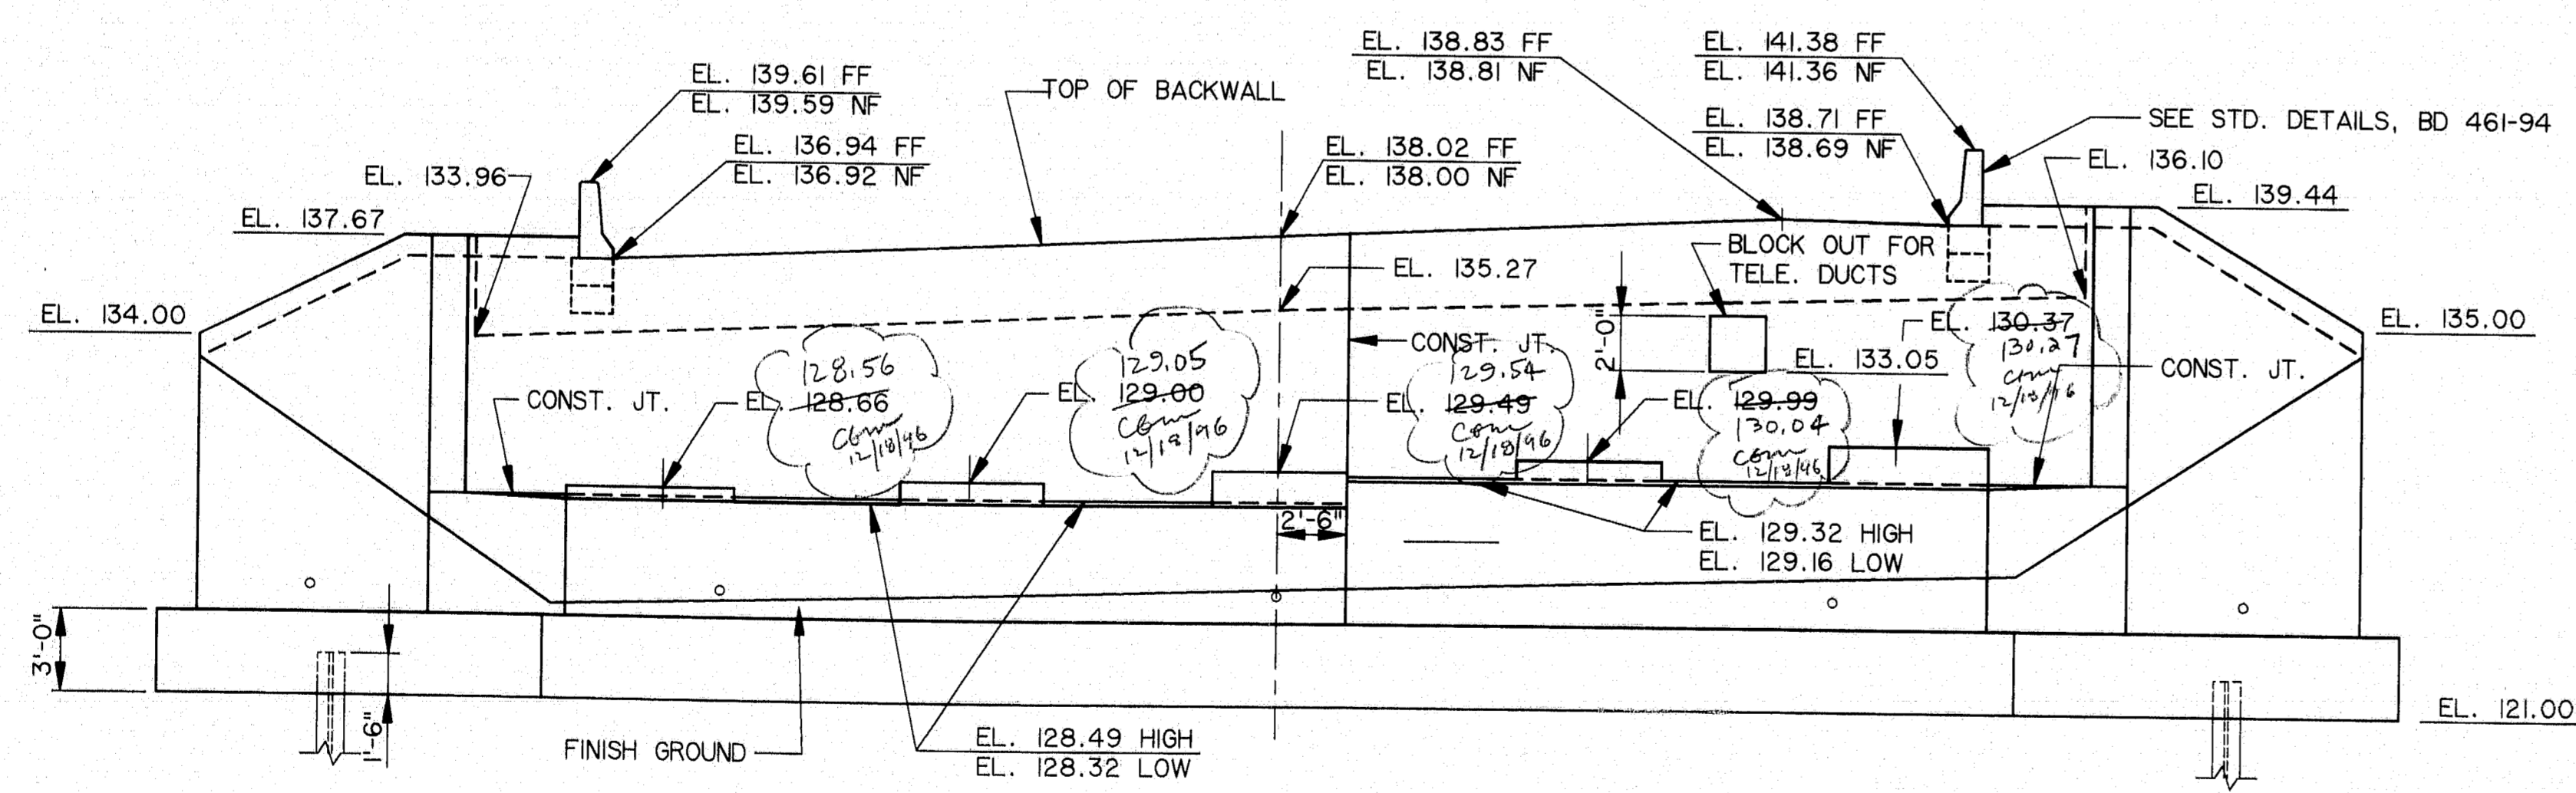

ELEVATION

- NOTES**
1. MAXIMUM PILE LOAD = 68 TONS
  2. FOR ADDITIONAL NOTES SEE ABUTMENT 1.

NO.	REVISION	BY	DATE	IN CHARGE OF
		DESIGNED:	SM	9/94
		DRAWN:	RJT	9/94
		CHECKED:	DWR	9/94
				CJM




**115-221**


STEEL ALTERNATIVE  
STATE OF MAINE  
DEPARTMENT OF TRANSPORTATION  
WATERVILLE - WINSLOW PROJECT  
DONALD V. CARTER BRIDGE  
OVER  
KENNEBEC RIVER  
ABUTMENT 2 (CONCRETE)

SHEET B26 OF B86    AUGUSTA, MAINE


F.H.W.A. RES. NO.	STATE	PROJECT NUMBER	SHEET NO.	TOTAL SHEETS
1	MAINE	0009(002)	36	103

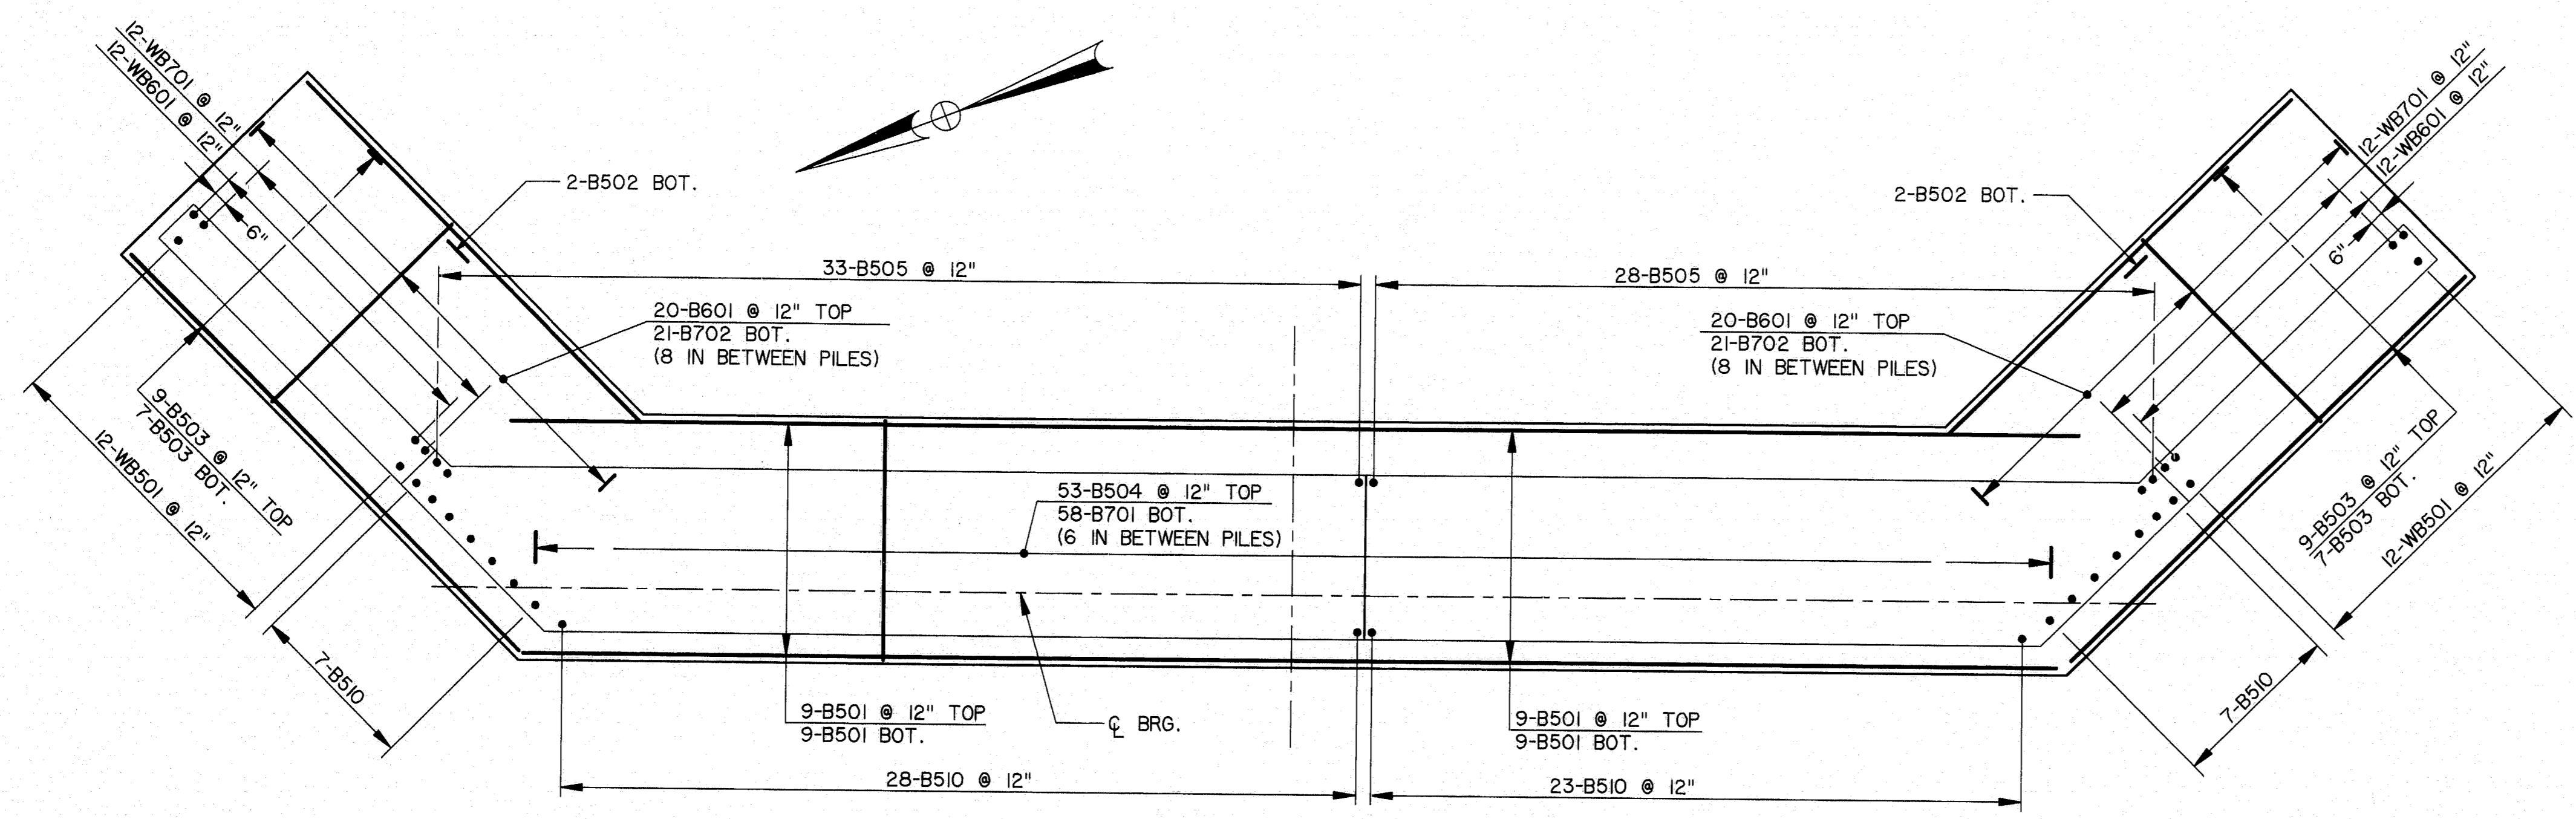

PLAN - ABUTMENT NO. 2

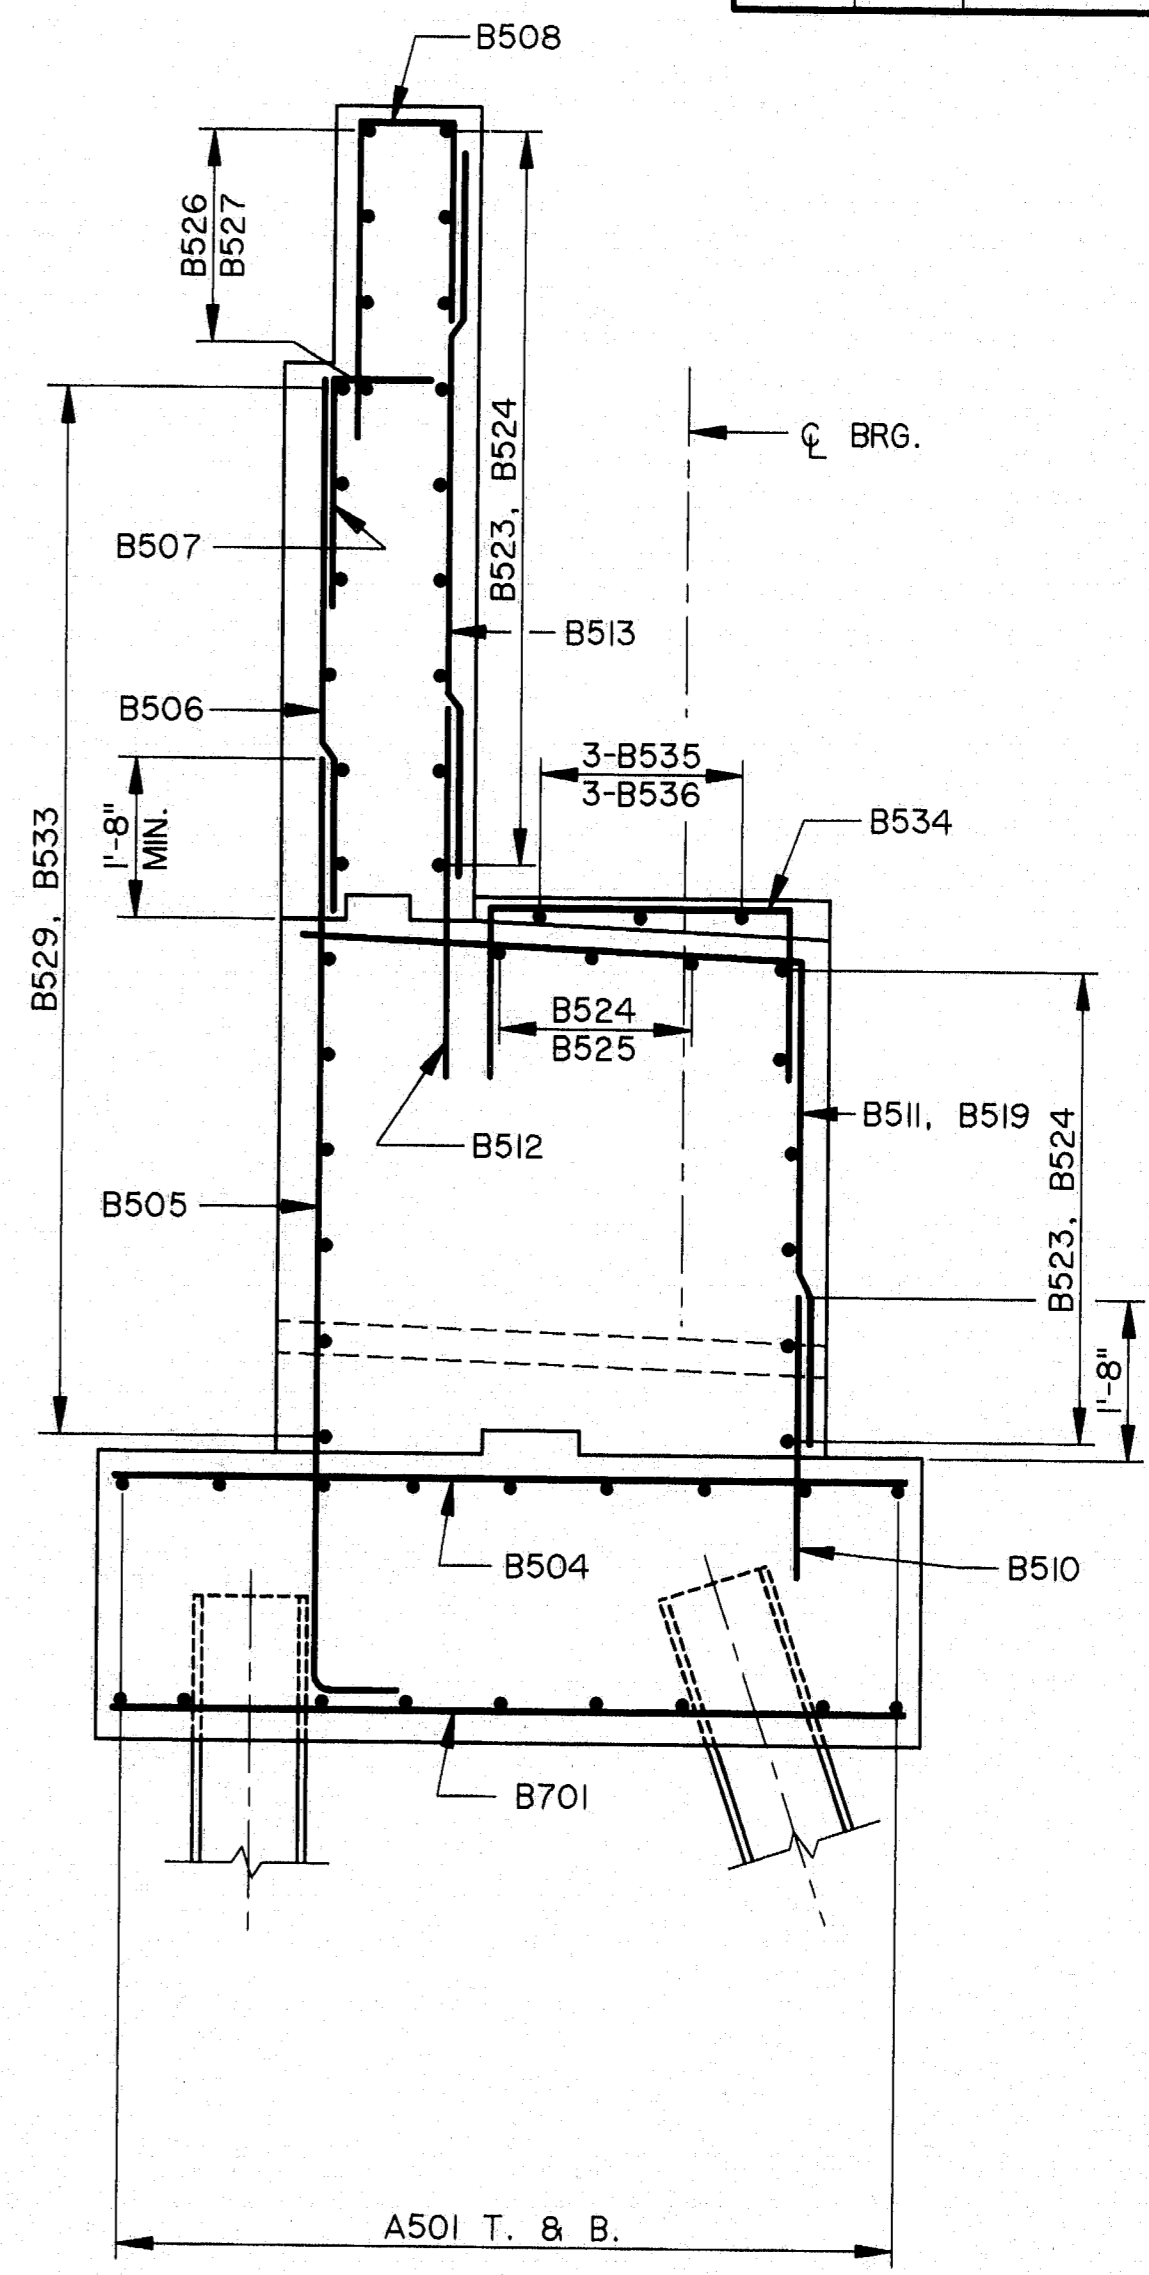

SECTION A-A

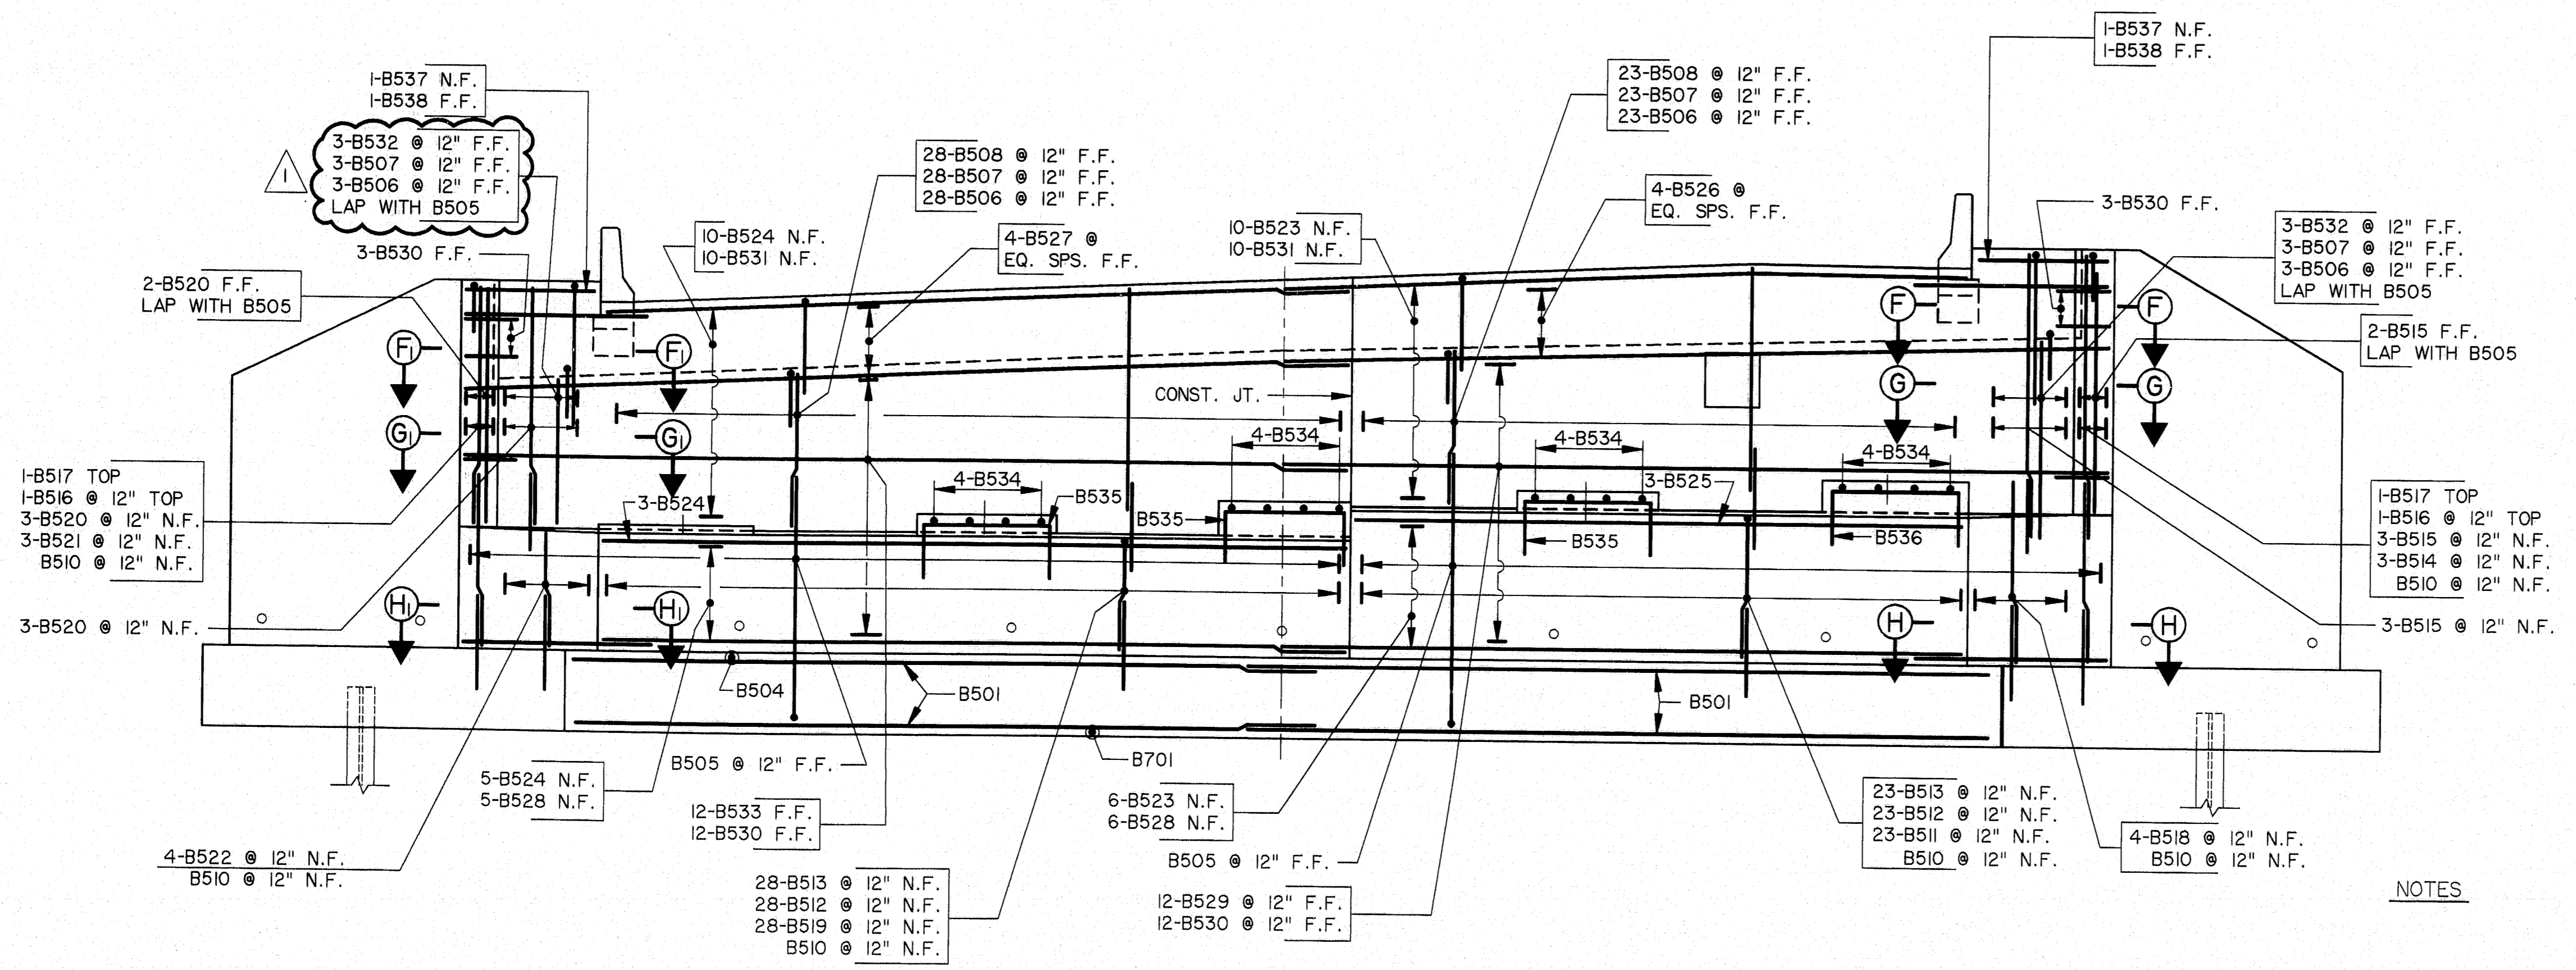

ELEVATION


NOTES

1. FOR END POST BRACKET REINFORCEMENT, SEE SHEET B73.
2. FOR SECTIONS F-F, G-G, H-H, F1 - F1, G1 - G1, H1 - H1, SEE SHEET B28.

*AS BUILT  
Cem 12/10/96*

115-222

STATE OF MAINE DEPARTMENT OF TRANSPORTATION WATERVILLE - WINSLOW PROJECT DONALD V. CARTER BRIDGE OVER KENNEBEC RIVER ABUTMENT 2 (RE-STEEL)
SHEET B27 OF B86 AUGUSTA, MAINE

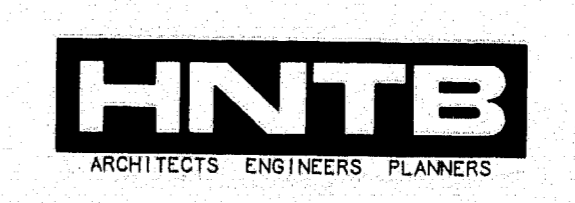


NO.	REVISION	BY	DATE	IN CHARGE OF	CJM
		DESIGNED: RJR	9/94		
		DRAWN: LS	9/94		
		CHECKED: JFW	9/94		




DWG: (WINGWALL STR. DOCUMENT) (2009) (002) (002) (002)


F.W.A. REG. NO.	STATE	PROJECT NUMBER	SHEET NO.	TOTAL SHEETS
1	MAINE	0009 (002)	38	103

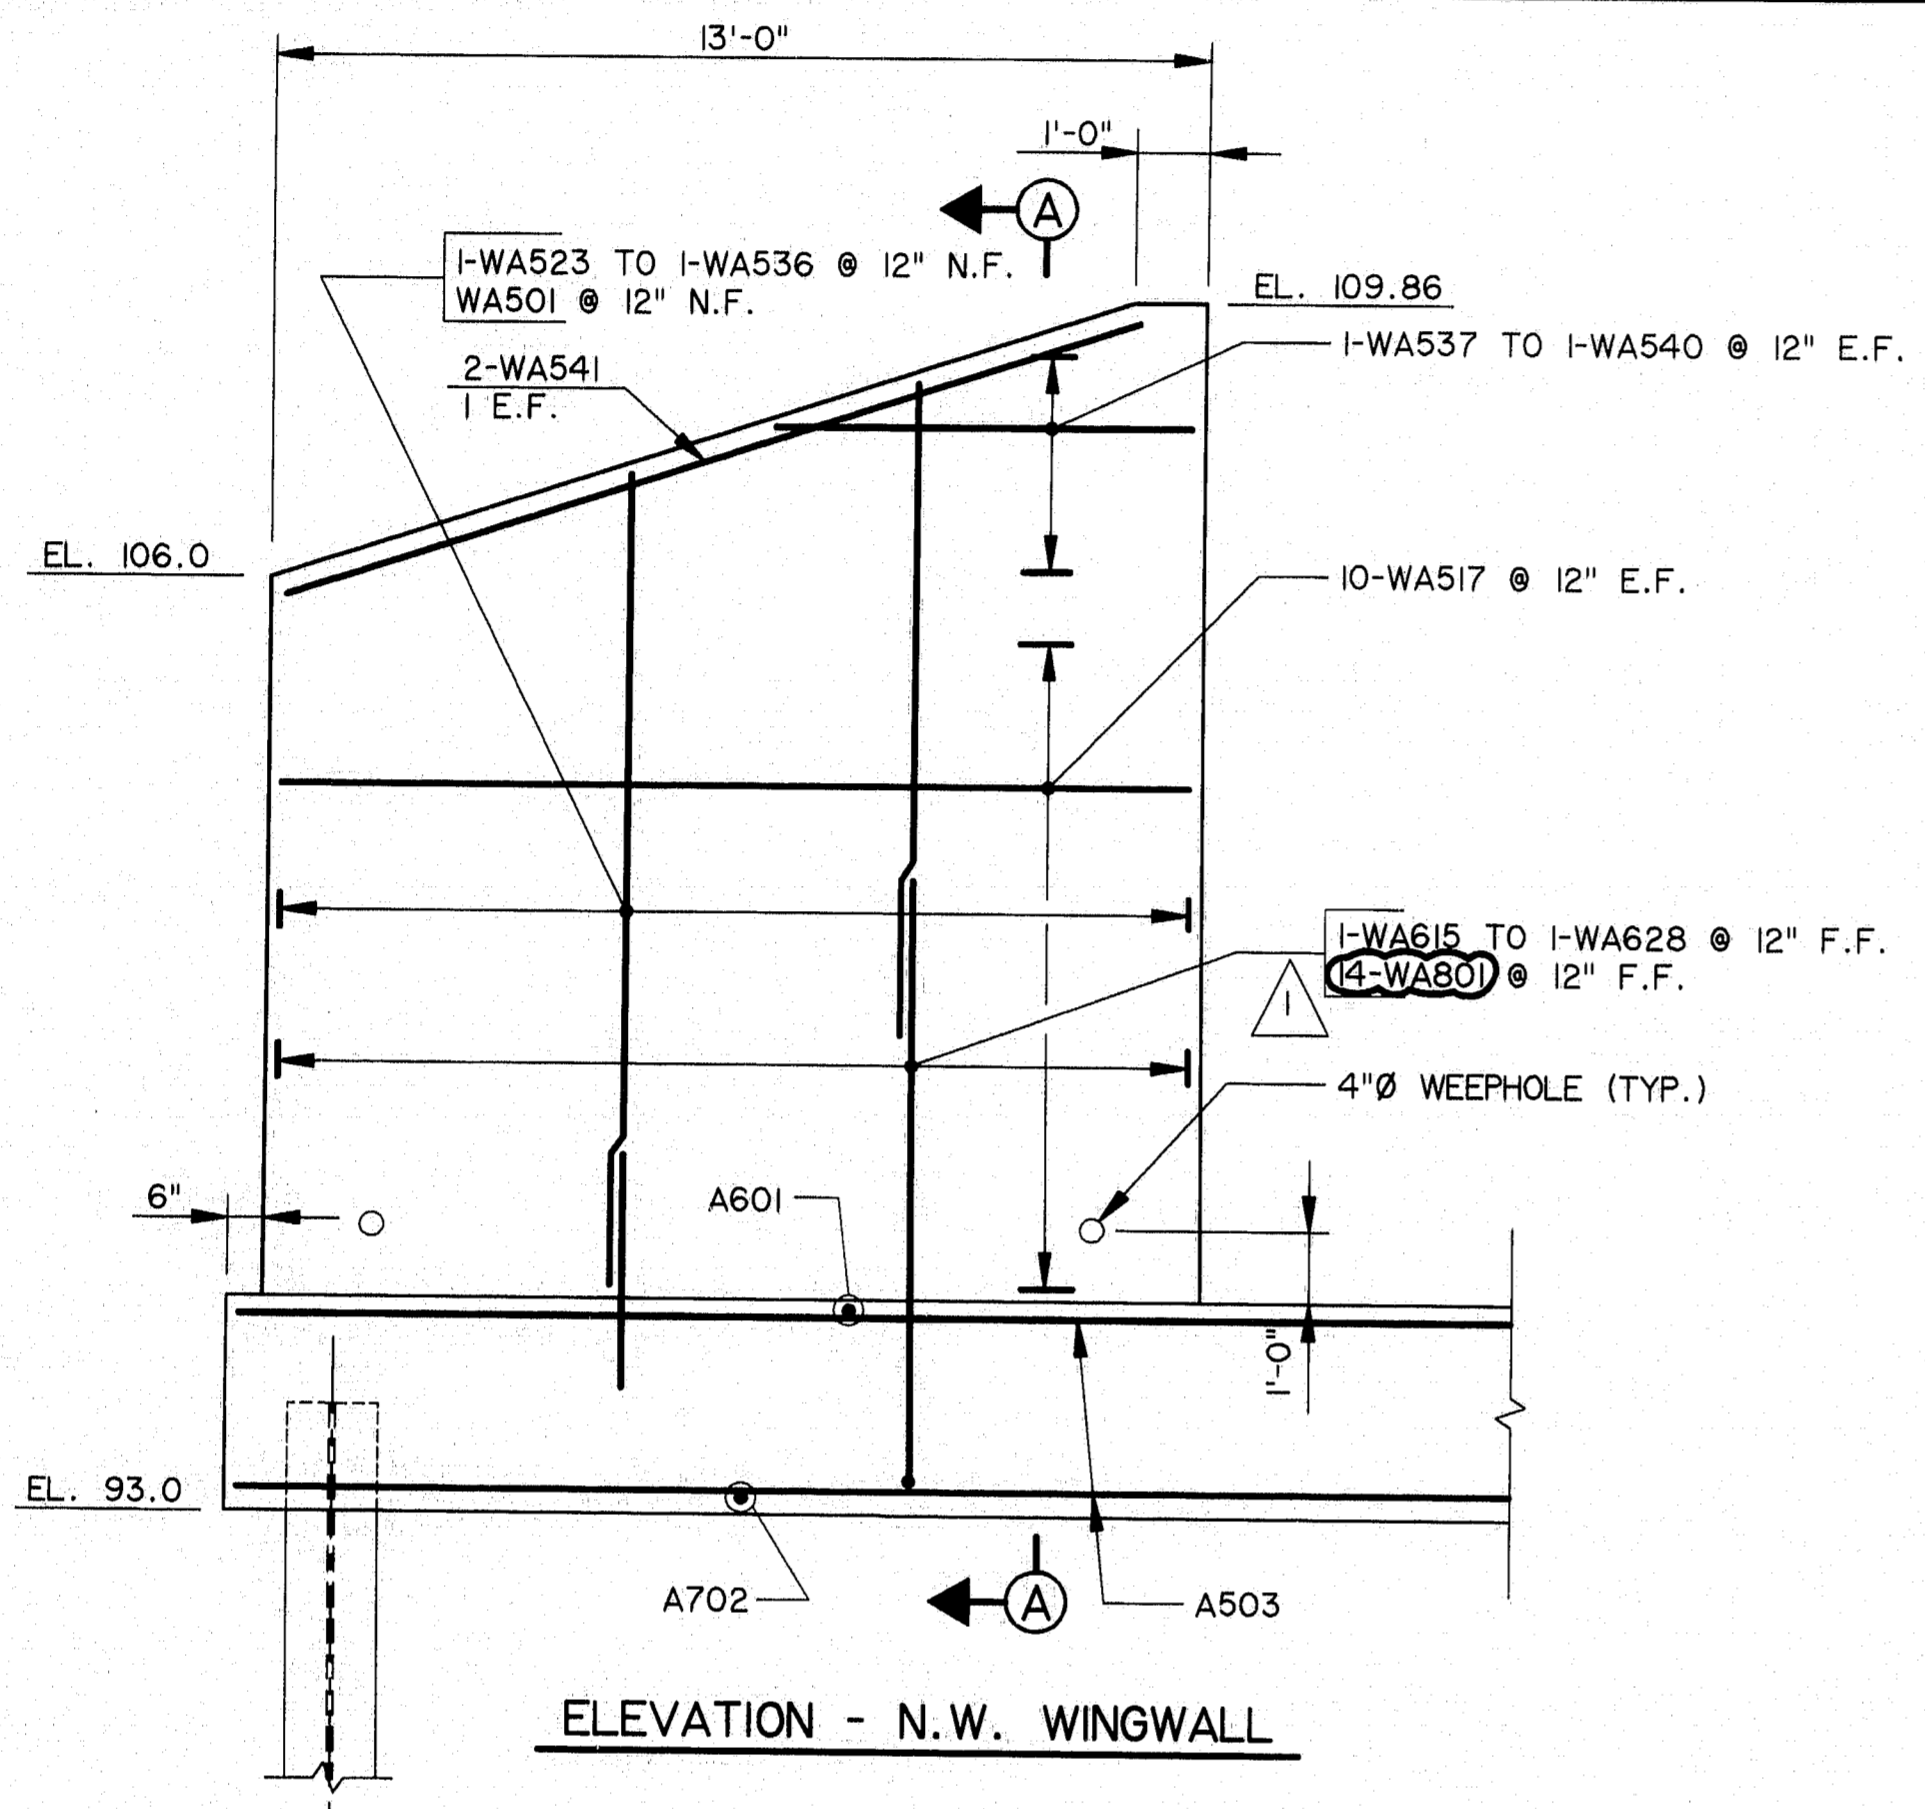


ELEVATION - N.W. WINGWALL

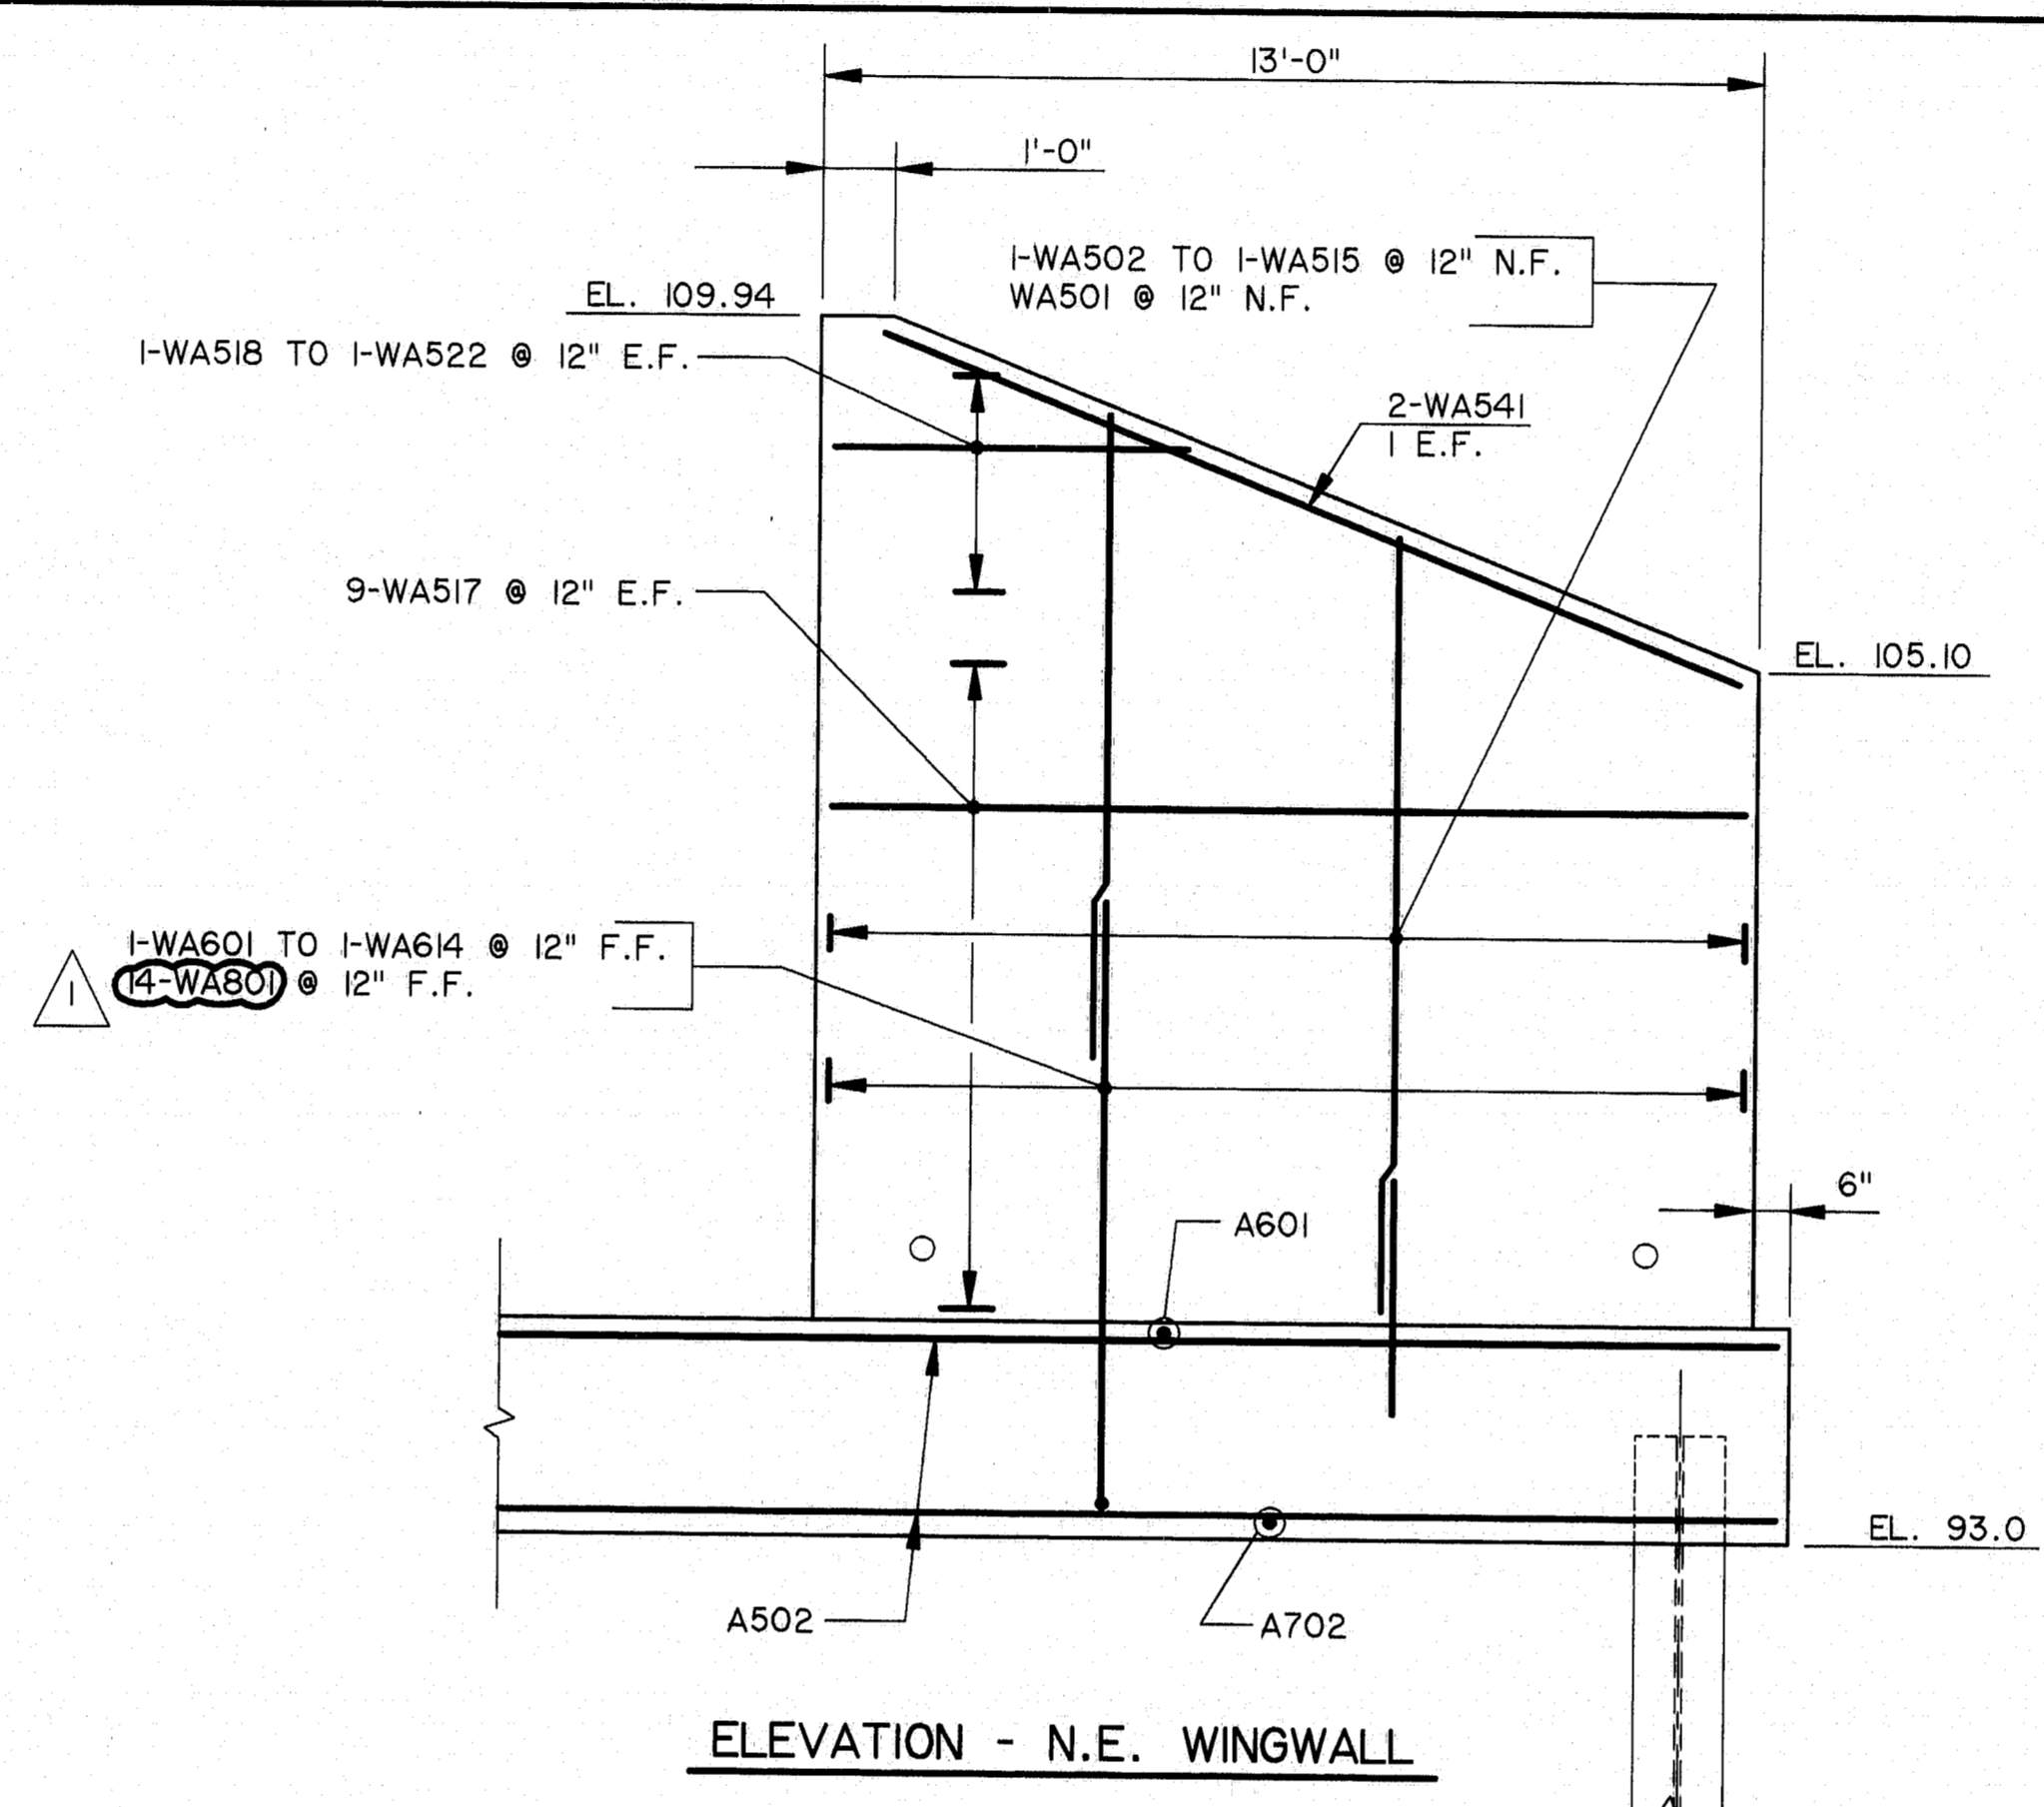


ELEVATION - N.E. WINGWALL

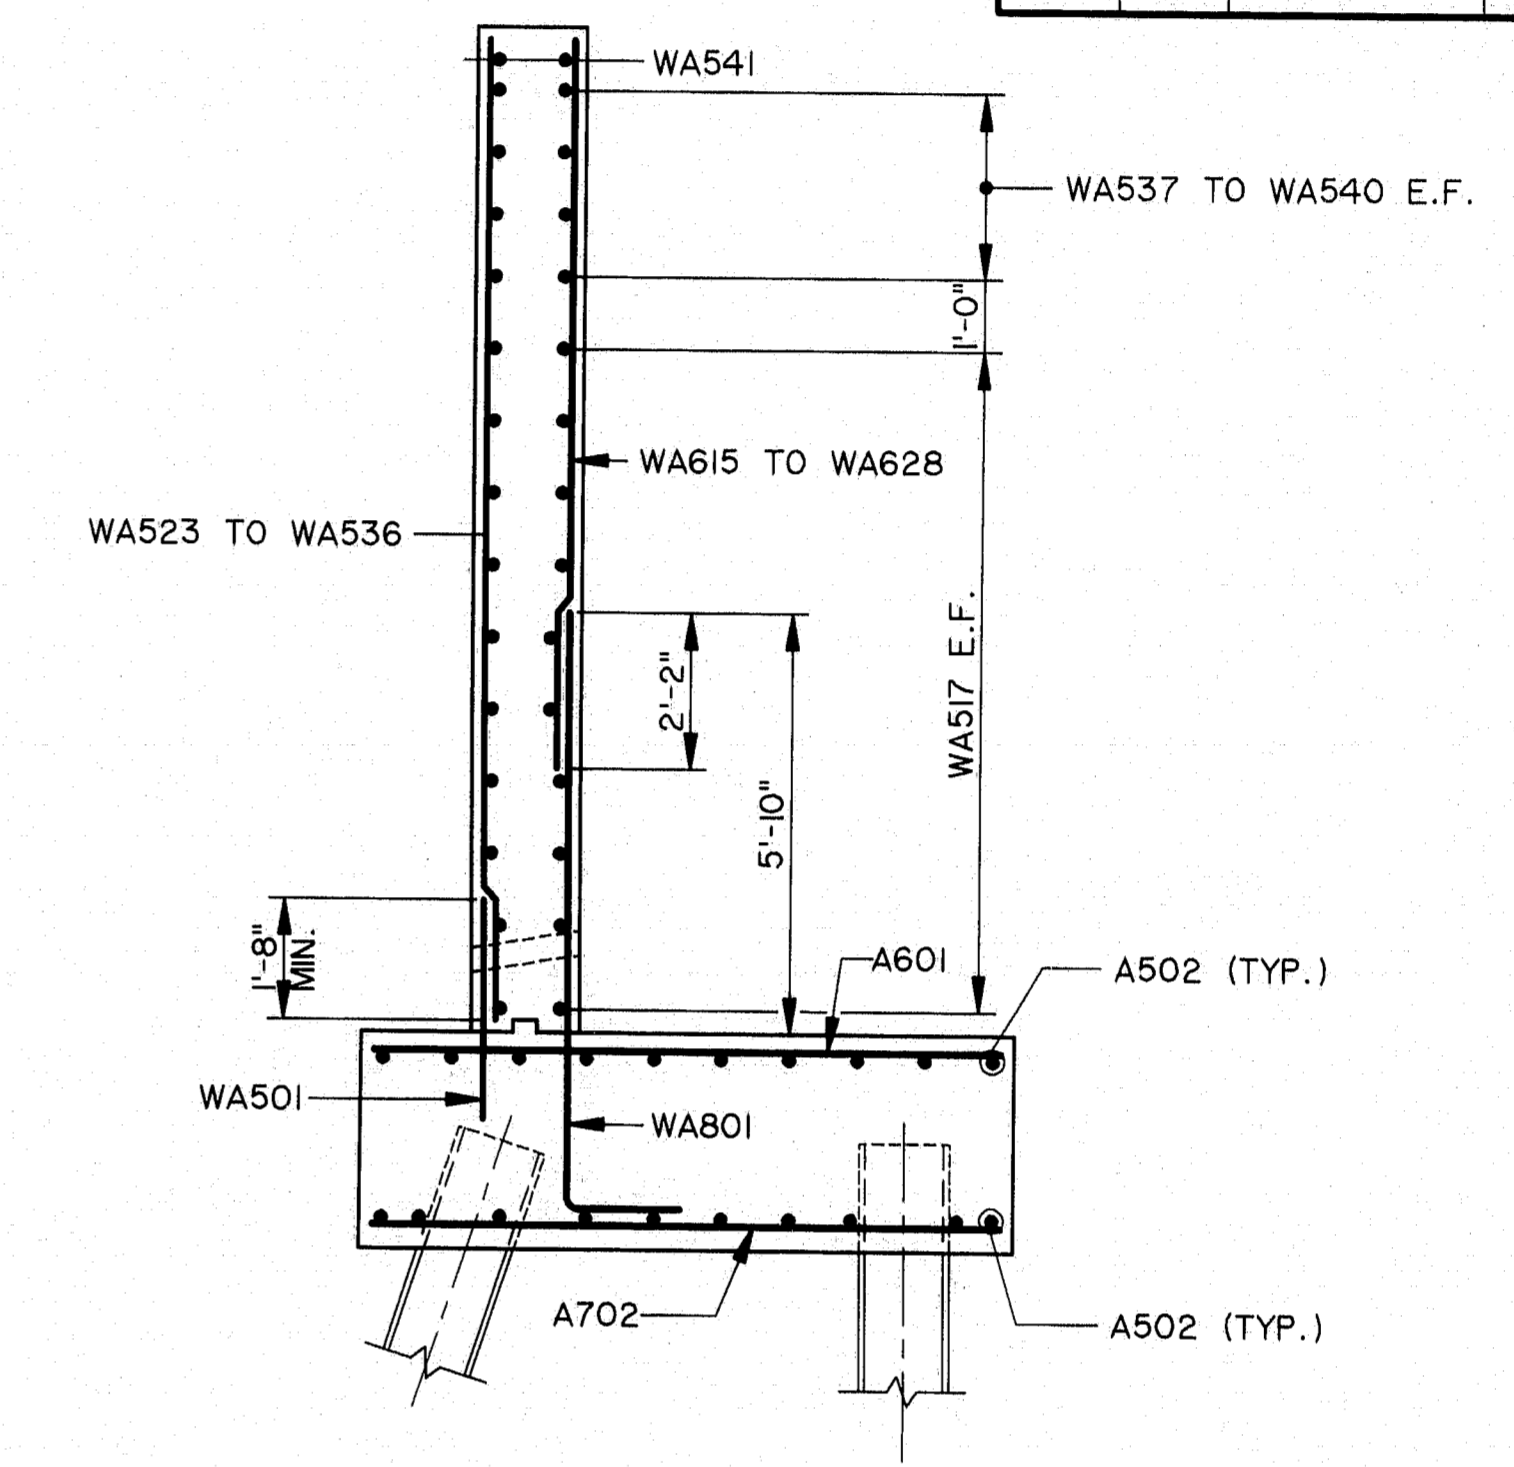


SECTION A-A

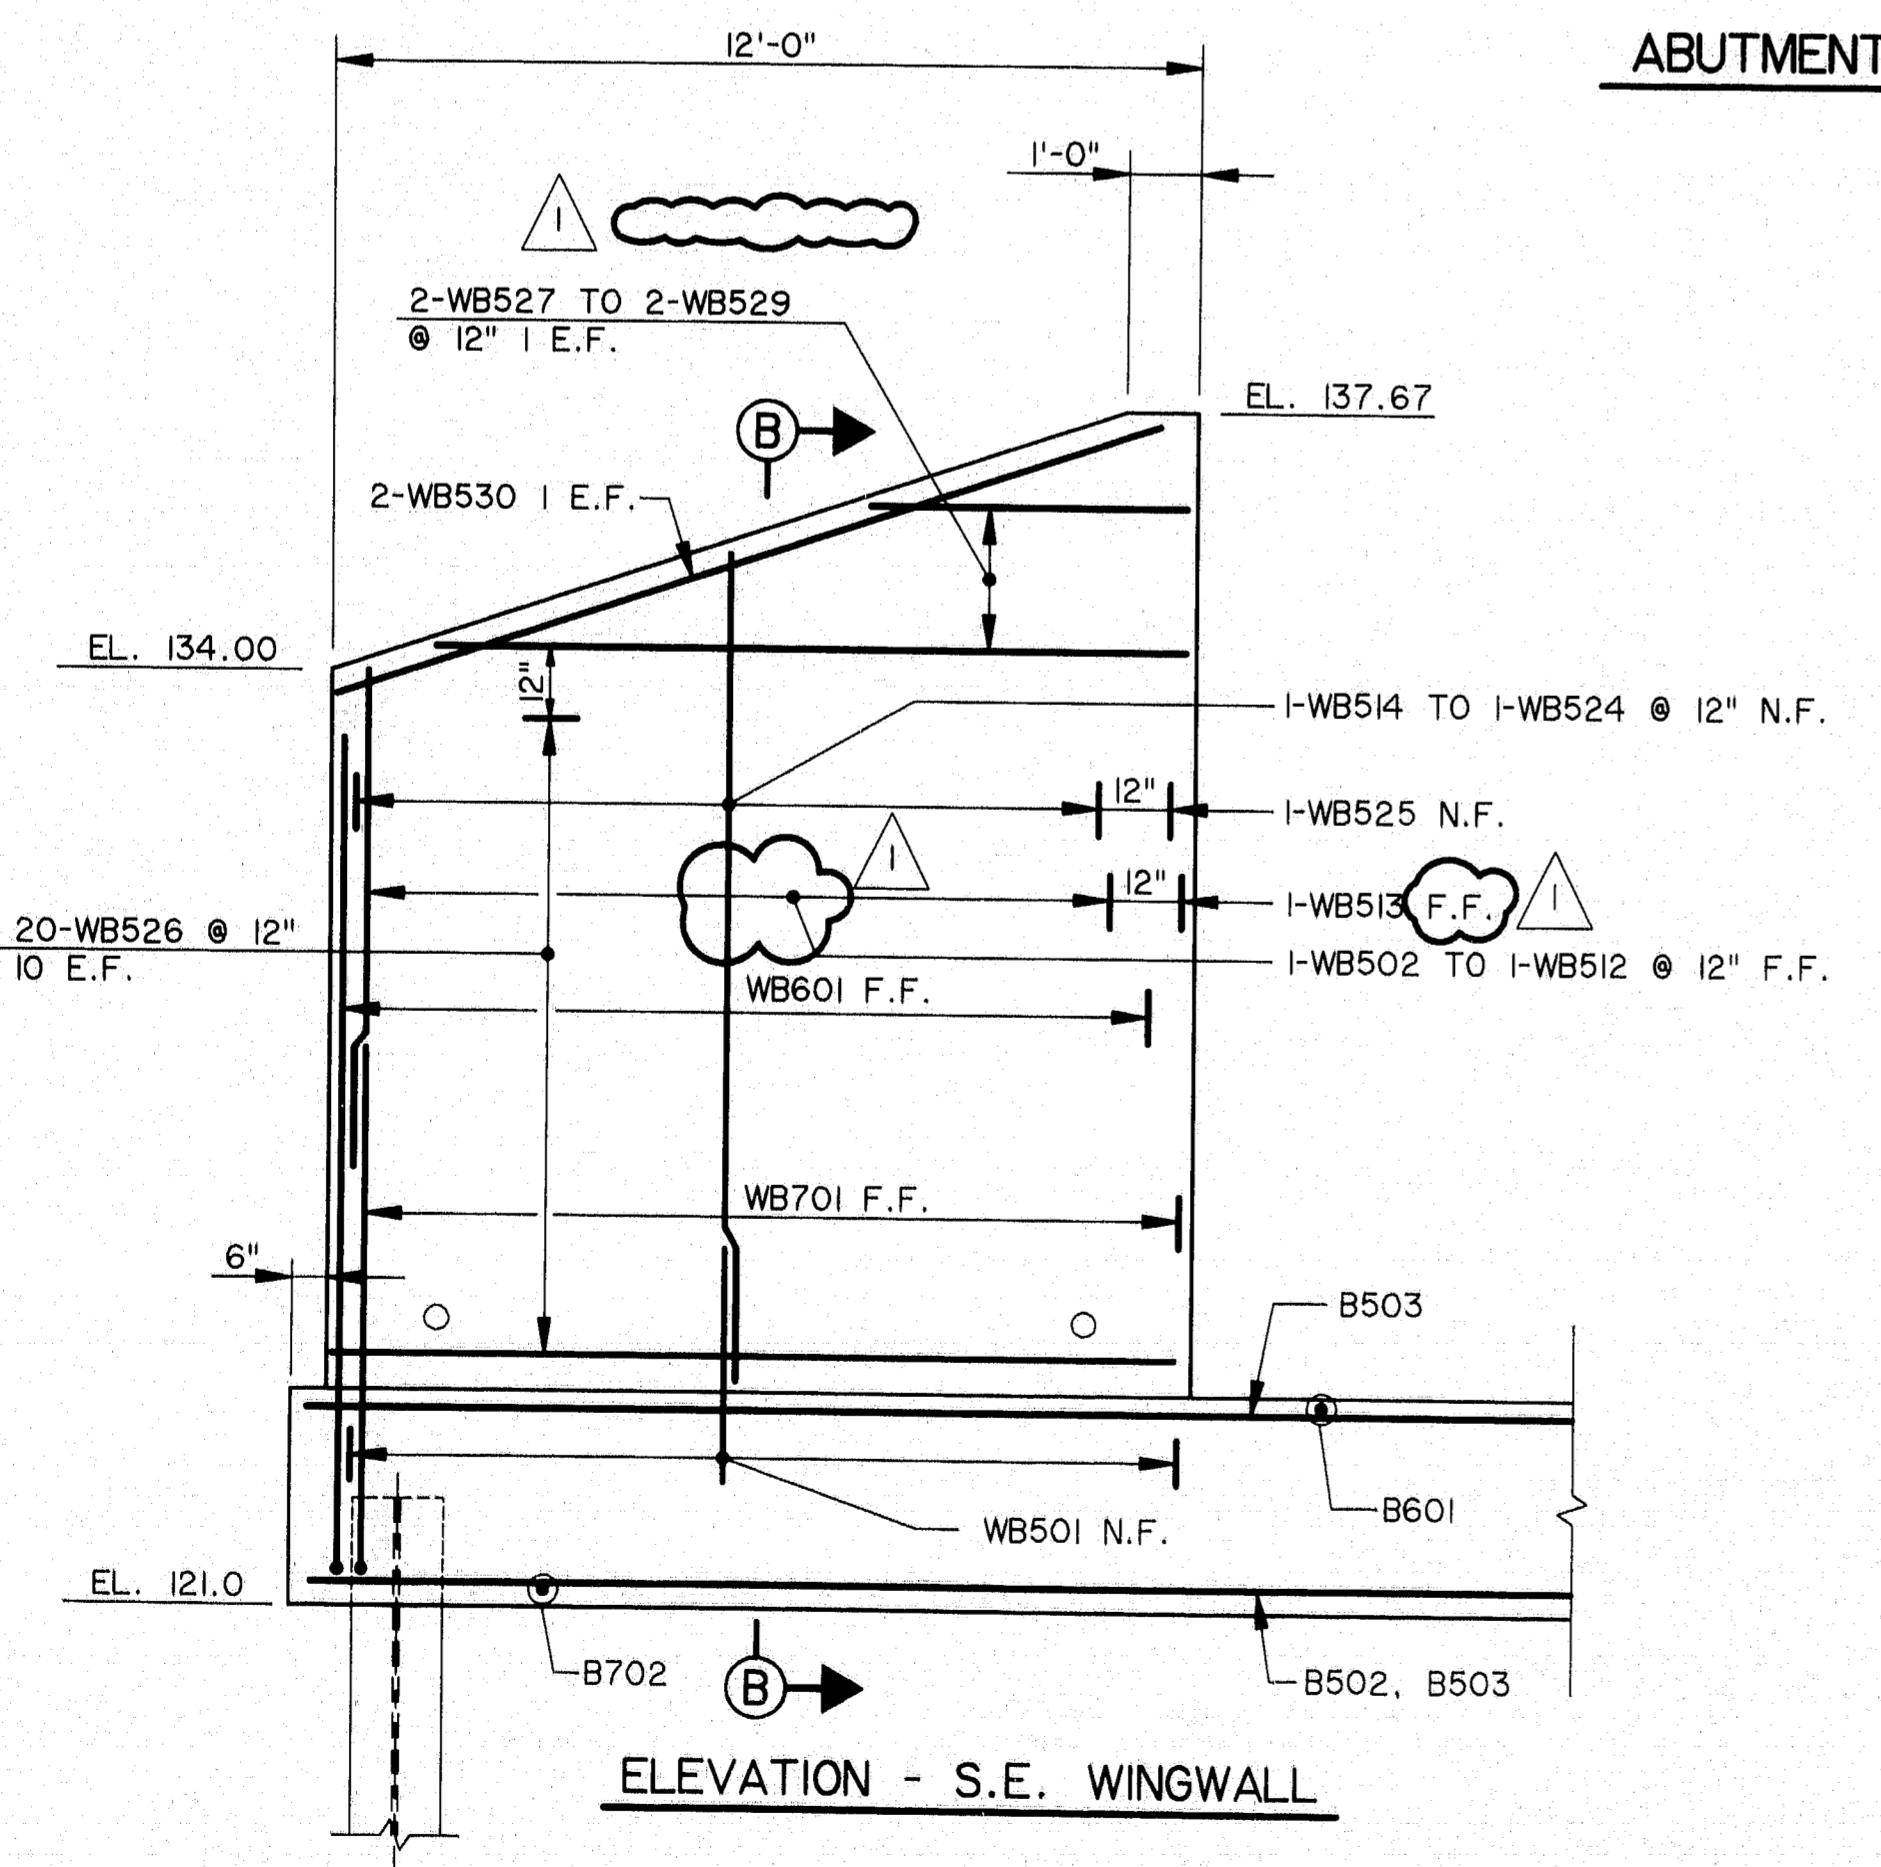

ELEVATION - S.E. WINGWALL

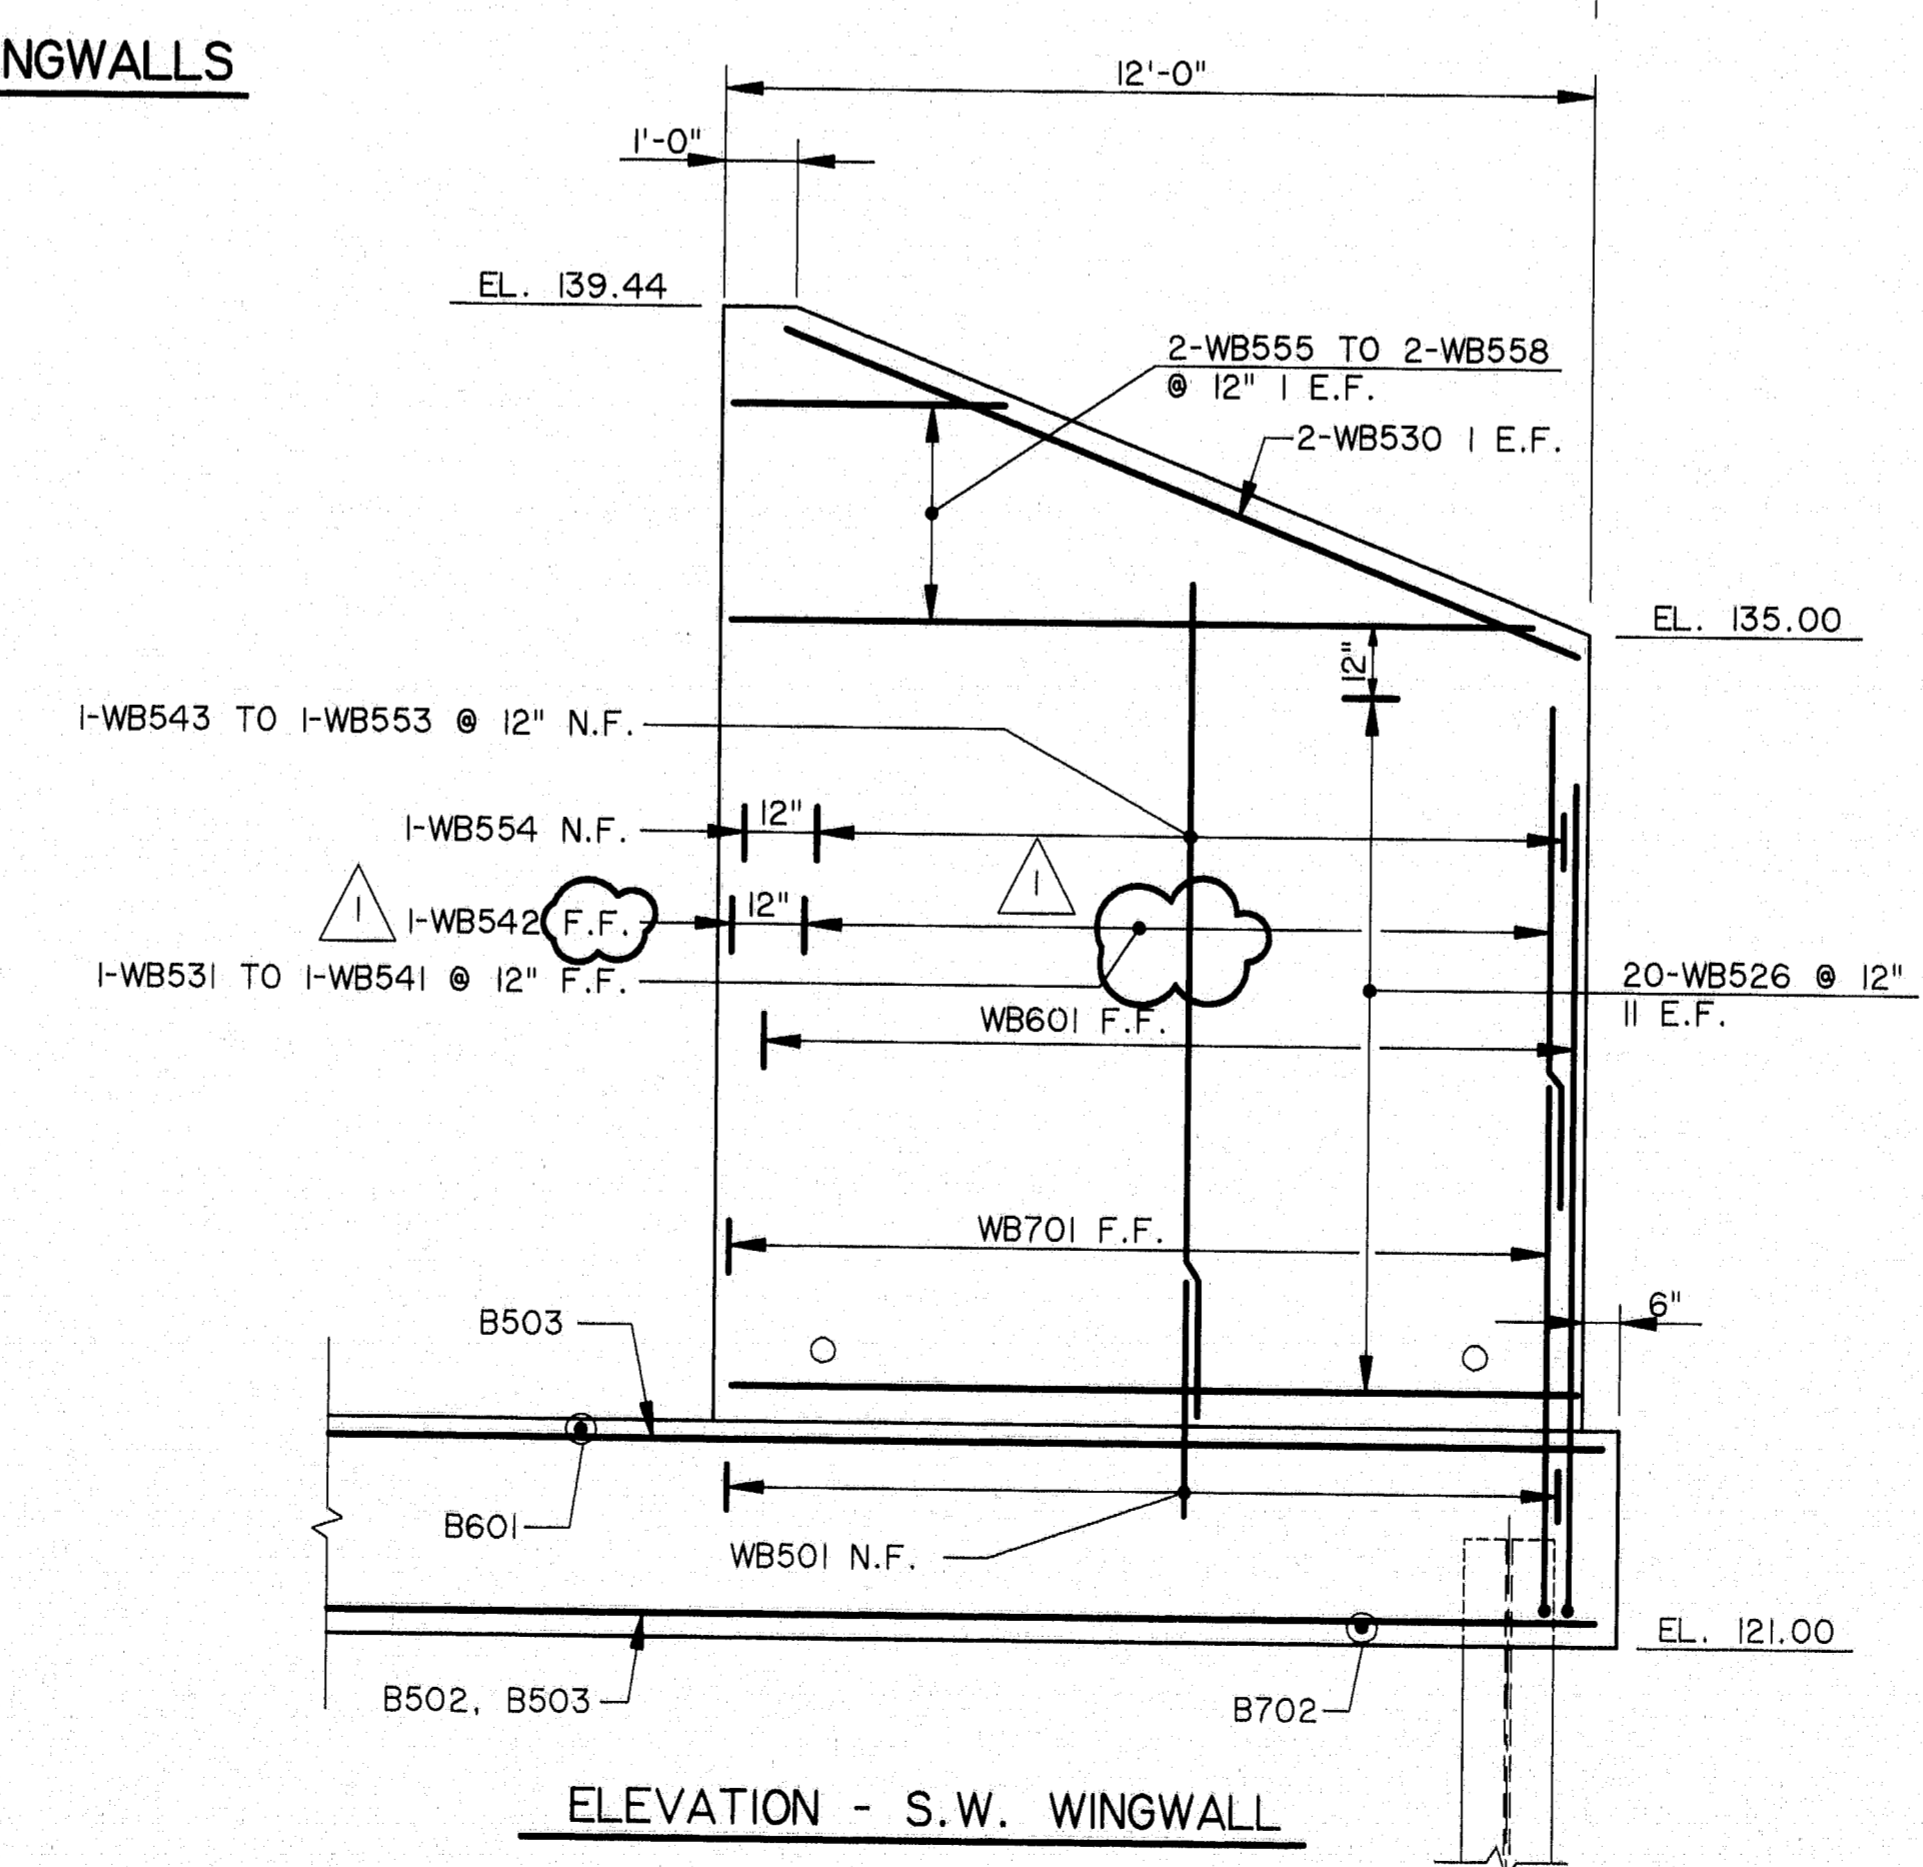

ELEVATION - S.W. WINGWALL

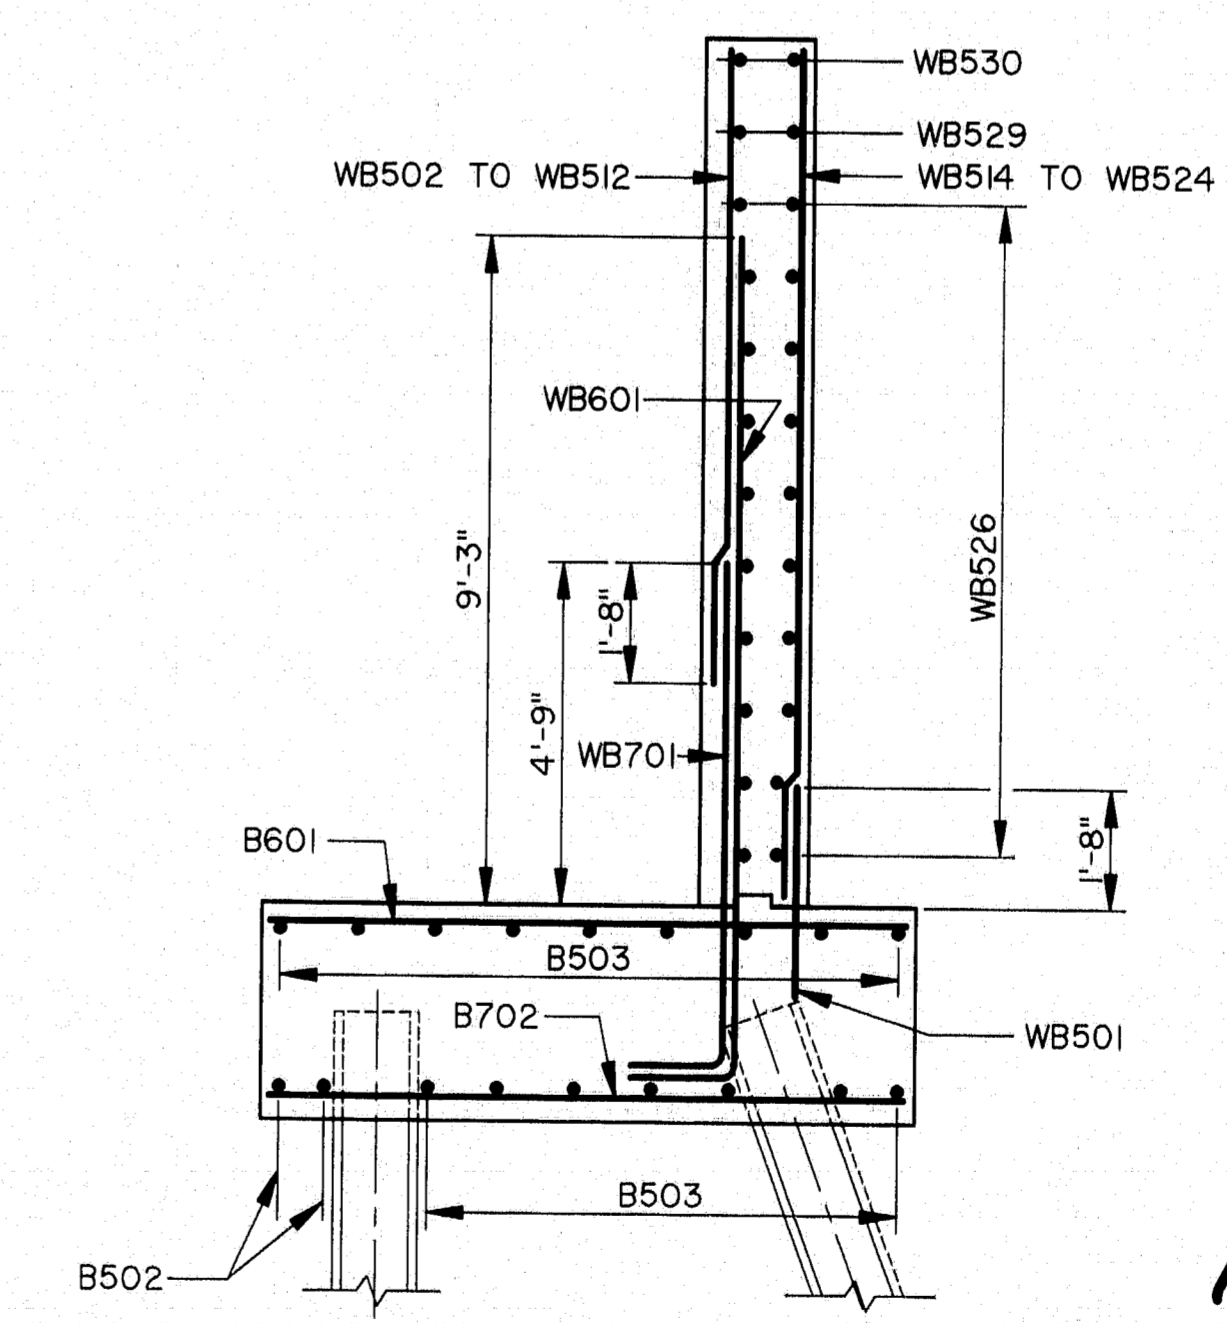


SECTION B-B

*AS BUILT*  
*from 11/14/96*

**115-224**

STEEL ALTERNATIVE
STATE OF MAINE
DEPARTMENT OF TRANSPORTATION
WATERVILLE - WINSLOW PROJECT
DONALD V. CARTER BRIDGE
OVER
KENNEBEC RIVER
WINGWALL DETAILS
SHEET B29 OF B86 AUGUSTA, MAINE


NOTES  
1. FOR ADDITIONAL DETAILS, SEE SHEETS B24 & B26.

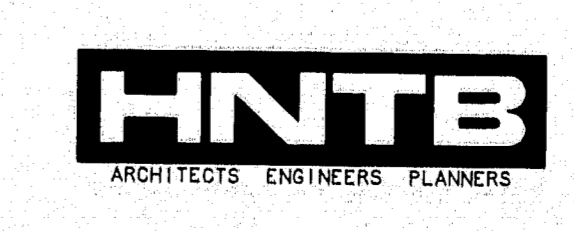


NO.	REVISION	BY	DATE	IN CHARGE OF
		DESIGNED:	AD	9/94
		DRAWN:	LS	9/94
		CHECKED:	RJR	9/94
				CJM

ABUTMENT NO. 2 - WINGWALLS

F.H.W.A. REG. NO.	STATE	PROJECT NUMBER	SHEET NO.	TOTAL SHEETS
1	MAINE	00091002	39	103

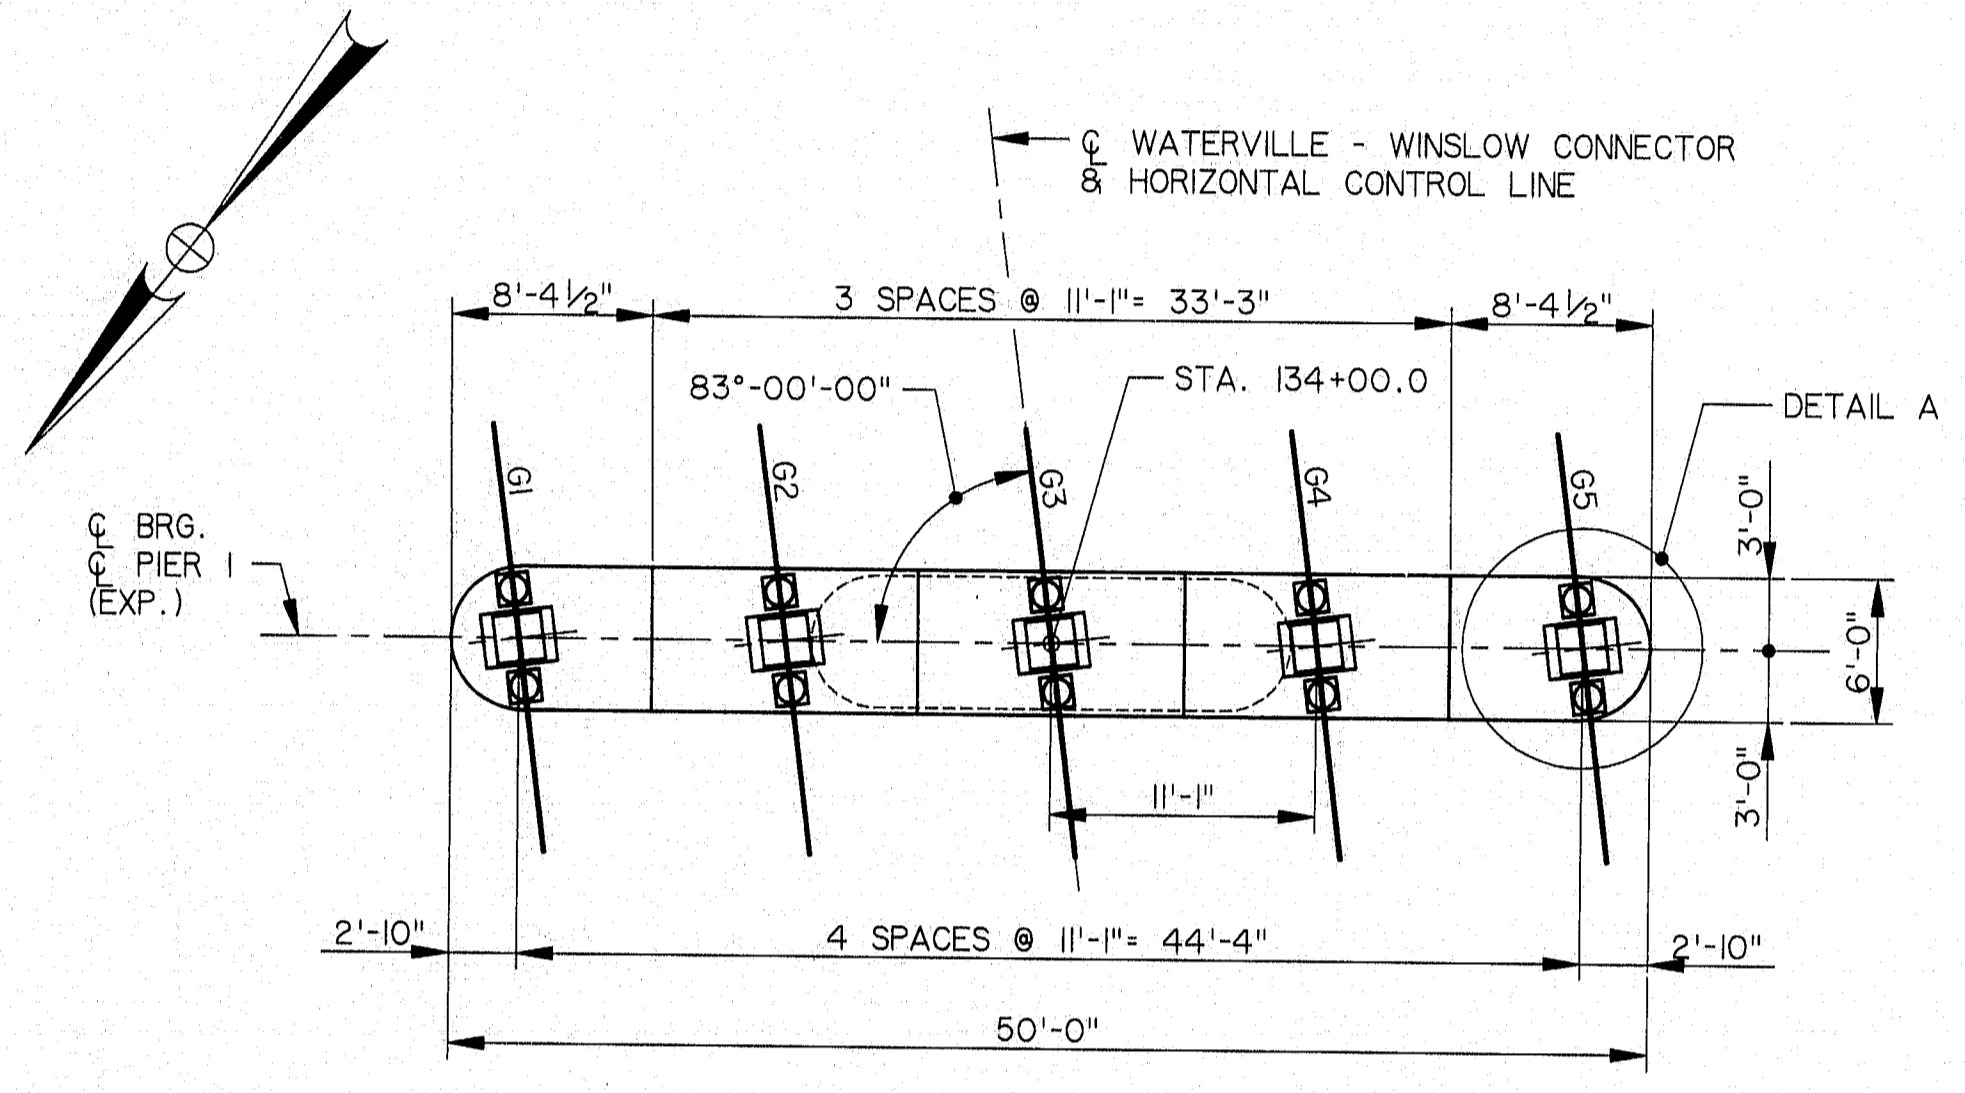

PLAN

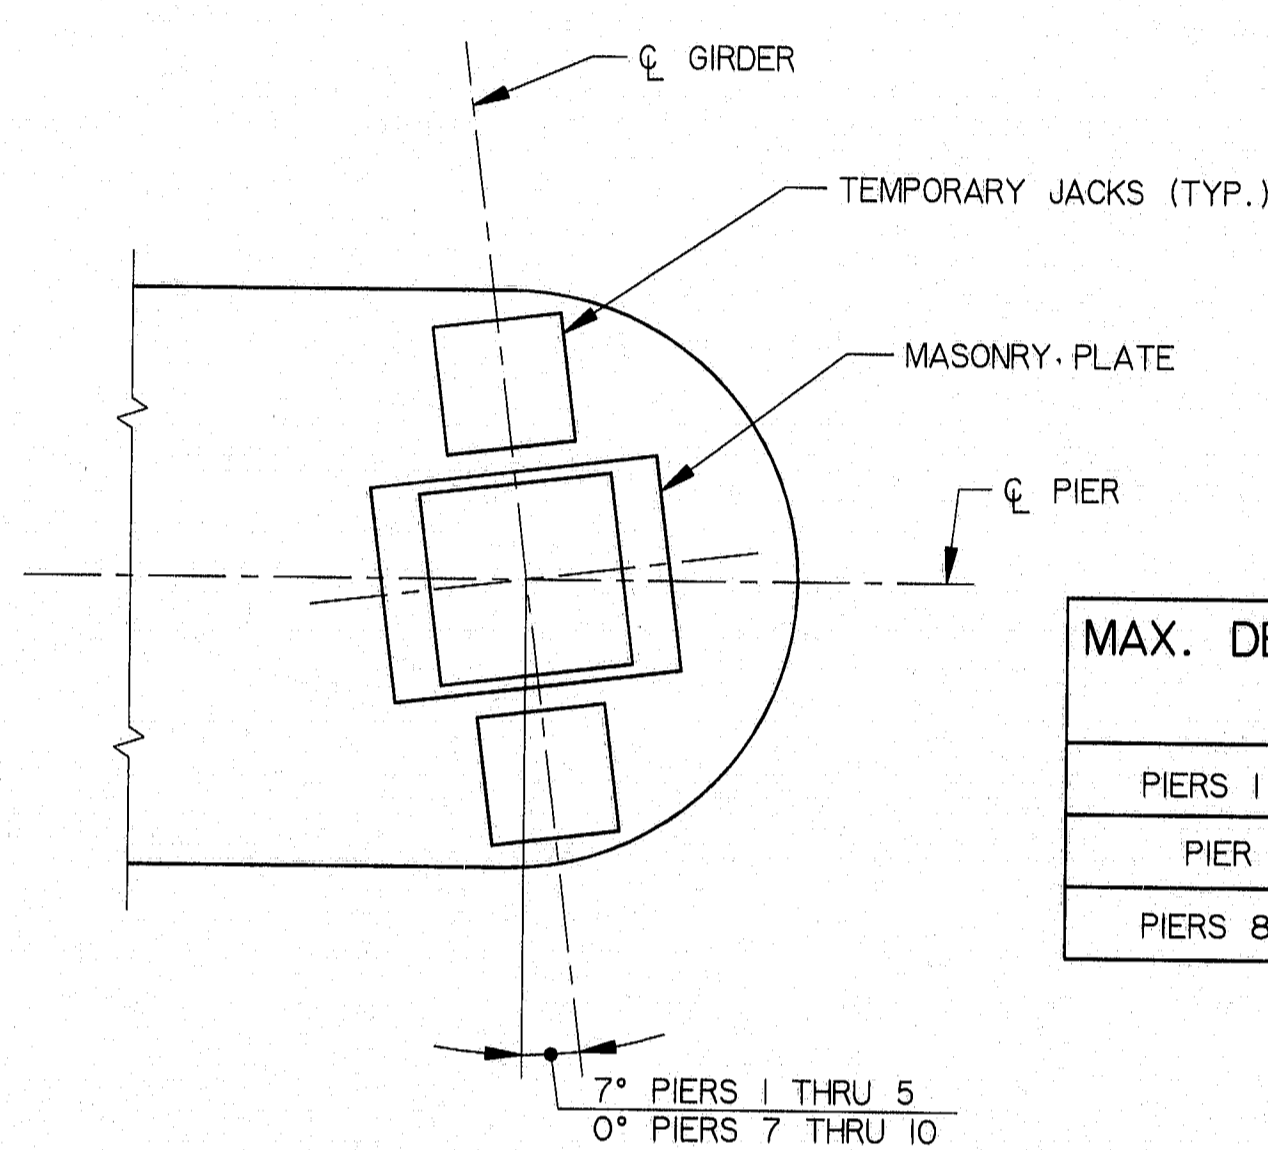

DETAIL A  
TYP. PIERS 1 THRU 5 AND 7 THRU 10


MAX. DEAD LOAD REACTION PER GIRDER	
PIERS 1 - 5	627 K
PIER 7	432 K
PIERS 8 - 10	341 K

PIER NOTES


1. REINFORCING STEEL SHALL HAVE 3 INCHES MINIMUM COVER UNLESS OTHERWISE INDICATED.
2. THE METHOD OF PLACING DOWELS IN THE CONCRETE SEAL SHALL BE APPROVED BY THE ENGINEER.
3. MAXIMUM CALCULATED PILE LOAD = 113 TONS (GROUP IV).
4. SEAL CONCRETE DIMENSIONS ARE PREDICATED ON THE USE OF STANDARD SHEET PILE PDA27 OR EQUIVALENT STEEL SHEET PILING. USING APPROPRIATE STANDARD ROLLED CORNERS. PAY DIMENSIONS FOR SEAL CONCRETE SHALL BE TO THE NEAT LINES SHOWN PLUS 5" ALL AROUND.
5. FOR CATWALK DETAILS, SEE SHEETS B65-B67.
6. FOR BEARING DEVICE DETAILS, SEE SHEETS B62-B63.
7. BEARING PAD ELEVATIONS MAY VARY, SEE SHEET B62, NOTE 2.

DESIGN CRITERIA


1. BUOYANCY - WATER LEVEL ASSUMED AT ELEVATION 56.3 (Q50).
2. STREAM FLOW - VELOCITY = 4.8 FEET PER SECOND AT PIERS 1 THRU 5 AND 0.9 F.P.S. AT PIERS 6 THRU 8. FLOW DIRECTION IS AT 0° SKEW TO LONGITUDINAL CENTERLINE OF PIERS 1 THRU 6, 13.30° AT PIER 7 AND 18.1° AT PIER 8.
3. WIND - 40 PSF.
4. ICE - THICKNESS 24 INCHES, PRESSURE 100 PSI AT ELEVATION 56.3 30 PERCENT OF NOSE FORCE APPLIED TRANSVERSE TO PIER.

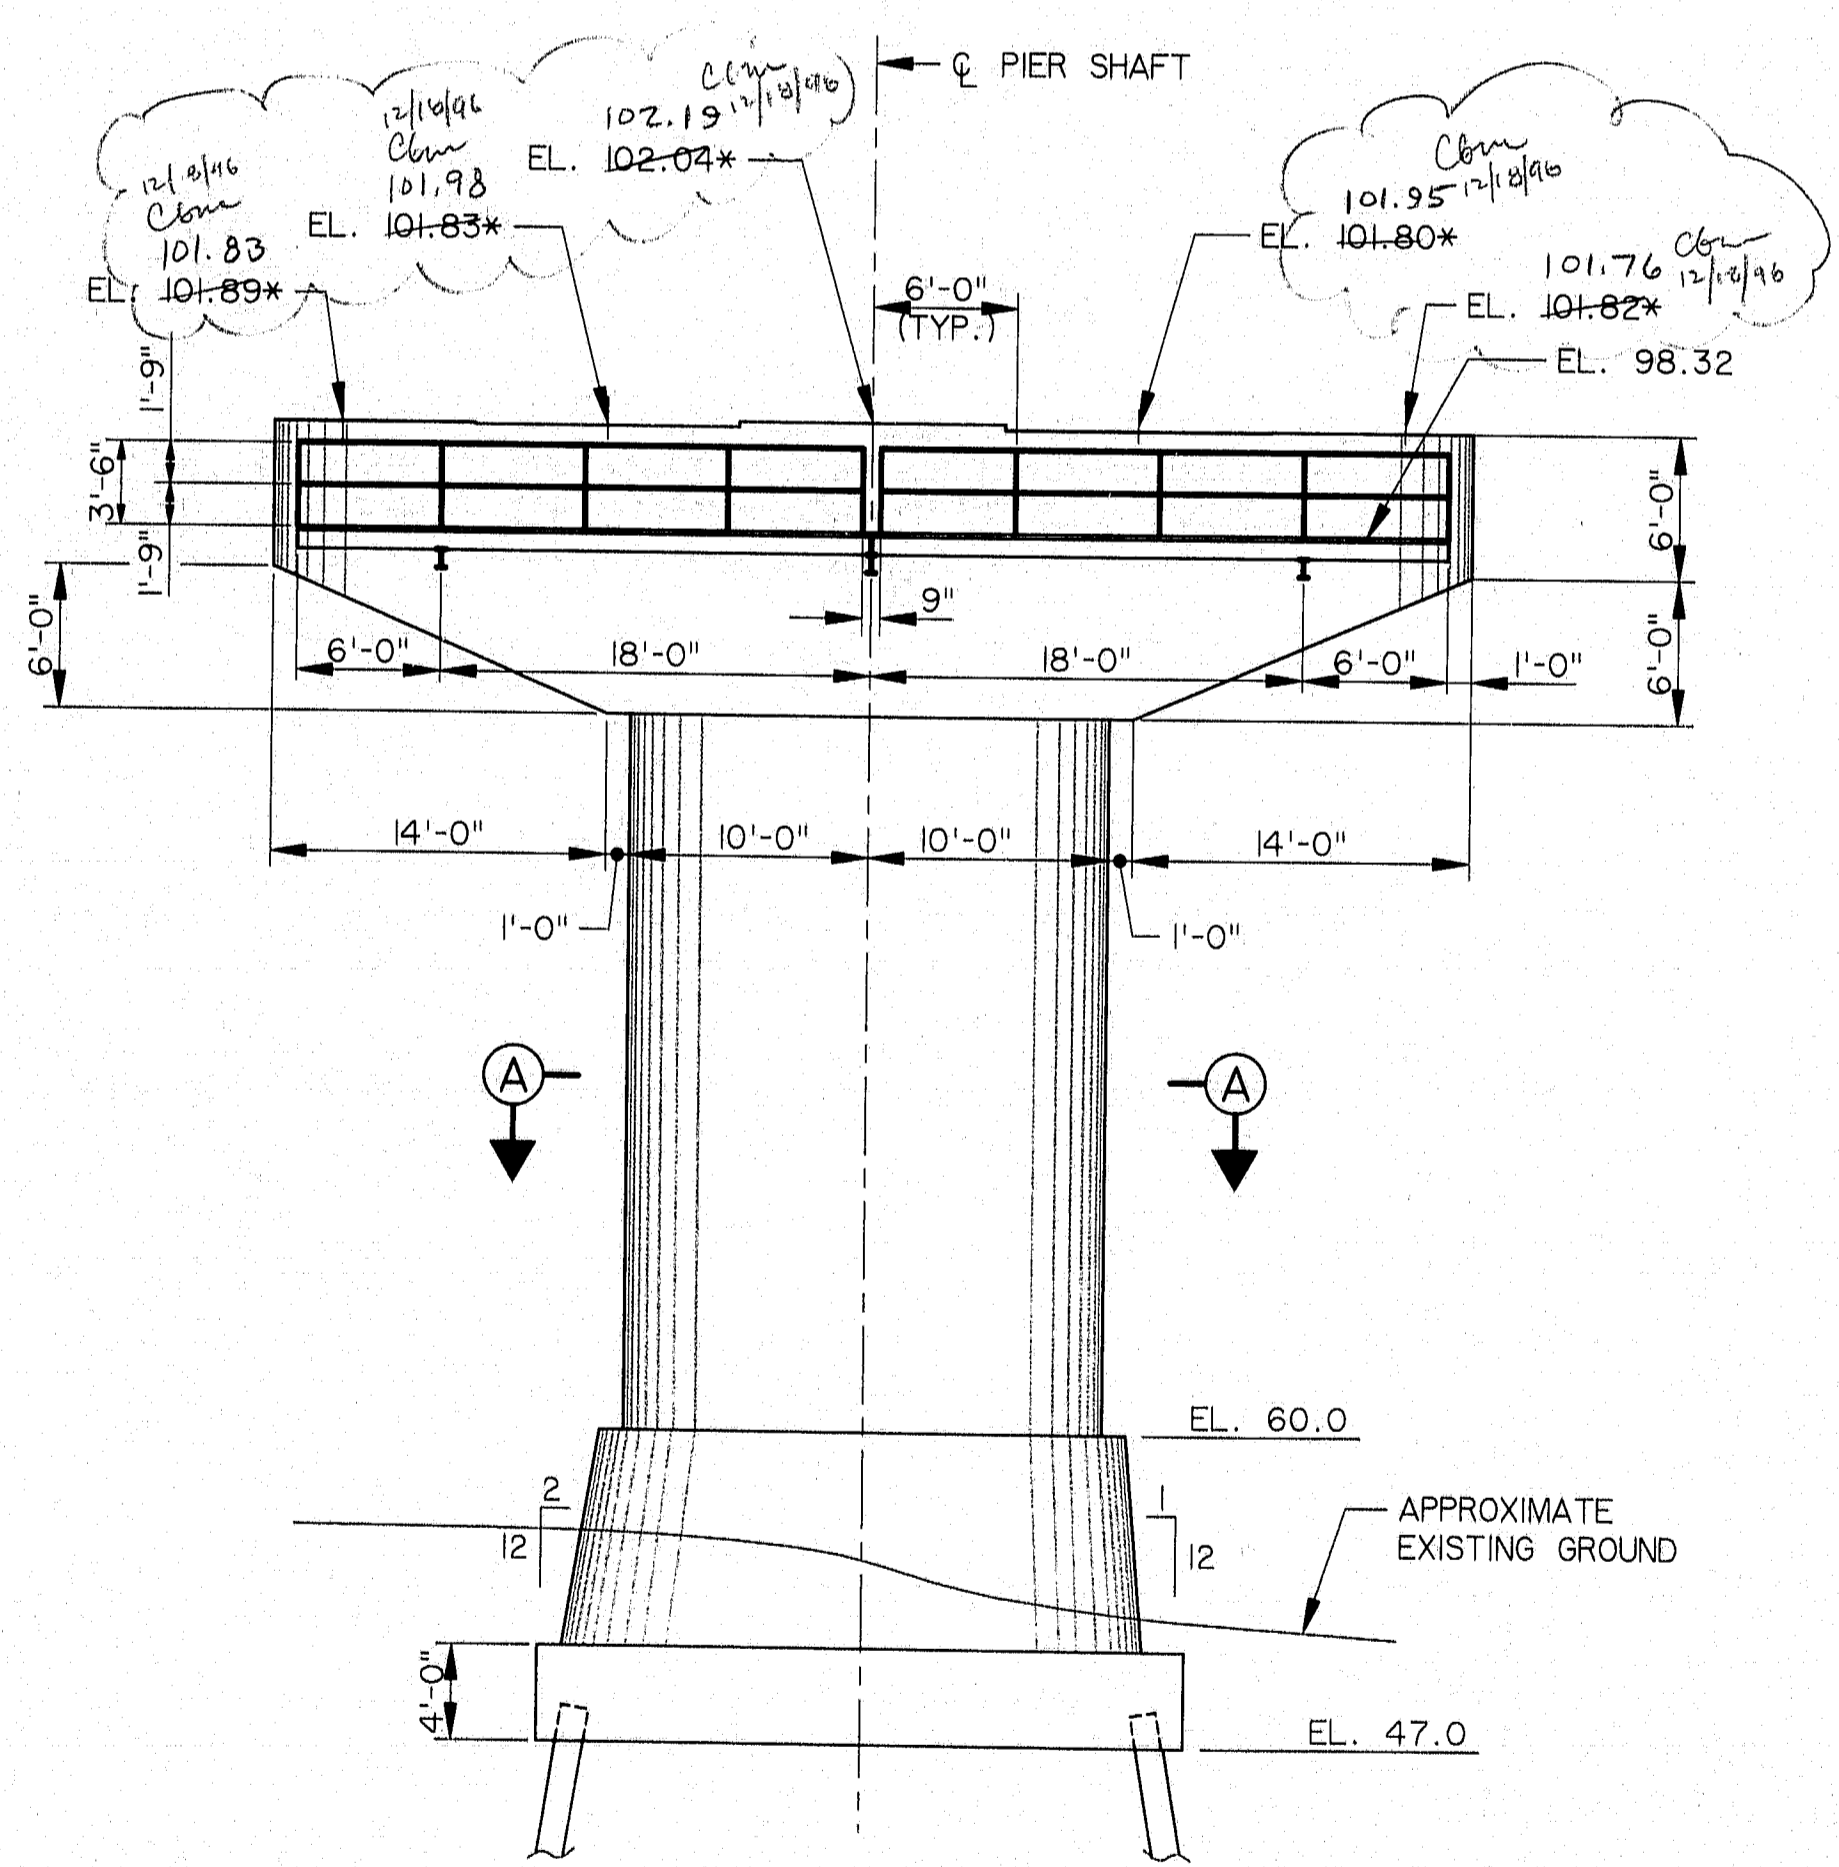

ELEVATION  
(LOOKING UPSTATION)

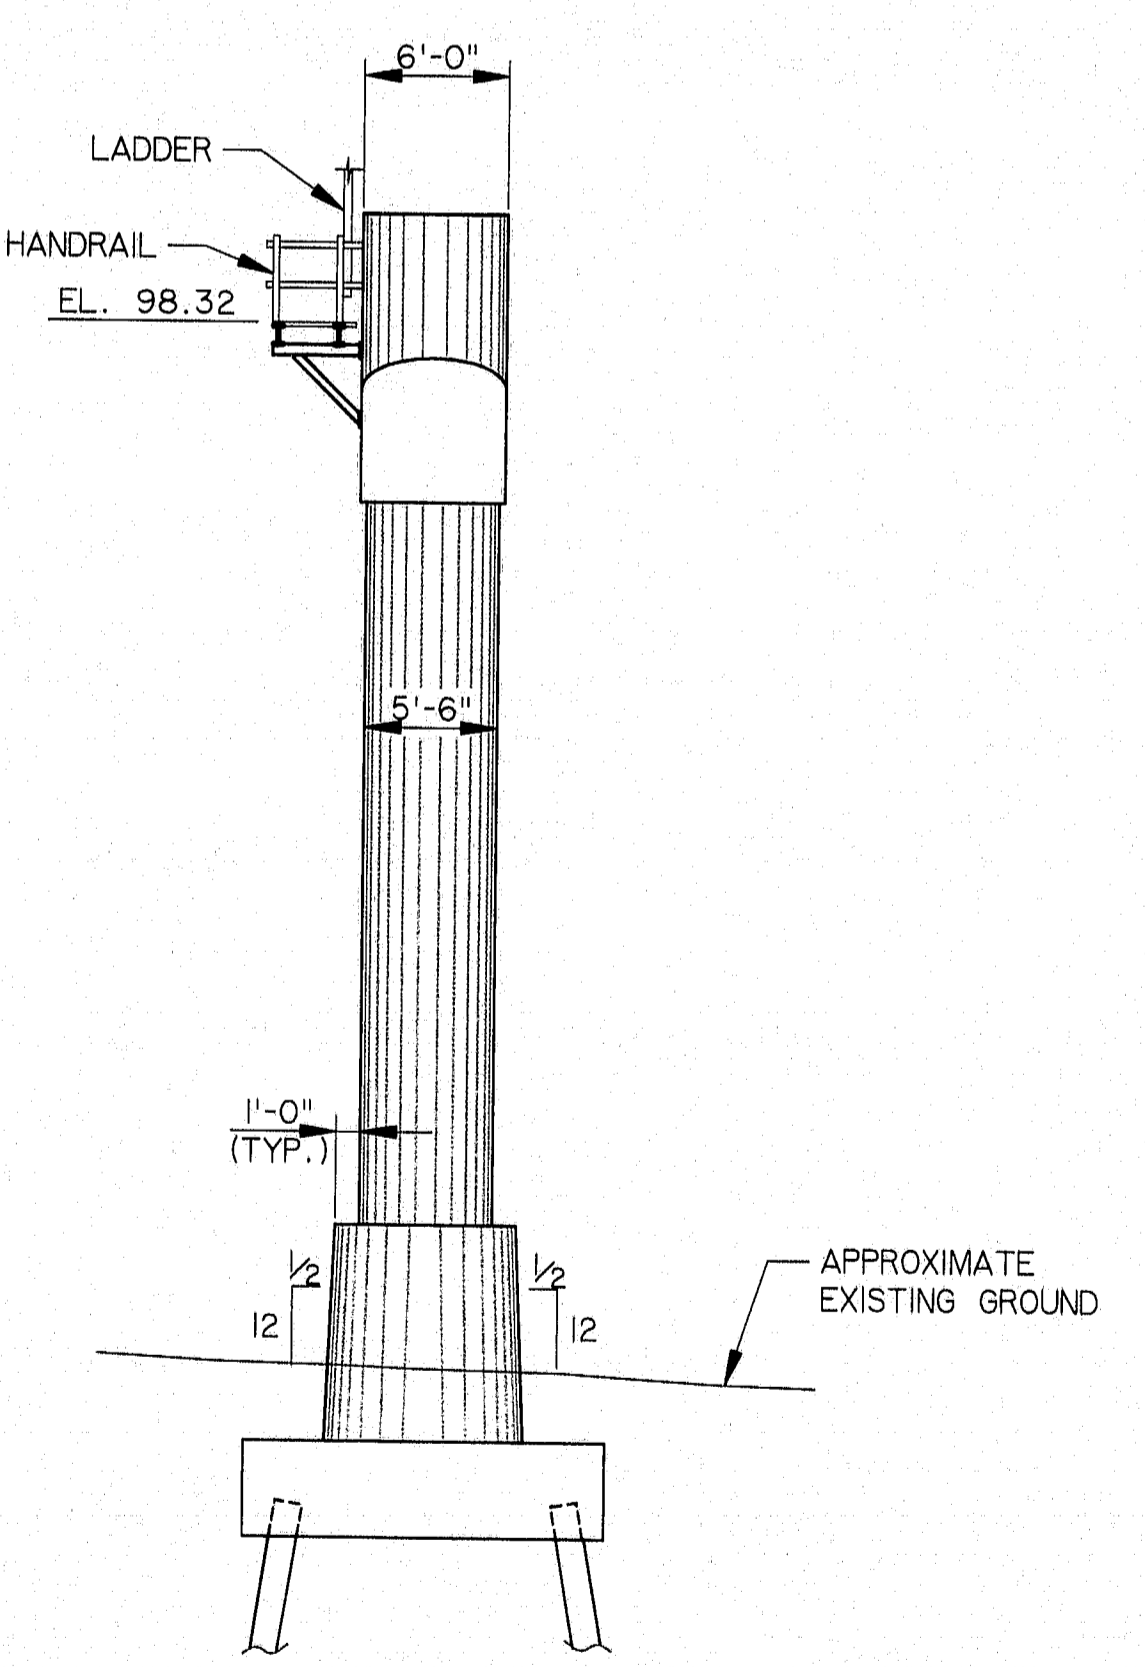


SIDE ELEVATION

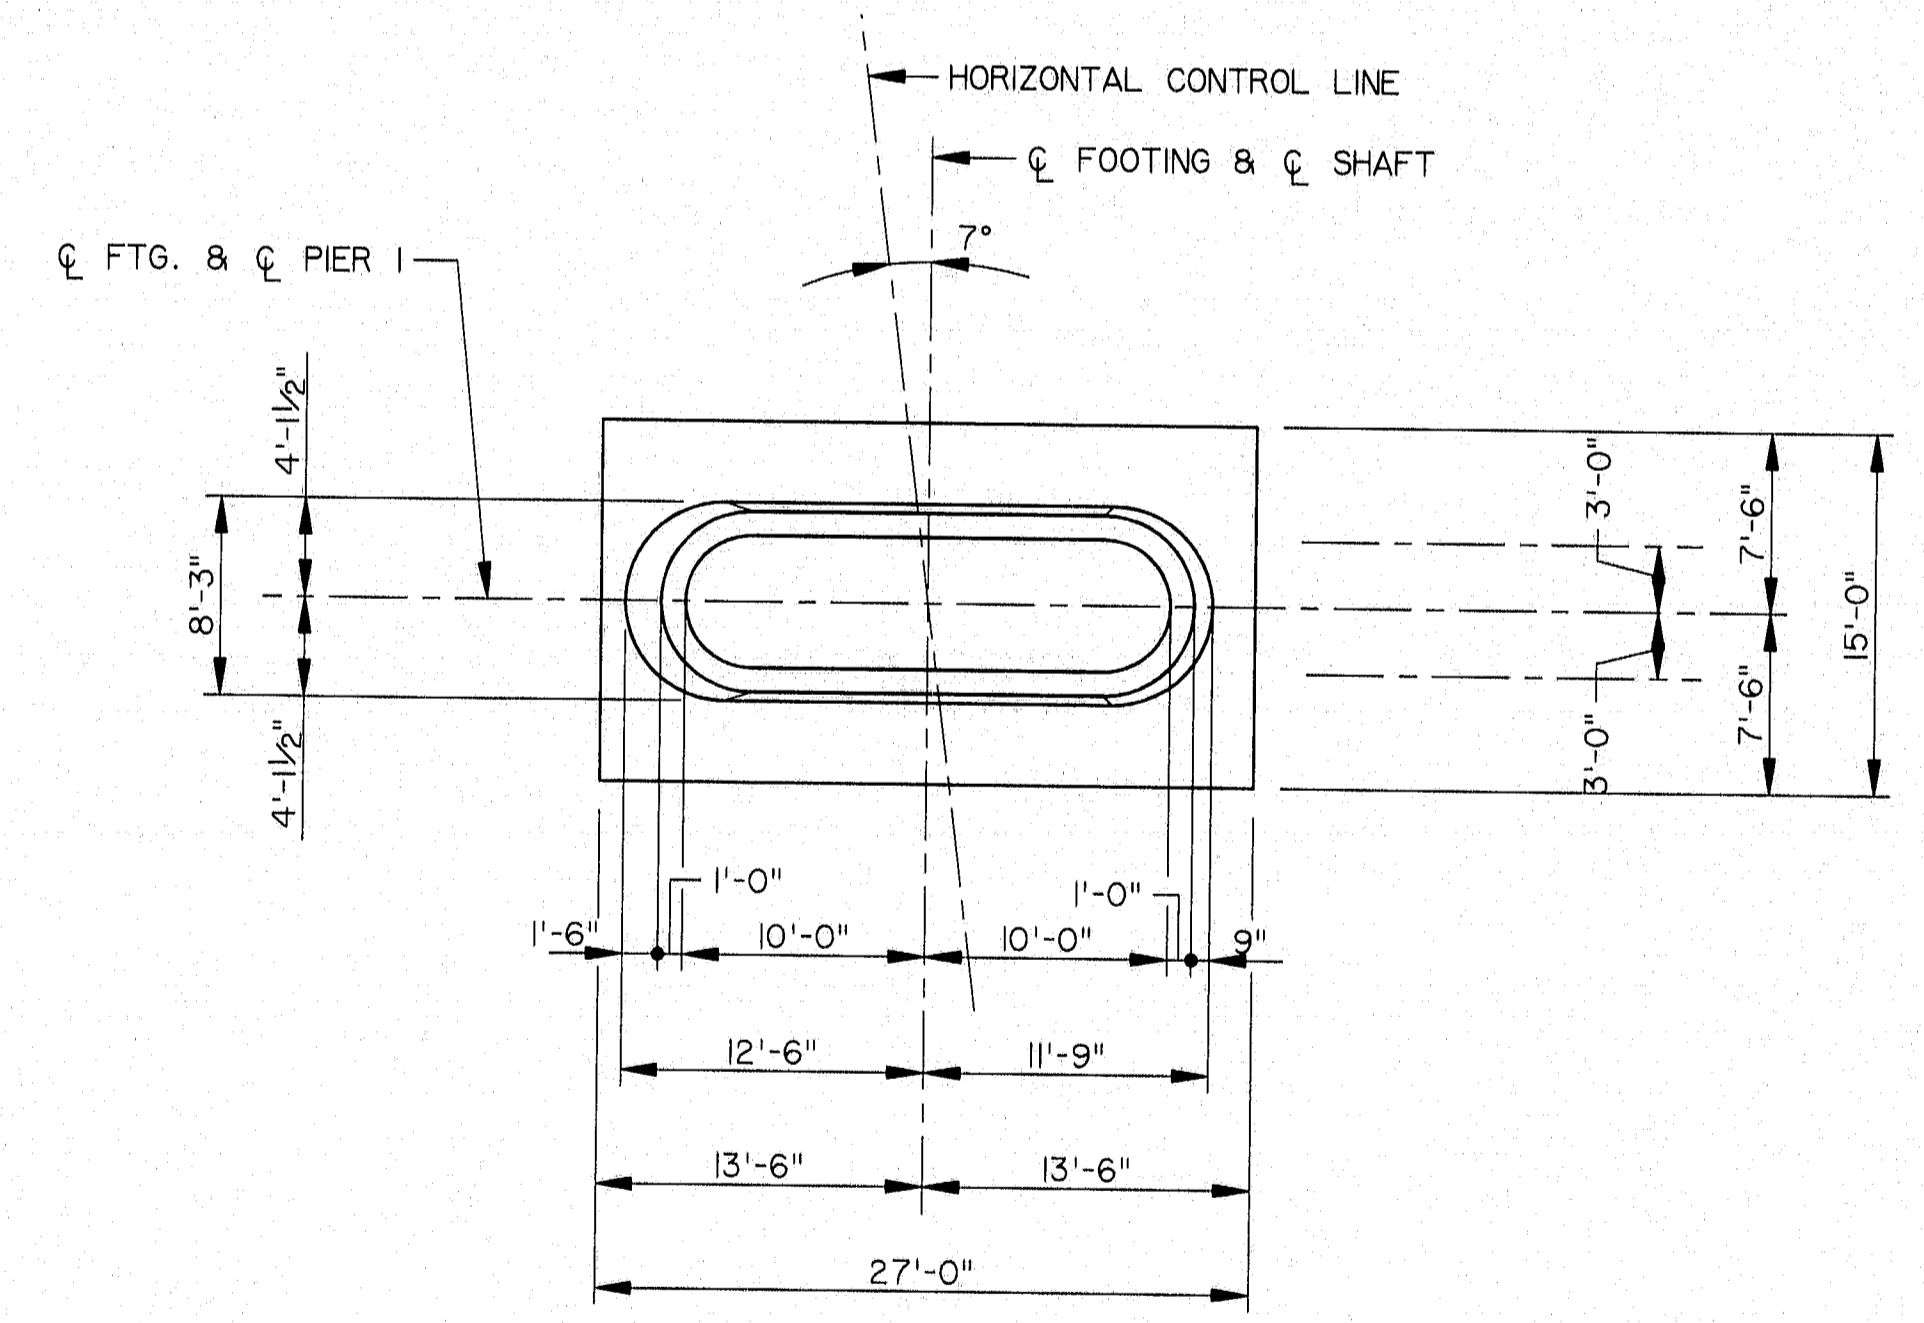

SECTION A-A


\* SEE NOTE 7

NO.	REVISION	BY	DATE	IN CHARGE OF
		DESIGNED:	SM	9/94
		DRAWN:	RJT	9/94
		CHECKED:	DWR	9/94
		BY	CJM	

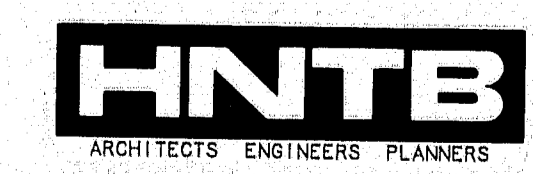


**115-225**  
STEEL ALTERNATIVE  
STATE OF MAINE  
DEPARTMENT OF TRANSPORTATION  
WATERVILLE - WINSLOW PROJECT  
DONALD V. CARTER BRIDGE  
OVER  
KENNEBEC RIVER  
  
PIER 1 DETAILS  
SHEET B30 OF B86 AUGUSTA, MAINE


F.H.W.A. REG. NO.	STATE	PROJECT NUMBER	SHEET NO.	TOTAL SHEETS
1	MAINE	0009(002)	40	103

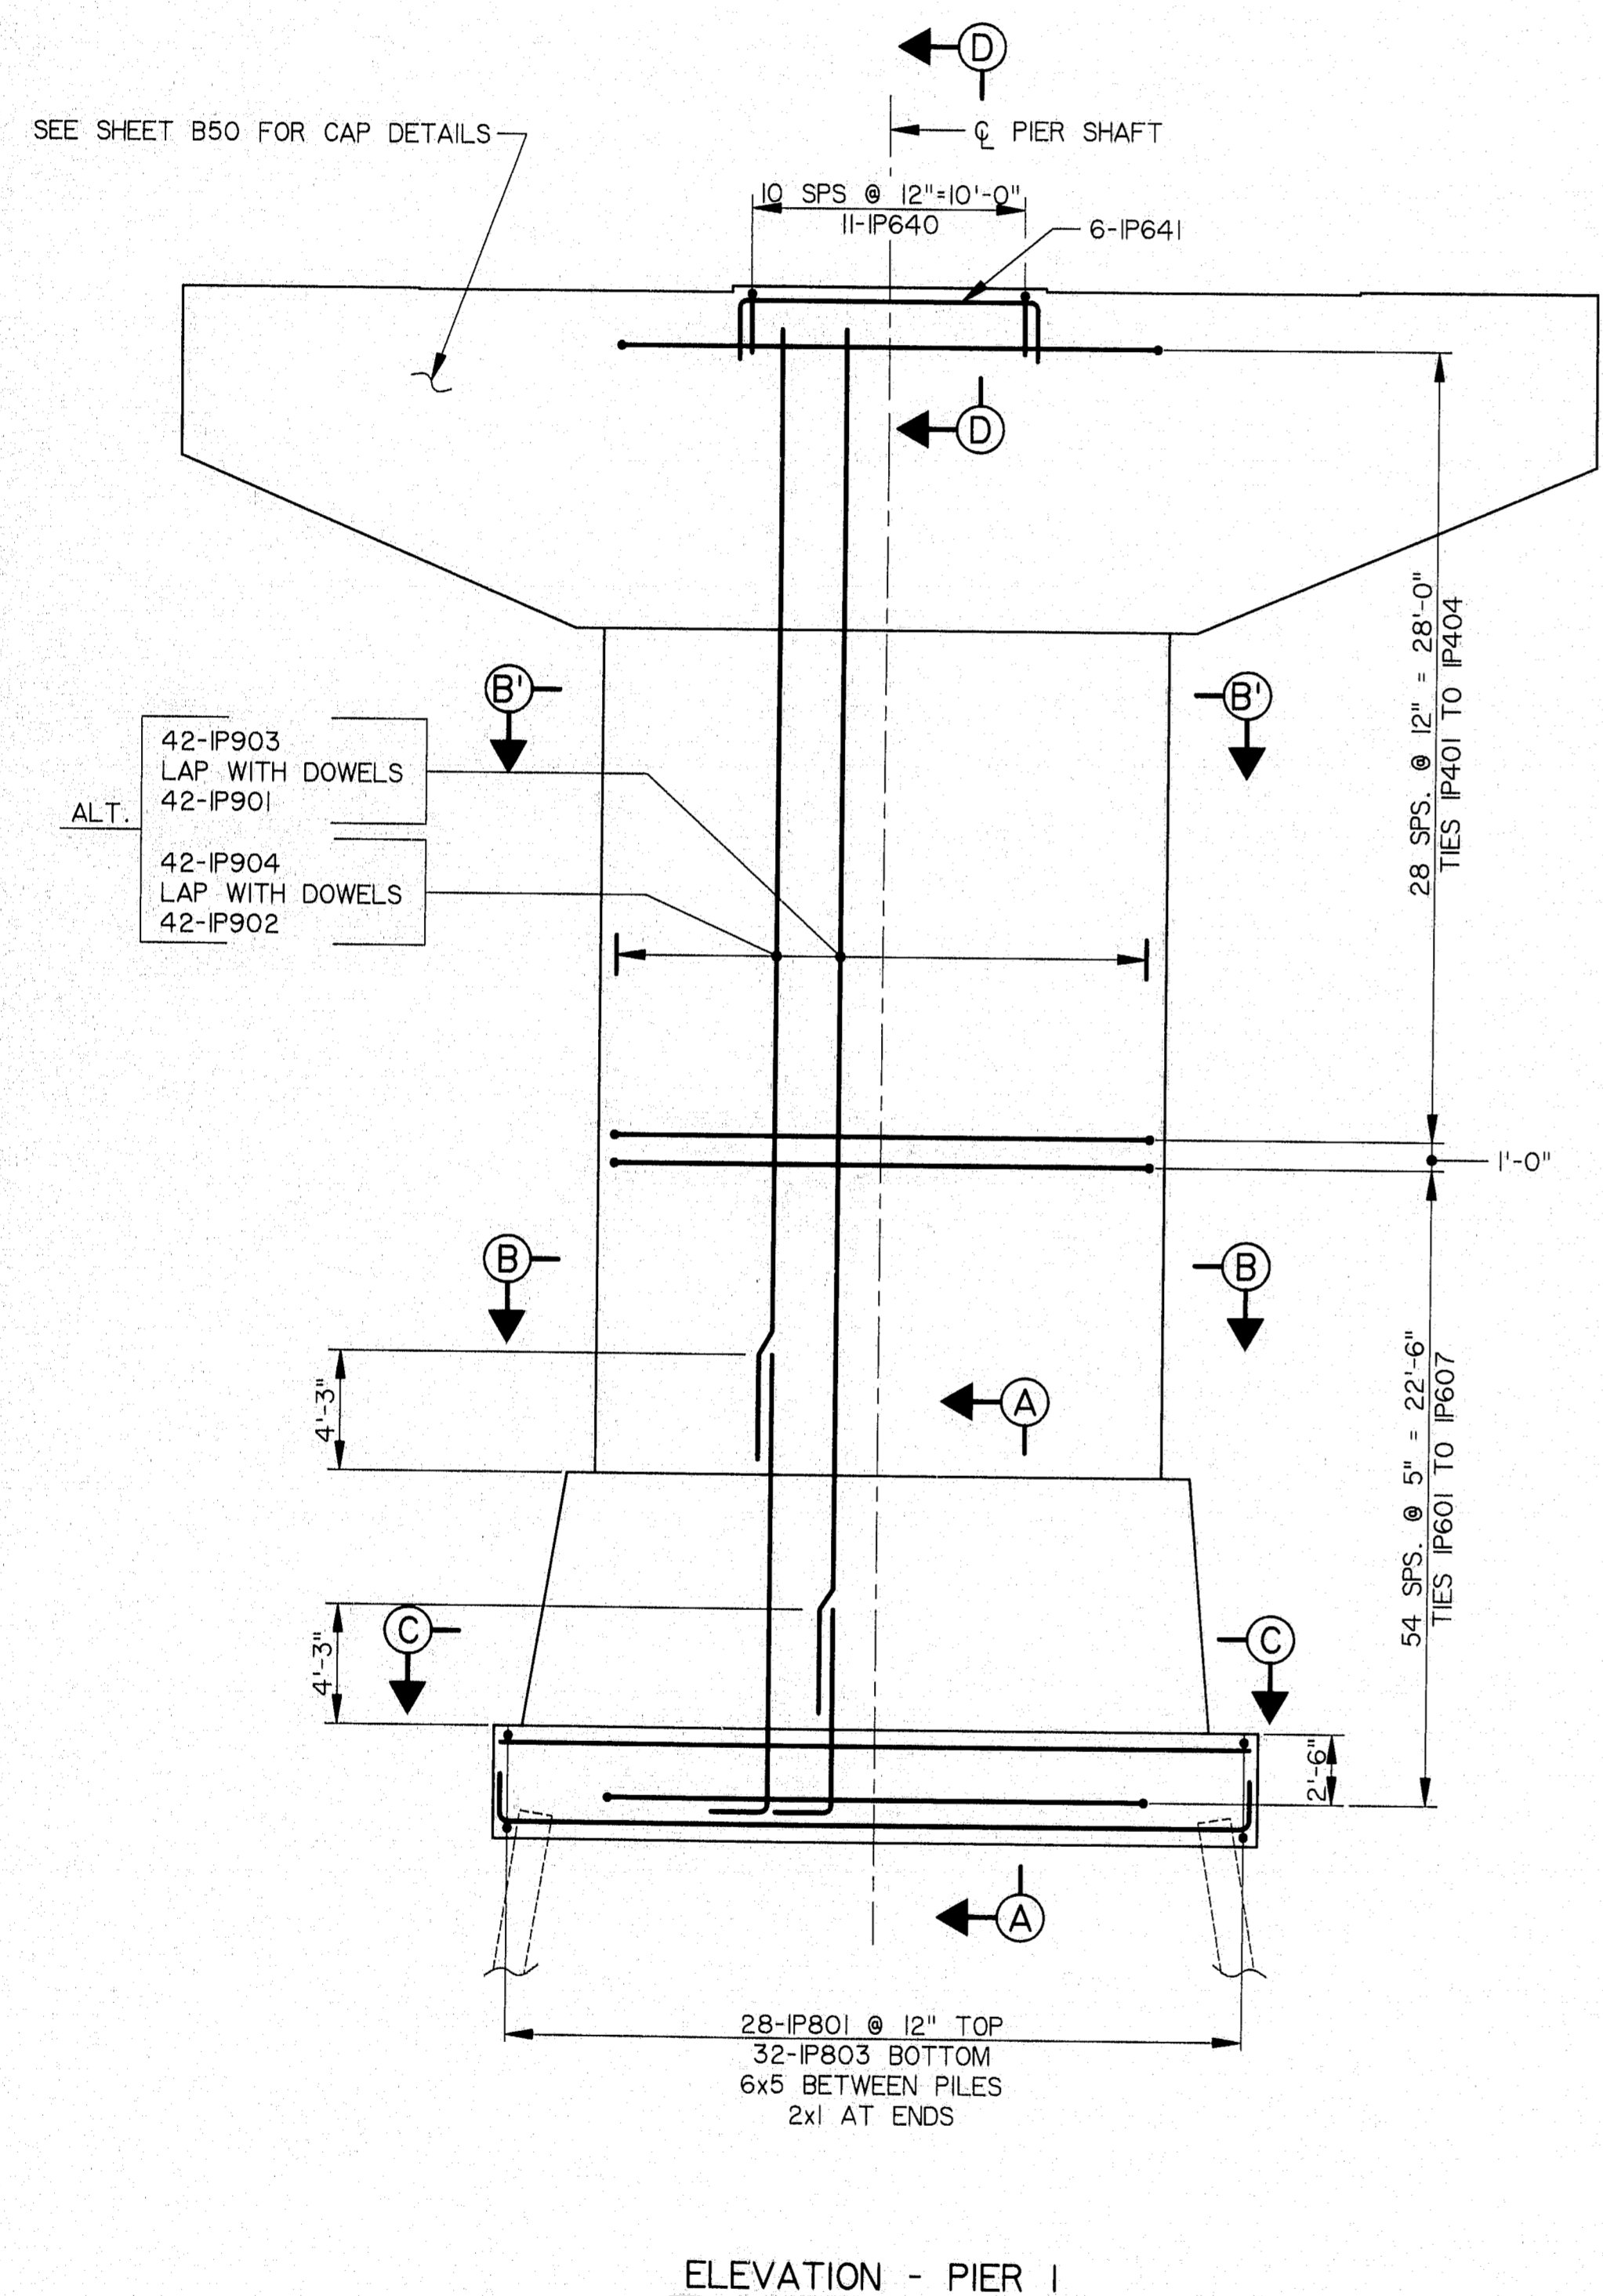


ELEVATION - PIER I

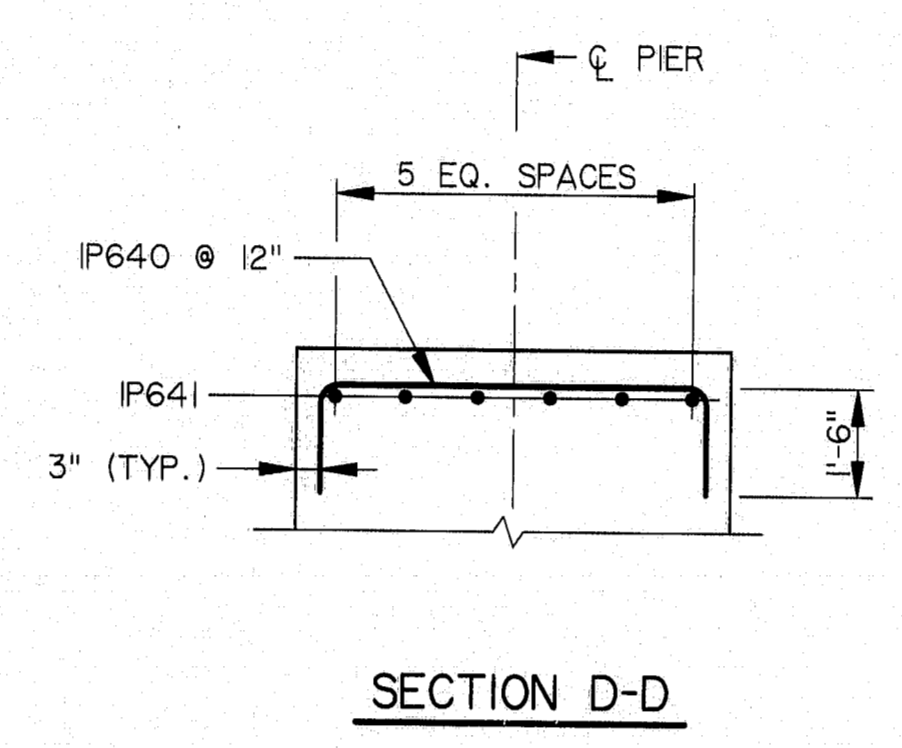

SECTION D-D

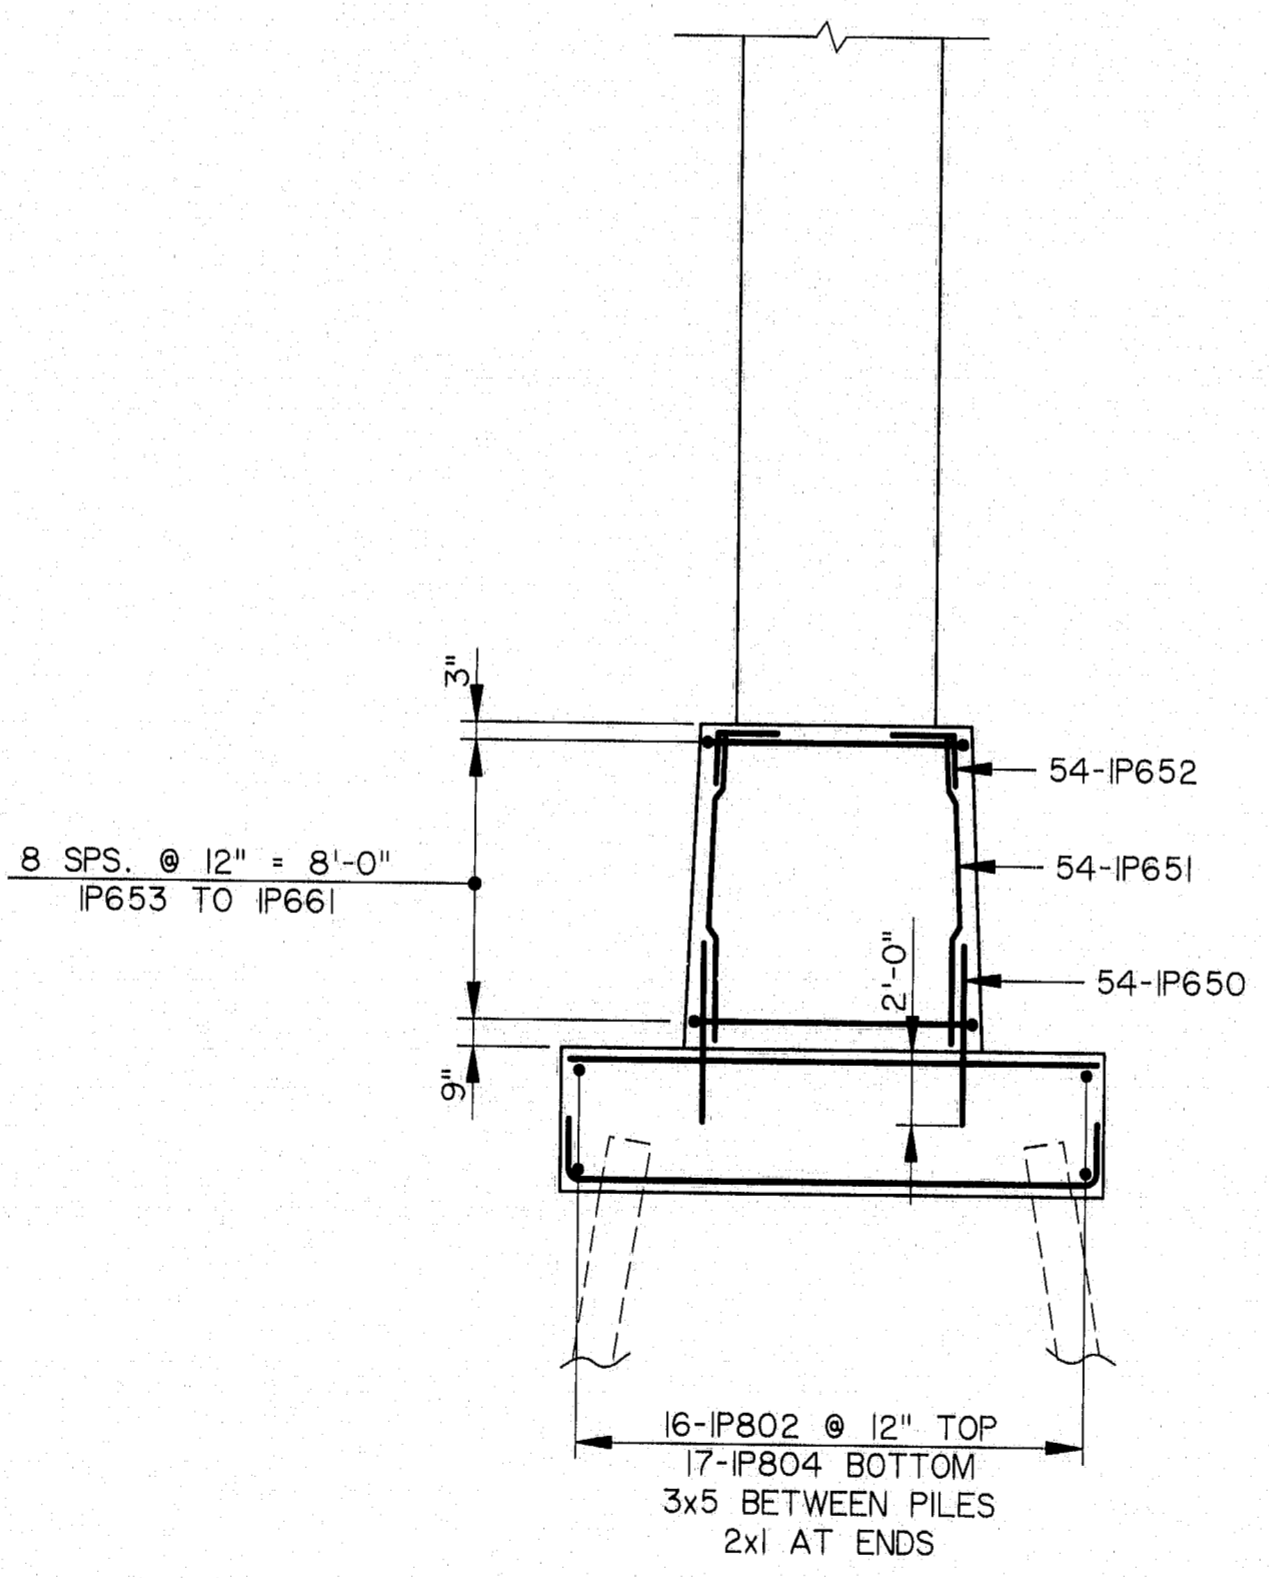


SECTION A-A

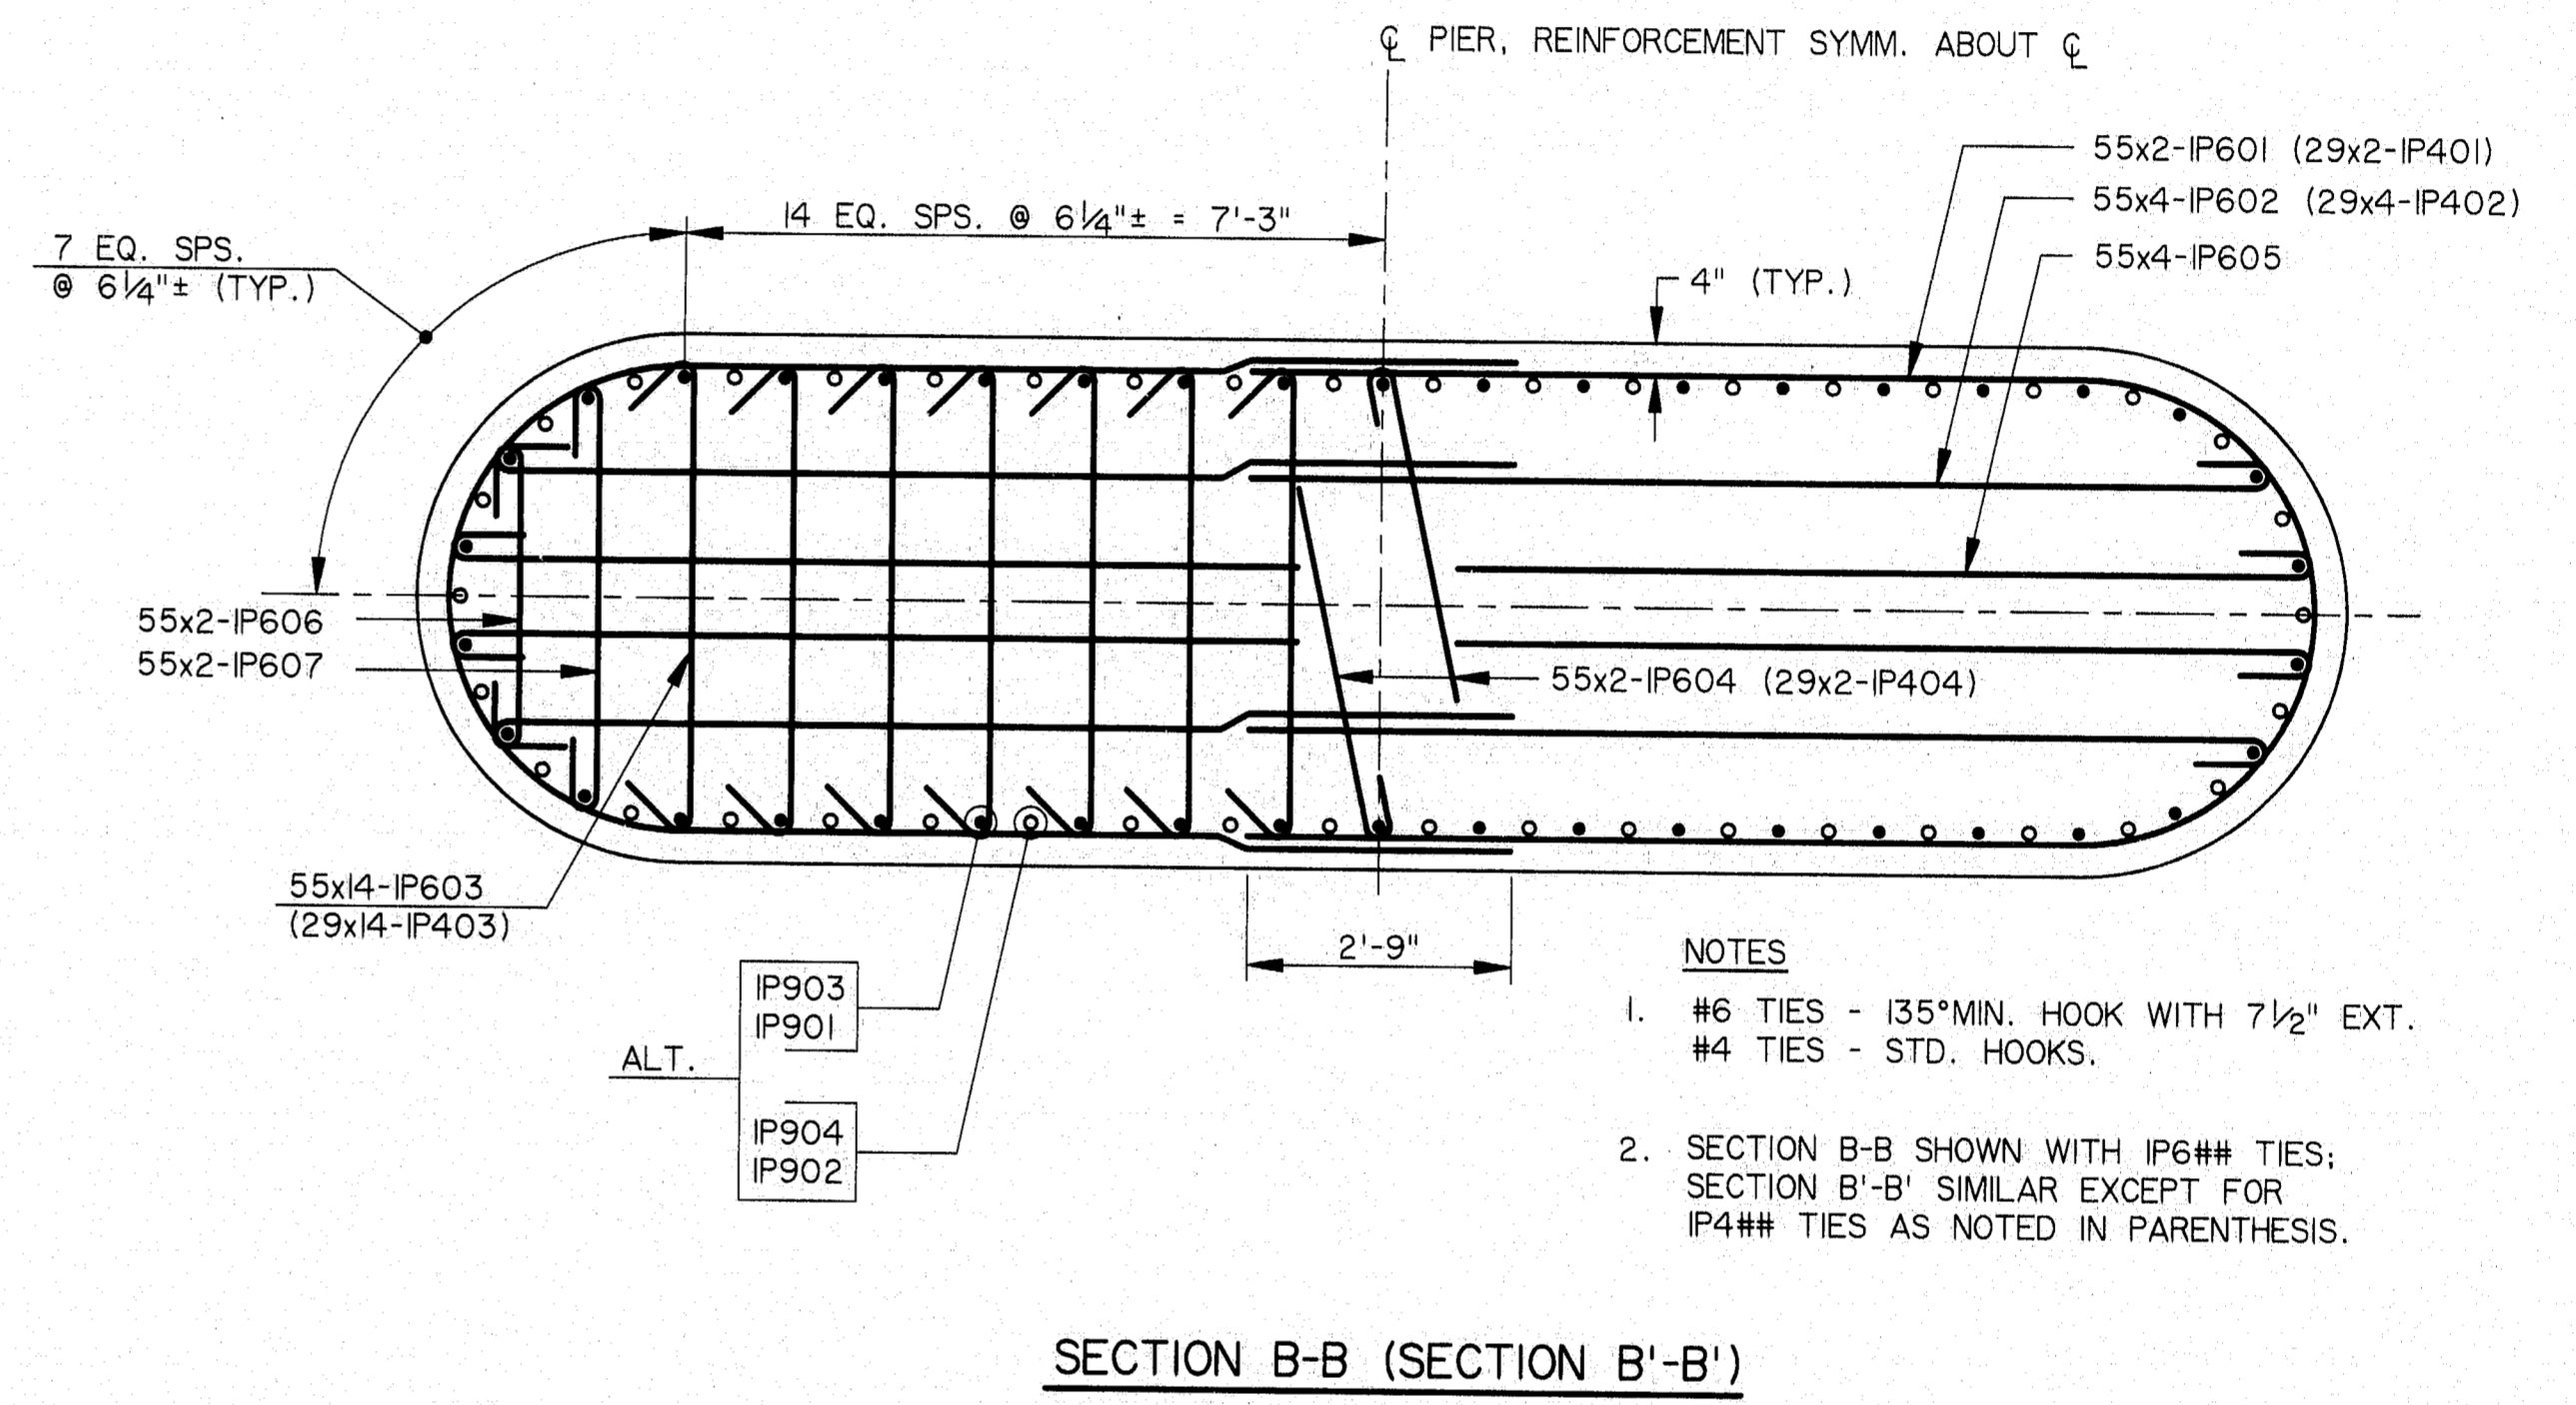

SECTION B-B (SECTION B'-B')

- NOTES
- #6 TIES - 135° MIN. HOOK WITH 7 1/2" EXT. #4 TIES - STD. HOOKS.
  - SECTION B-B SHOWN WITH IP6## TIES; SECTION B'-B' SIMILAR EXCEPT FOR IP4## TIES AS NOTED IN PARENTHESIS.

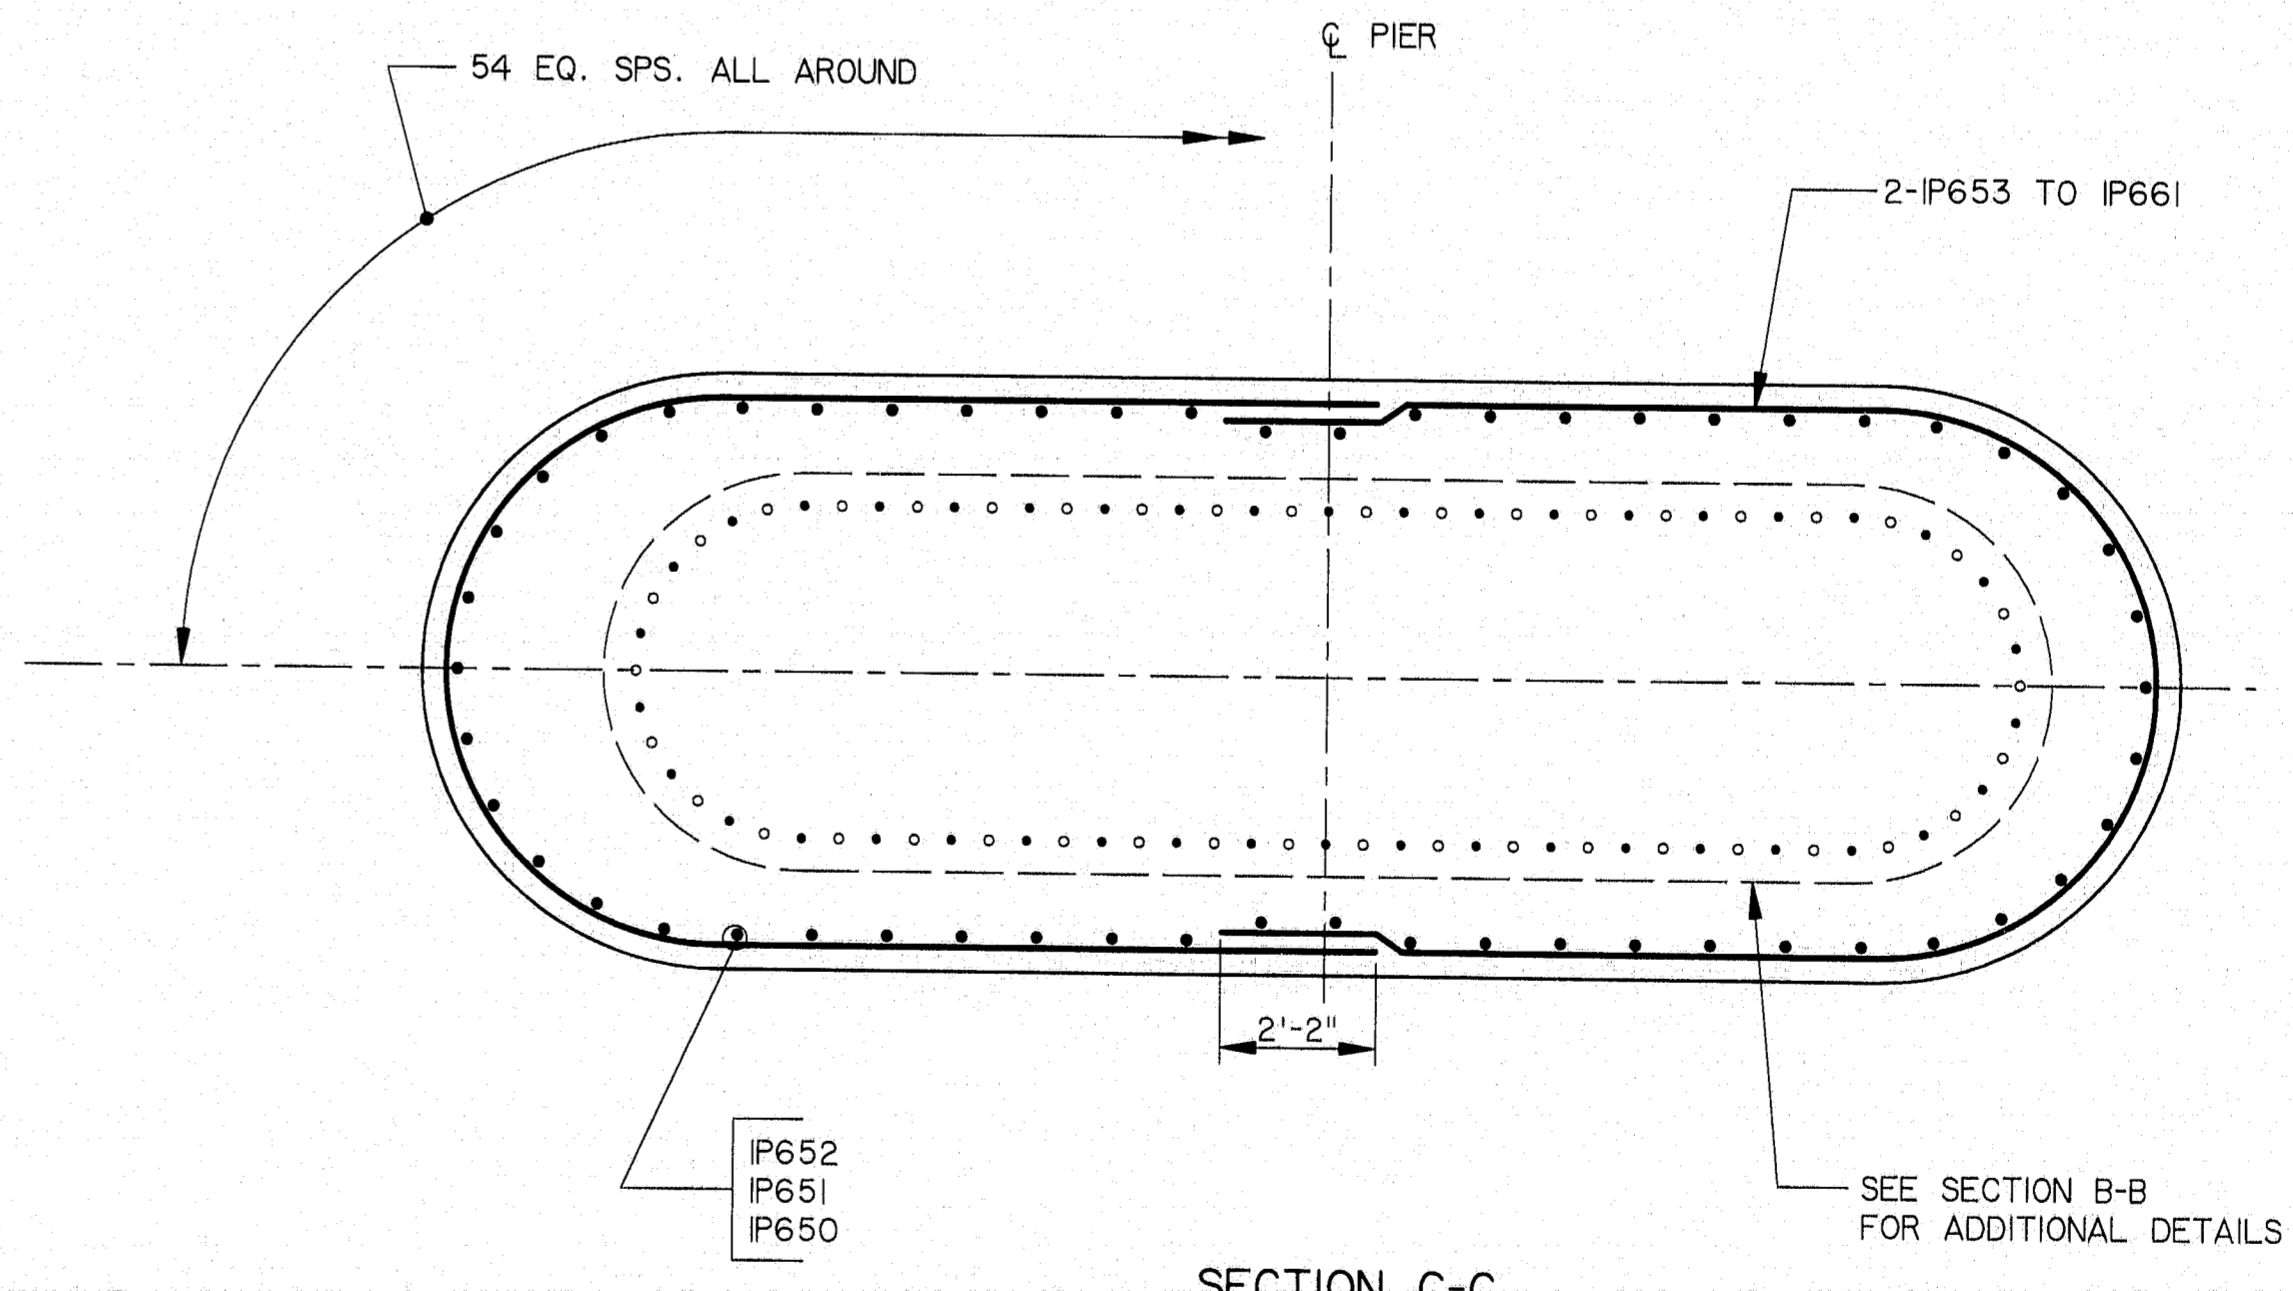


SECTION C-C

115-226

STEEL ALTERNATIVE


STATE OF MAINE DEPARTMENT OF TRANSPORTATION
WATERVILLE - WINSLOW PROJECT DONALD V. CARTER BRIDGE OVER KENNEBEC RIVER
PIER I RE-STEEL
SHEET 831 OF 886 AUGUSTA, MAINE

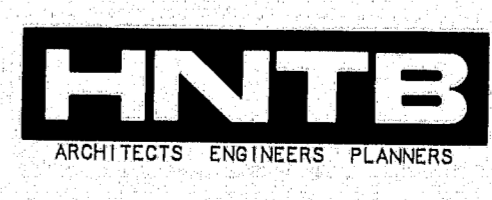


NO.	REVISION	BY	DATE	IN CHARGE OF
		DESIGNED:	SM	9/94
		DRAWN:	RJT	9/94
		CHECKED:	DWR	9/94
				CJM

AS BUILT  
DATE 11/19/94


F.P.A.A. REG. NO.	STATE	PROJECT NUMBER	SHEET NO.	TOTAL SHEETS
1	MAINE	0009(002)	41	103

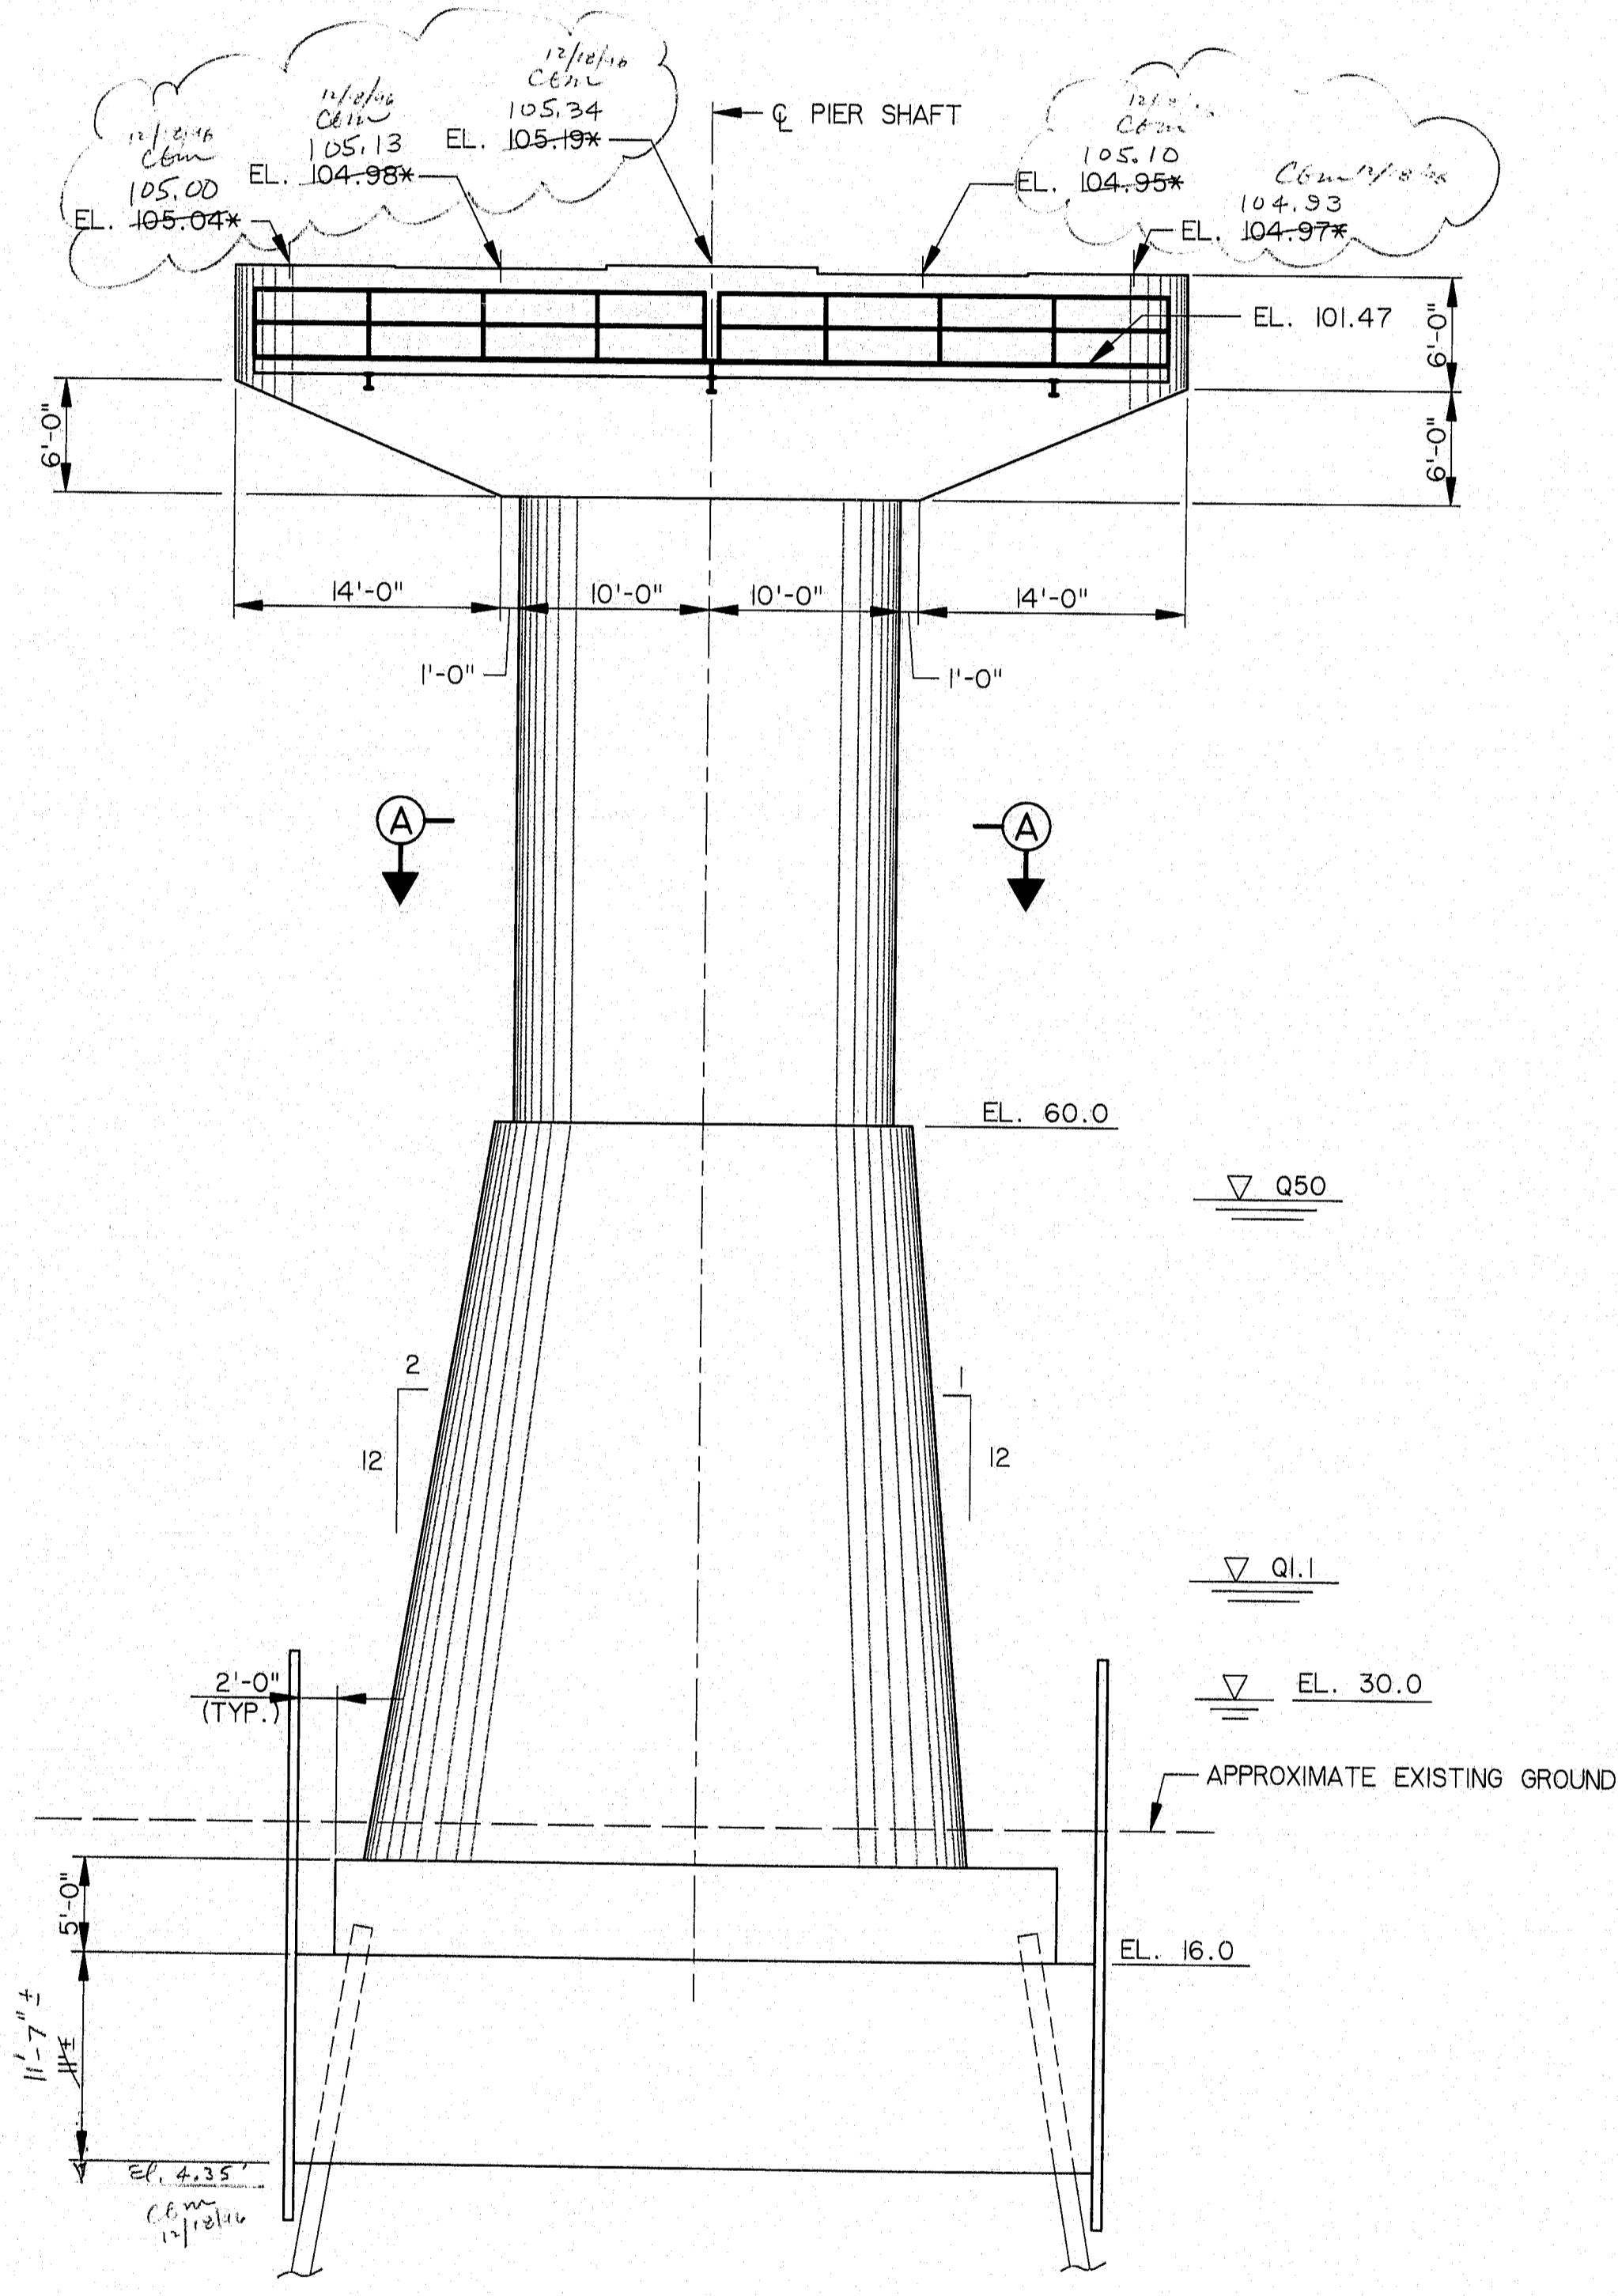


ELEVATION - PIER 2  
LOOKING UPSTATION

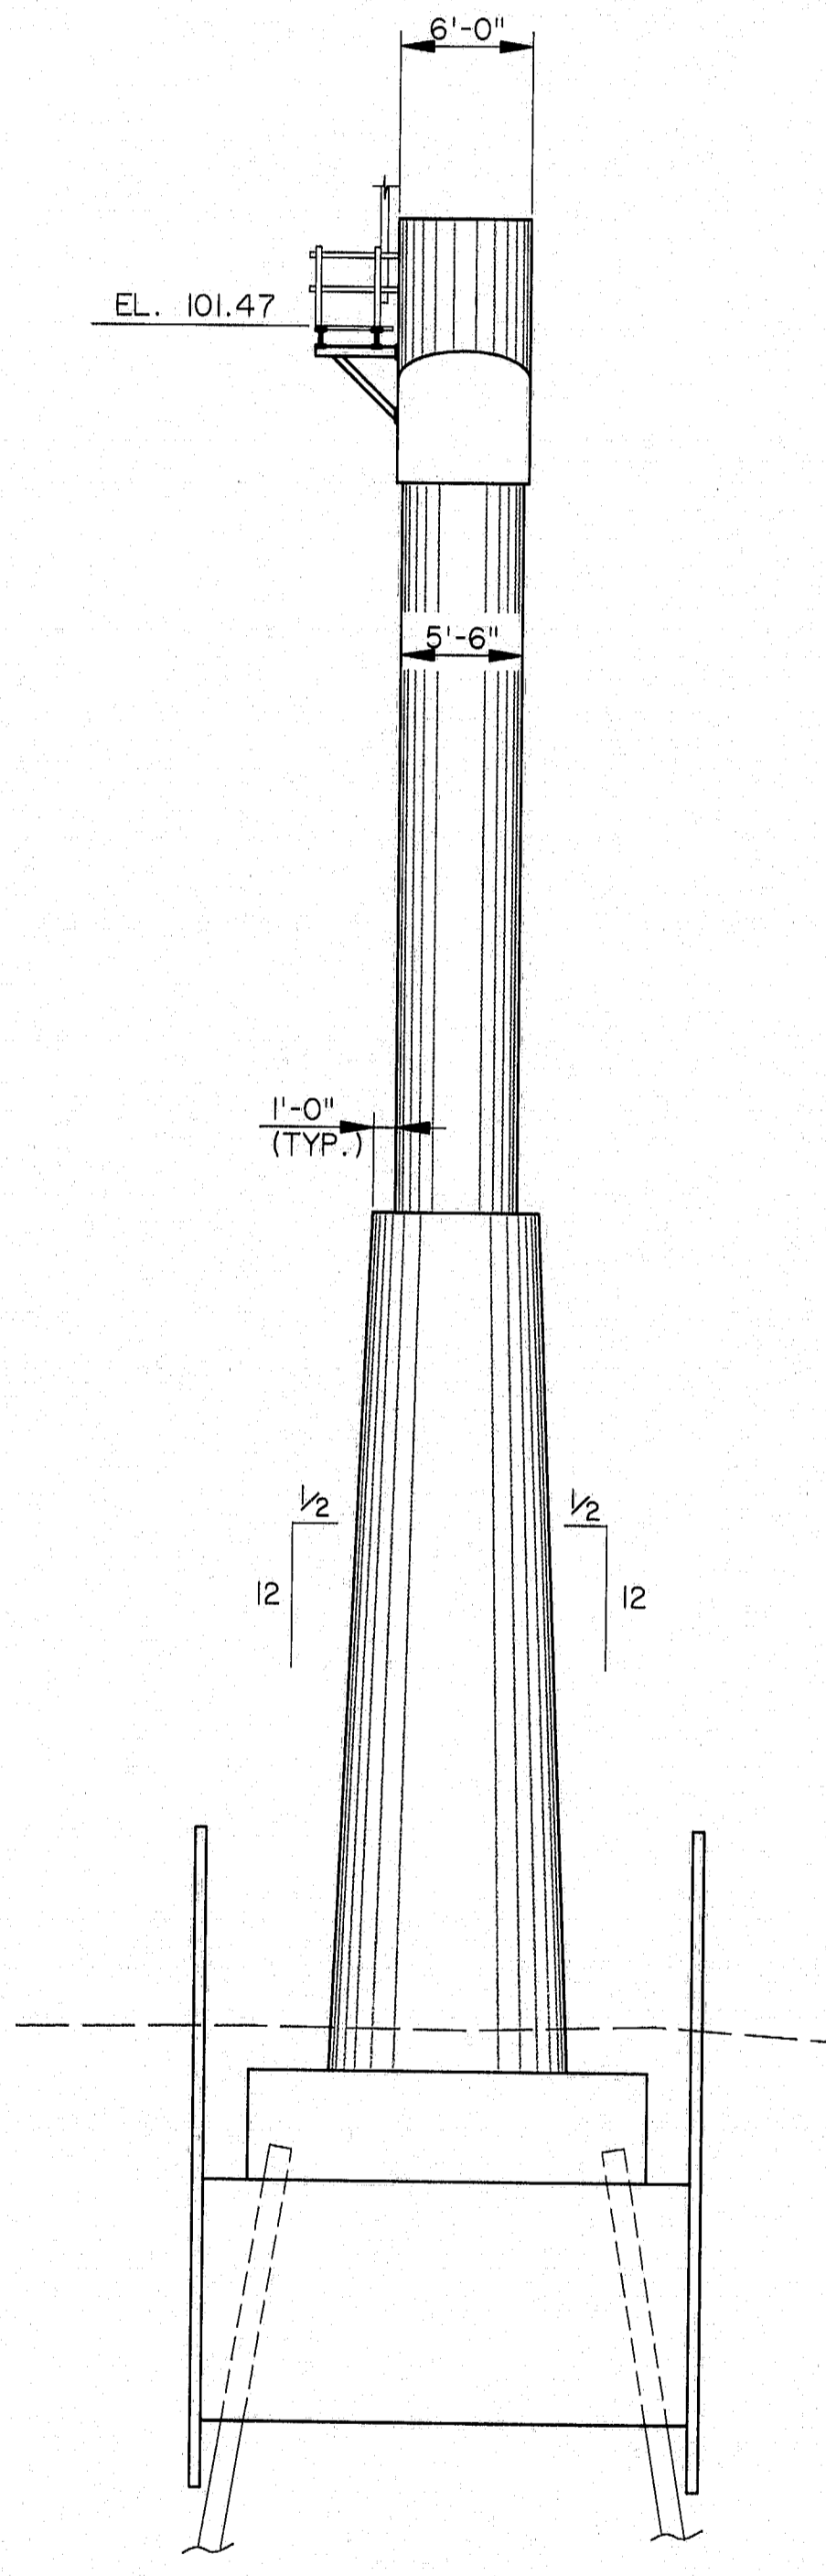

SIDE ELEVATION

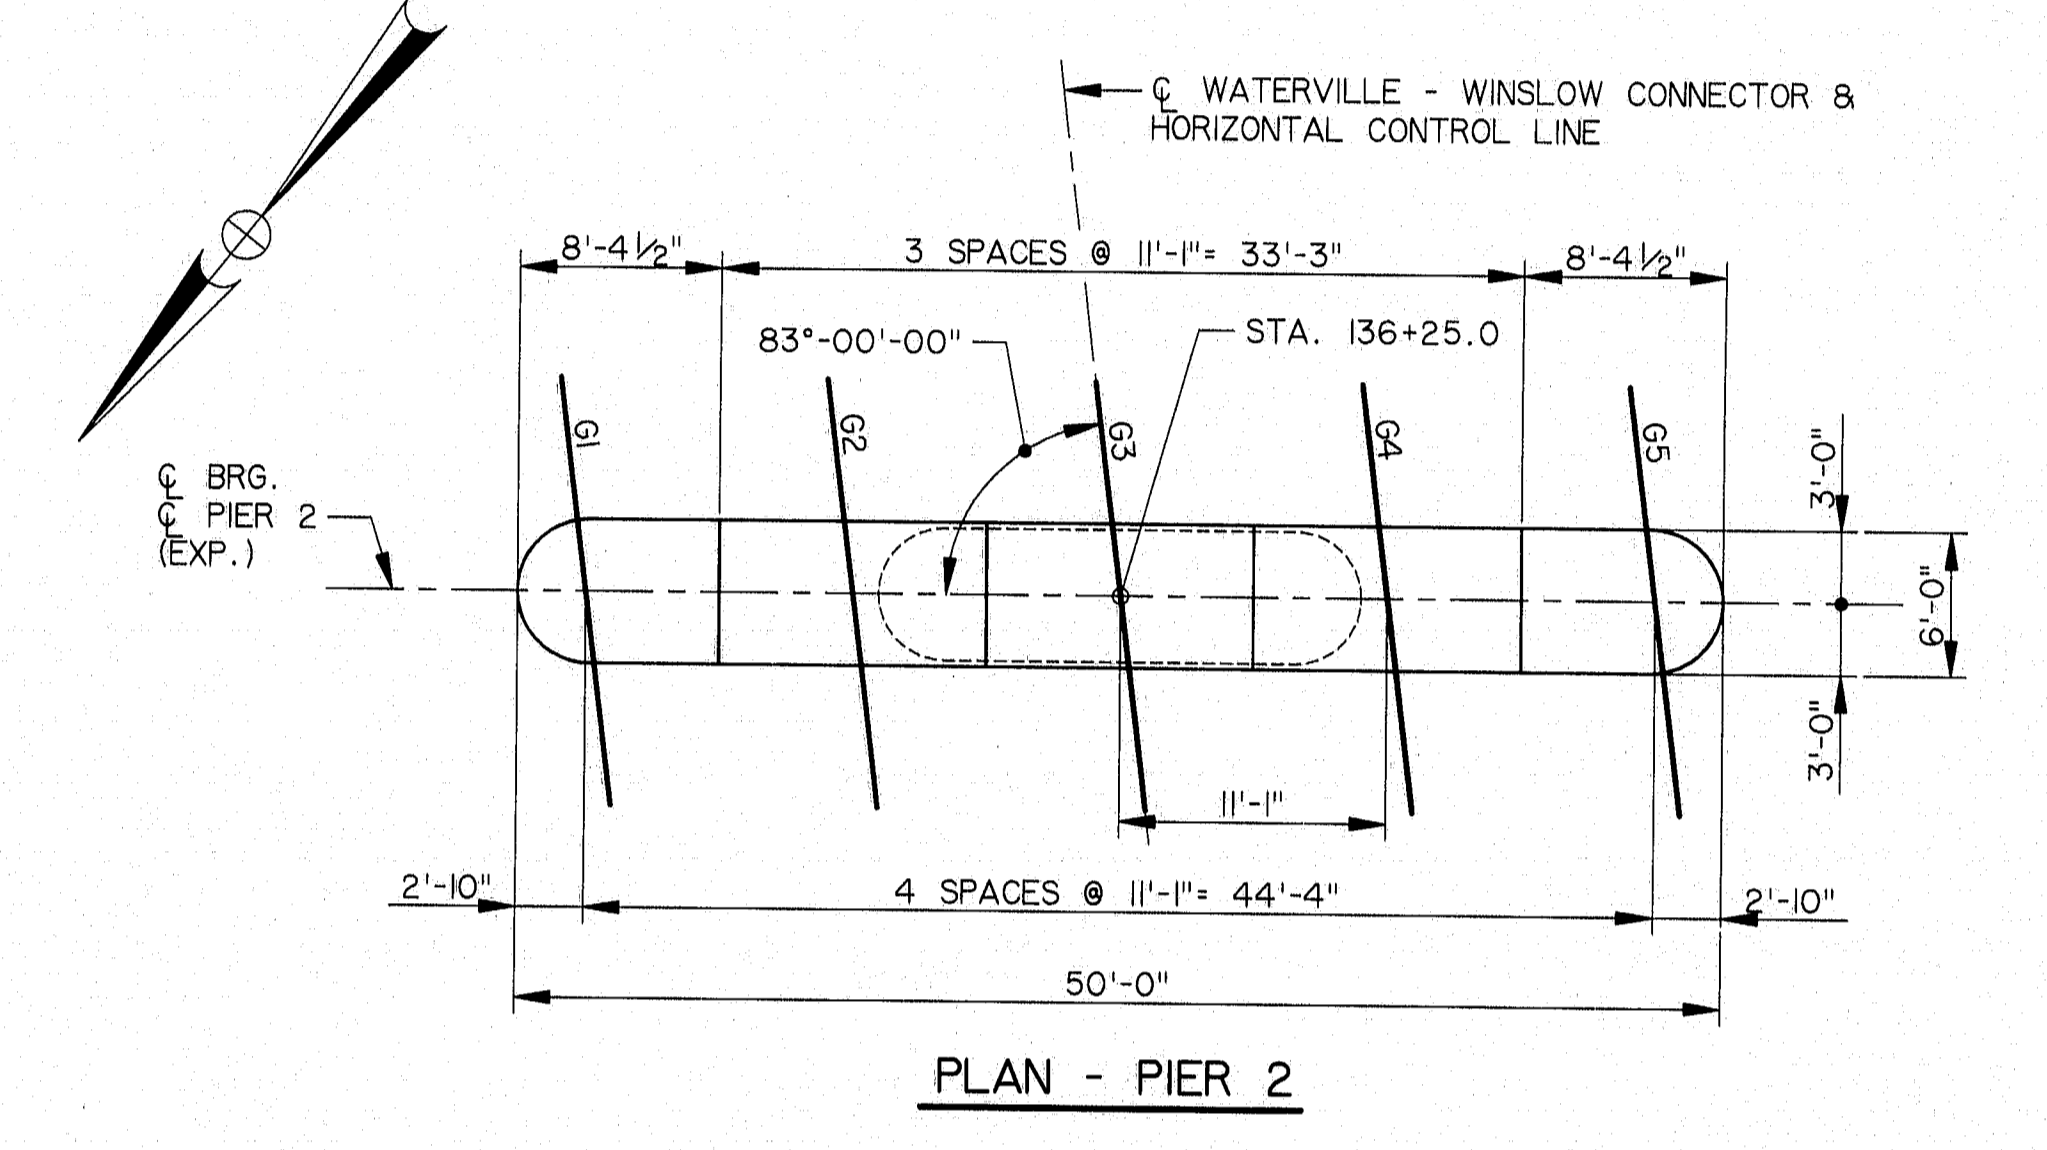

PLAN - PIER 2

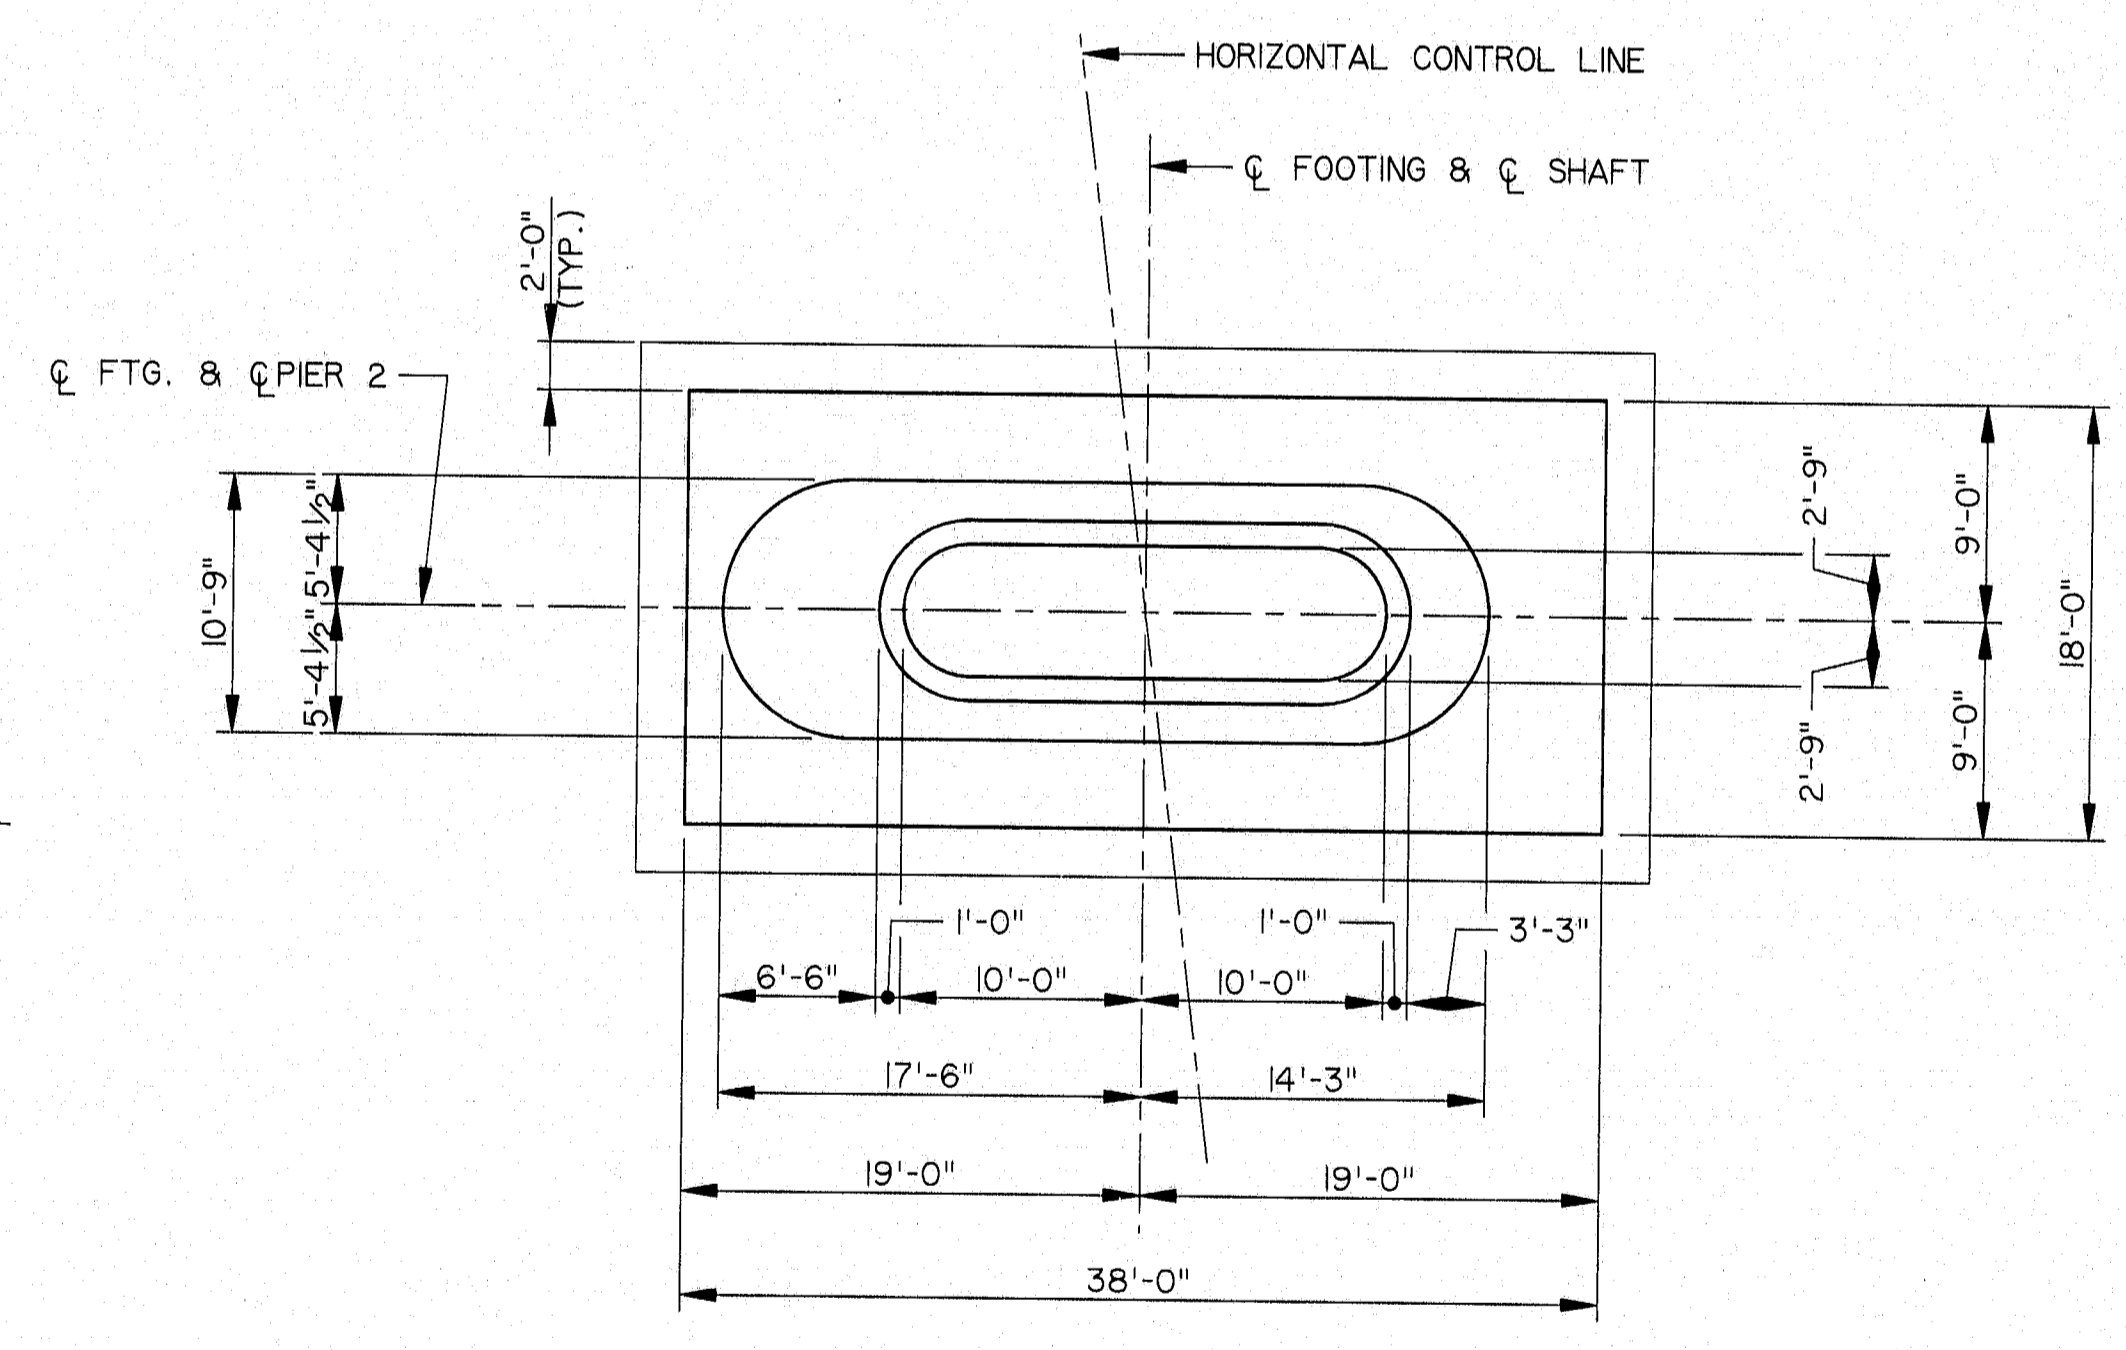

SECTION A-A

\* SEE NOTE 7, SHEET B30.

NOTES:

1. MAXIMUM CALCULATED PILE LOAD = 119 TONS (GROUP: IV)
2. SEE SHEET B30 FOR ADDITIONAL NOTES.

NO.	REVISION	BY	DATE	IN CHARGE OF
		DESIGNED:	SM	9/94
		DRAWN:	RJT	9/94
		CHECKED:	DWR	9/94
			CJM	



**115-227**


STEEL ALTERNATIVE  
STATE OF MAINE  
DEPARTMENT OF TRANSPORTATION

WATERVILLE - WINSLOW PROJECT  
DONALD V. CARTER BRIDGE  
OVER  
KENNEBEC RIVER


PIER 2 DETAILS

SHEET B32 OF B66 AUGUSTA, MAINE


F.W.A. REG. NO.	STATE	PROJECT NUMBER	SHEET NO.	TOTAL SHEETS
1	MAINE	0009(002)	42	103

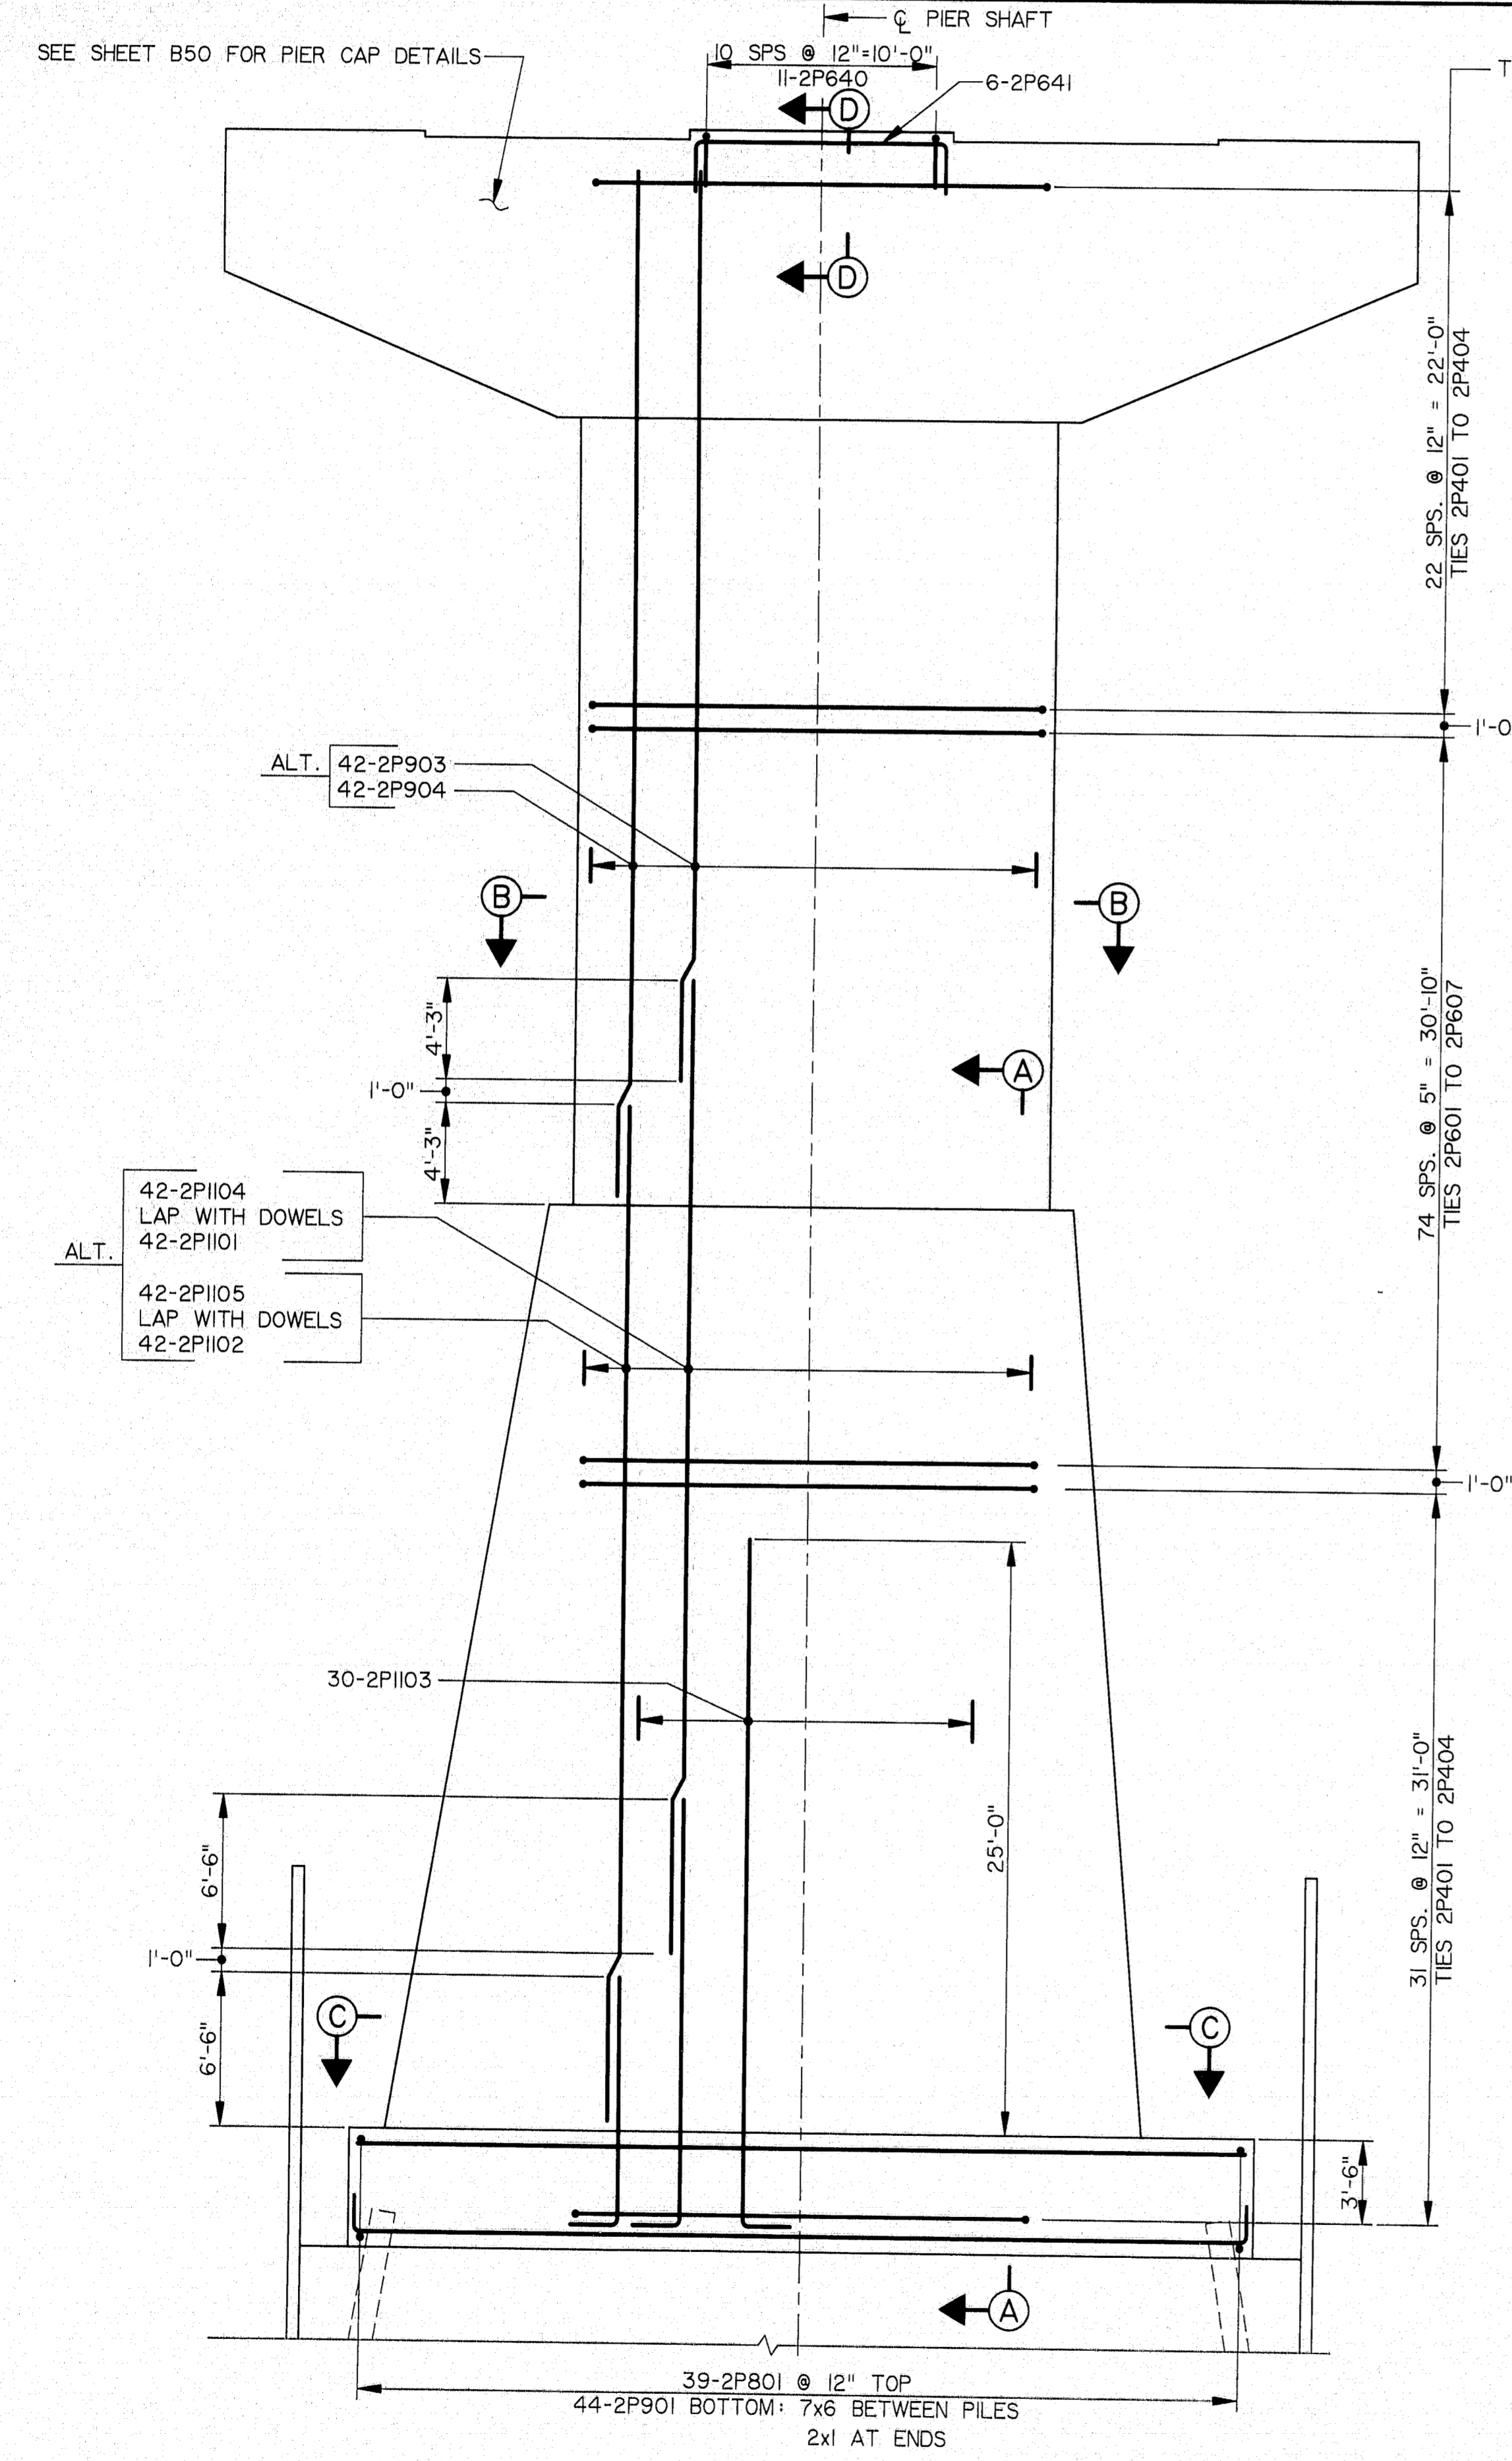


ELEVATION - PIER 2

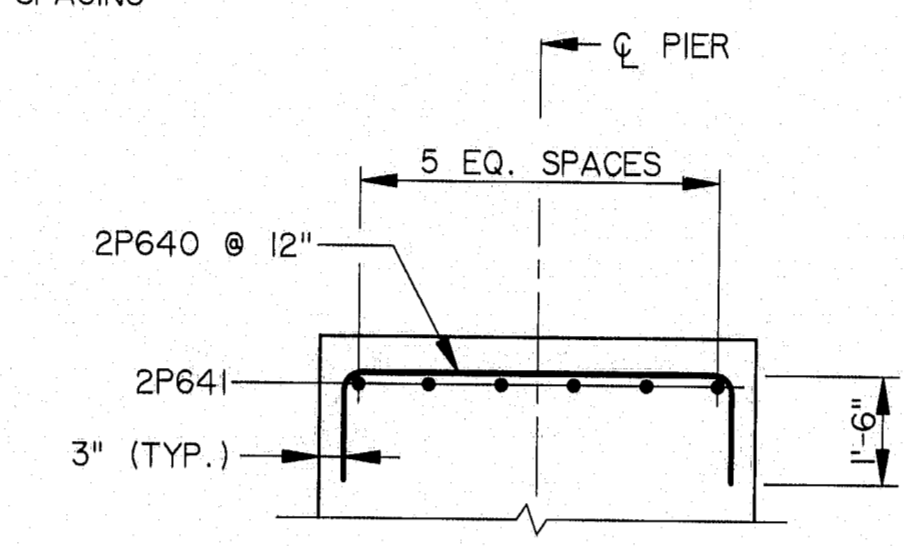

SECTION D-D

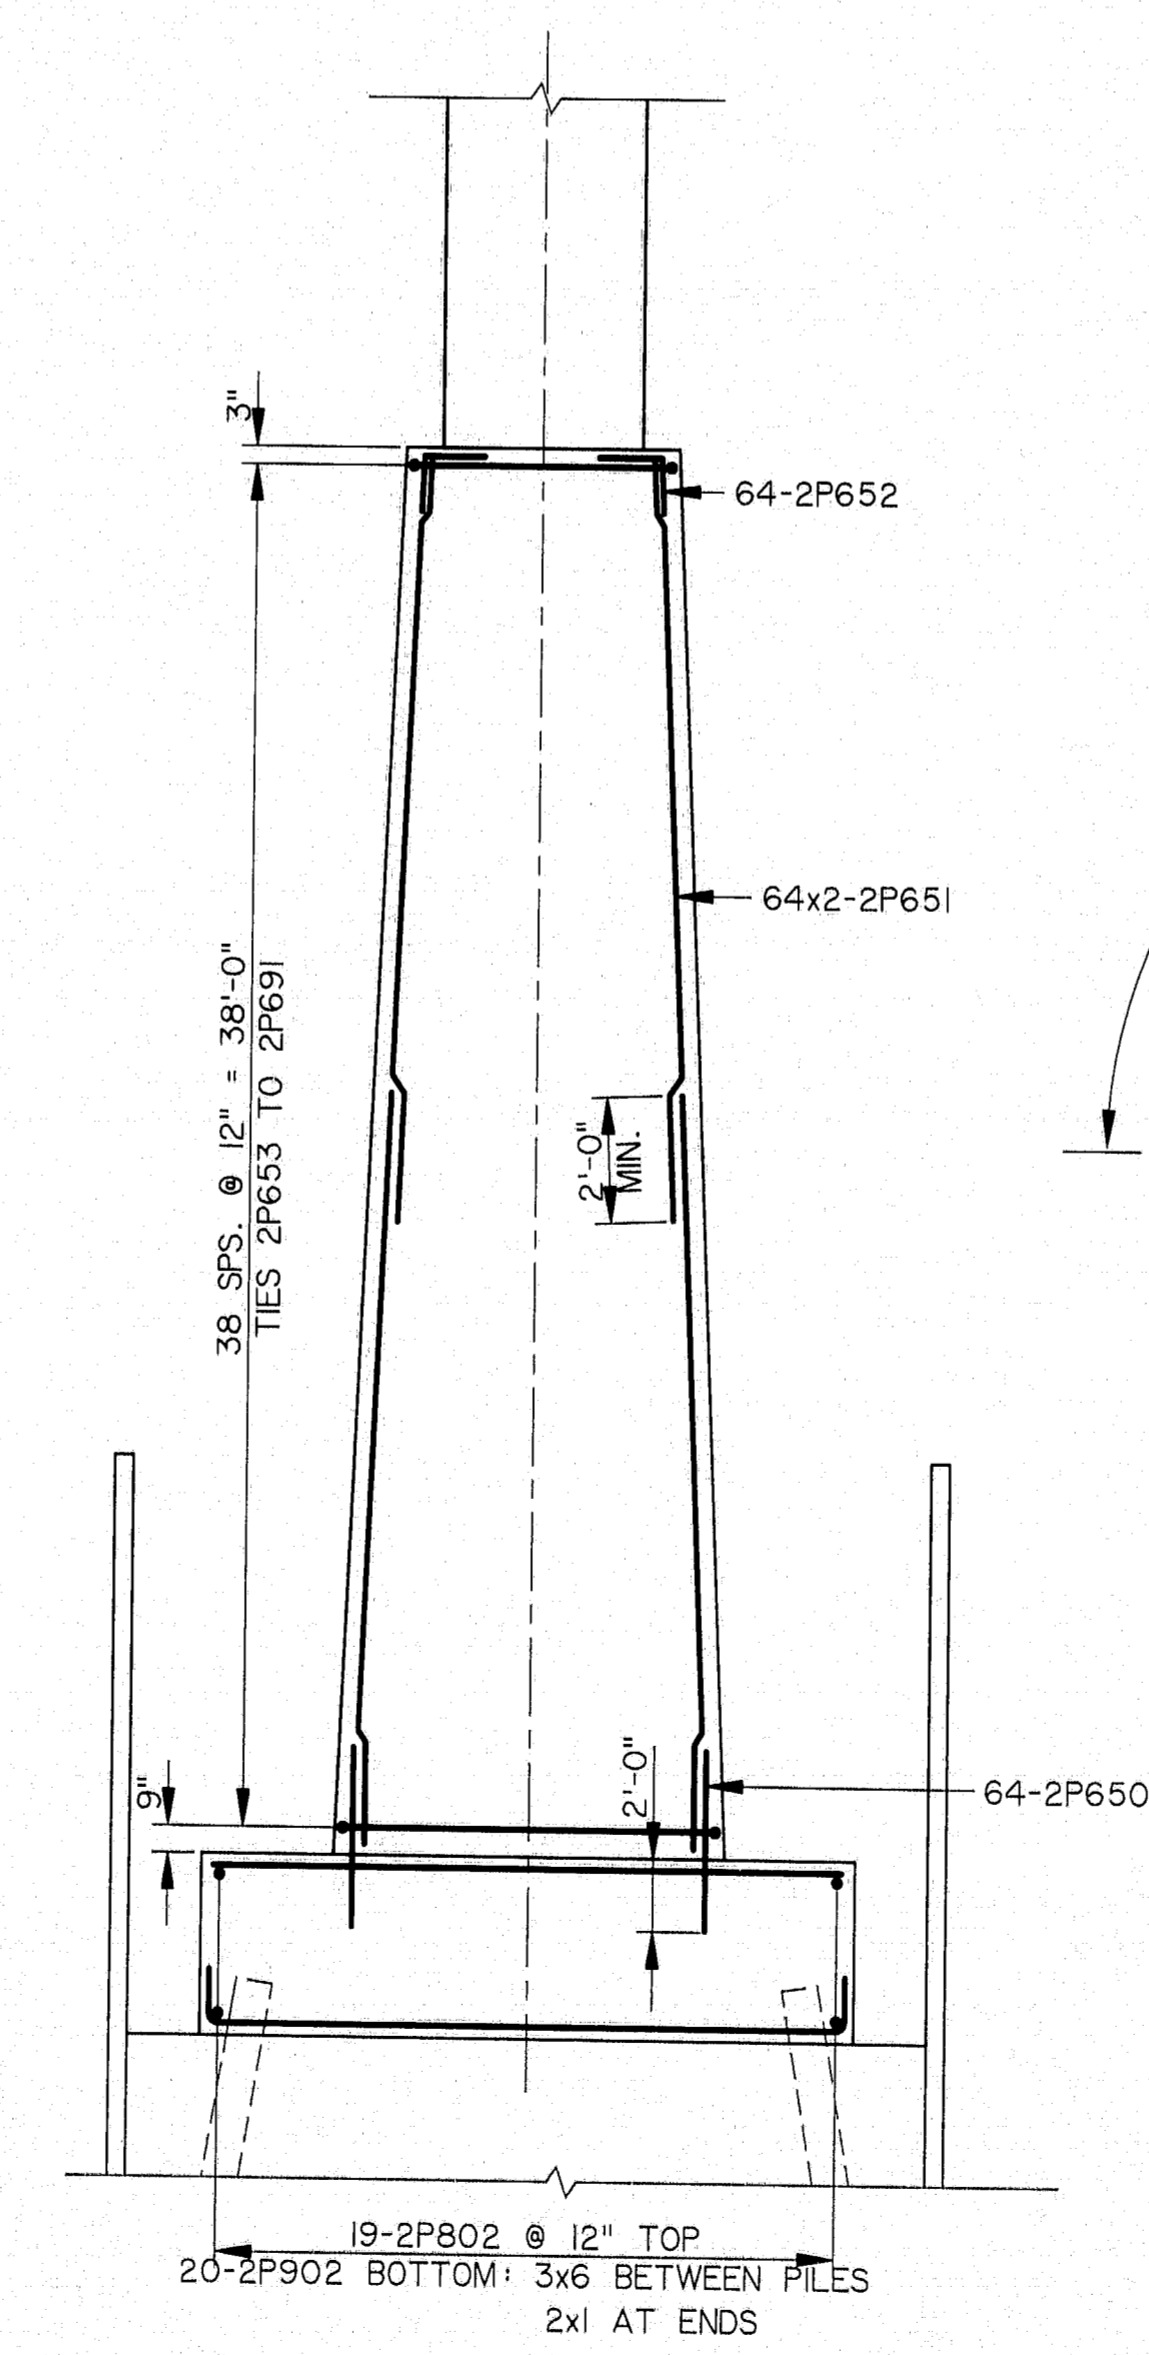


SECTION A-A

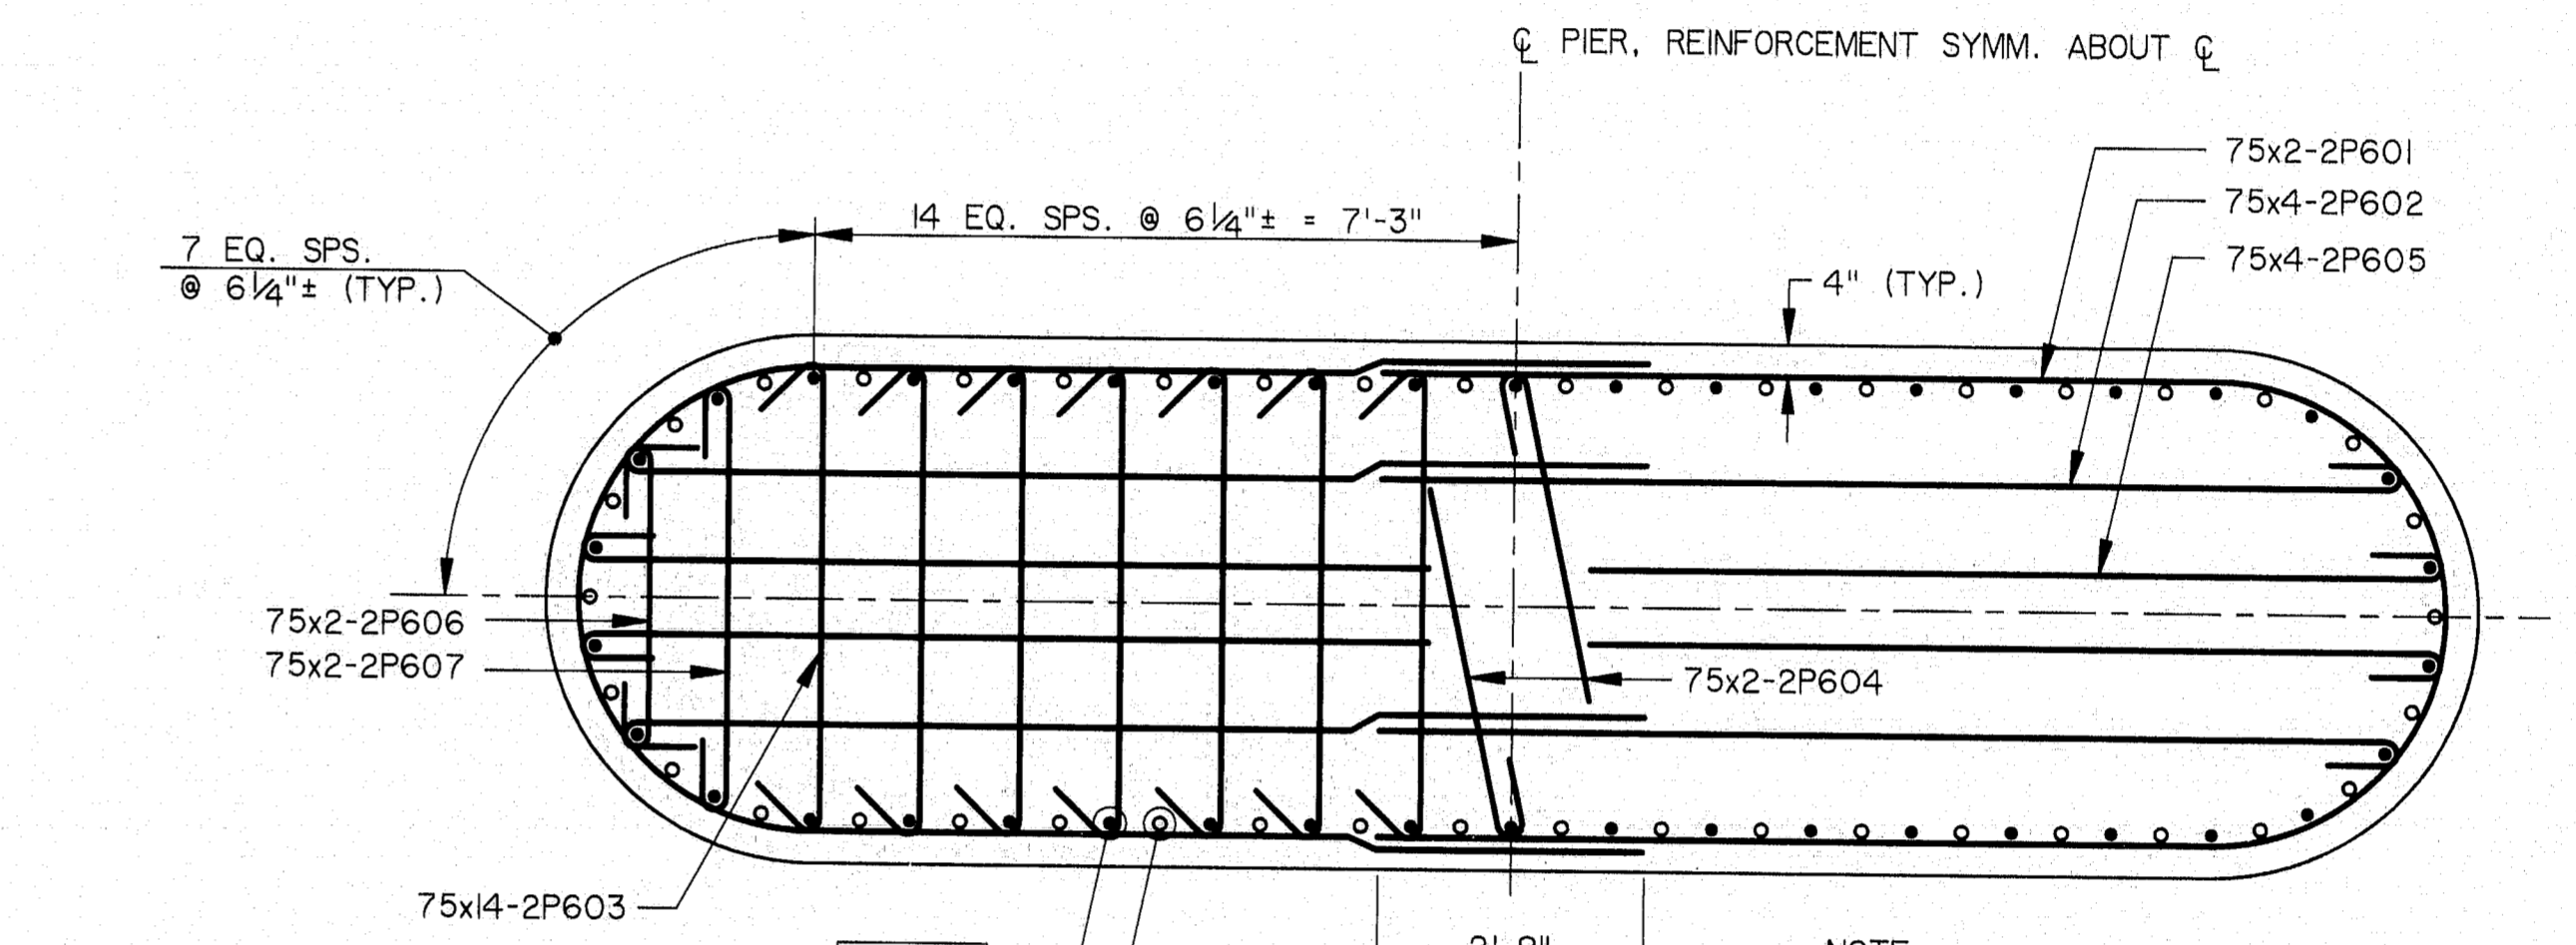

SECTION B-B

NOTE  
#6 TIES - 135" MIN. HOOK WITH 7 1/2" EXT.

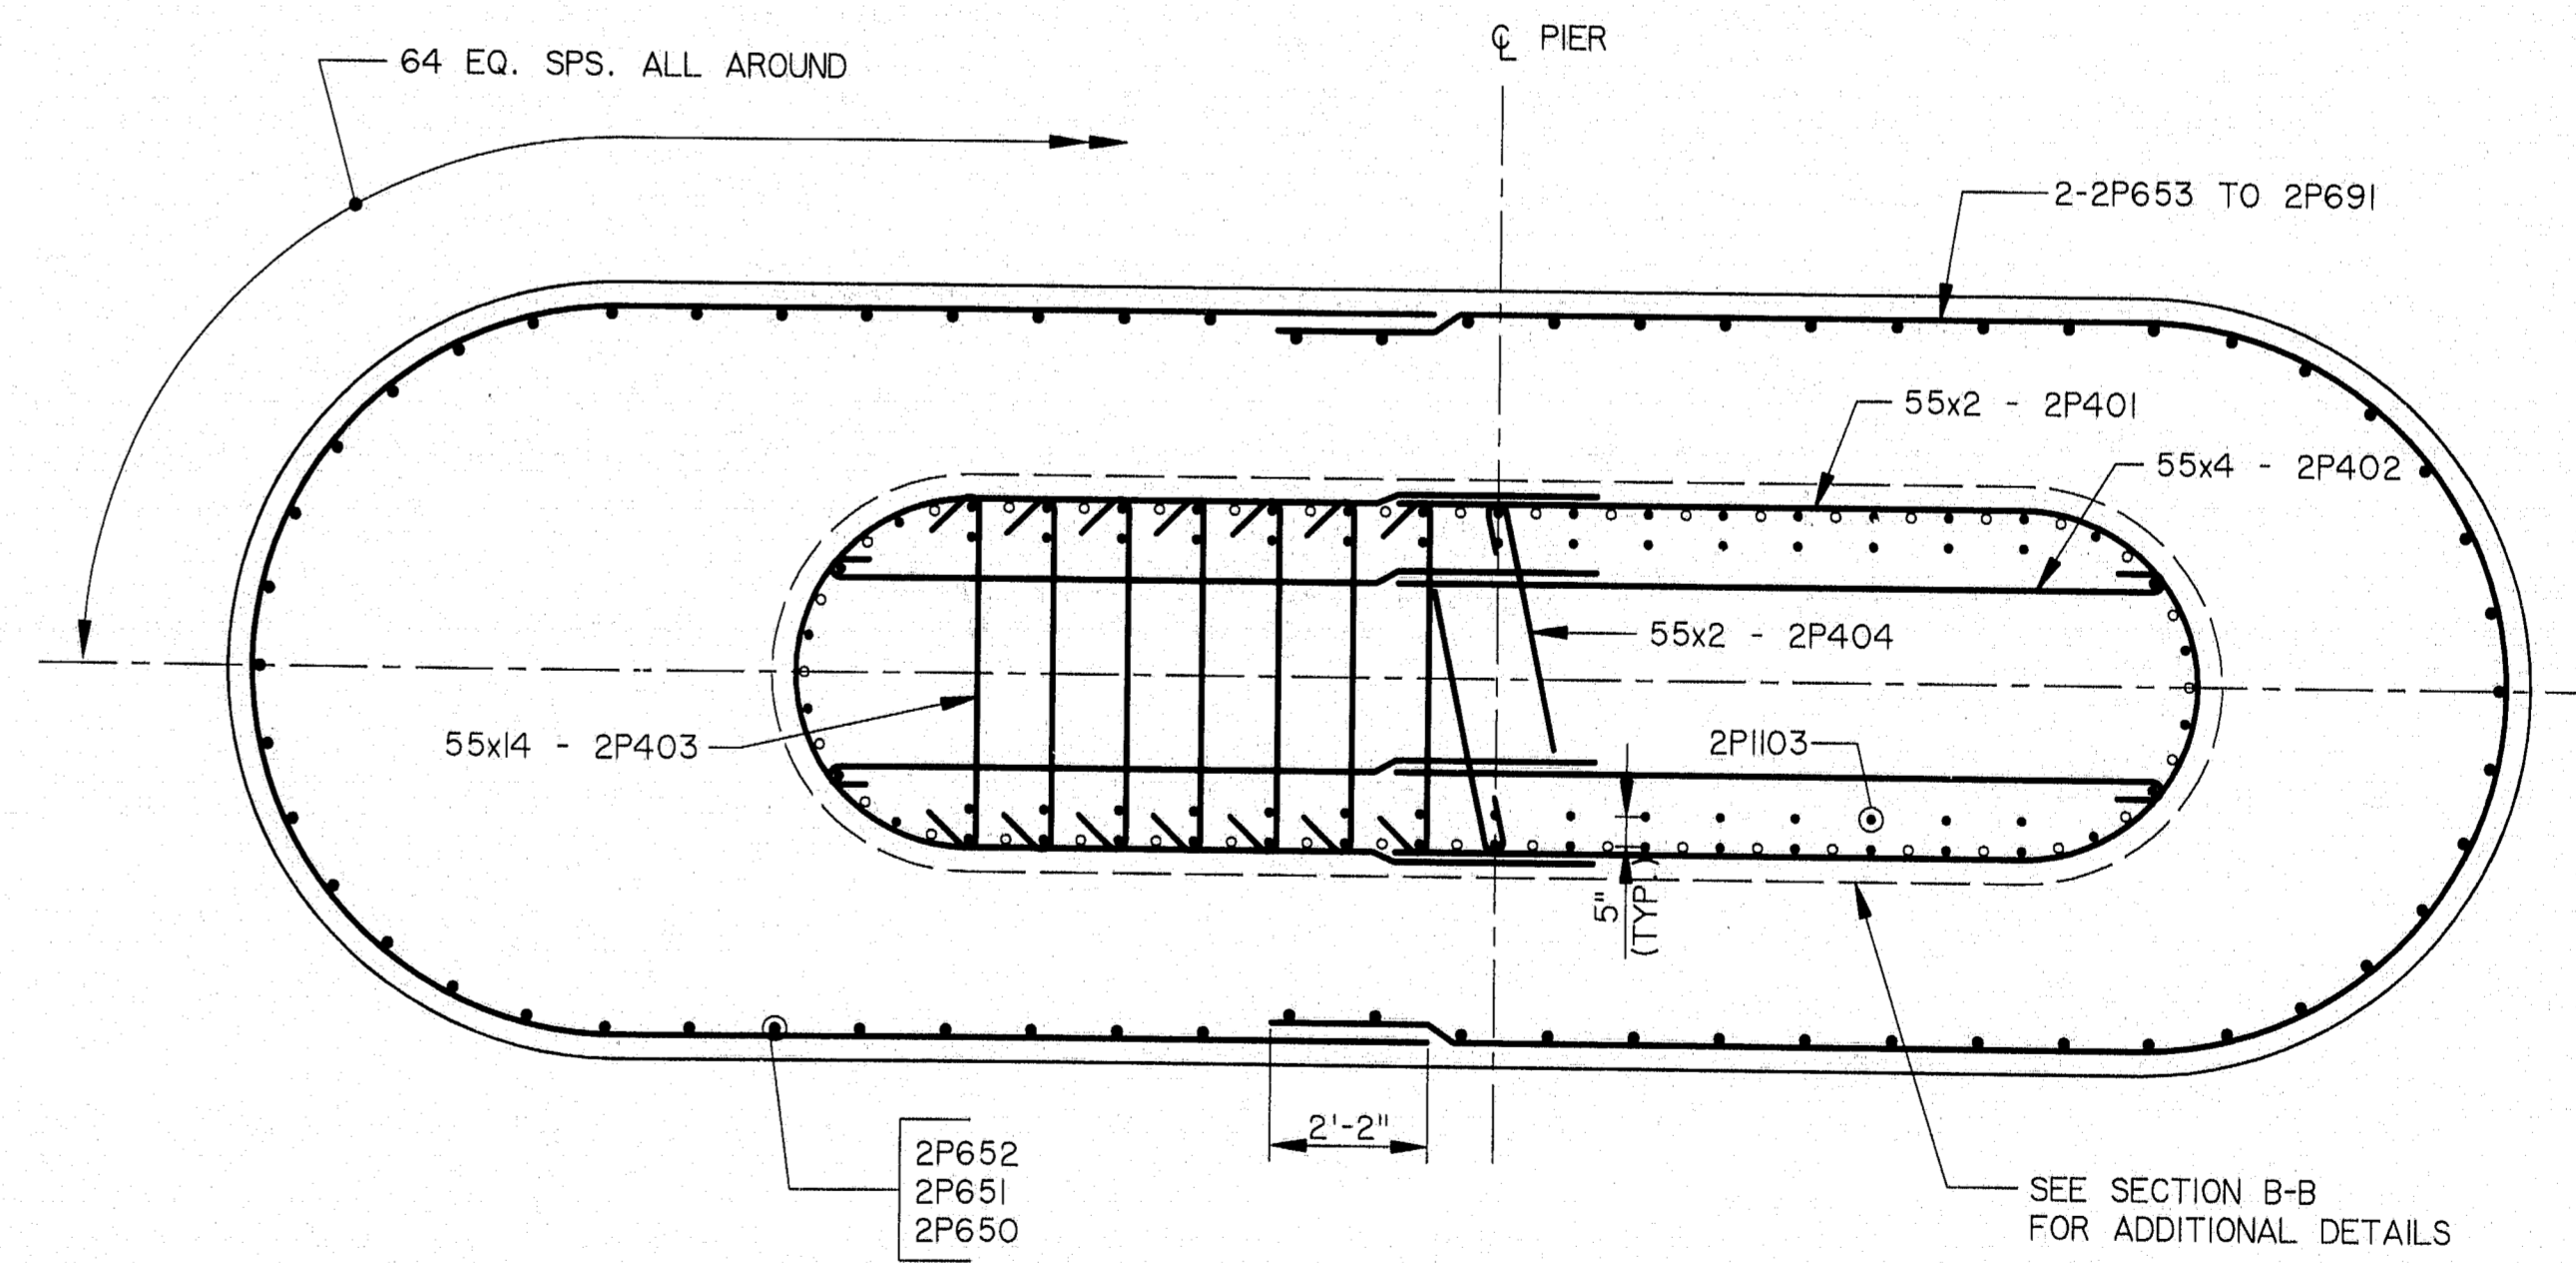

SECTION C-C

NO.	REVISION	BY	DATE	IN CHARGE OF	CJM
		DESIGNED: DWR	9/94		
		DRAWN: LS	9/94		
		CHECKED: SM	9/94		



115-228  
STEEL ALTERNATIVE


STATE OF MAINE  
DEPARTMENT OF TRANSPORTATION

WATERVILLE - WINSLOW PROJECT  
DONALD V. CARTER BRIDGE  
OVER  
KENNEBEC RIVER


PIER 2 RE-STEEL

SHEET B33 OF B86 AUGUSTA, MAINE


F.H.W.A. REG. NO.	STATE	PROJECT NUMBER	SHEET NO.	TOTAL SHEETS
1	MAINE	000910021	43	103

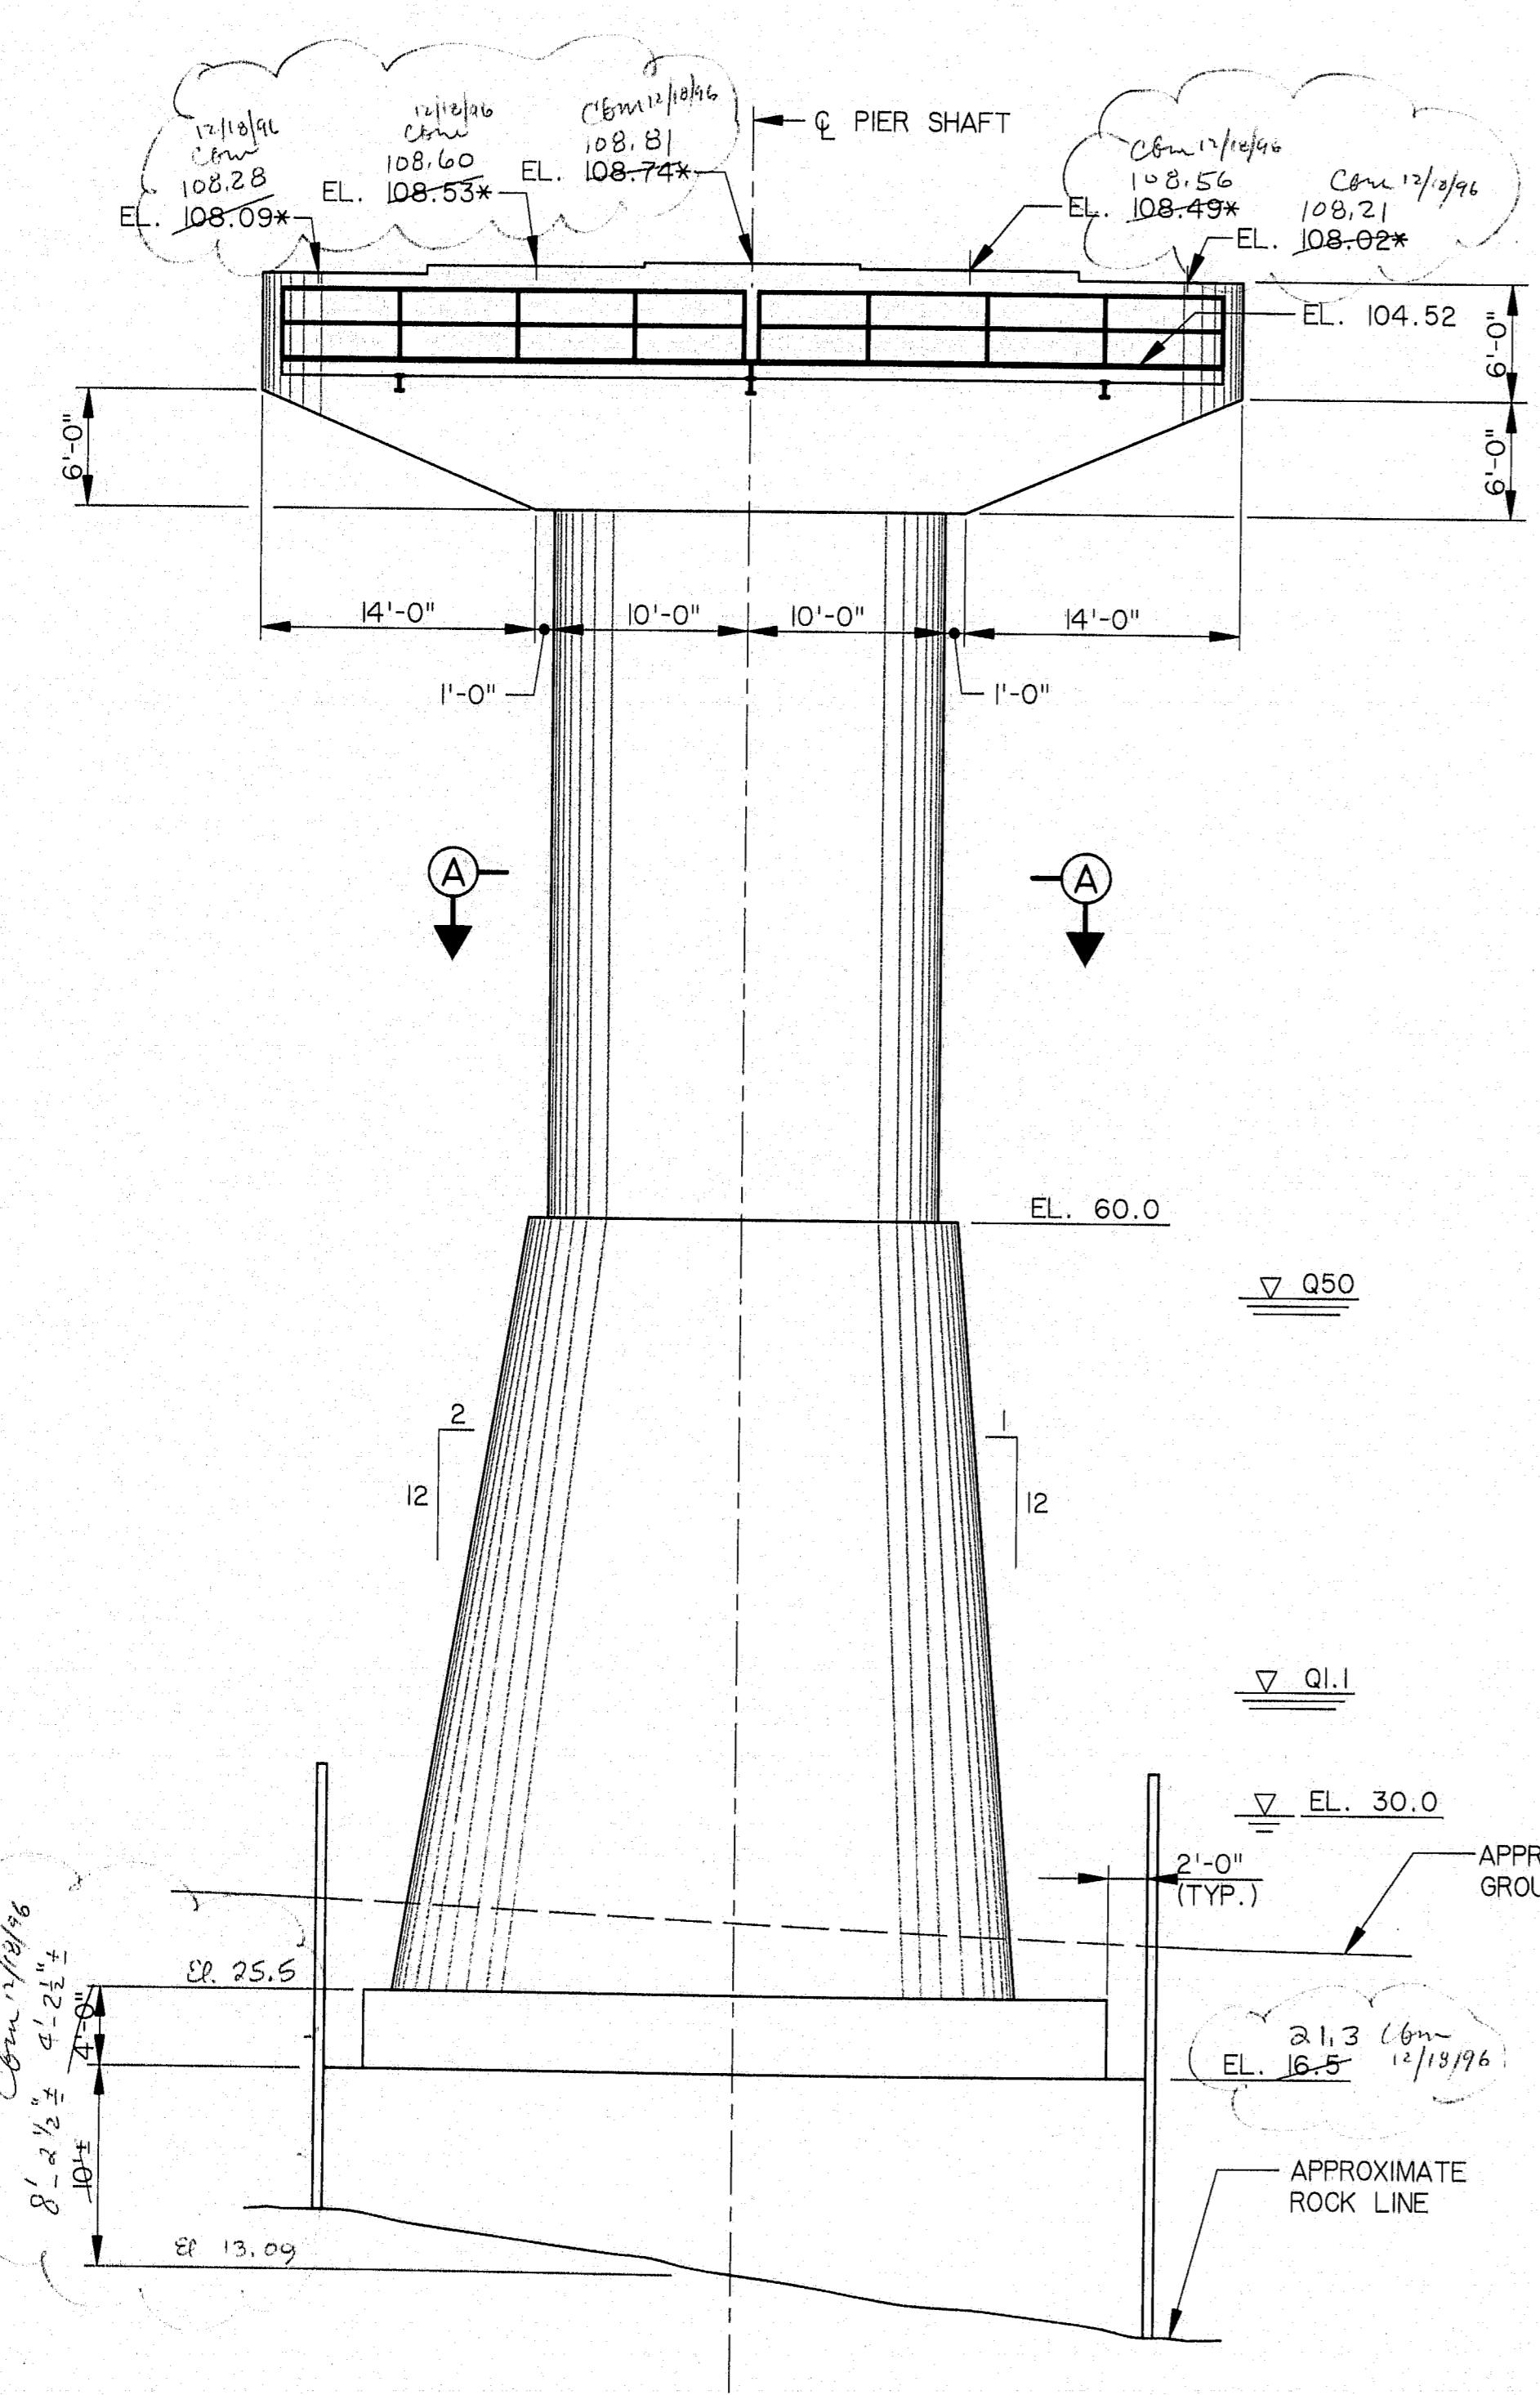


ELEVATION  
(LOOKING UPSTATION)

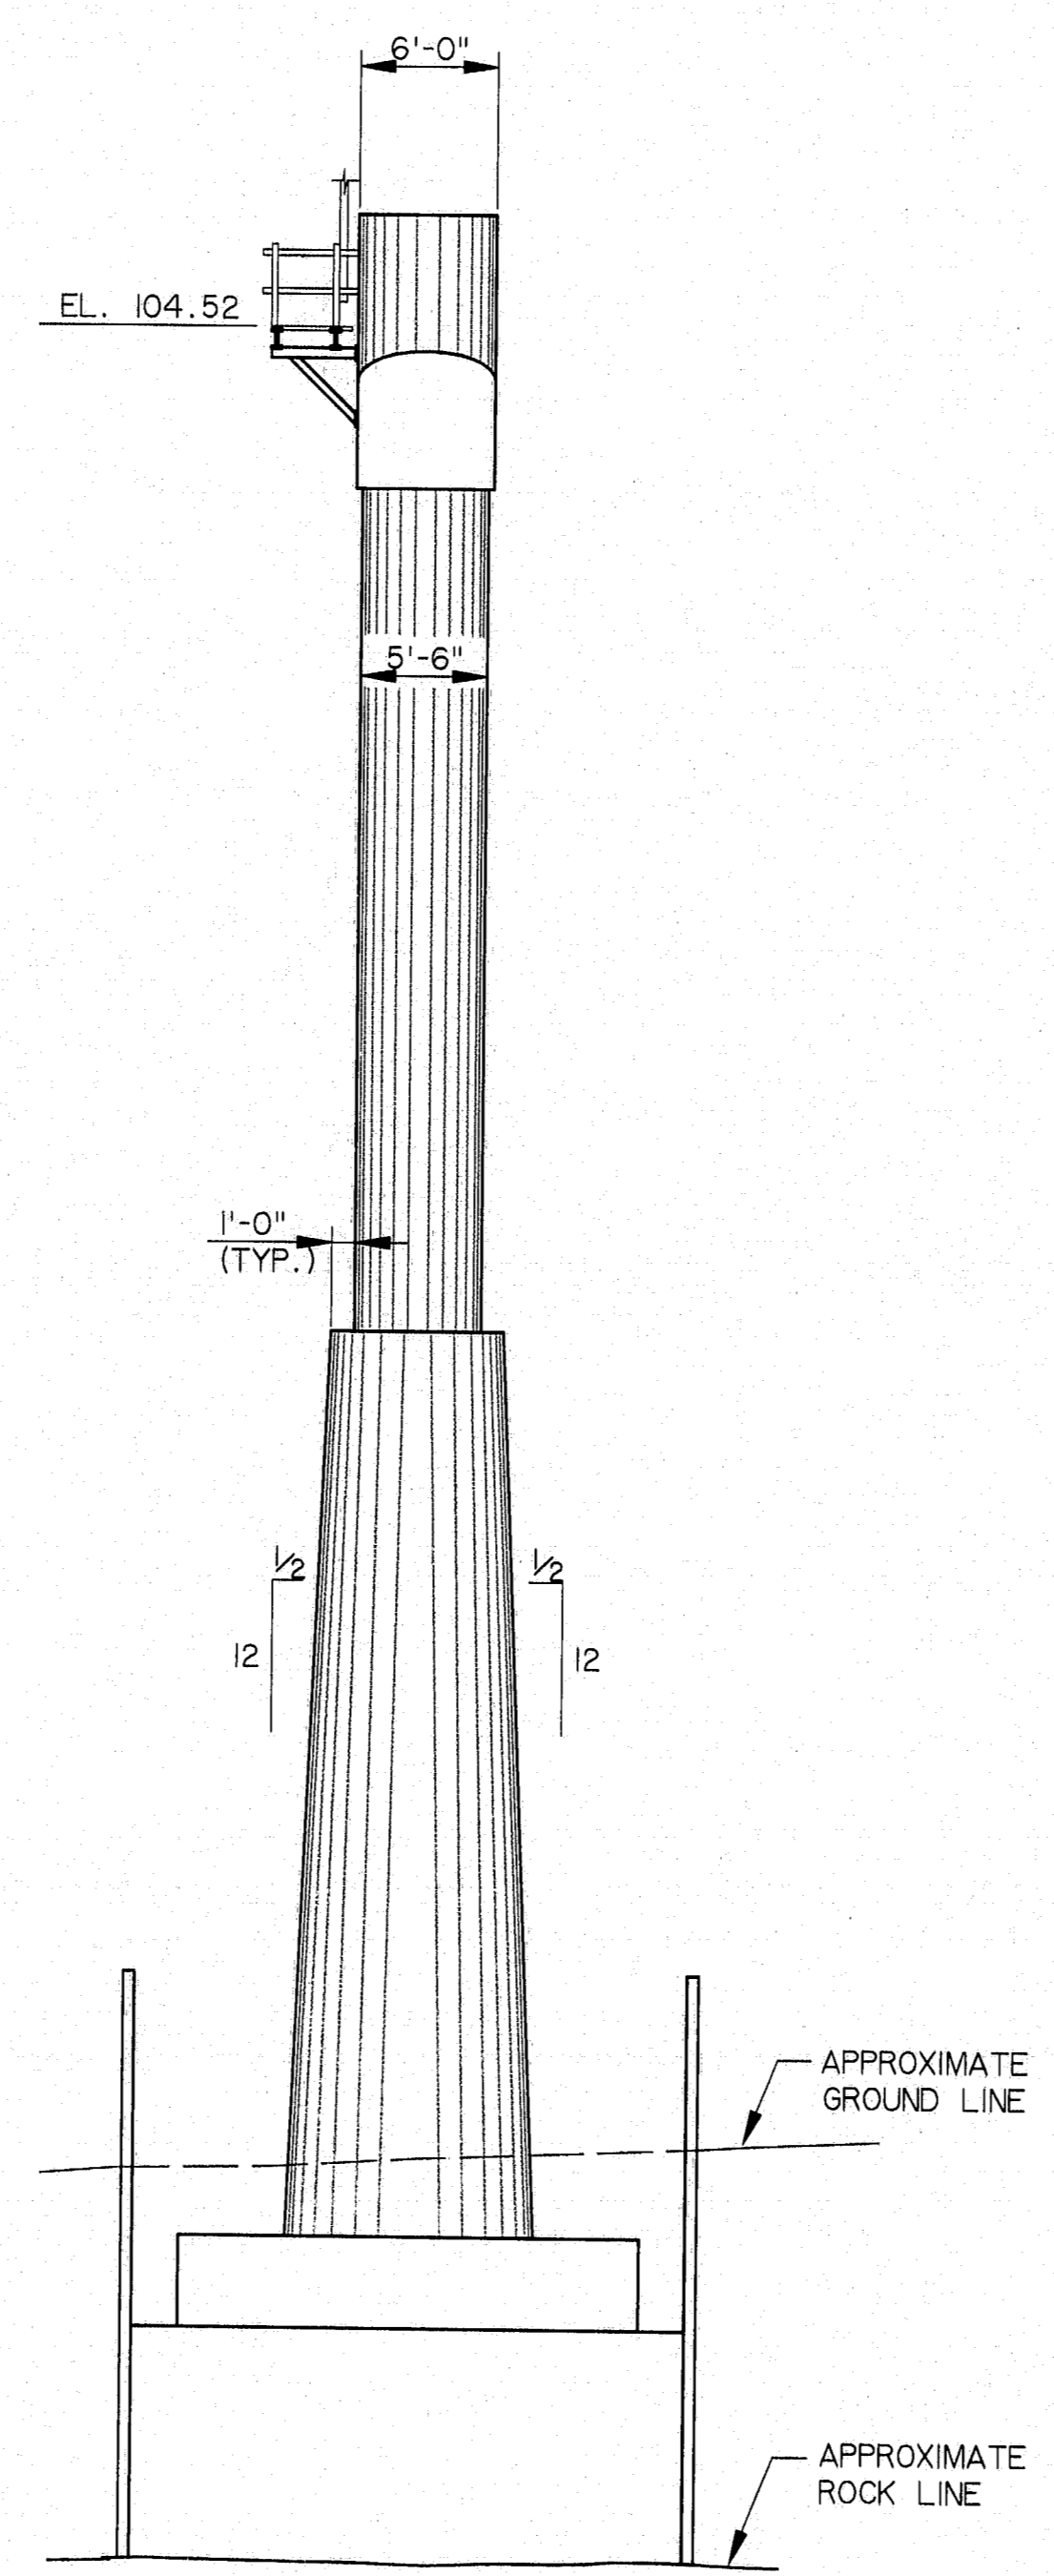

SIDE ELEVATION

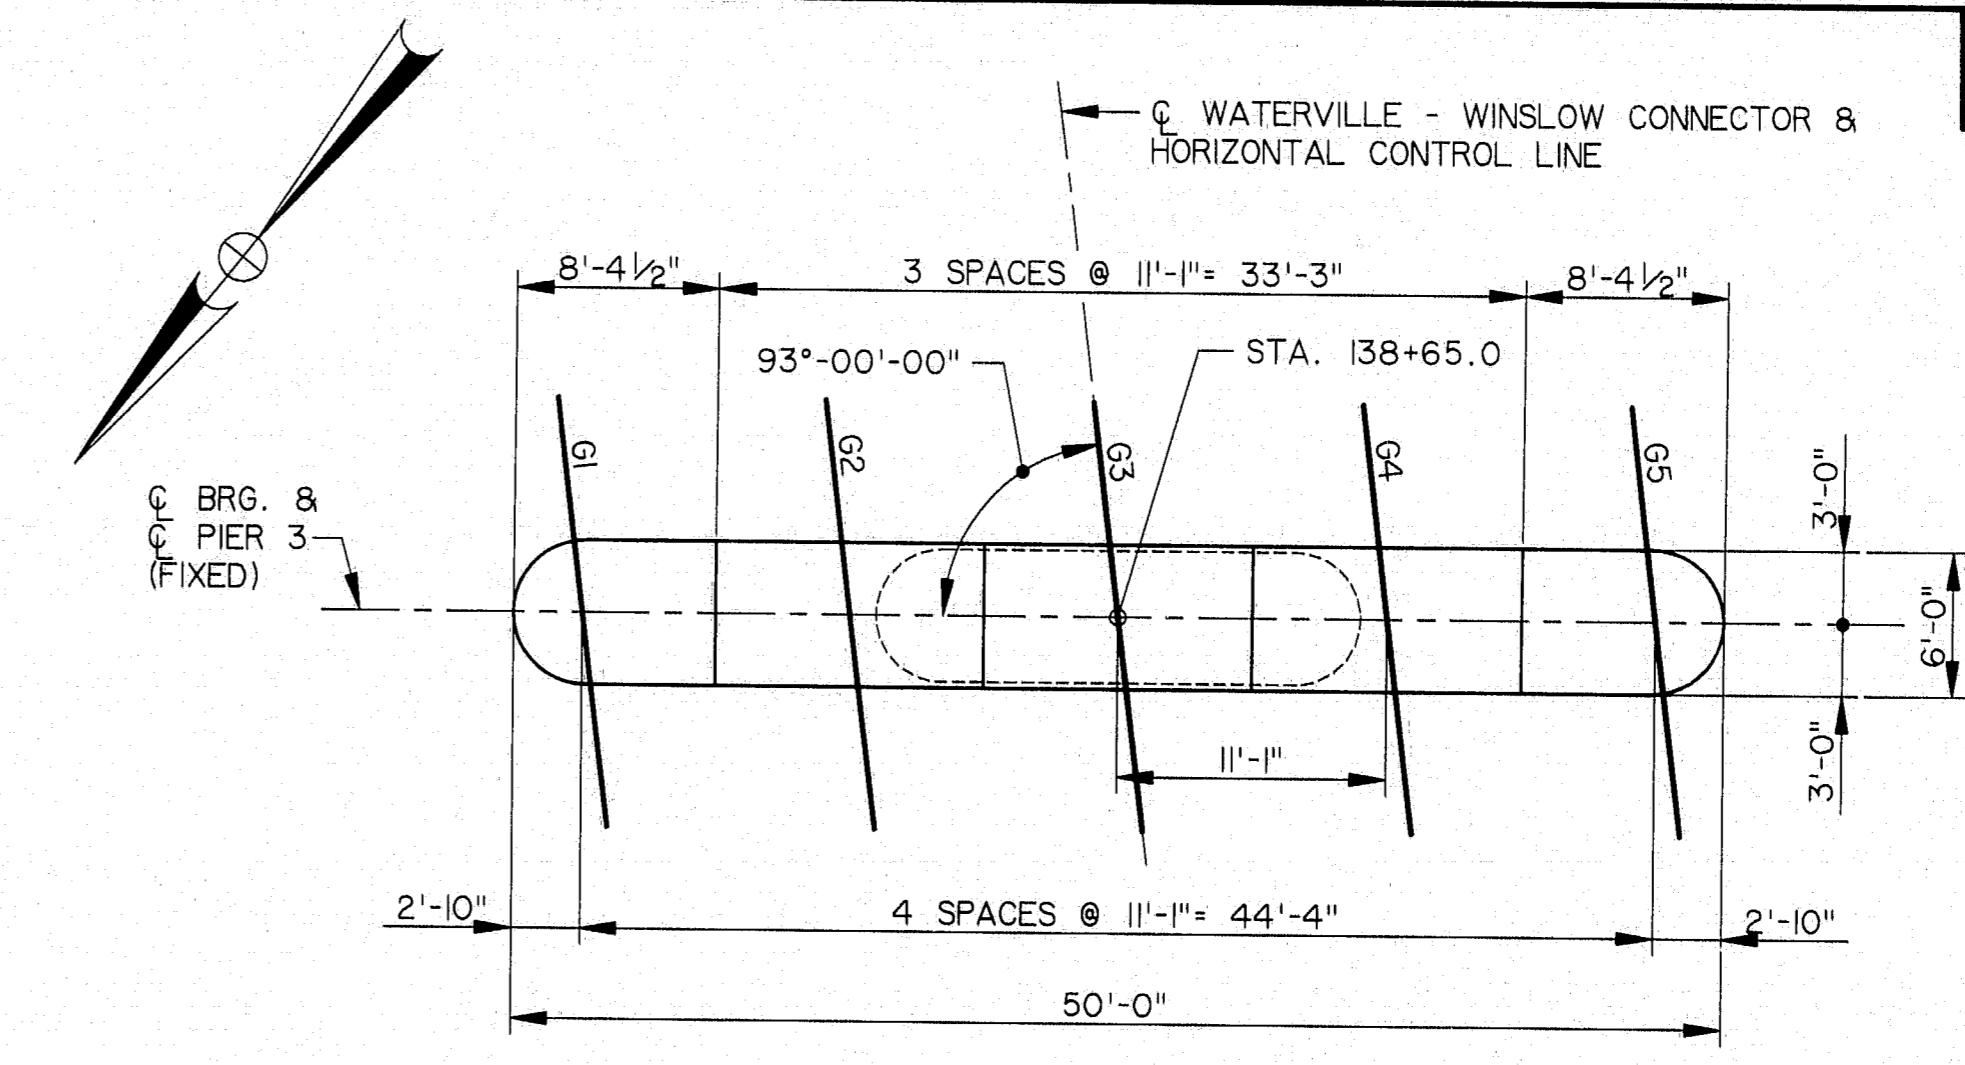

PLAN - PIER 3

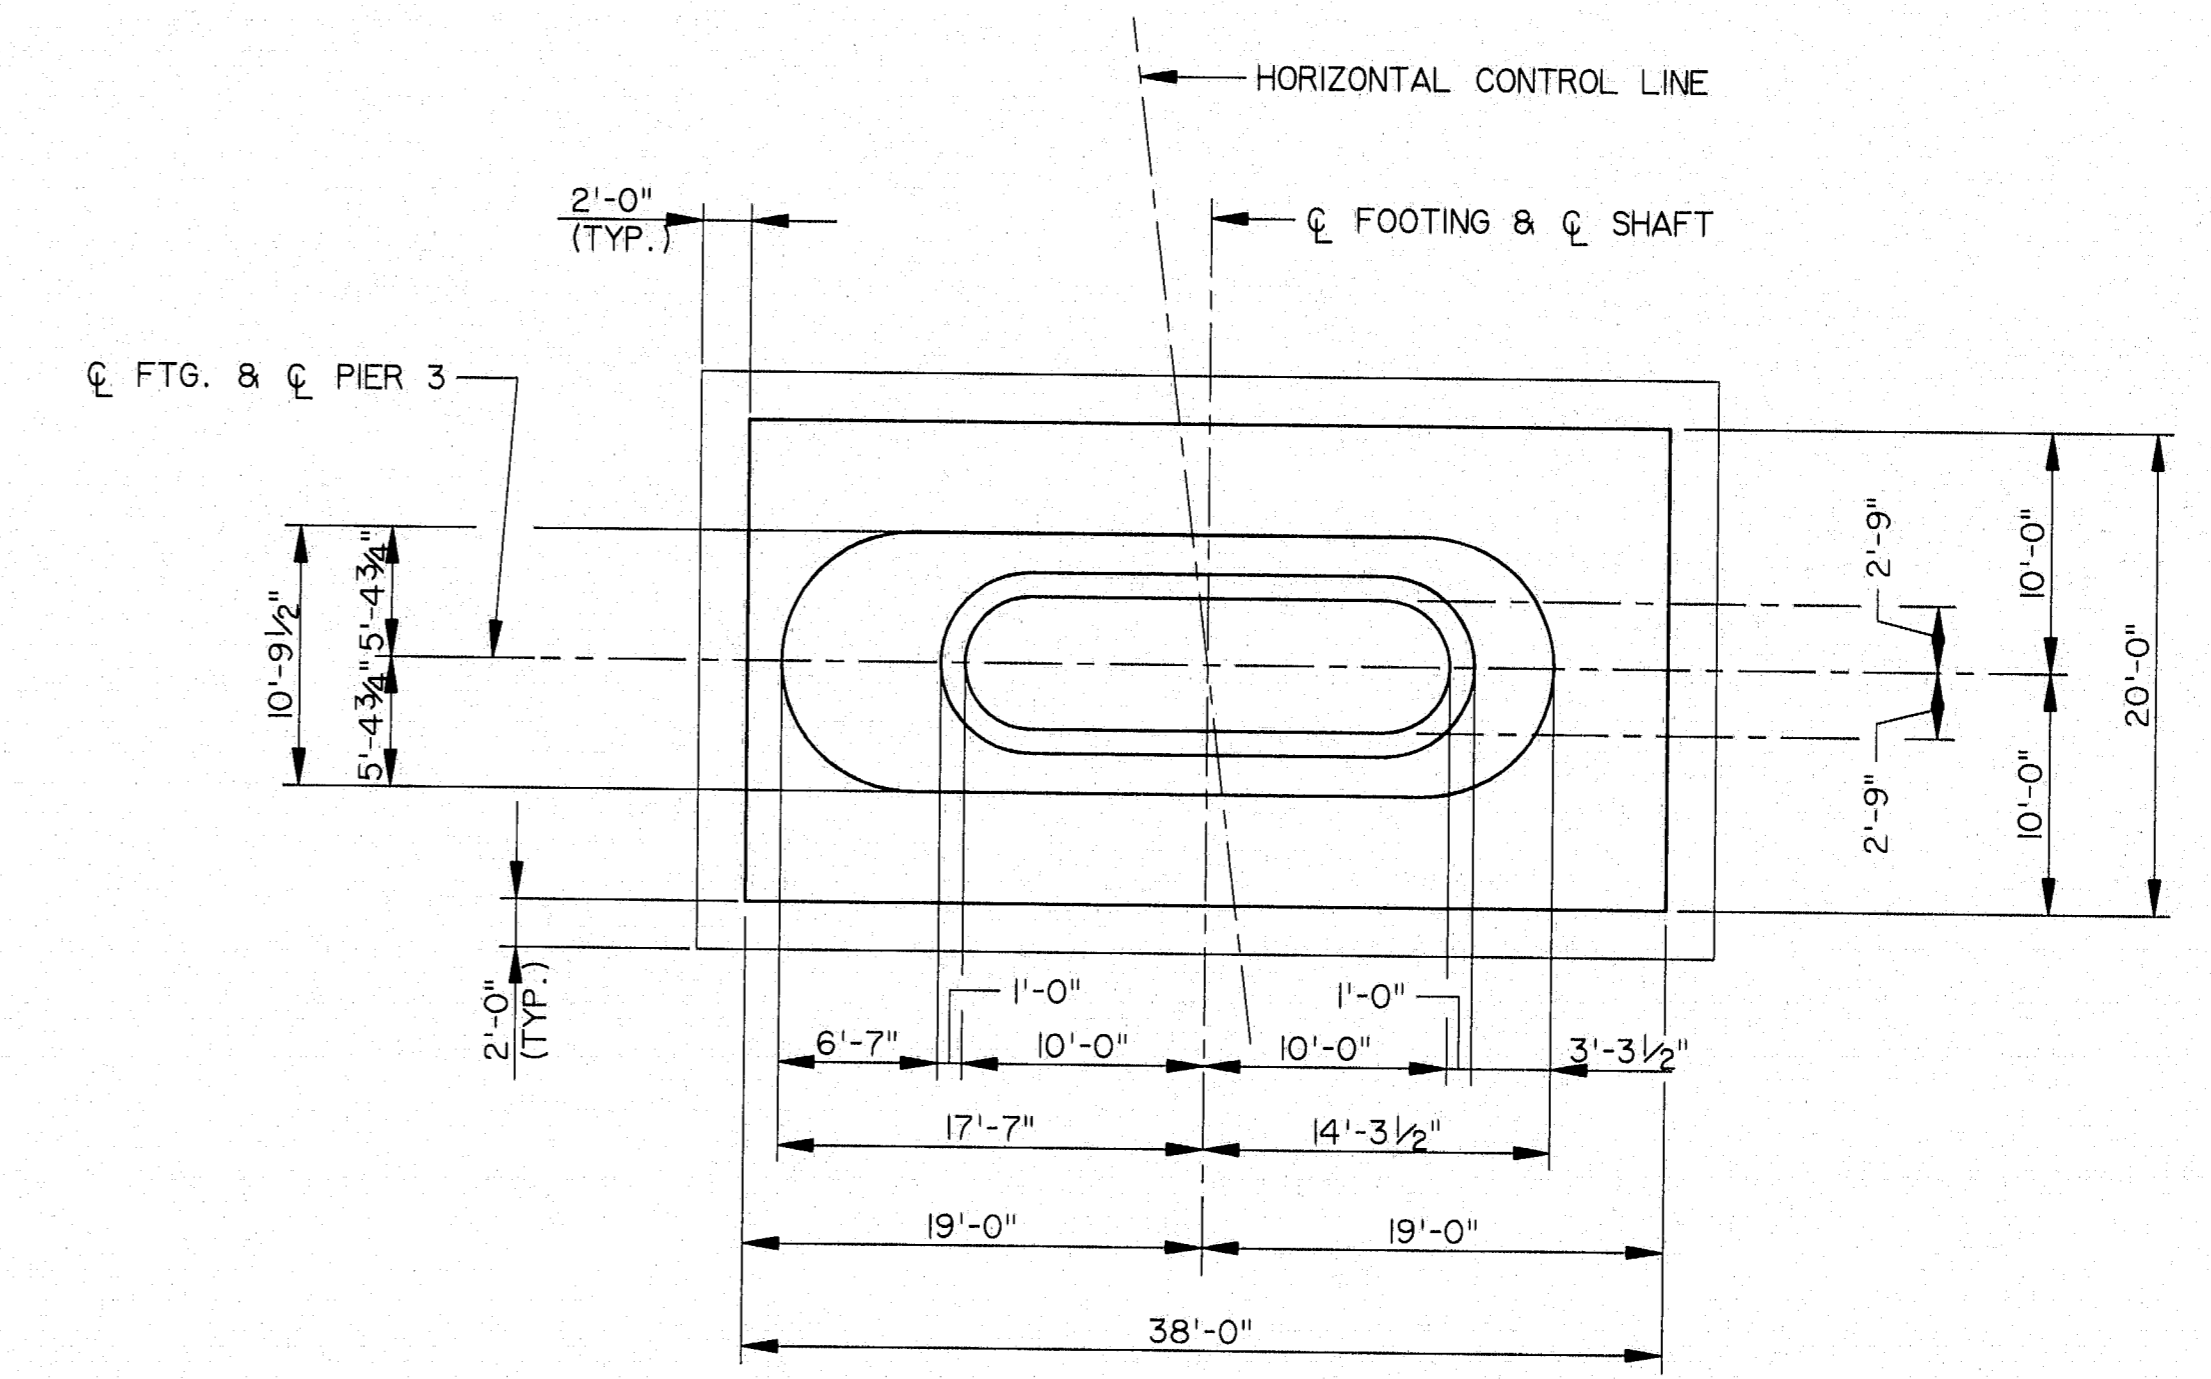

SECTION A-A

NOTES:

1. MAXIMUM CALCULATED FOOTING PRESSURE = 14.9 T.S.F. (GROUP; SEISMIC)\*
- \* ULTIMATE CAPACITY OF FOUNDATION SUPPORTING ROCK IS USED IN CONJUNCTION WITH SEISMIC LOADING.
2. SEE SHEET B30 FOR ADDITIONAL NOTES.



NO.	REVISION	BY	DATE	IN CHARGE OF	CJM
		DESIGNED:	SM	8/94	
		DRAWN:	RJT	8/94	
		CHECKED:	DWR	8/94	




**115-229**  
STEEL ALTERNATIVE  
STATE OF MAINE  
DEPARTMENT OF TRANSPORTATION  
WATERVILLE - WINSLOW PROJECT  
DONALD V. CARTER BRIDGE  
OVER  
KENNEBEC RIVER  
PIER 3 DETAILS  
SHEET B34 OF B86 AUGUSTA, MAINE

DATE: 9/24/94 STA: 0+00.00 DRAWN: LS BY: DWR


F.R.W.A. REV. NO.	STATE	PROJECT NUMBER	SHEET NO.	TOTAL SHEETS
1	MAINE	0009 (002)	44	103

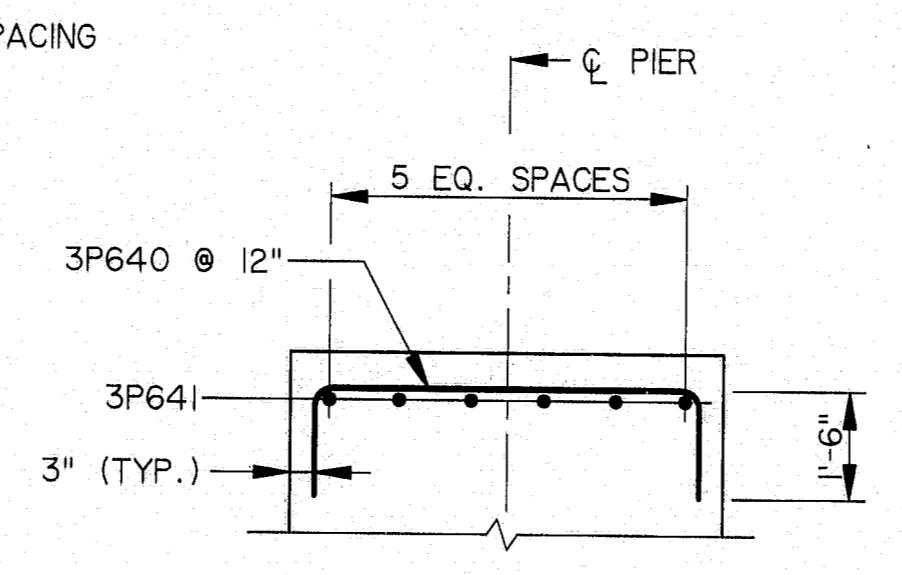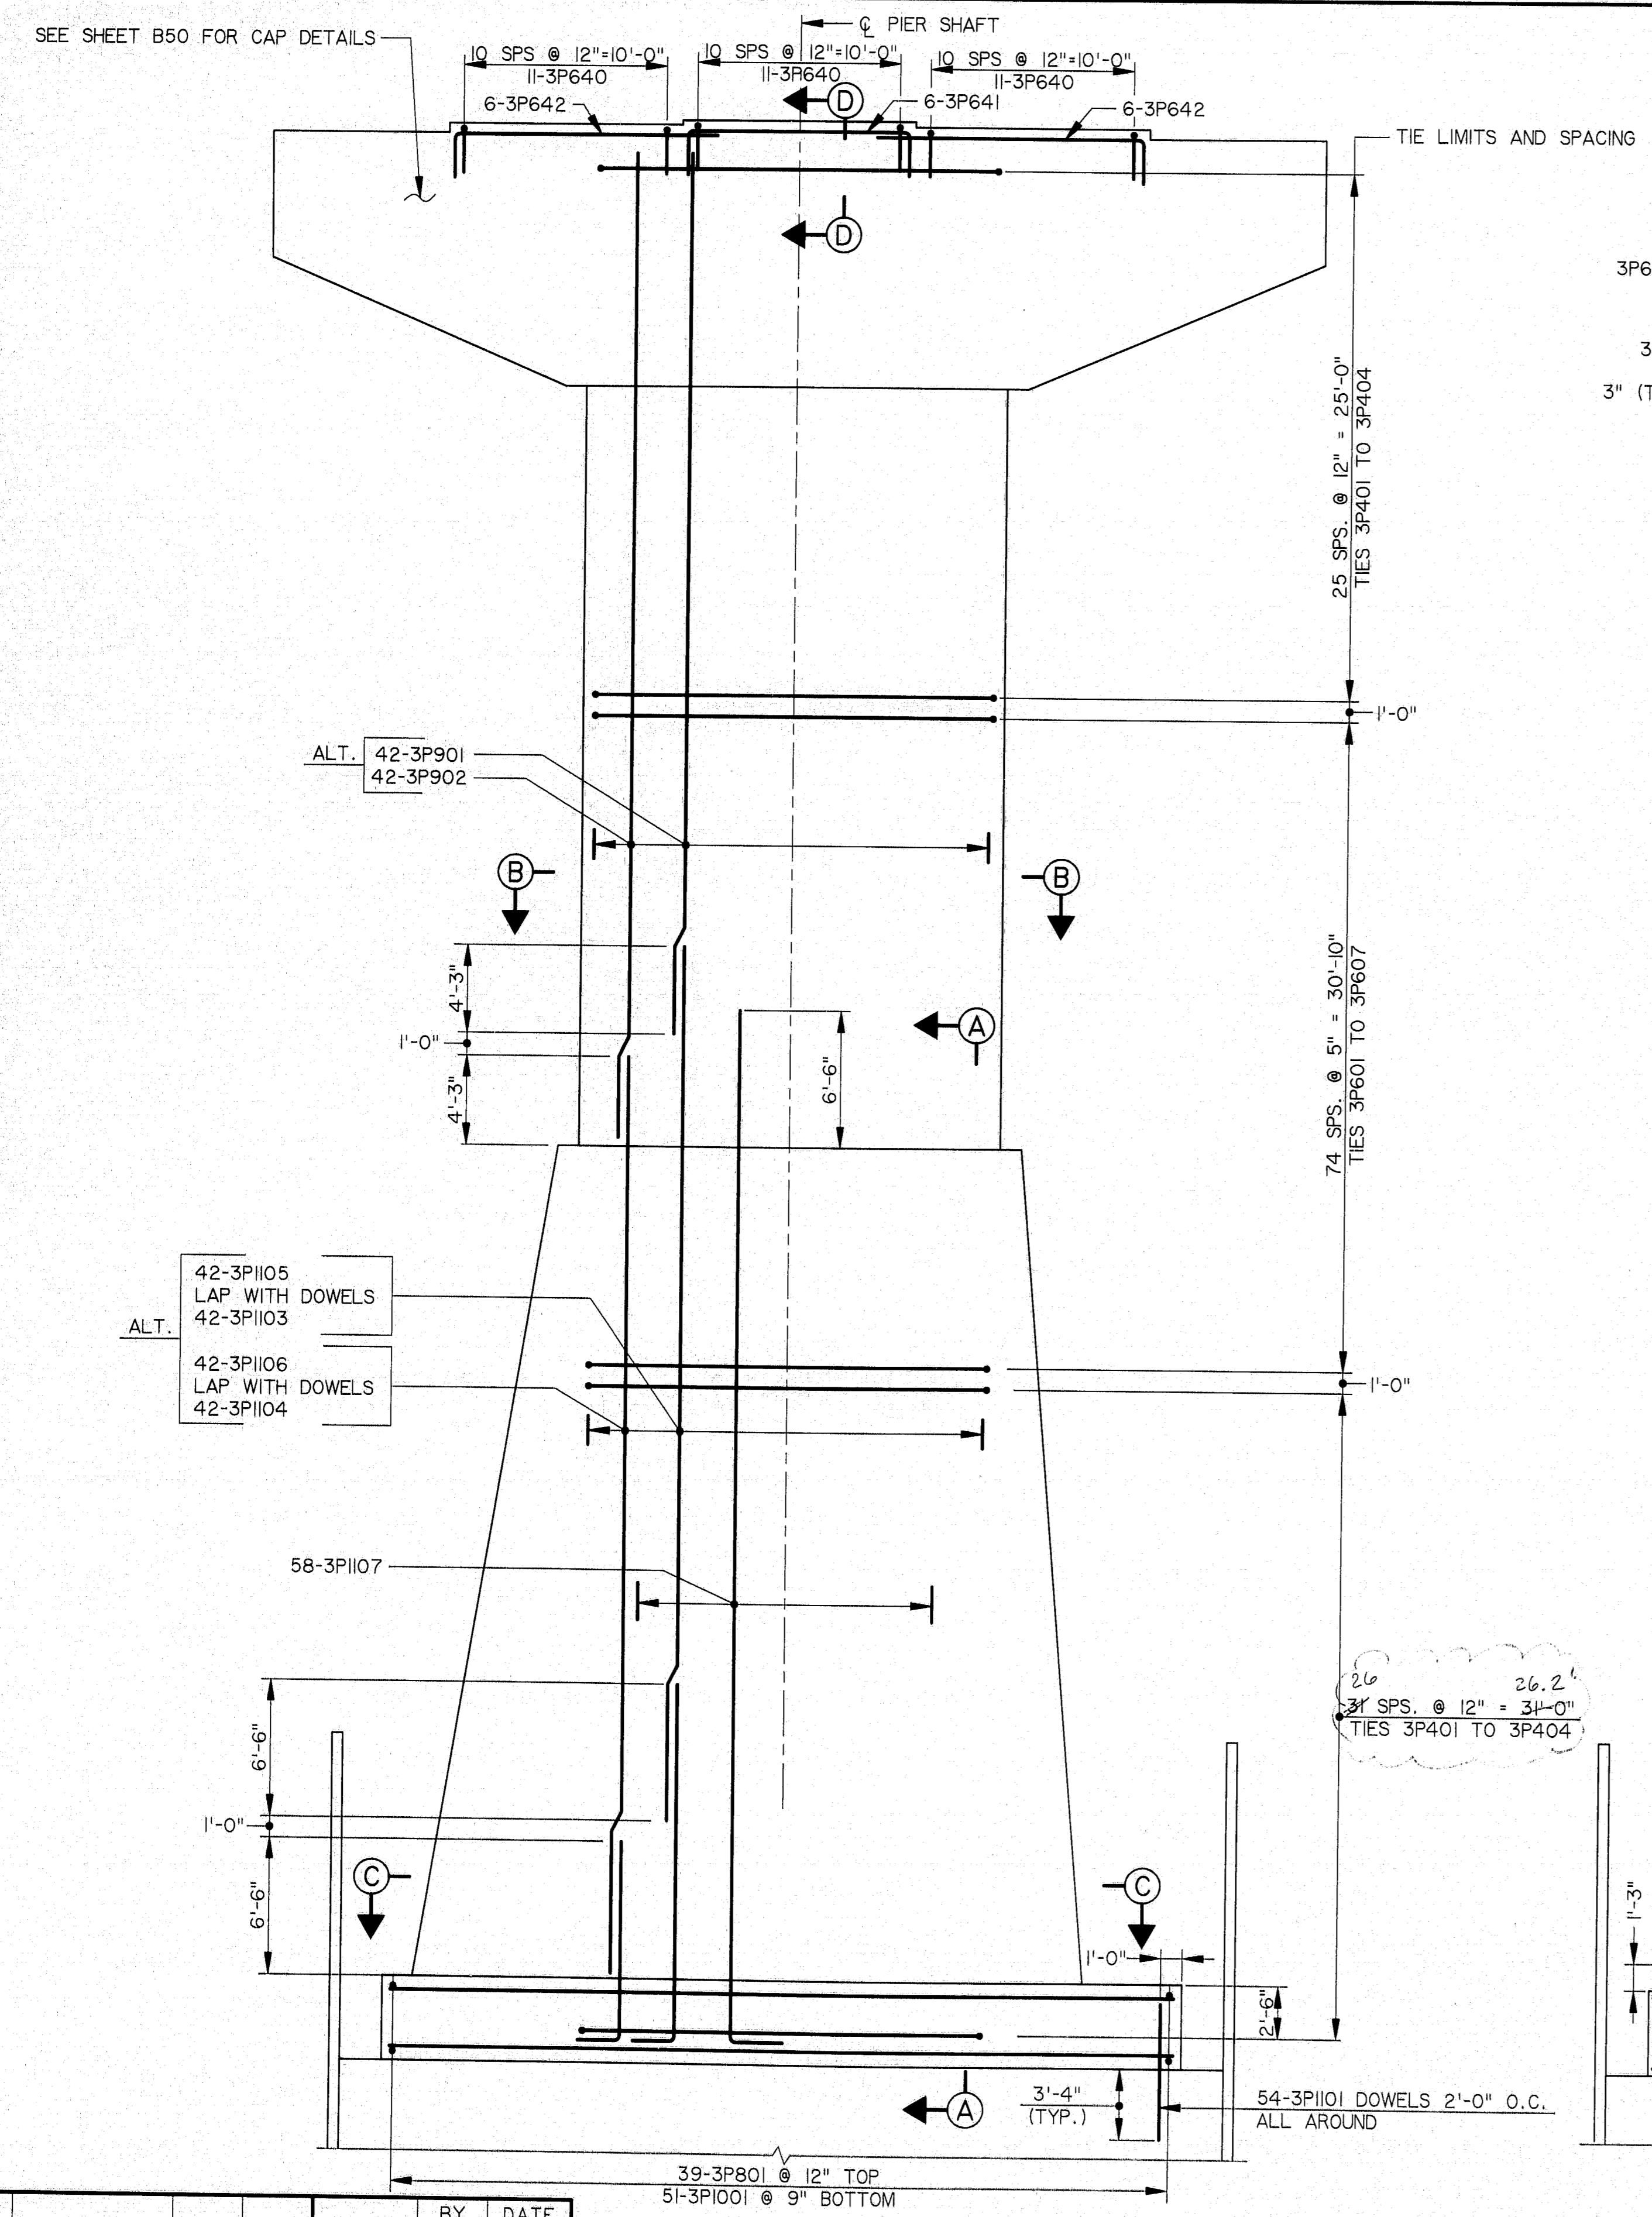


SECTION D-D

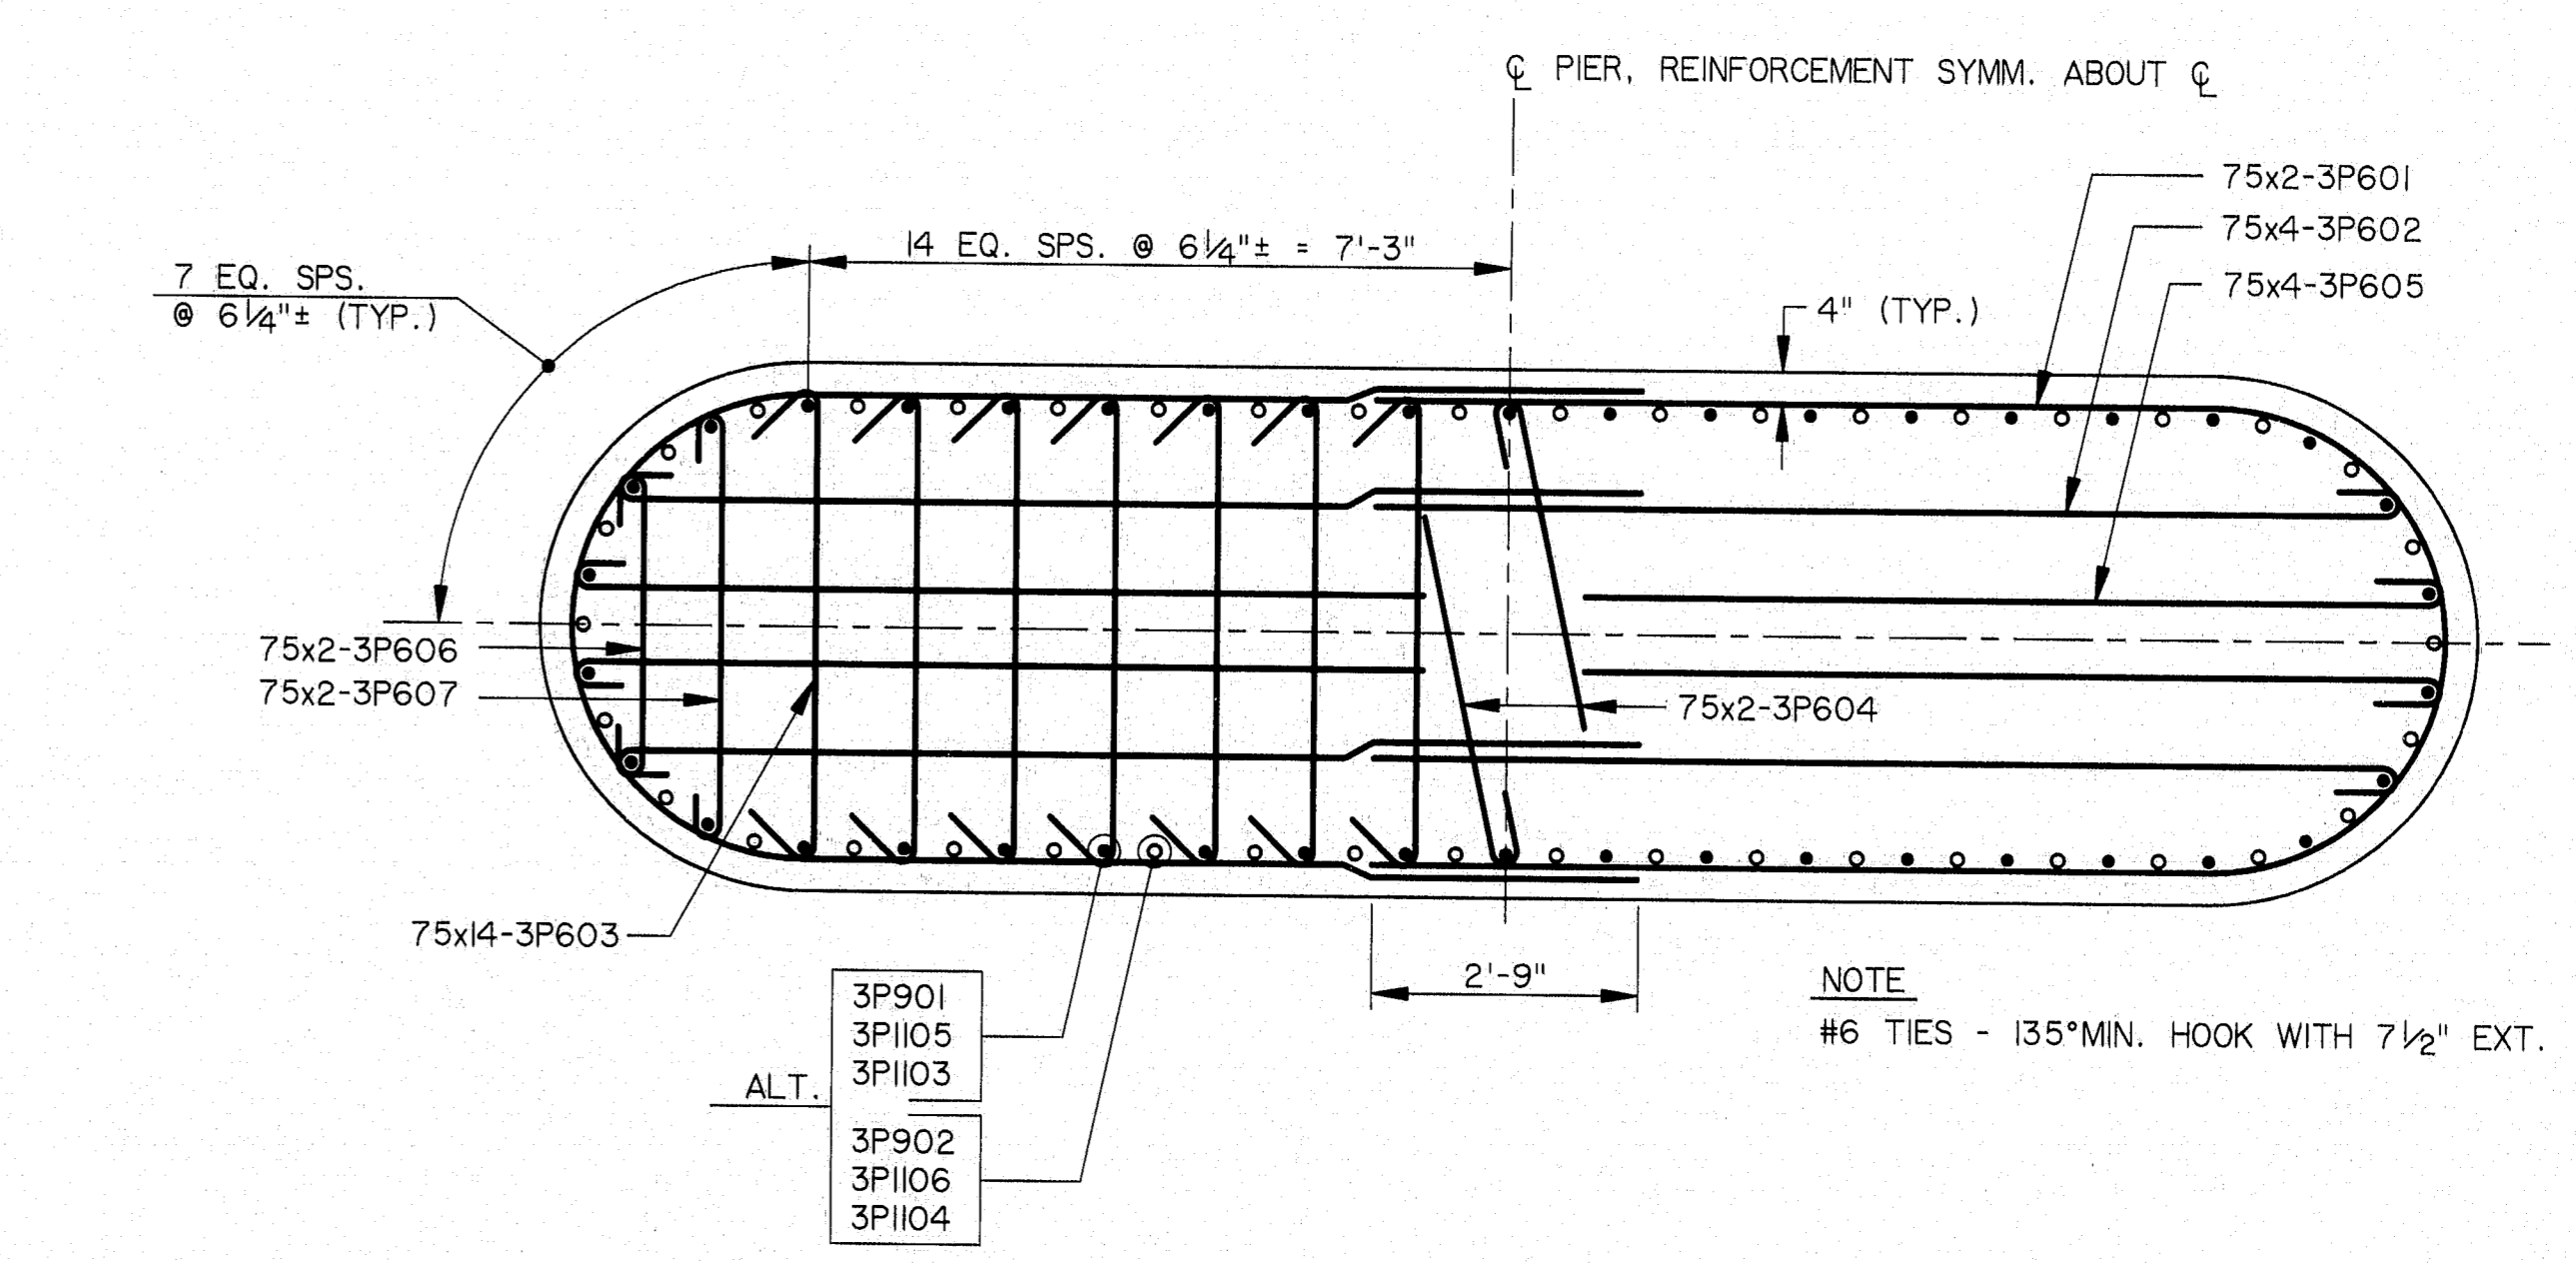

SECTION B-B

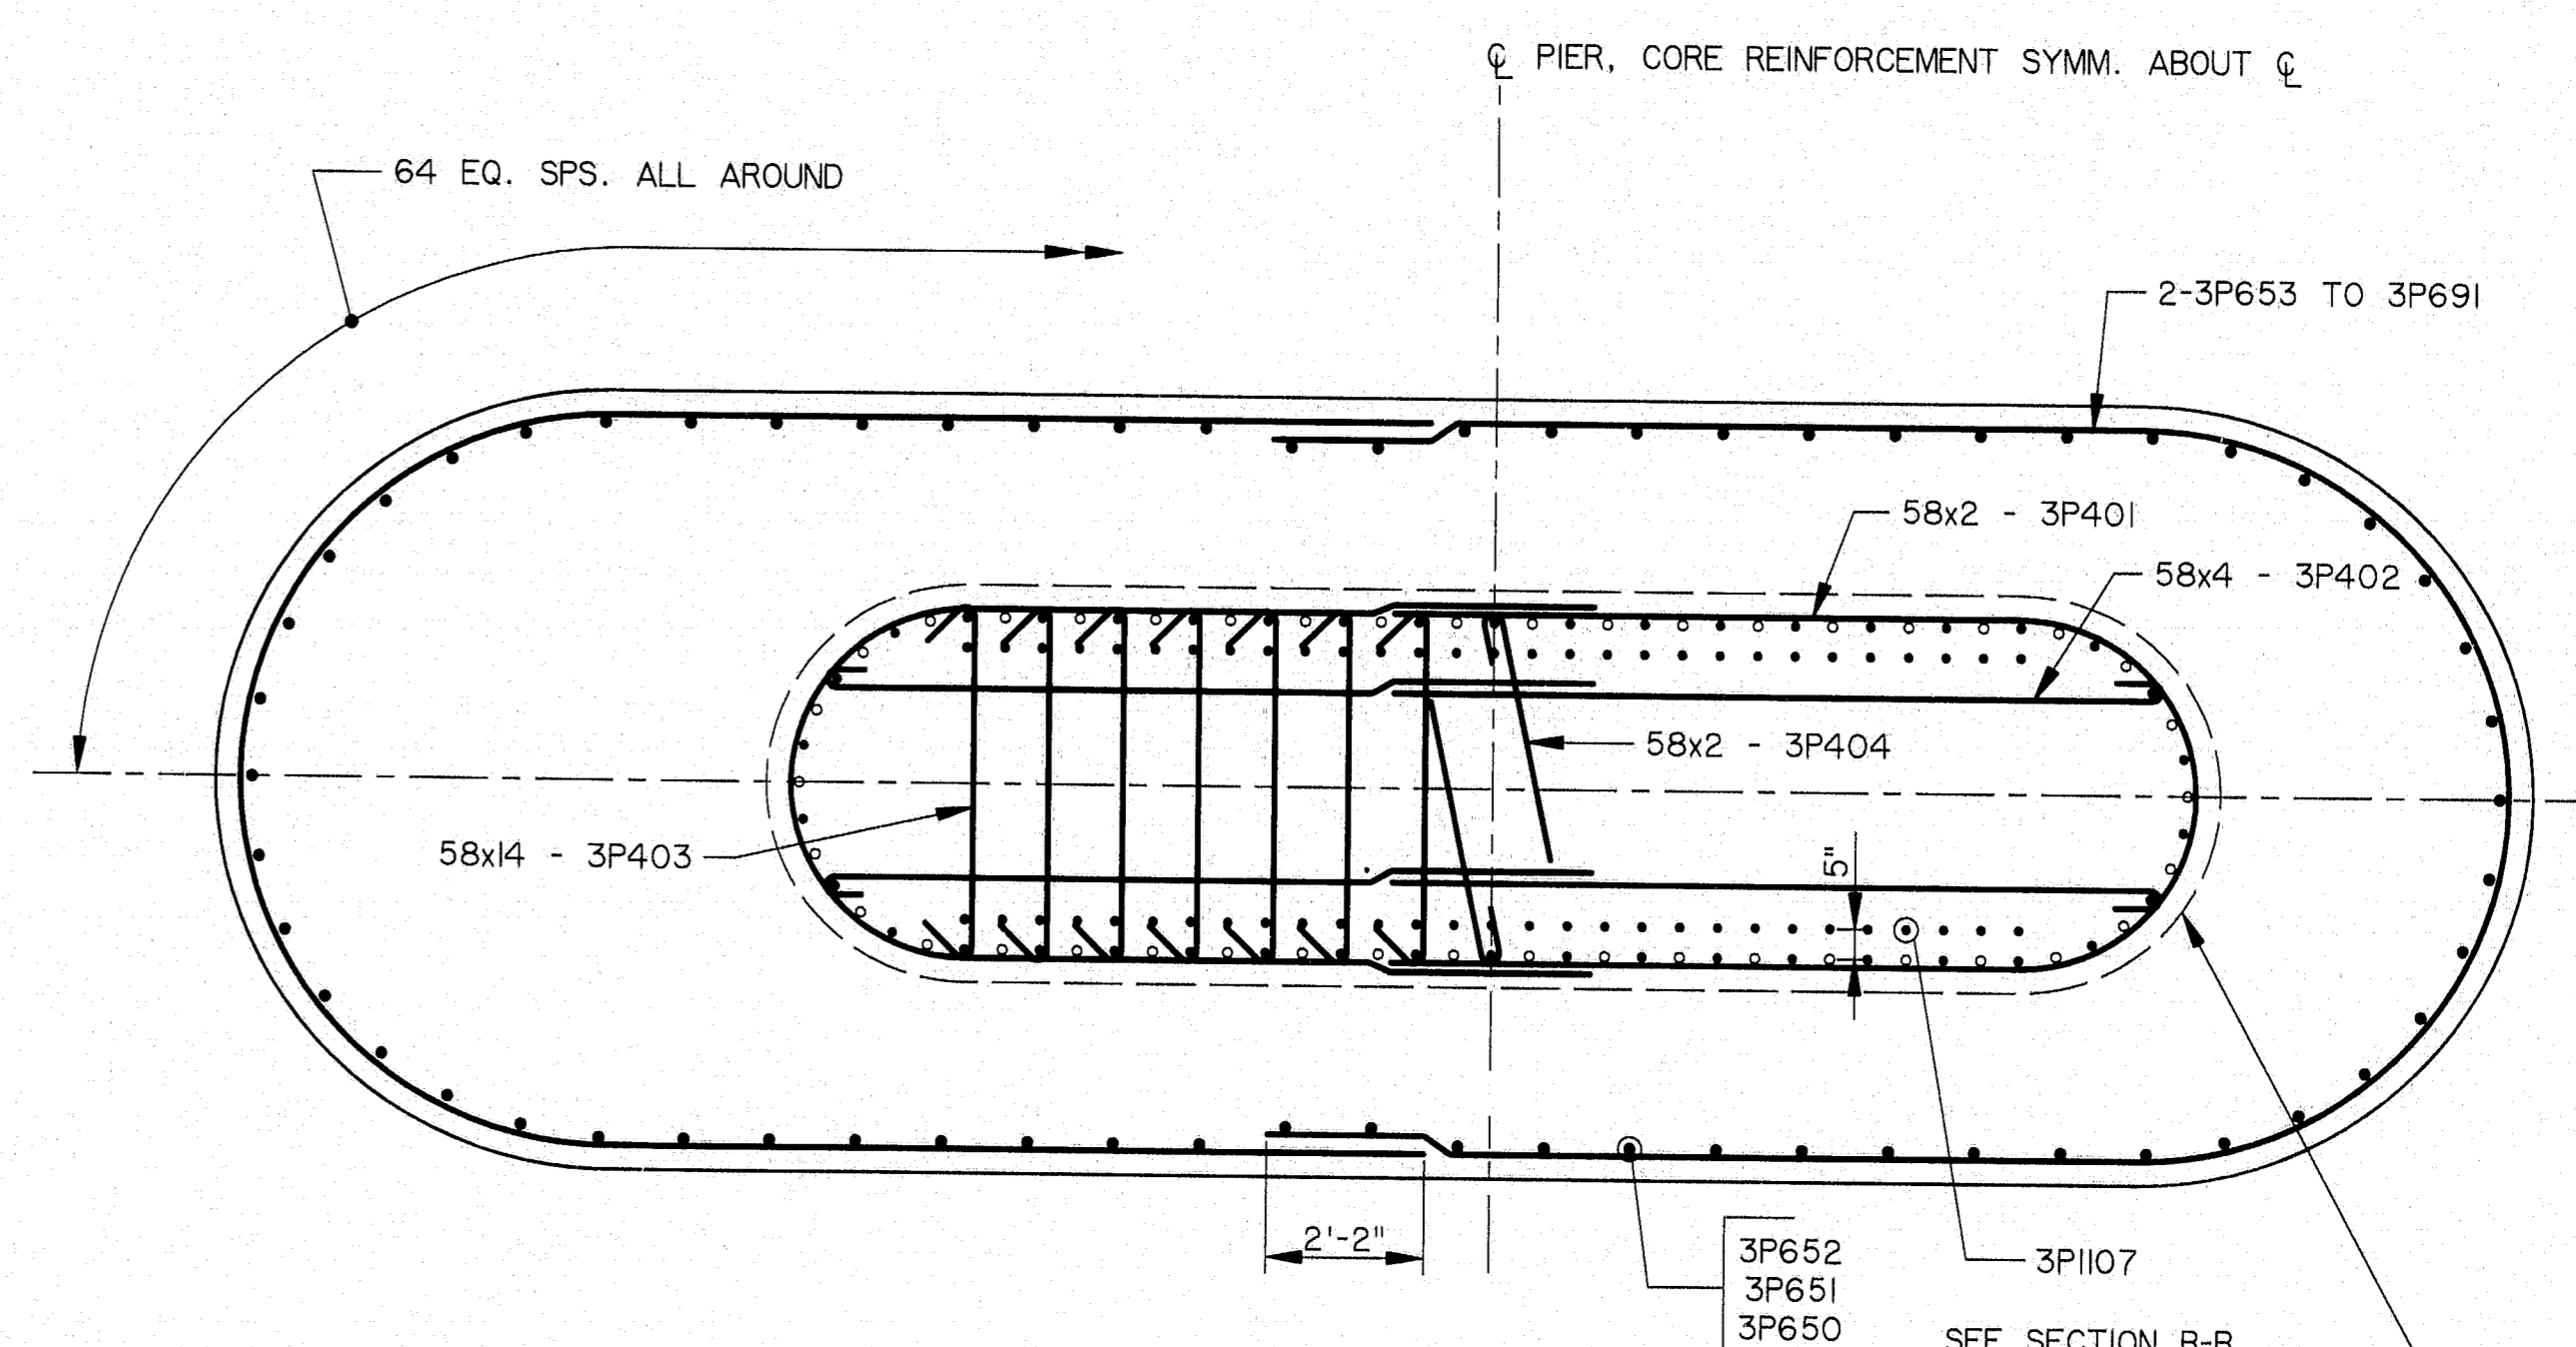

SECTION C-C

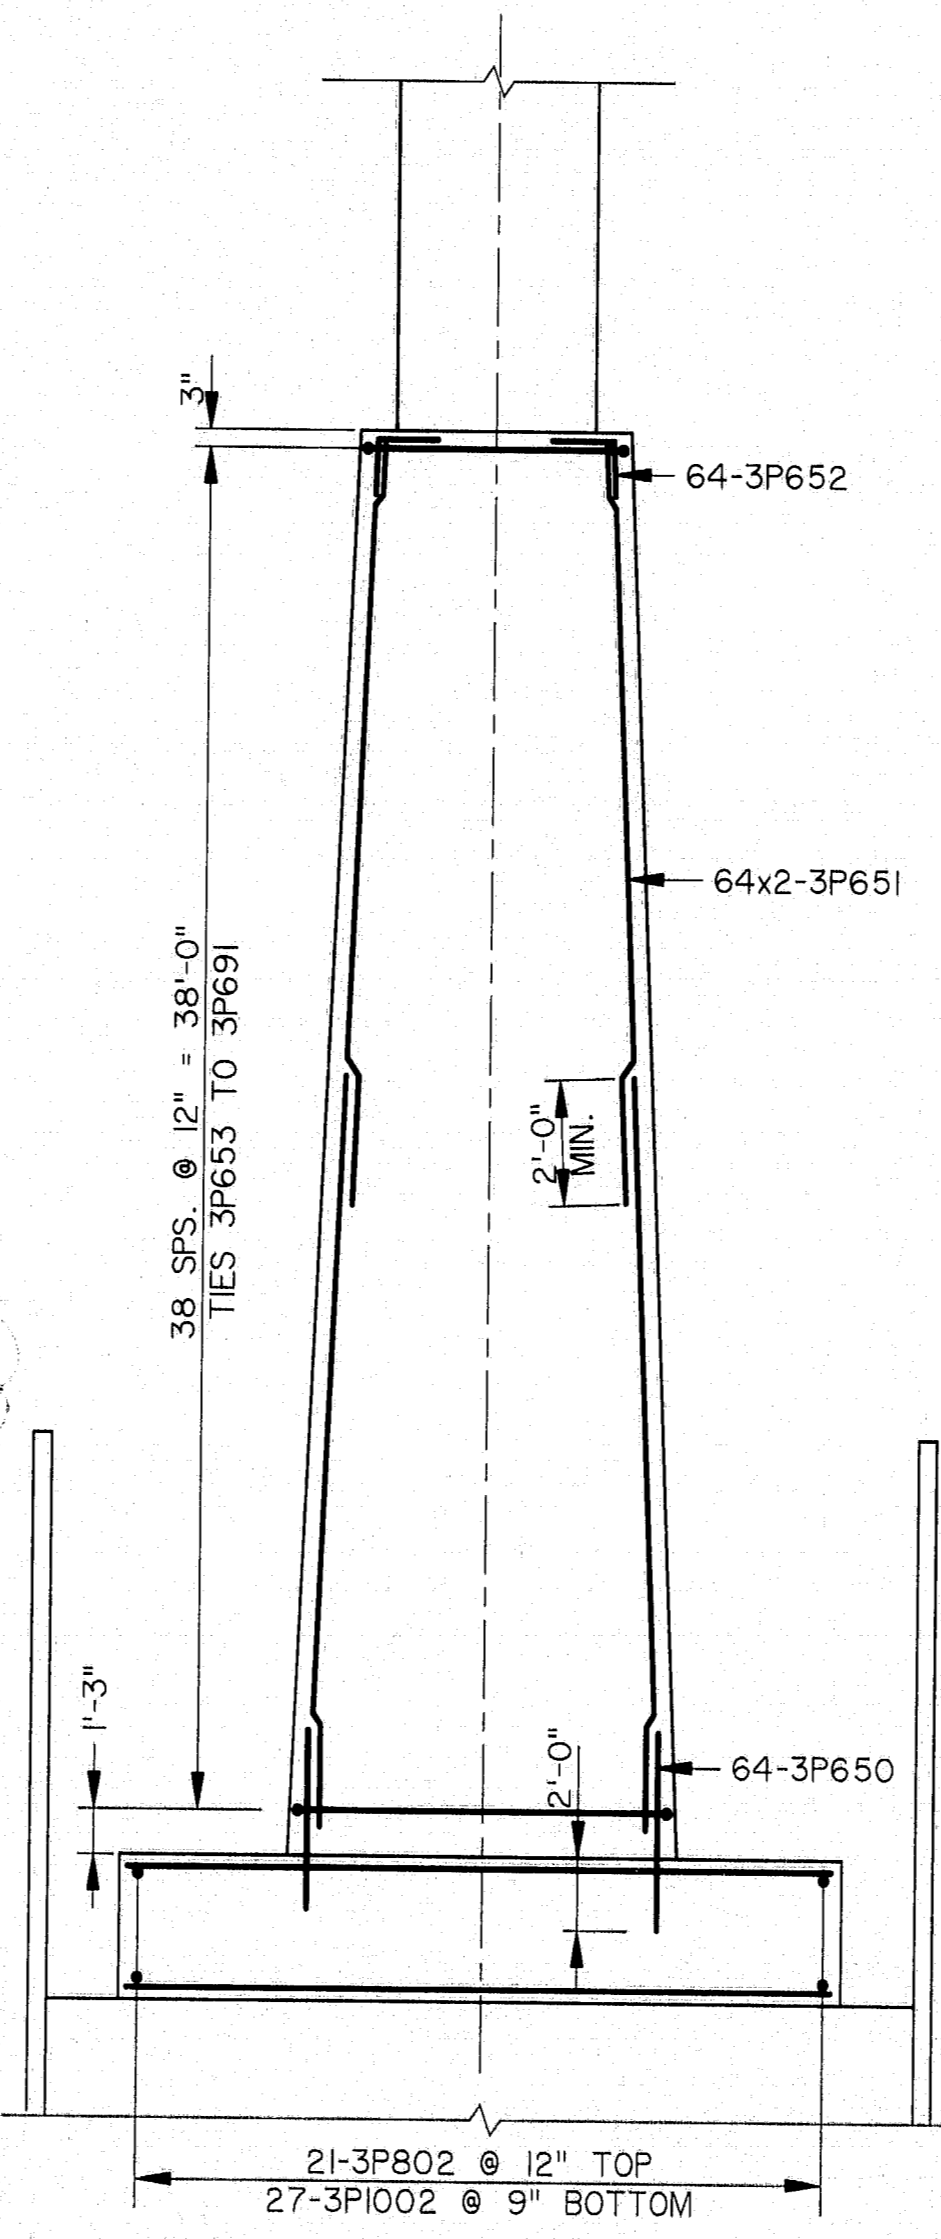

SECTION A-A


ELEVATION - PIER 3

NO.	REVISION	BY	DATE	IN CHARGE OF
		DESIGNED:	DWR	9/94
		DRAWN:	LS	9/94
		CHECKED:	SM	9/94
				CJM




**115-230**  
 STEEL ALTERNATIVE  
 STATE OF MAINE  
 DEPARTMENT OF TRANSPORTATION  
 WATERVILLE - WINSLOW PROJECT  
 DONALD V. CARTER BRIDGE  
 OVER  
 KENNEBEC RIVER  
 PIER 3 RE-STEEL  
 SHEET B35 OF B86 AUGUSTA, MAINE


F.H.W.A. RES. NO.	STATE	PROJECT NUMBER	SHEET NO.	TOTAL SHEETS
1	MAINE	00091002	45	103

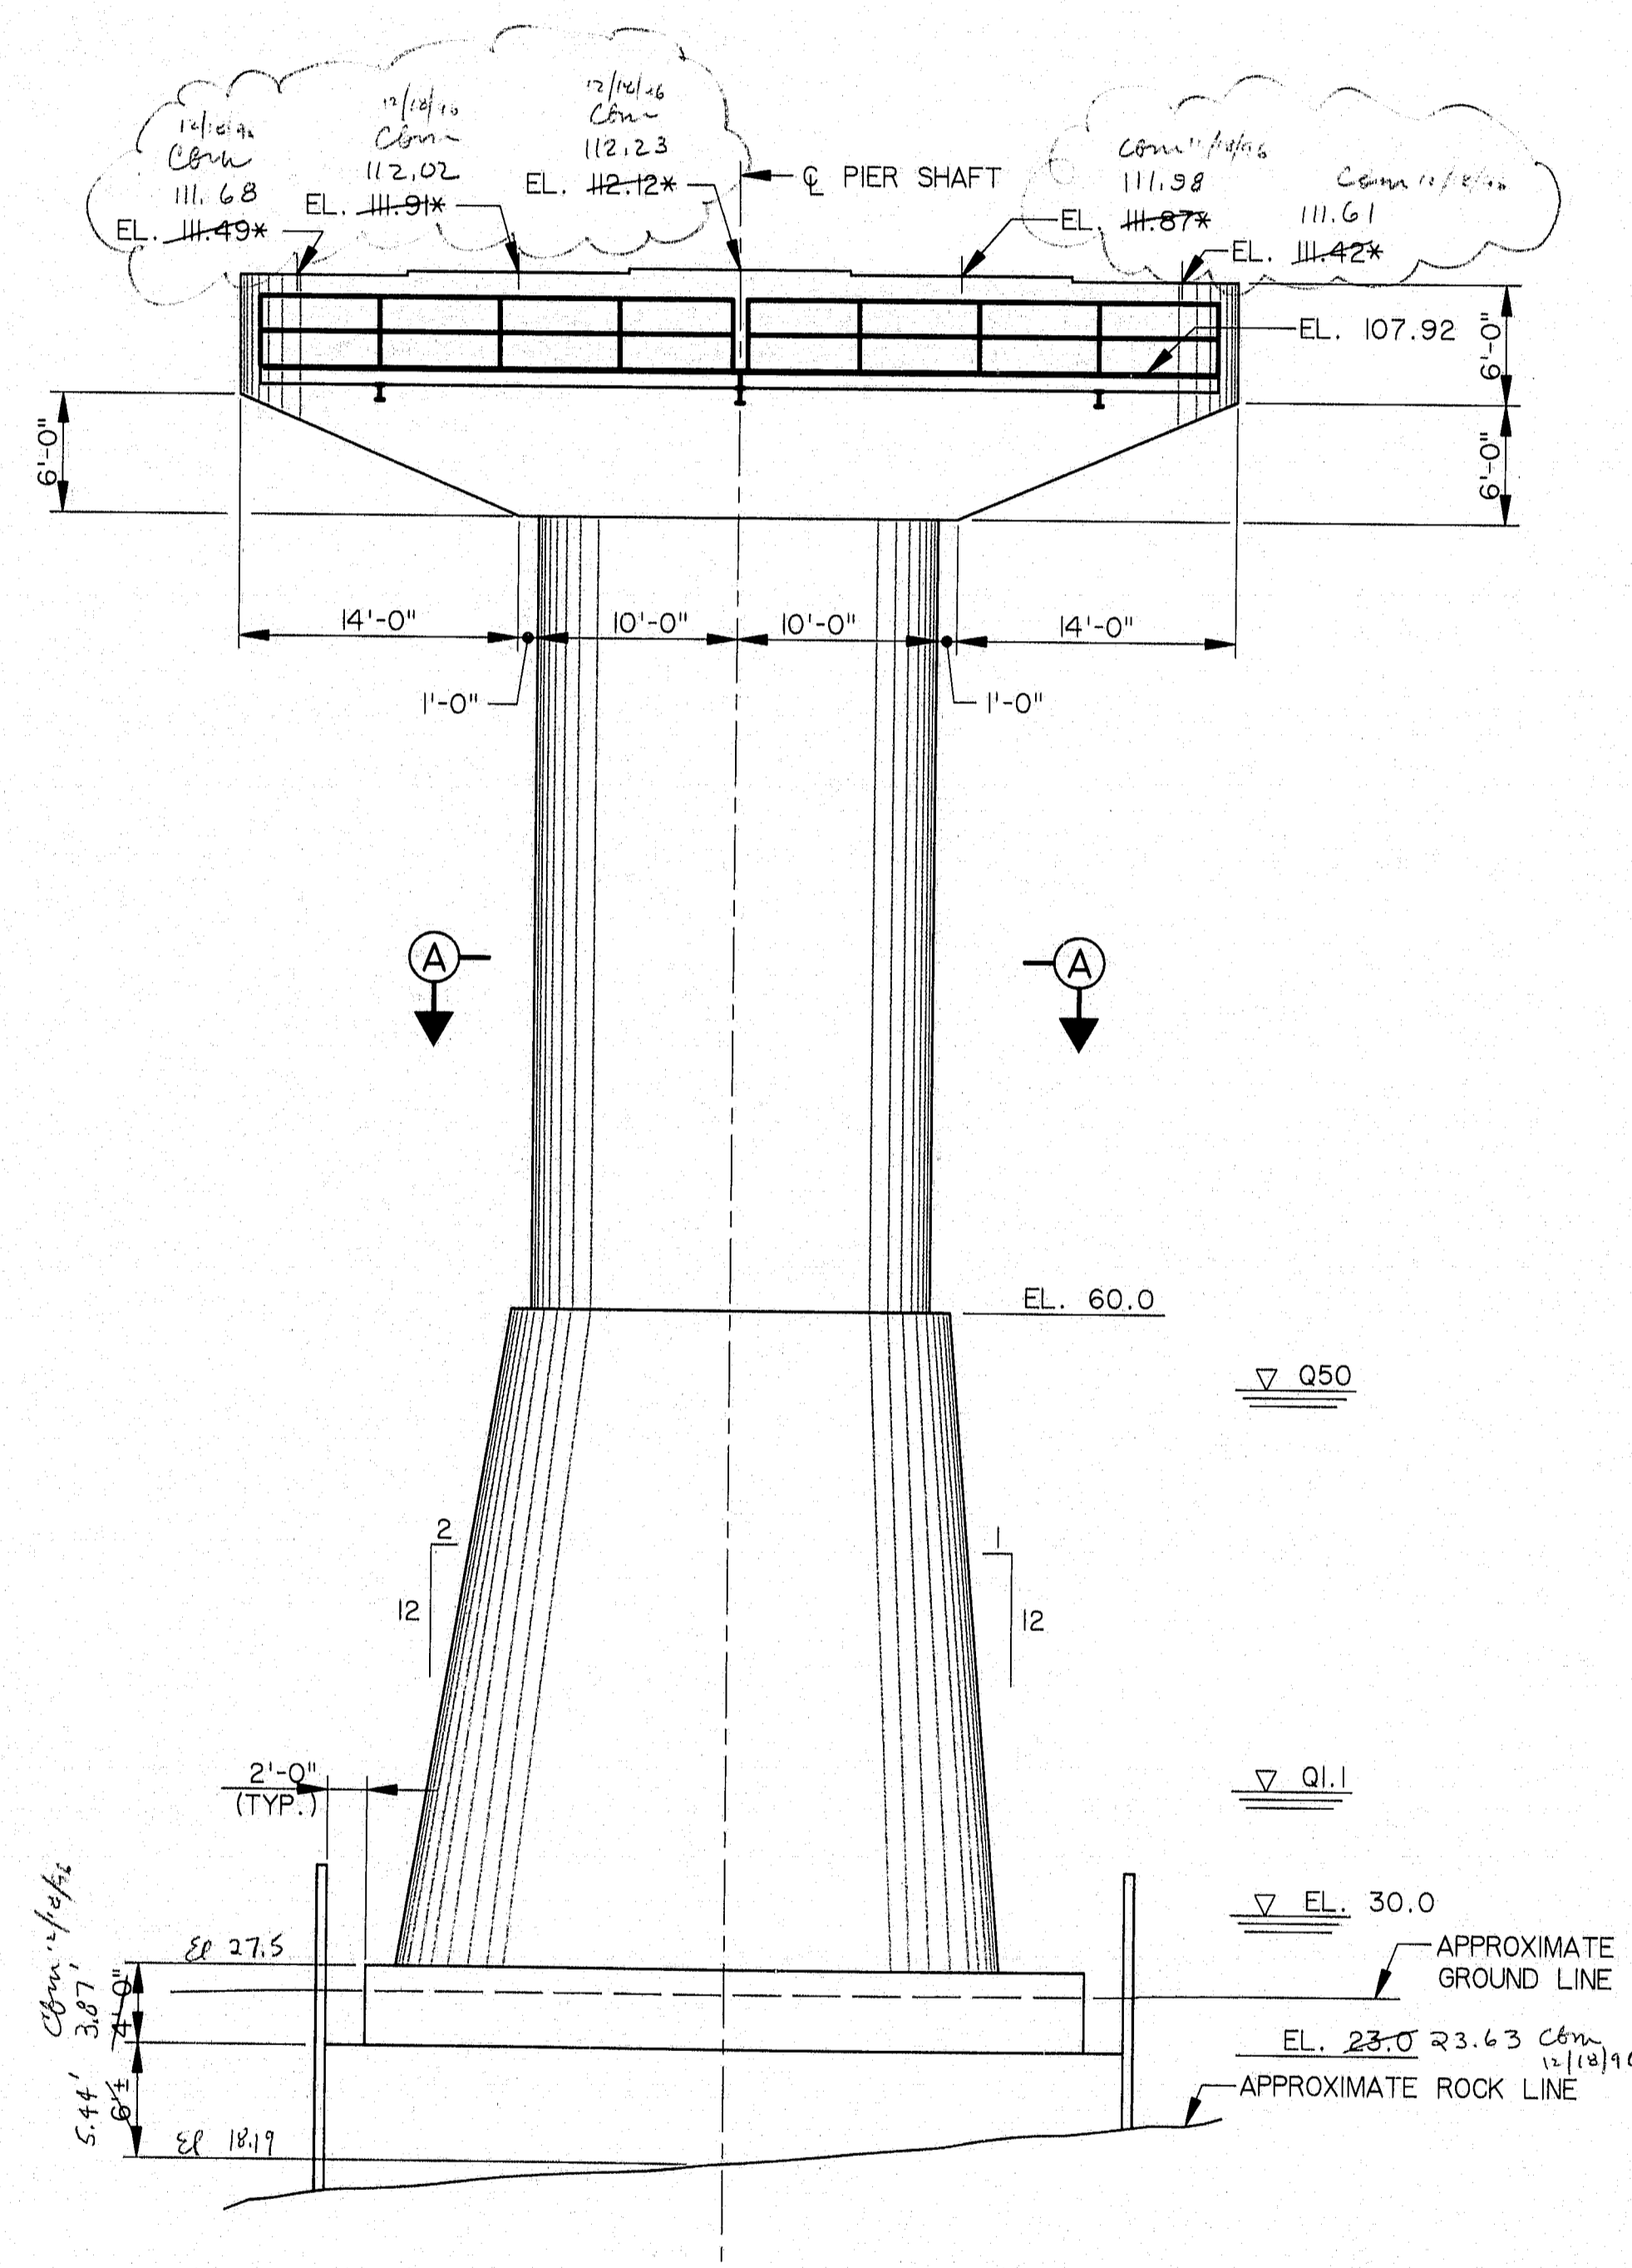


ELEVATION  
(LOOKING UPSTATION)

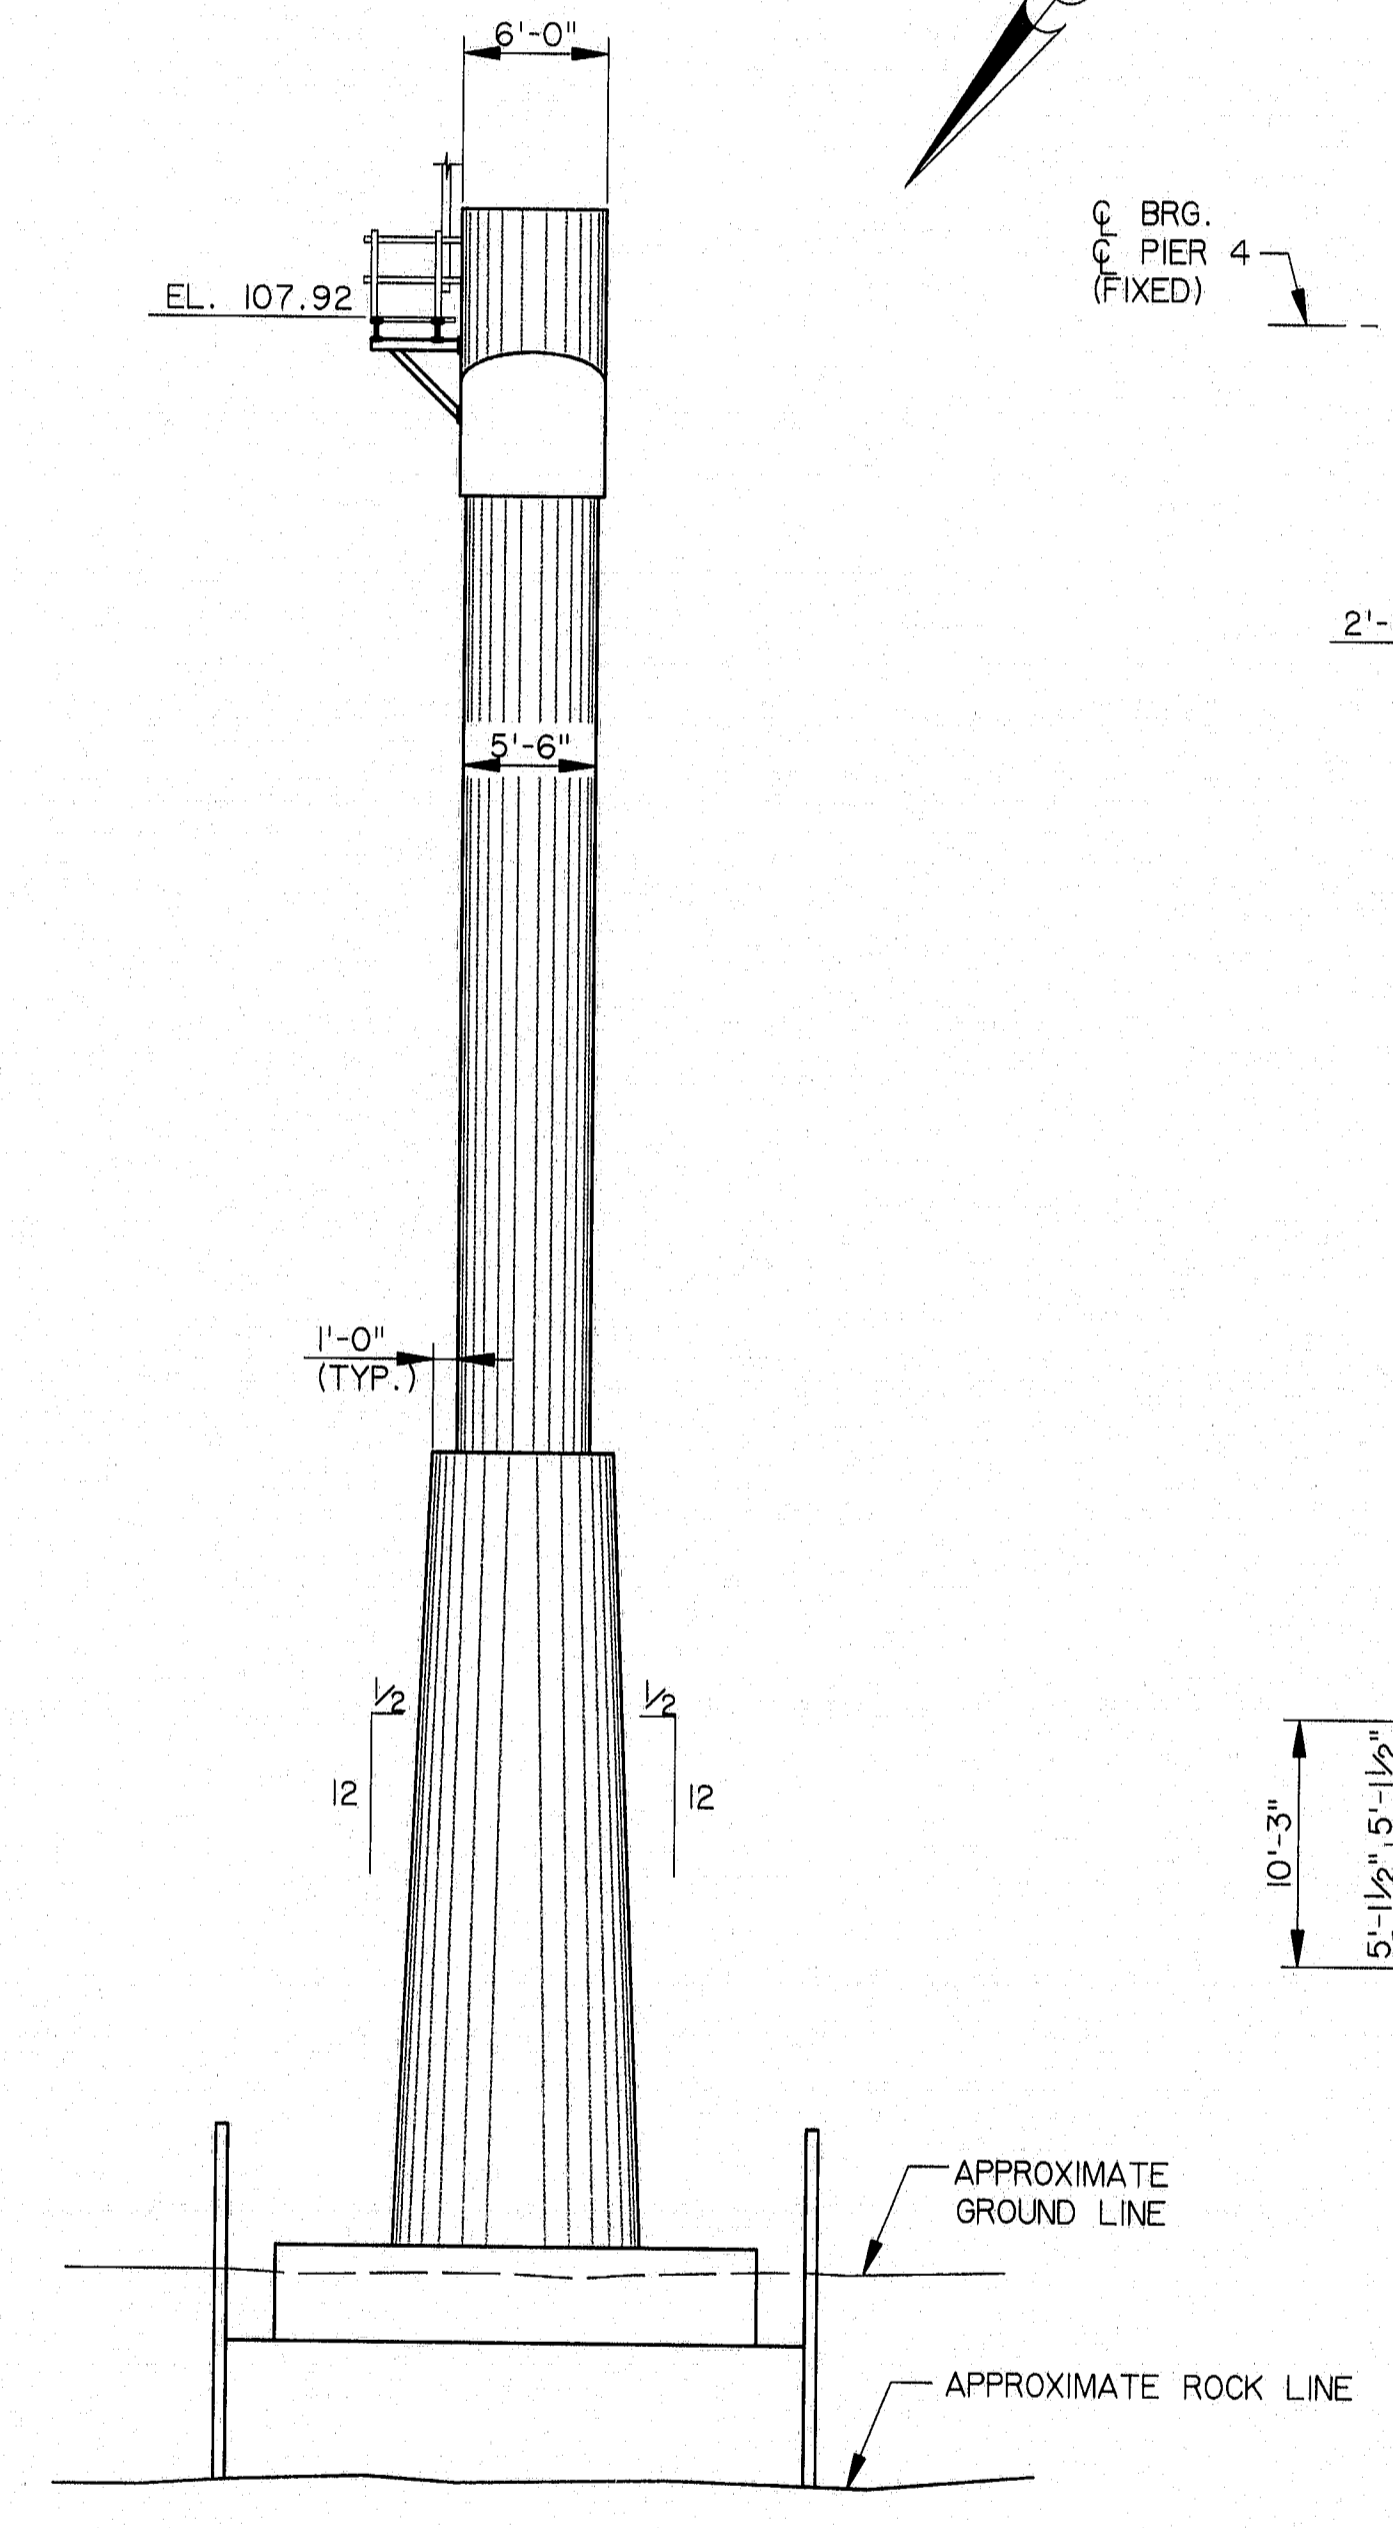

SIDE ELEVATION

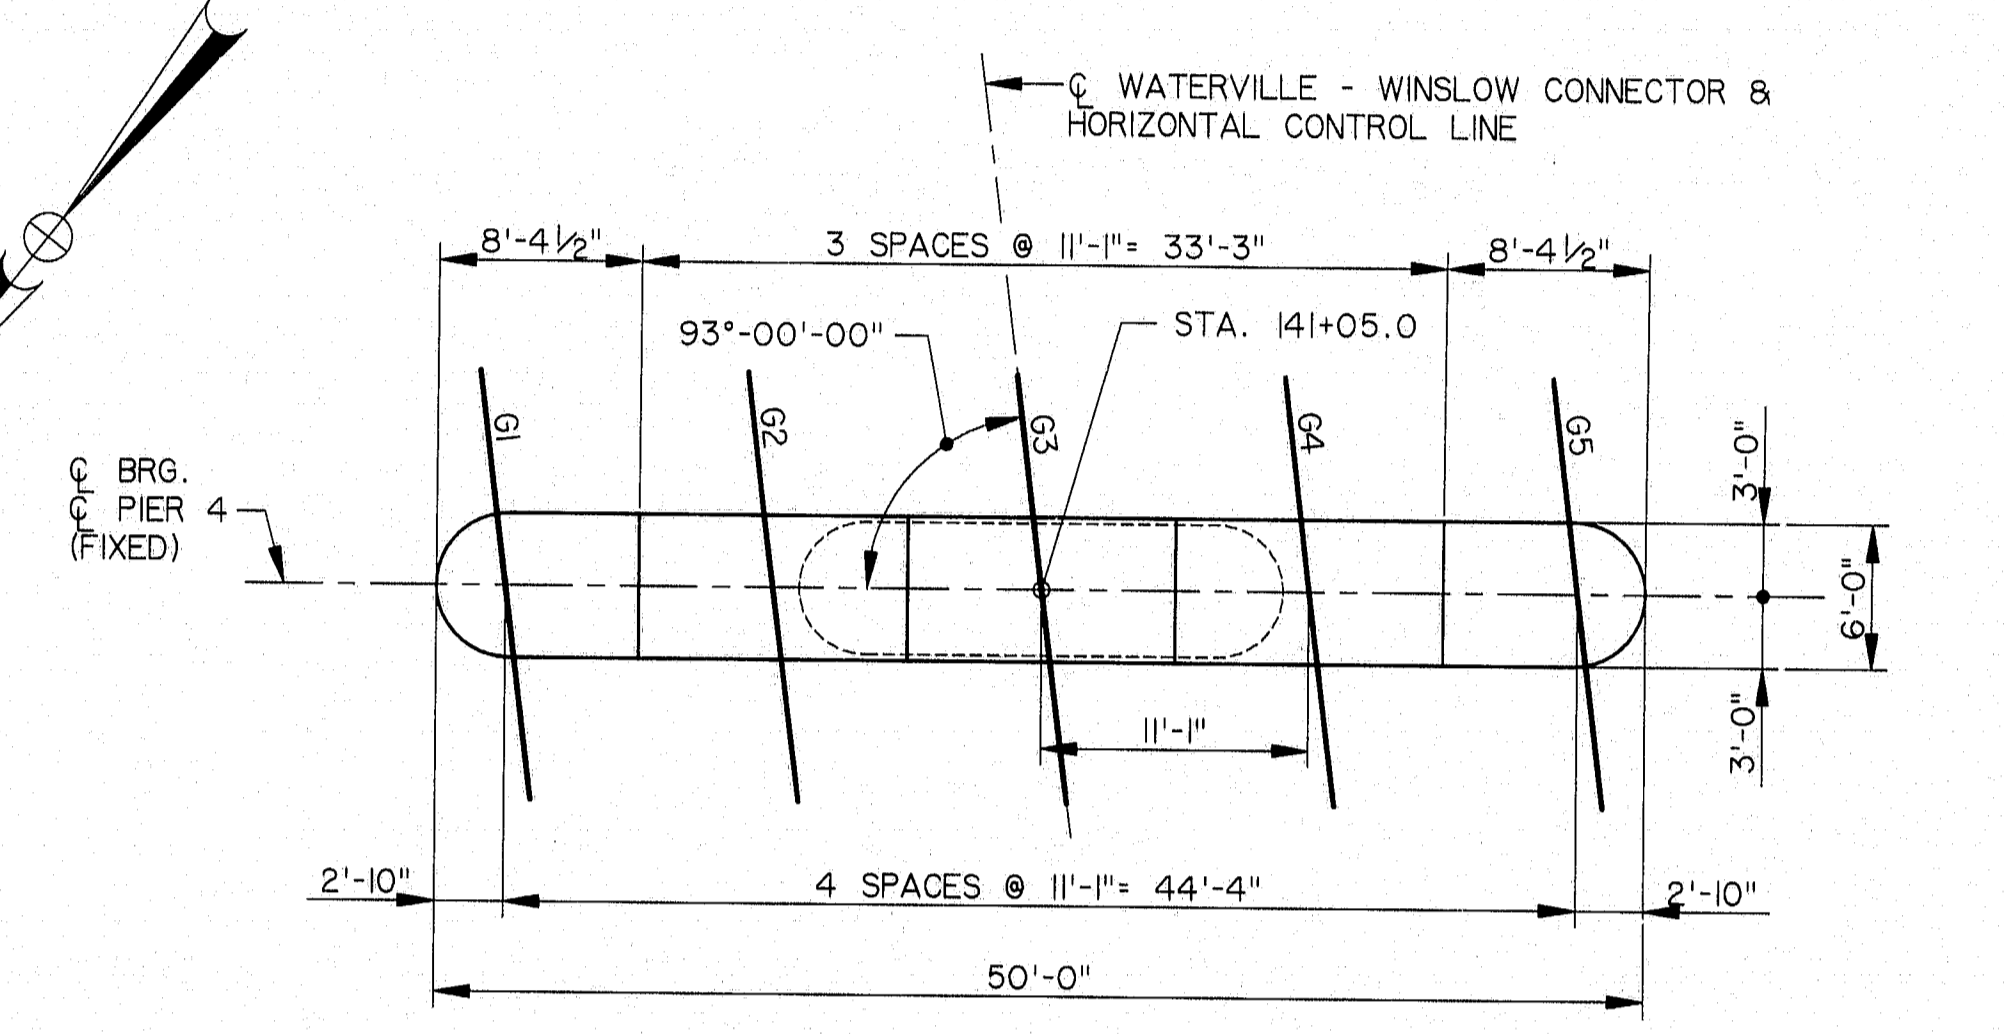

PLAN

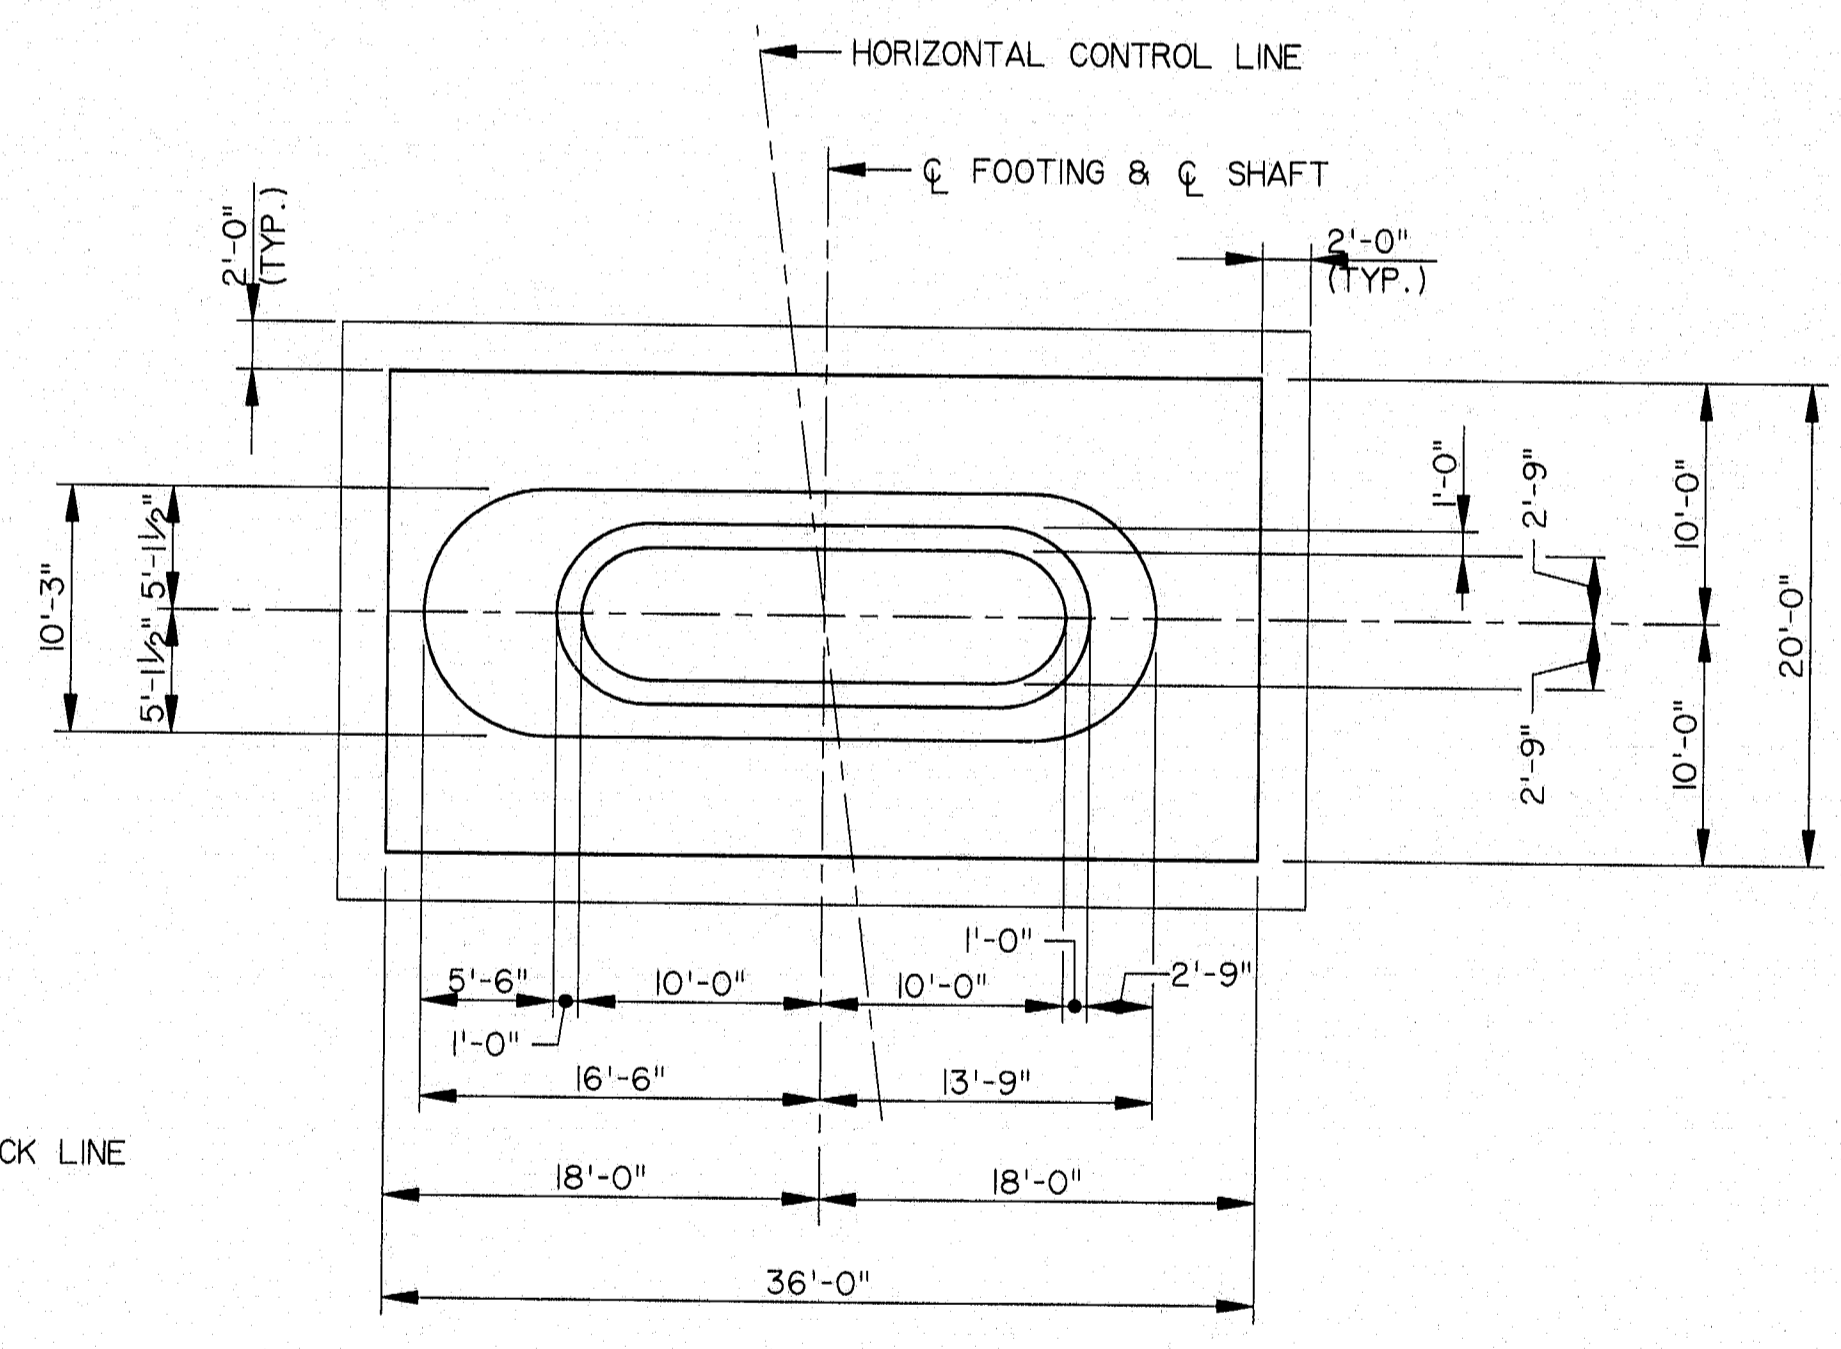

SECTION A-A

NOTES:

- MAXIMUM CALCULATED FOOTING PRESSURE = 16.3 T.S.F. (GROUP SEISMIC)  
ULTIMATE CAPACITY OF FOUNDATION SUPPORTING ROCK IS USED IN CONJUNCTION WITH SEISMIC LOADING.
- SEE SHEET B30 FOR ADDITIONAL NOTES.

\* SEE NOTE 7, SHEET B30.

NO.	REVISION	BY	DATE	IN CHARGE OF
		BY	DATE	
		DESIGNED: SM	9/94	
		DRAWN: RJT	9/94	
		CHECKED: DWR	9/94	
				CJM



**115-231**  
STEEL ALTERNATIVE



STATE OF MAINE  
DEPARTMENT OF TRANSPORTATION

WATERVILLE - WINSLOW PROJECT  
DONALD V. CARTER BRIDGE  
OVER  
KENNEBEC RIVER


PIER 4 DETAILS

SHEET B36 OF B86 AUGUSTA, MAINE


F.R.S.A. REG. NO.	STATE	PROJECT NUMBER	SHEET NO.	TOTAL SHEETS
1	MAINE	0008(002)	46	103

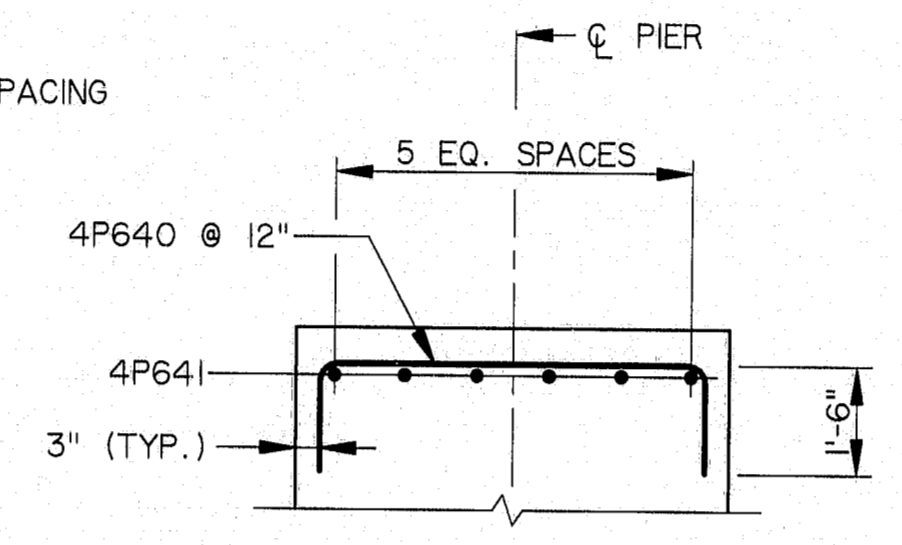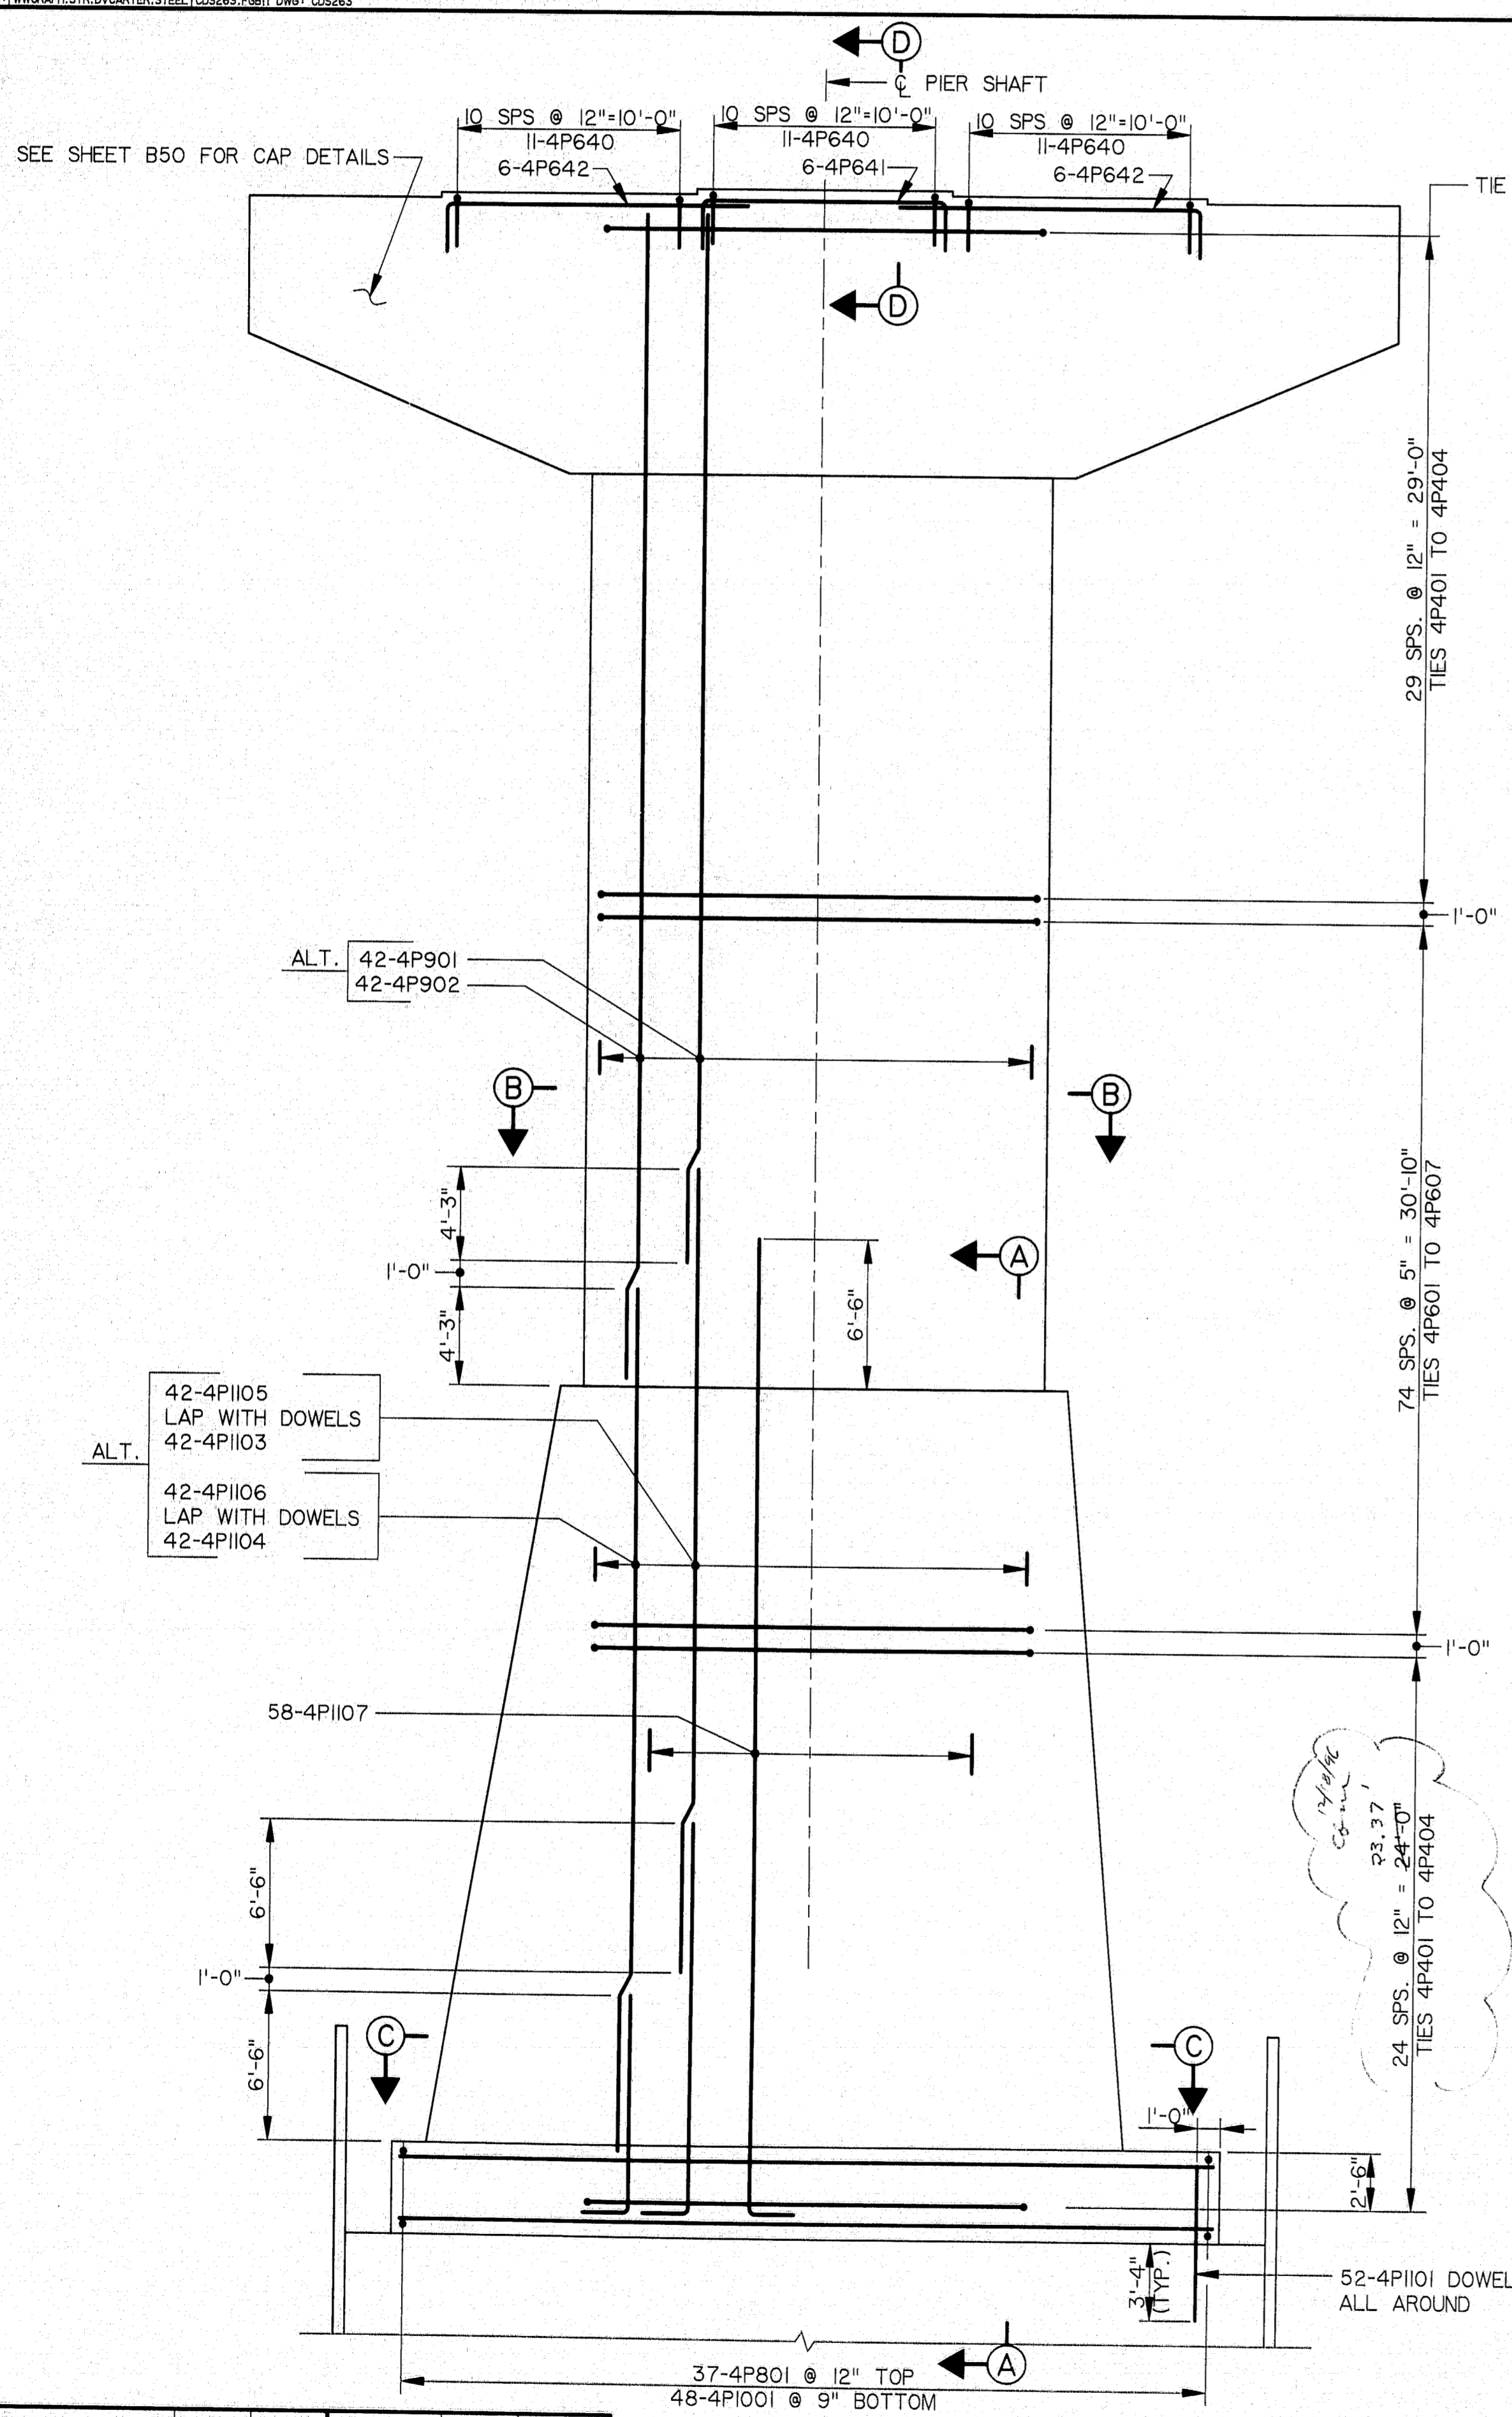


SECTION D-D

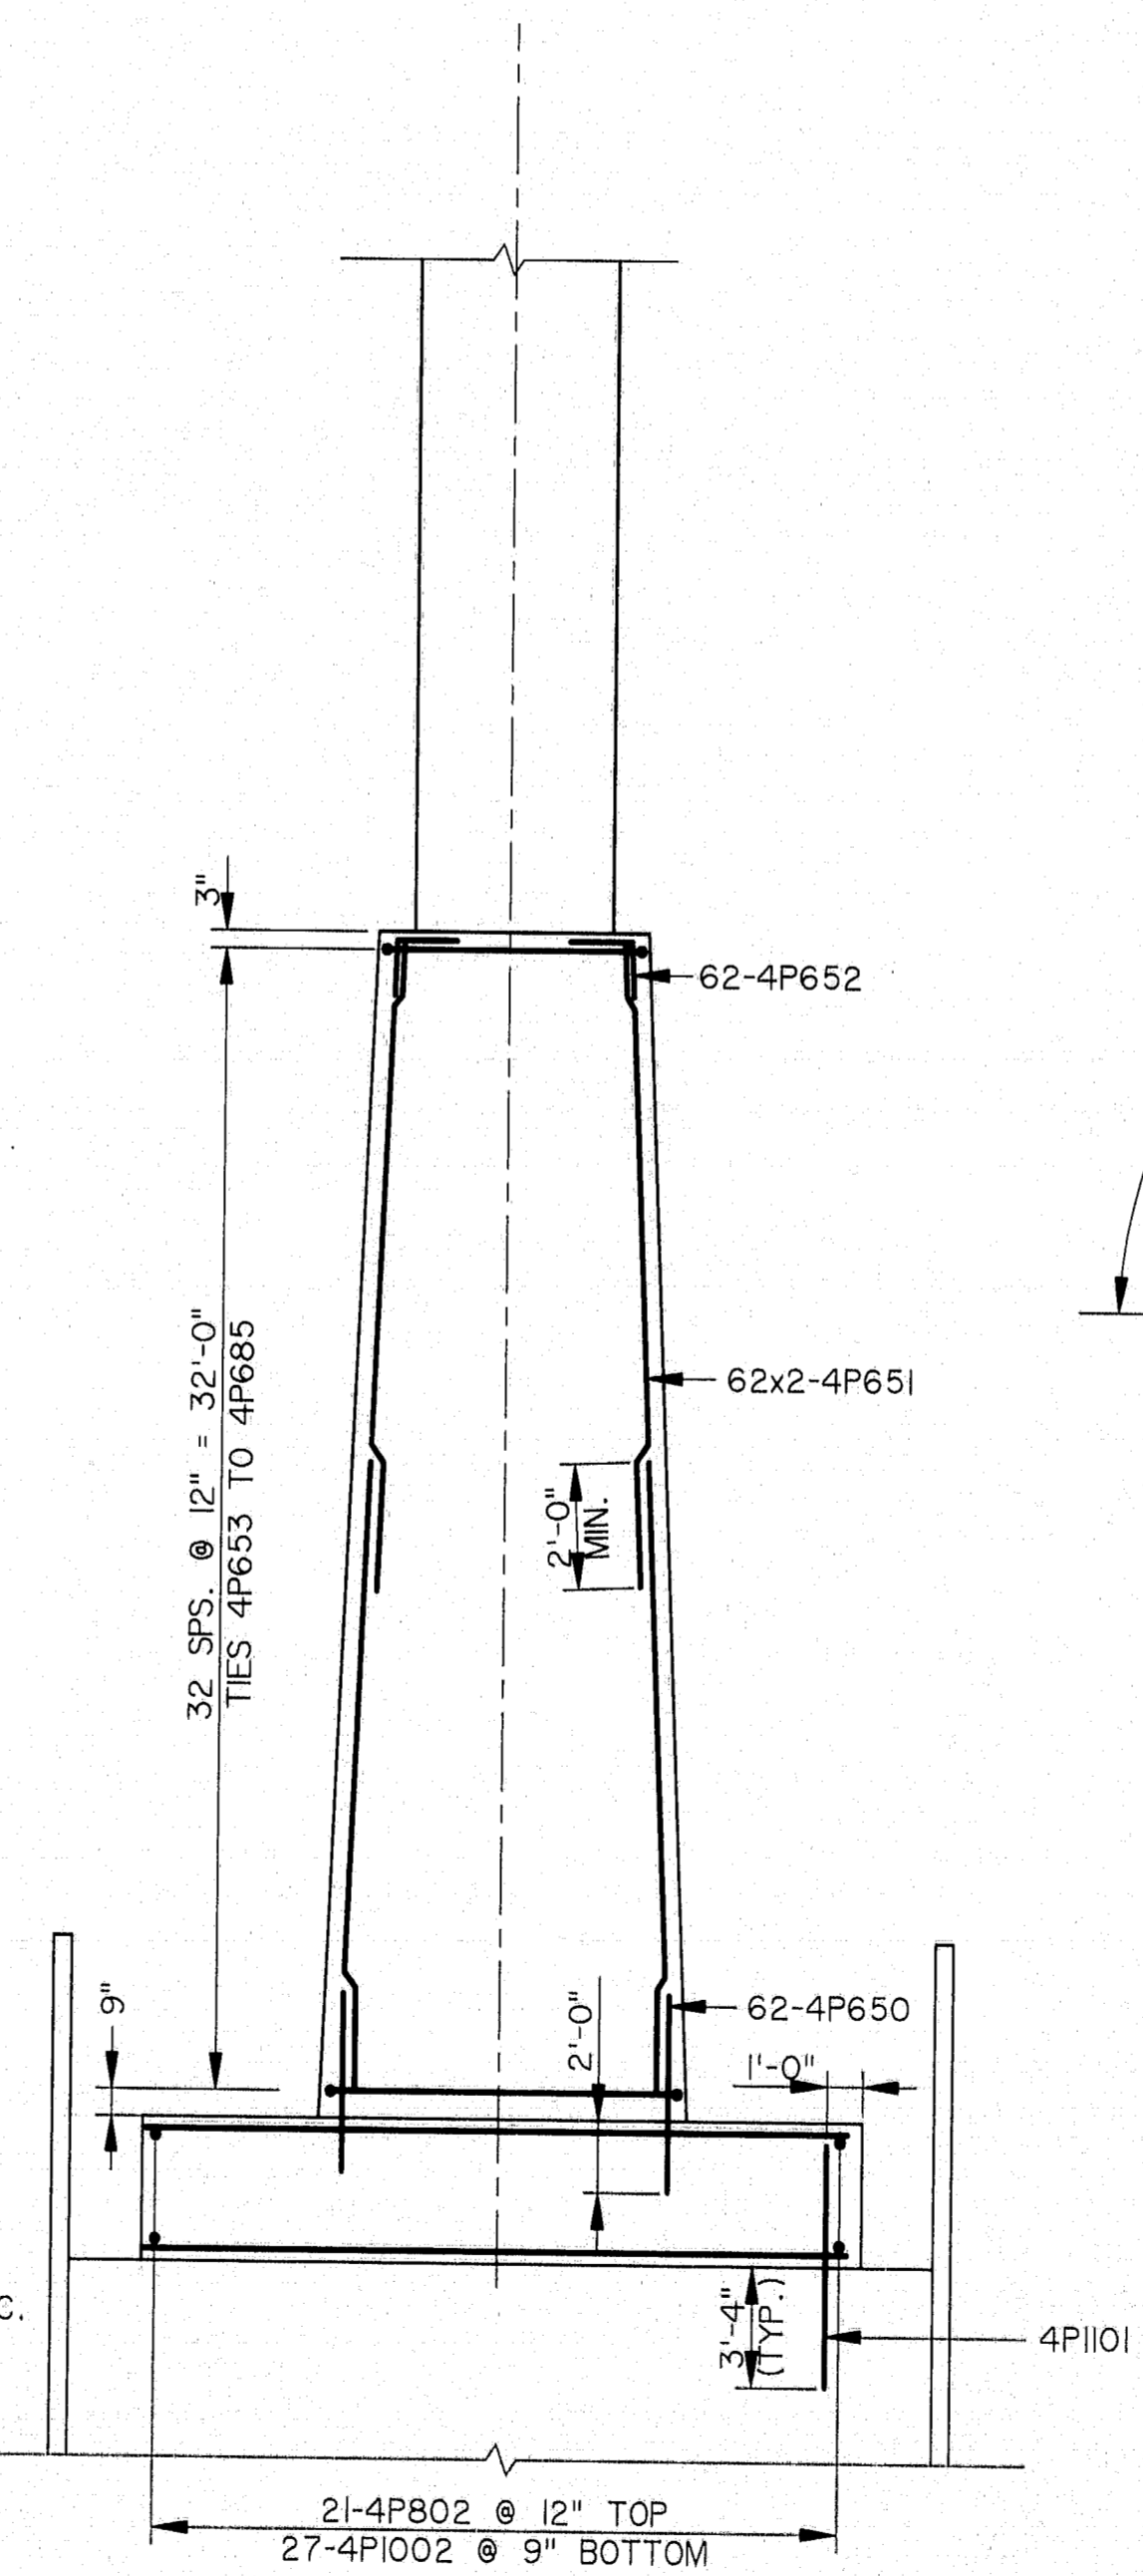

SECTION A-A

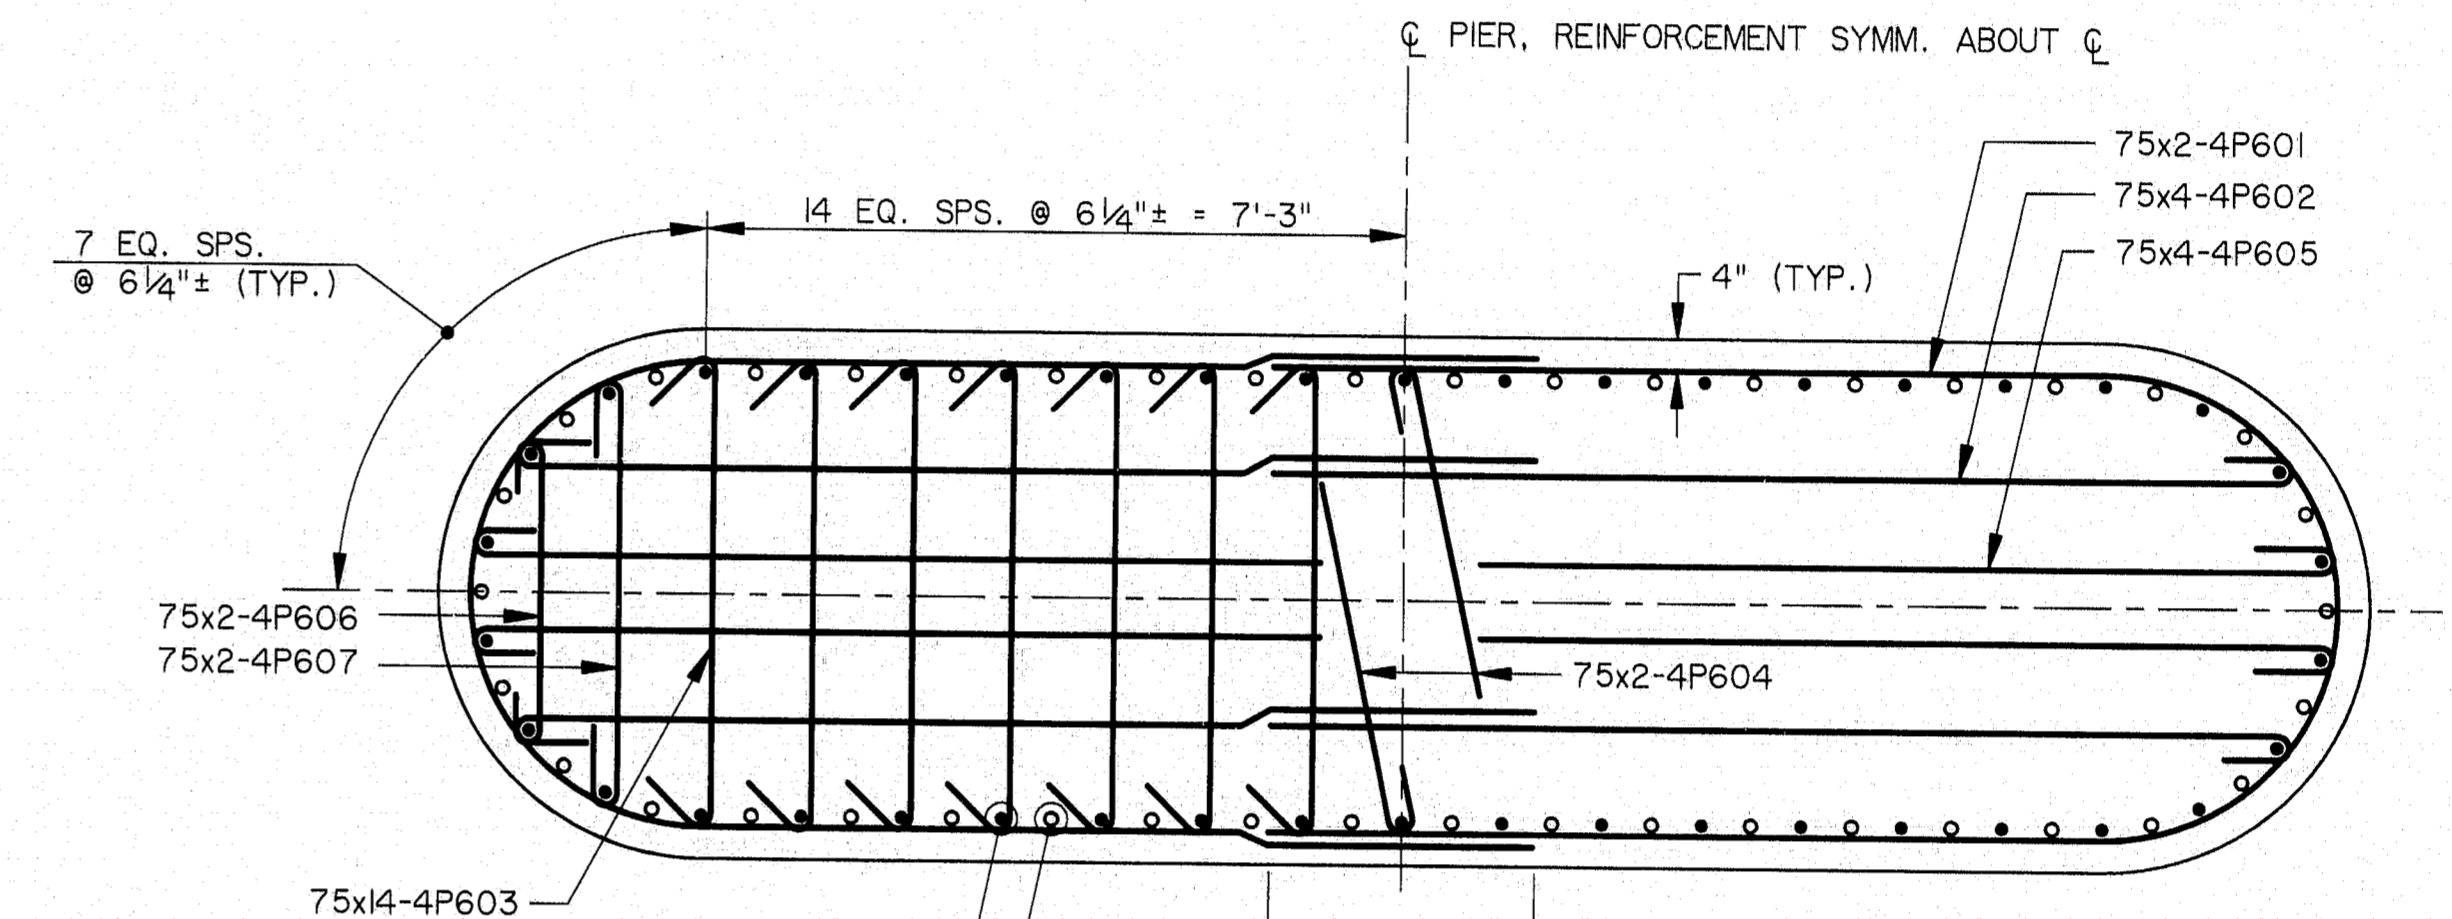

SECTION B-B

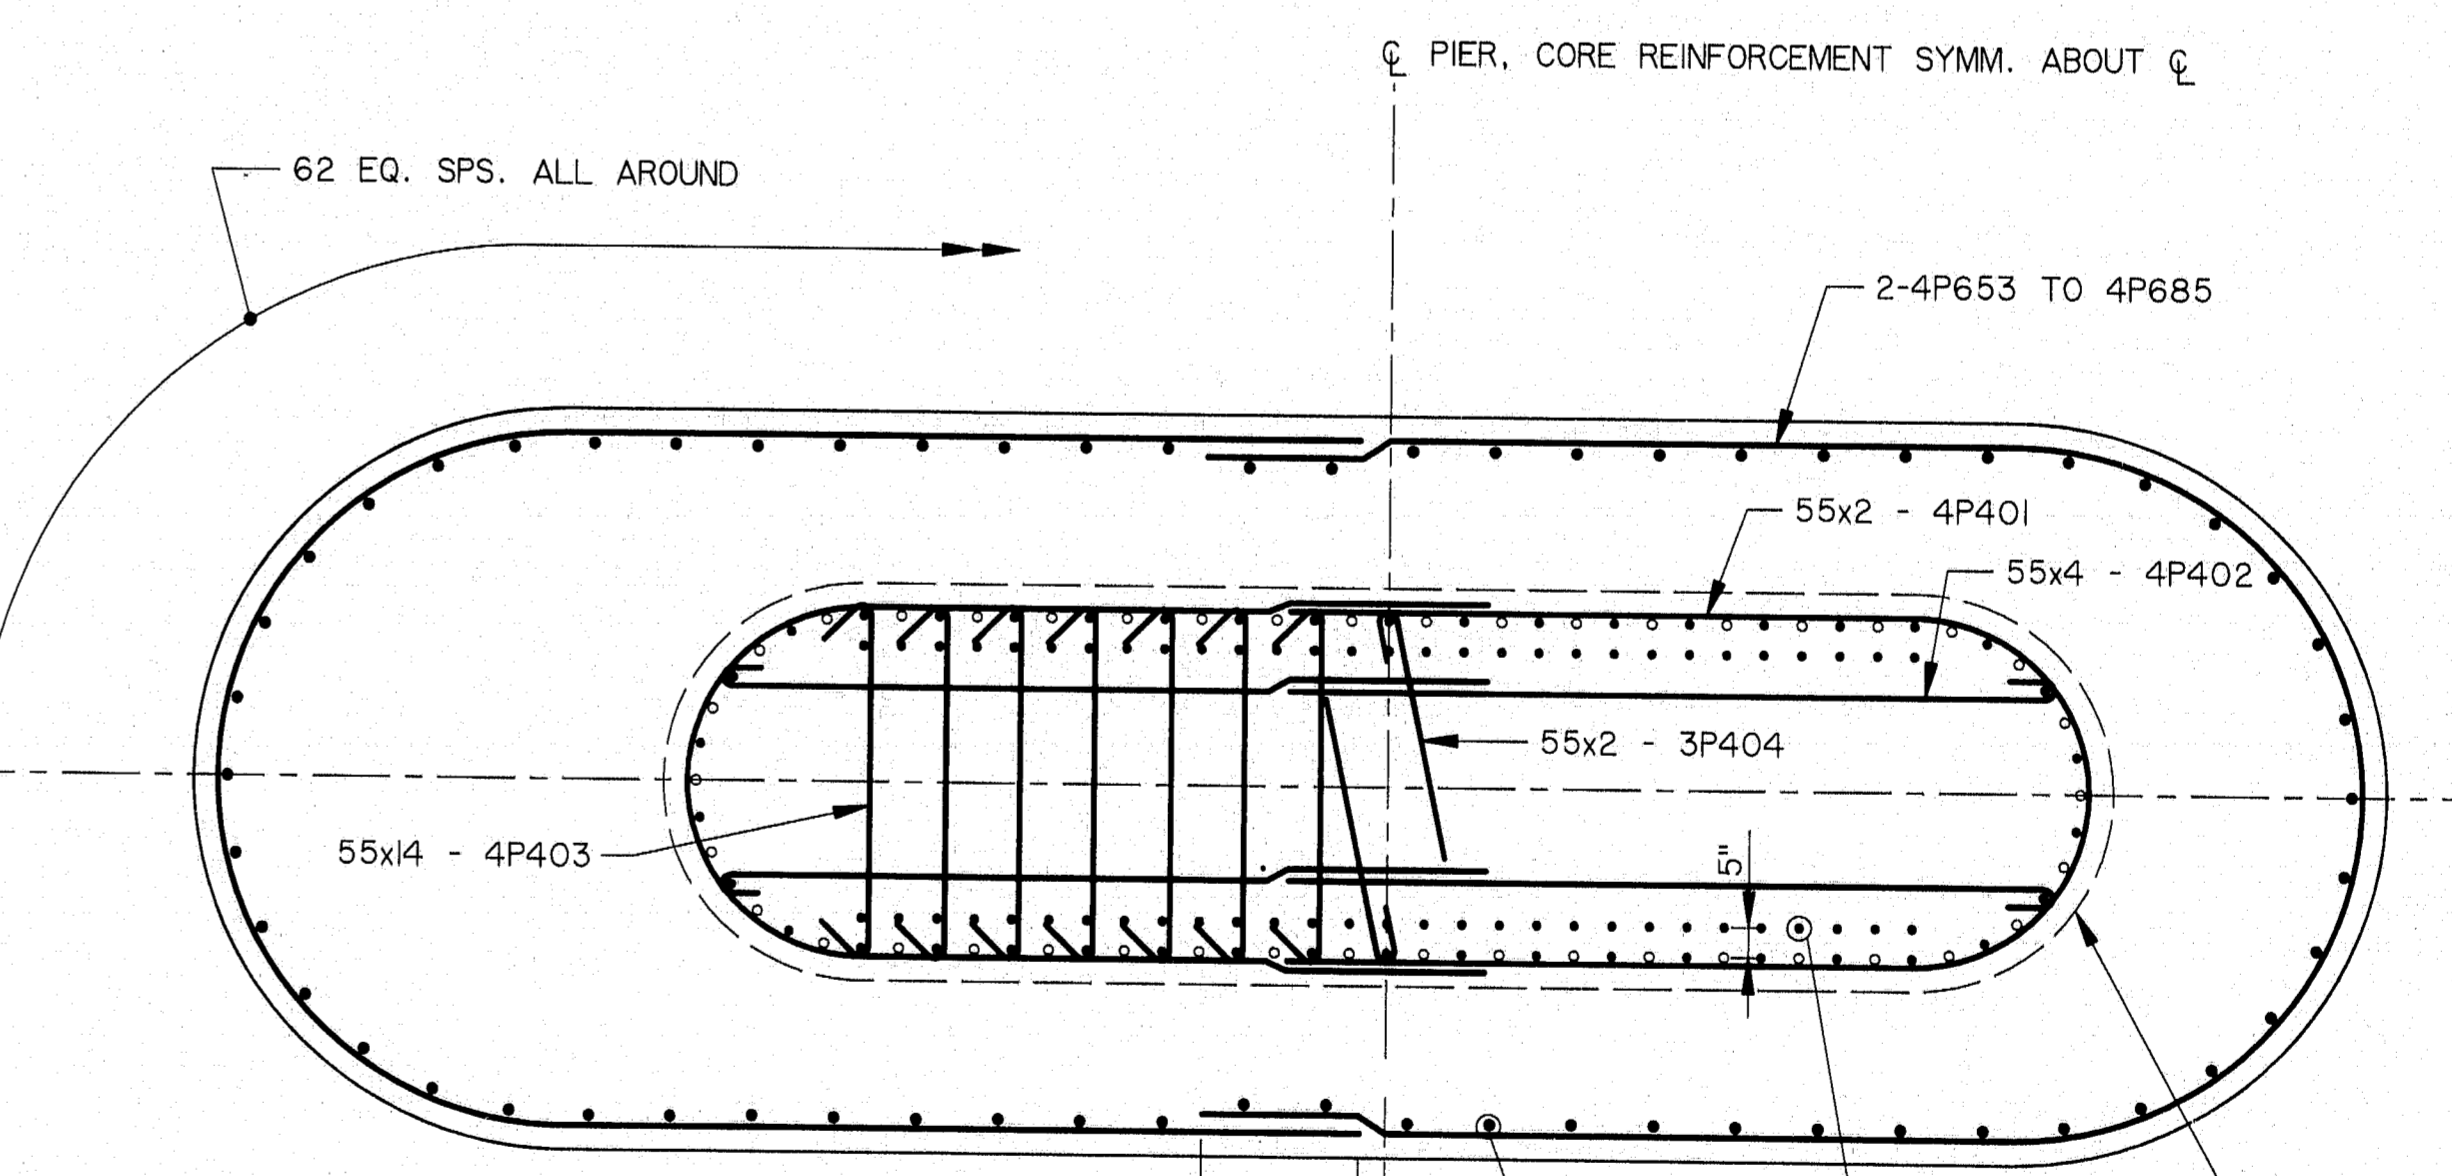

SECTION C-C

NO.	REVISION	BY	DATE	IN CHARGE OF
		DESIGNED:	SM	9/94
		DRAWN:	RJT	9/94
		CHECKED:	DWR	9/94
			CJM	

ELEVATION - PIER 4

**115-232**  
STEEL ALTERNATIVE

STATE OF MAINE  
DEPARTMENT OF TRANSPORTATION


WATERVILLE - WINSLOW PROJECT  
DONALD V. CARTER BRIDGE  
OVER  
KENNEBEC RIVER

PIER 4 RE-STEEL

SHEET B37 OF B86 AUGUSTA, MAINE




F.H.W.A. REG. NO.	STATE	PROJECT NUMBER	SHEET NO.	TOTAL SHEETS
1	MAINE	0009(002)	47	103

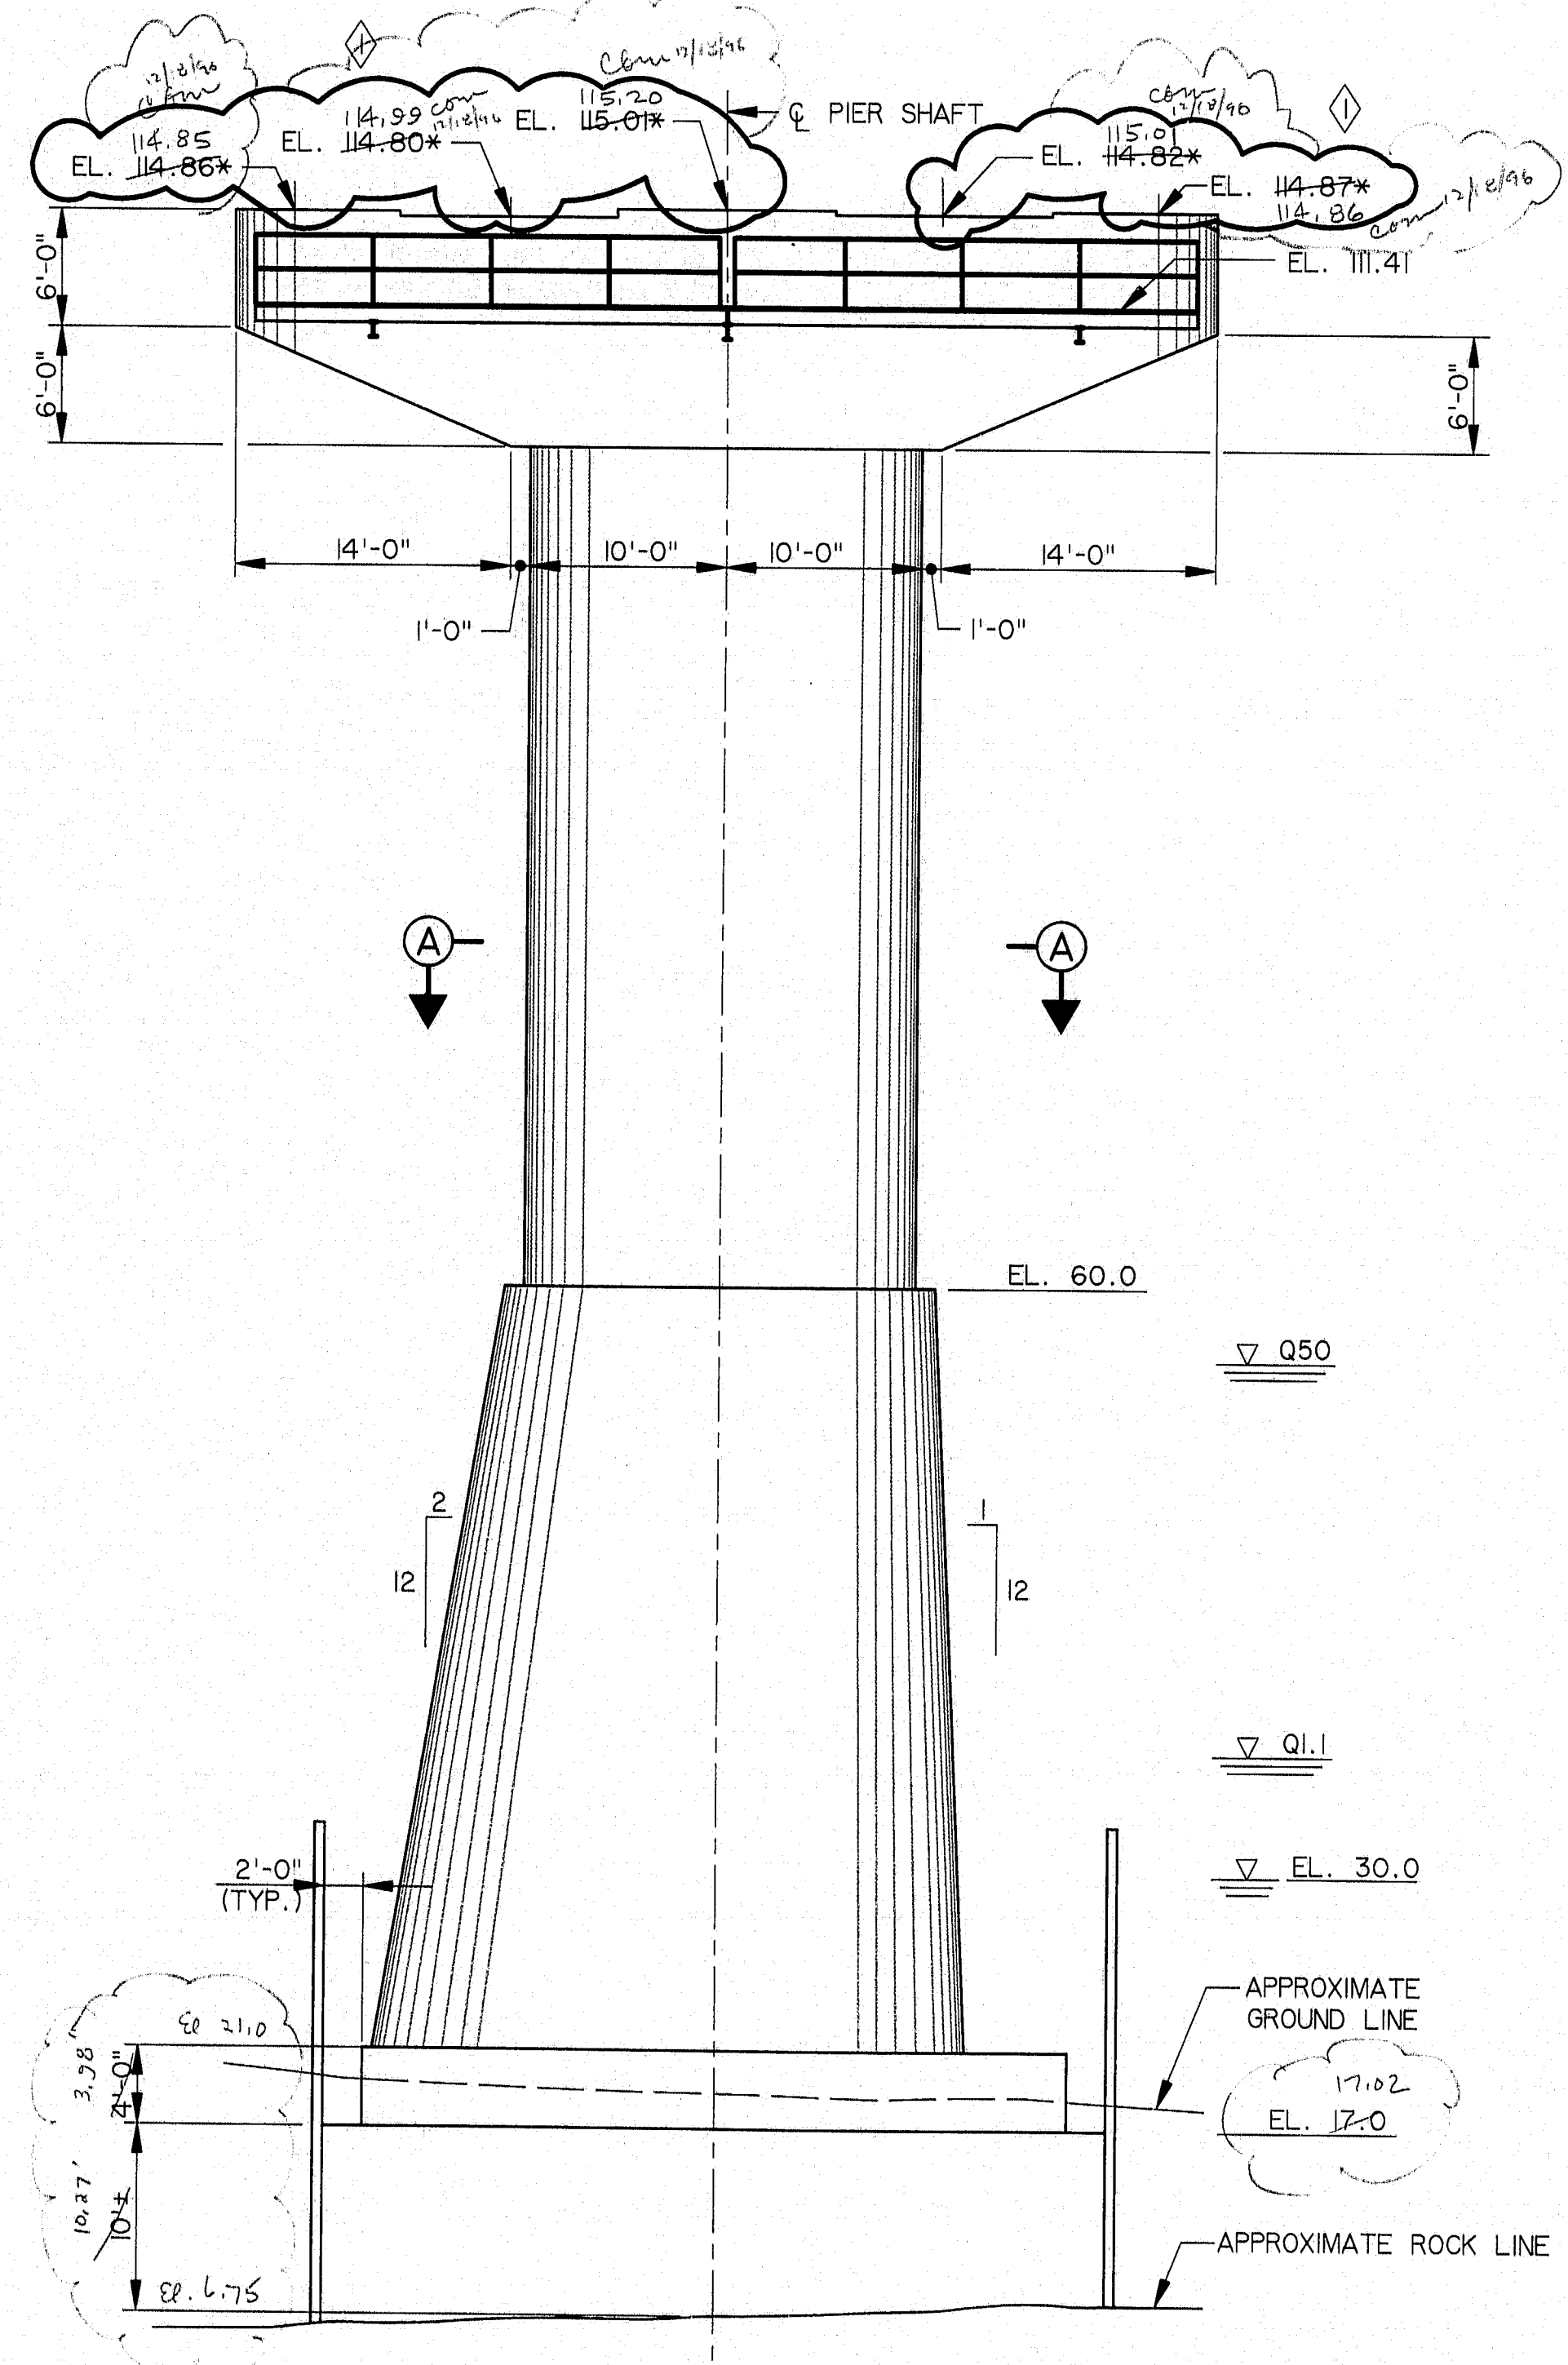


ELEVATION  
(LOOKING UPSTATION)


\* SEE NOTE 7, SHEET B30.

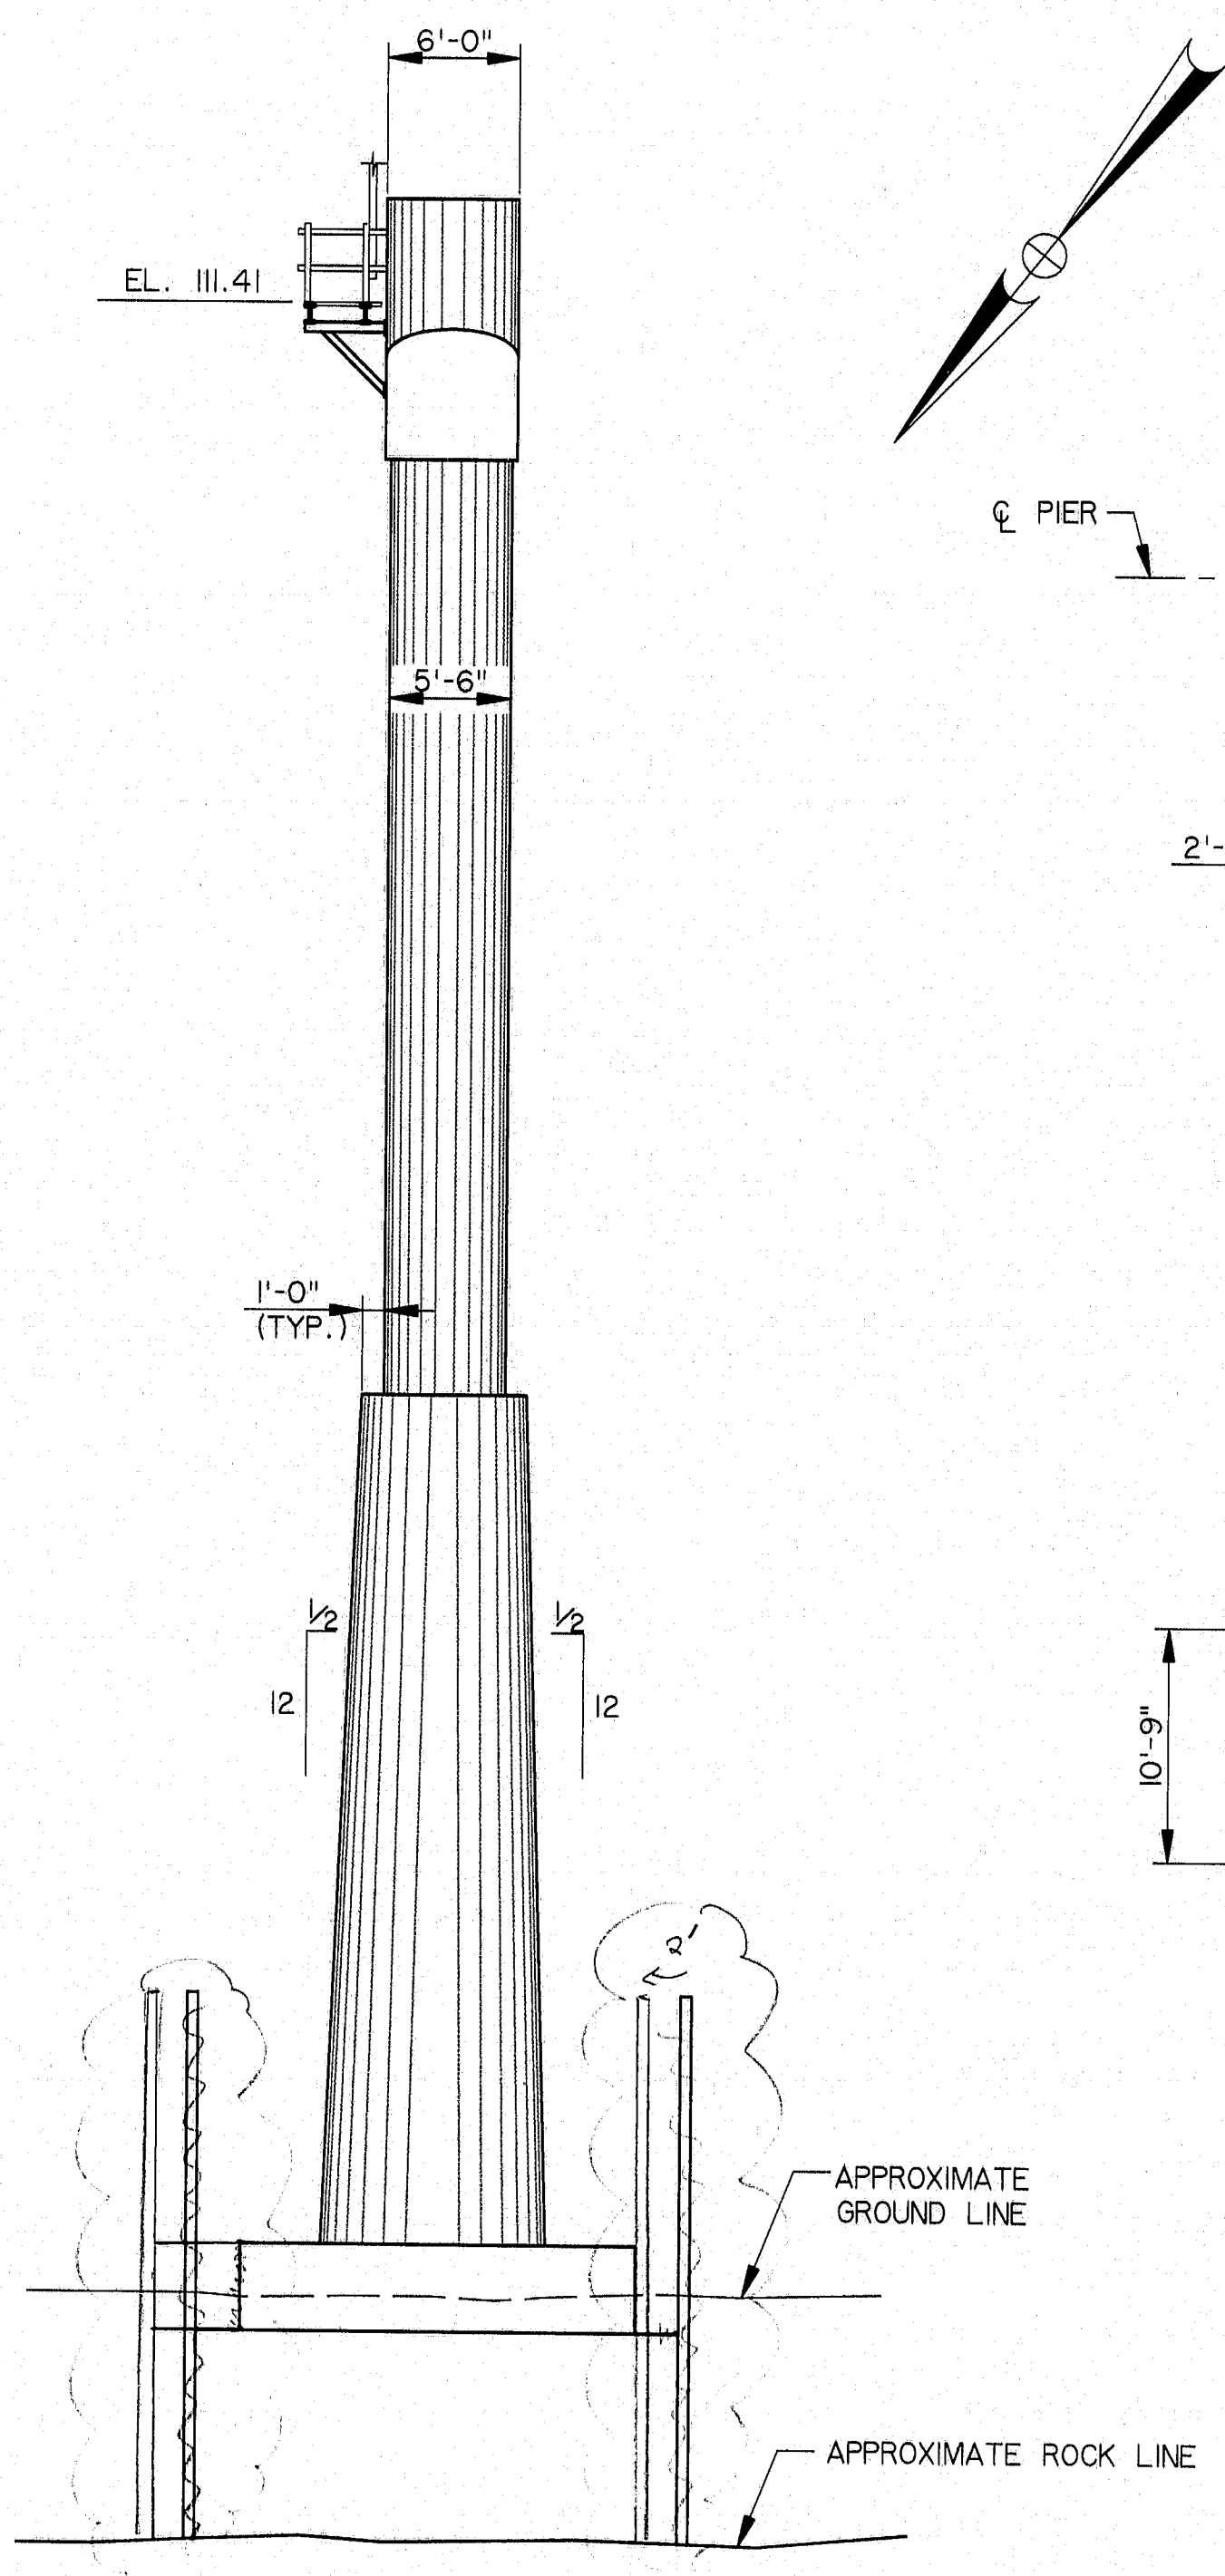

SIDE ELEVATION

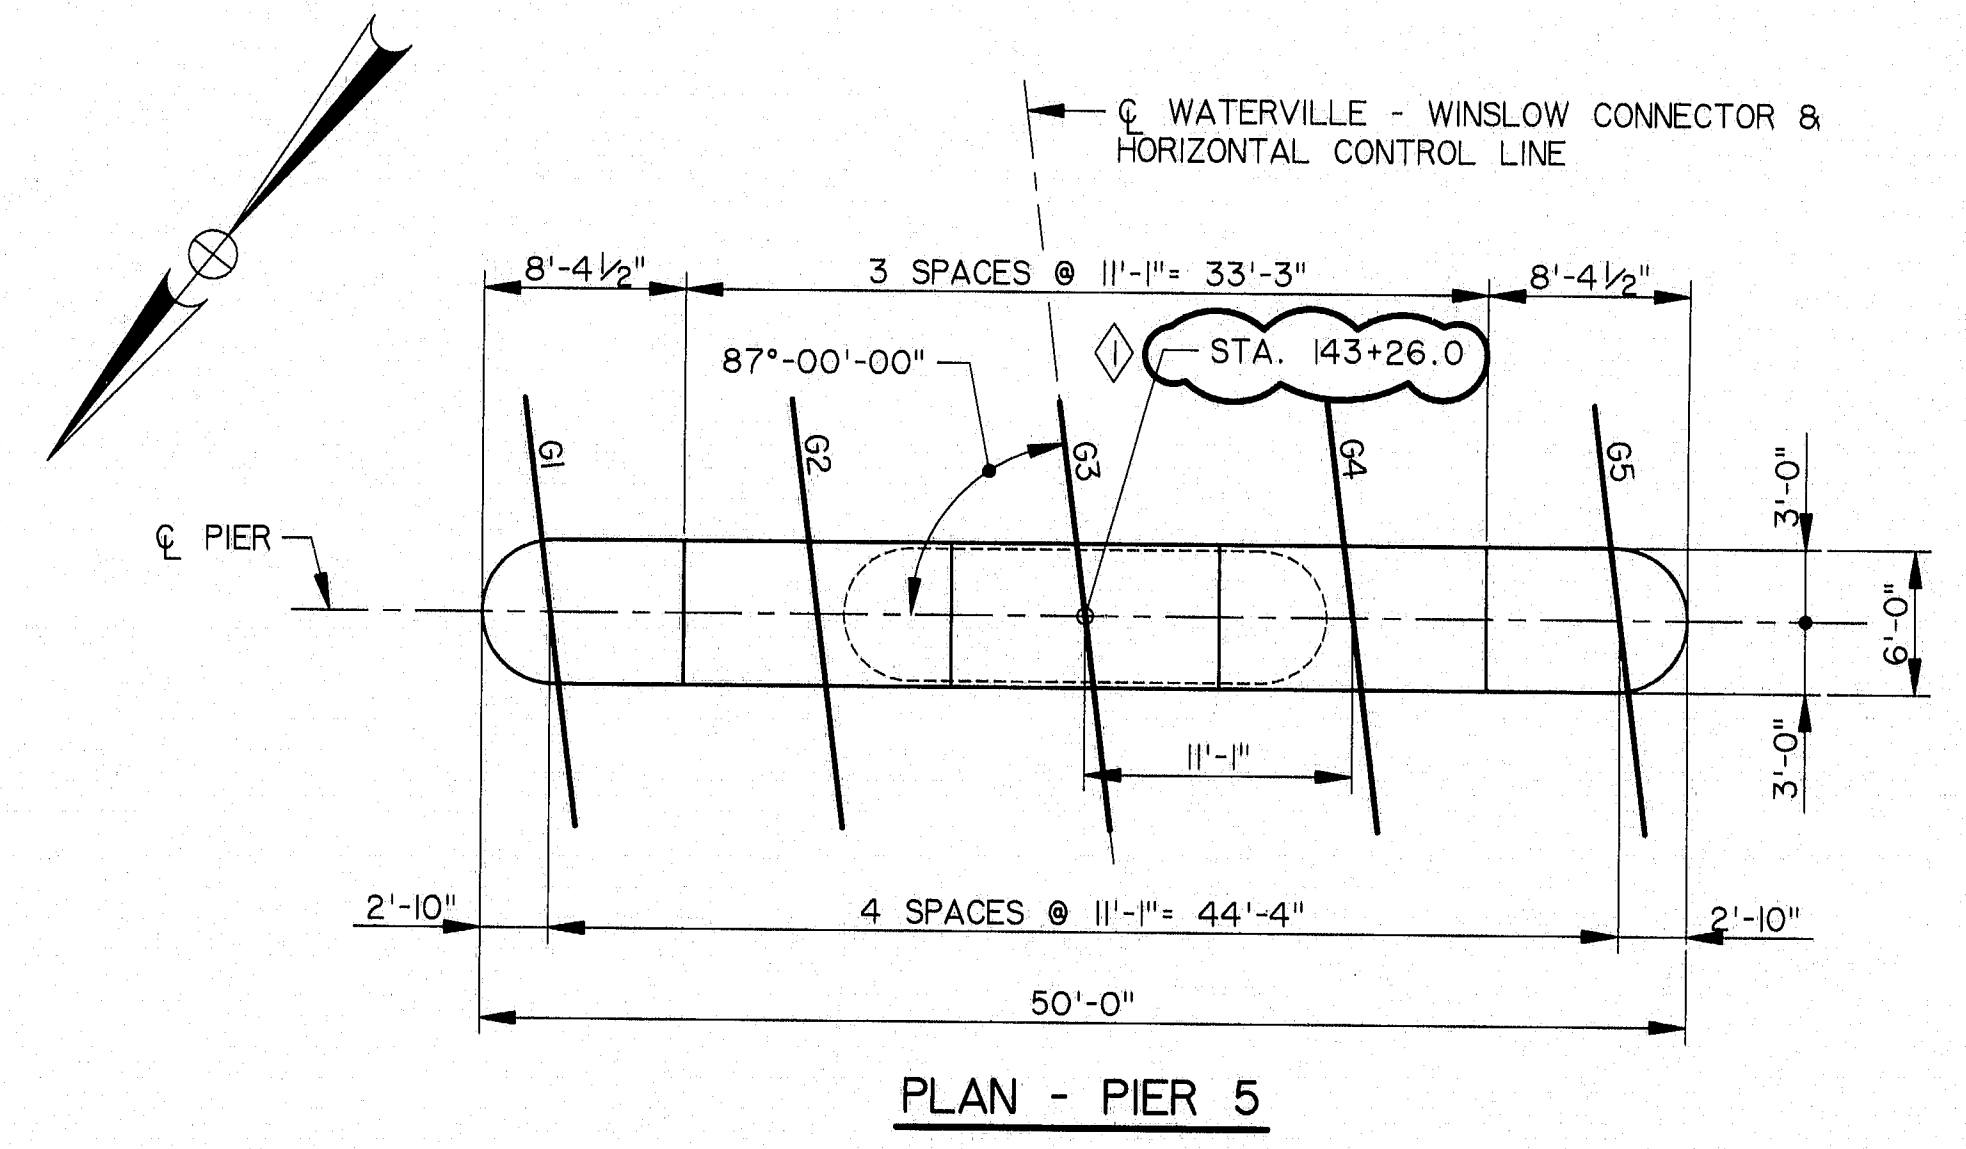

PLAN - PIER 5

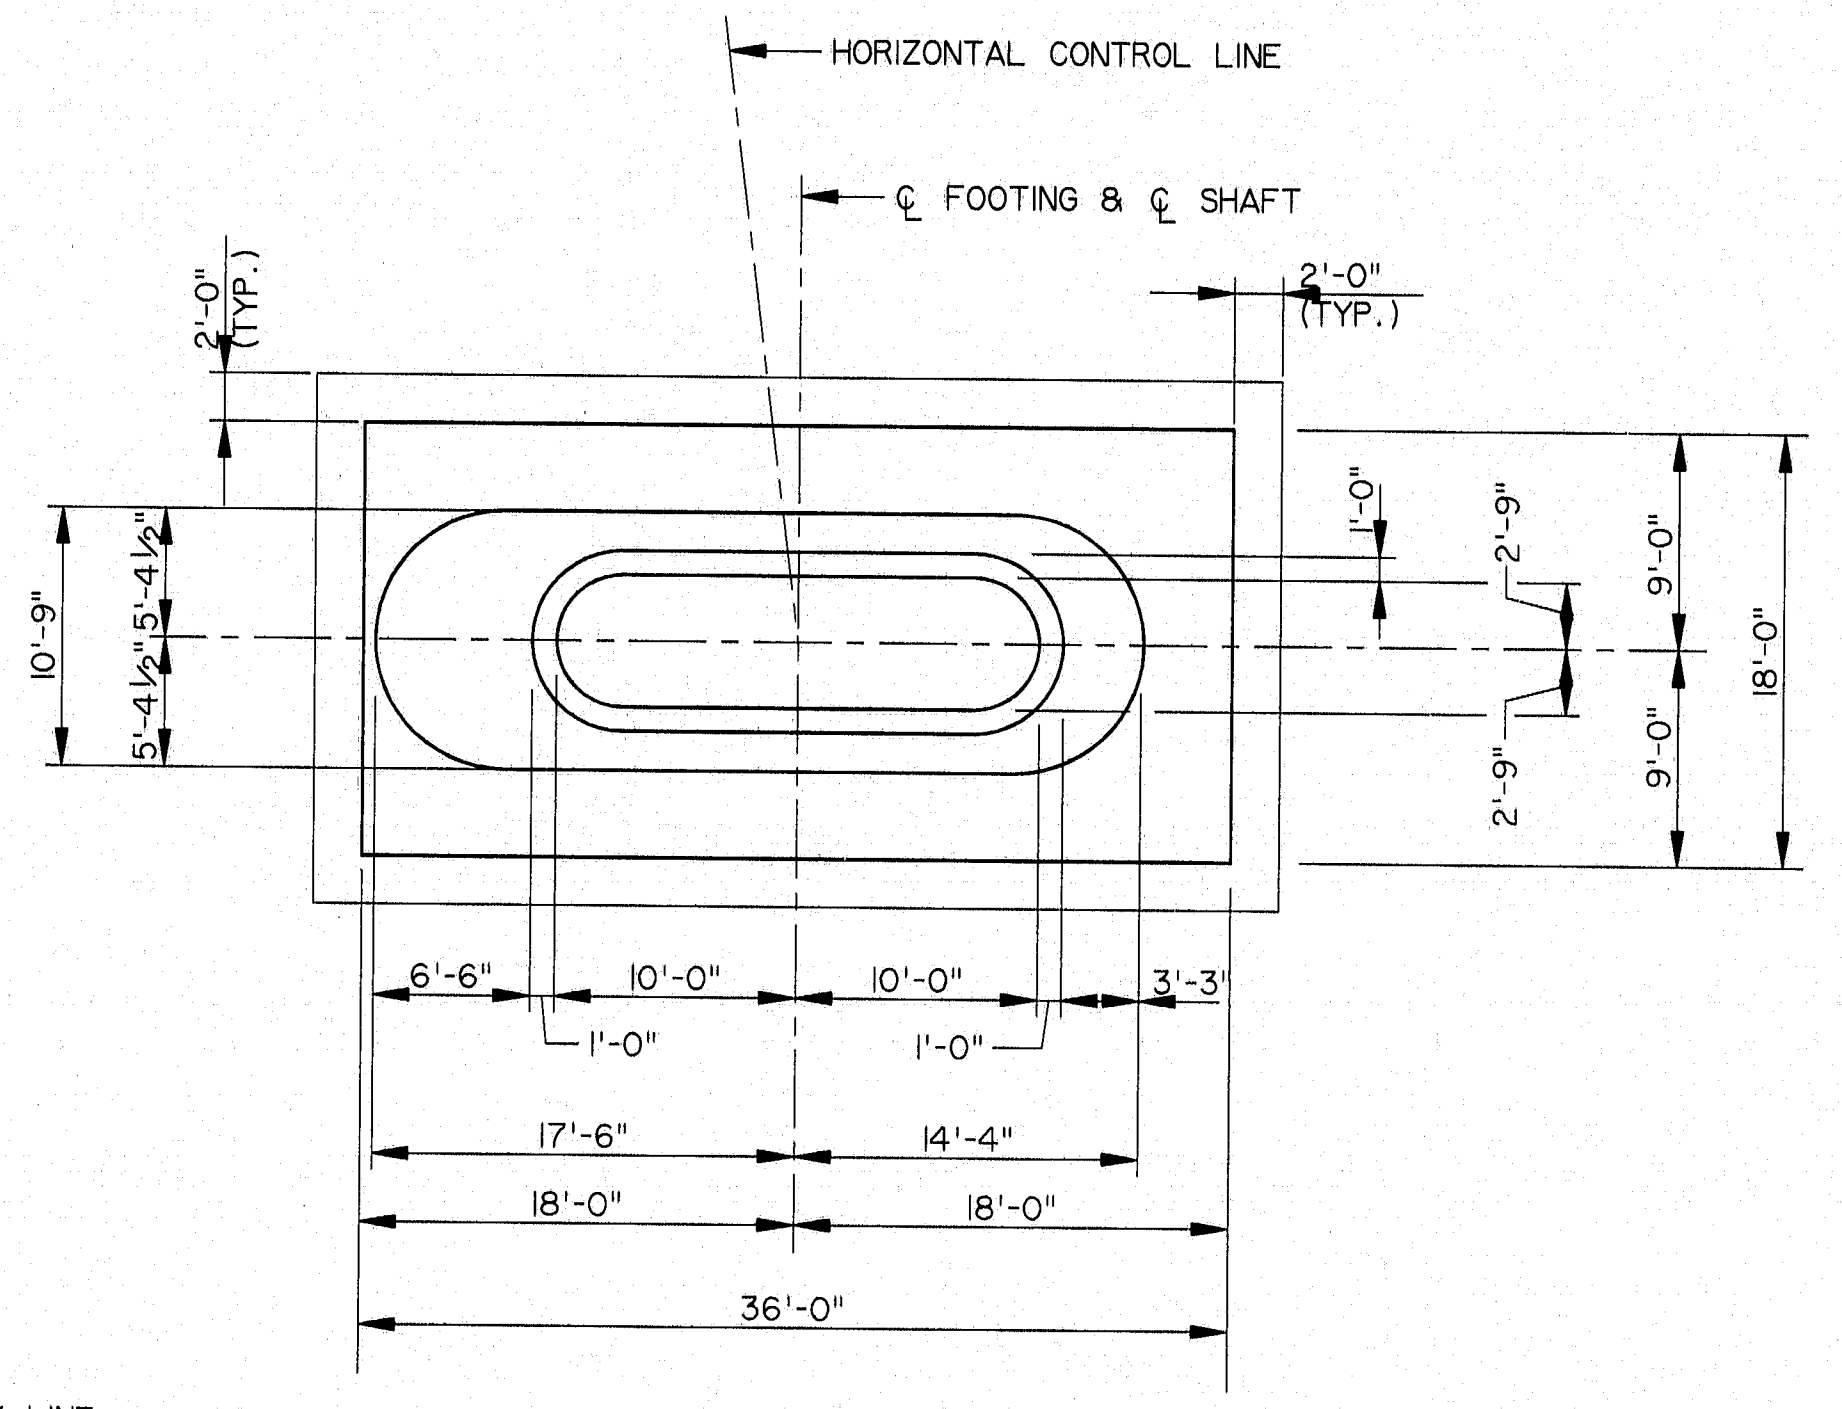


SECTION A-A

NOTES:

1. MAXIMUM CALCULATED FOOTING PRESSURE = 8.9 T.S.F. (GROUP: SEISMIC).
2. SEE SHEET B30 FOR ADDITIONAL NOTES.


NO.	REVISION	BY	DATE	IN CHARGE OF
1	PIER EL. & STA.	JFW	10/98	DWR
	DESIGNED:	SM	9/94	
	DRAWN:	RJT	9/94	
	CHECKED:	DWR	9/94	
				CJM

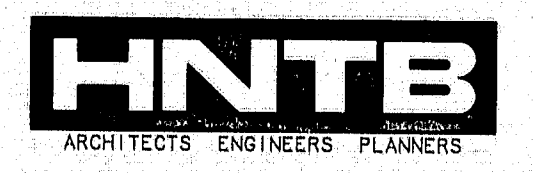


115-233

STEEL ALTERNATIVE STATE OF MAINE DEPARTMENT OF TRANSPORTATION
WATERVILLE - WINSLOW PROJECT DONALD V. CARTER BRIDGE OVER KENNEBEC RIVER
PIER 5 DETAILS
SHEET B38 OF B86 AUGUSTA, MAINE

F.D.S.A. REG. NO.	STATE	PROJECT NUMBER	SHEET NO.	TOTAL SHEETS
1	MAINE	0009 (002)	48	103

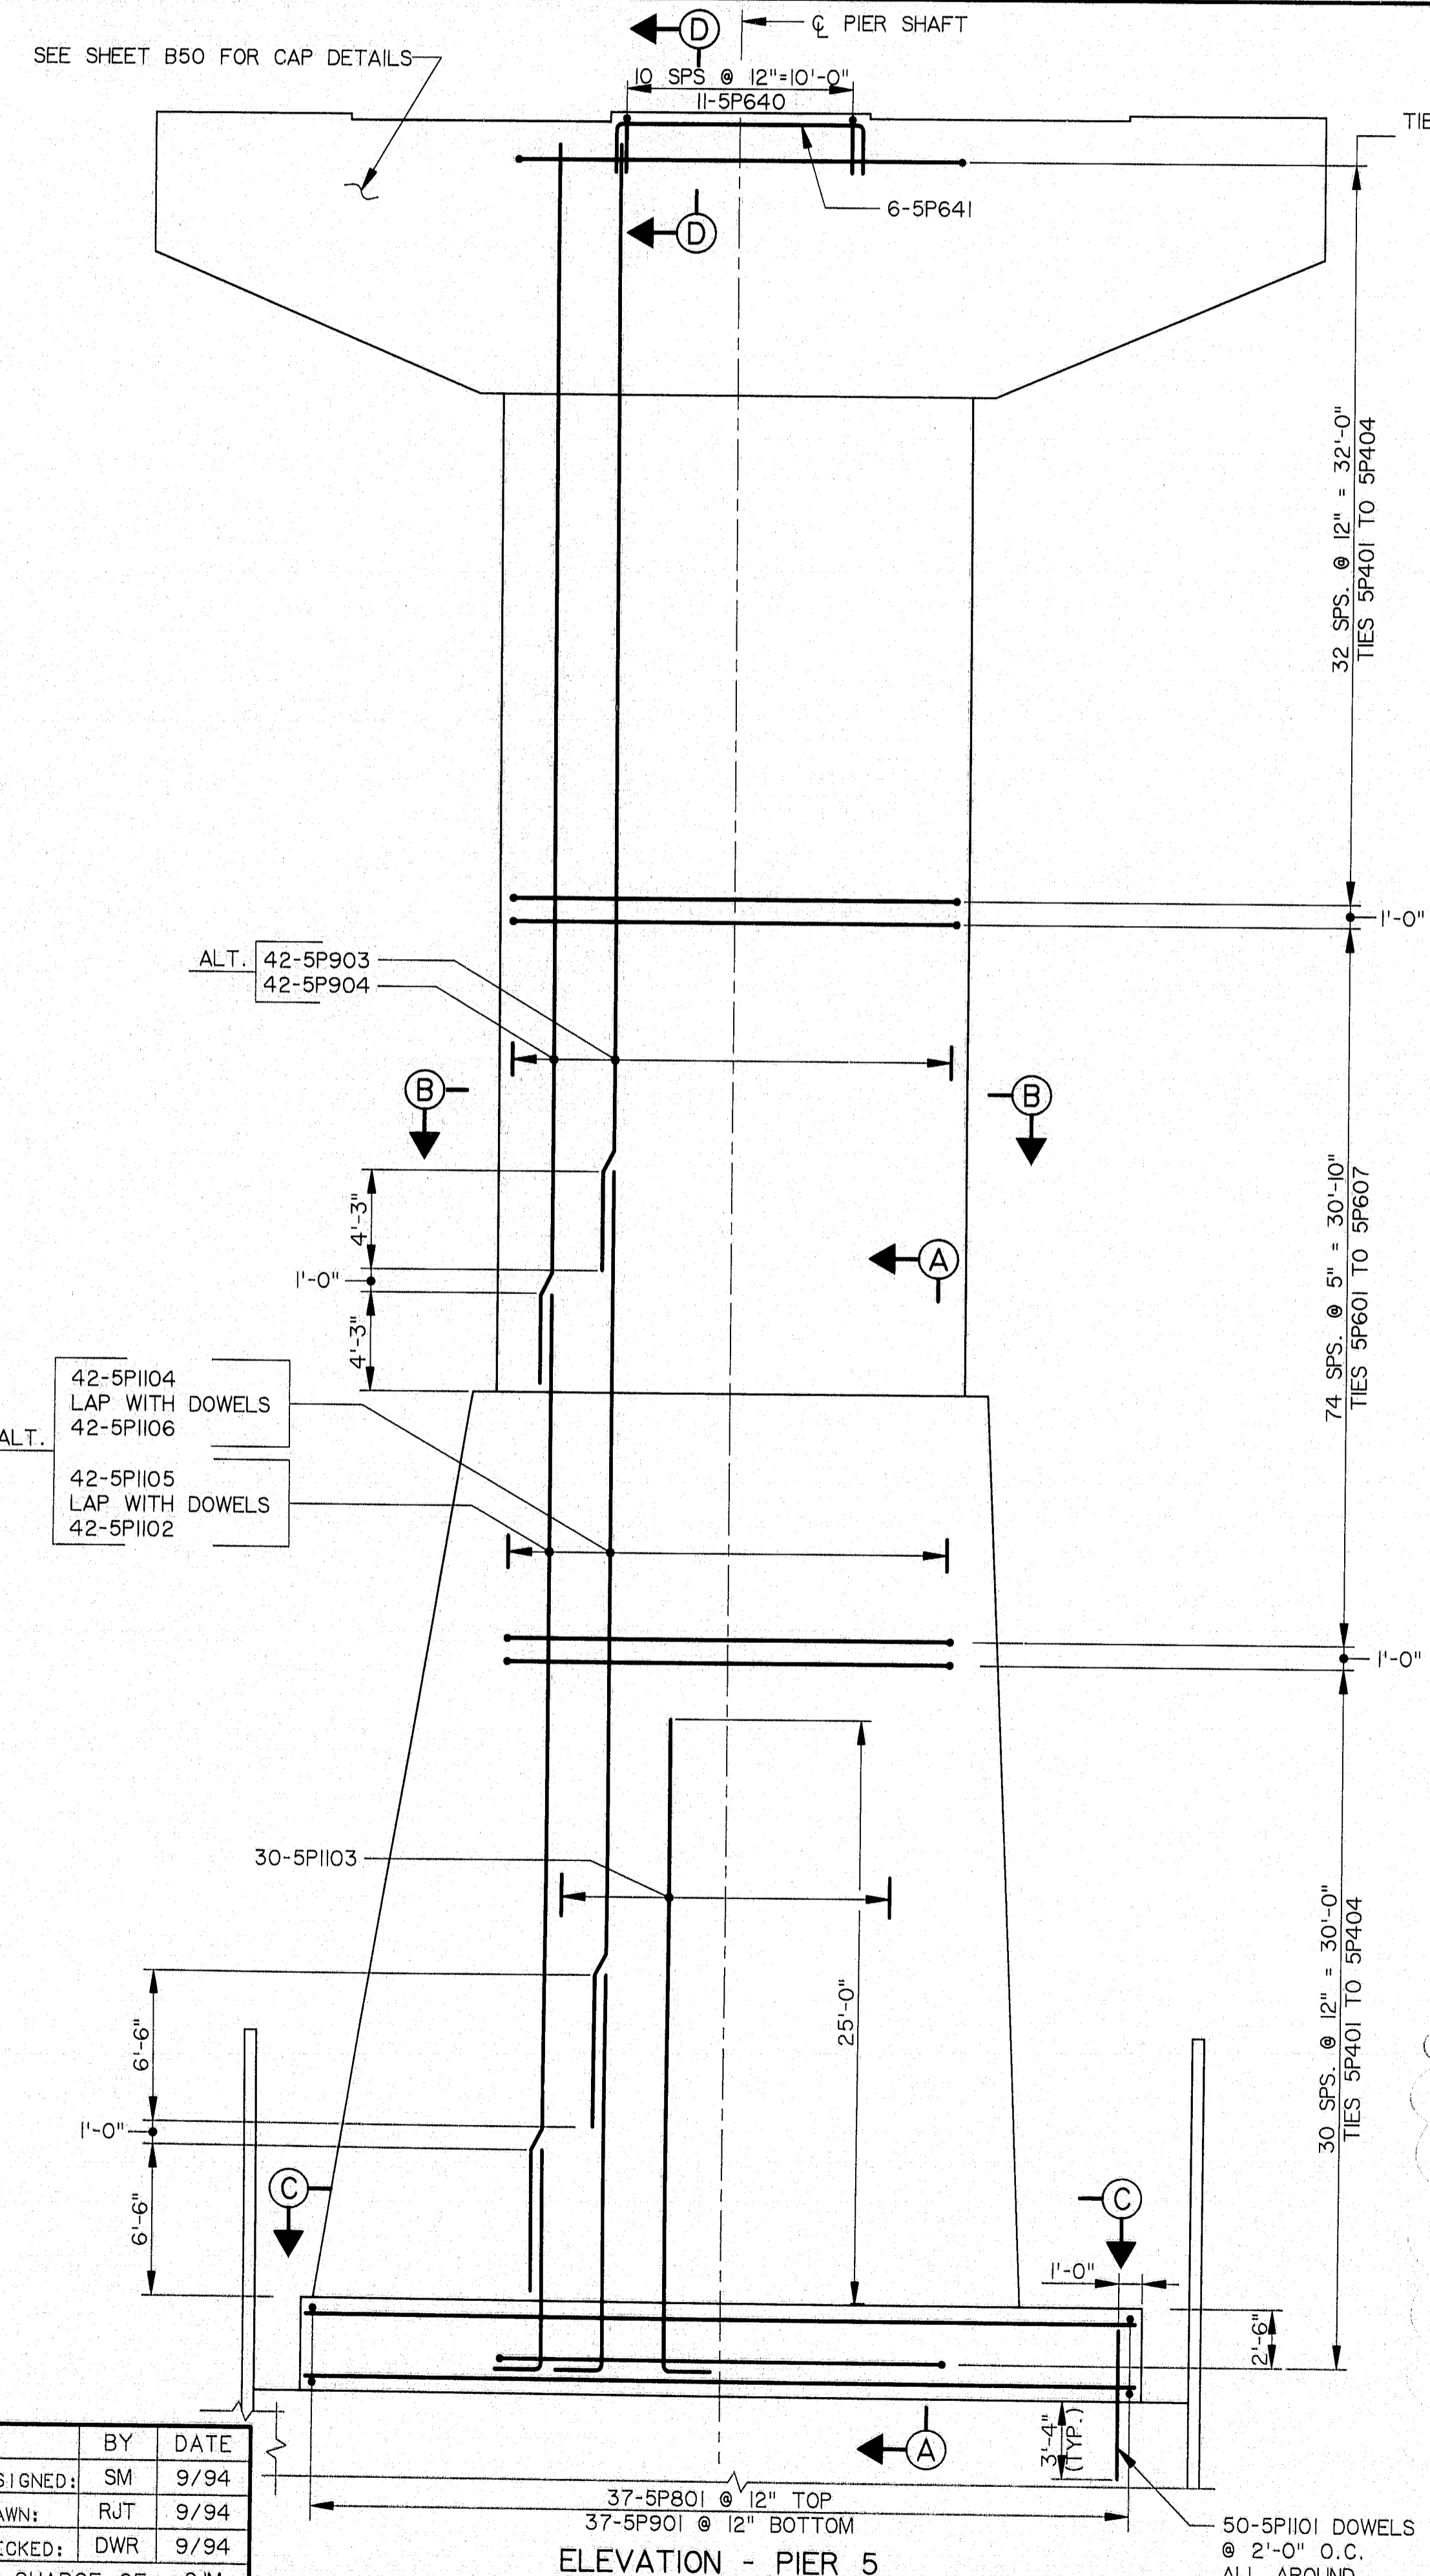

NO.	REVISION	BY	DATE	IN CHARGE OF	CJM
DESIGNED:	SM	9/94			
DRAWN:	RJT	9/94			
CHECKED:	DWR	9/94			

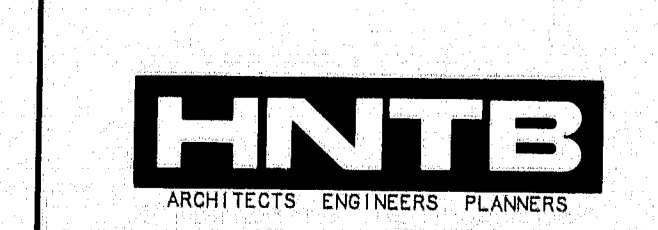

**115-234**











STEEL ALTERNATIVE  
STATE OF MAINE  
DEPARTMENT OF TRANSPORTATION

WATERVILLE - WINSLOW PROJECT  
DONALD V. CARTER BRIDGE  
OVER  
KENNEBEC RIVER

PIER 5 RE-STEEL

SHEET B39 OF B86 AUGUSTA, MAINE

F.P.A. & RES. NO.	STATE	PROJECT NUMBER	SHEET NO.	TOTAL SHEETS
1	MAINE	0009 (002)	49	103

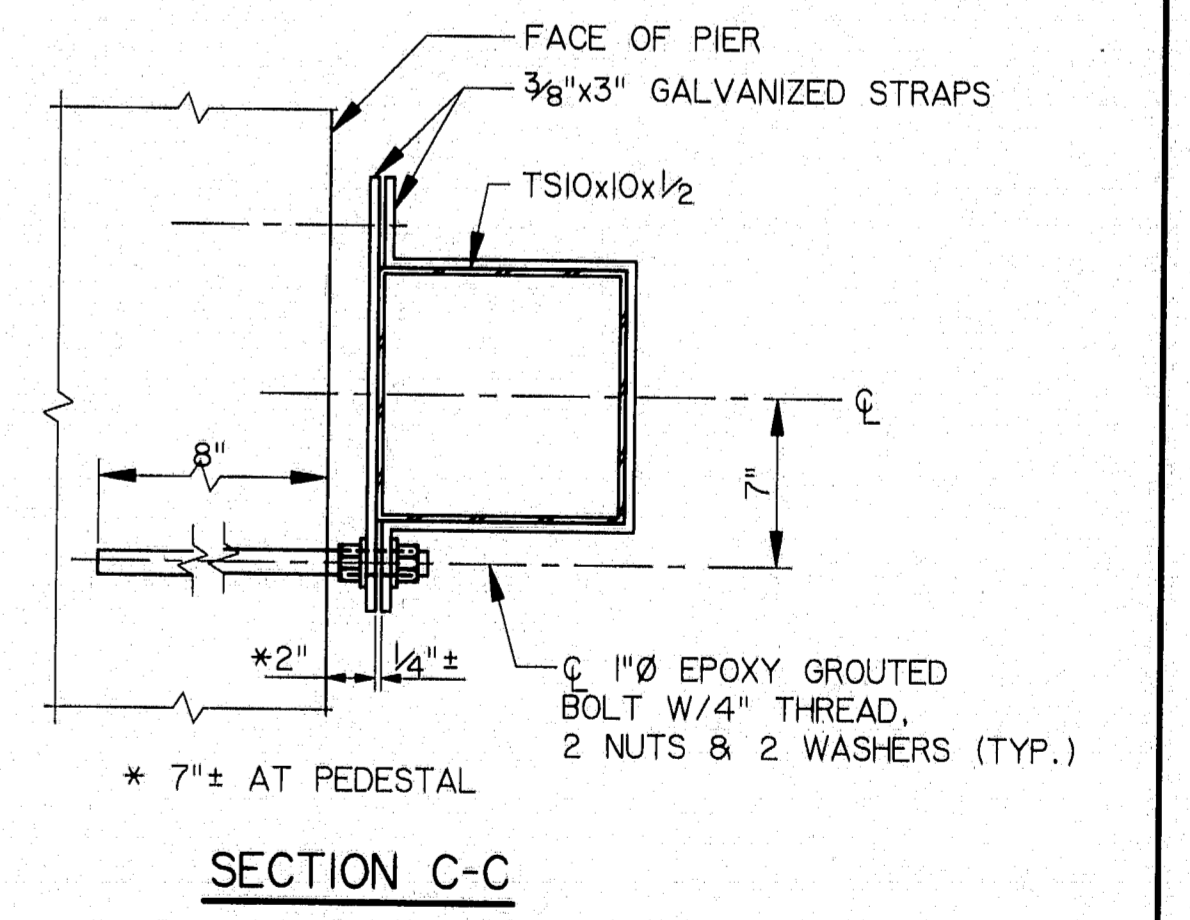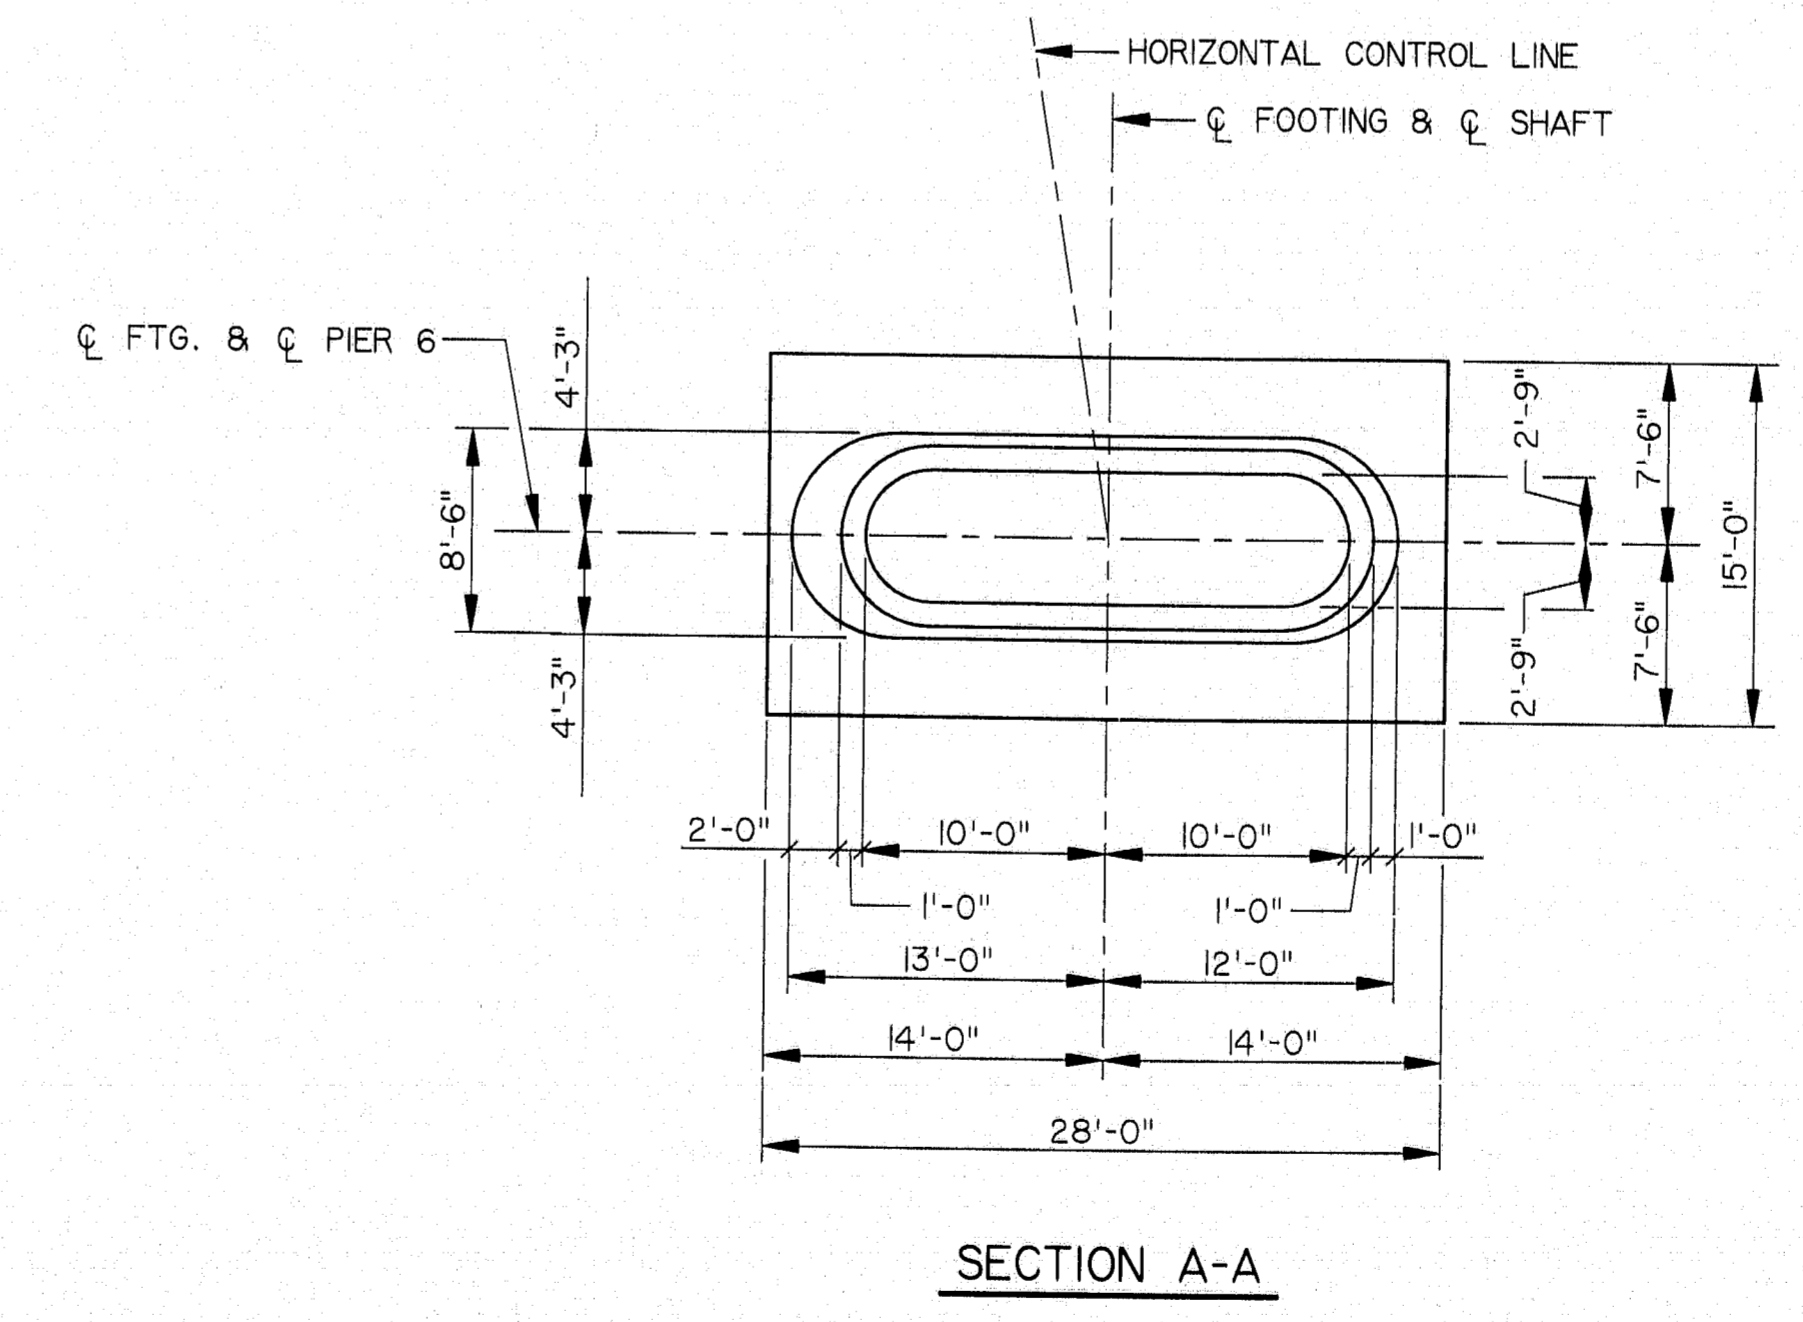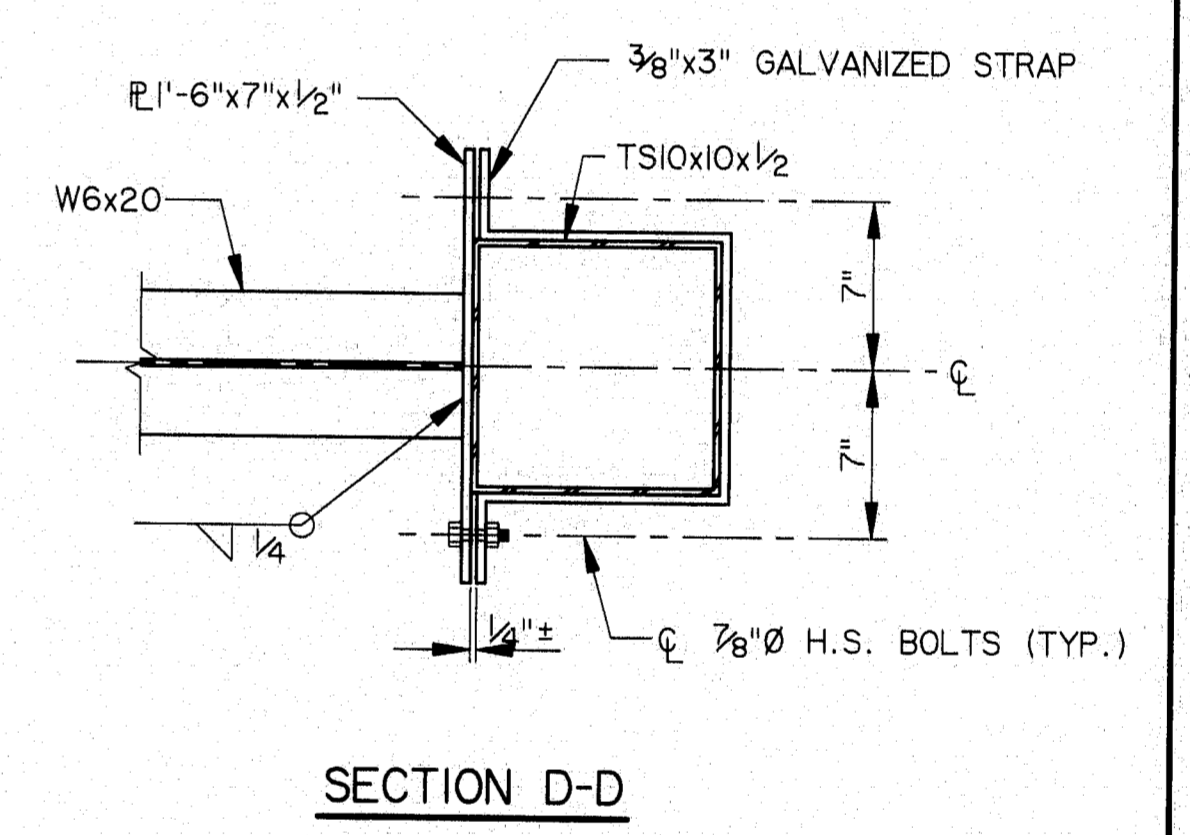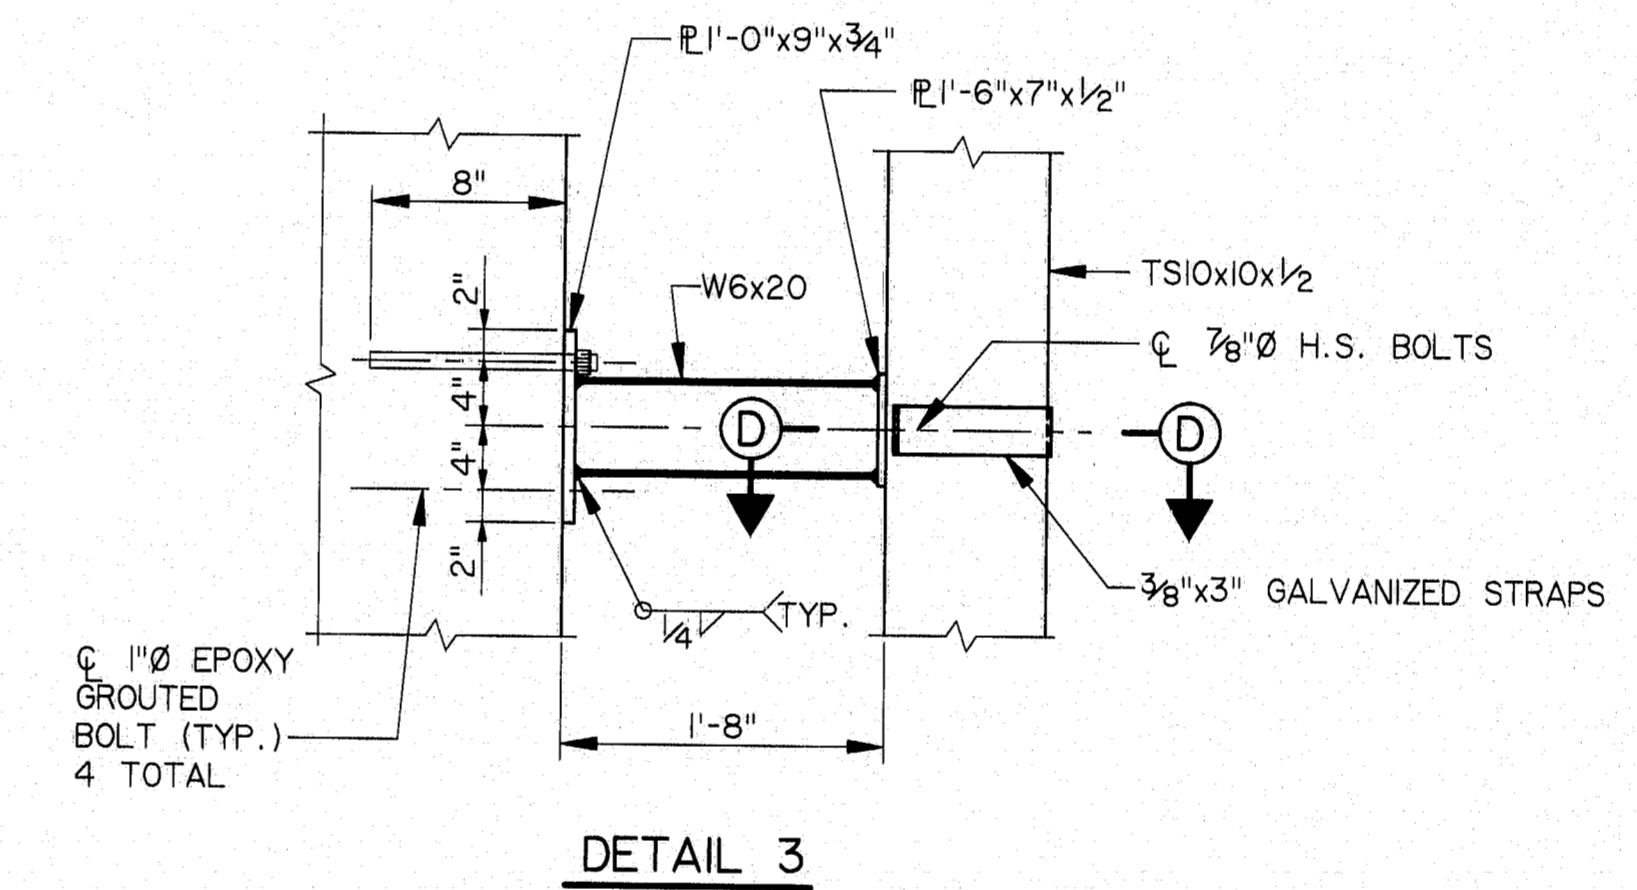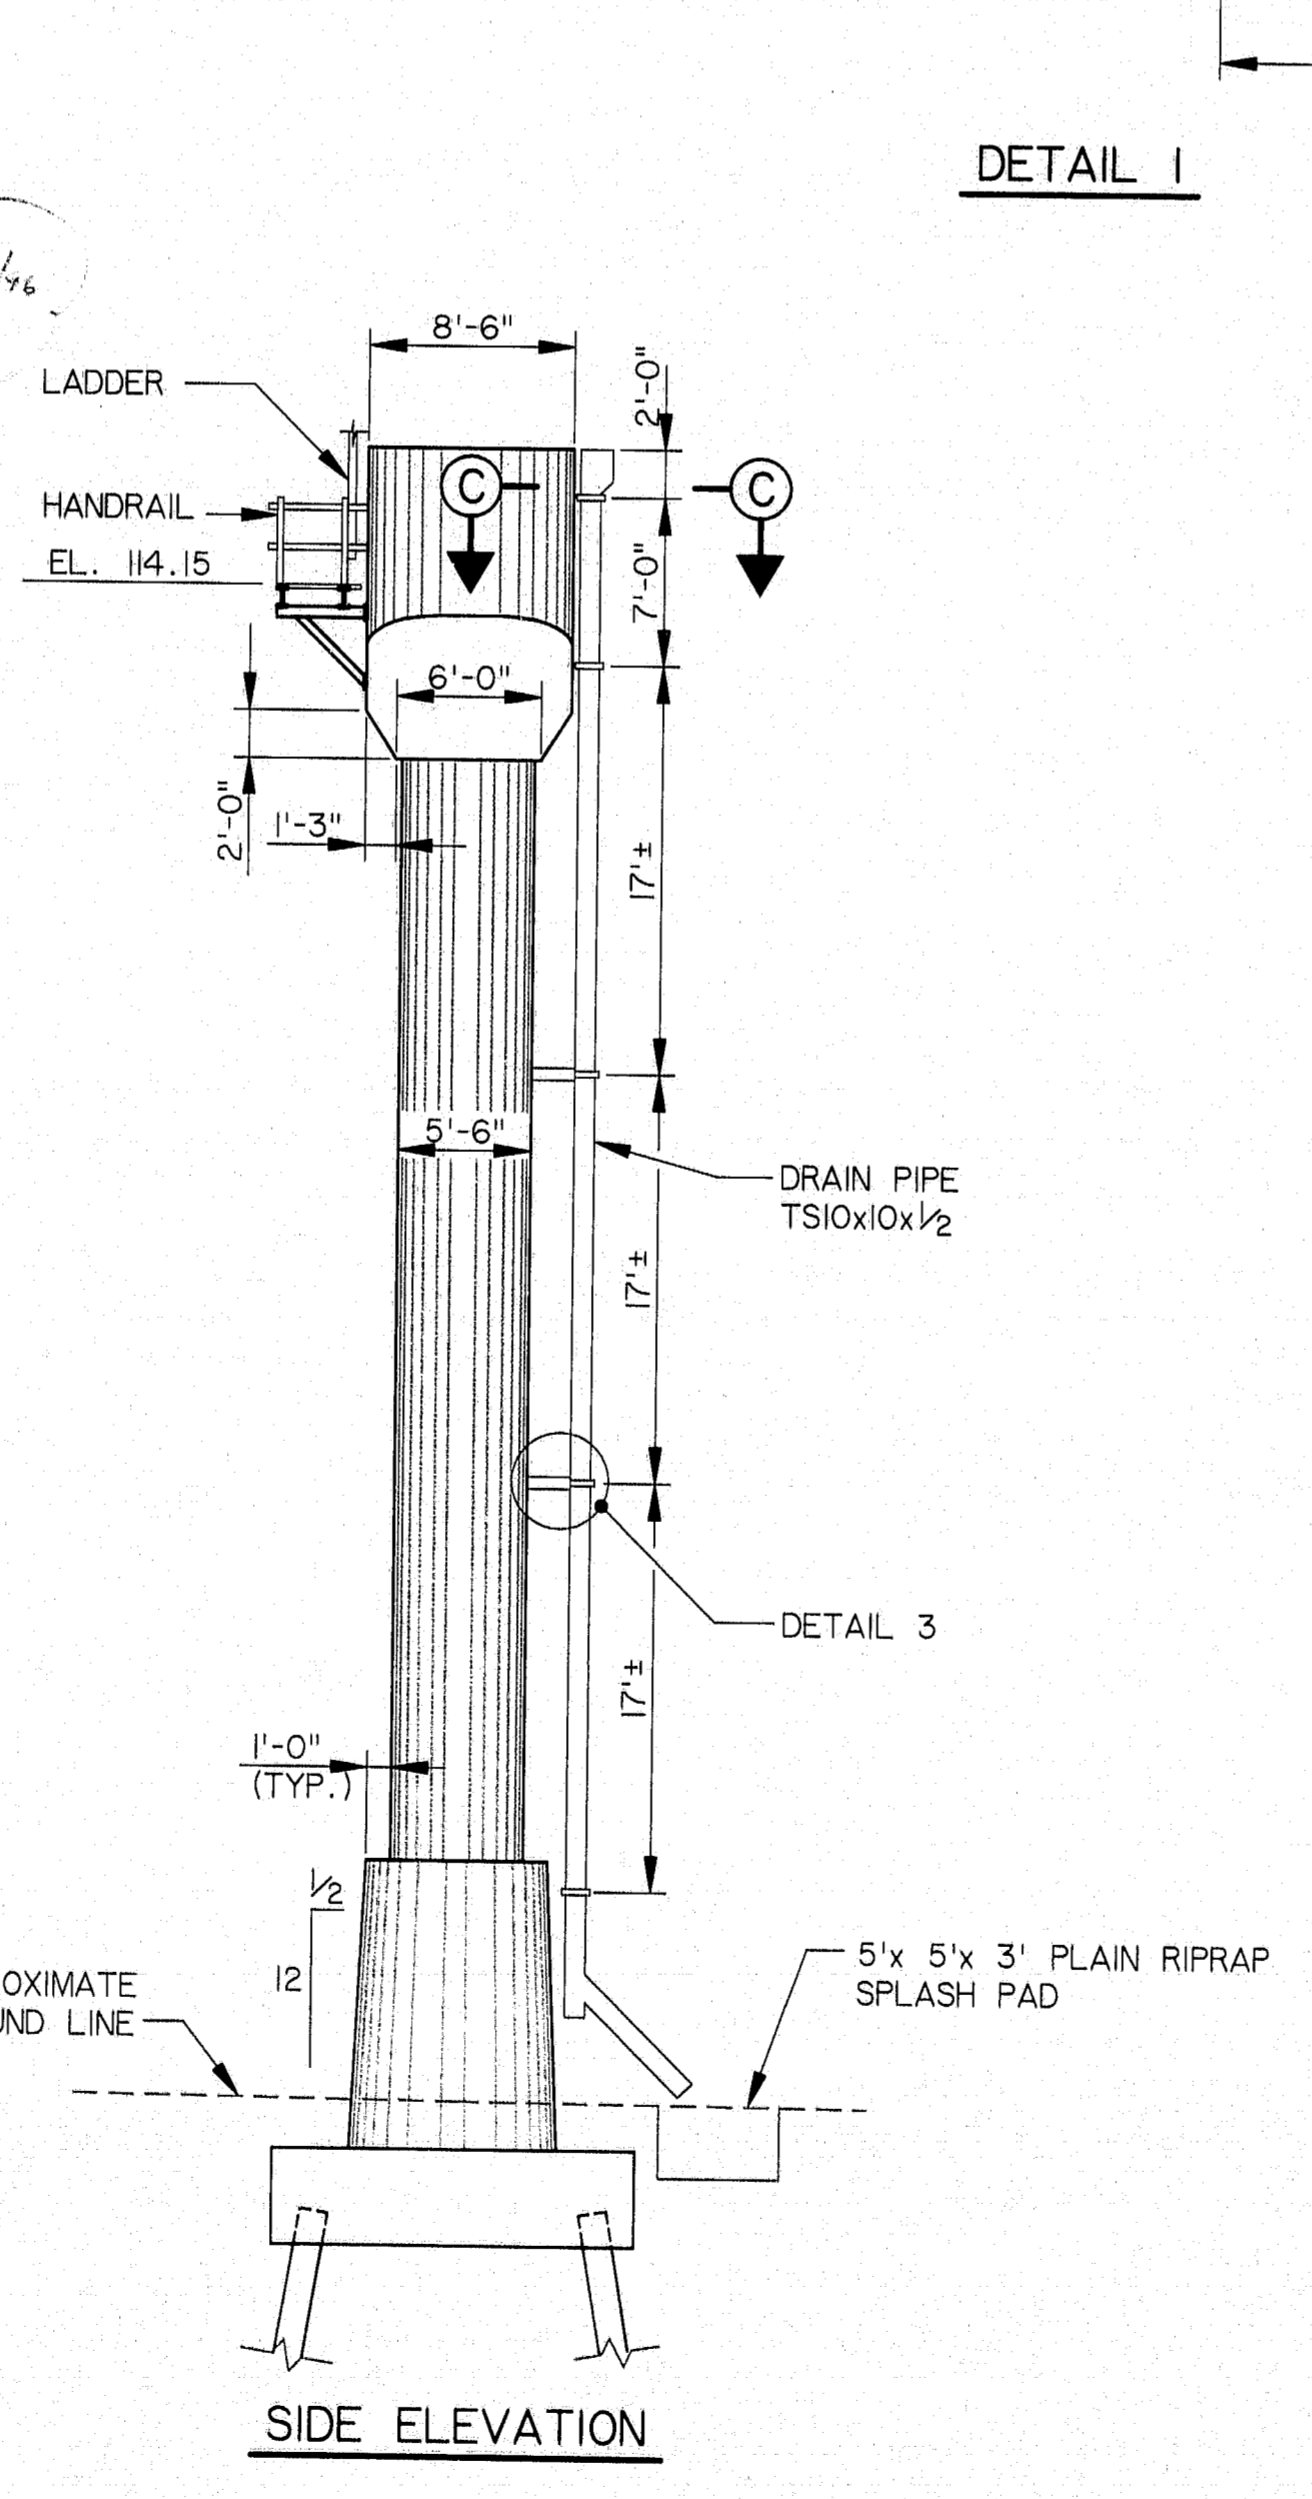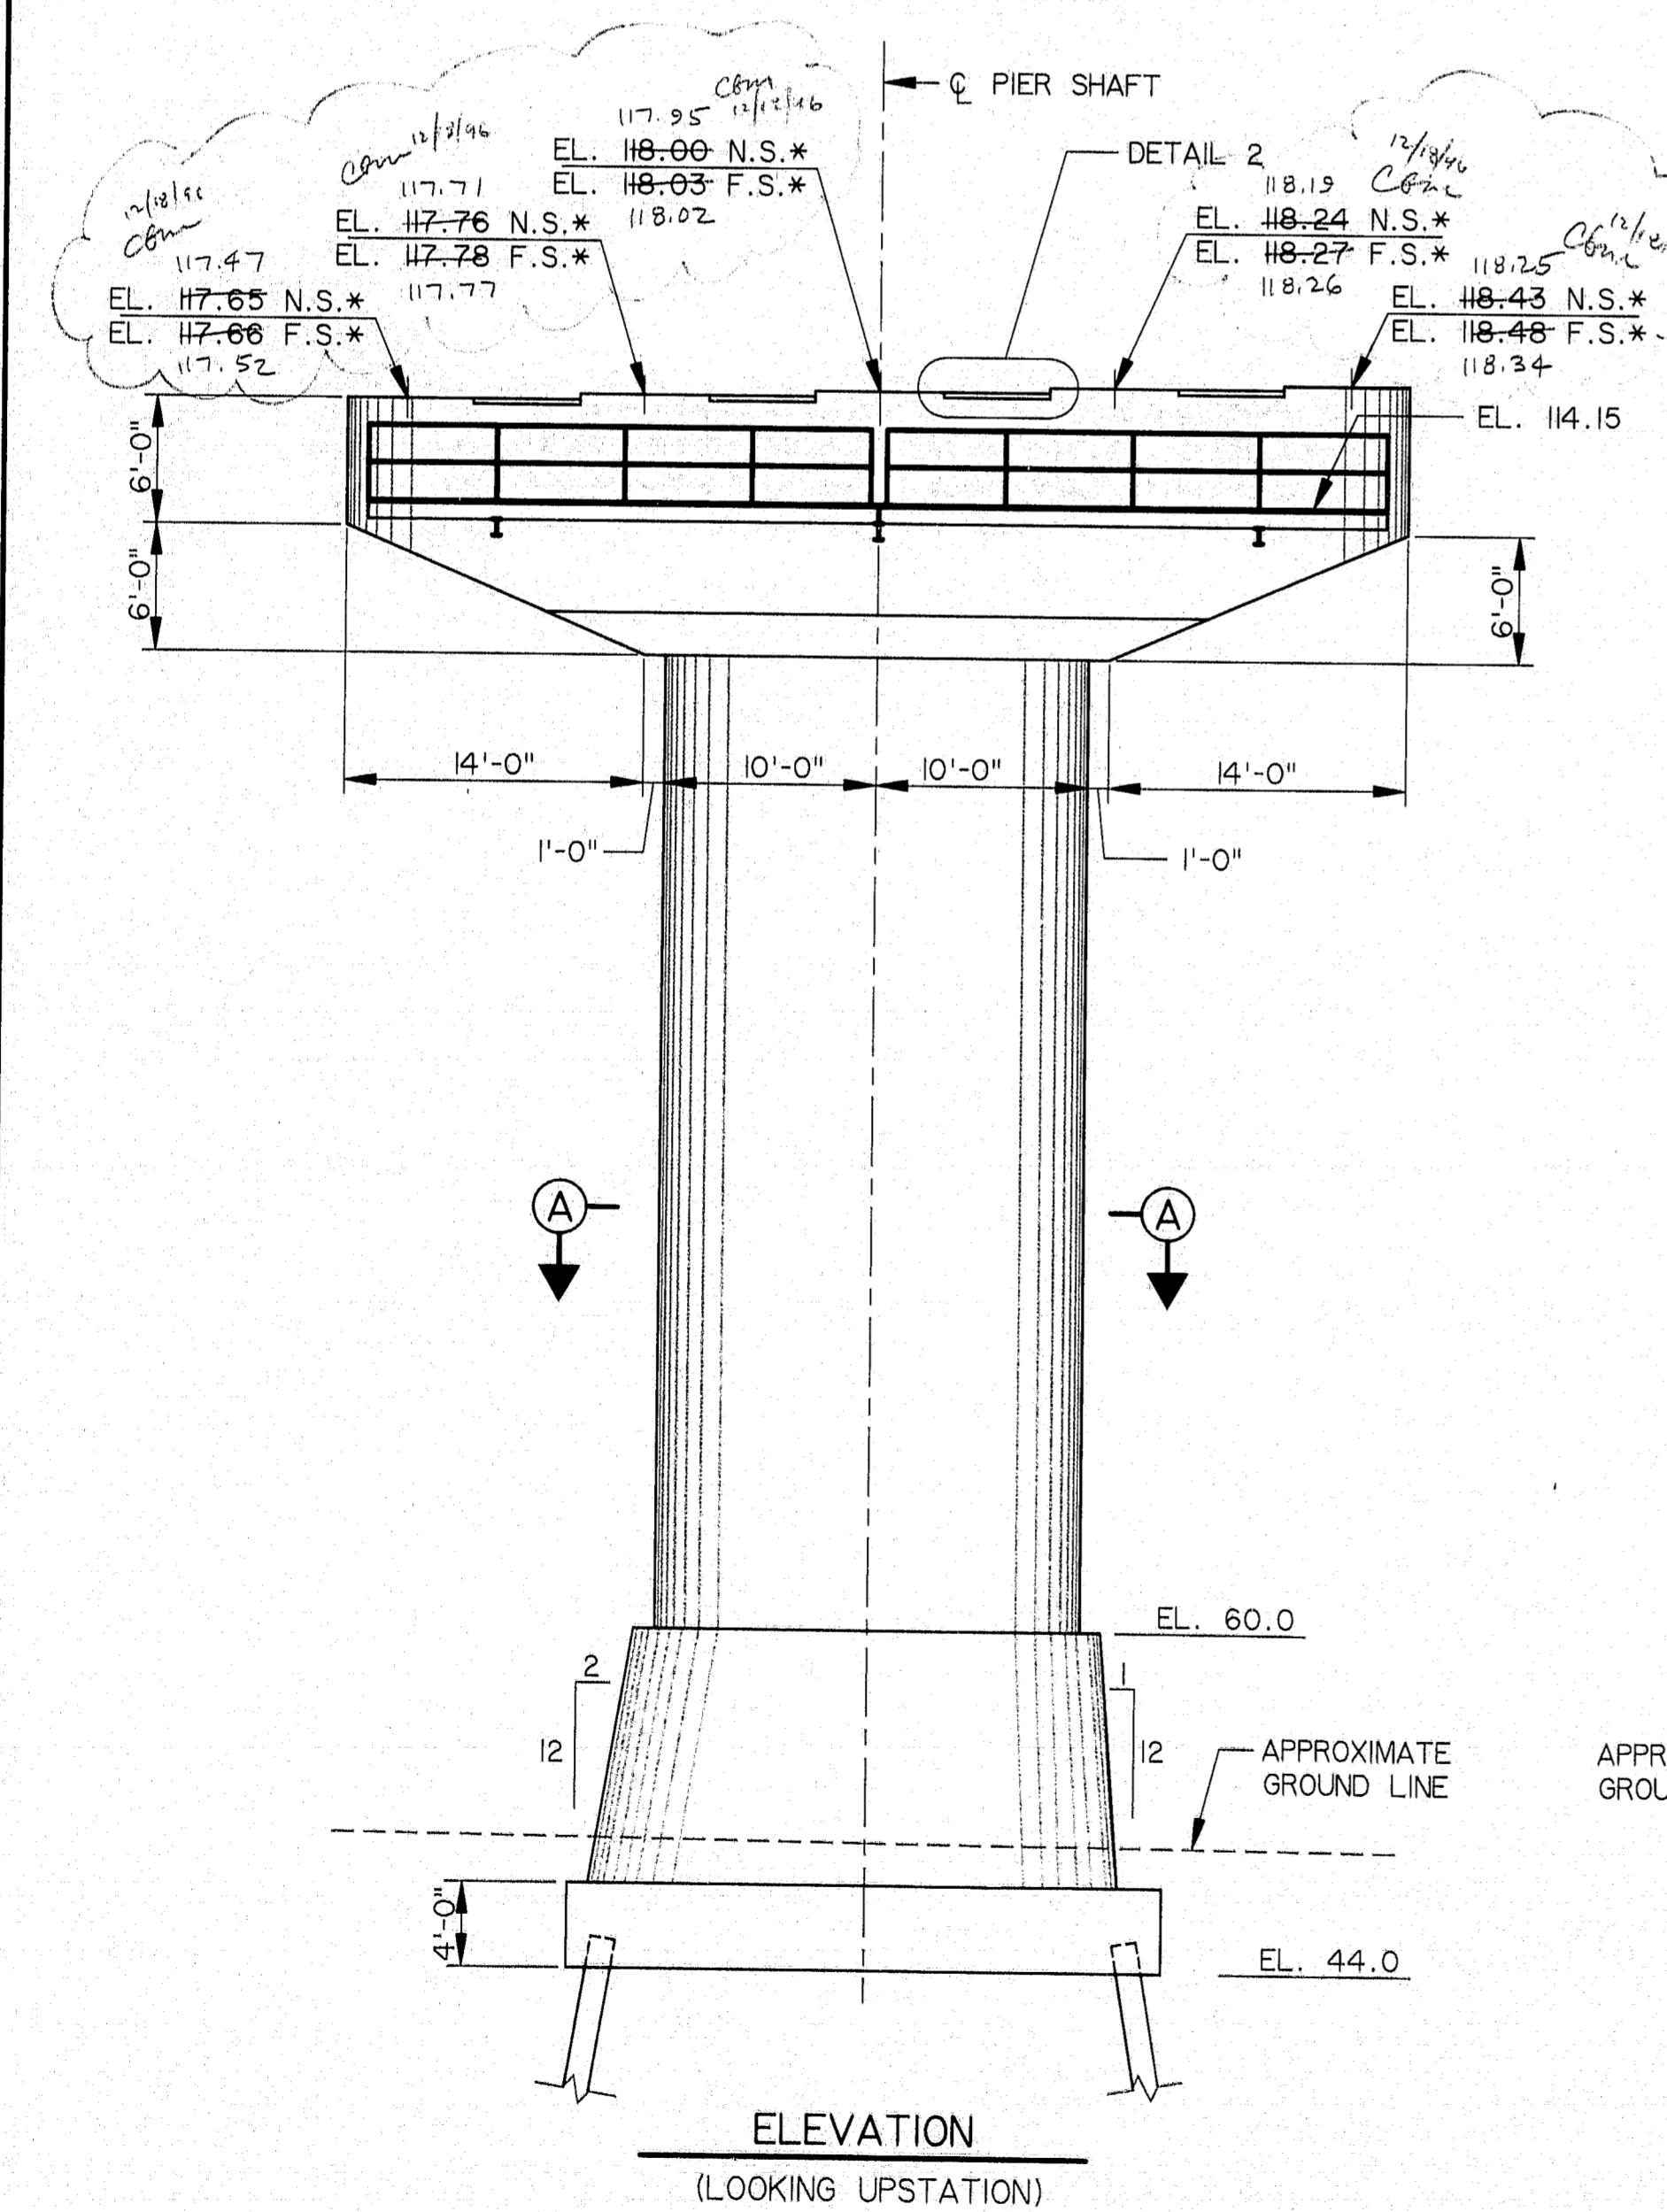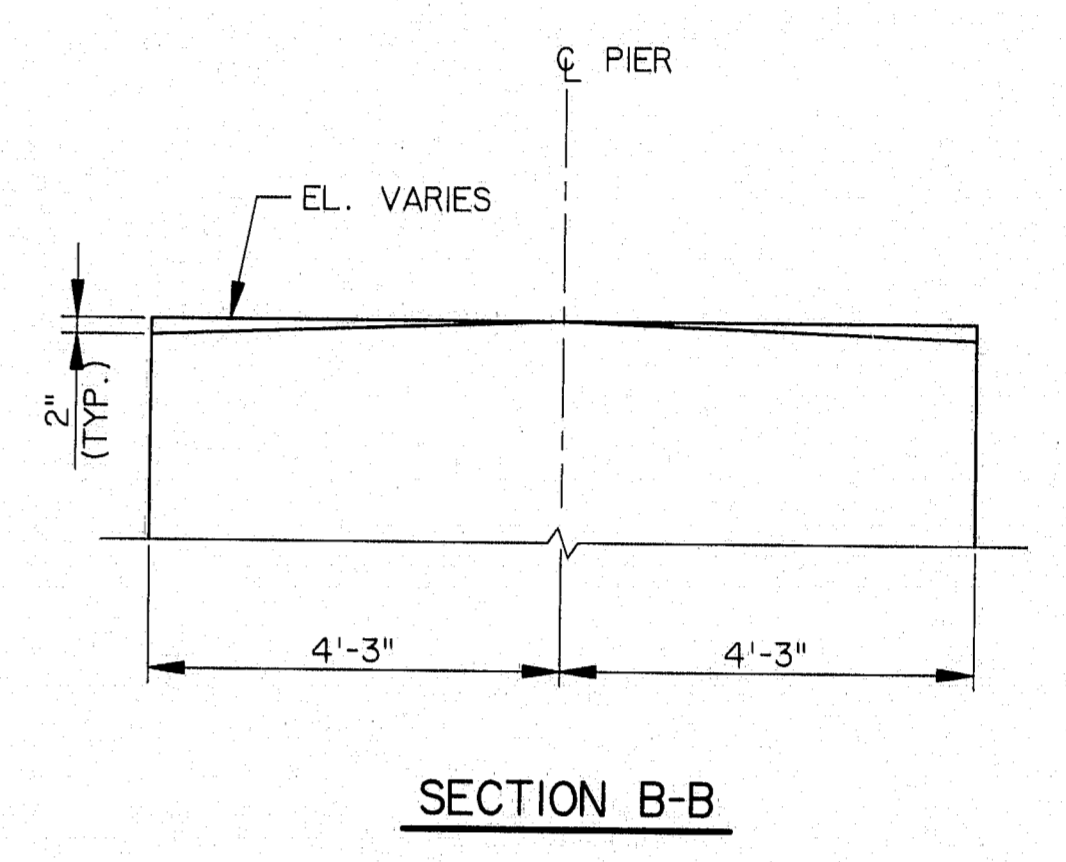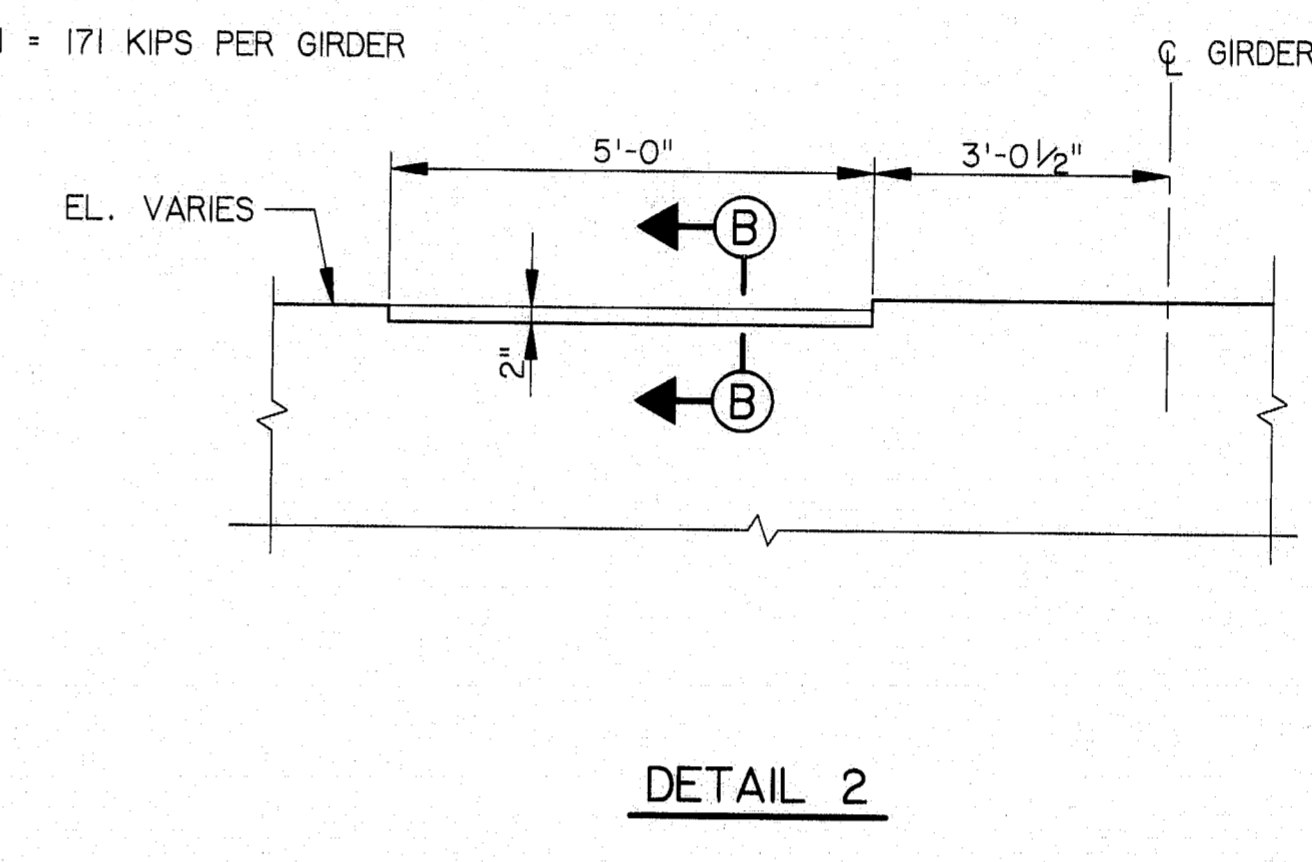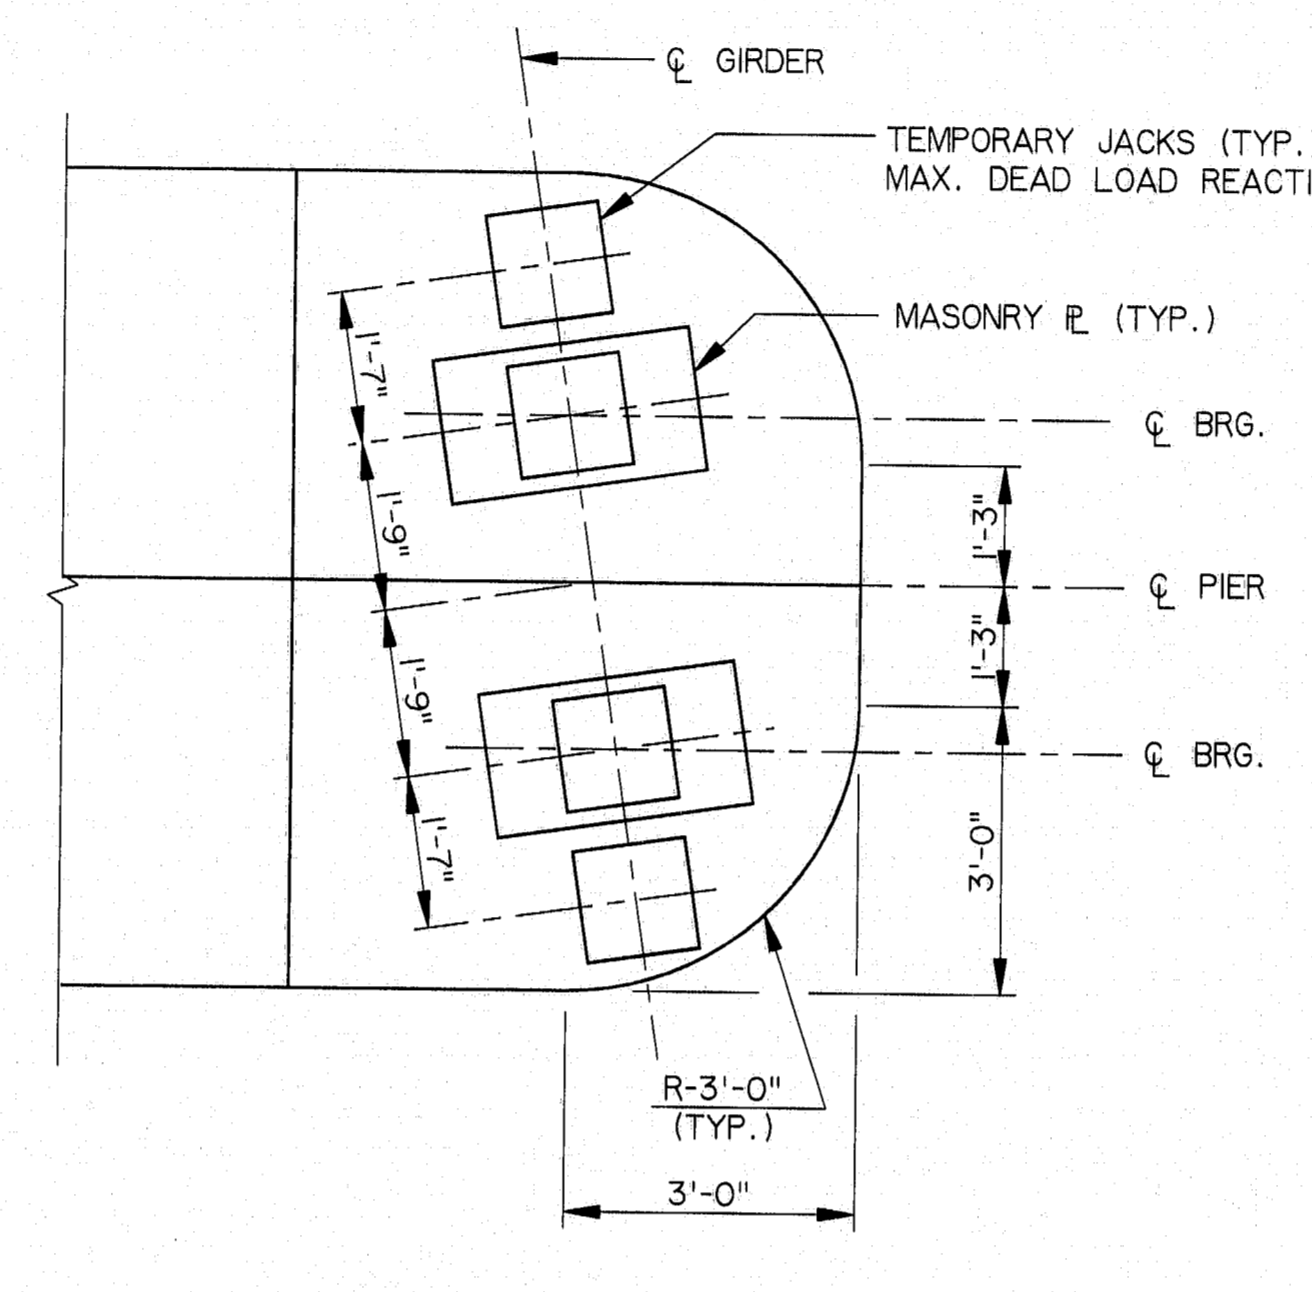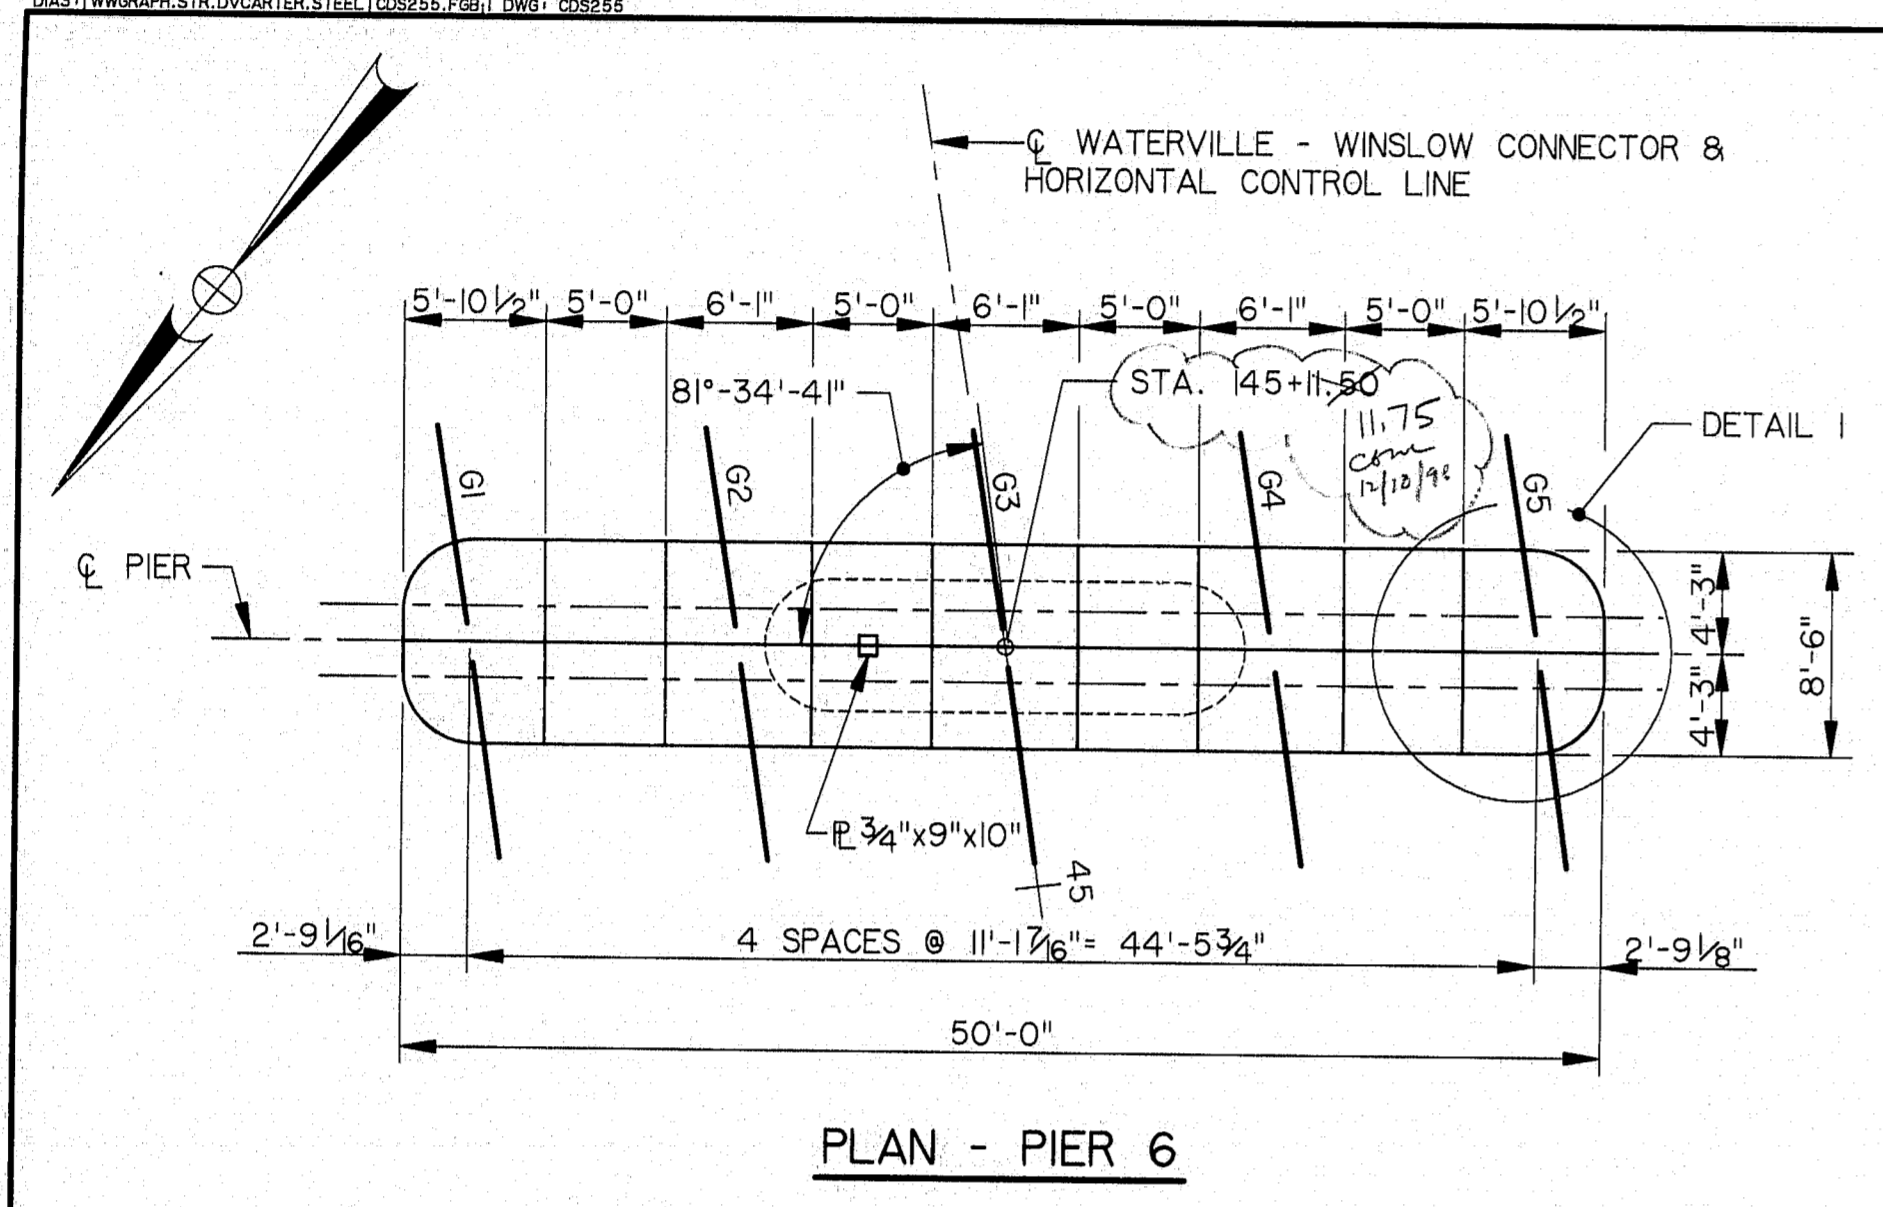

NO.	REVISION	BY	DATE	IN CHARGE OF
		BY	DATE	
		DESIGNED: SM	9/94	
		DRAWN: RJT	9/94	
		CHECKED: DWR	9/94	
				CJM

\* SEE NOTE 7, SHEET B30.

- NOTES:**
1. MAXIMUM CALCULATED PILE LOAD = 111 TONS (GROUP: 1).
  2. SEE SHEET B30 FOR ADDITIONAL NOTES.



**115-235**  
STEEL ALTERNATIVE


STATE OF MAINE  
DEPARTMENT OF TRANSPORTATION

WATERVILLE - WINSLOW PROJECT  
DONALD V. CARTER BRIDGE  
OVER  
KENNEBEC RIVER


**PIER 6 DETAILS**

SHEET B40 OF B86 AUGUSTA, MAINE


F.N.A.A. REG. NO.	STATE	PROJECT NUMBER	SHEET NO.	TOTAL SHEETS
1	MAINE	00091002	50	103

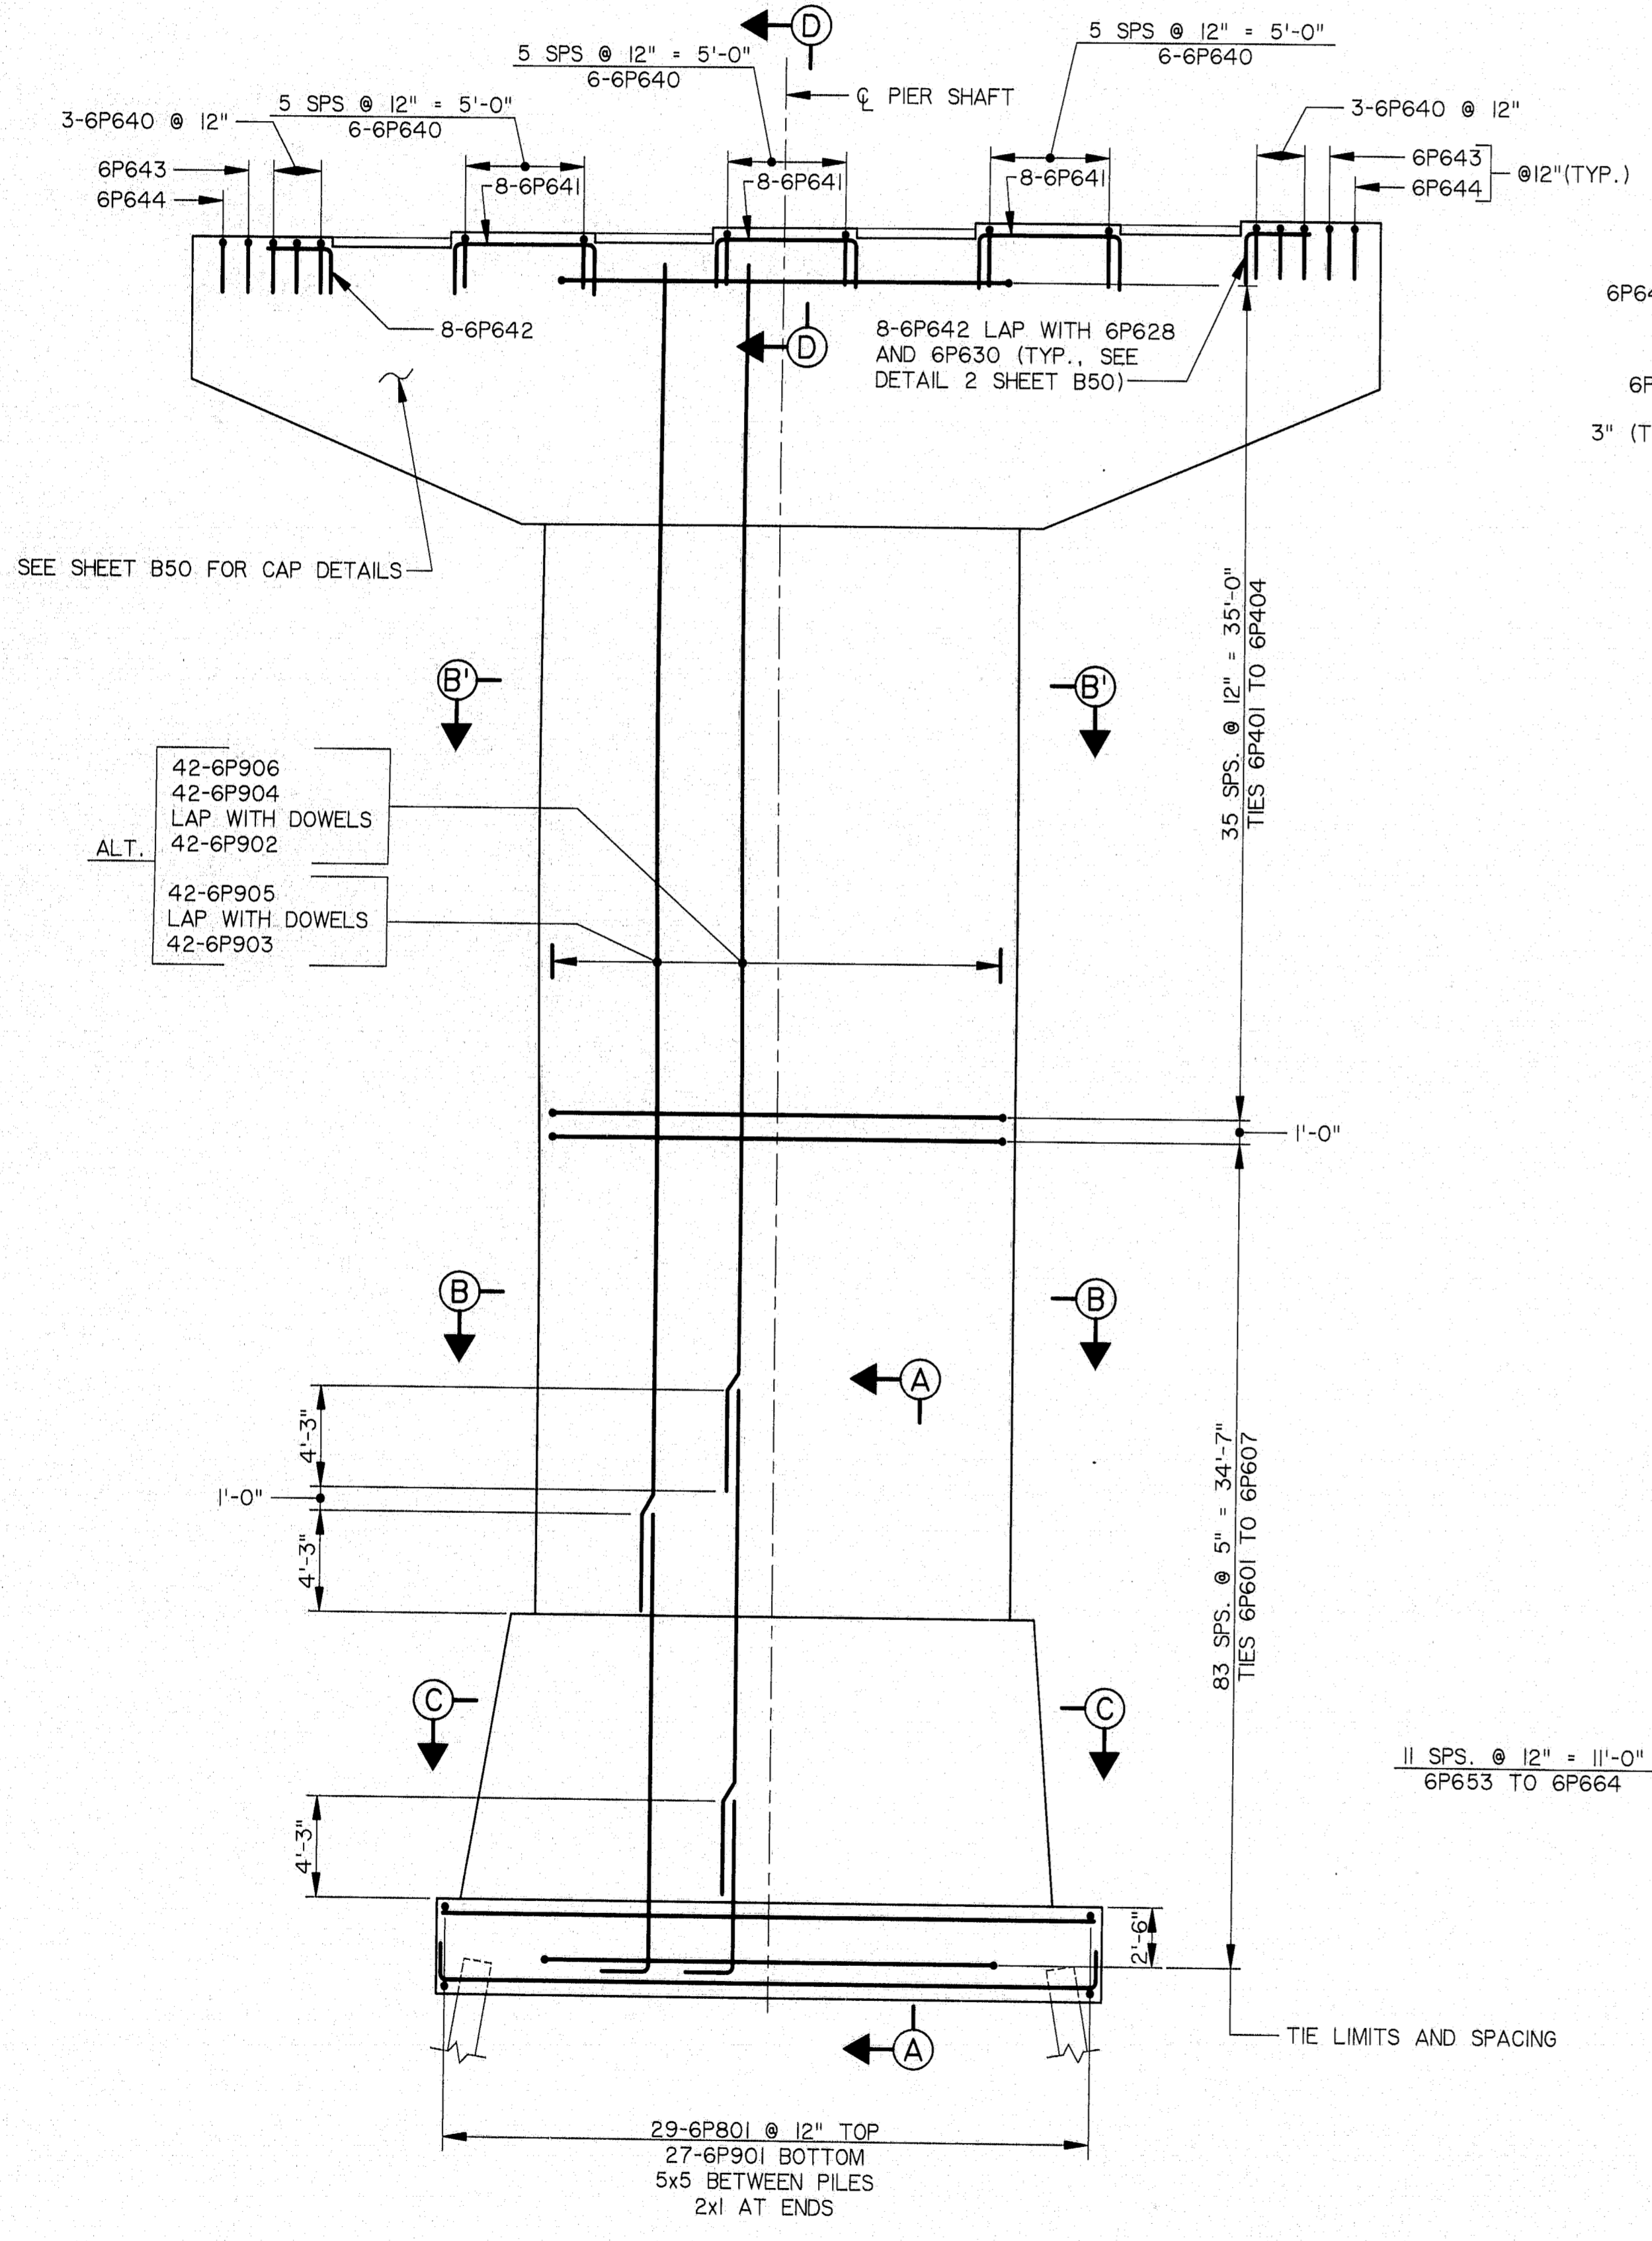


ELEVATION - PIER 6

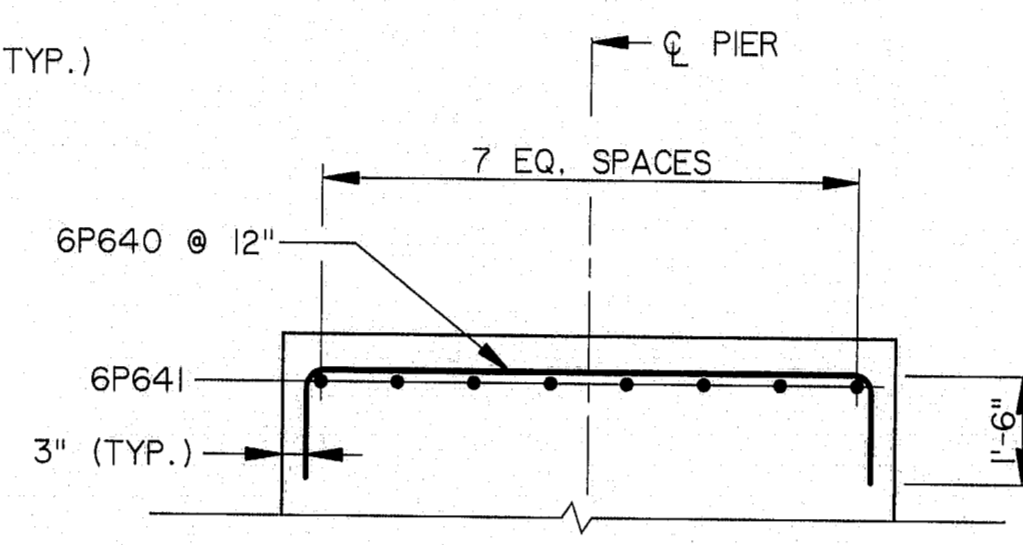

SECTION D-D

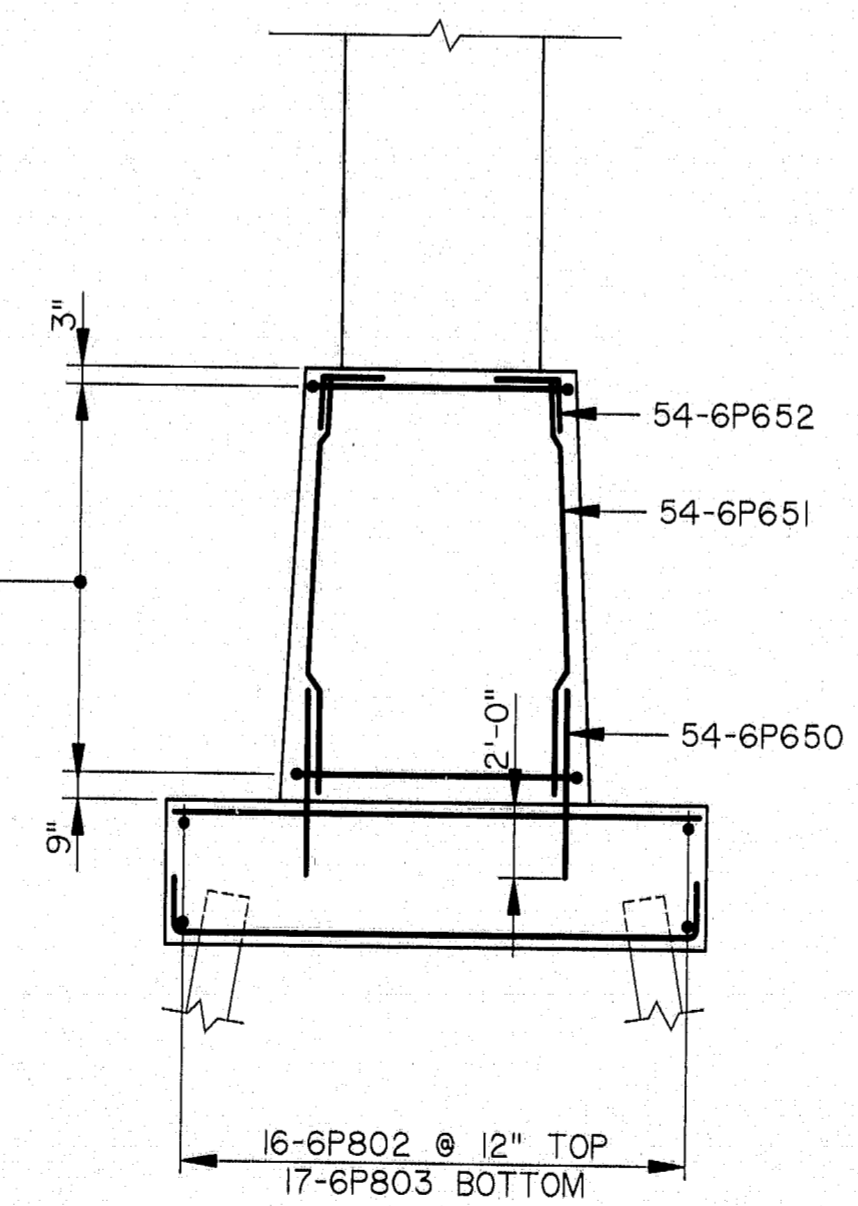


SECTION A-A

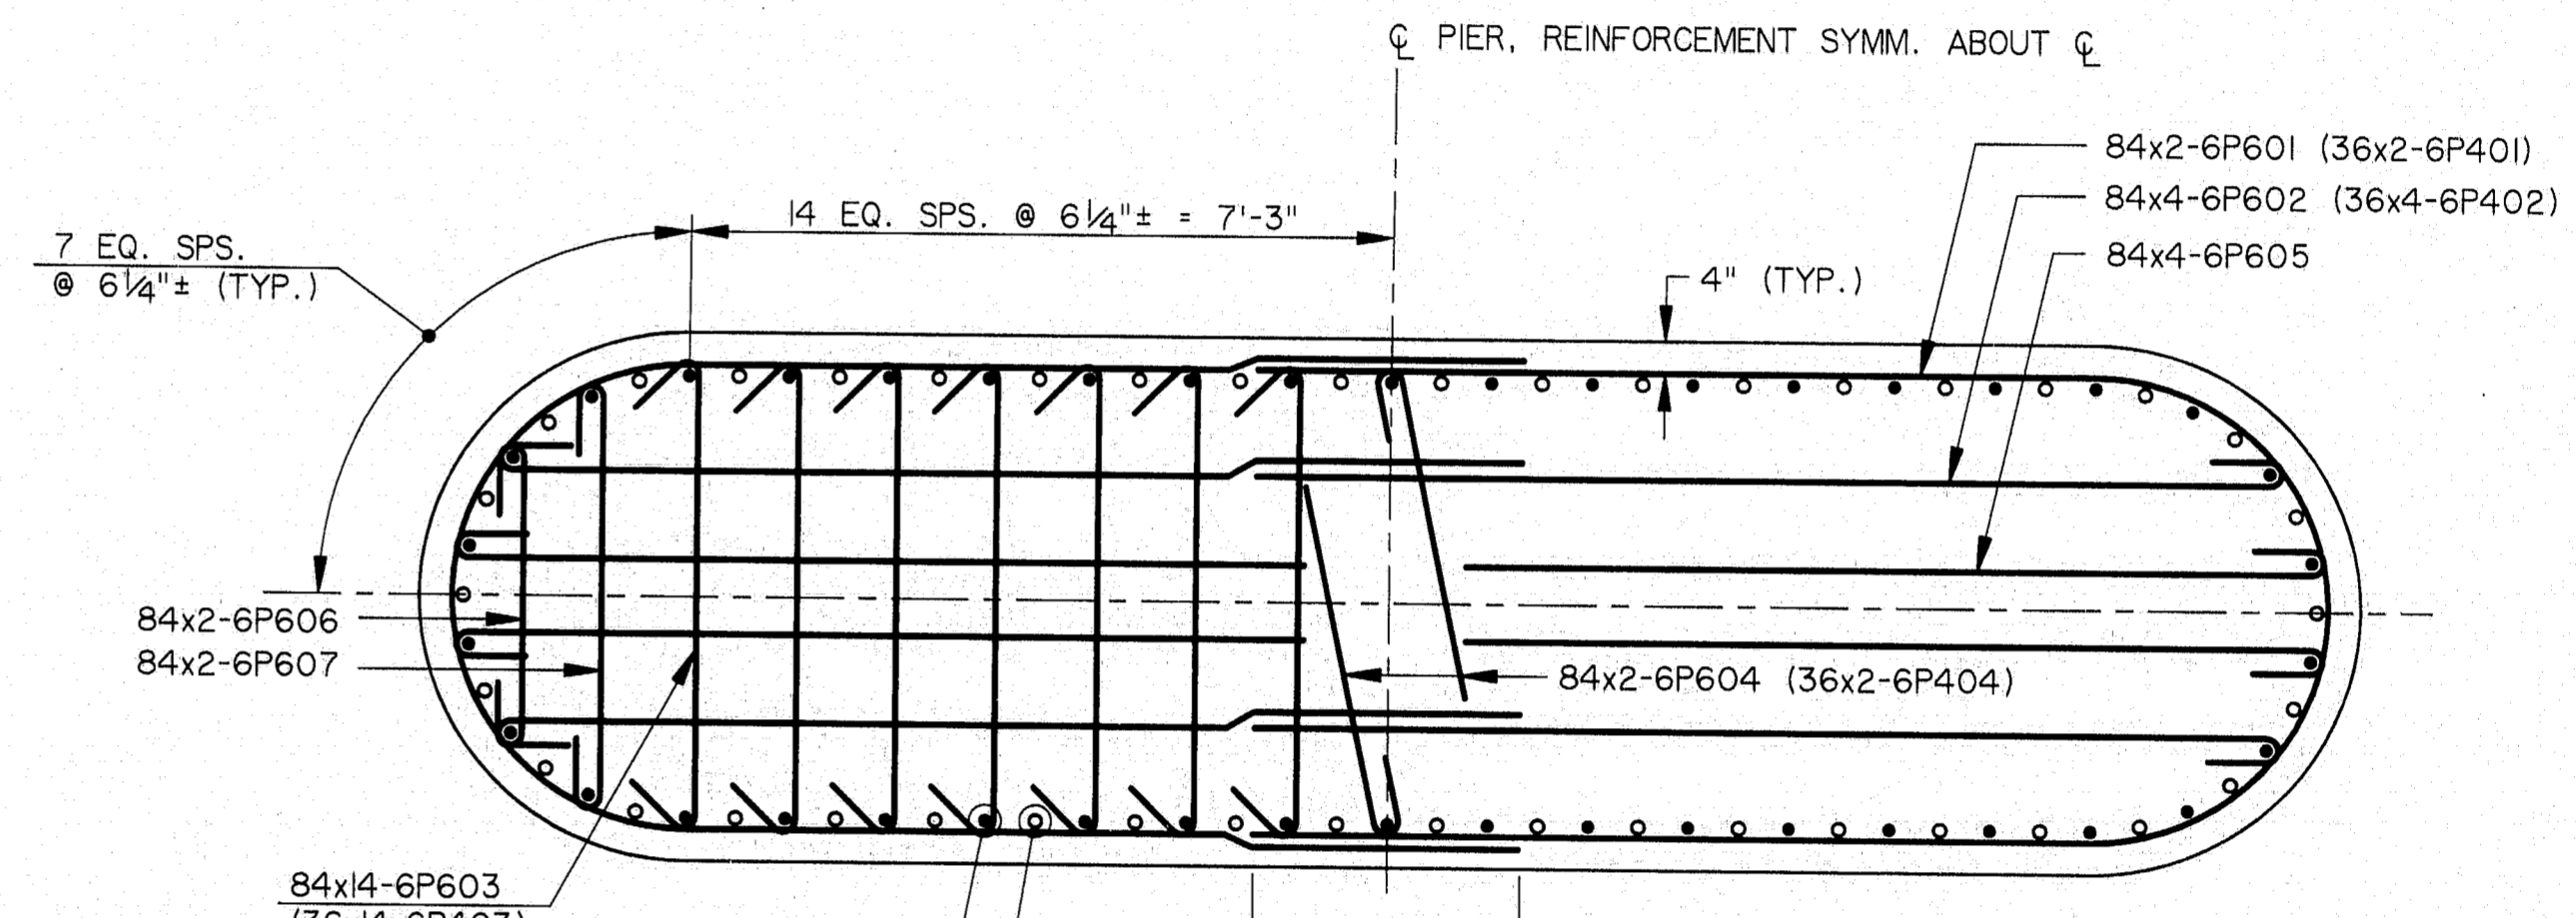

SECTION B-B (SECTION B'-B')

- NOTES
- #6 TIES - 135° MIN. HOOK WITH 7 1/2" EXT. #4 TIES - STD. HOOKS.
  - SECTION B-B SHOWN WITH 6P6## TIES. SECTION B'-B' SIMILAR EXCEPT FOR 6P4## TIES AS NOTED IN PARENTHESIS.

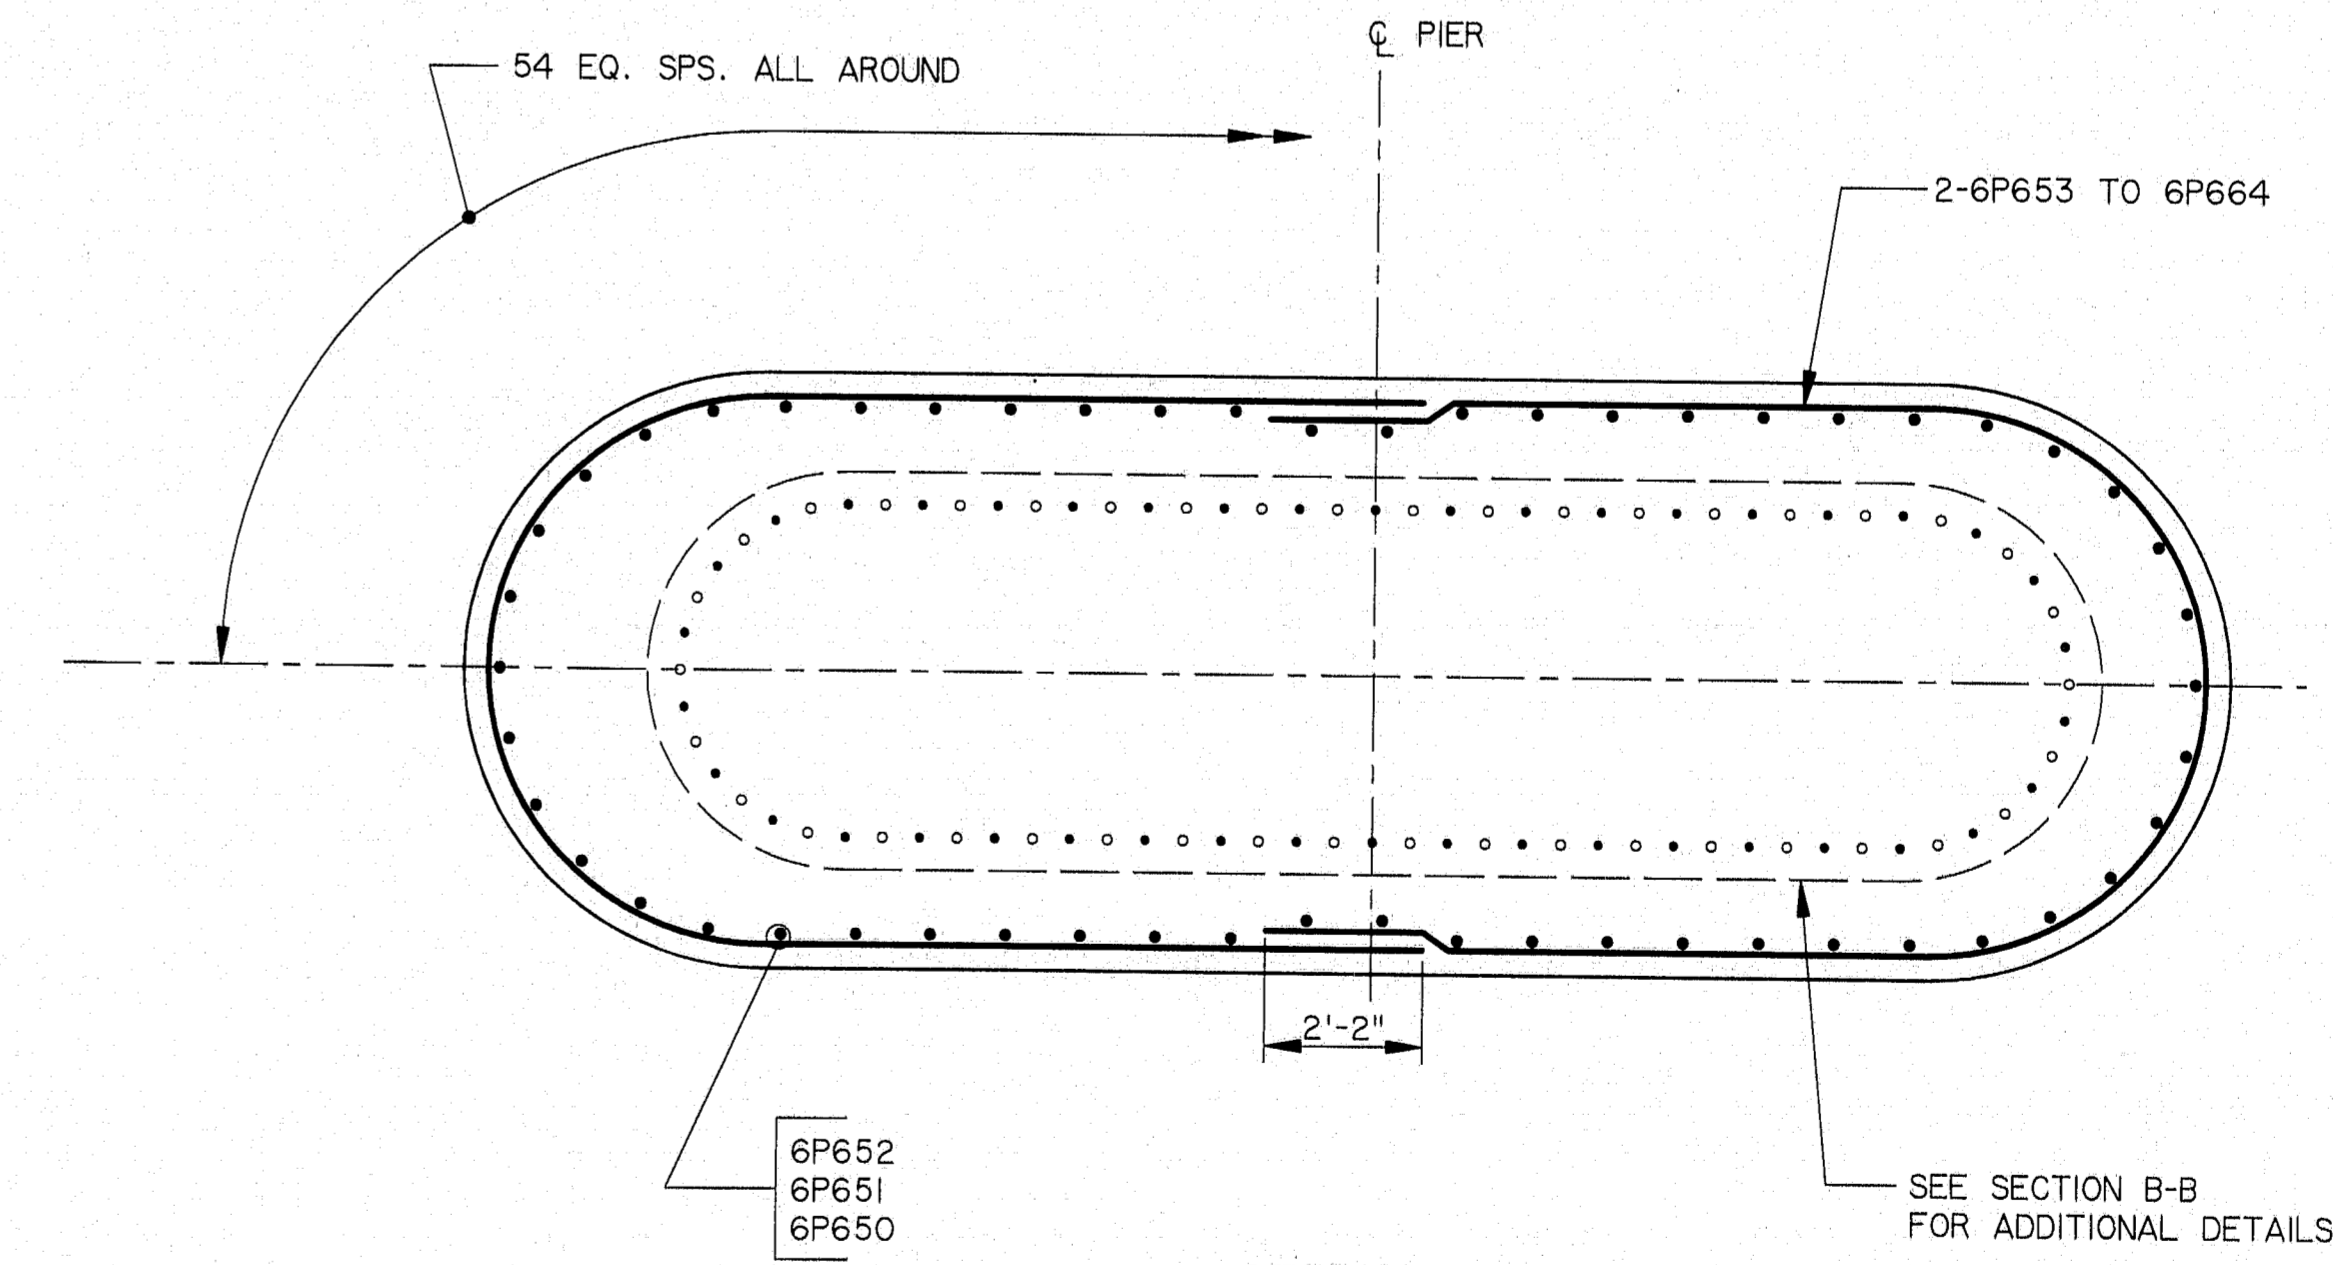

SECTION C-C


115-236

STEEL ALTERNATIVE
STATE OF MAINE DEPARTMENT OF TRANSPORTATION
WATERVILLE - WINSLOW PROJECT DONALD V. CARTER BRIDGE OVER KENNEBEC RIVER
PIER 6 RE-STEEL
SHEET B41 OF B86 AUGUSTA, MAINE




NO.	REVISION	BY	DATE	IN CHARGE OF	CJM
		DESIGNED:	SM	9/94	
		DRAWN:	RJT	9/94	
		CHECKED:	DWR	9/94	
		BY			


F.R.A. REG. NO.	STATE	PROJECT NUMBER	SHEET NO.	TOTAL SHEETS
1	MAINE	0009 (002)	51	103

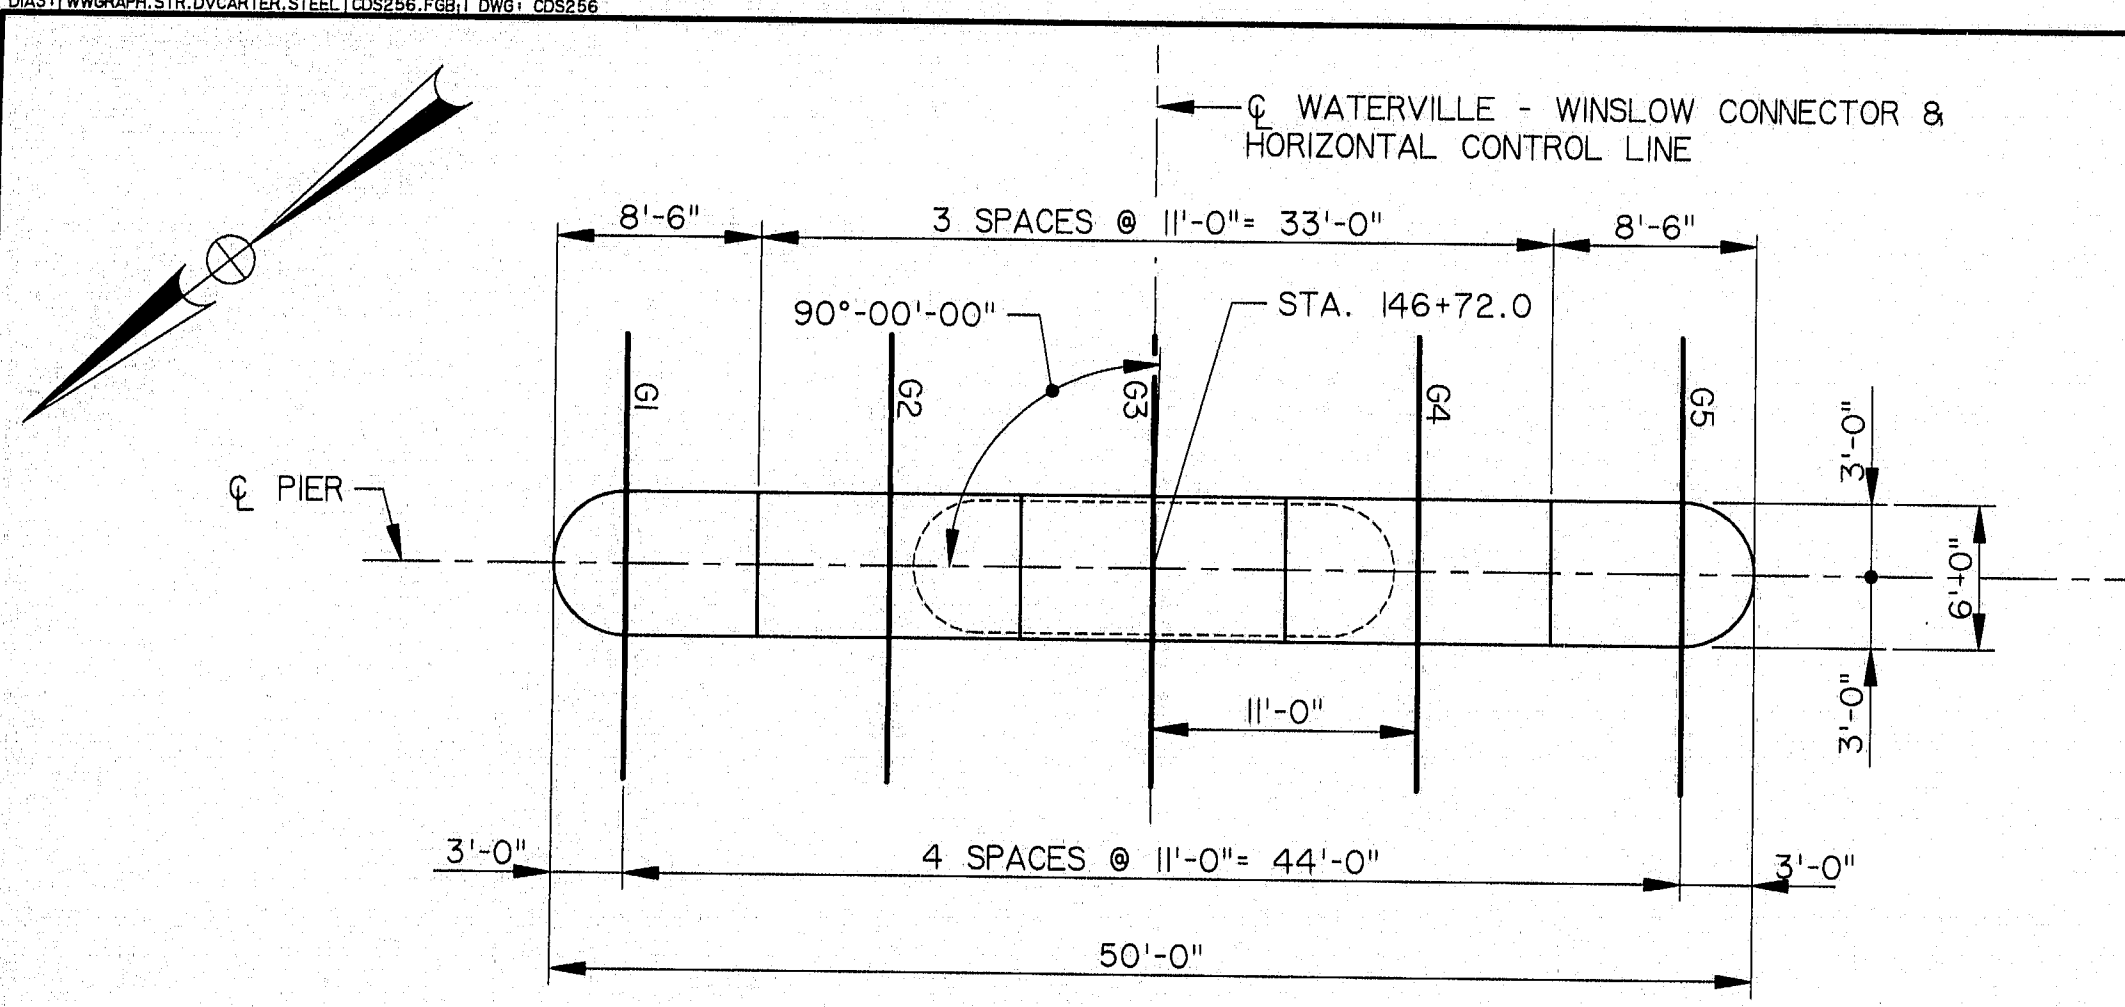


PLAN - PIER 7

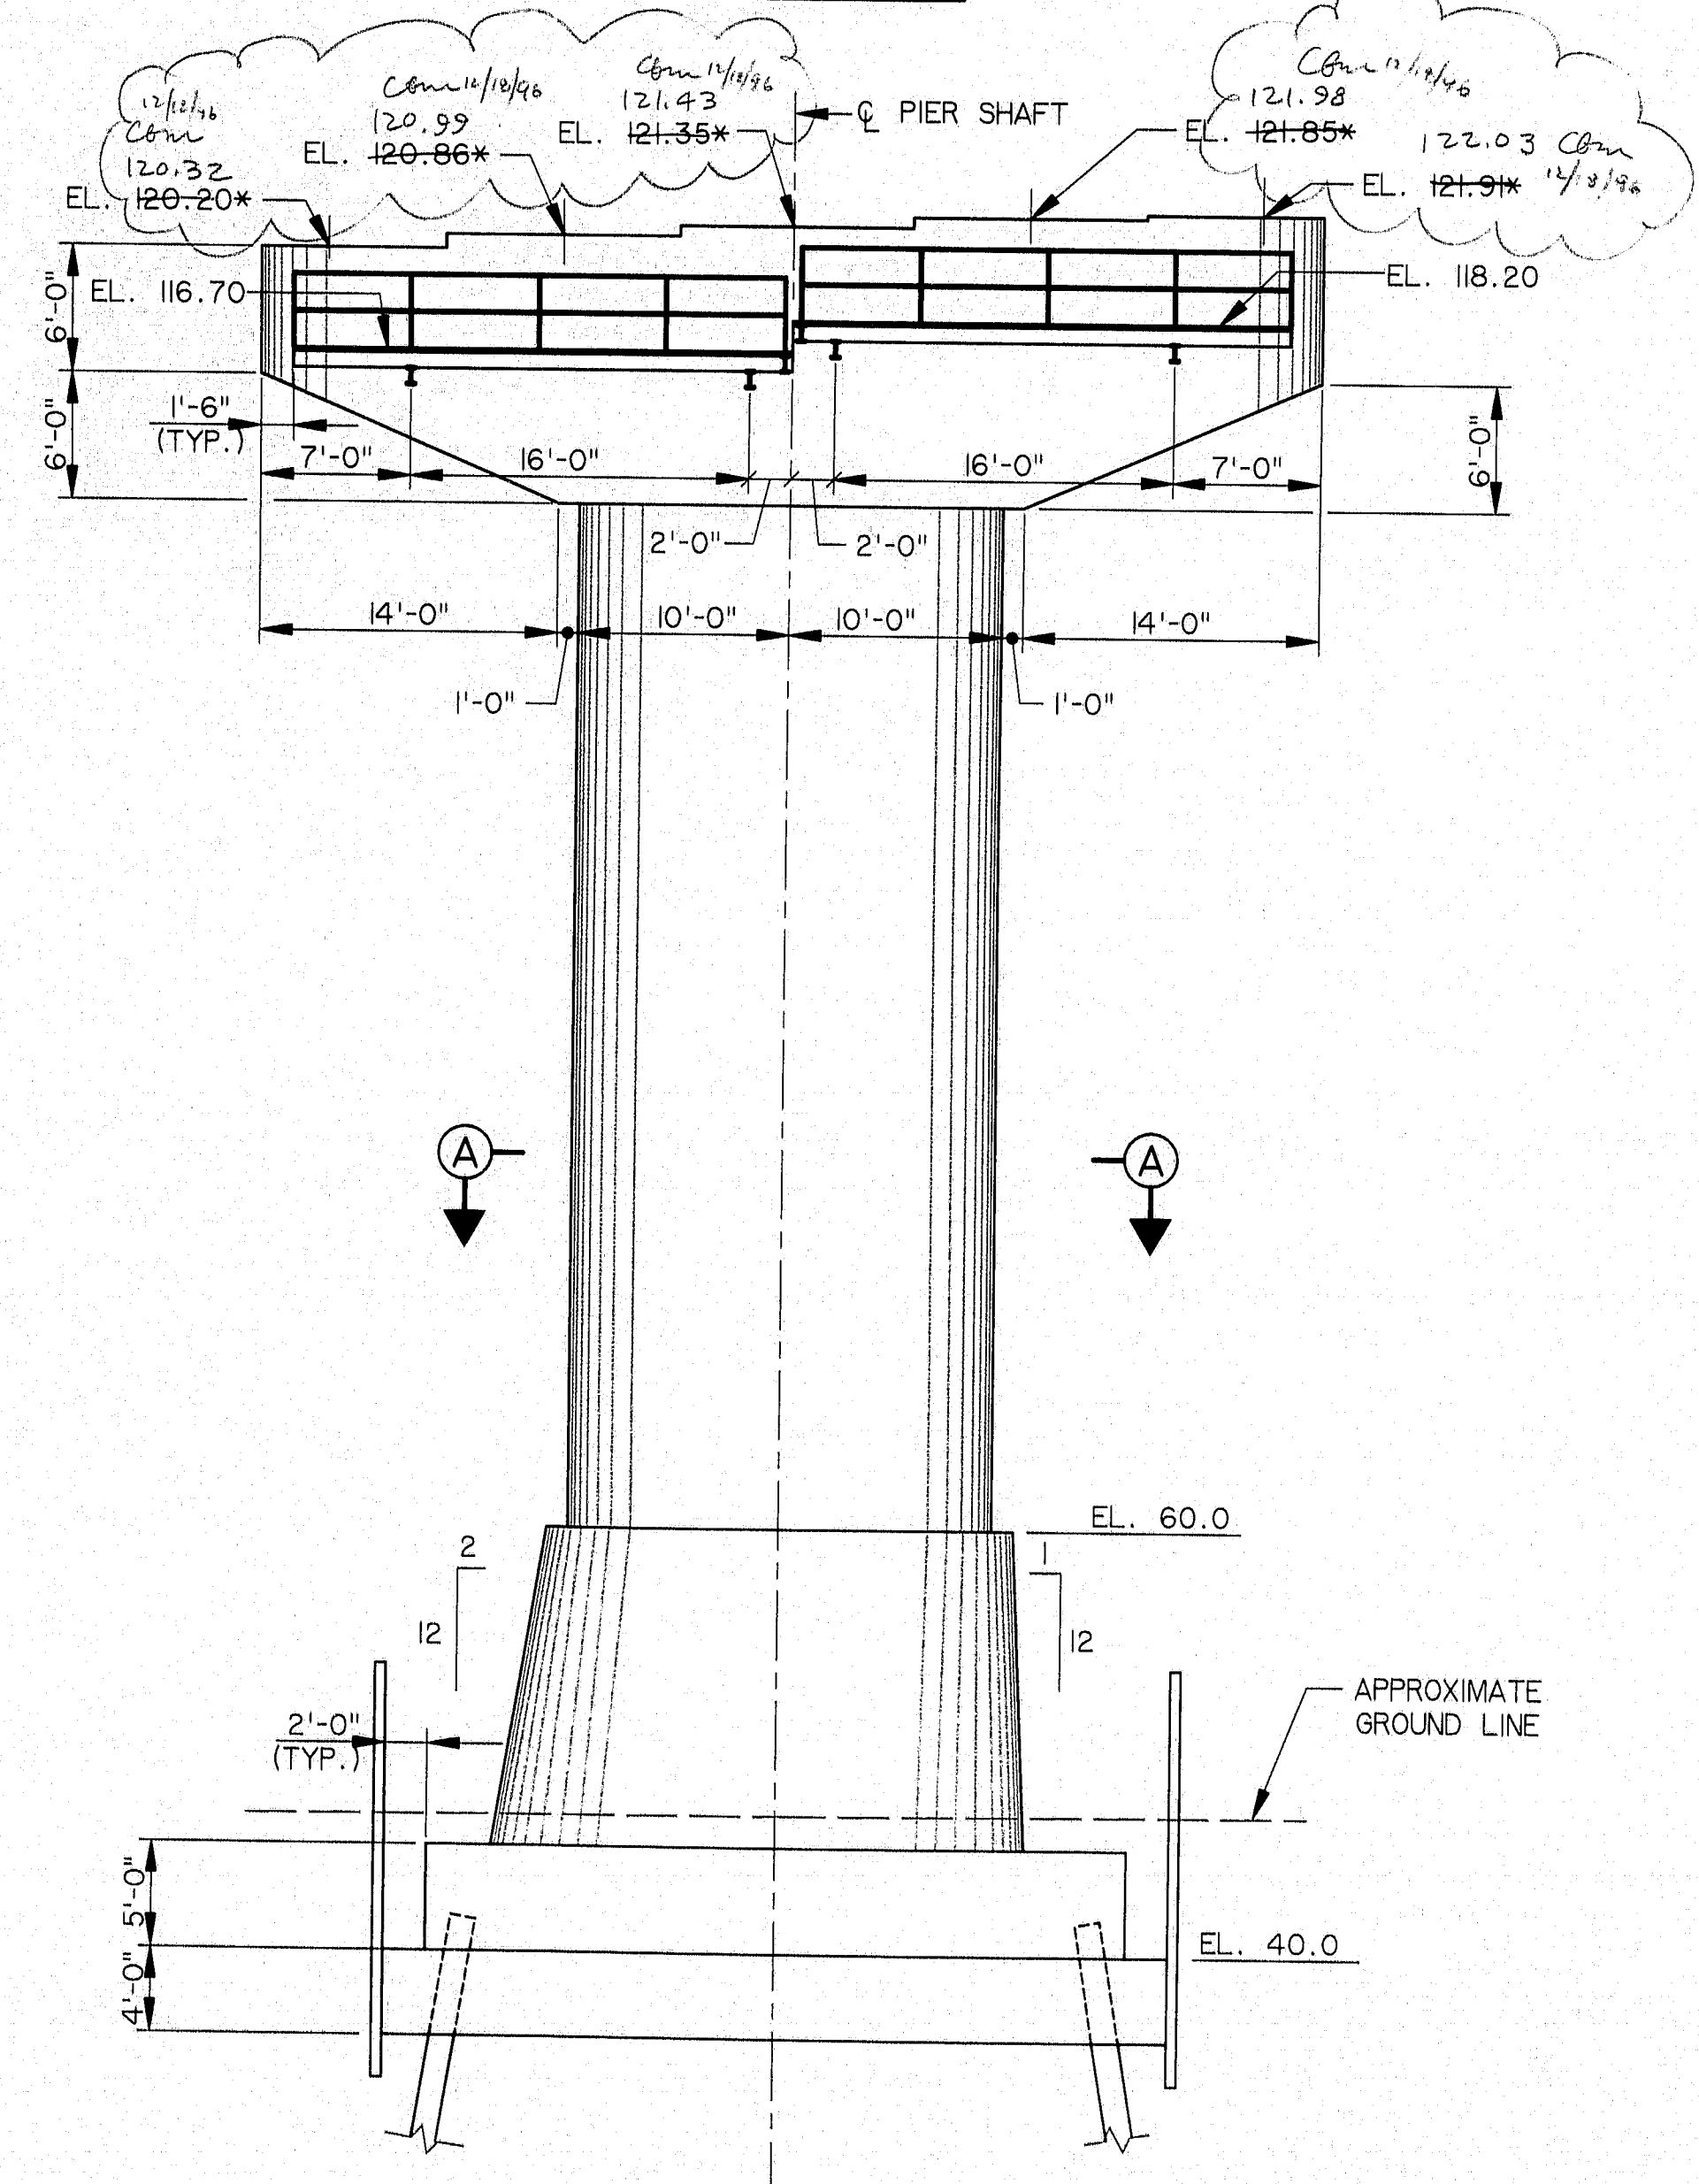

ELEVATION  
(LOOKING UPSTATION)

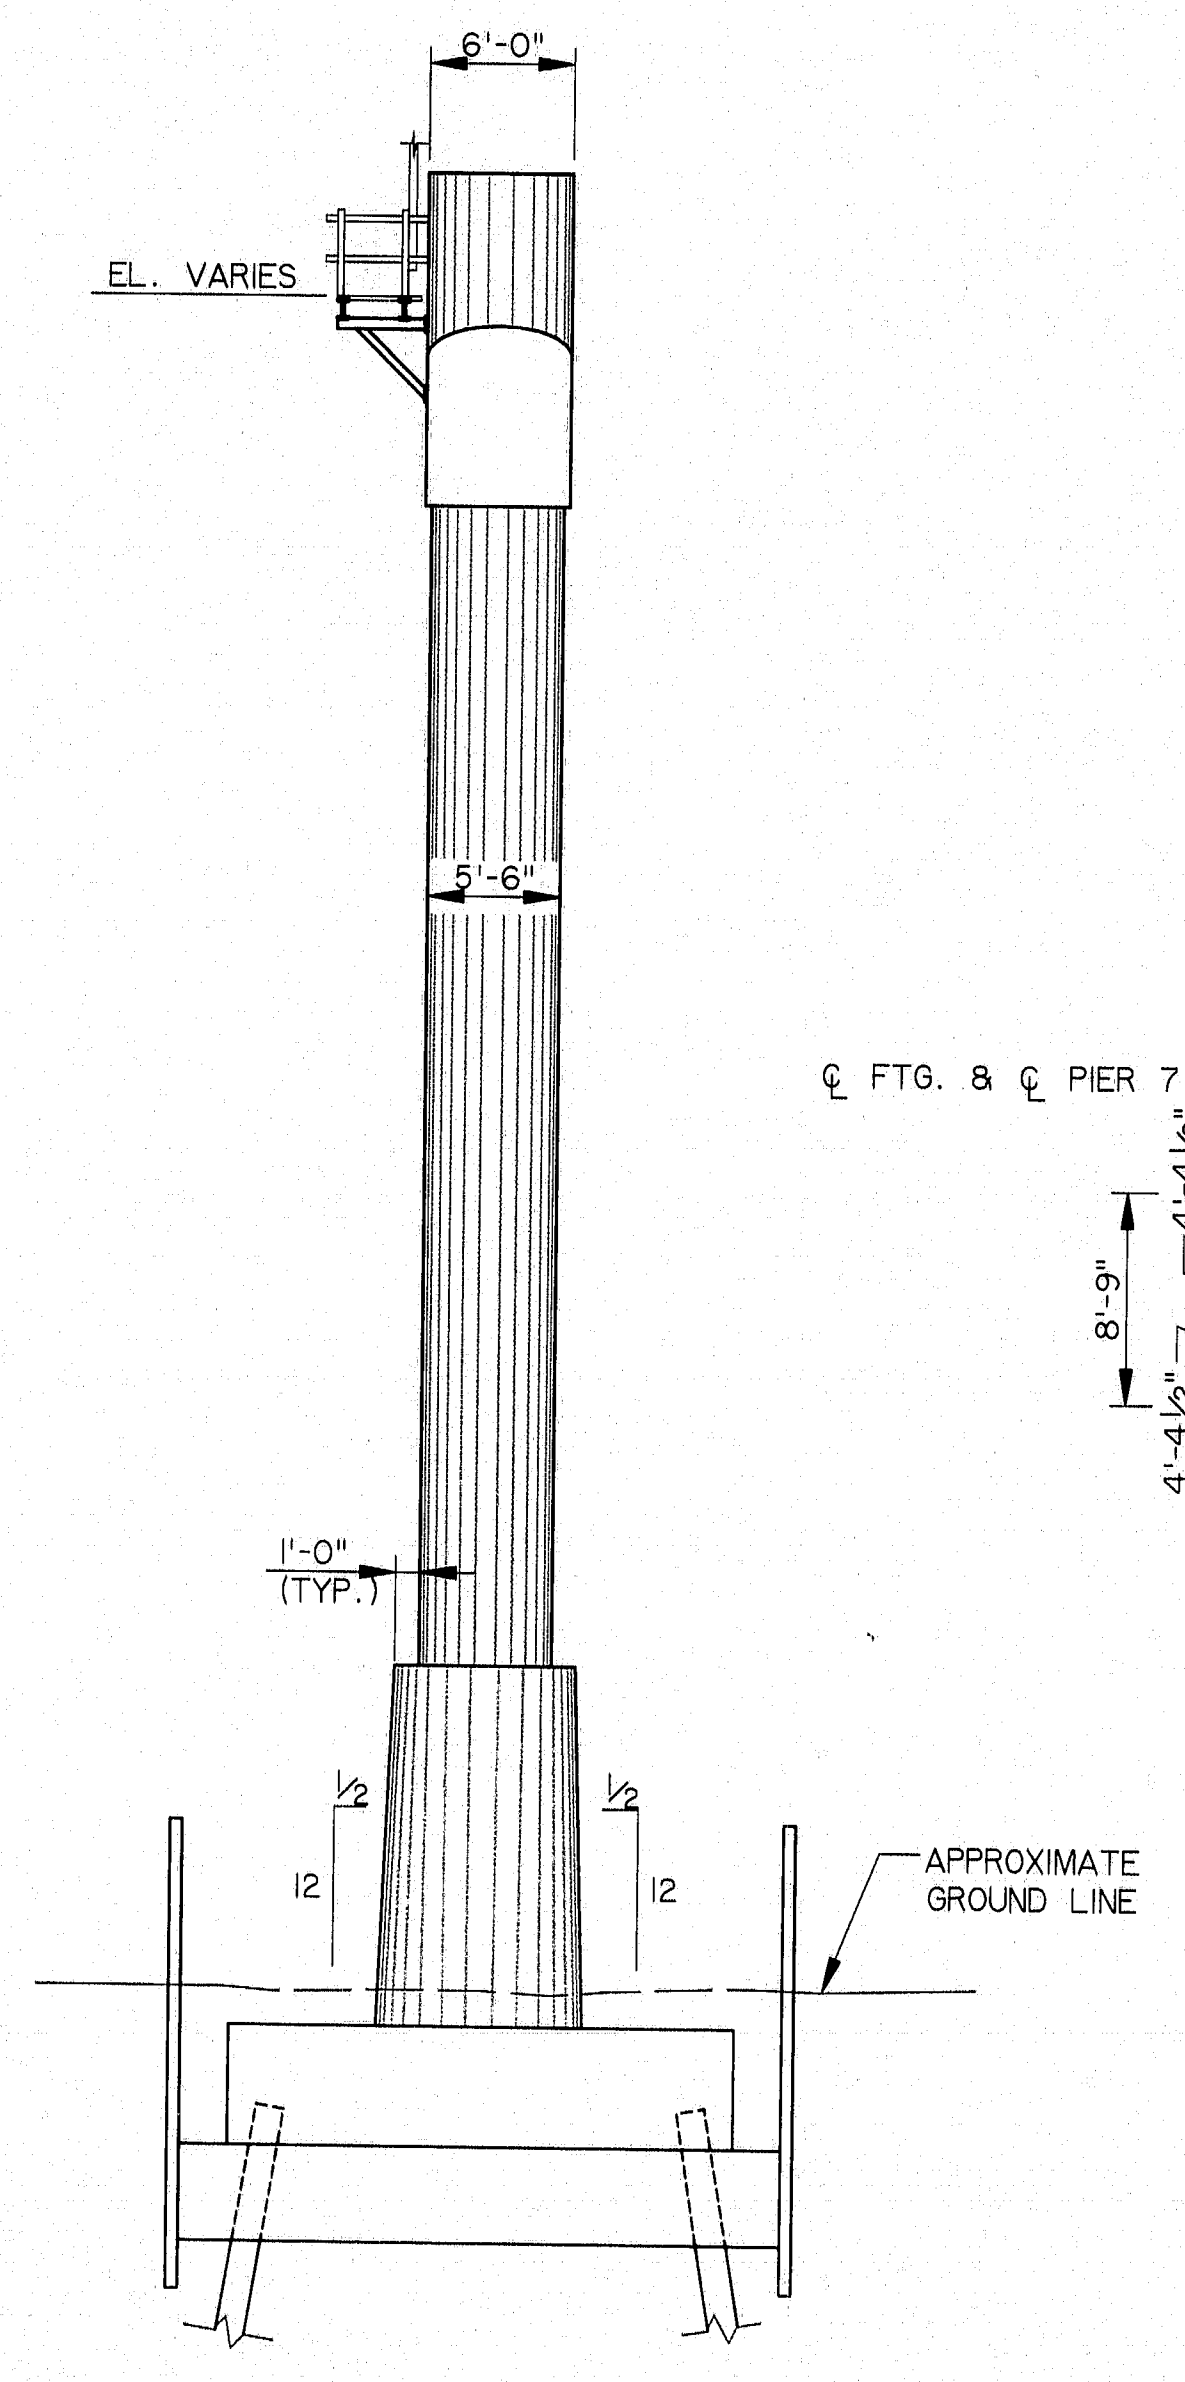

SIDE ELEVATION

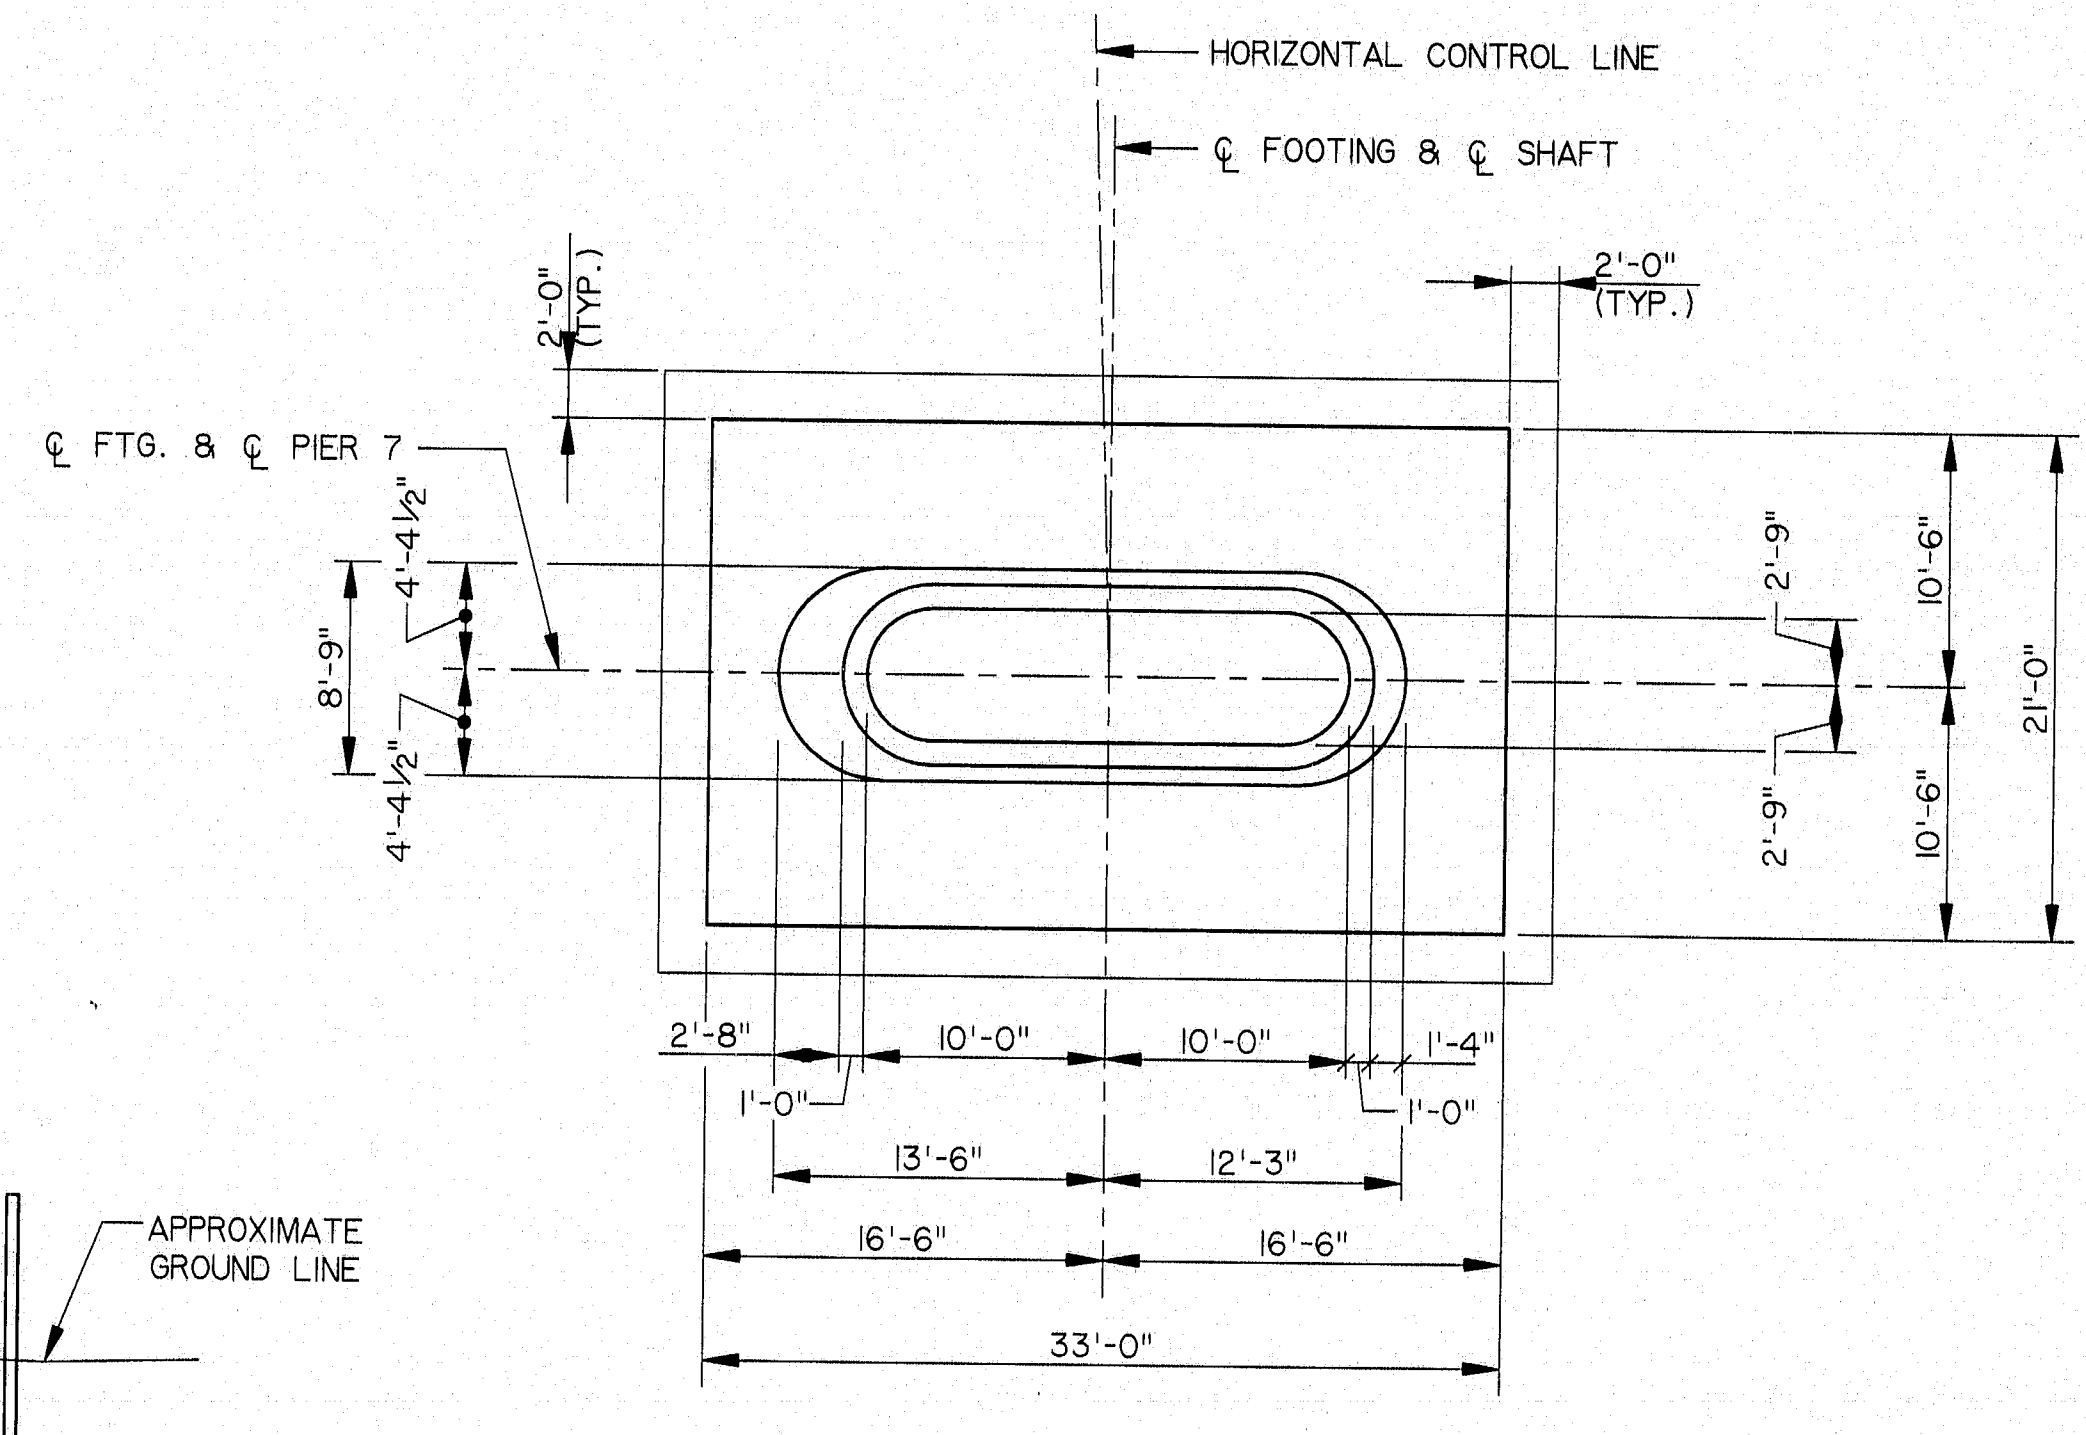


SECTION A-A

NOTES:

1. MAXIMUM CALCULATED PILE LOAD = 164 TONS (GROUP SEISMIC)\*.  
\* ULTIMATE CAPACITY OF PILE USED IN CONJUNCTION WITH SEISMIC LOADS.
2. SEE SHEET B30 FOR ADDITIONAL NOTES.

NO.	REVISION	BY	DATE	IN CHARGE OF	CJM
		DESIGNED:	SM	9/94	
		DRAWN:	RJT	9/94	
		CHECKED:	DWR	9/94	

\* SEE NOTE 7, SHEET B30.

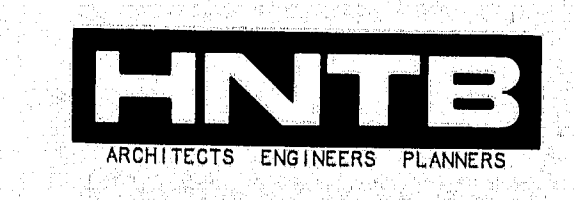

**115-237**  
STEEL ALTERNATIVE

STATE OF MAINE  
DEPARTMENT OF TRANSPORTATION






WATERVILLE - WINSLOW PROJECT  
DONALD V. CARTER BRIDGE  
OVER  
KENNEBEC RIVER

PIER 7 DETAILS

SHEET B42 OF B86 AUGUSTA, MAINE

10/11/94 11:58 AM 10/11/94 11:58 AM 10/11/94 11:58 AM

F.I.N.A. REG. NO.	STATE	PROJECT NUMBER	SHEET NO.	TOTAL SHEETS
1	MAINE	0009(002)	52	103

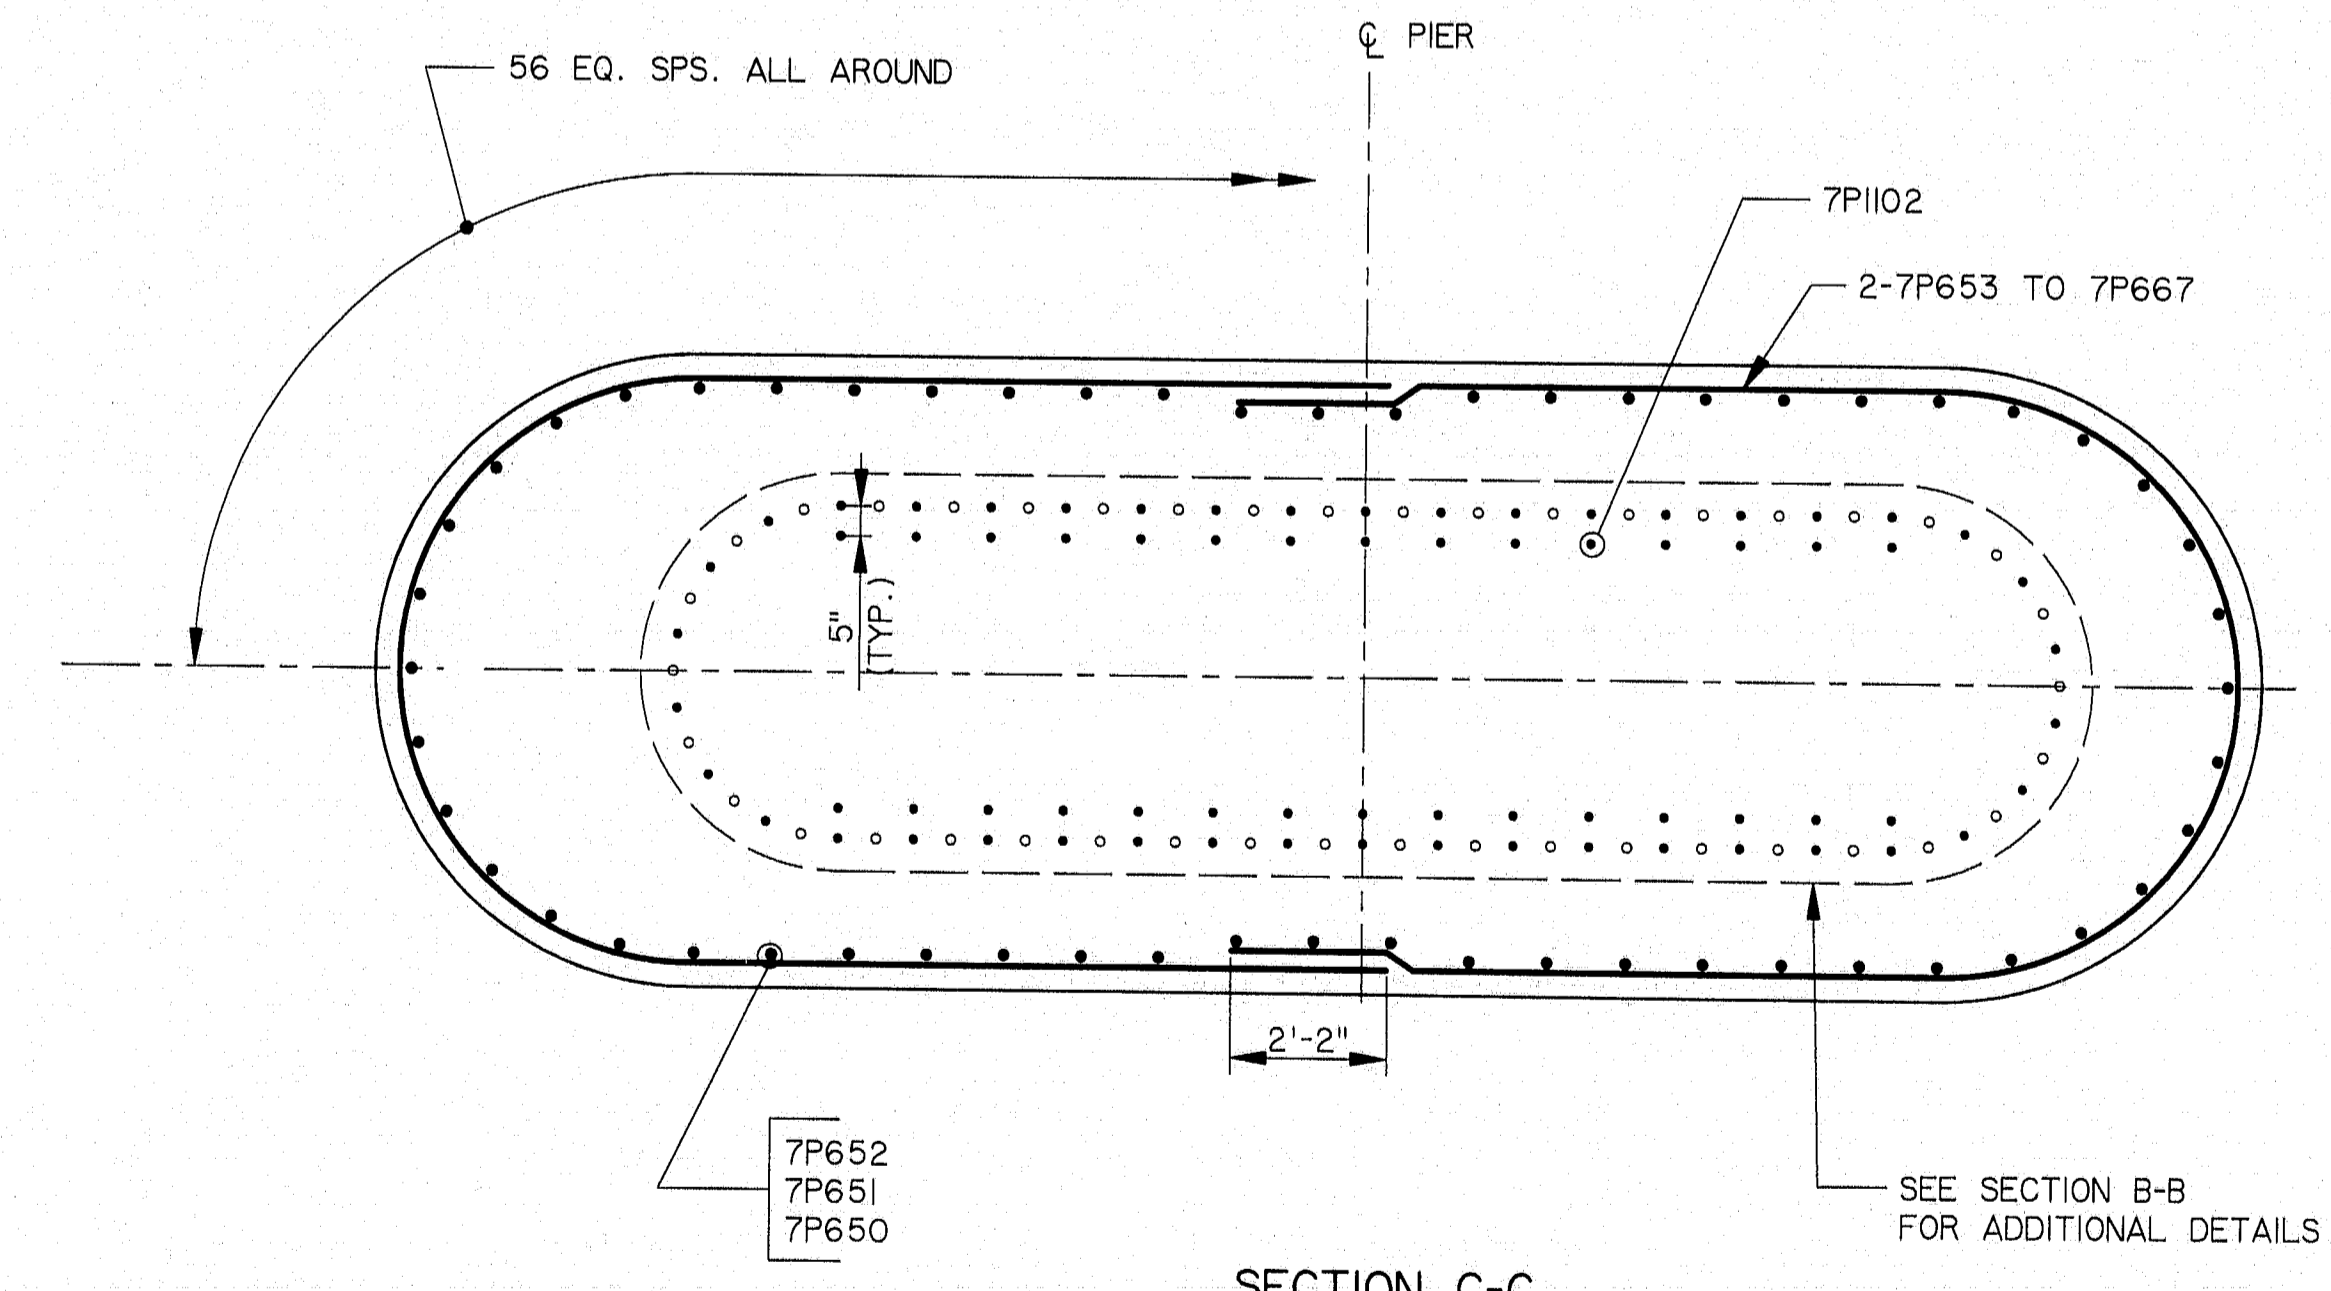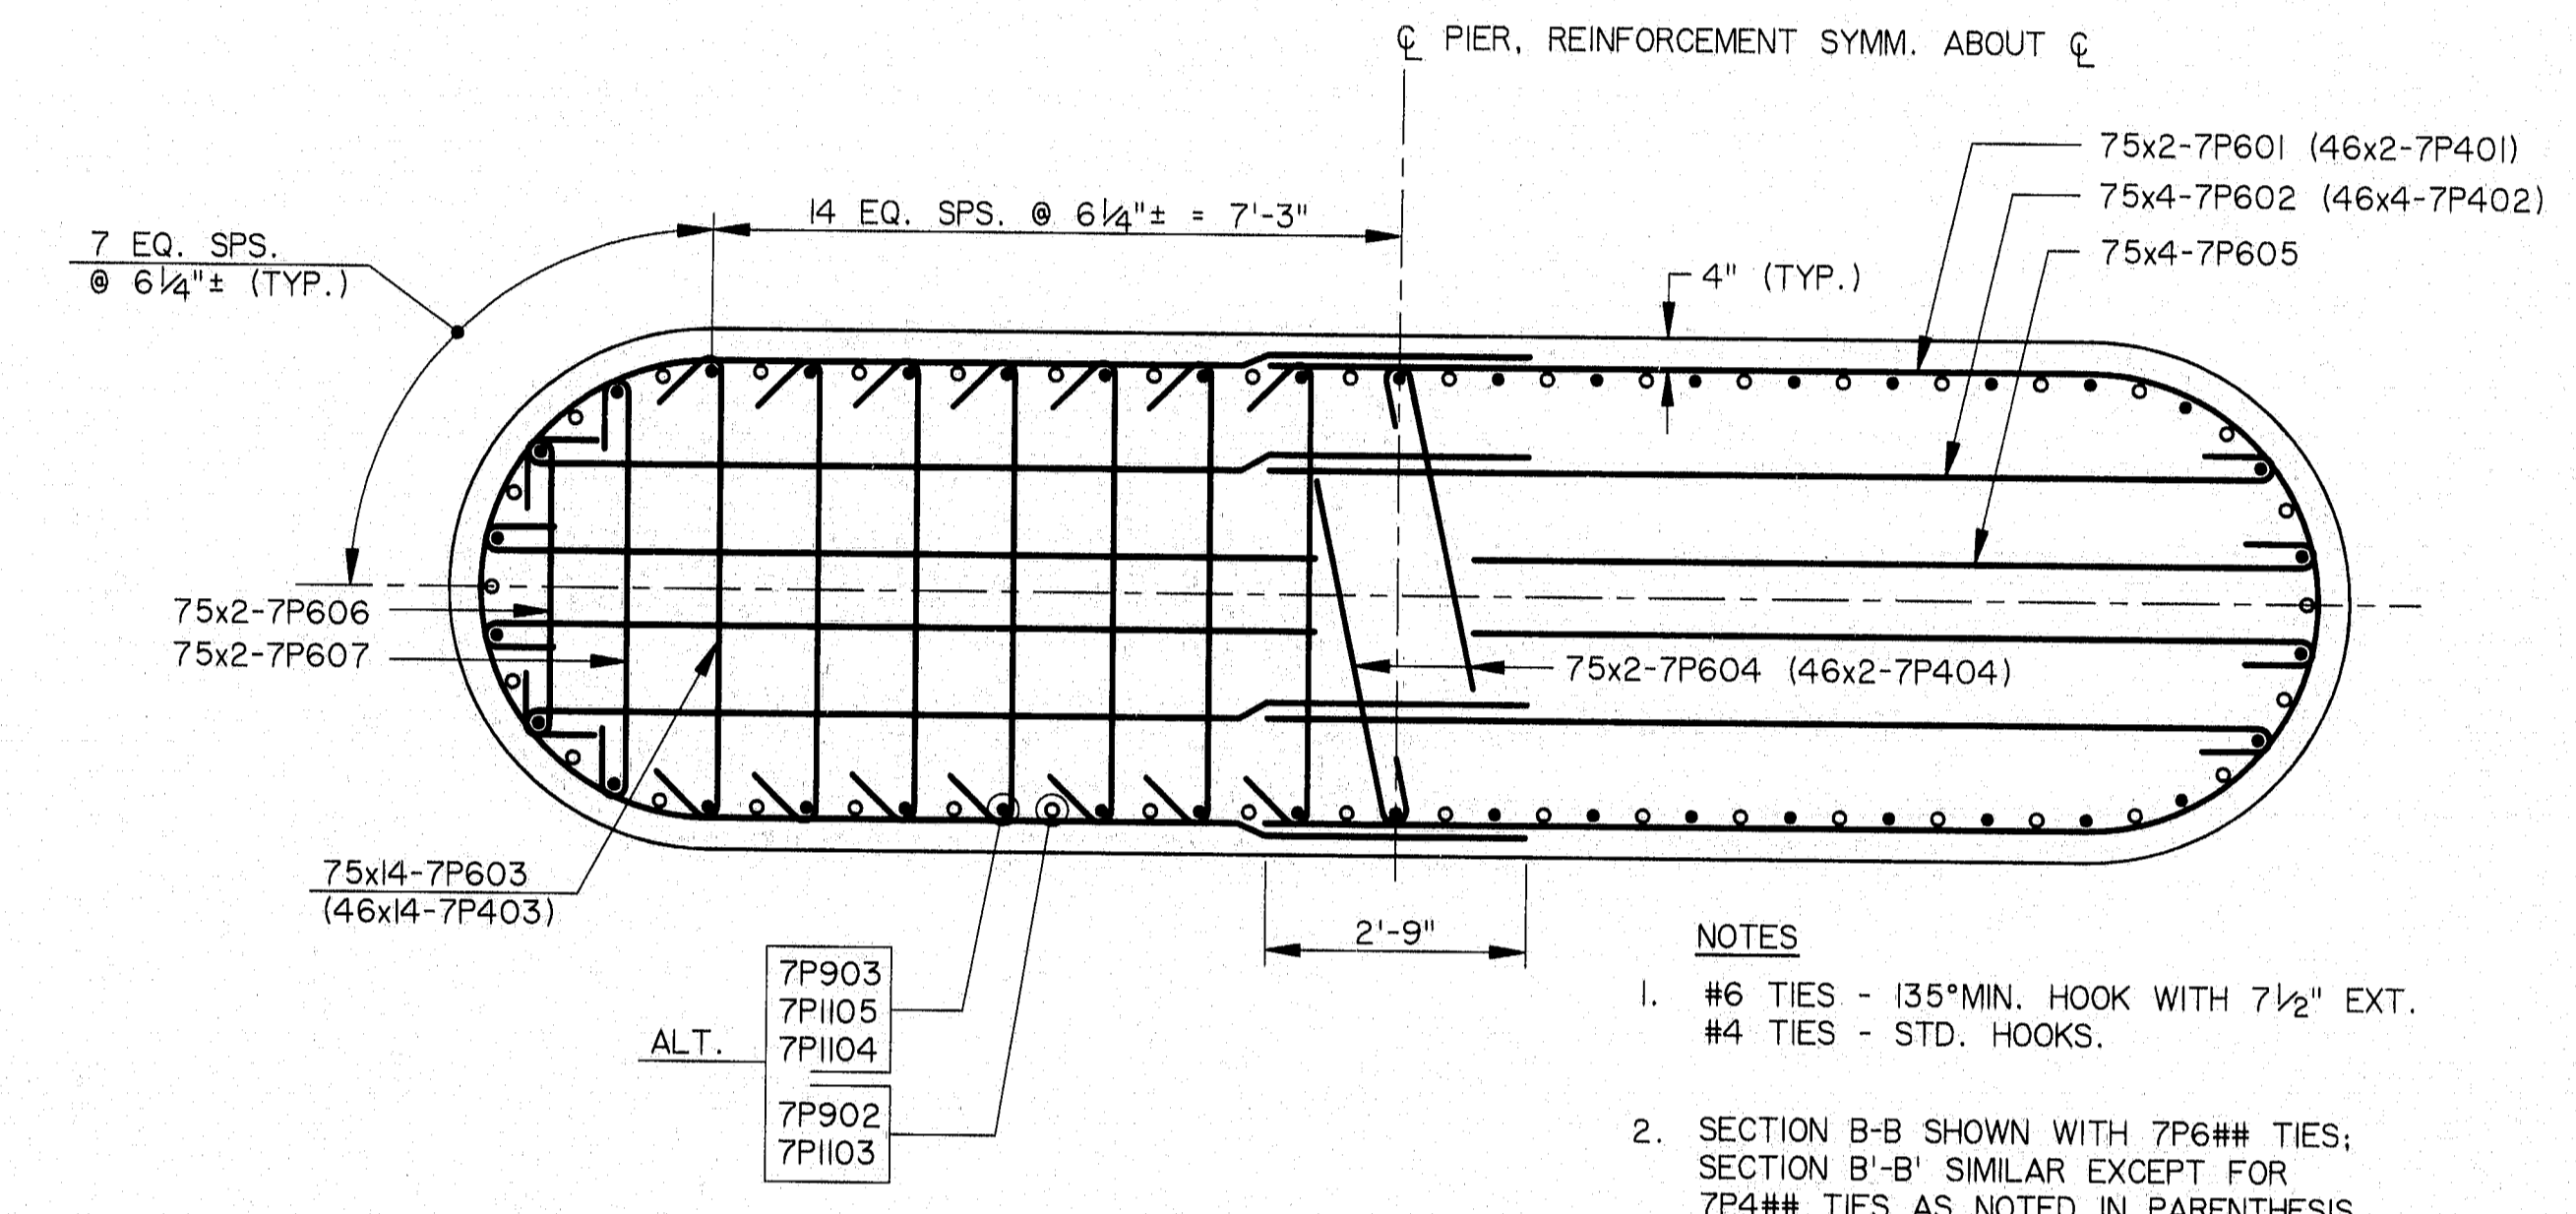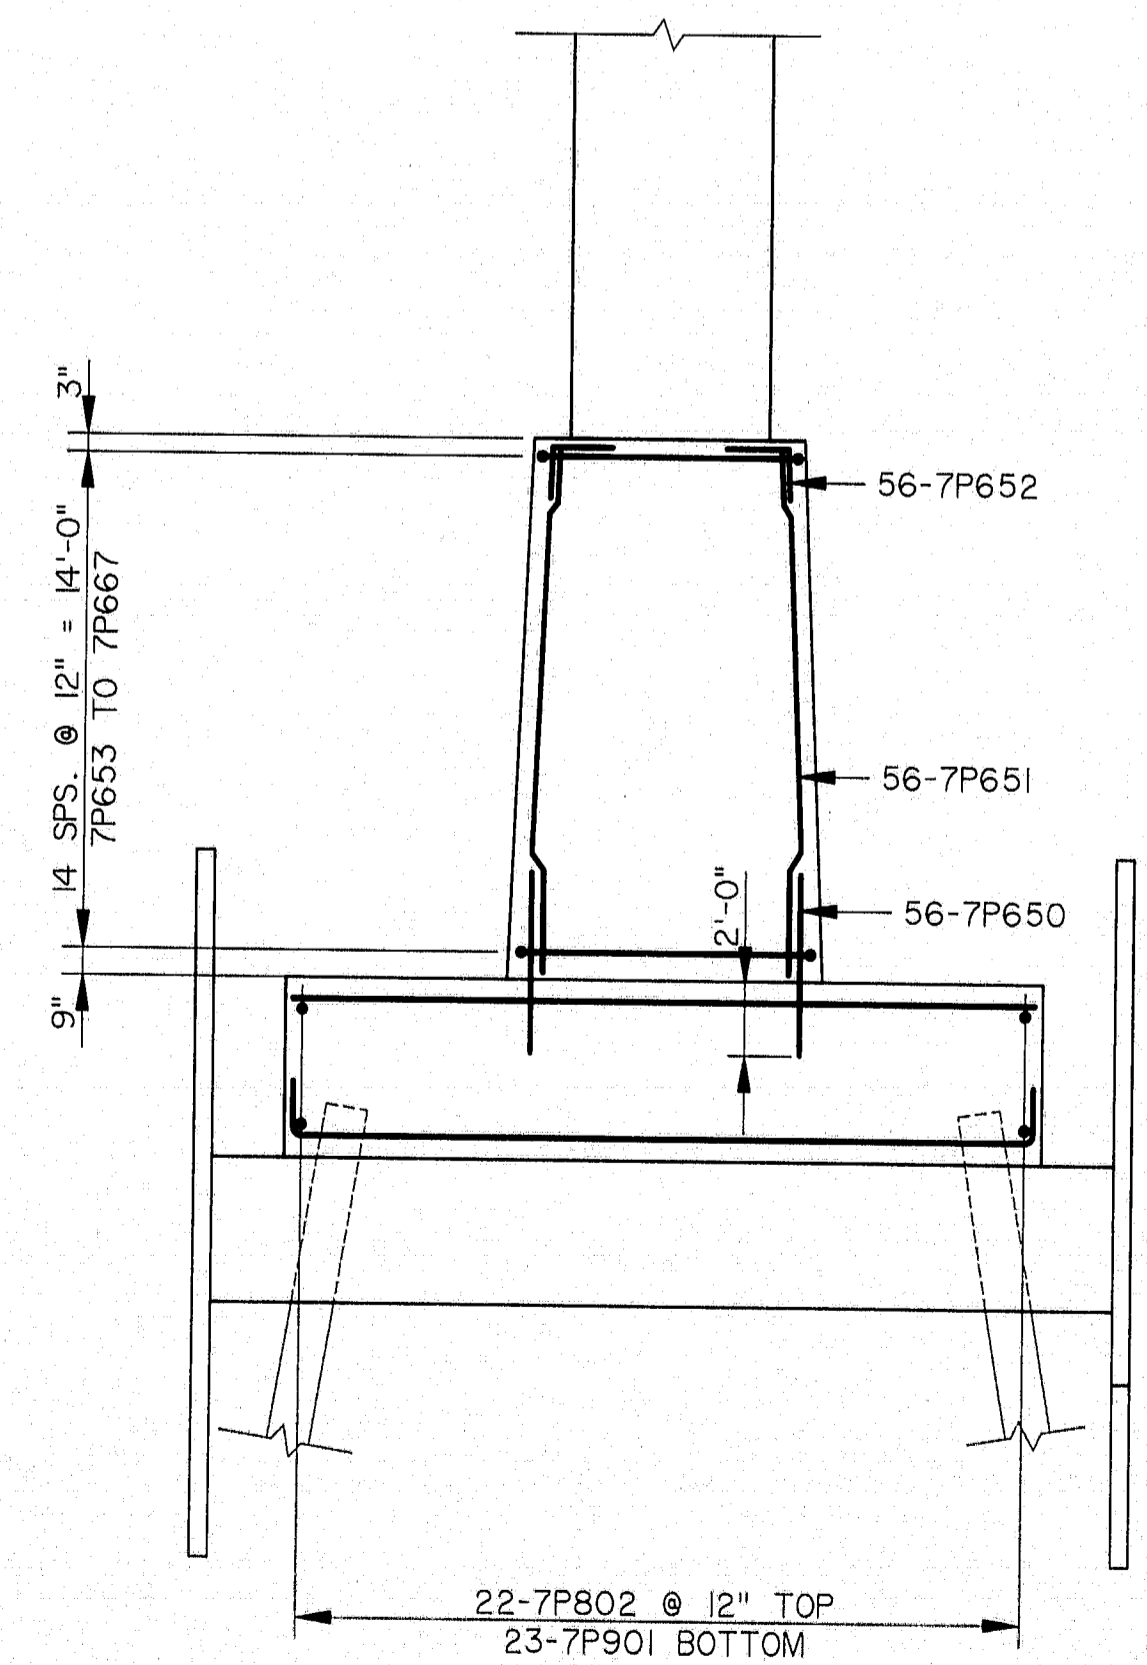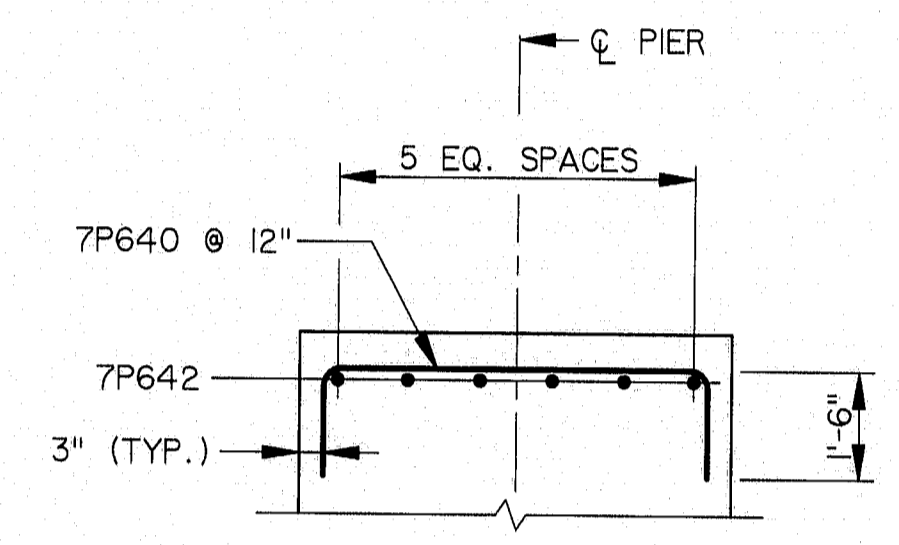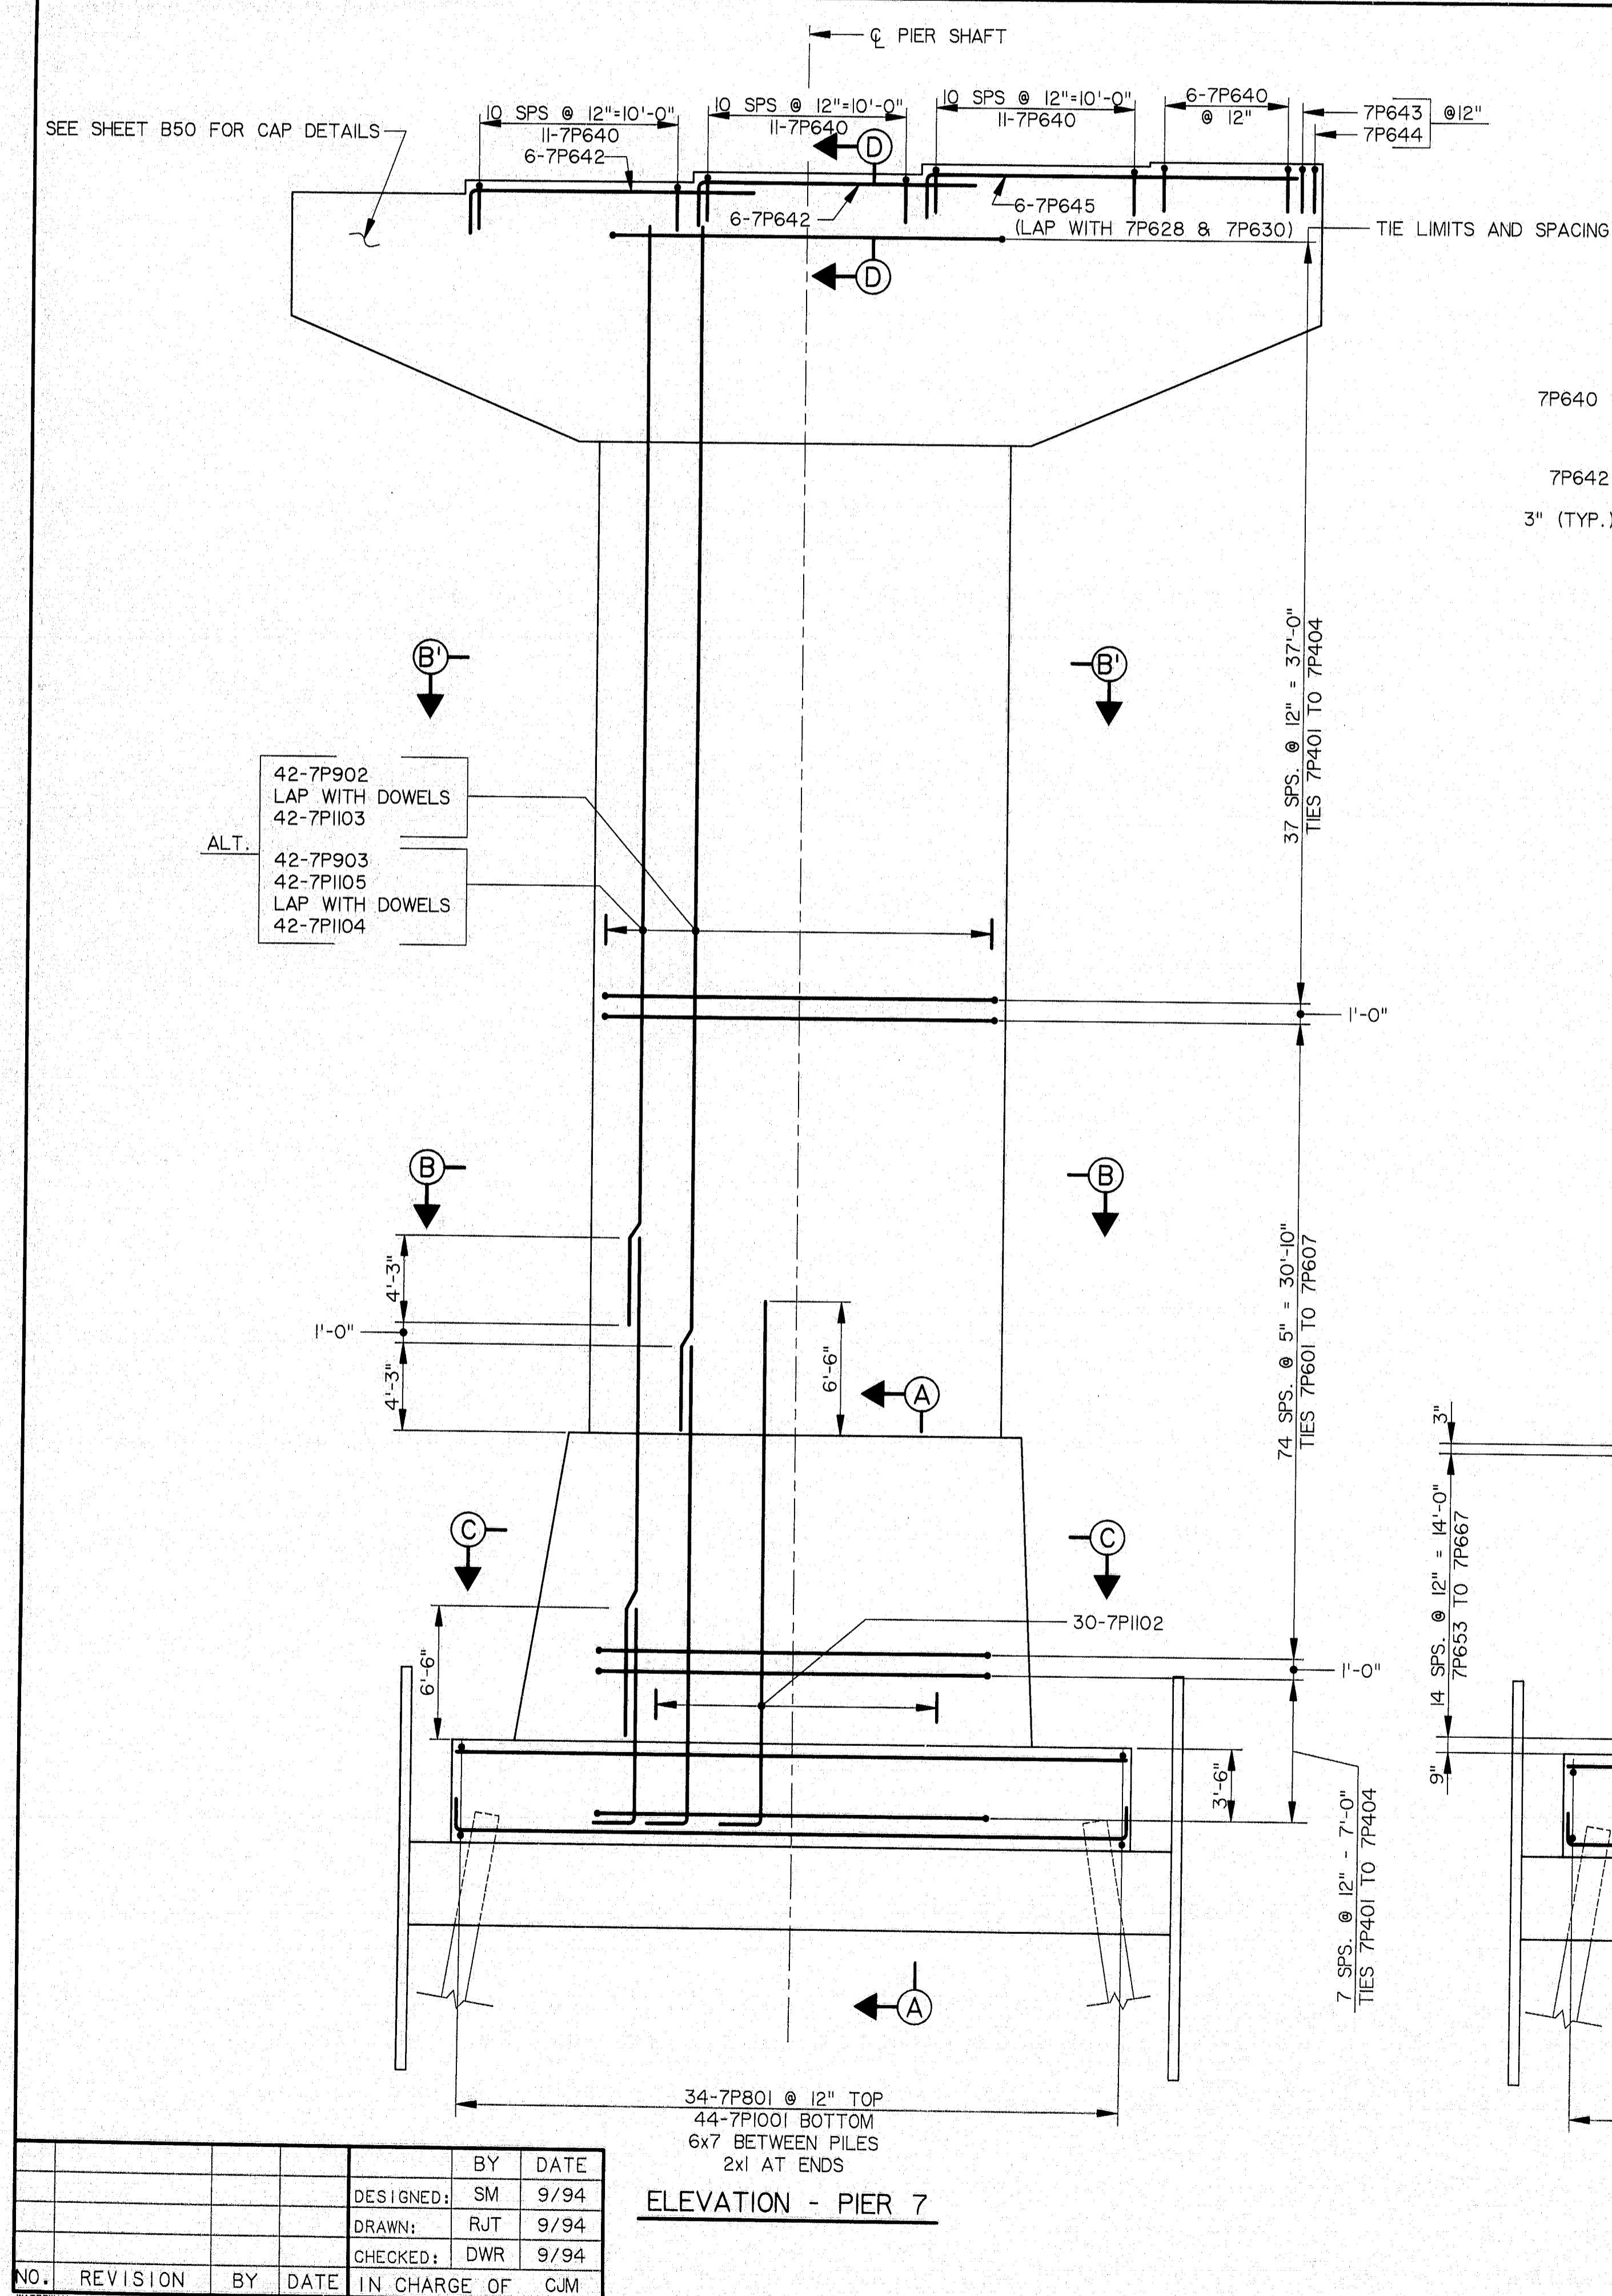



NO.	REVISION	BY	DATE	IN CHARGE OF
		DESIGNED: SM	9/94	
		DRAWN: RUT	9/94	
		CHECKED: DWR	9/94	
		BY DATE		CJM

ELEVATION - PIER 7




115-238  
STEEL ALTERNATIVE  
STATE OF MAINE  
DEPARTMENT OF TRANSPORTATION  
WATERVILLE - WINSLOW PROJECT  
DONALD V. CARTER BRIDGE  
OVER  
KENNEBEC RIVER  
PIER 7 RE-STEEL  
SHEET B43 OF B86 AUGUSTA, MAINE


F.H.A. REG. NO.	STATE	PROJECT NUMBER	SHEET NO.	TOTAL SHEETS
1	MAINE	0009 (002)	53	103

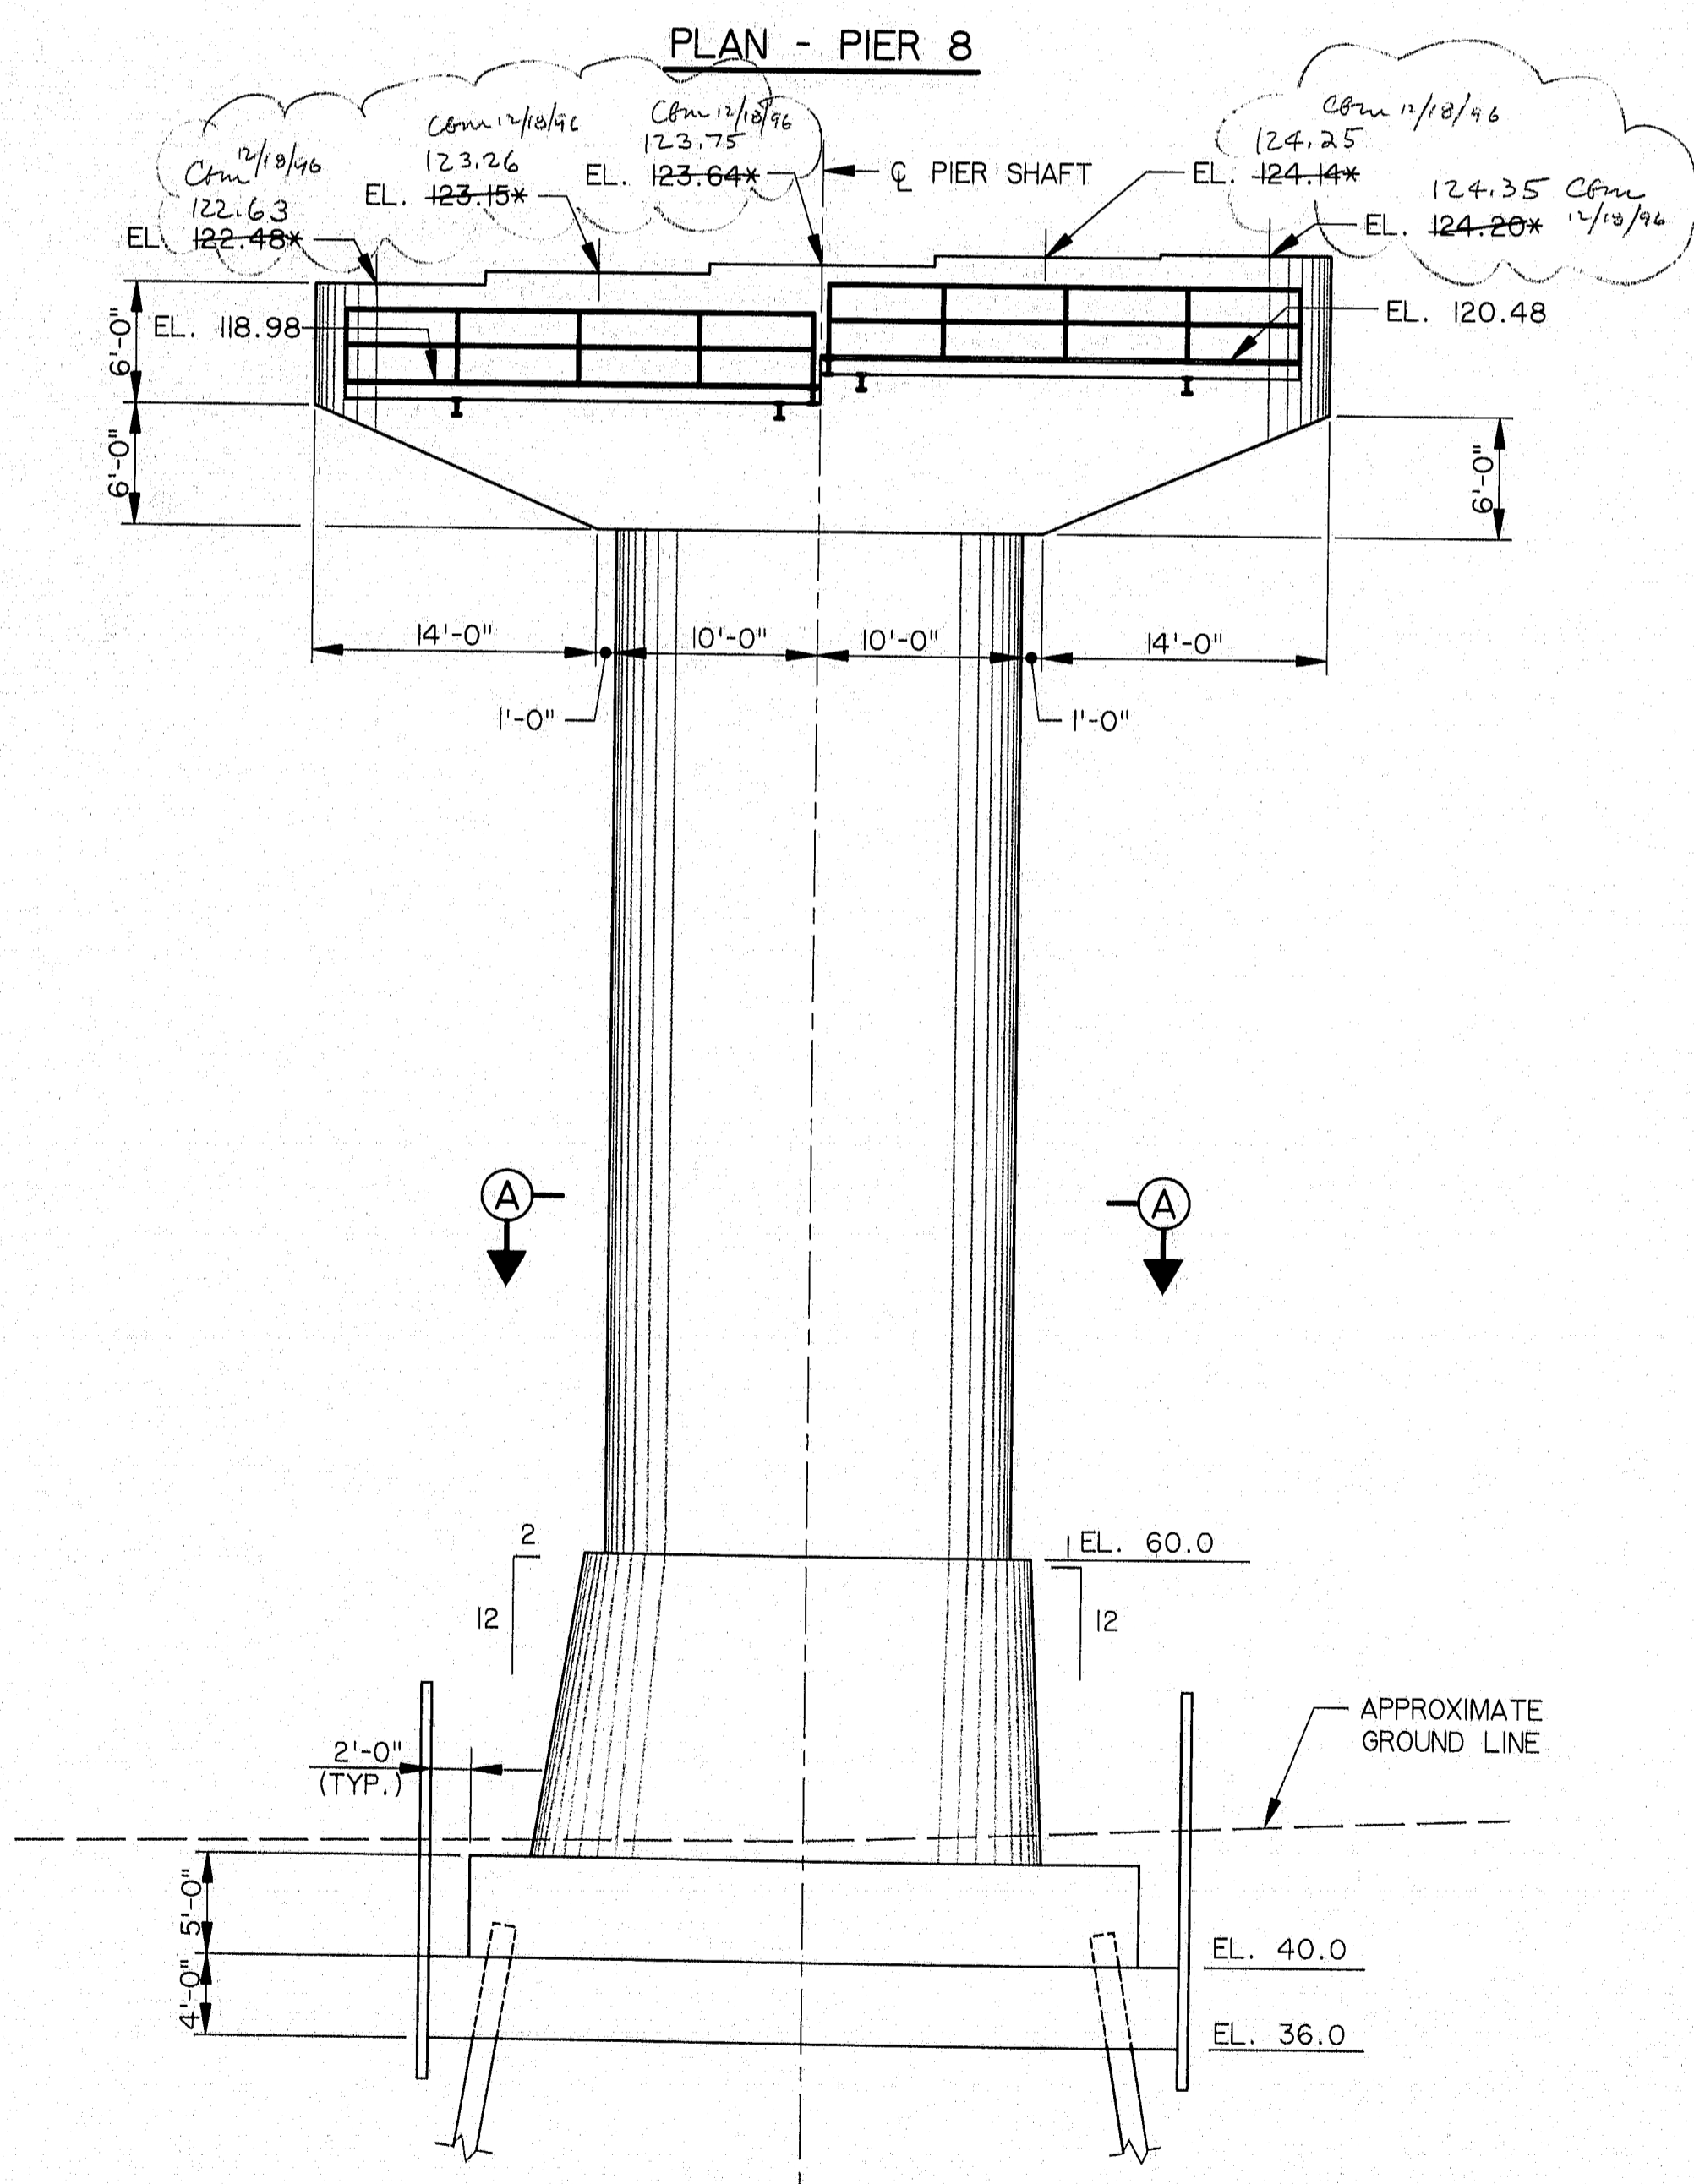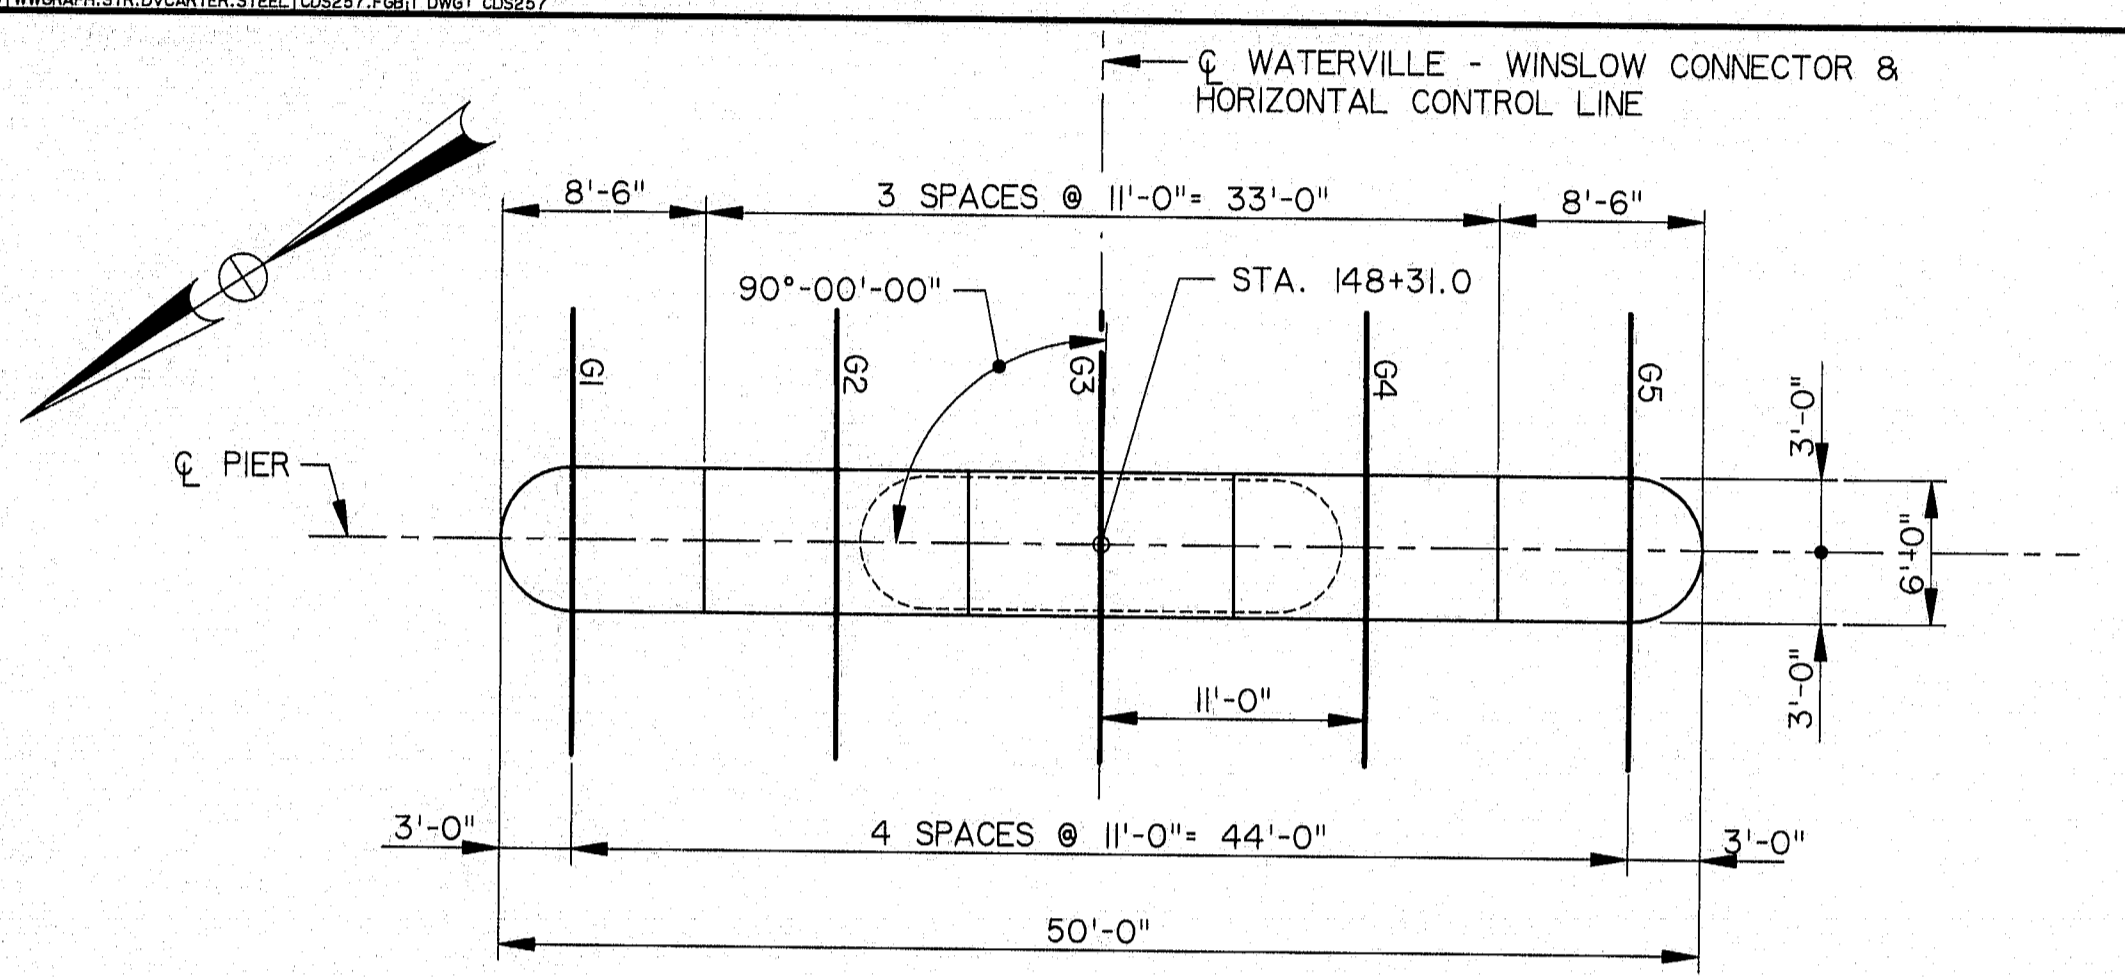

ELEVATION  
(LOOKING UPSTATION)

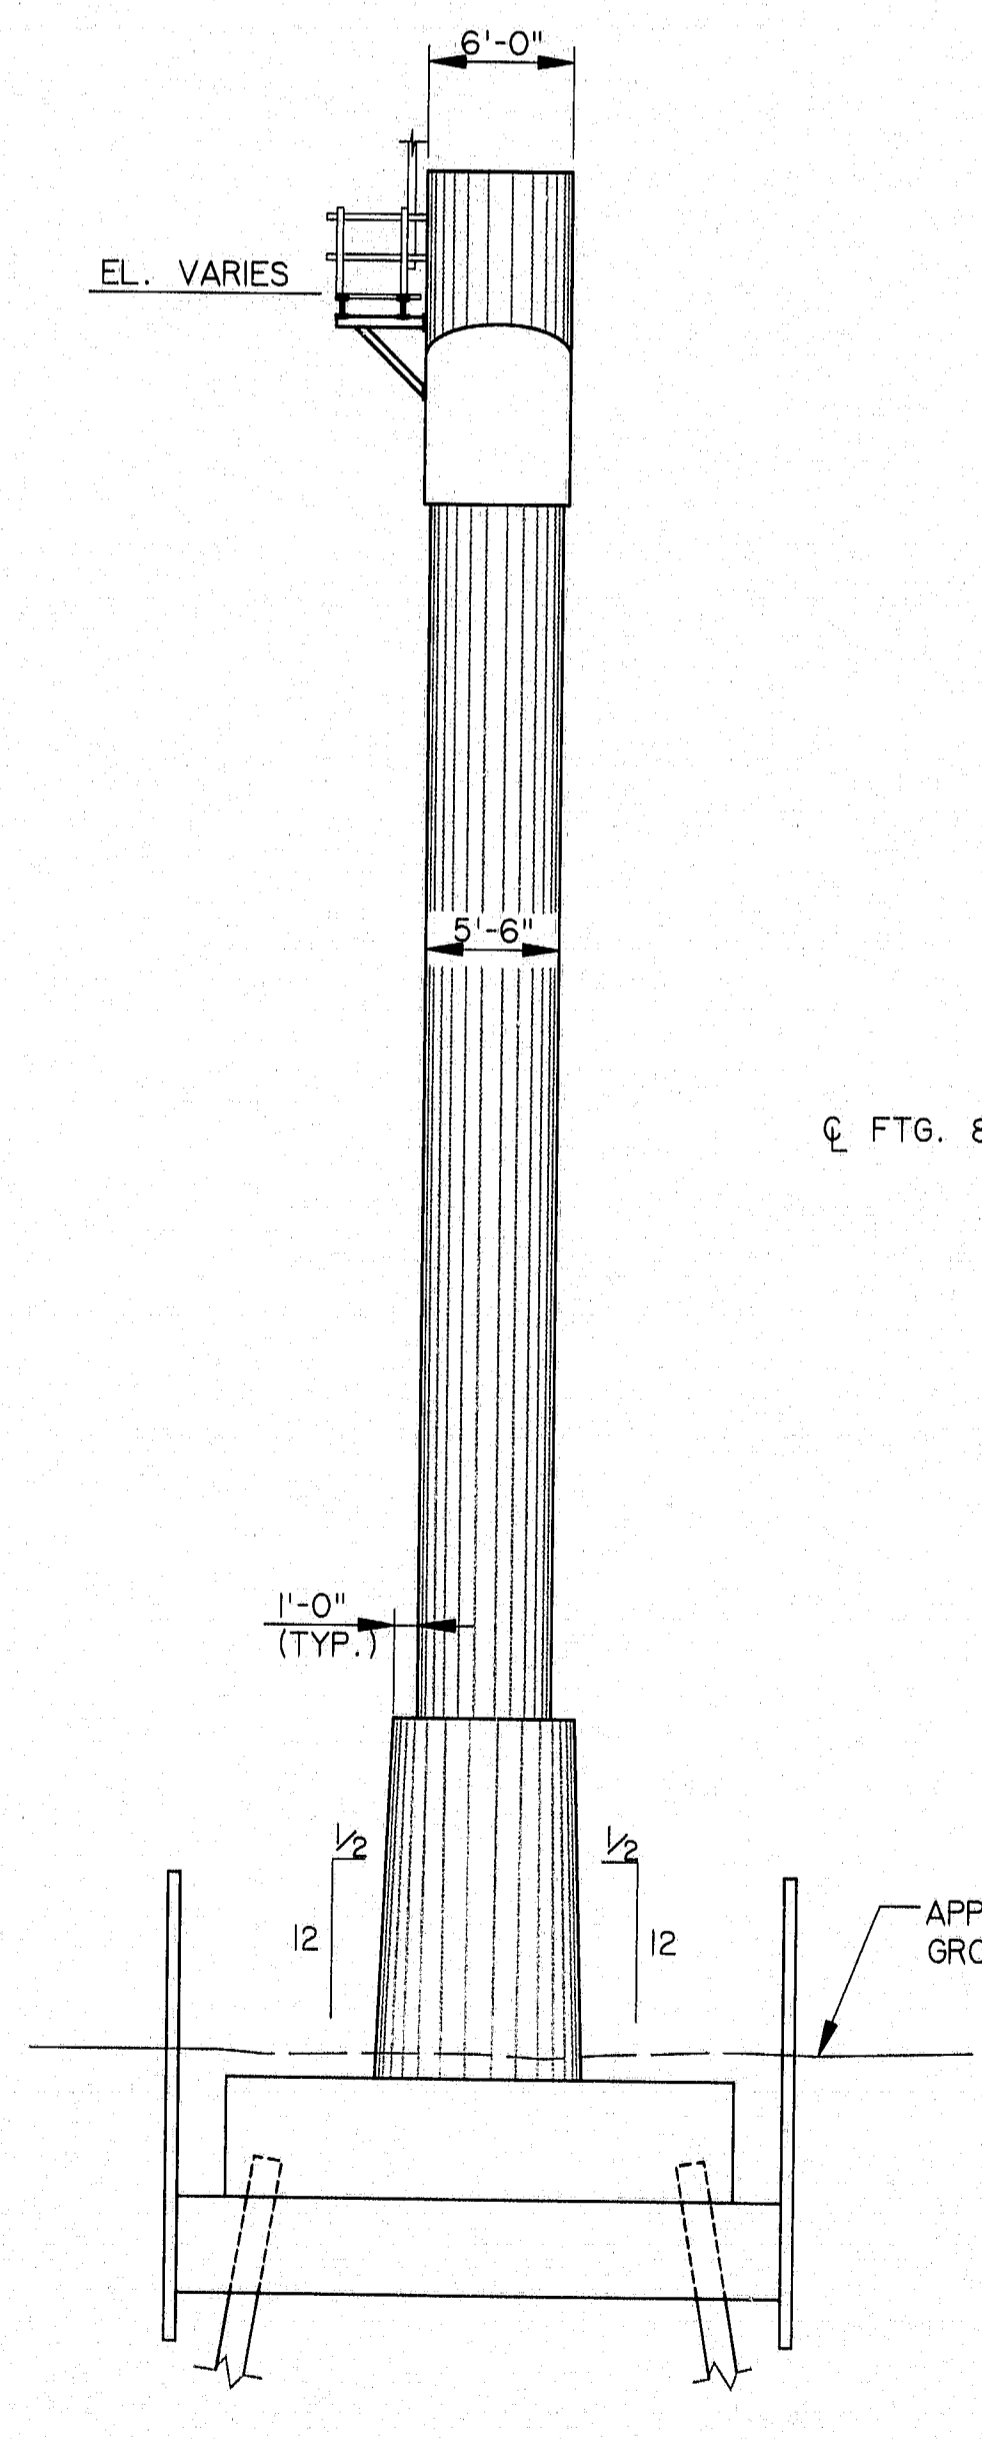

SIDE ELEVATION

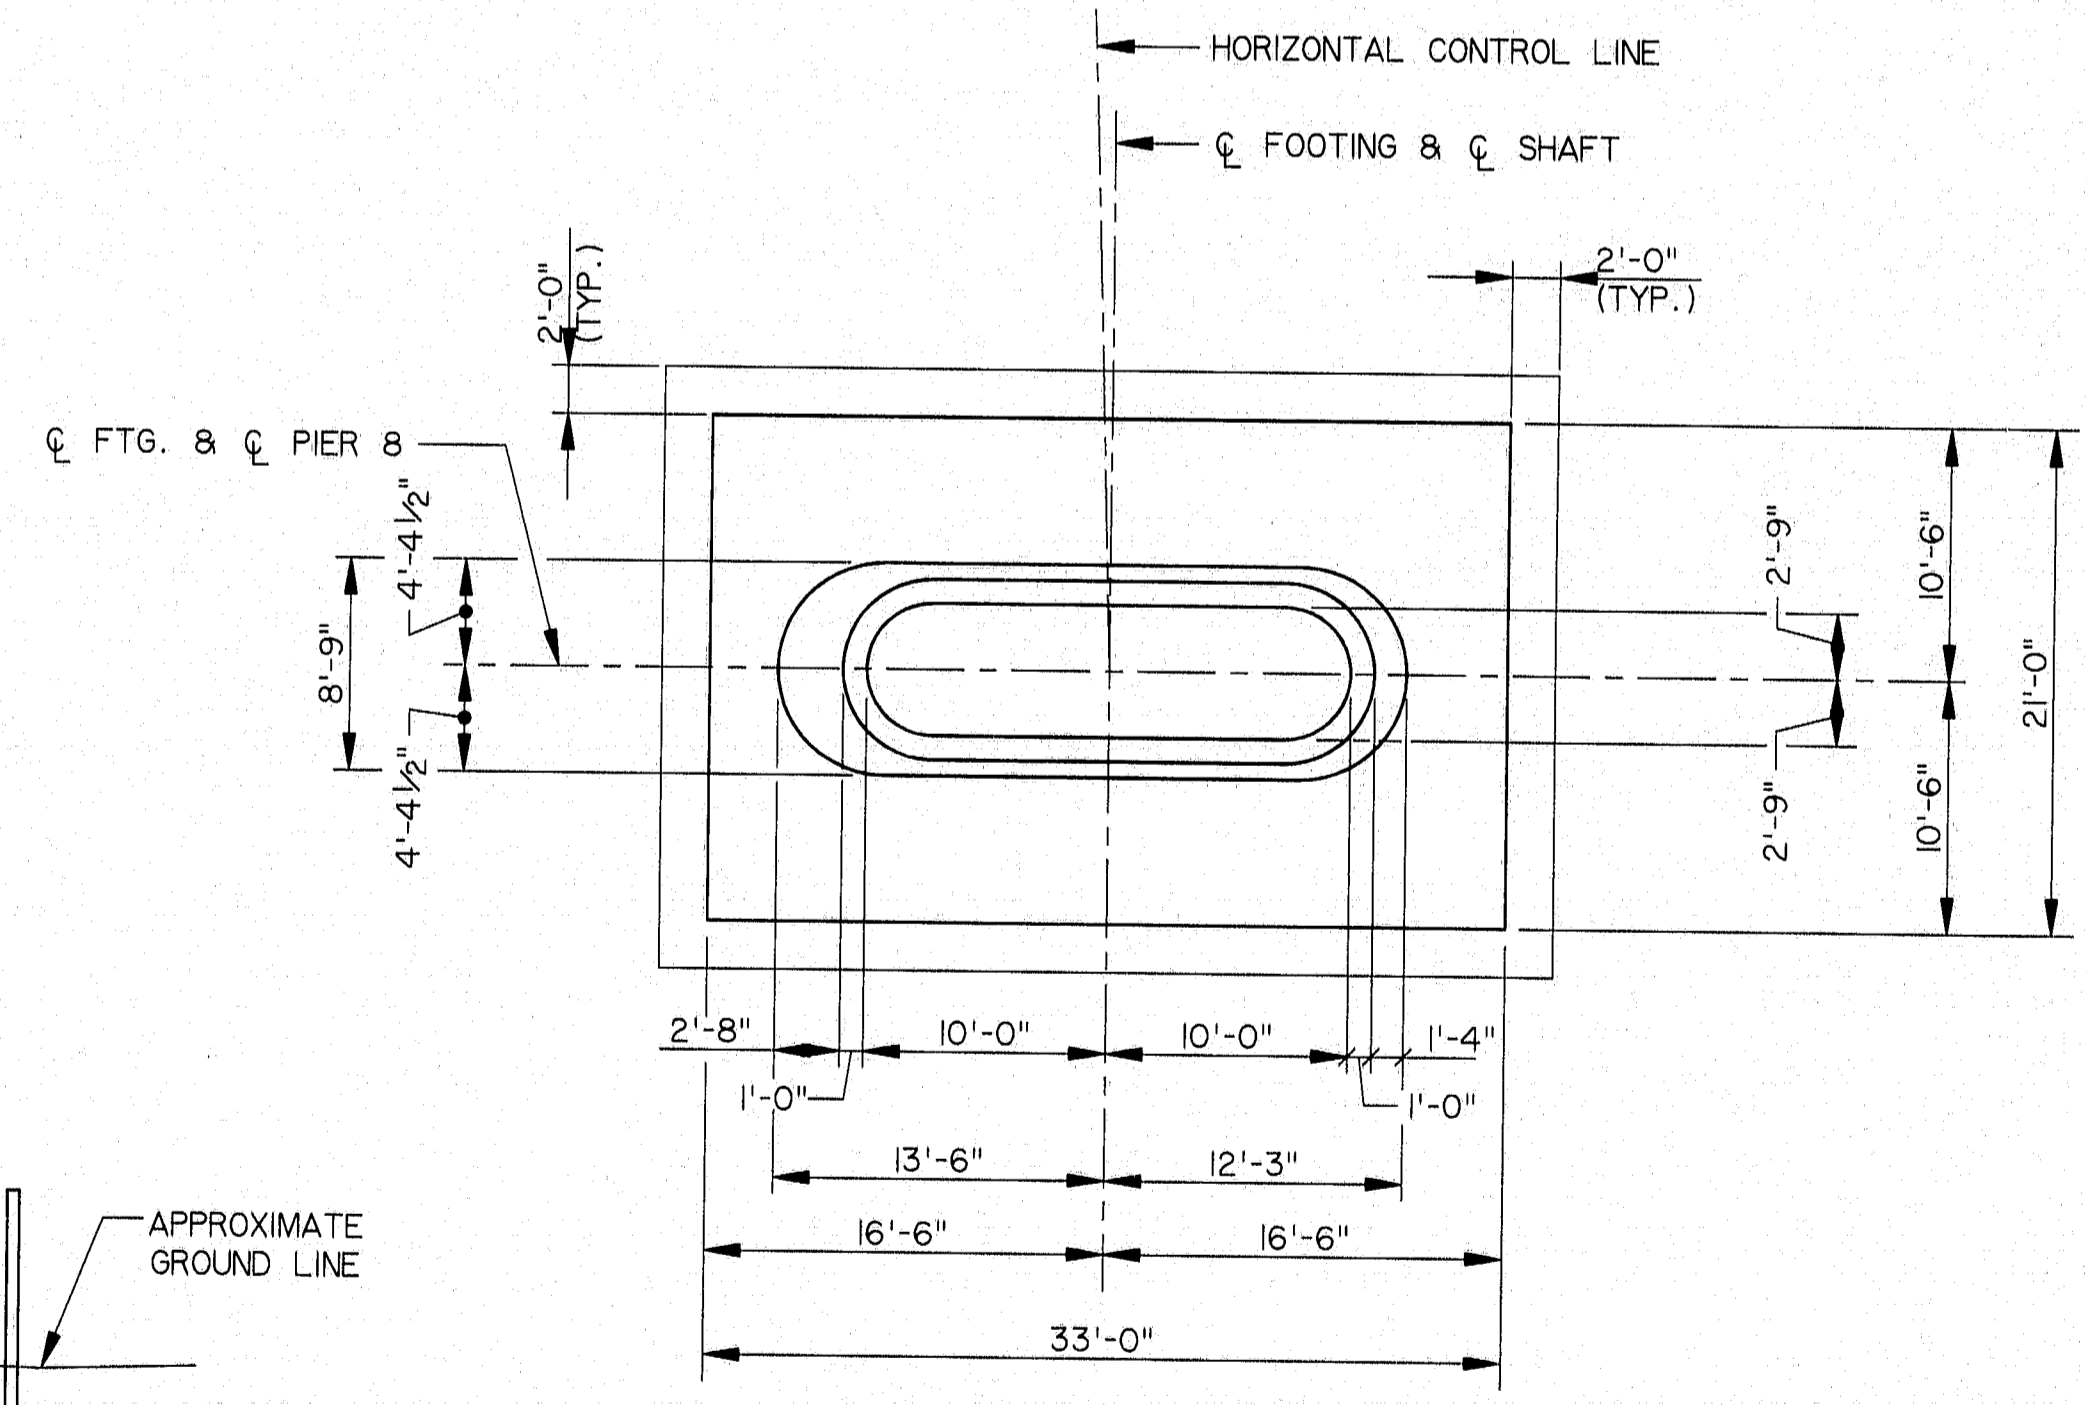


SECTION A-A

NOTES:

- MAXIMUM CALCULATED PILE LOAD = 157 TONS (GROUP SEISMIC)\*  
\* ULTIMATE CAPACITY OF PILE IS USED IN CONJUNCTION WITH SEISMIC LOADS.
- SEE SHEET B30 FOR ADDITIONAL NOTES.

NO.	REVISION	BY	DATE
		DESIGNED: SM	9/94
		DRAWN: RJT	9/94
		CHECKED: DWR	9/94
		IN CHARGE OF: CJM	






\* SEE NOTE 7, SHEET B30.

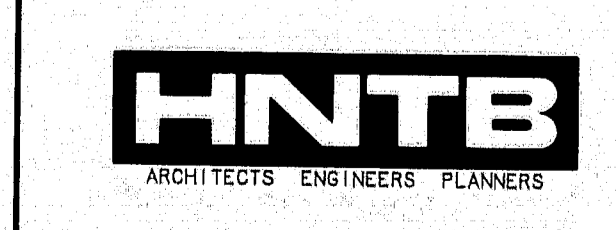

**115-239**  
STEEL ALTERNATIVE  
STATE OF MAINE  
DEPARTMENT OF TRANSPORTATION  
WATERVILLE - WINSLOW PROJECT  
DONALD V. CARTER BRIDGE  
OVER  
KENNEBEC RIVER  
**PIER 8 DETAILS**  
SHEET B44 OF B86 AUGUSTA, MAINE


115-240(1) STEEL REINFORCED CONCRETE PIER 8 (2) 115-240(1) PIER 8 (3) 115-240(1) PIER 8

F.M.A. REG. NO.	STATE	PROJECT NUMBER	SHEET NO.	TOTAL SHEETS
1	MAINE	0009(1002)	54	103

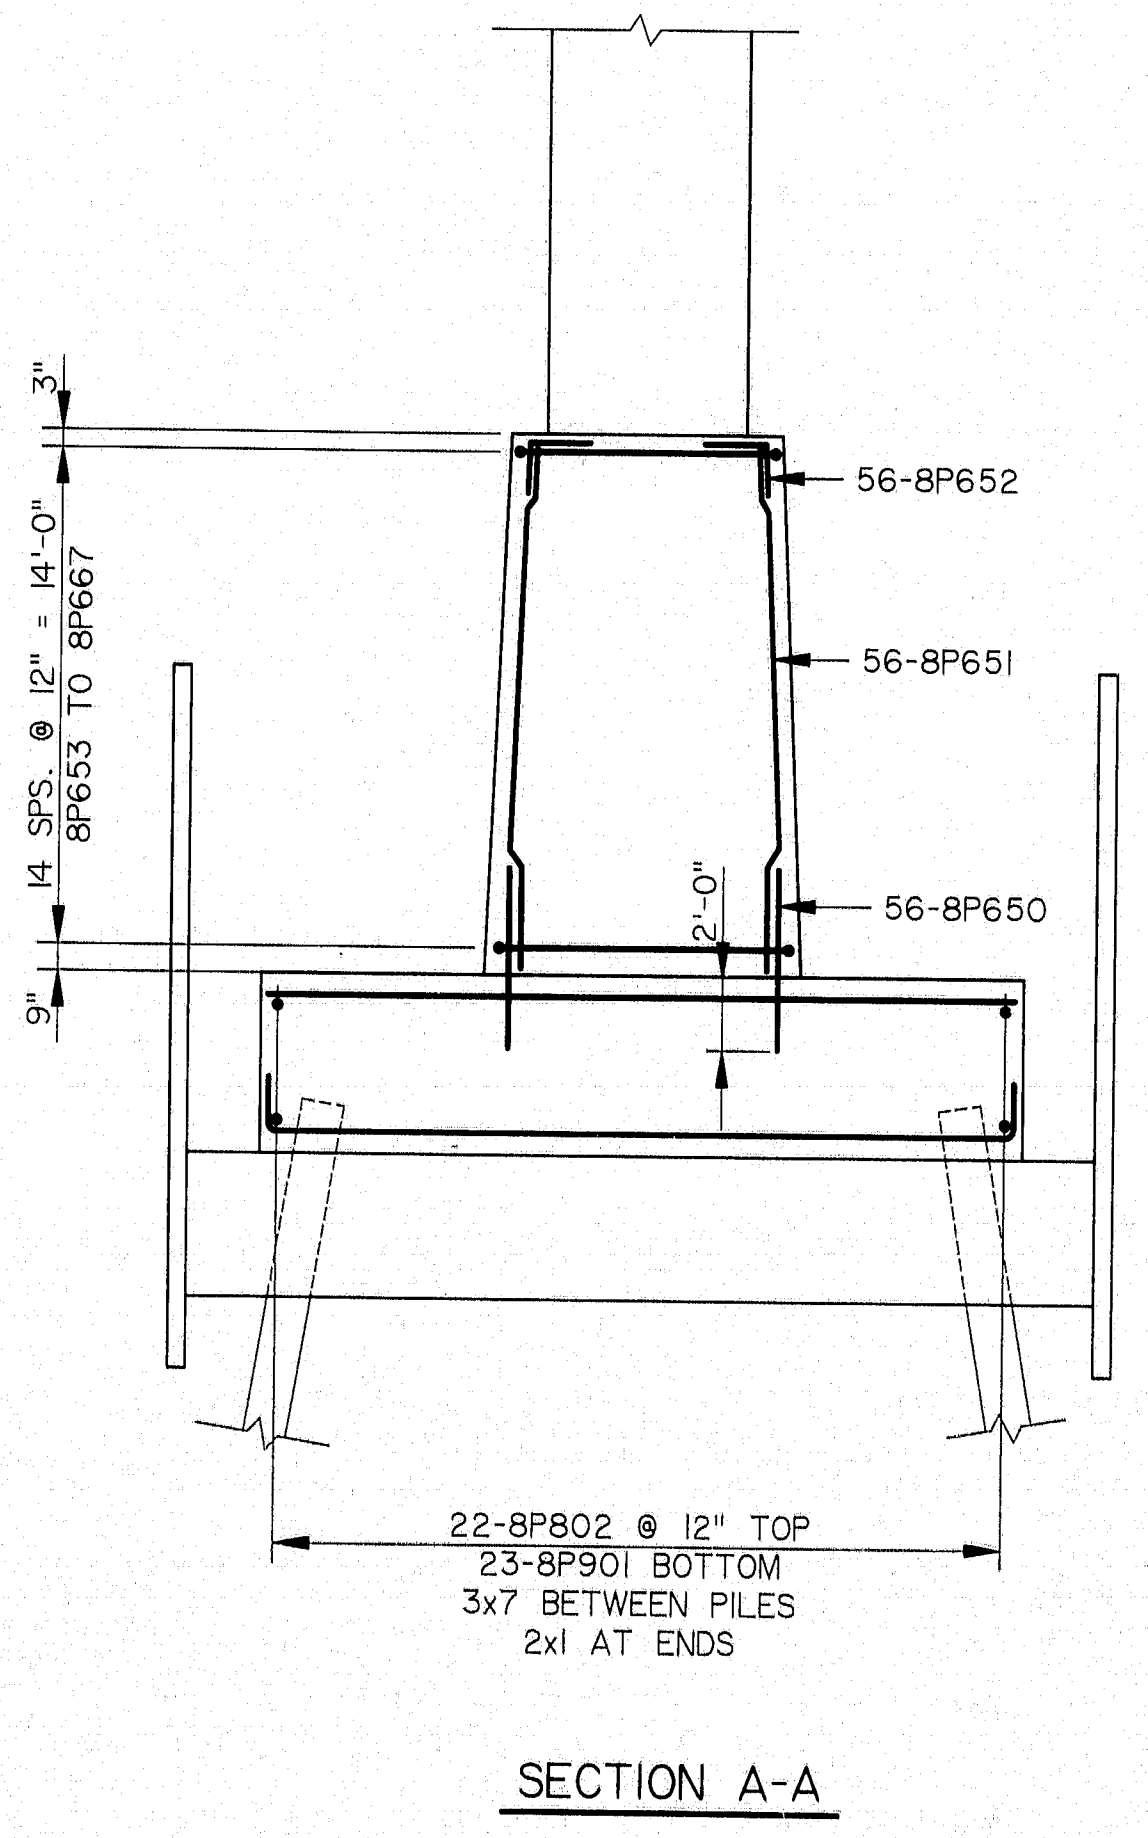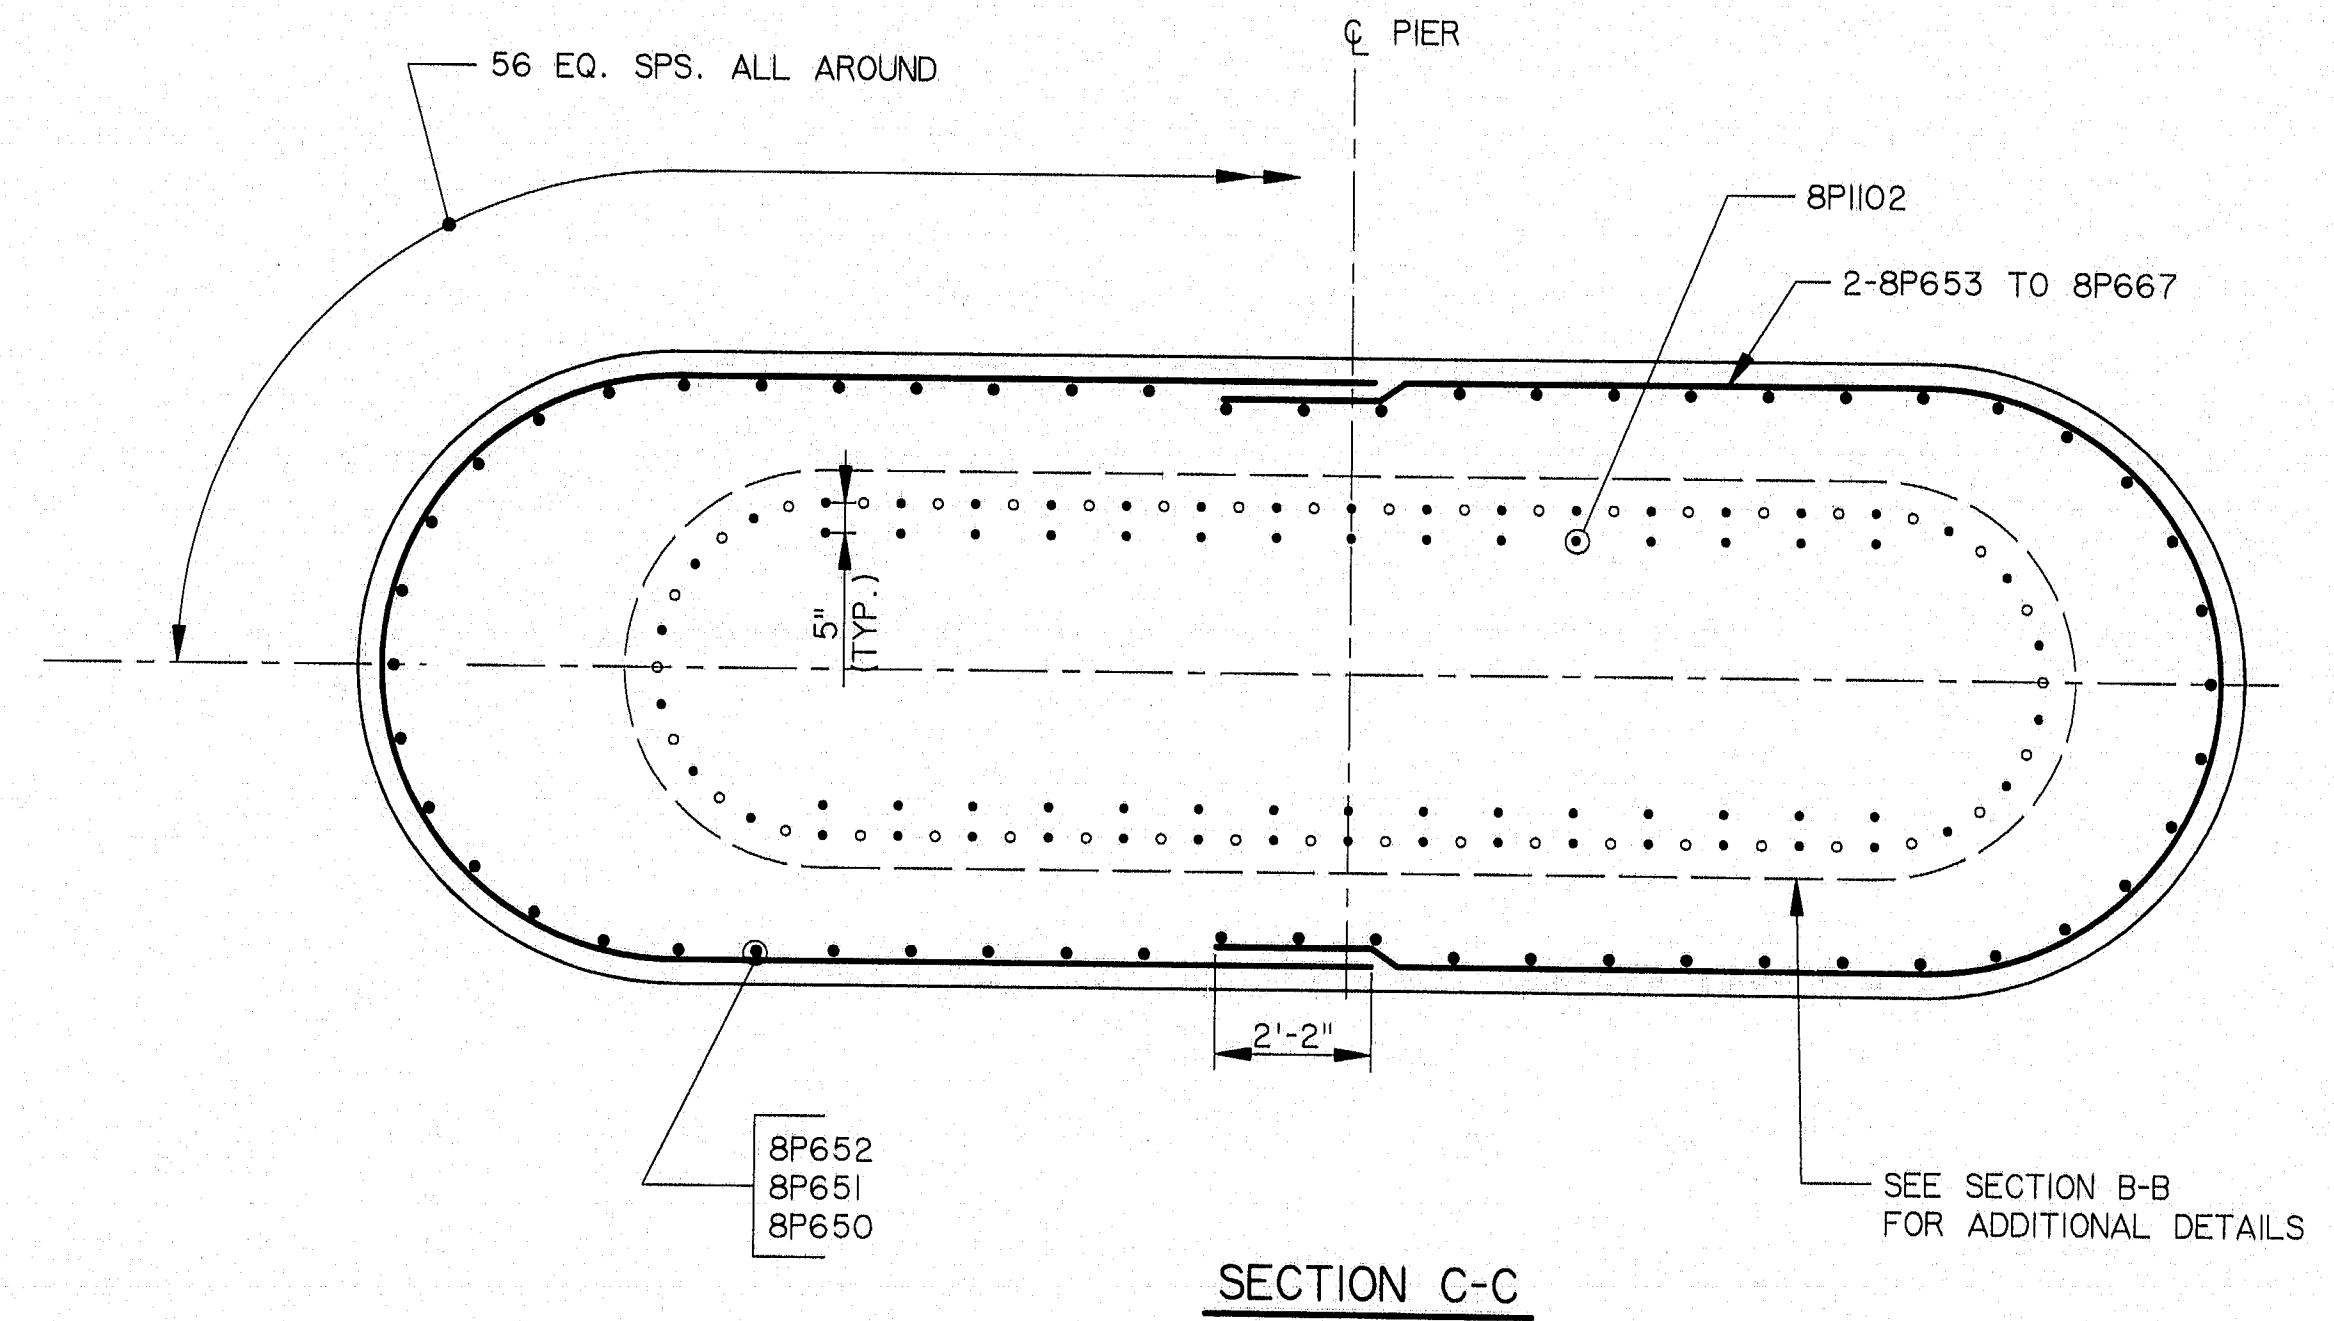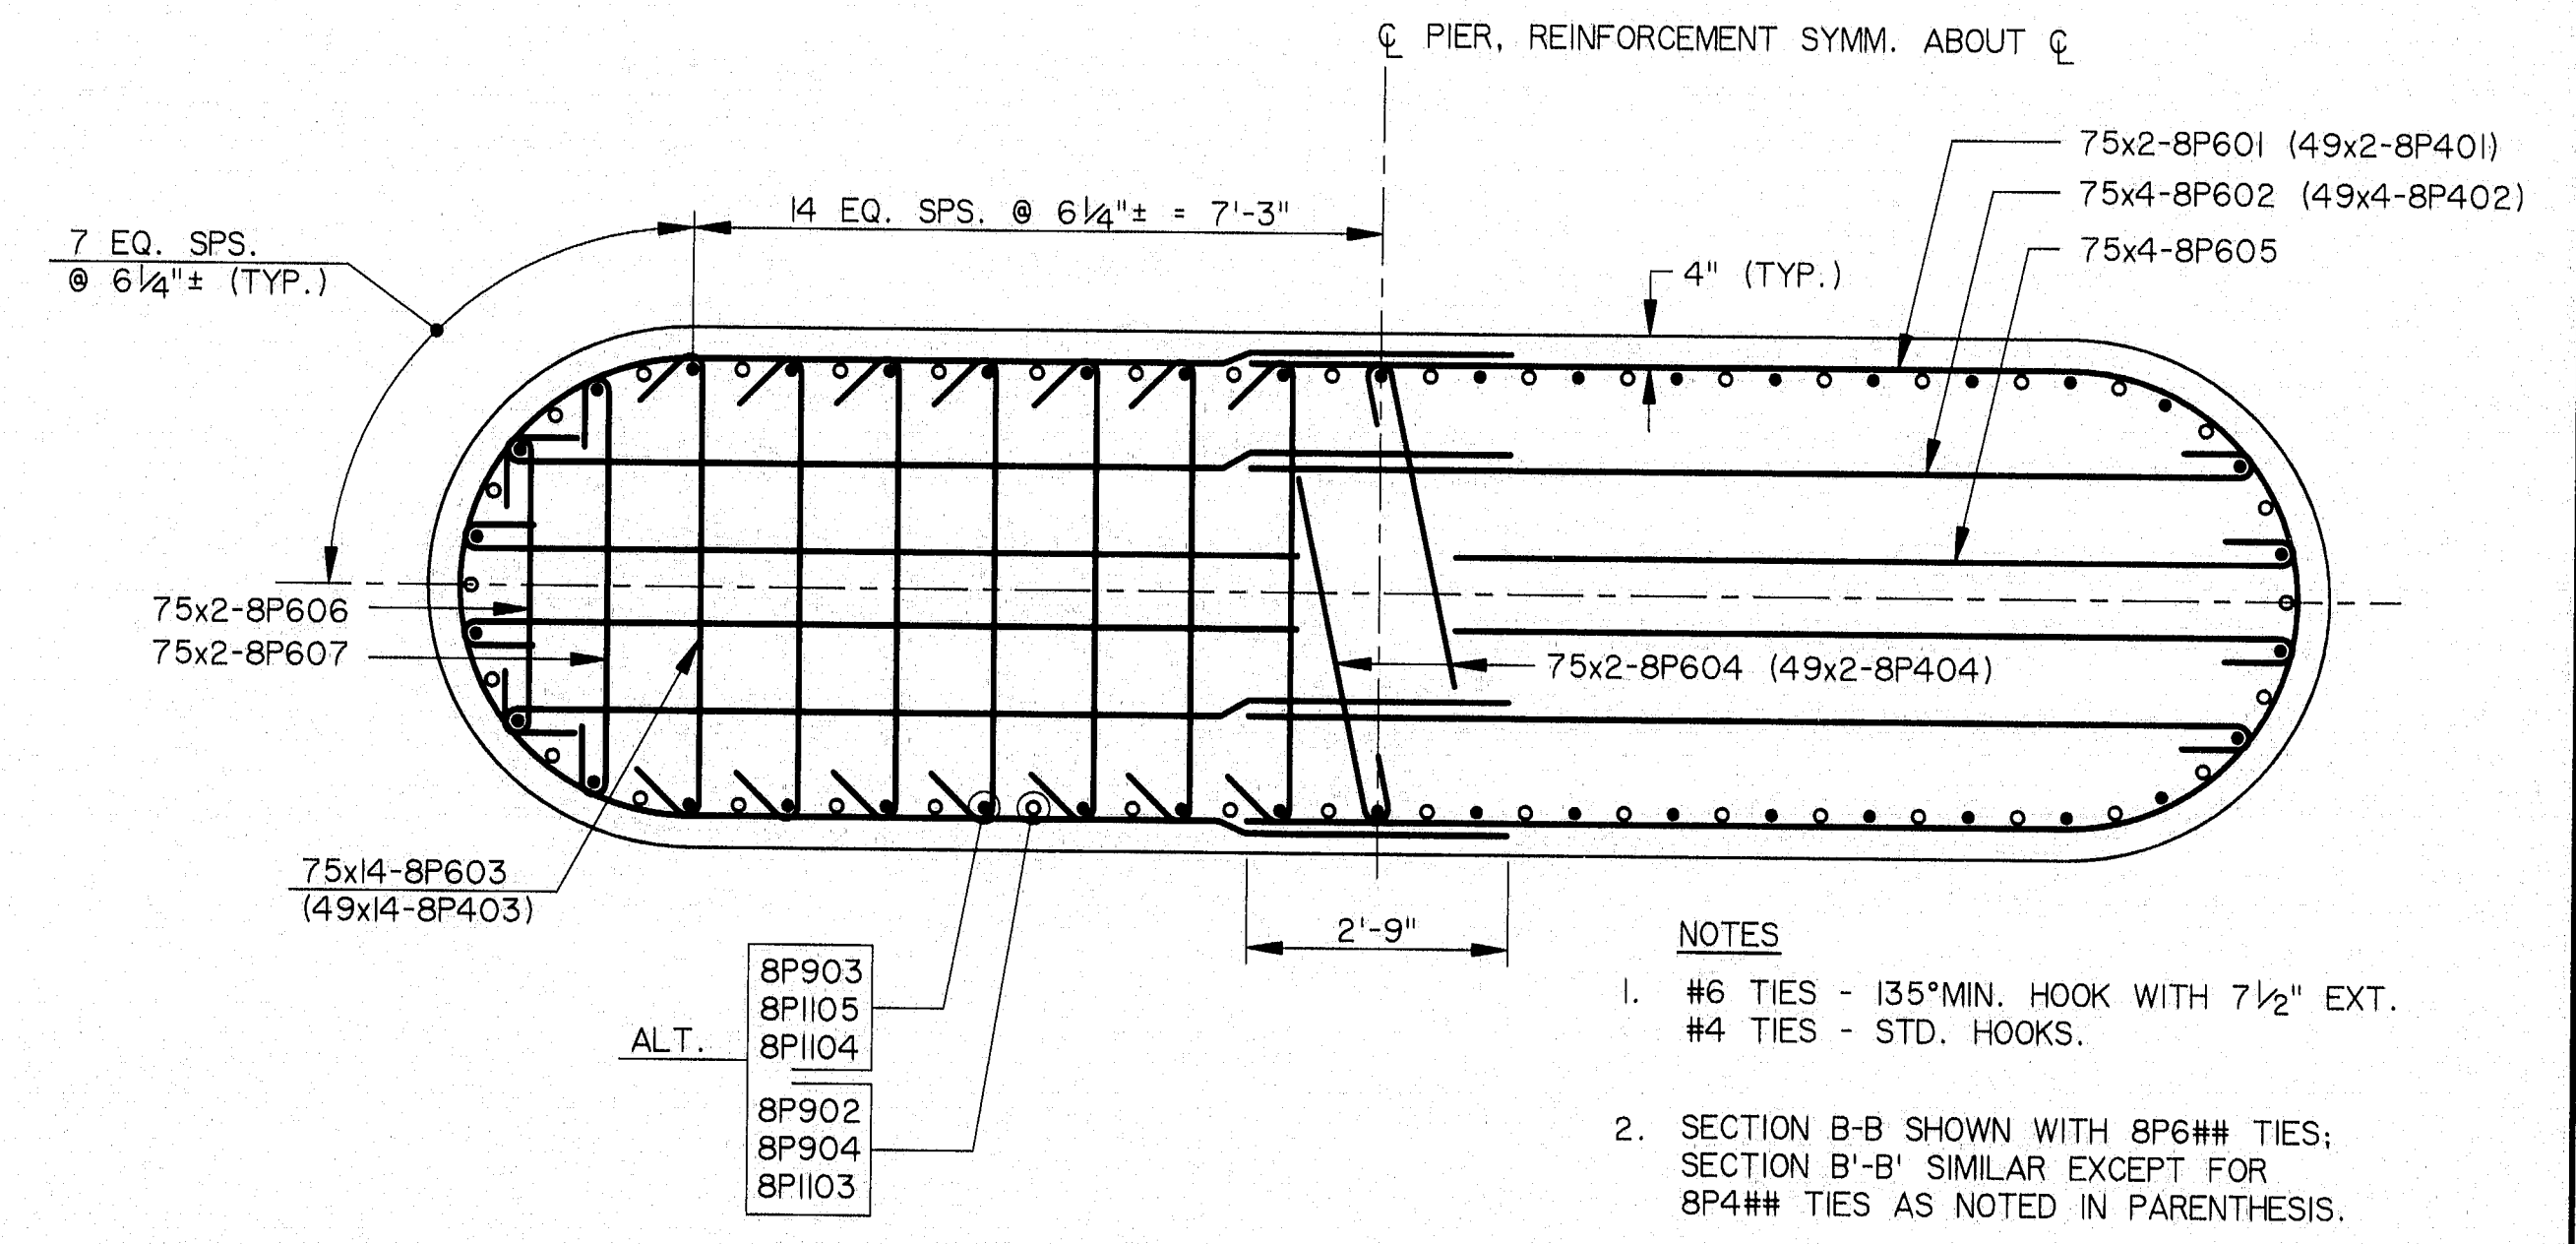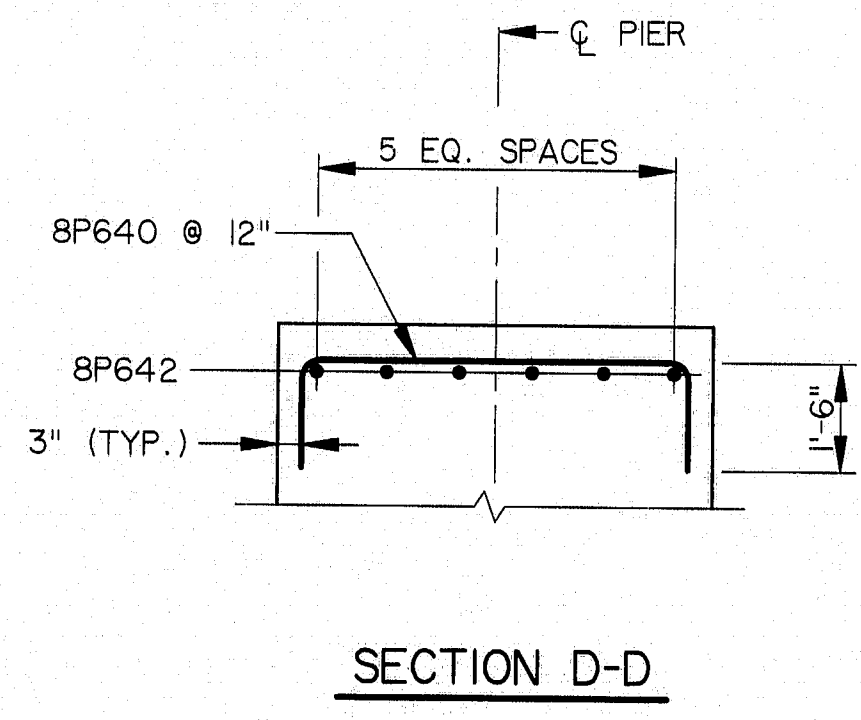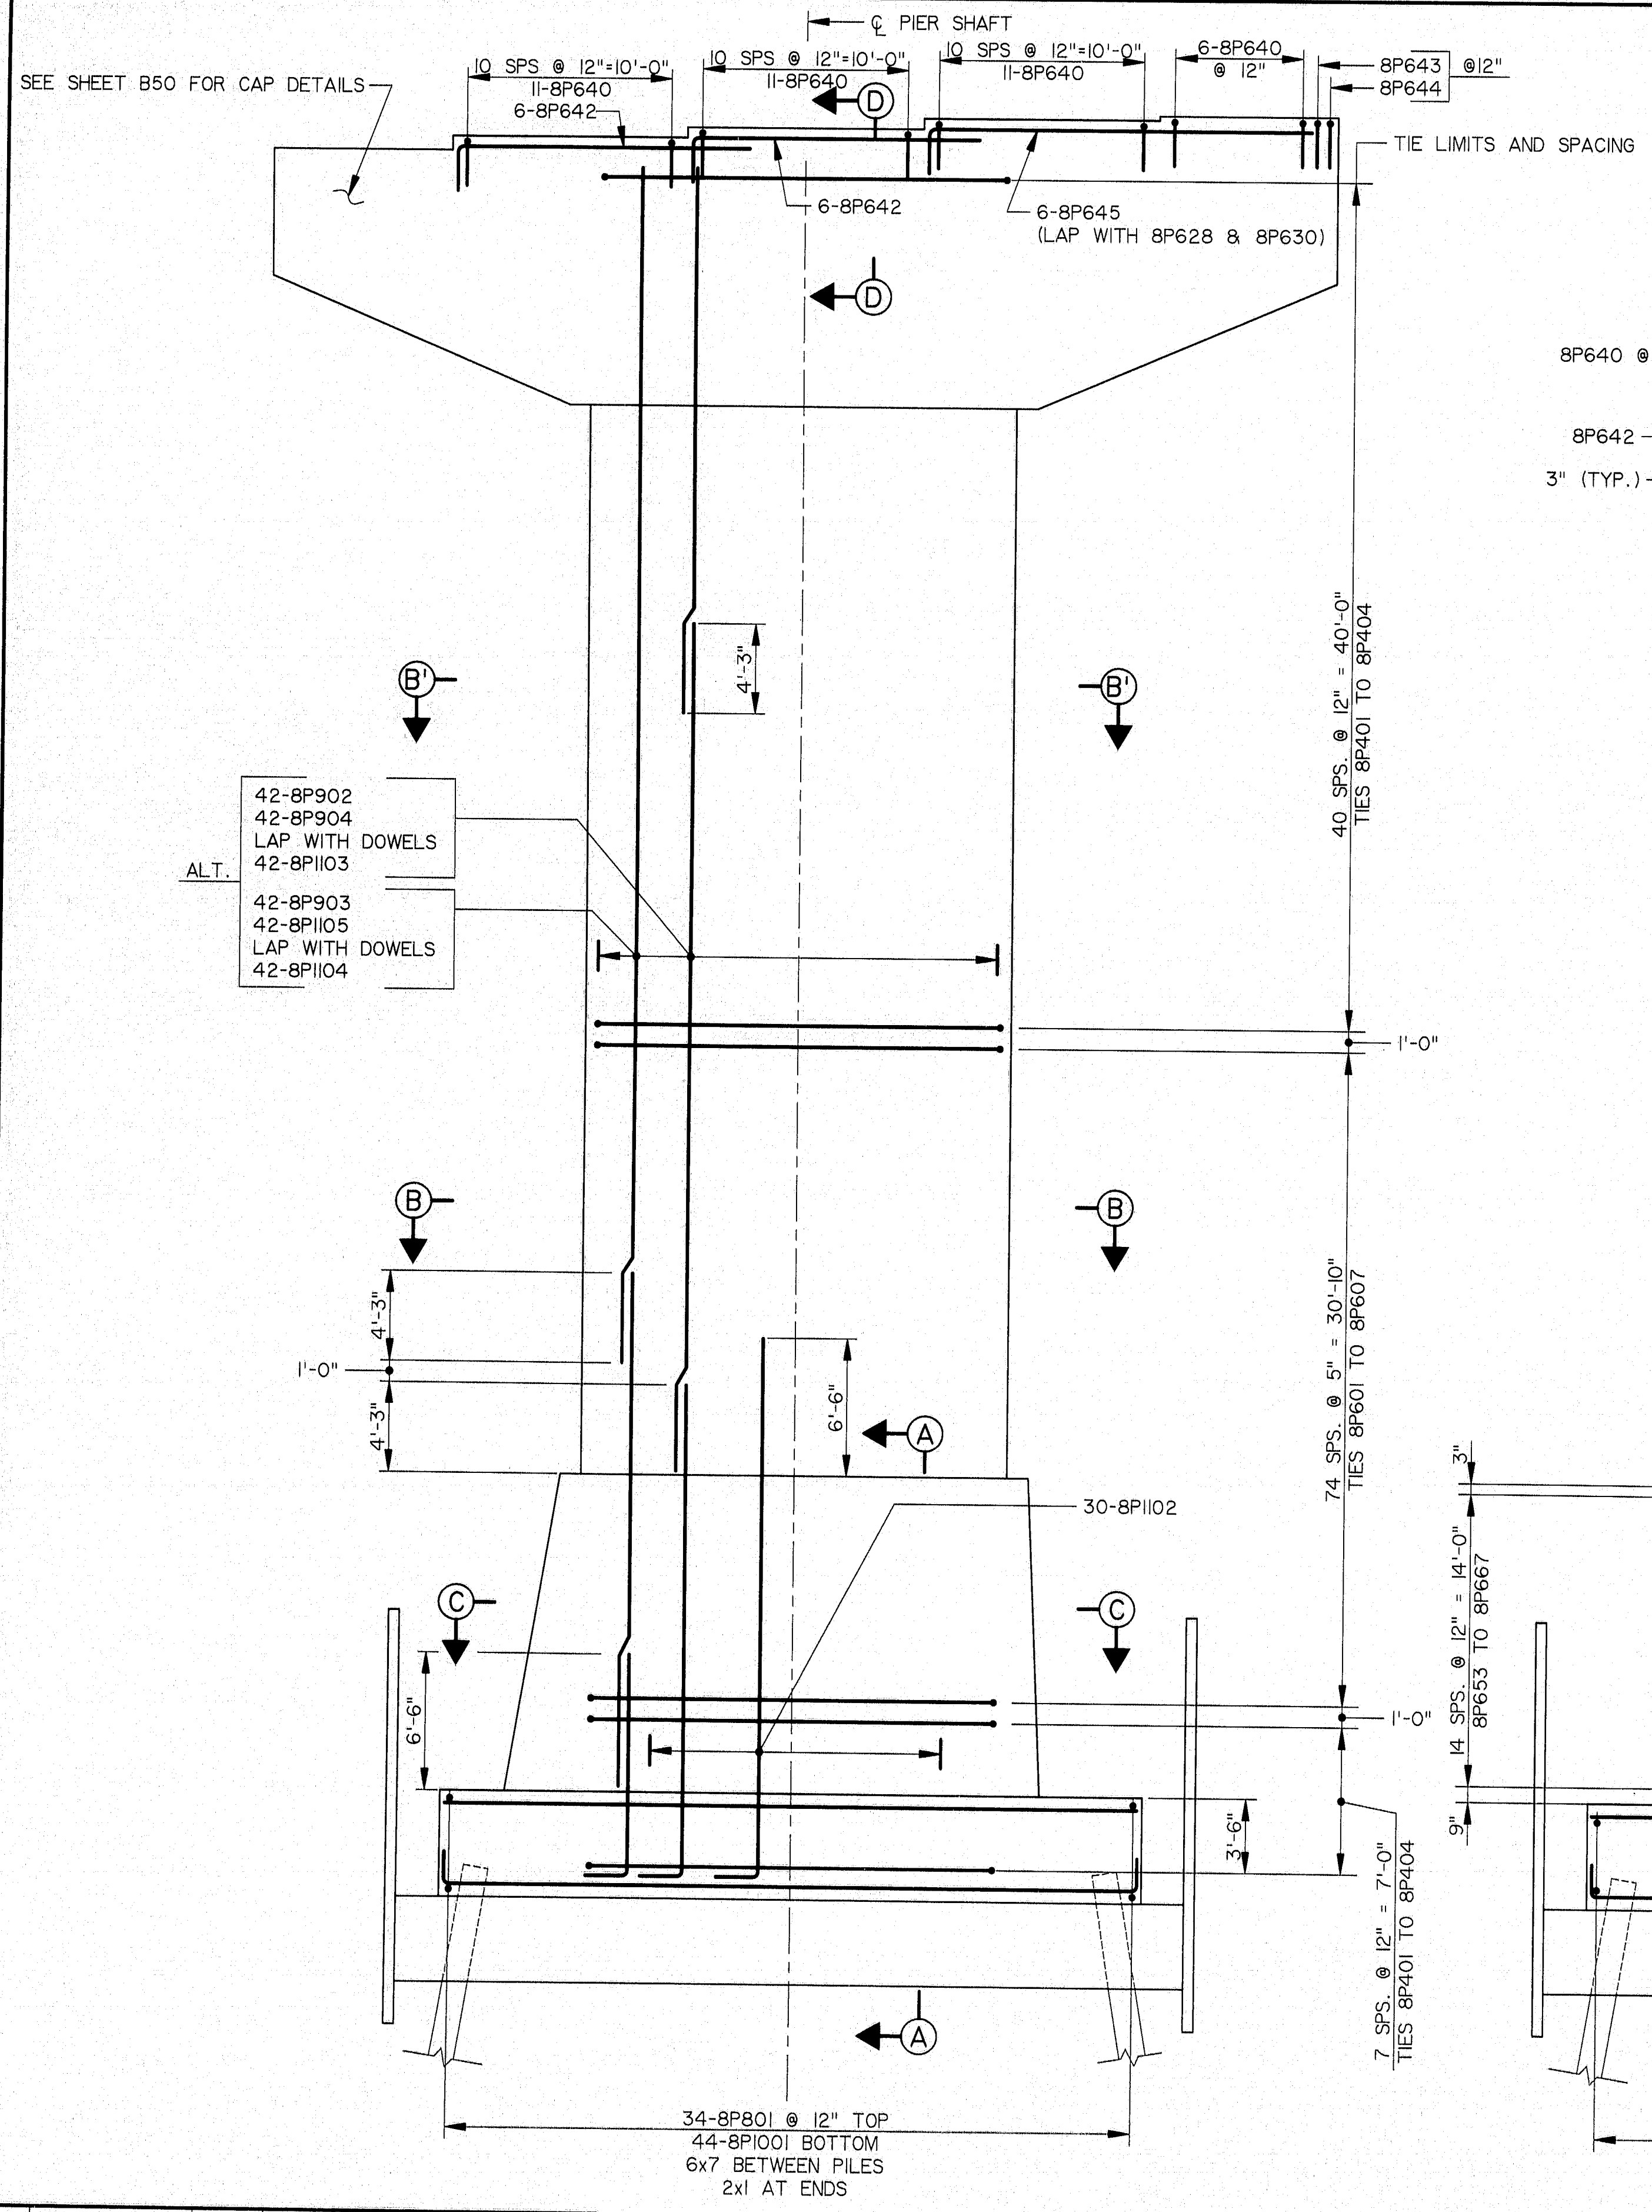

NO.	REVISION	BY	DATE	IN CHARGE OF

ELEVATION - PIER 8

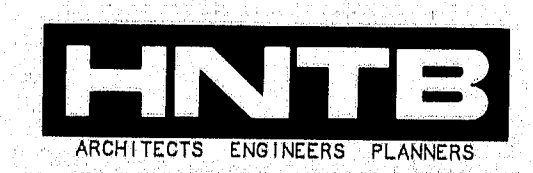

115-240

STEEL ALTERNATIVE

STATE OF MAINE

DEPARTMENT OF TRANSPORTATION

WATERVILLE - WINSLOW PROJECT

DONALD V. CARTER BRIDGE


OVER

KENNEBEC RIVER


PIER 8 RE-STEEL

SHEET B45 OF B86 AUGUSTA, MAINE

F. N. A. REG. NO.	STATE	PROJECT NUMBER	SHEET NO.	TOTAL SHEETS
1	MAINE	0009 (002)	55	103

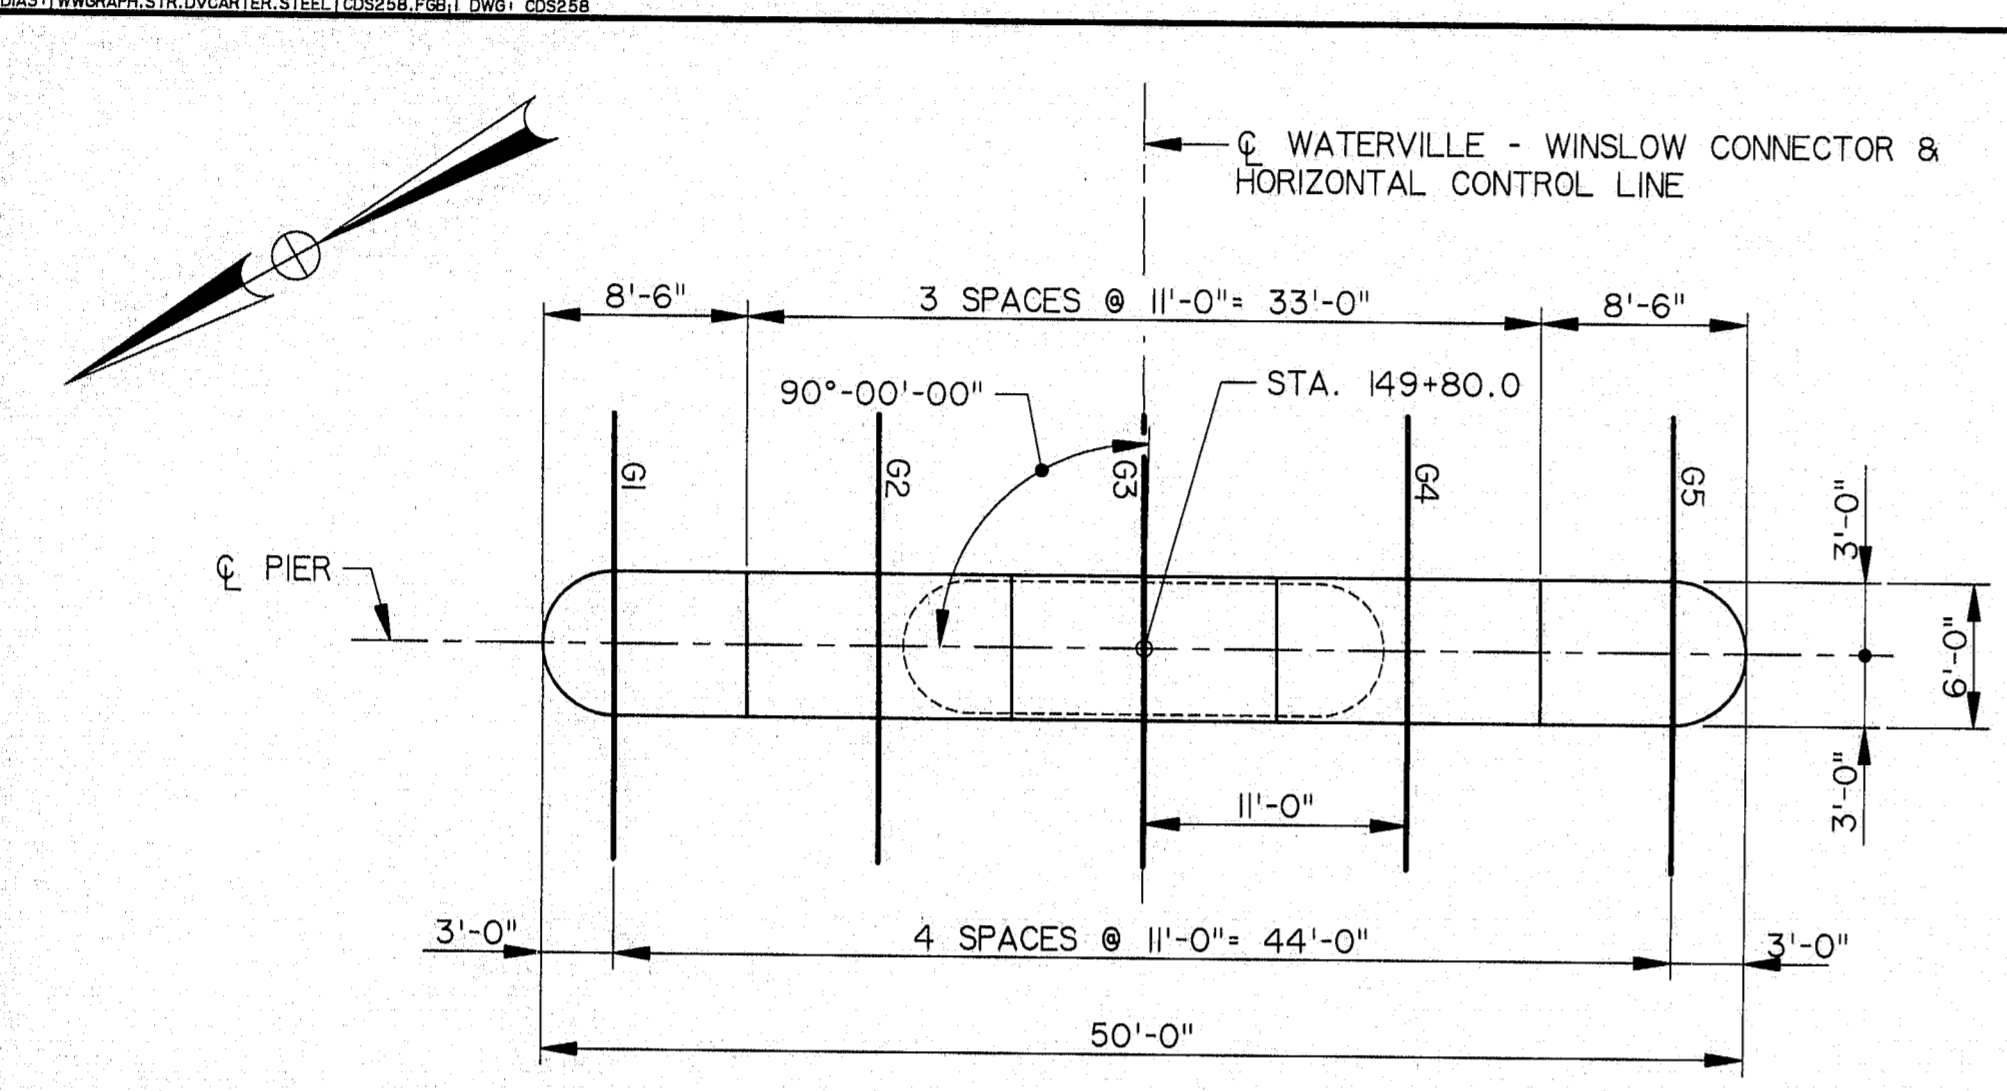


PLAN - PIER 9

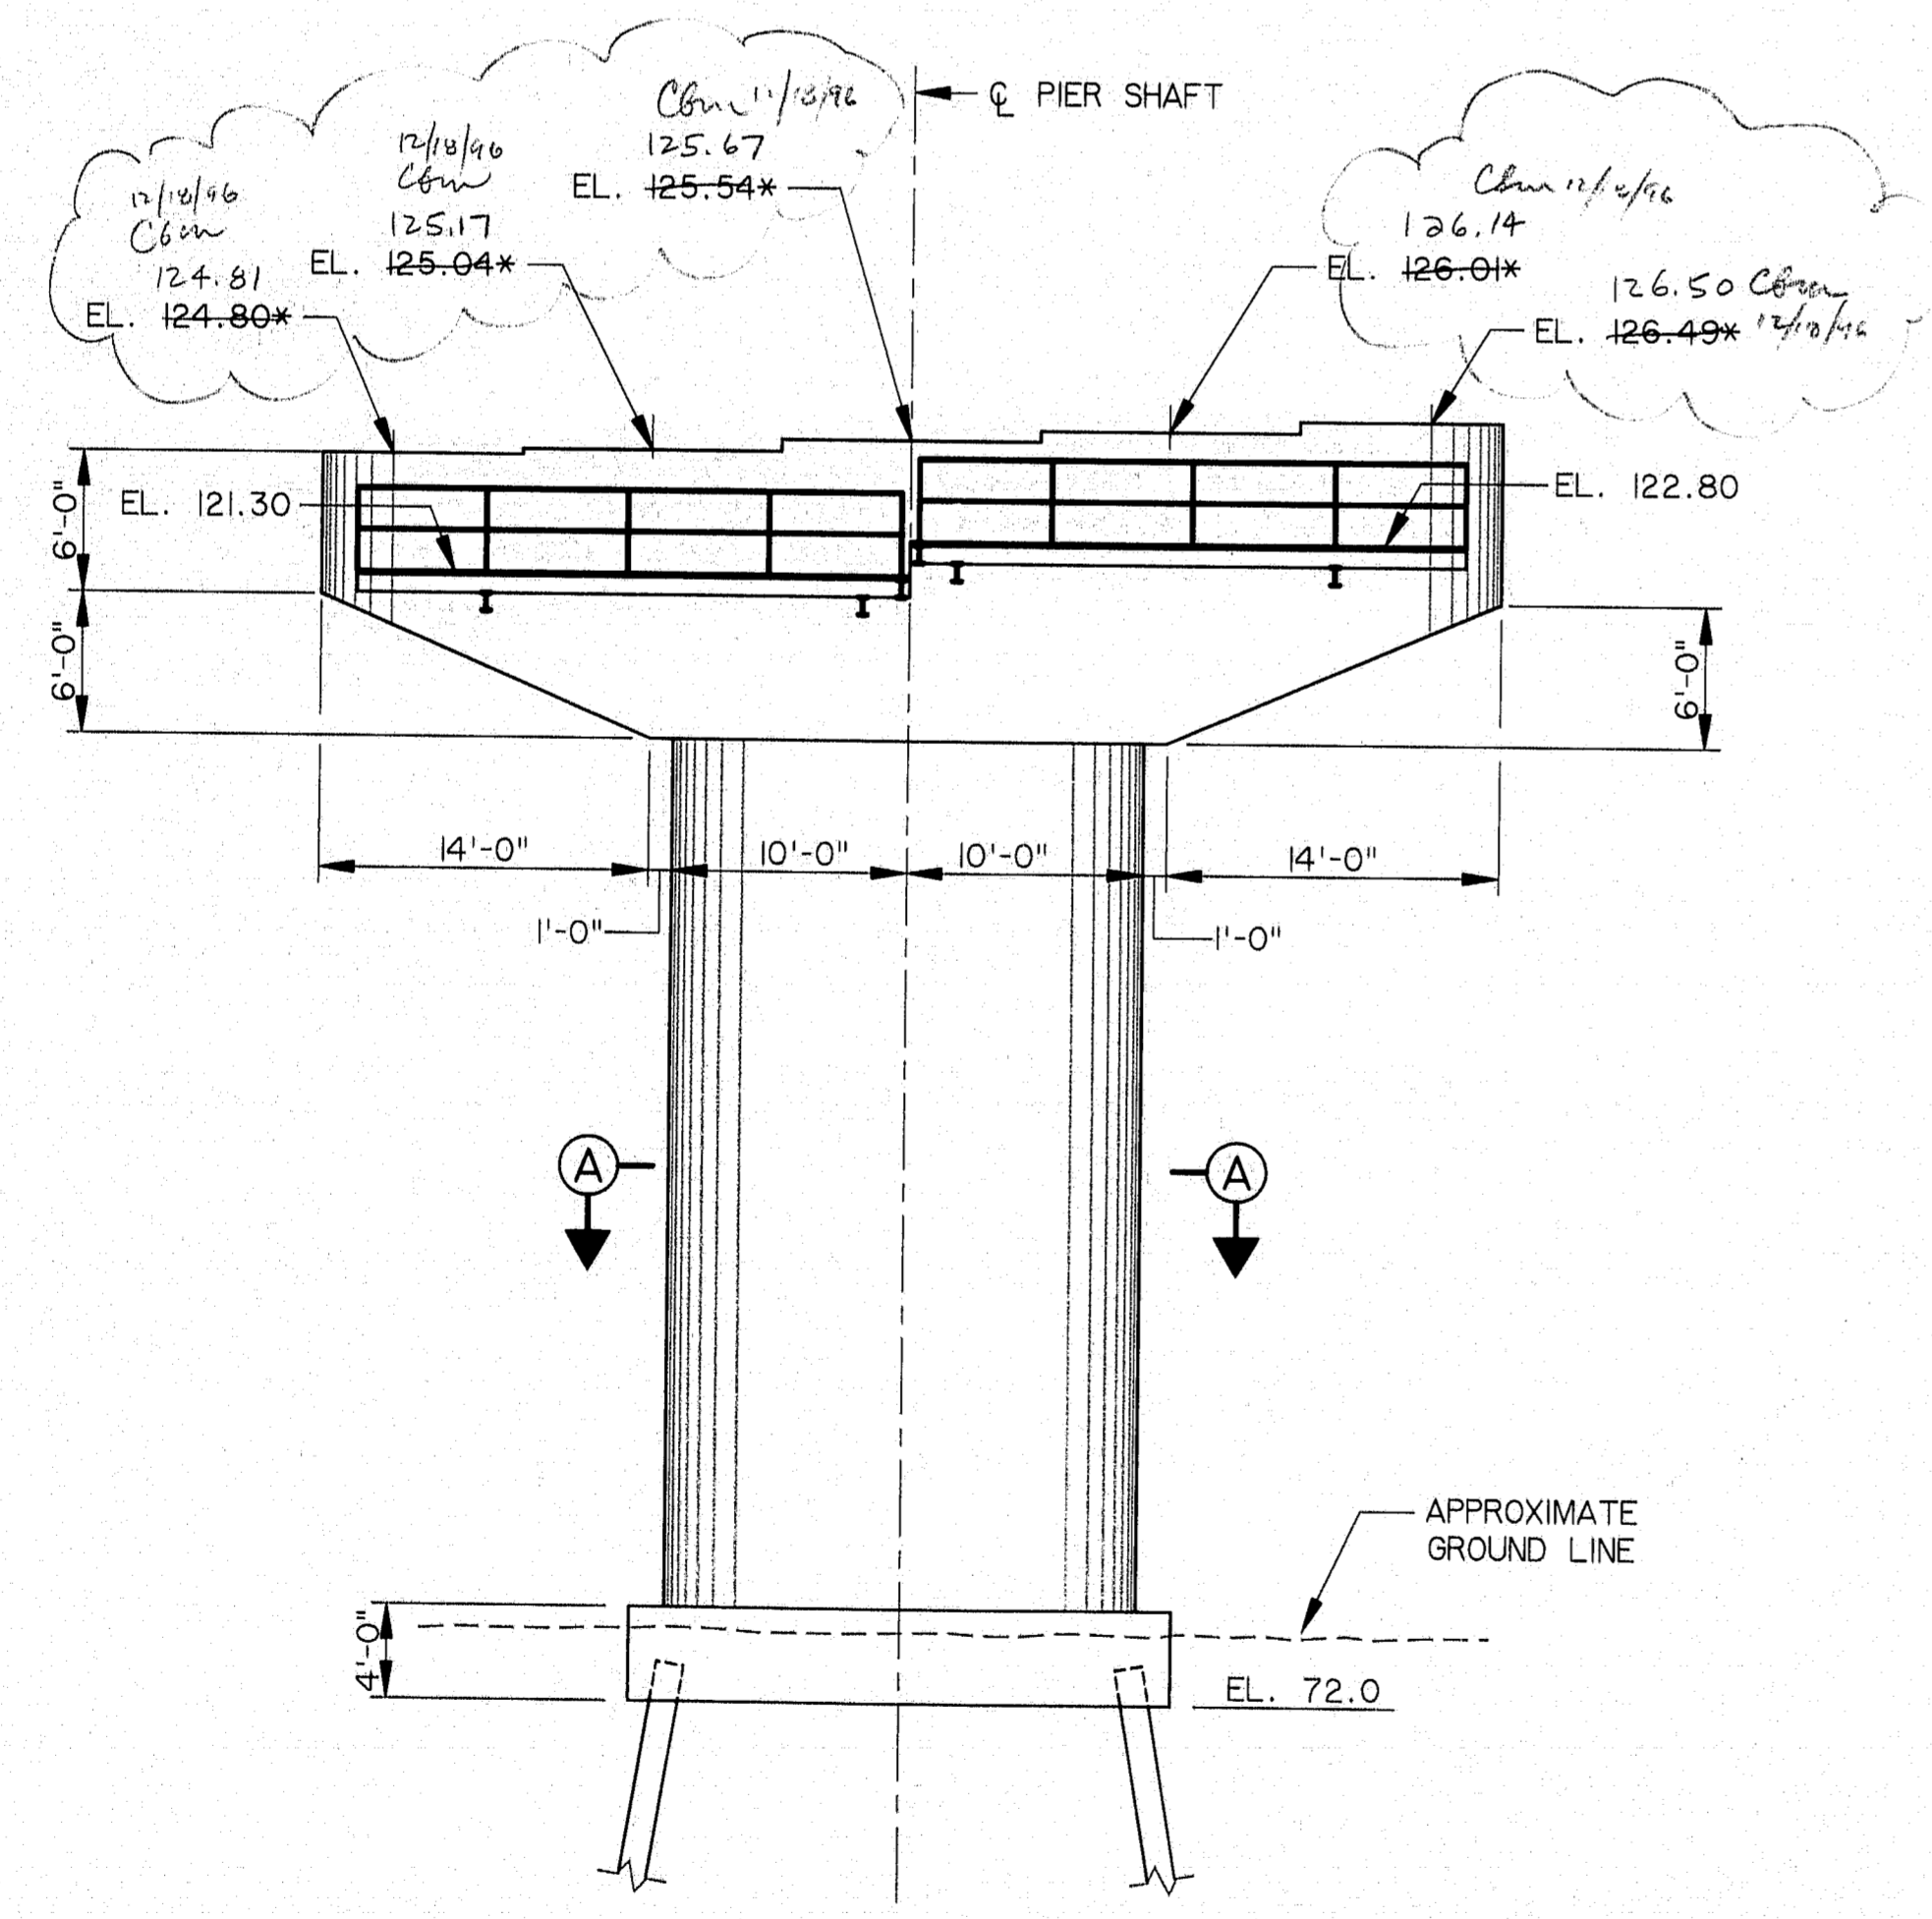


ELEVATION  
(LOOKING UPSTATION)

\* SEE NOTE 7, SHEET B30.

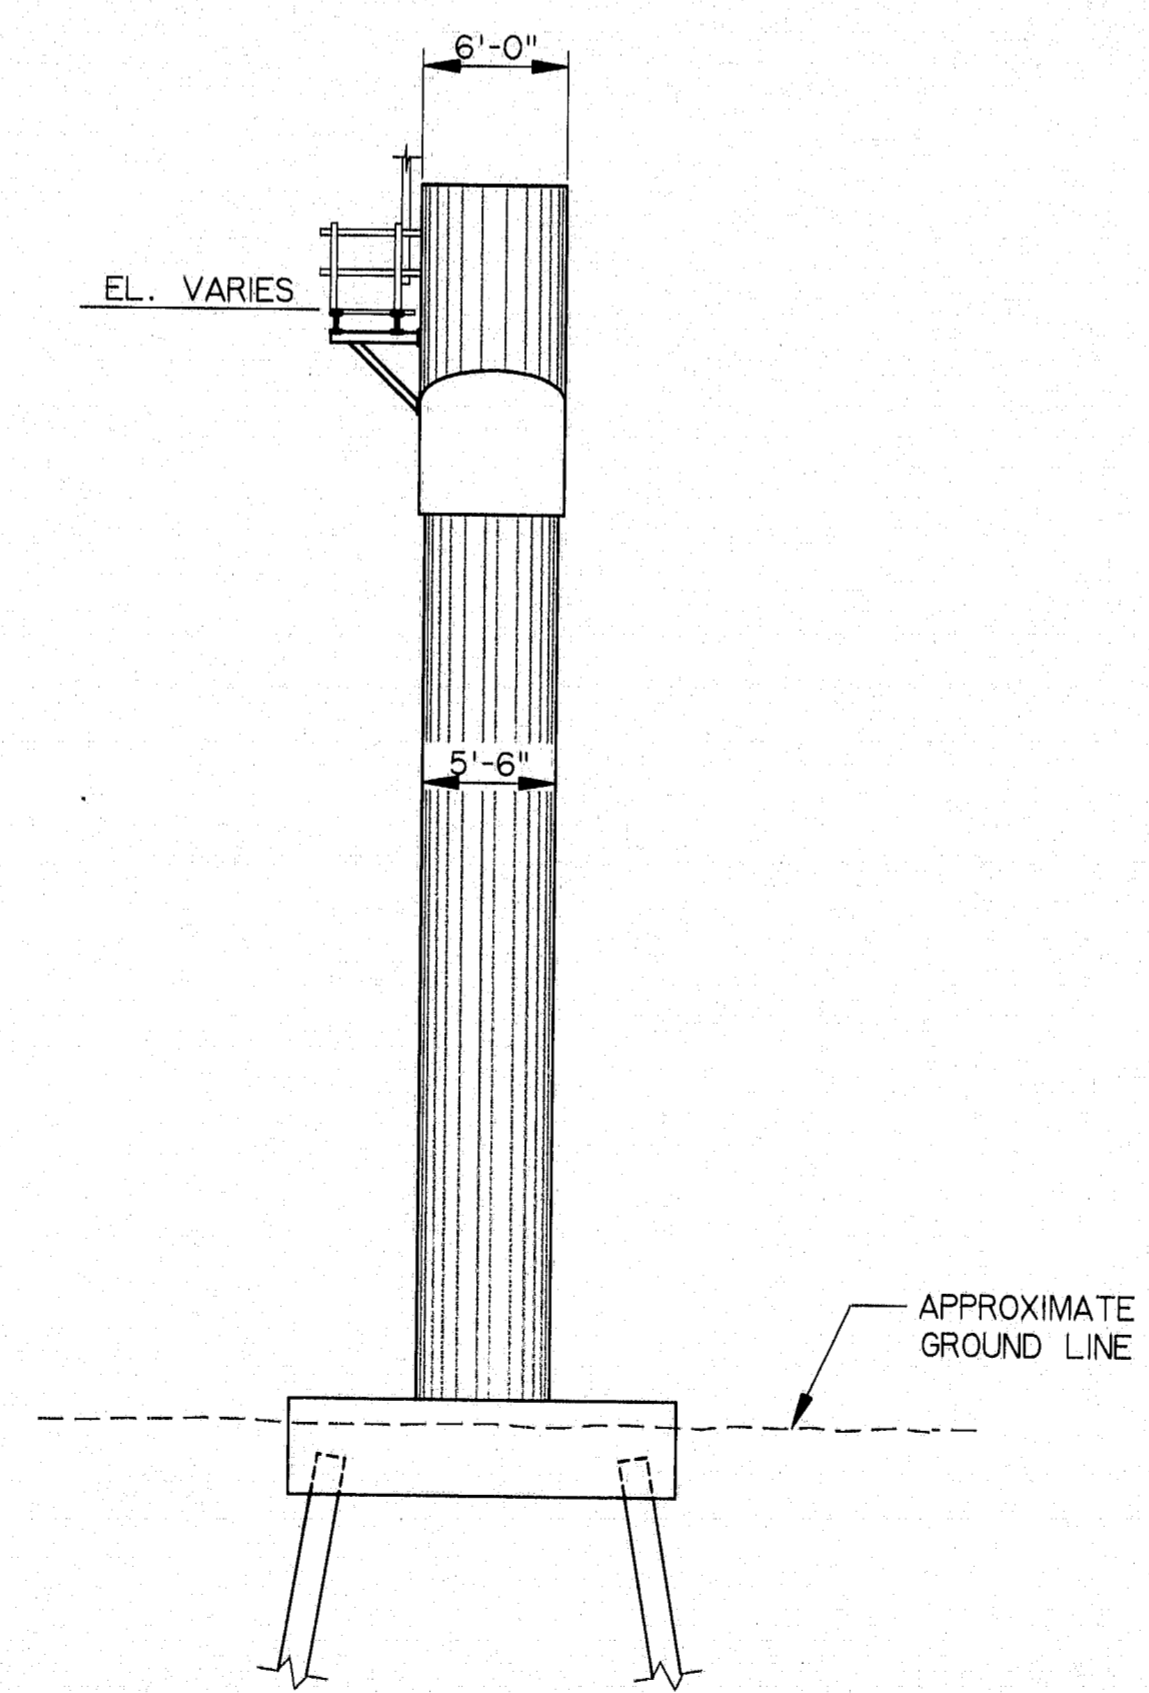

SIDE ELEVATION  
1/8" = 1'-0"

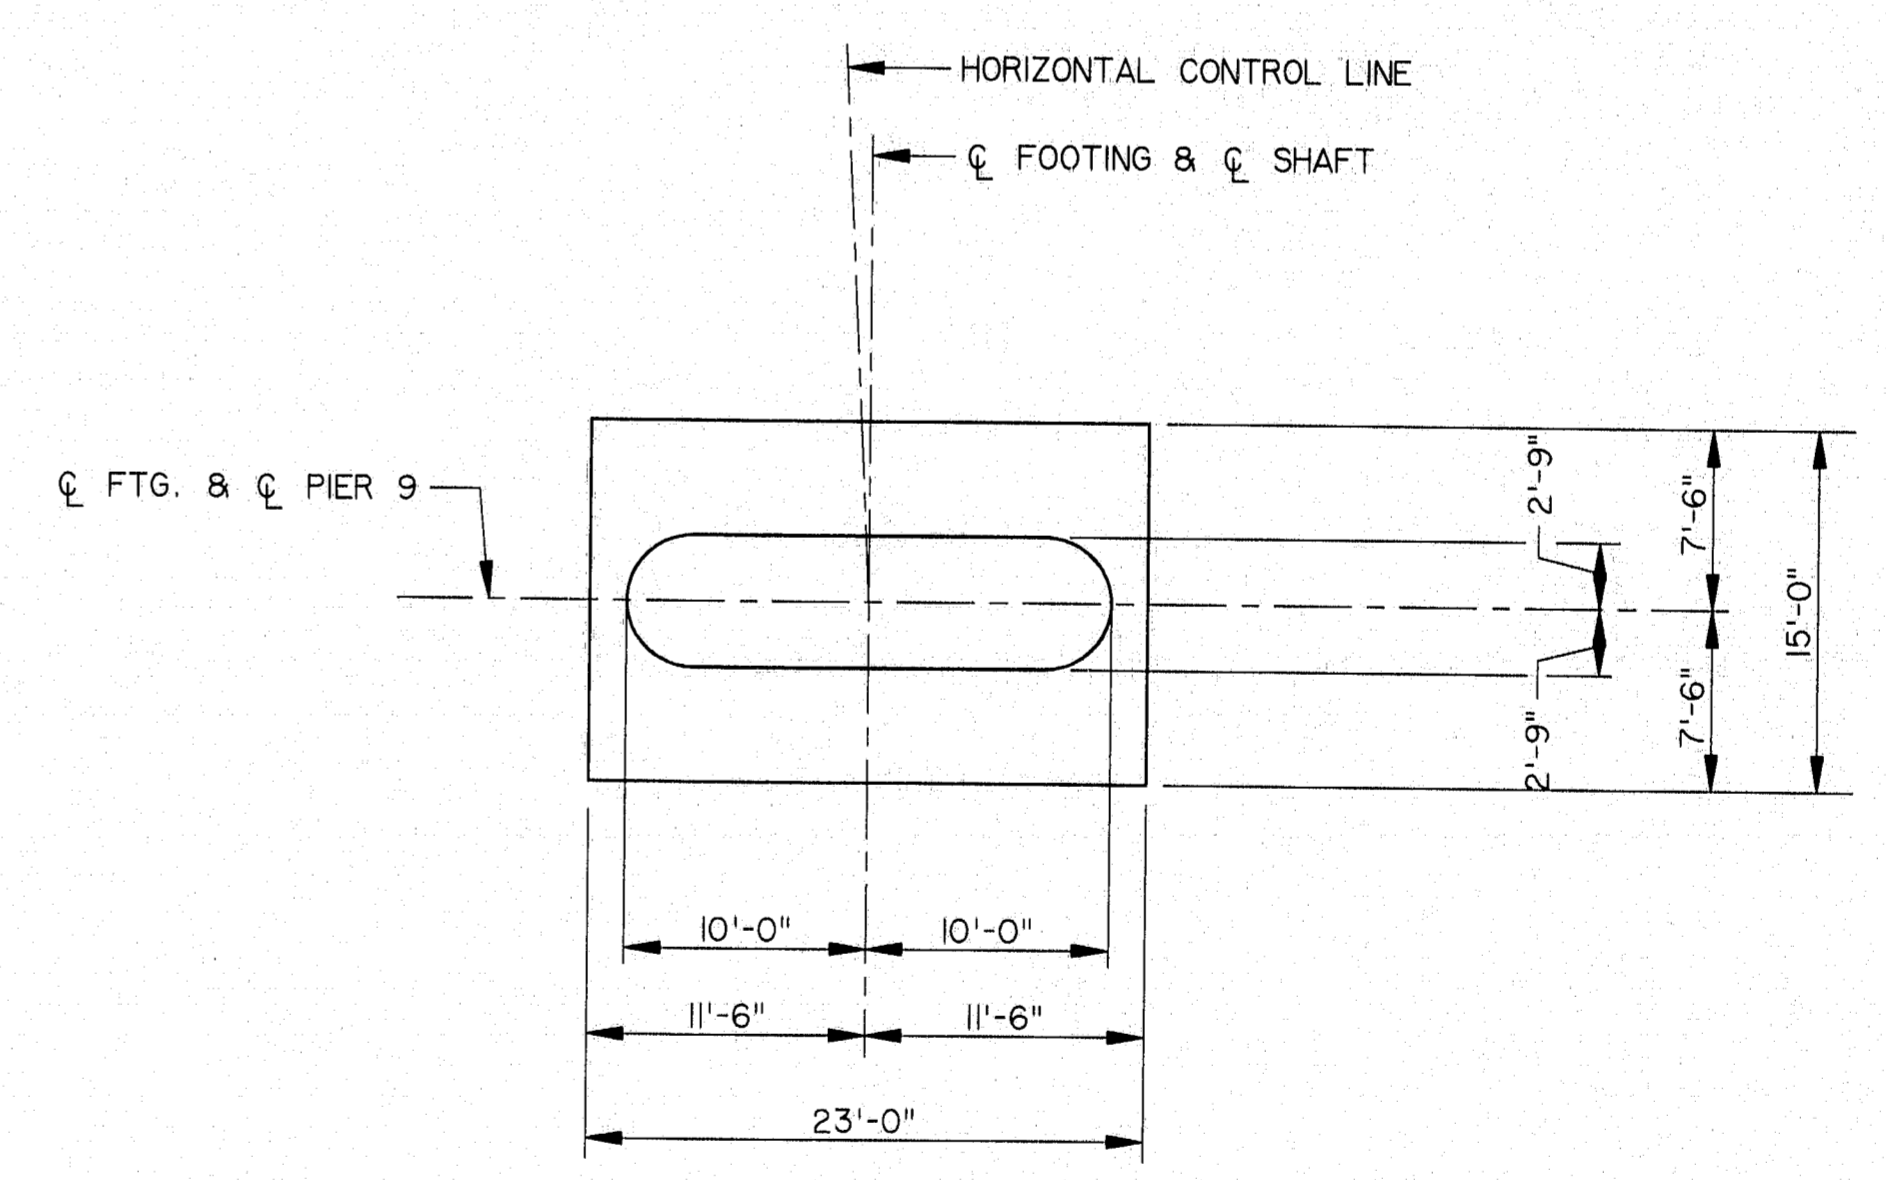


SECTION A-A

NOTES:


1. MAXIMUM CALCULATED PILE LOAD = 116 TONS (GROUP 1).
2. SEE SHEET B30 FOR ADDITIONAL NOTES.

NO.	REVISION	BY	DATE	IN CHARGE OF
		DESIGNED: SM	9/94	
		DRAWN: RJT	9/94	
		CHECKED: DWR	9/94	
				CJM

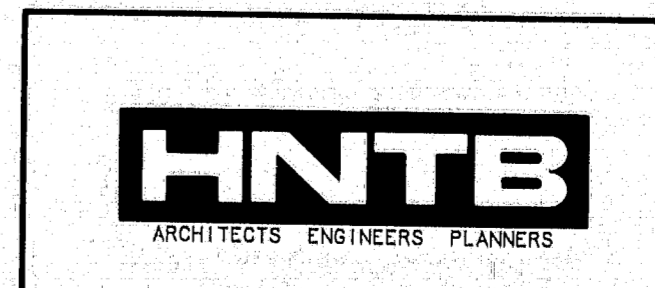


**115-241**  
STEEL ALTERNATIVE  
STATE OF MAINE  
DEPARTMENT OF TRANSPORTATION  
WATERVILLE - WINSLOW PROJECT  
DONALD V. CARTER BRIDGE  
OVER  
KENNEBEC RIVER  
**PIER 9 DETAILS**  
SHEET B46 OF B86 AUGUSTA, MAINE


F. R. W. A. REG. NO.	STATE	PROJECT NUMBER	SHEET NO.	TOTAL SHEETS
1	MAINE	0009(002)	56	103

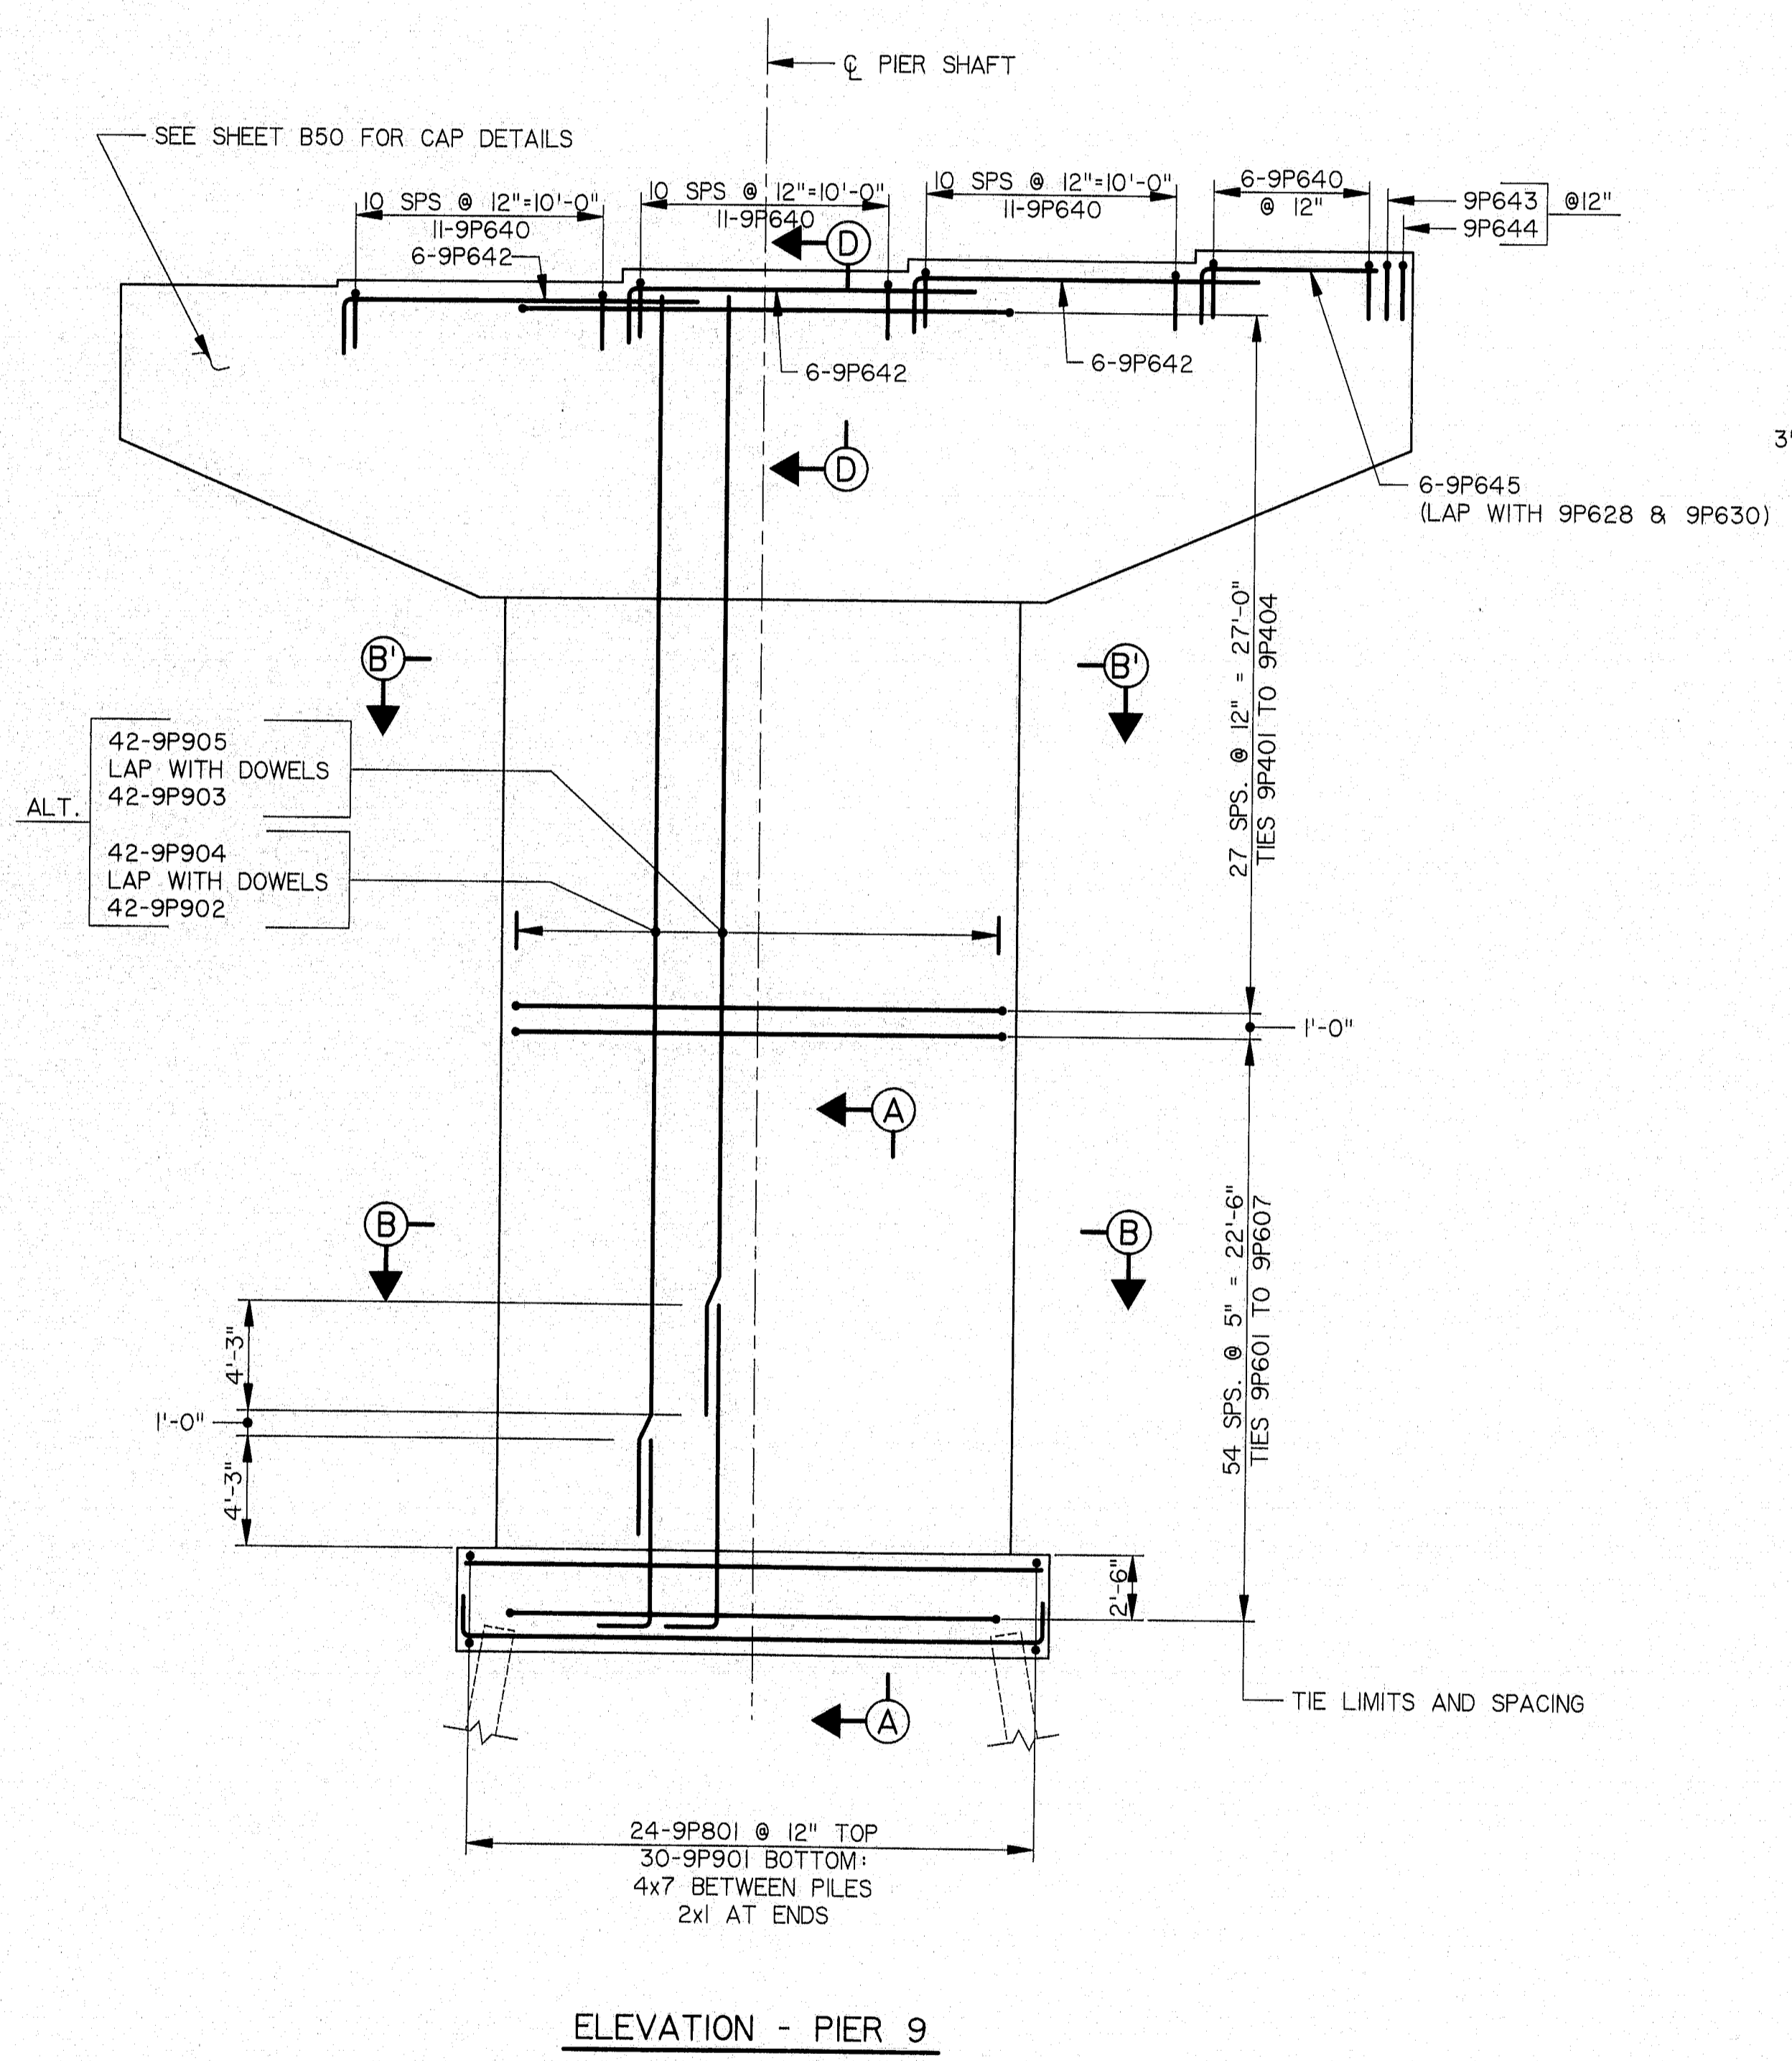


ELEVATION - PIER 9

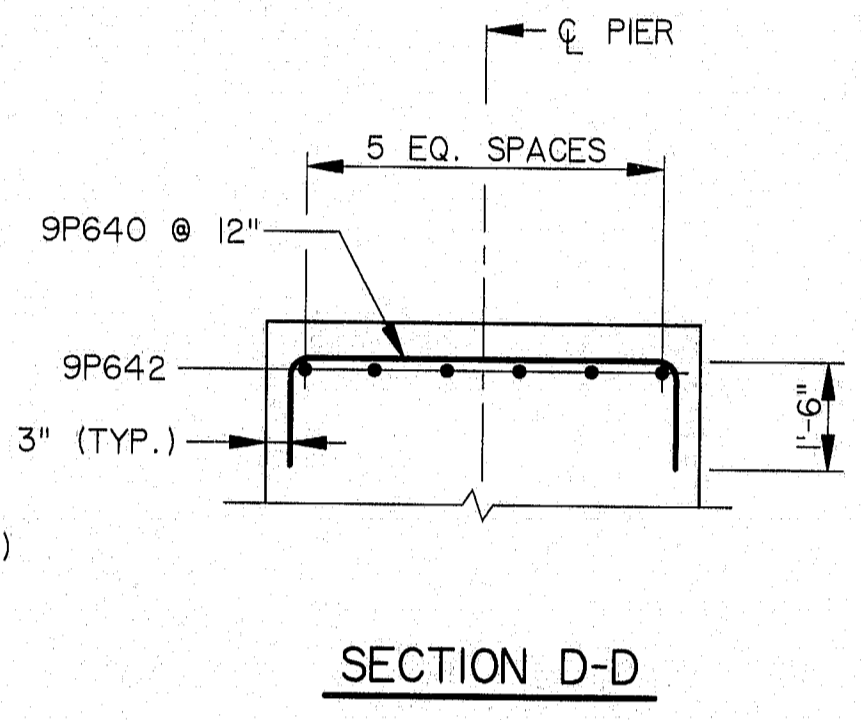

SECTION D-D

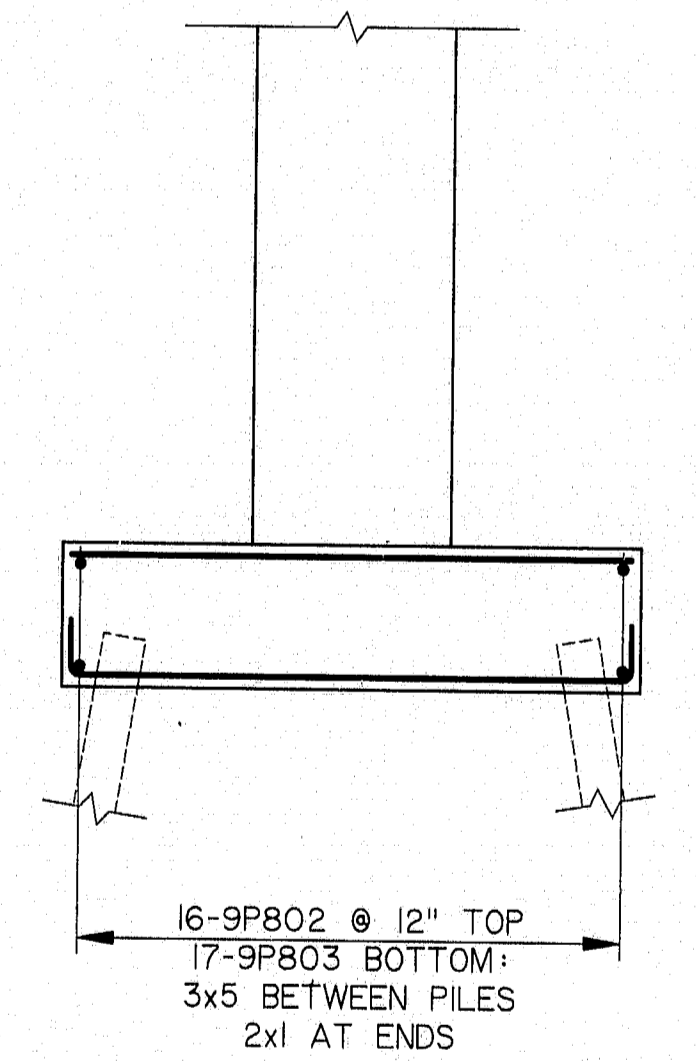

SECTION A-A

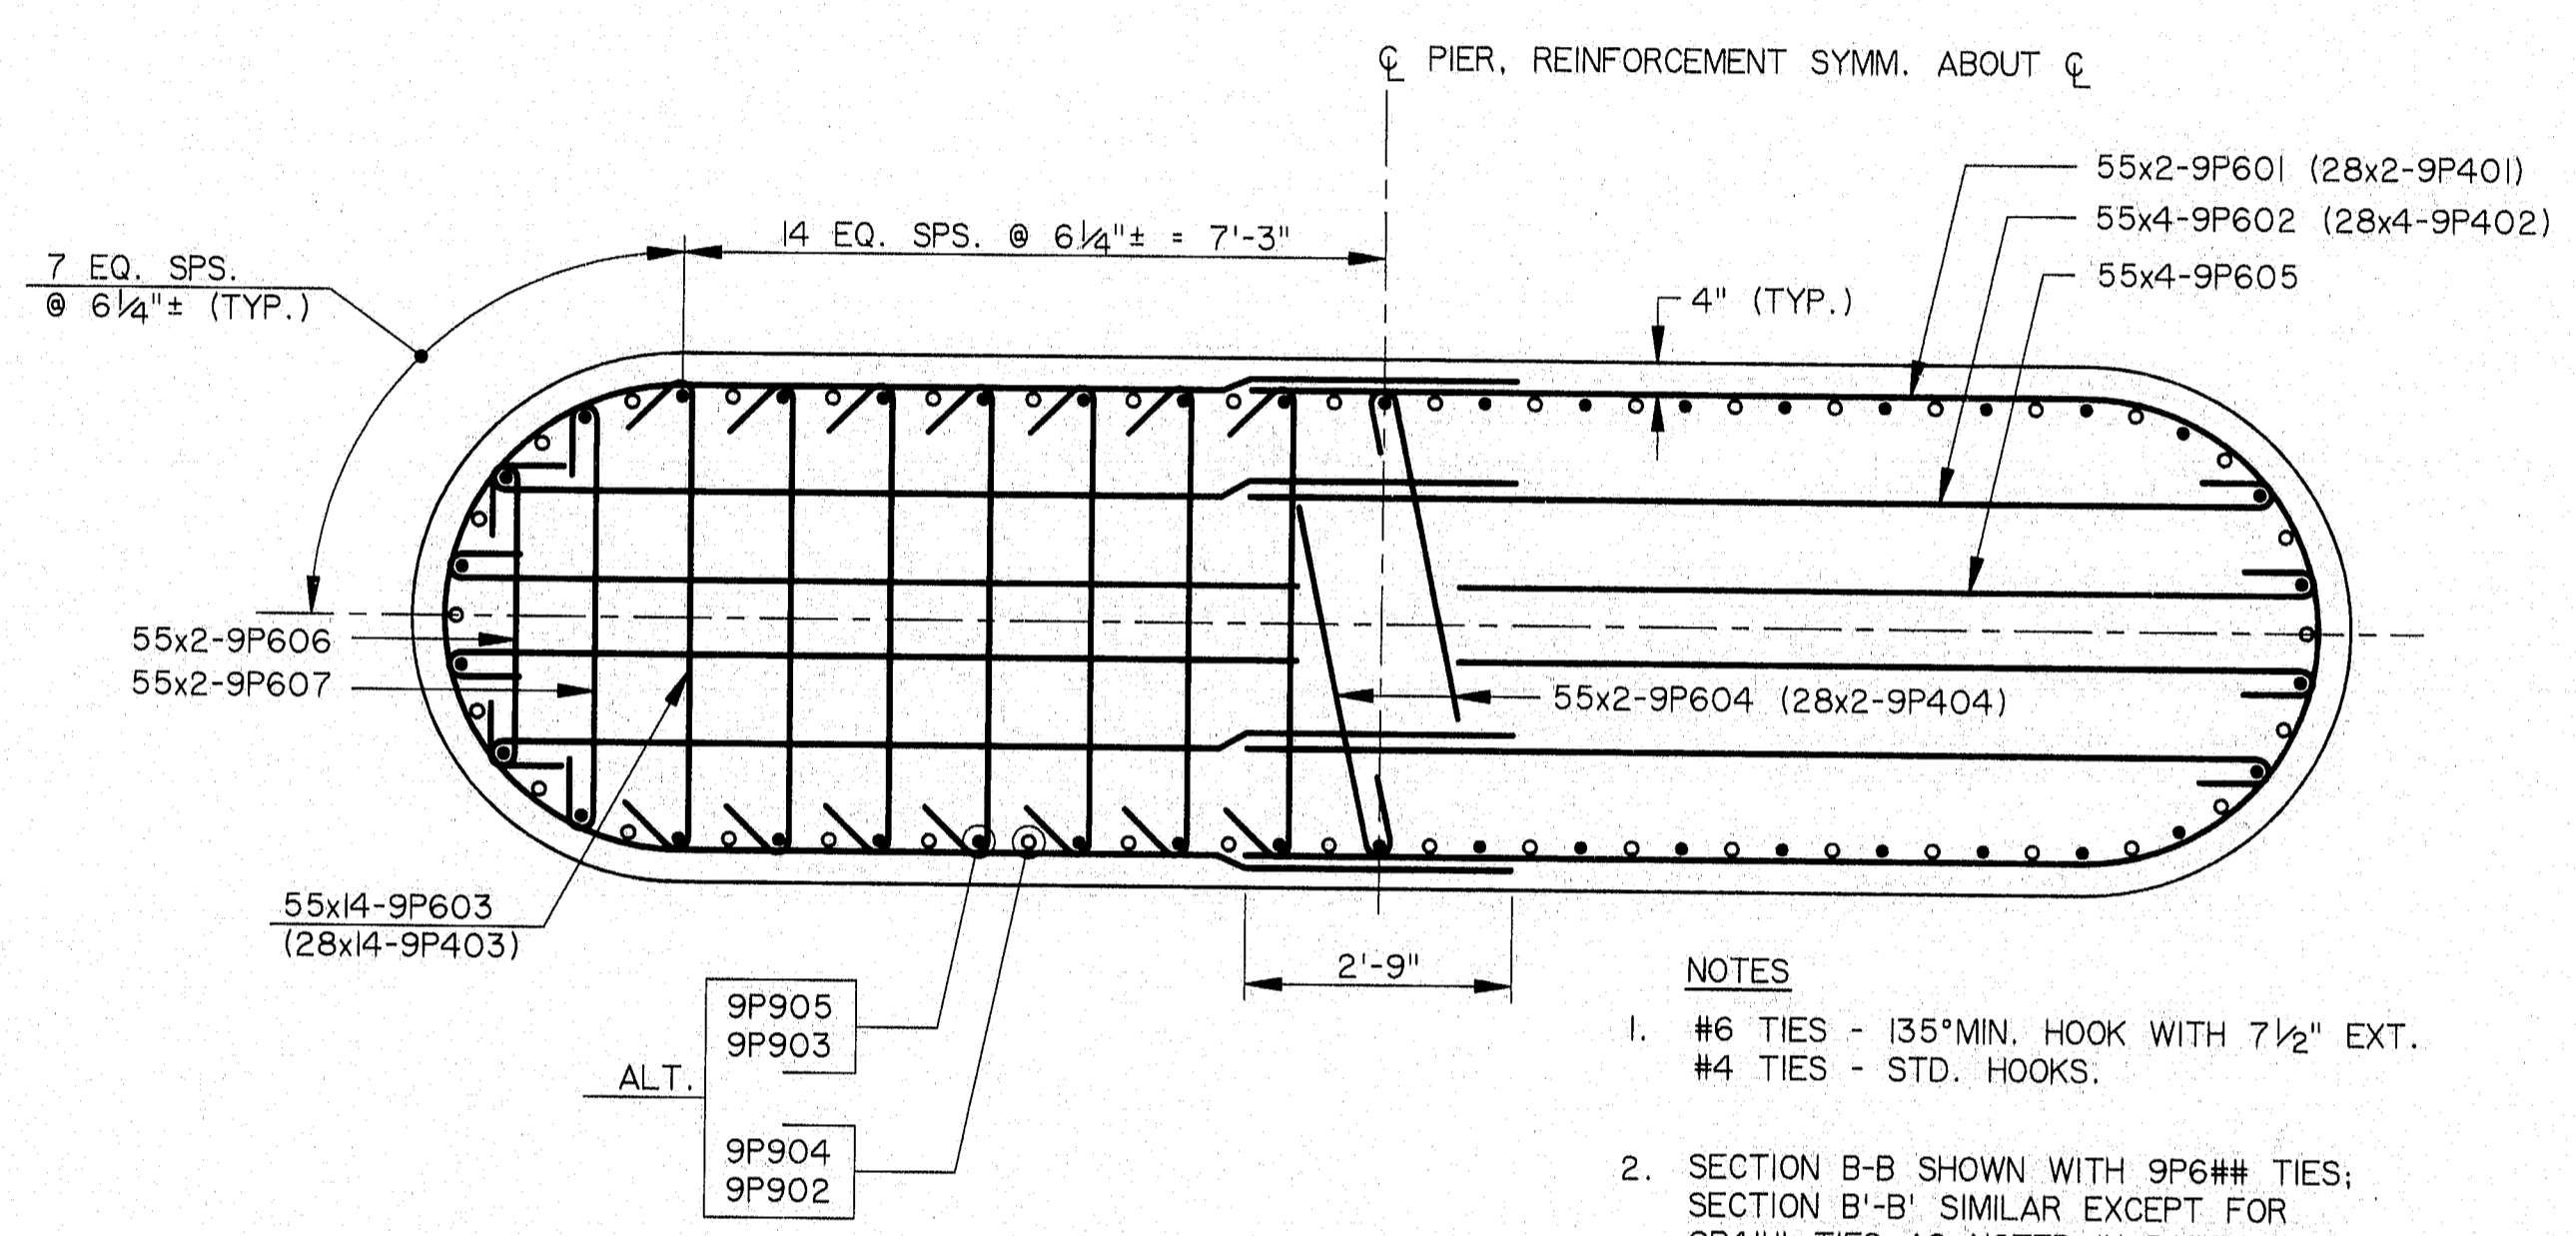


SECTION B-B (SECTION B'-B')

- NOTES
- #6 TIES - 135° MIN. HOOK WITH 7 1/2" EXT. #4 TIES - STD. HOOKS.
  - SECTION B-B SHOWN WITH 9P6## TIES; SECTION B'-B' SIMILAR EXCEPT FOR 9P4## TIES AS NOTED IN PARENTHESIS.

*As Built  
Draw 12/1/16*





115-242

NO.	REVISION	BY	DATE	IN CHARGE OF	CJM
		DESIGNED:	SM	9/94	
		DRAWN:	RJT	9/94	
		CHECKED:	DWR	9/94	

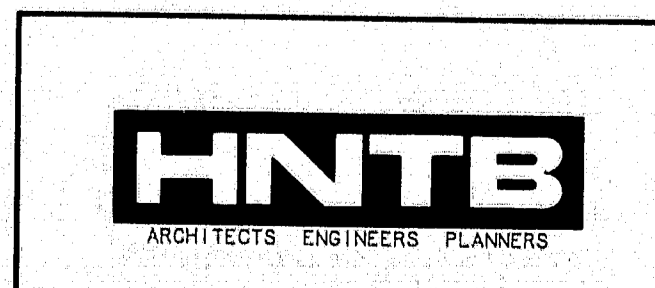

STEEL ALTERNATIVE  
STATE OF MAINE  
DEPARTMENT OF TRANSPORTATION  
WATERVILLE - WINSLOW PROJECT  
DONALD V. CARTER BRIDGE  
OVER  
KENNEBEC RIVER  
PIER 9 RE-STEEL  
SHEET B47 OF 886 AUGUSTA, MAINE

F.H.R.A. REG. NO.	STATE	PROJECT NUMBER	SHEET NO.	TOTAL SHEETS
1	MAINE	00091002	57	103

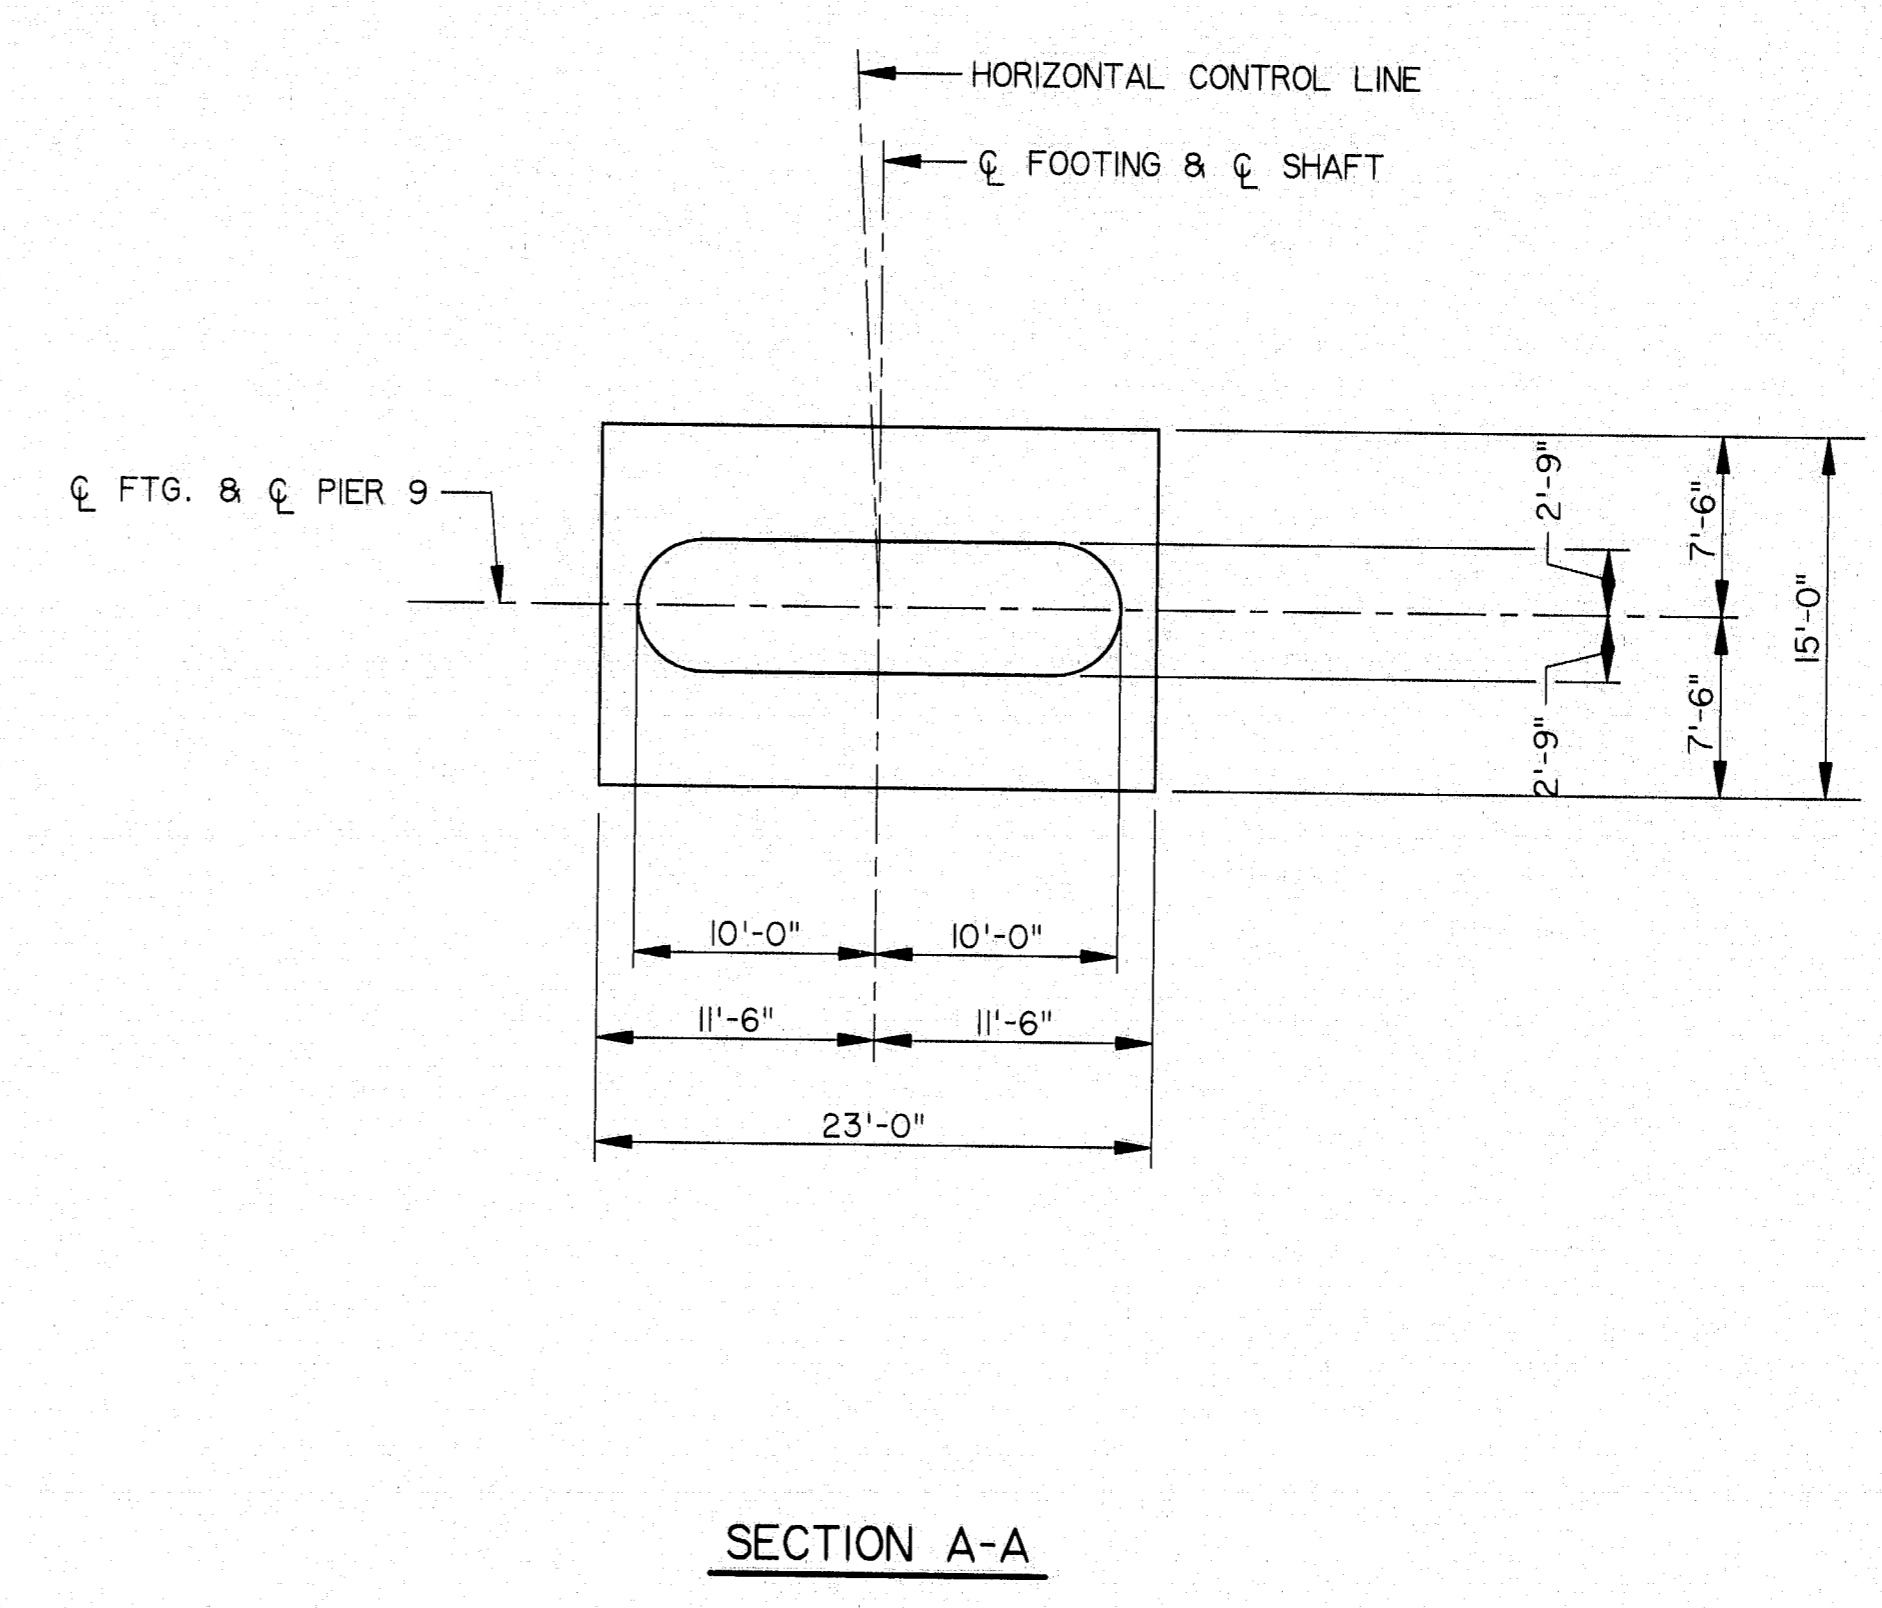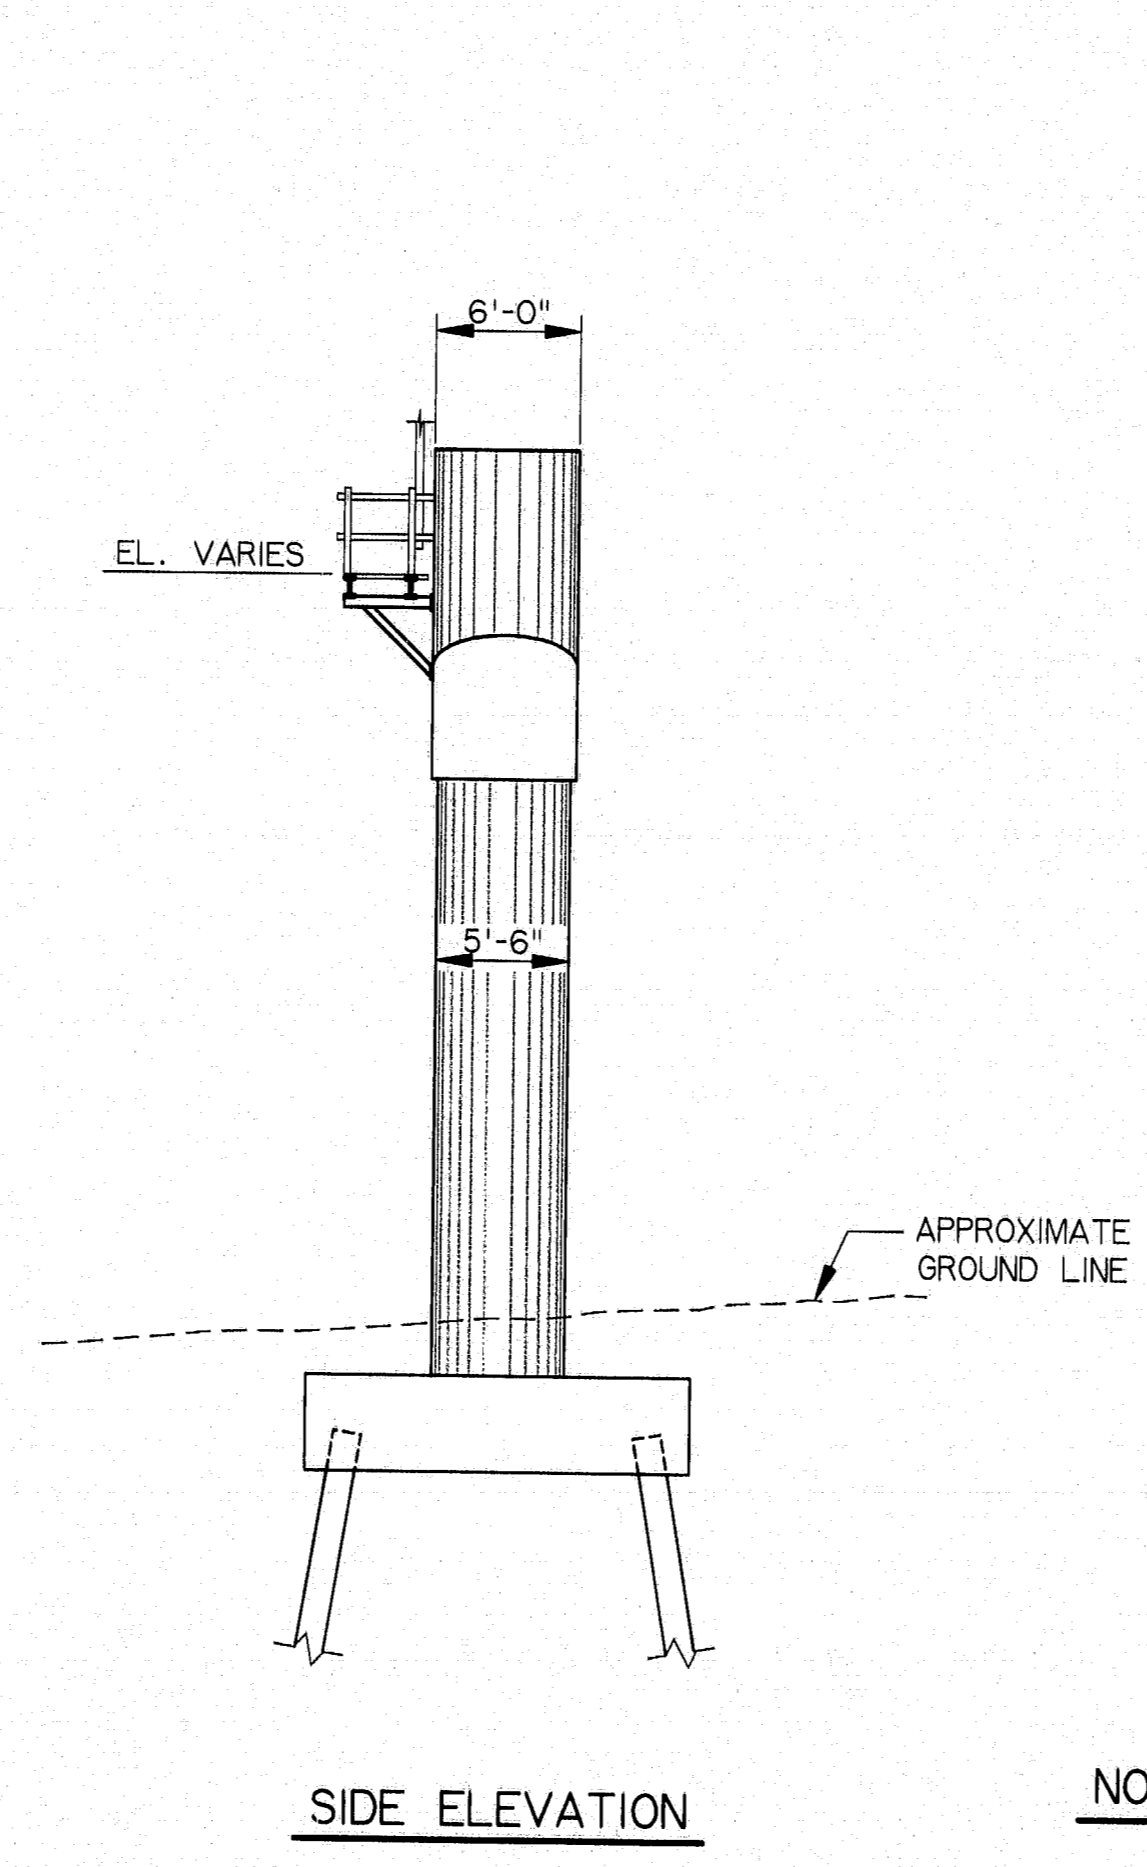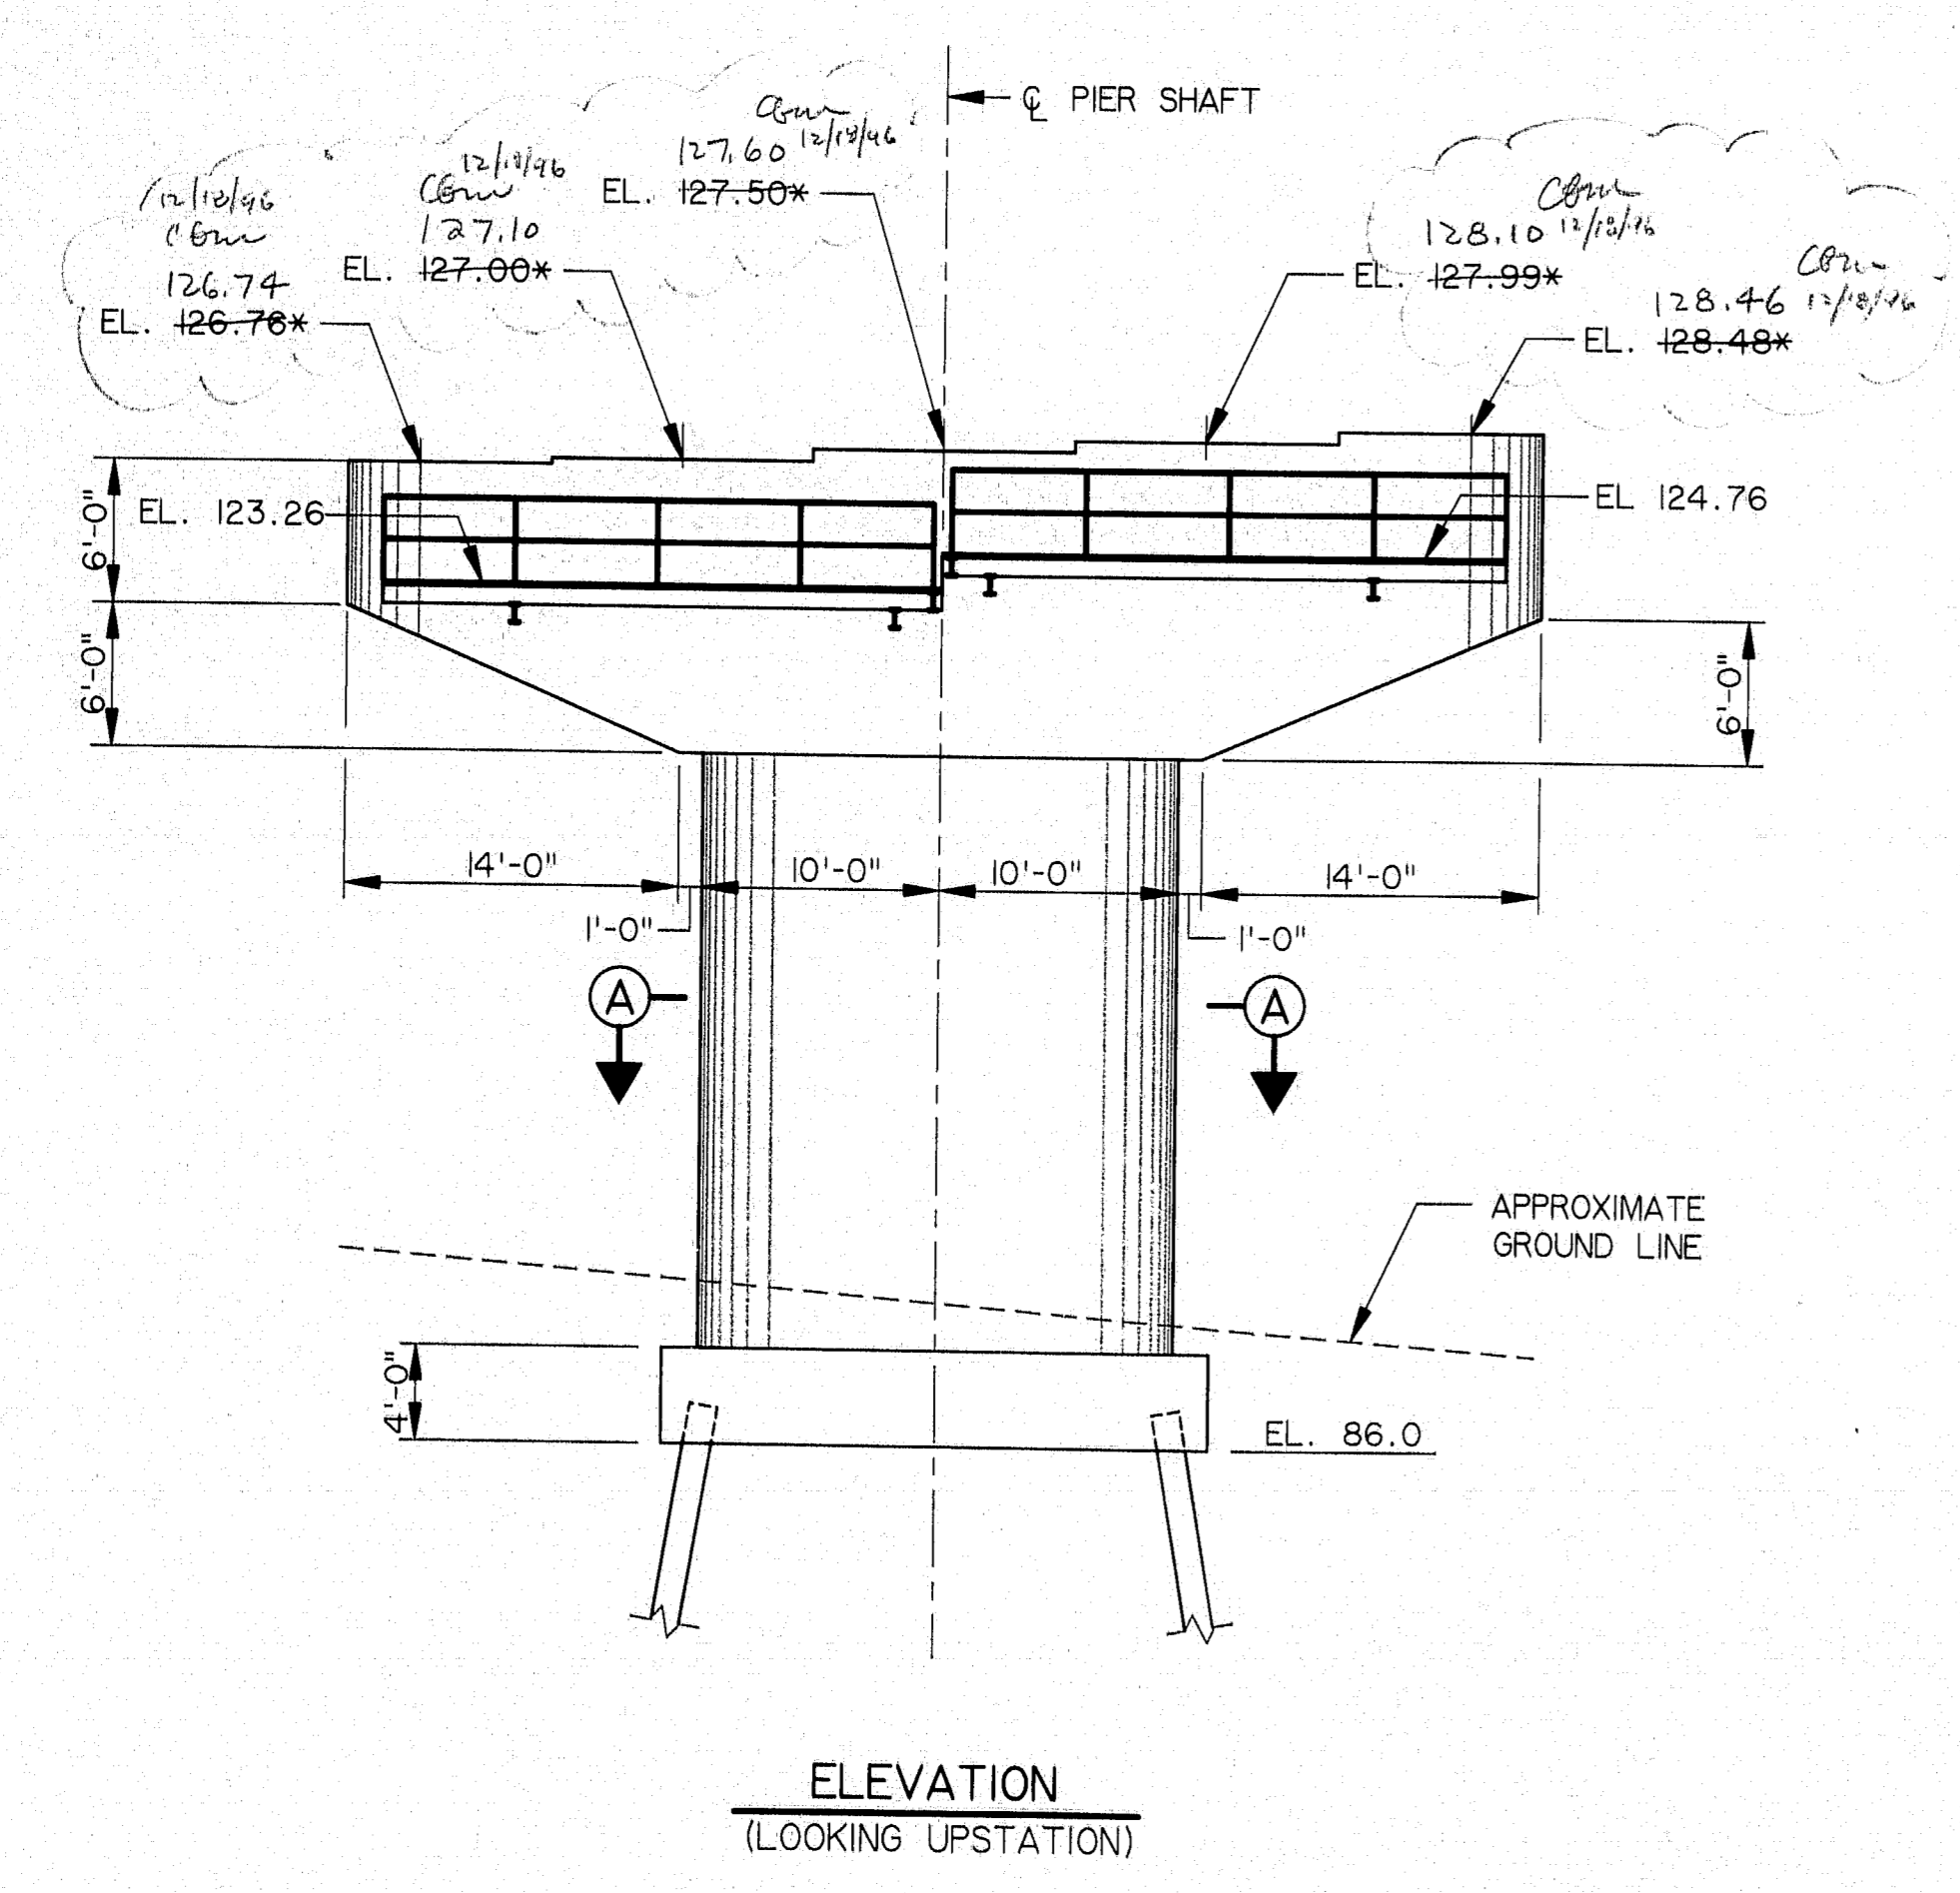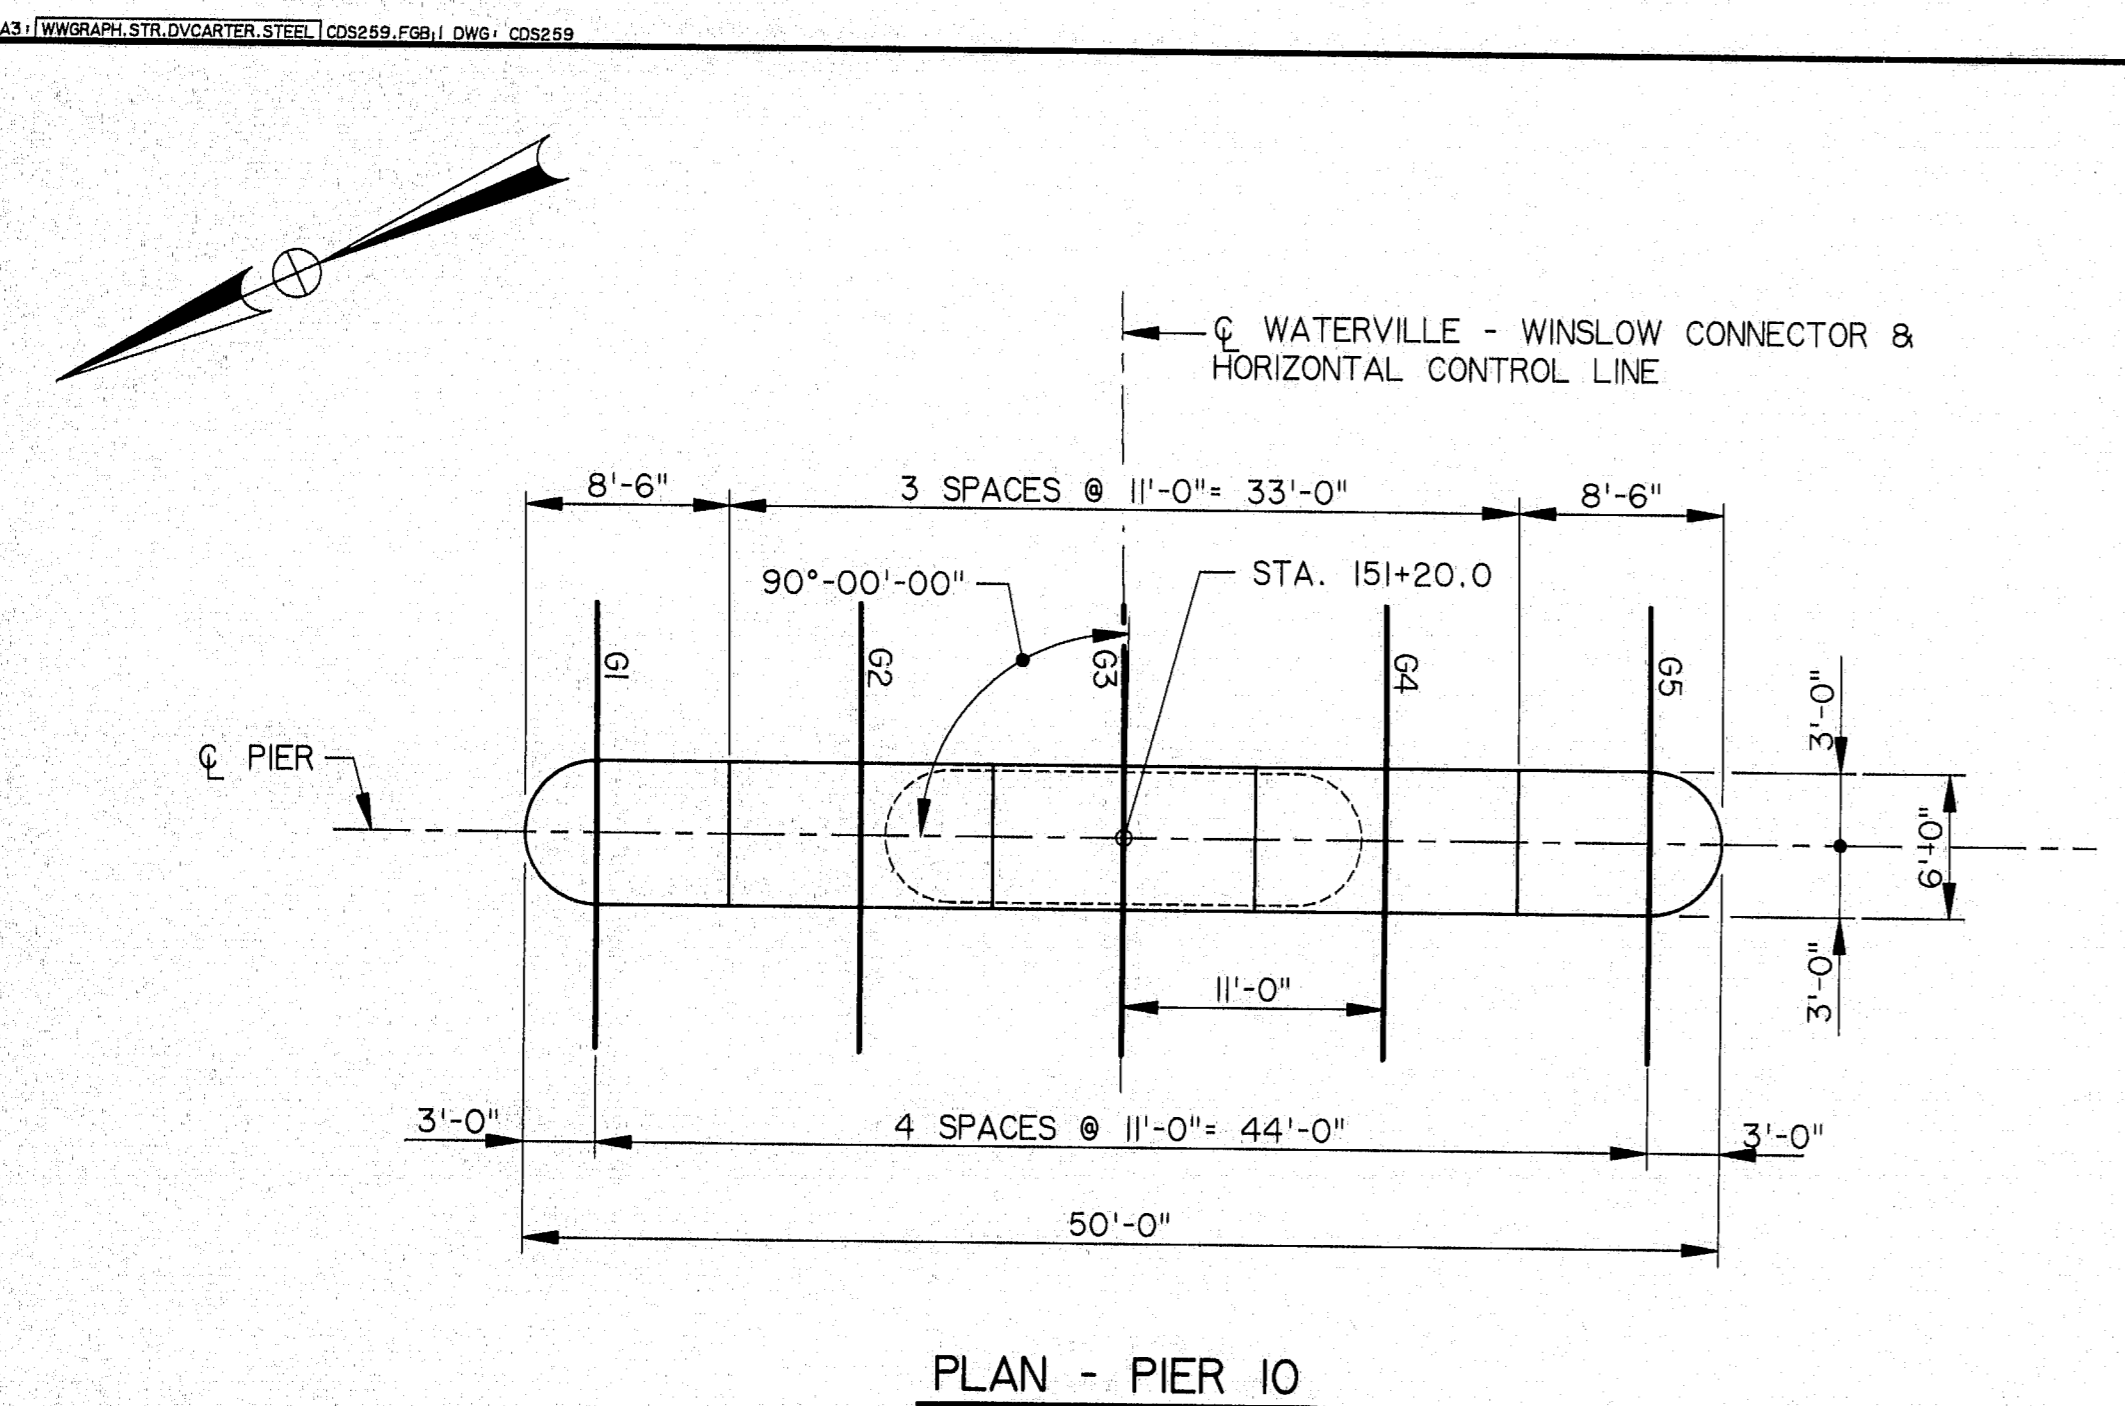

- NOTES:
1. MAXIMUM CALCULATED PILE LOAD = 107 TONS (GROUP # 1).
  2. SEE SHEET B30 FOR ADDITIONAL NOTES.


\* SEE NOTE 7, SHEET B30.

NO.	REVISION	BY	DATE	IN CHARGE OF
		DESIGNED:	SM	9/94
		DRAWN:	RJT	9/94
		CHECKED:	DWR	9/94
			CJM	




**115-243**  
STEEL ALTERNATIVE  
STATE OF MAINE  
DEPARTMENT OF TRANSPORTATION  
WATERVILLE - WINSLOW PROJECT  
DONALD V. CARTER BRIDGE  
OVER  
KENNEBEC RIVER  
PIER 10 DETAILS  
SHEET B48 OF B86 AUGUSTA, MAINE


F.D.S. REG. NO.	STATE	PROJECT NUMBER	SHEET NO.	TOTAL SHEETS
1	MAINE	0009 (002)	5B	103

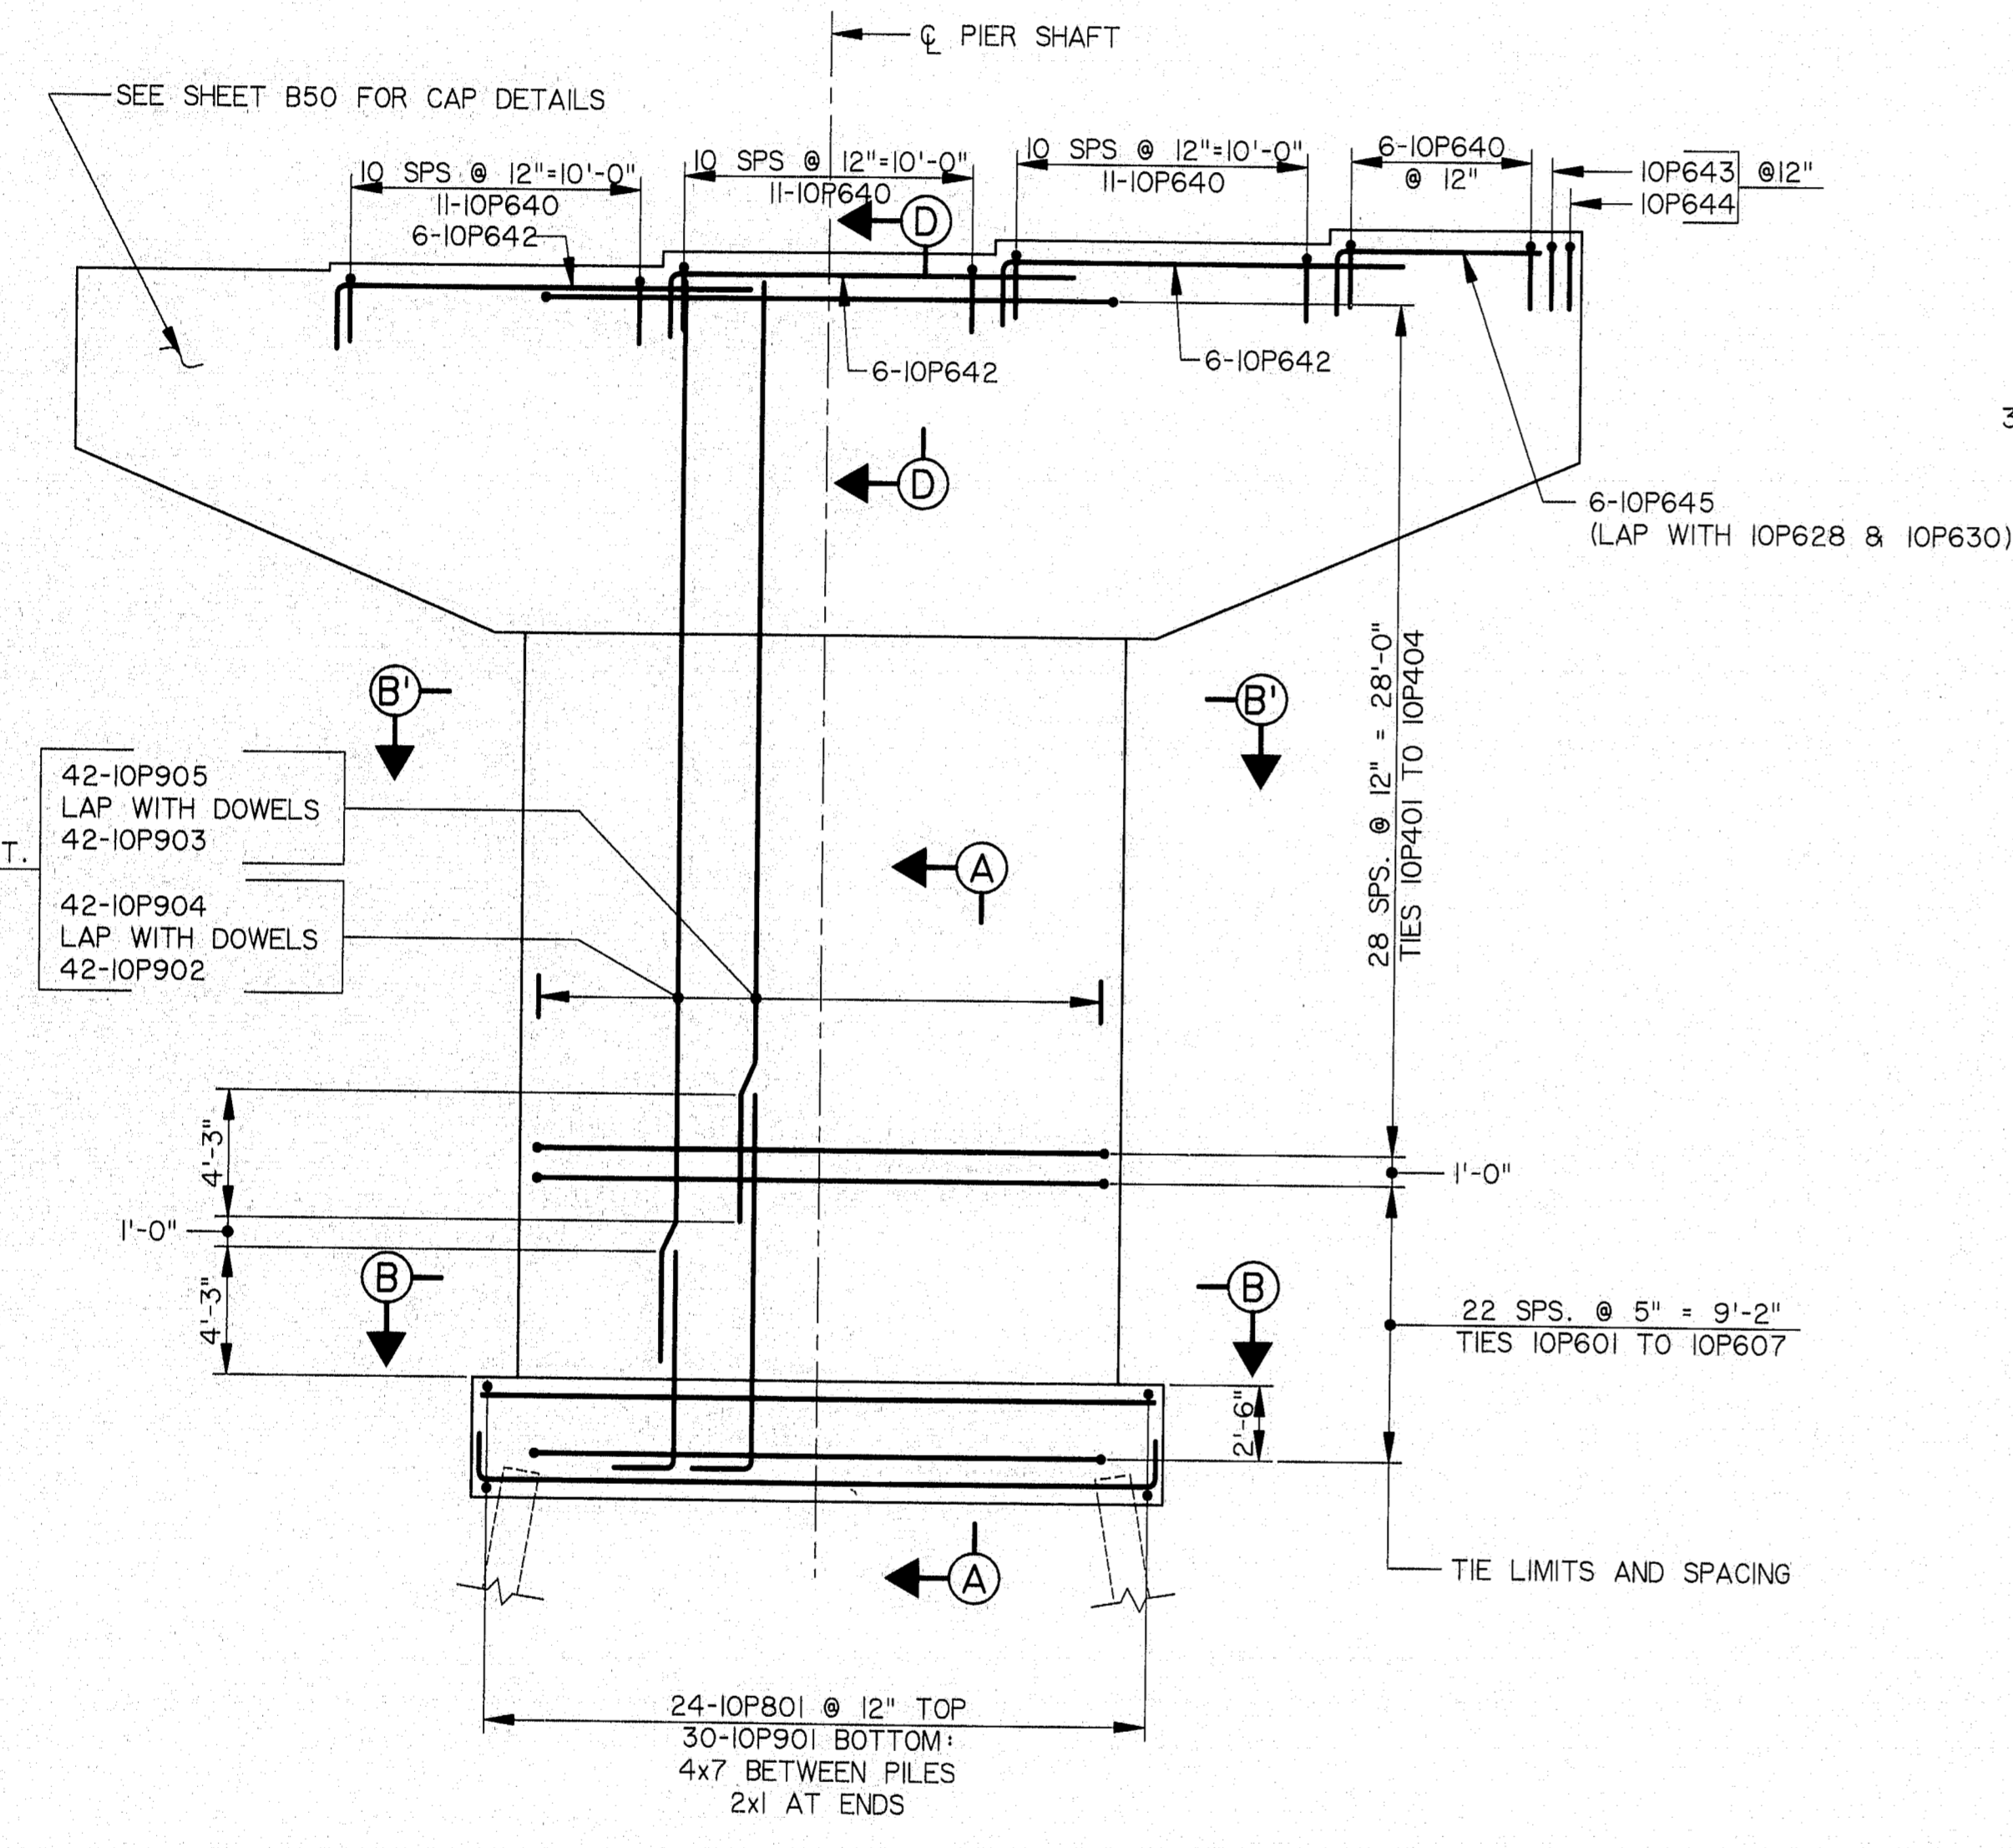


ELEVATION - PIER 10

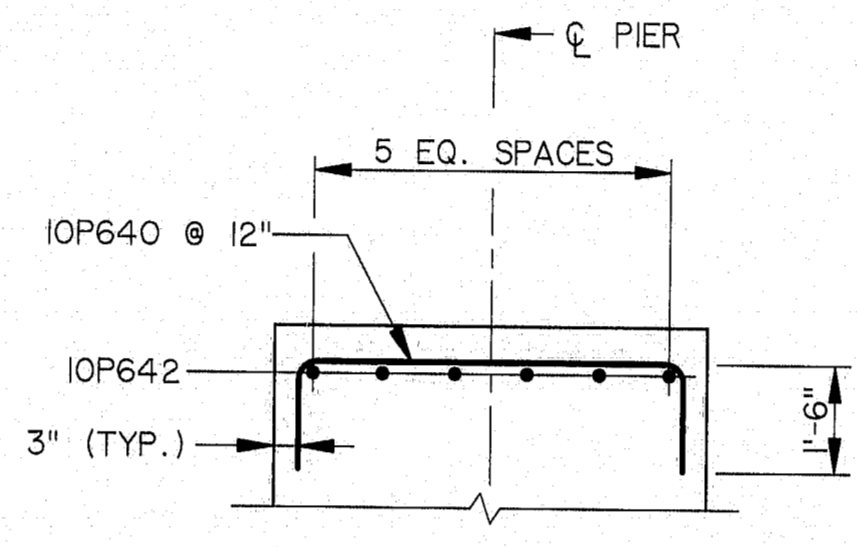

SECTION D-D

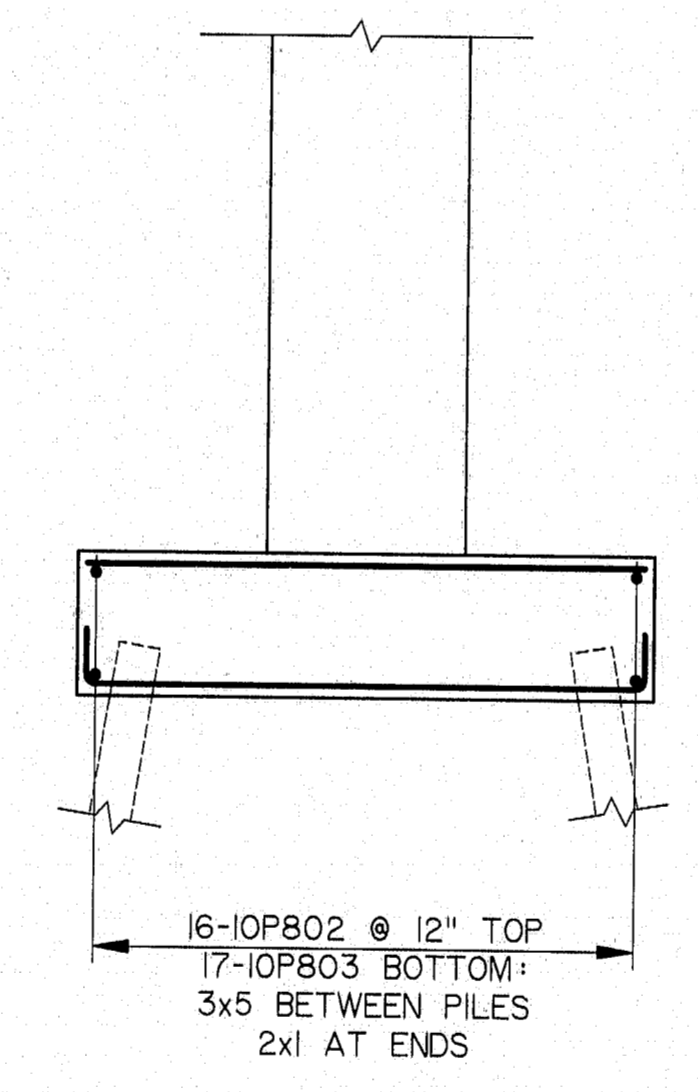

SECTION A-A

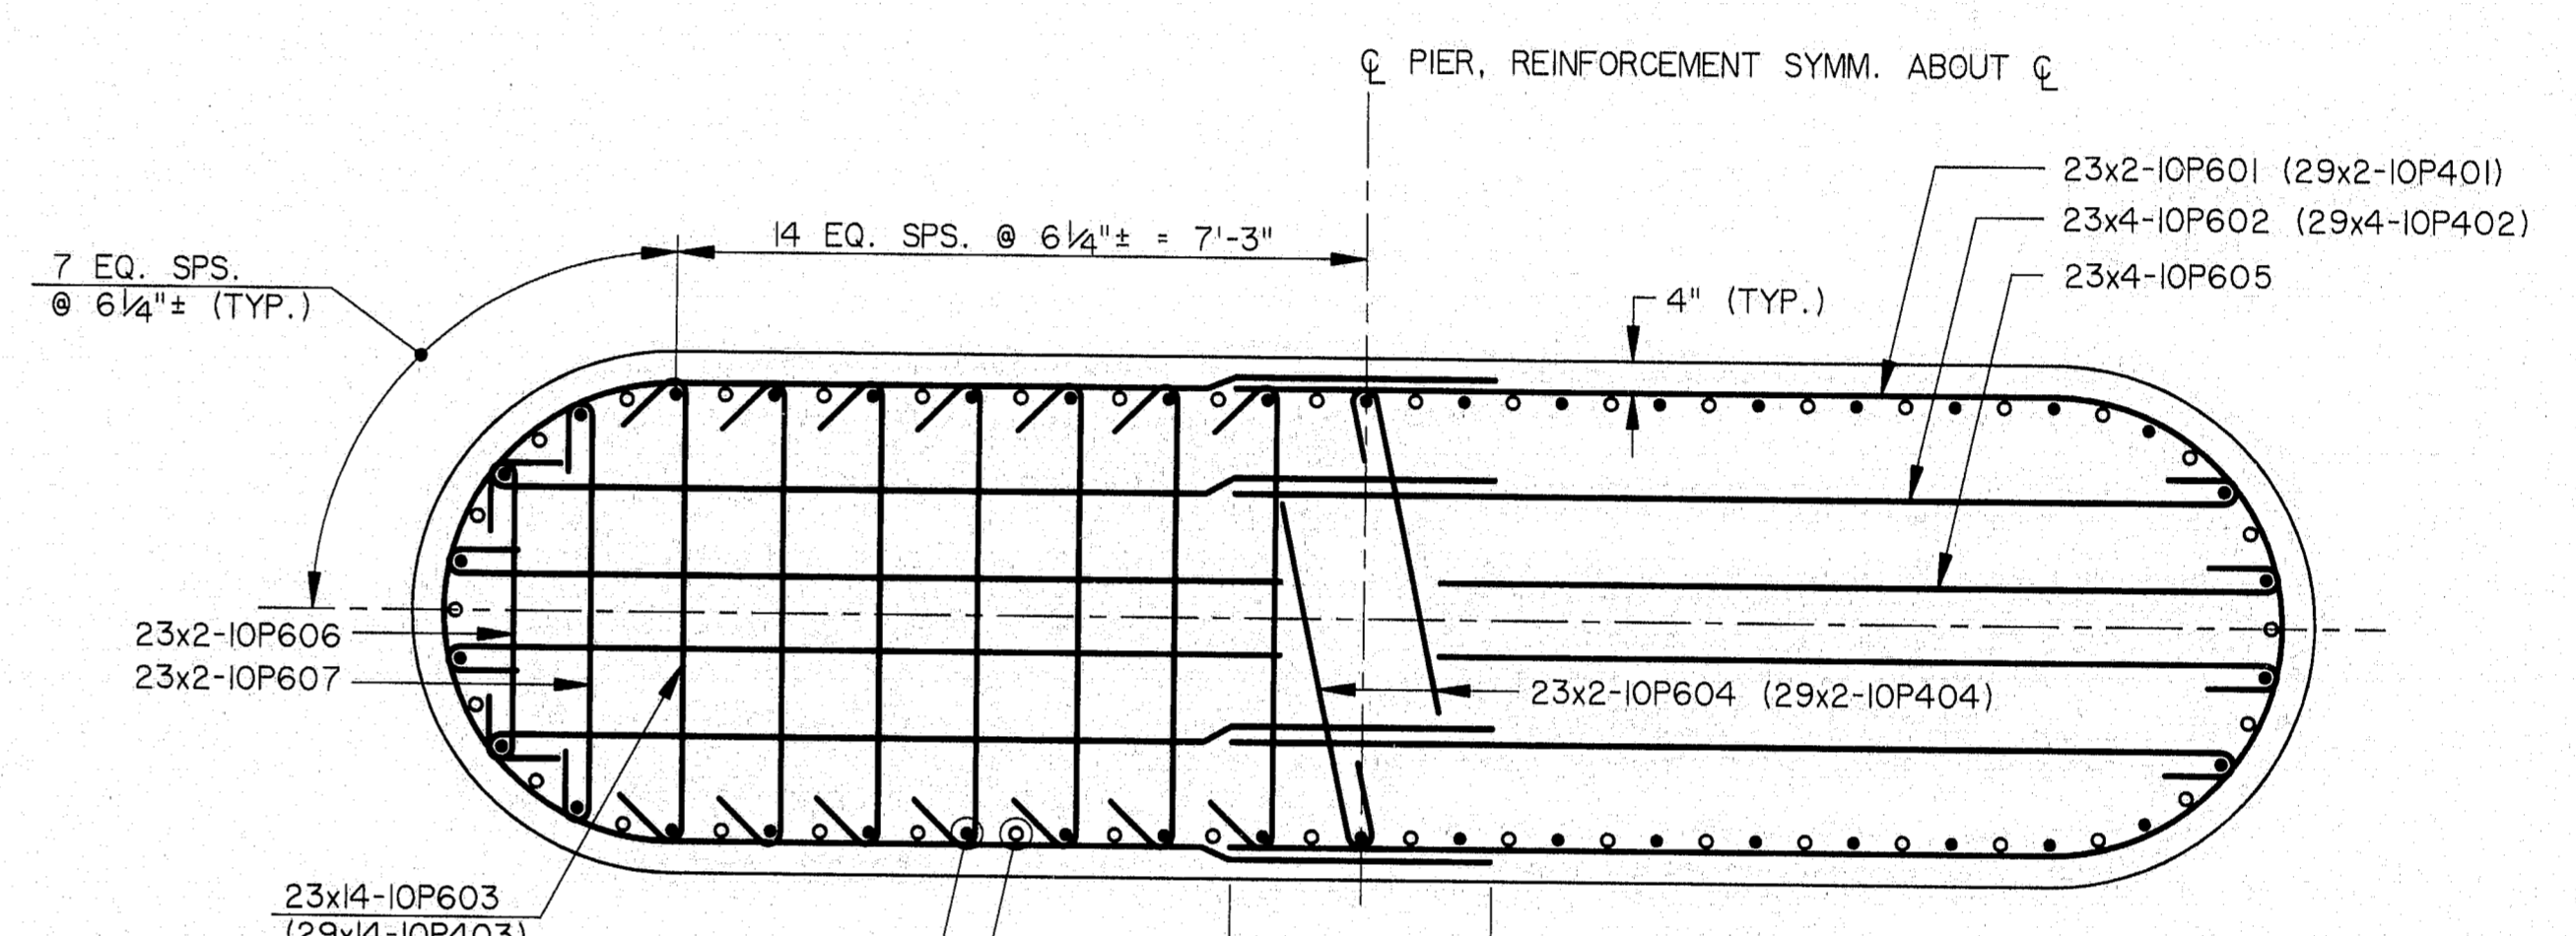

SECTION B-B (SECTION B'-B')

- NOTES
- #6 TIES - 135° MIN. HOOK WITH 7 1/2" EXT. #4 TIES - STD. HOOKS.
  - SECTION B-B SHOWN WITH IOP6## TIES; SECTION B'-B' SIMILAR EXCEPT FOR IOP4## TIES AS NOTED IN PARENTHESIS.

DESIGNED:	SM	9/94		
DRAWN:	RJT	9/94		
CHECKED:	DWR	9/94		
NO. REVISION	BY	DATE	IN CHARGE OF	CJM



*As Built*  
*12/18/96*

**115-244**  
STEEL ALTERNATIVE


STATE OF MAINE  
DEPARTMENT OF TRANSPORTATION

WATERVILLE - WINSLOW PROJECT  
DONALD V. CARTER BRIDGE  
OVER  
KENNEBEC RIVER


PIER 10 RE-STEEL

SHEET B49 OF B86 AUGUSTA, MAINE


F.H.W.A. REG. NO.	STATE	PROJECT NUMBER	SHEET NO.	TOTAL SHEETS
1	MAINE	0009/0021	59	103

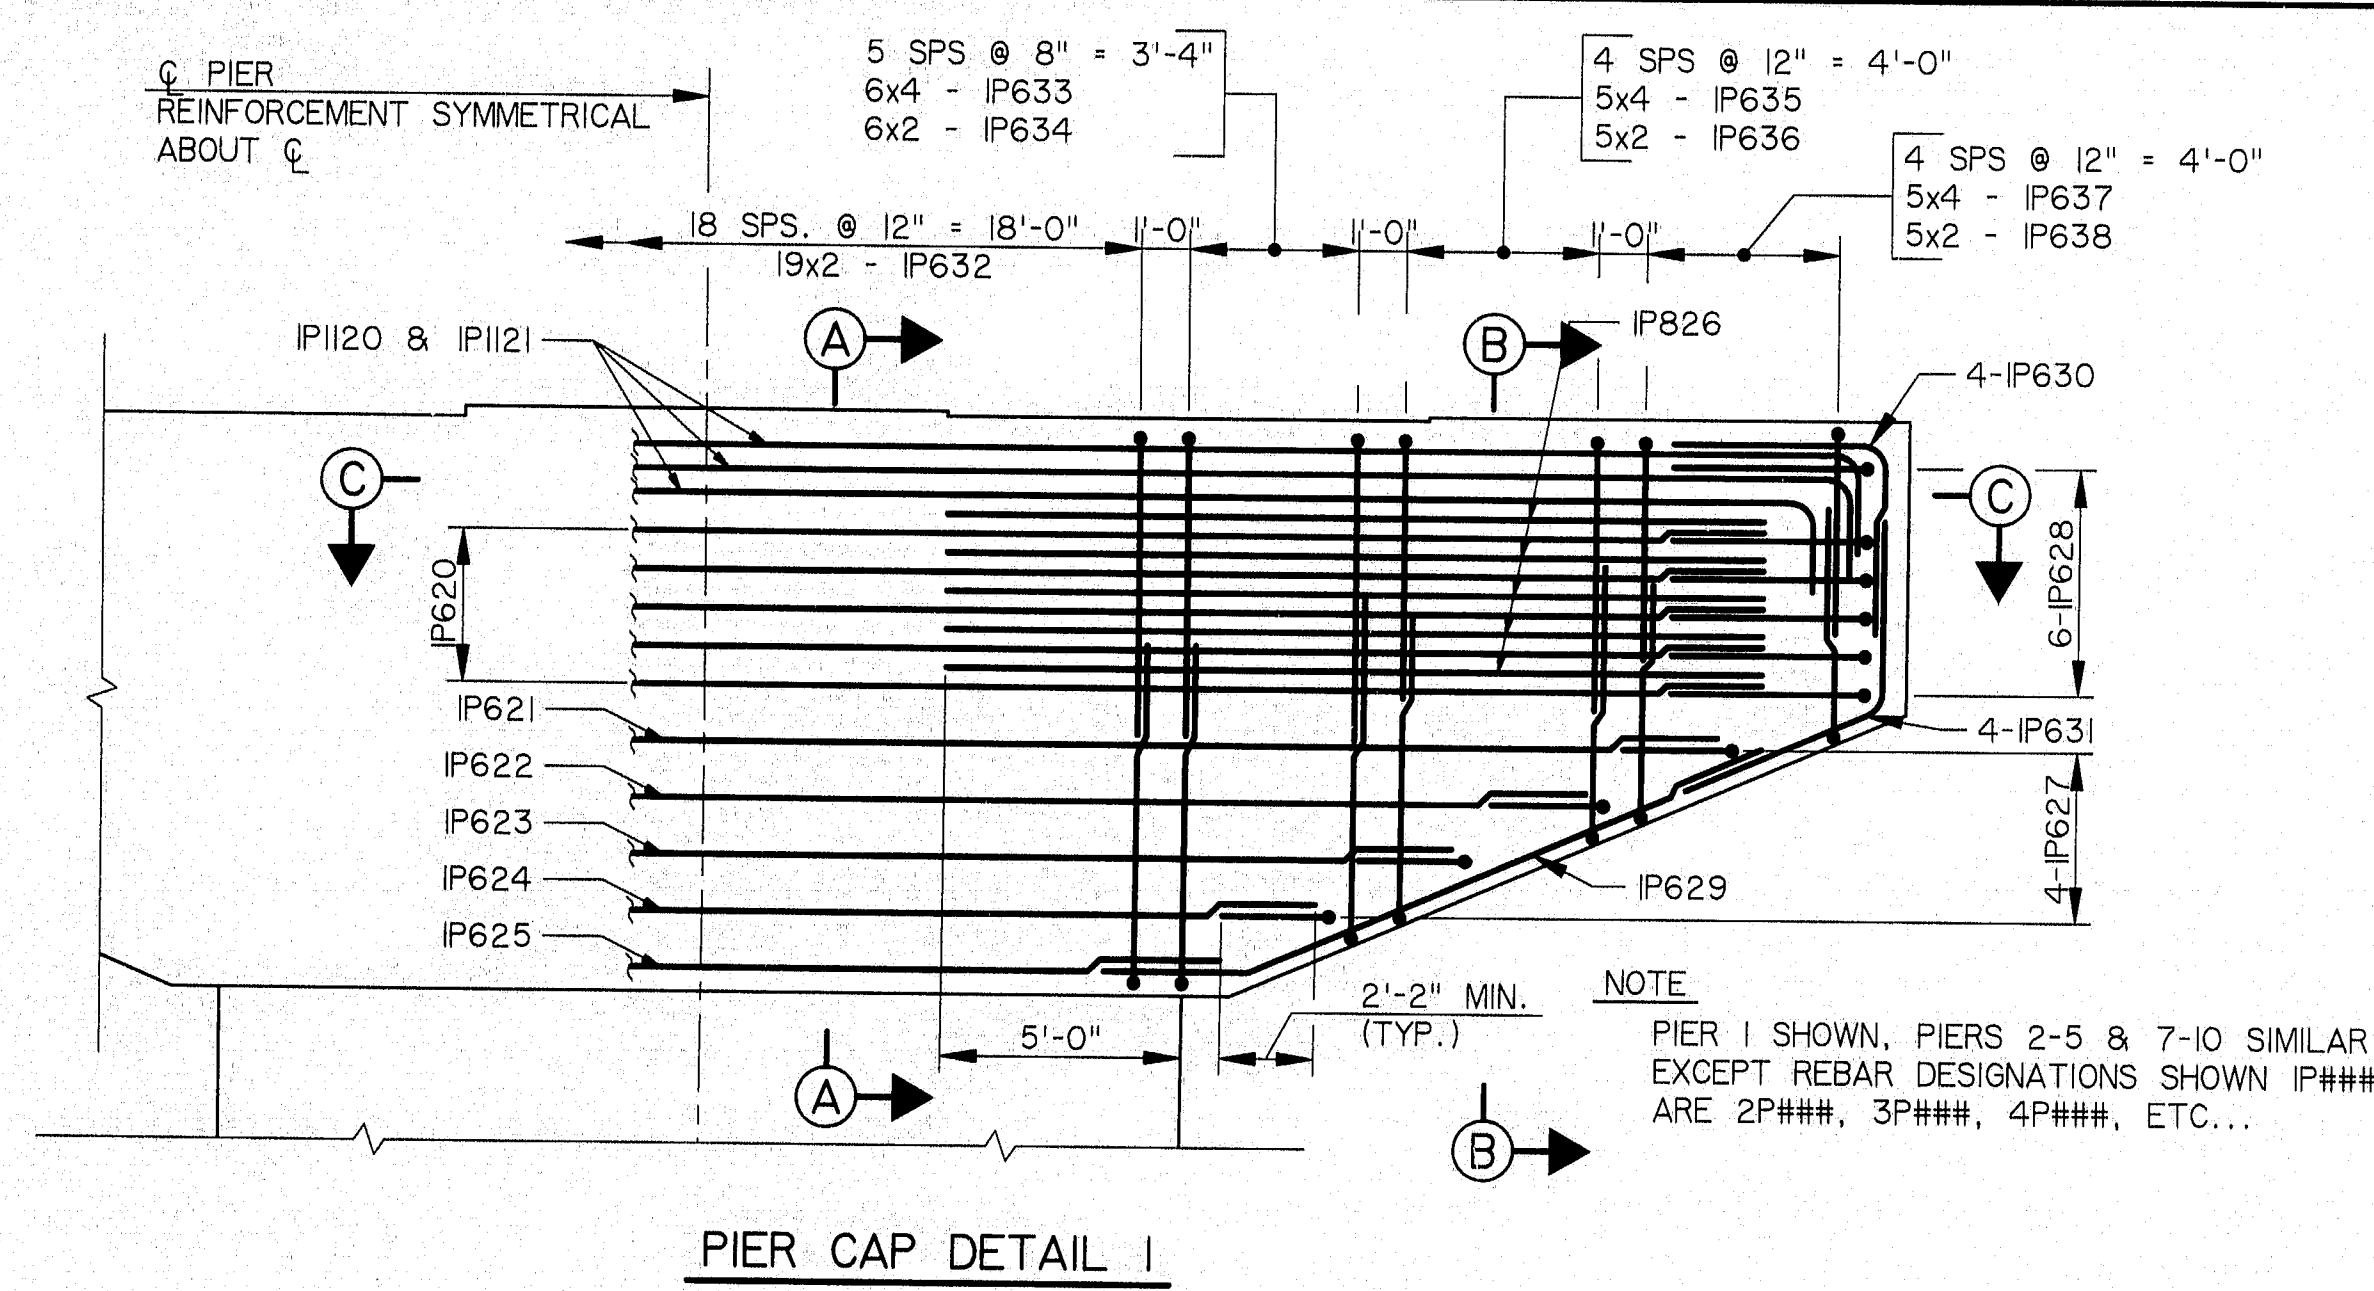


PIER CAP DETAIL 1

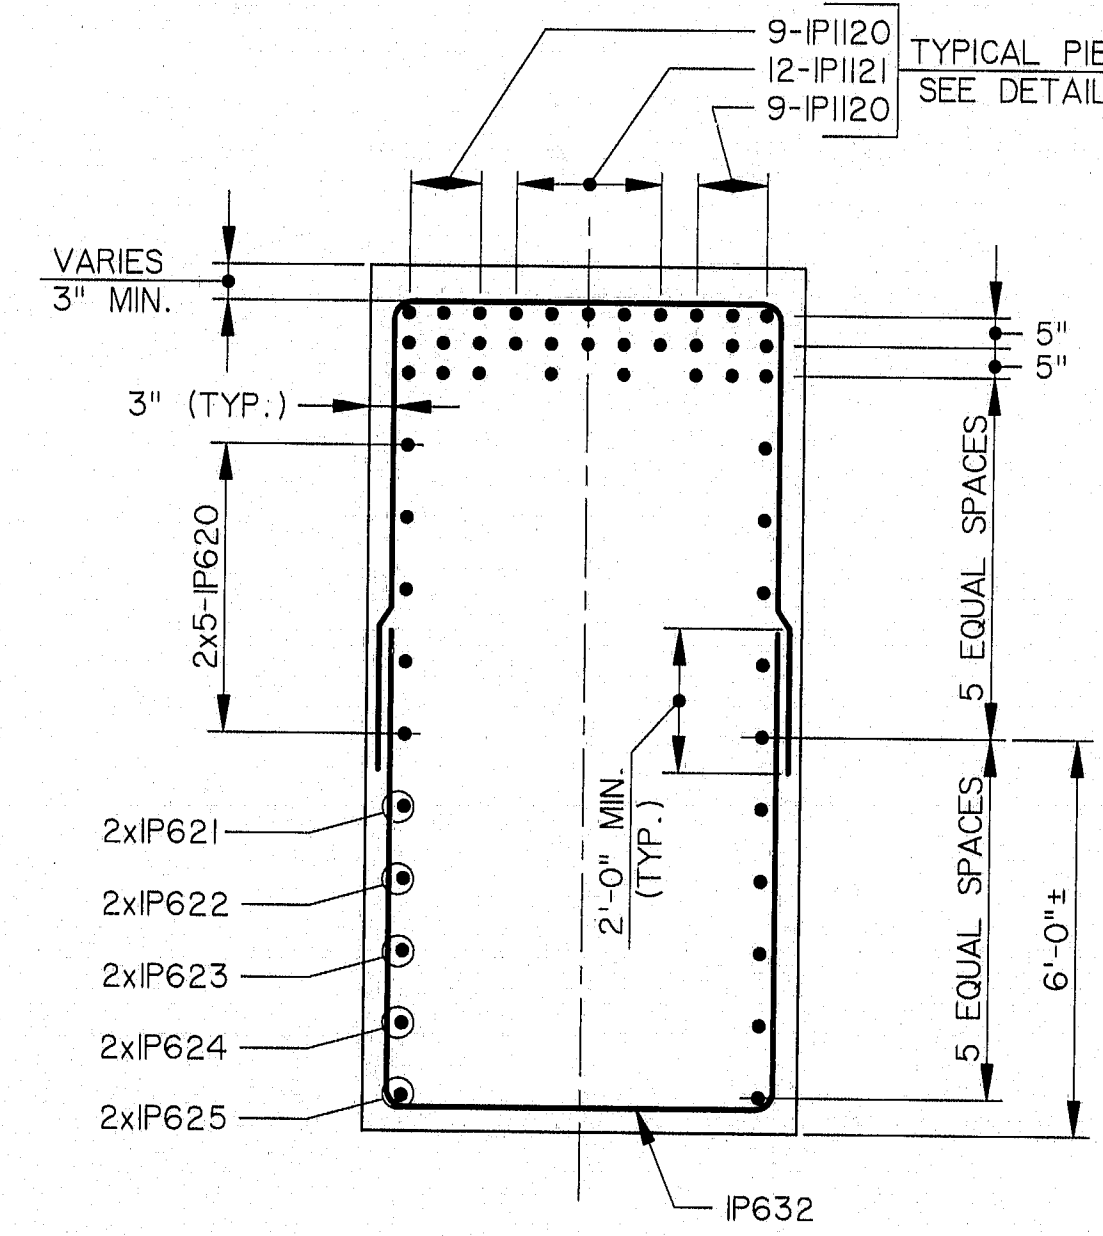


SECTION A-A

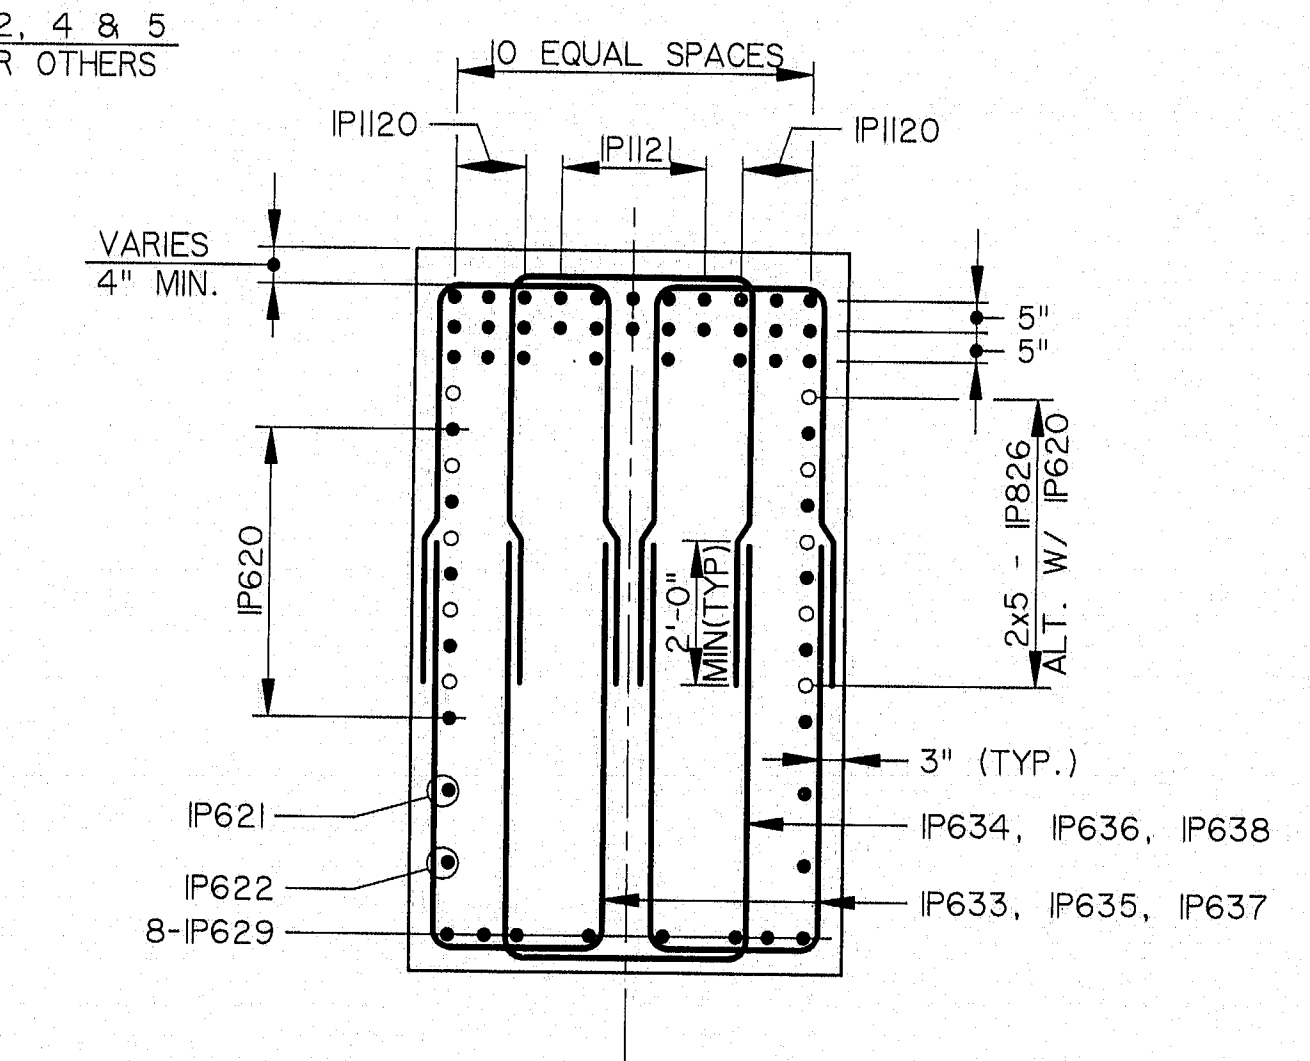


SECTION B-B

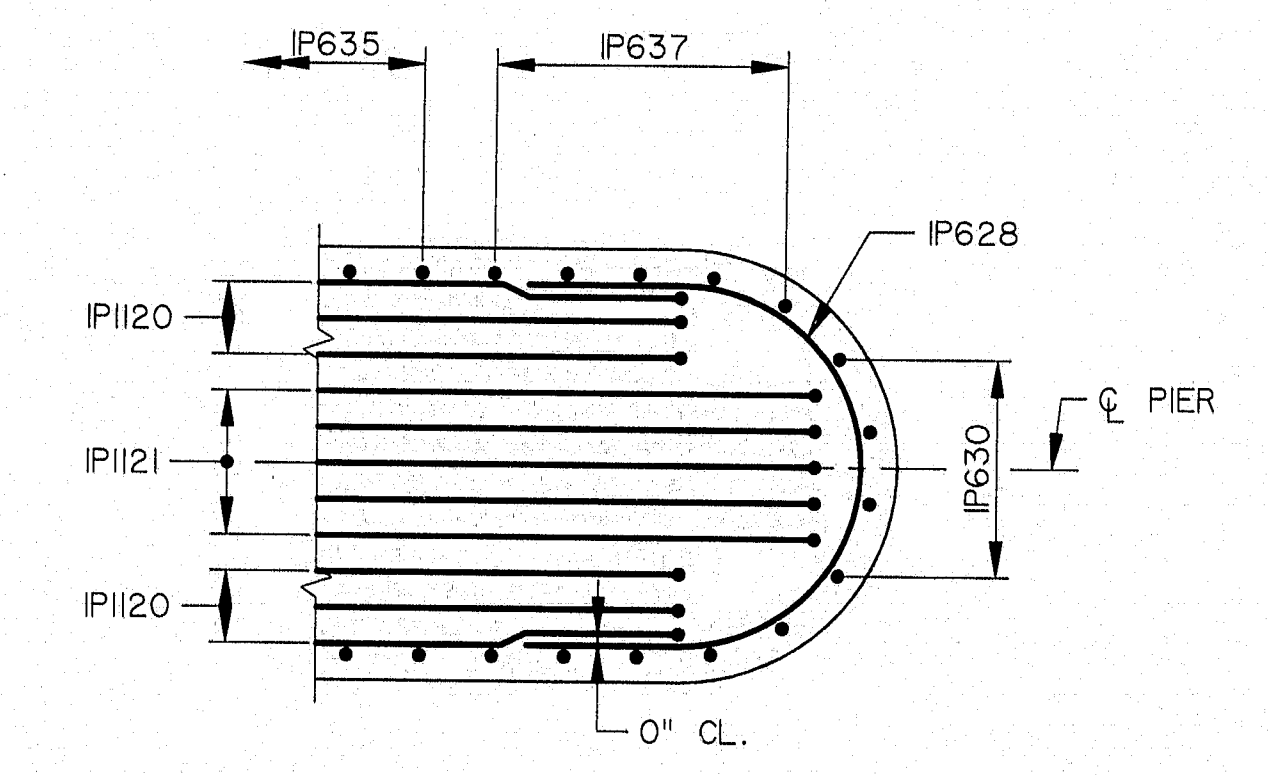


SECTION C-C

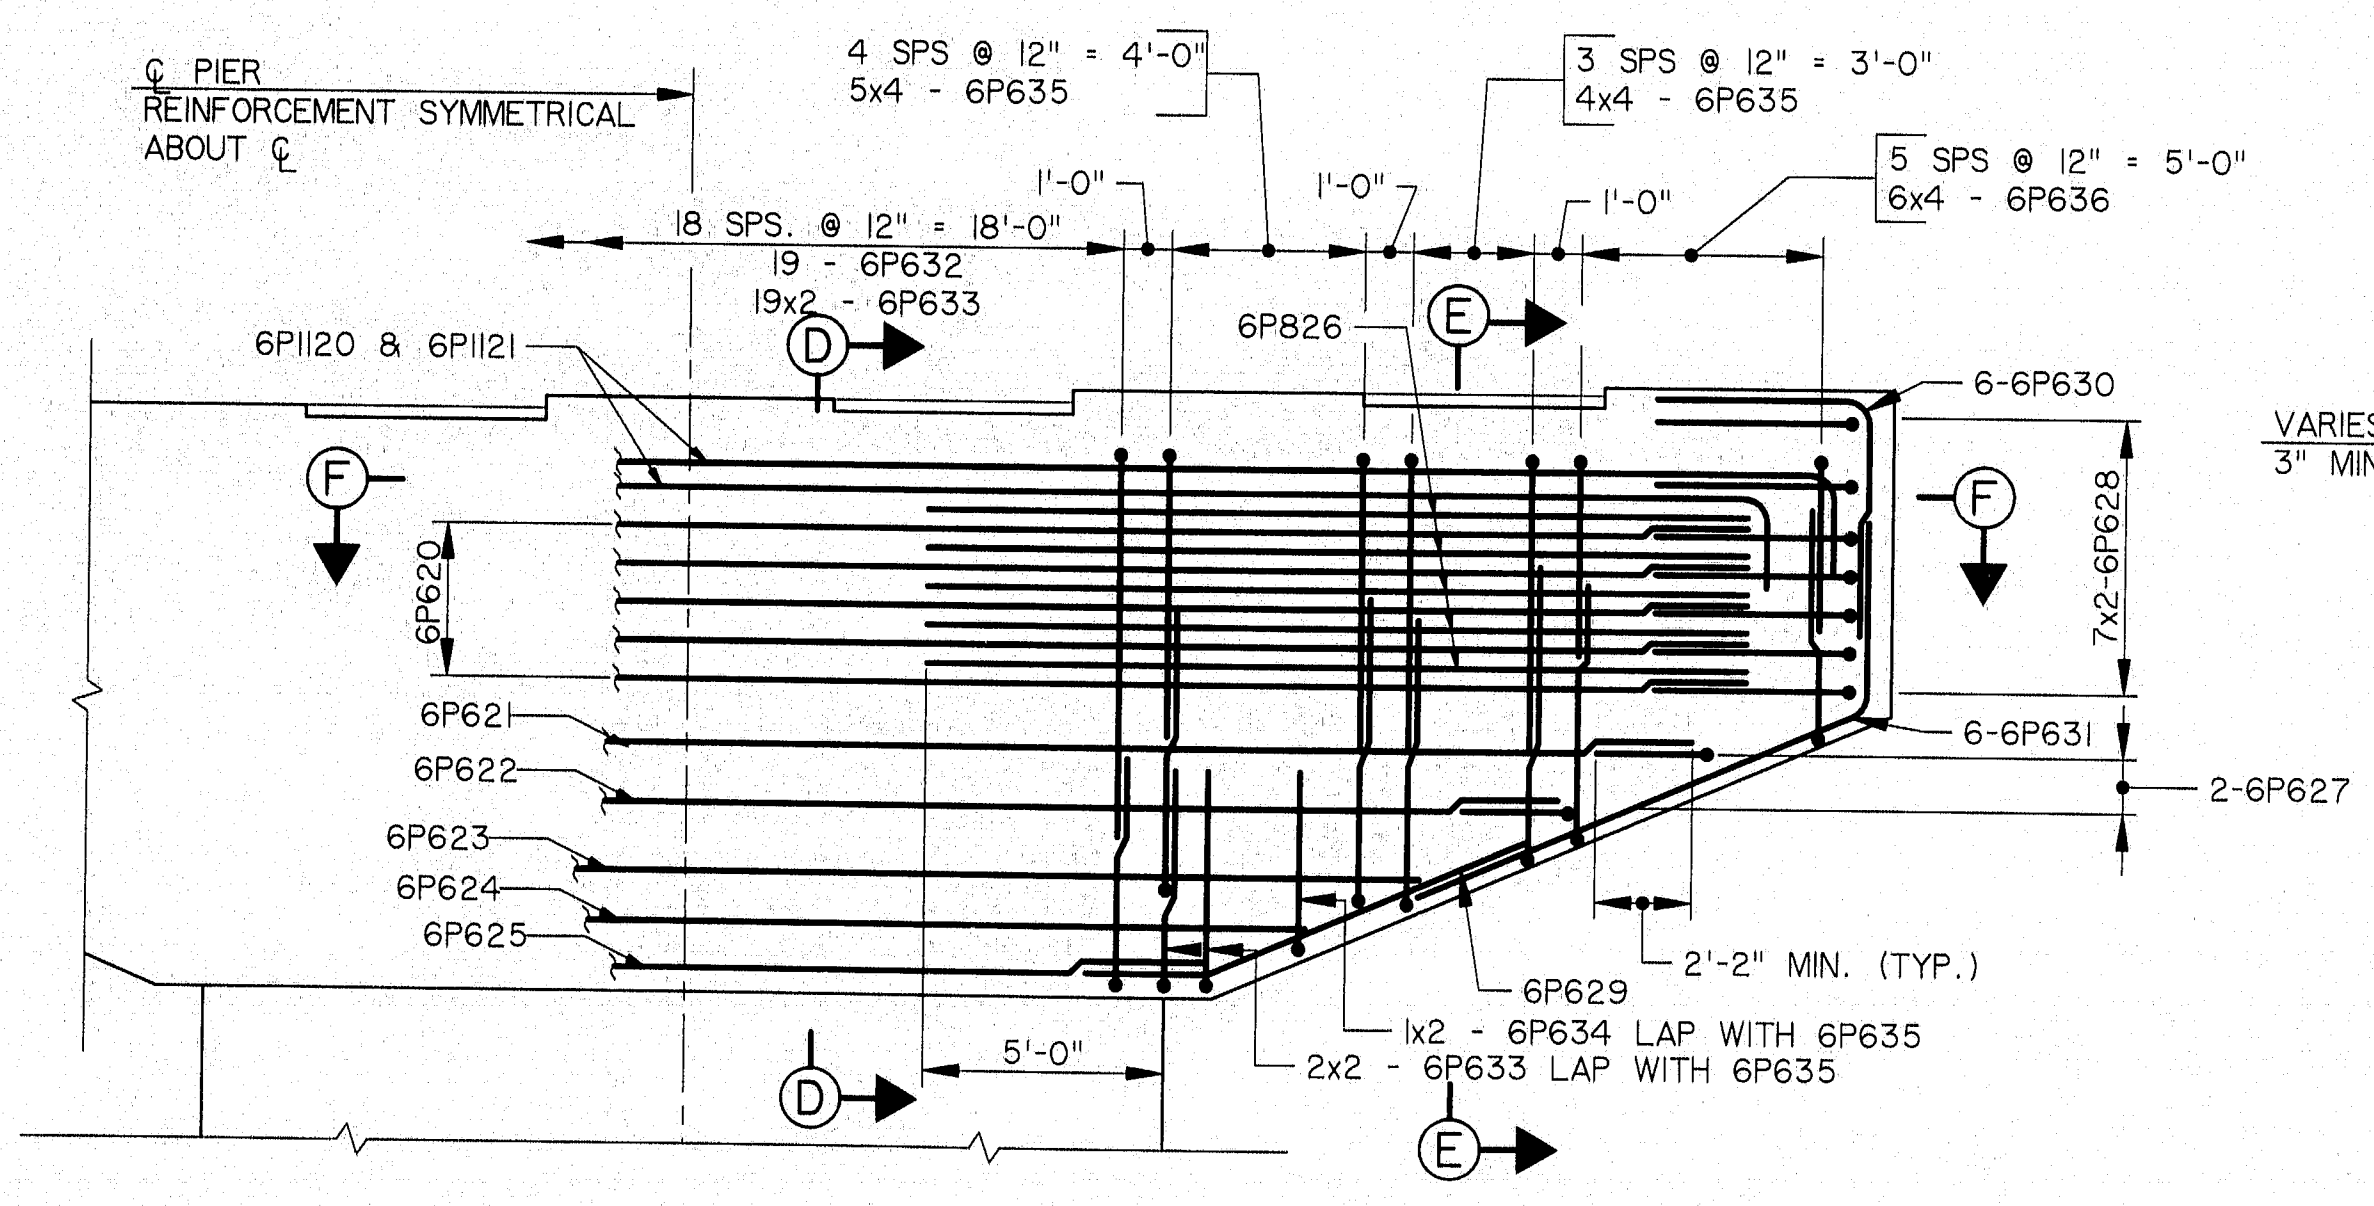


PIER CAP DETAIL 2 (PIER 6)

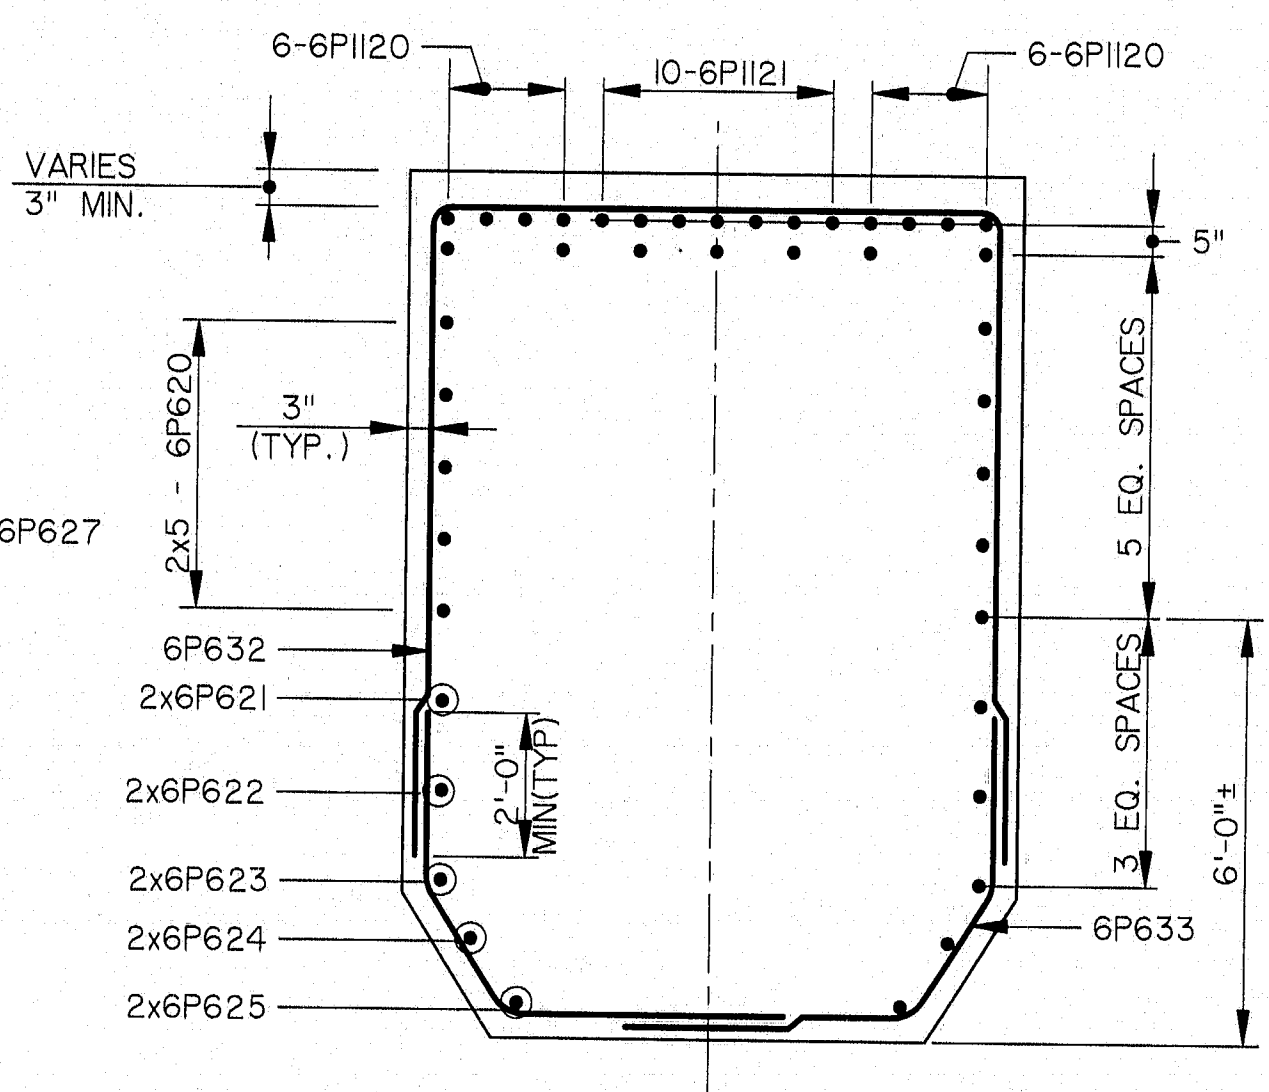


SECTION D-D

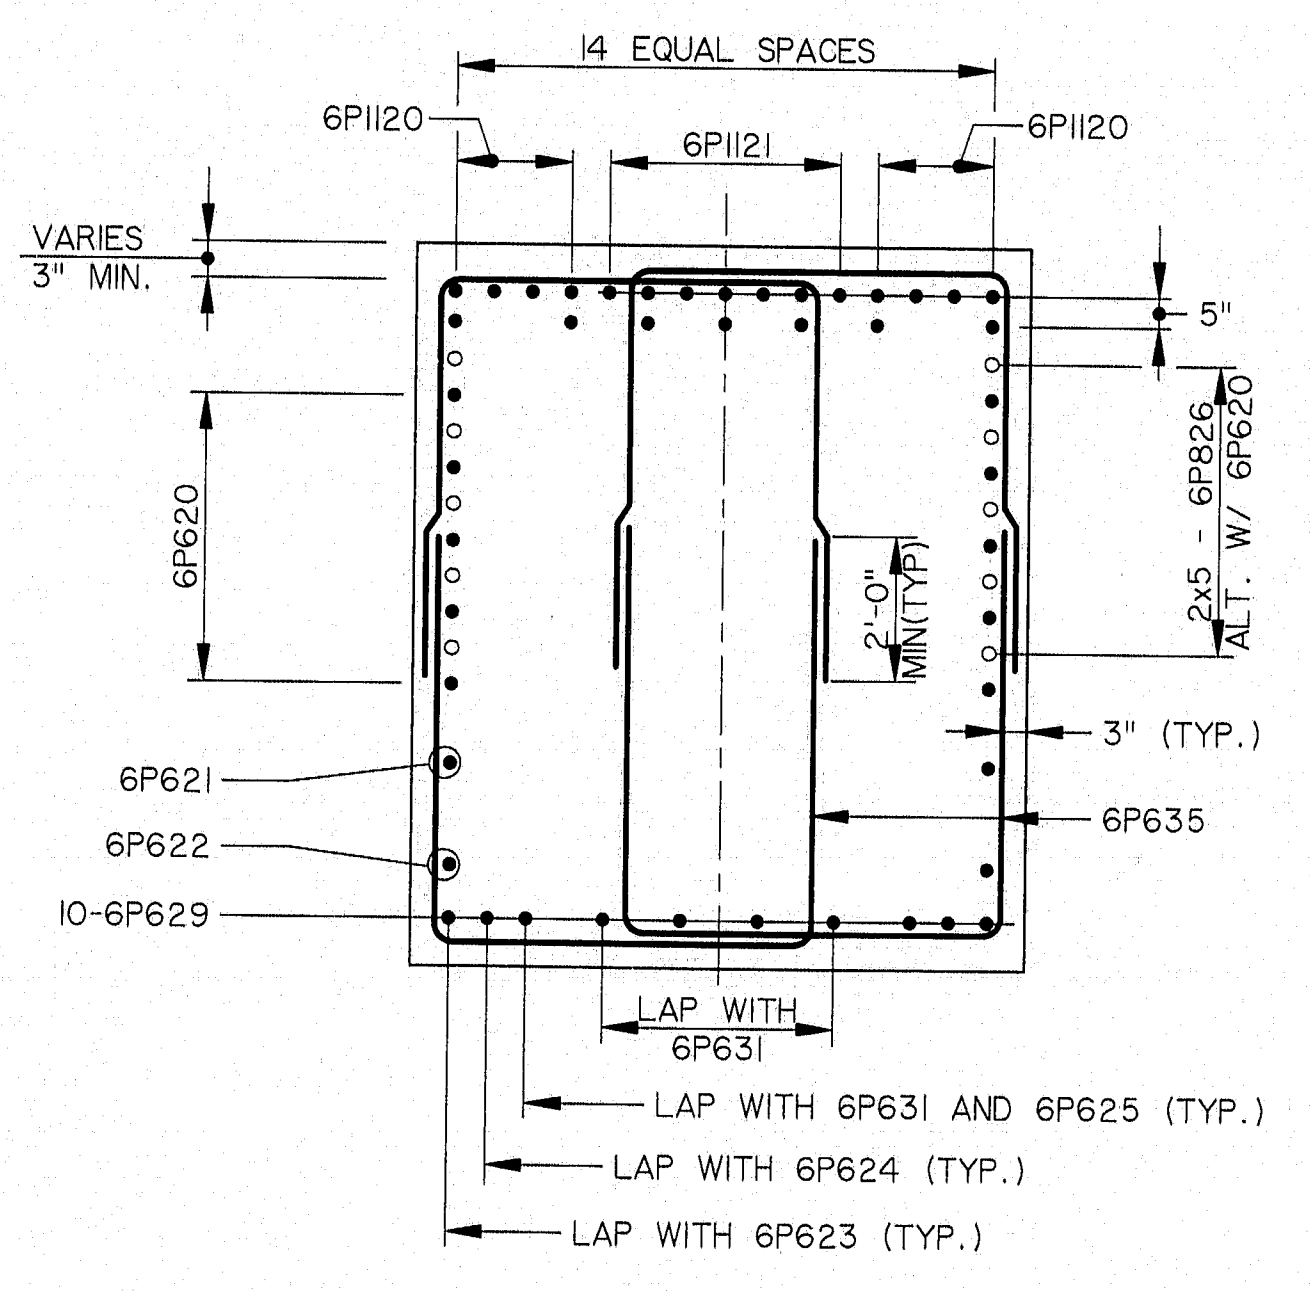


SECTION E-E

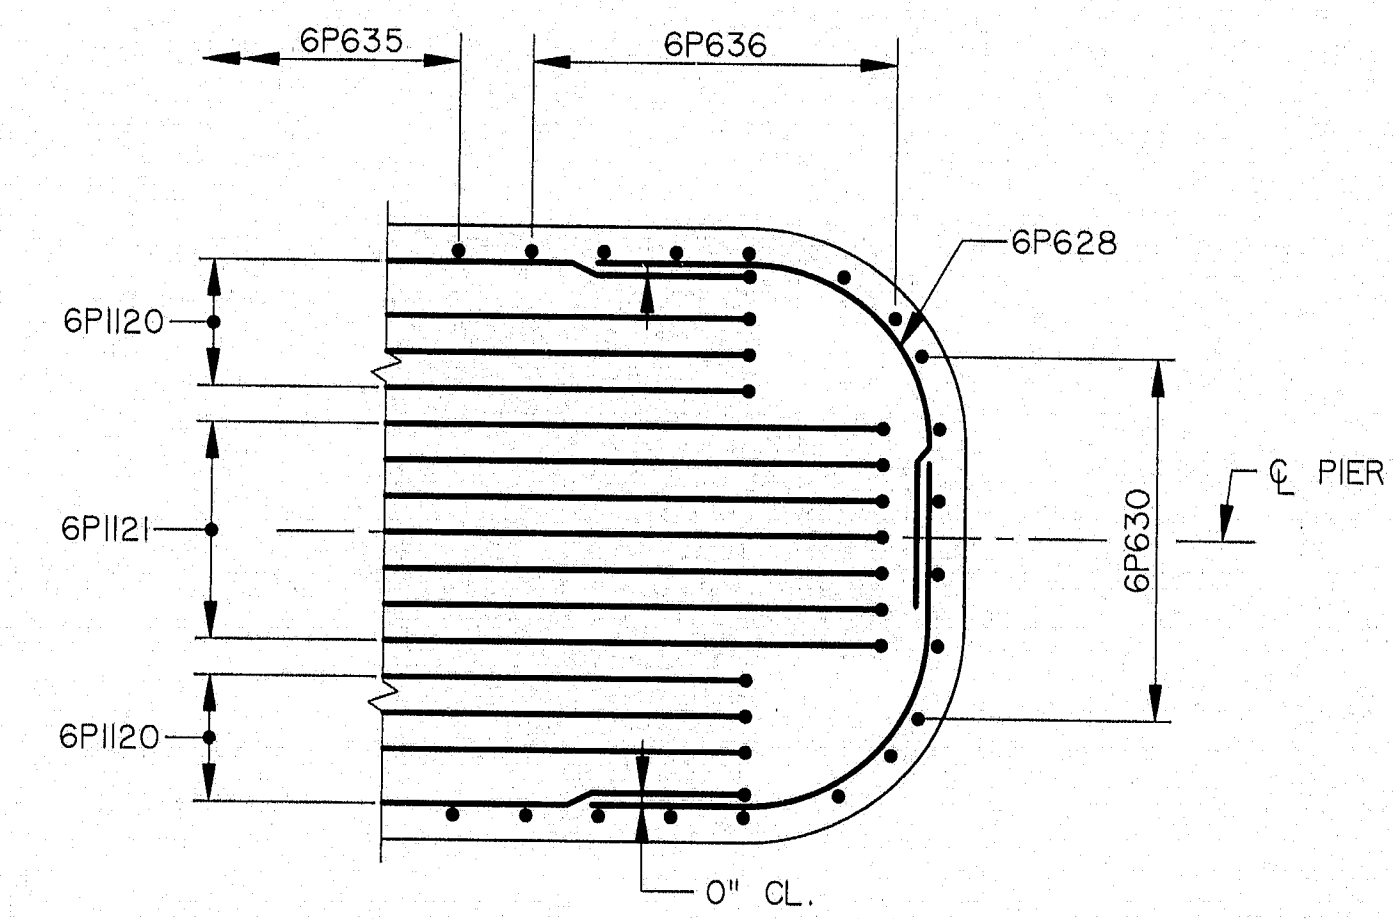


SECTION F-F

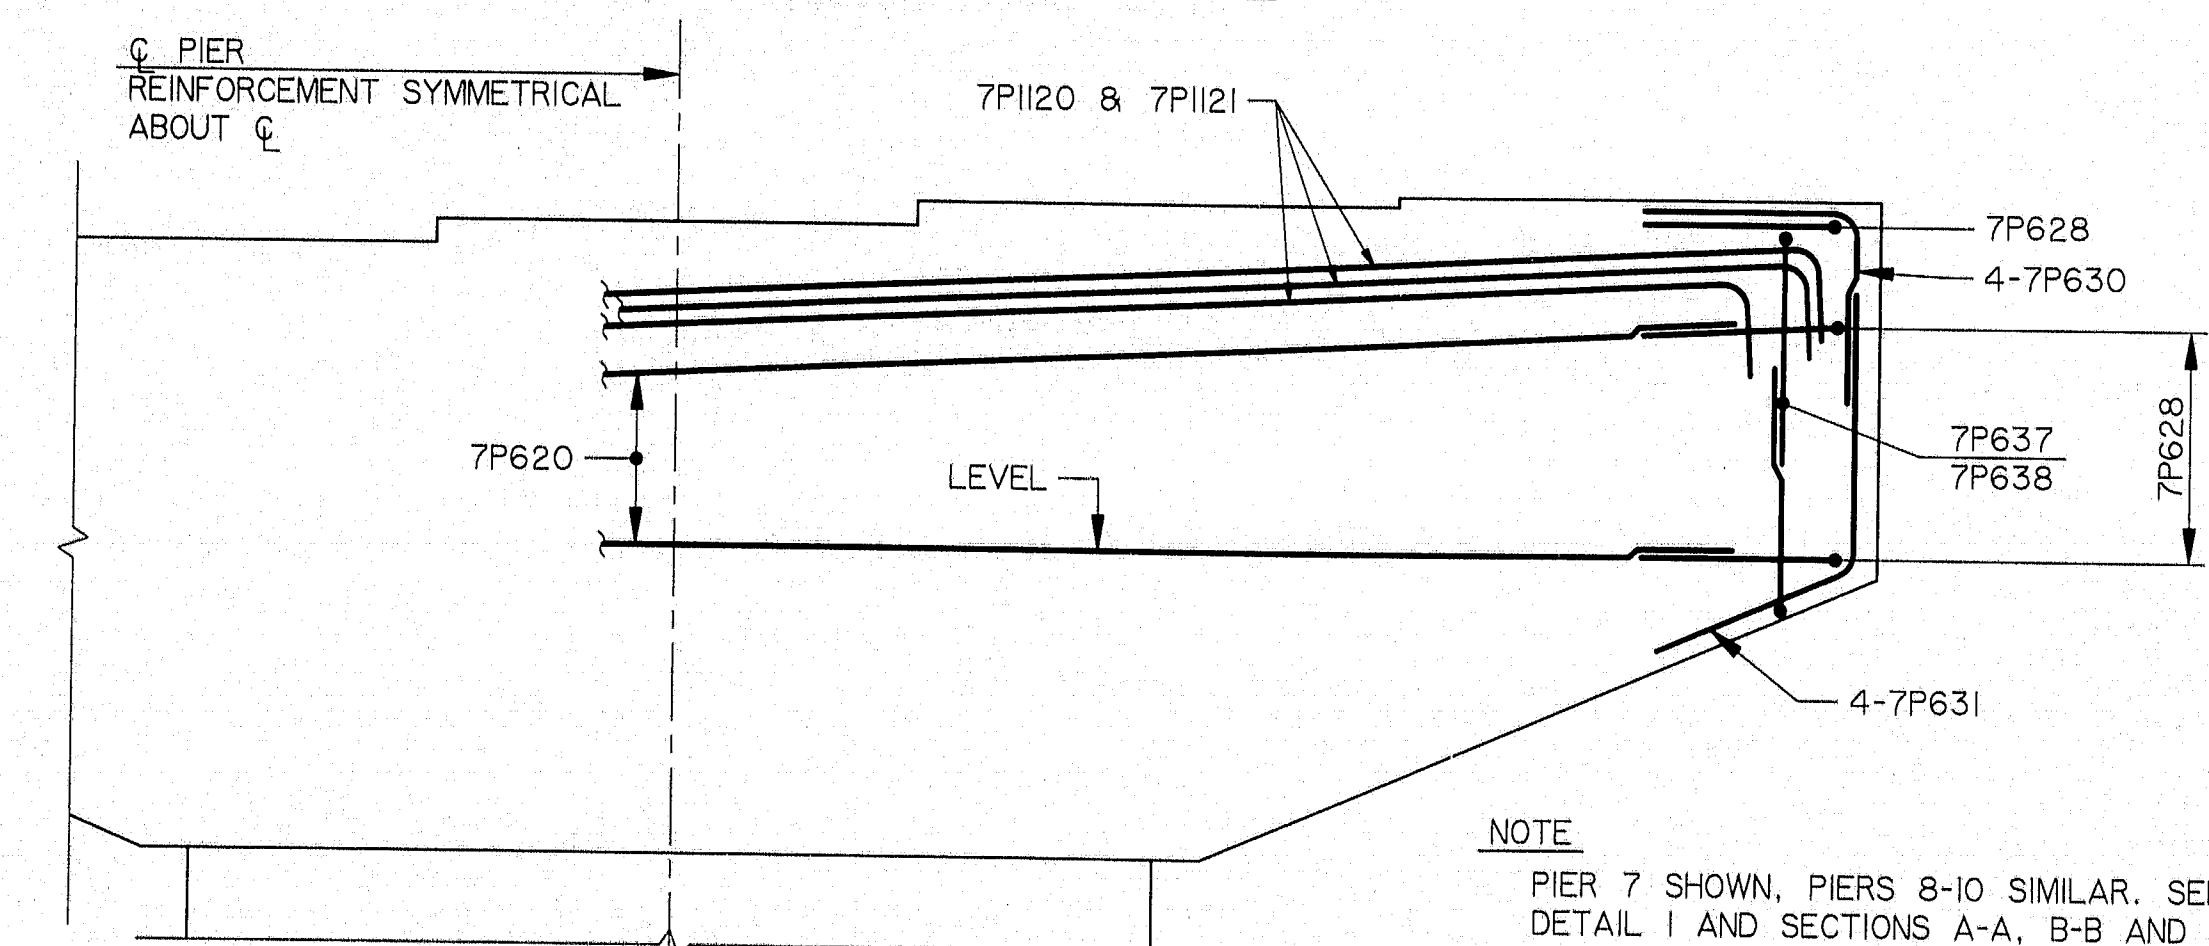


PIER CAP DETAIL 3 (PIERS 7-10)

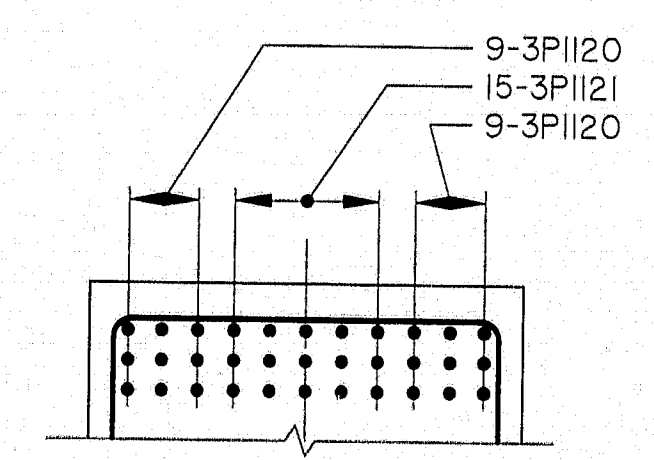


PIER 3

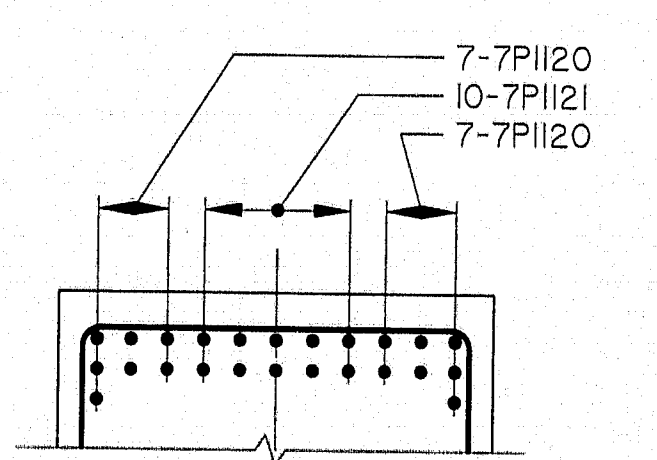

PIER 7

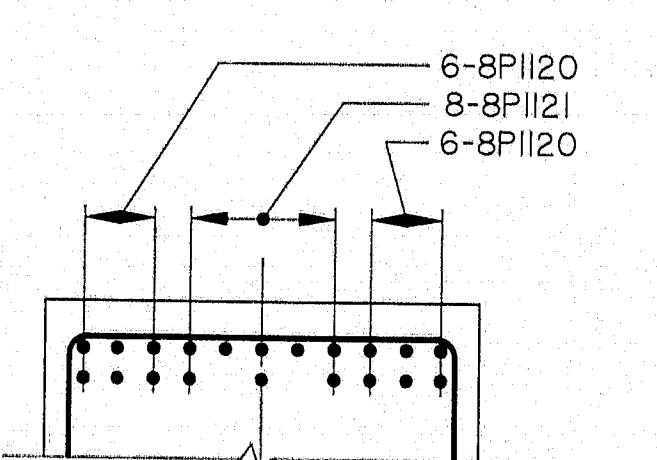

PIERS 8, 9 & 10

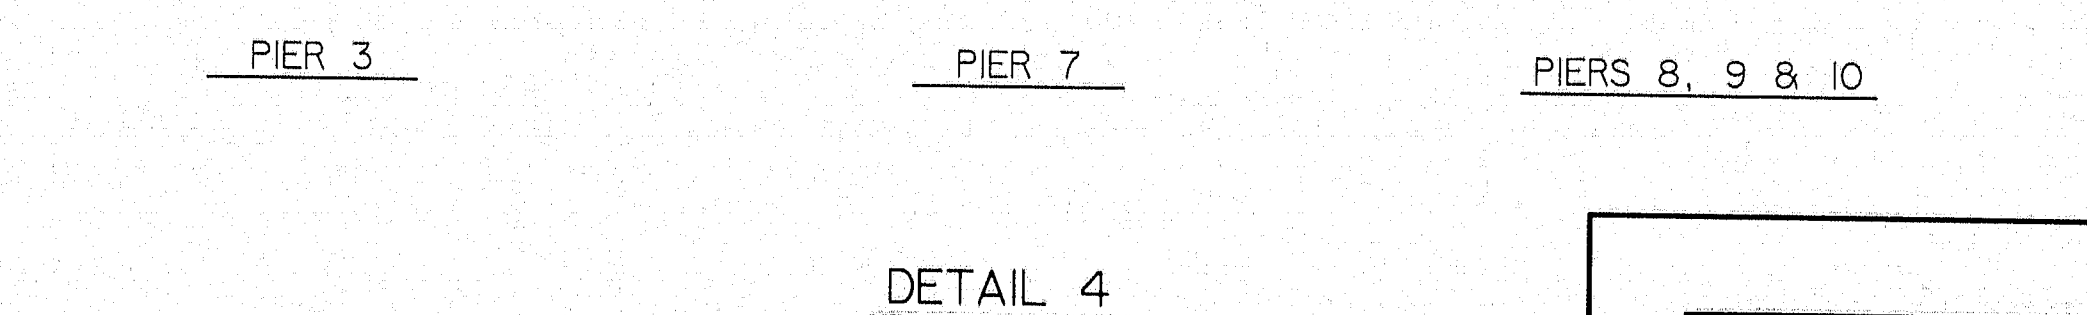

DETAIL 4

NO.	REVISION	BY	DATE	IN CHARGE OF	CJM
		BY	DATE		
		DESIGNED:	DWR	9/94	
		DRAWN:	RJT	9/94	
		CHECKED:	SM	9/94	



115-245  
STEEL ALTERNATIVE  
STATE OF MAINE  
DEPARTMENT OF TRANSPORTATION  
WATERVILLE - WINSLOW PROJECT  
DONALD V. CARTER BRIDGE  
OVER  
KENNEBEC RIVER  
PIER CAP DETAILS  
SHEET B50 OF B86 AUGUSTA, MAINE

*AS per  
Cem  
1/2/94*