

ESTIMATE OF QUANTITIES

ITEM DESCRIPTION	TOTAL QUANTITIES
STRUCTURAL EARTH EXCAVATION - PIERS	675 C.Y.
STRUCTURAL ROCK EXCAVATION - PIERS	20 C.Y.
GRAVEL BORROW	23,650 C.Y.
PORTLAND CEMENT CONCRETE, ABUTMENTS & RETAINING WALLS	400 C.Y.
PORTLAND CEMENT CONCRETE, PIERS	520 C.Y.
PORTLAND CEMENT CONCRETE, PIERS (PLACED UNDER WATER)	750 C.Y.
PORTLAND CEMENT CONCRETE, ROADWAY & SIDEWALK ON STEEL BRIDGES	450 C.Y.
PORTLAND CEMENT	3,365 BBLs
STRUCTURAL STEEL, FABRICATED & DELIVERED	LUMP SUM
STRUCTURAL STEEL, ERECTION	LUMP SUM
STRUCTURAL STEEL, FIELD PAINTING	LUMP SUM
STEEL RAIL, ALTERNATE "B"	956 L.F.
REINFORCING STEEL, DELIVERED	203,000 LBS
REINFORCING STEEL, PLACED	203,000 LBS
STEEL H-BEAM PILES 42 LBS./SQ.FT.	3,730 L.F.
STEEL H-BEAM PILES 73 LBS./SQ.FT.	1,500 L.F.
COFFERDAM PIER 1 NORTHBOUND	LUMP SUM
COFFERDAM PIER 2 NORTHBOUND	LUMP SUM
COFFERDAM PIER 1 SOUTHBOUND	LUMP SUM
COFFERDAM PIER 2 SOUTHBOUND	LUMP SUM
ALUMINUM RAIL, ALTERNATE "A"	956 L.F.
GRANITE BRIDGE CURB	988 L.F.
PLAIN RIPRAP	2,000 C.Y.
HAND LAID RIPRAP	1,340 C.Y.
EPOXY RESIN SURFACE SEALANT	190 SY.

* BITUMINOUS CONCRETE SURFACE COURSE, TYPE A 223 TONS

* MEMBRANE WATERPROOFING 1,990 SY.

ESTIMATED QUANTITY OF STRUCTURAL STEEL INCLUDING DRAINS = 575,600 LBS.

* NOT A PART OF THIS CONTRACT.

INDEX OF SHEETS

SHEET NUMBER	TITLE
1	INDEX, QUANTITIES, GENERAL PLAN
2	SURVEY
3	FOUNDATION SURVEY
4 THRU 7	BORING DETAILS
8	ABUTMENT 1 NORTHBOUND
9	ABUTMENT 2 NORTHBOUND
10	ABUTMENT 1 SOUTHBOUND
11	ABUTMENT 2 SOUTHBOUND
12	PIER 1 NORTHBOUND
12A	PIER 2 NORTHBOUND
13	PIERS 1 & 2 SOUTHBOUND
14	STRUCTURAL STEEL NORTHBOUND & SOUTHBOUND
15	ARMORED JOINT & EXPANSION DAM
16 & 17	SUPERSTRUCTURE NORTHBOUND & SOUTHBOUND
18	REINFORCING STEEL
BD 101-62	STANDARD DETAIL - BEARING PEDESTALS
BD 102-62	STANDARD DETAIL - BRIDGE RAIL
BD 103-62	STANDARD DETAIL - BEAM SPLICES

SPECIFICATIONS

DESIGN: A.A.S.H.O. Standard Specifications for Highway Bridges, 1961, with Interim Specifications.

CONTRACT: State of Maine, State Highway Commission, Standard Specifications for Highways and Bridges, Revision of January 1956, and Supplemental Specifications.

LIVE LOADING

H20-S16-44 as modified for Interstate Highways.

ALLOWABLE STRESSES


Concrete ($n=10$) $\sim f_c = 1200$ psi.
Reinf. Steel, Int. Grap. $\sim f_s = 20,000$ psi.
Structural Steel $\sim f_s = 20,000$ psi.

CONCRETE CLASSIFICATION




PIER SEALS: Class "3"
ALL OTHER: Class "A"

DESIGN T.H.K. DETAIL E.E.L. CHECK	BRIDGE NO.
STATE HIGHWAY COMMISSION BRIDGE DIVISION	
SEBASTICOOK RIVER BRIDGE	
IN THE TOWN OF PITTSFIELD	
SOMERSET COUNTY	
GENERAL PLAN	
SHEET 1 OF 13 AUGUSTA, MAINE FEB. 1963	



M-1980

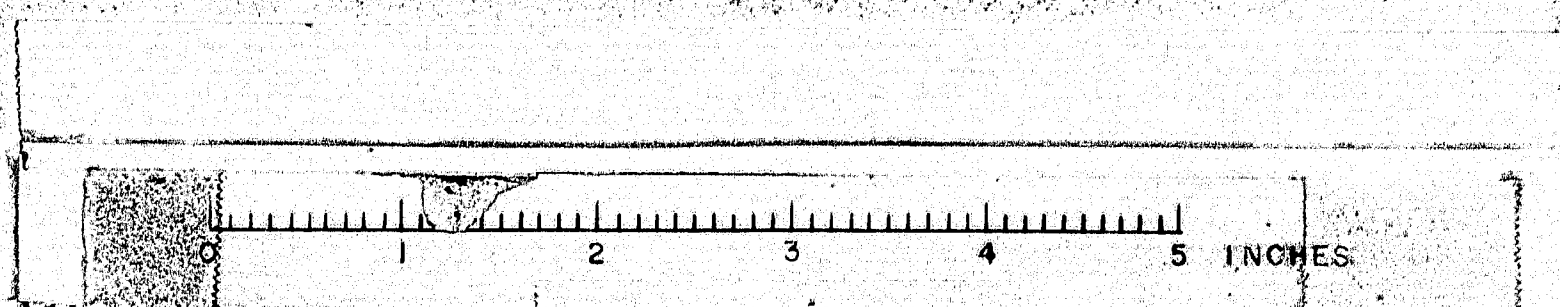

NOTES
 STREAM - Water controlled by dam at Waverly Mills. Present stage, low water. Practically no water flowing over dam. High stage, 4.0' higher than present.
 UTILITIES - C.M.R. Co.

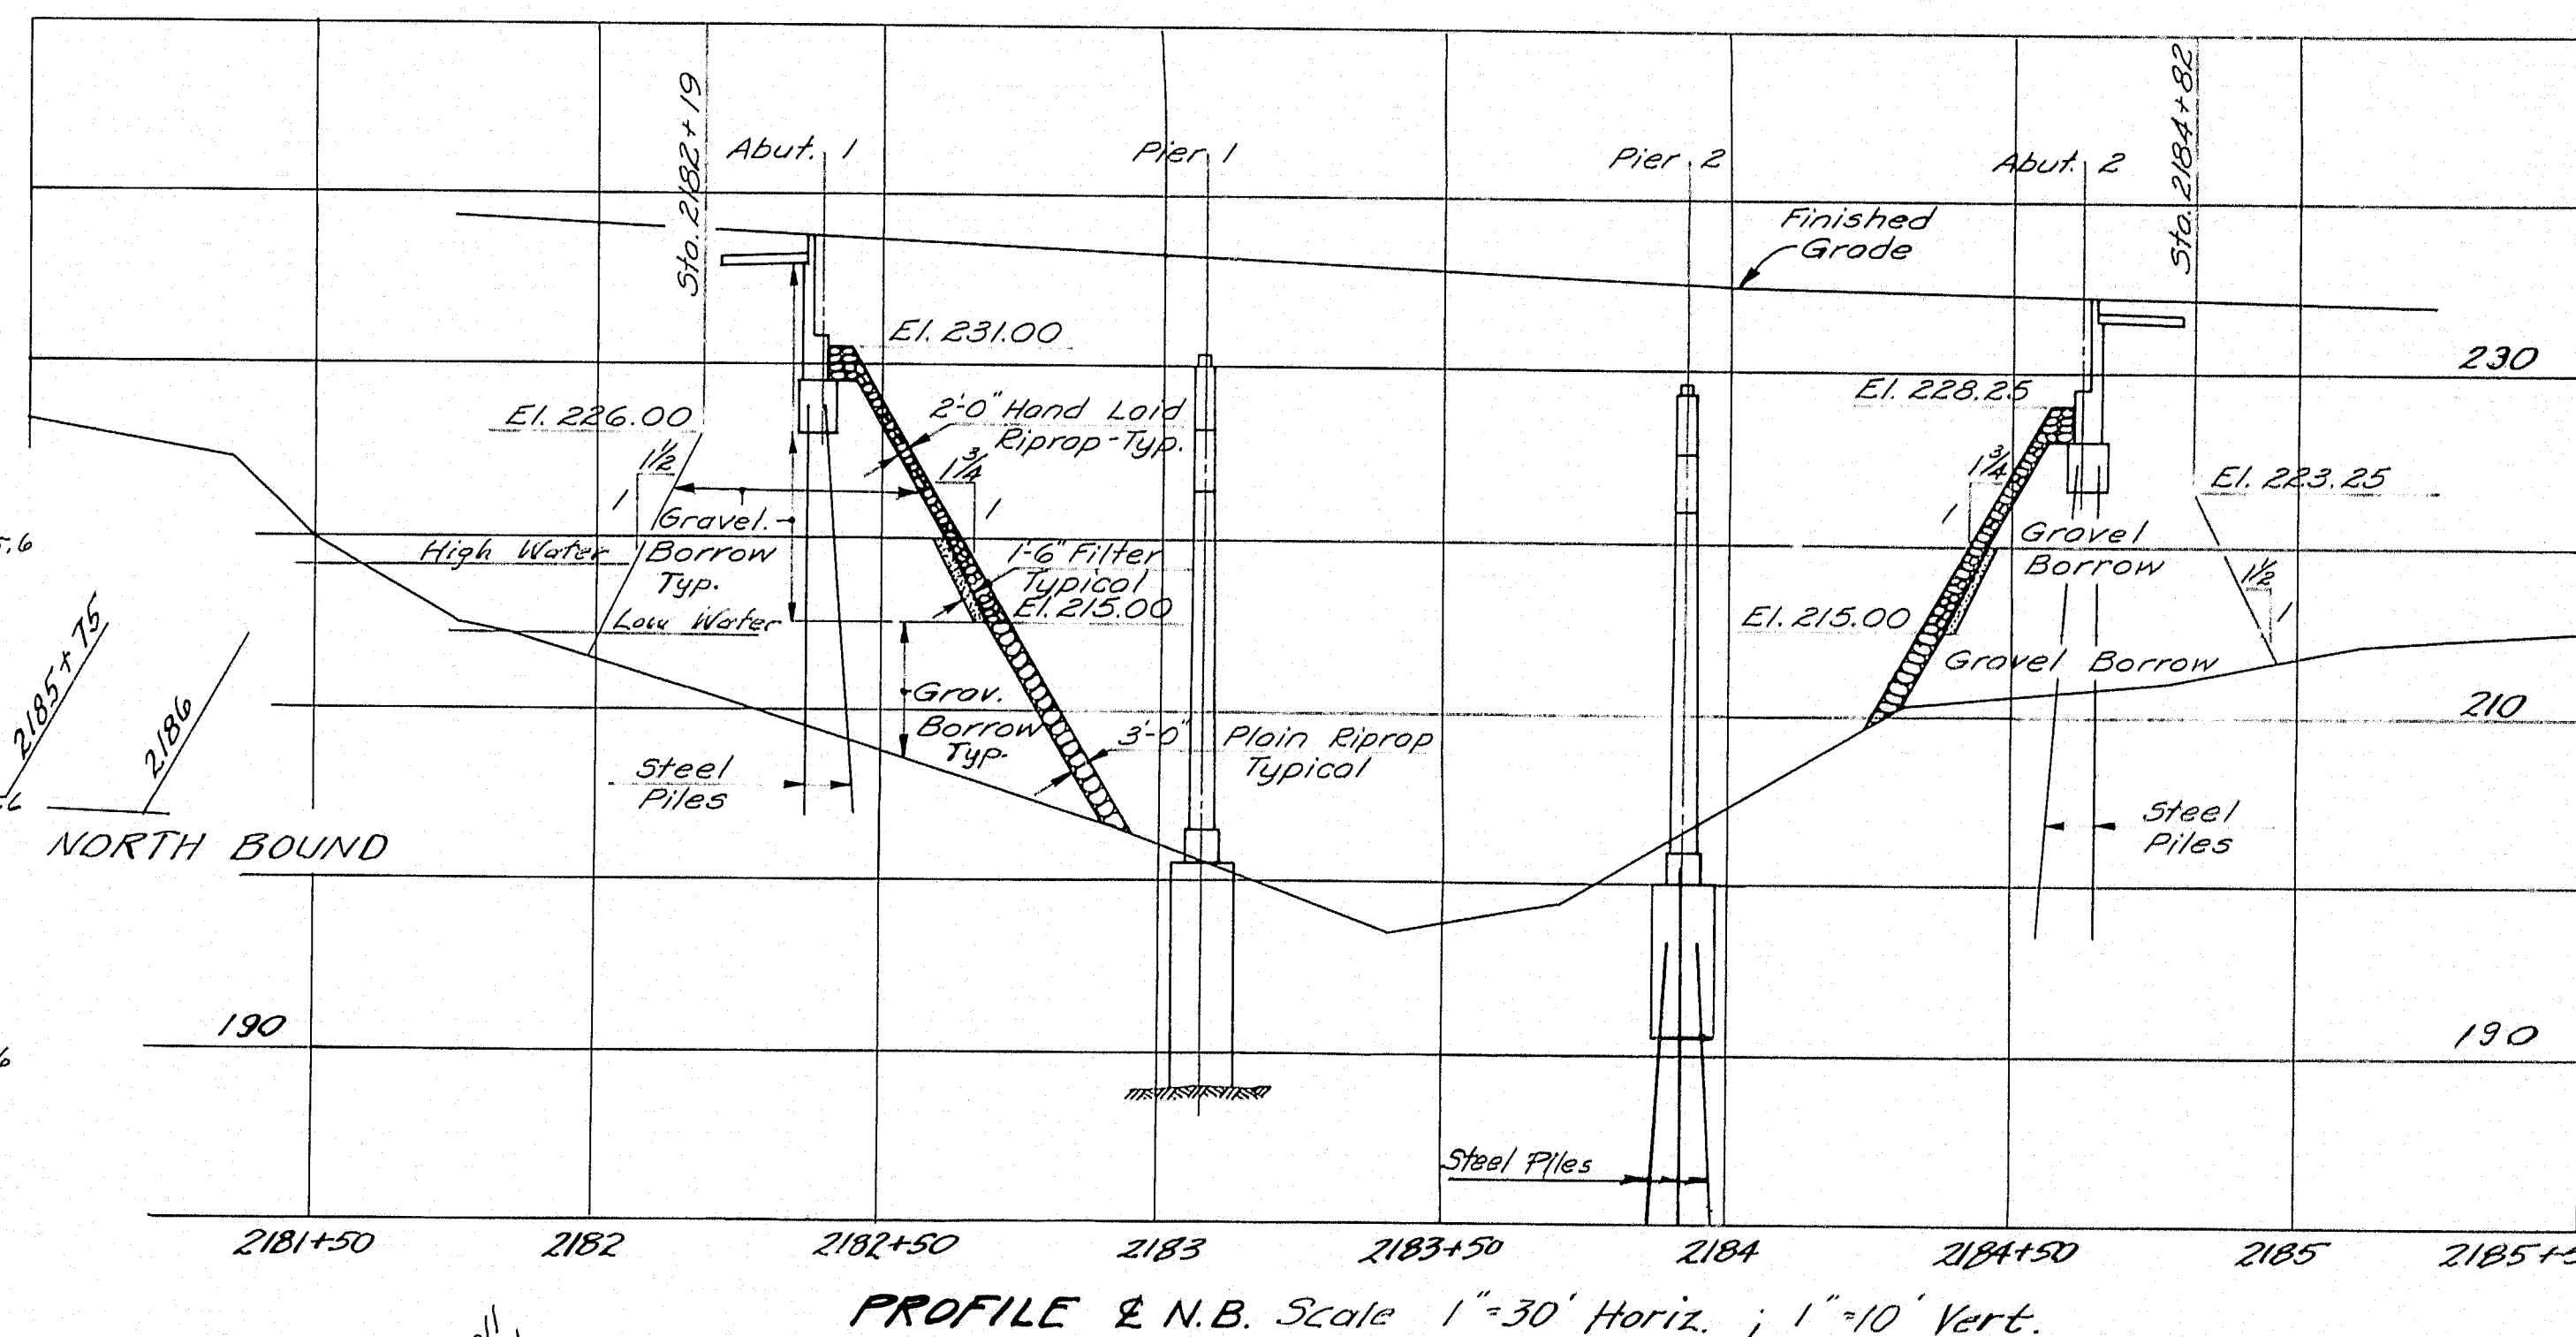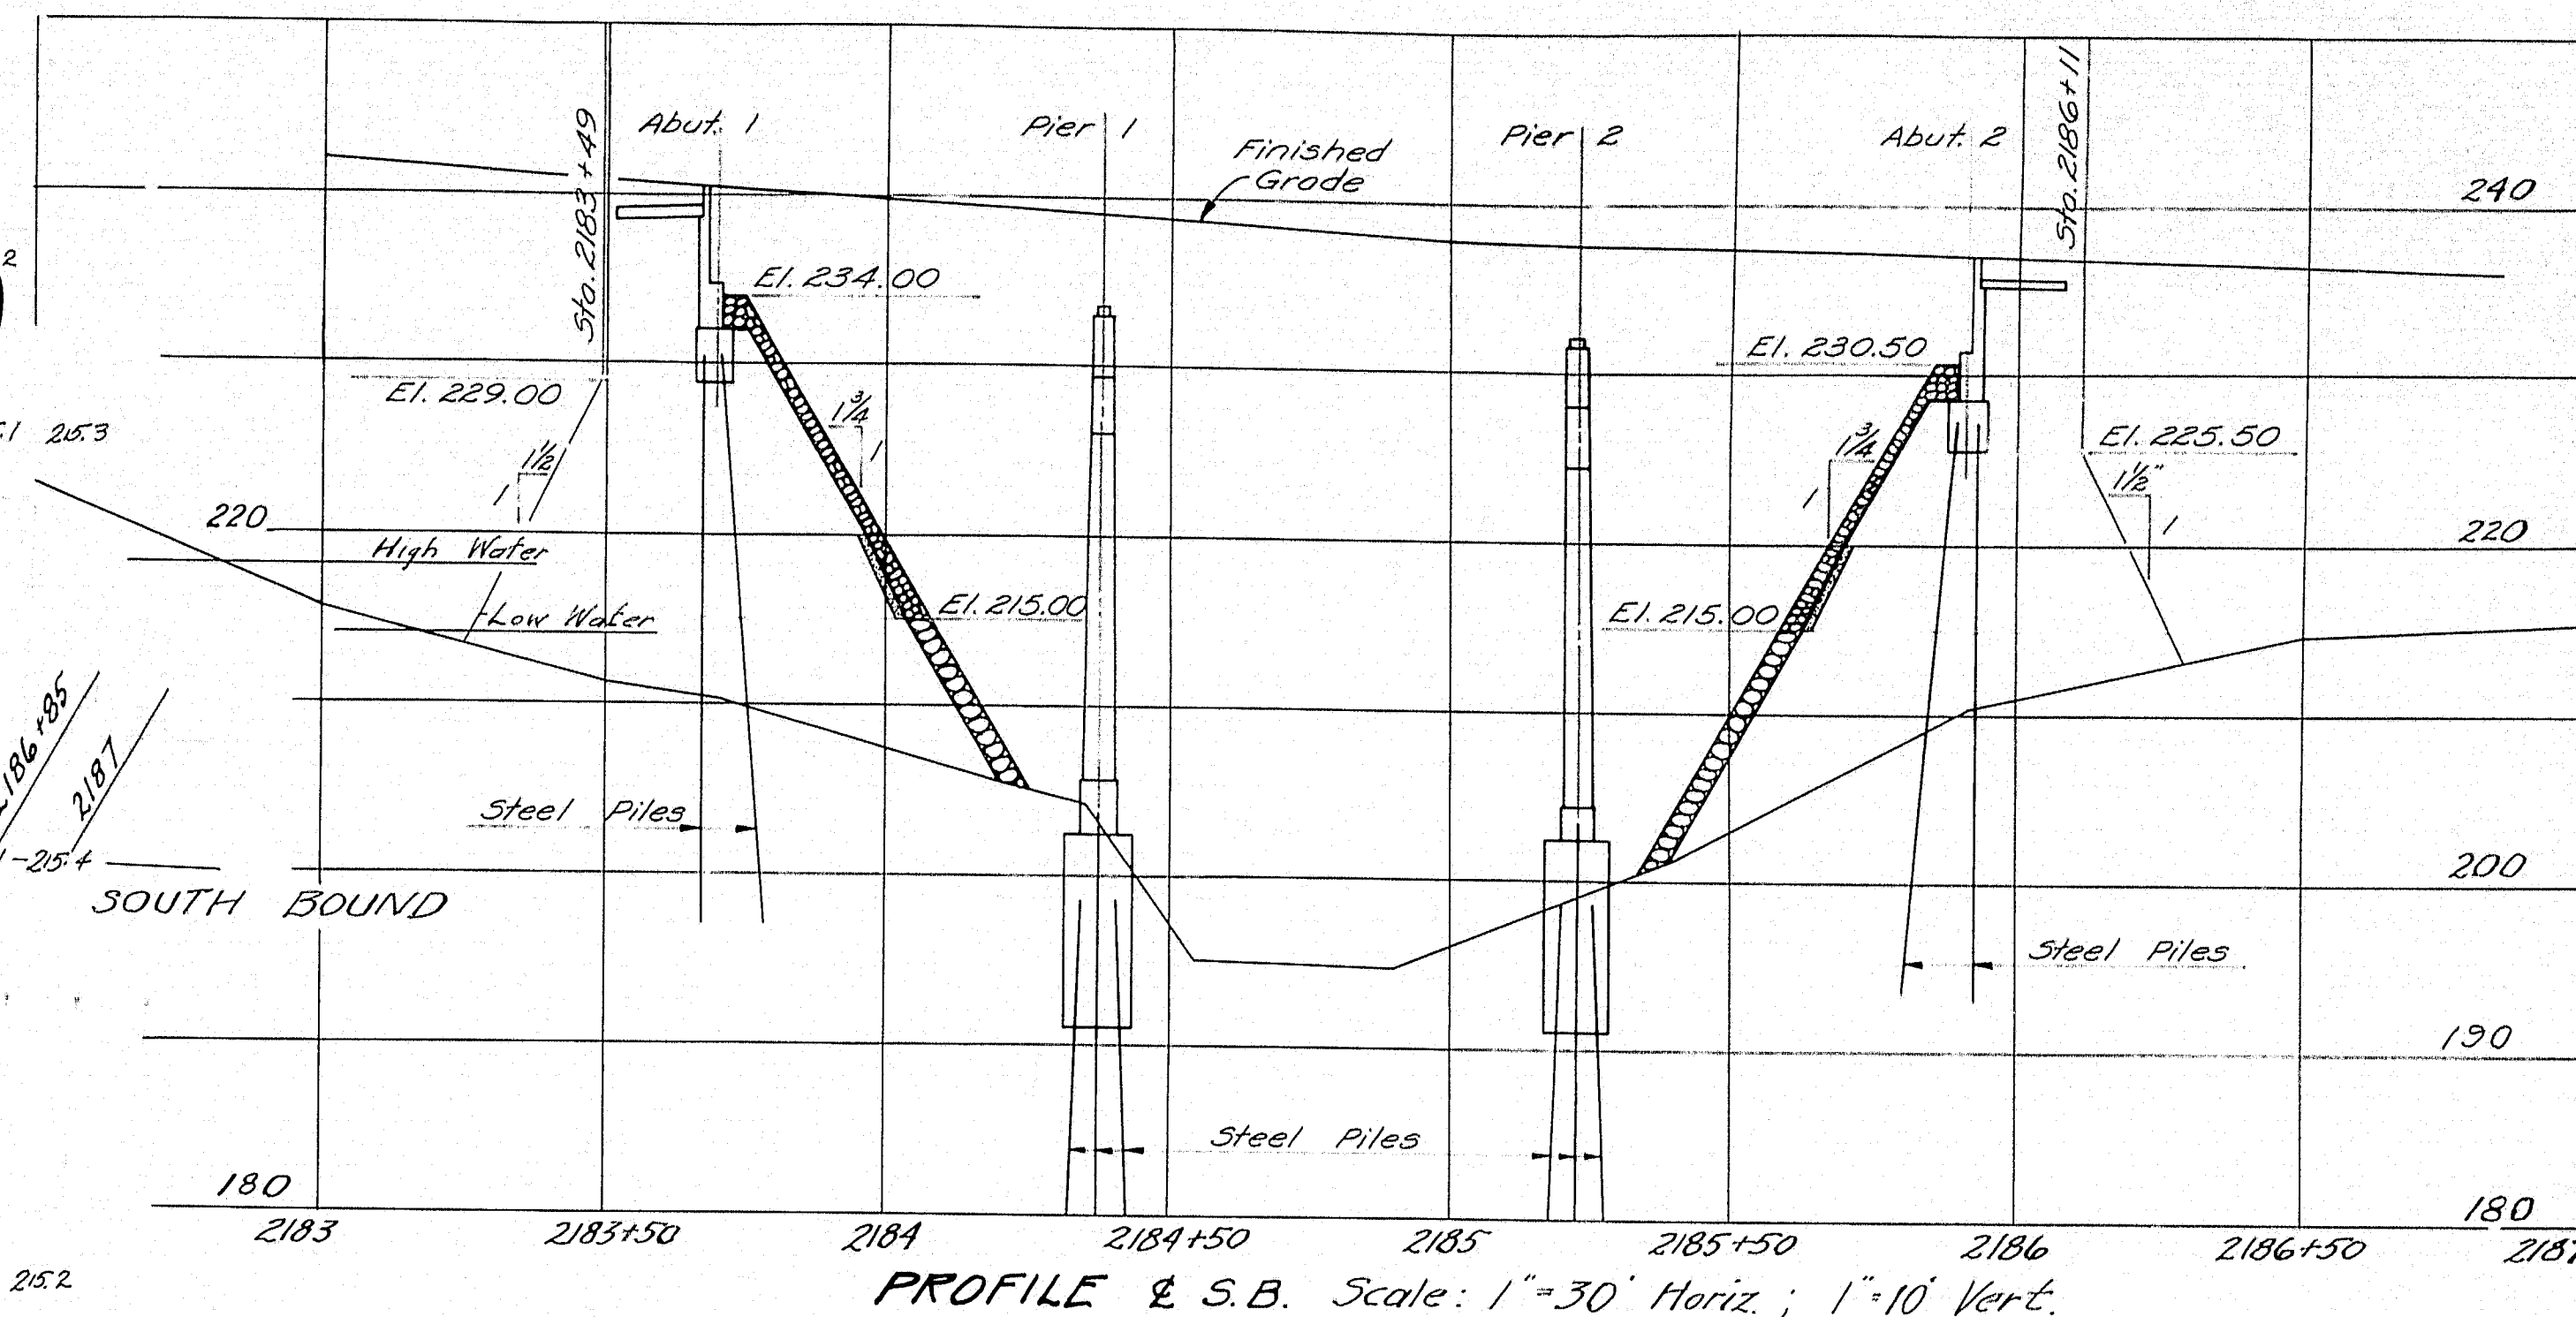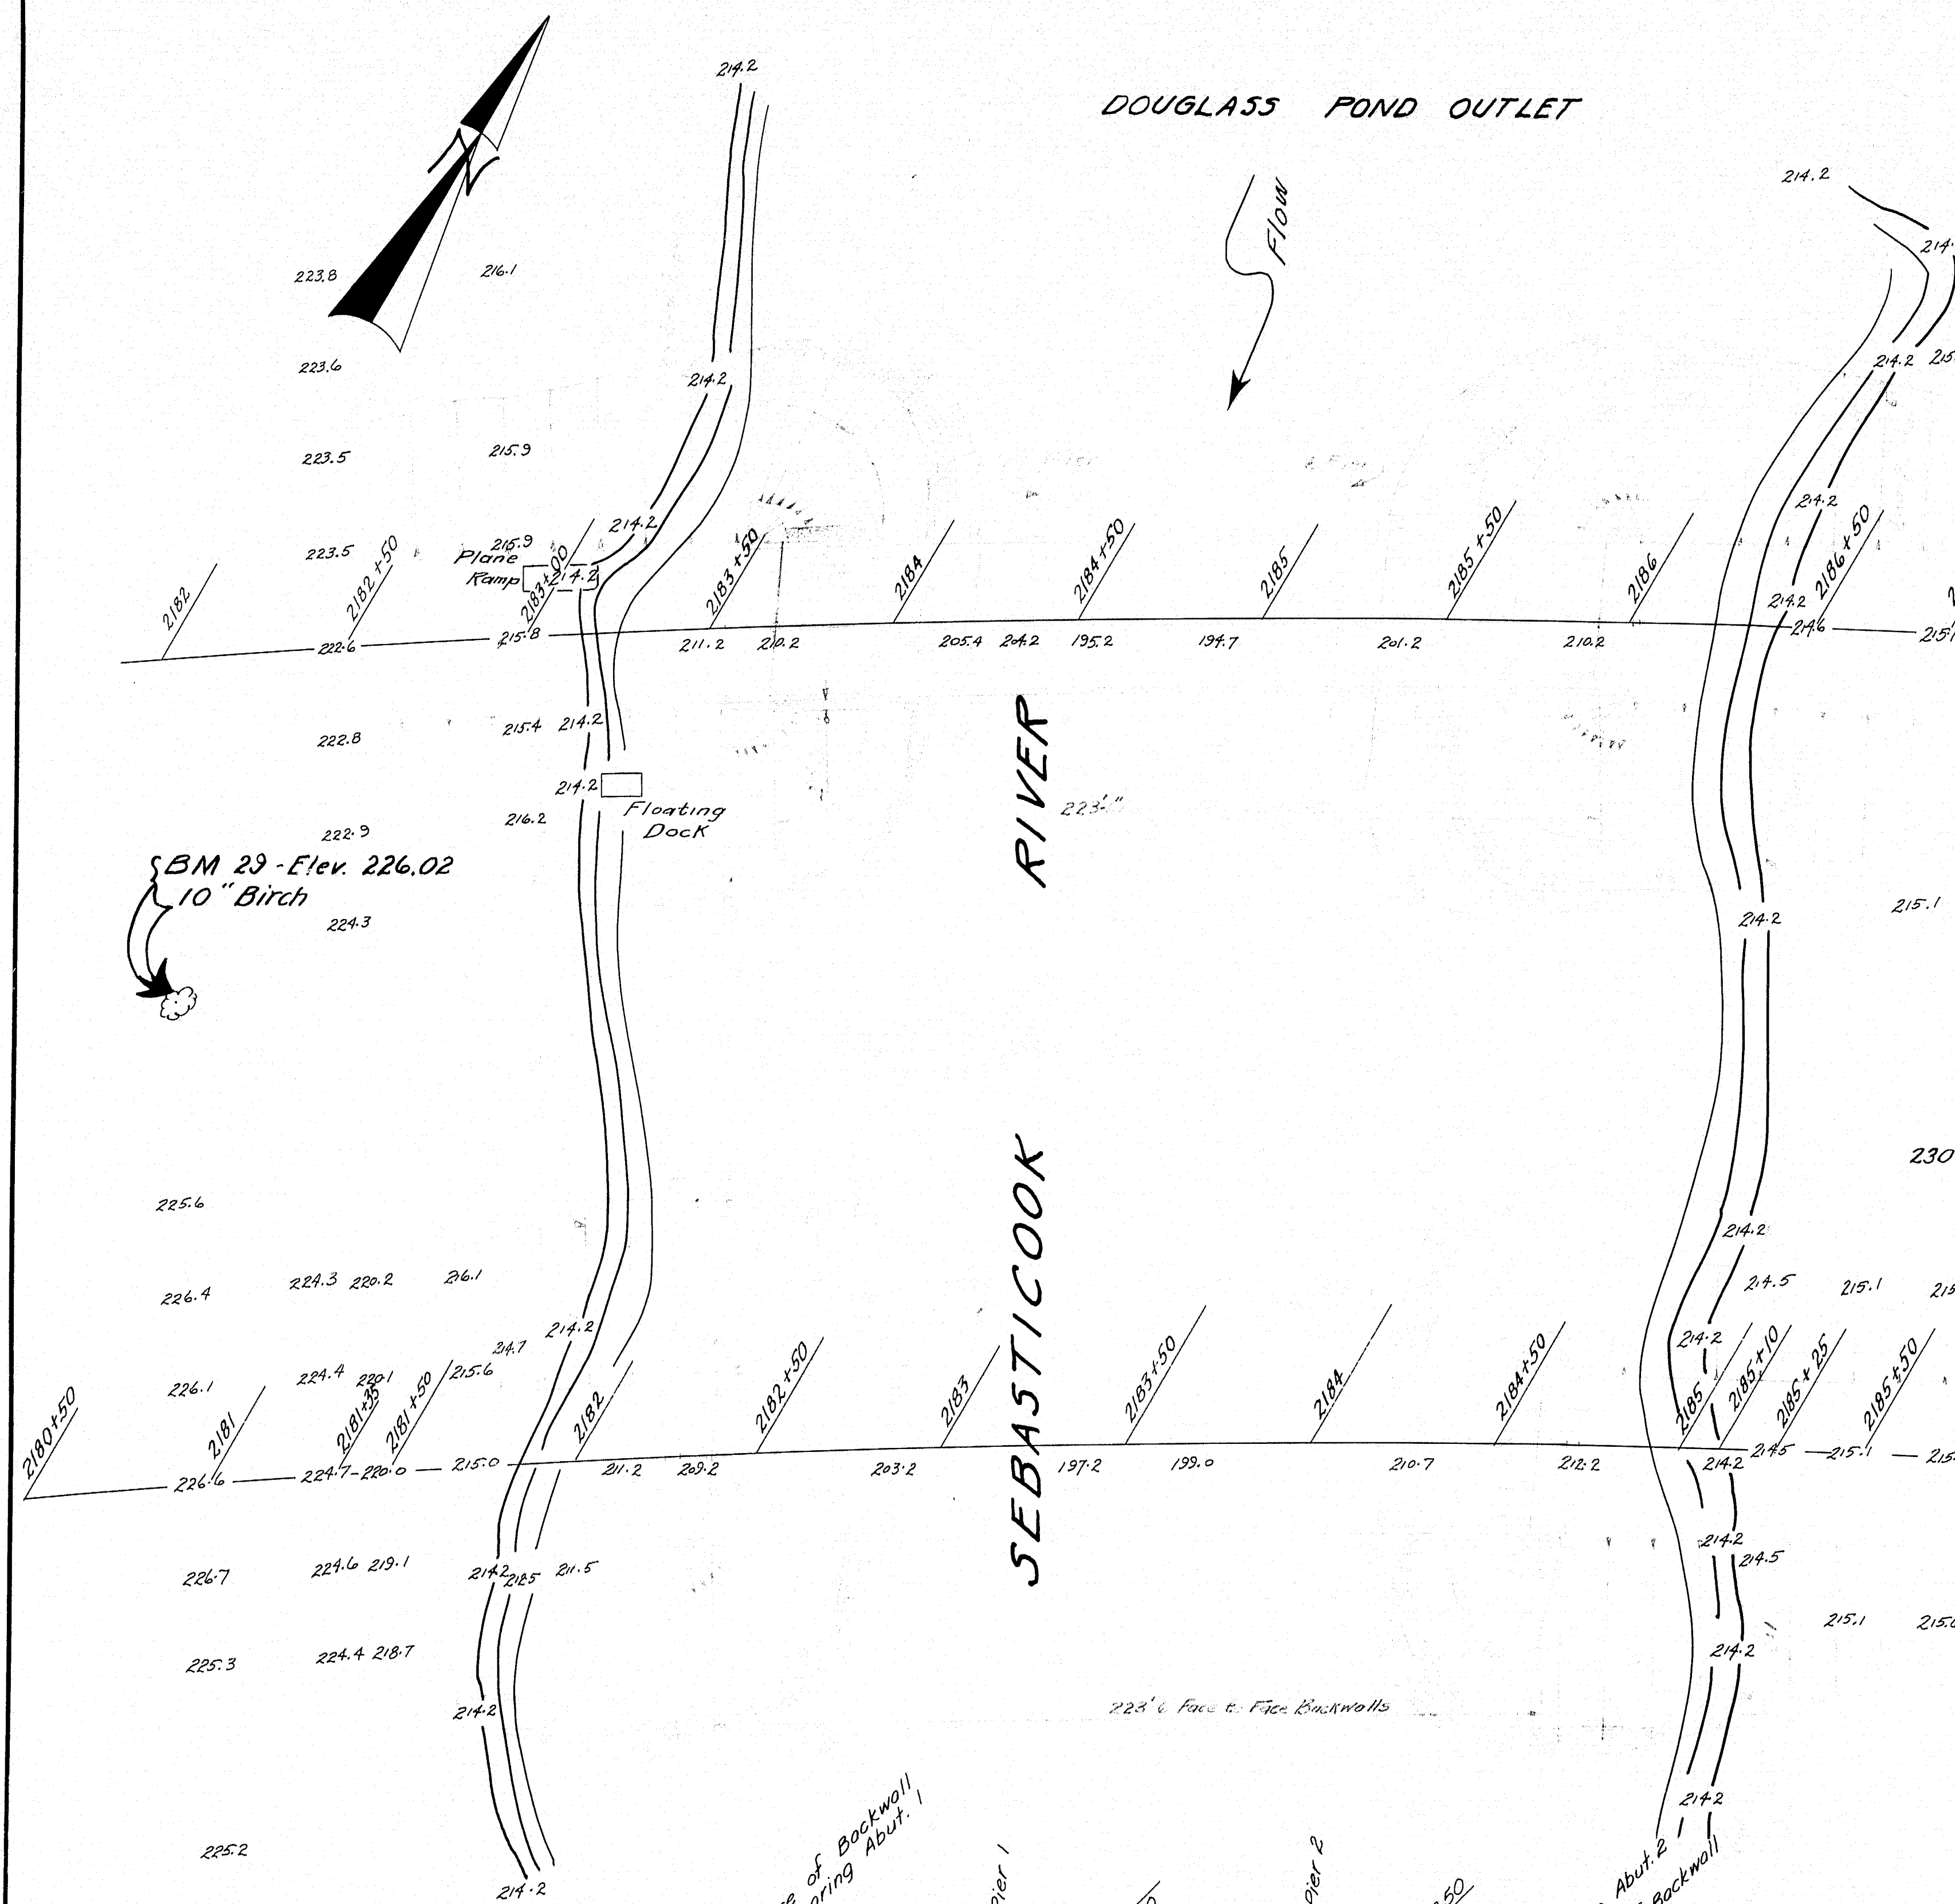


CURVE DATA	
S.B.	N.B.
P.I. 2178+78.36	P.I. 2178+08.23
Δ 53°-45'-05"	Δ 53°-45'-05"
D 1°-15'	D 1°-15'
T 2322.99	T 2322.99
L 4300.12	L 4300.12
R 4583.66	R 4583.66

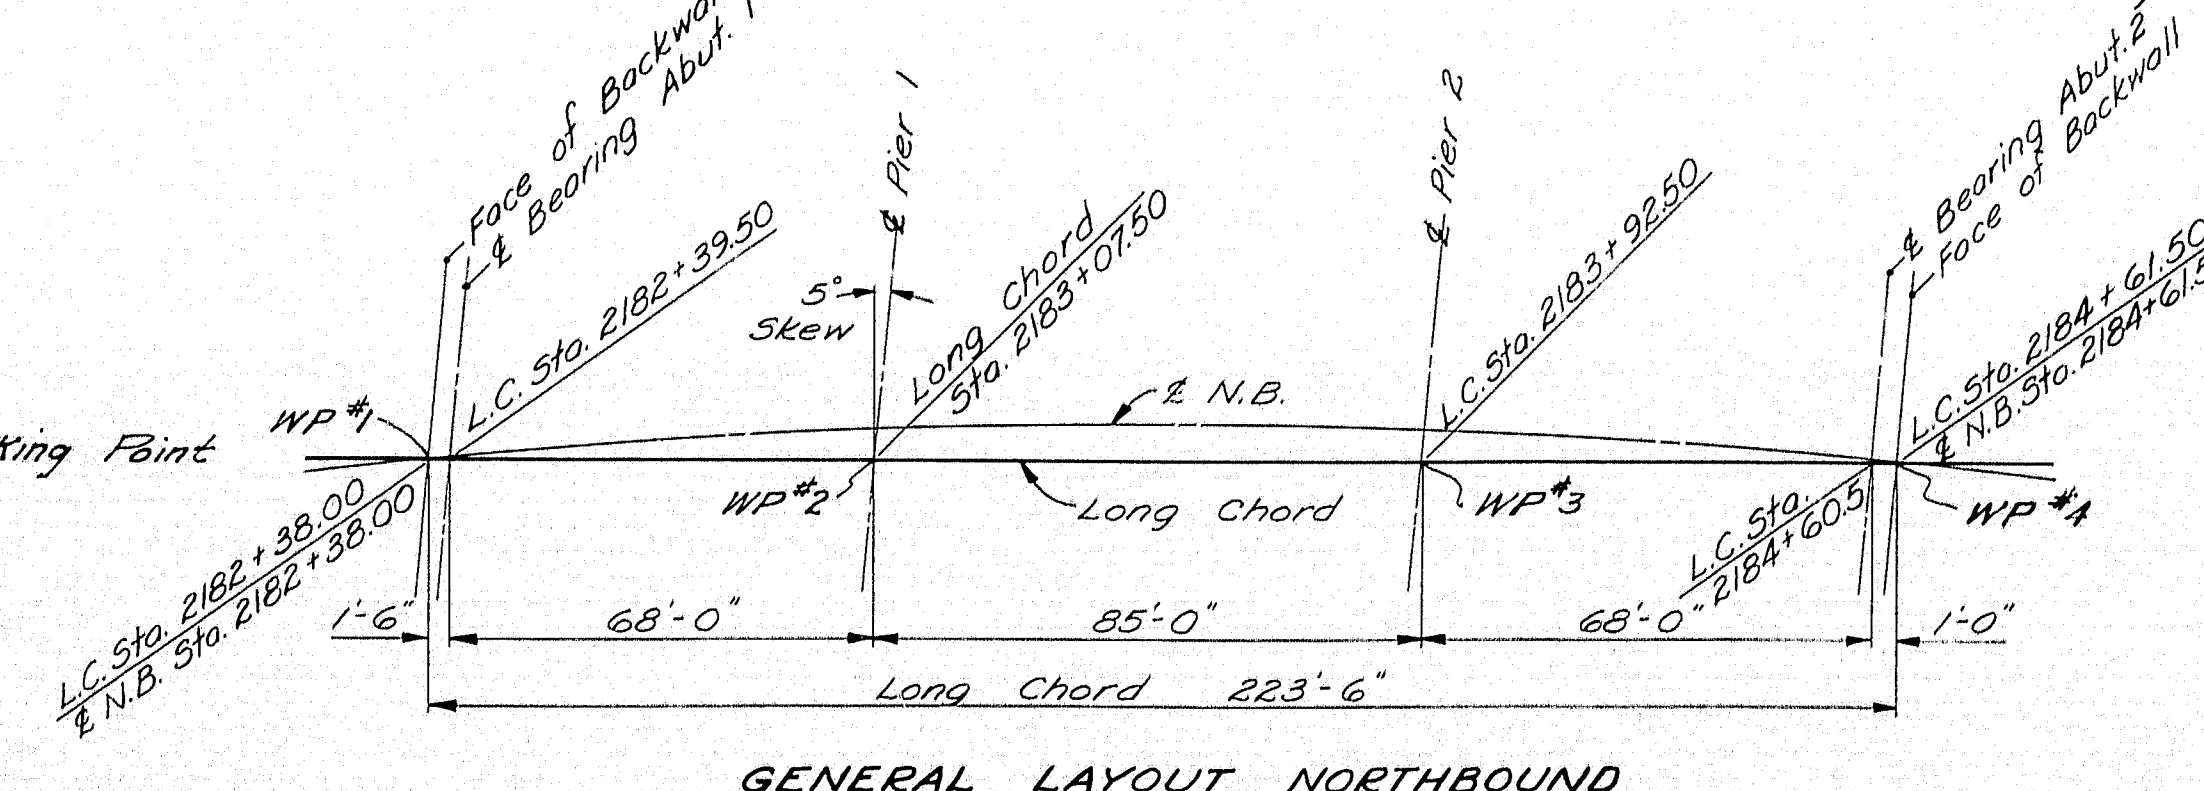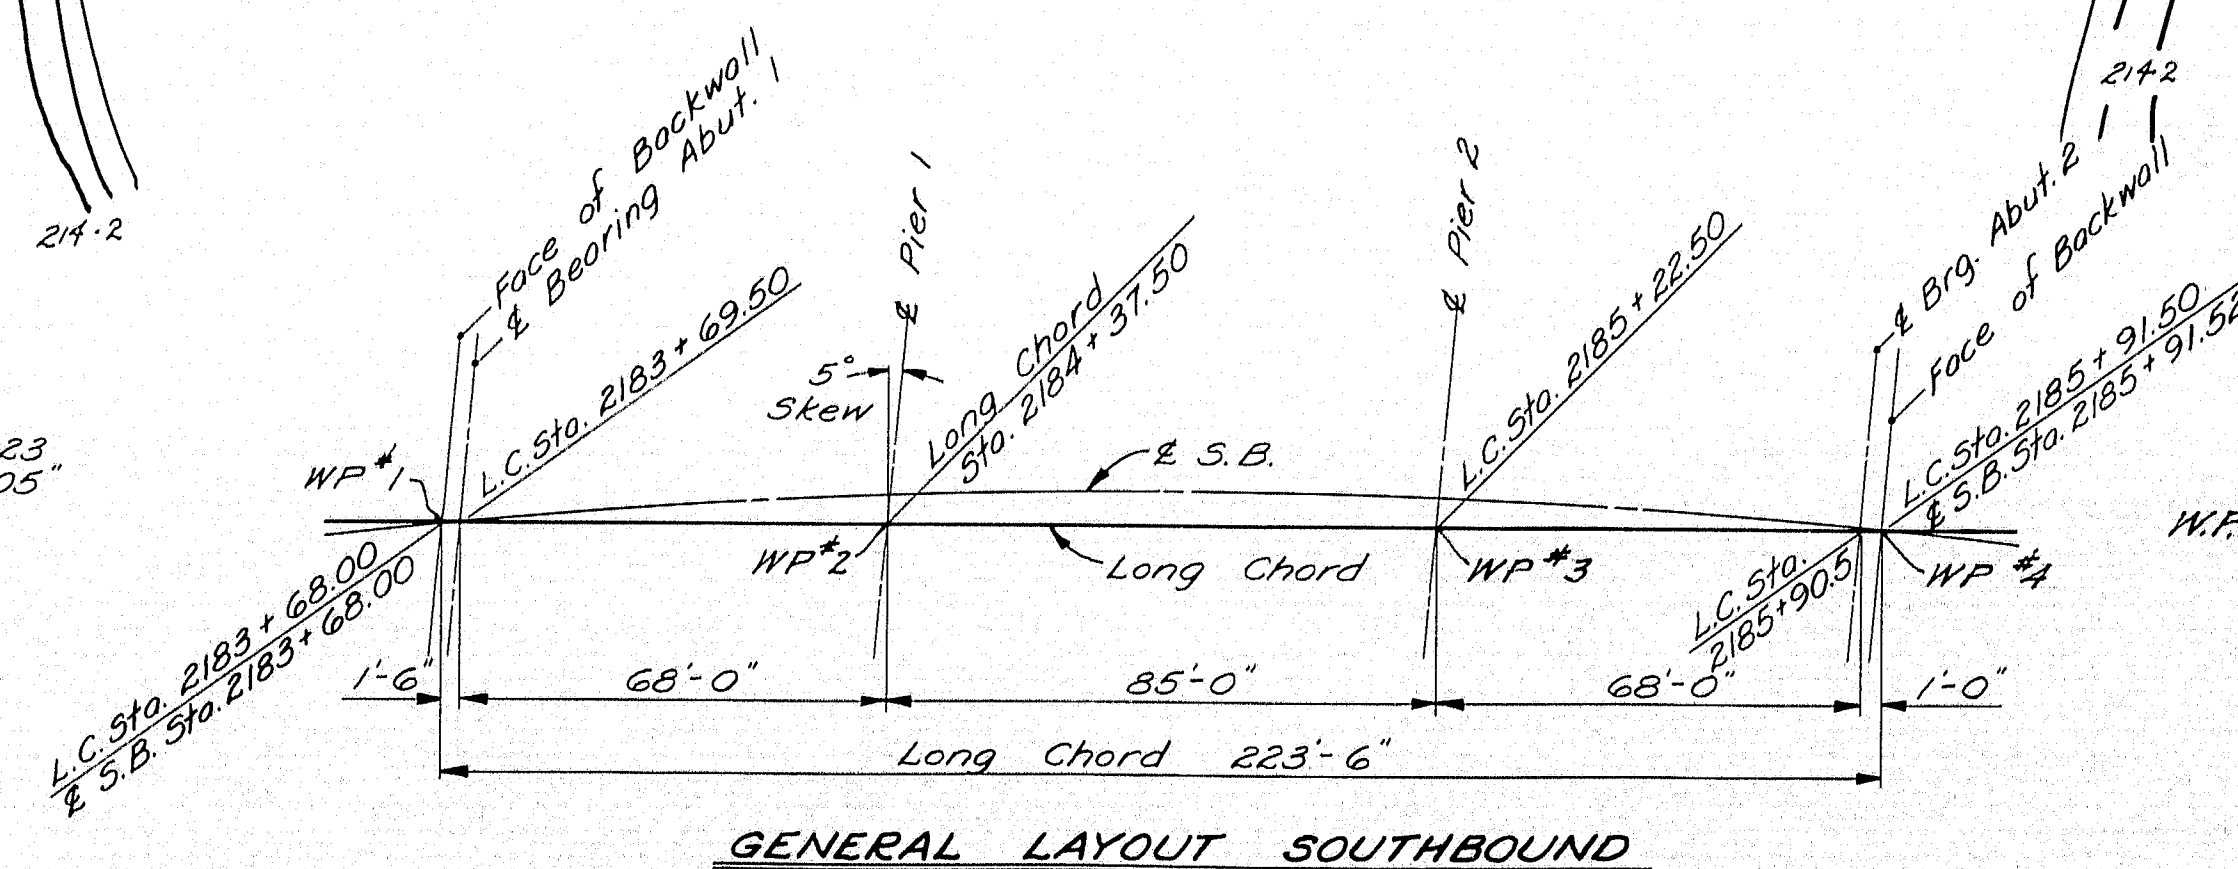


DESIGN - T.H.R.
 TRACE - P. Ault
 CHECK -
 BRIDGE NO. 1
 SURVEY - BLAKE
 PLOT - P. Ault
 STATE HIGHWAY COMMISSION
 BRIDGE DIVISION
SEBASTICOOK RIVER BRIDGE
 IN THE TOWN OF
PITTSFIELD
SOMERSET COUNTY
 SURVEY
 SHEET 2 OF 18 AUGUSTA, MAINE JULY 1962

M-1981

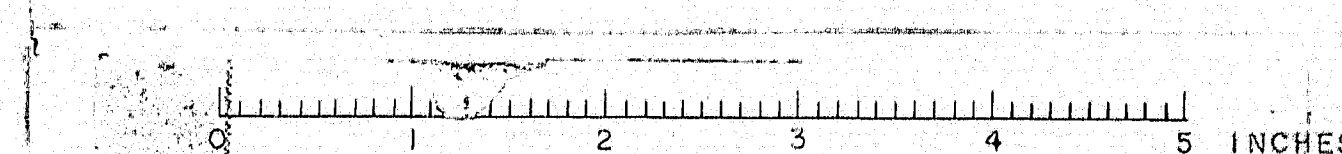

BORING AB-22 STATION 2182+0 & N.B.L.


CASING SIZE 2 1/2"

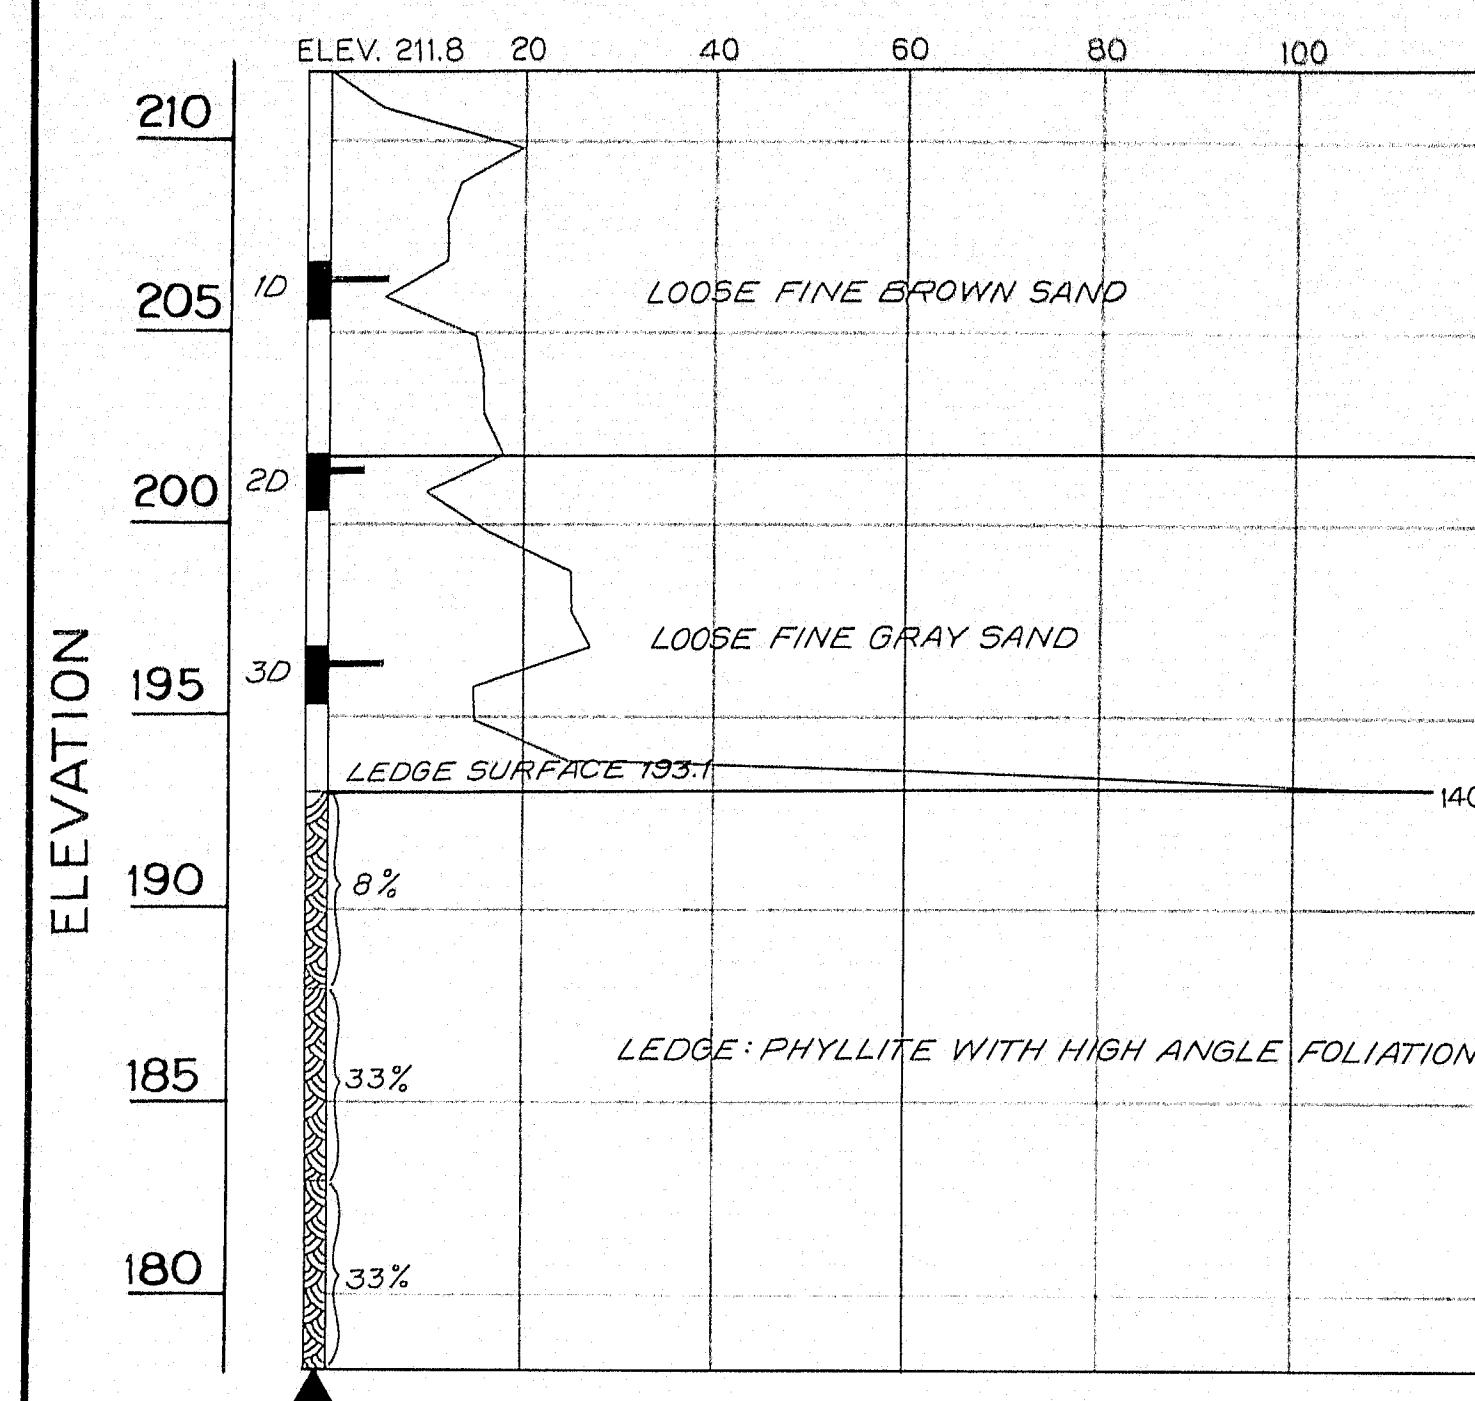

BORING AB-36 STATION 2182+41 20' Lt. N.B.L.


CASING SIZE 2 1/2"

ABUTMENT NO. 1

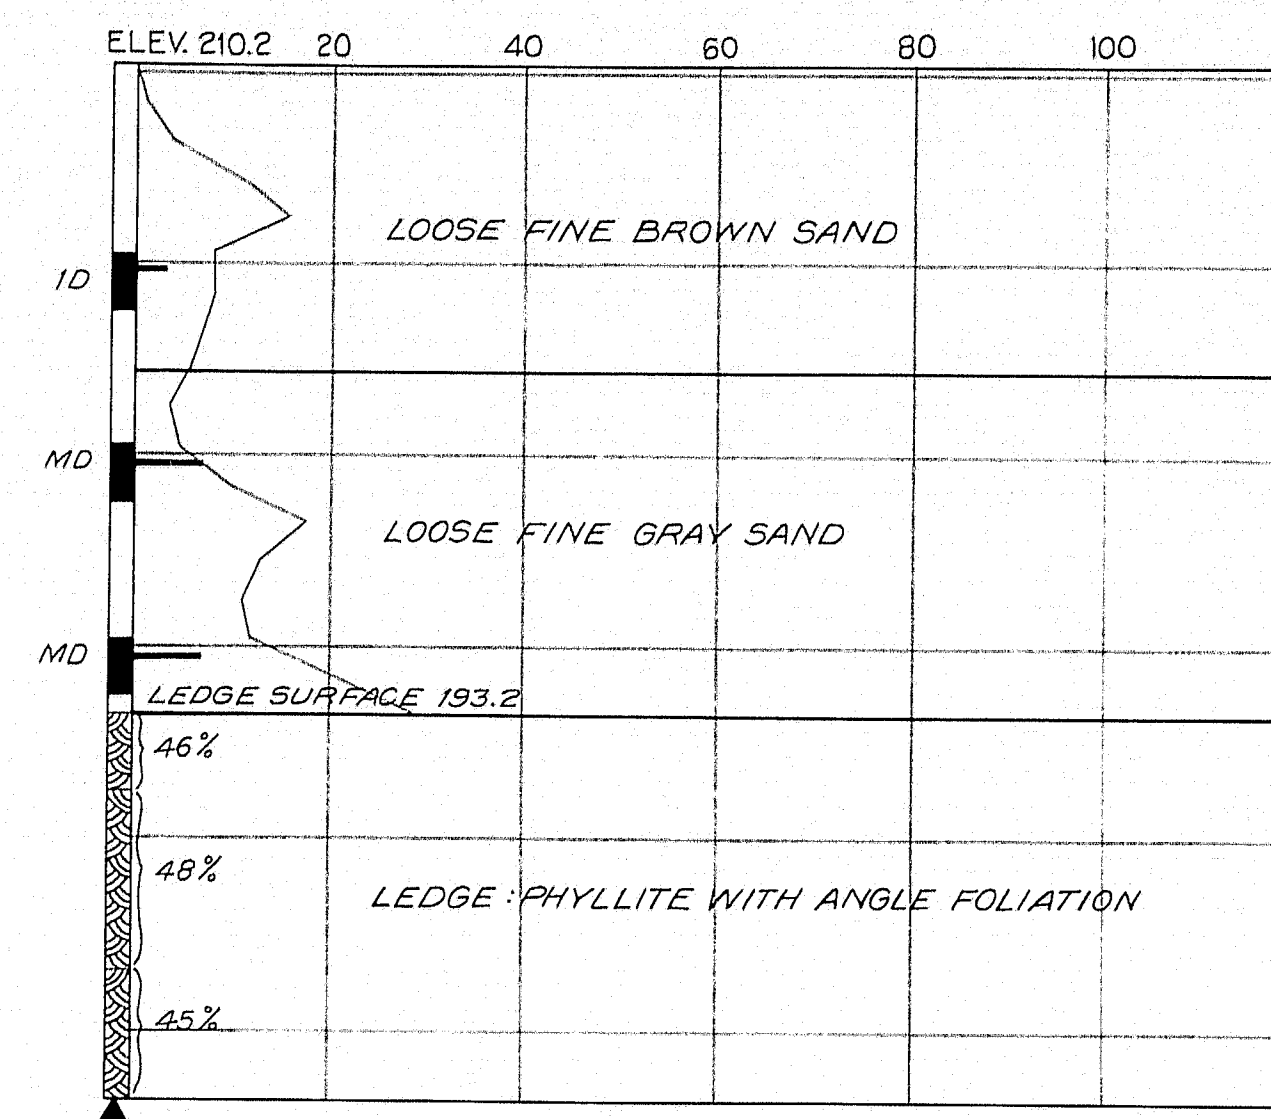

BORING AB-23 STATION 2183+0 & N.B.L.


CASING SIZE 2 1/2"

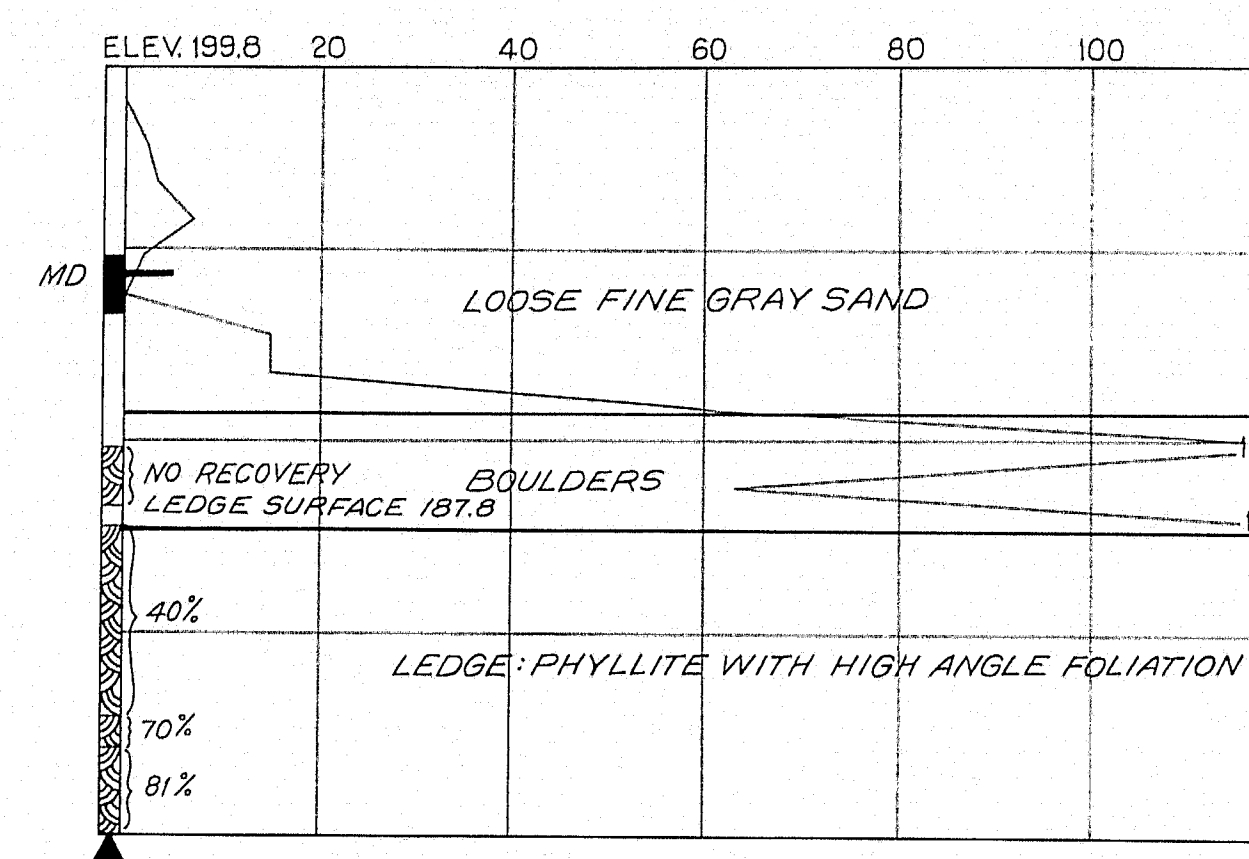

BORING AB-35 STATION 2183+06 20' Rt. N.B.L.

CASING SIZE 2 1/2"


PIER NO. 1

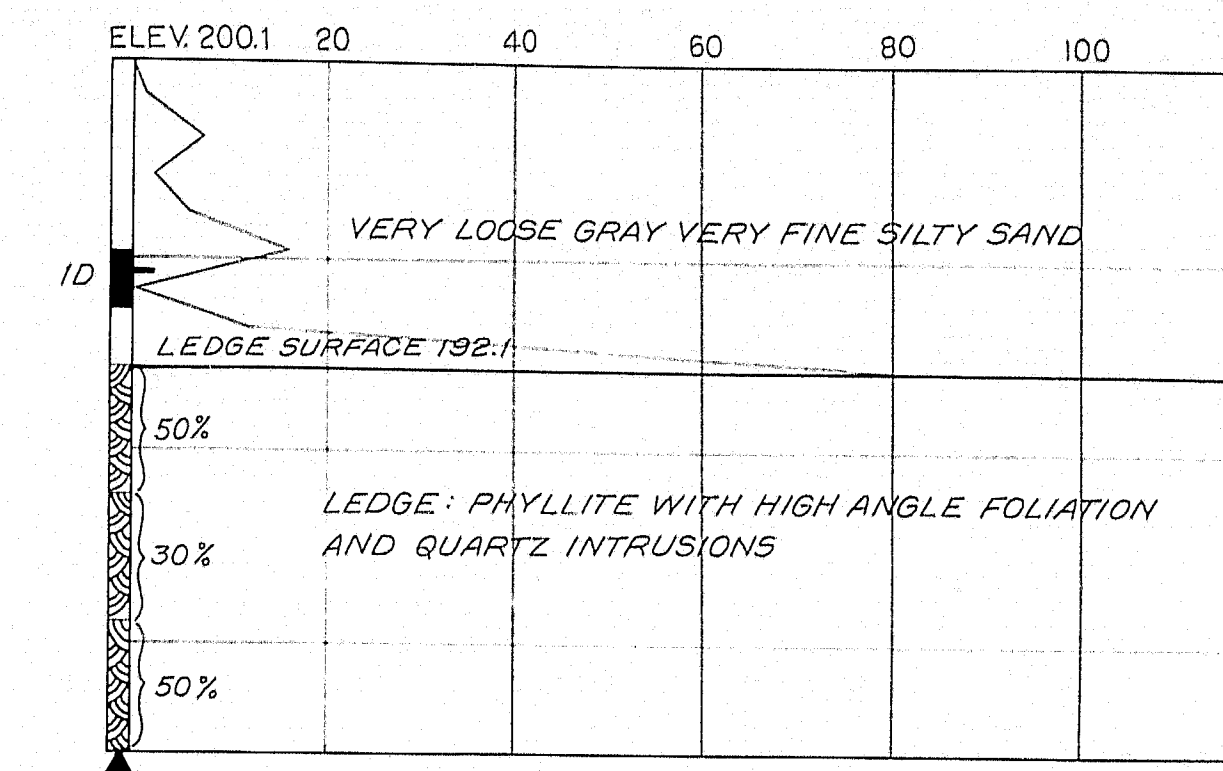

BORING AB-34 STATION 2183+94 20' Lt. & N.B.


CASING SIZE 2 1/2"

PIER NO. 2

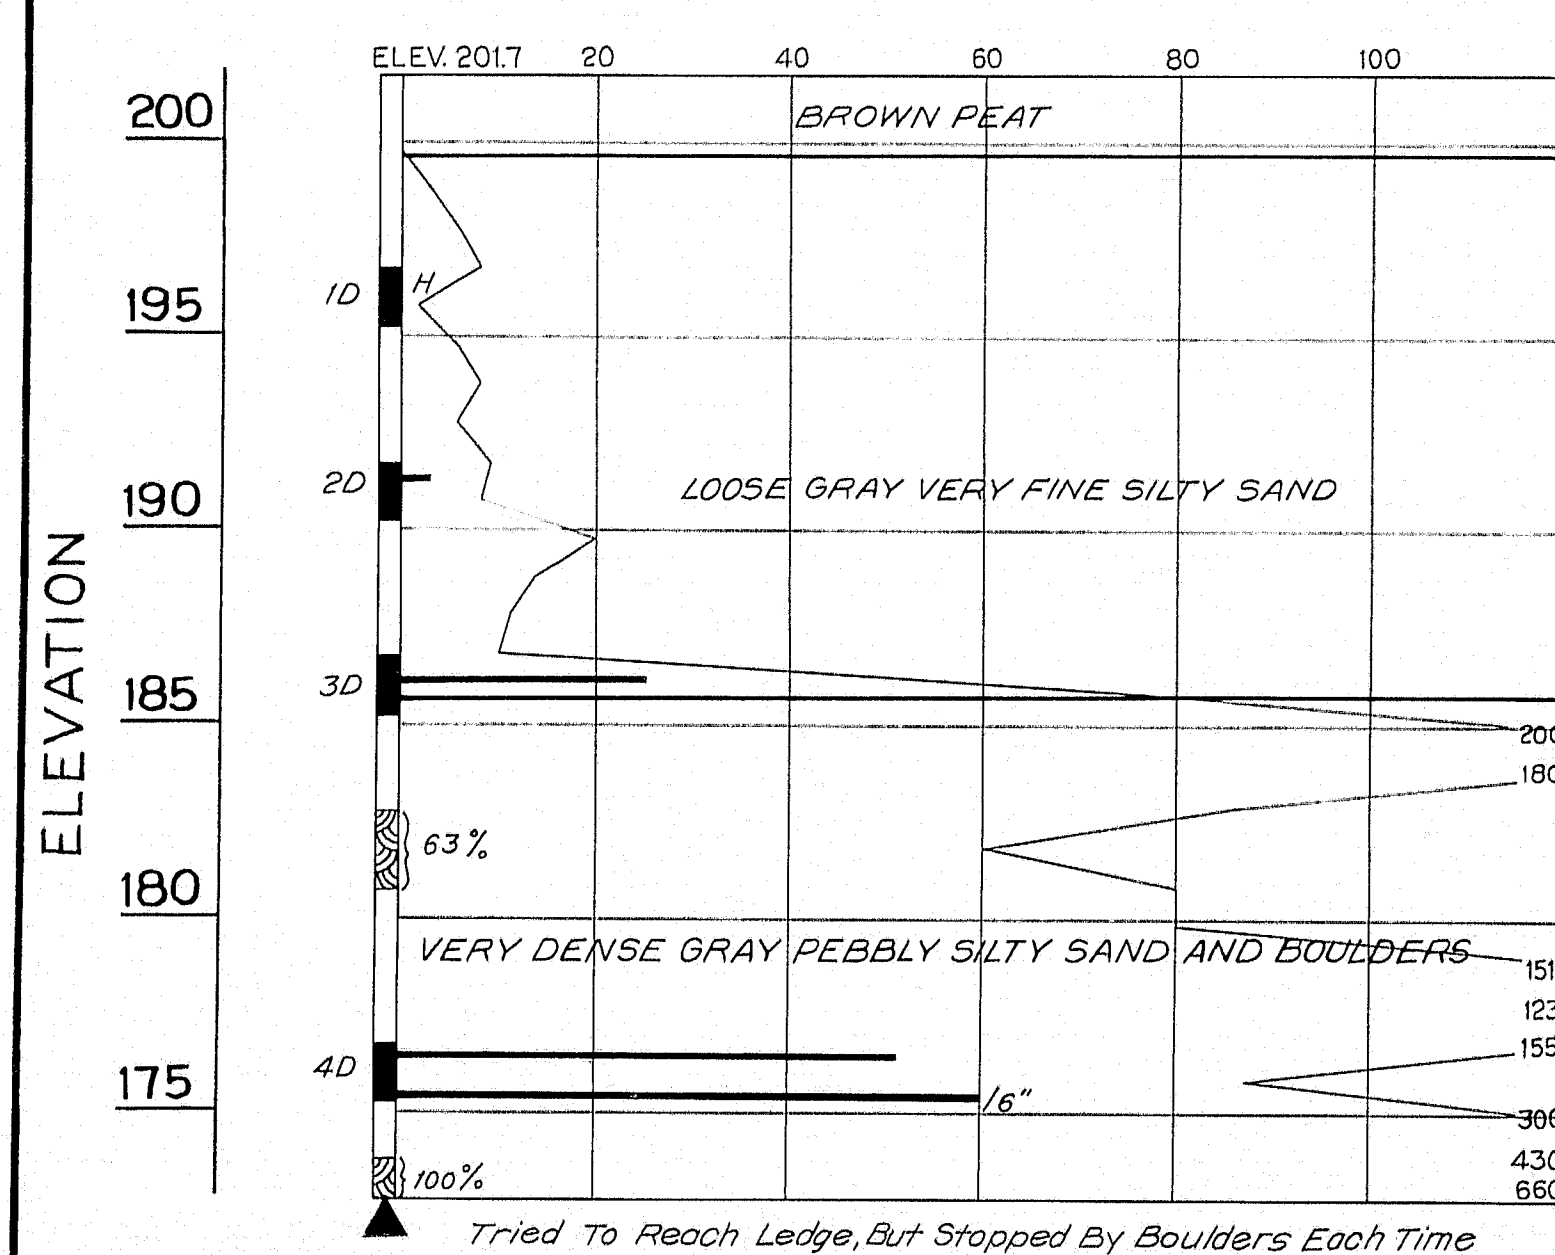

BORING AB-24 STATION 2184+0 & N.B.


CASING SIZE 2 1/2"

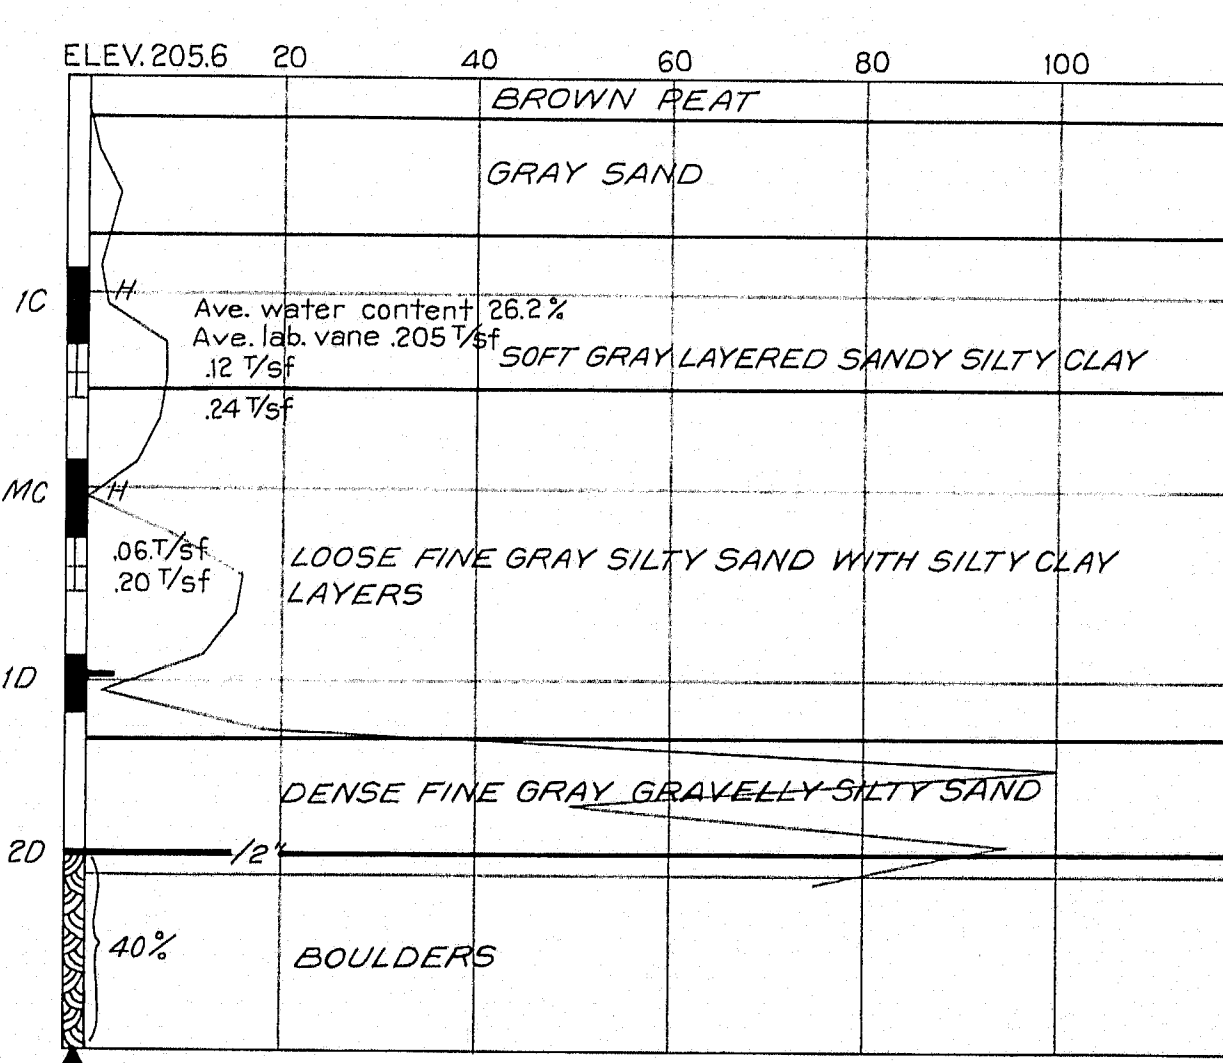

BORING AB-33 STATION 2183+91 20' Rt. & N.B.

CASING SIZE 2 1/2"

PIER NO. 2

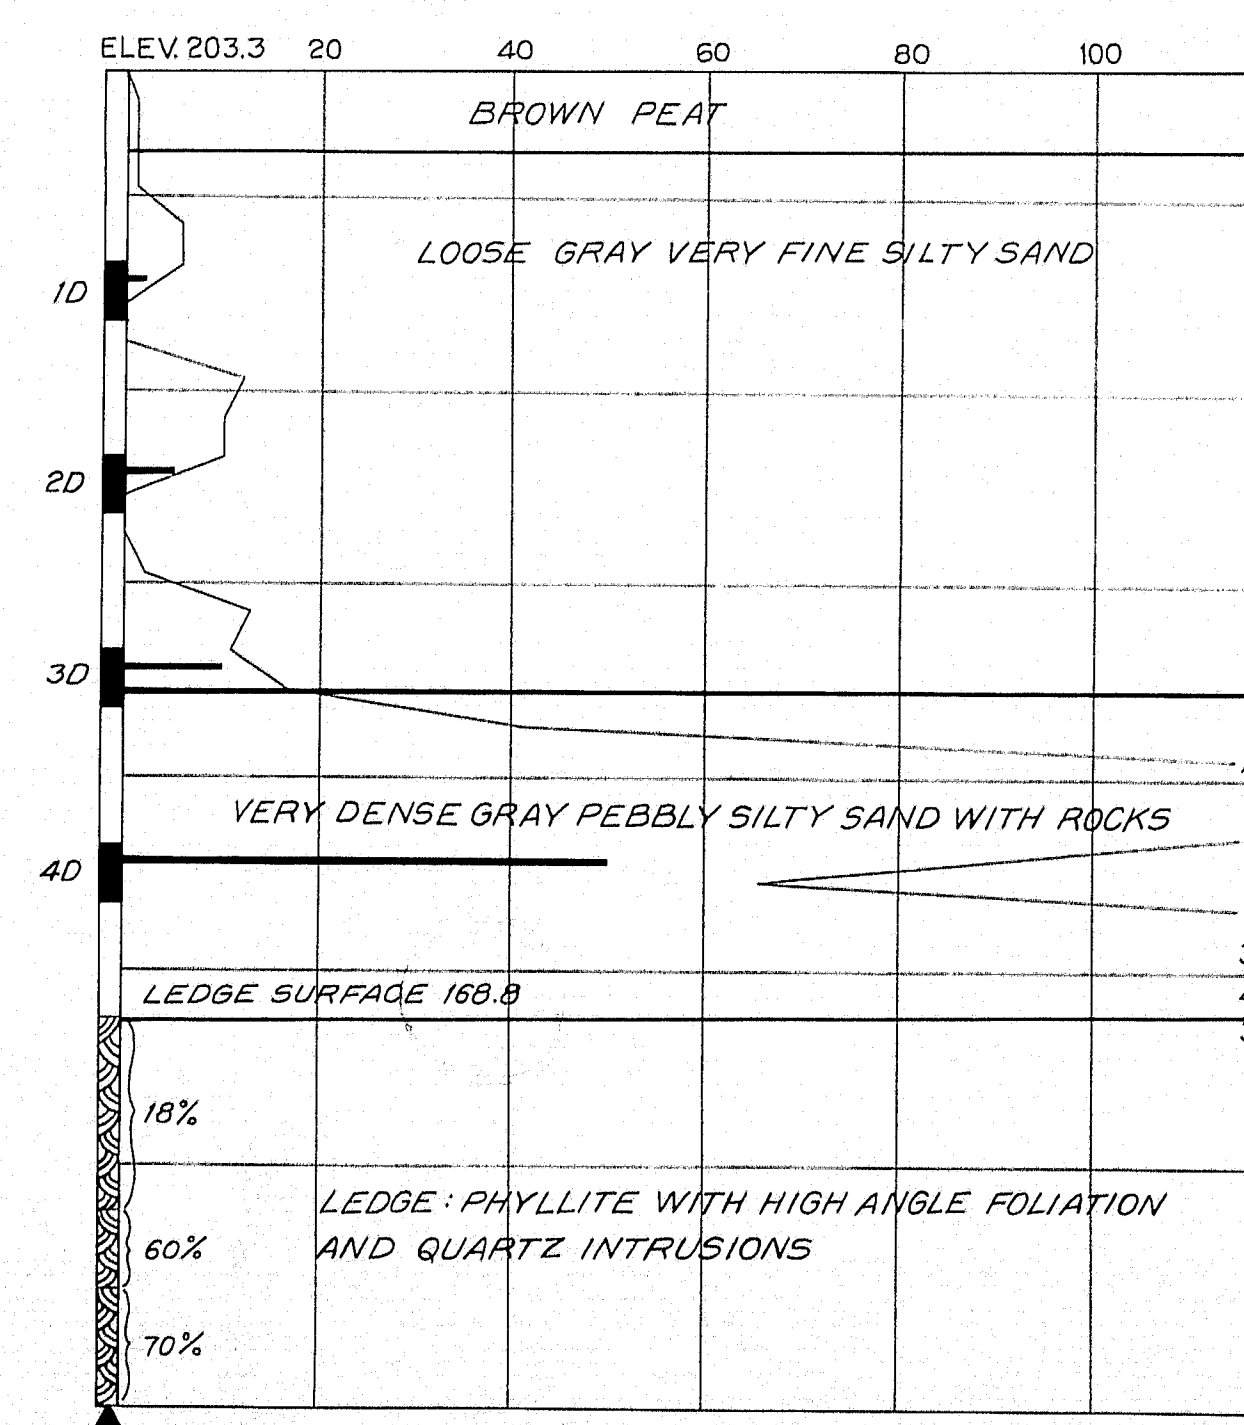


BORING NOTES

NUMBER OF BLOWS REQUIRED TO DRIVE EXTRA HEAVY CASING ONE FOOT WITH 400 FT. LBS. OF ENERGY PER BLOW
LOCATION OF SAMPLE OR SAMPLE ATTEMPT
S & H SAMPLER # 1290'S
2" O.D. 16 GA. SEAMLESS TUBING
UNSUCCESSFUL SAMPLE ATTEMPT AND TYPE OF SAMPLER
NUMBER OF BLOWS REQUIRED TO DRIVE SPOON OR TUBING ONE FOOT WITH 350 FT. LBS. OF ENERGY PER BLOW
SAMPLING SPOON OR SEAMLESS TUBING DRIVEN BY STATIC WEIGHT OF DRILL RODS AND HAMMER
FIELD VANE TEST
BOTTOM OF BORING (MAY NOT BE BOTTOM OF SOIL STRATA)
LOCATIONS CORED BY DIAMOND BIT AND PER CENT RECOVERY OF ROCK

DESIGN-- TRACE-- CHECK--	BRIDGE NO. SURVEY-- PLOT--
STATE HIGHWAY COMMISSION BRIDGE DIVISION	
SEBASTICOOK RIVER BRIDGE	
IN THE TOWN OF PITTSFIELD SOMERSET COUNTY	
BORING DETAILS	


SHEET 4 OF 18 AUGUSTA, MAINE

M-1983

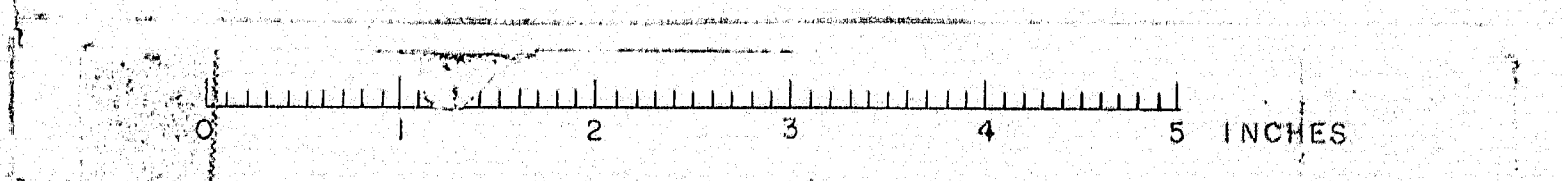


ABUTMENT NO. 2

BORING AB-32 STATION 2184+59 20' Rt. & N.B.				
CASING SIZE	DRIVING RESISTANCE	VANE SHEAR STRENGTH	WATER CONTENT	
4" & 2 1/2"	Blows/Ft.	Tons/Sq. Ft.	Percent	
	20 40	0.2 0.4 0.6	10 20 30	

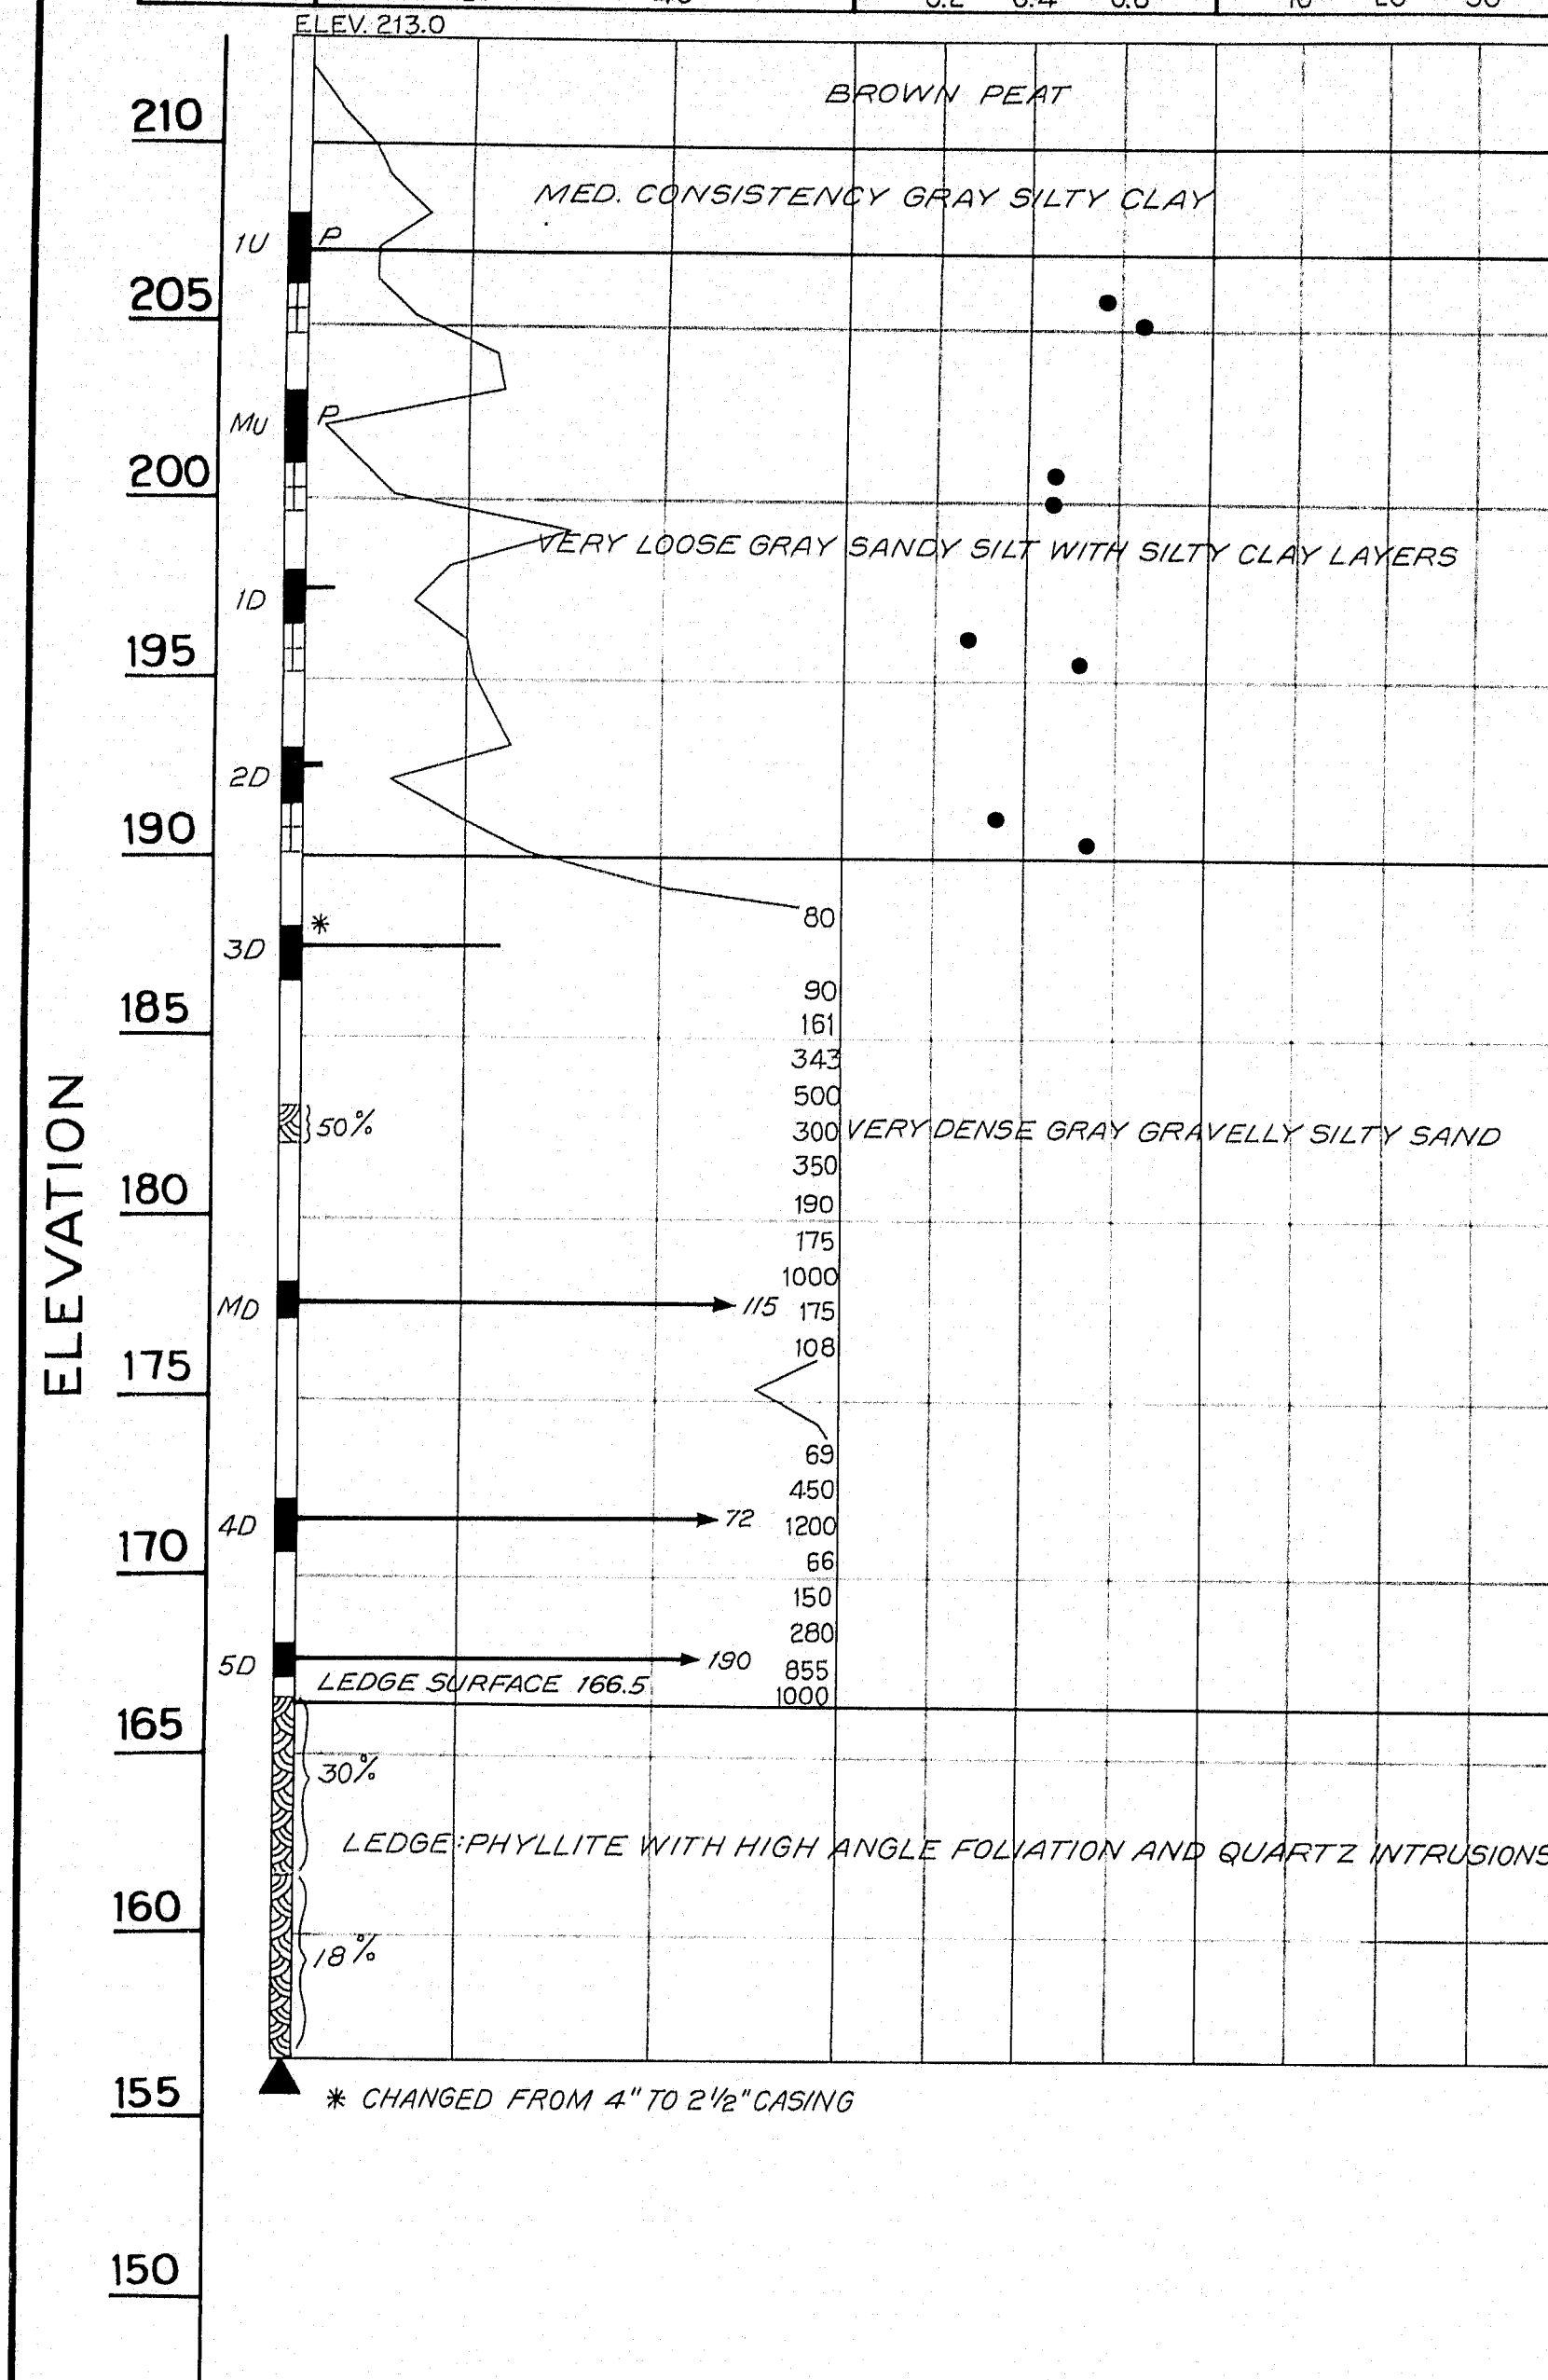


BORING AB-25 STATION 2185+0 & N.B.

DRIVING RESISTANCE	VANE SHEAR STRENGTH	WATER CONTENT
Blows/Ft.	Tons/Sq. Ft.	Percent
20 40	0.2 0.4 0.6	10 20 30

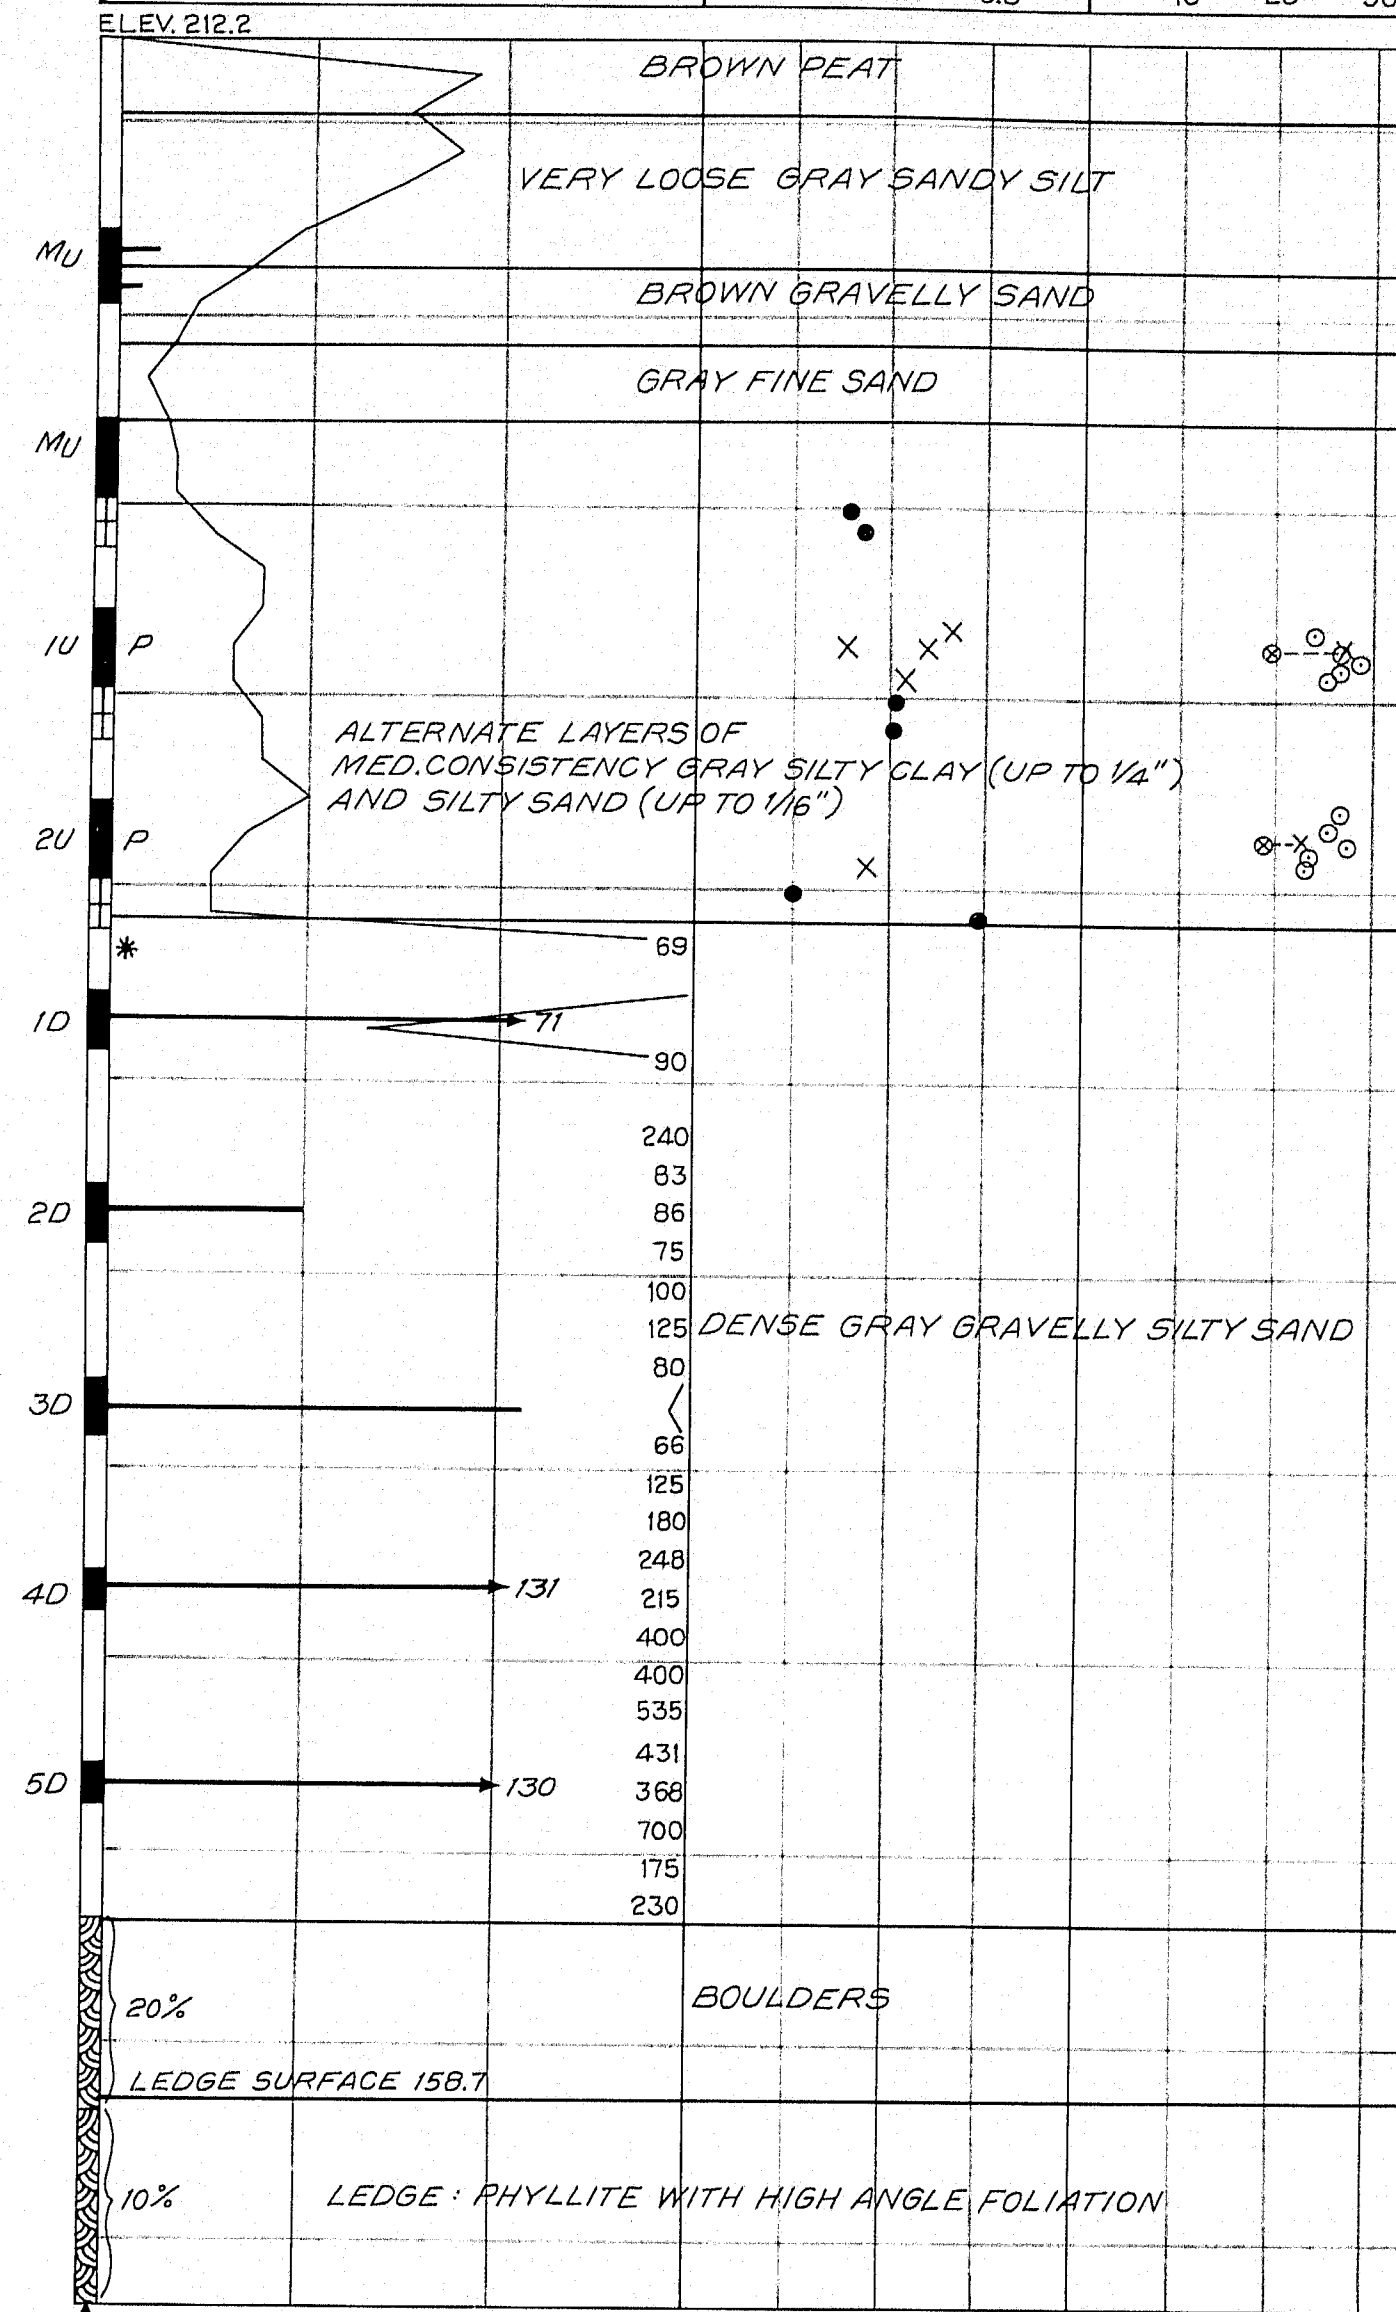


BORING AB-30 STATION 2185+30 100 Lt. & N.B.

DRIVING RESISTANCE	VANE SHEAR STRENGTH	WATER CONTENT
Blows/Ft.	Tons/Sq. Ft.	Percent
20 40	0.2 0.4 0.6	10 20 30

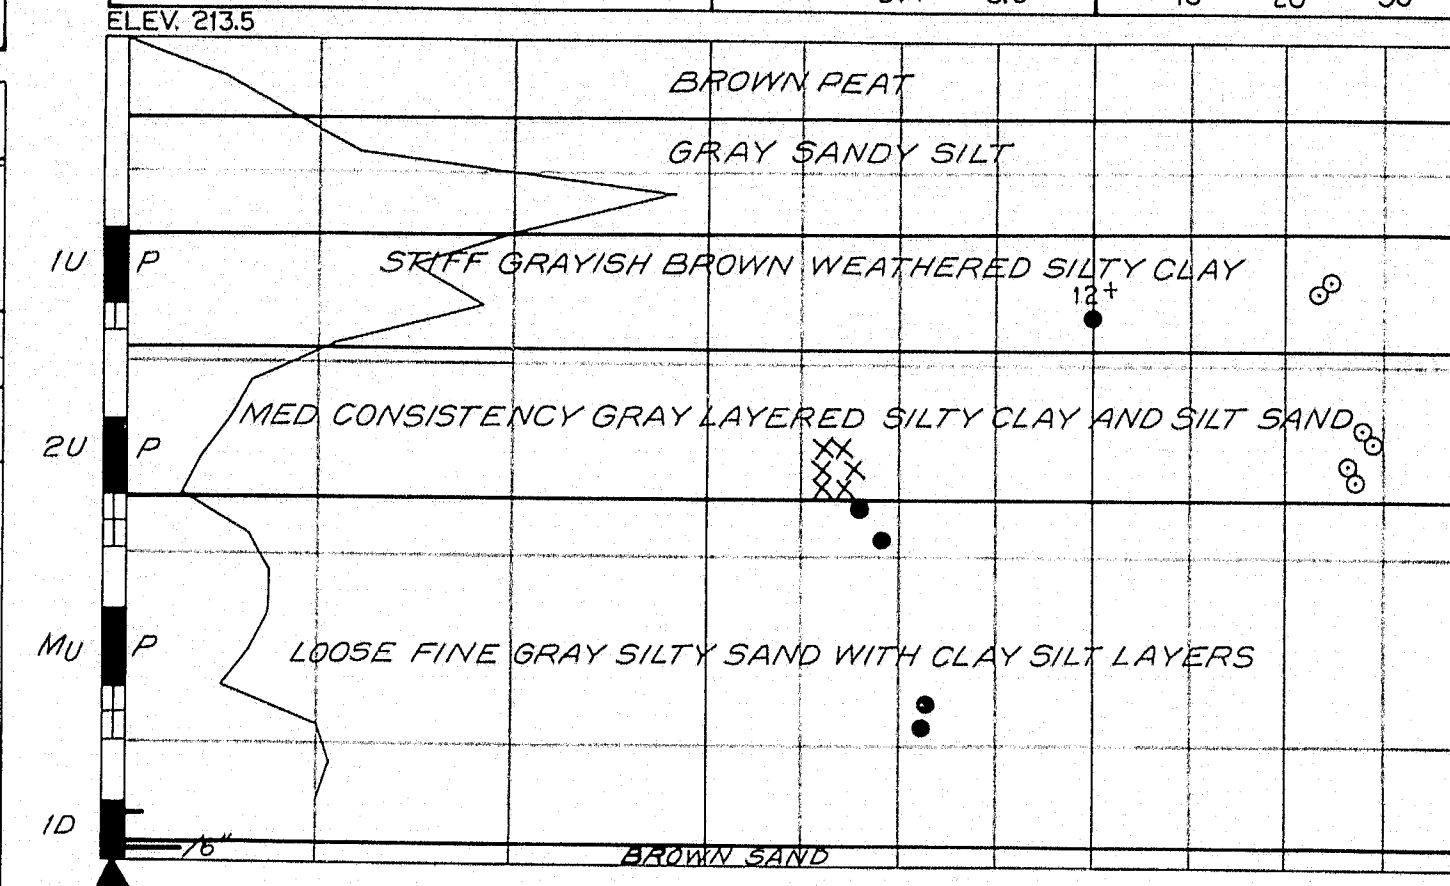


BORING AB-31 STATION 2185+0 50' Rt. & N.B.

DRIVING RESISTANCE	VANE SHEAR STRENGTH	WATER CONTENT
Blows/Ft.	Tons/Sq. Ft.	Percent
20 40	0.2 0.4 0.6	10 20 30

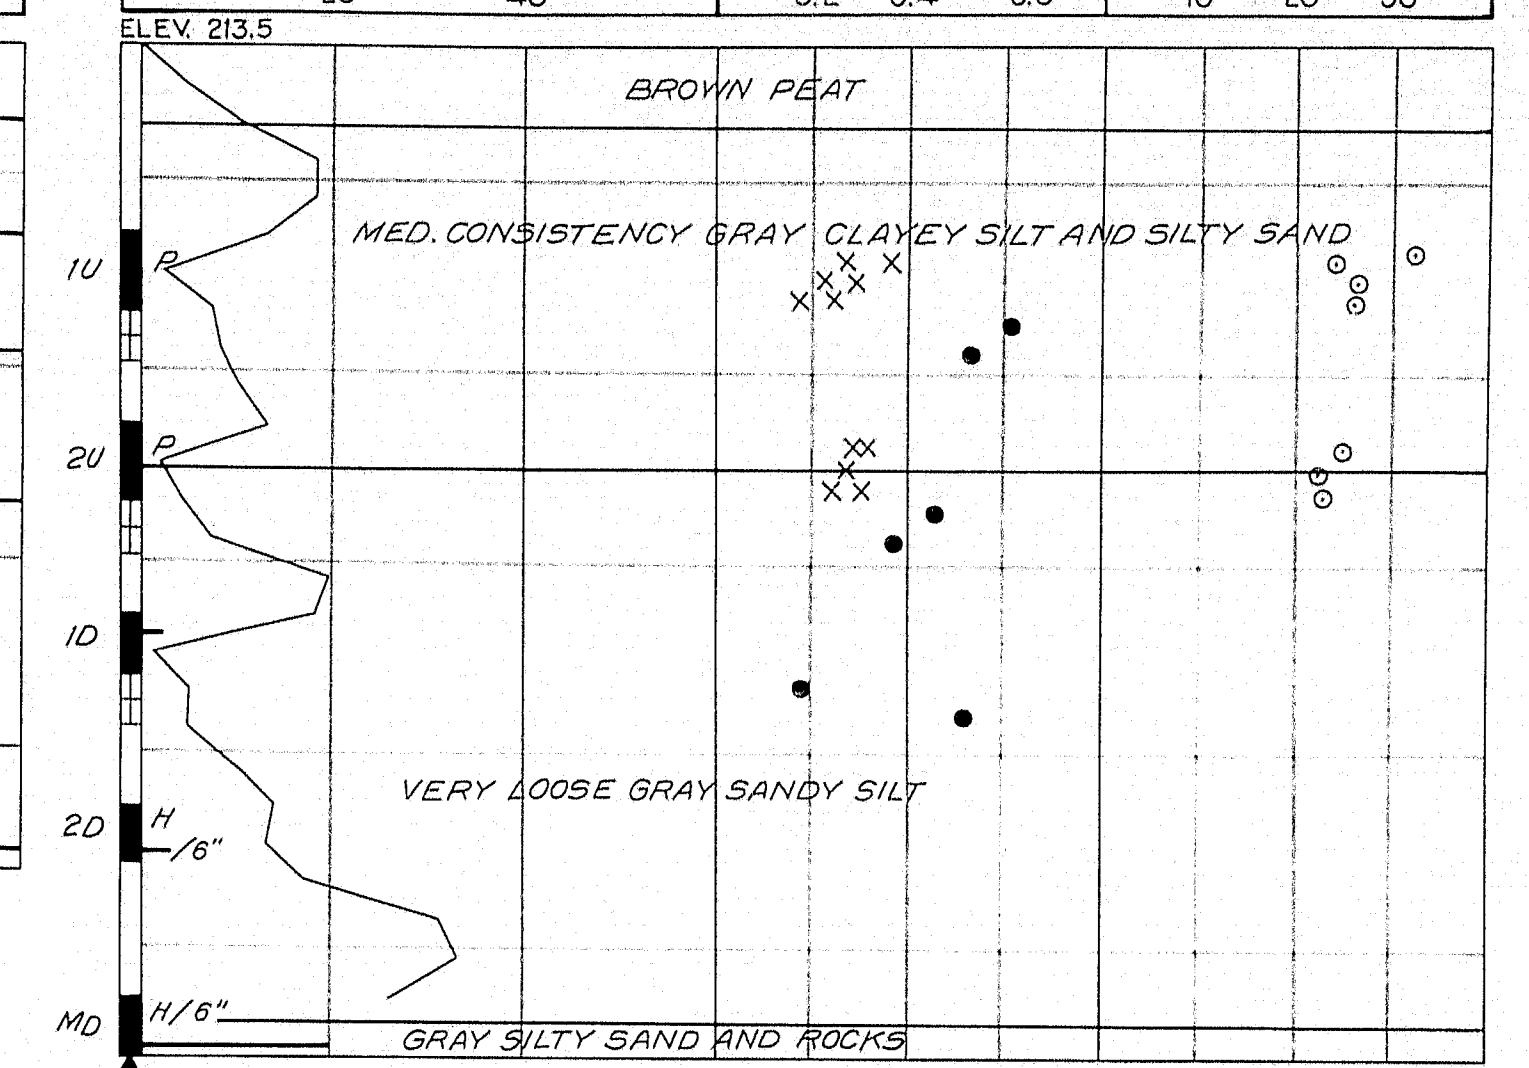

TRANSVERSE SECTIONS

(NORTHBOUND)

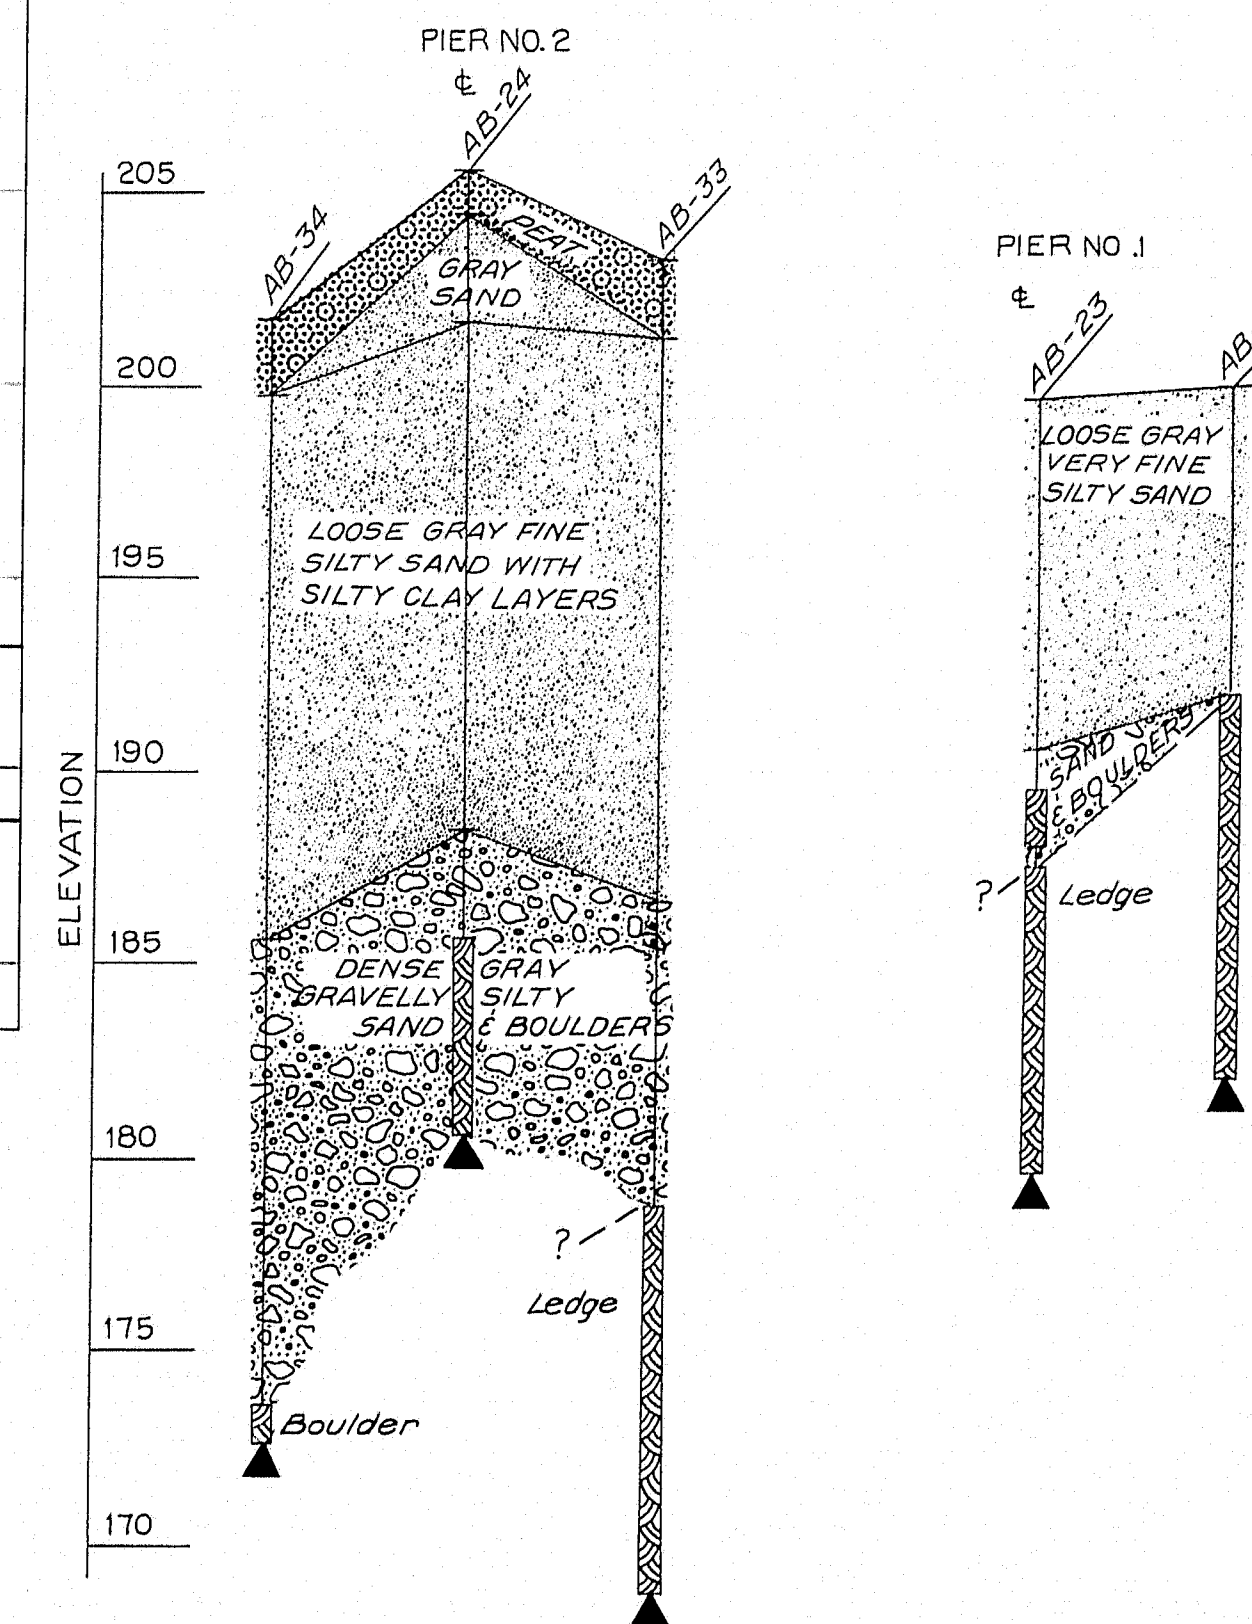


BORING NOTES


- NUMBER OF BLOWS REQUIRED TO DRIVE EXTRA HEAVY CASING ONE FOOT WITH 400 FT. LBS. OF ENERGY PER BLOW
- LOCATION OF SAMPLE OR SAMPLE ATTEMPT
- S & H SAMPLER #1290'S
- 3 1/2" O.D. 16 GA. SEAMLESS TUBING
- UNSUCCESSFUL SAMPLE ATTEMPT AND TYPE OF SAMPLER
- NUMBER OF BLOWS REQUIRED TO DRIVE SPOON OR TUBING ONE FOOT WITH 350 FT. LBS. OF ENERGY PER BLOW
- SAMPLING SPOON OR SEAMLESS TUBING DRIVING BY STATIC WEIGHT OF DRILL RODS AND HAMMER
- PISTON SAMPLE
- FIELD VANE TEST
- BOTTOM OF BORING (MAY NOT BE BOTTOM OF SOIL STRATA)
- LOCATIONS CORED BY DIAMOND BIT AND PER CENT RECOVERY OF ROCK
- SHEAR NOTES
- FIELD VANE SHEAR STRENGTHS
- LABORATORY VANE SHEAR STRENGTHS
- WATER CONTENT NOTES
- NATURAL WATER CONTENTS, GIVEN AS PER CENT OF DRY WEIGHT
- X PLASTIC AND LIQUID LIMITS

DESIGN— TRACE— CHECK—	BRIDGE NO. SURVEY— PLOT—
STATE HIGHWAY COMMISSION BRIDGE DIVISION	
SEBASTICOOK RIVER BRIDGE	
IN THE TOWN OF PITTSFIELD SOMERSET COUNTY	
BORING DETAILS	
SHEET 5 OF 18 AUGUSTA, MAINE	


M-1984

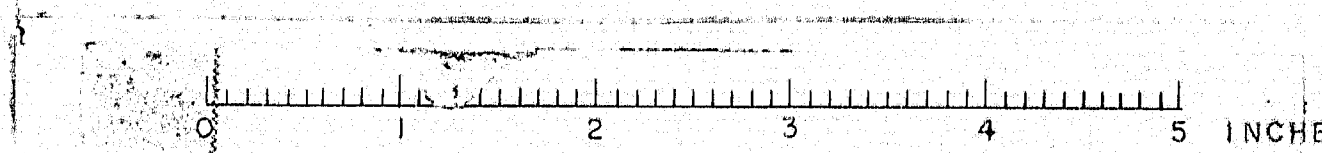


BORING AB-42 STATION 2183+70 & S.B.

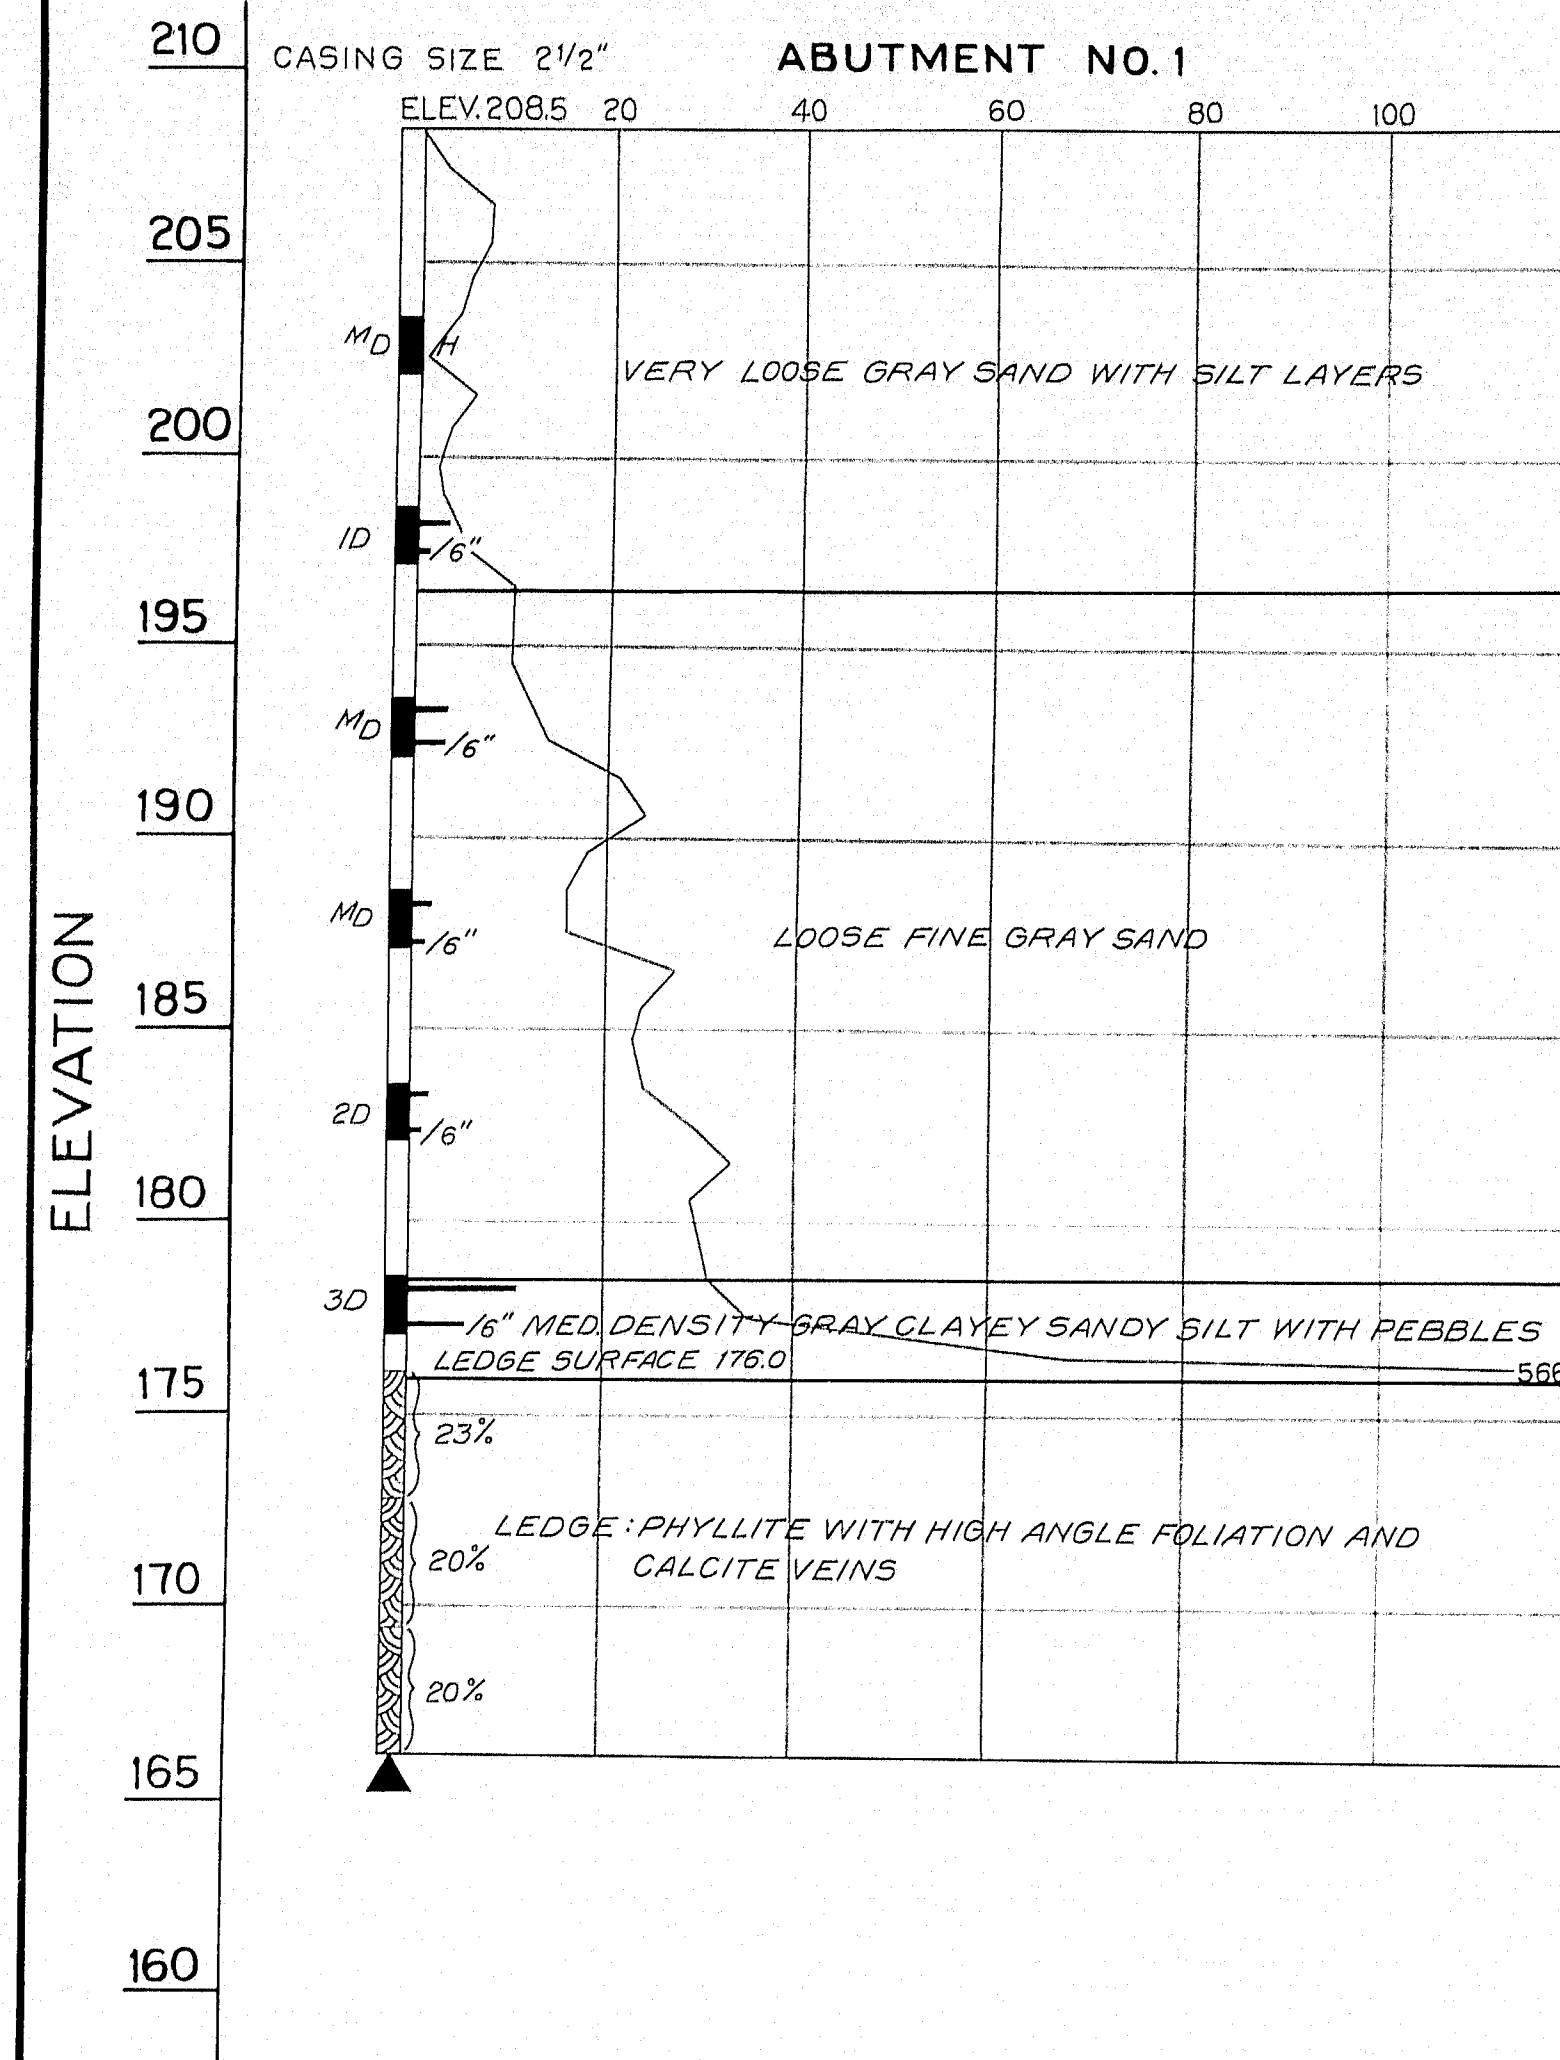


BORING AB-28 STATION 2184+0 & S.B.

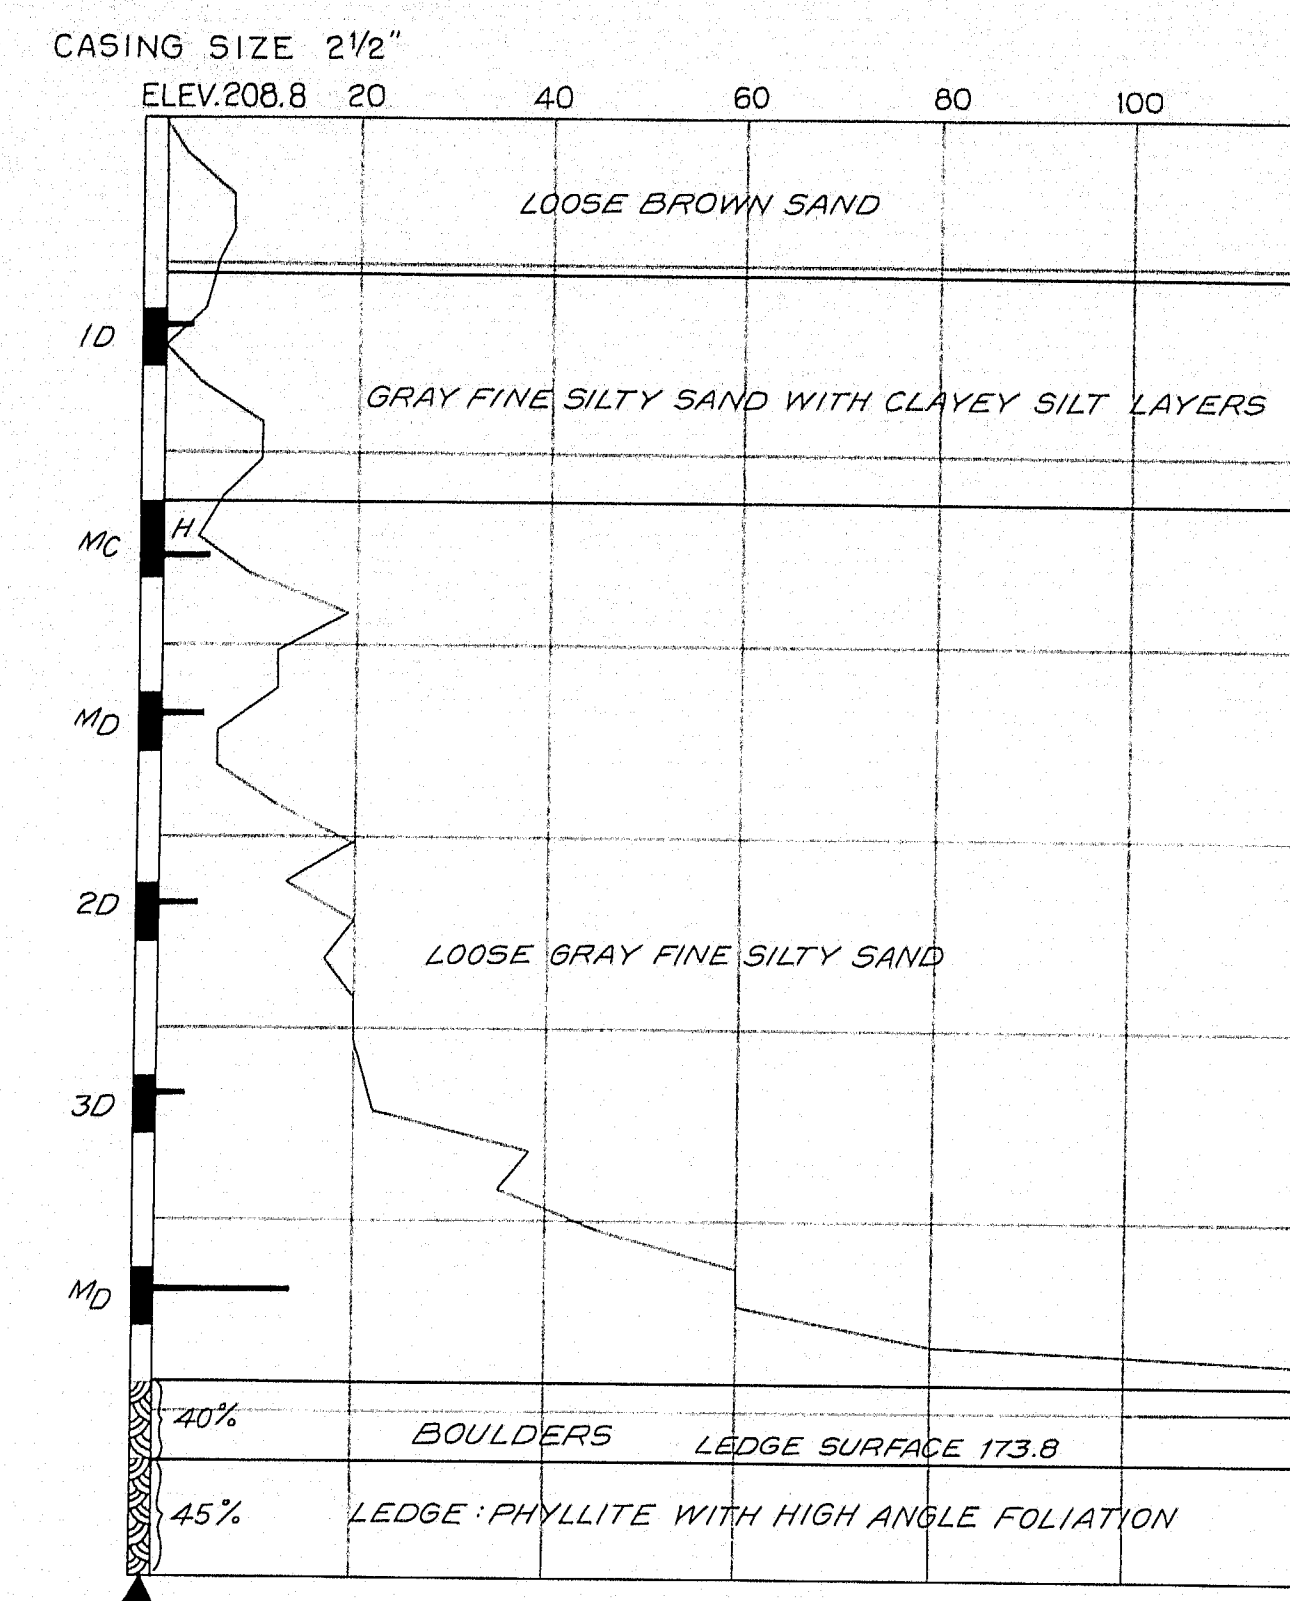


BORING AB-40 STATION 2184+39 20' Lt. S.B.

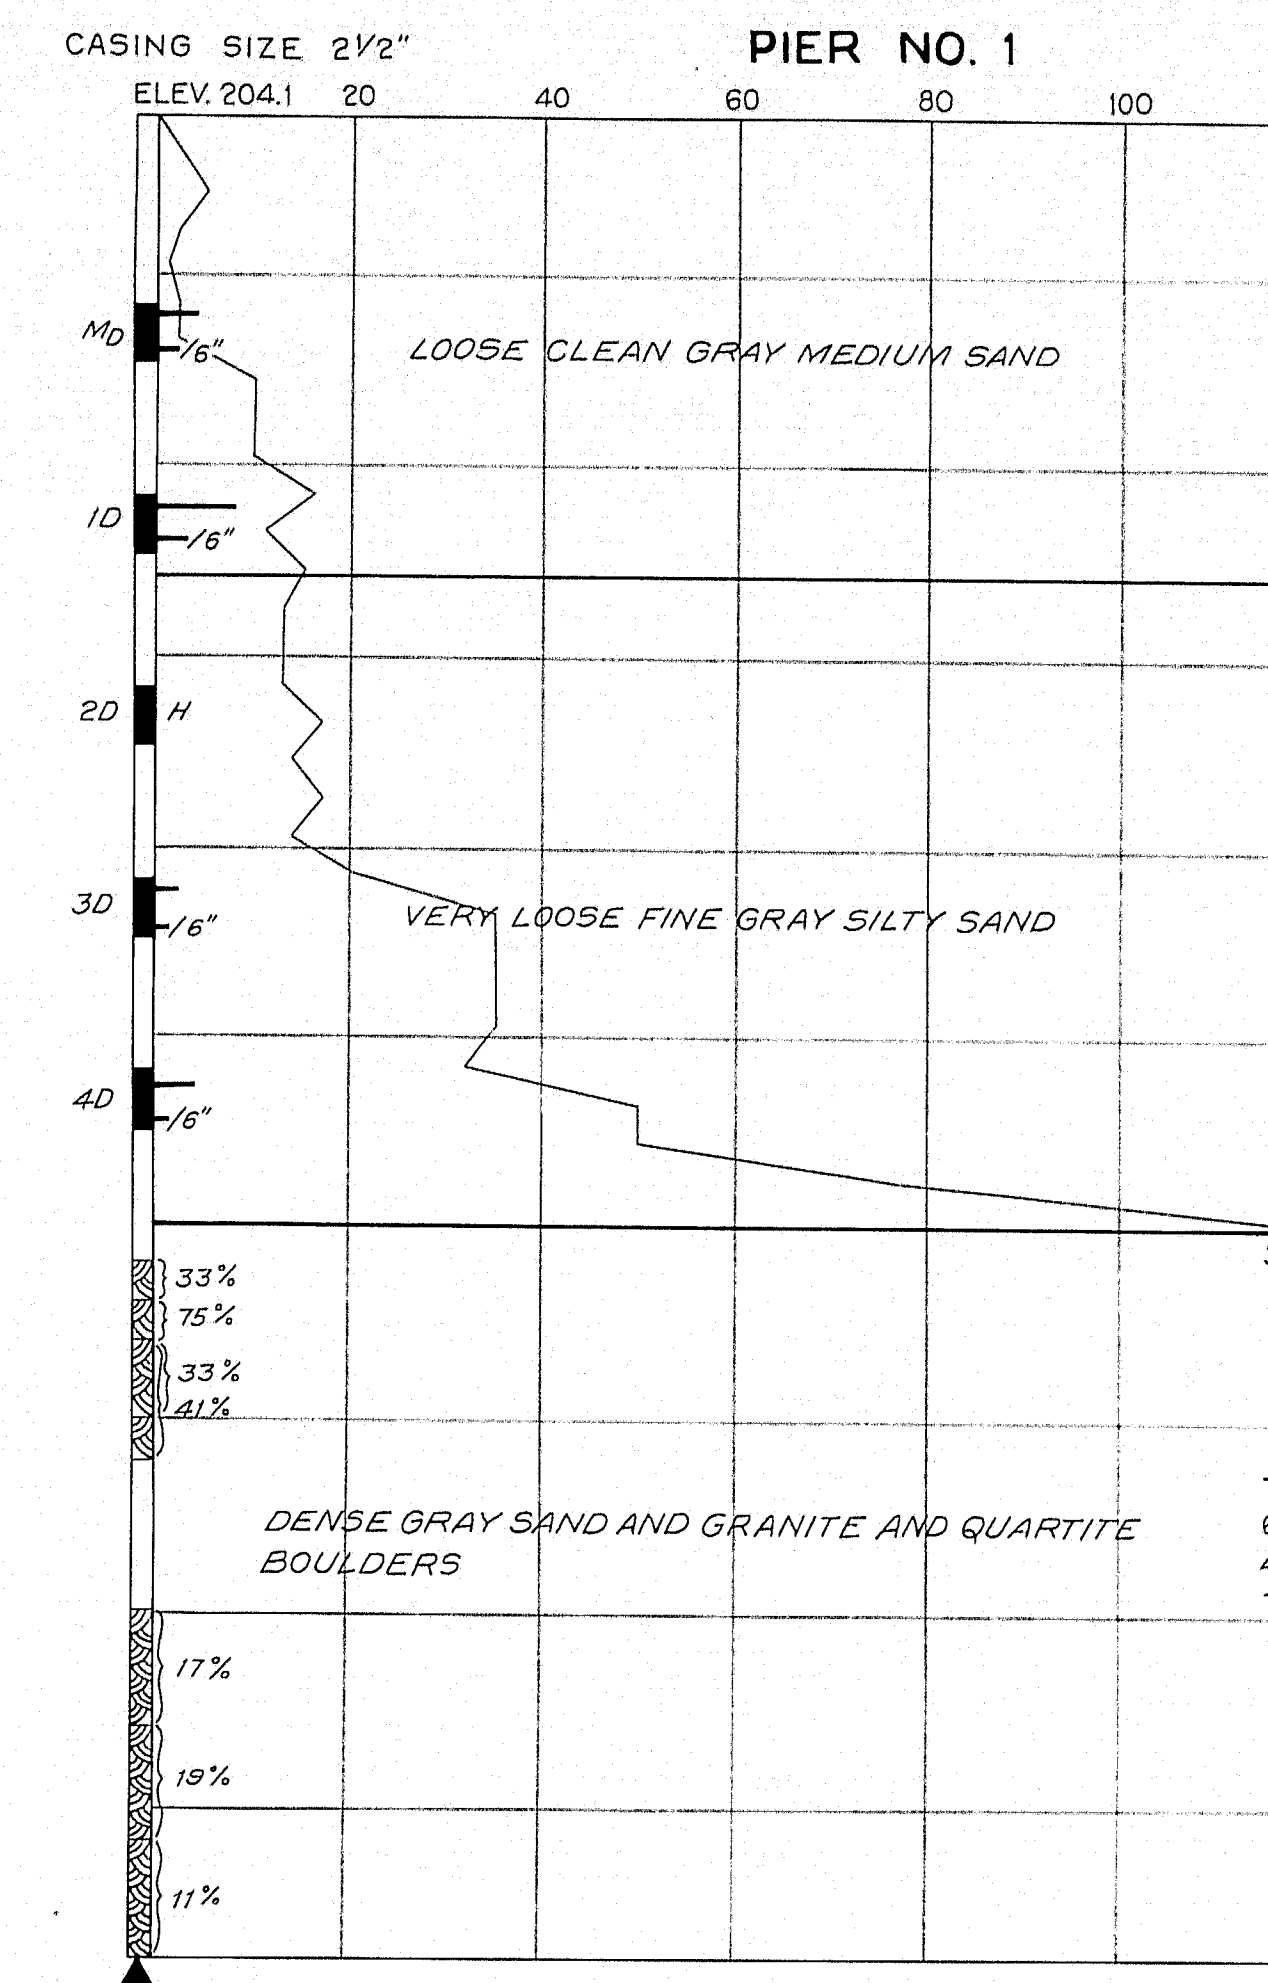


BORING AB-43 STATION 2184+37 & S.B.

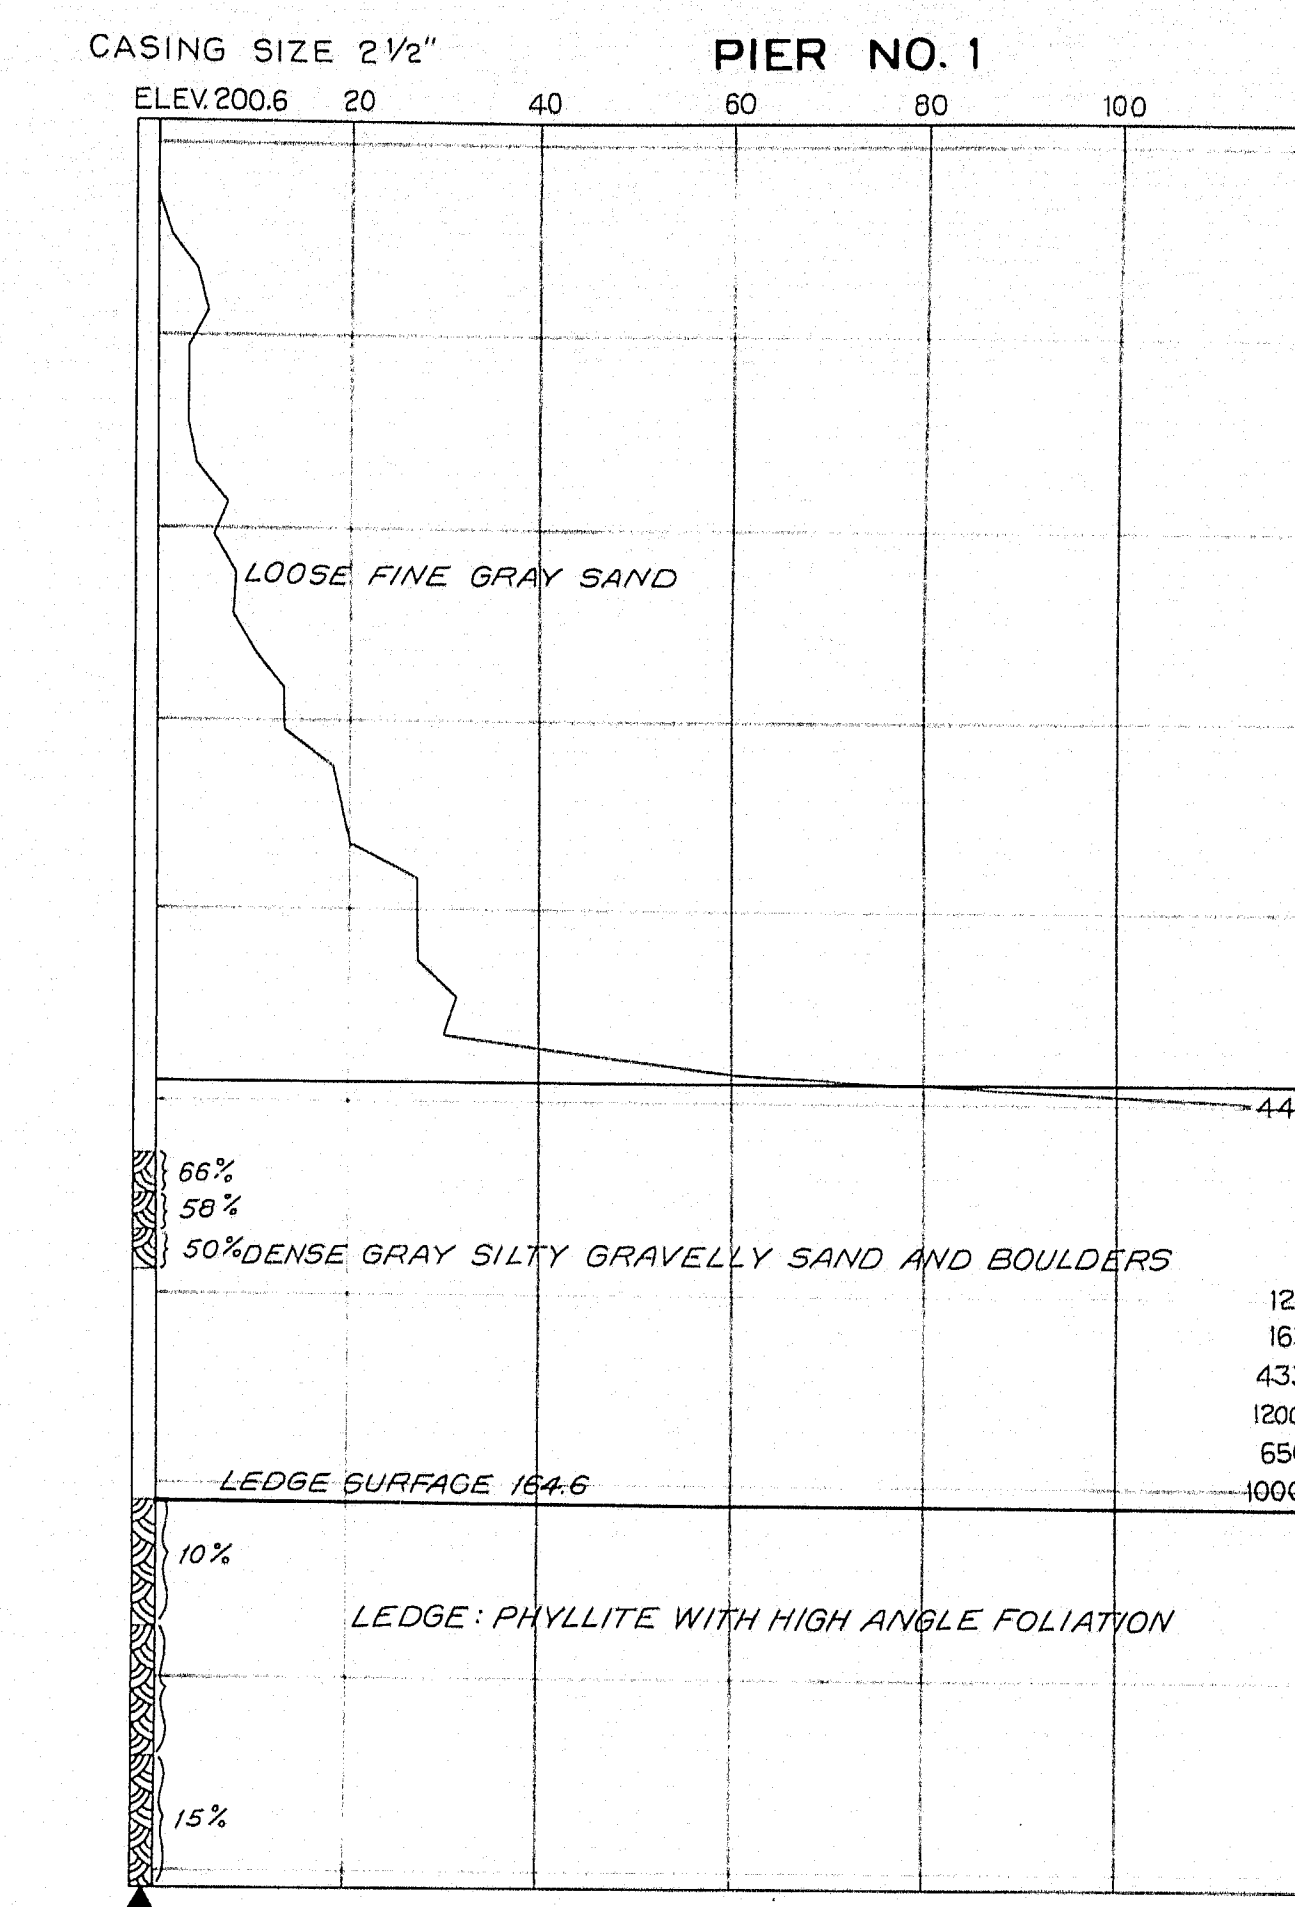


BORING AB-41 STATION 2184+36 20' Rt. S.B.

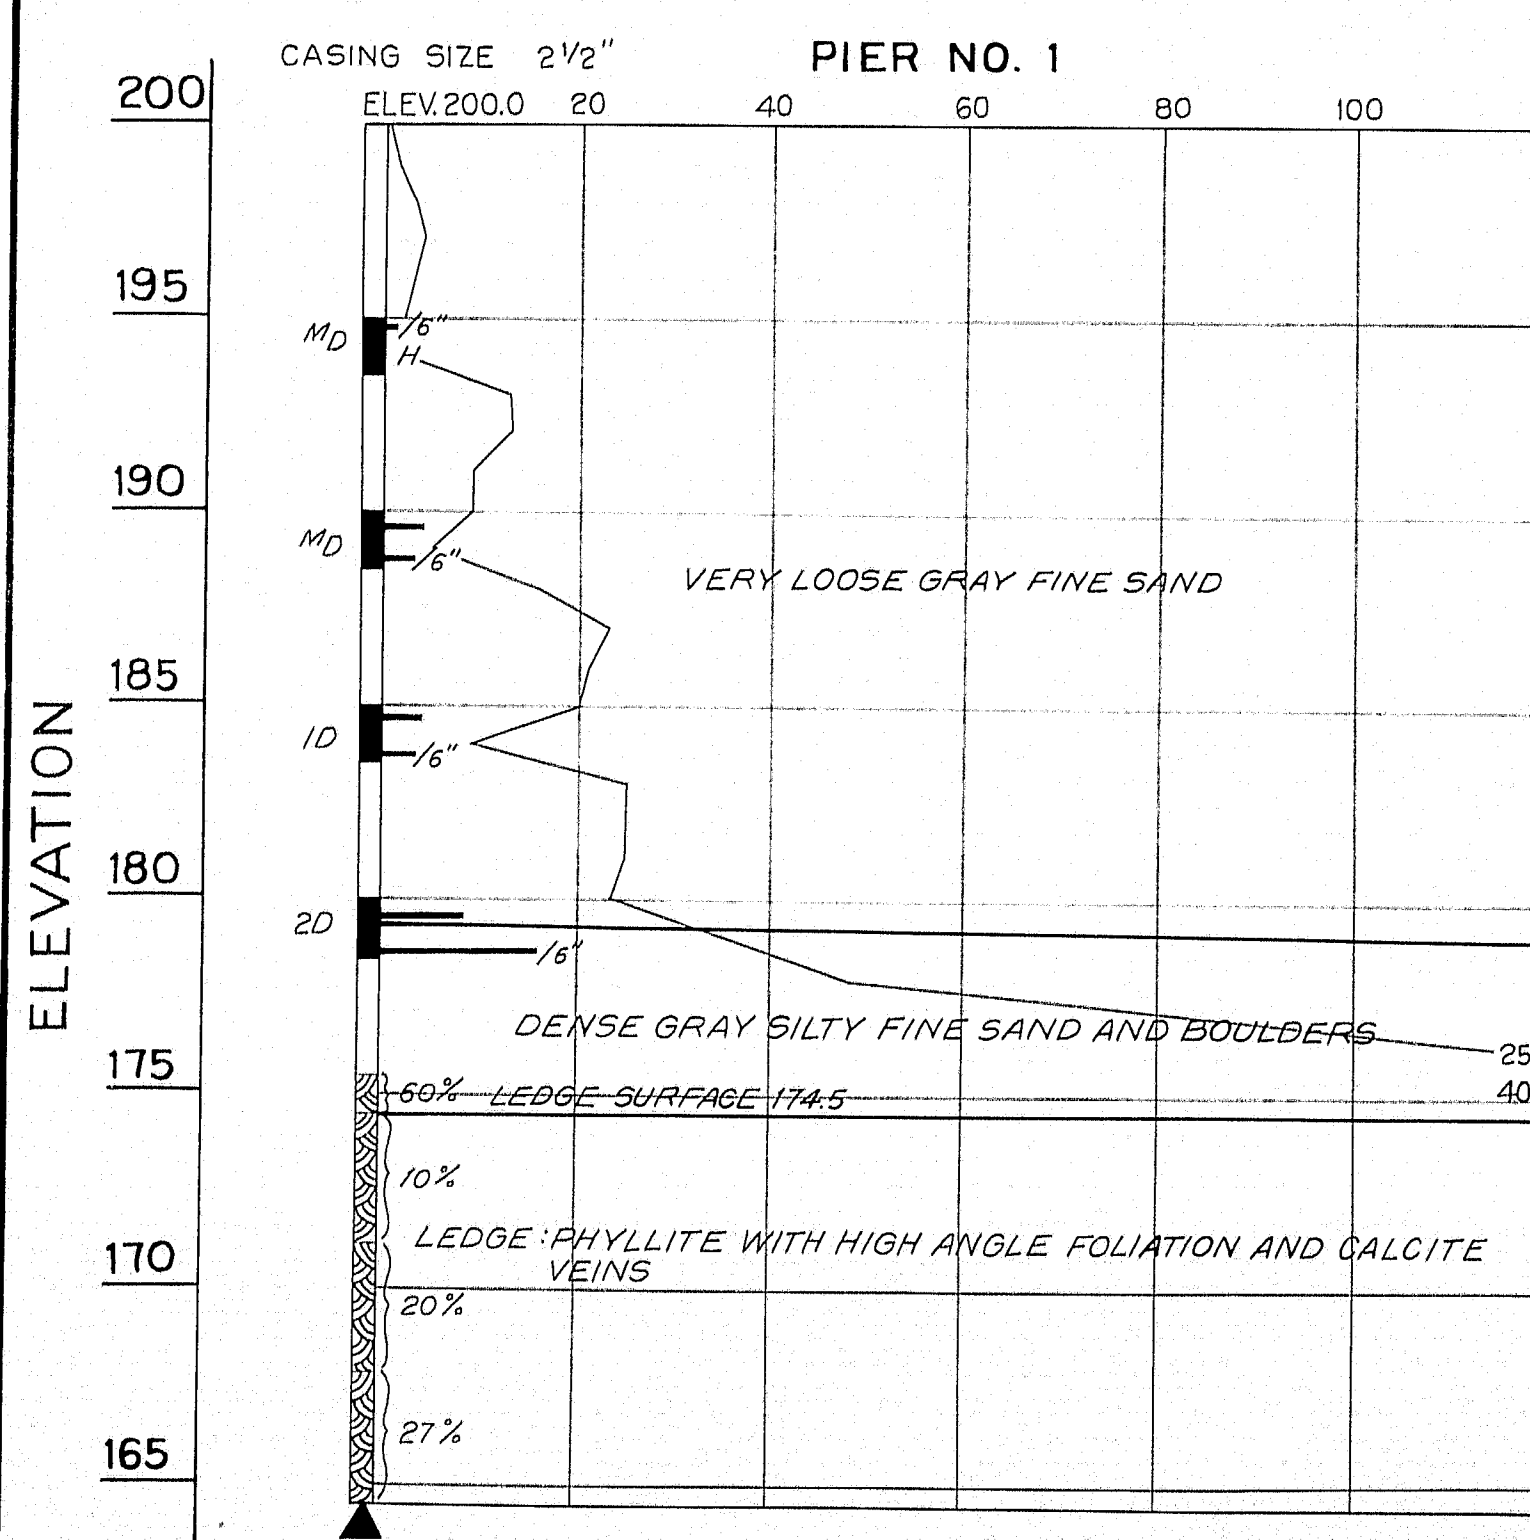

BORING AB-27 STATION 2185+0 & S.B.

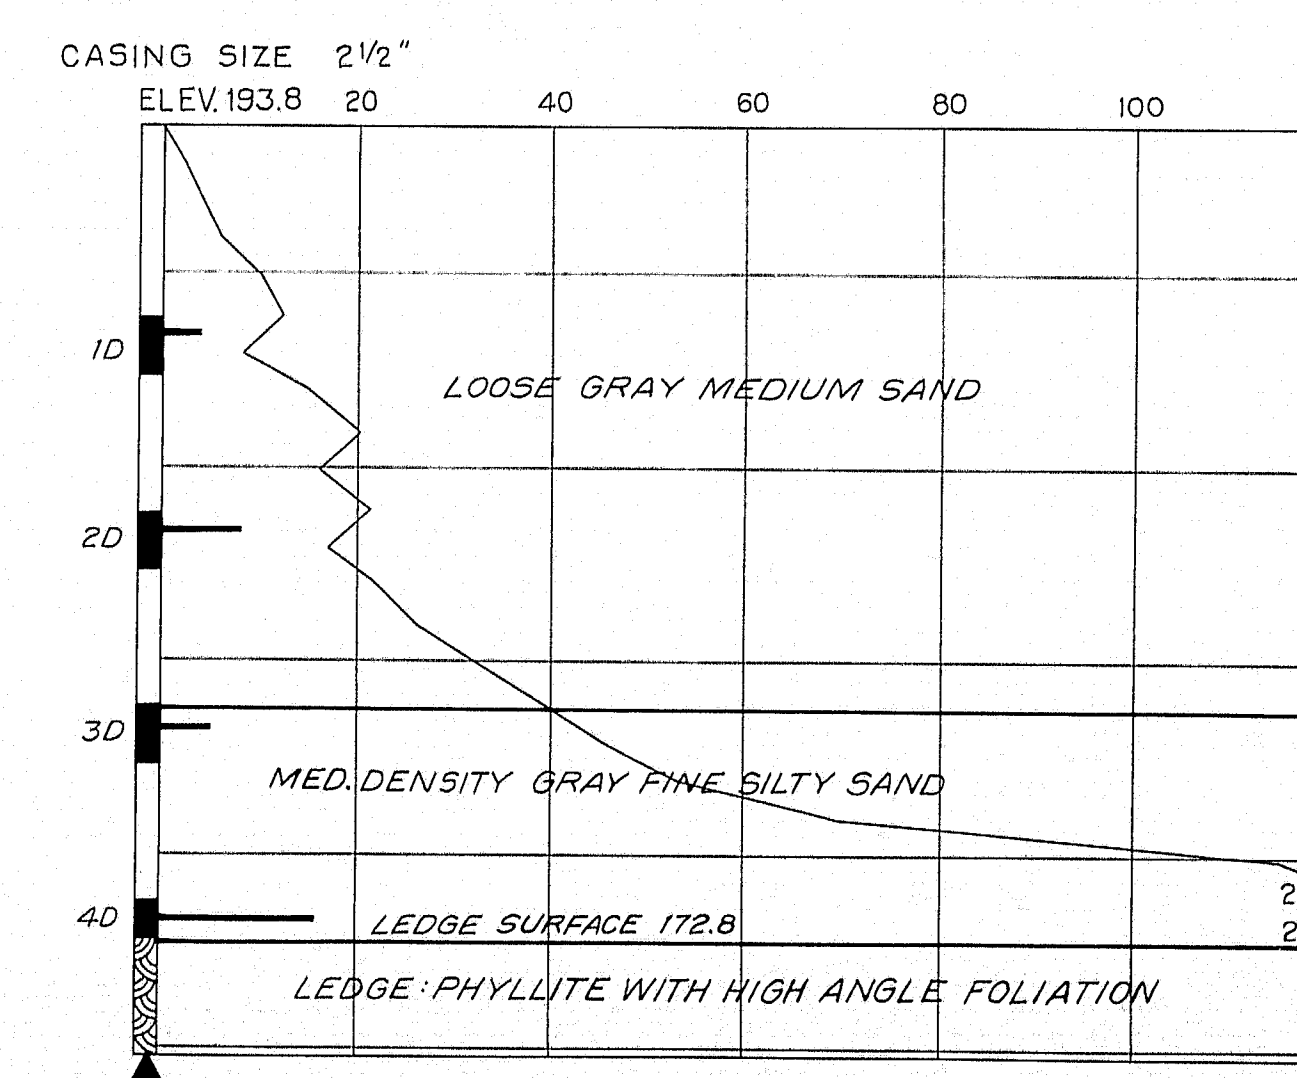

BORING AB-39 STATION 2185+24 20' Lt. S.B.

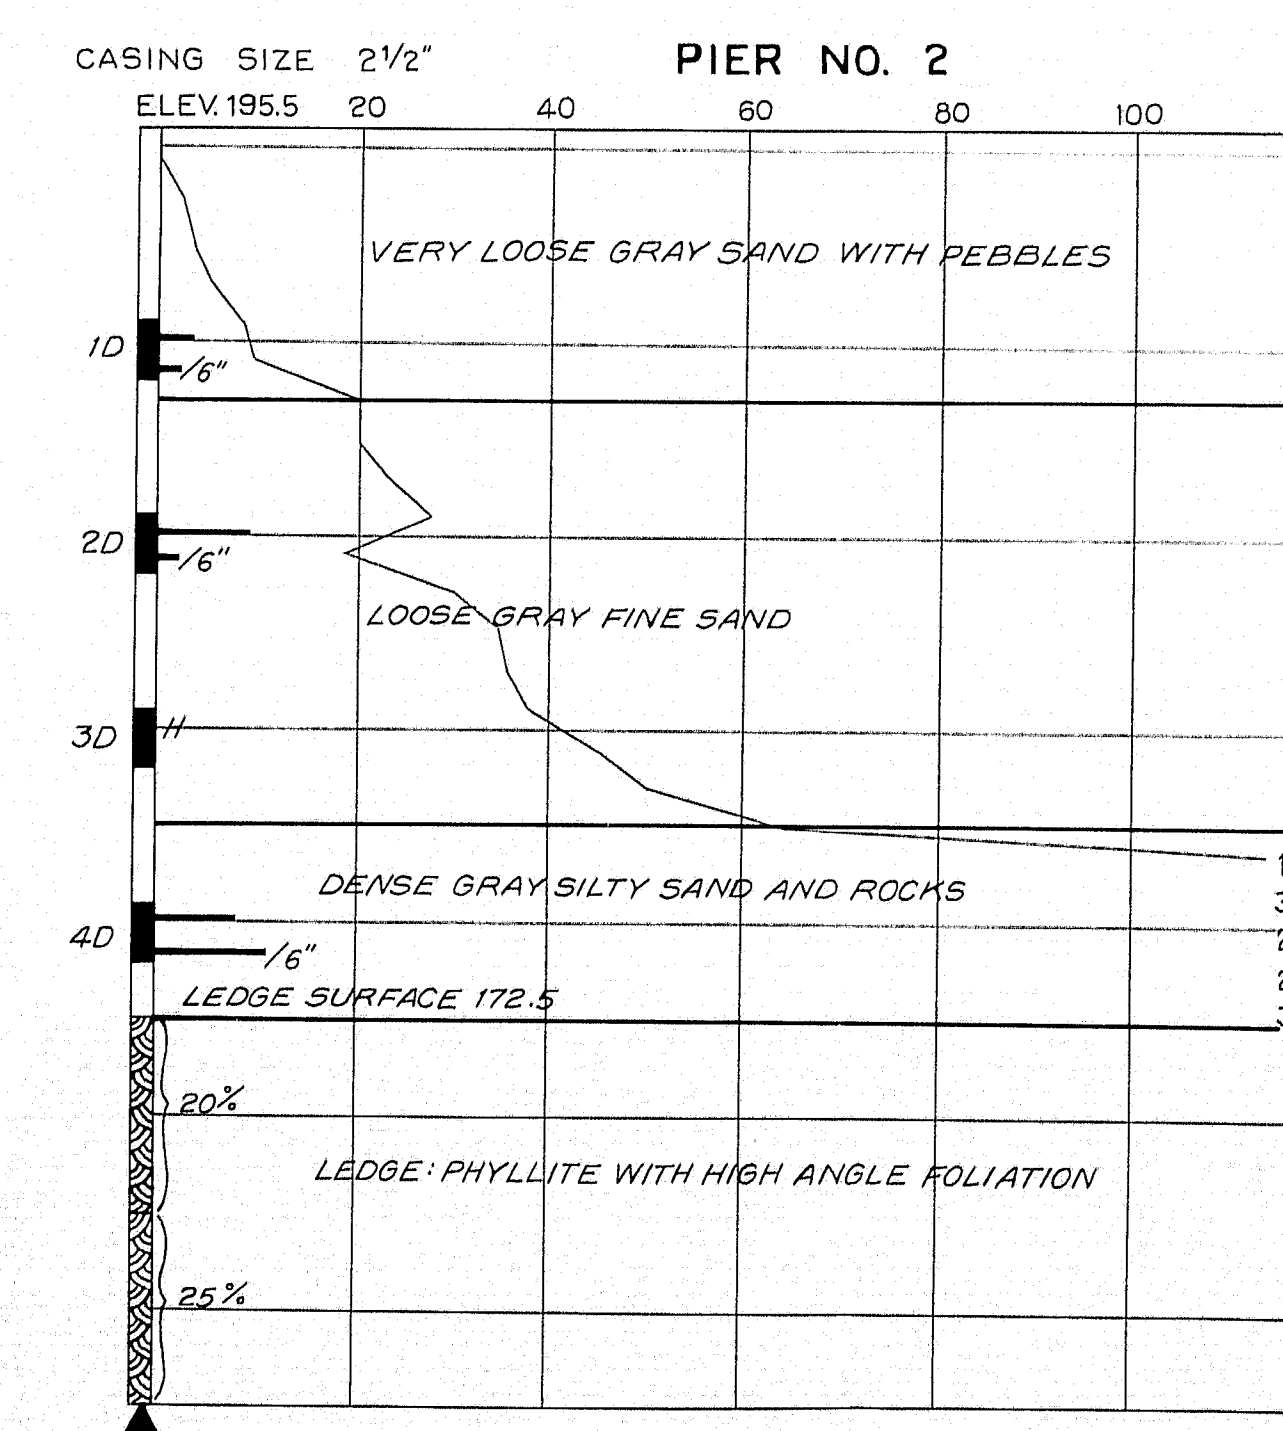

BORING NOTES

NUMBER OF BLOWS REQUIRED TO DRIVE EXTRA HEAVY CASING ONE FOOT WITH 400 FT. LBS. OF ENERGY PER BLOW.

LOCATION OF SAMPLE OR SAMPLE ATTEMPT

S & H SAMPLE # 1290'S

UNSUCCESSFUL SAMPLE ATTEMPT AND TYPE OF SAMPLER

NUMBER OF BLOWS REQUIRED TO DRIVE SPOON OR TUBING ONE FOOT WITH 350 FT. LBS. OF ENERGY PER BLOW

SAMPLING SPOON OR SEAMLESS TUBING DRIVEN BY STATIC WEIGHT OF DRILL RODS AND HAMMER

BOTTOM OF BORING (MAY NOT BE BOTTOM OF SOILS STRATA)

LOCATIONS CORED BY DIAMOND BIT AND PER CENT RECOVERY OF ROCK

DESIGN--
TRACE--
CHECK--

BRIDGE NO.
SURVEY--
PILOT--

STATE HIGHWAY COMMISSION
BRIDGE DIVISION


SEBASTICOOK RIVER BRIDGE

IN THE TOWN OF
PITTSFIELD
SOMERSET COUNTY

BORING DETAILS


SHEET 6 OF 18 AUGUSTA, MAINE

M-1985

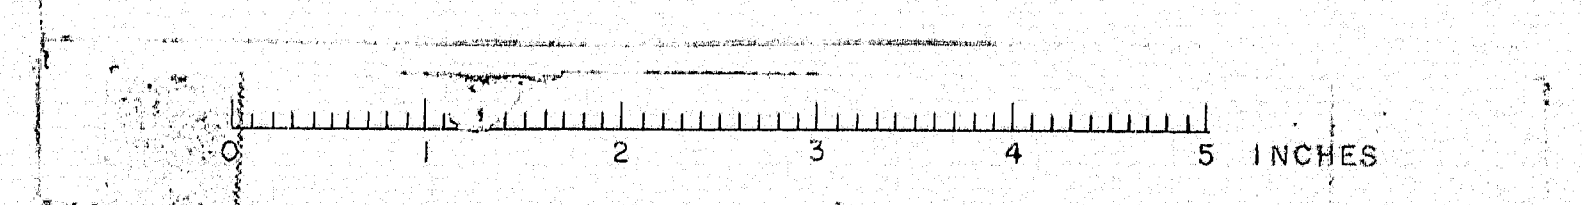


ABUTMENT NO. 2


BORING AB-37 STATION 2185 90 S.B.

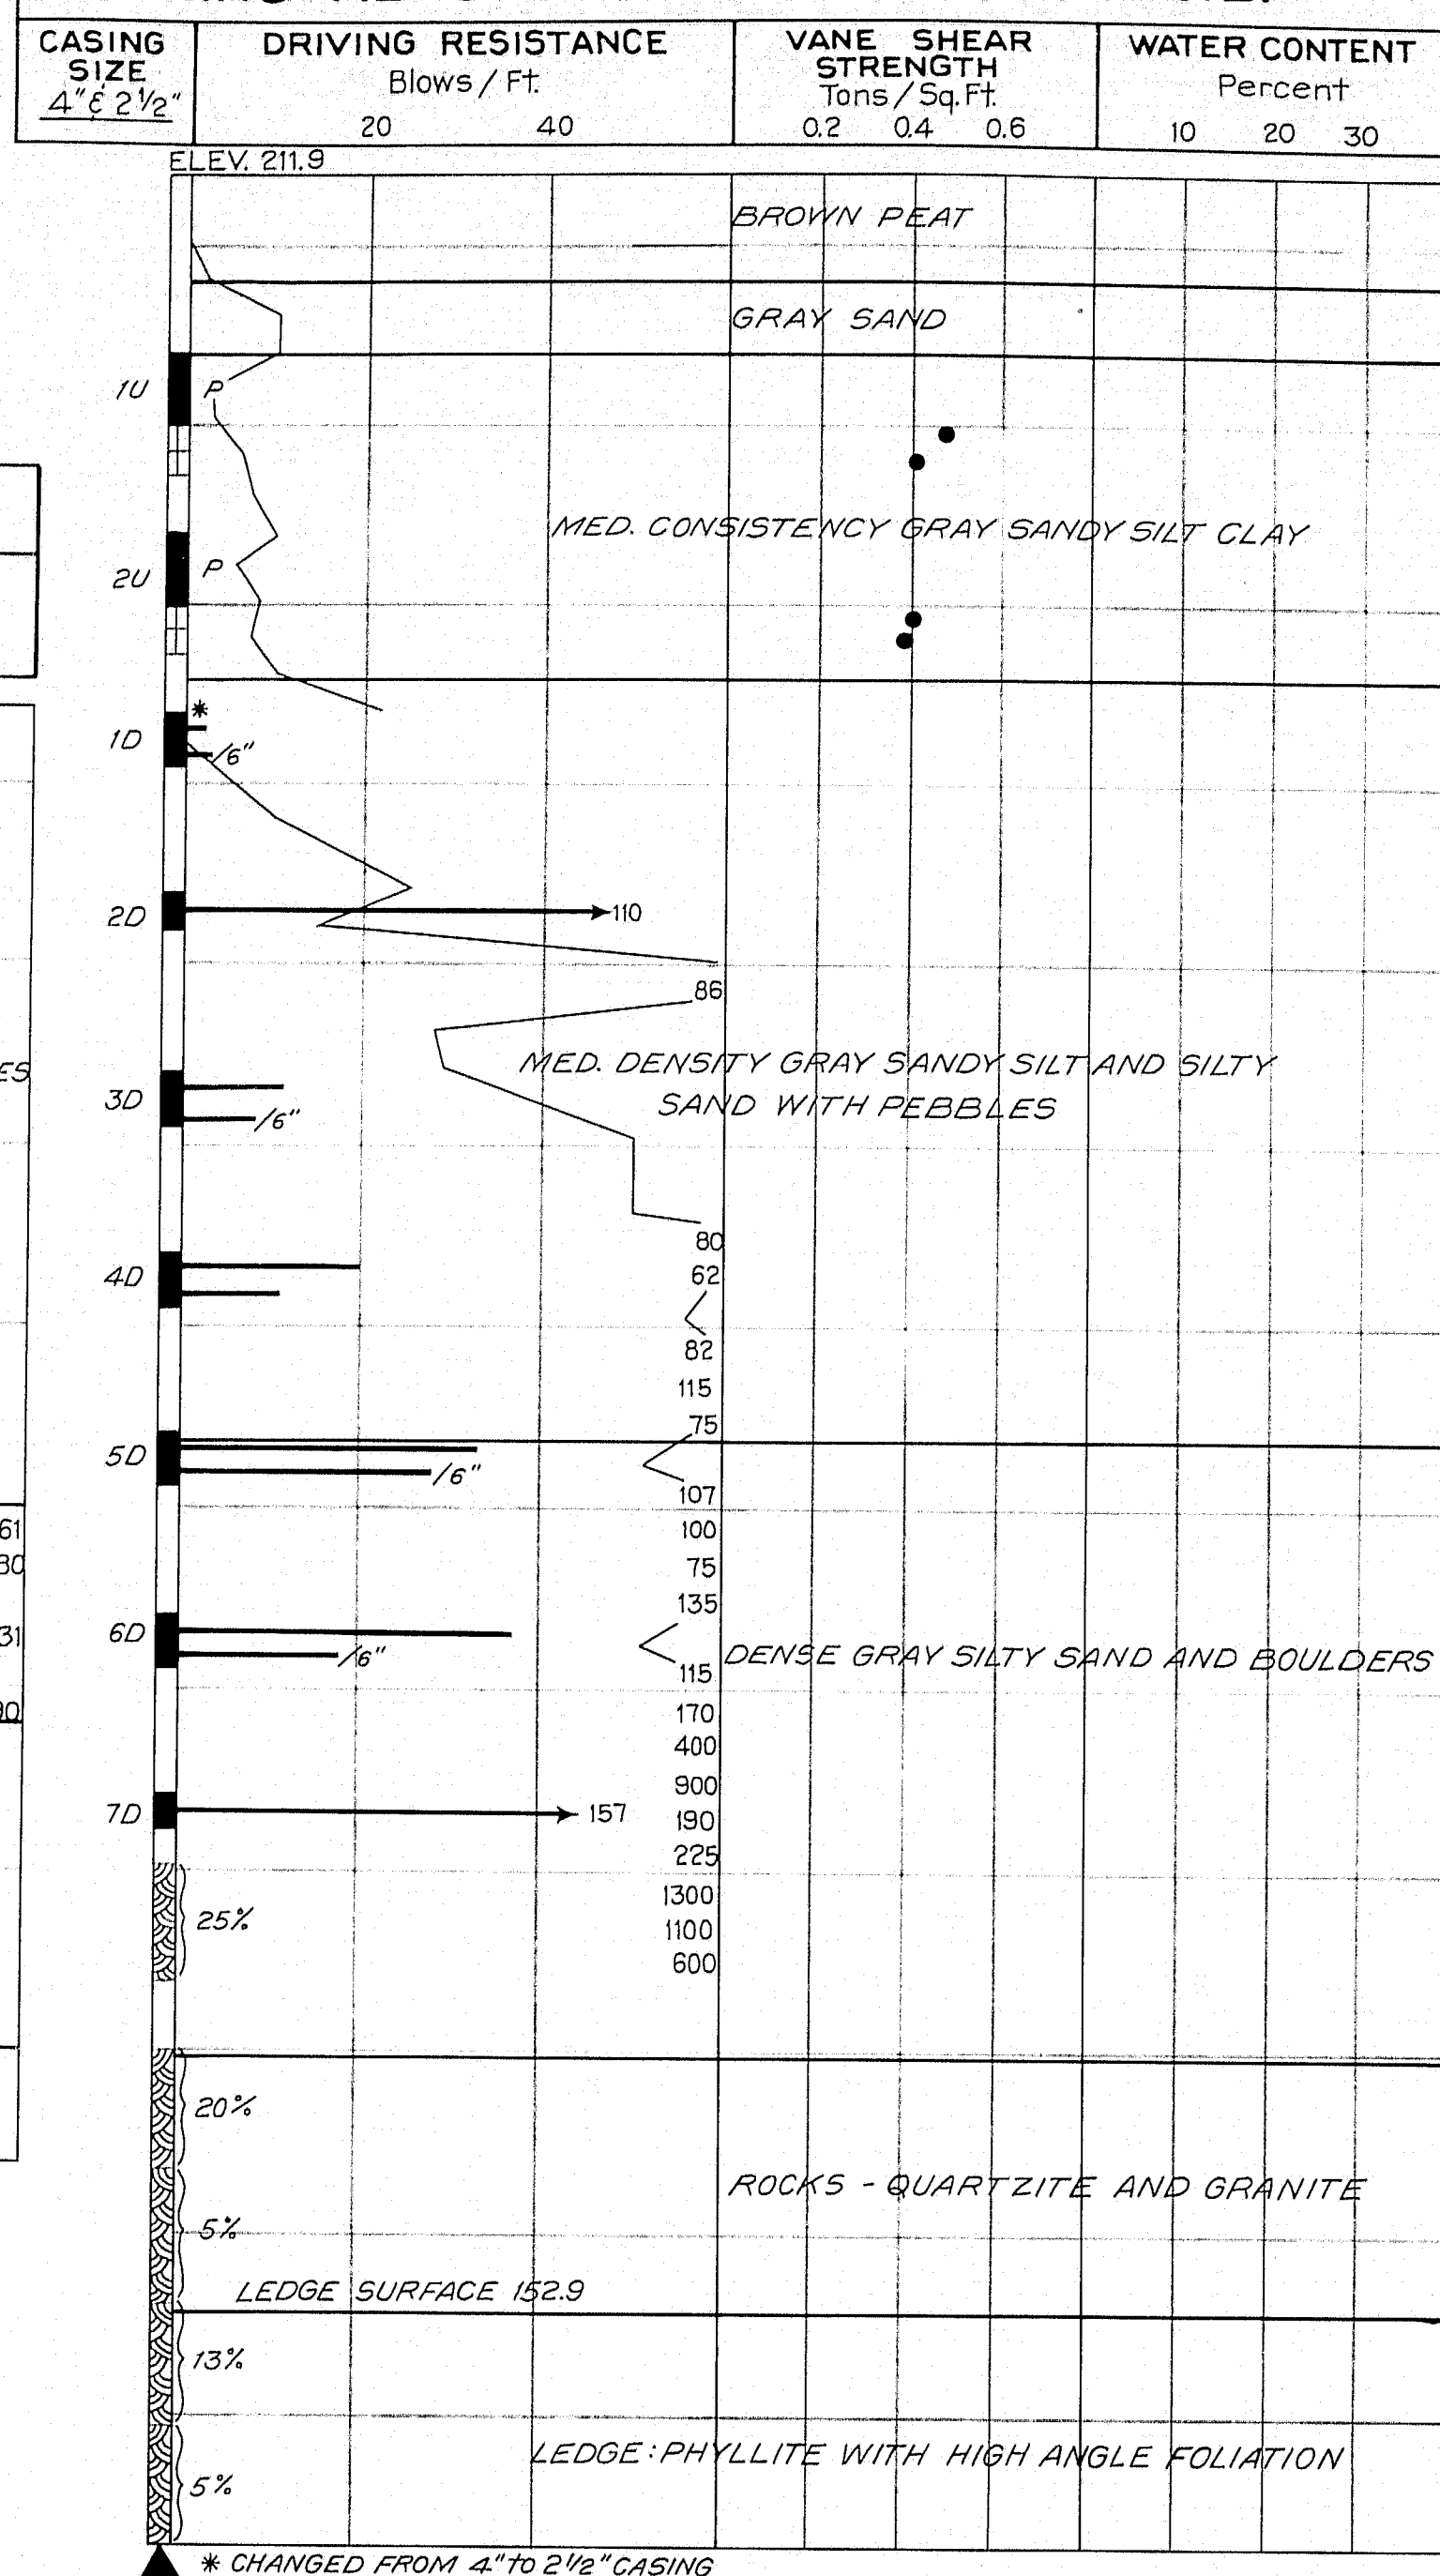

BORING AB-26 STATION 2186 +0 & S.B.

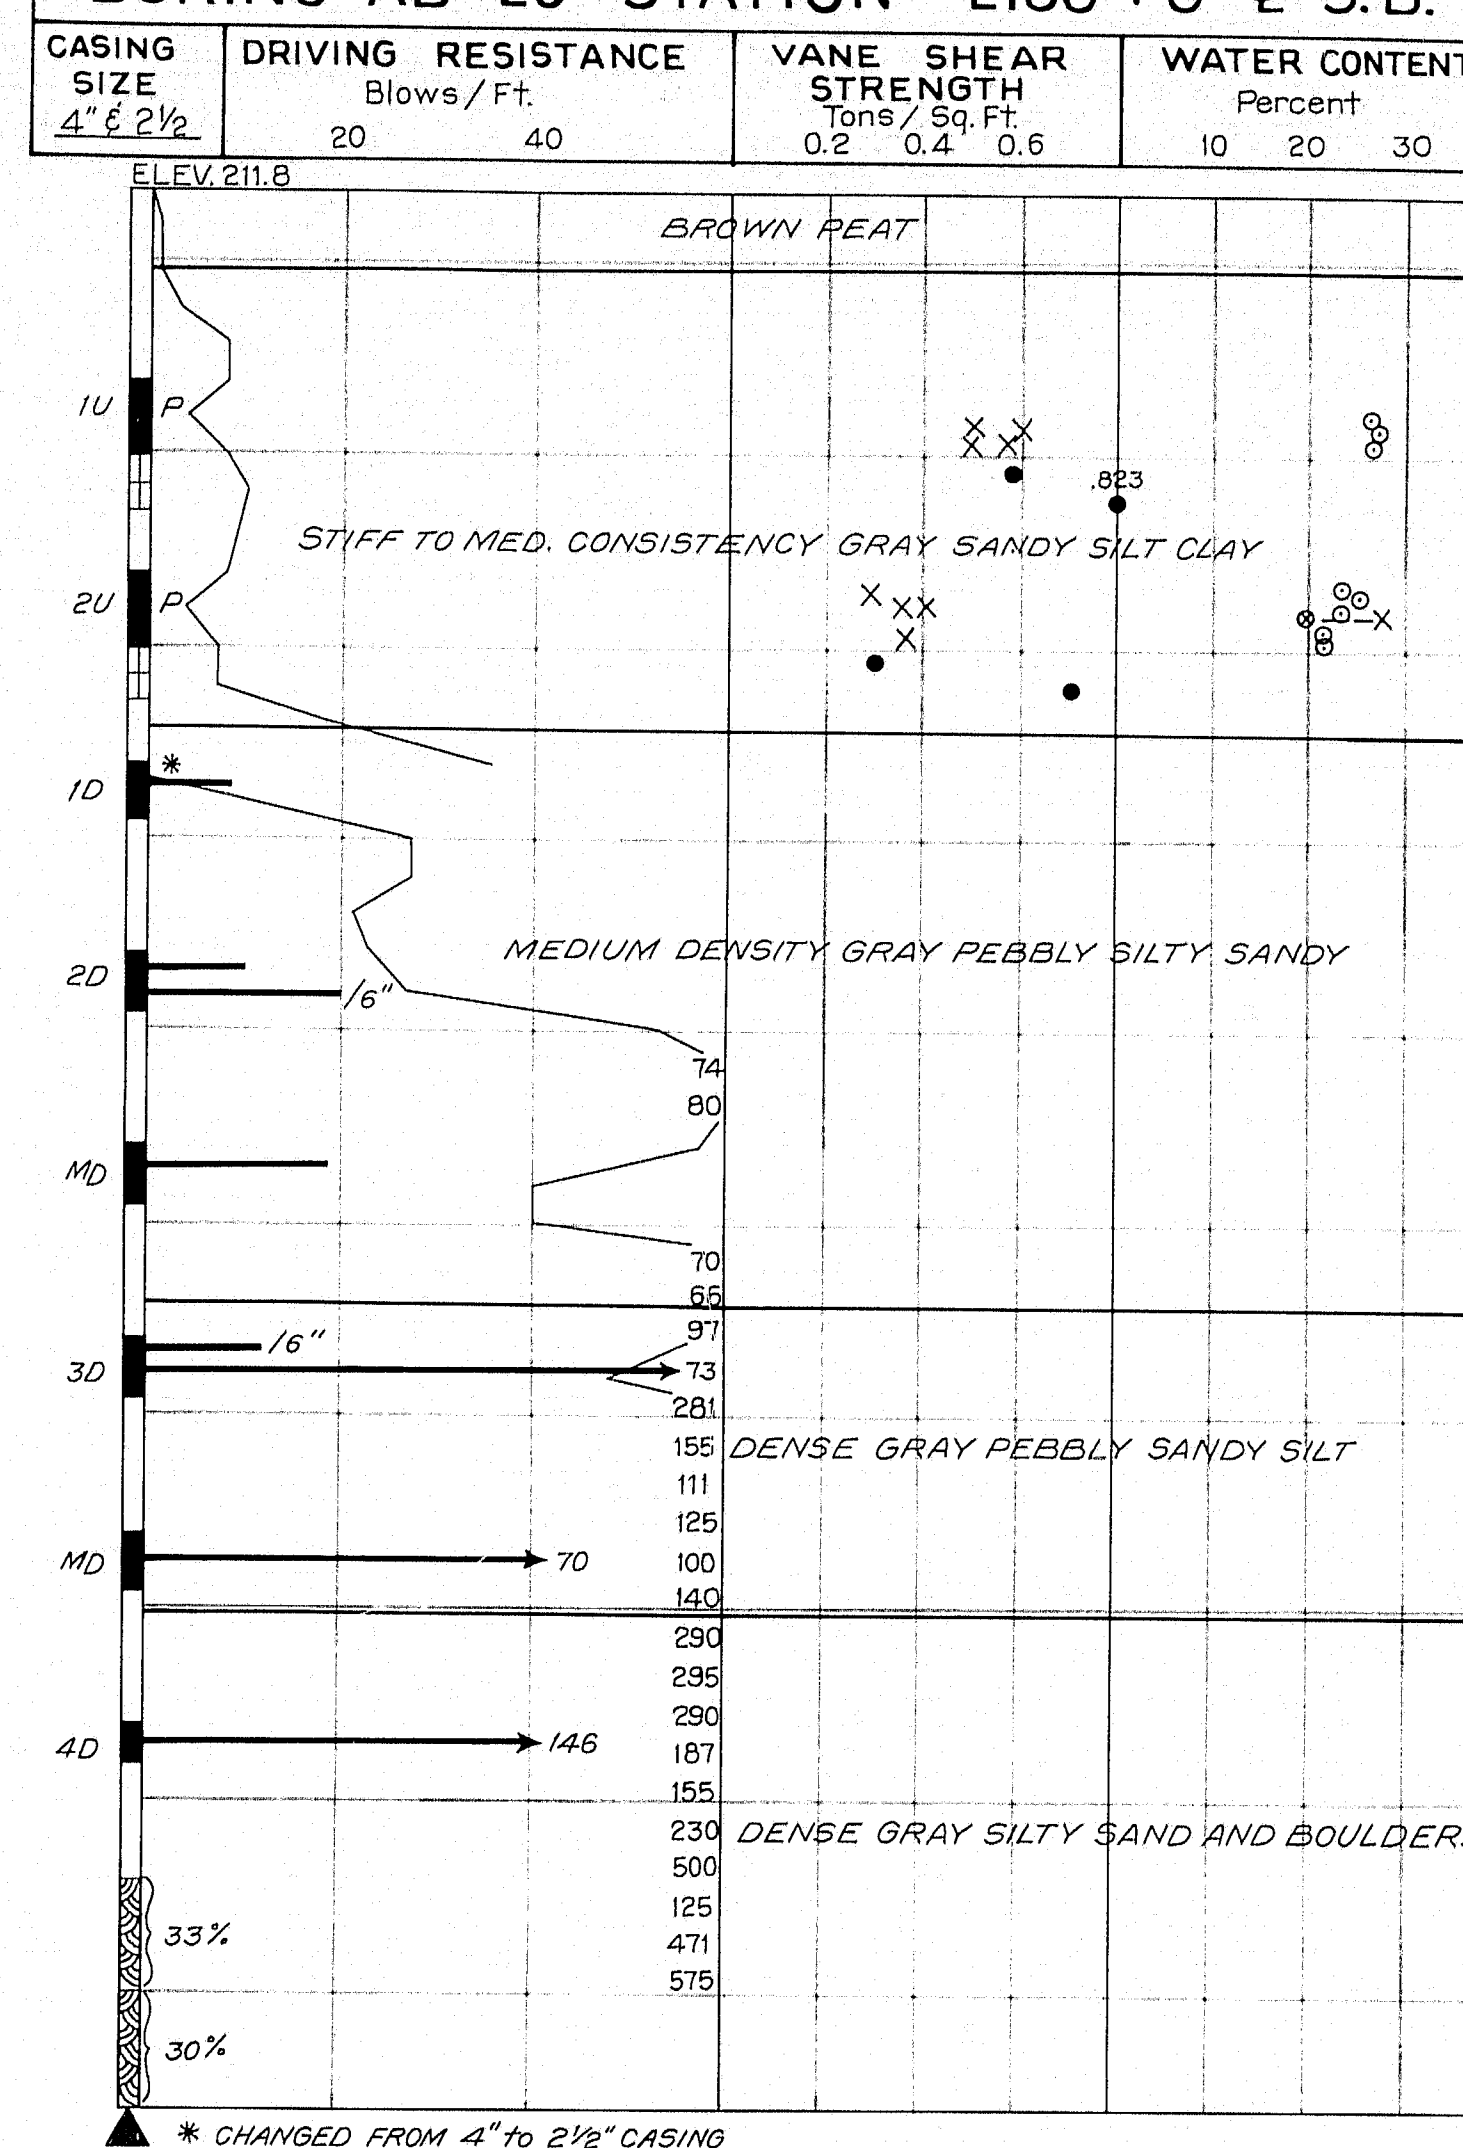


BORING AB-29 STATION 2186 +30 60' L. & S.B.

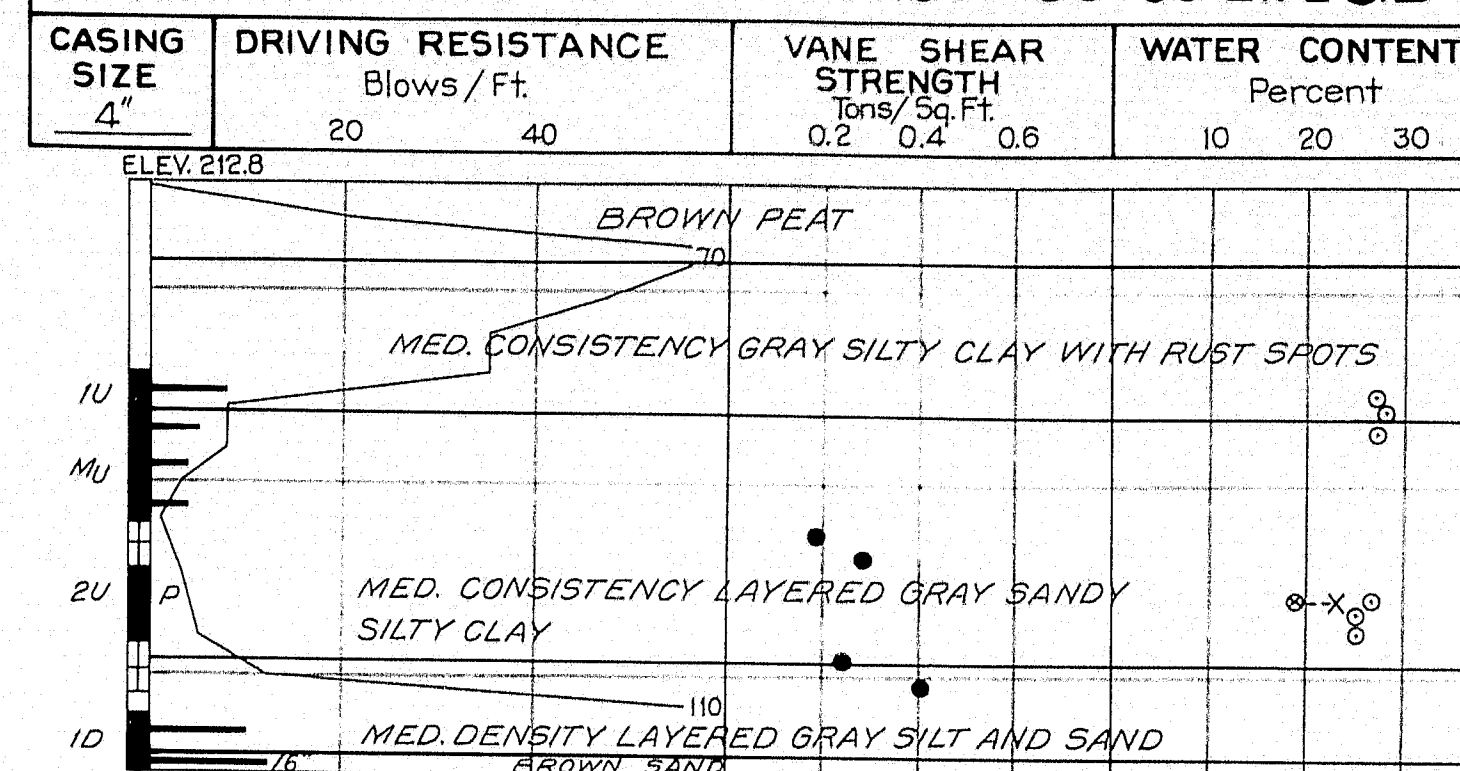

TRANSVERSE SECTIONS

(SOUTHBOUND)

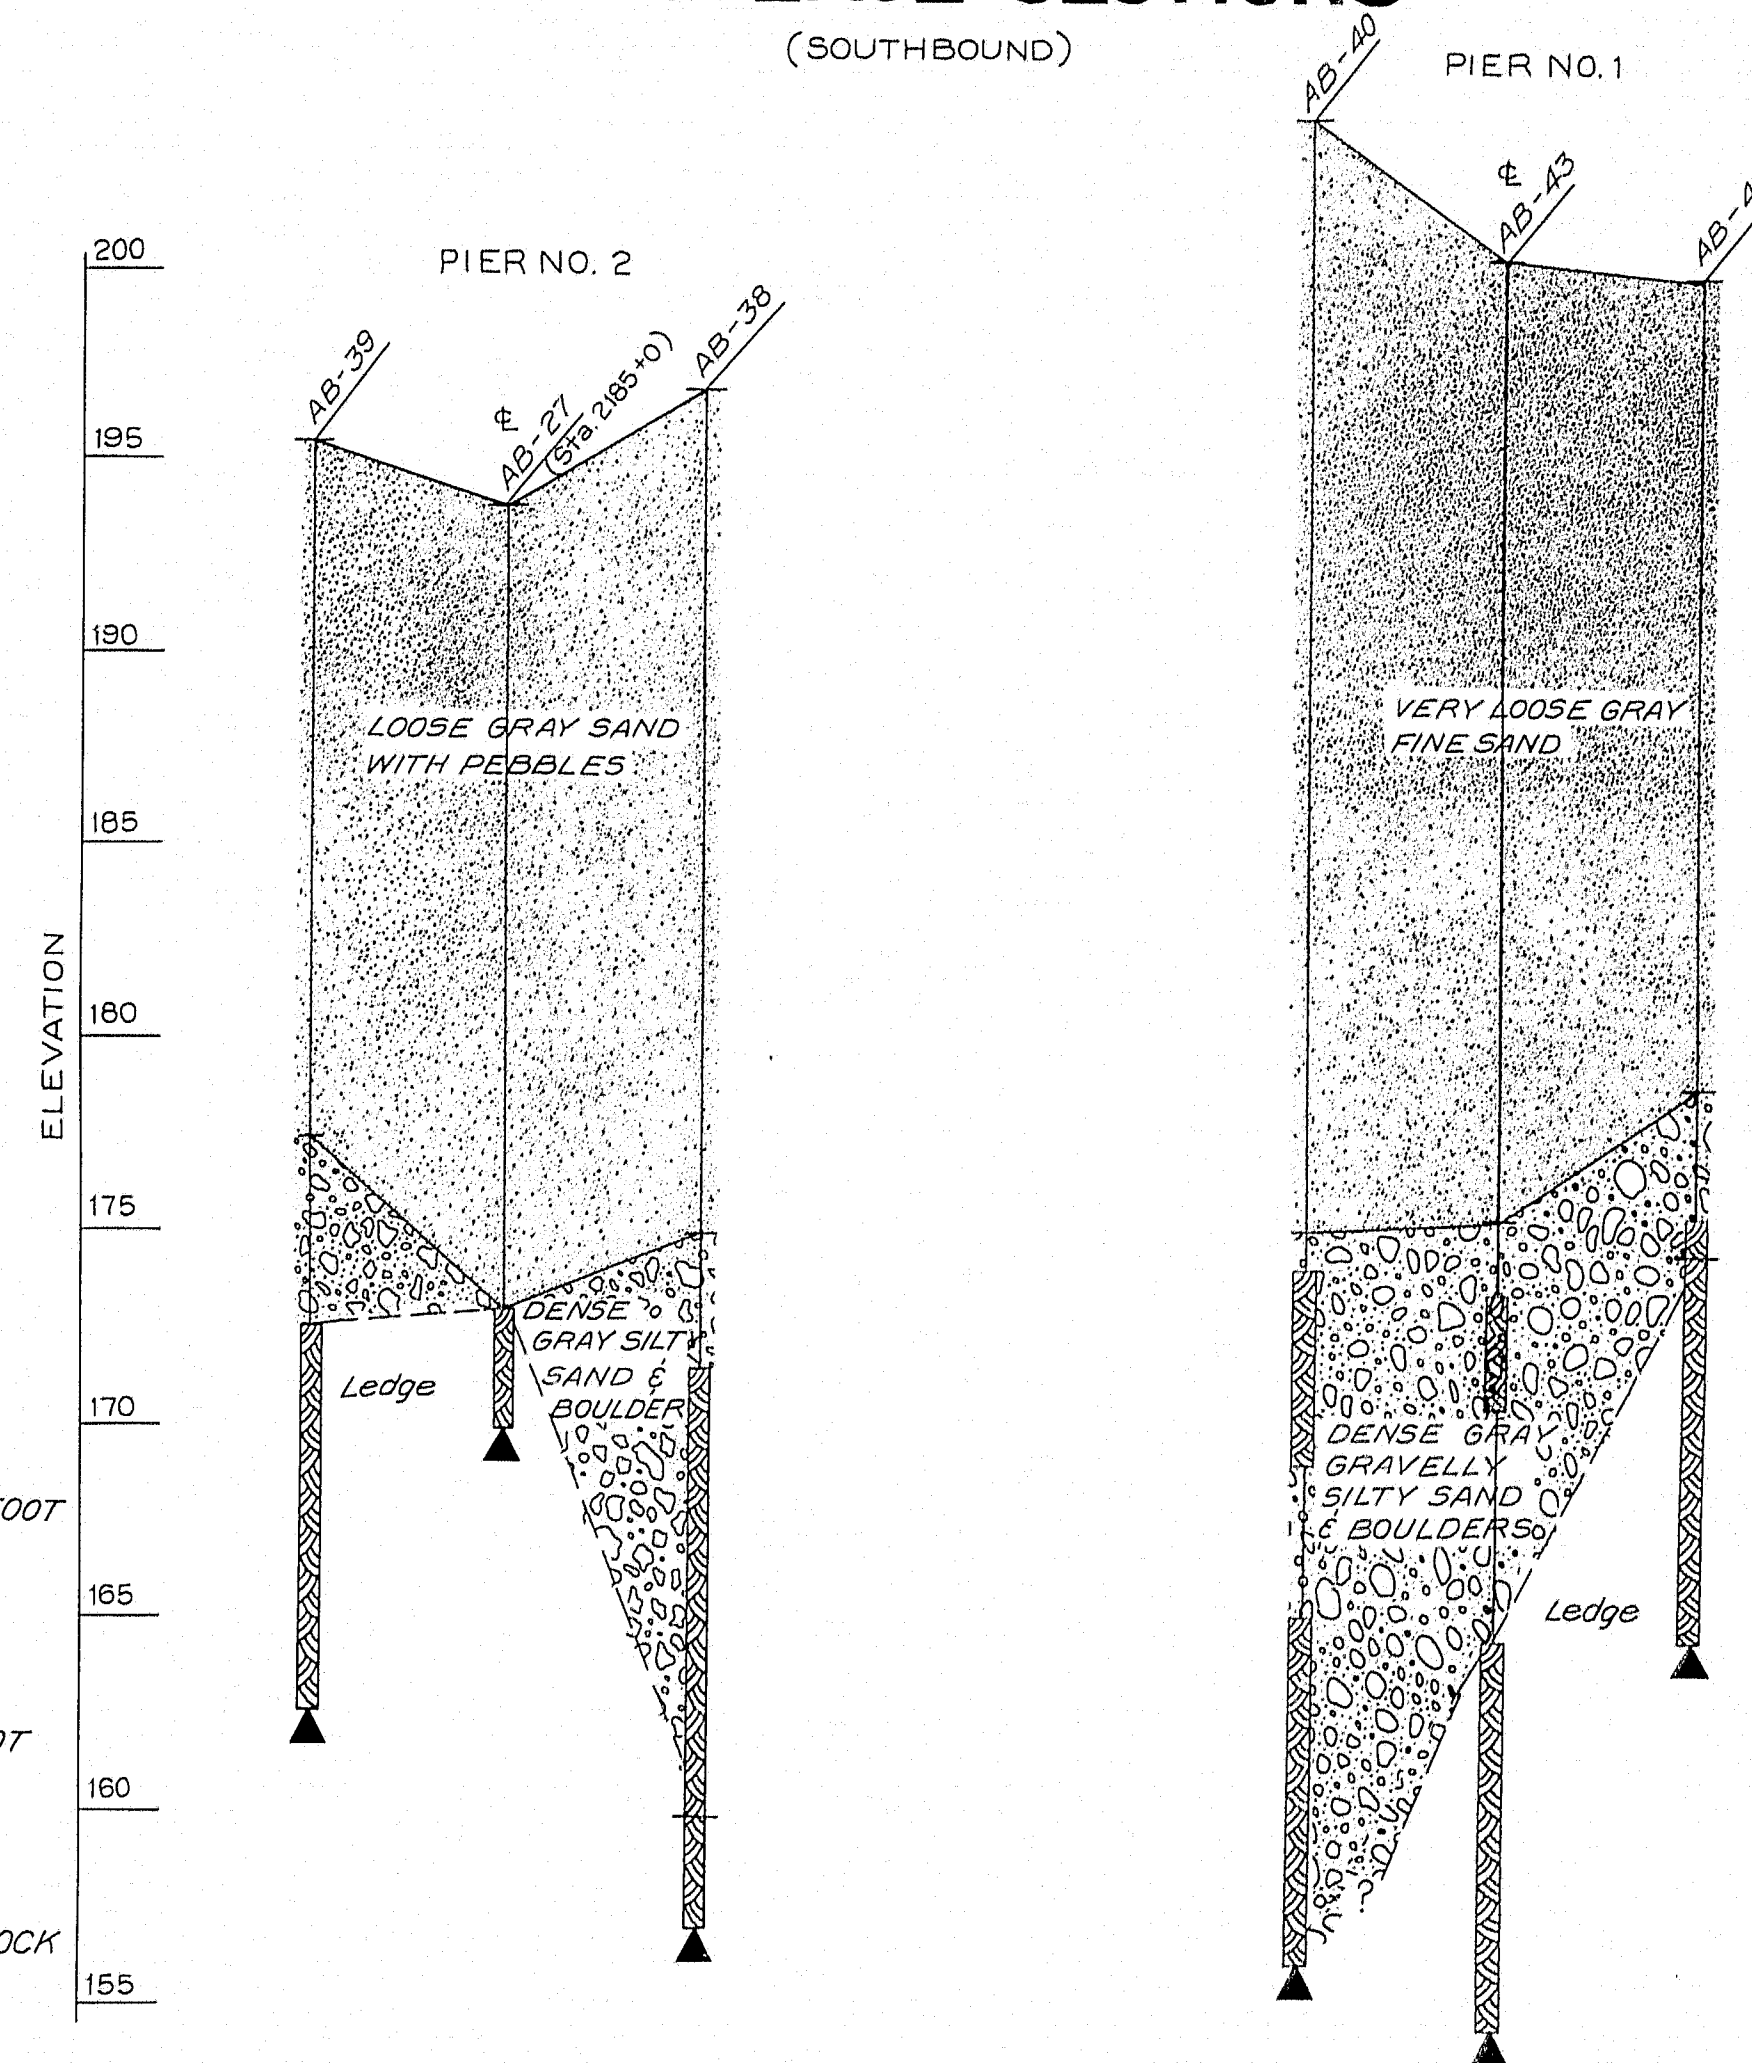

BORING NOTES

- NUMBER OF BLOWS REQUIRED TO DRIVE EXTRA HEAVY CASING ONE FOOT WITH 400 FT. LBS. OF ENERGY PER BLOW
- LOCATION OF SAMPLE OR SAMPLE ATTEMPT
- S & H SAMPLER #1290
- 3 1/2" O.D. 16 GA. SEAMLESS TUBING
- UNSUCCESSFUL SAMPLE ATTEMPT AND TYPE OF SAMPLER
- NUMBER OF BLOWS REQUIRED TO DRIVE SPOON OR TUBING ONE FOOT WITH 350 FT. LBS. OF ENERGY PER BLOW
- PISTON SAMPLER
- FIELD VANE TEST
- BOTTOM OF BORING (MAY NOT BE BOTTOM OF SOIL STRATA)
- LOCATIONS CORED BY DIAMOND BIT AND PER CENT RECOVERY OF ROCK
- SHEAR NOTES
- FIELD VANE SHEAR STRENGTHS
- LABORATORY VANE SHEAR STRENGTHS
- WATER CONTENT NOTES
- NATURAL WATER CONTENTS, GIVEN AS PER CENT OF DRY WEIGHT
- PLASTIC AND LIQUID LIMITS

DESIGN—
TRACE—
CHECK—

BRIDGE NO.
SURVEY—
PLOT—

STATE HIGHWAY COMMISSION
BRIDGE DIVISION


SEBASTICOOK RIVER BRIDGE

IN THE TOWN OF
PITTSFIELD
SOMERSET COUNTY

BORING DETAILS


SHEET 7 OF 18 AUGUSTA, MAINE

M-1986

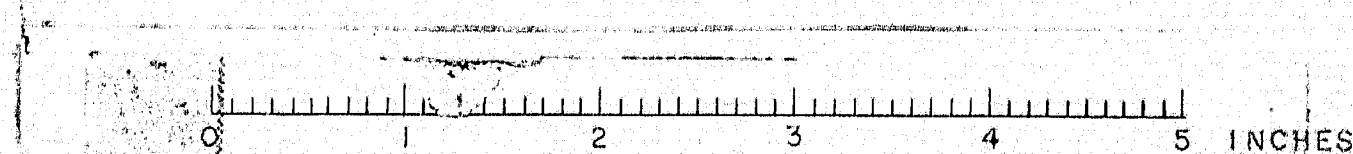


B.P.R. REG. NO.	STATE	PROJECT NUMBER	SHEET NO.	TOTAL SHEETS
1	MAINE	1-95-7(35)	53	225


FRONT ELEVATION

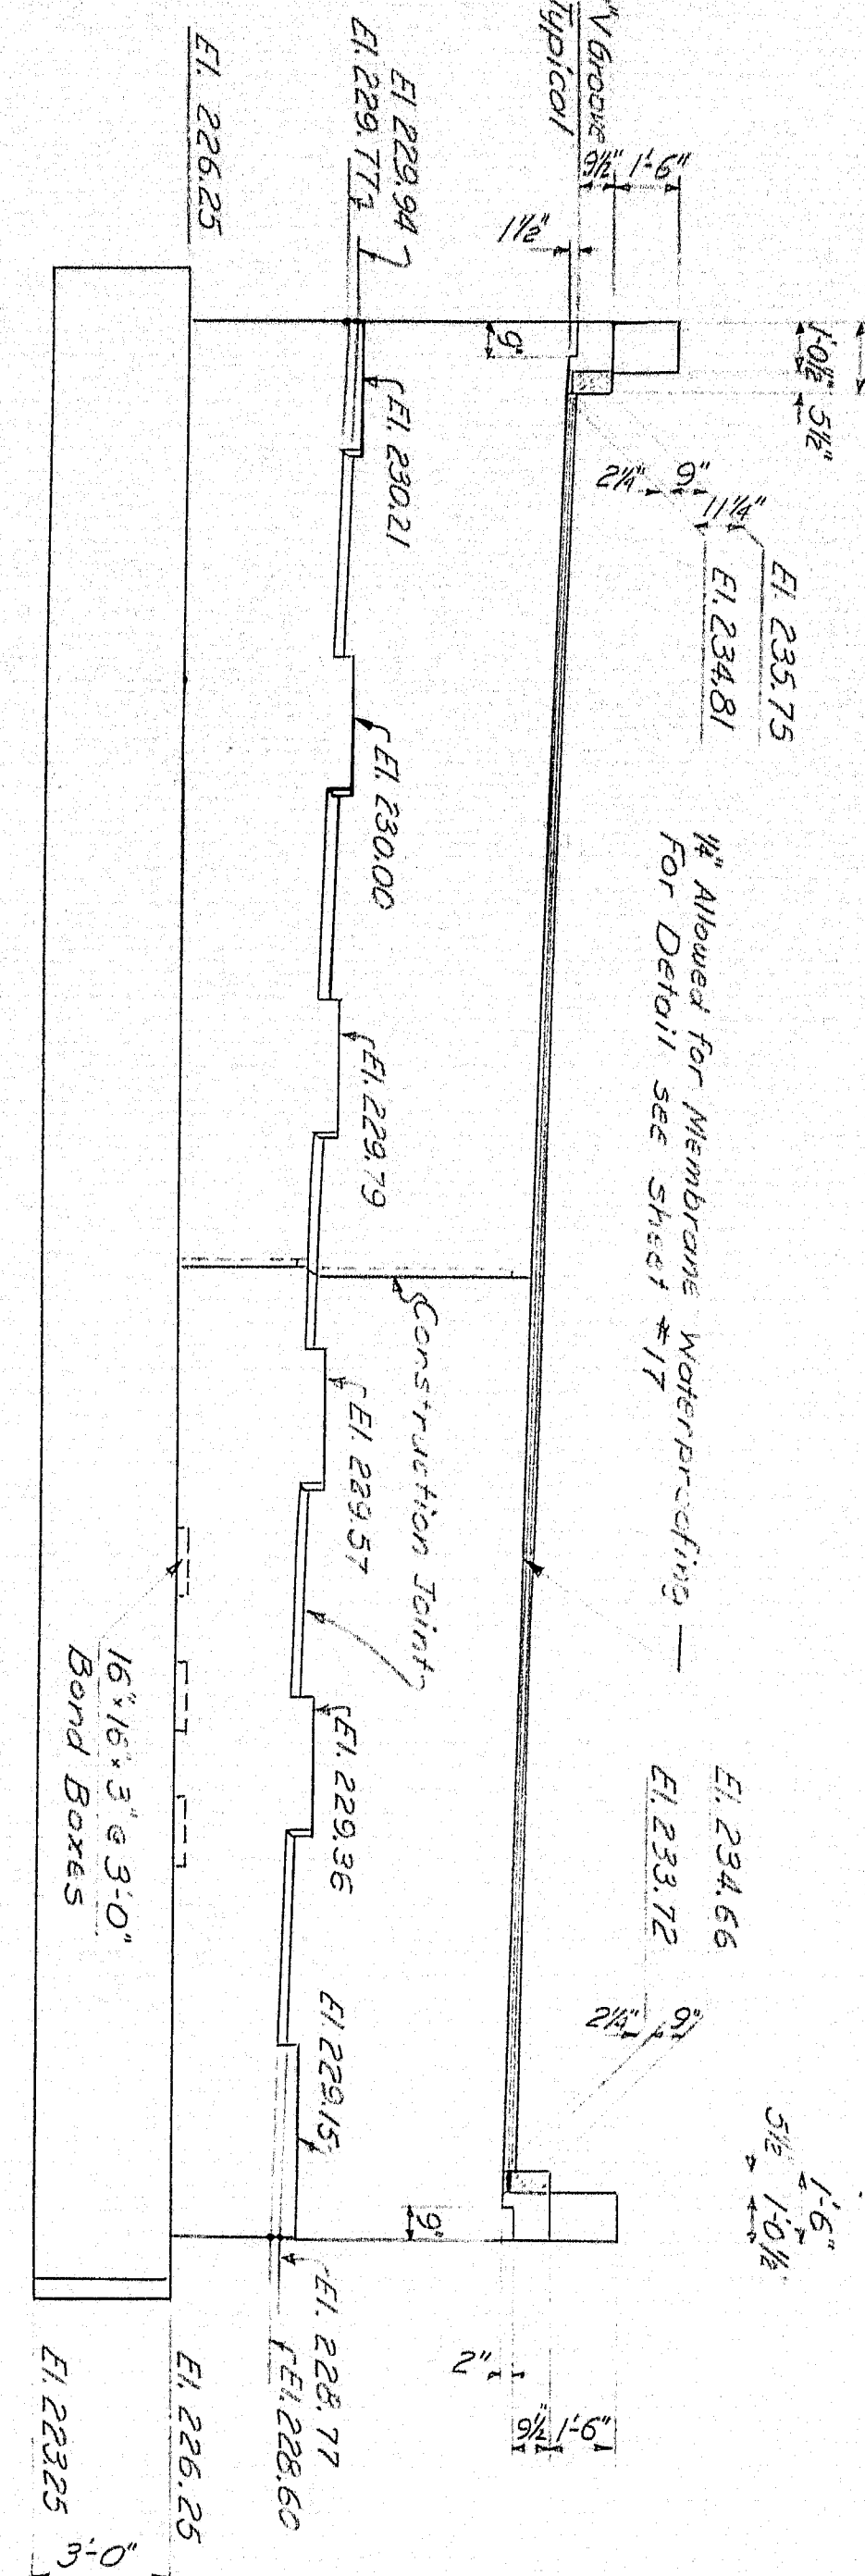

U.S. WING ELEVATION

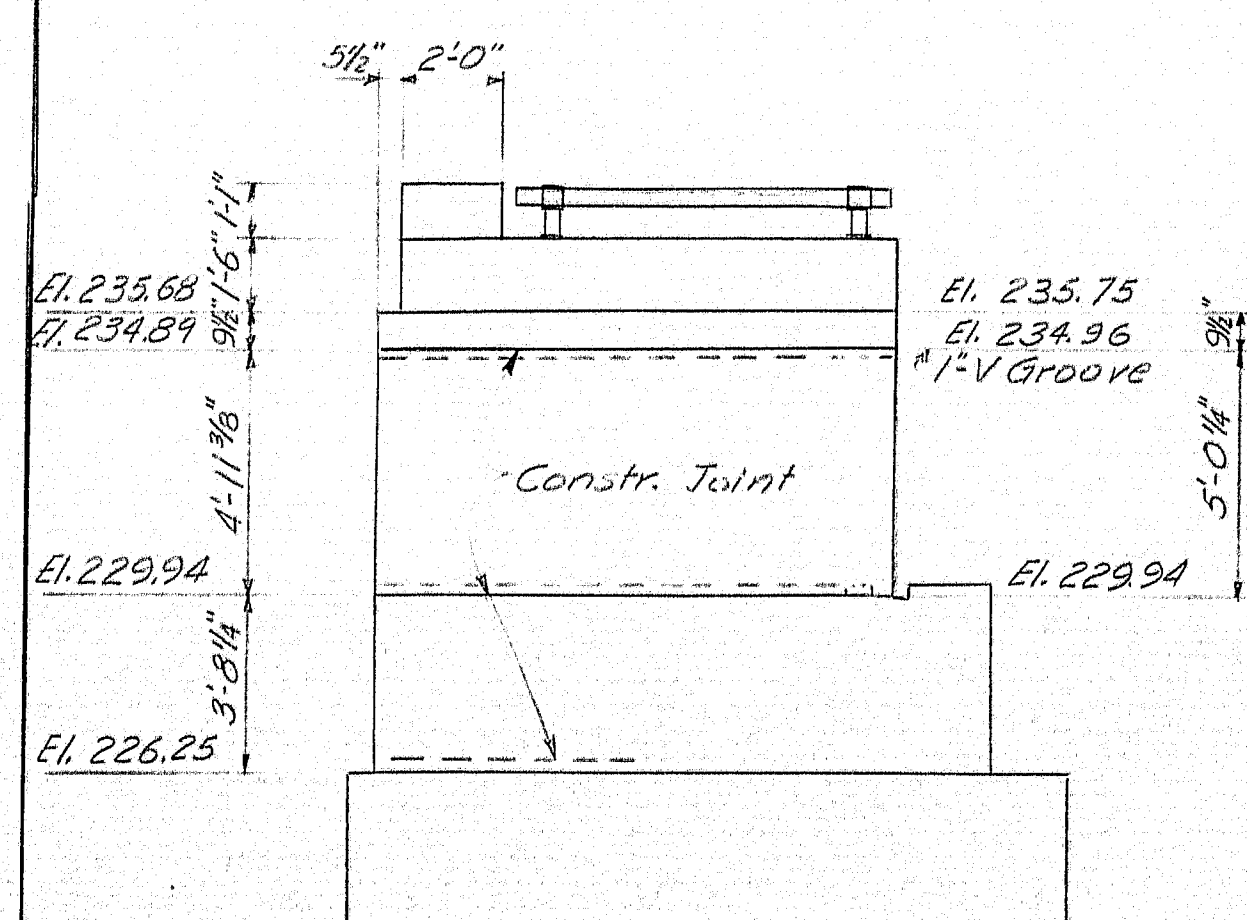


D.S. WING ELEVATION

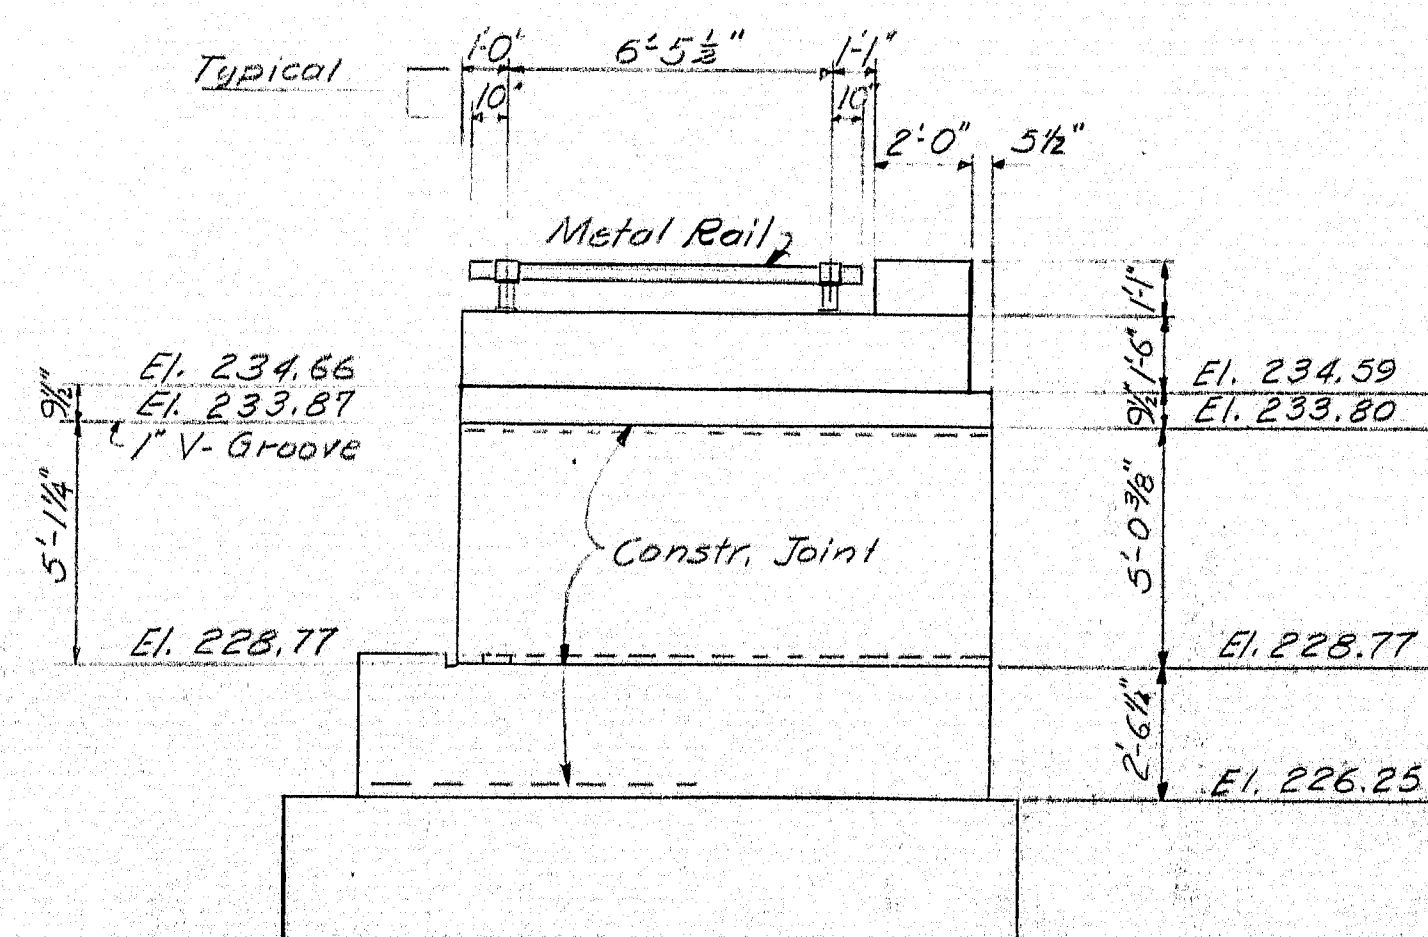


REINFORCING STEEL THE SAME AS ABUTMENT #1 N.B.
EXCEPT - SUBSTITUTE BAR A11 WITH A31
BAR A12 WITH A32


PLAN

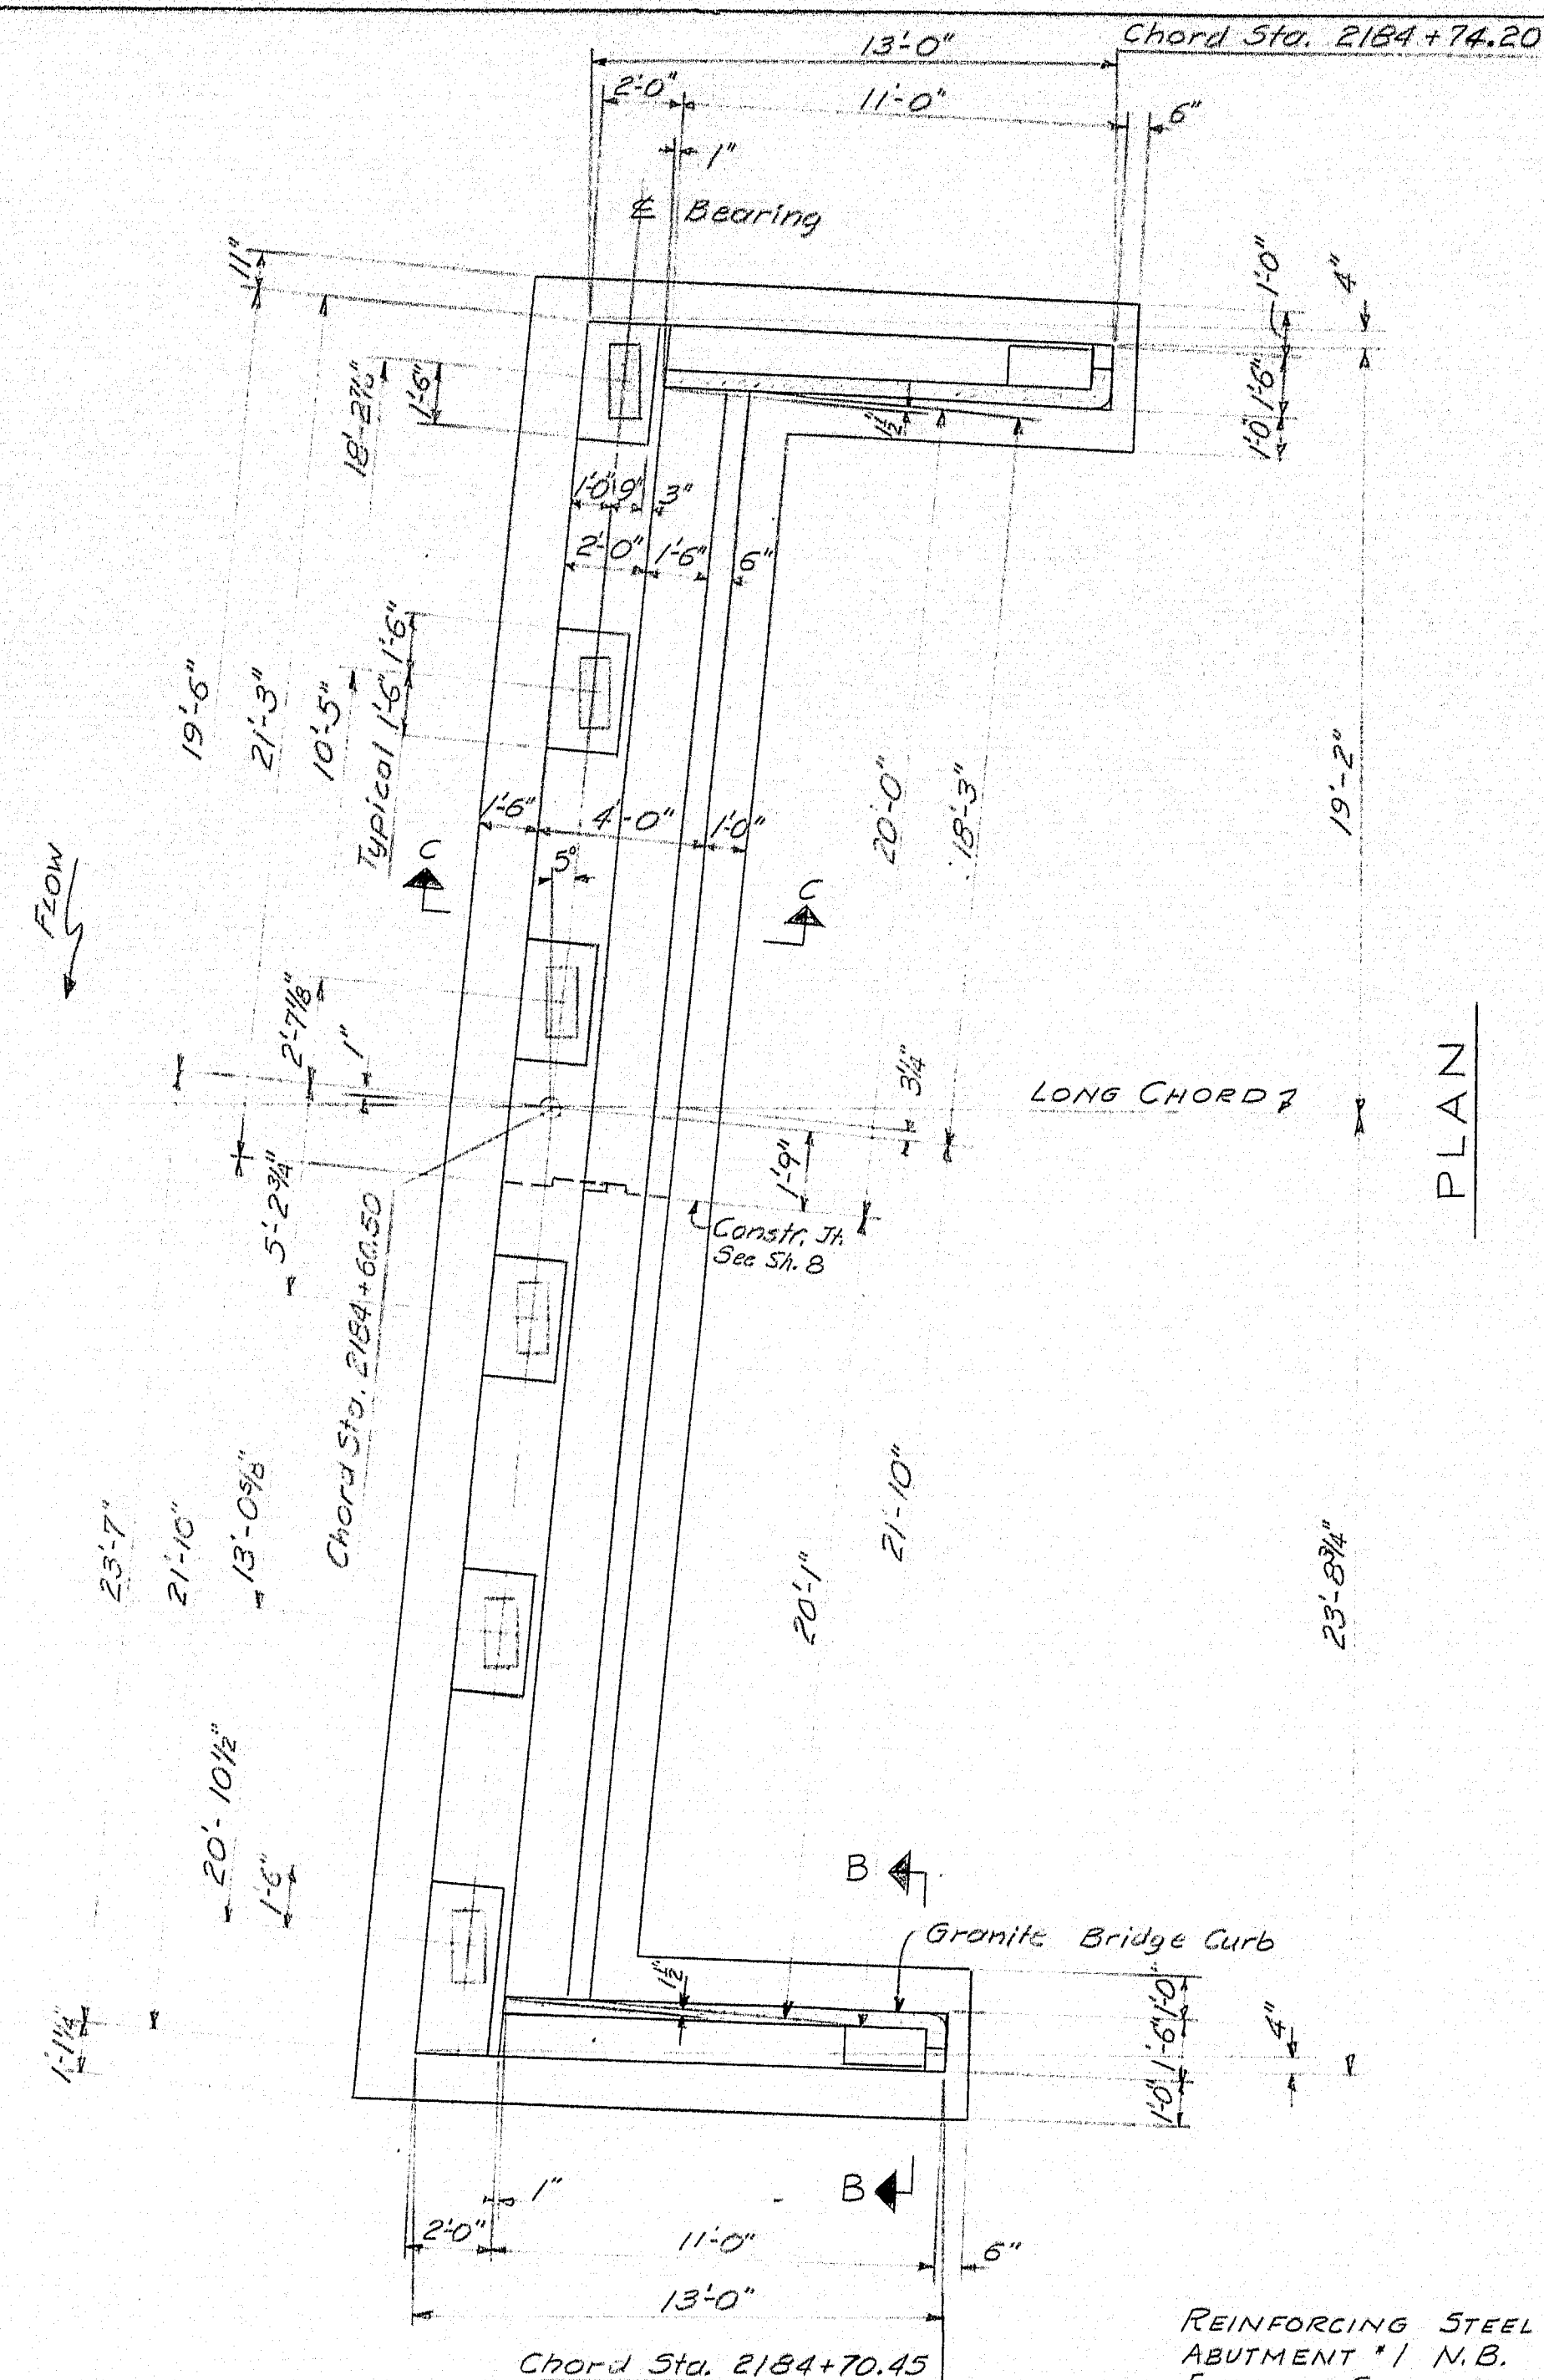

REAR ELEVATION

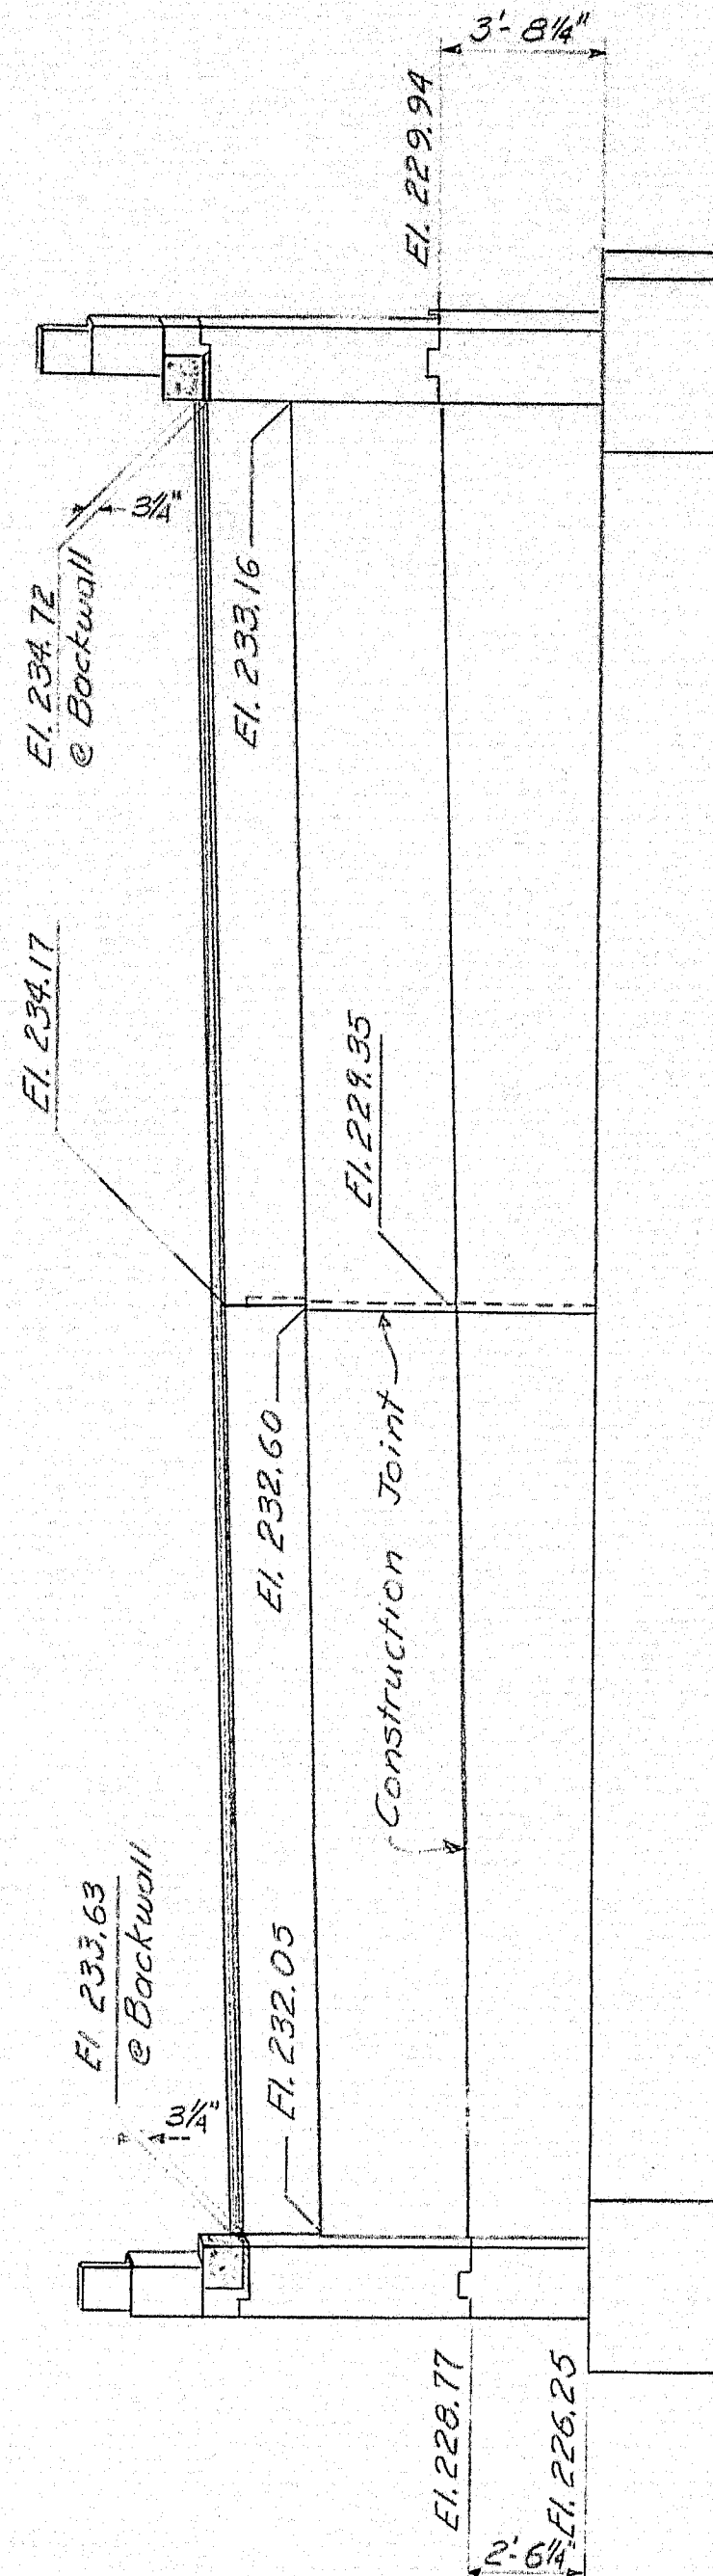


SECTION C-C

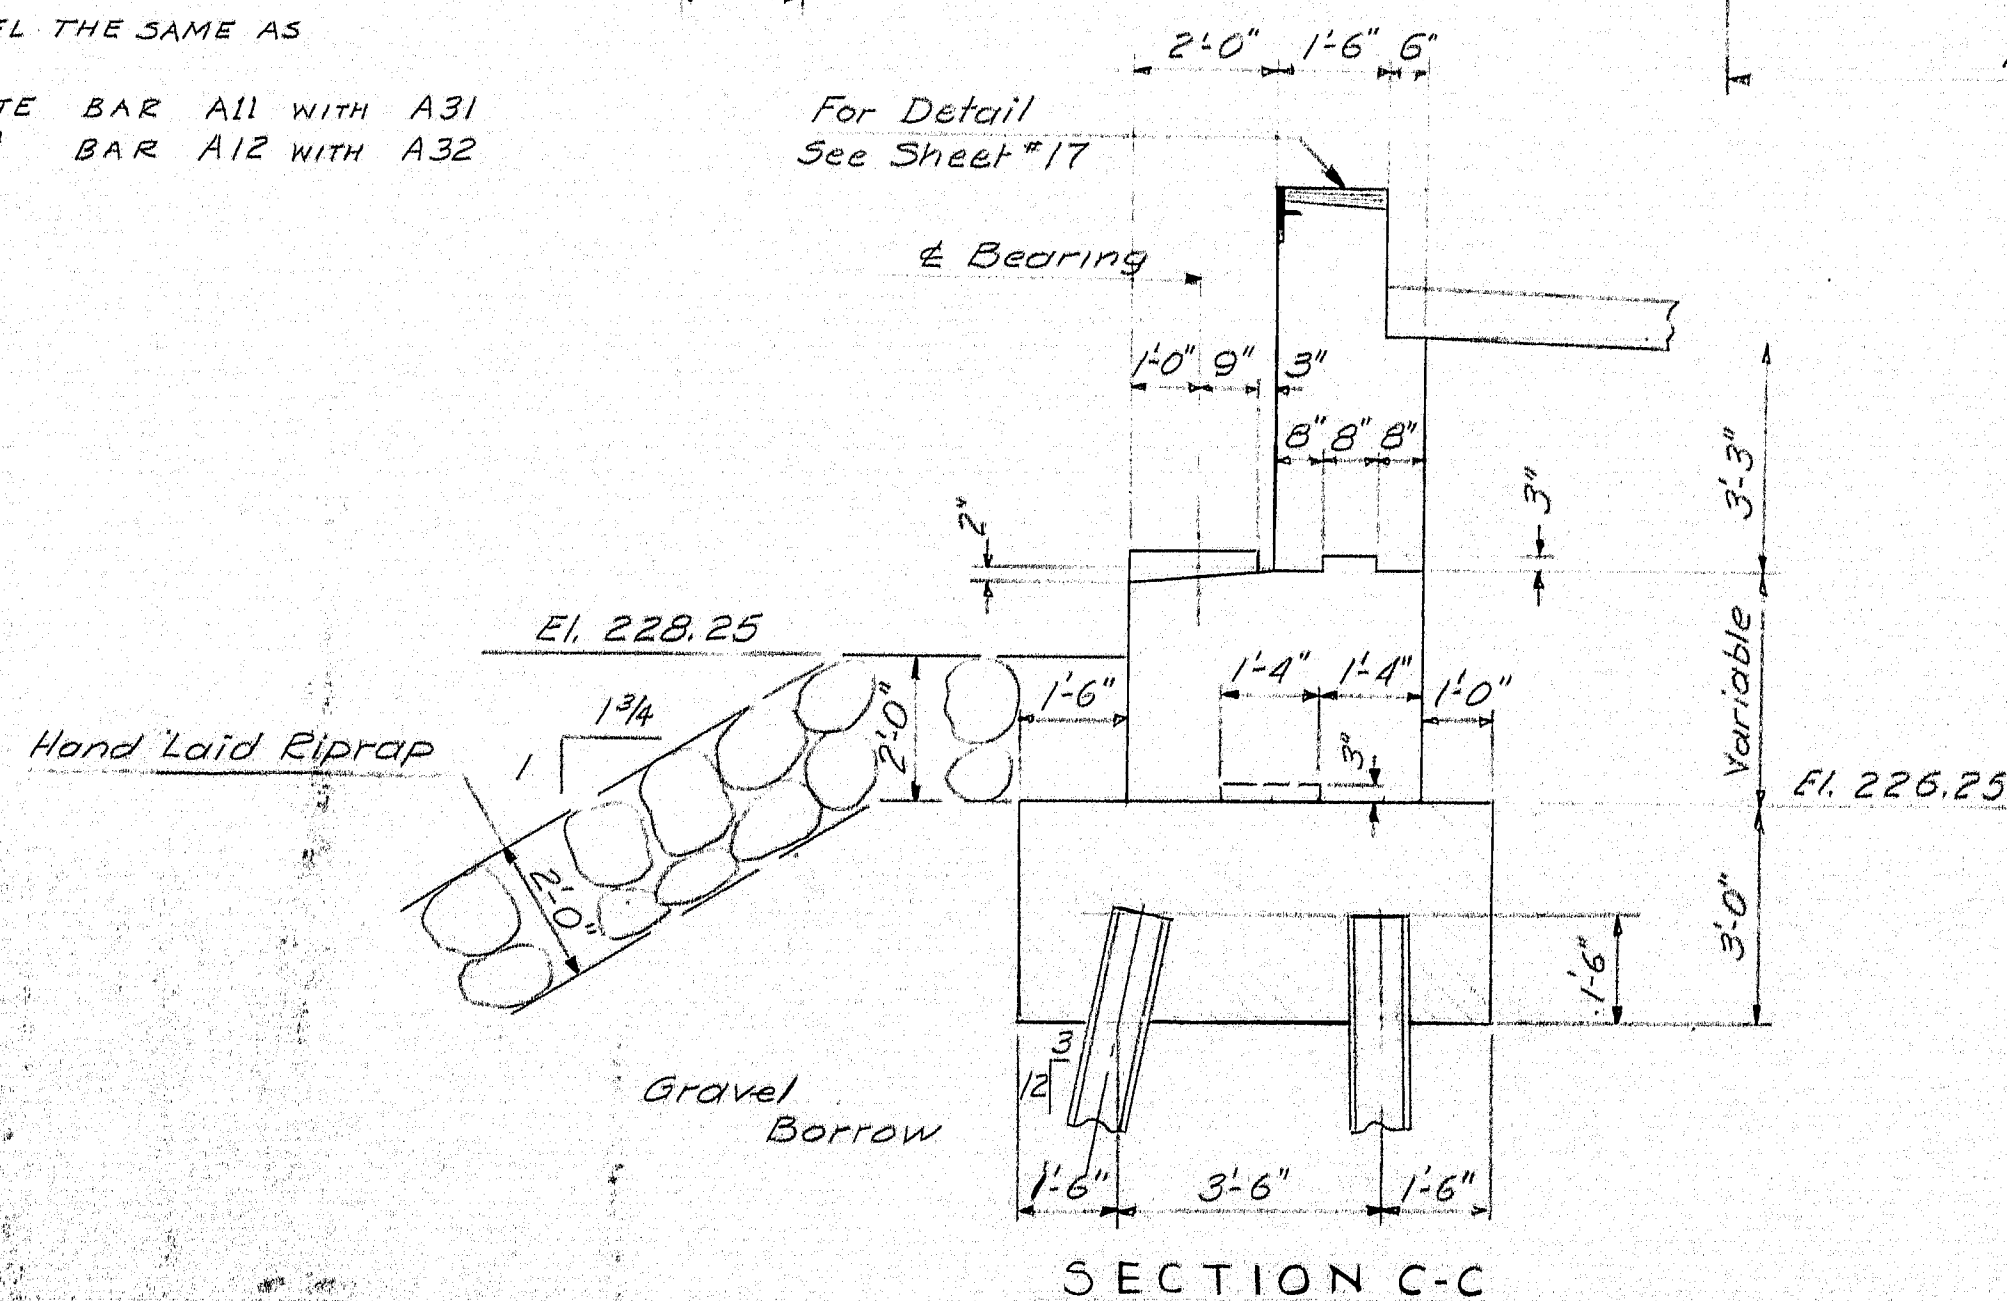


FILES: 10BD42 - H Steel Bearing Piles driven to ledge
or practical refusal
Estimated Length = 45'
Allowable Load = 37 tons/ft
All piles shown thus to be battered 3 1/4" in the direction of the arrow.

FOOTING PLAN

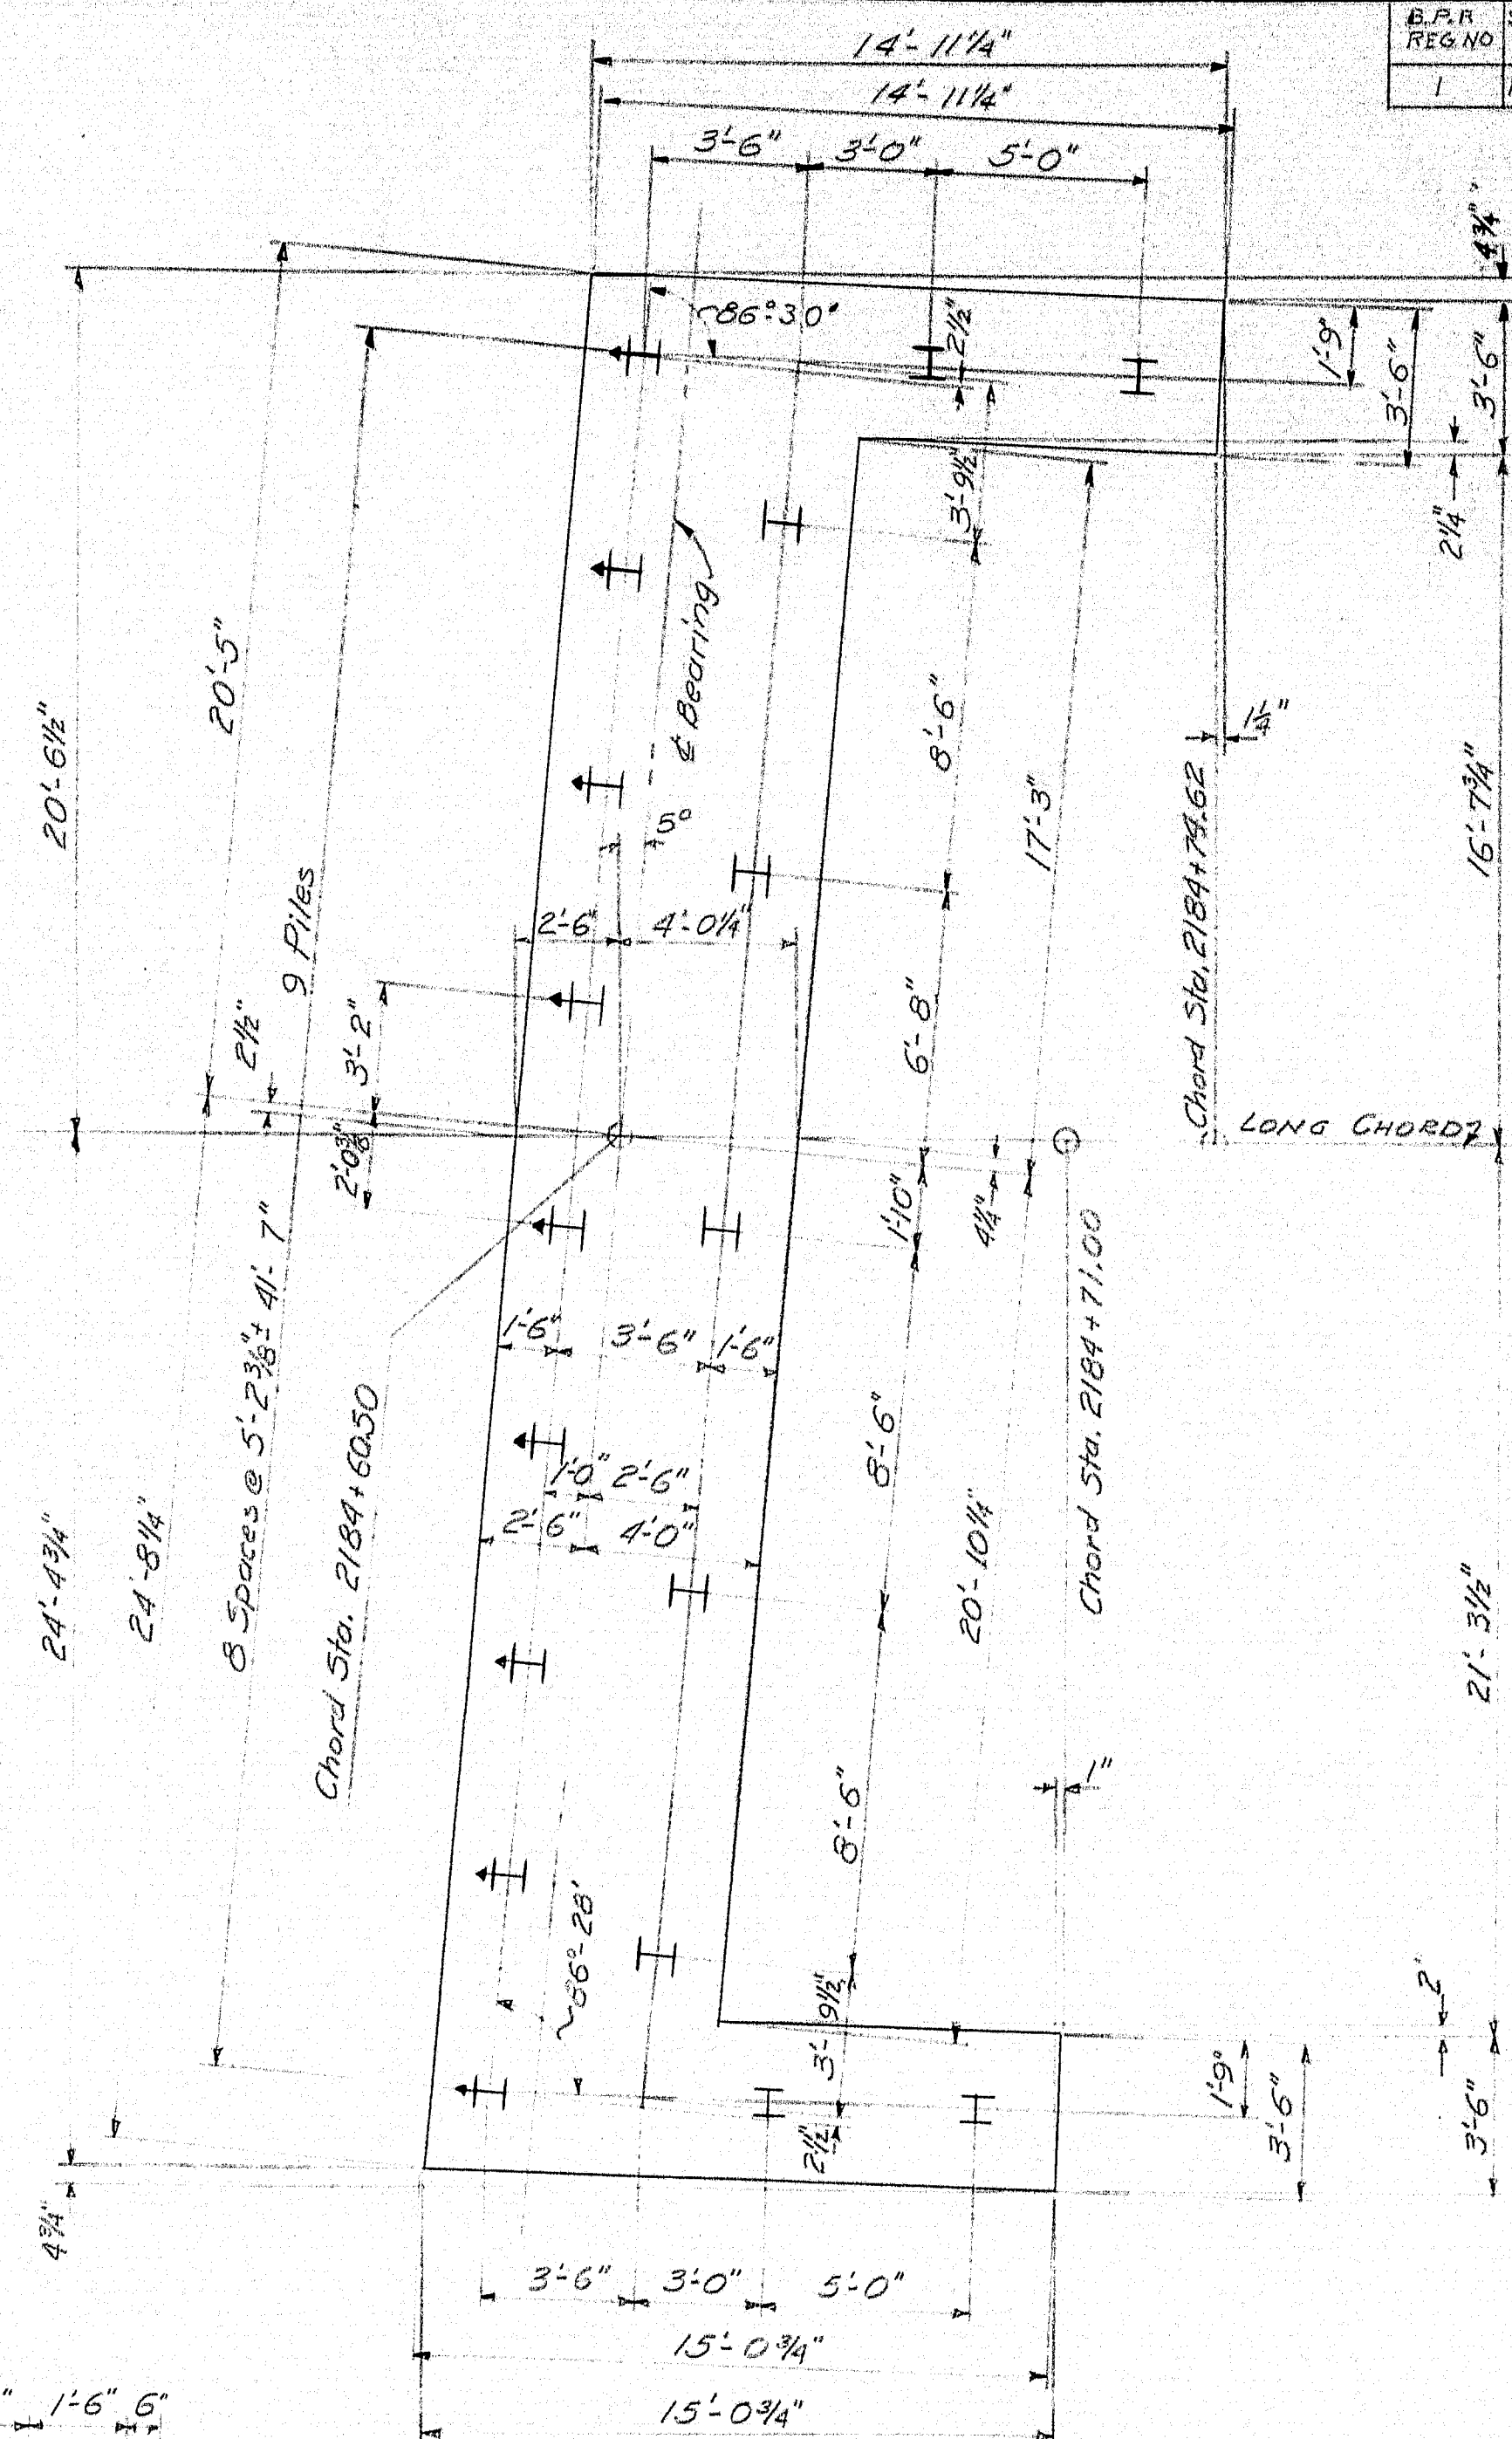


For General Abutment Notes and Reinforcing Steel see sheet #8
For Approach Slab and Granite Bridge Curb see sheet #15
For Section B-B see sheet #8

DESIGN T.H.K.
CHECK T.H.K.
STATE HIGHWAY COMMISSION
BRIDGE DIVISION
SEBASTICOOK RIVER BRIDGE
IN THE TOWN OF
PITTSFIELD
SOMERSET COUNTY
ABUTMENT 2 N.B.
SHEET 9 OF 18 AUGUSTA, MAINE FEB 1963

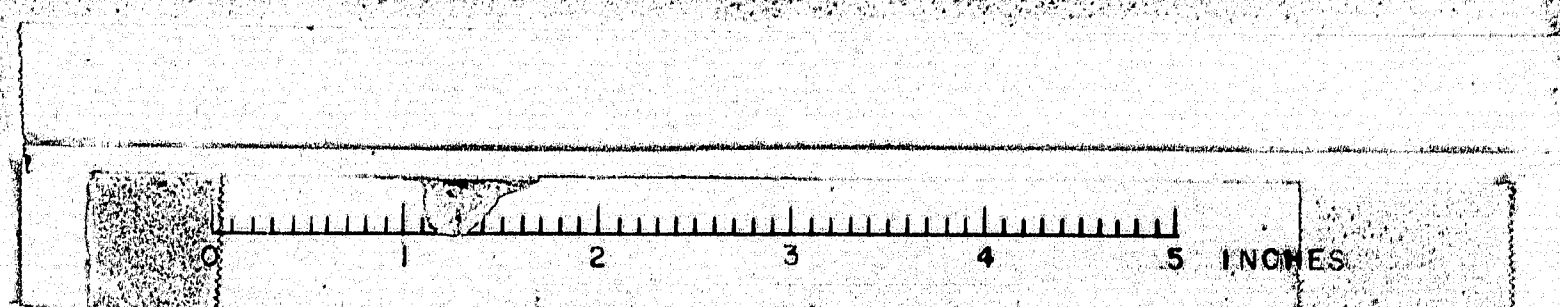


REAR ELEVATION


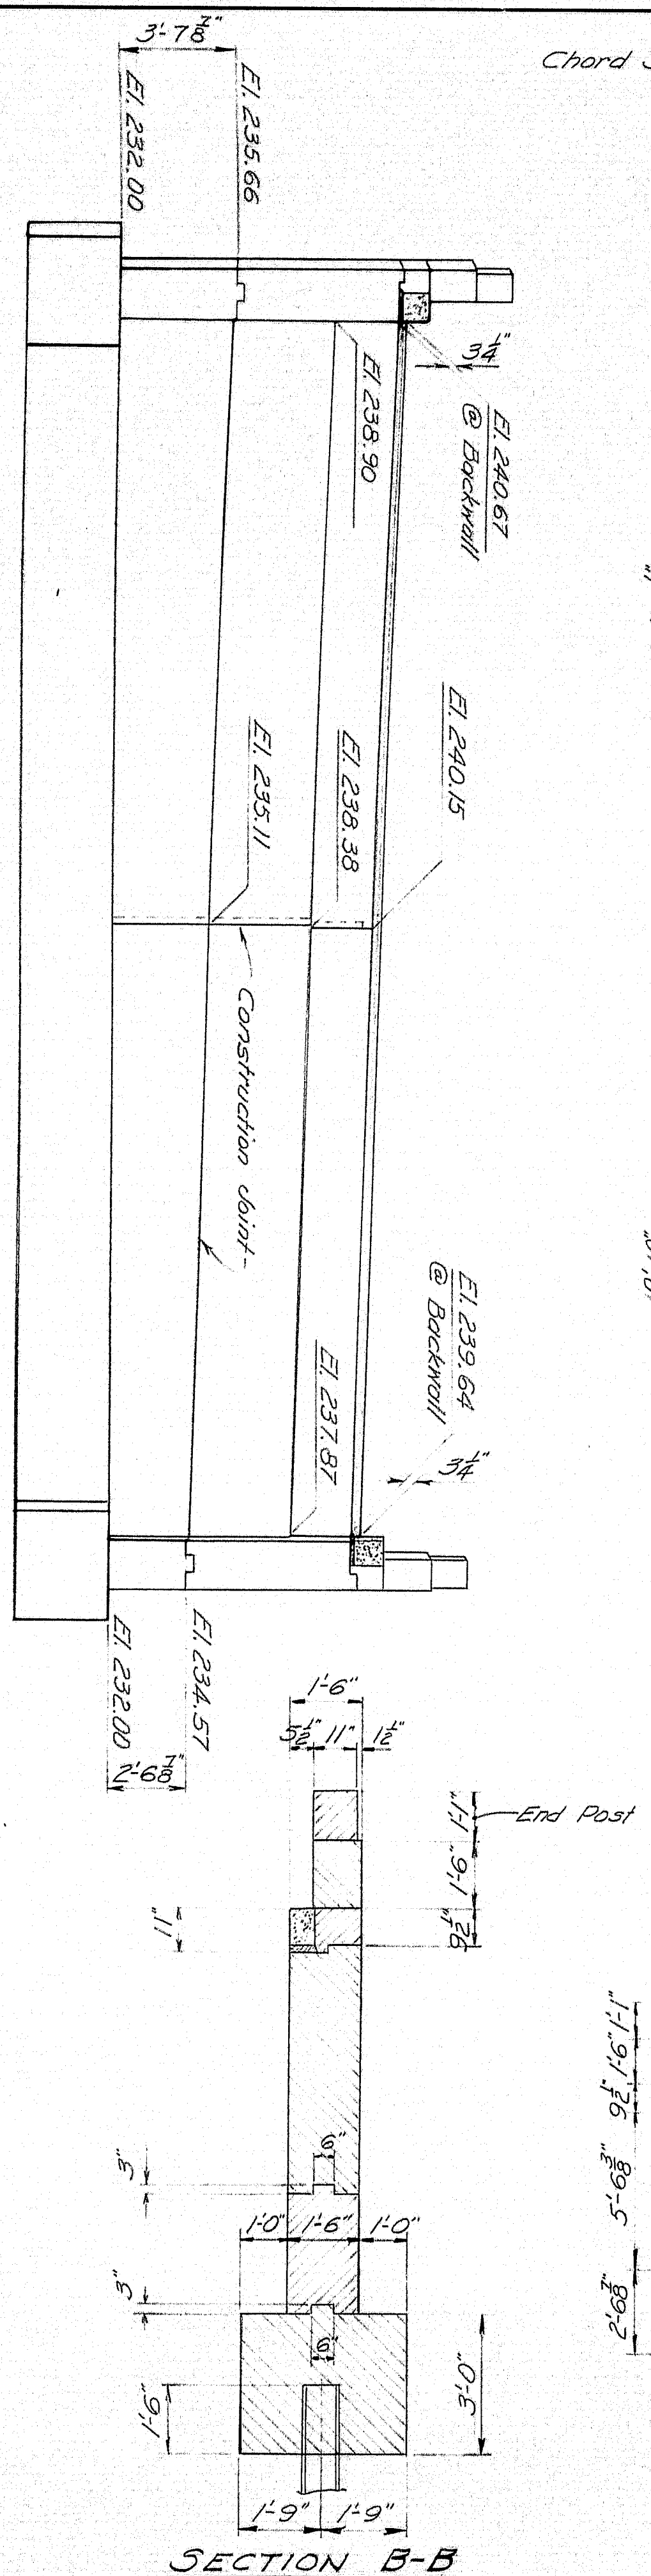


SECTION B-B

D.S. WING ELEVATION

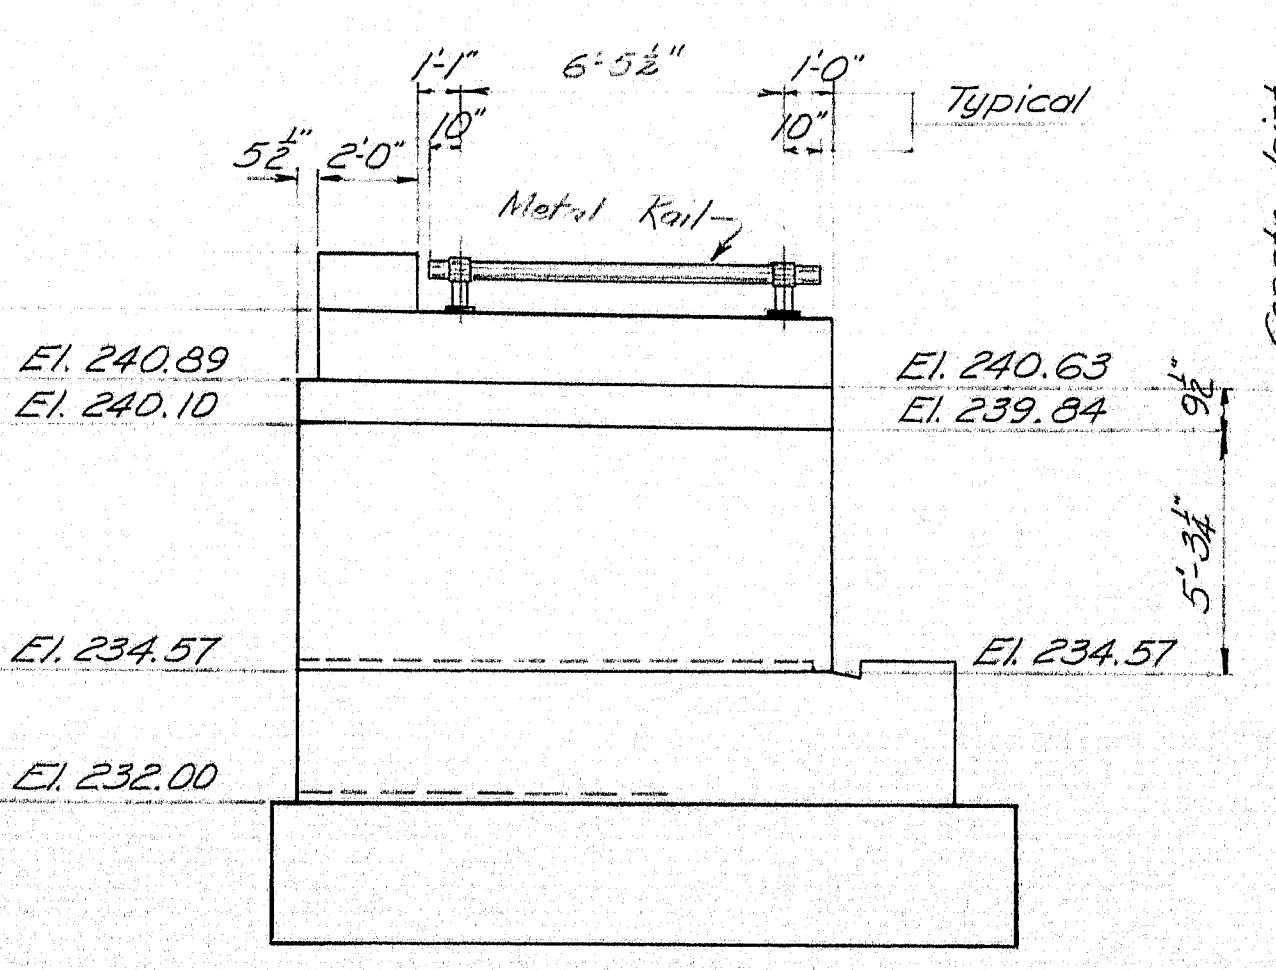


U.S. WING ELEVATION

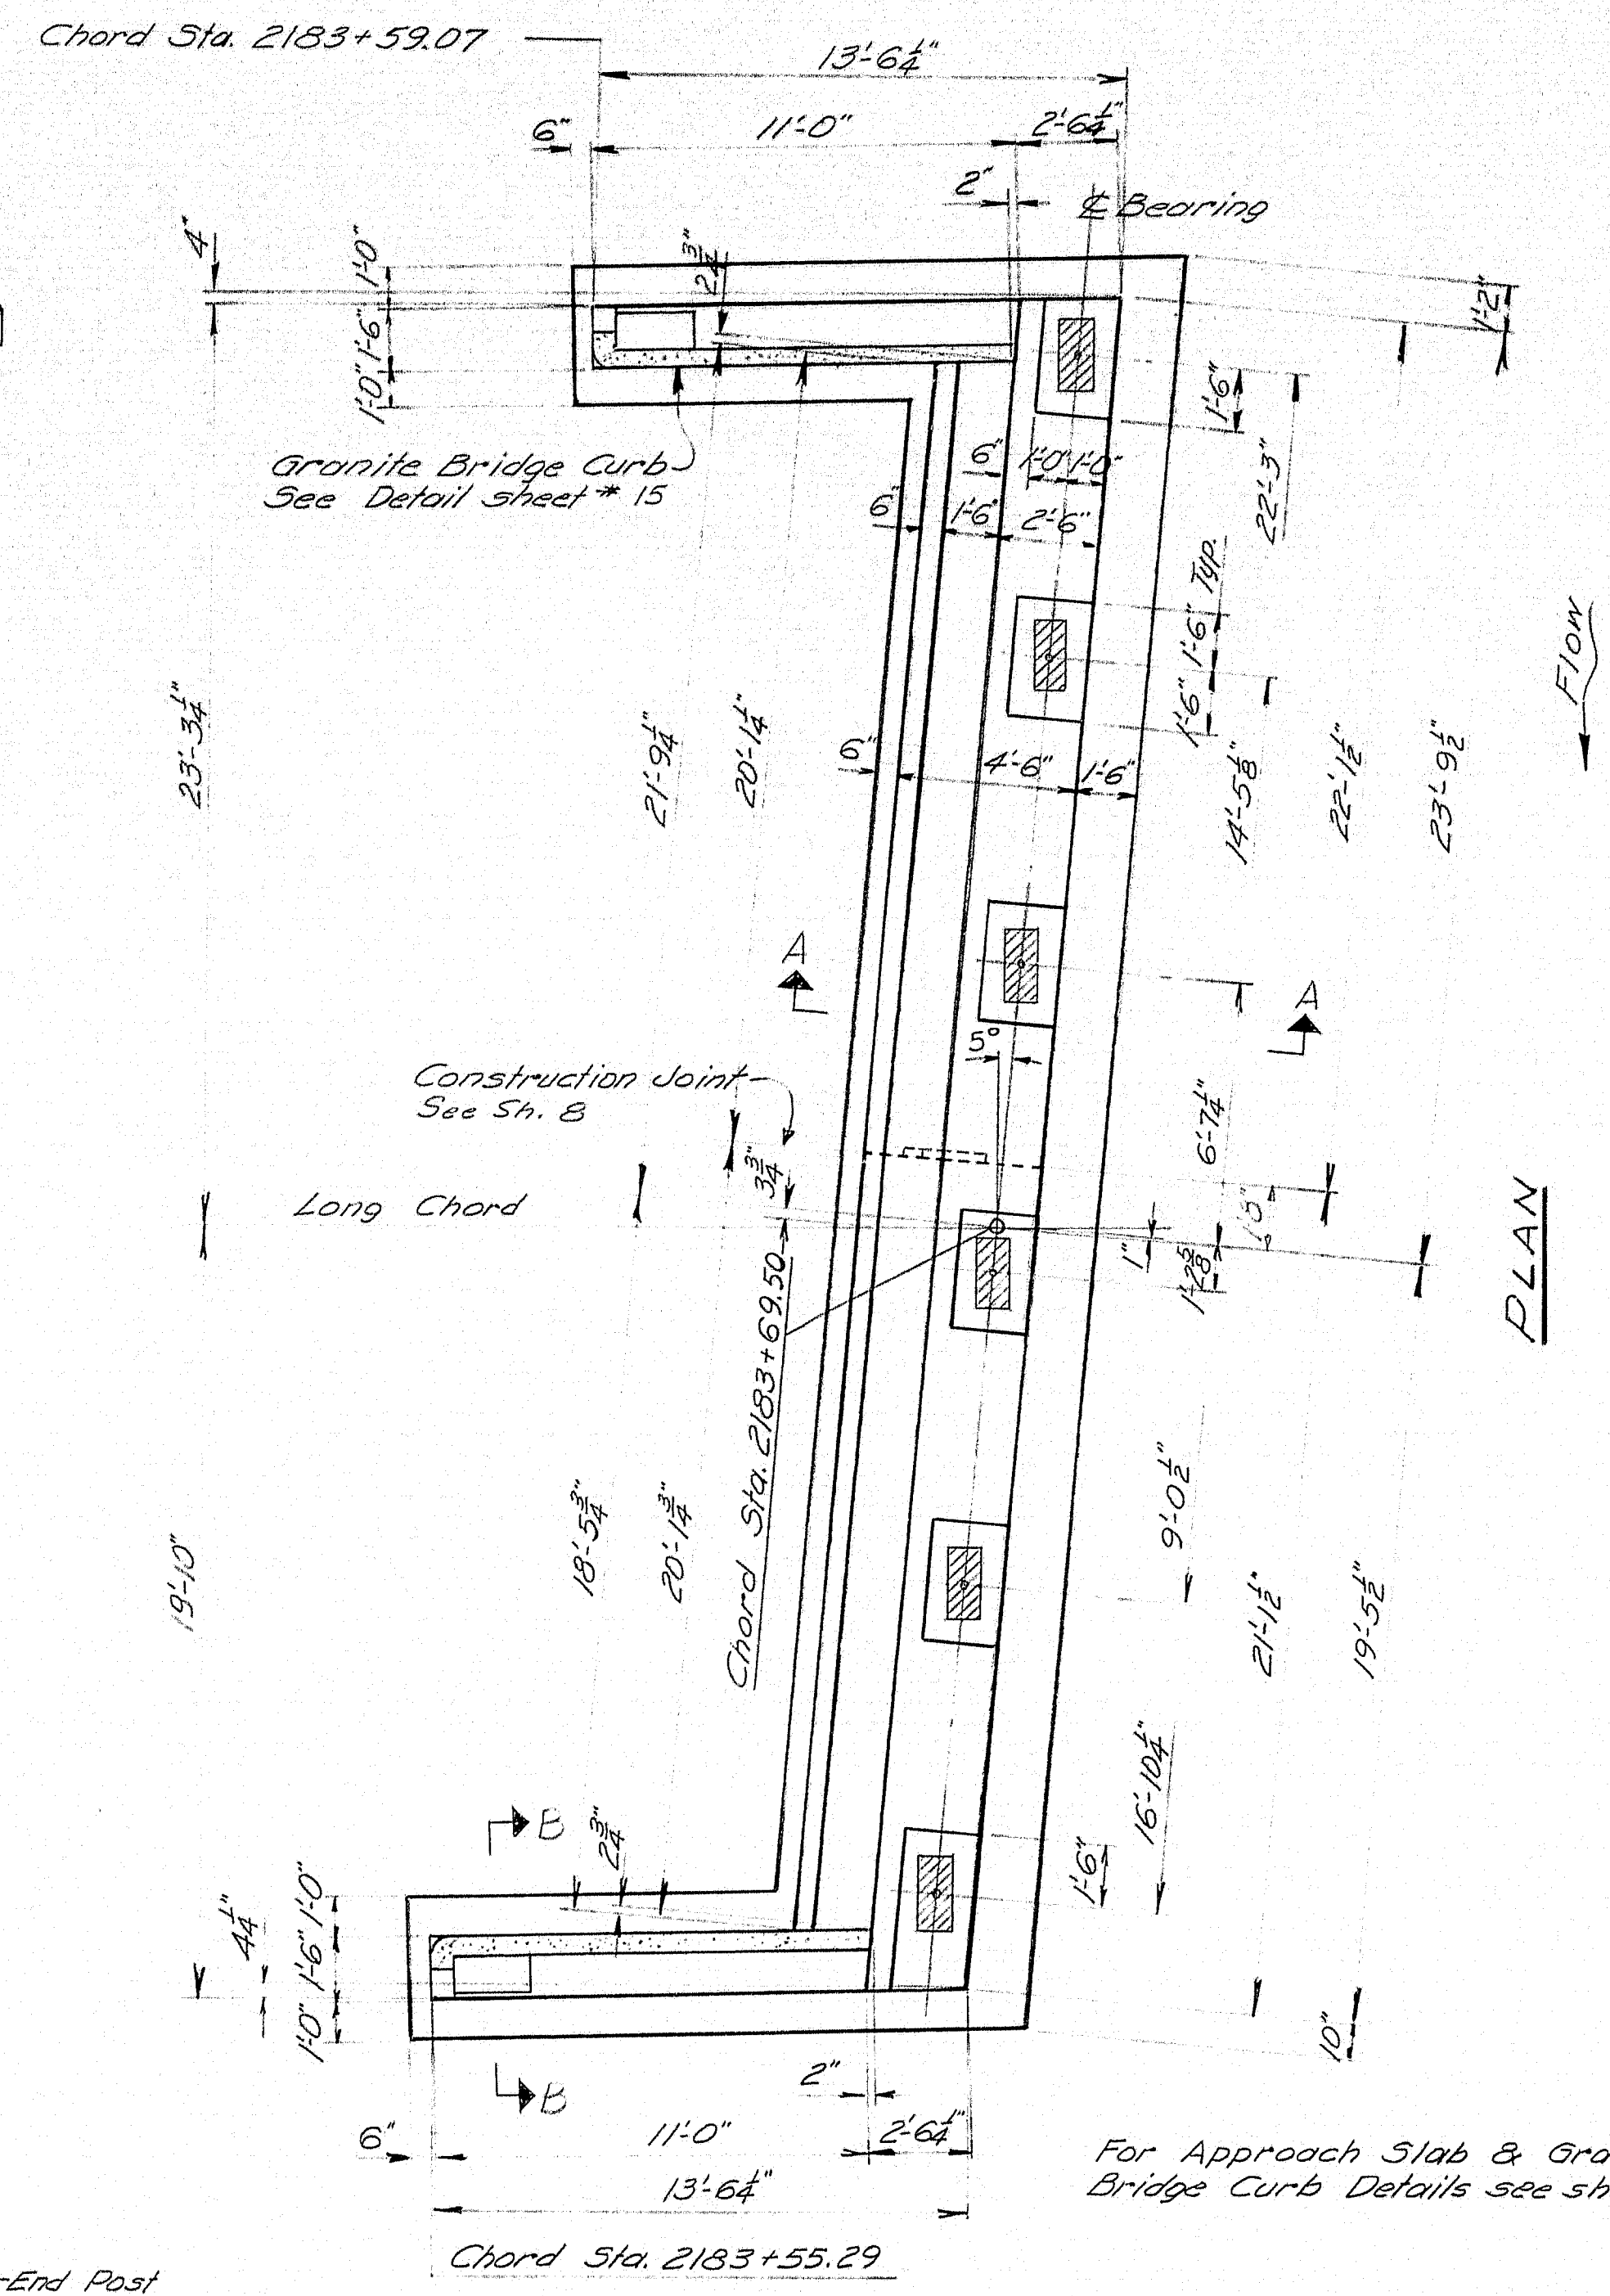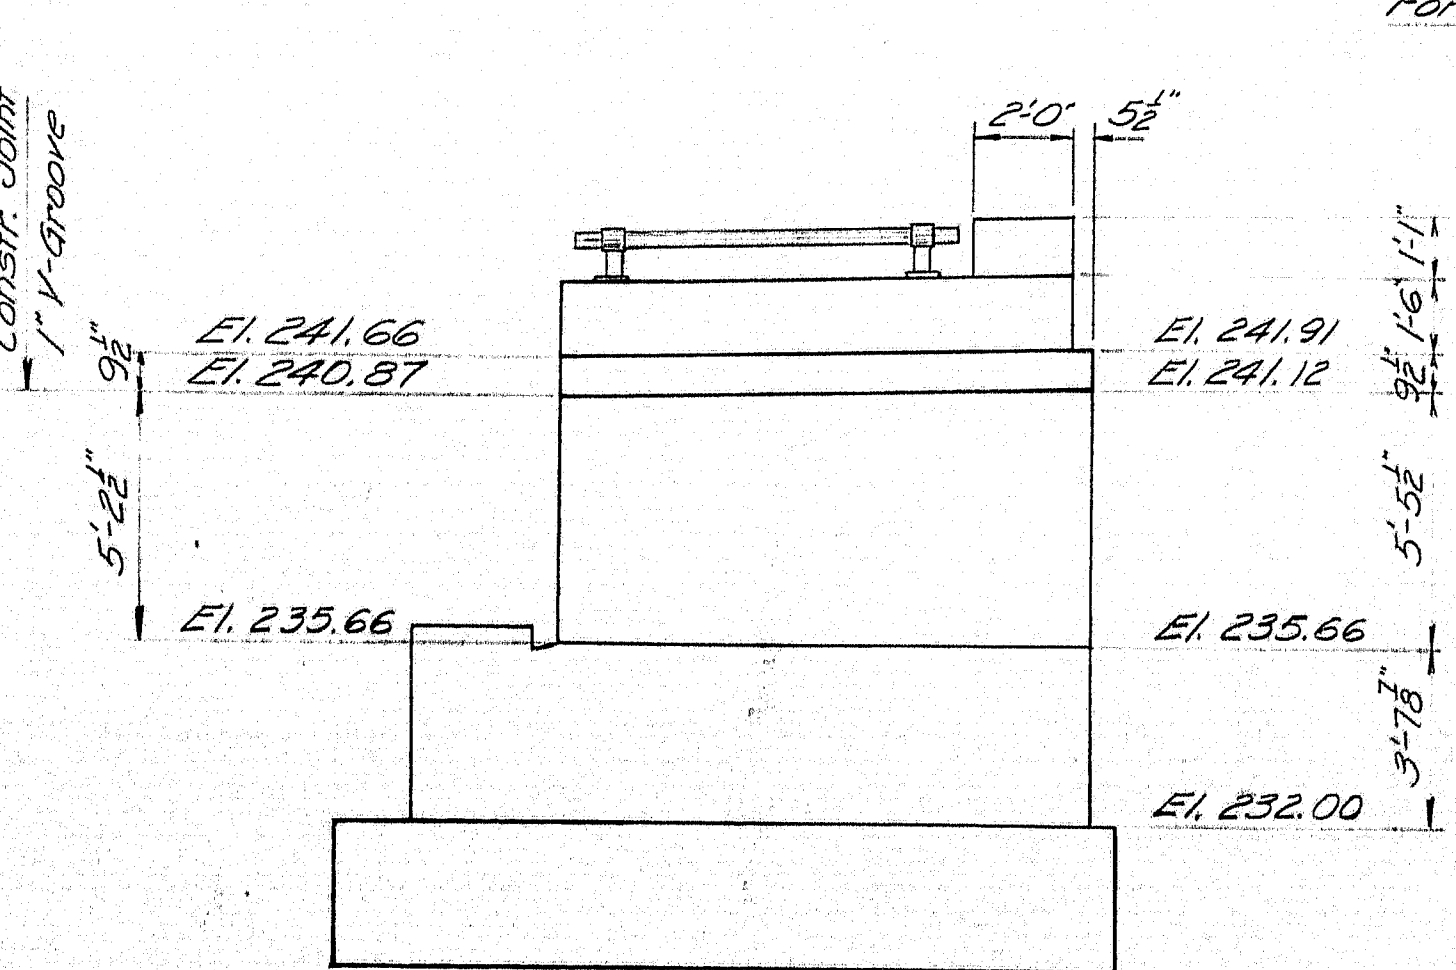


PLAN

FRONT ELEVATION

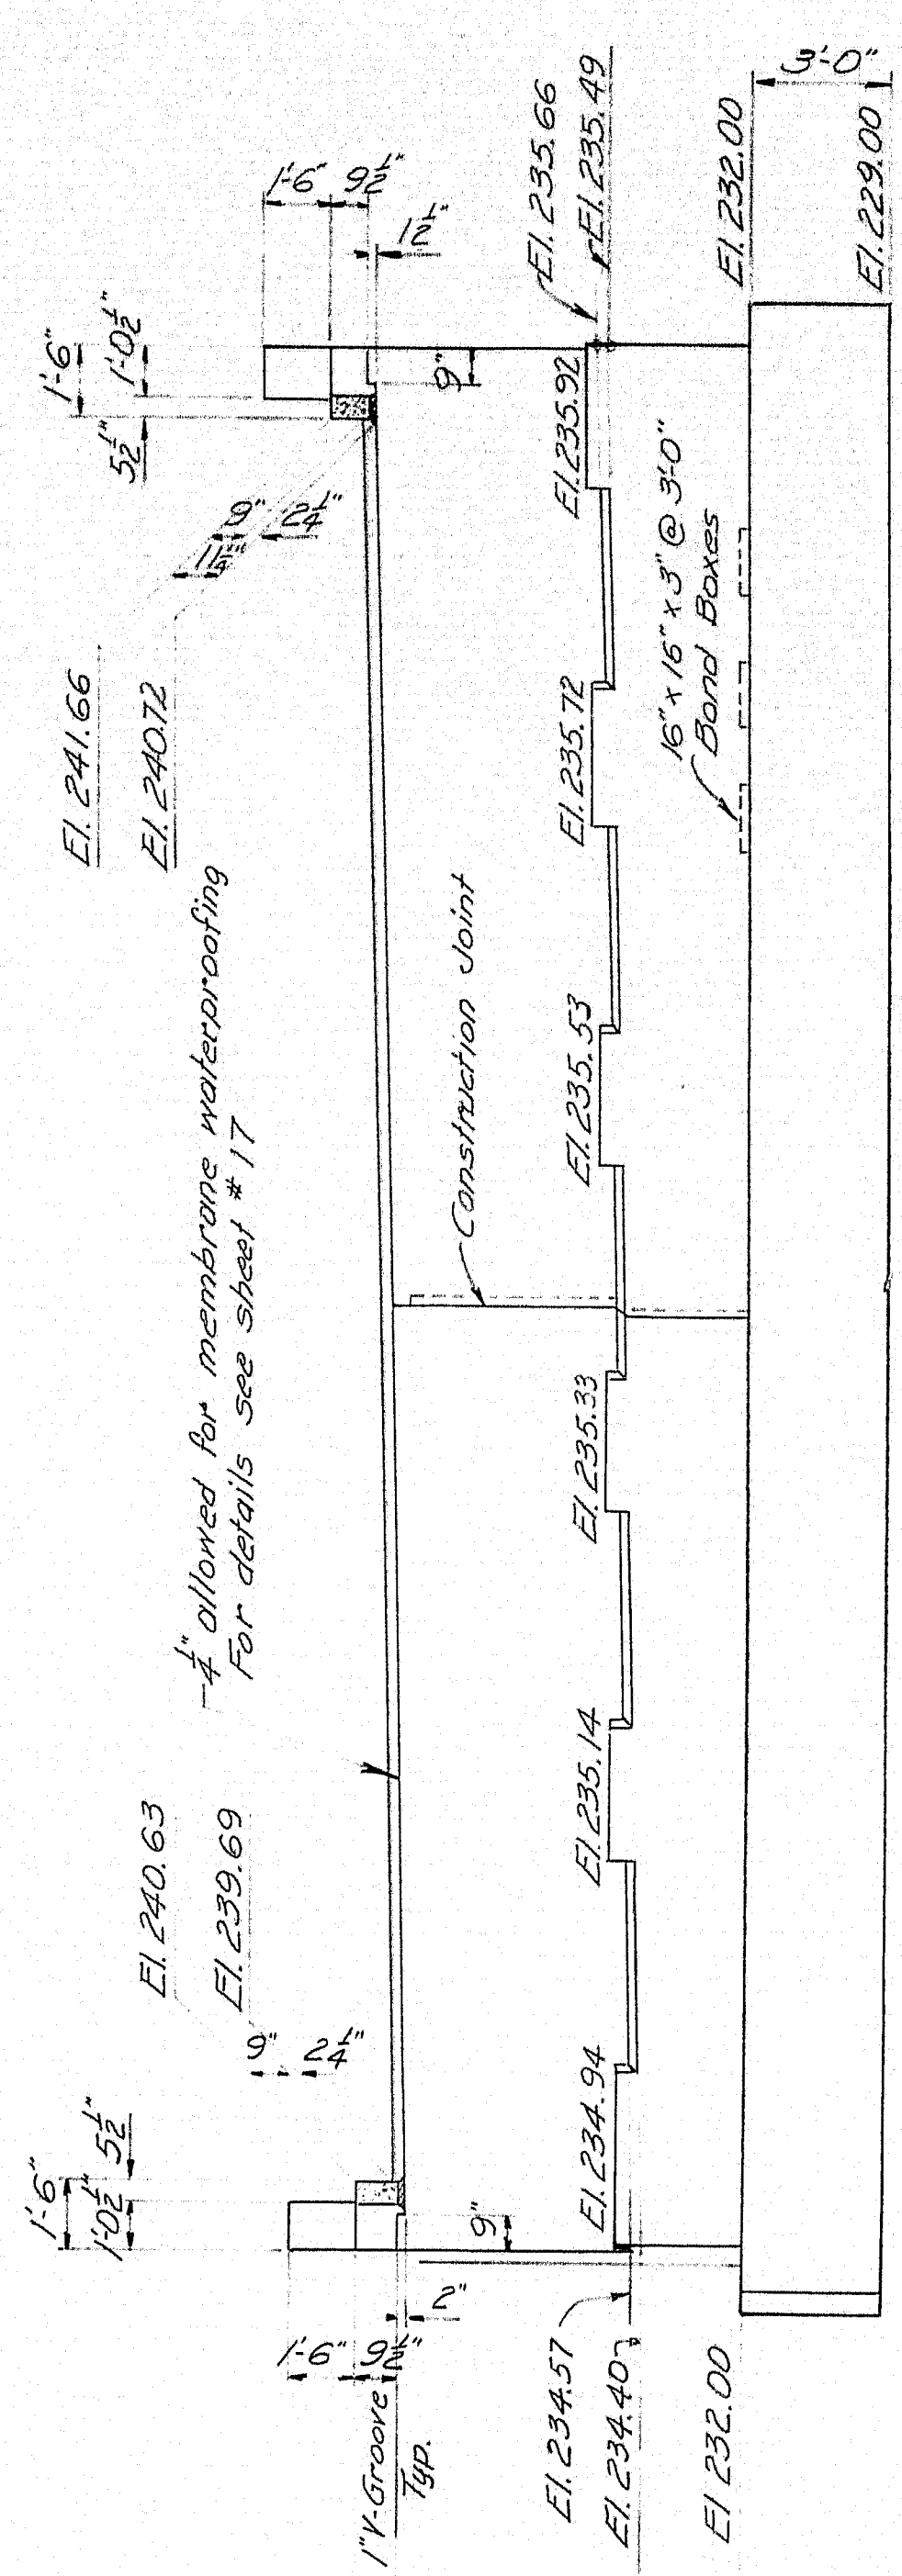

For detail see sh. # 17

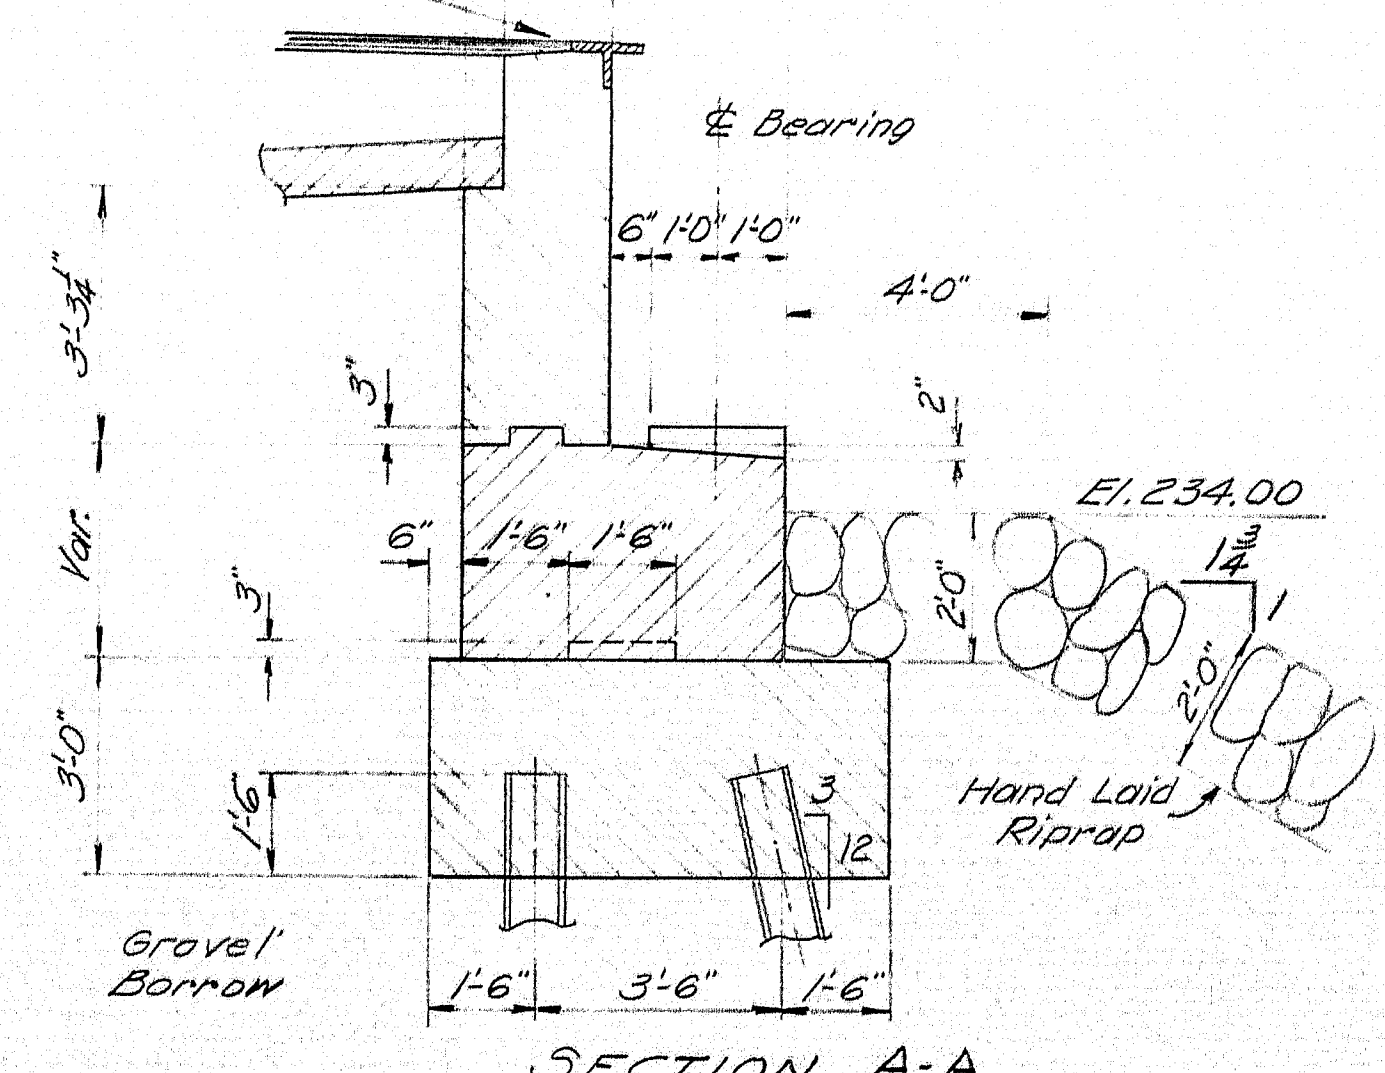

SECTION A-A

For General Abutment Notes, Section B-B, and Reinforcing Steel layout see sheet # 3

DESIGN - T.H.K.	DETAIL - R.R.
TRACE - G.W.C.	
CHECK - A.R.S.	

STATE HIGHWAY COMMISSION
BRIDGE DIVISION


SEBASTICOOK RIVER BRIDGE

IN THE TOWN OF
PITTSFIELD
SOMERSET COUNTY


ABUTMENT NO. 1 - SOUTHBOUND

SHEET 10 OF 18 AUGUSTA, MAINE FEB 1963





FOOTING PLAN

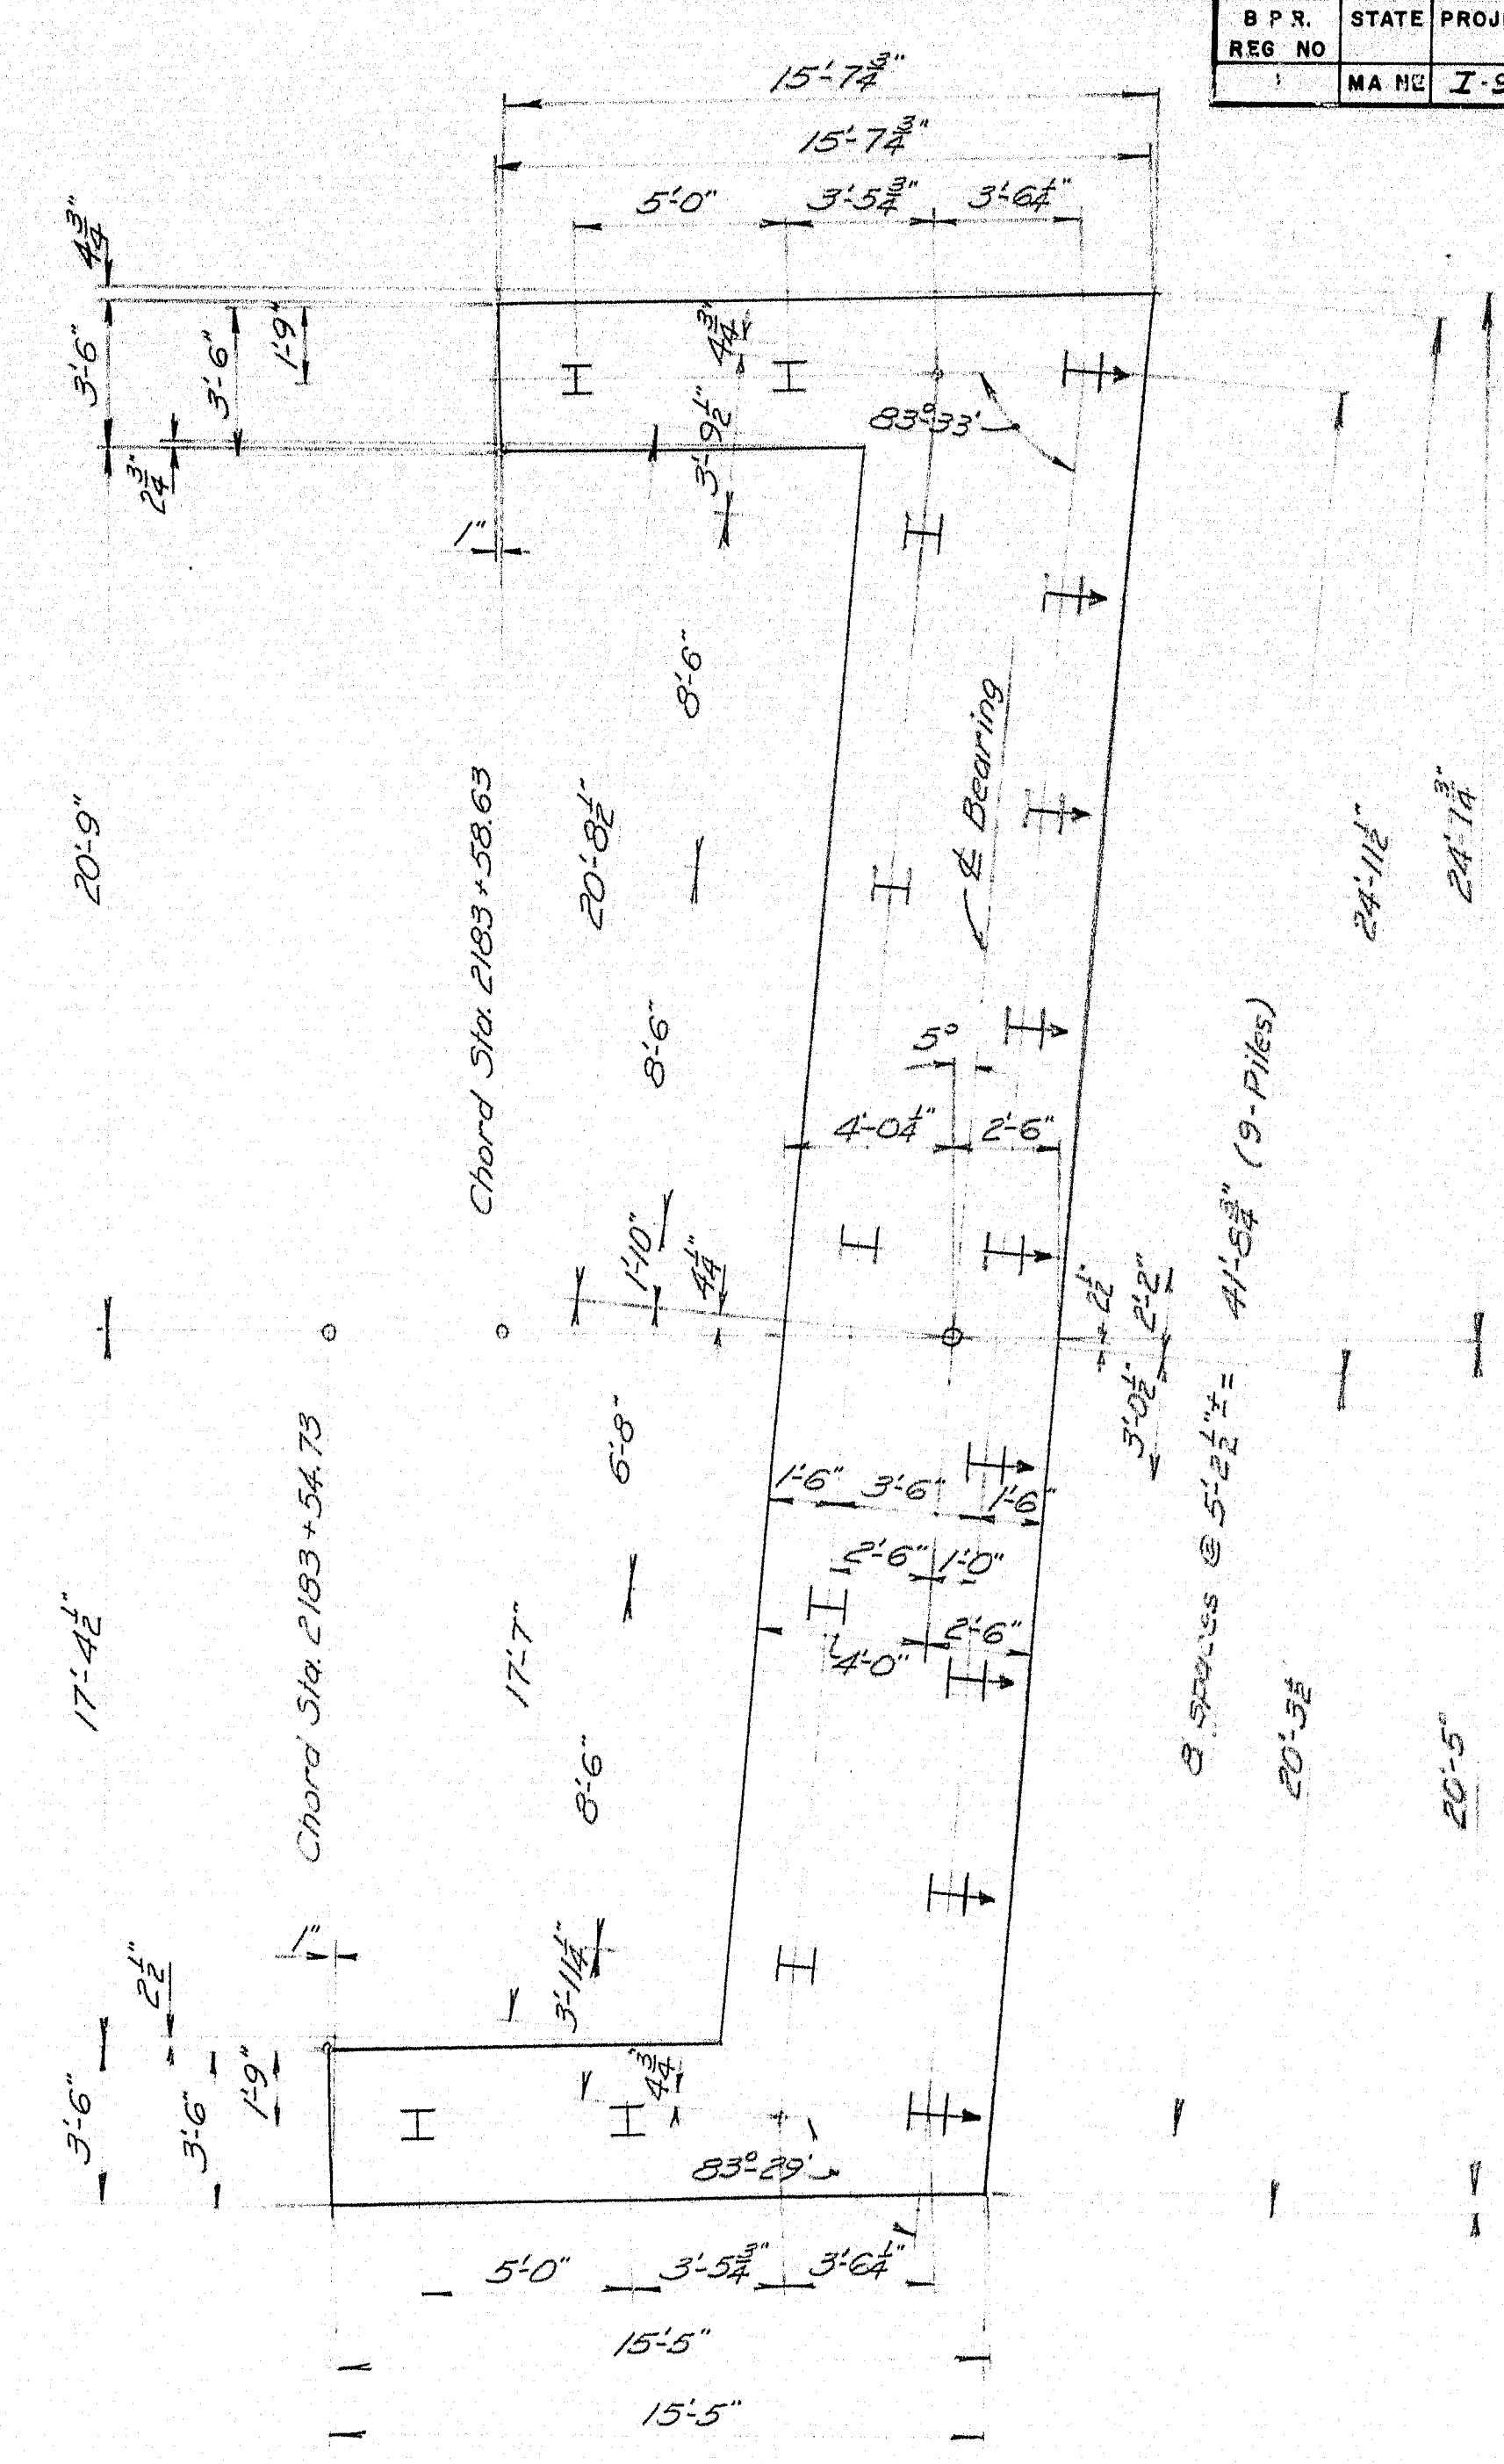



PILES: 10 50 42" H Steel Bearing Piles driven to ledge or practical refusal.
Estimated Length = 60'
Allowable Load = 37 tons / pile.
All piles shown thus H to be battered 3/14 in direction of arrow.

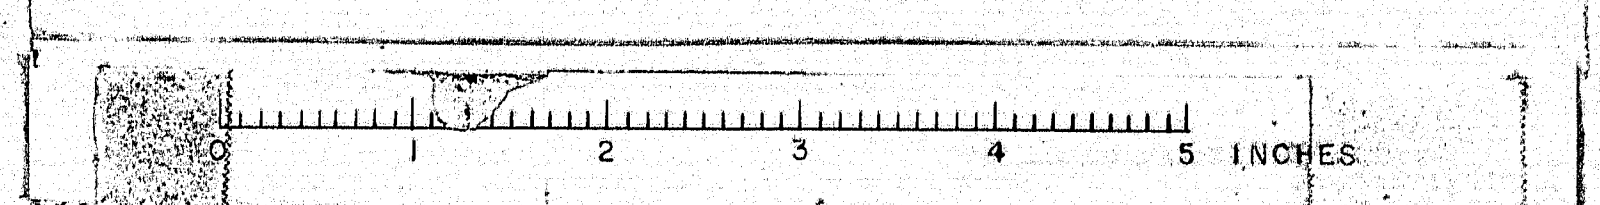


S. P. R.	STATE	PROJECT NUMBER	SHEET	TOTAL
REG. NO.	MAINE	1-95-7 (35)	NO.	SHEETS
1			55	225

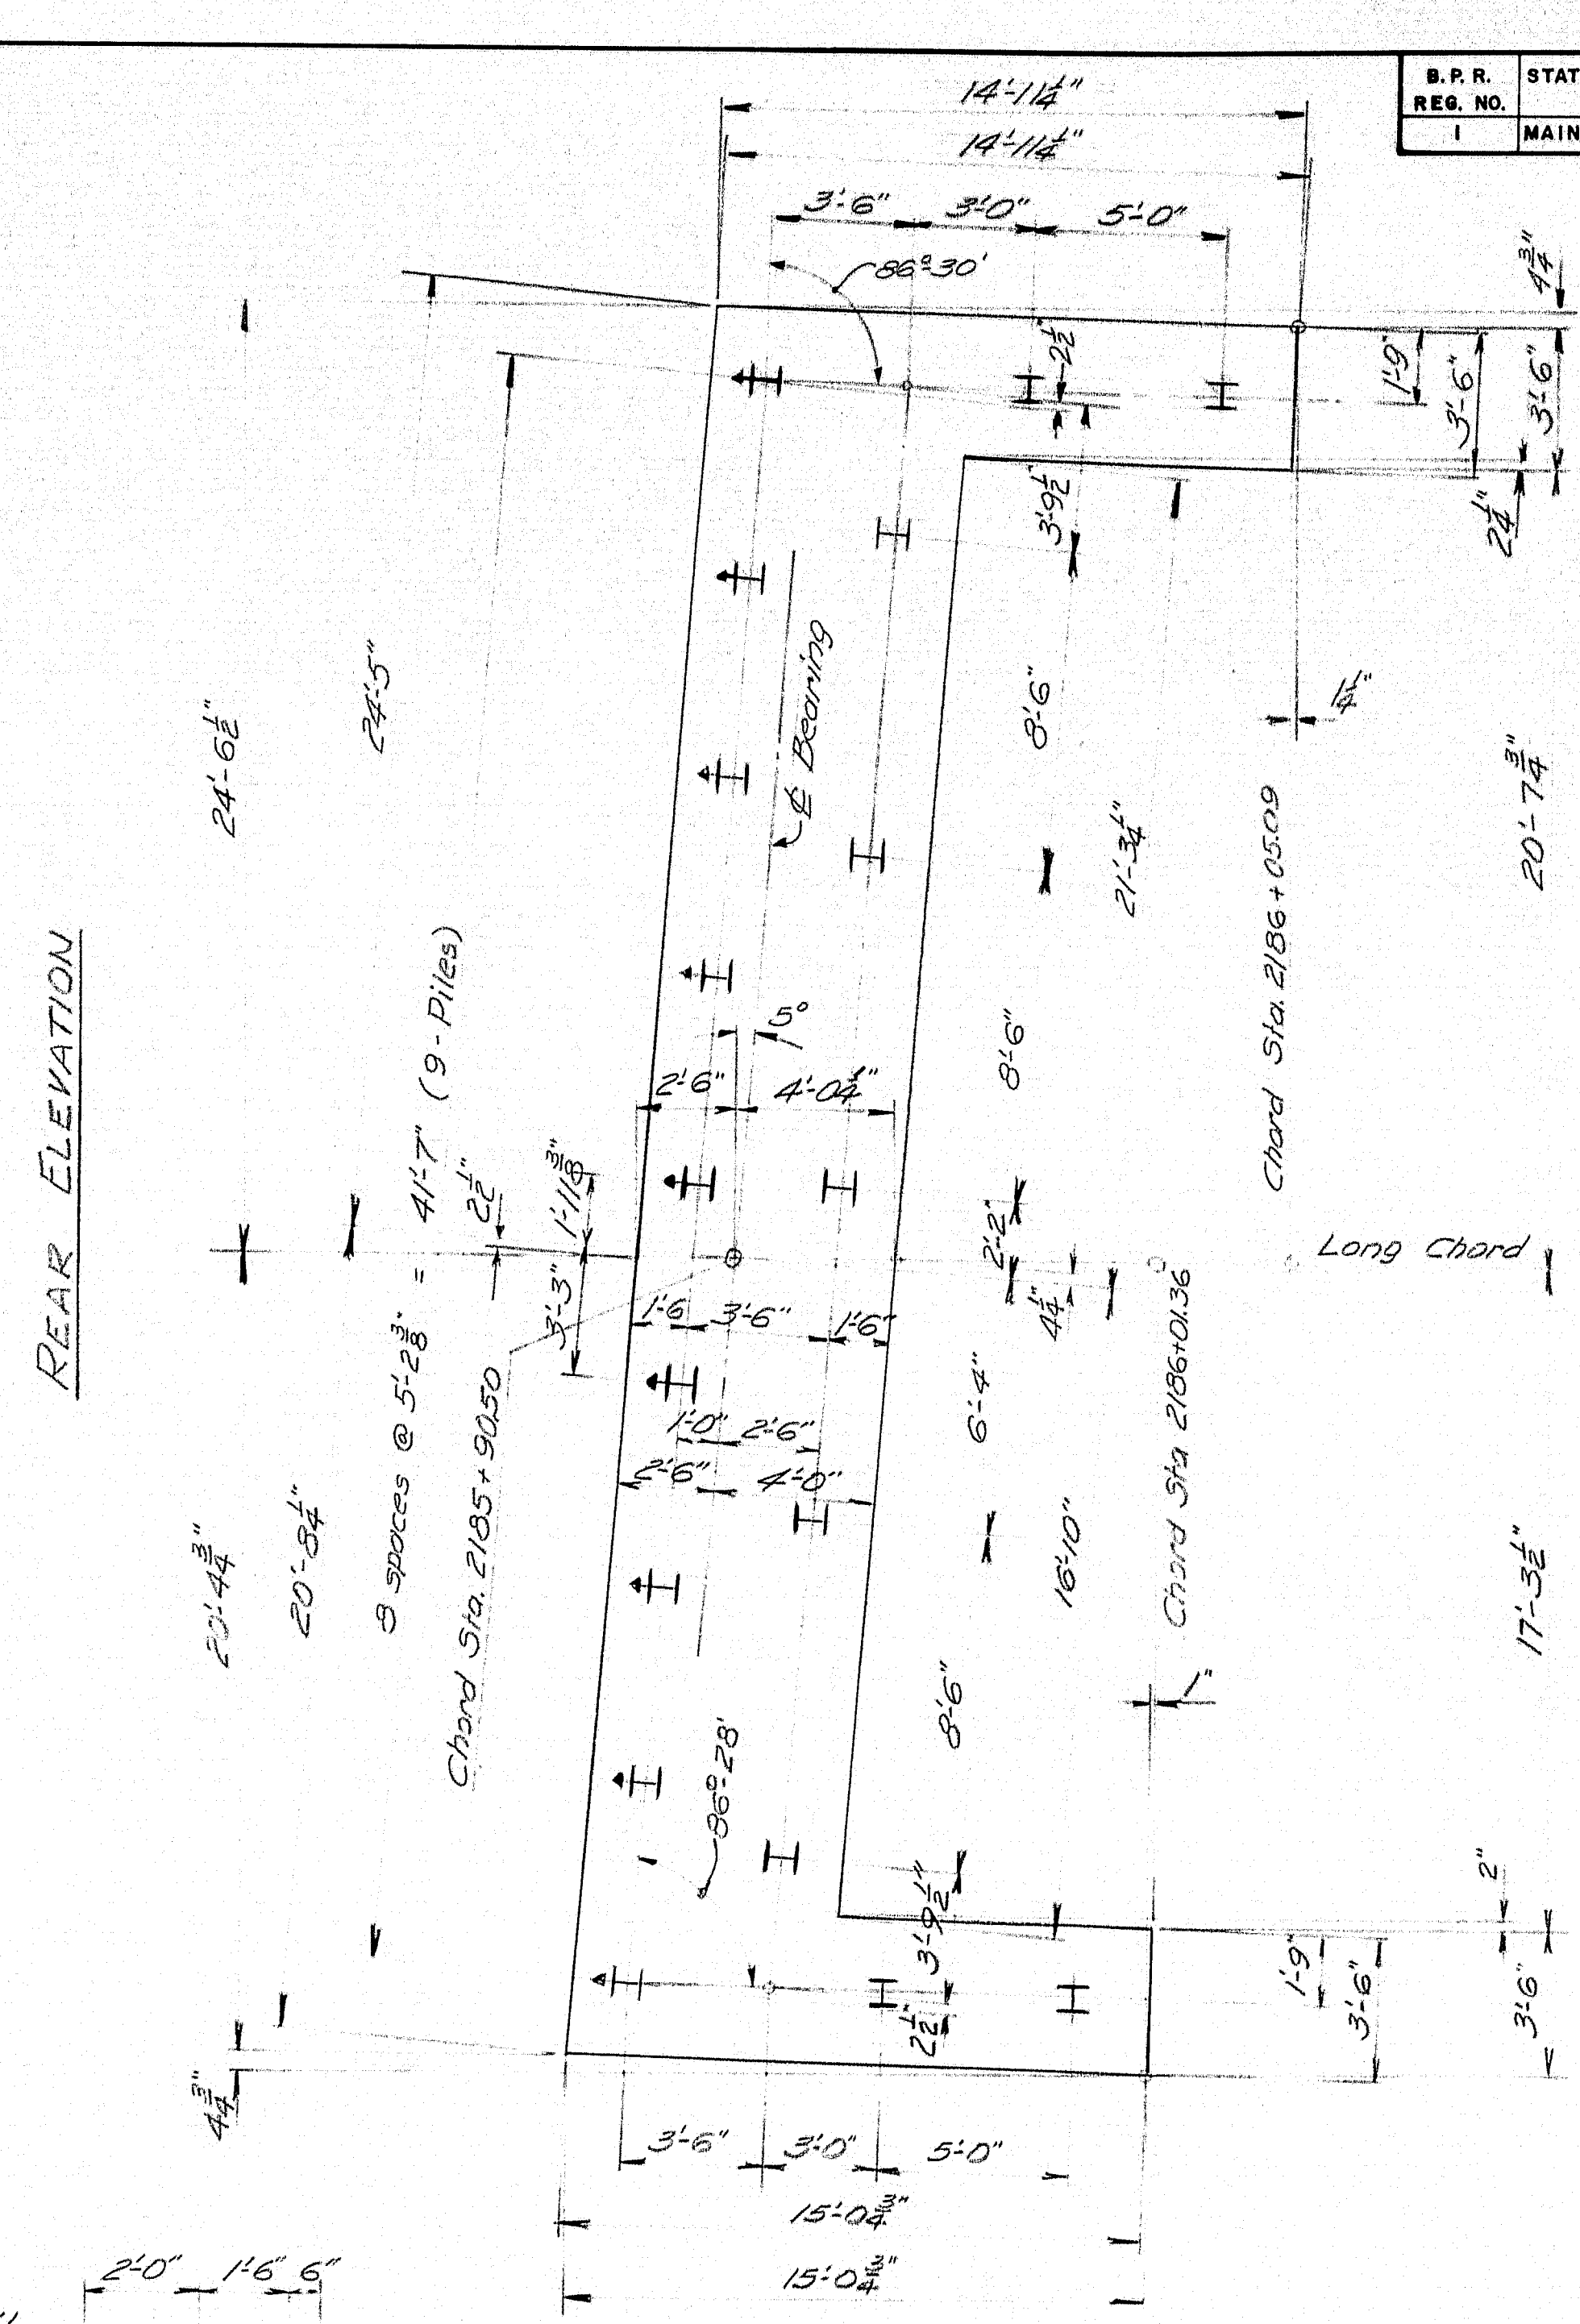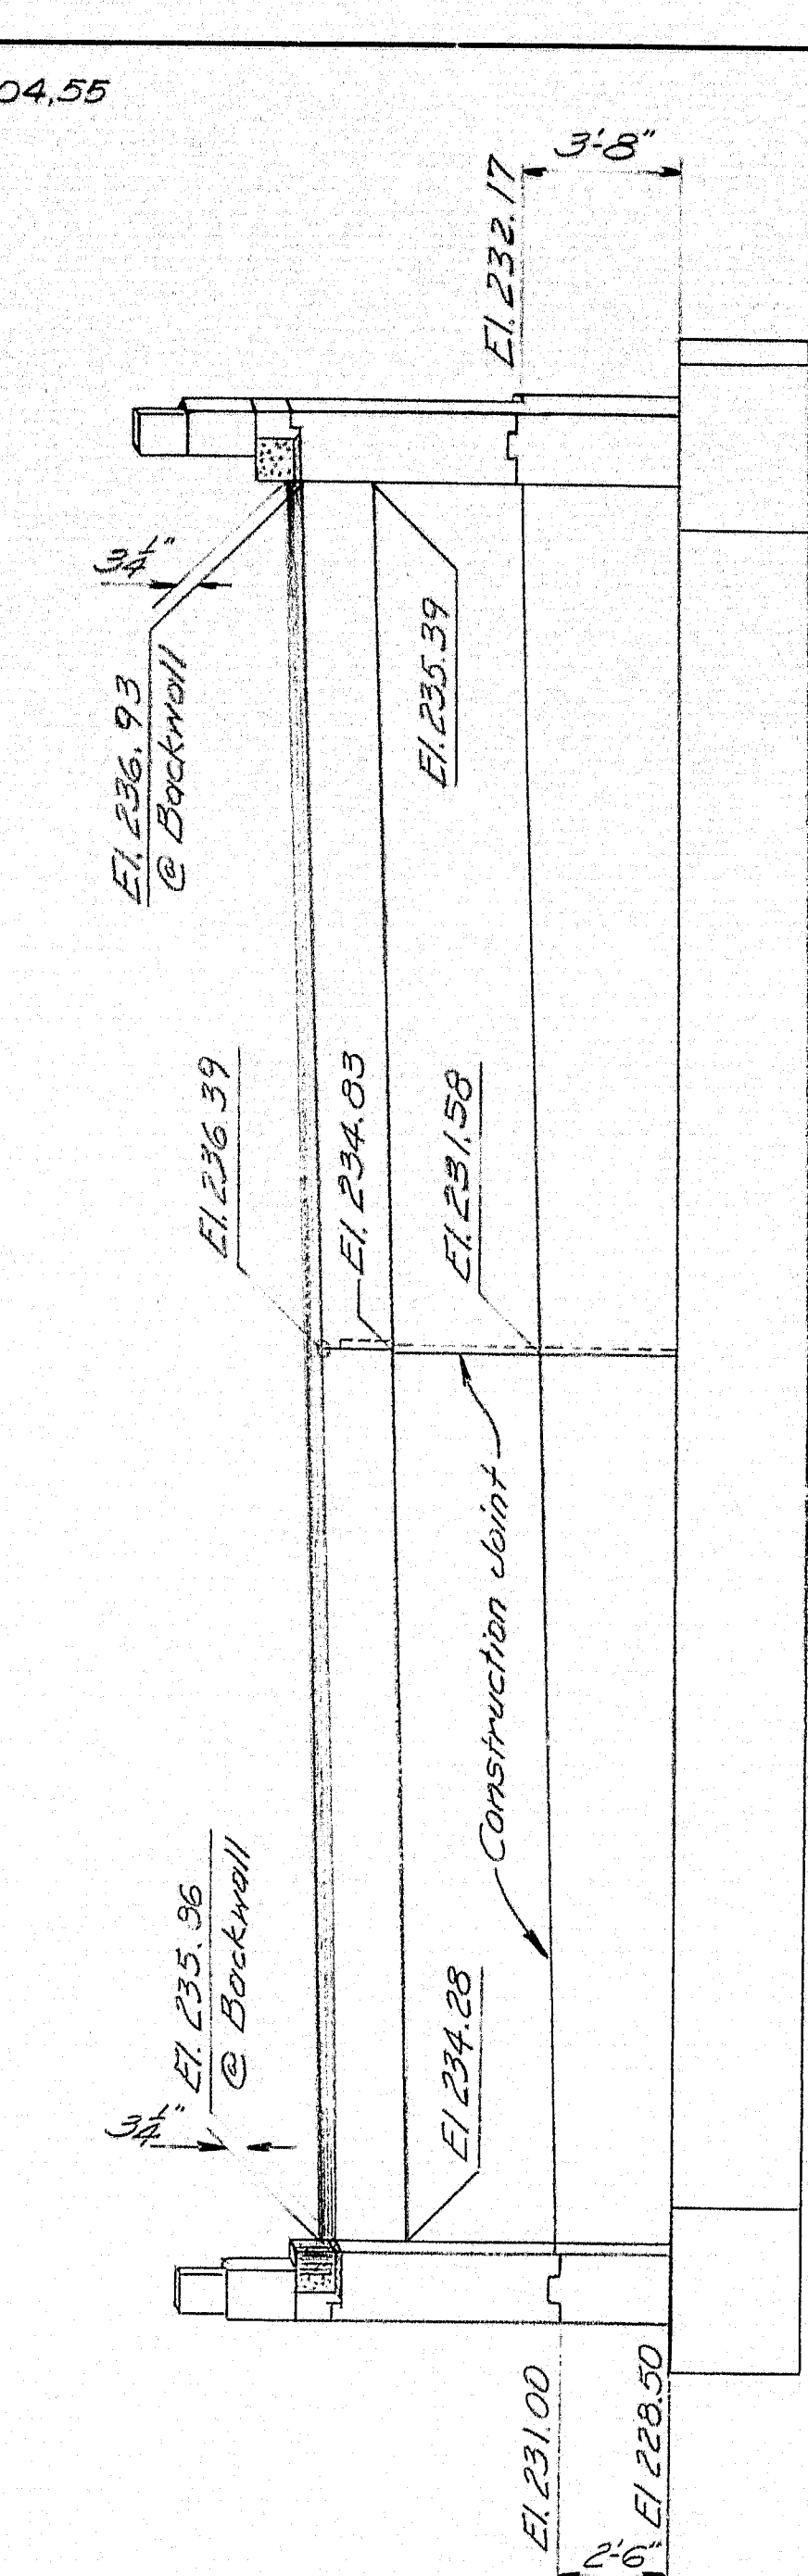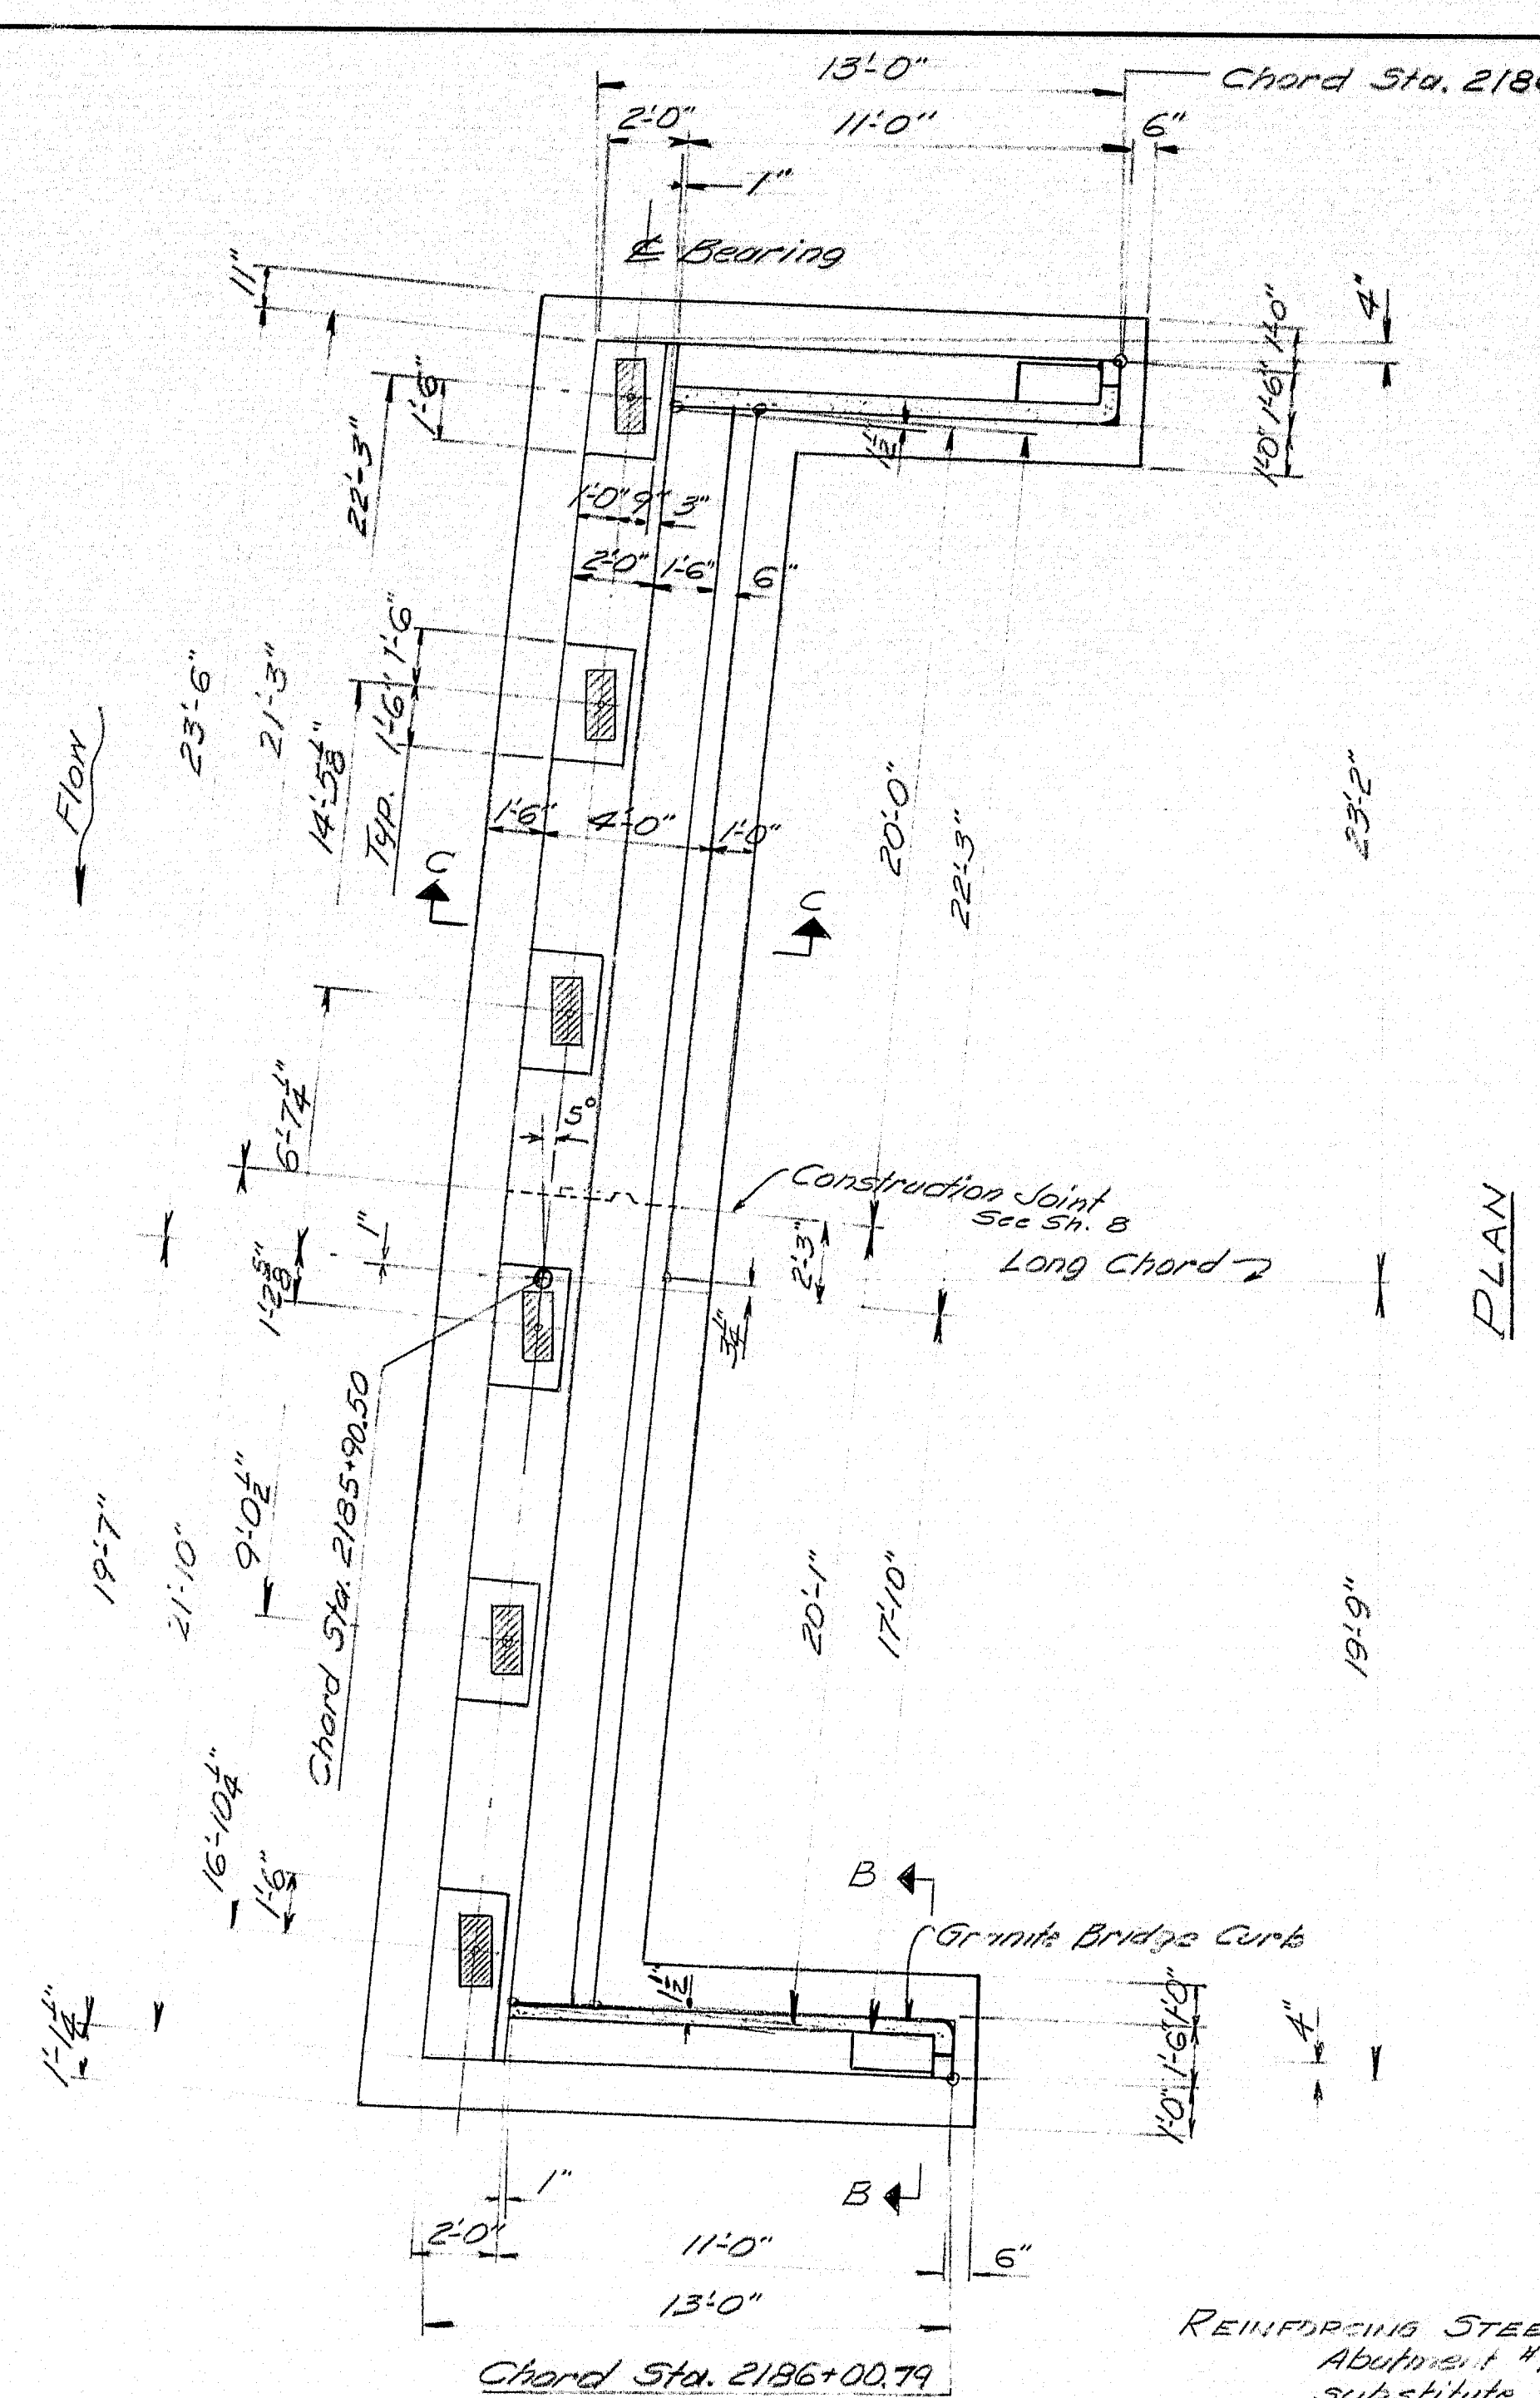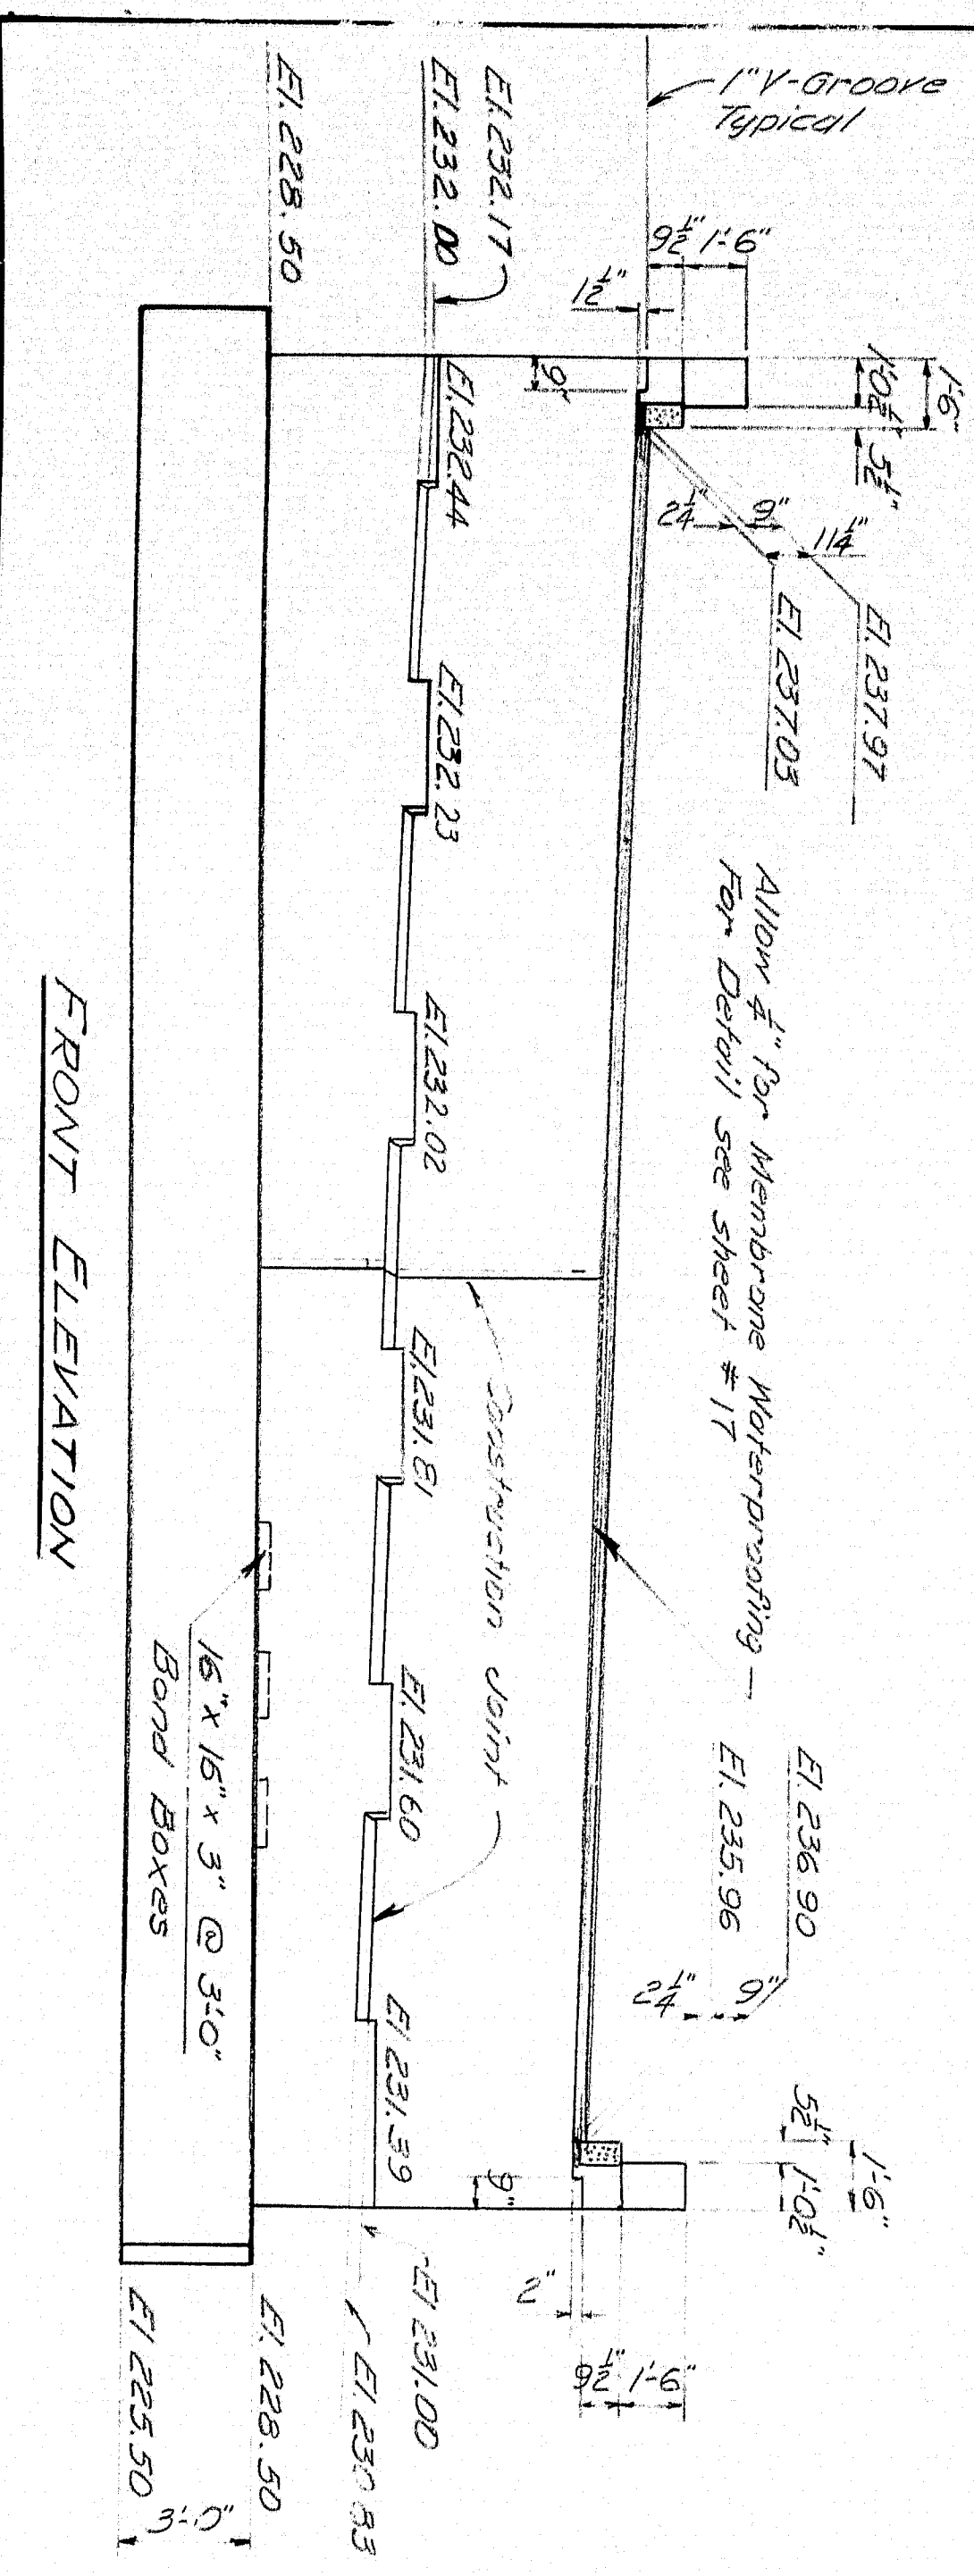

PILES: 10 BD 42 - H Steel Bearing Piles driven to ledge or practical refusal.
 Estimated Length = 62'
 Allowable Load = 37 tons/pile
 All piles shown thus H+ to be battered 3 3/4\"/>

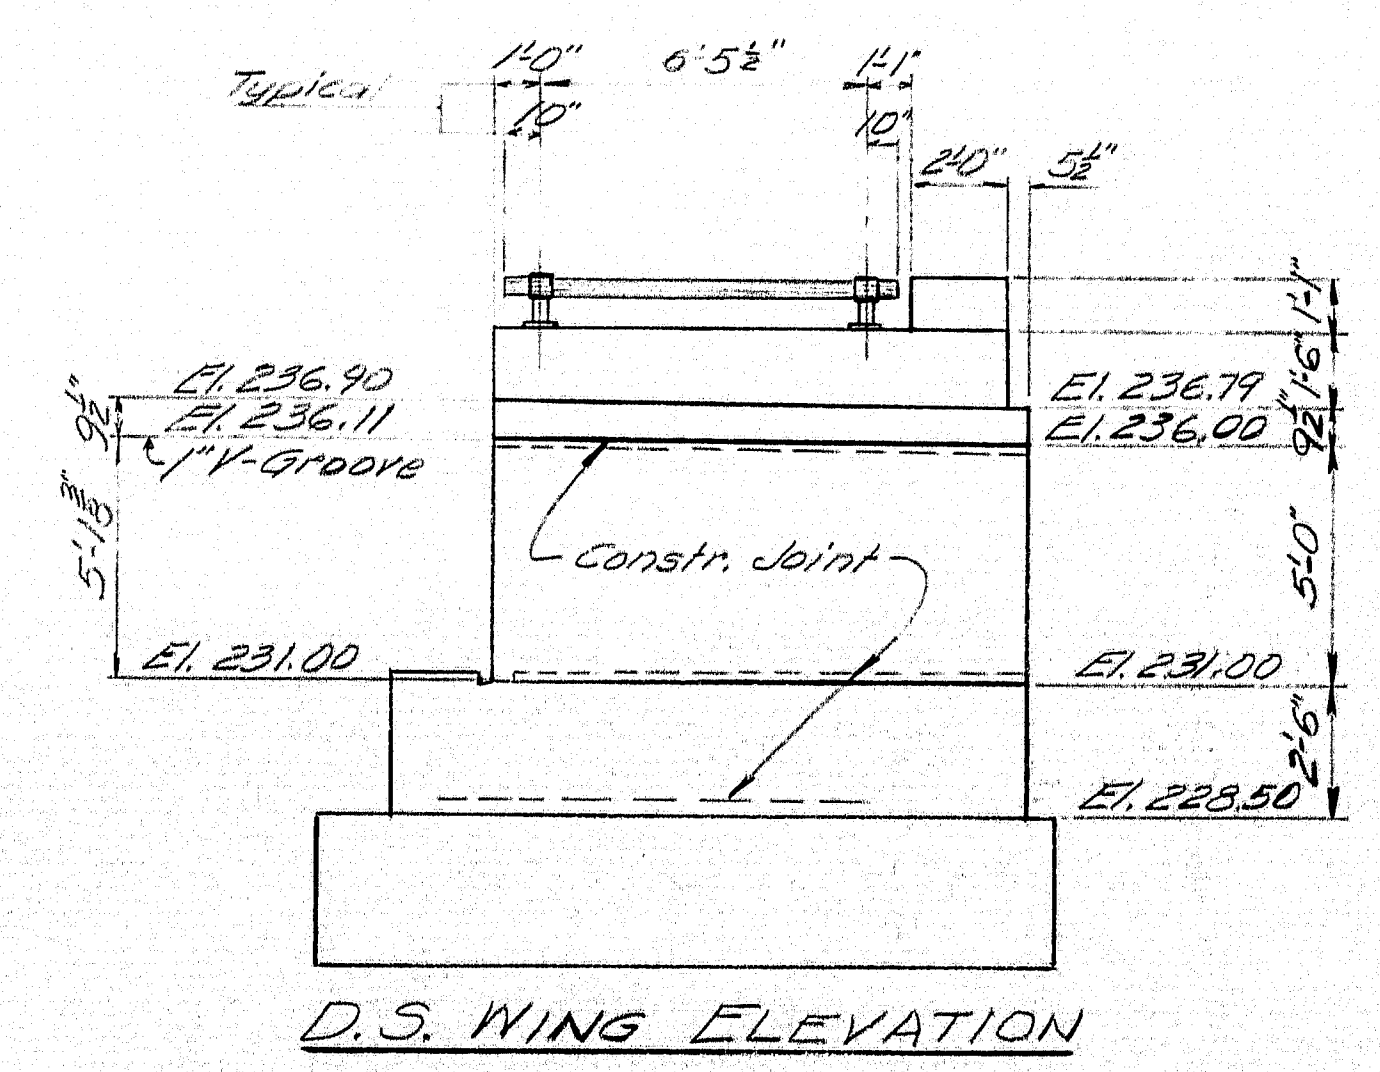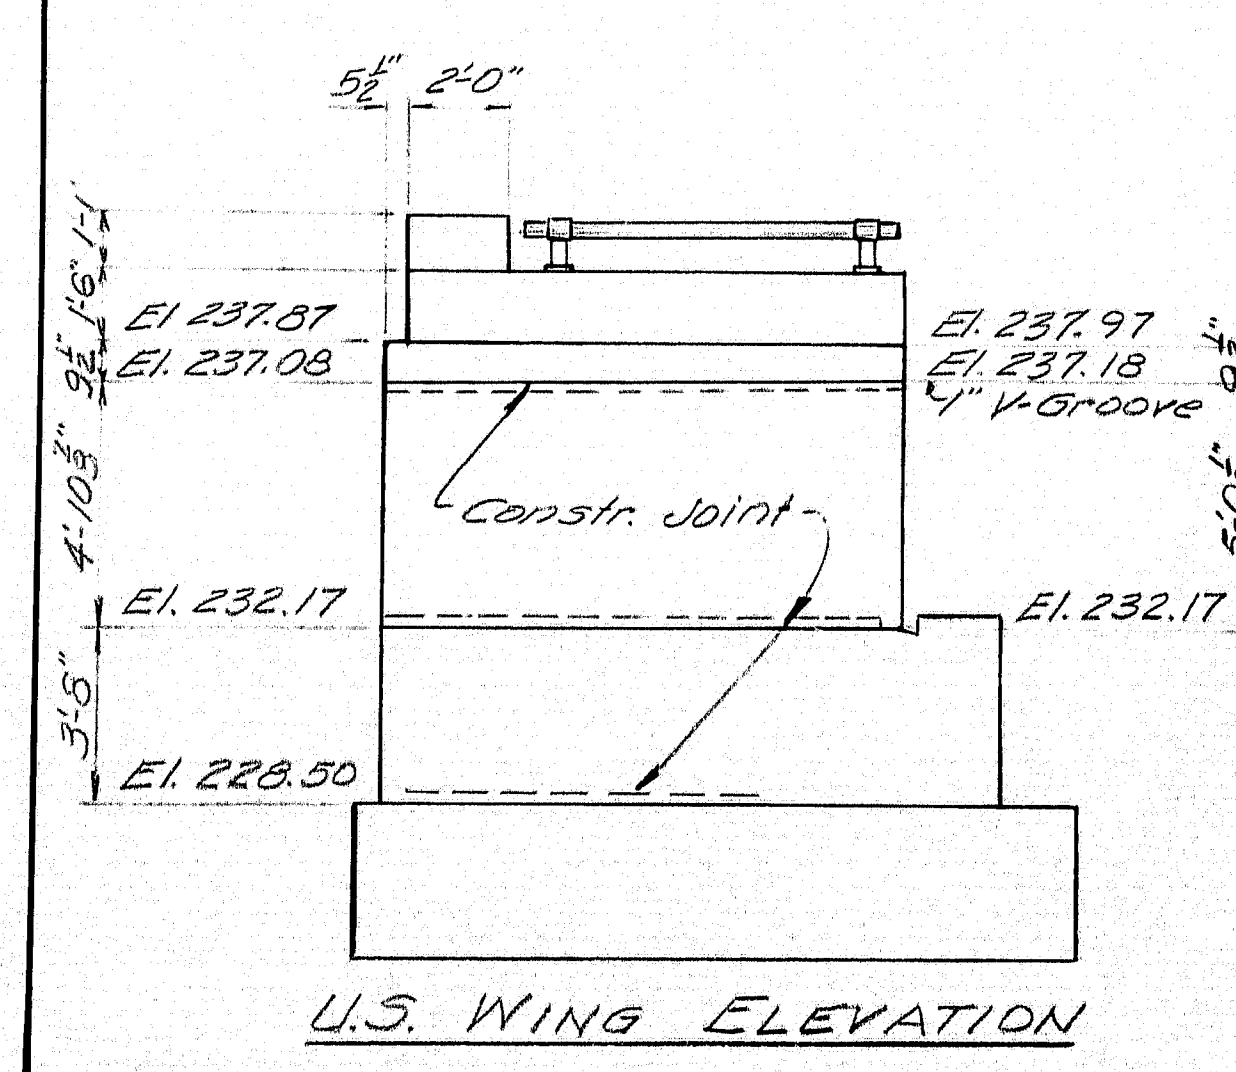



REINFORCING STEEL - same as for Abutment #1 N.B., except substitute bar A11 for A31 and bar A12 for A32.

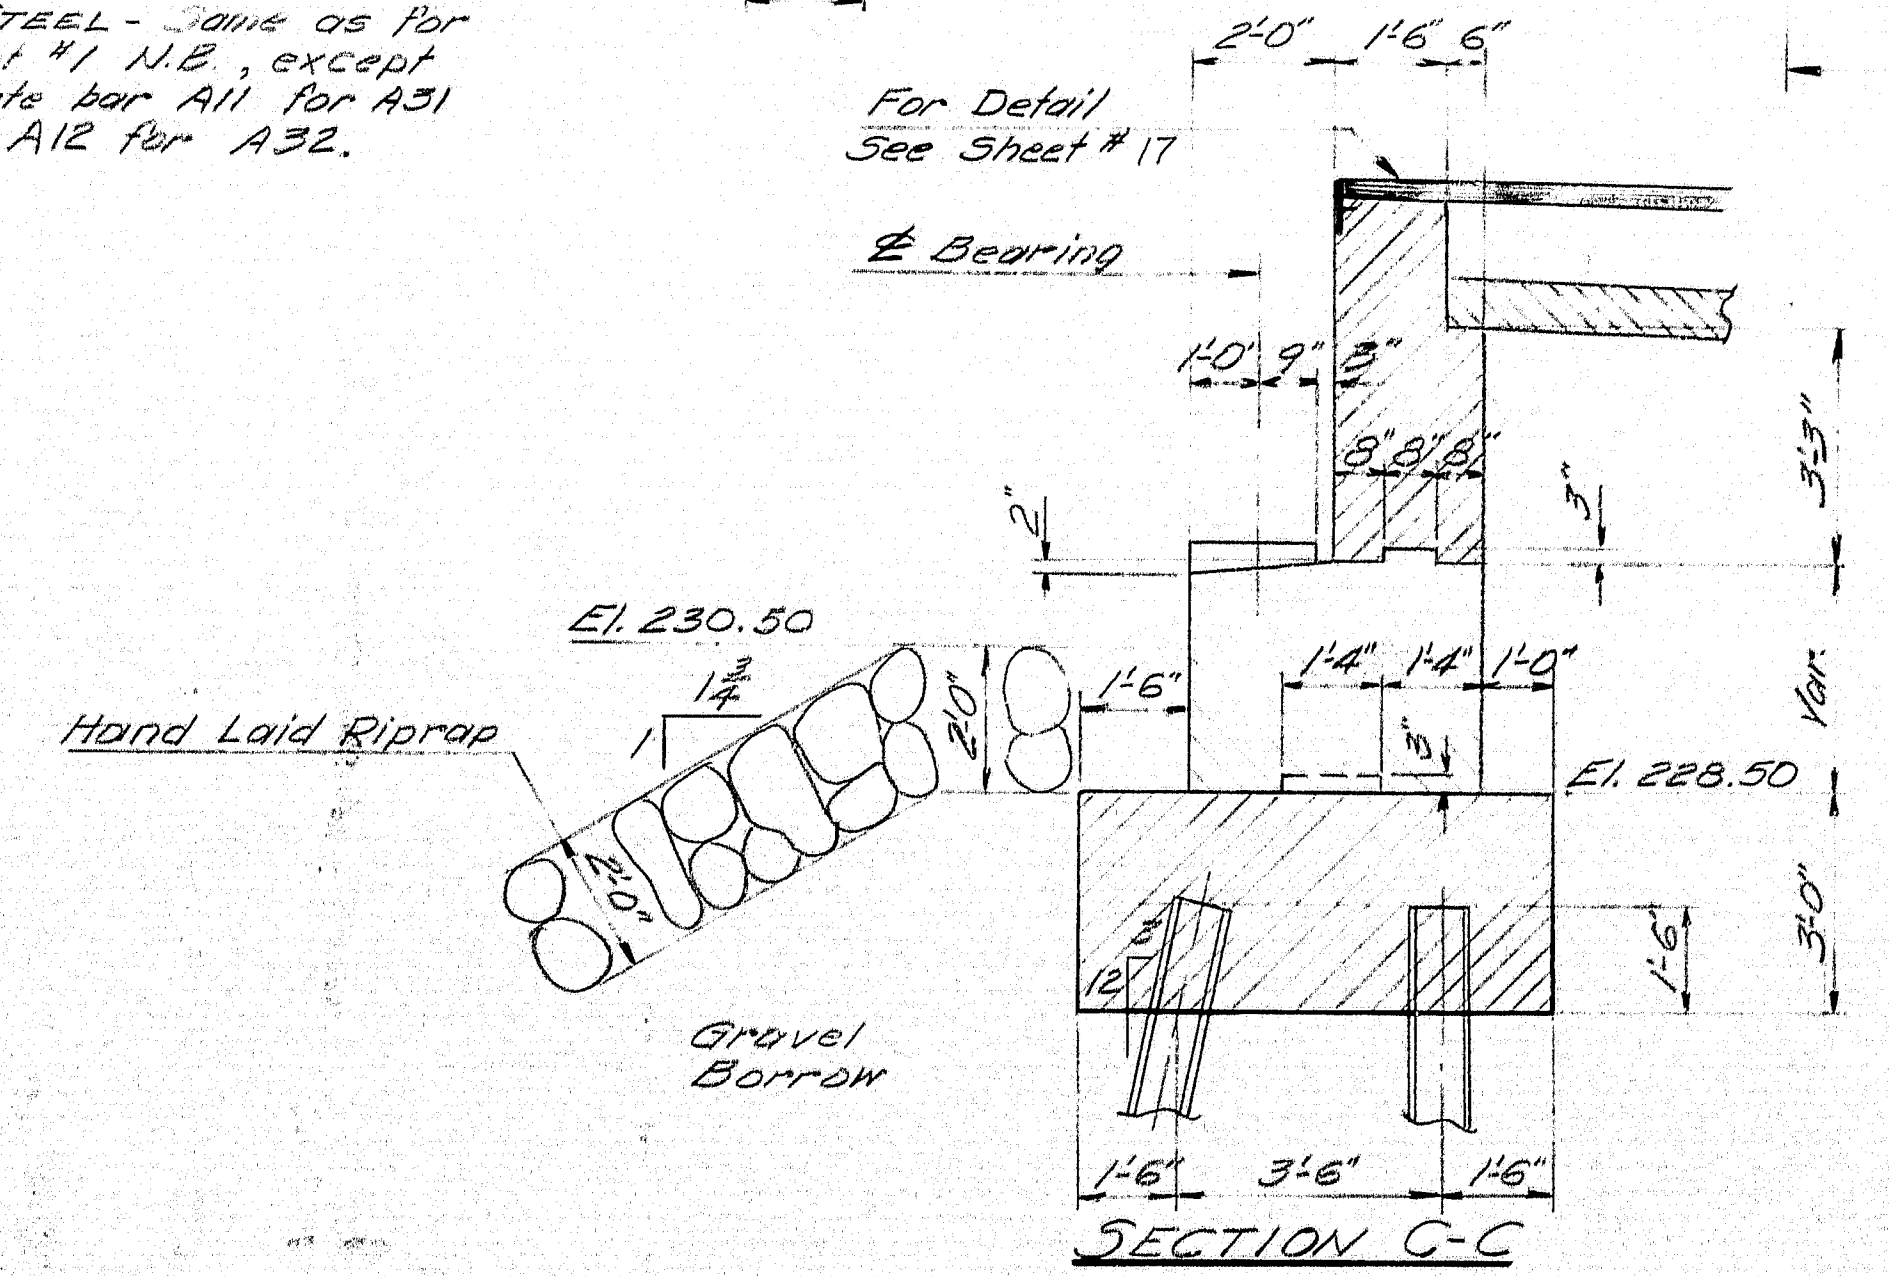

For General Abutment Notes, Section B-B, and Reinforcing Steel, see sheet # 3
 For Approach Slab and Granite Bridge Curb, see sheet # 15

DESIGN - T.H.K.	DETAIL - R.D.
TRACE - G.M.C.	
CHECK - A.R.S.	
STATE HIGHWAY COMMISSION BRIDGE DIVISION	
SEBASTICOOK RIVER BRIDGE	
IN THE TOWN OF PITTSFIELD SOMERSET COUNTY	
ABUTMENT NO. 2, SOUTHBOUND	
SHEET 11 OF 18 AUGUSTA, MAINE FEB 1963	

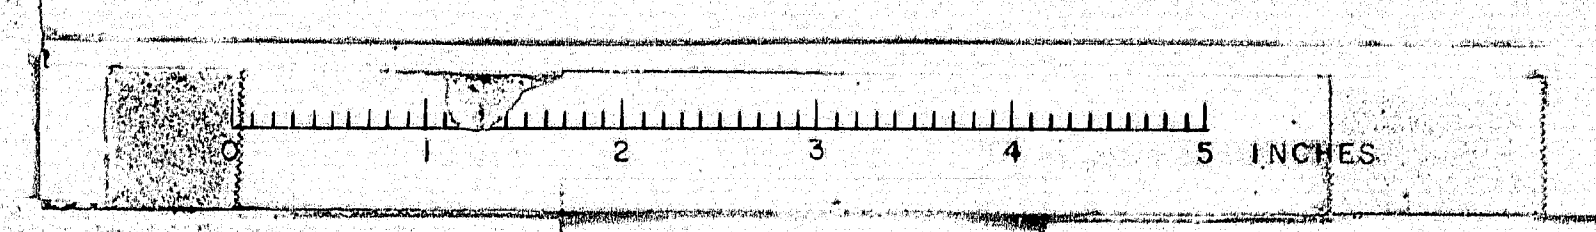

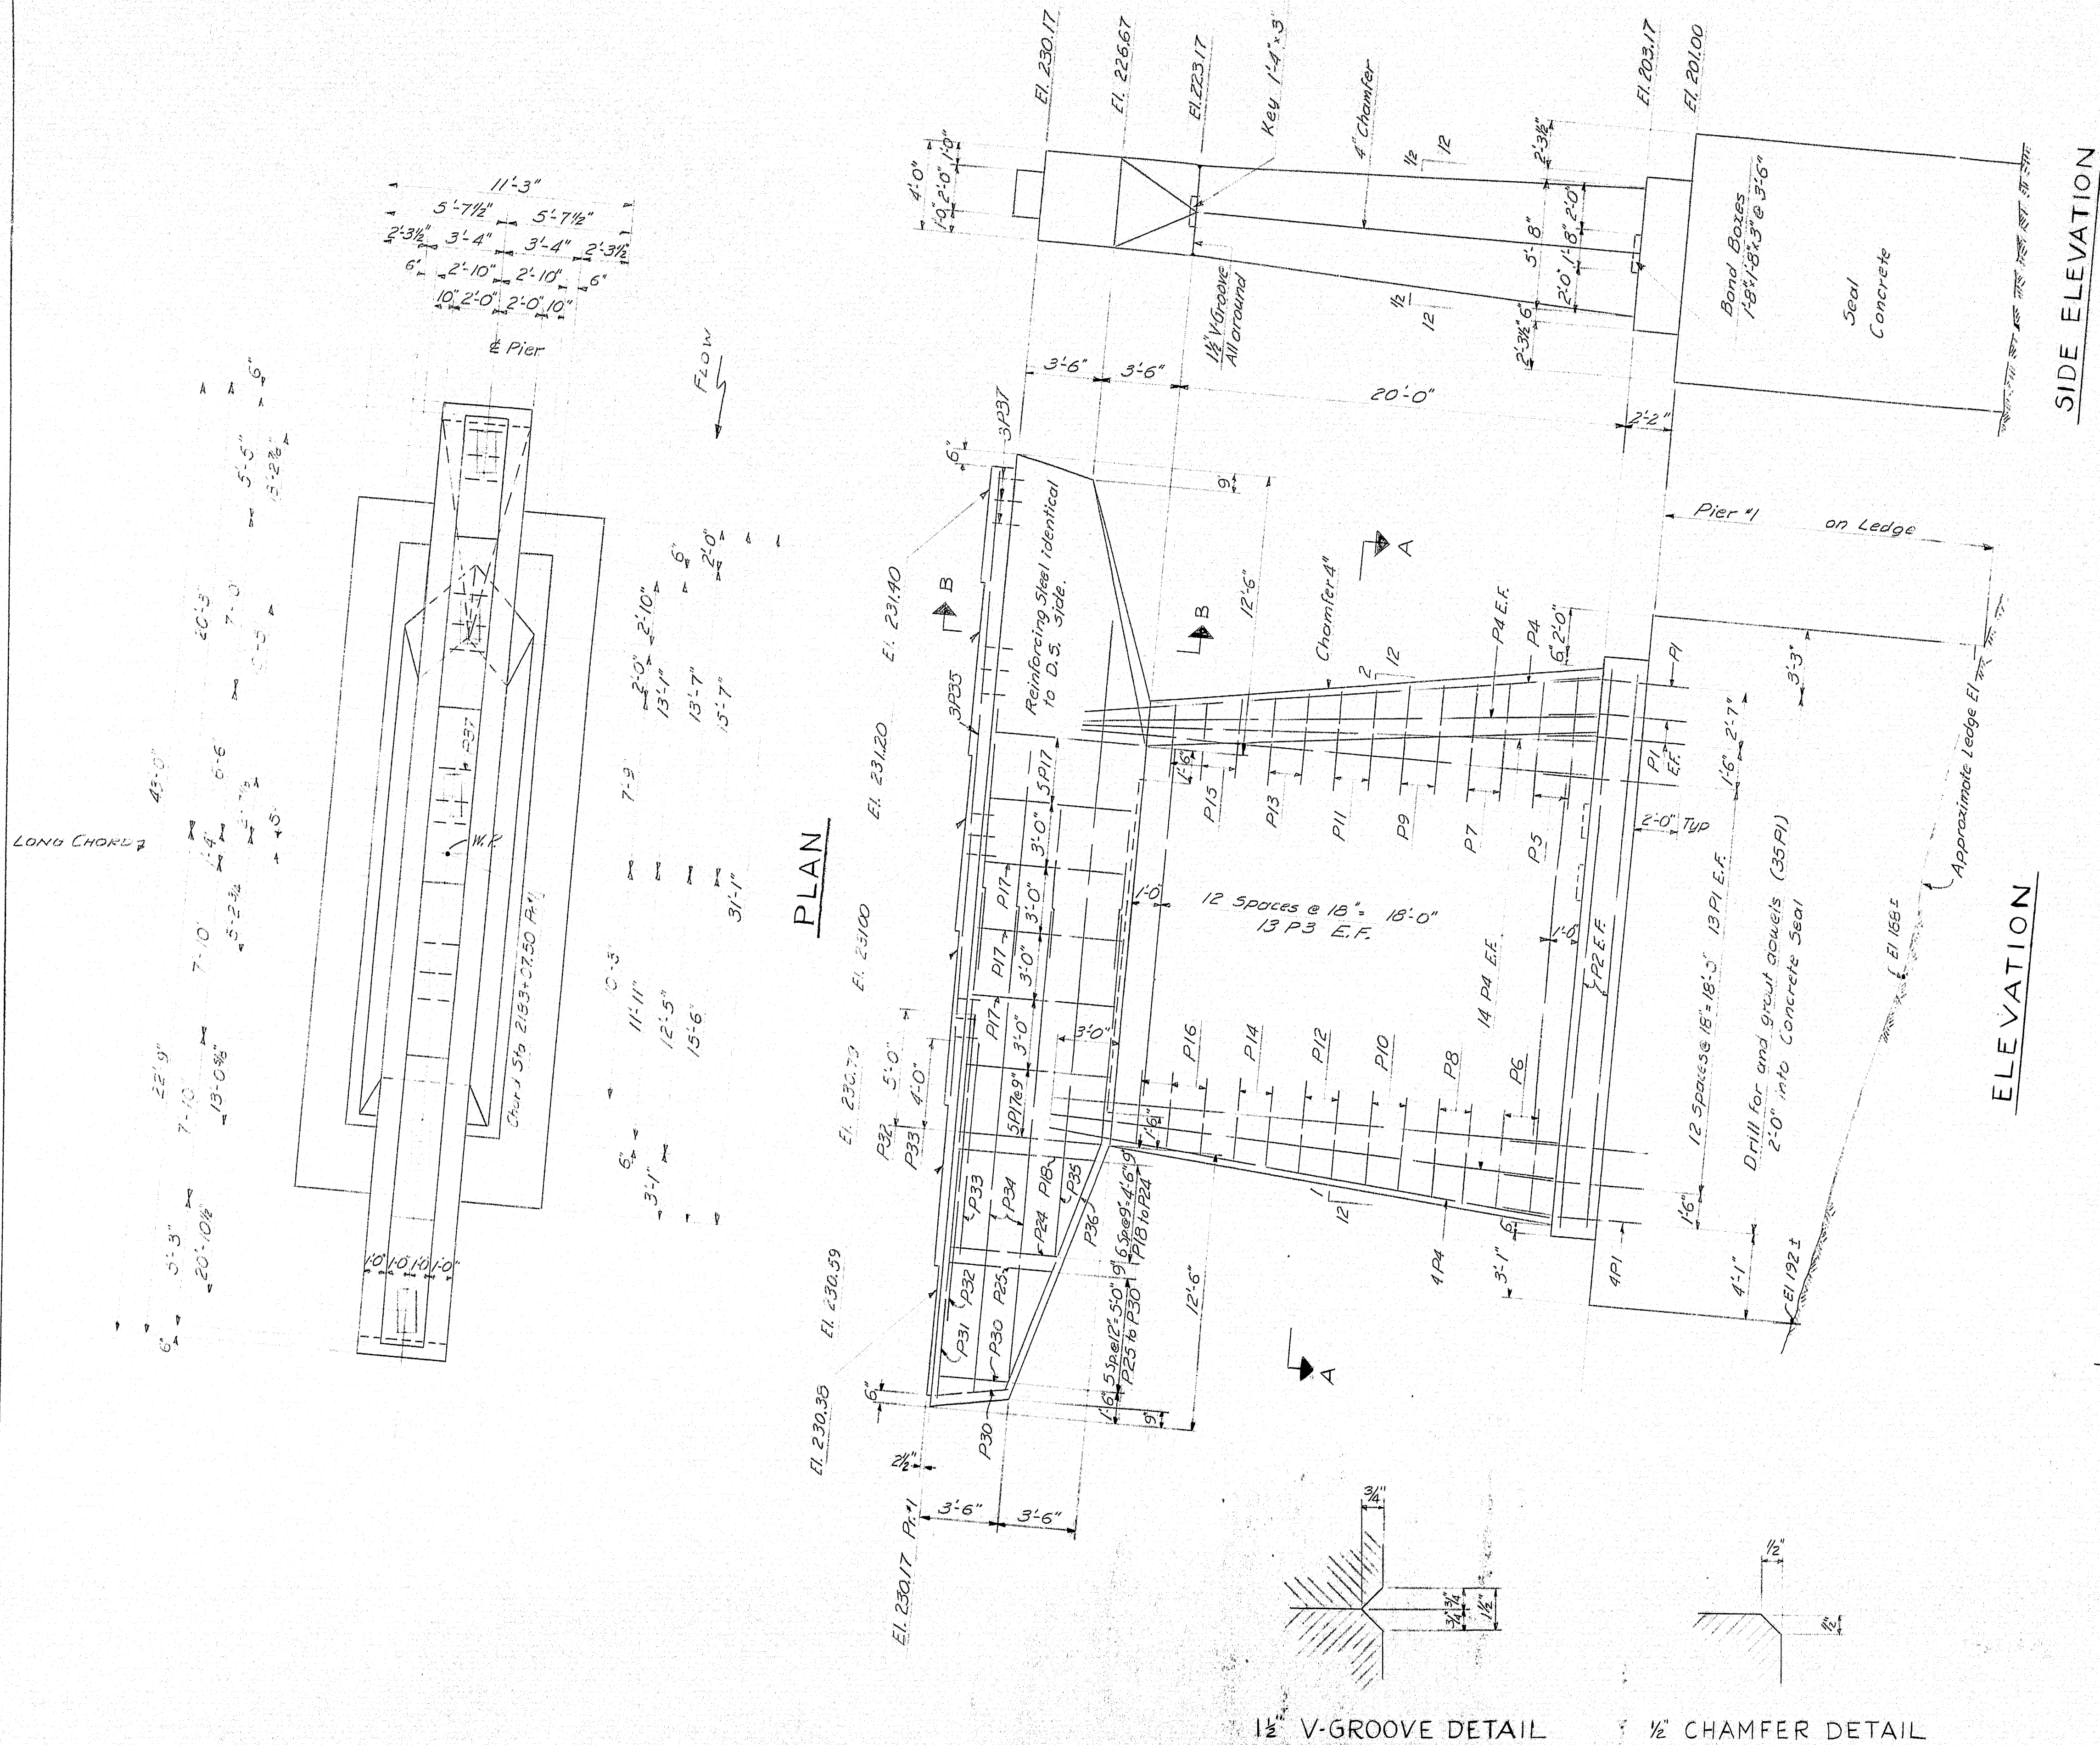

GENERAL PIER NOTES:

Dress bearing areas larger all around than masonry plates, and to exact elevations shown. Caulk around edges of masonry plates with an approved caulking material. Payment to be incidental to contract items.

Seal concrete dimensions are given predicated on use of MP-116, DP2 I-27 or equivalent steel sheet piling with appropriate standard rolled corners. Pay dimensions for seal concrete shall be neat dimensions as shown, plus ten (10) inches.

The depths of the concrete seals have been calculated assuming a water elevation of 216.0 and bottom of footings at elevations shown. Seal concrete is intended to be placed under water and to be paid for under Item 701-36.

Payment for drilling and grouting dowels into concrete seal shall be incidental to Items 705-13 and 705-14.

Piers were designed for a six inch thickness of ice applied at elevation 219.0 and a stream flow of 5 Msec.

All reinforcing steel to be 5 inches clear, unless otherwise shown.

Chamfer all exposed edges 1/2", unless otherwise noted.

E.F. = Each Face

DESIGN T.H.K.
DETAIL T.H.K.
CHECK R.R.S.


STATE HIGHWAY COMMISSION
BRIDGE DIVISION


SEBASTICOOK RIVER BRIDGE

IN THE TOWN OF
PITTSFIELD
SOMERSET COUNTY

PIER 1 N.B.

SHEET 12 OF 18 AUGUSTA, MAINE FEB. 1963

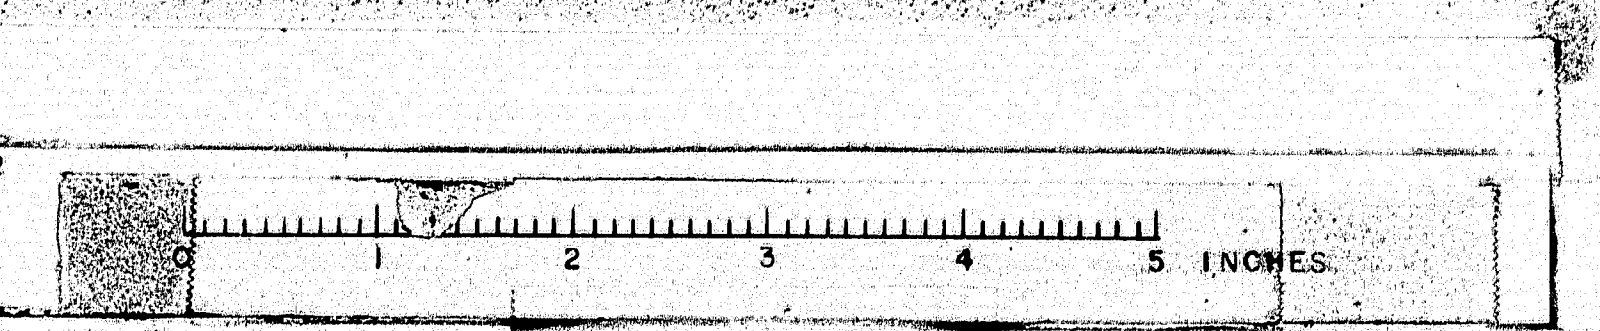

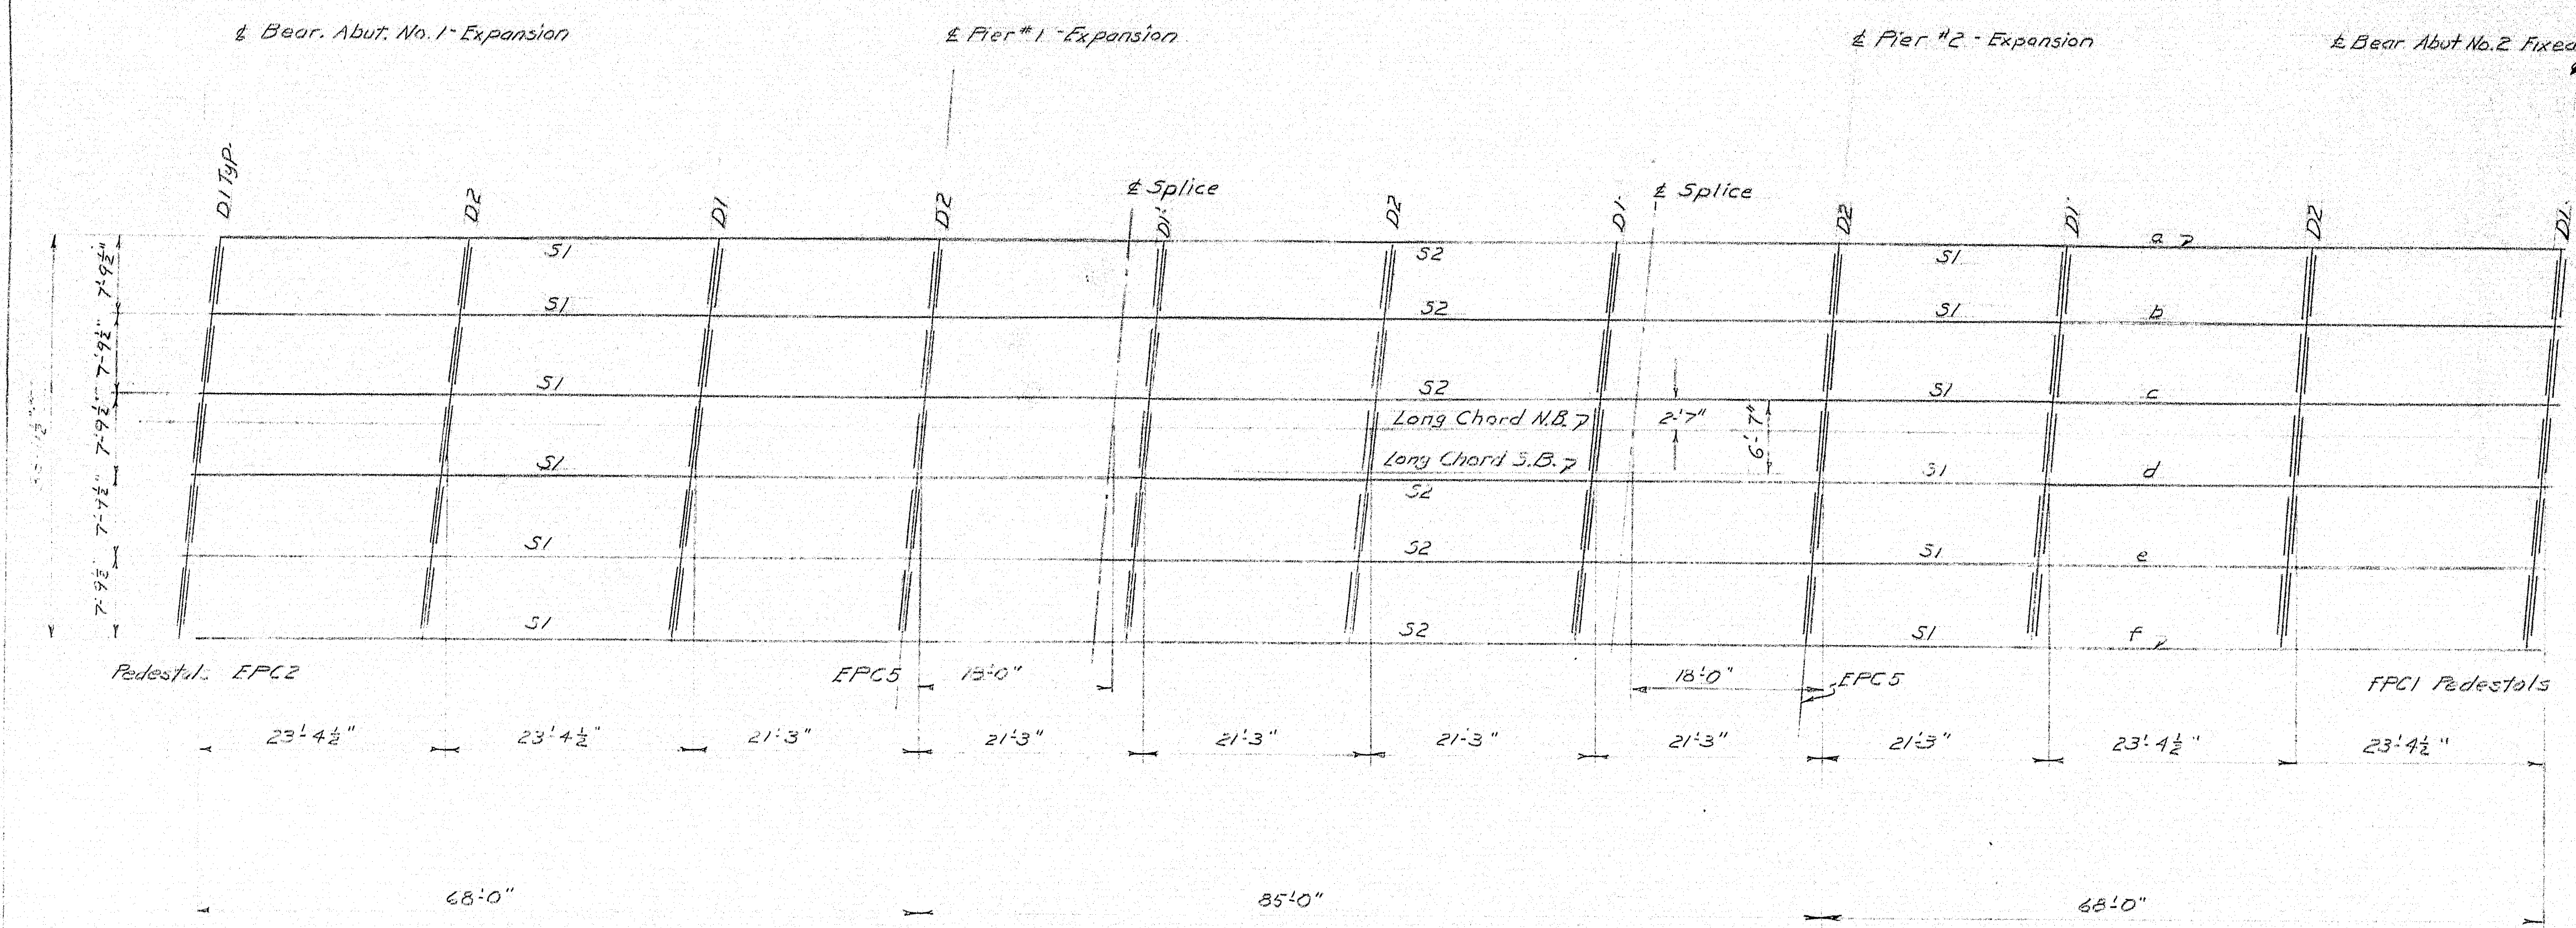


BLOCKING TABLE

Span	point	elevation point L see table B	bottom of slab grades above points on beams indicated						elevation point R see table B
			a	b	c	d	e	f	
1	0	240.07	240.04	239.80	239.70	239.57	239.31	239.12	239.00
	1/4	239.74	239.75	239.55	239.35	239.16	238.86	238.76	238.70
	1/2	239.39	239.39	239.14	238.94	238.71	238.54	238.34	238.34
	3/4	239.01	239.00	238.80	238.60	238.36	238.20	238.01	237.97
	1	238.67	238.65	238.45	238.24	238.04	237.84	237.64	237.61
	1 1/4	238.37	238.35	238.15	237.94	237.74	237.54	237.34	237.31
2	0	238.11	238.09	237.89	237.68	237.48	237.28	237.04	237.04
	1/4	237.83	237.81	237.61	237.40	237.20	236.99	236.79	236.76
	1/2	237.54	237.52	237.32	237.11	236.90	236.69	236.49	236.46
	3/4	237.27	237.25	237.05	236.84	236.63	236.42	236.22	236.19
	1	237.04	237.05	236.84	236.63	236.42	236.21	236.01	235.97
	1 1/4	236.79	236.80	236.59	236.38	236.17	235.96	235.76	235.70
3	0	236.47	236.48	236.28	236.07	235.86	235.65	235.45	235.57
	1/4	236.16	236.17	235.96	235.75	235.54	235.33	235.13	235.31
	1/2	235.85	235.86	235.65	235.44	235.23	235.02	234.82	234.81
	3/4	235.54	235.55	235.34	235.13	234.92	234.71	234.51	234.50
	1	235.23	235.24	235.03	234.82	234.61	234.40	234.20	234.19
	1 1/4	234.92	234.93	234.72	234.51	234.30	234.09	233.89	233.87


Blocking Table (continued)

Span	point	elevation point L see table B	bottom of slab grades above points on beams indicated						elevation point R see table B
			a	b	c	d	e	f	
1	0	237.04	237.06	236.86	236.65	236.44	236.23	236.03	235.99
	1/4	236.77	236.78	236.58	236.37	236.16	235.95	235.75	235.72
	1/2	236.48	236.49	236.29	236.08	235.87	235.66	235.46	235.42
	3/4	236.19	236.20	236.00	235.79	235.58	235.37	235.17	235.11
	1	235.90	235.91	235.71	235.50	235.29	235.08	234.88	234.81
	1 1/4	235.61	235.62	235.42	235.21	235.00	234.79	234.59	234.57
2	0	235.31	235.32	235.12	234.91	234.70	234.49	234.29	234.37
	1/4	235.02	235.03	234.83	234.62	234.41	234.20	234.00	234.15
	1/2	234.73	234.74	234.54	234.33	234.12	233.91	233.71	233.91
	3/4	234.44	234.45	234.25	234.04	233.83	233.62	233.42	233.41
	1	234.15	234.16	233.96	233.75	233.54	233.33	233.13	233.10
	1 1/4	233.86	233.87	233.67	233.46	233.25	233.04	232.84	232.87
3	0	233.57	233.58	233.38	233.17	232.96	232.75	232.55	232.55
	1/4	233.28	233.29	233.09	232.88	232.67	232.46	232.26	232.27
	1/2	232.99	233.00	232.80	232.59	232.38	232.17	231.97	231.97
	3/4	232.70	232.71	232.51	232.30	232.09	231.88	231.68	231.68
	1	232.41	232.42	232.22	232.01	231.80	231.59	231.39	231.39
	1 1/4	232.12	232.13	231.93	231.72	231.51	231.30	231.10	231.10

Note: In order to compensate for dead load deflection and irregularities in the rolling of steel, set the elevations in this table above of the points indicated below where the slab forms are started.

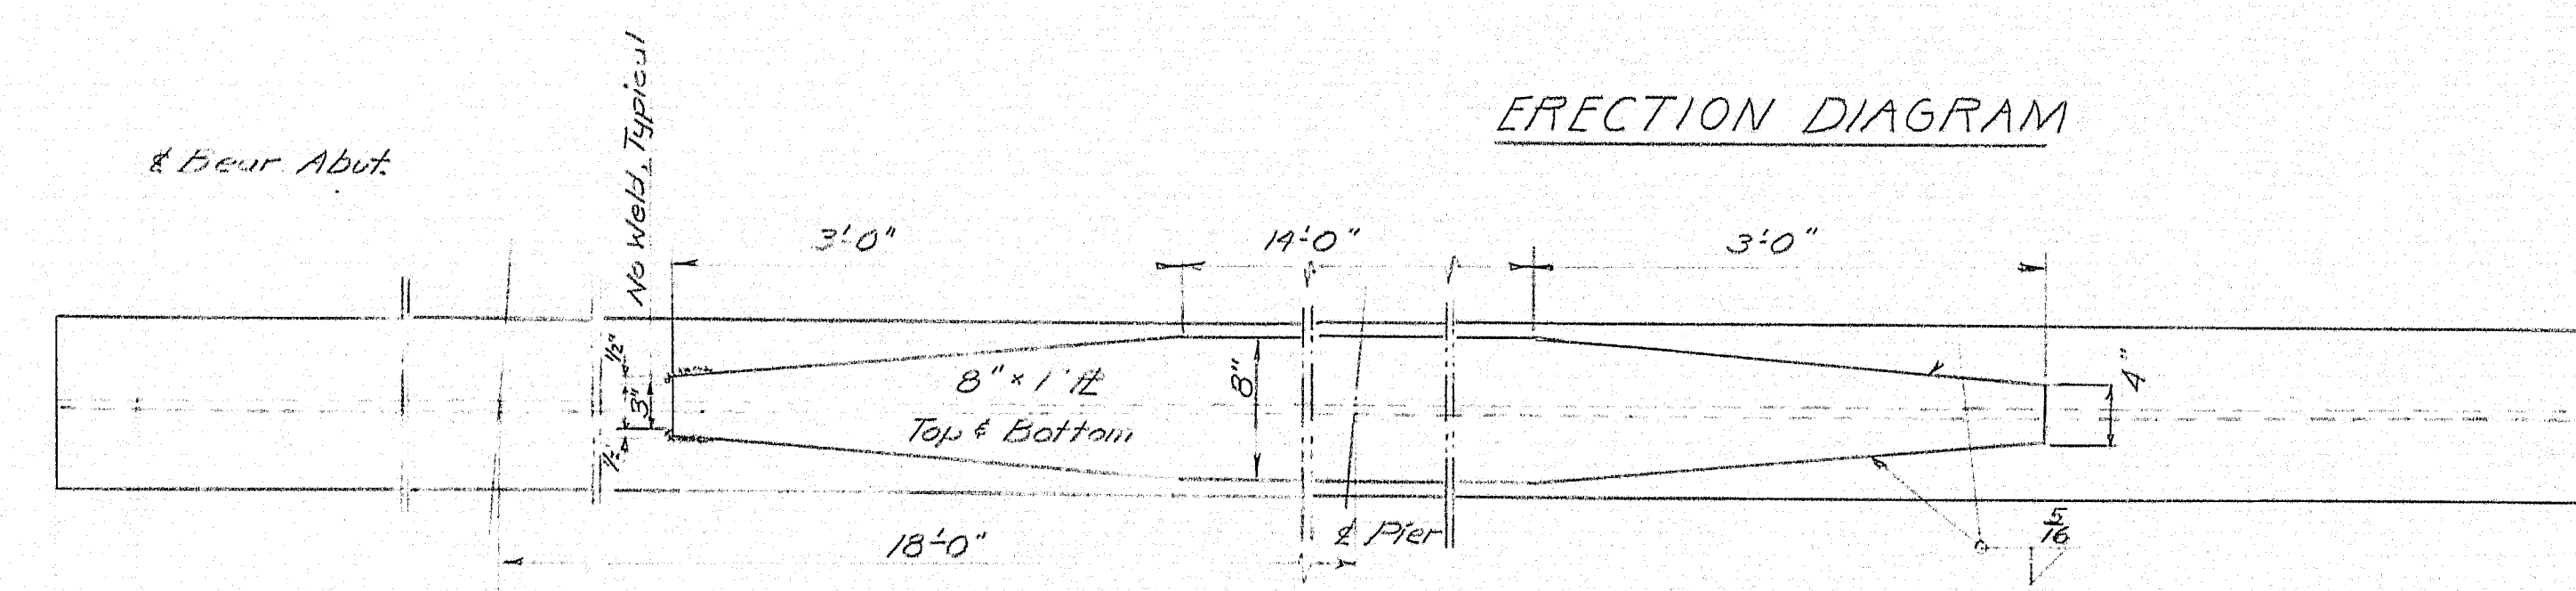

For Pedestals See "Standard Details BD 101-62"
 Bearing Pedestals
 12 EPC2 Required @ Abut. #1
 24 EPC5 Required @ Piers #1 & #2
 12 EPC1 Required @ Abut. #2
 For Beam Splices See Standard Details BD 103-62

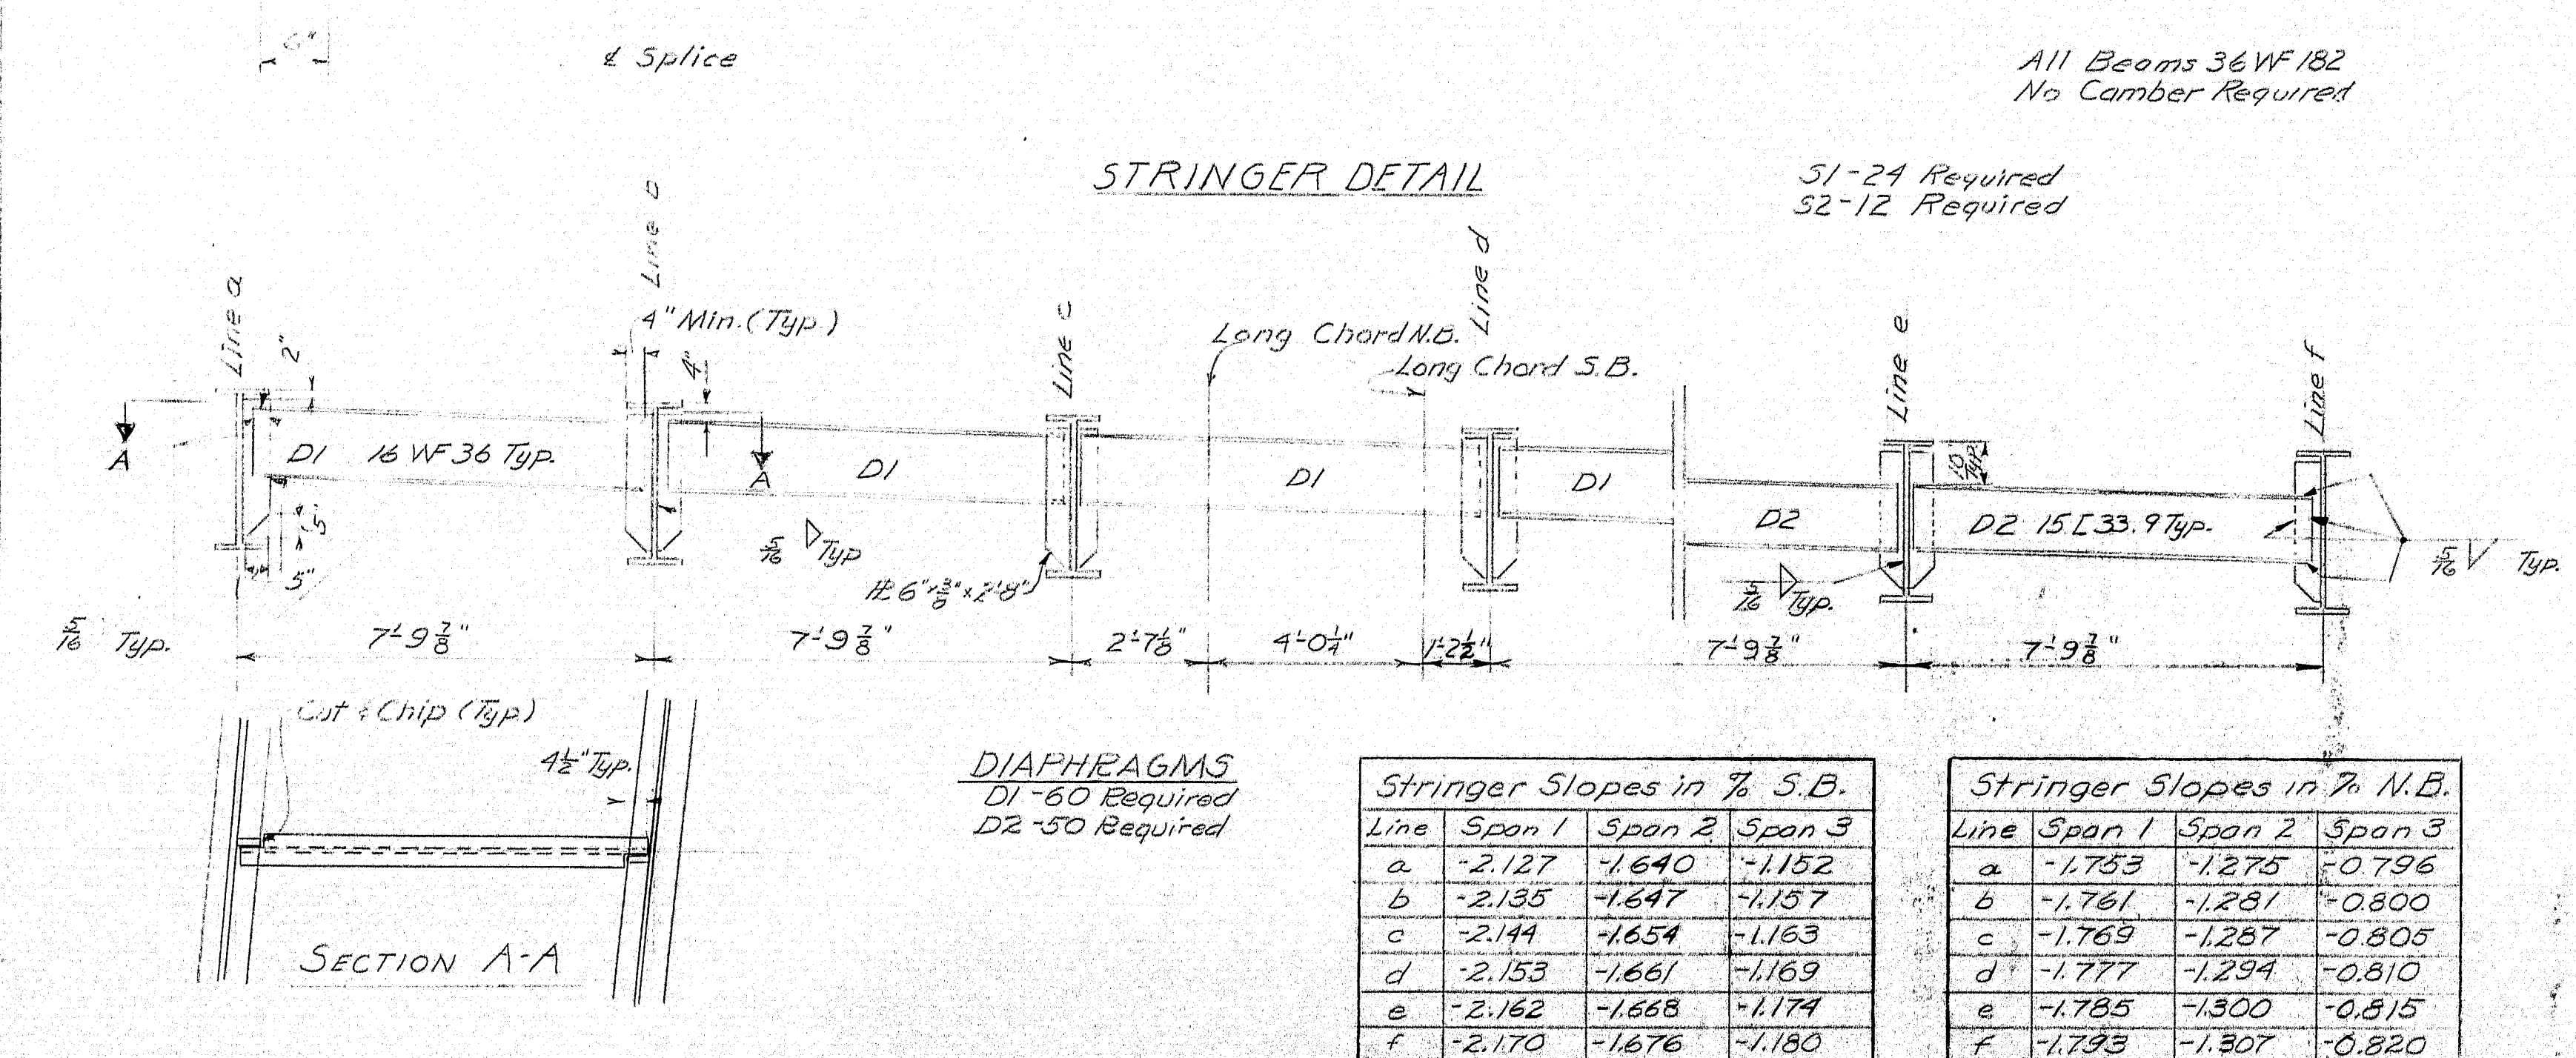


Stringer Slopes in % S.B.

Line	Span 1	Span 2	Span 3
a	-2.127	-1.640	-1.152
b	-2.135	-1.647	-1.157
c	-2.144	-1.654	-1.163
d	-2.153	-1.661	-1.169
e	-2.162	-1.668	-1.174
f	-2.170	-1.676	-1.180

Stringer Slopes in % M.B.


Line	Span 1	Span 2	Span 3
a	-1.783	-1.275	-0.796
b	-1.781	-1.281	-0.800
c	-1.769	-1.287	-0.805
d	-1.777	-1.294	-0.810
e	-1.785	-1.300	-0.815
f	-1.793	-1.307	-0.820


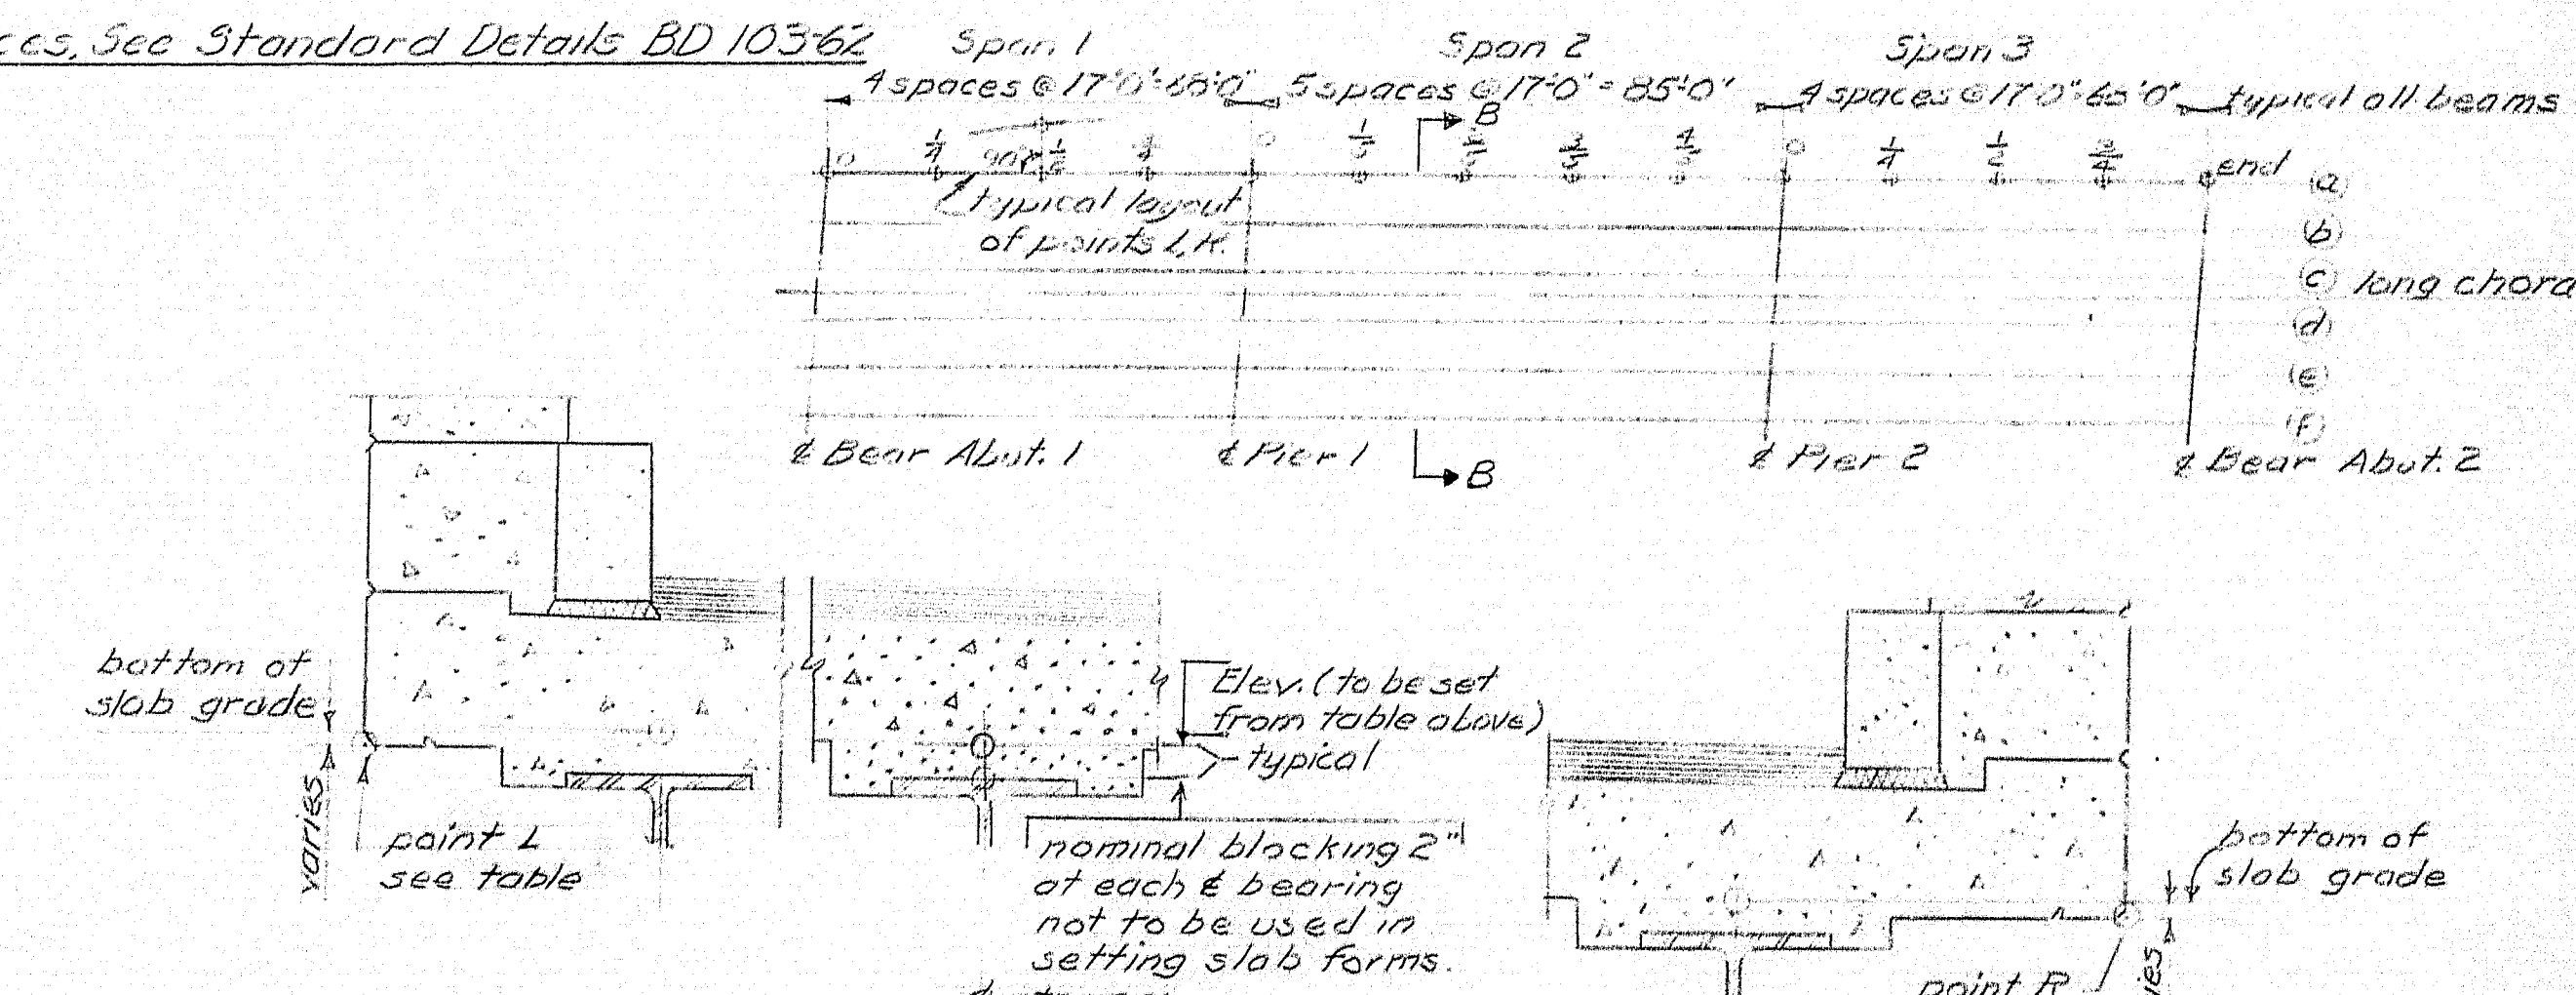


SPECIFICATIONS
 Fabrication & Erection: State of Maine, Standard Specifications, Highways & Bridges, Revision of Jan. 1956 and supplements.
 Design & Detail: A.A.S.H.O. Standard Specification of 1961, and revisions.
 Materials: Stringers, cover plates, and splice plates shall conform to A.S.T.M. designation A-36. Other members shall conform to A.S.T.M. designation A7 or A36.

NOTES
 1. Dimensions are horizontal except where otherwise stated.
 2. For armored joints and other structural steel see Sh. 15.
 3. No point where concrete in contact with steel.



DESIGN Z.H.K. DET. E.M.R.D. SURVEY NO. 1
 TRACE B.H. PLOT
 CHECK R.R.S.
 STATE HIGHWAY COMMISSION
 BRIDGE DIVISION
SEBASTICOOK RIVER BRIDGE
 IN THE TOWN OF
PITTSFIELD
SOMERSET COUNTY
 STRUCTURAL STEEL N.B. 1-36
 SHEET 14 OF 15 AUGUSTA, MAINE FEB 1963

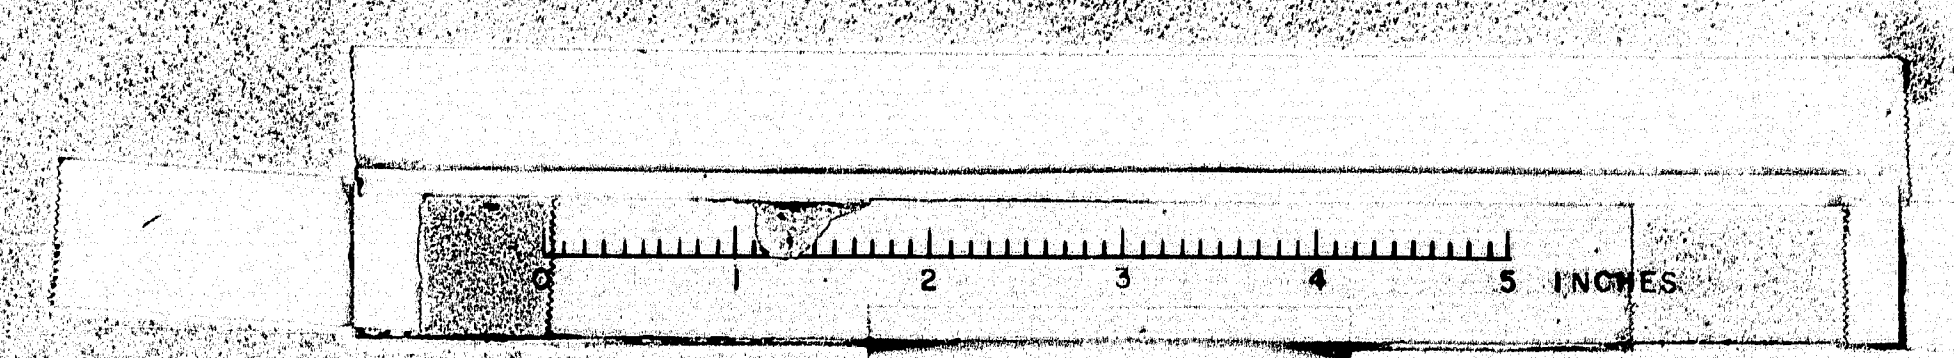

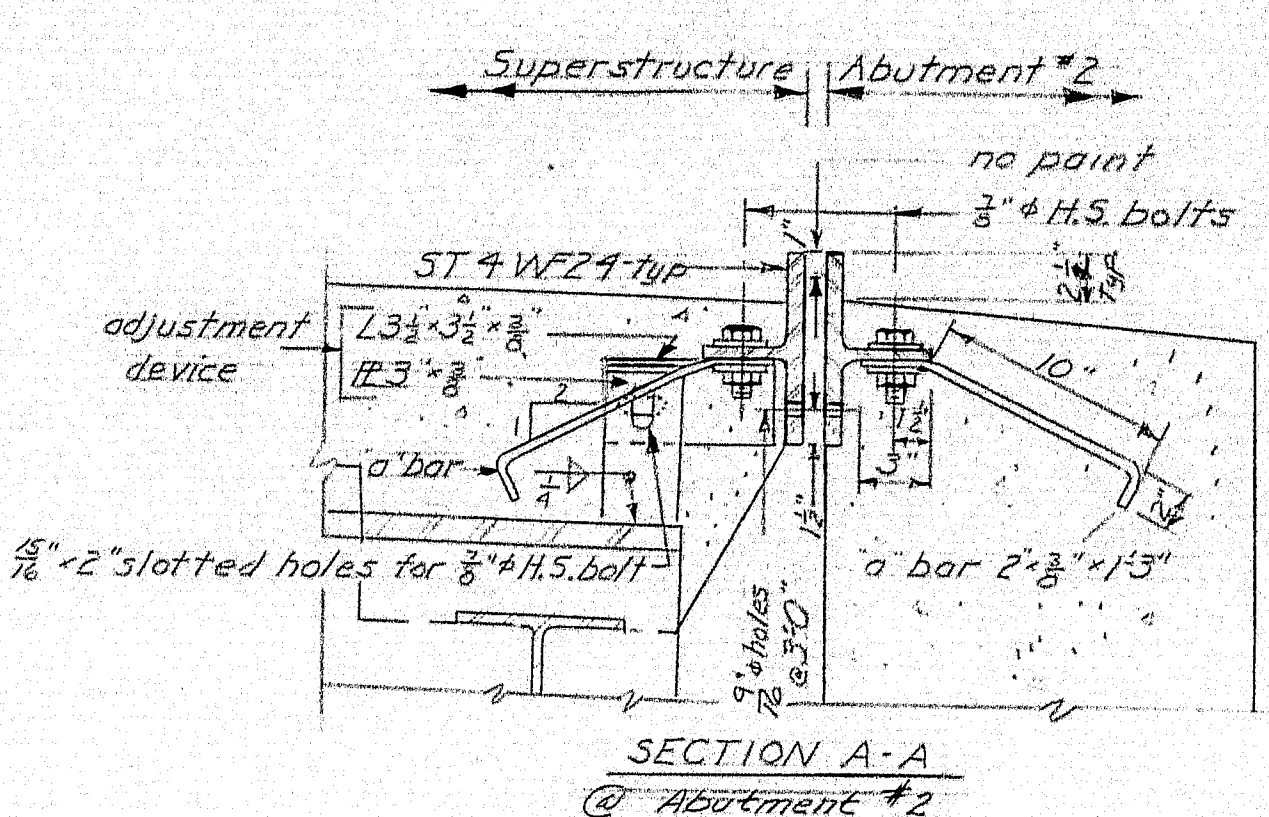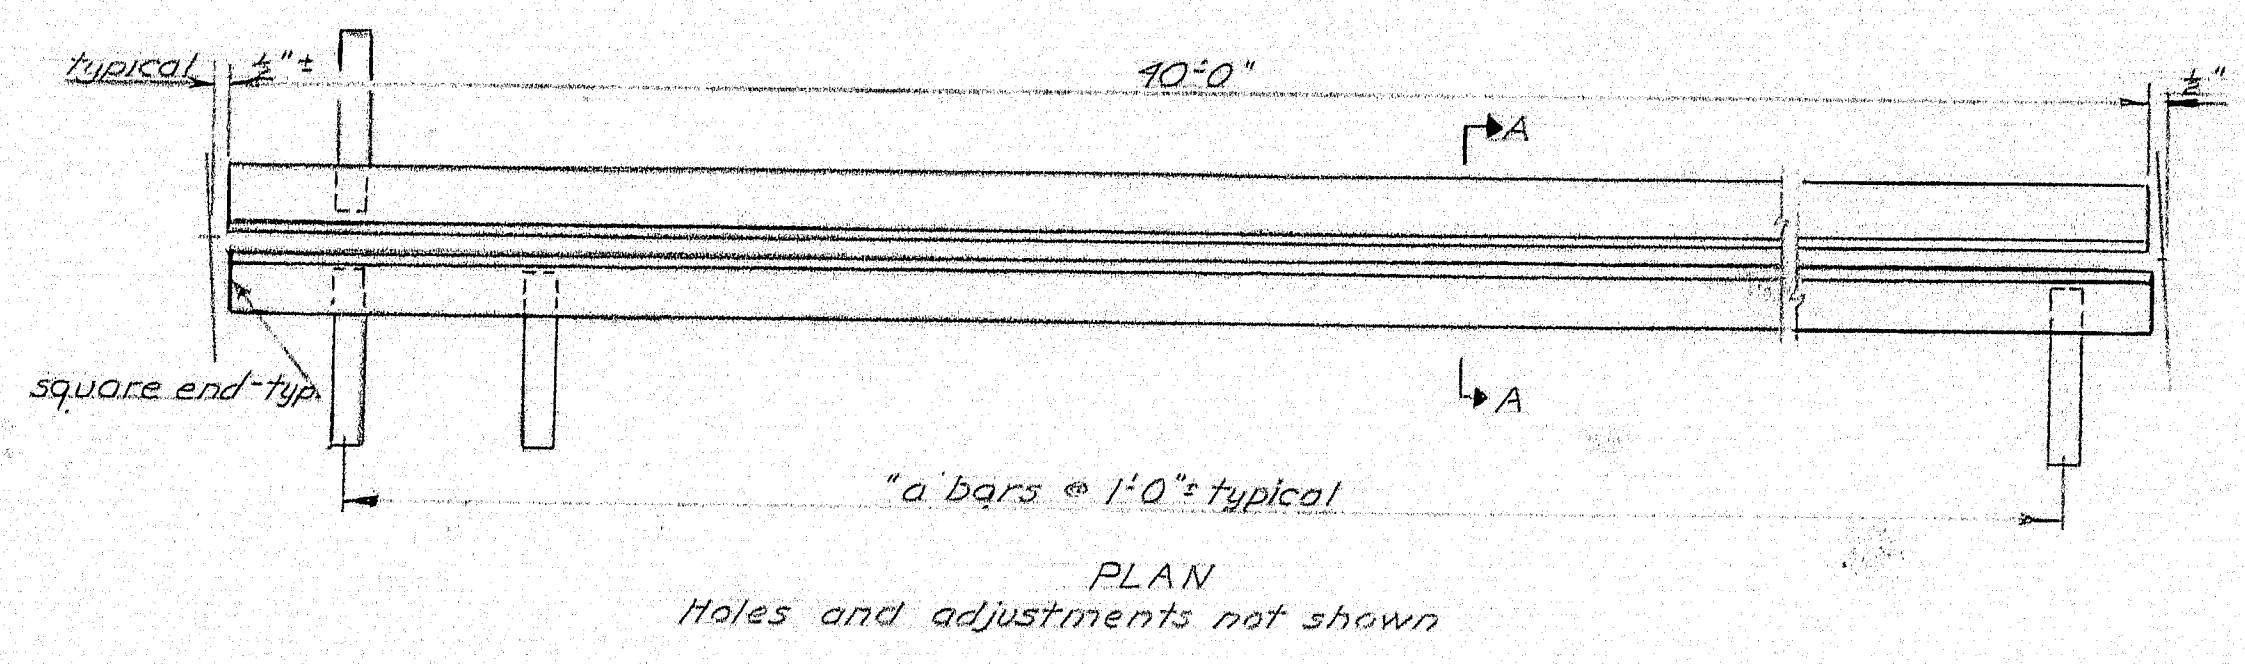




ARMORED JOINT DETAILS

Notes
Two each required as shown: 1 for S.B. lane, 1 for N.B. lane.
No allowance for slope or vertical curvature is necessary in fabrication.
Armored joints may be fabricated in halves lengthwise and welded in the field in a manner approved by the Engineer.
Adjustment device plates shall be approximately centered on stringers.
Weld adjustment device together after armored joint is in position.

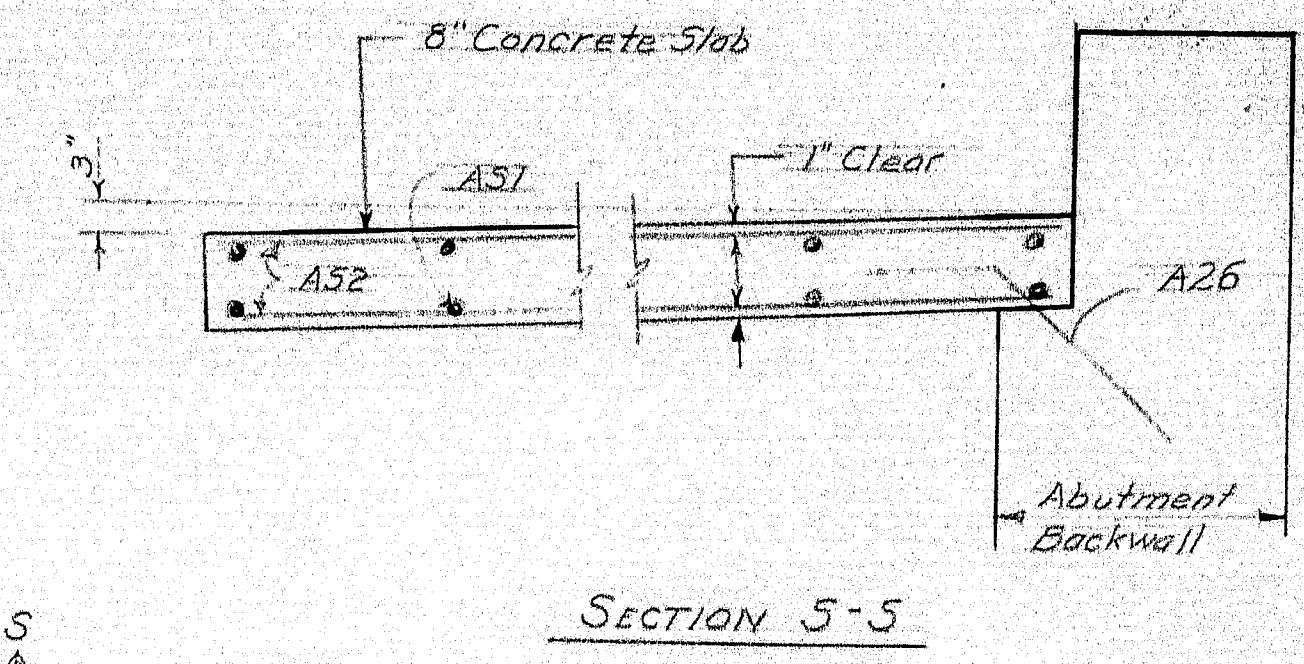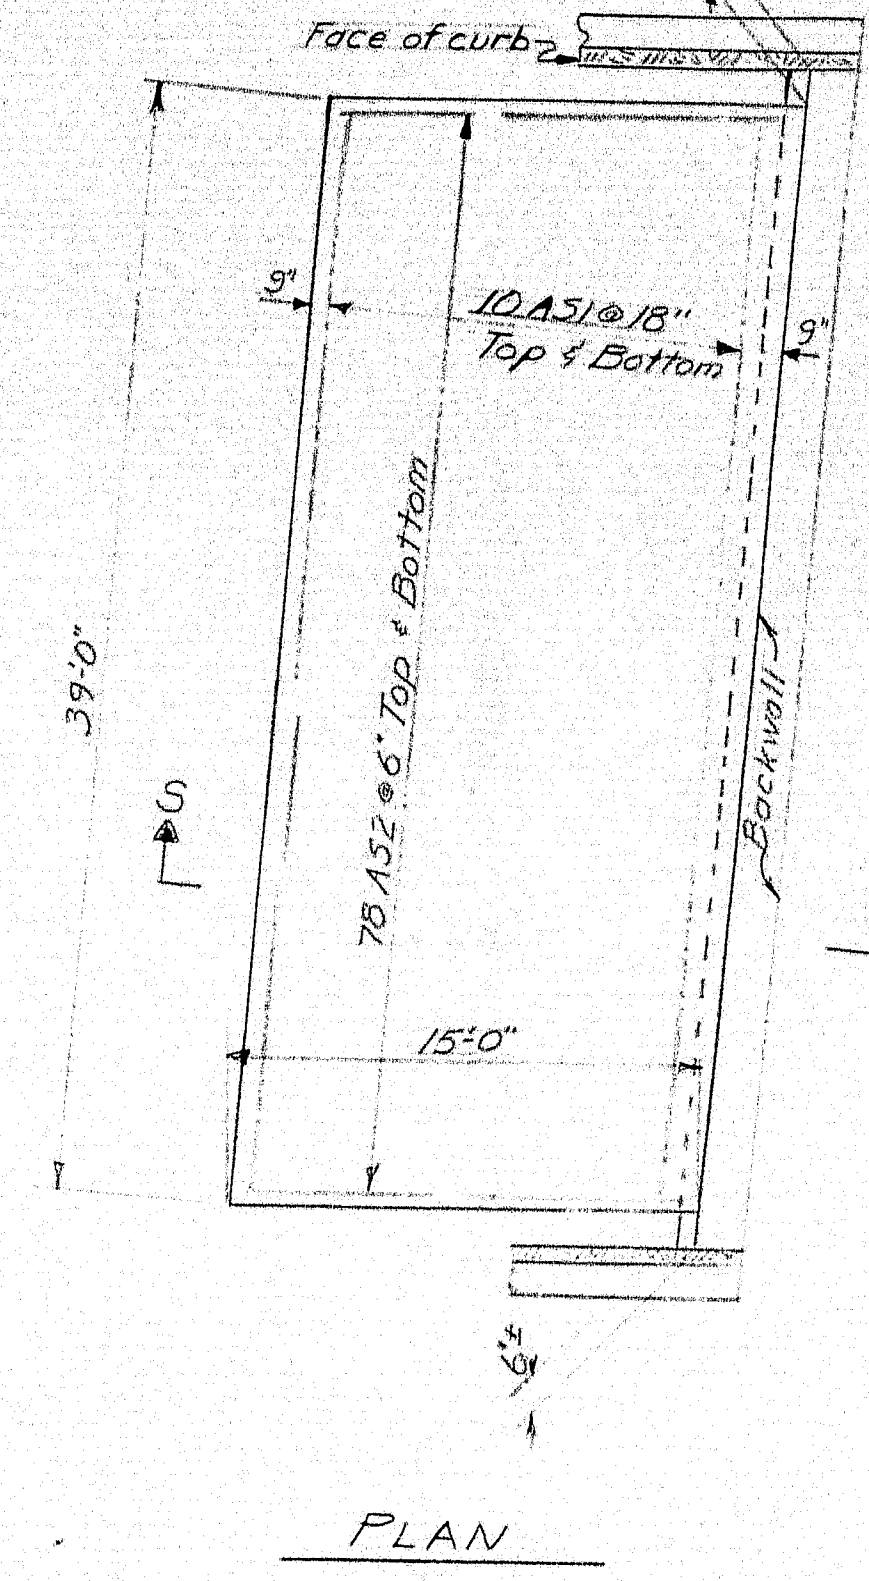


APPROACH SLAB DETAILS

Approach slab concrete to be class A and to be paid for under Item 701-34 Portland Cement Concrete, Abutments and Retaining Walls.

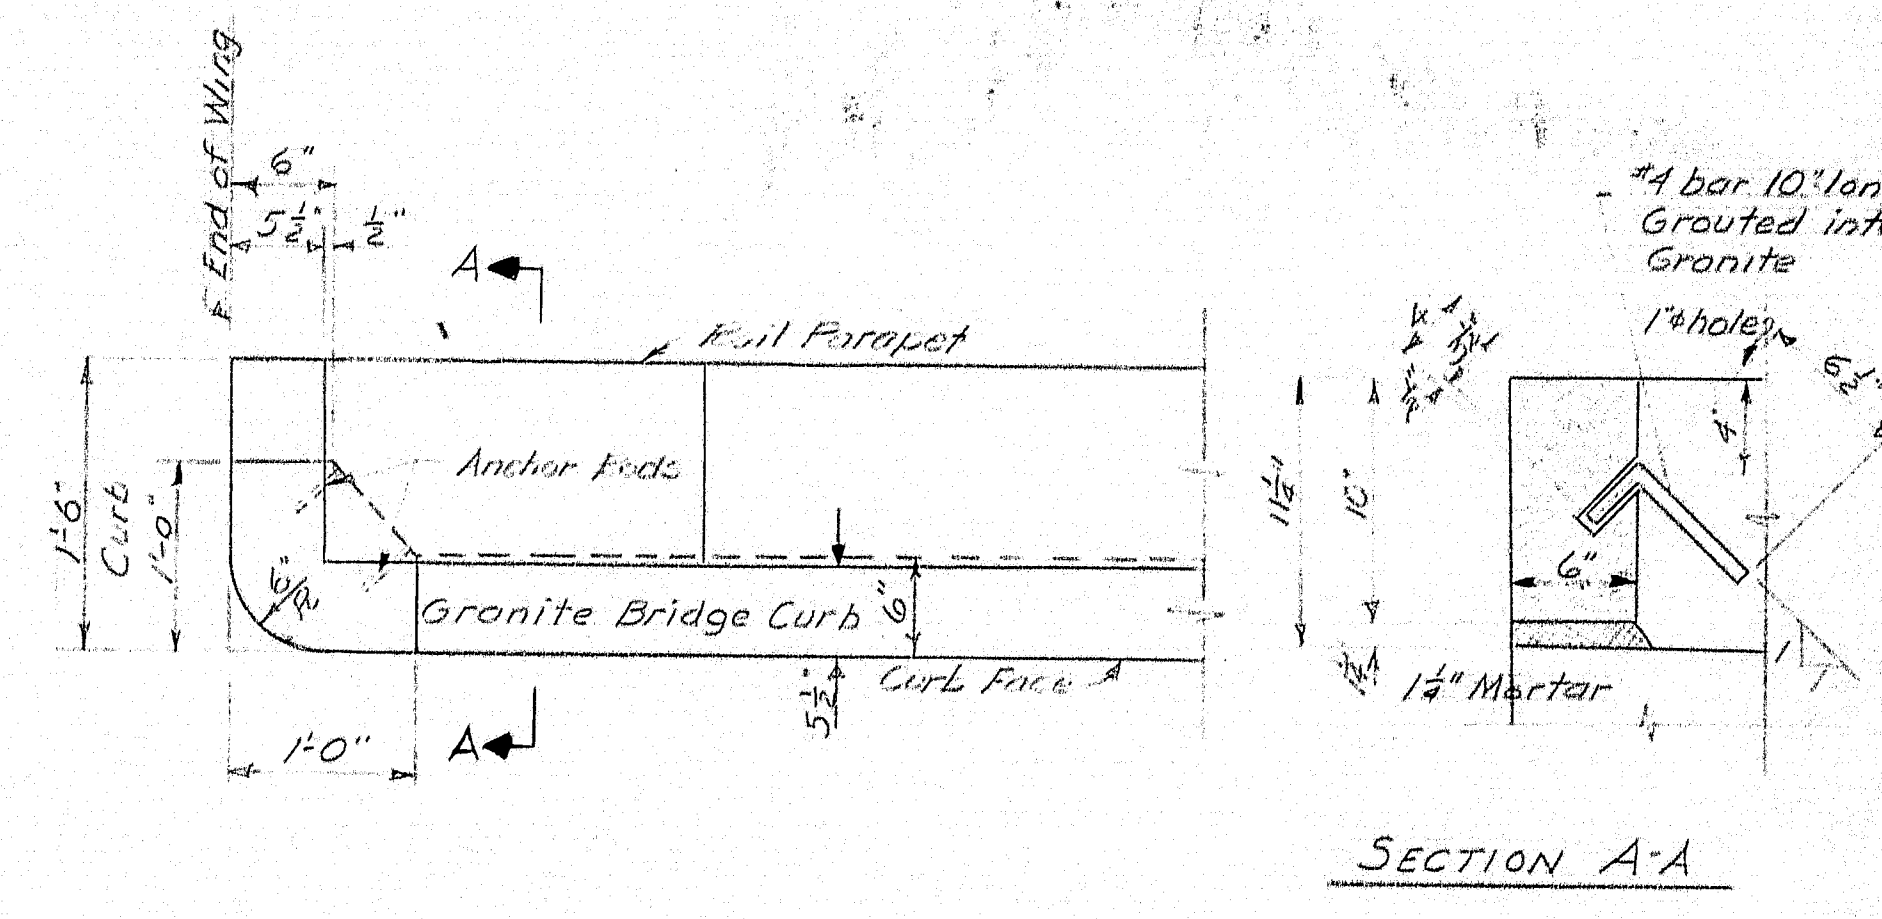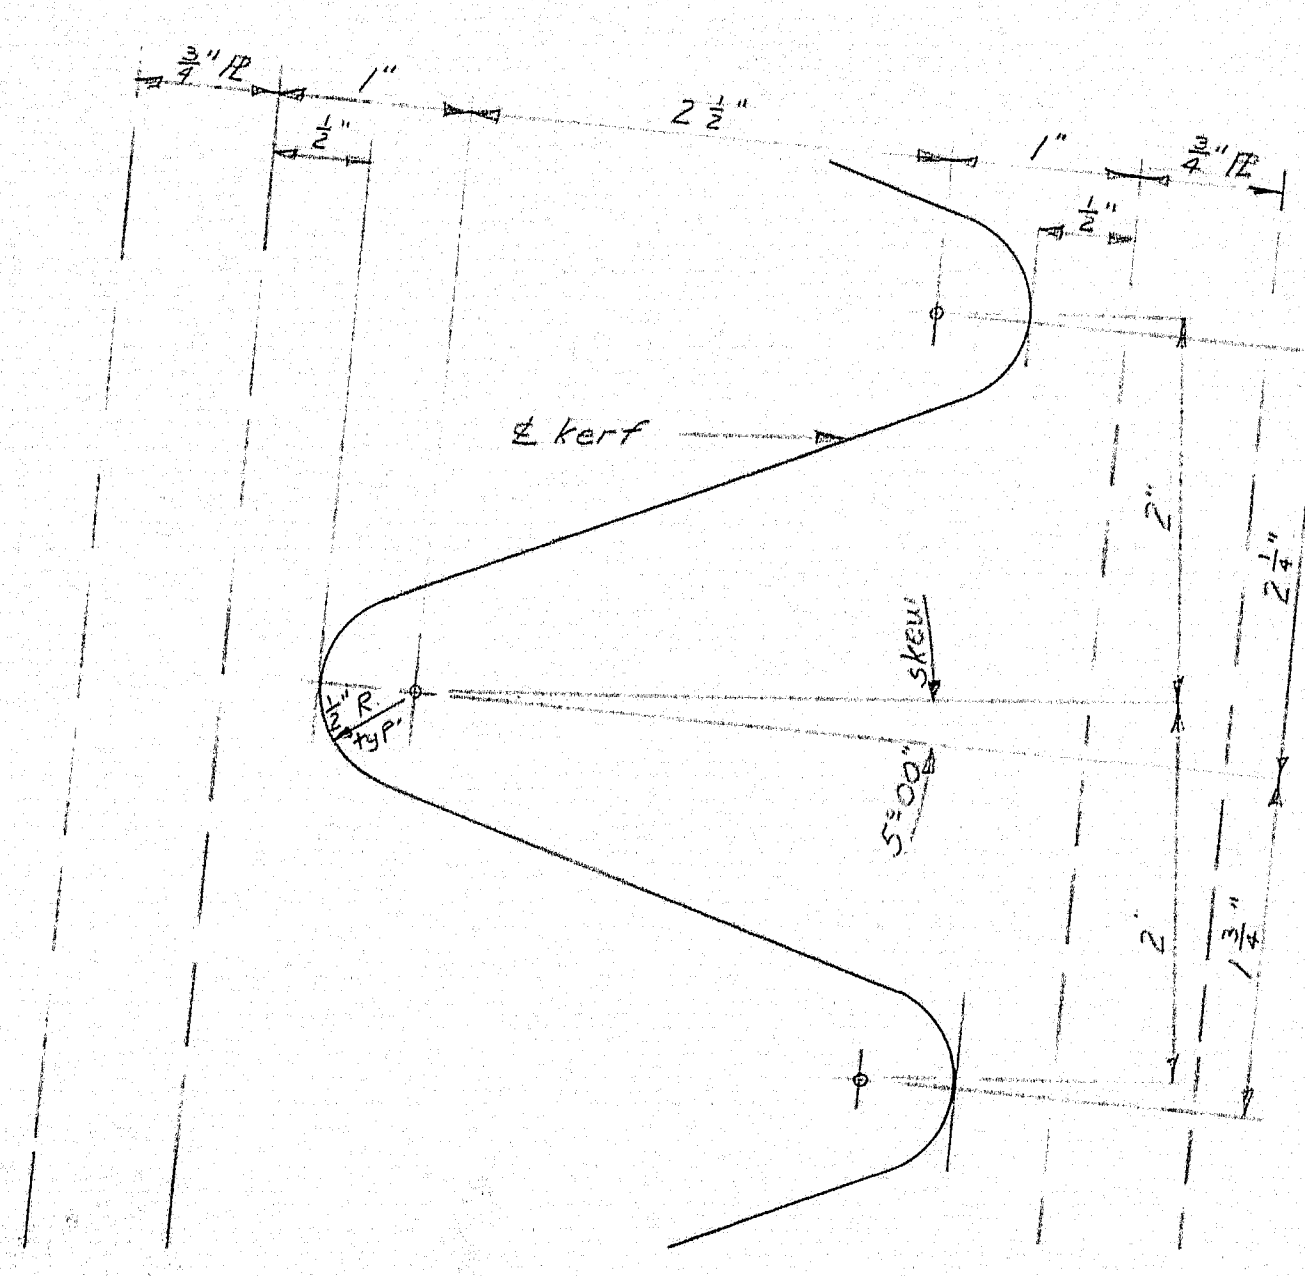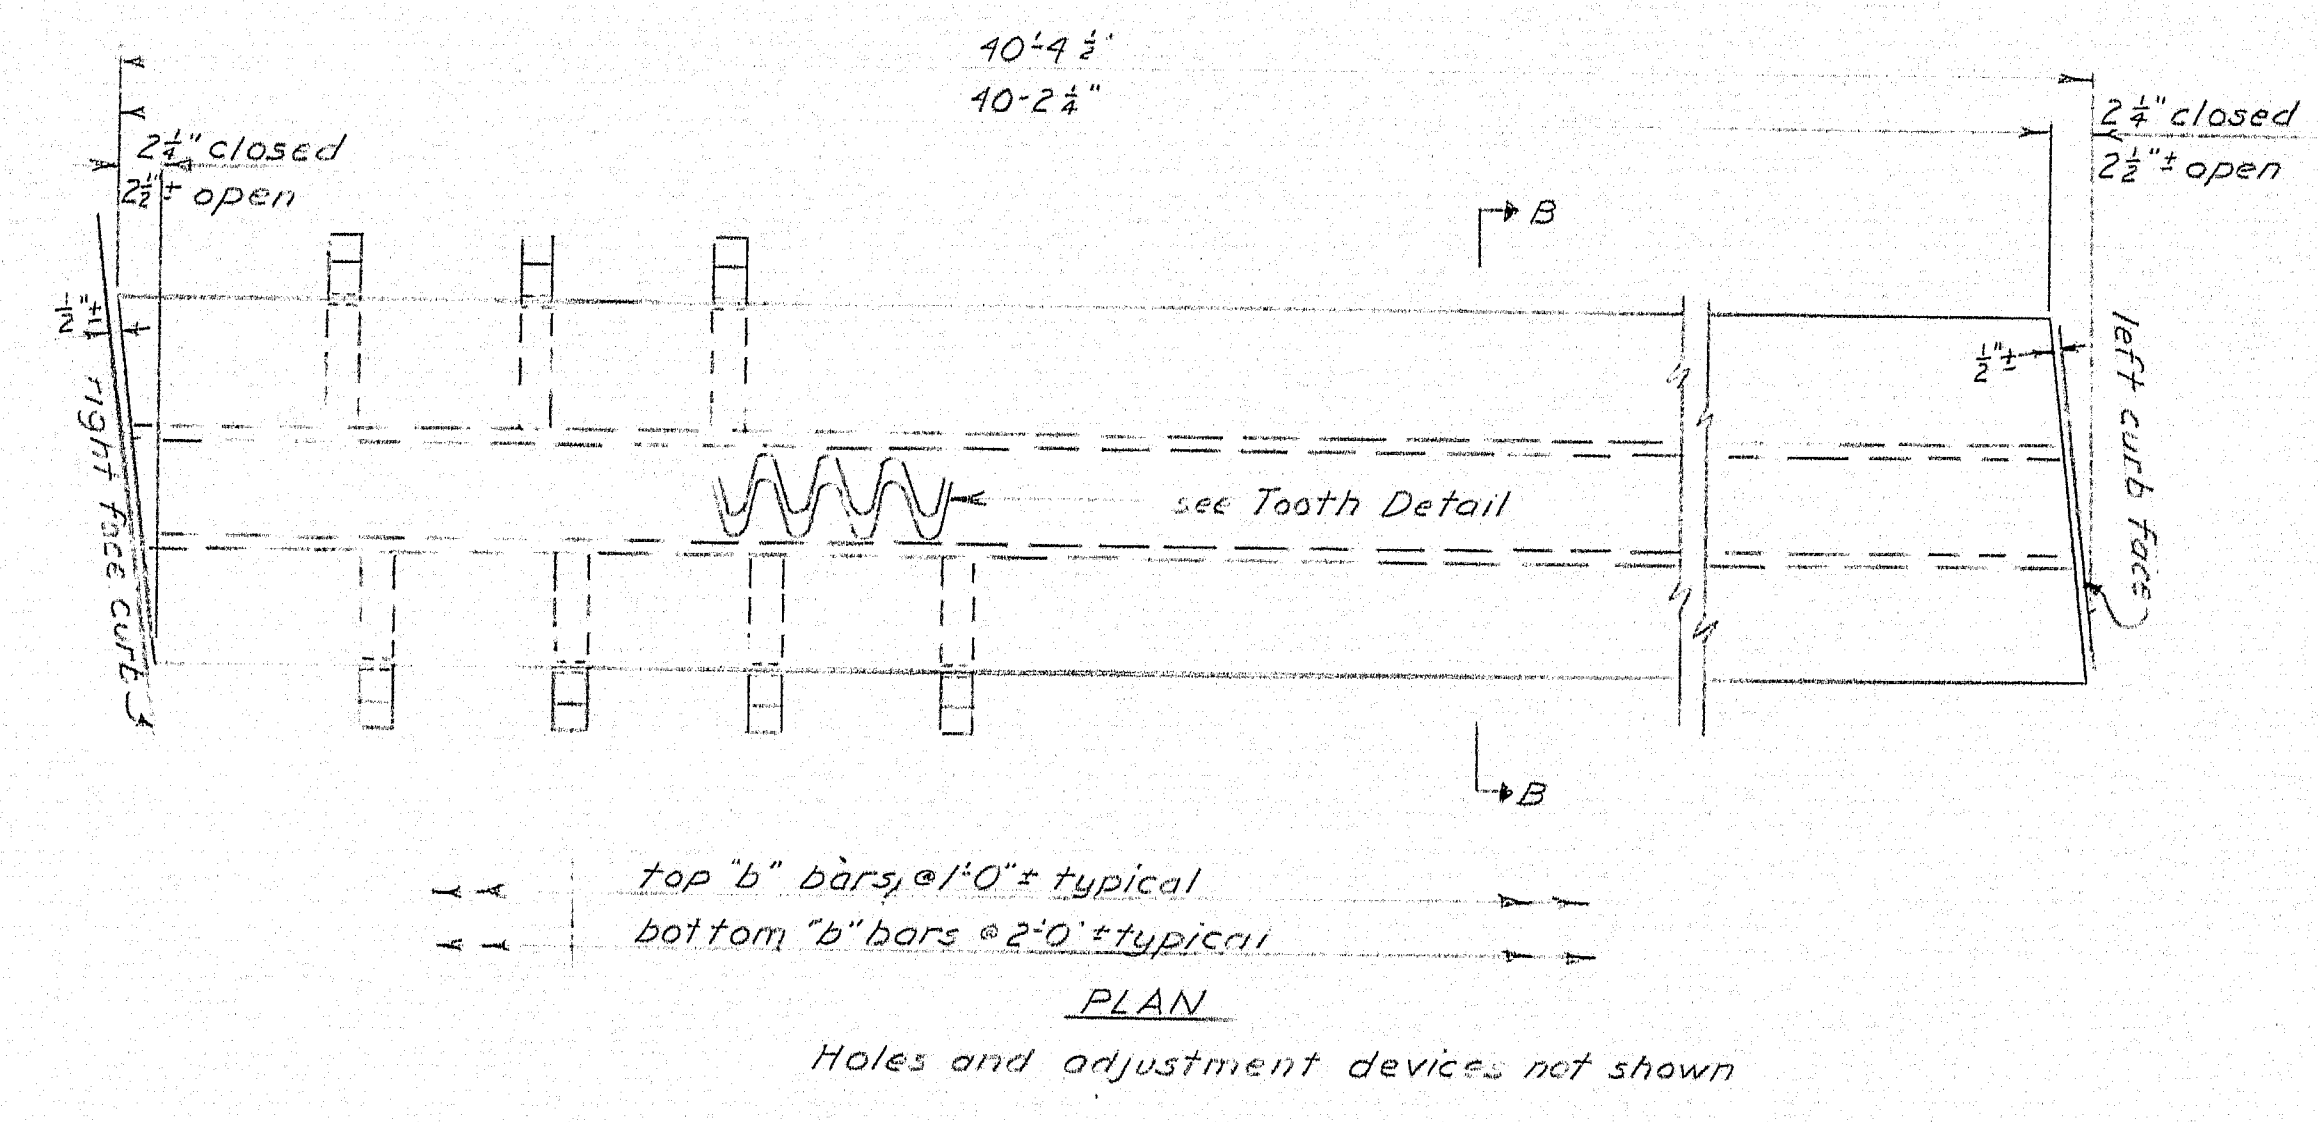

GRANITE BRIDGE CURB DETAIL AT ABUTMENT WINGS


Note: 4 bar 10" long not included in Rein. Steel Schedule

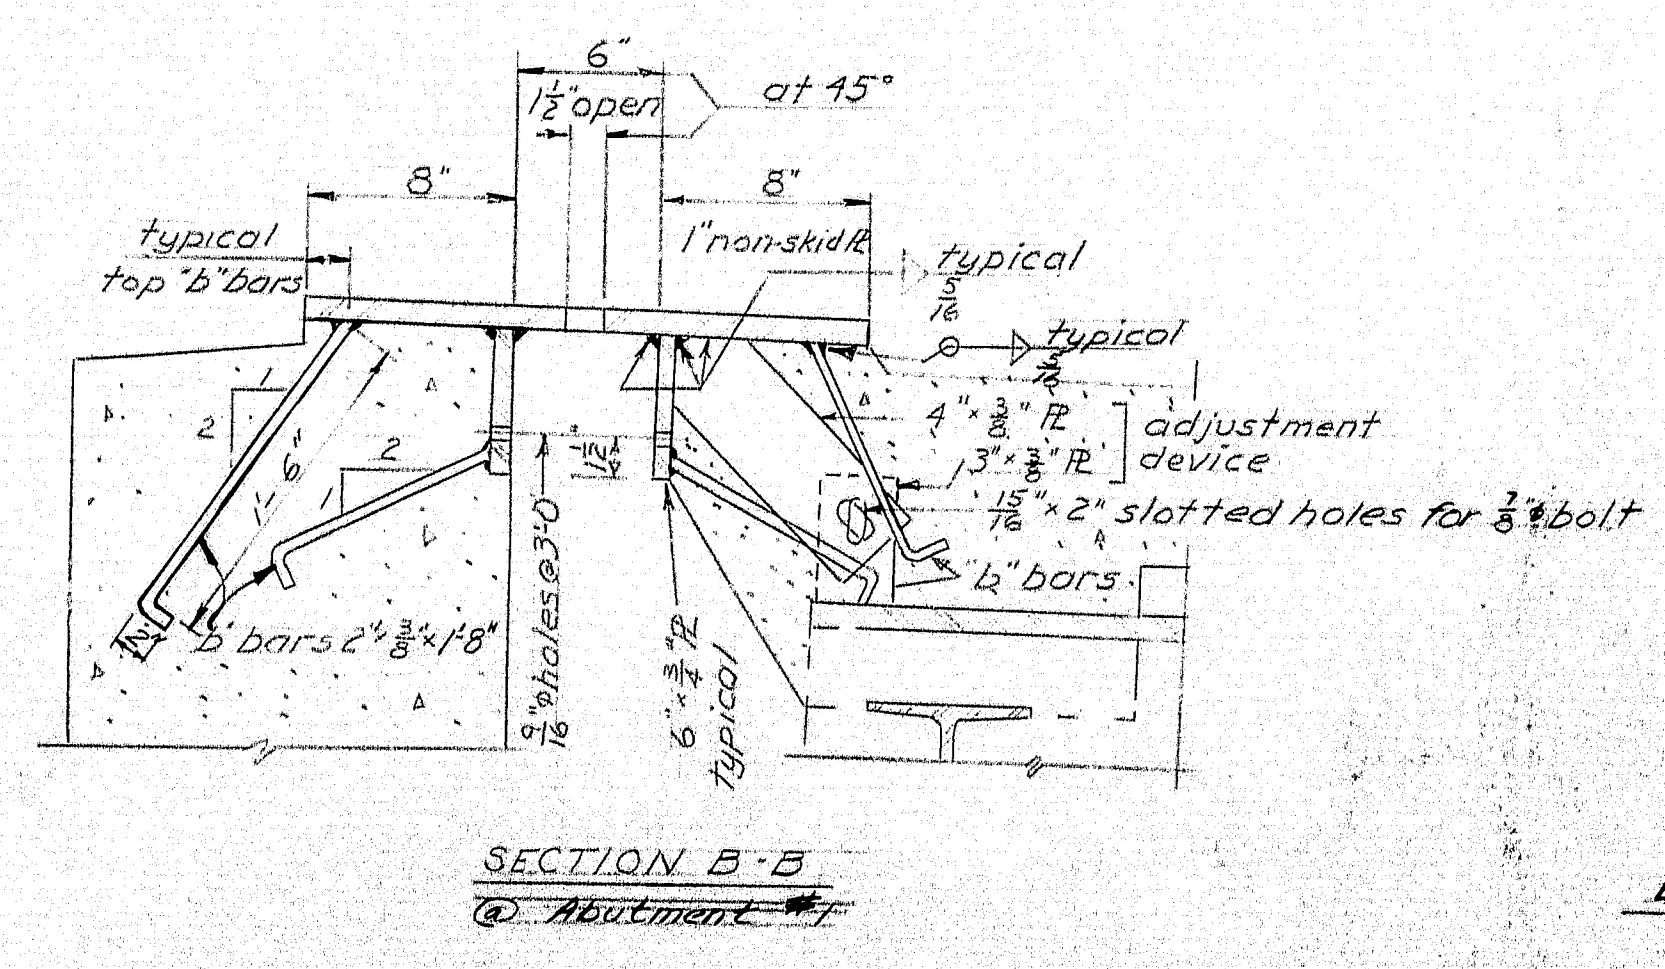


Notes: similar to notes for armored joints




EXPANSION DAM DETAILS

DESIGN T.M.K. & R.D.
TRACE
CHECK
STATE HIGHWAY COMMISSION BRIDGE DIVISION
SEBASTICOOK RIVER BRIDGE
IN THE TOWN OF PITTSFIELD
SOMERSET COUNTY
ARMORED JOINT AND EXPANSION DAMS
SHEET 15 OF 18 AUGUSTA, MAINE FEB. 1963

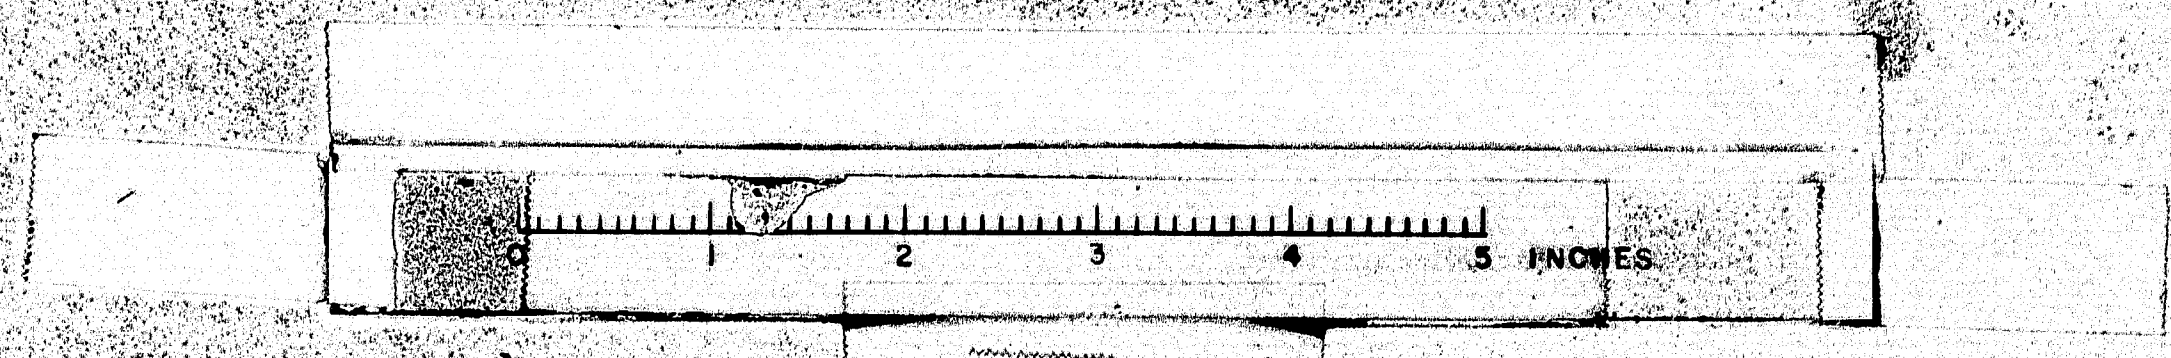

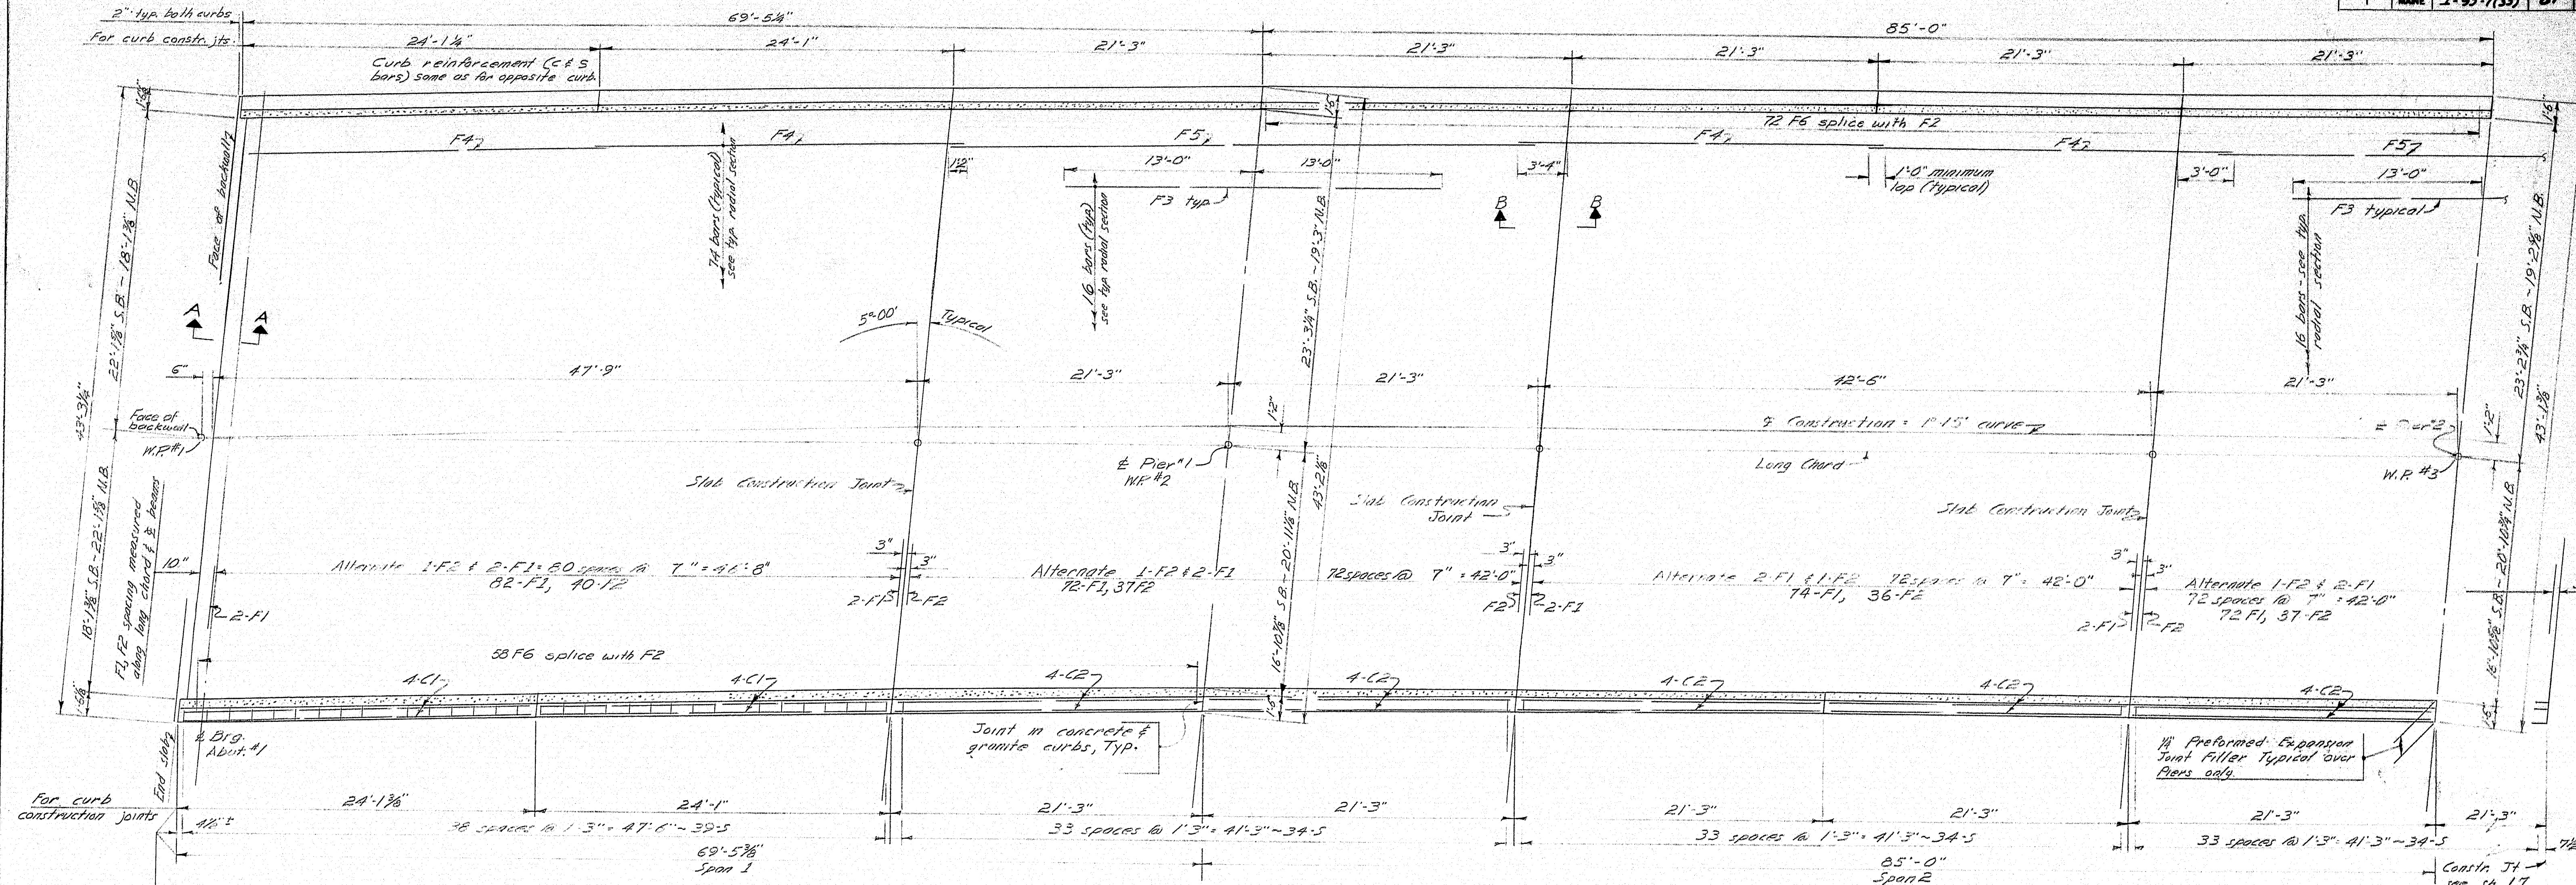


Area dimensioned along fascia and are equal to their chord lengths. Curved curb are along the equal lengths of adjacent fascia areas. Dimensions horizontal (typical).

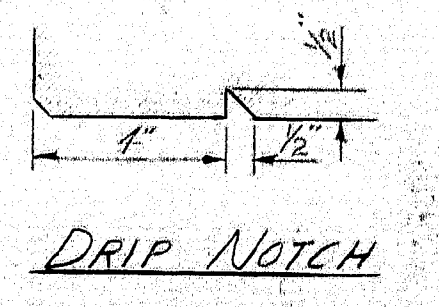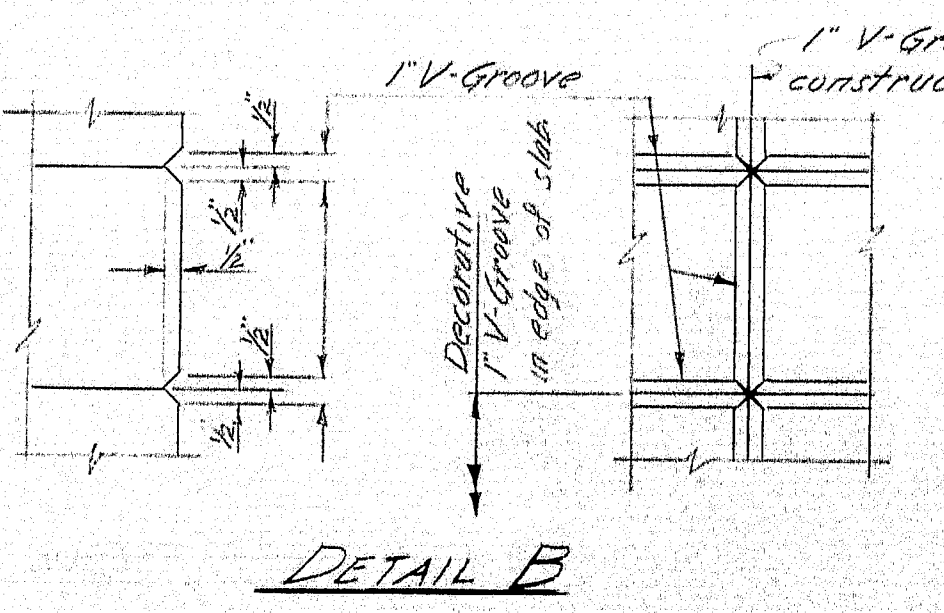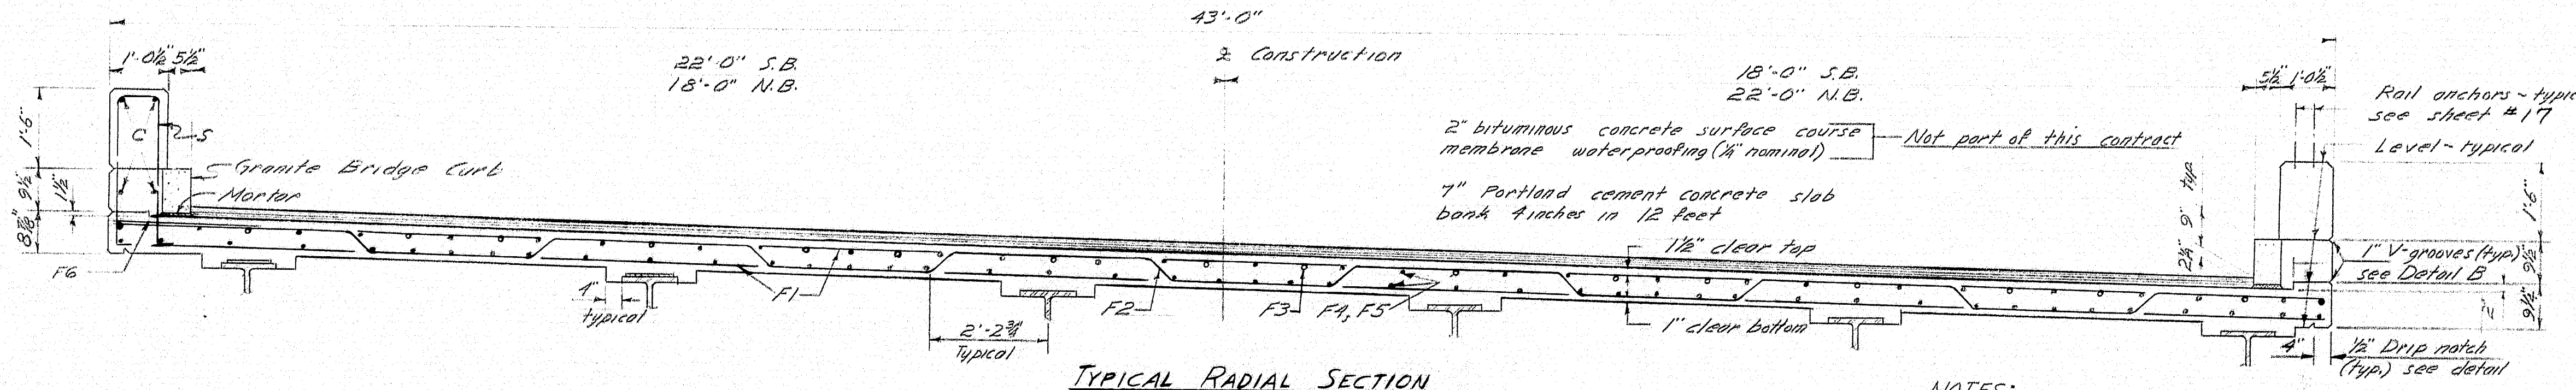

NOTES:
 Reinforcing-Steel for curbs shall be in place before slab concrete is placed, and that for rail parapets before curb concrete is placed.
 Concrete Placement-For slab sequence, see sheet #17.
 Concrete for curbs shall not be placed until slab concrete has been in place 7 days. During the 7 days forms may be constructed, but only hand equipment will be allowed on slab.
 Chaining-All exposed edges of concrete 1/2".
 Rail-For plan see sheet #17.
 Joints-For joints at ends of slab see Sections A-A & C-C, sheet #17. At all other (i.e., intermediate) joints in slab and concrete curbs, break the bond between concrete surfaces with a coat of asphalt paint.
 Blacking-See sheet #.


Work this sheet with sheet #17

DESIGN T.H.K. DETAIL E.D. CHECK A.R.S.	TRACE R.T.A.
STATE HIGHWAY COMMISSION BRIDGE DIVISION	
SEBASTICOOK RIVER BRIDGE	
IN THE TOWN OF PITTSFIELD	
SOMERSET COUNTY	
SUPERSTRUCTURE NO. 130	
SHEET 16 OF 18 AUGUSTA, MAINE FEB 1963	

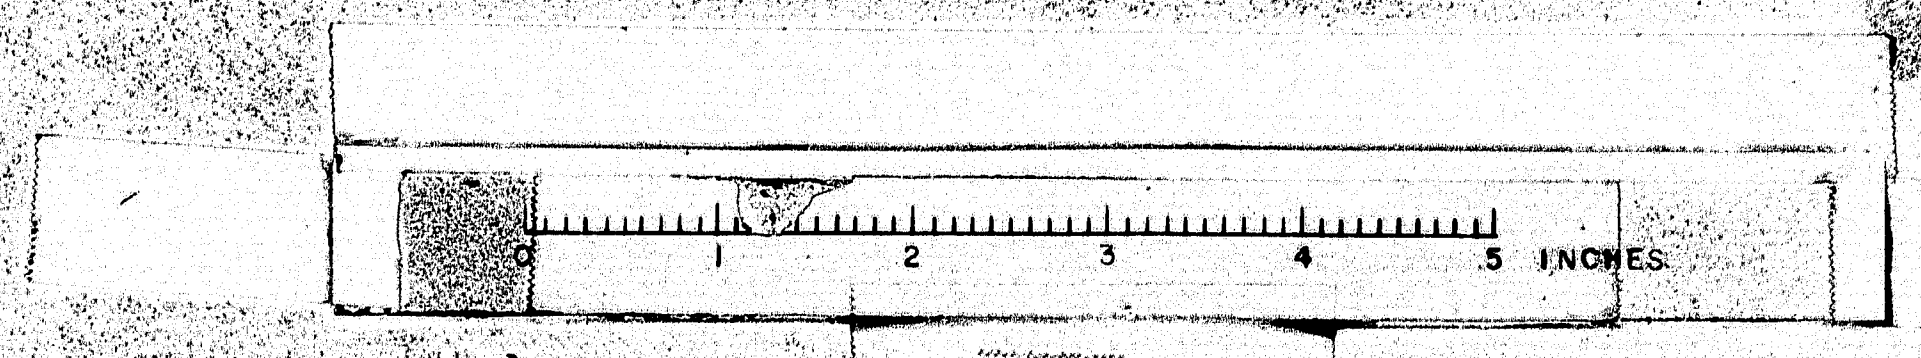


B. R. R.	STATE	PROJECT NUMBER	SHEET NO.	TOTAL SHEETS
1	MAINE	I-95-7 (33)	62	225


Notes: Bridge Rail, see Standard Details
B.D. 102-62.
Distance from E. End Post to
end of Rail = 8" typ.

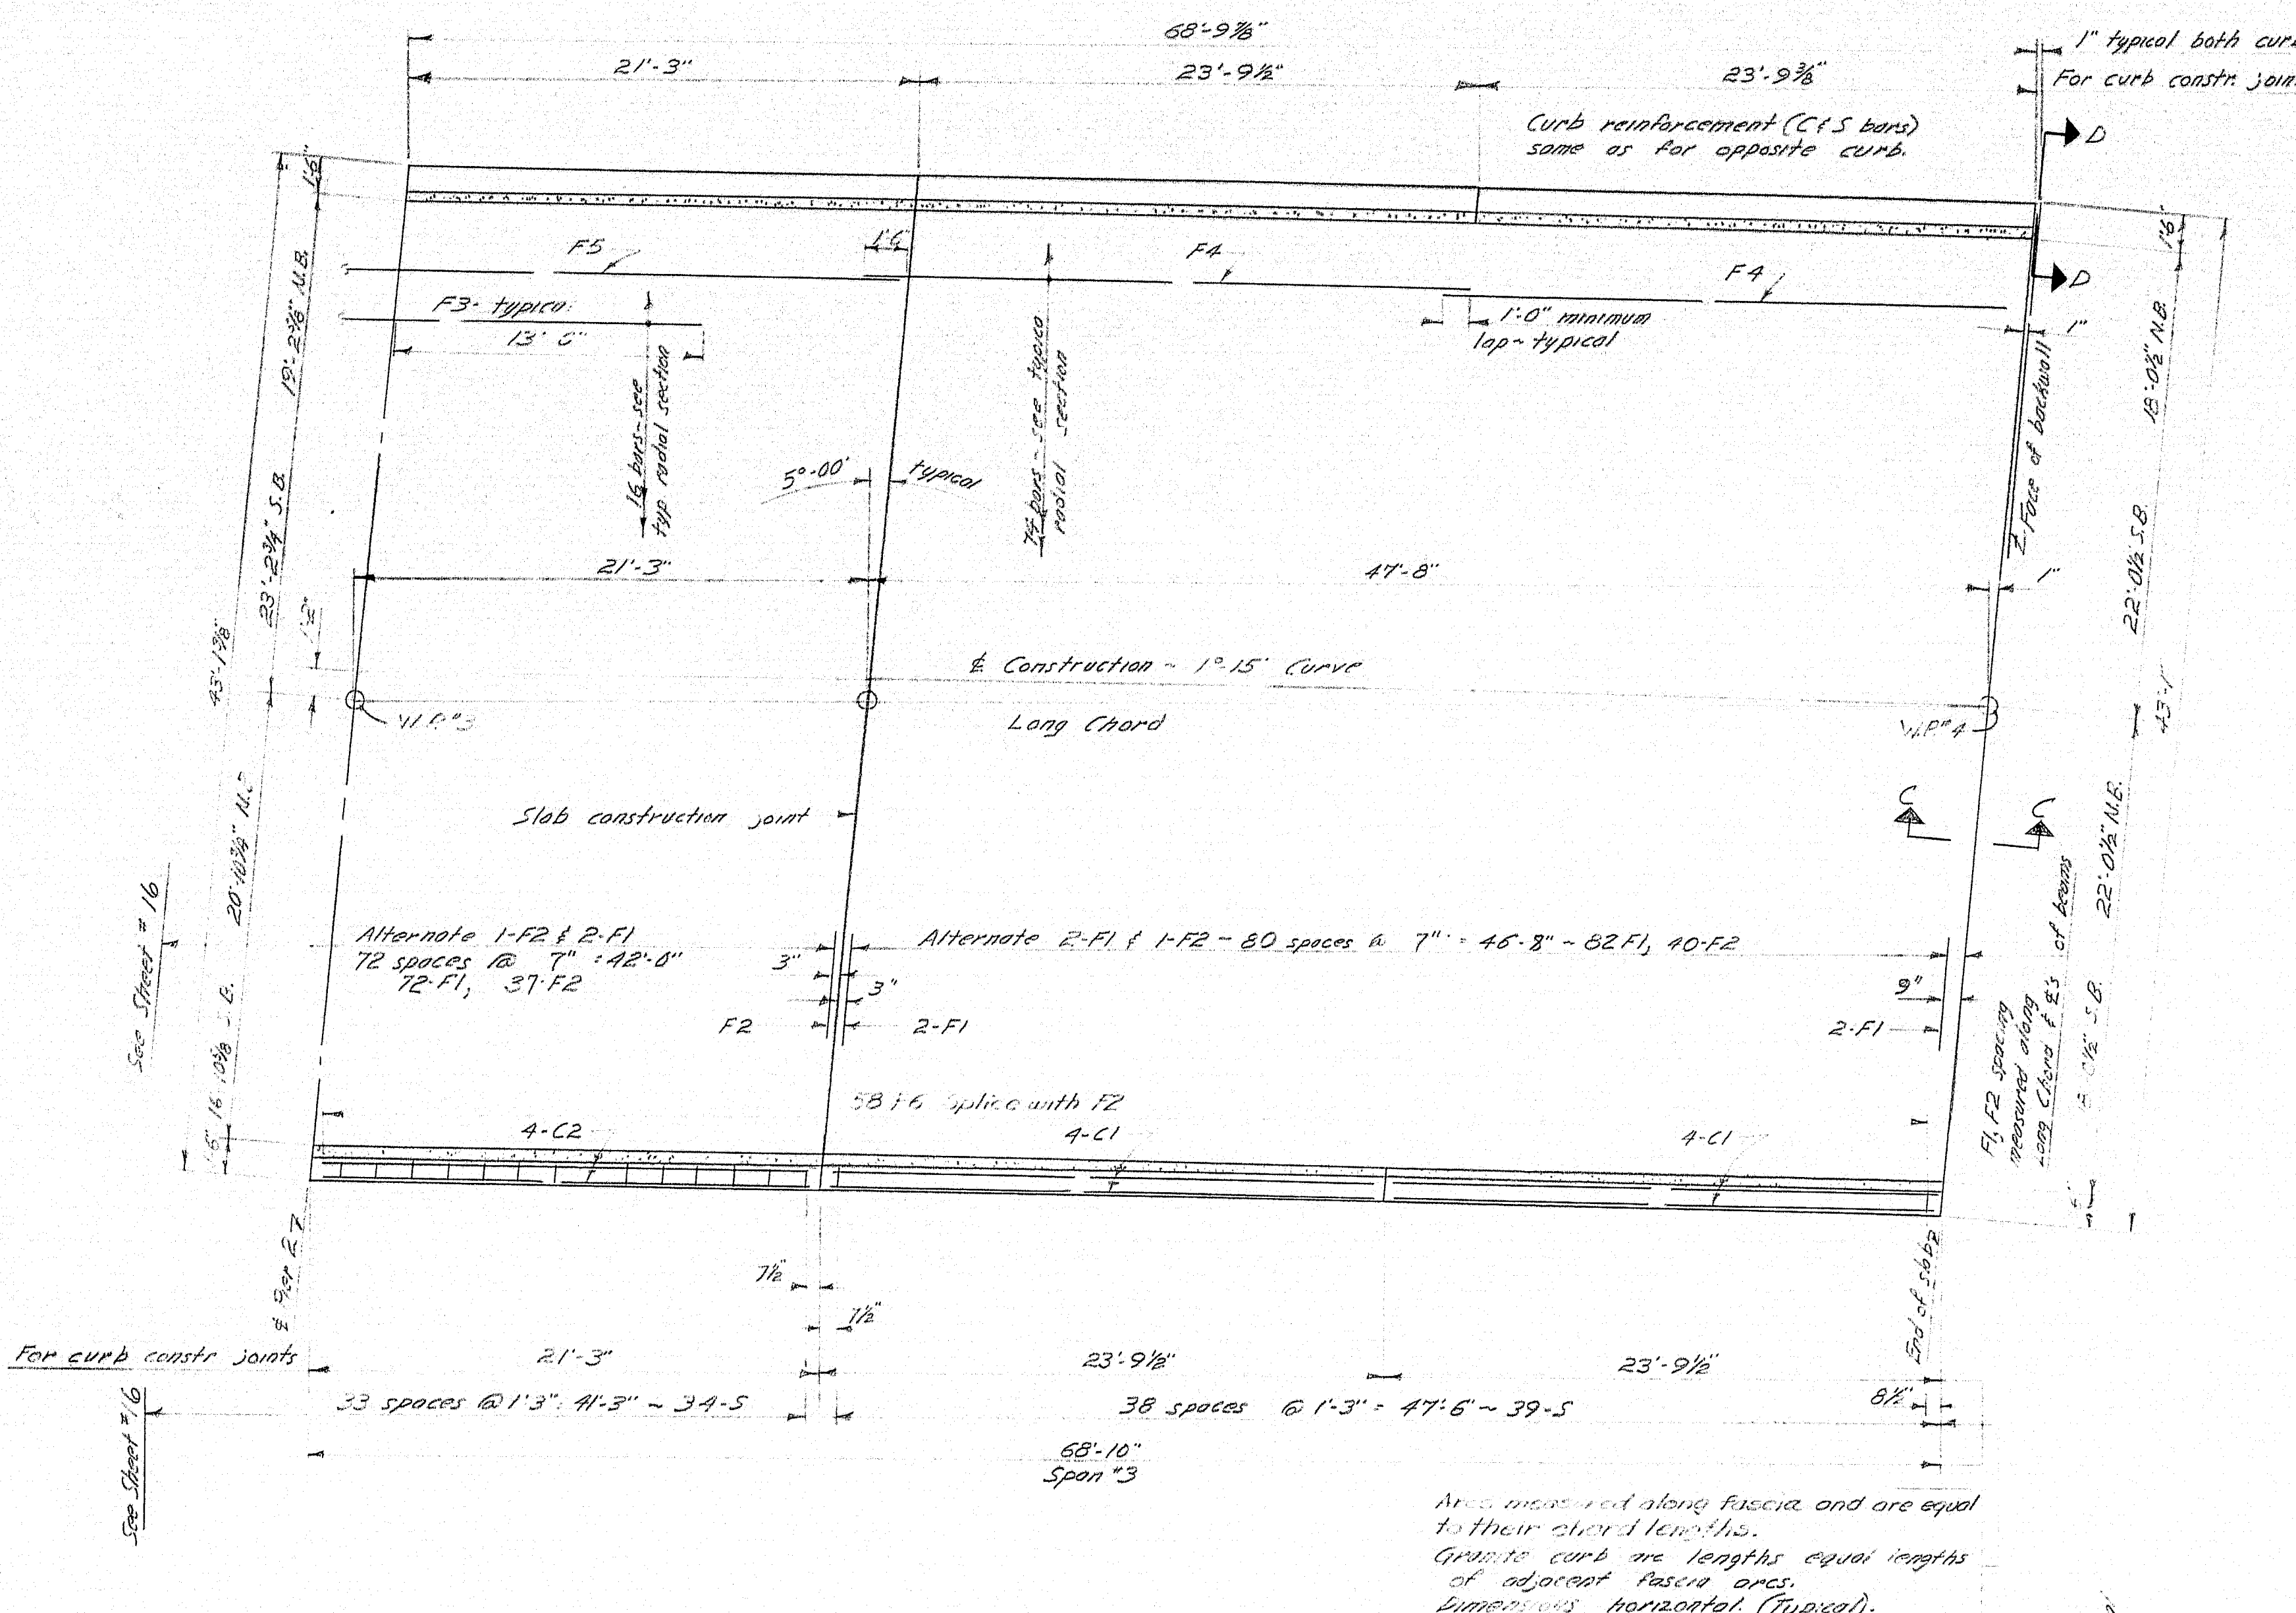


PLAN

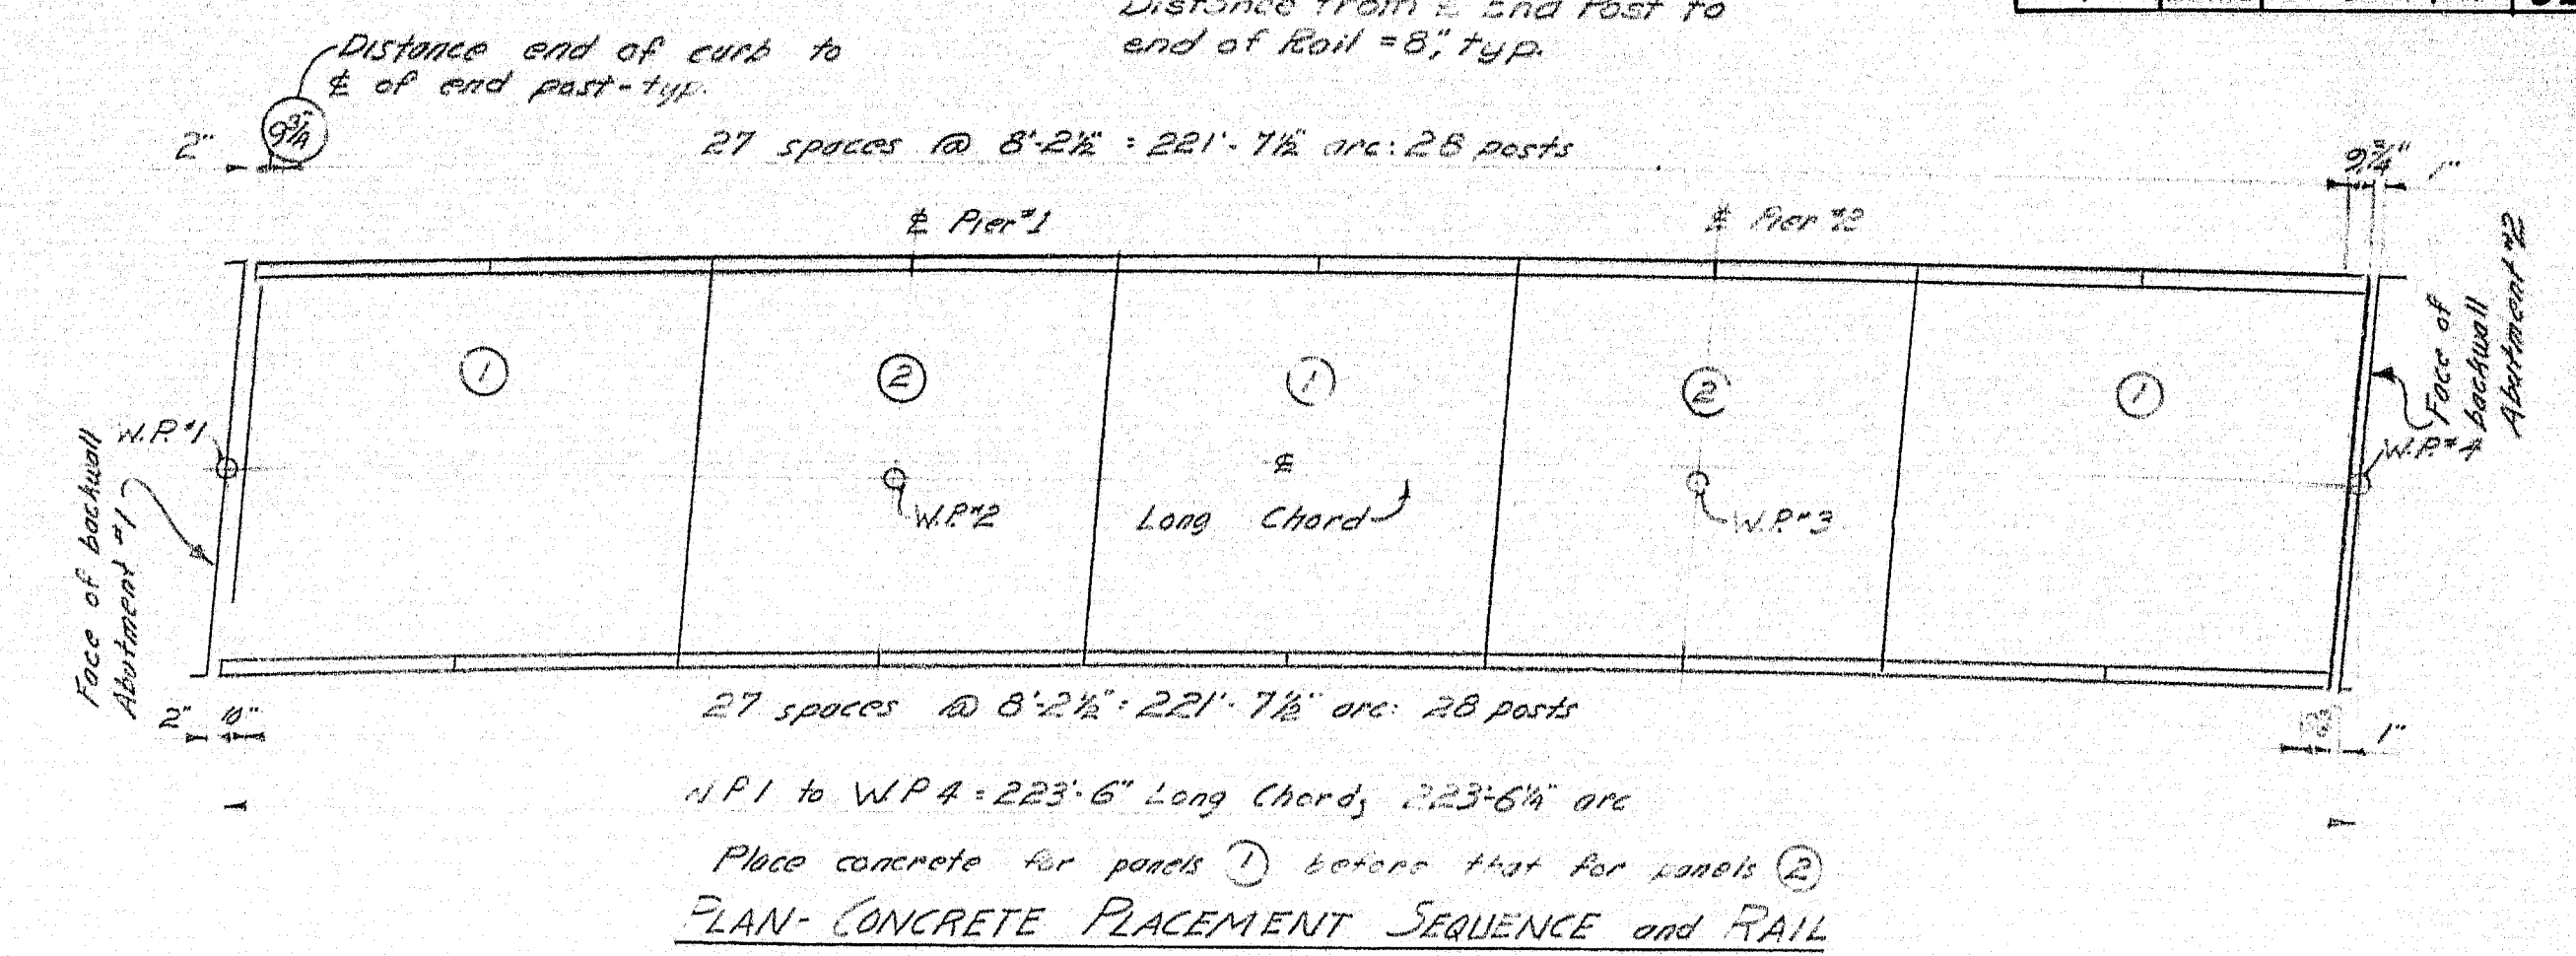


PLAN- CONCRETE PLACEMENT SEQUENCE and RAIL

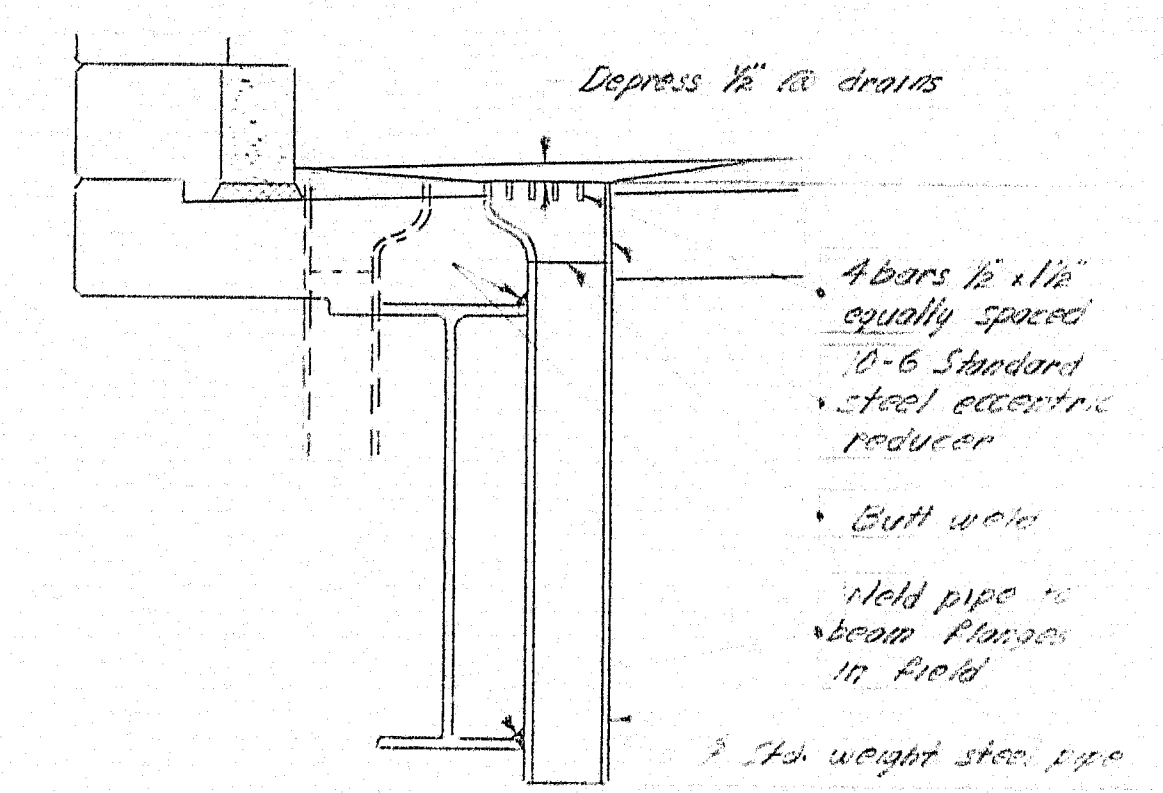

SECTION A-A

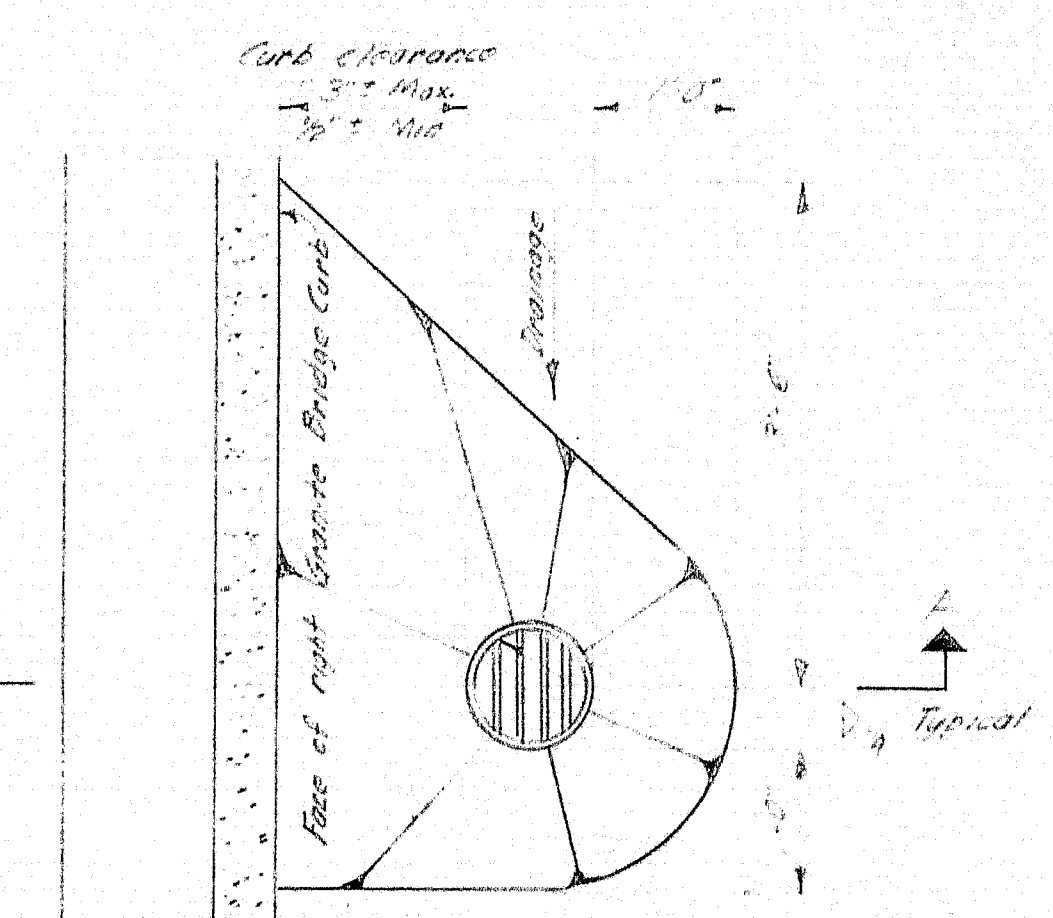


PLAN

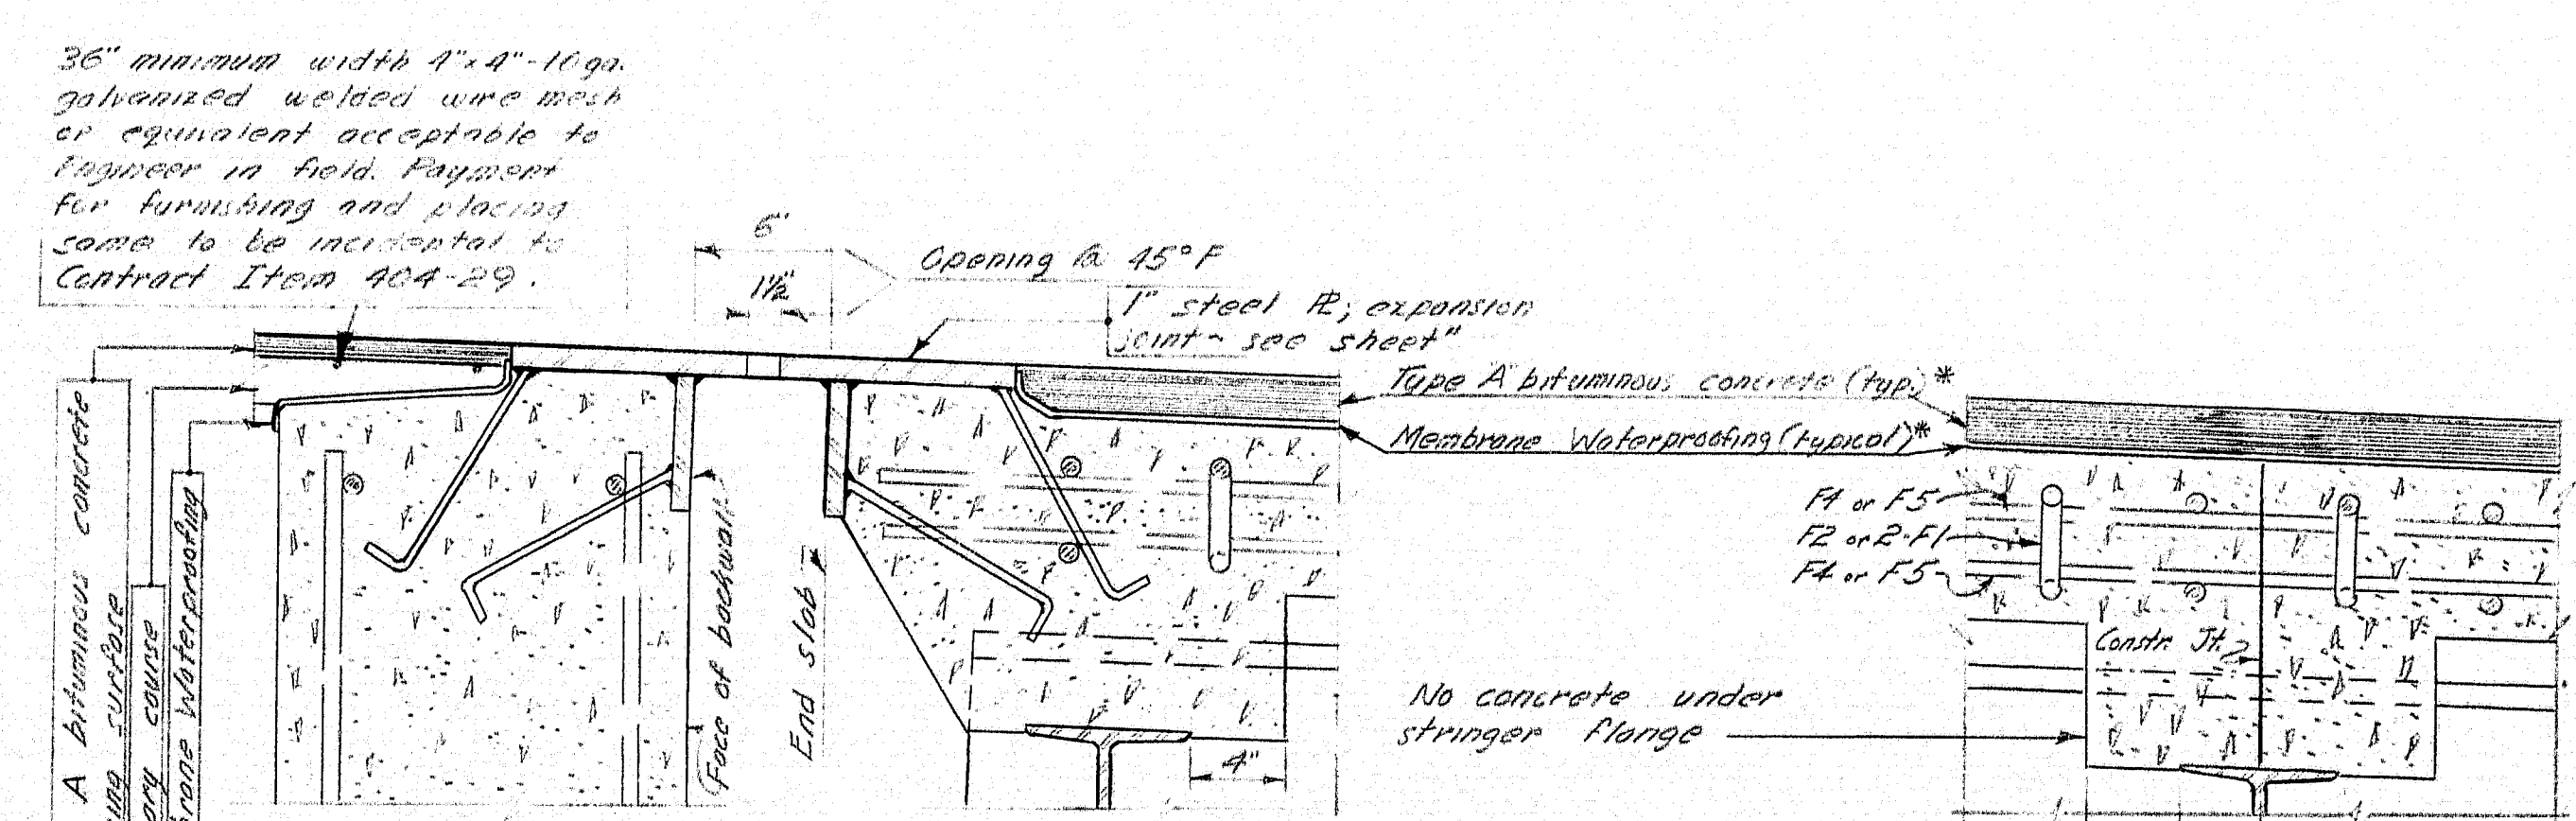


SECTION A-A


Items marked * are not part of this contract

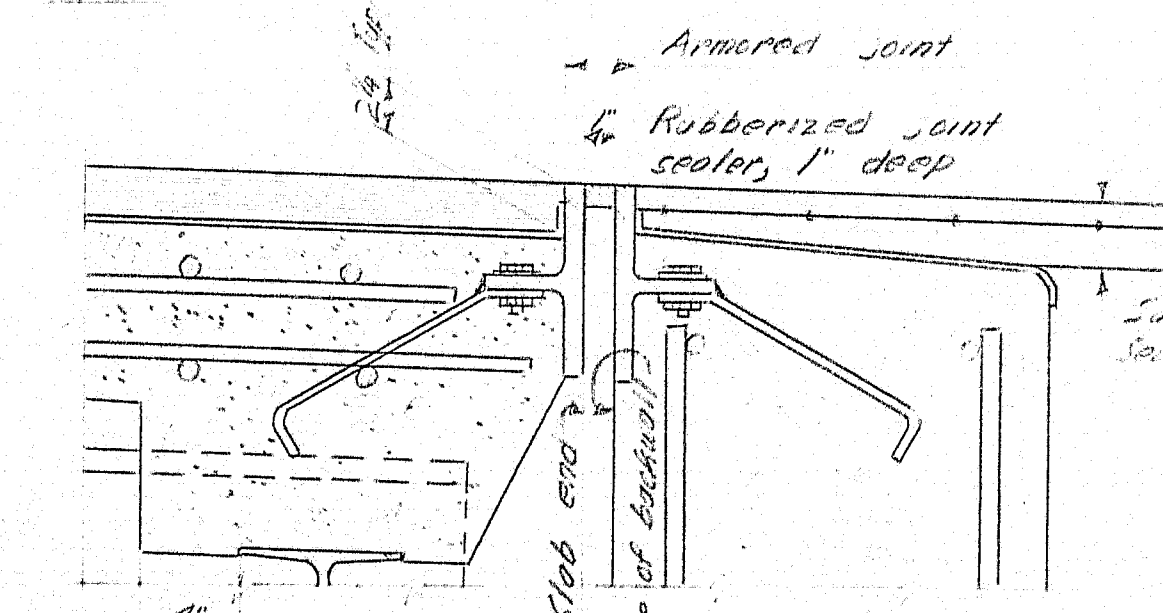

SECTION C-C

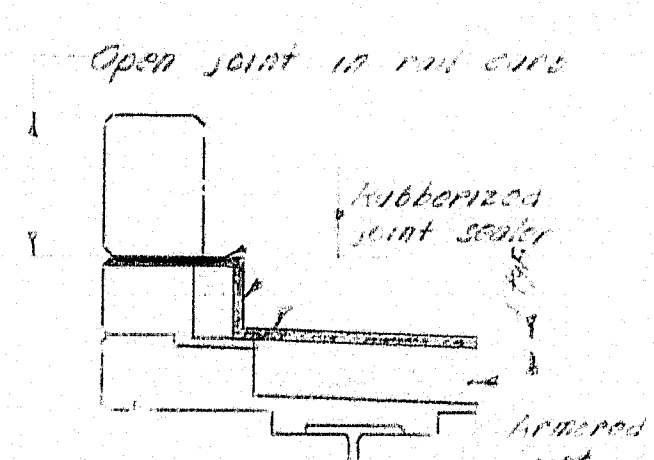

SECTION D-D

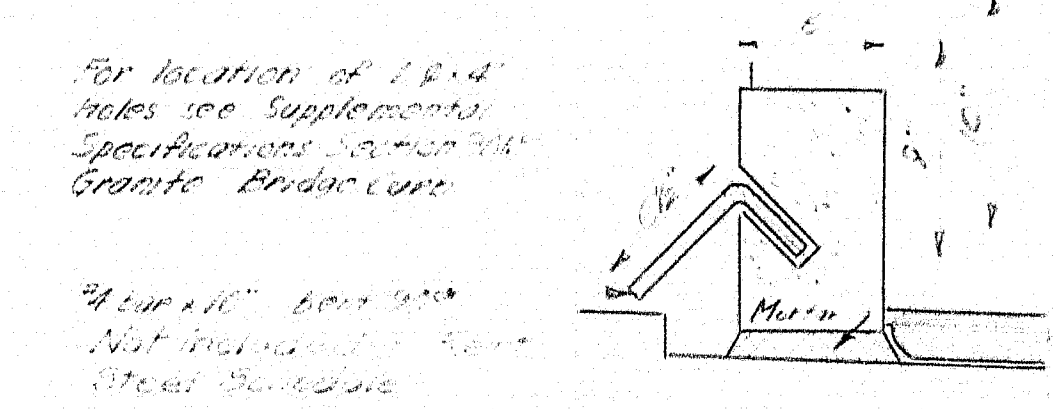

SECTION GRANITE BRIDGE CURB

NOTE:
Opening between slab and backwall of Abutment 2 is to be sealed along the top of the curb, along the roadway with rubberized joint sealer.
Rubberized joint sealer shall be supported on non-bituminous material. At the contractor's option the supporting material may be left in place or removed. If left in place, said material shall be compressible in accordance with A.S.H.O. specification M153-54. If removed, bonding with the rubberized joint sealer shall be prevented by a method satisfactory to the Engineer (layer of fine sand, wax paper, etc.)

SECTION B-B
TYPICAL SLAB CONSTRUCTION JOINT

DESIGN T.H.K. DETAIL E.D.
TRACE E.T.A.
CHECK A.E.S.

STATE HIGHWAY COMMISSION
BRIDGE DIVISION


SEBASTICOOK RIVER BRIDGE

IN THE TOWN OF
PITTSFIELD
SOMERSET COUNTY


SUPERSTRUCTURE N.B. & S.B.

SHEET 17 OF 18 AUGUSTA, MAINE FEB 1963

M-1997

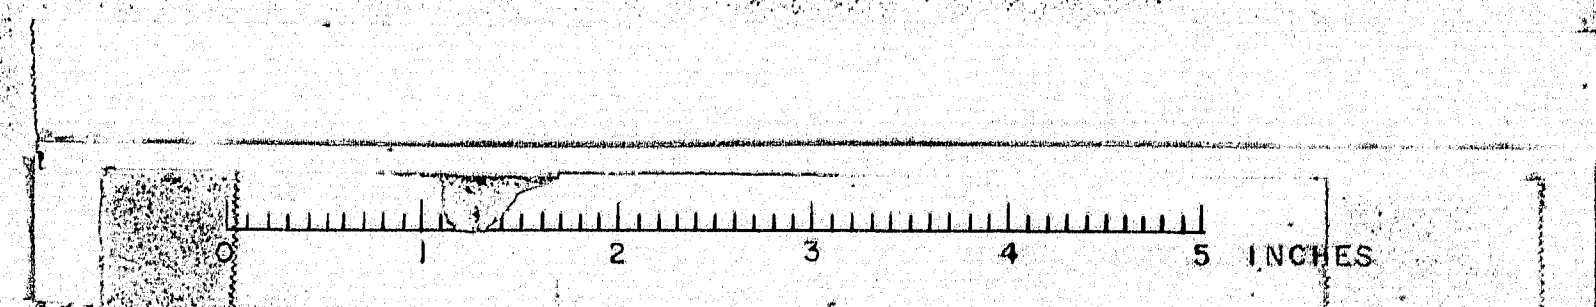

PIERS

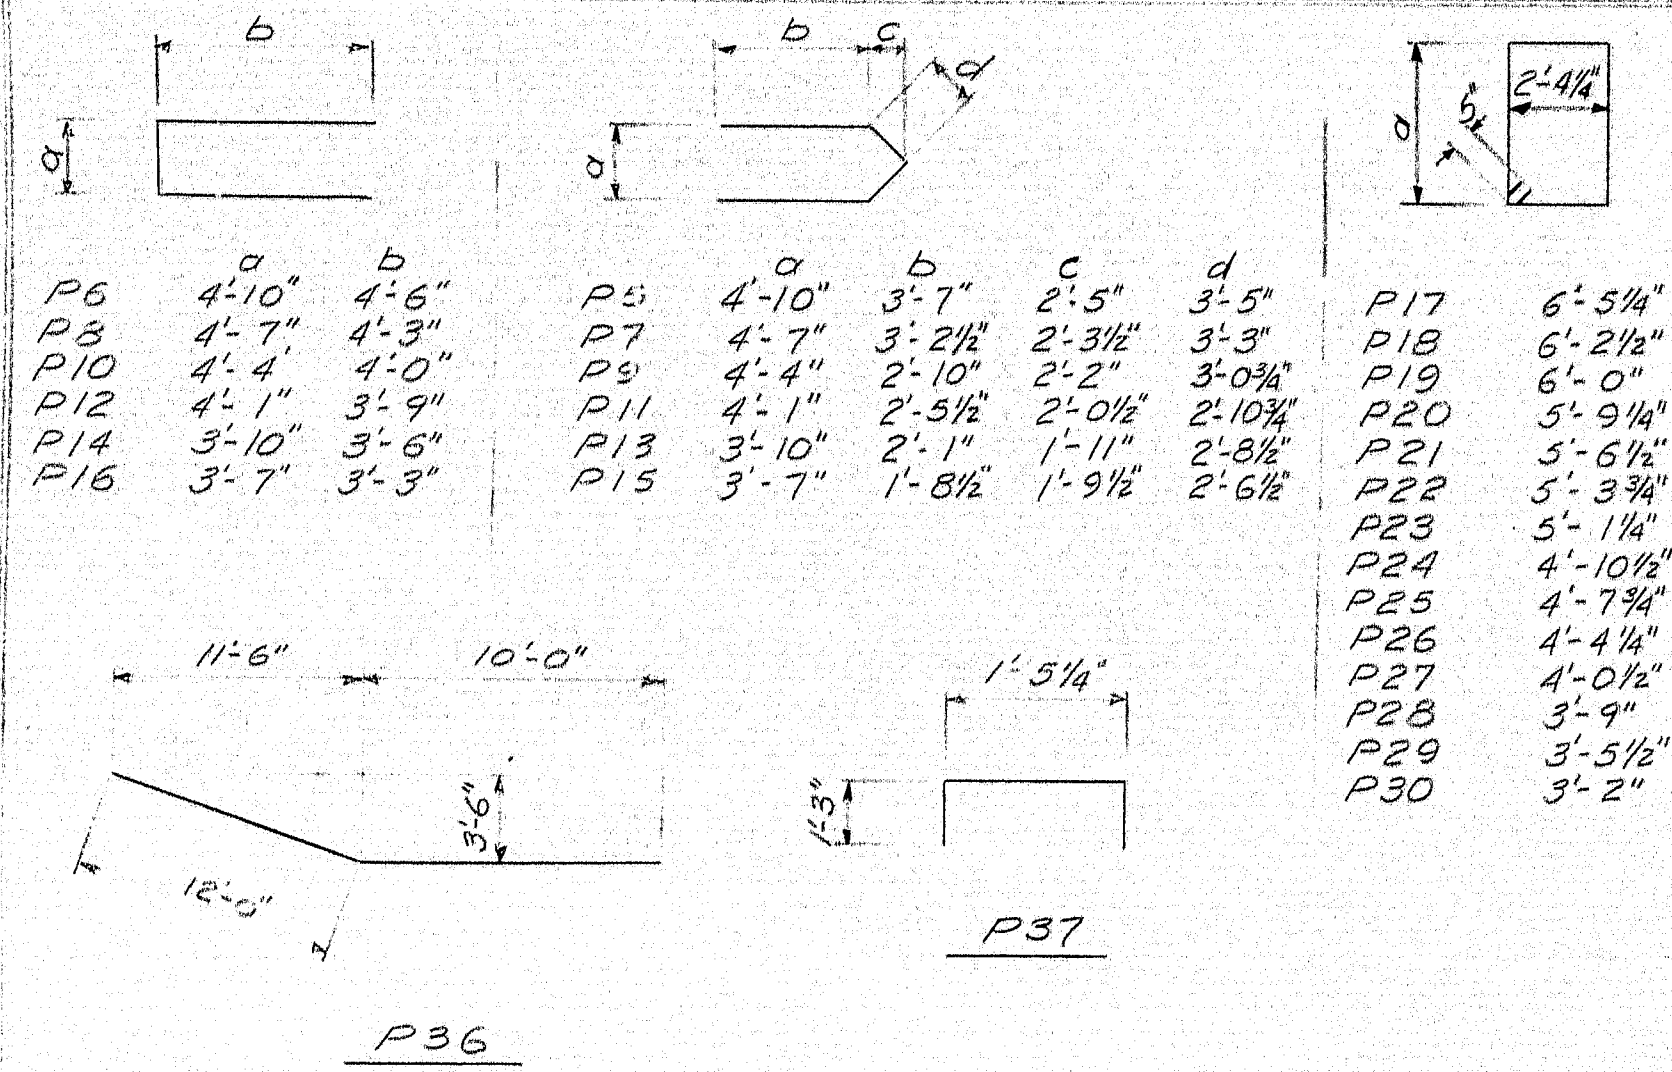


All dimensions to center of bars

MARK	SIZE	LENGTH	NUMBER					LOCATION
			PIER 1 NB	PIER 2 NB	PIER 1 SB	PIER 2 SB	TOTAL	
P6	*5	13'-10"	2	1	2	2	7	Shaft
P8		13'-1"	2	2	2	2	8	
P10		12'-4"	2	2	2	2	8	
P12		11'-7"	2	2	2	2	8	
P14		10'-10"	2	2	2	2	8	
P16	*5	10'-1"	3	3	3	3	12	Shaft
P5	*5	14'-0"	2	1	2	2	7	Shaft
P7		12'-10"	2	2	2	2	8	
P9		11'-10"	2	2	2	2	8	
P11		10'-8"	2	2	2	2	8	
P13		9'-7"	2	2	2	2	8	
P15	*5	8'-6"	3	3	3	3	12	Shaft
P17	*6	18'-5"	26	26	26	26	104	Cap
P18		18'-0"	4	4	4	4	16	
P19		17'-7"	4	4	4	4	16	
P20		17'-1"	4	4	4	4	16	
P21		16'-8"	4	4	4	4	16	
P22		16'-3"	4	4	4	4	16	
P23		15'-9"	4	4	4	4	16	
P24		15'-4"	4	4	4	4	16	
P25		14'-10"	4	4	4	4	16	
P26		14'-3"	4	4	4	4	16	
P27		13'-8"	4	4	4	4	16	
P28		13'-1"	4	4	4	4	16	
P29		12'-6"	4	4	4	4	16	
P30	*6	11'-11"	3	3	3	3	32	Cap
P36	*7	22'-0"	8	8	8	8	32	Cap
P37	*6	4'-0"	12	12	12	12	48	Cap & Bearings

P1	*7	6'-6"	35	35	35	105	Seal-dowels
P2	*6	25'-6"	4	7	7	25	Distribution Slab
P3	*5	16'-6"	26	24	26	102	Shaft
P4	*6	23'-0"	35	35	35	105	Shaft
P31	*11	23'-0"	8	8	8	32	Cap
P32	*11	13'-6"	6	6	6	24	Cap
P33	*11	9'-6"	14	14	14	56	Cap
P34	*6	22'-0"	8	8	8	32	Cap
P35	*6	28'-0"	5	5	5	20	Cap & Bearings
P38	*7	8'-0"		35		35	Seal-dowels
P39	*6	6'-4"		26	26	78	Distribution Slab
P40	*6	21'-0"		35		35	Shaft

ABUTMENTS

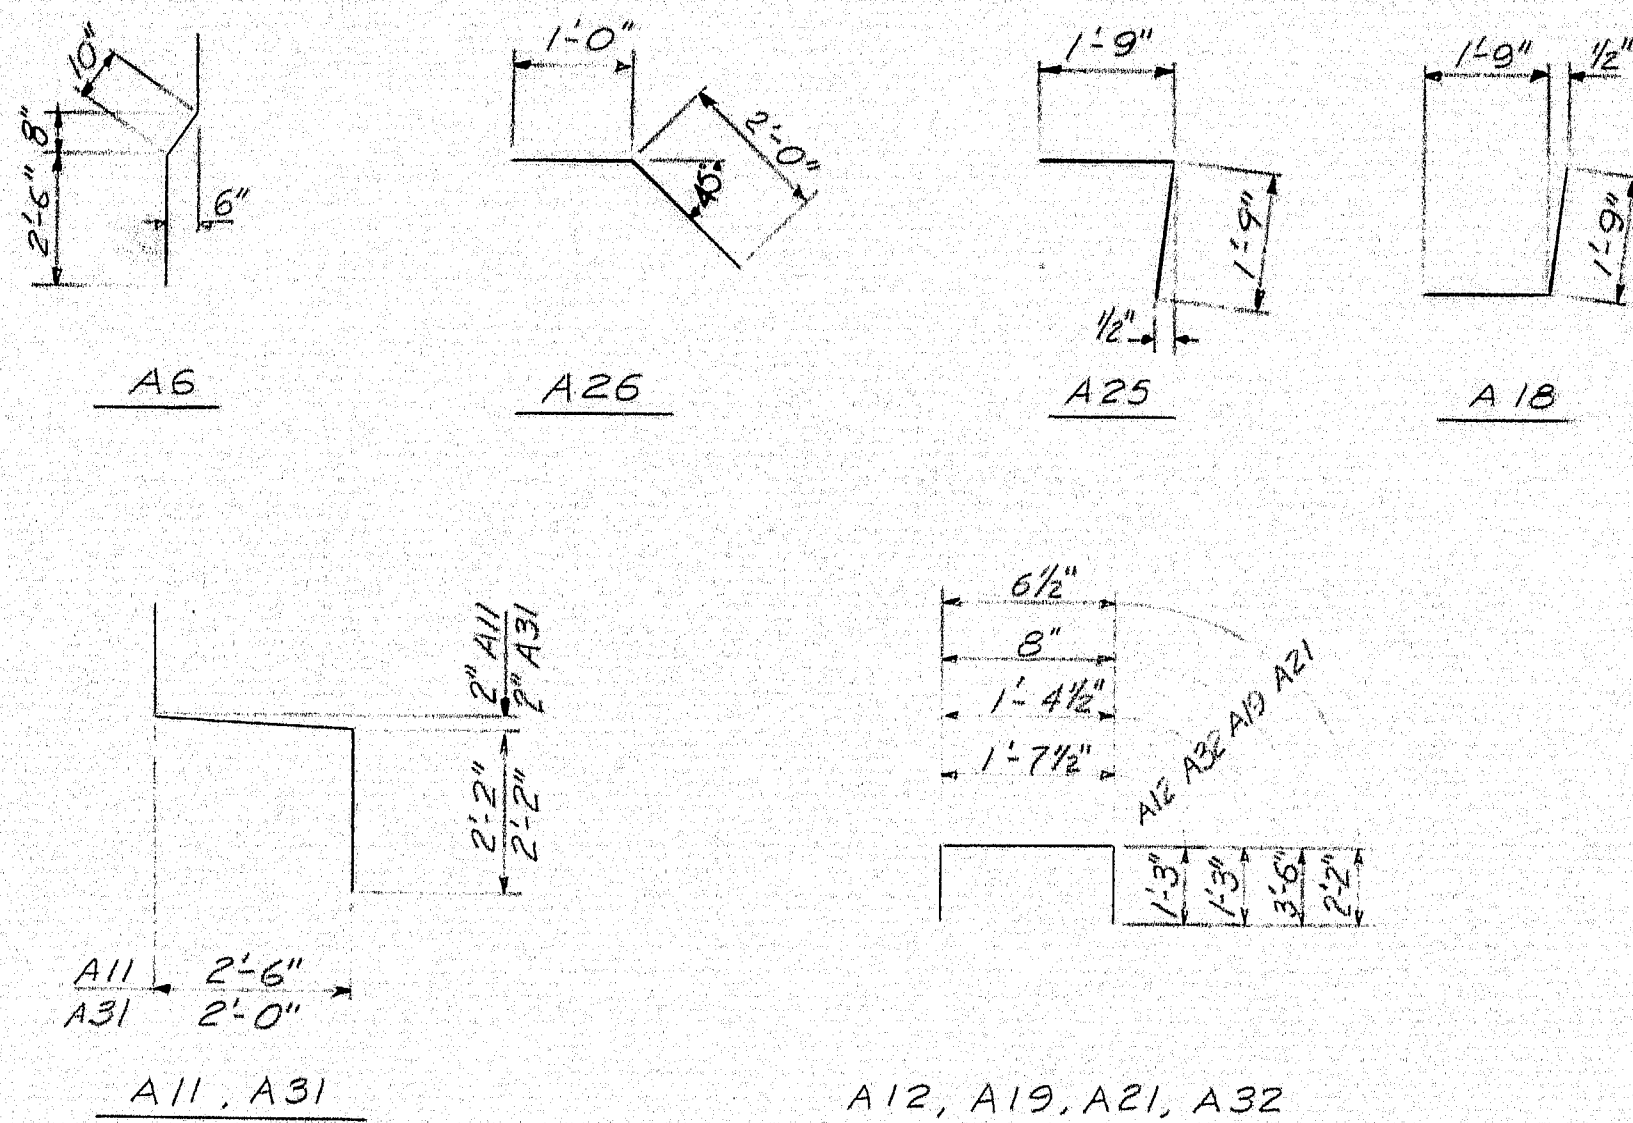


All dimensions to center of bars

MARK	SIZE	LENGTH	NUMBER					LOCATION
			AB. 1 NB	AB. 2 NB	AB. 1 SB	AB. 2 SB	TOTAL	
A6	*5	5'-1"	40	40	40	40	160	Backwall
A11	*5	6'-4"	28		28		56	Bridge Seat
A12	*5	4'-2"	18		18		36	Bearings
A18	*6	3'-6"	11	11	11	11	44	D.S. Wings
A19	*5	7'-8"	22	22	22	22	88	U.S. & D.S. Wings
A21	*5	4'-10"	6	6	6	6	24	End Posts
A25	*6	3'-6"	13	13	13	13	52	U.S. Wings
A26	*5	3'-0"	26	26	26	26	104	Backwall to Appr. Sl.
A31	*5	5'-10"		28		28	56	Bridge Seat
A32	*5	4'-0"		18		18	36	Bearings

A1	*6	6'-0"	78	78	78	78	312	Footing
A2	*6	23'-3"	28	28	28	28	112	Footing
A3	*6	14'-5"	16	16	16	16	64	Footing
A4	*6	3'-0"	36	36	36	36	144	Footing
A5	*5	5'-0"	20	20	20	20	80	Footing to Backwall
A7		5'-6"	20	20	20	20	80	" " "
A8		23'-0"	15	15	15	15	60	Backwall
A9		21'-6"	15	15	15	15	60	" " "
A10		3'-4"	28	28	28	28	112	Footing to Br. Seat
A13		2'-8"	18	18	18	18	72	Bearings
A14	*5	5'-8"	11	11	11	11	44	D.S. Wings
A15	*6	6'-2"	11	11	11	11	44	D.S. Wings
A16	*4	10'-6"	21	21	21	21	84	U.S. & D.S. Wings
A17	*6	10'-6"	24	24	24	24	96	" " "
A20	*4	10'-0"	8	8	8	8	32	" " "
A22	*4	1'-8"	8	8	8	8	32	End Posts
A23	*5	6'-9"	11	11	11	11	44	U.S. Wings
A24	*6	7'-3"	11	11	11	11	44	U.S. Wings
A27	*5	4'-9"	58	58	58	58	232	Backwall & Wings
A31	*4	38'-6"	20	20	20	20	80	Approach Slabs
A32	*6	14'-6"	156	156	156	156	624	" " "

SUPERSTRUCTURE SLAB

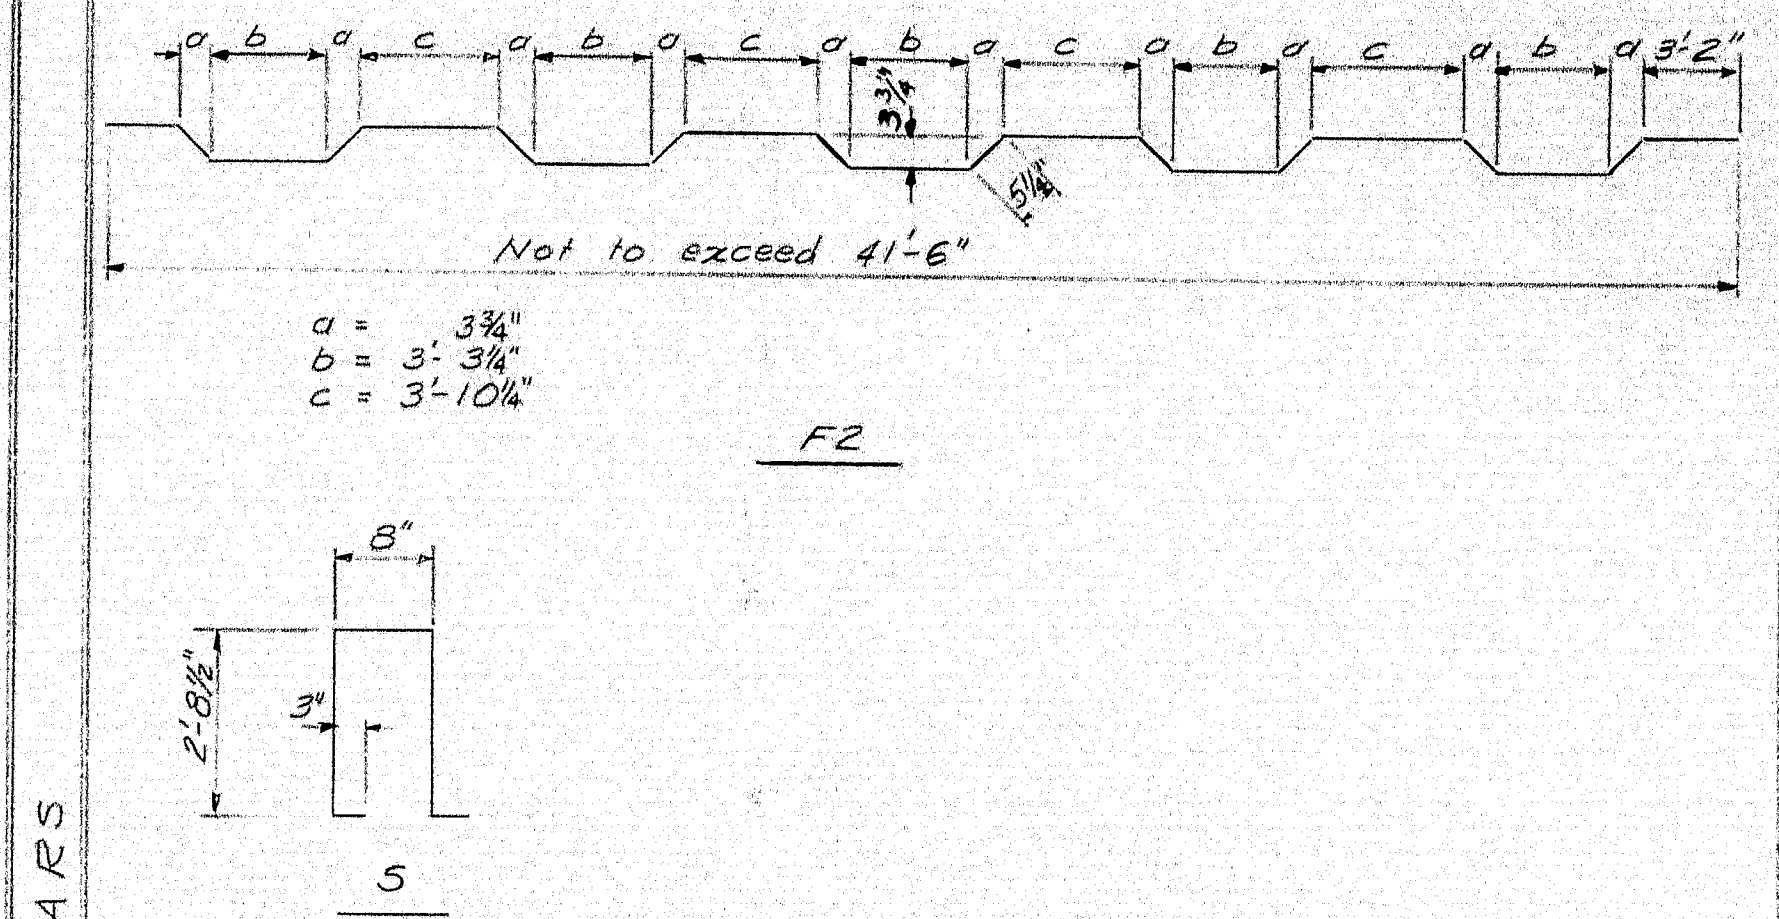


All dimensions to center of bars


MARK	SIZE	LENGTH	NUMBER			LOCATION
			NORTHBOUND	SOUTHBOUND	TOTAL	
F2	*6	42'-9"	190	190	380	Slab Transverse bars
S	*4	6'-7"	360	360	720	Curbs
F1	*6	42'-9"	382	382	764	Slab Transverse bars
F3	*6	26'-0"	32	32	64	Over Piers
F4	*6	25'-2"	444	444	888	Slab Longit. bars
F5	*6	40'-0"	148	148	296	" " "
F6	*6	3'-0"	188	188	376	Slab Transverse bars
C1	*4	23'-7"	32	32	64	Curbs
C2	*4	20'-11"	48	48	96	Curbs

All Reinforcing Steel to be Intermediate Grade.

DESIGN T.H.K.
 DETAIL T.H.K. & R.D.
 CHECK A.R.S.
 STATE HIGHWAY COMMISSION
 BRIDGE DIVISION
SEBASTICOOK RIVER BRIDGE
 IN THE TOWN OF
PITTSFIELD
SOMERSET COUNTY
 REINFORCING STEEL
 SHEET 18 OF 18 AUGUSTA, MAINE FEB 1963


M-1998

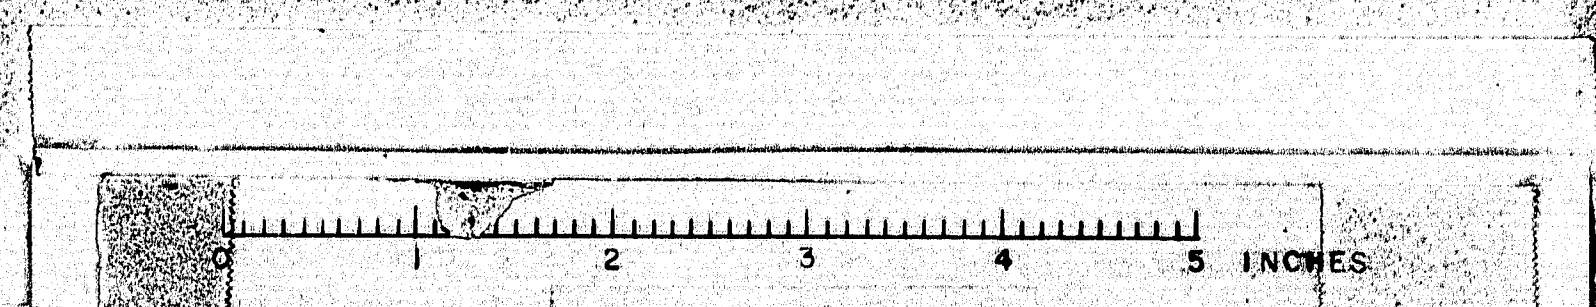

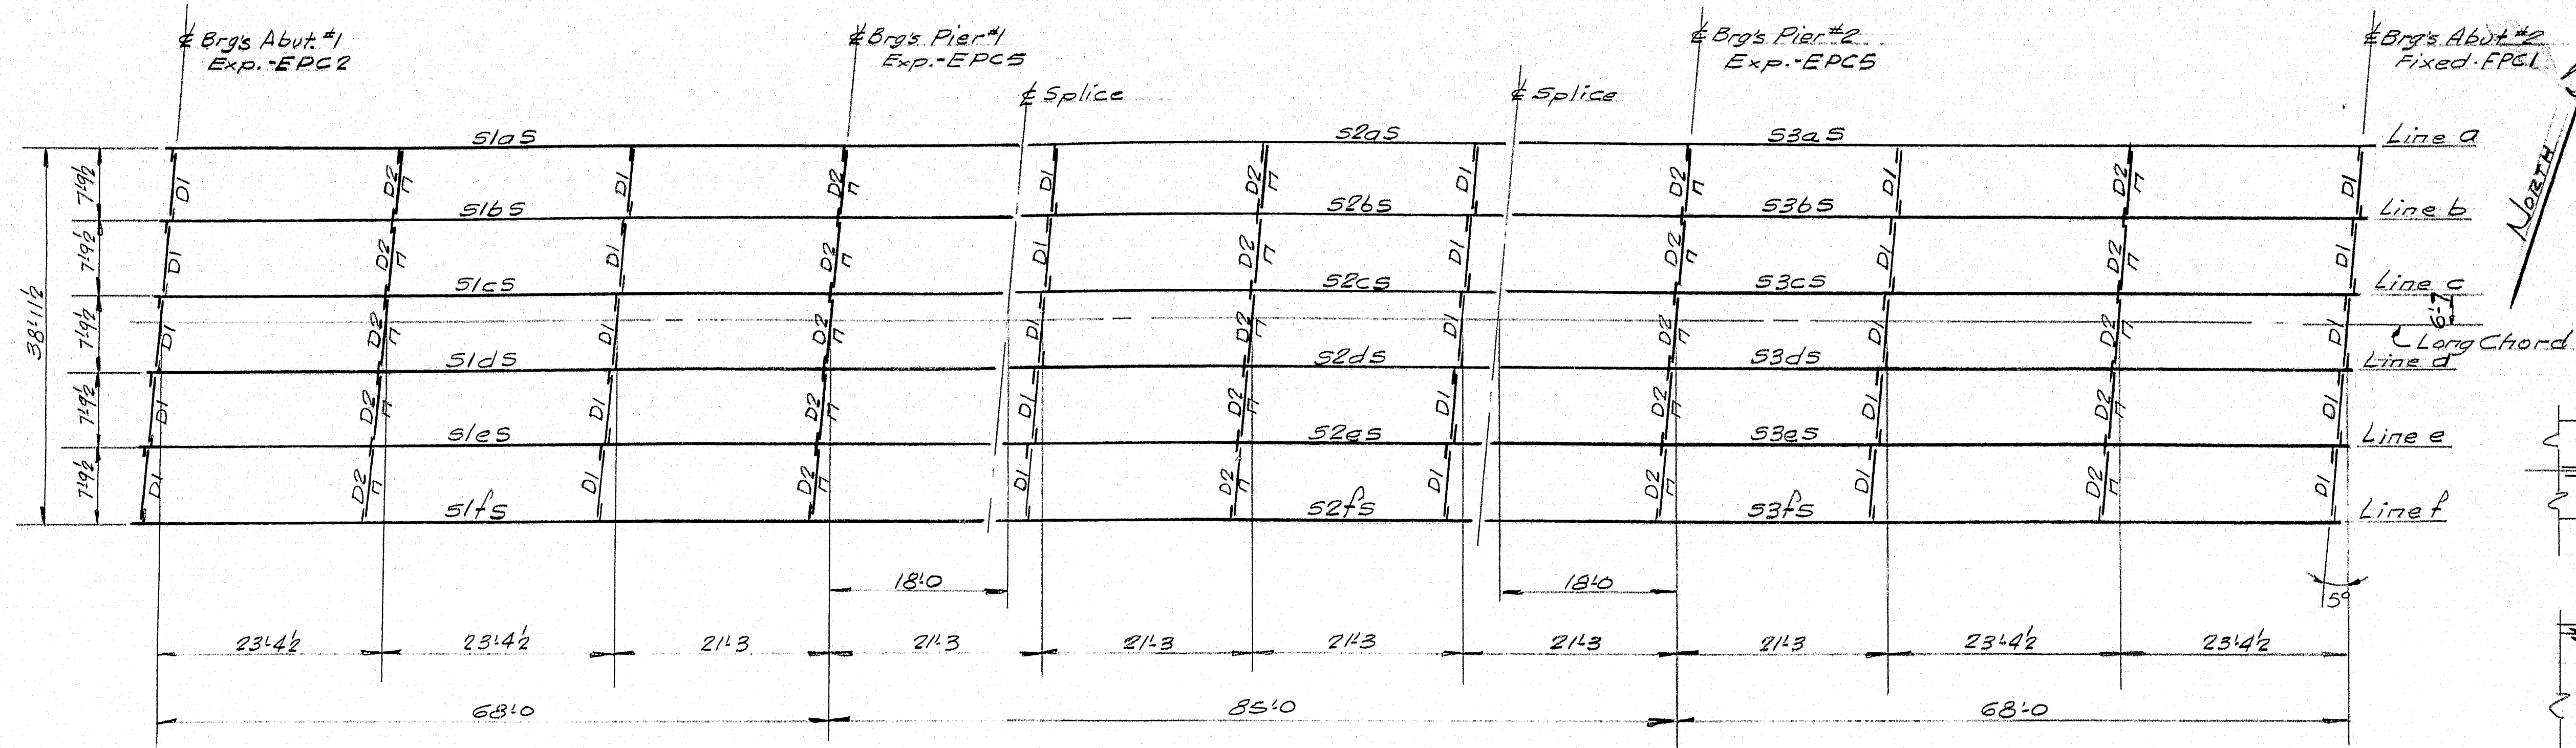


FRAMING PLAN
Dimensions Horizontal


Diaphragms D1-16WF36
D2-15F33.9

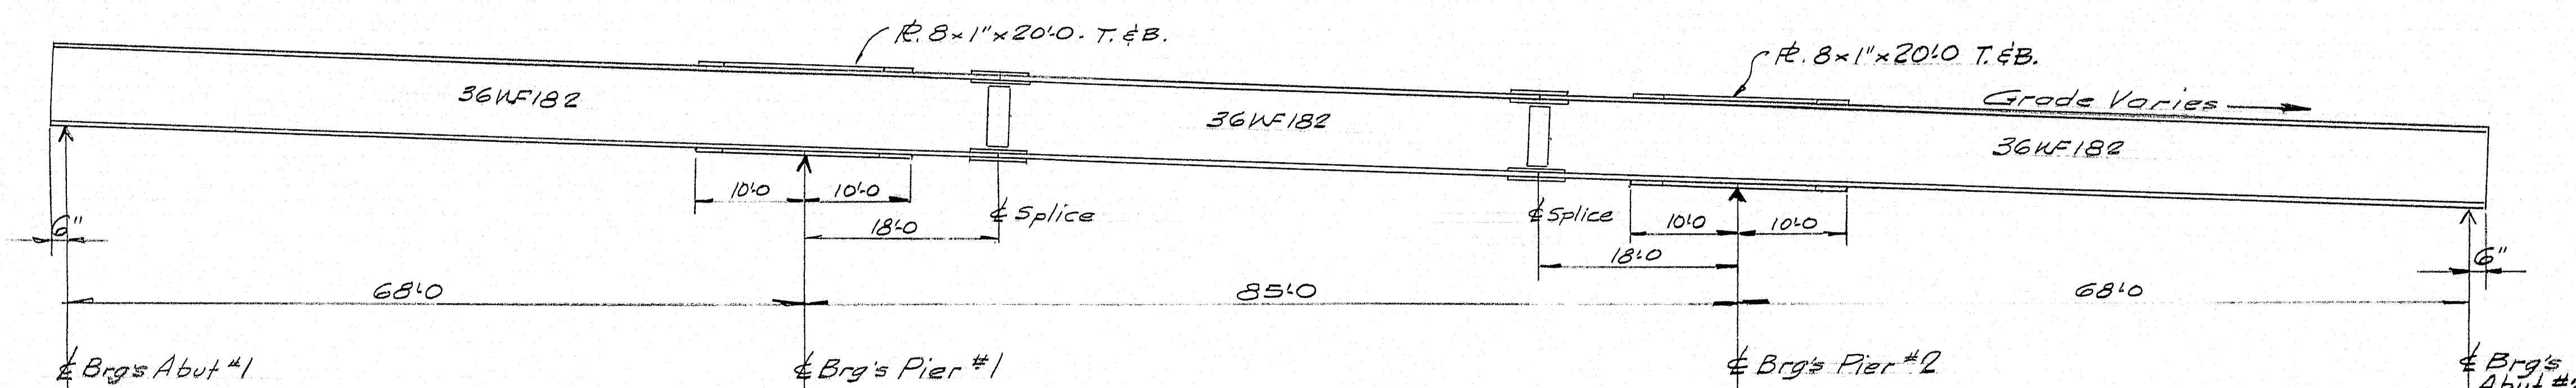

ELEVATION

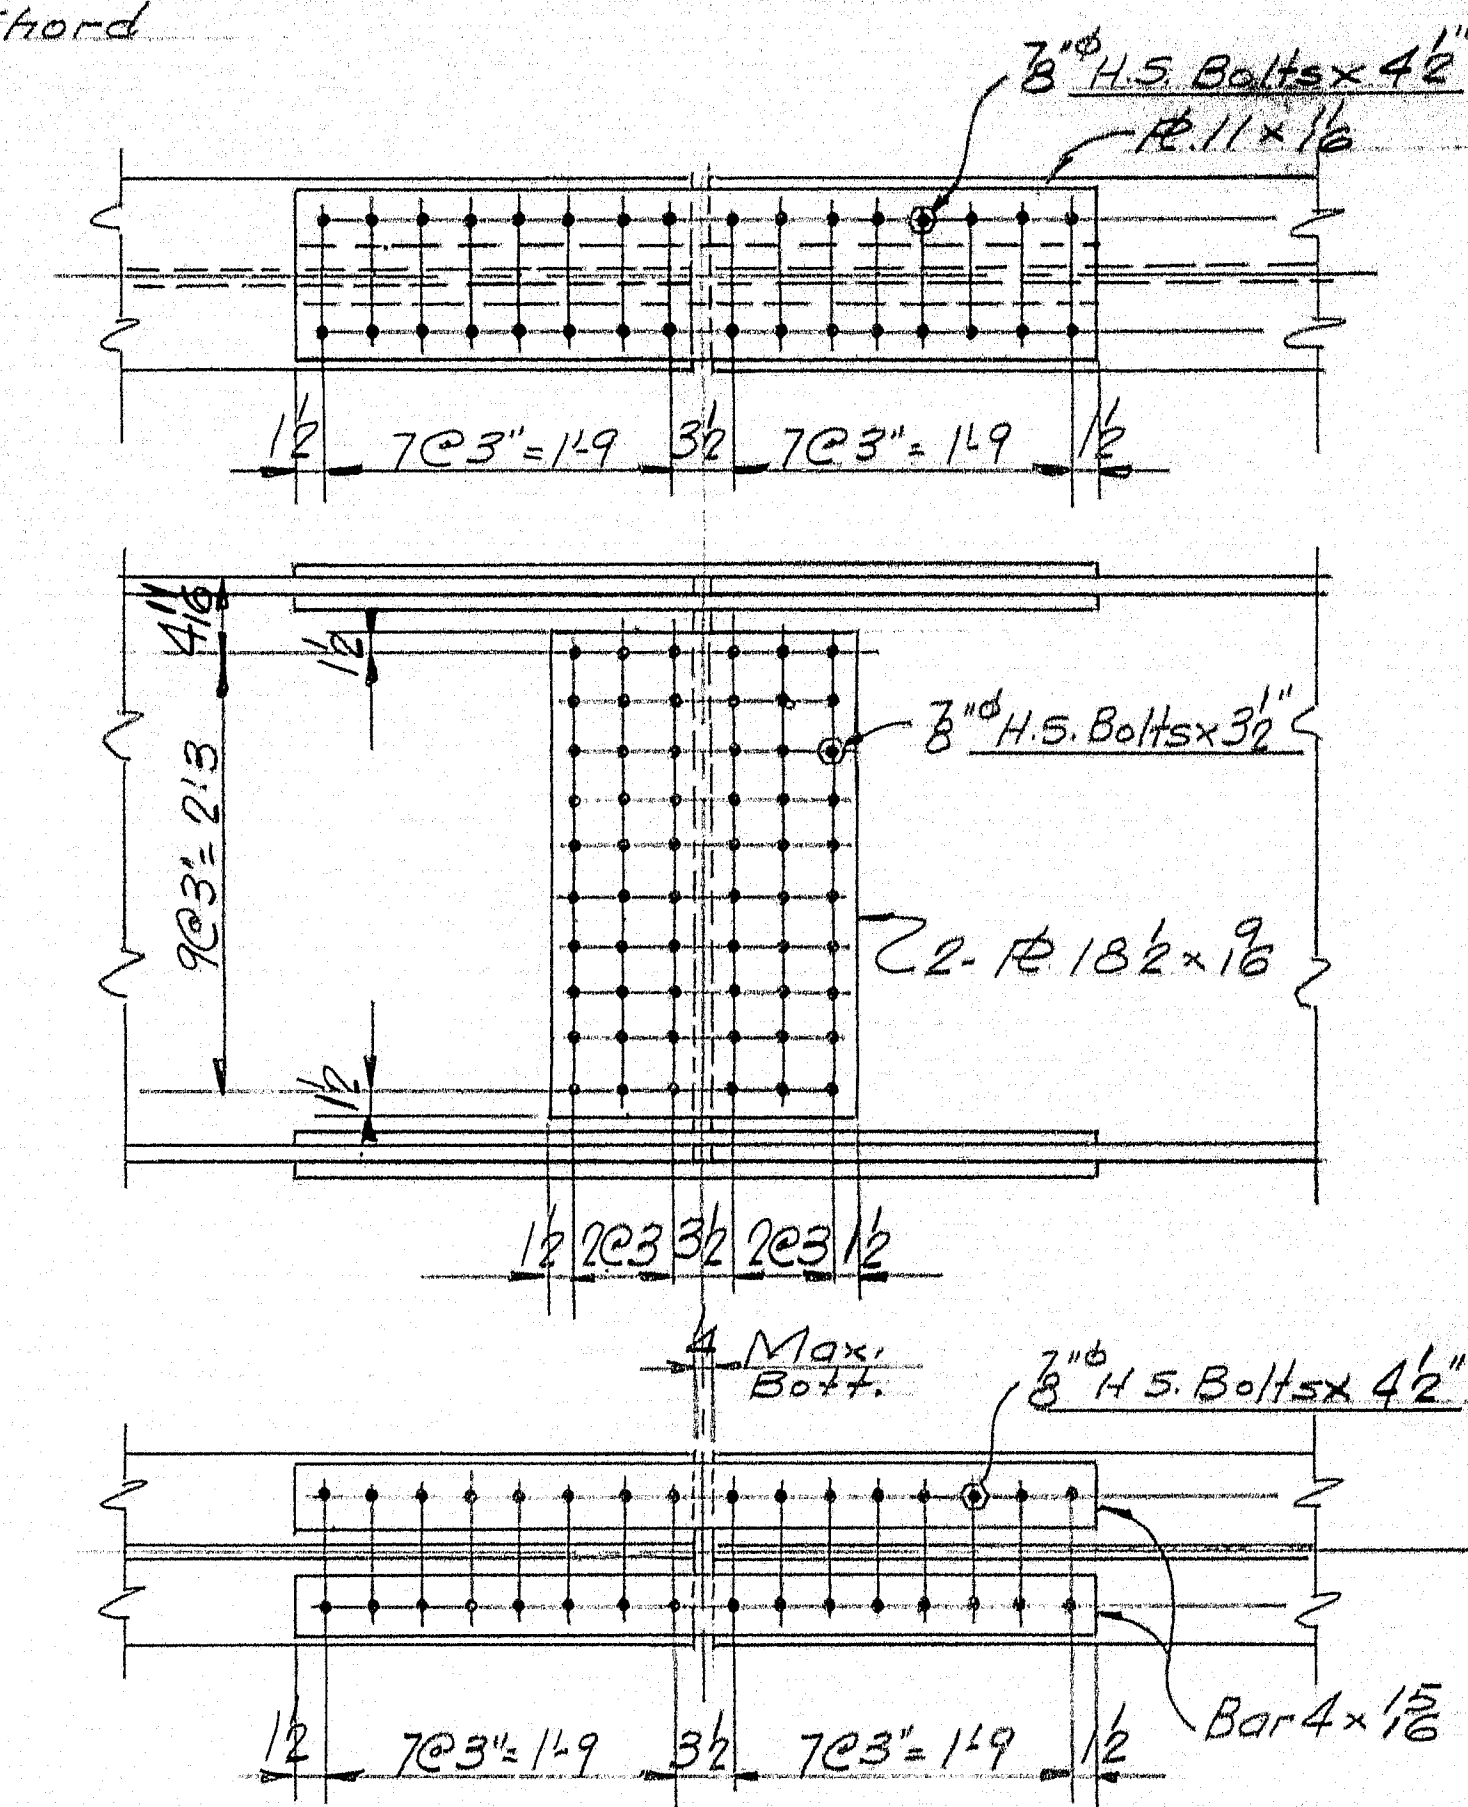

SPICE DETAIL

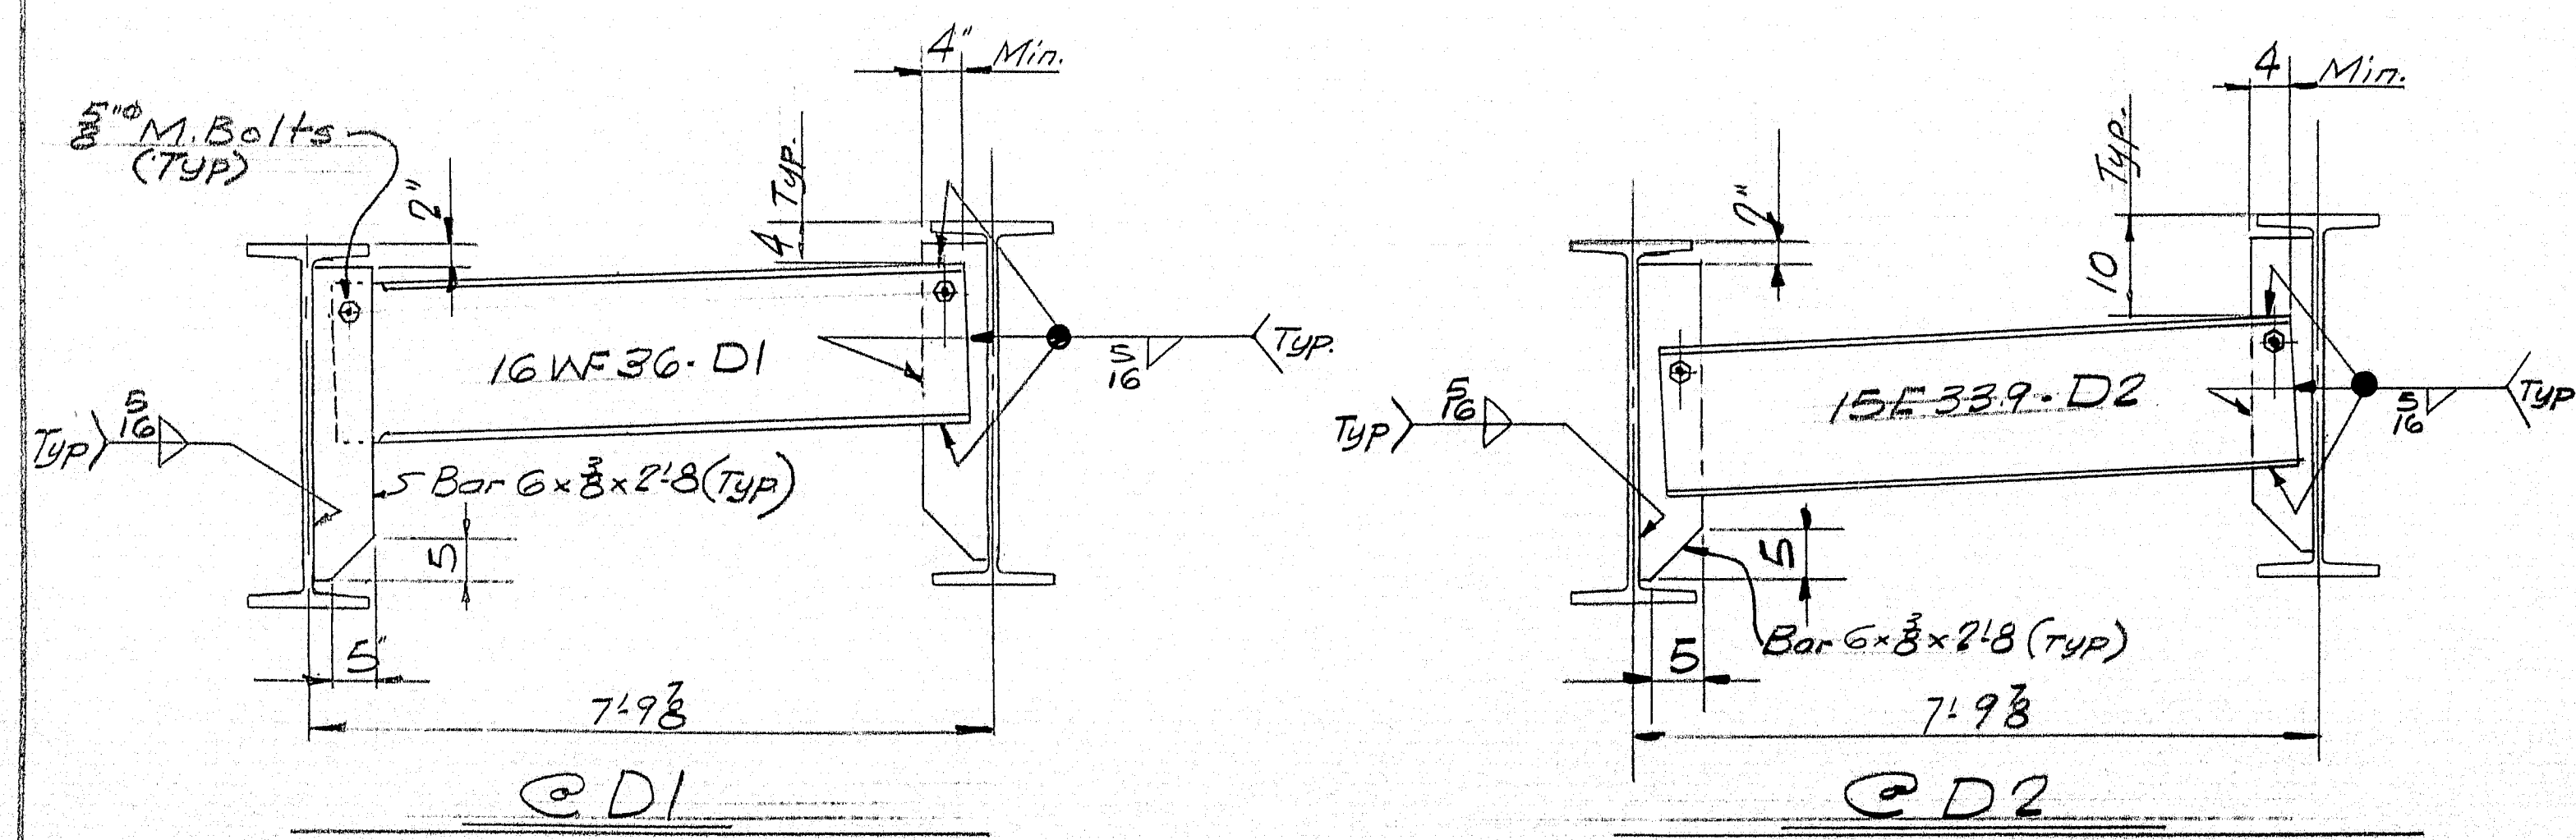


DIAPHRAGM DETAILS
Looking West


GENERAL NOTES

- 1) Material for stringers, cover plates & splices shall conform to A.S.T.M. Desig. A36. All other steel shall conform to either A.S.T.M. A36 or A7.
- 2) Holes in field splices of continuous beams are to be sub-punched (or sub-drilled) and reamed while assembled in the shop and connecting parts to be match marked and bolted for shipment.
- 3) Bearings to be field welded to stringers


SOUTH BOUND	
FRAMING PLAN	
Bancroft & Martin Rollings Mills Company South Portland 7, Maine	
SEBASTICOOK BRIDGE PITTSFIELD, MAINE	
CUSTOMER CIANCHETTE BROS.	
DESIGNER MAINE S.H.C. BRIDGE DIV.	
ORDER NO. 1/VERBAL	DWG. NO. B63-48-E1

DRAWN	4-3-63 J.P.F.
REVISION	
REVISION	
REVISION	

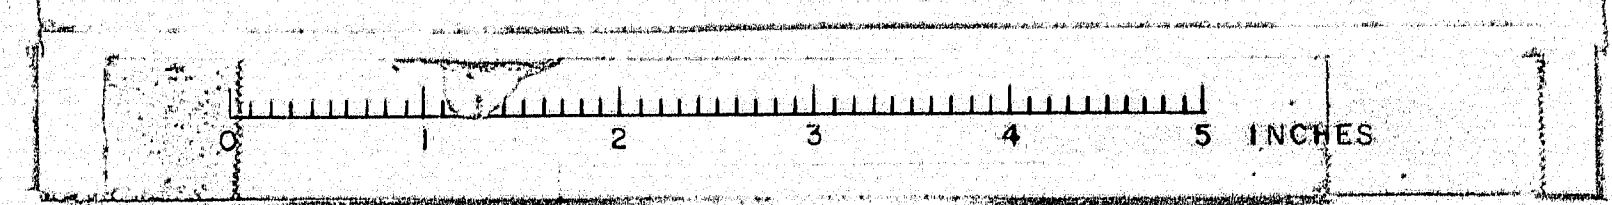


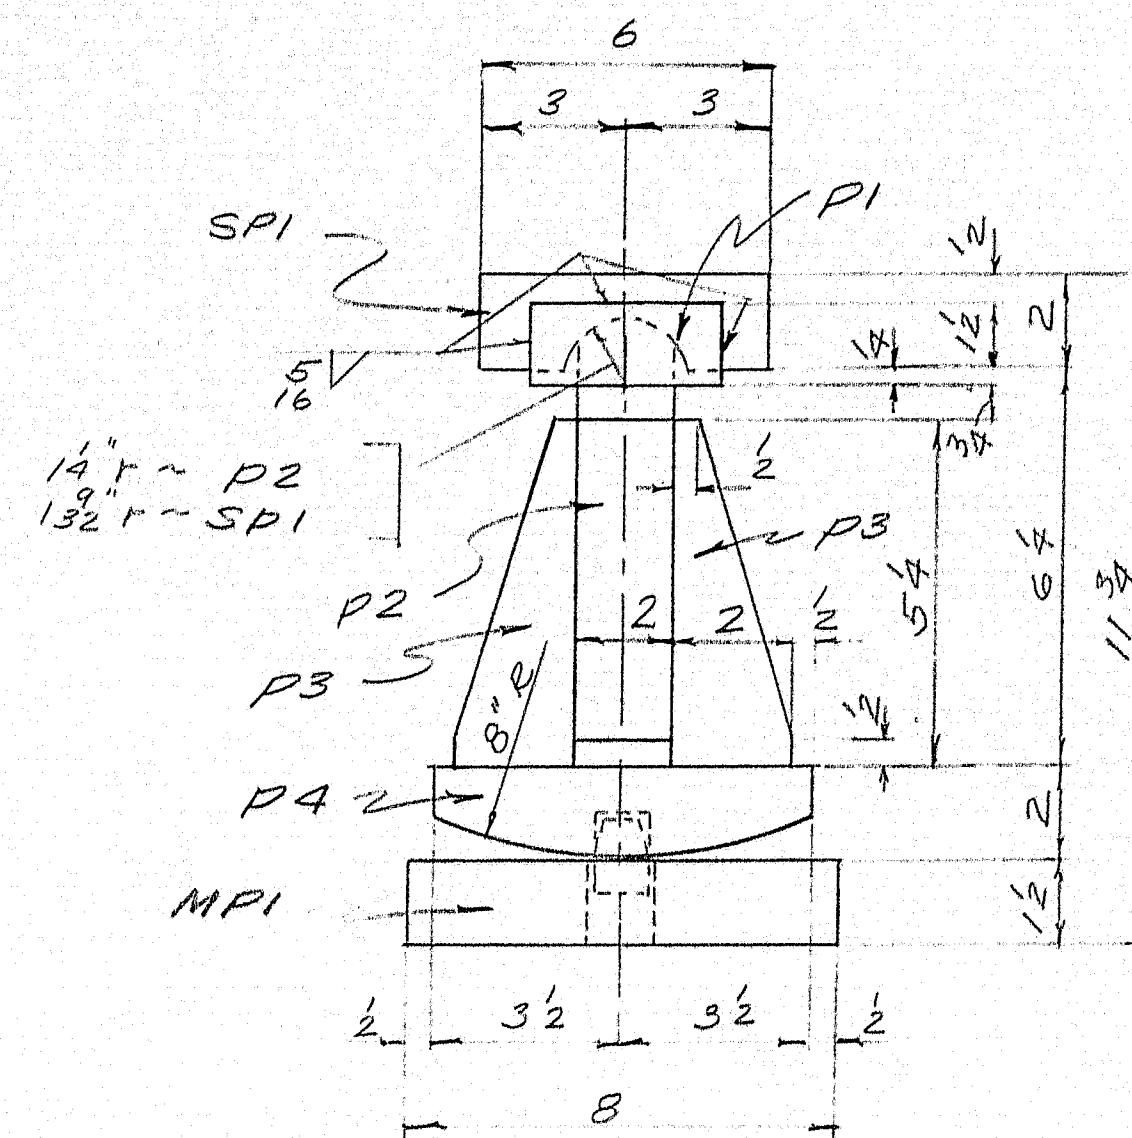






EXPANSION PEDESTAL EPC2 ~ 12 REQ'D.

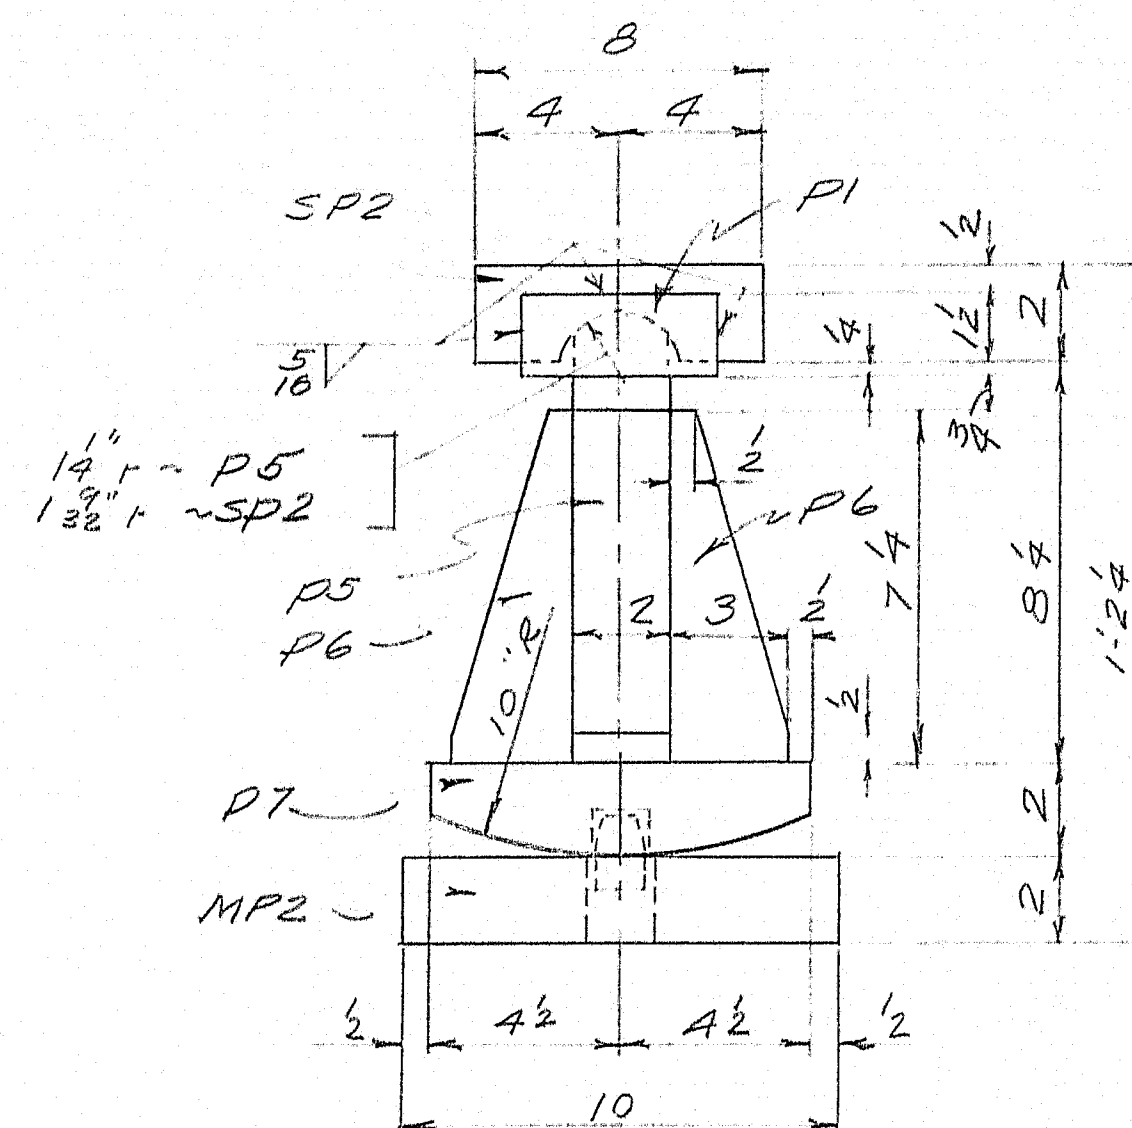


EXPANSION PEDESTAL EPC5 ~ 24 REQ'D.

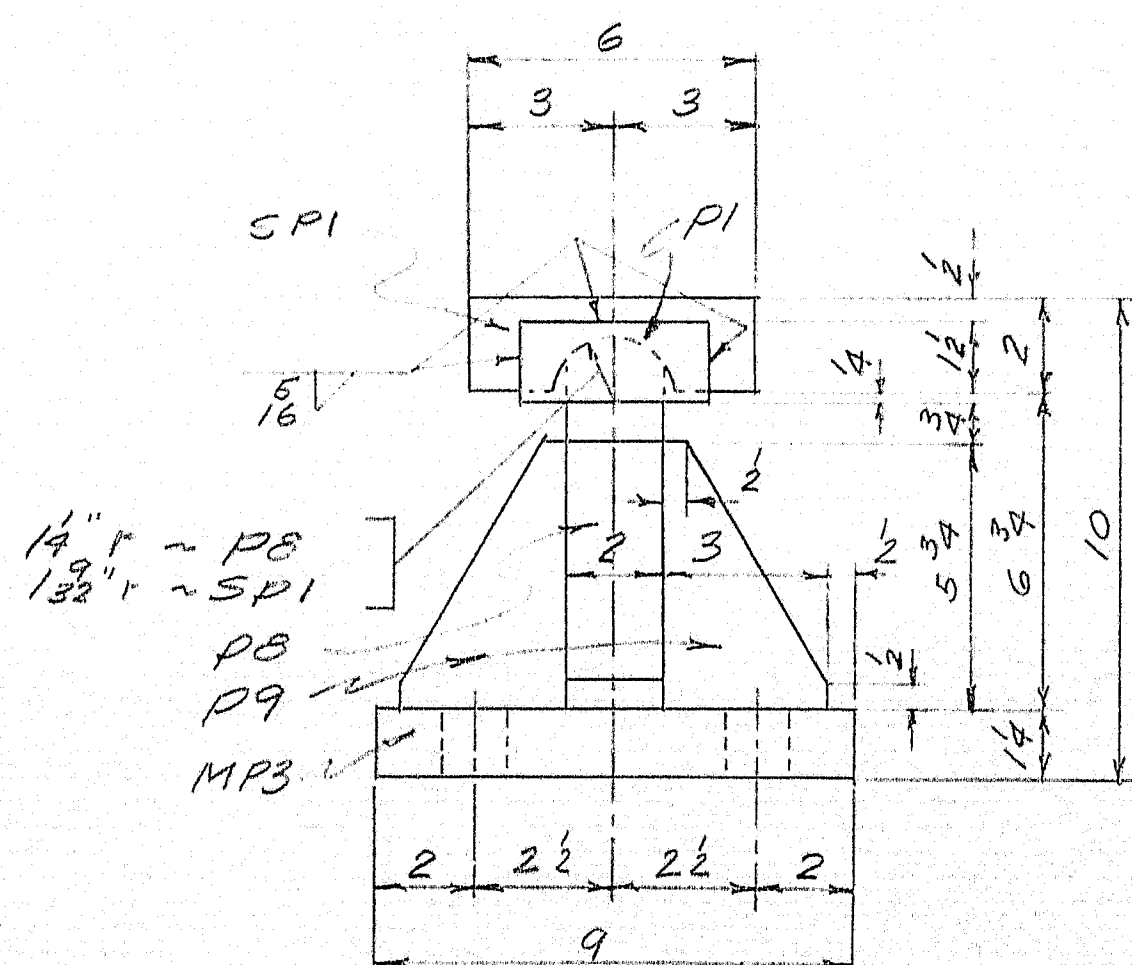

FIXED PEDESTAL FPC1 ~ 12 REQ'D.

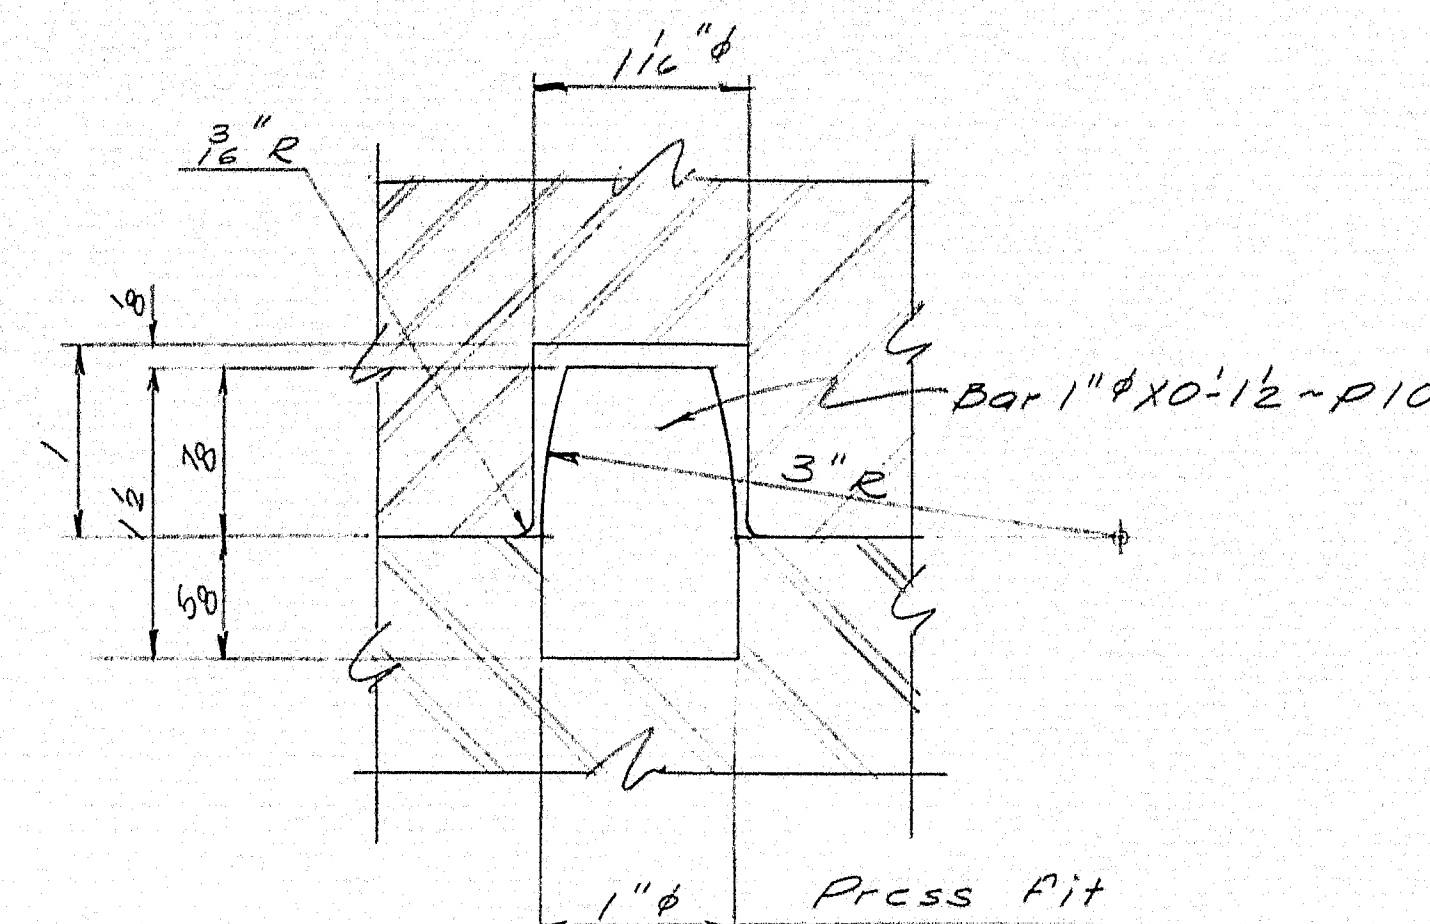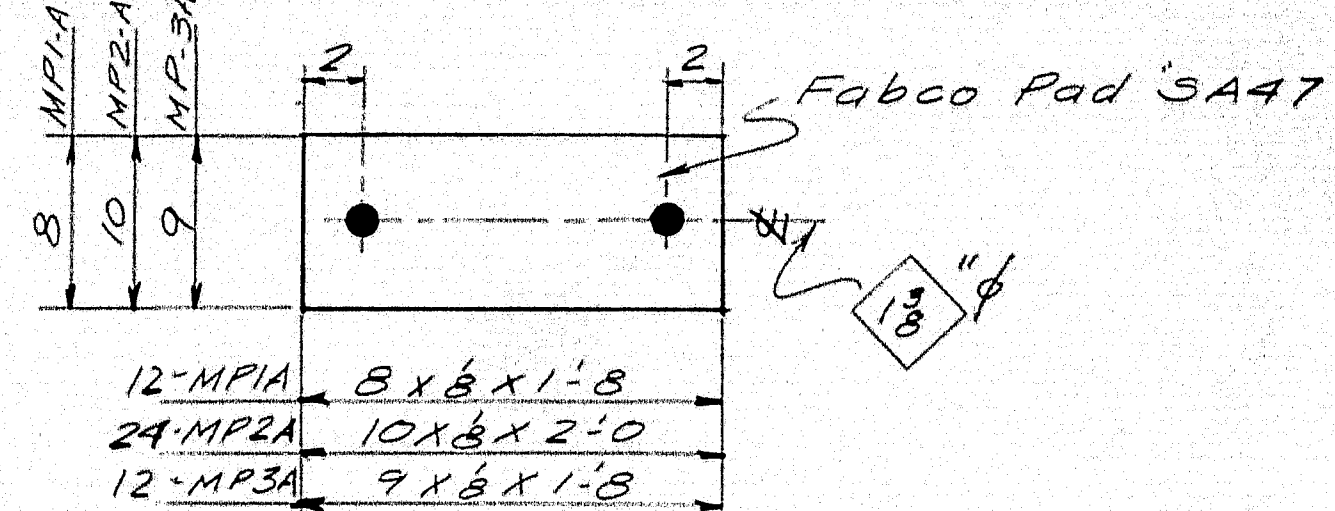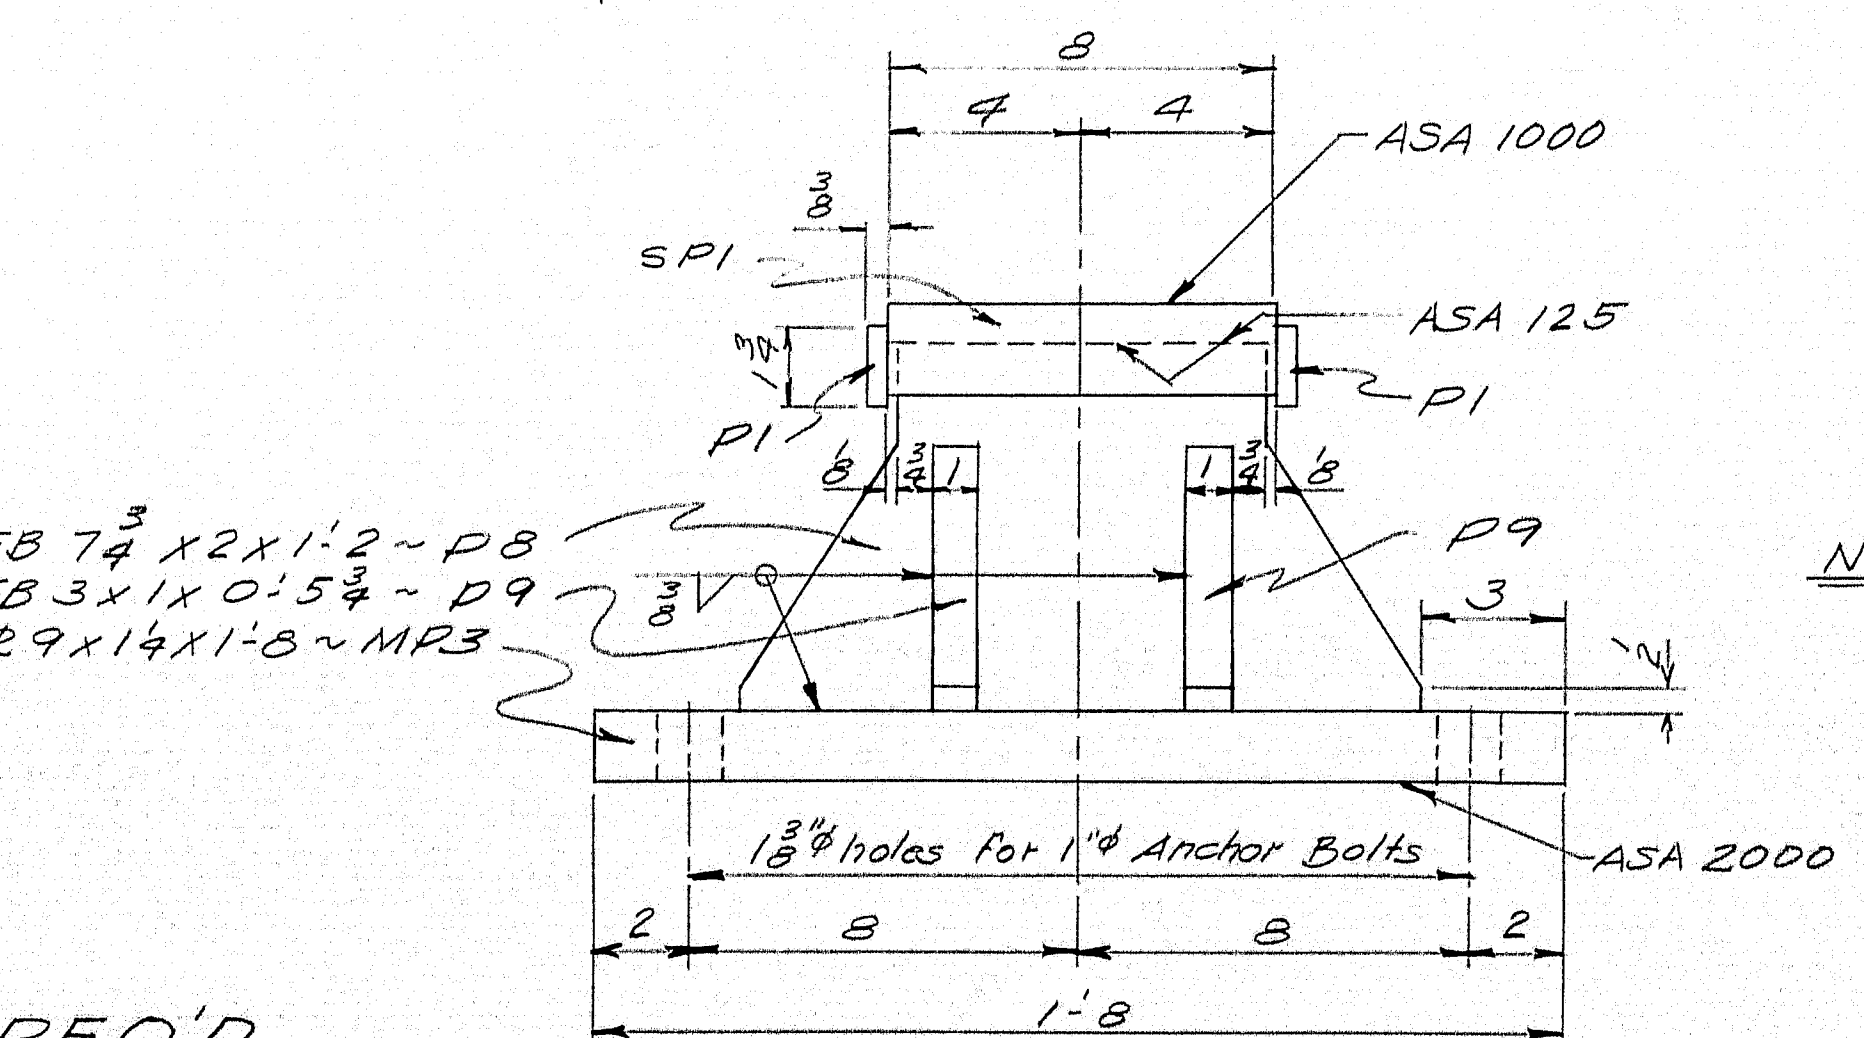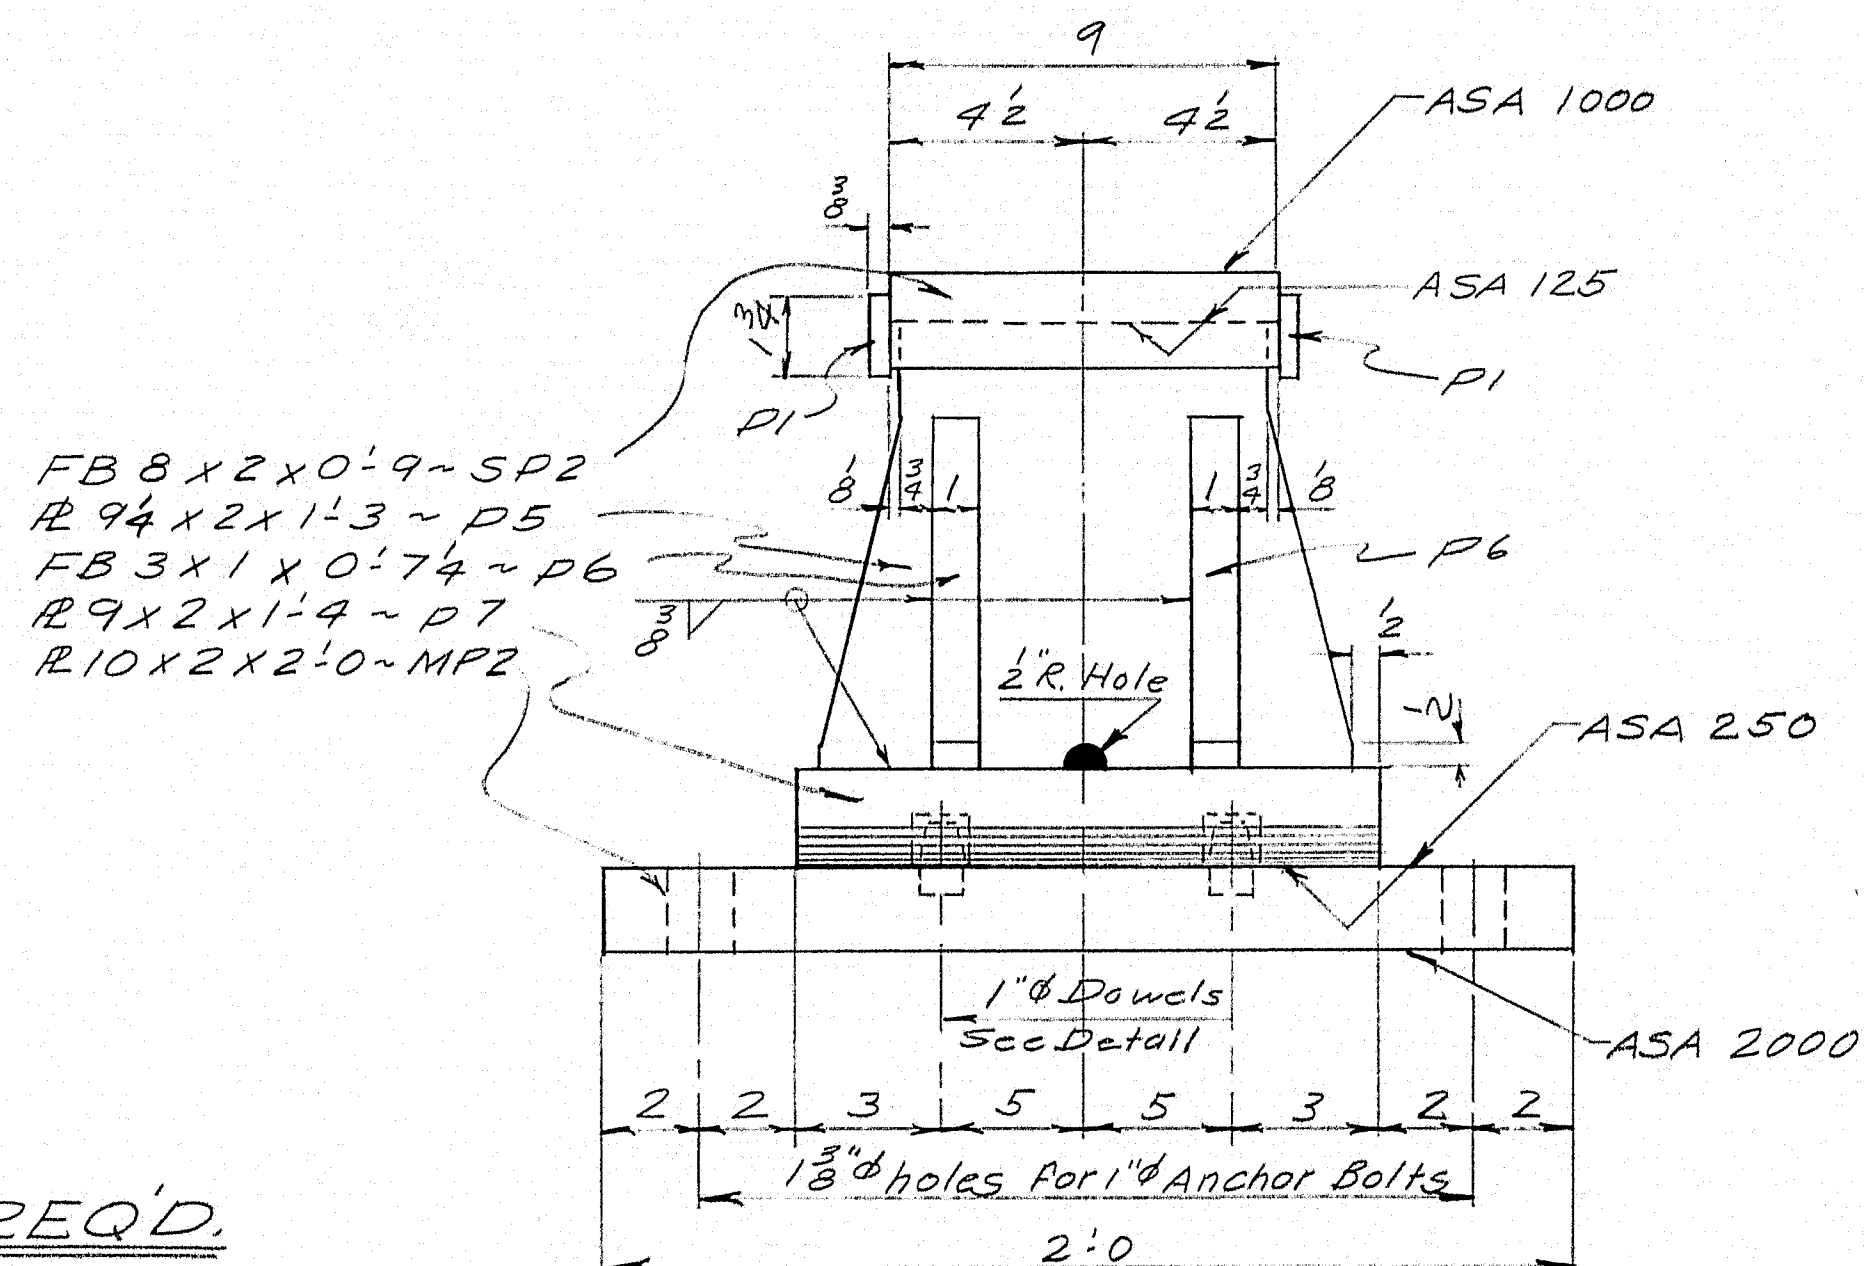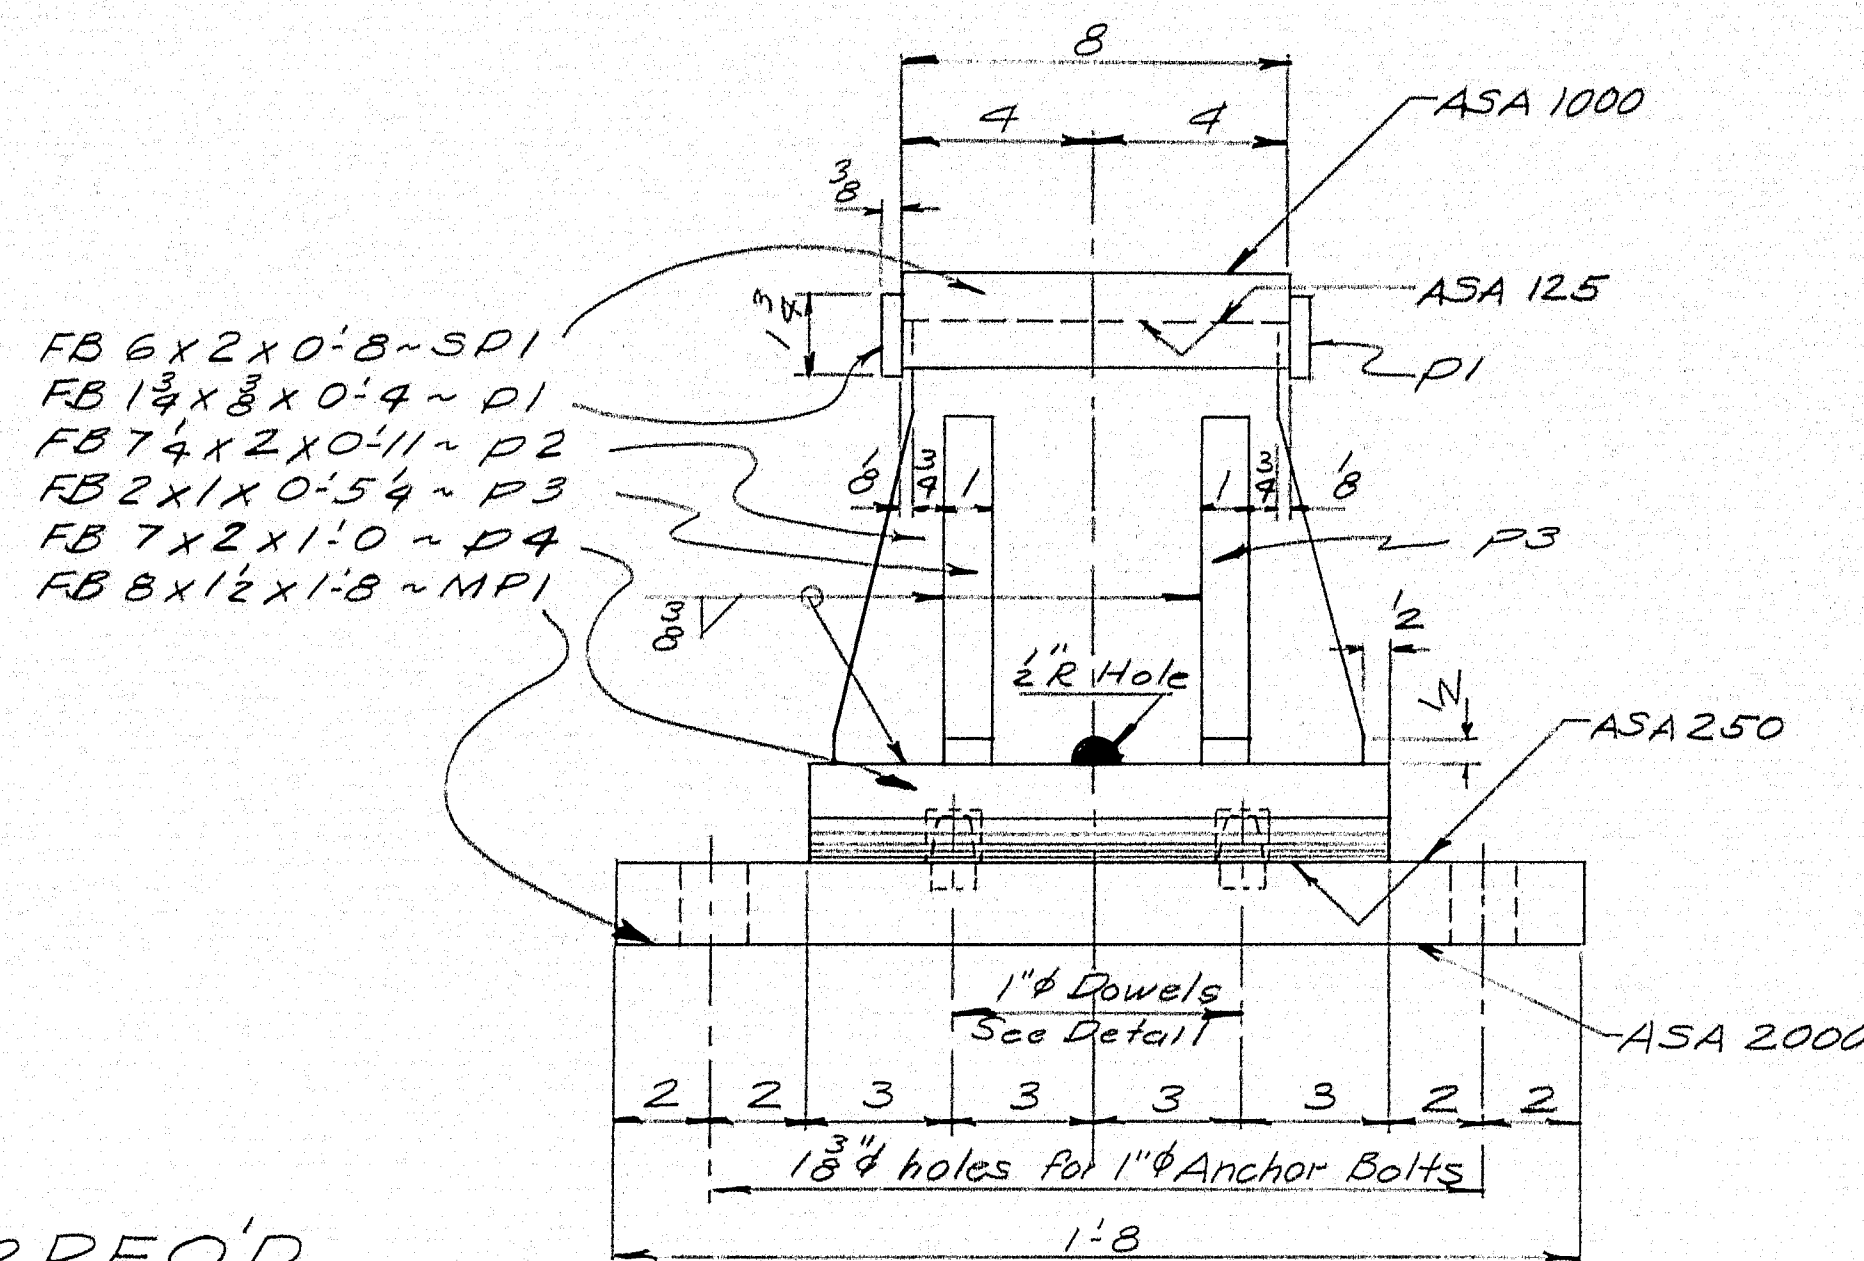

DOWEL DETAIL

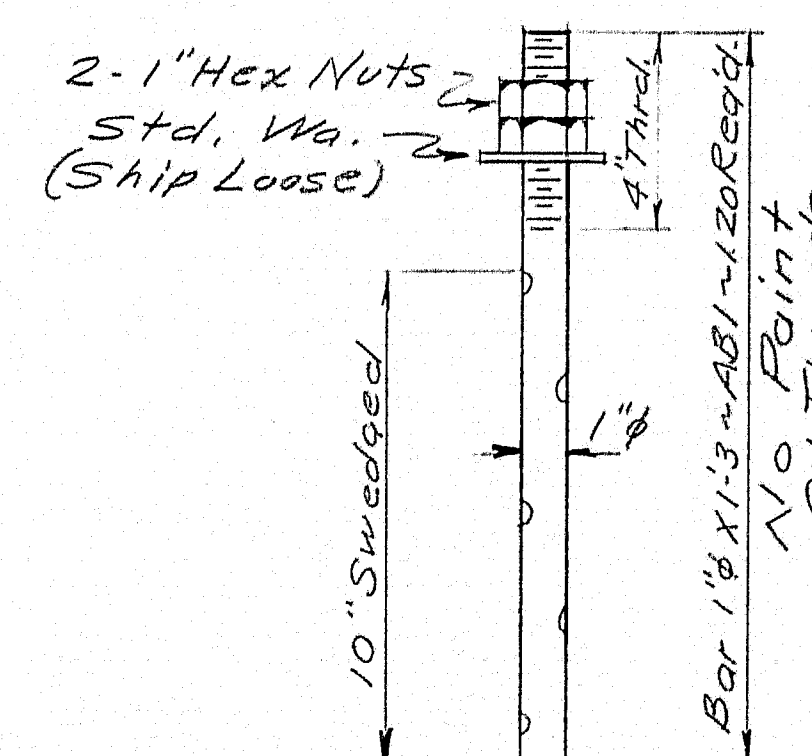

ANCHOR BOLT

NOTE: No Paint on Surfaces Finished ASA 125 & ASA 250. Coat With Hot Mixture of White Lead & Tallow. No Paint on Top Surface and 3/4" Down From Top Surface on SPI & SP2. Coat With Boiled Linseed Oil.

SHIP		BILL OF MATERIAL				DWG. NO. B63-48-S1
MARK	NO.	MARK	SHAPE	LENGTH	WT.	REMARKS
						(Machined)
SP1	24		FB 6x2	0 8		Field Weld to Stringer
SP2	24		FB 8x2	0 9		do
EPC2	12		Shop Assy			
EPC5	24		do			
FPC1	12		do			
	96	P1	FB 1 3/4x3	0 4		
	12	P2	FB 7 1/4x2	0 11		
	48	P3	FB 2x1	0 54		
	12	P4	FB 7x2	1 0		Machined
	24	P5	R 9 1/4x2	1 3		
	96	P6	FB 3x1	0 74		
	24	P7	R 9x2	1 4		Machined
	12	P8	FB 7 1/4x2	1 2		
	48	P9	FB 3x1	0 54		
	72	P10	Bar 1" d	0 12		Machined
	12	MPI	FB 8x1 1/2	1 8		do
	24	MP2	R 10x2	2 0		do
	12	MP3	R 9x1 1/4	1 8		do
*AB1	120		Bar 1" d	1 3		Thread one end Swedged
	240	Shop	1" Hex Nut			
Field	120		1" Std. Washer			
MPIA	12		8x8	1 8		Fabco Pad 'SA47'
MP2A	24		10x8	2 0		do
MP3A	12		9x8	1 8		do
Allow Extra For All Machined Parts						
All Material to be A.S.T.M. A-36 unless noted.						
* A.S.T.M. A-7						

SHOP CONNECTIONS: WELDED
FIELD CONNECTIONS: WELDED
HOLES: AS NOTED
PAINT: PER ME. STATE SPECS
RED LEAD & OIL & AS NOTED

BEARING DETAILS


Bancroft & Martin Inc.
South Portland 7, Maine

SEBASTICOOK RIVER BRIDGE
PITTSFIELD, MAINE

CUSTOMER CIANCHETTE BROS.
DESIGNER ME. S.H.C.

ORDER NO. VERBAL DWG. NO. B63-48-S1

DRAWN	3-18-63	TFG
REVISION		
REVISION		
REVISION		

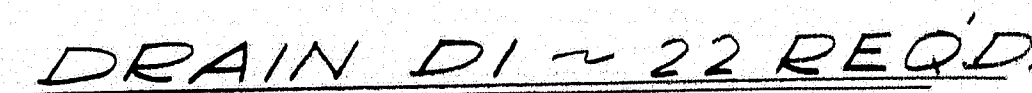

SHOP CONNECTIONS: *WELDED*
FIELD CONNECTIONS: *WELDED*
HOLES: *—*
PAINT: *PER ME. STATE SPECS*
RED LEAD & OIL & AS
NOTED

Bancroft & Martin Inc.
South Portland 7, Maine


SEBASTICOOK RIVER BRIDGE
PITTSFIELD, MAINE


CUSTOMER CIANCHETTE BROS
DESIGNER ME. S. H. C.

ORDER NO. _____ DWG. NO. B.63-48-52

DRAWN	3-19-63	TFG
REVISION		
REVISION		
REVISION		

89-160

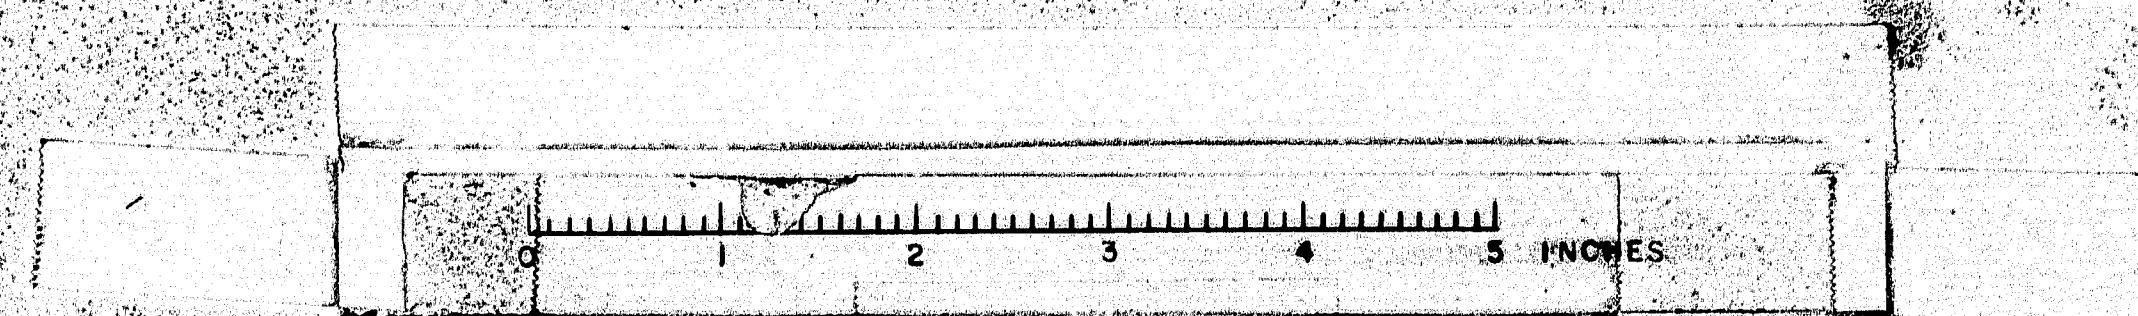

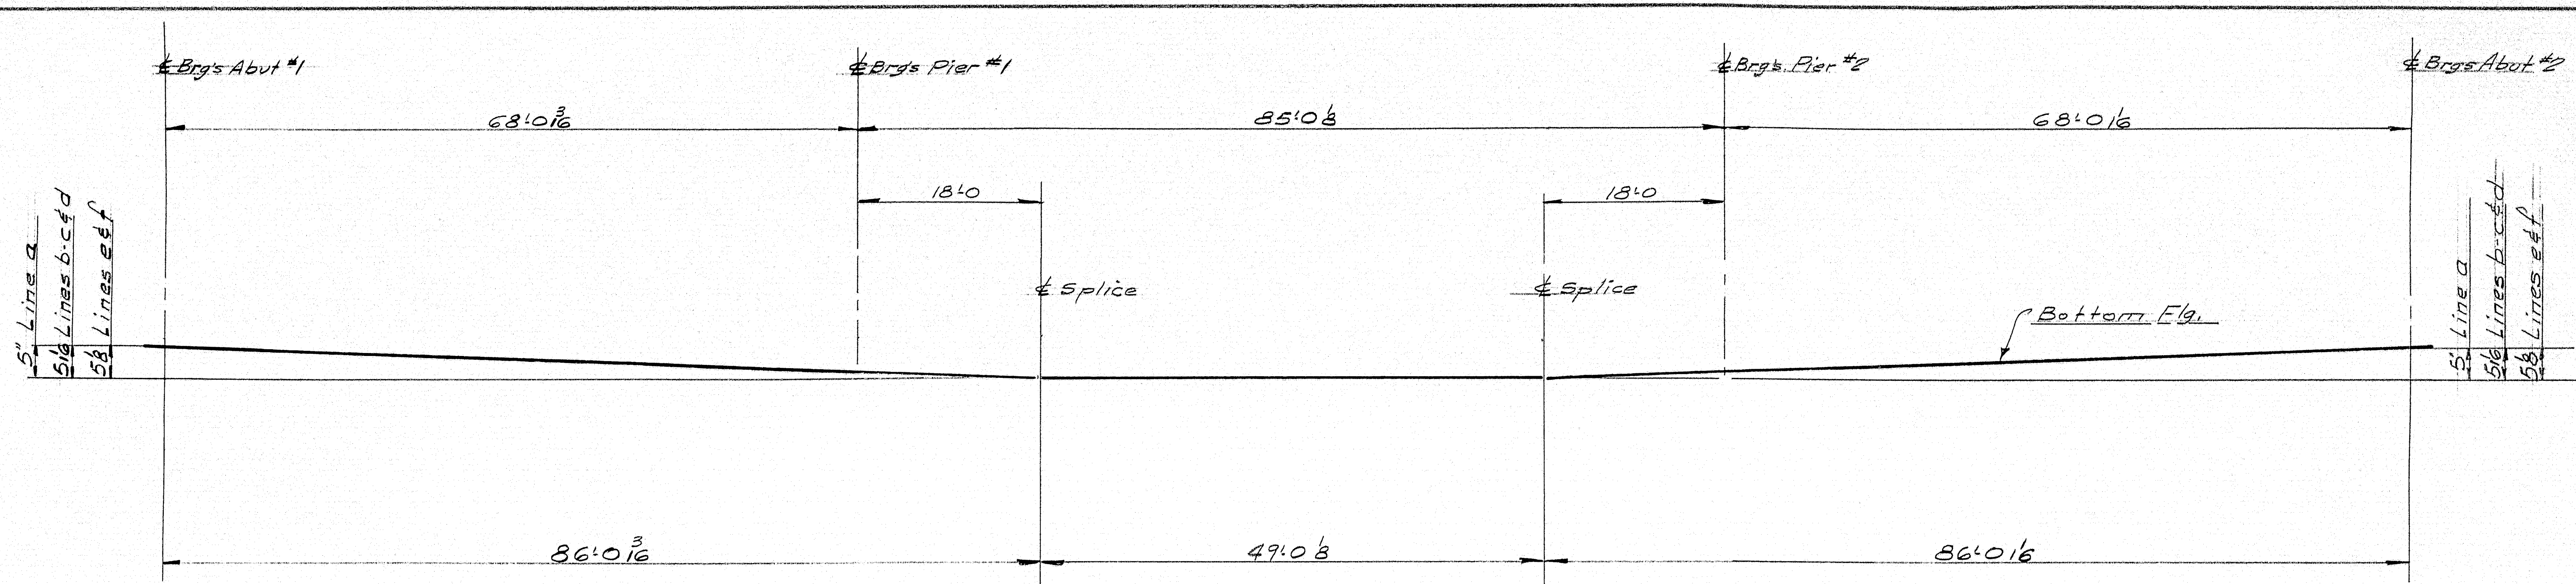

SHOP LAYOUT

1/4" Max gap @ Bottom of splices.

SOUTH BOUND

SHOP LAYOUT

Bracecraft & Martin Rolling Mills Company
South Portland 1, Maine


SEBASTICOOK BRIDGE
PITTSFIELD, MAINE


CUSTOMER CIANCHETTE BROS.
DESIGNER MAINE S. H. C. BRIDGE DIV.

ORDER NO. VERBAL DWG. NO. B63-48-S3

APP 422.63

DRAWN	4-3-63	J.P.F.
REVISION		
REVISION		
REVISION		

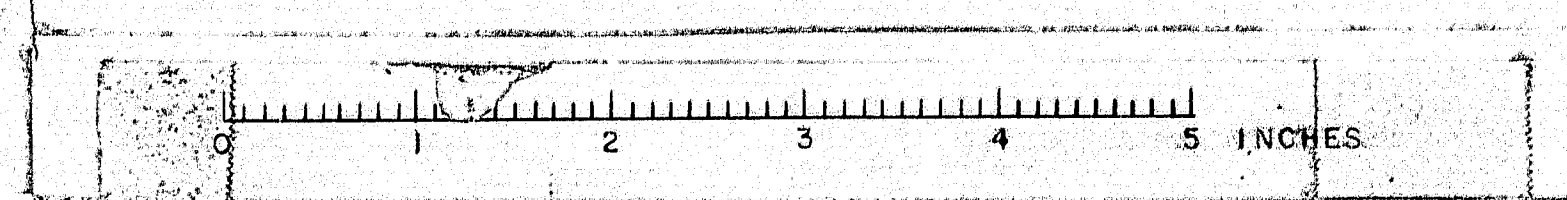

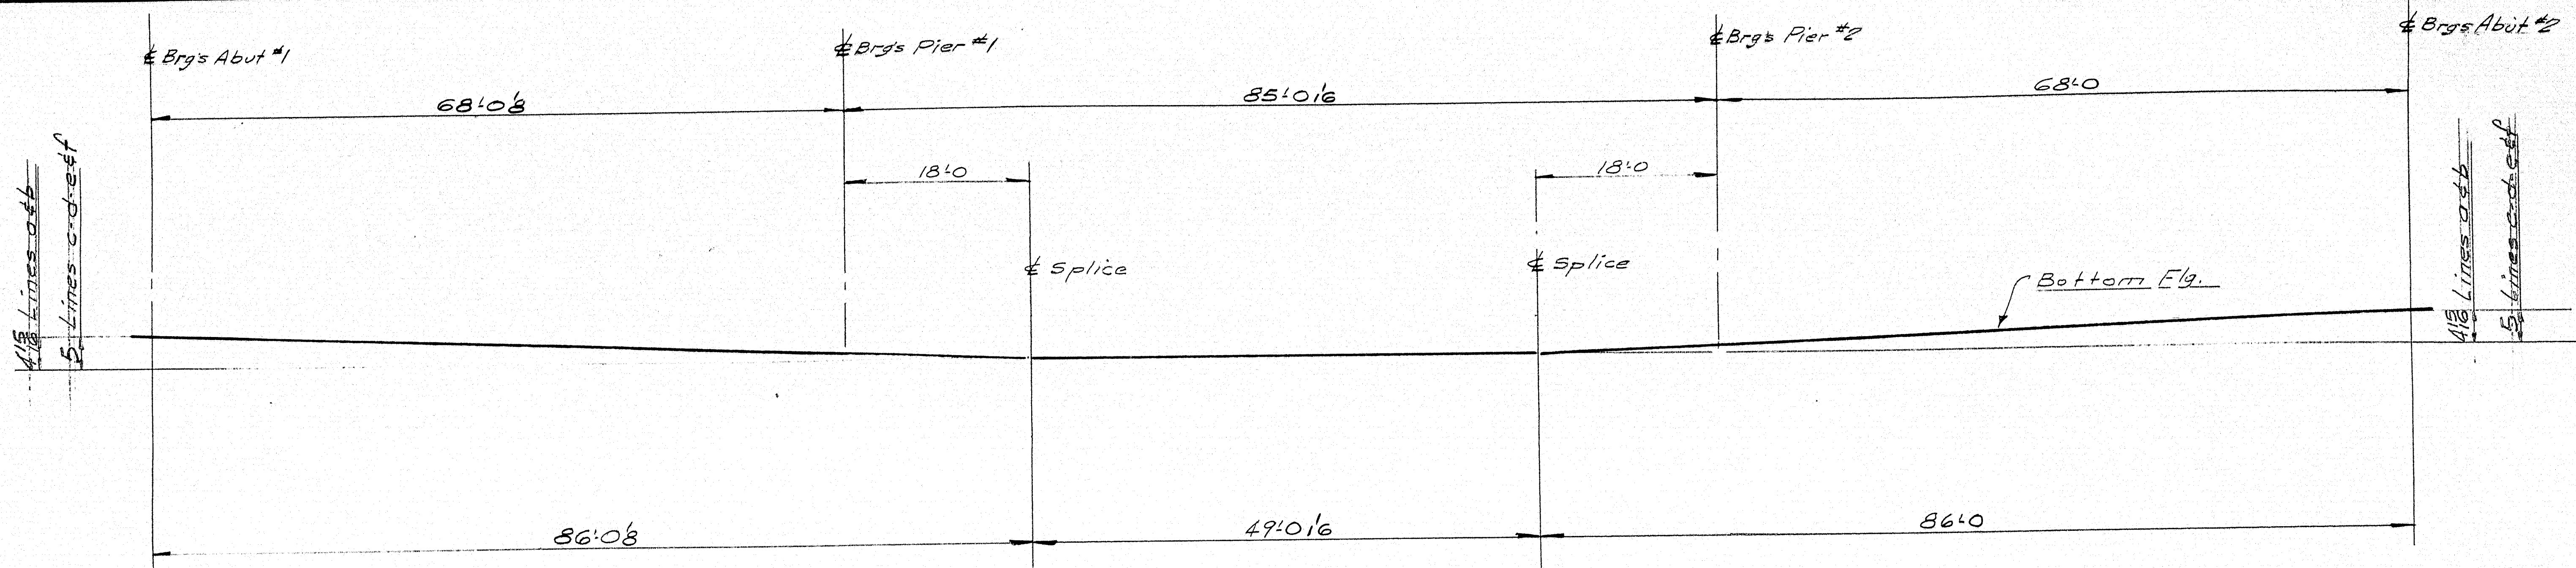

SHOP LAYOUT

4" Max gap @ Bottom of splices.


NORTHBOUND	
SHOP LAYOUT	
Bancroft & Martin Rolling Mills Company South Portland, Maine	
SEBASTICOOK BRIDGE PITTSFIELD, MAINE	
CUSTOMER CIANCHETTE BROS.	
DESIGNER MAINE S. H. C. BRIDGE DIV.	
ORDER NO. VERBAL	DWG. NO. B63-48-54

APR 4-22-63



DRAWN	4-3-63	J.P.F.
REVISION		
REVISION		
REVISION		

6


89-170

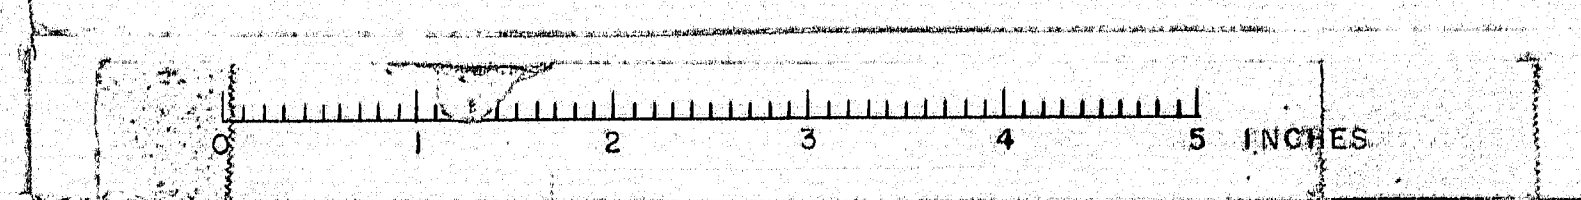

Sections taken looking down @ web

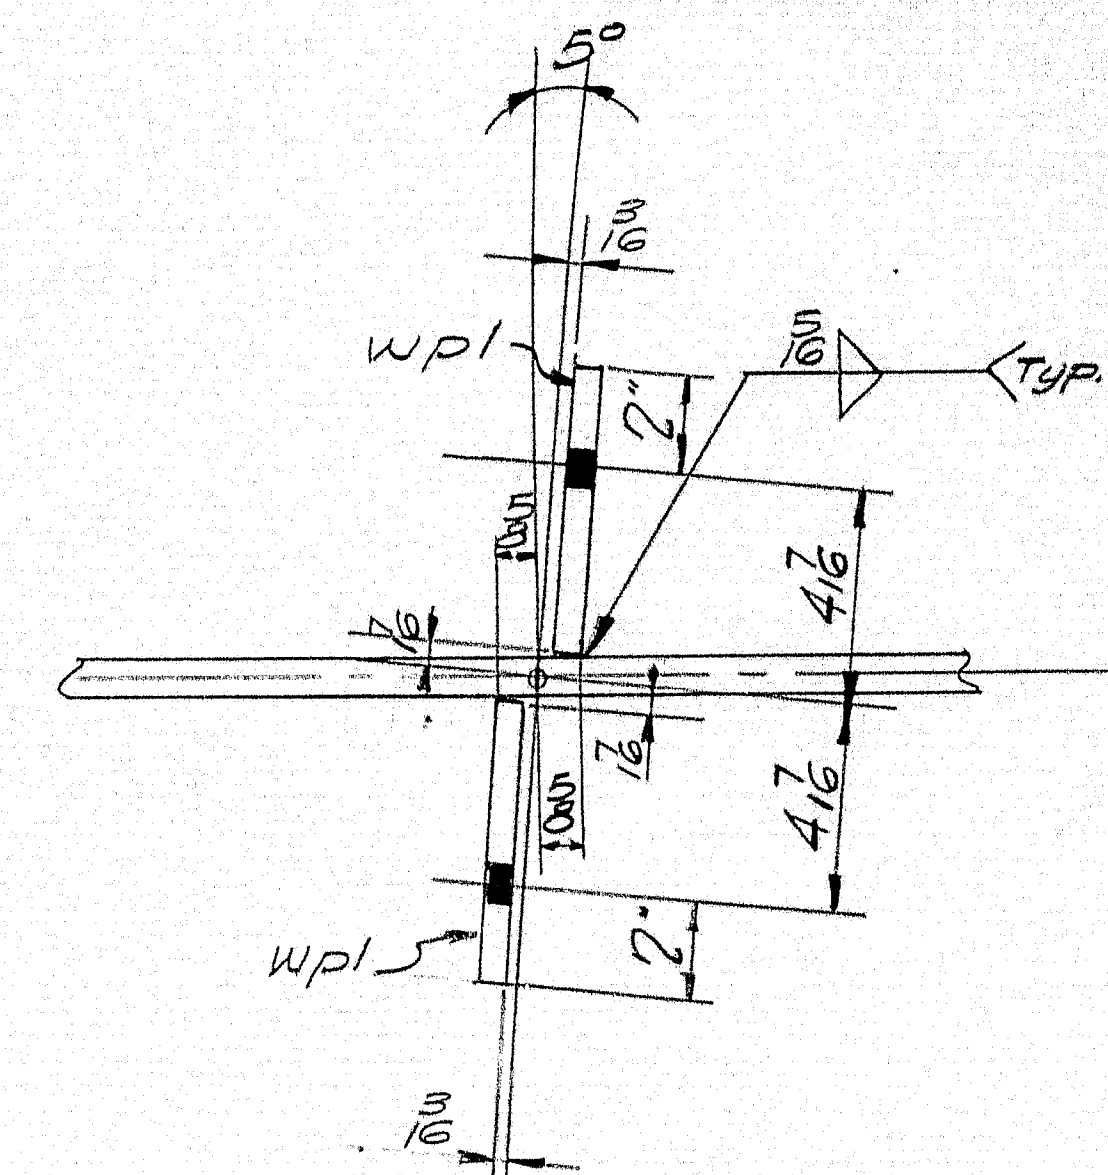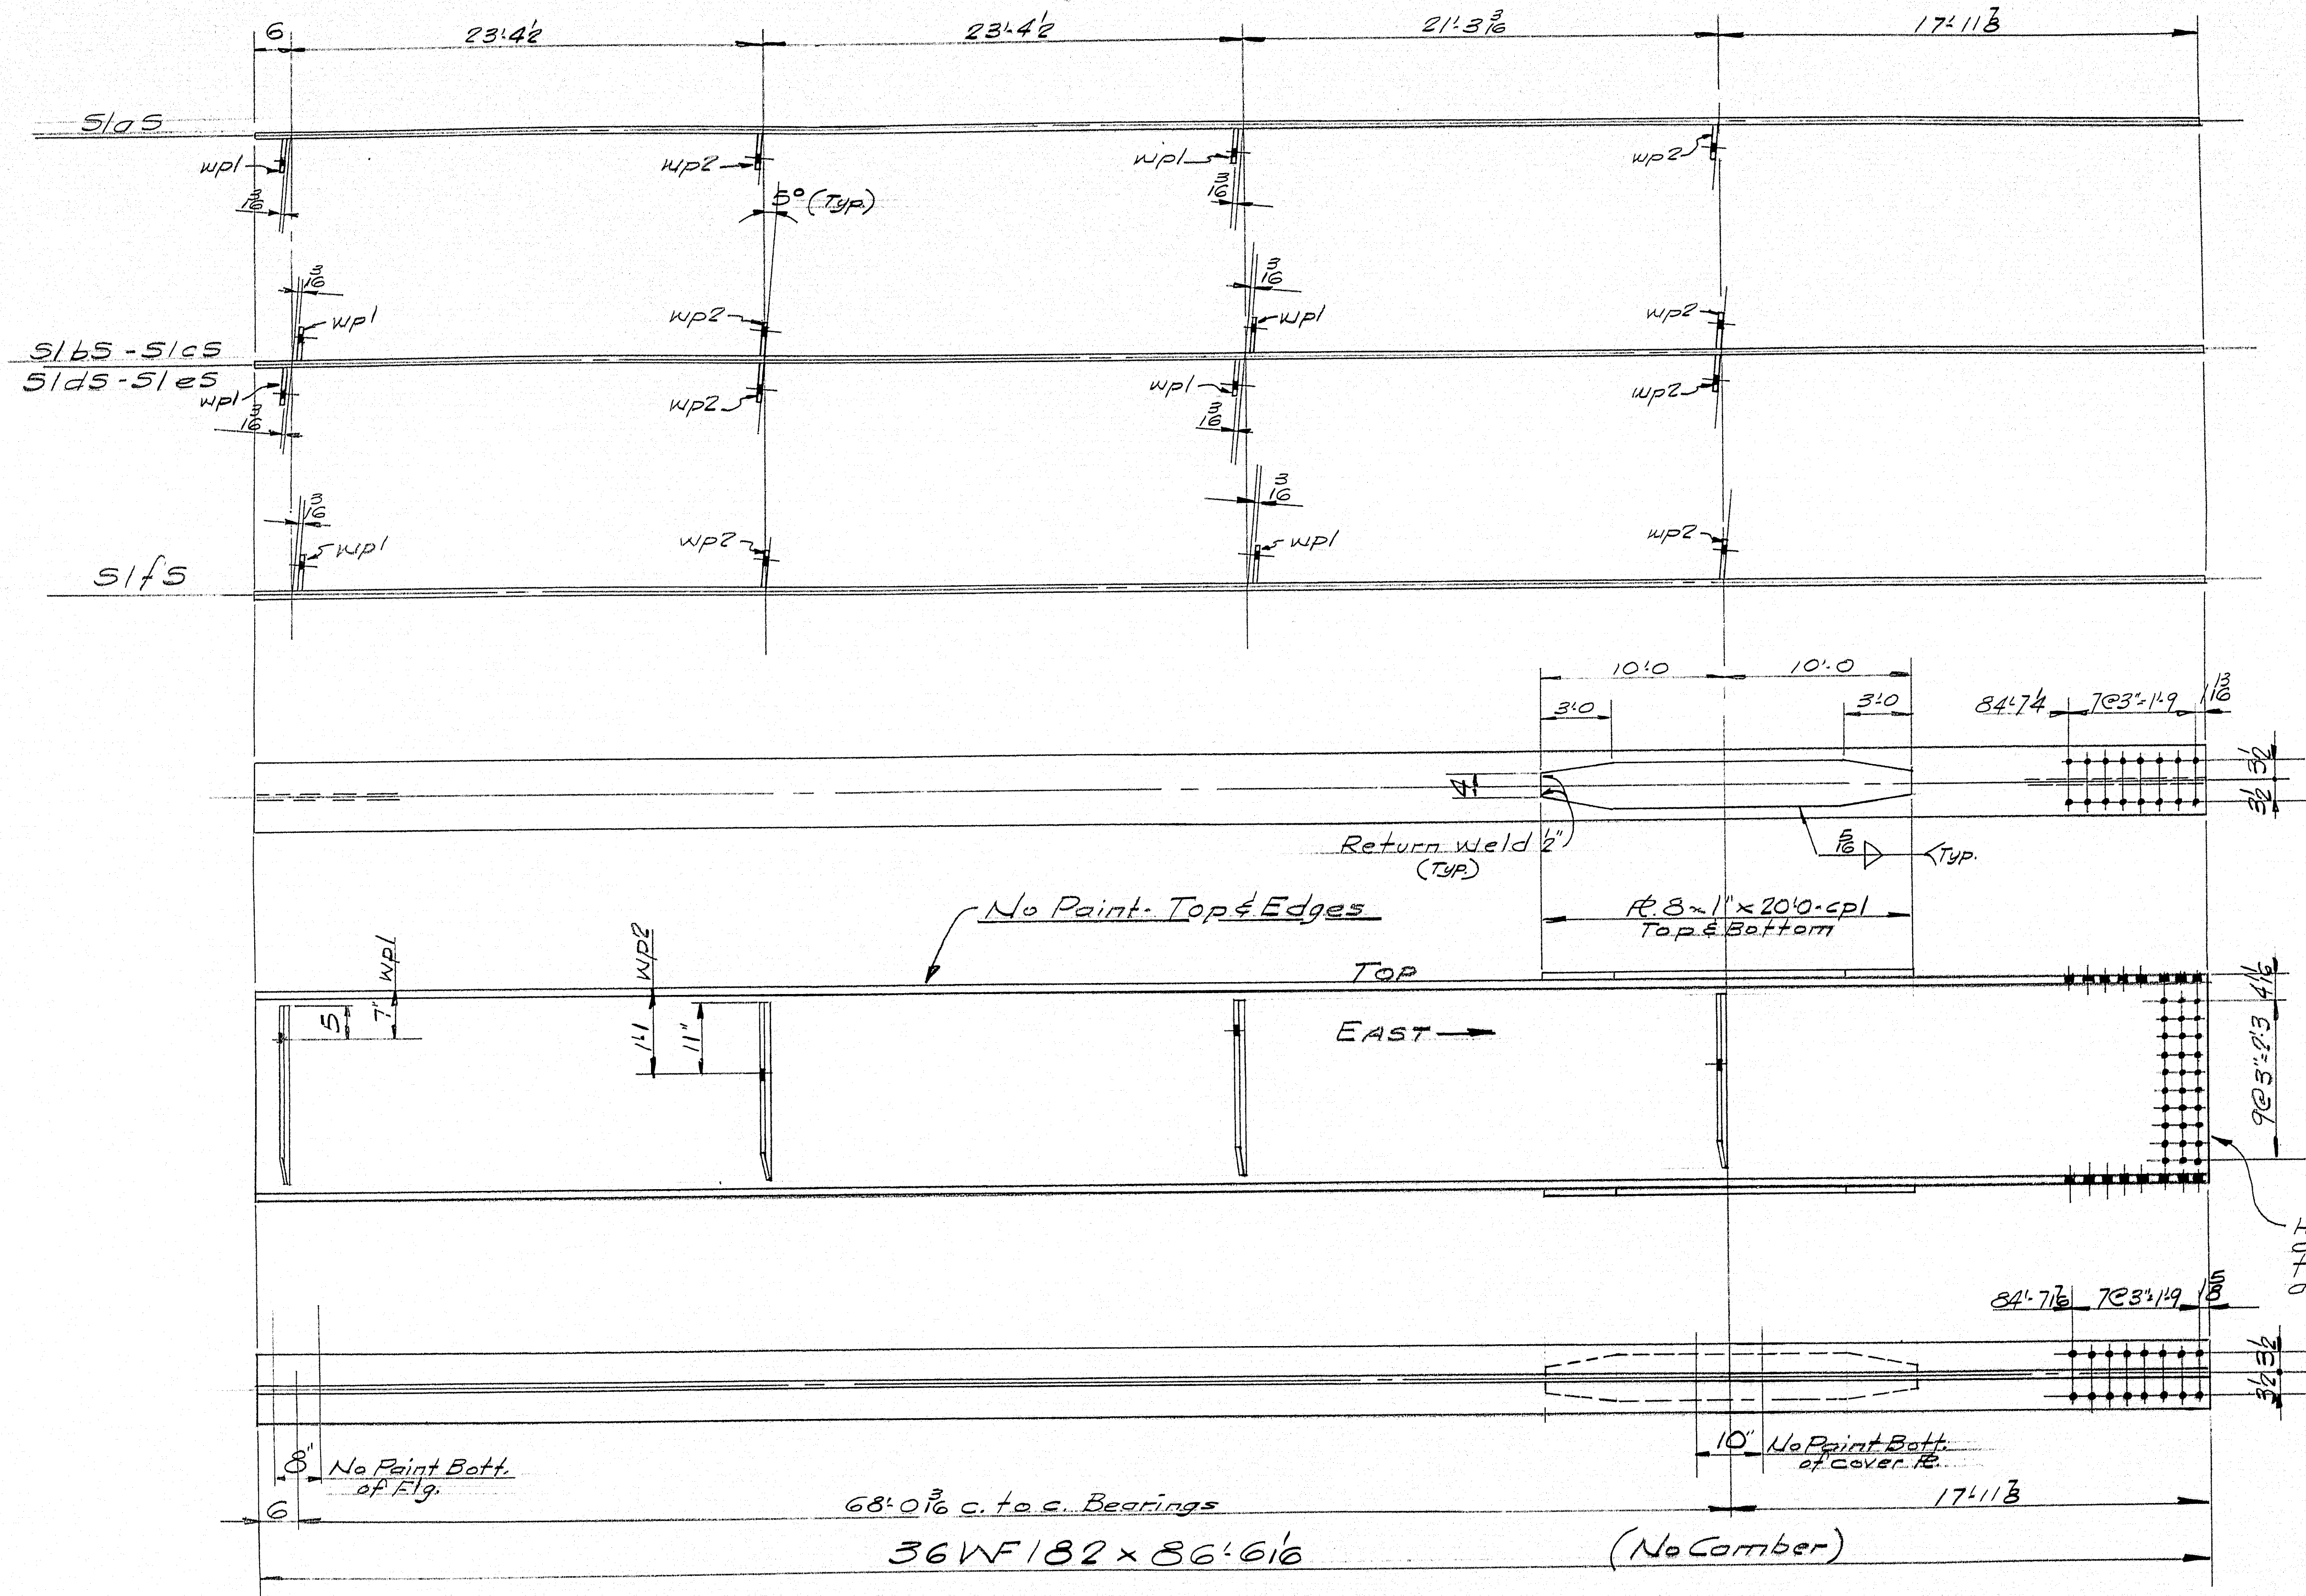

Detail @ wp1

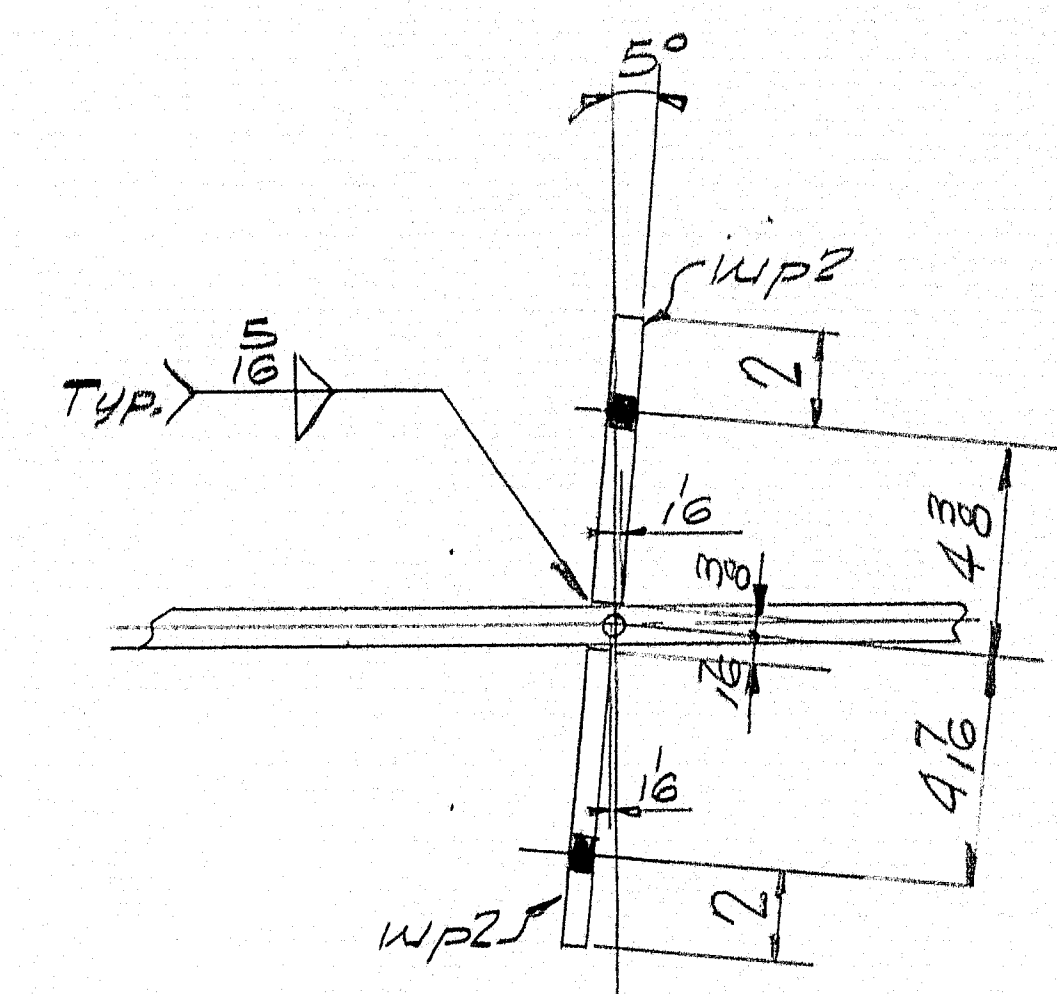

Detail @ wp2

Holes in web are to be drilled using spl as a template while beams are shop assembled

SPICE NOTE

HOLES ARE FOR HIGH TENSILE BOLTS
They are to be free from burrs
and shall not be painted on any
surface within 5" of such open
holes.


For Bill of Materials
General Notes see Dwg. 55

SOUTHBOUND	
STRINGER DETAILS: SPAN 1	
Ramsco & Martin Holdings, Mills Company	
South Portland, Maine	
SEBASTICOOK BRIDGE	
PITTSFIELD, MAINE	
CUSTOMER CIANCHETTE BROS.	
DESIGNER MAINE S.H.G. BRIDGE DIV.	
ORDER NO. VERBAL	DWG. NO. 563-48-55


DRAWN	4.5.63 JRR
REVISION	
REVISION	
REVISION	

APP-4-22-63

5/a S - ONE REQ'D.
 5/b S - ONE REQ'D.
 5/c S - ONE REQ'D.
 5/d S - ONE REQ'D.
 5/e S - ONE REQ'D.
 5/f S - ONE REQ'D.

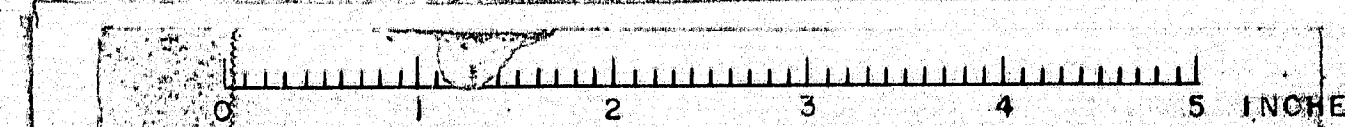

Sections taken looking down @ web.

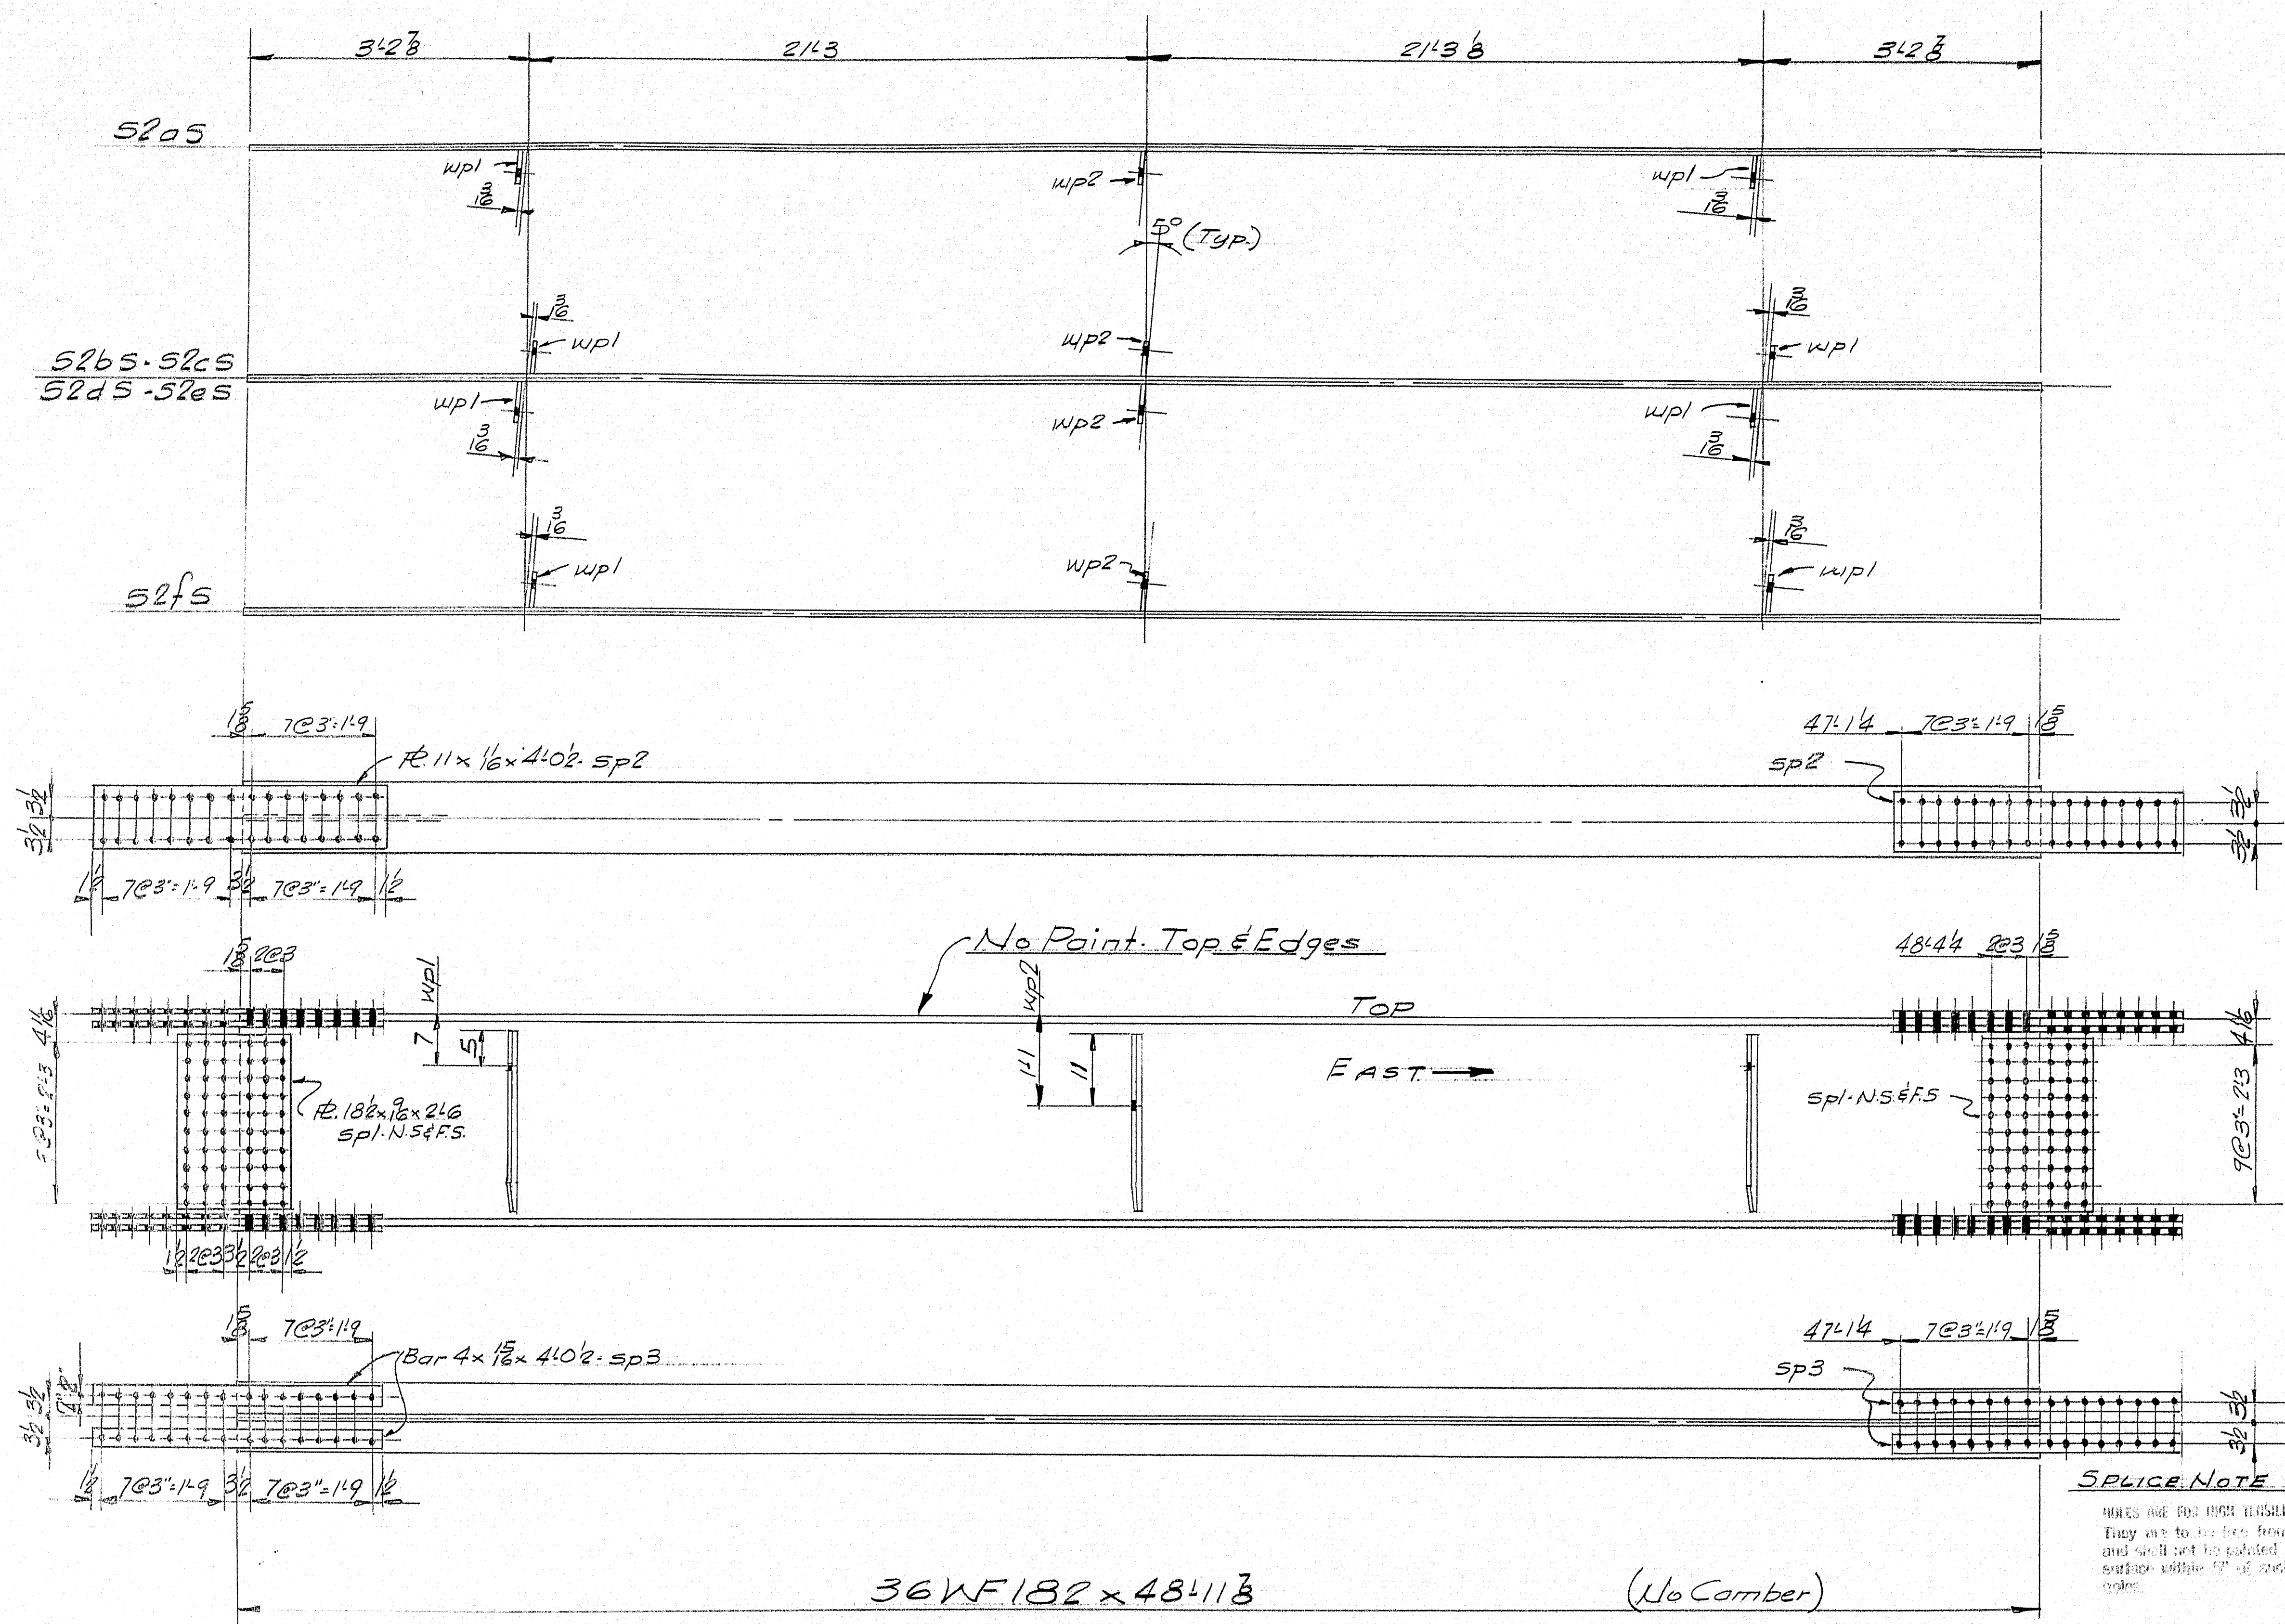

52a5 - ONE REQ'D.
52b5 - ONE REQ'D.
52c5 - ONE REQ'D.

52d5 - ONE REQ'D.
52e5 - ONE REQ'D.
52f5 - ONE REQ'D.

GENERAL NOTES

- 1) Material for stringers, cover plates & splices shall conform to A.S.T.M. A-36. All other steel shall conform to either A.S.T.M. A-36 or A-7.
- 2) Holes in field splices are to be sub-punched (or sub-drilled) and reamed while assembled in the shop & connecting parts to be match marked & bolted for shipment. For shop layout see Dwg. 53.
- 3) Holes: Splices: 1/2" ϕ 16" x wp 1/2" ϕ

SHIP		BILL OF MATERIAL				DWG. NO. B63-48-SG
MARK	NO.	MARK	SHAPE	LENGTH	WT.	REMARKS
51a5	1		36WF182	86' 6 1/2"		No Camber
51b5	1			86' 6 1/2"		
51c5	1			86' 6 1/2"		
51d5	1			86' 6 1/2"		
51e5	1			86' 6 1/2"		
51f5	1			86' 6 1/2"		
52a5	1			48' 11 3/8"		
52b5	1			48' 11 3/8"		
52c5	1			48' 11 3/8"		
52d5	1			48' 11 3/8"		
52e5	1			48' 11 3/8"		
52f5	1			48' 11 3/8"		
53a5	1			86' 5 1/2"		
53b5	1			86' 5 1/2"		
53c5	1			86' 5 1/2"		
53d5	1			86' 5 1/2"		
53e5	1			86' 5 1/2"		
53f5	1			86' 5 1/2"		
			36WF182	86' 5 1/2"		No Camber
24	cpl		R. 8 x 1"	20' 0"		
24	sp1		R. 18 1/2 x 1/2"	2' 6"		
24	sp2		R. 11 x 1/2"	4' 0 1/2"		
48	sp3		Bar 4 x 1/2"	4' 0 1/2"		
60	wpl		Bar 6 x 3/8"	2' 8"		
50	wpl		Do	2' 8"		
FIELD	760		3" H.S. BOLTS	0' 32"		Web (720)
Do	800		Do	0' 42"		Figs (760)
Do	3120		3" HARD WASHERS			
ITEM 702-103						

This Bill of Material also covers Dwg's 55 & 57


SHOP CONNECTIONS: Welded
FIELD CONNECTIONS: Bolted-Welded
HOLES: See General Notes
PAINT: Per Maine Specs. & As Noted

SOUTH BOUND	
STRINGER DETAILS: SPAN 2	
Pancroft & Martin Inc. South Portland 7, Maine	
SEBASTICOOK BRIDGE PITTSFIELD, MAINE	
CUSTOMER: CLANCHETTE BROS.	
DESIGNER: MAINE S.H.C. BRIDGES	
ORDER NO. VERBAL	DWG. NO. B63-48-SG

APP 4-22-63

DRAWN	4-5-63 JRR
REVISION	
REVISION	
REVISION	

Sections taken looking down @ web

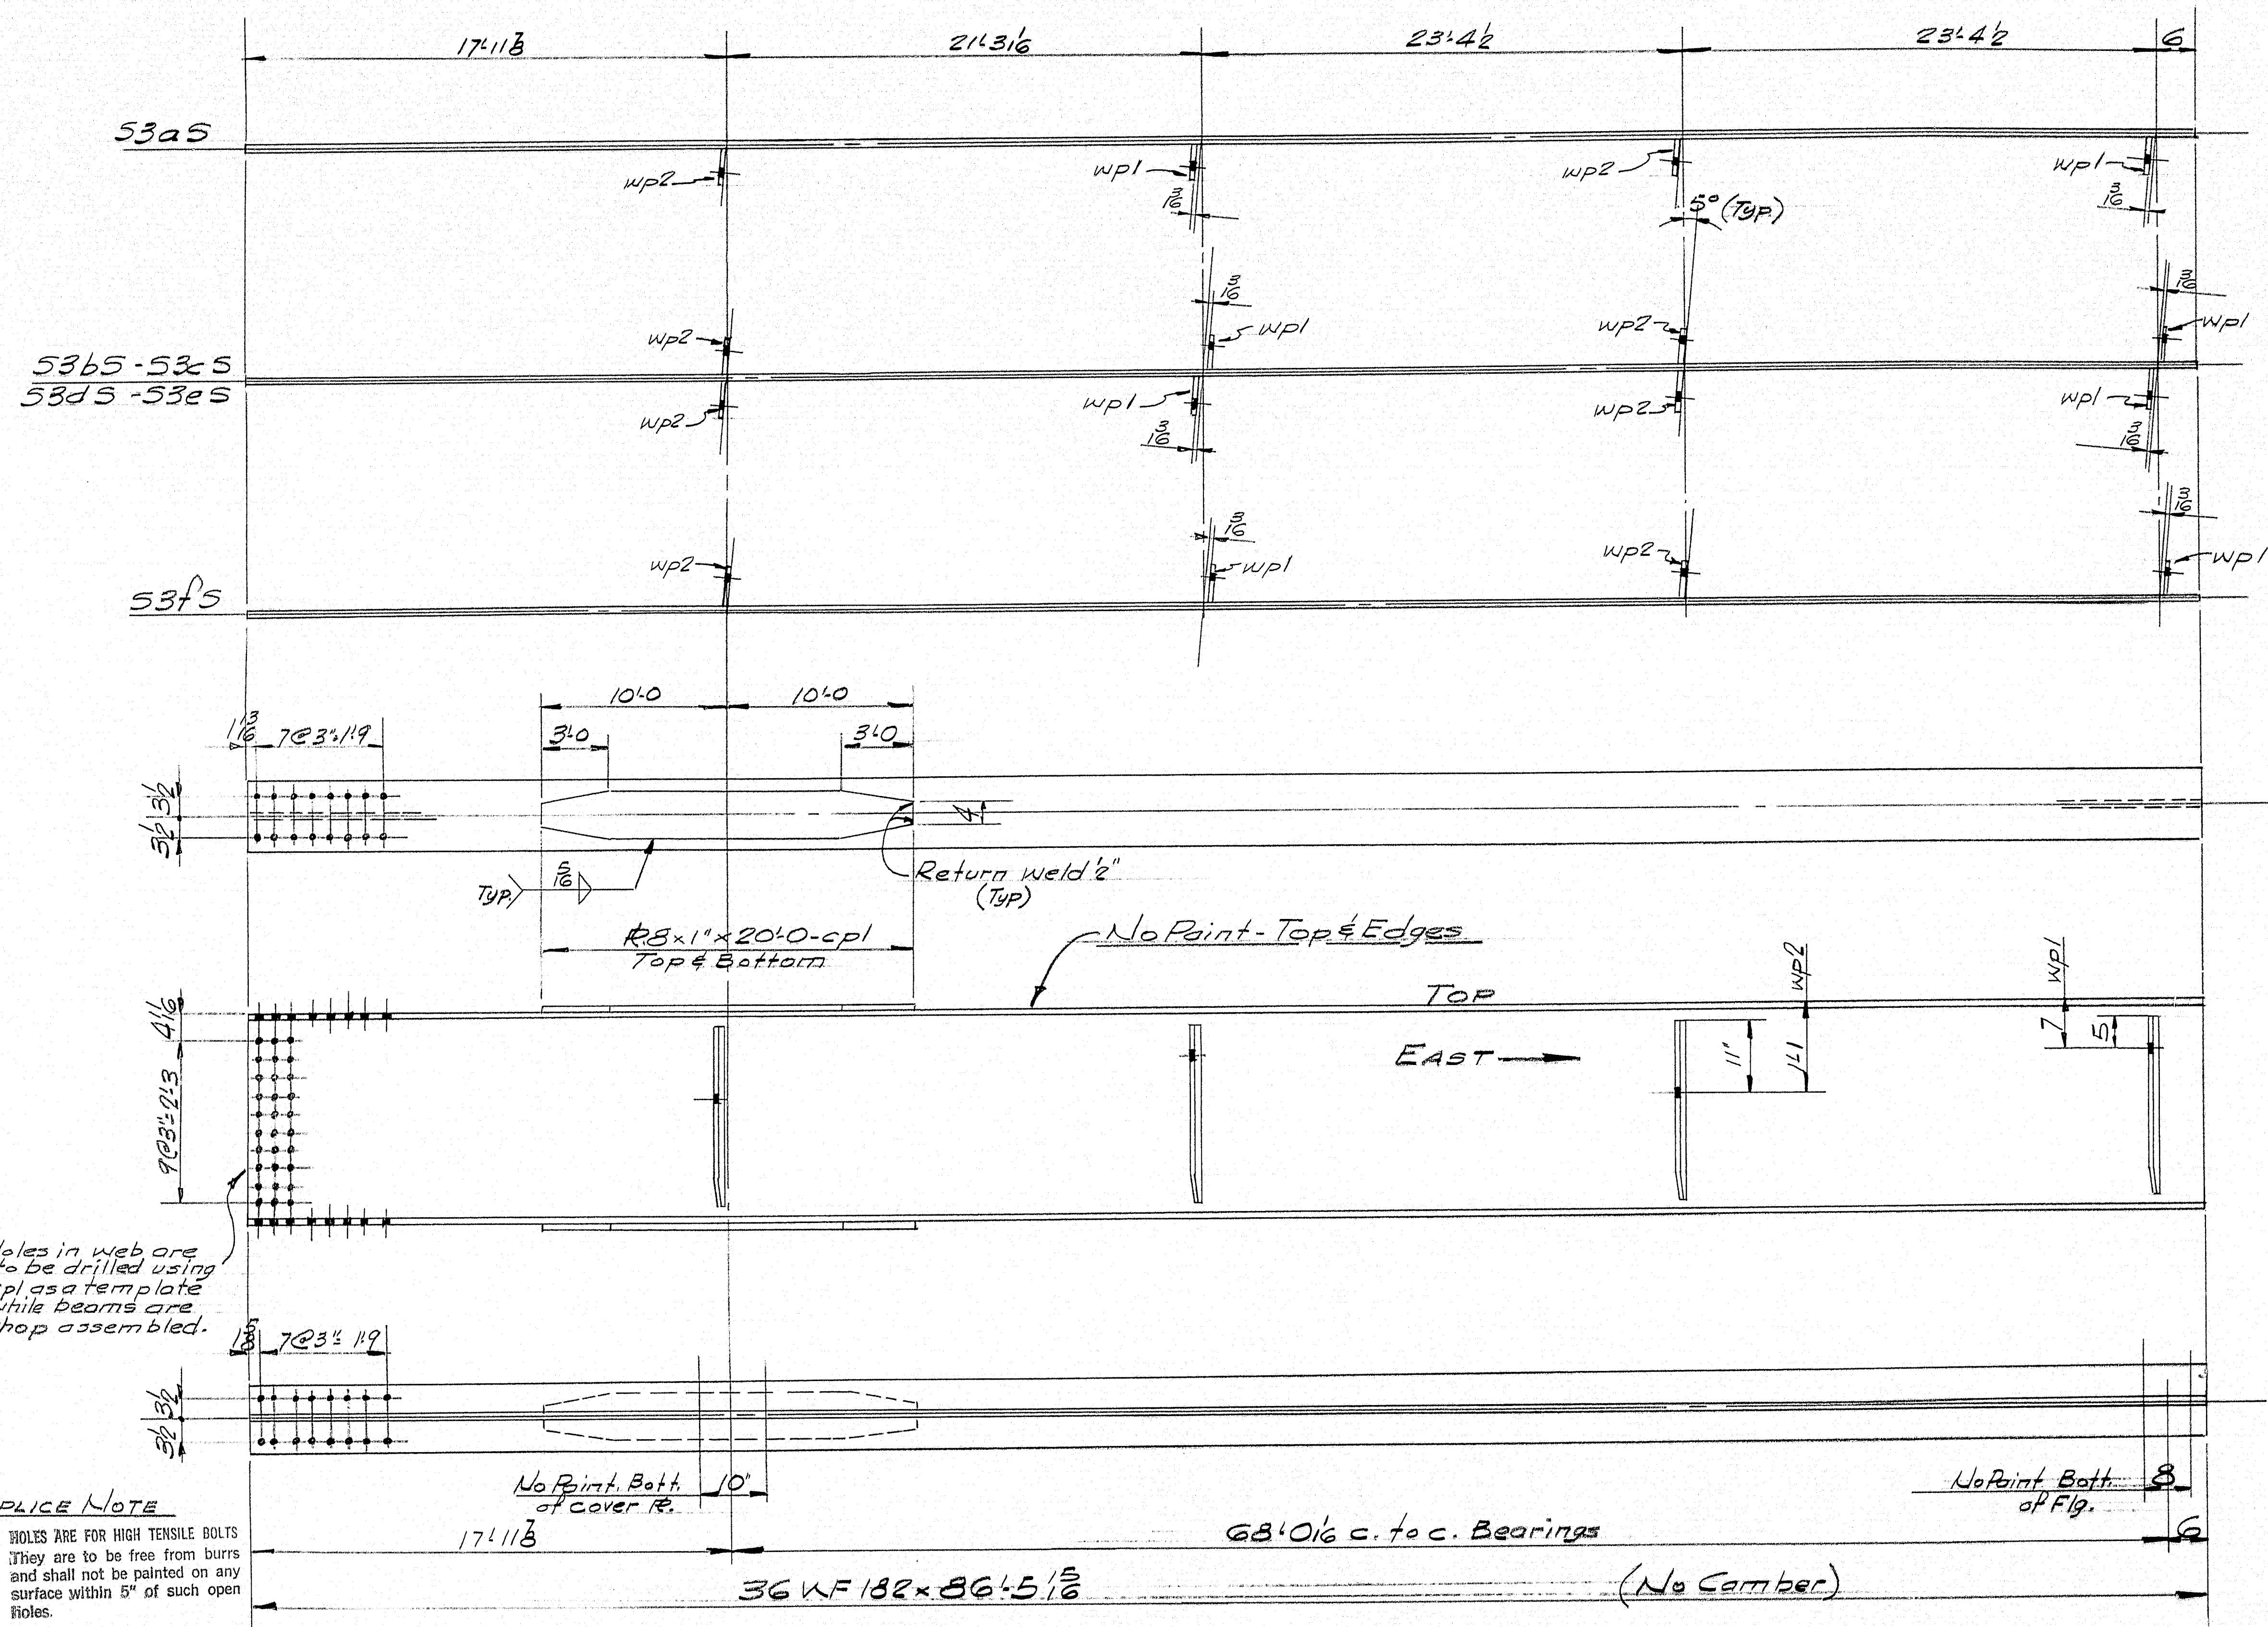

Holes in web are to be drilled using spl as a template while beams are shop assembled.

SPICE NOTE

HOLES ARE FOR HIGH TENSILE BOLTS
They are to be free from burrs
and shall not be painted on any
surface within 5" of such open
holes.

53a5 - ONE REQ'D


5365 - ONE REG'D.

53CS - ONE REQ'D


53d5 - ONE REQ'D

53e5 - ONE REG'D

53fs - ONE REGID

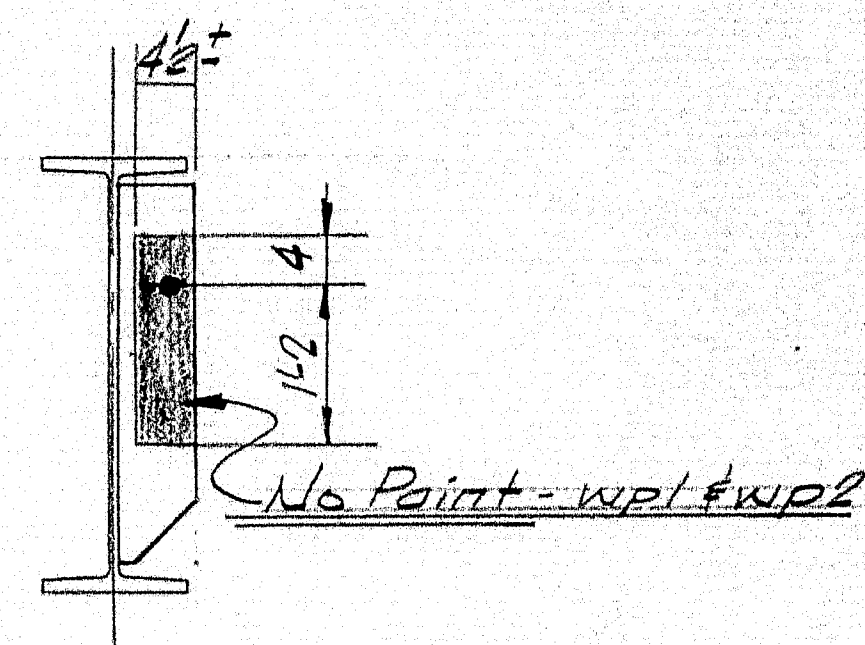

Typ. Detail @ Web Plates

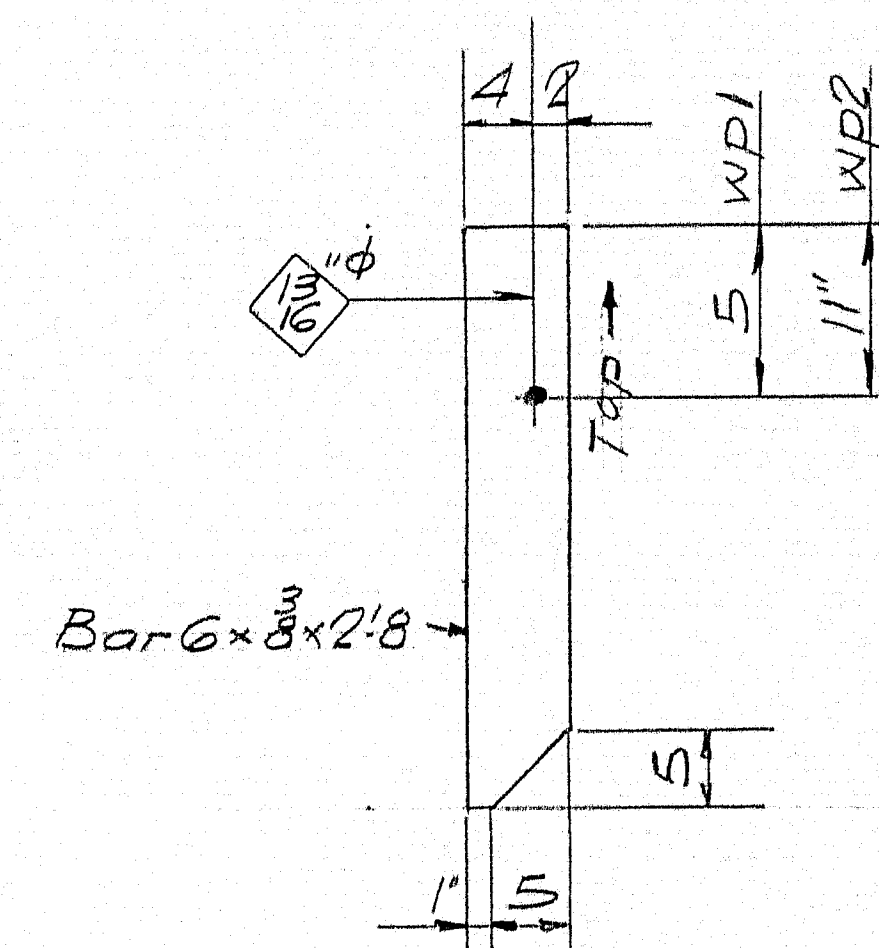

wpl - Detail (60 Reg'd)

wp2-Detail (50 Req'd.)

For Bill of Materials & General Notes see DWG 56

SOUTH BOUND


STRINGER DETAILS- SPAN 3

Bancroft & Martin Rolling Mills Company
South Portland 7, Maine




SEBASTICOOK BRIDGE
PITTSFIELD, MAINE

CUSTOMER CIANCHETTE BROS.
DESIGNER MAINE S.H.C. BRIDGE DIV.

ORDER NO. VERBAL DWG. NO. 563-48-57

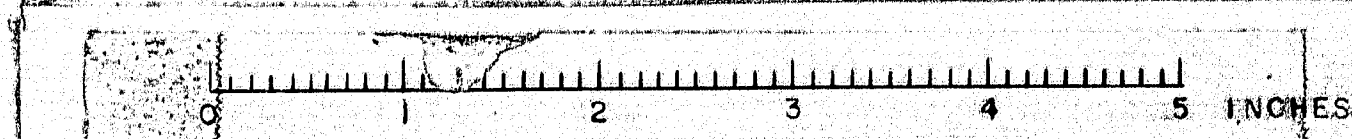

Sections taken looking down @ web

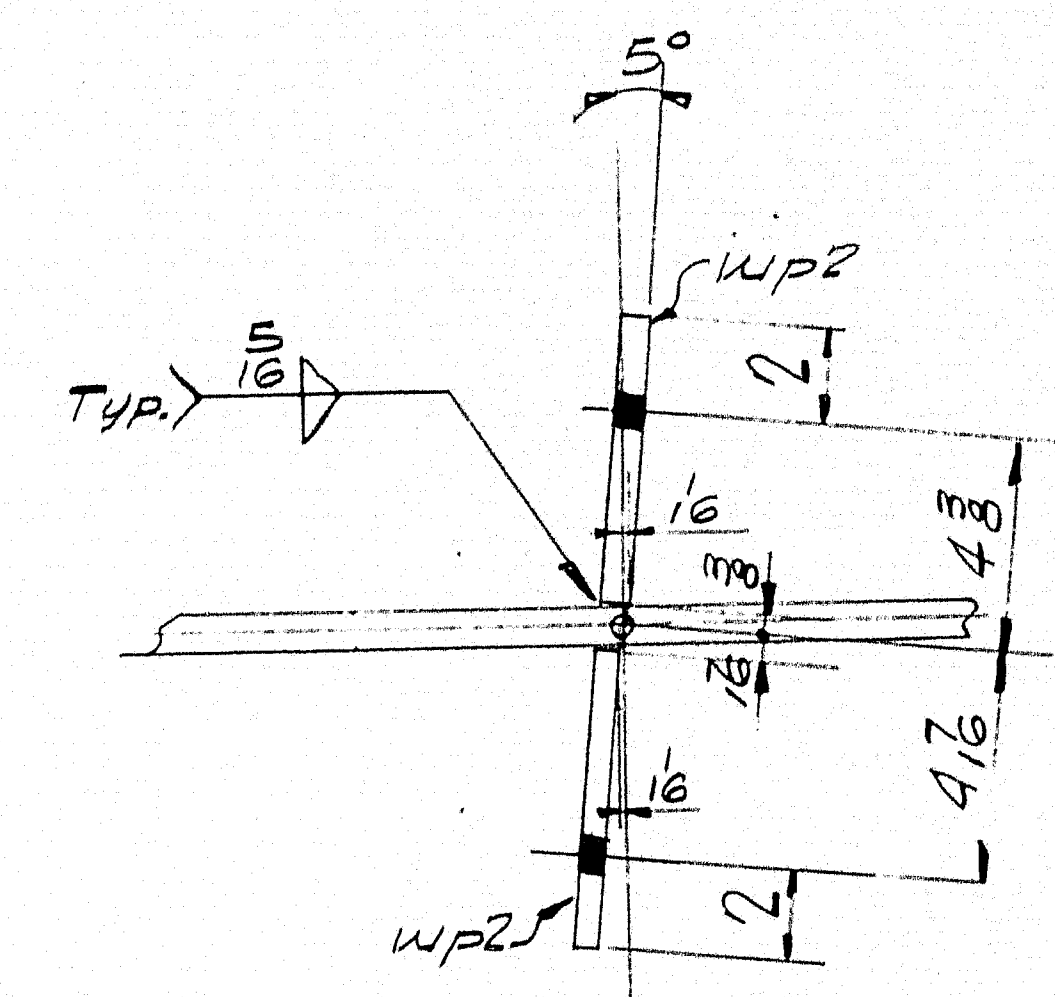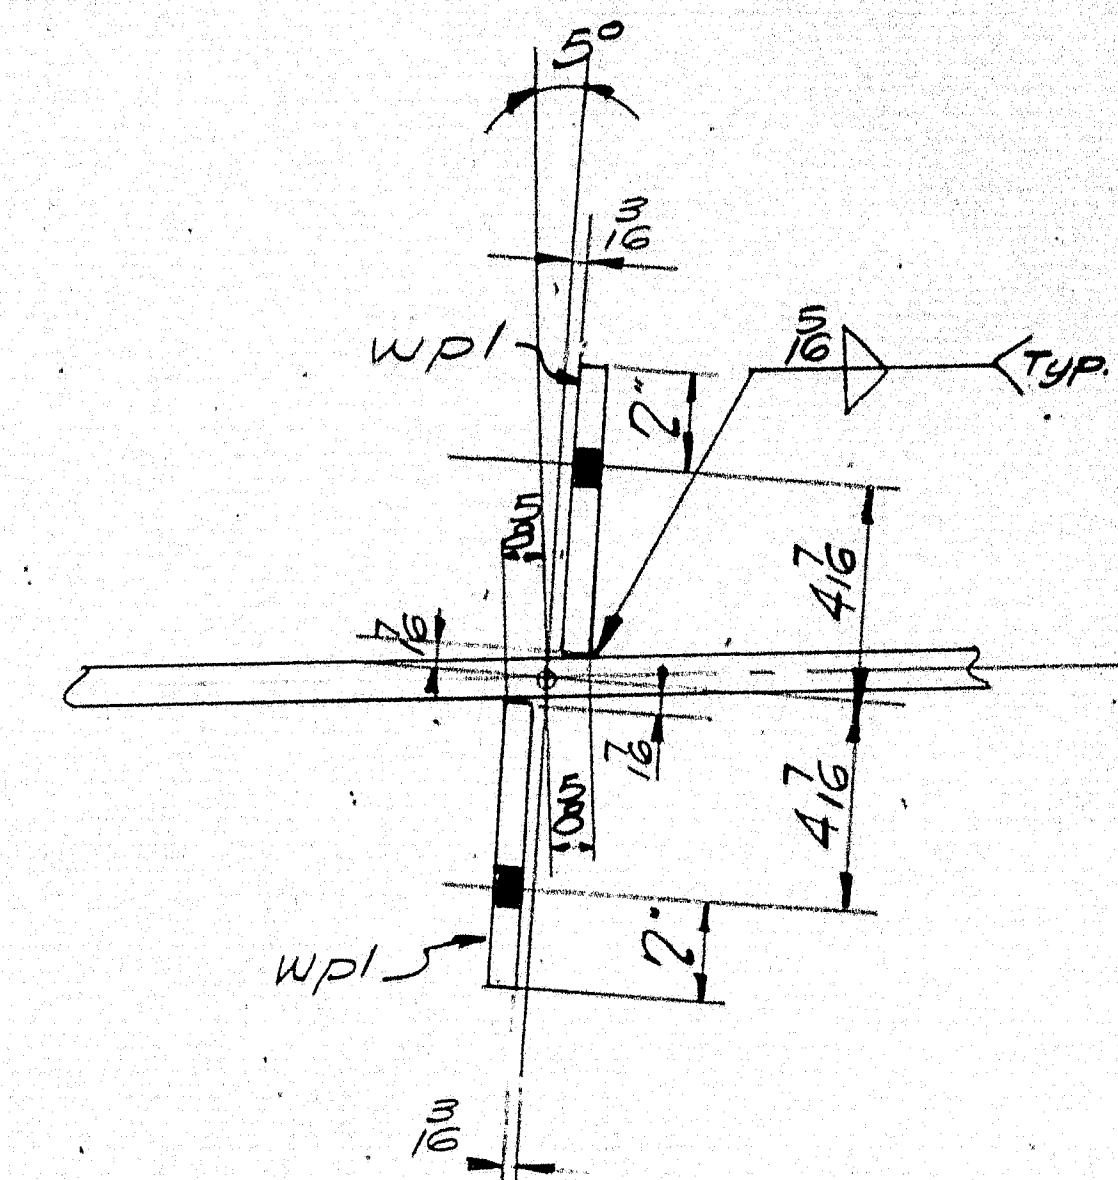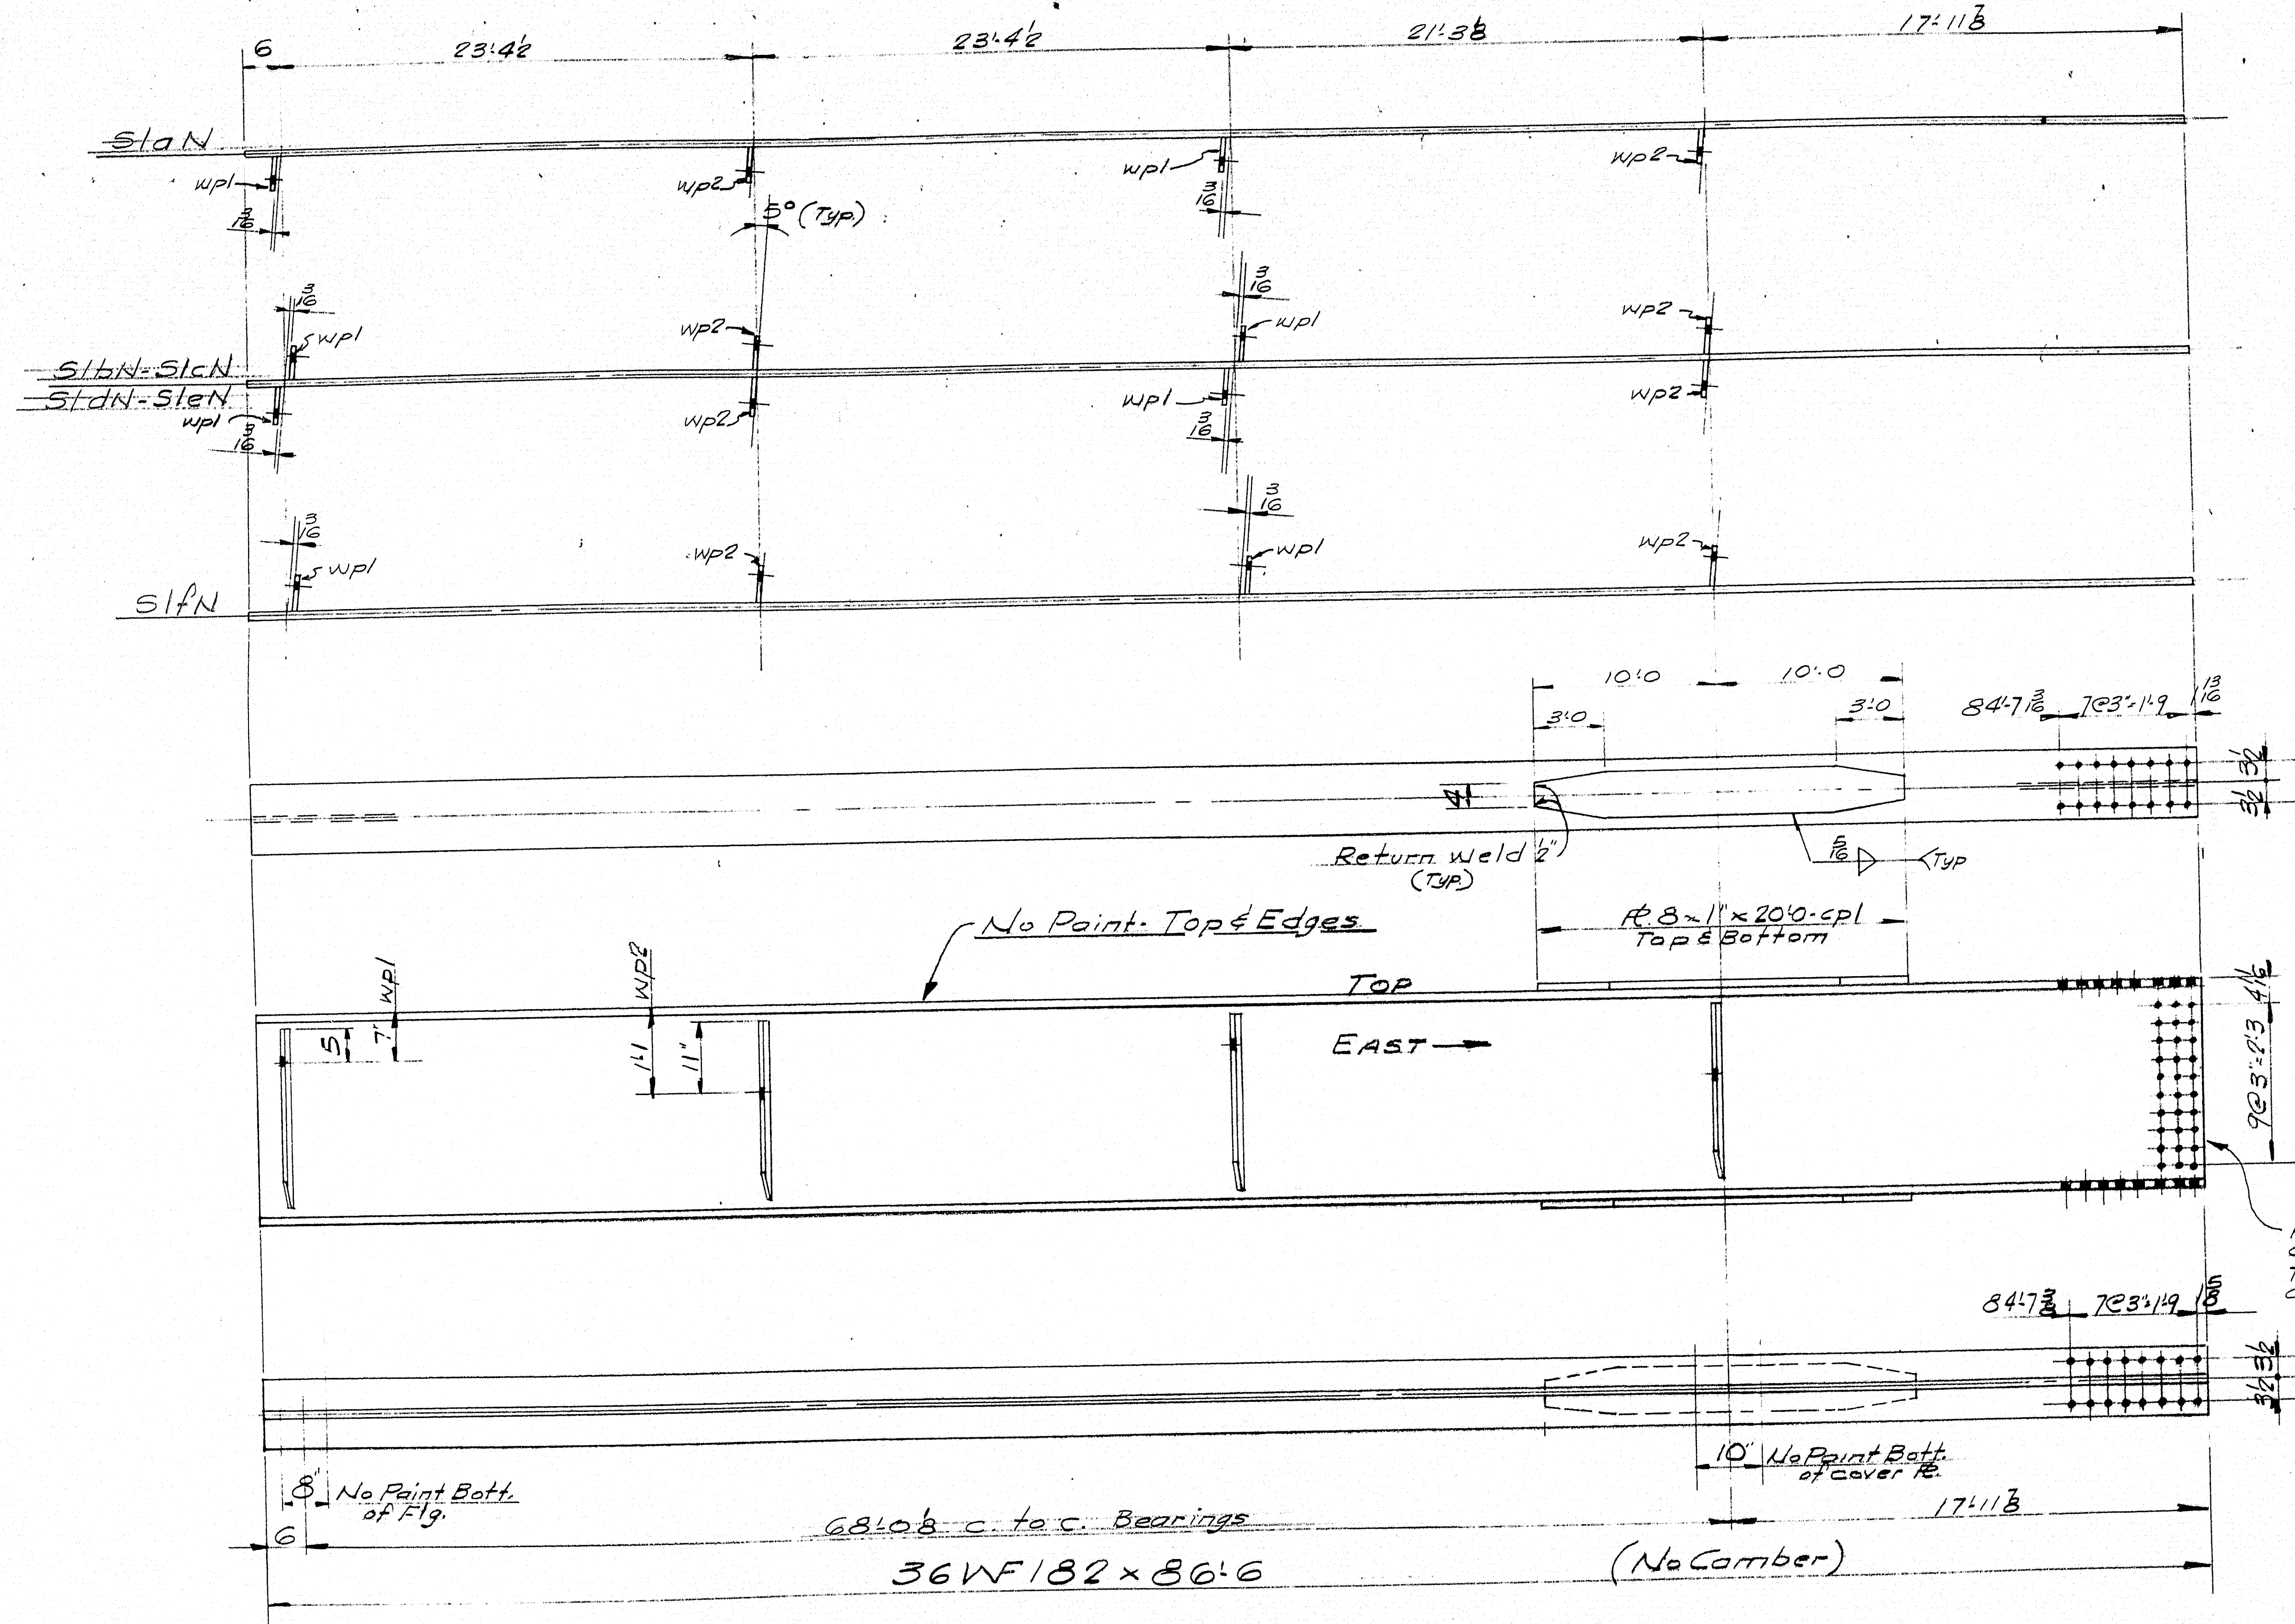

Holes in web are to be drilled using sp1 as a template while beams are shop assembled

SPICE NOTE

HOLES ARE FOR HIGH TENSILE BOLTS. They are to be free from burrs and shall not be painted on any surface within 5" of such open holes.

For Bill of Material & General Notes see Dwg 59

NORTH BOUND	
STRINGER DETAILS - SPAN 1	
Bancroft & Martin Rolling Mills Company	
South Portland 7, Maine	
SEBASTICOOK BRIDGE	
PITTSFIELD, MAINE	
CUSTOMER CIANCHETTE BROS	
DESIGNER MAINE S. H. C. BRIDGE DIV	
ORDER NO. VERBAL	DWG. NO. B63-48-53

DRAWN	4.5-63 UPR
REVISION	
REVISION	
REVISION	


SlabN - ONE REQ'D.
SlabN - ONE REQ'D.
68'0 1/8" c to c. Bearings
36WF182 x 86'6"

(No Camber)

89-174

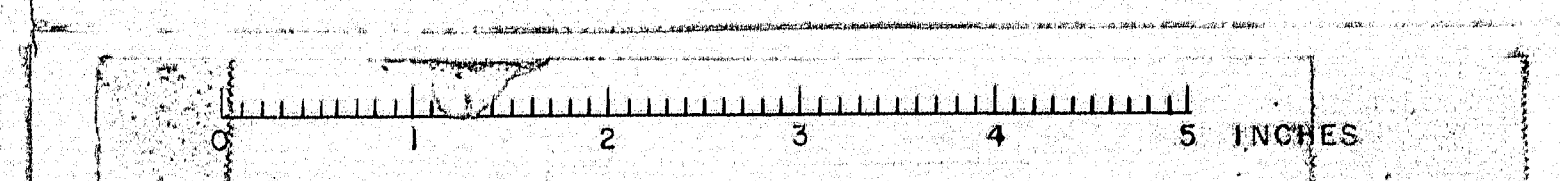

Sections taken looking down @ web.

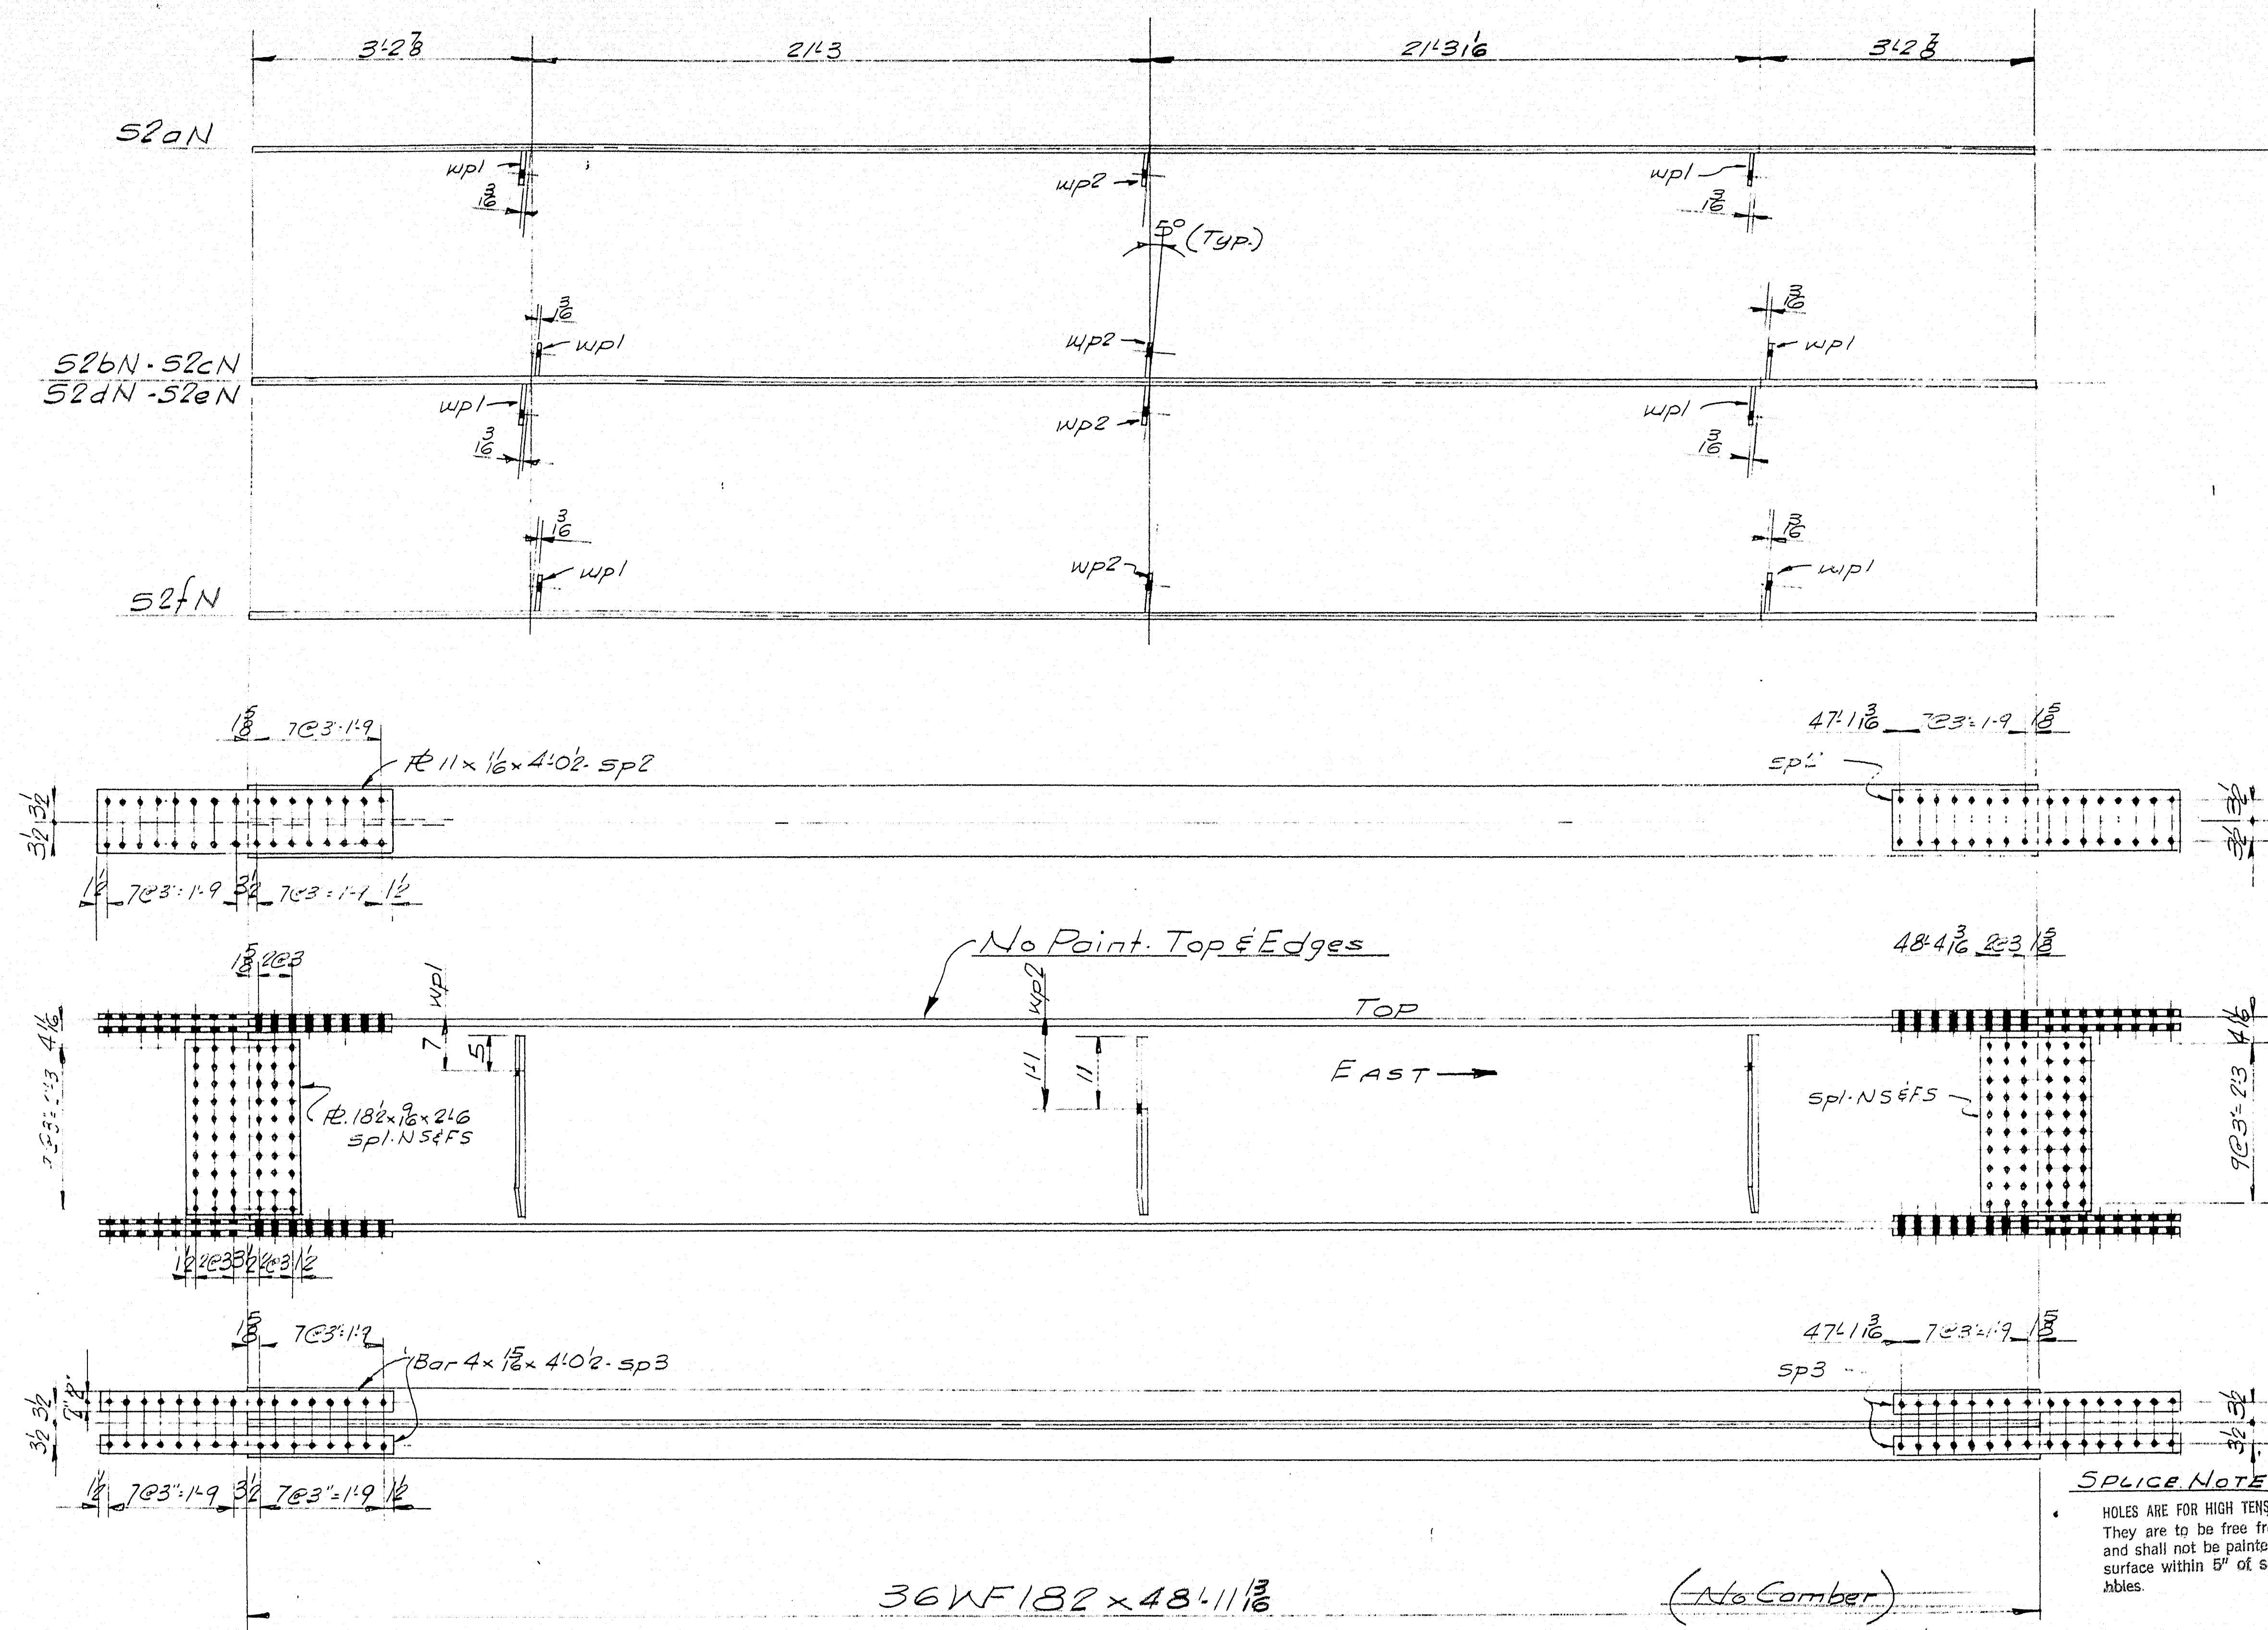

- | | |
|-------------------|-------------------|
| S2aN - ONE REQ'D. | S2dN - ONE REQ'D. |
| S2bN - ONE REQ'D. | S2eN - ONE REQ'D. |
| S2cN - ONE REQ'D. | S2fN - ONE REQ'D. |

GENERAL NOTES

1. Material for stringers, cover plates & splices shall conform to A.S.T.M. A-36. All other steel shall conform to either A.S.T.M. A-36 or A-7.
2. Holes in field splices are to be sub-punched (or sub-drilled) and reamed while assembled in the shop & connecting parts to be match marked & bolted for shipment. For shop layout see Dwg. 54.
3. Holes: splices 1 1/2" ϕ re. 'wp' 1 1/2" ϕ

SPICE NOTE

HOLES ARE FOR HIGH TENSILE BOLTS. They are to be free from burrs and shall not be painted on any surface within 5" of such openings.

SHIP		BILL OF MATERIAL				DWG. NO. B63-48-S9
MARK	NO.	MARK	SHAPE	LENGTH	WT.	REMARKS
S1aN	1		36WF182	86'6"		No Camber
S1bN	1			86'6"		
S1cN	1			86'6"		
S1dN	1			86'6"		
S1eN	1			86'6"		
S1fN	1			86'6"		
S2aN	1			48'11 1/2"		
S2bN	1			48'11 1/2"		
S2cN	1			48'11 1/2"		
S2dN	1			48'11 1/2"		
S2eN	1			48'11 1/2"		
S2fN	1			48'11 1/2"		
S3aN	1			86'5 3/8"		
S3bN	1			86'5 3/8"		
S3cN	1			86'5 3/8"		
S3dN	1			86'5 3/8"		
S3eN	1			86'5 3/8"		
S3fN	1			86'5 3/8"		
	24	Cpl	10'8" x 1"	20'0"		No Camber
	24	Sp1	10'8" x 1"	2'0"		
	24	Sp2	10'11" x 1"	4'0"		
	48	Sp3	Bar 4 x 1/2"	4'0"		
	60	Wpl	Bar 6 x 3/8"	2'8"		
	50	Wp2	Do	2'8"		
FIELD	760		3" H.S. BOLTS	0'37"		Web (720)
Do	800		Do	0'42"		Flg's (768)
Do	3120		3" H.S. HARD 3 WASHERS			
ITEM 708-103						

This Bill of Material also covers Dwg's 58 & 510


SHOP CONNECTIONS: Welded
FIELD CONNECTIONS: Bolted-Welded
HOLES: See General Notes
PAINT: Per Maine Specs. & As Noted

APR 4, 1963

NORTHBOUND	
STRINGER DETAILS: SPAN 2	
Bancroft & Martin Inc. South Portland 7, Maine	
SEBASTICOOK BRIDGE PITTSFIELD, MAINE	
CUSTOMER: DIANCHETTE, BROS.	
DESIGNER: MAINE S.H.C. BRIDGE DIV.	
ORDER NO. VERBAL	DWG. NO. B63-48-S9

DRAWN	4-5-63 J.R.F.
REVISION	
REVISION	
REVISION	

Sections taken looking down @ web

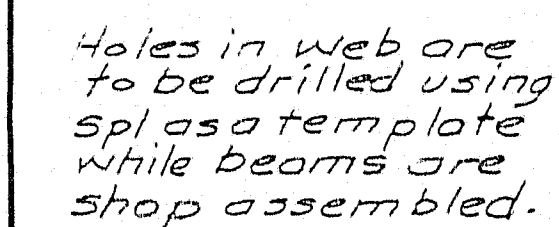

SPORTS ARE A GOOD THING, BUT THEY ARE NOT THE ONLY THING. THEY ARE NOT THE ONLY THING THAT CAN HELP US TO LIVE BETTER. THEY ARE NOT THE ONLY THING THAT CAN HELP US TO LIVE BETTER. THEY ARE NOT THE ONLY THING THAT CAN HELP US TO LIVE BETTER.

No Pint Bott.
at cover R.

17:11E

6840 c. to c. Bearings

36 WF 182 x 86.53

(No Camber)

53a N - ONE REQ'D.


536N - ONE REQ'D.

53cN - ONE REQ'D

53DN - ONE REQ'D.

53eN - ONE REG'D

53fN - ONE REQ'D

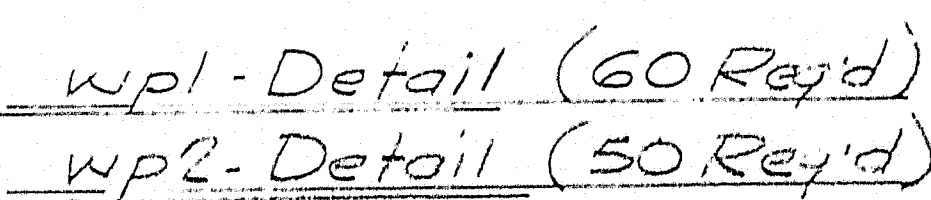

For Bill of Material & General Notes see DWG 59

NORTHBOUND

STRINGER DETAILS-SPAN 3

Bancroft & Martin Rolling Mills Company
South Portland 7, Maine


SEBASTICOOK BRIDGE
PITTSFIELD, MAINE


CUSTOMER CIANCHETTE BROS.
DESIGNER MAINE S.H.C. BRIDGE DIV.

ORDER NO. <u>VERBAL</u>	DWG. NO. <u>B63-48-510</u>
-------------------------	----------------------------

DRAWN	4-5-63	J.P.F.
REVISION		
REVISION		
REVISION		

89-176

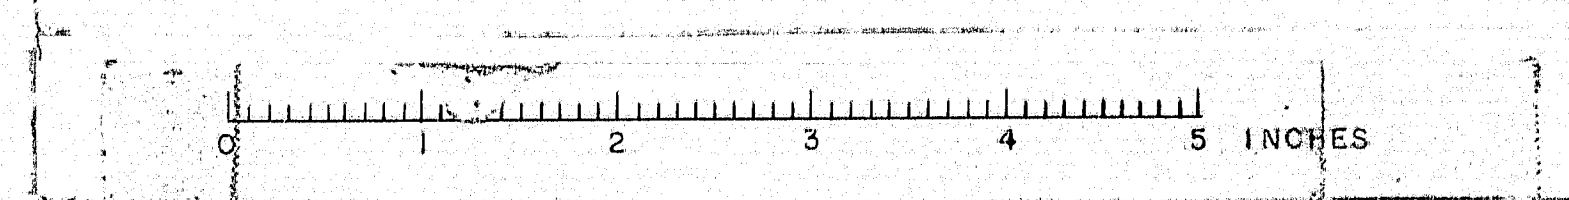

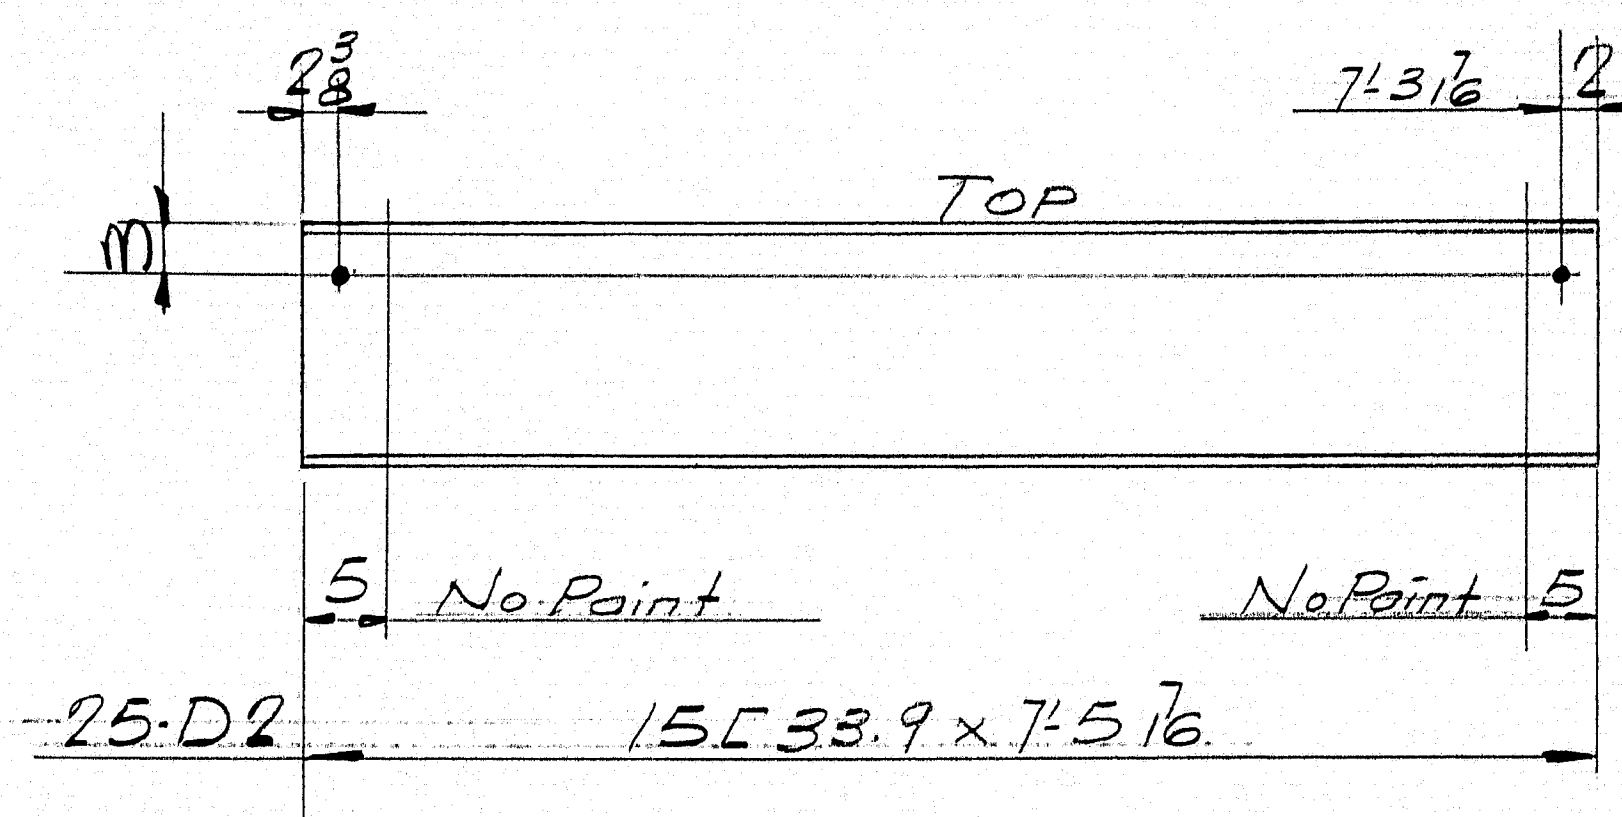[illegible]

SHOP CONNECTIONS:
FIELD CONNECTIONS: 5th Temp. M. Bolts - Welded
HOLES: 1/2" ϕ
PAINT: Per Maine Specs & as noted

SOUTHBOND

DIAPHRAGMIS

Bancroft & Martin Inc.
South Portland 7, Maine

SEBASTICOOK BRIDGE
PITTSFIELD, MAINE


CUSTOMER CIANCHETTE BROS
DESIGNER MAINE S. H. C. BRIDGE DIV


ORDER NO. <u>VERBAL</u>	DWG. NO. <u>B63-48-S-11</u>
-------------------------	-----------------------------

89-177

DRAWN	4-5-63	J.P.
REVISION		
REVISION		
REVISION		

89-177

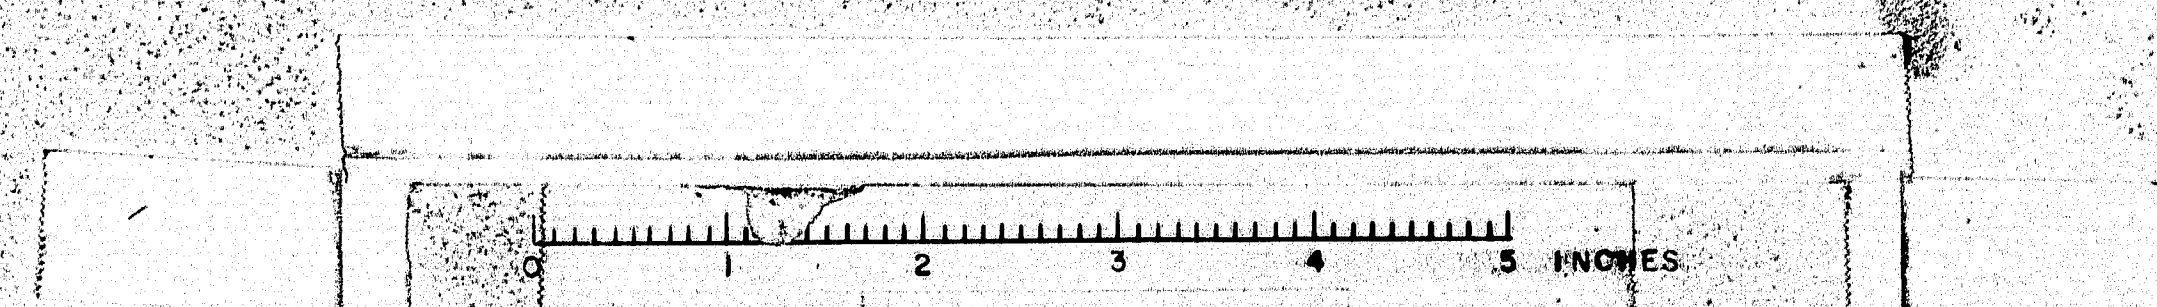

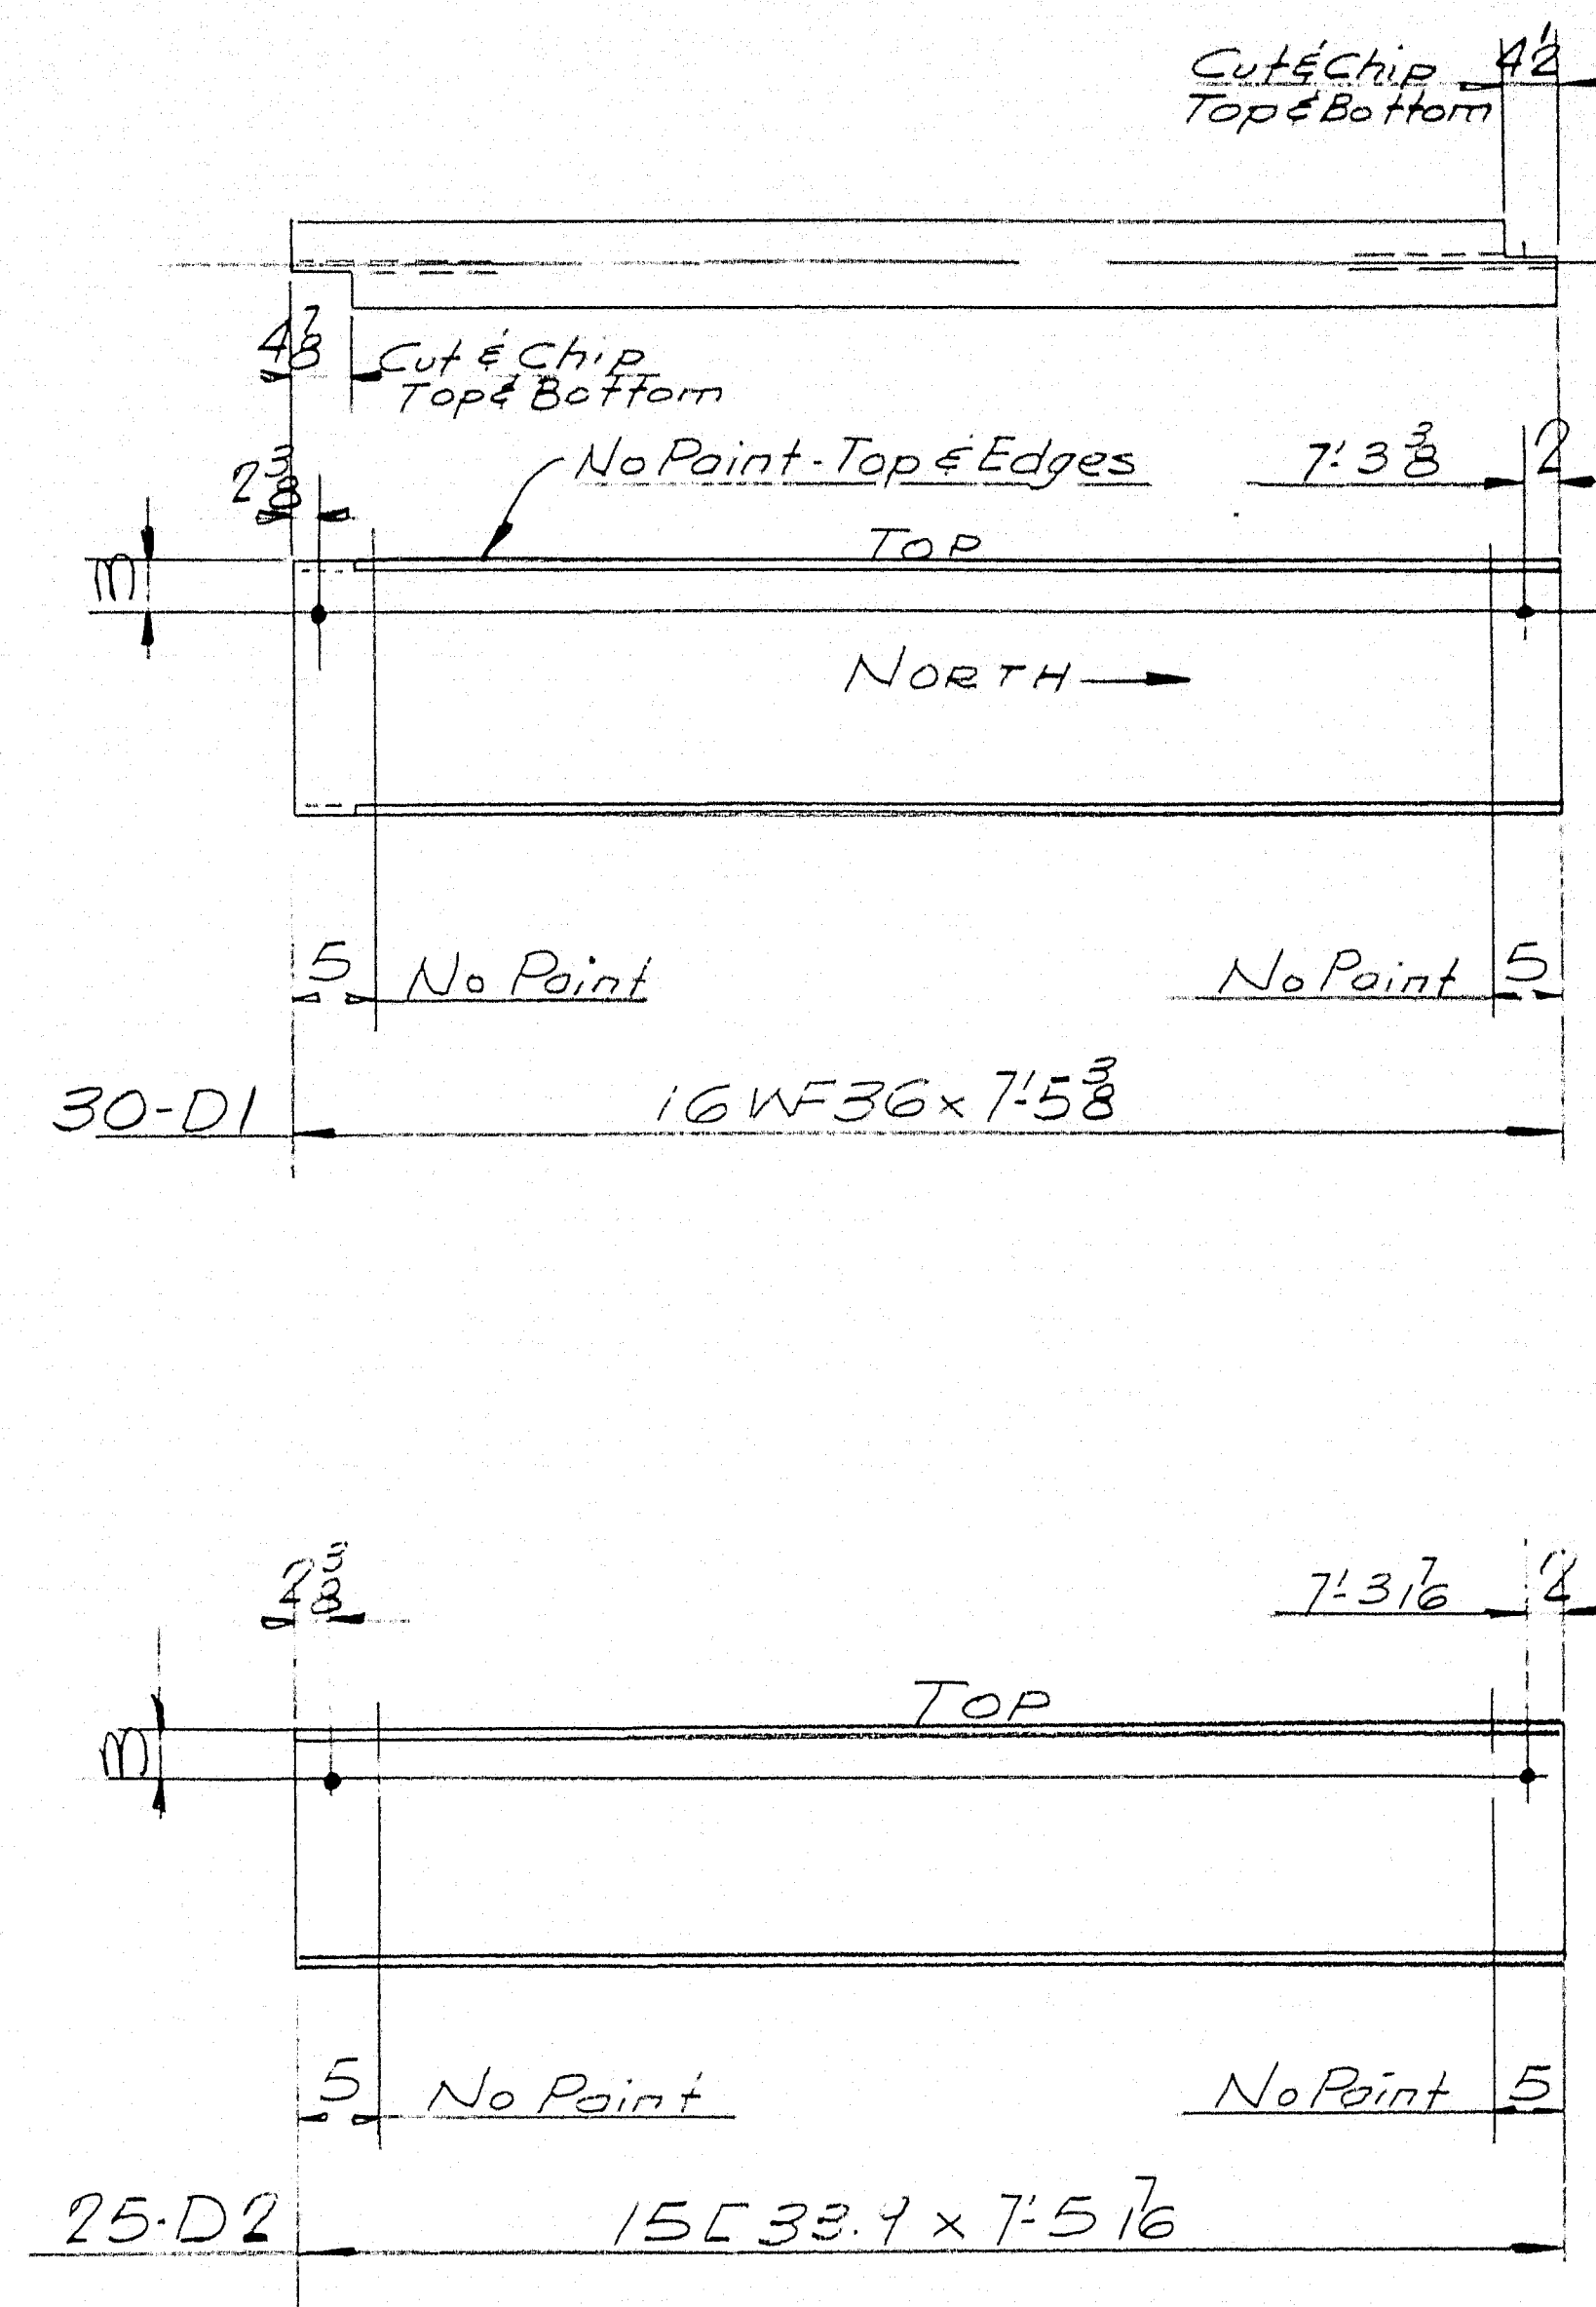[illegible]

SHOP CONNECTIONS:
FIELD CONNECTIONS: 3 Temp M. Bolts - Welded
HOLES: 1/2" ϕ
PAINT: Per Maine Specs & as noted

2001 07 13

NORTHBOUND

DIAPHRAGMS


Bancroft & Martin Inc.
South Portland 7, Maine


SEBASTICOOK BRIDGE
PITTSFIELD, MAINE

CUSTOMER CIANCHETTE BROS.
DESIGNER MAINE S. H. C. BRIDGE DIV.

ORDER NO. <u>VERBAL</u>	DWG. NO. <u>B63-48-512</u>
-------------------------	----------------------------




DRAWN	4-563	J.P.
REVISION		
REVISION		
REVISION		

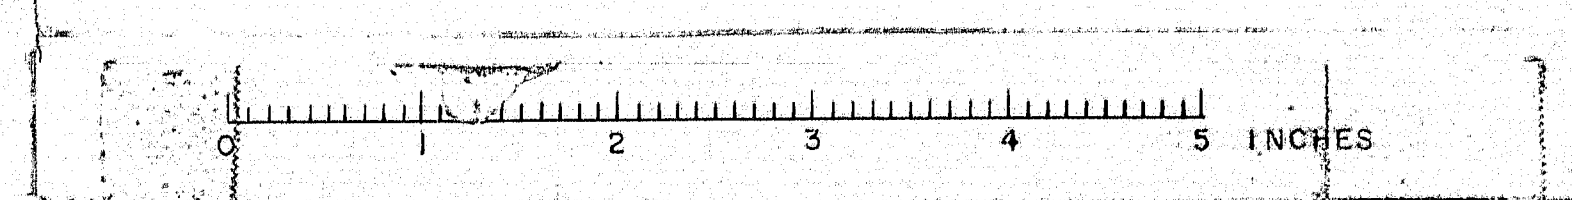

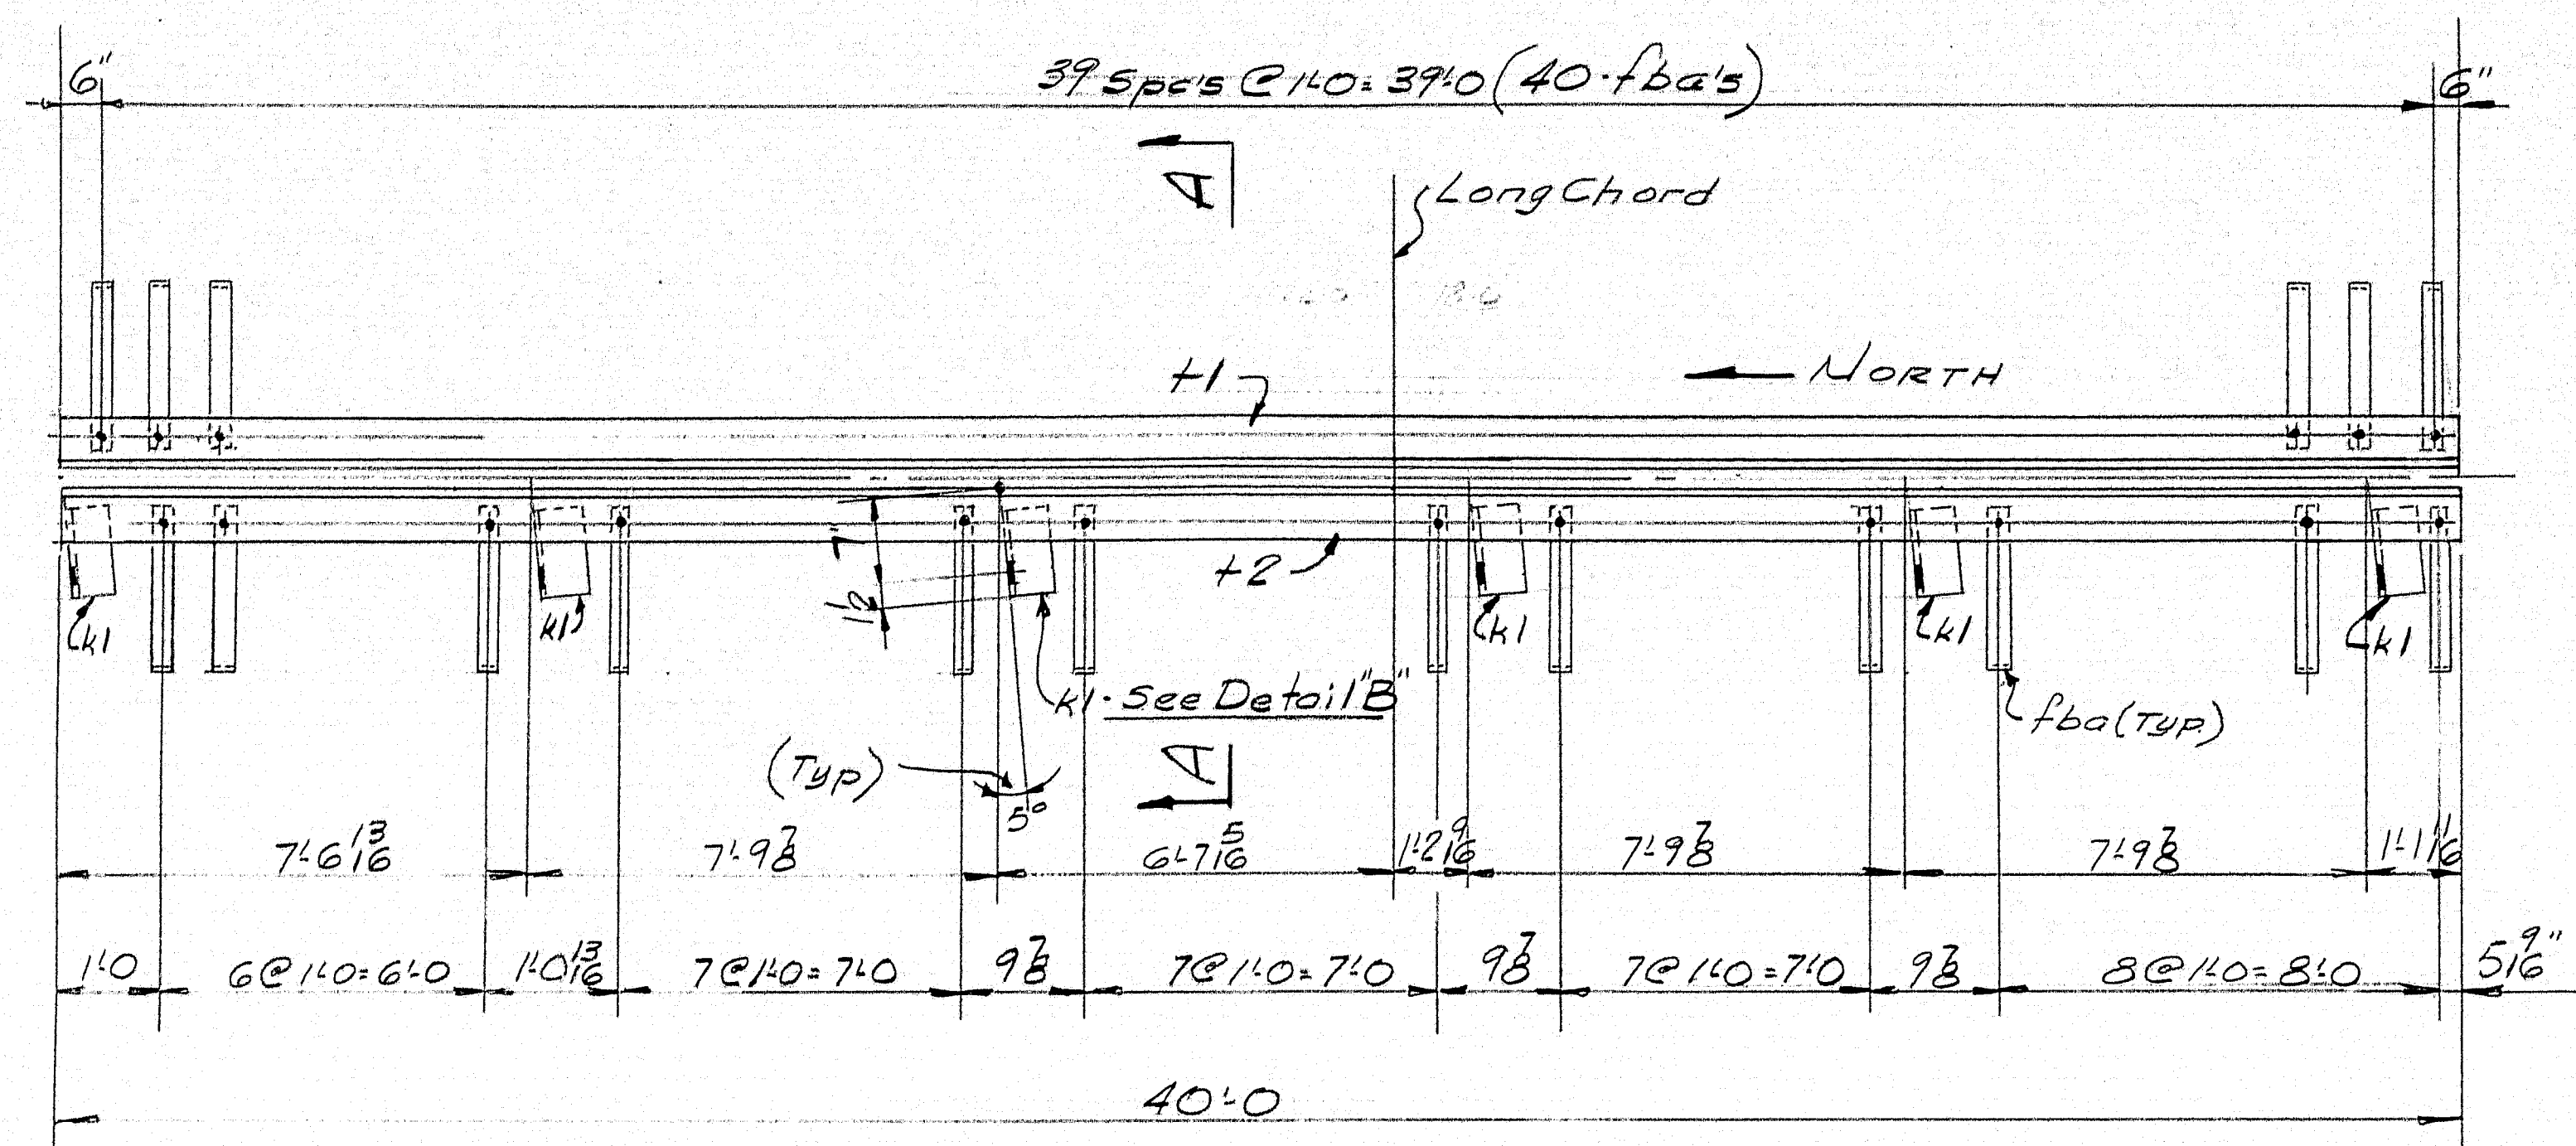

AJ1- ONE REG'D

Fasten together w/ $\frac{1}{2}$ " ϕ Bolts for shipment

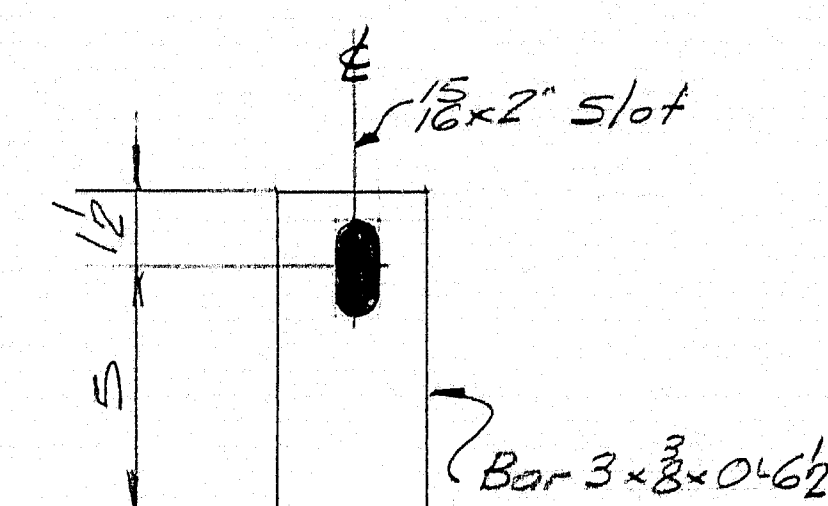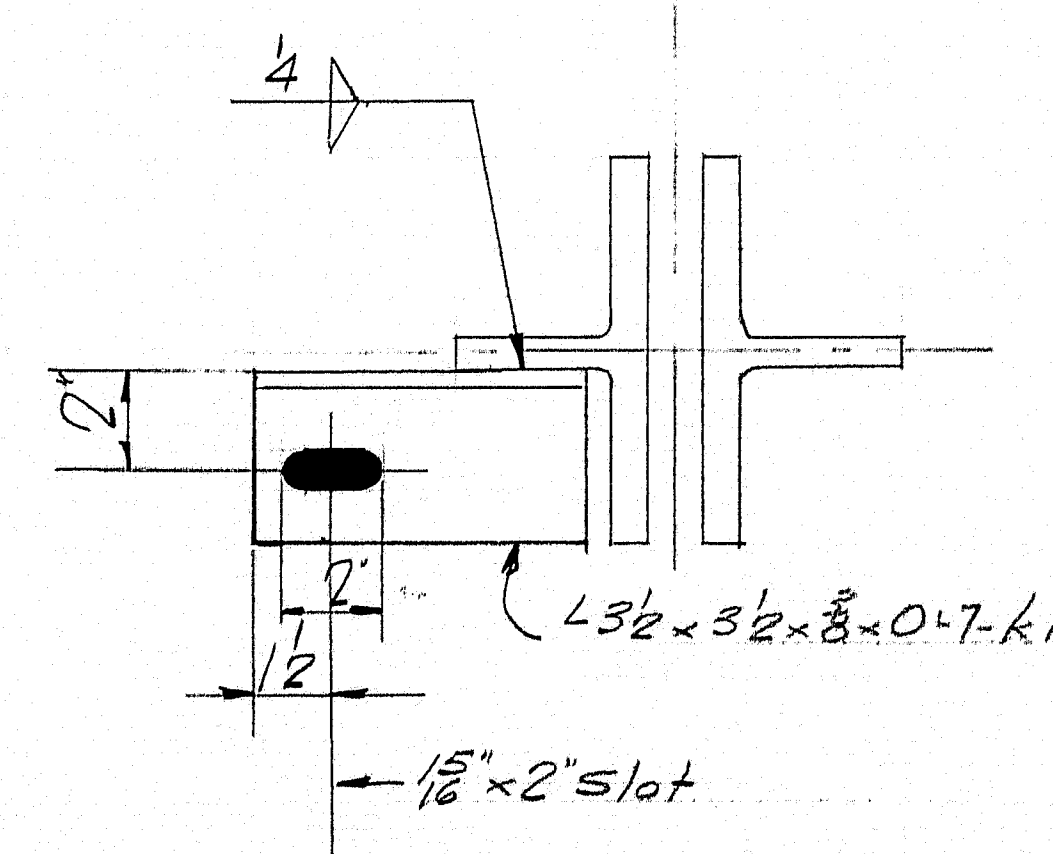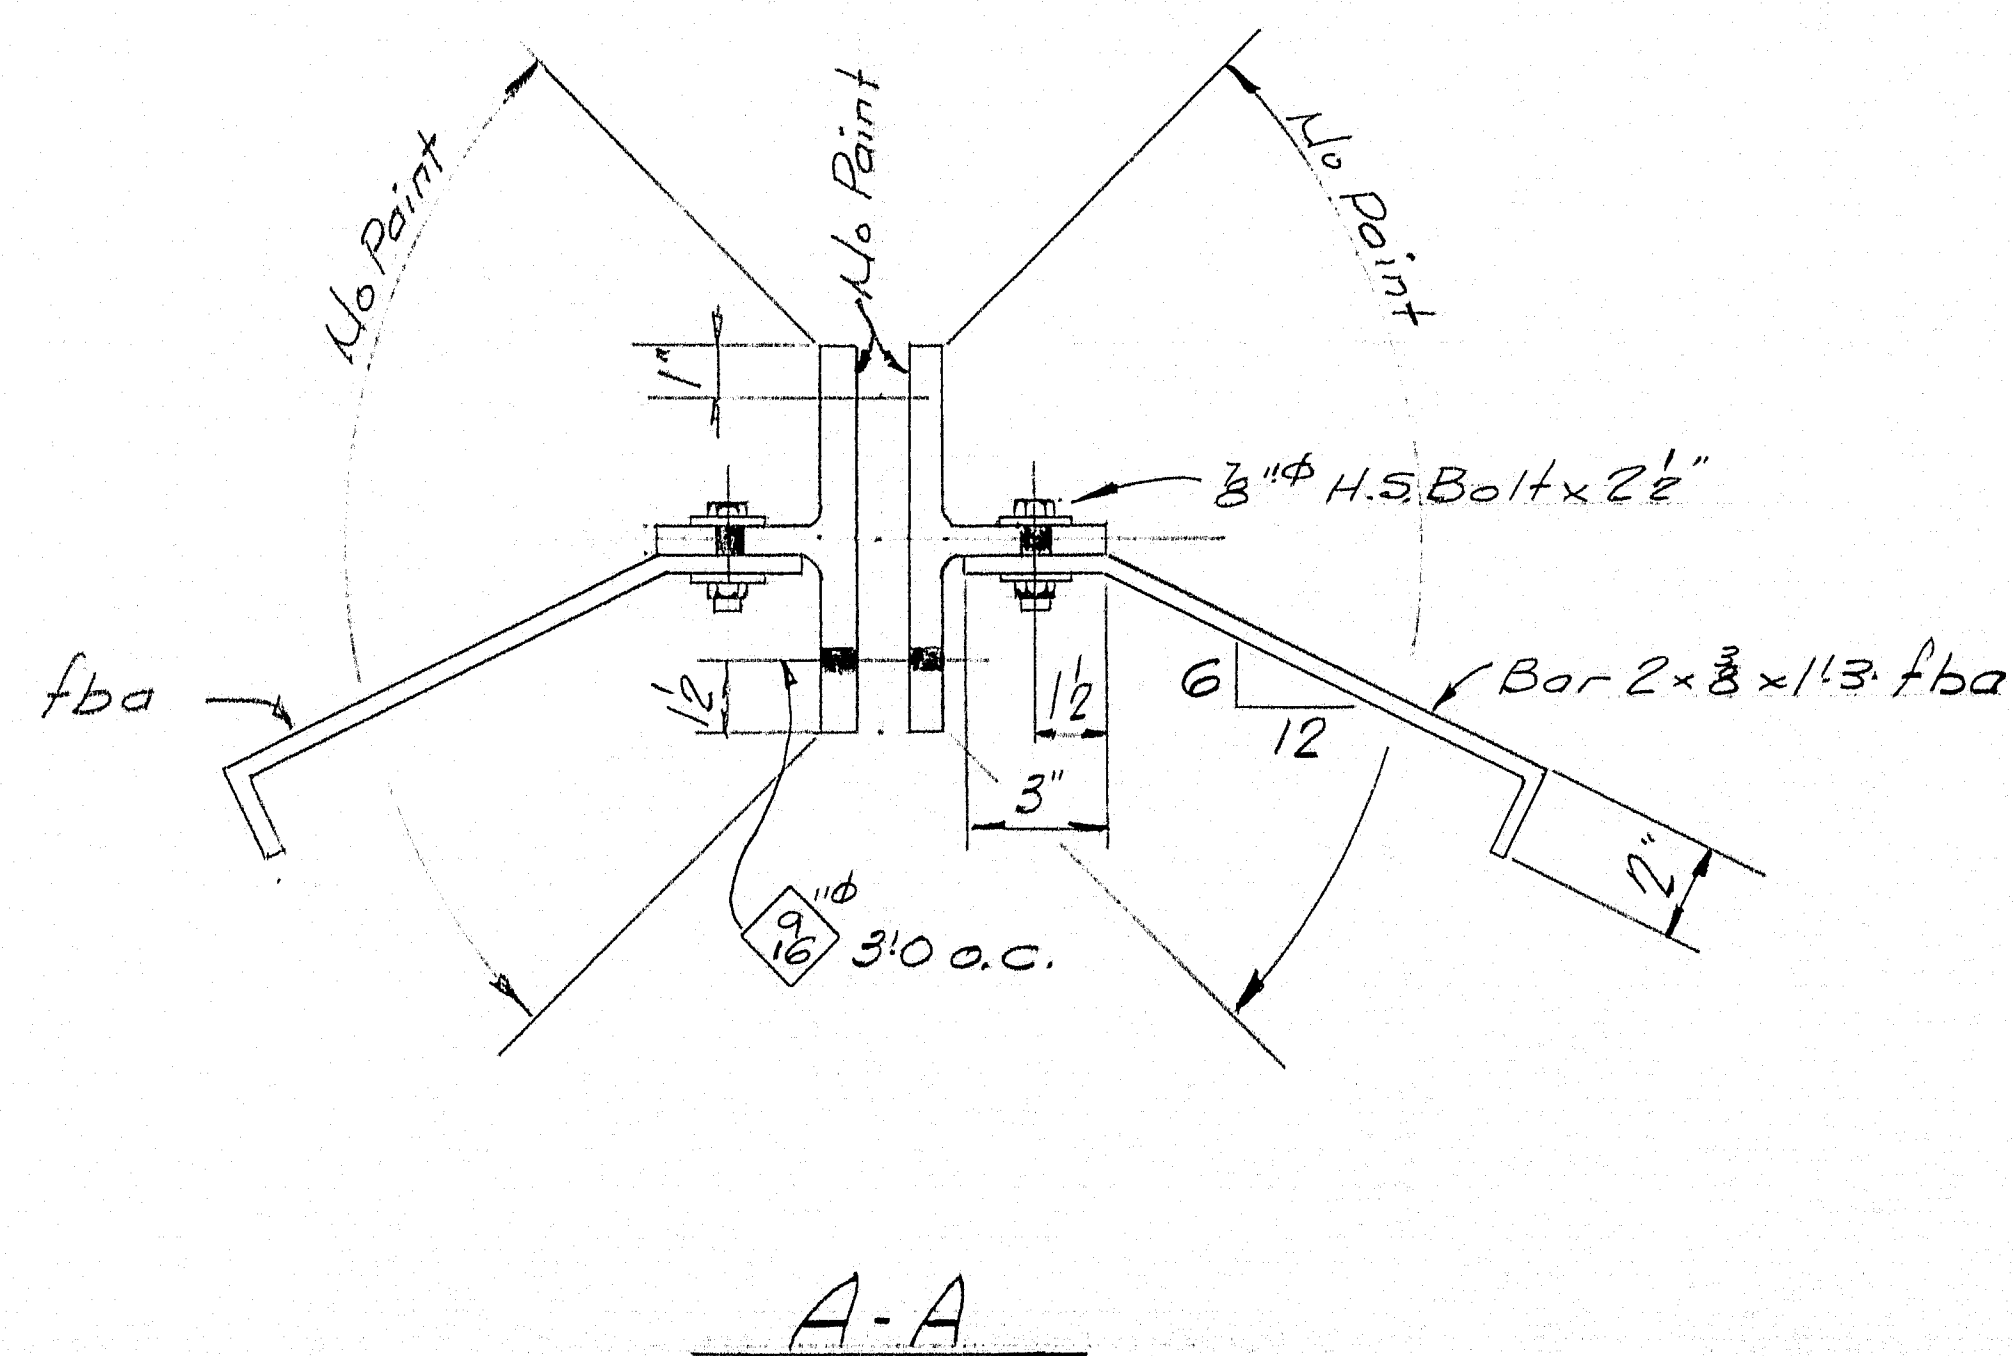

b1-6 Req'd.

No Point
Bolt to kl for shipment
1-3" M. Bolt x 2"

[illegible]

SHOP CONNECTIONS: Bolted-Welded
FIELD CONNECTIONS: Welded
HOLES: 1/2" unless noted
PAINT: Per Maine Specs & as noted

SOUTHBOUND

ARMORED JOINT - ABUT. #2

Bancroft & Martin Inc.
South Portland 7, Maine

SEBASTICOOK BRIDGE
PITTSFIELD, MAINE


CUSTOMER CIANCHETTE BROS.
DESIGNER MAINE S.H.C. BRIDGE DIV.

ORDER NO. VERBAL DWG. NO. B63-48-S/E

DRAWN	4-8-63	J.P.A.
REVISION		
REVISION		
REVISION		

89-179

STATE OF MAINE
DEPARTMENT OF TRANSPORTATION

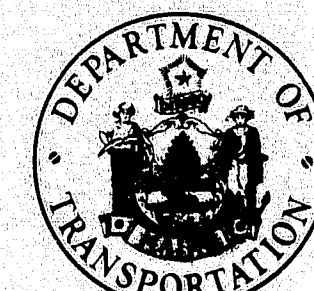

PLANS

BRIDGE WEARING SURFACE
REPLACEMENTS

PROJECT NO. IR-95-7 (96)

I-95 NB over SEBASTICOOK RIVER (5990)
I-95 SB over SEBASTICOOK RIVER (1446)
I-95 NB over NORTH MAIN STREET (5989)
I-95 SB over NORTH MAIN STREET (1445)
I-95 NB over WEBB ROAD (5984)
I-95 SB over WEBB ROAD (1449)
I-95 NB over SOMERSET AVENUE (5985)
I-95 SB over SOMERSET AVENUE (1447)
I-95 NB over MAINE CENTRAL R.R. (5988)
I-95 NB over ROUTE 152 (5987)
I-95 SB over ROUTE 152 & MAINE CENTRAL R.R. (5986)

IN THE TOWN OF
PITTSFIELD
SOMERSET COUNTY

CONVENTIONAL SIGNS			
COUNTY LINES	=====	TRAVELLED WAY - PROPOSED	=====
TOWN LINES	=====	UNDERGROUND UTILITIES - EXISTING	-----
PROPERTY LINES	=====	UNDERGROUND UTILITIES - PROPOSED	-----
R/W LINES - EXISTING	=====	RAILROAD - SINGLE TRACK	=====
R/W LINES - NEW - ACCESS CONTROL	=====	RAILROAD - DOUBLE TRACK	=====
R/W LINES - NEW - NO ACCESS CONTROL	=====	UTILITY POLE - EXISTING	=====
CULVERT - EXISTING	=====	UTILITY POLE - JOINT OCCUPANCY	=====
CULVERT - PROPOSED	=====	PROPOSED UTILITY POLE - TEMPORARY	=====
CURBING - EXISTING	=====	PROPOSED UTILITY POLE - PERMANENT	=====
CURBING - PROPOSED	=====	TREES	=====
TRAVELLED WAY - EXISTING	=====	WOODS	=====

INDEX OF SHEETS
SHEET DESCRIPTION

1. Title Sheet
2. Estimated Quantities
3. General Plans & Sections
4. General Plans
5. Sections
6. Joint Details
7. End Post & Guard Rail Connection Detail
8. Reinforcing Steel Schedule
9. BD 125-82 Expansion Device
10. BD 127-81 Miscellaneous Details (Barriers)
11. (HD-5) Type 3 Guard Rail (Terminal Connector)
- 12 thru 14. Traffic Control Plans

SPECIFICATIONS


DESIGN: LOAD FACTOR DESIGN PER AASHTO STANDARD SPECIFICATIONS FOR HIGHWAY BRIDGES 1983, AND INTERIM SPECIFICATIONS THROUGH 1985.

CONTRACT: STATE OF MAINE, DEPARTMENT OF TRANSPORTATION, STANDARD SPECIFICATIONS HIGHWAYS AND BRIDGES, REVISION OF JAN. 1984.

MATERIALS: CONCRETE--CLASS AA
REINFORCING STEEL--ASTM A615, GRADE 60.

BASIC DESIGN STRESSES: CONCRETE-- $f'_c = 3,000$ PSI;
REINFORCING STEEL-- $f_y = 60,000$ PSI.

PLANS OF THE EXISTING BRIDGES ARE AVAILABLE FOR THE CONTRACTOR'S REFERENCE AT THE BRIDGE DESIGN OFFICE IN AUGUSTA. THE PLANS ARE REPRODUCTIONS OF ORIGINAL DRAWINGS AS PREPARED FOR THE CONSTRUCTION OF THE BRIDGES AND IT IS VERY UNLIKELY THAT THE PLANS WILL SHOW ANY CONSTRUCTION FIELD CHANGES OR ANY ALTERATIONS WHICH MAY HAVE BEEN MADE TO THE BRIDGES DURING THEIR LIFE SPAN.

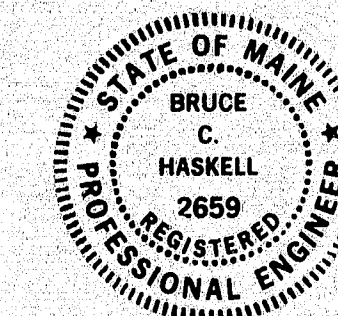

CARROLL E. TAYLOR & ASSOCIATES
CONSULTING ENGINEERS
410 SUMMER STREET
AUBURN MAINE

APPROVED:

STATE OF MAINE
DEPARTMENT OF TRANSPORTATION
COMMISSIONER

DATE

June 13, 1988

Richard A. Coleman
CHIEF ENGINEER

June 13, 1988

99-459

As b. 11 Report 1/1/88

UNITED STATES
DEPARTMENT OF TRANSPORTATION
FEDERAL HIGHWAY ADMINISTRATION
REGION 1

APPROVED:

DIVISION ADMINISTRATOR DATE

NOTE

All work contemplated under this contract to be governed by and in conformity with the STANDARD SPECIFICATIONS (revision of January 1984) and supplementals thereto, except as modified on the plans and in the special provisions.

ESTIMATED QUANTITIES		TOTAL QUANTITY	UNIT	S.B.OVER SEBASTICOOK RIVER	N.B.OVER SEBASTICOOK RIVER	S.B.OVER N. MAIN STREET	N.B.OVER N. MAIN STREET	S.B.OVER WEBB ROAD	N.B.OVER WEBB ROAD	S.B.OVER SOMERSET AVENUE	N.B.OVER SOMERSET AVENUE	S.B.OVER M.C.R.R. ROUTE 152	N.B.OVER M.C.R.R. ROUTE 152	N.B.OVER ROUTE 152
ITEM NO.	DESCRIPTION													
202.127	REMOVAL OF EXISTING BITUMINOUS PAVEMENT	1	L.S.	0.12	0.12	0.07	0.07	0.07	0.07	0.08	0.08	0.17	0.08	0.07
202.202	Removing Pavement Surface	7377	S.Y.	683	683	683	683	683	683	683	683	683	615	615
403.10	HOT BITUMINOUS PAVEMENT GRADING D	1898	TONS	210	210	146	146	146	146	151	151	286	155	151
403.121	HOT BITUMINOUS PAVEMENT GRADING E (SHIMMING)	108	TONS	10	10	10	10	10	10	10	10	10	9	9
410.15	Emulsified Asphalt Applied	736	G	68	68	68	68	68	68	68	68	68	62	62
503.12	Reinforcing Steel, Fabricated and Delivered	5448	Lbs.	503	503	503	503	503	503	503	503	418	503	503
503.13	Reinforcing Steel, Placing	5448	Lbs.	503	503	503	503	503	503	503	503	418	503	503
506.142	FIELD PAINT EXISTING STRUCTURAL STEEL	1	L.S.	0.15	0.15	0.06	0.06	0.06	0.06	0.07	0.07	0.17	0.08	0.07
508.13	MEMBRANE WATERPROOFING	1	L.S.	0.11	0.11	0.08	0.08	0.08	0.08	0.08	0.08	0.14	0.08	0.08
514.06	CURING BOX FOR CONCRETE CYLINDERS	1	EACH											
518.30	REHAB. OF STRUCTURAL CON. SLAB-TO-REINFORCING STEEL	5625	S.F.	445	445	217	163	162	162	229	229	1310	929	890
518.31	REHAB. OF STRUCTURAL CON. SLAB-TO-BELOW REINF. STEEL	2655	S.F.	267	445	108	0	0	0	114	114	393	619	595
520.2401	BRIDGE JOINT MODIFICATION	10	EA.	1	1	1	2	1	1	1	1	1	1	1
520.2402	BRIDGE JOINT MODIFICATION	5	EA.	1	1	1	1	1	1	1	1	1	1	1
520.2403	Bridge Joint Modification	6	EA.	1	1	1	1	1	1	1	1	1	1	1
526.301	Temporary Concrete Barrier, Type I	1	L.S.	0.10	0.10	0.10	0.10	0.10	0.10	0.10	0.10	0.10	0.05	0.05
606.173	Bridge Connections	22	EA.	2	2	2	2	2	2	2	2	2	2	2
627.611	6 inch Solid White Pavement Marking Line	3,600	L.F.	360	360	360	360	360	360	360	360	360	180	180
627.621	6 inch Broken White Pavement Marking Line	3,600	L.F.	360	360	360	360	360	360	360	360	360	180	180
627.631	6 inch Solid Yellow Pavement Marking Line	3,600	L.F.	360	360	360	360	360	360	360	360	360	180	180
627.67	Removing Pavement Markings	1,600	S.F.	160	160	160	160	160	160	160	160	160	80	80
627.681	Temporary 6 inch Painted Pavement Marking Line, Yellow or White	3,600	L.F.	360	360	360	360	360	360	360	360	360	180	180
627.69	Temporary 4 inch Plastic Pavement Marking Line, Yellow or White	1,600	L.F.	160	160	160	160	160	160	160	160	160	80	80
639.20	Field Office Type C	1	EA.	0.10	0.10	0.10	0.10	0.10	0.10	0.10	0.10	0.10	0.05	0.05
652.30	Flashing Arrow Board	2	EA.	0.20	0.20	0.20	0.20	0.20	0.20	0.20	0.20	0.20	0.10	0.10
652.31	Type I Barricade	100	EA.	10	10	10	10	10	10	10	10	10	5	5
652.33	Drum	20	EA.	2	2	2	2	2	2	2	2	2	1	1
652.34	Cone	20	EA.	2	2	2	2	2	2	2	2	2	1	1
652.35	Construction Signs	700	S.F.	70	70	70	70	70	70	70	70	70	35	35
652.361	Maintenance of Traffic Control Devices	1	L.S.	0.10	0.10	0.10	0.10	0.10	0.10	0.10	0.10	0.10	0.05	0.05
652.38	Flagger	500	M.H.	50	50	50	50	50	50	50	50	50	25	25
659.10	Mobilization	1	L.S.	0.10	0.10	0.10	0.10	0.10	0.10	0.10	0.10	0.10	0.05	0.05
= BREAKDOWN OF LUMP SUM QUANTITIES =														
202.127	REMOVAL OF EXISTING BITUMINOUS PAVEMENT	9420	S.Y.	987	987	599	599	598	598	631	631	1442	683	660
506.142	FIELD PAINT EXISTING STRUCTURAL STEEL	1934500	LB.	287800	287800	115350	115350	113000	113000	132500	132600	355600	147800	133800
508.13	MEMBRANE WATERPROOFING	8420	S.Y.	987	987	599	599	598	598	631	631	1442	683	660

F.R.S.A. REG. NO.	STATE	PROJECT NUMBER	SHEET NO.	TOTAL SHEETS
1	MAINE	IR-95-7 (96)	2	14

CARROLL E. TAYLOR & ASSOCIATES
CONSULTING ENGINEERS
410 SUMMER STREET
AUBURN MAINE

STATE OF MAINE
DEPARTMENT OF TRANSPORTATION

PITTSFIELD
ESTIMATED QUANTITIES


SHEET 2 OF 14 AUGUSTA, MAINE

As built Dec 1989
99-460
Pittsfield


PROJECT DESIGN ENGINEER
DESIGN - DETAILED
CHECKED
REVISIONS
FIELD CHANGES
PLANS
BY DATE
PAV
B.C.H.

BRUNING 44 132 4770-1

F.R.A. REV. NO.	STATE	PROJECT NUMBER	SHEET NO.	TOTAL SHEETS
1	MAINE	IR-95-7(96)	3	14

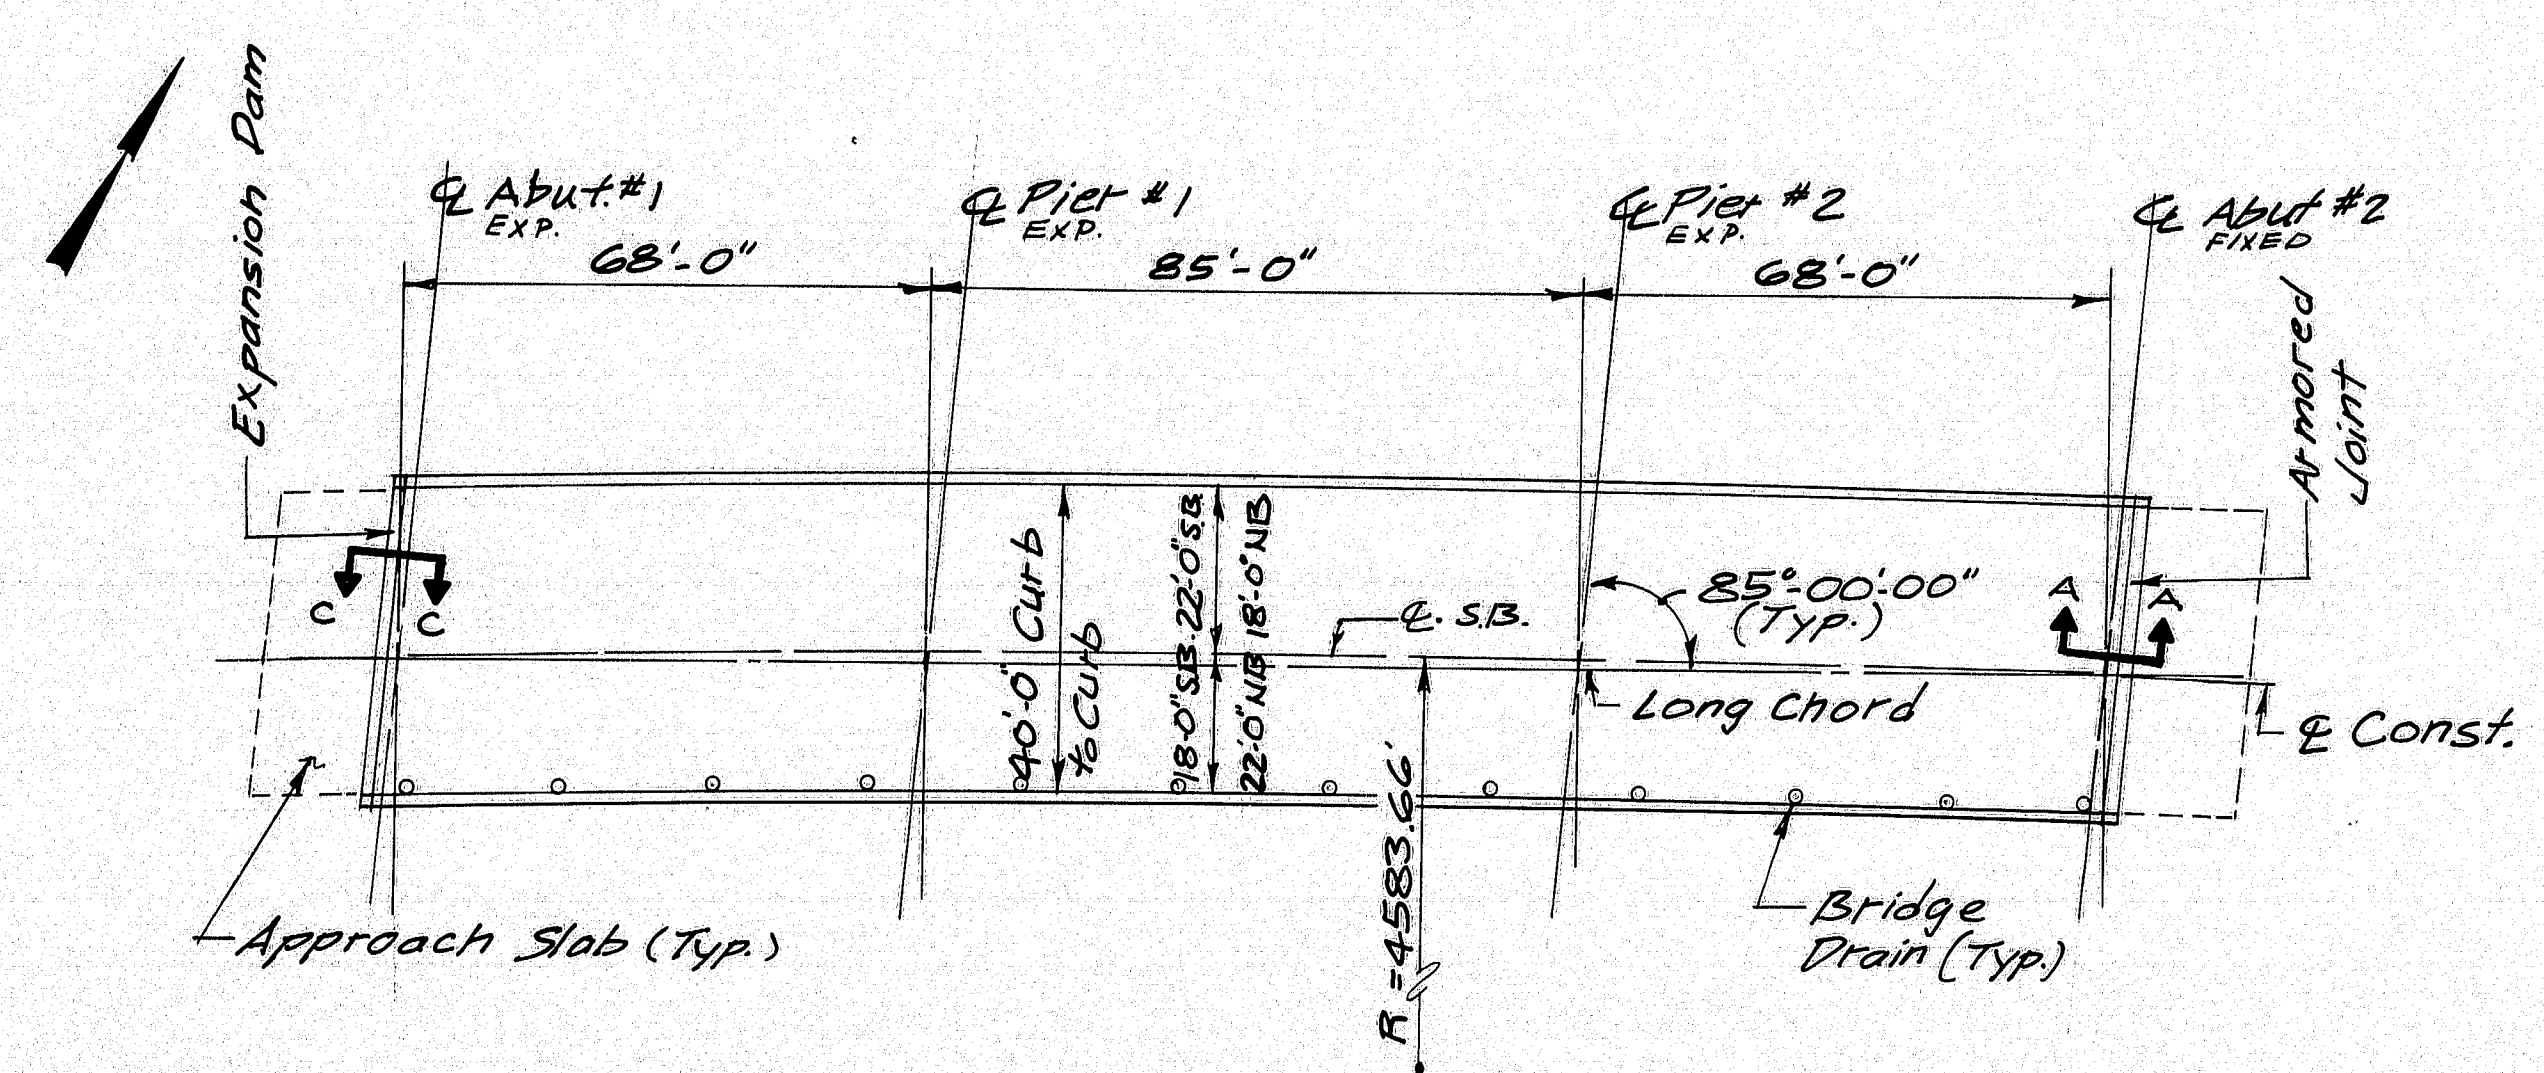


I-95 SOUTHBOUND AND NORTHBOUND OVER SEBASTCOOK RIVER 5990 N.B. 1446 S.B.

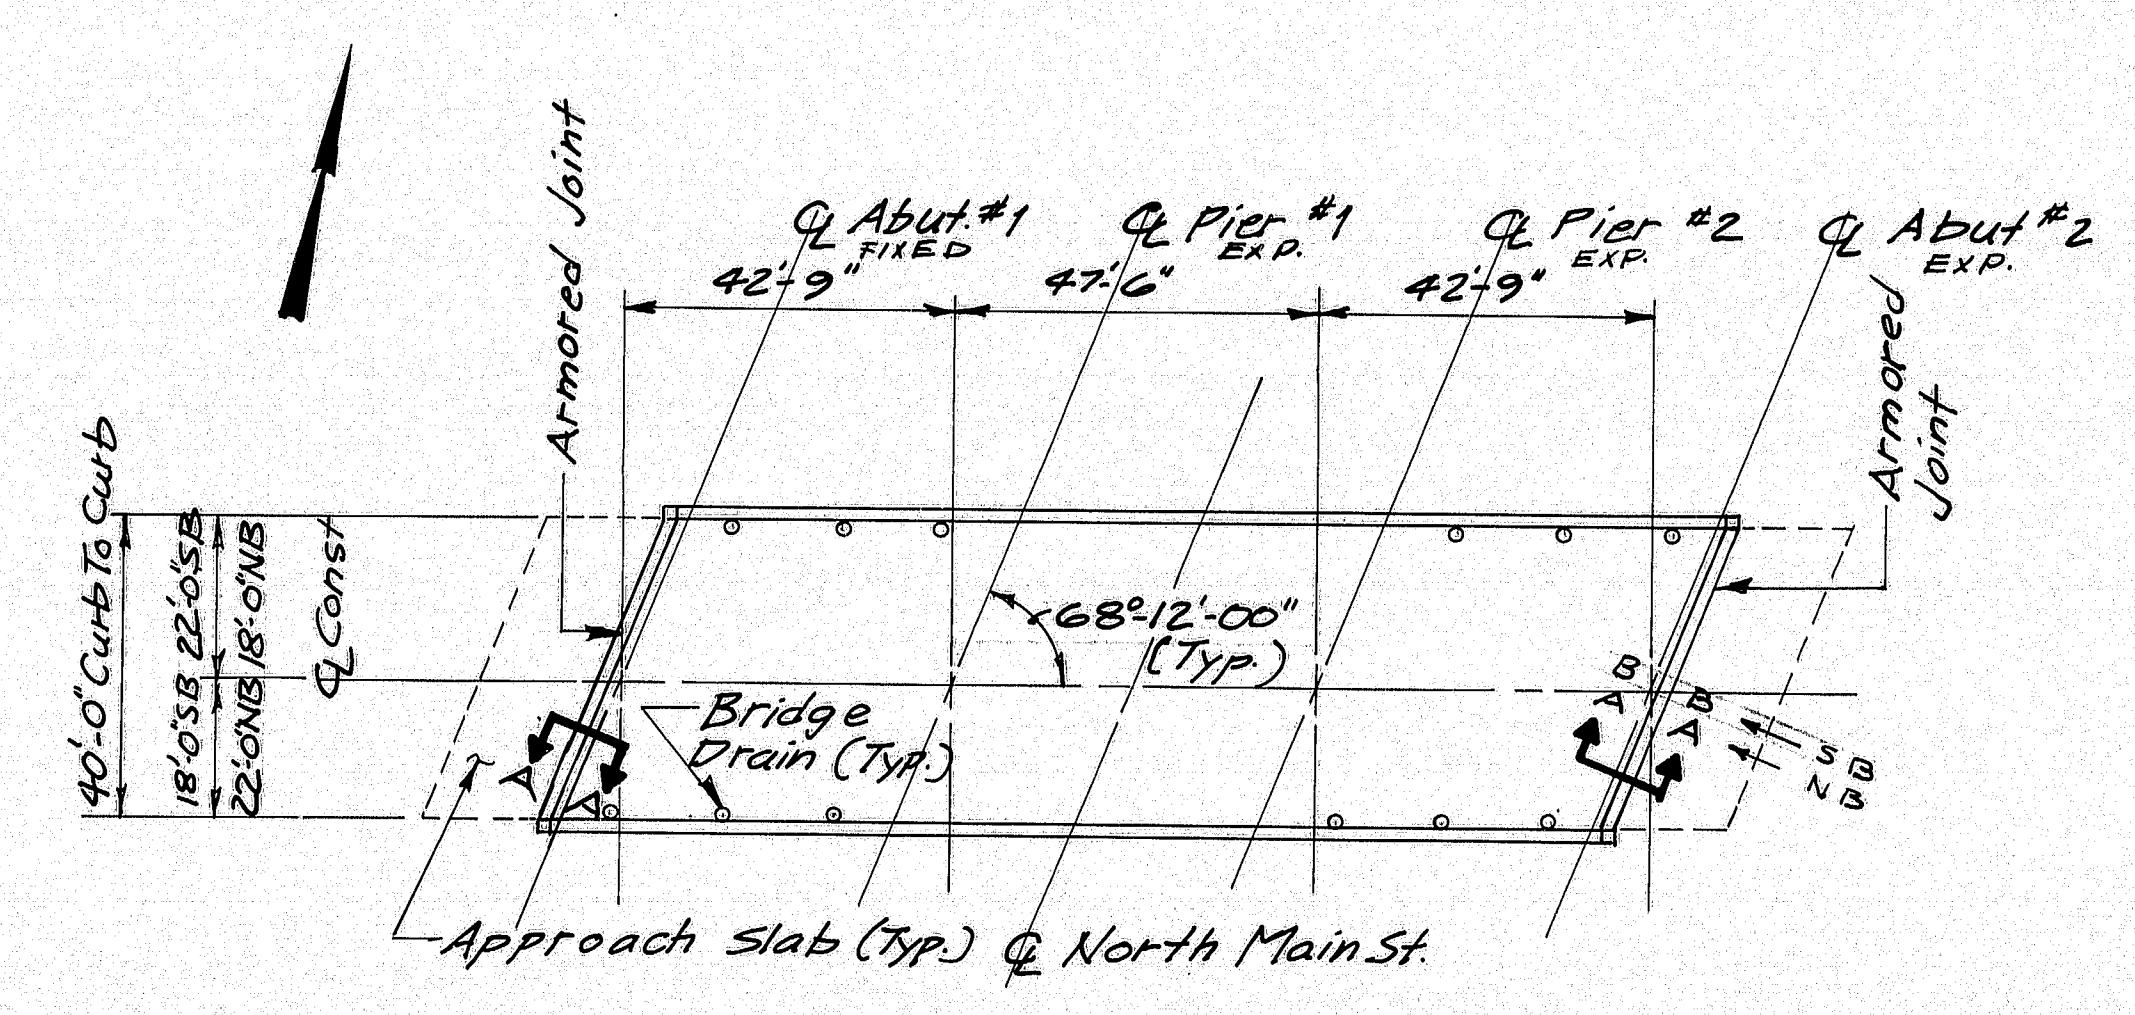


I-95 SOUTHBOUND AND NORTHBOUND OVER NORTH MAIN STREET 5989 N.B. 1445 S.B.

SCOPE OF WORK





ALL BRIDGES:
 REMOVE 2-INCH BITUMINOUS WEARING SURFACE AND REMOVE EXISTING MEMBRANE WATER-PROOFING.
 REPAIR DECK AS NECESSARY.
 MODIFY EXPANSION JOINTS *where indicated*.
 INSTALL 3-INCH BITUMINOUS WEARING SURFACE PLUS MEMBRANE *waterproofing*.
 CLEAN AND PAINT ALL STRUCTURAL STEEL.
 MODIFY APPROACH PAVEMENT FOR NEW GRADES.

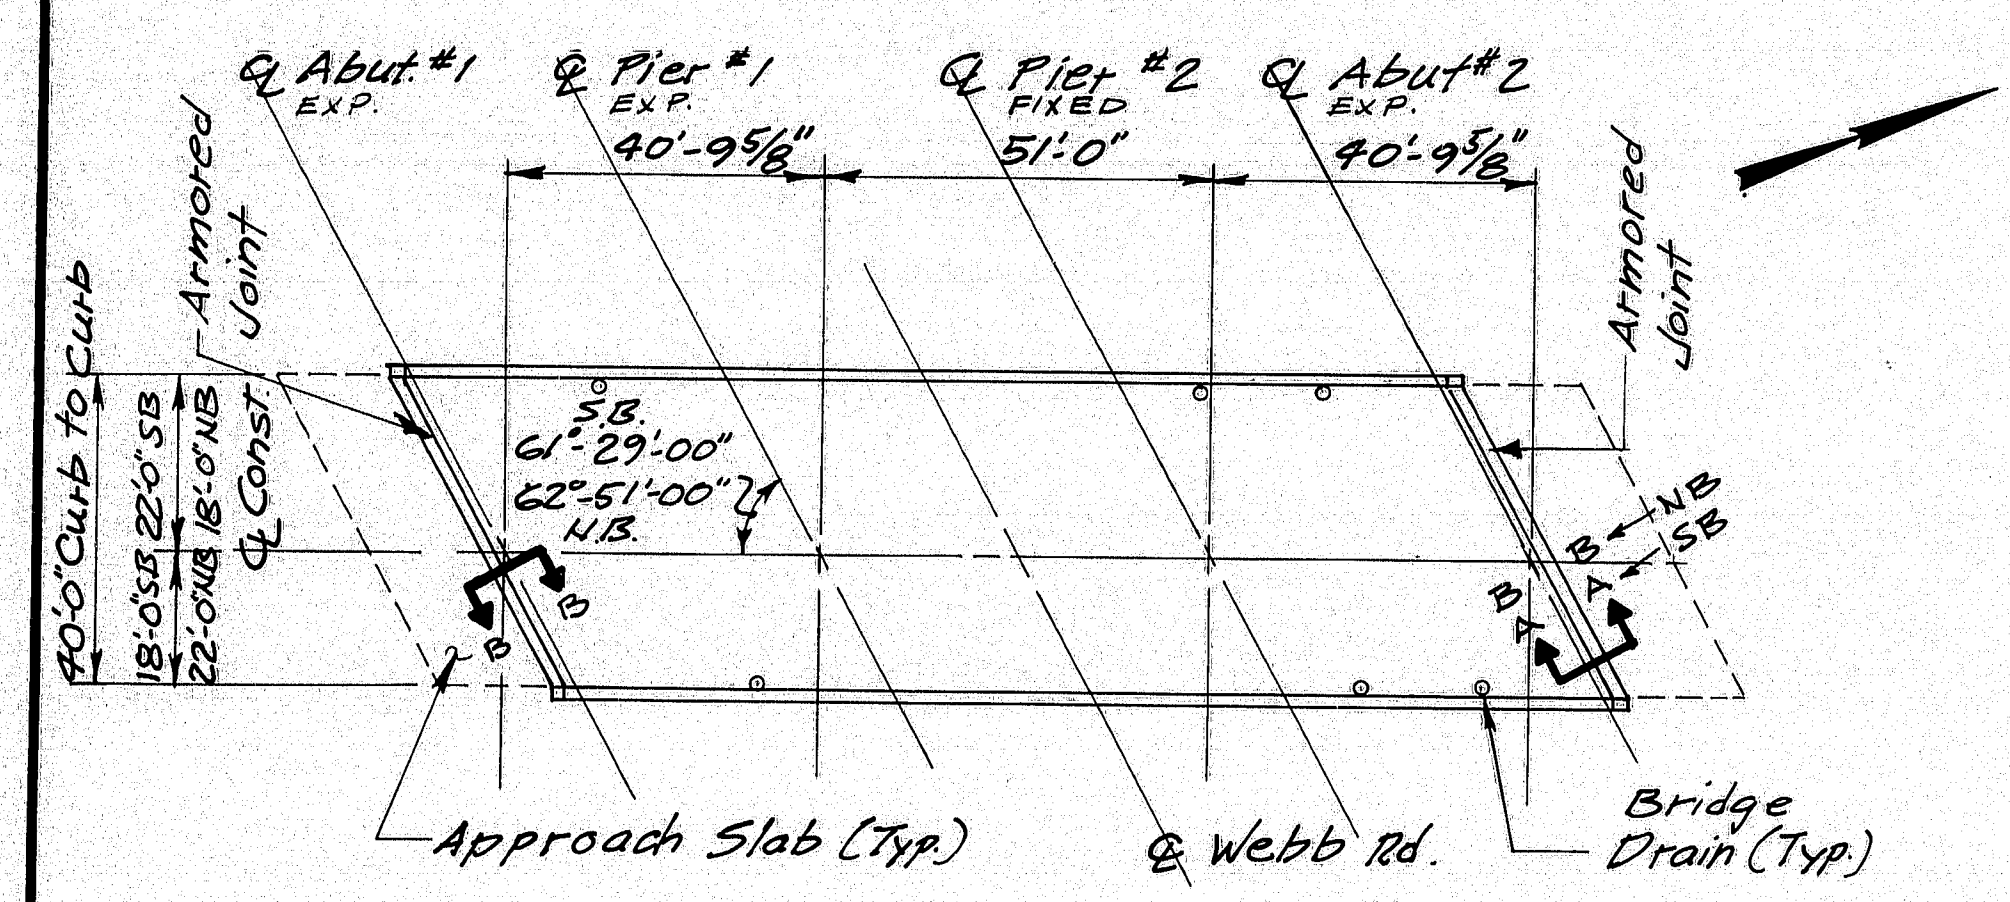

I-95 SOUTHBOUND AND NORTHBOUND OVER WEBB ROAD 5984 N.B. 1449 S.B.

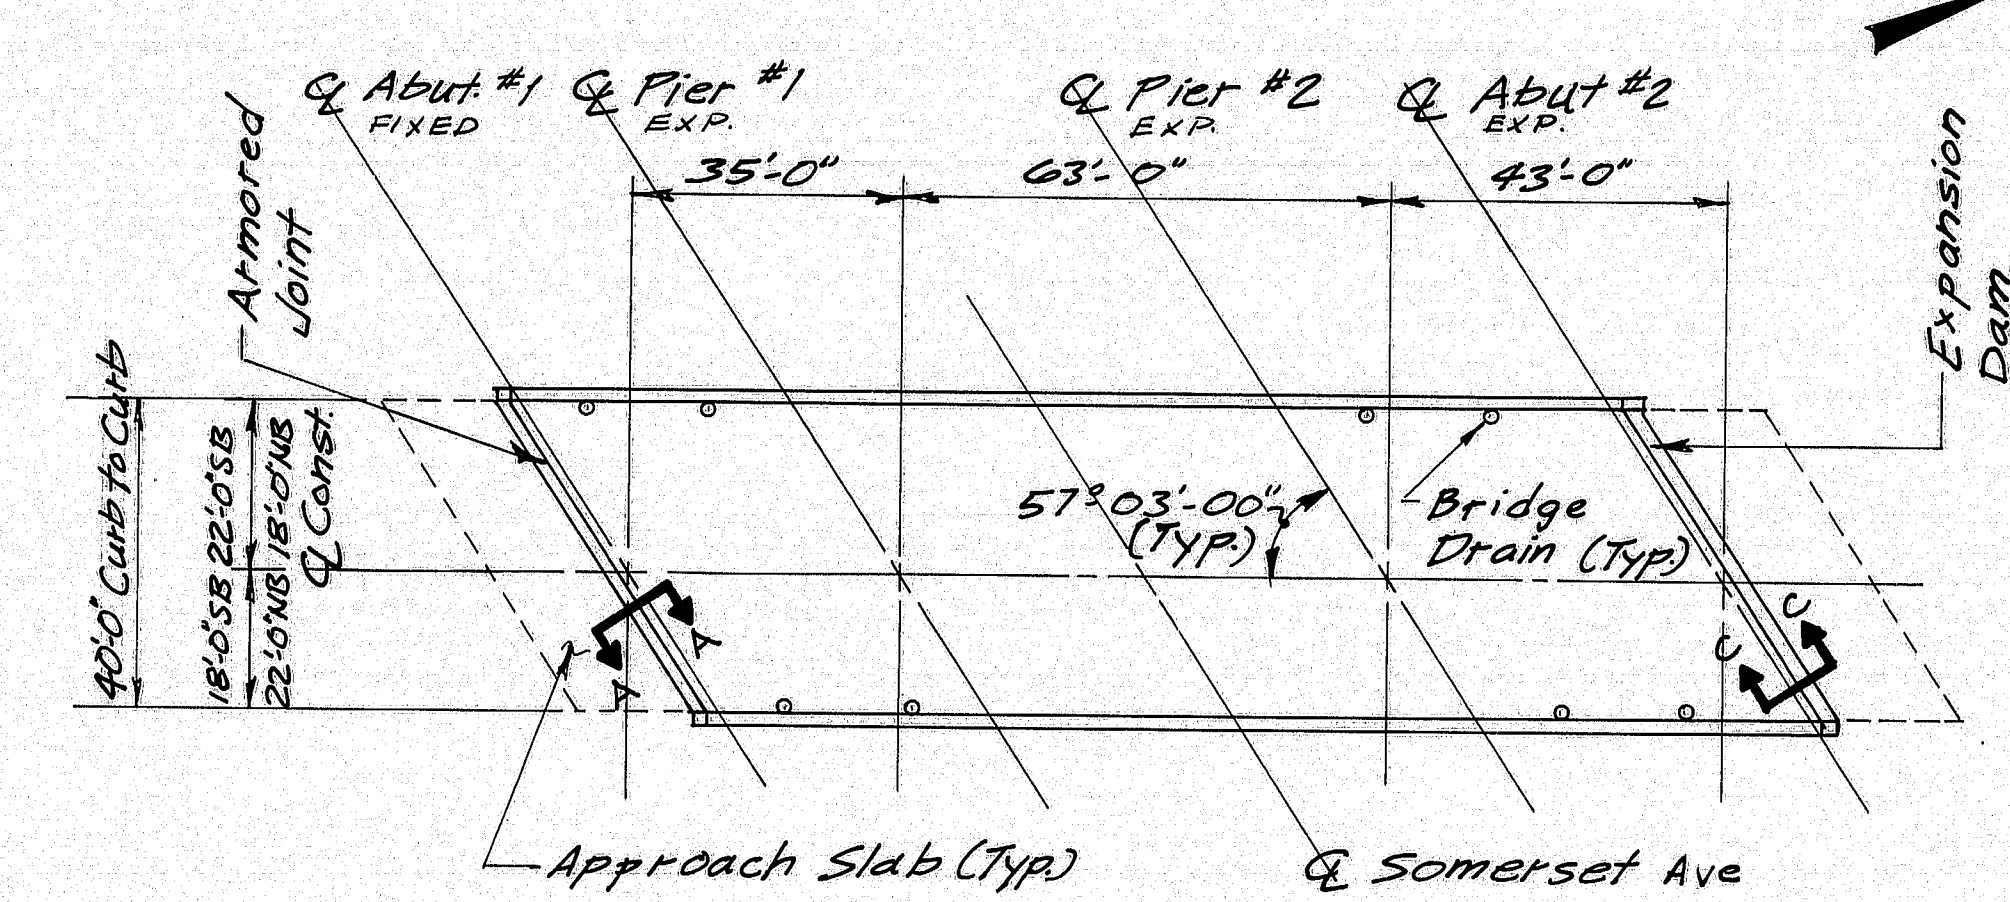

I-95 SOUTHBOUND AND NORTHBOUND OVER SOMERSET AVENUE 5985 N.B. 1447 S.B.

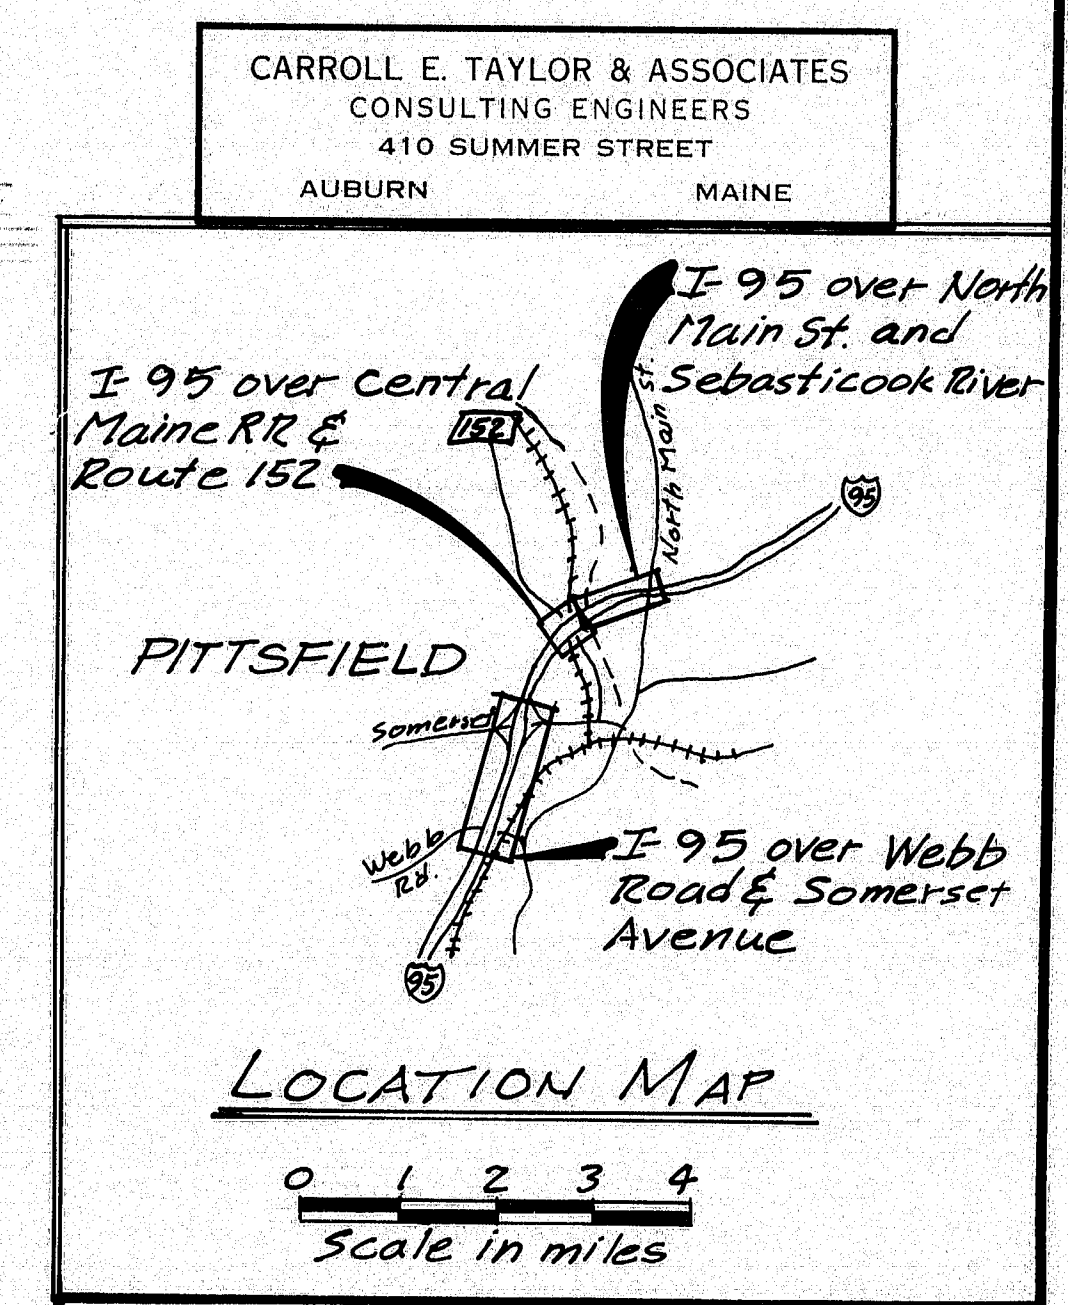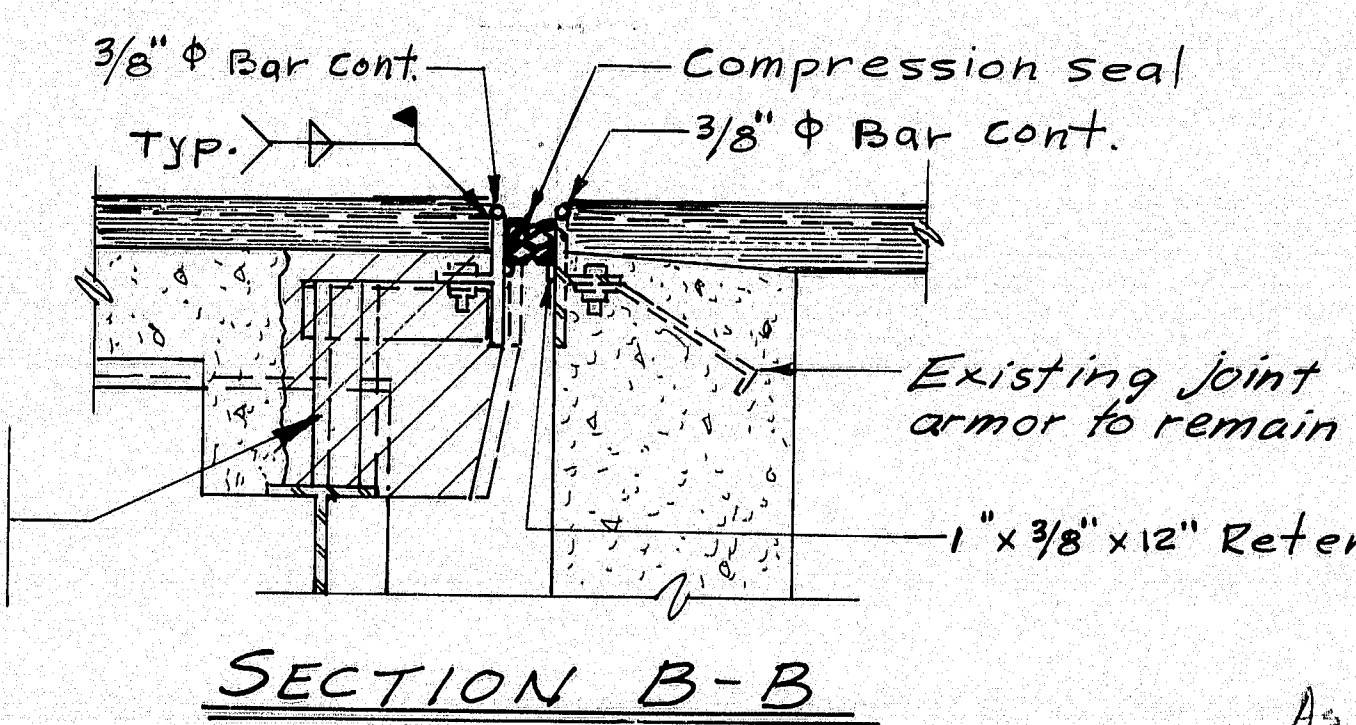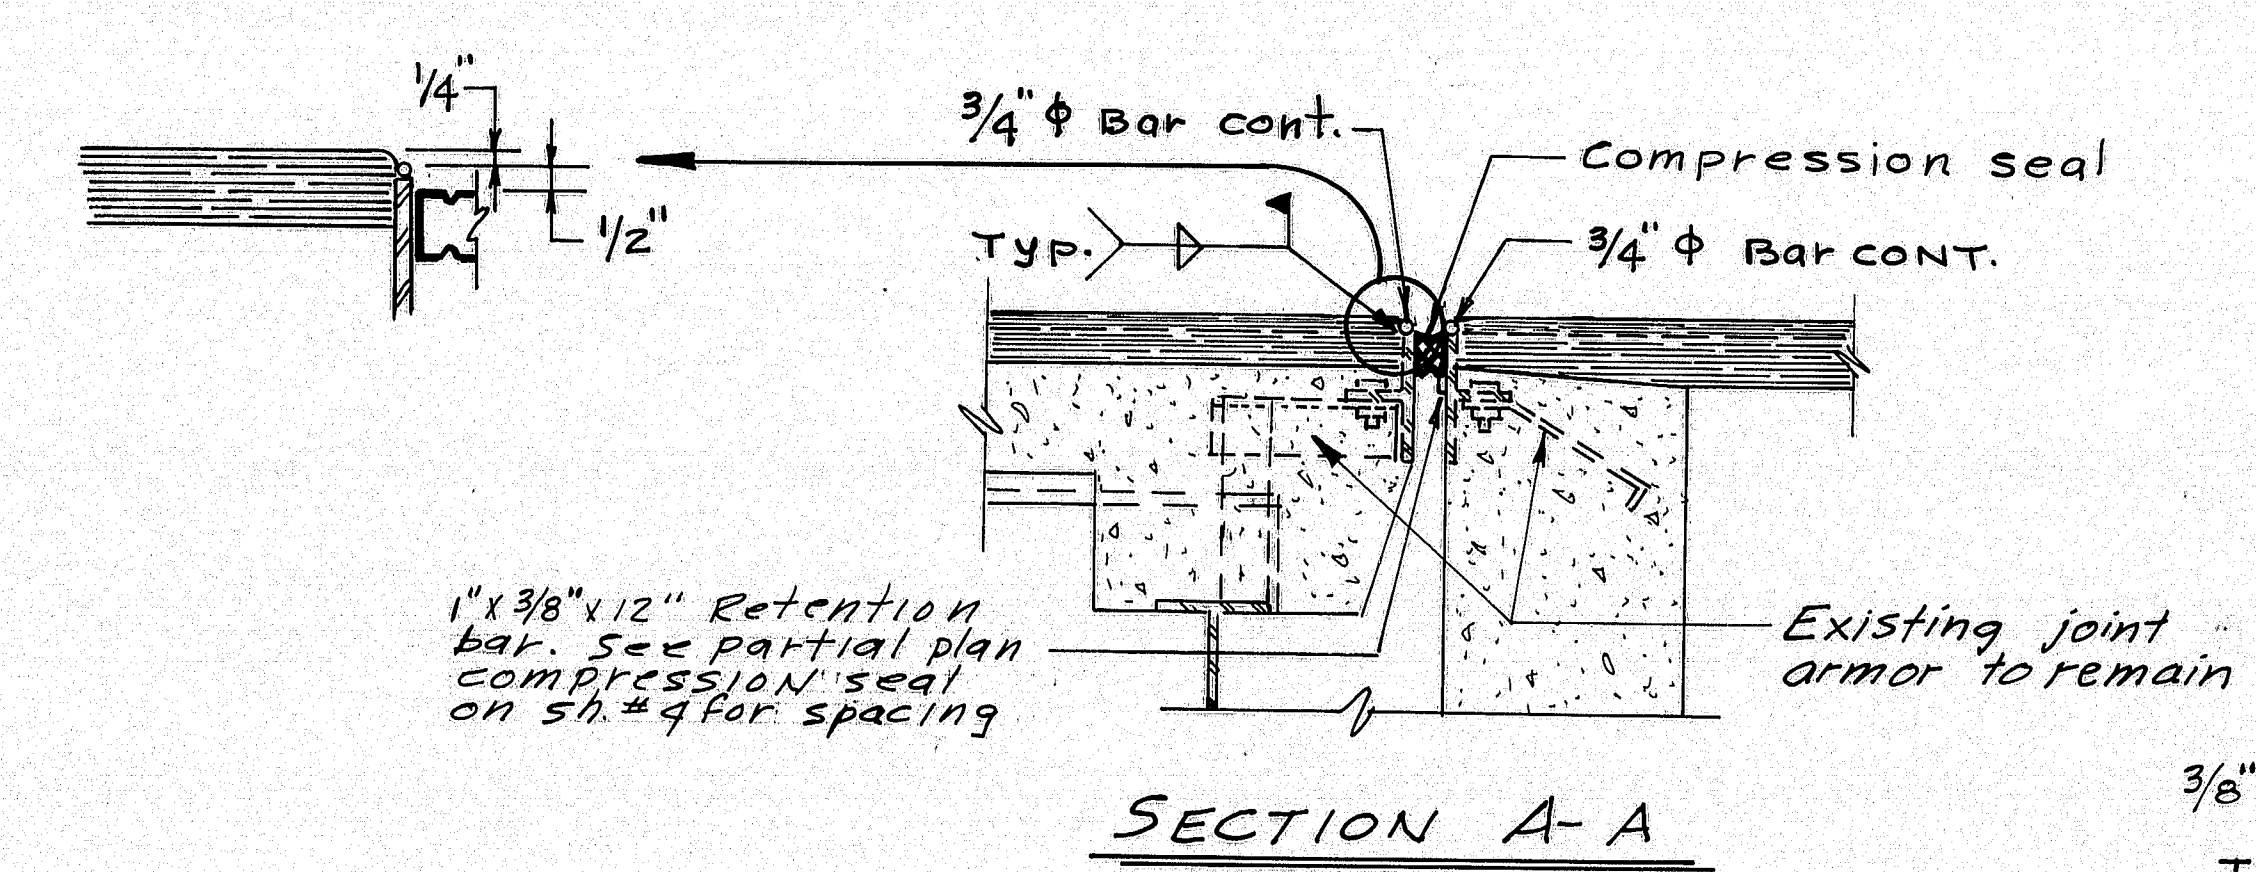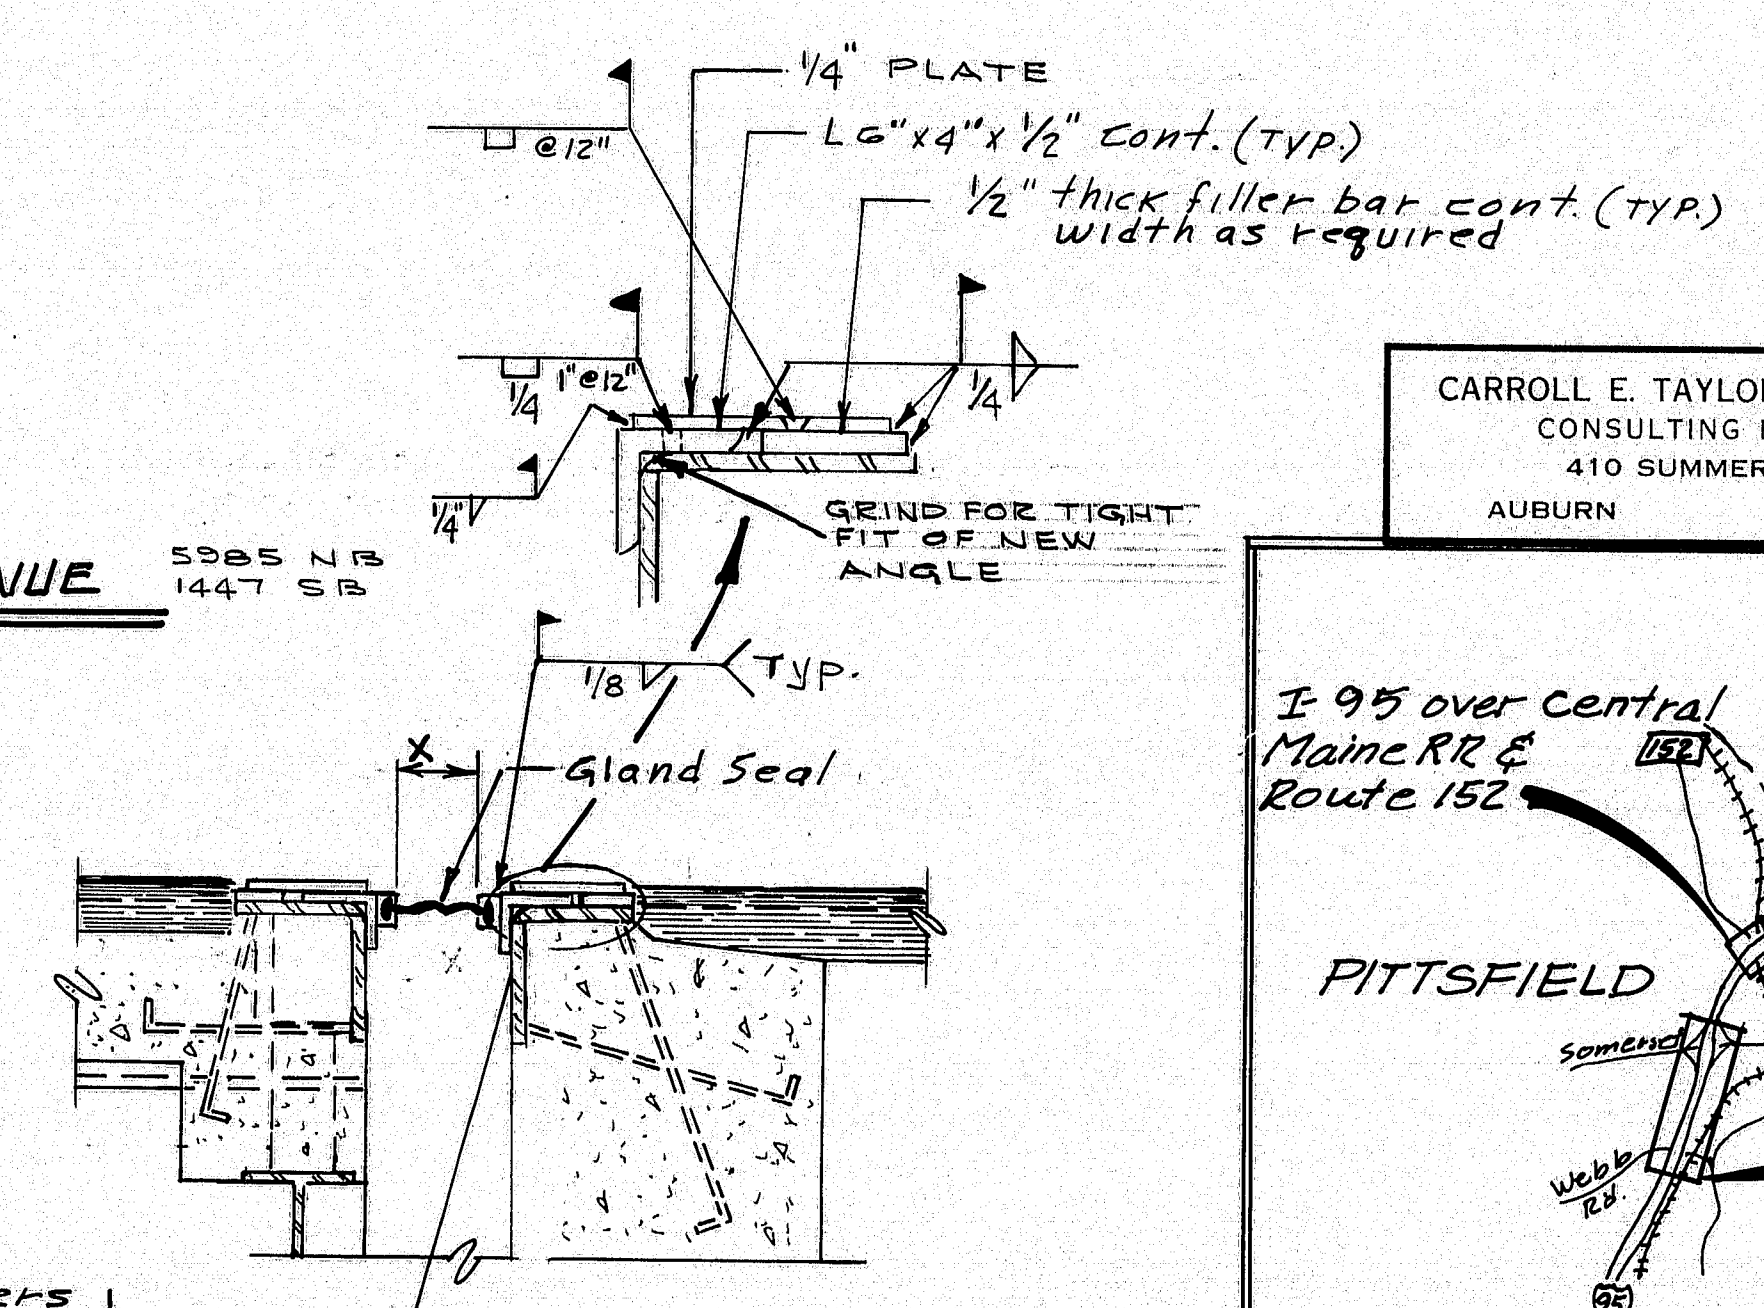

STATE OF MAINE
 DEPARTMENT OF TRANSPORTATION

**INTERSTATE 95
 SOUTHBOUND AND NORTHBOUND
 OVER**

Sebastcook River, North Main
 Street, Webb Road, Somerset
 Avenue, Central Maine RR & Route 152
 PITTSFIELD

GENERAL PLAN & SECTIONS


SHEET 3 OF 14 AUGUSTA, MAINE

PROJECT DESIGN ENGINEER	BY	DATE
DESIGN - DETAILED	DAY	D.O.L.
CHECKED	B.C.H.	
REVISIONS		
FIELD CHANGES		

BRUNING 44-132-457/10-1


99-461
 As built Dec 1999 Rgn

F.R.N.A. REV. NO.	STATE	PROJECT NUMBER	SHEET NO.	TOTAL SHEETS
1	MAINE	IR-95-7(96)	4	14

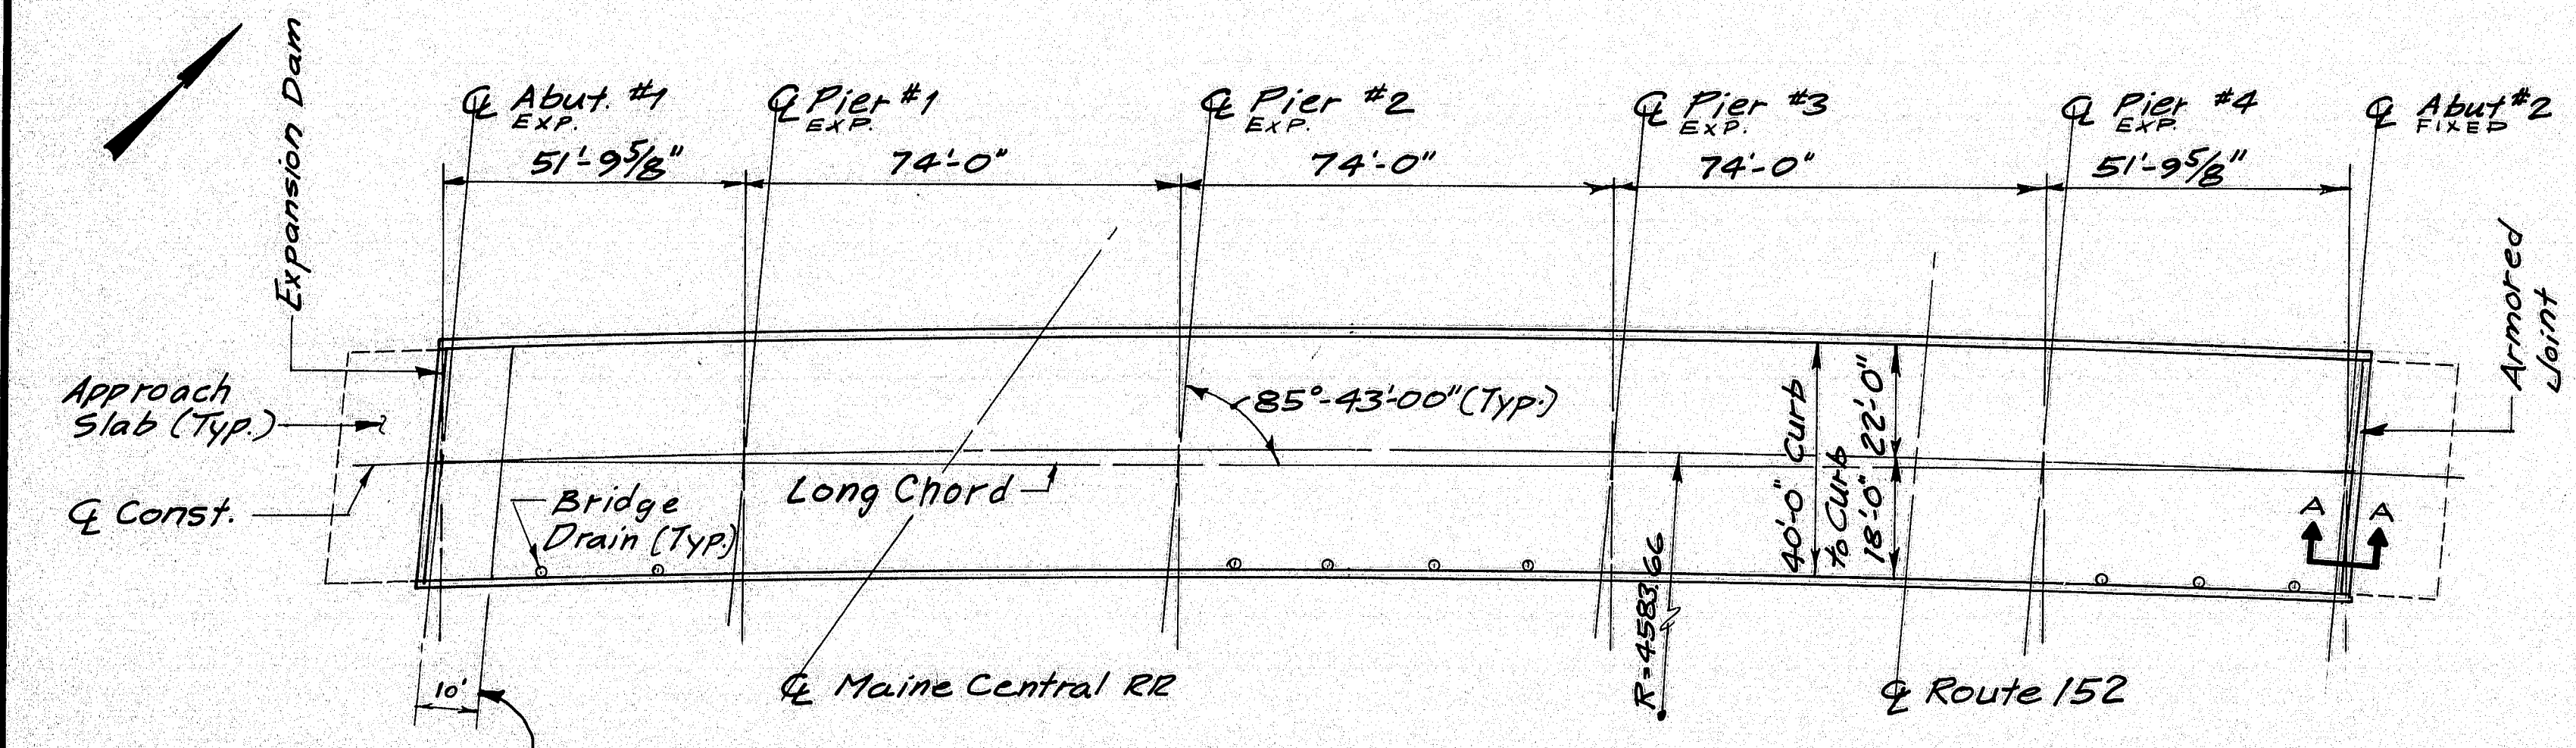


TRANSITION NEW PAVEMENT THICKNESS TO MATCH EXIST FINGER JOINT HEIGHT


I-95 SOUTHBOUND OVER MAINE CENTRAL RR AND ROUTE 152 5986

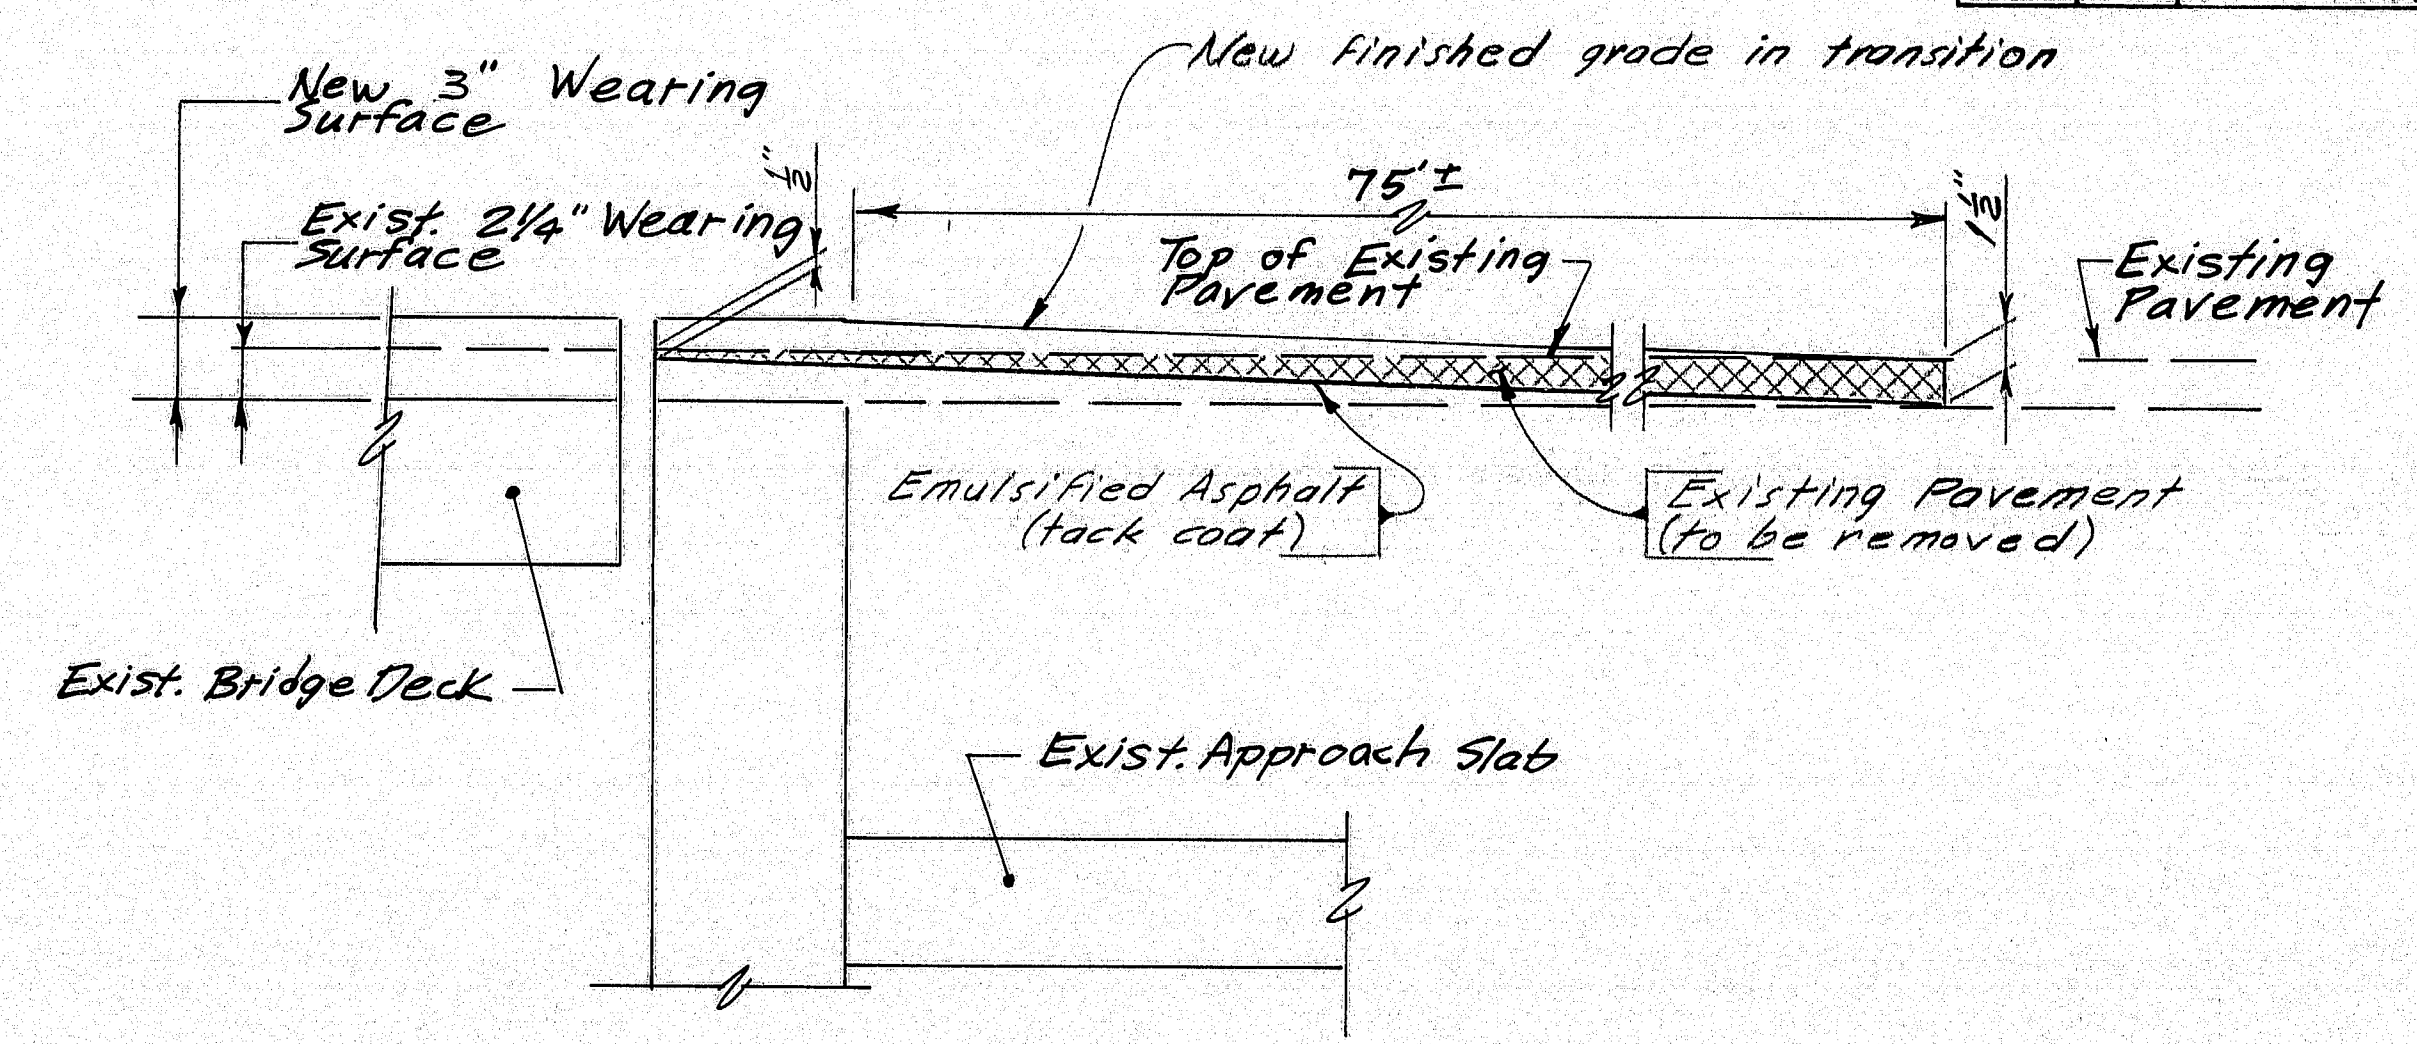

APPROACH PAVEMENT TRANSITION
(Typical all bridges, Each end.)

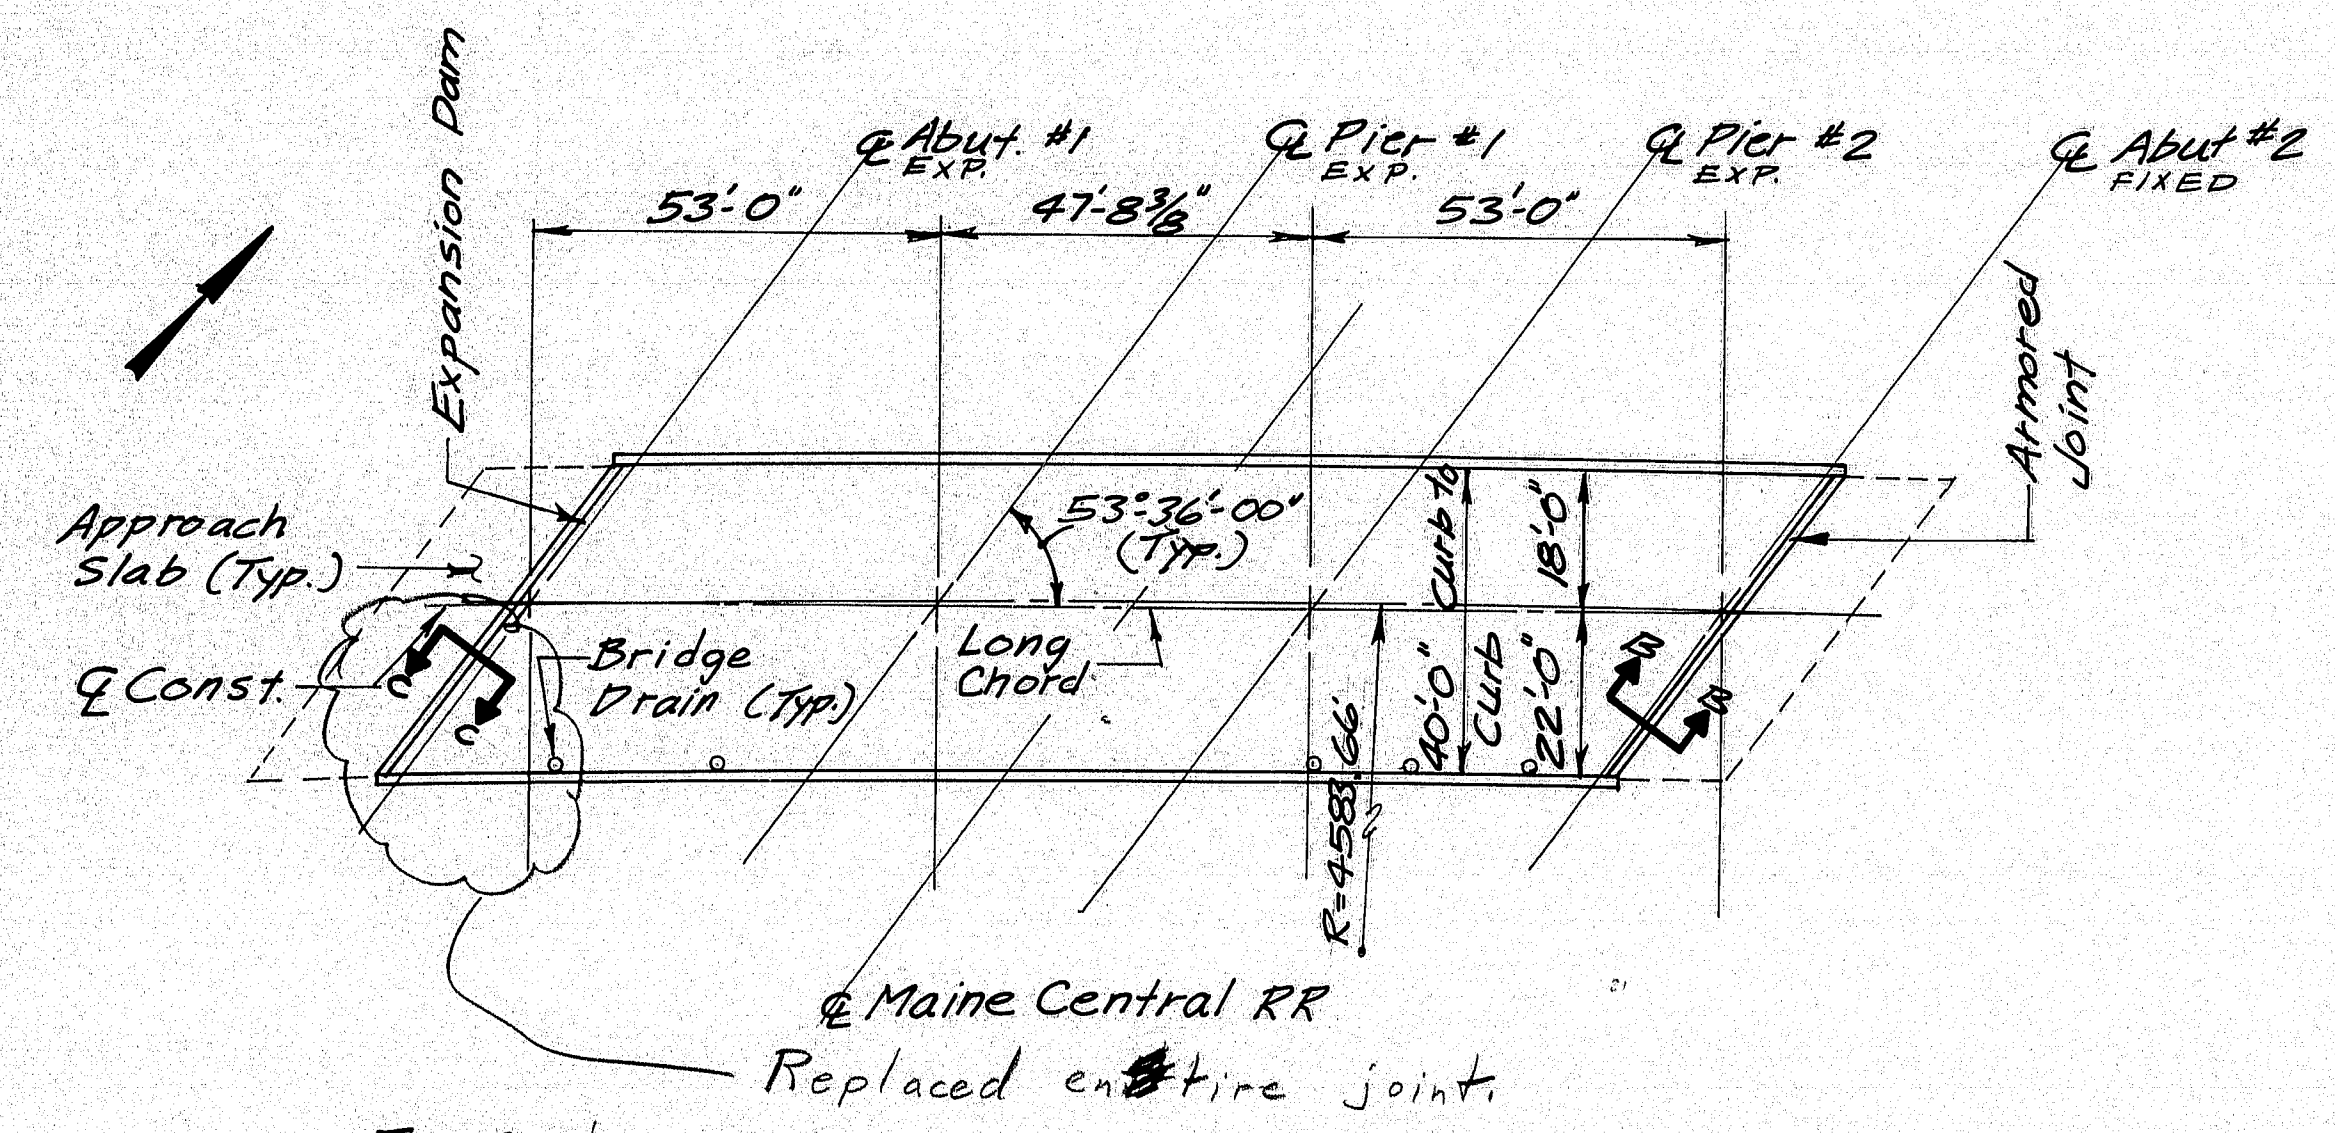

I-95 NORTHBOUND OVER MAINE CENTRAL RR 5988

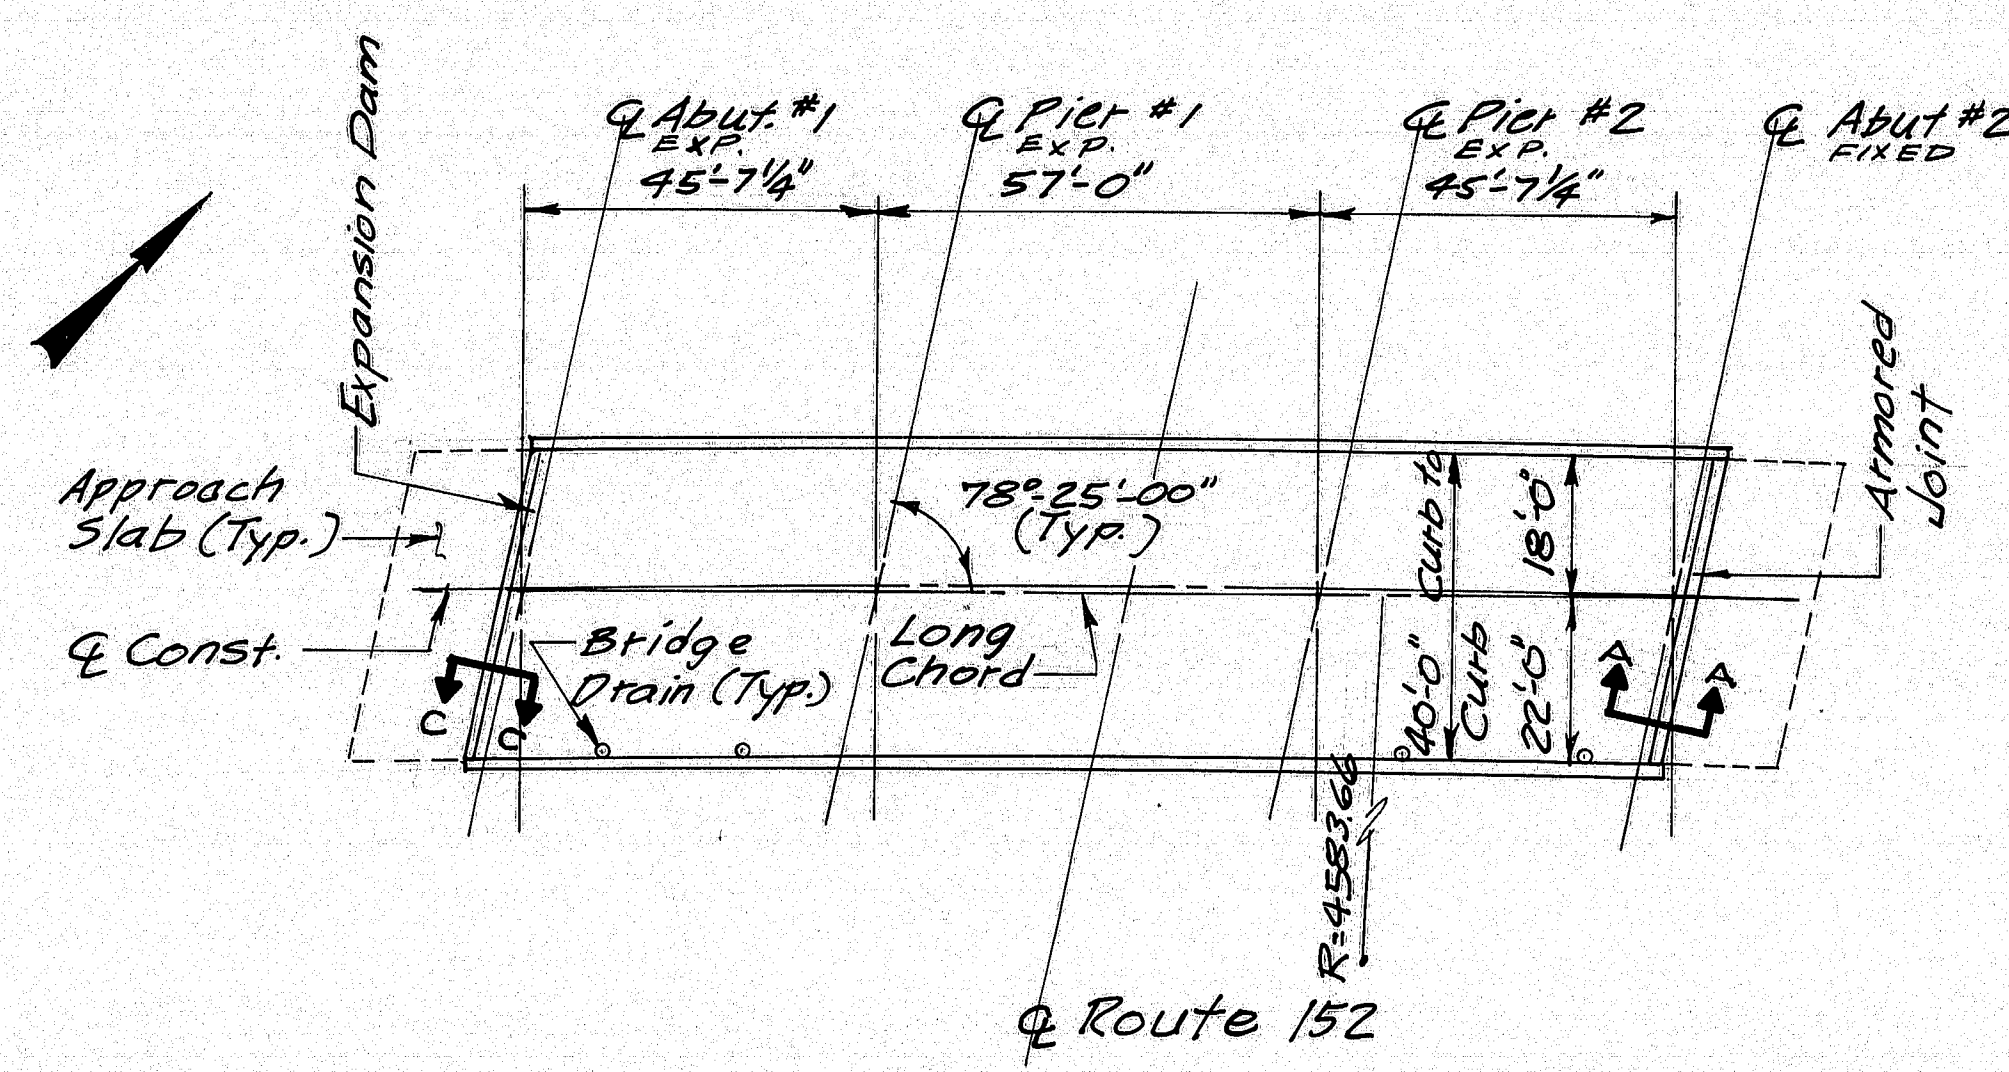


I-95 NORTHBOUND OVER ROUTE 152 5987

- CONSTRUCTION NOTES**
1. MAINTAIN ONE 1/5-FOOT MINIMUM TRAFFIC LANE AT ALL TIMES.
 2. ALL WORK SHALL BE DONE BEHIND TEMPORARY CONCRETE BARRIERS.
 3. THE TOP SURFACE OF THE EXISTING CONCRETE SLABS SHALL BE REPAIRED AS DIRECTED BY THE ENGINEER.
 4. DEPRESS THE BITUMINOUS WEARING SURFACE AROUND THE EXISTING BRIDGE DRAINS AS DIRECTED BY THE ENGINEER.
 5. BECAUSE OF STAGED CONSTRUCTION, SOME EXPANSION JOINTS MAY REQUIRE CONSTRUCTION JOINTS. THESE SHALL BE AS APPROVED BY THE ENGINEER AS TO TYPE AND LOCATIONS.
 6. PAYMENT FOR DRILLING AND GROUTING ASSOCIATED WITH MODIFICATIONS OF THE JOINTS WILL BE CONSIDERED INCIDENTAL TO THE BRIDGE JOINT MODIFICATION ITEMS.
 7. PAYMENT FOR REMOVING AND RE-INSTALLING BRIDGE RAIL OR GUARDRAIL, AS NEEDED TO ACCOMPLISH JOINT MODIFICATIONS, WILL BE CONSIDERED INCIDENTAL TO THE BRIDGE JOINT MODIFICATION ITEMS.
 8. PAYMENT FOR REMOVING AND REPLACING PORTIONS OF END POSTS (CONCRETE PARAPET AND CURB) WILL BE CONSIDERED INCIDENTAL TO THE BRIDGE JOINT MODIFICATION ITEMS.
 9. PAYMENT FOR CUTTING, REMOVING, OR REPLACING GRANITE CURB WHERE CALLED FOR WILL BE CONSIDERED INCIDENTAL TO THE BRIDGE JOINT MODIFICATION ITEMS.
 10. REINFORCING STEEL SHALL HAVE A MINIMUM COVER OF 2 INCHES UNLESS NOTED OTHERWISE.
 11. WHERE GRANITE CURB IS CALLED FOR TO BE REMOVED TO MODIFY A JOINT OR TO INSTALL A SEAL, ONLY THE SMALLEST AMOUNT NECESSARY TO ACCOMPLISH THE WORK SHALL BE REMOVED. IT IS PREFERABLE TO REMOVE CURB TO AN EXISTING JOINT, BUT IF A JOINT IS MORE THAN 3 FEET AWAY THE CURB SHALL BE SAW CUT IN THE FIELD. THE DECISION ABOUT WHETHER TO CUT OR NOT, AND WHERE, SHALL BE THE ENGINEER'S.
 12. SEE STANDARD DETAIL SH 80/25-82 FOR ADDITIONAL EXPANSION DEVICE DETAILS.
 13. THE REMOVAL OF THE EXISTING BITUMINOUS PAVEMENT ON THE APPROACHES SHALL be paid for under Item 202.202.

1. SEALS TO BE FURNISHED SHALL HAVE A MOVEMENT RATING OF:
 - EXIST. - NB & SB N. MAIN ST. (ABUT. #1)
 - 2 7/8" - SB/SEBASTICOOK R. (ABUT. #1)
 - 2 7/8" - NB/SEBASTICOOK R. (ABUT. #1)
 - 2" - NB/MCRR (ABUT. #1)
 - 1 7/8" - SB/SOMERSET AVE. (ABUT. #2)
 - 1 7/8" - NB/SOMERSET AVE. (ABUT. #2)
 - 1 7/8" - NB/ROUTE 152 (ABUT. #1)
 - 1 3/4" - SB/N. MAIN ST. (ABUT. #2)
 - 1 3/4" - NB/N. MAIN ST. (ABUT. #2)
 - 1 1/4" - SB/WEBB ROAD (ABUT. #1)
 - 1 1/4" - NB/WEBB ROAD (ABUT. #1)
 - 5/8" - SB/WEBB ROAD (ABUT. #2)
 - 5/8" - NB/WEBB ROAD (ABUT. #2)
 - EXIST. - SB/SOMERSET AVE. (ABUT. #1)
 - EXIST. - SB/SEBASTICOOK R. (ABUT. #2)
 - EXIST. - NB/SEBASTICOOK R. (ABUT. #2)
 - EXIST. - NB/SOMERSET AVE. (ABUT. #1)
 - EXIST. - SB/MCRR & ROUTE 152 (ABUT. #2)
 - 5/8" - NB/MCRR (ABUT. #2)
 - EXIST. - NB/ROUTE 152 (ABUT. #2)
2. SEALS SHALL BE APPROVED BY THE ENGINEER PRIOR TO FABRICATION OF THE JOINT ARMOR.
3. COMPRESSION SEAL JOINT OPENINGS WILL VARY DEPENDING ON THE DIMENSIONS OF THE SEAL SELECTED BY THE CONTRACTOR. THE JOINT OPENING SHALL BE SET ACCORDING TO THE OPENING SHOWN ON THE APPROVED SHOP DETAIL DRAWINGS.
4. THE SEAL ADJUSTMENT CHART SHOWS THE ADJUSTMENT NECESSARY TO ADJUST THE JOINT OPENING SHOWN ON THE SHOP DETAIL DRAWINGS FOR TEMPERATURES OTHER THAN 45°F. ADJUSTMENT IS TO BE MEASURED PARALLEL TO THE CENTERLINE OF CONSTRUCTION.

- I-95 N.B. & S.B. OVER SOMERSET AVE. - ABUT. 2
- I-95 N.B. OVER ROUTE 152 - ABUT. 1
- I-95 N.B. OVER MCRR - ABUT. 1
- I-95 N.B. & S.B. OVER SEBASTICOOK RIVER
- I-95 S.B. & N.B. OVER N. MAIN STREET
- I-95 S.B. & N.B. OVER WEBB ROAD - ABUT. #1
- I-95 S.B. & N.B. OVER WEBB ROAD - ABUT. #2

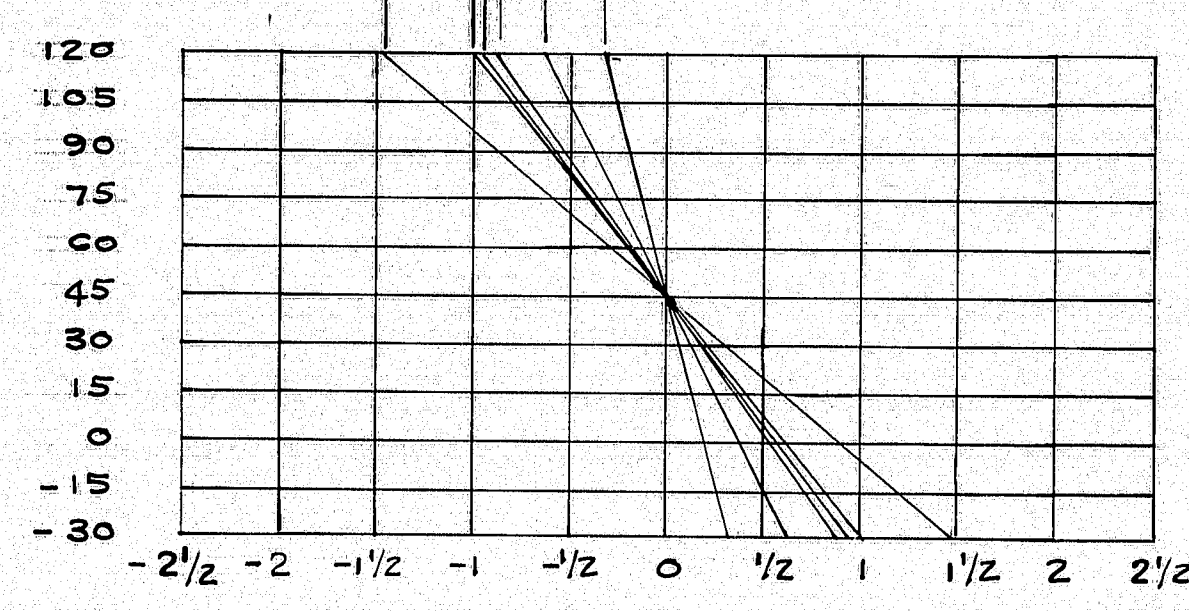

SETTING

99-462
Revised as built Dec 1989
Ripman

CARROLL E. TAYLOR & ASSOCIATES
CONSULTING ENGINEERS
410 SUMMER STREET
AUBURN MAINE

STATE OF MAINE
DEPARTMENT OF TRANSPORTATION

INTERSTATE 95
SOUTHBOUND AND NORTHBOUND
OVER

Sebasticook River, North Main
Street, Webb Road, Somerset
Avenue, Central Maine RR & Route 152
PITTSFIELD


GENERAL PLANS

SHEET 4 OF 14 AUGUSTA, MAINE


PROJECT DESIGN ENGINEER	DATE
BY	DAK
CHECKED	BSH
REVISIONS	
FIELD CHANGES	
PLANS	

BRUNING 44132 4/7/84


F.R.A. REG. NO.	STATE	PROJECT NUMBER	SHEET NO.	TOTAL SHEETS
1	MAINE	IR-95-7(96)	5	14

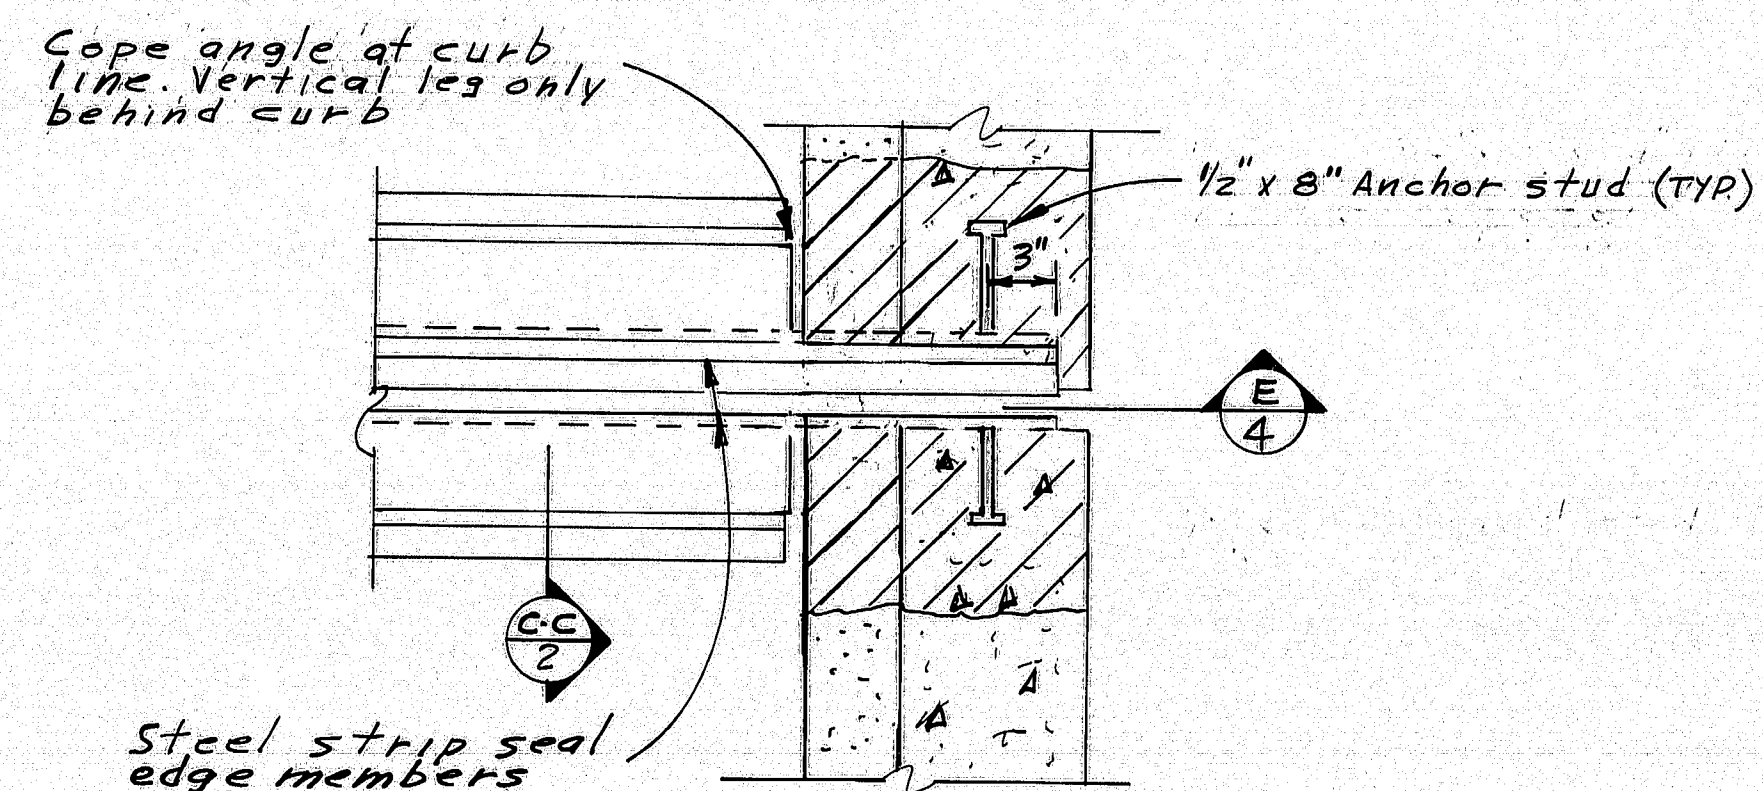


PARTIAL PLAN - GLAND SEAL
See sheet-5 for add'l details

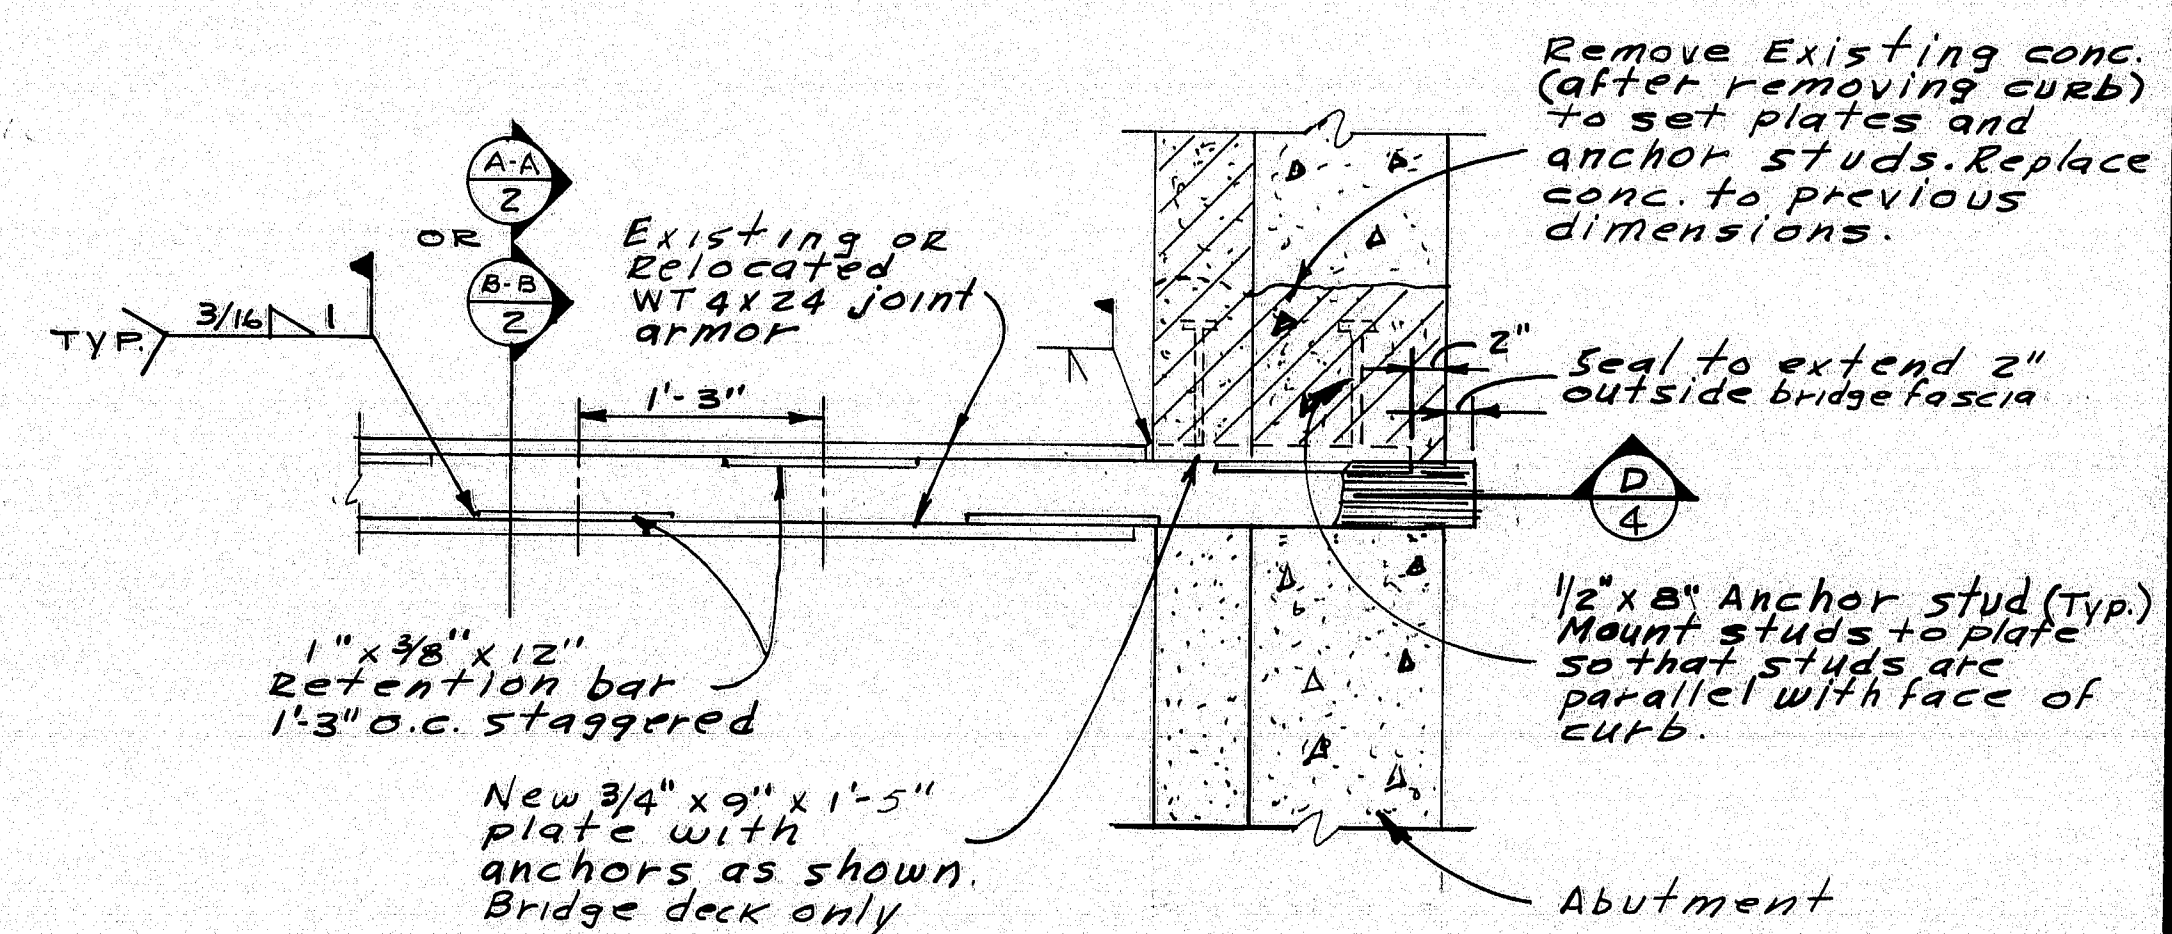


PARTIAL PLAN - COMPRESSION SEAL
See sheet-5 for add'l details

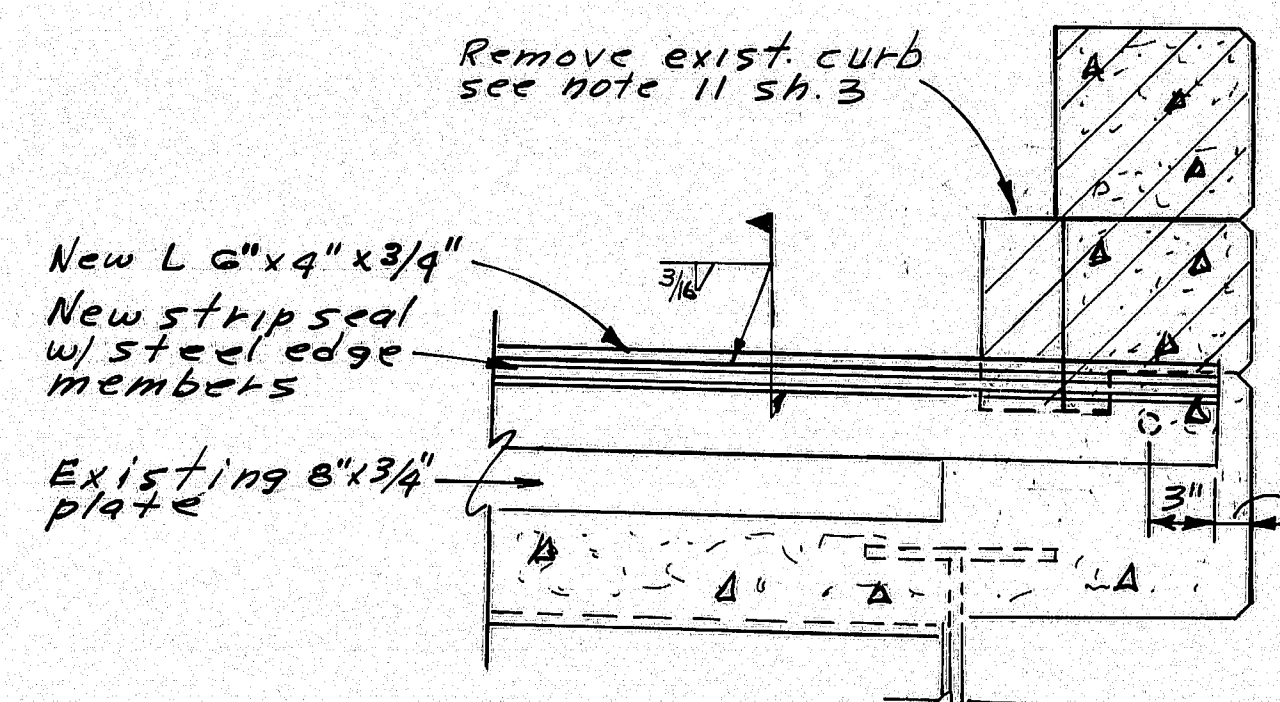

SECTION E

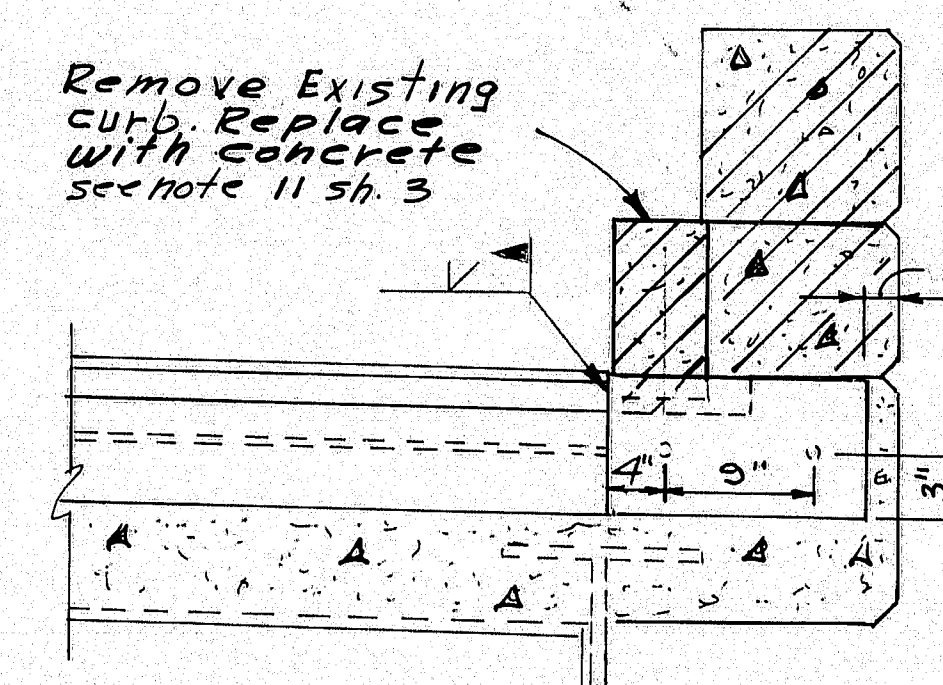

SECTION D

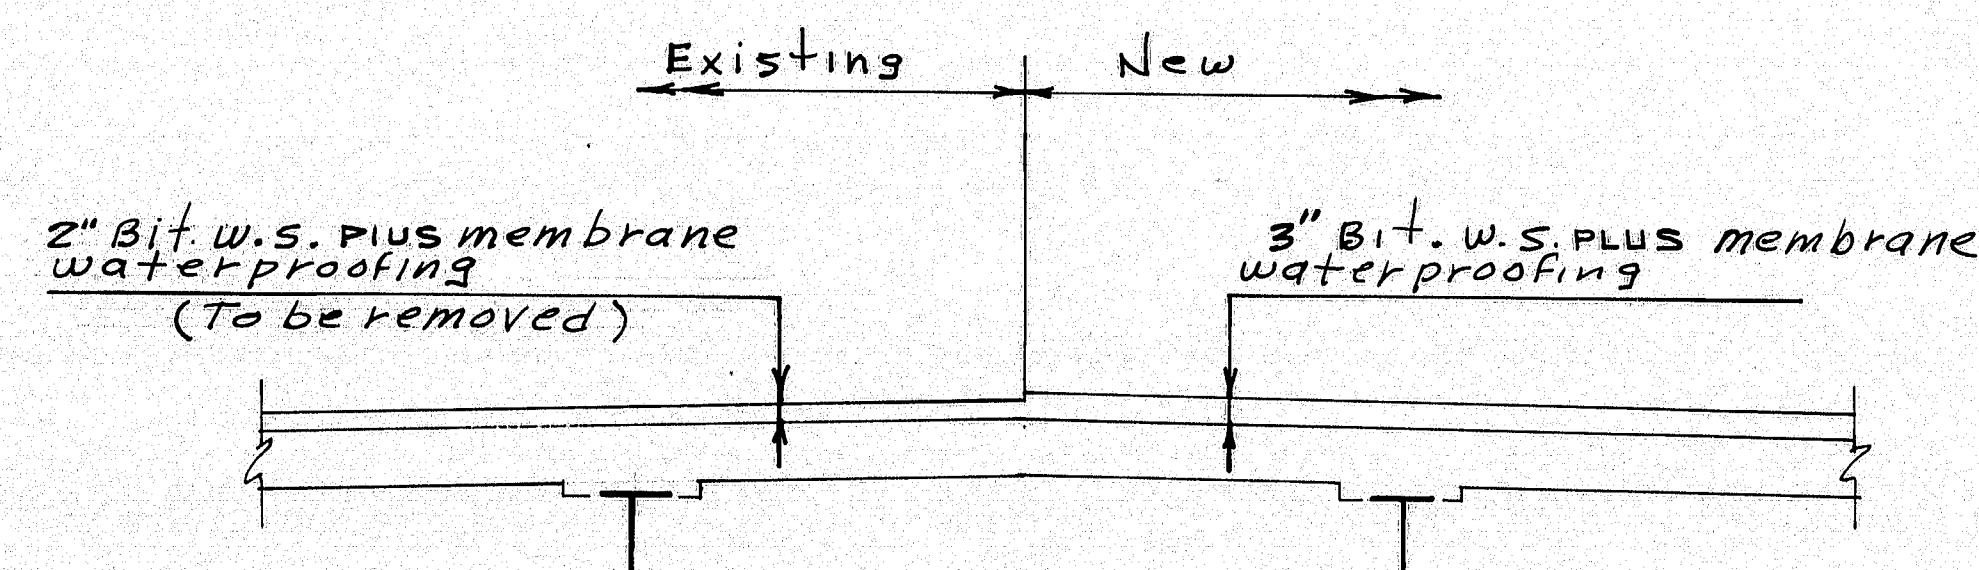


TYPICAL CROSS SECTION

PROJECT DESIGN ENGINEER	BY	DATE
DESIGN - DETAILED	DAV	06/11
CHECKED	BCH	
FIELD CHANGES		

CARROLL E. TAYLOR & ASSOCIATES
CONSULTING ENGINEERS
410 SUMMER STREET
AUBURN MAINE




STATE OF MAINE
DEPARTMENT OF TRANSPORTATION
INTERSTATE 95
SOUTHBOUND AND NORTHBOUND
OVER
Sebasticook River, North Main
Street, Webb Road, Somerset
Avenue, Central Maine RR & Route 152
PITTSFIELD
SECTIONS
SHEET 5 OF 14 AUGUSTA, MAINE

99-463
As built Dec '09
Rgn

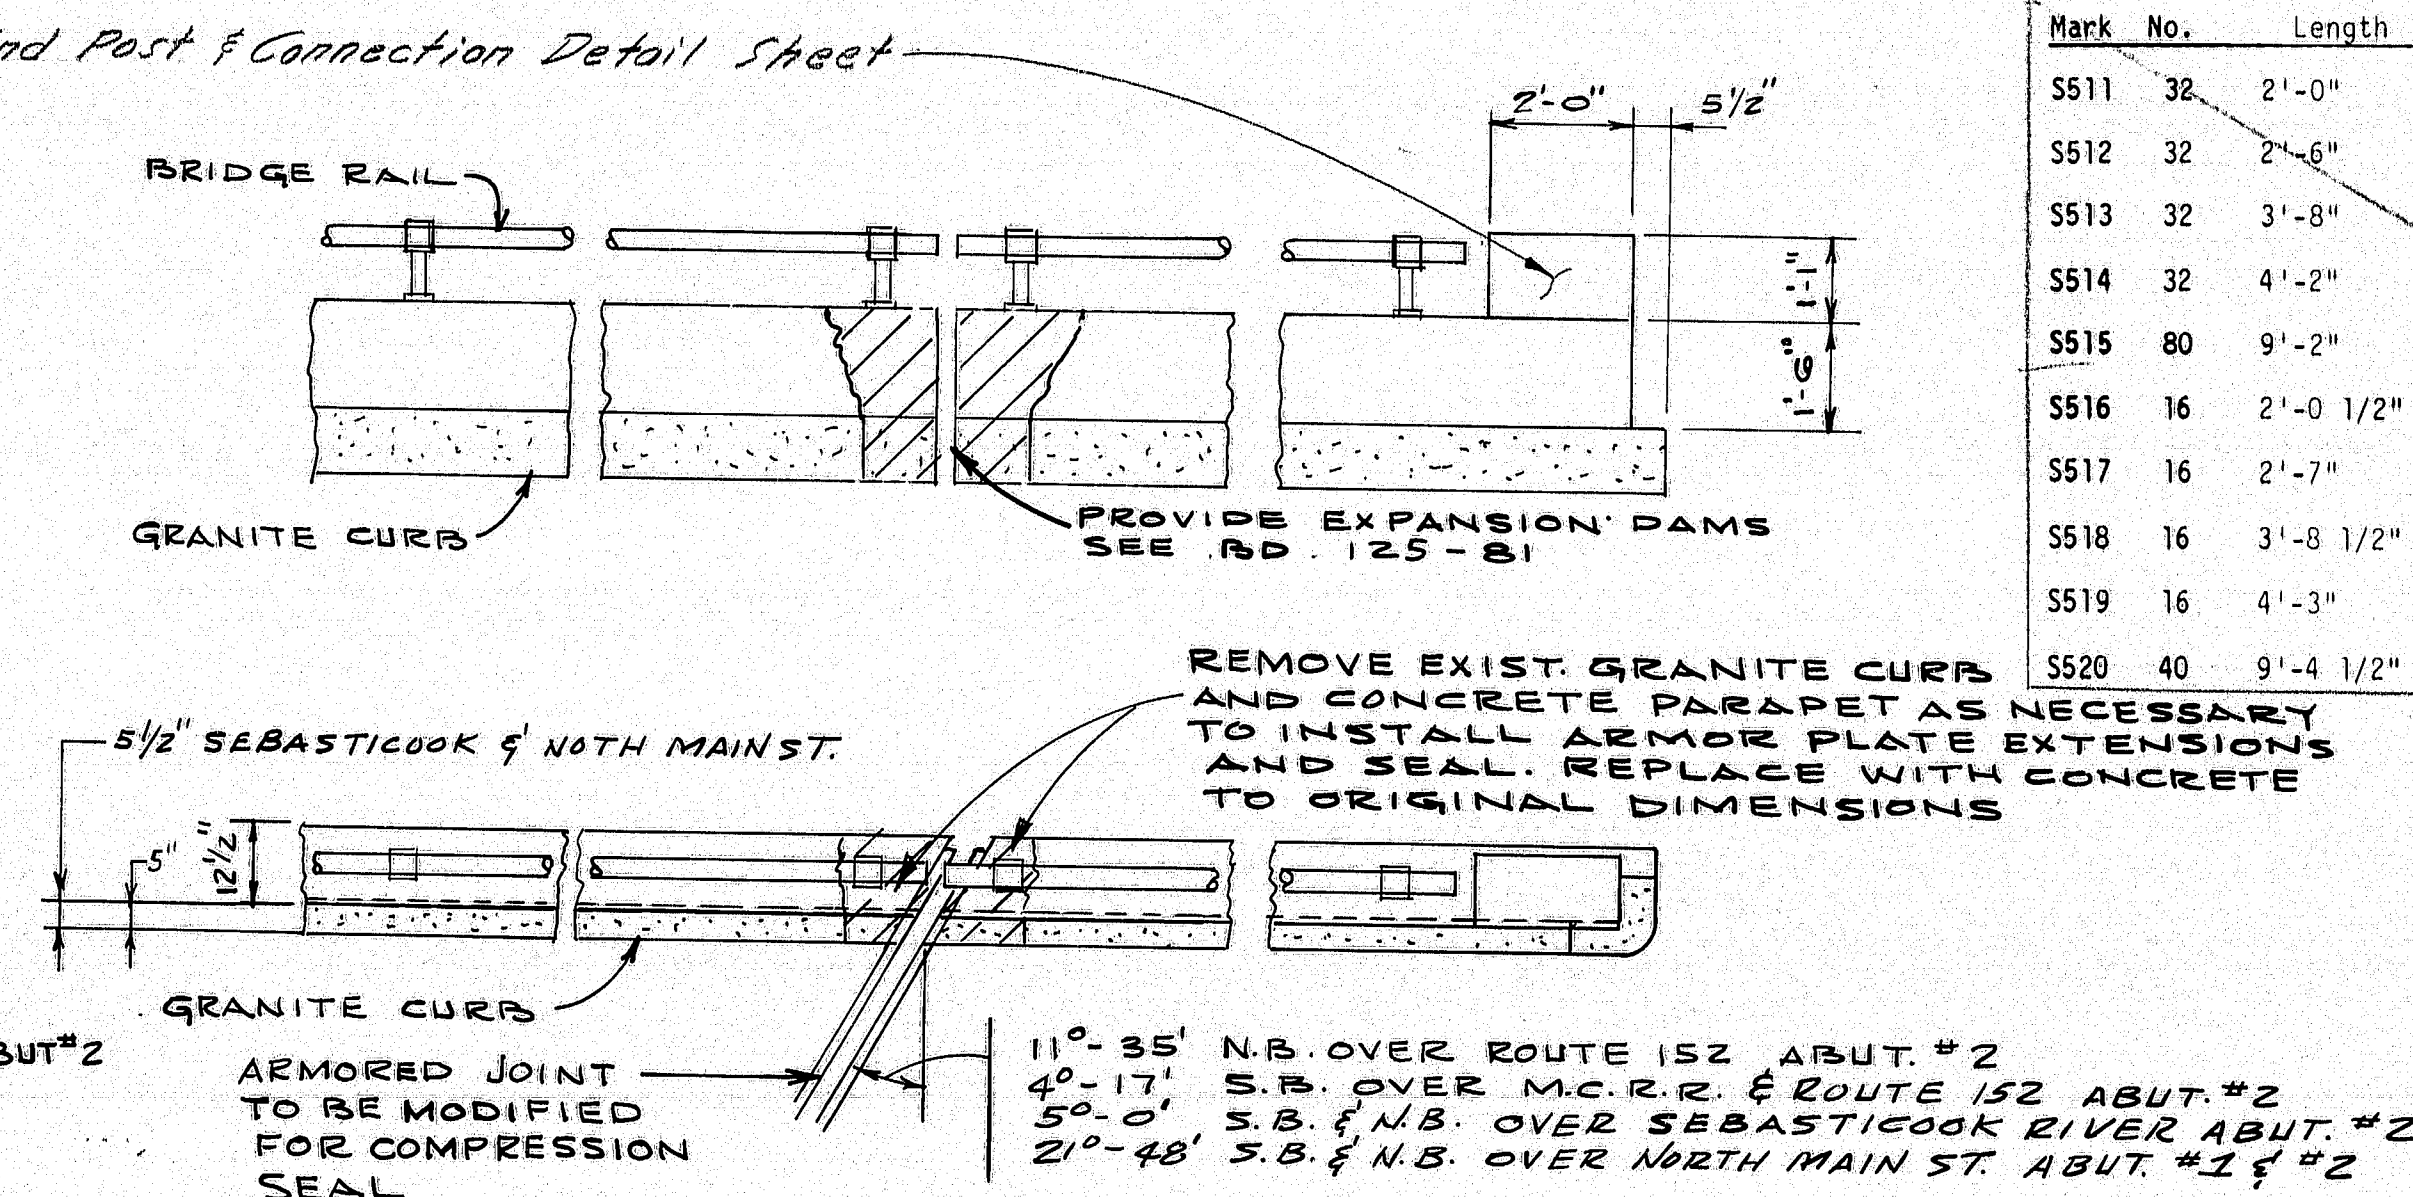

Bent Bars										FORMA.		STATE	PROJECT NUMBER	SHEET NO.	TOTAL SHEETS
Mark	No.	Length	Type	A	B	C	D	E	F	G	H				
5511	32	2'-0"	VA		0-8	0-8	0-8								0-7
5512	32	2'-6"	VA		0-8	1-2	1-2								1-1
5513	32	3'-8"	VA		1-6	0-8	0-8								0-7
5514	32	4'-2"	VA		1-6	1-2	1-2								1-1
5515	80	9'-2"	PP	0-8	0-11	0-6 1/2	1-6	0-9 1/2	2-8	2-1					
5516	16	2'-0 1/2"	VA		0-8	0-8 1/2	0-8								0-7
5517	16	2'-7"	VA		0-8	1-3	0-8								1-0
5518	16	3'-8 1/2"	VA		1-6	0-8 1/2	1-6								0-7
5519	16	4'-3"	VA		1-6	1-3	1-6								1-0
5520	40	9'-4 1/2"	PP	0-8	0-11	0-6	0-6	0-10 1/2	2-8	2-3					







COMPRESSION SEAL DETAILS

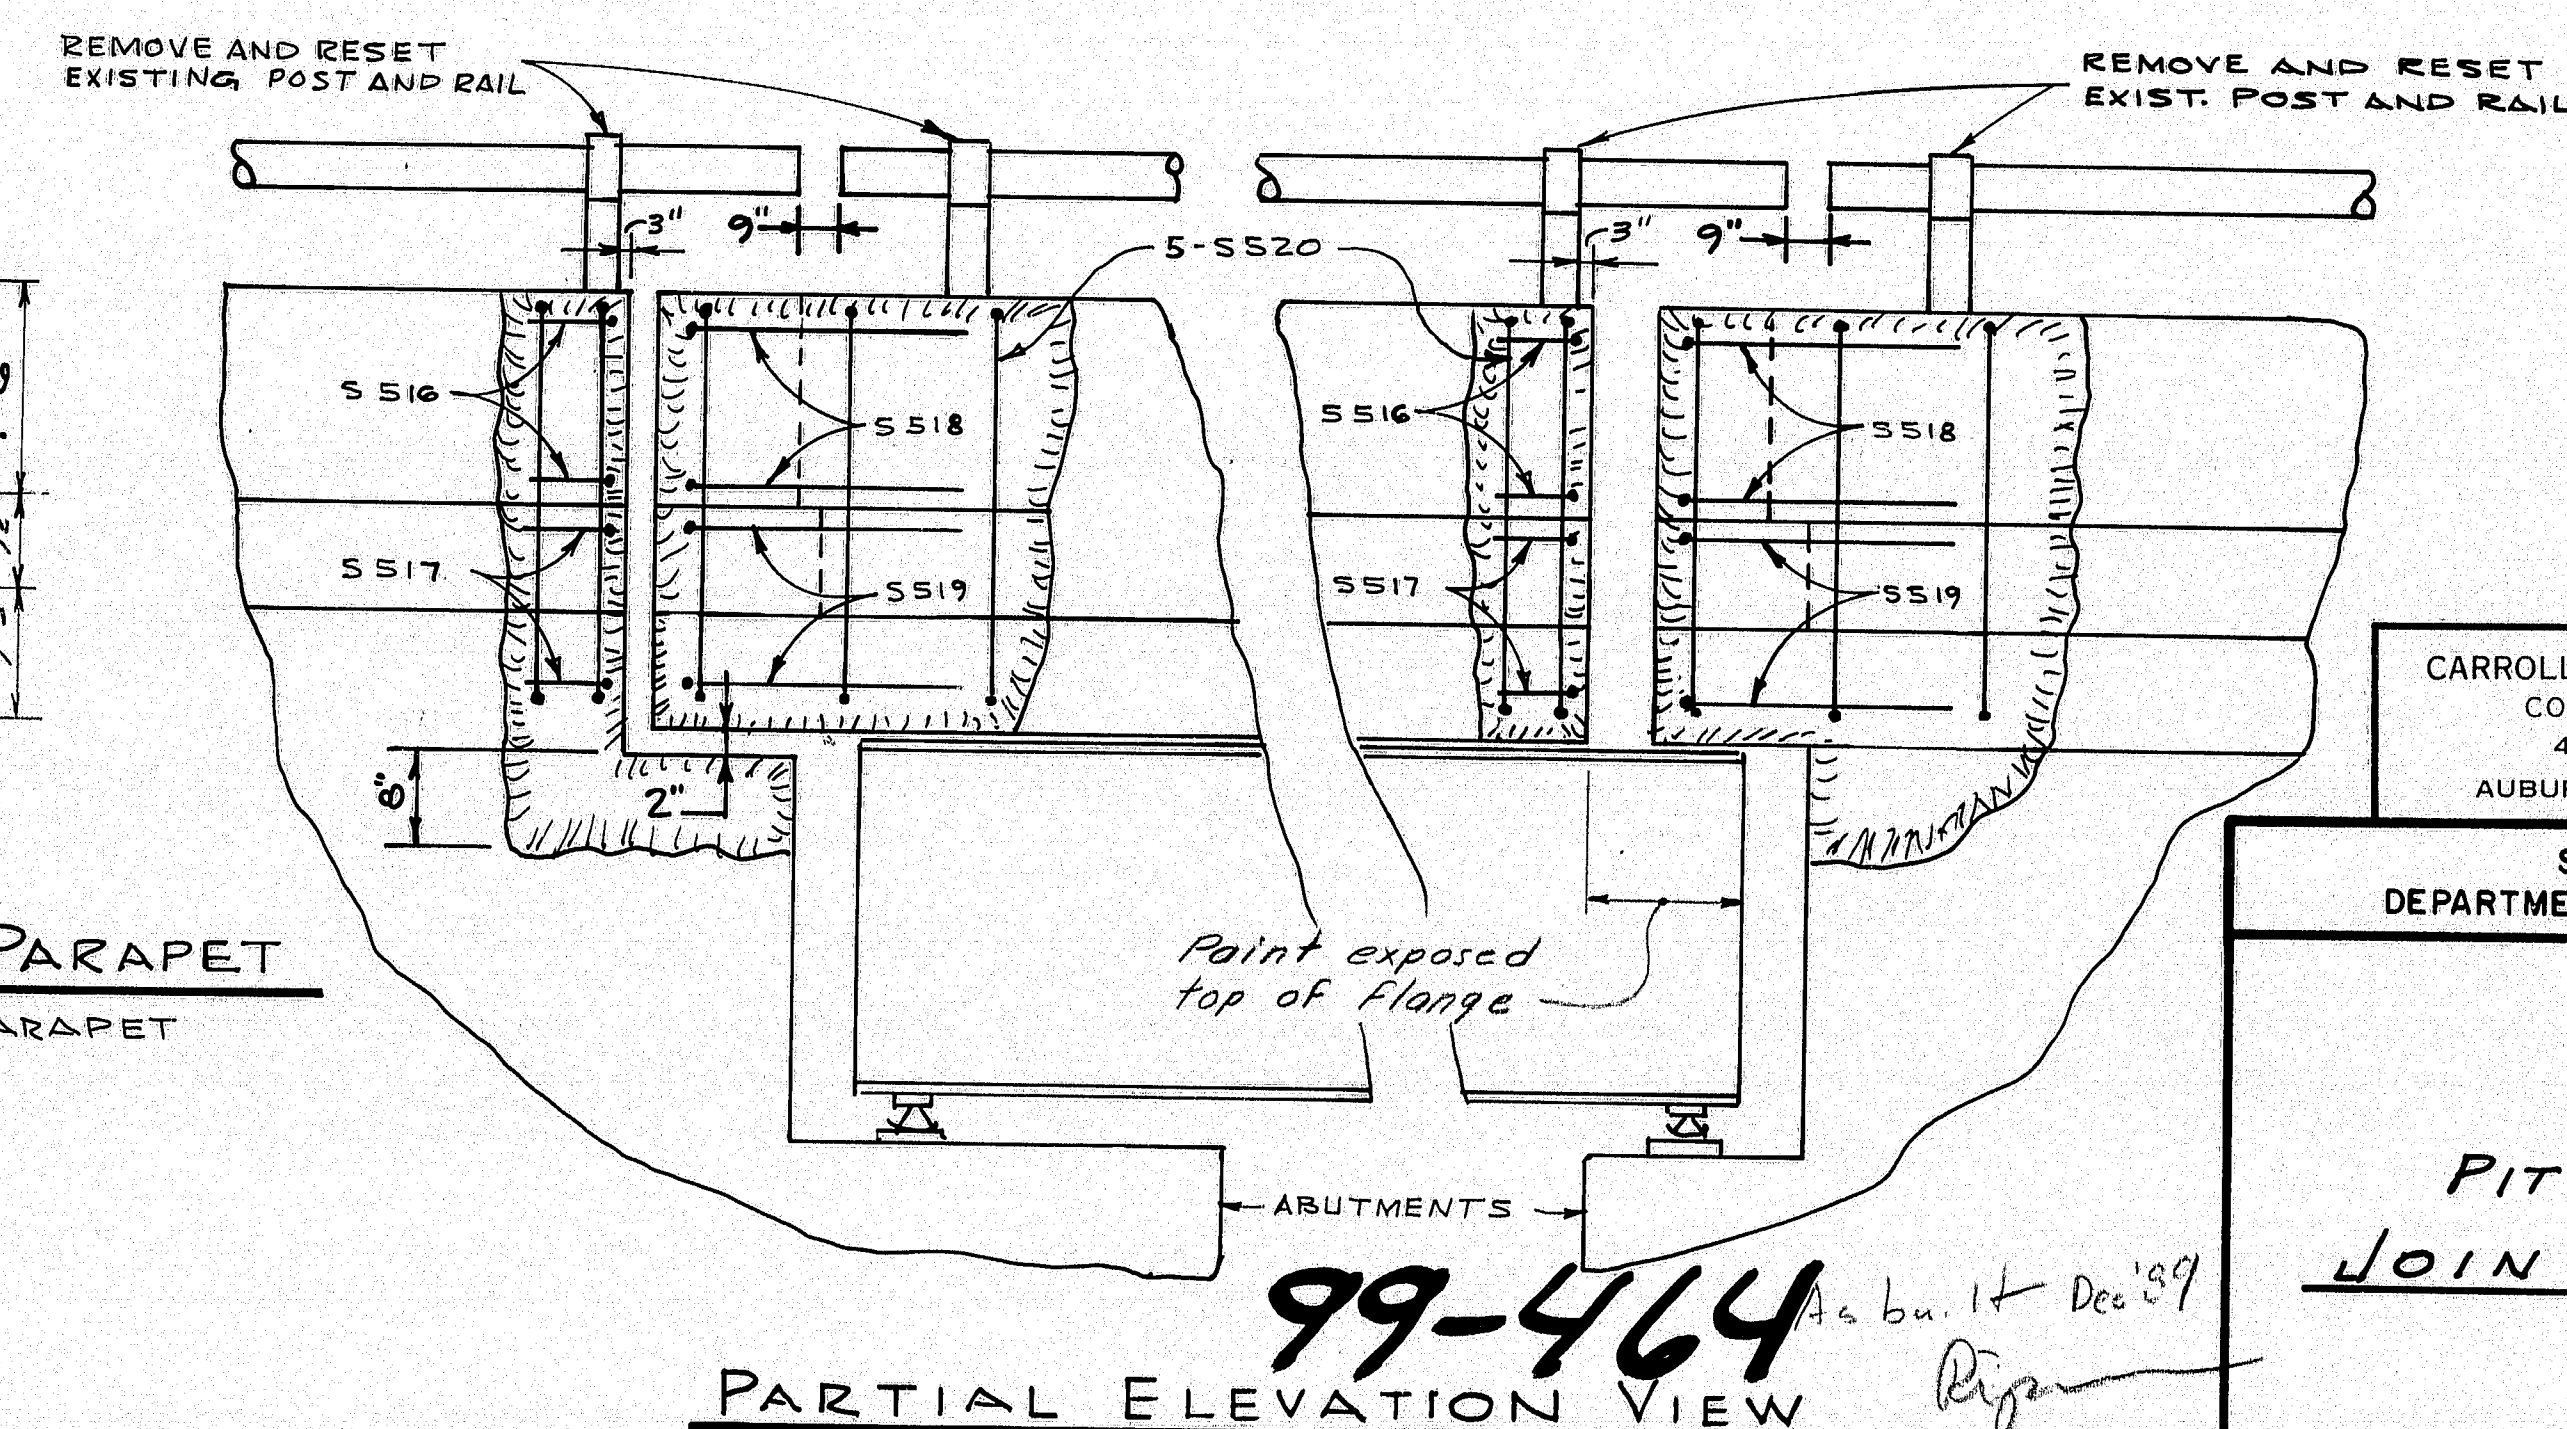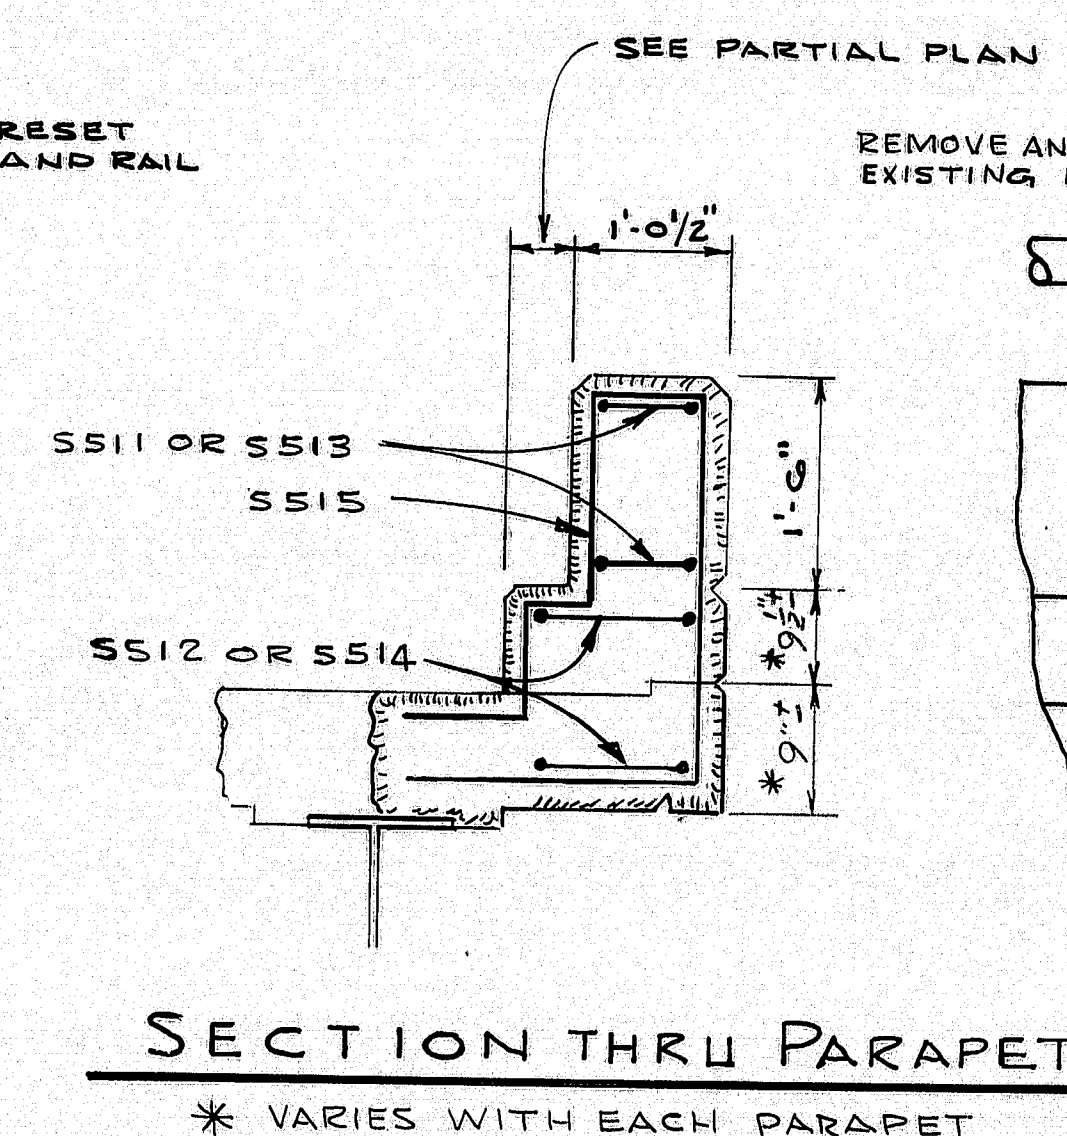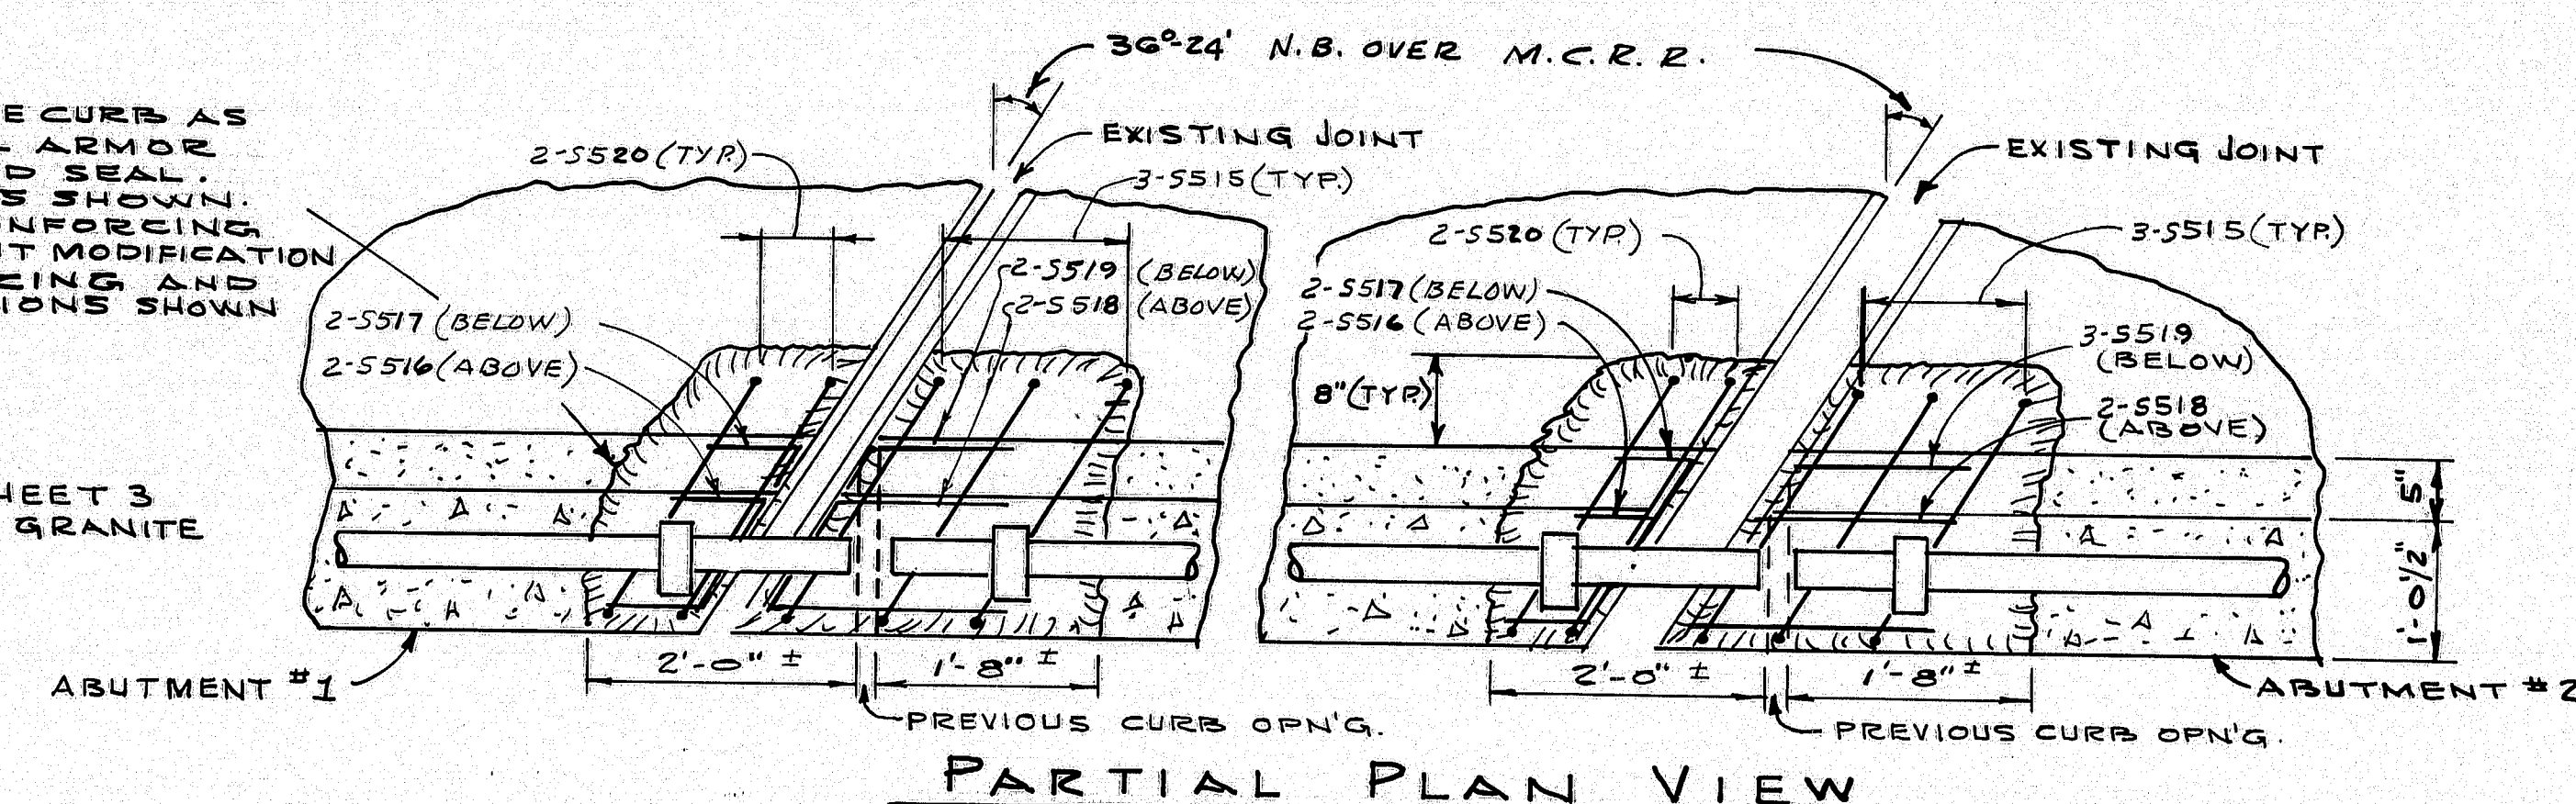

SHEET 6 OF 14 AUGUSTA, MAINE

PLANS	PROJECT DESIGN ENGINEER		BY	DATE
	DESIGN - DETAILED	DAV	D.O.D.	
	CHECKED		B.C.H.	
	REVISIONS			
	FIELD CHANGES			

RUNING 44-132 45710.1

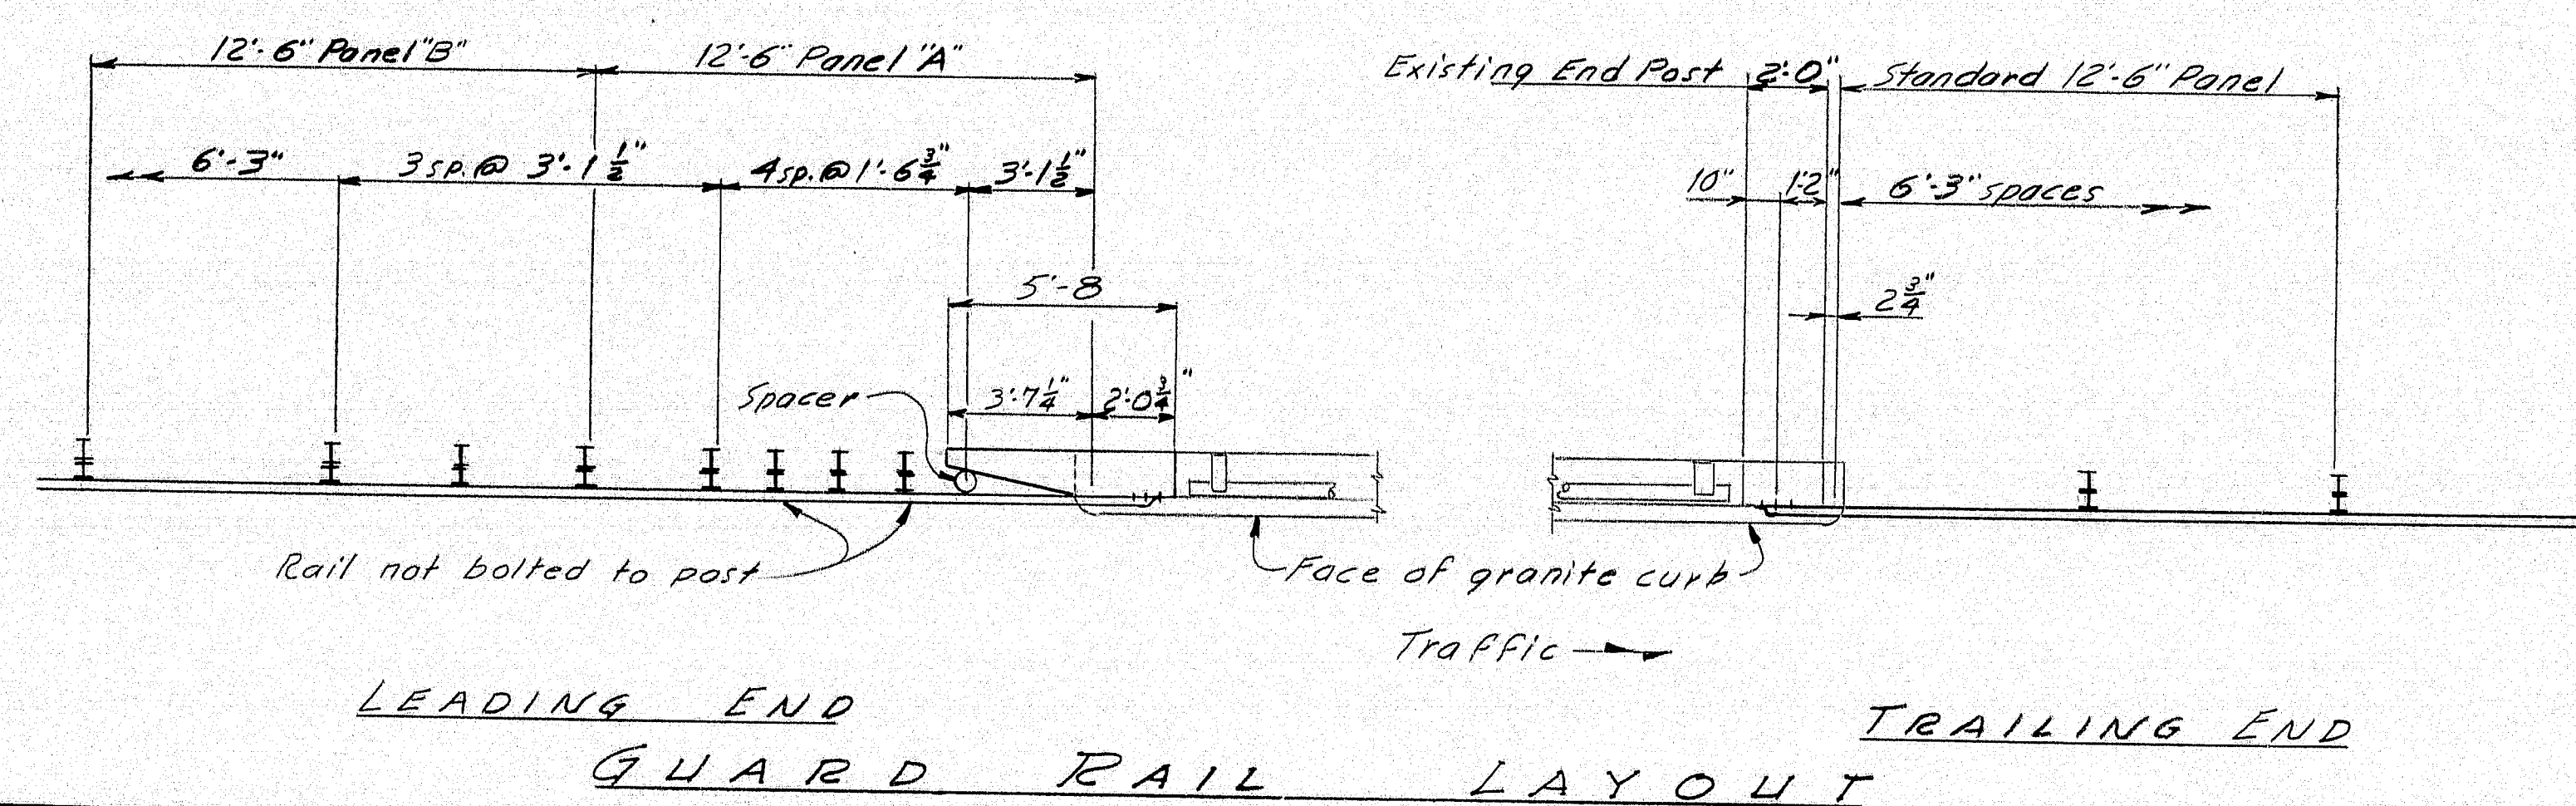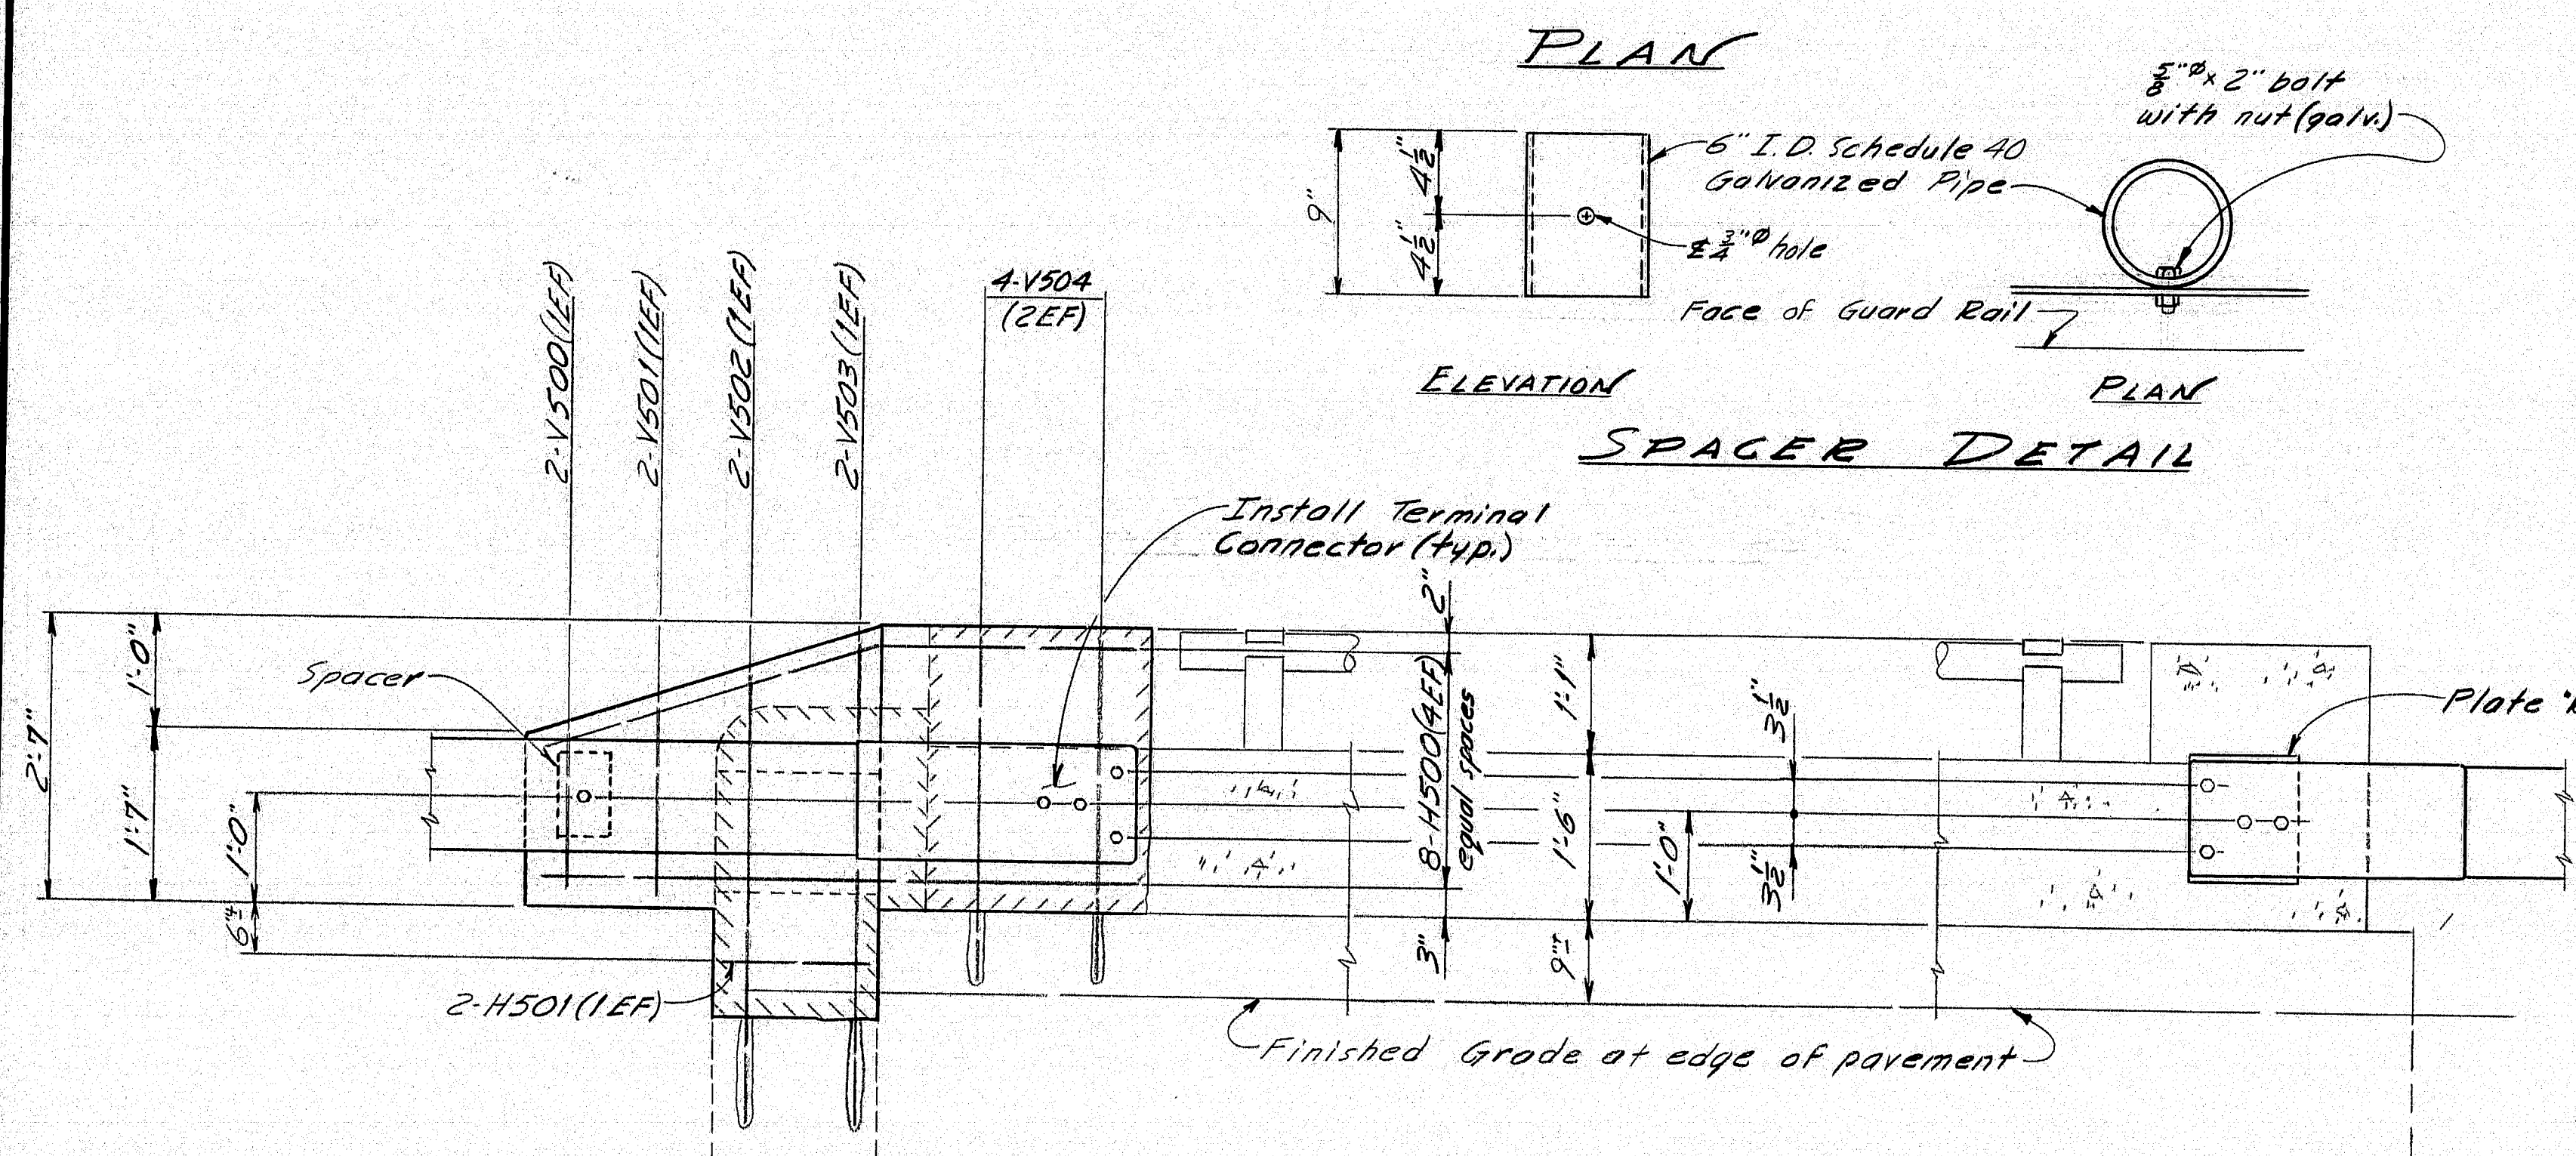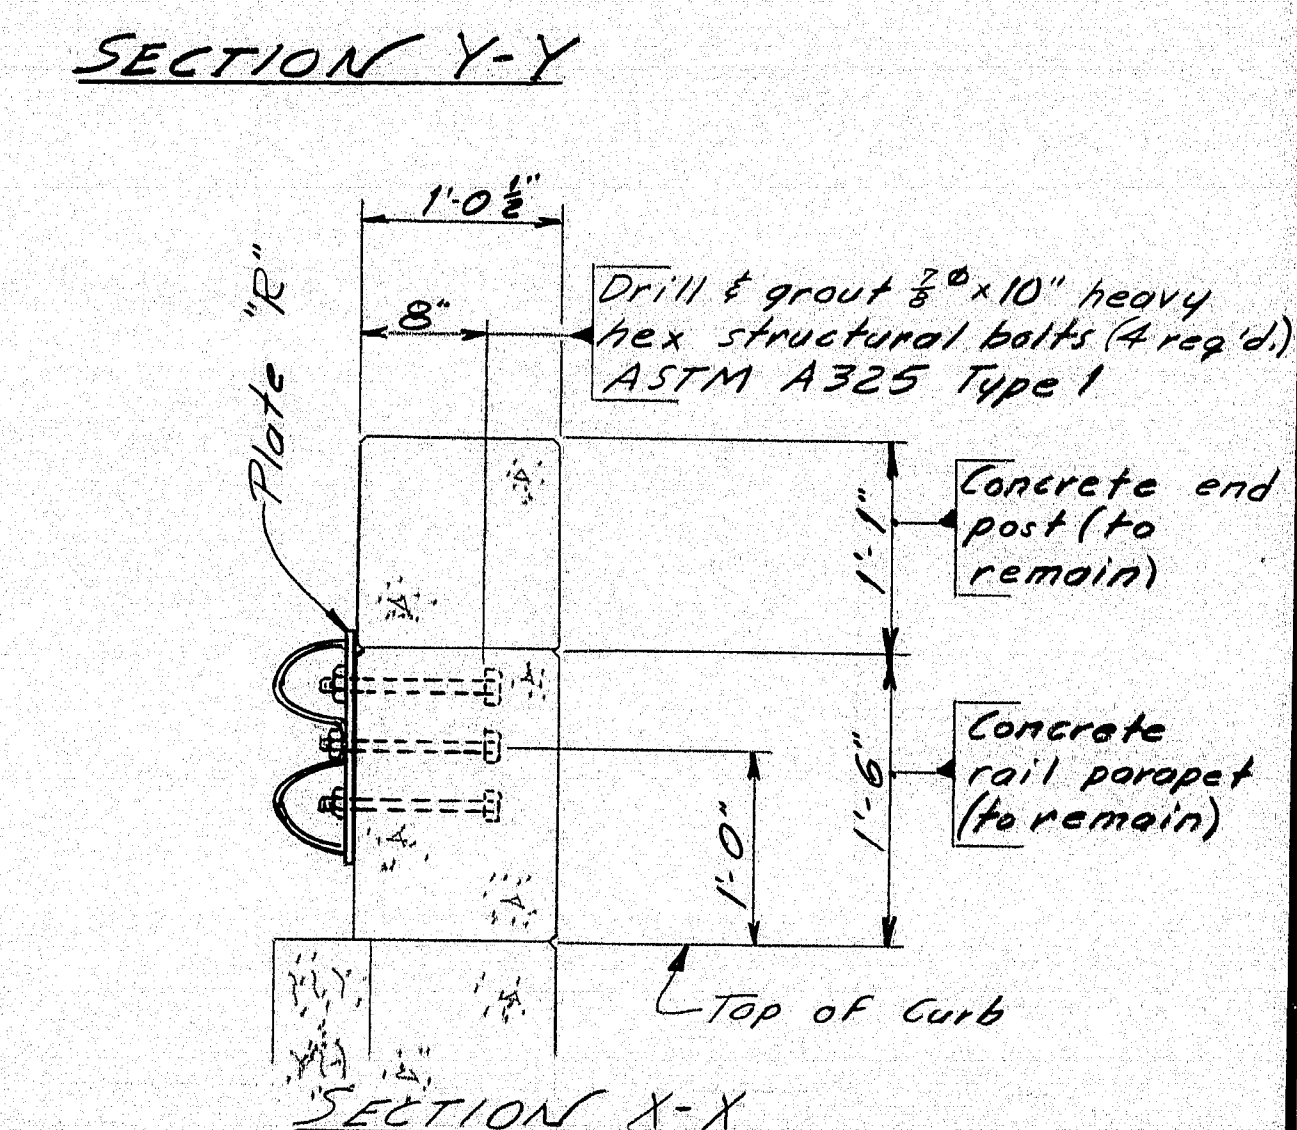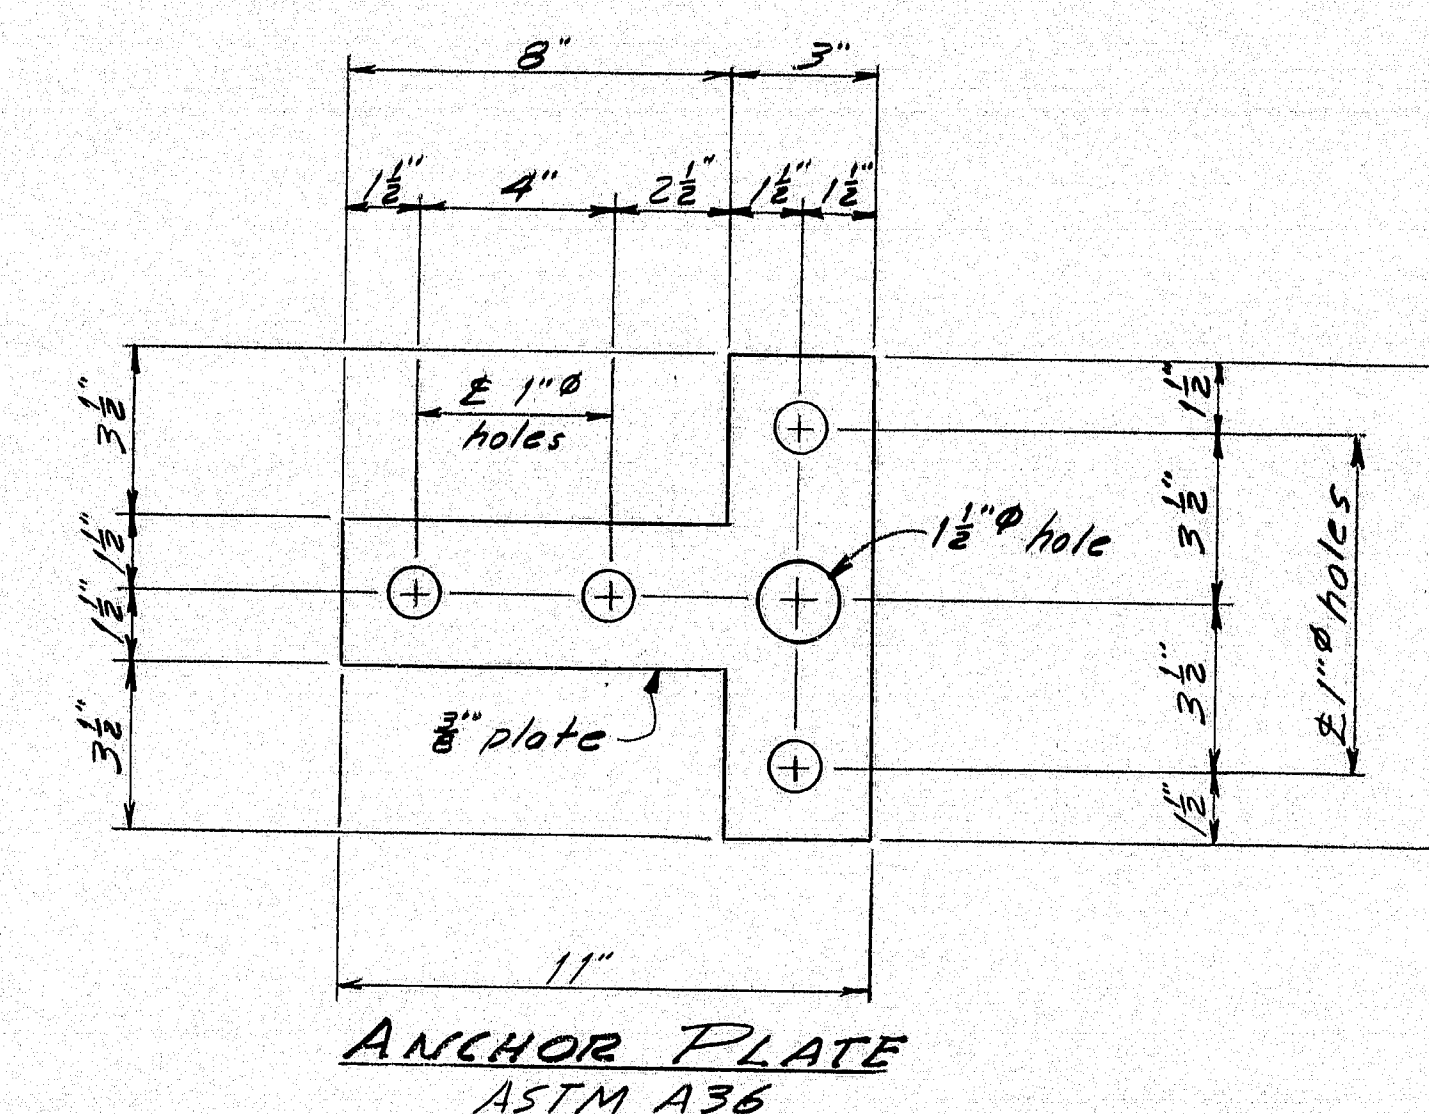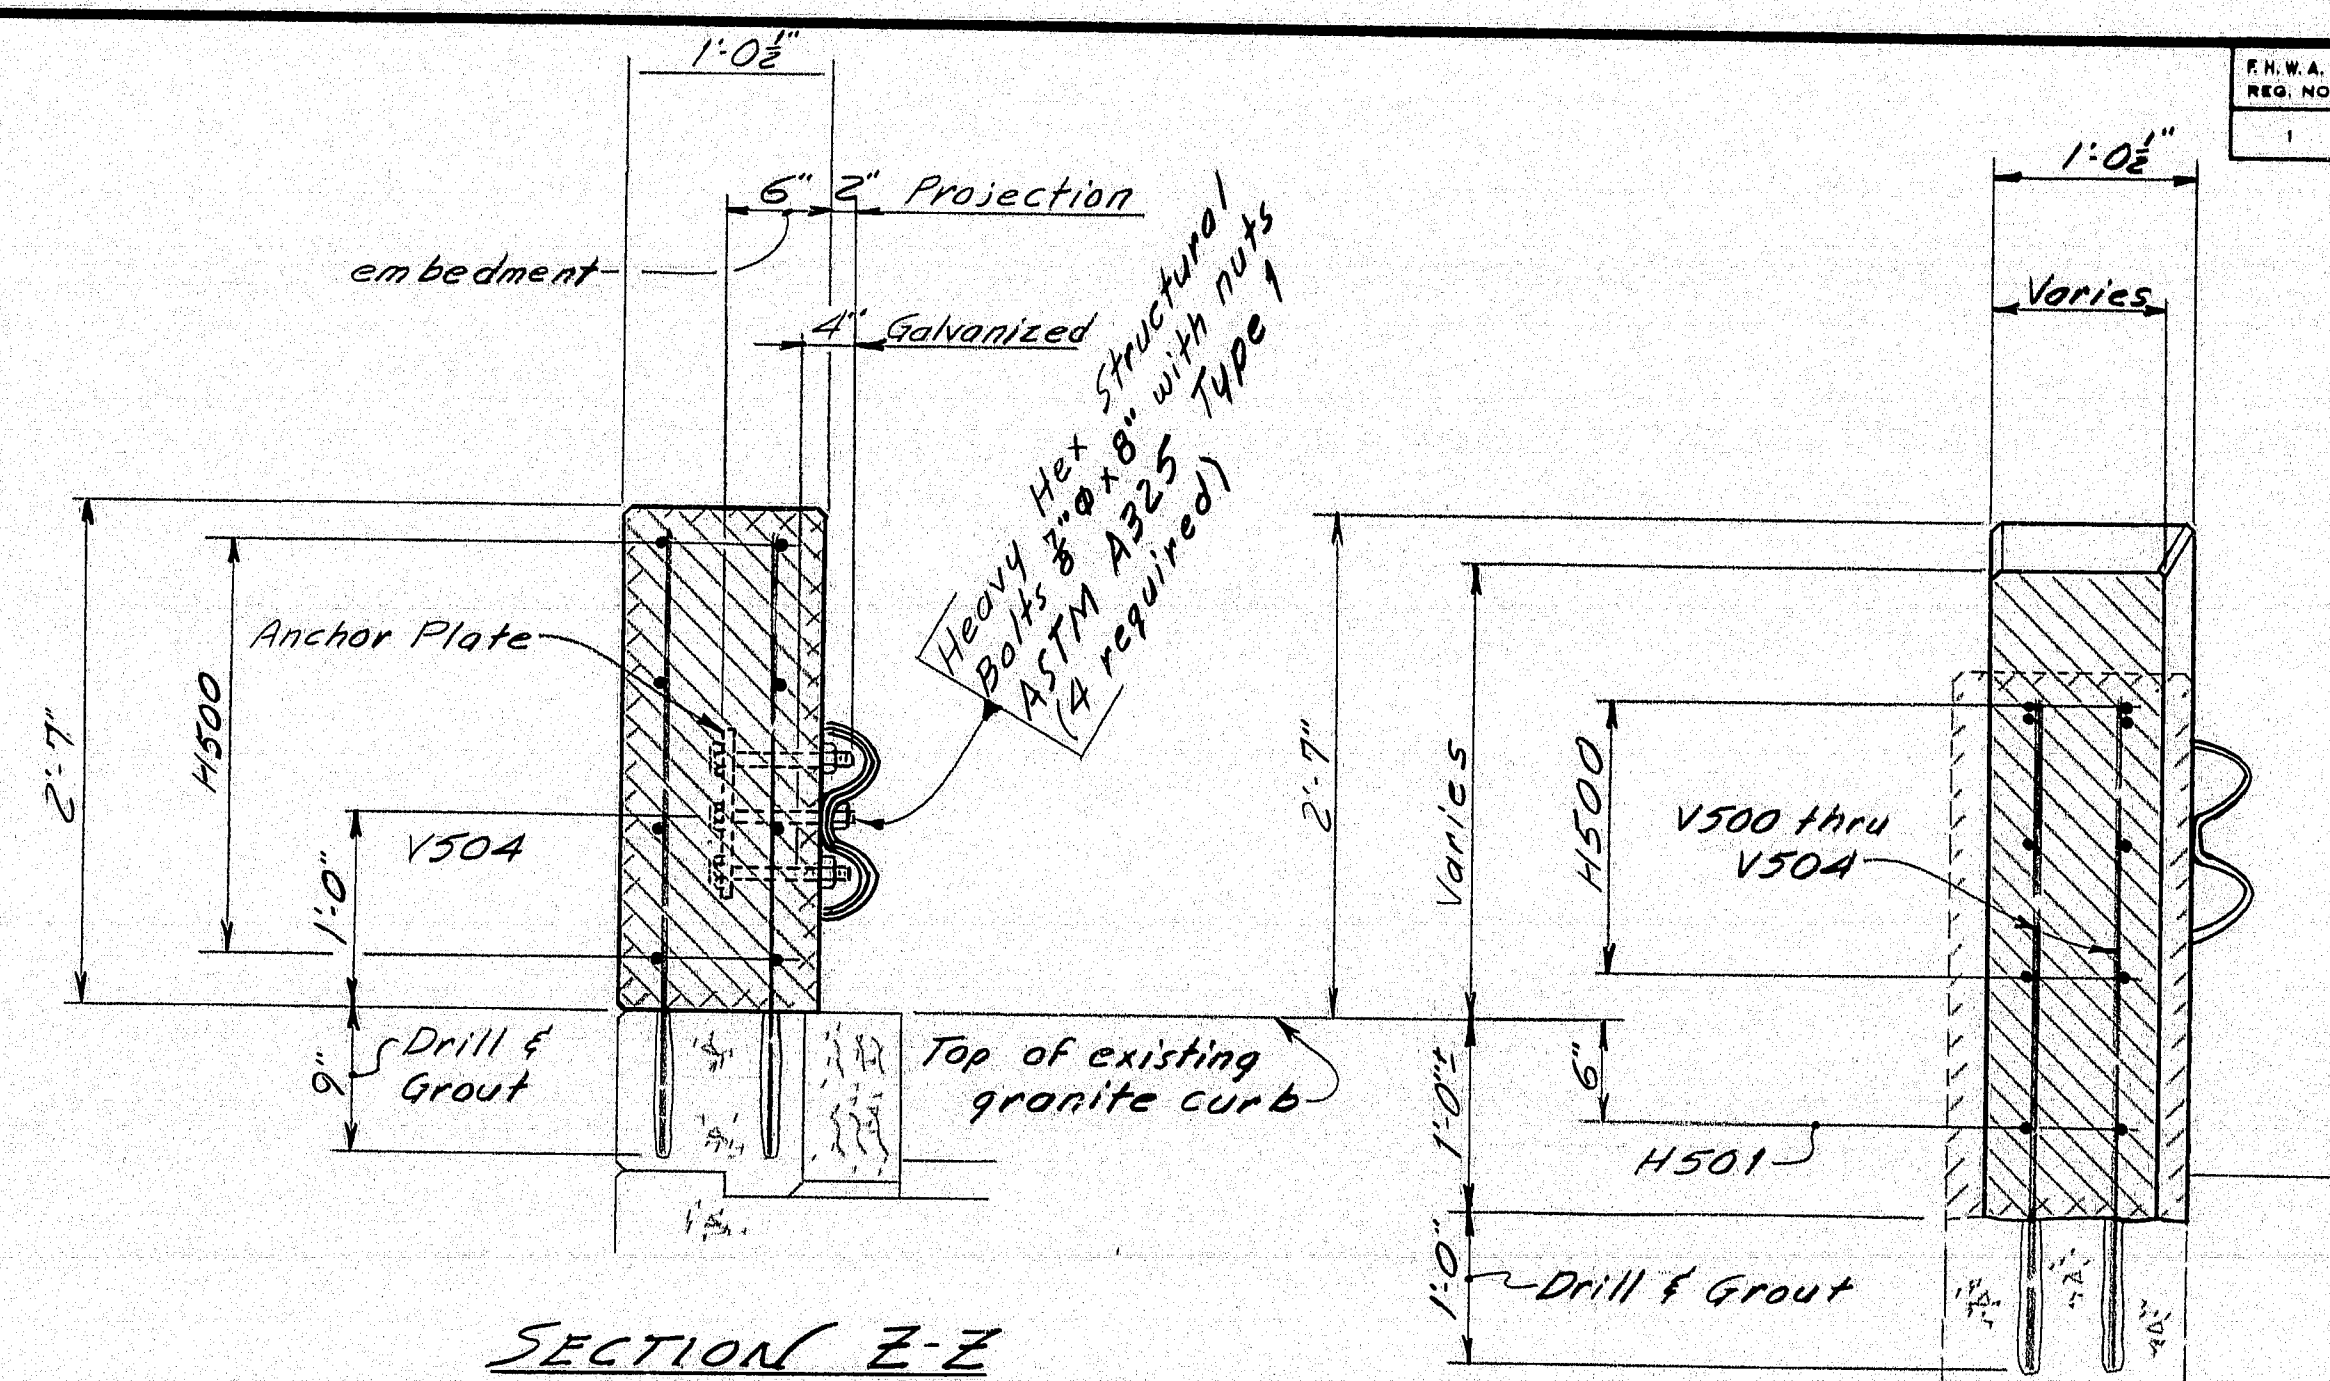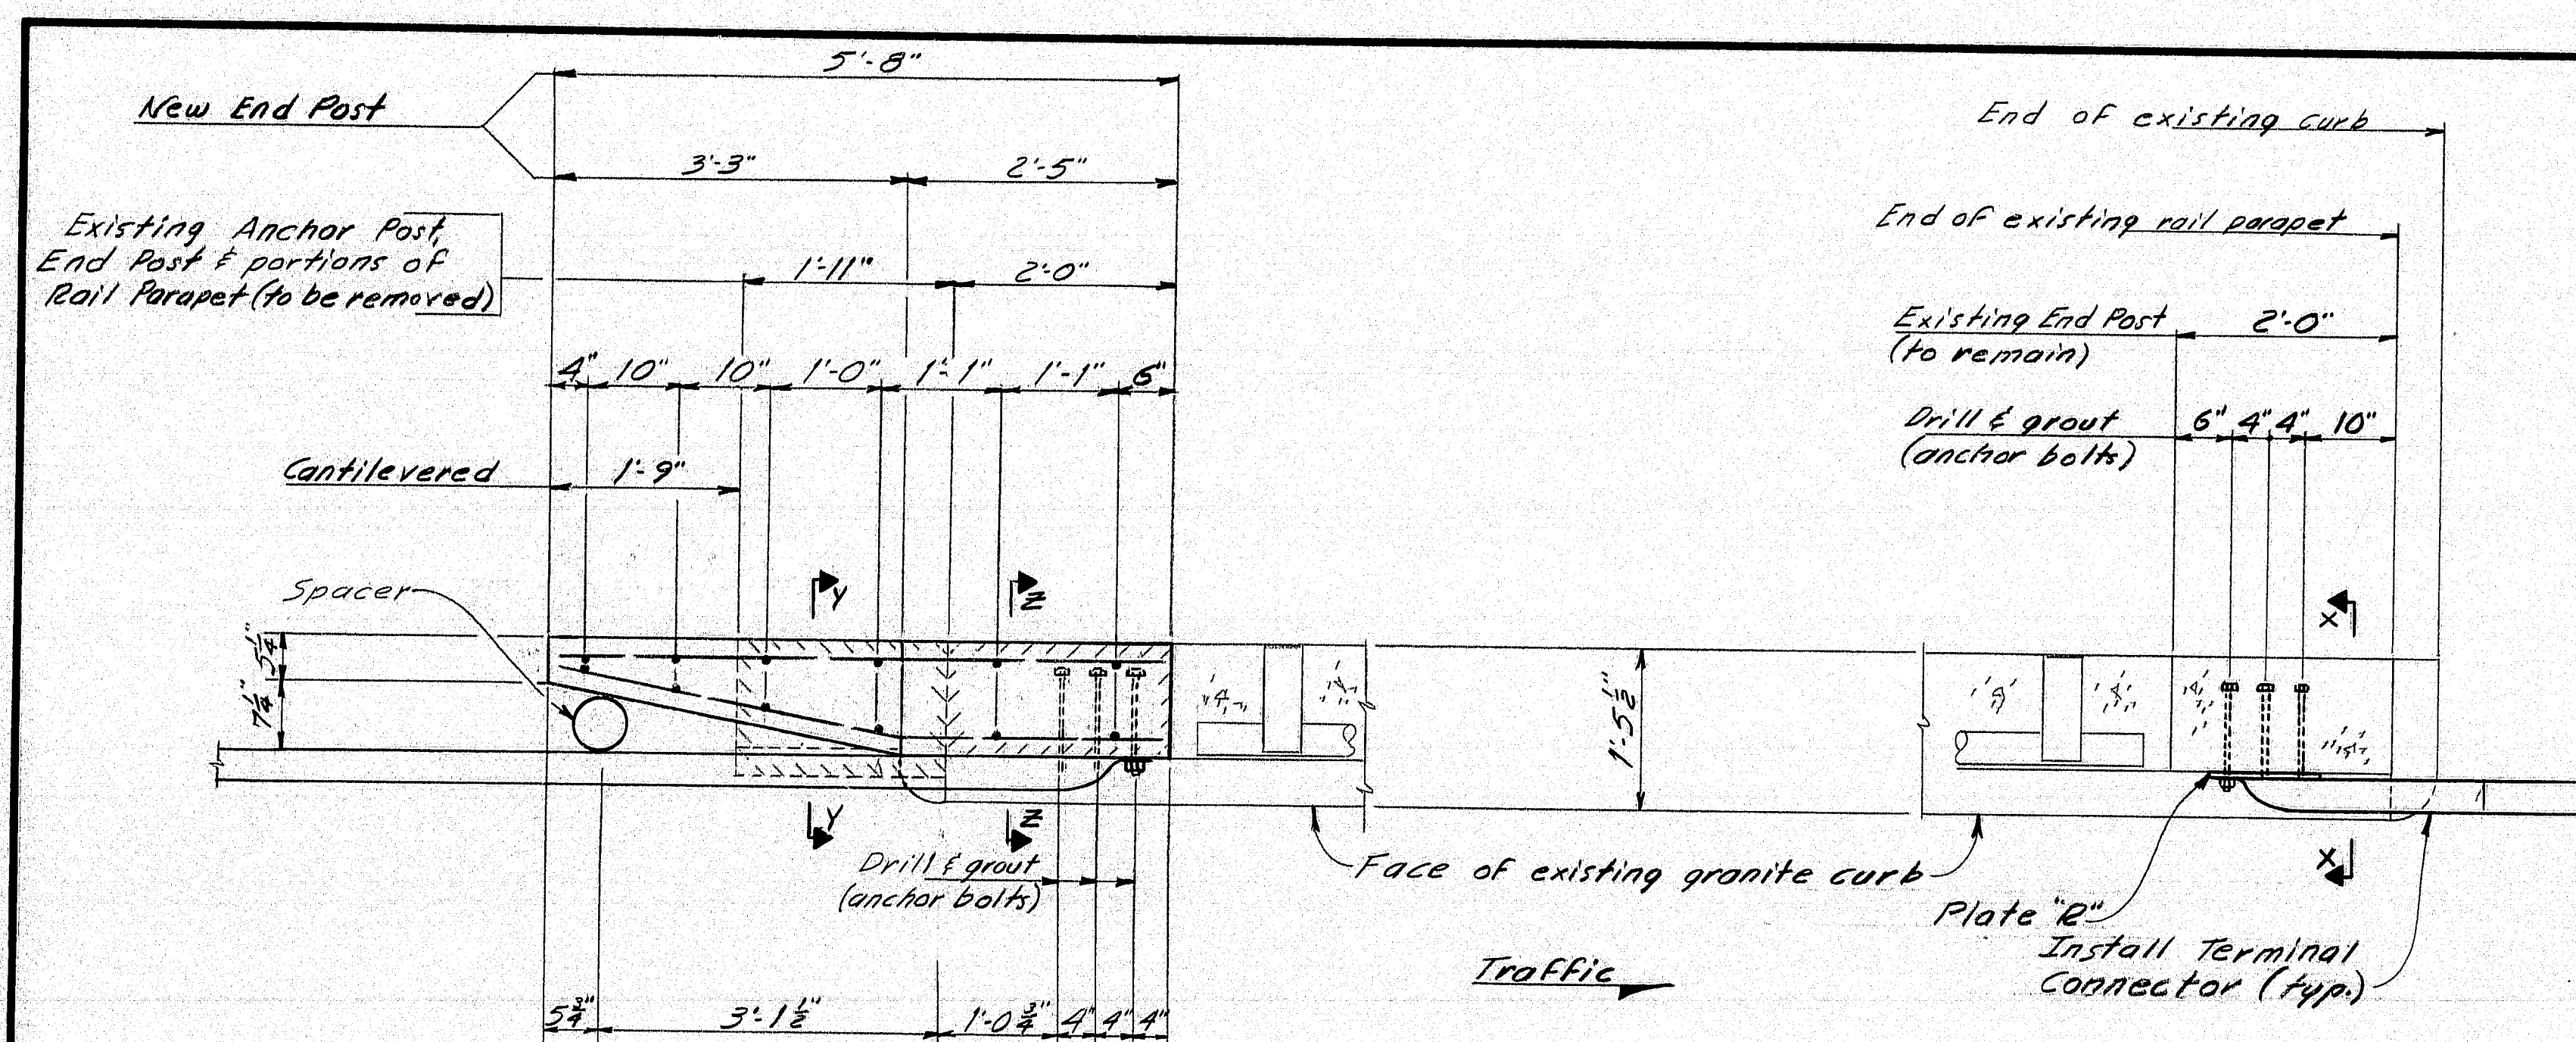

- NOTES

1. Reinforcing steel shall have a minimum cover of 2 inches unless otherwise indicated.
 2. Removing of existing reinforcing steel shall be at a minimum.
 3. Existing reinforcing steel to remain shall be cleaned as directed prior to placing new concrete.
 4. Mortar for grouting dowels shall contain an approved post-shrink additive. Payment for drilling and grouting of dowels shall be considered incidental to Item 503.13, Reinforcing Steel, Placing.
 5. After installation of guard rail is complete, upset the thread on the anchor bolts in three places around each bolt at the junction of the nut and the exposed thread, with a center punch or similar tool.
 7. Payment for all labor, material and equipment required for the installation of terminal connectors and their anchorage systems on the trailing ends of all bridges shall be considered incidental to Item 506.173, Bridge Connections.
- | |
|--|
| STATE OF MAINE
DEPARTMENT OF TRANSPORTATION |
| END POST & GUARD RAIL |

STATE OF MAINE
DEPARTMENT OF TRANSPORTATION

END POST & GUARD RAIL

END POST & GUARD RAIL

CONNECTION DETAIL

PITTSFIELD

INTERSTATE 95 OVER
Sebasticook River, North Main St,
Webb Road, Somerset Avenue,
Central Maine R.R. Route 152
Northbound & Southbound

SHEET 7 OF 14 AUGUSTA, MAINE

SHEET 7 OF 77 AUGUSTA, MAINE

PROJECT DESIGN ENGINEER	BY	DATE
DESIGN - DETAILED	PTA	5-88
CHECKED		
REVISIONS		
FIELD CHANGES		

PROJECT DESIGN ENGINEER	BY	DATE
DESIGN - DETAILED	PTA	5-88
CHECKED		
REVISIONS		
FIELD CHANGES		

DATE 5-28
BY RJA
DESIGN - DETAIL
CHECKED
REVISIONS
FIELD CHANGES
PLANS

REINFORCING STEEL SCHEDULE																										
STRAIGHT BARS													BENT BARS													
MARK	NO.	LENGTH	LOCATION	MARK	NO.	LENGTH	LOCATION	MARK	NO.	LENGTH	LOCATION	MARK	NO.	LENGTH	TYPE	A	B	C	D	E	F	G	H	O	R	LOCATION
SEBASTICOOK RIVER NB & SB (END POST)													TYPICAL AT ALL JOINTS (adjust to fit)													
H500	32	5'-4"	8 each	H500	16	5'-4"	8 each	H500	32	5'-4"	8 each															
H501	8	1'-2"	2 each	H501	4	1'-2"	2 each	H501	8	1'-2"	2 each															
V500	8	1'-5"	2 each	V500	4	1'-5"	2 each	V500	8	1'-5"	2 each															
V501	1	1'-8"	1	V501	1	1'-8"	1	V501	1	1'-8"	1															
V502	1	4'-0"	1	V502	1	4'-0"	1	V502	1	4'-0"	1															
V503	8	4'-4"	2 each (dowel)	V503	4	4'-4"	2 each (dowel)	V503	8	4'-4"	2 each (dowel)															
V504	16	3'-0"	4 each (dowel)	V504	8	3'-0"	4 each (dowel)	V504	16	3'-0"	4 each (dowel)															
NORTH MAINE STREET NB & SB (END POST)																										
H500	32	5'-4"	8 each	H500	16	5'-4"	8 each																			
H501	8	1'-2"	2 each	H501	4	1'-2"	2 each																			
V500	8	1'-5"	2 each	V500	4	1'-5"	2 each																			
V501	1	1'-8"	1	V501	1	1'-8"	1																			
V502	1	4'-0"	1	V502	1	4'-0"	1																			
V503	8	4'-4"	2 each (dowel)	V503	4	4'-4"	2 each (dowel)																			
V504	16	3'-0"	4 each (dowel)	V504	8	3'-0"	4 each (dowel)																			
ROUTE 152 NB (END POST)																										
H500	32	5'-4"	8 each	H500	16	5'-4"	8 each																			
H501	8	1'-2"	2 each	H501	4	1'-2"	2 each																			
V500	8	1'-5"	2 each	V500	4	1'-5"	2 each																			
V501	1	1'-8"	1	V501	1	1'-8"	1																			
V502	1	4'-0"	1	V502	1	4'-0"	1																			
V503	8	4'-4"	2 each (dowel)	V503	4	4'-4"	2 each (dowel)																			
V504	16	3'-0"	4 each (dowel)	V504	8	3'-0"	4 each (dowel)																			
ROUTE 152 & MAINE																										
WEBB ROAD NB & SB (END POST)																										
H500	32	5'-4"	8 each	H500	16	5'-4"	8 each																			
H501	8	1'-2"	2 each	H501	4	1'-2"	2 each																			
V500	8	1'-5"	2 each	V500	4	1'-5"	2 each																			
V501	1	1'-8"	1	V501	1	1'-8"	1																			
V502	1	4'-0"	1	V502	1	4'-0"	1																			
V503	8	4'-4"	2 each (dowel)	V503	4	4'-4"	2 each (dowel)																			
V504	16	3'-0"	4 each (dowel)	V504	8	3'-0"	4 each (dowel)																			

FWA RES. NO. 1	STATE MAINE	PROJECT NUMBER IP-95-7(96)	SHEET 8	TOTAL SHEETS 14
----------------------	----------------	-------------------------------	------------	-----------------------

TYPE-BENDING DIAGRAMS

All dimensions are out to out of reinf. bar.
Bending details and hooks shall conform to the recommendations of the current revision of ACI Standard 318.1.
Reinforcing Bar: ASTM A615 Grade 60

GENERAL NOTES

- First digit(s) following the letter of the Mark indicates size of reinf. bar.
Mark (A502) bar size - #5
Mark (P1001) bar size - #10
Mark (S603) bar size - #6
- Each truss bar, Type B, may be replaced by two (2) straight bars (one top & one bottom) of the same bar size as the truss bar. Payment in either case shall be based on truss bars as scheduled on plans.

As built Dec 89
New Bent Bar Type 53 9-26-83
Revised ACI Standard 5-12-83

REVISIONS

REVISIONS	DATE

STATE OF MAINE
DEPARTMENT OF TRANSPORTATION

REINFORCING STEEL SCHEDULE

PITTSFIELD

INTERSTATE 95 OVER

Sebasticoak River North Maine St.
Webb Road, Somerset Avenue,
Central Maine RR & Route 152
Northbound & Southbound

99-466

SHEET 8 OF 14 AUGUSTA, MAINE