

B.P.R. REG. NO.	STATE PROJ. NO.	FED. AID PROJ. NO.	SHEET NO.	TOTAL SHEETS
1	MAINE	1-95-8(6)180	1	35


# STATE OF MAINE STATE HIGHWAY COMMISSION

## PLAN AND PROFILE STATE HIGHWAY #95 BANGOR


PENOBSCOT COUNTY  
FEDERAL AID PROJECT NO. I-95-8(6)180  
INTERSTATE #95 OVER STILLWATER AVENUE

TOTAL LENGTH 0.142 MILES


PLAN 1 IN. = 50 FT. or as Noted  
SCALES PROFILE { HOR. 1 IN. = 50 FT.  
VER. 1 IN. = 5 FT.  
CROSS SECTIONS 1 IN. = 10 FT.

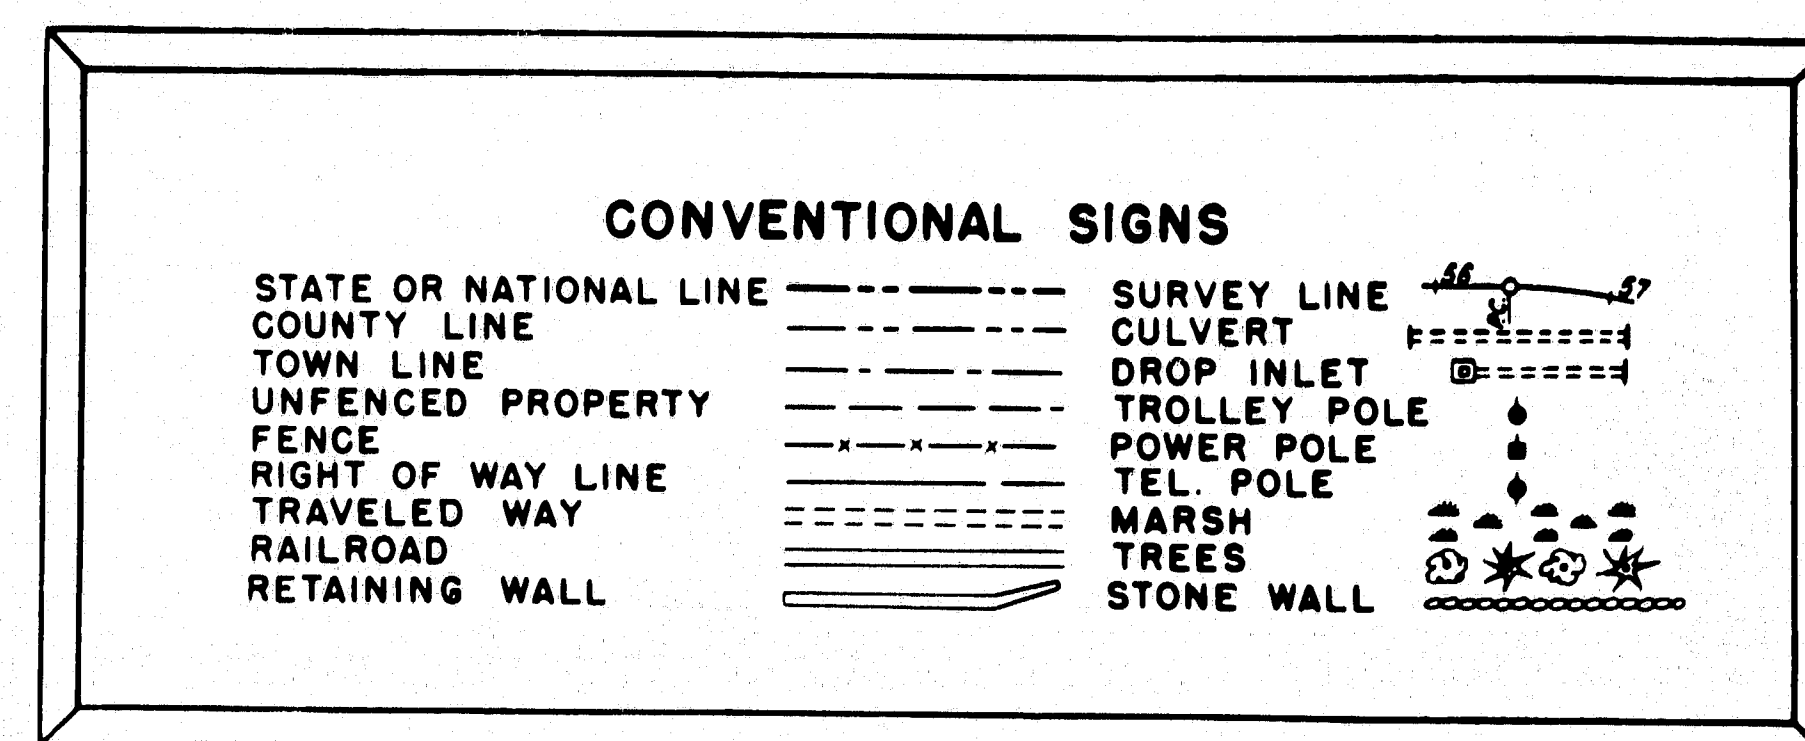

All work contemplated under this contract to be governed by and in conformity with the Standard Specifications, Highways and Bridges, revision of Jan. 1956, except as modified on these plans and by the Special Provisions.

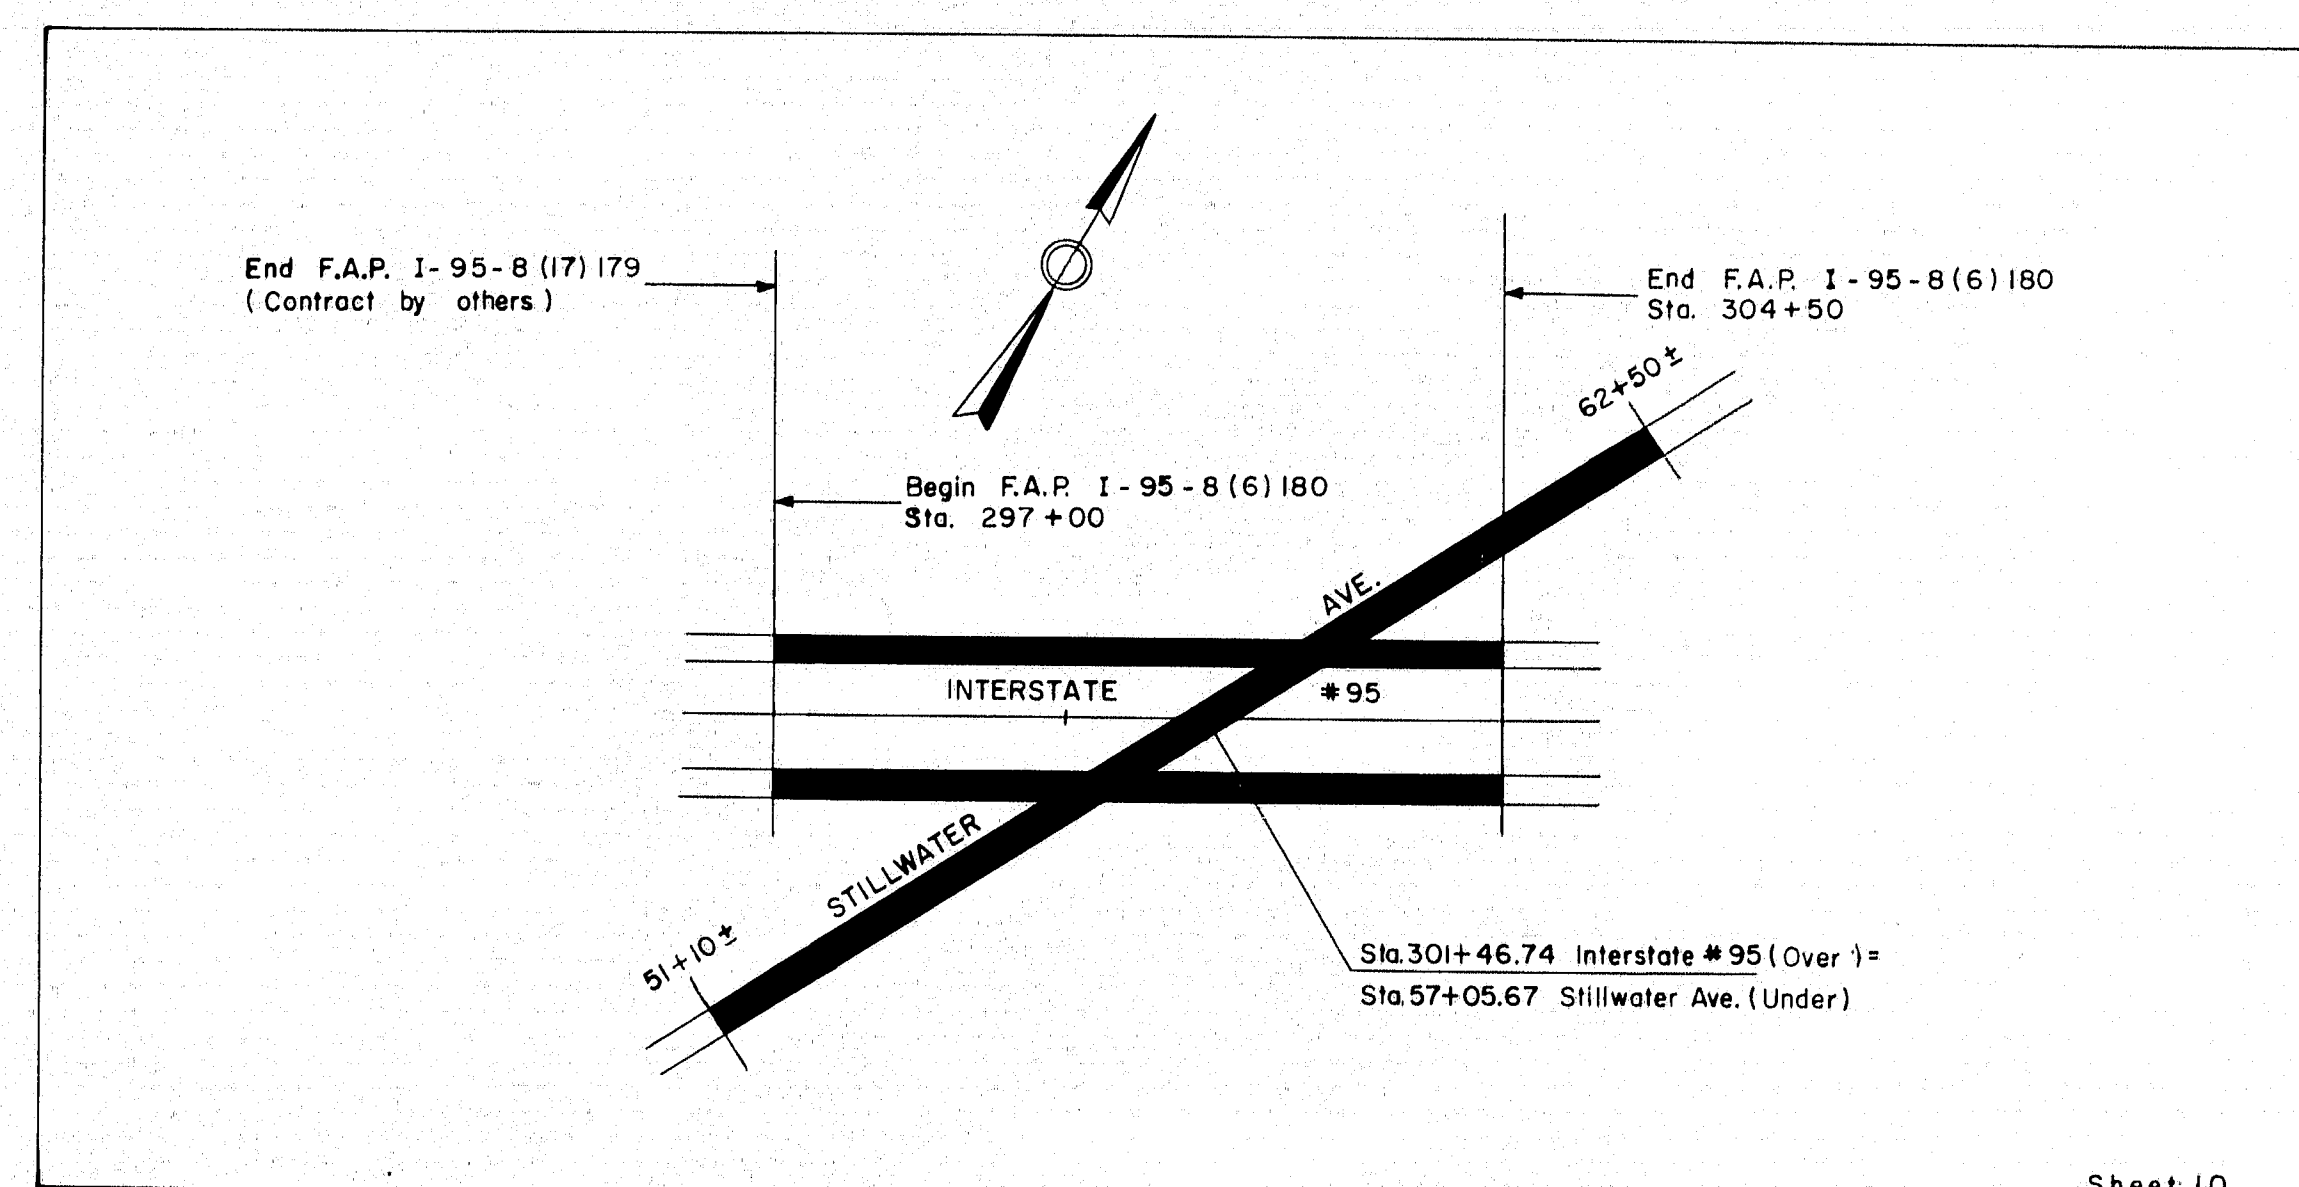

LAYOUT PLAN  
Scale: 1" = 200'

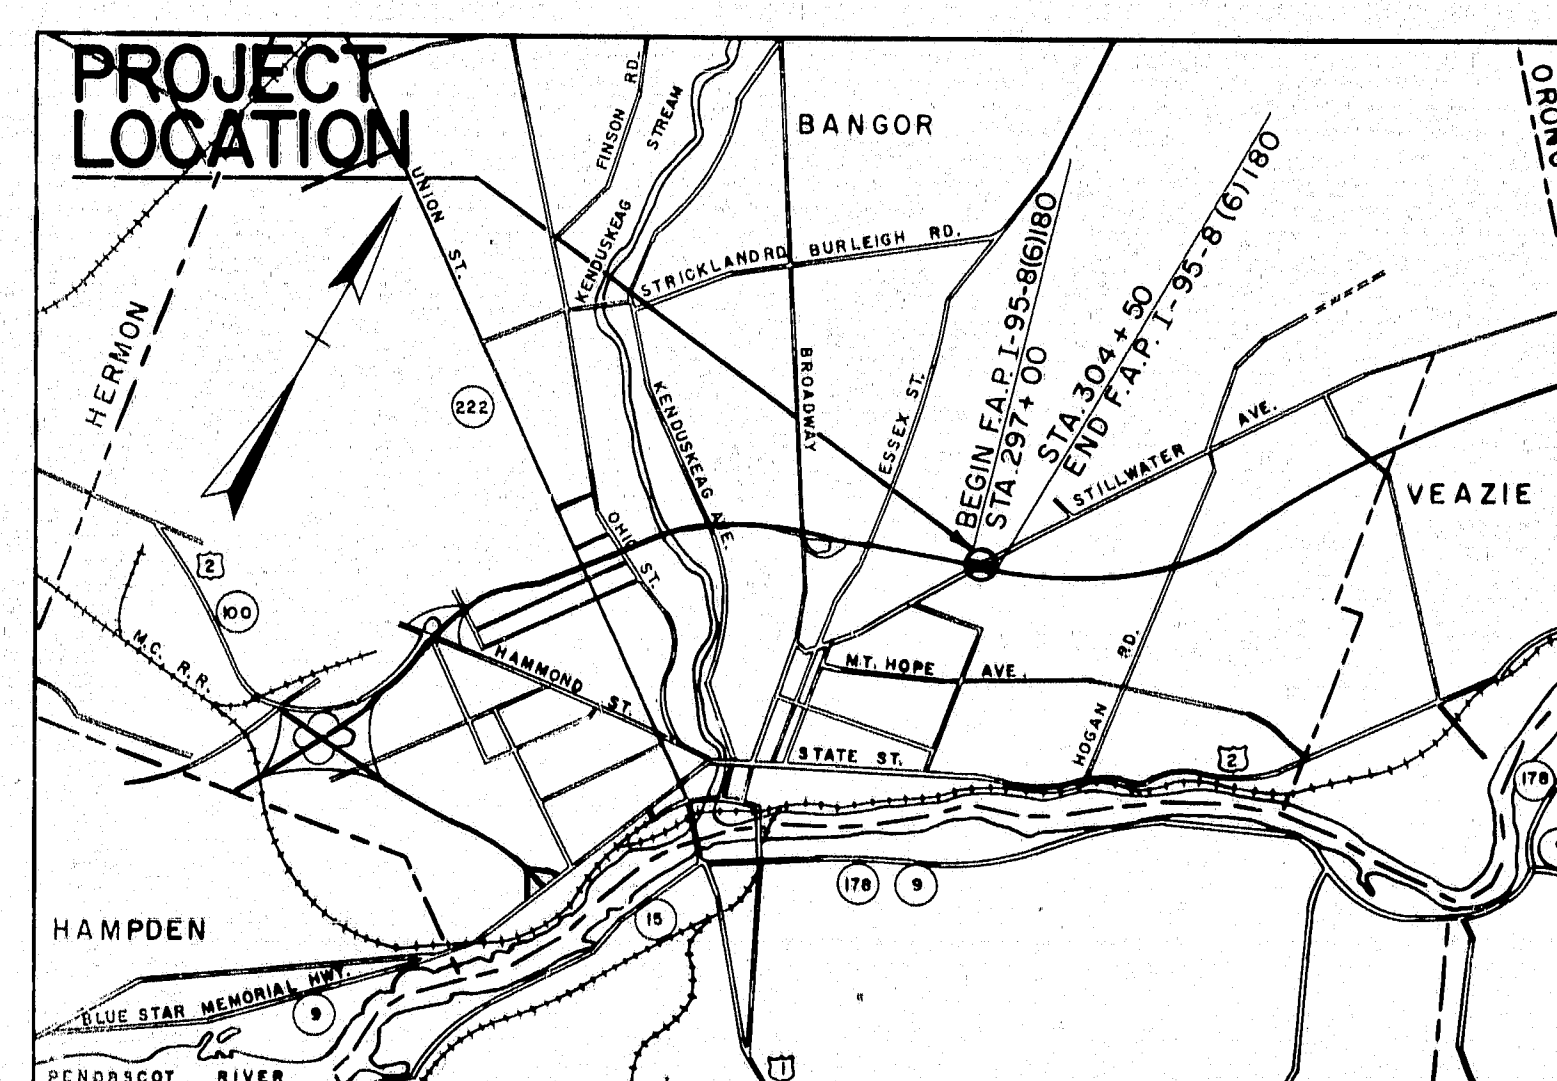

A PORTION OF PENOBSCOT COUNTY  
APPROX. SCALE: 1 IN. = 1 MILE

### INDEX OF SHEETS

- Sheet No.
- Title sheet
  - Typical sections
  - Quantity sheet
  - Standard details
  - Special details
  - General plan and profile 297+00 to 304+50
  - Profile, Stillwater Ave.
  21. Bridge
  - 22 - 35. Cross sections

AS BUILT  
1960

INTERSTATE	STILLWATER AVE
A.D.T. (1960) = 4675	630
A.D.T. (1980) = 7970	855
D.H.V. (1980) = 1200	86
D. (1980) = 65%	65%
T. (1980) = 15%	8%
V. (M.P.H.) = 60	30

CONSULTING ENGINEERS  
THE CLARKESON ENGINEERING COMPANY, INC.  
BOSTON MASS.  
7/21/58  
DATE

APPROVED:  
MAINE STATE HIGHWAY COMMISSION

Chairman

Chief Engineer

Chief Engineer

Chief Engineer

DEPARTMENT OF COMMERCE  
BUREAU OF PUBLIC ROADS  
REGION I

APPROVED:

DIVISION ENGINEER DATE




# GRADING CONTRACT - STAGE CONSTRUCTION

Interstate #95 to be constructed to top of Gravel Base only unless otherwise indicated or specified.

B.R.R. REG. NO.	STATE	PROJECT NO.	SHEET NO.	TOTAL SHEETS
1	MAINE	1-95-B(6)	2	35

BANGOR INTERSTATE

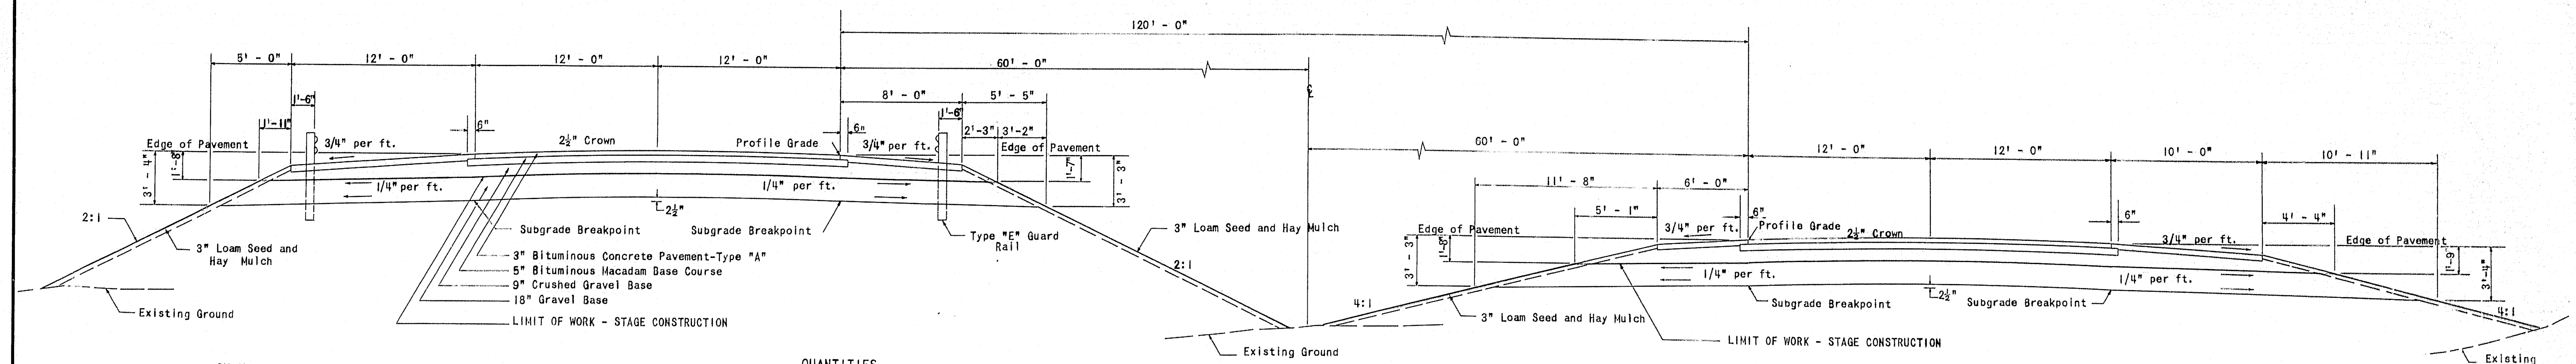


QUANTITIES	CY/100 L.F.
12' PAVED SHOULDER	
4" Bituminous Macadam Surface	14.66
Crushed Gravel Base (to 2:1 Slope)	37.92
18" Gravel Base (to 2:1 Slope)	83.08

QUANTITIES	CY/100 L.F.
24' PAVEMENT	
3" Bituminous Concrete	22.22
5" Bituminous Macadam Base Course	38.58
9" Crushed Gravel Base	66.67
18" Gravel Base	133.33

INTERSTATE #95  
TYPICAL SECTION - NORMAL  
Scale: 1" = 5' - 0"

QUANTITIES	CY/100 L.F.
8' PAVED SHOULDER	
4" Bituminous Macadam Surface	9.72
Crushed Gravel Base to Slope	29.23
18" Gravel Base to Slope	62.80
6' PAVED SHOULDER	
4" Bituminous Macadam Surface	7.25
Crushed Gravel Base to Slope	27.46
18" Gravel Base to Slope	73.74

QUANTITIES	CY/100 L.F.
10' PAVED SHOULDER	
4" Bituminous Macadam Surface	12.19
Crushed Gravel Base to Slope	36.33
18" Gravel Base to Slope	91.92

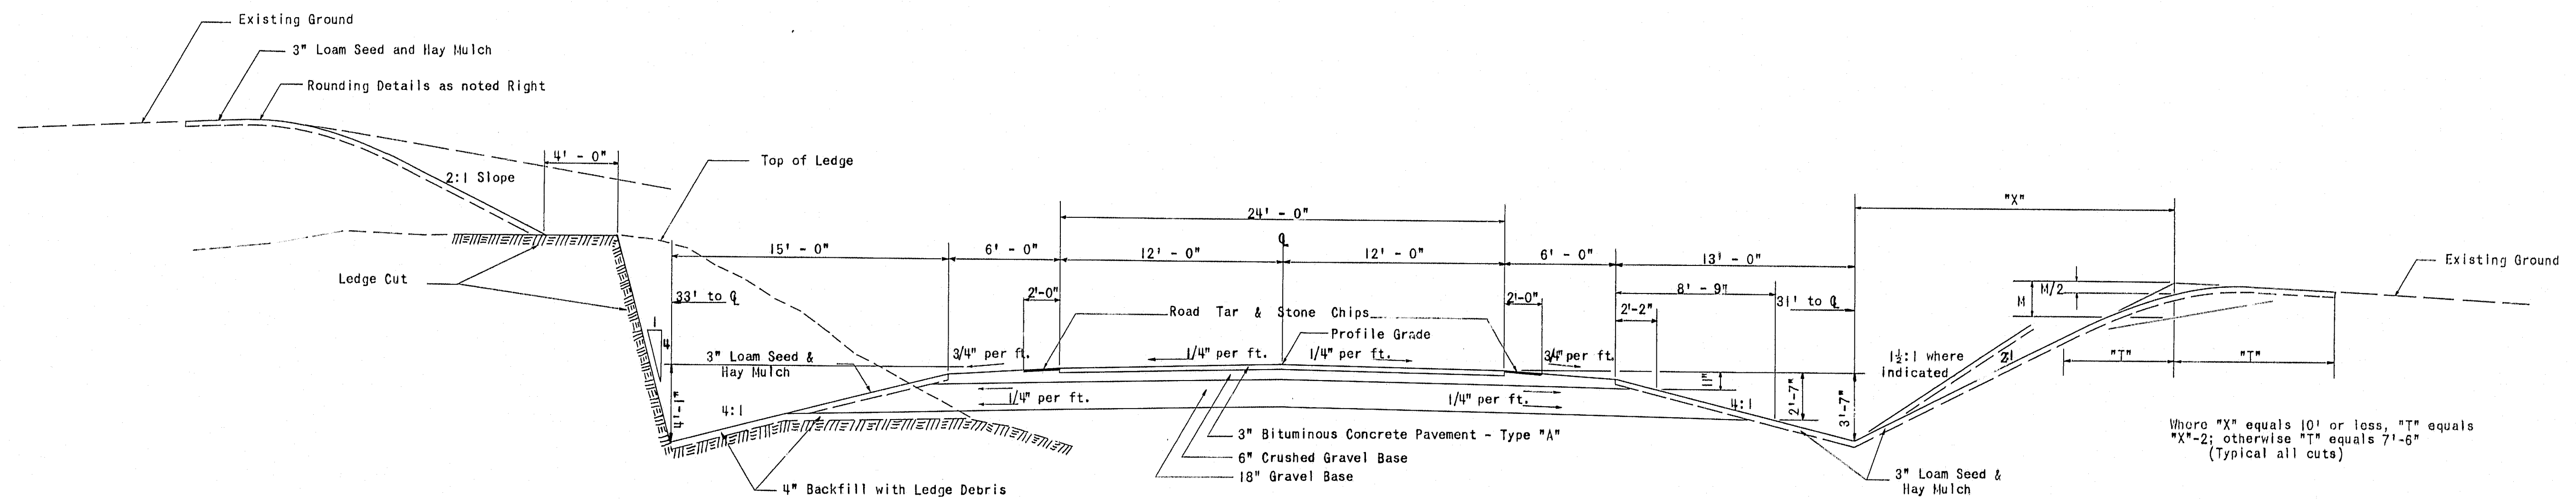

STILLWATER AVENUE  
TYPICAL SECTION  
Scale: 1" = 5' - 0"

QUANTITIES	C.Y./100 L.F.
24' PAVEMENT	
3" Bituminous Concrete Surface	22.22
6" Crushed Gravel Base	44.44
18" Gravel Base	133.33
6' SHOULDER	
Crushed Gravel (to 4:1 Slope)	14.40
Gravel Base (to 4:1 Slope)	57.57

- NOTES:
1. Use 4:1 Slopes for fills less than 10' deep.
  2. Use 2:1 Slopes for fills of depth of 10' or over.
  3. Bituminous Concrete Surface - Type "A" to consist of 1" surface and 2" binder.
  4. Interstate Highway to be constructed to top of gravel base only, unless otherwise indicated.

MAINE STATE HIGHWAY COMMISSION  
AUGUSTA, MAINE

TYPICAL SECTIONS

THE CLARKESON ENGINEERING CO., INC.  
CONSULTING ENGINEERS  
BOSTON MASSACHUSETTS



ESTIMATED QUANTITIES			
ITEM NO.	DESCRIPTION	QUANTITY	UNIT
202-5	Removing Trees (9" to 24")	13	Each
202-6	Removing Trees (over 24")	1	Each
203-9	Earth Excavation	11,900	C.Y.
203-10	Rock Excavation	6,400	C.Y.
204-10	Structural Earth Excavation - Drainage	25	C.Y.
204-11	Structural Rock Excavation - Drainage	20	C.Y.
204-12	Structural Earth Excavation, Abuts. and Retaining Walls	240	C.Y.
204-13	Structural Rock Excavation, Abuts. and Retaining Walls	20	C.Y.
204-14	Structural Earth Excavation - Piers	160	C.Y.
204-15	Structural Rock Excavation - Piers	120	C.Y.
204-18	Structural Rock Excavation-Fencing	100	L.F.
205-8	Common Borrow	23,500	C.Y.
205-9	Granular Borrow	7,600	C.Y.
302-7	Gravel Base Course - In Place Measurement	5,790	C.Y.
302-9	Crushed Gravel Base Course - In Place Measurement	900	C.Y.
303-5	Overhaul (In Place Measure)	32,000	Yd. Hl.
303-6	Overhaul (Pit Measure)	43,200	Yd. Hl.
303-5	Stripping Pits	1,350	C.Y.
310-6	Sprinkling	50	Units
311-6	Calcium Chloride	4	Tons
401-11	Gravel Surface Course	10	C.Y.
402-16	Stone Chips	15	Tons
404-28	Bituminous Concrete Surface Course, Type "A"	540	Tons
501-7	Road Tar	540	Gals.
602-11	15 Inch Asphalt Coated Corrugated Metal Pipe	70	L.F.
602-14	24 Inch Asphalt Coated Corrugated Metal Pipe	50	L.F.
603-13	24 Inch Reinforced Concrete Pipe	40	L.F.
607-7	Metal Endwalls for 24 Inch Pipe	1	Each
701-33	Portland Cement Concrete, Abuts. and Retaining Walls	550	C.Y.
701-35	Portland Cement Concrete, Piers	290	C.Y.
701-40	Portland Cement Concrete, Roadway & S.W. Slabs on St. Bridges	470	C.Y.
701-47	Portland Cement	1,970	C.Y.
702-103	Structural Steel, Fabricated and Delivered	727,900	Lbs.
702-104	Structural Steel, Erection	727,900	Lbs.
703-9	Bronze or Copper-Alloy Bearing & Expansion Plates, Delivered	1,350	Lbs.
703-10	Bronze or Copper-Alloy Bearing & Expansion Plates, Placing	1,350	Lbs.
705-13	Reinforcing Steel, Delivered	225,000	Lbs.
705-14	Reinforcing Steel, Placing	225,000	Lbs.
708-16	Steel H-Beam Piles 42 lbs. per ft.	1,000	L.S.
709-5	Bridge Drainage	1	L.S.
710-5	Shear Connectors, Delivered and Placed	1	L.S.
804-6	French Drains	210	C.Y.
807-15	Aluminum Railing	950	L.F.
906-18	Fencing Metal Posts	2,470	L.F.
907-10	Hand Laid Rip-Rap	10	C.Y.
908-8	Loam Excavation	3,500	C.Y.
909-7	Sodding	700	S.Y.
910-10	Seeding - Parkway Mixture	90	Units
912-8	Hay Mulch	10	Tons
914-6	Project Markers	1	Each
917-6	Traffic Officers	200	H. Hrs.
926-7	Removal or Razing Buildings No. 1	1	Each
926-8	Removal or Razing Buildings No. 2	1	Each
926-9	Removal or Razing Buildings No. 3	1	Each
926-10	Removal or Razing Buildings No. 4	1	Each
929-10	Portable Barricade	2	Each
930-13	Portable Barricade with Flashing Lights	2	Each
933-6	Slope Paving for Bridges	1,380	S.Y.
915-6	Right of Way Monuments	2	Each
	Gravel For Foundations	30	C.Y.

REMOVING TREES		
STATION	SIDE	REMARK
Stillwater Ave.		
53 + 40	Rt. - 23'	18" Elm
53 + 75	Rt. - 20'	15" Elm
56 + 00	Rt. - 28'	22" Elm
56 + 22	Rt. - 26'	22" Elm
56 + 95	Rt. - 21'	28" Elm
59 + 34	Rt. - 18'	22" Elm
59 + 57	Rt. - 18'	16" Elm
60 + 00	Rt. - 19'	20" Elm
60 + 24	Rt. - 22'	16" Elm
60 + 57	Rt. - 23'	13" Elm
61 + 40	Rt. - 26'	12" Elm
61 + 63	Rt. - 26'	12" Elm
61 + 87	Rt. - 28'	12" Elm
62 + 30	Rt. - 29'	14" Elm
60 + 33	Lt. - 30'	13" Elm
60 + 10	Lt. - 20'	14" Elm

GRAVEL BASE COURSE	
STATION TO STATION	DESCRIPTION
298 + 50 to 301 + 50 Lt.	18" Gravel
296 + 50 to 299 + 05 Rt.	18" Gravel Base
301 + 50 to 304 + 00 Rt.	18" Gravel Base
Stillwater Avenue	18" Gravel Base

DRIVEWAYS		
STATION	SIDE	DESCRIPTION
Stillwater Ave.		
61 + 00	Left	1" Gravel Surface Course with a 45" Gravel Base.

FENCING - METAL POSTS			
STATION TO STATION	SIDE	LENGTH	REMARK
297 + 00 to 297 + 85	Rt.	85'	
52 + 92 to 54 + 18	Lt.	125'	Stillwater Ave.
298 + 288 to 298 + 288	Rt.	40'	
56 + 10 to 53 + 93	Rt.	217'	Stillwater Ave.
299 + 04 to 304 + 50	Rt.	546'	
297 + 00 to 303 + 93	Lt.	693'	
60 + 20 to 56 + 40	Lt.	180'	Stillwater Ave.
302 + 40 to 301 + 60	Lt.	80'	
59 + 80 to 60 + 00	Rt.	40'	Stillwater Ave.
60 + 00 to 61 + 20	Rt.	120'	
58 + 18 to 56 + 73	Lt.	155'	
57 + 16 to 58 + 98	Rt.	182'	

LOAM EXCAVATION			
STATION TO STATION	EST. DEPTH	AV. WIDTH	LENGTH
297 + 50 to 302 + 00 Lt.	4' 0"	110' 00"	450' 400'
297 + 00 to 305 + 00 Rt.	1'	60'	750'

PORTABLE BARRICADES		
STATION	NO.	REMARK
Stillwater Ave.		
North	1	
South	1	
North	1	With Flashing Lights
South	1	" " "

SODDING		
STATION TO STATION	SIDE	REMARK
297 + 00 to 300 + 00		Q
299 + 90 to 302 + 10 Lt.		Lt.
302 + 90 to 304 + 50		Rt.
Stillwater Ave.		
61 + 10 to 61 + 80		Lt.
61 + 00 to 62 + 50		Rt.
60 + 00 to 60 + 50		Rt.


ROADWAY CULVERTS						
STATION	SIZE	ACCOMP. LEFT	RCP	ACCOMP. RIGHT	PIPE CONN.	METAL E.W.
Stillwater Ave.						
59 + 50	24"	10'	40'	8'	1	1
60 + 50 to 61 + 10	15"	64'				

SUMMARY OF CLASSIFIED EXCAVATION AND BORROW	
Total Earth Excavation from Cross Sections	11,622 C.Y.
Estimated Earth Shrinkage Factor (-15%)	1,793
Available Fill from Earth Excavation	9,829 C.Y.
Total Rock Excavation from Cross Sections	6,336 C.Y.
Estimated Rock Swellage Factor (+40%)	2,534
Available Fill from Rock Excavation	8,870 C.Y.
Earth Fill Required from Cross Sections	43,262 C.Y.
Plus Loam Excavation in Fills	3,500
Sub-total	46,762 C.Y.
Less Available Fill from Rock Excavation	8,870
Sub-total	37,892 C.Y.
20% Granular Borrow	7,578
Earth Fill Required	30,314 C.Y.
Earth Fill Required	30,314 C.Y.
Available Earth Fill	9,879
Borrow	20,435 C.Y.
Common Borrow 20435 + 3065 =	23,500 C.Y.
Granular Borrow =	7,600 C.Y.
Earth Excavation 11622 + 278 =	11,900 C.Y.
Rock Excavation	6,400 C.Y.
Undetermined Origin	









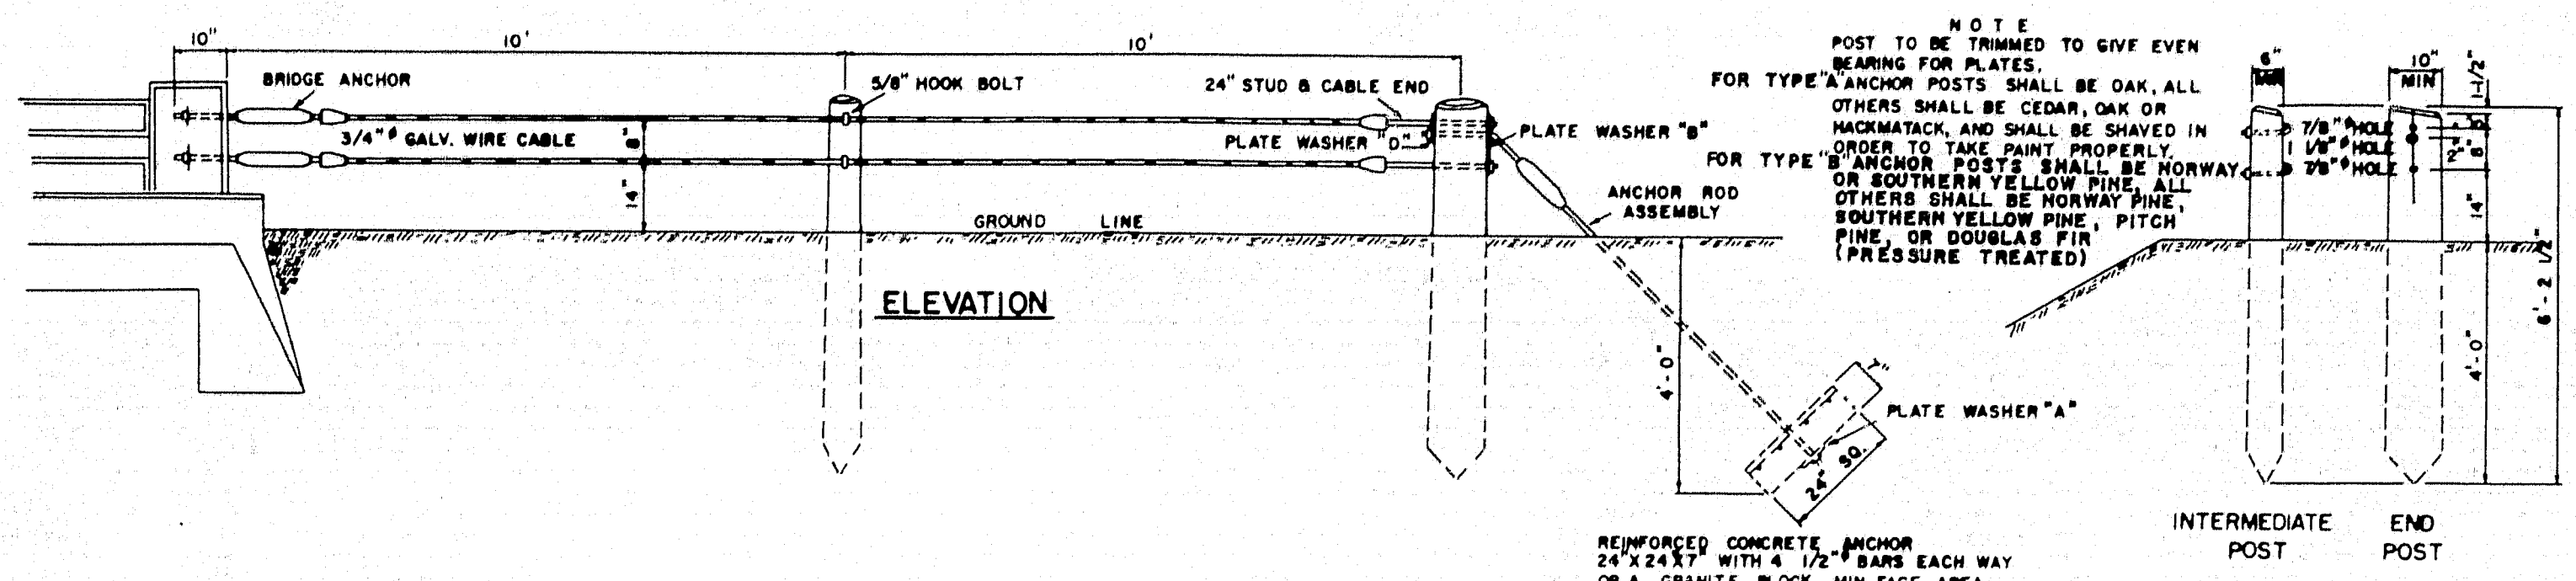


GUARD RAIL TYPE "A" & "B"

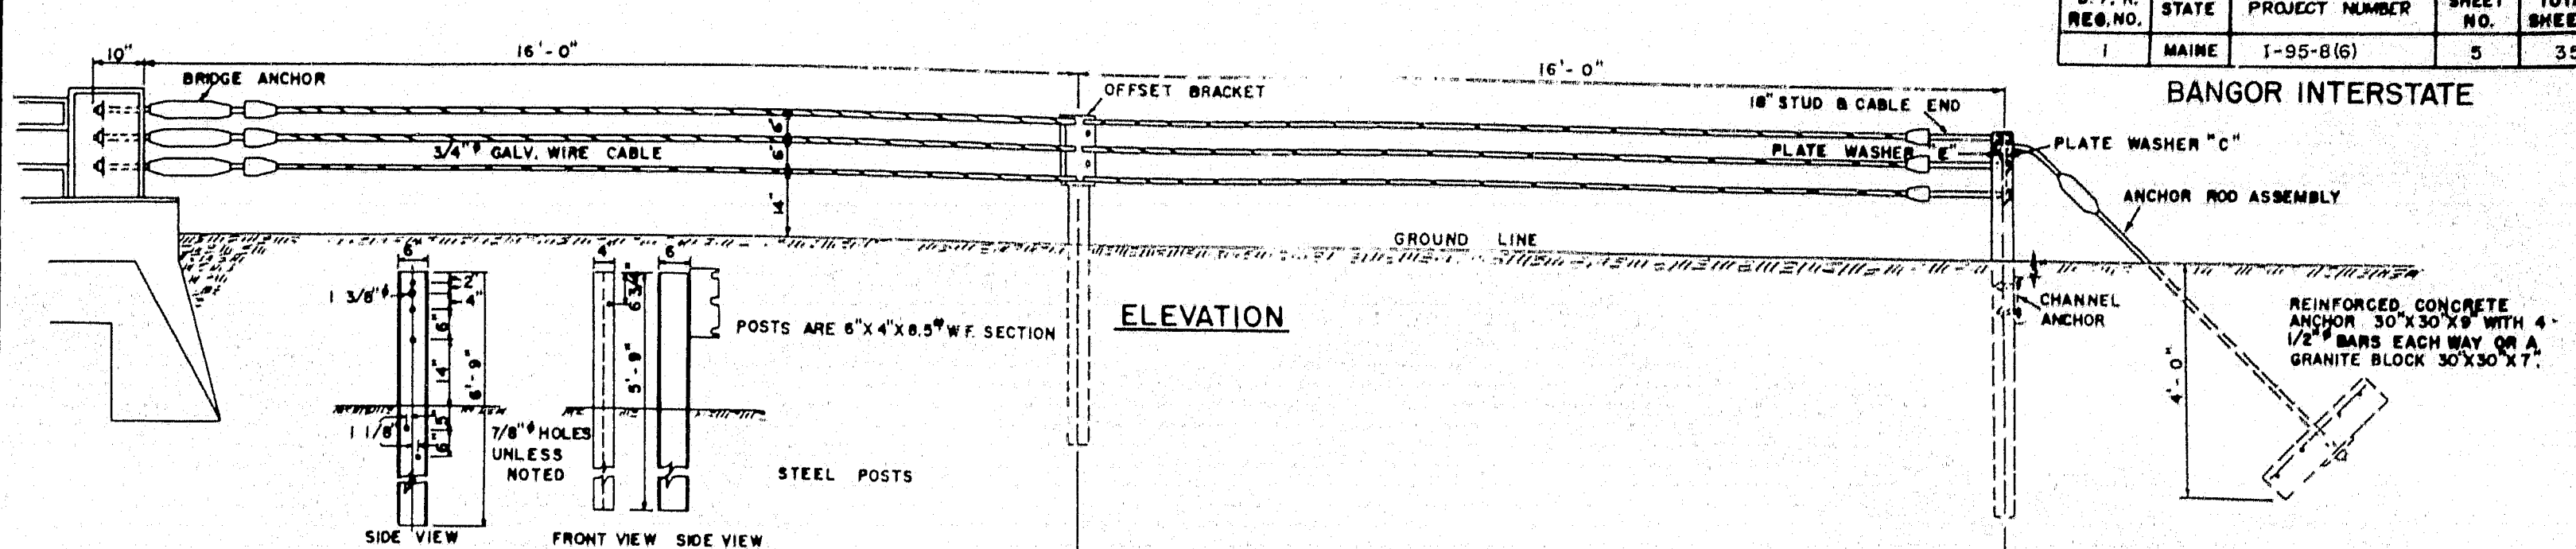


GUARD RAIL TYPE "C"

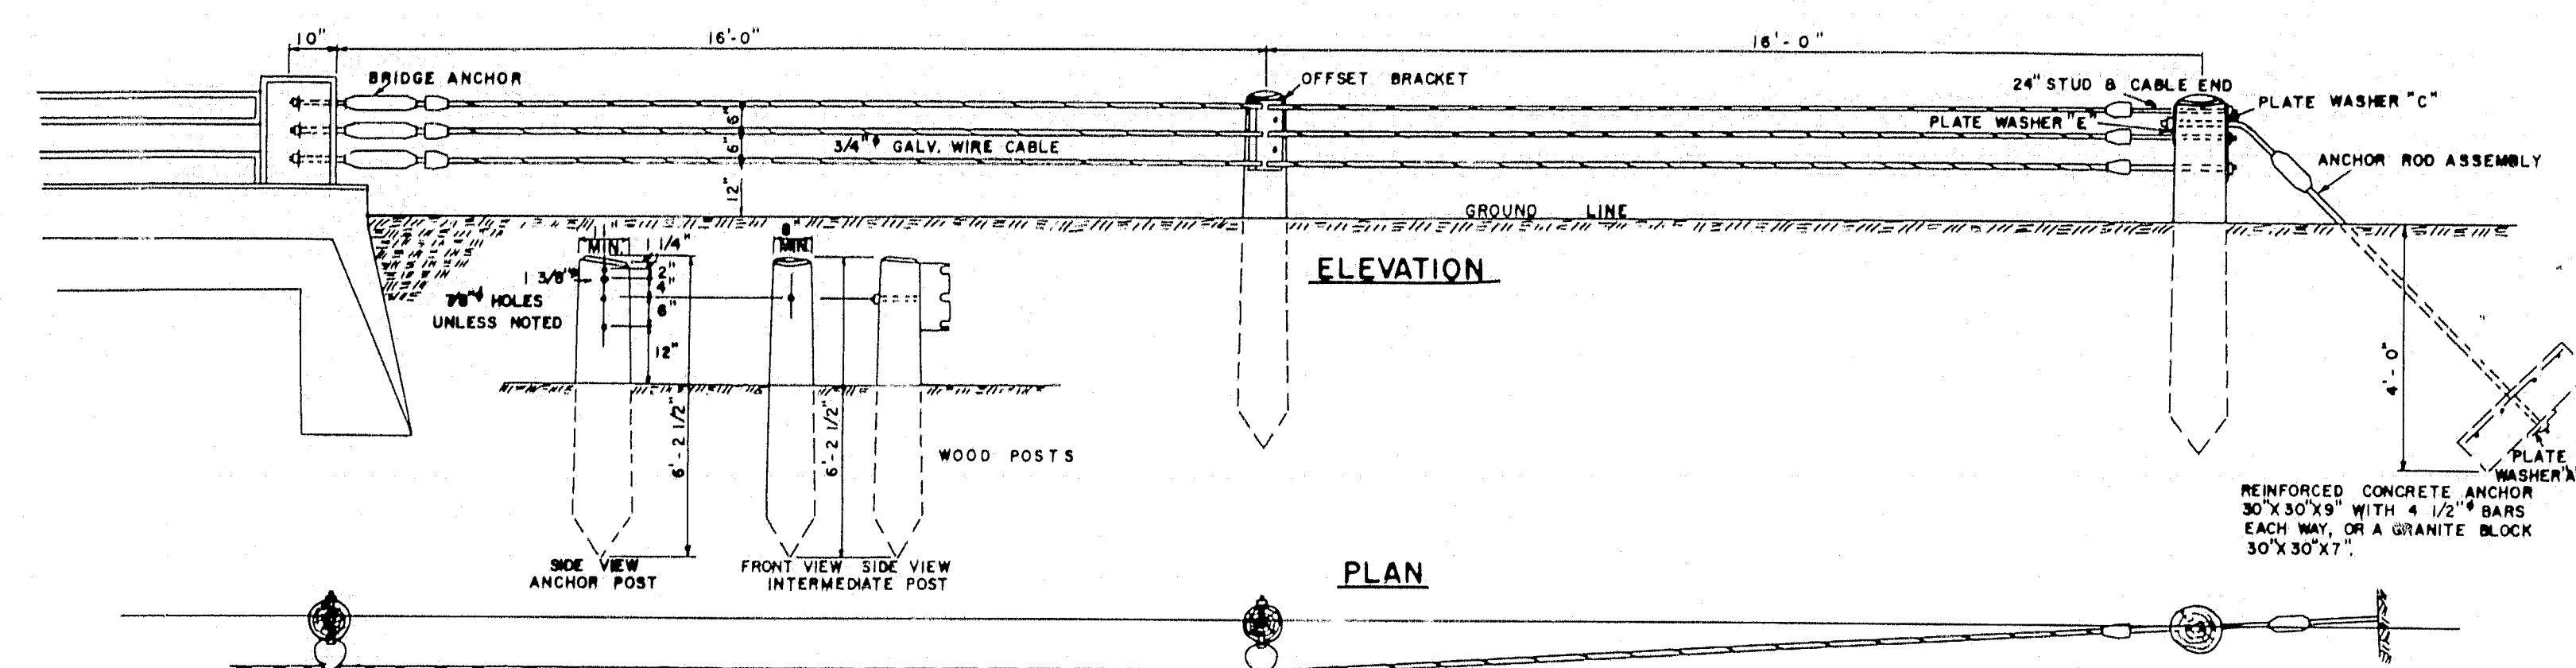


GUARD RAIL TYPE "D"

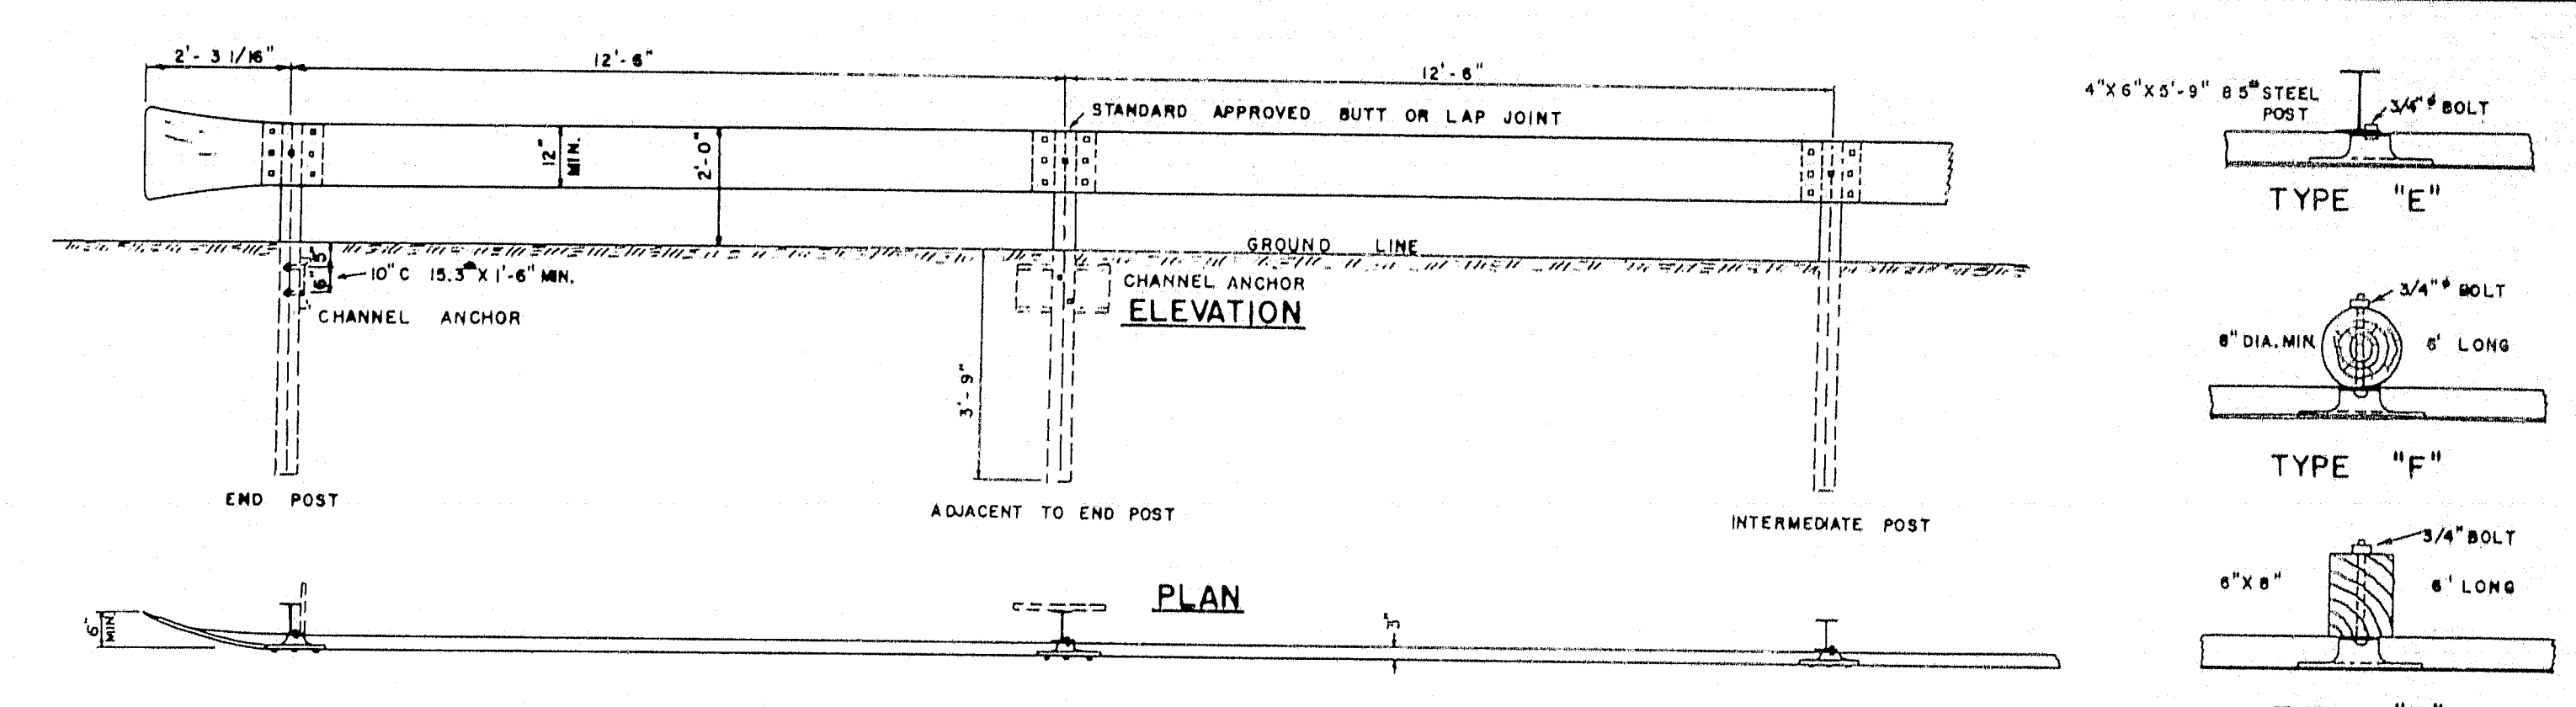


GUARD RAIL TYPE "E", "F" & "G"

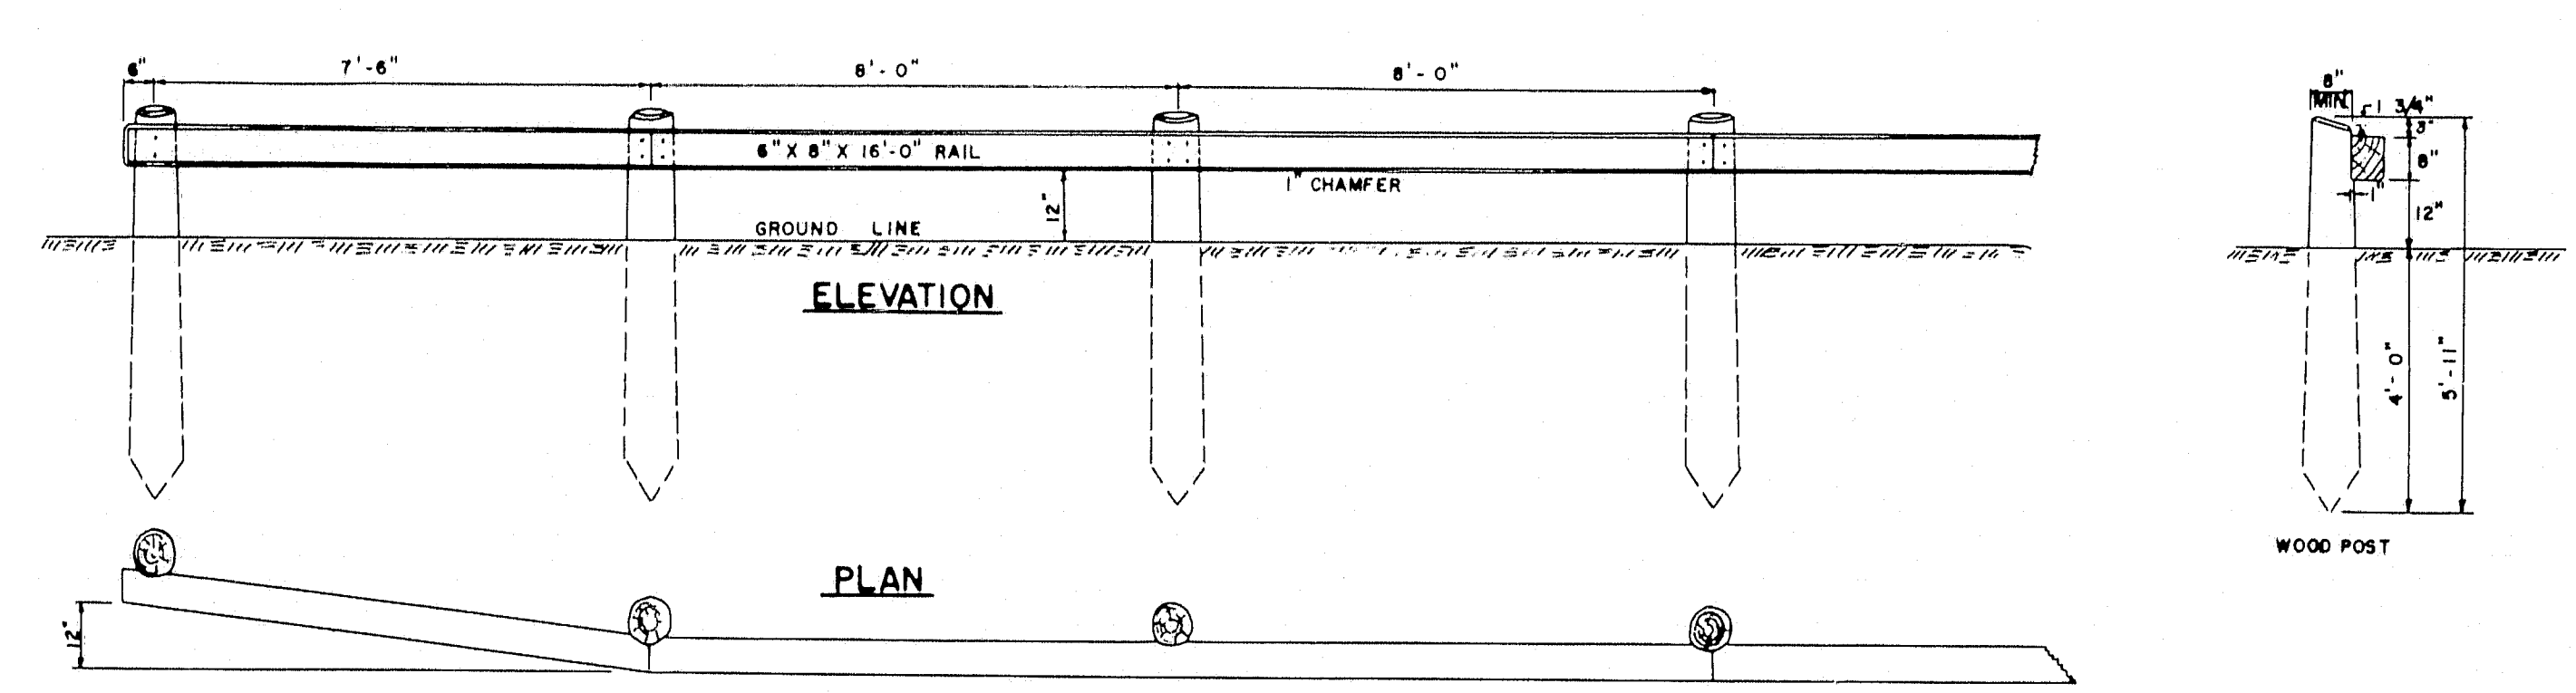


GUARD RAIL TYPE "H"

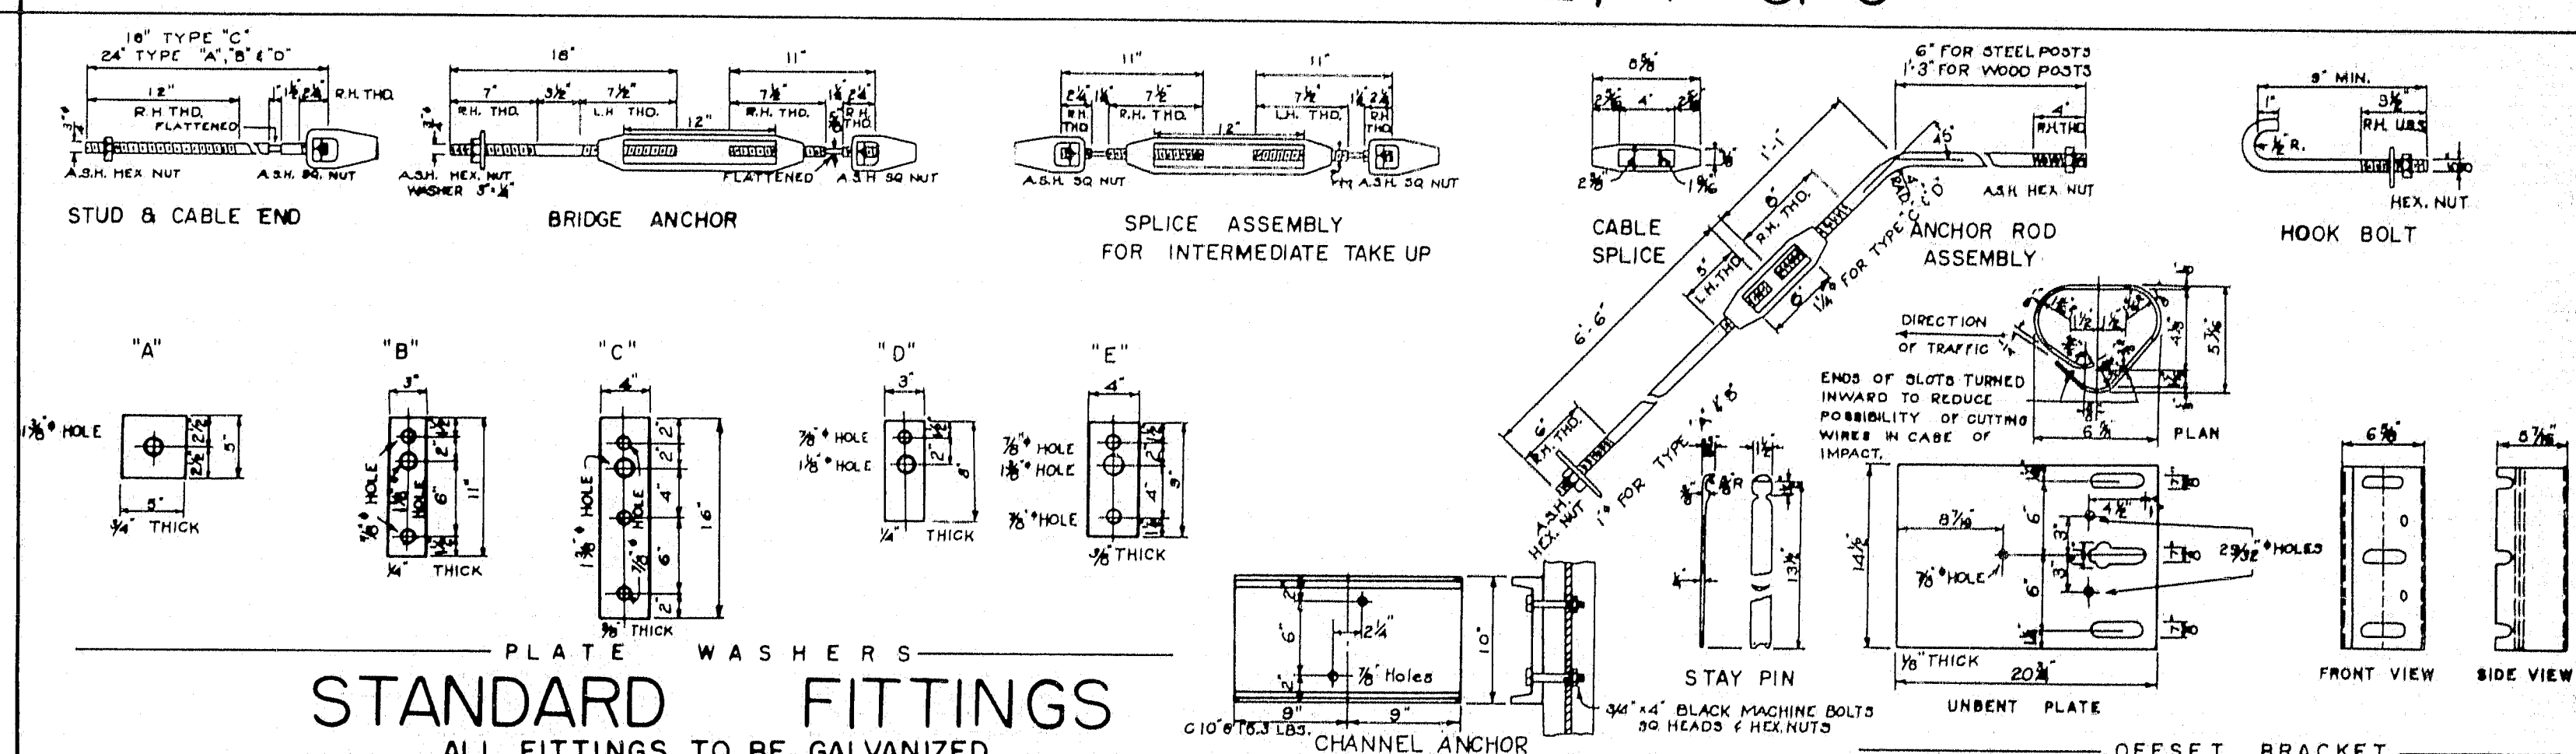


STANDARD FITTINGS  
ALL FITTINGS TO BE GALVANIZED

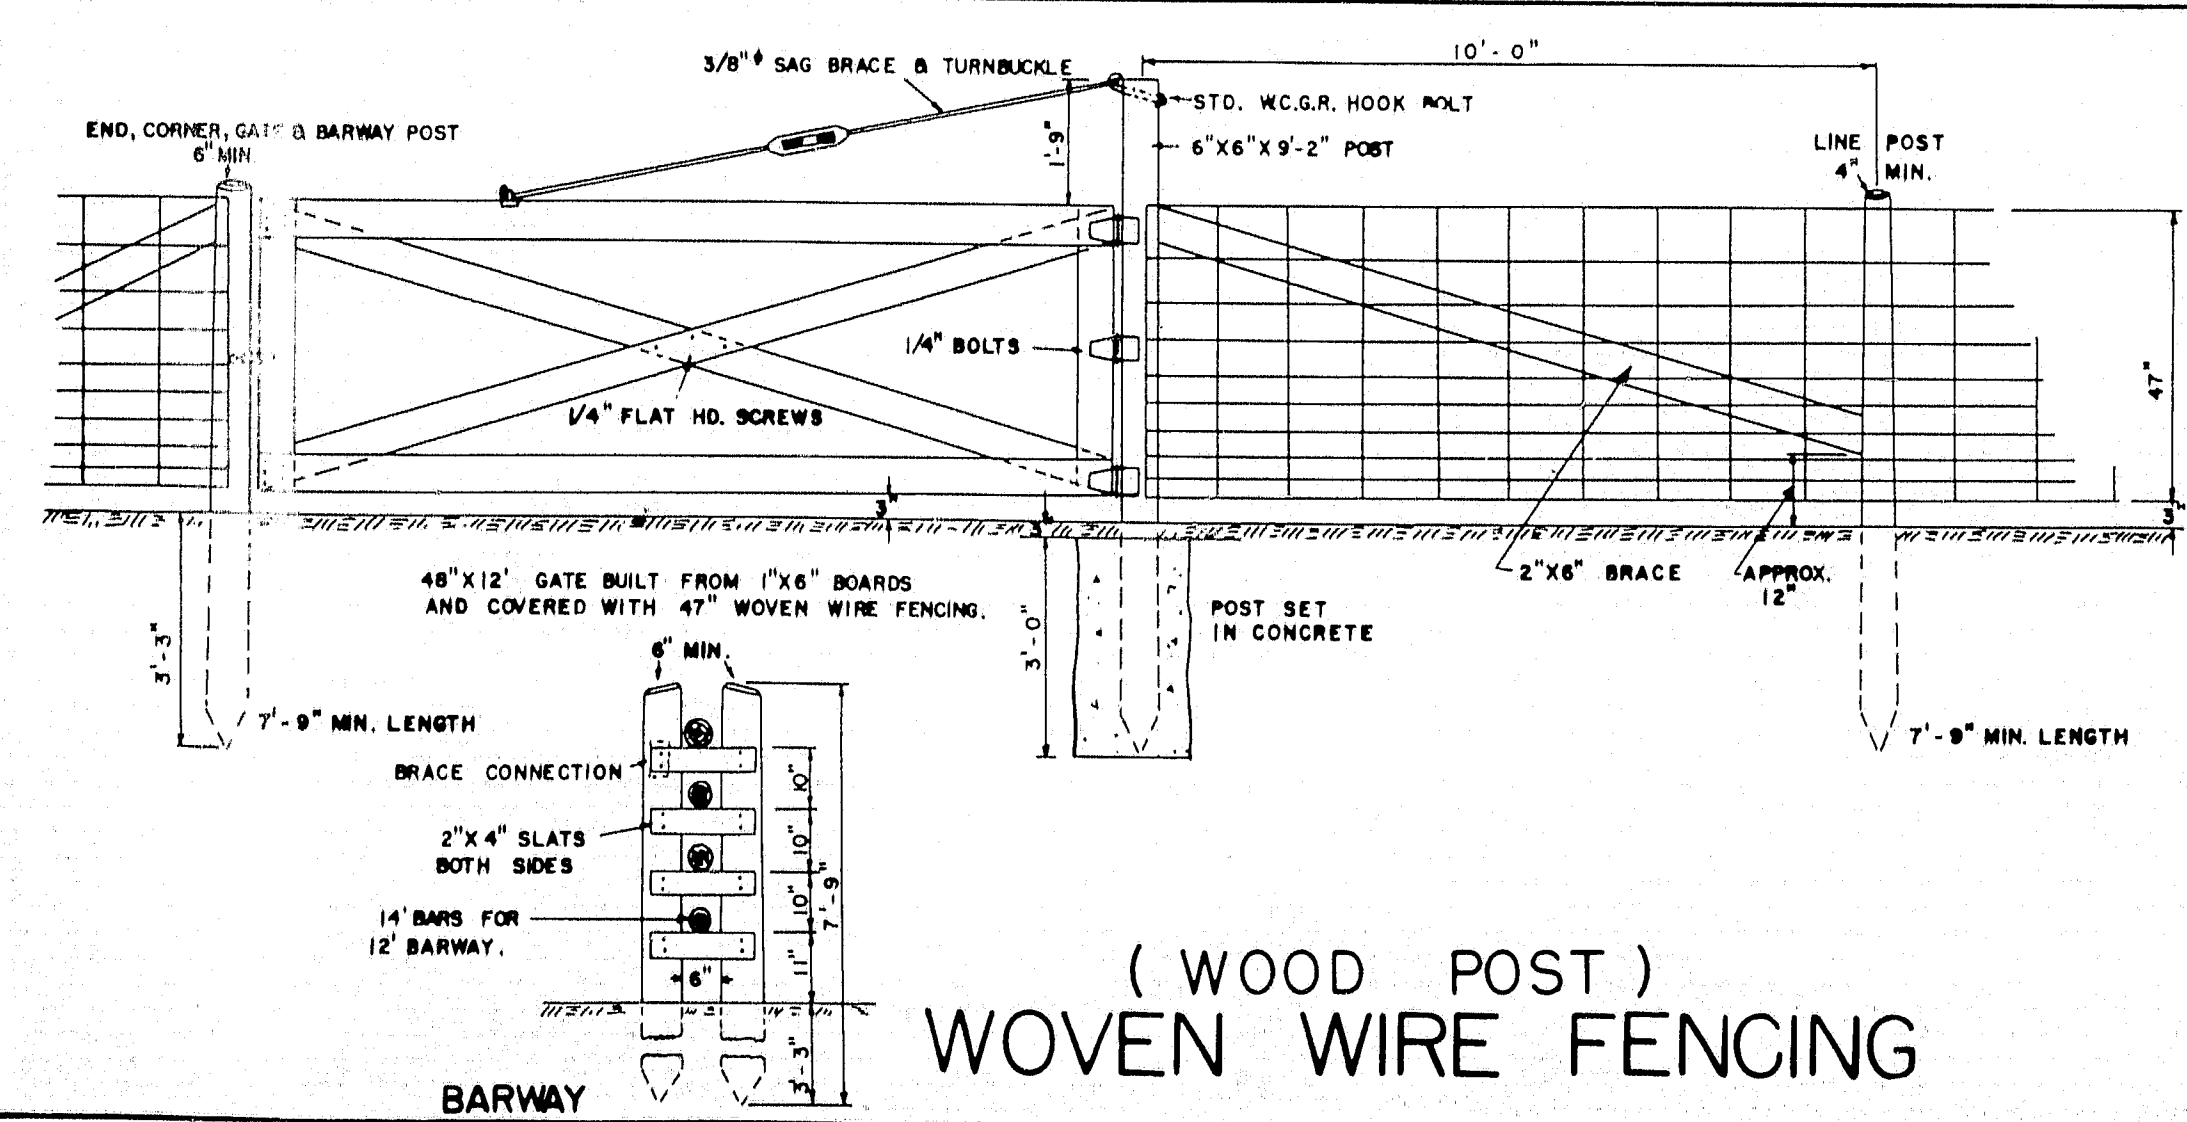

(WOOD POST)  
WOVEN WIRE FENCING

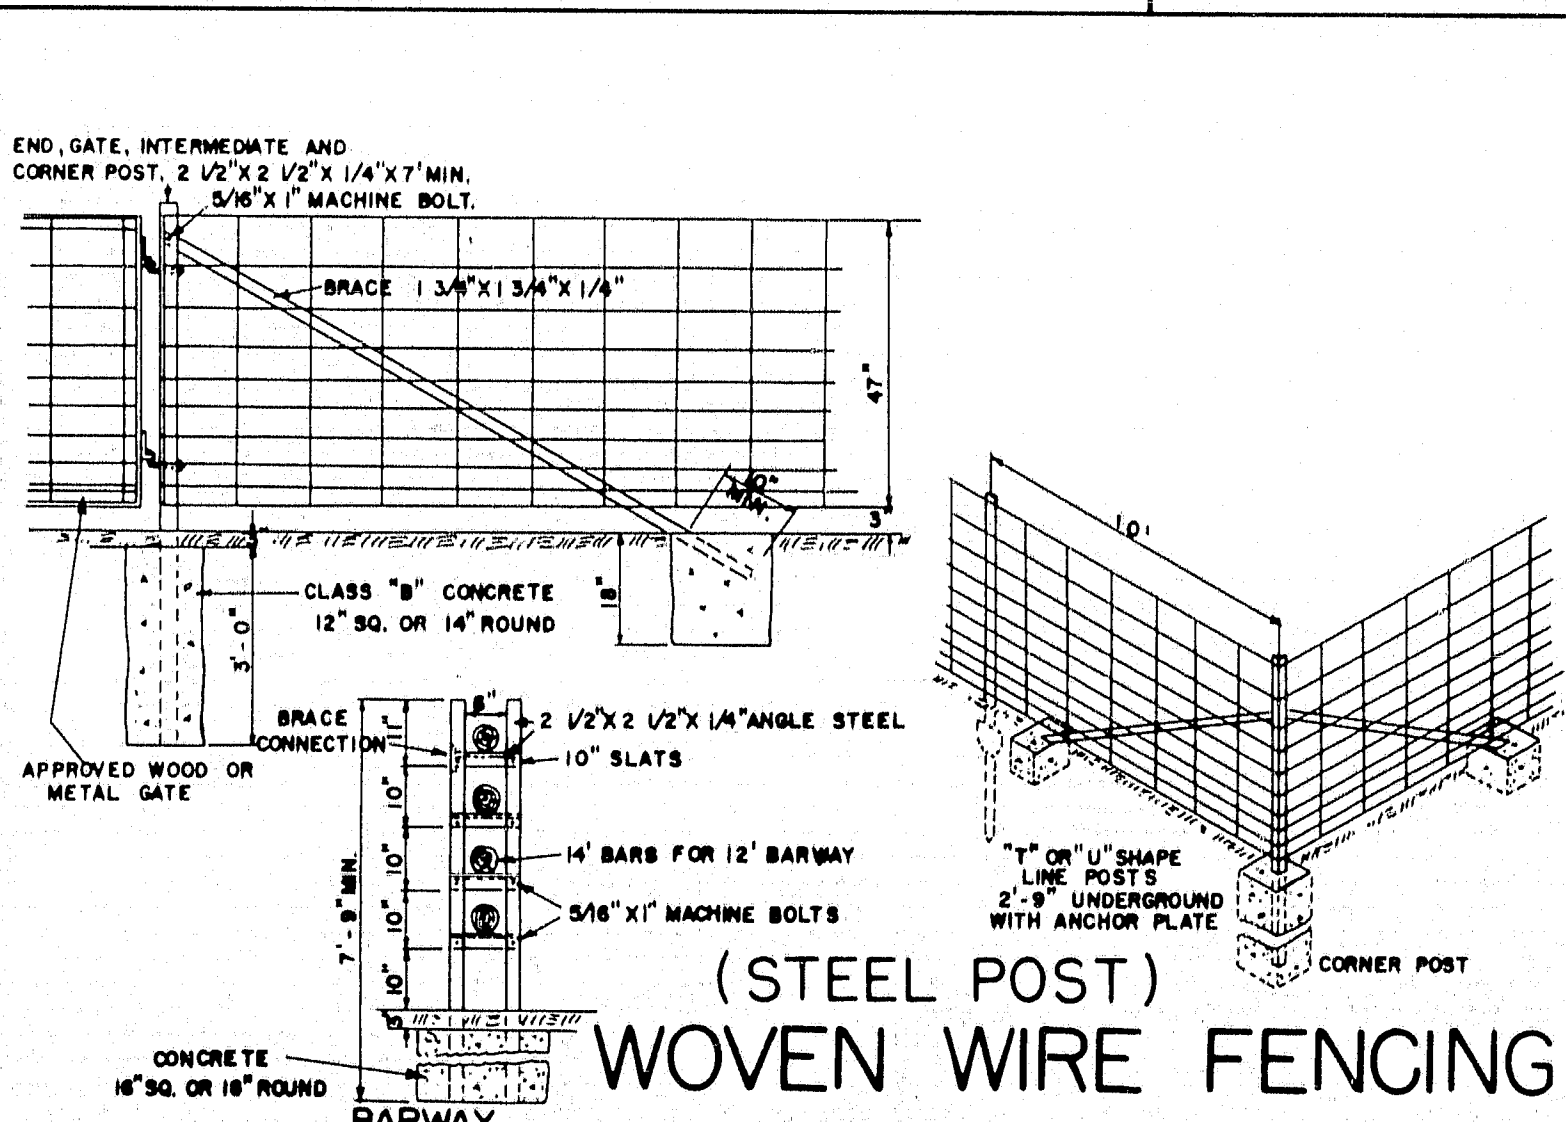

(STEEL POST)  
WOVEN WIRE FENCING

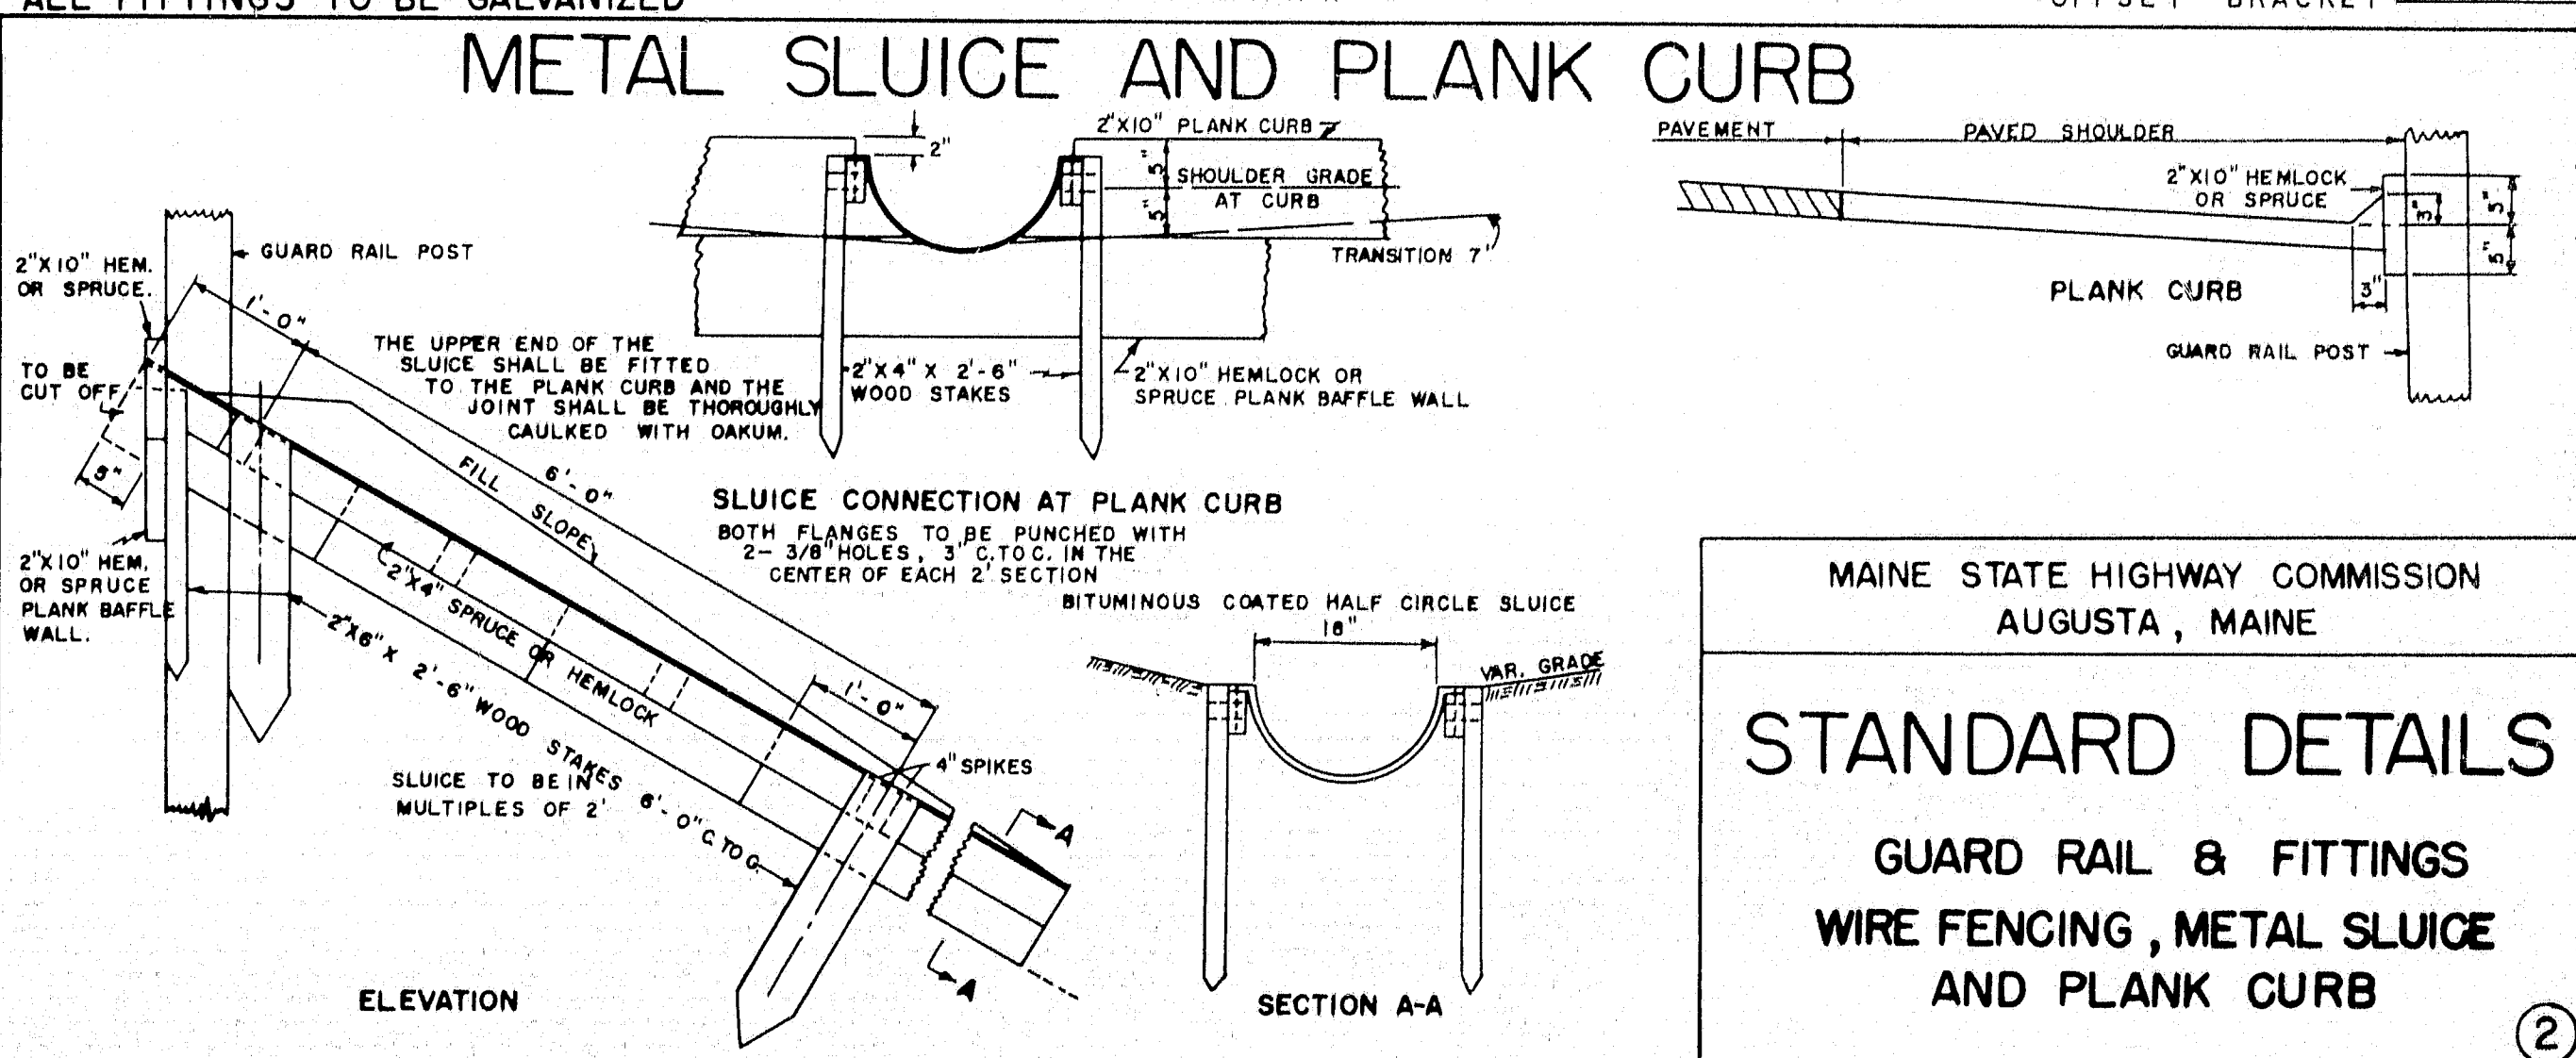

METAL SLUICE AND PLANK CURB


MAINE STATE HIGHWAY COMMISSION  
AUGUSTA, MAINE

**STANDARD DETAILS**

GUARD RAIL & FITTINGS  
WIRE FENCING, METAL SLUICE  
AND PLANK CURB




## PIPE CONNECTIONS

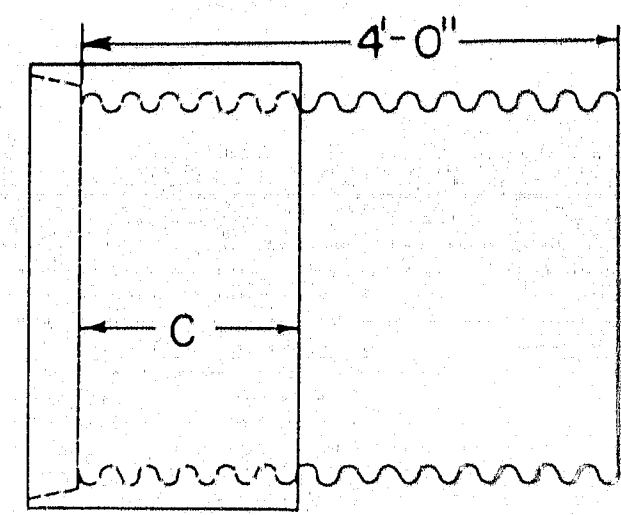

GROOVE END COMBINATION  
For 30" to 72" inclusive, diameter connection  
between concrete and metal pipe

"C" = 17" min. for sizes 30" to 48" incl.  
"C" = 23" min. for sizes over 48"

Asphalt coated corrugated metal pipe  
shall conform to the latest  
standard specifications

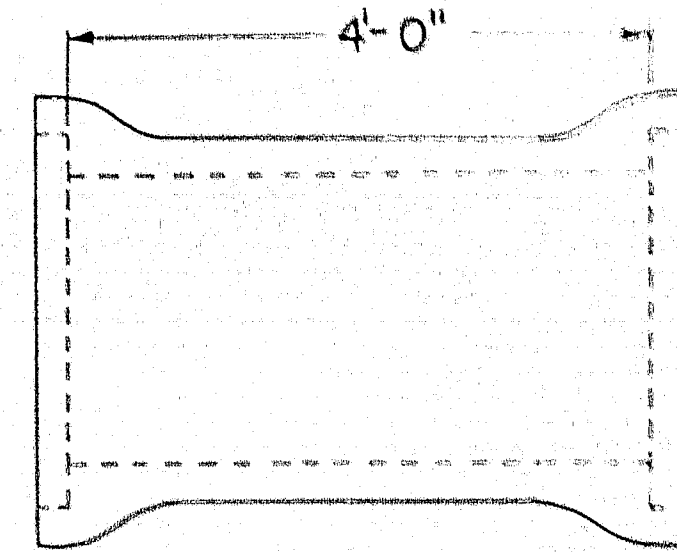


REINFORCED CONCRETE PIPE CONNECTOR  
DOUBLE BELL

For 12" to 24" inclusive, diameter connection  
between concrete and metal pipe


Reinforced concrete pipe shall  
conform to the latest standard  
specifications

## RIGHT OF WAY MONUMENTS & PROJECT MARKERS

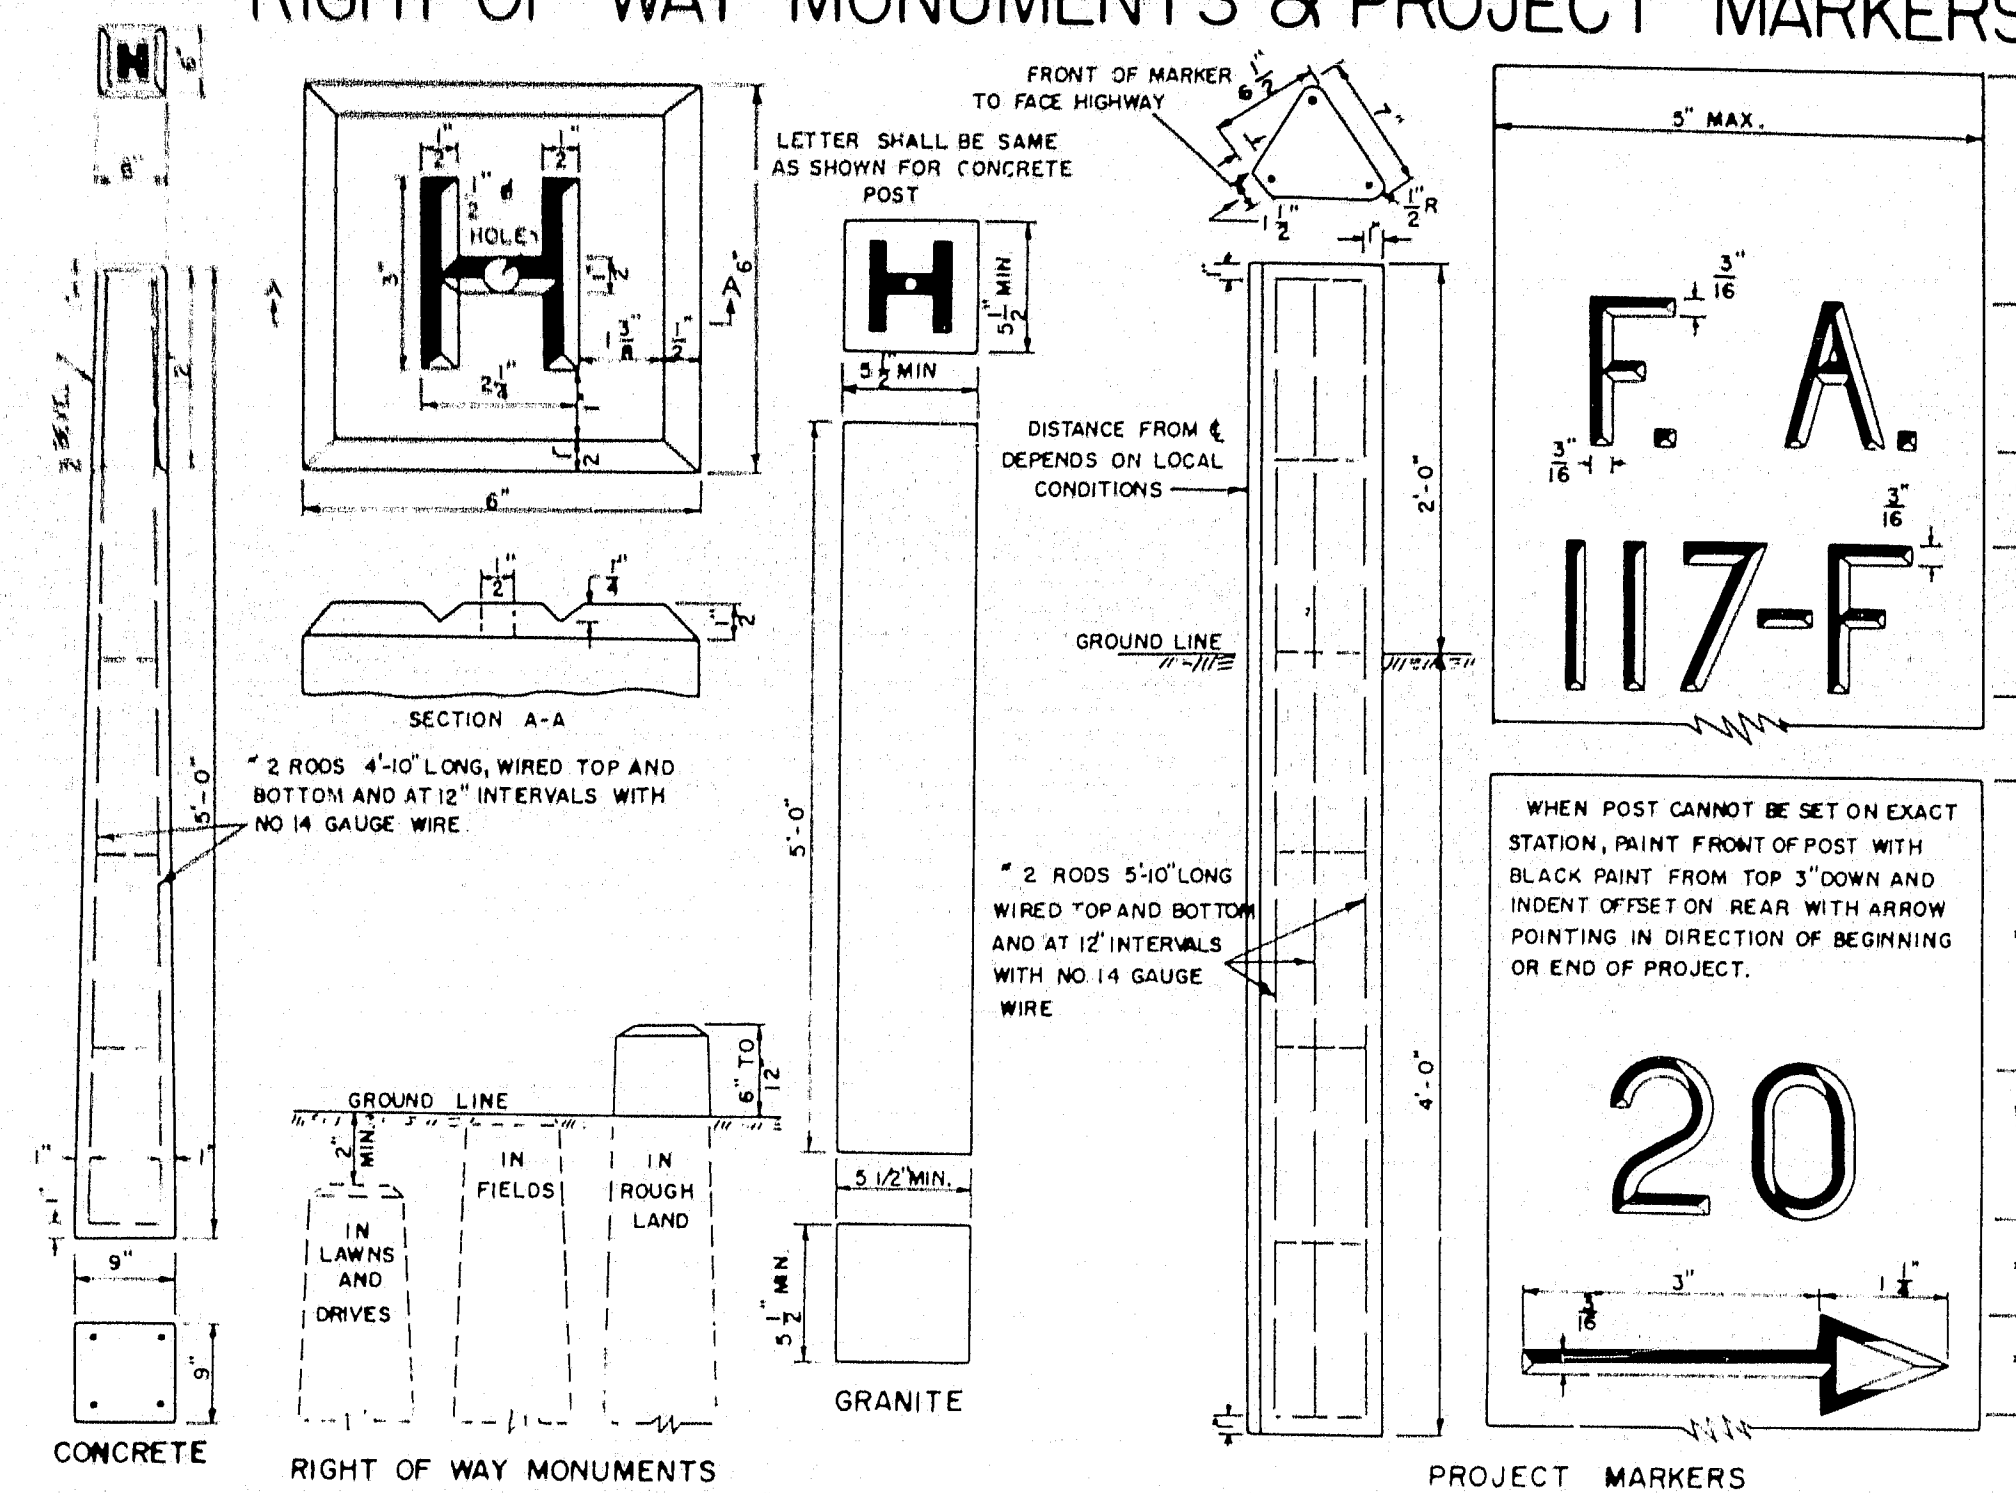


## GRANITE CURB & EDGING

B. P. R.	STATE	PROJECT NO.	SHEET NO.	TOTAL SHEETS
1	MAINE	1-95-B(6)	6	35

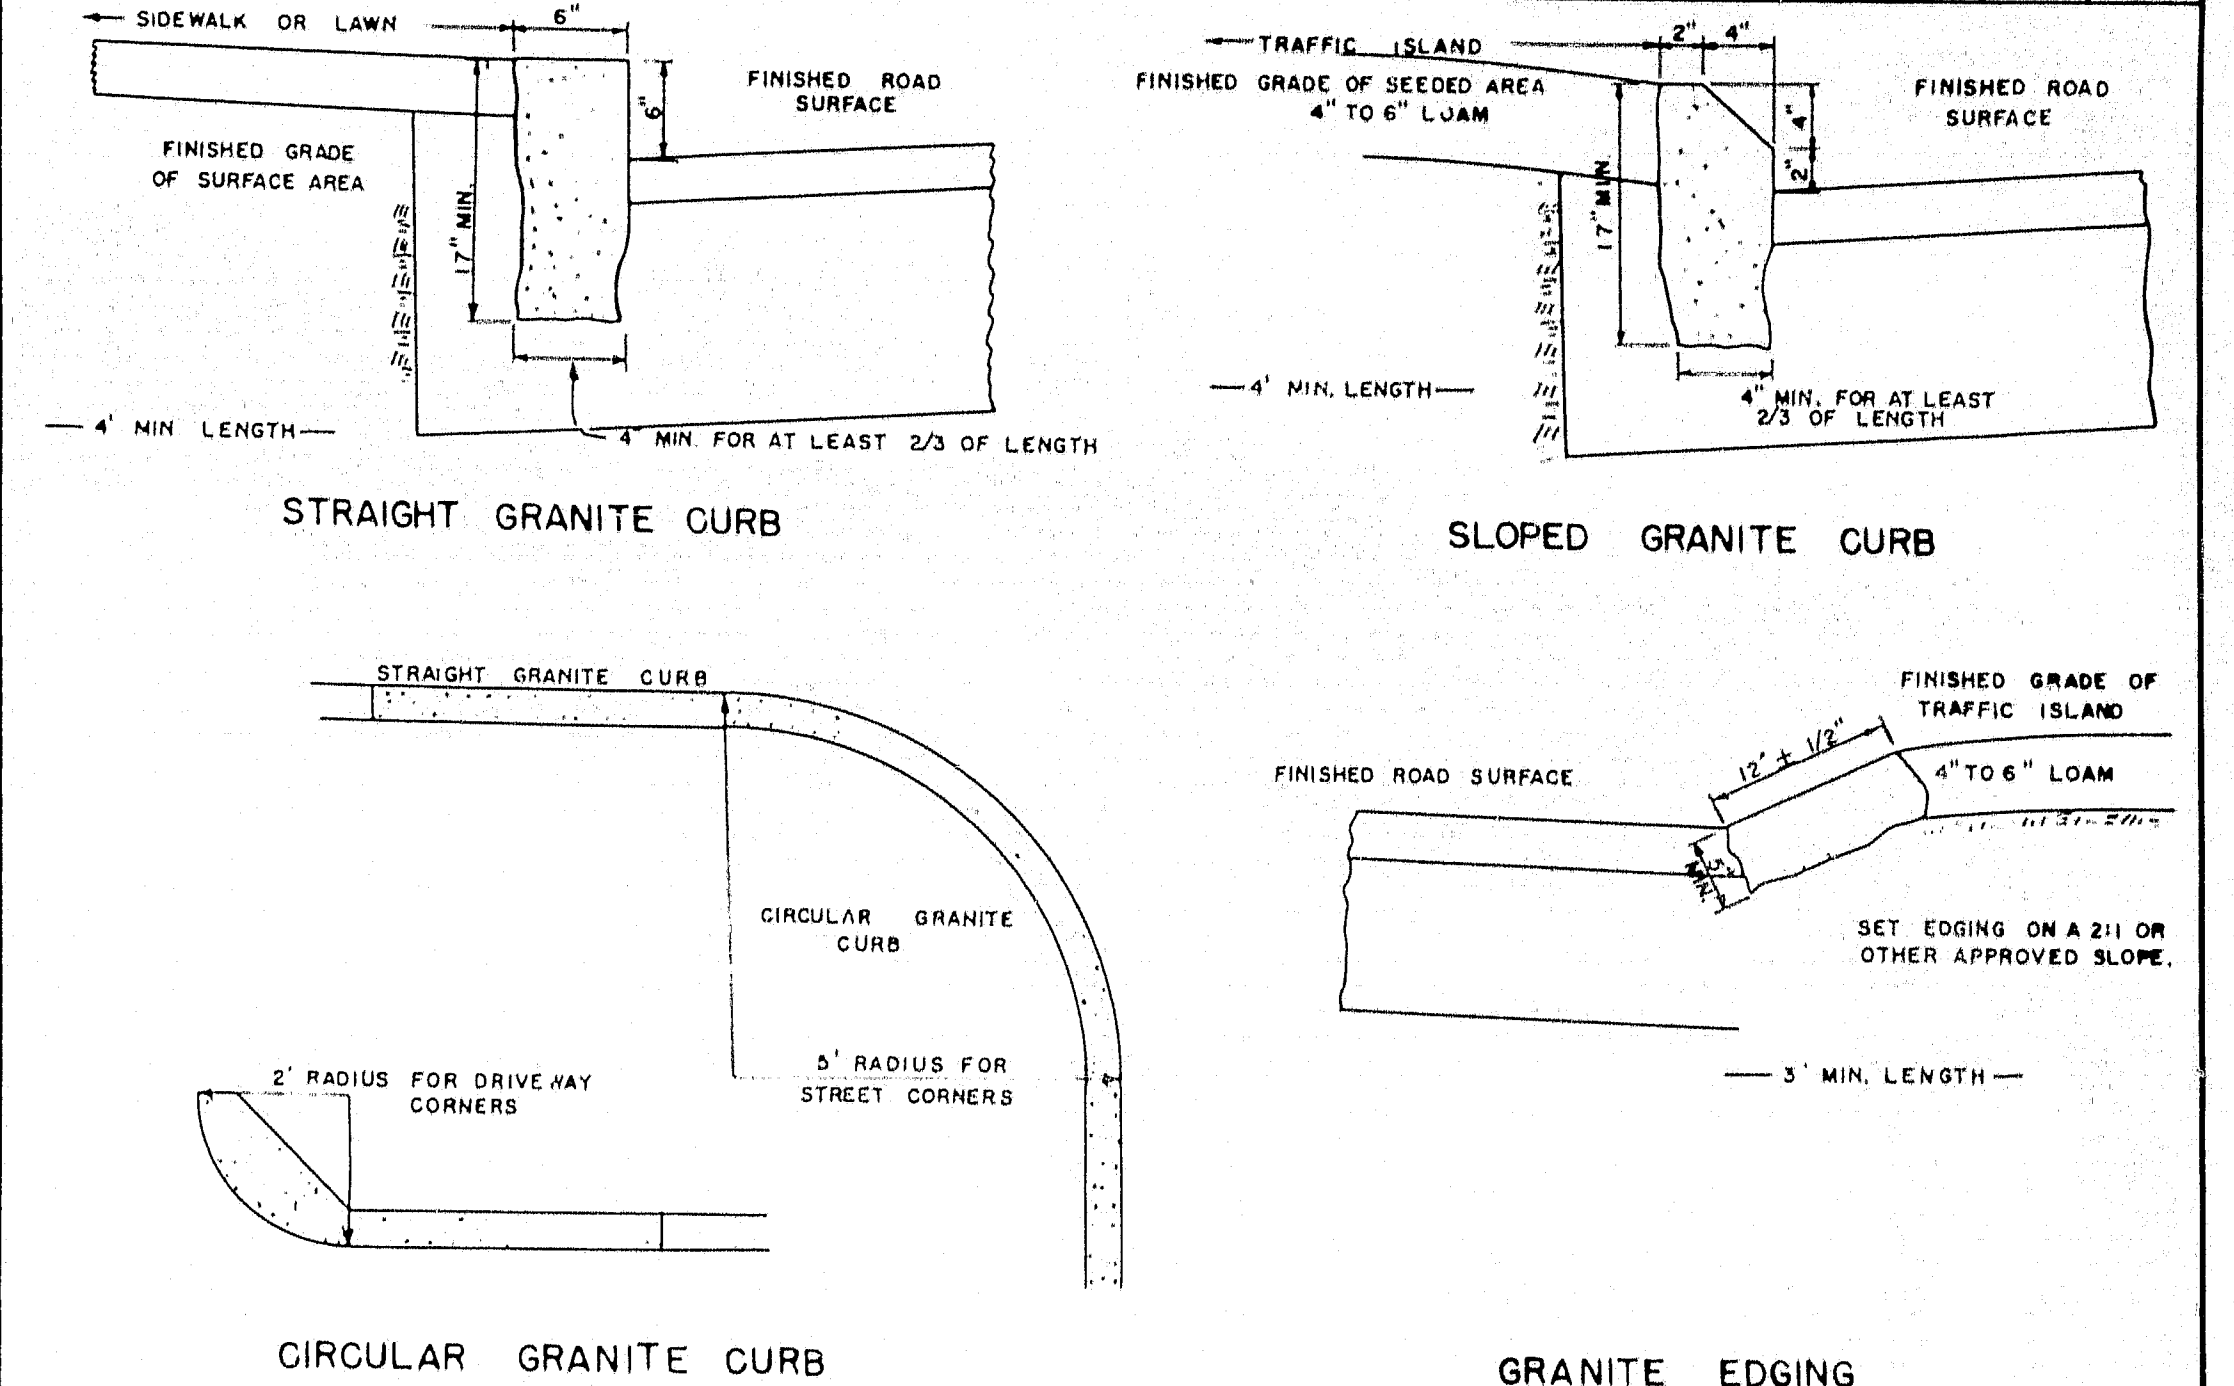


## CONCRETE STEPS

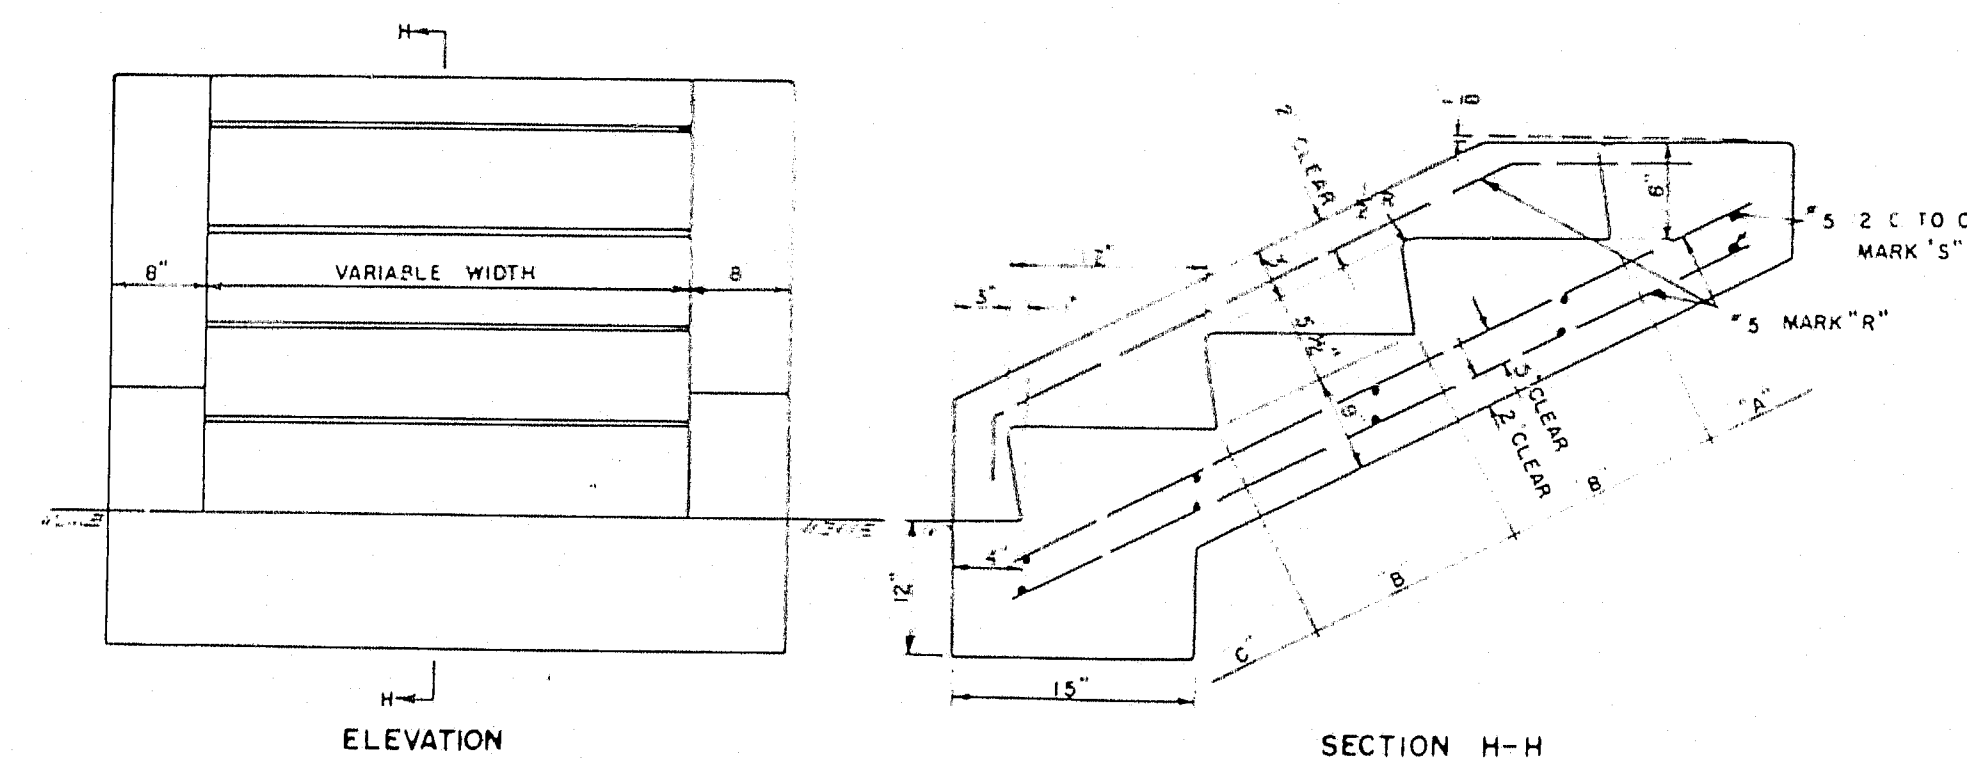


CONCRETE CLASS "A"		
SECTION	STEPS	PARAPET EACH WALL
"A" HEADER	032 CU. YDS	022 CU. YDS
"B" 1A INTER ST.	040 CU. YDS	040 CU. YDS
"C" FOOTER	071 CU. YDS	065 CU. YDS

REINFORCING STEEL			
MARK	SIZE	NUMBER	LENGTH (EACH)
R	"5	3 EACH PARAPET	"8" FOR "A"
		1043 LBS PER FT.	"13" FOR EACH "B"
		2 EACH FT. OF WIDTH	"16" FOR "C"
S	"5	2 FOR "A"	6 EACH PARAPET
		2 FOR EACH "B"	"12" PER FT. OF WIDTH
		4 FOR "C"	


## TREE WELLS

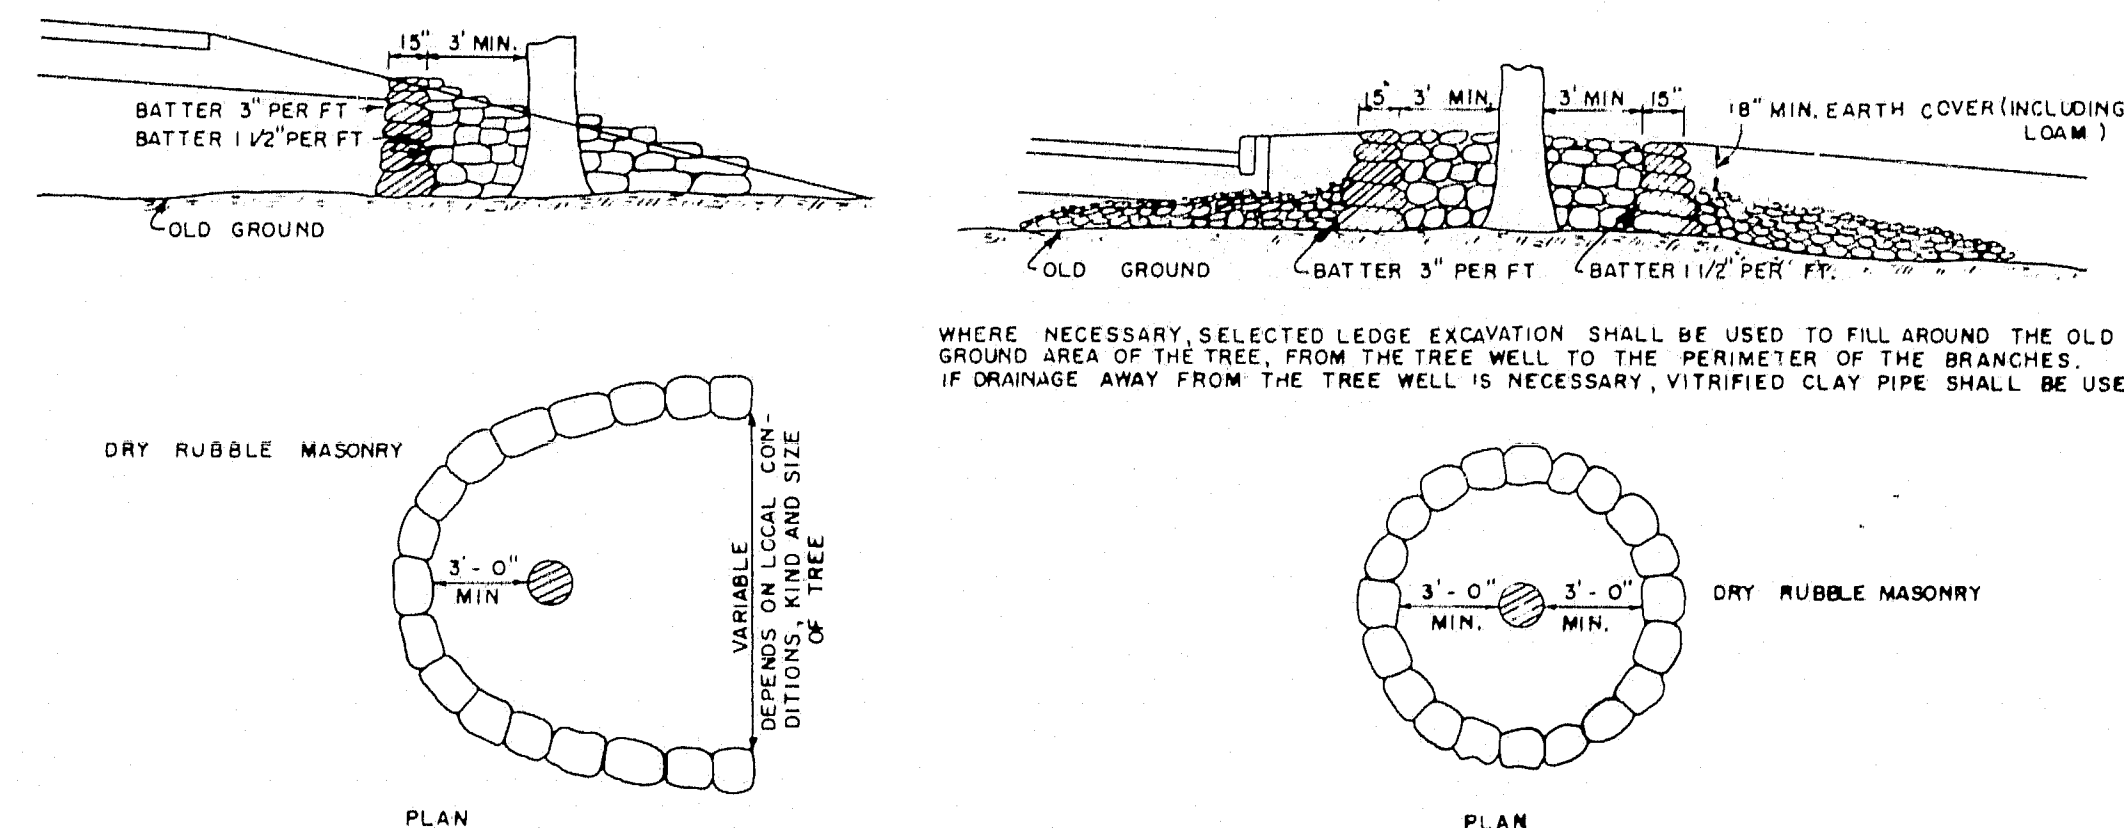


## STONE GUTTER

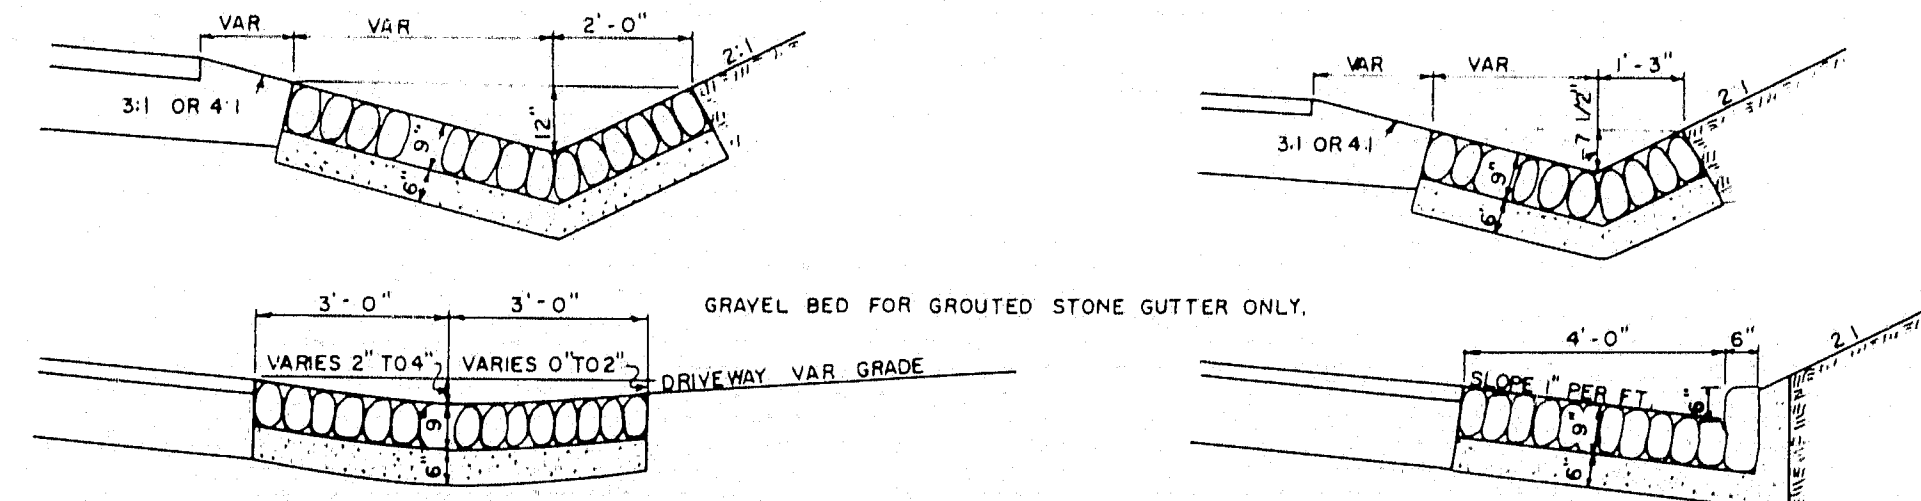


## CONCRETE CURB

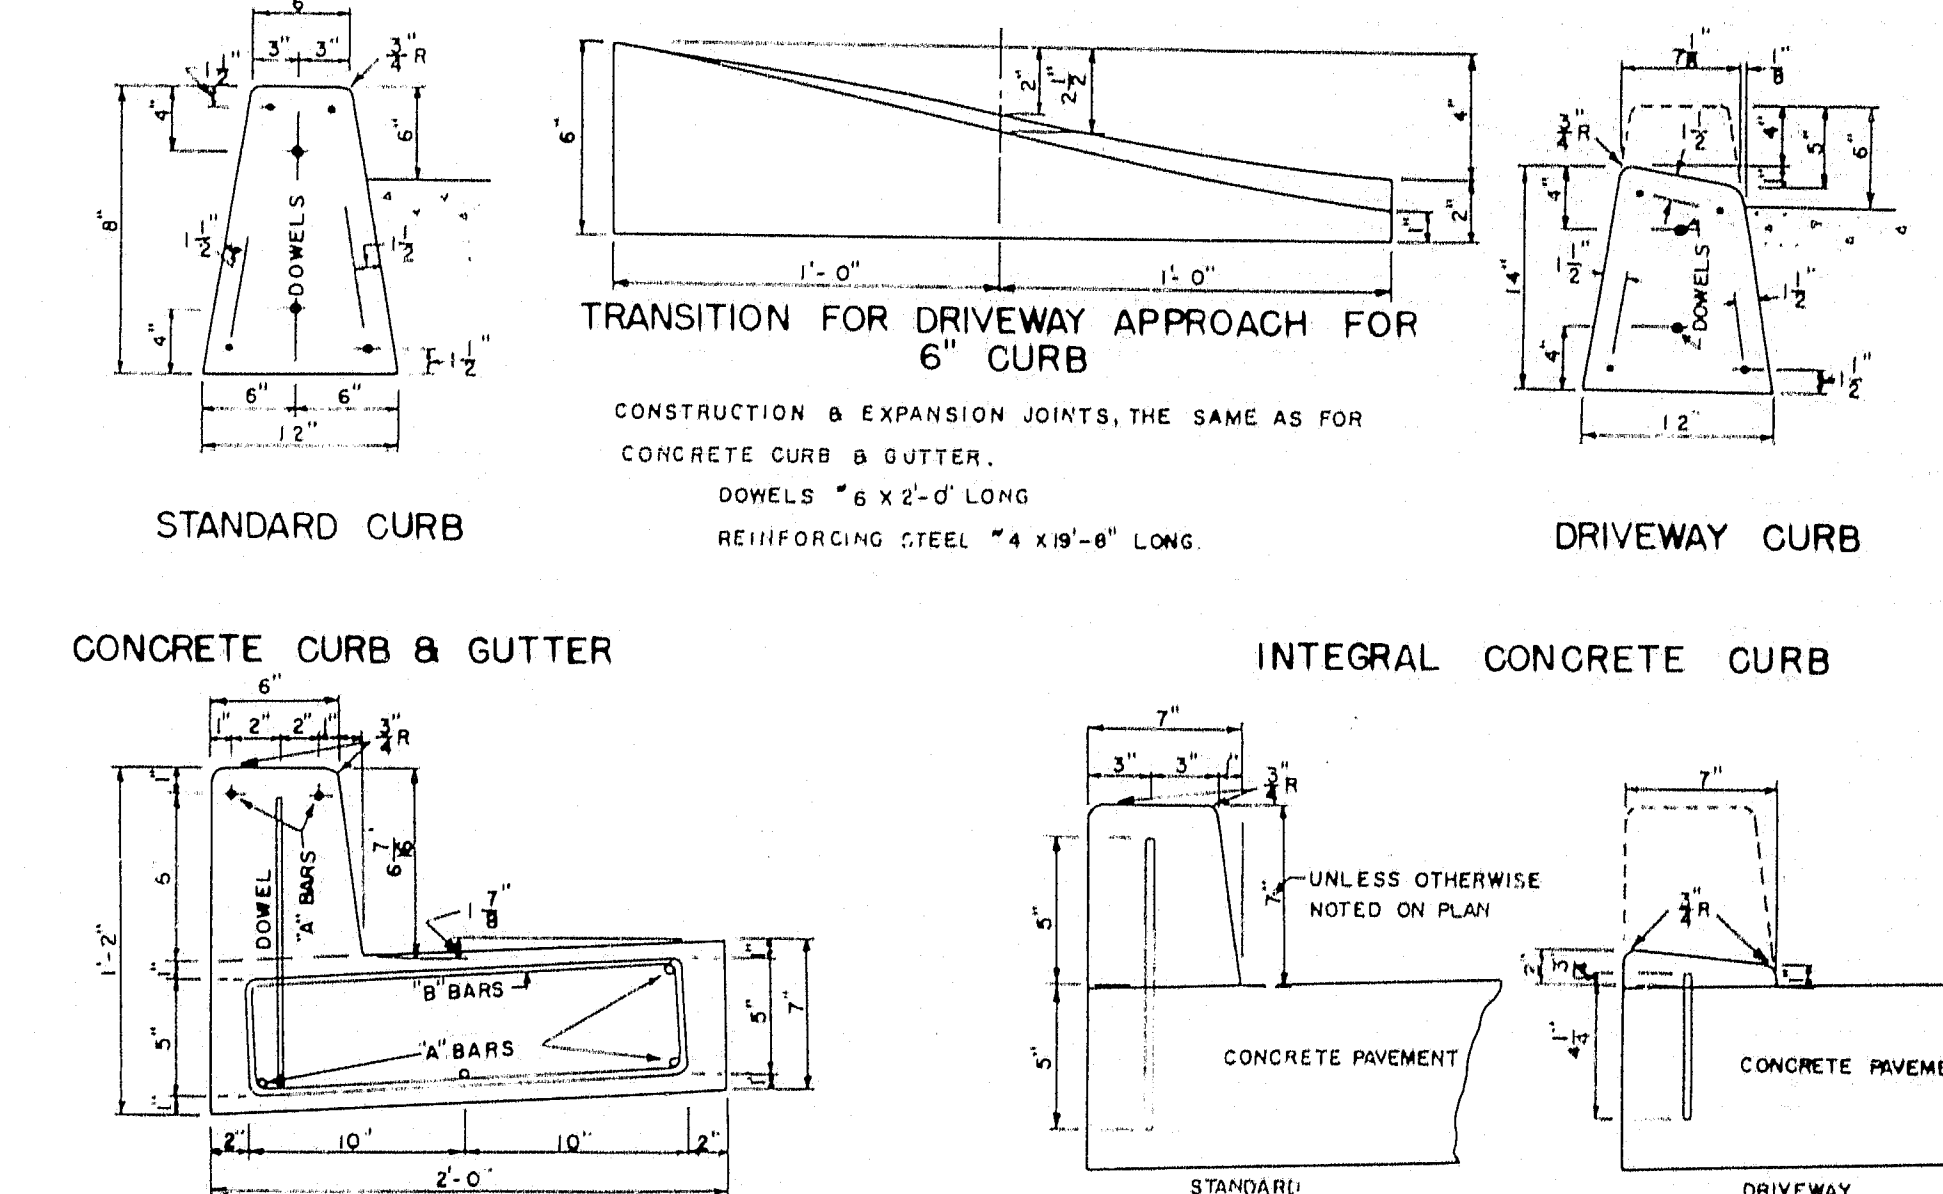


## CONCRETE PIPE CRADLE

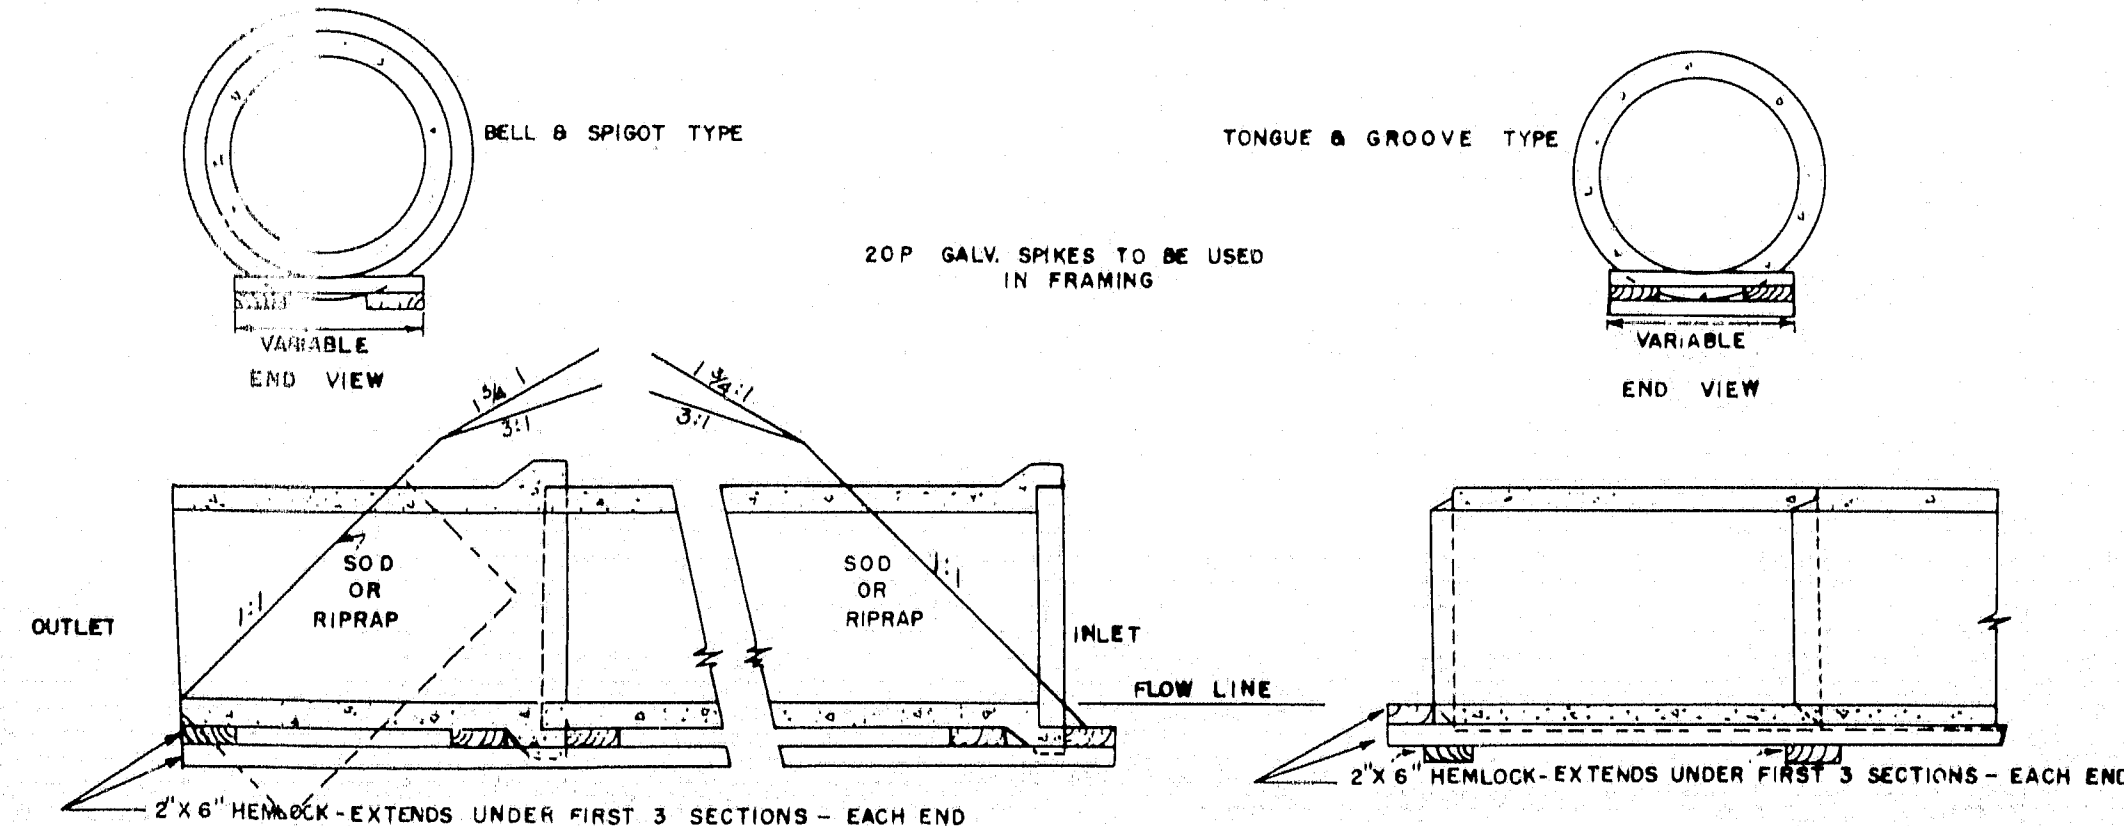


## SODDED GUTTER

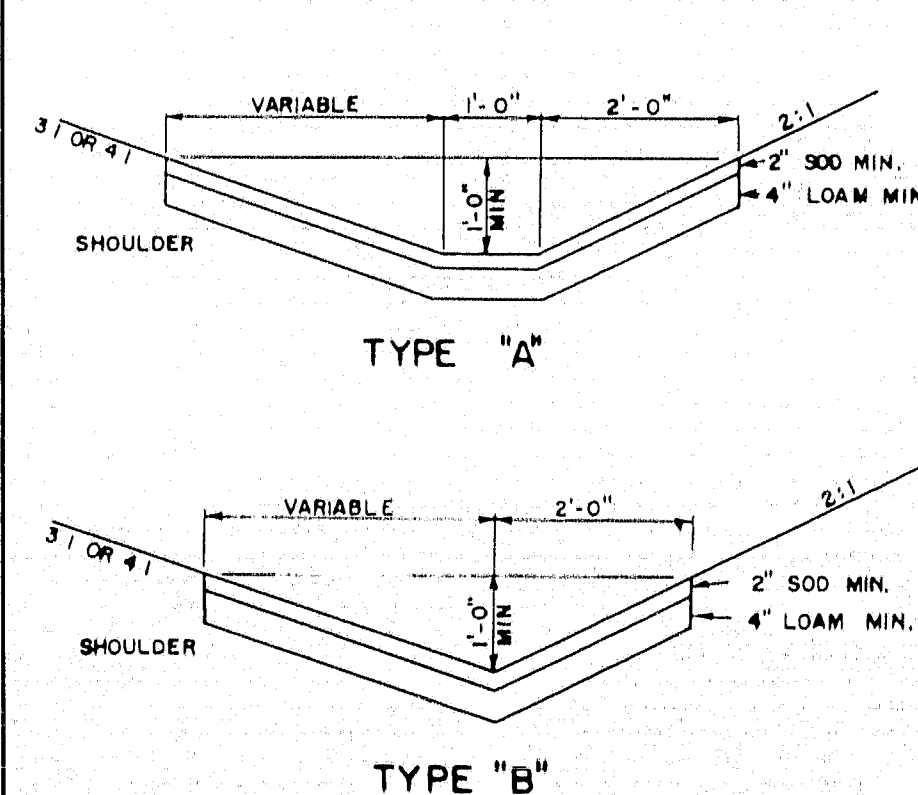

## FIELD STONE CURB

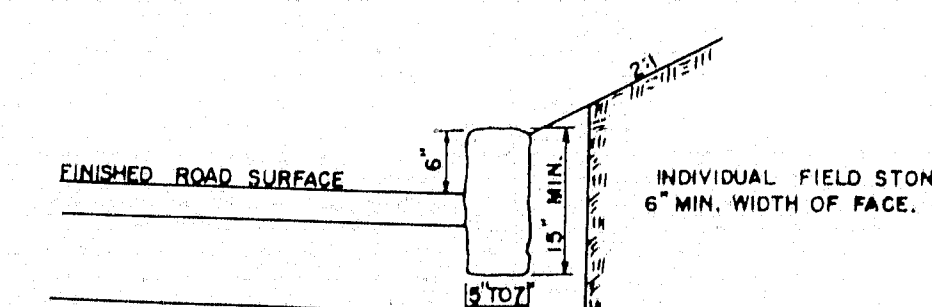

## CONCRETE COLLAR

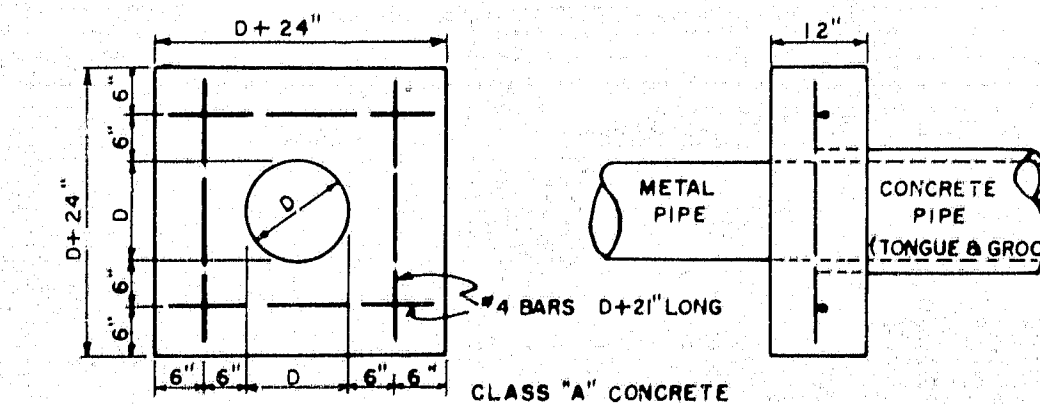


MAINE STATE HIGHWAY COMMISSION  
AUGUSTA, MAINE

STANDARD DETAILS  
MISCELLANEOUS ITEMS


3

78-6





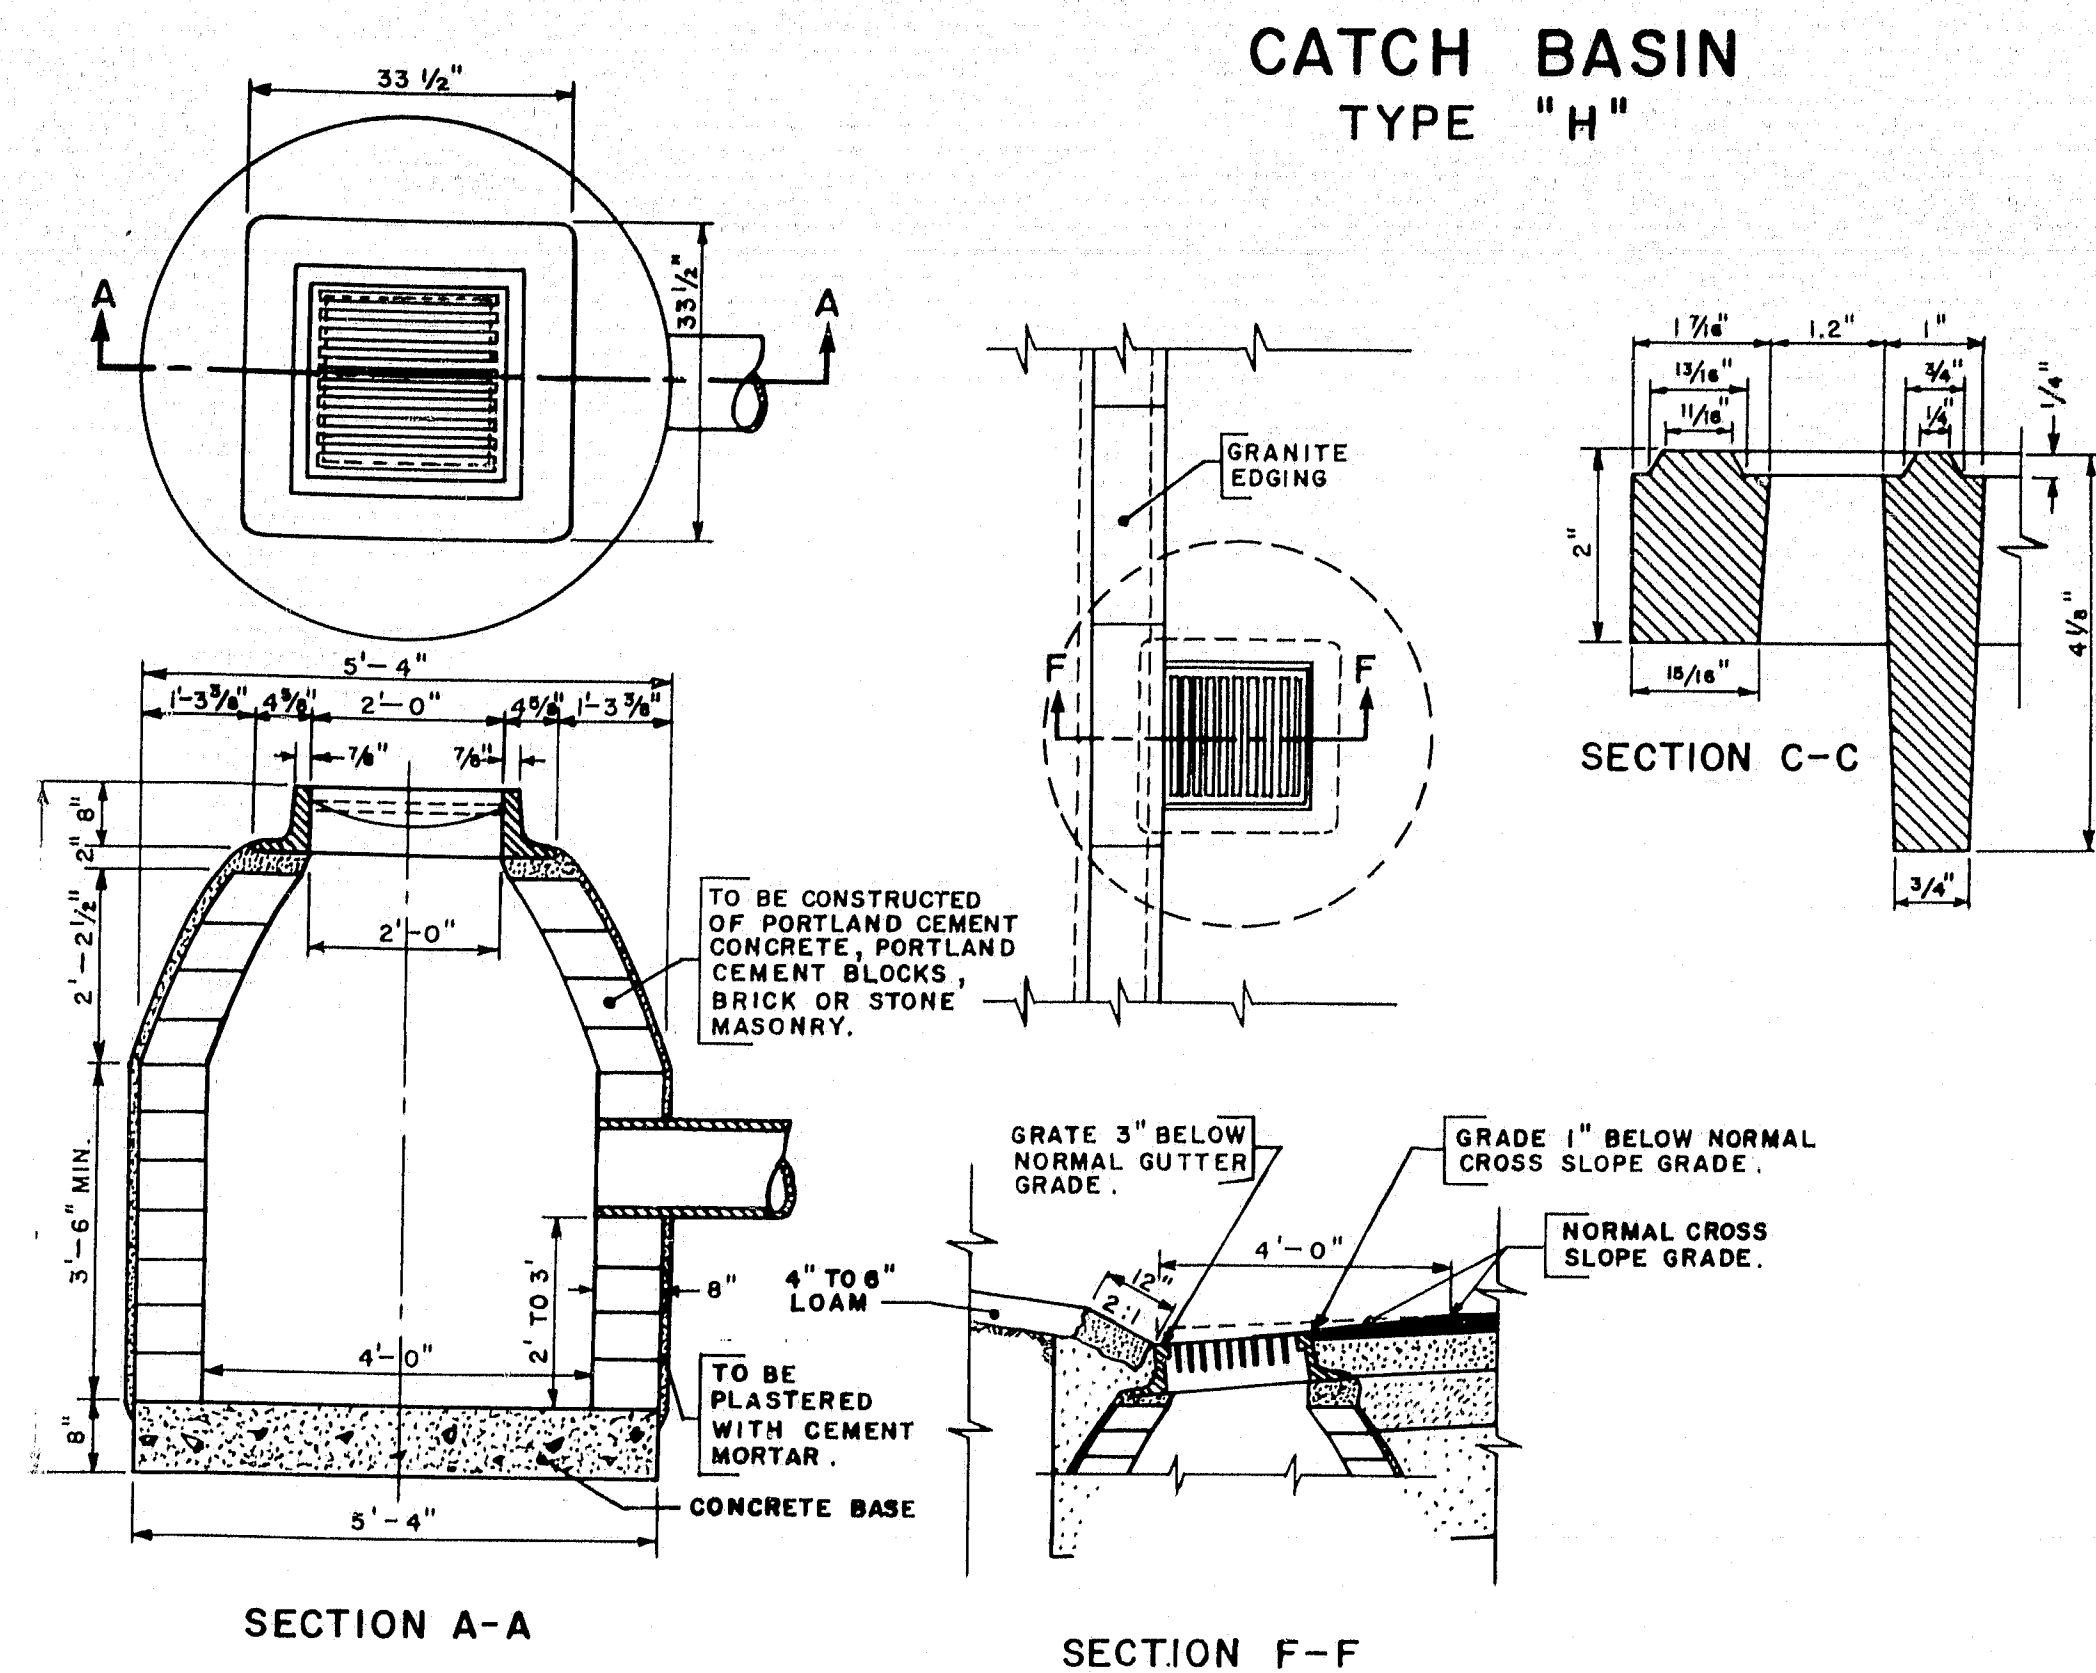


DETAIL OF CATCH BASIN  
IN GRANITE EDGING AREA

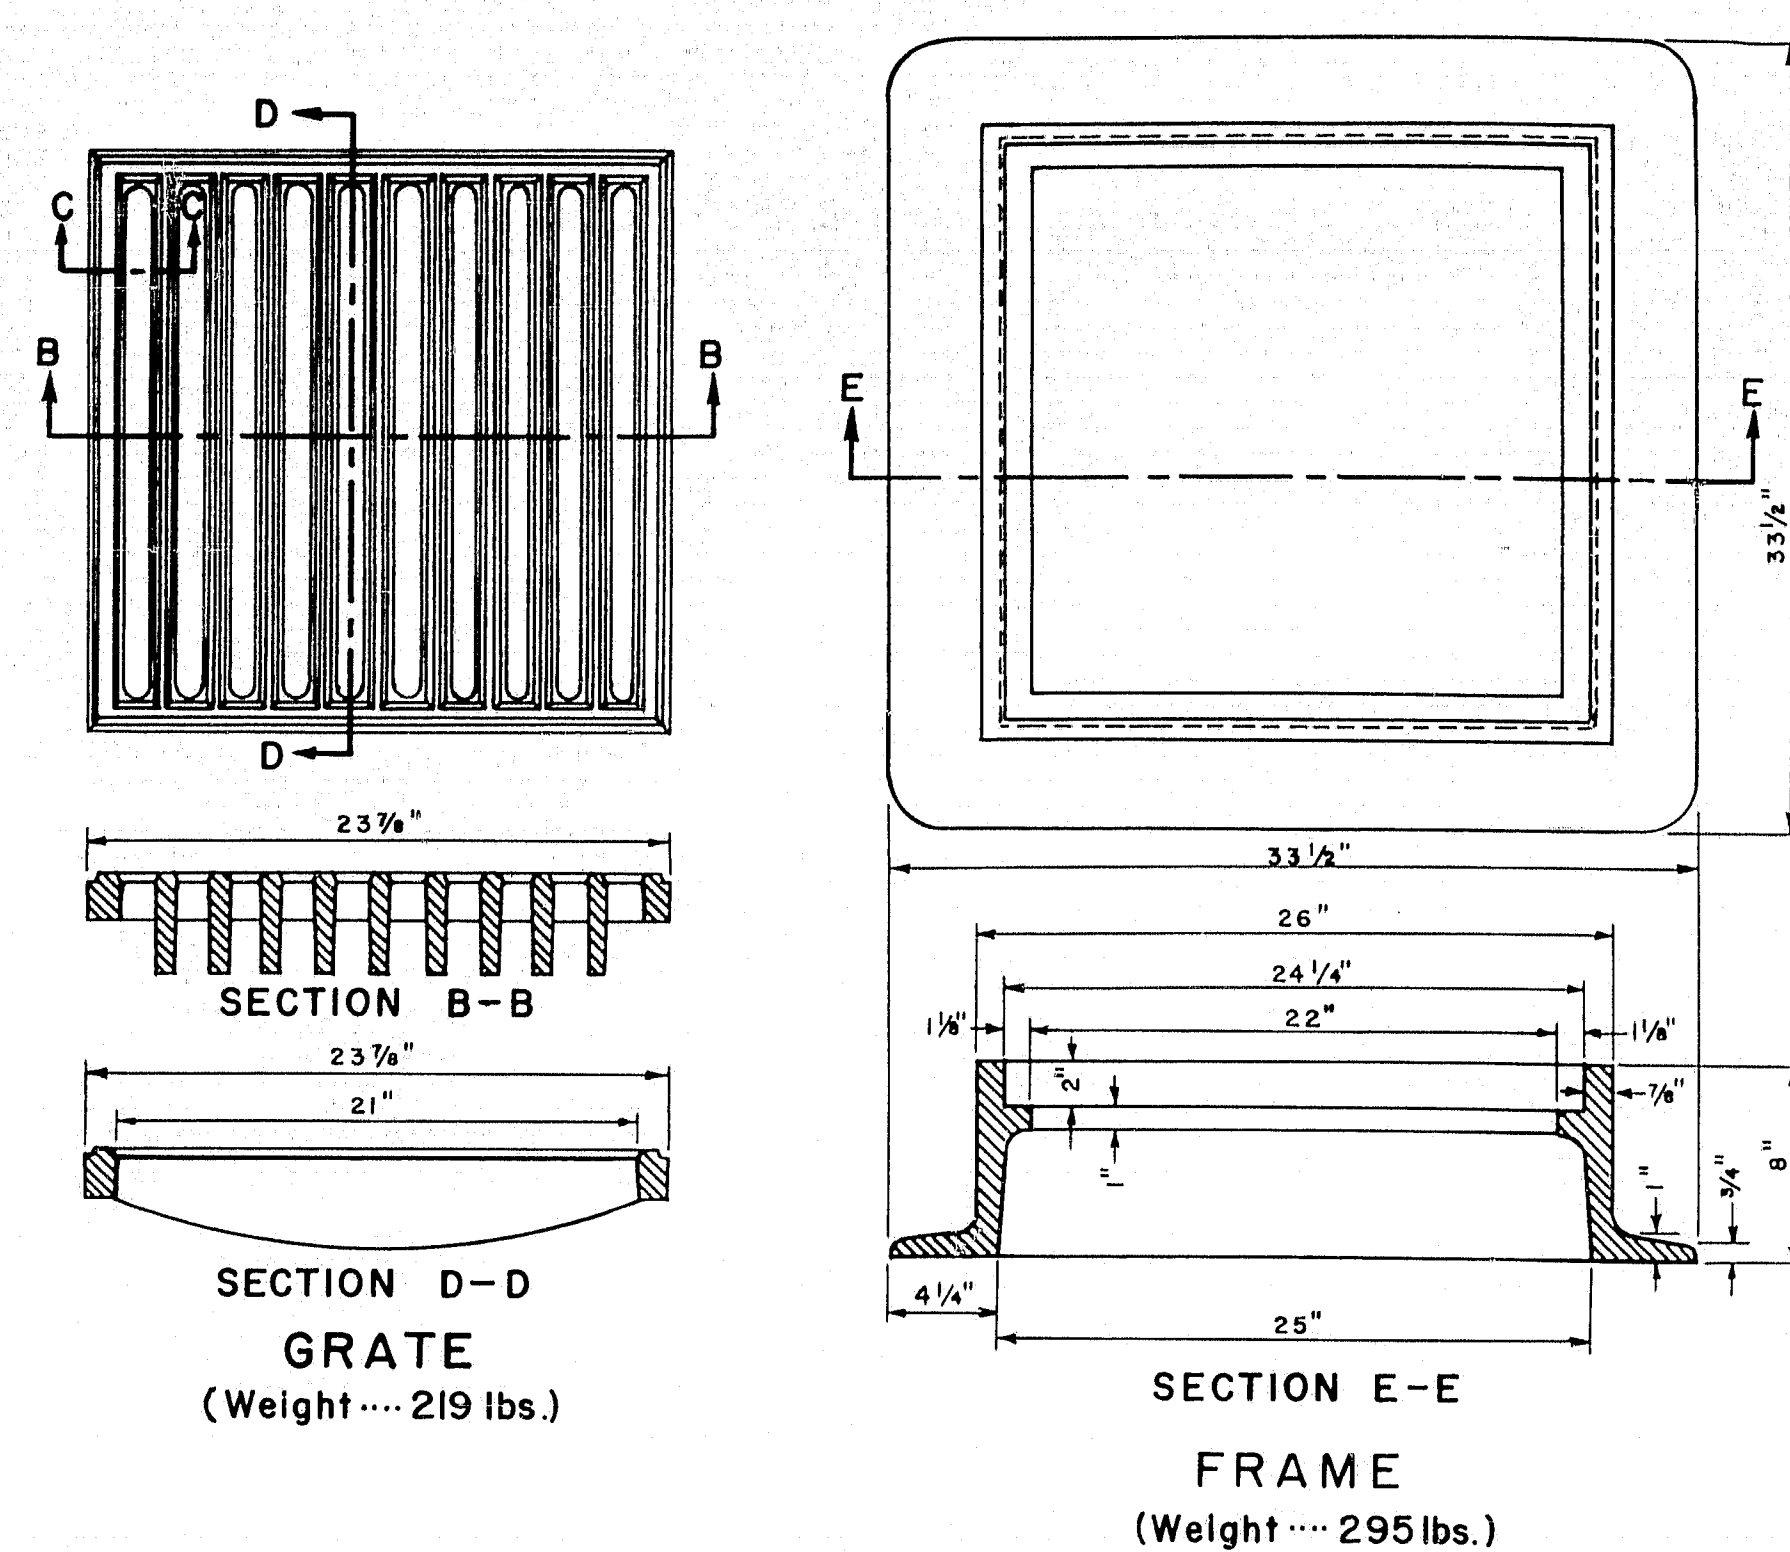

**Note:** TYPE "H" CATCH BASIN IS TO BE USED IN GRANITE EDGING AREA. (When this type of catch basin is used with sloped or straight curb, the curb on gutter line shall be cut to fit flange.)

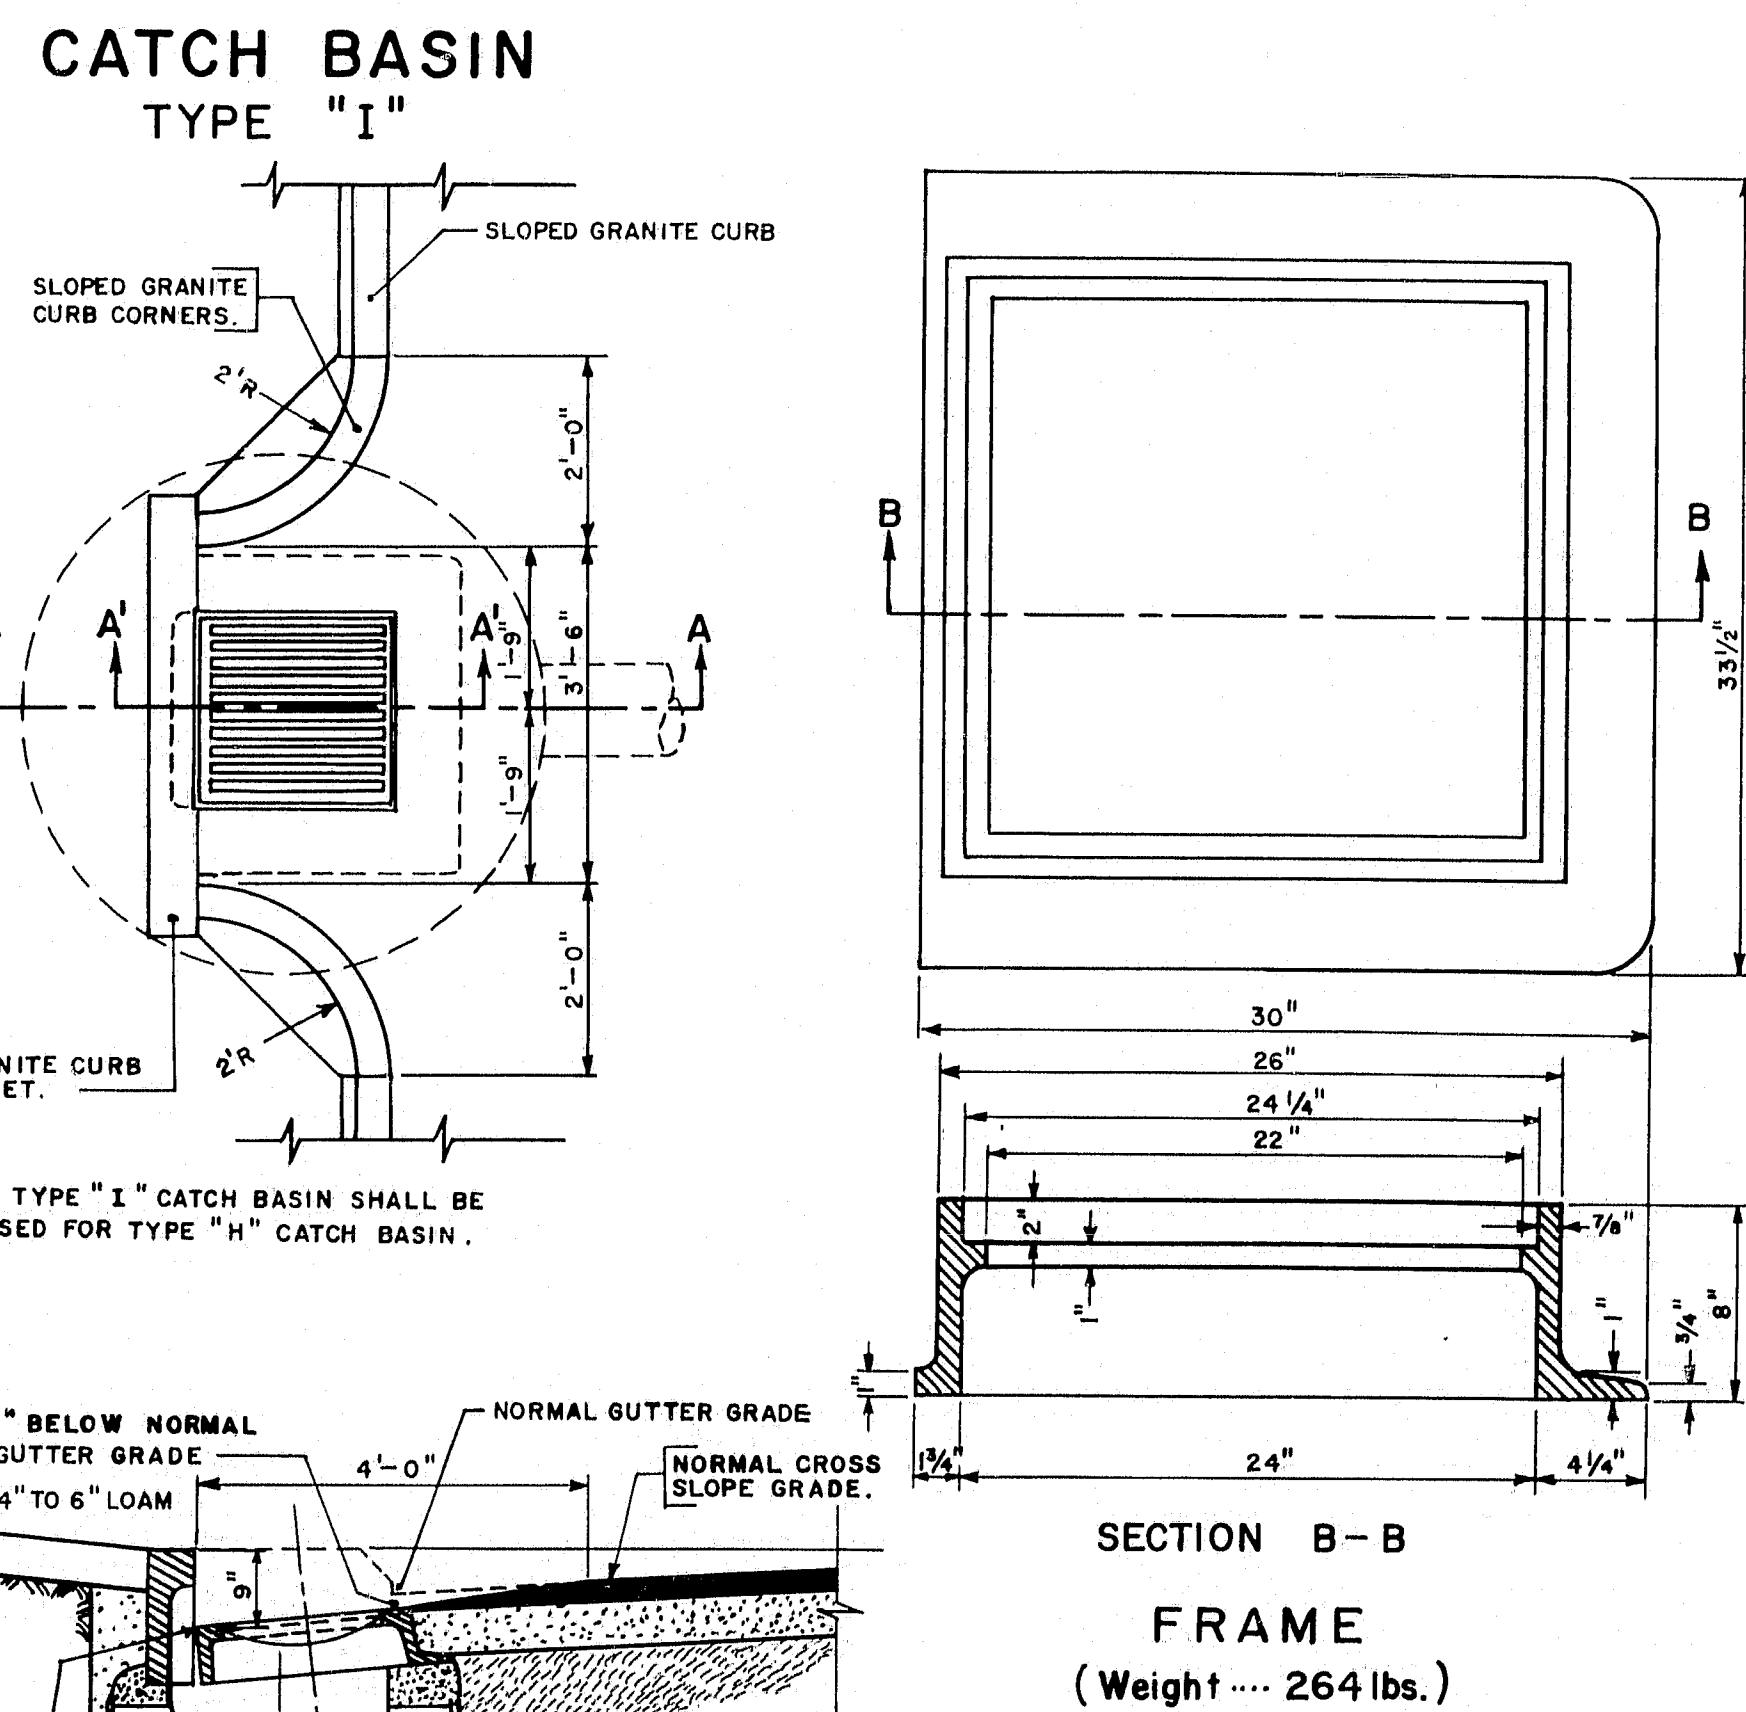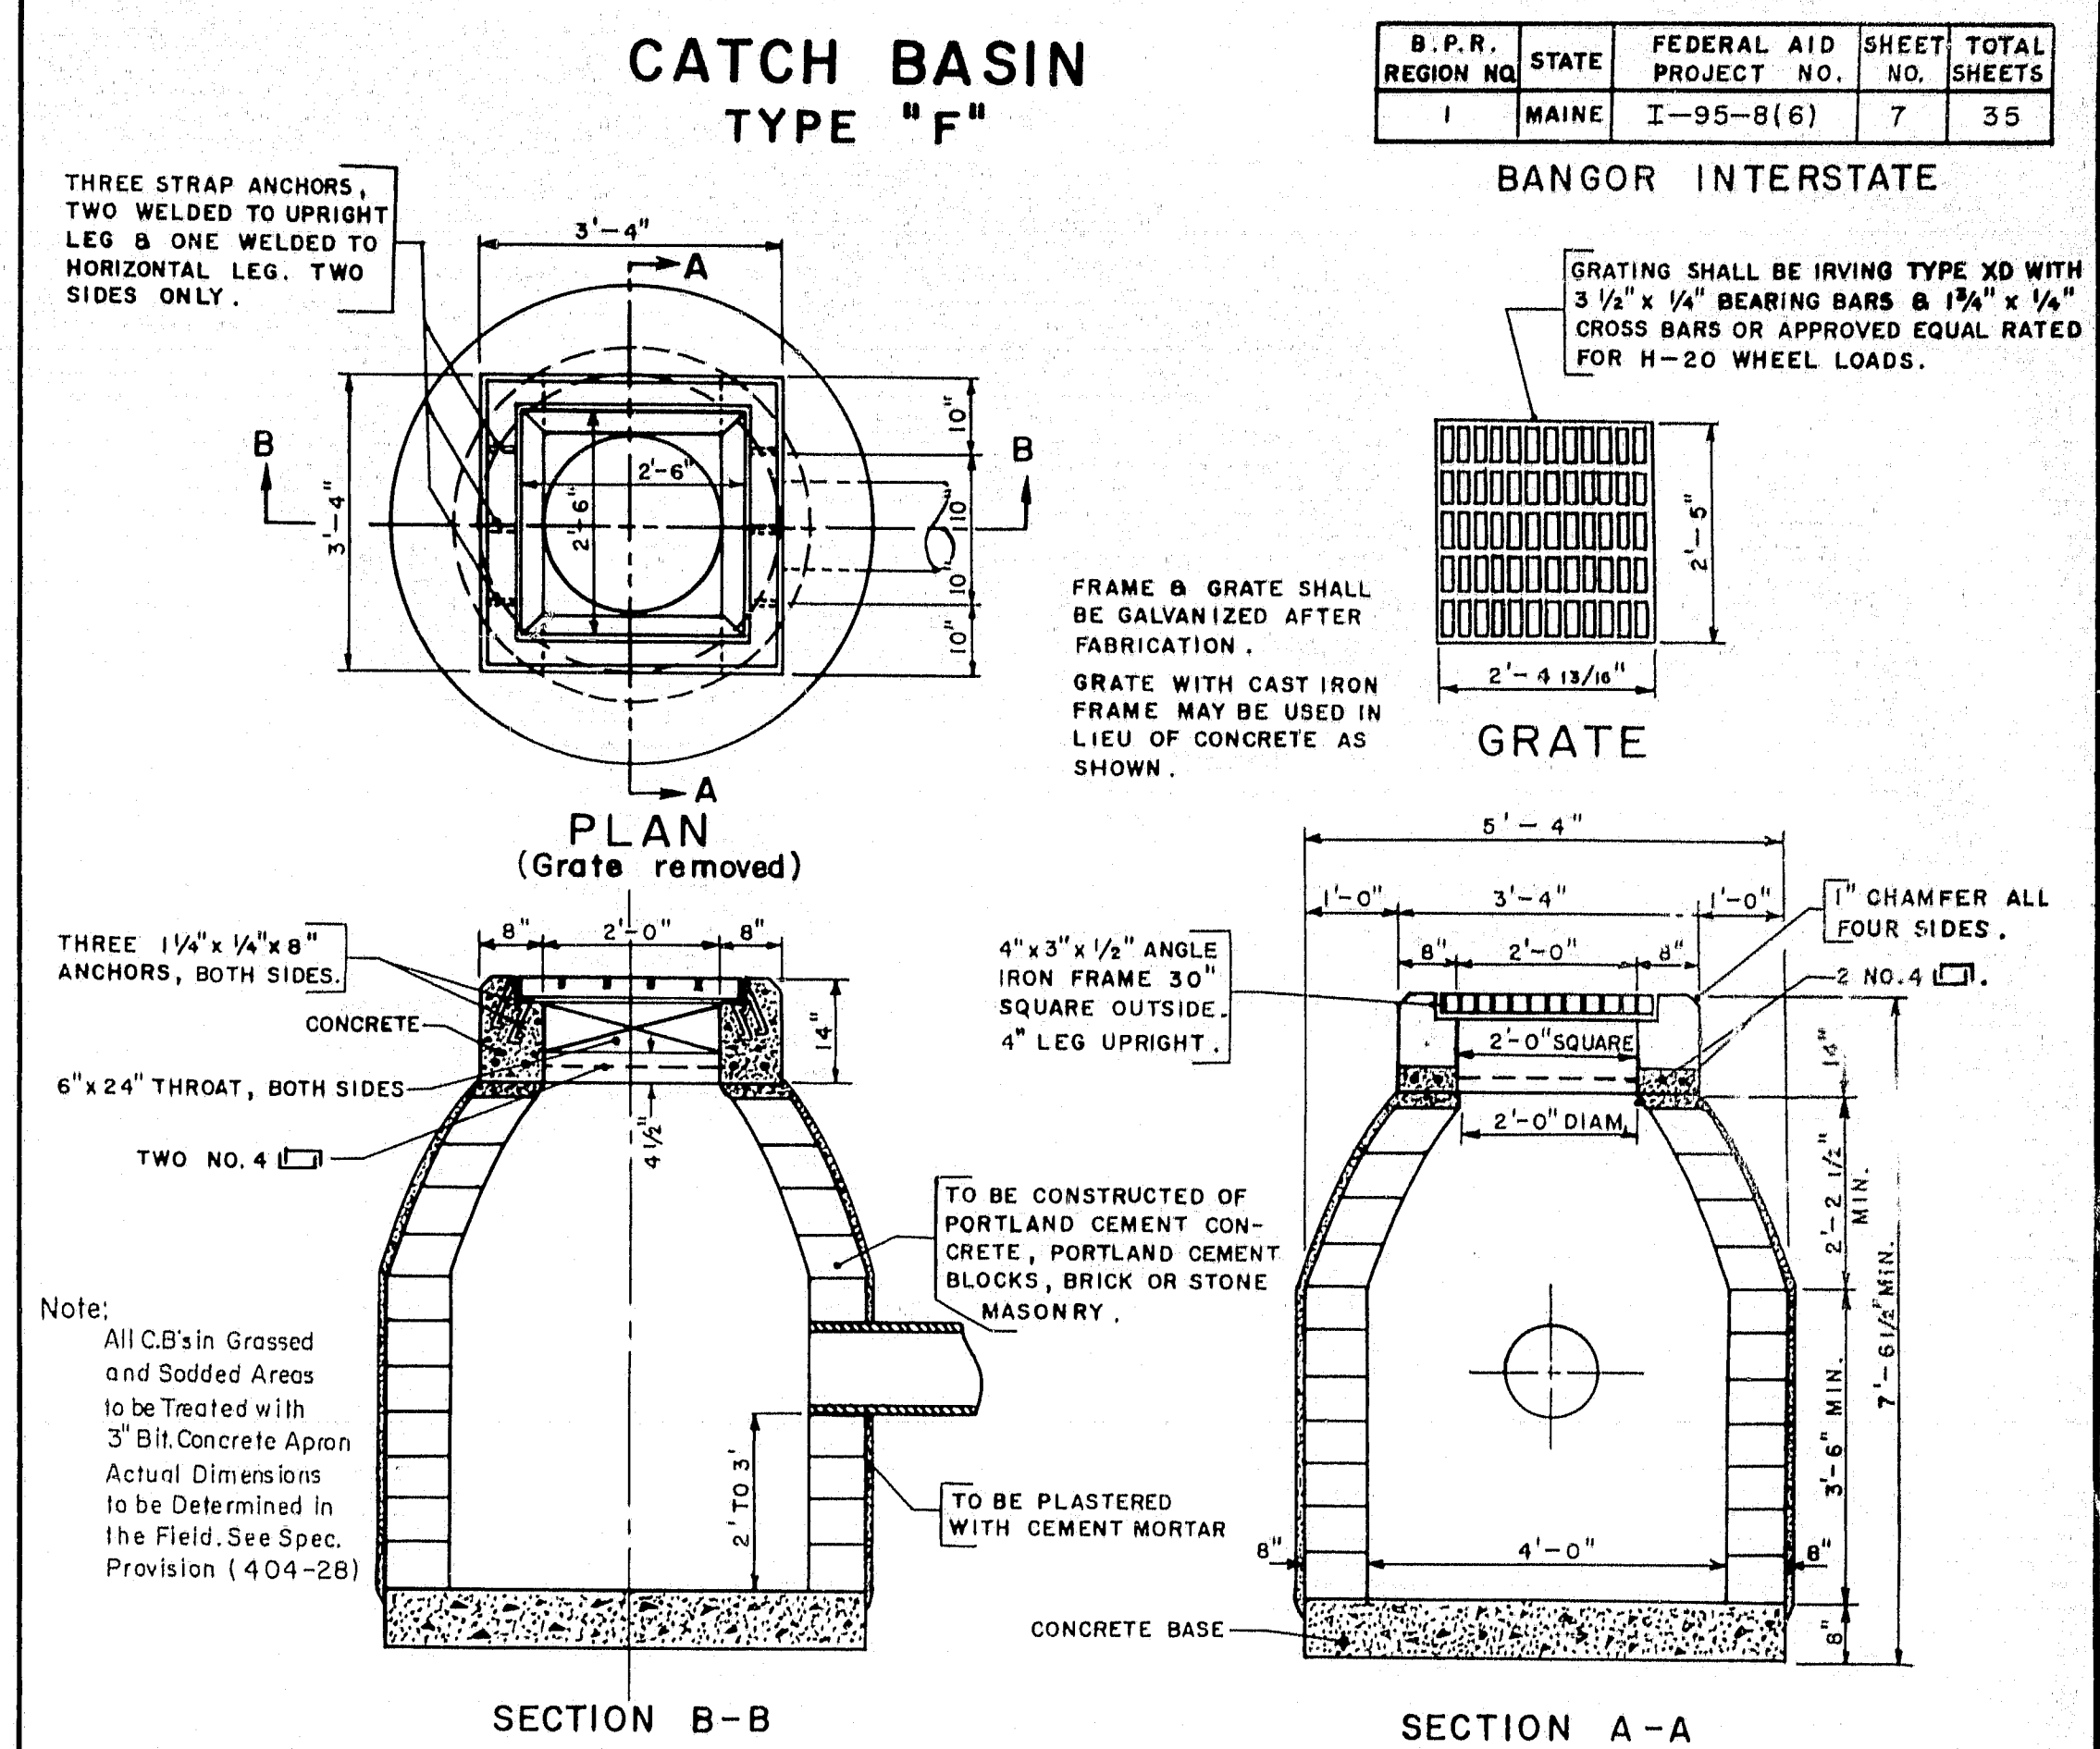

**Note:** TYPE "I" CATCH BASIN IS TO BE USED IN SLOPED CURB AREA. (This type may also be used in straight curb areas.)

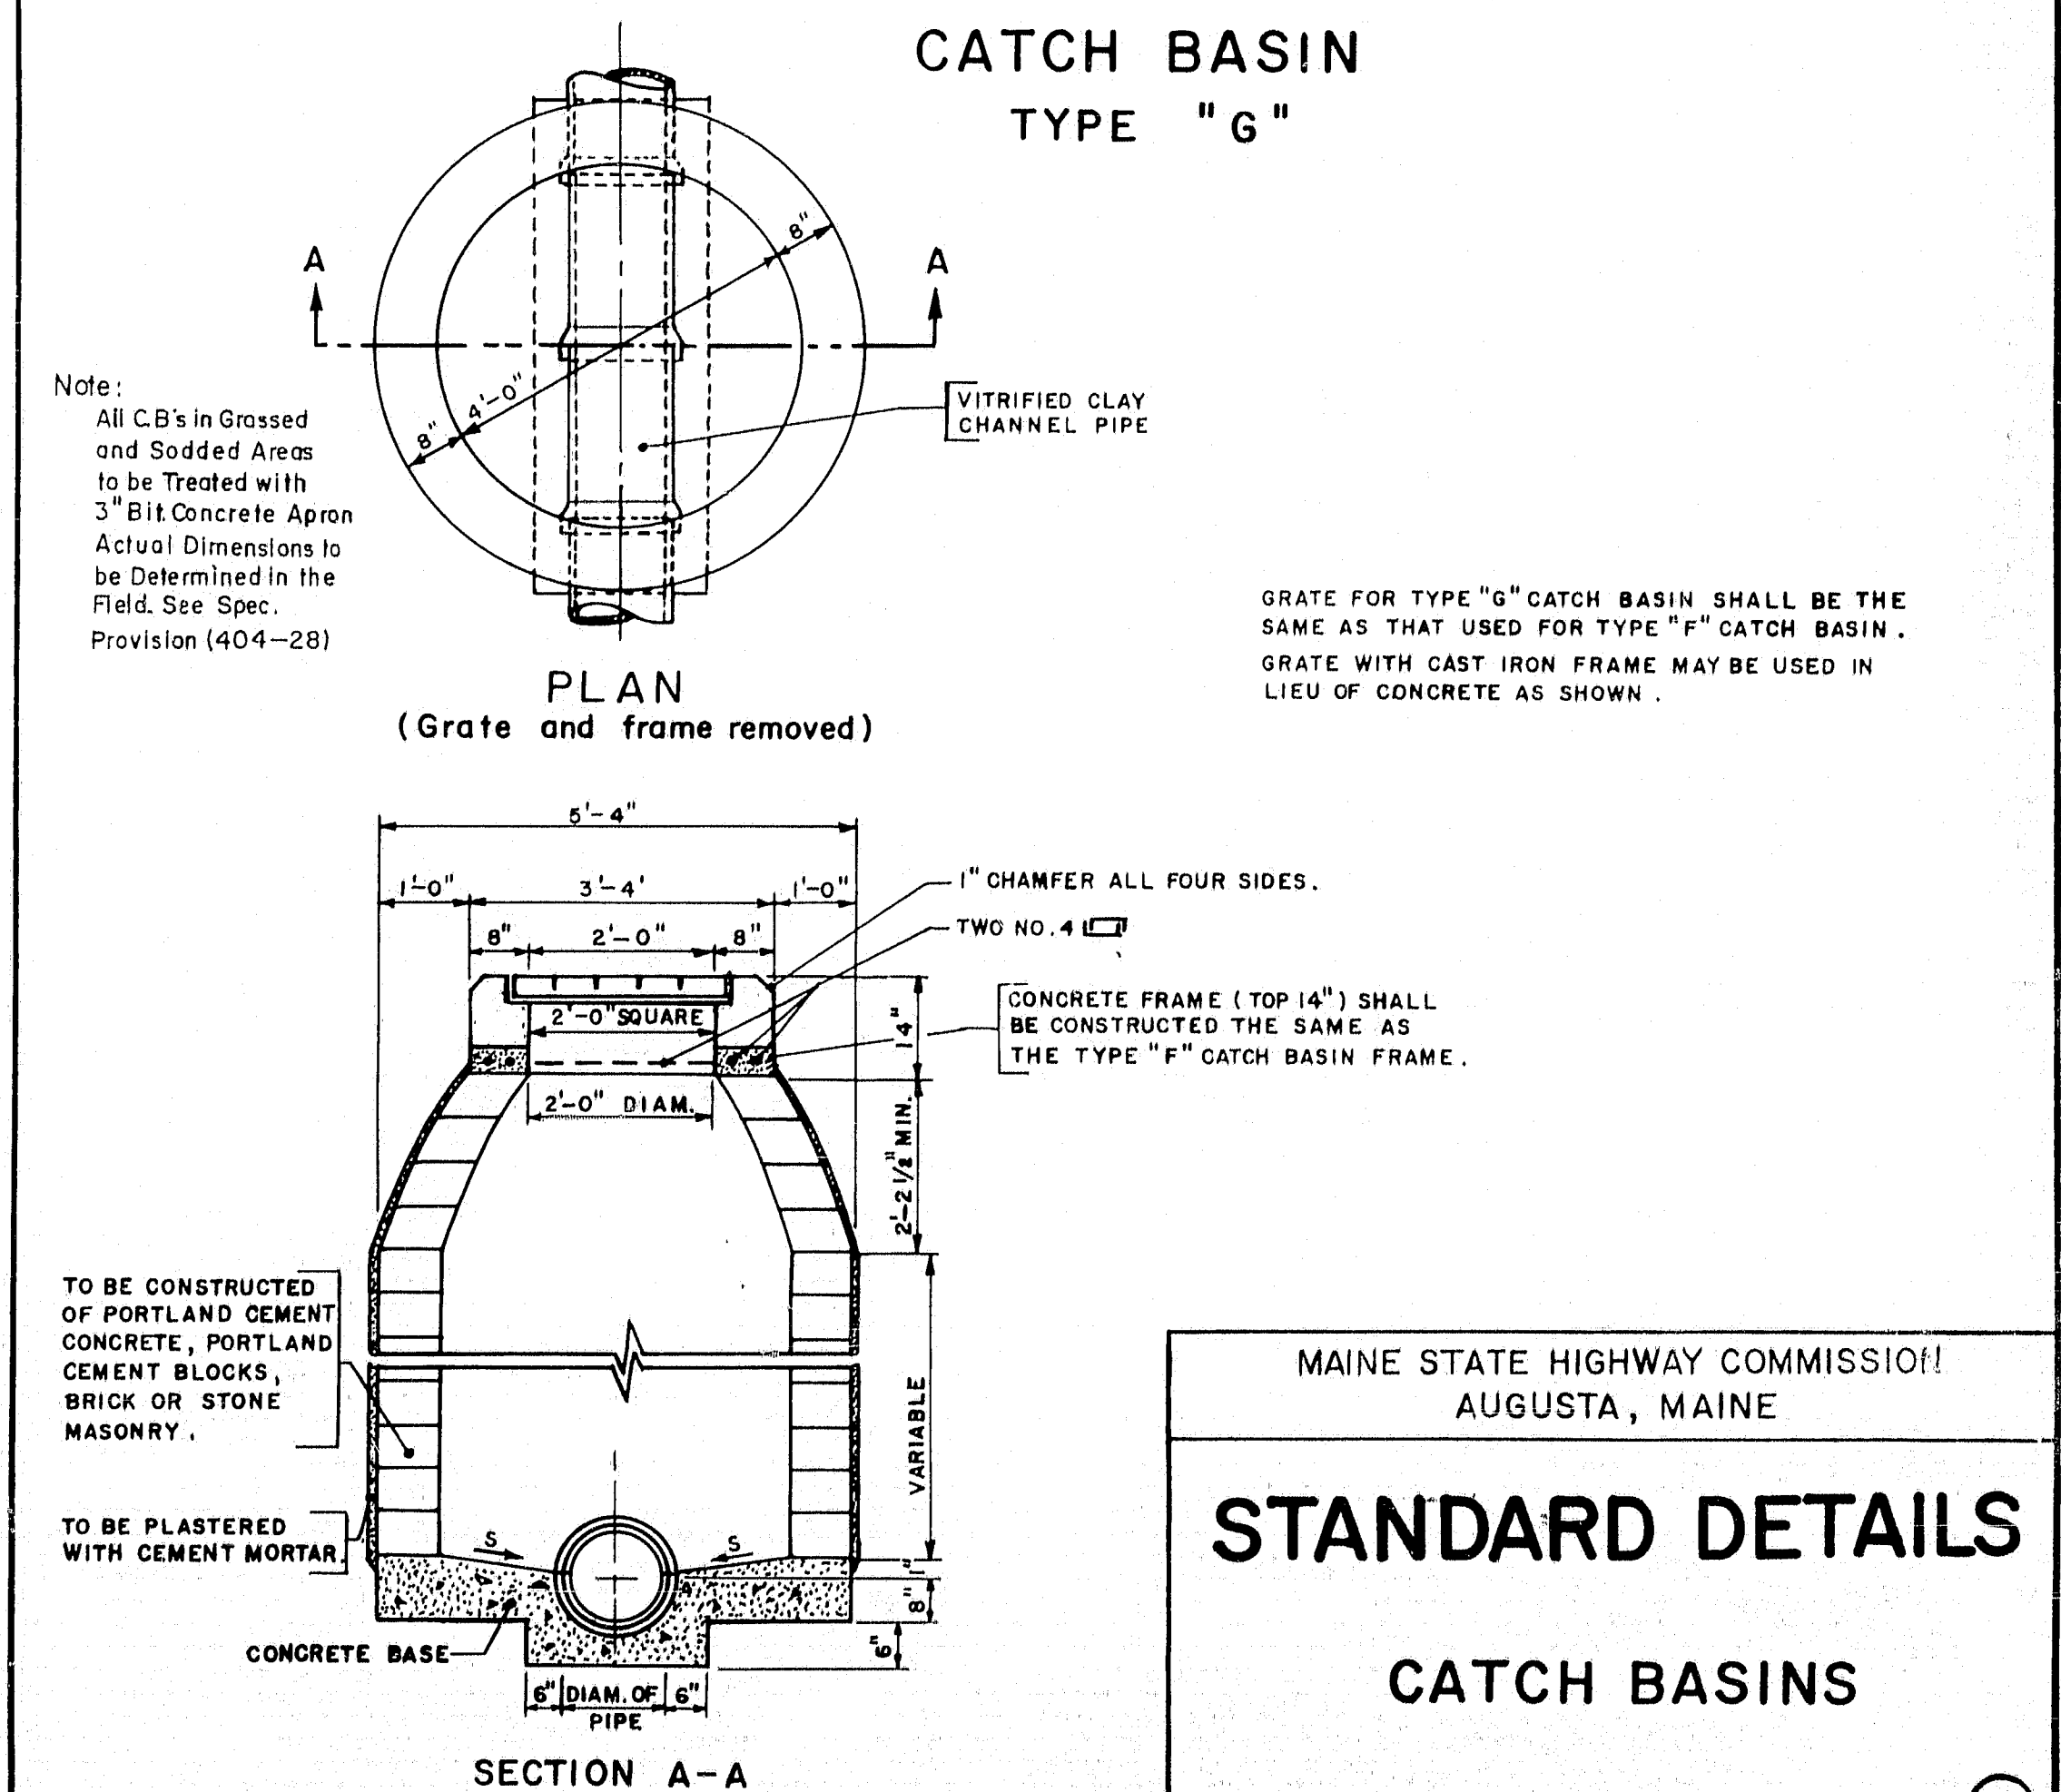


MAINE STATE HIGHWAY COMMISSION  
AUGUSTA, MAINE

## STANDARD DETAILS


### CATCH BASINS



# BENDS AND BANDS for A.C.C.M.P. MEDIAN DRAINAGE

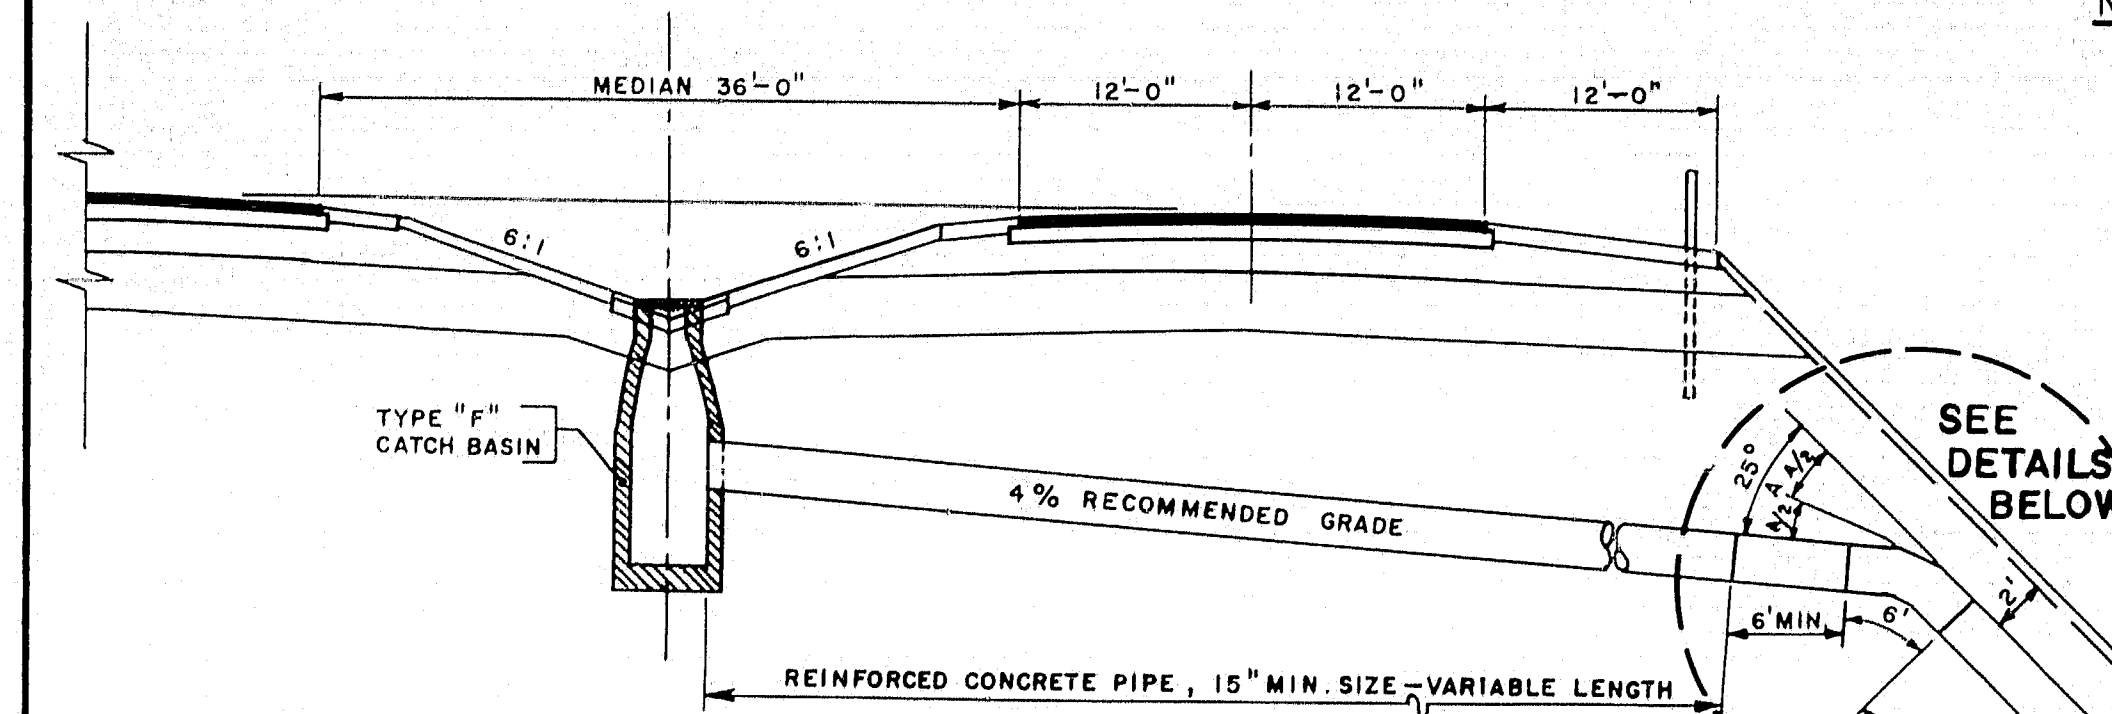

DRAINAGE SECTION

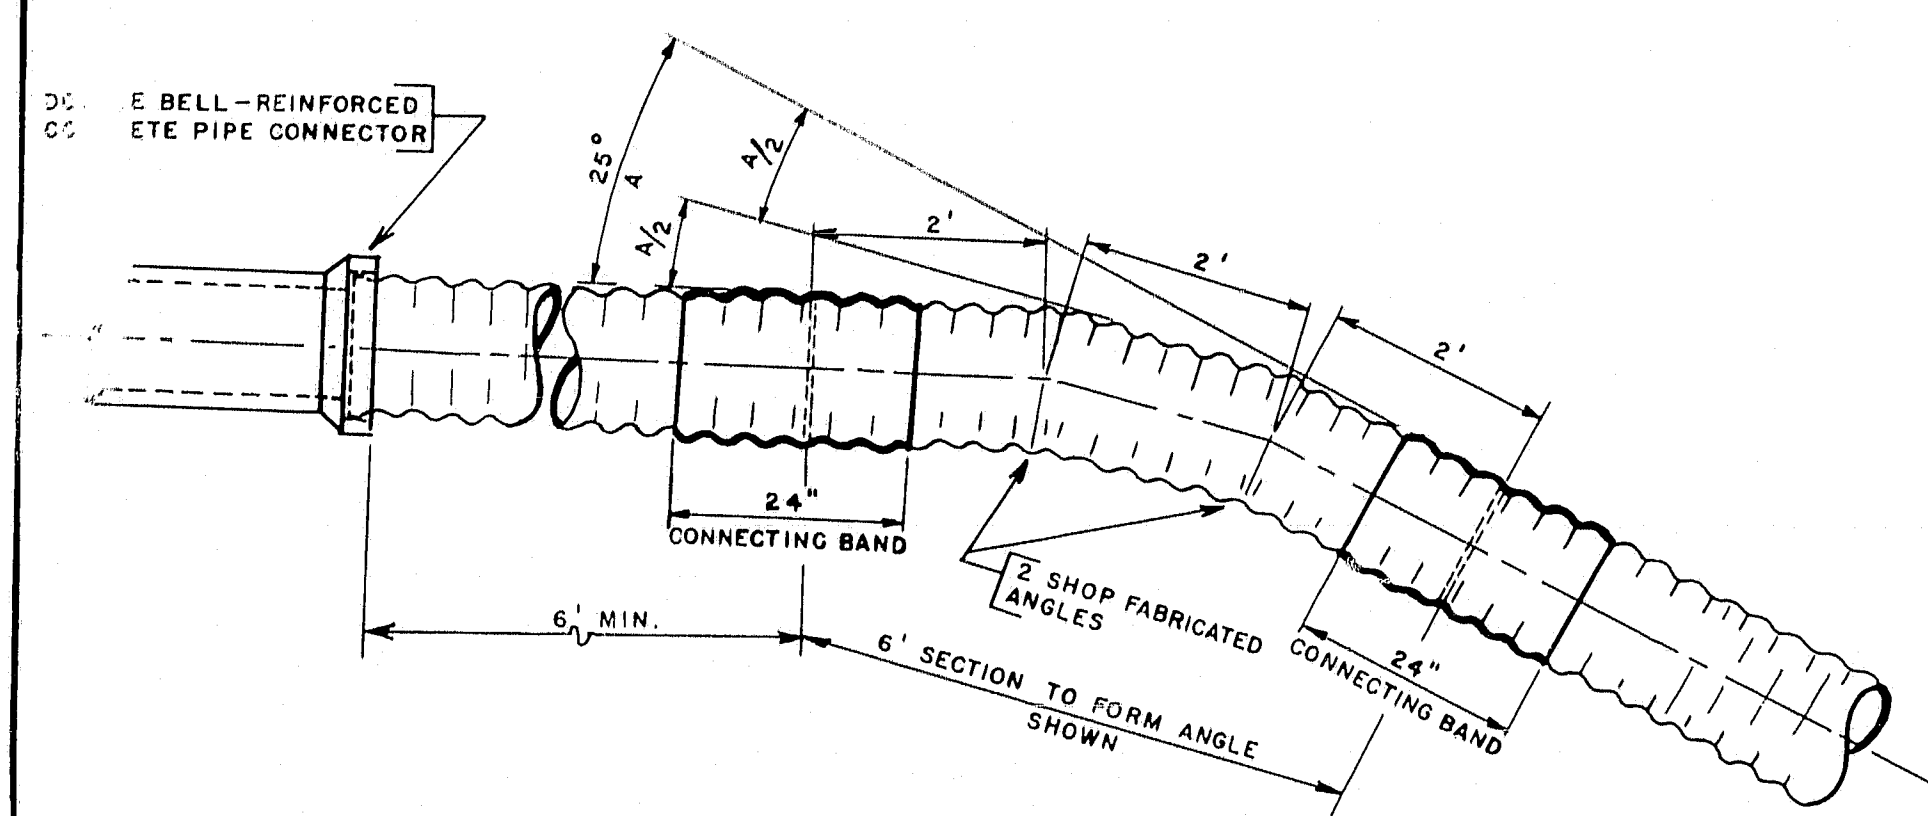


DETAIL OF SIX-FOOT BENDS

**NOTE:** 24" CONNECTING BANDS SHALL BE USED ON THE ENDS OF EACH ANGLE SECTION. THESE BANDS SHALL BE WATER TIGHT AND DRAWN SECURE BY MEANS OF FOUR THREADED GALVANIZED RODS 1/2" ROUND, PLACED UNIFORMLY EACH SIDE OF THE PIPE ENDS, AND TIGHTENED WITH SILO TYPE LUGS. THE LONGITUDINAL SEAM UNDER THE COLLAR SHALL BE WELDED AND RIVETS OMITTED.

WHEN STRAIGHT LENGTH OF A.C.C.M.P. ON SLOPE EXCEEDS 20 FEET, 24" BAND OR BANDS SHALL BE USED IN THE SAME MANNER AS DESCRIBED ABOVE. AN ITEM COVERING EACH SIZE OF 24" CONNECTING BANDS SHALL BE INCLUDED IN THE PROPOSAL.


BID ITEMS FOR 15", 18" & 24" A.C.C.M.P. SIX FOOT SECTION TO FORM 25° ANGLE SHALL BE SHOWN IN THE ITEM DESCRIPTION AS "SIX FOOT BENDS". WHEN FILL IS 10' OR MORE IN DEPTH AT THE OUTSIDE SHOULDER BERM USE OUTLET FROM CATCH BASIN AS SHOWN; WHEN FILL IS LESS THAN 10' USE STRAIGHT GRADE LINE FROM CATCH BASIN TO OUTLET END OF PIPE.

SEE DETAILS BELOW

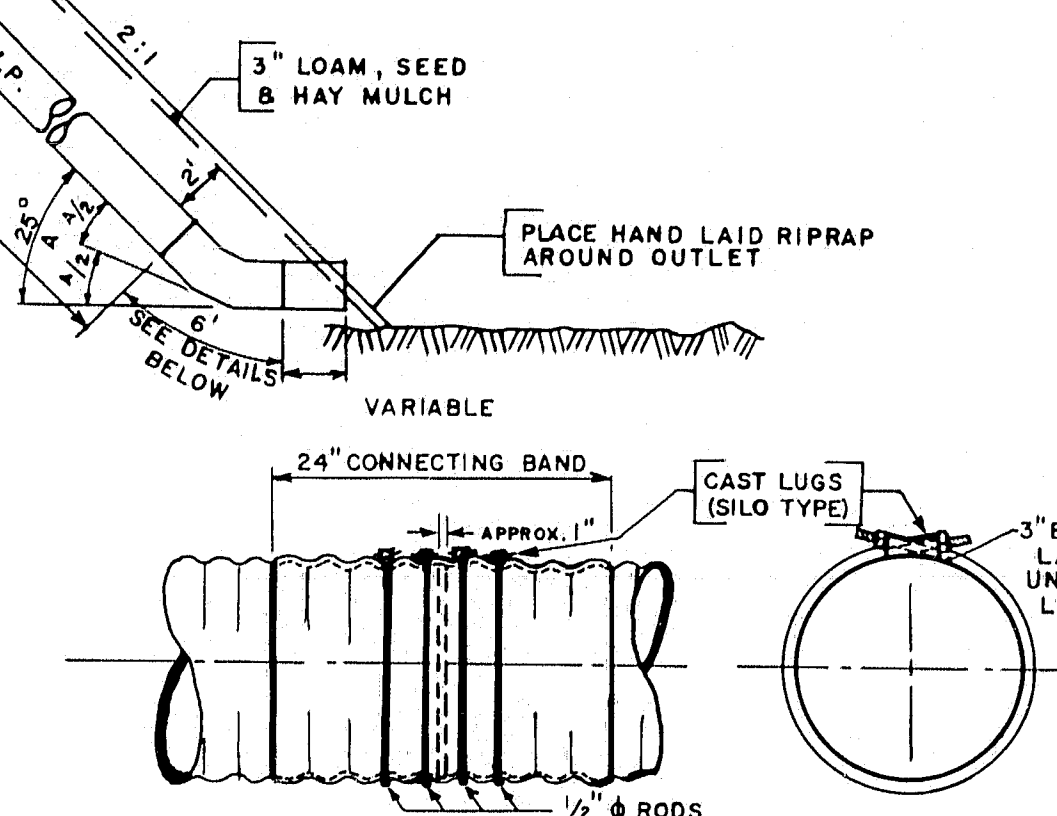


DETAIL OF 24" CONNECTING BANDS

# METAL ENDWALLS

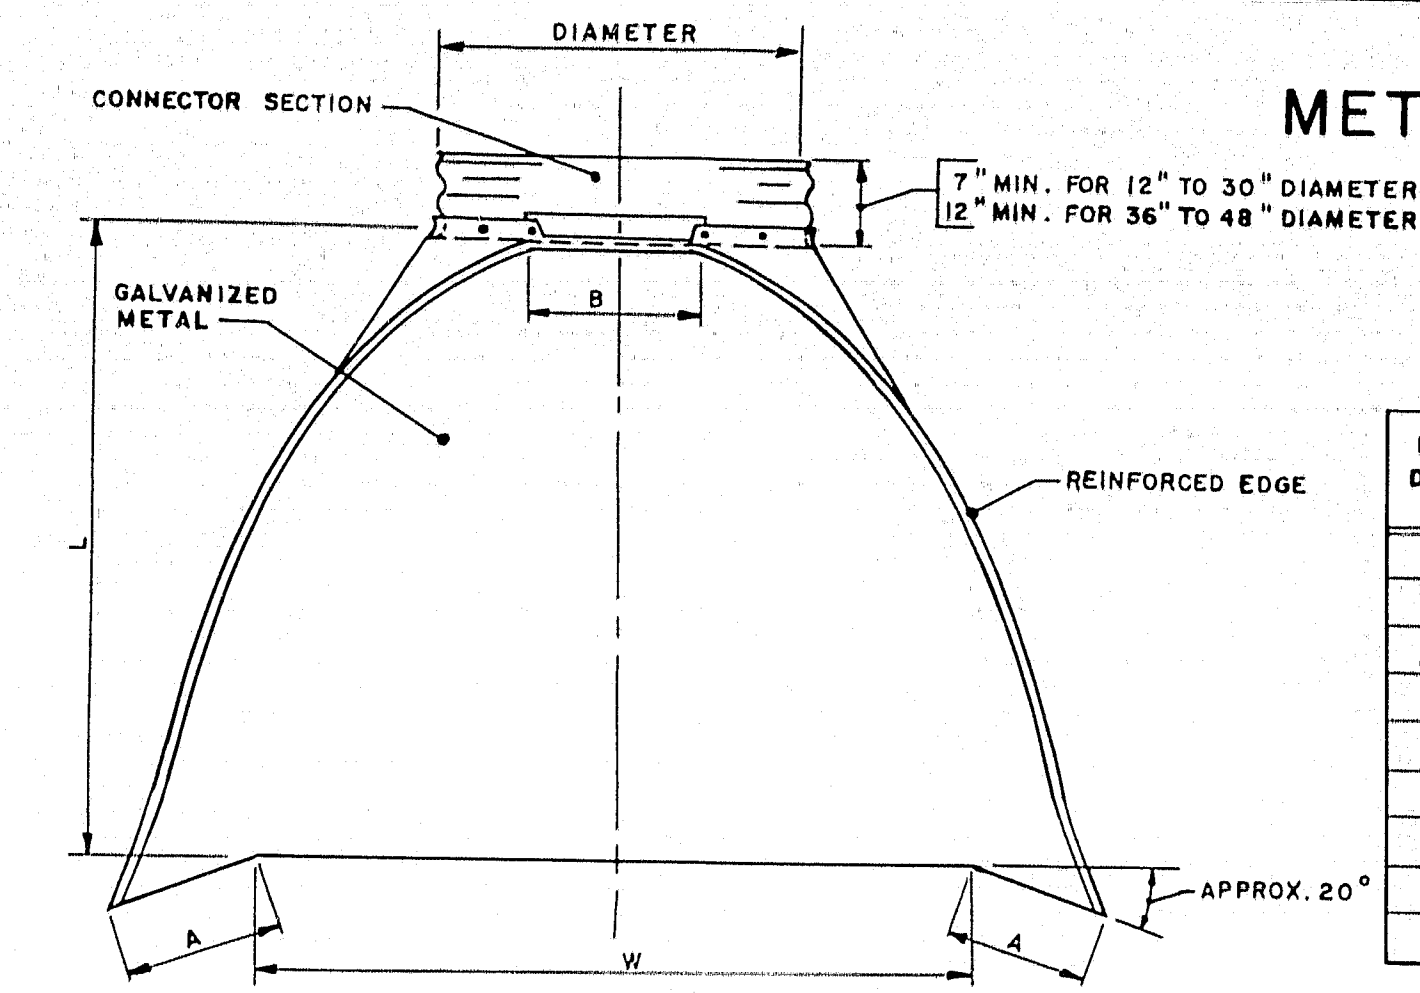


PLAN

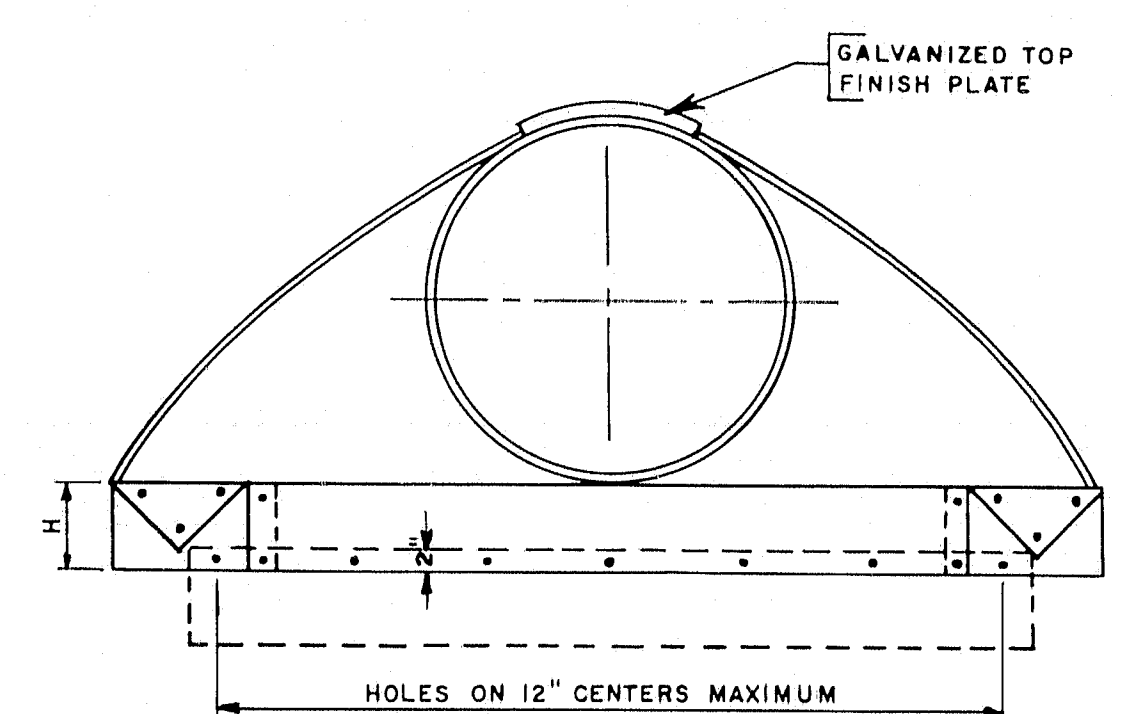

ELEVATION

PIPE DIAM.	GAUGE	DIMENSIONS					
		A	B	H	L	W	TOL.
12"	16	4 1/2"	6"	6"	21"	24"	
15"	16	6"	8"	6"	26"	30"	
18"	16	7"	9"	6"	31"	36"	
21"	16	8 1/2"	11"	6"	36"	42"	
24"	14	9 1/2"	12"	6"	42"	48"	
30"	14	12"	15"	7 1/4"	52 1/2"	60"	
36"	12	14"	18"	9"	63"	72"	
42"	12	16"	21"	10 1/2"	73 1/2"	84"	

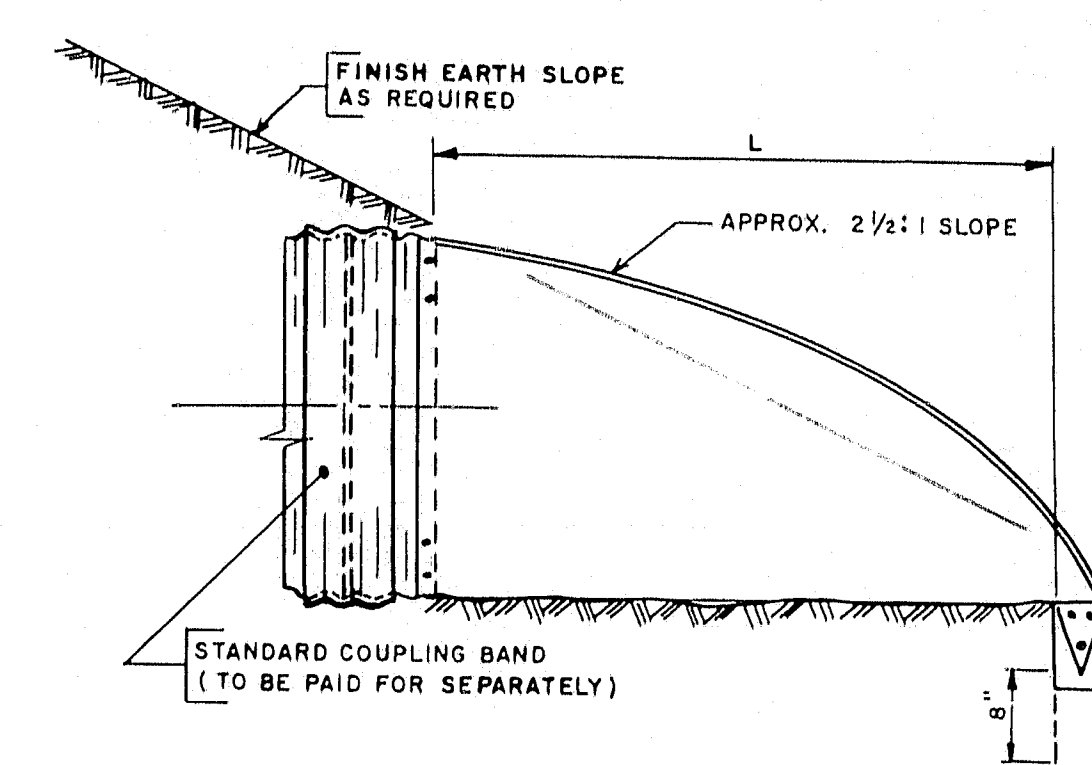

SIDE ELEVATION

TOE PLATE TO BE PUNCHED TO MATCH HOLES IN SKIRT LIP. LENGTH OF TOE PLATE IS W+10" FOR 12" TO 30" DIAMETER PIPE, INCLUSIVE, AND W+22" FOR 36" TO 42" DIAMETER PIPE INCLUSIVE.


SKIRT SECTION FOR 12" TO 24" DIAMETER PIPE, INCLUSIVE, TO BE MADE IN ONE PIECE. SKIRT SECTION FOR 30" TO 48" DIAMETER PIPE MAY BE MADE FROM TWO SHEETS JOINED BY RIVETING OR BOLTING ON CENTERLINE.

CONNECTOR SECTION, CORNER PLATE AND TOE PLATE TO BE SAME GAUGE AS SKIRT AND EACH TO BE GALVANIZED. TOE PLATE TO BE INCLUDED IN UNIT COST.


B. P. R. REGION NO.	STATE	FEDERAL AID PROJECT NO.	SHEET NO.	TOTAL SHEETS
1	MAINE	1-95-8(6)	8	35

BANGOR INTERSTATE

# CUT SLOPE DRAIN

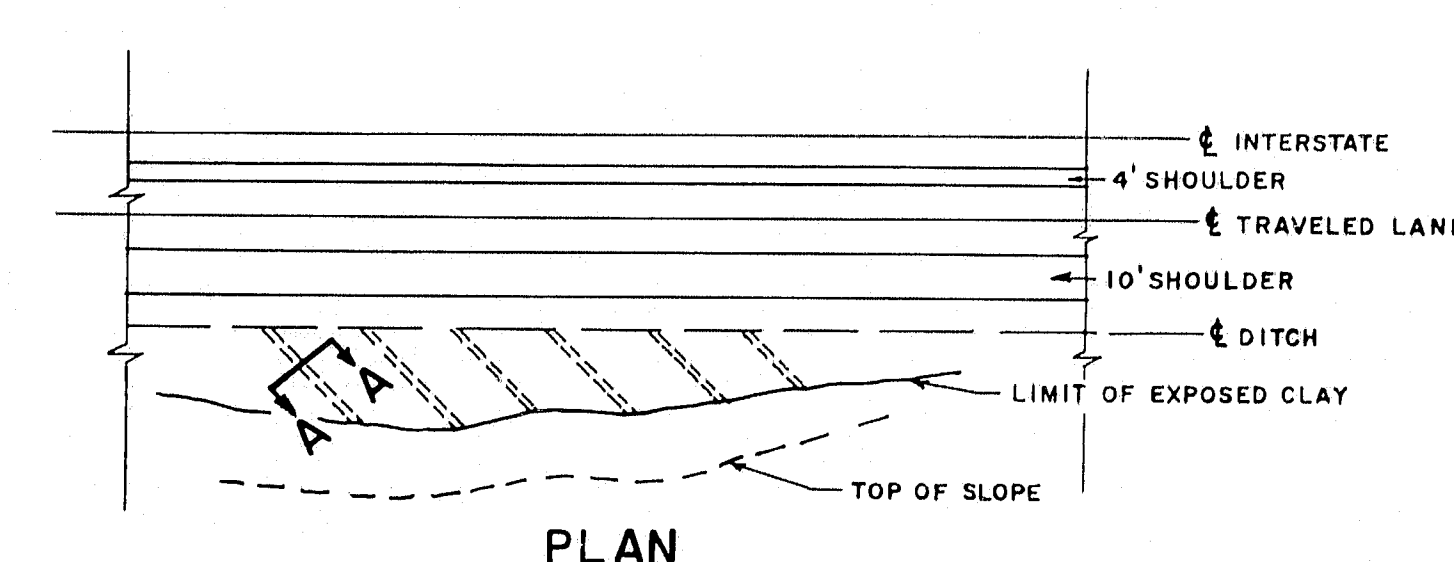


PLAN

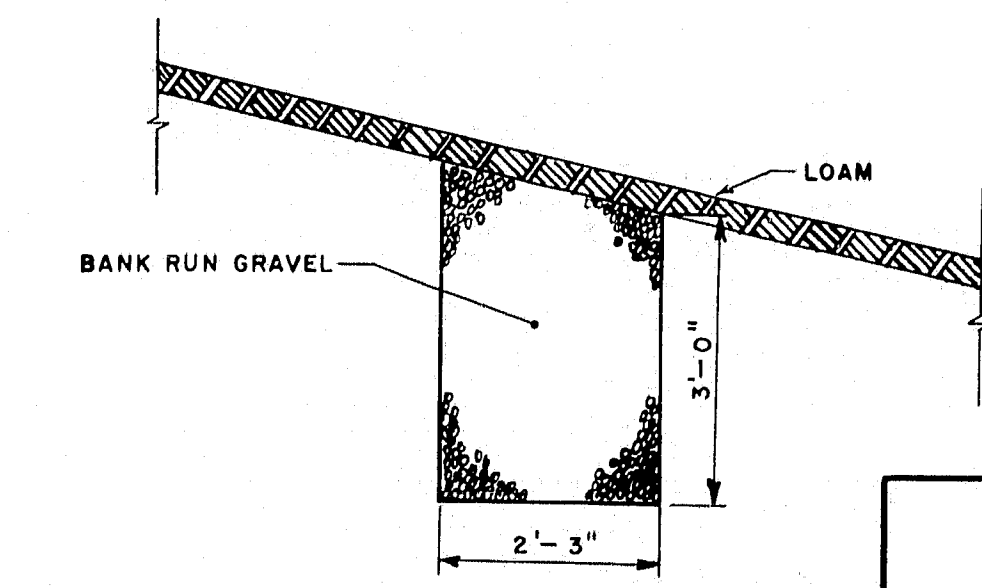


SECTION A-A

# 9-FOOT MEDIAN

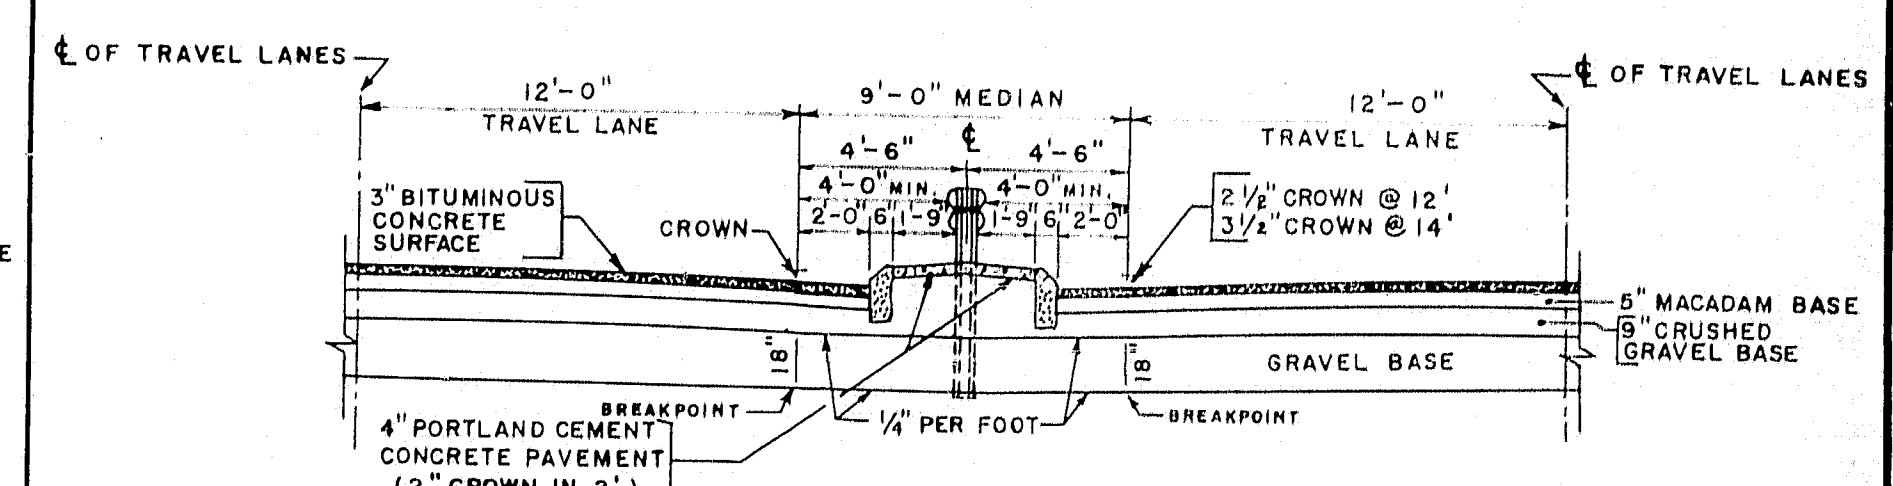


STEEL POST

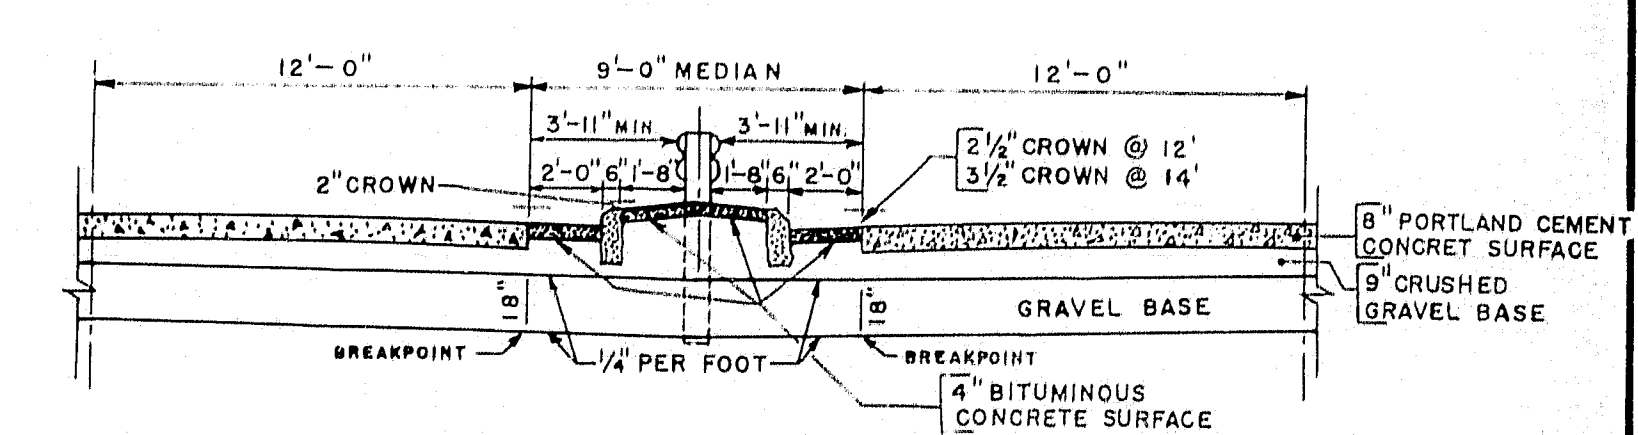

WOOD POST

# BITUMINOUS CONCRETE CURB

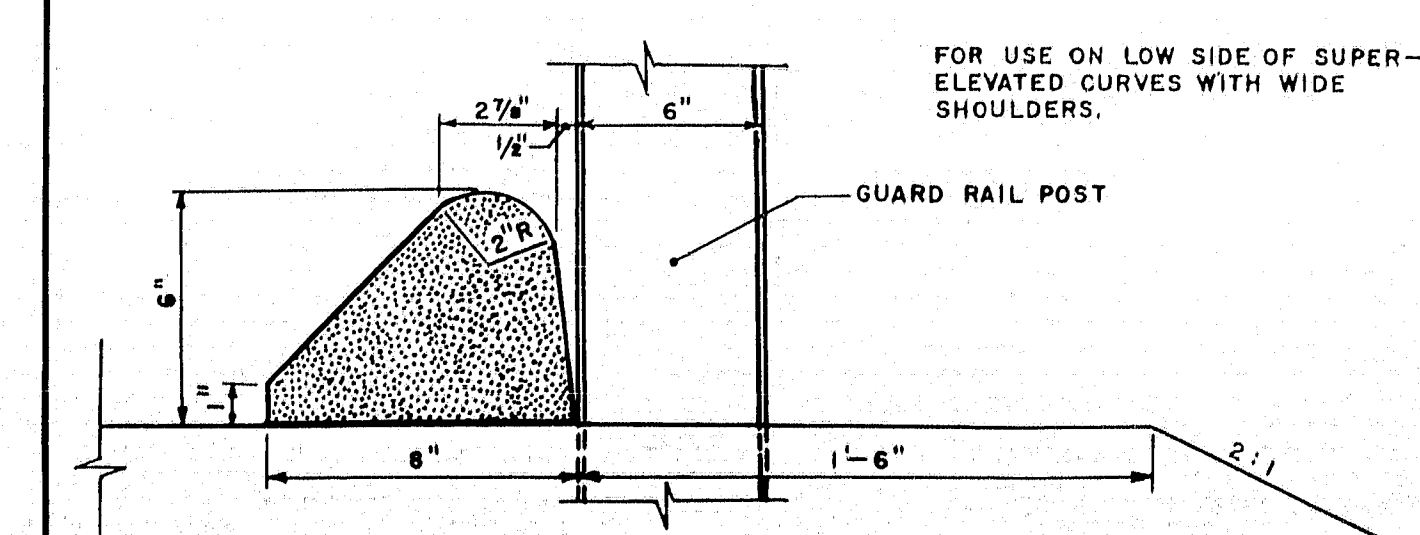

GUARD RAIL POST

MAINE STATE HIGHWAY COMMISSION  
AUGUSTA, MAINE


## STANDARD DETAILS

BENDS & BANDS, METAL ENDWALLS, GUARD RAIL ON RAMP, CUT SLOPE DRAIN, 9-FOOT MEDIAN & BITUMINOUS CONCRETE CURB






B. P. R. REG. NO.	STATE	PROJECT NO.	SHEET NO.	TOTAL SHEETS
1	MAINE	I-95-B(6)	9	35

BANGOR INTERSTATE

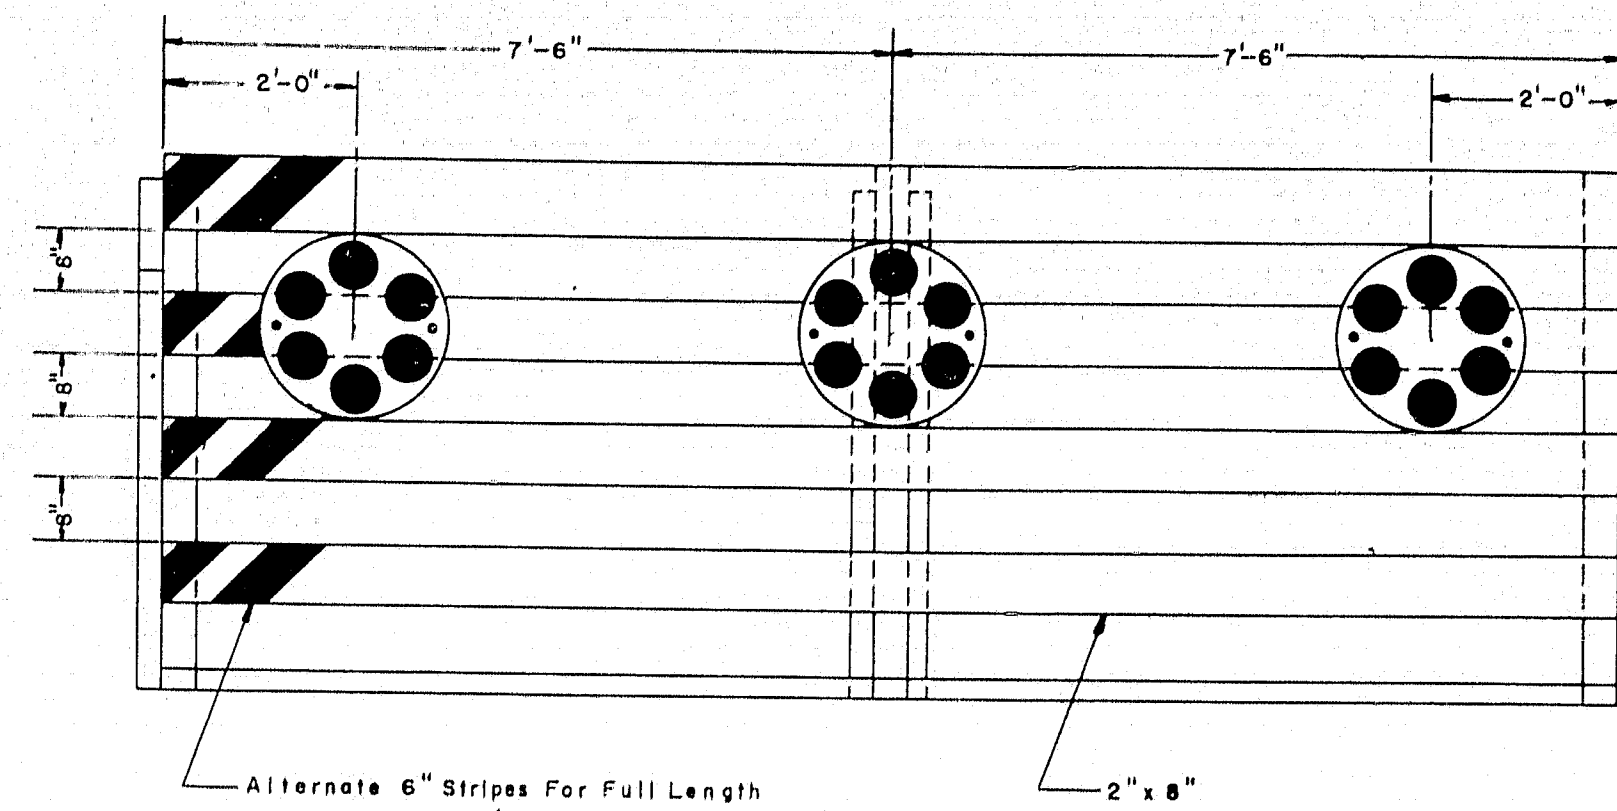


PORTABLE BARRICADE  
Scale:  $\frac{1}{2}" = 1'$

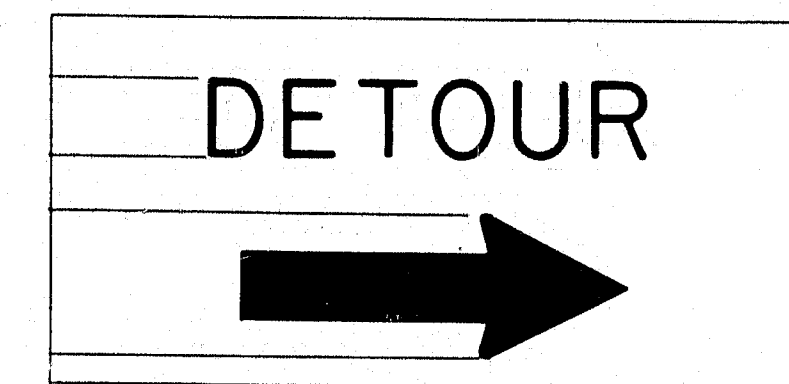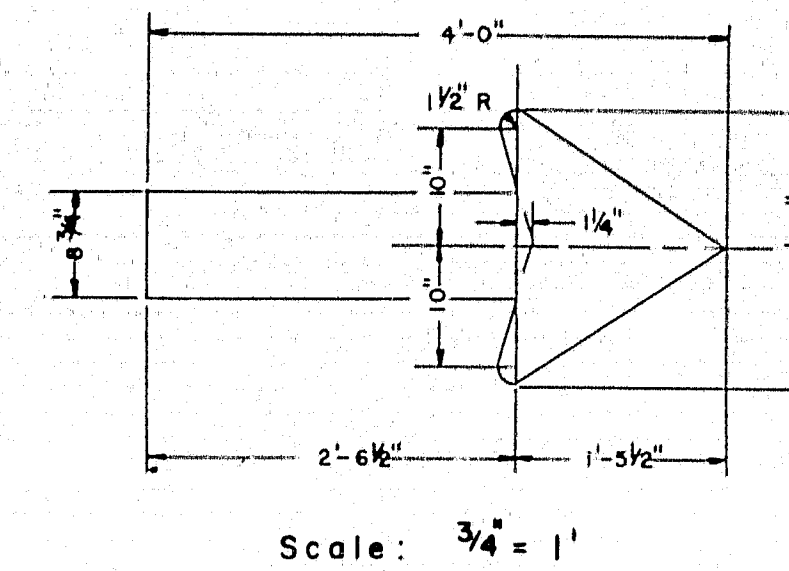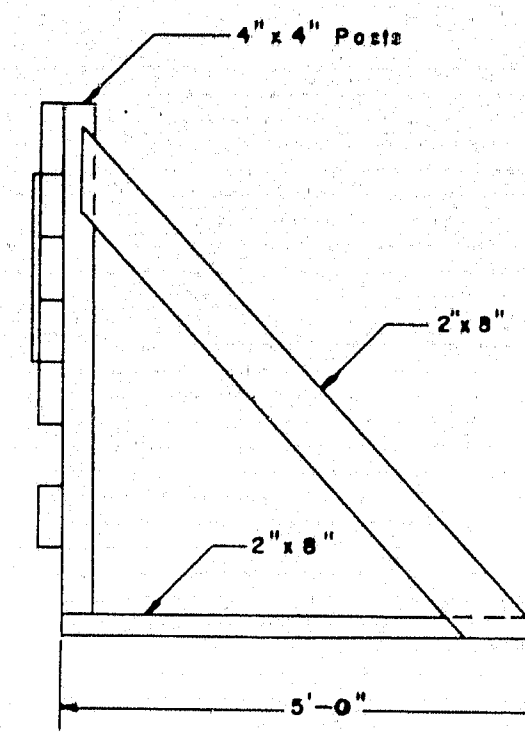


DETOUR SIGN FOR  
PORTABLE BARRICADE  
Scale:  $\frac{1}{2}" = 1'$

GENERAL NOTES:

1. Lumber sizes for use on Barricades shall be 2"x8" except for Posts which shall be 4"x4".
2. Detour Sign shall be  $\frac{5}{8}"$  thick plywood.
3. Alternate 6" stripes shall be painted or screened in black on a background of silver reflective sheeting.
4. The word "DETOUR" and Arrow shall be painted or screened in black on a background of yellow reflective sheeting.
5. Flashing Lights shall be Mounted to permit rotation to face oncoming traffic.
6. Reflector clusters shall consist of a red background with red Reflectors similar to AGA Designation \*1816-A1 (PDON).
7. The Barricades shall be securely anchored in place by means of sandbags, weights, or large stones.
8. Location of Service and Meter to be determined after Power Source has been decided.

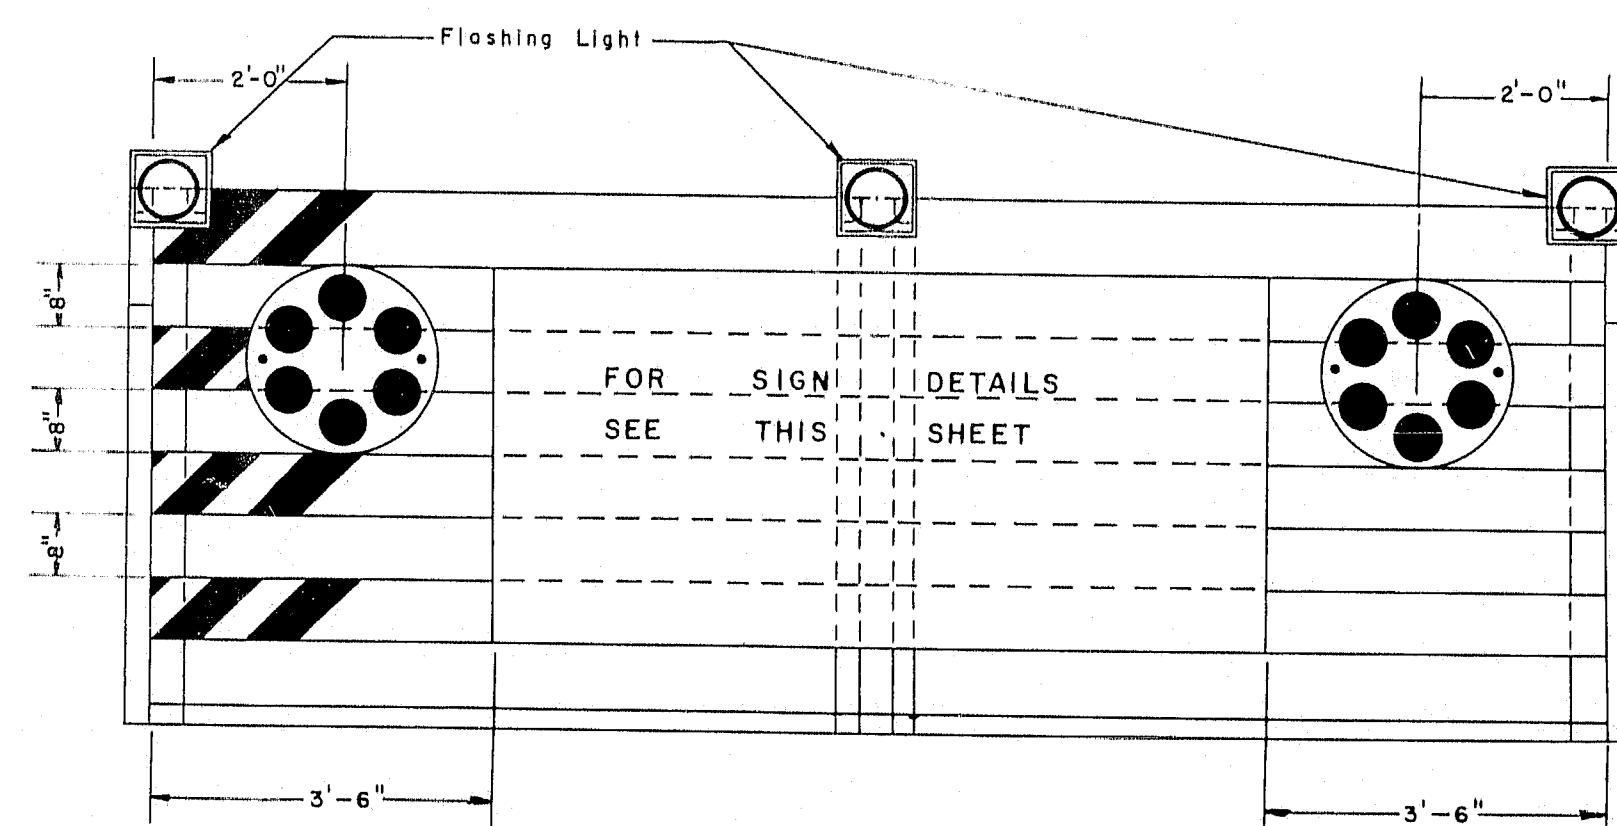

PORTABLE BARRICADE  
WITH FLASHING LIGHTS  
AND DETOUR SIGN  
Scale:  $\frac{1}{2}" = 1'$

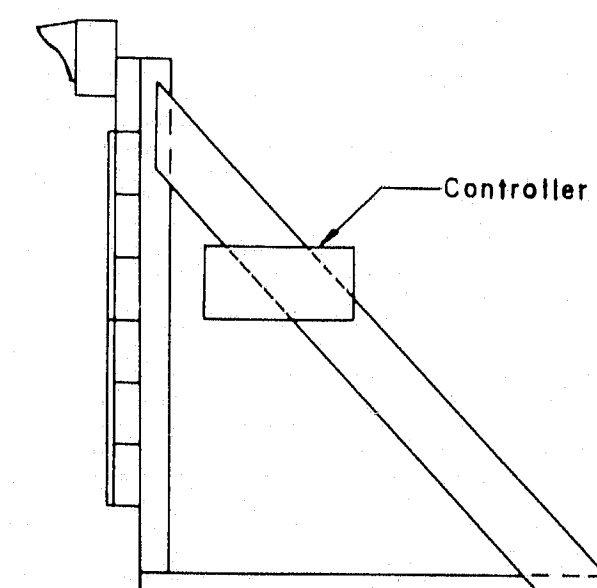

MAINE STATE HIGHWAY COMMISSION  
AUGUSTA, MAINE

SPECIAL DETAILS

PORTABLE BARRICADES




SCALE: AS NOTED

THE CLARKESON ENGINEERING CO., INC.  
CONSULTING ENGINEERS  
BOSTON MASSACHUSETTS





B.P.R.	STATE	PROJECT NO.	SHEET NO.	TOTAL SHEETS
1	MAINE	I-95-8(6)	10	35

BANGOR INTERSTATE

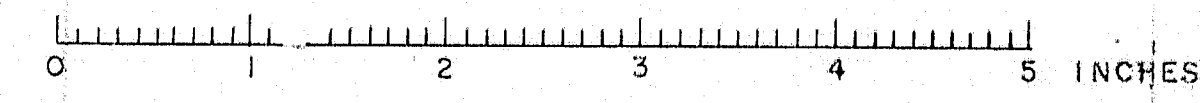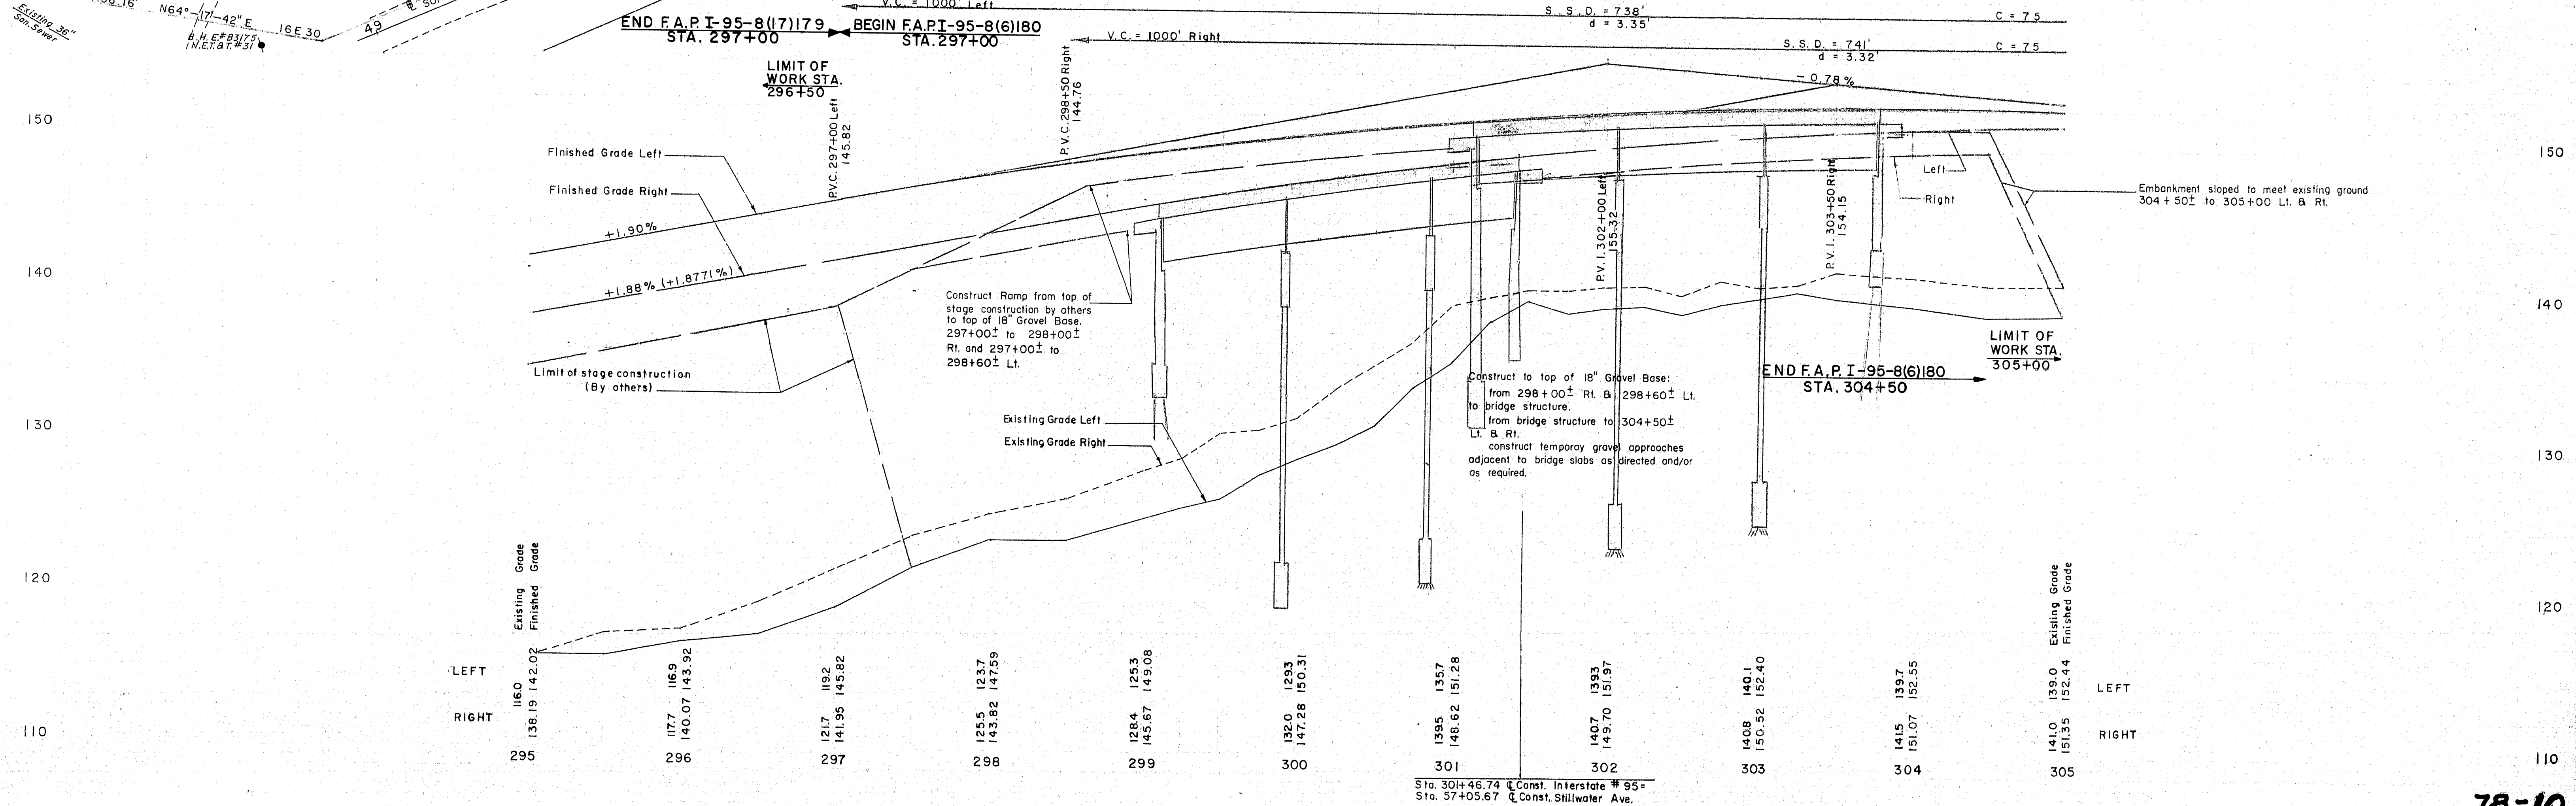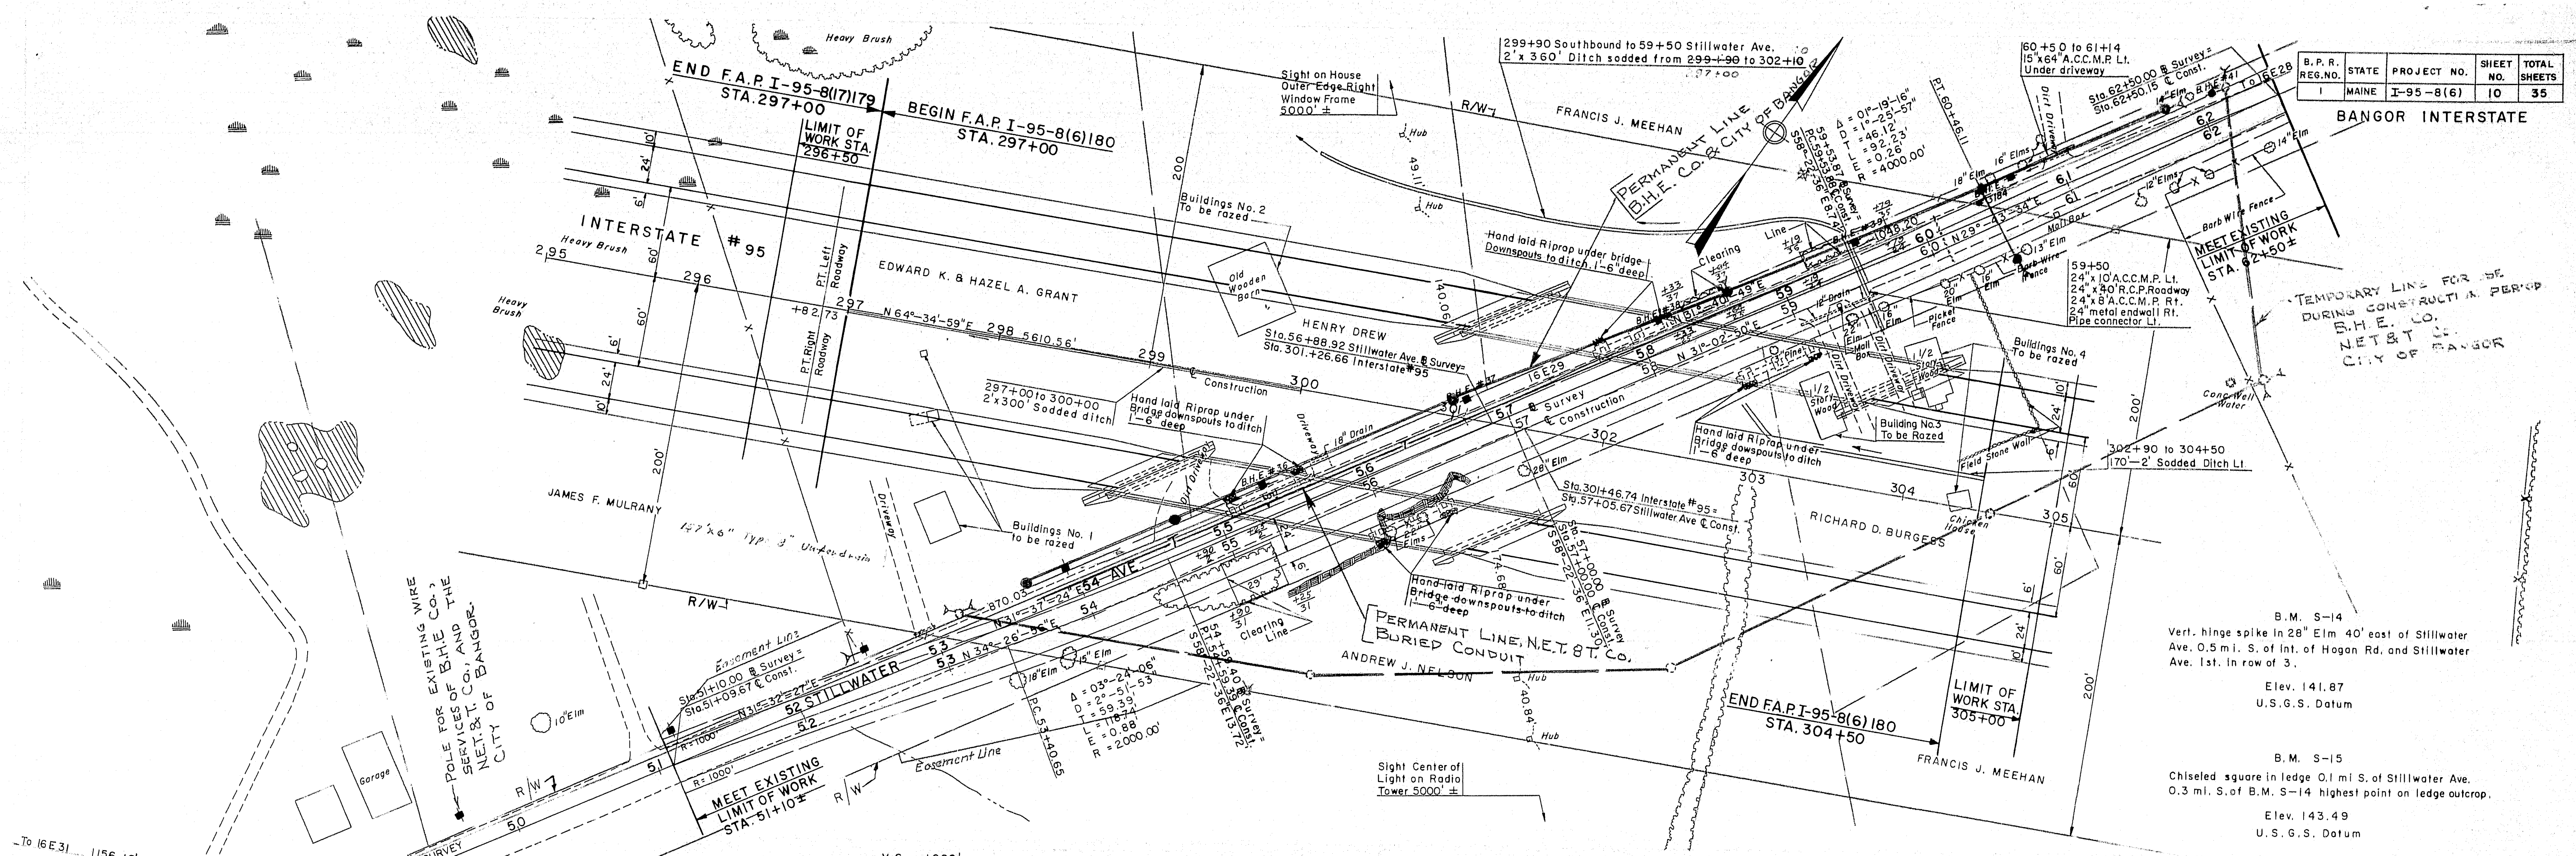



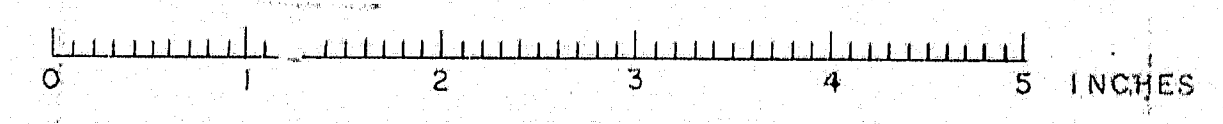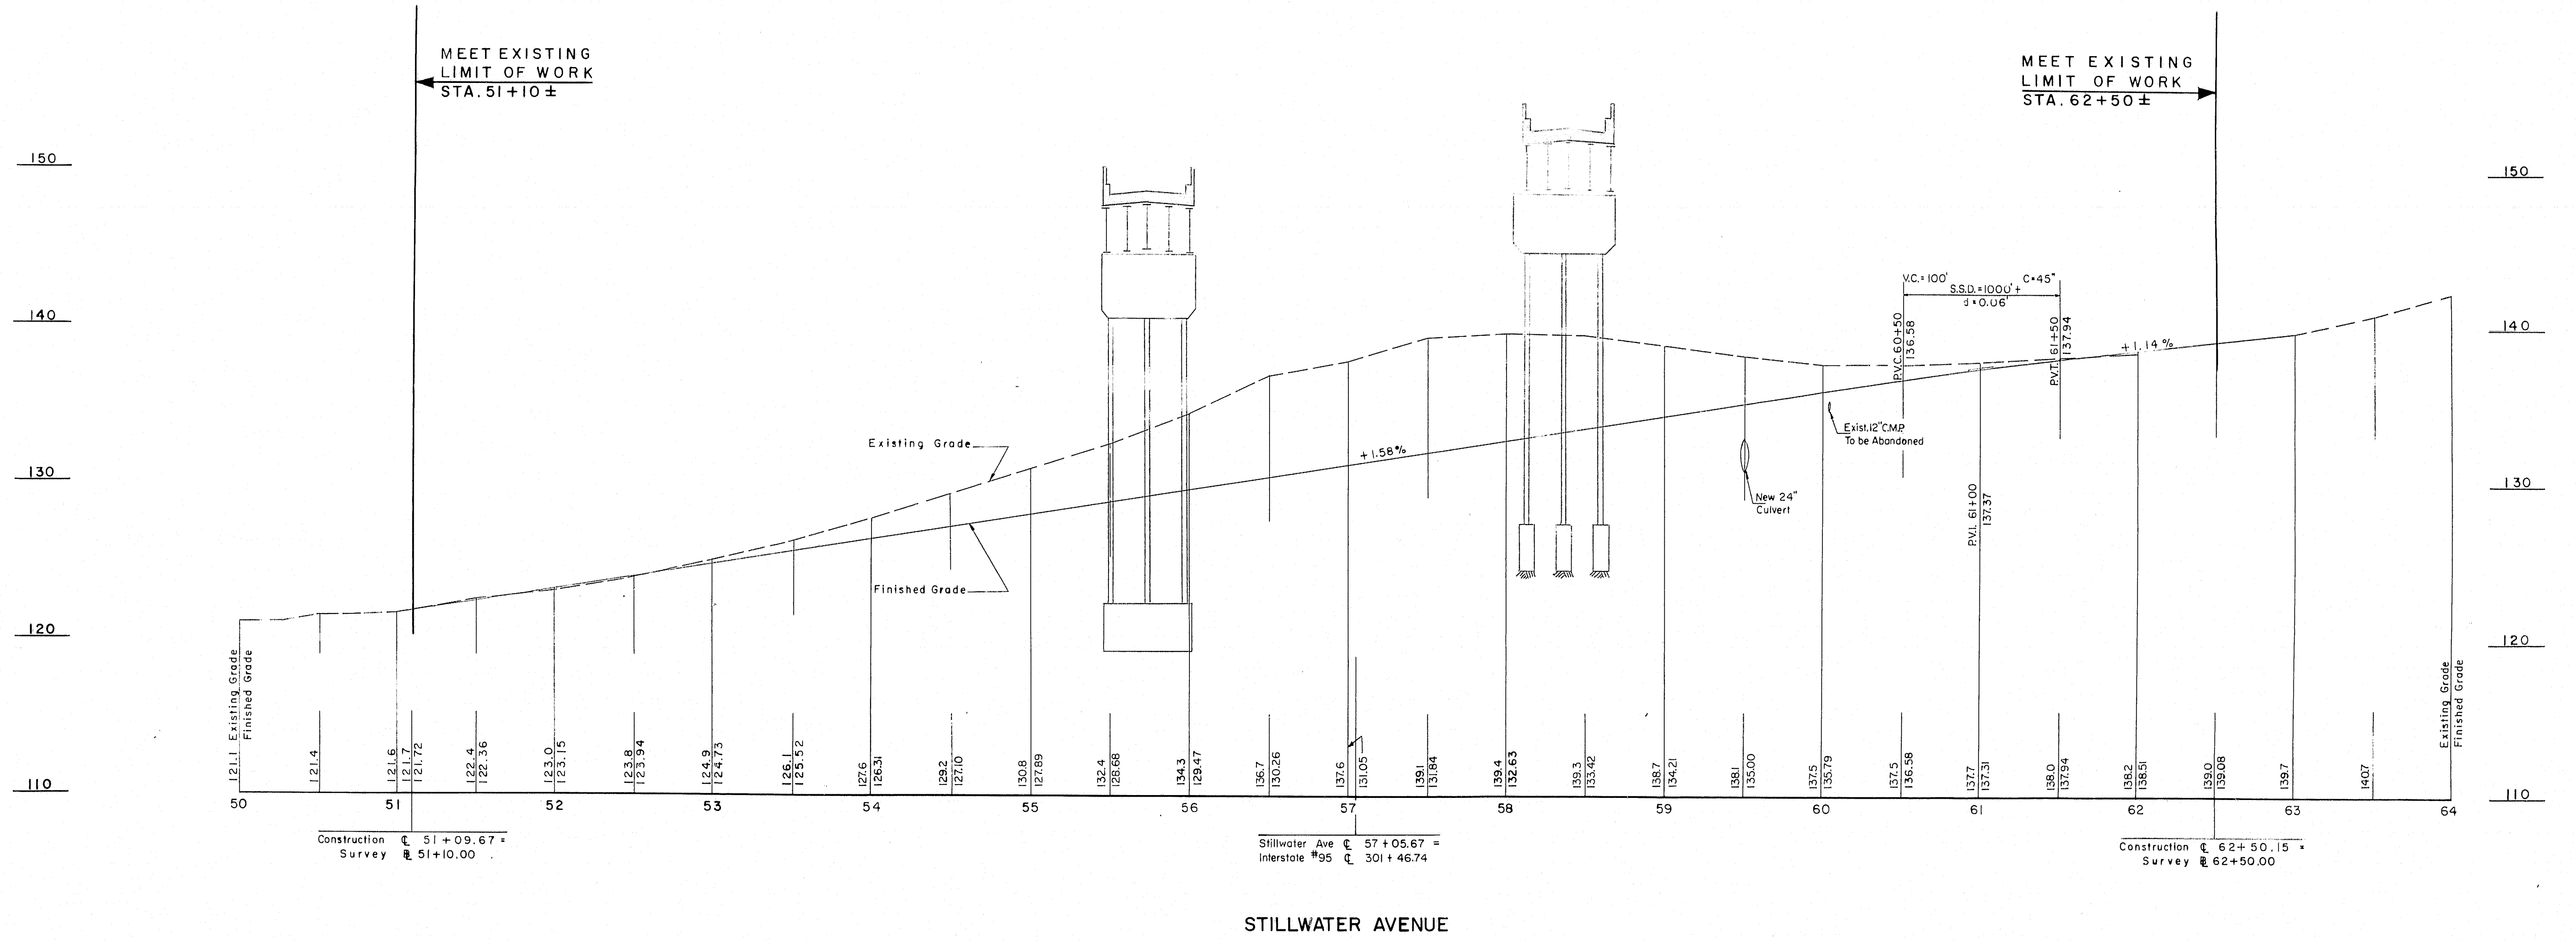



B.P.R. REG NO.	STATE	PROJECT NO.	SHEET NO.	TOTAL SHEETS
1	MAINE	I-95-8(6)	12	35

## BANGOR INTERSTATE

### GENERAL NOTES

#### FOUNDATION:

Foundations may be altered, if necessary, to suit conditions encountered in construction.

#### DESIGN:

In accordance with the Specifications of the American Association of State Highway Officials for H20-S16-44 loading (1957 Edition) modified for military requirements.

Design Stresses: Structural Steel  $f_s = 18,000$  psi  
Reinforcing Steel  $f_s = 18,000$  psi  
Concrete (n=10)  $f_c = 1,200$  psi

#### CONSTRUCTION:

State of Maine Standard Specifications to be followed except as noted in Special Provisions.

#### REINFORCEMENT:

All bars shall have deformations conforming to A.S.T.M. Designation A305. Unless otherwise shown on plans, reinforcing bars shall be lapped 20 diameters to make a splice, except that main reinforcing bars near the top of slabs and beams having more than 12" of concrete under the bars shall be lapped 35 diameters to make a splice.

#### STRUCTURAL STEEL:

Wherever cover plates and/or shear connectors are welded to beams, beams and plates shall be weldable structural steel A.S.T.M. Designation A373.

#### BENCH MARK:


- BM S-14 Vertical hinge spike in 28' Elm, 40' east of Stillwater Ave, 0.5 miles south of intersection of Hogan Rd. & Stillwater Ave., 1st in row of 3. Elevation 141.87 U.S.G.S. Datum.  
BM S-15 Chiseled square in ledge, 0.1 miles south of Stillwater Ave, 0.3 miles south of BM S-14, highest point on ledge outcrop. Elevation 143.49 U.S.G.S. Datum.

### ESTIMATED QUANTITIES (NOT GUARANTEED)


STRUCTURAL EARTH EXCAVATION, ABUTMENTS AND RETAINING WALLS	240 CU. YDS.
STRUCTURAL ROCK EXCAVATION, ABUTMENTS AND RETAINING WALLS	20 CU. YDS.
STRUCTURAL EARTH EXCAVATION, PIERS	160 CU. YDS.
STRUCTURAL ROCK EXCAVATION, PIERS	120 CU. YDS.
GRAVEL BASE COURSE-IN PLACE MEASUREMENT	690 CU. YDS.
PORTLAND CEMENT CONCRETE, ABUTMENTS AND RETAINING WALLS	550 CU. YDS.
PORTLAND CEMENT CONCRETE, PIERS	290 CU. YDS.
PORTLAND CEMENT CONCRETE, ROADWAY AND SIDEWALK SLABS	
ON STEEL BRIDGES	470 CU. YDS.
PORTLAND CEMENT	1970 BBL'S.
BRIDGE DRAINAGE	1 LUMP SUM
STRUCTURAL STEEL, FABRICATED AND DELIVERED	727,900 LBS.
STRUCTURAL STEEL, ERECTION	727,900 LBS.
BRONZE OR COPPER-ALLOY BEARING AND EXPANSION PLATES, DELIVERED	1,350 LBS.
BRONZE OR COPPER-ALLOY BEARING AND EXPANSION PLATES, PLACING	1,350 LBS.
REINFORCING STEEL, DELIVERED	225,000 LBS.
REINFORCING STEEL, PLACING	225,000 LBS.
SHEAR CONNECTORS, DELIVERED AND PLACED	1 LUMP SUM
STEEL H-BEAM PILES (42 LBS./FT.)	1,000 LIN. FT.
FRENCH DRAINS	210 CU. YDS.
ALUMINUM RAILING	950 LIN. FT.
SLOPE PAVING FOR BRIDGES	1,380 SQ. YDS.

DESIGN	CHECK	D.S.	BRIDGE NO.
DRAWN E.K.	APPROVED C.J.M.	W.A.H.	SURVEY PLOT
STATE HIGHWAY COMMISSION			
INTERSTATE #95			
OVER			
STILLWATER AVENUE			
IN THE CITY OF			
BANGOR			
PENOBSCOT COUNTY			
KEY PLAN & PROFILES			


SHEET 1 OF 10 AUGUSTA, MAINE

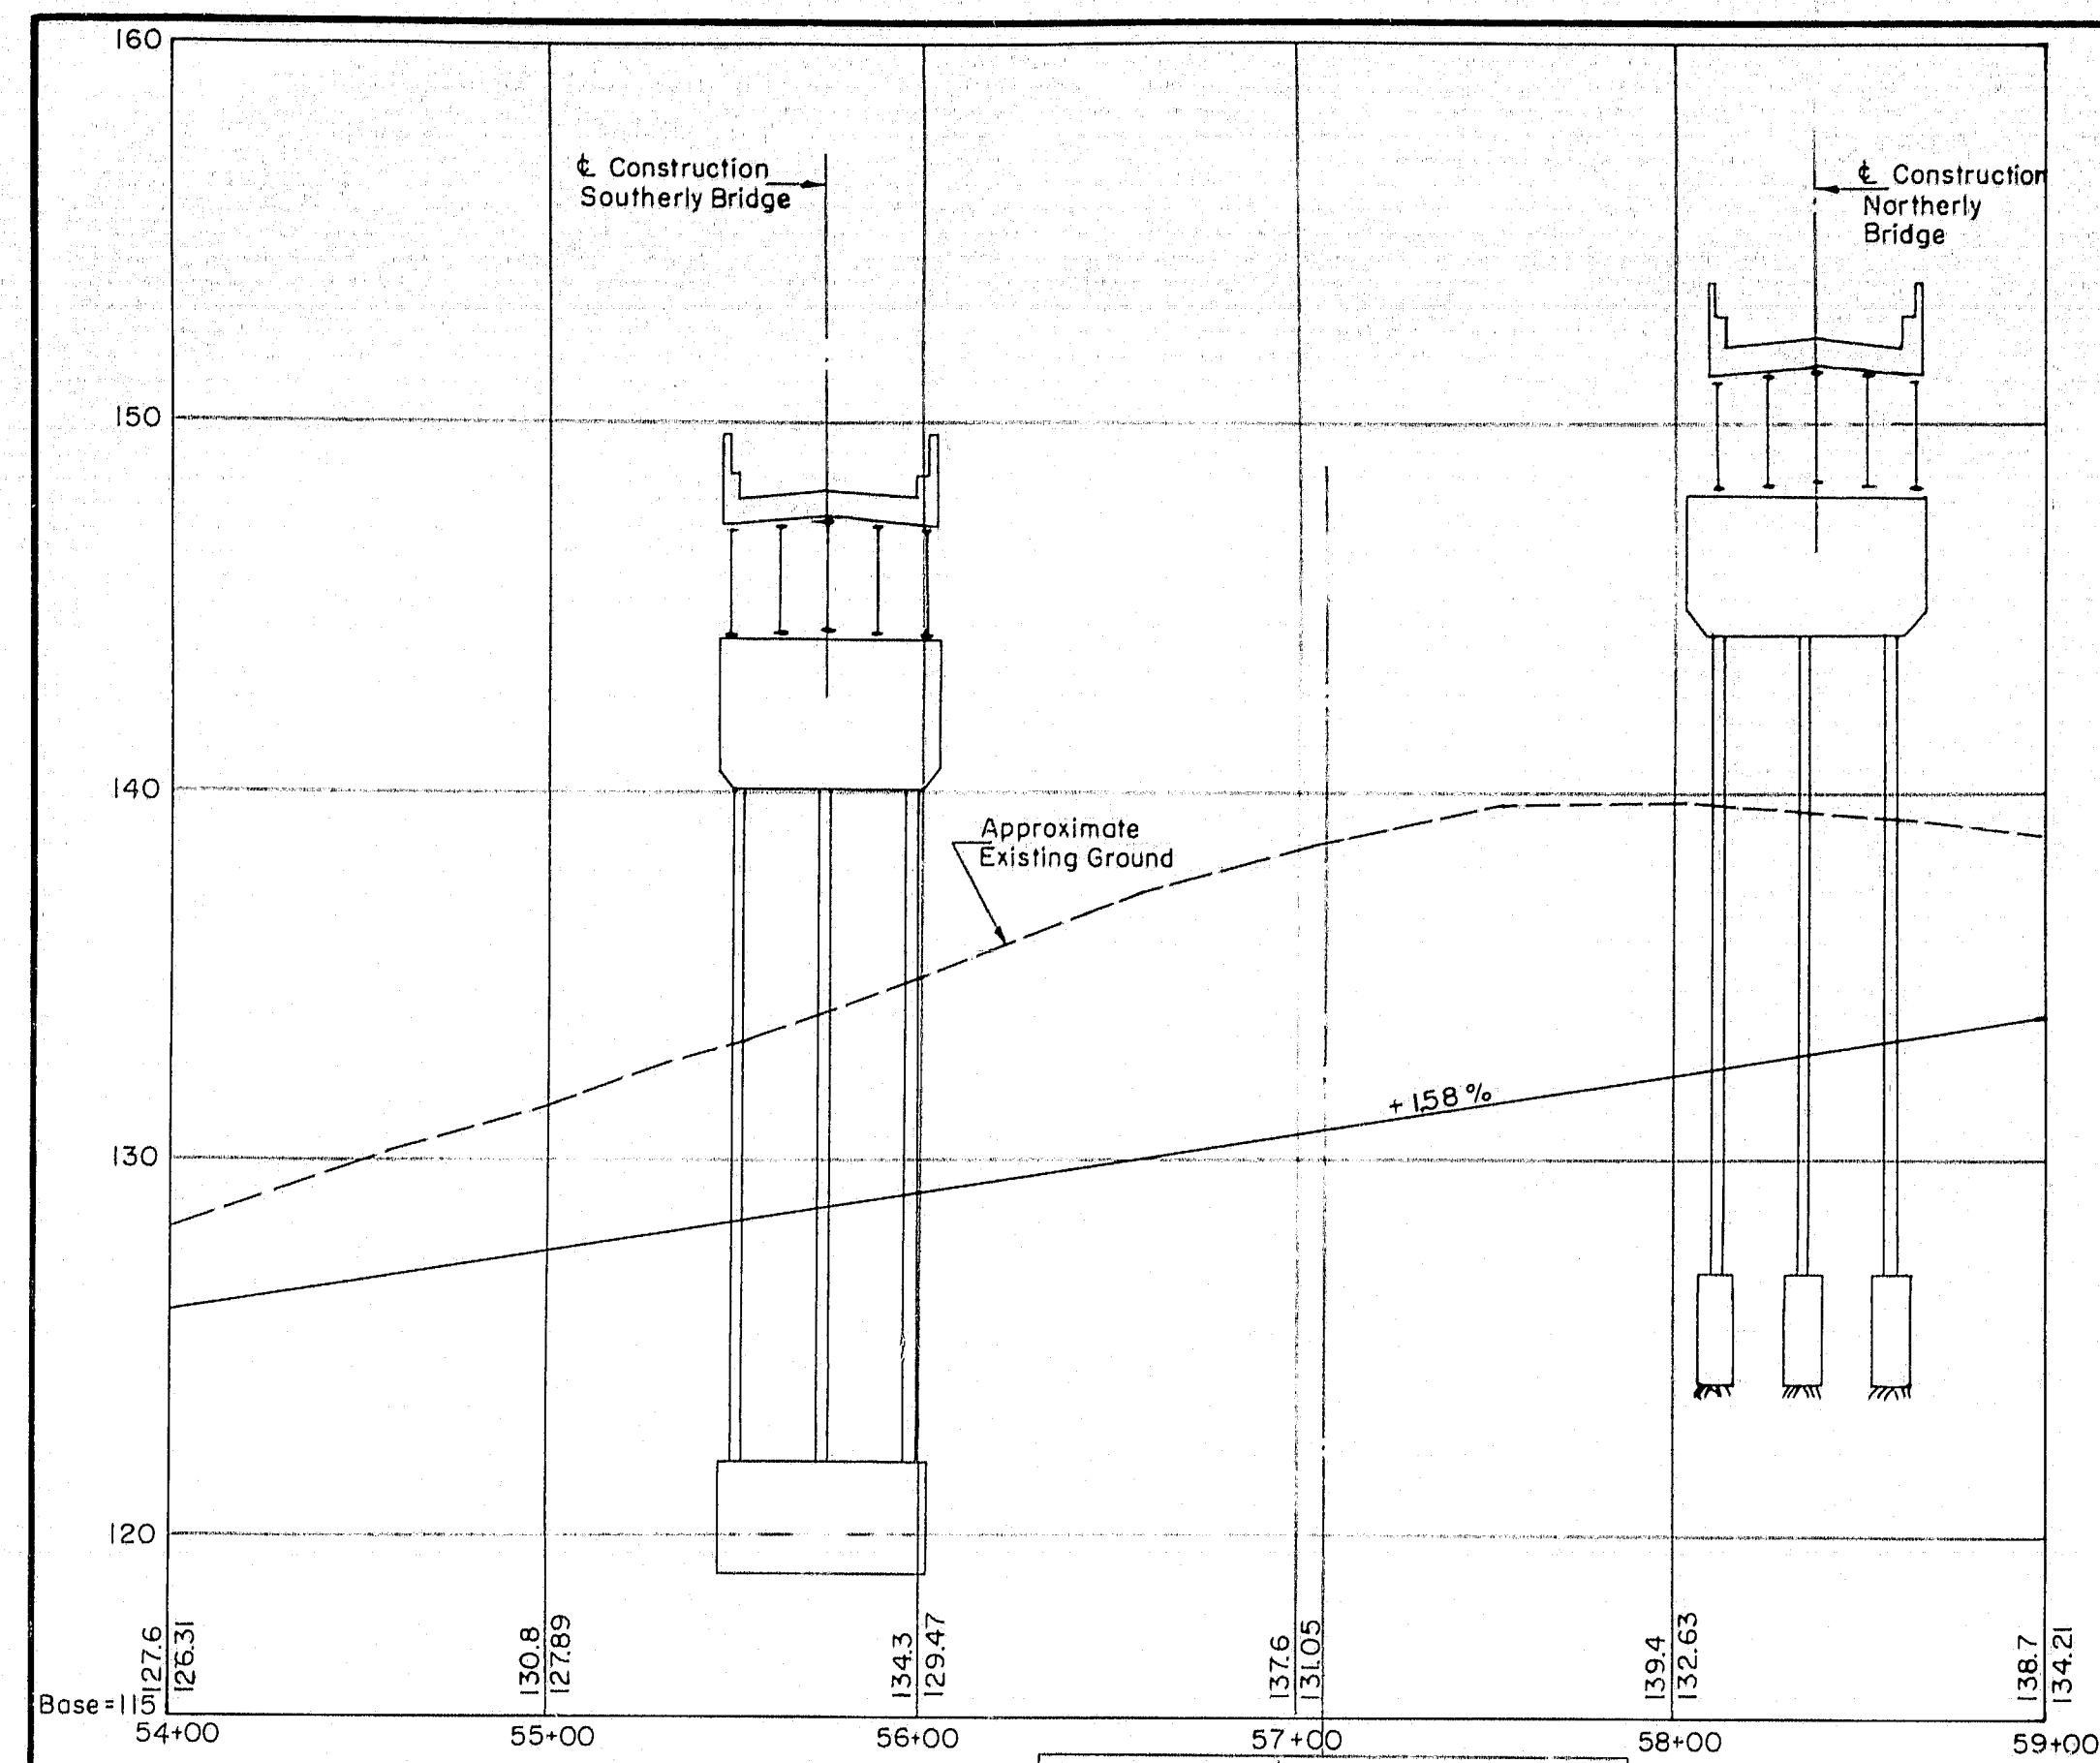


PROFILE ALONG STILLWATER AVENUE

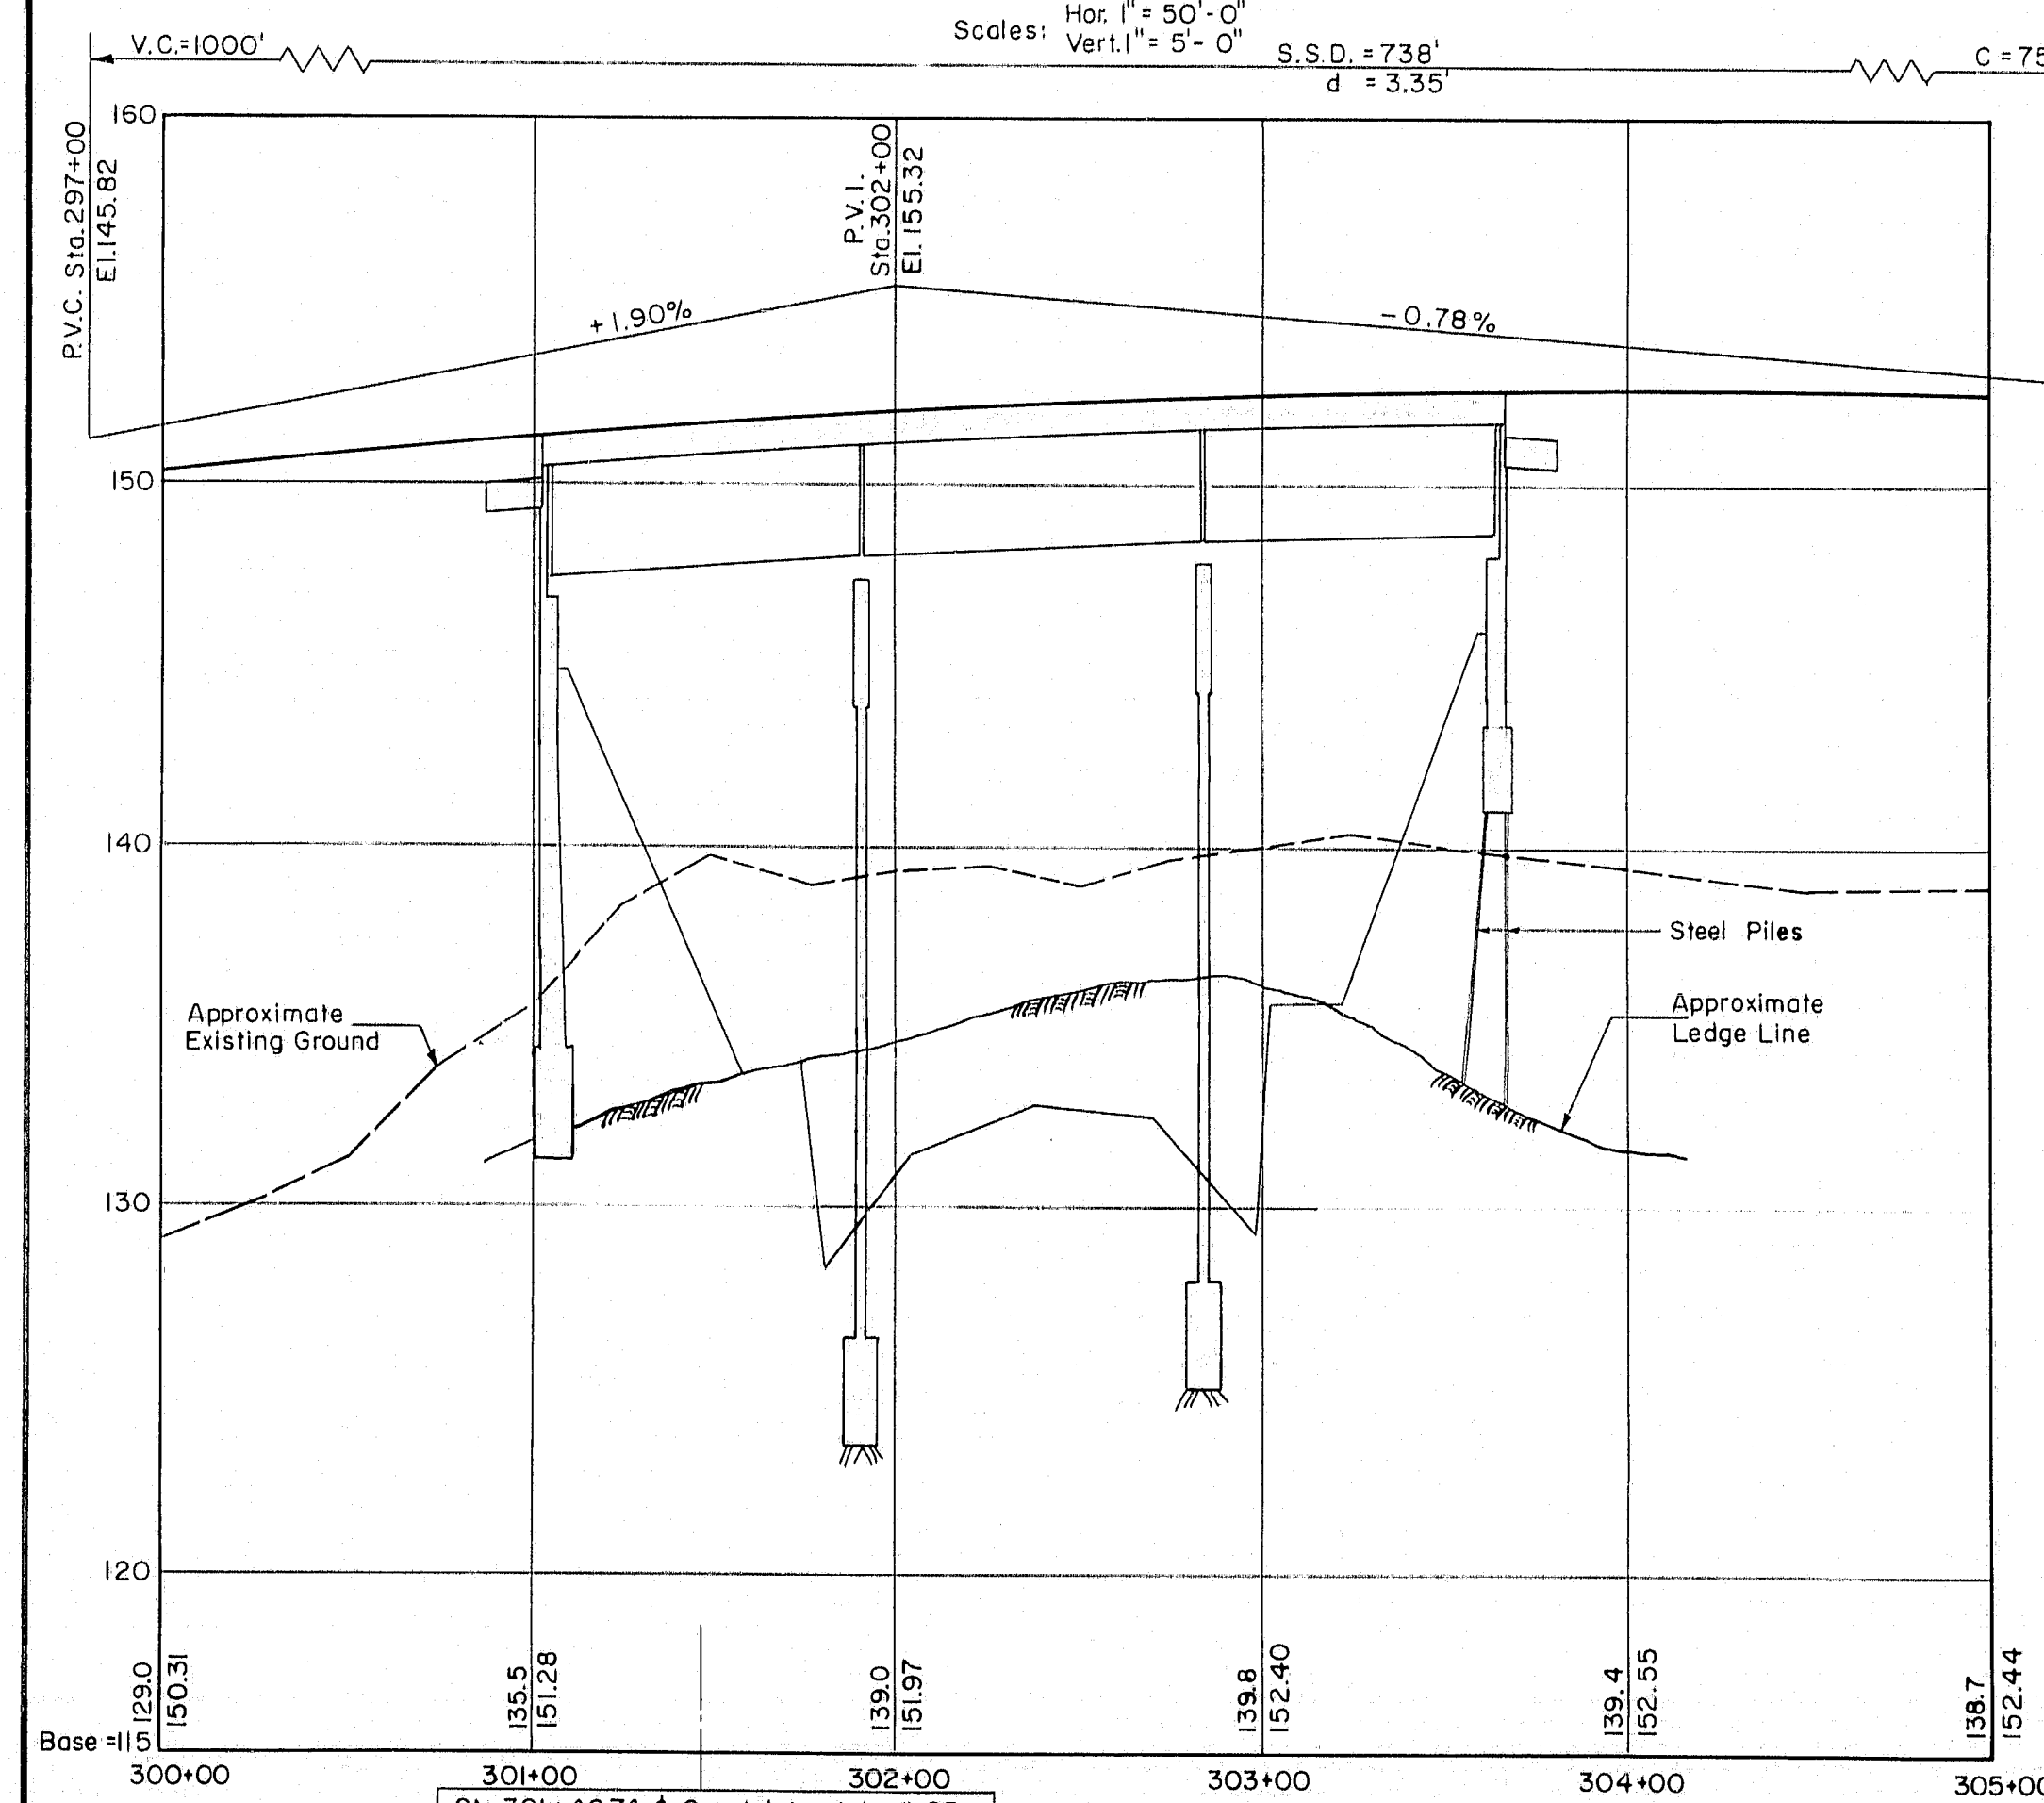

PROFILE ALONG INTERSTATE #95 NORTHERLY BRIDGE

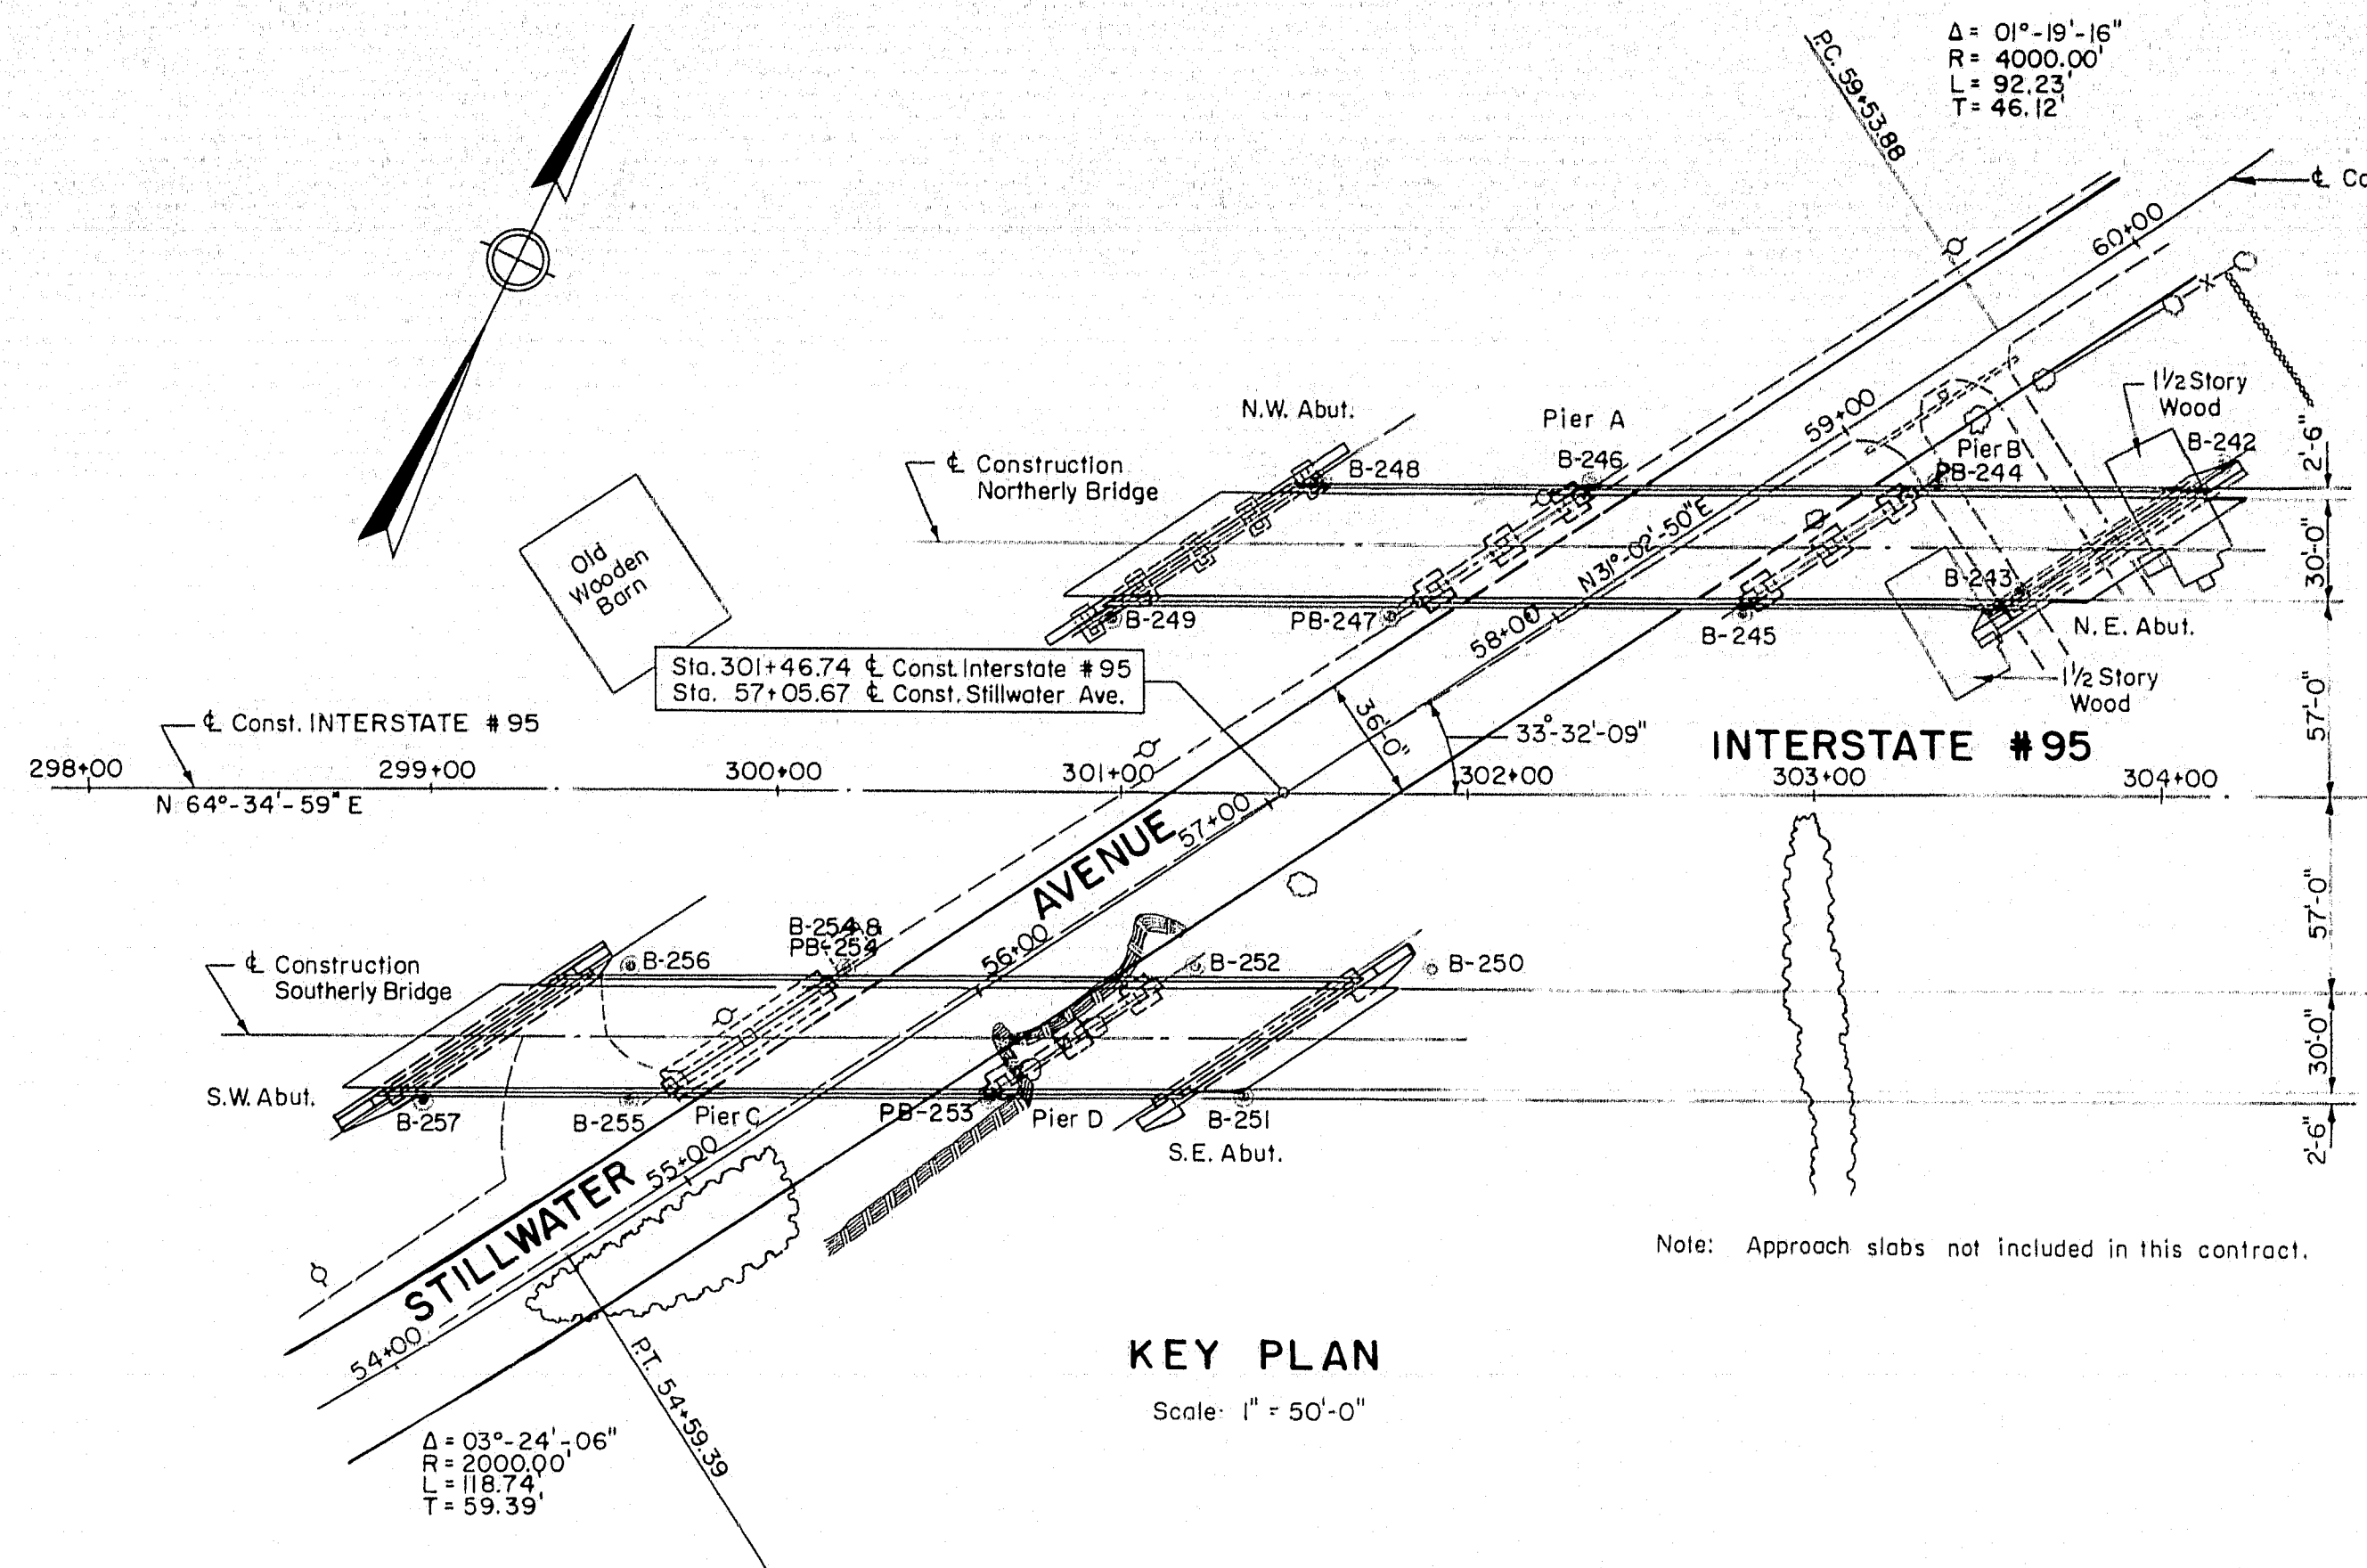


KEY PLAN


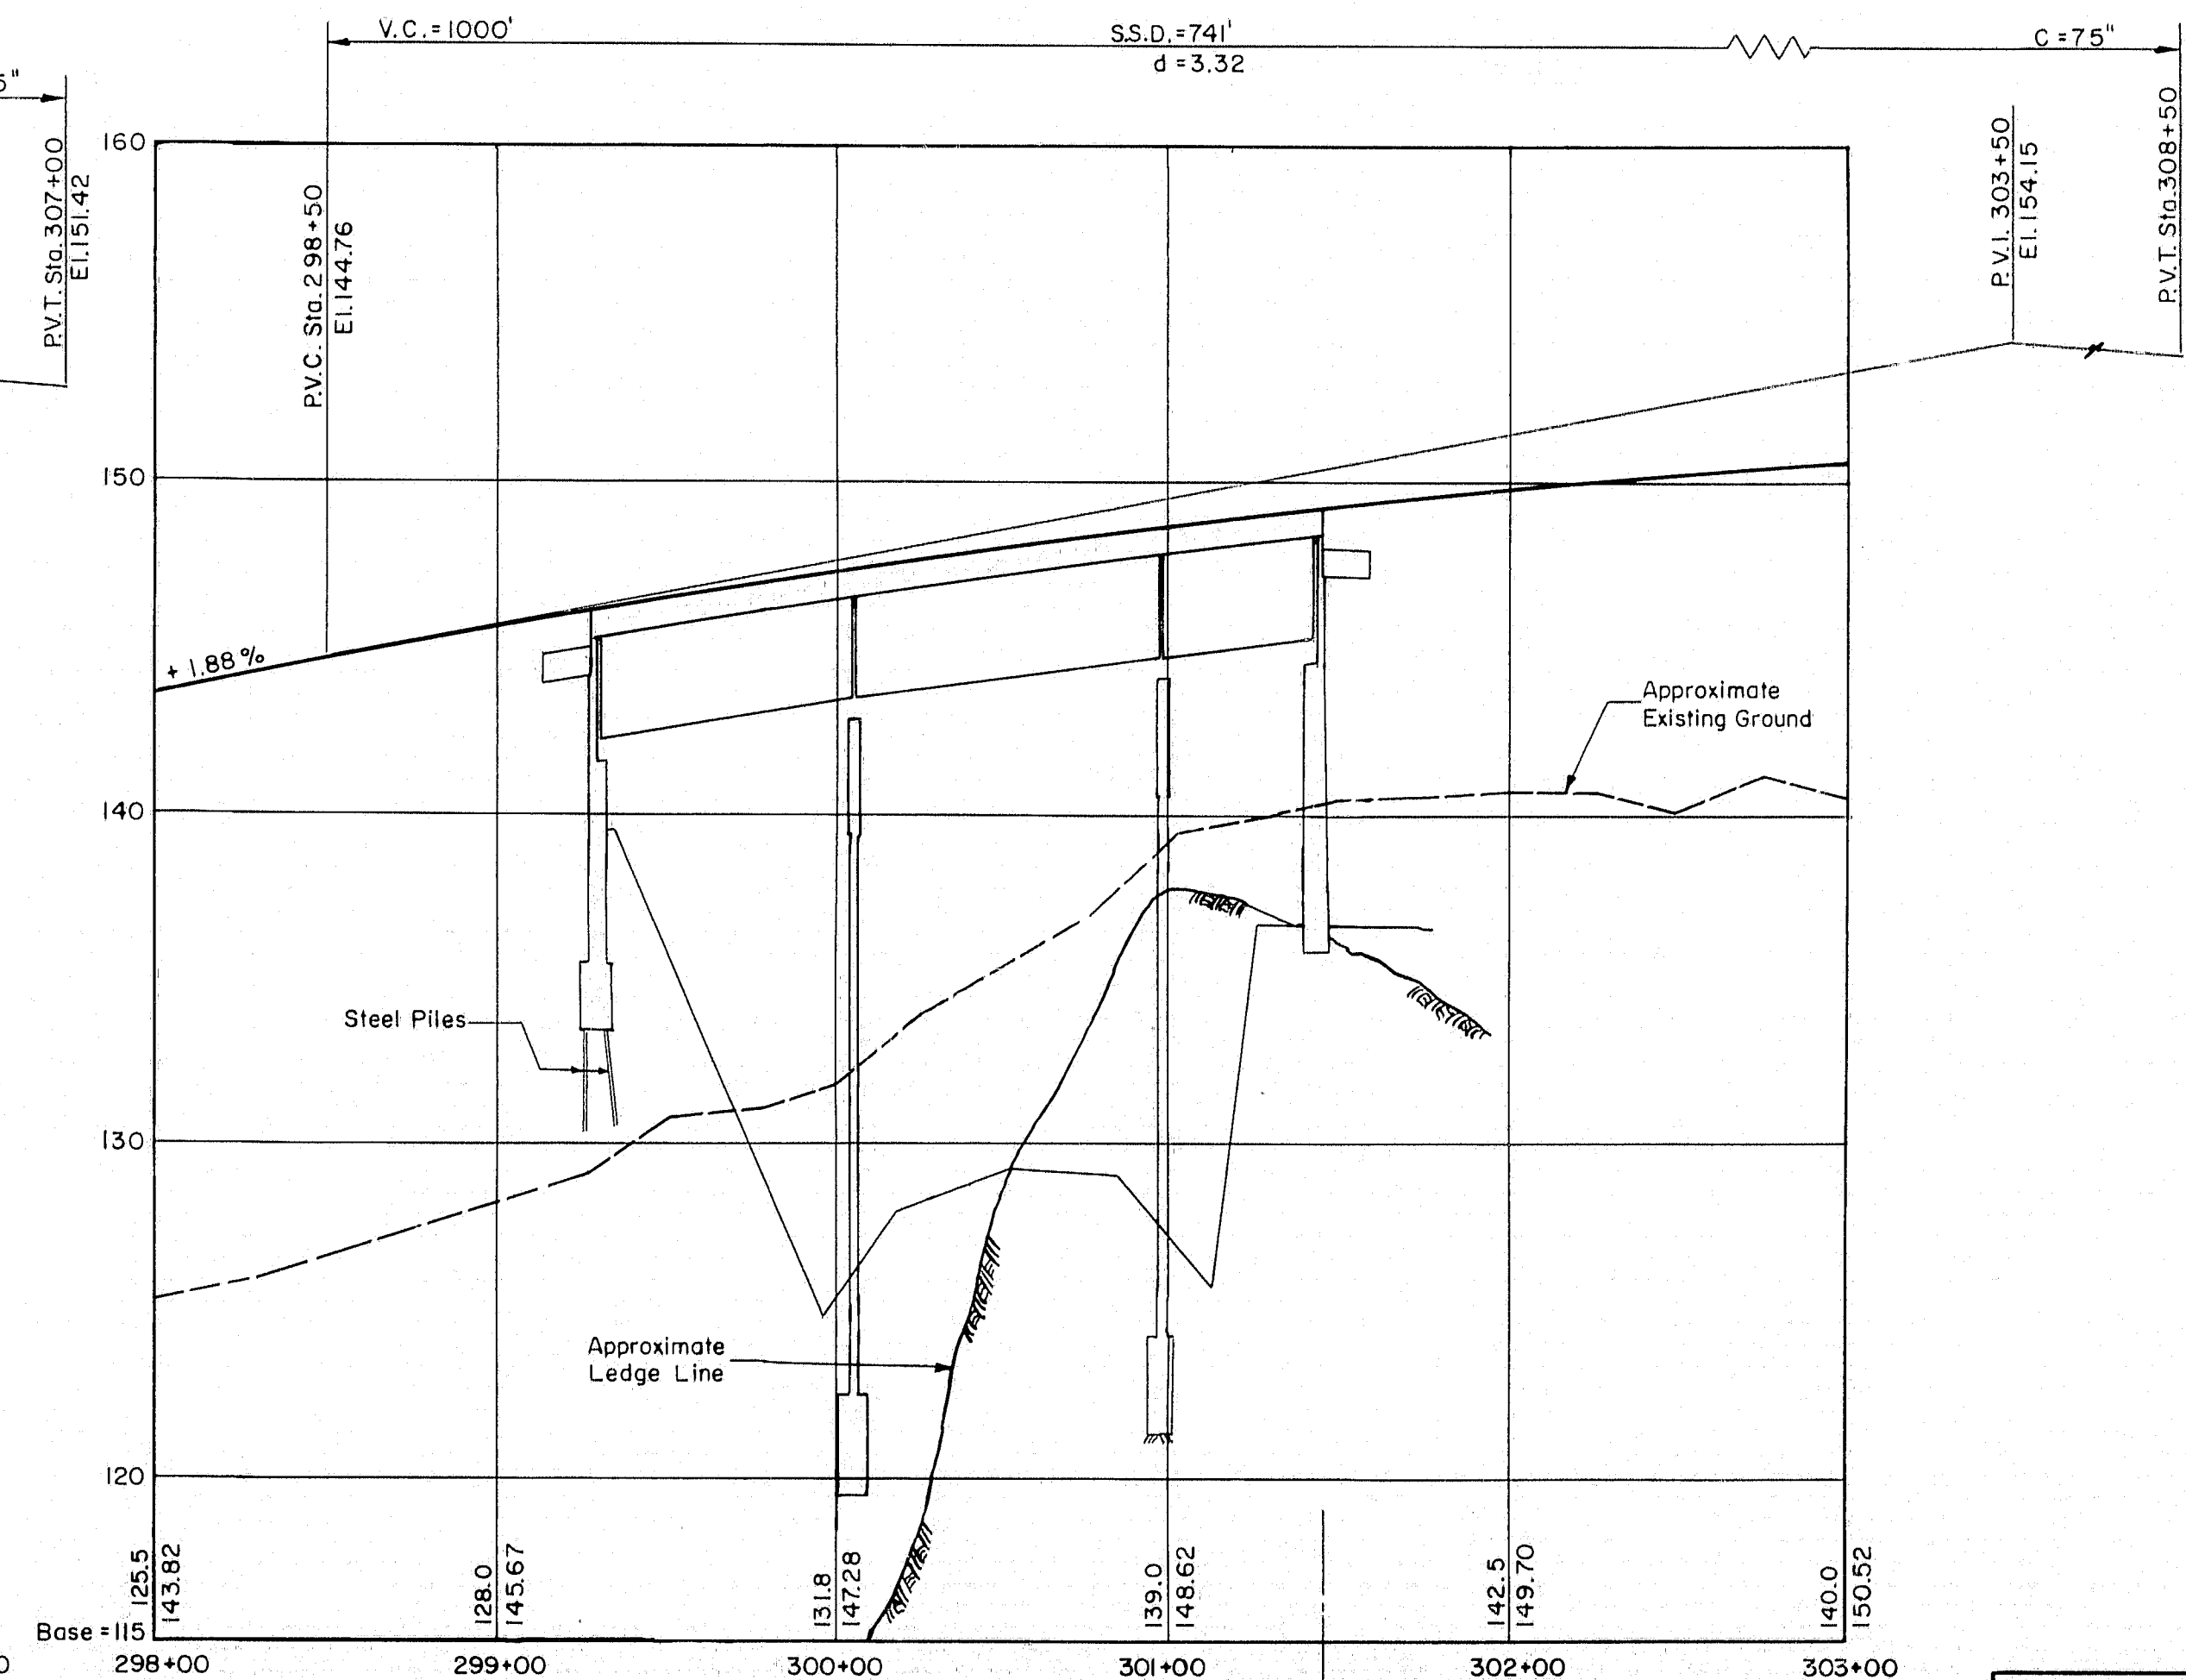


PROFILE ALONG INTERSTATE #95 SOUTHERLY BRIDGE


APPROVED BY *Wm. A. Henderson* DATE 7/25/58  
THE CLARKESON ENGINEERING CO., INC.  
CONSULTING ENGINEERS  
BOSTON MASSACHUSETTS

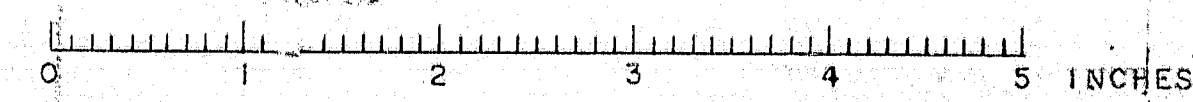



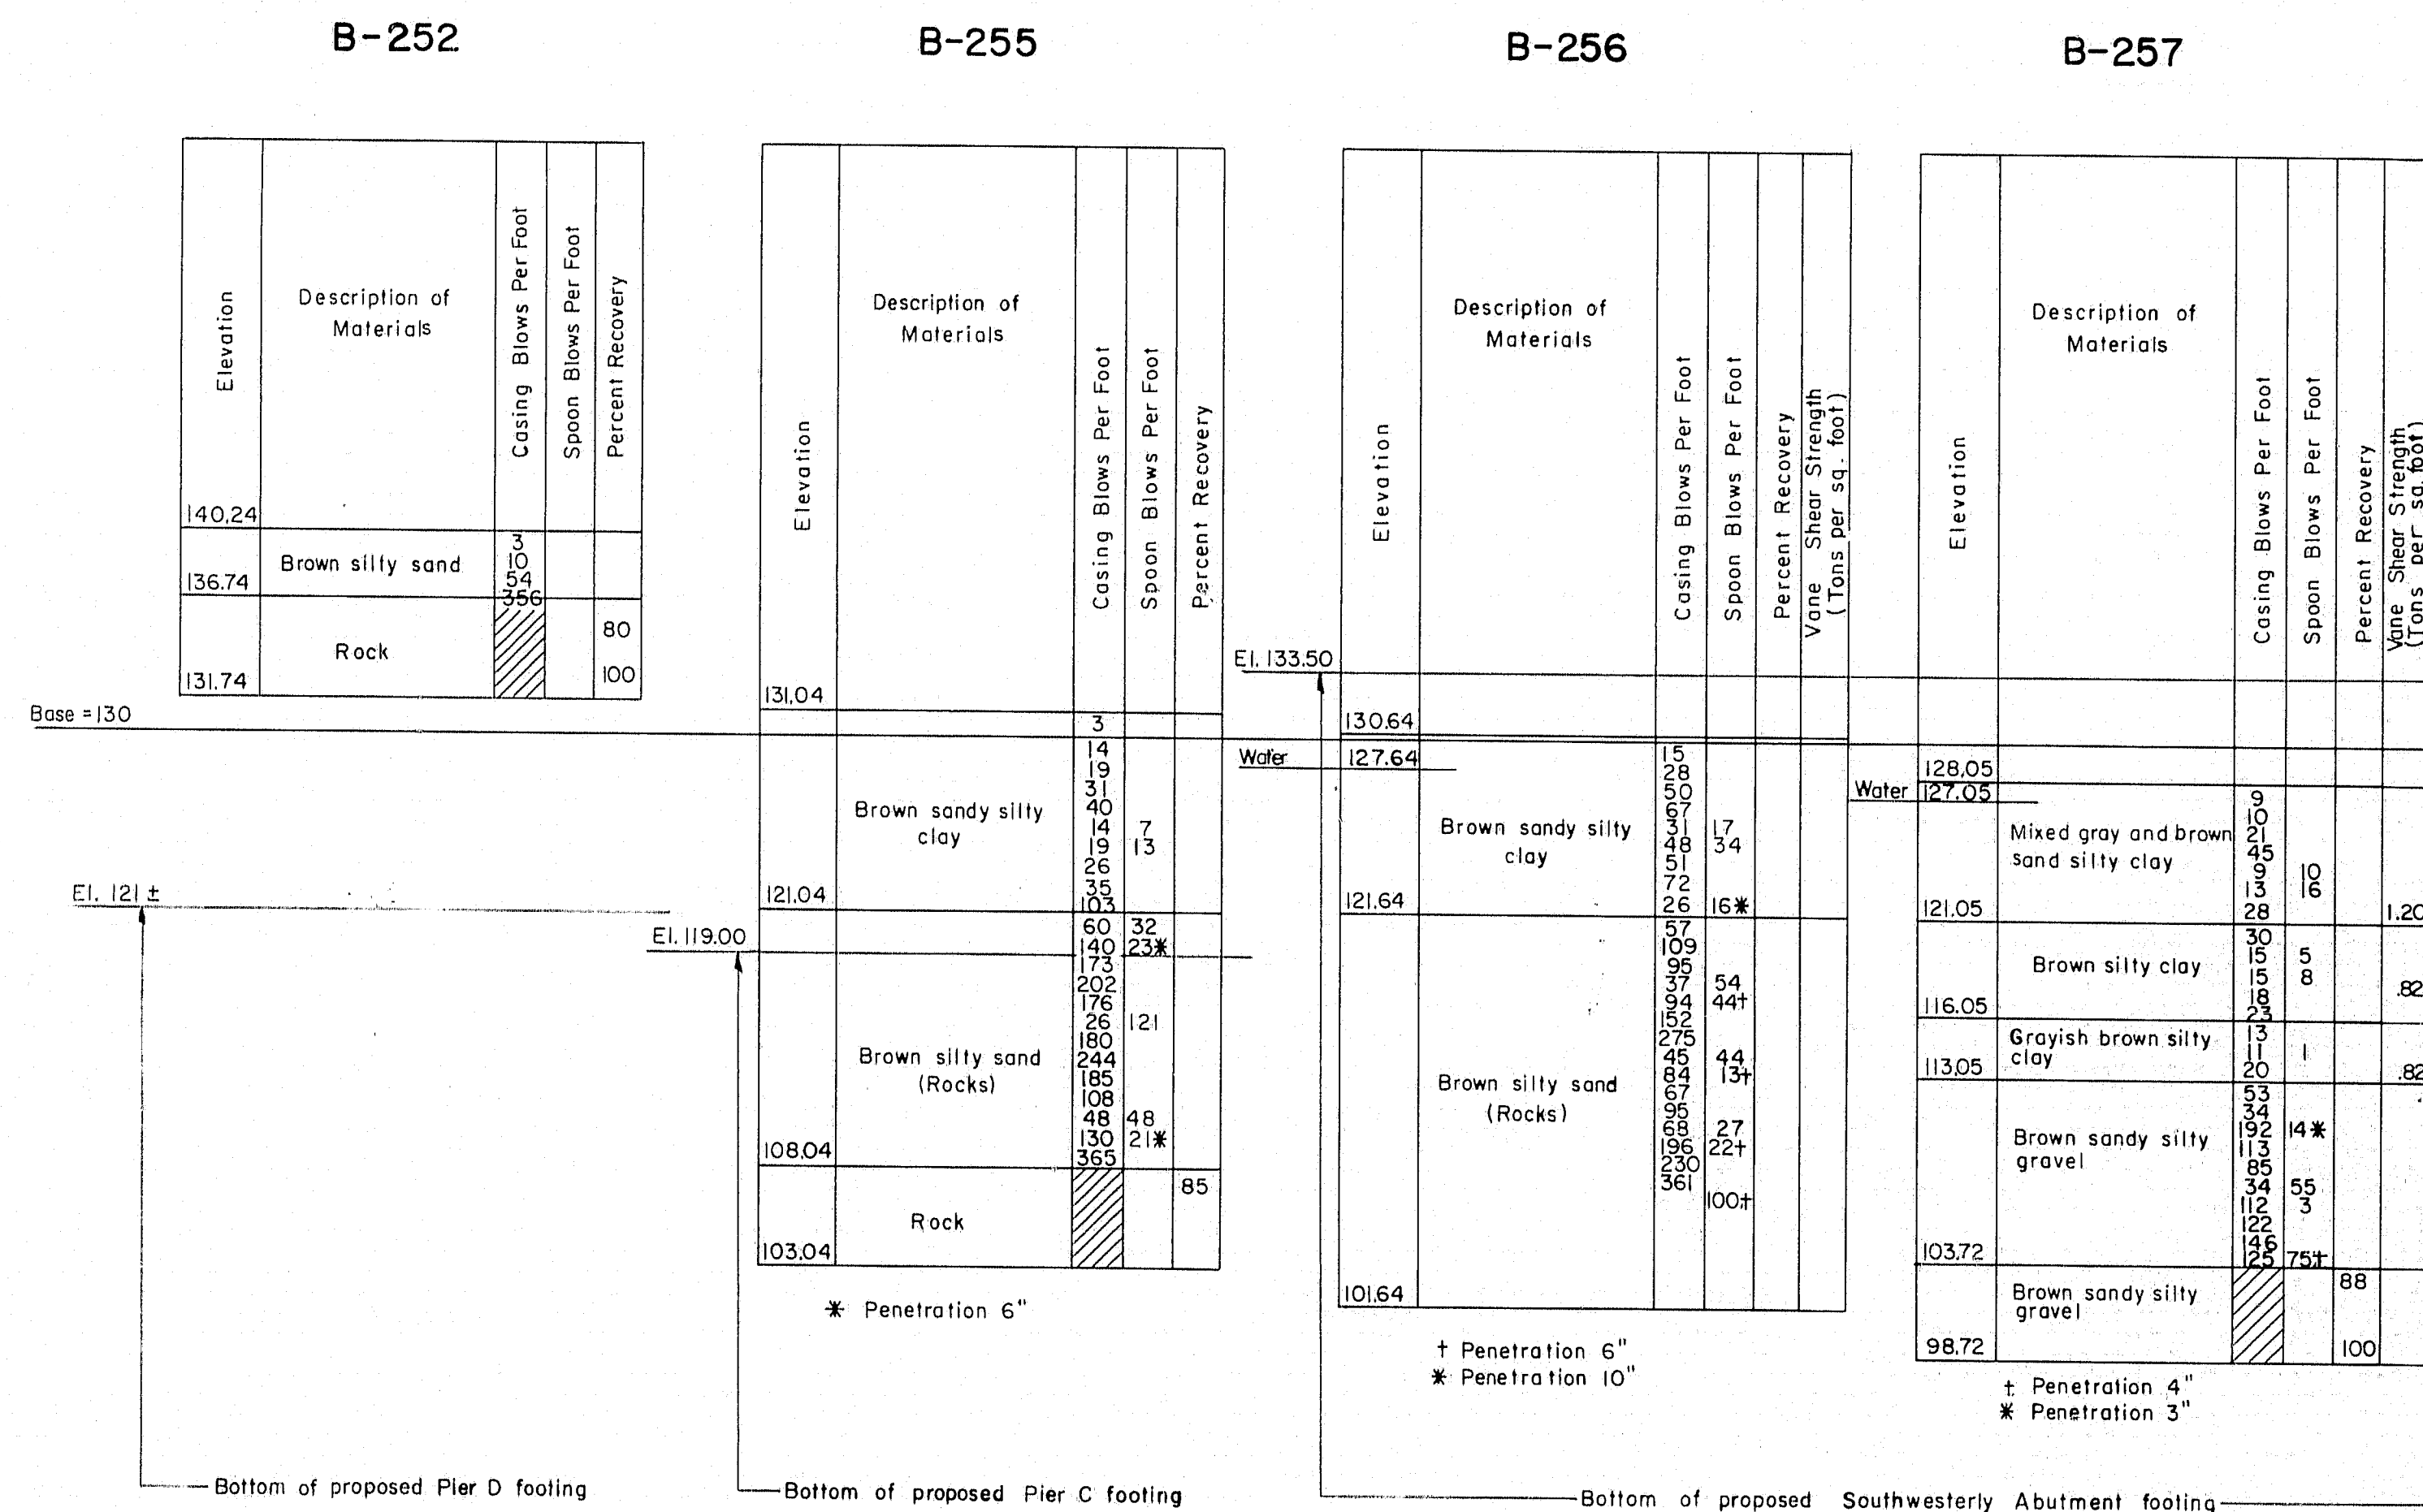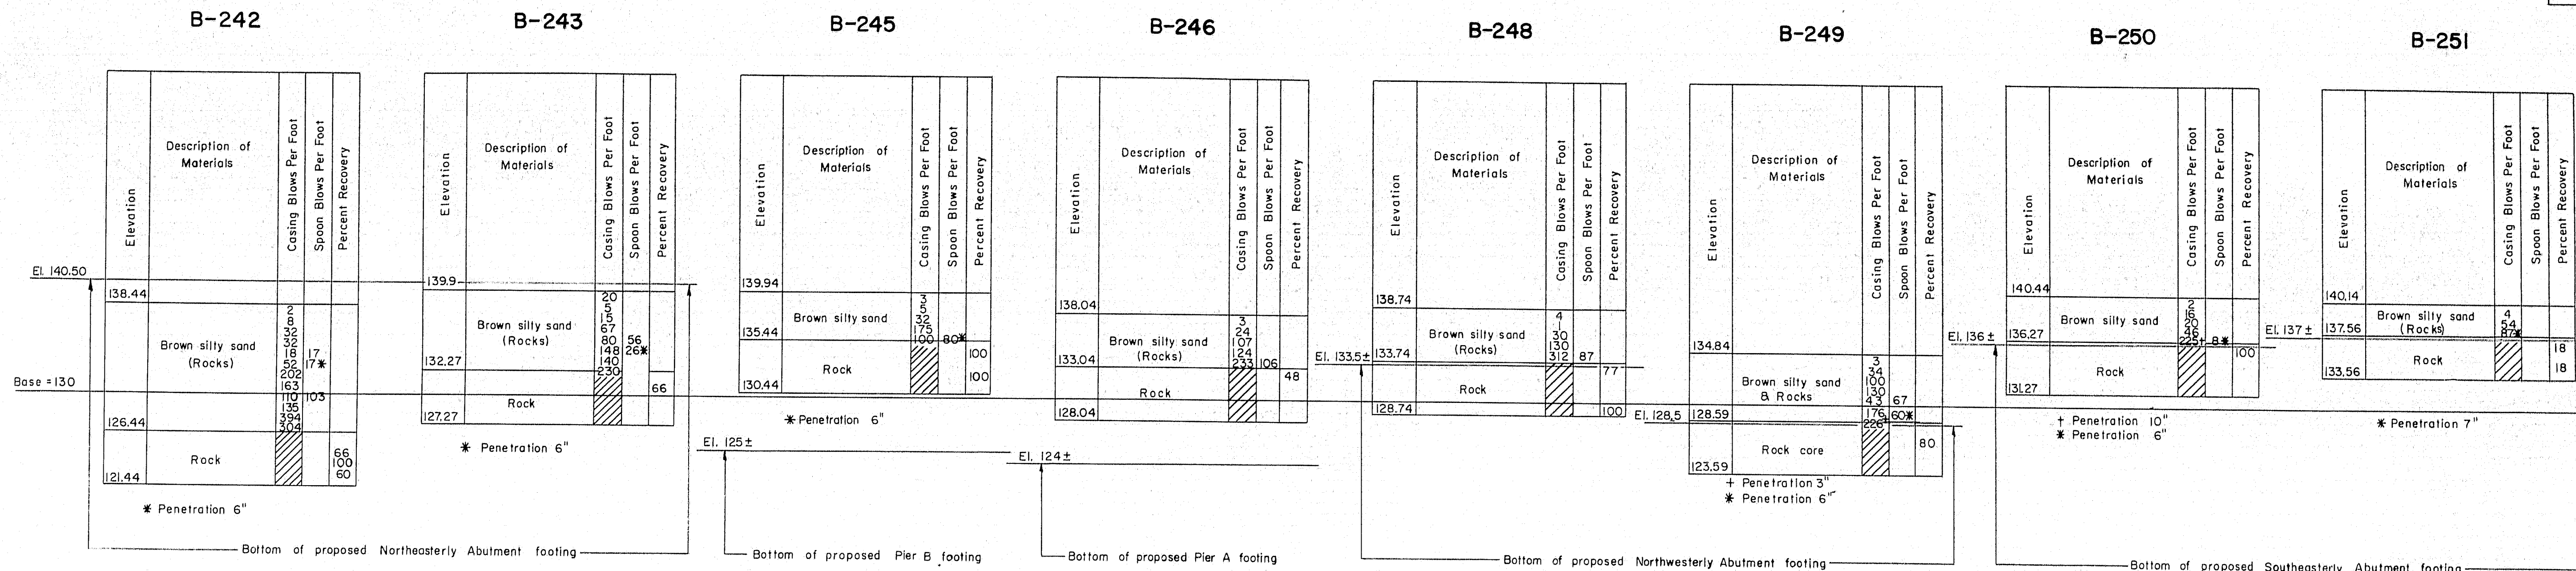

B-254

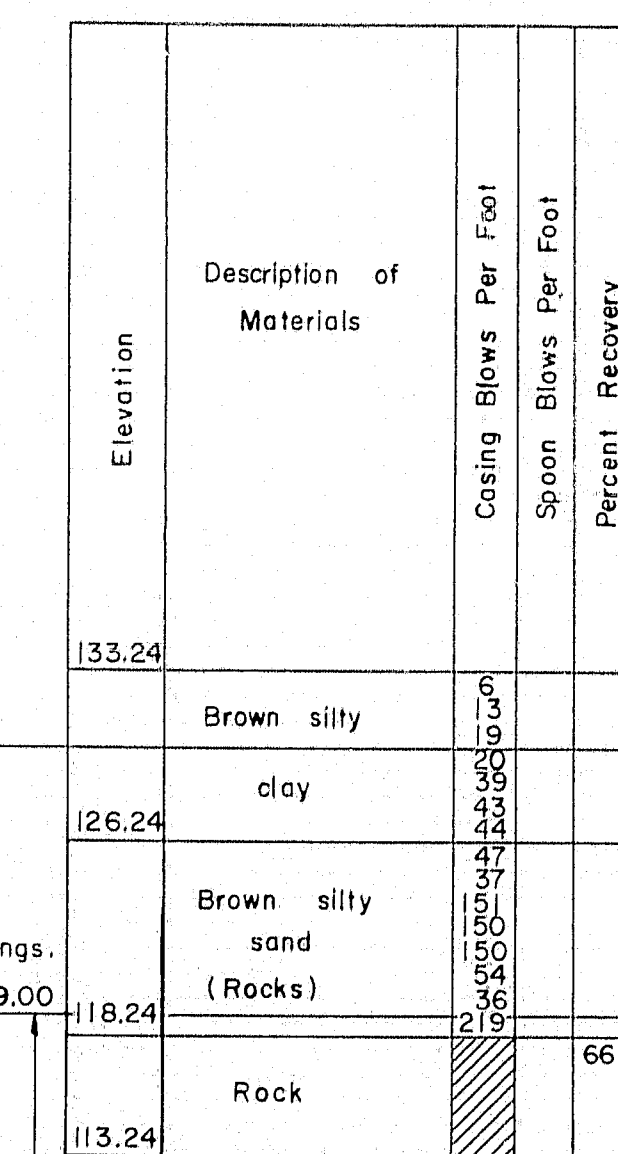

Punching No.	Ground Elevation	Depth	Remarks
PB253	133.64	0'-1'	Refusal Ledge out crop
PB254	133.24	0'-1' 1'-7' 7'-7.5' 7.5'-7.8'	Hand Hammer 225 blows 200 blows Refusal Probably ledge
PB-247	138.74	0'-15' 1.5'-4.0'	Hand Hammer Refusal Probably ledge
PB244	141.07	0'-4'	Refusal

Punchings were driven to refusal surface using 1" rods and a 35# hammer.

### BORING LOG

Scale: 1/8" = 1'-0"

- NOTES: 1. Location of borings are shown on the Key Plan thus: ● B-242, location of punchings are shown thus: ● PB253.  
2. Borings and punchings are taken for the purpose of design and show condition of boring points only, but do not necessarily show nature of materials to be encountered during construction.  
3. The Contractor is to form his own opinion of the character of the materials, and to make his own interpretation of the borings and punchings.  
4. The Engineer does not warrant the findings as being accurate or complete.  
5. Figures in boring columns indicate blows per foot on 2 1/2" casing or 1" spoon produced by a 356 # hammer with a fall of 14" and 12" respectively.  
6. Borings and punchings were taken by the Maine State Highway Commission during the months of April and May, 1958.

### THE CLARKESON ENGINEERING CO., INC.

DESIGN	CHECK H. P.	BRIDGE NO.
DRAWN E.K.	APPROVED W.A.H. C.J.M.	SURVEY PLOT

STATE HIGHWAY COMMISSION  
INTERSTATE #95




OVER  
STILLWATER AVENUE  
IN THE CITY OF  
BANGOR  
PENOBSCOT COUNTY  
BORING DATA

SHEET 2 OF 10 AUGUSTA, MAINE



B.P.R. REG. NO.	STATE	PROJECT NO.	SHEET NO.	TOTAL SHEETS
1	MAINE	I-95-9(6)	14	35

# BANGOR INTERSTATE

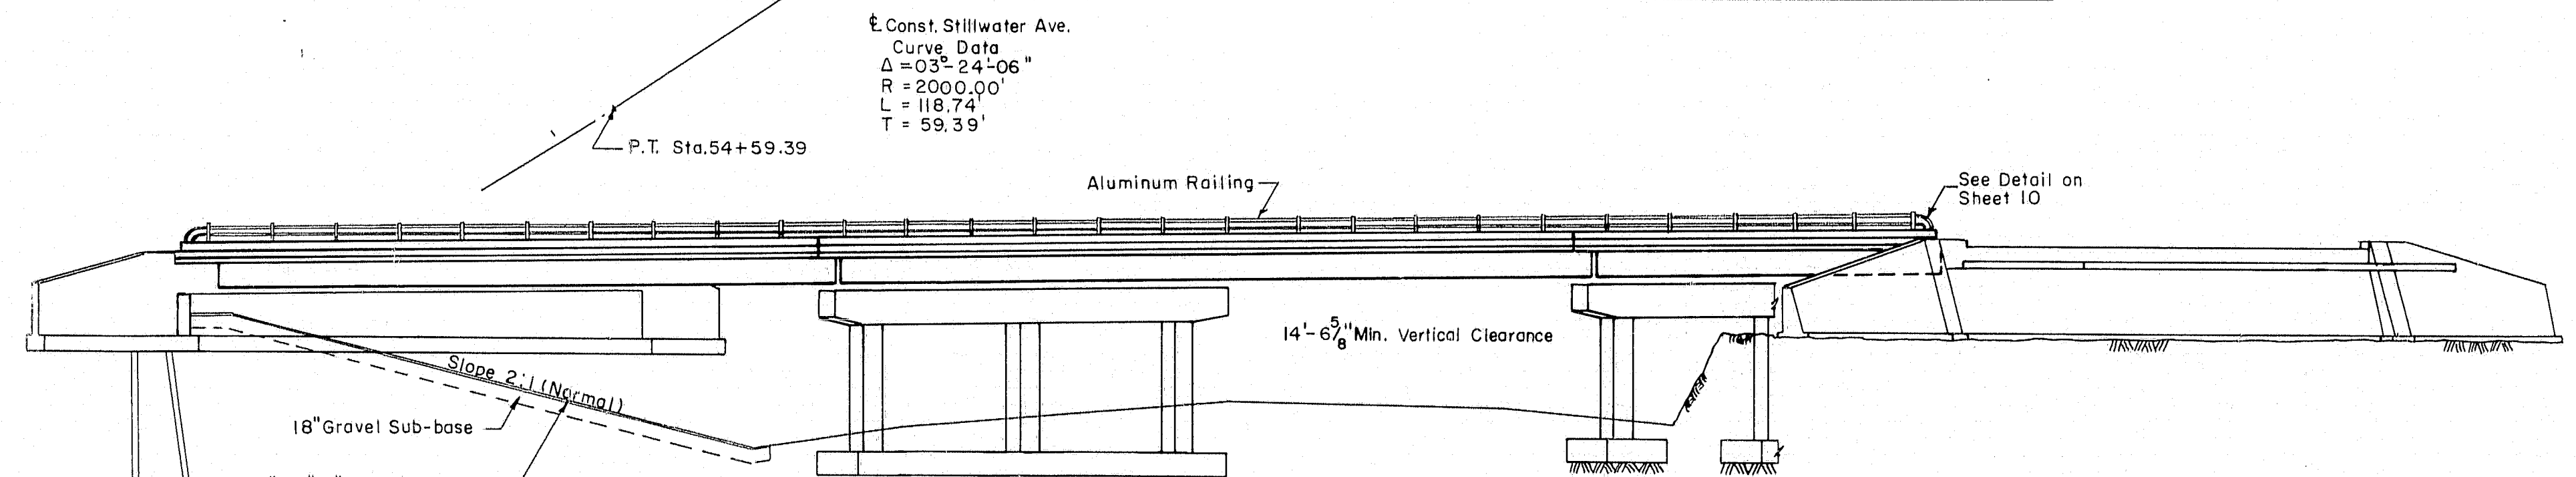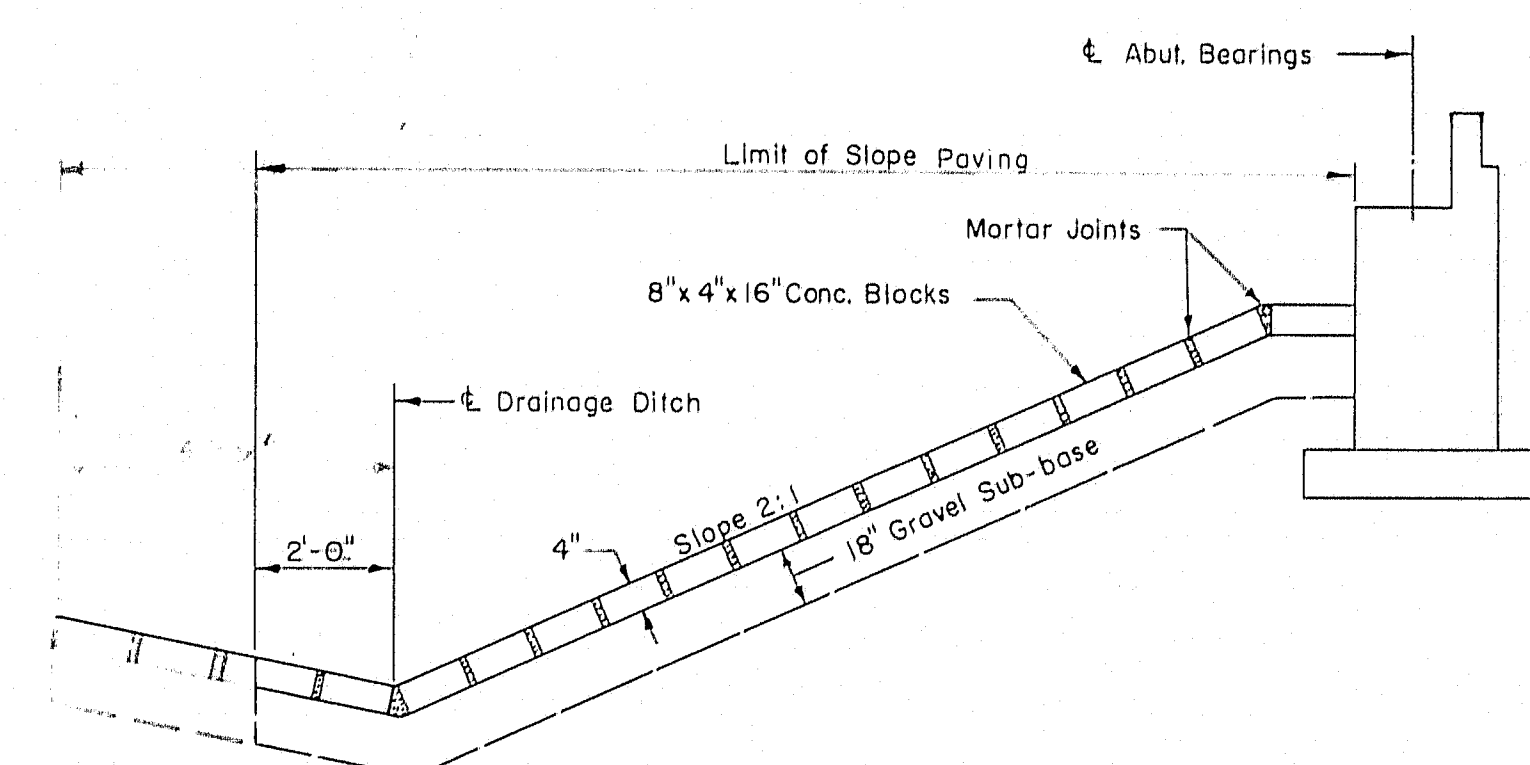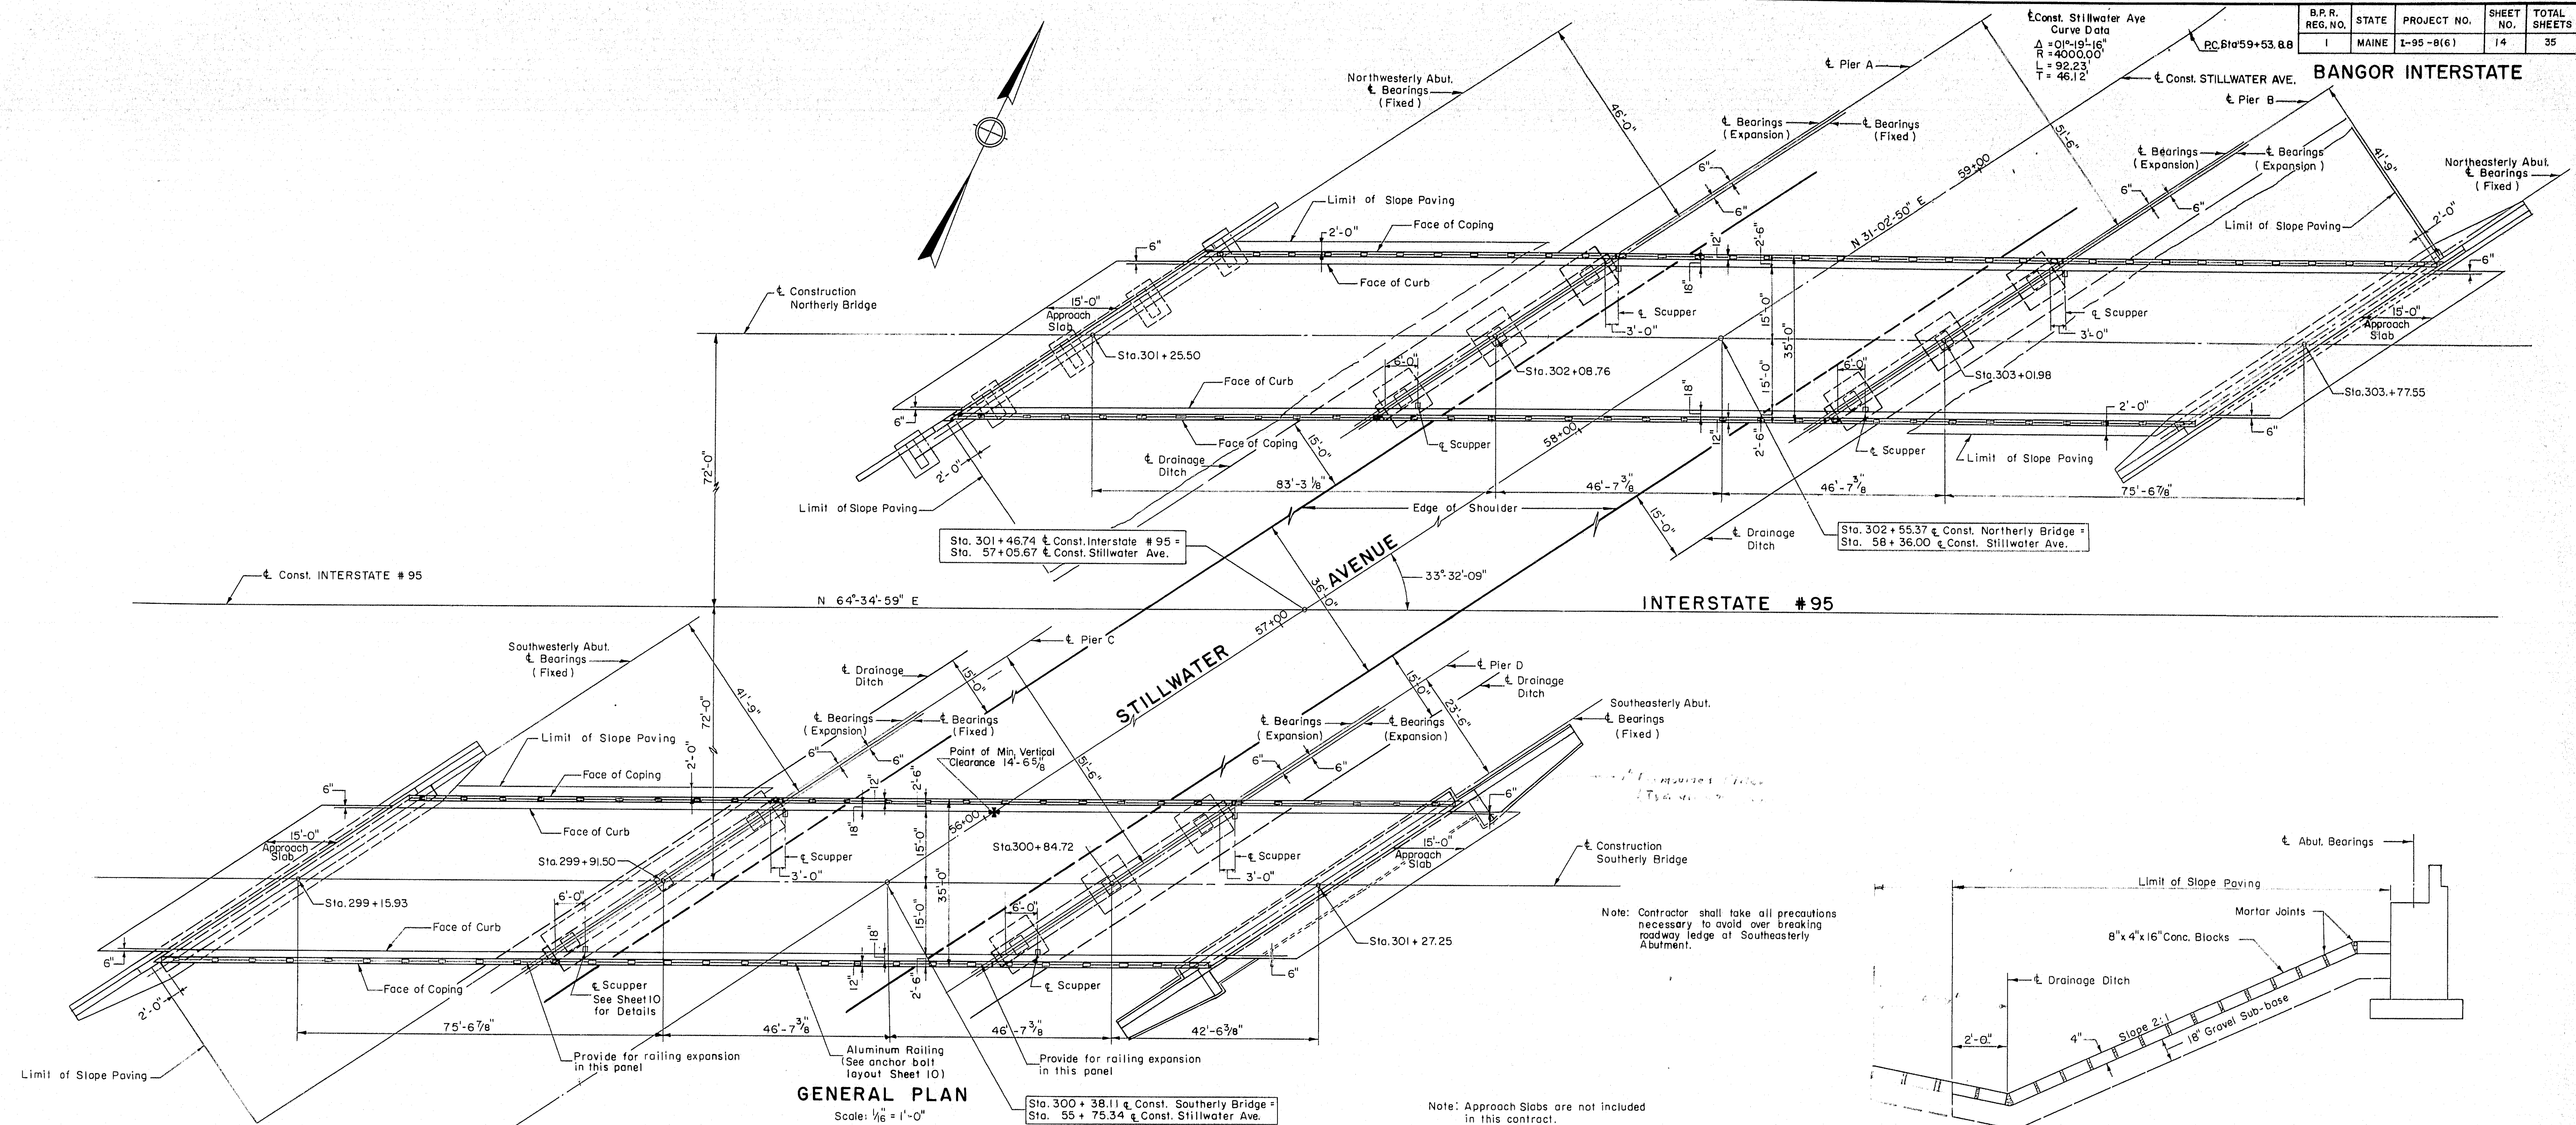

THE CLARKSON ENGINEERING CO., INC.			
DESIGN J.T.	CHECK D.S.	BRIDGE NO.	SURVEY
DRAWN E.K.	APPROVED W.A.H.	PROJECT NO.	PLOT
STATE HIGHWAY COMMISSION			
INTERSTATE #95			
OVER			
STILLWATER AVENUE			
IN THE CITY OF			
BANGOR			
PENOBSCOT COUNTY			
GENERAL PLAN & ELEVATION			
SHEET 3 OF 10 AUGUSTA, MAINE			

















# BANGOR INTERSTATE

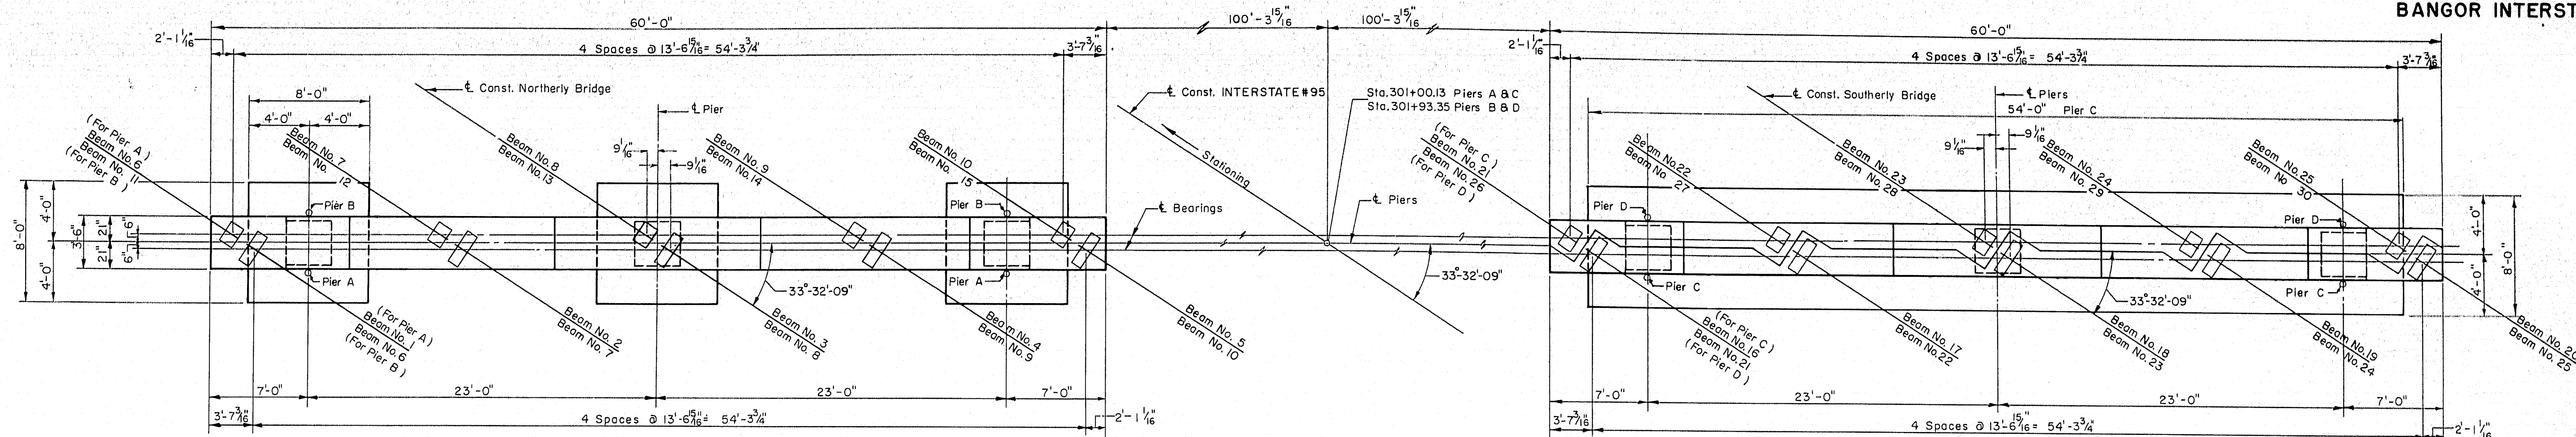


PLAN PIER A  
PLAN PIER B (SIMILAR)  
Scale: 3/16" = 1'-0"

PLAN PIER C  
PLAN PIER D (SIMILAR AS NOTED)  
Scale: 3/16" = 1'-0"


Note: Footings for Pier D  
Same as Piers A & B

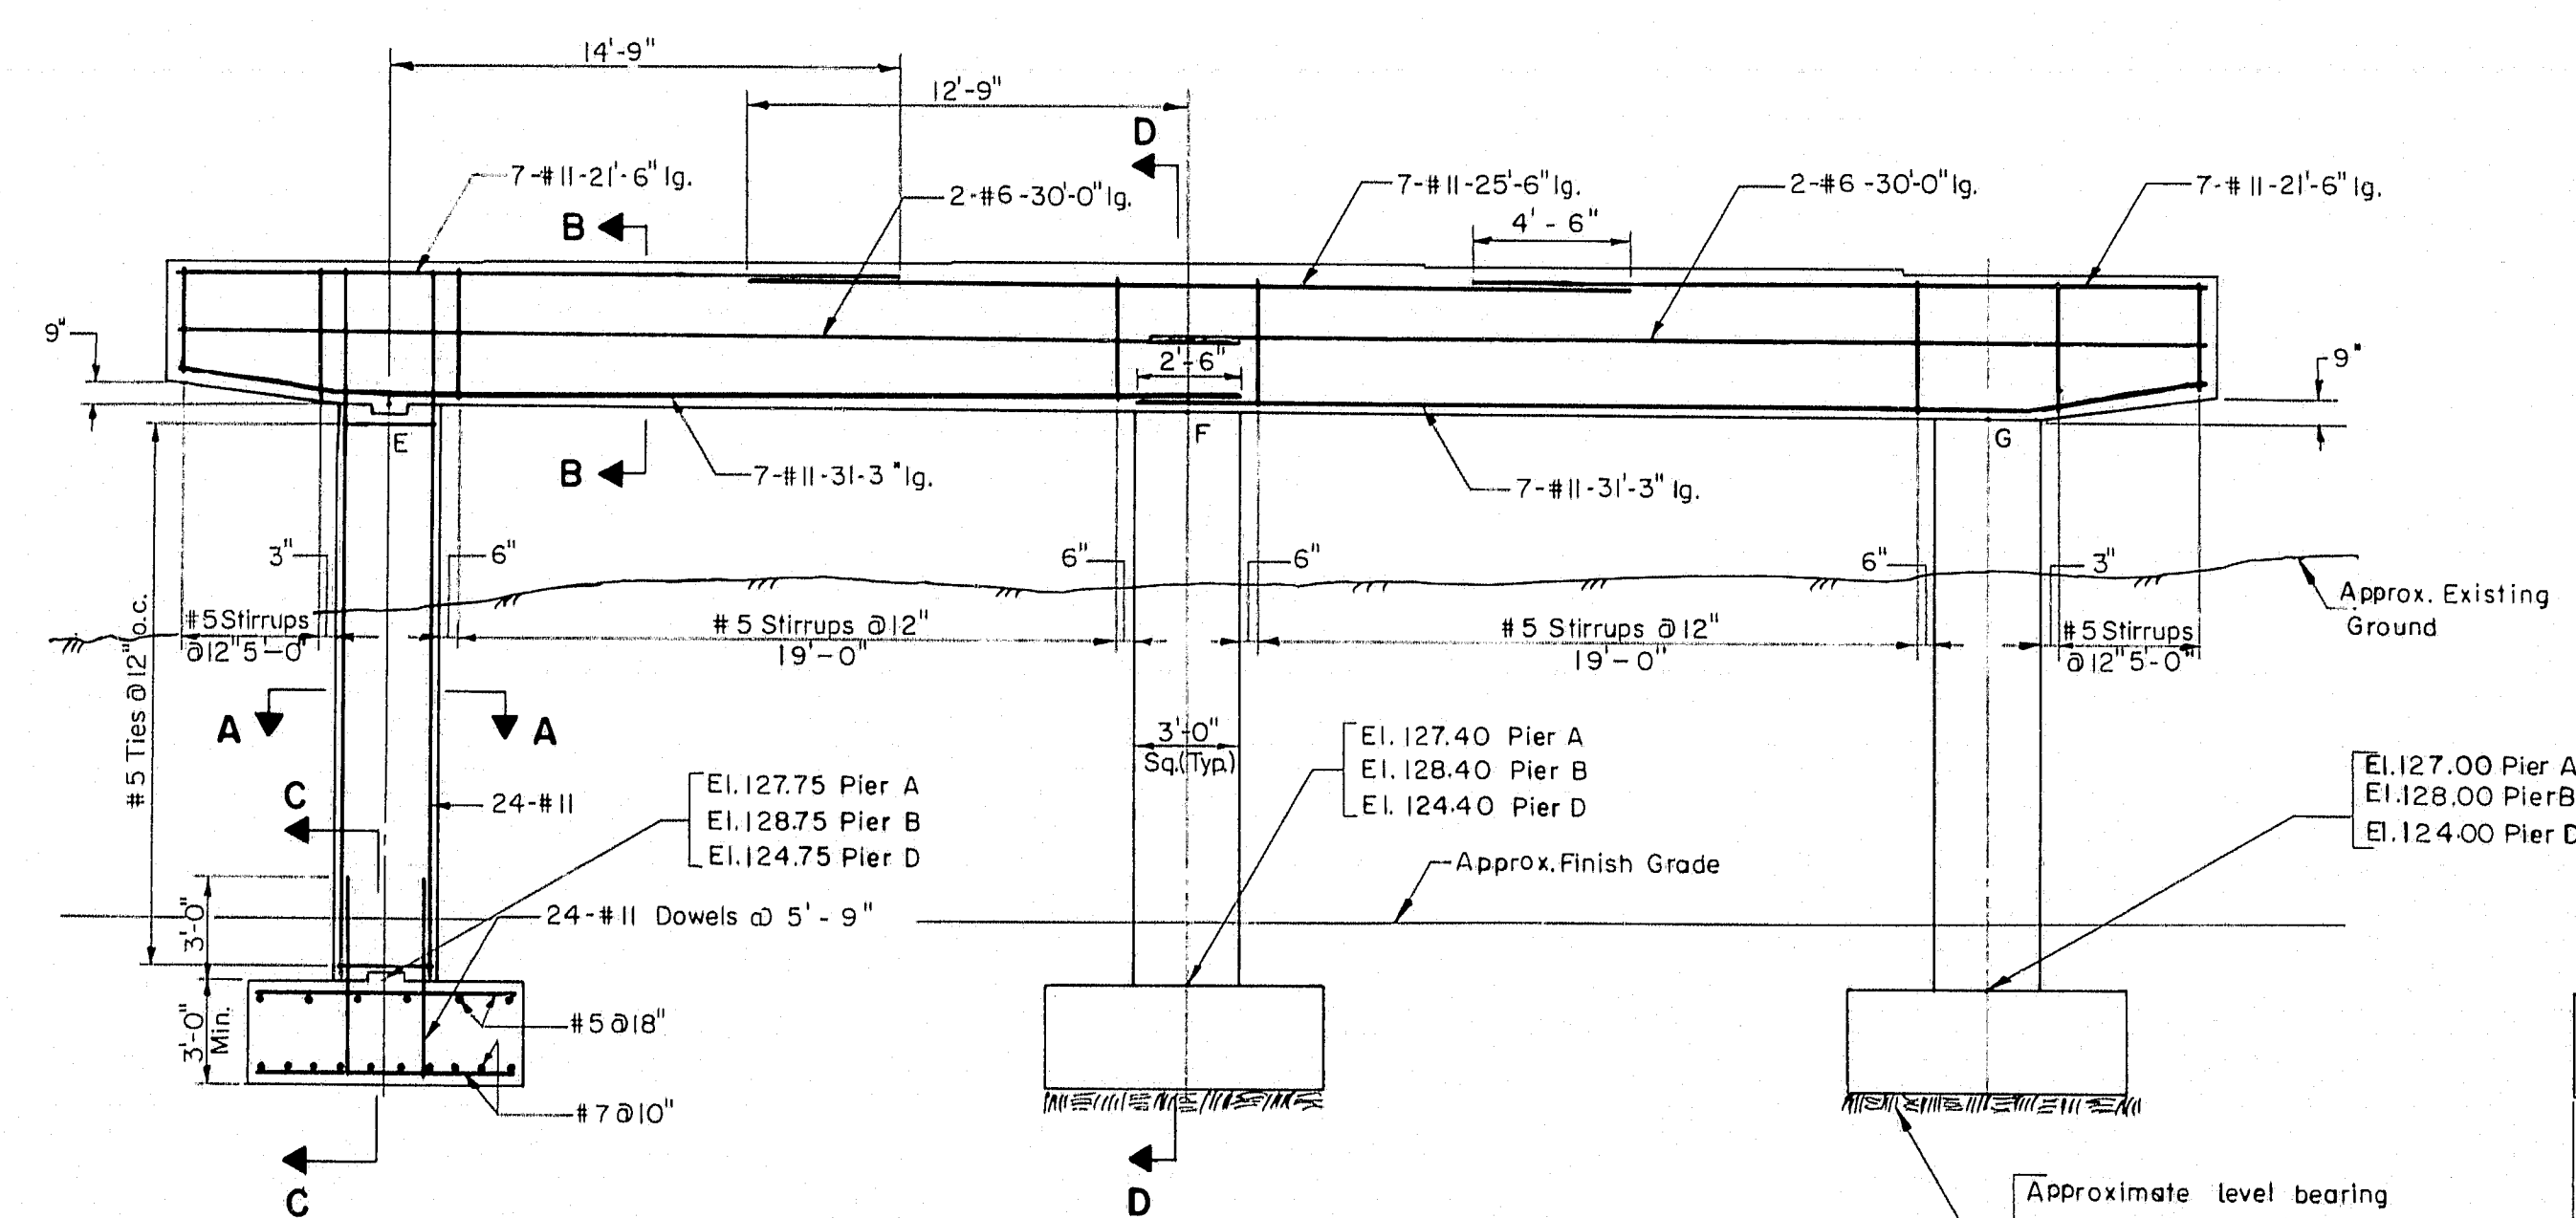

ELEVATION PIER A  
ELEVATION PIER B & D (SIMILAR)  
Scale: 3/16" = 1'-0"

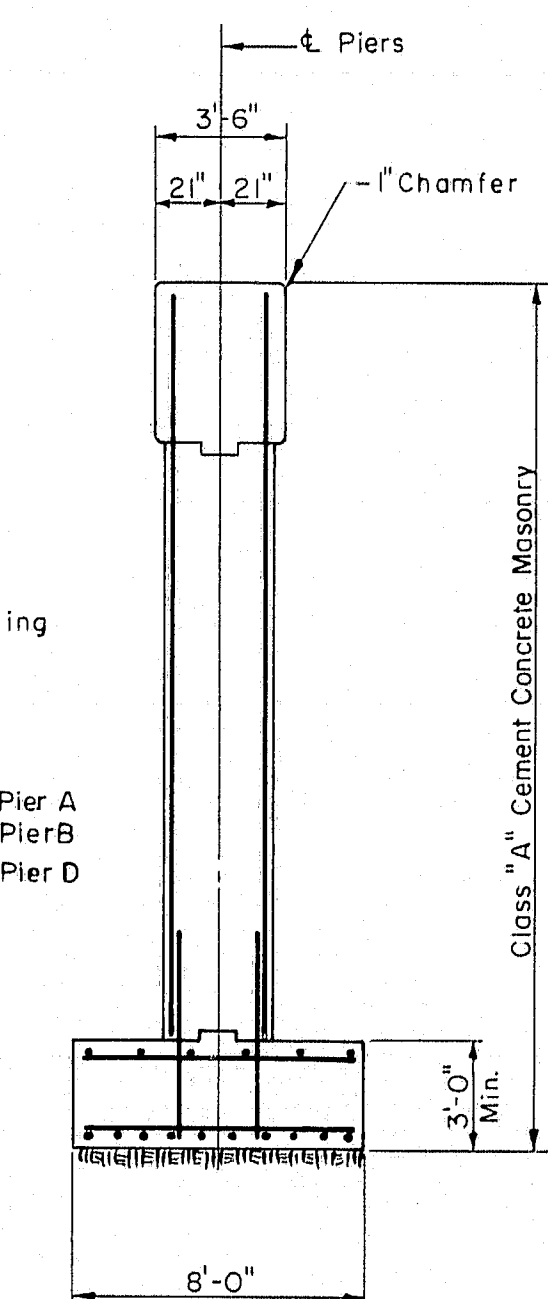


SECTION D-D  
Scale: 3/16" = 1'-0"

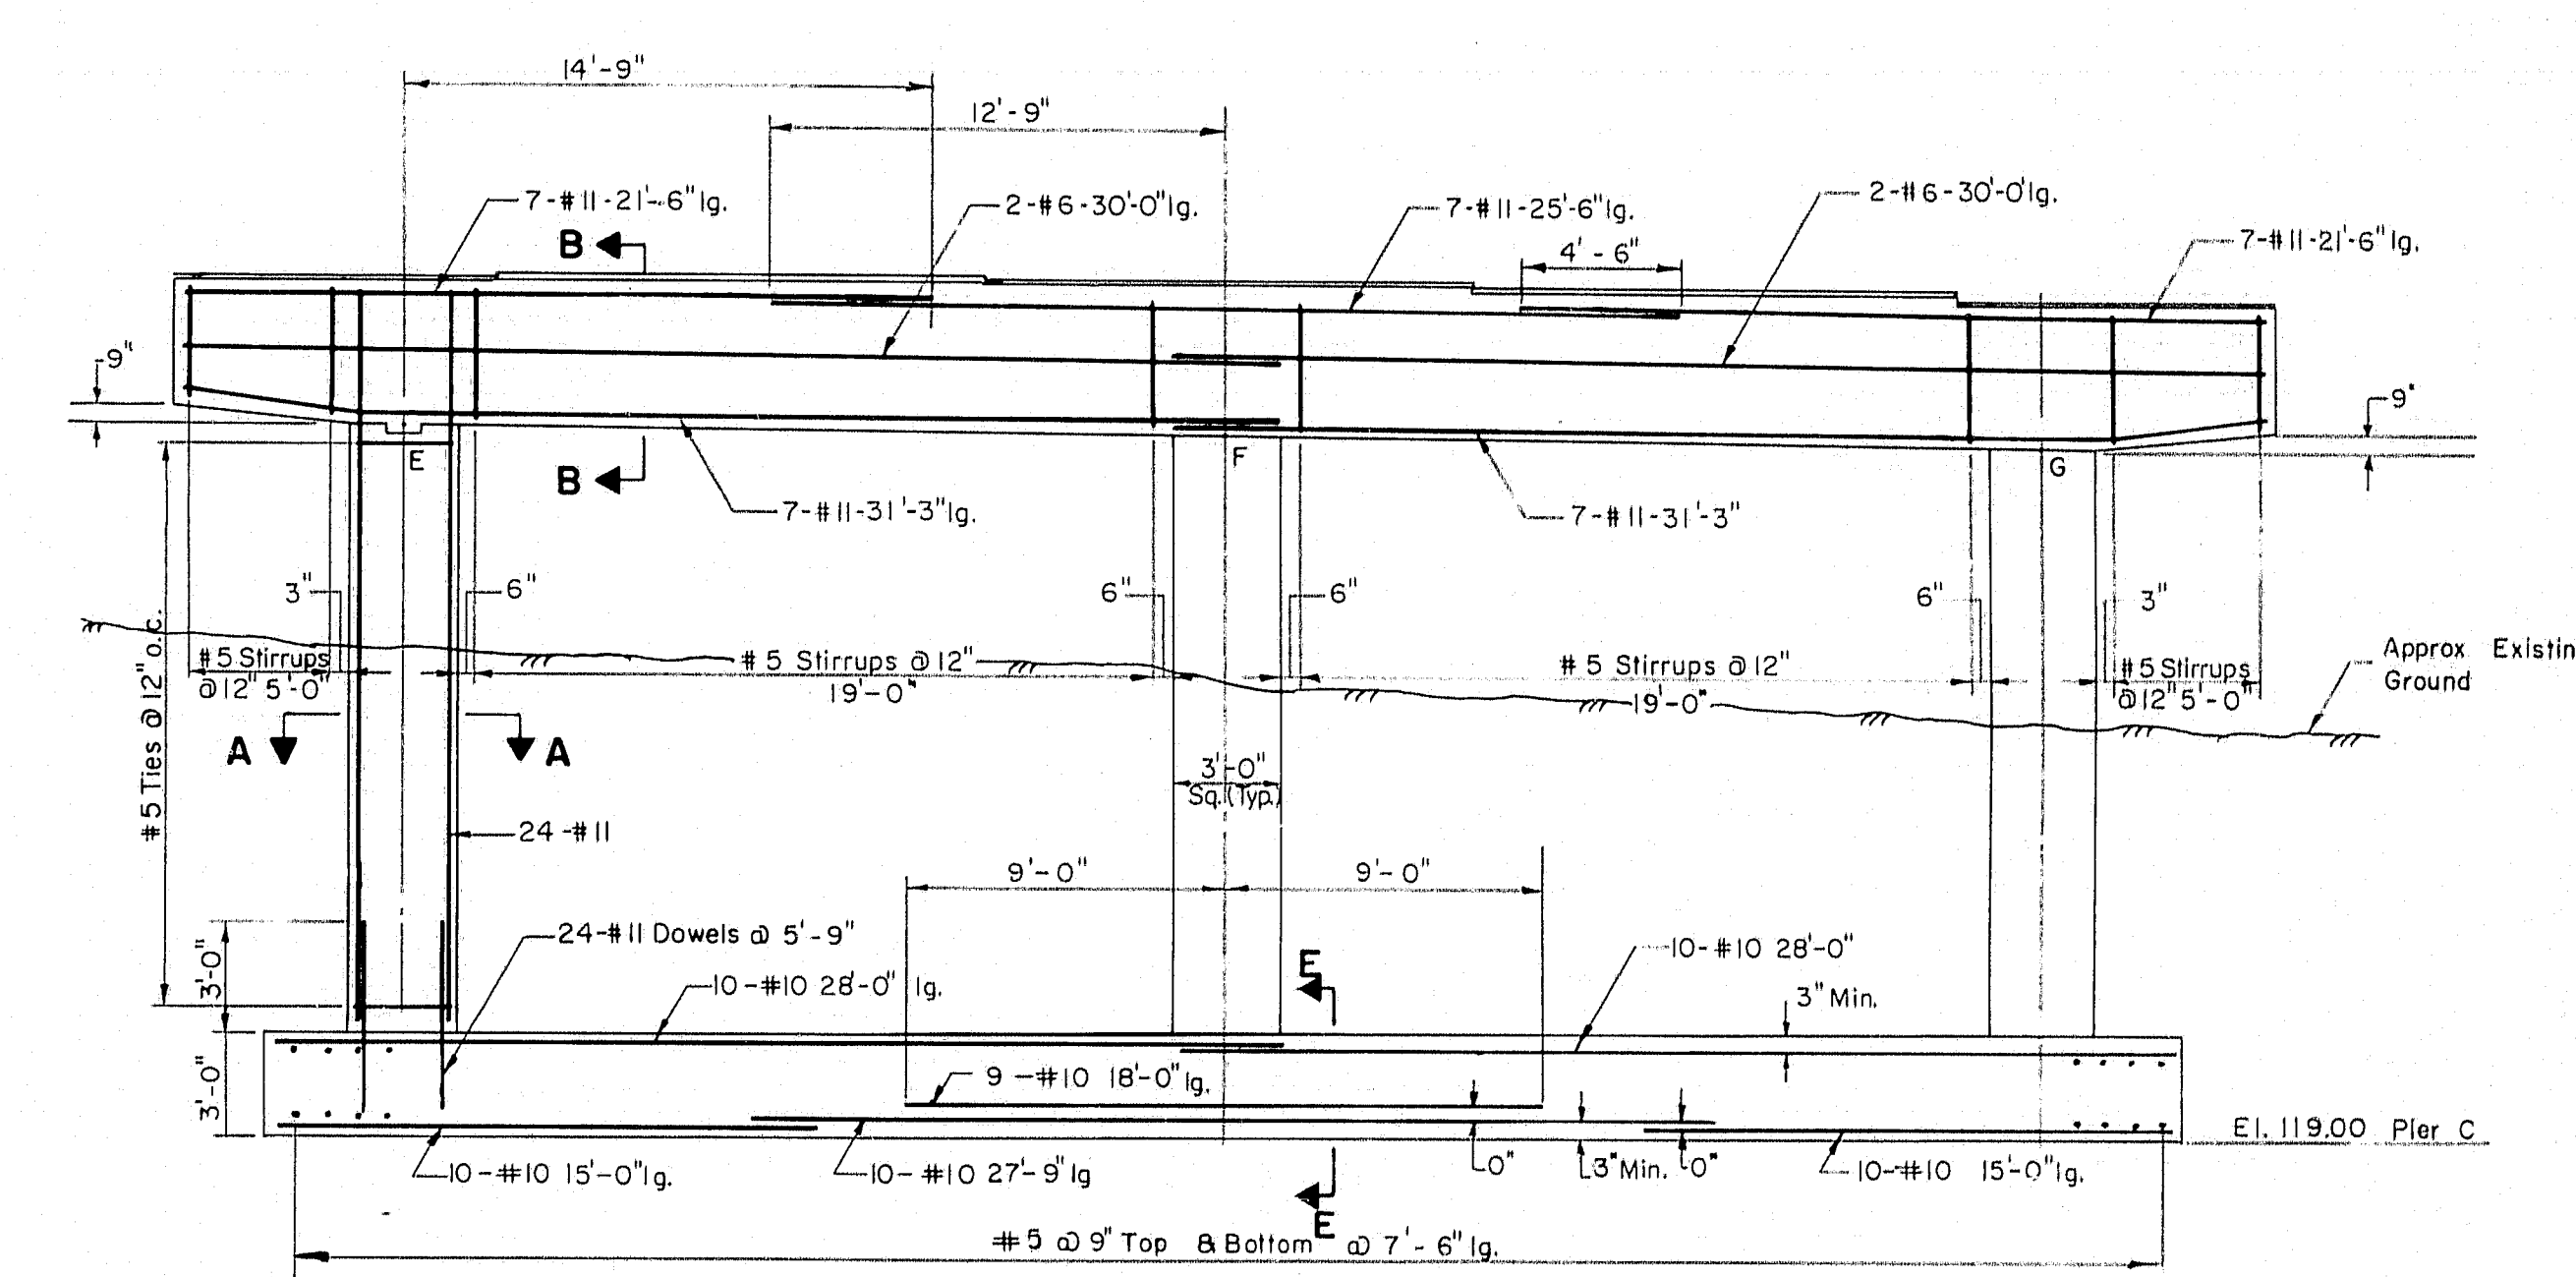


ELEVATION PIER C  
Scale: 3/16" = 1'-0"


Max. Bearing Pressure 3700#/sq. ft.

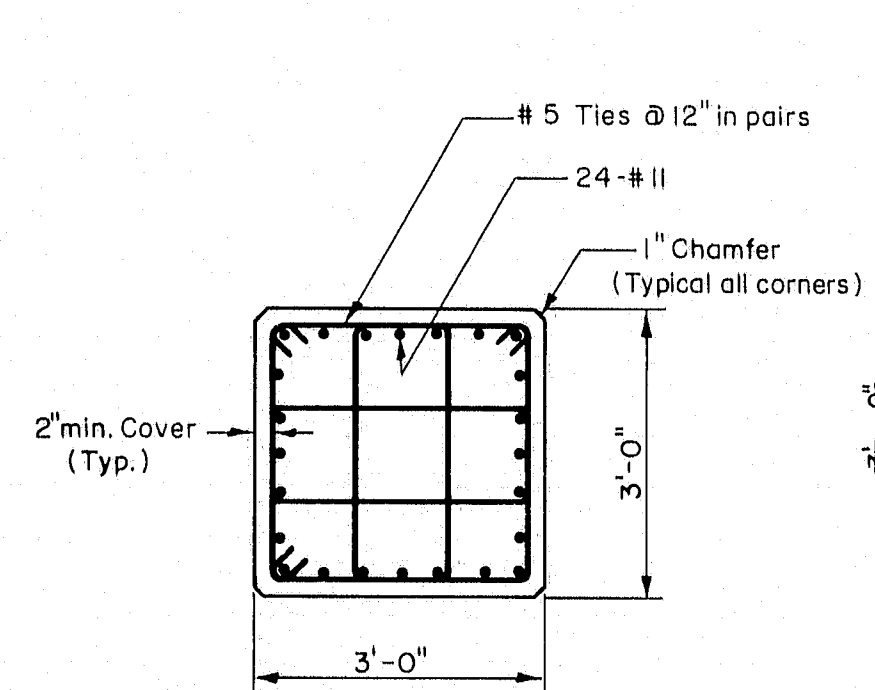

SECTION A-A  
Scale: 1/2" = 1'-0"

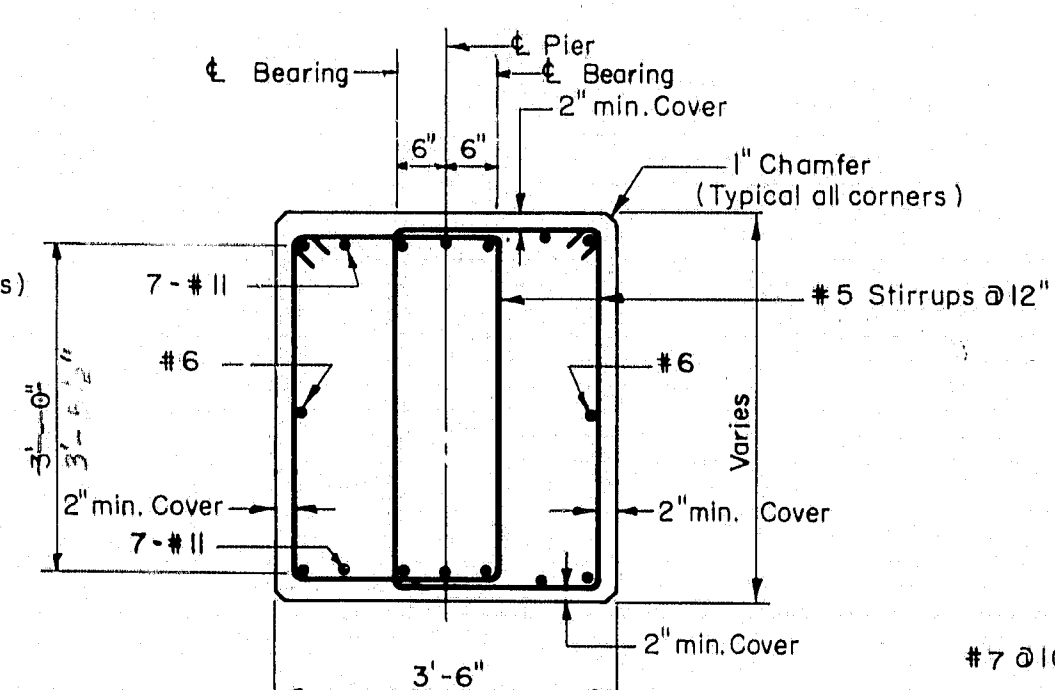


SECTION B-B  
Scale: 1/2" = 1'-0"

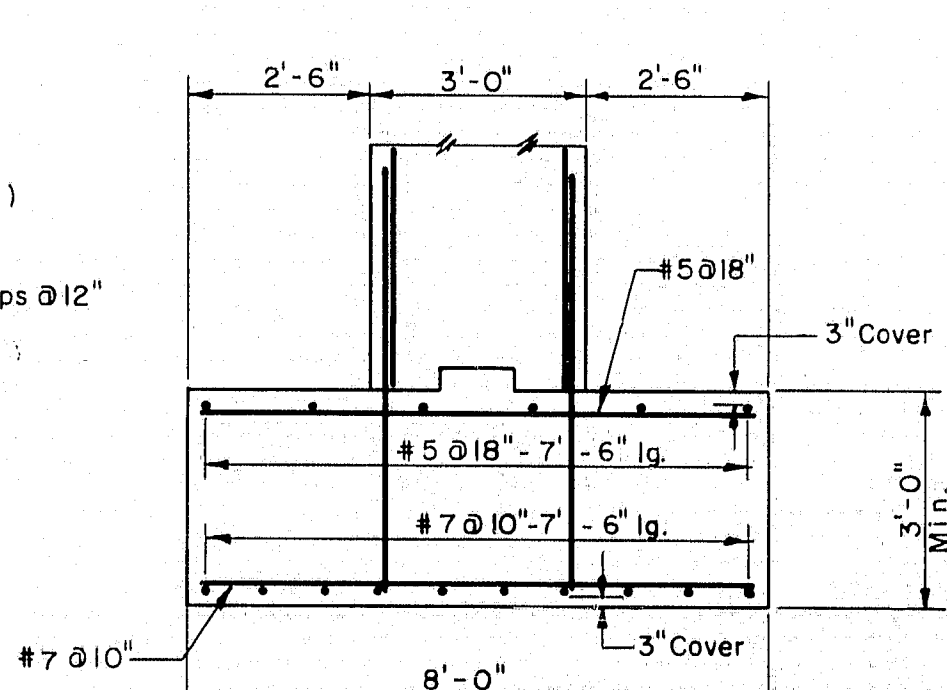

SECTION C-C  
Scale: 3/16" = 1'-0"

ELEVATIONS AT TOP OF PIER COLUMNS				
Pier	Col.	E	F	G
Pier A	144.13	144.07	143.95	143.83
Pier B	144.47	144.40	144.34	144.21
Pier C	139.87	139.13	138.79	138.44
Pier D	140.21	140.02	140.14	140.14

SCHEDULE OF BEAM SEAT ELEVATIONS											
Beam No.	Pier A	Beam No.	Pier B	Beam No.	Pier C	Beam No.	Pier D	Beam No.	Pier A	Beam No.	Pier B
1	147.69	6	147.97	11	142.97	21	144.21	26	147.69	11	147.97
2	147.83	7	148.13	12	142.99	22	144.26	27	147.83	12	148.13
3	147.85	8	148.18	13	142.91	23	144.20	28	147.85	13	148.18
4	147.70	9	148.07	14	142.65	24	143.98	29	147.70	14	148.07
5	147.45	10	147.84	15	142.29	25	143.64	30	147.45	15	147.84

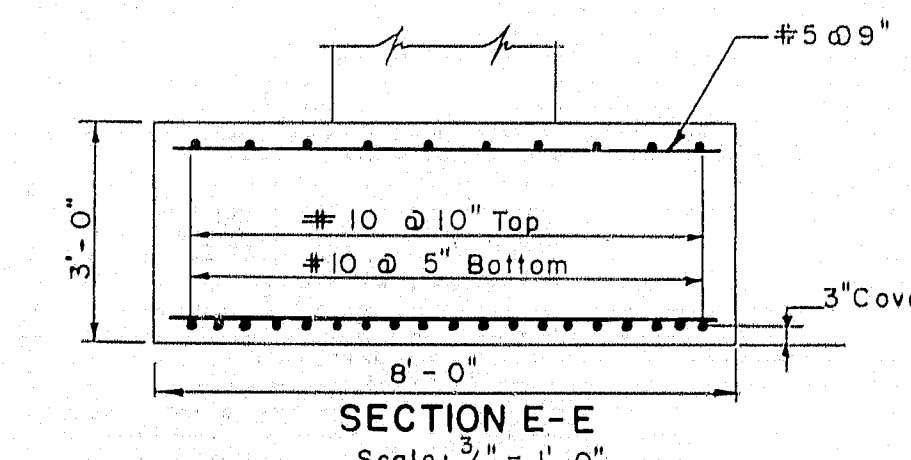

SECTION E-E  
Scale: 1/2" = 1'-0"

THE CLARKSON ENGINEERING CO., INC.

DESIGN J.T. B.D.S. CHECK D.S. BRIDGE NO. SURVEY PLOT

DRAWN E.K. APPROVED W.A.H.-C.J.M.

STATE HIGHWAY COMMISSION

INTERSTATE #95

OVER

STILLWATER AVENUE


IN THE CITY OF

BANGOR

PENOBSCOT COUNTY

PIERS

SHEET 7 OF 10 AUGUSTA, MAINE

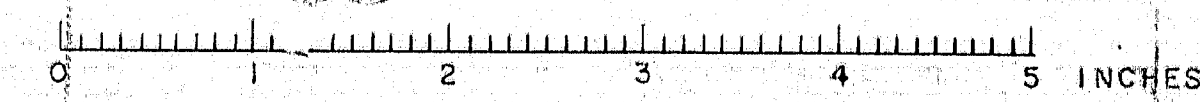















B.P.R.	STATE	PROJECT NO.	SHEET NO.	TOTAL SHEETS
1	MAINE	I-95-8 (6)	20	35


# BANGOR INTERSTATE

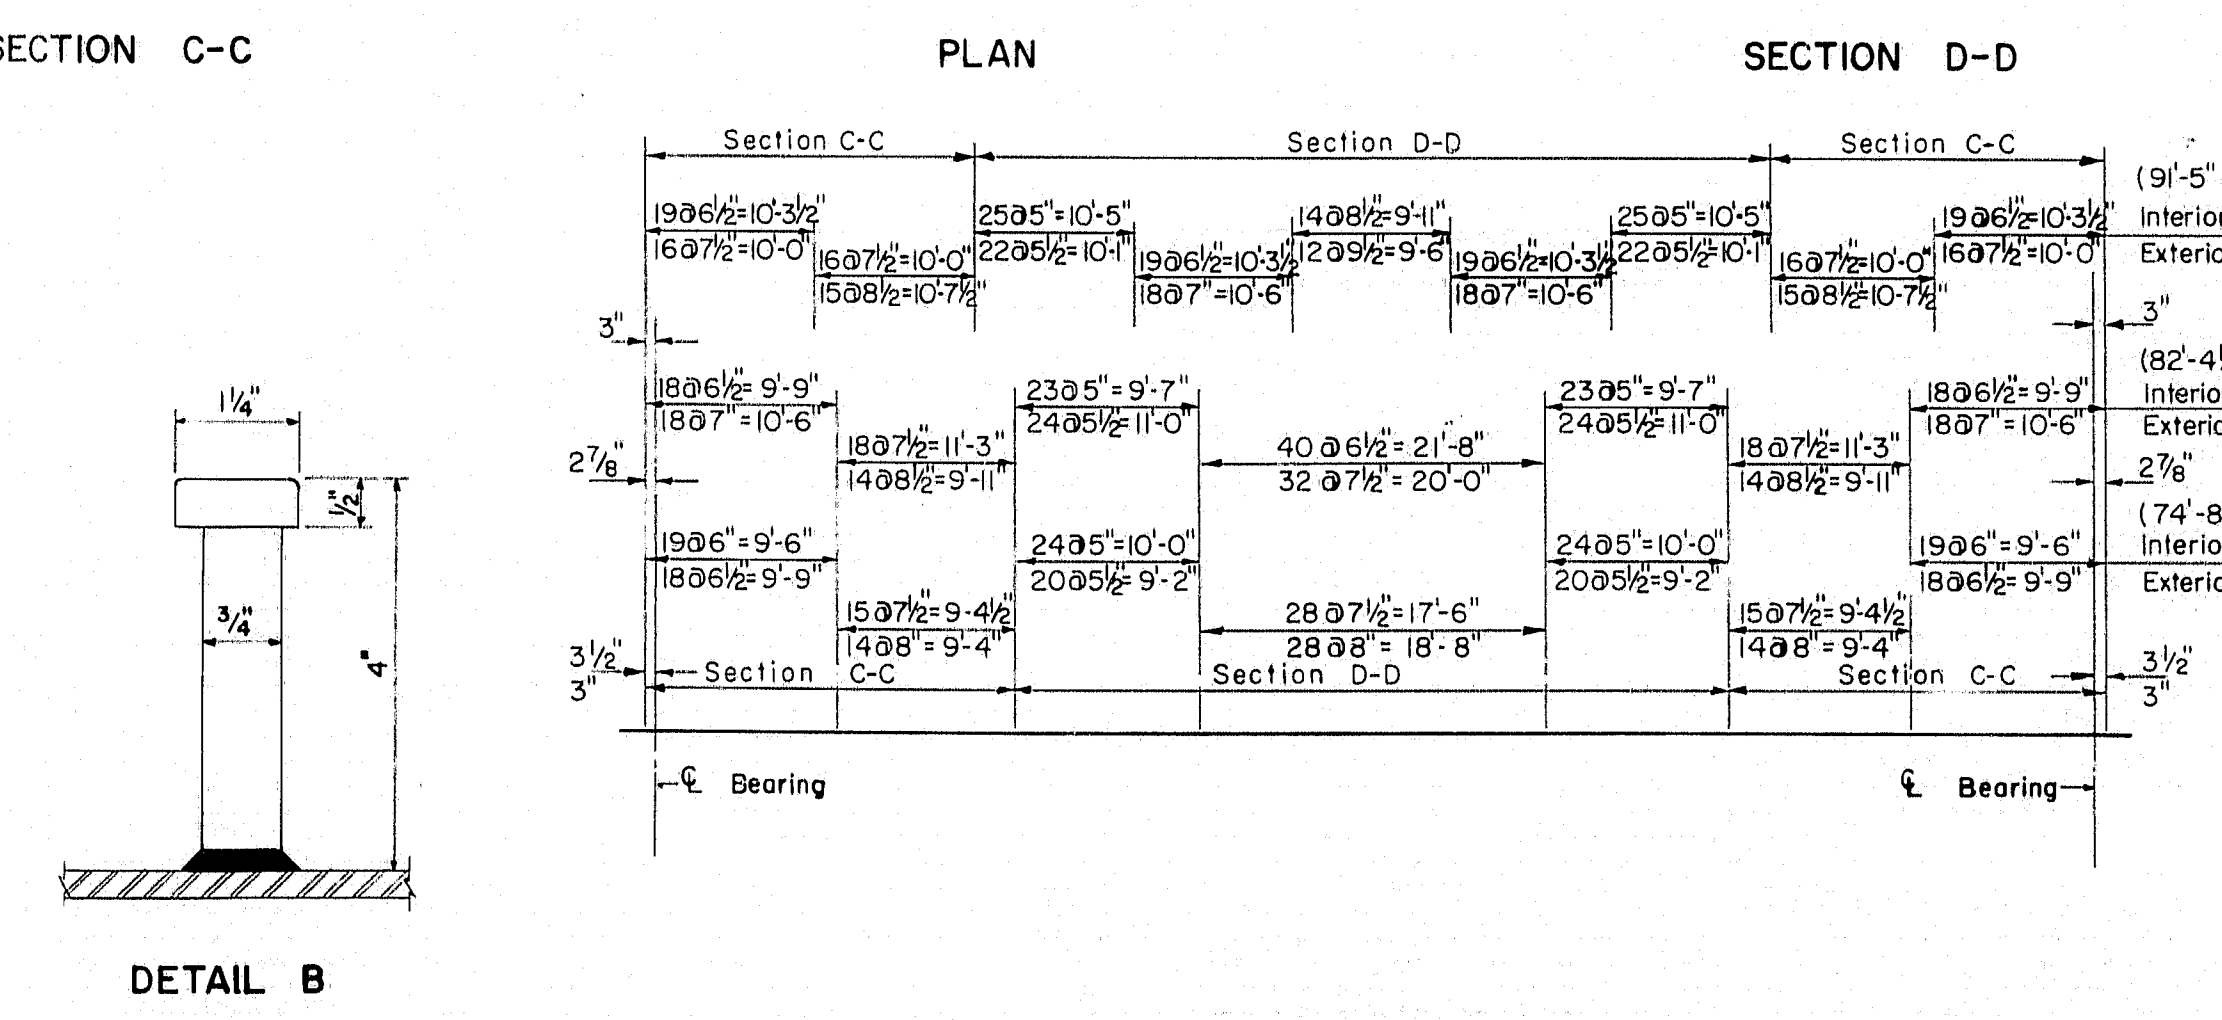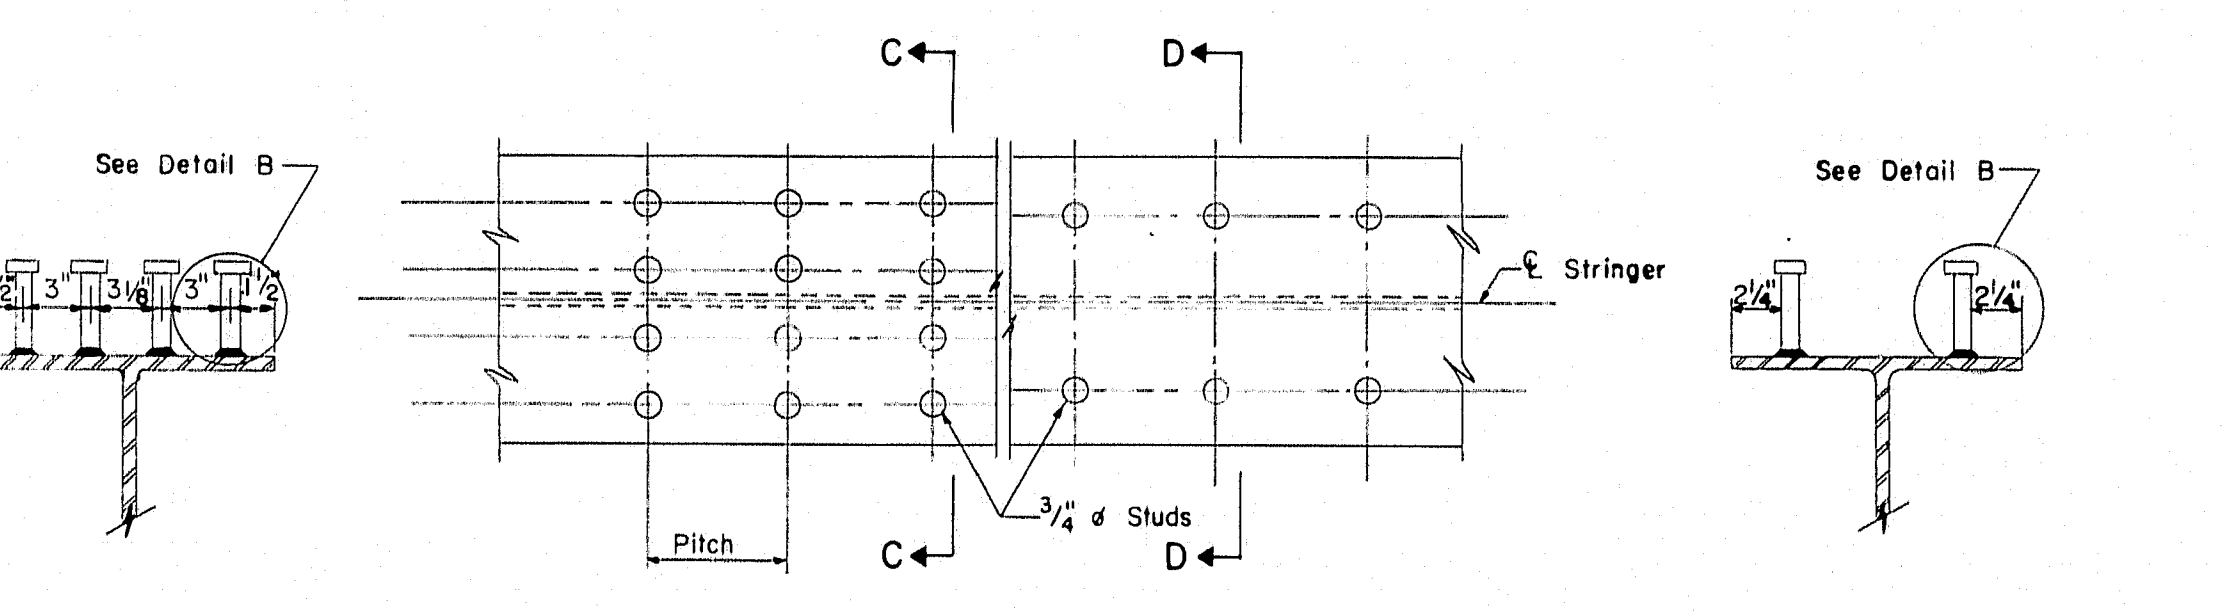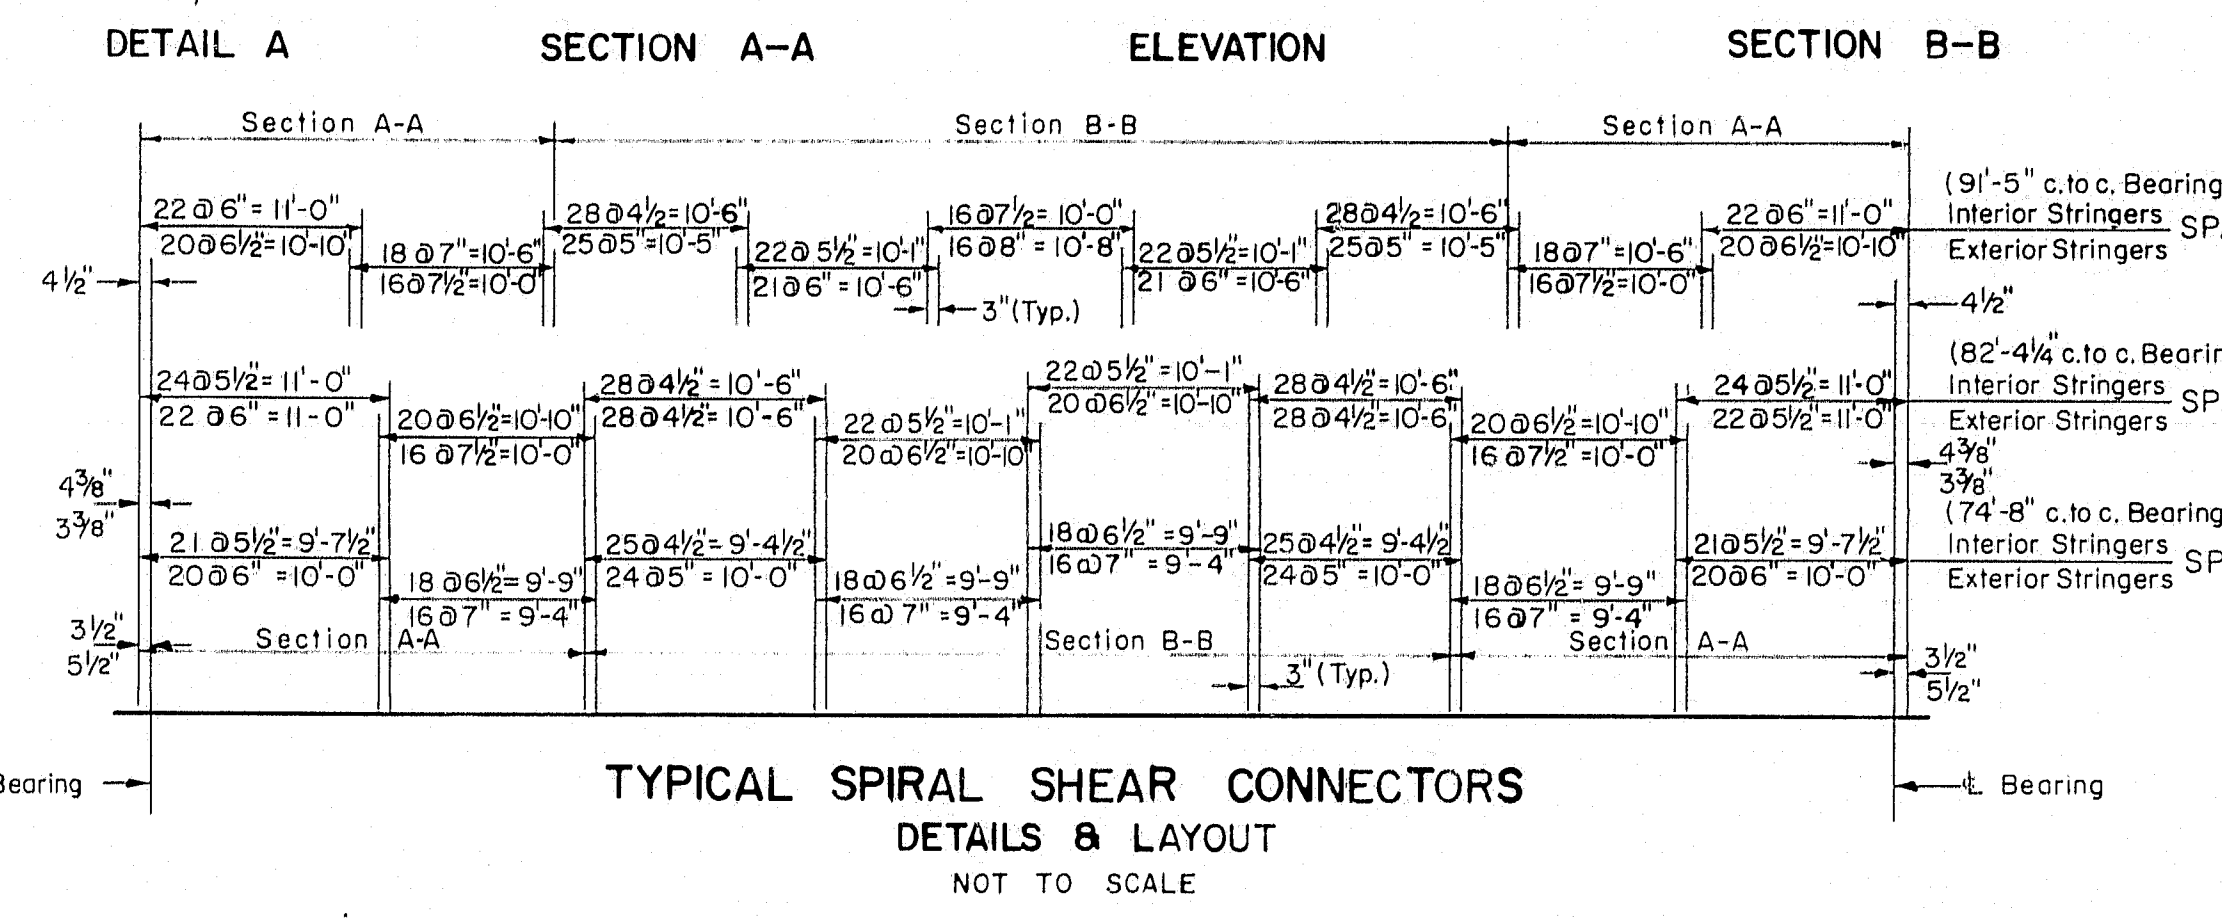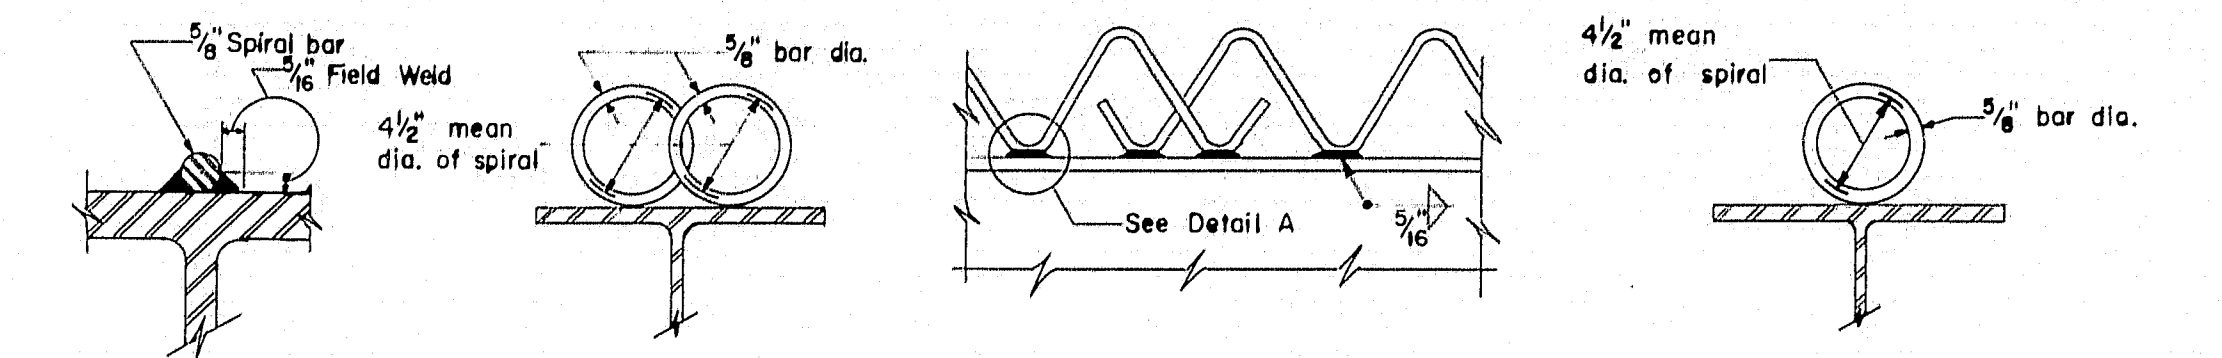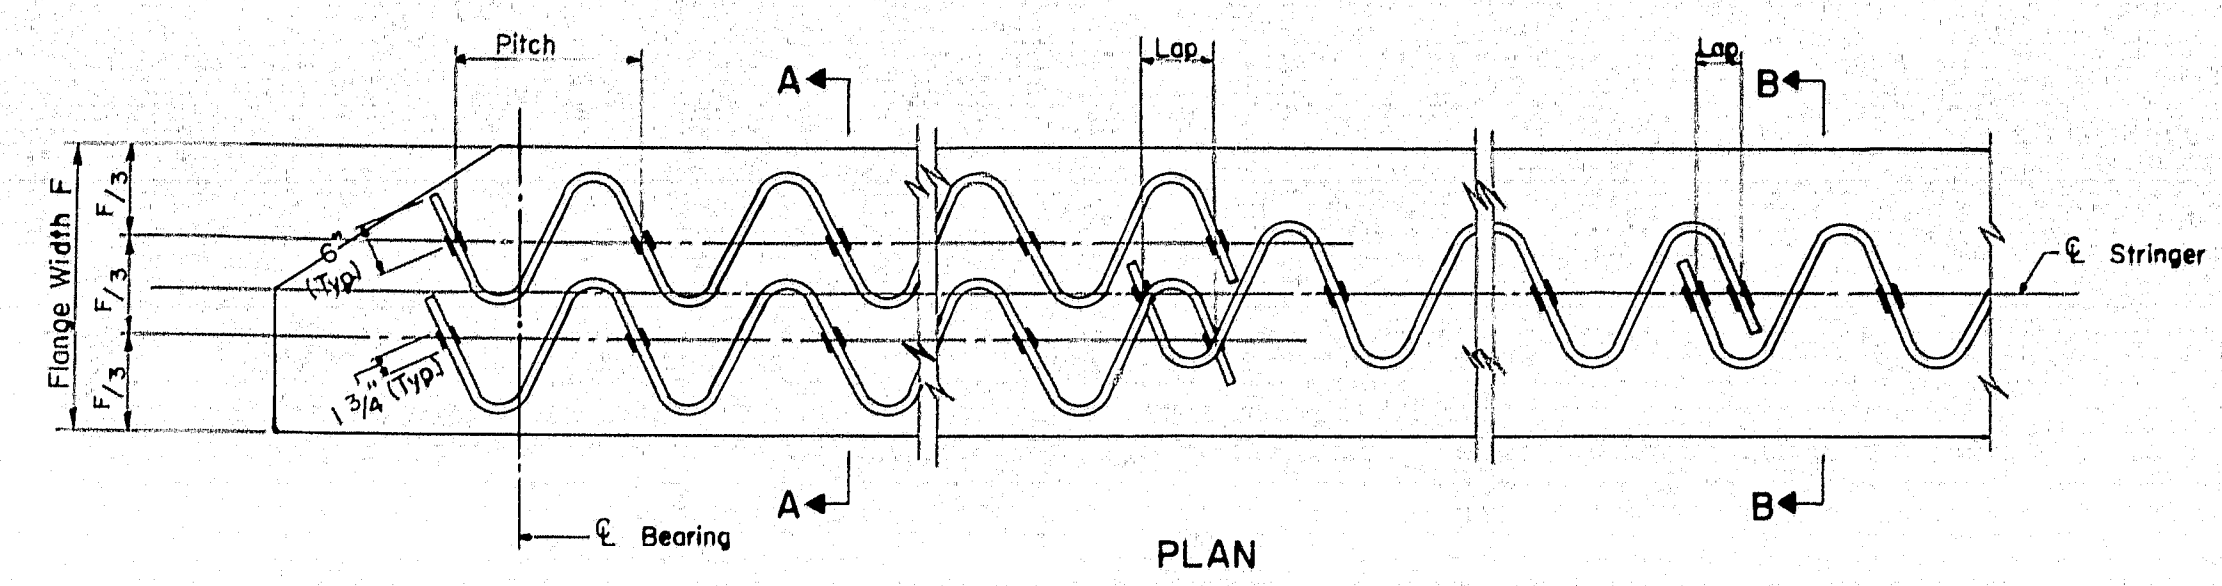

TYPICAL STUD SHEAR CONNECTORS  
DETAILS & LAYOUT  
NOT TO SCALE

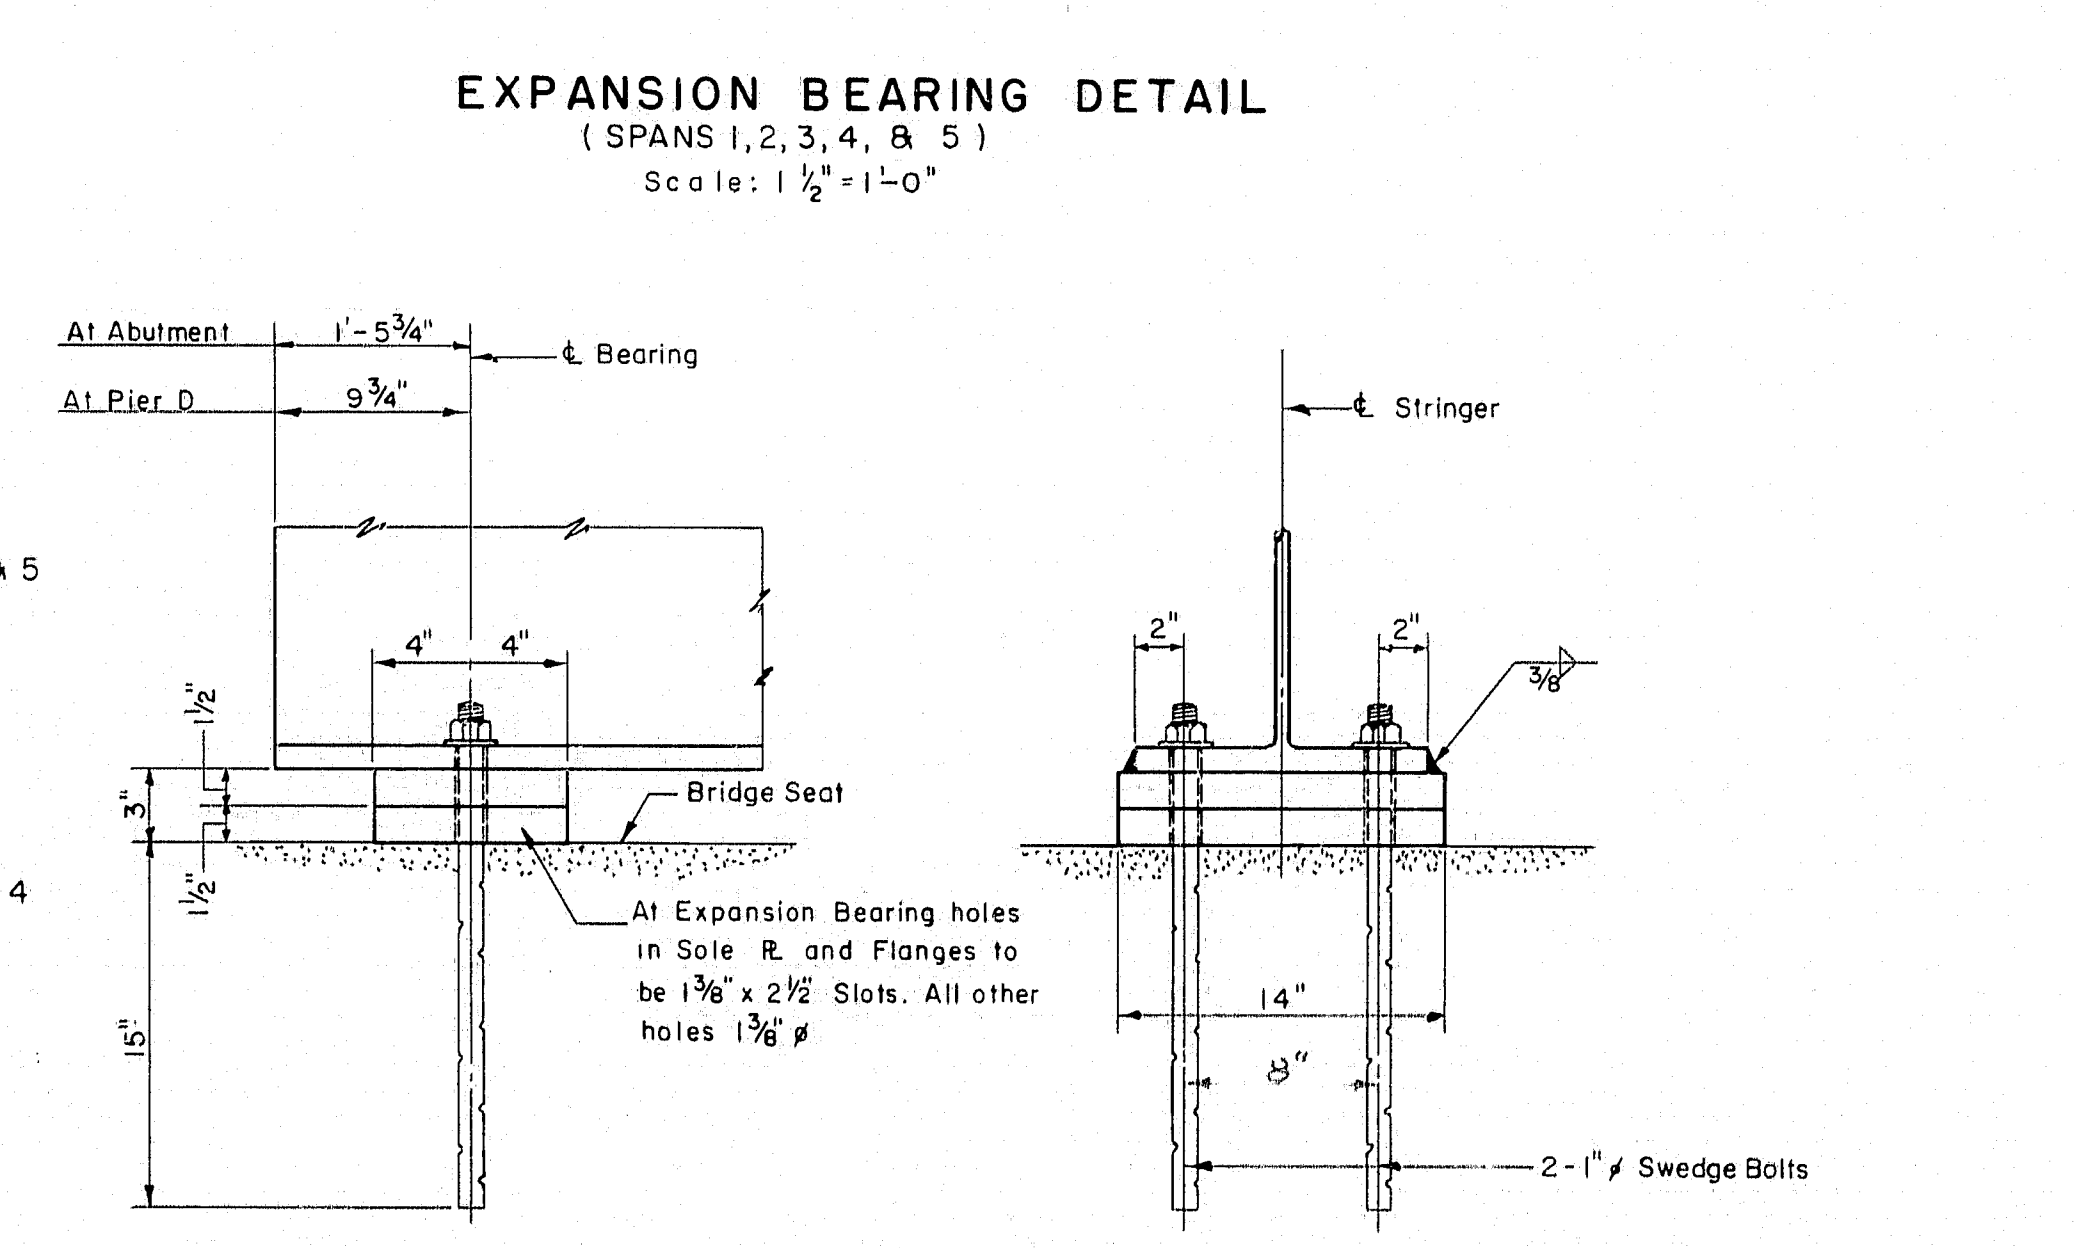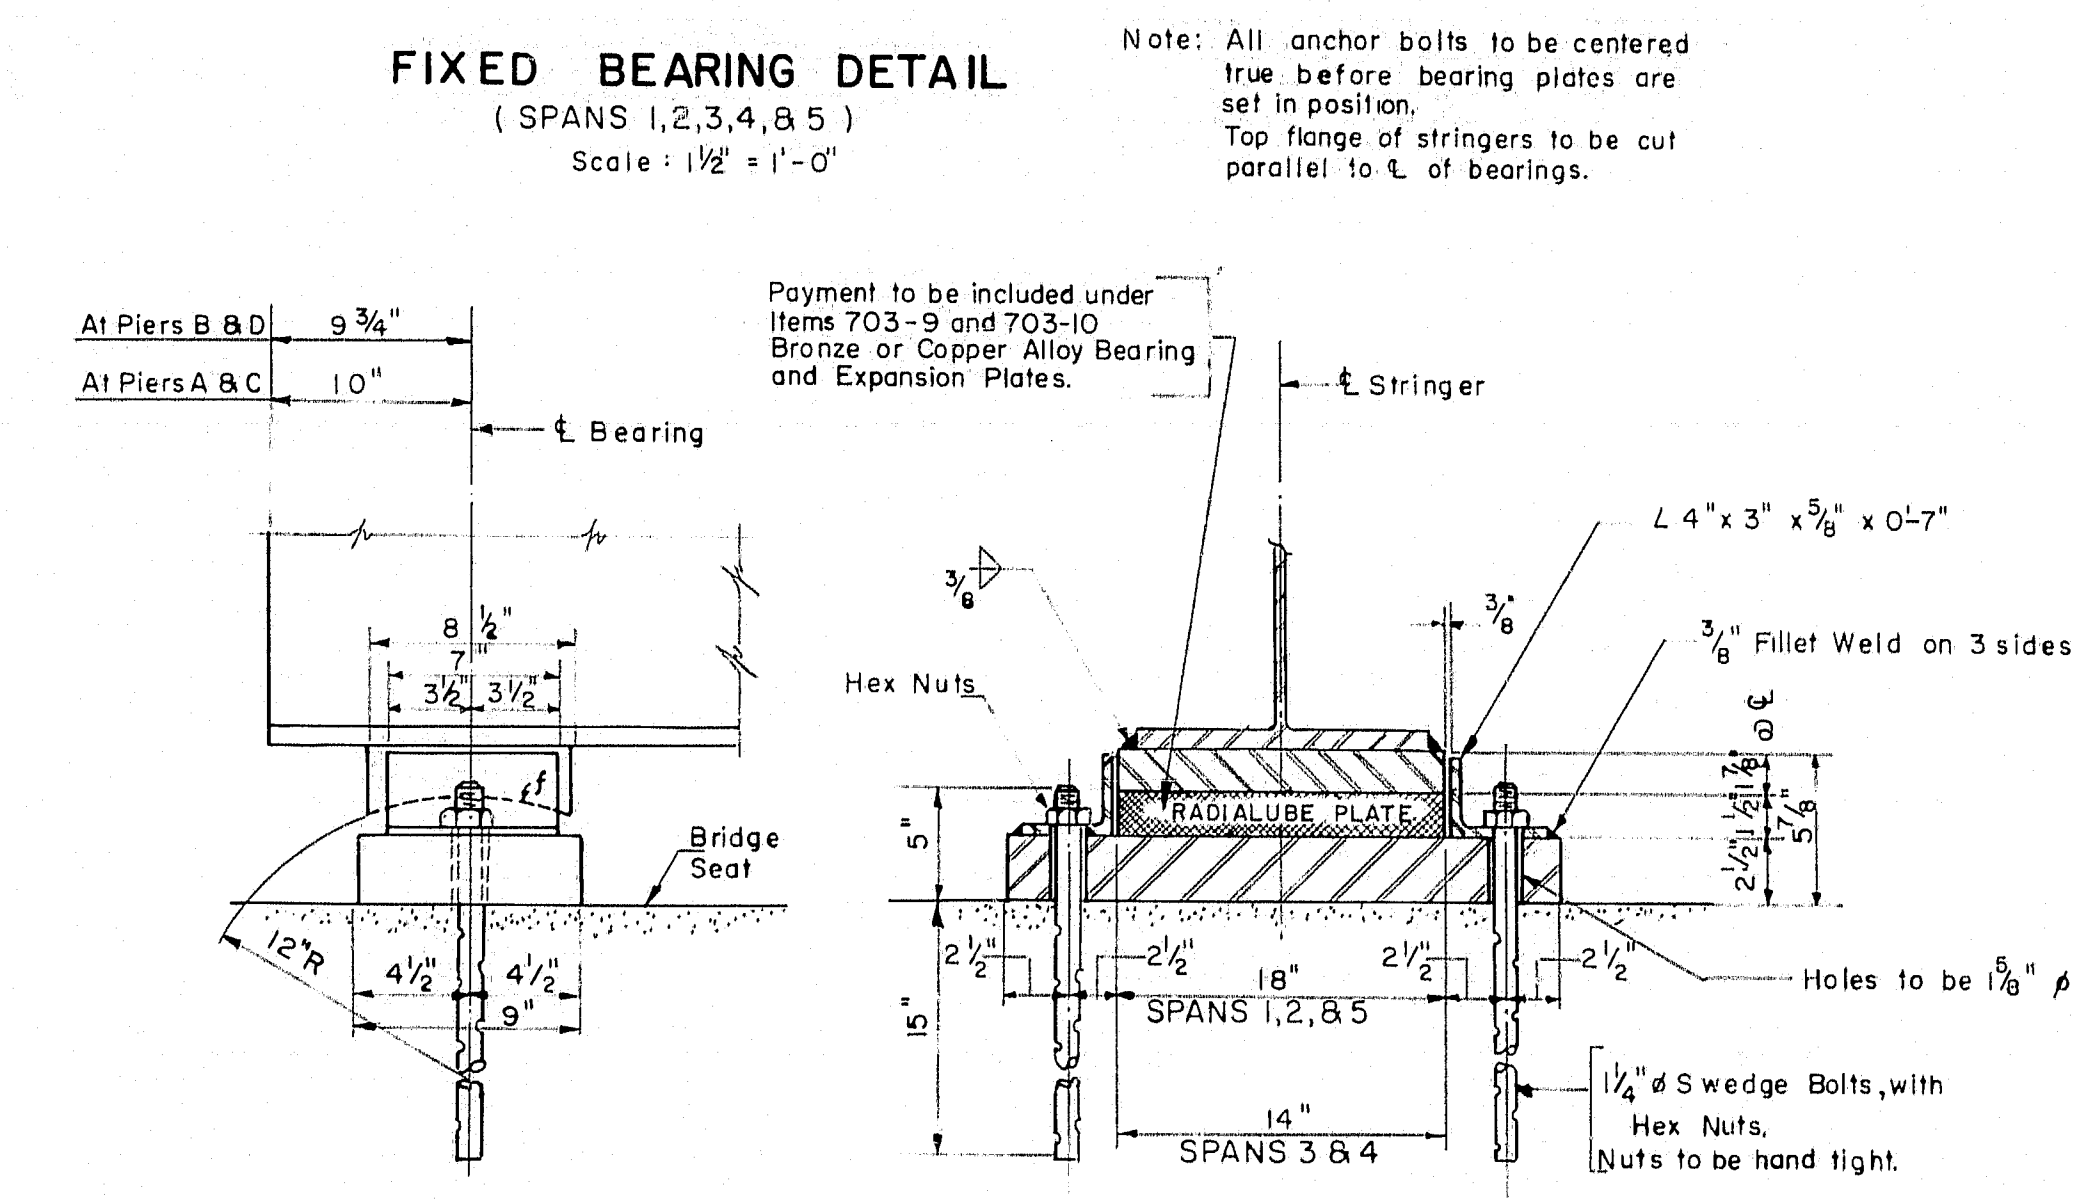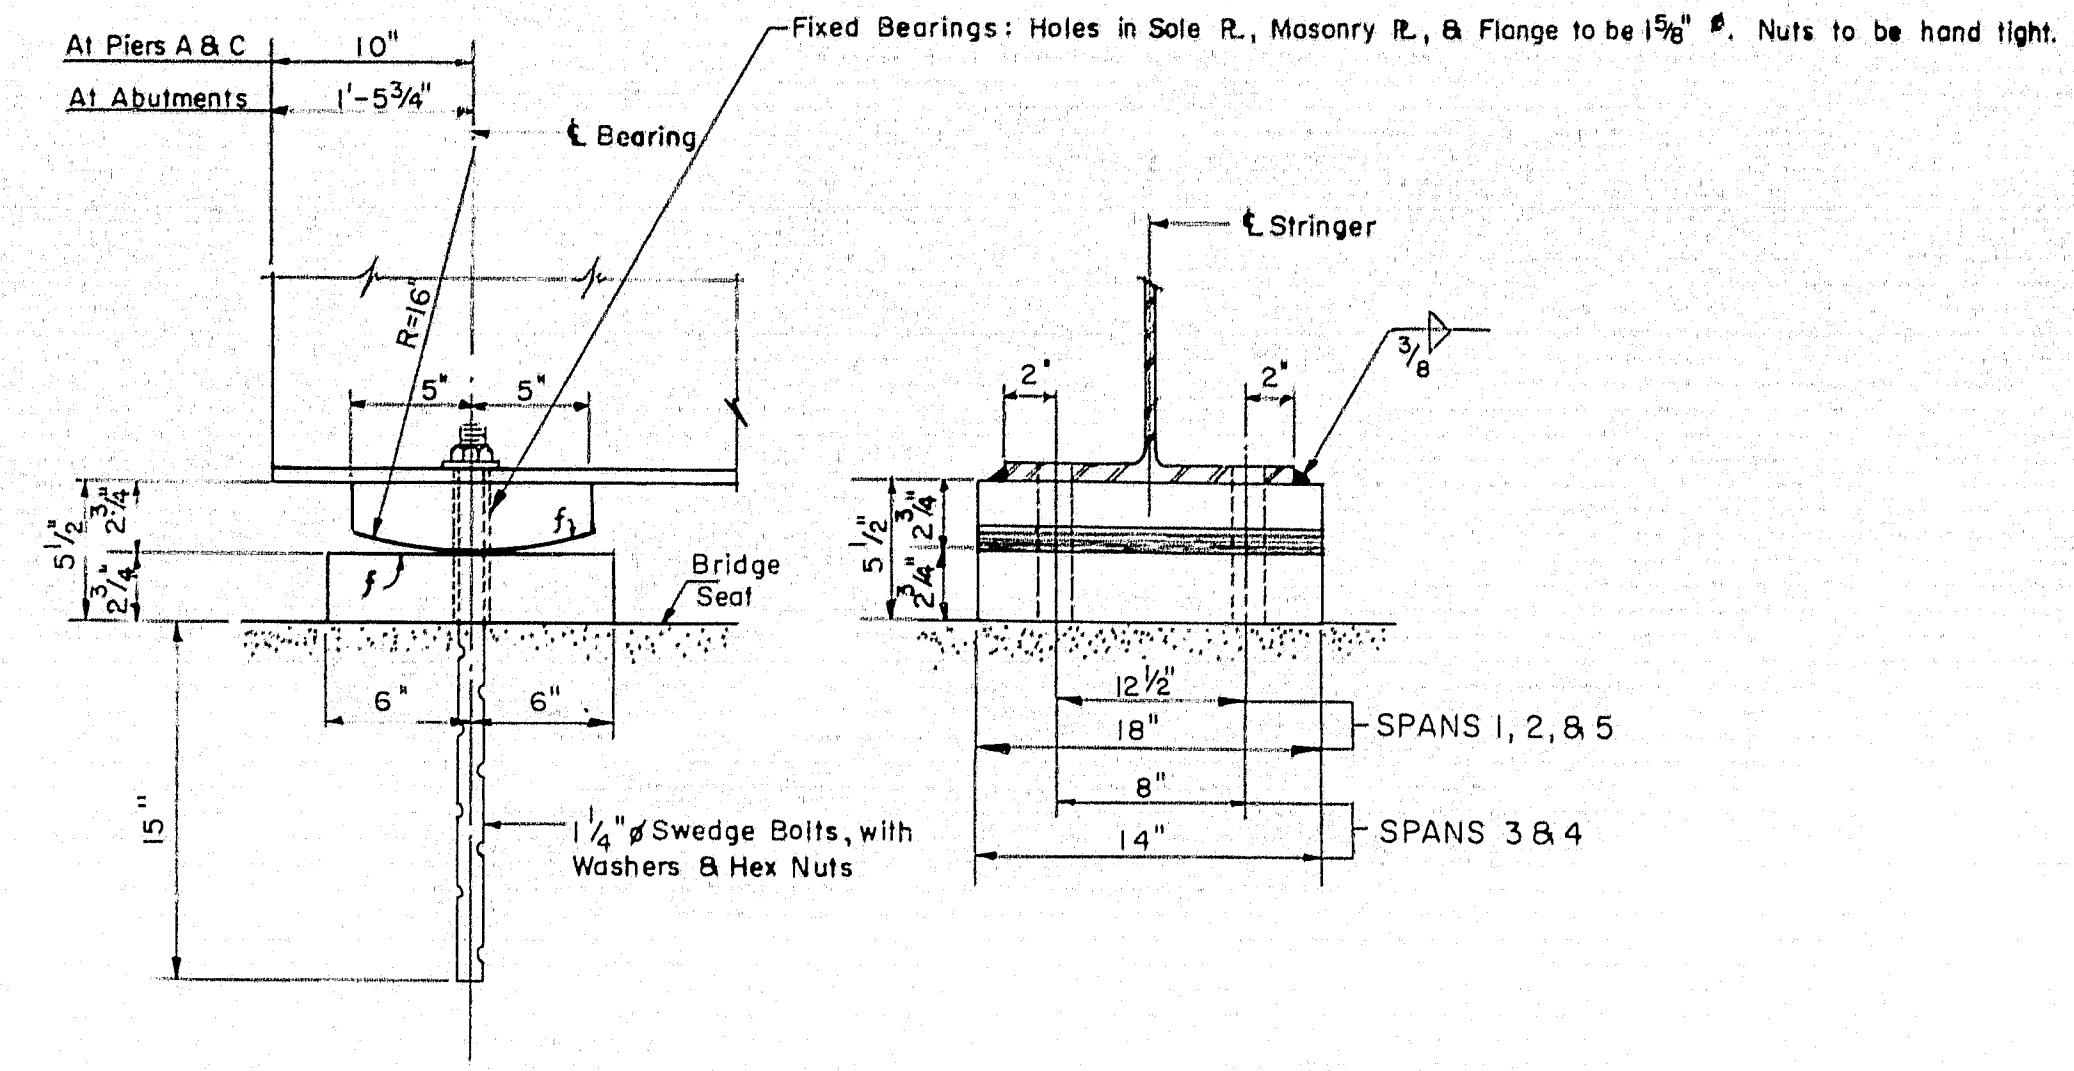


FIXED AND EXPANSION BEARING DETAILS  
SPAN 6  
Scale: 1/2" = 1'-0"

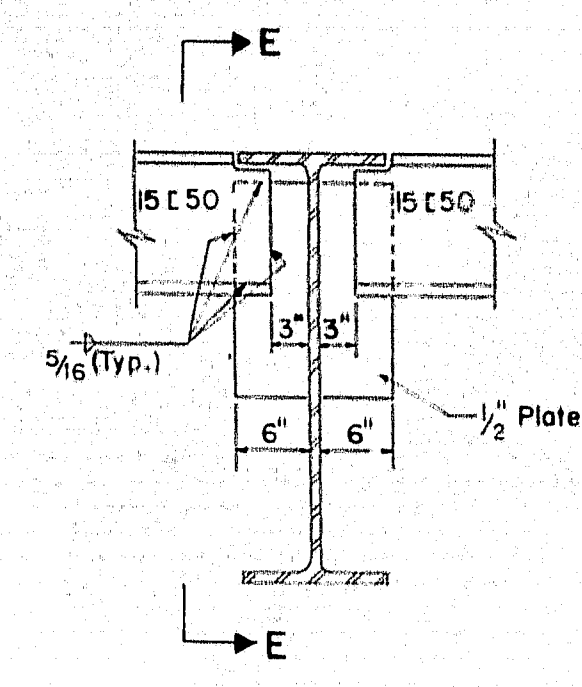

WELDED END DIAPHRAGM CONNECTION


Scale: 3/4" = 1'-0"

Note: Welds to be shop or field welded.

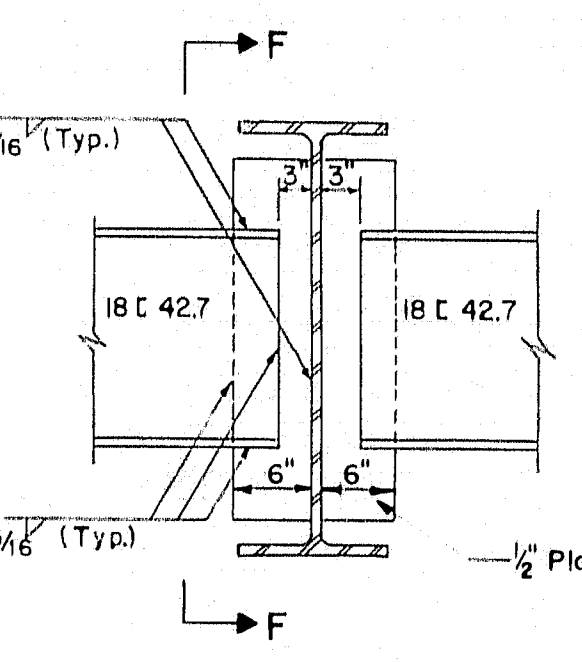

WELDED DIAPHRAGM CONNECTION

Scale: 3/4" = 1'-0"

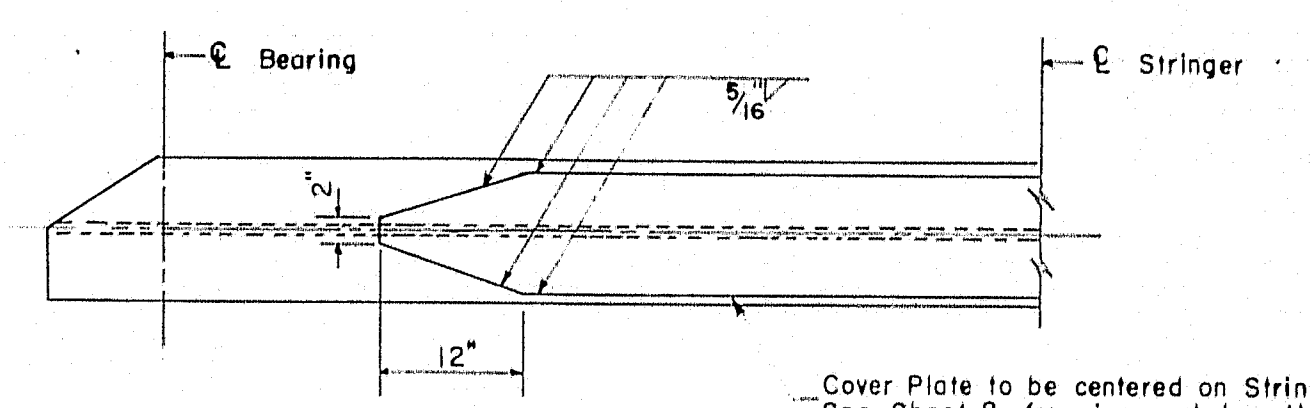

COVER PLATE DETAIL

NOT TO SCALE


THE CLARKSON ENGINEERING CO., INC.			
DESIGN	CHECK	H.P.	BRIDGE NO.
DRAWN	F.P.D. & REM.	APPROVED	SURVEY
		W.A.H.	PLOT
		C.J.W.	
STATE HIGHWAY COMMISSION			
INTERSTATE #95			
OVER			
STILLWATER AVE.			
IN THE CITY OF			
BANGOR			
PENOBSCOT COUNTY			
SUPERSTRUCTURE DETAILS			

SHEET 9 OF 10 AUGUSTA, MAINE




B.P.R. REG. NO.	STATE	PROJECT NO.	SHEET NO.	TOTAL SHEETS
1	MAINE	I-95-B (6)	21	35


# BANGOR INTERSTATE

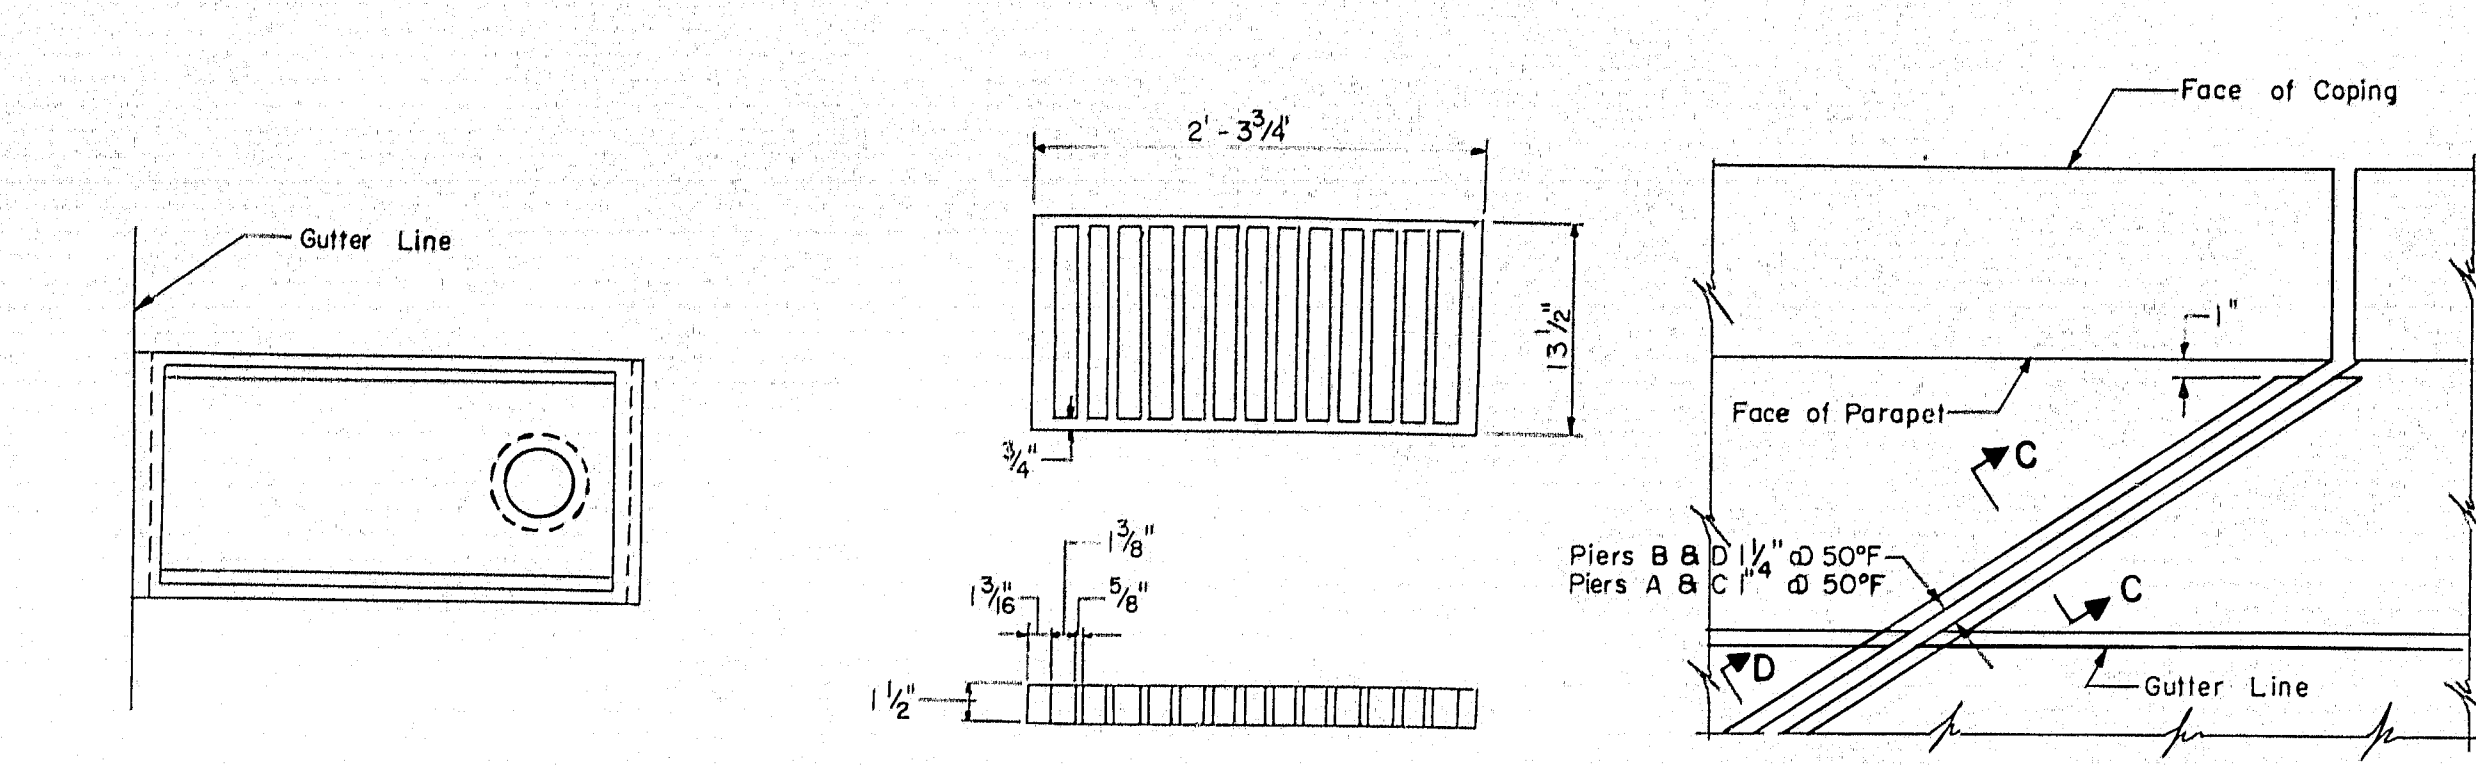


PLAN OF EXPANSION JOINT  
Scale: 1" = 1'-0"

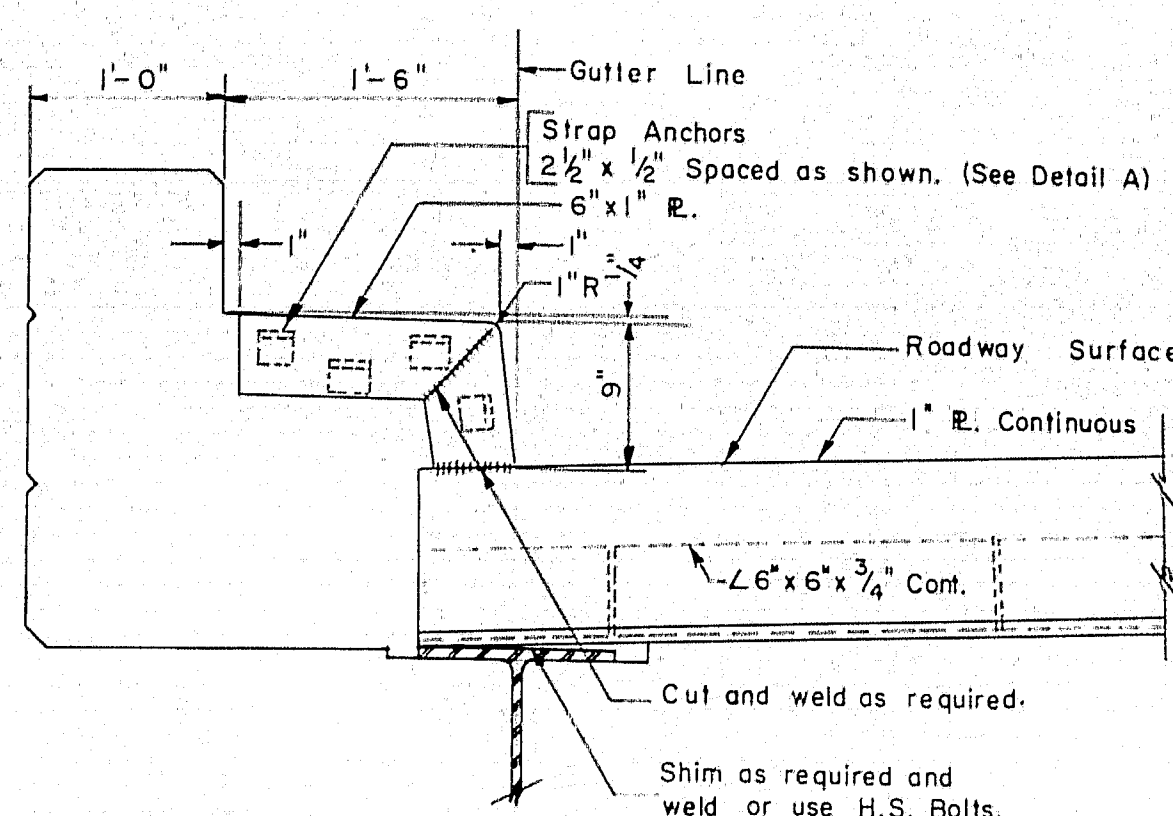


SAFETY WALK EXPANSION JOINT DETAIL  
Scale: 1" = 1'-0"

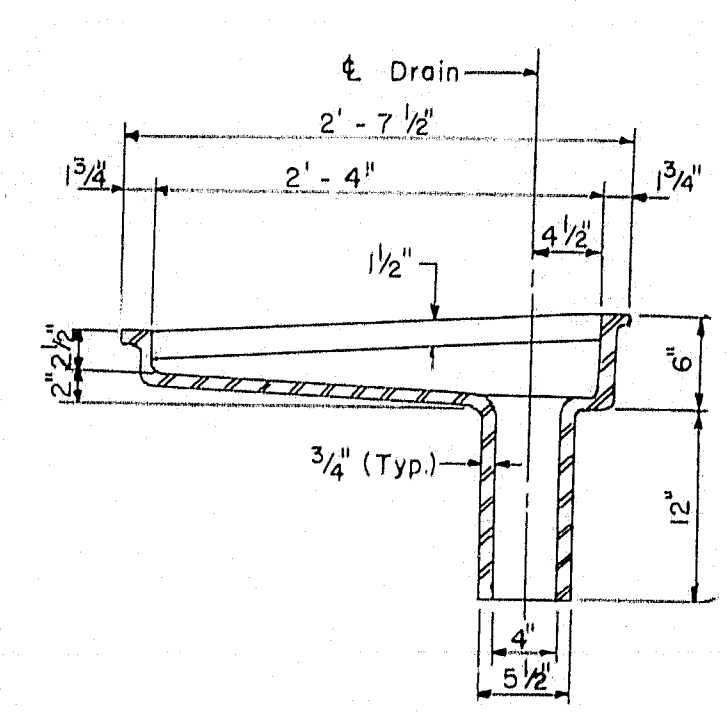


SCUPPER DETAILS  
Scale: 1" = 1'-0"

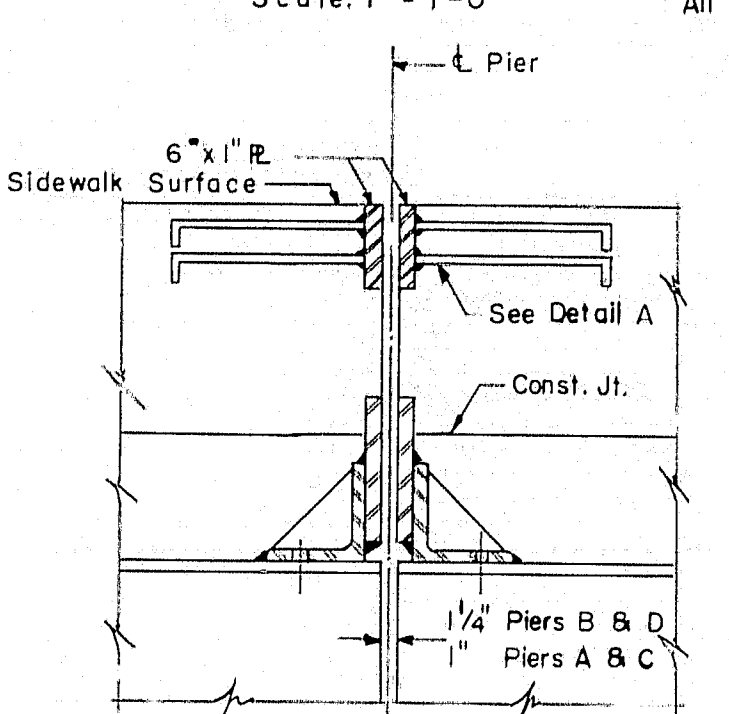


SECTION C-C  
Scale: 1" = 1'-0"

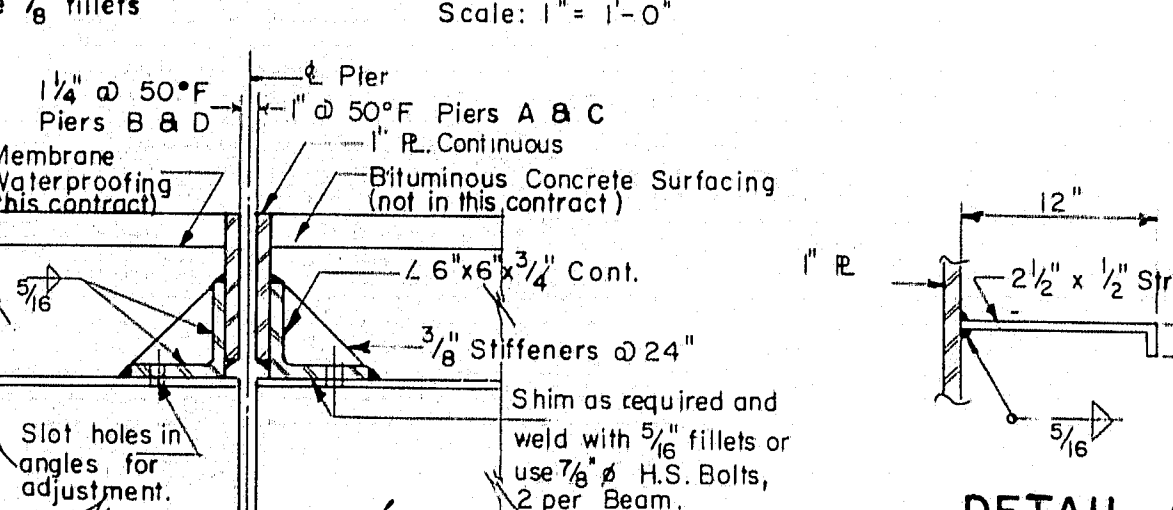


SECTION D-D  
Scale: 1" = 1'-0"

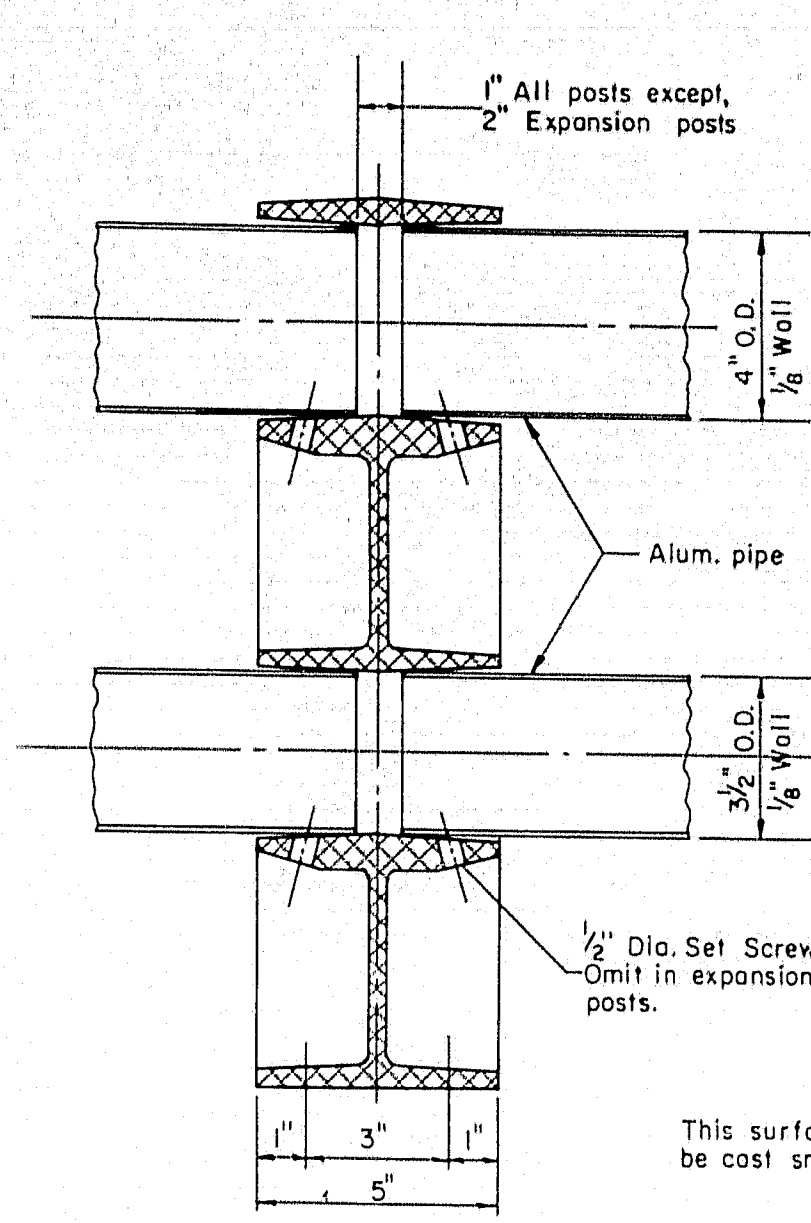


SECTION B-B  
Scale: 1" = 1'-0"

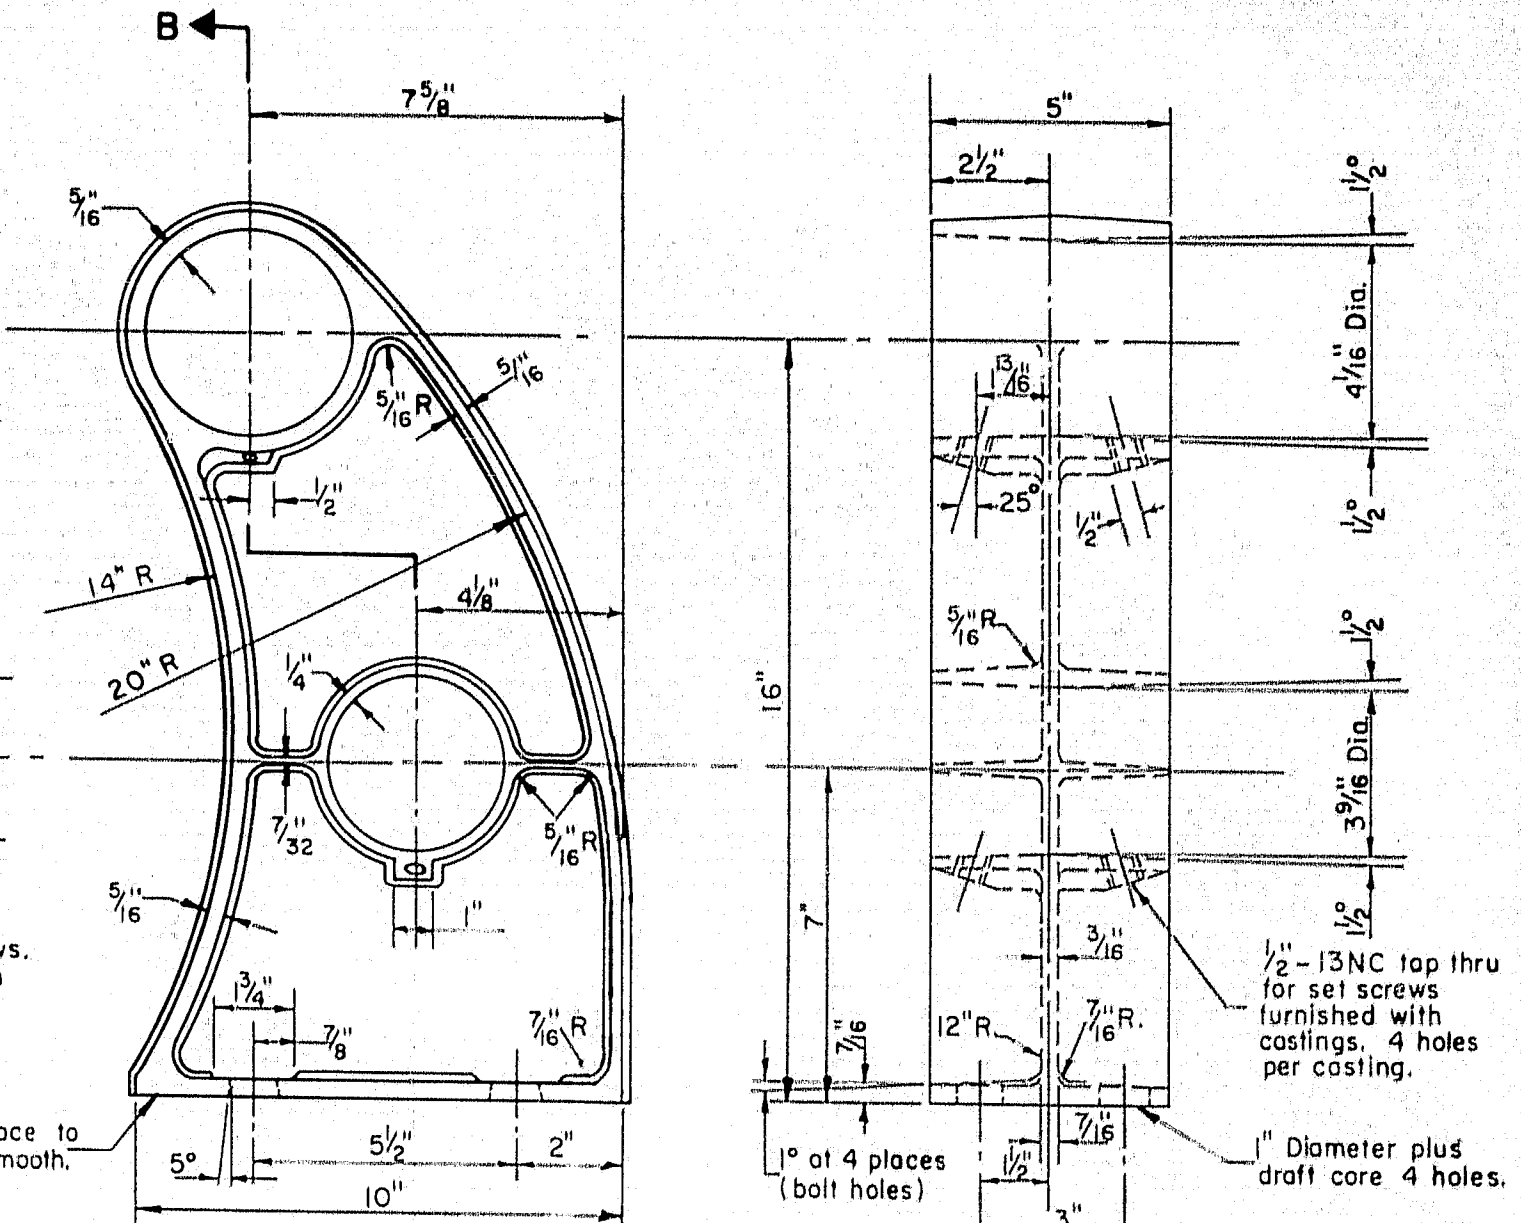


ALUMINUM RAIL DETAILS  
Scale: 3" = 1'-0"

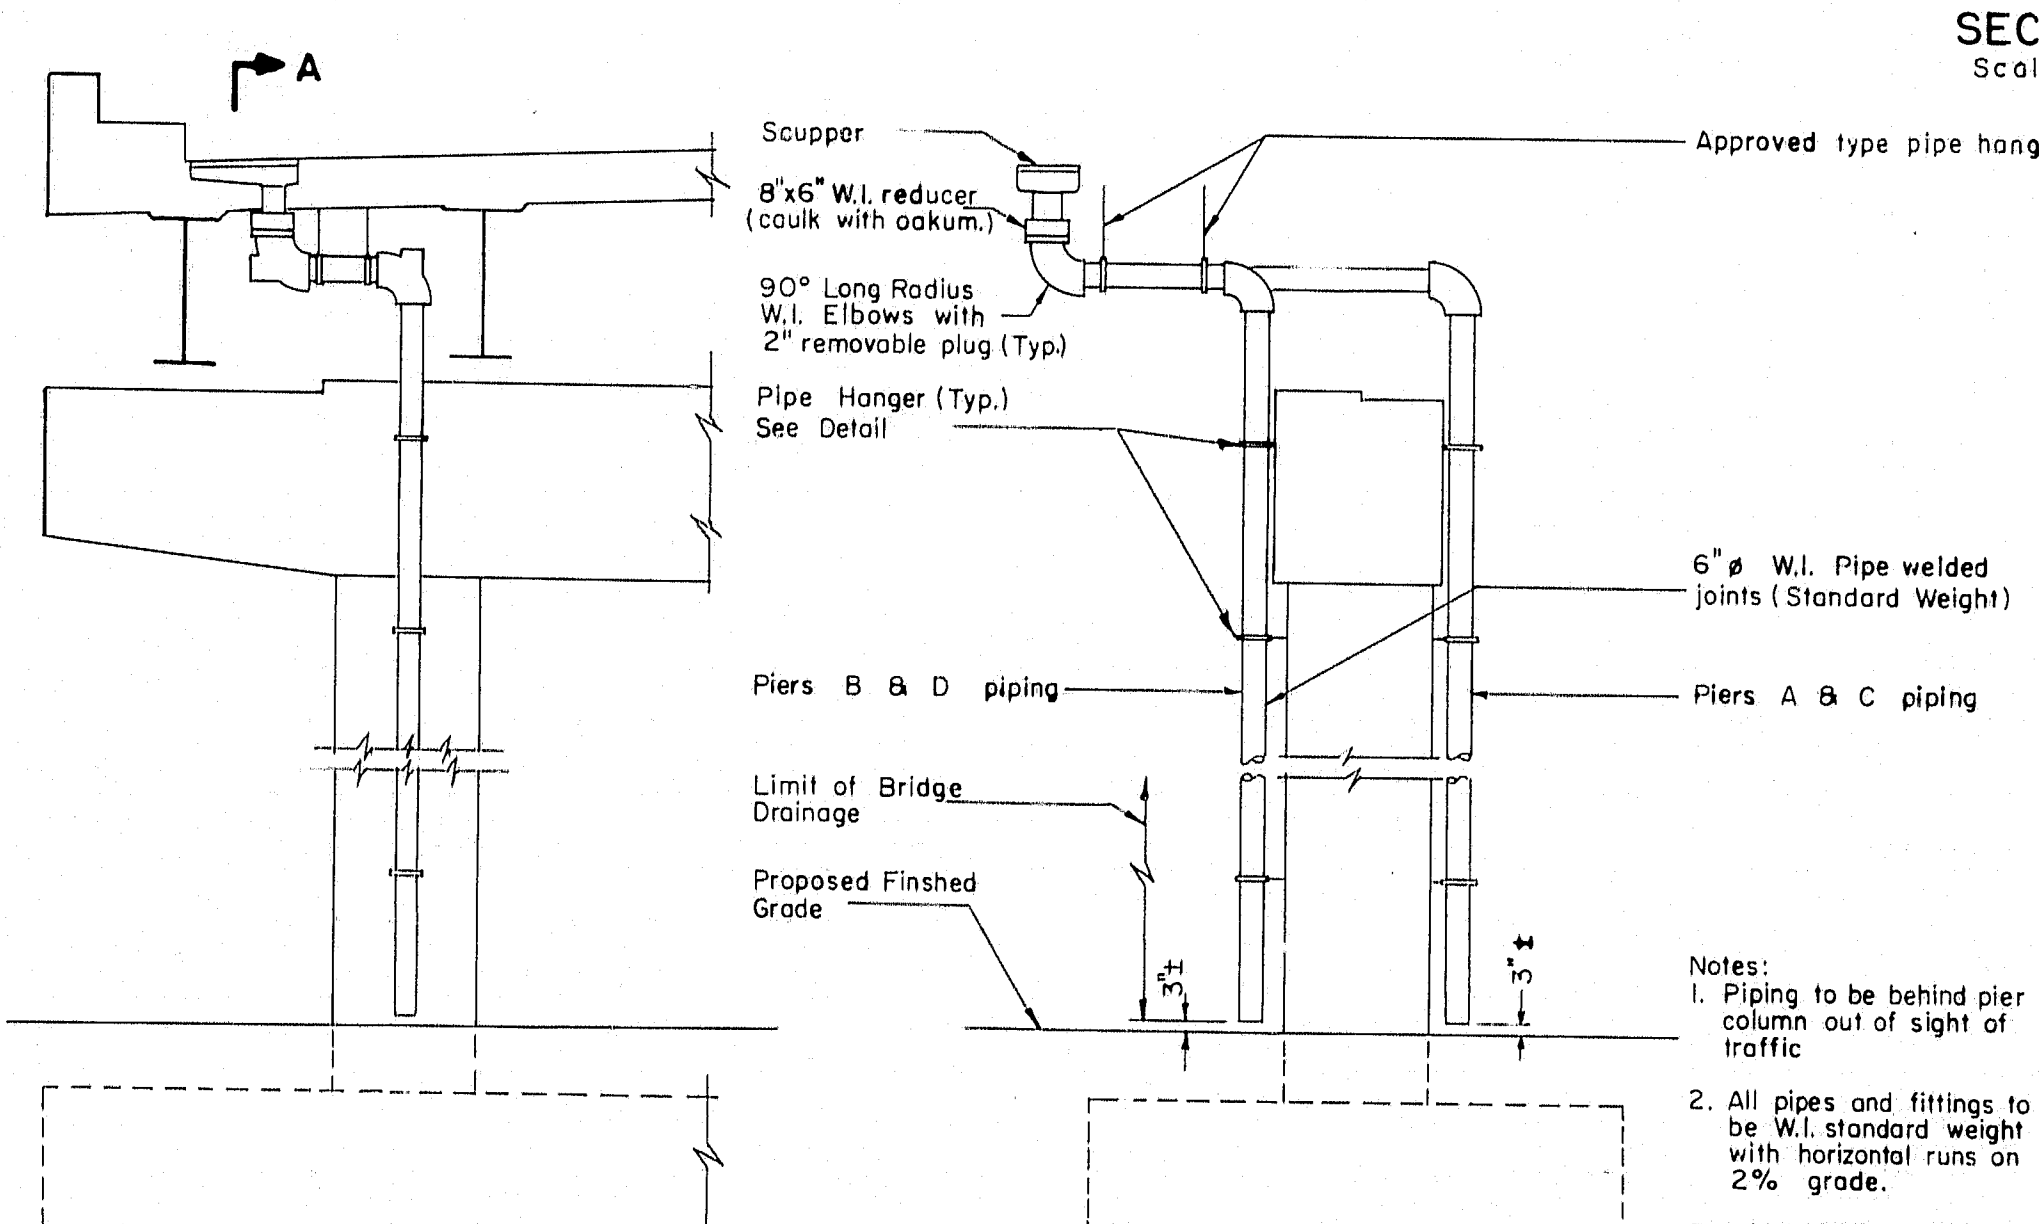


PIPE DETAILS AT PIERS  
Scale: 1/4" = 1'-0"

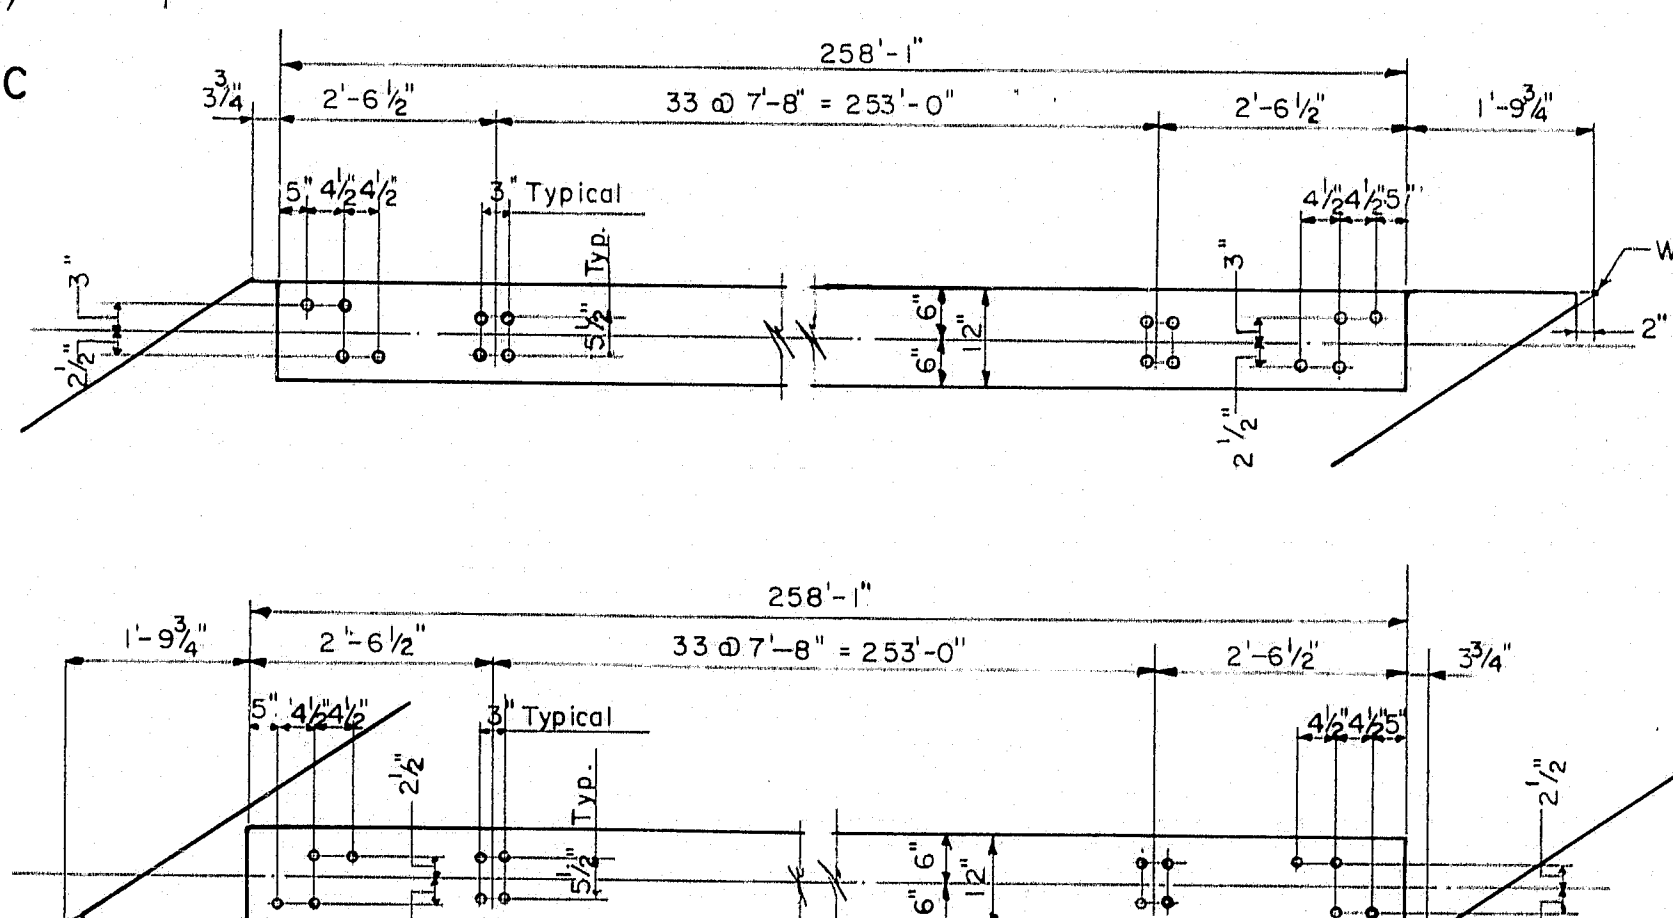


RAILING ANCHOR BOLT LAYOUT NORTHERLY BRIDGE  
Scale: 1/2" = 1'-0"

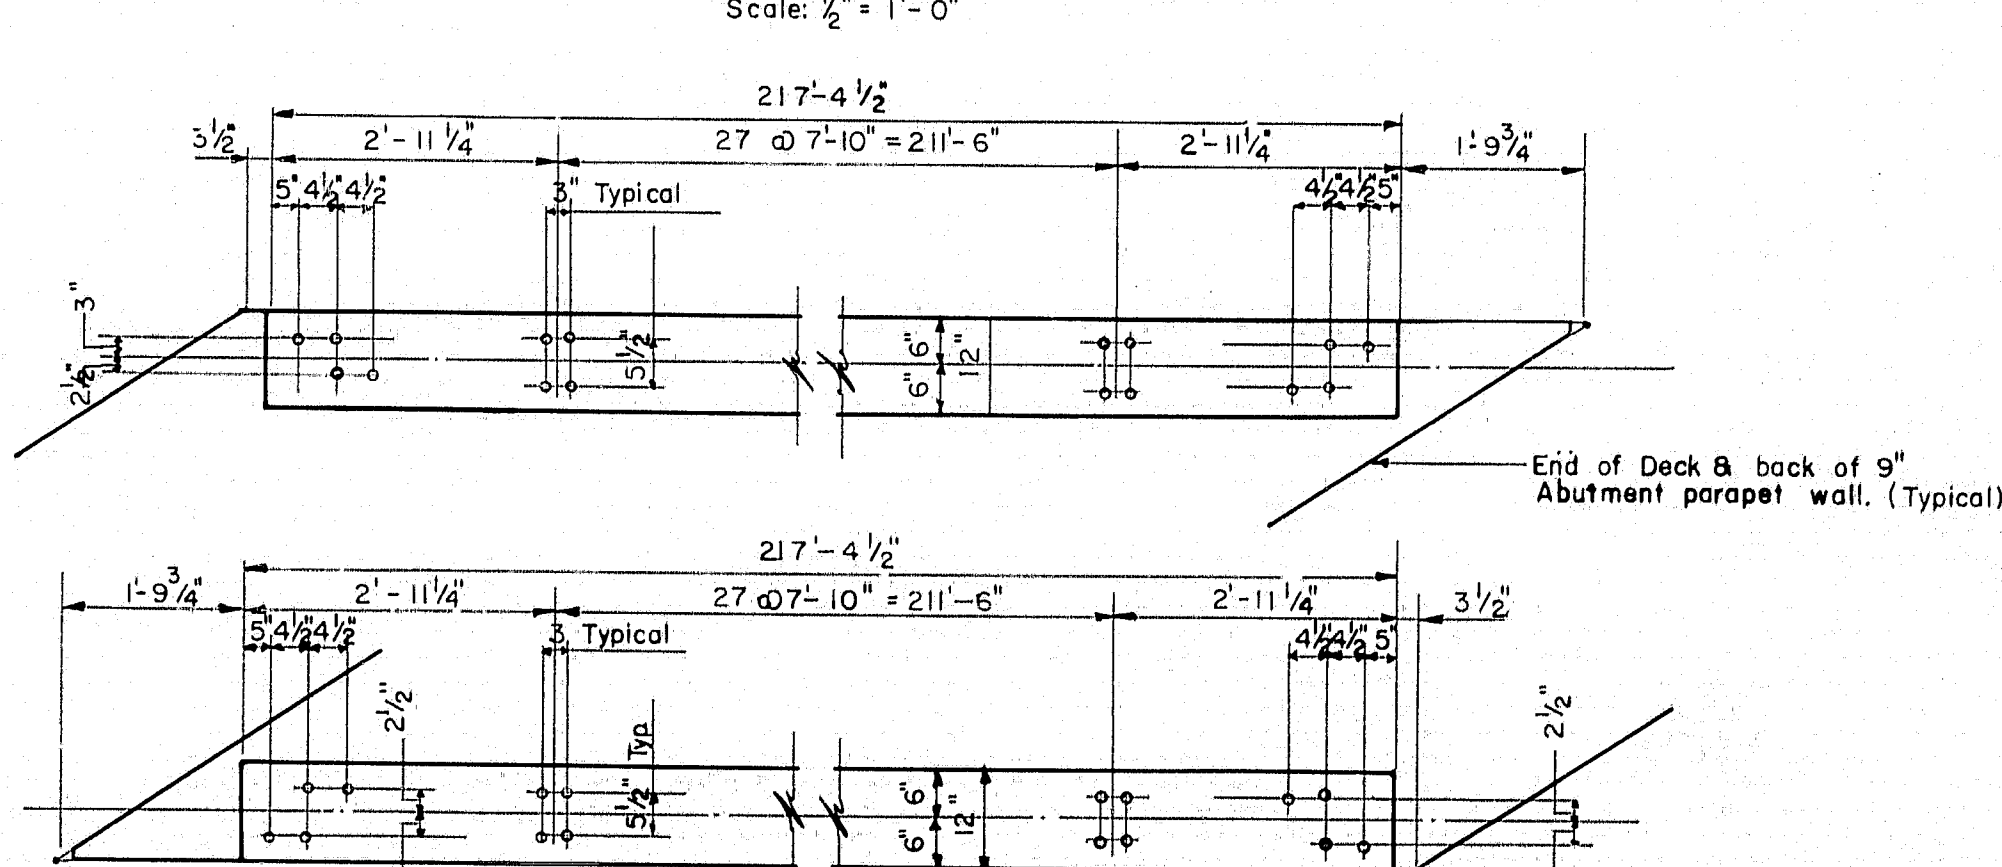


RAILING ANCHOR BOLT LAYOUT SOUTHERLY BRIDGE  
Scale: 1/2" = 1'-0"

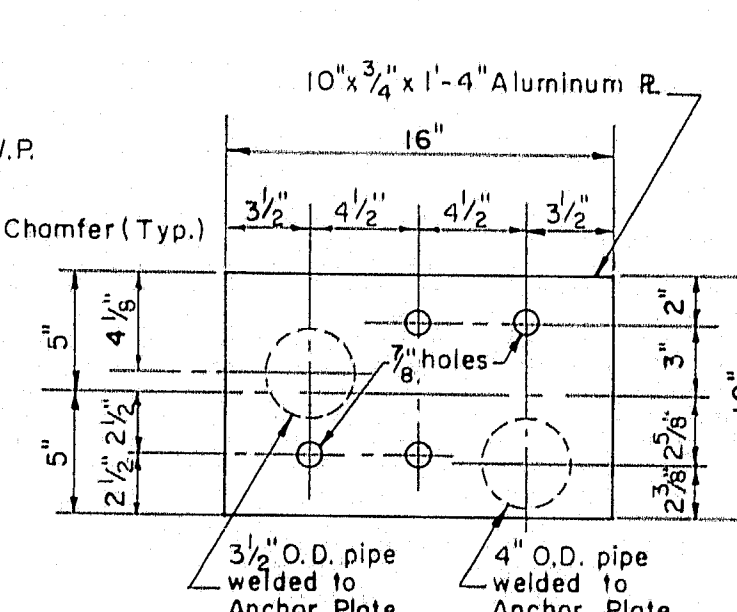

DETAIL A  
Scale: 1" = 1'-0"

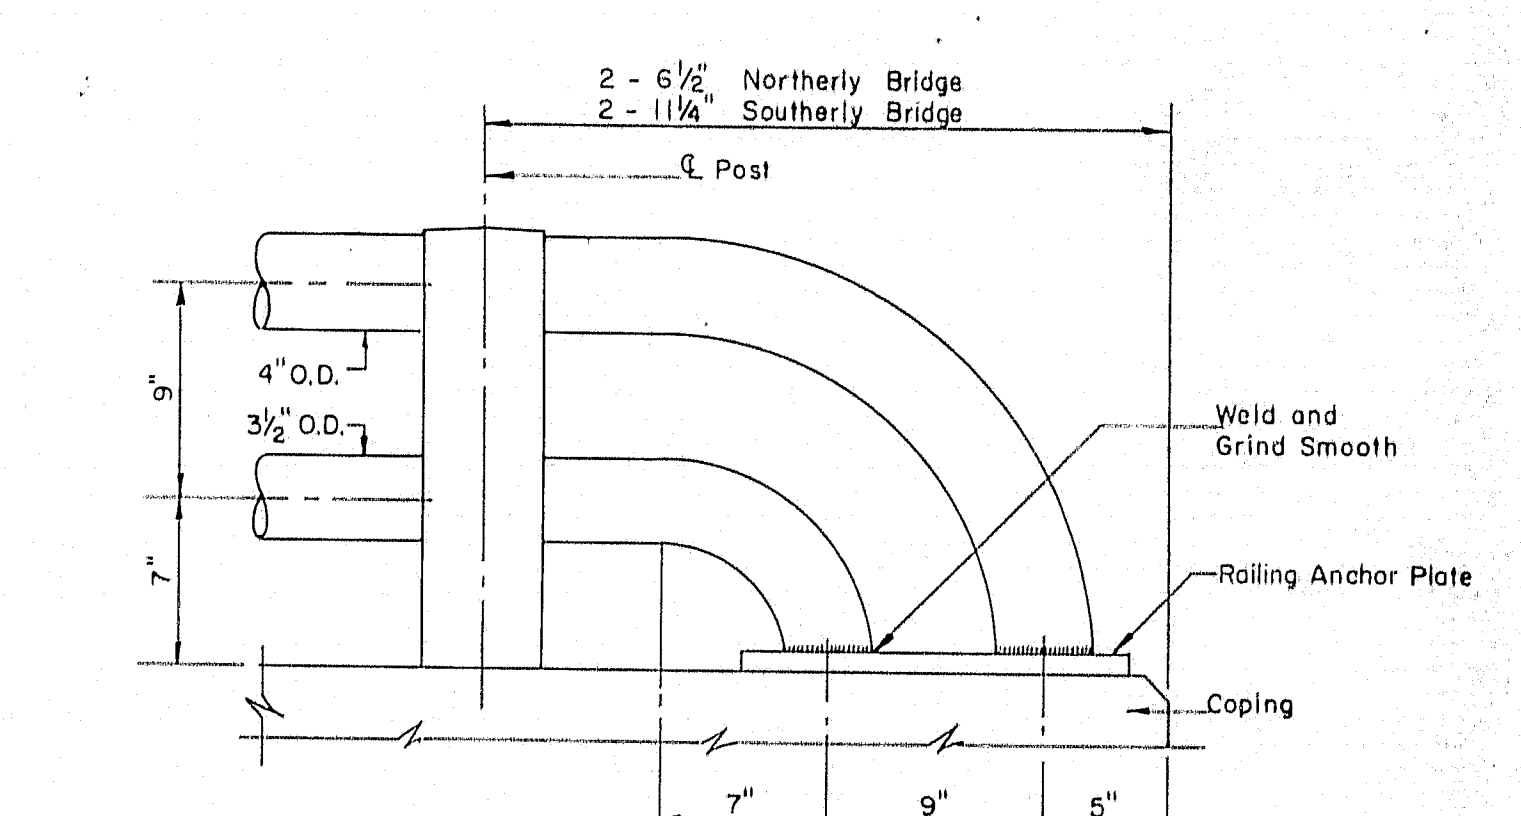

END RAILING DETAIL  
Scale: 1/2" = 1'-0"

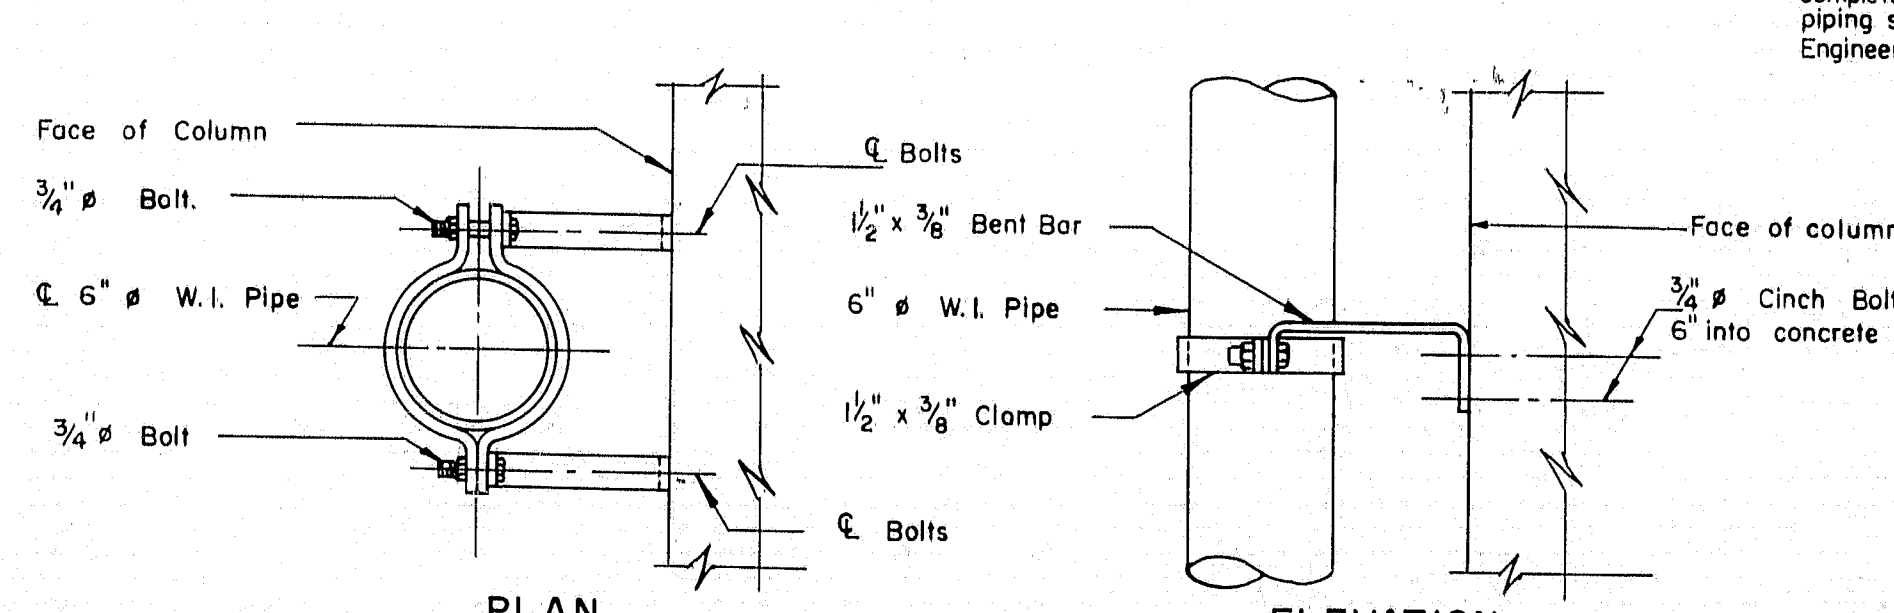


PIPE HANGER DETAILS  
Scale: 1/2" = 1'-0"

THE CLARKSON ENGINEERING CO., INC.			
DESIGN	CHECK	H.P.	BRIDGE NO
DRAWN	D.E.S.	APPROVED	W.A.H. SURVEY
			PLOT
STATE HIGHWAY COMMISSION			
INTERSTATE #95			
OVER			
STILLWATER AVE.			
IN THE CITY OF			
BANGOR			
PENOBSCOT COUNTY			
DETAILS			
SHEET 10 OF 10 AUGUSTA, MAINE			




B. P. R.	STATE	PROJECT NO.	SHEET NO.	TOTAL SHEETS
1	MAINE	I-95-8(6)	22	35


Interstate Highway to be Constructed  
to Top of Gravel Base only, Unless  
otherwise Indicated

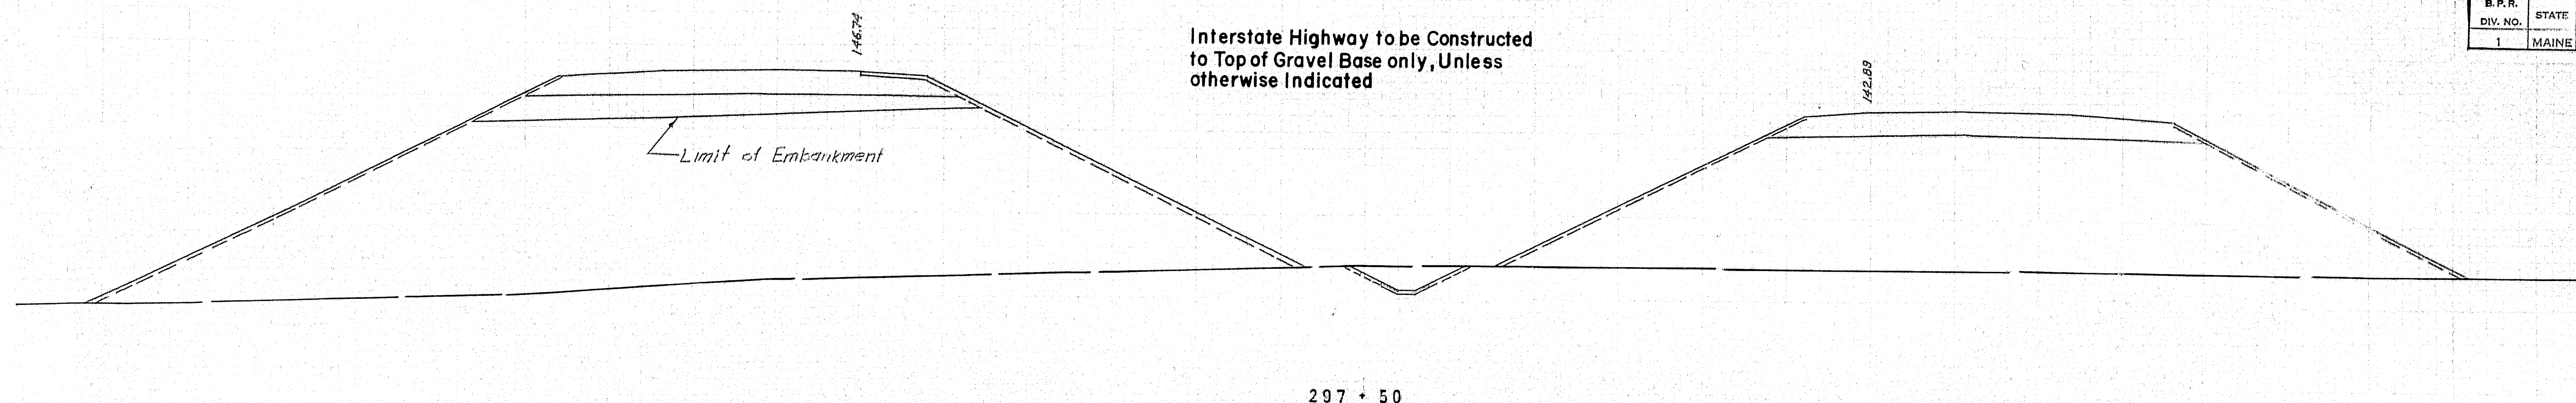

EMBANKMENT 126 CU. YD.  
EARTH EXCAVATION 41 CU. YD.

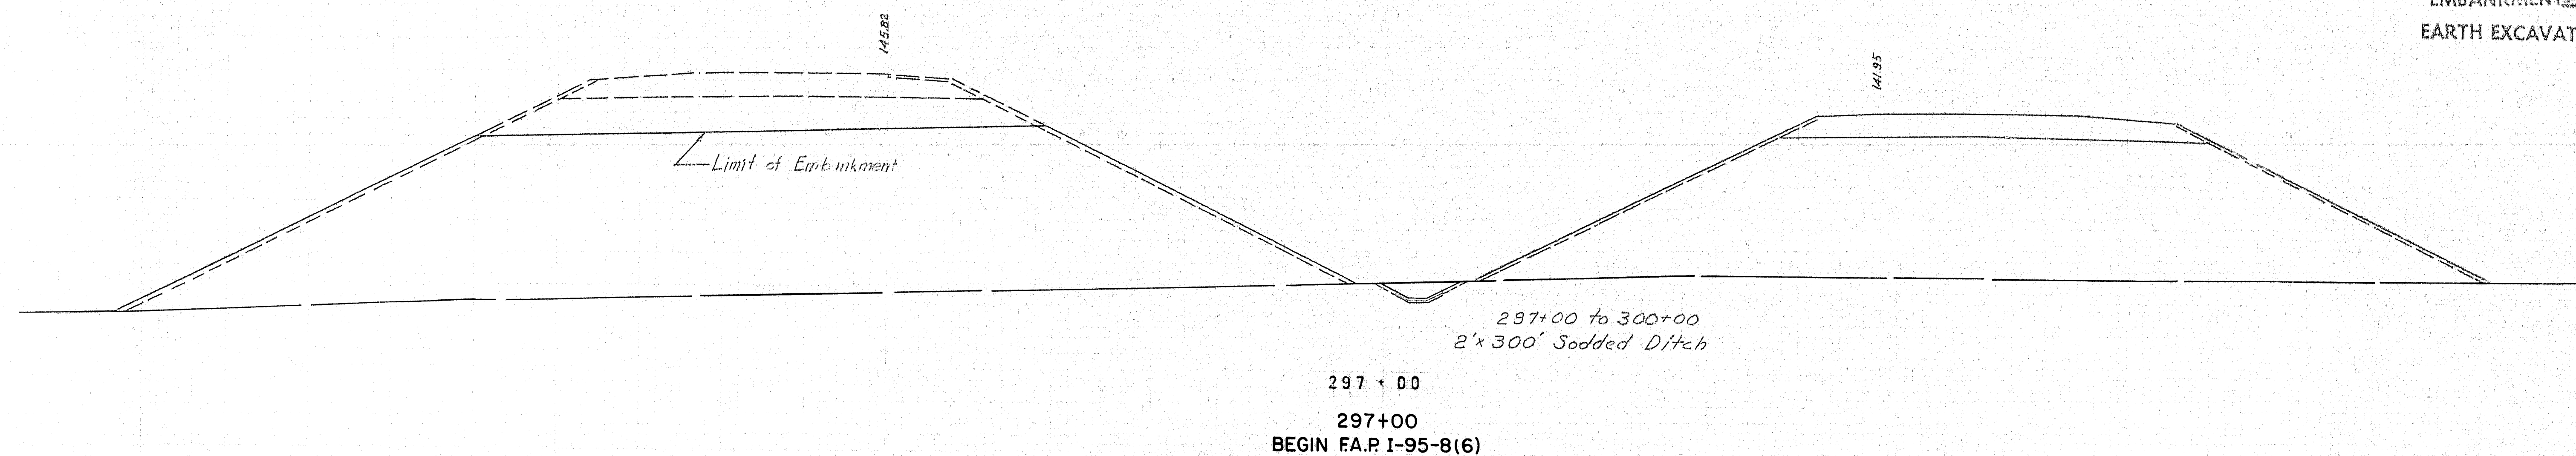


EARTH EXCAVATION 15 CU. YD.

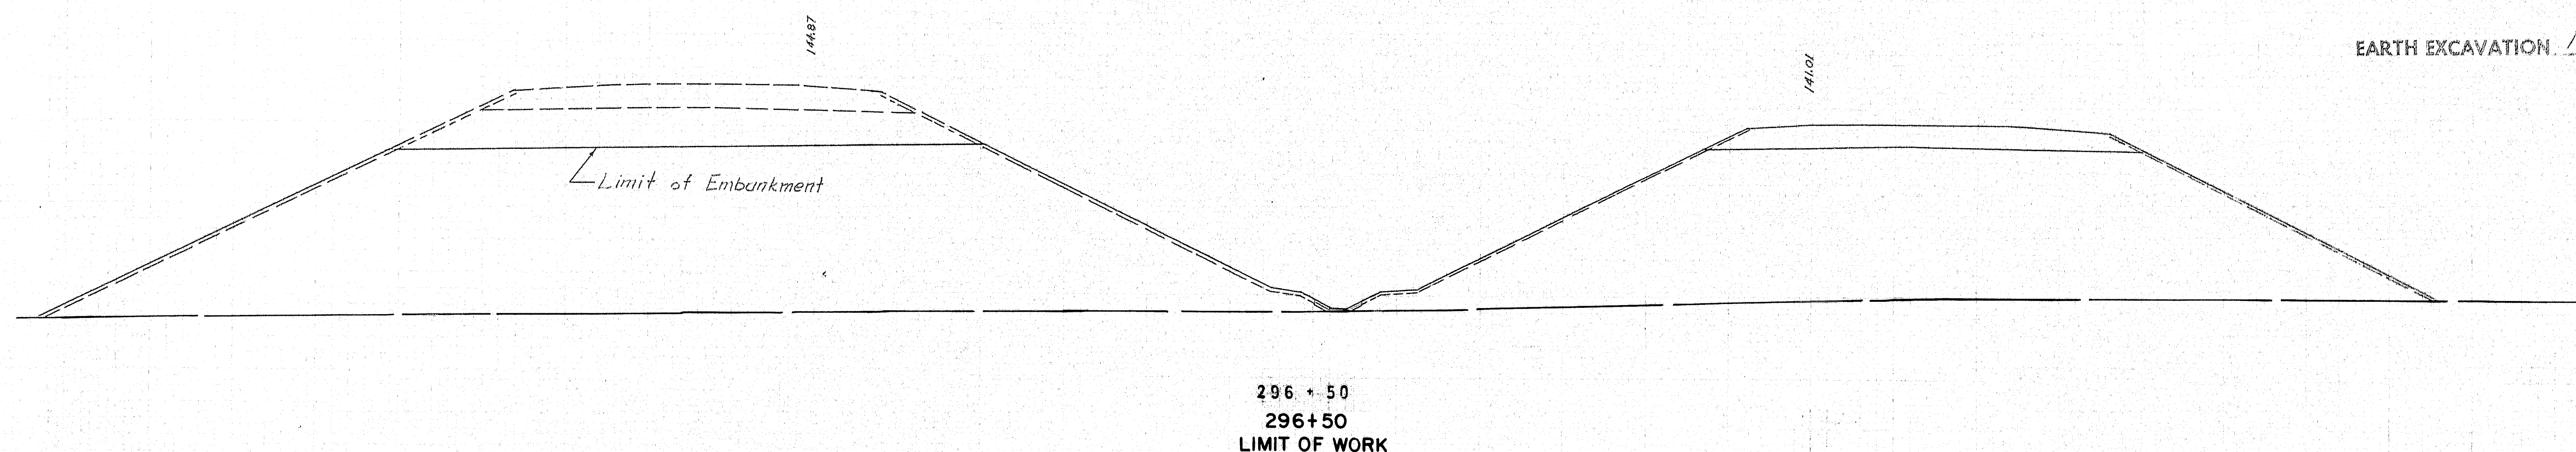




B.P.R. REG. NO.	STATE	PROJECT NO.	SHEET NO.	TOTAL SHEETS
1	MAINE	I-95-B(6)	23	35

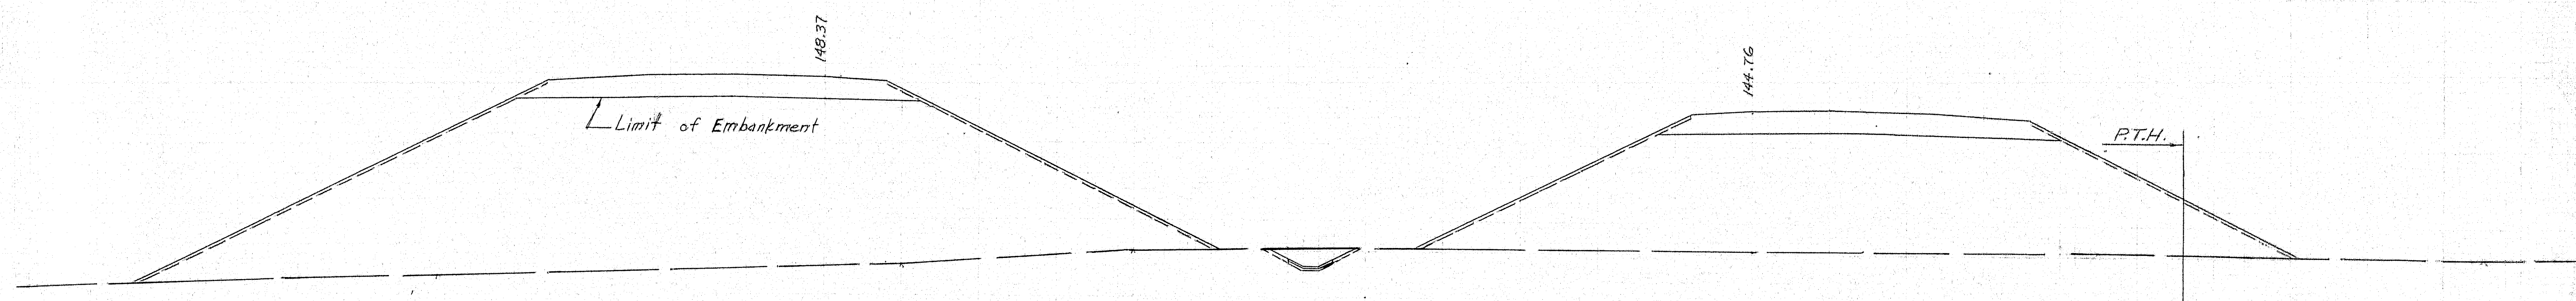

298+50

110


EMBANKMENT 5246 CU. YD.  
EARTH EXCAVATION 43 CU. YD.

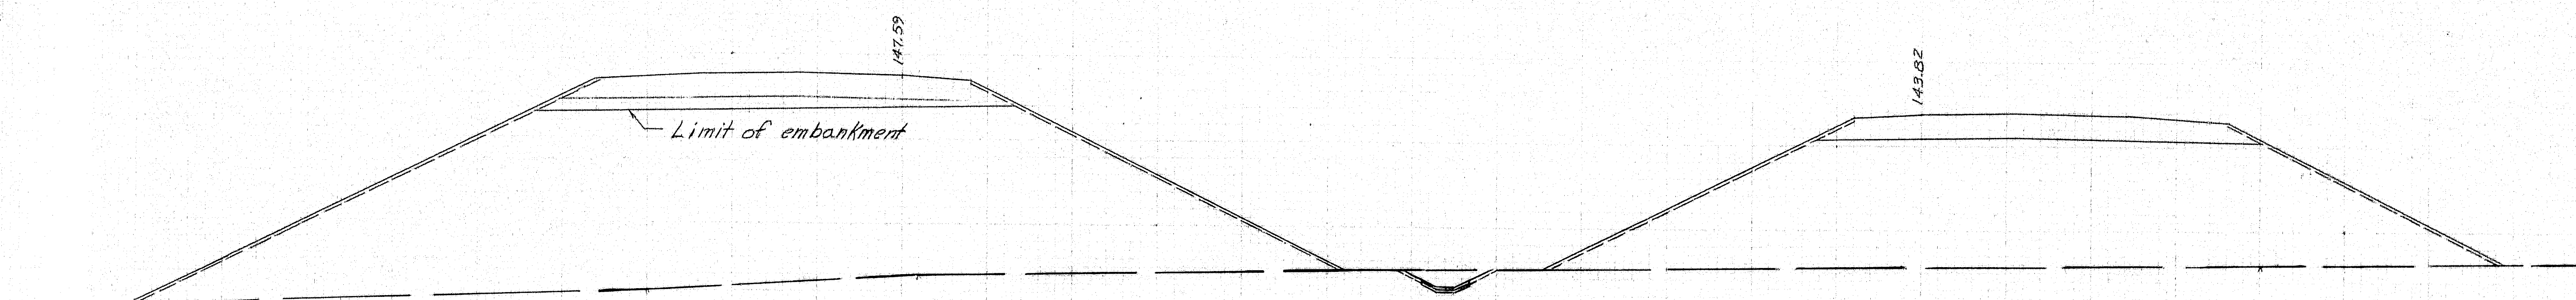

298+00

110

EMBANKMENT 6128 CU. YD.  
EARTH EXCAVATION 43 CU. YD.

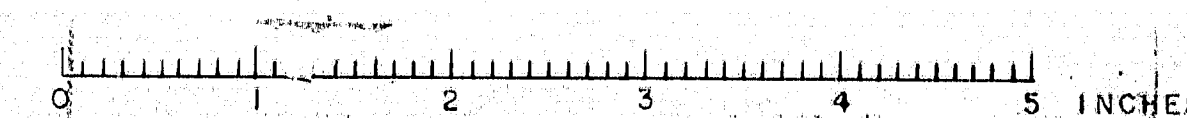



B. P. R. REG. NO.	STATE	PROJECT NO.	SHEET NO.	TOTAL SHEETS
1	MAINE	1-95-8(6)	24	35

EMBANKMENT 163 CU. YD.  
EARTH EXCAVATION 25 CU. YD.



EMBANKMENT 1245 CU. YD.  
EARTH EXCAVATION 29 CU. YD.

EMBANKMENT 2278 CU. YD.  
EARTH EXCAVATION 27 CU. YD.

EMBANKMENT 5426 CU. YD.  
EARTH EXCAVATION 50 CU. YD.




B. P. R. REG. NO.	STATE	PROJECT NO.	SHEET NO.	TOTAL SHEETS
1	MAINE	1-95-8(6)	25	35

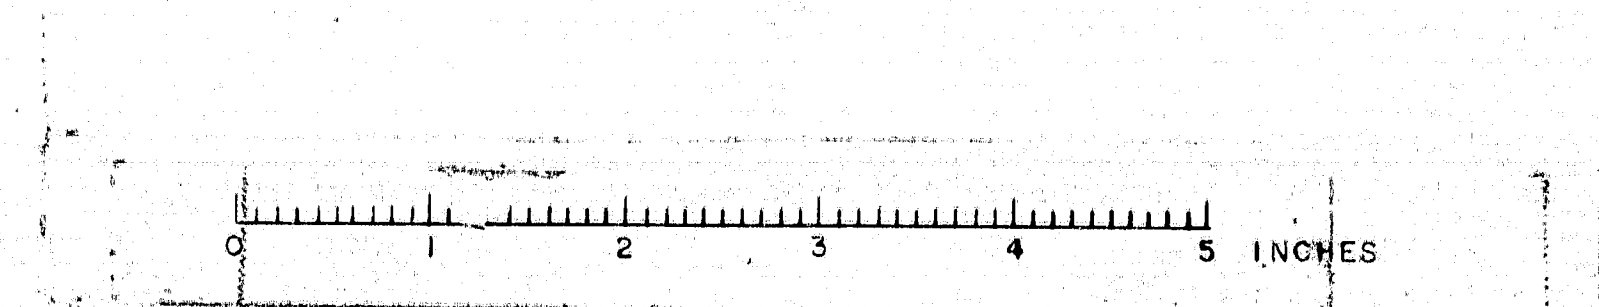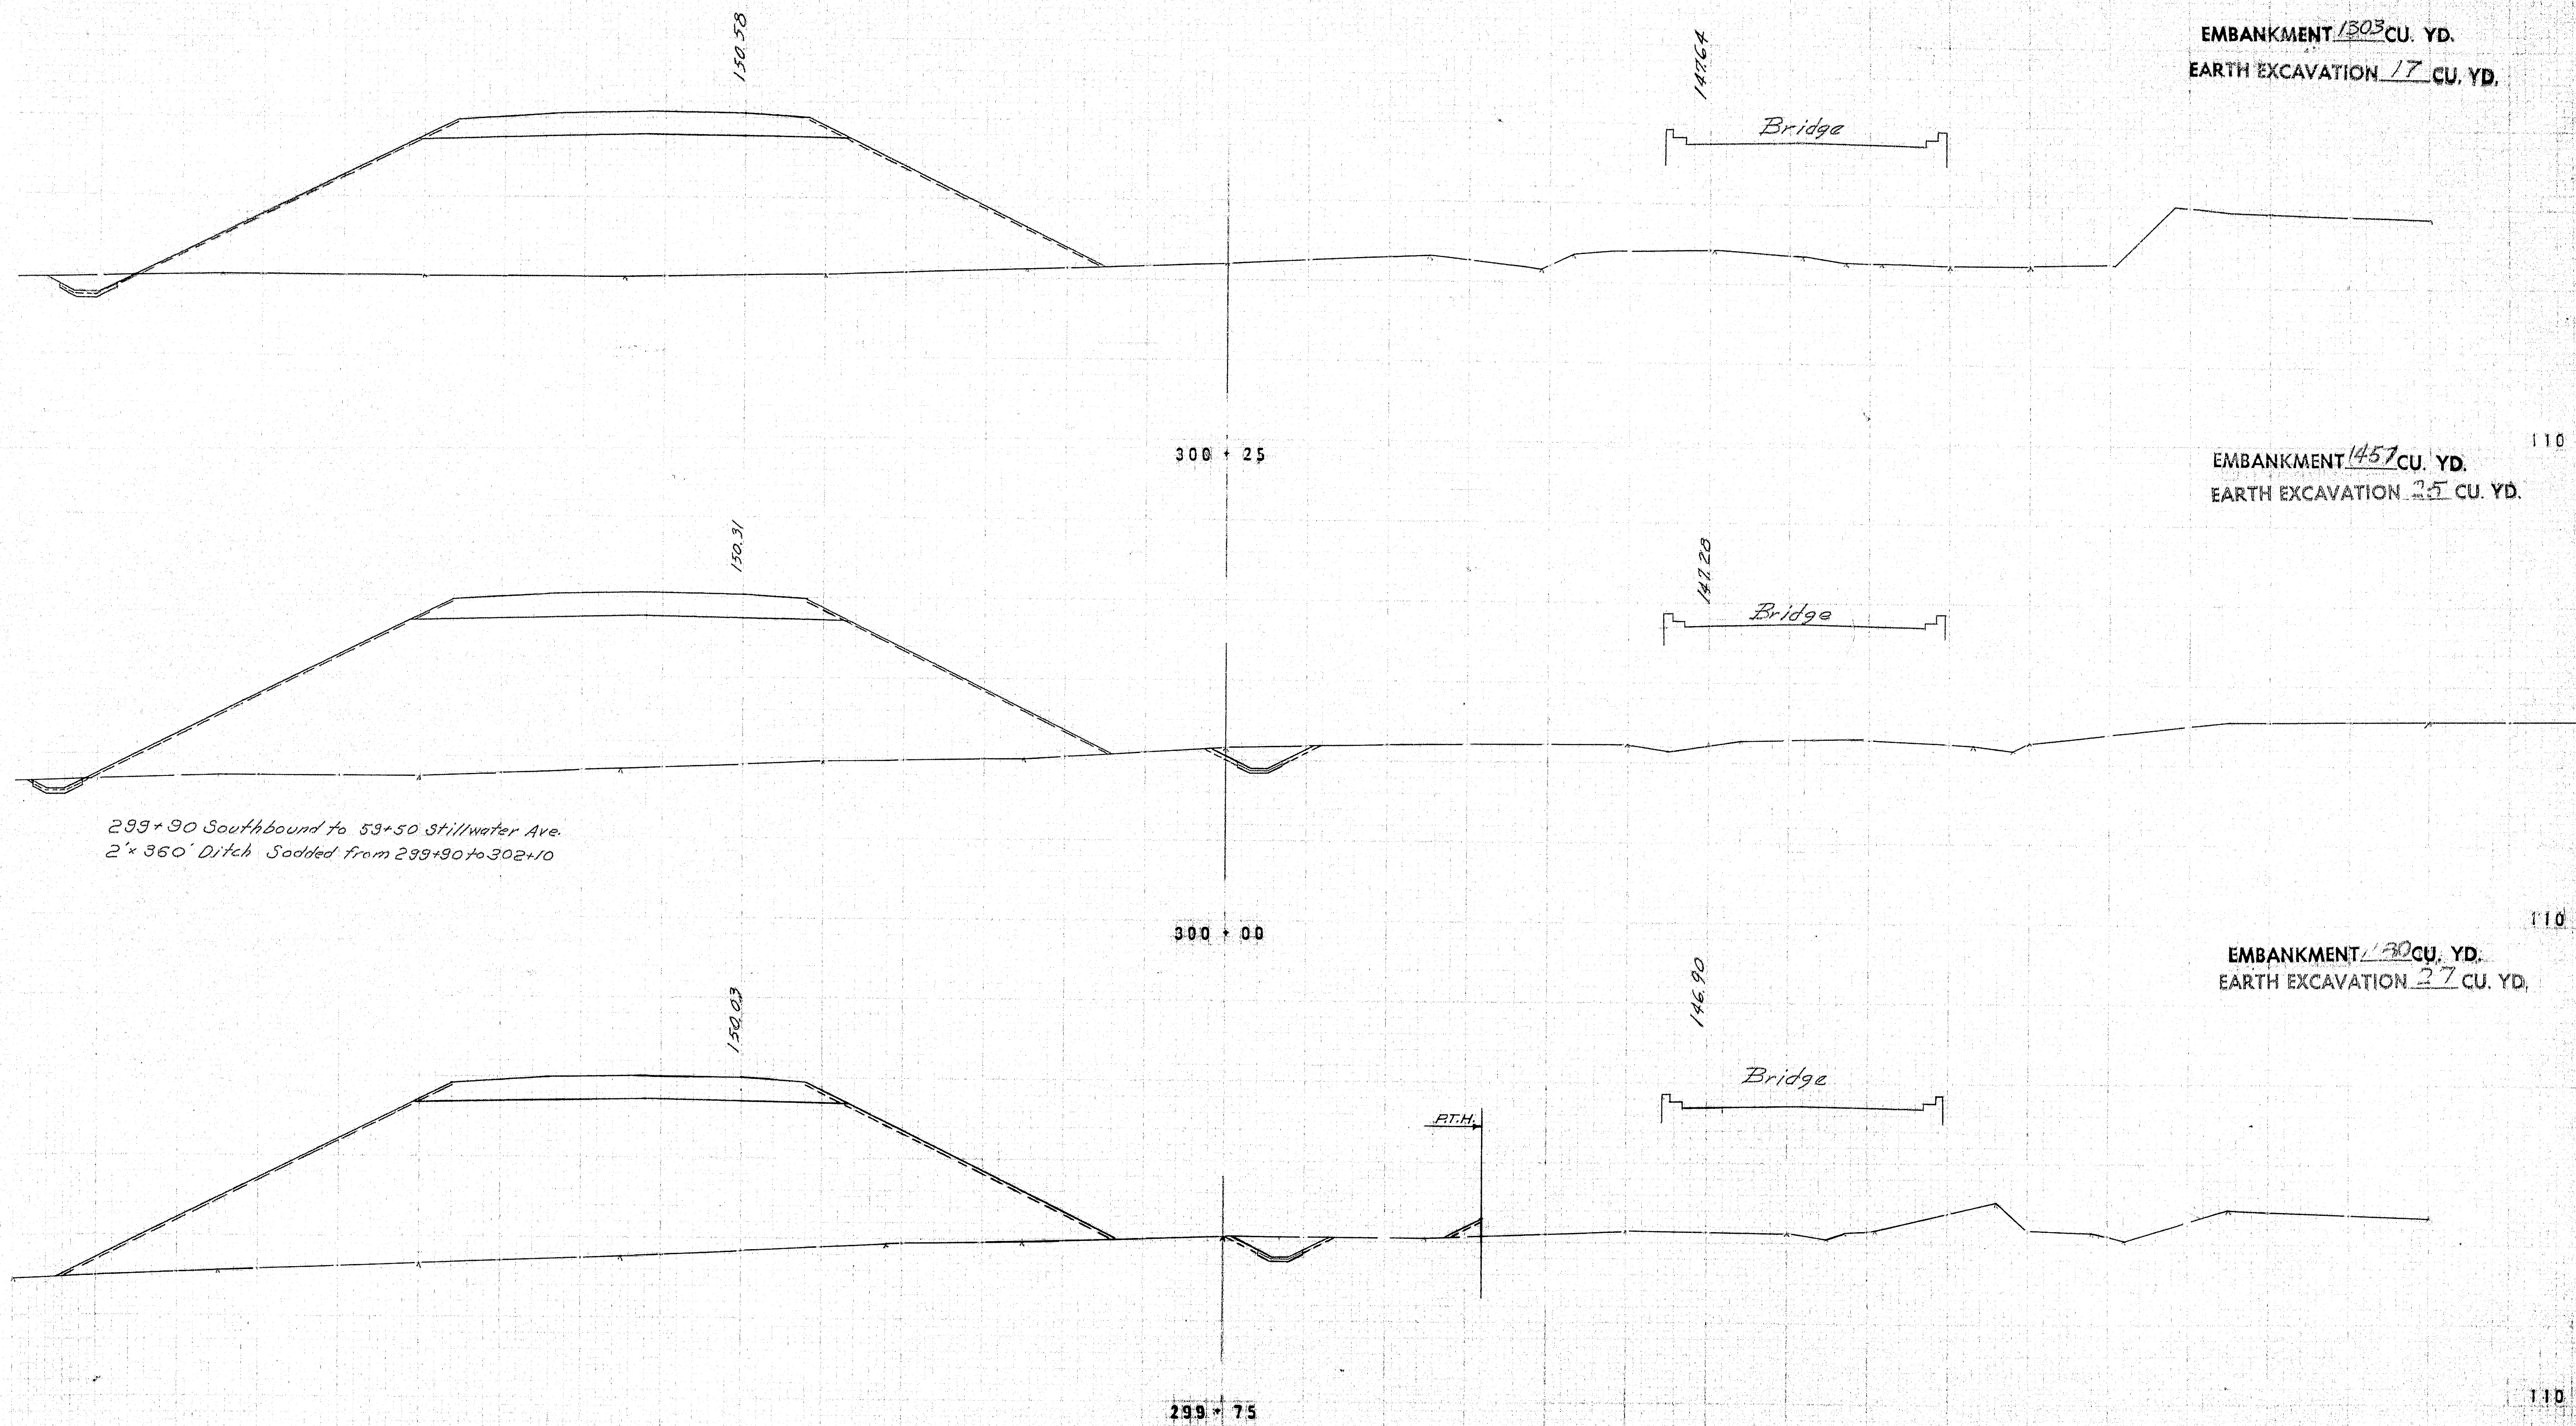




INTERSTATE 895 - MAJOR				
B. P. R. REG. NO.	STATE	PROJECT NO.	SHEET NO.	TOTAL SHEETS
1	MAINE	1-95-8(6)	26	35



EMBANKMENT 727 CU. YD.  
EARTH EXCAVATION 50 CU. YD.

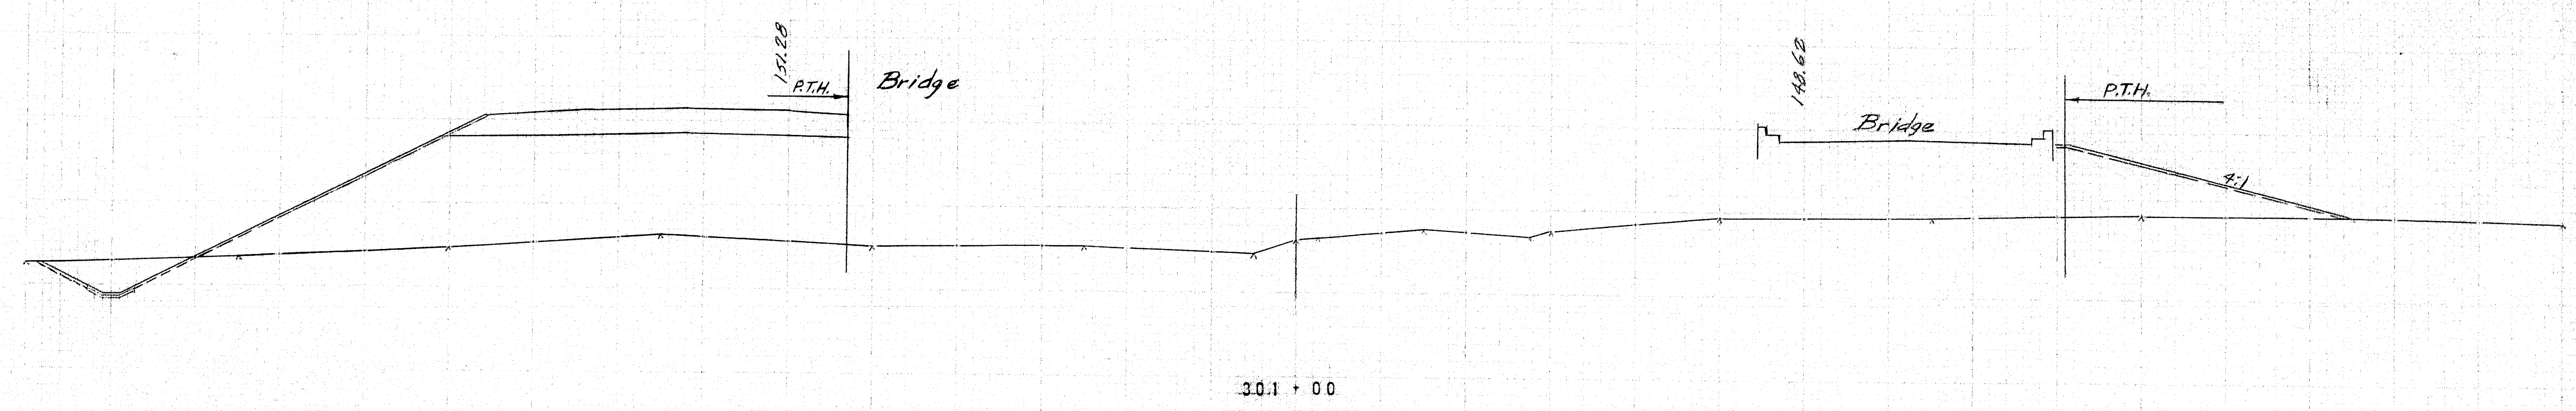

EMBANKMENT 225 CU. YD.  
EARTH EXCAVATION 37 CU. YD.

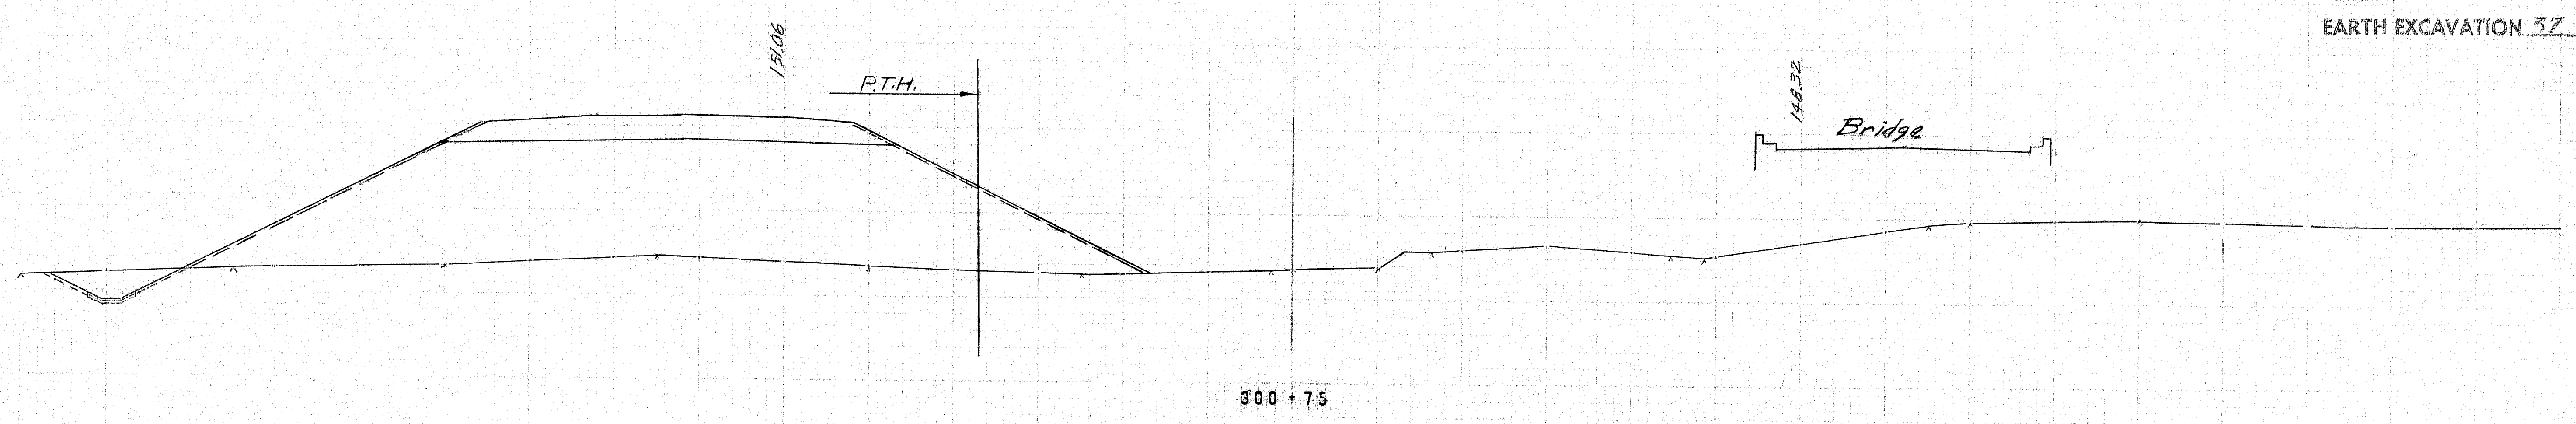


EMBANKMENT 1116 CU. YD.  
EARTH EXCAVATION 25 CU. YD.

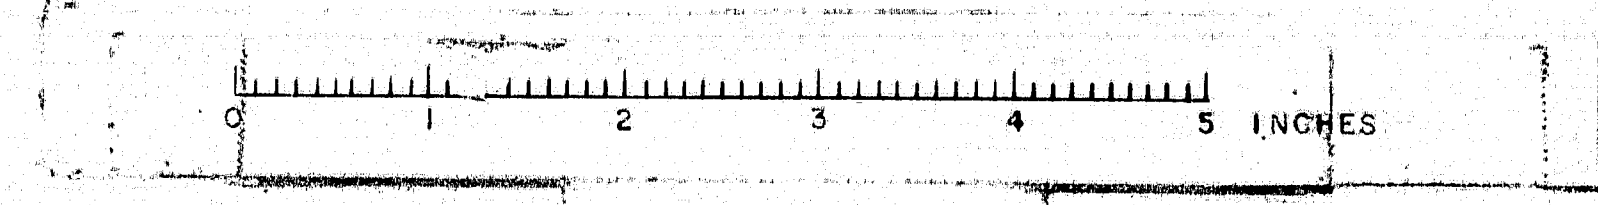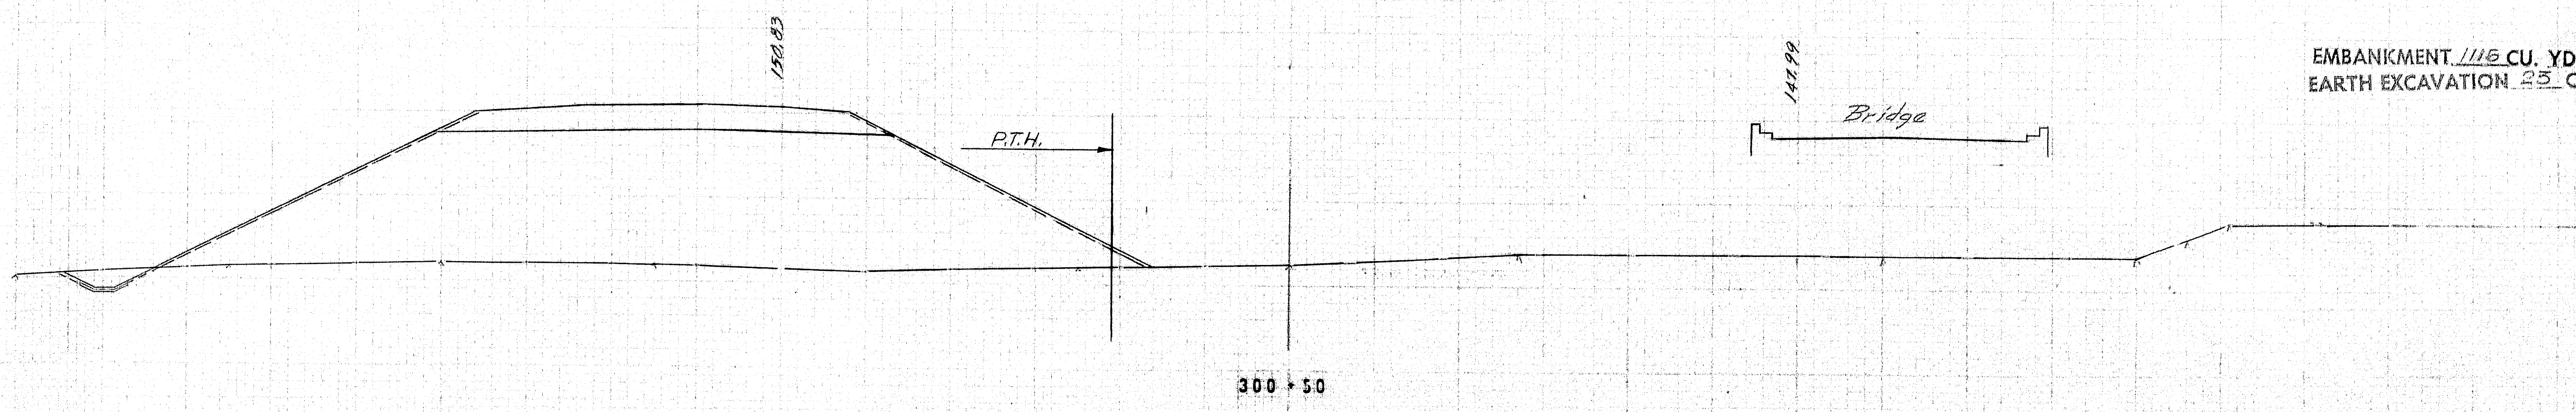




B. P. R. REG. NO.	STATE	PROJECT NO.	SHEET NO.	TOTAL SHEETS
1	MAINE	I-95-B(6)	27	35


EMBANKMENT 511 CU. YD.  
EARTH EXCAVATION 20 CU. YD.

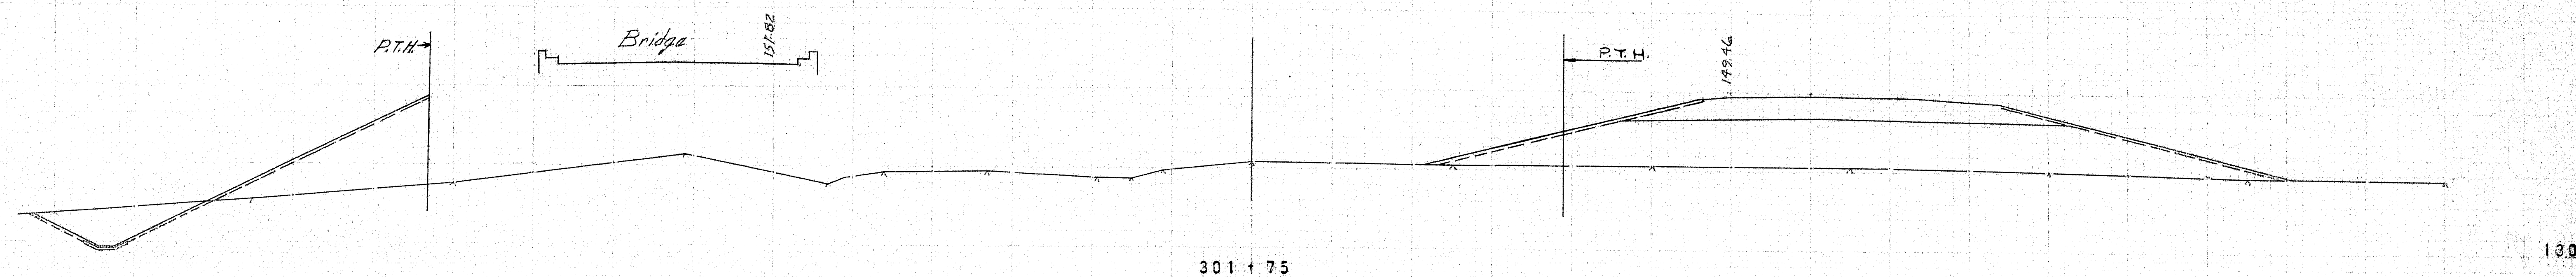

EMBANKMENT 548 CU. YD.  
EARTH EXCAVATION 22 CU. YD.

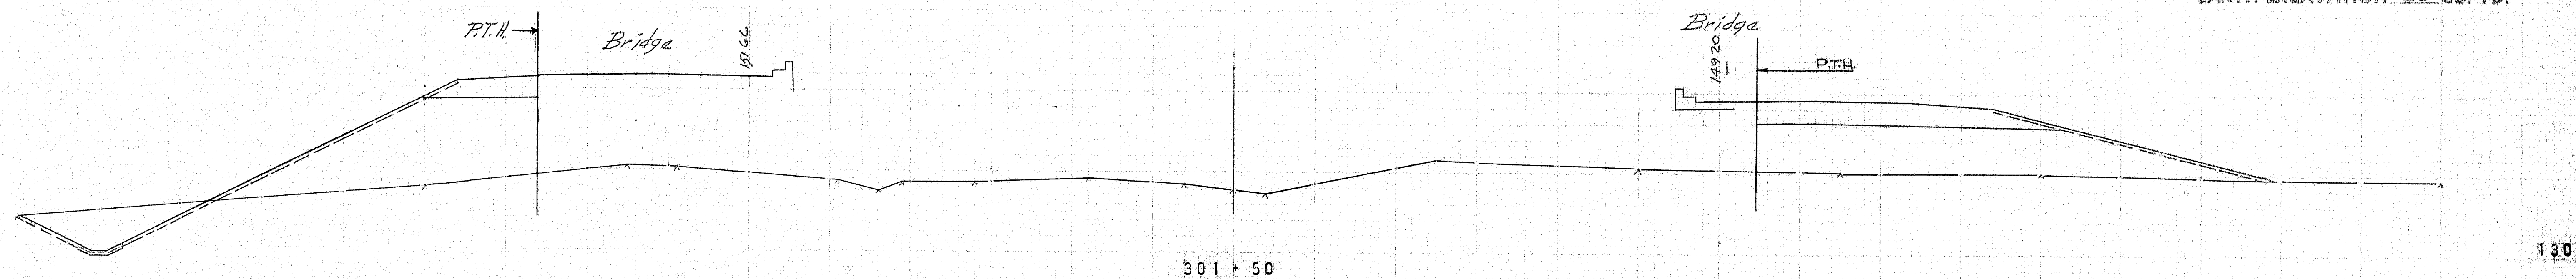


EMBANKMENT 530 CU. YD.  
EARTH EXCAVATION 23 CU. YD.

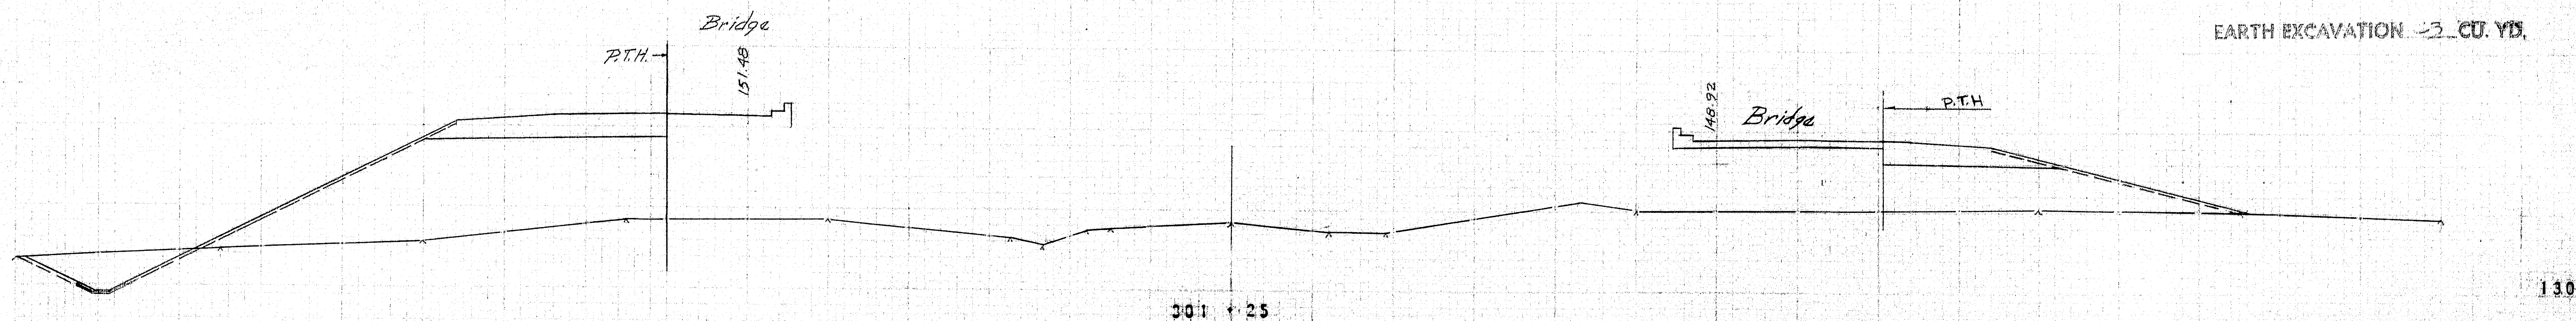




S. P. R. REG. NO.	STATE	PROJECT NO.	SHEET NO.	TOTAL SHEETS
1	MAINE	I-95-8(6)	20	35



EMBANKMENT 431 CU. YD.  
EARTH EXCAVATION 21 CU. YD.

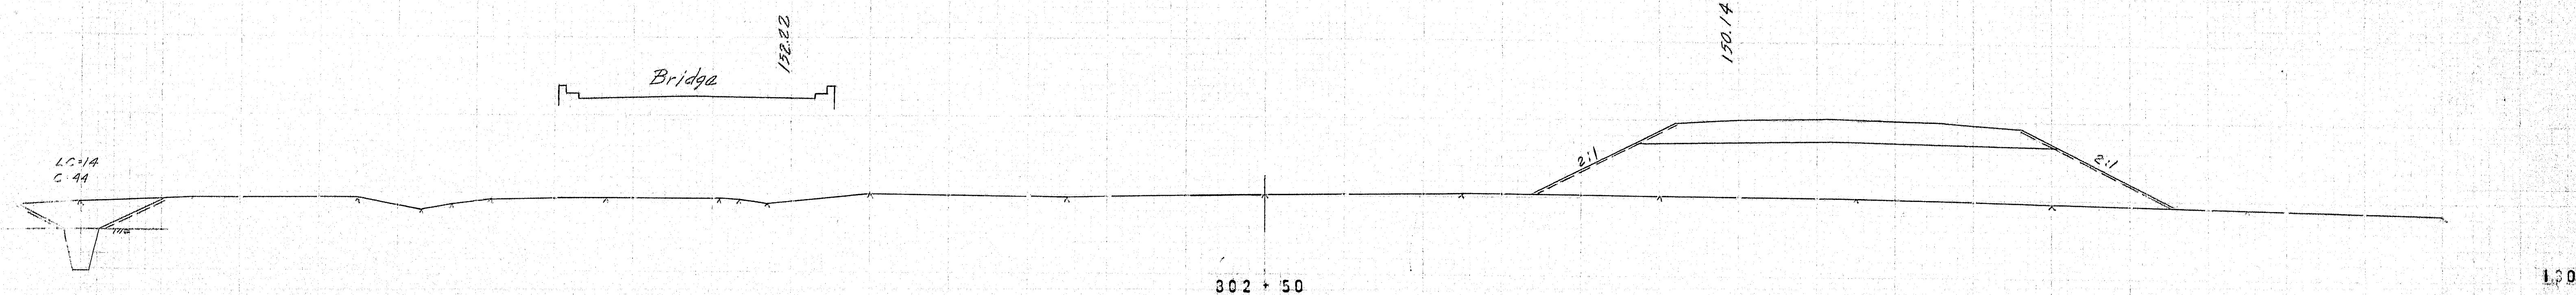

EMBANKMENT 449 CU. YD.  
EARTH EXCAVATION 33 CU. YD.

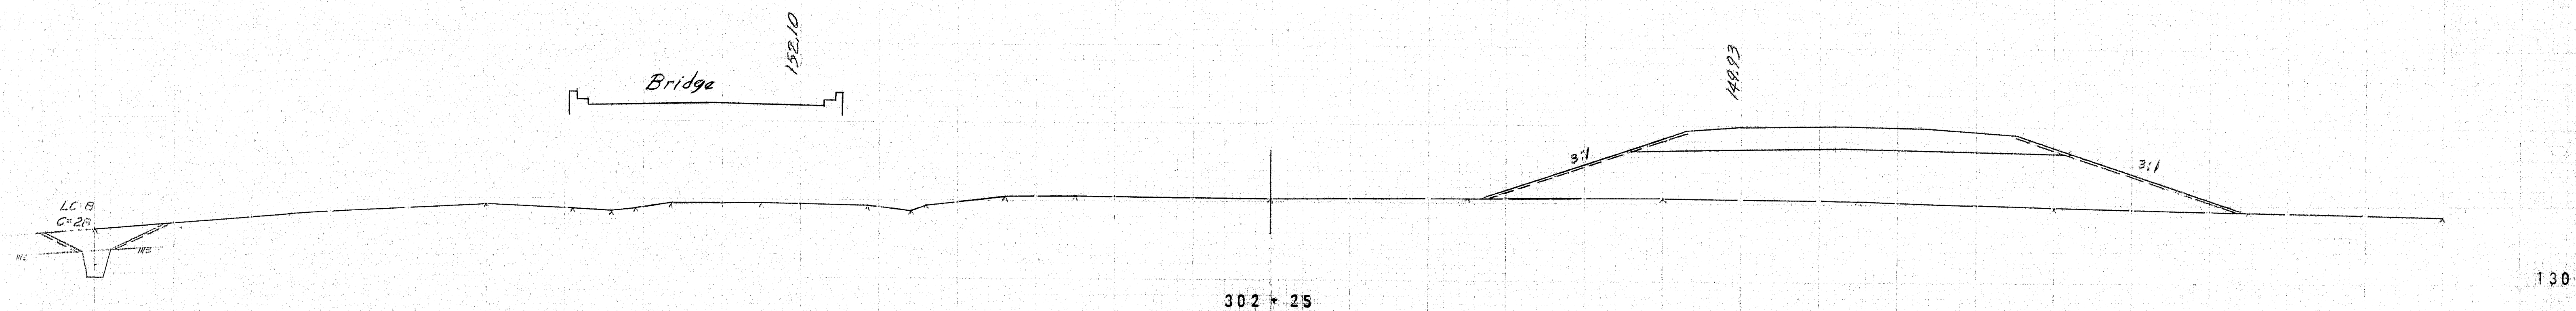


EMBANKMENT 456 CU. YD.  
EARTH EXCAVATION 52 CU. YD.

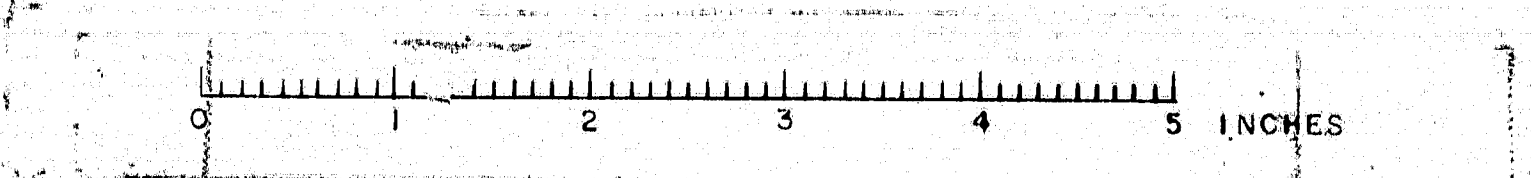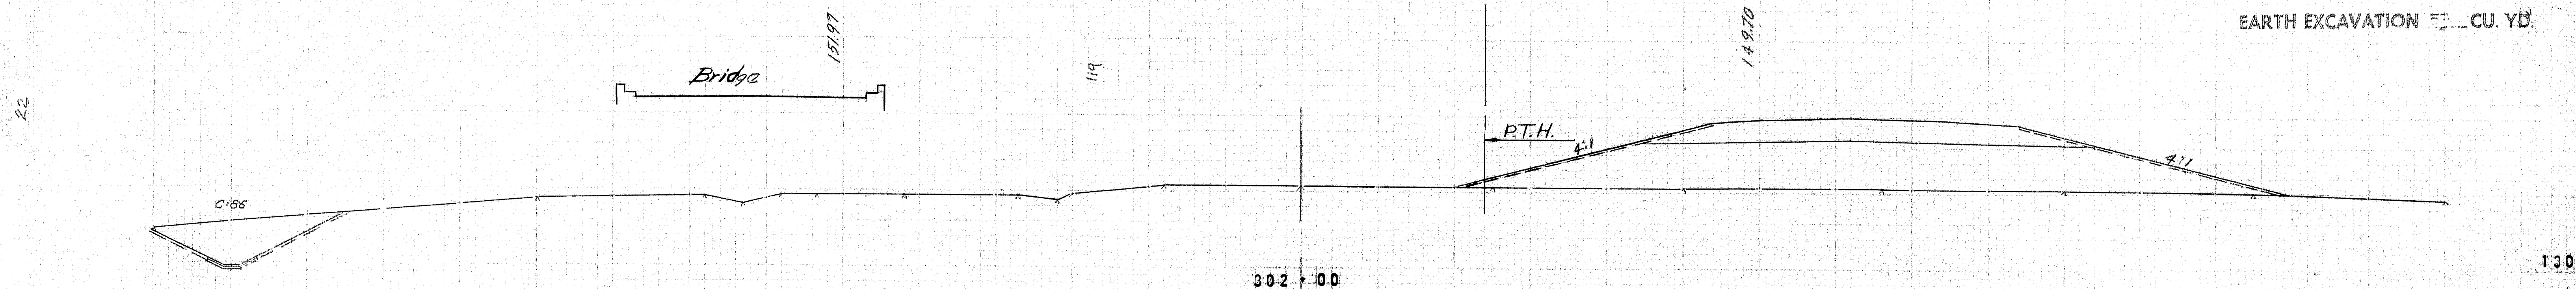




B. P. R. REG. NO.	STATE	PROJECT NO.	SHEET NO.	TOTAL SHEETS
1	MAINE	I-95-8(6)	29	35



EMBANKMENT 134 CU. YD.  
EARTH EXCAVATION 12 CU. YD.

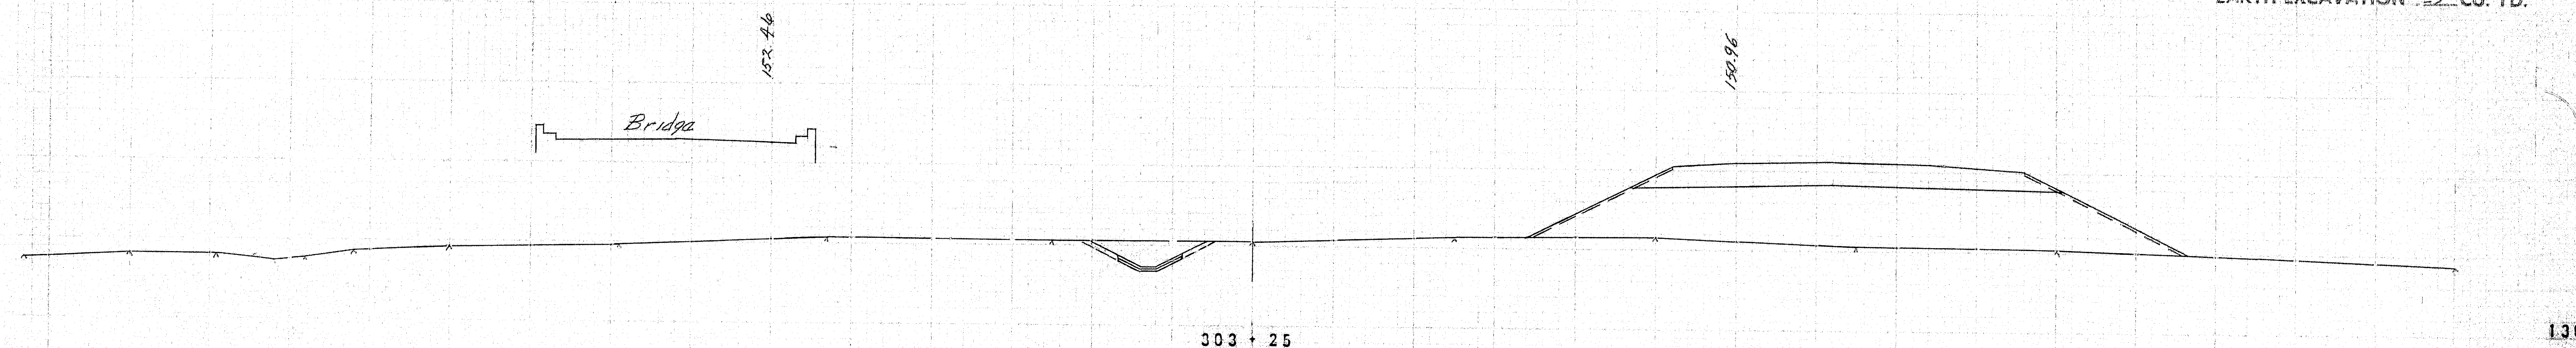

EMBANKMENT 141 CU. YD.  
EARTH EXCAVATION 31 CU. YD.

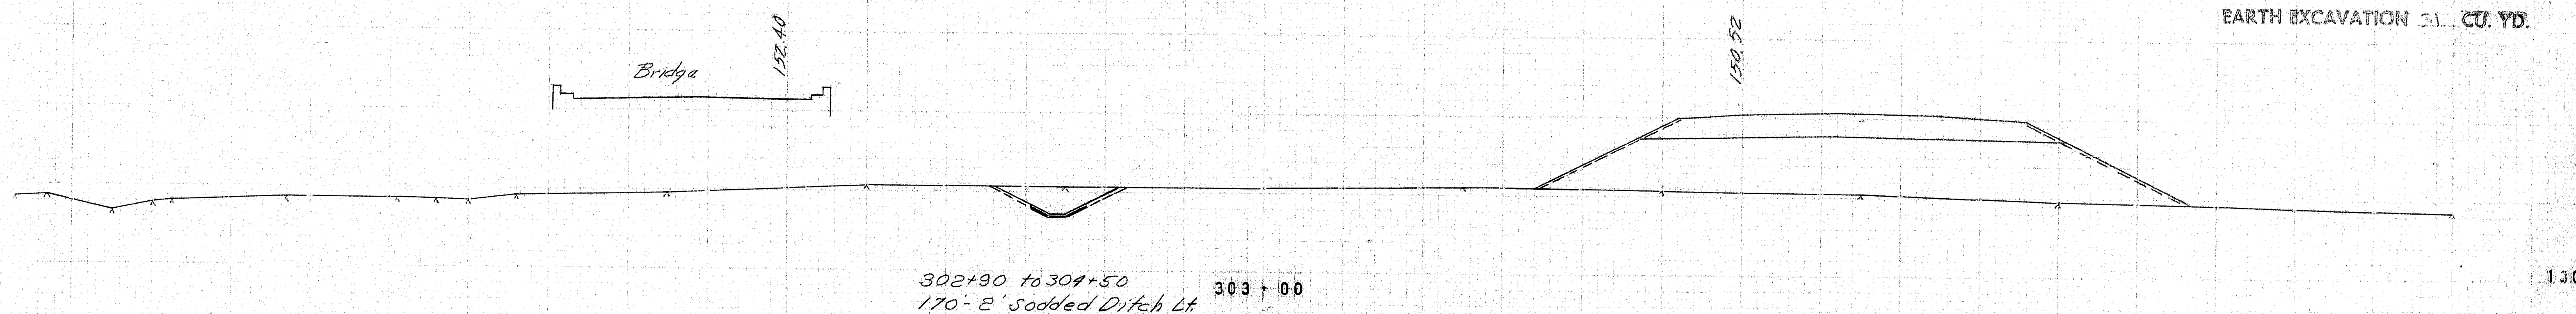


EMBANKMENT 130 CU. YD.  
EARTH EXCAVATION 12 CU. YD.

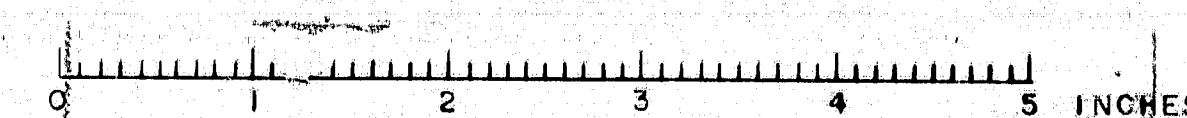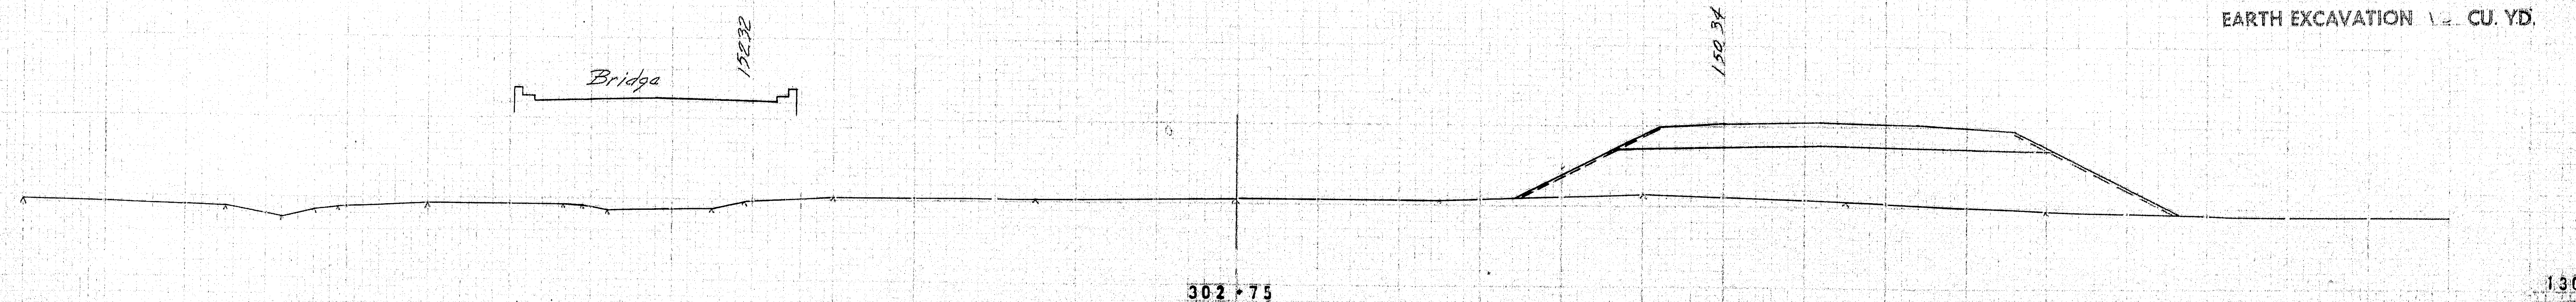




INTERSTATE #95 - BANGOR				
B. P. R. REG. NO.	STATE	PROJECT NO.	SHEET NO.	TOTAL SHEETS
1	MAINE	1-95-8(6)	30	35

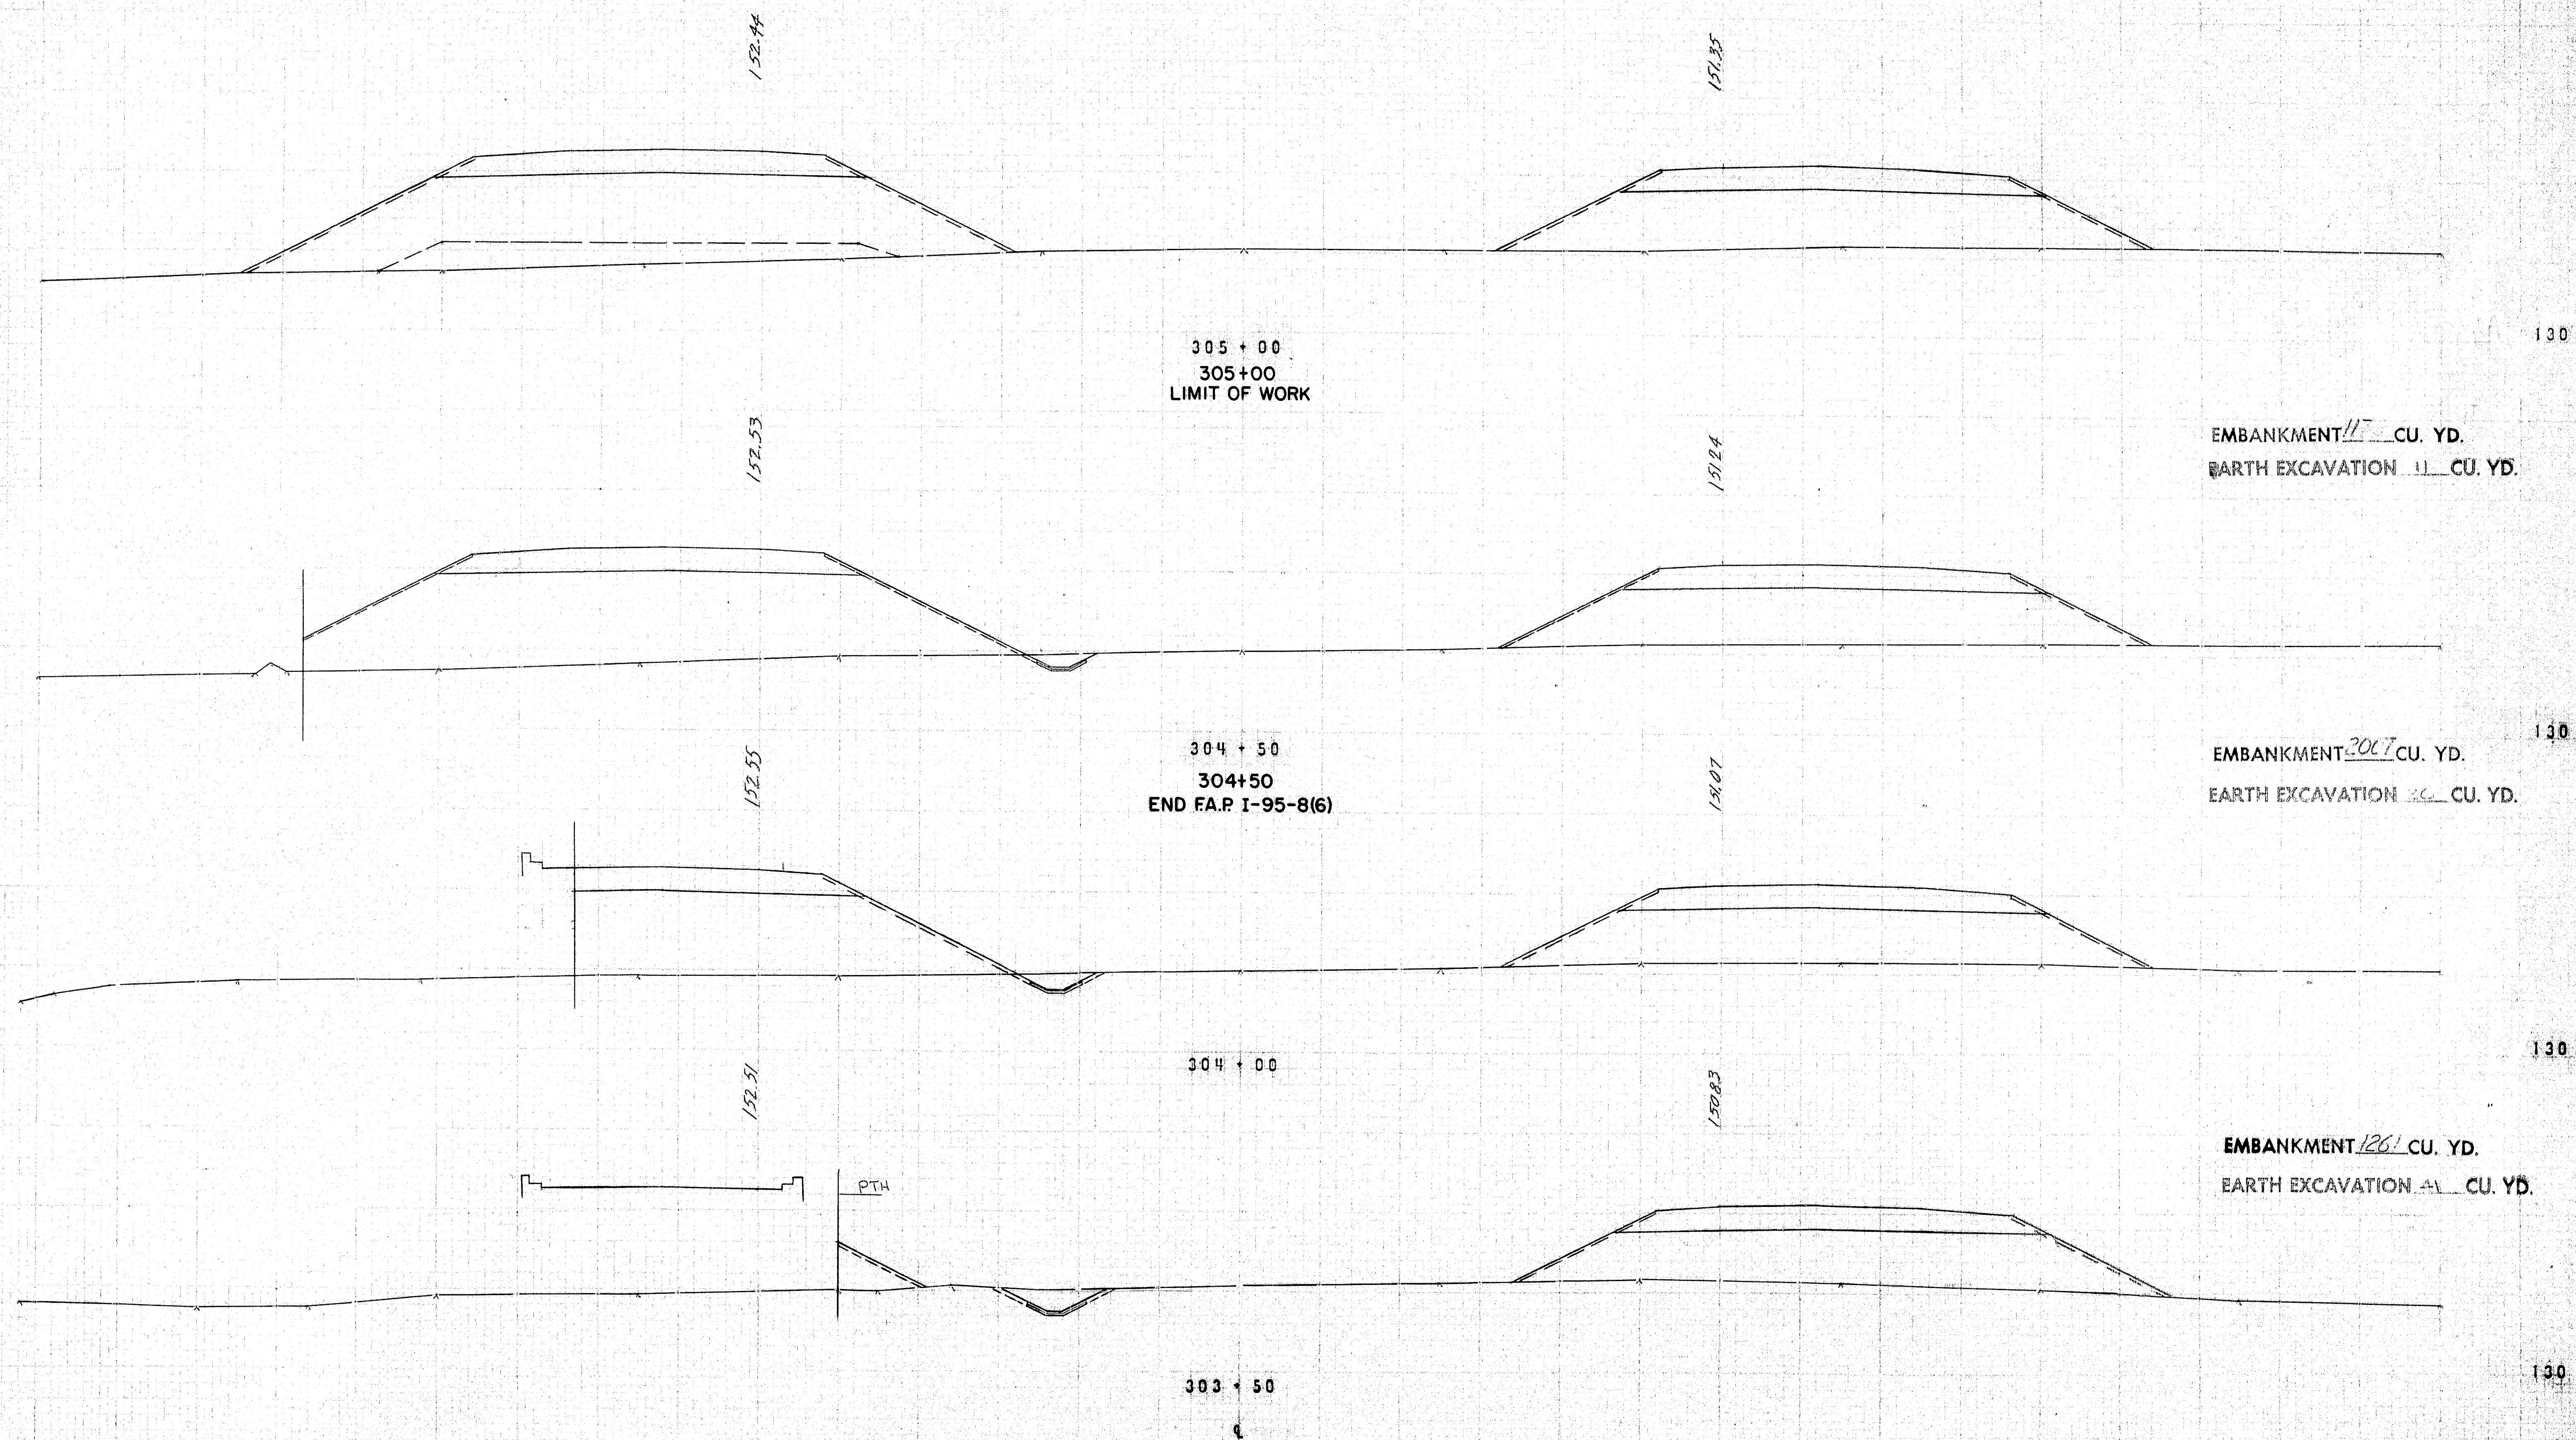




D. P. R. REG. NO.	STATE	PROJECT NO.	SHEET NO.	TOTAL SHEETS
1	MAINE	1-95-8(6)	31	35

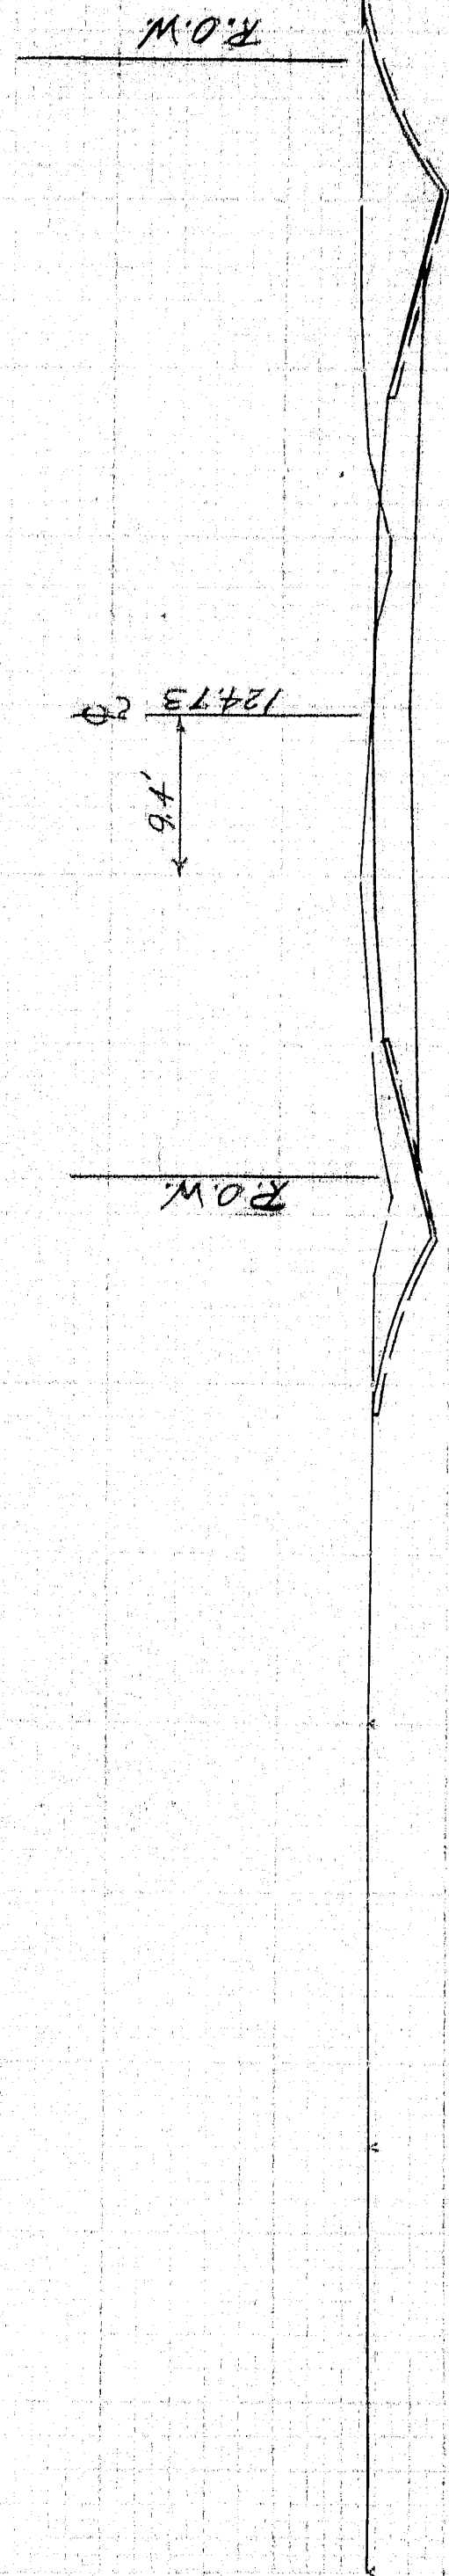


53 + 00

EARTH EXCAVATION 363 CU. YD.

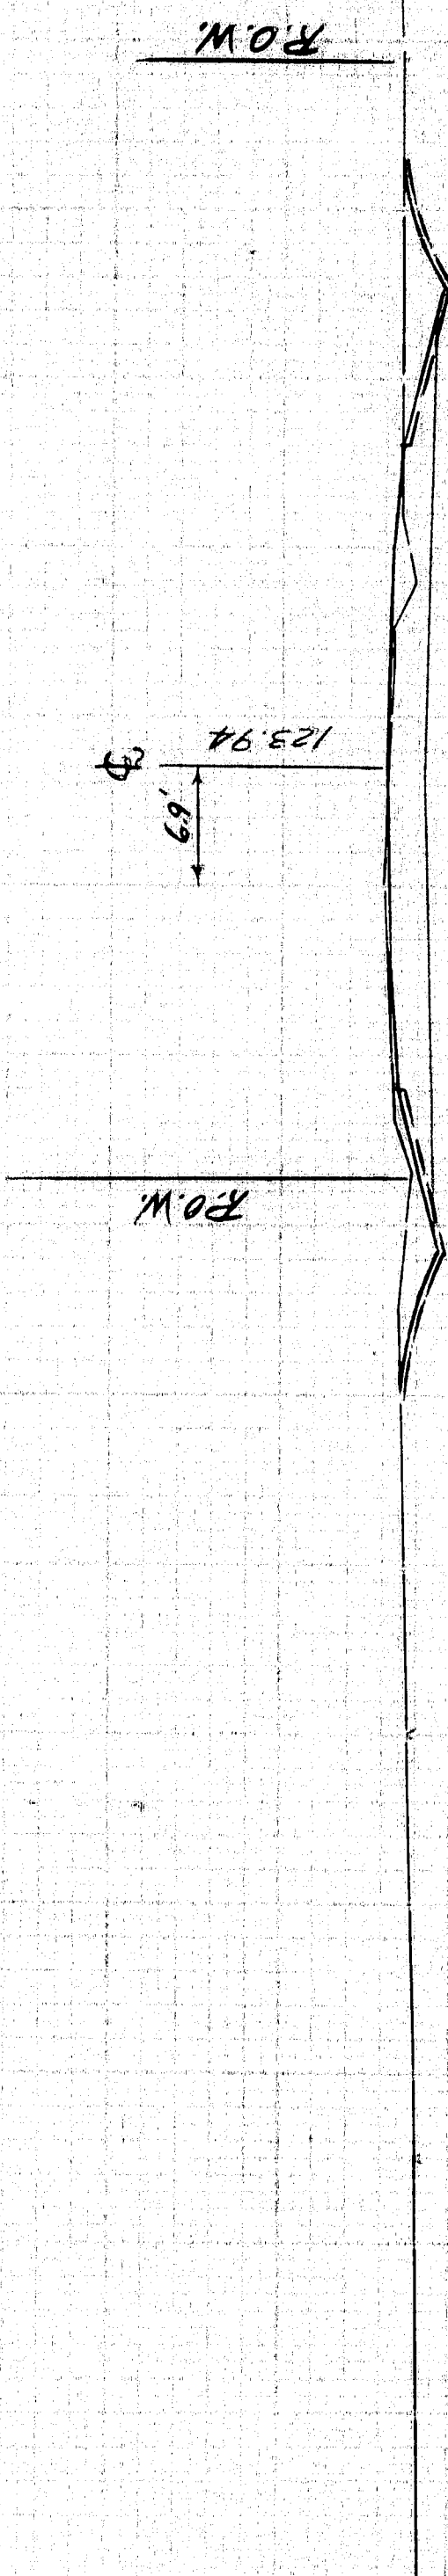


52 + 50

EARTH EXCAVATION 248 CU. YD.

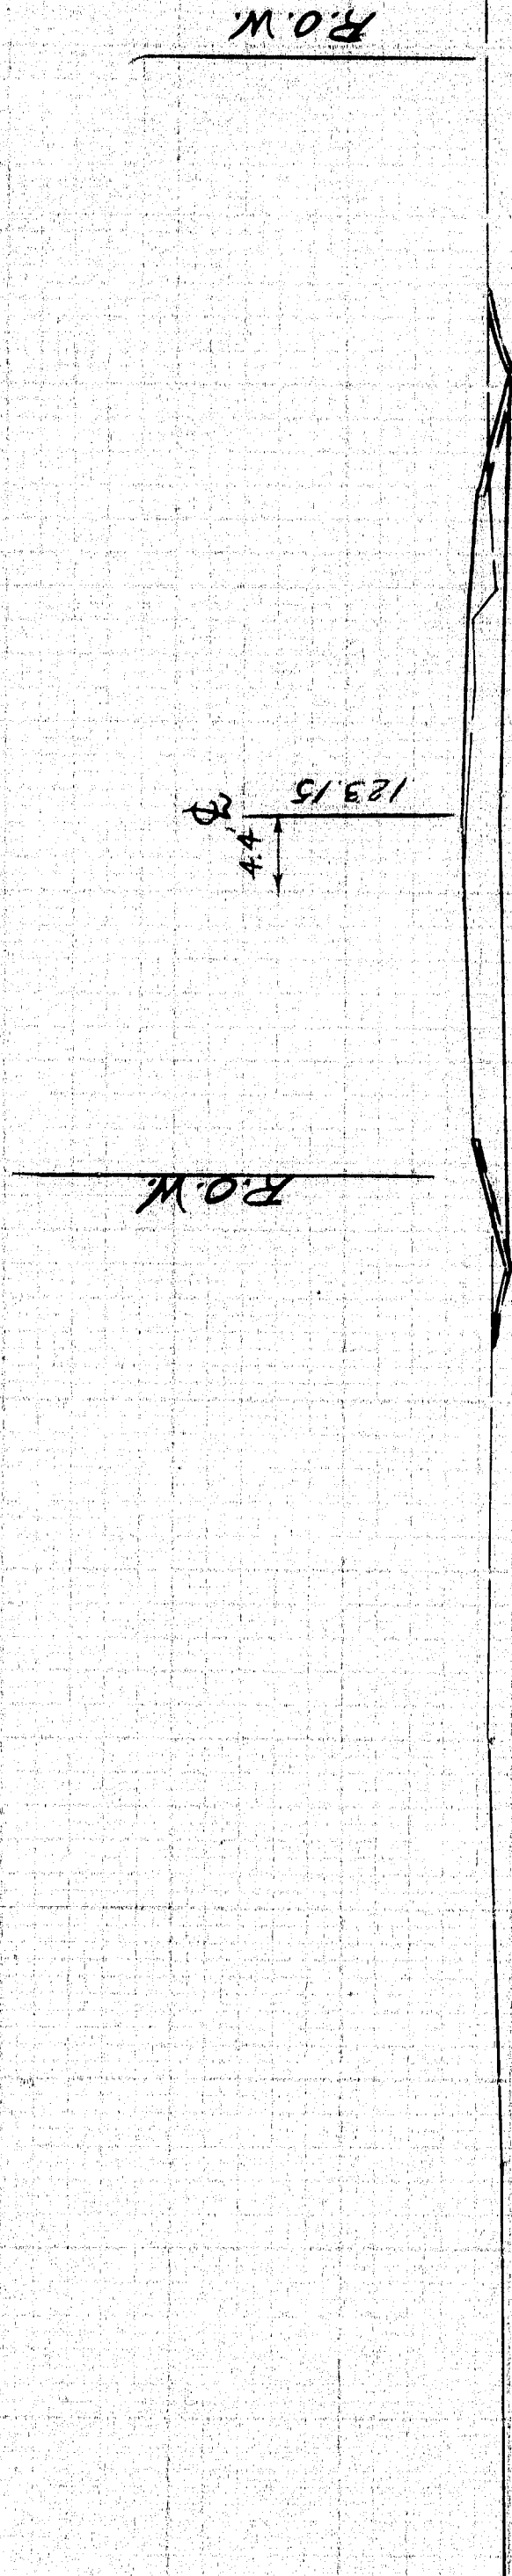


52 + 00

EARTH EXCAVATION 206 CU. YD.

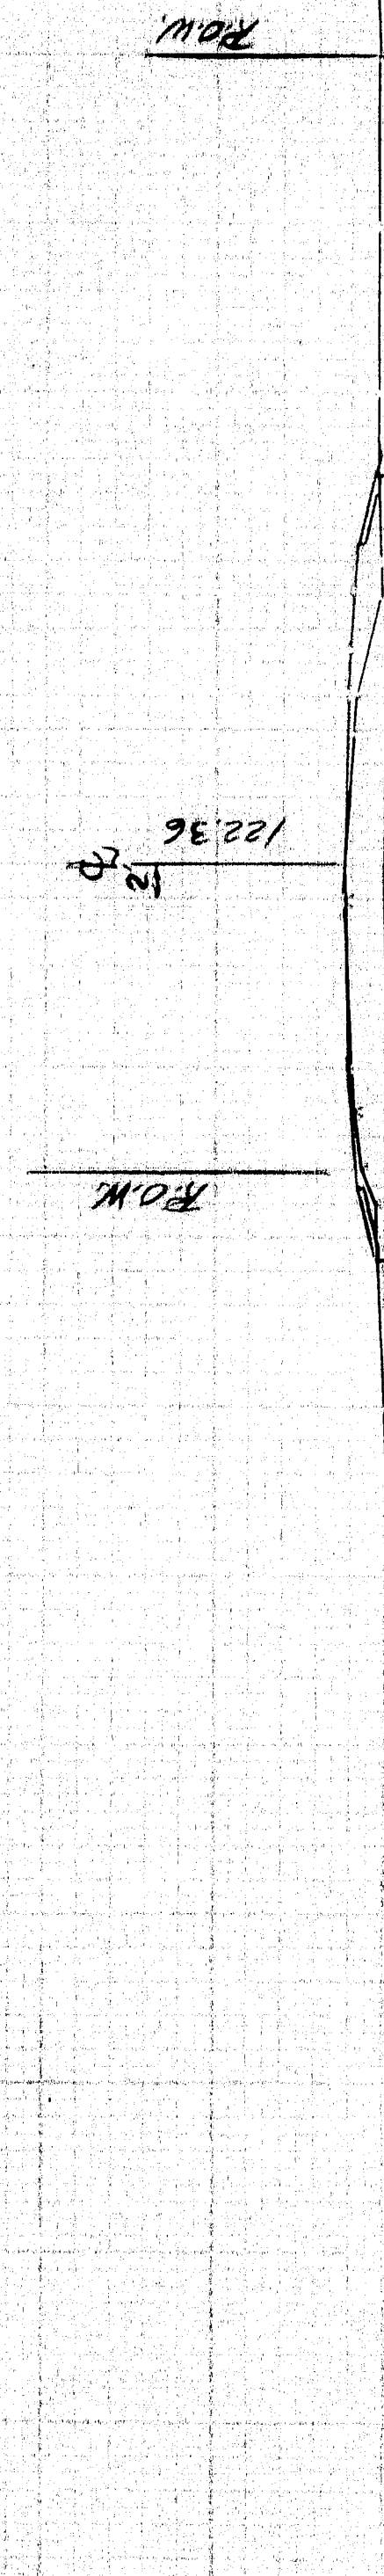

51 + 50

EARTH EXCAVATION 126 CU. YD.

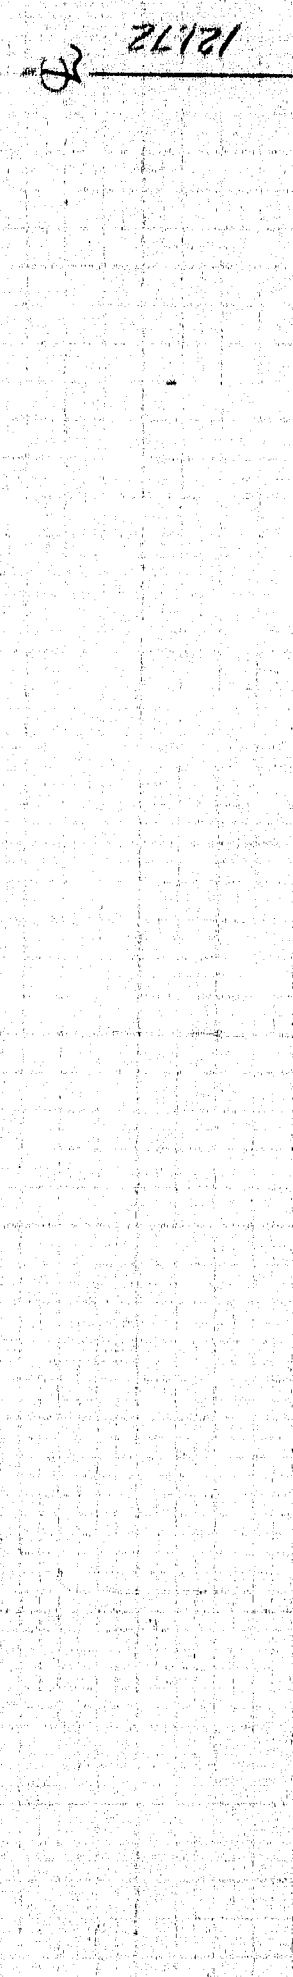


51 + 10

51 + 10  
LIMIT OF WORK


Survey



D. P. H. REG. NO.	STATE	PROJECT NO.	SHEET NO.	TOTAL SHEETS
1	MAINE	1-95-8(6)	32	35

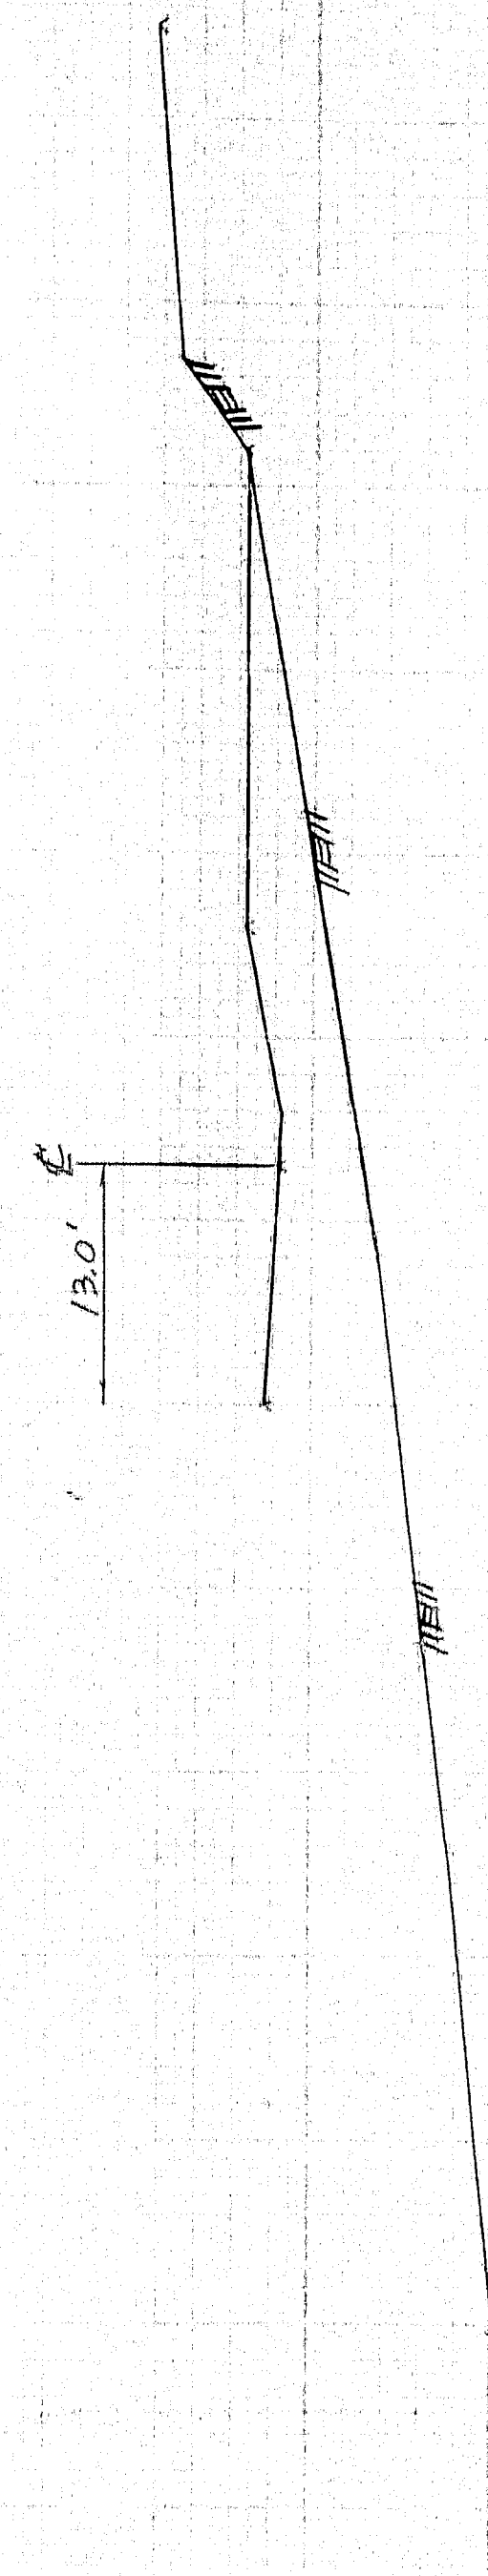


55 + 27

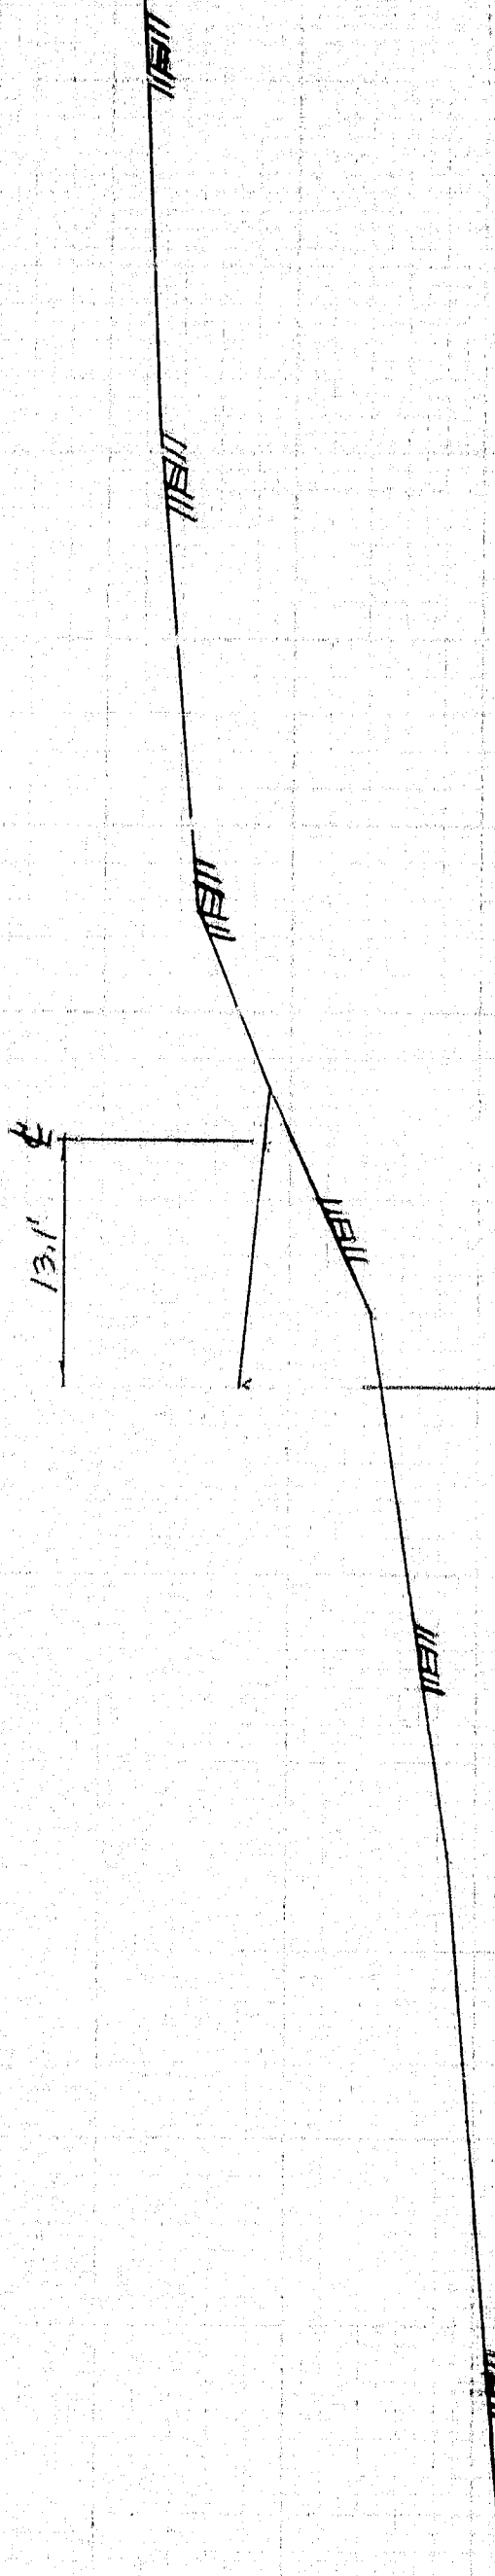


55 + 23

Survey

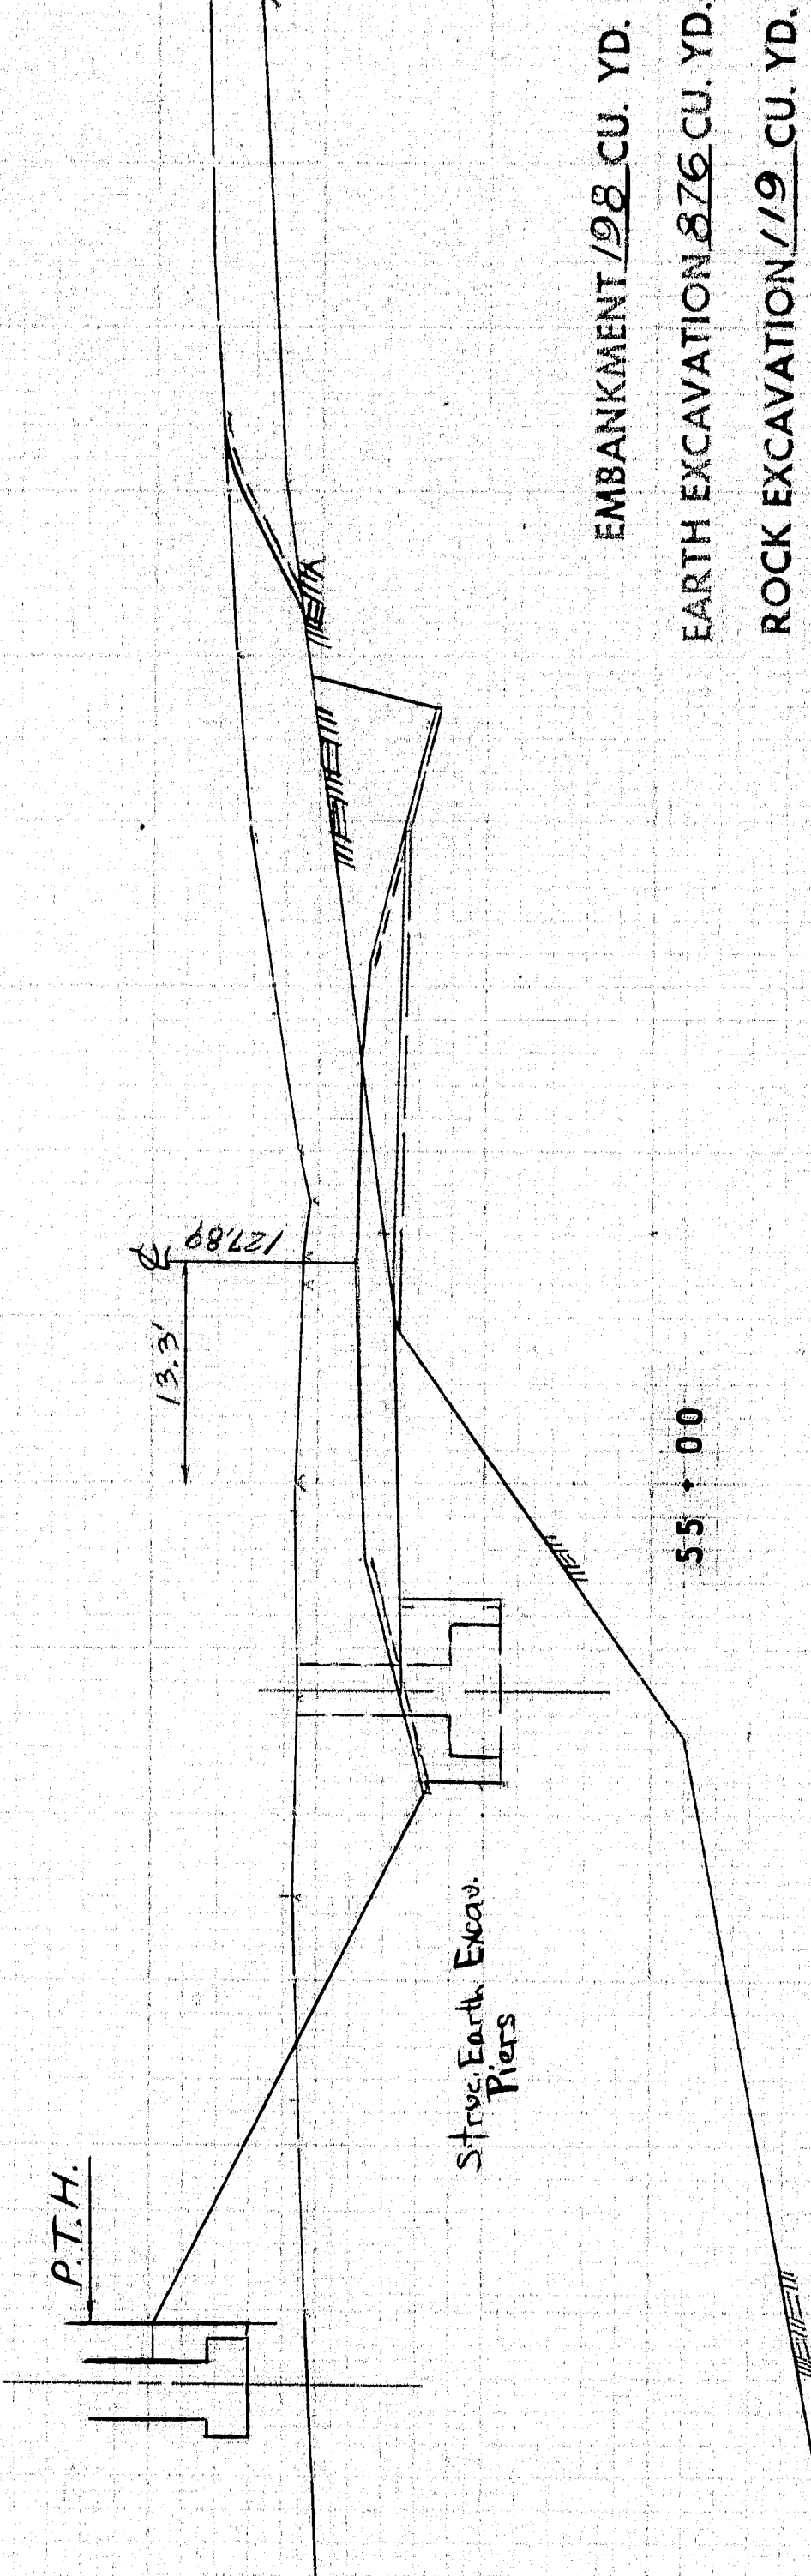


55 + 00


Struc. Earth Exca.  
Piers

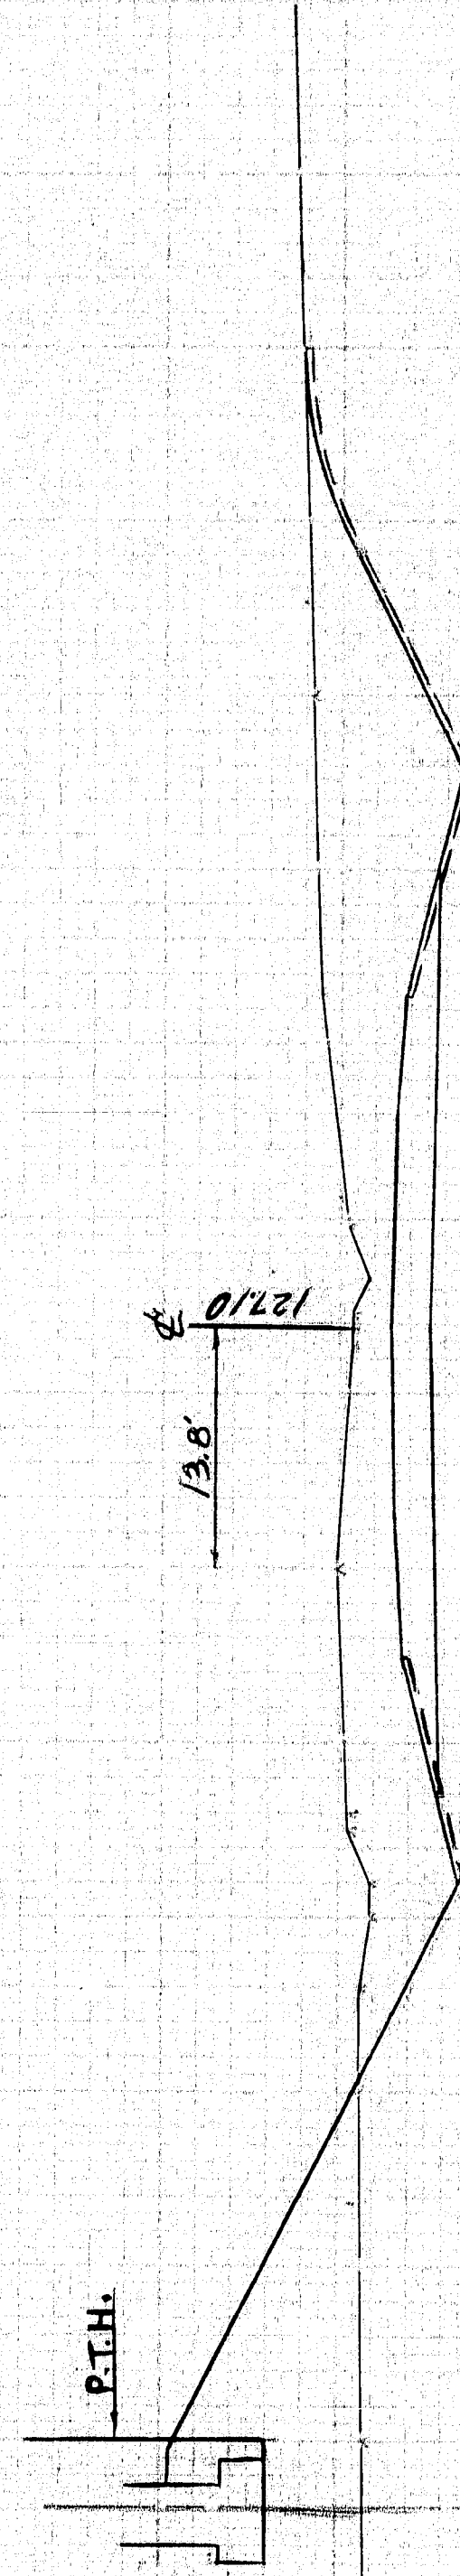

54 + 50

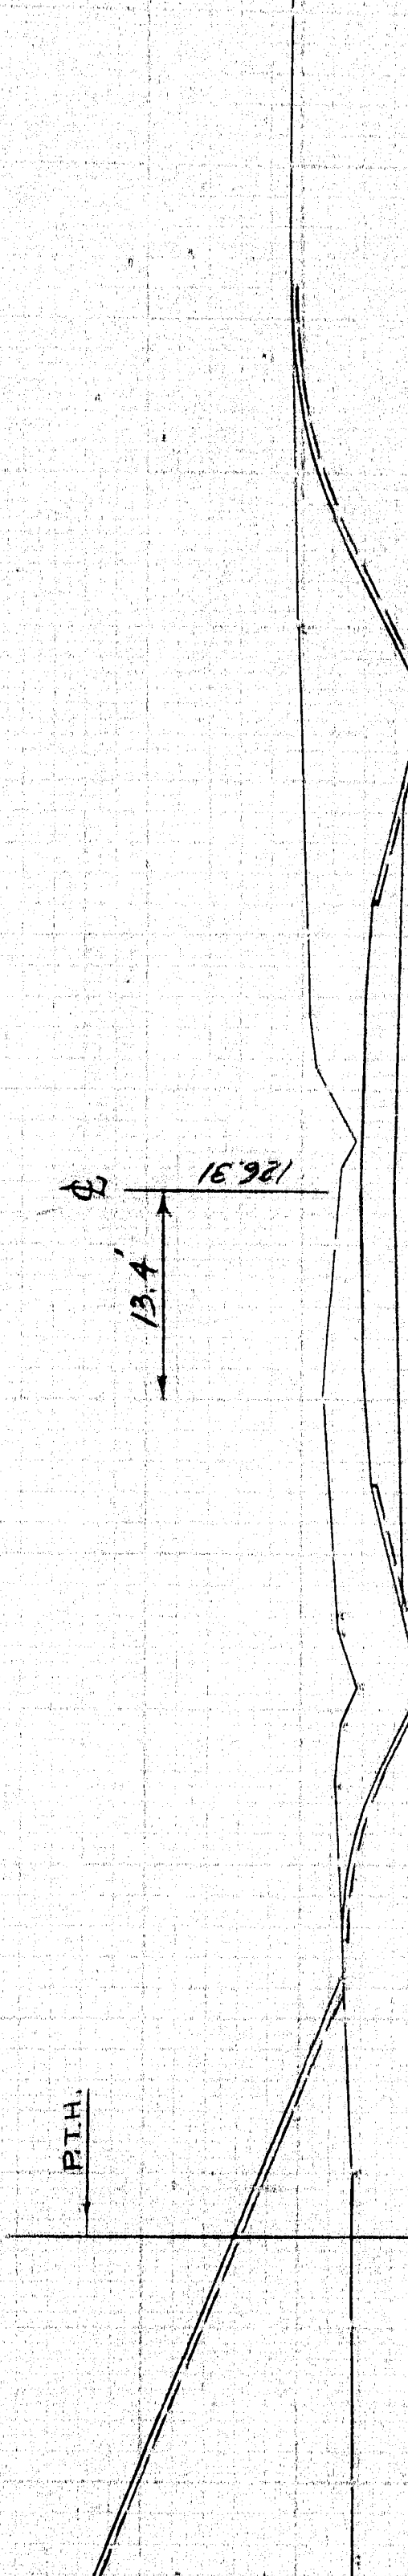


54 + 00

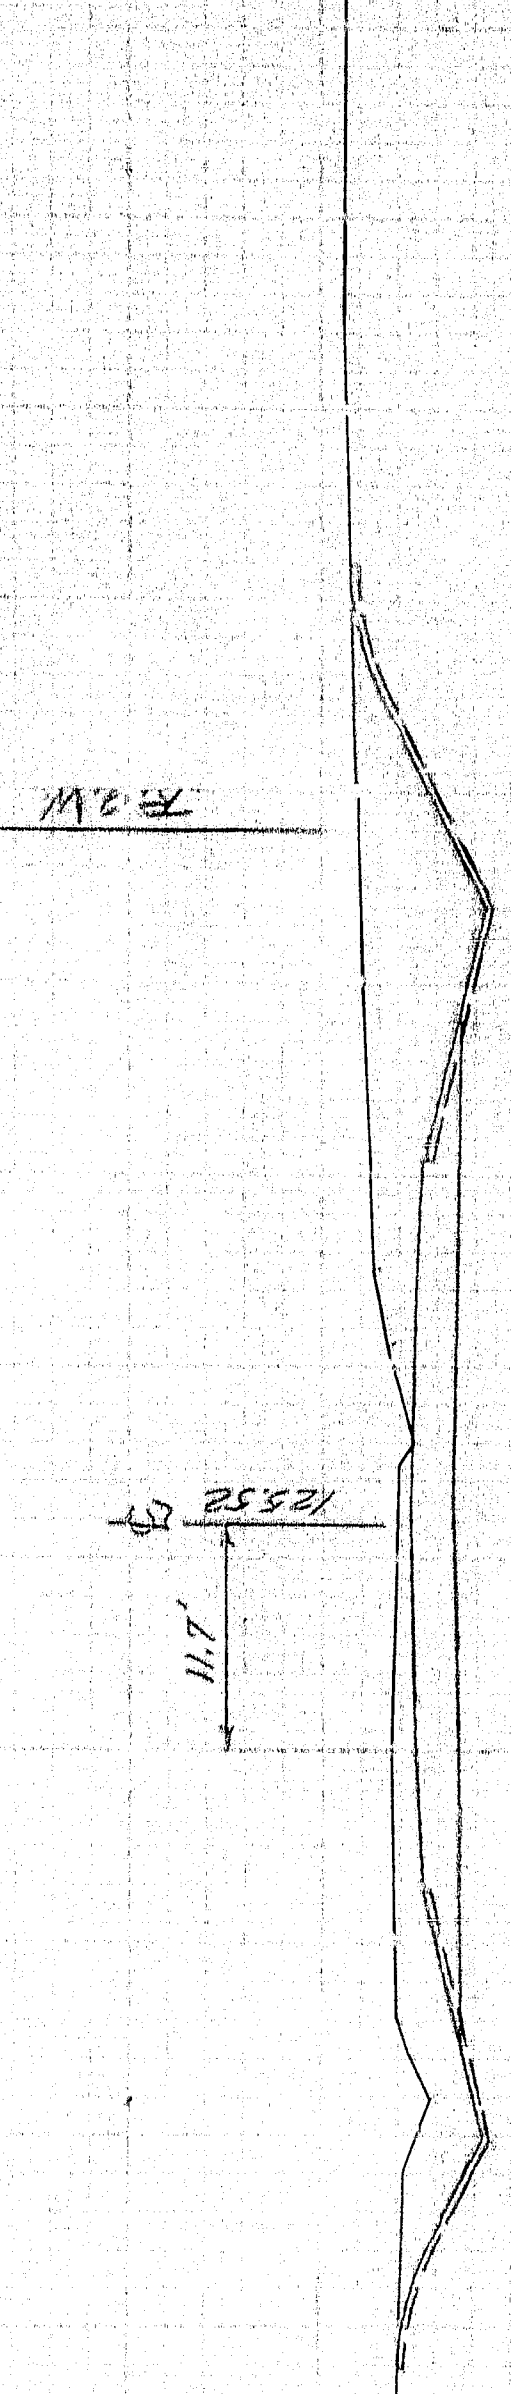







53 + 50

Survey

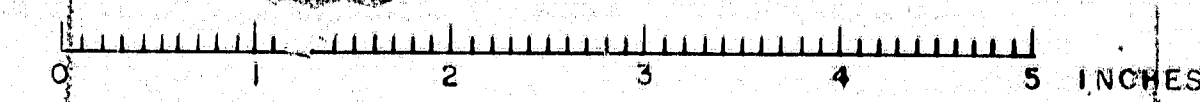



B.P.R. REG. NO.	STATE	PROJECT NO.	SHEET NO.	TOTAL SHEETS
1	MAINE	I-95-8(6)	33	35

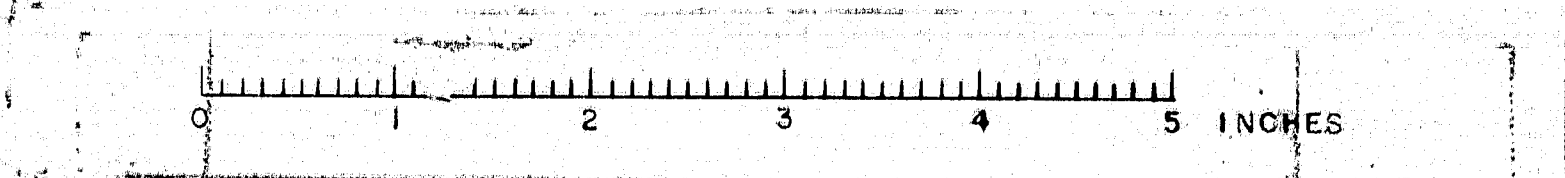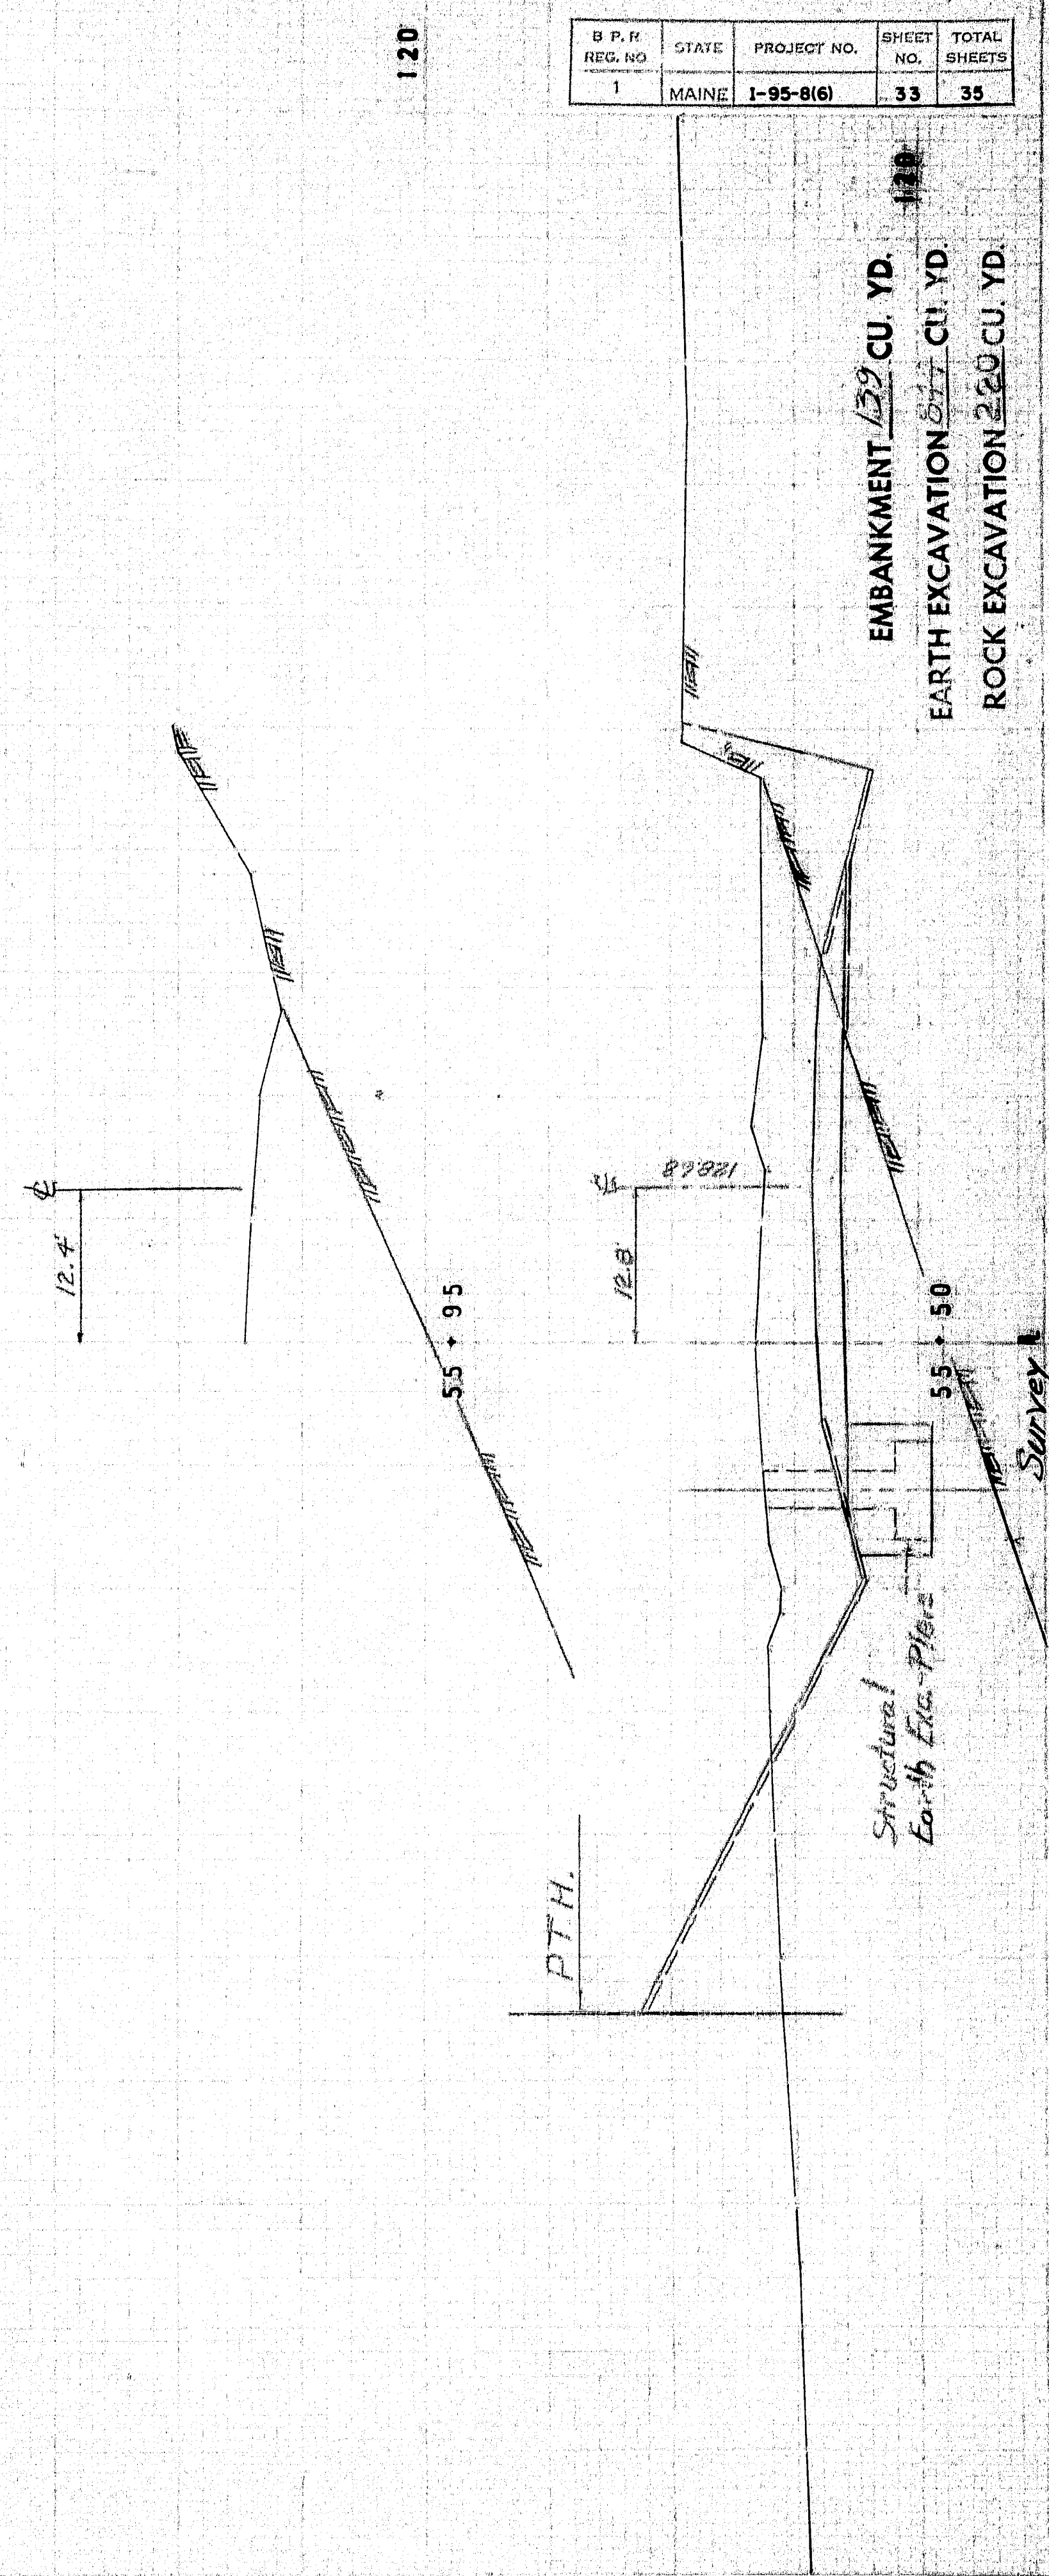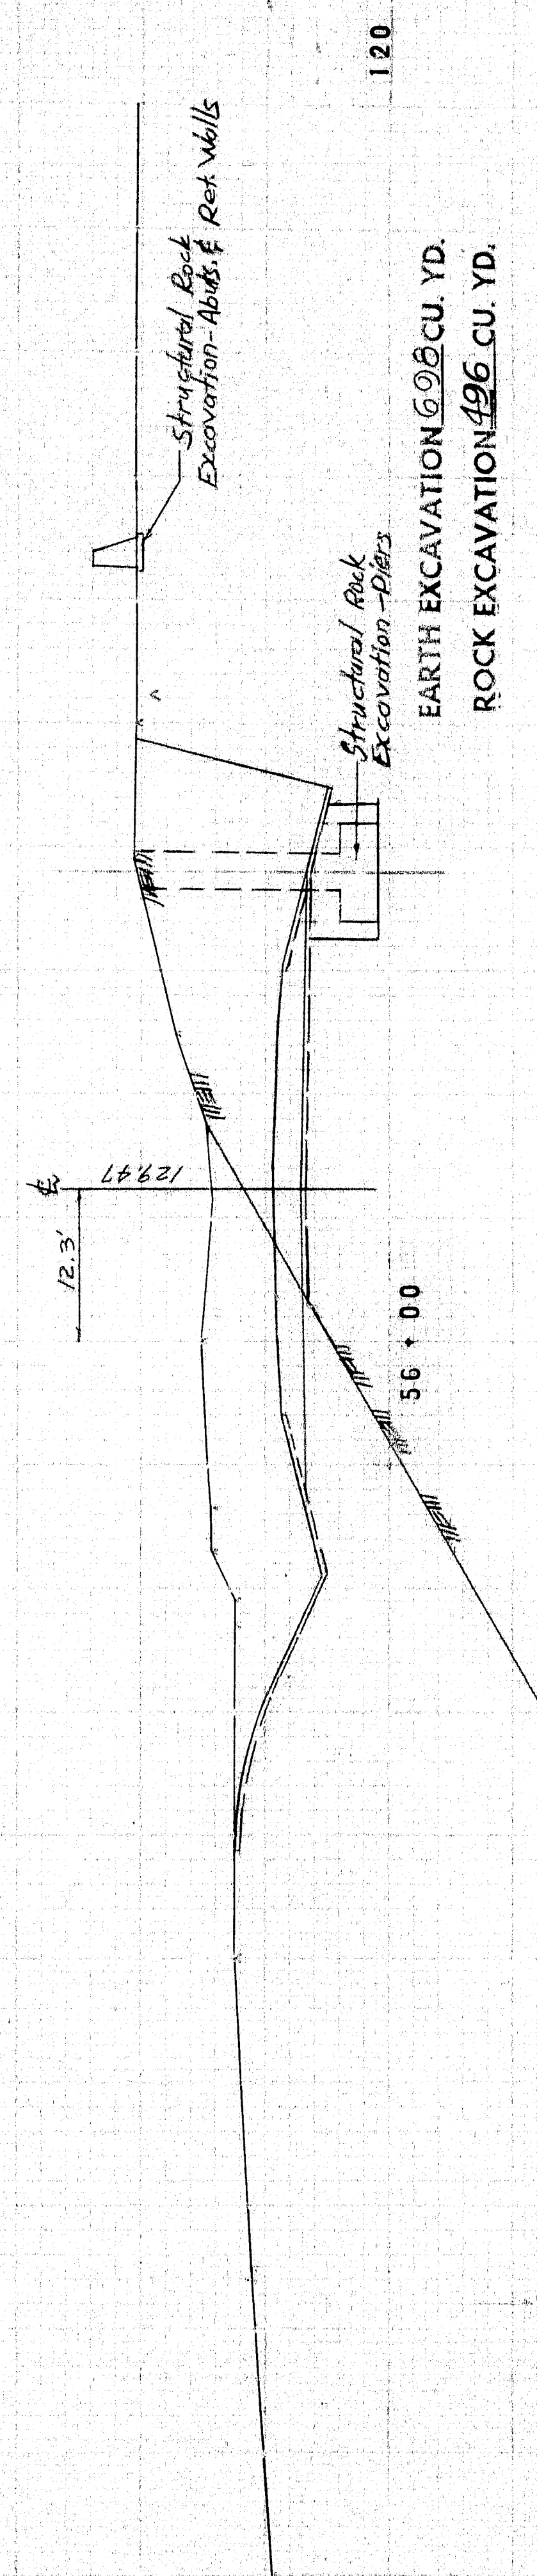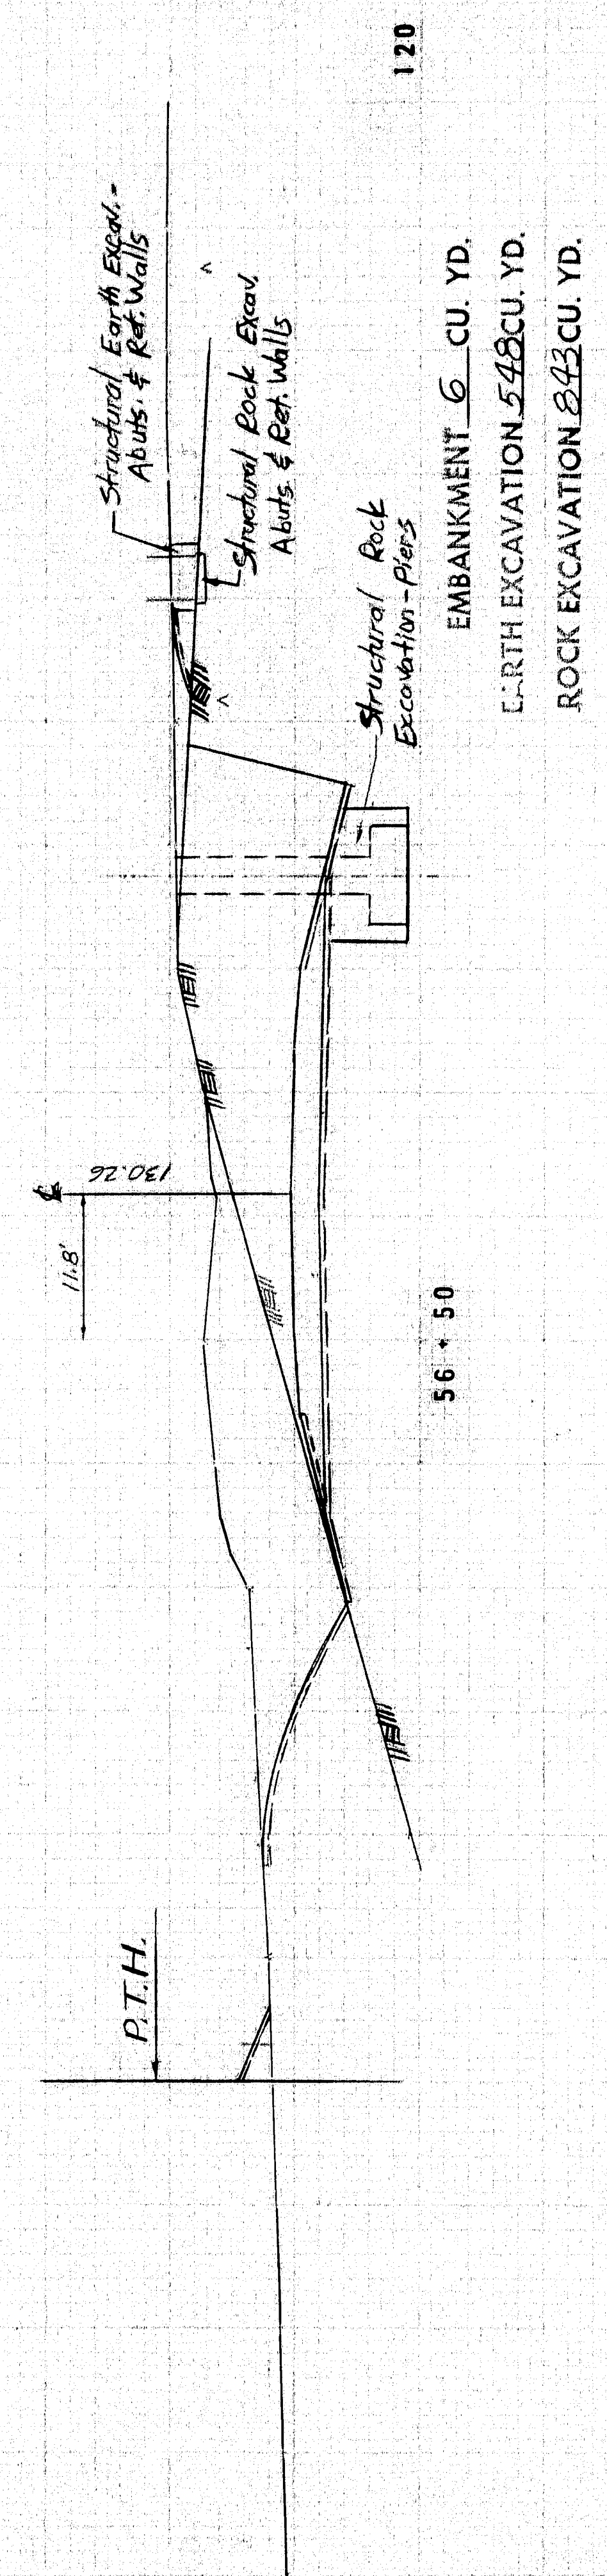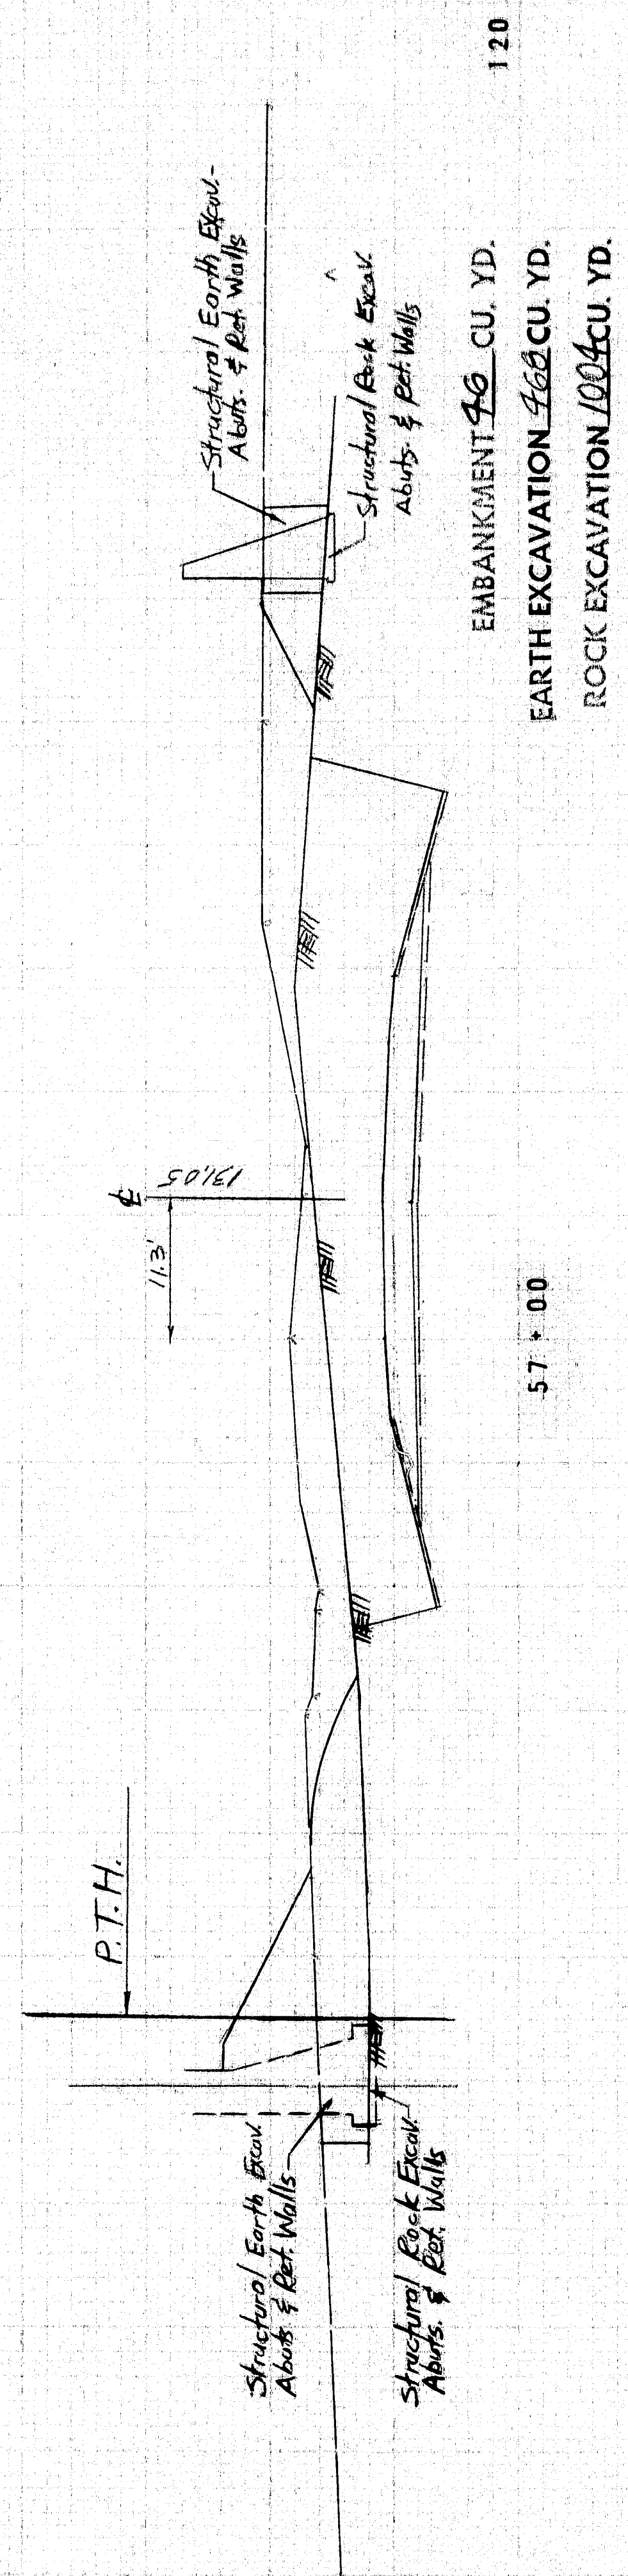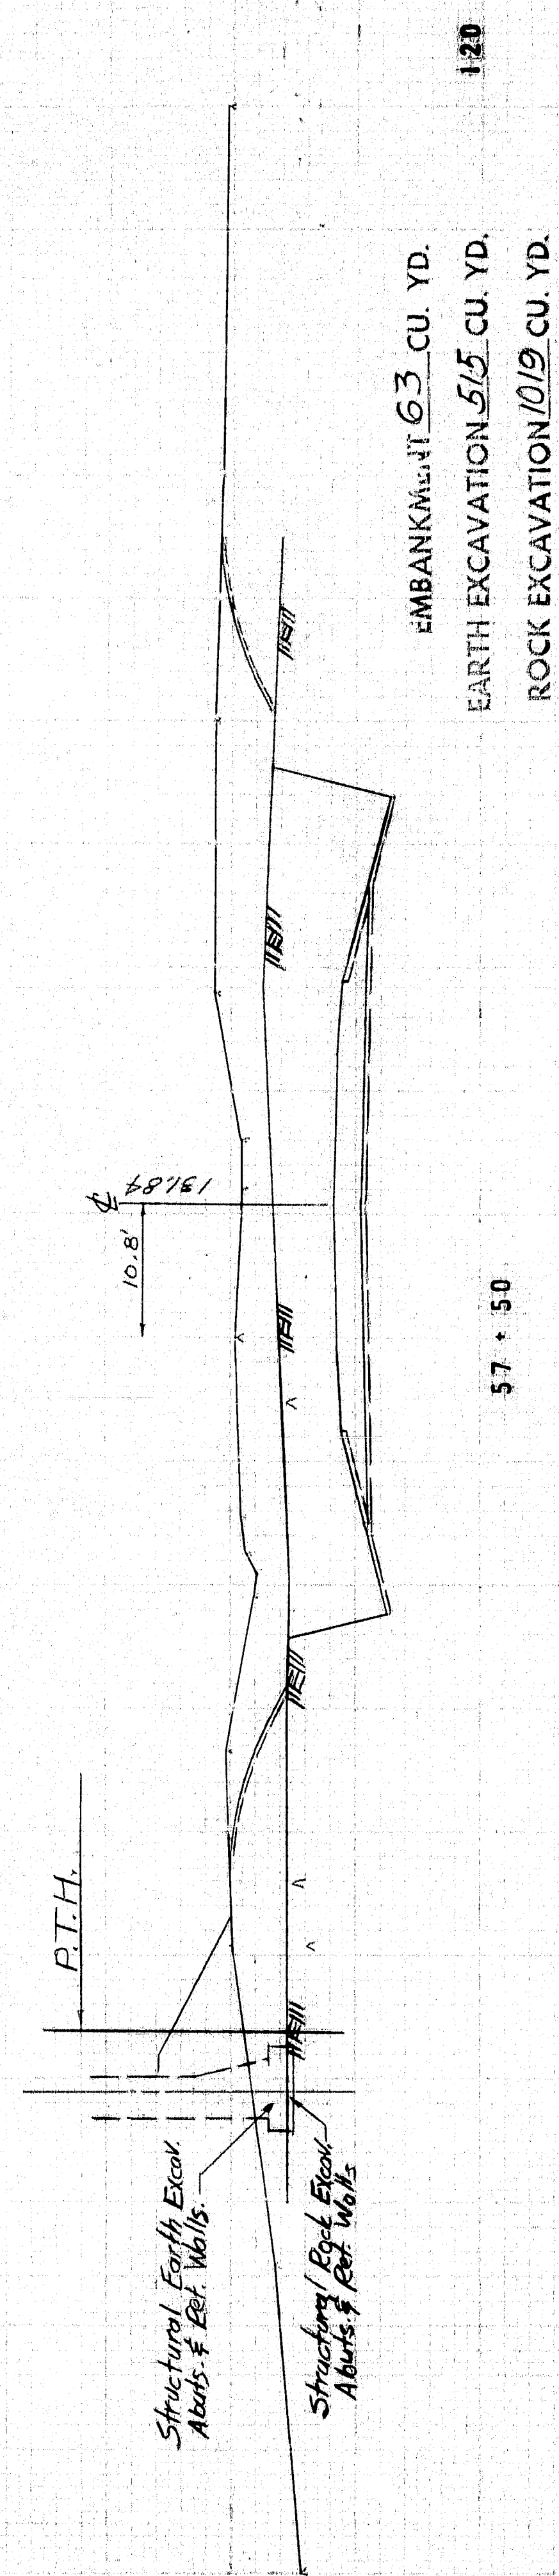




STILLWATER AVE. - INTERSTATE 205 - BRIDGE


Survey

1-95-8(6)

D.P.R. REG. NO.	STATE	PROJECT NO.	SHEET NO.	TOTAL SHEETS
1	MAINE	1-95-8(6)	34	35

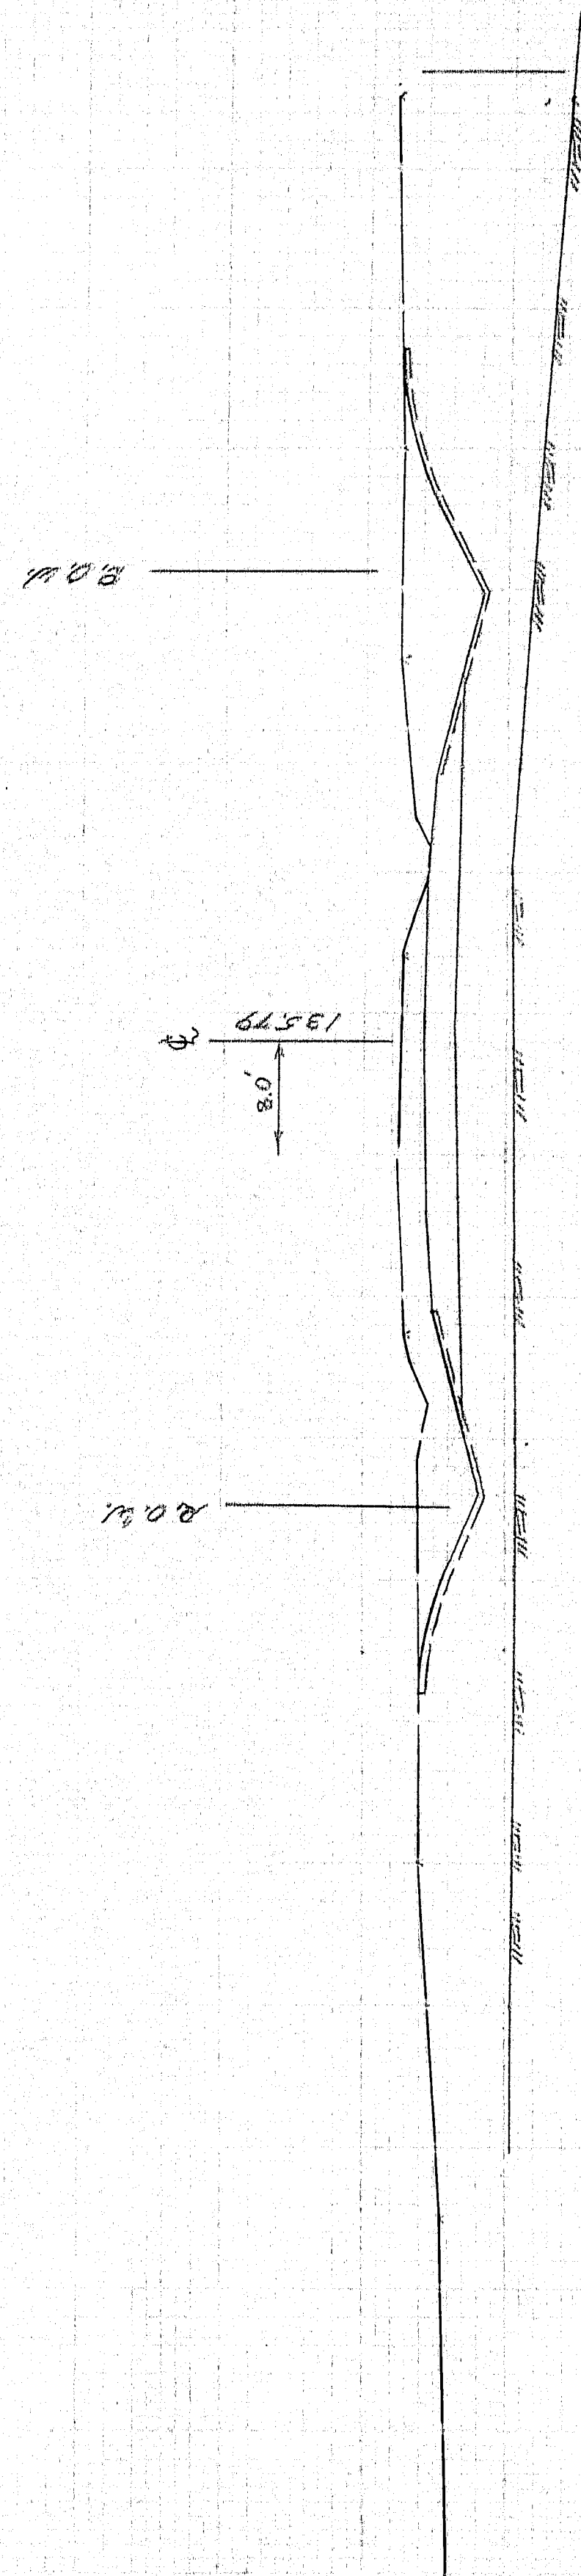

EMBANKMENT 120 CU. YD.  
EARTH EXCAVATION 1033 CU. YD.  
ROCK EXCAVATION 120 CU. YD.

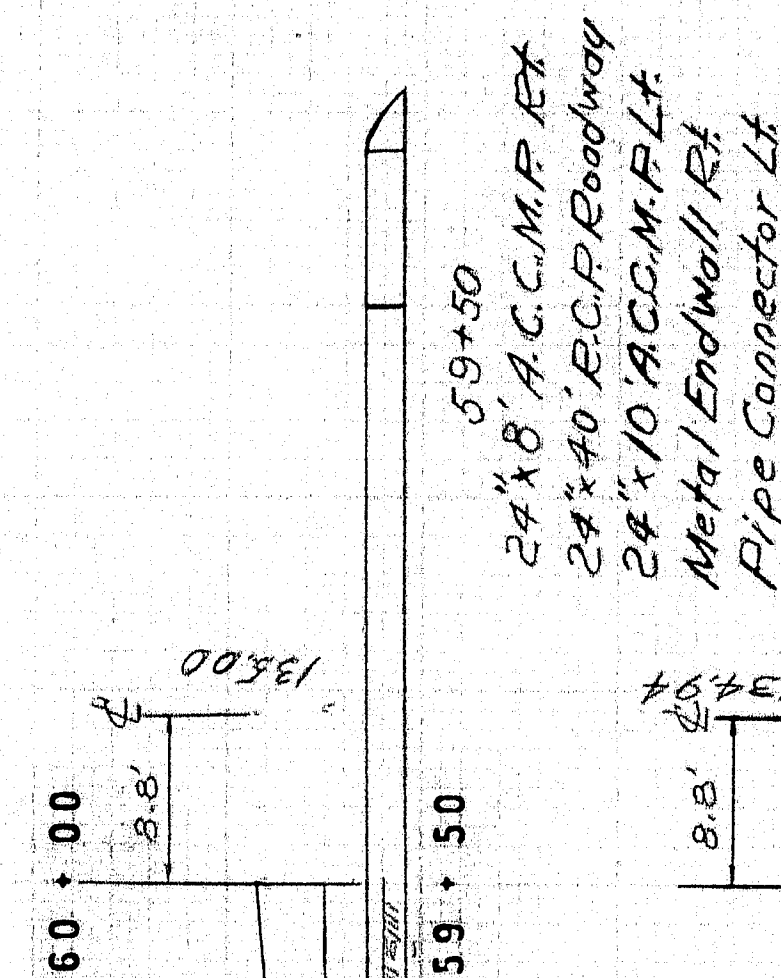


24"x8" A.C.C.M.P. EX  
24"x40" R.C.P. Roadway  
24"x10" A.C.C.M.P. LT  
Metal End Wall R/L  
Pipe Connector Lt

59 + 46

9.1'

59 + 16

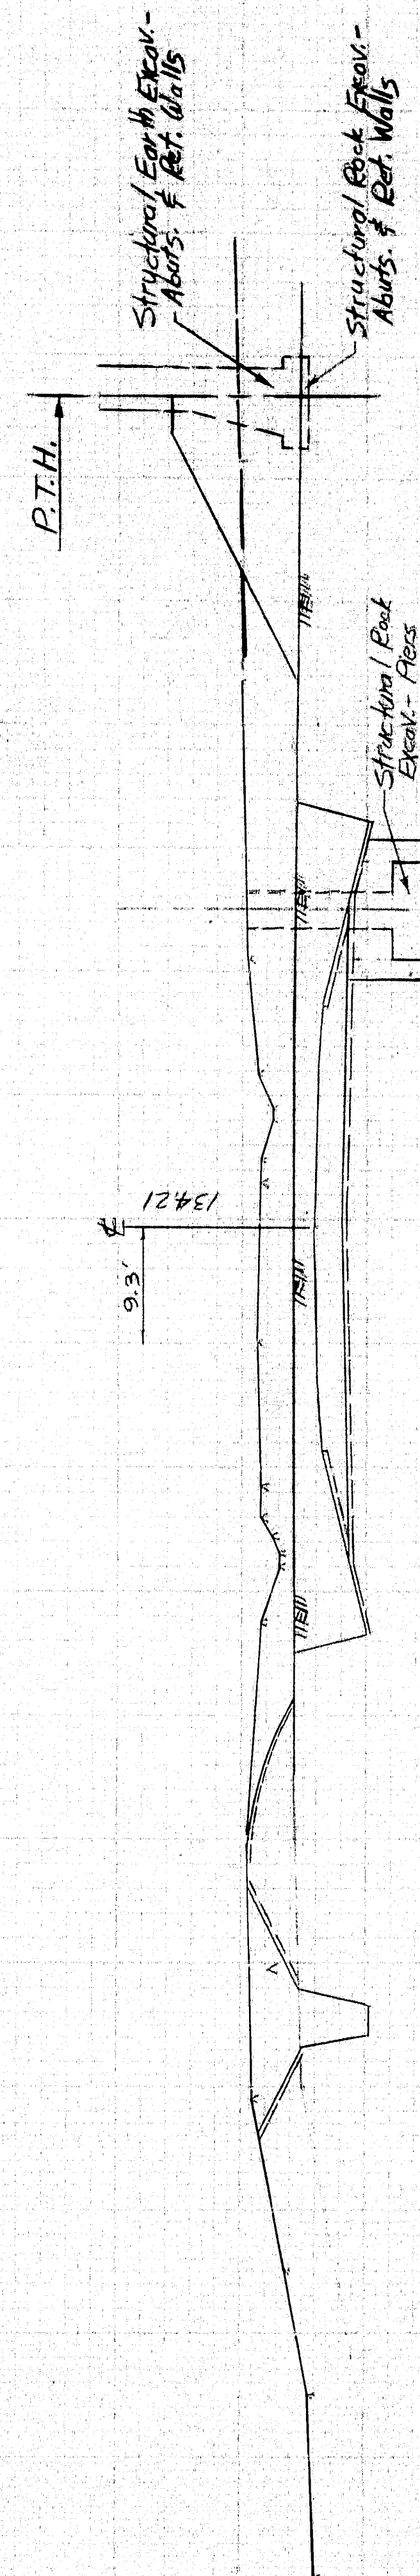


EMBANKMENT 39 CU. YD.  
EARTH EXCAVATION 446 CU. YD.  
ROCK EXCAVATION 641 CU. YD.

59 + 00

9.8'


58 + 50

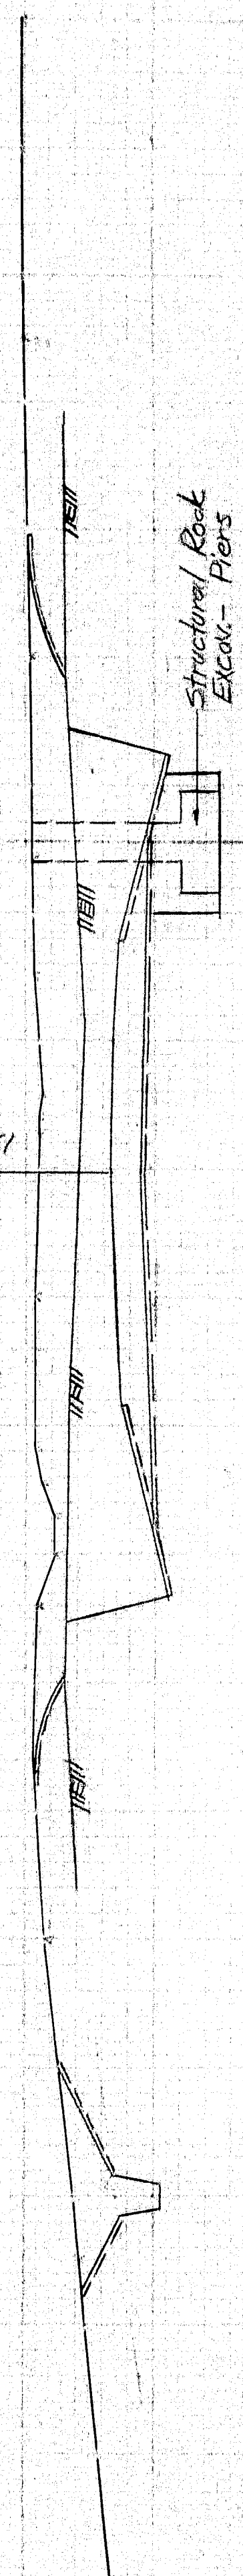

EMBANKMENT 39 CU. YD.  
EARTH EXCAVATION 446 CU. YD.  
ROCK EXCAVATION 641 CU. YD.

10.3'

58 + 00

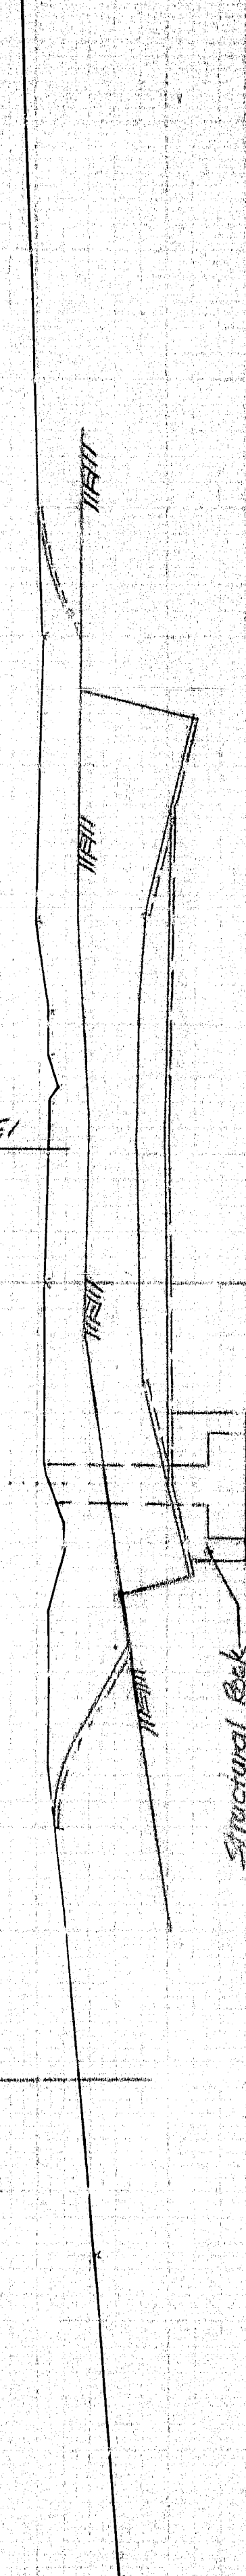


EMBANKMENT 39 CU. YD.  
EARTH EXCAVATION 446 CU. YD.  
ROCK EXCAVATION 641 CU. YD.



D.P.R. REG. NO.	STATE	PROJECT NO.	SHEET NO.	TOTAL SHEETS
1	MAINE	1-95-8(6)	35	35


120  
EARTH EXCAVATION 157 CU. YD.

62+50  
LIMIT OF WORK

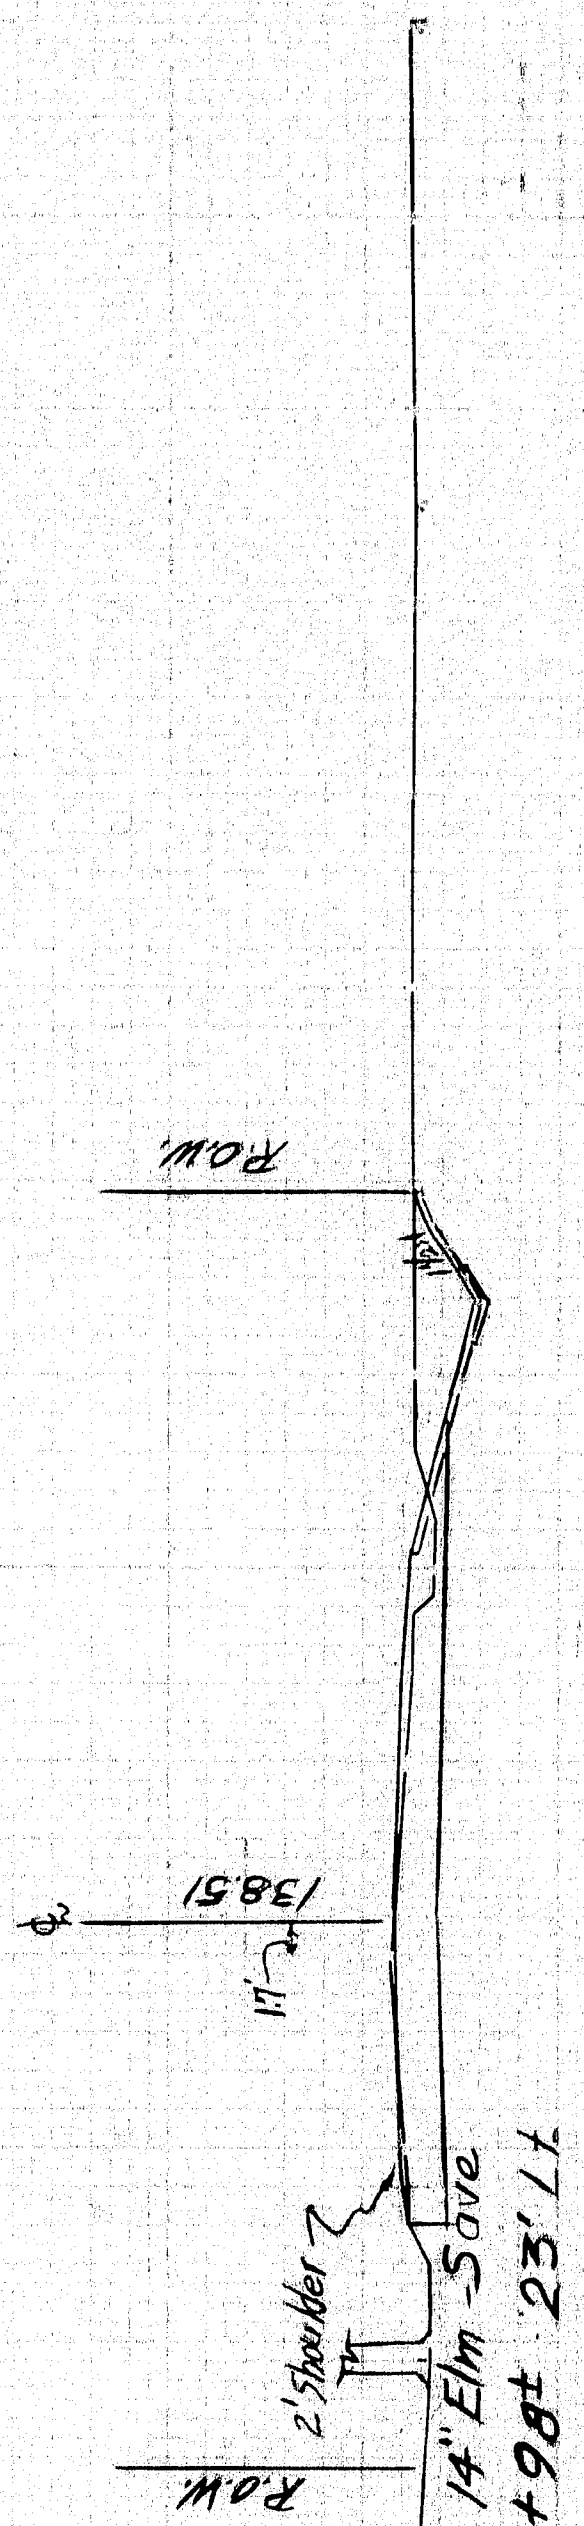


120  
EARTH EXCAVATION 222 CU. YD.

62+00

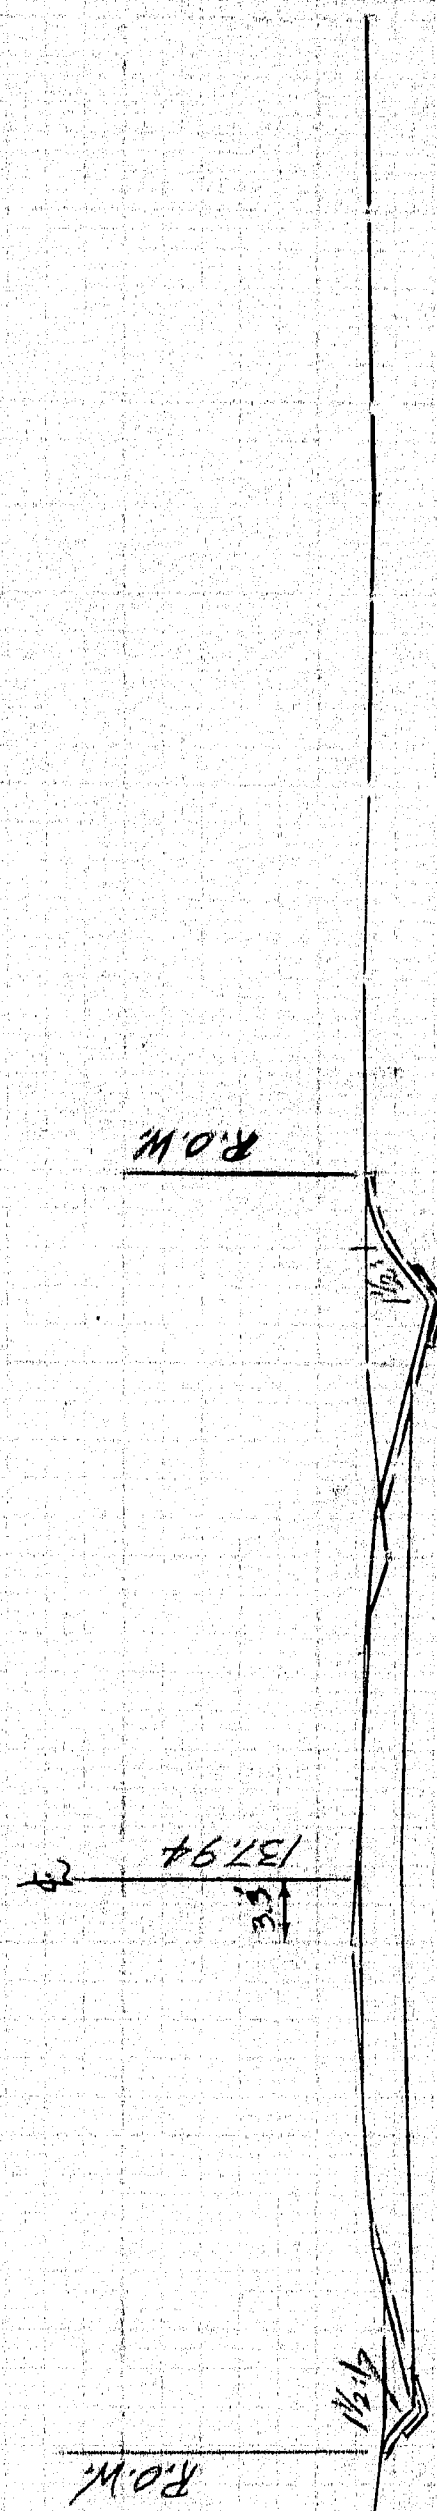

120  
EARTH EXCAVATION 248 CU. YD.

61+50

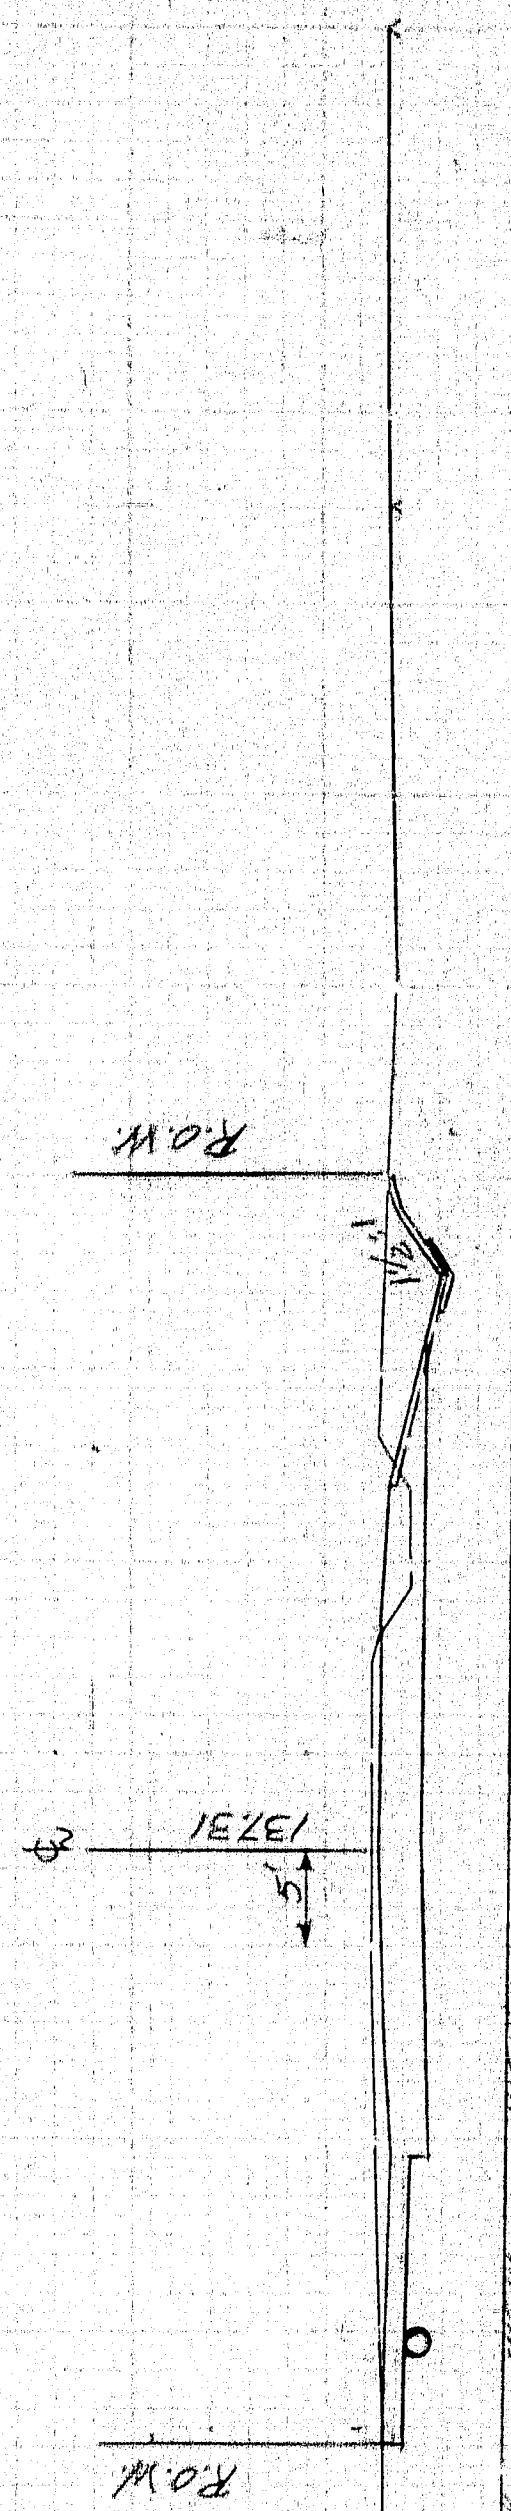

120  
EARTH EXCAVATION 294 CU. YD.

61+00

16' Elm + 18' 28' Lt - Save  
18' Elm + 5' 30' Lt - Save

Note:  
Where trees are to be Saved  
Hand Excavate in accordance  
With Subsection 203-4  
of Standard Specs.




120  
EARTH EXCAVATION 441 CU. YD.

60+50

60+50 to 61+4  
15' x 60' ACCUM. P. LT.

Survey 1

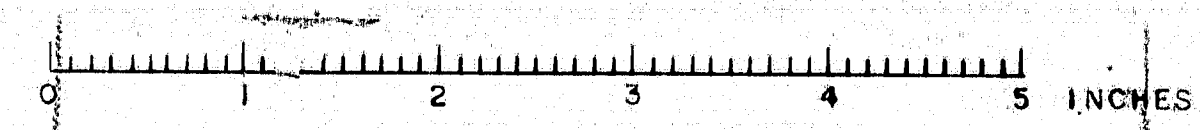











Ledge X-Section  
Stillwater Ave.

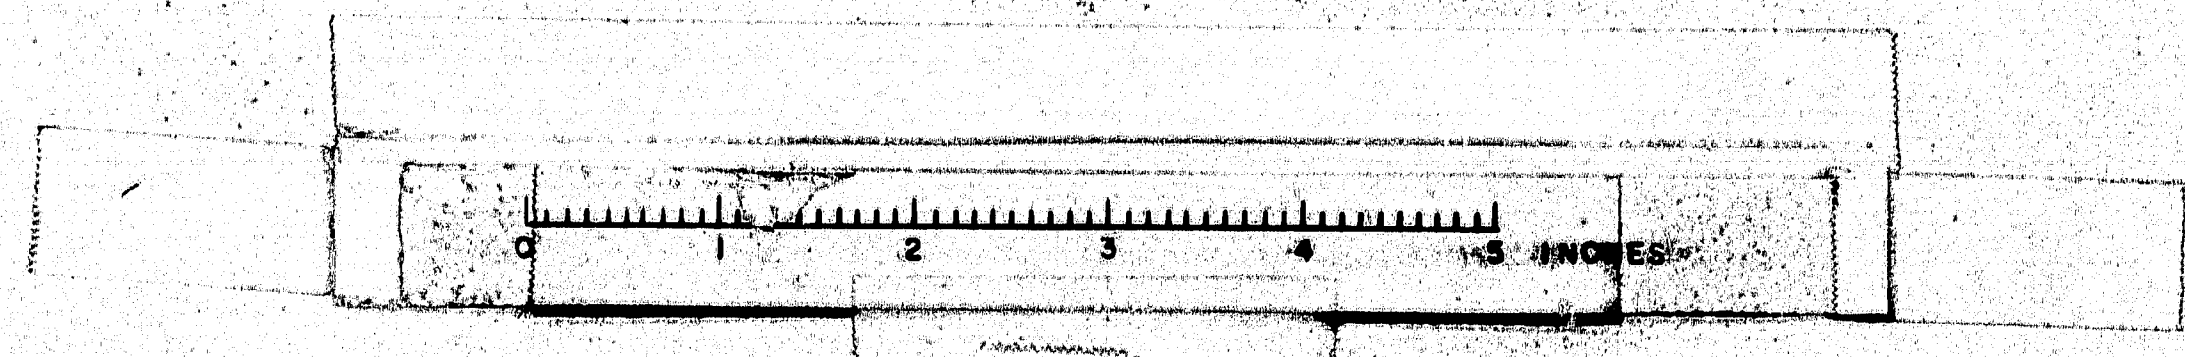




D.P.R. REG. NO.	STATE	PROJECT NO.	SHEET NO.	TOTAL SHEETS
1	MAINE	1-15-6(6)182	3	10

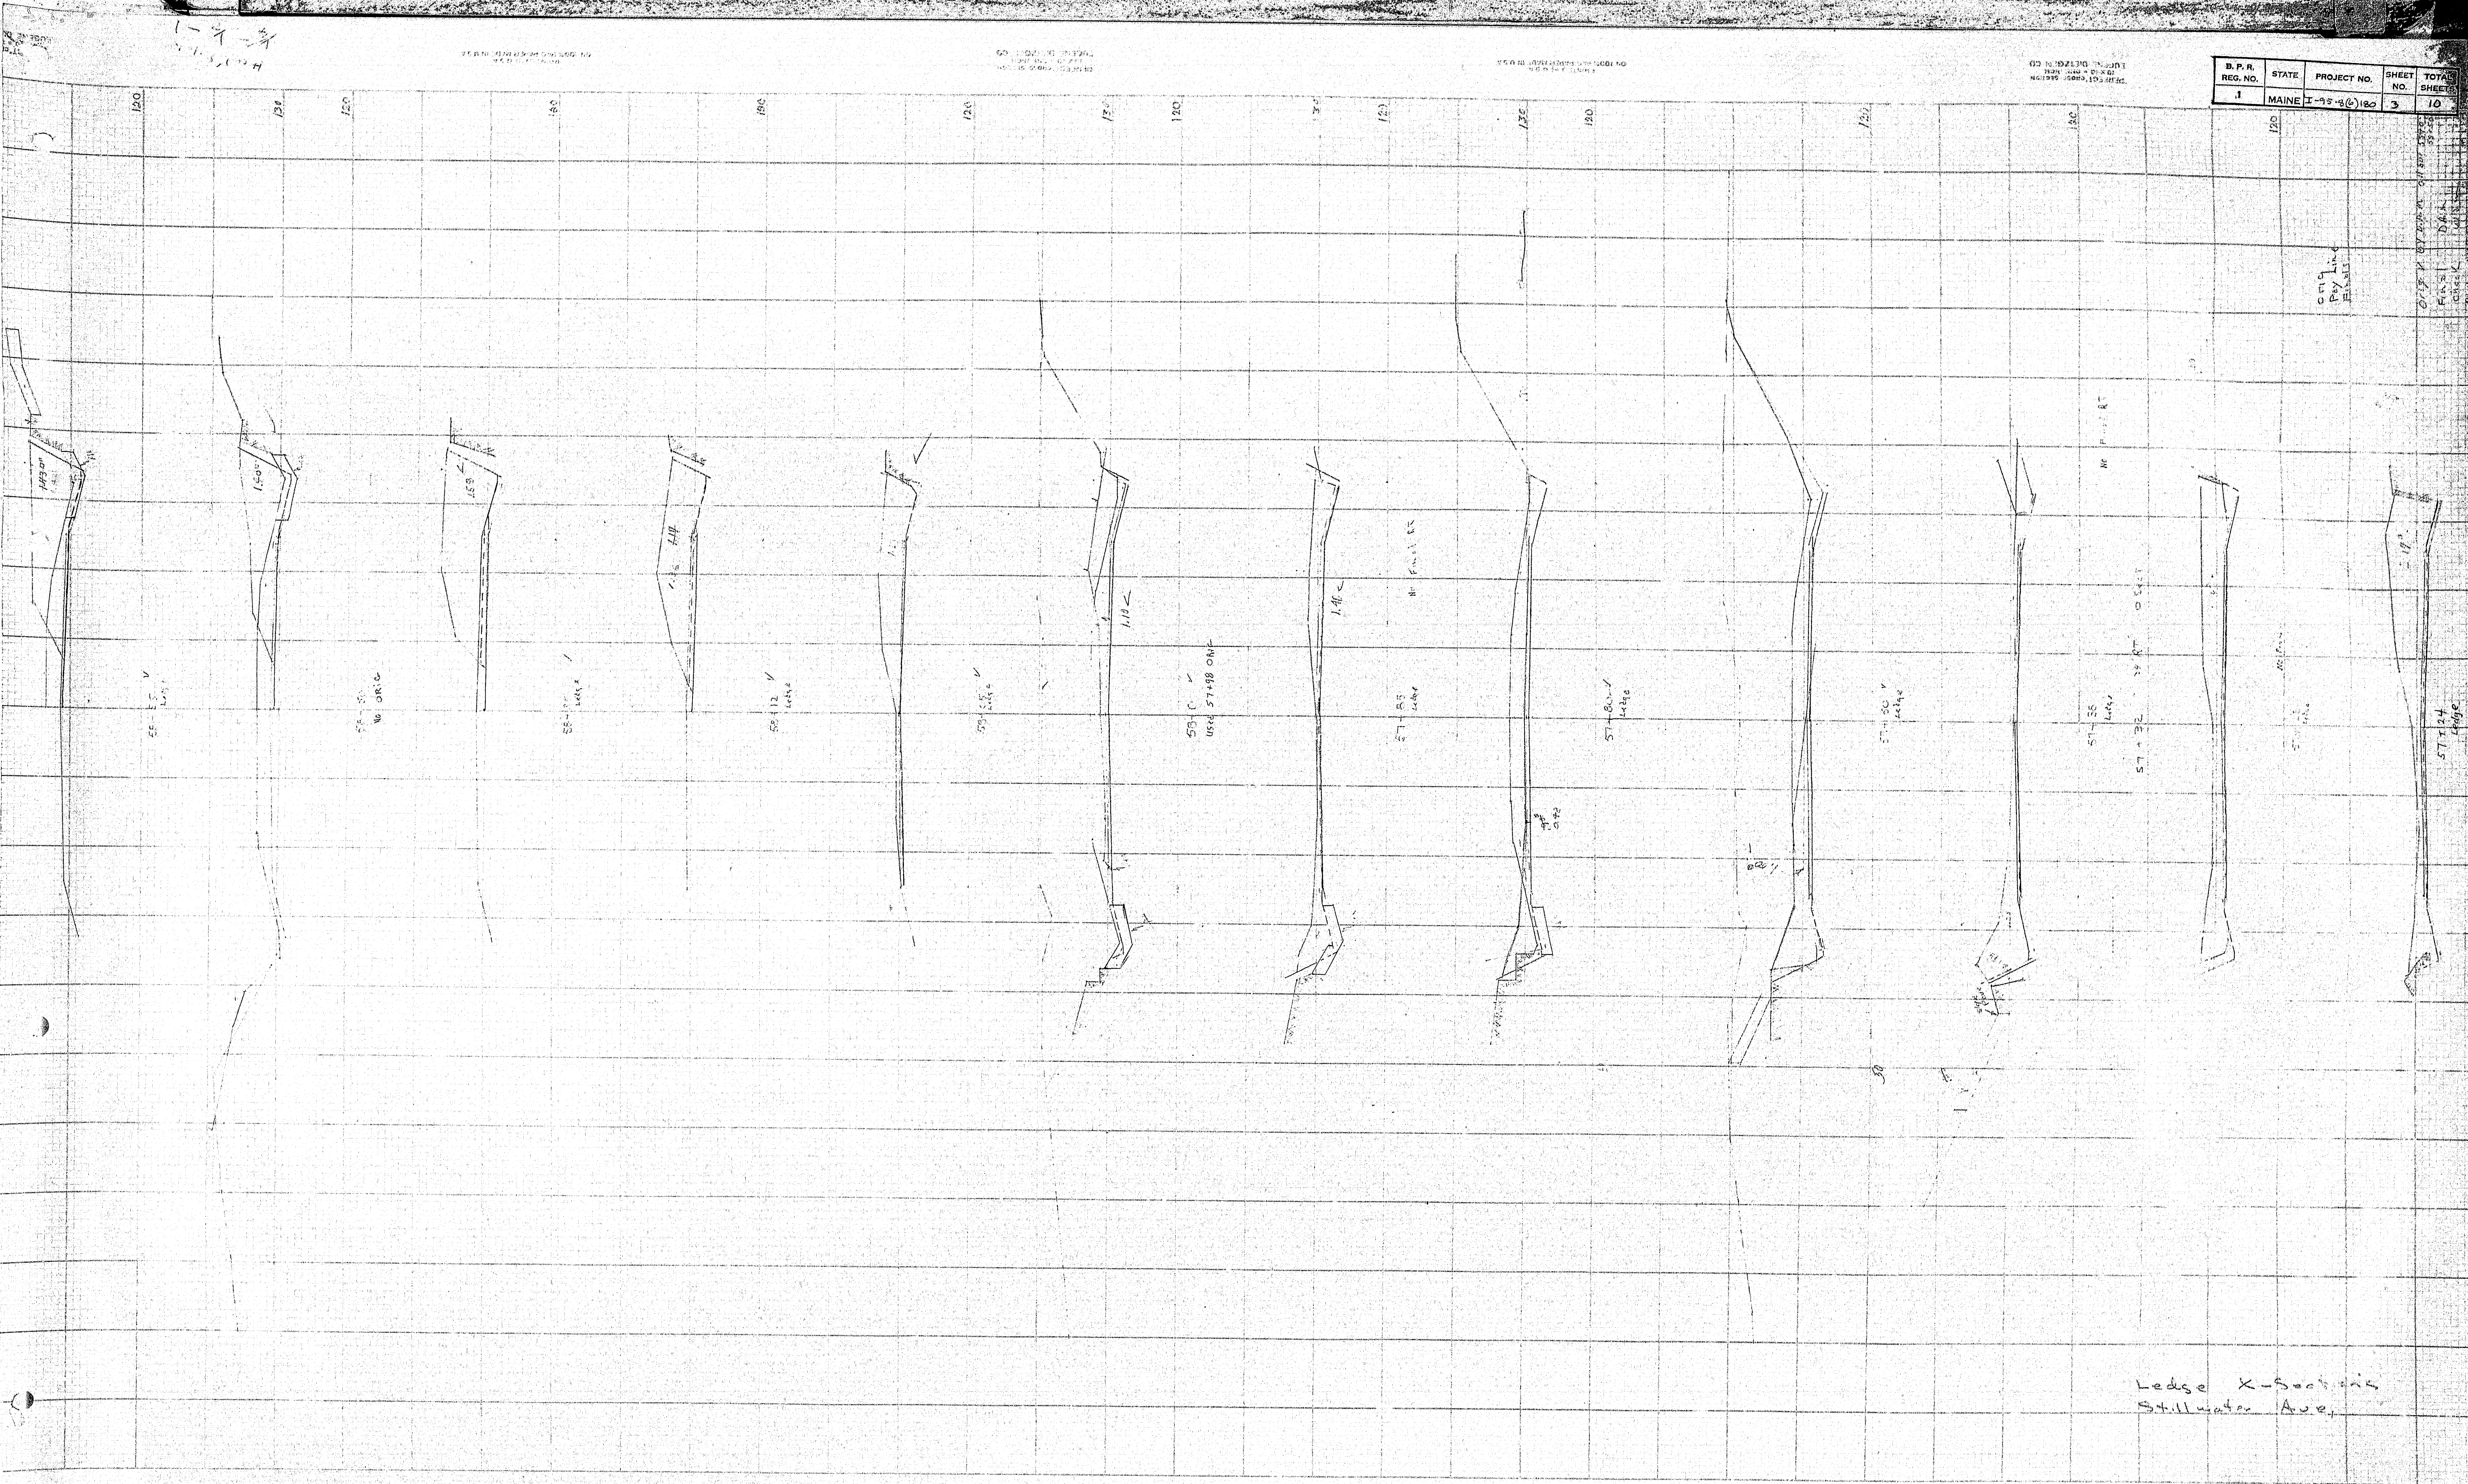

Ledge X-1000  
Stillwater Ave.

78-35C

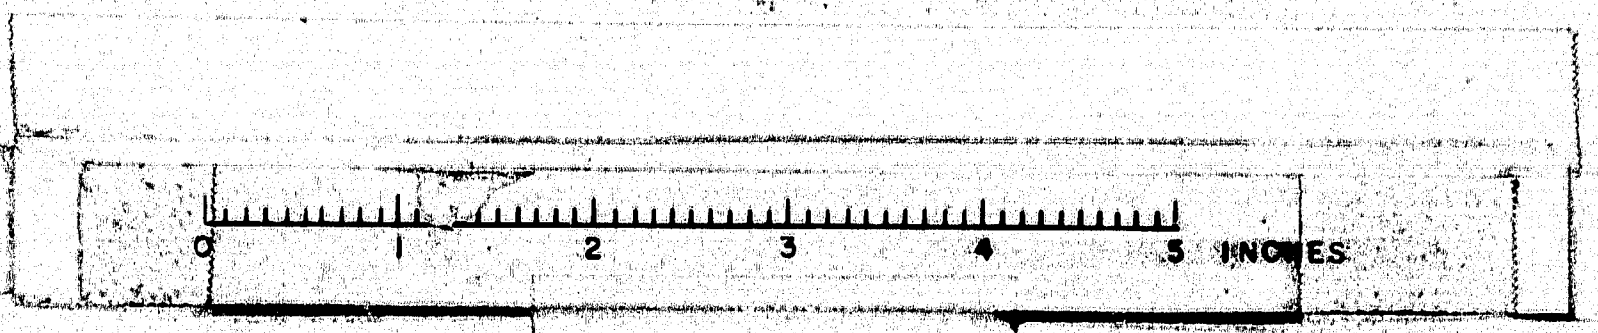



FINAL SURVEY	DATE
BY	
REVIEWED	
NOTED	
NO.	


ORIGINAL SURVEY	DATE
BY	
REVIEWED	
NOTED	
NO.	

B. P. R.	STATE	PROJECT NO.	SHEET NO.	TOTAL SHEETS
II.	MAINE	1-15-2(1)160	4	10

1. 1/2" = 100' SCALE  
 2. 1/4" = 100' SCALE  
 3. 1/8" = 100' SCALE  
 4. 1/16" = 100' SCALE  
 5. 1/32" = 100' SCALE  
 6. 1/64" = 100' SCALE  
 7. 1/128" = 100' SCALE  
 8. 1/256" = 100' SCALE  
 9. 1/512" = 100' SCALE  
 10. 1/1024" = 100' SCALE  
 216. 1/105312291668557186697918027683670432318895095400549111254310975536" = 100' SCALE  
 217. 1/210624583337114373395836055367340864637790190801098222508621951072" = 100' SCALE  
 218. 1/421249166674228746791672110734681729275580381602196445017243902144" = 100' SCALE  
 219. 1/842498333348457493583344221469363458551160763204392890034487804288" = 100' SCALE  
 220. 1/1684996666896914987166688442938726917102321526408785780068975608576" = 100' SCALE  
 221. 1/3369993333793829974333376885877453834204643052817571560137951217152" = 100' SCALE  
 222. 1/6739986667587659948666753771754907668409286105635143120275902434304" = 100' SCALE  
 223. 1/1347997333517531989733350754350981533



B. P. H. REG. NO.	STATE	PROJECT NO.	SHEET NO.	TOTAL SHEETS
1.	MAINE	1-45-86) 180	5	10

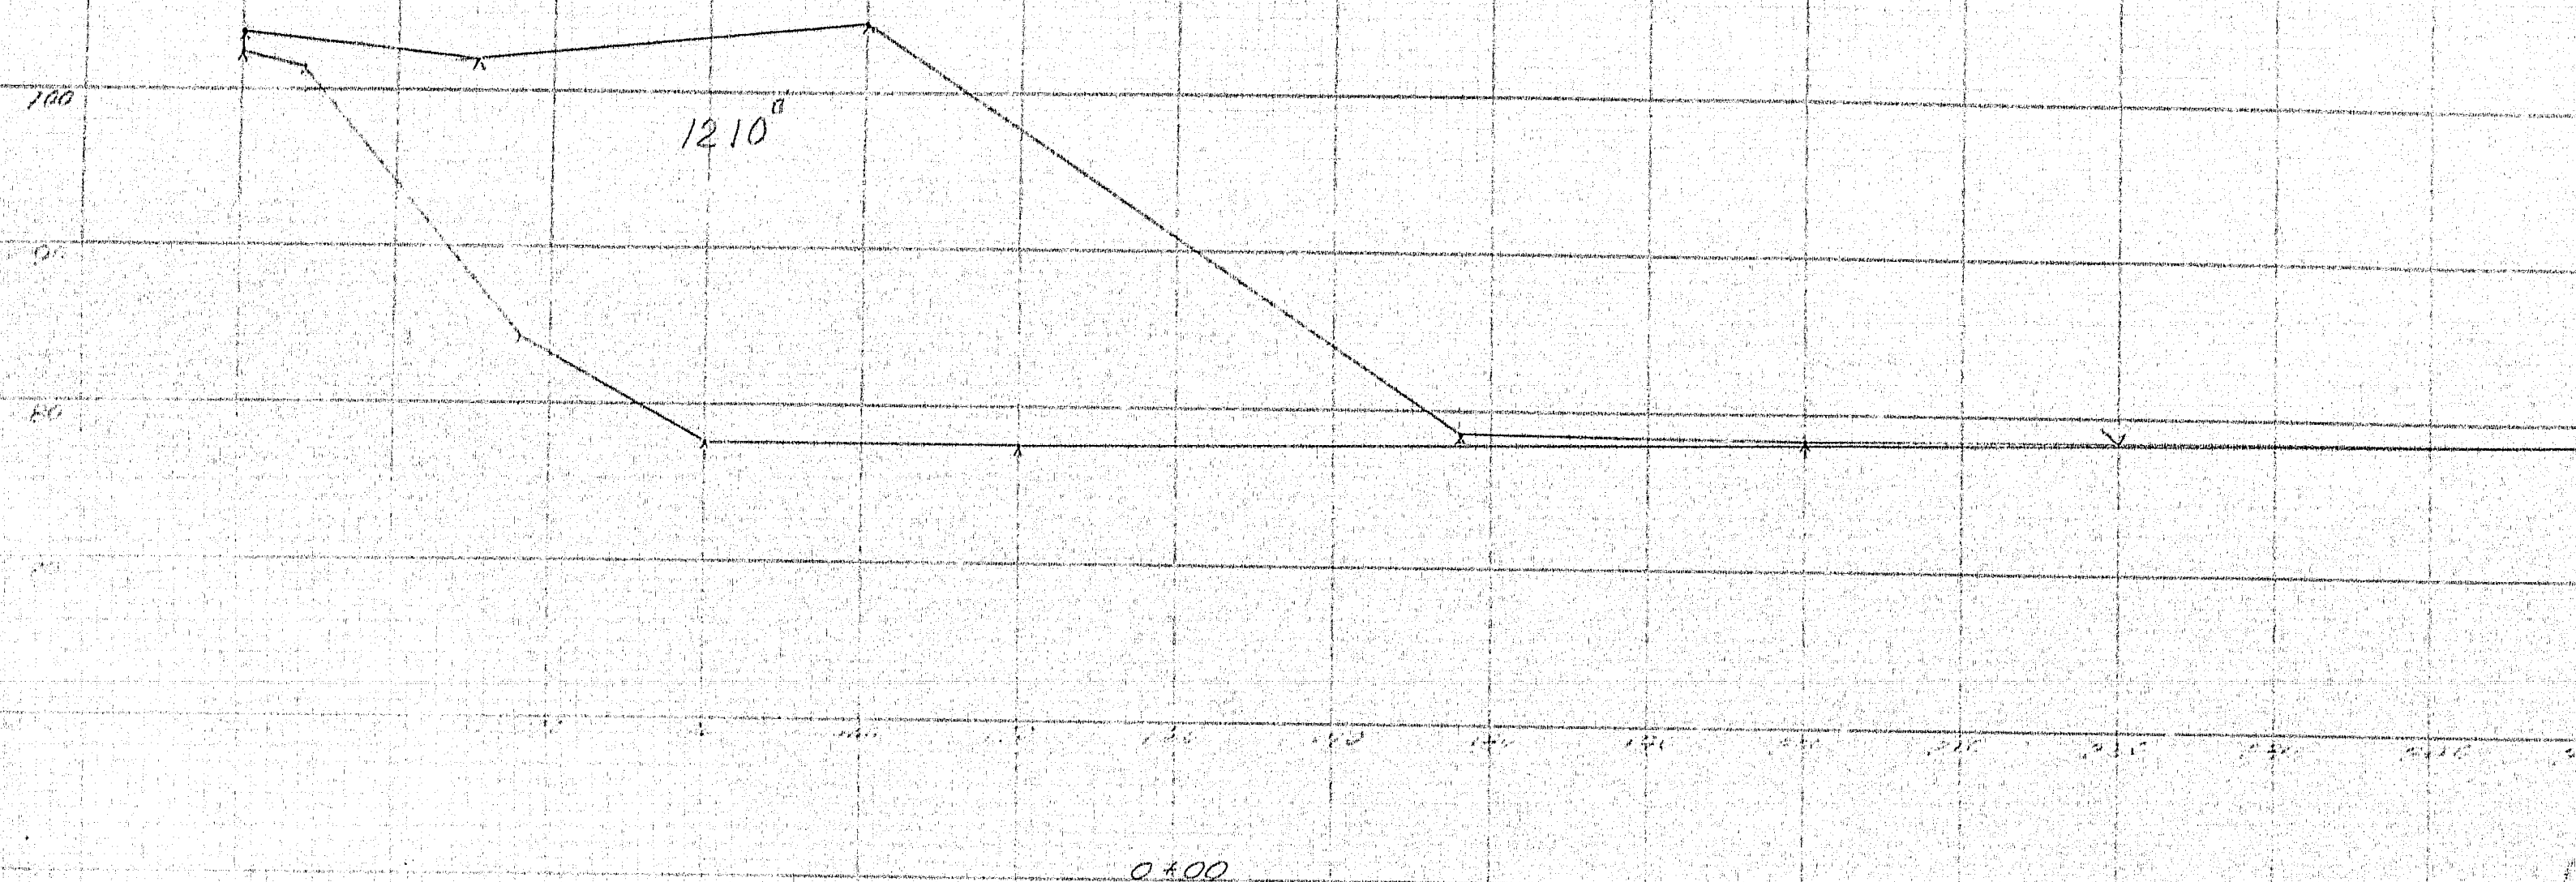

Note: "0" Section 10' back from Sta. 1210.2 (estimated)

THE CLARKESON ENG. CO.  
original and final x sections

B&A pit #2  
1-25-86 (6) 130

NOTE: ORIGINAL SECTIONS TAKEN  
FROM BK # 1852 PG. 140

original  
final  
checked by  
PL by

ORIGINAL Y SECT  
FINAL X SECT  
PL E. H. T.  
BR 651 PG 22  
BR 651 PG 21


PRINTED IN U.S.A.  
ON 100% PAPER MADE IN U.S.A.

PERFECT COPY SECTION  
10 X 10 - ONE INCH  
EUGENE DIEZGEN CO.




PRINTED IN U.S.A.  
ON 100% PAPER MADE IN U.S.A.

PERFECT COPY SECTION  
10 X 10 - ONE INCH  
EUGENE DIEZGEN CO.

78-35 E

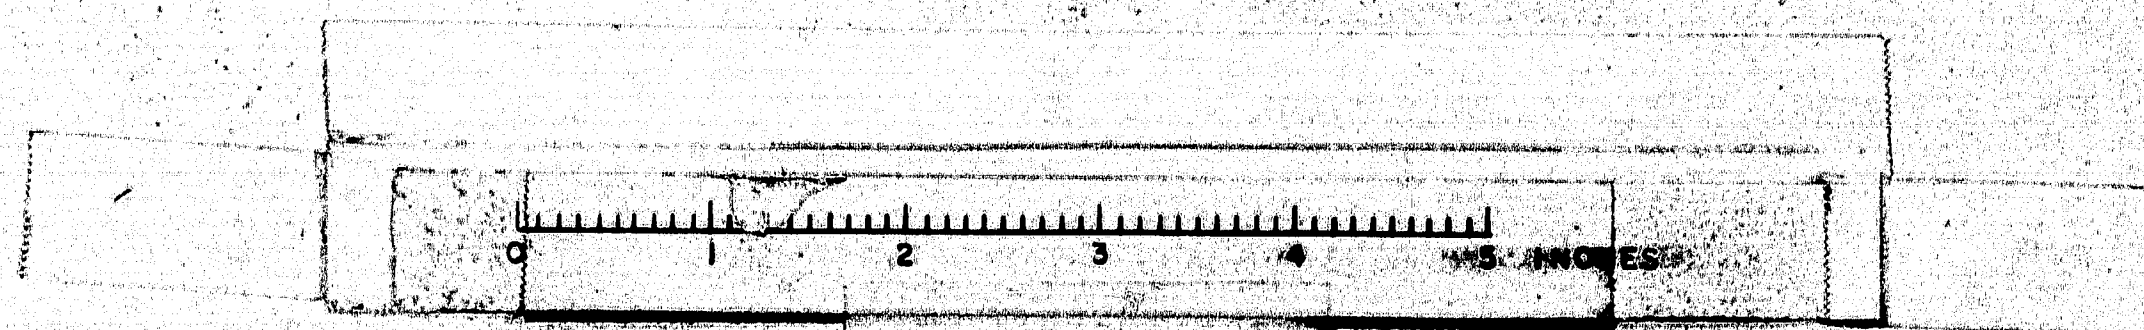



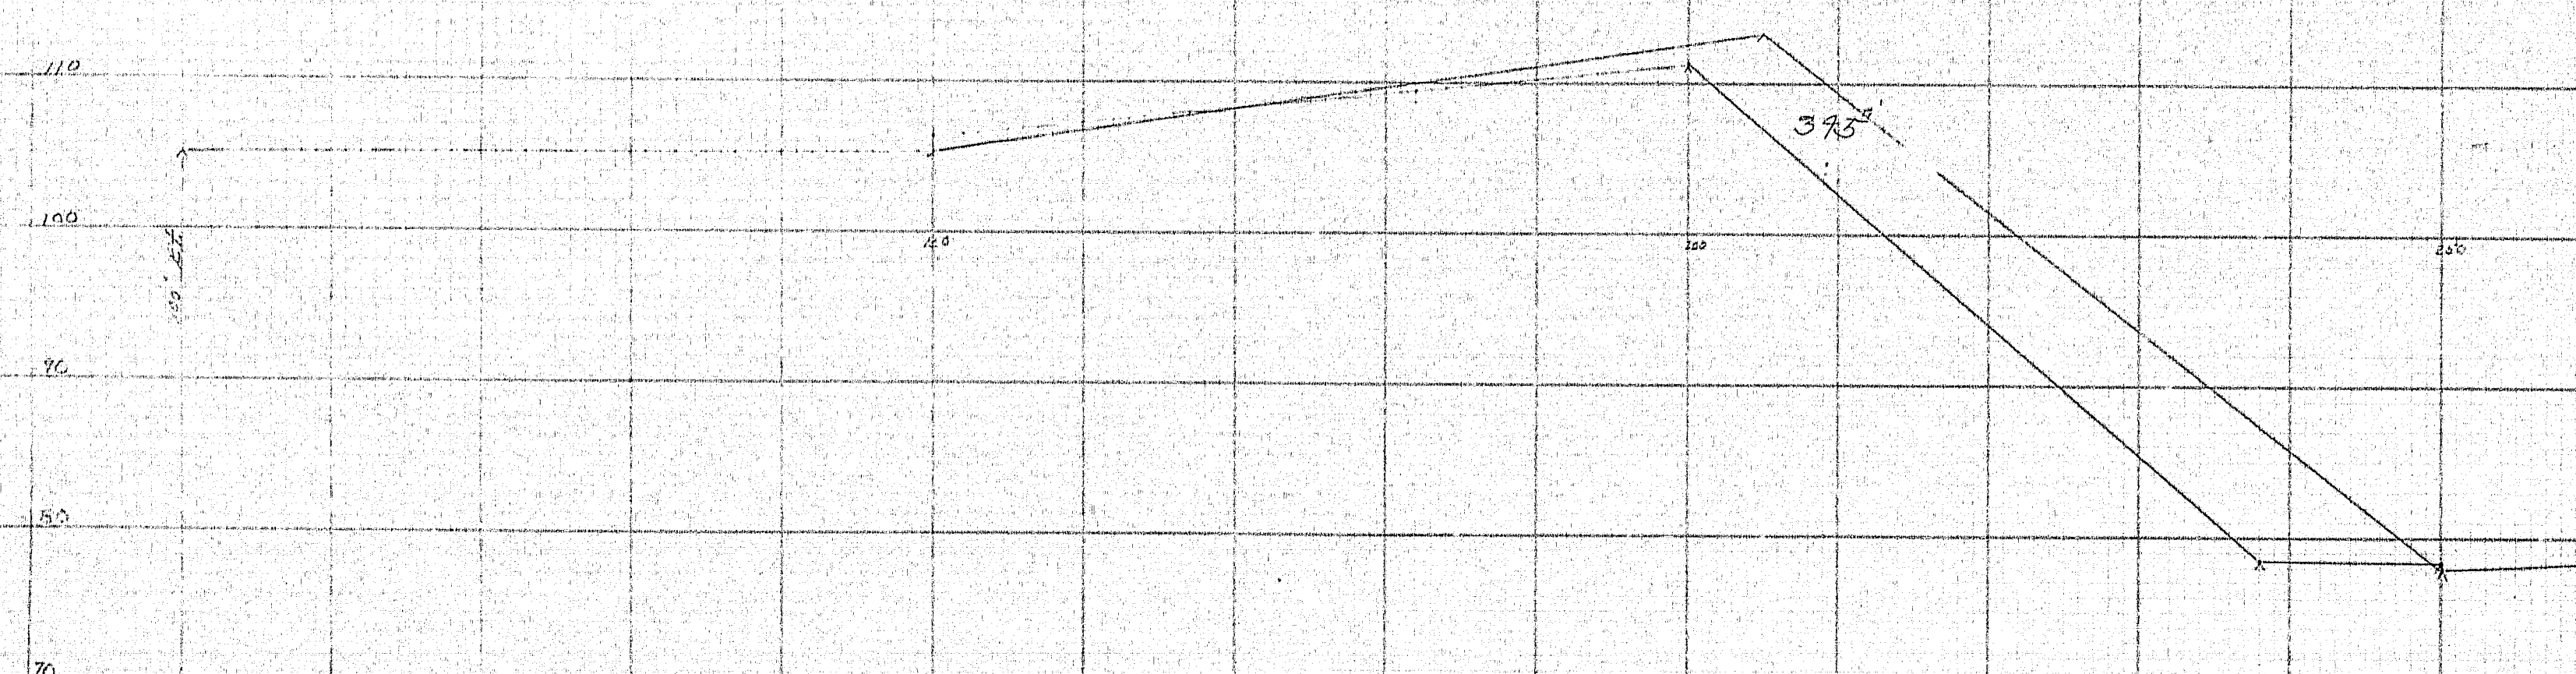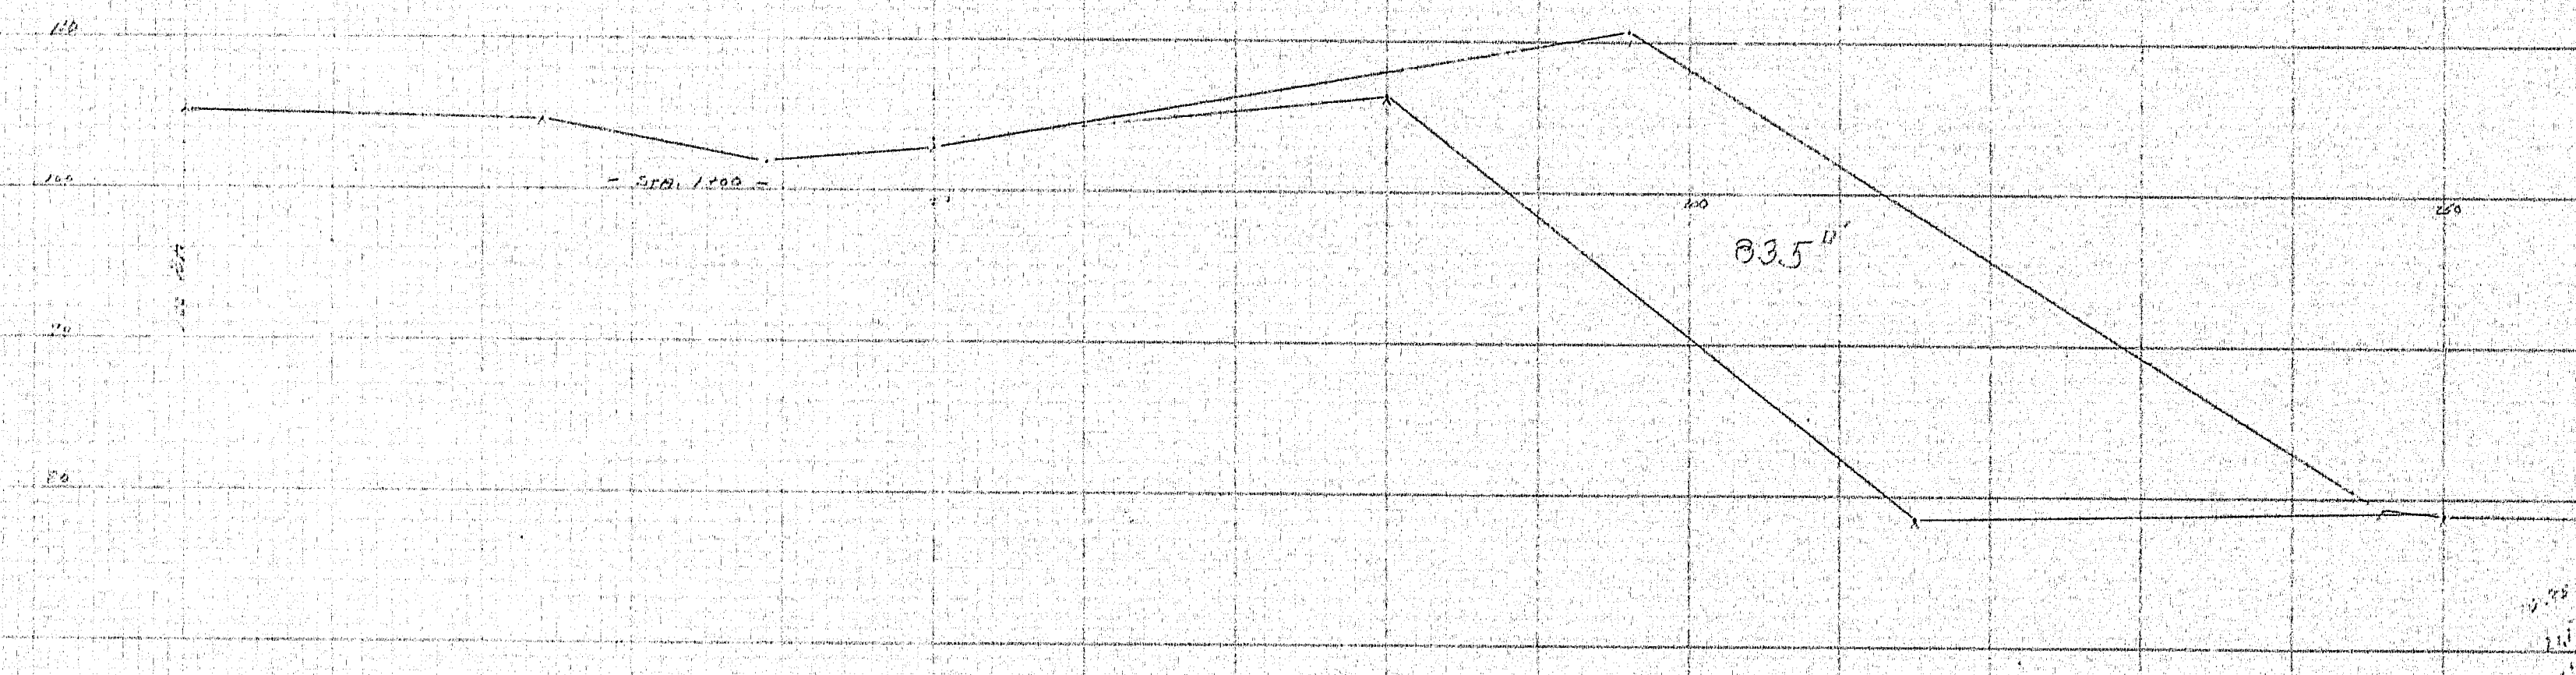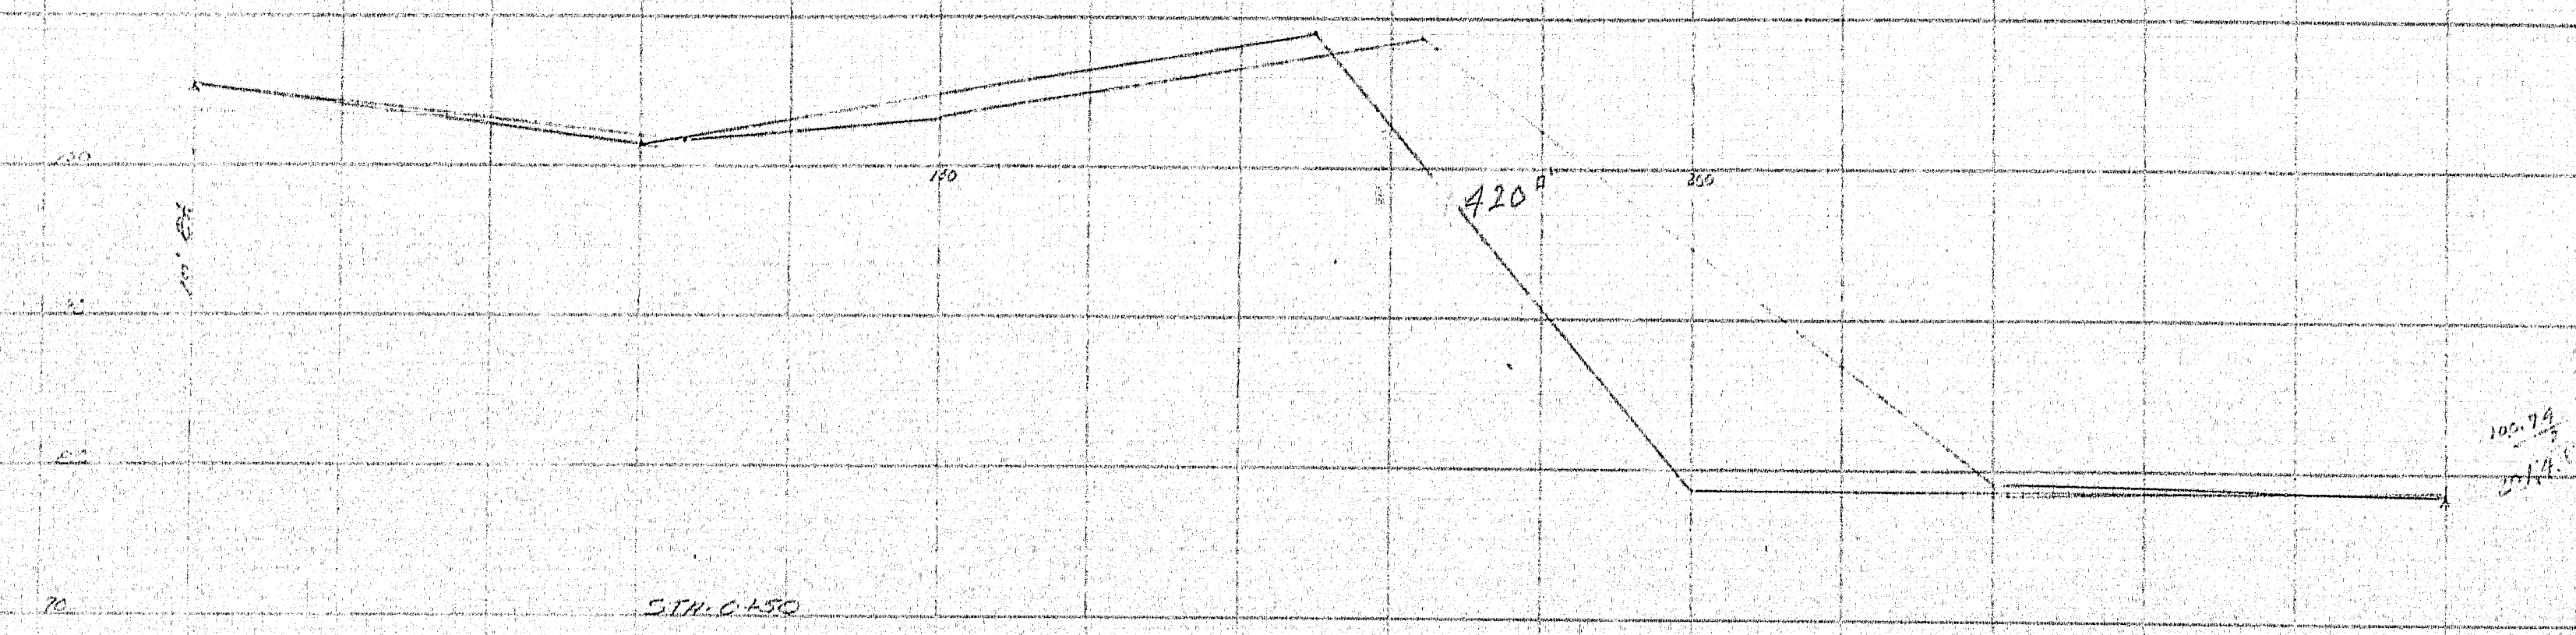

THE CLARKSON ENG CO  
original and final sections

NOTE: ORIGINAL SECTIONS TAKEN FROM BK 11/1852 PG 140

Original plotted by: J.A.A.  
Final checked by: J.A.A. JNT  
PL by: JNT  
PL by: D.A.M.

Original 1" VERT. 1" HORIZ. 10  
Final 1" VERT. 1" HORIZ. 10

ORIGINAL 1" VERT. 1" HORIZ. 10  
FINAL 1" VERT. 1" HORIZ. 10

THE CLARKSON ENG CO  
10 x 10 ONE INCH  
EUGENE DIEZGEN CO


PRINTED IN U.S.A.  
ON 100% RAG PAPER MADE IN U.S.A.

"PERFECT" CROSS SECTION  
10 x 10 ONE INCH  
EUGENE DIEZGEN CO

PRINTED IN U.S.A.  
ON 100% RAG PAPER MADE IN U.S.A.



"PERFECT" CROSS SECTION  
10 x 10 ONE INCH  
EUGENE DIEZGEN CO

70-35 F

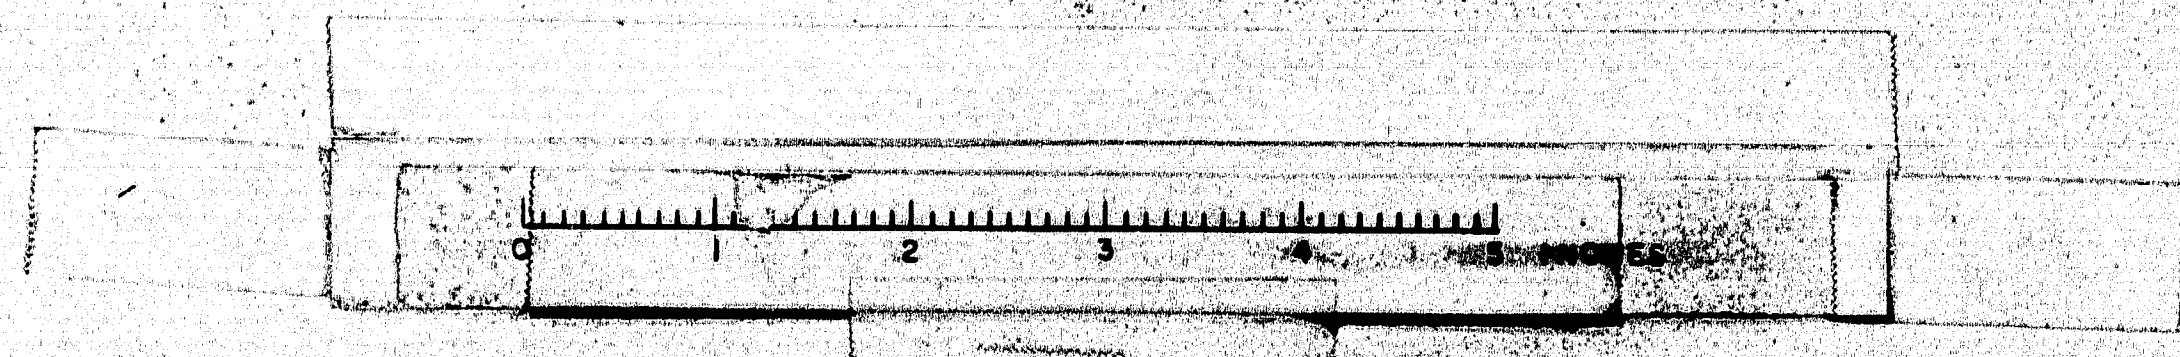



B. P. R. REG. NO.	STATE	PROJECT NO.	SHEET NO.	TOTAL SHEETS
1	MAINE	1-5-26-180	7	10

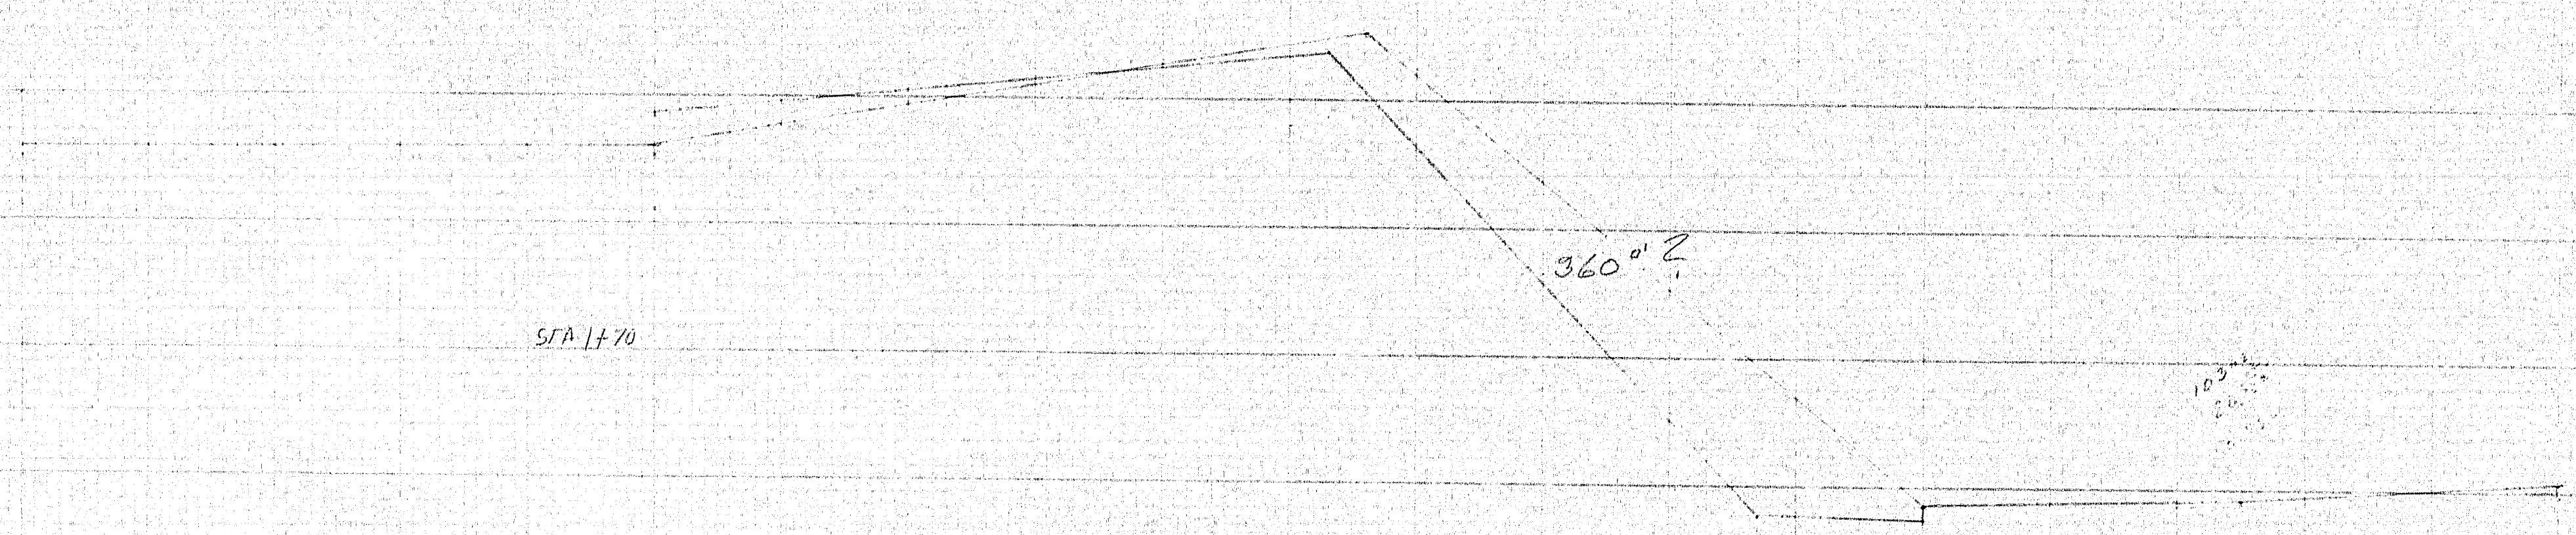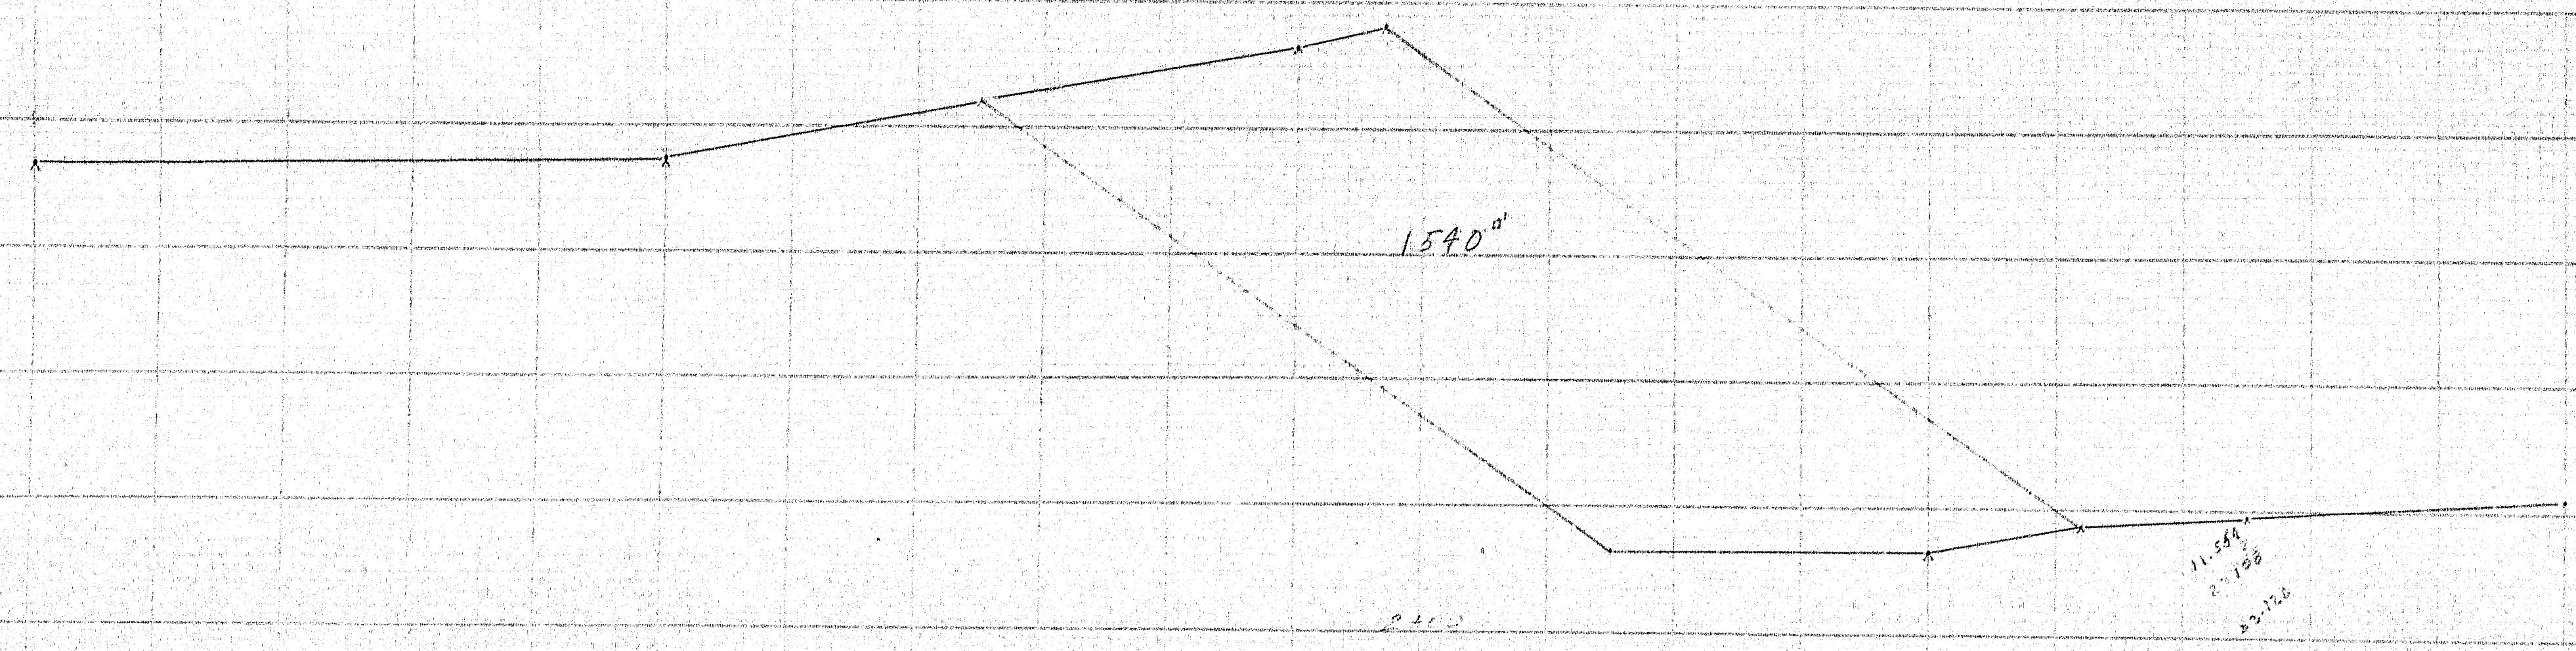

THE CLARKESON ENG CO.  
original and final X sections

B. & A. pit #2  
I-95-B-(16)-180  
NOTE: ORIGINAL SECTIONS TAKEN FROM BK #1852, PG 140  
Original plotted by  
Final checked by  
PL by PL V  
ORIGINAL & SECT. BOOK  
FINAL 7-18-51

PRINTED IN U.S.A.  
EUGENE DIEZGEN CO.


PRINTED IN U.S.A.  
EUGENE DIEZGEN CO.

PRINTED IN U.S.A.  
EUGENE DIEZGEN CO.

PRINTED IN U.S.A.  
ON 100% RECYCLED PAPER


PRINTED IN U.S.A.  
EUGENE DIEZGEN CO.

70-356

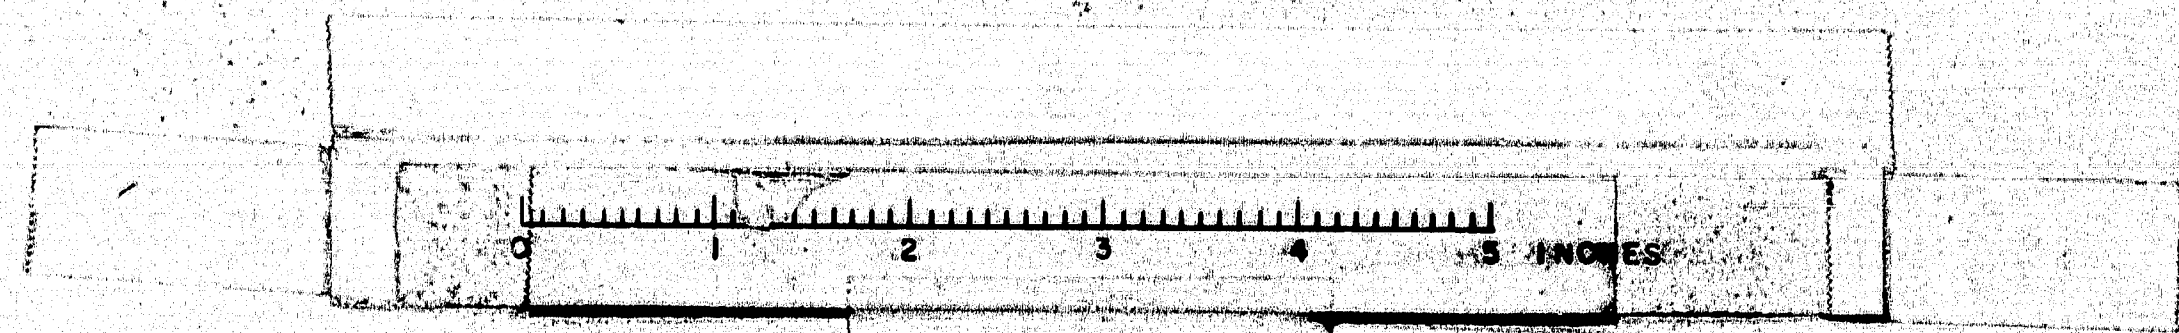




# Harris Common Burrow Pit

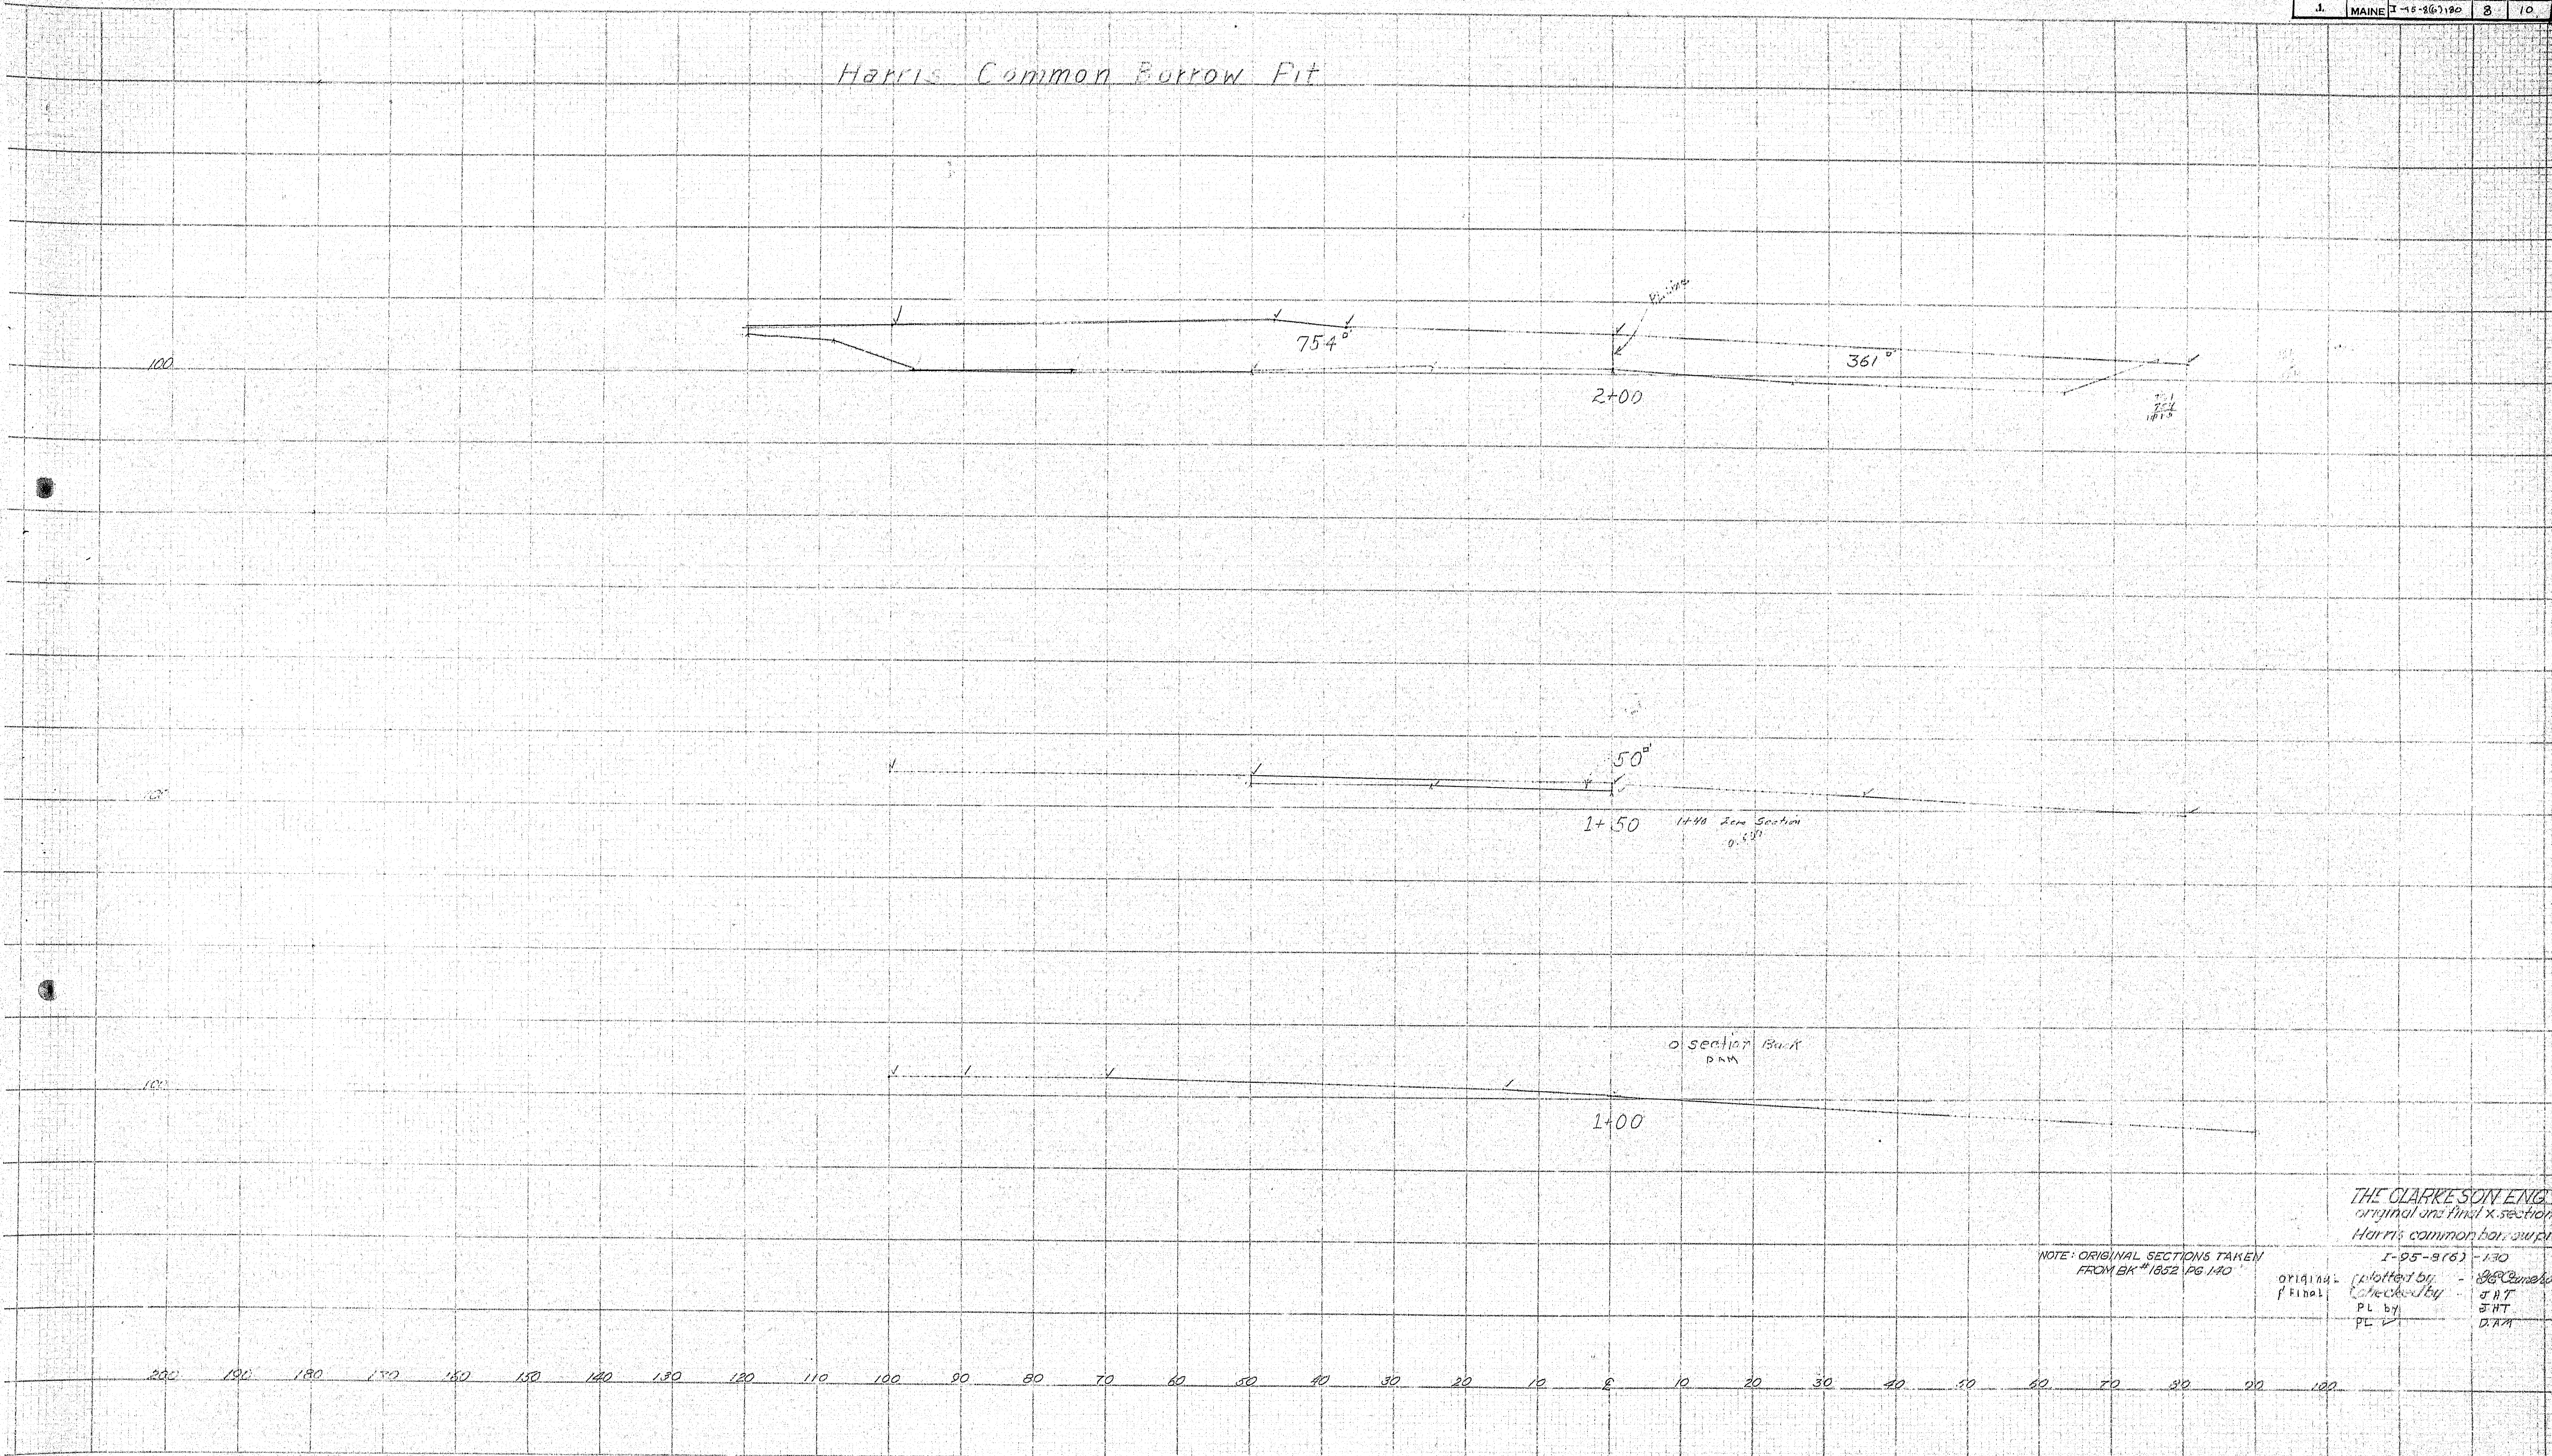

THE CLARKE SON ENG CO.  
original and final x-sections  
Harris common burrow pit

NOTE: ORIGINAL SECTIONS TAKEN  
FROM BK #1852 PGS 140

ORIGINAL: plotted by - J.R. Emerson  
Final: checked by - J.R.T.  
PL by - J.H.T.  
PE - D.A.M.

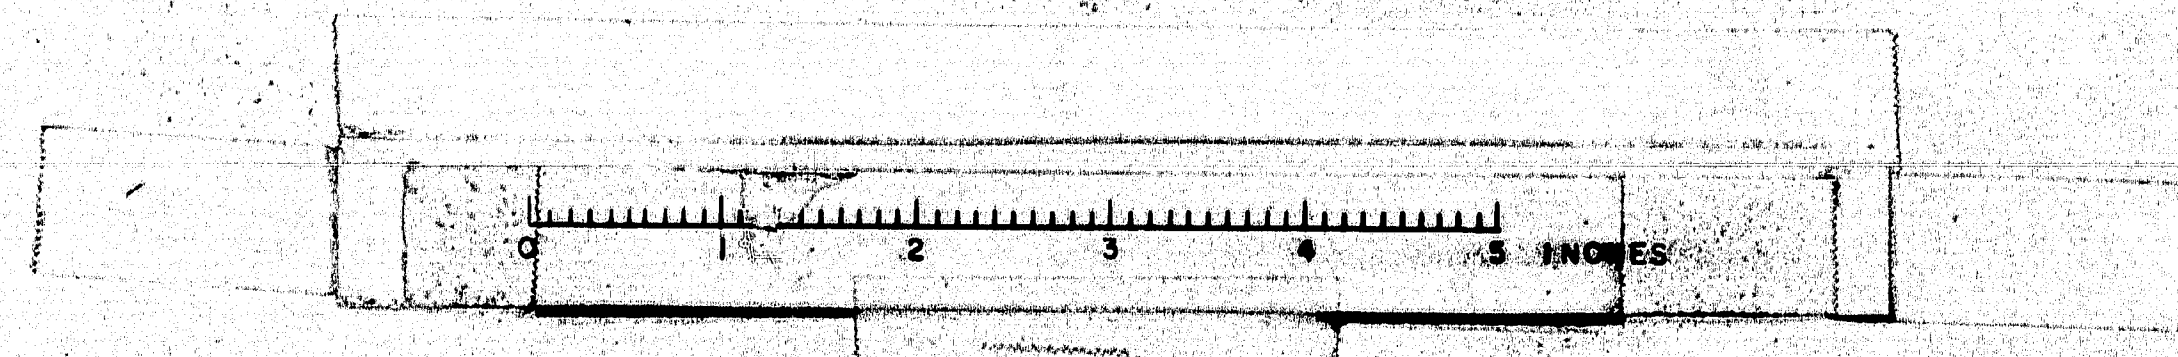








B. P. R. REG. NO.	STATE	PROJECT NO.	SHEET NO.	TOTAL SHEETS
1	MAINE	1-12-84-160	10	10

A section Sta. 5+10

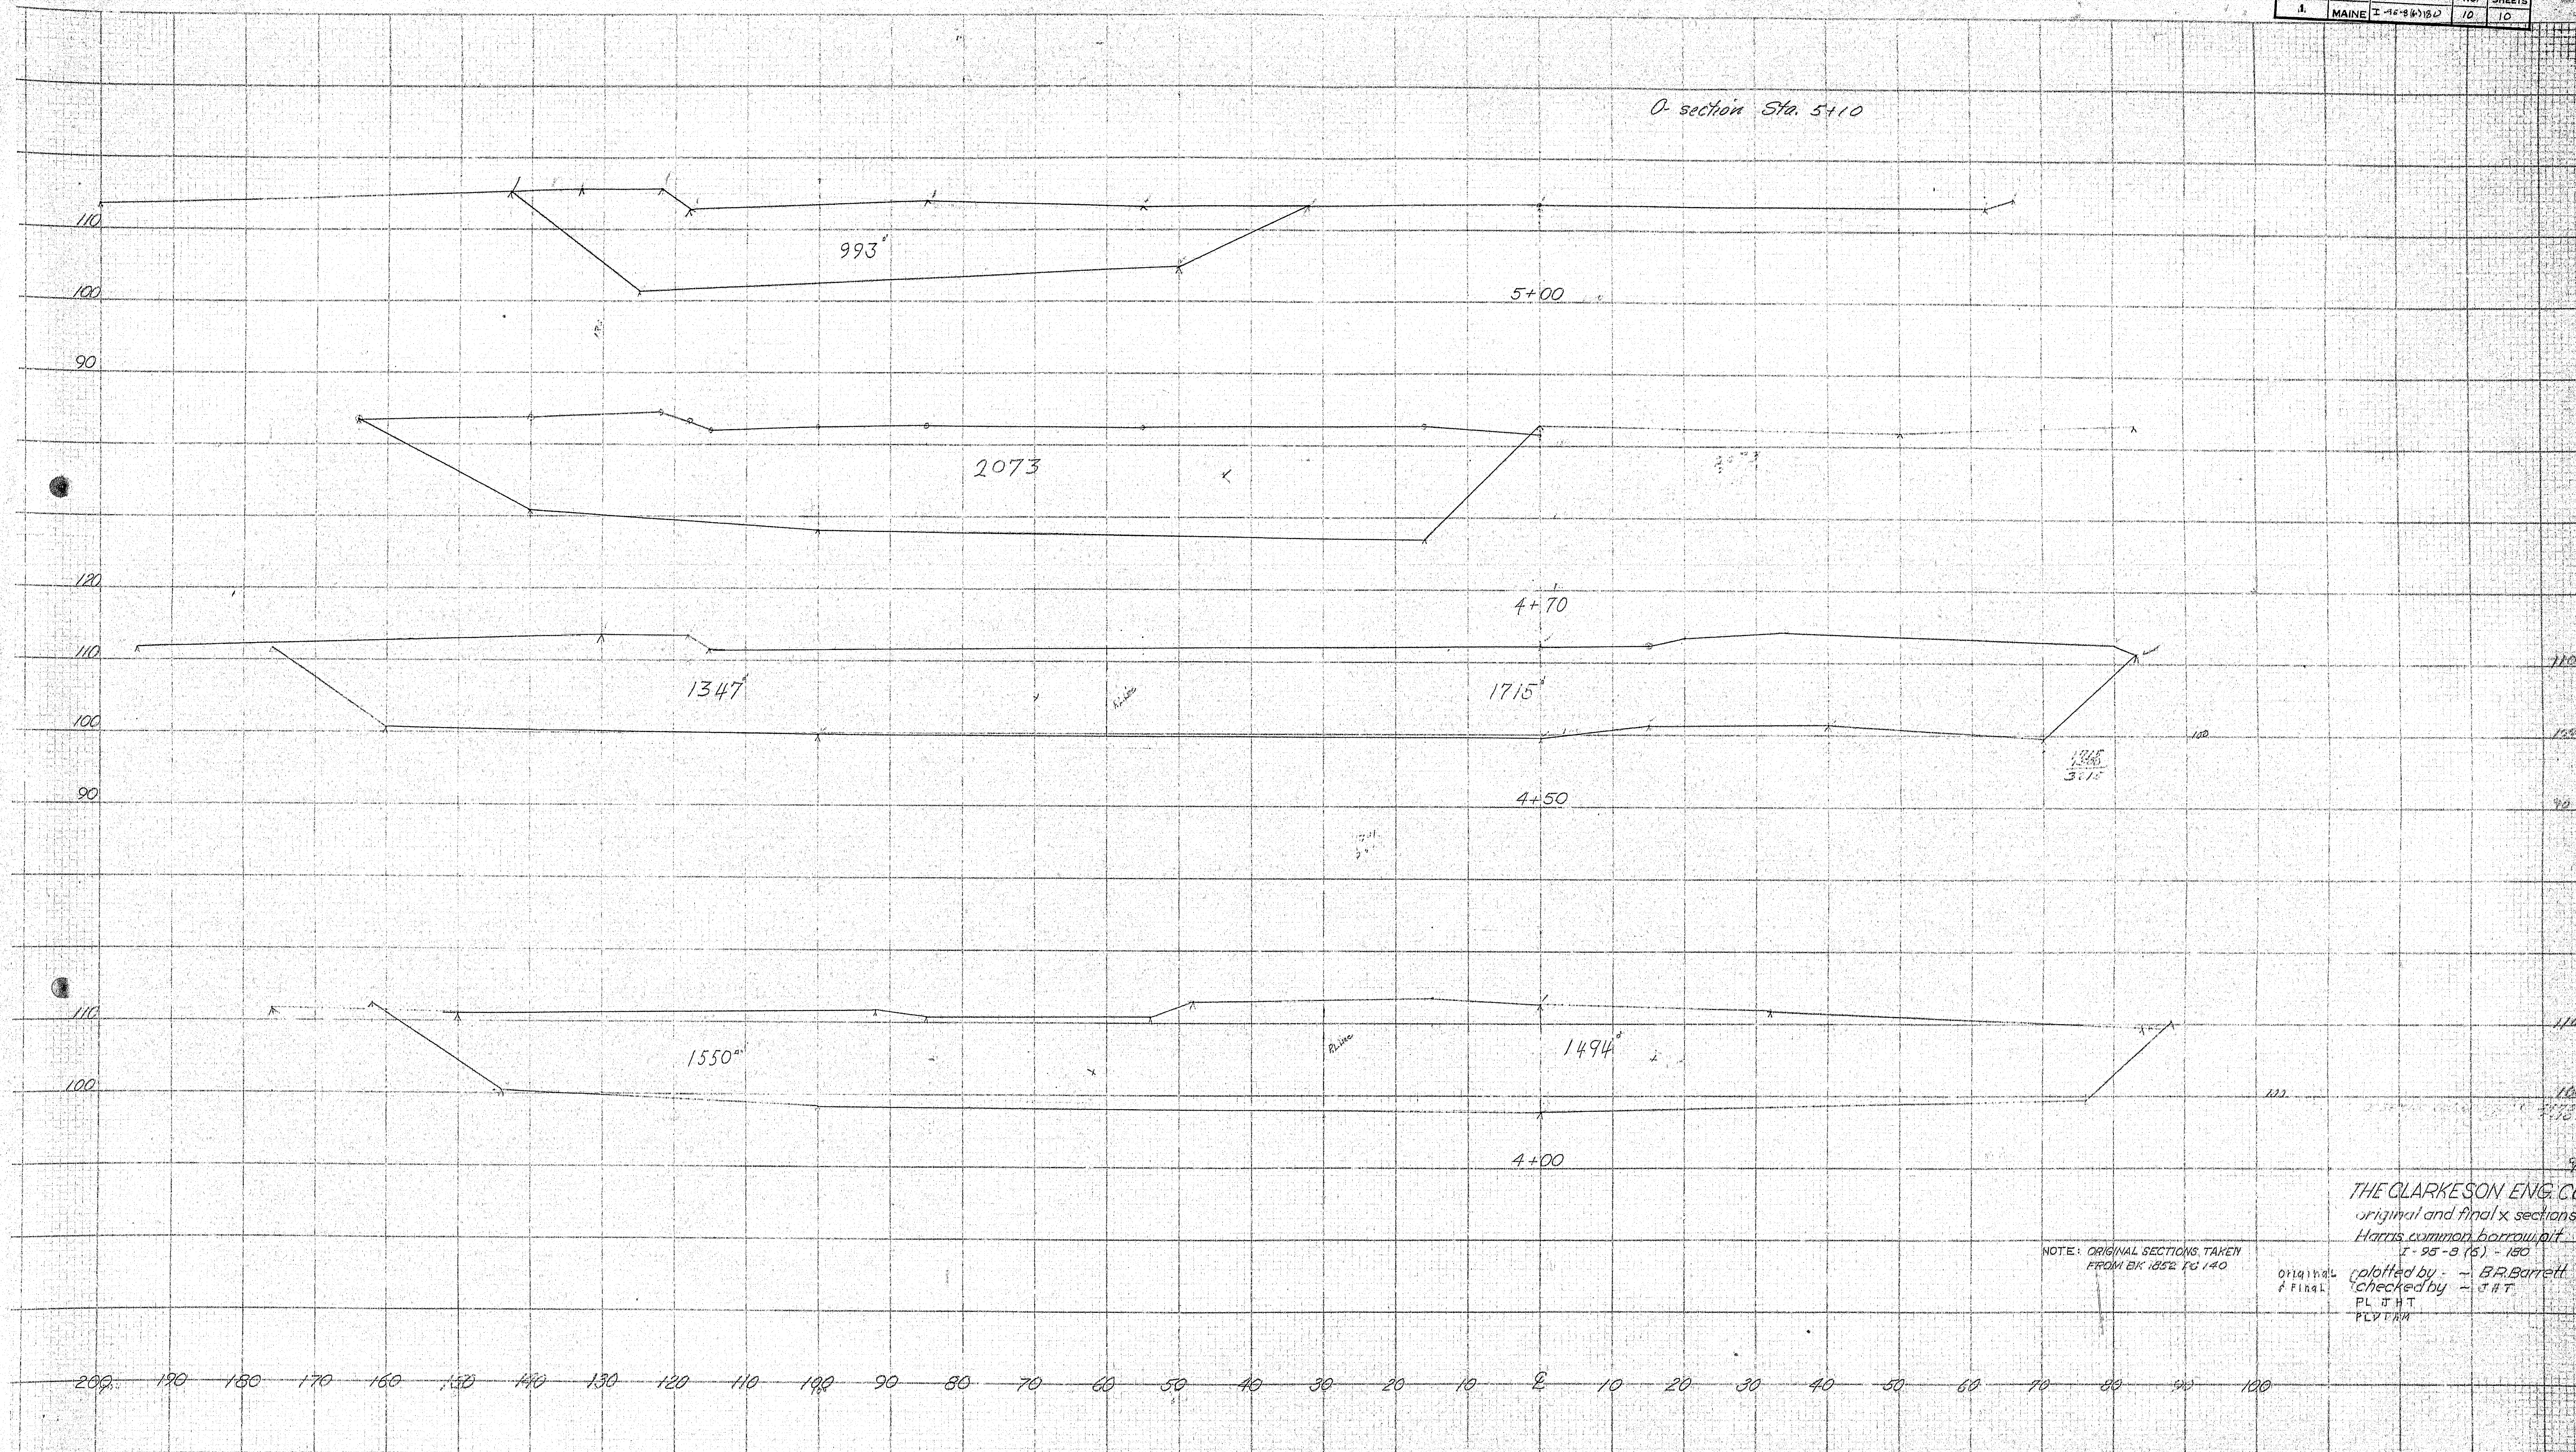

NOTE: ORIGINAL SECTIONS TAKEN FROM BK 1852 TO 140

THE CLARKSON ENG. CO.  
original and final x sections  
Harris common borrow pit  
I-95-S (5) - 180  
original plotted by - B.R. Barrett  
checked by - J.H.T.  
PLT J.H.T.  
PLT J.H.T.


PERFECT cross section  
10 x 10 - ONE INCH  
EUGENE DIEZEL CO.

PERFECT cross section  
10 x 10 - ONE INCH  
EUGENE DIEZEL CO.

PERFECT cross section  
10 x 10 - ONE INCH  
EUGENE DIEZEL CO.

PERFECT cross section  
10 x 10 - ONE INCH  
EUGENE DIEZEL CO.

78-35

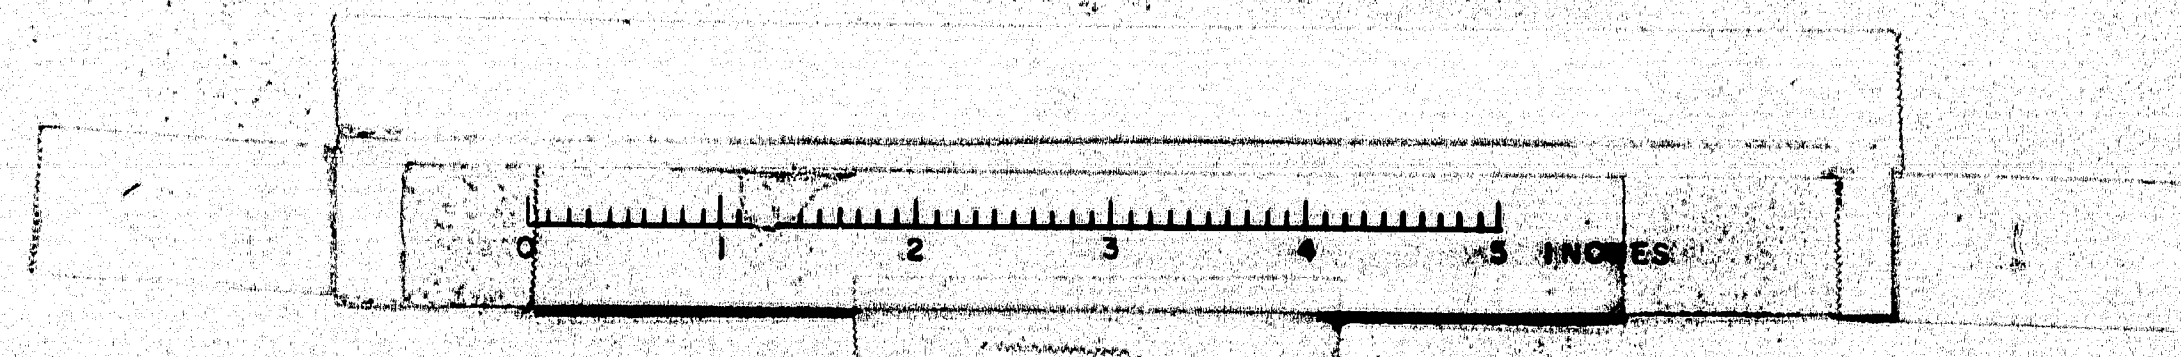



ST. Illwater Ave.

orig. plotted - W.J.M  
orig. check - W.J.M

2-59  
1-20-60

DAVID L. HART 11-510

الحمد لله

 $55+23$ 

0+55

 $54 + 50$ 

54+0

 $53 + 50$ 
$$53+0$$

52+50

52+0


51 + 50

51 + 0

B. P. R. REQ. NO.	STATE	PROJECT NO.	SHEET NO.	TOTAL SHEET
1	MAINE	1-95-8(6)100	1	4

## Stillwater Arc


Red Vinyl

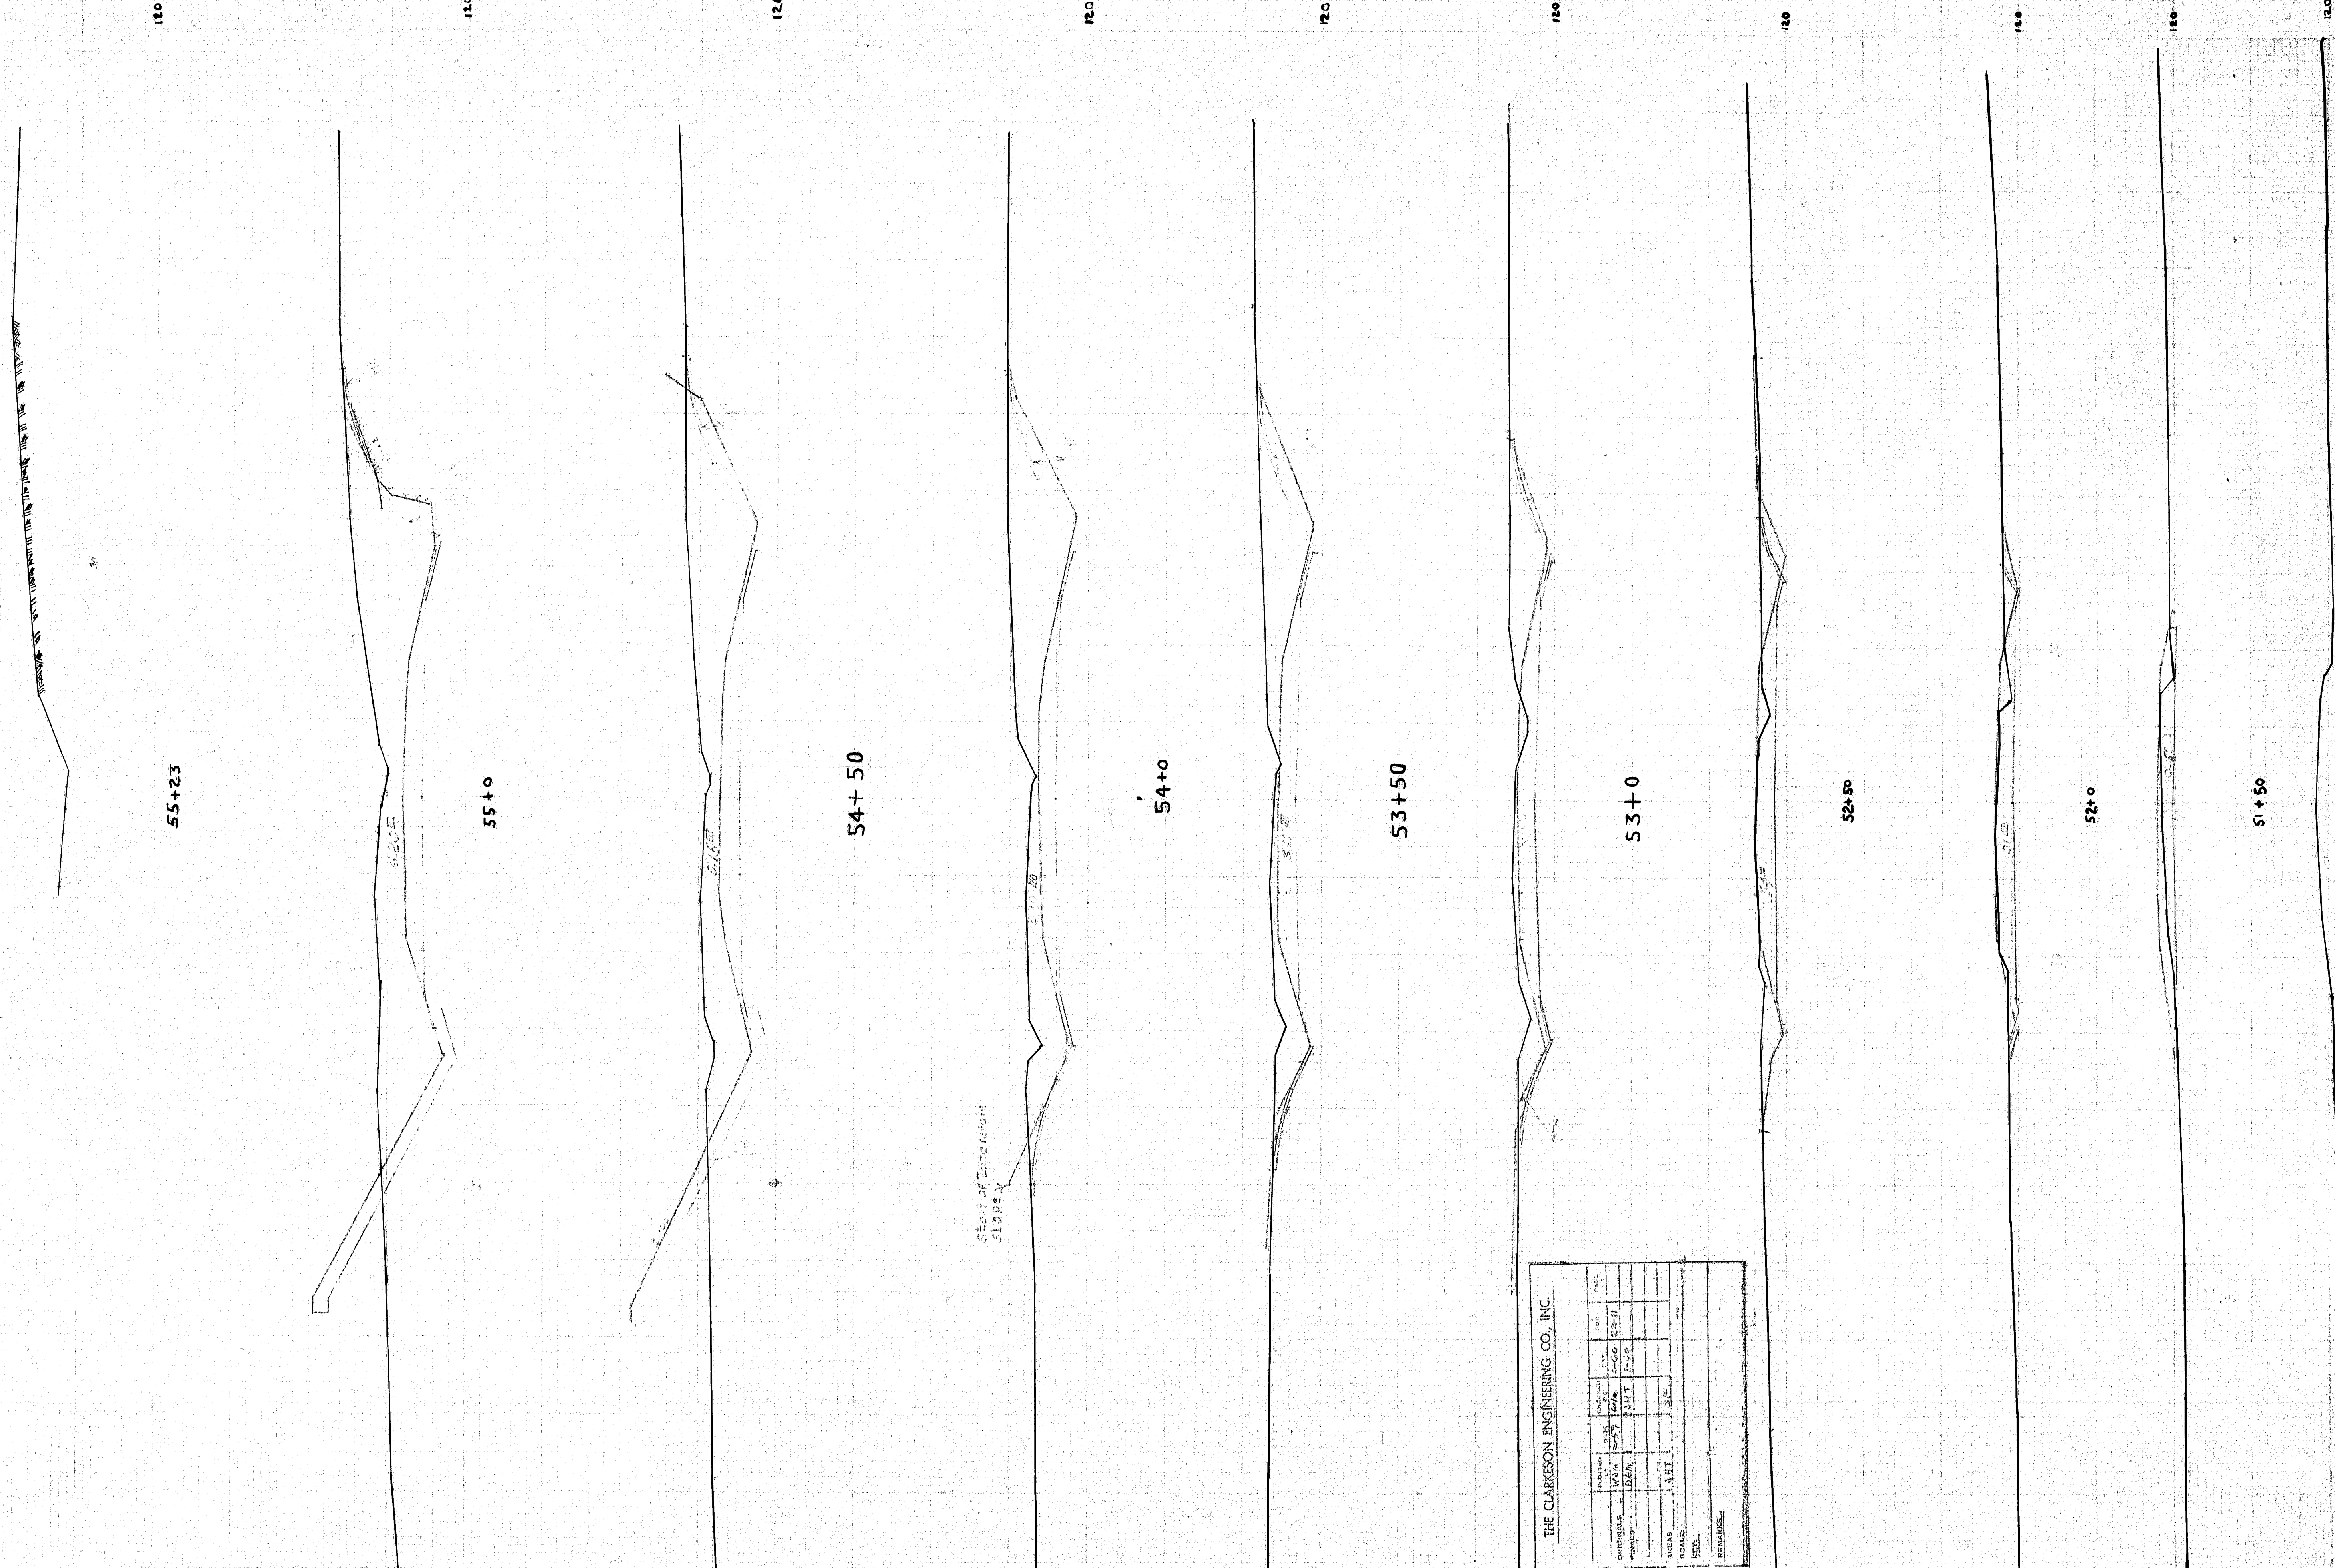

THE CLARSON ENGINEERING CO. INC.

	RELIGION	RACE	DATE OF BIRTH	AGE	SEX	EDUCATION	STATUS	REMARKS
OMPHAS	W.M.	W	1-27	1-00	M	1-00	2-11	
WENNER	D.M.				F			
LARAG								
GRABER								
HILL								
KENNARD								

REMARKS:

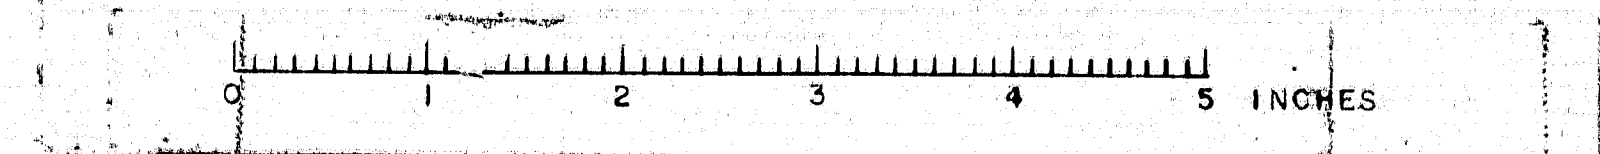

**78-36**



# STILLWATER AVE

Stillwater Ave. 1-20-40  
 photo. by WJM  
 orth. check by DAM

DAM 1947 11-2-54

4

140

58+50

140

58+00

130

57+50

130

57+00

130

56+50

130

56+00

130

55+95

130

56+50

130

55+27

Stillwater Ave				
B.P.R. REG. NO.	STATE	PROJECT NO.	SHEET NO.	TOTAL SHEETS
1	MAINE	1-95-26100	2	4

THE CLARKESON ENGINEERING CO., INC.				
DESIGNED BY	WJM	DATE	1-20-40	
CHECKED BY	DAM	DATE	11-2-54	
APPROVED BY				
SCALE	1" = 10'			
REVISIONS				

0 1 2 3 4 5 INCHES



# Stillwater Ave

ORIG. PLOTTED BY W/M  
CHECK BY D/M

DA 11  
1/15/60


## Stillwater Ave

STATE	PROJECT NO.	SHEET NO.	TOTAL SHEETS
MASS	95-0(6)/80	3	4

Red Line



THE CLARKESON ENGINEERING CO., INC.				
DATE	BY	CHKD	APPD	REMARKS
1/15/60	W/M	D/M		

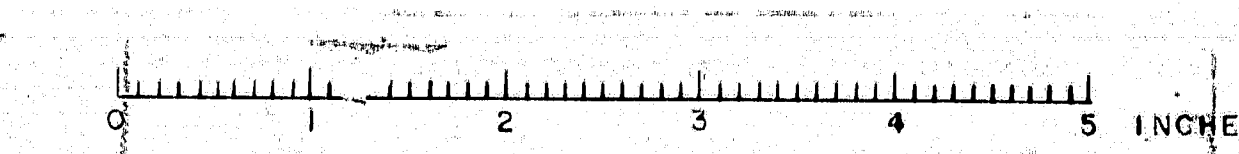



Stillwater Ave

Orig. Plotted by WJM  
Checked by DAM

1-2-40  
1-2-40  
1-2-40

Stillwater Ave

S.P.R. REG. NO.	STATE	PROJECT NO.	SHEET NO.	TOTAL SHEETS
1	MAINE	1-25-2(6) 40	1	4

1-2-40

THE CLARKSON ENGINEERING CO., INC.			
ORIGINALS	DATE	BY	REMARKS
MADE	1-2-40	WJM	
CHECKED			
SCALE			
REV.			
REMARKS			

0 1 2 3 4 5 INCHES