

STATE OF MAINE  
STATE HIGHWAY COMMISSION



# BANGOR-BREWER BRIDGE

OVER

PENOBSCOT RIVER


BETWEEN THE CITIES OF

BANGOR AND BREWER

PENOBSCOT COUNTY

## INDEX OF SHEETS

- |   |   |
|---|---|
| 1. TITLE SHEET                            | 28. LIGHTING DETAILS                          |
| 2. GENERAL PLAN & ELEVATION               | 29. TYPICAL SECTIONS                          |
| 3. FOUNDATION DATA                        | 30. PLAN - UNION STREET STA. 21 TO 23         |
| 4. BORING LOGS NO. 1                      | 31. PLAN - UNION STREET STA. 24 TO 26         |
| 5. BORING LOGS NO. 2                      | 32. PLAN - HAYMARKET SQUARE                   |
| 6. BORING LOGS NO. 3                      | 33. PLAN - SUMMER STREET - RAMP "A"           |
| 7. FOOTING PLAN                           | 34. PLAN - UNION STREET STA. 27 TO 29         |
| 8. UNION STREET ABUTMENT                  | 35. PLAN - TOLL PLAZA                         |
| 9. RAMP "B" ABUTMENT                      | 36. PLAN - MAIN ST. INTERSECTION - BREWER     |
| 10. BREWER ABUTMENT                       | 37. PROFILES - RAMP "A"                       |
| 11. BREWER ABUTMENT                       | 38. PROFILES - RAMP "C"                       |
| 12. PIER 1                                | 39. PROFILES - SUMMER STREET                  |
| 13. PIERS 2-3-4                           | 40. PROFILES - RAMP "B"                       |
| 14. PIERS 5-6-9-10                        | 41. PROFILES - BREWER                         |
| 15. PIERS 7 & 8                           | 42. RETAINING WALLS - RAMP "A" & UNION STREET |
| 16. PIERS 11-12-13-14-15                  | 43. RETAINING WALLS - SUMMER STREET           |
| 17. SLAB REINFORCING                      | 44. RETAINING WALLS - RAMP "B"                |
| 18. SLAB & HANDRAIL DETAILS               | 45. RETAINING WALLS - RAMP "C" & TOLL PLAZA   |
| 19. EXPANSION JOINTS AND BENDING DIAGRAMS | 46. DETAILS - GARAGE RAMP & STAIRS            |
| 20. FRAMING PLAN - SPANS 1-4              | 47. DRAINAGE DETAILS                          |
| 21. STEEL DETAILS - SPANS 1-4             | 48. TOLL ISLANDS & CANOPY                     |
| 22. STEEL DETAILS - SPANS 1-4             | 49. UTILITY BUILDING                          |
| 23. FRAMING PLAN - SPANS 5-11             | 50. TOLL BOOTH DETAILS                        |
| 24. STEEL DETAILS - SPANS 5-11            | 51. HEATING DETAILS & GUARD FENCE             |
| 25. FRAMING PLAN - SPANS 12-16            | 52. STANDARD DETAILS                          |
| 26. STEEL DETAILS - SPANS 12-16           | 53-59. CROSS SECTIONS                         |
| 27. SHOES                                 |   |

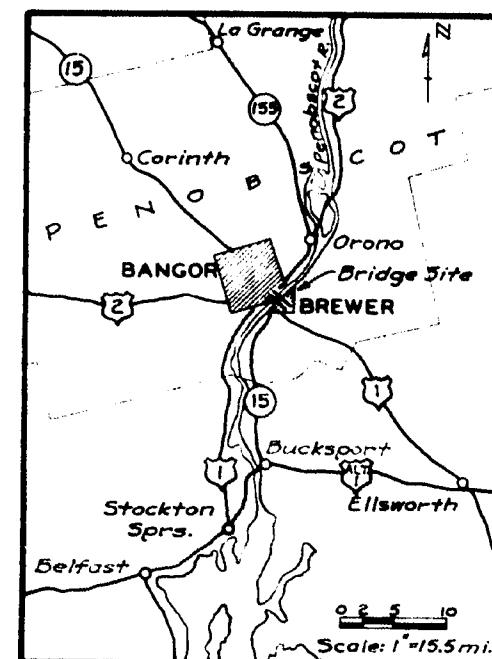

LOCATION MAP




HARRINGTON AND CORTELYOU  
CONSULTING ENGINEERS  
KANSAS CITY, MO.

APPROVED:  
MAINE STATE HIGHWAY COMMISSION

*Charles B. Water*  
CHAIRMAN

*Harley W. Wicks*

*Harold R. Emery*  
CHIEF ENGINEER

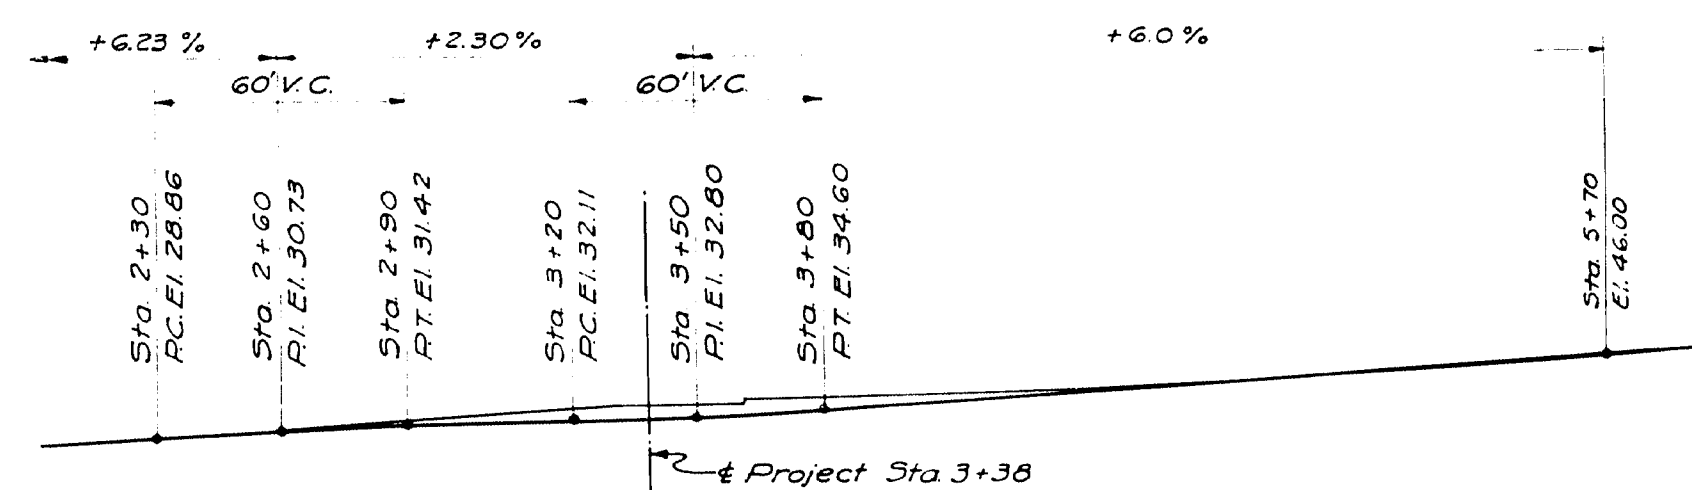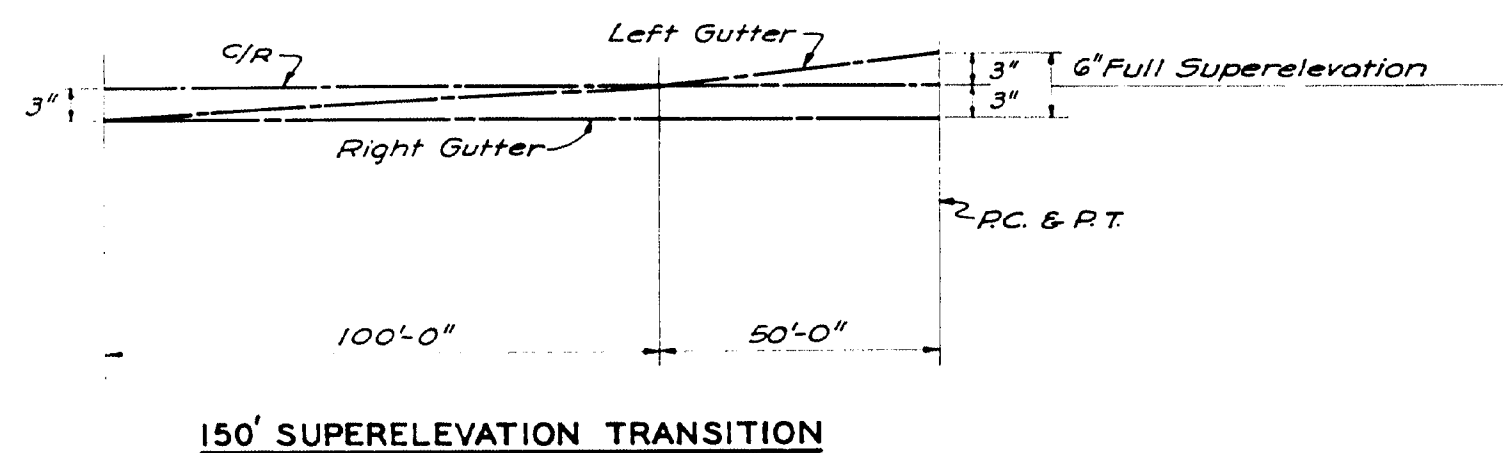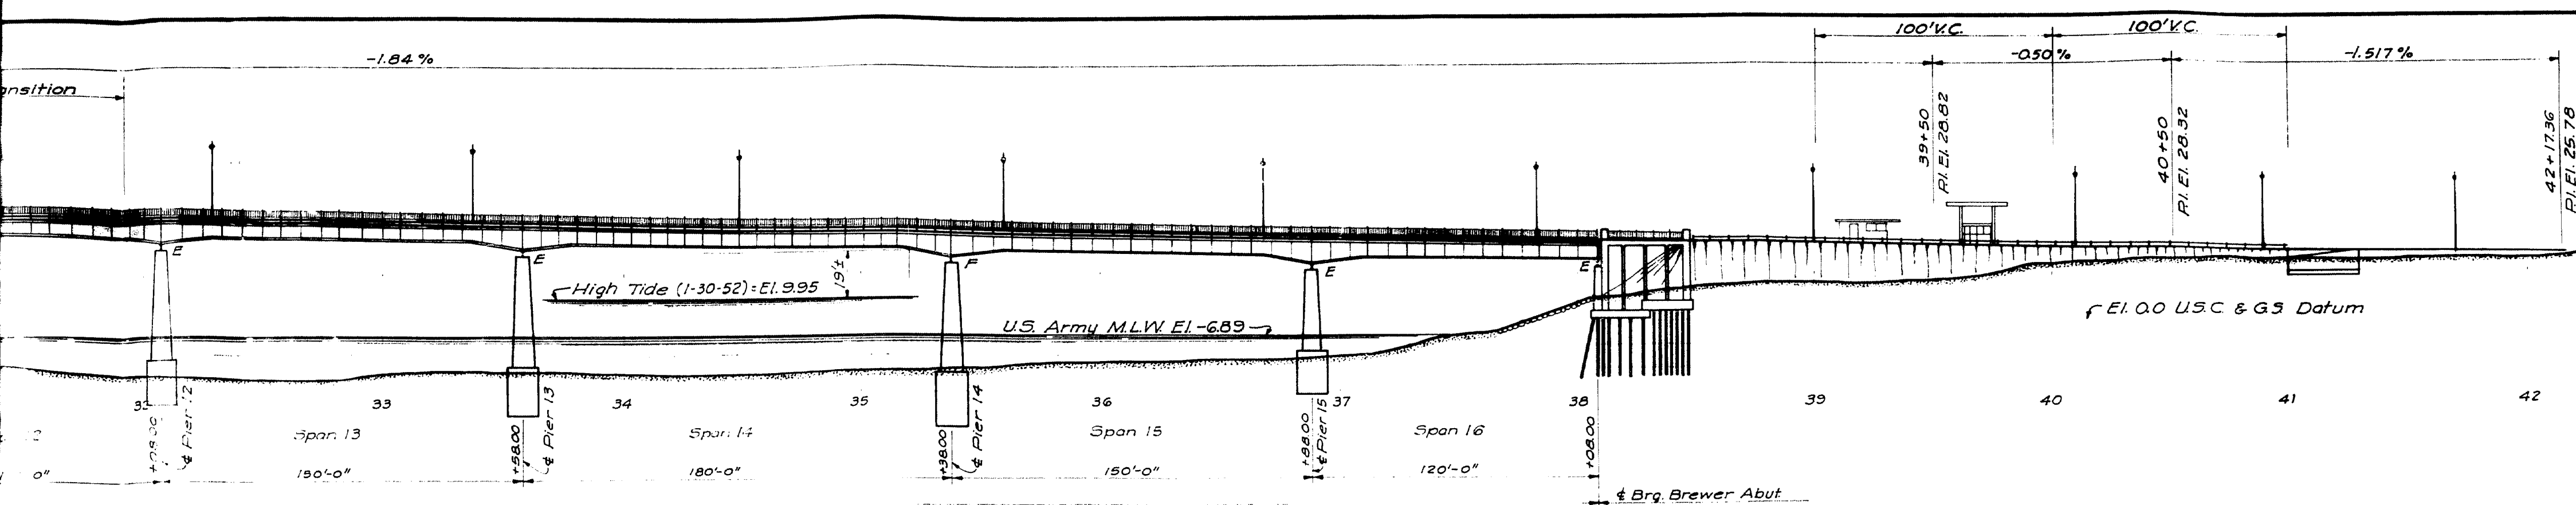


#### GENERAL NOTES (DESIGN)

Specifications: A.A.S.H.O. Standard Specifications for Highway Bridges 1949

Loading: H 20-516-44  
 Allowable Unit Stresses: ( $n = 10$ )  
 $f_s$  (Structural) = 18,000 p.s.i.  
 $f_s$  (Reinforcing) = 18,000 p.s.i.  
 $f_c$  = 1,000 p.s.i.



Datum: Elevations shown refer to U.S.C. & G.S. "Mean Sea Level" datum.

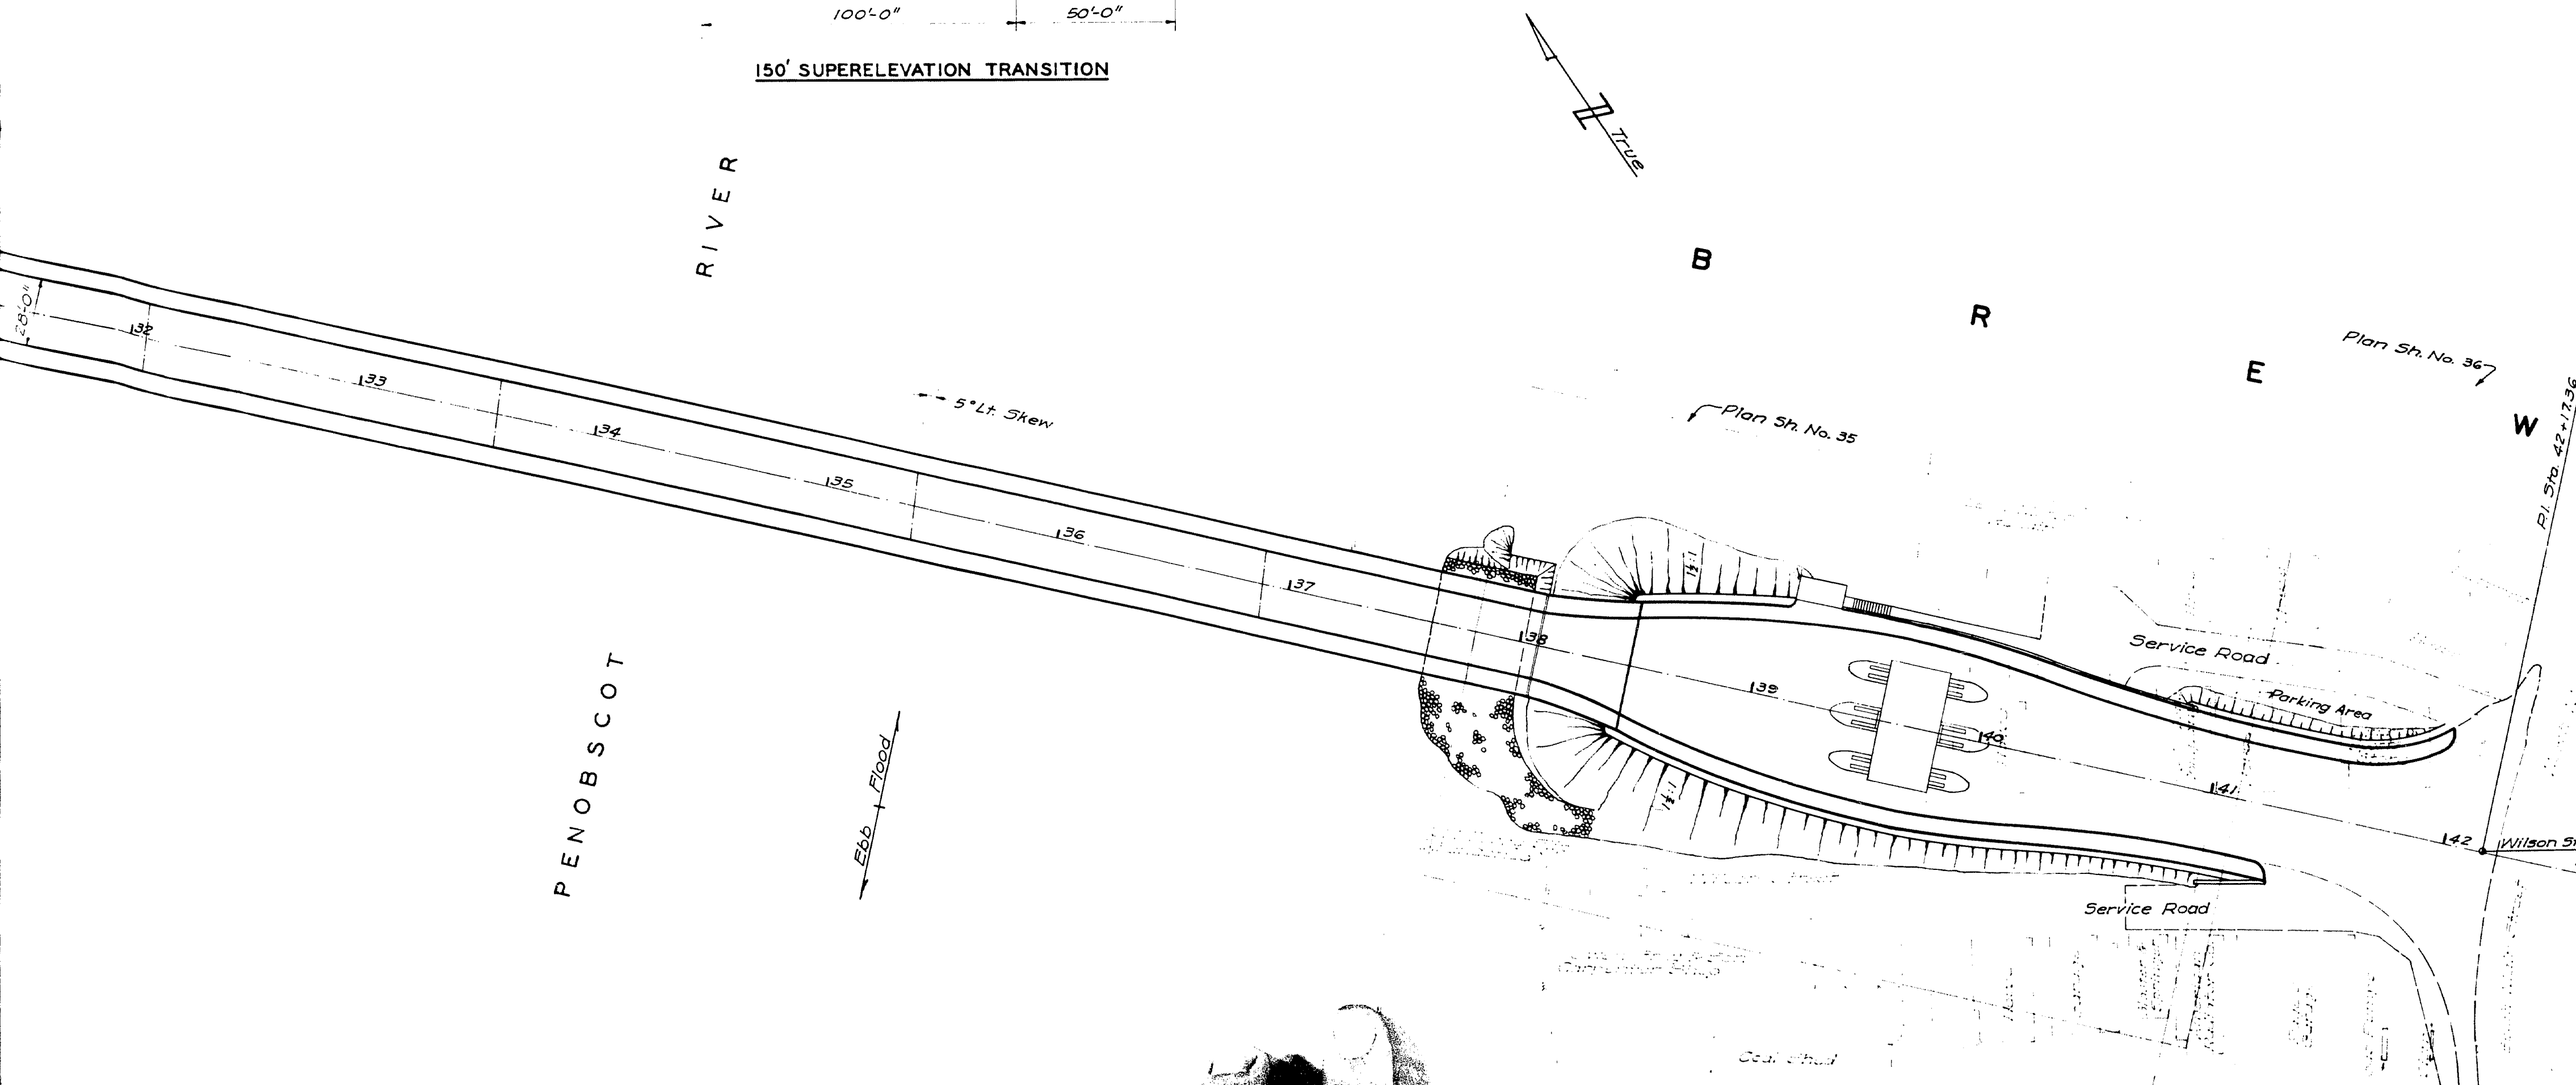

STATE OF MAINE  
 STATE HIGHWAY COMMISSION  
**BANGOR-BREWER BRIDGE  
 OVER PENOBSCOT RIVER  
 BANGOR, MAINE**  
 GENERAL PLAN & ELEVATION  
 HARRINGTON AND CORTELYOU  
 CONSULTING ENGINEERS  
 KANSAS CITY, MO.  
 DETAILED GEG 3-28-52 10-3-52 SCALE: 1"= 40'-0"  
 TRACED E.R.J. 11-13-52  
 CHECKED E.M.N. 1-18-53 **SHEET NO. 2**



2 3 4 5 INCHES




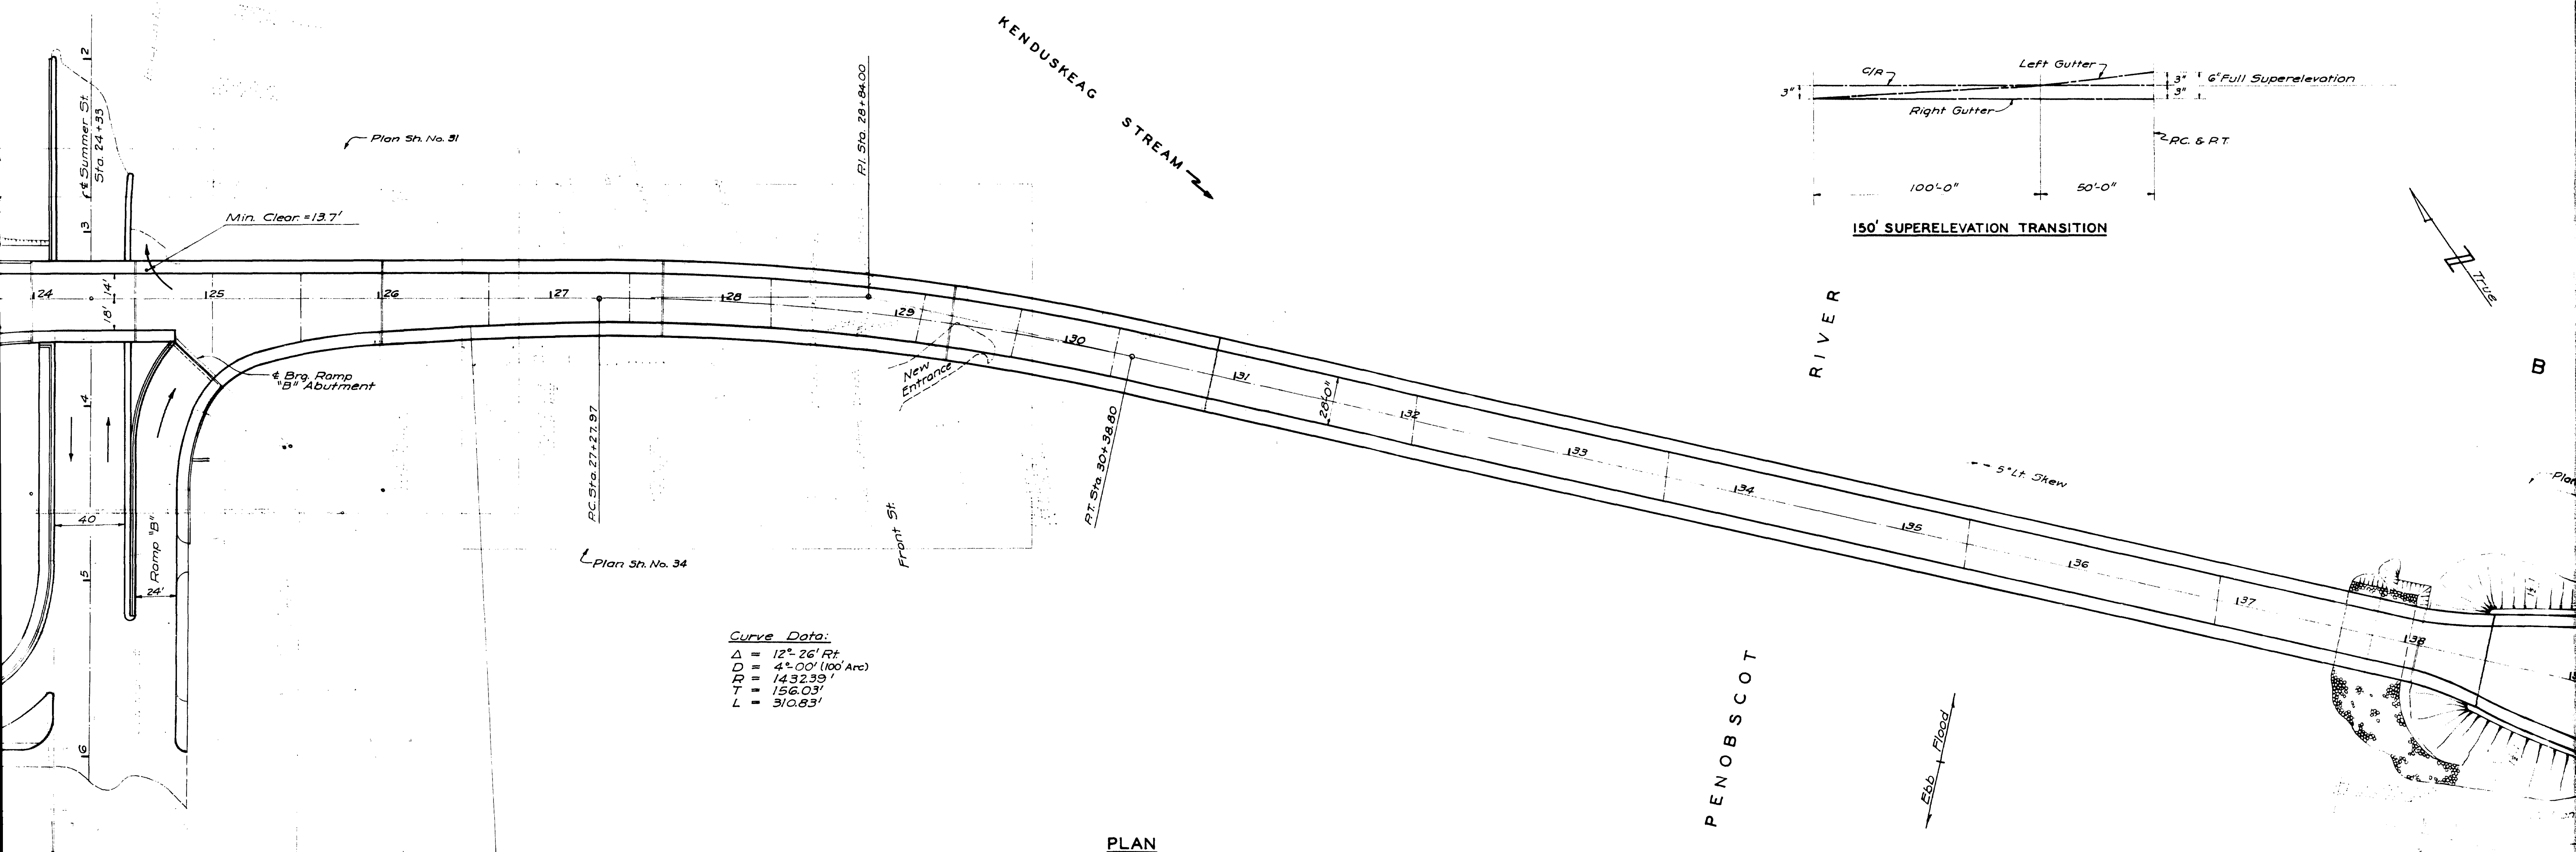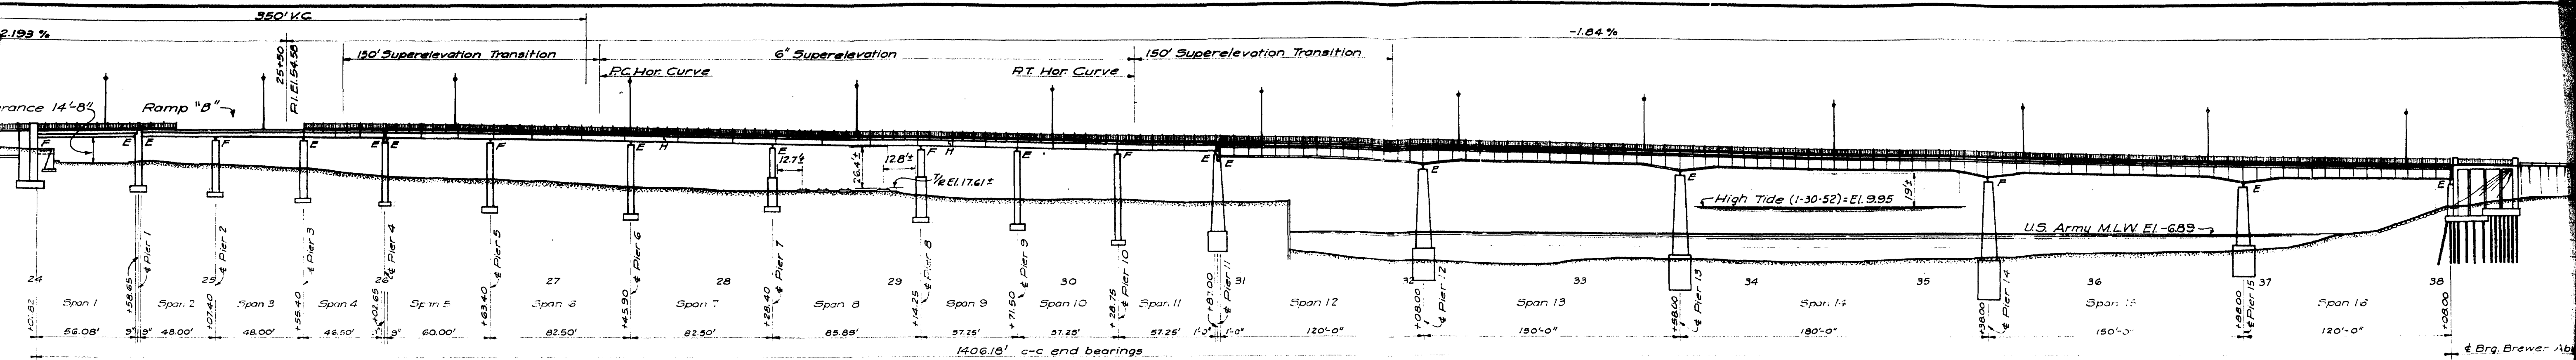


Curve Data:  
 $\Delta = 12^\circ 26' \text{ Rt.}$   
 $D = 4^\circ 00' (100' \text{ Arc})$   
 $R = 1432.33'$   
 $T = 156.03'$   
 $L = 310.83'$

0 1 2 3 4 5 INCHES

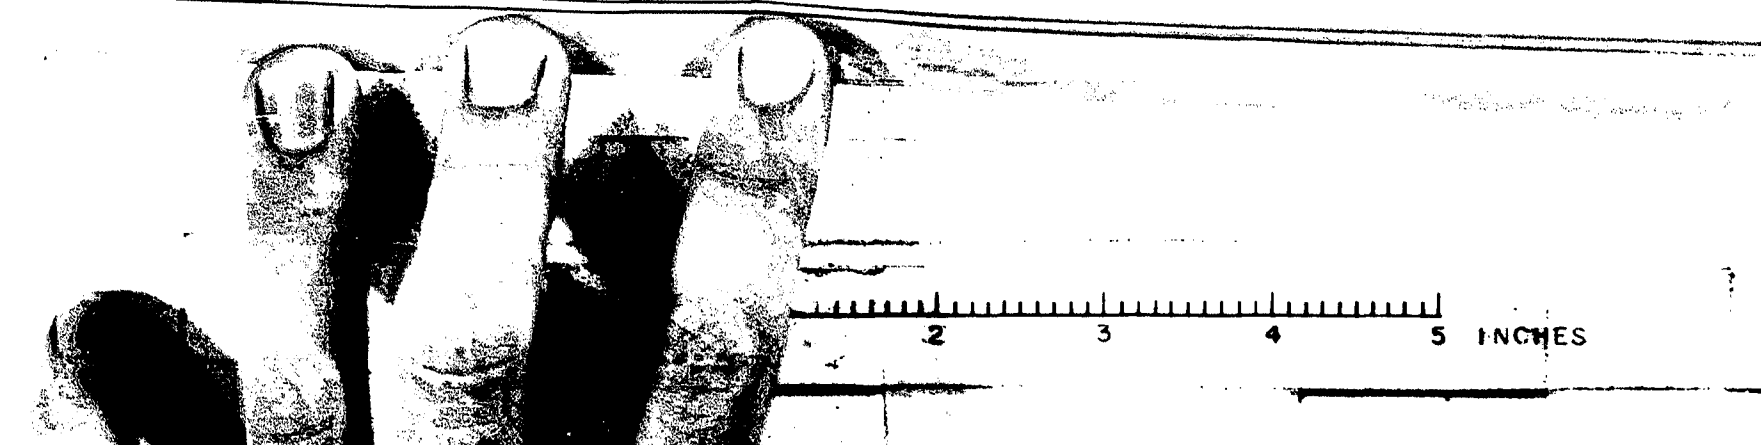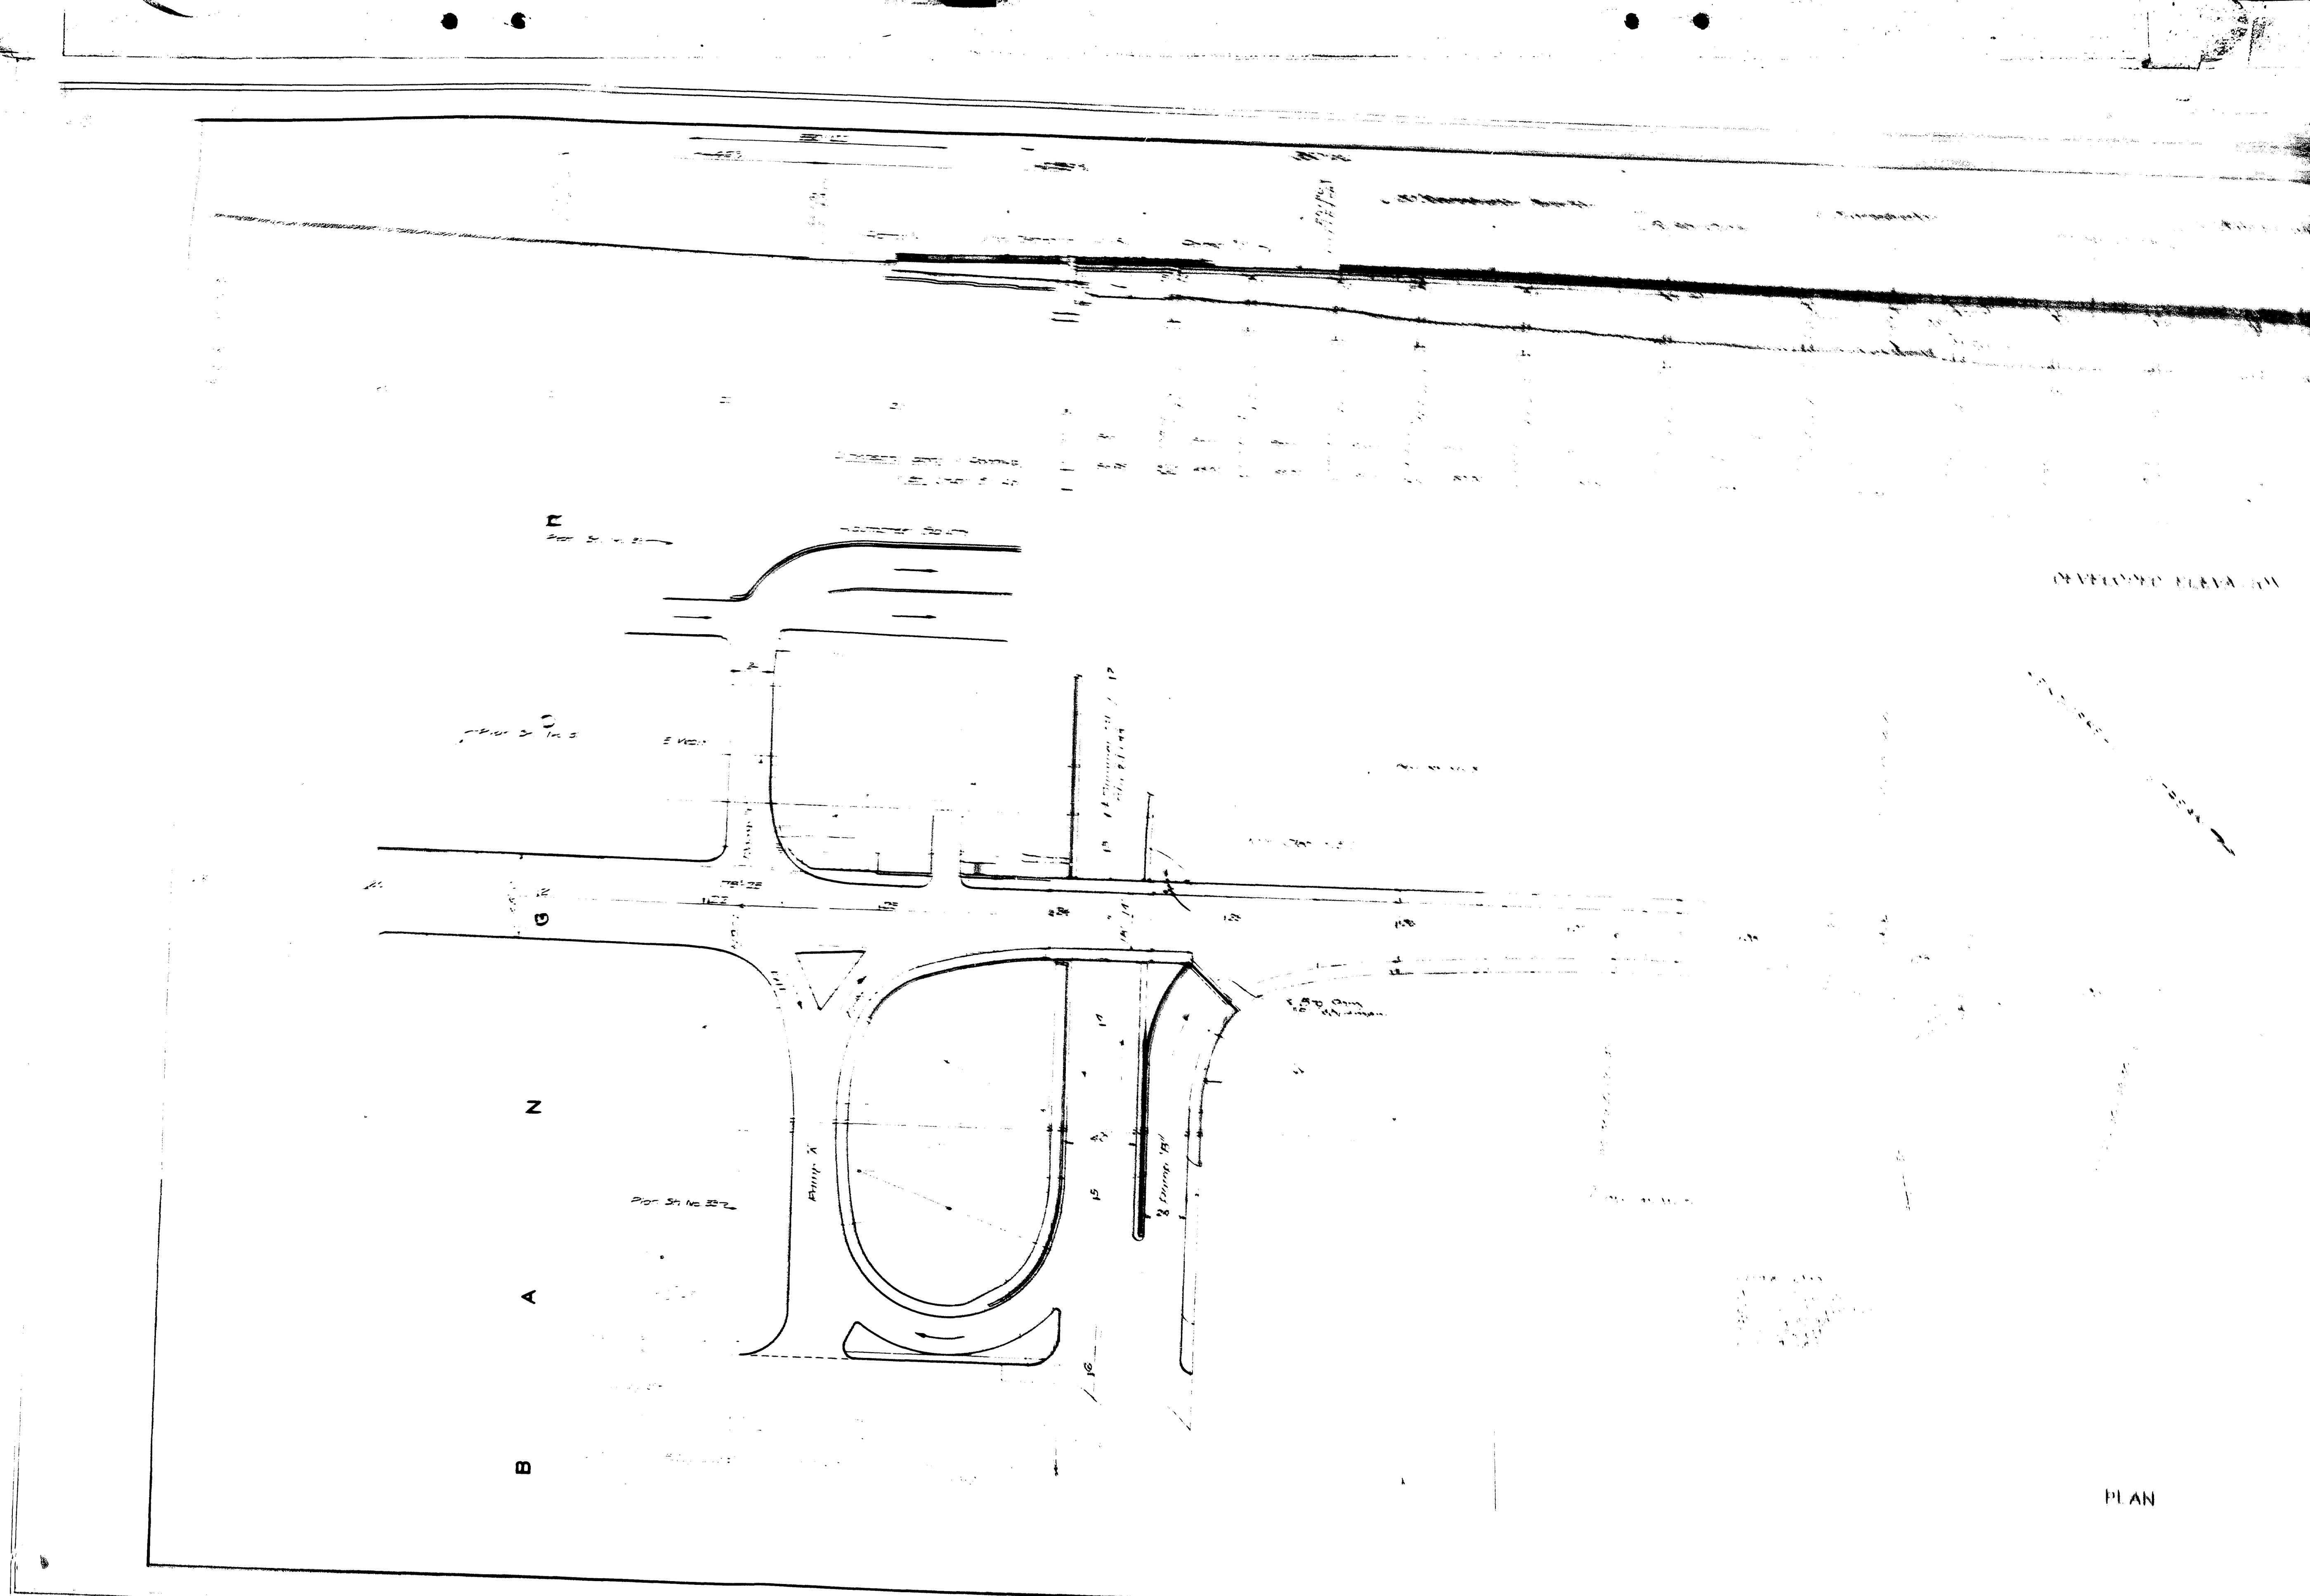

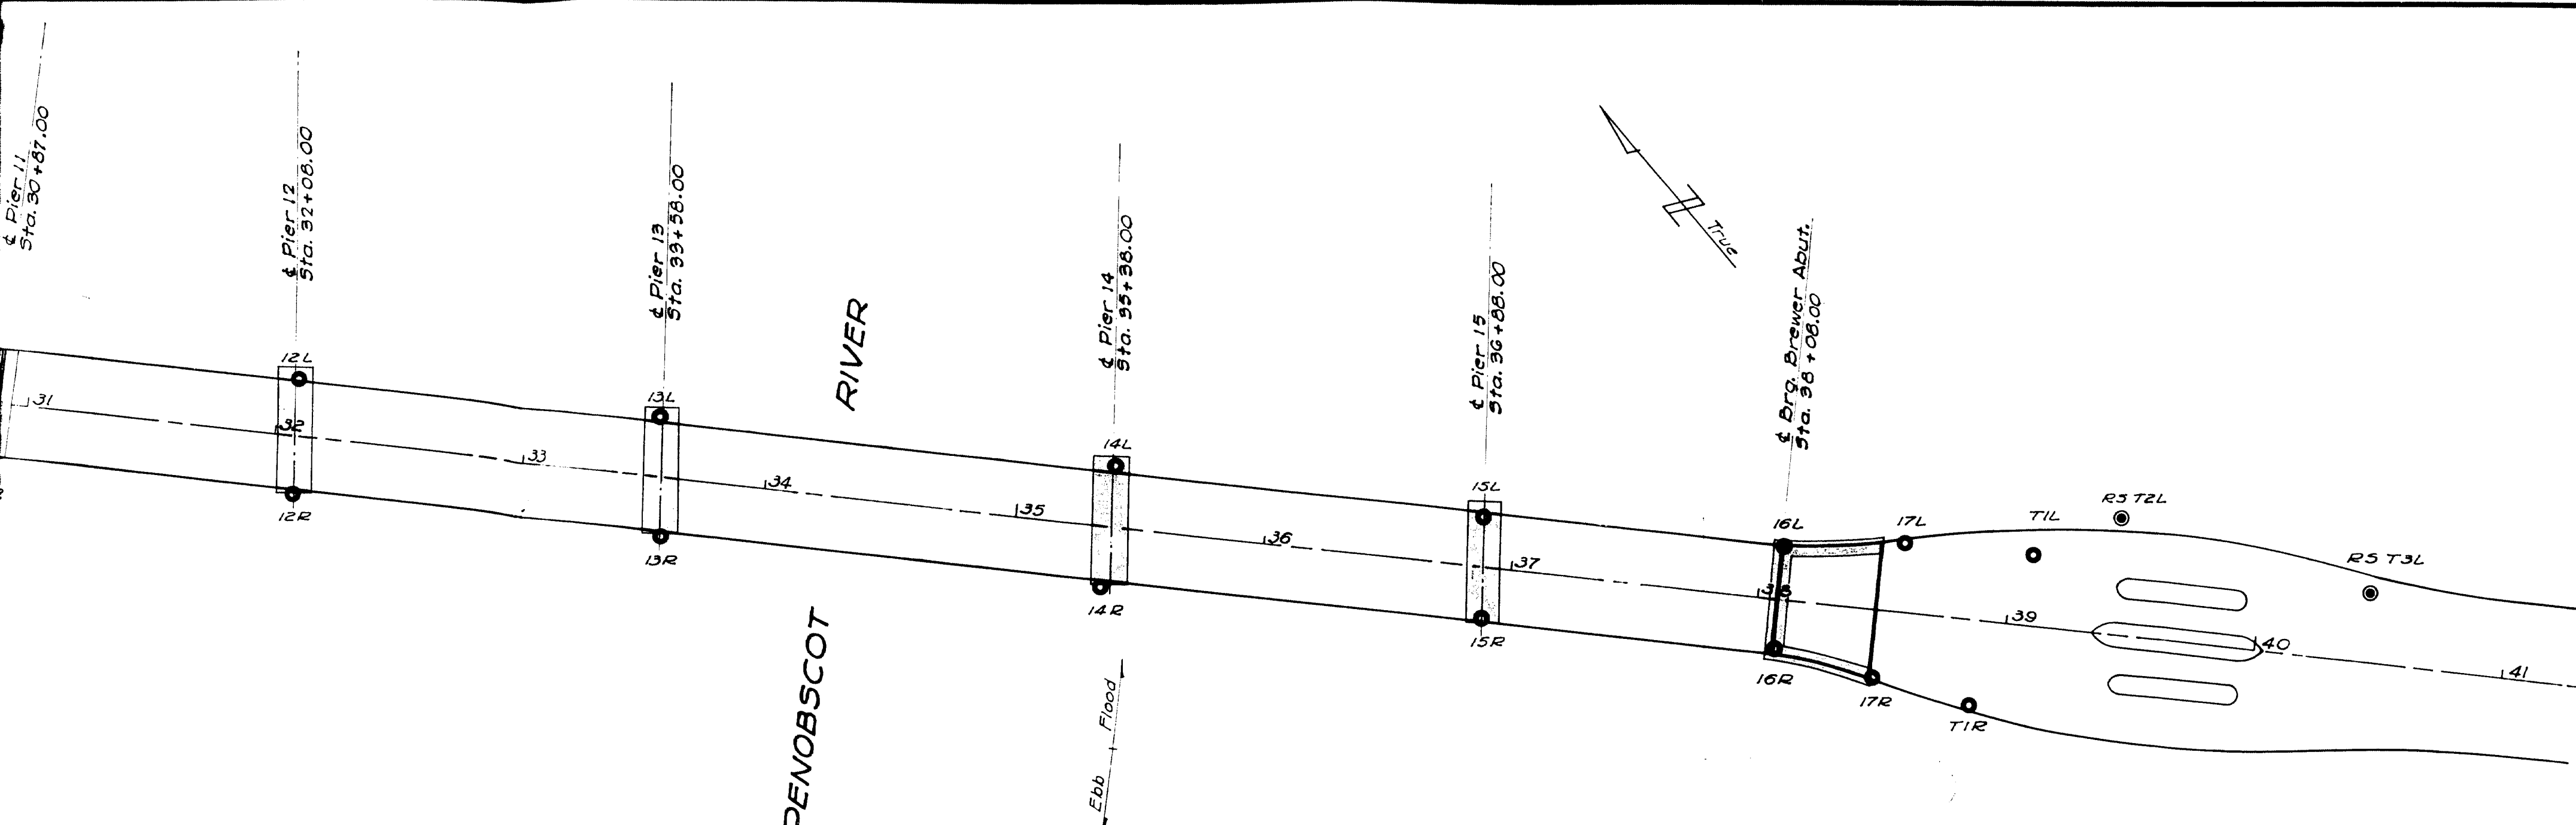

PLAN  
Scale: 1" = 40'

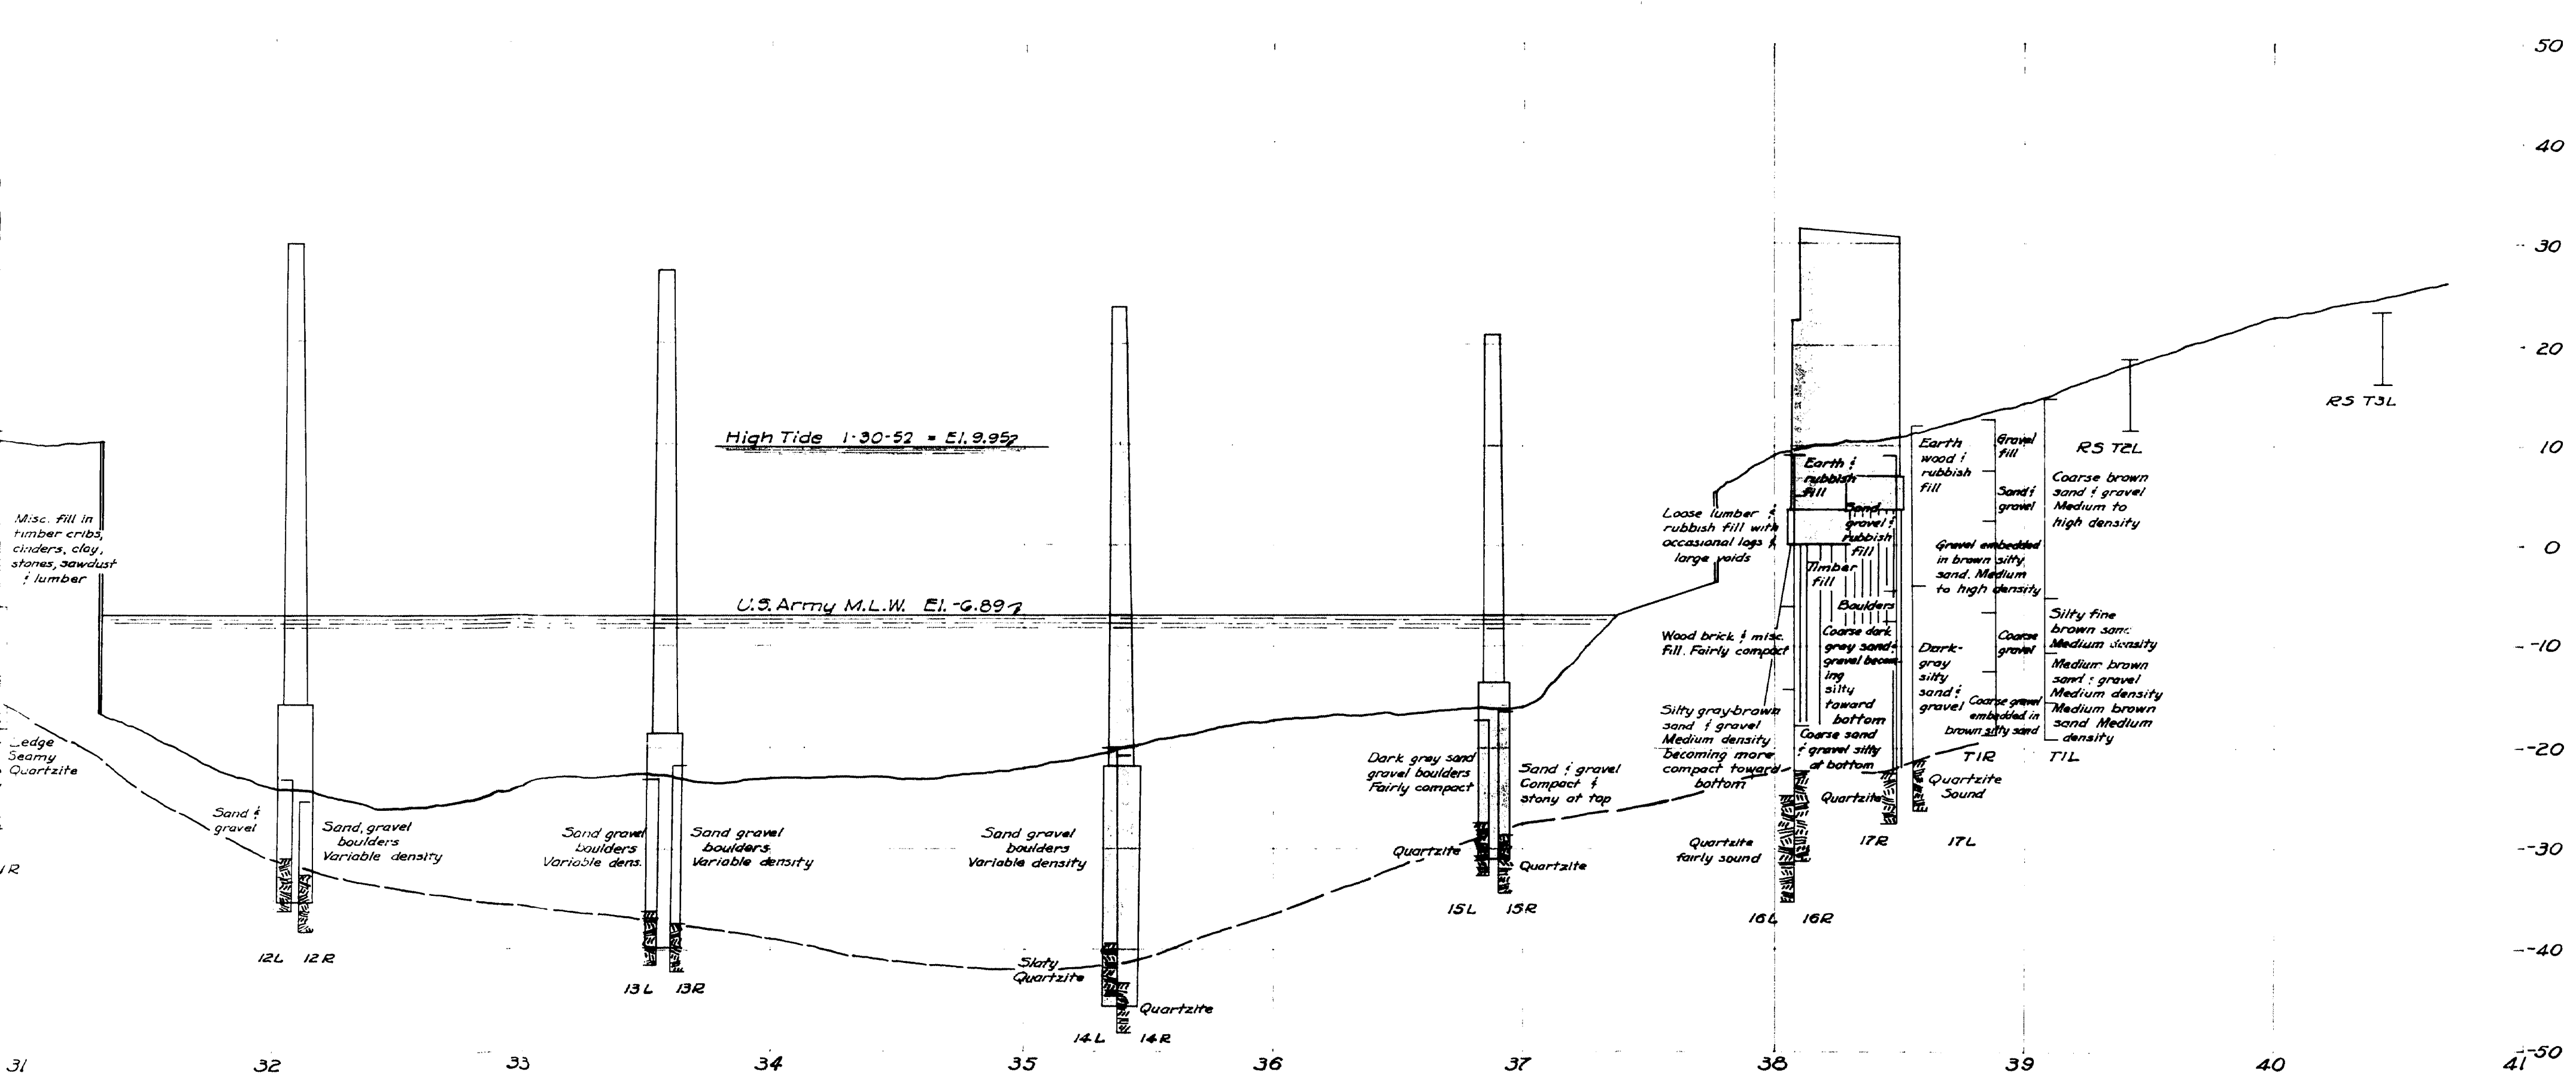

NOTE:  
The soil stratification illustrated on this drawing has been developed by interpretation of, and interpolation between, the various soil borings. It is, therefore, speculative, and no warranty is implied with respect to the continuity of soil layers, or to the elevations of the soil boundaries except of the actual boring locations. Depths and thicknesses of the latter are subject to the inaccuracies inherent in the drilling methods. Factual data obtained in making the borings appears on Sheets entitled "Boring Logs". The descriptions of the various soil layers are based upon the driller's field classification and upon the engineer's inspection of samples and interpretation of the driller's record.

PROFILE  
Scale:  
H 1" = 40'  
V 1" = 10'


STATE OF MAINE  
STATE HIGHWAY COMMISSION  
**BANGOR-BREWER BRIDGE  
OVER PENOBSCOT RIVER  
BANGOR MAINE**


FOUNDATION DATA

HARRINGTON AND CORTEYOU  
CONSULTING ENGINEERS  
KANSAS CITY, MO.


DETAILED G.H.K. 10-31-52  
TRACED E.R.J. 11-5-52  
CHECKED G.E.G. 1-15-53

SCALE: AS SHOWN  
SHEET NO. 3

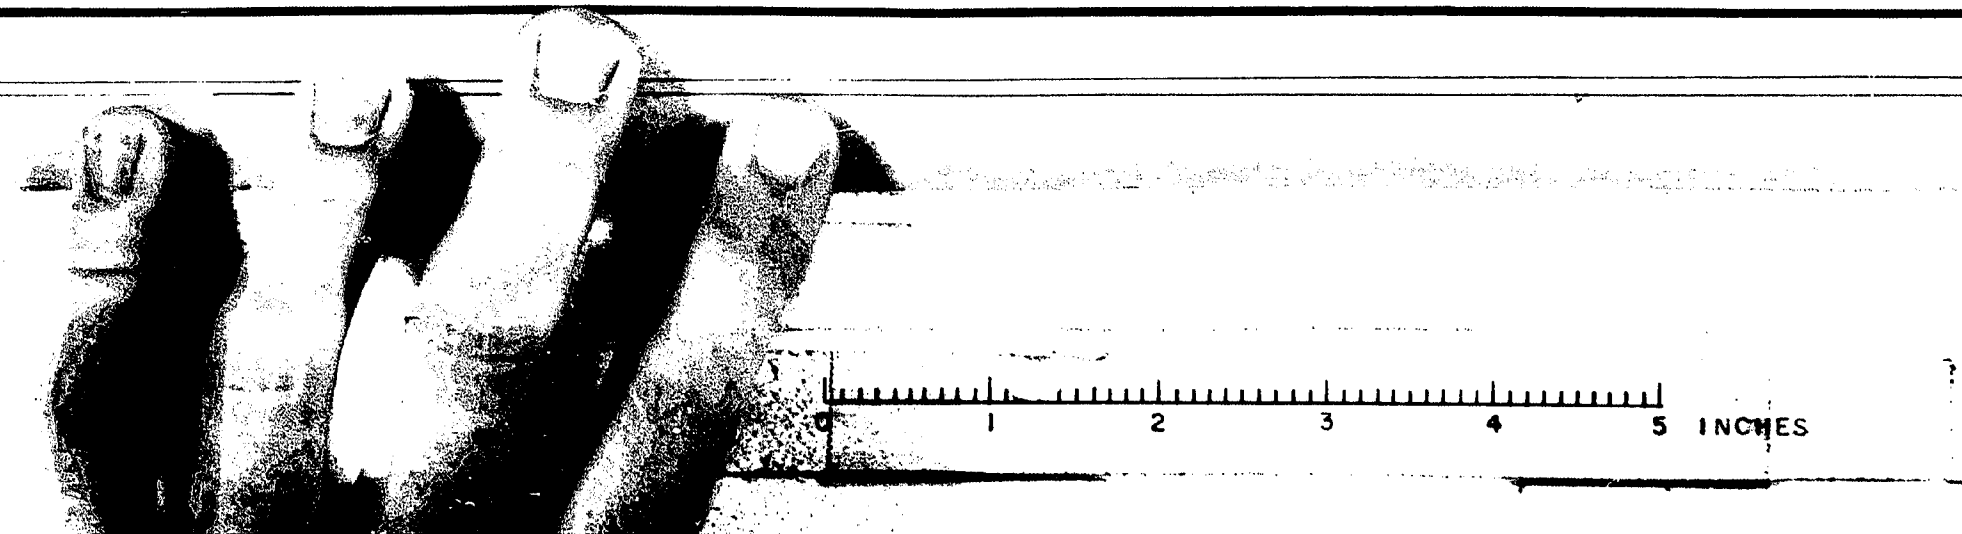

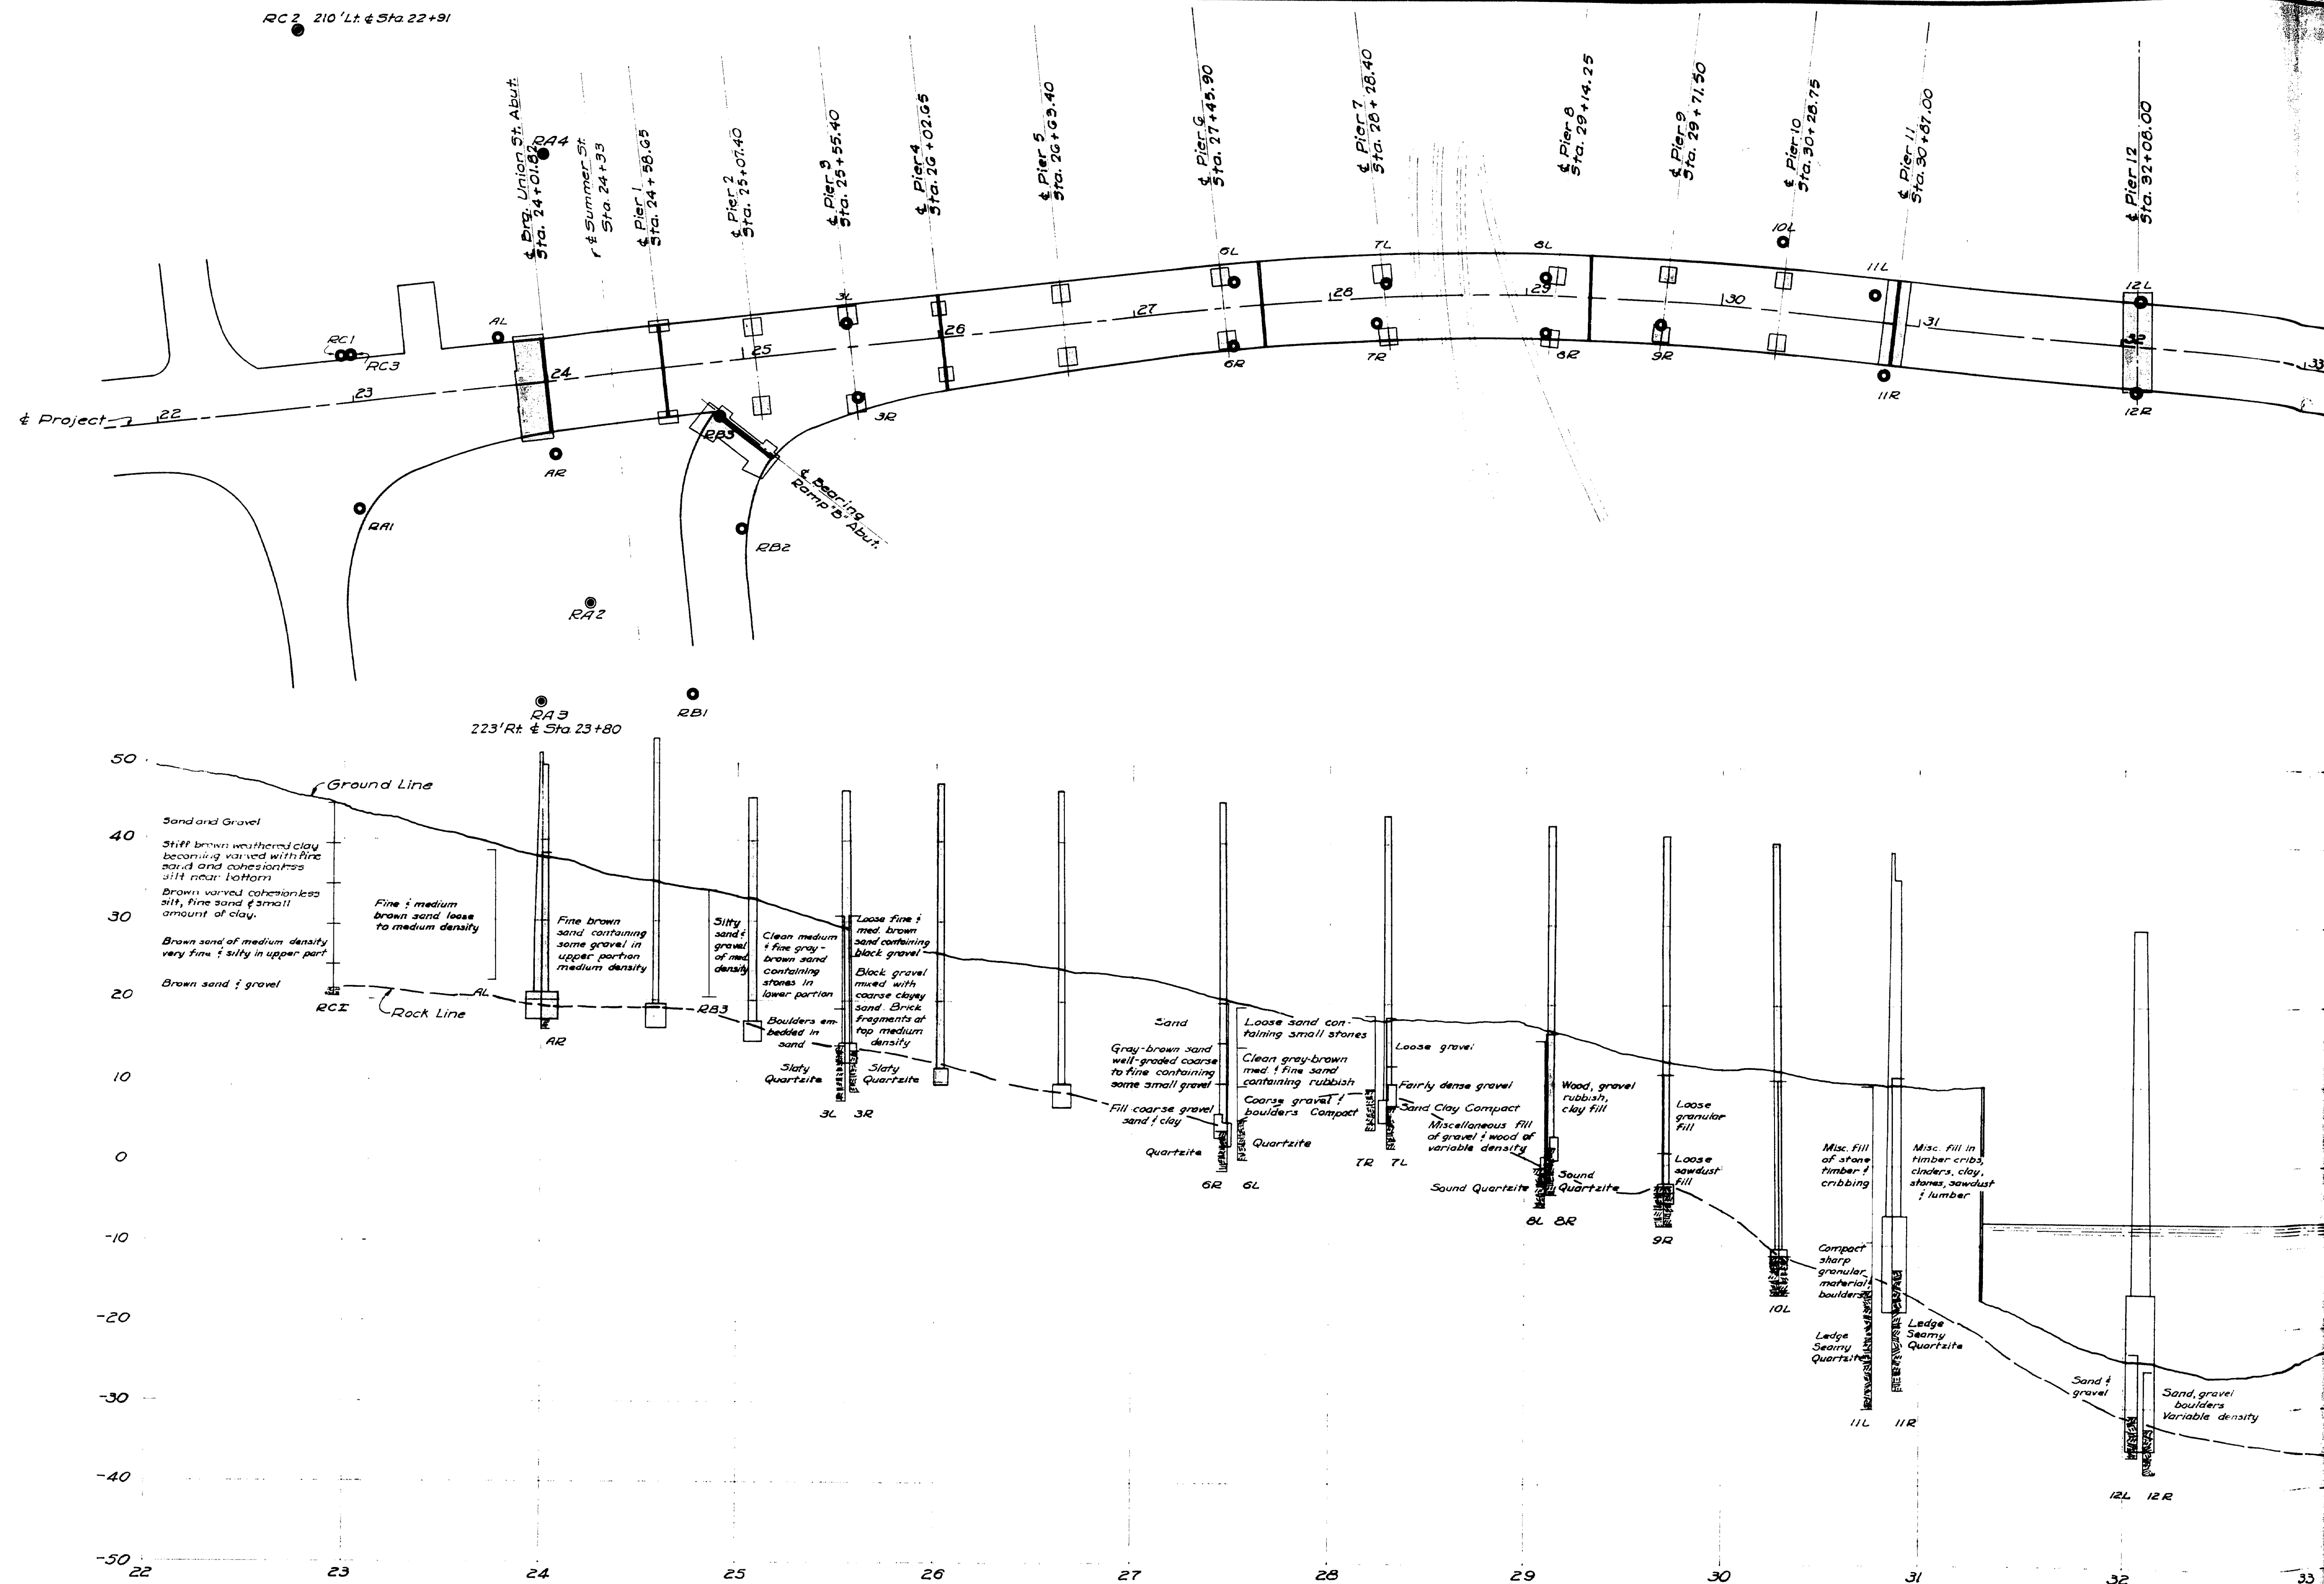




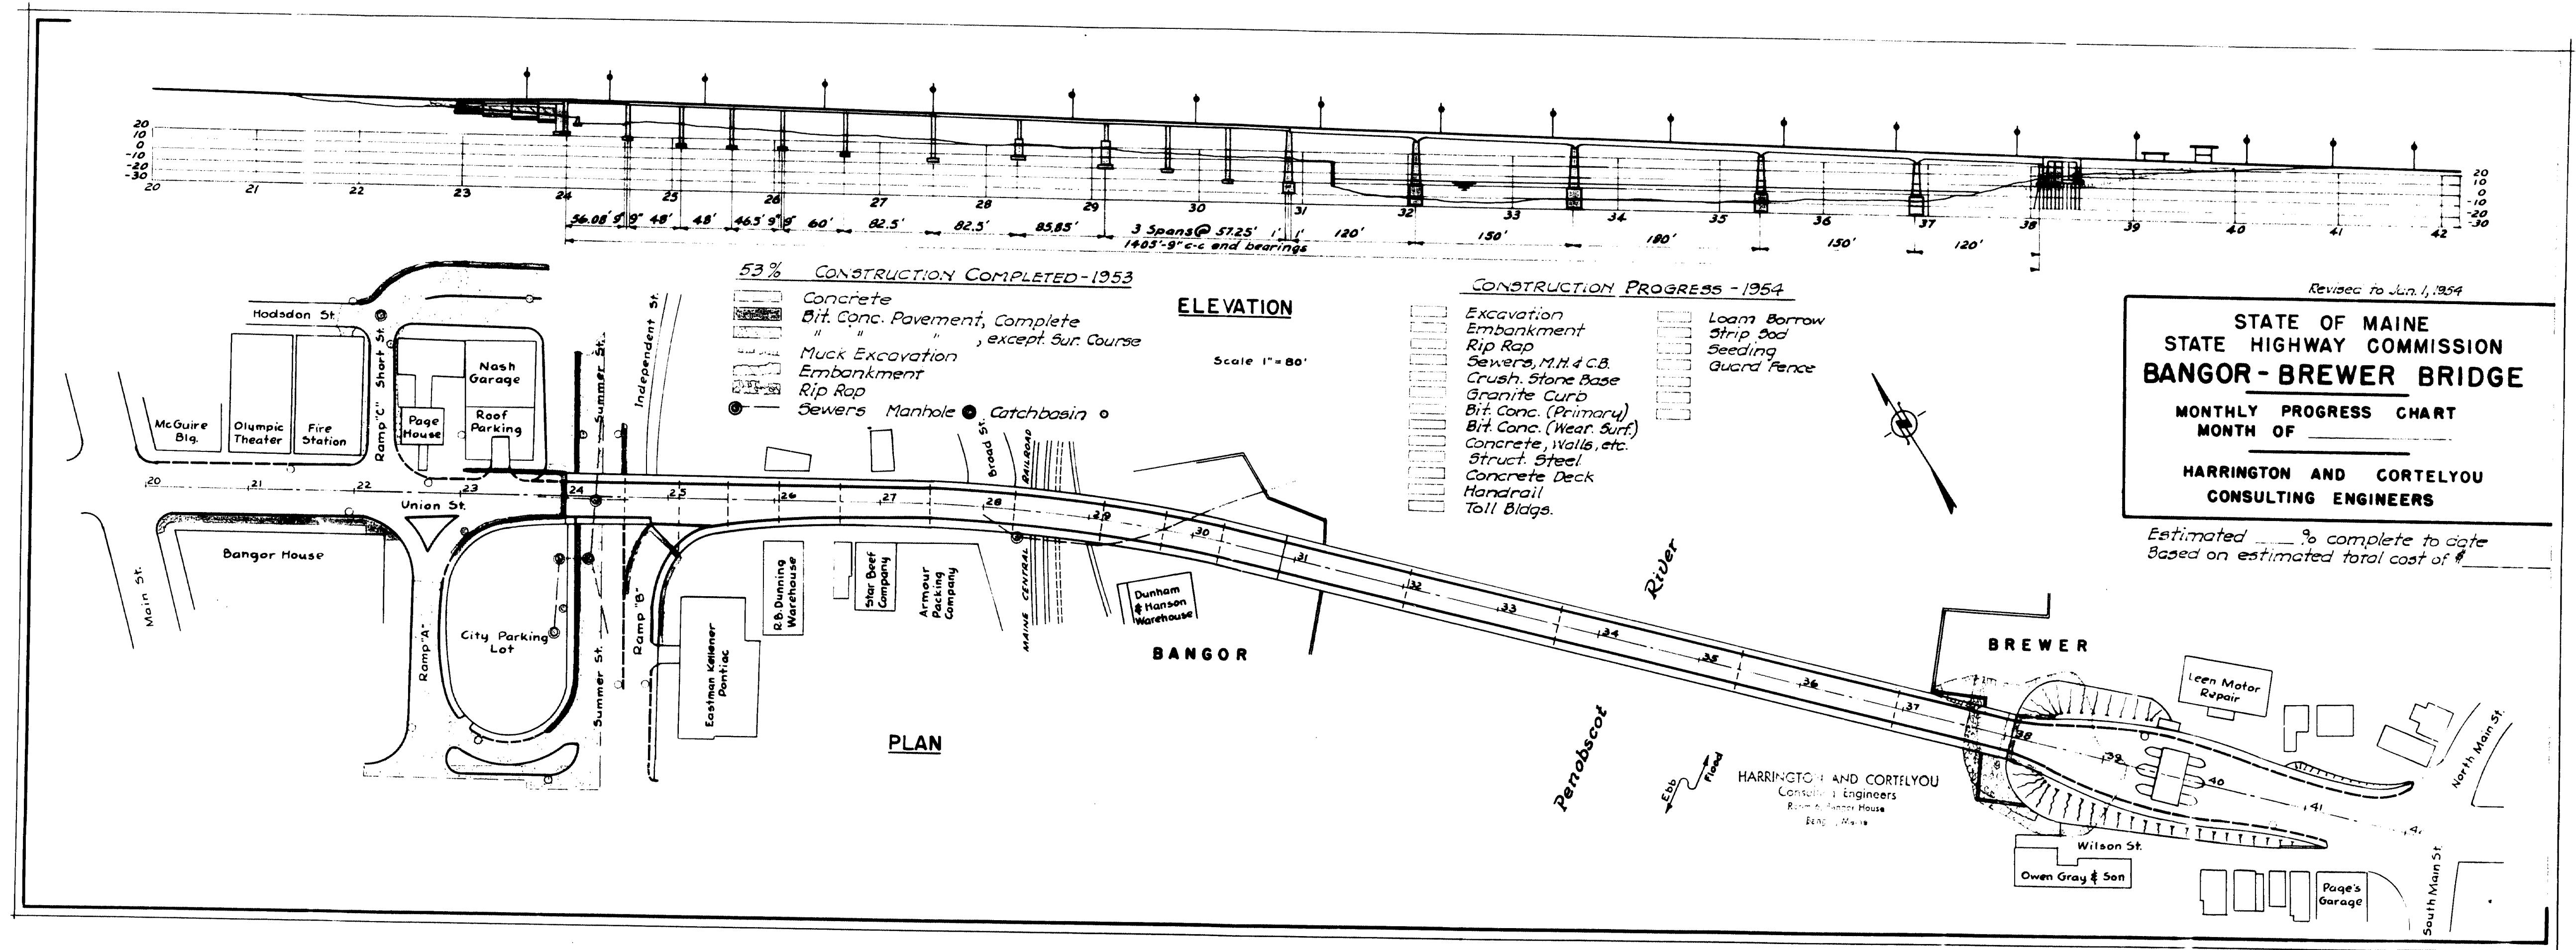


0 1 2 3 4 5 INCHES


BORING #RC1  
24' Lt. & Sta. 22+96

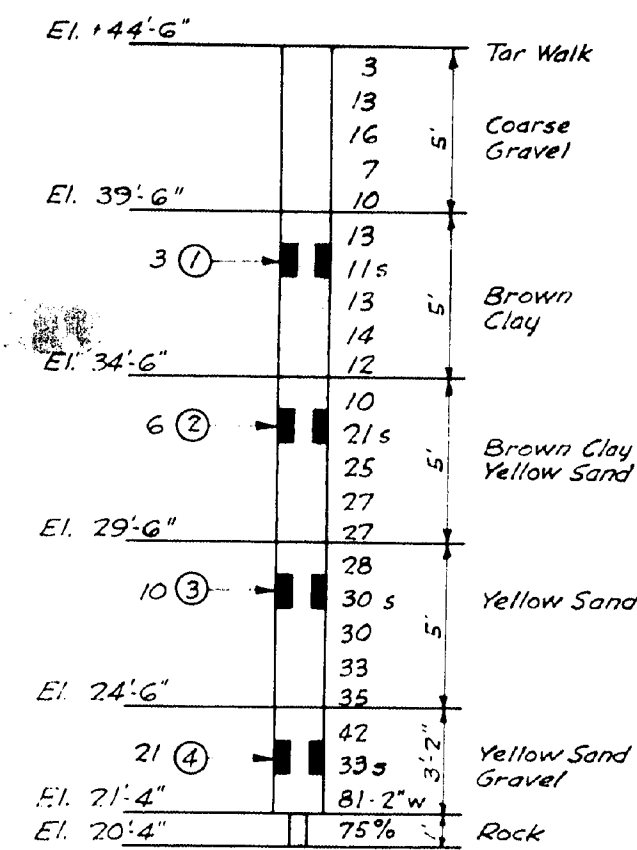


ROD SOUNDING #RC2  
210' Lt. & Sta. 22+91

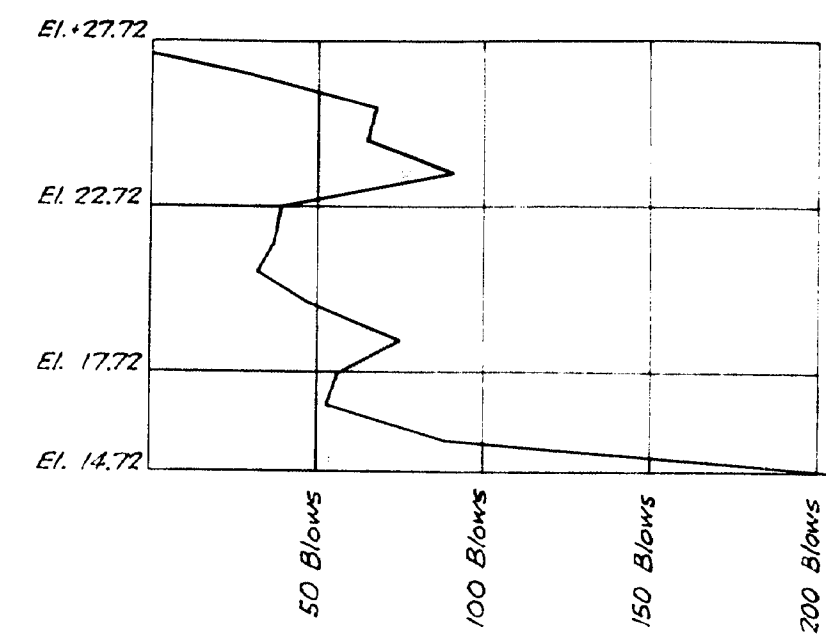


BORING #RC3  
24' Lt. & Sta. 23+01

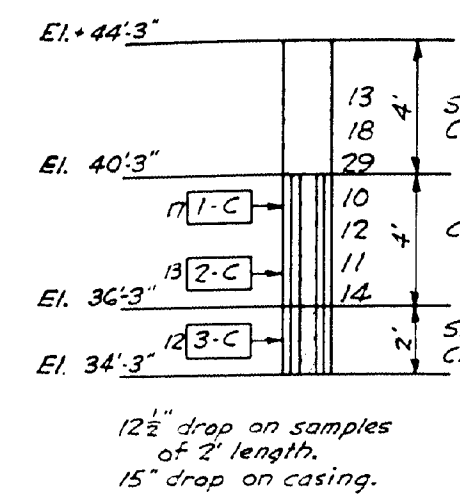


BORING #RA1  
53' Rt. & Sta. 22+98

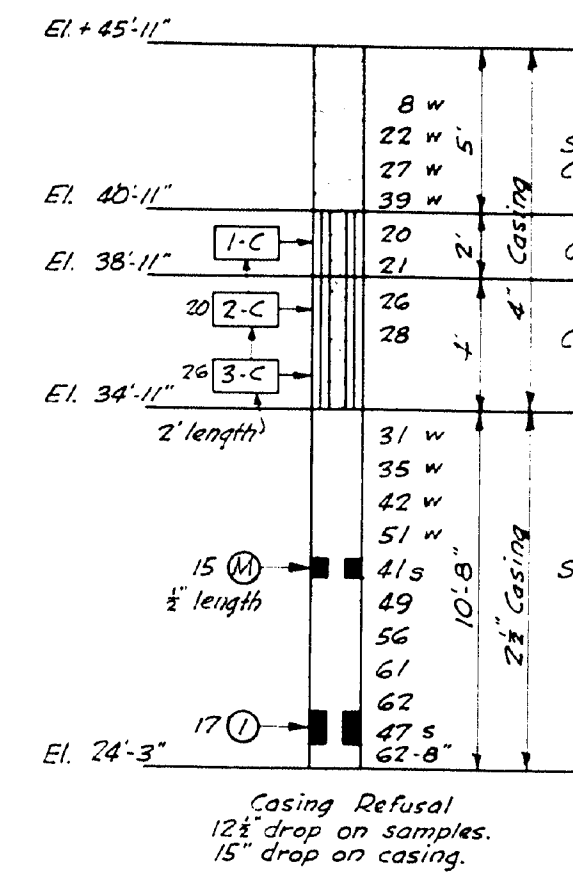


ROD SOUNDING #RA2  
115' Rt. Sta. 24+10

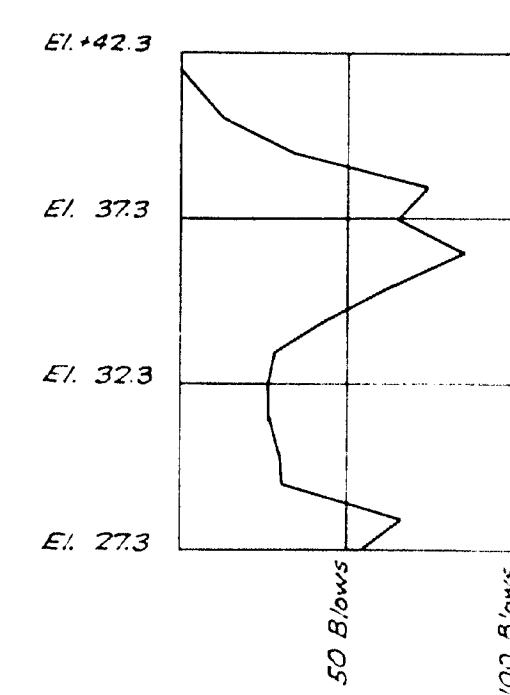


ROD SOUNDING #RA3  
223' Rt. & Sta. 23+80

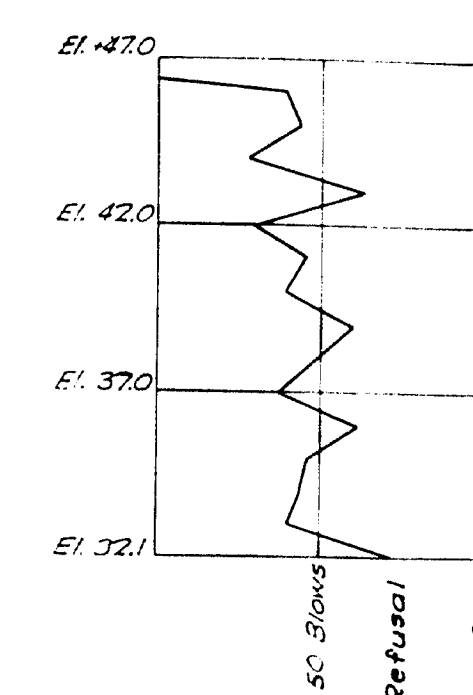


ROD SOUNDING #RA4  
115' Lt. & Sta. 24+10

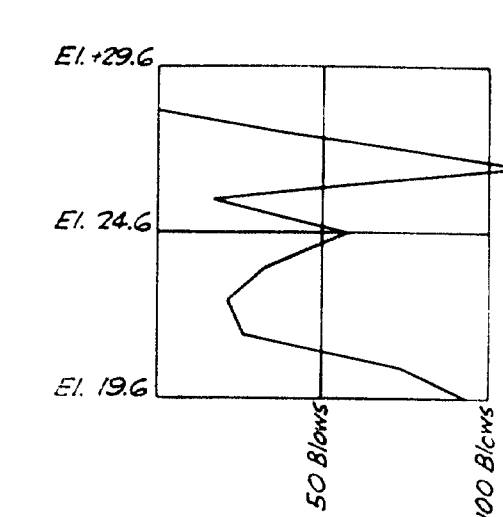


BORING #AR  
365' Rt. & Sta. 24+00

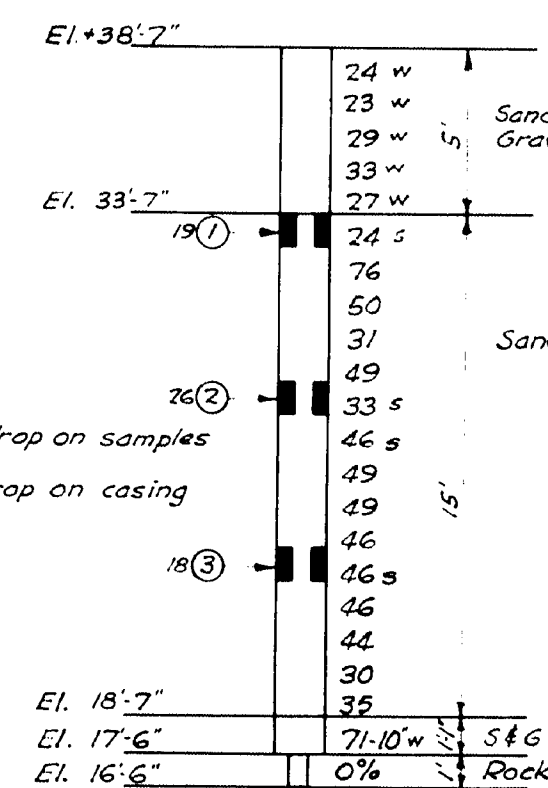


BORING #AL  
23' Lt. & Sta. 23+77

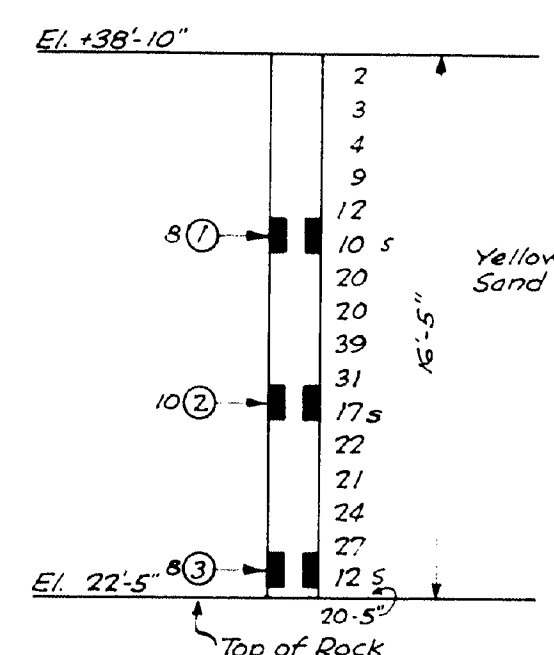


BORING #RB1  
165' Rt. & Sta. 24+56

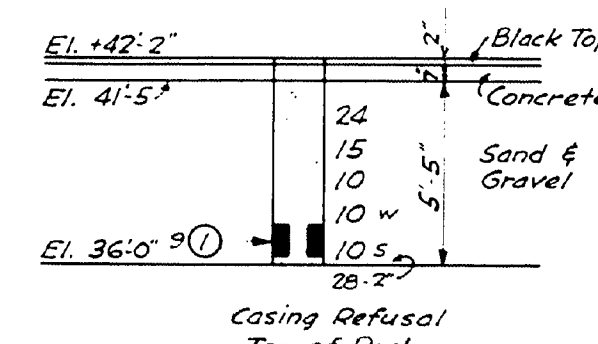


BORING #RB2  
85' Rt. & Sta. 24+90

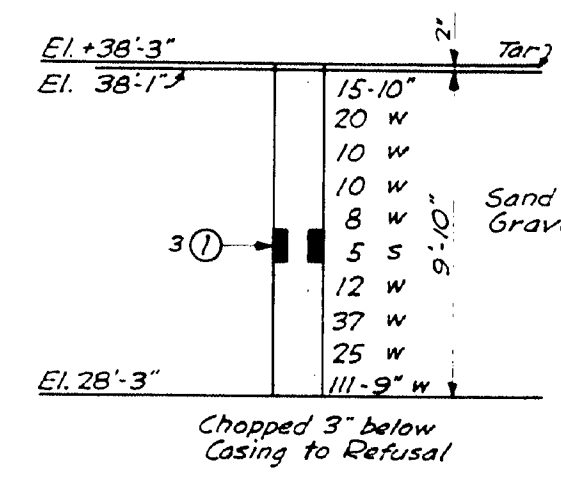


BORING #RB3  
27' Rt. & Sta. 24+85

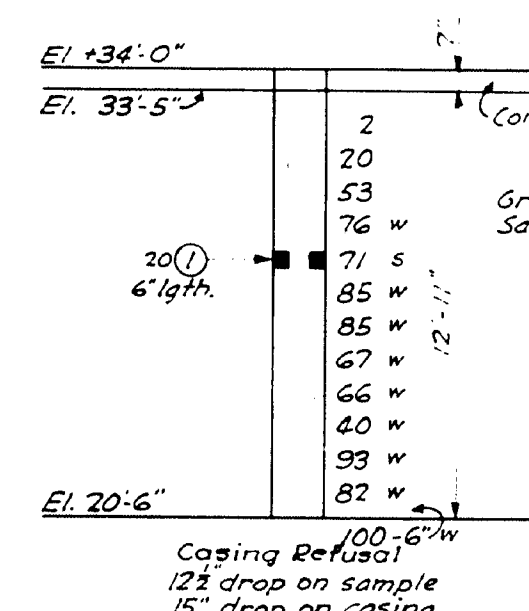


BORING #3L  
12' Lt. & Sta. 25+54

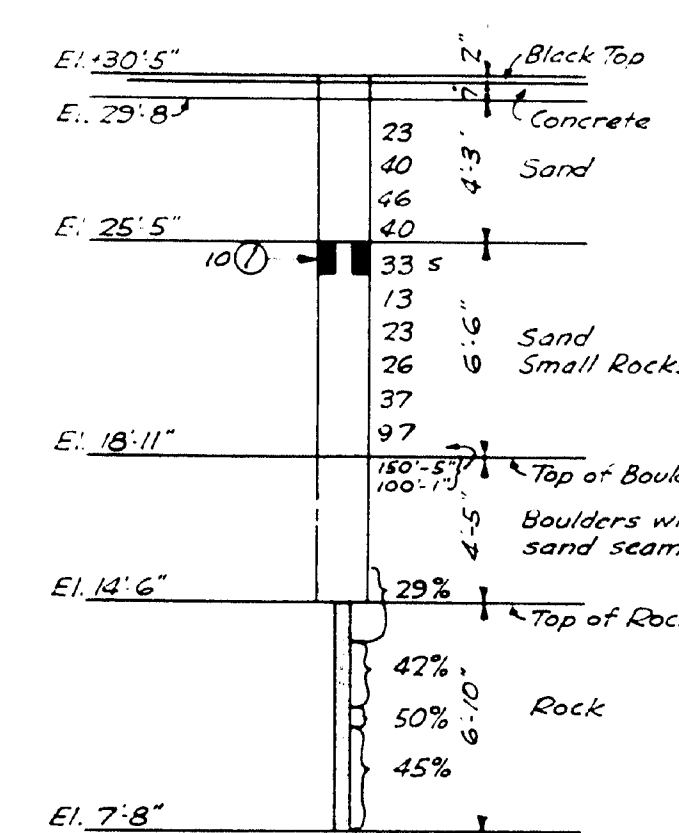


BORING #3R  
255' Rt. & Sta. 25+56

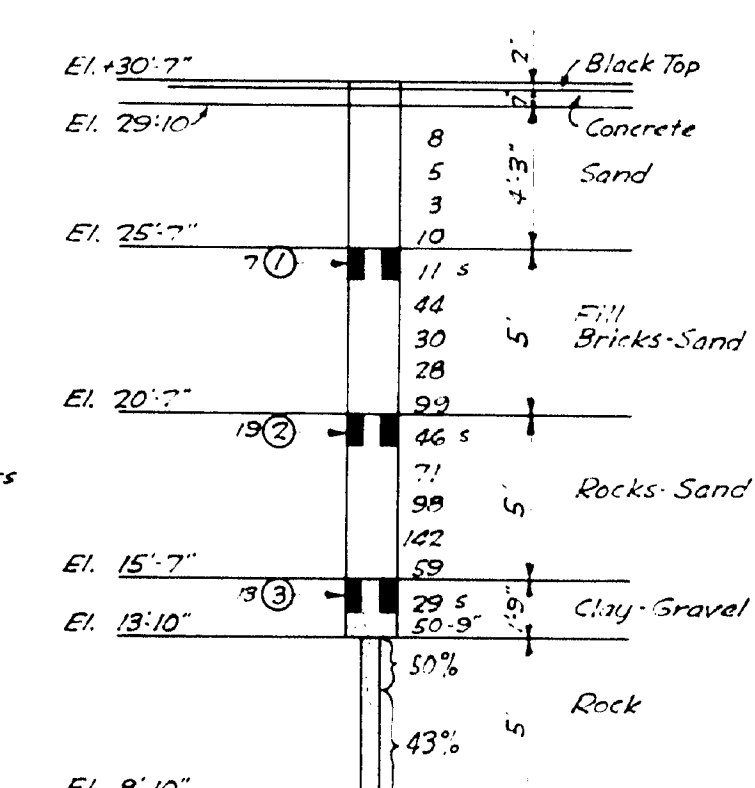


BORING #6L  
13' Lt. & Sta. 27+52.6

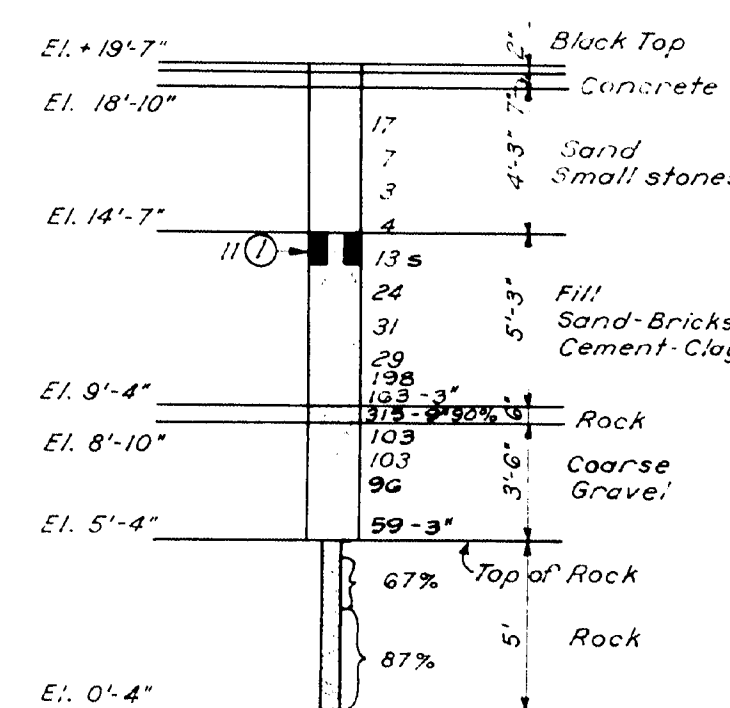


BORING #6R  
19' Rt. & Sta. 27+48.5

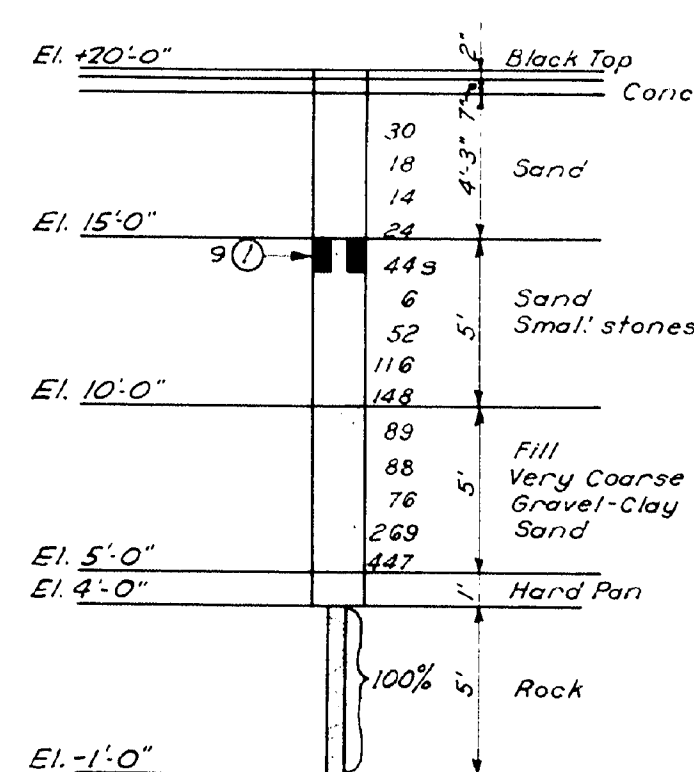


BORING #7L  
7' Lt. Tang. Sta. 28+29

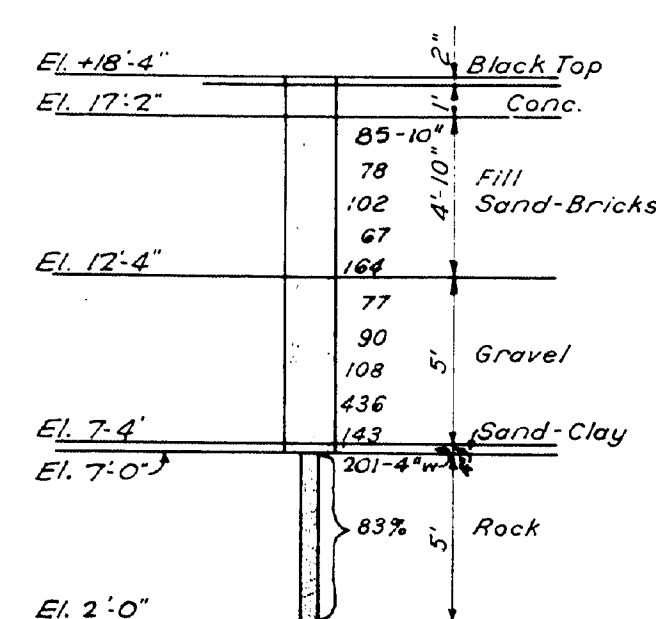


BORING #7R  
13' Rt. Tang. Sta. 28+23

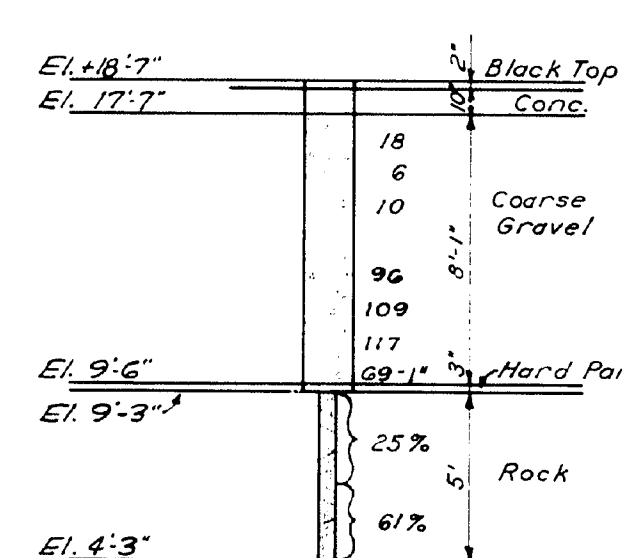


BORING #8L  
9' Lt. Tang. Sta. 29+10

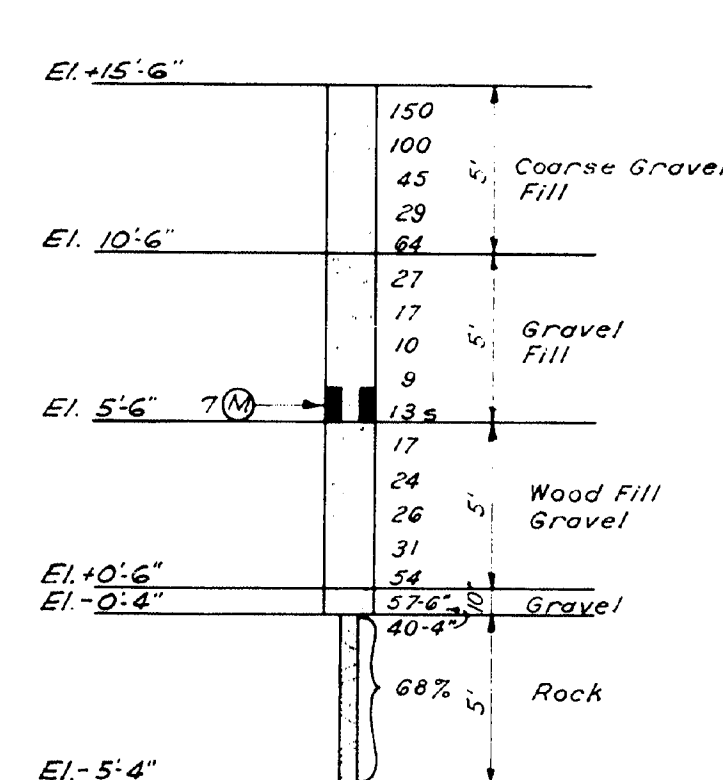


BORING #8R  
19' Rt. Tang. Sta. 29+10.5

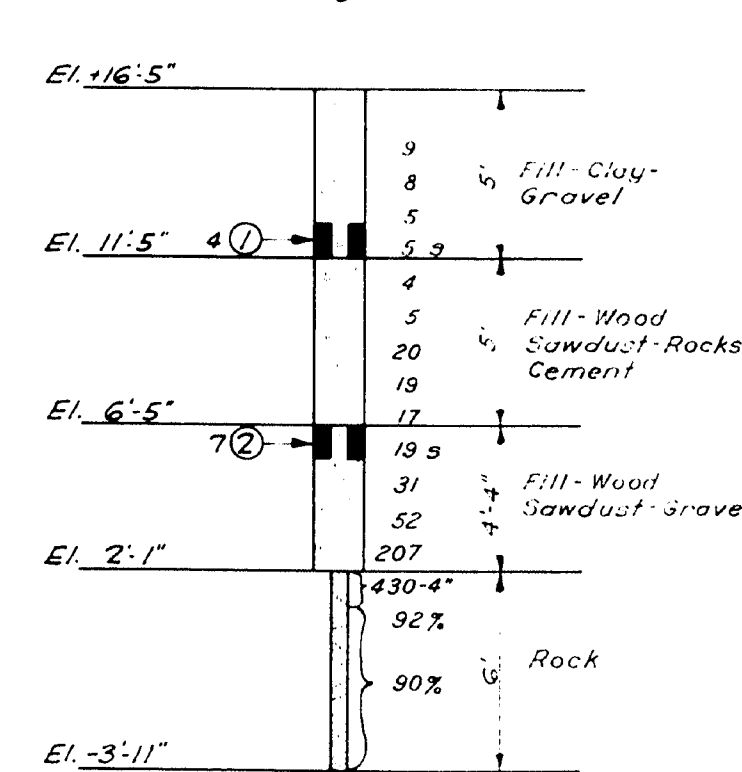


BORING #9R  
11 1/2' Rt. & Sta. 29+70.6

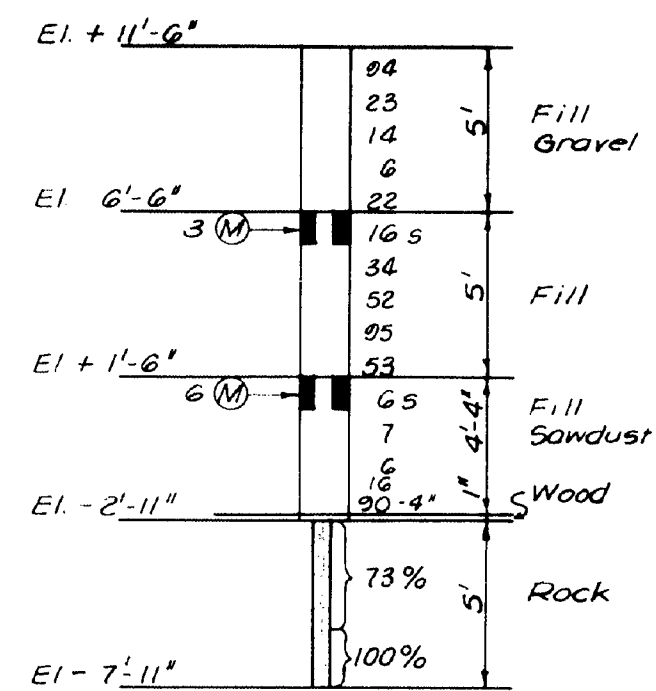


BORING #10L  
35' Lt. & Sta. 30+28

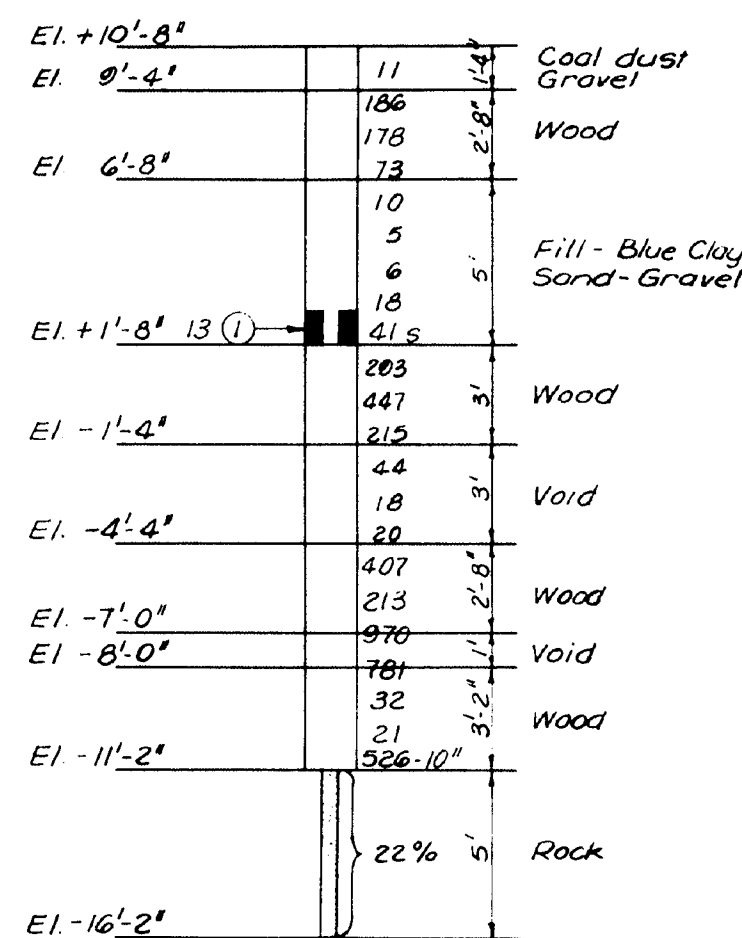


BORING #11L  
13' Lt. & Sta. 30+76

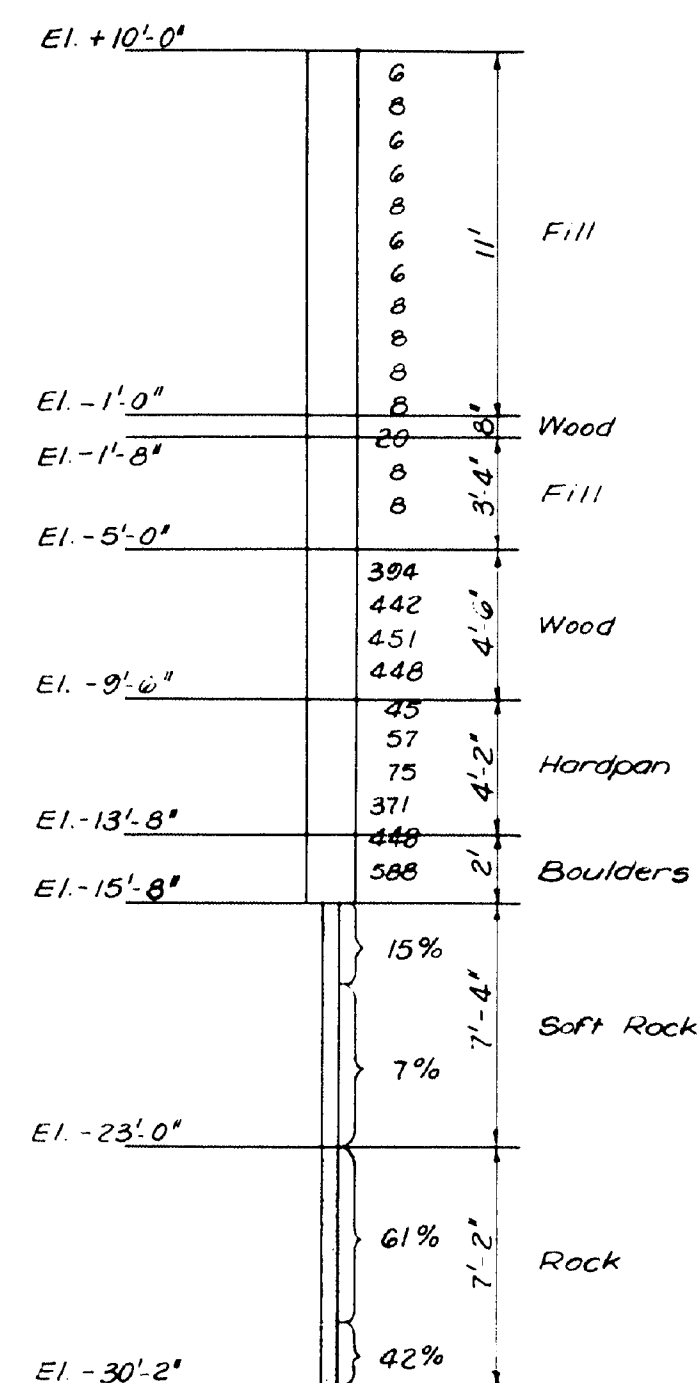


BORING #11R  
26 1/2' Rt. & Sta. 30+86

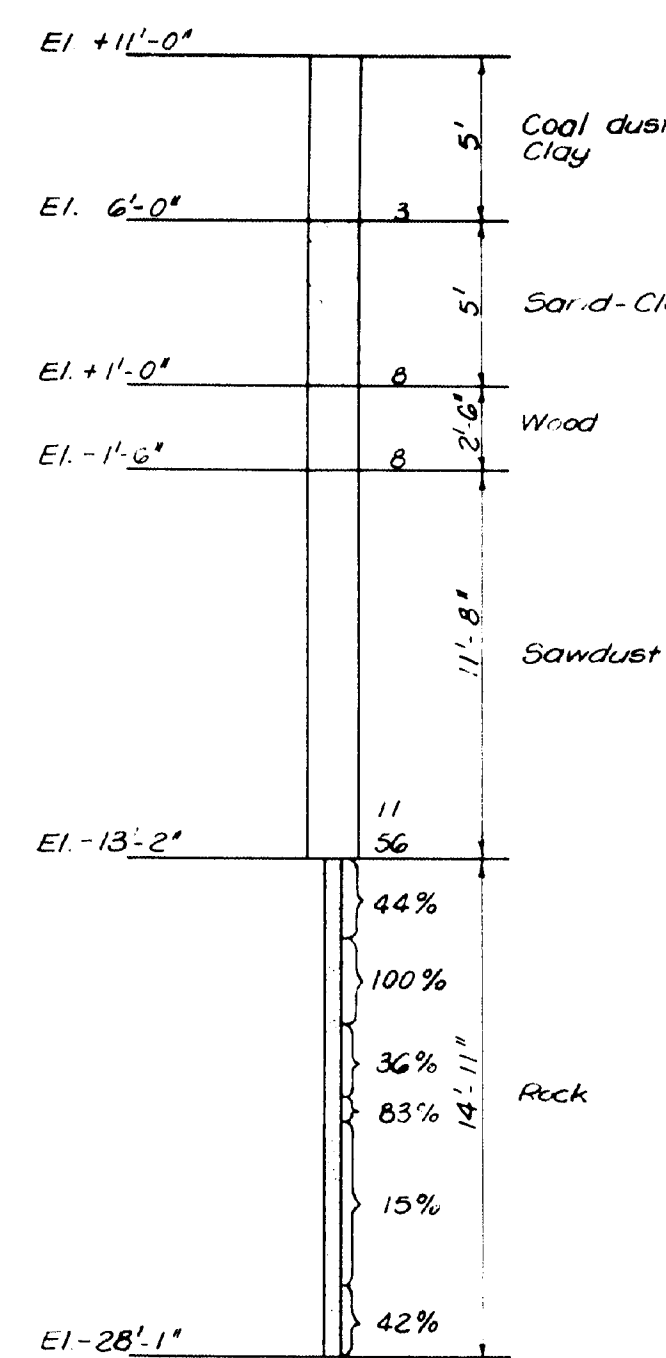


BORING #12L  
23' Lt. & Sta. 32+07

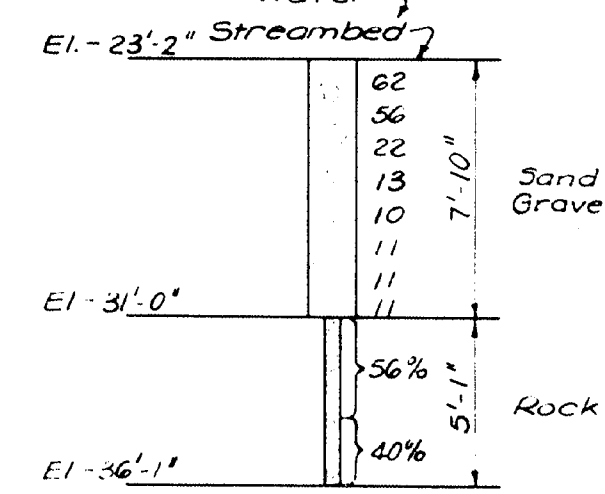


BORING #12R  
23' Rt. & Sta. 32+10

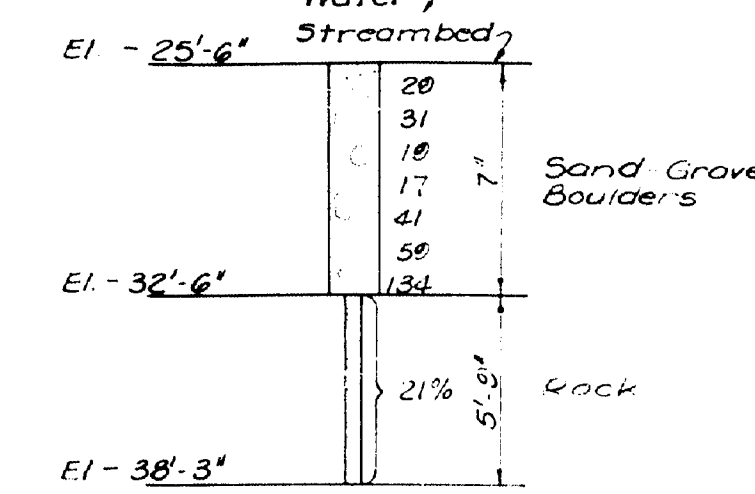


BORING #13L  
24' Lt. & Sta. 33+55

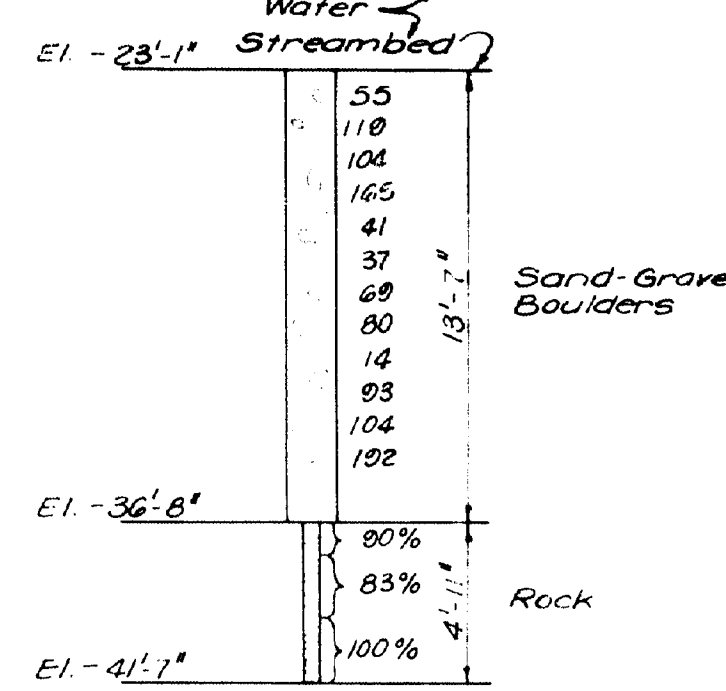


BORING #13R  
23' Rt. & Sta. 33+61

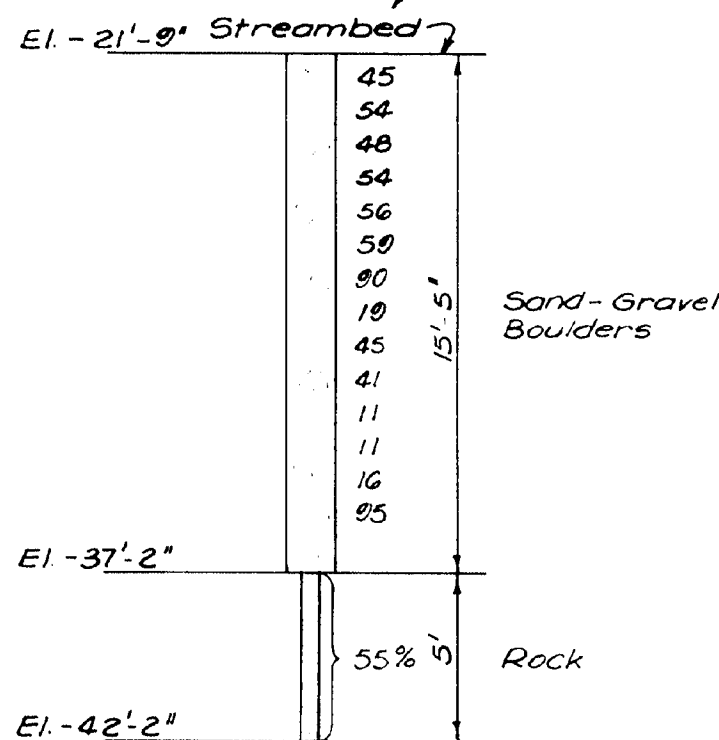


BORING #14L  
24' Lt. & Sta. 35+37

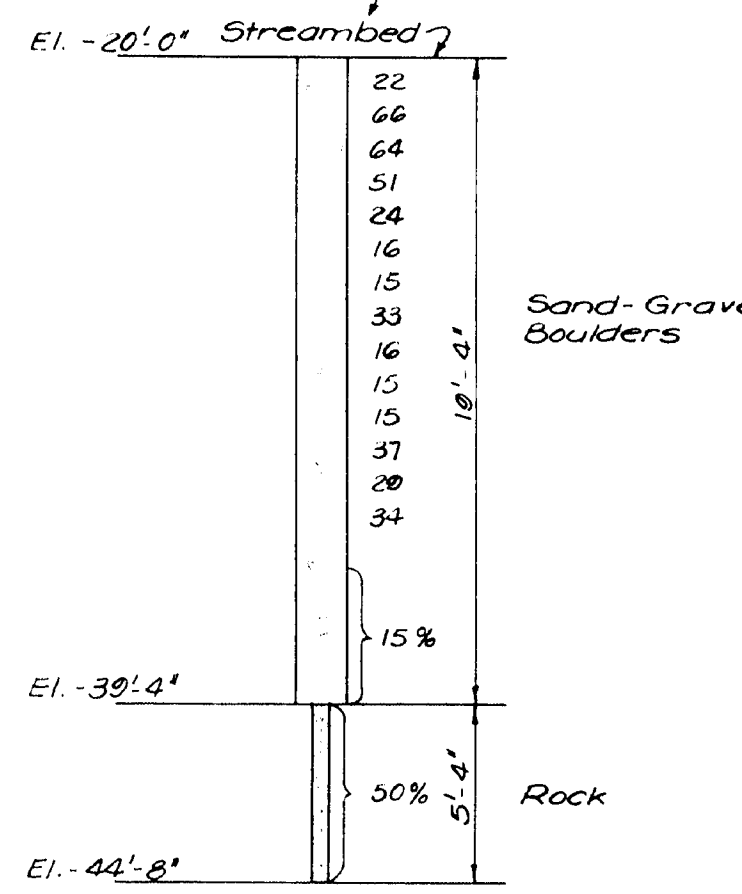


BORING #14R  
24' Rt. & Sta. 35+37

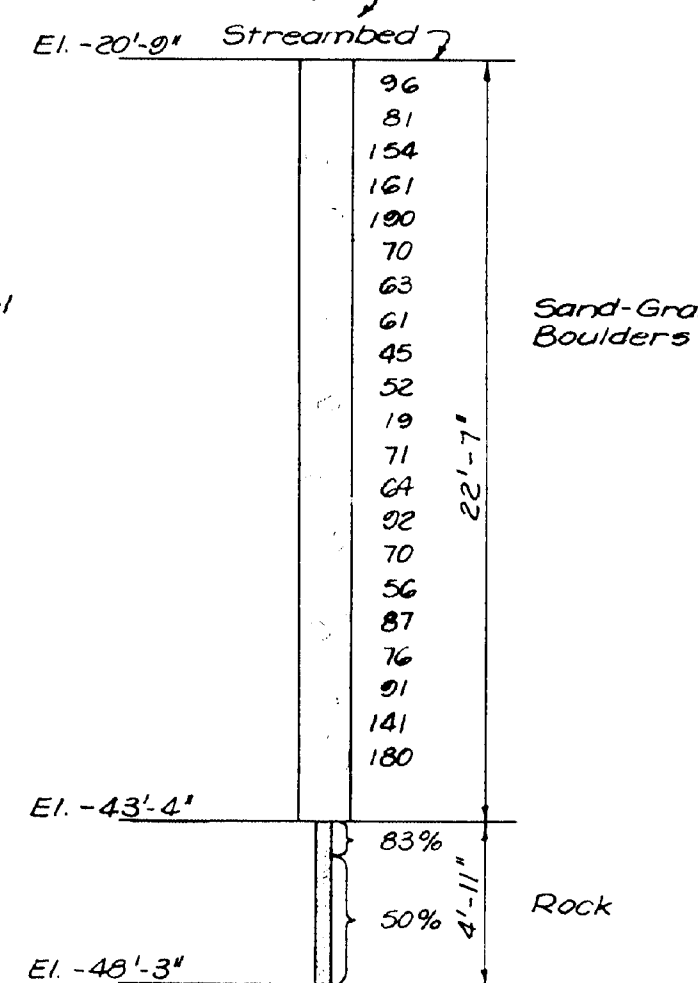

BORING #15L  
20' Lt. & Sta. 36+86

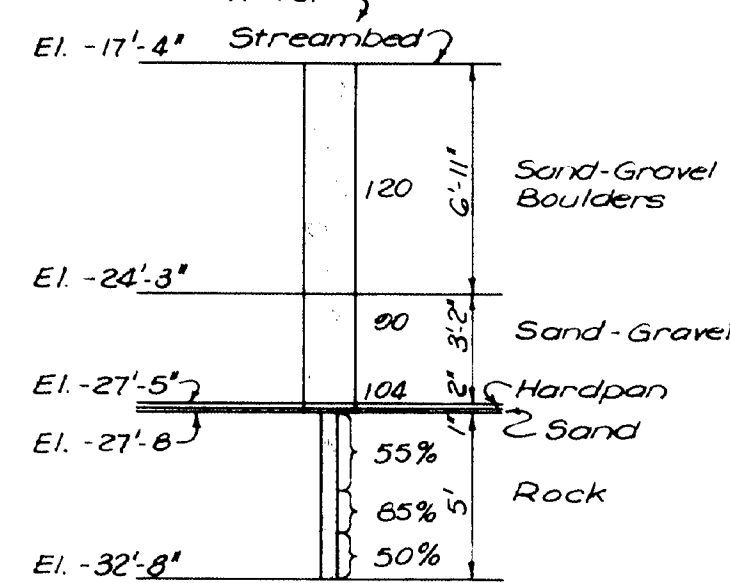

BORING #15R  
20' Rt. & Sta. 36+90

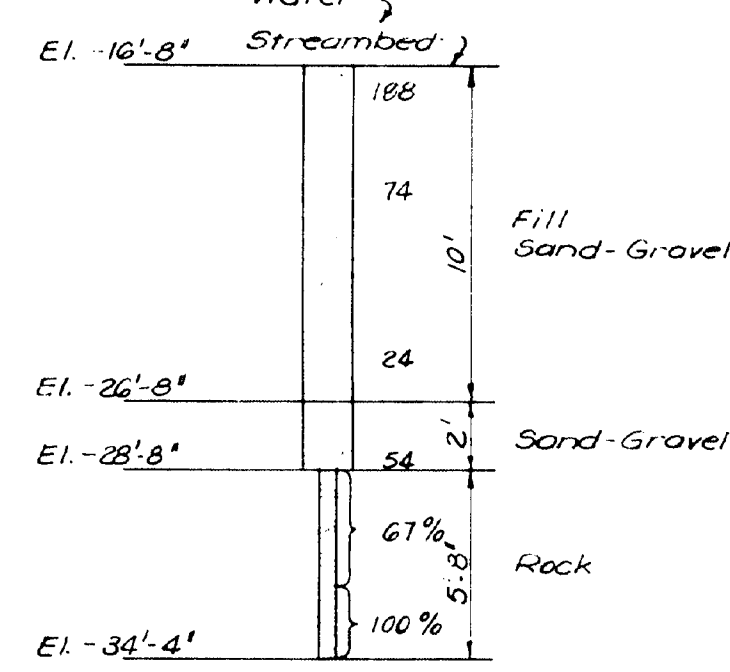

For Notes see Sh. No. 6.

STATE OF MAINE  
STATE HIGHWAY COMMISSION  
BANGOR-BREWER BRIDGE  
OVER PENOBSCOT RIVER  
BANGOR MAINE


BORING LOGS #2

HARRINGTON AND GORTLEYOU  
CONSULTING ENGINEERS  
KANSAS CITY, MO.


DETAILED G.H.K. 10-15-52 SCALE: 1" = 5'-0"  
TRACED F.W.D. 11-4-52  
CHECKED G.E.G. 1-18-53

SHEET NO. 5


68-5

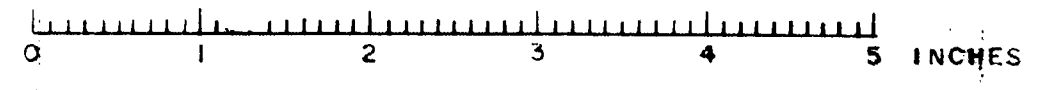


BORING #16L  
21.5' Lt. & Sta. 38+08

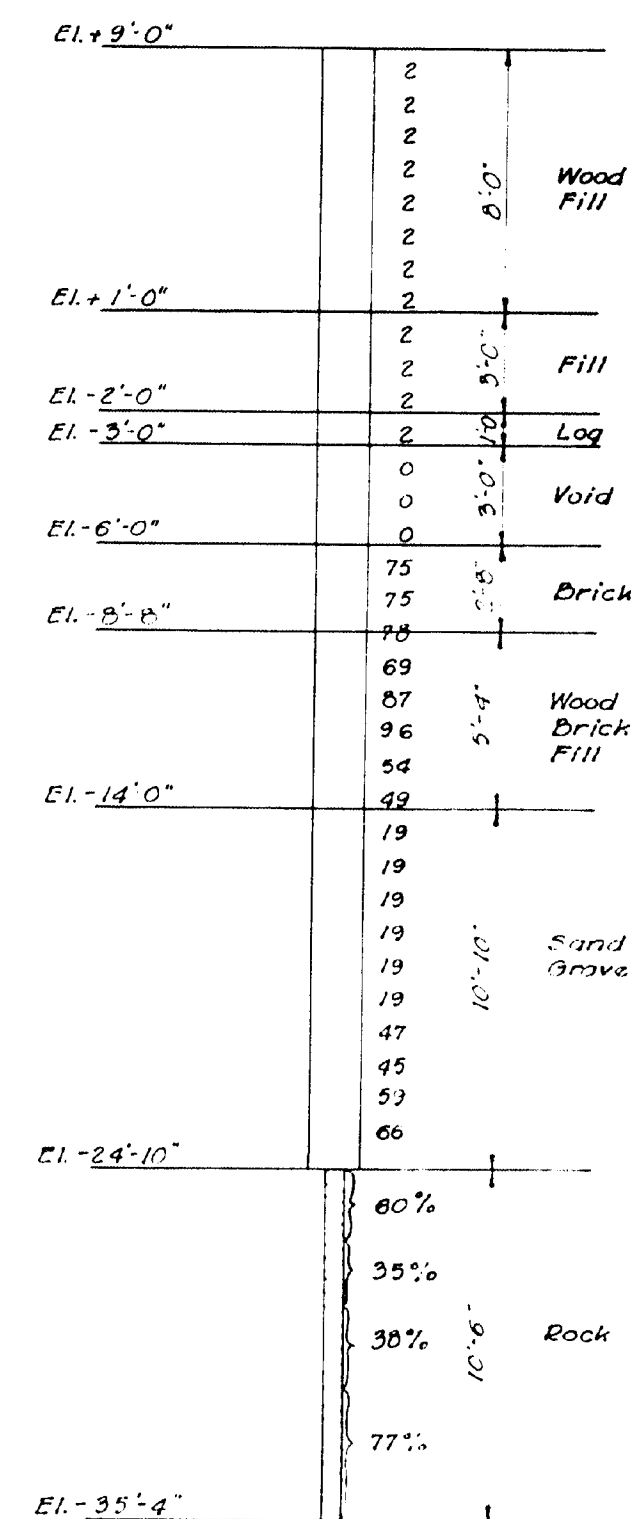


BORING #16R  
20' Rt. & Sta. 38+08

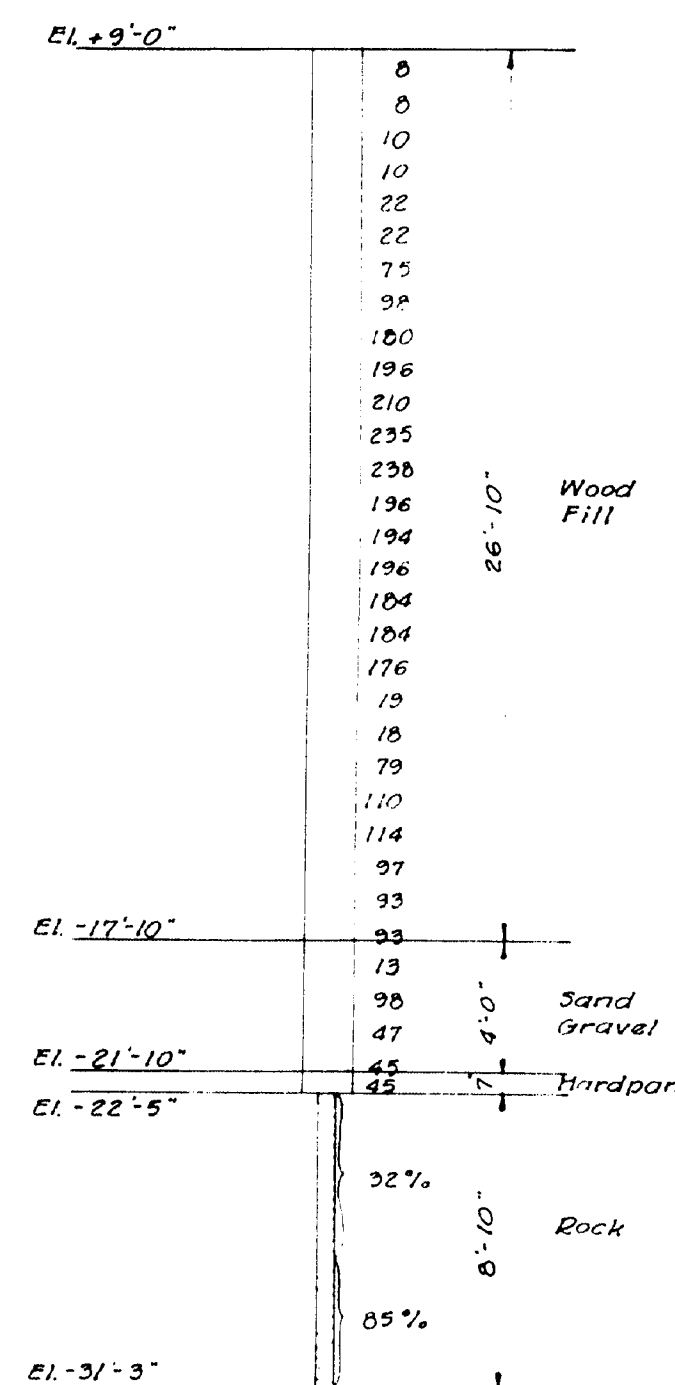


BORING #17L  
27.5' Lt. & Sta. 38+50

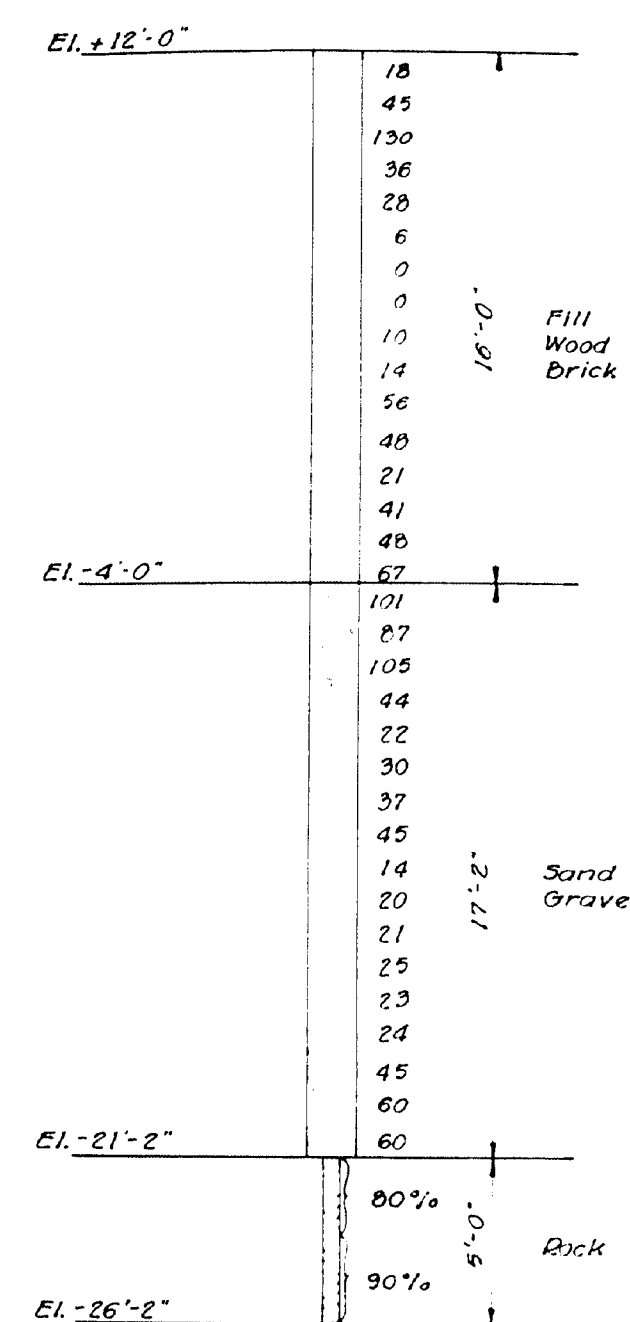


BORING #17R  
27' Rt. & Sta. 38+49

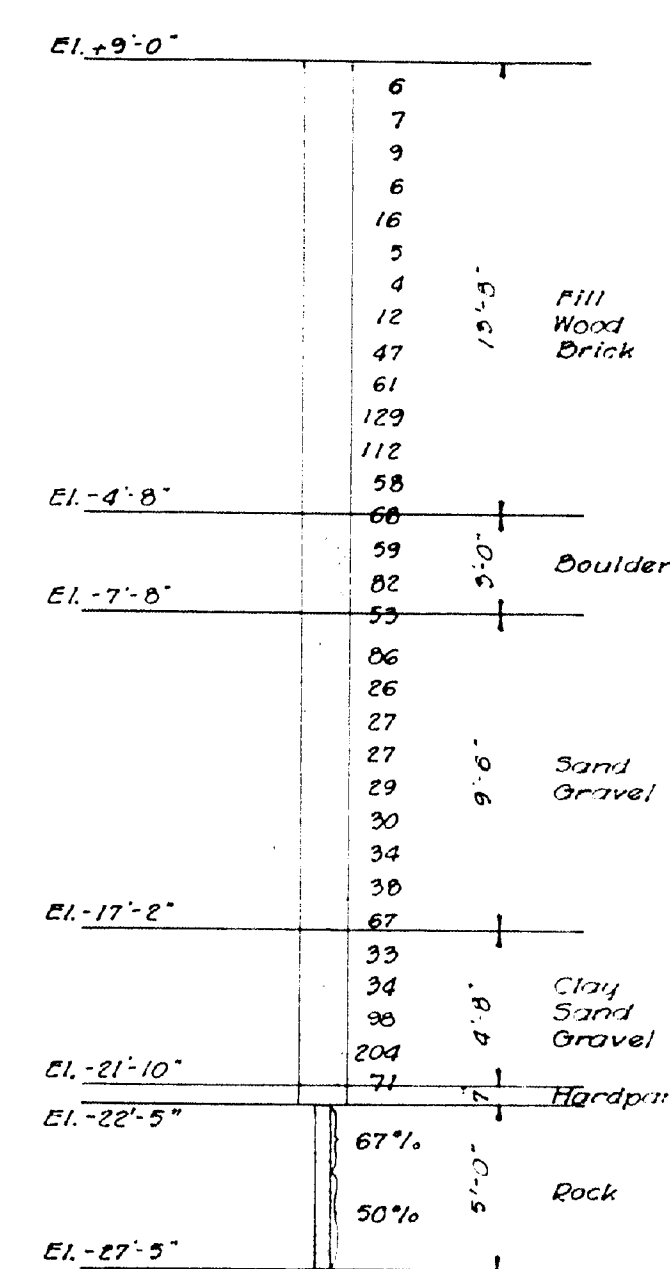


BORING #TIL  
29' Lt. & Sta. 39+08

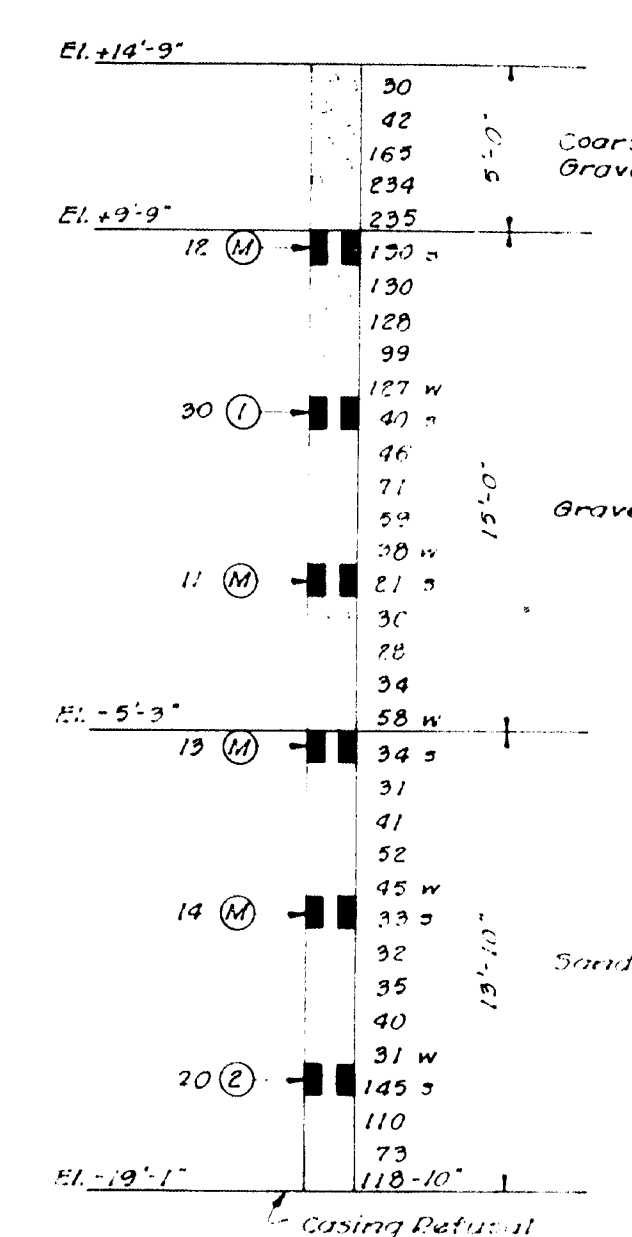


BORING #TIR  
34' Rt. & Sta. 38+88

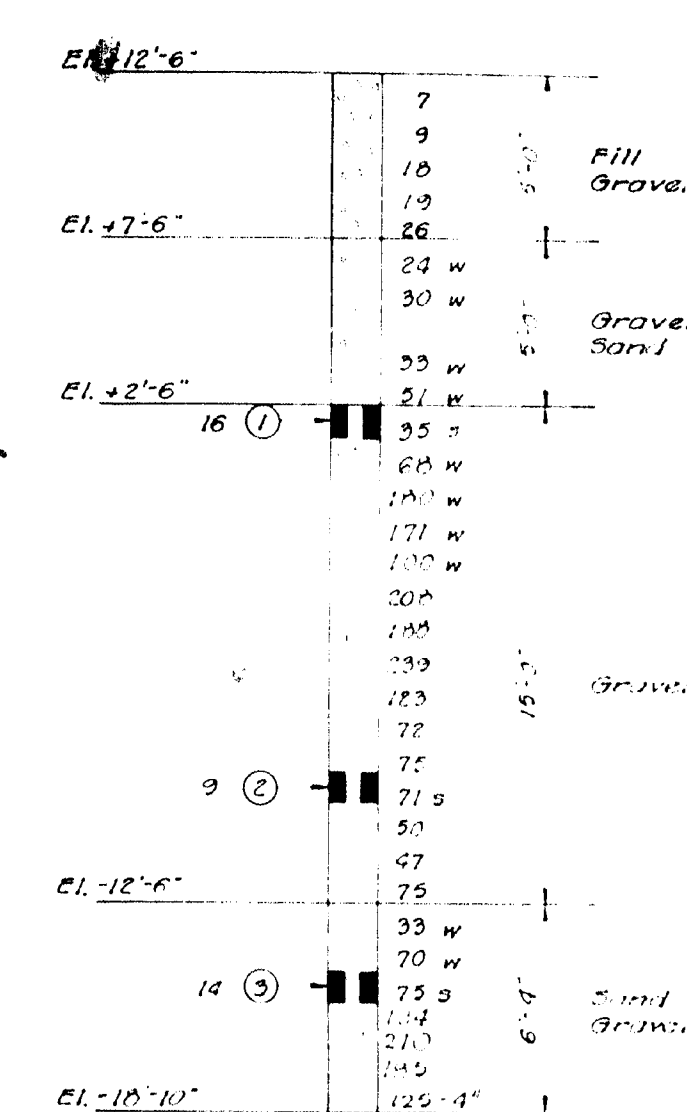

ROD SOUNDING #T2L  
47' Lt. & Sta. 39+42

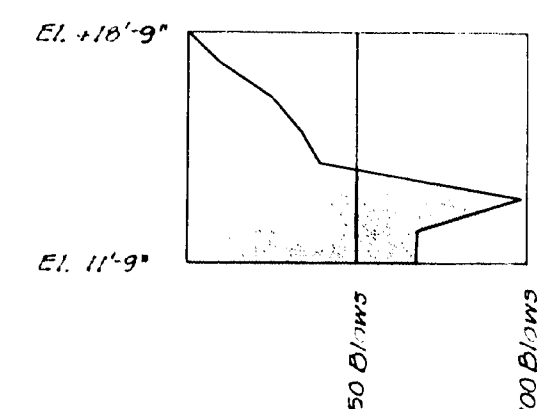

ROD SOUNDING #T3L  
28' Lt. & Sta. 40+43

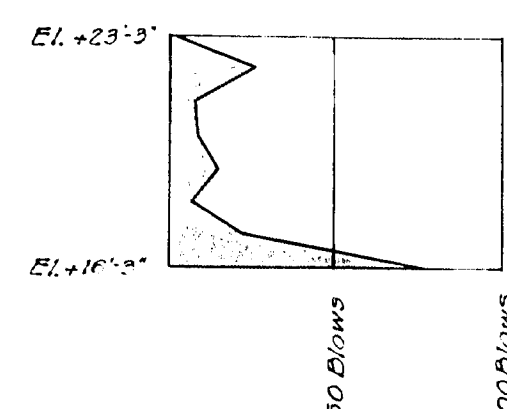

# NOTES:

1. Location and designation of Dry Samples indicated thus: (D) -
2. Location and designation of Continuous Samples indicated thus: (C) -
3. Unsuccessful attempts to secure samples indicated thus: (U) -
4. Dry Samples taken in a Split-tube Sampler.
5. Continuous Samples taken in 2" O.D. 10 Ga. seamless tubing.
6. Figure to left of Sample Markers indicate number of 15" drops of 332 lb. hammer required to drive Sampler 12" (unless otherwise shown).
7. Number of 15" drops of 332 lb. hammer required to drive 22" extra heavy casing one foot indicated thus: (E) 12 (unless otherwise shown).
8. "w" or "s" indicates hole was "washed" or "sampled" ahead of casing.
9. Recovery of rock core indicated thus: (R) 50%

STATE OF MAINE  
STATE HIGHWAY COMMISSION  
**BANGOR-BREWER BRIDGE  
OVER PENOBSCOT RIVER  
BANGOR, MAINE**  
BORING LOGS #3  
HARRINGTON AND CORTELYOU  
CONSULTING ENGINEERS  
KANSAS CITY, MO.  
DETAILED G.H.K. 10-15-52 SCALE: 1" = 5'-0"  
TRACED S.P. 11-5-52  
CHECKED G.E.G. 1-15-53 SHEET NO. 8

62-6



stations shown @ ±  
bearing except Piers 1, 4 & 11

See Sheet No. 42 for  
Retaining Wall Details,  
Union Street and  
Ramp 'A'.

Ramp 'B' Abutment footings  
to be in place prior to pouring  
of Ramp 'B' Retaining Wall  
footings.  
See Sheet No. 44 for Ramp 'B'  
Retaining Wall Details.

RI Sta 26+04.00  
Curve Data:  
Δ = 12°-26' Rt.  
D = 4°-00'  
R = 1432.39'  
T = 156.05'  
L = 310.05'

NOTES:  
For footing sizes see Pier  
Details.  
For Abutment layout see  
Abutment Details.  
For Foundation Data and  
Borings see Sheet No. 3-G.

STATE OF MAINE  
STATE HIGHWAY COMMISSION  
BANGOR-BREWER BRIDGE  
OVER PENOBSCOT RIVER  
BANGOR, MAINE

FOOTING PLAN

HARRINGTON AND CORTELYOU  
CONSULTING ENGINEERS  
KANSAS CITY, MO.

DETAILED J.B. 10-21-52  
TRACED E.W. 11-12-52  
CHECKED E.W. 1-18-53

SCALE: 1" = 30'-0"





SHEET NO. 7

62-7

0 1 2 3 4 5 INCHES





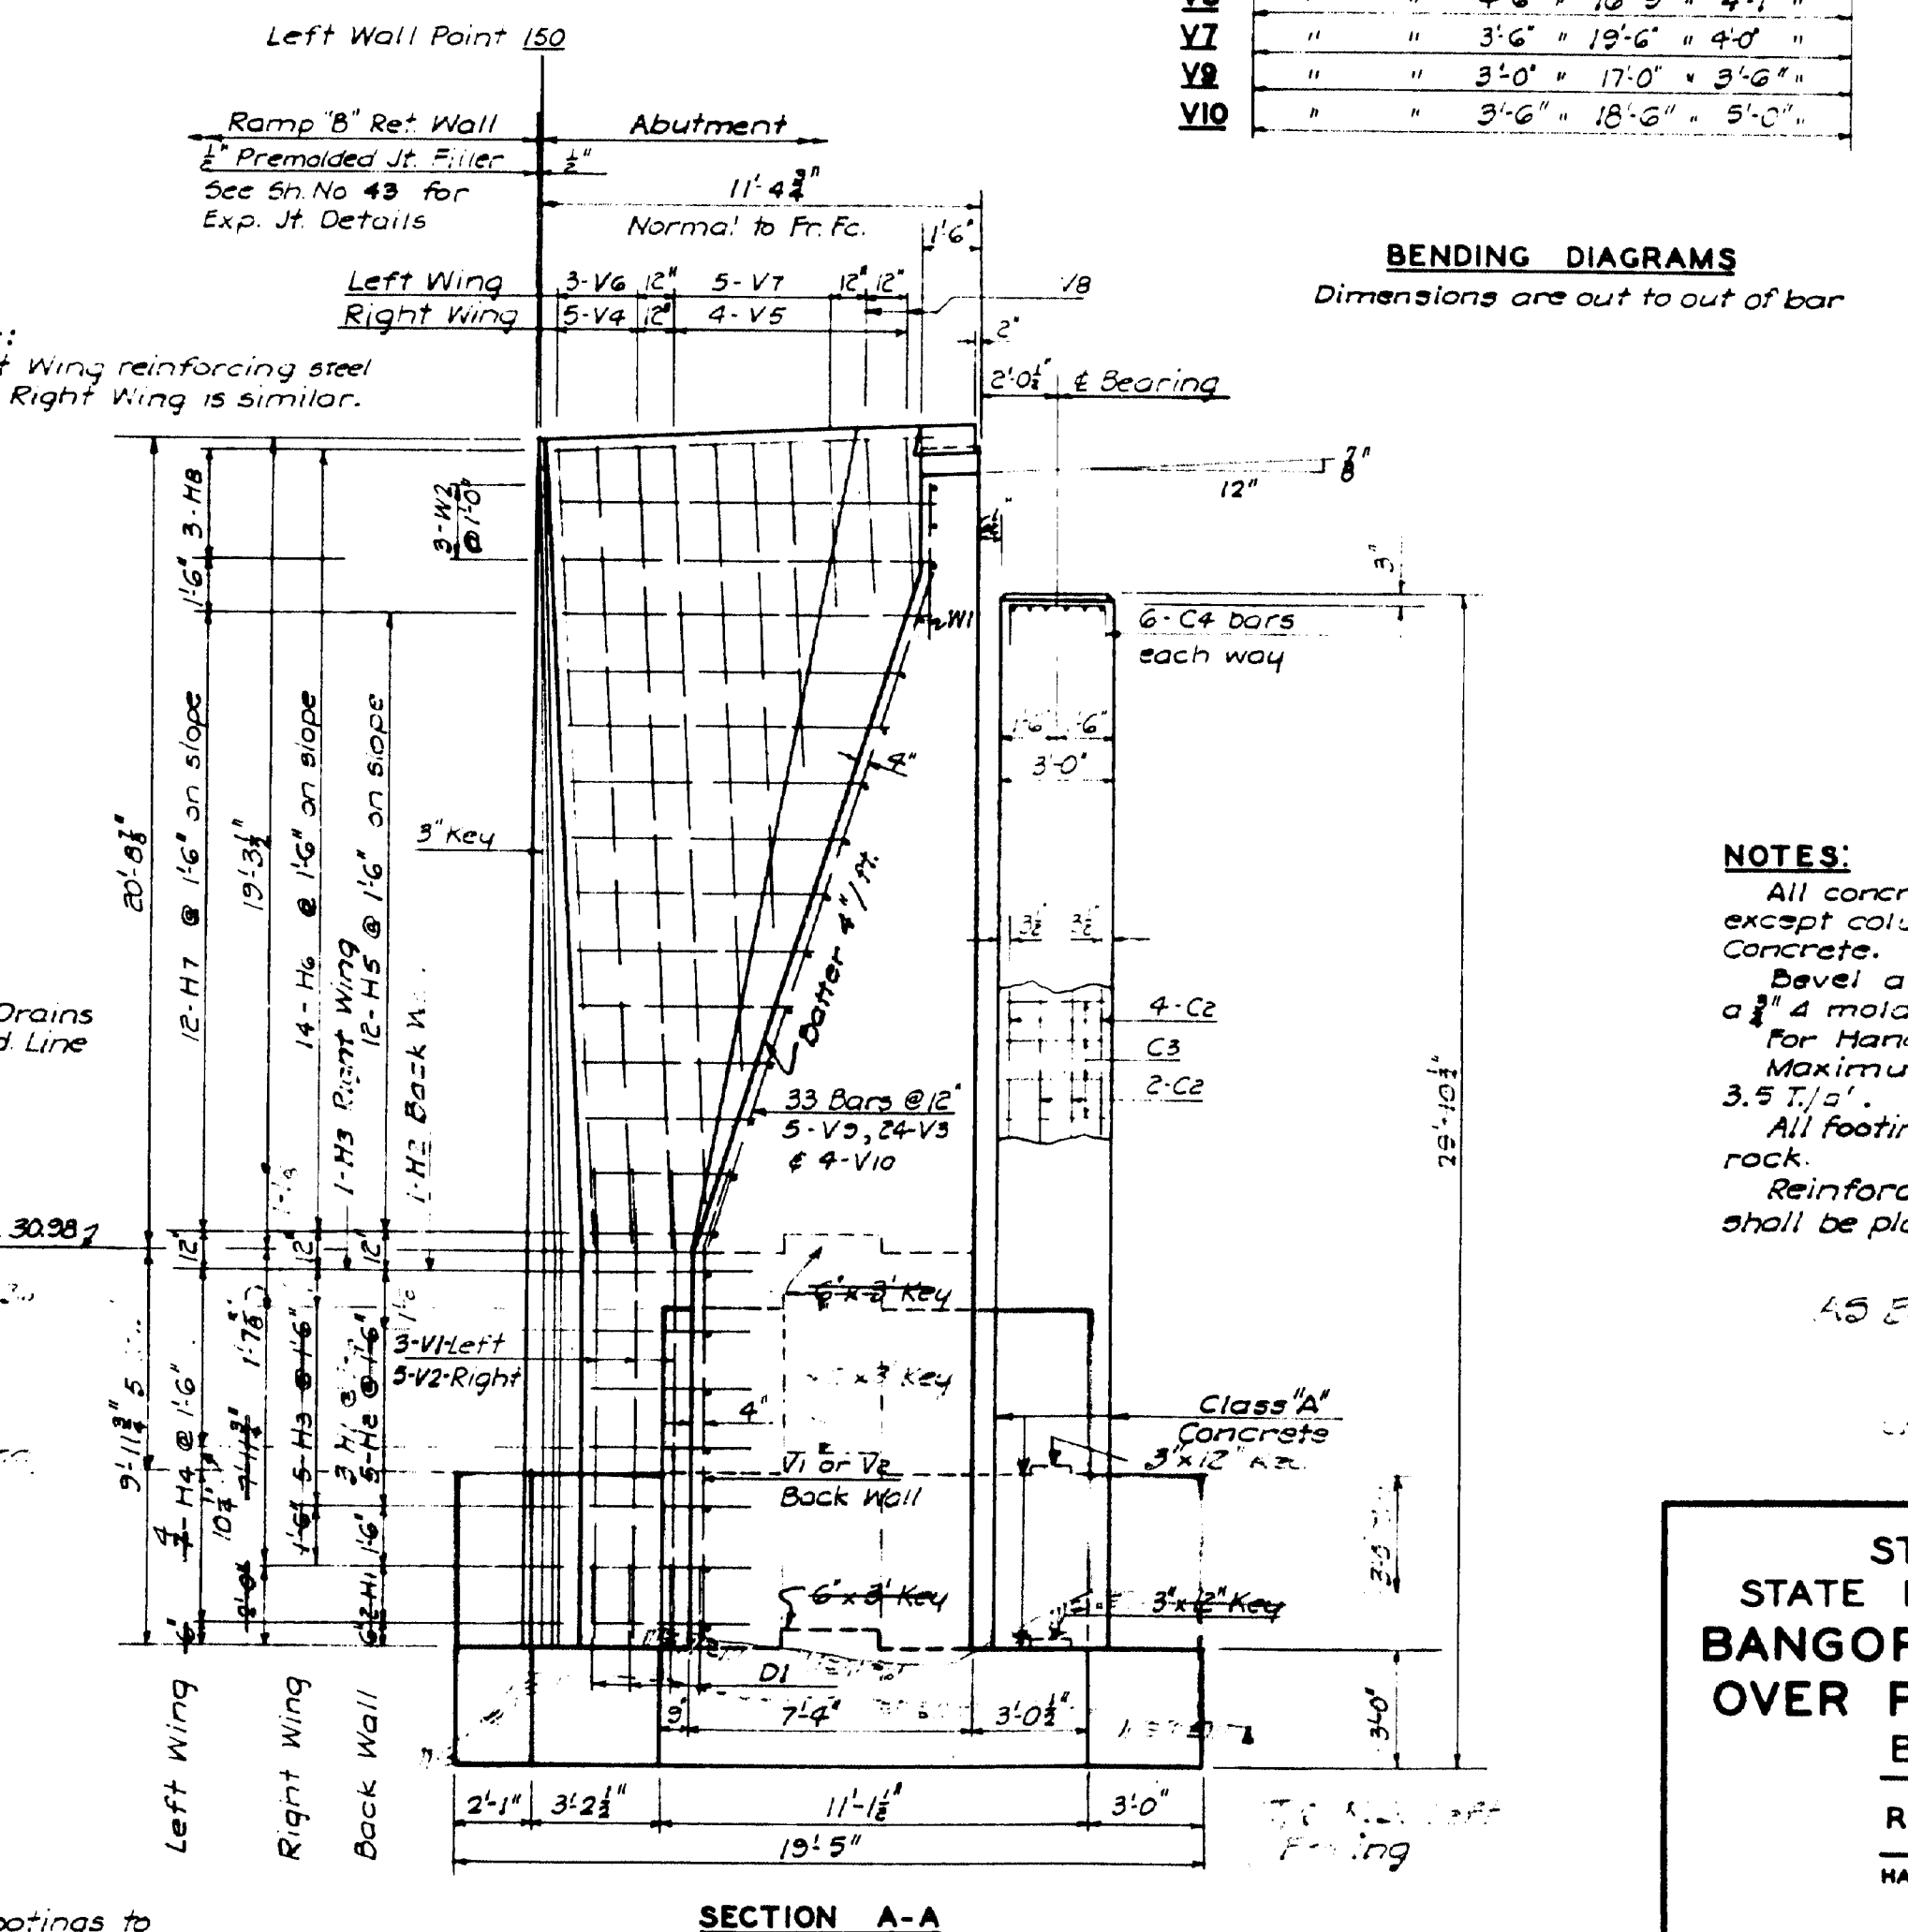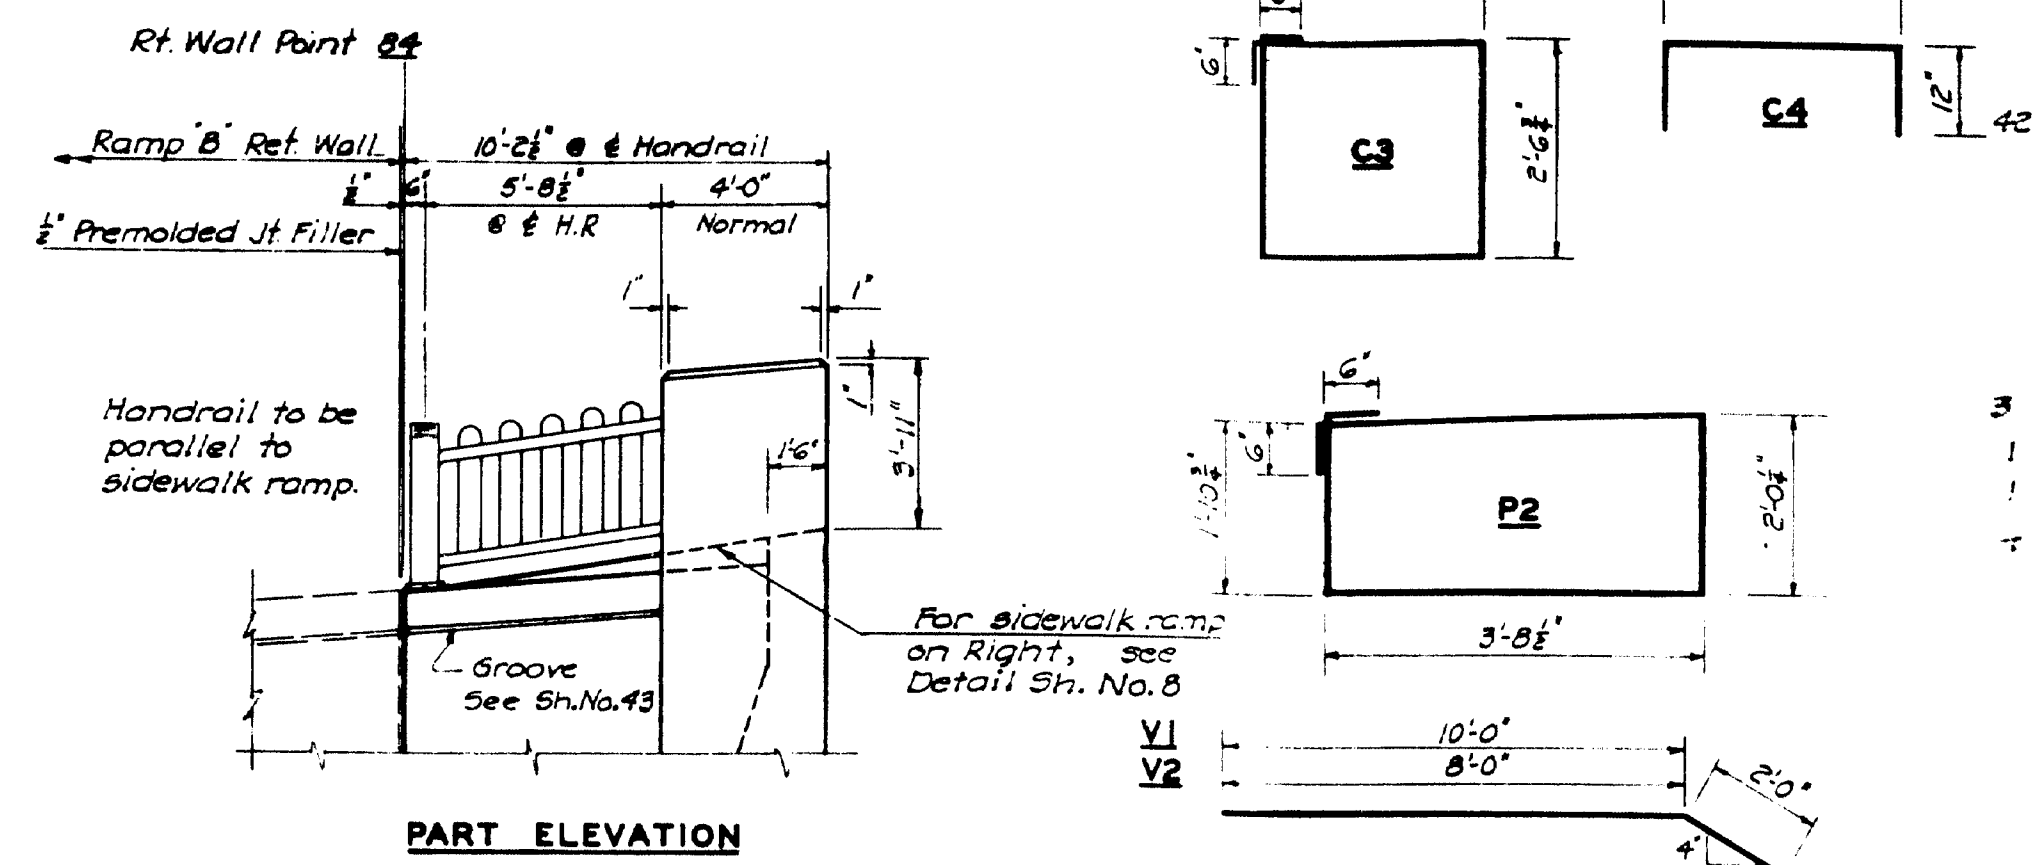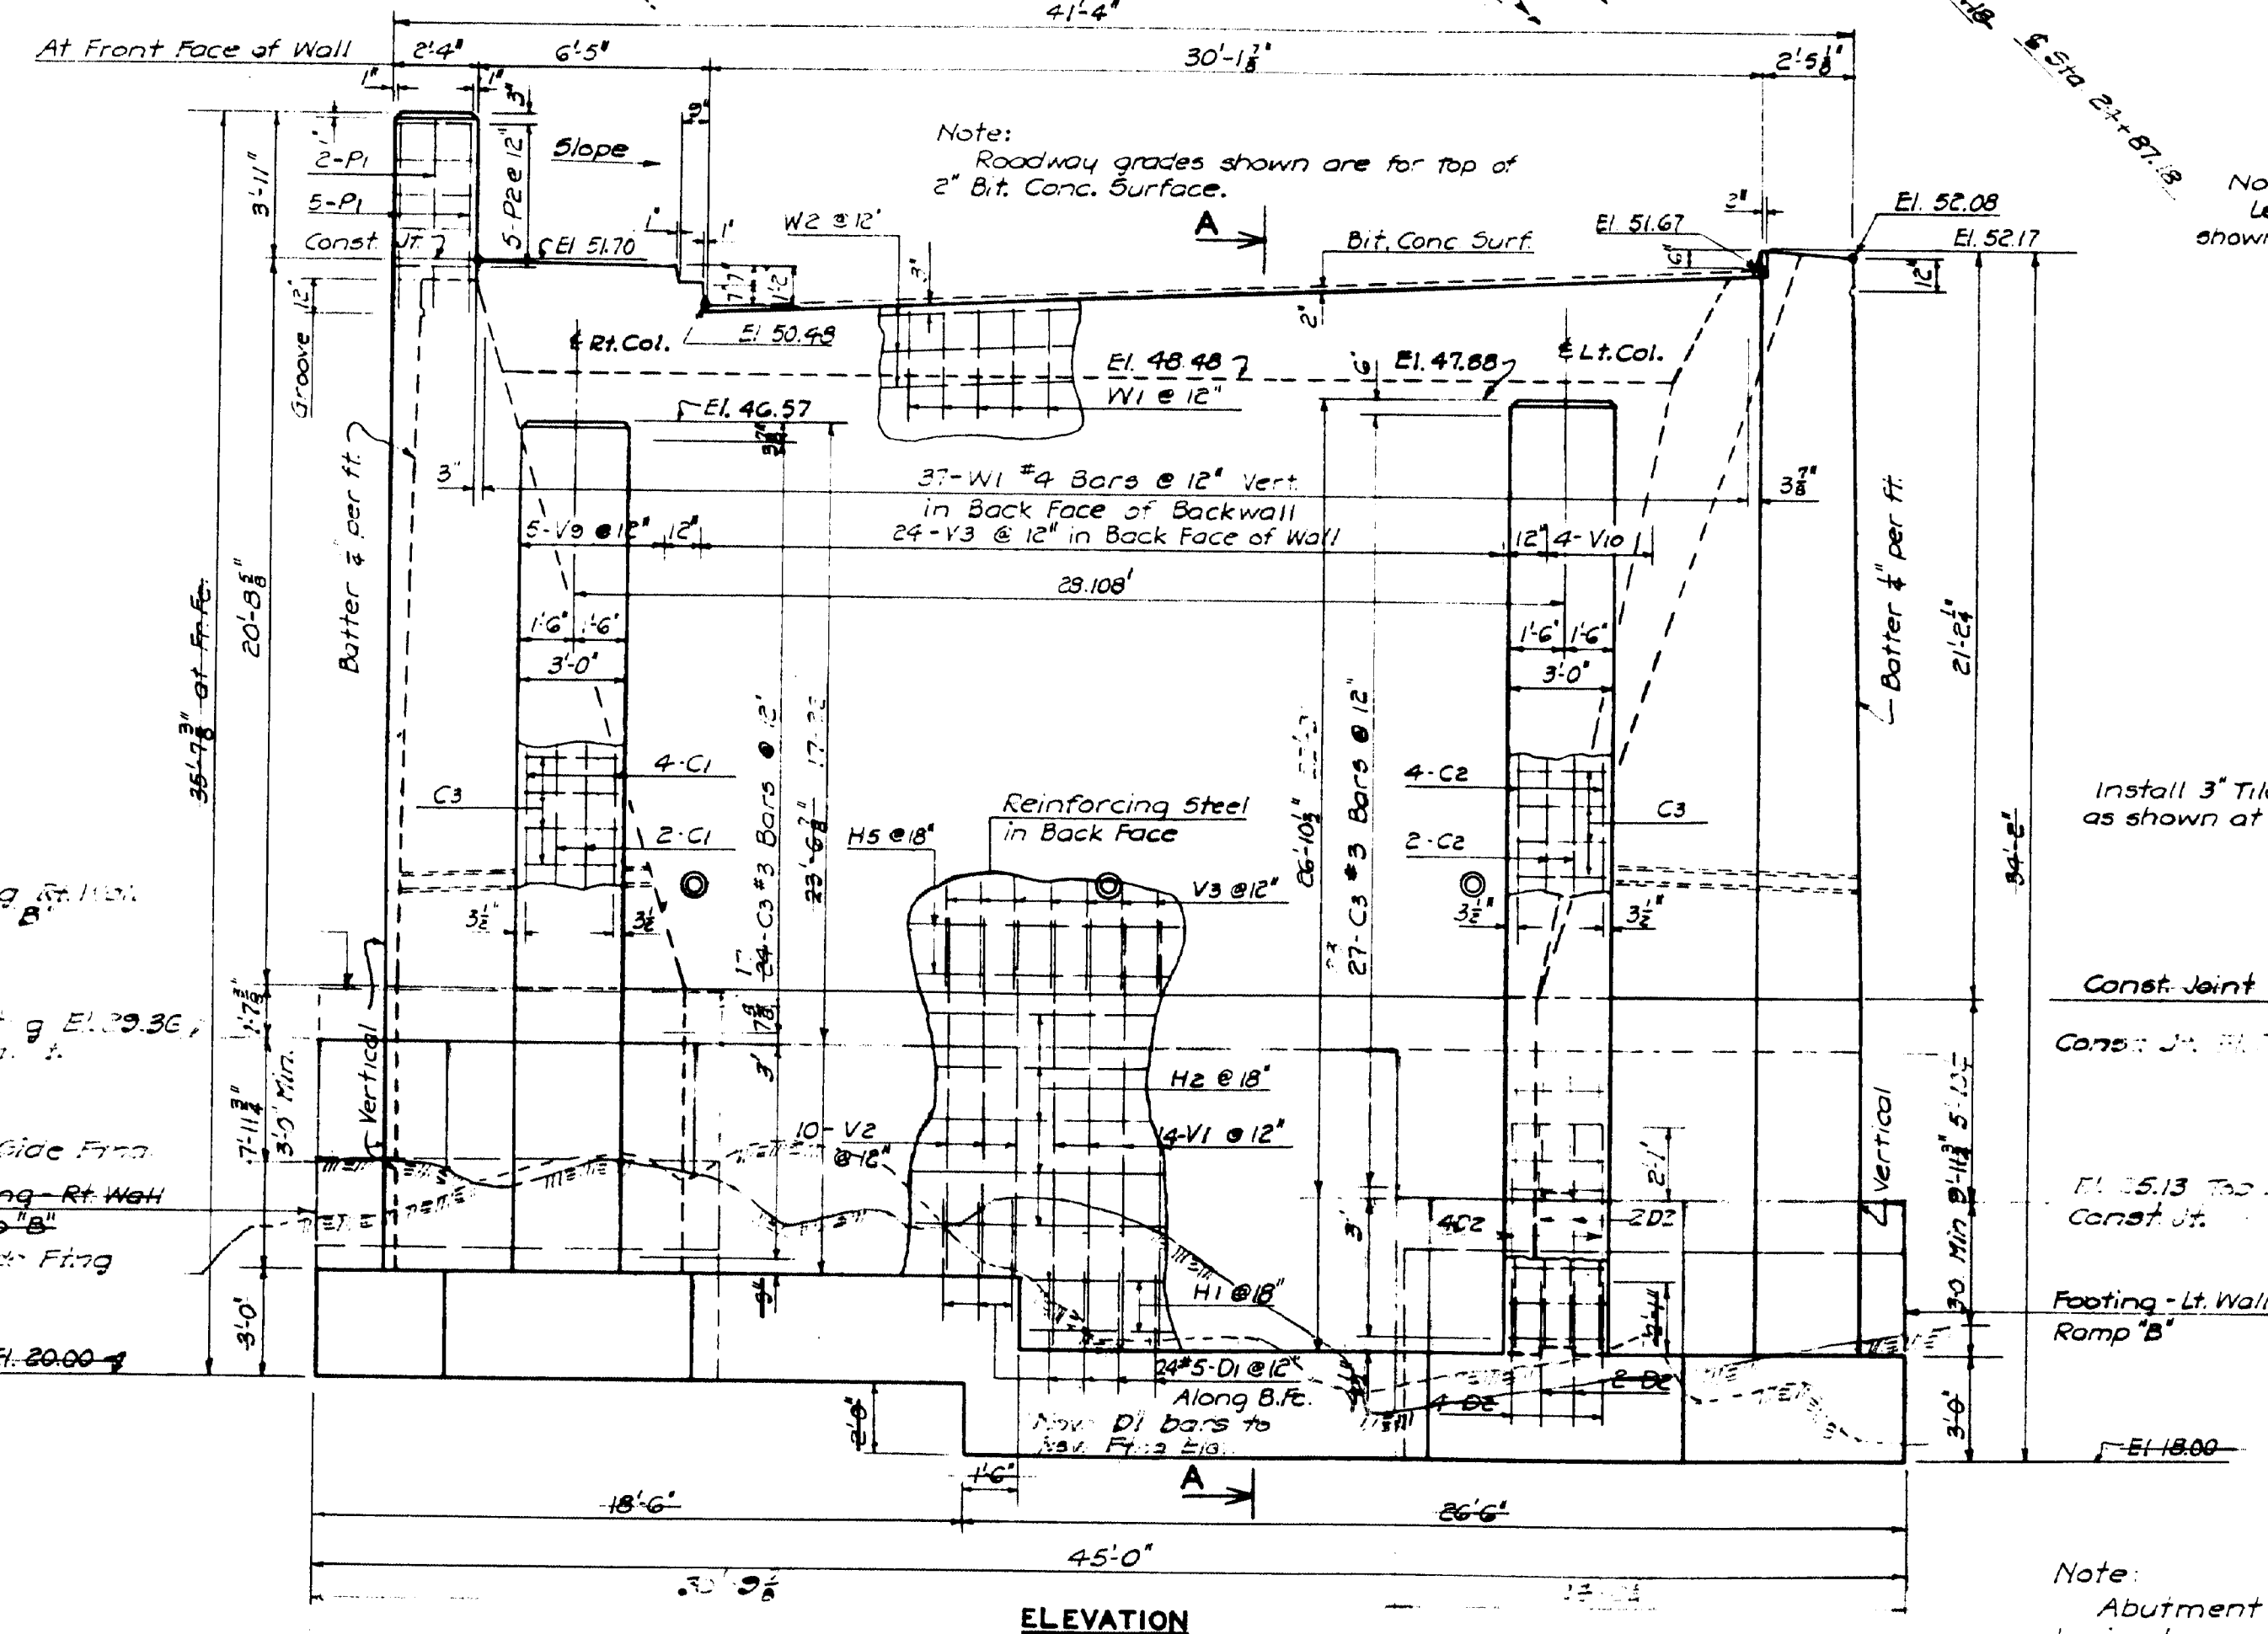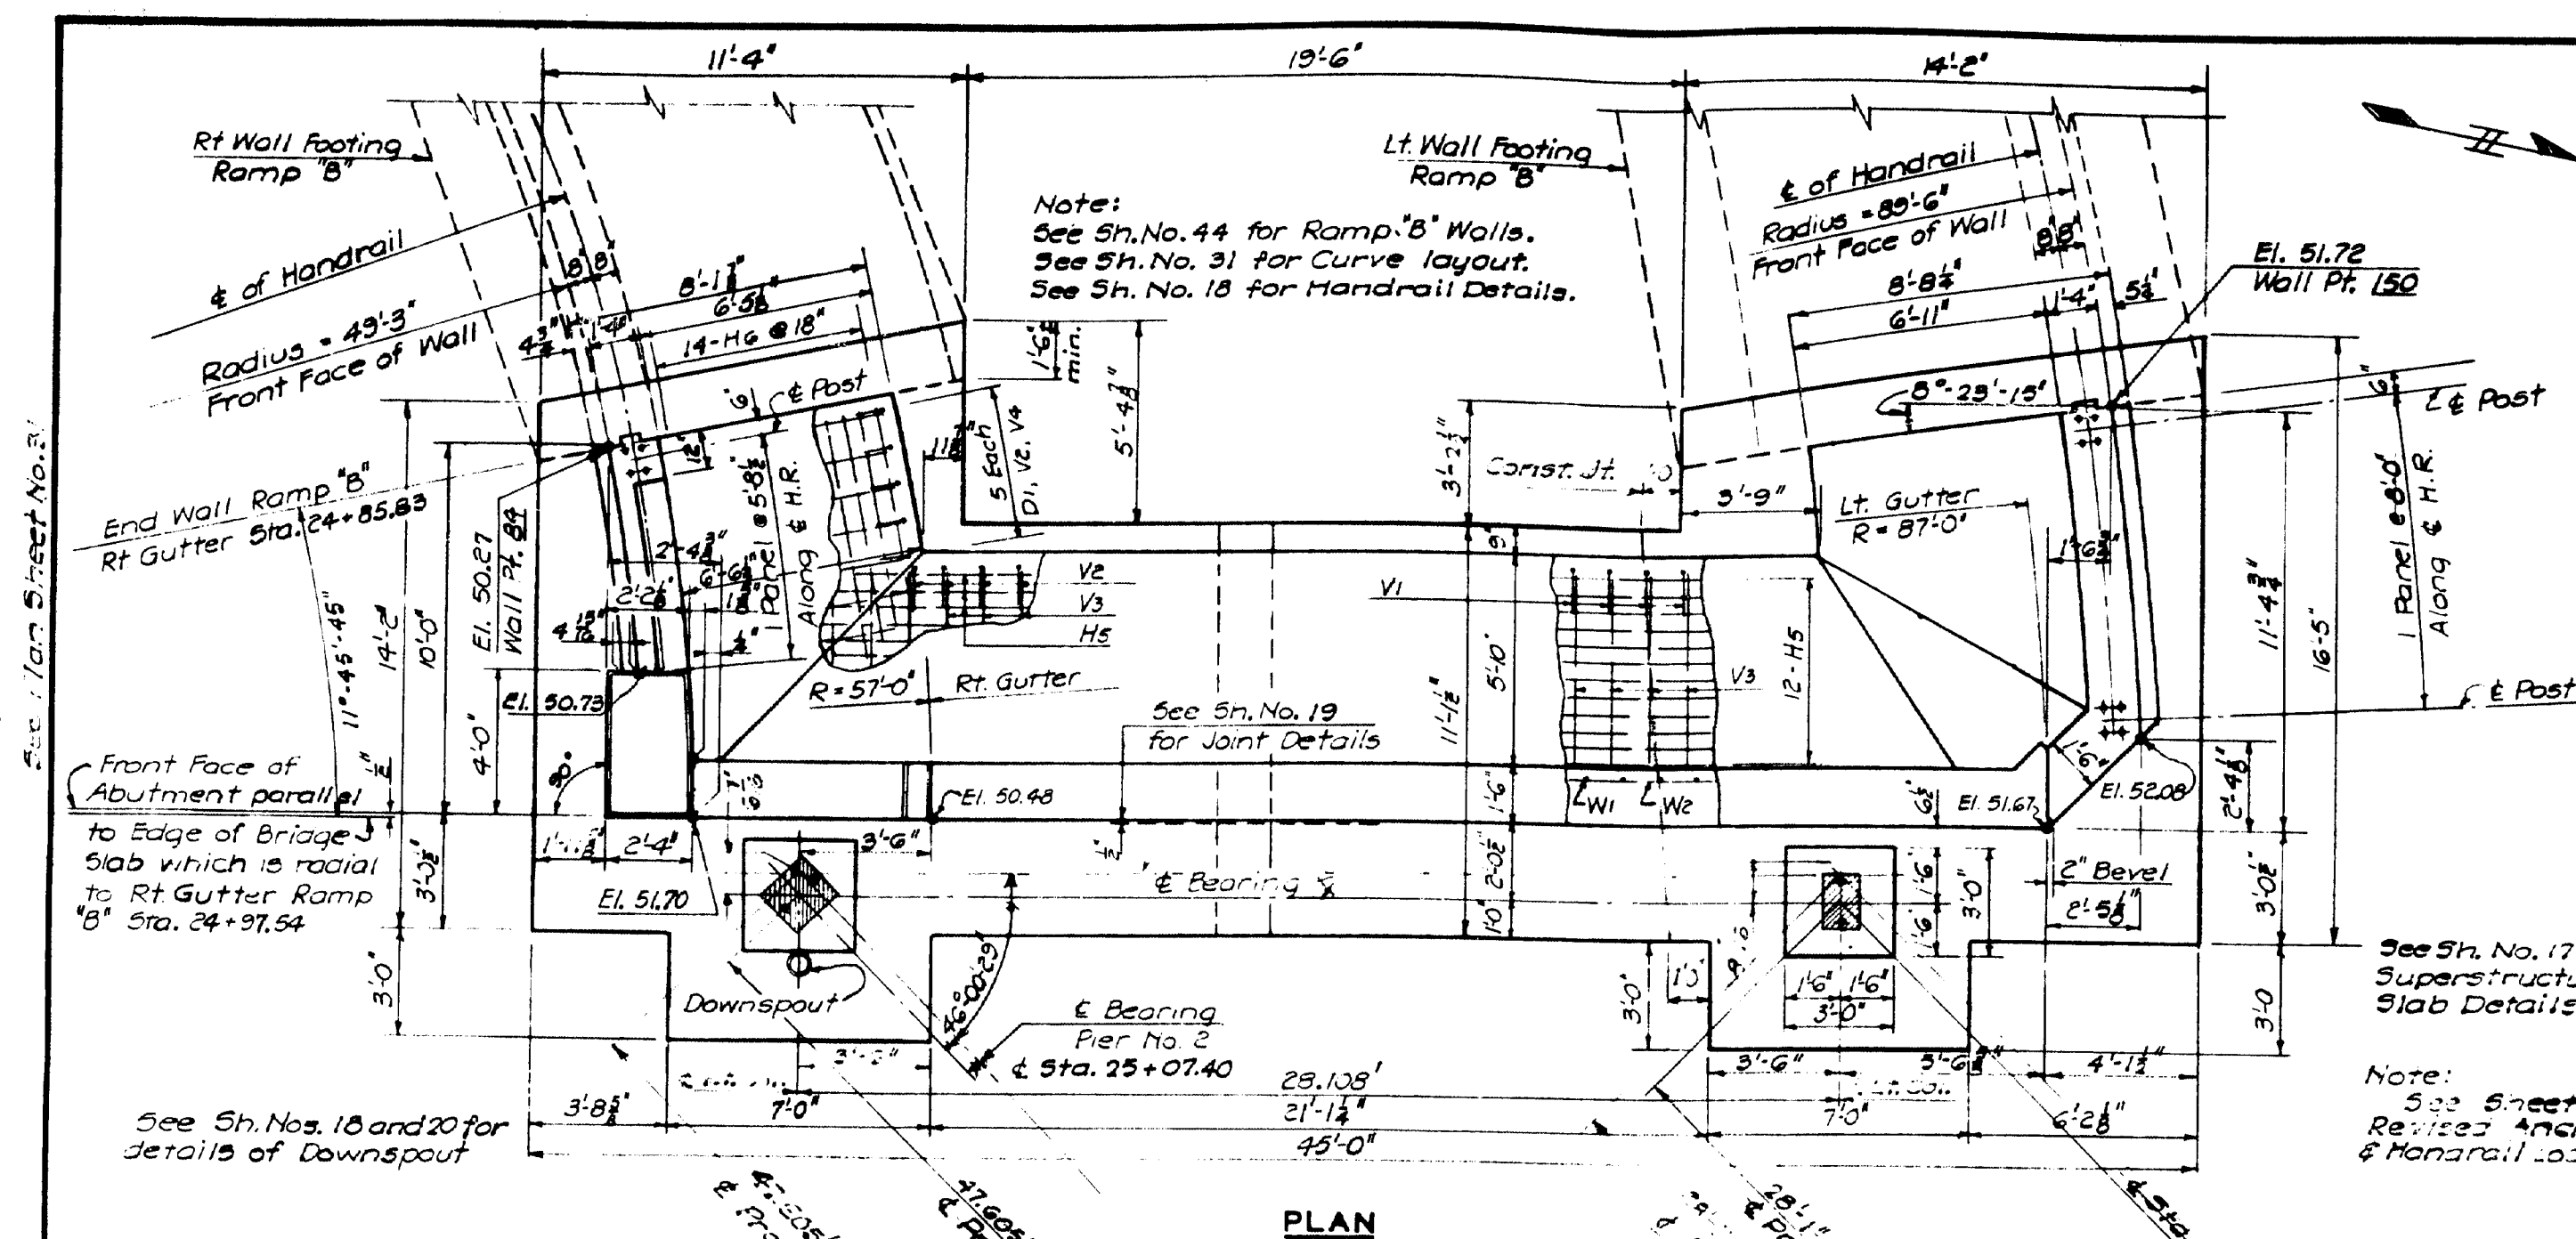

Mark	No.	Size	Shape	Length
C1	12	5		23'-4"
C2	12	5		26'-6"
C3	24	3		11'-3"
C4	24	4		4'-7"
D1	32	5		3'-6"
D2	24	5		4'-2"
H1	2	4		16'-6"
H2	5	4		26'-6"
H3	5	4		5'-3"
H4	7	4		4'-5"
H5	12	4		30'-7 1/2"
H6	14	4		7'-6"
H7	12	4		6'-3 1/2"
H8	3	4		9'-6"
P1	12	4		5'-0"
P2	5	4		12'-4"
V1	17	4		12'-0"
V2	15	4		10'-0"
V3	24	4		18'-6"
V4	5	4		20'-0"
V5	4	4		10'-7 1/2"
V6	3	4		21'-7"
V7	5	4		11'-6"
V8	2	4		4'-0"
V9	5	4		10'-0"
V10	4	4		11'-0"
W1	37	4		4'-0"
W2	3	4		35'-0"

**NOTES:**

All concrete shall be Class "B" Concrete except columns which shall be Class "A" Concrete.

Bevel all exposed edges with a 1/4" mauling unless otherwise noted.

For Handrail Details see Sheet No. 18.

Maximum Design Footing Pressure = 3.5 T/SF.

All footings shall be carried to sound rock.

Reinforcing under bearing plates shall be placed to clear anchor bolts.

**AS BUILT REVISIONS**

HARRINGTON & CORTELYOU  
CONSULTING ENGINEERS  
KANSAS CITY, MO.

**STATE OF MAINE  
STATE HIGHWAY COMMISSION  
BANGOR-BREWER BRIDGE  
OVER PENOBSCOT RIVER  
BANGOR, MAINE**












**RAMP "B" ABUTMENT**

HARRINGTON & CORTELYOU  
CONSULTING ENGINEERS  
KANSAS CITY, MO.

DETAILED Z.E.W. 10-17-52  
TRACED Repr. 11-6-52  
CHECKED G.H.B. 1-18-52

SCALE: 1" = 1'-0"

SHEET NO. 9

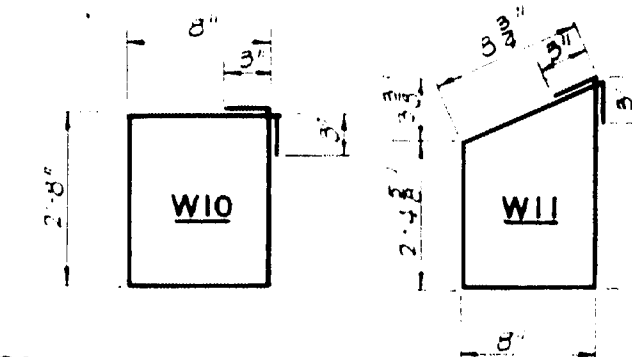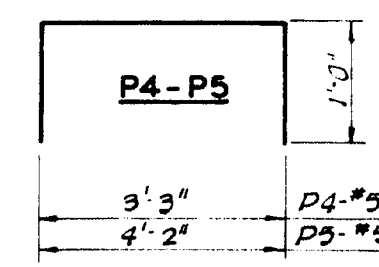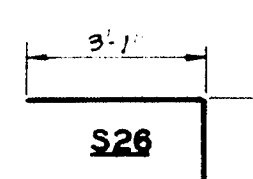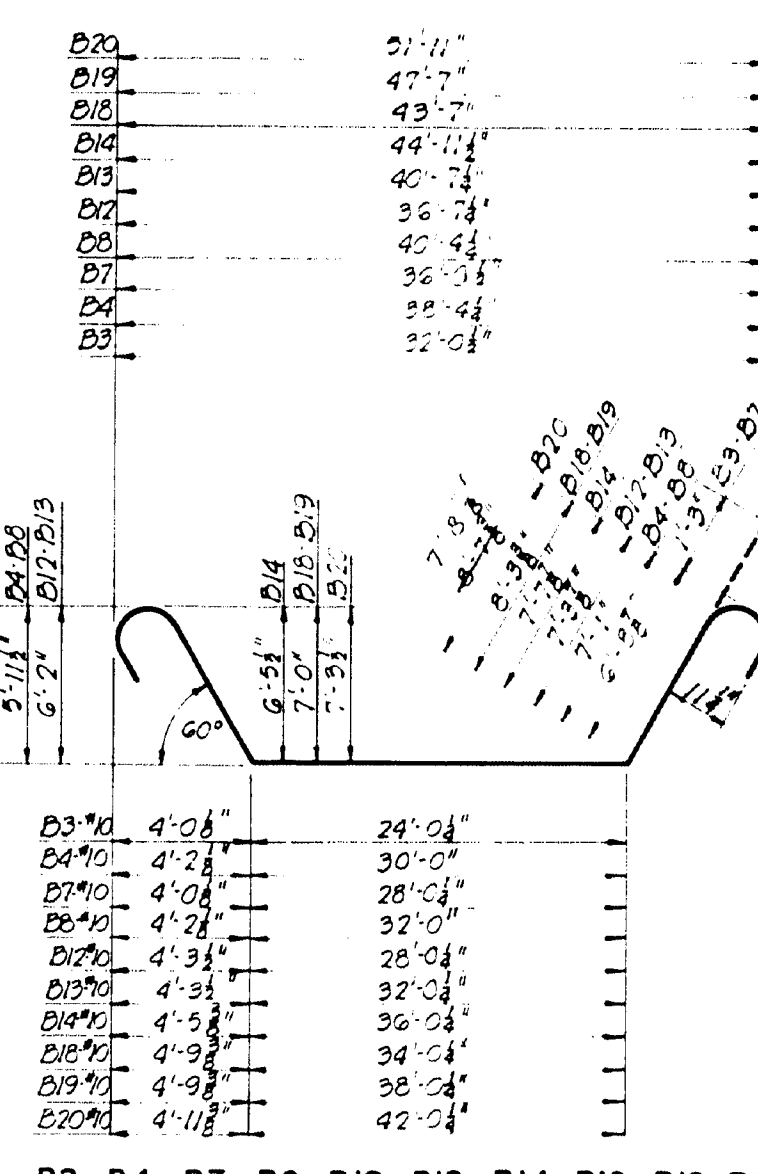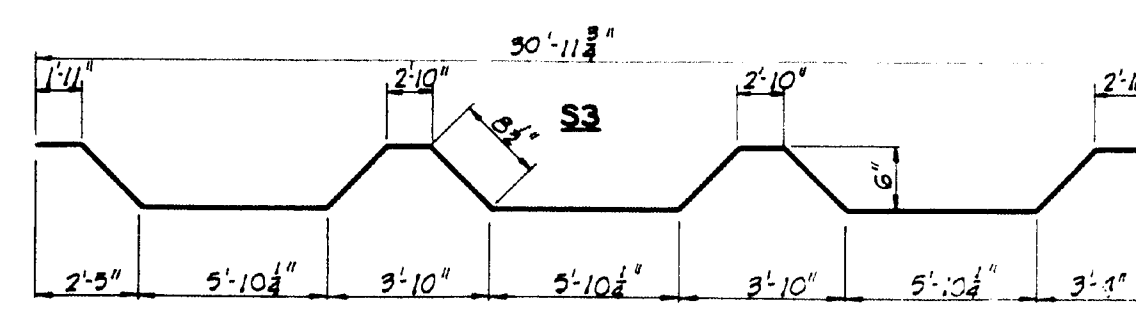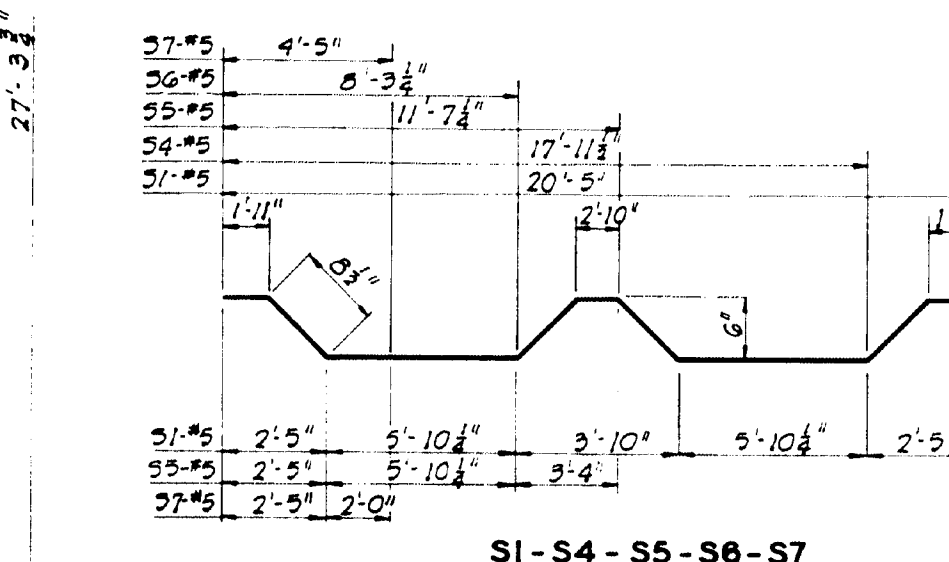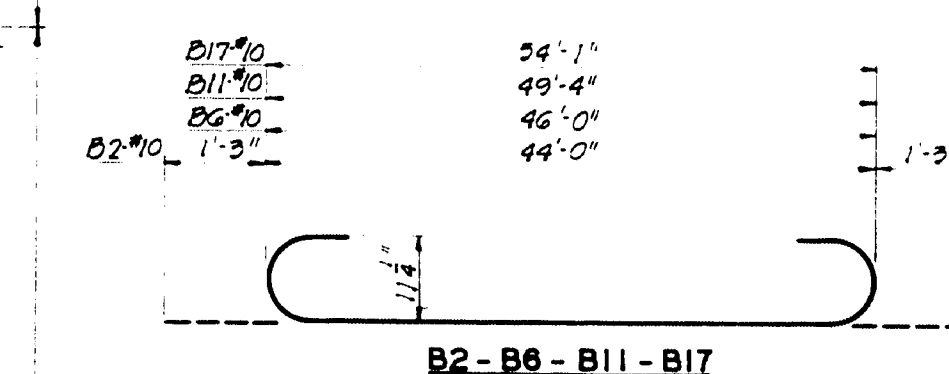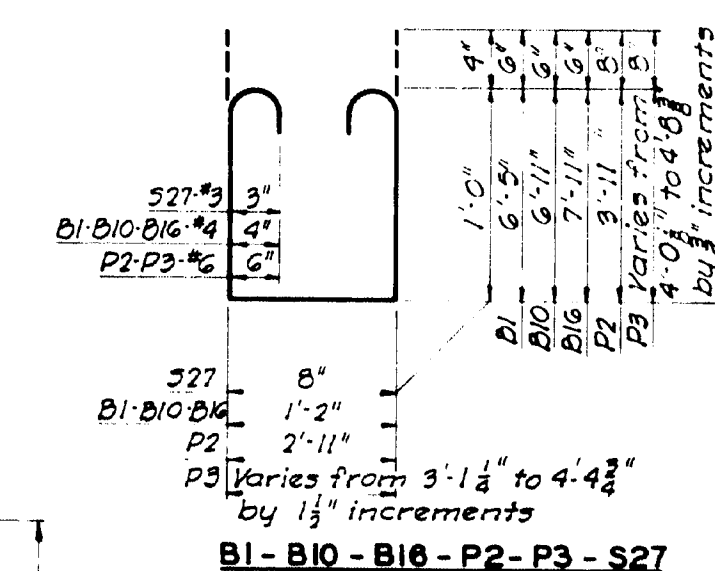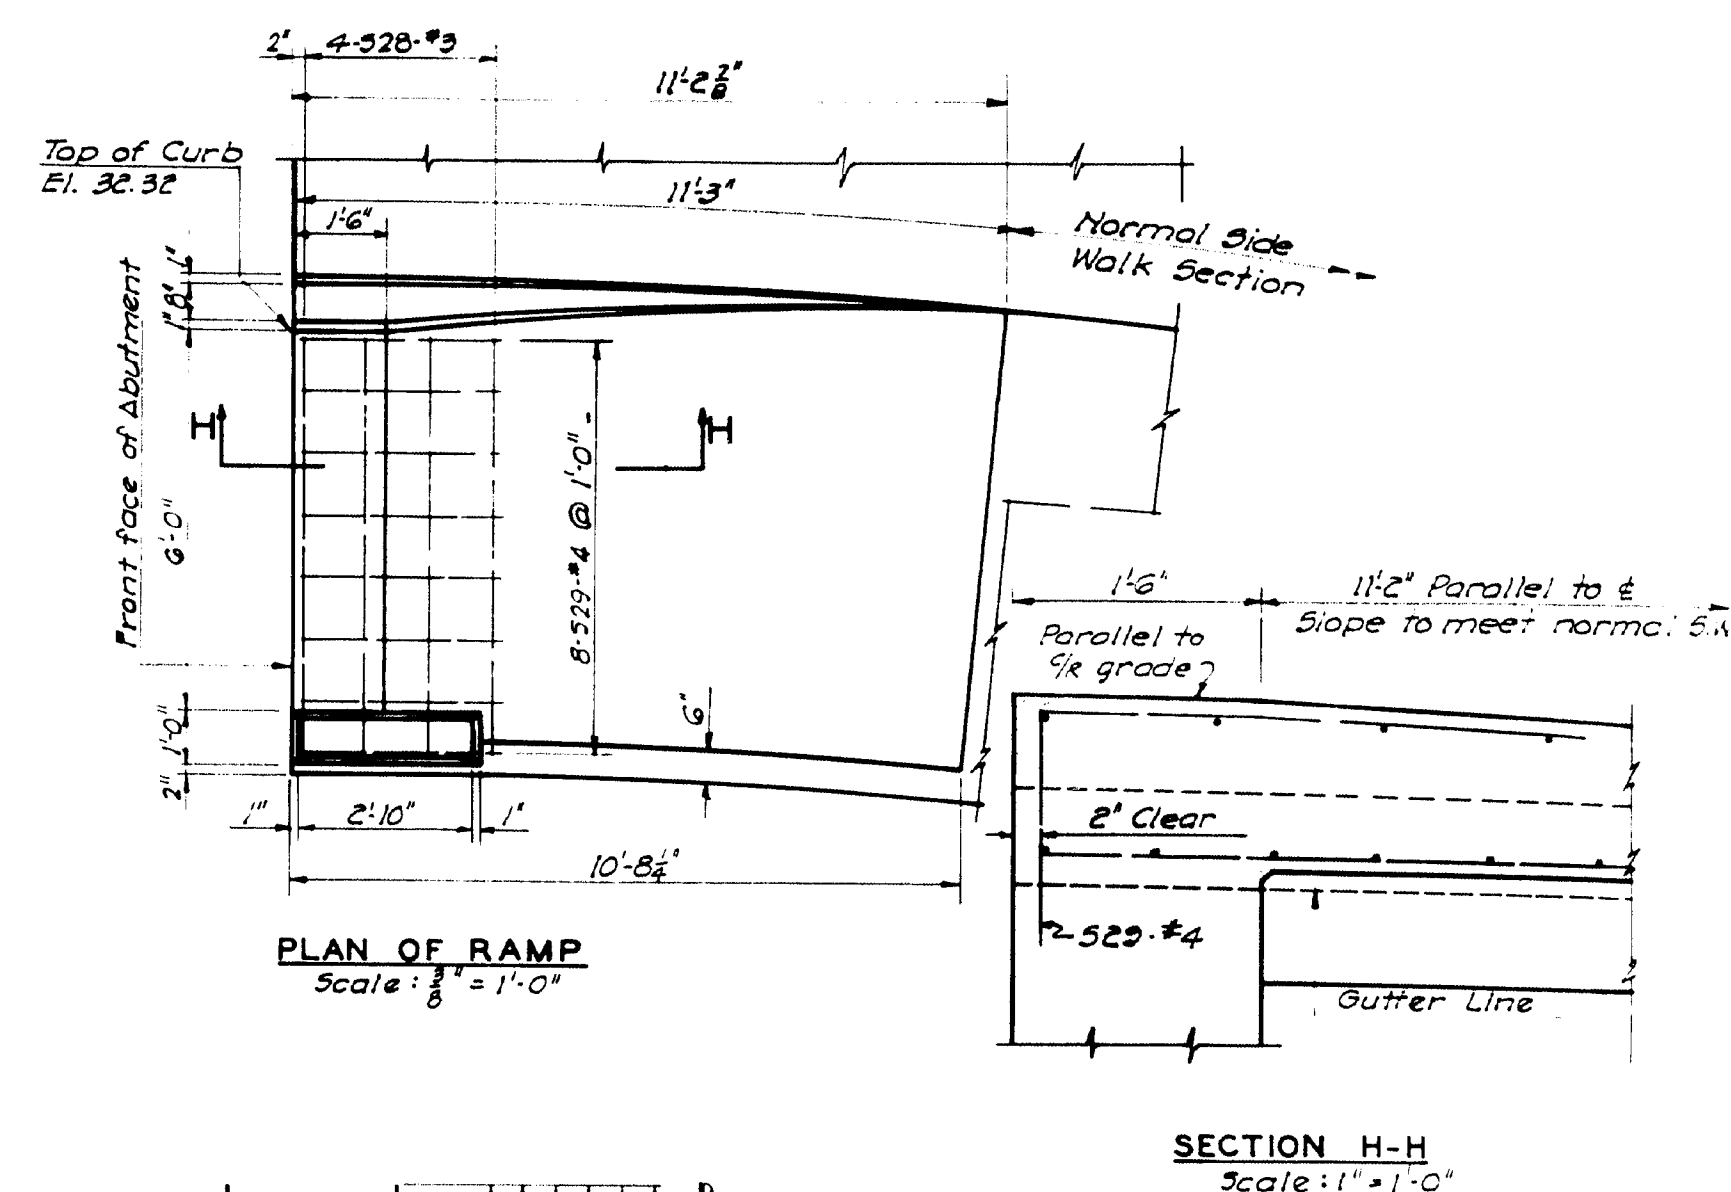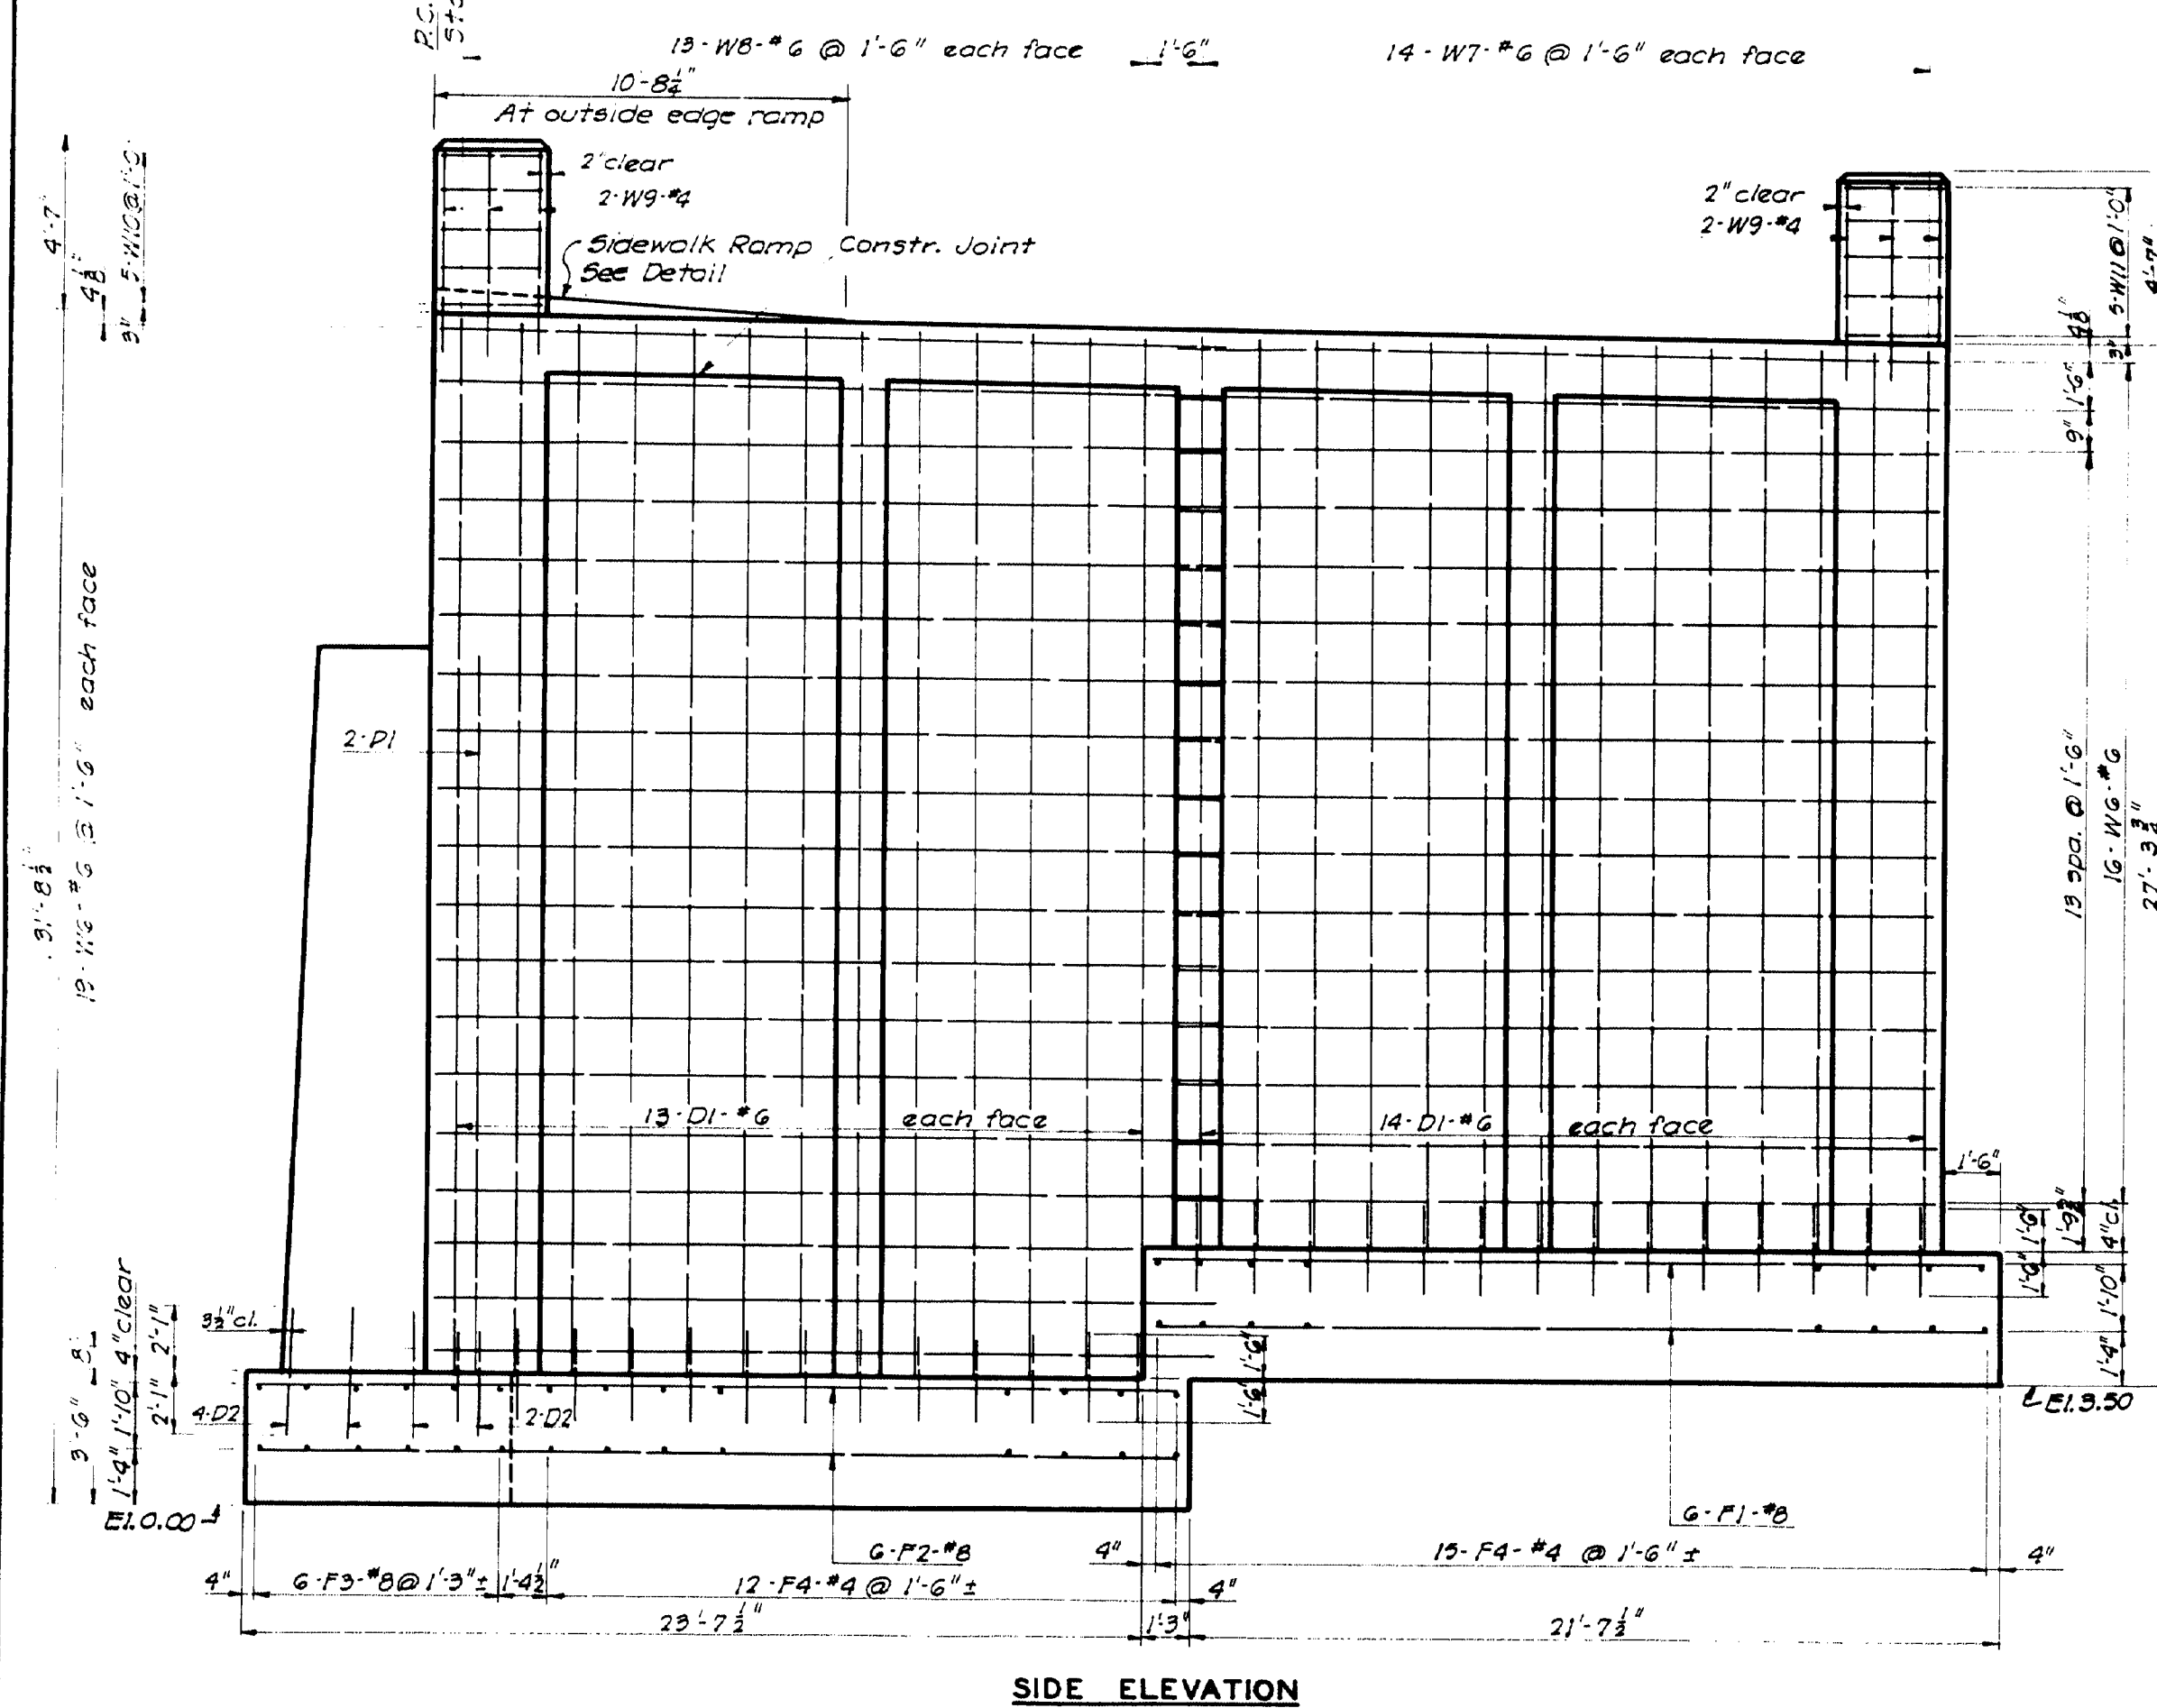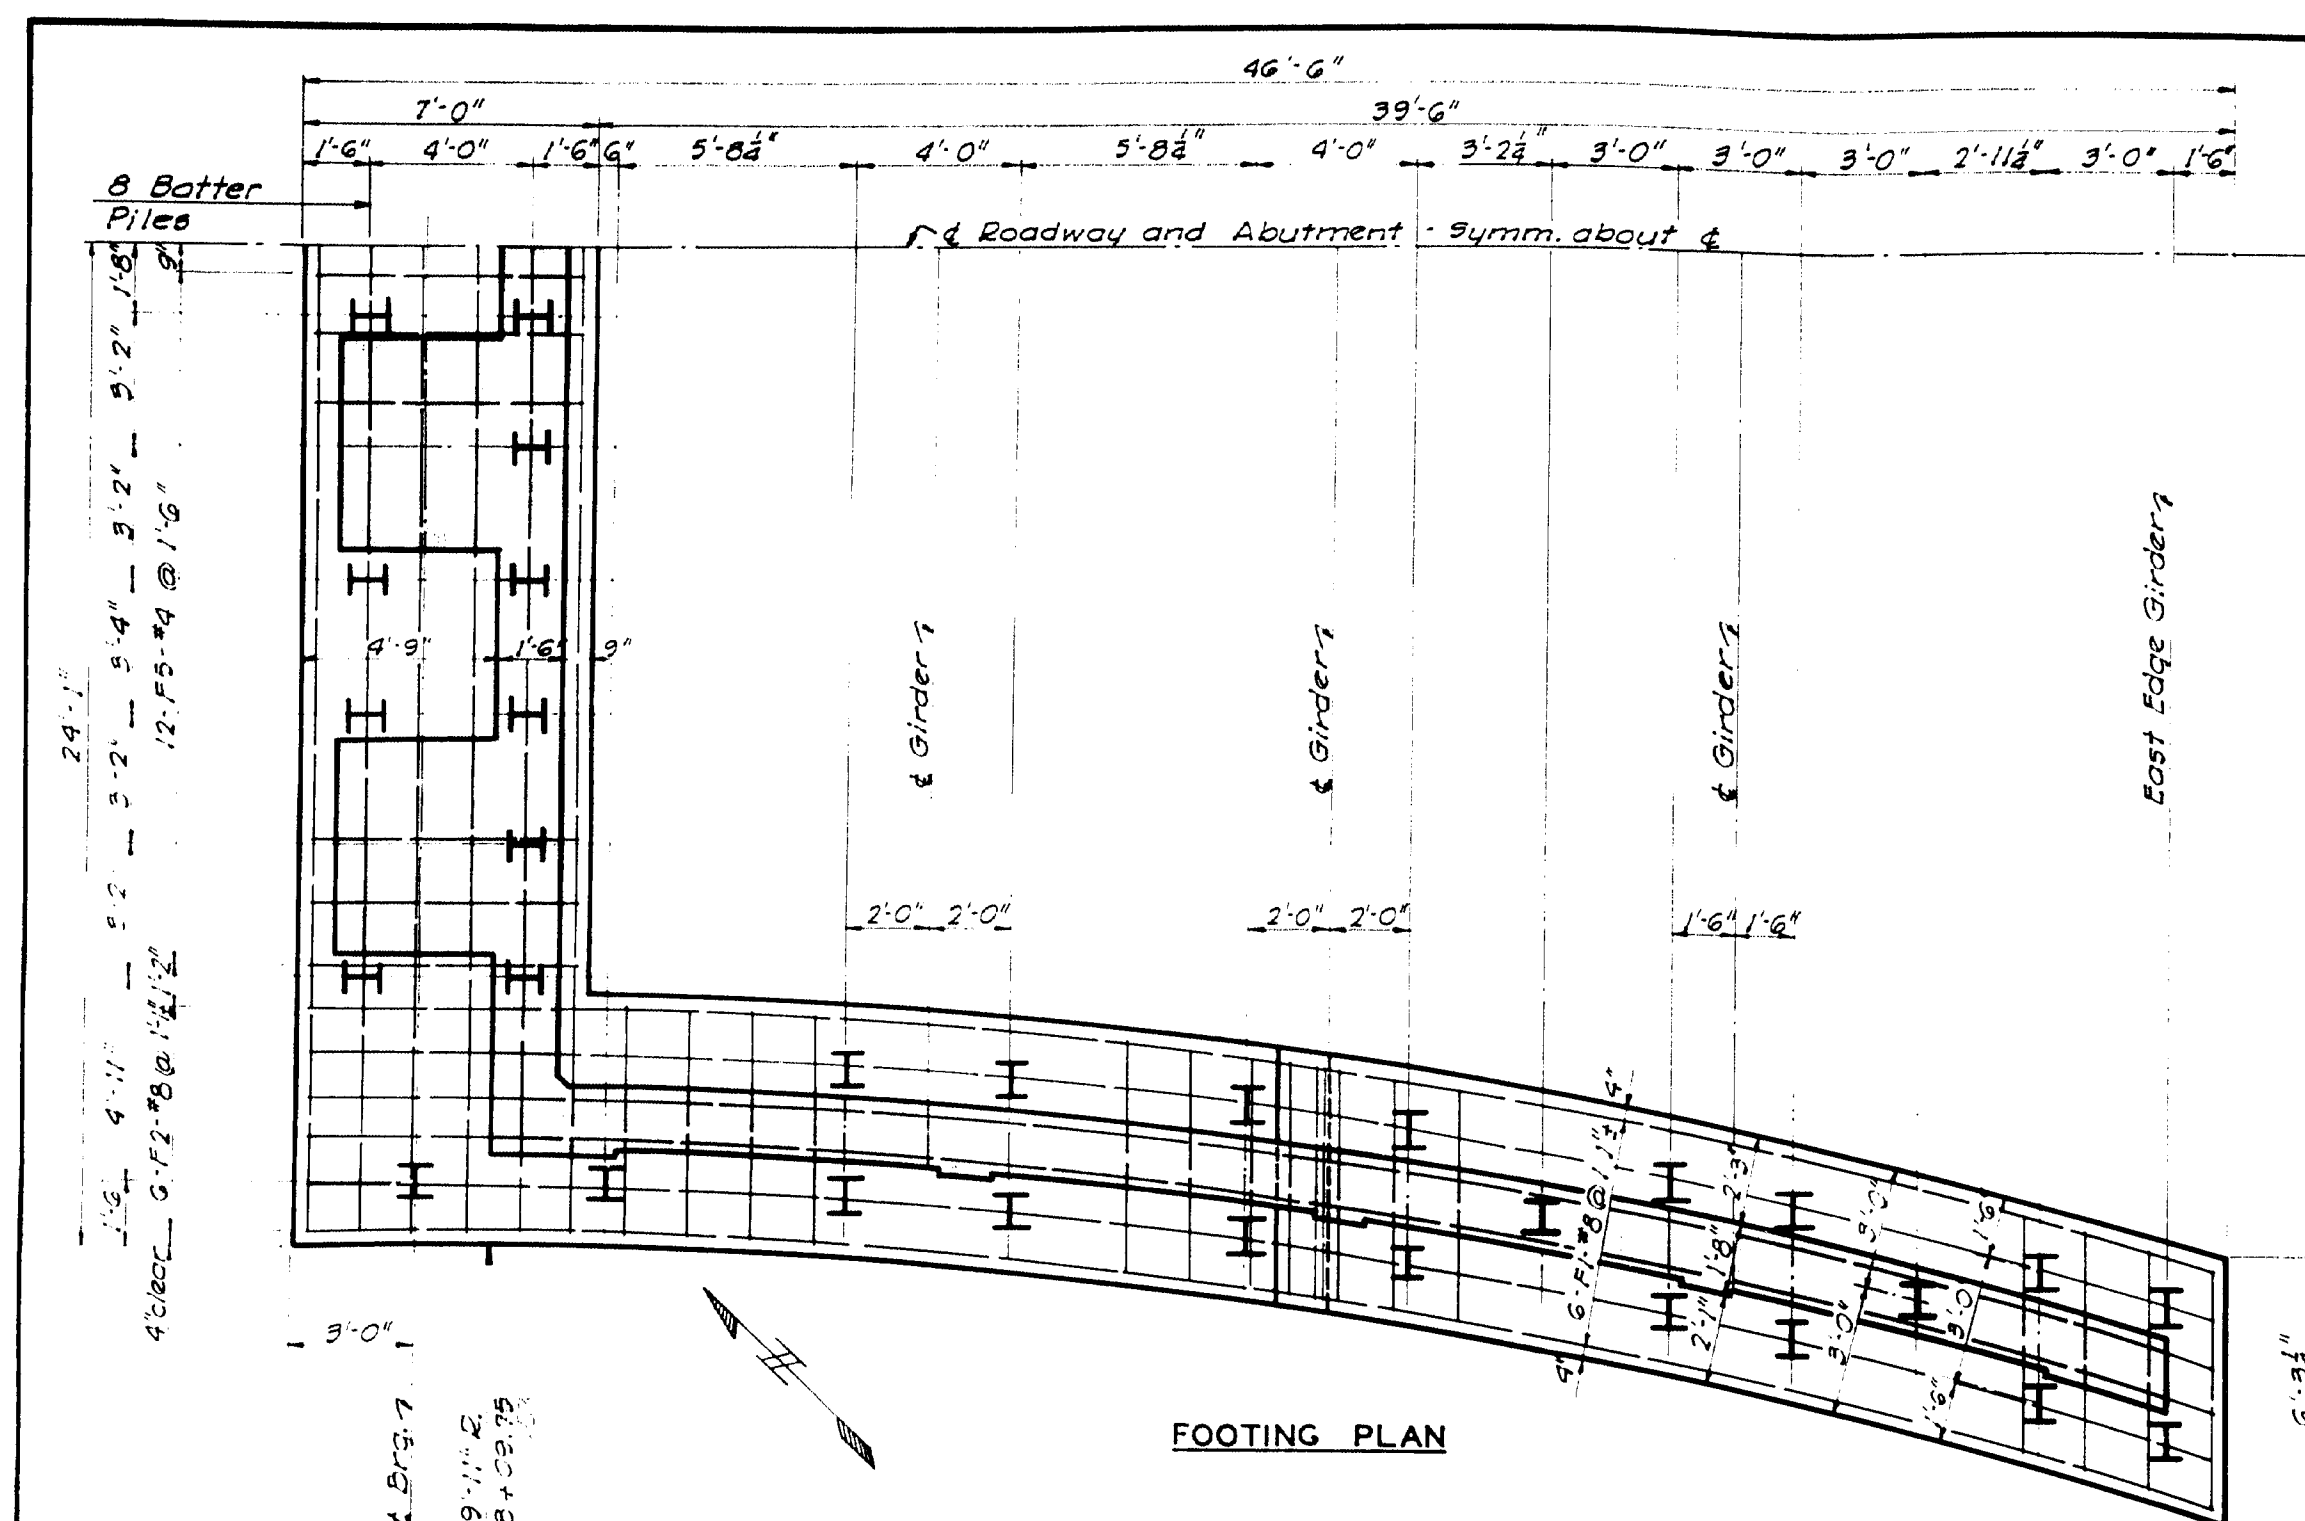

BILL OF REINFORCING									
Mk.	No.	Size	Shape	Length	Mk.	No.	Size	Shape	Length
519	G	4	—	37' 4"	B1	97	4		19' 0"
520	5	4	—	98' 10"	B2	6	10		46' 6"
521	1	4	—	40' 4"	B3	4	10		40' 0"
522	12	5	—	40' 0"	B4	2	10		46' 8"
523	36	4	—	21' 0"	B5	2	10		41' 0"
524	192	3	—	7' 9"	B6	6	10		48' 6"
525	54	4	—	5' 0"	B7	2	10		44' 0"
526	16	4	—	4' 2"	B8	2	10		48' 0"
527	82	3		3' 0"	B9	2	10		43' 0"
528	8	3		6' 11"	B10	32	4		16' 0"
529	16	4		5' 0"	B11	6	10		51' 10"
					B12	2	10		45' 2"
					B13	2	10		49' 2"
W1	60	G	—	22' 4"	B14	2	10		53' 10"
W2	68	G	—	22' 4"	B15	2	10		46' 0"
W3	4	G	—	14' 0"	B16	35	4		18' 0"
W4	4	G	—	9' 4"	B17	6	10		56' 7"
W5	8	G	—	20' 2"	B18	2	10		53' 1"
W6	140	G	—	20' 5"	B19	2	10		57' 1"
W7	56	G	—	23' 9"	B20	2	10		64' 5"
W8	52	G	—	27' 2"	B21	2	10		51' 0"
W9	24	4	—	5' 5"	B22	6	4		29' 8"
W10	10	4		7' 3"	B23	3	G		11' 4"
W11	10	4		7' 0"	B24	6	4		10' 5"
					B25	36	4		6' 0"
					B26	6	4		6' 8"

**NOTES:**

- All concrete shall be Class "A".
- Bevel all exposed edges with  $\frac{3}{4}" \Delta$  molding except as shown.
- Fillet as shown shall be  $2" \Delta$
- Grain tile shall not be paid for directly but shall be included in unit price for Class "A" concrete.
- For Handrail Details see Sheet No. 18.
- For Expansion Joint Details see Sheet No. 19.
- Fills shall be placed and compacted so that the elevation inside and outside of walls is about the same at all times.
- All construction joints shall be keyed. Both horiz. and vert. joints.
- Crown of Roadway elevations shown are to top of 2" Bituminous Concrete Surface.
- Design Pile Loads:
  - DL = 26.7 T/Pile Maximum
  - DL + LL = 34.3 T/Pile Maximum
- Gravel borrow shall be placed to bottom of footing prior to driving piling. See Sheet No. 41.
- Reinforcing under bearing plates shall be placed to clear anchor bolts.

STATE OF MAINE  
HIGHWAY COMMISSION  
OR-BREWER BRIDGE  
PENOBSCOT RIVER  
BANGOR, MAINE

---

BREWER ABUTMENT








HARRINGTON AND CORTELYOU  
CONSULTING ENGINEERS  
KANSAS CITY, MO.

R. 8-7-92  
D. 12-5-92  
E.W. 1-15-93

SCALE:  $\frac{1}{4}'' = 1'-0''$


SHEET NO. 10




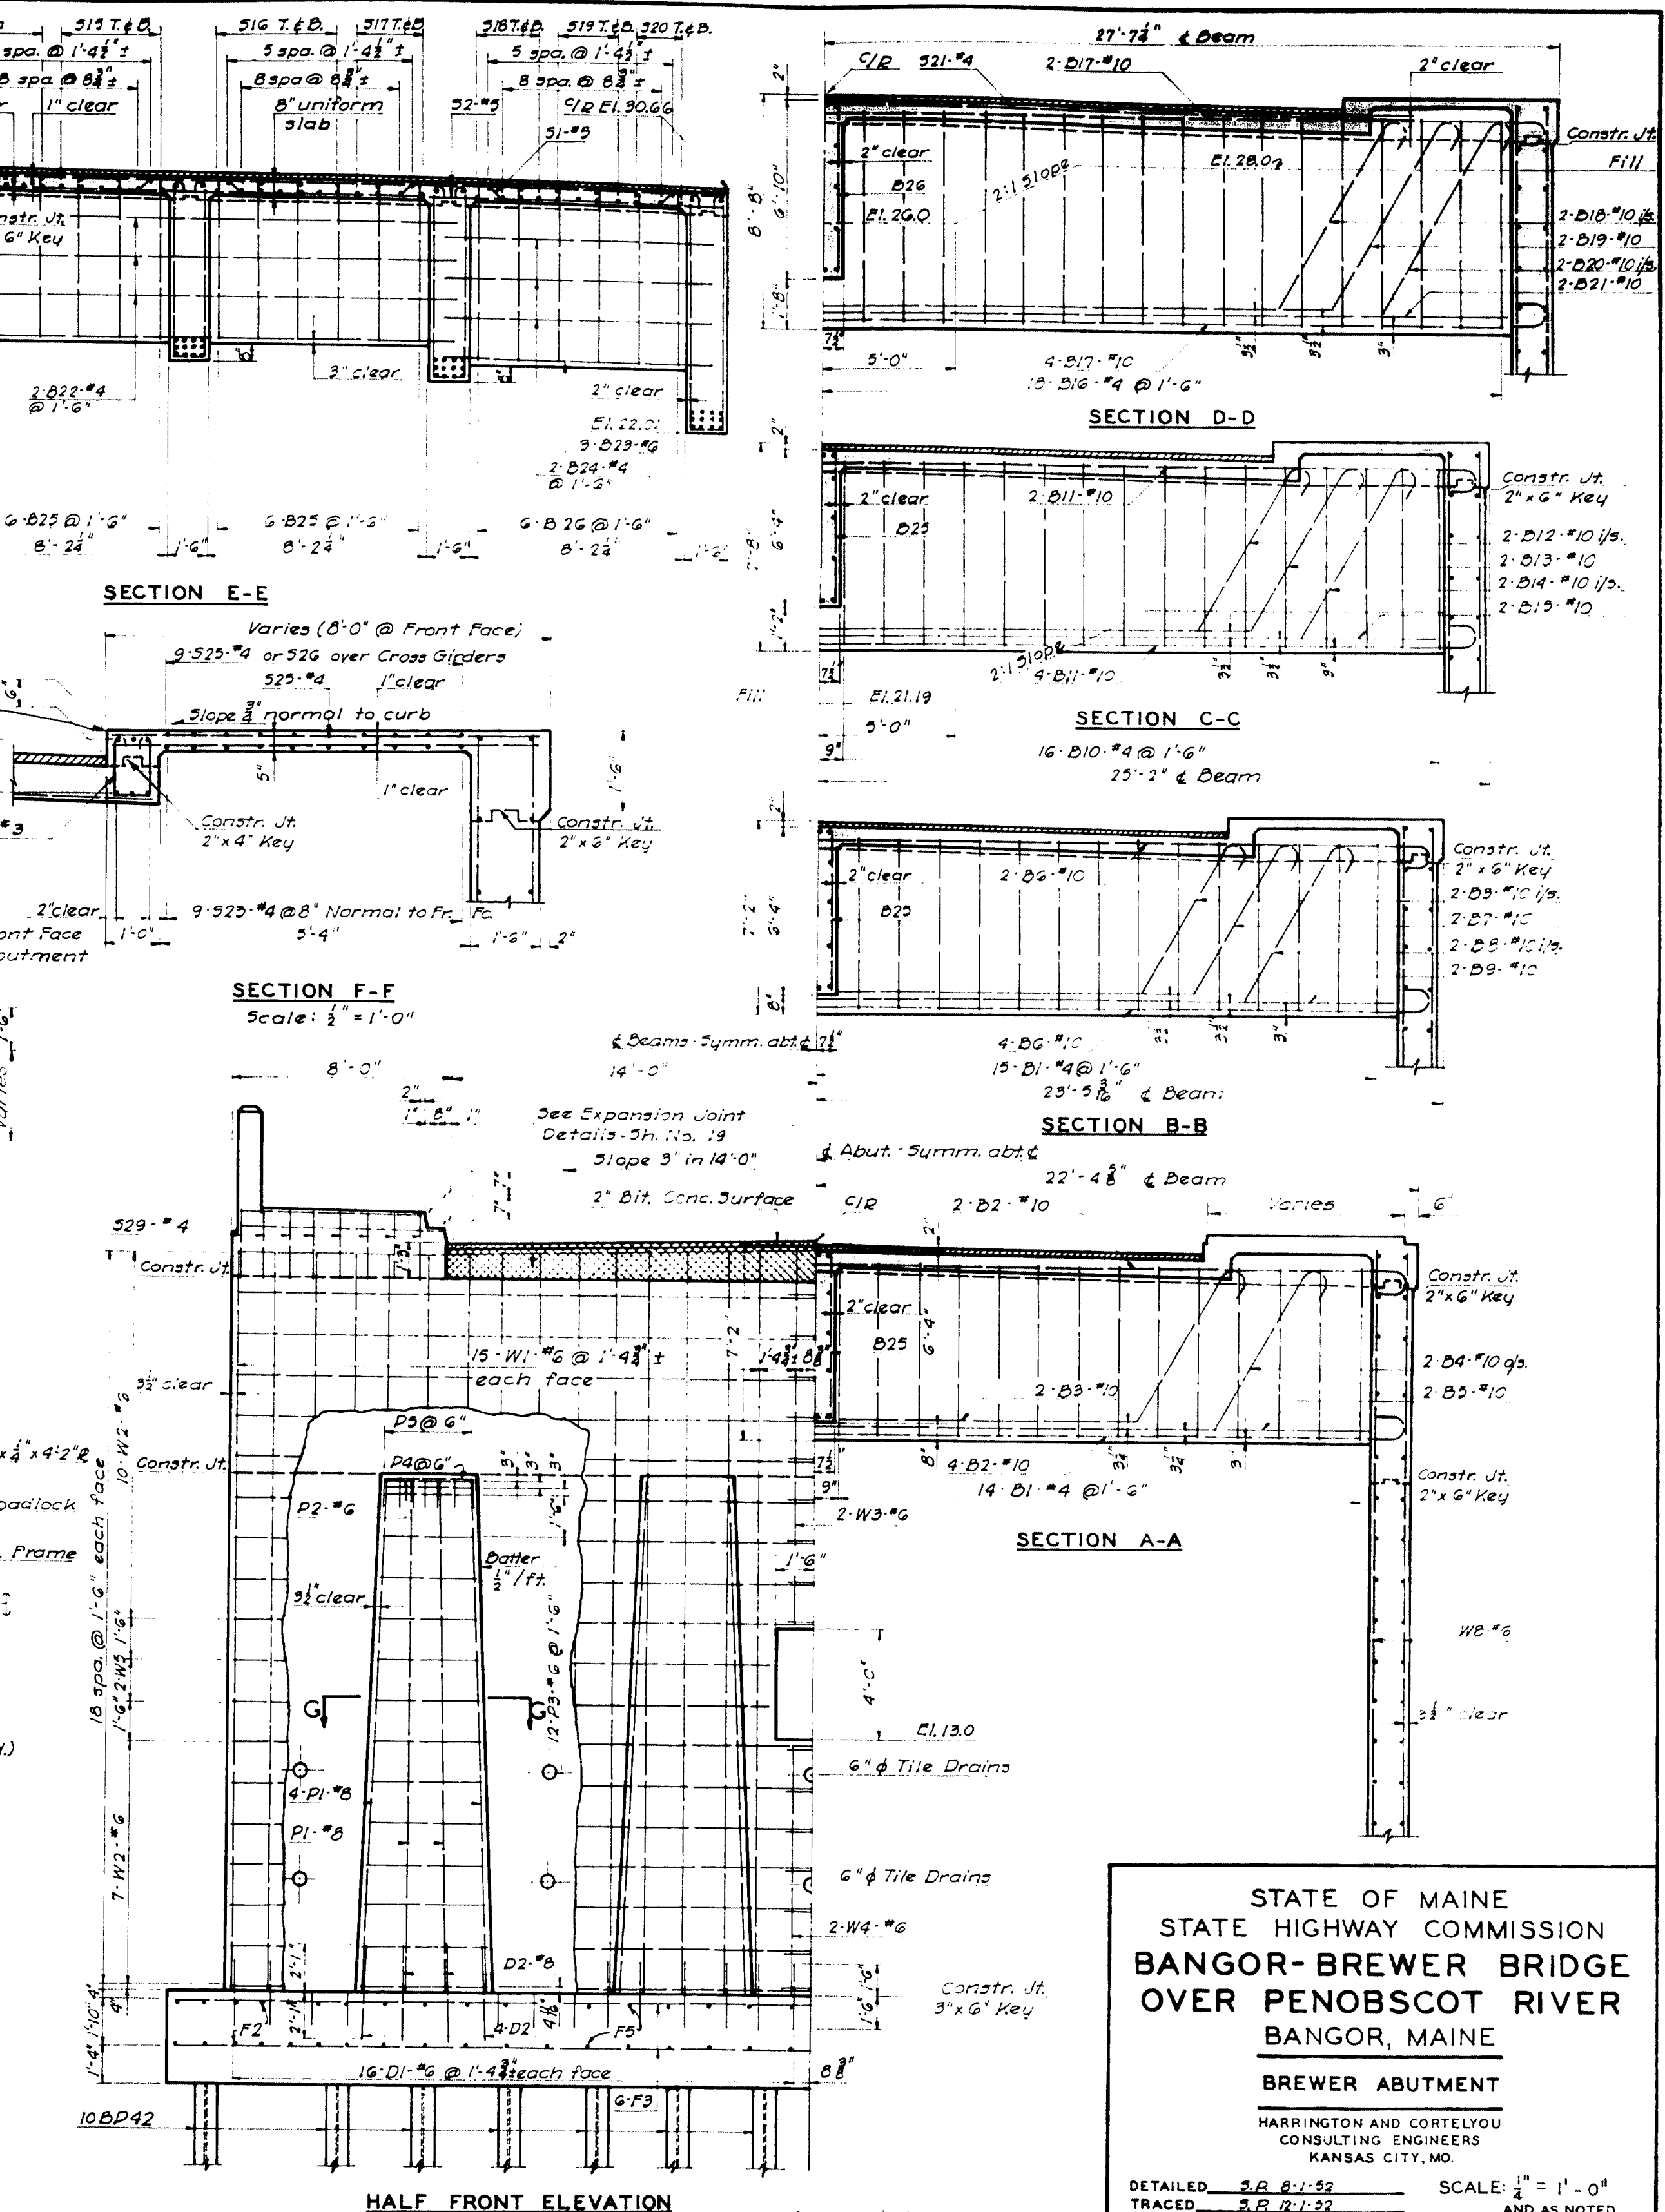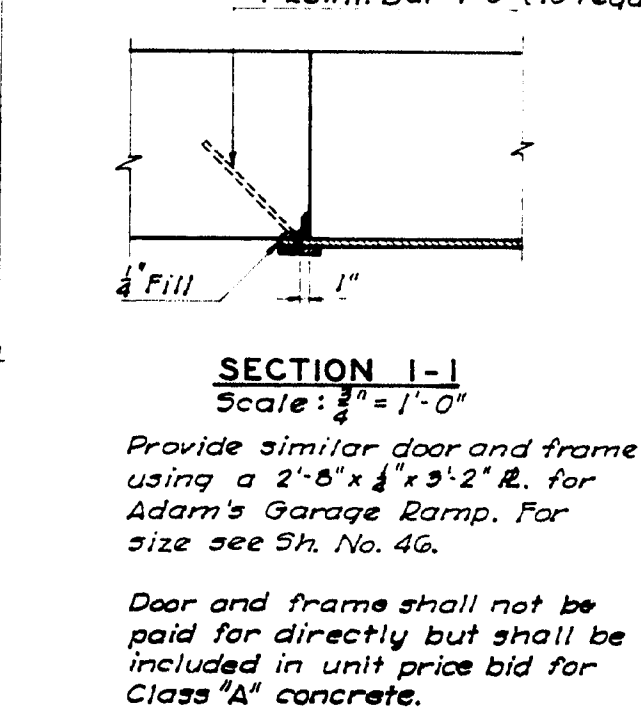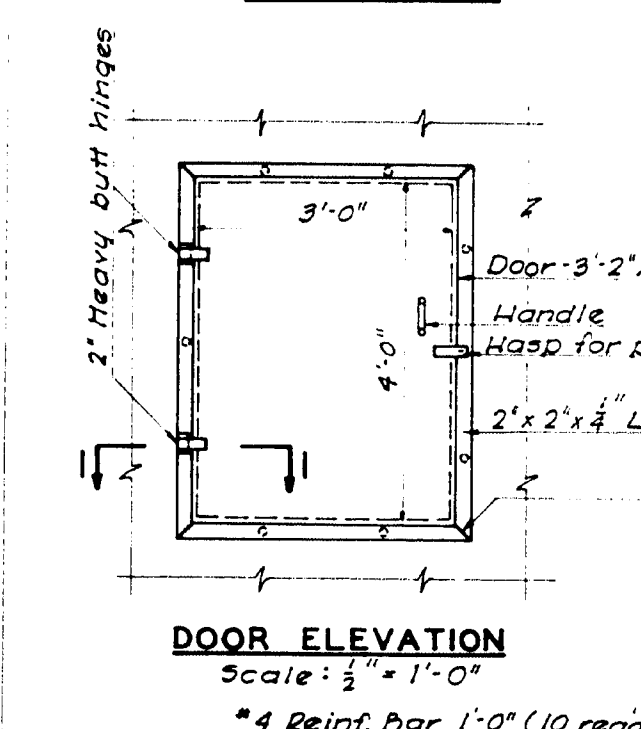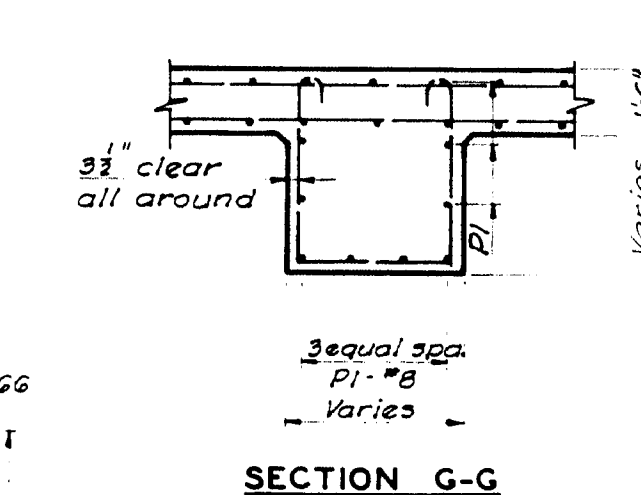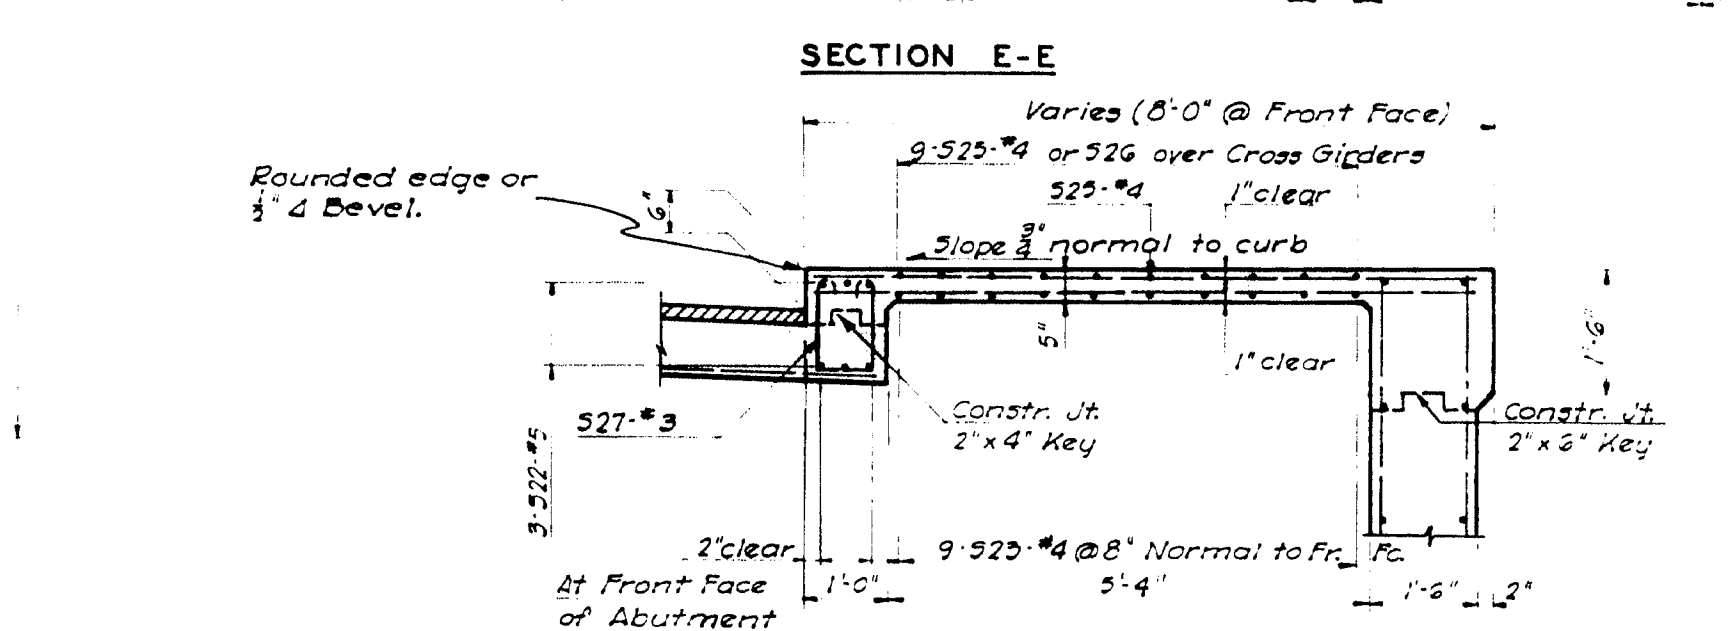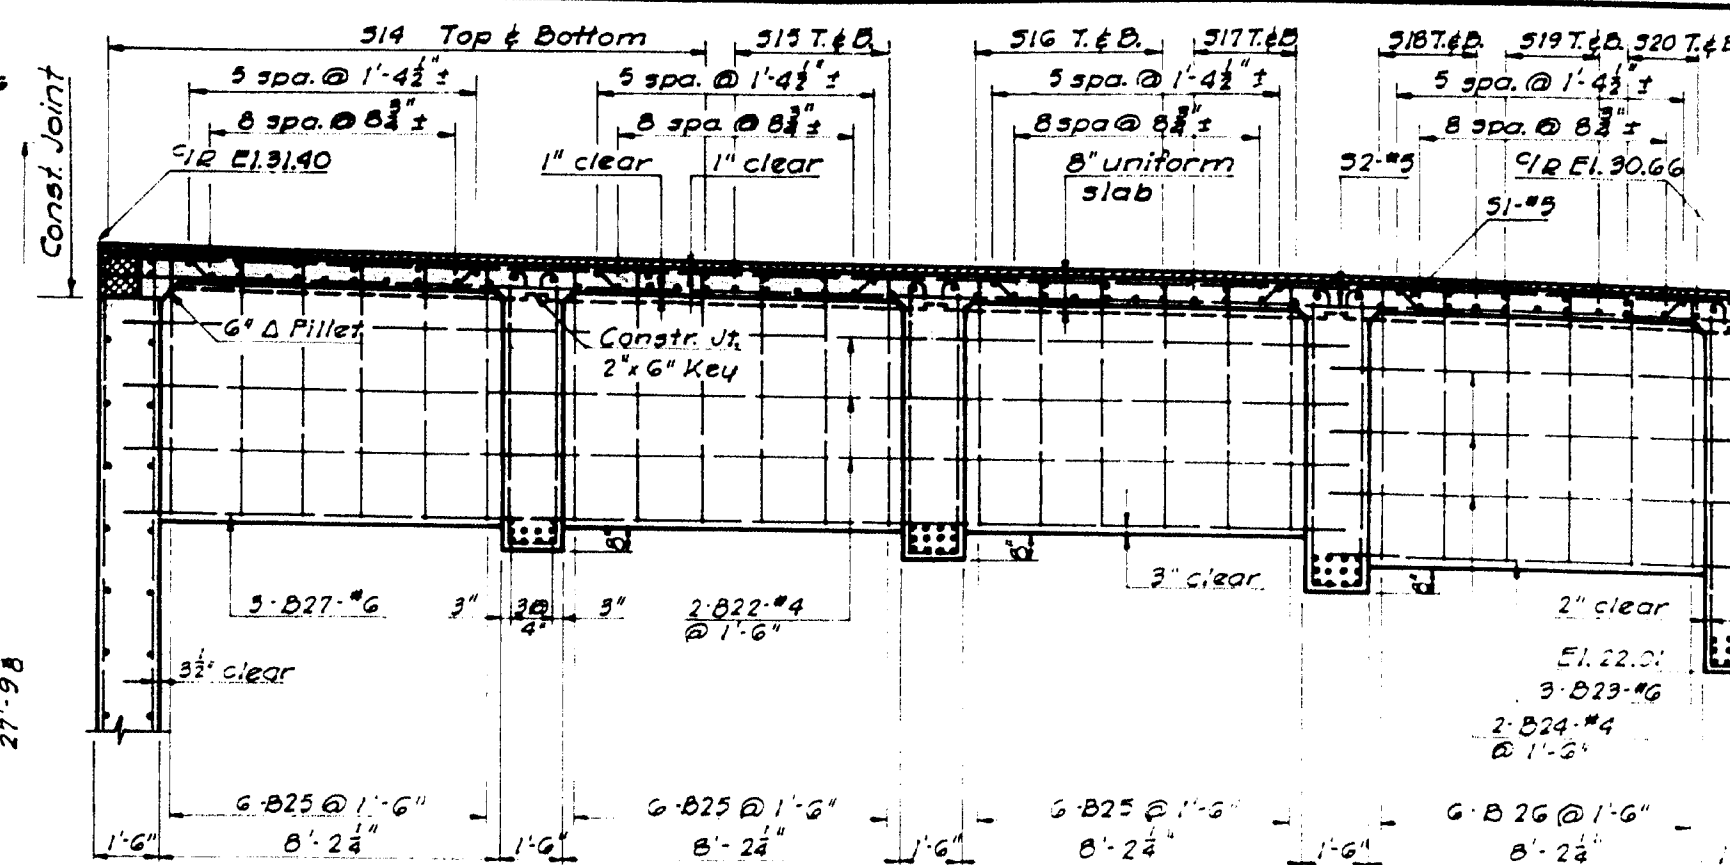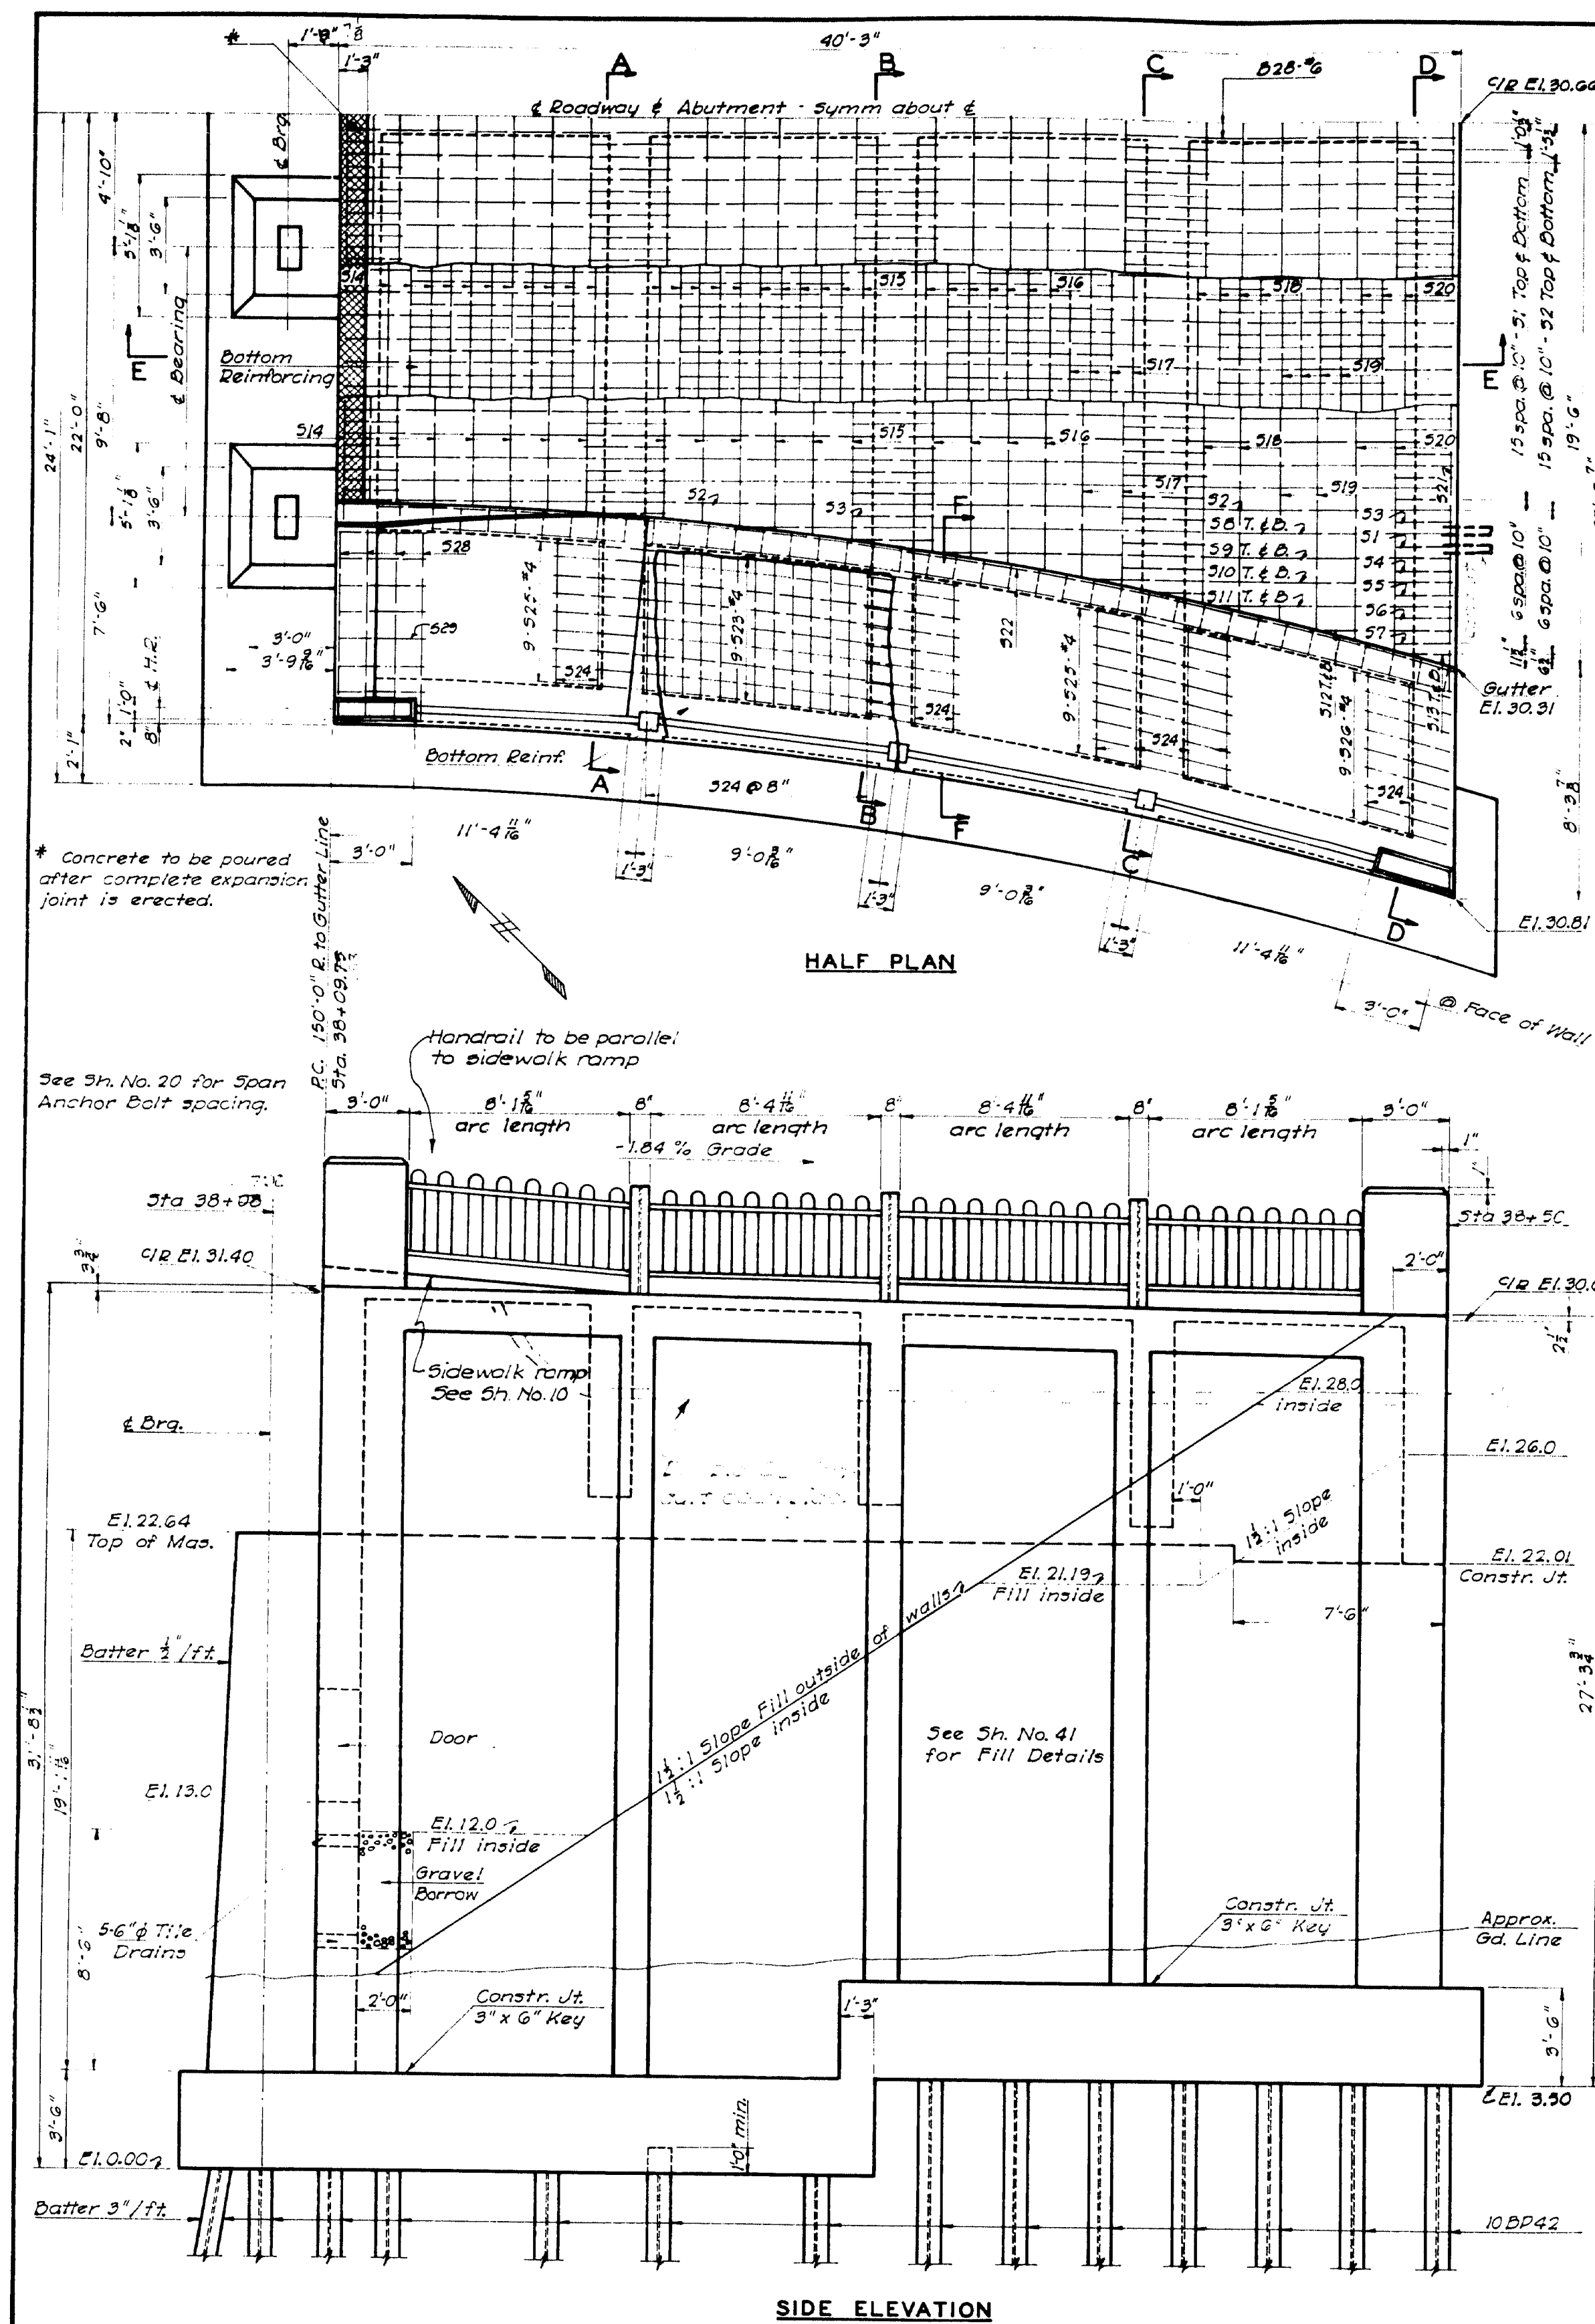


STATE OF MAINE  
STATE HIGHWAY COMMISSION  
**BANGOR-BREWER BRIDGE  
OVER PENOBSCOT RIVER**  
BANGOR, MAINE  
**BREWER ABUTMENT**  
HARRINGTON AND CORTELYOU  
CONSULTING ENGINEERS  
KANSAS CITY, MO.

DETAILED 3.2.81.32 SCALE: 1" = 1'-0"  
TRACED 3.2.12.32 AND AS NOTED  
CHECKED 2.2.12.32 SHEET NO. 11

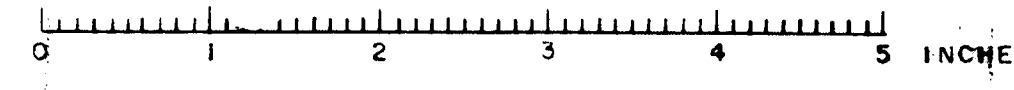

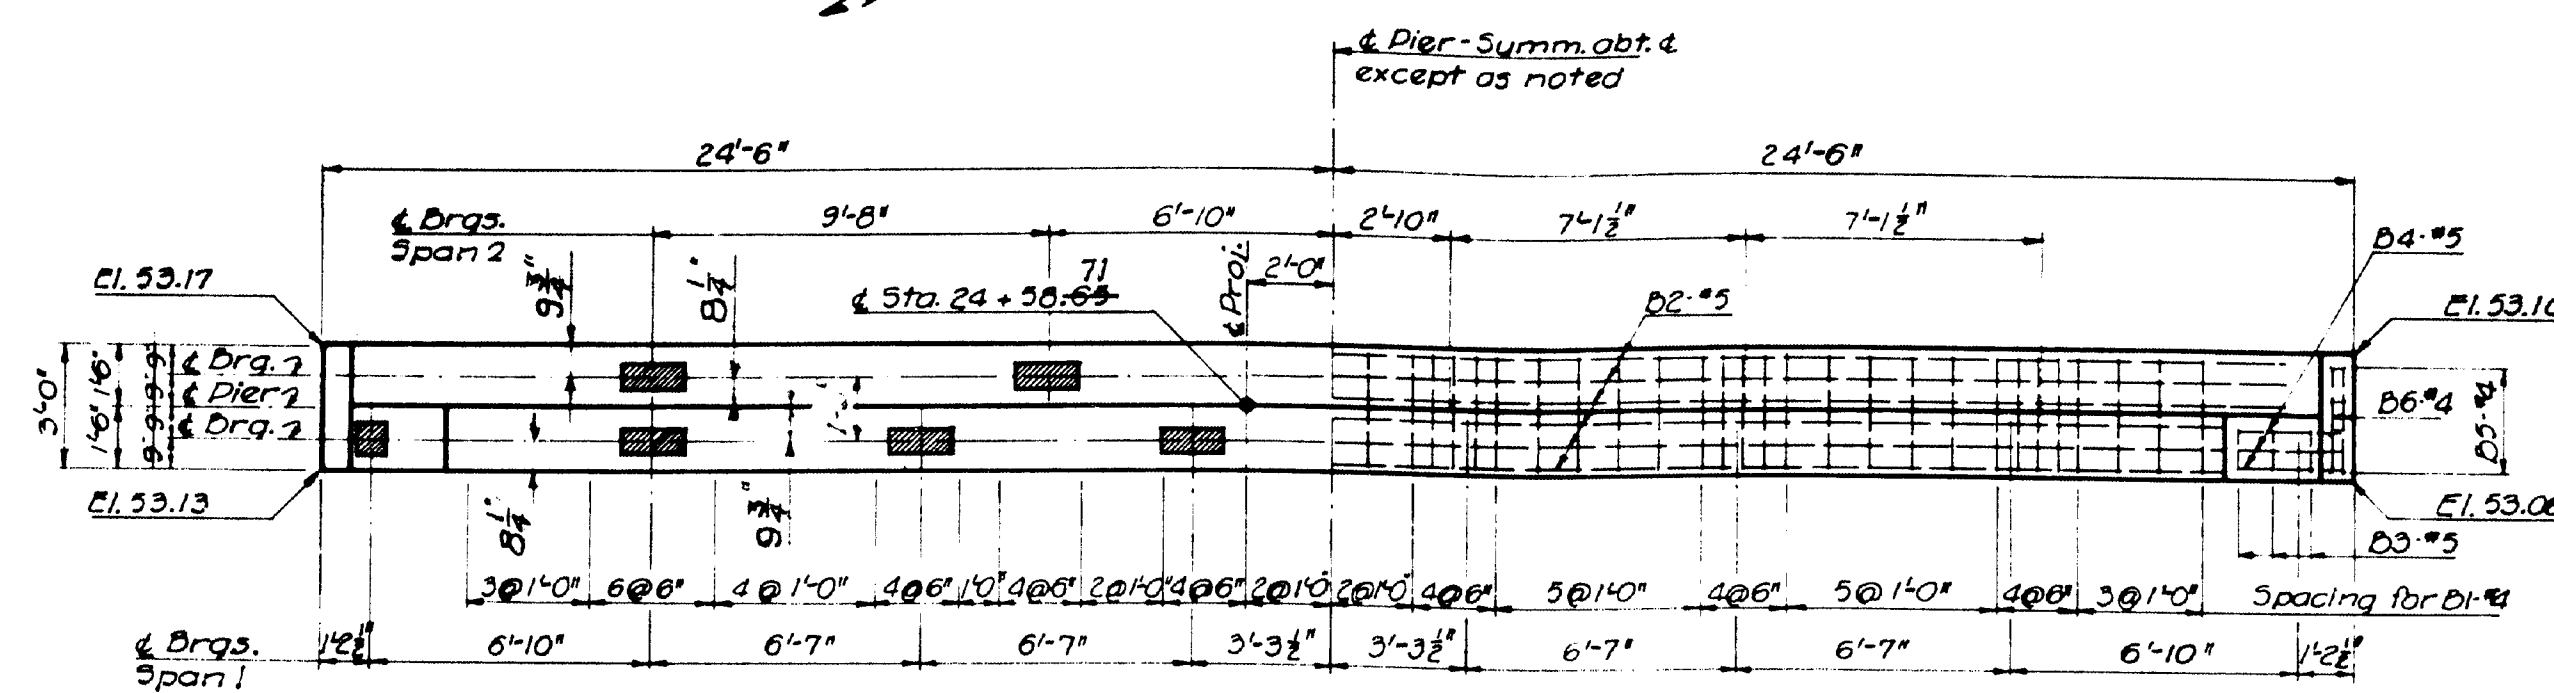


PLAN

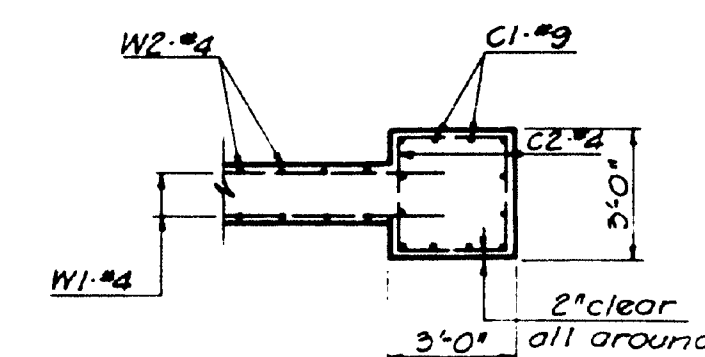


SECTION B-B


BILL OF REINFORCING				
	Mk.	No.	Size	Shape
Pier 1	D1	30	4	
	D2	13	5	
	D3	6	5	
	D4	6	5	
	D5	6	4	
	D6	20	4	
Pier 2	C1	12	9	
	C2	24	9	
	C3	24	5	
	F1	24	7	
	F2	40	5	
	W1	40	4	
Pier 3	W2	43	4	
	W3	2	11	
	W4	6	11	

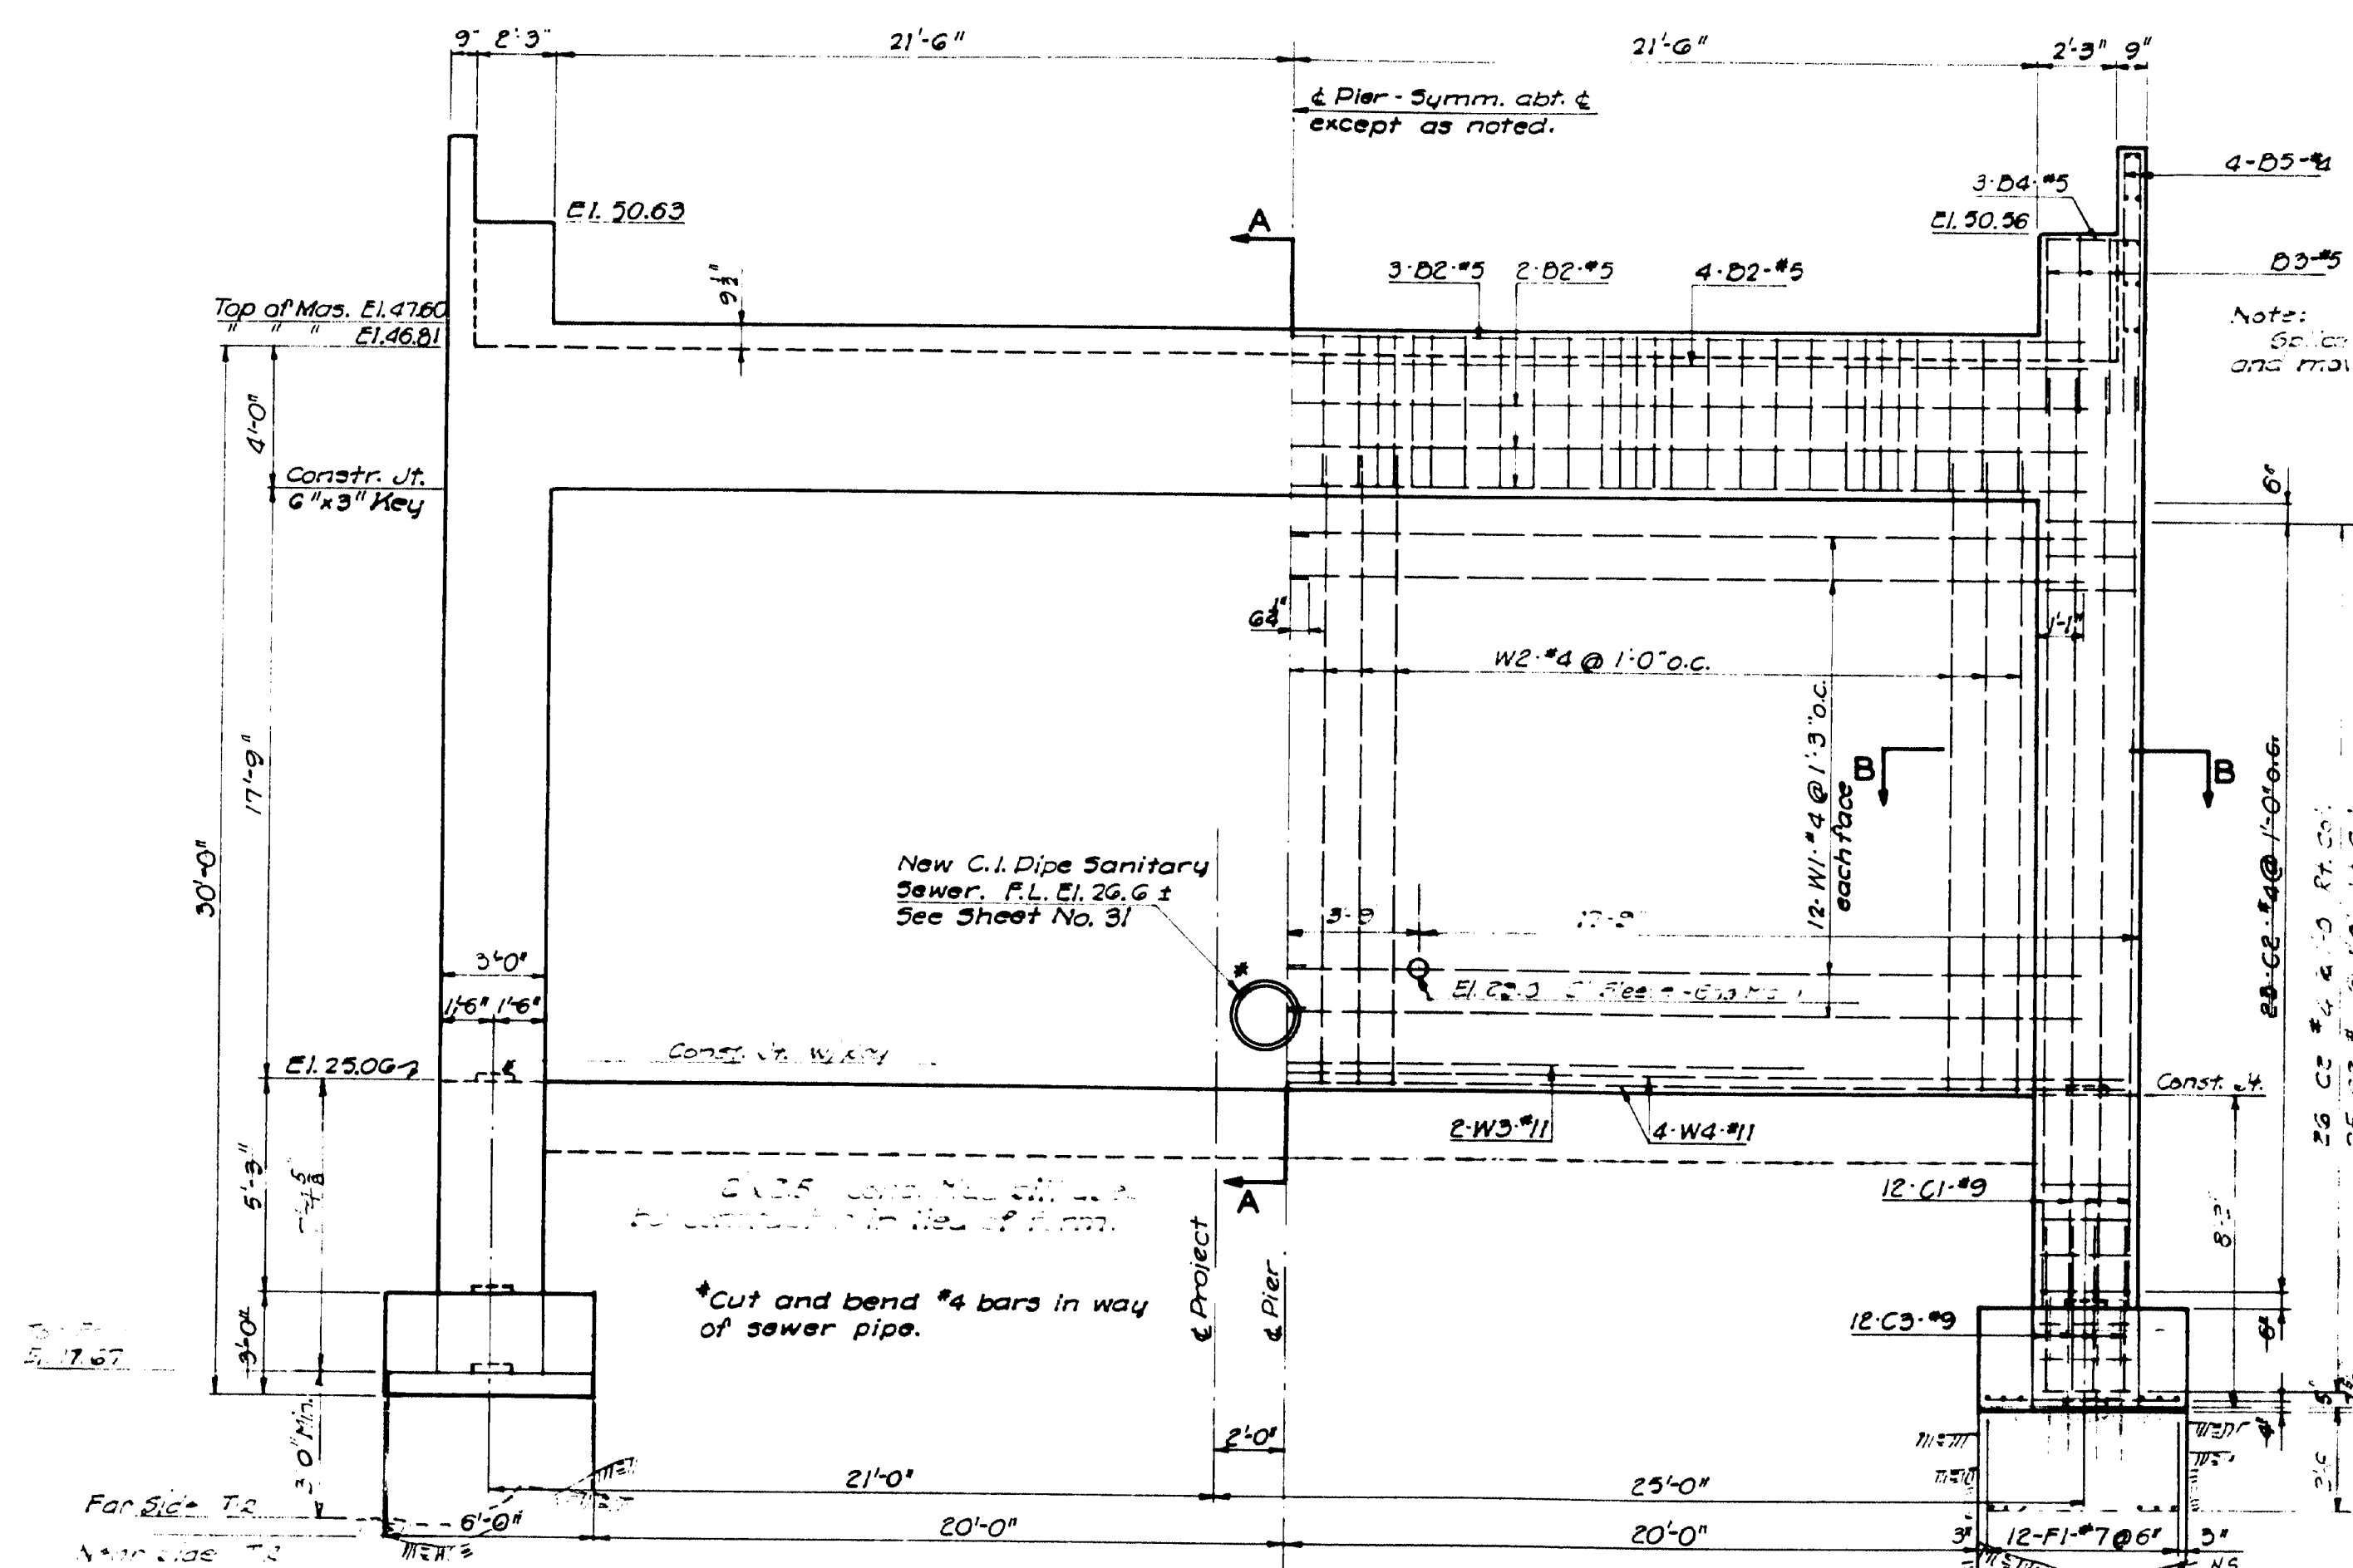


ELEVATION

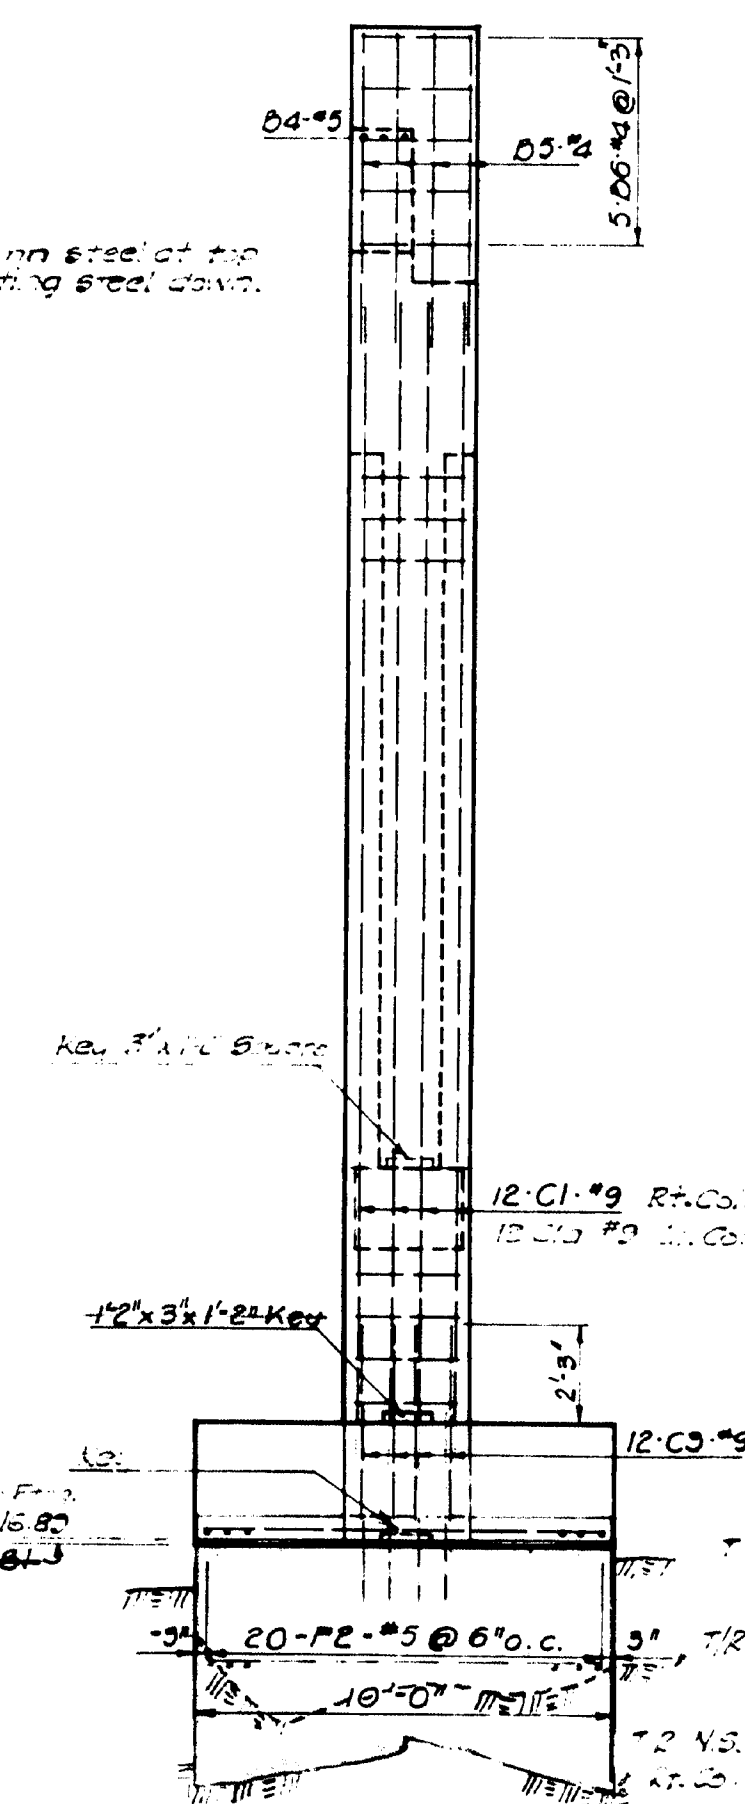

END VIEW

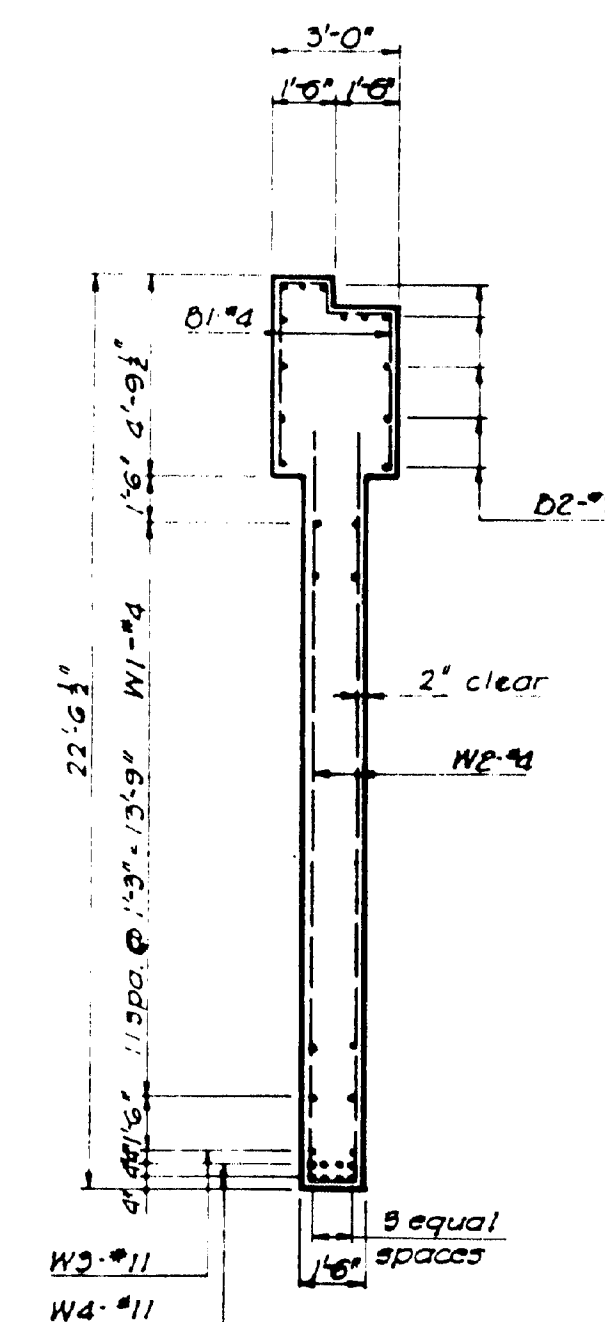

SECTION A-A

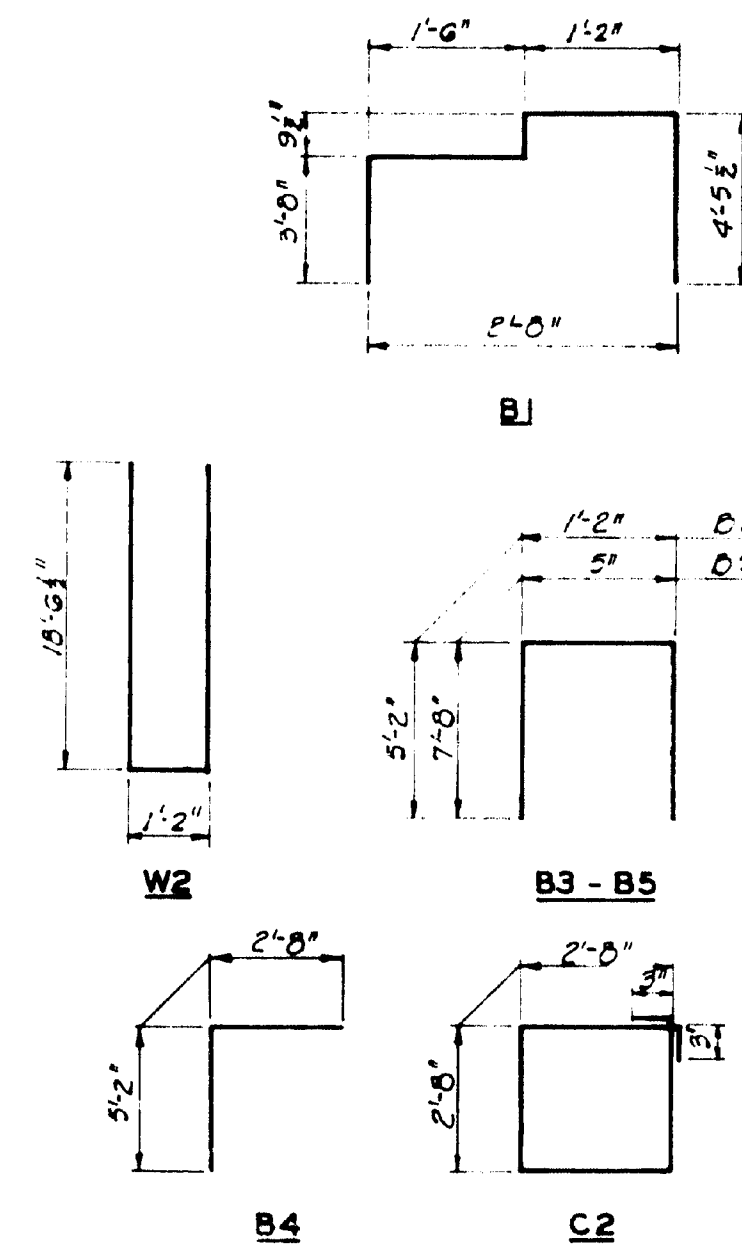

BENDING DIAGRAMS

NOTES:  
For General Notes see Sheet No. 14.  
Maximum Design Footing Pressure:  
DL + LL = 4.8 Tons/sq'

STATE OF MAINE  
STATE HIGHWAY COMMISSION  
BANGOR-BREWER BRIDGE  
OVER PENOBSCOT RIVER  
BANGOR, MAINE

PIER 1

HARRINGTON AND CORTELYOU  
CONSULTING ENGINEERS  
KANSAS CITY, MO.

AS BUILT DRAWING  
HARRINGTON & CORTELYOU  
Consulting Engineers  
C.R.W. - L.E.W. 3-0-5-5





DETAILED 3-10-27-32  
TRACED 11-6-32  
CHECKED 1-15-53

SCALE: 1" = 1'-0"  
SHEET NO. 12

62-12








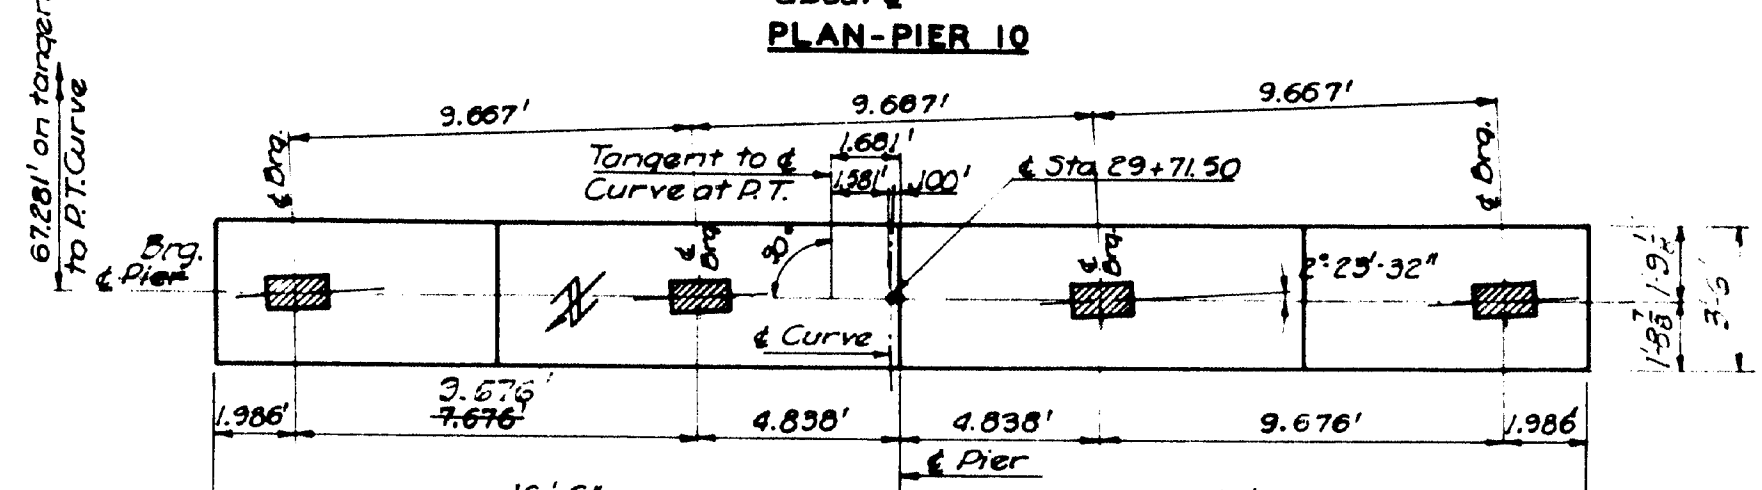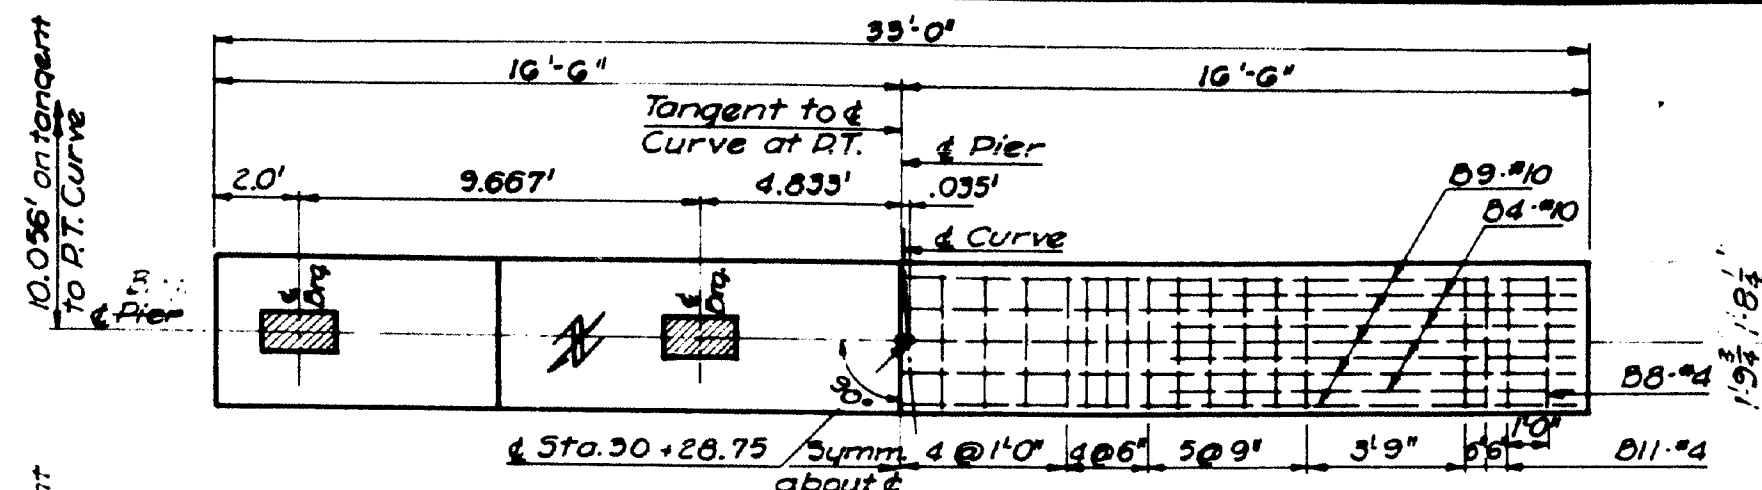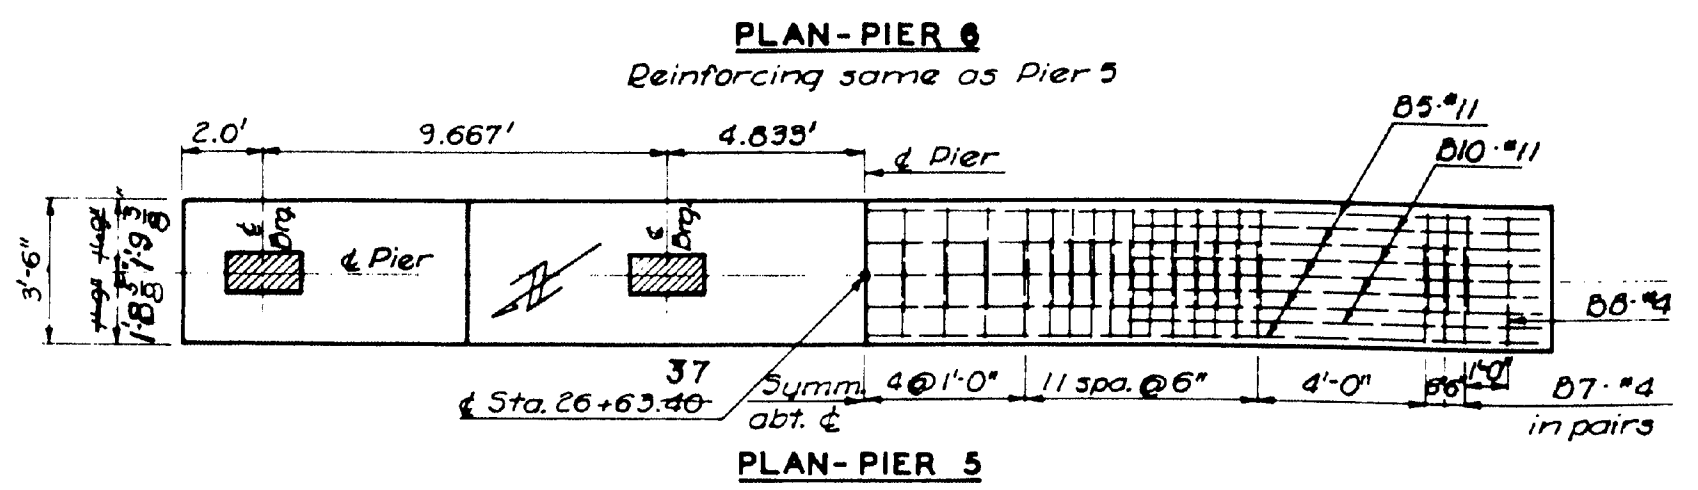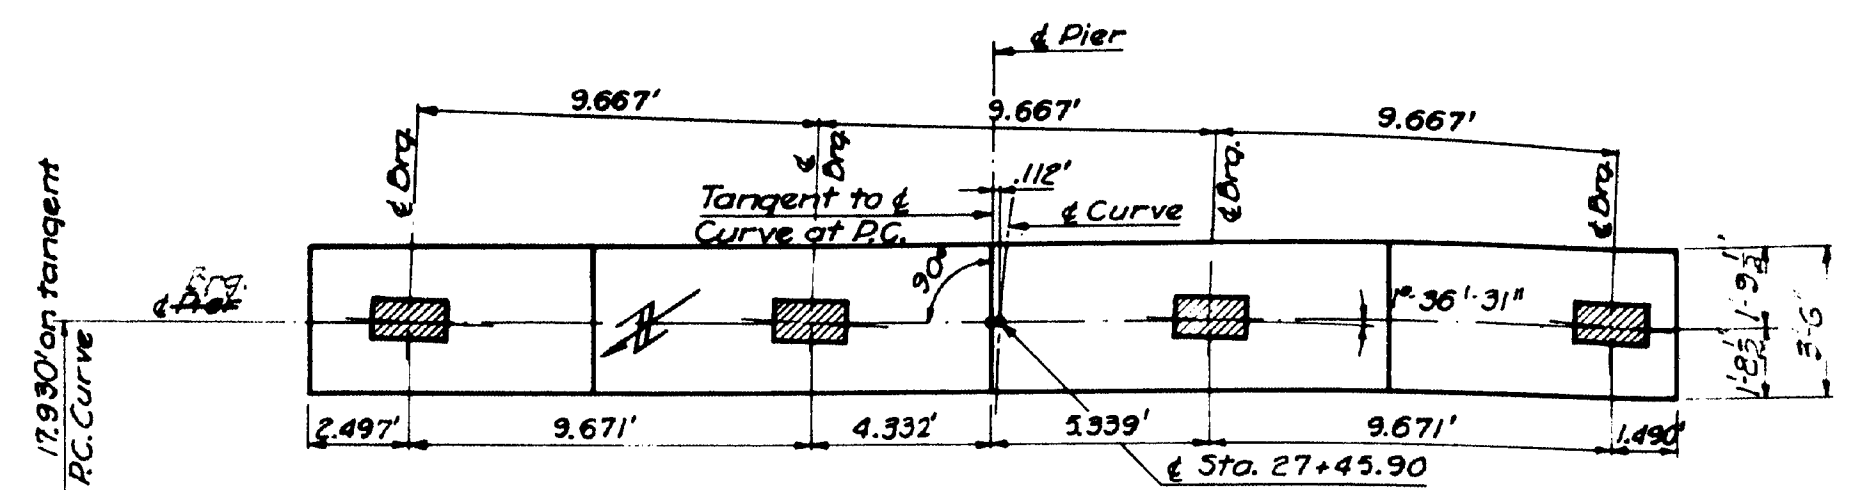

Pier	Mk.	No.	Size	Shape	Length
Pier 5	B1	3	9		15' 0"
	B2	4	11		17' 0"
	B3	5	11		34' 6"
	B4	8	10		9' 9"
	B5	5	11		32' 8"
	B6	2	5		32' 8"
	B7	74	4		15' 8"
	B8	2	4		15' 2"
	B9	5	10		32' 8"
	B10	33	4		15' 2"
Pier 6	C1	24	9		4' 6"
	C2	24	9		36' 0"
	C3	12	9		15' 2"
	C4	12	9		40' 0"
	C5	12	9		39' 2"
	F1	72	6		8' 6"

BILL OF REINFORCING					
	Mk.	No.	Size	Shape	Length
Pier	B2	4	11	—	17' 0"
9	B3	5	11	⌒	34' 6"
	B4	8	10	—	9' 9"
	B5	5	11	—	32' 8"
	B6	2	4	□	13' 2"
	B7	5	10	—	32' 8"
	B11	33	4	□	15' 2"
12 74	C1	24	9	—	4' 6"
	C5	24	9	—	43' 6"
	C7	74	4	□	13' 2"
	C56	12	9	—	39' 2"
	F2	64	6	—	7' 6"
Pier	B2	4	11	—	17' 0"
10	B3	5	11	⌒	34' 6"
	B4	8	10	—	9' 9"
	B6	2	5	—	32' 8"
	B8	2	4	□	13' 2"
	B9	5	10	—	32' 8"
	B11	33	4	□	15' 2"
13 84	C1	24	9	—	4' 6"
	C6	24	9	—	50' 6"
	C7	74	4	□	13' 2"
	C56	12	9	—	45' 1"
	F2	64	6	—	7' 6"

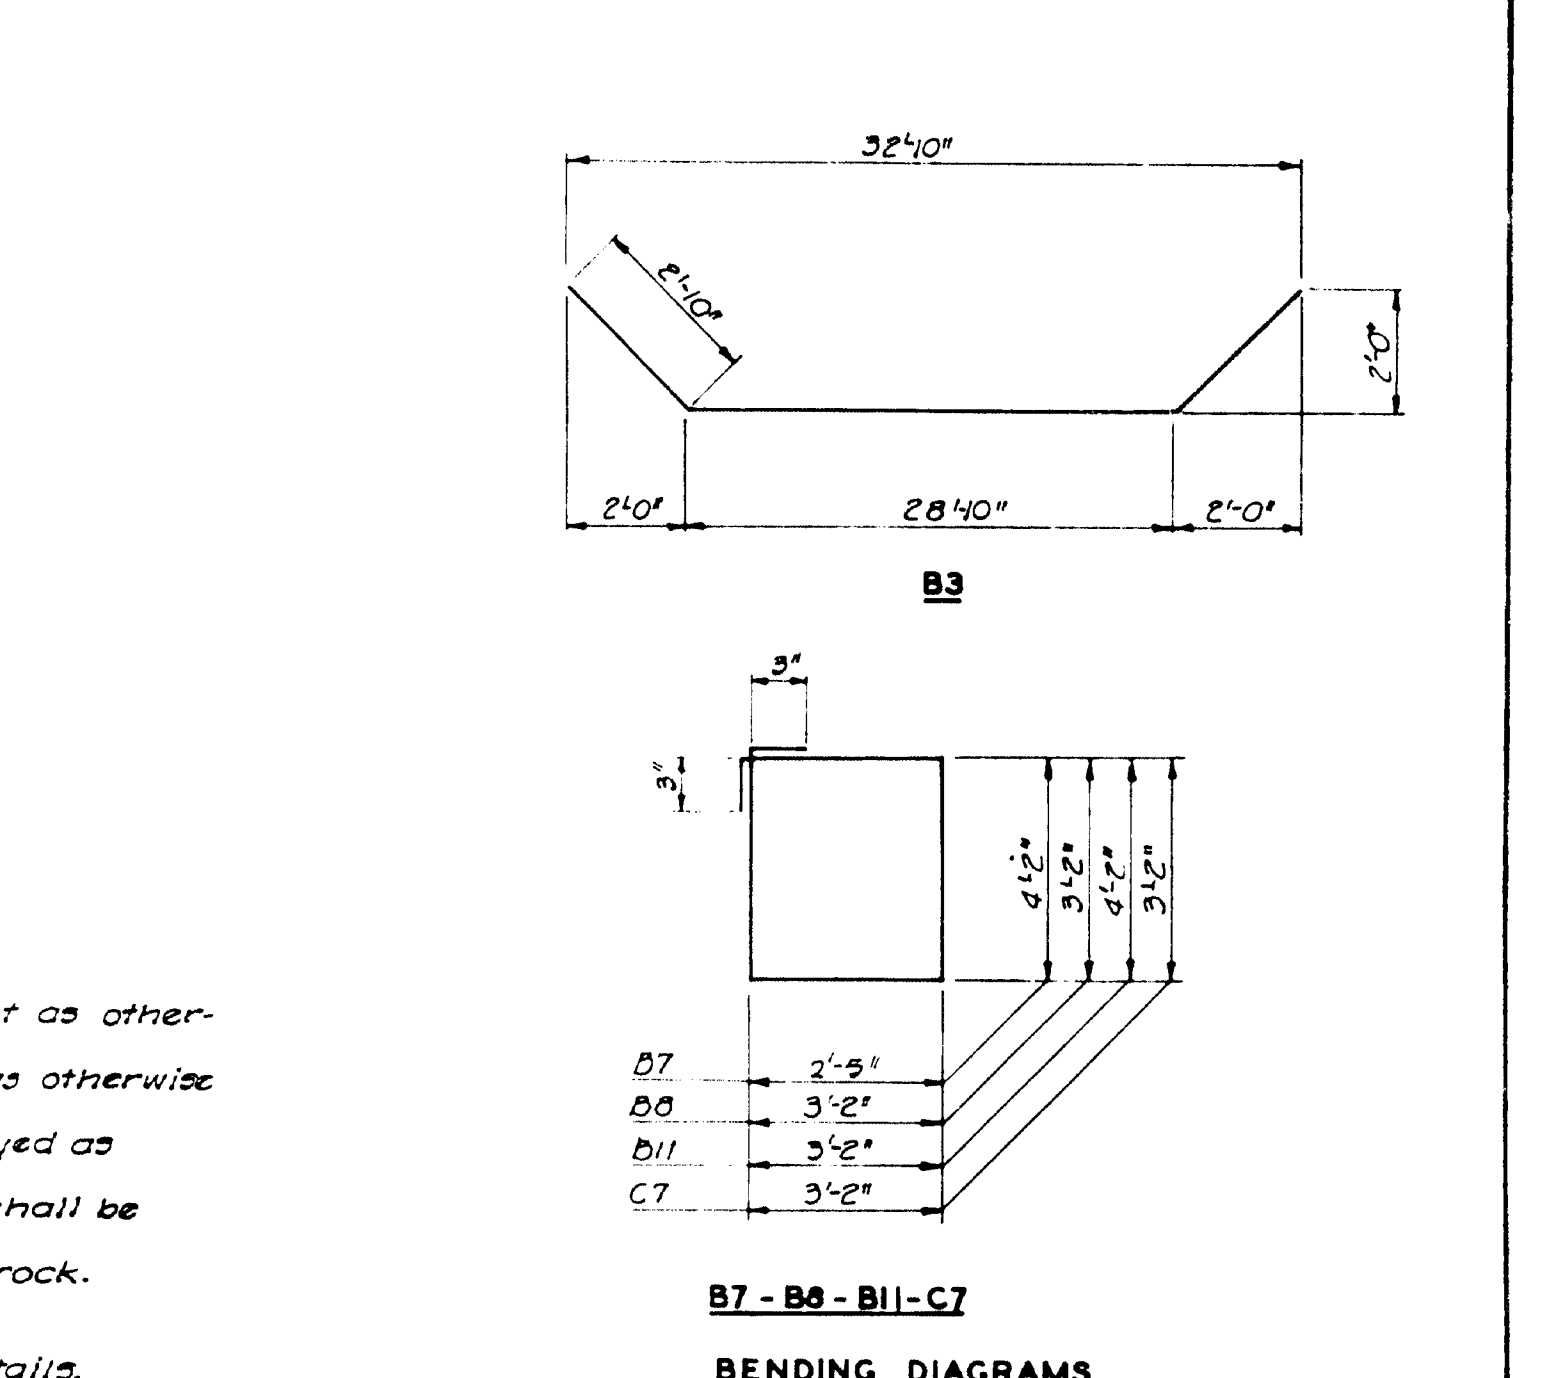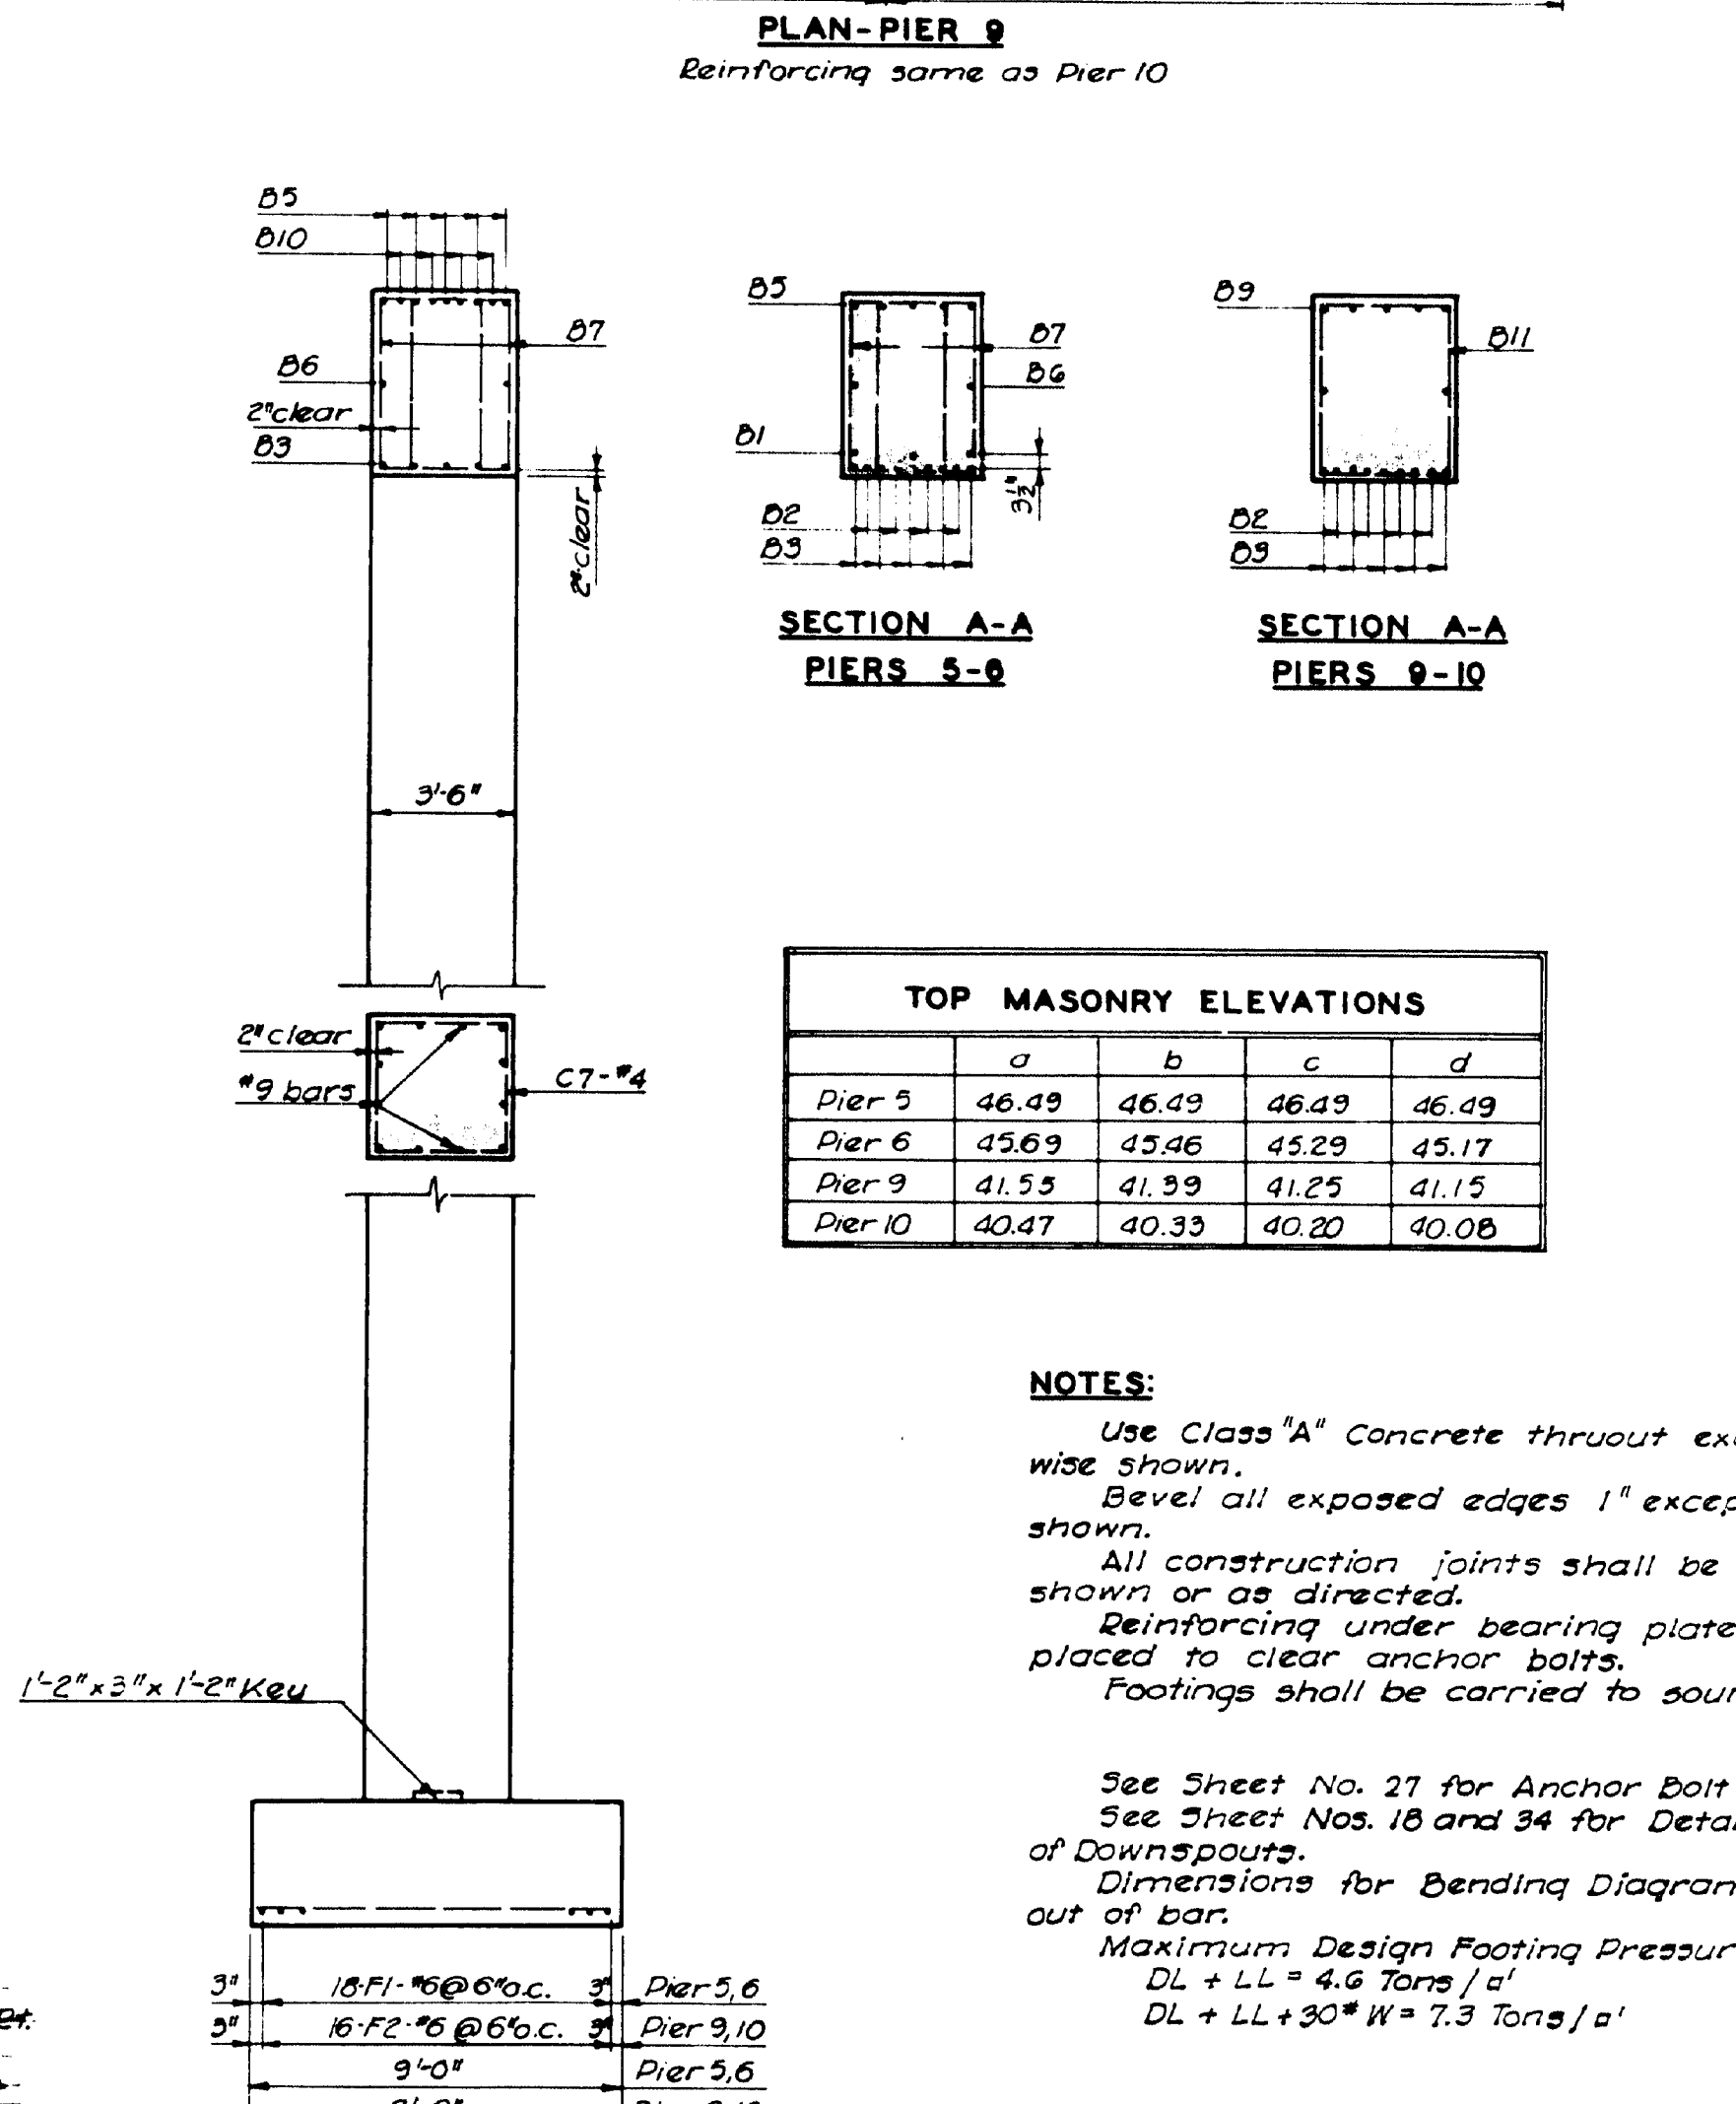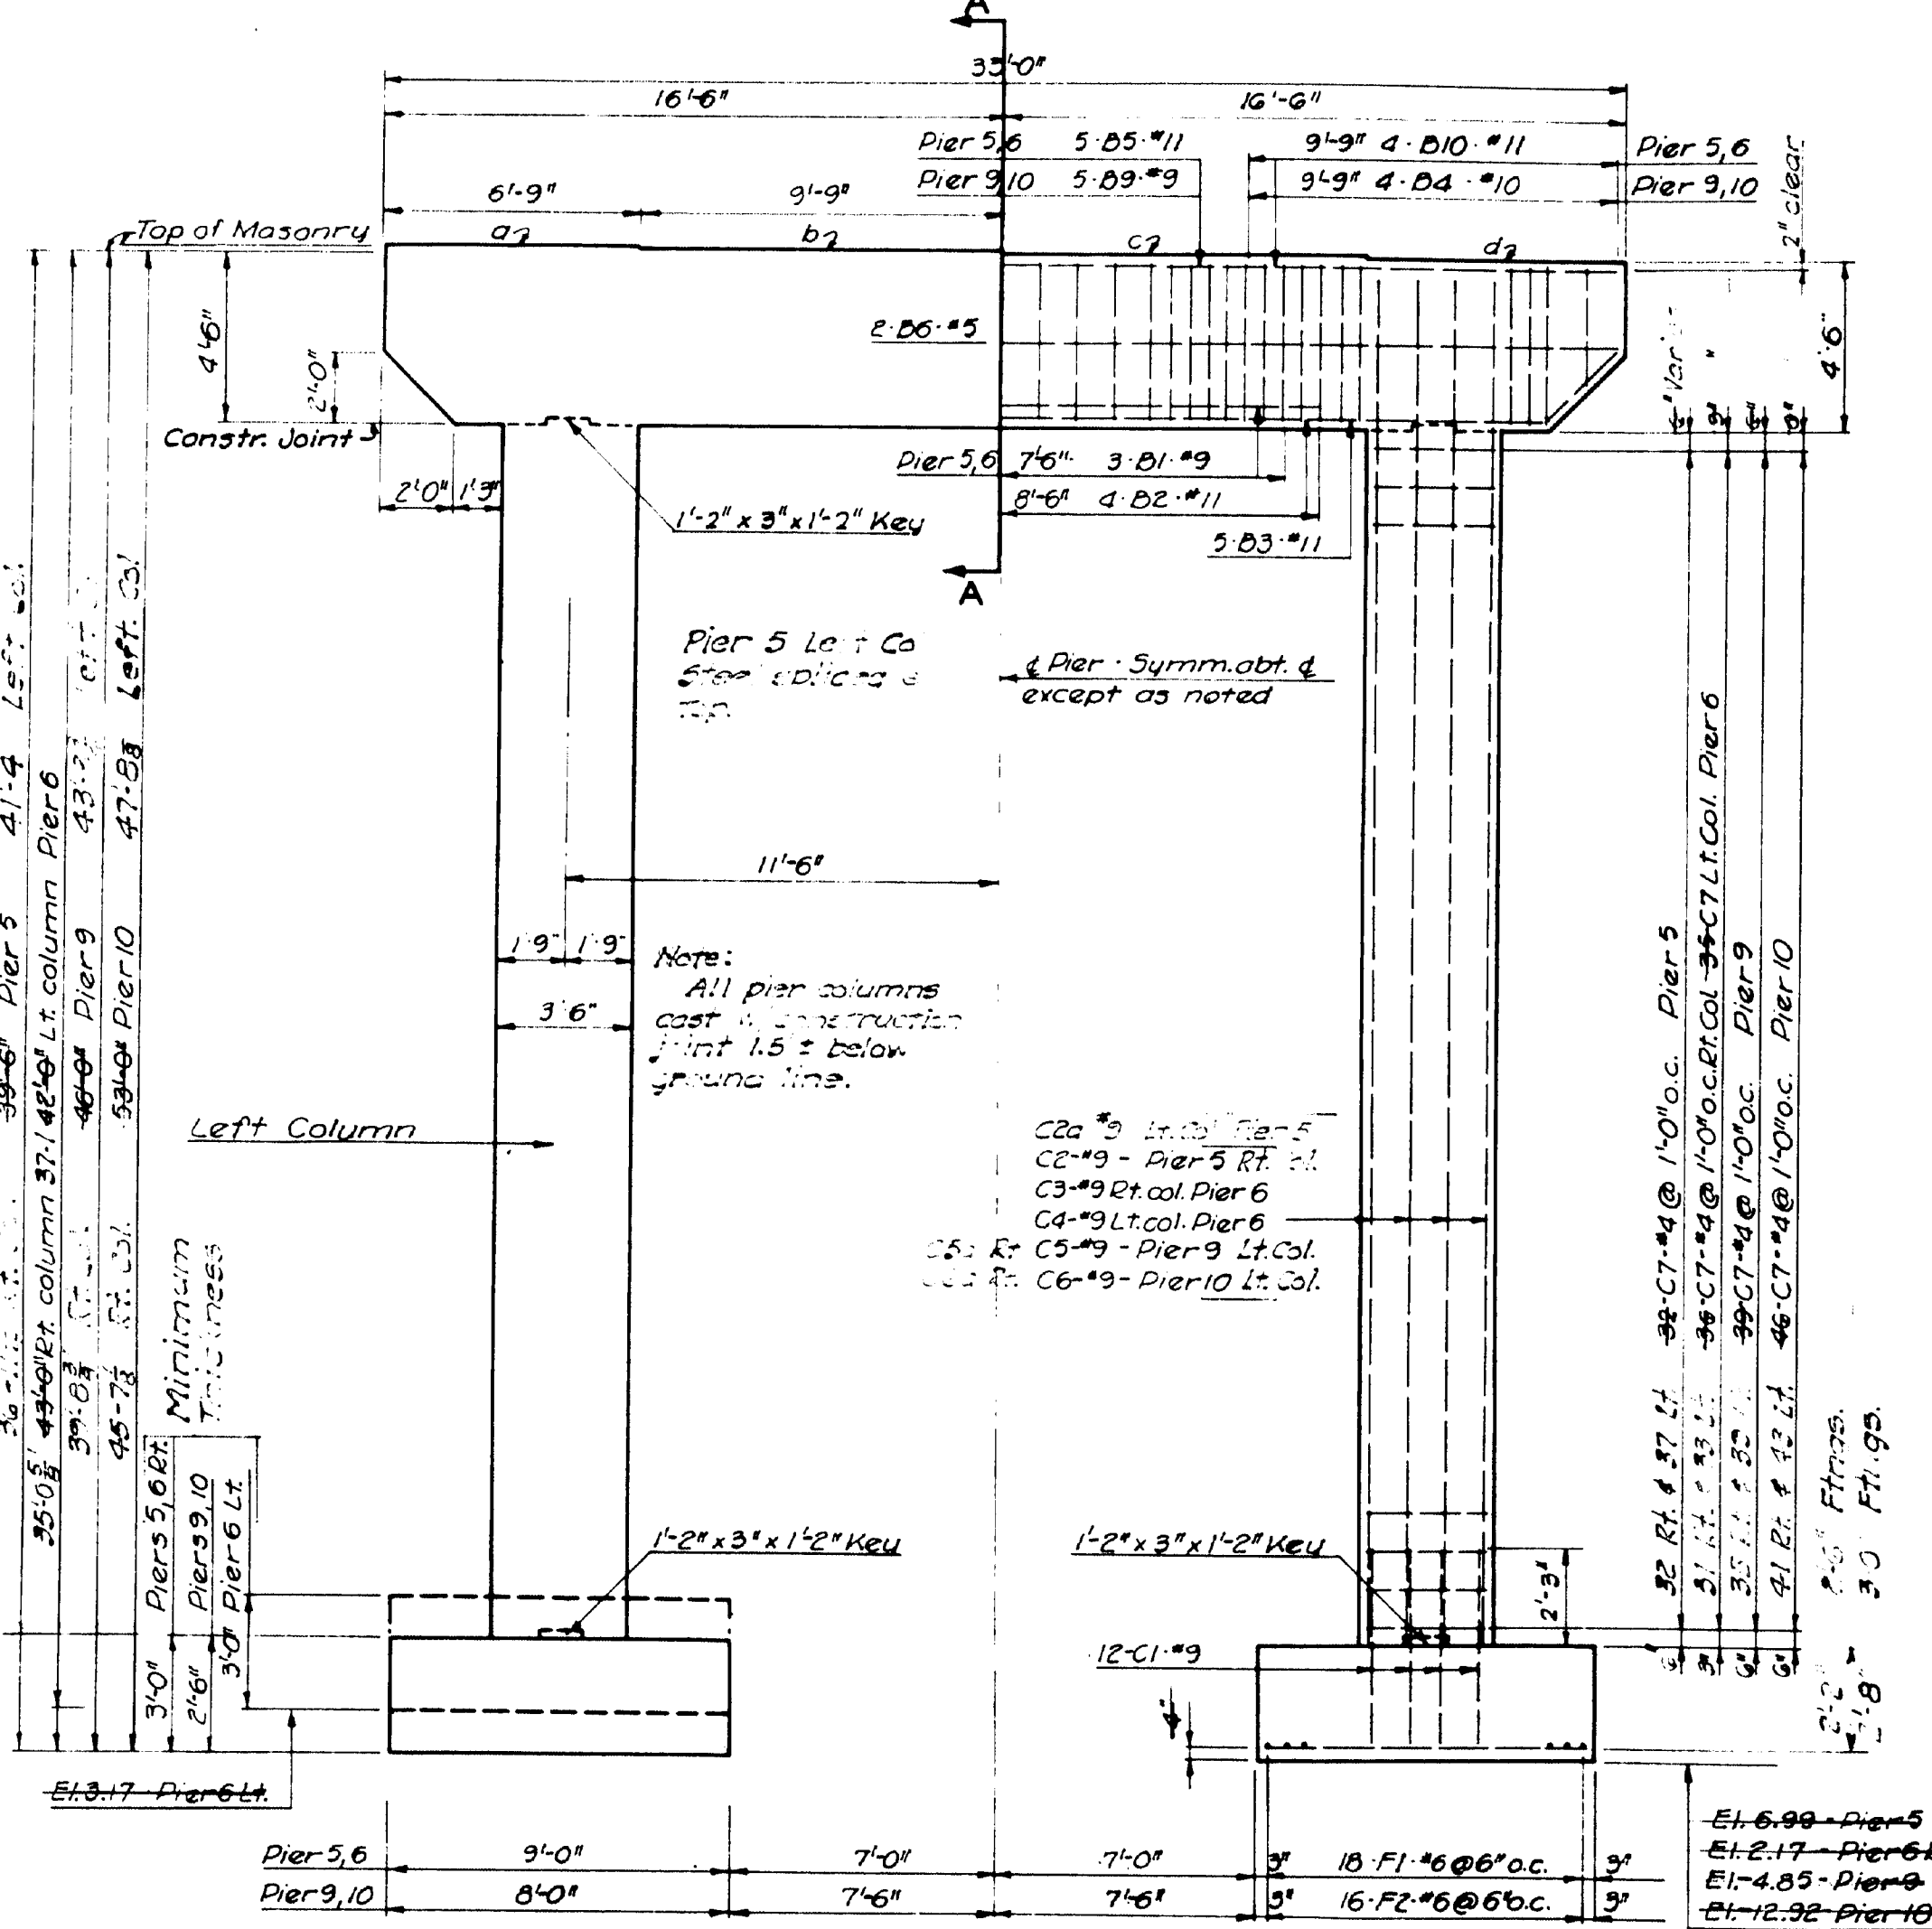

	a	b	c	d
Pier 5	46.49	46.49	46.49	46.49
Pier 6	45.69	45.46	45.29	45.17
Pier 9	41.55	41.39	41.25	41.15
Pier 10	40.47	40.33	40.20	40.08

**NOTES:**

Use Class "A" Concrete thruout except as otherwise shown.

Bevel all exposed edges 1" except as otherwise shown.

All construction joints shall be keyed as shown or as directed.

Reinforcing under bearing plates shall be placed to clear anchor bolts.

Footings shall be carried to sound rock.

See Sheet No. 27 for Anchor Bolt Details.

See Sheet Nos. 18 and 34 for Details and Locations of Downspouts.

Dimensions for Bending Diagrams are out to out of bar.

Maximum Design Footing Pressure  
 $DL + LL = 4.6 \text{ Tons/ft}^2$   
 $DL + LL + 30" W = 7.3 \text{ Tons/ft}^2$

	Pier 5	Pier 6	Pier 9	Pier 10
Top of Footing	5.6	8.32	-2.16	-7.25
Ave. Bottom of Pier	2.1	3.9	-5.4	-1.1


	Pier 5	Pier 6	Pier 9	Pier 10
Top of Footing	9.5	17.12	1.45	-5.51
Ave. Bottom of Pier	5.5	5.3	-0.5	-8.7

AS BUILT REVISIONS


HARRINGTON & CORTELYOU  
 Consulting Engineers  
 C.E.A. 3-2-54

STATE OF MAINE  
 STATE HIGHWAY COMMISSION  
**BANGOR-BREWER BRIDGE**  
 OVER PENOBSCOT RIVER  
 BANGOR, MAINE  
 PIERS 5-6-9-10  
 HARRINGTON & CORTELYOU  
 CONSULTING ENGINEERS  
 KANSAS CITY, MO.  
 DETAILED S.B. 10-17-32 SCALE: 1" = 1'-0"  
 TRACED R.E.C. 11-8-32  
 CHECKED Z.E.W. 1-15-33  
 SHEET NO. 14




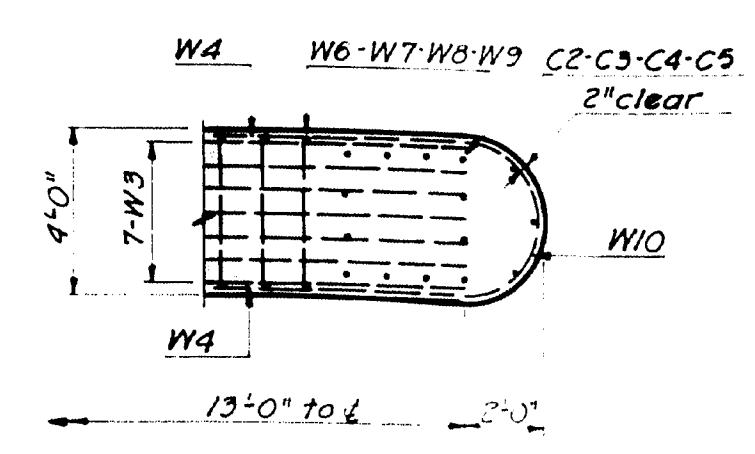


SECTION THRU COLUMN

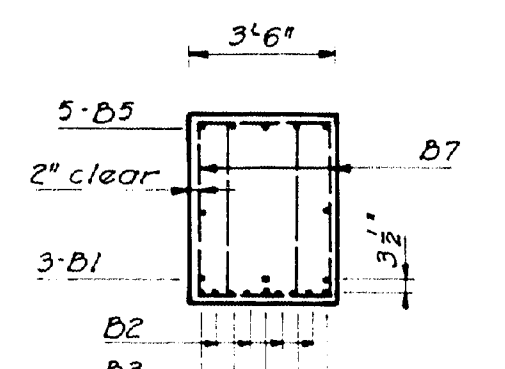

SECTION A-A

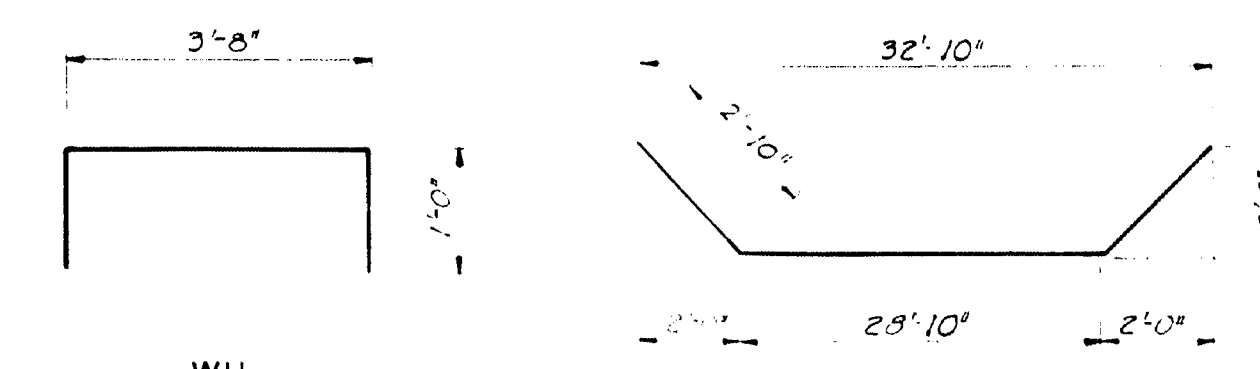

### BENDING DIAGRAMS

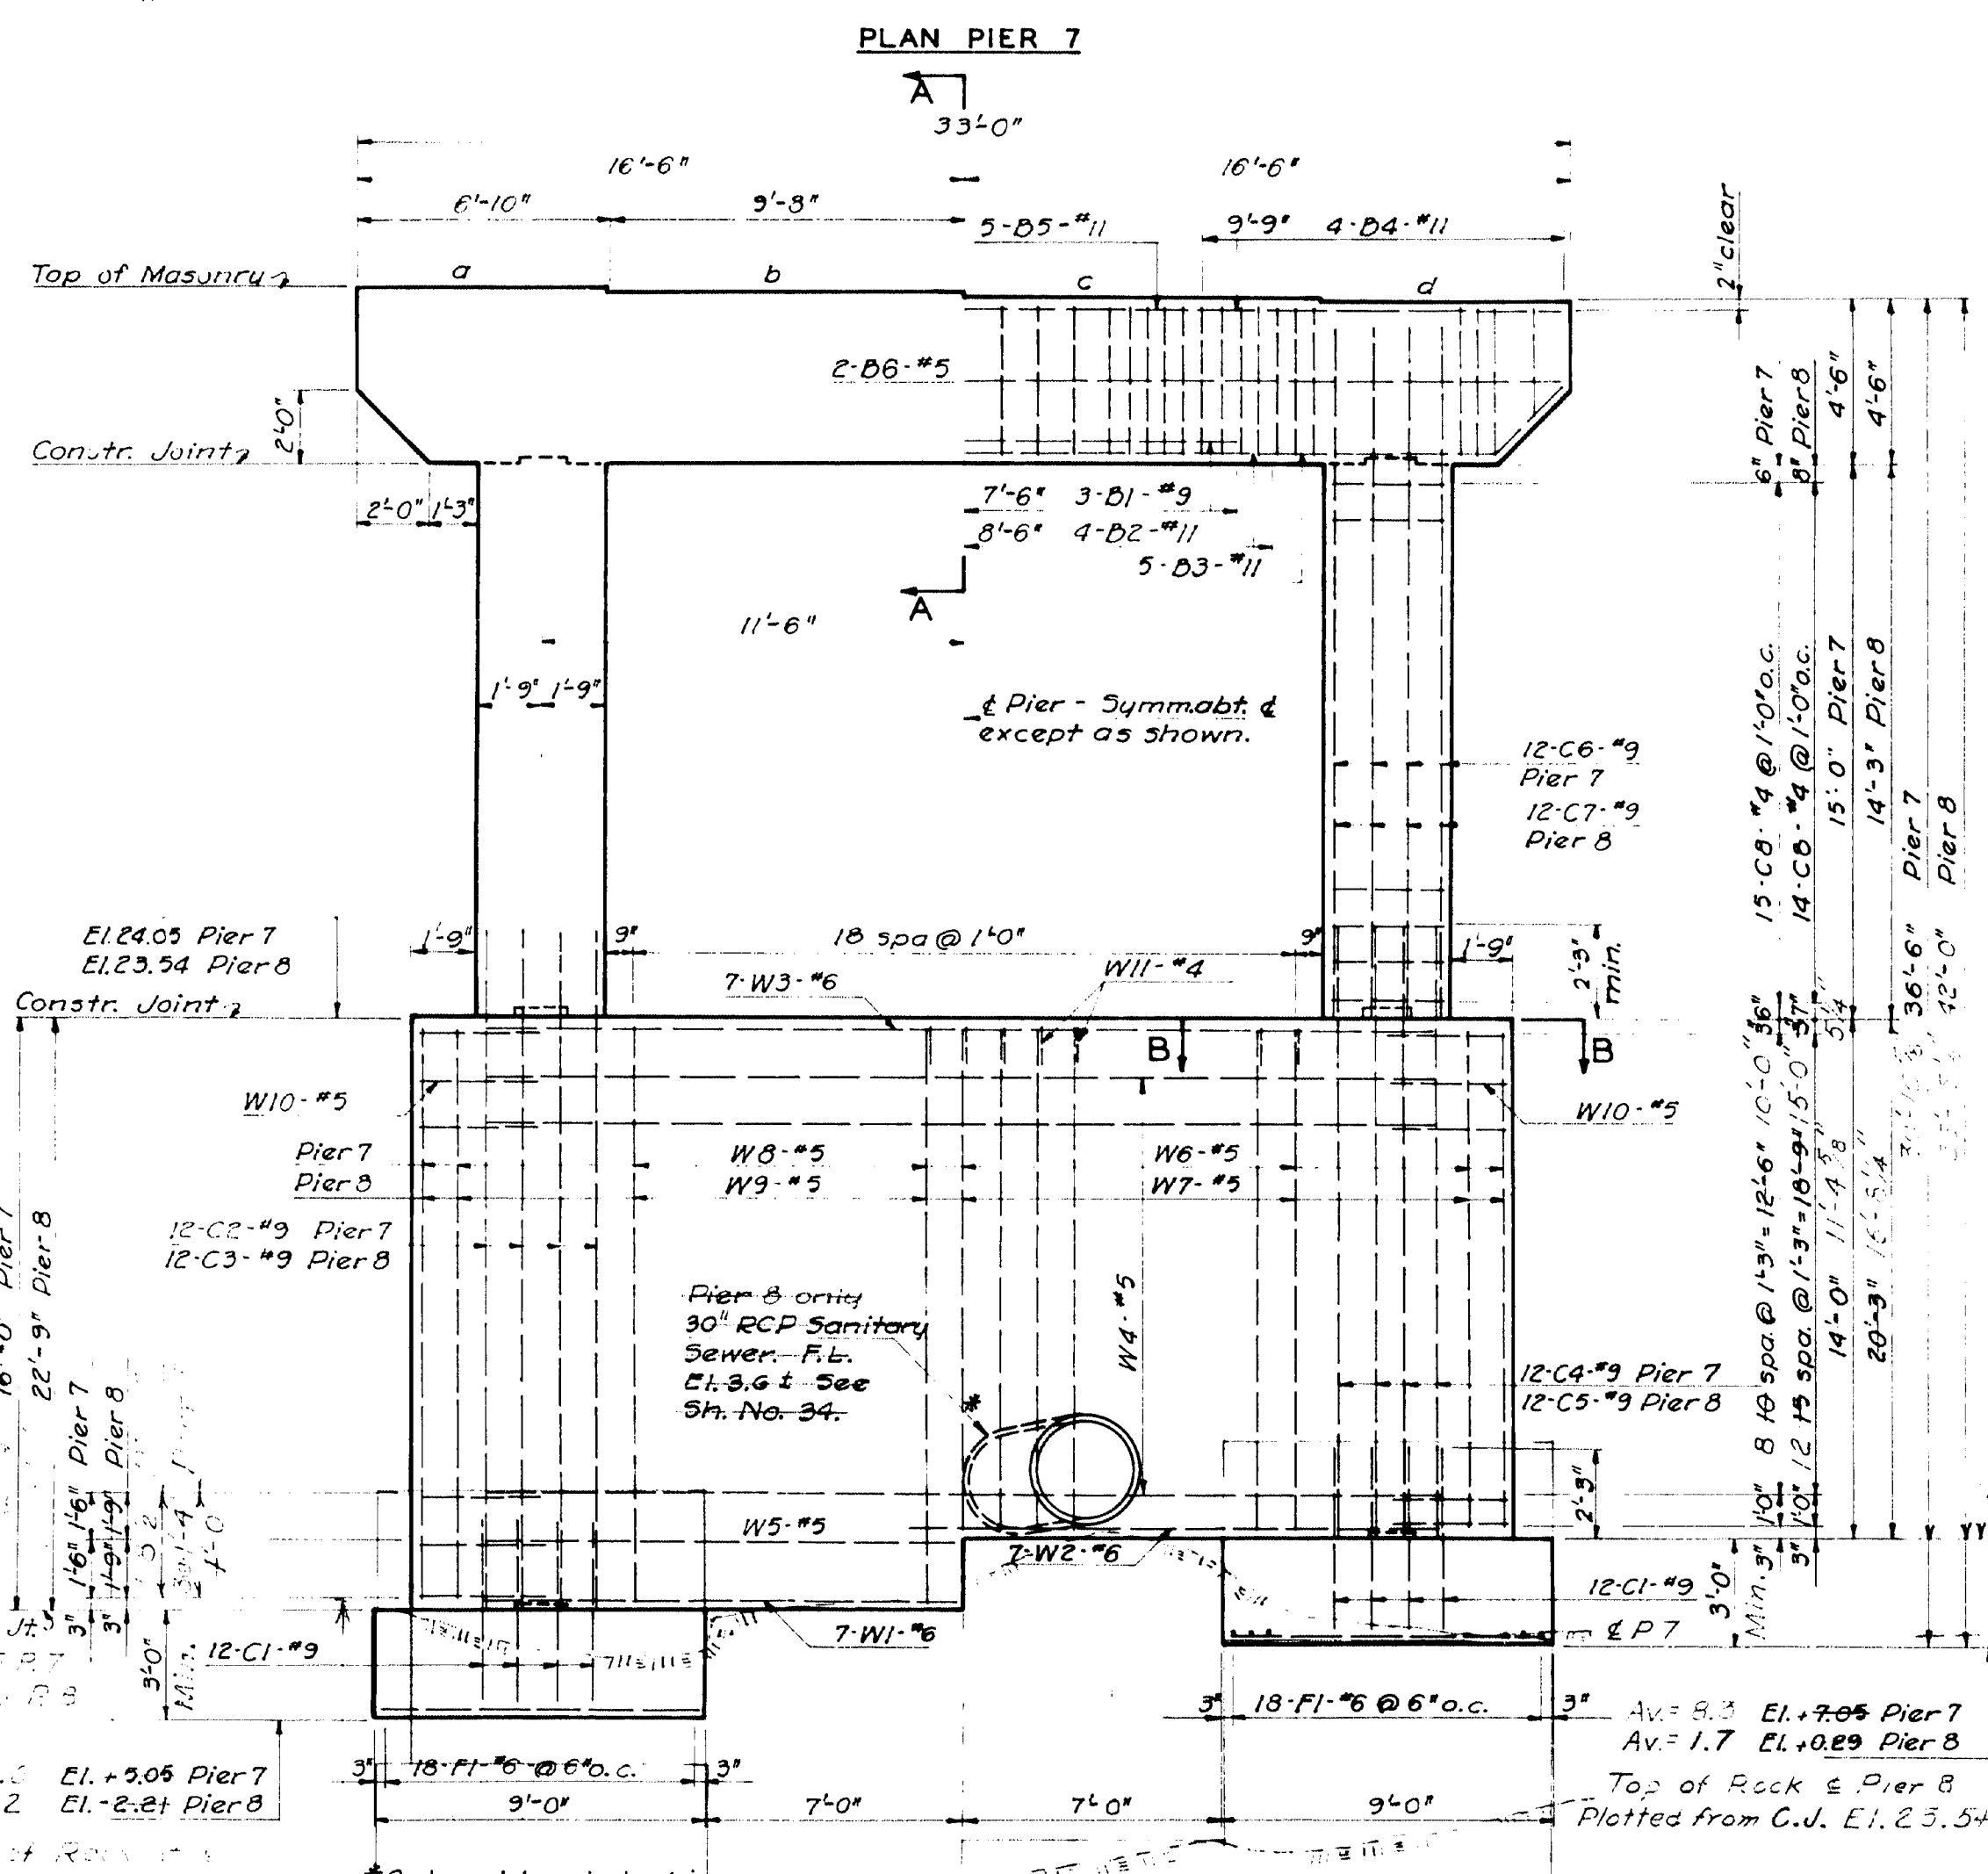

END VIEW

BILL OF REINFORCING						Length
No.	Mk.	No.	Size	Shape	Length	
Pier	B1	3	9	—	15'	0"
7	B2	4	11	—	17'	0"
	B3	5	11	∧	34'	6"
	B4	8	11	—	9'	9"
	B5	5	11	—	32'	8"
	B6	2	5	—	32'	8"
	B7	74	4	□	13'	8"
	B8	2	4	□	13'	2"
	C1	24	9	—	4'	6"
	C2	12	9	—	18'	3"
	C4	12	9	—	16'	3"
	C6	24	9	—	19'	0"
	C8	30	4	□	13'	2"
	FI	72	6	—	8'	6"
	WI	7	6	—	13'	0"
	W2	7	6	—	14'	6"
	W3	7	6	—	26'	0"
	W4	30	5	—	26'	0"
	W5	2	5	—	13'	0 1/2"
	W8	23	5	—	13'	9"
	W8	21	5	—	15'	2"
	W10	25	5	U	8'	5"
	W11	19	4	U	5'	8"
Pier	B1	3	9	—	15'	0"
8	B2	4	11	—	17'	0"
	B3	5	11	∧	34'	6"
	B4	8	11	—	9'	9"
	B5	5	11	—	32'	8"
	B6	2	5	—	32'	8"
	B7	74	4	□	13'	8"
	B8	2	4	□	13'	2"
	C1	24	9	—	4'	6"
	C3	12	9	—	23'	0"
	C5	12	9	—	22'	6"
	C7	24	9	—	18'	6"
	C8	28	4	□	13'	2"
	FI	72	6	—	8'	6"
	WI	7	6	—	13'	0"
	W2	7	6	—	14'	6"
	W3	7	6	—	26'	0"
	W4	30	5	—	26'	0"
	W5	2	5	—	13'	0"
	W7	23	5	—	20'	0"
	W9	21	5	—	22'	6"
	W10	35	5	U	8'	5"
	W11	19	4	U	5'	8"


**NOTES:**  
For General Notes see Sheet No. 14  
Maximum Design Footing Pressure  
DL + LL = 4.6 Tons/ft<sup>2</sup>  
DL + LL + 30°W. = 5.9 Tons/ft<sup>2</sup>

STATE OF MAINE  
STATE HIGHWAY COMMISSION  
**BANGOR-BREWER BRIDGE  
OVER PENOBSCOT RIVER  
BANGOR, MAINE**

**PIERS 7 & 8**


**HARRINGTON AND CORTELYOU  
CONSULTING ENGINEERS  
KANSAS CITY, MO.**

DETAILED G.H.W. 10-17-32 SCALE:  $\frac{1}{4}'' = 1' - 0''$   
TRACED S.P. 10-23-32  
CHECKED Z.E.W. 1-15-33 SHEET NO. 15

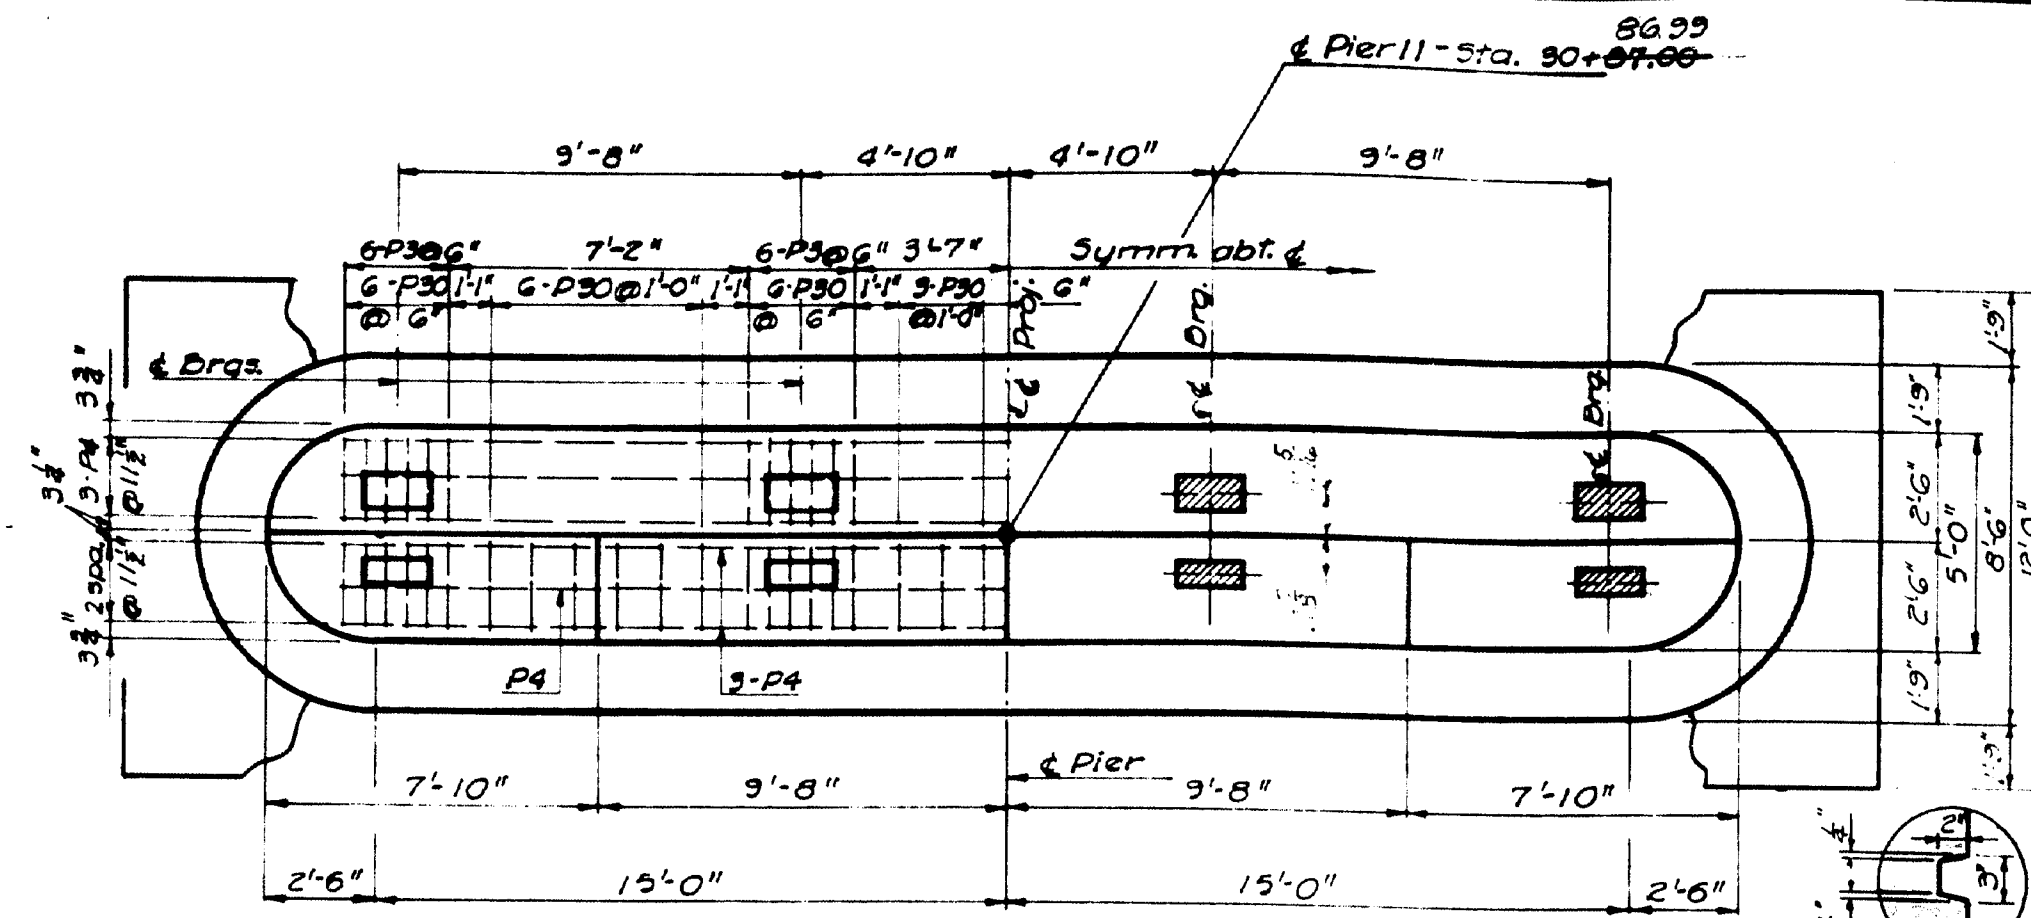


See Sheet No. 27 for Anchor Bolt spacing.  
Maximum Design Base Pressure:  
 $DL + LL = 5.1 \text{ Tons/a'}$   
 $DL + LL + 30^*W_{ice} = 9.1 \text{ Tons/a'}$

PLAN

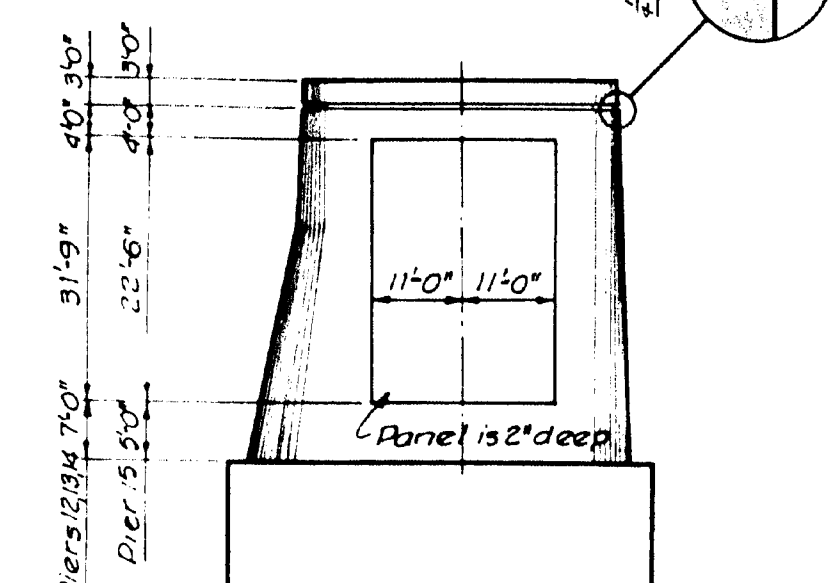


**SECTION A-A**

PANEL DETAIL

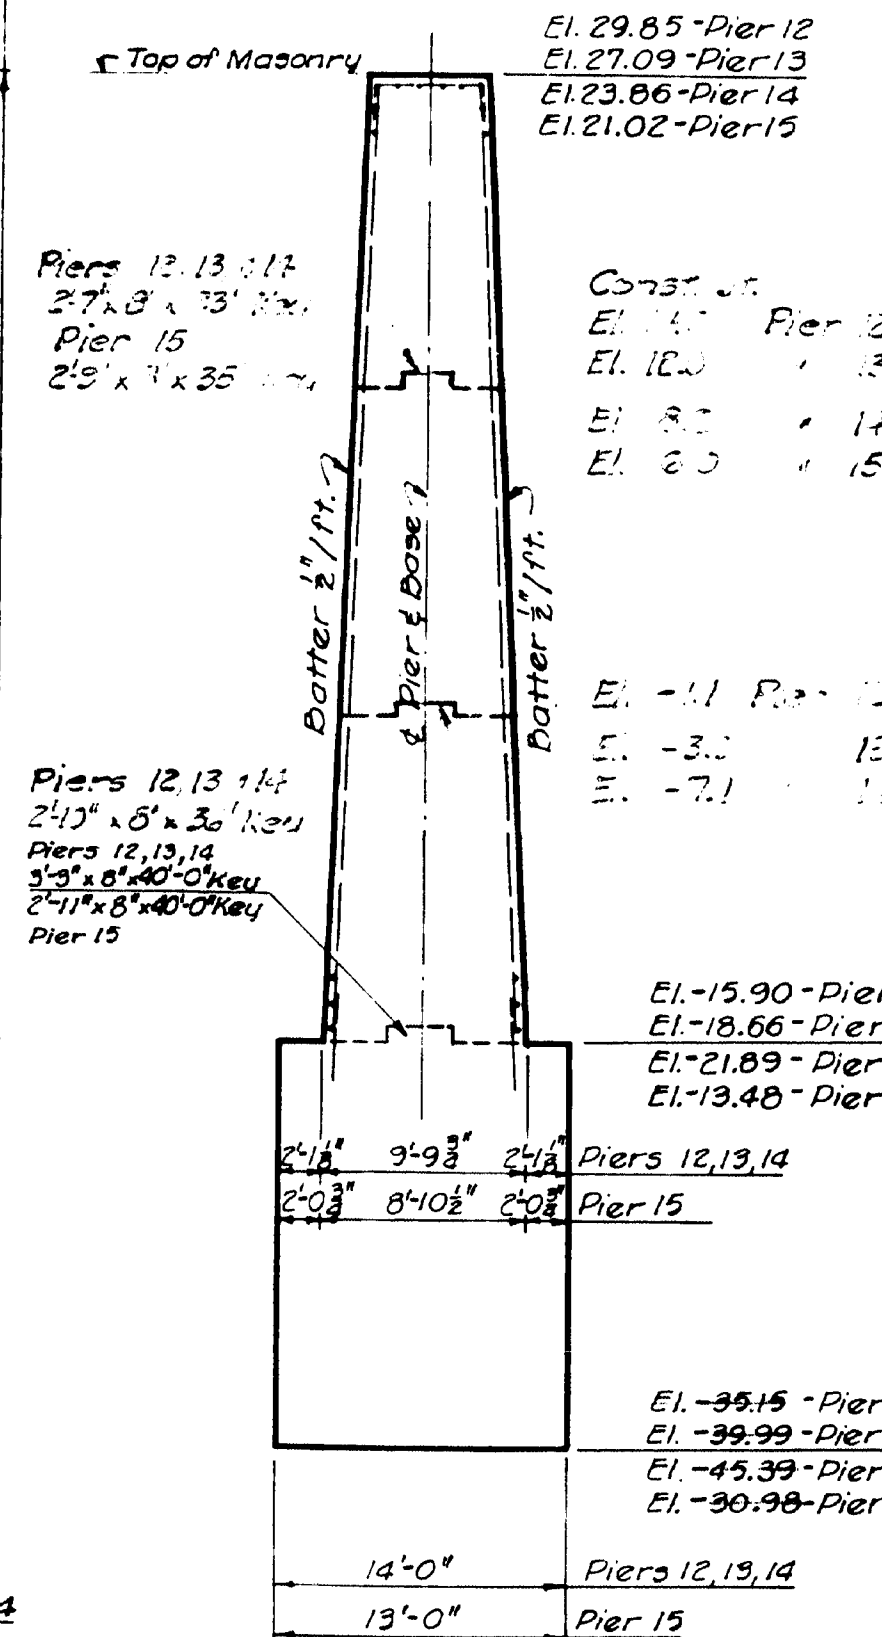

**SECTION B-B**

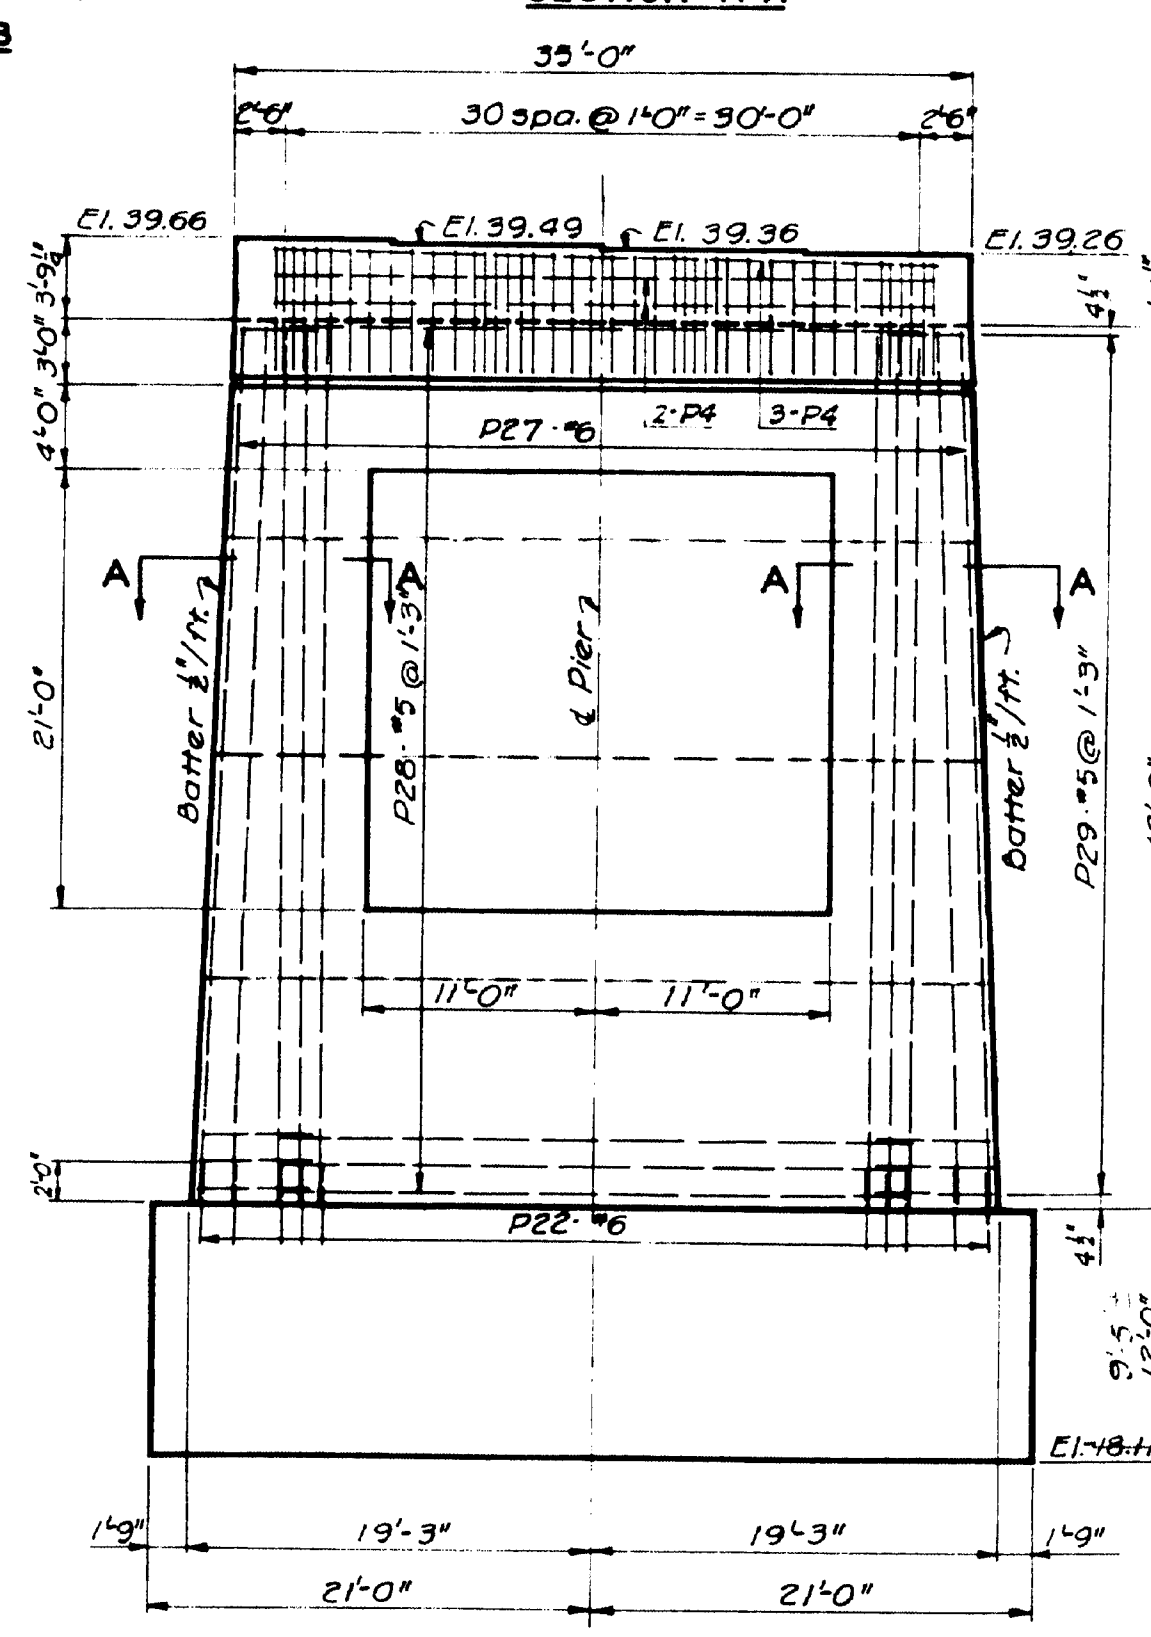

**ELEVATION**

## SECTION

Mk.	D varies by 1 <sup>st</sup> increment		C varies by 2 <sup>nd</sup> increment	
	Min.	Max.	Min.	Max.
D16	5'-5 $\frac{1}{2}$ "	6'-4 $\frac{1}{2}$ "	1'-4"	1'-4"
D17	5'-5 $\frac{1}{2}$ "	6'-4 $\frac{1}{2}$ "	do	do
D18	5'-5 $\frac{1}{2}$ "	6'-4 $\frac{1}{2}$ "	do	do
D19	5'-5 $\frac{1}{2}$ "	6'-0 $\frac{1}{2}$ "	do	do
D20	5'-5 $\frac{1}{2}$ "	9'-2 $\frac{1}{2}$ "	do	do
D21	5'-5 $\frac{1}{2}$ "	8'-2 $\frac{1}{2}$ "	do	do
D23	7'-0"	9'-2 $\frac{1}{2}$ "	1'-6 $\frac{1}{2}$ "	5'-0 $\frac{1}{2}$ "
D24	6'-0 $\frac{1}{2}$ "	9'-2 $\frac{1}{2}$ "	1'-4 $\frac{1}{2}$ "	6'-1 $\frac{1}{2}$ "
D25	6'-5 $\frac{1}{2}$ "	9'-2 $\frac{1}{2}$ "	1'-5 $\frac{1}{2}$ "	6'-0 $\frac{1}{2}$ "
D26	6'-2 $\frac{1}{2}$ "	8'-2 $\frac{1}{2}$ "	1'-4 $\frac{1}{2}$ "	5'-6 $\frac{1}{2}$ "
D29	4'-4 $\frac{1}{2}$ "	7'-0"	1'-4"	1'-4"

Cut one bar each length;  
except cut 2 ea. 10th, for P29

### BENDING DIAGRAMS

BENDING DIAGRAMS  
Dimensions shown are to outside of bar


## PIERS 11 - 12 - 13 - 14 - 15

HARRINGTON AND CORTELYOU


**CONSULTING ENGINEERS**  
KANSAS CITY, MO.

DETAILED S.P. 10-19-52 SCALE:  $\frac{1}{4}'' = 1' - 0''$   
 TRACED Repro. 11-6-52 AND AS NOTED  
 CHECKED Z.E.W. 1-15-53 SHEET NO. 18

62-16

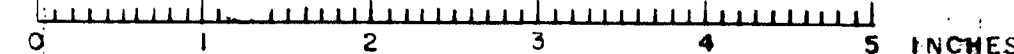



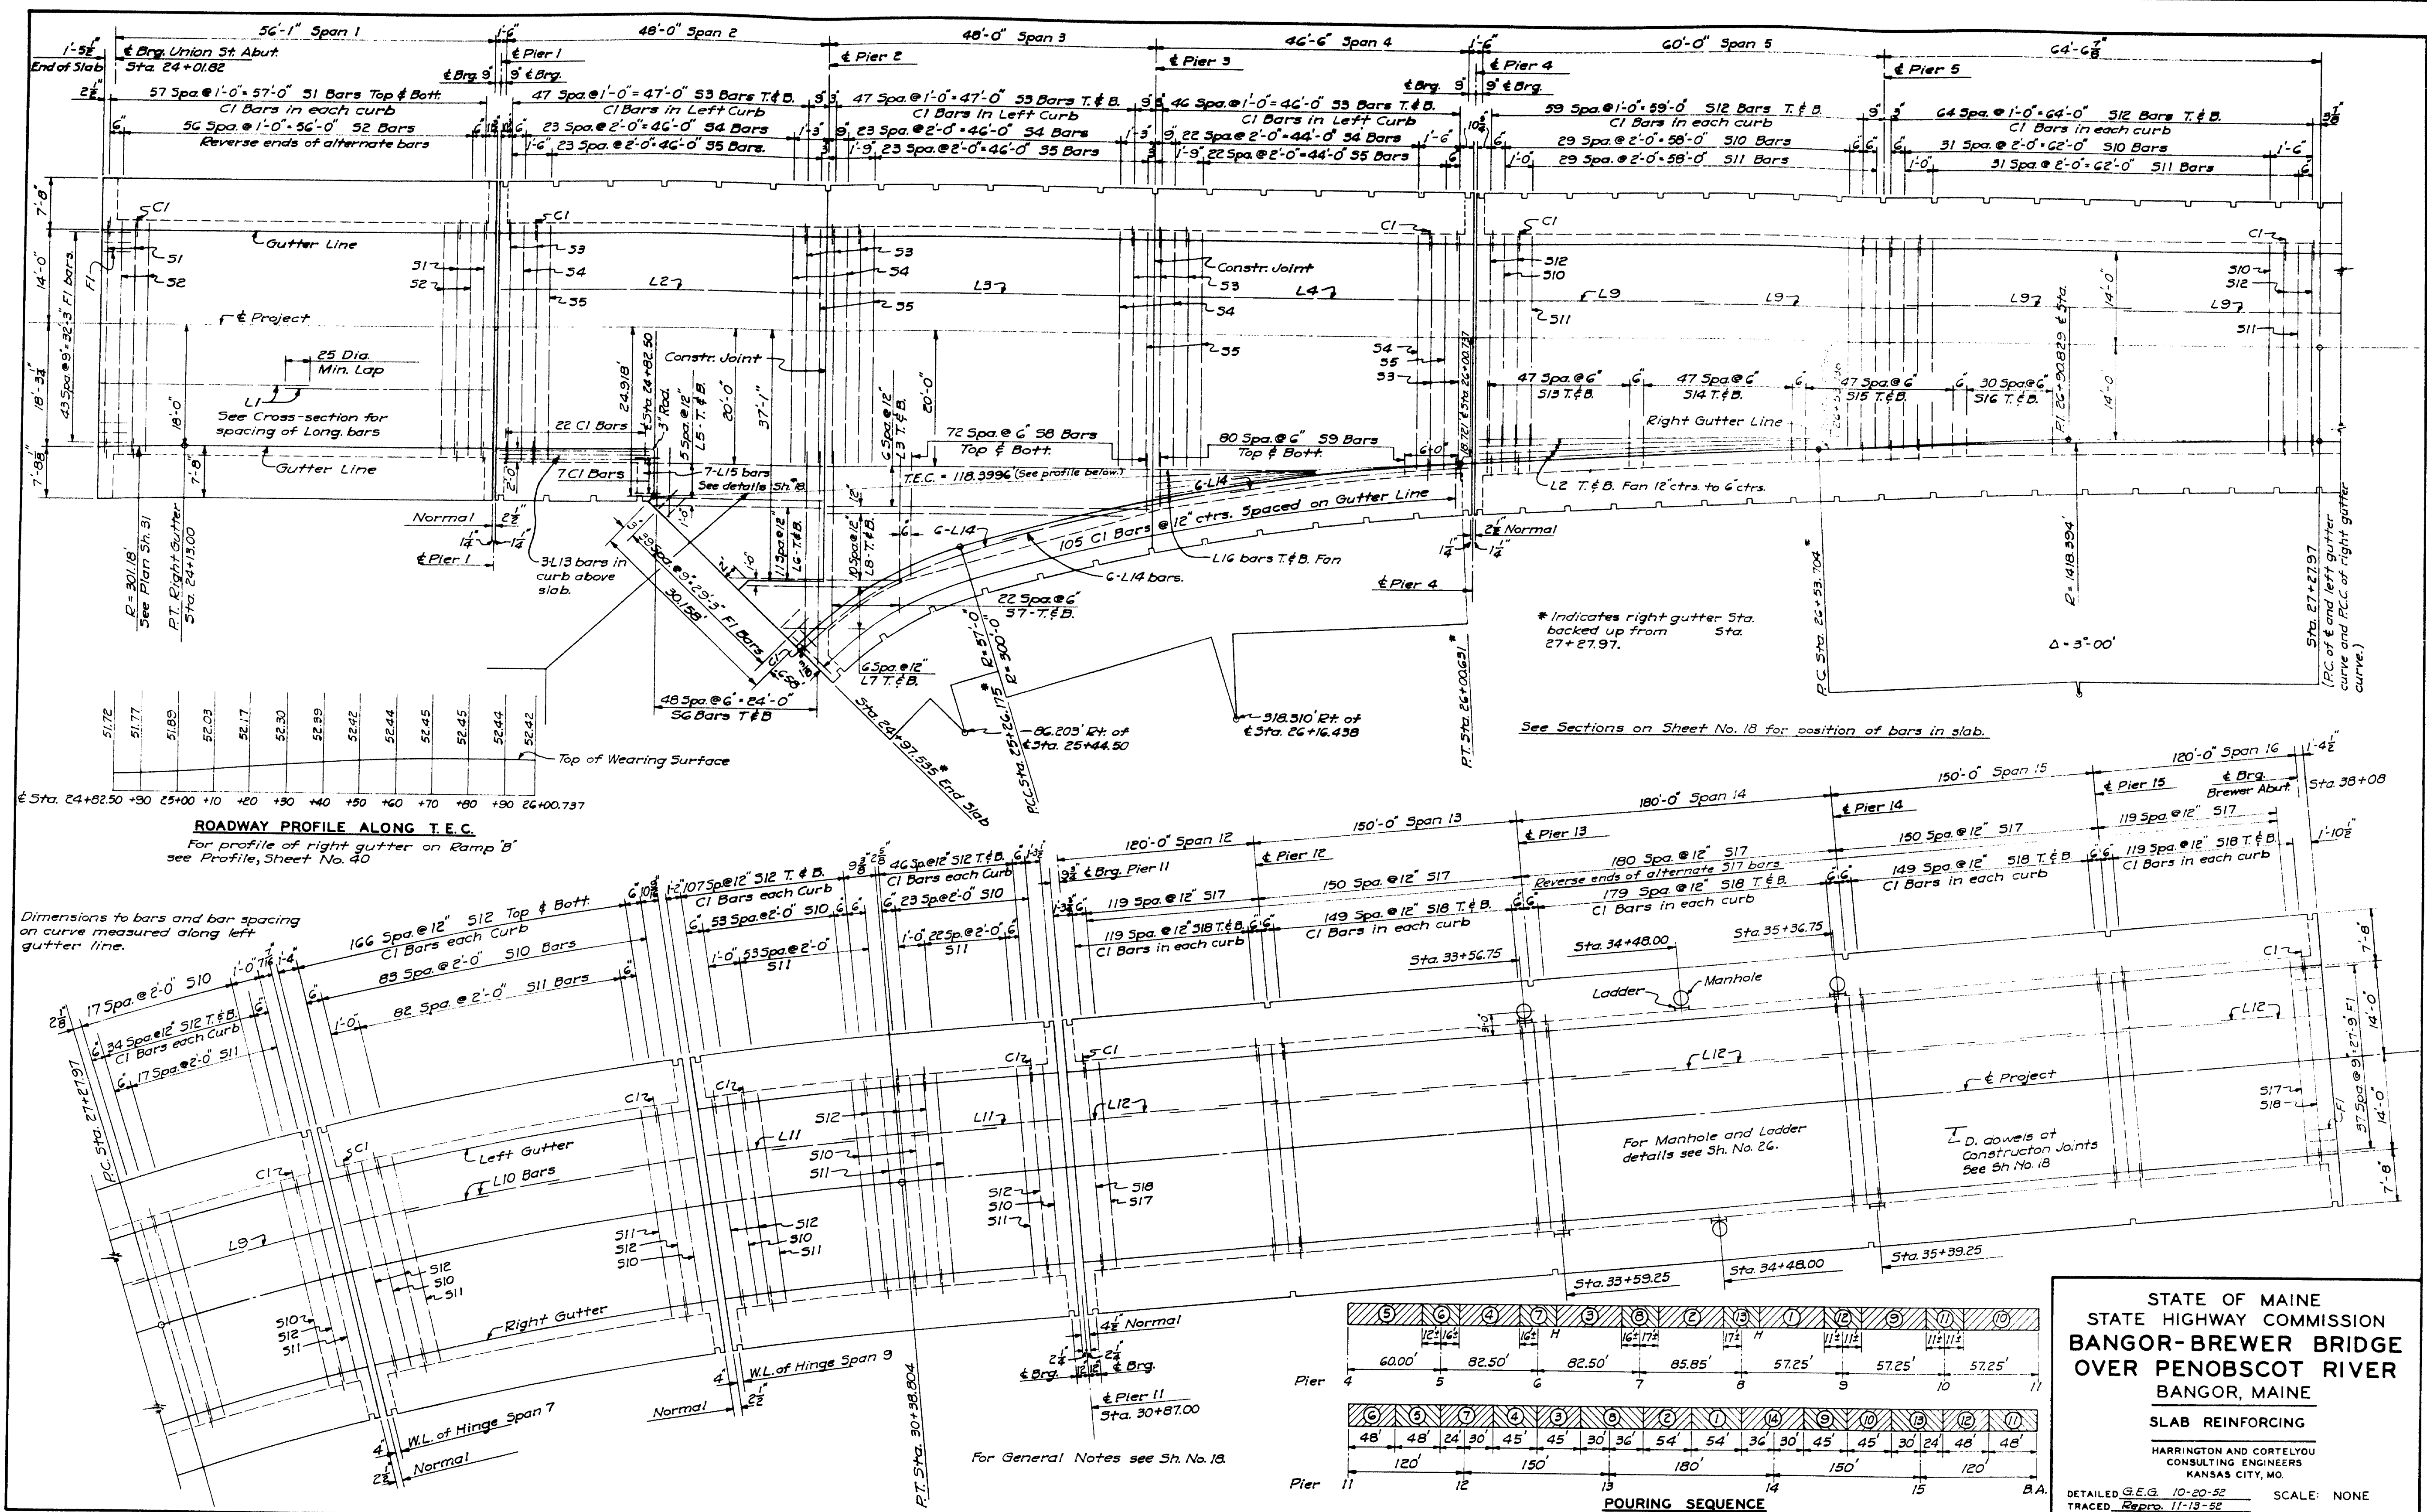

STATE OF MAINE  
 STATE HIGHWAY COMMISSION  
**BANGOR-BREWER BRIDGE**  
 OVER PENOBSCOT RIVER  
 BANGOR, MAINE

**SLAB REINFORCING**


HARRINGTON AND CORTELYOU  
 CONSULTING ENGINEERS  
 KANSAS CITY, MO.

DETAILED G.E.G. 10-20-32  
 TRACED R.E.G. 11-13-32  
 CHECKED R.M.C. 1-18-33

SCALE: NONE

**SHEET NO. 17**



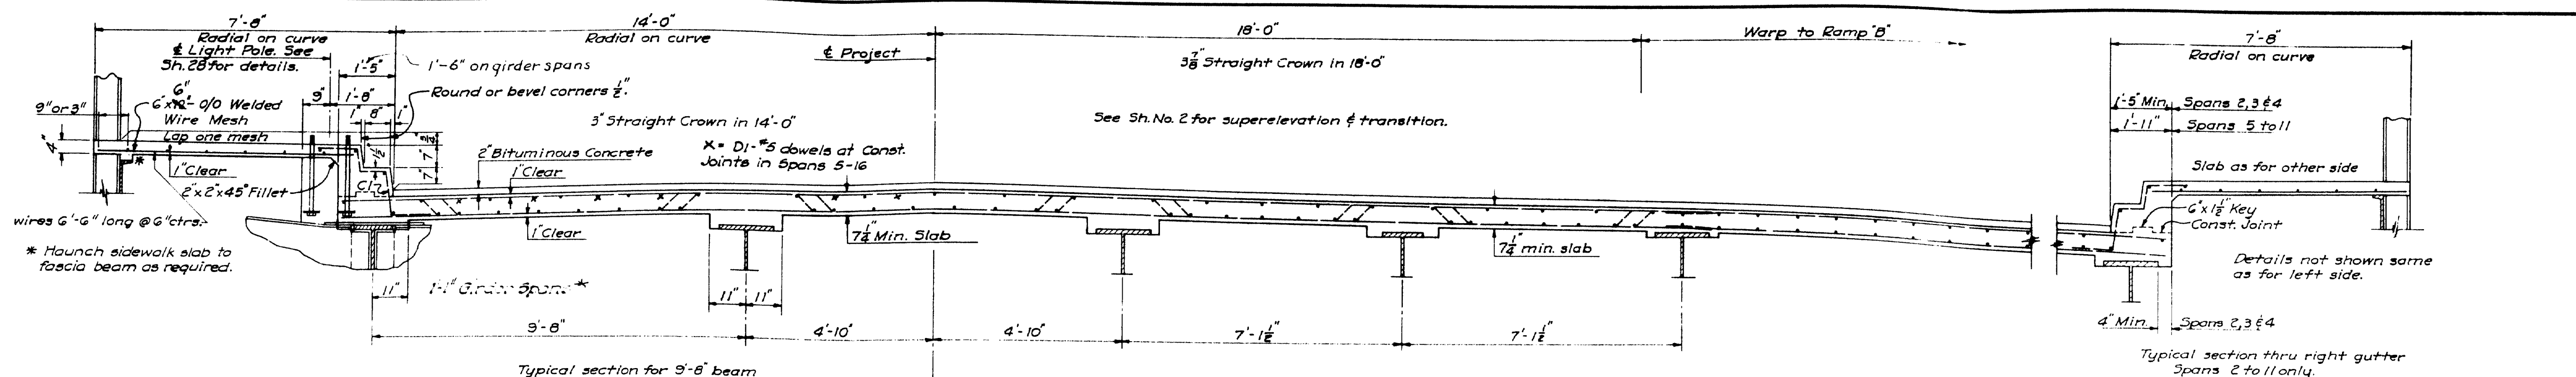


\* Provide 3" over 2" over 1" for #12 letter to contractor. See C. 1. 2. 3. 4.

Typical section for 9'-6" beam spacing. Symmetrical about & Project except as shown.

Typical for Spans 2, 3 & 4.

### TYPICAL SECTION - SPANS 2-16 INCL.

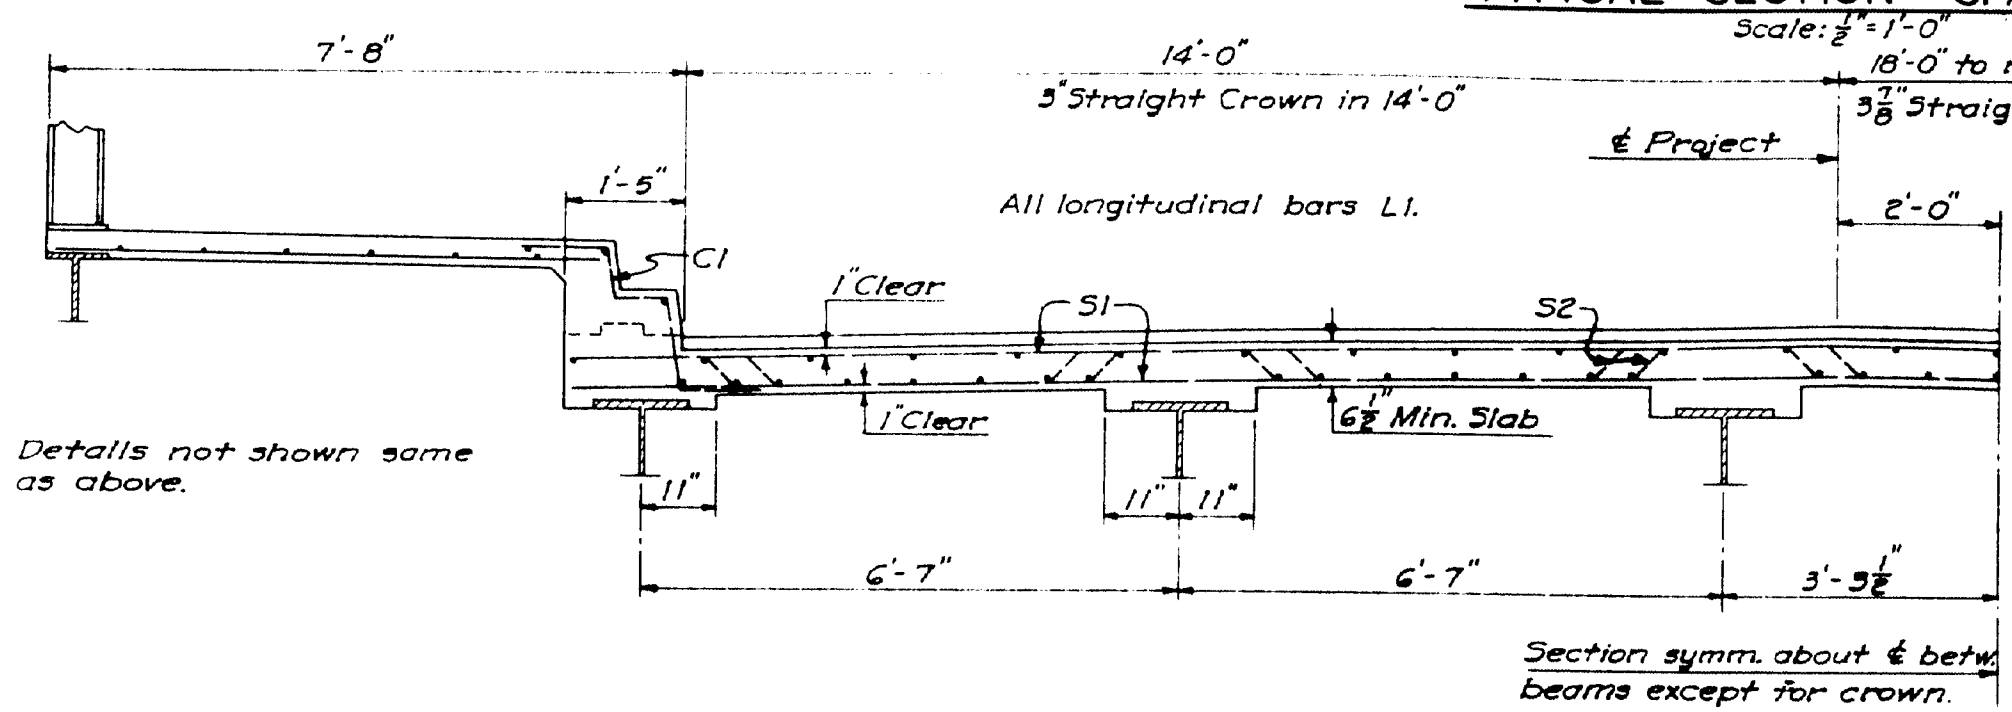


### TYPICAL SLAB CONSTRUCTION JOINT

Sidewalk joint similar

### SECTION THRU END OF RIGHT CURB AT RAMP 'B'

Section taken parallel to & Project Scale: 1/2" = 1'-0"

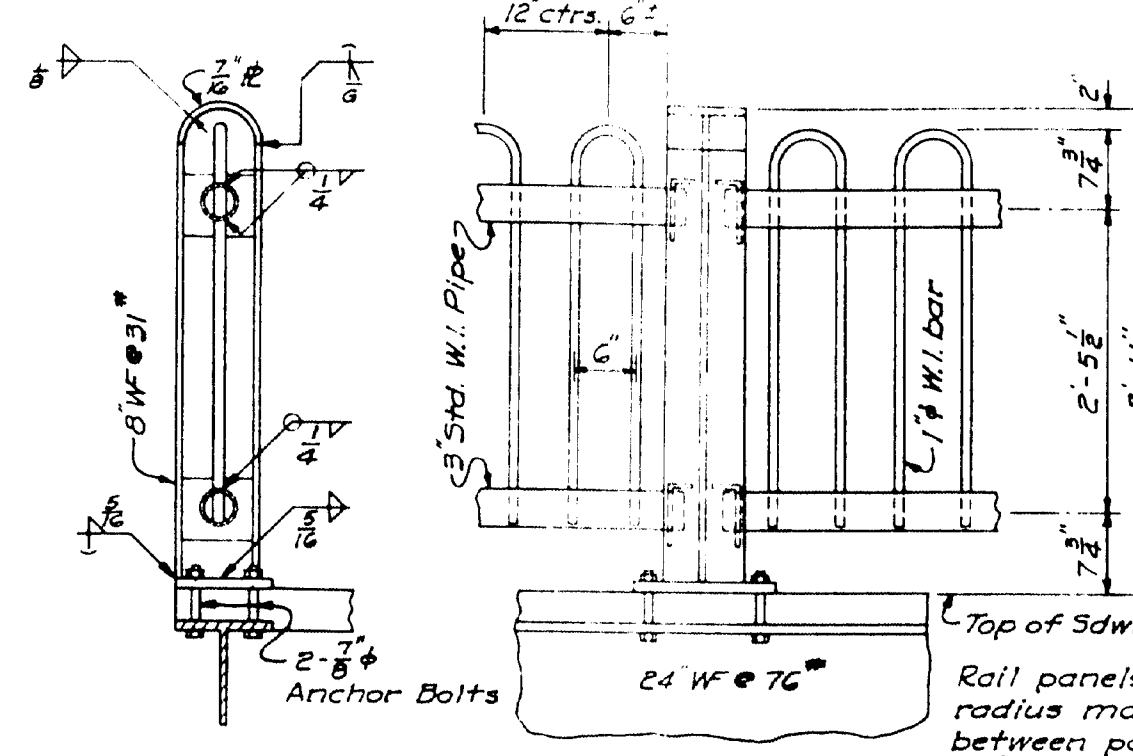


### TYPICAL HANDRAIL DETAILS

Base R shown used on Span I only. Posts on other spans bolt to brackets and/or fascia beam. See Sh. No. 22 and other Steel Details. Scale: 1/2" = 1'-0"

### HANDRAIL EXPANSION DETAILS


Details at Brewer Abut. same as for Pier II except for connection to concrete post on Abut. See detail. Scale: 1/2" = 1'-0"

**NOTES:**  
All concrete in deck shall be Class A.  
Bevel all exposed edges of concrete & except as noted.  
Construction joints shall be made at locations indicated or as approved by the Engineer. The sequence of placing concrete shall be as shown. All falsework shall be removed before the floor is placed. Concrete in roadway slabs shall set 3 days before curbs and walks are poured thereon.  
The finished floor shall be constructed to theoretical grade by increasing or decreasing the depth of concrete haunches over the beams or girders to provide for dead load deflection, vertical curves and variations in steel fabrication.  
Handrails shall be parallel to grade and posts and spindles shall be vertical.  
Final adjustment of railing shall be made after roadway slab is in place and prior to placing the sidewalk concrete.

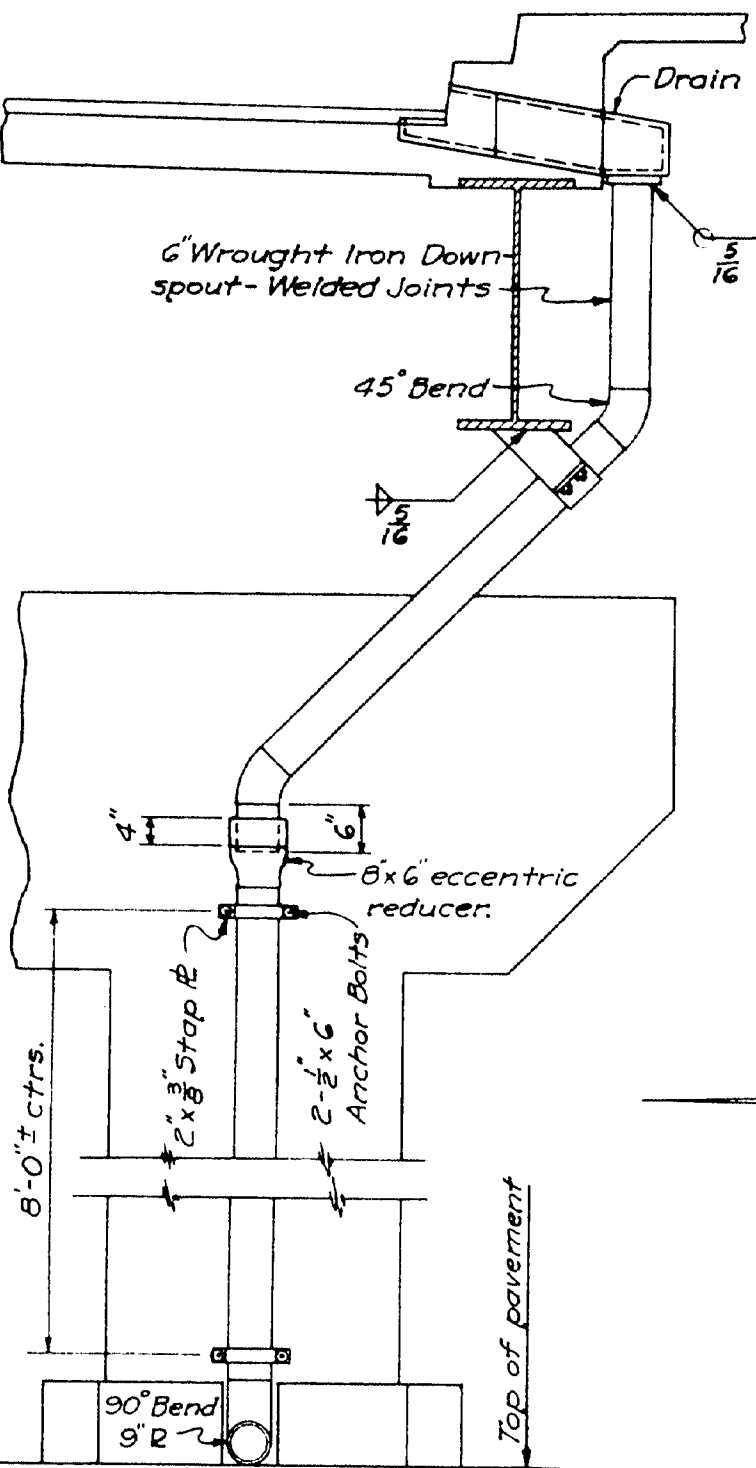


### DOWNSPOUT DETAILS

Details shown above are of piers. Details at Union St. Abut. similar except as shown on Sh. Nos. 8 & 43. Scale: 1/2" = 1'-0"

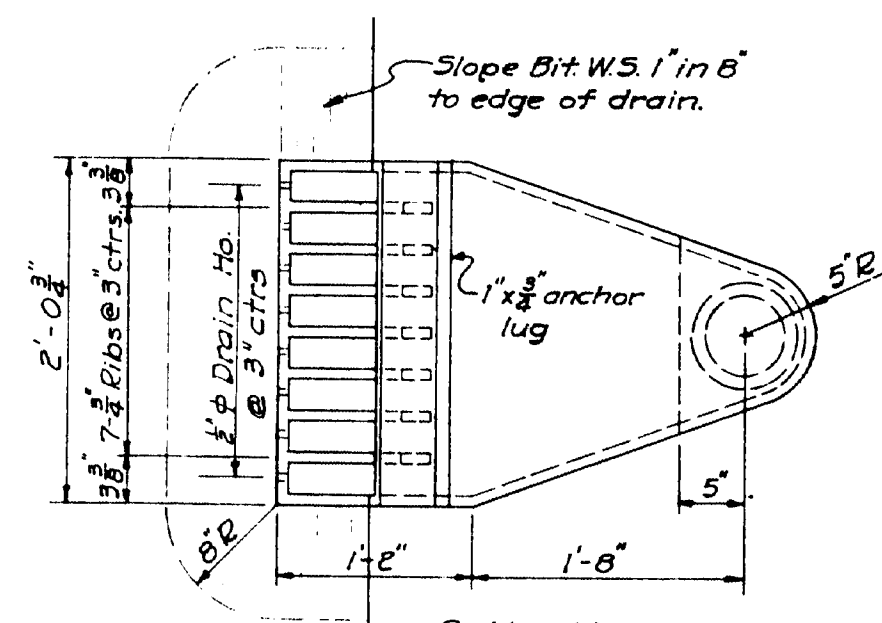


### TYPE "A" DRAIN DETAILS

All metal thickness to be 3/8" unless otherwise shown. Material: Cast Iron. Scale: 1/2" = 1'-0"

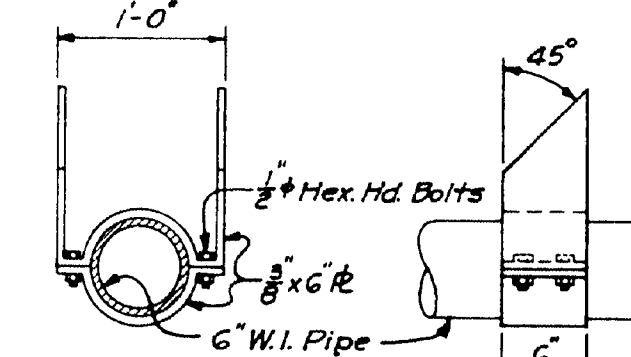

### DOWNSPOUT BRACKET

Scale: 1/2" = 1'-0"

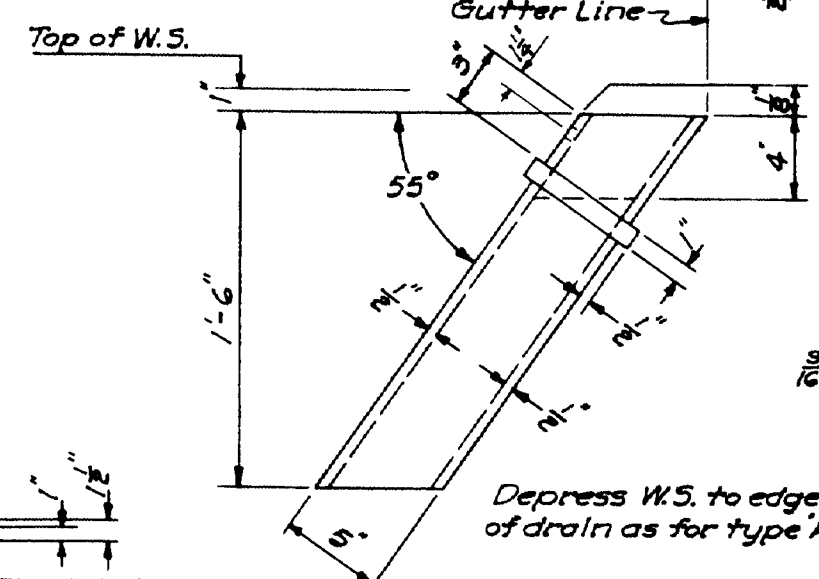


### TYPE "B" DRAIN DETAILS

Material: Cast Iron


### DRAIN EXTENSION DETAILS

Scale: 1/2" = 1'-0"

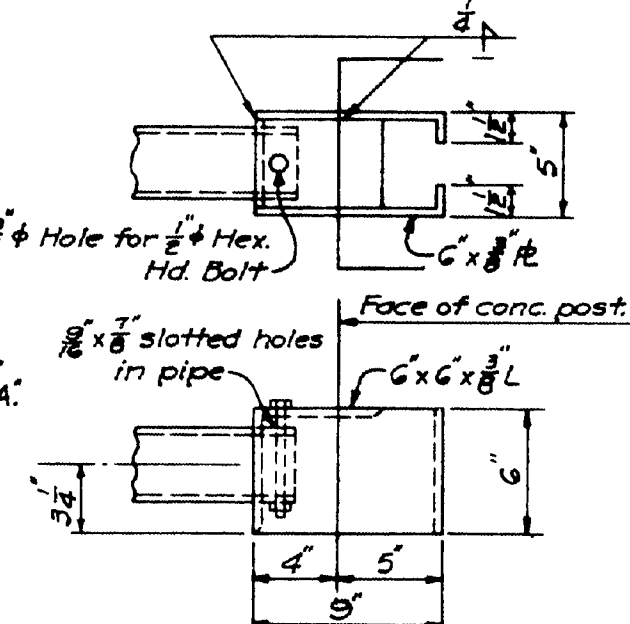

### HANDRAIL CONNECTION TO CONCRETE POST

Material: Wrought Iron  
For both railings at Union St. and Brewer Abutments and downstream railing at Ramp 'B' Abutment.

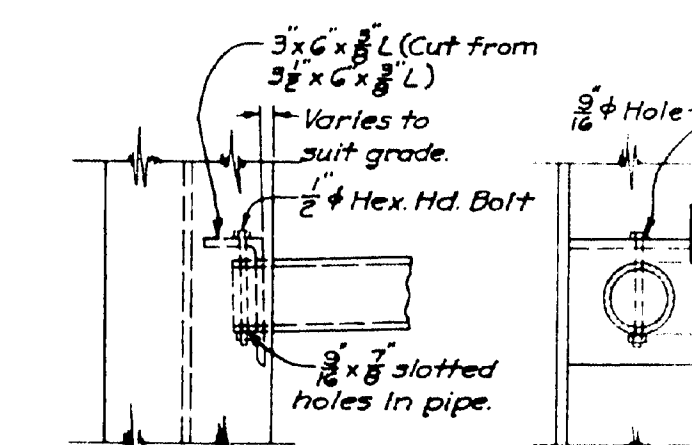


### TYPICAL HANDRAIL CONNECTION

For U-bolt details see Sh. No. 19. Cut mesh to clear.


### BASE PLATE - SPAN I

Scale: 1/2" = 1'-0"

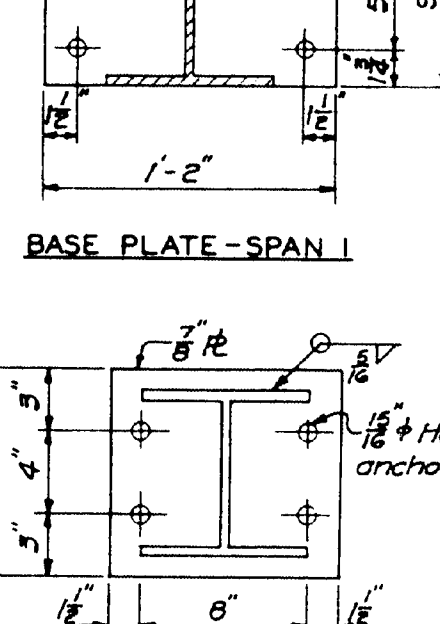

### BASE PLATE - WALLS & ABUTMENTS

See Shop Details for Handrail & Drain Revisions.

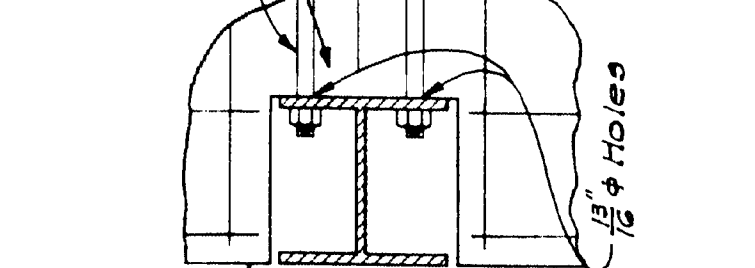

### SIDEWALK DETAILS AT HANDRAIL POSTS SPANS 2 TO 16

STATE OF MAINE  
BANGOR-BREWER BRIDGE  
OVER PENOBSCOT RIVER  
BANGOR, MAINE











### SLAB & HANDRAIL DETAILS

HARRINGTON AND CORTELYOU  
CONSULTING ENGINEERS  
KANSAS CITY, MO.

DETAILED G.E.G. 10-31-52  
TRACED R.E.P. 11-13-52  
CHECKED F.M.C. 1-13-53

SCALE: 1/2" = 1'-0"  
AS NOTED  
SHEET NO. 18

As Built Revisions: 12-7-54

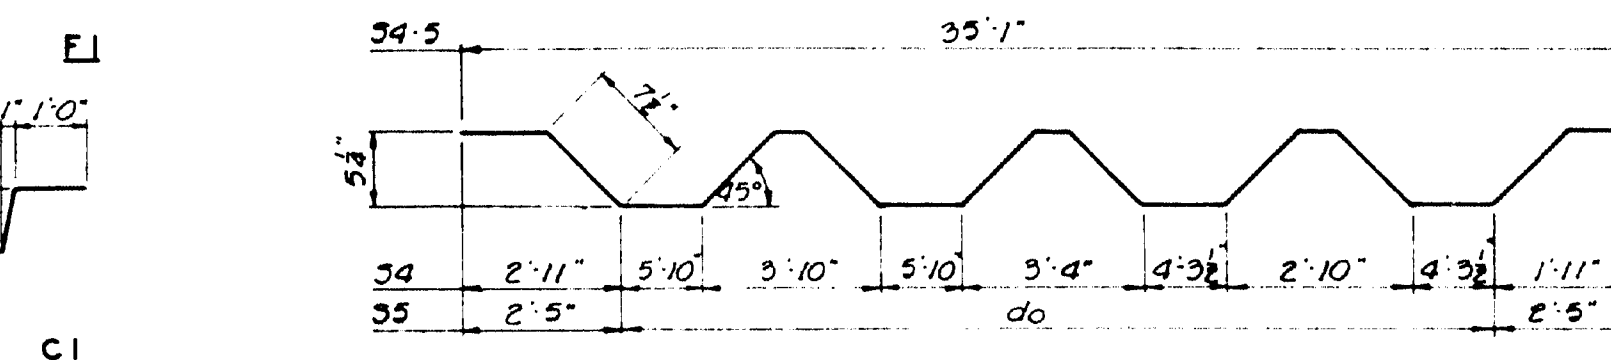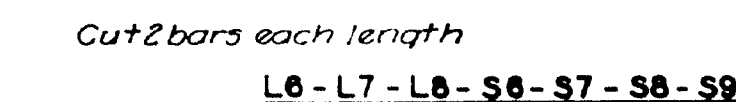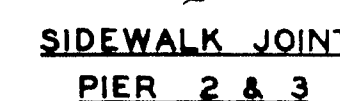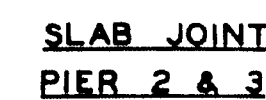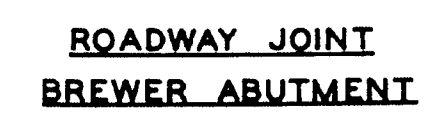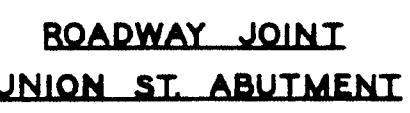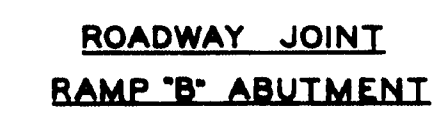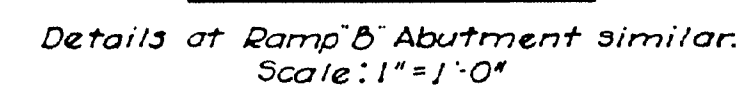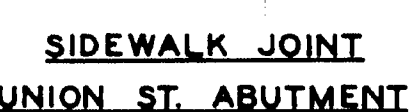
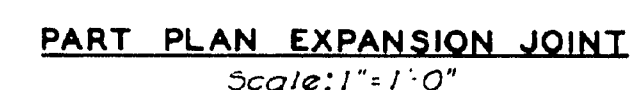
‡ Average Length

As Built Revisions CFM, ZEW 12-17-54

E:  $\frac{3}{4}'' = 1' - 0''$   
AND AS NOTED  
SHEET NO. 19


**62-19**



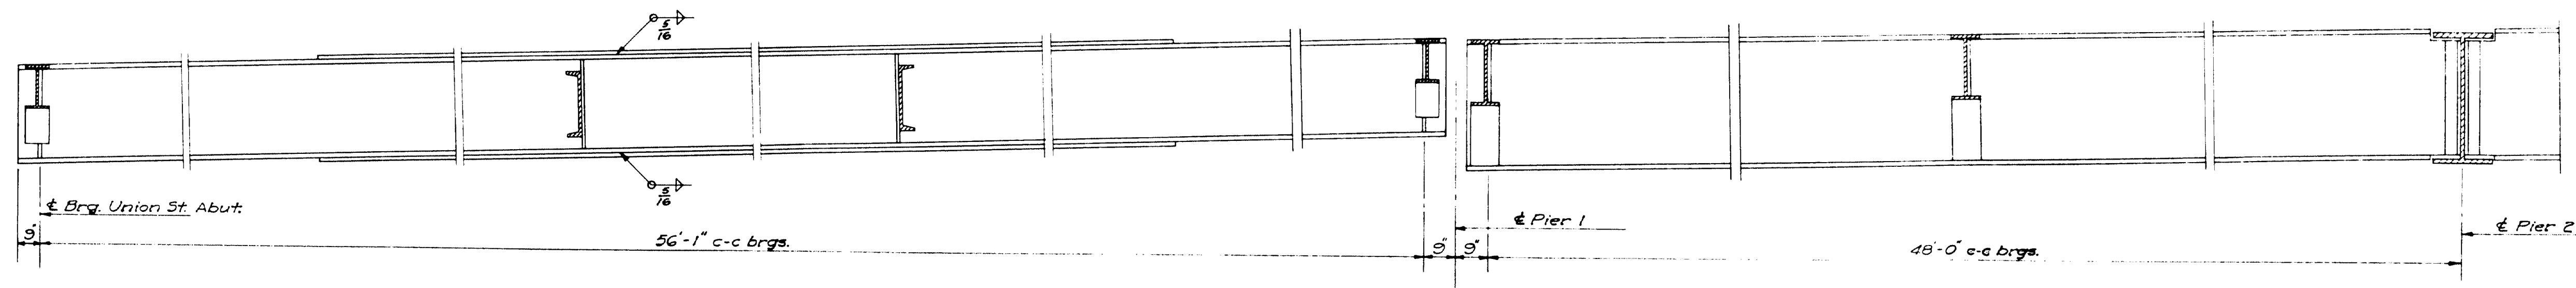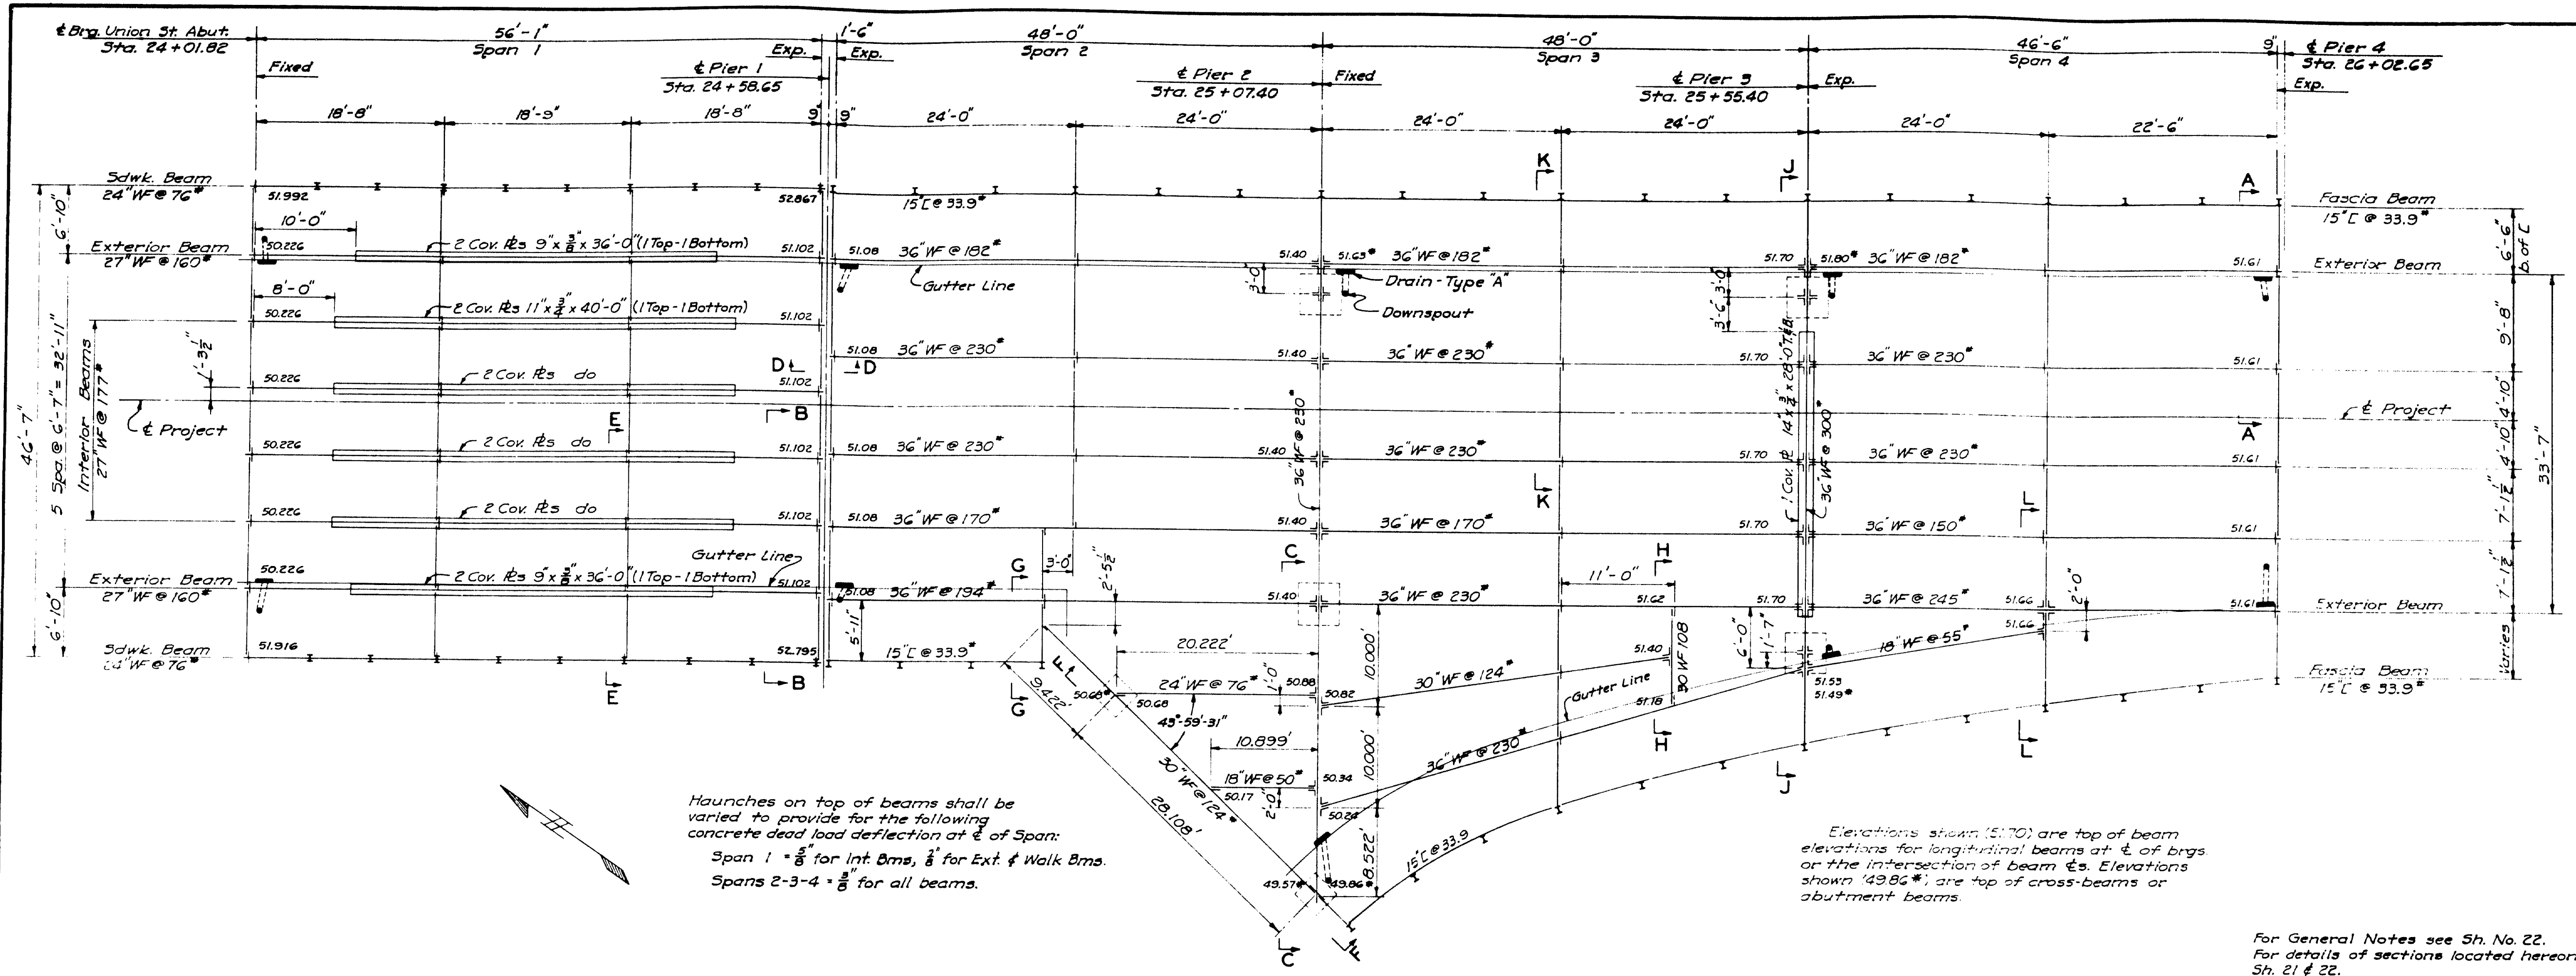

STATE OF MAINE  
STATE HIGHWAY COMMISSION  
**BANGOR-BREWER BRIDGE**  
OVER PENOBSCOT RIVER  
BANGOR, MAINE  
**FRAMING PLAN**  
SPANS 1-4  
HARRINGTON AND CORTELYOU  
CONSULTING ENGINEERS  
KANSAS CITY, MO.  
DETAILED G.E.G. 9-22-52  
TRACED Repro 10-6-52  
CHECKED P.M.C. 1-15-53  
SCALE: AS NOTED  
SHEET NO. 20



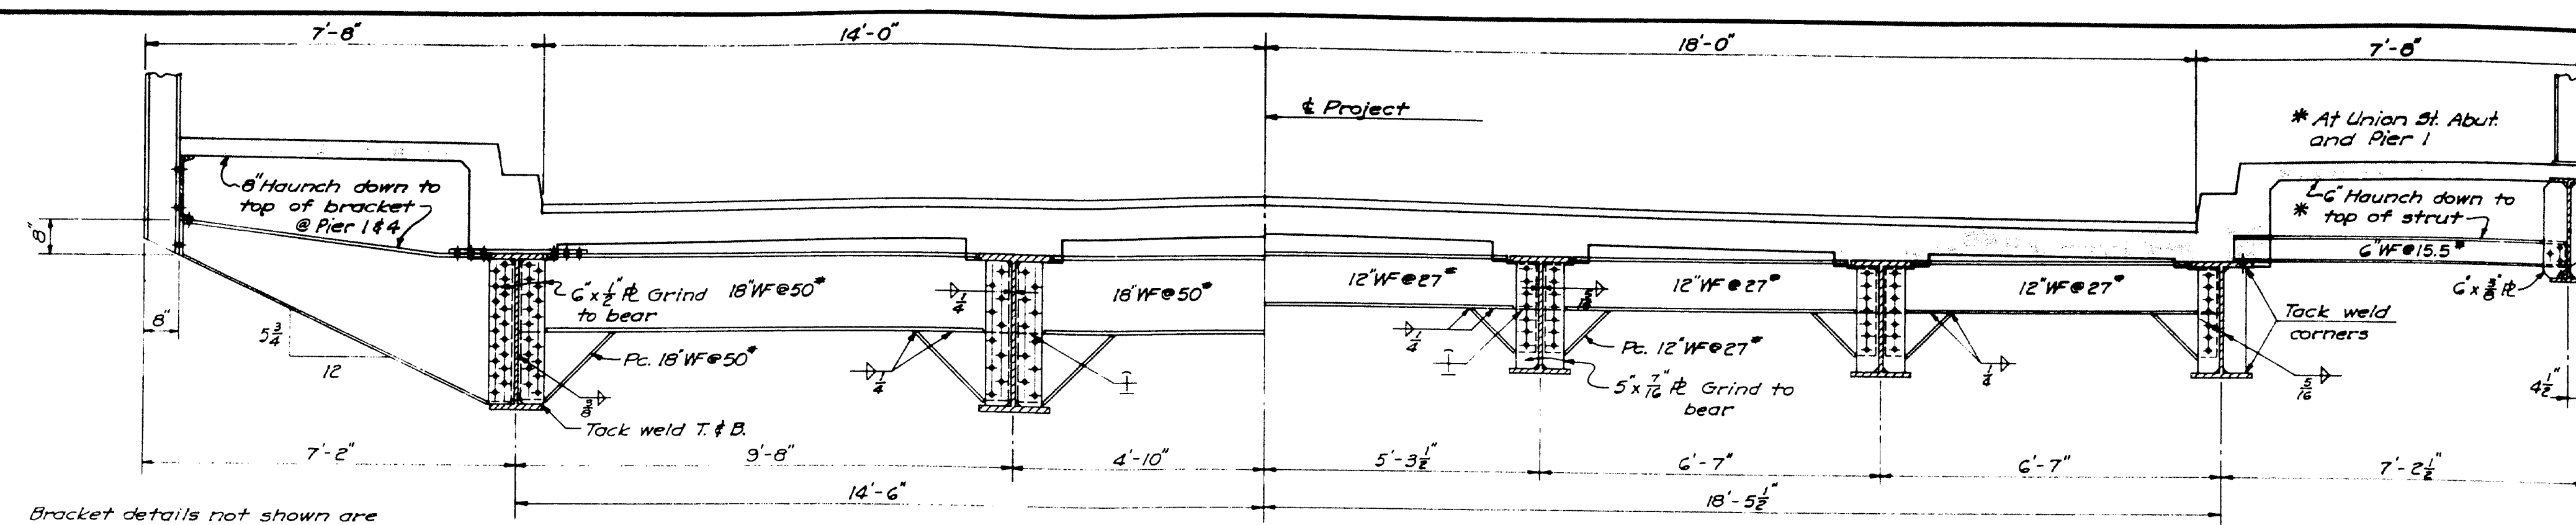


Bracket details not shown are same as for typical bracket. See Sec. K-K. Haunch concrete on fascia beam for D.L. deflection and vertical curve.


**SECTION A-A**  
End bearing stiffeners to be  $6 \times \frac{1}{2}$  Rls ground to bear.

Scale:  $\frac{1}{2}$ " = 1'-0"


**SECTION B-B**  
Typical end brg details Span 1. End bearing stiffeners to be  $5 \times \frac{1}{2}$  Rls, ground to bear, except as shown. See Sh. No. 27 shoes and anchor bolts.

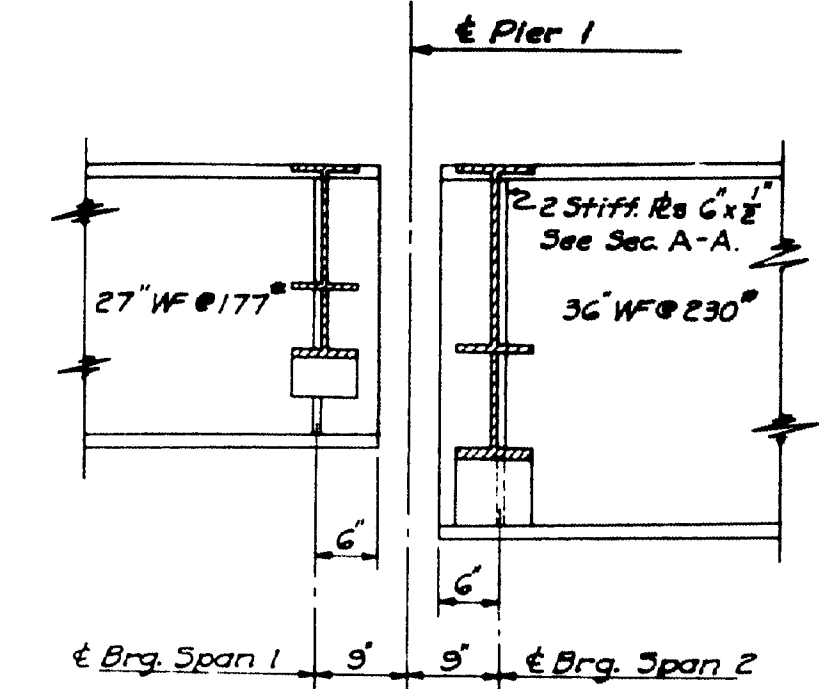


**SECTION D-D**  
Scale:  $\frac{3}{4}$ " = 1'-0"

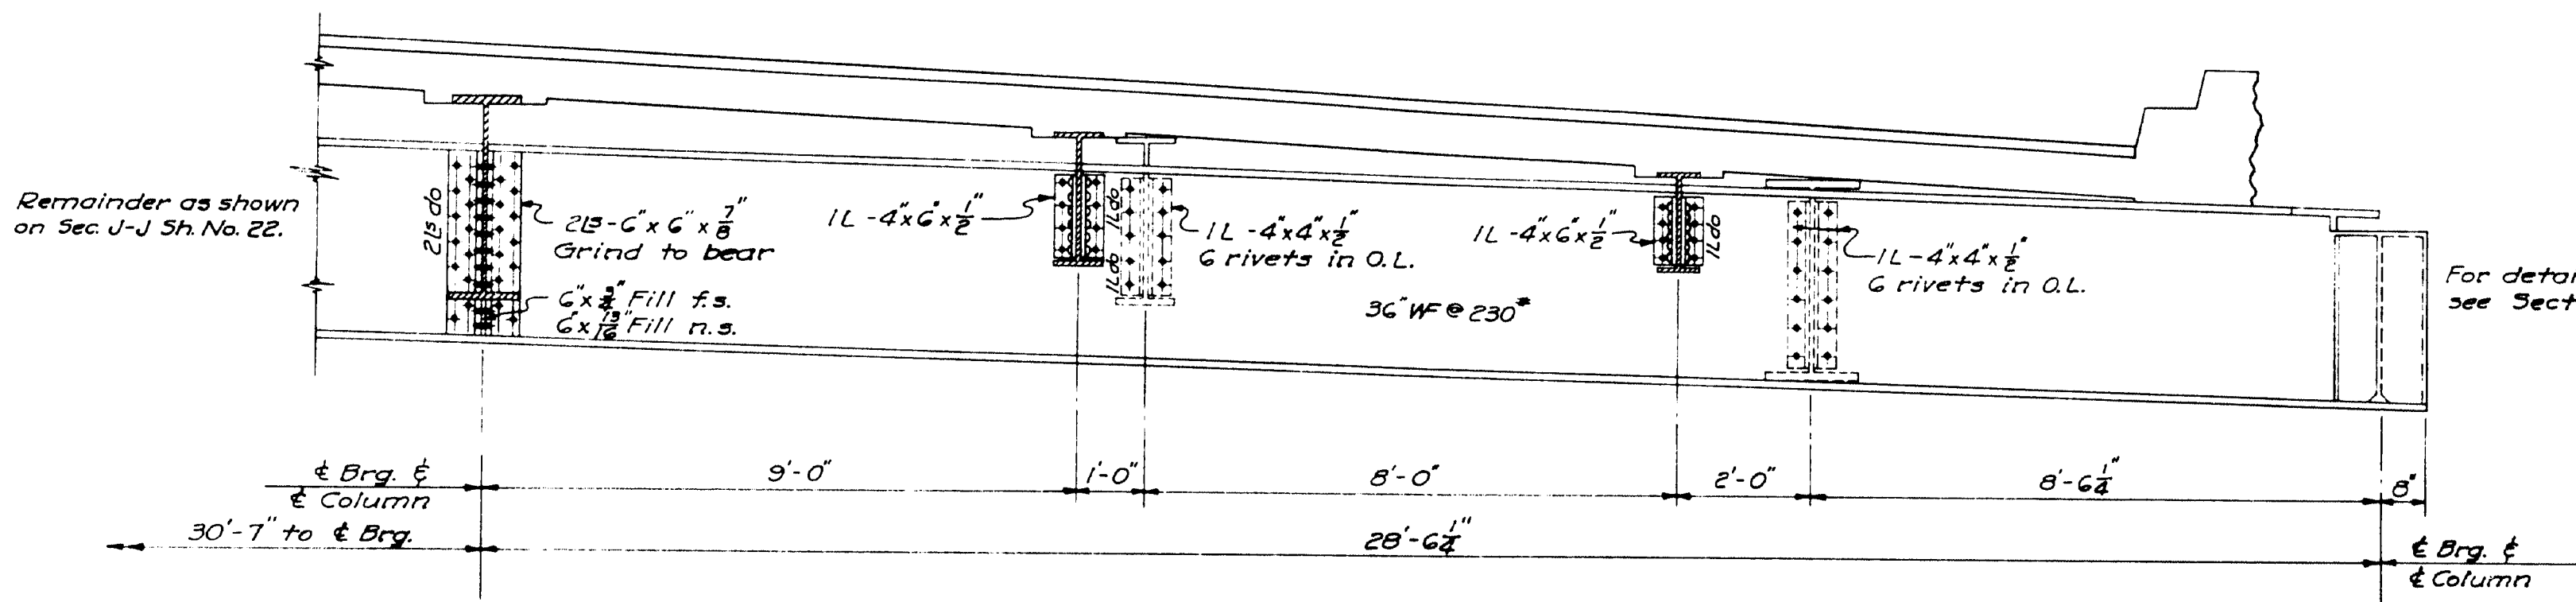


For details of brg. stiffeners see Section F-F.

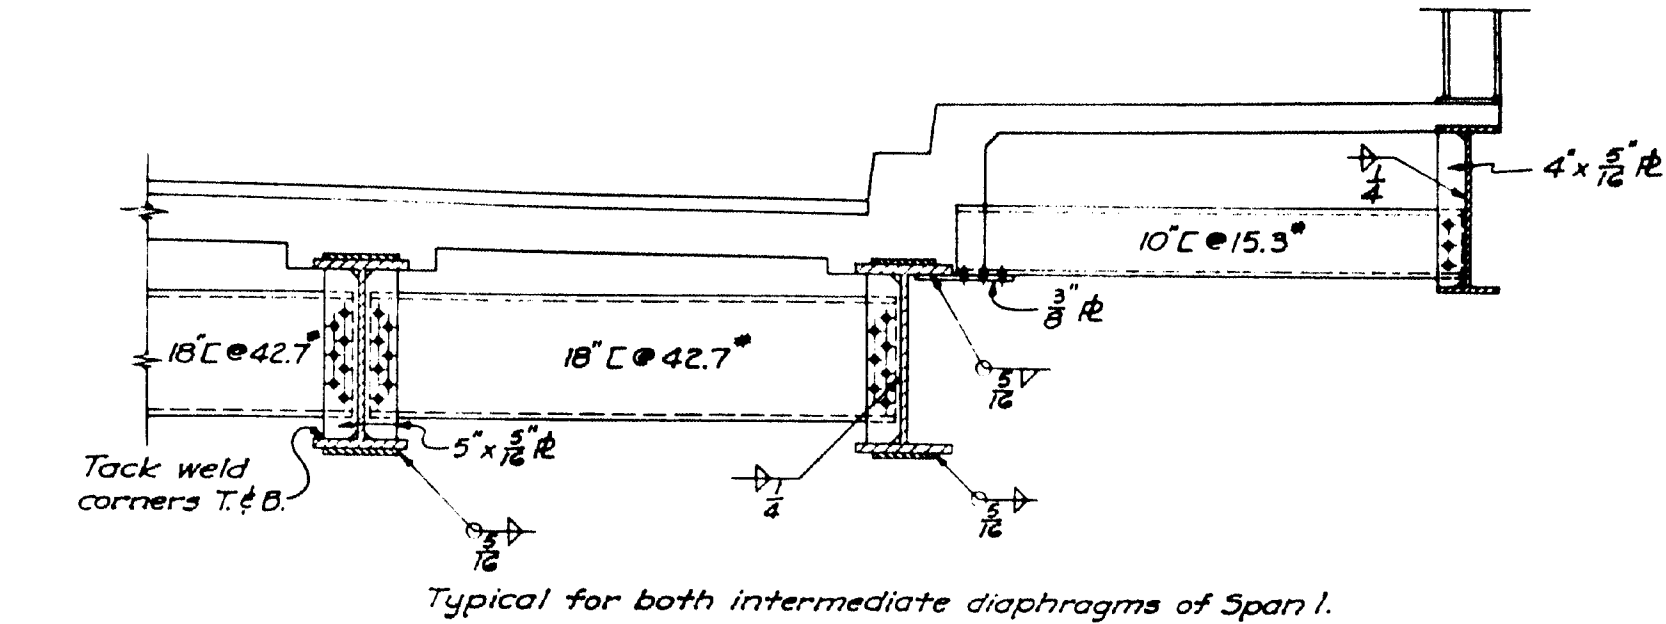


**SECTION E-E**  
Scale:  $\frac{1}{2}$ " = 1'-0"

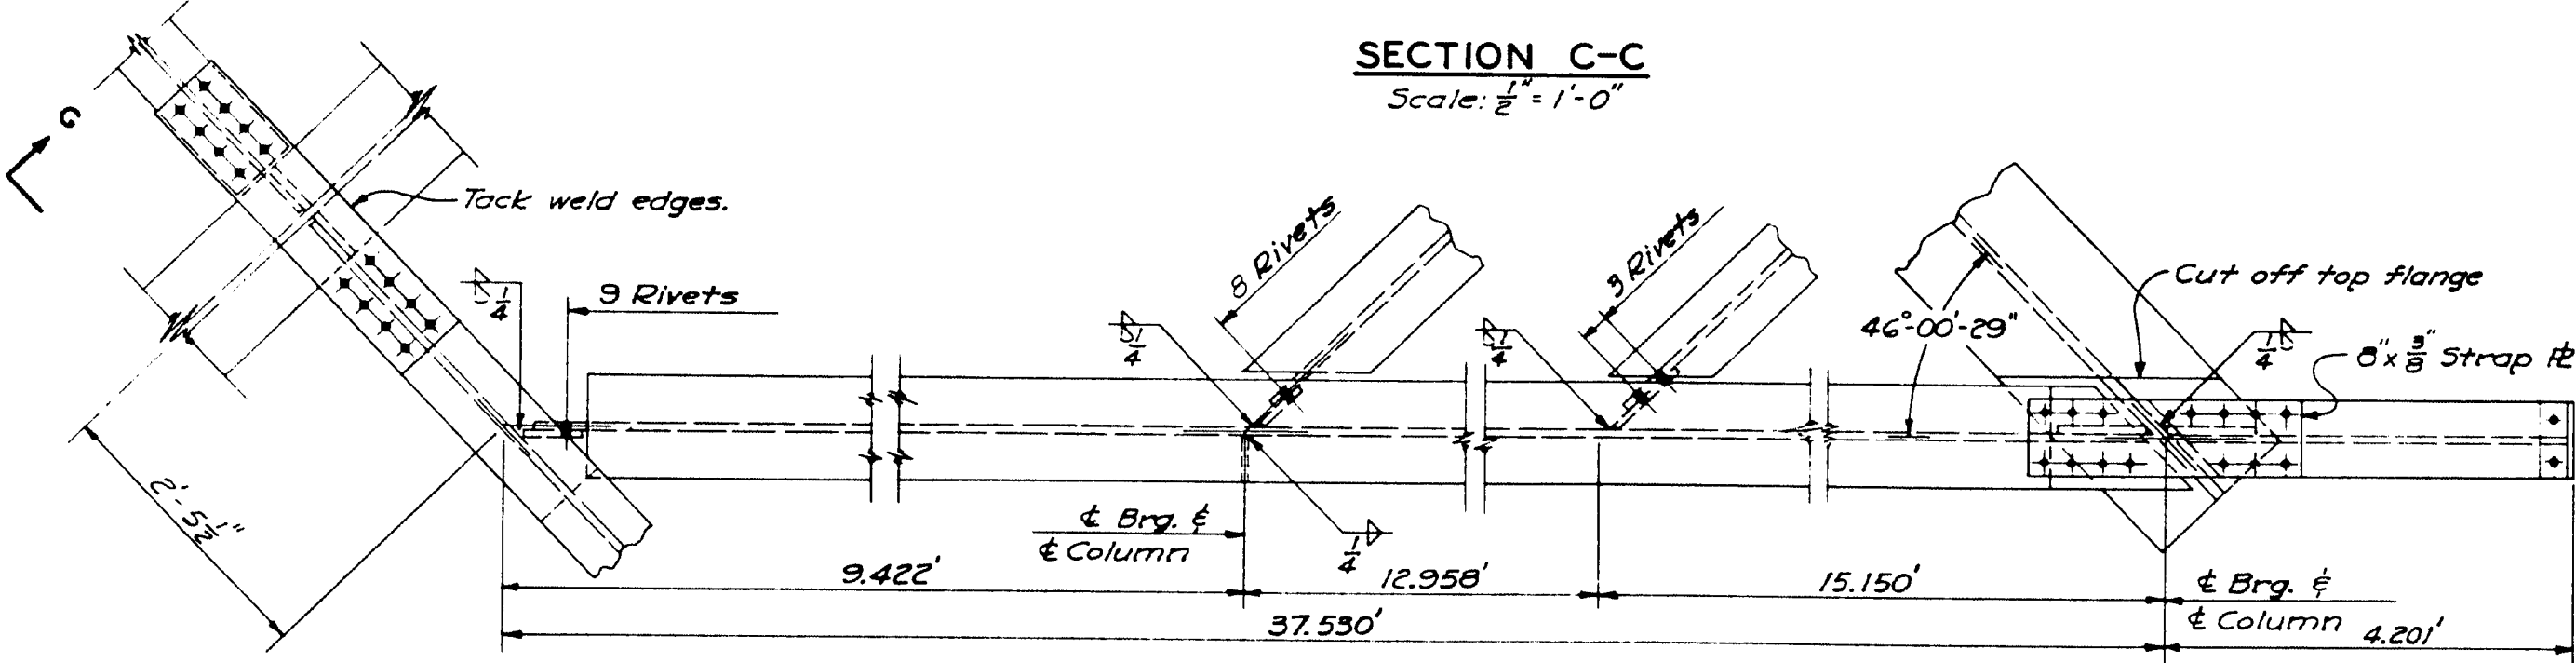

**SECTION G-G**  
Scale:  $\frac{1}{2}$ " = 1'-0"

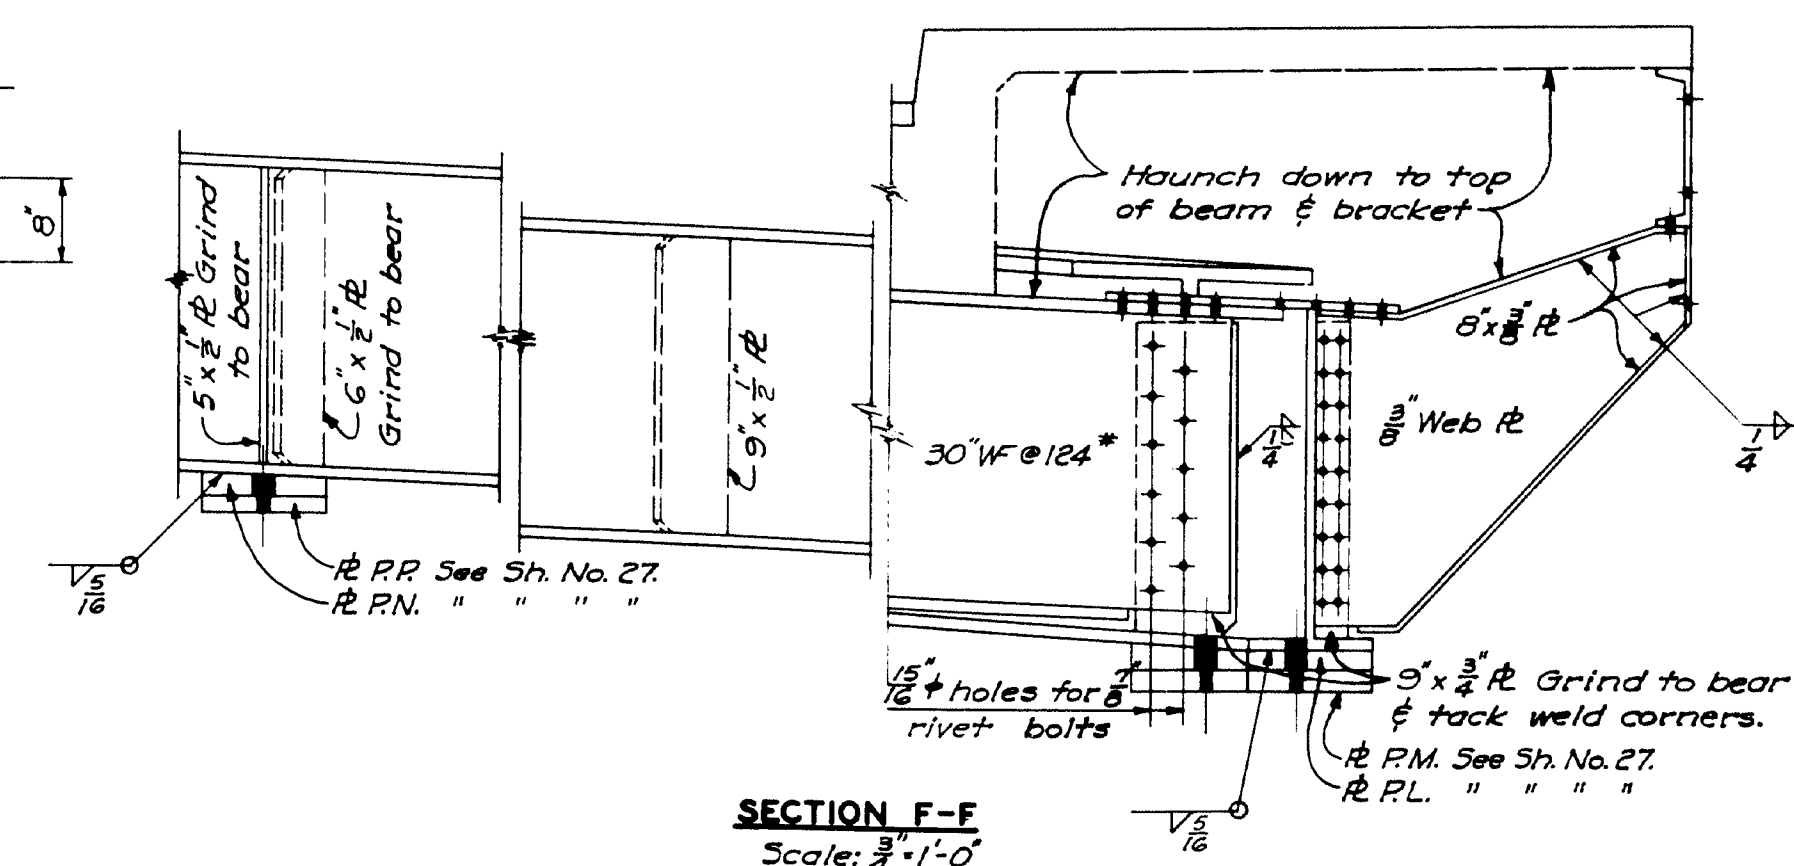



**SECTION F-F**  
Scale:  $\frac{3}{4}$ " = 1'-0"

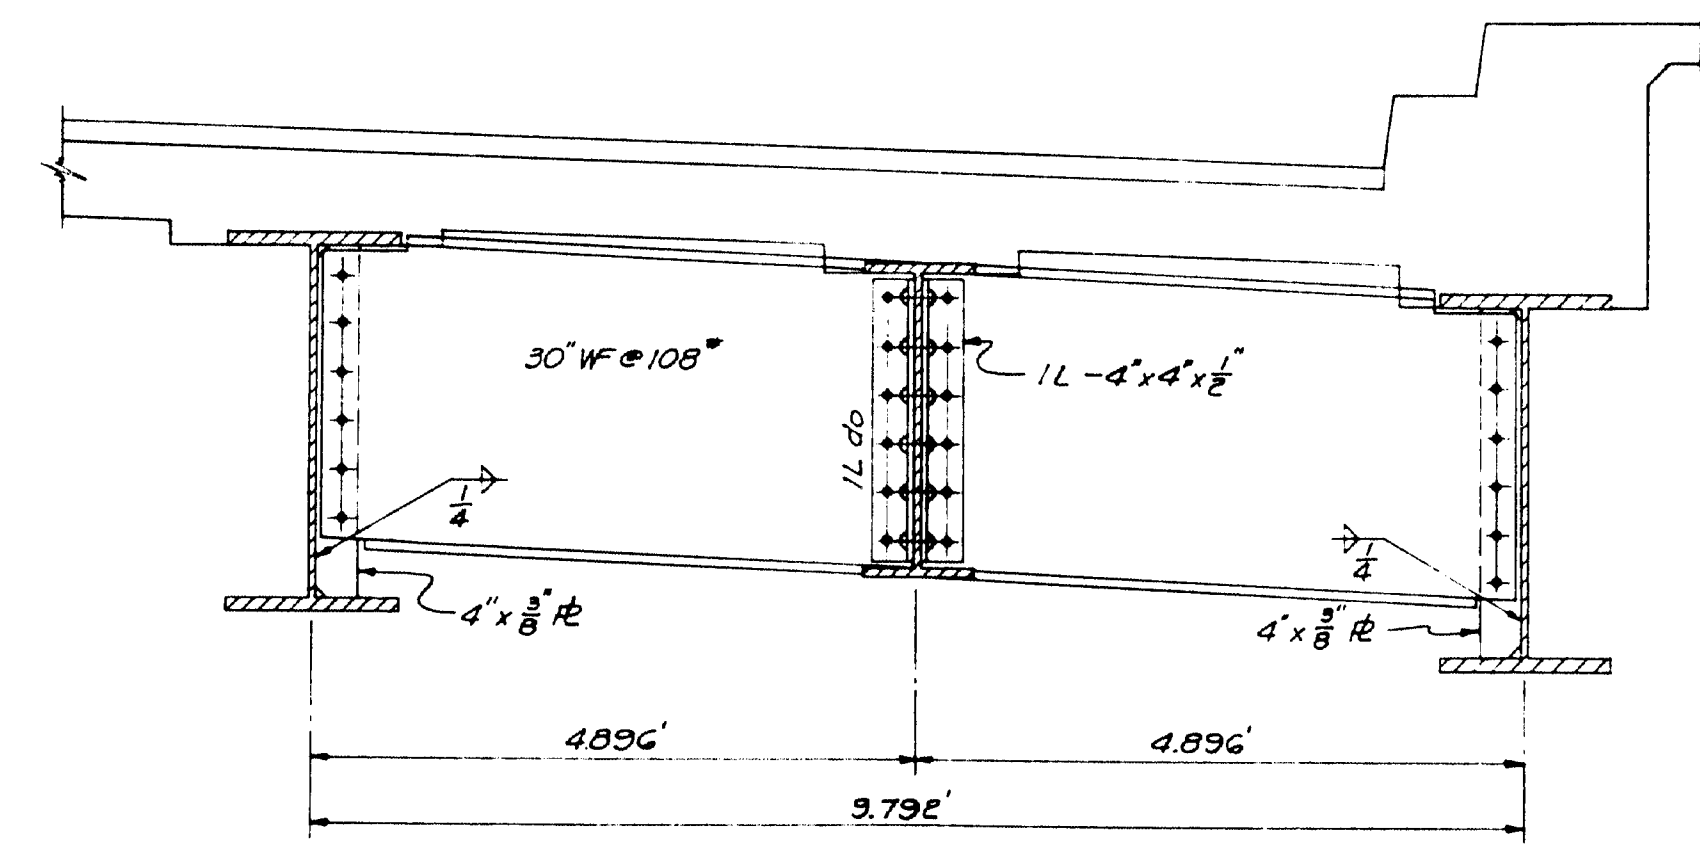


**SECTION H-H**  
Scale:  $\frac{3}{4}$ " = 1'-0"

For General Notes see Sheet No. 22.  
For location of sections see Sh. No. 20.


STATE OF MAINE  
STATE HIGHWAY COMMISSION  
**BANGOR-BREWER BRIDGE**  
OVER PENOBSCOT RIVER  
BANGOR, MAINE  
STEEL DETAILS  
SPANS 1-4  
HARRINGTON AND CORTELYOU  
CONSULTING ENGINEERS  
KANSAS CITY, MO.  
DETAILED G.E.G. 9-22-52  
TRACED Repro. 10-6-52  
CHECKED F.H.C. 1-15-53  
SCALE AS NOTED  
SHEET NO. 21

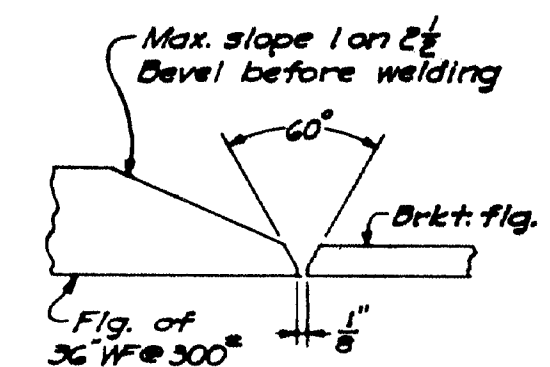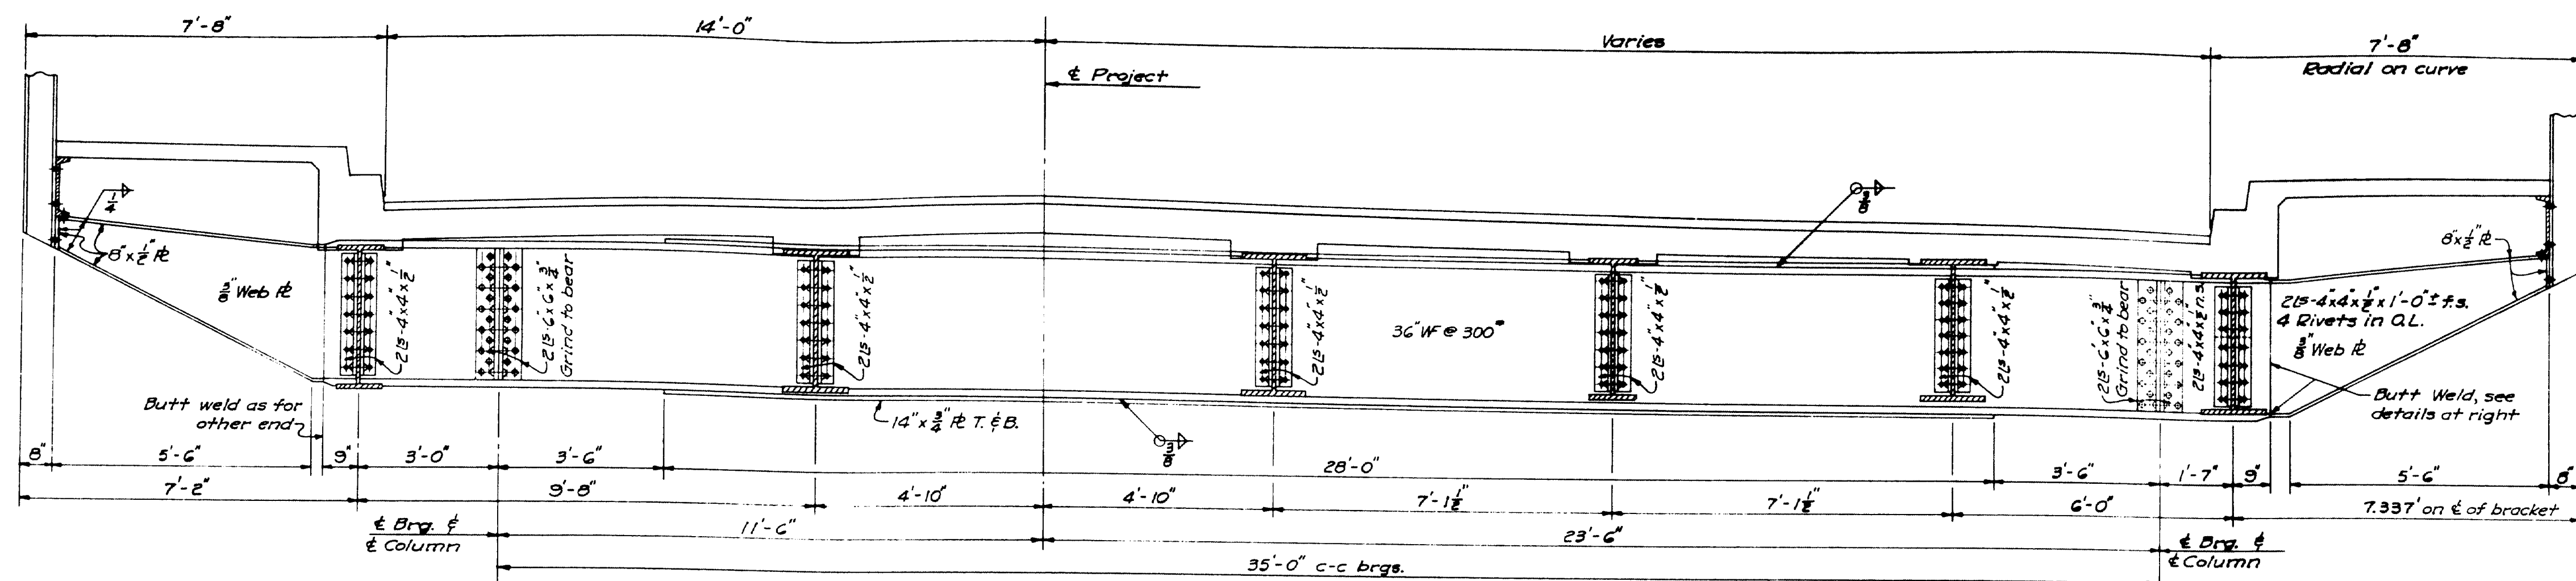

FLANGE WELD

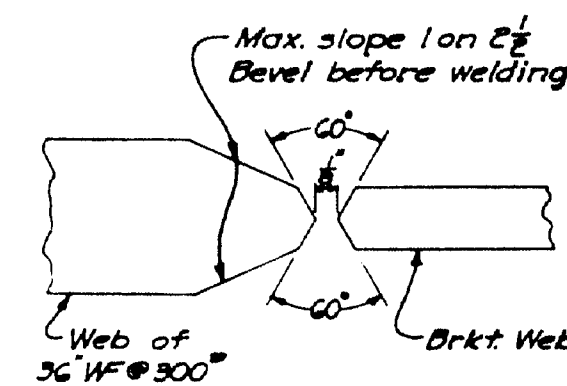

WEB WELD


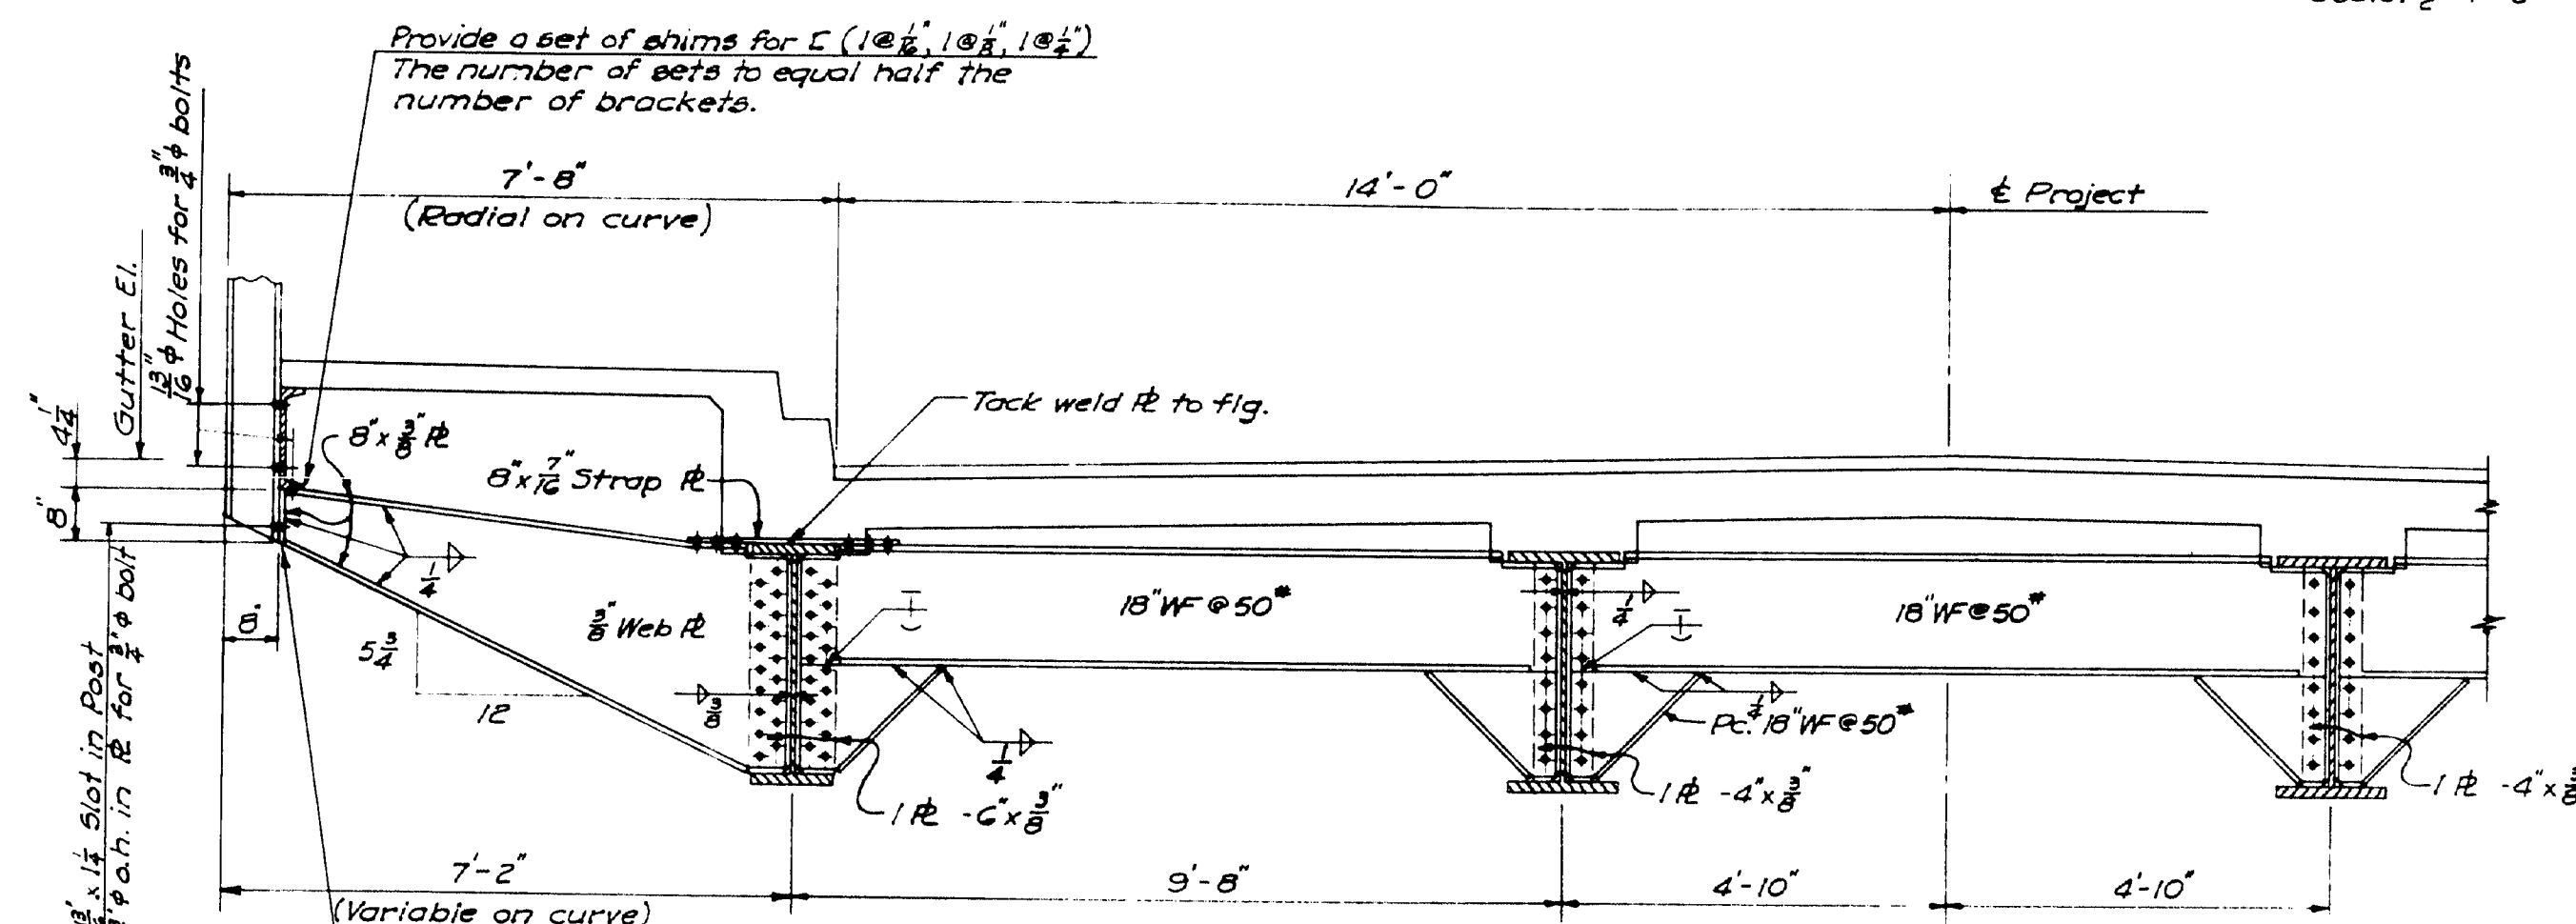


To provide for adjustment, furnish 1/2 full size shims in a quantity equal to the number of posts.


Bolts shall be standard bolts with hexagonal heads and nuts. They shall be threaded to such a length that not more than one thread will be within the grip of the metal. Bolts will extend entirely through their nuts, but not more than 1/4" beyond them. Number of bolts furnished shall be 5 percent more than the actual number shown on the plans for each size and length.

NOTES:

- Use 3/4" rivets thruout. Open holes 1 1/2".
- Bearing stiffeners shall be vertical and shall be ground to bear at bottom.
- Dimensions are horizontal and refer to top of top flange.
- No camber is required.
- For shoe details see Sheet No. 27.
- All material is carbon steel.
- For location of sections see Sh. No. 20.
- See Section K-K for handrail post connection and details.

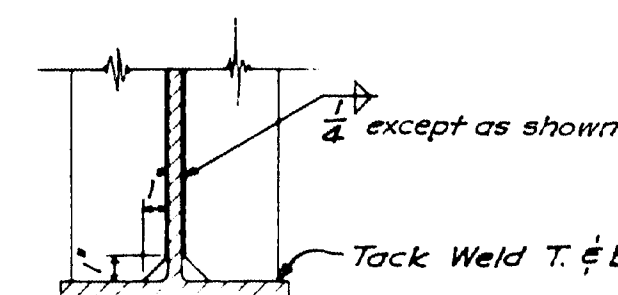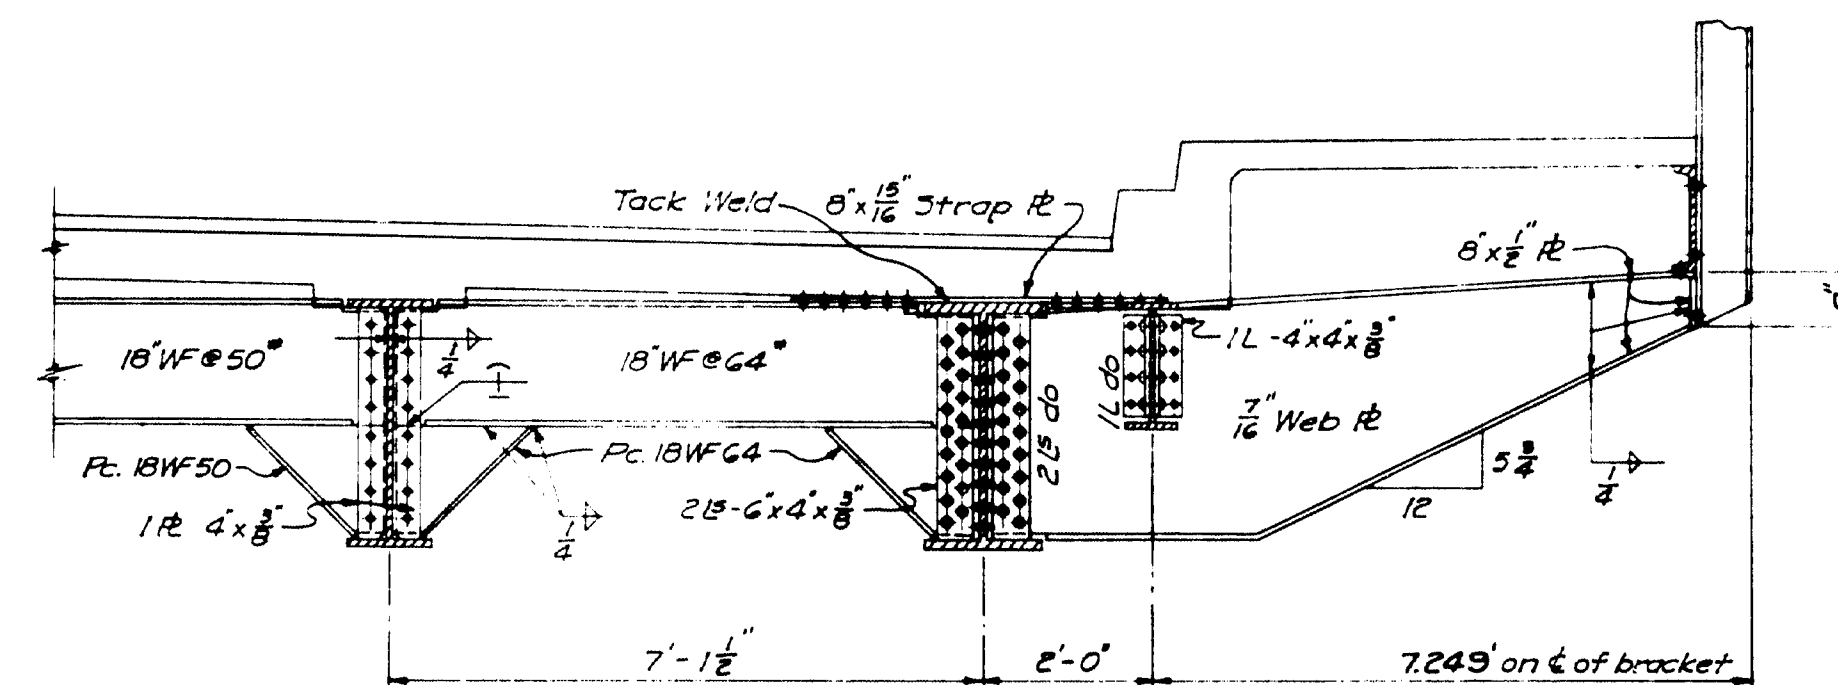

WELDED STIFFENER DETAILS

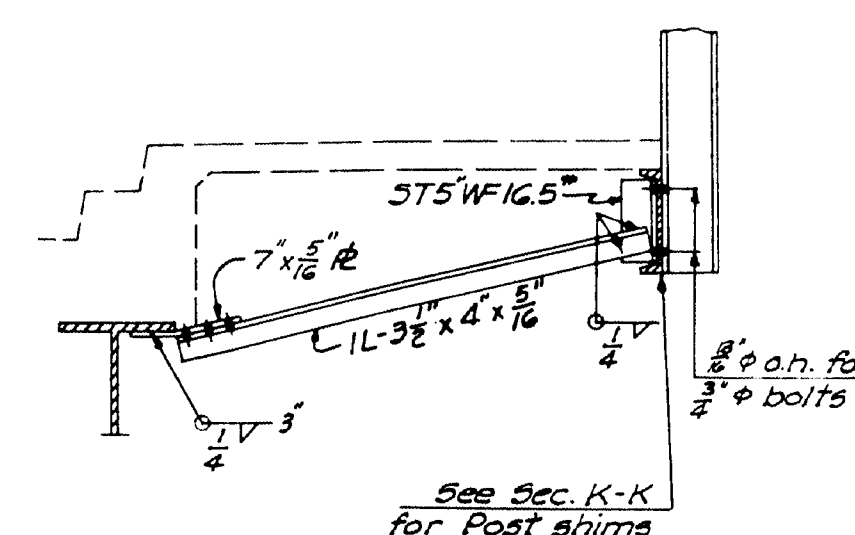

STRUTS AT INTERMEDIATE HANDRAIL POSTS


STATE OF MAINE  
STATE HIGHWAY COMMISSION  
BANGOR-BREWER BRIDGE  
OVER PENOBSCOT RIVER  
BANGOR, MAINE  
STEEL DETAILS  
SPANS 1-4

HARRINGTON AND CORTELYOU  
CONSULTING ENGINEERS  
KANSAS CITY, MO.


DETAILED G.E.G. 9-22-52  
TRACED Repr. 10-6-52  
CHECKED F.M.C. 1-15-53  
SCALE: AS NOTED  
SHEET NO. 22

62-22



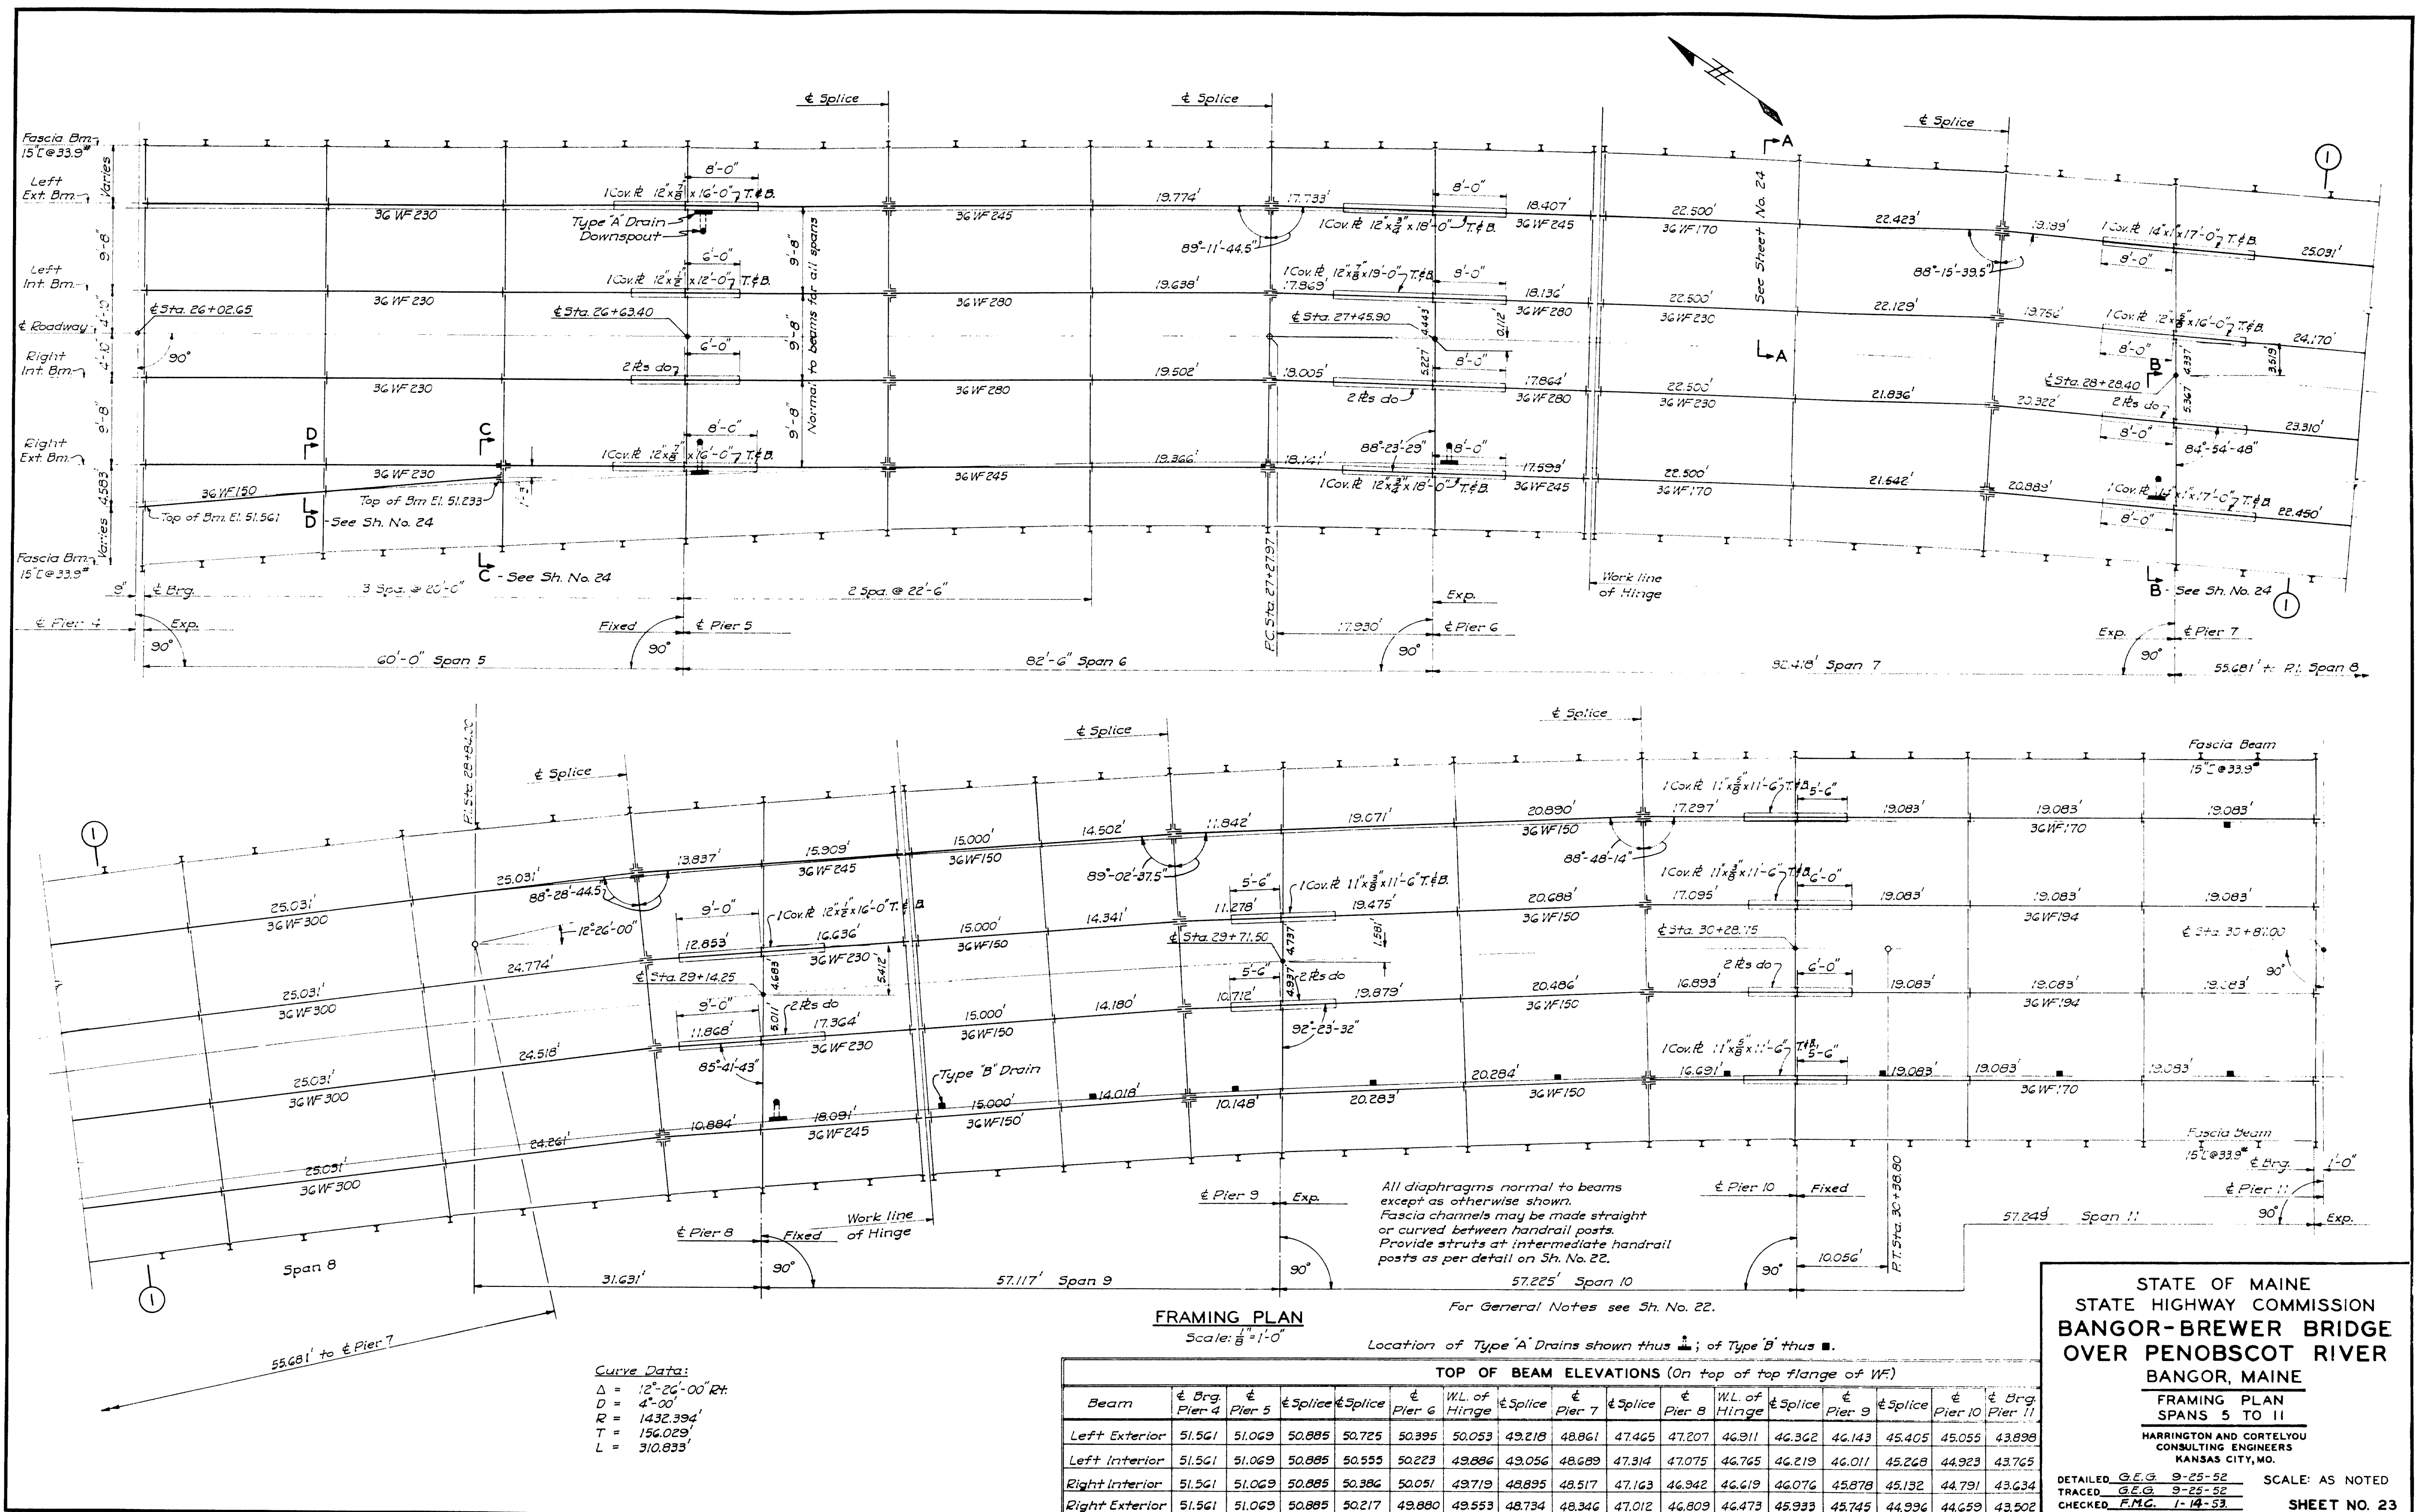



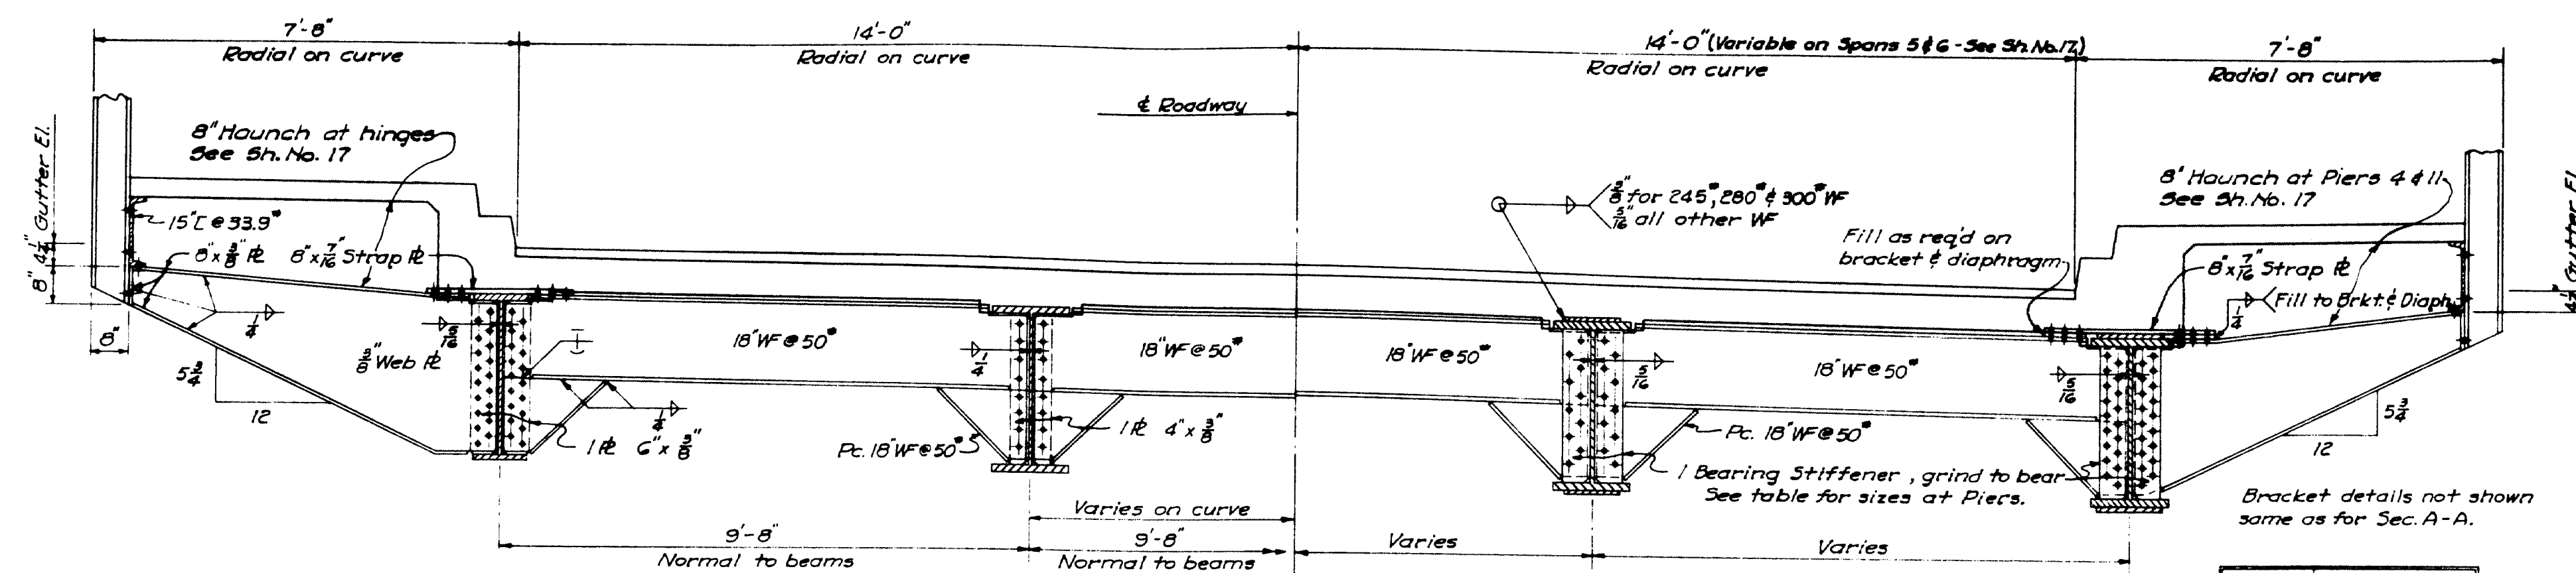


SECTION A-A TYPICAL INTERMEDIATE DIAPHRAGMS

SECTION B-B TYPICAL DIAPHRAGMS AT PIERS

Scale:  $\frac{1}{2}'' = 1'-0''$


Bearing stiffeners to be vertical, all other stiff. may be normal to beams. Stiffener welding same as for Spans 1 to 4 except as shown. See Sh. No. 22.

Pier	Stiff Size
4 & 11	6" x 1" Rls
5, 6 & 8	6" x 1" Rls
9 & 10	6" x 1" Rls
7	6" x 1" Rls

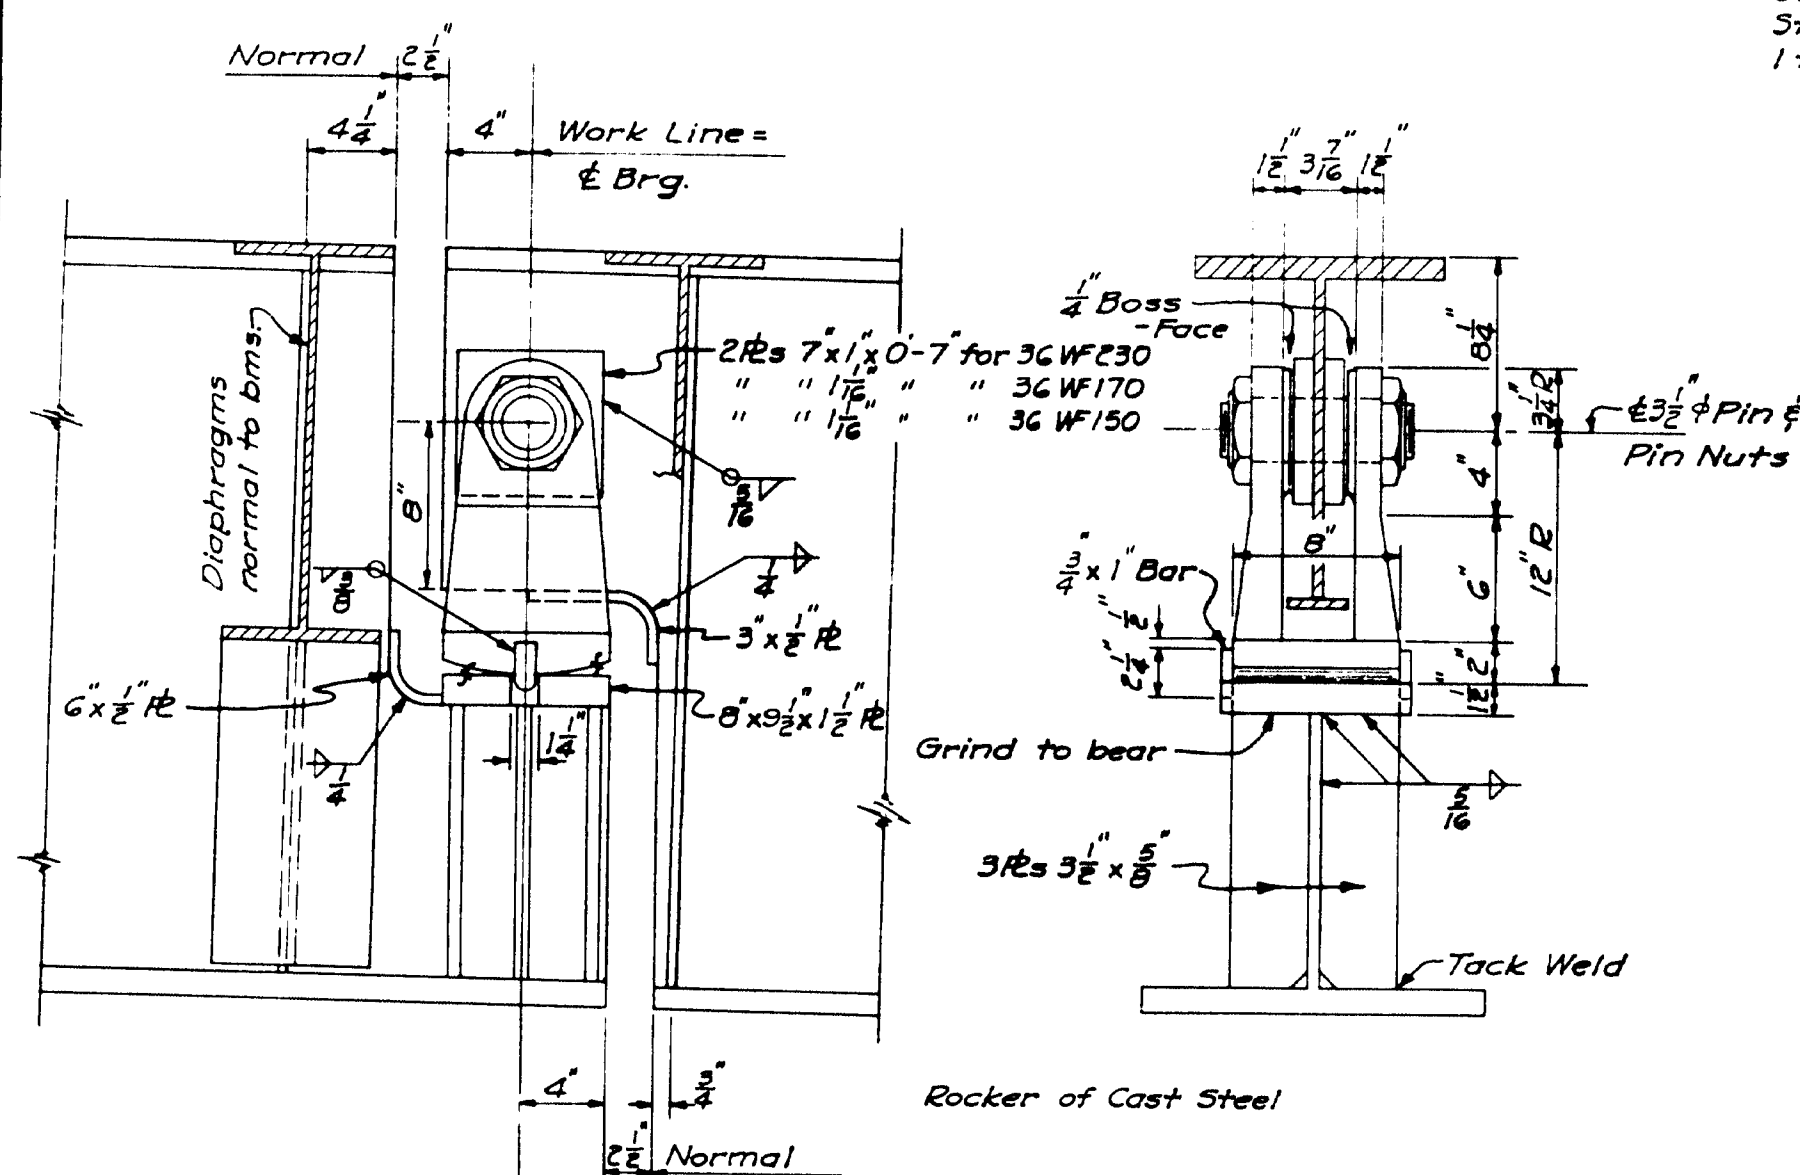


HINGE DETAILS

Scale:  $\frac{1}{2}'' = 1'-0''$

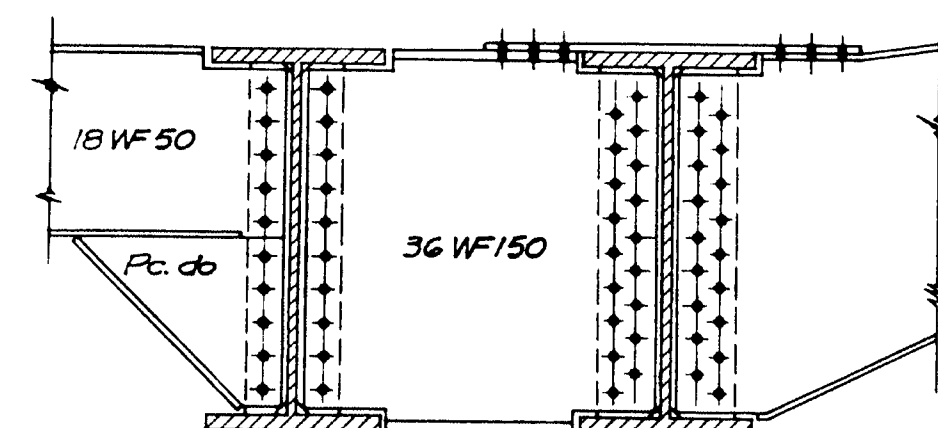


SECTION D-D

Scale:  $\frac{3}{4}'' = 1'-0''$

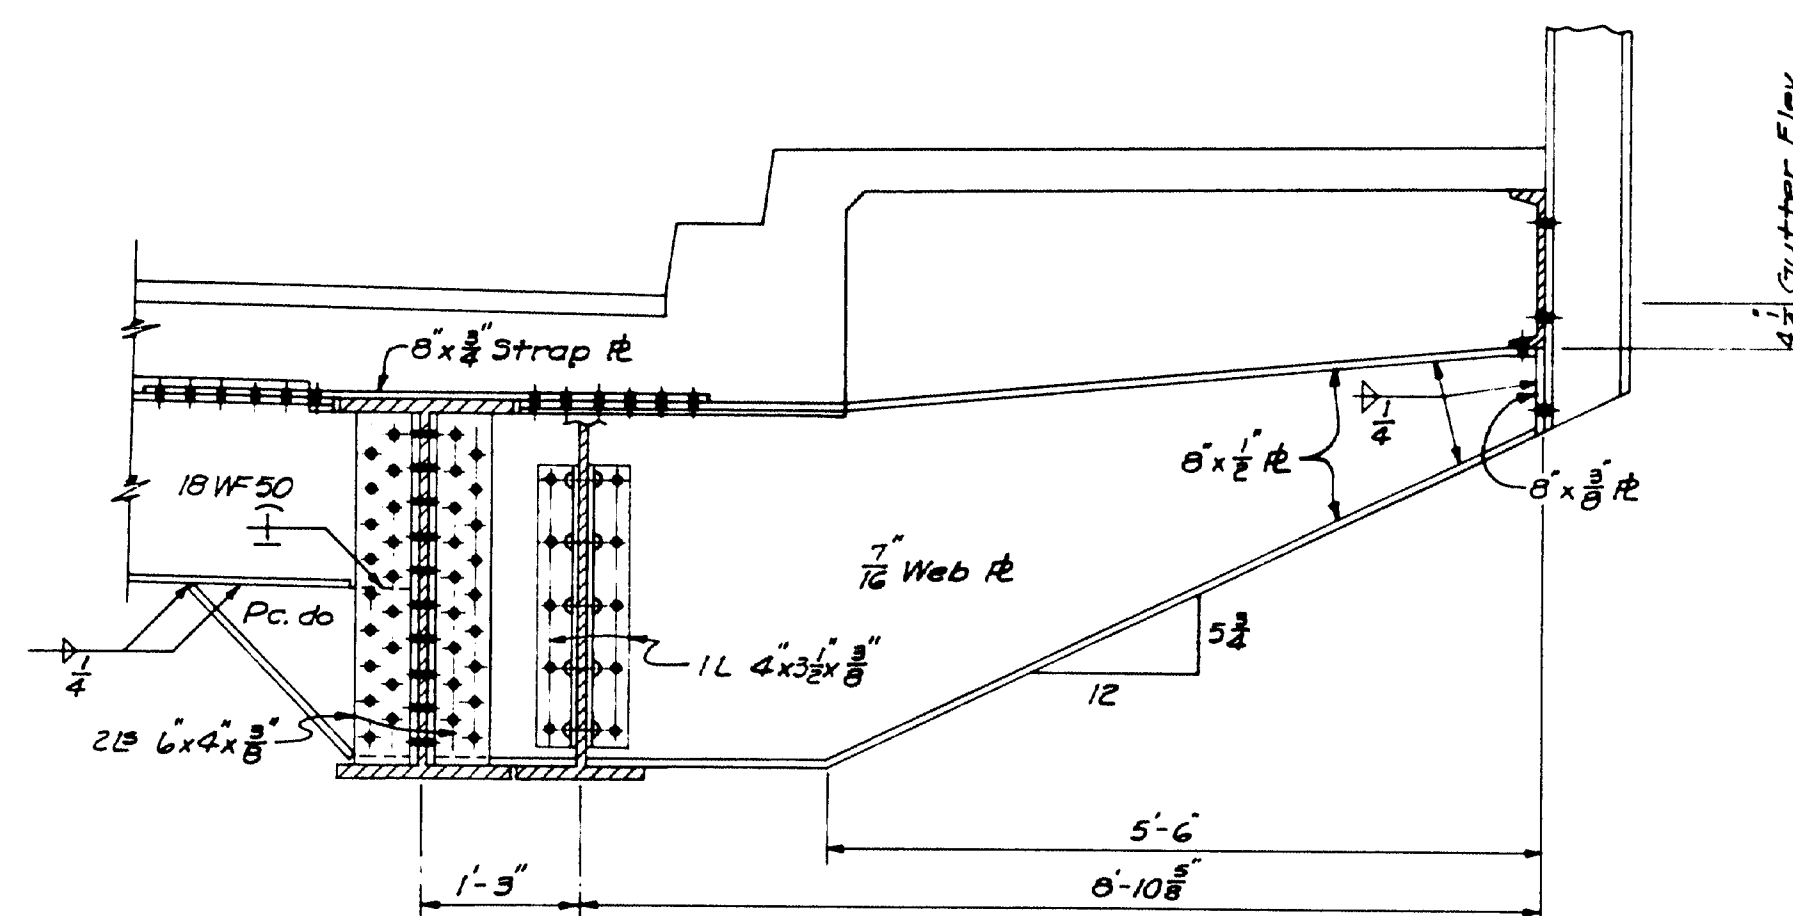

SECTION C-C


Scale:  $\frac{3}{4}'' = 1'-0''$

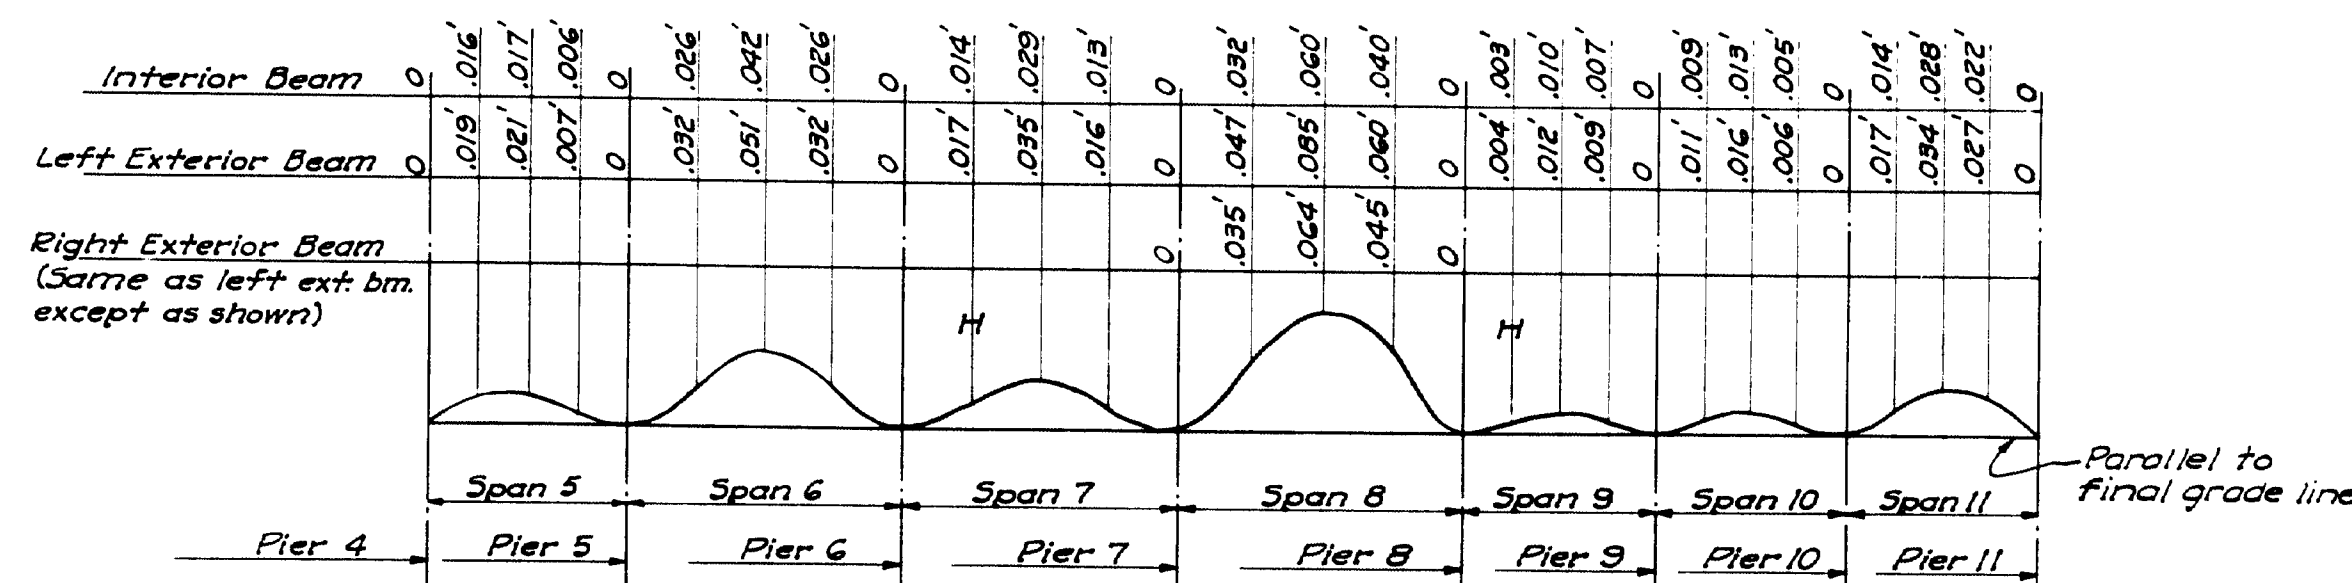

CONCRETE DEAD LOAD CAMBER


Values for concrete dead load only, shown at quarter & mid-points of spans, except where marked "H" indicating hinge.

For General Notes see Sh. No. 22.  
For location of sections see Sh. No. 23.

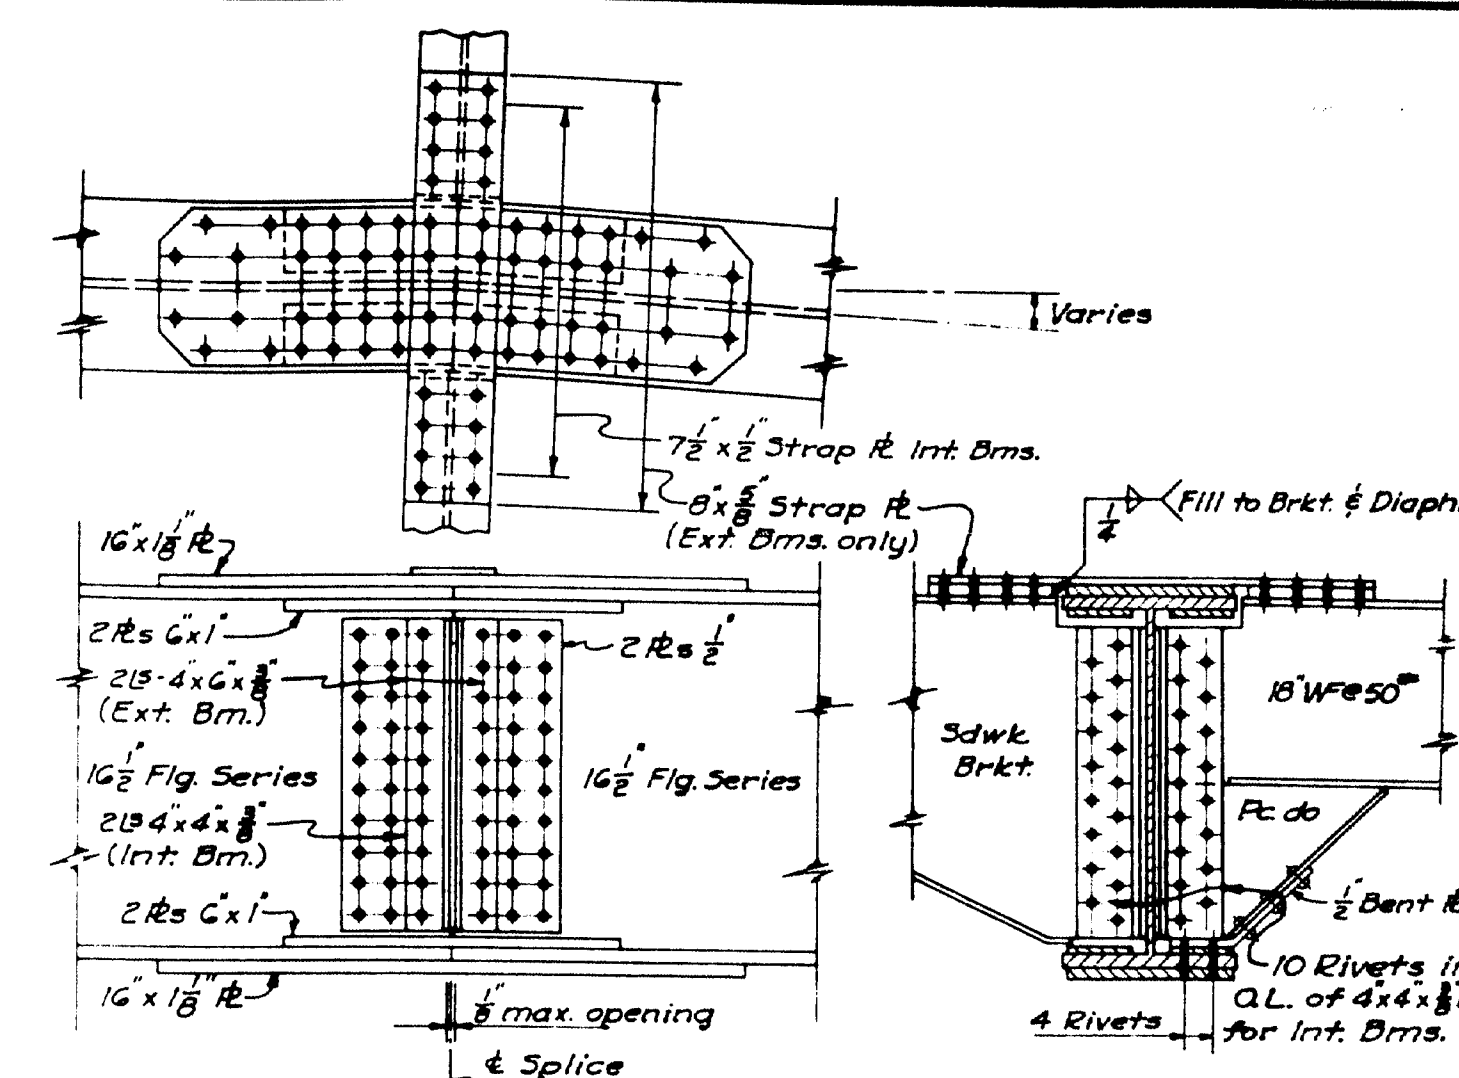

TYPICAL SPLICE FOR 18 1/2 FLANGE BEAMS

Exterior beam shown; interior beams same except as noted. Fill as req'd. Scale:  $\frac{3}{4}'' = 1'-0''$

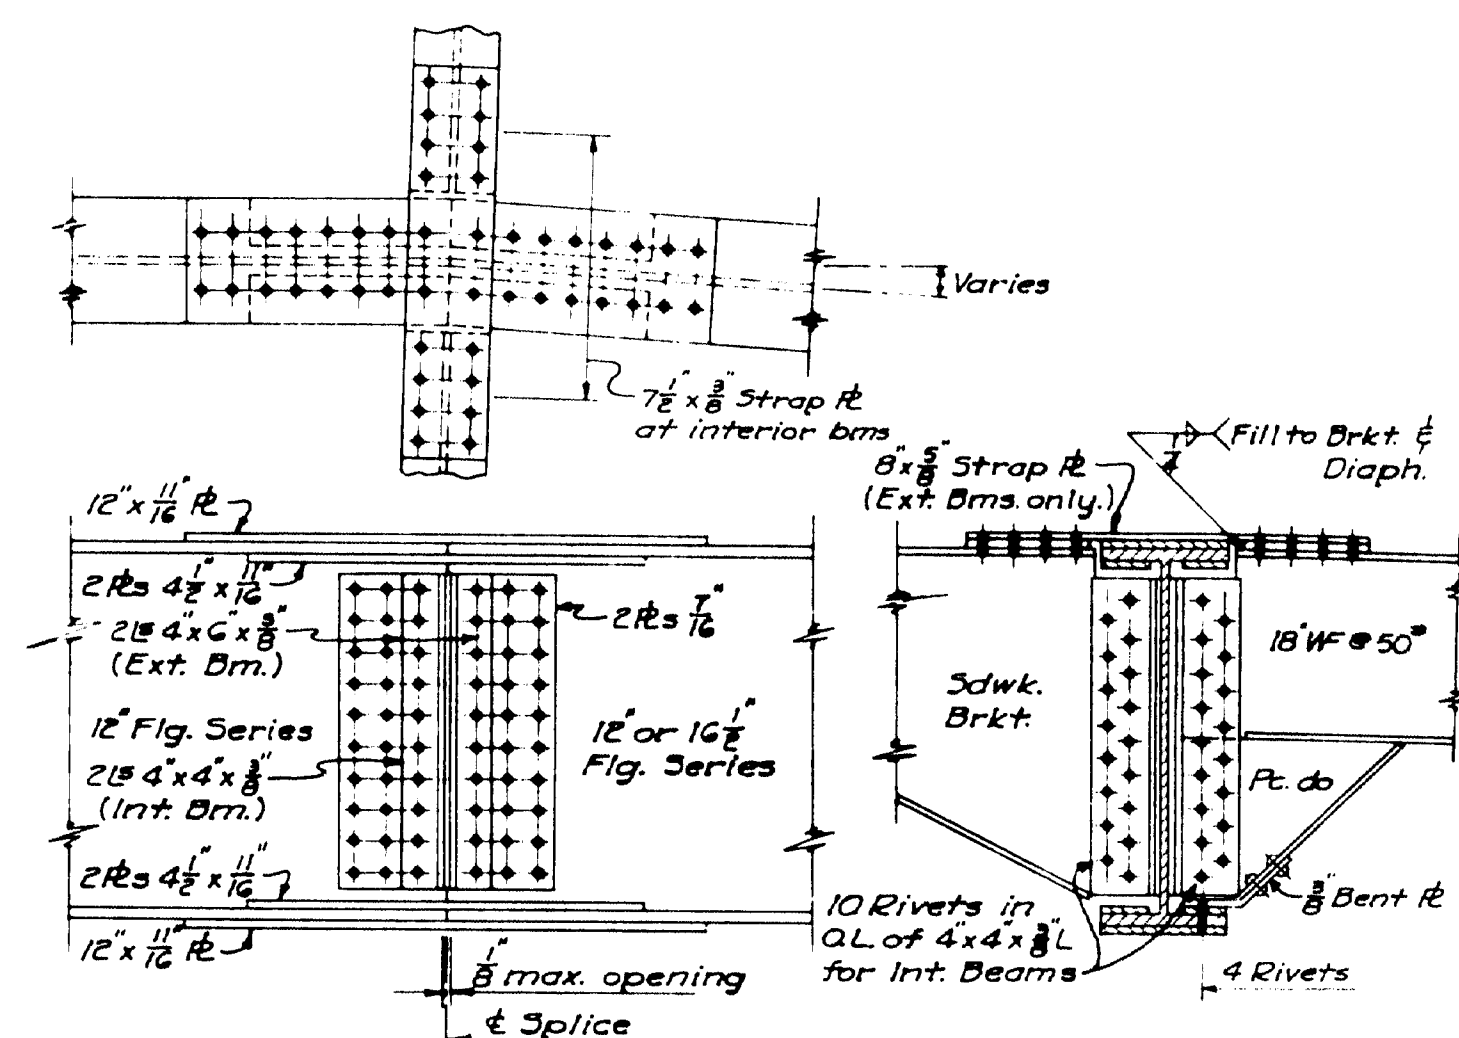

TYPICAL SPLICE FOR 12 TO 16 1/2 AND 12 TO 12 FLANGE SERIES

Exterior beam shown; interior beams same except as noted. Fill as req'd. Scale:  $\frac{3}{4}'' = 1'-0''$



STATE OF MAINE  
STATE HIGHWAY COMMISSION  
BANGOR-BREWER BRIDGE  
OVER PENOBSCOT RIVER  
BANGOR, MAINE

STEEL DETAILS  
SPANS 5-11

HARRINGTON AND CORTELYOU  
CONSULTING ENGINEERS  
KANSAS CITY, MO.


DETAILED G.E.B. 10-1-52  
TRACED E.P.R. 10-6-52  
CHECKED F.M.C. 1-14-53

SCALE: AS NOTED  
SHEET NO. 24

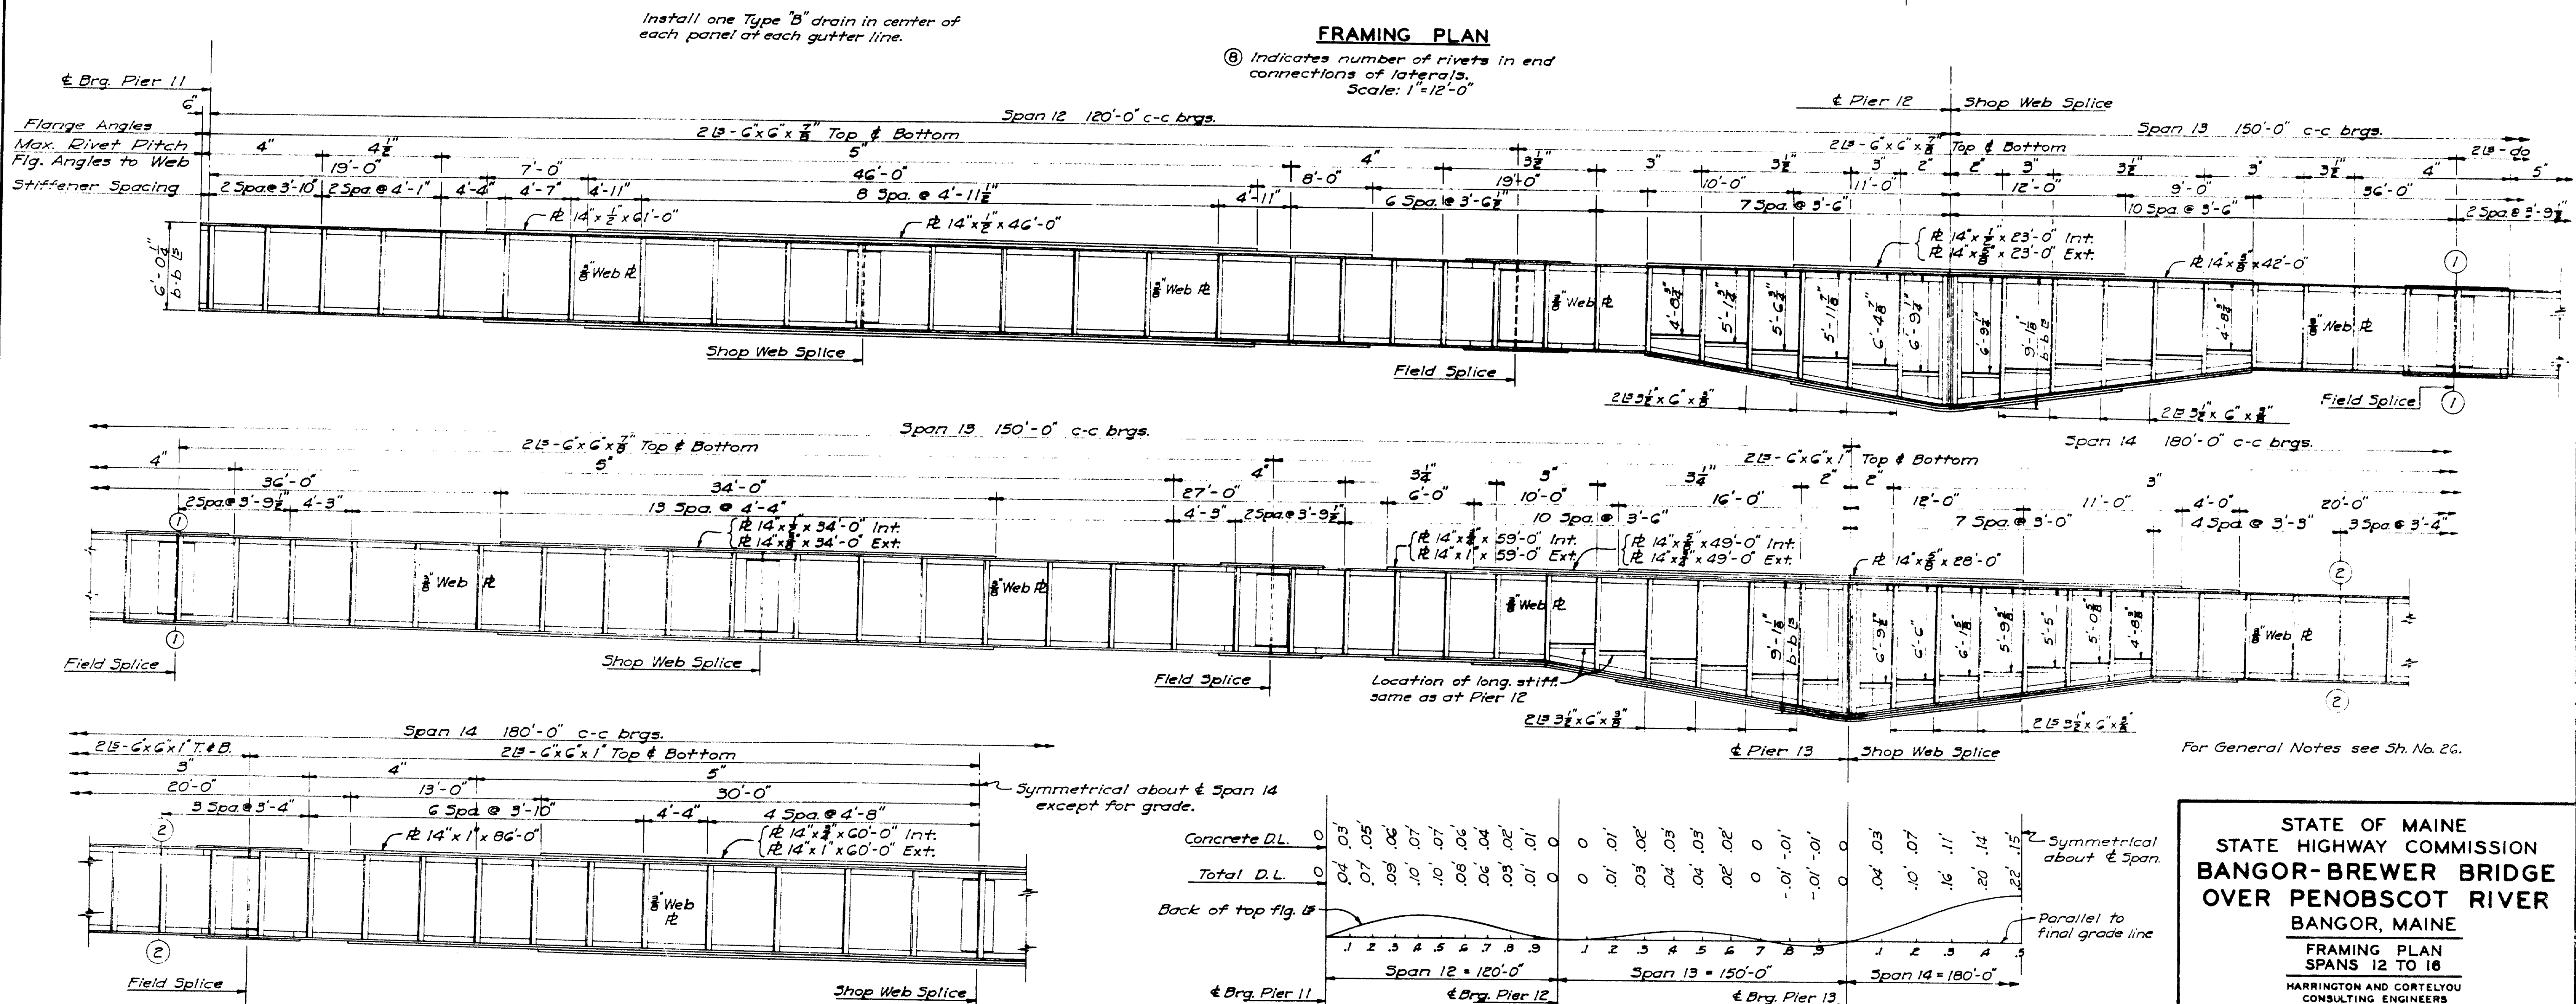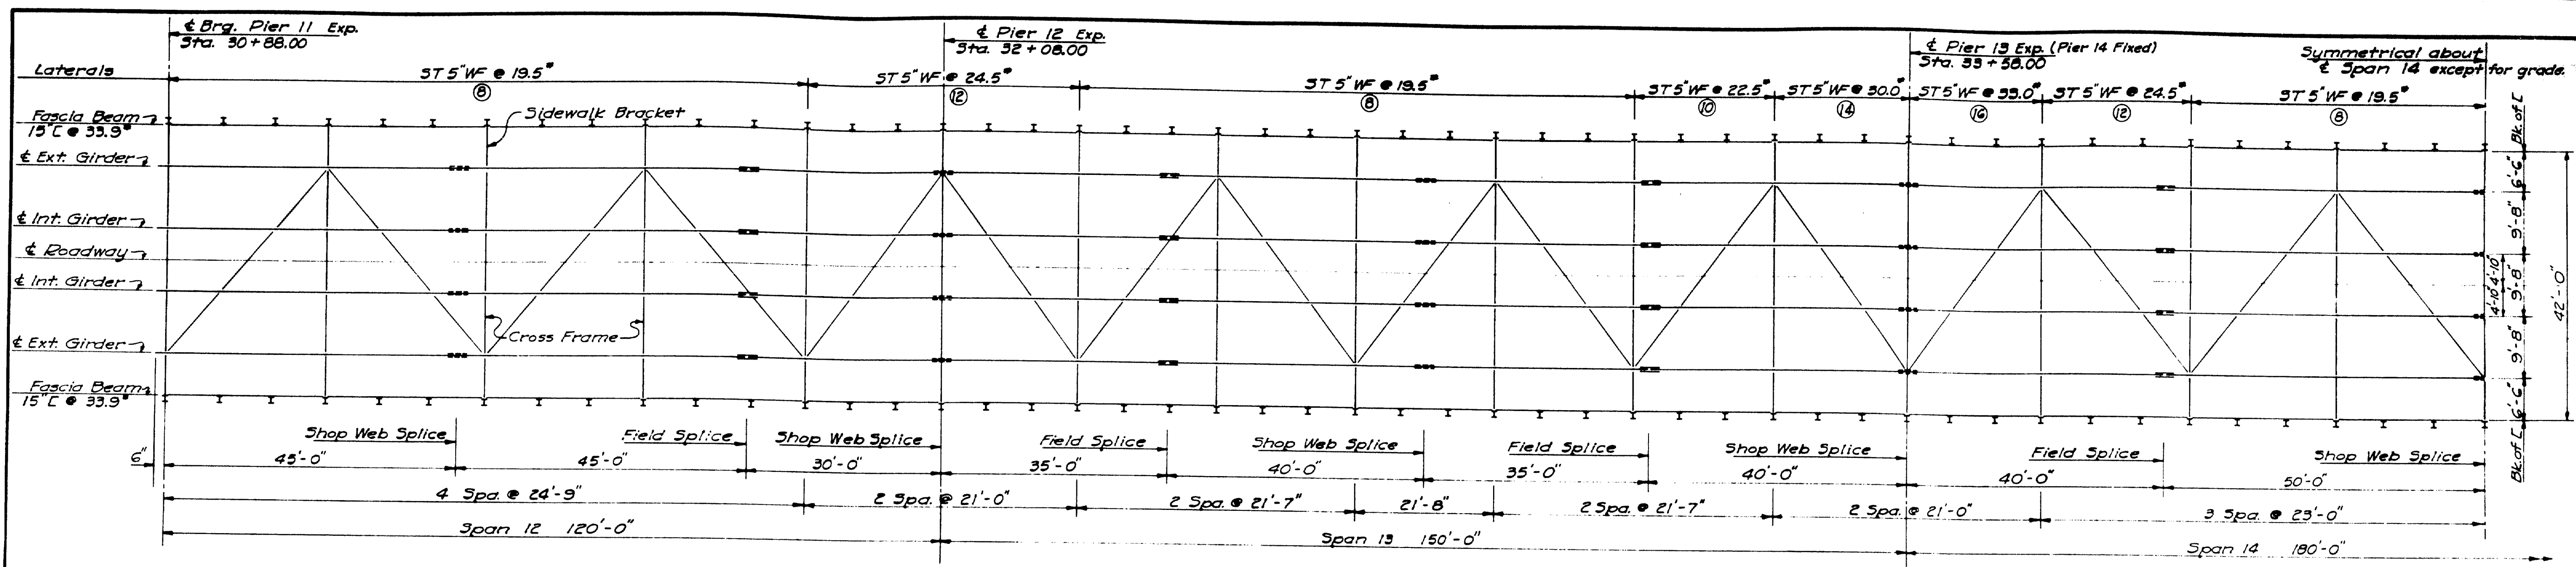

STATE OF MAINE  
 STATE HIGHWAY COMMISSION  
**BANGOR-BREWER BRIDGE**  
 OVER PENOBSCOT RIVER  
 BANGOR, MAINE  
 FRAMING PLAN  
 SPANS 12 TO 14  
 HARRINGTON AND CORTELYOU  
 CONSULTING ENGINEERS  
 KANSAS CITY, MO.  
 DETAILED G.E.G. 8-14-52  
 TRACED, REPRO. 9-8-52  
 CHECKED F.M.C. 1-15-53  
 SCALE:  $\frac{3}{16}$ " = 1'-0" &  
 AS NOTED  
 SHEET NO. 25





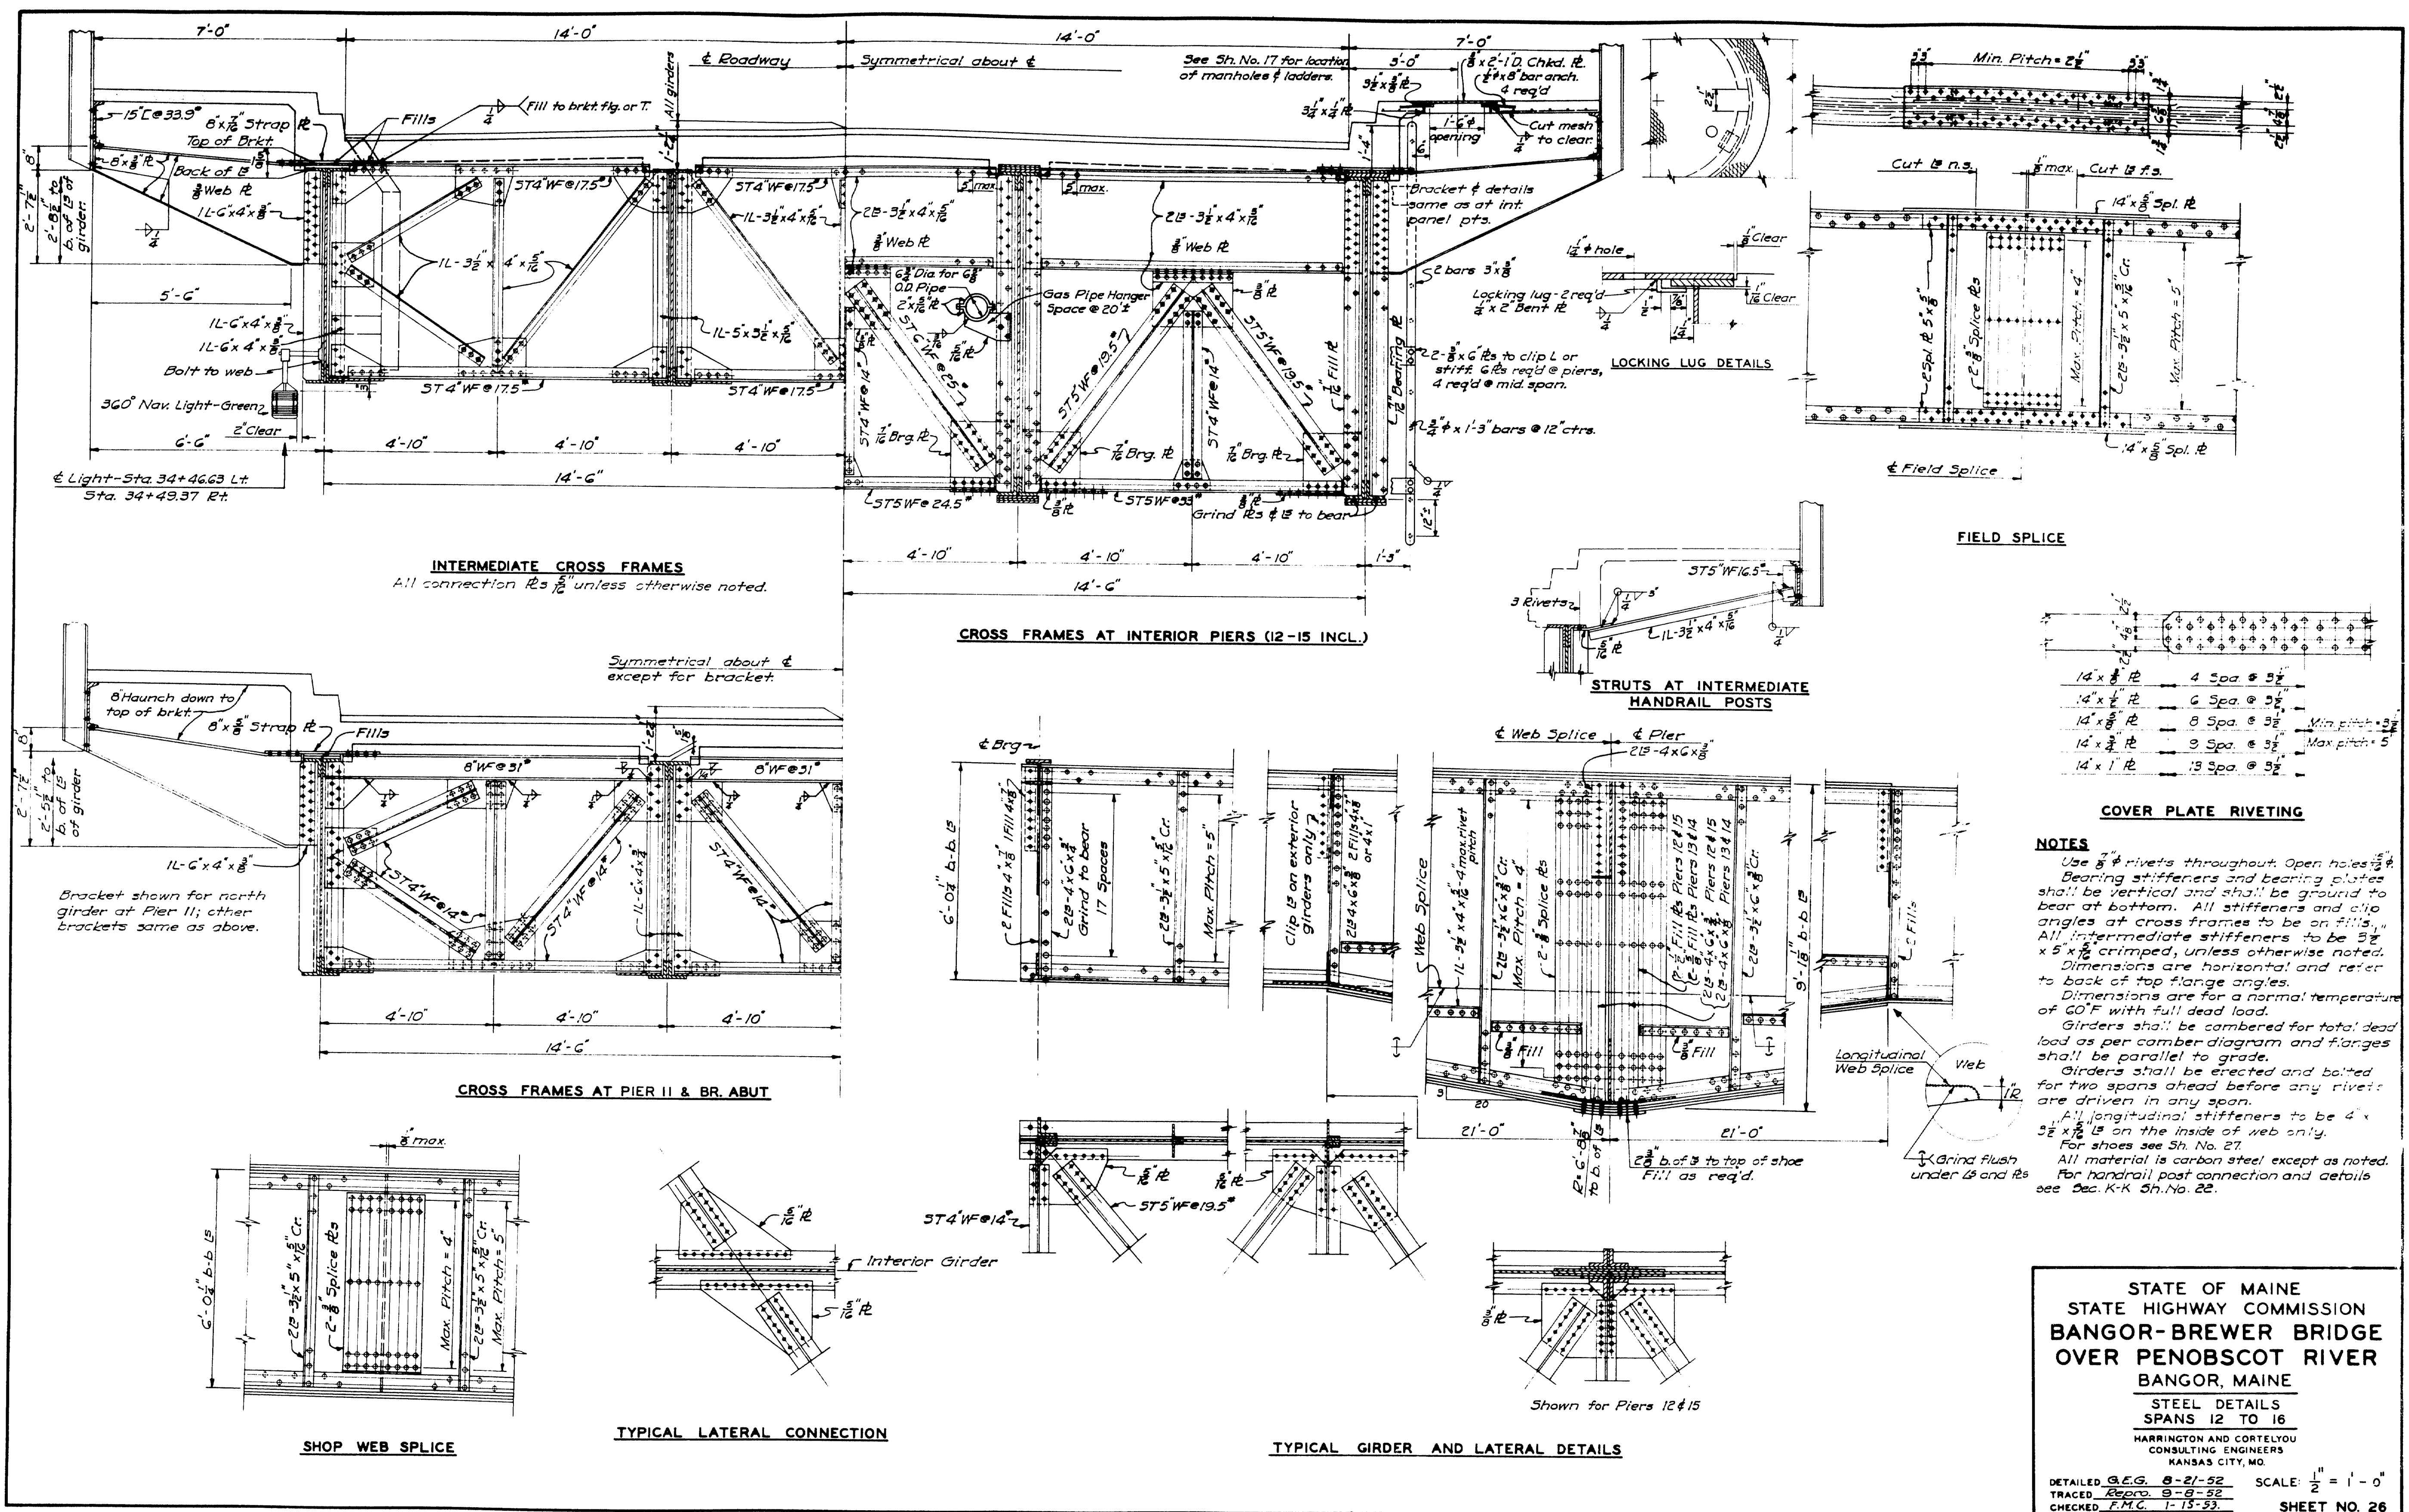

STATE OF MAINE  
STATE HIGHWAY COMMISSION  
**BANGOR-BREWER BRIDGE**  
OVER PENOBSCOT RIVER  
BANGOR, MAINE  
STEEL DETAILS  
SPANS 12 TO 16  
HARRINGTON AND CORTELYOU  
CONSULTING ENGINEERS  
KANSAS CITY, MO.  
DETAILED G.E.G. 8-21-52  
TRACED, Repro. 8-8-52  
CHECKED F.M.C. 1-15-53  
SCALE:  $\frac{1}{2}'' = 1'-0''$   
SHEET NO. 26



\* Roadway Beams only

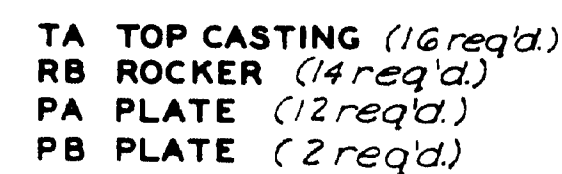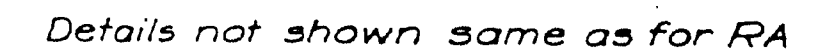

NOTES:

NOTE:  
All base plates and pins shall be structural carbon steel and all top castings, rockers and bolsters shall be cast steel.

Bottoms of all bolsters and base plates shall be rough cut to a plane surface.

Shop weld all top castings or top plates to beam flanges with  $\frac{3}{16}$ " continuous fillet weld all around unless holes are provided for turned bolts.

Lead plates to extend  $\frac{1}{2}$ " beyond edges of base plates and bolsters.

See Structural Metallurgical quantities  
for bearing shim Ss use

STATE OF MAINE  
STATE HIGHWAY COMMISSION  
**BANGOR-BREWER BRIDGE**  
**OVER PENOBSCOT RIVER**  
BANGOR, MAINE

## SHOES


HARRINGTON AND CORTELYOU  
CONSULTING ENGINEERS  
KANSAS CITY, MO.


DETAILED E.R. Jr. 10-23-52  
TRACED Repra 11-6-52  
CHECKED F.M.C. 1-16-53.

DETAILED E.R. Jr. 10-23-52  
TRACED Repra 11-6-52  
CHECKED F.M.C. 1-16-53.




SCALE:  $1\frac{1}{2}"=1'-0"$  &  
AS NOTED  
SHEET NO 27

As Built Revisions ZEW 12-14-54

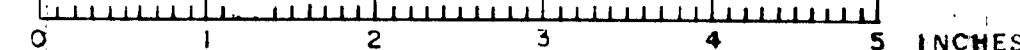

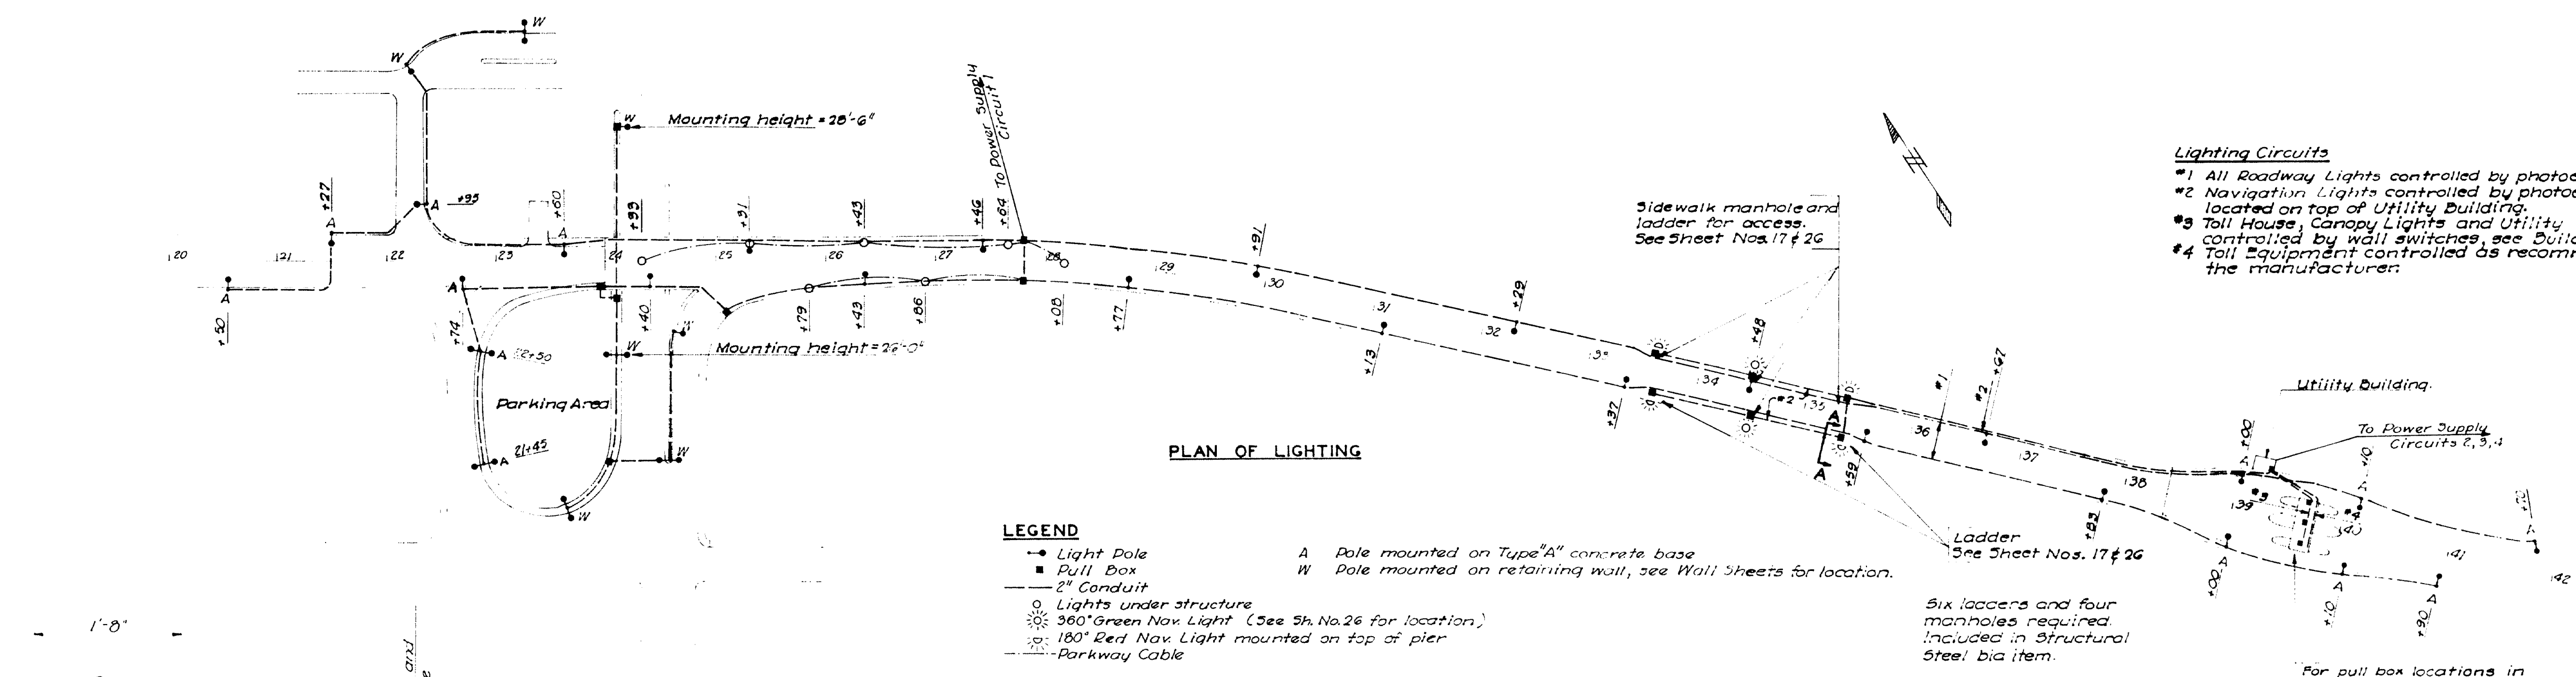


- Lighting Circuits**
- \*1 All Roadway Lights controlled by photoelectric relay.
  - \*2 Navigation Lights controlled by photoelectric relay, located on top of Utility Building.
  - \*3 Toll House, Canopy Lights and Utility Building controlled by wall switches, see Building Details.
  - \*4 Toll Equipment controlled as recommended by the manufacturer.

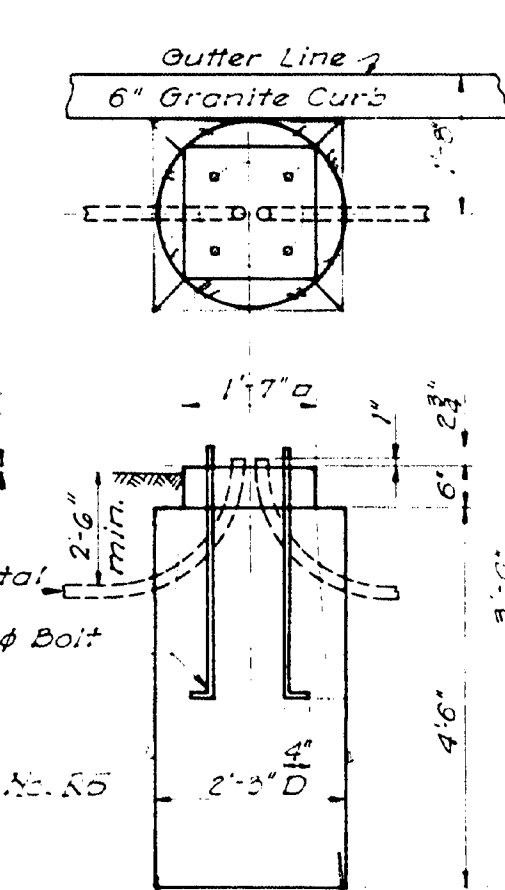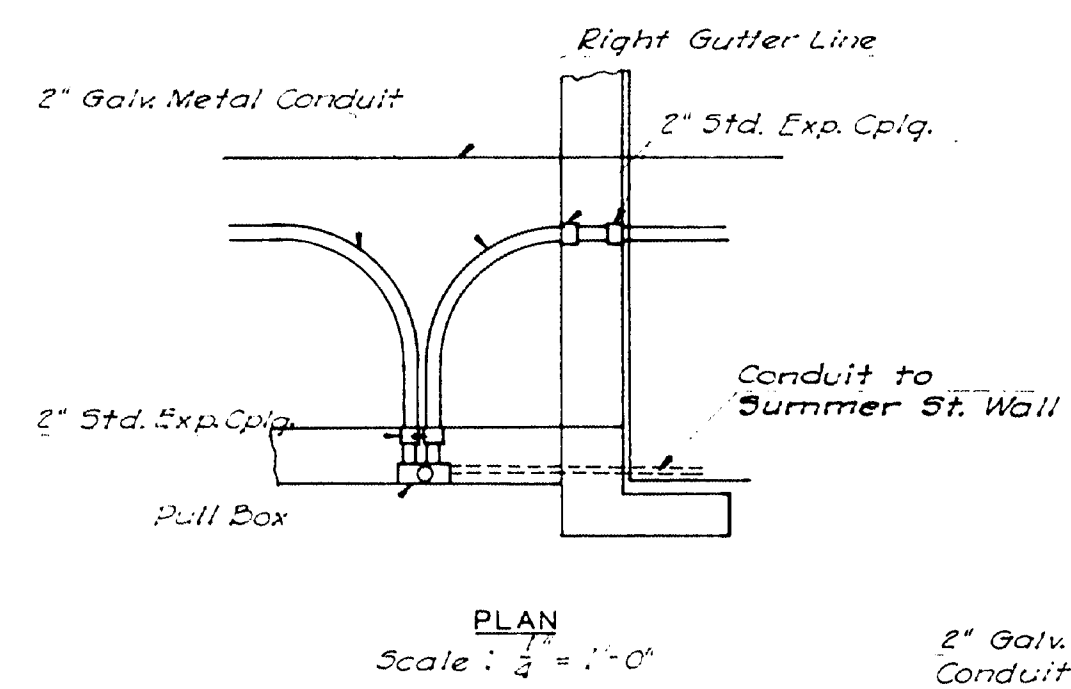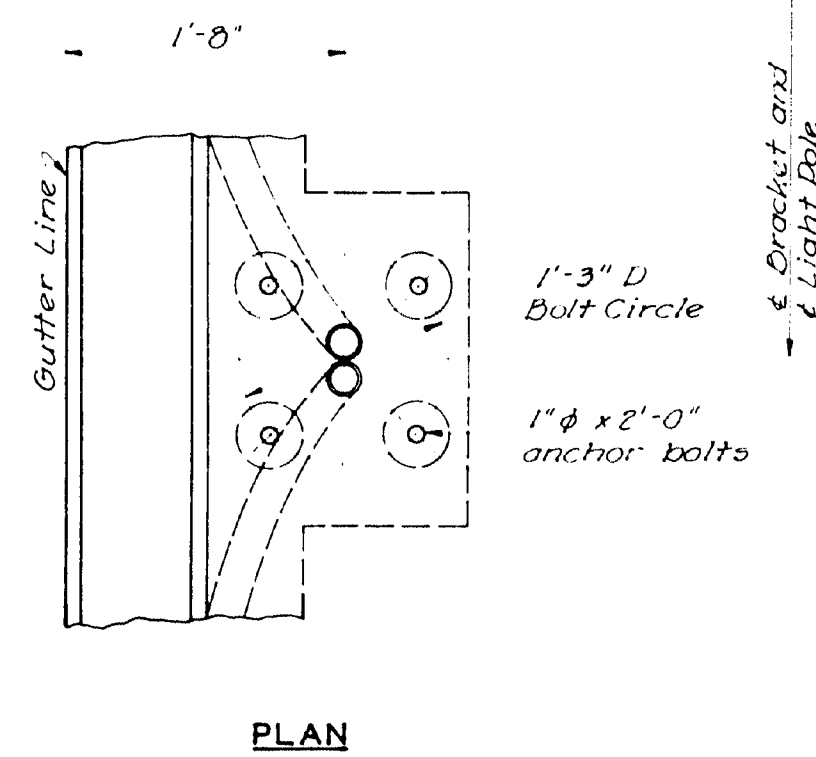

**LIGHT POLE BASE "A"**


Anchor bolts for light poles on retaining walls same as shown above.

Scale: 1/8" = 1'-0"

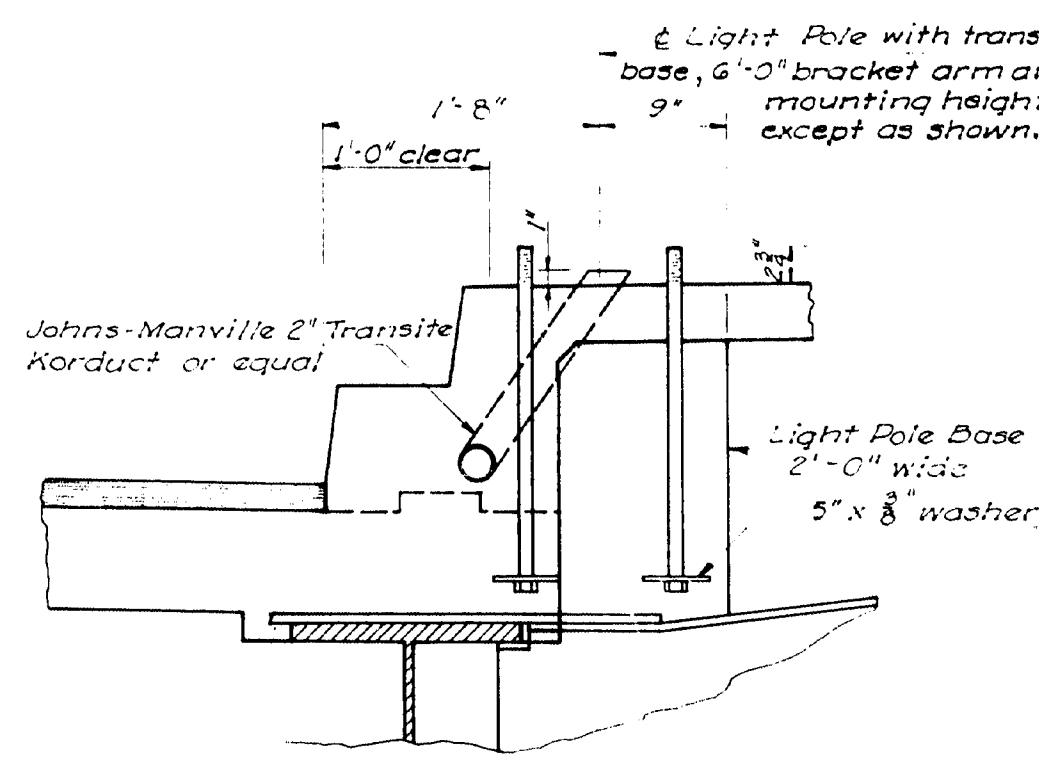


**TYPICAL LIGHT POLE BASE ON STRUCTURE**

For light pole bases on retaining walls see wall details.

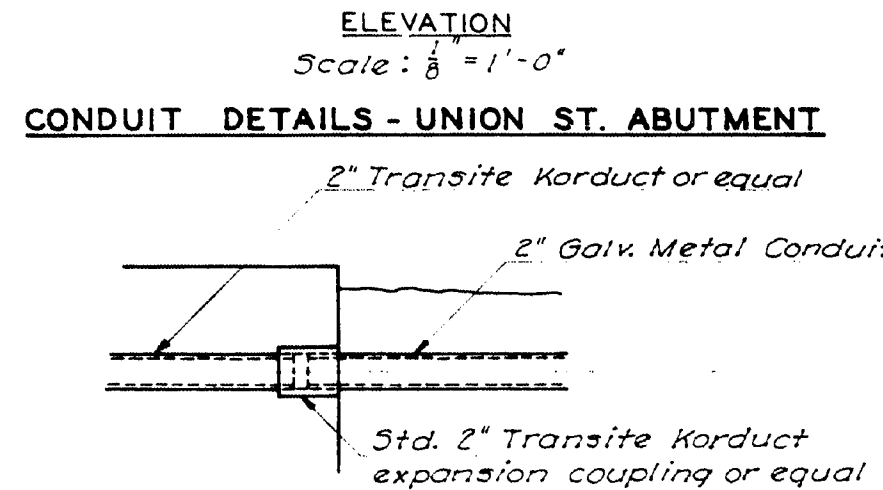


**CONDUIT EXPANSION JOINT**

at ends of walls and abutments

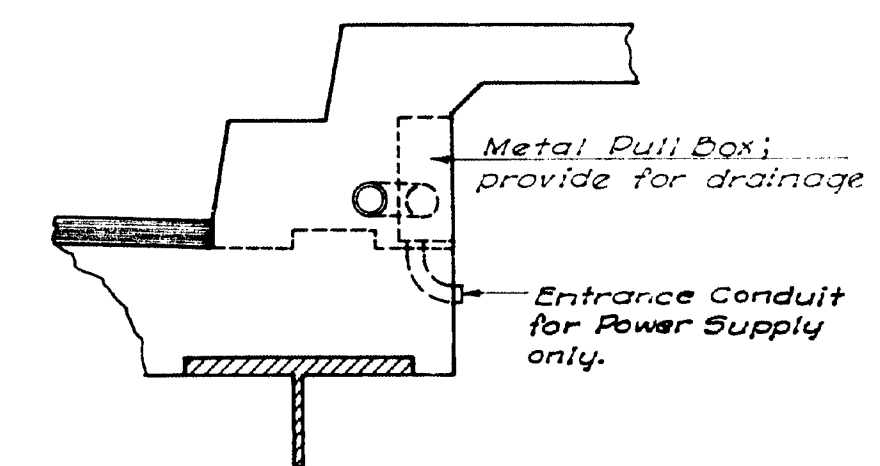


**PULL BOX ON STRUCTURE**

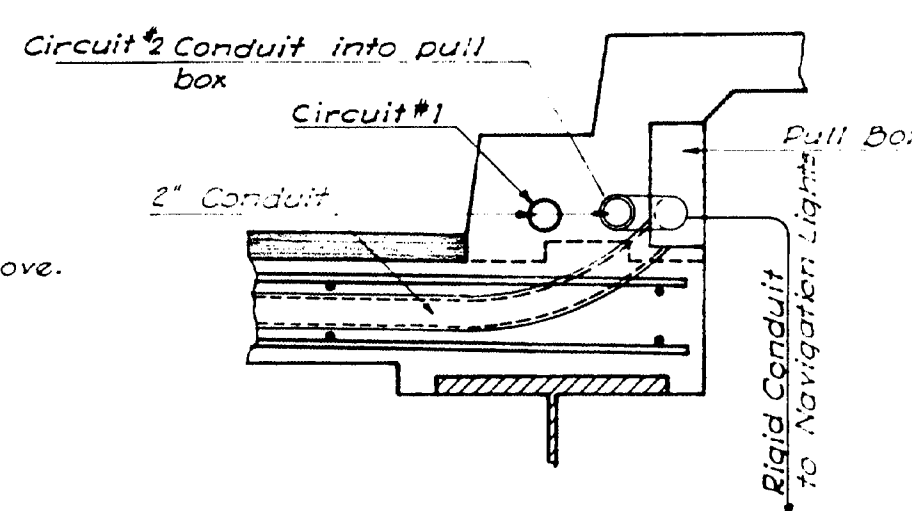

**CONDUIT FOR PARKWAY CABLE**

Details shown are typical for all haunches thru which parkway cable must pass. Parkway cable to be fastened to back of curb under sidewalk at intervals not greater than 5'-0" with suitable loops provided at expansion joints.

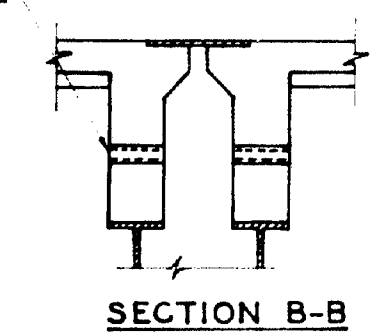

**NOTES:**

Power Supply to Utility Building and to pull box at Sta. 27+ shall be overhead wires installed by Bangor Hydro-Electric Co. The Contractor shall provide suitable entrances and all conduit beyond same.

All conduit in concrete shall be Johns-Manville 2" Transite Korduct or equal and all underground conduit shall be 2" Galvanized metal conduit.

Stationing shown for location of light poles on structure and light under structure is approximate. All light poles shall be centered on the nearest bracket. Lights under the structure shall be suspended from the bottom flange of the nearest bracket except at Sta. 24+33 where the bottom flange of the diaphragm at the 1/2" of roadway shall be used, and at Sta. 24+33 where the light shall be located between beams with clearance point on light not lower than bottom of beams.

For Circuit #1, the Contractor shall furnish and install all conduits, fittings, pull wire, 7 pull boxes and 27 light poles with single brackets and 3 light poles with twin brackets. All other equipment, including luminaires, incandescent fixtures, photoelectric relay, wiring and cable will be furnished and installed by Bangor Hydro-Electric Co.


For Circuit #2, the Contractor shall furnish and install all materials, pull wires, equipment, except wiring.

For Circuit #3, the Contractor shall furnish and install all materials, equipment and wiring.


For Circuit #4, all materials and equipment shall be furnished and installed by others.

STATE OF MAINE  
STATE HIGHWAY COMMISSION  
**BANGOR-BREWER BRIDGE  
OVER PENOBSCOT RIVER  
BANGOR, MAINE**  
**LIGHTING DETAILS**  
HARRINGTON AND CORTELYOU  
CONSULTING ENGINEERS  
KANSAS CITY, MO.

DETAILED G.E. 11-7-32 SCALE: 1" = 1'-0"  
TRACED S.P. 11-11-32 AND AS NOTED  
CHECKED F.M.C. 1-15-33 SHEET NO. 28

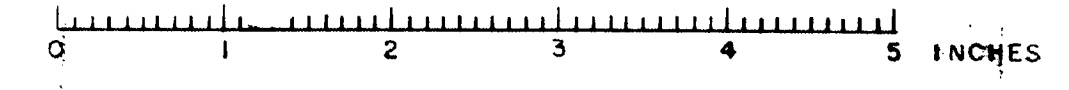



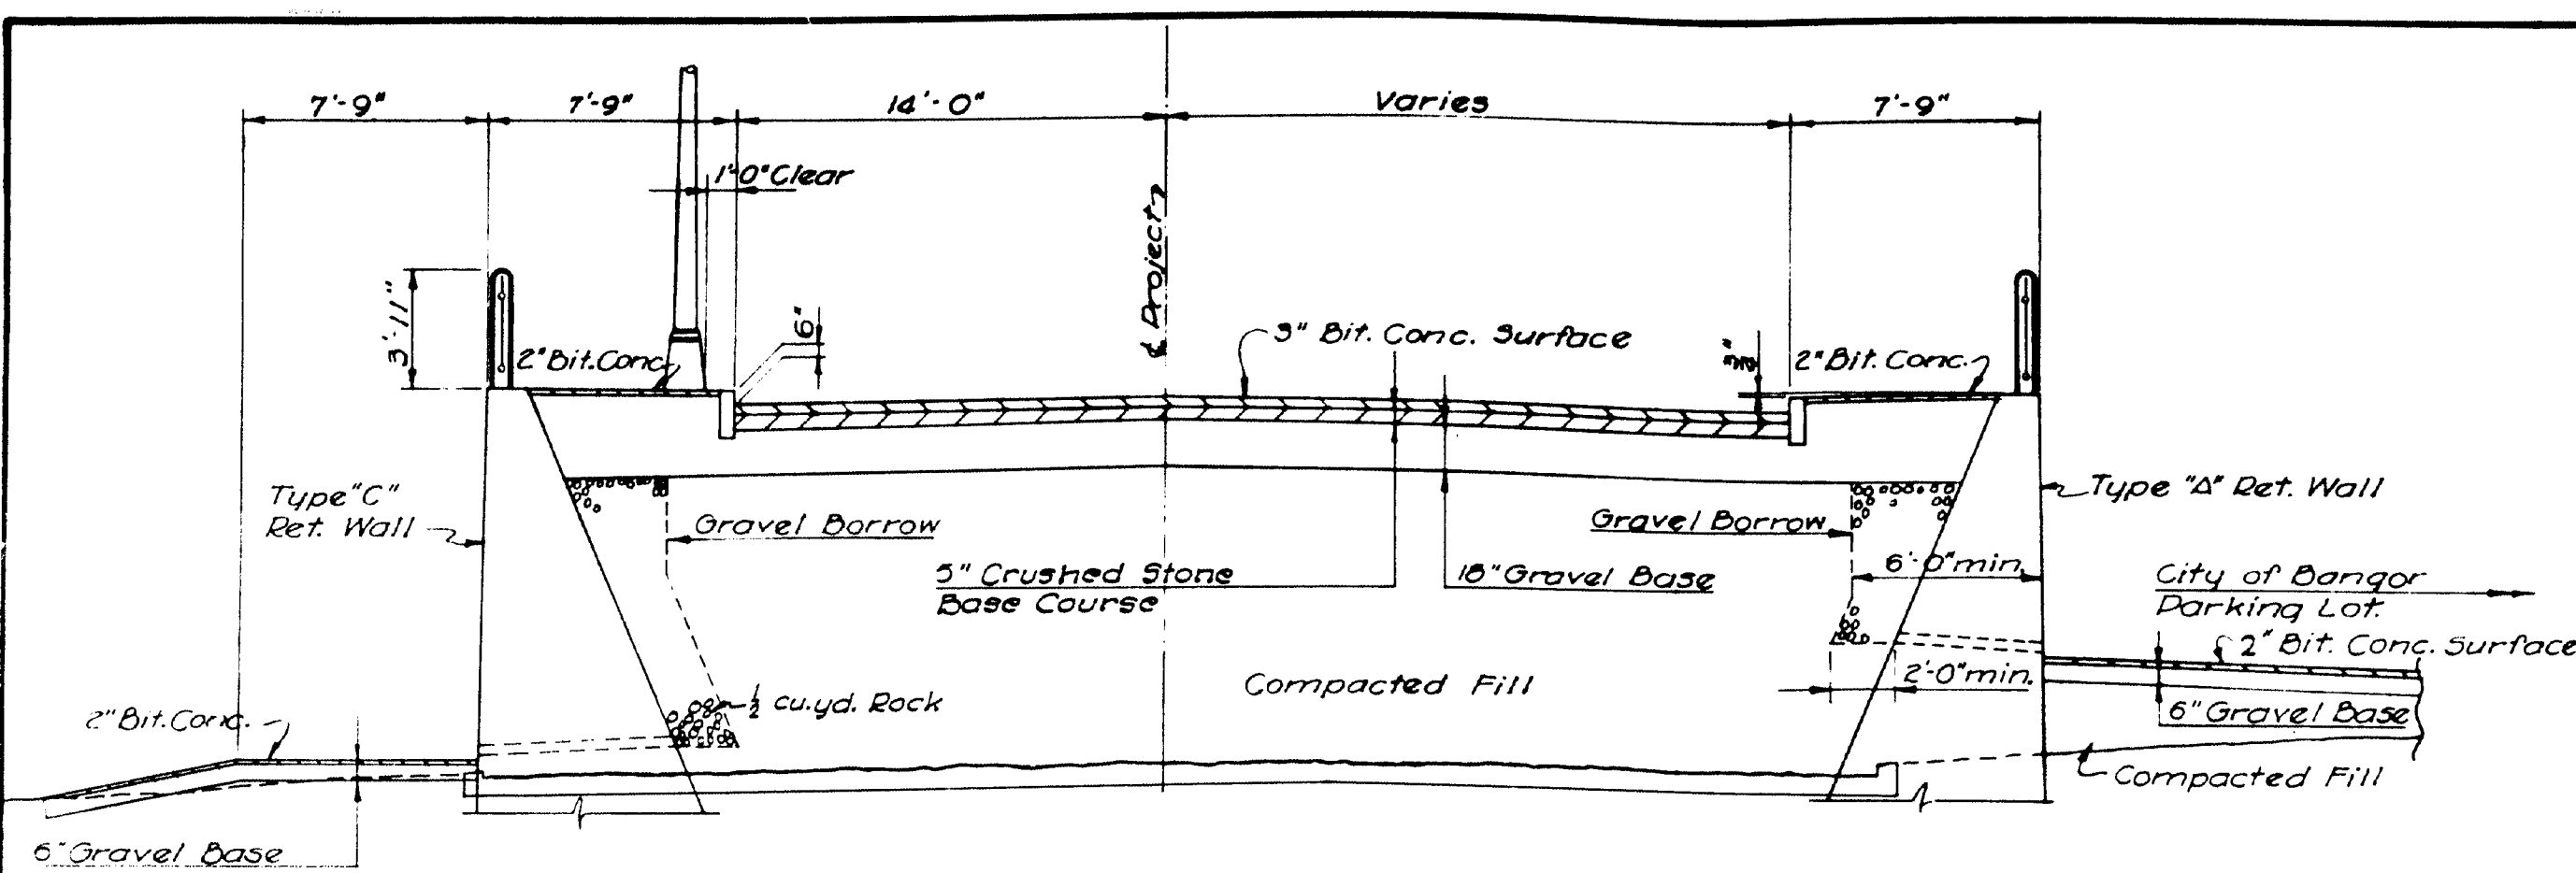

UNION STREET APPROACH

**GENERAL NOTES:**

Bituminous concrete surface of sidewalks to be sloped up  $\frac{1}{4}$ " from roadway curbs or down  $\frac{1}{4}$ " from top of retaining walls.

All curbs to be 6"x18" Granite and as noted.

Depth of bases shown may be changed to meet local conditions, as directed by Engineer.

At sections where new work is warped into existing pavements the base courses shall be warped gradually to fit base courses under existing pavements.


Roadway surface superelevation and transitions at ramp curves and intersections are indicated by construction contours on plan sheets. Normal Roadway Crown: 3" in 14'-0" (straight)

See cross sections, Sheet Nos. 63, 65 and Plan Sheet No. 41 for limits of rubbish fill, to be removed and replaced with Gravel Borrow on Brewer Approach.

For details of Adams Garage ramp see Sheet Nos. 42 & 46


Gravel Borrow to be placed behind all retaining walls and Ramp 'B' and Union Street Abutments for minimum distances of 6'-0" from front face of wall and 2'-0" from 3" tile drain openings as shown.

Place 4 cu yd of 2" Crushed Stone or Graded Gravel at each drain in walls and abutments. Payment shall be included in unit price bid for "Gravel Borrow."

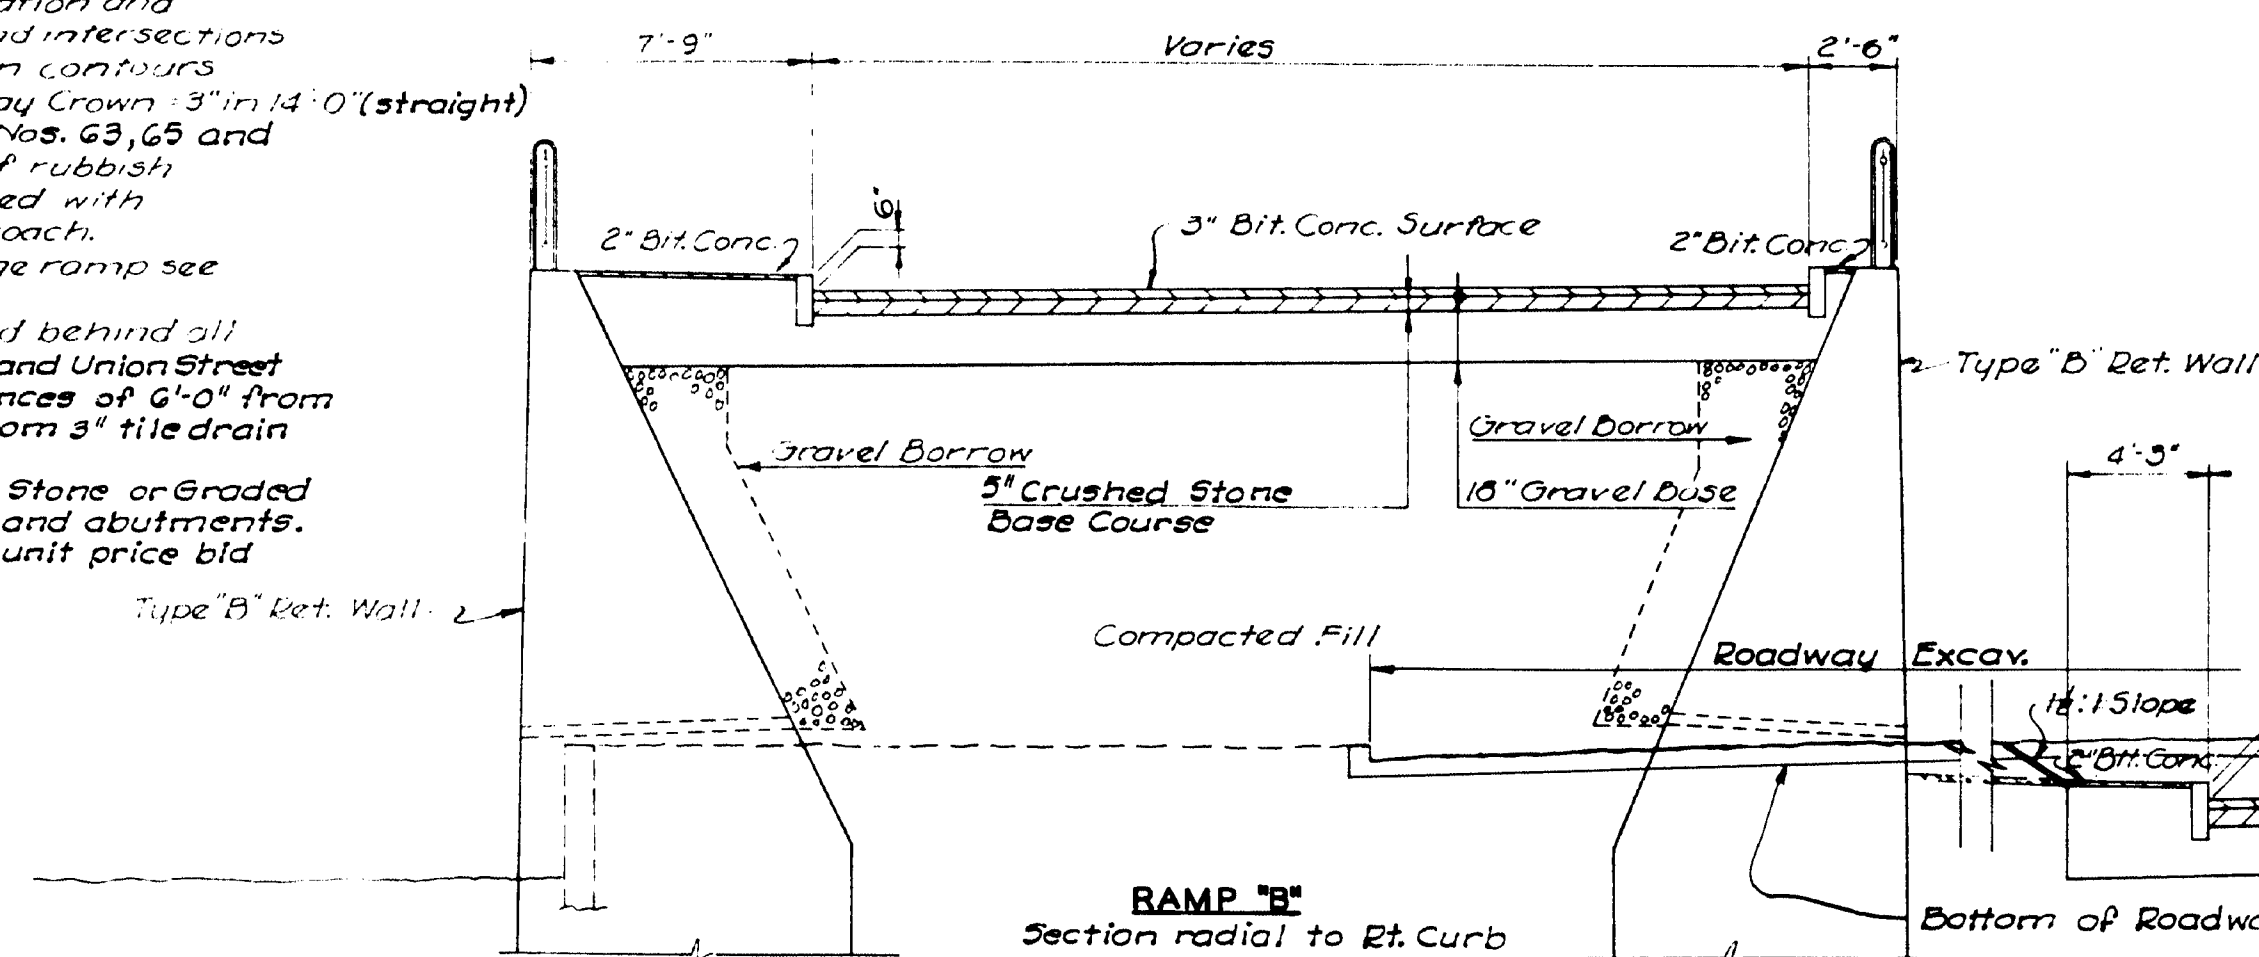


RAMP 'B'  
Section radial to Rt. Curb


SUMMER STREET & RAMP 'B'

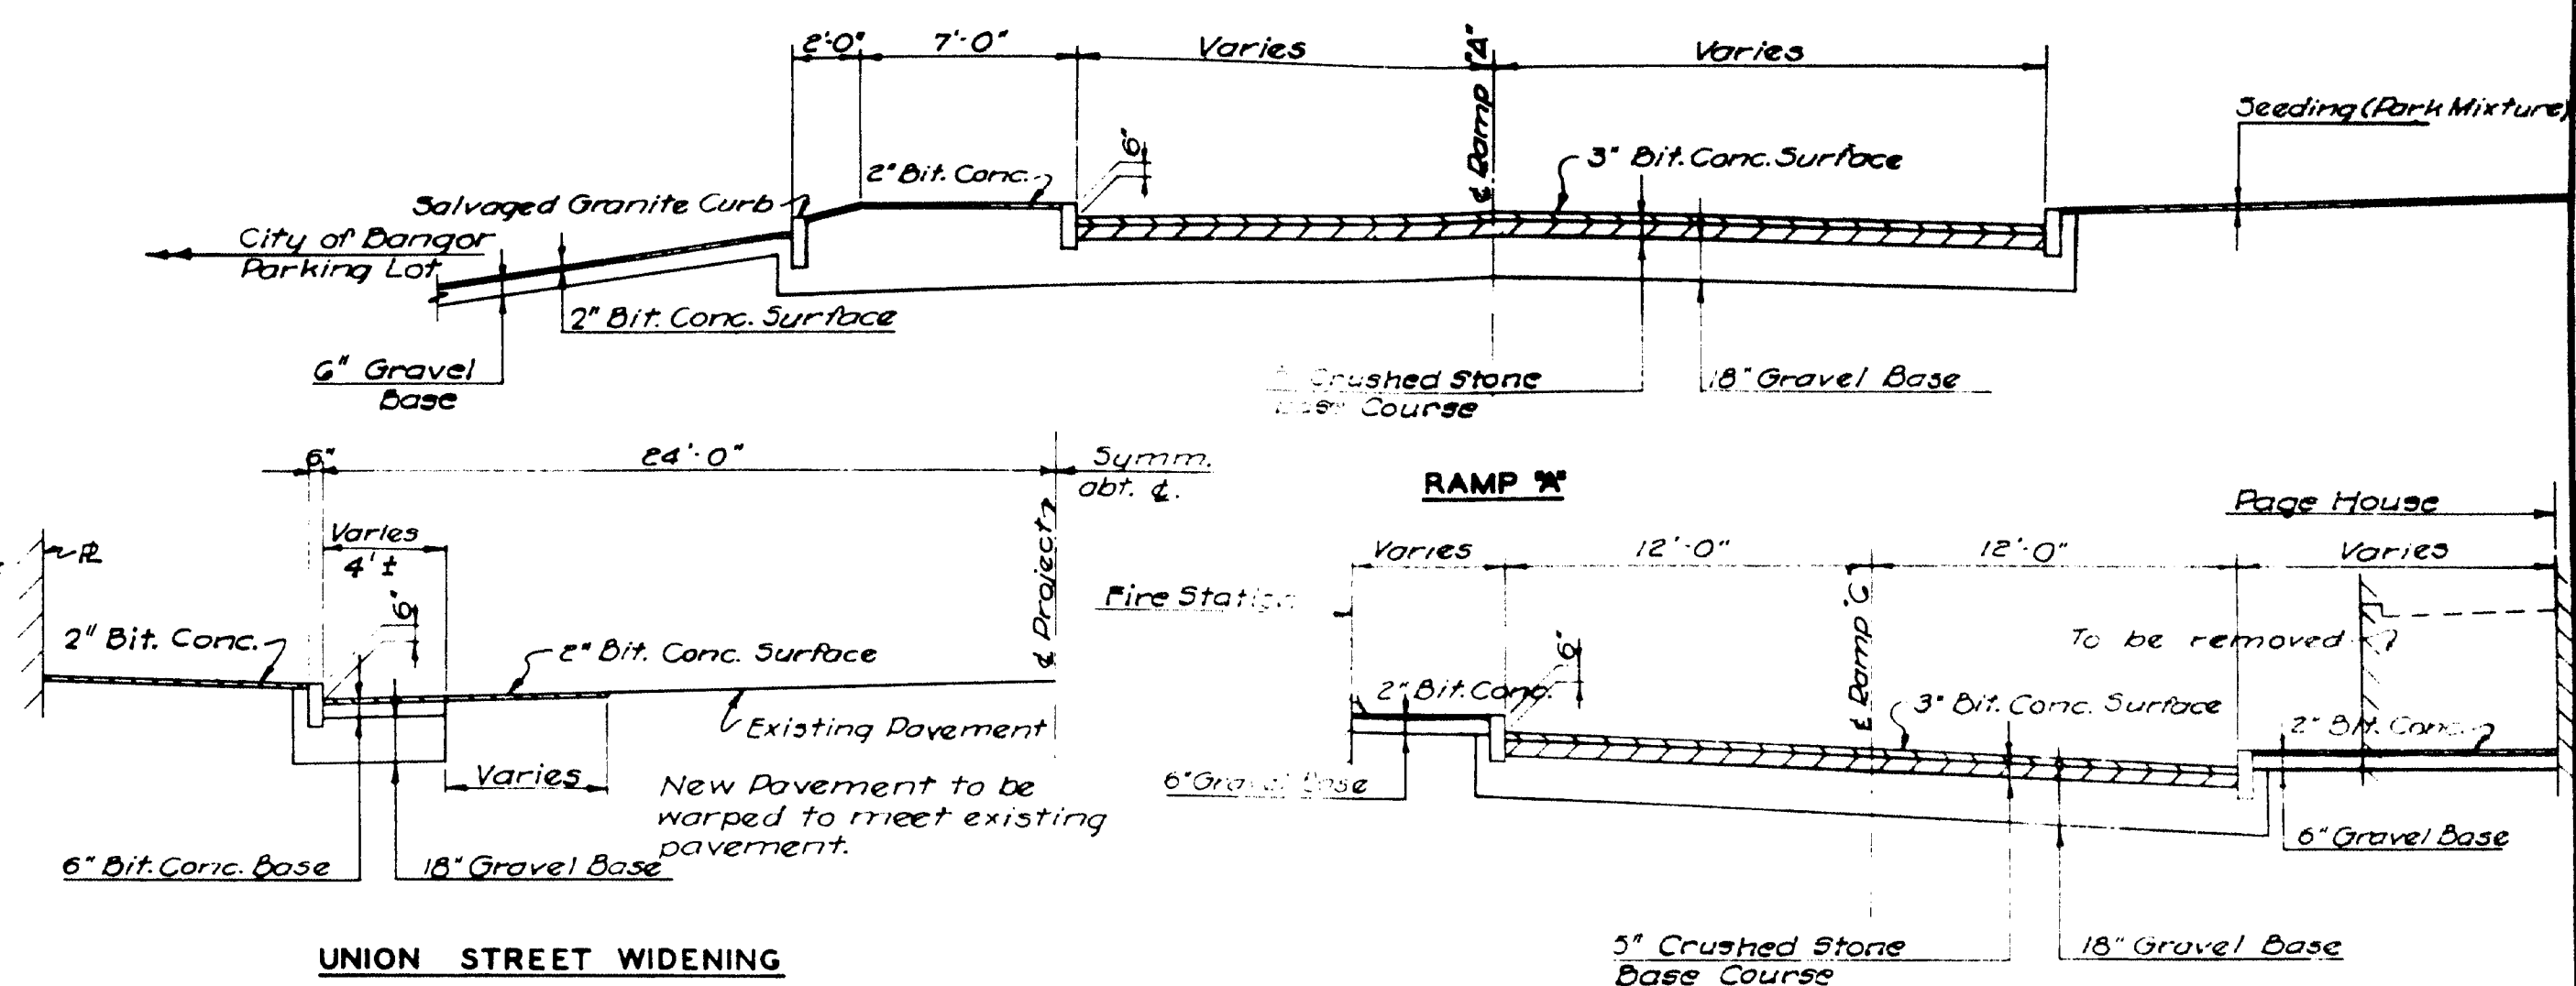


UNION STREET WIDENING

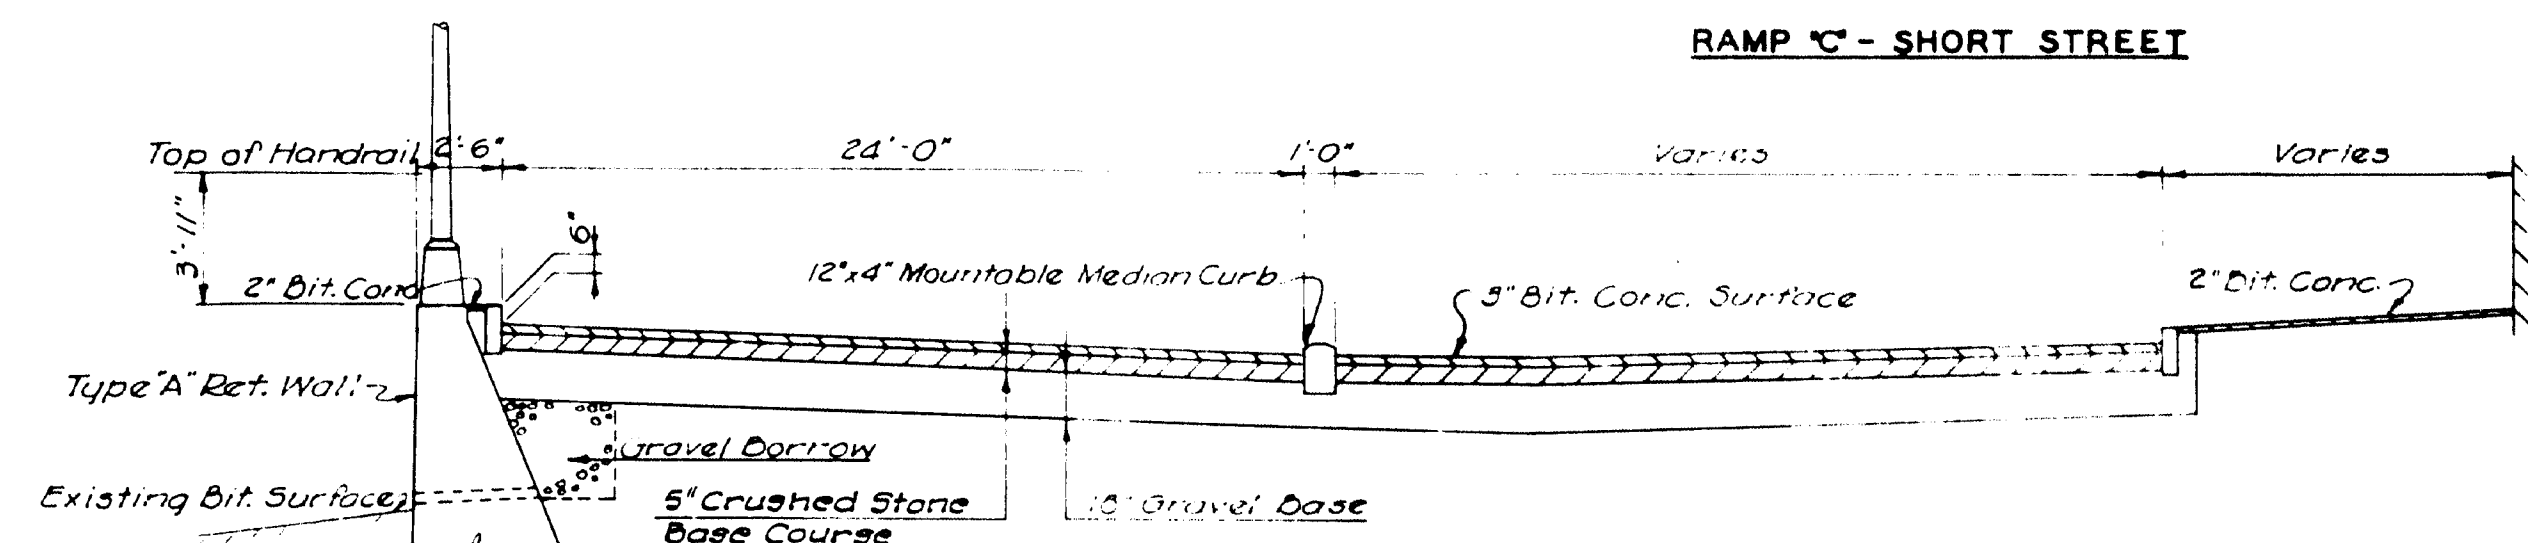

RAMP 'C' - SHORT STREET

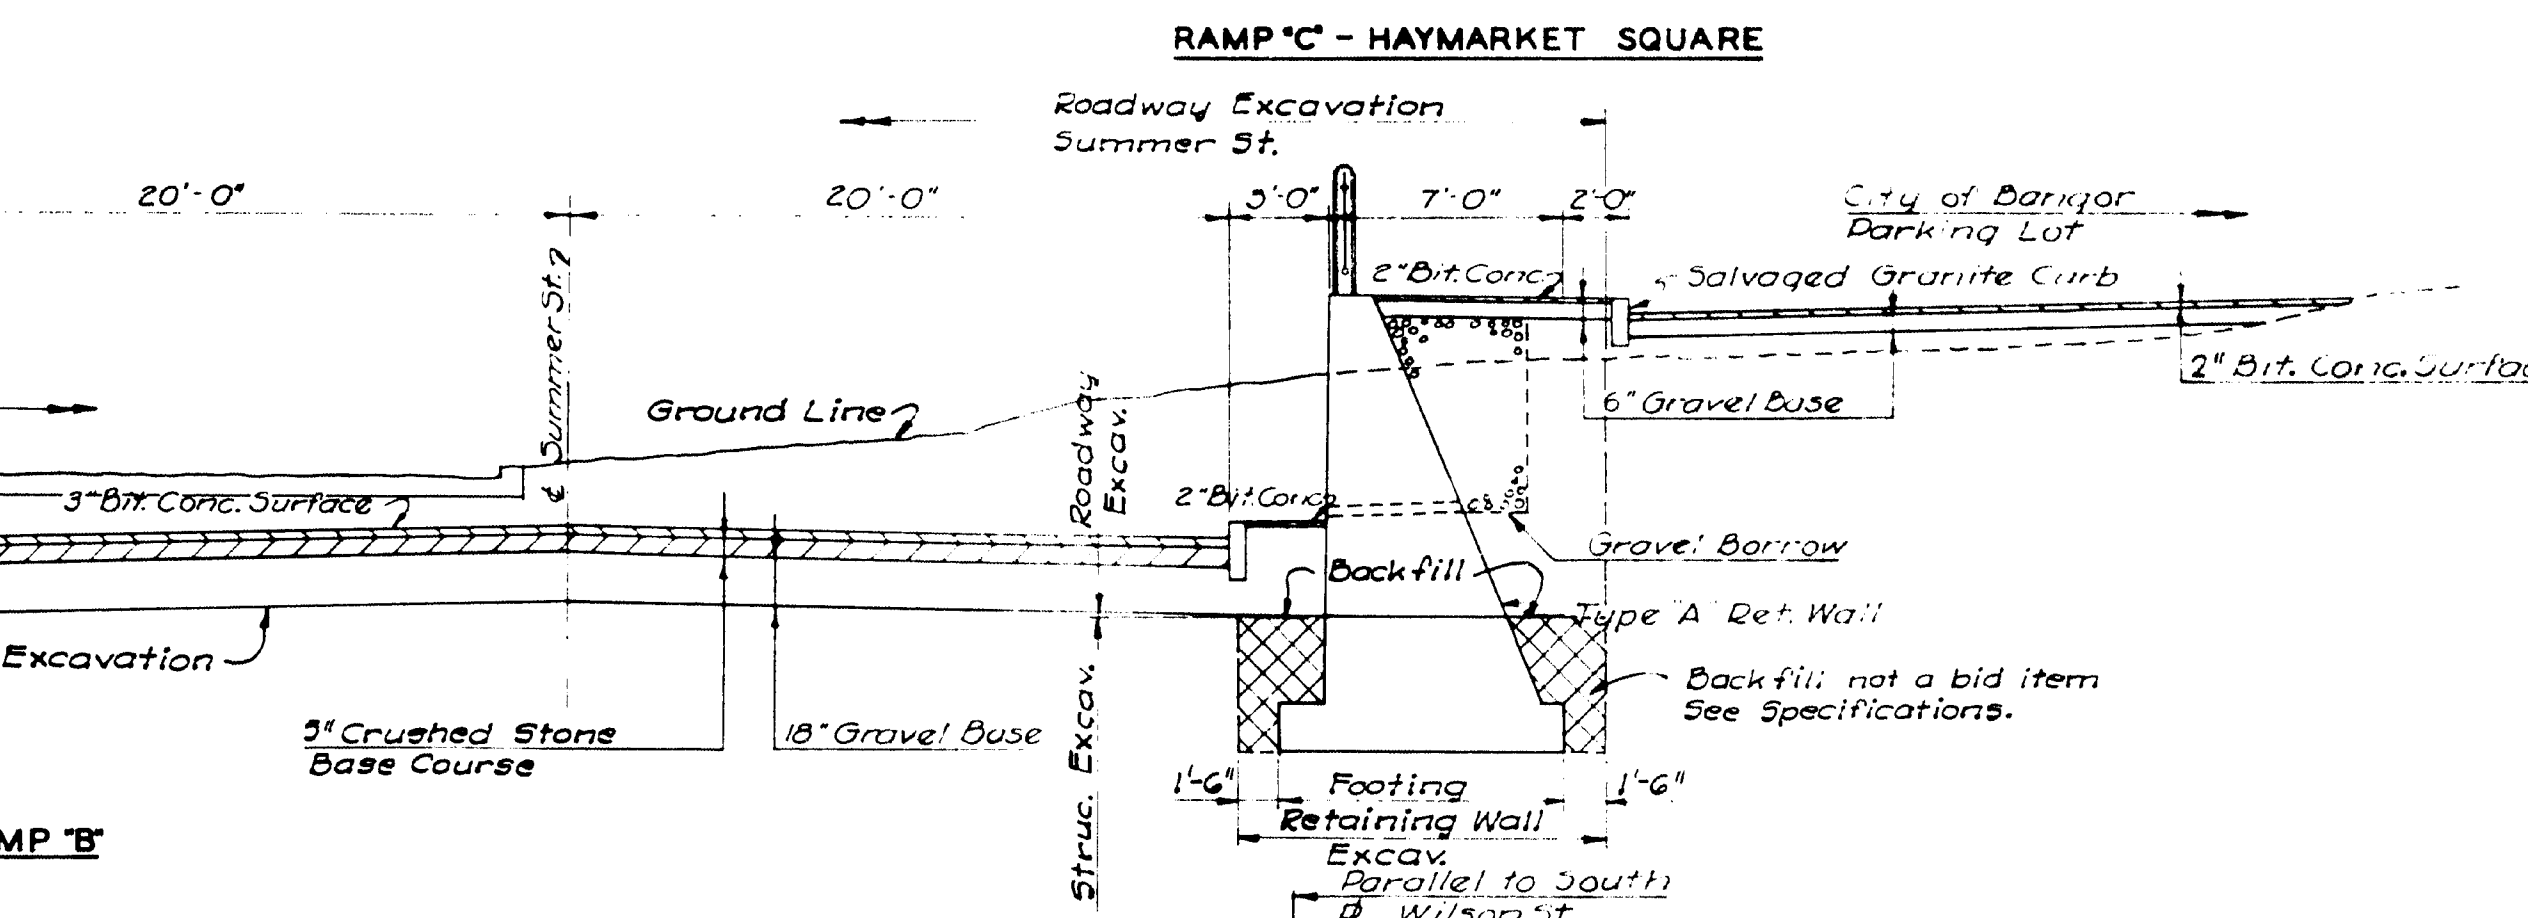

RAMP 'C' - HAYMARKET SQUARE

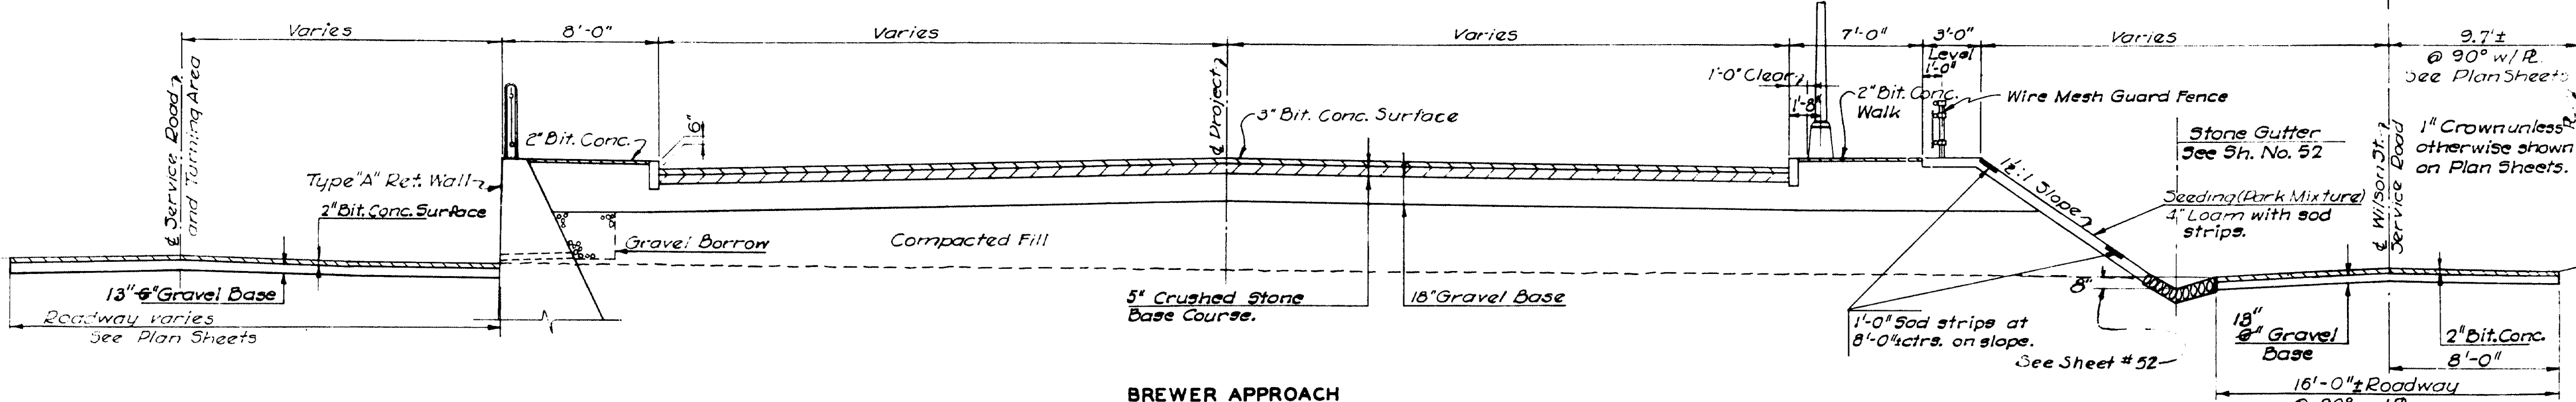

BREWER APPROACH

As Built Revisions: CFW/CEW 10-4-54

This Section Rt. Sta. 40+73 to 41+12.50

STATE OF MAINE  
STATE HIGHWAY COMMISSION  
BANGOR-BREWER BRIDGE  
OVER PENOBSCOT RIVER  
BANGOR, MAINE

**TYPICAL SECTIONS**

HARRINGTON AND CORTELYOU  
CONSULTING ENGINEERS  
KANSAS CITY, MO.

DETAILED 3/11/52-52  
TRACED 10-20-52  
CHECKED E.M.V. 1-12-53

SCALE: 1"=5'-0"

SHEET NO. 29

62-29



Sta. 21+32 Construct Type "C" Catch Basin 24' Lt. & Top Grate El. 52.75 Fl. El. 48.75 Connect to existing Sanitary Sewer w/8" VCP Remove existing catch basin

Sta. 22+75 (Ramp "C") Construct Type "C" Catch Basin as shown Top Grate El. 48.70 Fl. El. 43.70 Connect to existing Sanitary Sewer w/8" VCP

See Sh. No. 47 for Drainage Details

**Note:**

Estimated limits of pavement re-construction and re-surfacing are shown on these plans by shaded lines, and estimated quantities are based on areas shown. Final limits are to be determined in the field, by the Engineer.

Sta. 22+98 to Sta. 23+92.32 Construct Retaining Wall Left for "Gravel Base" See Sheet No. 42 for details.

**P.I. References:**

1. 60d Nail at P.I. (0°-11' Rt. and at 90° with Surv. Line - Sta. 7+21.67)
2. Cor. Brick Fire Station 37.47' N.
3. Top Fire Hyd. 35.67' 31°-76' E.N.E.
4. Nail in Pow. Pole 25.64' 53° W.

Right Curb Sta. 22+52.29

\* Raise window sills to new 3.W. level.


Payment for raising window sills to be included in unit price bid for "Gravel Base" See Sheet No. 42 for details.

Note: Plans for Short Street Entrance Stairs to be provided by Maine State Highway Comm.

Sta. 23+40.07-2075 Lt. to 53.25' Lt. Construct R.C. Ramp to garage roof See Sh. No. 46 for details.

2200' Lt. & Sta. 23+53.00

For Ramp Details See Sheet 46A

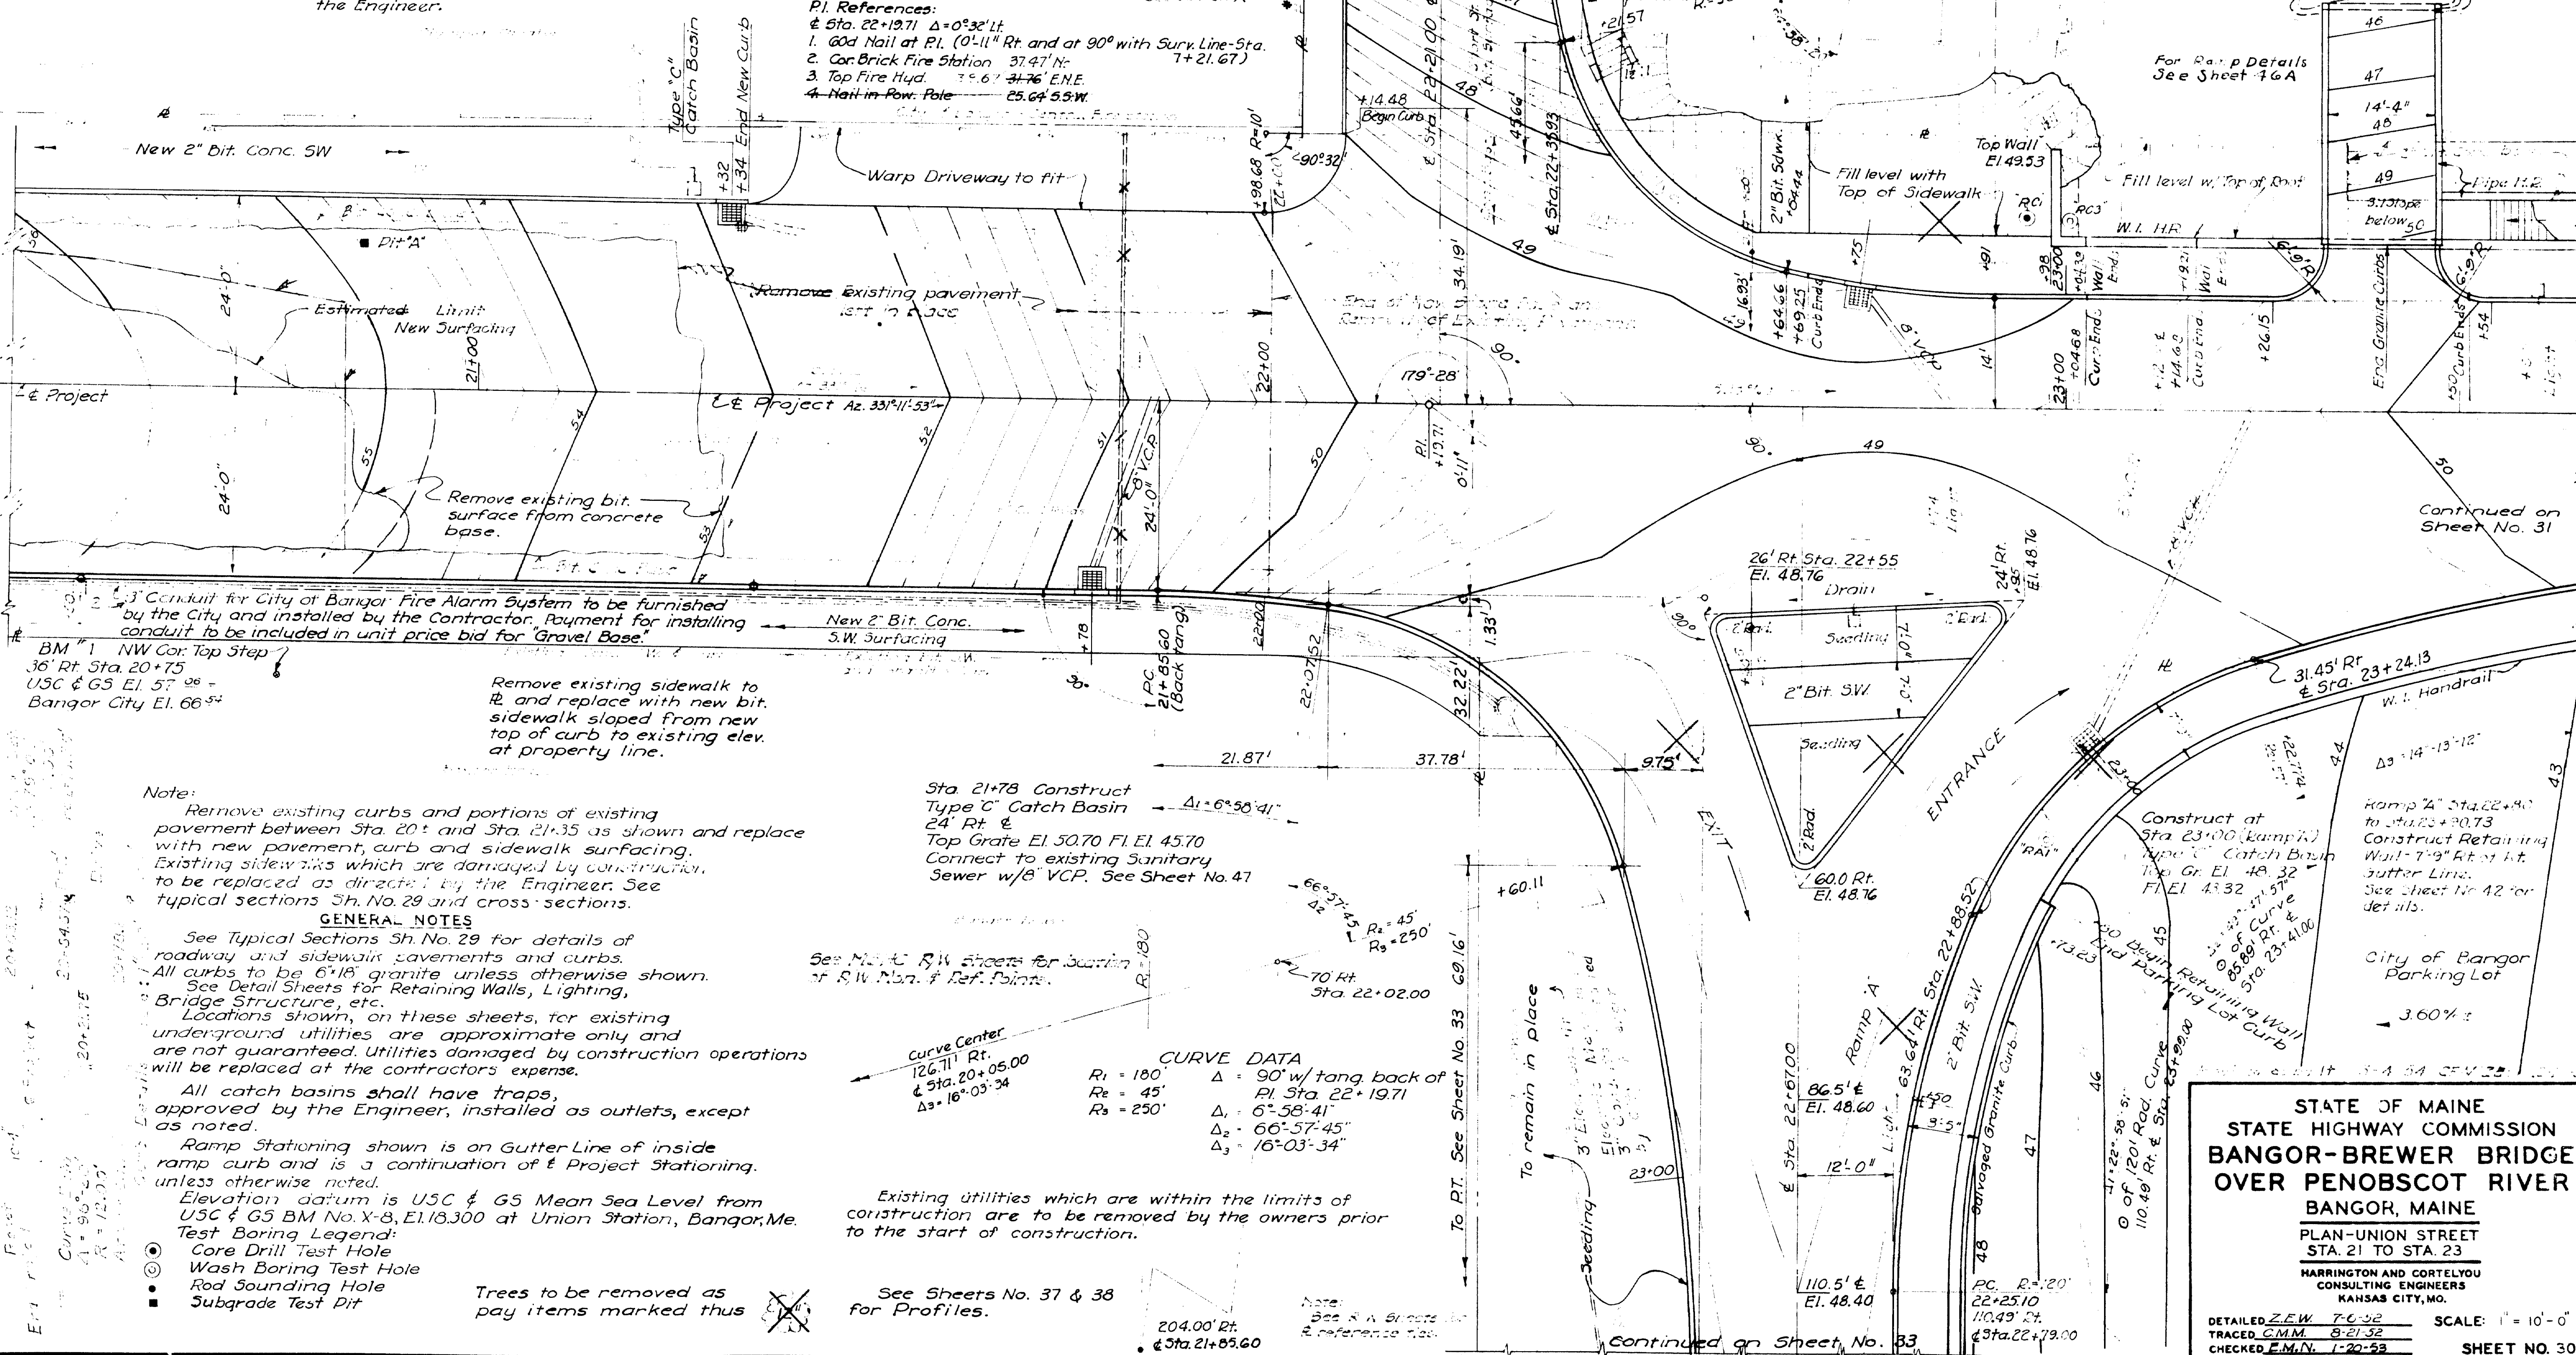

**Note:**

Remove existing curbs and portions of existing pavement between Sta. 20+ and Sta. 21+35 as shown and replace with new pavement, curb and sidewalk surfacing. Existing sidewalks which are damaged by construction, to be replaced as directed by the Engineer. See typical sections Sh. No. 29 and cross sections.

**GENERAL NOTES**

See Typical Sections Sh. No. 29 for details of roadway and sidewalk pavements and curbs. All curbs to be 6" 18" granite unless otherwise shown. See Detail Sheets for Retaining Walls, Lighting, Bridge Structure, etc.

Locations shown on these sheets, for existing underground utilities are approximate only and are not guaranteed. Utilities damaged by construction operations will be replaced at the contractor's expense.

All catch basins shall have traps, approved by the Engineer, installed as outlets, except as noted.

Ramp Stationing shown is on Gutter Line of inside ramp curb and is a continuation of E Project Stationing, unless otherwise noted.

Elevation datum is USC & GS Mean Sea Level from USC & GS BM No. X-8, El. 118.300 at Union Station, Bangor, Me.

**Test Boring Legend:**

- Core Drill Test Hole
- Wash Boring Test Hole
- Rod Sounding Hole
- Subgrade Test Pit

Trees to be removed as pay items marked thus

See M.A.C. R.W. Sheets for Section or R.W. Plan & Ref. Points.

Sta. 21+78 Construct Type "C" Catch Basin 24' Rt. & Top Grate El. 50.70 Fl. El. 45.70 Connect to existing Sanitary Sewer w/8" VCP. See Sheet No. 47

**CURVE DATA**

- |              |                                      |
|--------------|--------------------------------------|
| $R_1 = 180'$ | $\Delta = 90^\circ$ w/ tang. back of |
| $R_2 = 45'$  | PI Sta. 22+19.71                     |
| $R_3 = 250'$ | $\Delta_1 = 6^\circ 58' 41''$        |
|              | $\Delta_2 = 66^\circ 57' 45''$       |
|              | $\Delta_3 = 16^\circ 03' 34''$       |


Existing utilities which are within the limits of construction are to be removed by the owners prior to the start of construction.

See Sheets No. 37 & 38 for Profiles.

STATE OF MAINE  
STATE HIGHWAY COMMISSION  
**BANGOR-BREWER BRIDGE  
OVER PENOBSCOT RIVER**  
BANGOR, MAINE  
PLAN-UNION STREET  
STA. 21 TO STA. 23  
HARRINGTON AND CORTELYOU  
CONSULTING ENGINEERS  
KANSAS CITY, MO.


DETAILED J.E.W. 7-0-52  
TRACED G.M.M. 8-21-52  
CHECKED E.M.N. 1-22-53

SCALE: 1" = 10'-0"  
SHEET NO. 30

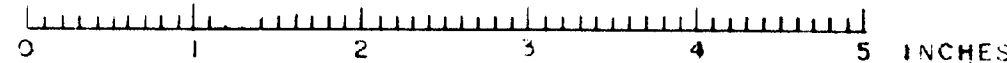





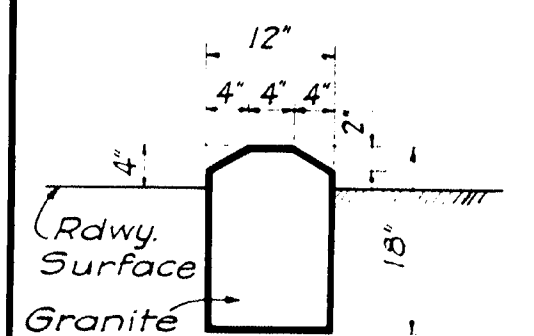

Construct Conc. Steps  
at end of Retaining Wall  
See Sh. No. 40

Place salvaged granite  
curbs against building  
foundation to retain SW

38'± Top Found. El. 37.2  
2" Bit S.W. El. 38.3

Warp to Exist. Pavmt  
3'-1"± 8" VCP

See Profile Sh. No. 38  
2" Bit S.W.

23+07.29  
Rt Gutter  
End 12'S.E.

Sta 21+06 (Lt. Gutter)  
Raise existing manhole  
to Top Grate El. 37.6

23+07.29  
Rt Gutter  
End 12'S.E.

23+07.29  
Rt Gutter  
End 12'S.E.

Sta 23+43 (Hodsdon St No. Curb)  
Const. Type "B" Catch Basin  
Top Gr. El. 38.3 Inlet El. 37.55  
FL El. 31.7 Connect to exist.  
sanitary sewer w/8" VCP  
Remove existing catch basin.  
See Sh. No. 47 for catch basin  
details.

Sta. 19+74 (Lt. Gutter)  
Const. Type "A" Catch Basin  
Top Grate El. 27.20 FL El. 23.20  
Connect to existing sanitary  
sewer w/8" VCP

Construct Type "A" Retaining Wall  
Left Sta 23+46.69 to Sta 25+24.98  
(Rt. Gutter Stationing)  
See Sh. No. 45 for Details.

Sta. 21+26 (Lt. Gutter)  
Const. Type "C" Catch Basin  
Top Gr. El. 38.80 FL El. 32.10  
Connect to existing sanitary  
sewer w/8" VCP  
Remove existing catch  
basin

Sta. 21+40.01 PT  
Lt. Gutter

Sta. 21+40.01 PT  
Lt. Gutter

SECTION B-B  
See Sheet R-1 for detail  
of underground at Sta. 2+07  
and 2+50 Summer St.

Root Parking Area  
70' Left of Project &  
Match Line

2+11 Summer St  
Begin Ret. Wall  
23' Rt  
See Sh. No. 43

2+11 Summer St  
Begin Ret. Wall  
23' Rt  
See Sh. No. 43


STATE OF MAINE  
STATE HIGHWAY COMMISSION  
BANGOR-BREWER BRIDGE  
OVER PENOBSCOT RIVER  
BANGOR, MAINE

PLAN  
HAYMARKET SQUARE  
HARRINGTON AND CORTELYOU  
CONSULTING ENGINEERS  
KANSAS CITY, MO.

DETAILED Z.E.W. 8-11-52  
TRACED E.R.J. 9-22-52  
CHECKED F.M.N. 1-20-53

SCALE: 1" = 10'-0"  
SHEET NO. 32

62-32

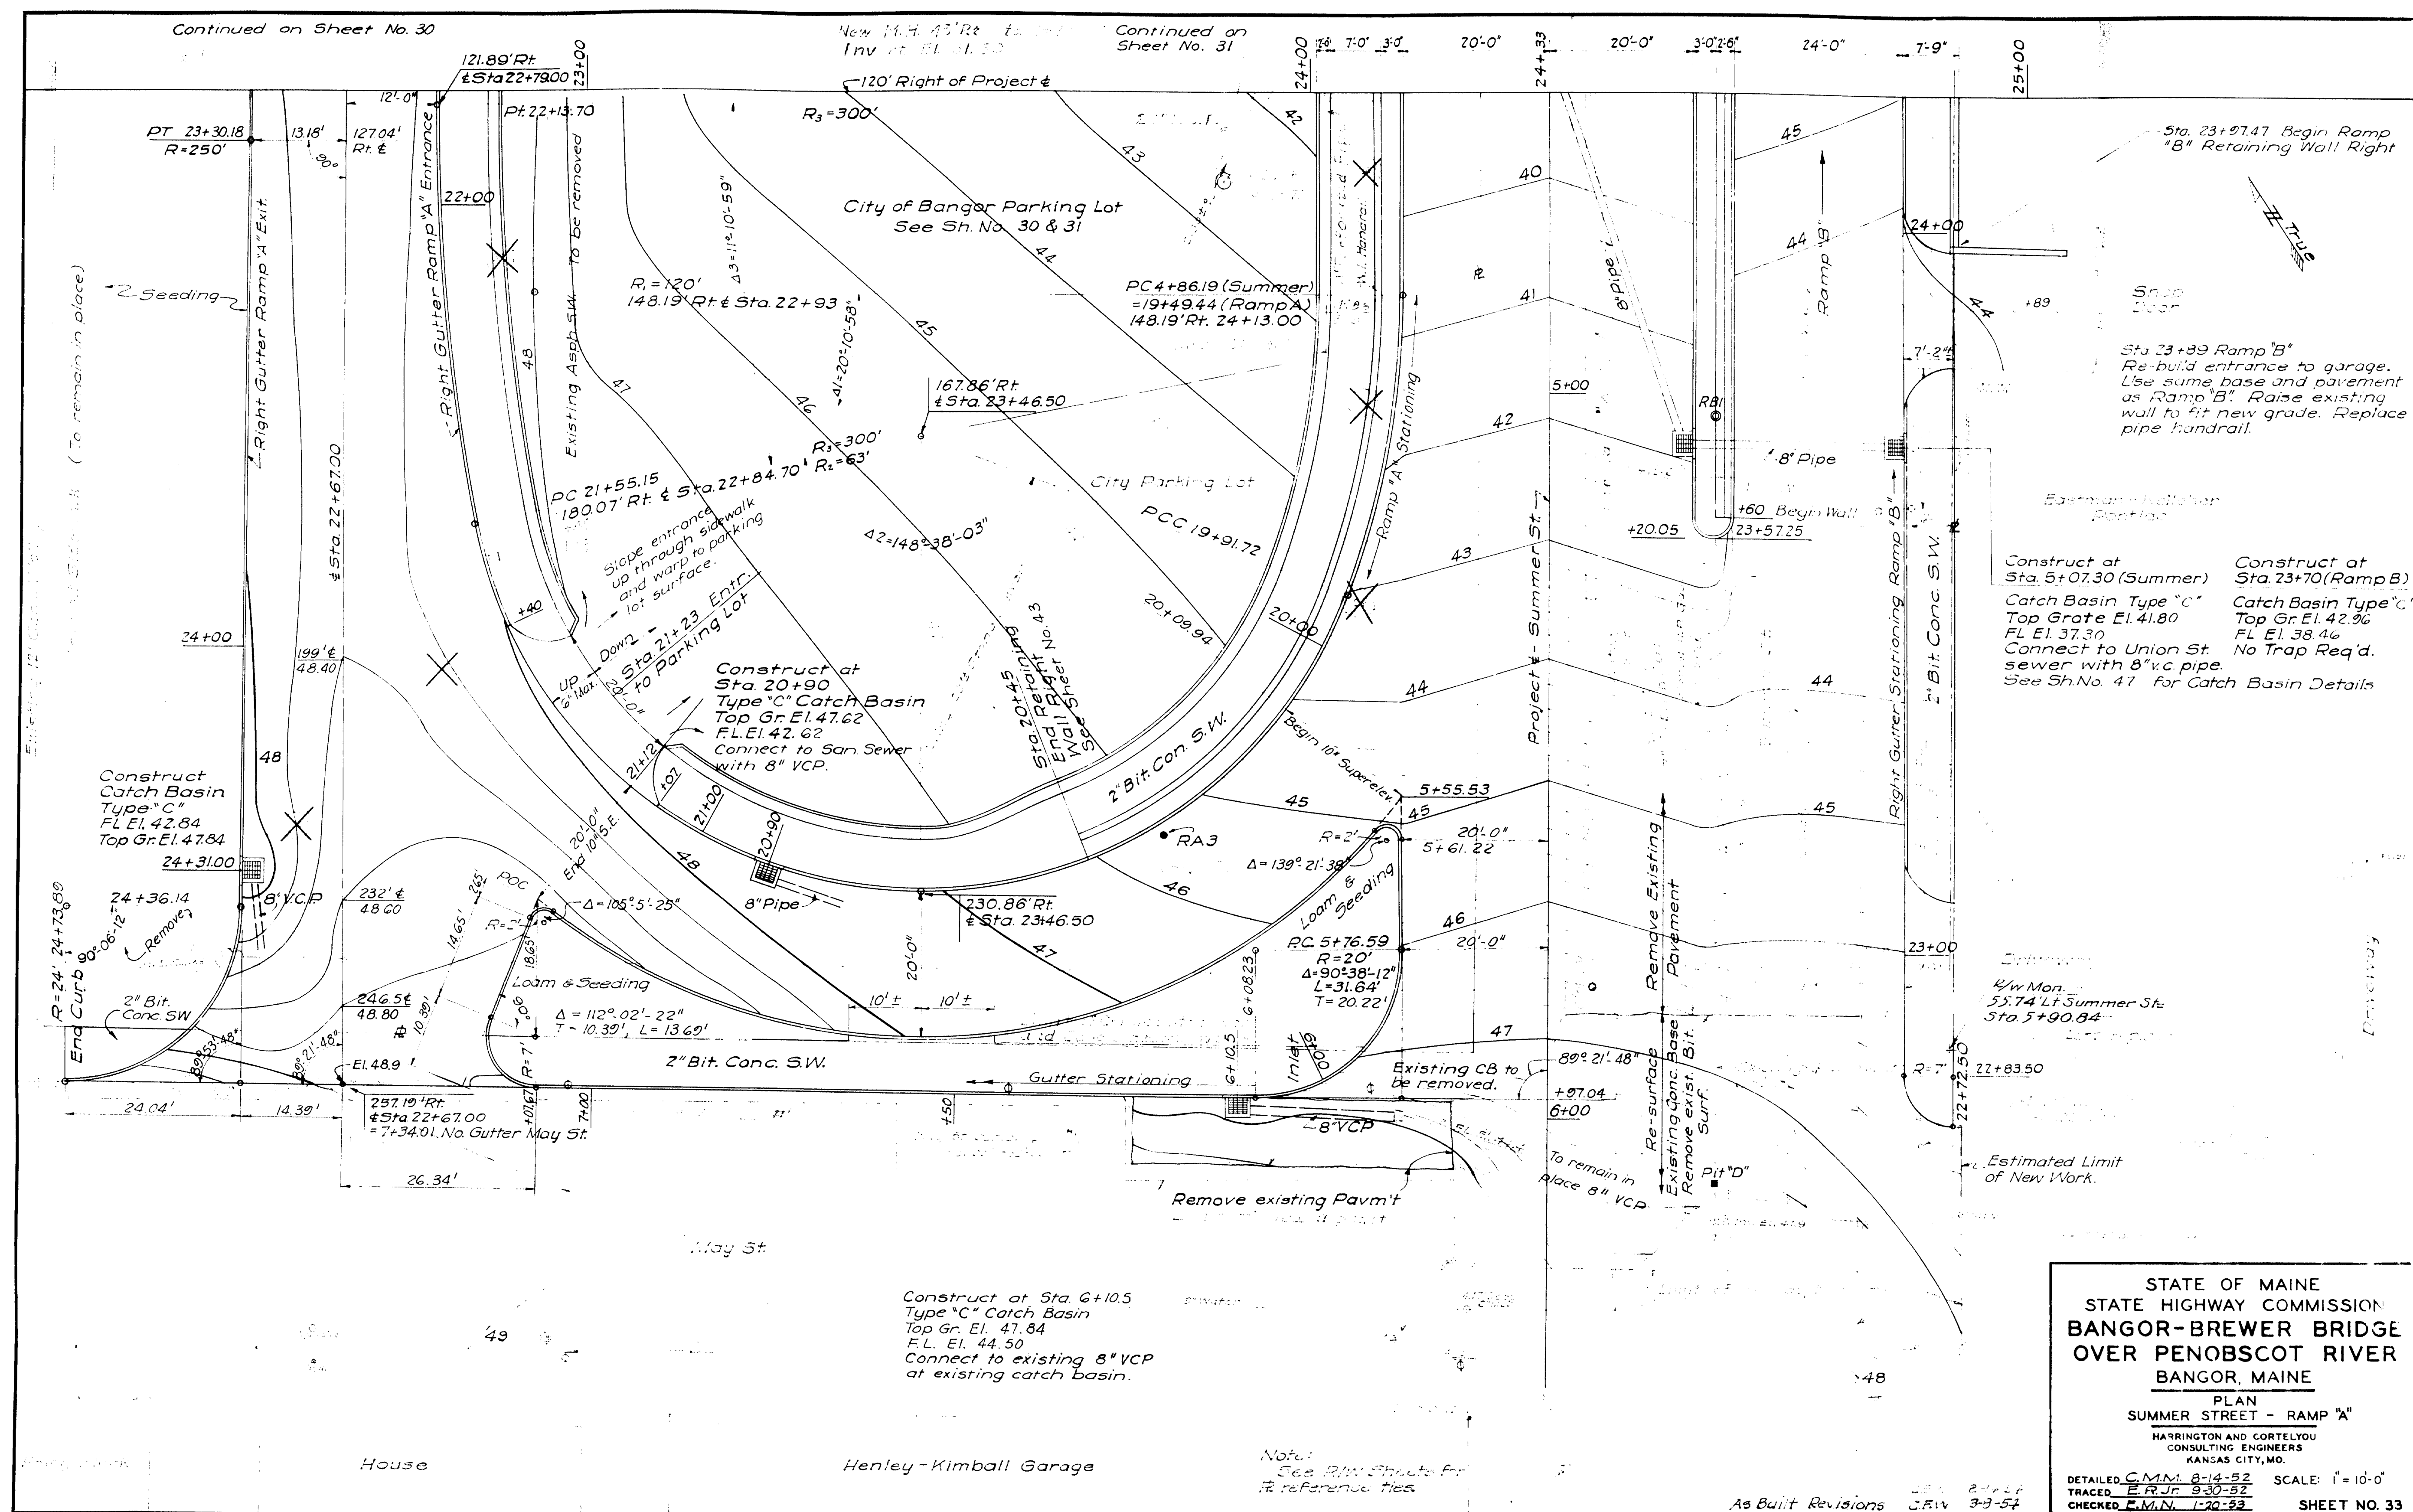



B.M. No. 7 Top W. Wheel South of  
Armour Truck Entrance.  
36.5' Rt. Sta. 27+23 El. 22.76




B.M. No. 8 Top of W. Anchor Bolt  
N.W. Cor. D&H Bldg.  
58' Rt. Sta. 29+37 El. 21.15

Construct Mound Entrance & provide for plank X-ing  
40' Rt. Sta. 29+00 as shown.  
Compact Embankment, 3" Gravel  
Surface Course

9' 20+00  
Construct New Sanitary Sewer as shown.  
From 25' Rt. Sta. 26+26 to 22' Rt. Sta. 28+30 24" R.C.P.  
From 22' Rt. Sta. 28+30 to 4' Rt. Sta. 29+11 30" R.C.P.  
Construct Standard Manhole @ 22' Rt. Sta. 28+30  
Top Manhole El. 18.77 FLEI 11.4 See Sh. No. 47 FLEI 11.00  
All existing services to be connected to new sewer.  
Remove existing manholes and sewer between limits  
of new sewer. New sewer to connect to existing sewer  
as shown. new Outfall as shown.

Note:  
Two frame buildings at approximately  
Sta. 30 and 31 to be removed. (See Specs.)

Remove Existing  
Sewer Manhole  
Top El. 16.0 FLEI 3.8  
Connect new sewer  
to existing sewer

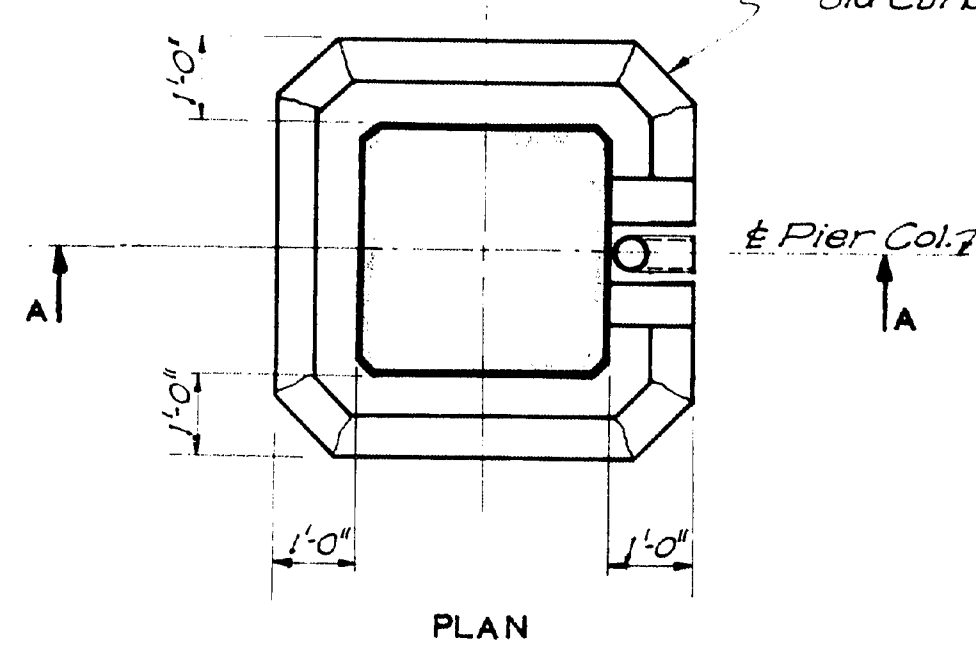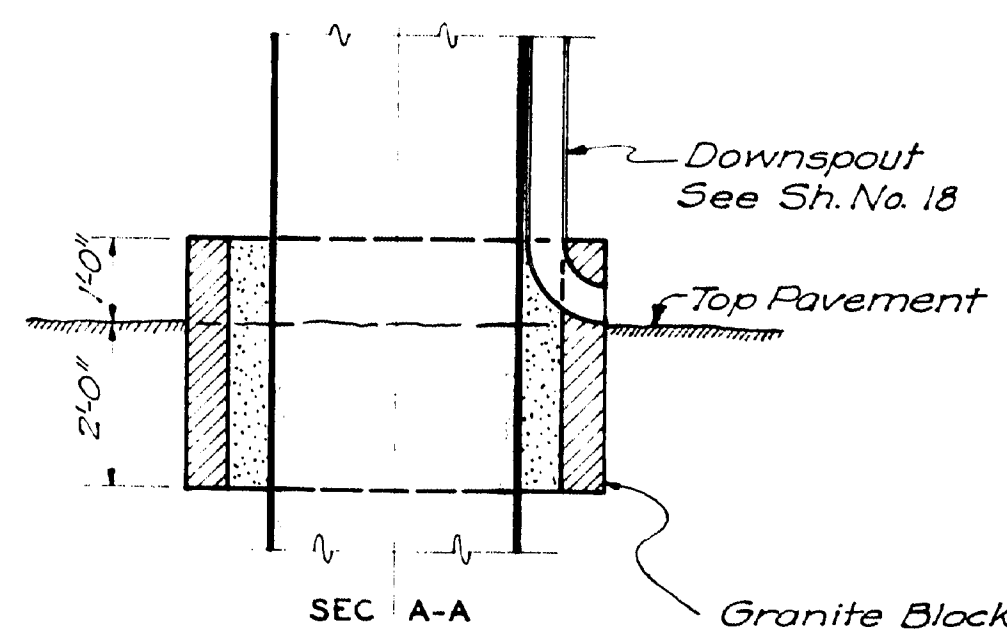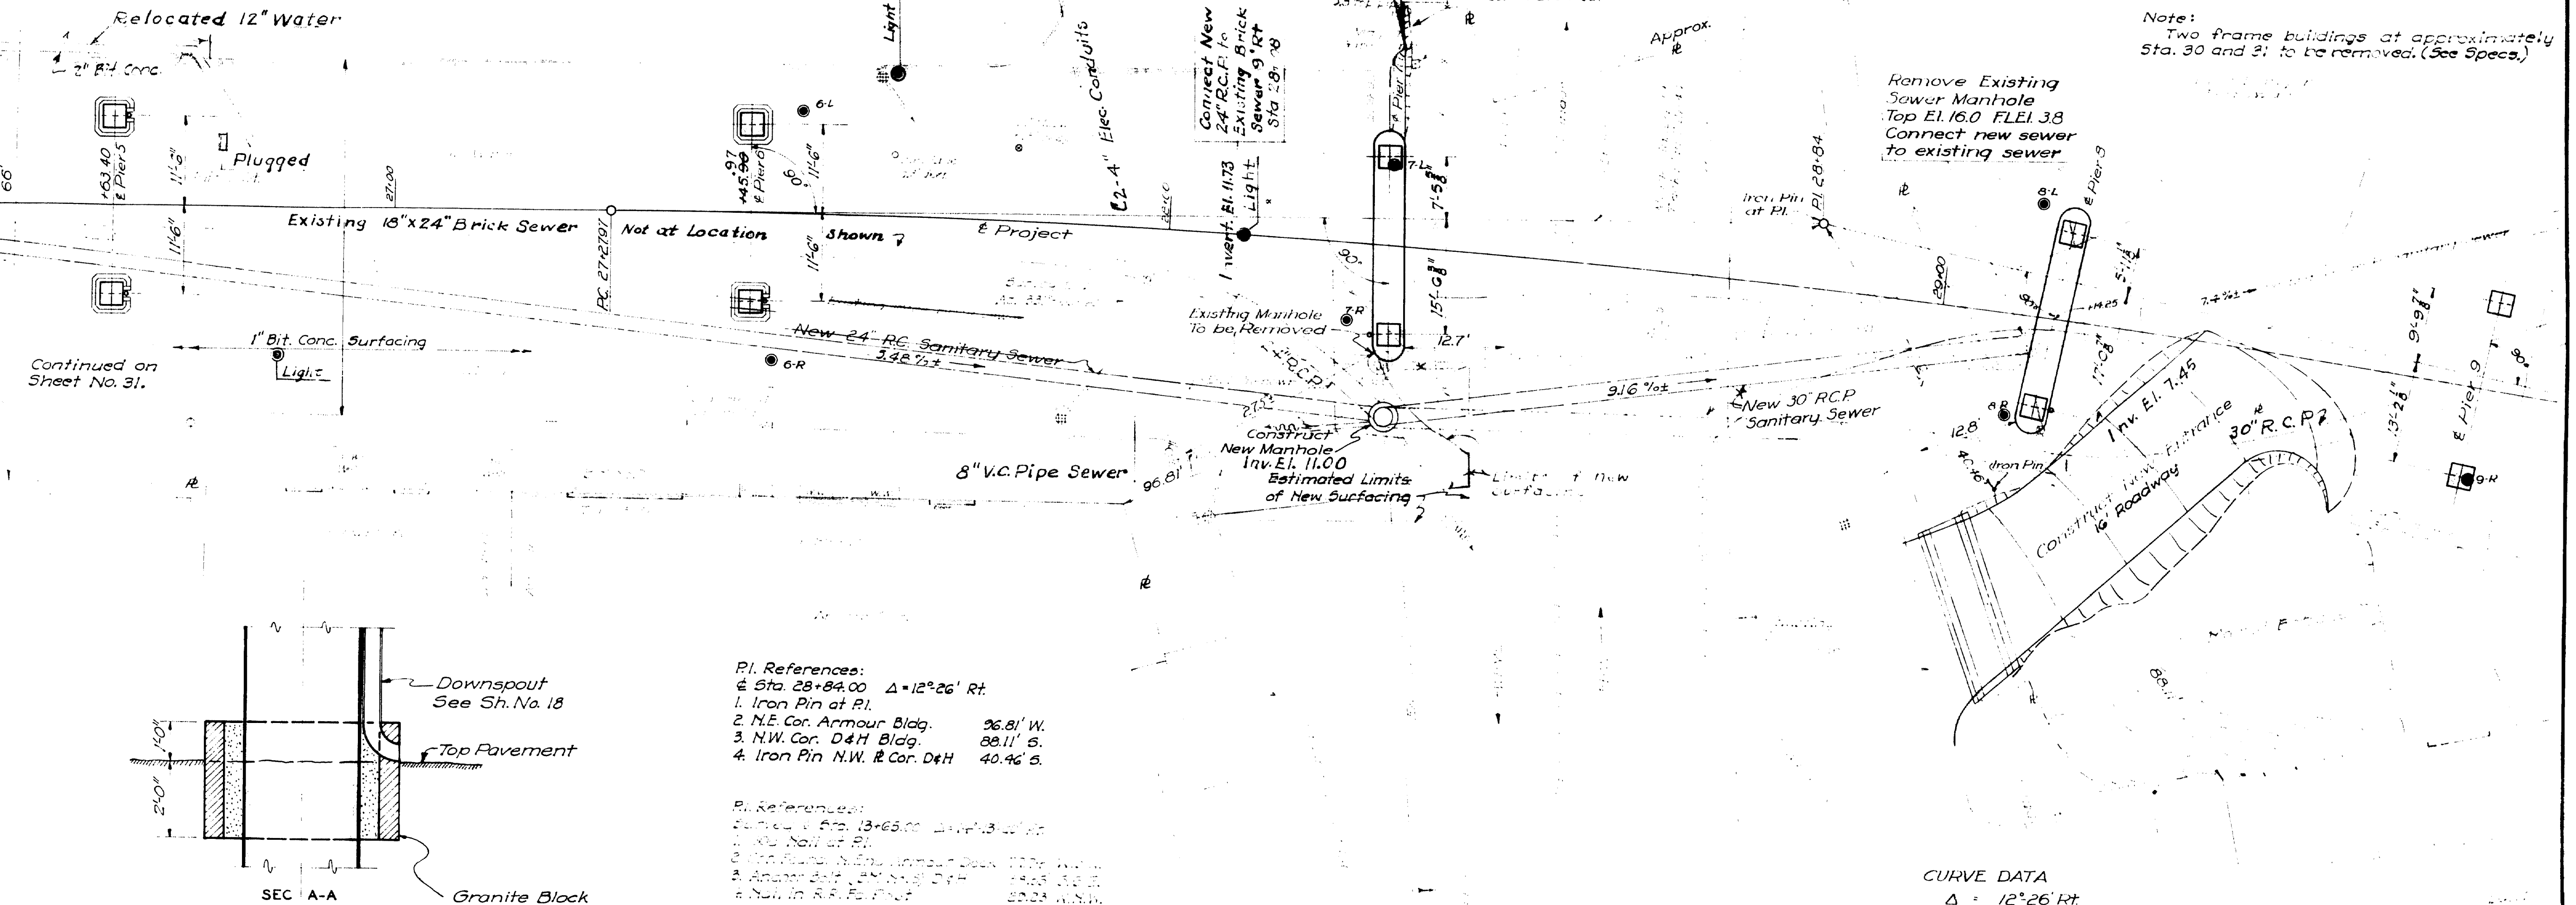

PIER CURBS  
Scale 1/2" = 1'-0"

P.I. References:  
@ Sta. 28+84.00 Δ = 12° 26' Rt.  
1. Iron Pin at P.I.  
2. N.E. Cor. Armour Bldg. 96.81' W.  
3. N.W. Cor. D&H Bldg. 88.11' S.  
4. Iron Pin N.W. R. Cor. D&H 40.46' S.

R.I. References:  
@ Sta. 13+65.00 Δ = 12° 26' Rt.  
1. Iron Pin at P.I.  
2. N.E. Cor. Armour Bldg. 96.81' W.  
3. N.W. Cor. D&H Bldg. 88.11' S.  
4. Iron Pin N.W. R. Cor. D&H 40.46' S.

Note:  
Existing sewer removed between the connection  
to the brick sewer at 9' Rt. Sta. 28+08 and the  
river side of Pier 8 Excavation except under  
the M.C.R.R. Main Line Tracks. See Sh. No. 23

NOTE:  
U.S. Engineer Department D.M. No. 1  
Elev. is 28.13' above "Mean Low Water."  
"The top of a disc set in a stone  
monument at the northeast corner  
of McLaughlin's Warehouse at the  
corner of Front and May Streets,  
Bangor, Me."  
Survey Datum (USC & GS Mean Sea  
Level) Elev. 21.24.

CURVE DATA  
Δ = 12° 26' Rt.  
D = 4° 00' (100' Arc)  
R = 1432.40'  
T = 156.03'  
L = 310.83'

STATE OF MAINE  
STATE HIGHWAY COMMISSION  
BANGOR-BREWER BRIDGE  
OVER PENOBSCOT RIVER  
BANGOR, MAINE  
PLAN-UNION STREET  
STA. 27 TO STA. 29  
HARRINGTON AND CORTELYOU  
CONSULTING ENGINEERS  
KANSAS CITY, MO.

DETAILED Z.E.W. 7-6-56  
TRACED C.M.M. 8-23-52  
CHECKED E.M.N. 7-20-53

SCALE: 1" = 10'-0"

SHEET NO. 34





# CITY OF BREWER

8" V.C.P. Top of Opening  
Not on Fire Hydrant Main  
and Wilson St. El. 28.85

Remove Existing Catch Basin  
New Catch Basin to be  
constructed at Sta. 42+24.00  
El. 28.85



Plan View of  
Catch Basin  
to be constructed at  
Sta. 42+24.00  
El. 28.85

END PROJECT STA. 42+24±

Warp New Surface to  
Existing Pavement

Estimated  
Limit of New Work

Remove Exist.  
Catch Basin

Warp to Existing Surfacing

Right Base Line

R/W

To be removed

Warp to  
Existing Surface

50' Radius  
41+55.64 P.C.

Wilson St.  
Service Road

Sta. 42+50 Right Base Line  
Construct Type "A" Catch Basin  
& Right of Base Line  
Top of Grade El. 23.62, El. El. 19.45  
Connect to existing sanitary sewer  
with 6" V.C.P.  
Remove existing catch basin  
Construct special Ditch Right of Right Base  
Line Sta. 42+20 to Sta. 42+00. See Sh. No. 41.  
Construct Type "A" Retaining Wall  
Rt. Sta. 41+00.18 to Sta. 41+30  
See Sh. No. 45 for Details.

Sta. 42+00 Left Gutter Line  
Construct Type "A" Catch Basin @ E. of  
Left Gutter Line  
Top Grade El. 25.31, EL. EL. 20.89  
Connect to Existing Sanitary Sewer  
with 6" V.C.P.  
Remove Existing Catch Basin 17' Left  
of Sta. 42+10.  
See Sh. No. 47 for Drainage Details

## NOTES:

New roadway and gutter surfacing is to  
be warped into existing surfaces as indicated  
on Plan Sheets and Profile Sheets.

Approximate limits of new pavement  
to be constructed are: Sta. 42+24; Left  
Gutter Line Sta. 42+53; and Right Base Line  
Sta. 43+30.

Final Limits of existing surfacing and  
base to be removed and replaced, to be determined  
in the field by the Engineer.

See Sheet No. 29 for Typical Sections.



See Sheet No. 41 for Grades.

See Sheet No. 30 for General Notes.

0 1 2 3 4 5 INCHES

STATE OF MAINE  
STATE HIGHWAY COMMISSION  
BANGOR-BREWER BRIDGE  
OVER PENOBSCOT RIVER  
BANGOR, MAINE  
PLAN  
MAIN ST. INTERSECTION-BREWER  
HARRINGTON AND CORTELYOU  
CONSULTING ENGINEERS  
KANSAS CITY, MO.  
DETAILED Z.E.W. A.E. 42  
TRACED P.L.L.G. 10-16-52  
CHECKED G.H.K. 1-20-53  
SCALE: 1" = 10'-0"  
SHEET NO. 36

62-36

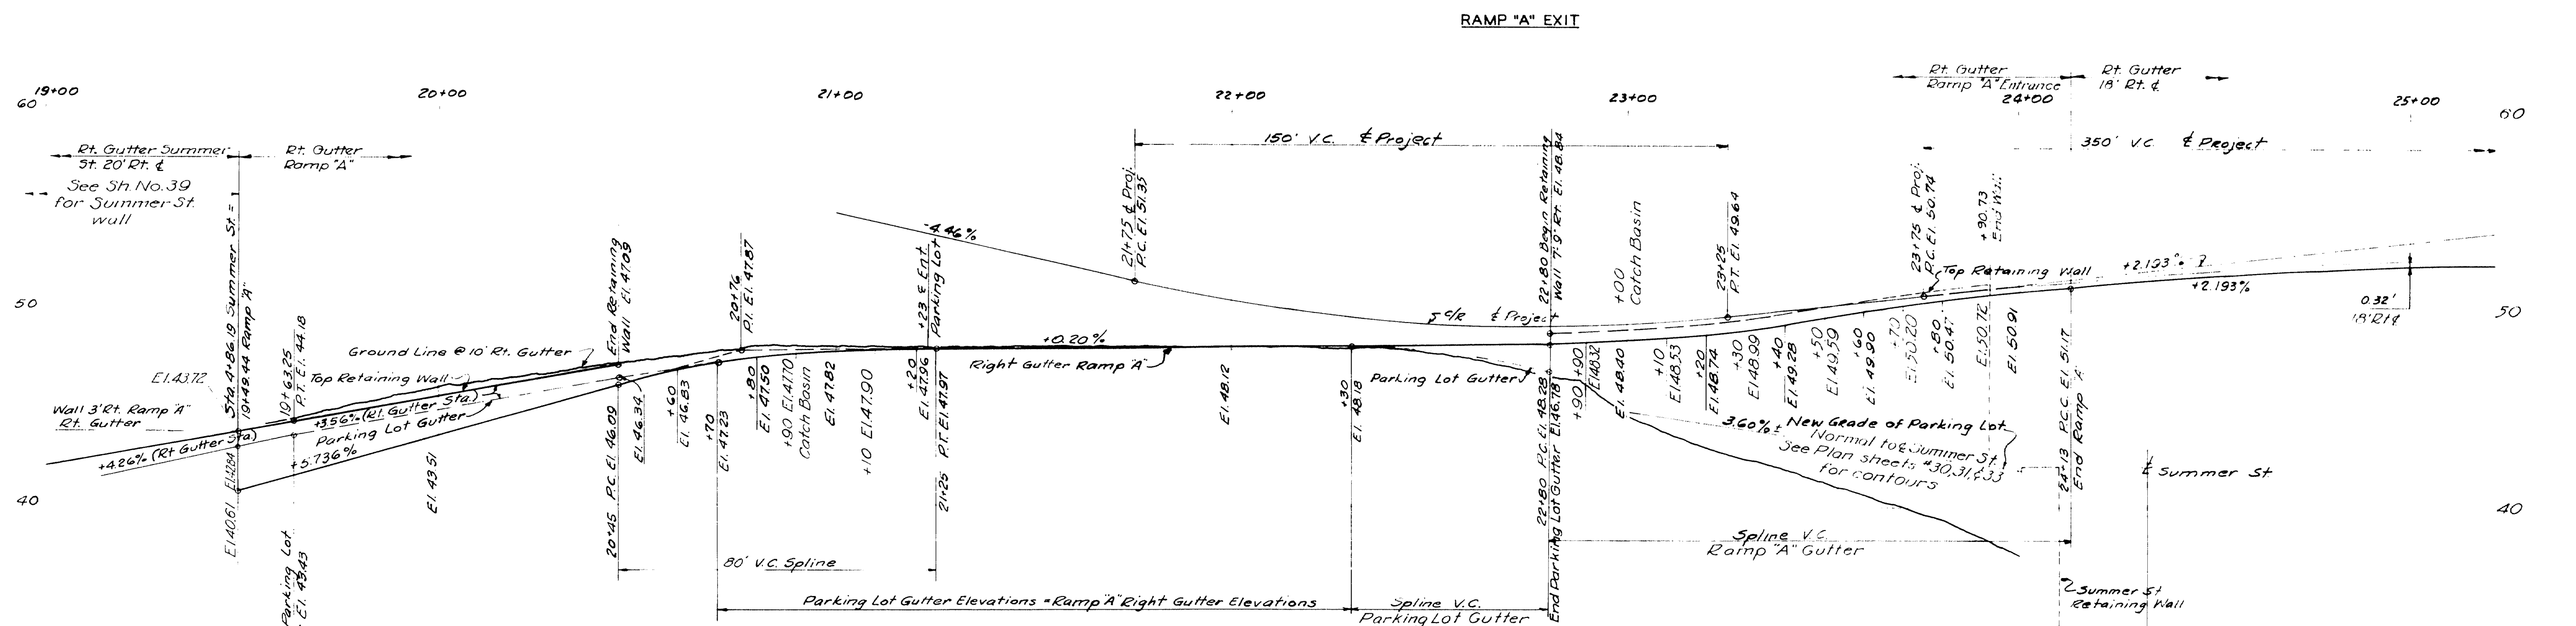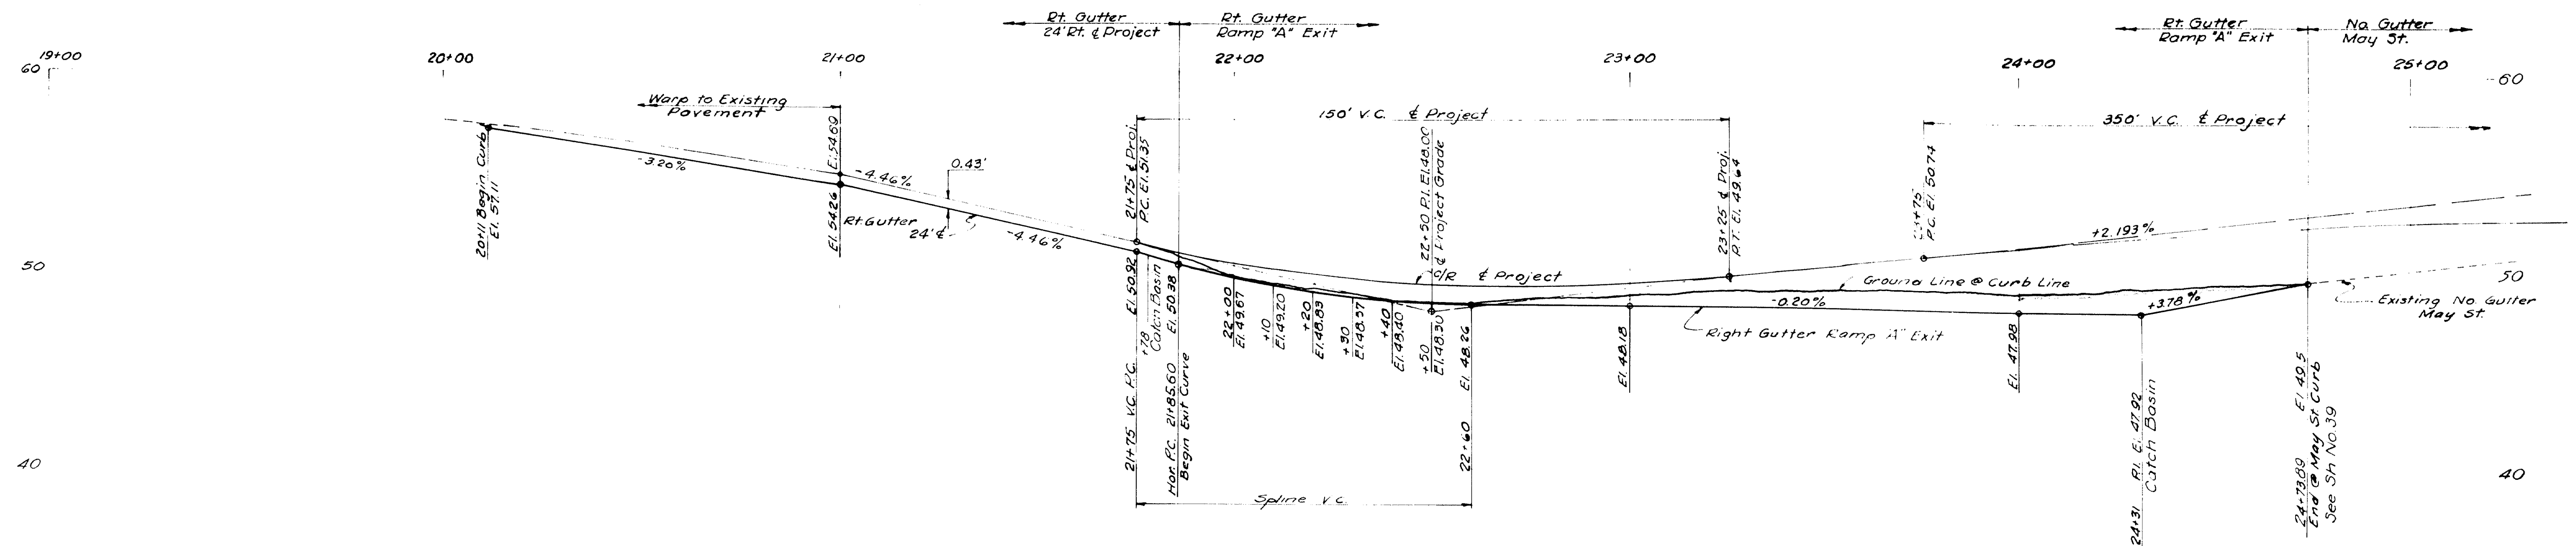

**RAMP "A" - ENTRANCE**  
Showing Right Gutter, Retaining Walls and Parking Lot Gutter.

Ramp Stationing shown is on gutter line of inside ramp curb and is a continuation of & Project Stationing, unless noted.


STATE OF MAINE  
STATE HIGHWAY COMMISSION  
**BANGOR-BREWER BRIDGE  
OVER PENOBSCOT RIVER  
BANGOR, MAINE**  
**PROFILES - RAMP "A"**  
HARRINGTON AND CORTELYOU  
CONSULTING ENGINEERS  
KANSAS CITY, MO.  
DETAILED C.M.M. 8-13-52  
TRACED H.R.W. 9-15-52  
CHECKED F.M.N. 1-20-53  
SCALE: 1"=4'-0" VERT.  
1"=20'-0" HOR.  
SHEET NO. 37

62-37

0 1 2 3 4 5 INCHES






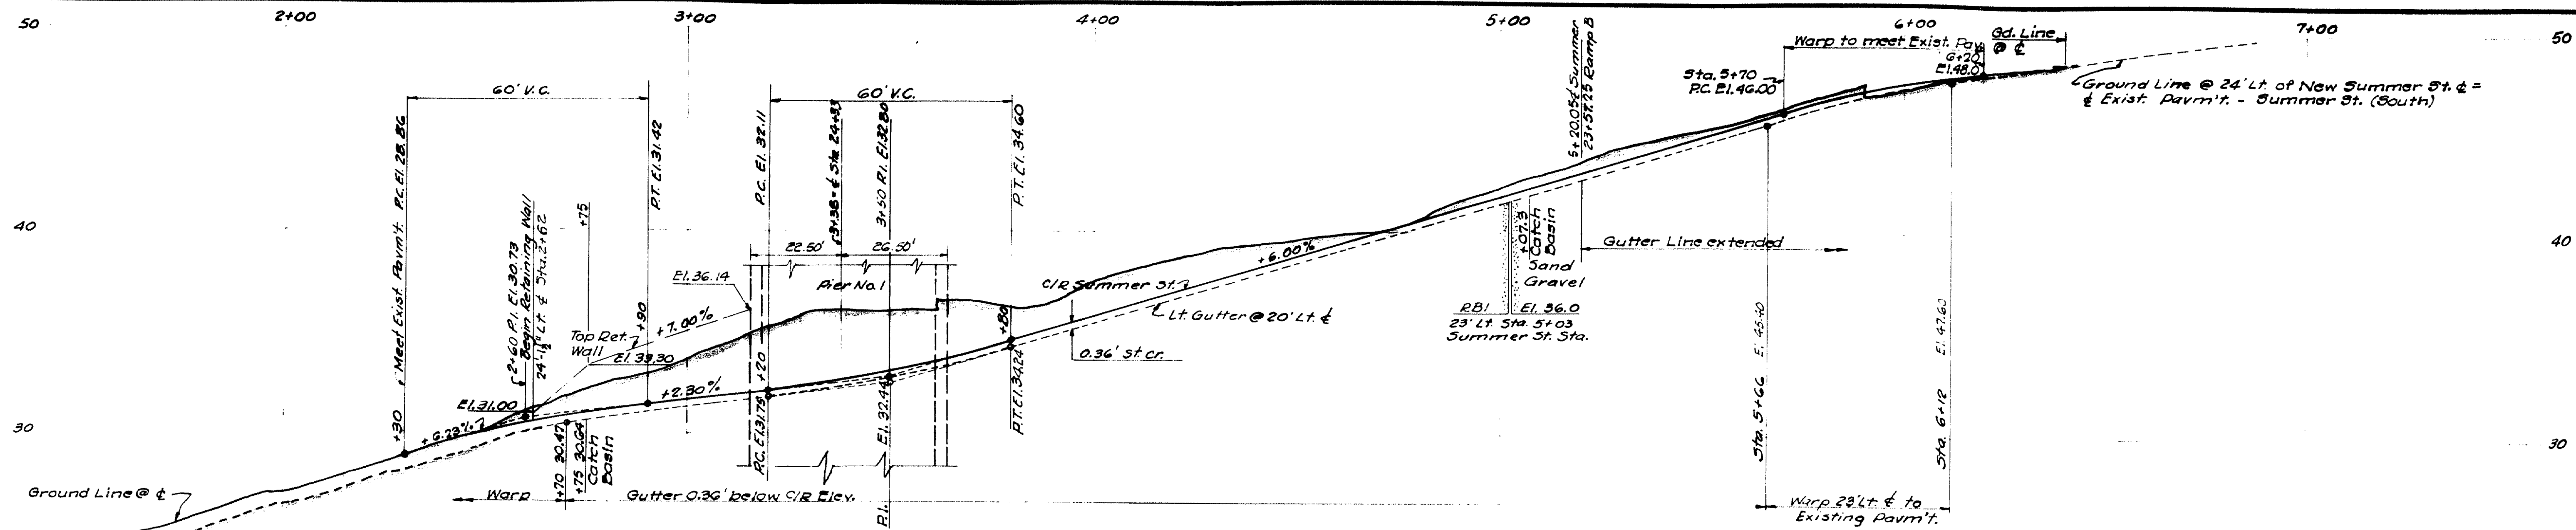

SUMMER STREET - LEFT

Showing 1/2", Left Gutter and Retaining Wall.

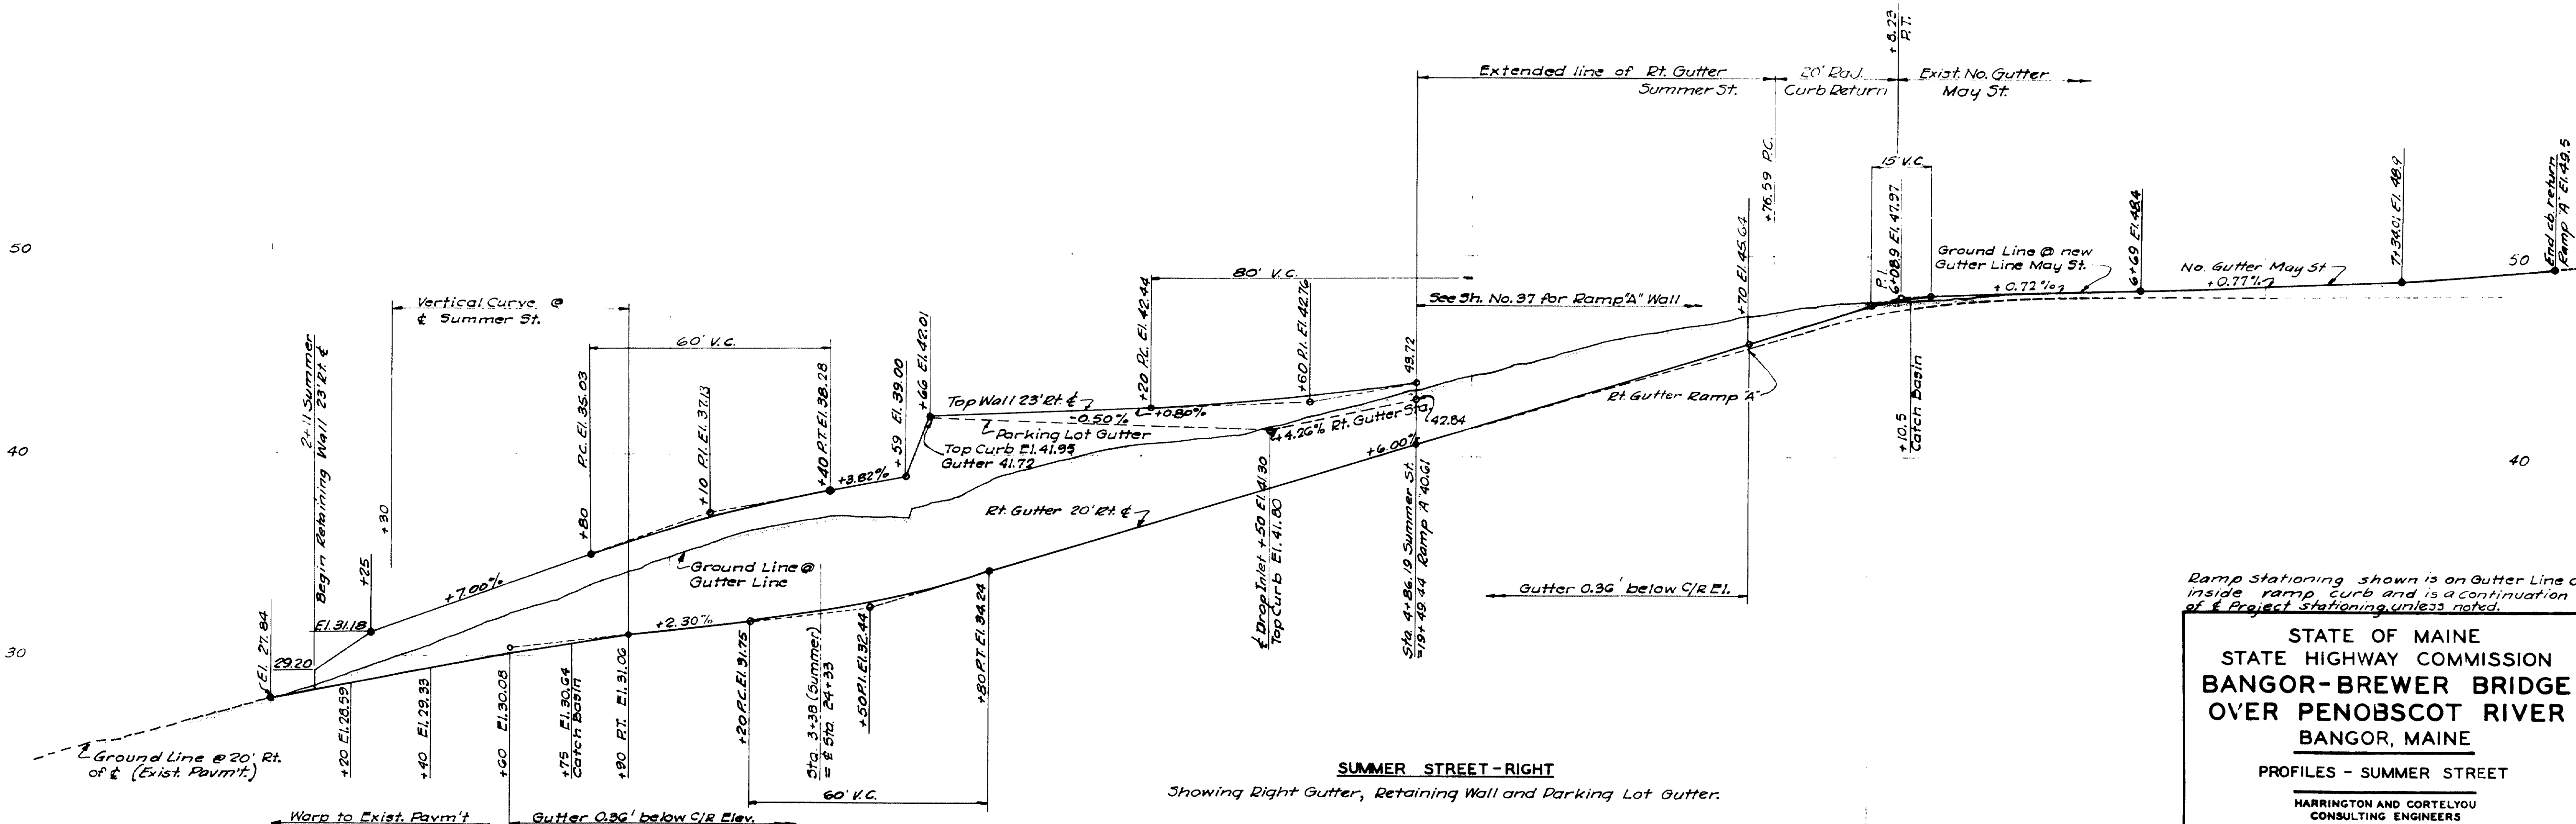

SUMMER STREET - RIGHT

Showing Right Gutter, Retaining Wall and Parking Lot Gutter.

Ramp Stationing shown is on Gutter Line of inside ramp curb and is a continuation of Project Stationing, unless noted.

STATE OF MAINE  
STATE HIGHWAY COMMISSION  
BANGOR-BREWER BRIDGE  
OVER PENOBSCOT RIVER  
BANGOR, MAINE



PROFILES - SUMMER STREET







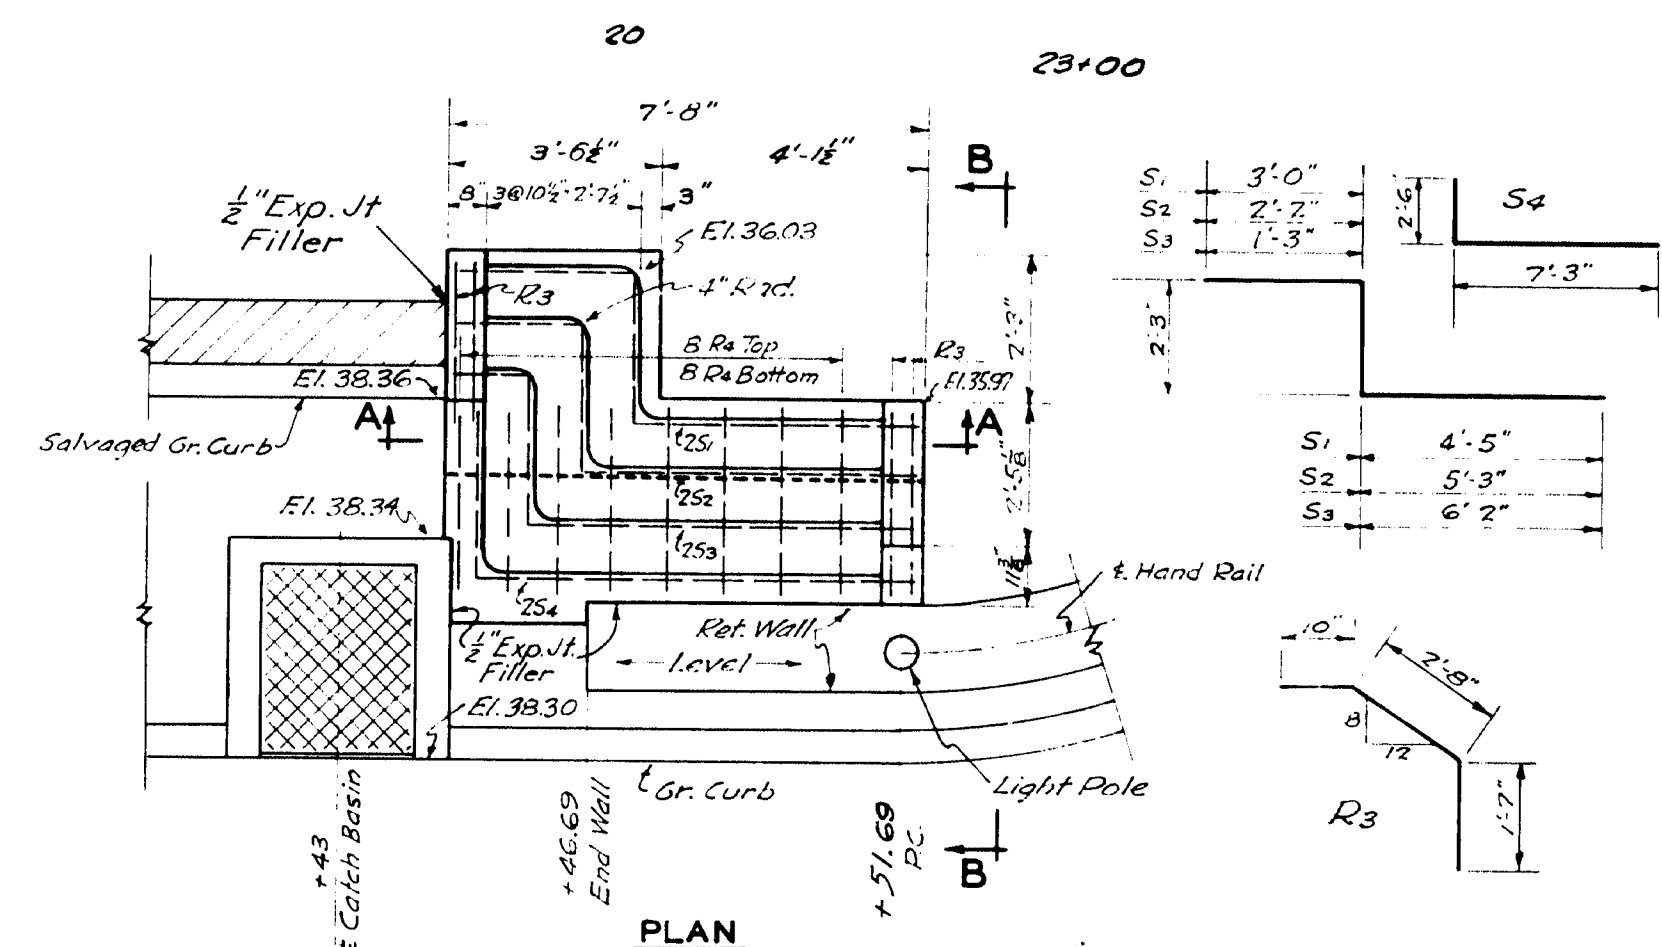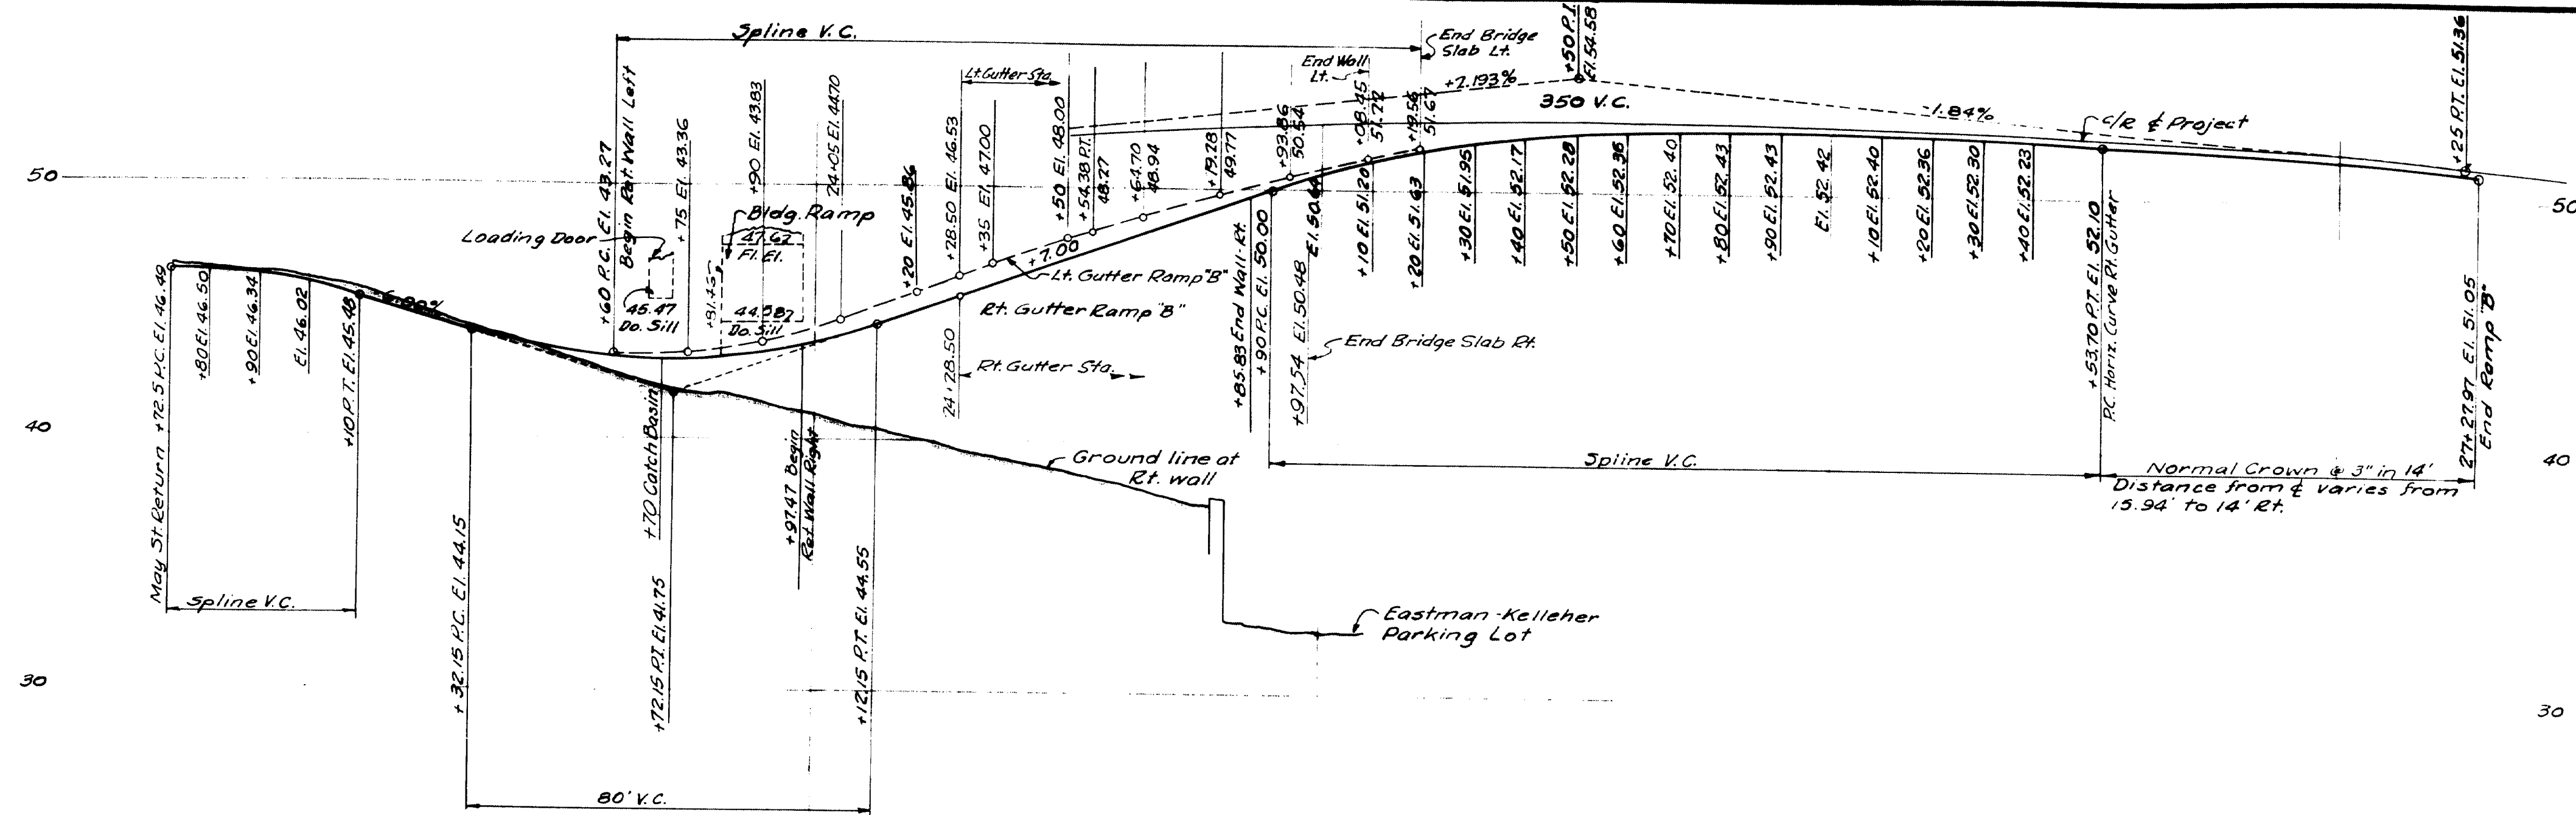

HARRINGTON AND CORTELYOU  
CONSULTING ENGINEERS  
KANSAS CITY, MO.


DETAILED 3D 8-11-52 SCALE: 1"=4'-0" VERT.  
TRACED H.F.W. 9-13-52 1"=20'-0" HOR.  
CHECKED E.M.N. 1-19-53 SHEET NO. 39

62-39








BILL OF REINFORCING				
Mark	No	Size No.	Shape	Length ft. in.
S <sub>1</sub>	2	5		9 8
S <sub>2</sub>	2	5		9 8
S <sub>3</sub>	2	5		9 8
S <sub>4</sub>	2	5		9 9
R <sub>1</sub>	6	5		3 0
R <sub>2</sub>	4	5		2 4
R <sub>3</sub>	4	5		5 1
R <sub>4</sub>	16	5		3 8

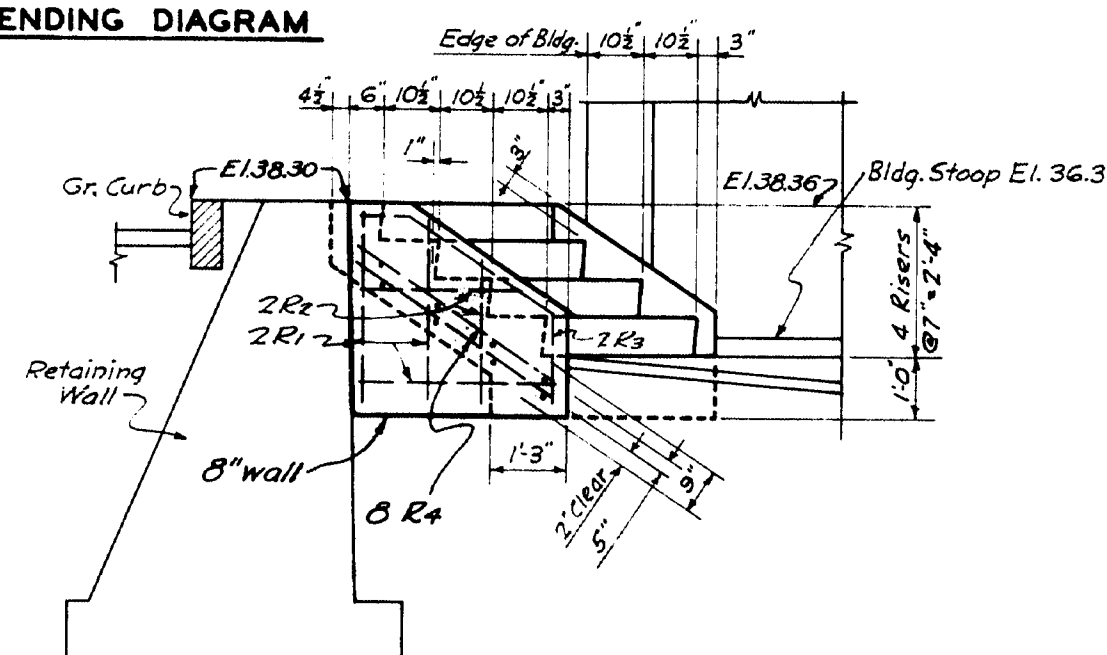


**SECTION B-B**

STEPS AT STA. 23+50 RIGHT GUTTER RAMP "C"  
See Sh. No. 32

CONCRETE STEP DETAILS  
Scale:  $\frac{3}{4}" = 1'-0"$

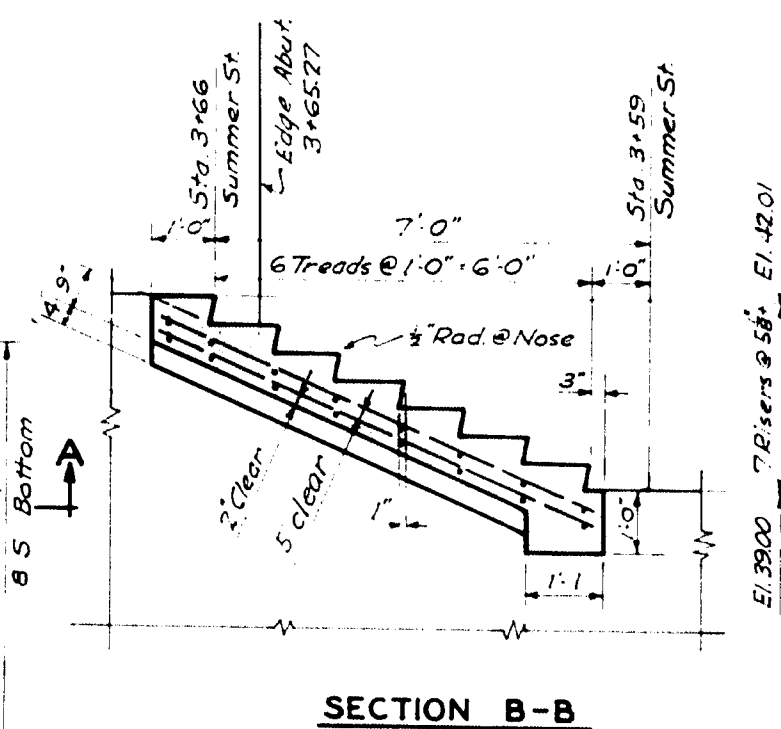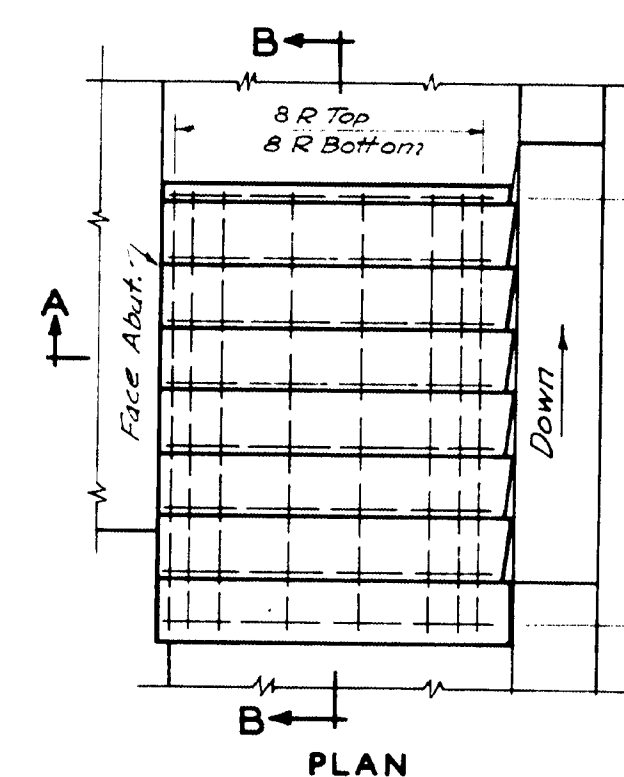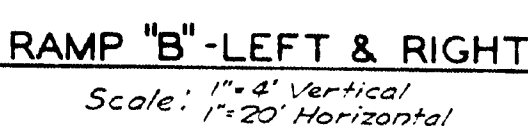

BILL OF REINFORCING				
Mark	No.	Size	Shape	Length
		No		ft. in.
S	76	5	—	7' 4"
R	16	5	—	5' 3"

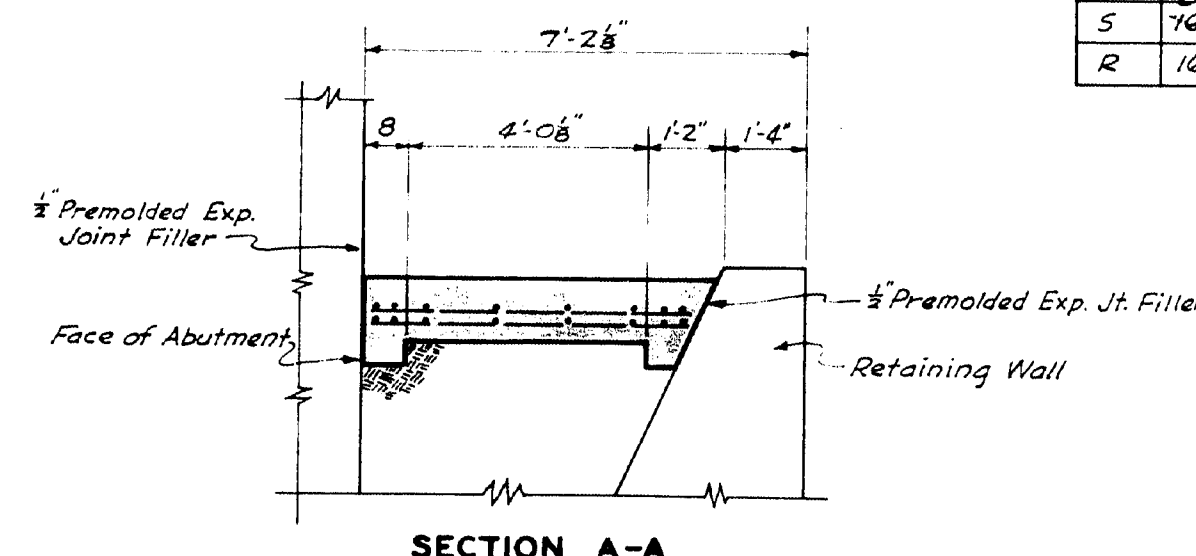

**SECTION A-A**

STEPS FOR SUMMER ST. WALL  
*See Sh. No. 31.*

Note:  
Steps at Left Gutter, Ramp  
"C", Sta. 21+1.5 are similar.


Ramp stationing shown is gutter line of inside ramp curb and is a continuation of & Project stationing, unless otherwise noted.




STATE OF MAINE  
STATE HIGHWAY COMMISSION  
**BANGOR-BREWER BRIDGE**  
**OVER PENOBSCOT RIVER**  
BANGOR, MAINE

PROFILES - RAMP "B"

HARRINGTON AND CORTELYOU  
CONSULTING ENGINEERS  
KANSAS CITY, MO.

DETAILED J.P. 8-14-52 SCALE: AS NOTED  
 TRACED H.F.W. 9-15-52  
 CHECKED E.M.N. 1-21-53 SHEET NO. 40

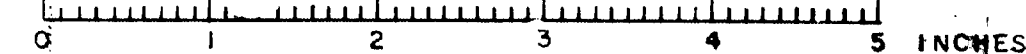

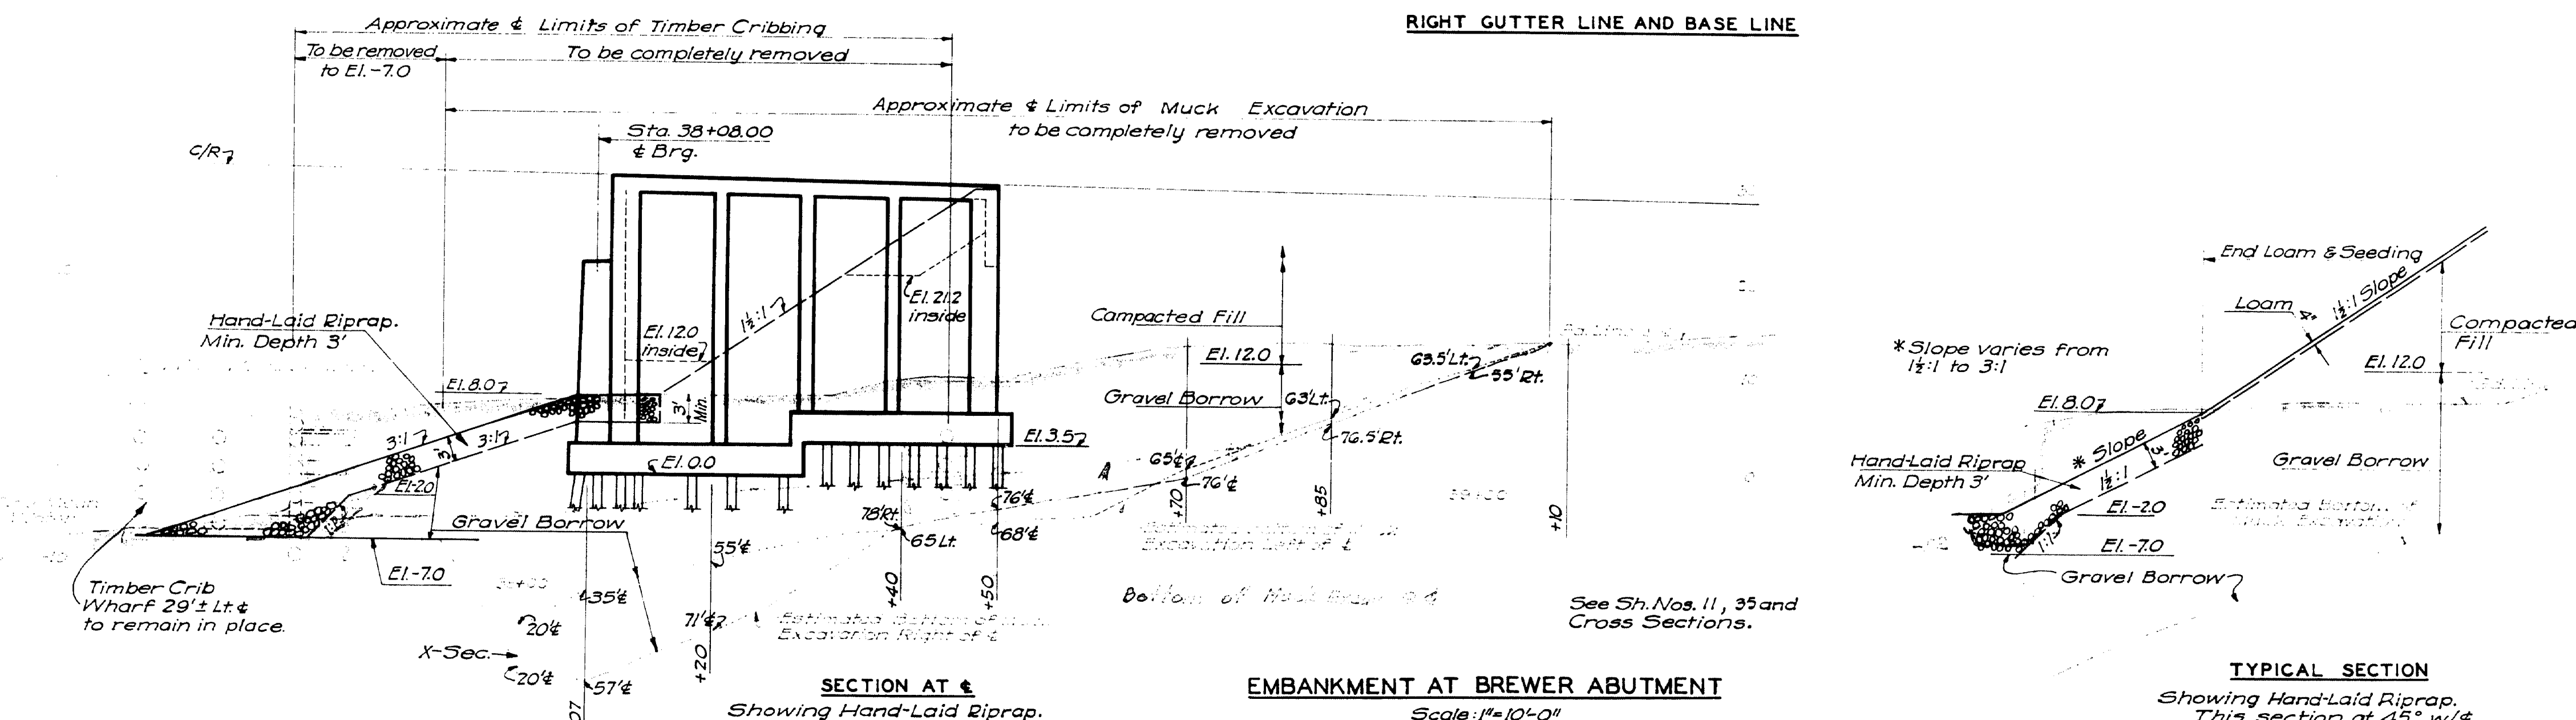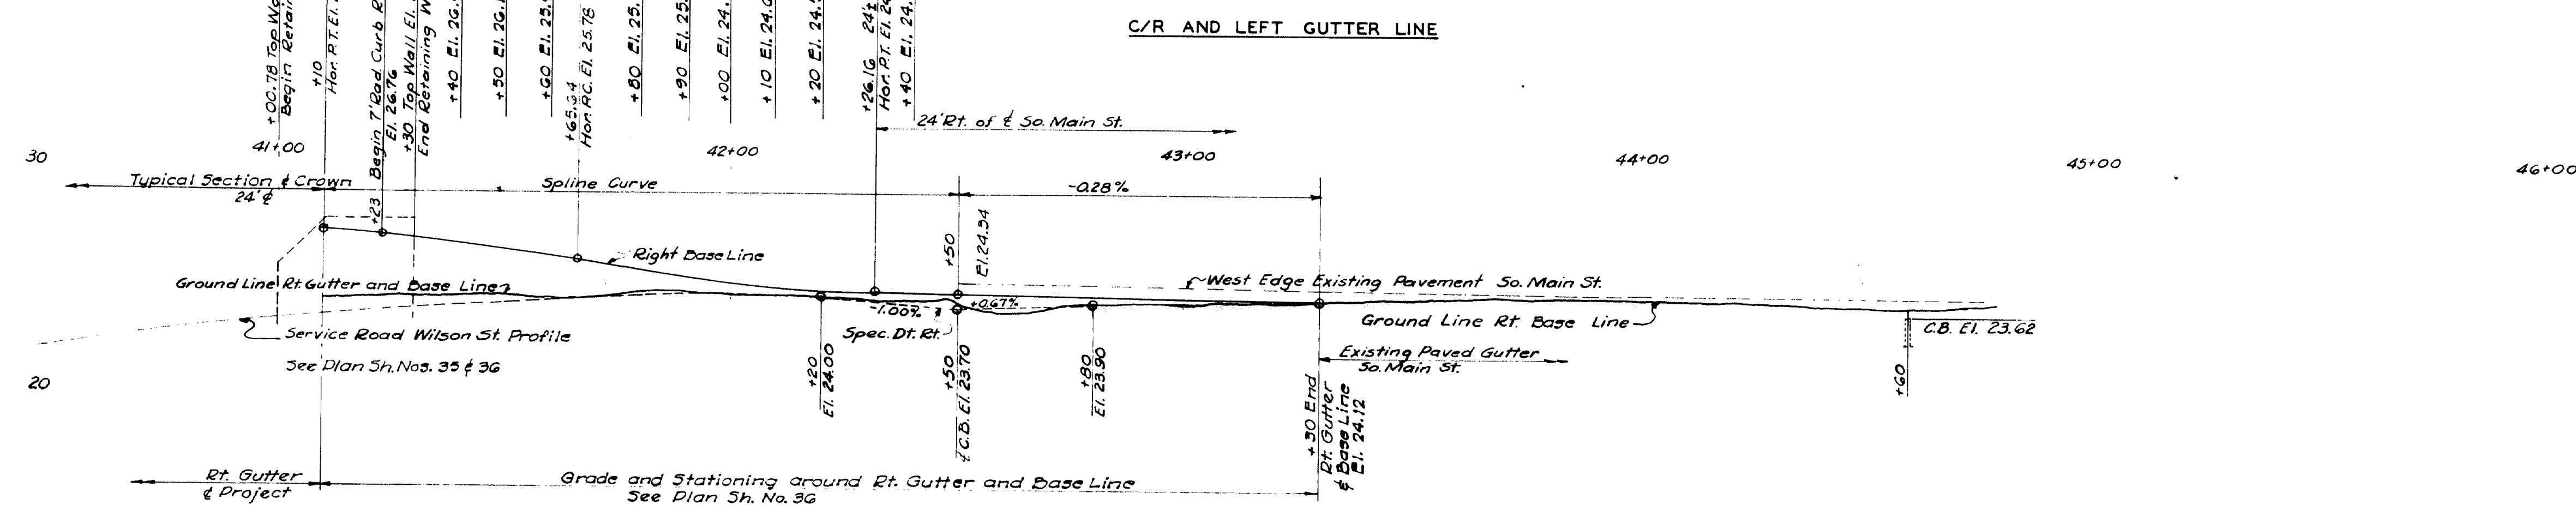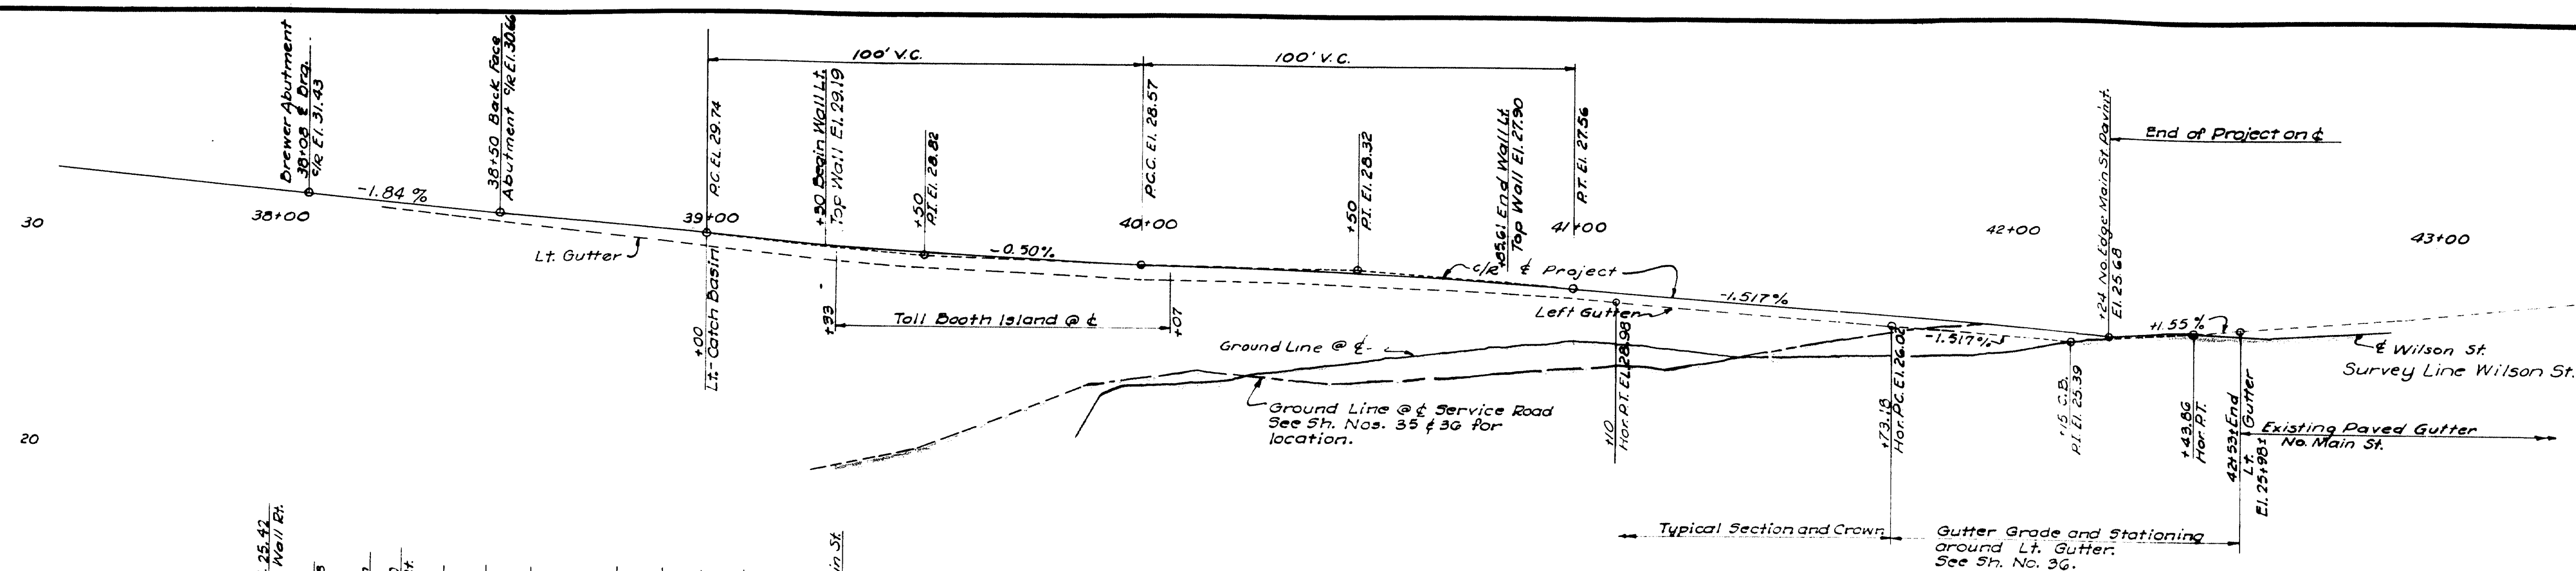

EMBANKMENT AT BREWER ABUTMENT

Scale: 1"=10'-0"

Gravel Borrow shall be placed to bottom of footing prior to driving Abutment piling. See Sh. No. 10.



TYPICAL SECTION  
Showing Hand-Laid Riprap.  
This section at 45° w/ε

Gutter Stationing shown is a continuation of Project Stationing around the 50' radius curves of left and right gutter lines.

STATE OF MAINE  
STATE HIGHWAY COMMISSION  
BANGOR-BREWER BRIDGE  
OVER PENOBSCOT RIVER  
BANGOR, MAINE  
PROFILES - BREWER  
HARRINGTON AND CORTELYOU  
CONSULTING ENGINEERS  
KANSAS CITY, MO.  
DETAILED C.M.M. 8-10-32  
TRACED H.E.W. 9-13-32  
CHECKED G.H.K. 1-20-33  
SCALE: 1"=4'-0" VERT.  
1"=20'-0" HOR.  
SHEET NO. 41

62-41



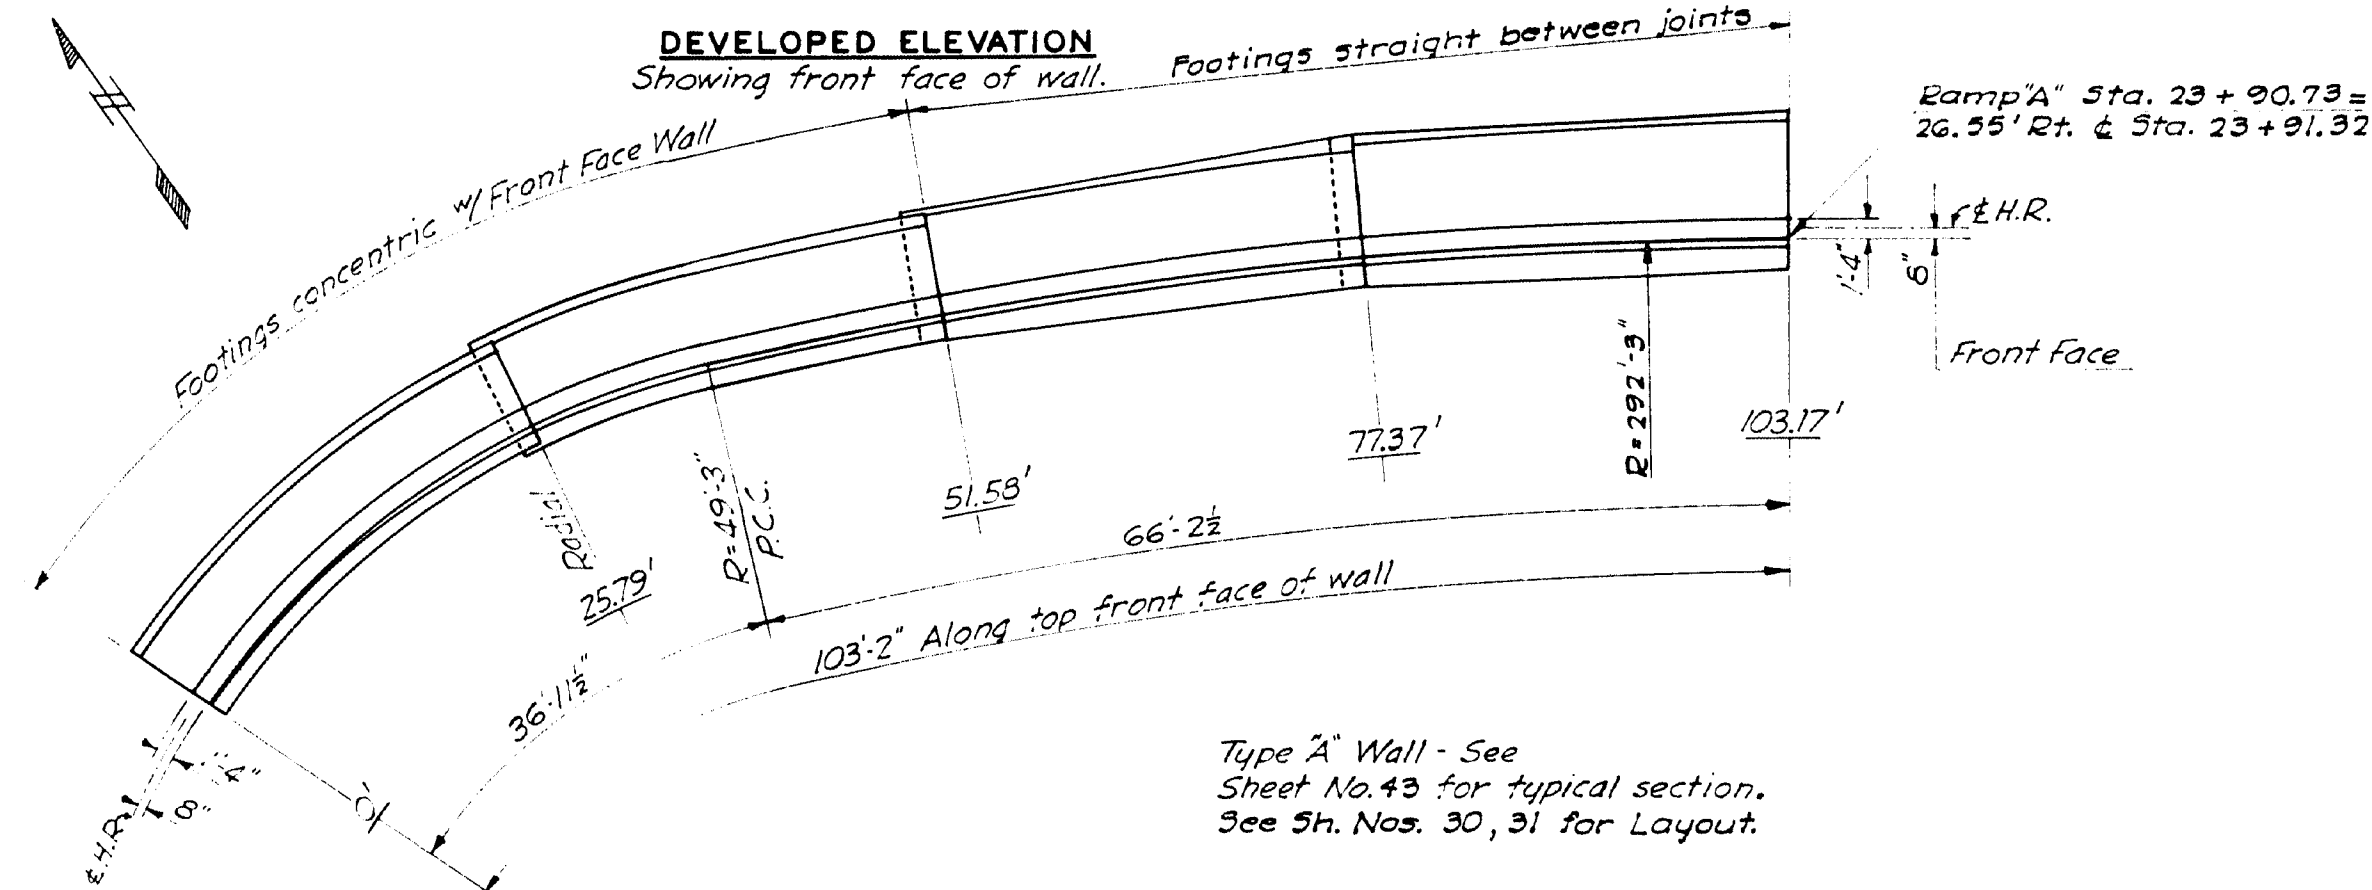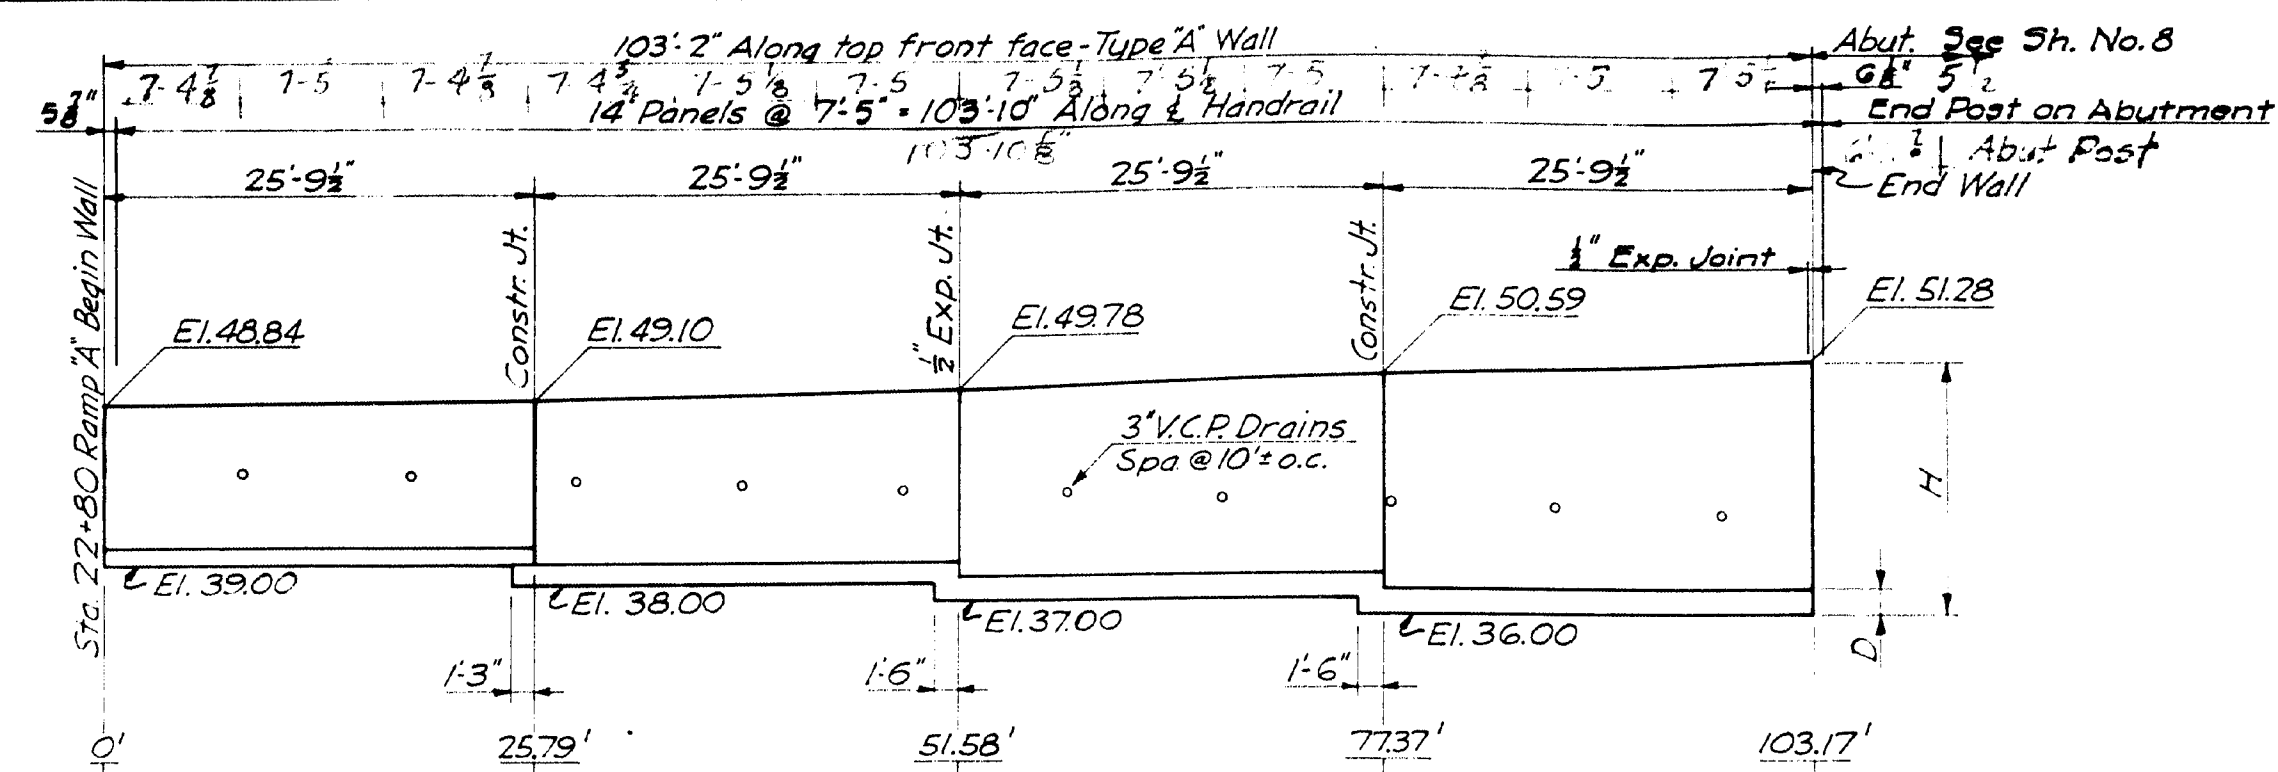


PLAN  
RAMP "A" WALL

Reinforcing steel shown is for section ahead.

RETAINING WALL DIMENSIONS & BILL OF REINFORCING

Sec. at	H	D	F	A	B	*4- $\frac{1}{2}$ " Reinforcing bars											
						Footing			Wall-Vertical			Wall-Horizontal					
						Mk	No.	Length	Mk	No.	Length	Mk	No.	Length			
Ramp "A" Type "A" Wall																	
0	9.84	1'-0"	6'-10"	1'-2 $\frac{3}{4}$ "	5'-2 $\frac{1}{2}$ "	D1	26	2'	1"	V1	26	9'	5"	H1	7	25'	3"
25.79	10.10	1'-0"	6'-10"	1'-2 $\frac{3}{4}$ "	5'-3 $\frac{3}{4}$ "												
25.79	11.10	1'-3"	7'-7"	1'-5 $\frac{5}{8}$ "	5'-7 $\frac{3}{8}$ "	D1	26	2'	1"	V2	26	10'	6"	H1	7	25'	3"
51.58	11.78	1'-3"	7'-7"	1'-5 $\frac{5}{8}$ "	5'-11 $\frac{1}{4}$ "												
51.58	12.78	1'-6"	8'-1"	1'-6 $\frac{3}{8}$ "	6'-3 $\frac{3}{4}$ "	D1	26	2'	1"	V3	26	12'	1"	H1	8	25'	3"
77.37	13.59	1'-6"	9'-1"	1'-9 $\frac{1}{8}$ "	6'-7 $\frac{3}{4}$ "												
77.37	14.59	1'-6"	9'-1"	1'-9 $\frac{1}{8}$ "	7'-0 $\frac{3}{4}$ "	D1	26	2'	1"	V4	26	14'	0"	H1	10	25'	3"
103.17	15.28	1'-6"	9'-6"	1'-10 $\frac{1}{8}$ "	7'-4 $\frac{1}{2}$ "												
Union Street-Type "C" Wall																	
End	11.27	1'-3"	8'-8"	2'-8 $\frac{1}{2}$ "	6'-11 $\frac{1}{2}$ "	D1	12	2'	1"	V1	12	10'	6"	H1	8	12'	0"
0	11.27	1'-3"	8'-8"	2'-8 $\frac{1}{2}$ "	6'-11 $\frac{1}{2}$ "	D1	12	2'	1"	V1	12	10'	6"	H2	8	16'	9"
17.15	11.50	1'-3"	8'-10"	2'-8 $\frac{1}{2}$ "	7'-0 $\frac{1}{2}$ "		12								10	11'	7"
17.15	12.14	1'-6"	9'-6"	3'-2 $\frac{1}{2}$ "	7'-5 $\frac{1}{2}$ "	D1	17	2'	1"	V2	17	11'	3"	H2	8	16'	9"
34.14	12.51	1'-6"	9'-8"	3'-2 $\frac{1}{2}$ "	7'-7 $\frac{1}{8}$ "										10		
34.14	14.04	1'-9"	10'-8"	3'-8 $\frac{1}{8}$ "	8'-5 $\frac{1}{2}$ "	D1	22	2'	1"	V3	22	*		H3	10	*	
56.00	14.50	1'-9"	10'-11"	3'-8 $\frac{1}{8}$ "	8'-7 $\frac{1}{8}$ "					B1	16	3'	6"	B2	3	15'	6"
56.00	16.58	2'-0"	12'-2"	4'-3 $\frac{3}{8}$ "	9'-8"	D1	19	2'	1"	V4	19	15'	6"	H4	11	18'	9"
75.17	17.00	2'-0"	12'-4"	4'-3 $\frac{3}{8}$ "	9'-10 $\frac{1}{2}$ "												
75.17	19.09	2'-3"	13'-8"	4'-9 $\frac{1}{8}$ "	10'-10 $\frac{1}{2}$ "	D1	19	2'	1"	V5	19	18'	0"	H4	13	18'	9"
94.32	19.50	2'-3"	13'-10"	4'-9 $\frac{1}{8}$ "	11'-1"												
						D2	31	2'	0"								

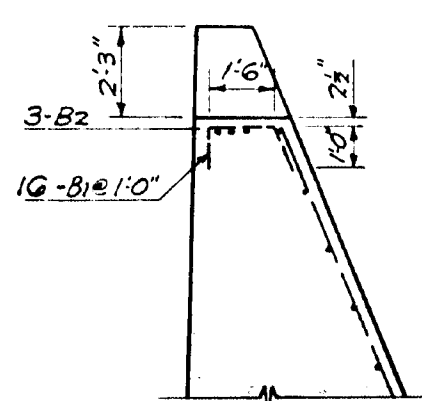


SECTION A-A  
Showing Ramp Span Seat


\*1/2" Vx @ 10'-8" lg. - 6 @ 13'-0" lg.  
\*8-Hs @ 2'-6" lg. - 2 @ 5'-6" lg.

See Sh. No. 43 for General Notes and details of expansion and construction joints and water stops.  
See Sh. No. 18 for Handrail Details.


Type "C" Wall:  
Design Footing Pressure: (2' Surcharge)  
Max. Toe Pressure = 1.27/ft.  
Heel Pressure = 0.87/ft.

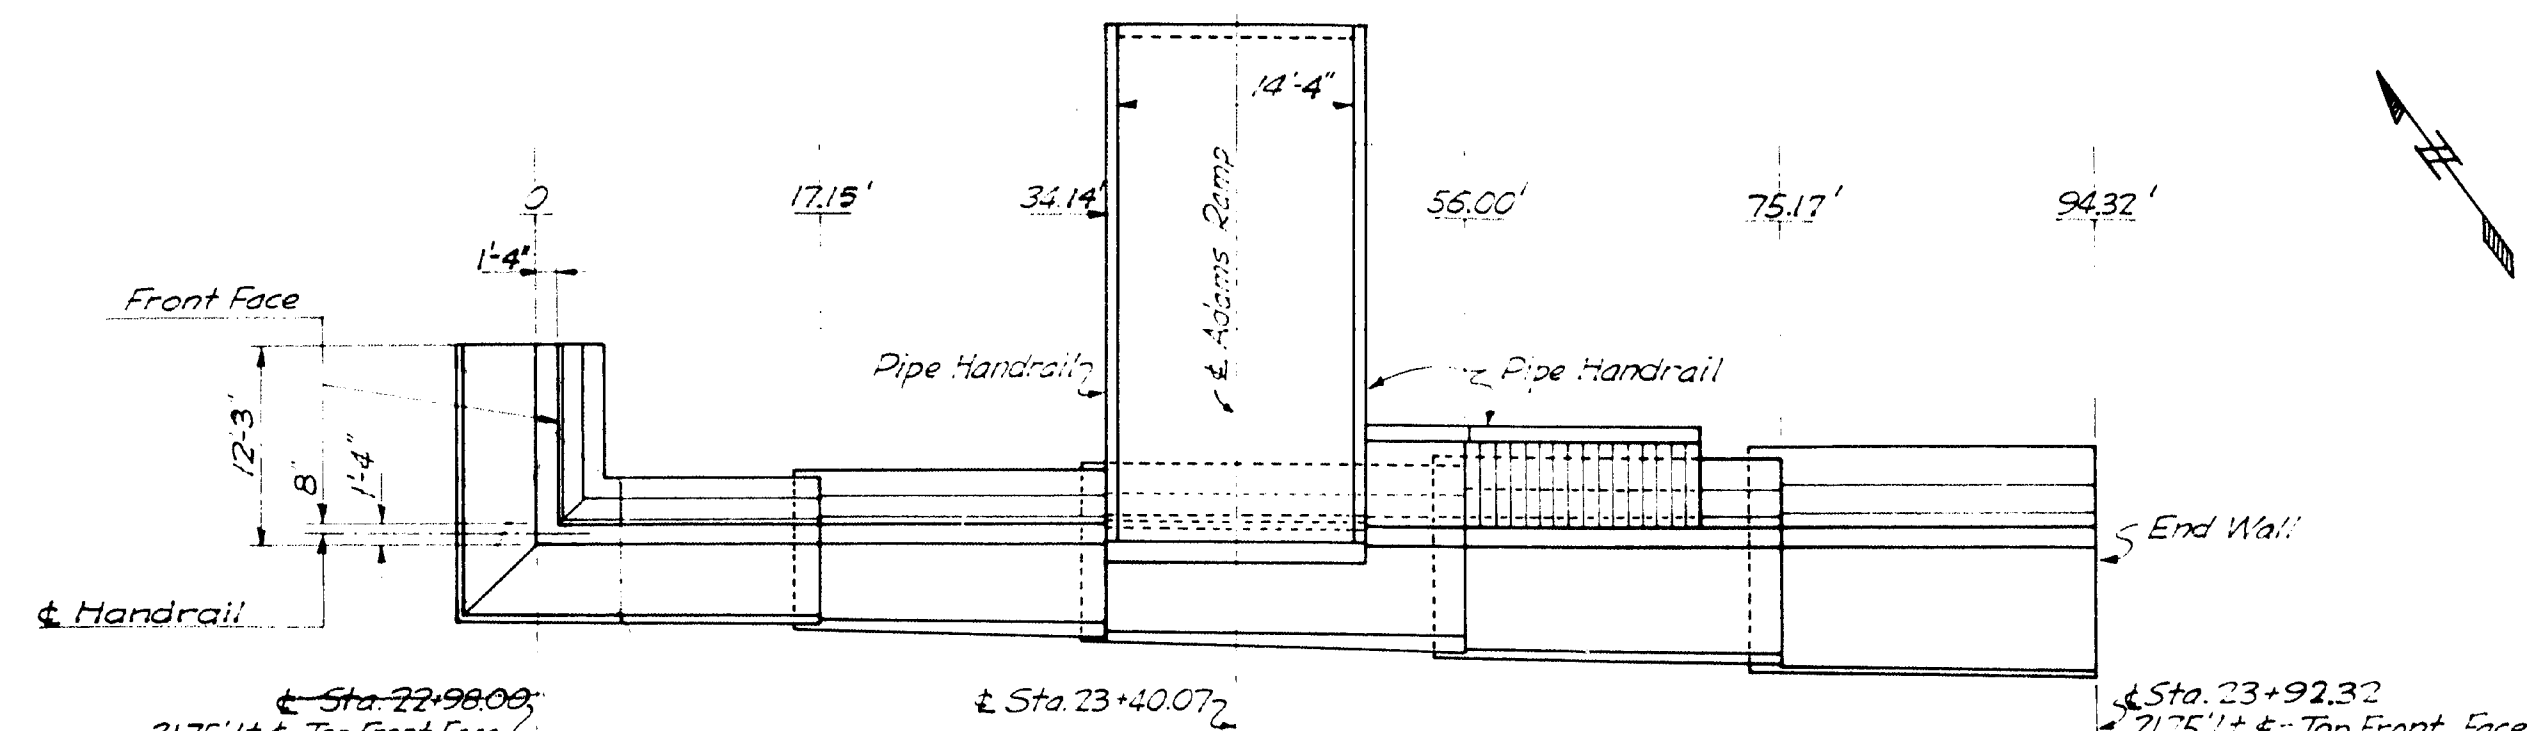

PLAN

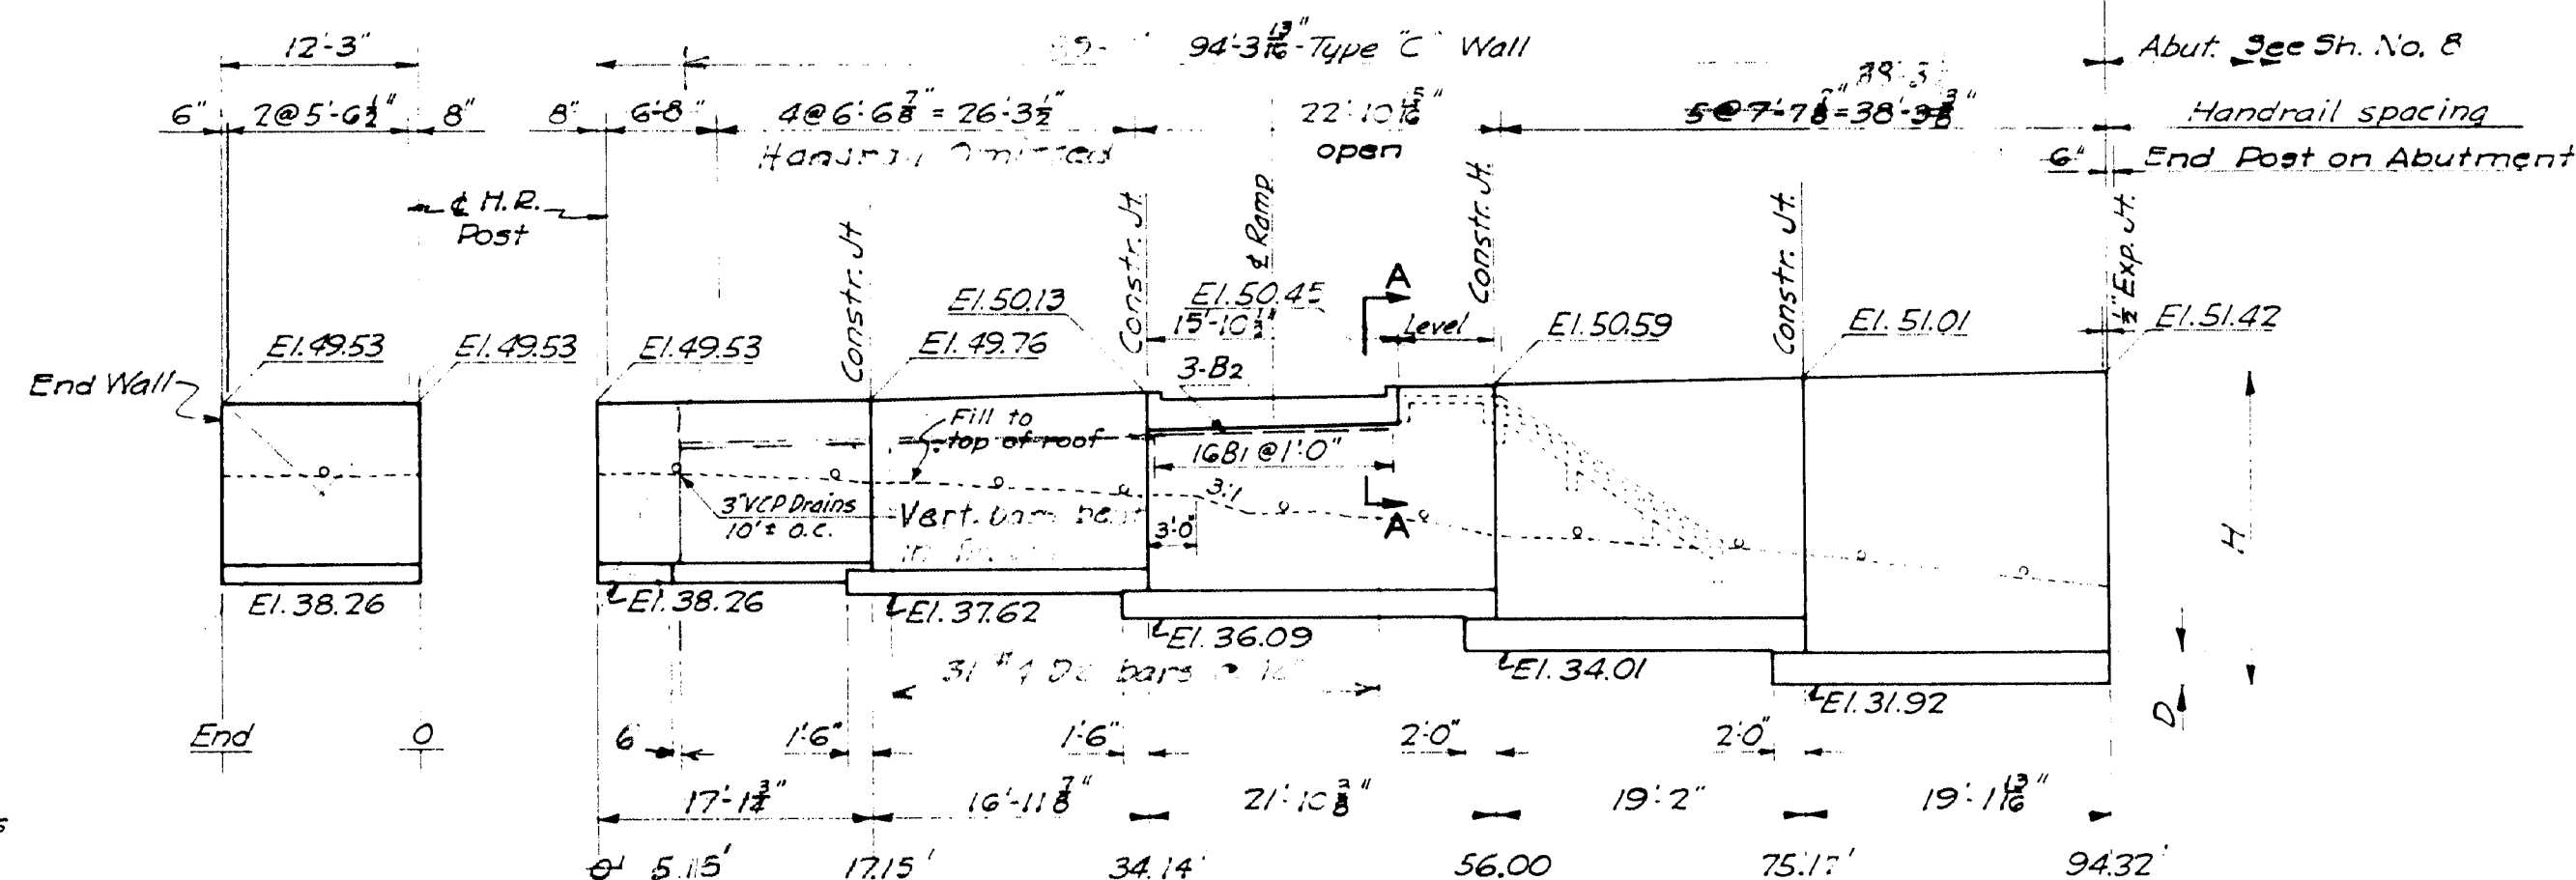


DEVELOPED ELEVATION  
Showing back face of wall  
UNION STREET WALL

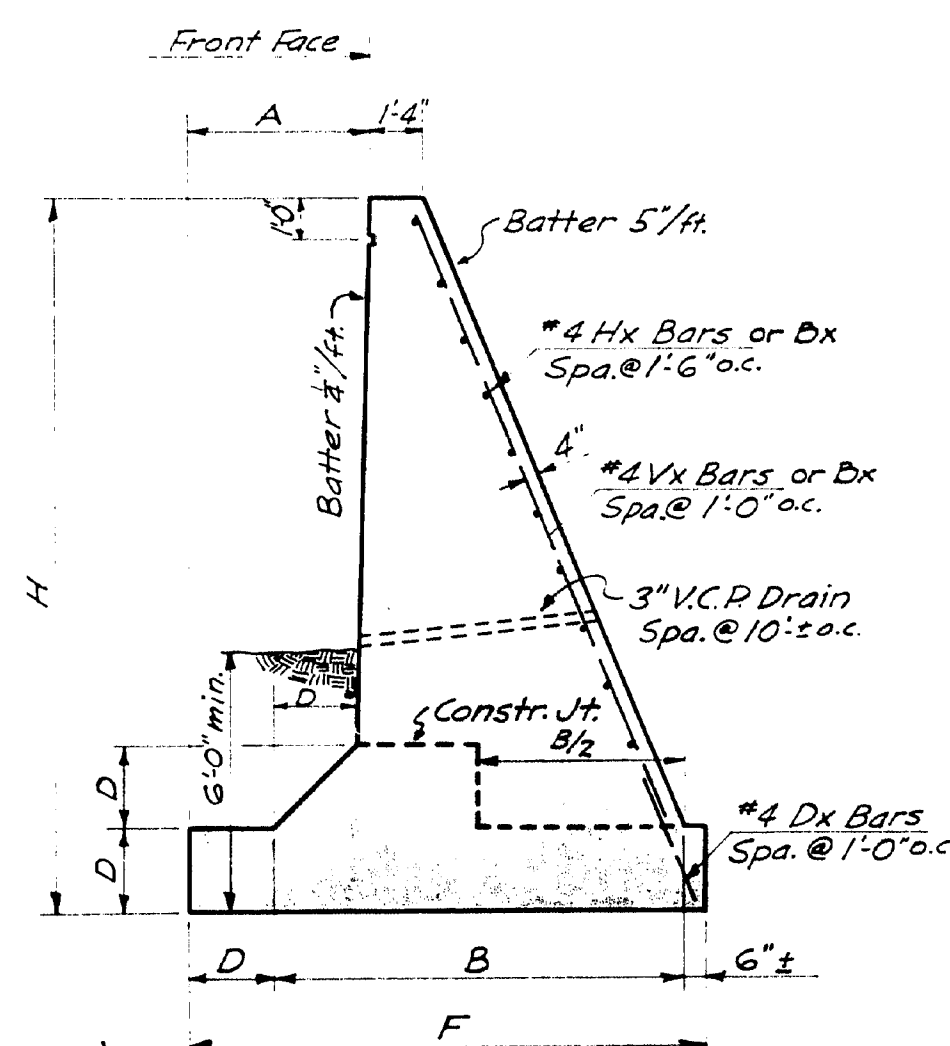

TYPICAL SECTION

RETAINING WALL - TYPE C  
Scale: 1/2" = 1'-0"

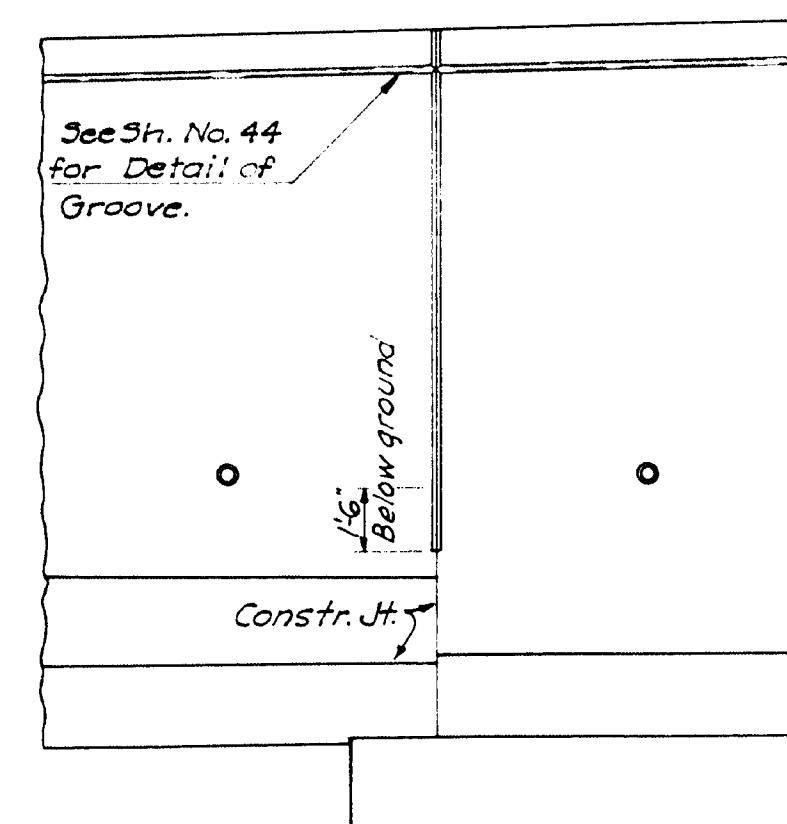

PART TYPICAL ELEVATION

Note: 46A  
See Sh. No. 46 for details of Adams  
Garage Ramp and Stairway.

See Sh. No. 44  
for Detail of  
Groove.


40' Built "Reinforced" 3-5-51

STATE OF MAINE  
STATE HIGHWAY COMMISSION  
BANGOR-BREWER BRIDGE  
OVER PENOBSCOT RIVER  
BANGOR MAINE  
RETAINING WALLS  
RAMP "A" & UNION STREET  
HARRINGTON AND CORTEYOU  
CONSULTING ENGINEERS  
KANSAS CITY, MO.



DETAILED S.P. 9-18-52  
TRACED H.V.K. 10-28-52  
CHECKED G.H.K. 1-20-53

SCALE: 1" = 10'-0"  
& AS NOTED  
SHEET NO. 42

62-42

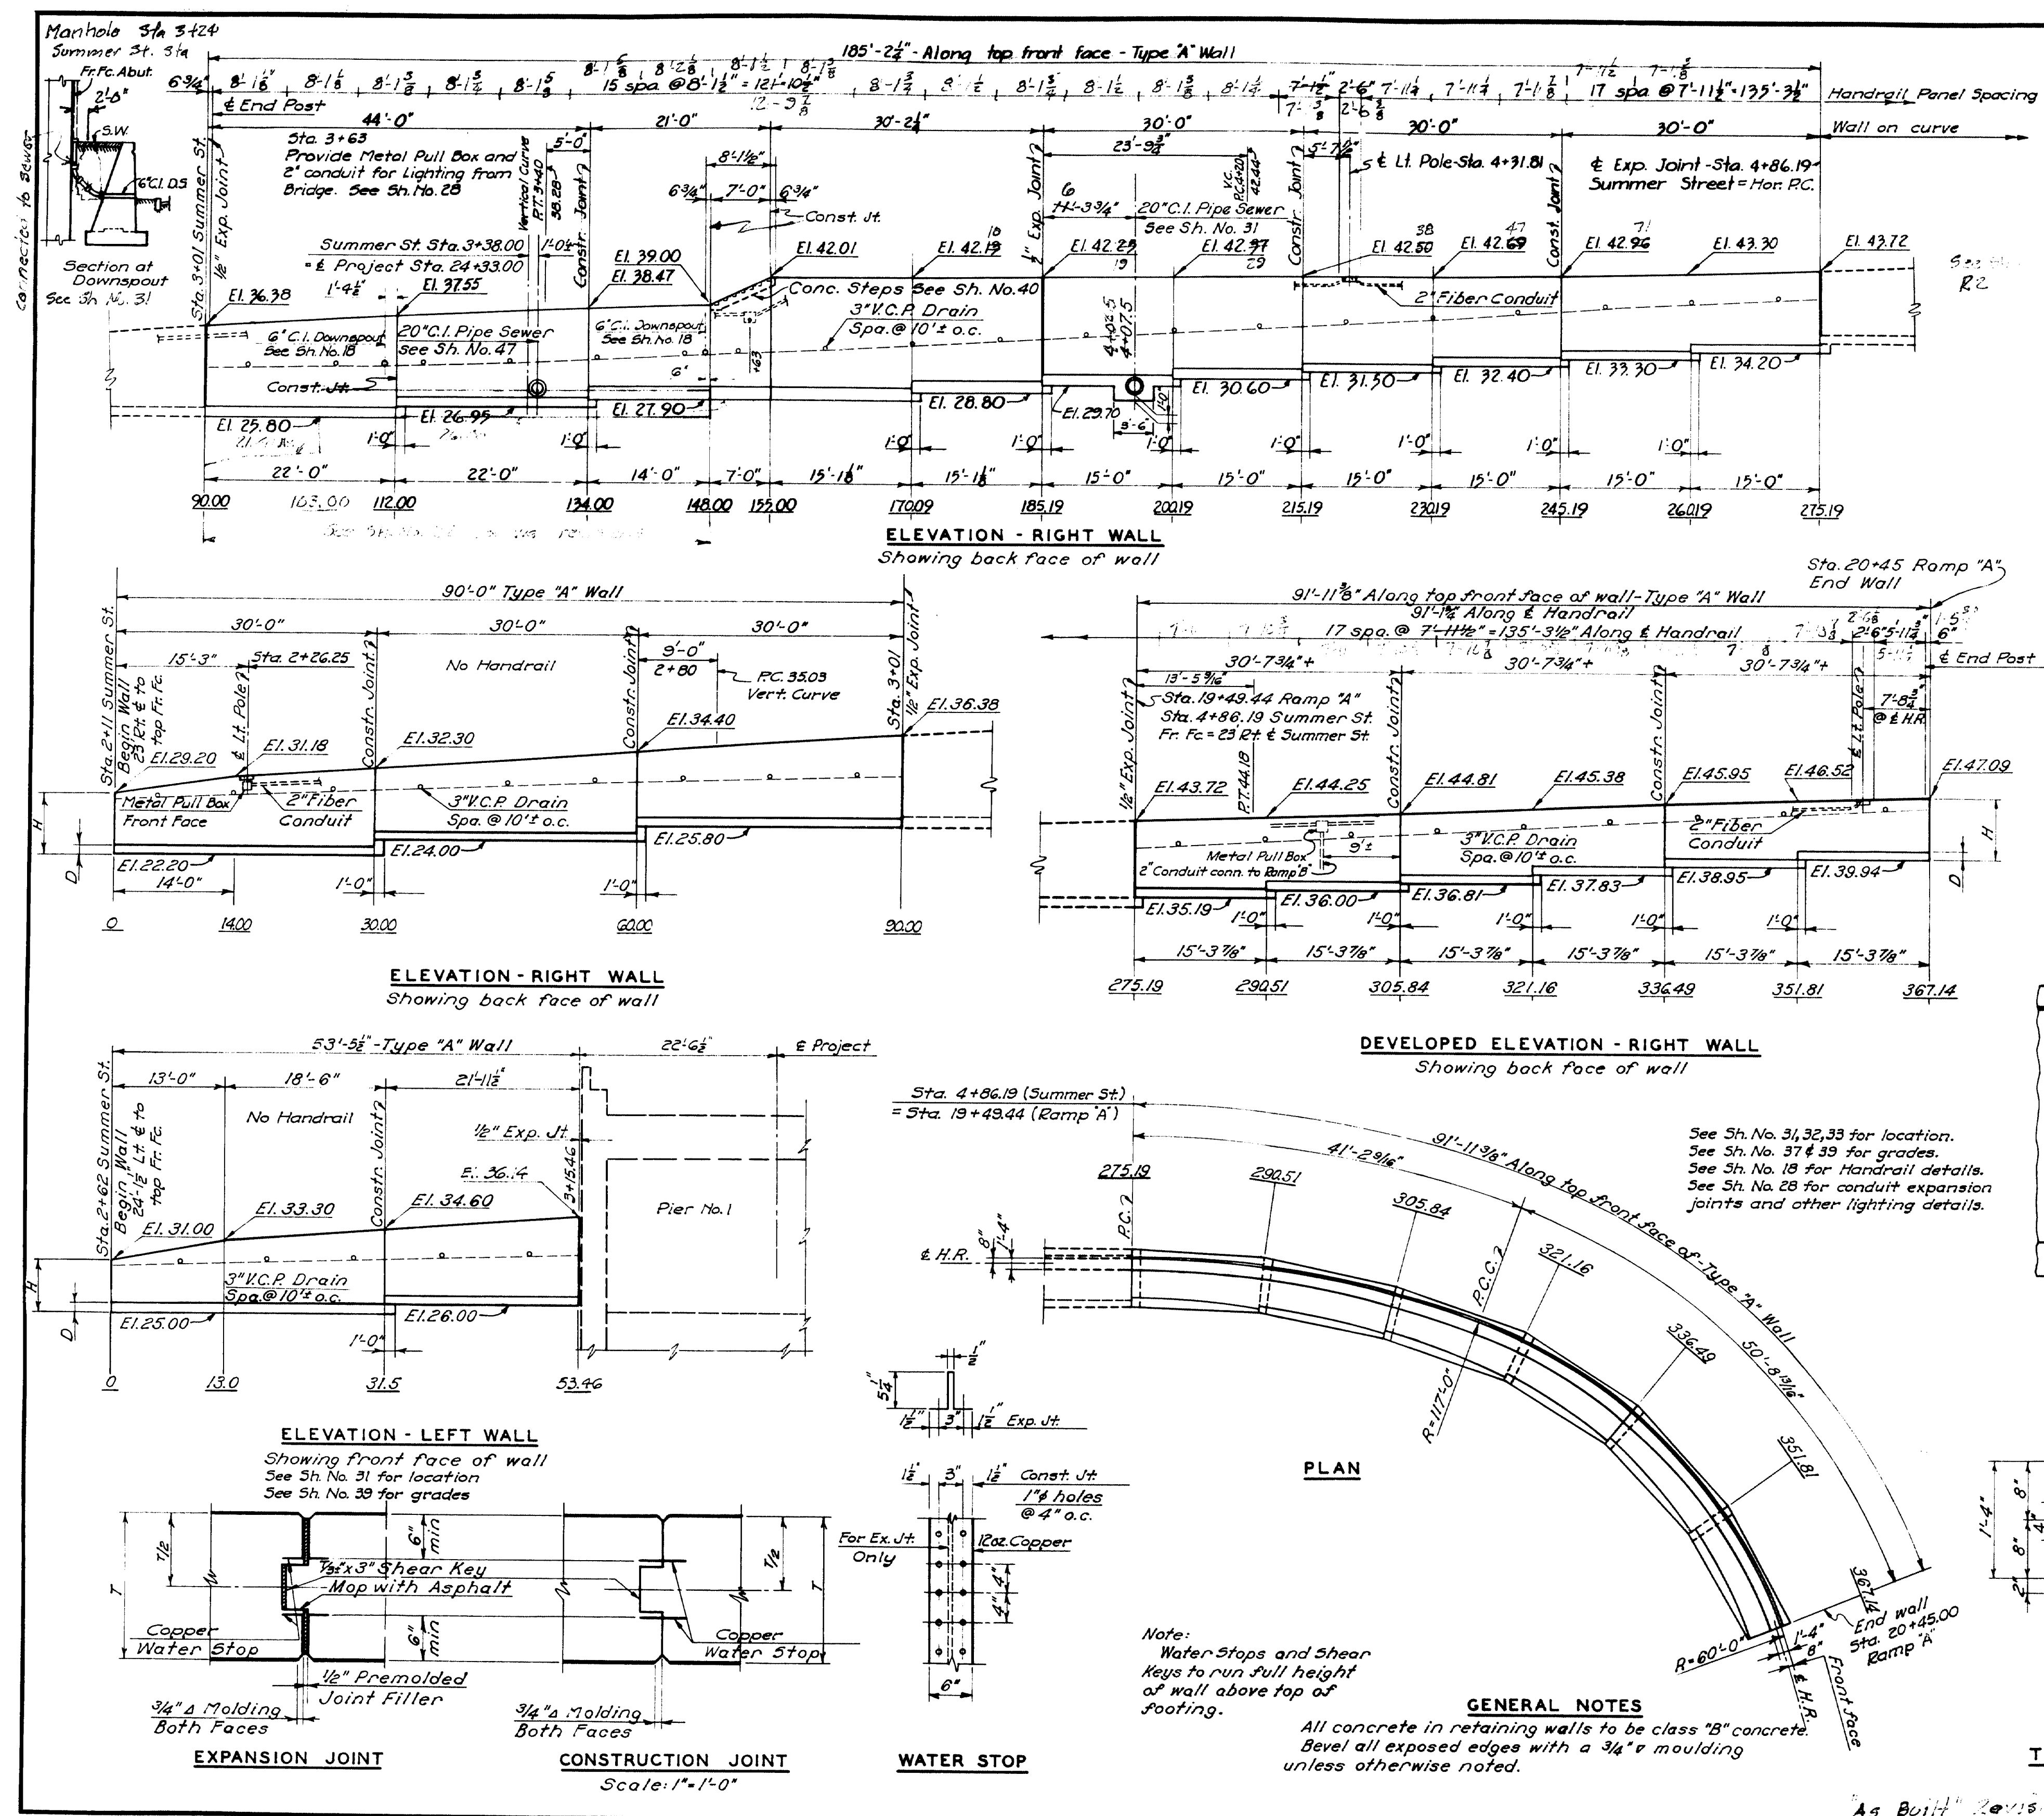






RETAINING WALL DIMENSIONS & BILL OF REINFORCING																	
Sec. at.	H	D	F	A	B	#4 Reinforcing Bars											
						Footing			Wall - Vertical			Wall - Horizontal					
						Mk	No.	Length	Mk	No.	Length	Mk	No.	Length	Mk	No.	Length
Right Wall - Type "A"																	
0	7.00	1'-0"	5'-2"	0'-9 3/4"	3'-11 1/2"	D2	14	7'	4"	-	-	-	-	H1	5	29'	6"
14	8.88	1'-0"	6'-3"	1'-1"	4'-9 3/4"	D1	16	2'	1"	V1	16	8'	6"	-	-	-	-
30	10.10	1'-0"	6'-10"	1'-2 3/4"	5'-3 3/4"	D1	30	2'	1"	V2	30	7'	9"	H1	6	29'	6"
60	10.40	1'-0"	7'-0"	1'-3 3/4"	5'-5 3/4"	D1	30	2'	1"	V3	30	8'	0"	H1	6	29'	6"
90	10.58	1'-0"	7'-2"	1'-3 3/4"	5'-6 3/4"	D1	22	2'	1"	V4	22	10'	1"	H2	7	21'	9"
112	11.75	1'-3"	7'-8"	1'-5"	5'-11 1/2"	D1	22	2'	1"	V5	22	10'	0"	H2	7	21'	9"
134	11.52	1'-3"	7'-6"	1'-4 3/4"	5'-9 3/4"	D1	21	2'	1"	V6	14	9'	8"	H2	7	20'	9"
148	11.10	1'-6"	7'-2"	1'-3 3/4"	5'-6 3/4"	-	-	-	-	V7	7	10'	2"	-	-	-	-
155	14.11	1'-6"	8'-10"	1'-8 1/2"	6'-10 1/2"	D1	15	2'	1"	V8	15	13'	6"	H3	9	30'	0"
170.09	14.23	1'-6"	8'-10"	1'-8 1/2"	6'-10 1/2"	D1	15	2'	1"	V9	15	12'	8"	-	-	-	-
185.19	13.45	1'-6"	8'-5"	1'-7 3/4"	6'-6 3/4"	D1	15	2'	1"	V10	15	12'	1"	H1	8	29'	6"
200.19	12.67	1'-3"	8'-2"	1'-6 1/2"	6'-4"	D1	15	2'	1"	V11	15	11'	2"	-	-	-	-
215.19	11.30	1'-3"	7'-9"	1'-5 1/4"	5'-11 1/2"	D1	15	2'	1"	V12	15	10'	8"	H1	7	29'	6"
230.19	11.19	1'-0"	7'-5"	1'-4 3/4"	5'-9 1/2"	D1	15	2'	1"	V13	15	9'	10"	-	-	-	-
245.19	10.56	1'-0"	7'-2"	1'-3 3/4"	5'-6 1/2"	D1	15	2'	1"	V14	15	9'	3"	H1	6	29'	6"
260.19	10.00	1'-0"	6'-10"	1'-2 3/4"	5'-3 3/4"	D1	15	2'	1"	V15	15	8'	7"	-	-	-	-
275.19	9.52	1'-0"	6'-7"	1'-1 1/2"	5'-0 3/4"	D1	16	2'	1"	V16	16	8'	0"	H4	5	30'	0"
290.51	9.06	1'-0"	6'-4"	1'-1 1/2"	4'-10 3/4"	D1	16	2'	1"	V17	16	7'	6"	-	-	-	-
305.84	8.81	1'-0"	6'-2"	1'-0 3/4"	4'-9"	D1	16	2'	1"	V18	16	7'	3"	H4	5	30'	0"
321.16	8.57	1'-0"	6'-0"	1'-0 3/4"	4'-7 3/4"	D1	16	2'	1"	V19	16	6'	9"	-	-	-	-
336.49	8.12	1'-0"	5'-9"	0'-11 1/2"	4'-5 3/4"	D1	16	2'	1"	V19	16	6'	3"	H4	4	30'	0"
351.81	7.57	1'-0"	5'-6"	0'-10 3/4"	4'-2 1/2"	D1	16	2'	1"	V20	16	5'	9"	-	-	-	-
367.14	7.15	1'-0"	5'-3"	0'-10"	4'-0 1/4"	-	-	-	-	-	-	-	-	-	-	-	-
Left Wall - Type "A"																	
0	6.00	1'-0"	4'-7"	0'-8"	3'-6 1/2"	D1	13	2'	1"	V1	13	5'	3"	H1	4	12'	6"
13.0	8.30	1'-0"	5'-10"	1'-0"	4'-6 1/4"	D1	19	2'	1"	V2	19	7'	9"	H2	6	20'	0"
31.5	9.60	1'-0"	6'-7"	1'-2"	5'-1 1/4"	D1	22	2'	1"	V3	22	8'	0"	H3	6	21'	6"
53.46	10.14	1'-0"	6'-11"	1'-4"	5'-4"	-	-	-	-	-	-	-	-	-	-	-	-

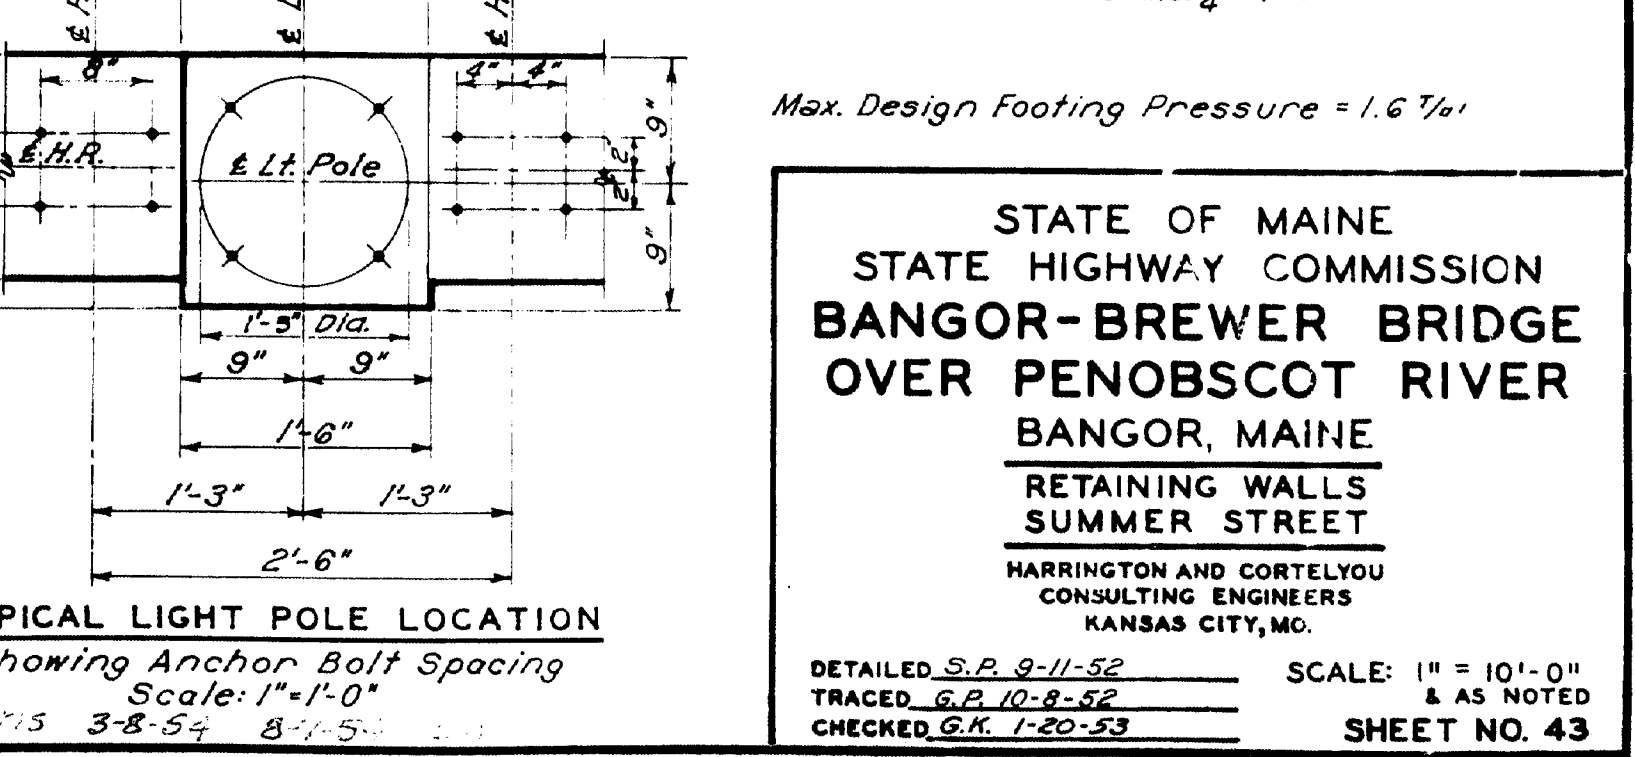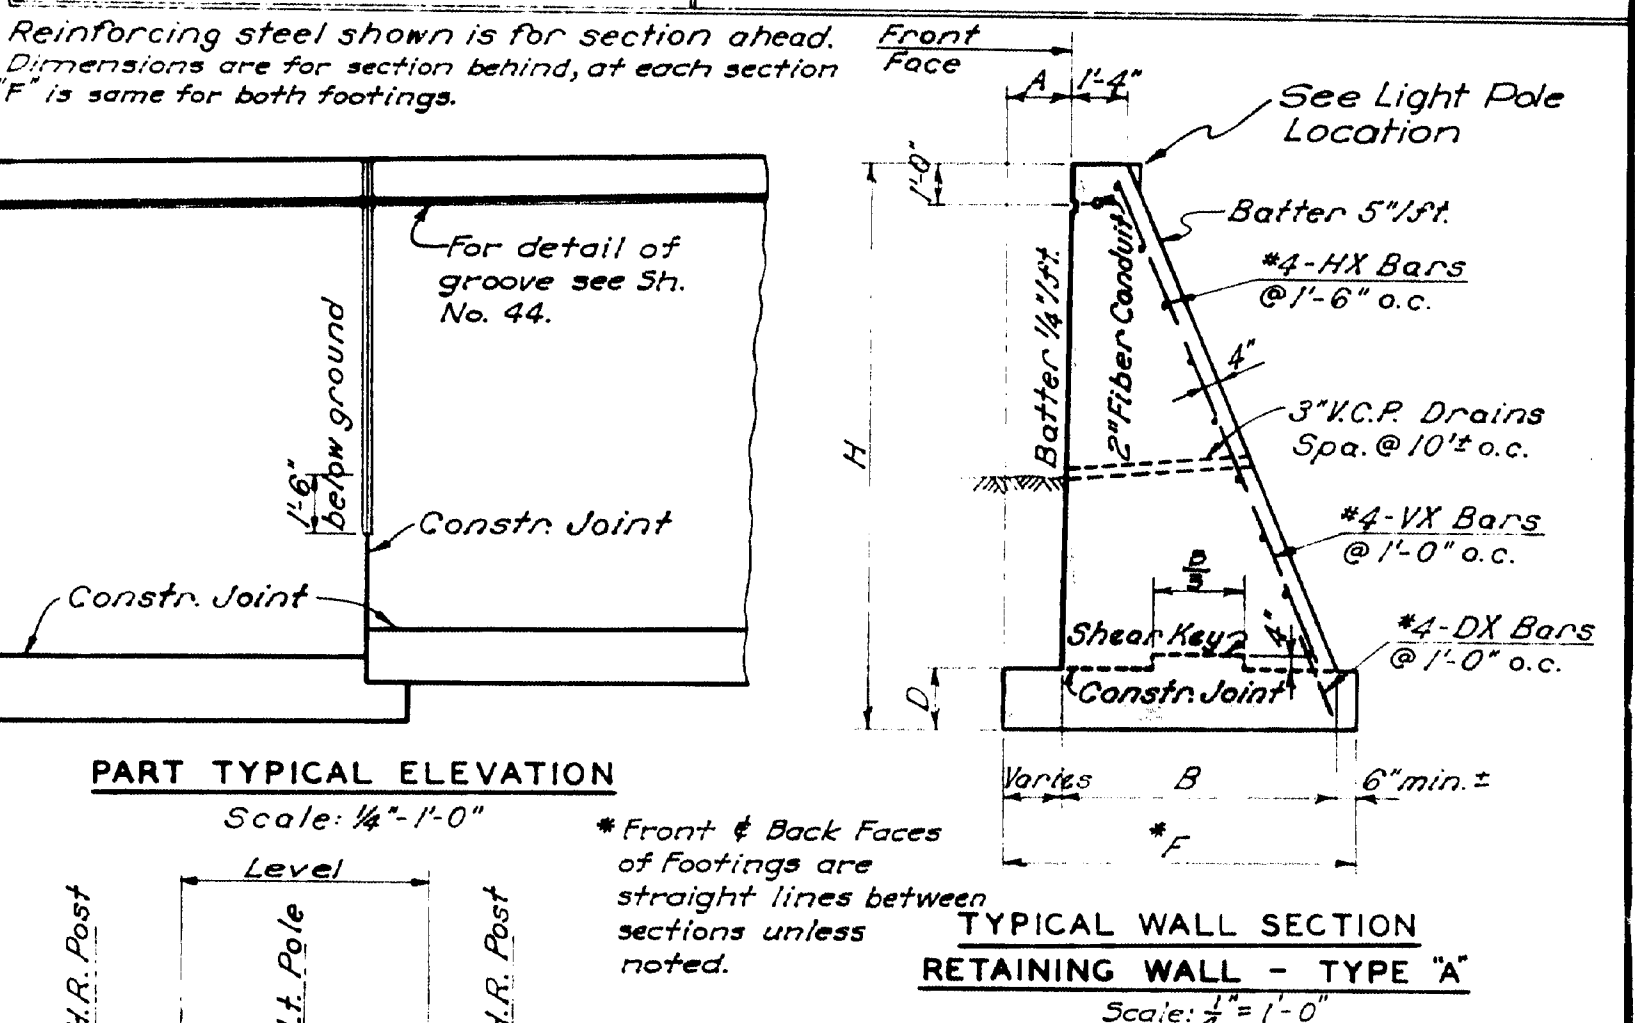

STATE OF MAINE  
STATE HIGHWAY COMMISSION  
**BANGOR-BREWER BRIDGE  
OVER PENOBSCOT RIVER**  
BANGOR, MAINE  
**RETAINING WALLS  
SUMMER STREET**  
HARRINGTON AND CORTELYOU  
CONSULTING ENGINEERS  
KANSAS CITY, MO.  
DETAILED S.P. 9-11-52  
TRACED 6-2-10-8-52  
CHECKED 6-1-20-53  
SCALE: 1" = 10'-0"  
AS NOTED  
SHEET NO. 43





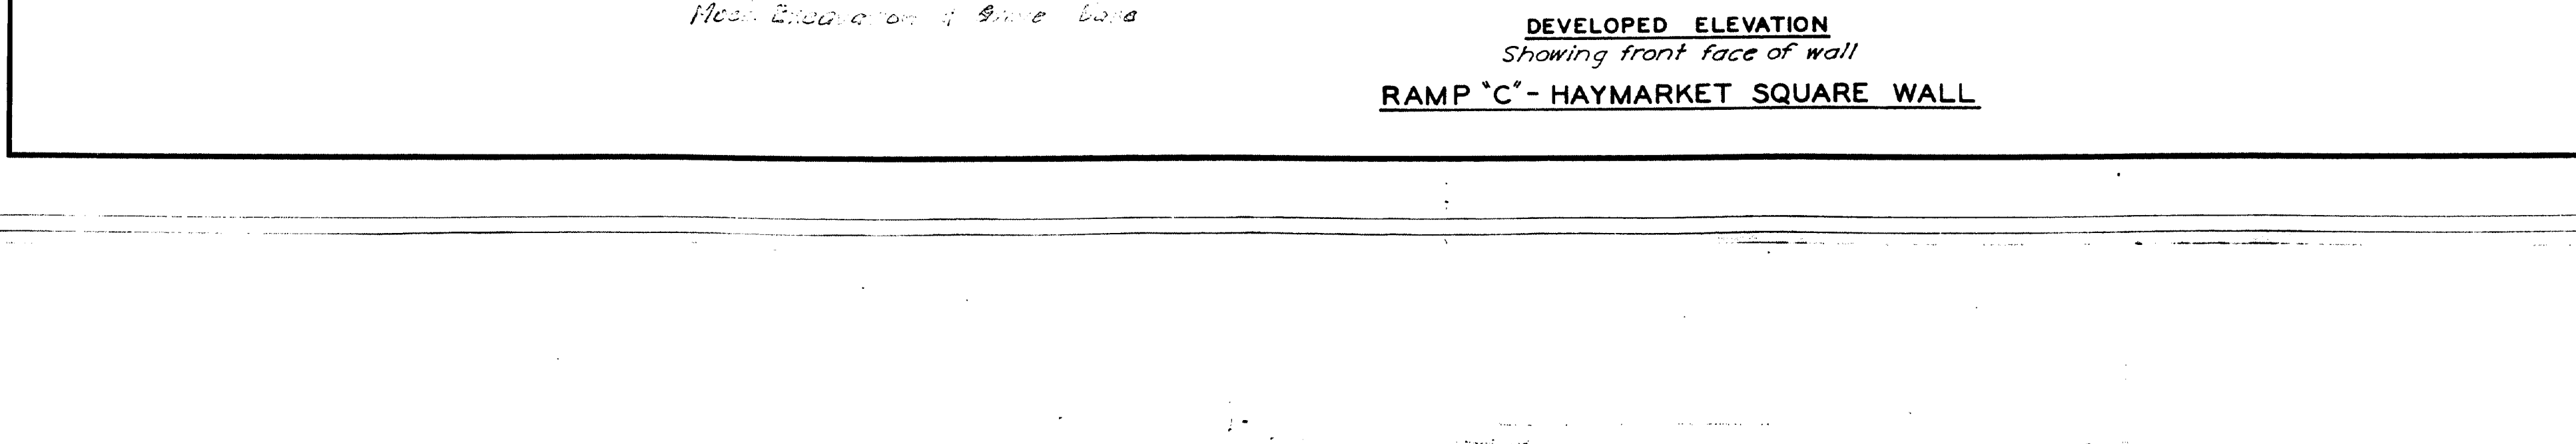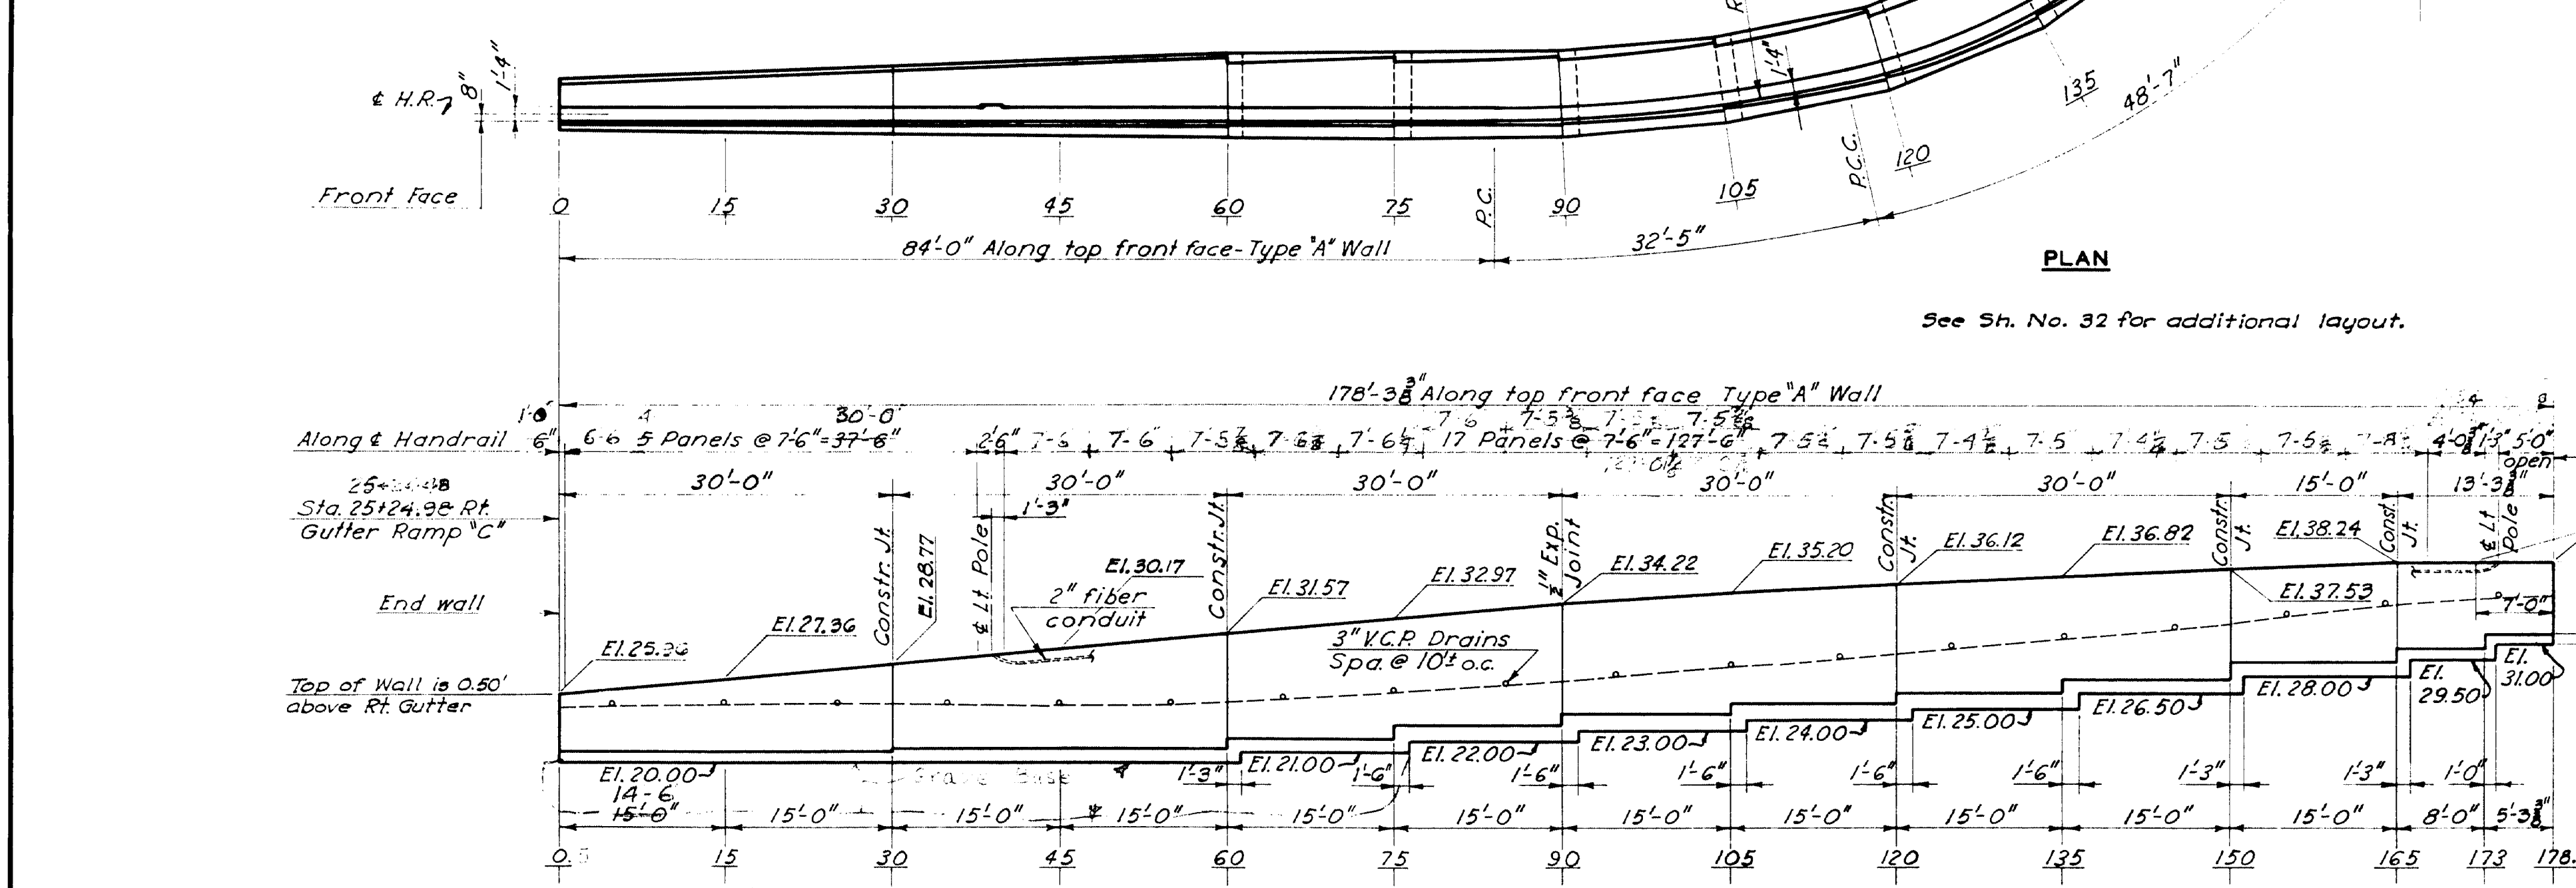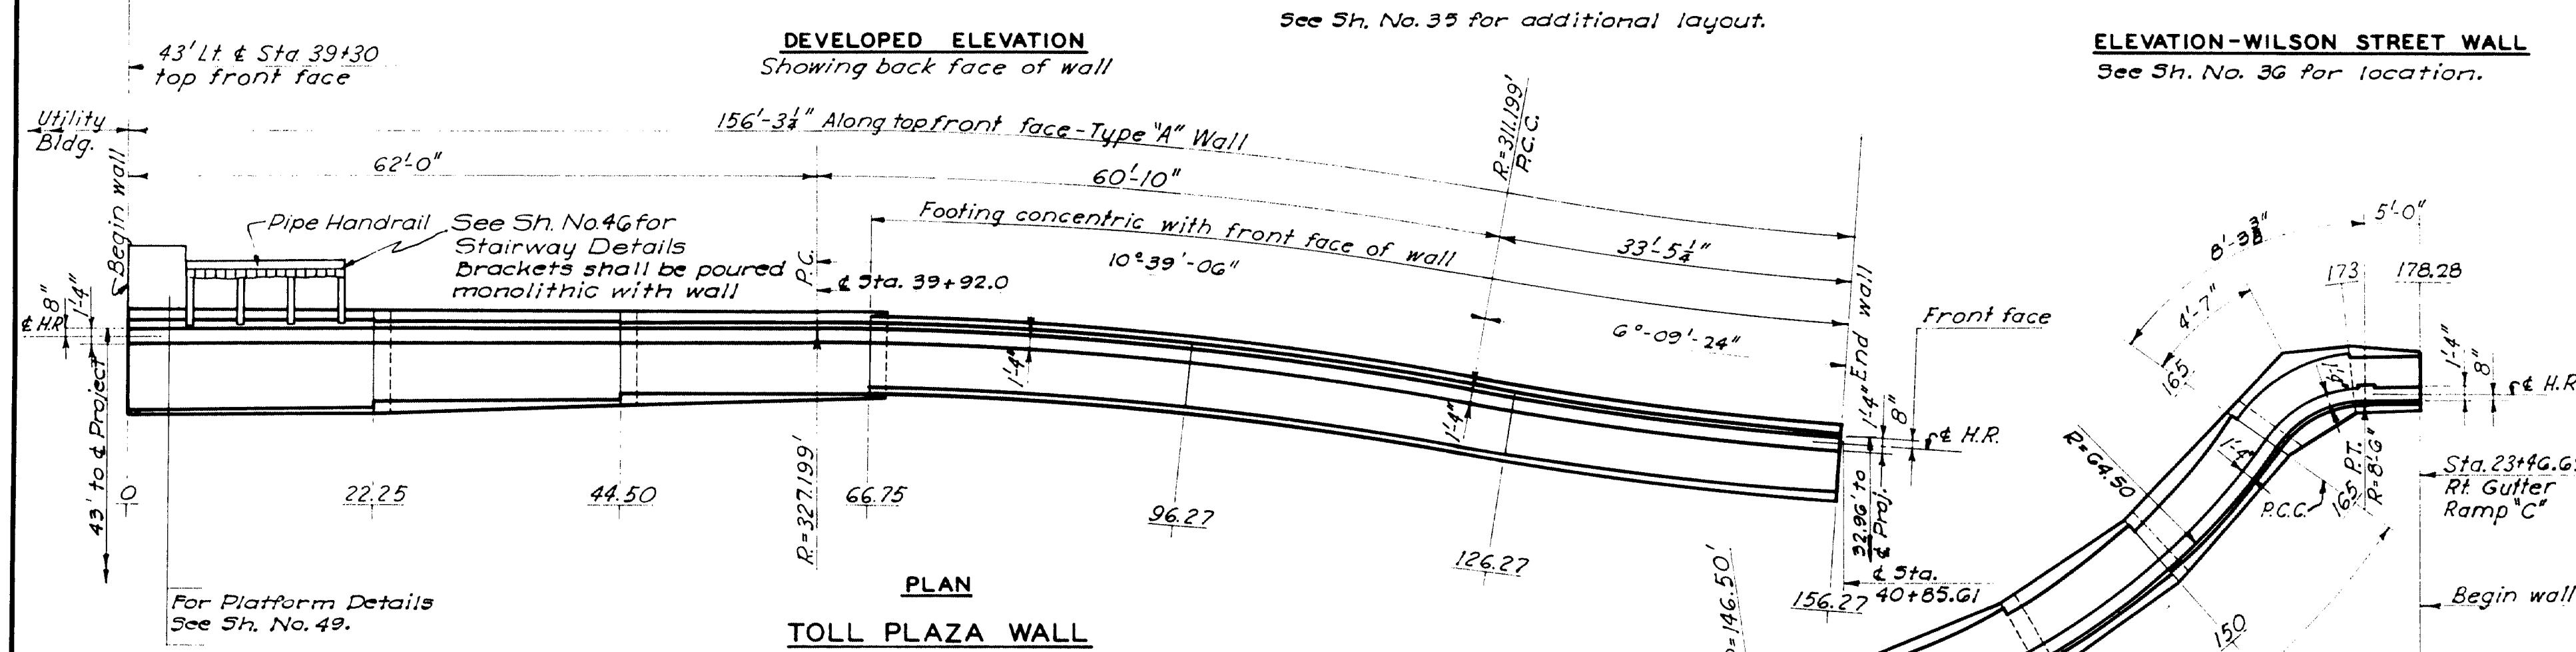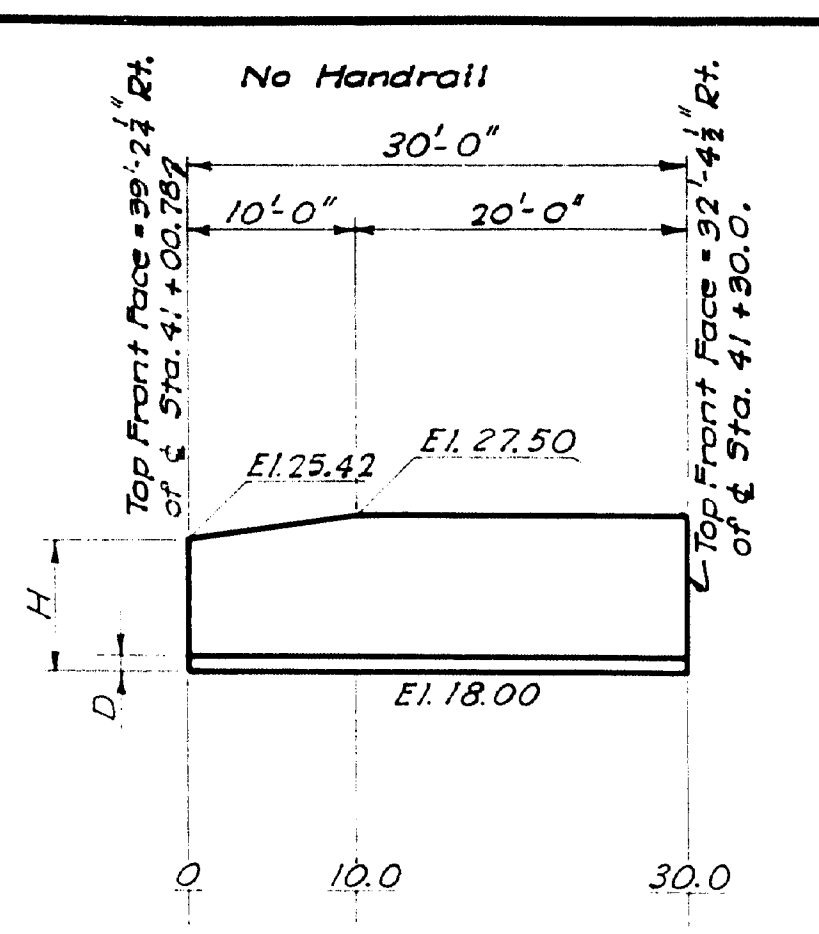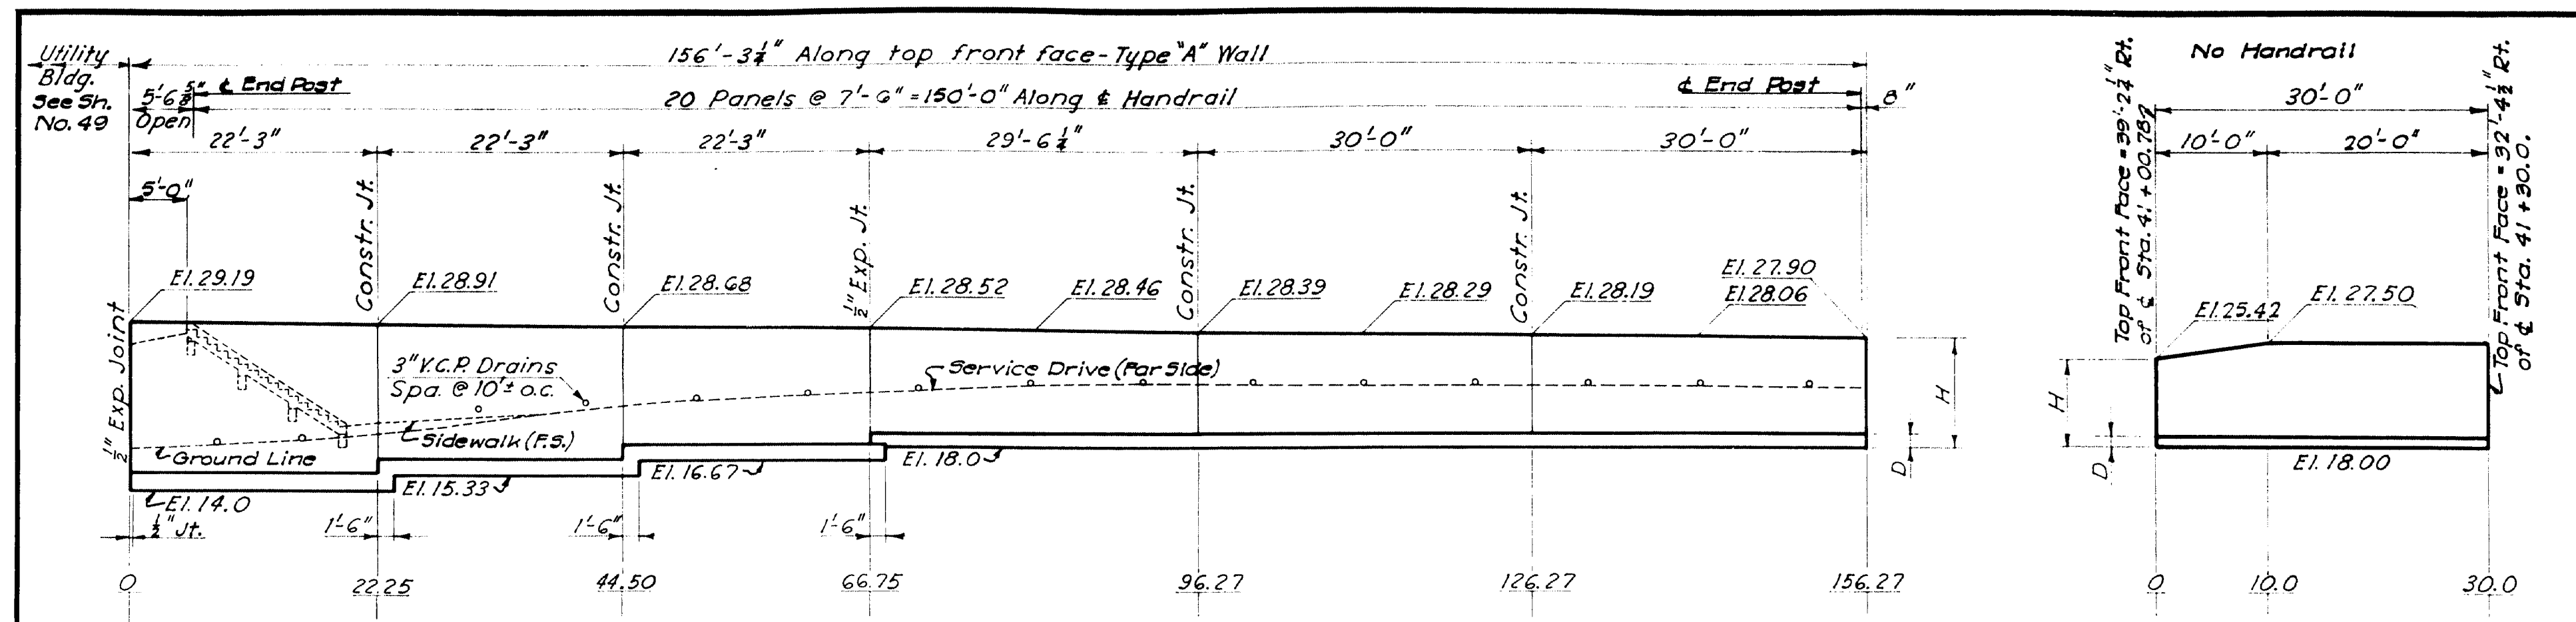

RETAINING WALL DIMENSIONS & BILL OF REINFORCING																	
Sec. at	H	D	F	A	B	2" #4 Reinforcing Bars											
						Footing			Wall-Vertical			Wall-Horizontal					
						Mk	No.	Length	Mk	No.	Length	Mk	No.	Length			
Toll Plaza Wall-Type "A" Wall																	
0	15.19	1'-6"	9'-5"	1'-10"	7'-3 3/8"	D1	22	2'	1"	V1	22	14'	4"	H1	10	21'	9"
22.25	14.91	1'-6"	9'-3"	1'-9"	7'-2 3/8"	D1	22	2'	1"	V2	22	12'	6"	H1	9	21'	9"
44.50	13.35	1'-6"	8'-5"	1'-7"	6'-6 1/8"	D1	22	2'	1"	V3	22	11'	0"	H1	7	21'	9"
66.75	11.85	1'-6"	7'-7"	1'-4 1/2"	5'-10 1/8"	-	-	-	-	-	-	-	-	-	-	-	-
66.75	10.52	1'-3"	7'-0"	1'-3"	5'-4 1/8"	D1	30	2'	1"	V4	30	9'	9"	H2	7	29'	0"
96.27	10.39	1'-3"	7'-0"	1'-3"	5'-4"	D1	30	2'	1"	V5	30	9'	6"	H3	7	29'	6"
126.27	10.19	1'-3"	7'-0"	1'-3"	5'-3"	D1	30	2'	1"	V6	30	9'	2"	H3	7	29'	6"
156.27	9.90	1'-3"	7'-0"	1'-3"	5'-1 3/8"	-	-	-	-	-	-	-	-	-	-	-	-
Wilson Street Wall-Type "A" Wall																	
0	7.42	1'-0"	5'-5"	1'-0"	4'-1 1/2"	D1	10	2'	1"	V1	10	6'	9"	H1	5	29'	6"
10	9.50	1'-0"	6'-6"	1'-1 1/2"	5'-0 1/2"	D1	20	2'	1"	V2	20	9'	1"	H2	1	19'	6"
30	9.50	1'-0"	6'-6"	1'-1 1/2"	5'-0 3/8"	-	-	-	-	-	-	-	-	-	-	-	-
Ramp "C" - Haymarket Square Wall-Type "A" Wall																	
0	5.96	1'-0"	4'-7"	0'-8"	3'-6"	D2	15	6'	0"	-	-	-	-	H1	5	29'	6"
15	-	-	-	-	-	D1	15	2'	1"	V1	15	6'	9"	-	-	-	-
30	8.77	1'-0"	6'-2"	1'-0 1/2"	4'-8 1/2"	D1	30	2'	1"	V2	15	8'	0"	H1	6	29'	6"
45	-	-	-	-	-	-	-	-	-	V3	15	9'	6"	-	-	-	-
60	11.57	1'-3"	7'-7"	1'-4 1/2"	5'-10 1/8"	D1	15	2'	1"	V4	15	10'	0"	H1	8	29'	6"
75	11.97	1'-3"	7'-9"	1'-5 1/2"	6'-0 1/8"	D1	15	2'	1"	V4	15	10'	0"	-	-	-	-
90	12.22	1'-6"	7'-9"	1'-5 1/2"	6'-0 1/8"	D1	15	2'	1"	V5	15	10'	5"	H1	8	29'	6"
105	12.20	1'-6"	7'-9"	1'-5 1/2"	6'-0 1/8"	D1	15	2'	1"	V5	15	10'	5"	-	-	-	-
120	12.12	1'-6"	7'-9"	1'-5 3/8"	5'-11 1/8"	D1	15	2'	1"	V6	15	10'	4"	-	-	-	-
135	11.82	1'-6"	7'-7"	1'-4 3/8"	5'-10 1/8"	D1	15	2'	1"	V7	15	9'	8"	-	-	-	-
150	11.03	1'-3"	7'-4"	1'-4"	5'-7 1/8"	D1	15	2'	1"	V8	15	8'	10"	H2	7	14'	6"
165	10.24	1'-3"	6'-10"	1'-2 1/2"	5'-3 3/4"	D1	8	2'	1"	V9	8	8'	1"	H2	6	14'	6"
173	8.80	1'-0"	6'-1"	1'-0 1/2"	4'-9"	D1	6	2'	1"	V10	6	6'	8"	-	-	-	-
178.28	7.30	1'-0"	5'-4"	0'-10 1/2"	4'-1 1/8"	-	-	-	-	-	-	-	-	-	-	-	-






Dimensions are for lower footing at each section, unless otherwise shown.  
Reinforcing steel is for section ahead.  
See Sheet No. 43 for Typical Details of Type 'A' Wall and General Notes.  
See Sheet No. 18 for Handrail Details.  
See Sheet No. 28 for Lighting Details.

STATE OF MAINE  
STATE HIGHWAY COMMISSION  
**BANGOR-BREWER BRIDGE  
OVER PENOBSCOT RIVER**  
BANGOR, MAINE  
RETAINING WALLS  
RAMP 'C' & TOLL PLAZA  
HARRINGTON AND CORTE-VOU  
CONSULTING ENGINEERS  
KANSAS CITY, MO.

DETAILED S.P. 9-16-52  
TRACED L.A.R. 9-25-52  
CHECKED G.H.K. 1-20-53  
SCALE: 1"=10'-0"  
SHEET NO. 45

62-45




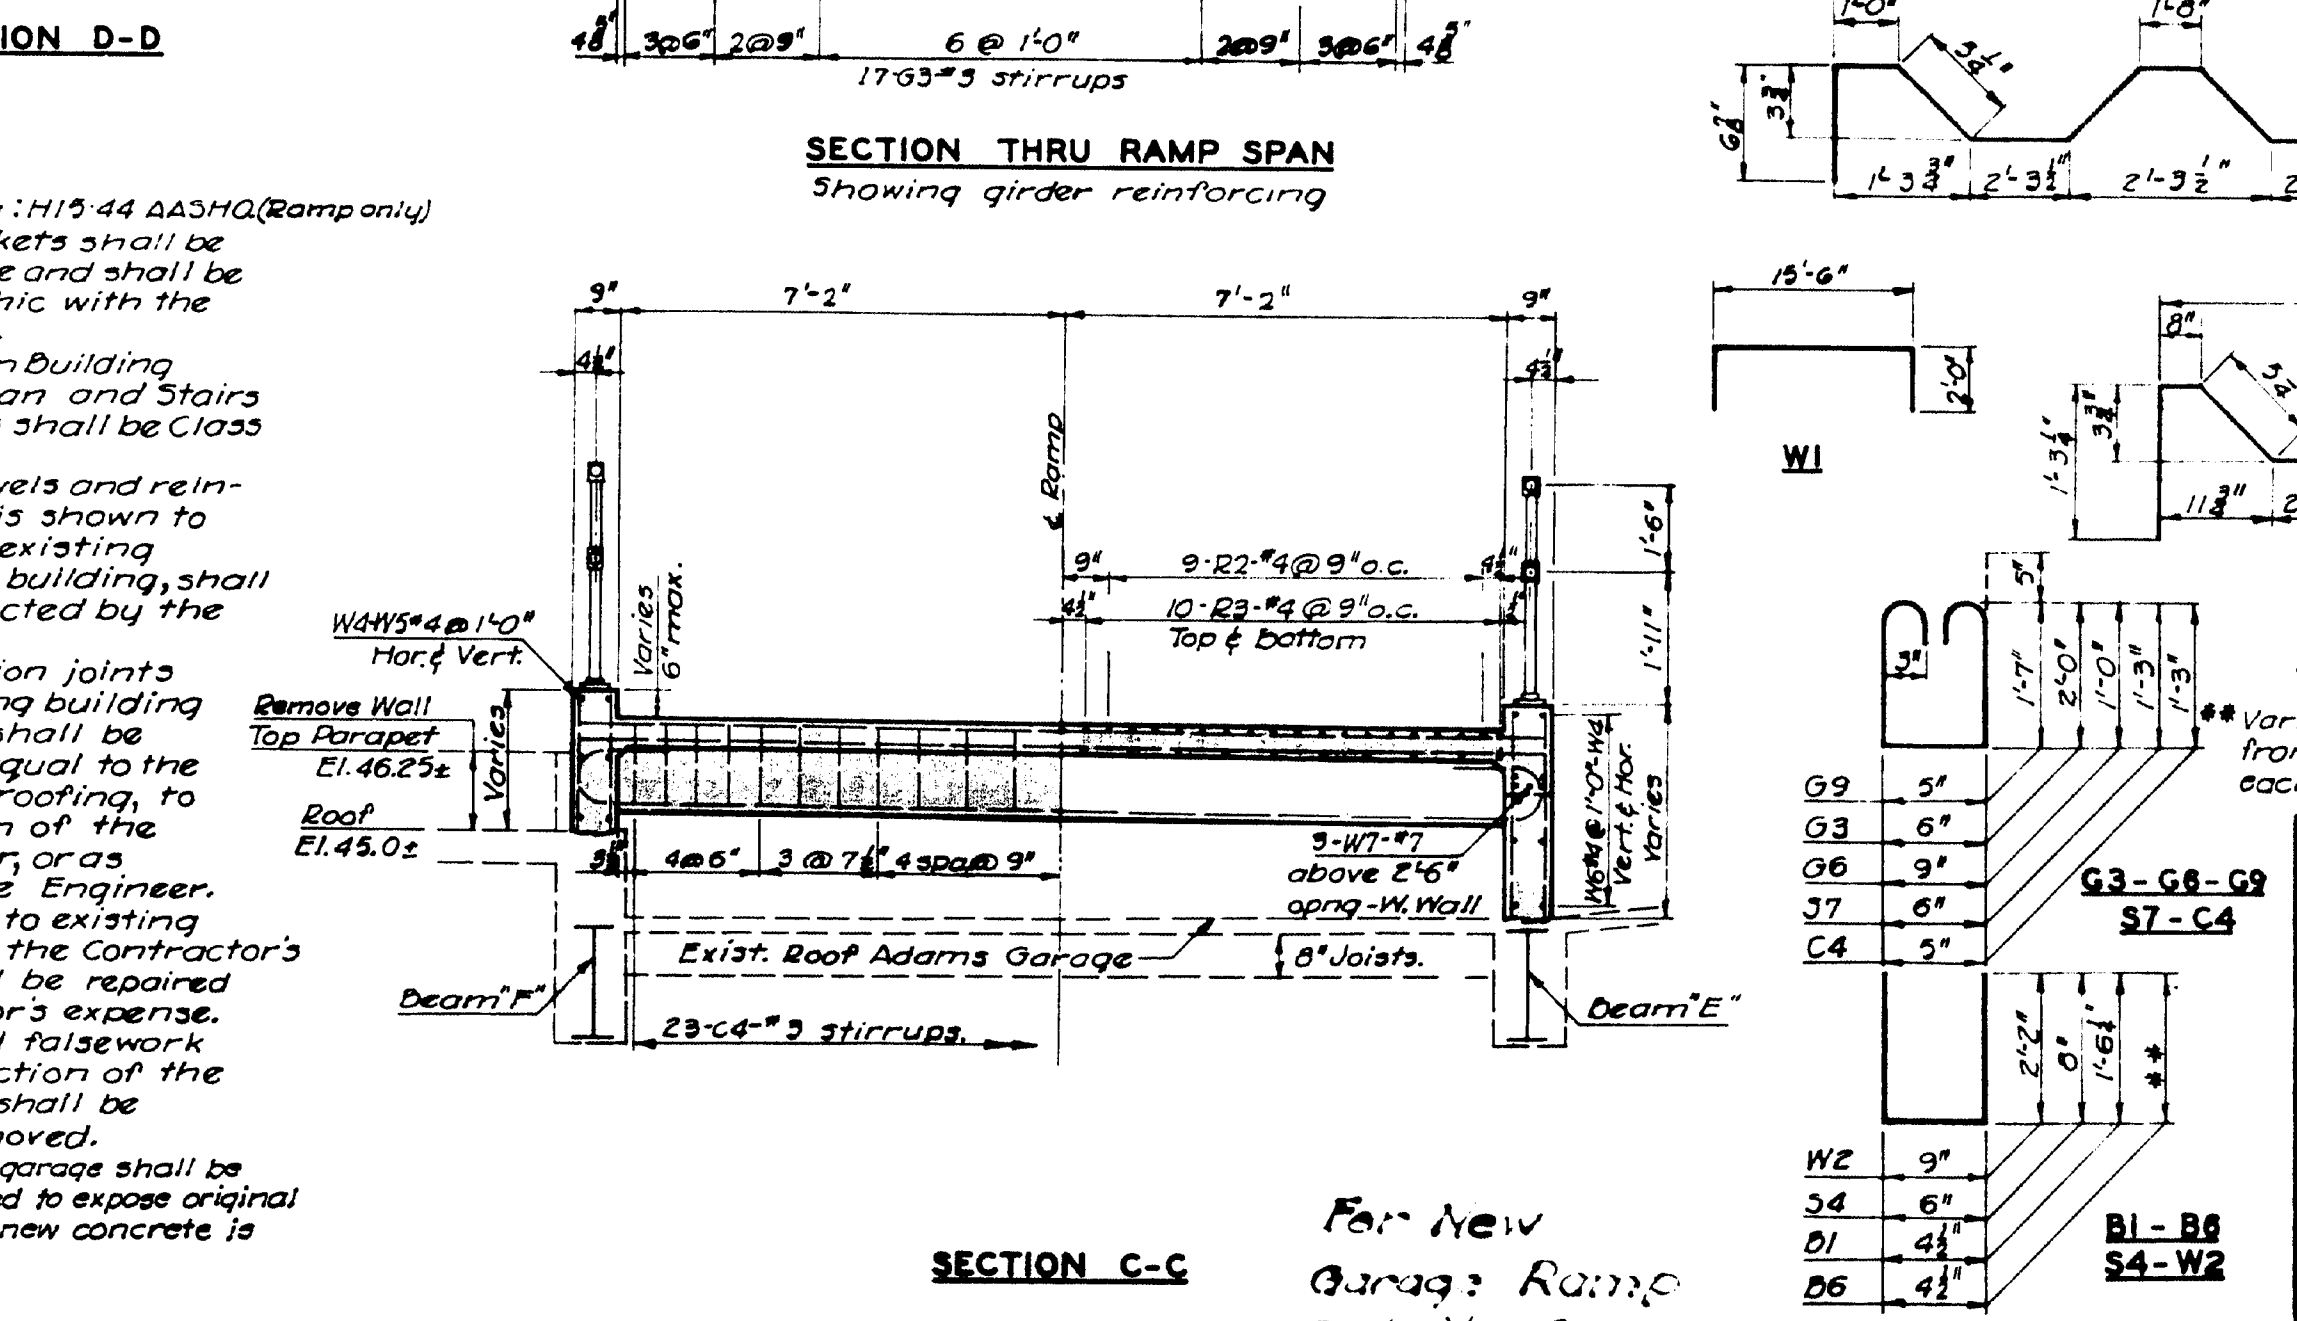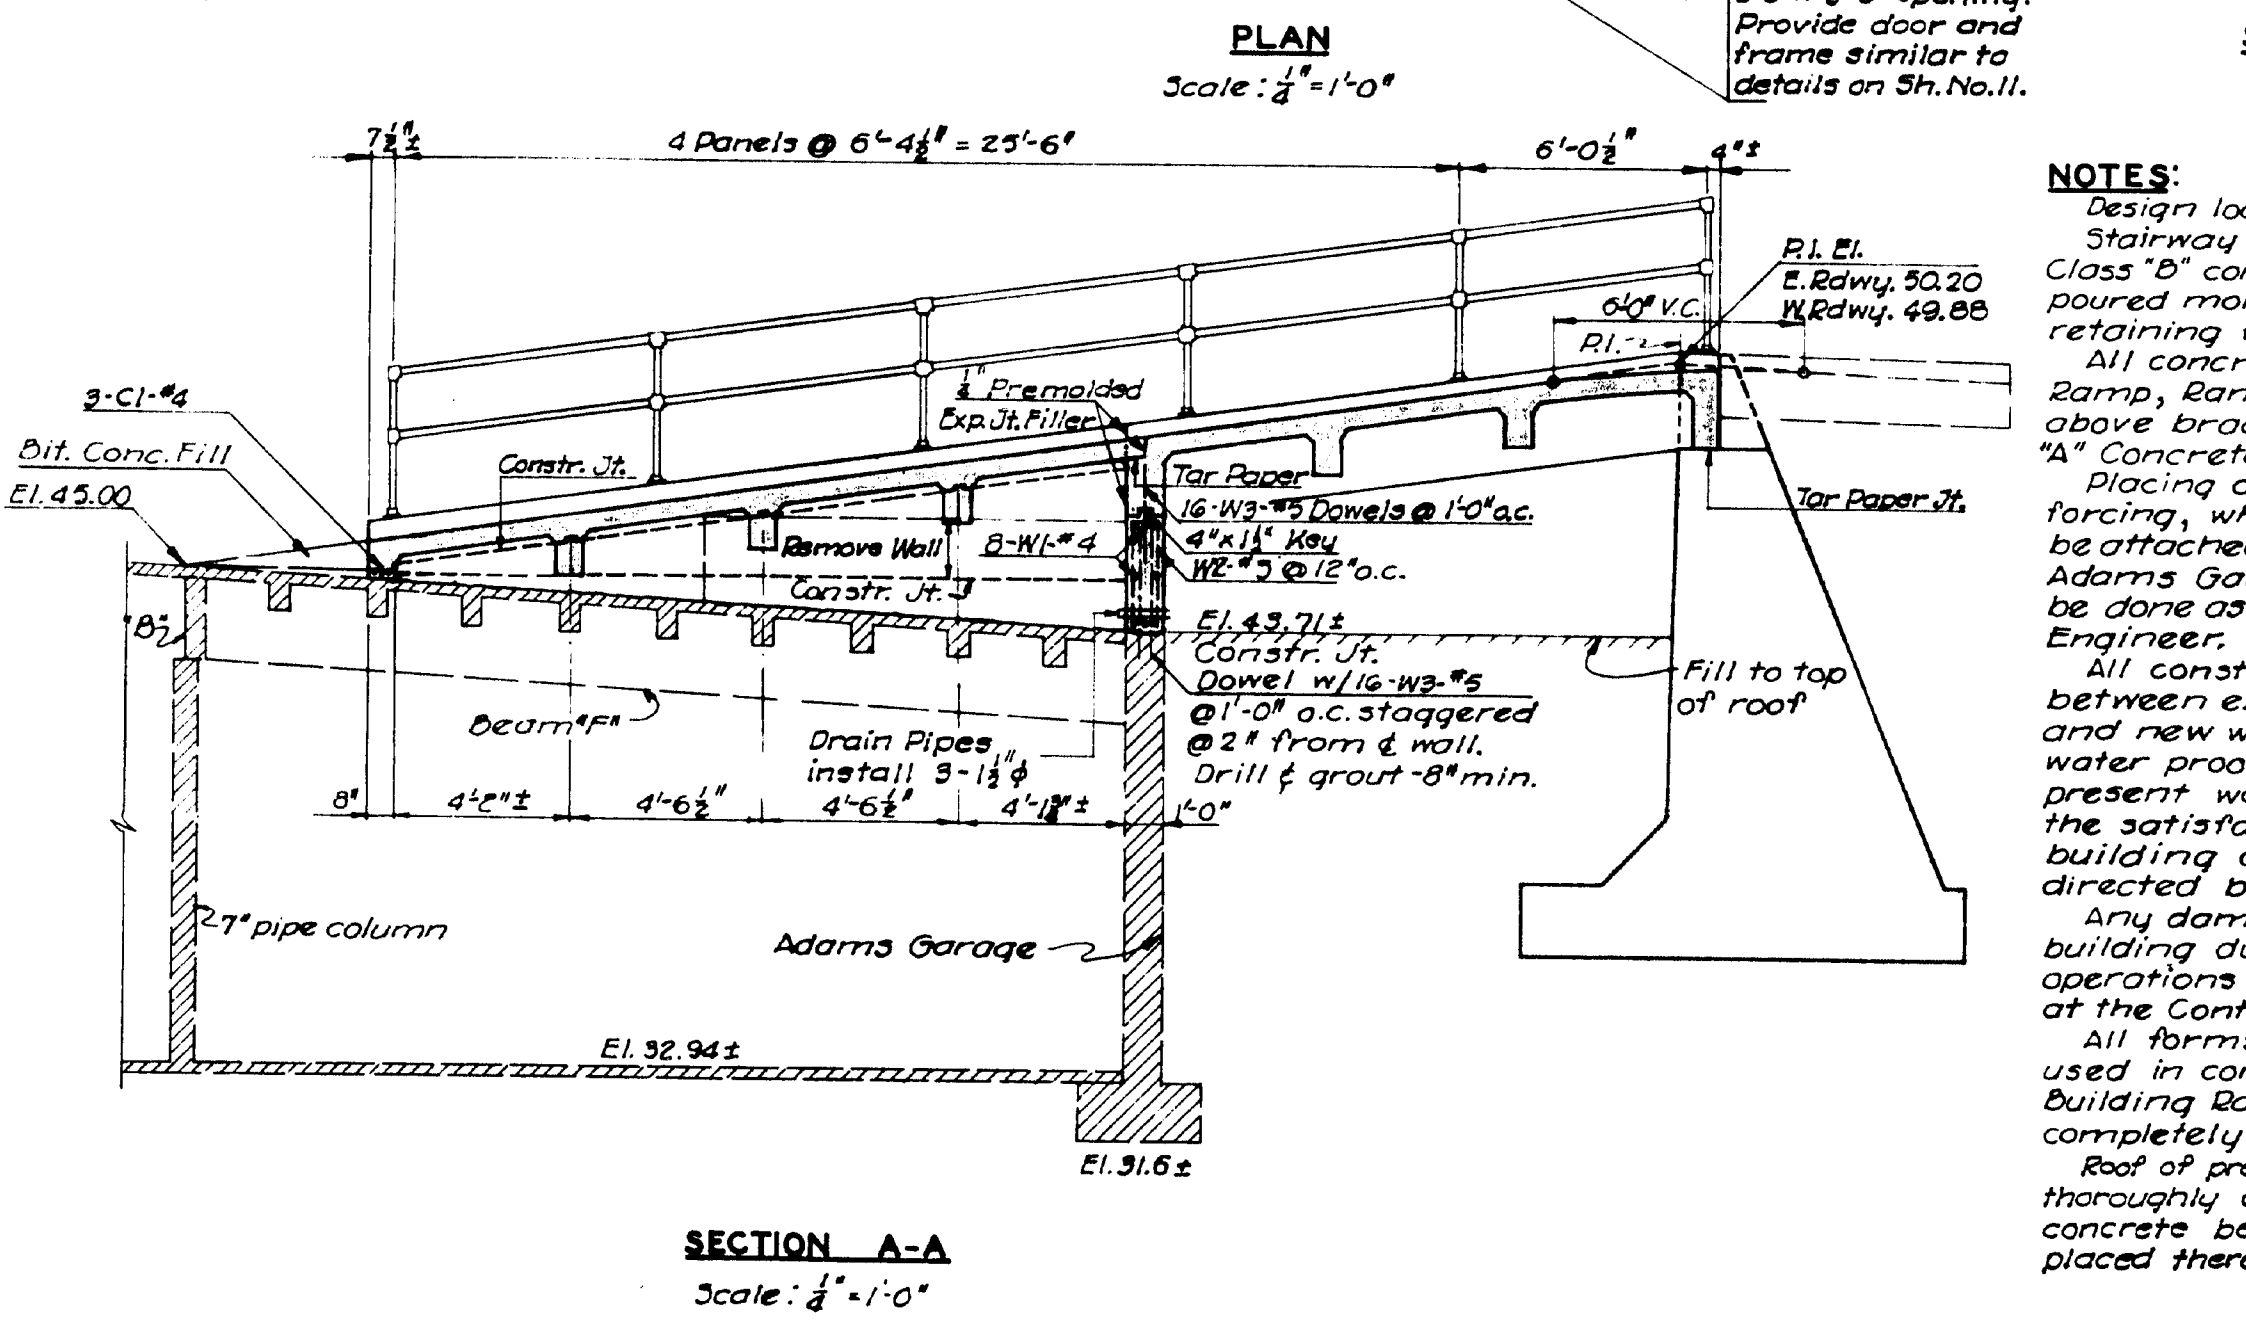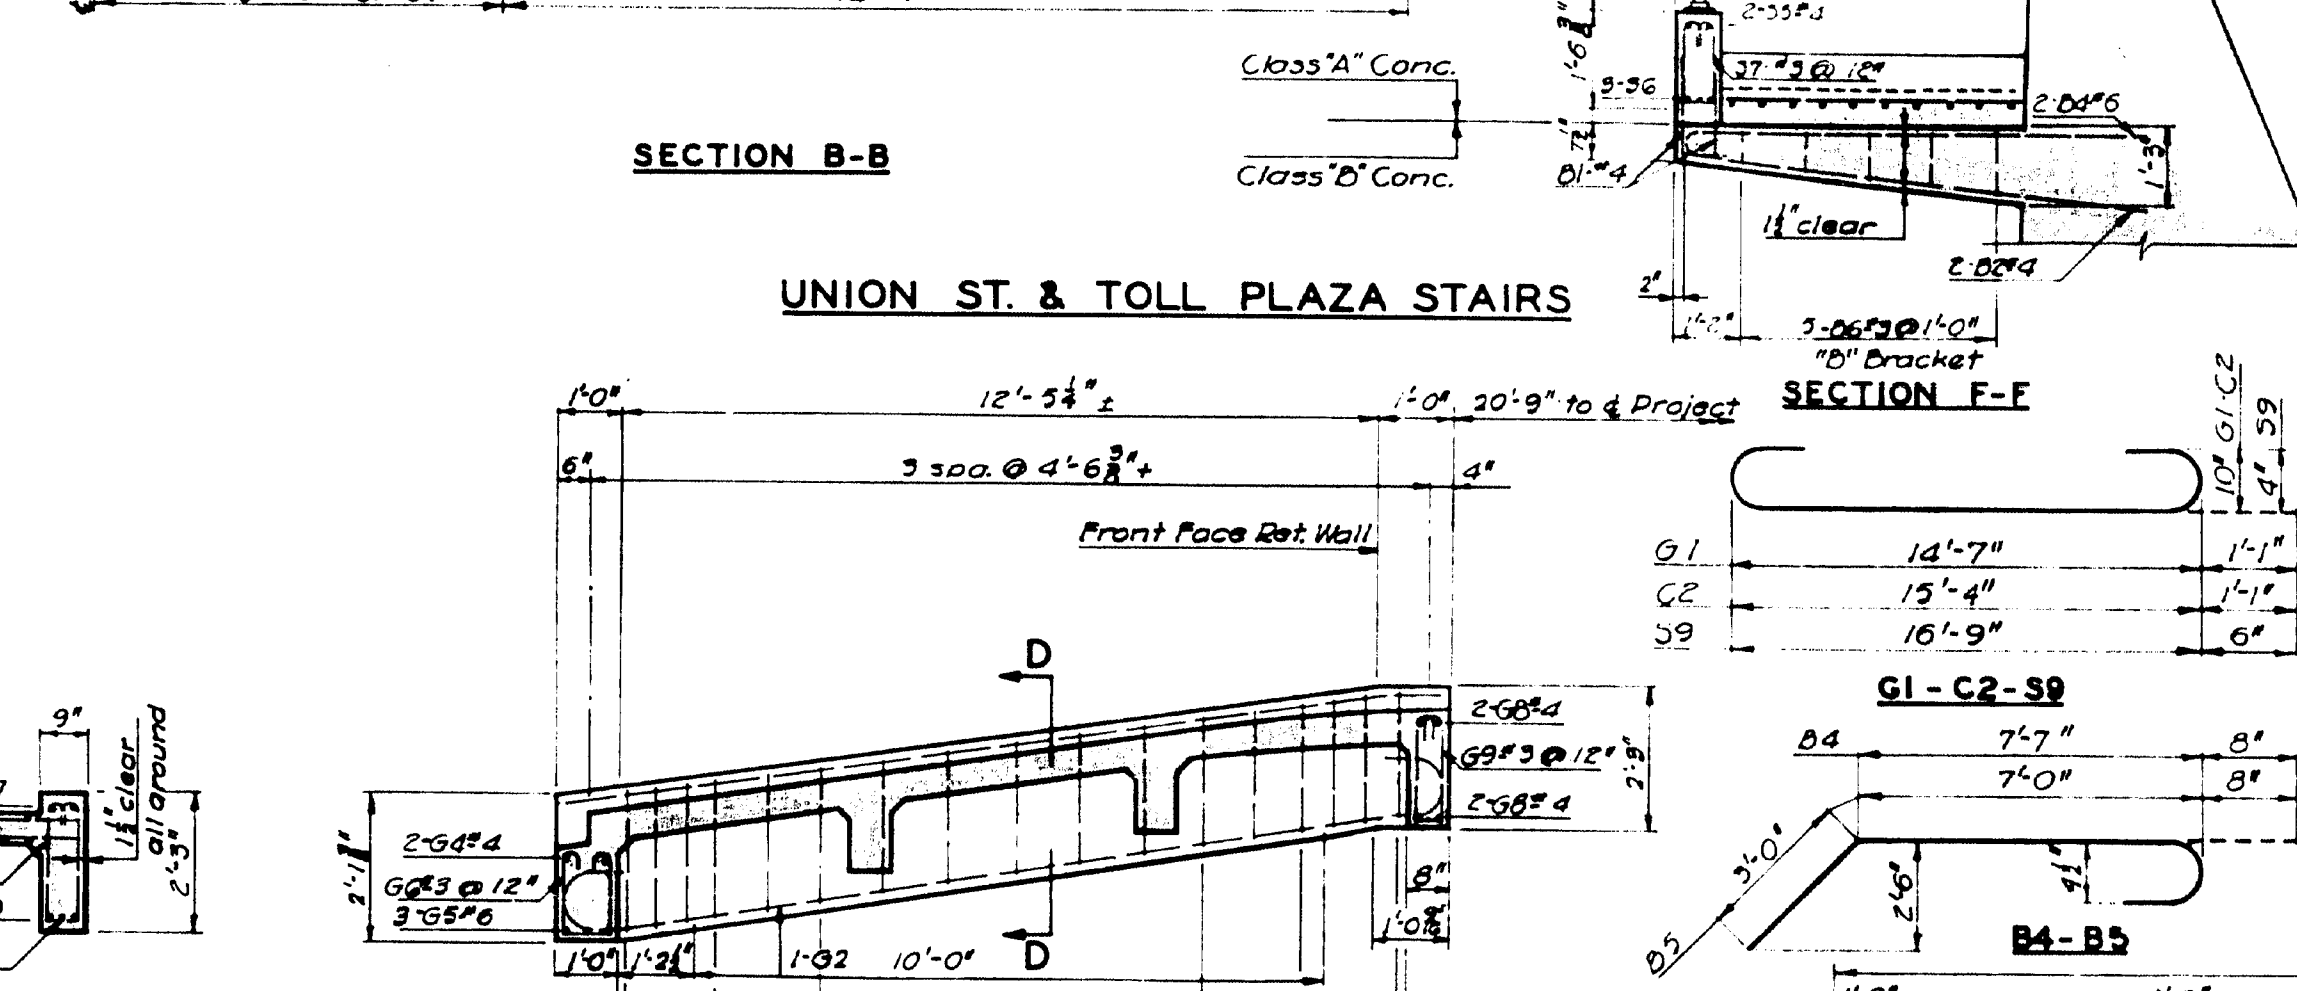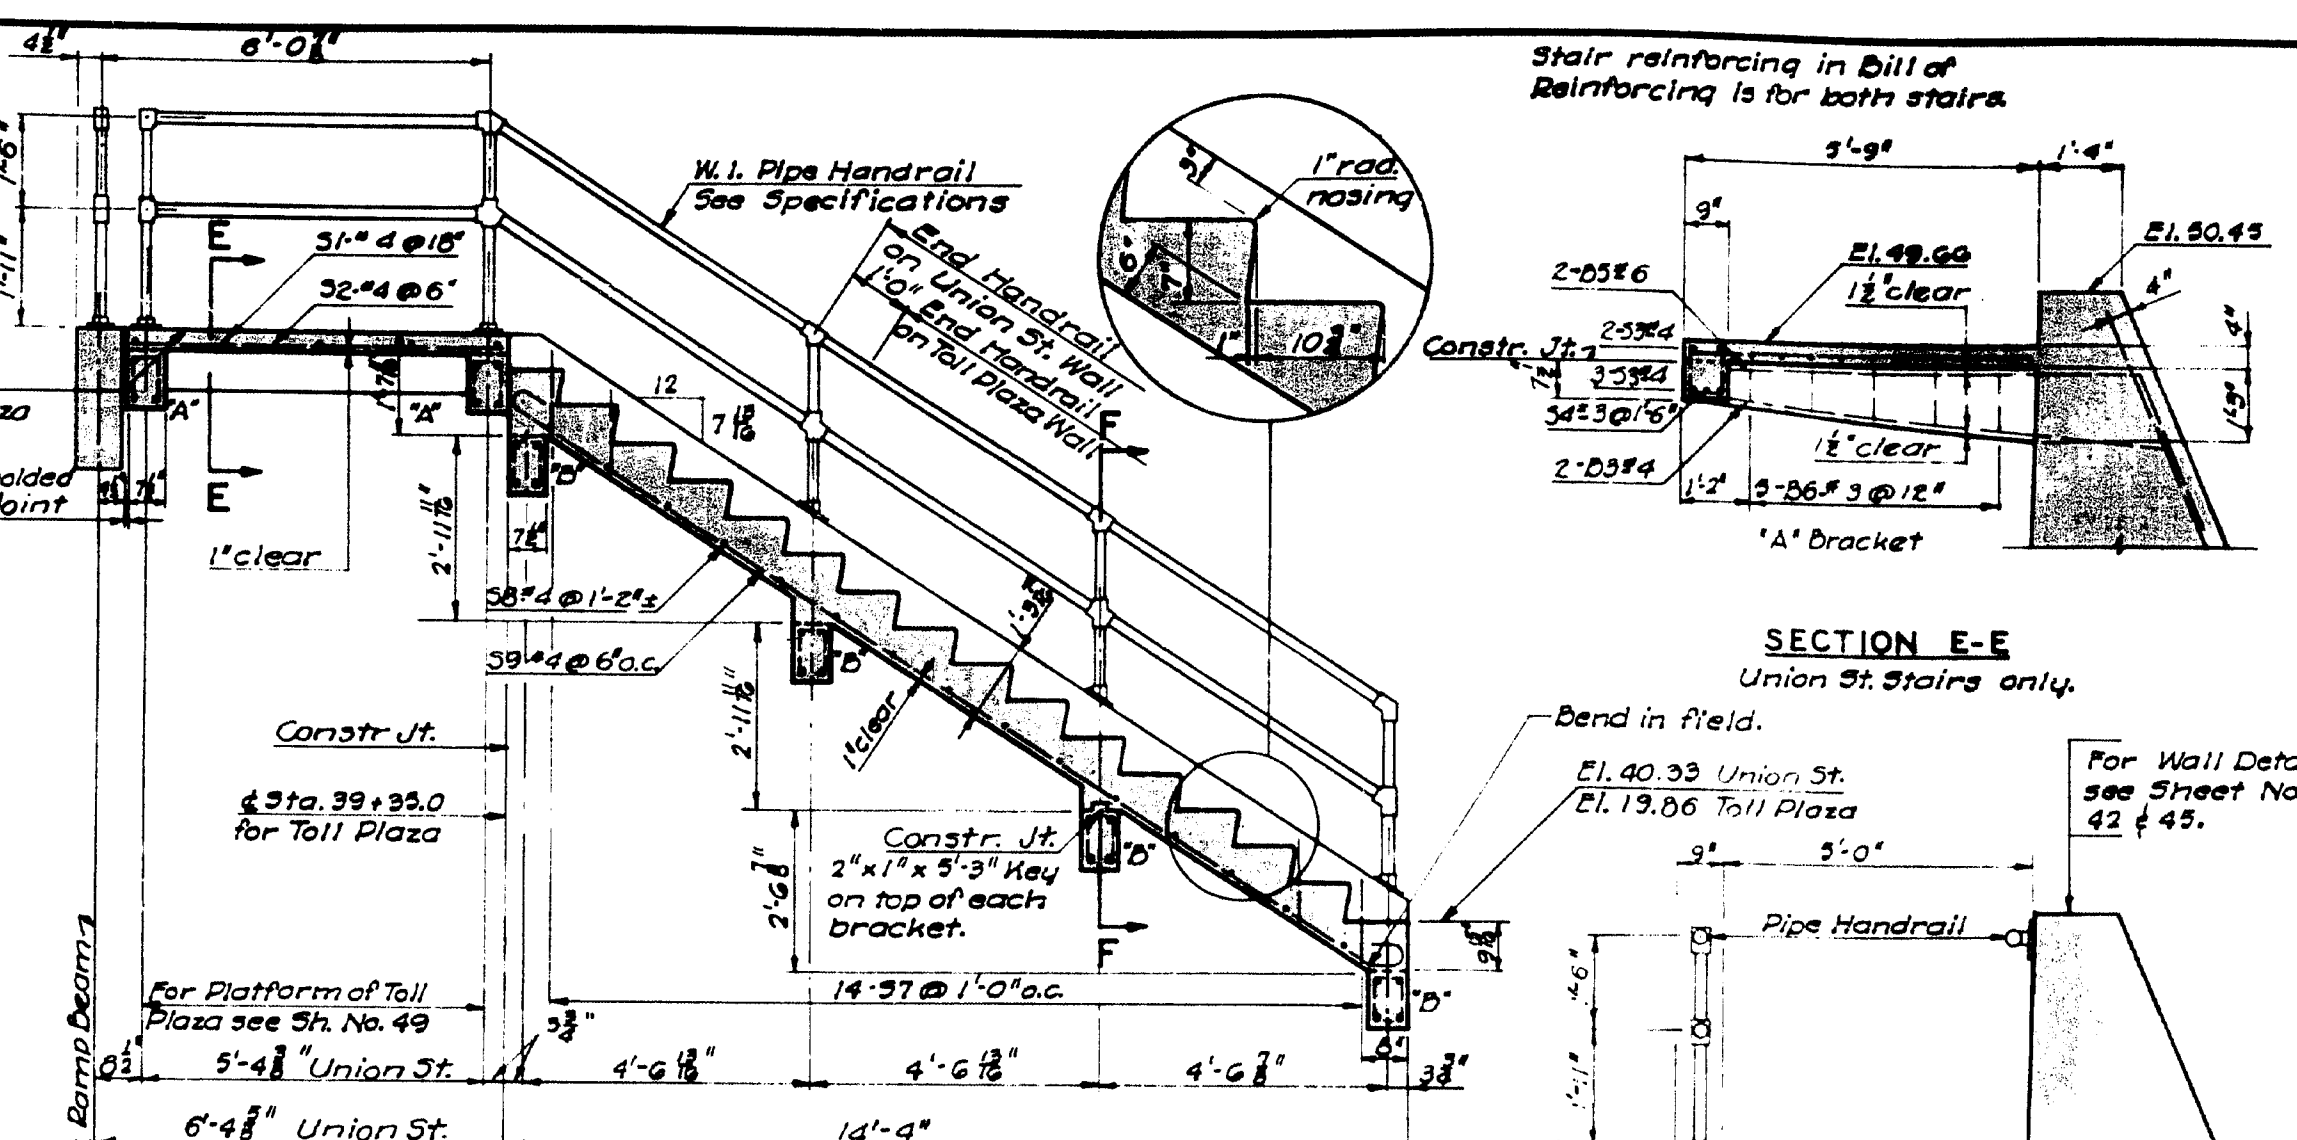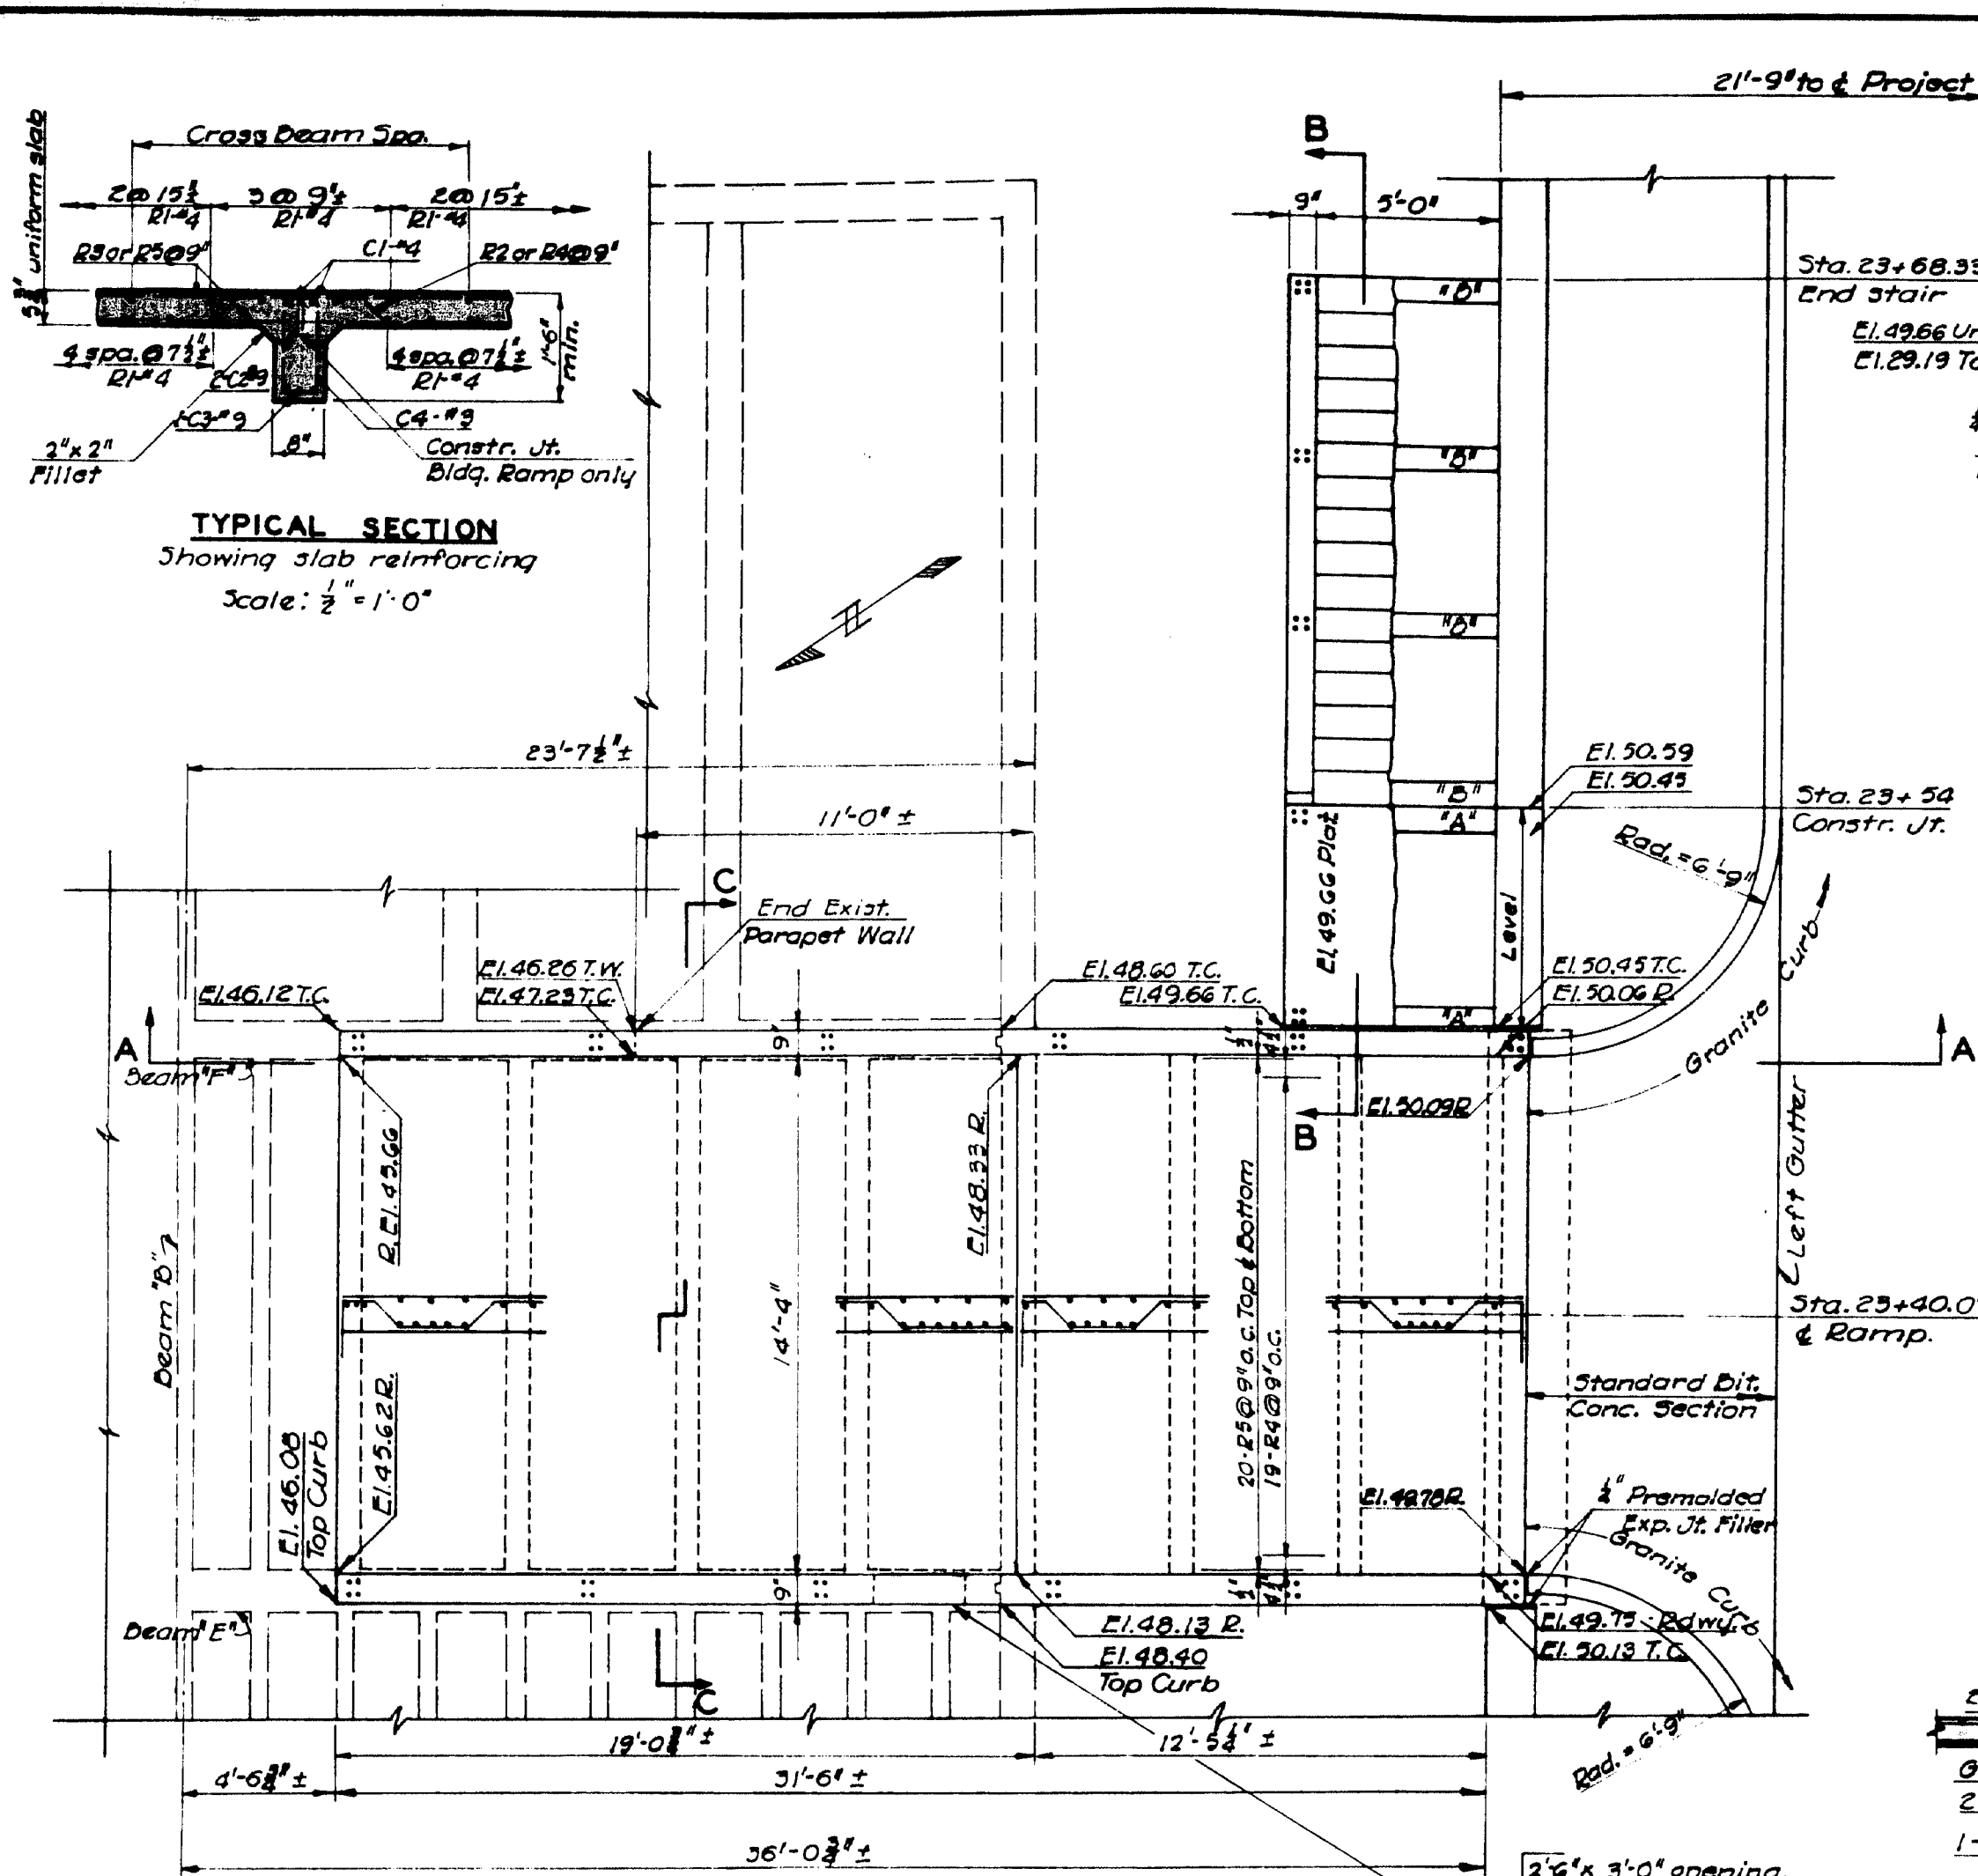

BILL OF REINFORCING						
Mk.	No.	Size	Shape	Length	Location	
D1	16	4		3' 8"	Stairs	
D2	16	4		7' 8"	do	
D3	4	4		7' 8"	Platform	
D4	16	6		8' 8"	Stairs	
D5	4	6		10' 8"	Platform	
D6	30	9		* 1' 9"	Platform & Stair	
C1	13	4		15' 7"	D.R. & S.	
C2	10	9		17' 6"	do	
C3	5	9		3' 0"	do	
C4	115	3		3' 9"	do	
G1	4	9		16' 9"	Ramp Span	
G2	2	9		10' 0"	do	
G3	34	3		5' 4"	do	
G4	2	4		15' 7"	do	
G5	3	6		15' 7"	do	
G6	16	3		3' 7"	do	
G7	4	7		14' 7"	do	
G8	4	4		15' 7"	do	
G9	16	3		4' 5"	do	
W1	74	4		15' 7"	B.R. & S.	
W2	19	"		19' 11"	Blgd. Ramp	
W3	40	"		18' 5"	do	
W4	19	"		17' 1"	Ramp Span	
W5	40	4		13' 9"	do	
S1	2	4		5' 4"	Platform	
S2	10	4		5' 5"	do	
S3	5	4		5' 9"	do	
S4	4	3		1' 10"	do	
S5	4	4		16' 9"	Stairs	
S6	6	5		16' 9"	do	
S7	28	3		3' 10"	do	
S8	30	4		5' 3"	do	
S9	20	4		17' 9"	do	
W1	8	4		19' 6"	Blgd. Ramp	
W2	16	3		5' 1"	do	
W3	32	5		2' 6"	do	
W4	14	4		18' 0"	do	
W5	36	4		* 2' 14"	do	
W6	36	4		* 2' 6"	do	
W7	3	7		6' 6"	do	

\* W5 Varies by  $\frac{1}{8}''$  in increments from 1'-0" to 3'-2"  
 \* W6 Varies by  $\frac{1}{8}''$  in increments from 9' to 4'-4"  
 \* Cut 2 each length.  
 \* Average length.

**NOTES:**  
 Design loading: H15-44 AA3HQ (Ramp only)  
 Stairway brackets shall be Class "B" concrete and shall be poured monolithic with the retaining walls.  
 All concrete in Building Ramp, Ramp Span and Stairs above brackets shall be Class "A" concrete.  
 Pacing of dowels and reinforcing, which is shown to be attached to existing Adams Garage building, shall be done as directed by the Engineer.  
 All construction joints between existing building and new work shall be water proofed equal to the present waterproofing, to the satisfaction of the building owner, or as directed by the Engineer.  
 Any damage to existing building due to the Contractor's operations shall be repaired at the Contractor's expense.  
 All forms and falsework used in construction of the Building Ramp shall be completely removed.  
 Roof of present garage shall be thoroughly cleaned to expose original concrete before new concrete is placed thereon.

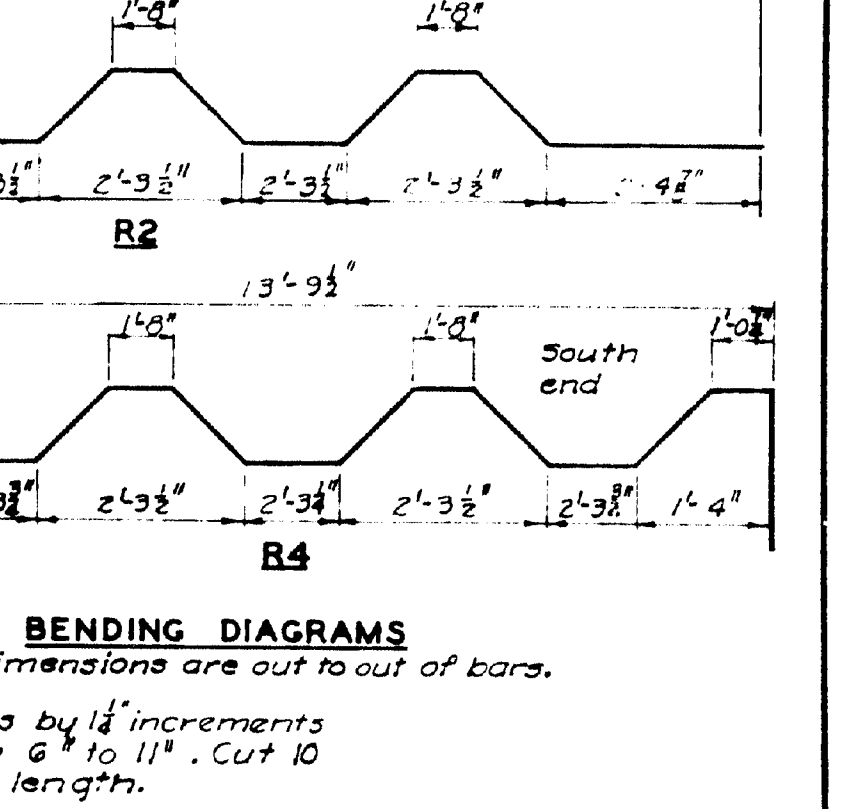

STATE OF MAINE  
 STATE HIGHWAY COMMISSION  
**BANGOR-BREWER BRIDGE  
 OVER PENOBSCOT RIVER**  
 BANGOR, MAINE  
 DETAILS  
 GARAGE RAMP & STAIRS  
 HARRINGTON AND CORTELYOU  
 CONSULTING ENGINEERS  
 KANSAS CITY, MO.  
 DETAILED S.P. 10-9-32  
 TRACED BY S.P. 11-6-32  
 CHECKED G.H.K. 1-20-53  
 SCALE:  $\frac{3}{8}'' = 1'-0''$   
 AND AS NOTED  
 SHEET NO. 48

ADAMS GARAGE RAMP


For New  
 Garage Ramp  
 Details See Sh. 48A

62-46







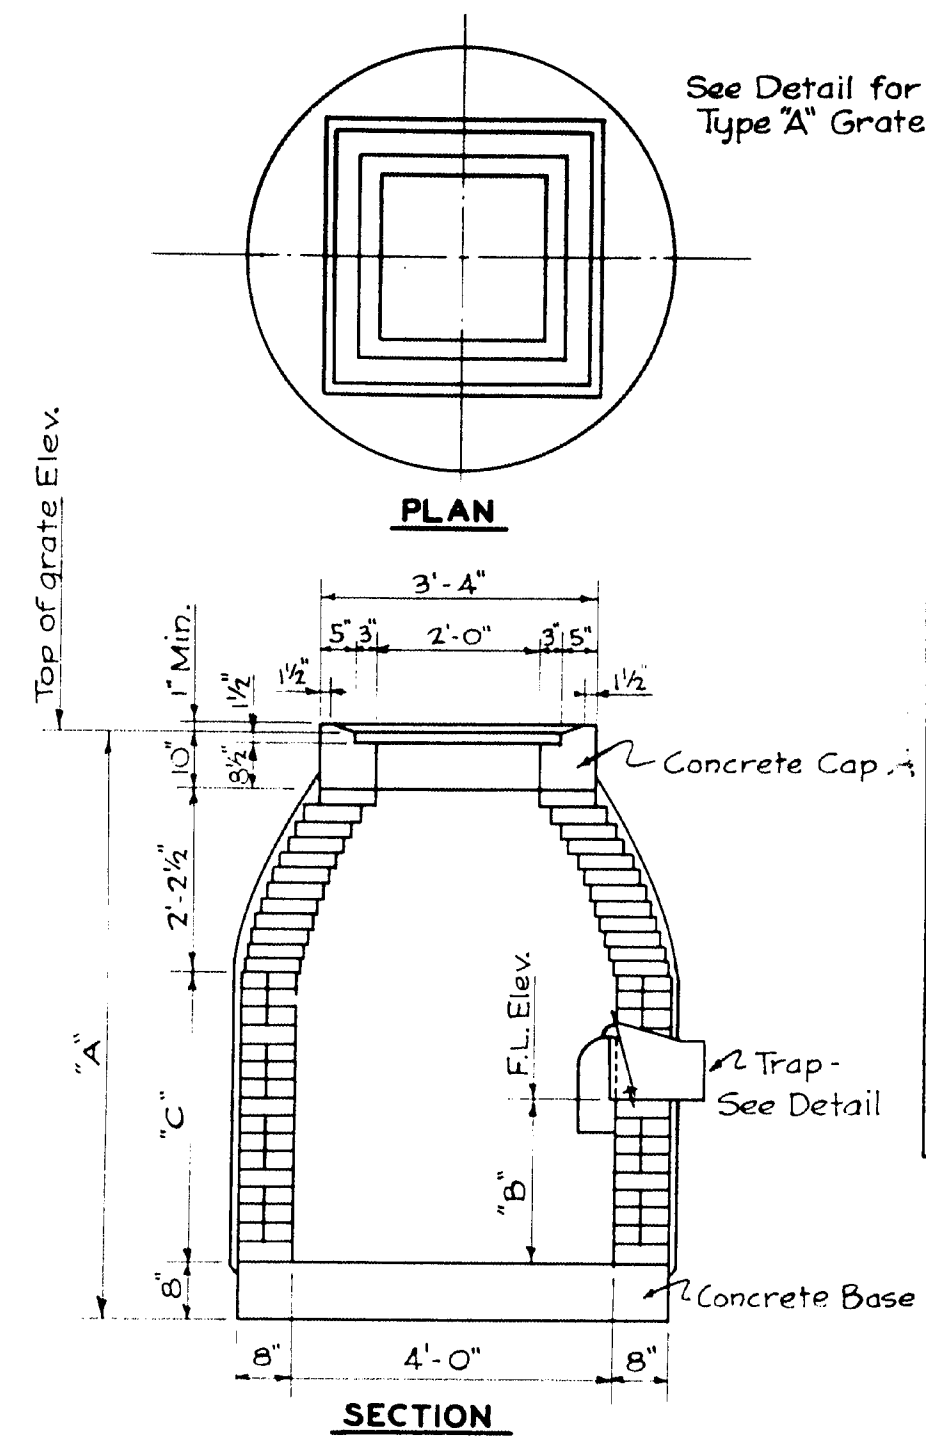


*Type 'A' Catch Basins shown at various locations along the project.*

Type	Station	Sheet No.	Top Gr. Elev.	F.L. Elev.	Dim. "A"	Dim. "B"	Dim. "C"	Quantity 8" V.C.P. Req'd.
A	19+74 (L. gutter Ramp "C")	32	27.20	23.20	7'-2"	2'-6"	3'-5 1/2"	18'
A	4+50 (Summer St.)	31	41.22	36.80	7'-2"	2'-1"	3'-5 1/2"	6'
C	24+31 (Ramp "A")	33	47.84	42.84	7'-8"	—	3'-11 1/2"	12'
C	20+90 (Ramp "A")	33	47.62	42.62	7'-8"	—	3'-11 1/2"	12'
C	6+10.5 (May St.)	33	47.84	44.50	6'-0"	—	2'-3 1/2"	24'
C	5+07.3 (Summer St.)	33	41.80	37.30	7'-2"	—	3'-5 1/2"	99'
C	*23+70 (Ramp "B")	33	42.96	38.46	7'-2"	—	3'-5 1/2"	27'
C	39+00 (Project)	35	29.10	24.10	7'-8"	—	3'-11 1/2"	33'
C	*40+90 (Project)	35	27.19	23.69	6'-2"	—	2'-5 1/2"	*18'
A	42+15 (L. gutter "Brewer")	36	25.31	20.89	7'-2"	2'-1"	3'-5 1/2"	27'
A	42+50 (R. Base Line "Brewer")	36	23.62	19.45	7'-2"	2'-4"	3'-5 1/2"	12'

\* No Trap Req'd.  
\* Requires 12" Asphalt Coated Corr. Metal Pipe



**TYPE "A" CATCH BASIN**  
4 Req'd.

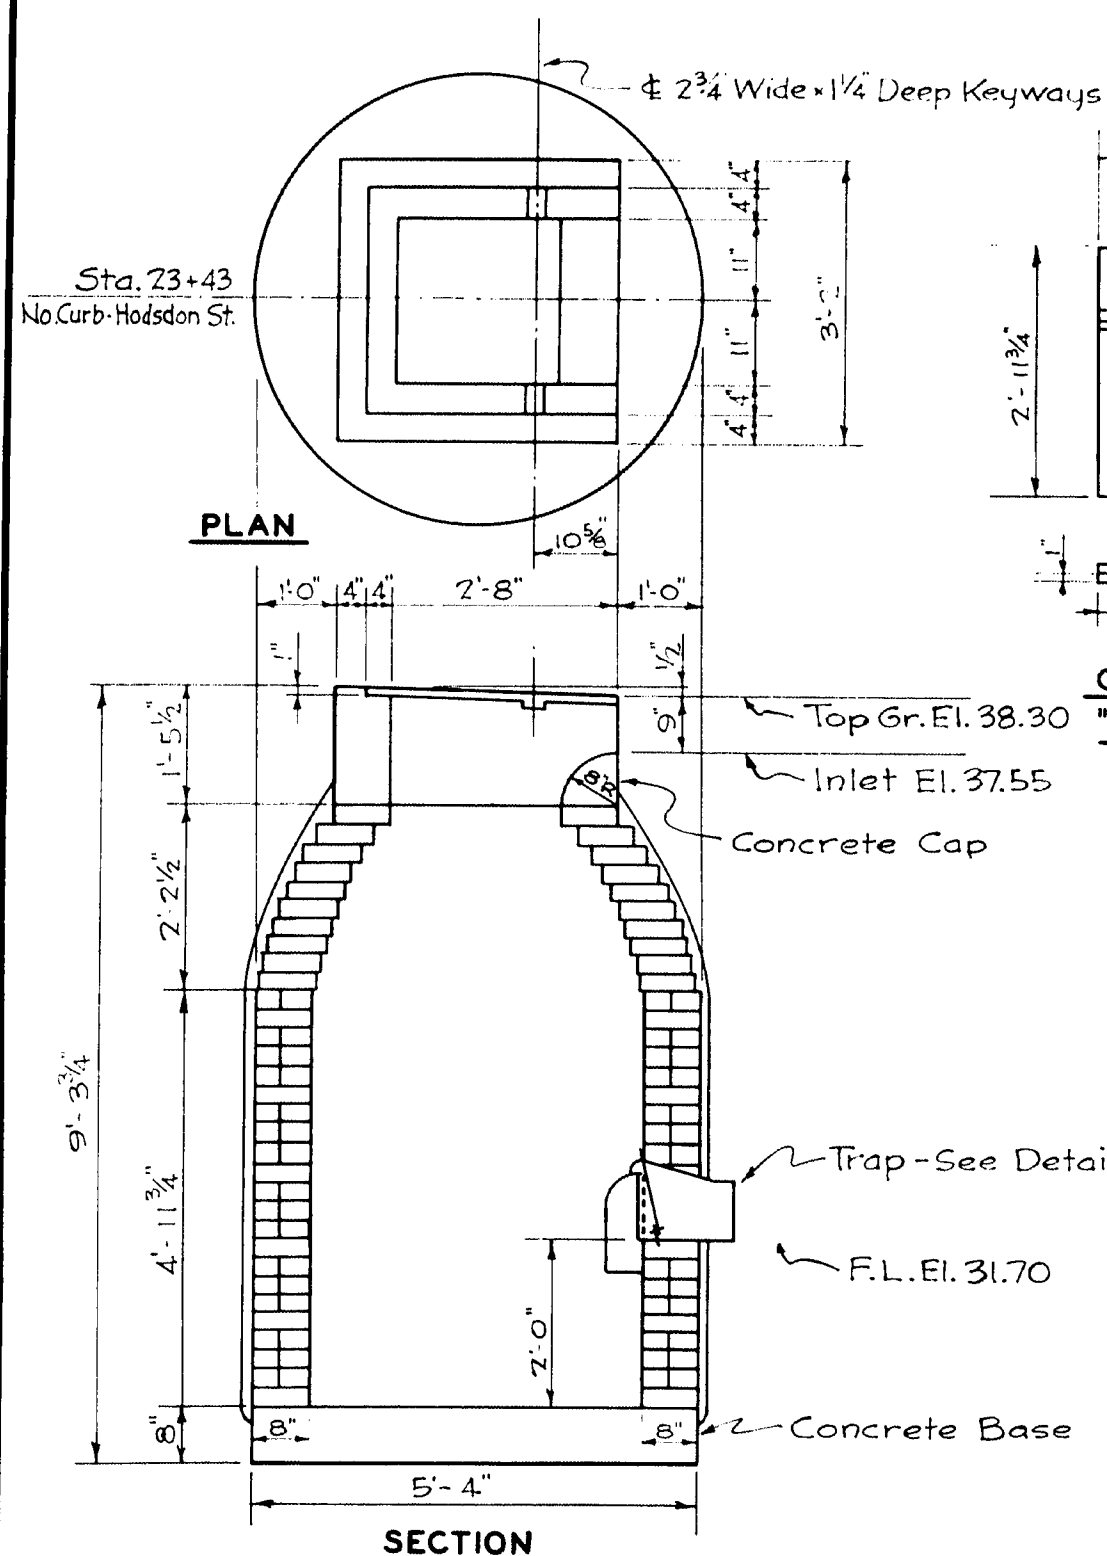

**TYPE "B" CATCH BASIN**

One Req'd - See Sh. No. 32  
Hodsdon St. - No. Curb - 12 of 8" V.C.P. Req'd.

**GRATE FOR TYPE "B" CATCH BASIN**

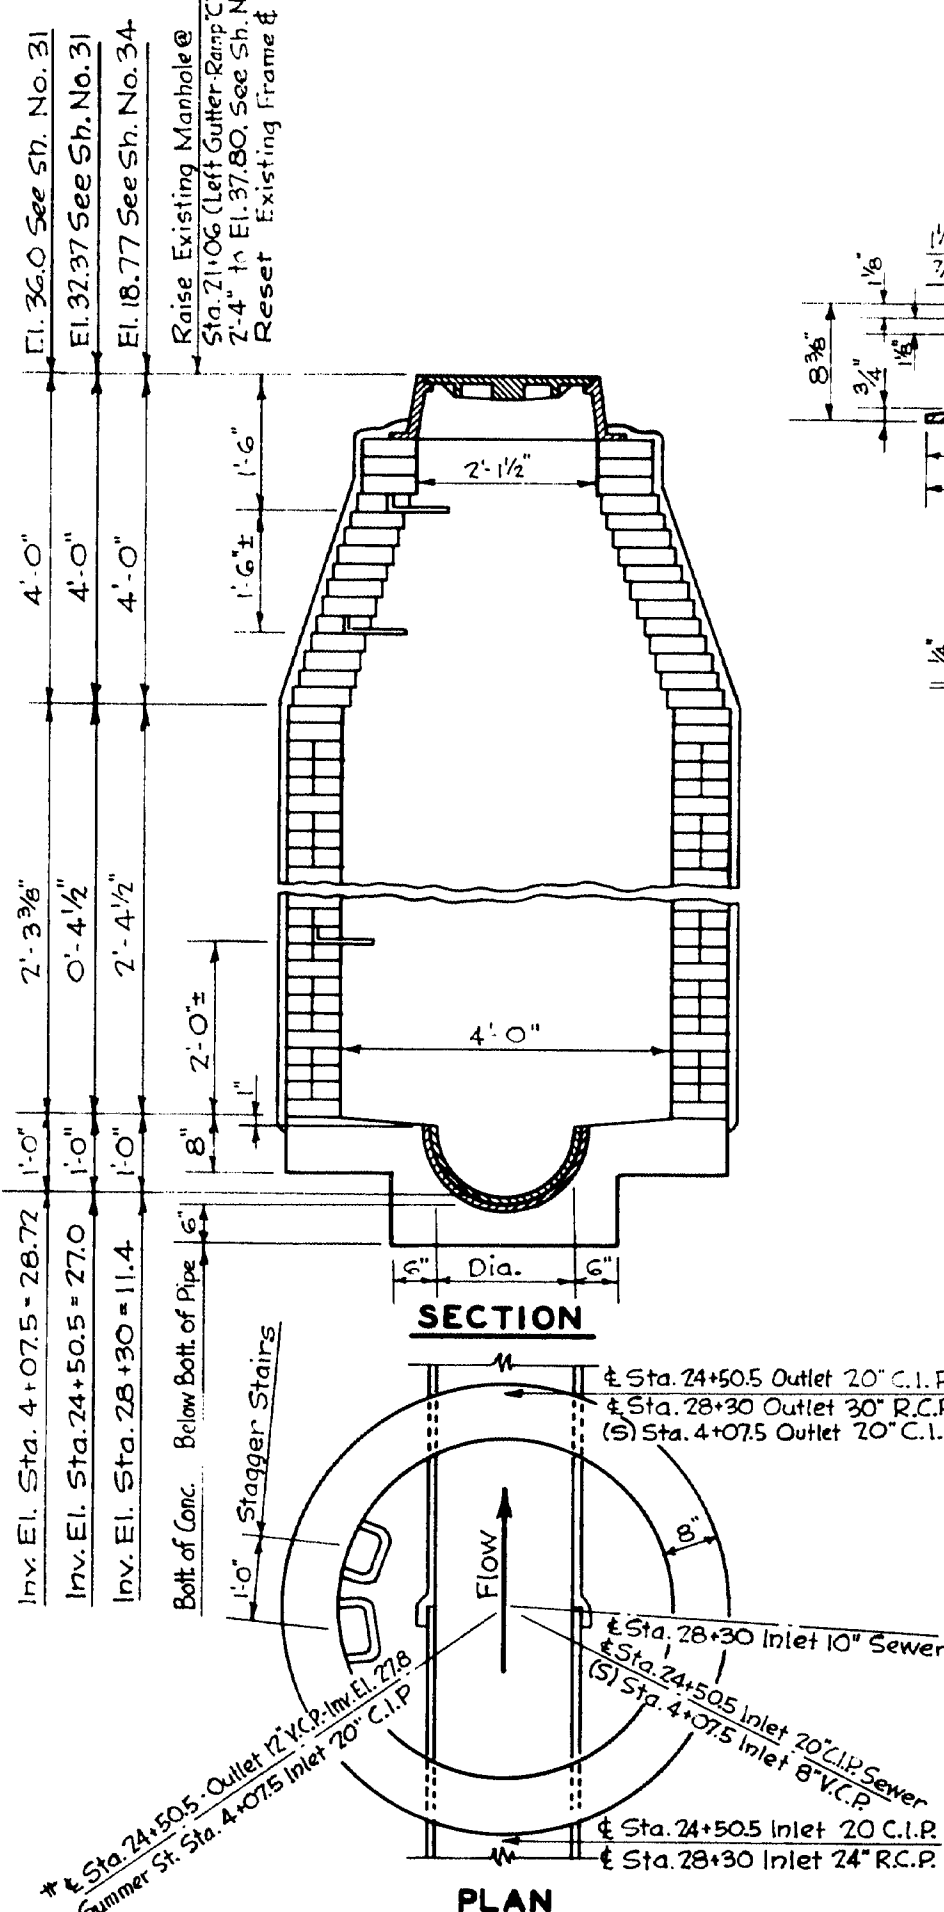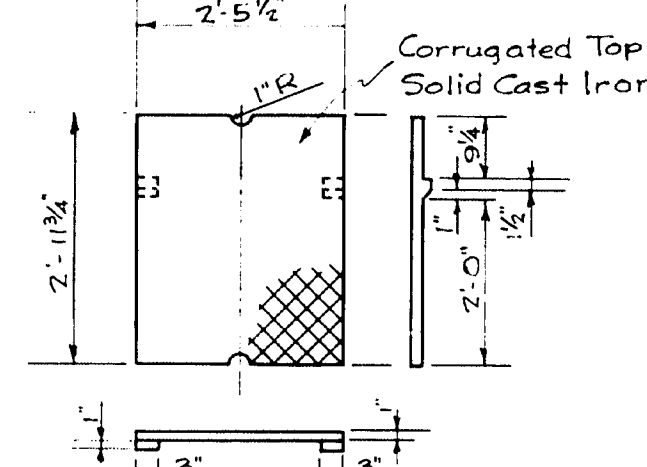


**MANHOLE**

3 Req'd

**ADDITIONAL SEWER QUANTITIES**



Location	Sheet No.	Description	Quantity
Sta. 28+30 to Sta. 29+11	34	30" R.C.P.	84'
Sta. 26+26 to Sta. 28+30	32 & 34	24" R.C.P.	204'
Sta. 23+85 to Sta. 24+62	31	20" C.I.P.	75'
Relocated Bangor House Sewer	31	20" C.I.P.	55'
Utility House Sewer	35	10" V.C.P.	145'
Summer St. Sewer	31	20" C.I.P.	75'
Summer St. Sewer Conn.	31	12" V.C.P.	40'

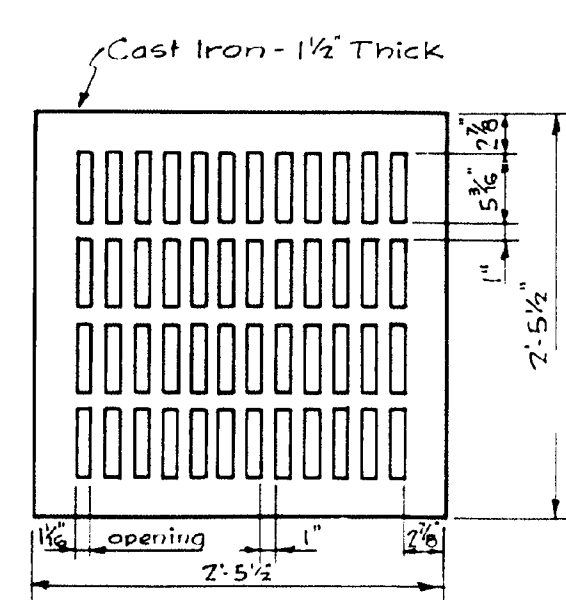

**TYPE "A" GRATE**


18 Req'd.

Scale: 1" = 1'-0"

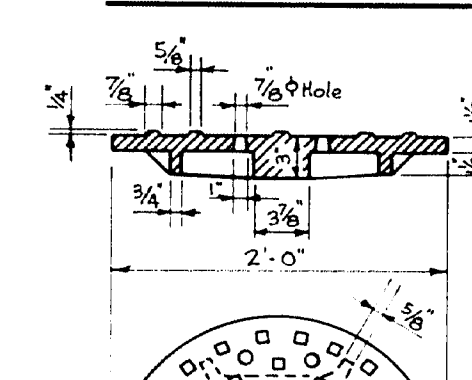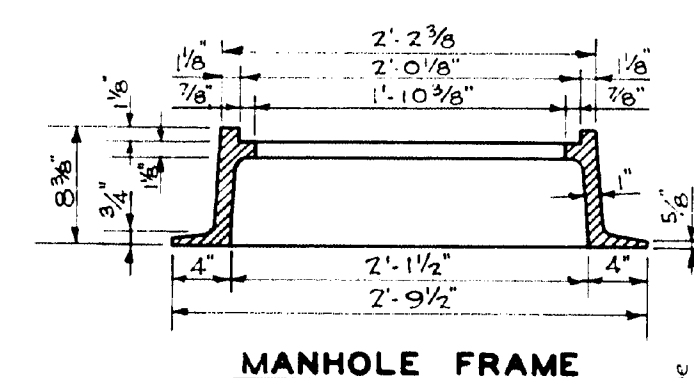

**MANHOLE COVER**

Scale: 1" = 1'-0"

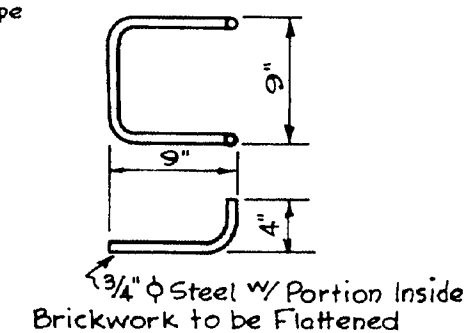

**TRAP**


17 Req'd

Scale: 1" = 1'-0"

\* Connection through Pier 1 Wall to existing 18" x 24" Brick Sewer at Sta. 24+62. See Sh. No. 12 & 31

Station	Sheet No.	Top Gr. Elev.	F.L. Elev.	Dim. "A"	Dim. "C"	Quantity 8" V.C.P. Req'd.
21+26 (Left Curb "Ramp C")	32	38.80	32.10	9'-4 1/2"	5'-8"	21'
21+32 (Project)	30	52.75	48.75	6'-8"	2'-11 1/2"	*10'
21+78 (Project)	30	50.70	45.70	7'-8"	3'-11 1/2"	74'
22+75 (Ramp "C")	30	48.70	43.70	7'-8"	3'-11 1/2"	18'
23+00 (Ramp "A")	30	48.32	43.32	7'-8"	3'-11 1/2"	45'
2+75 L. Summer St.	31	30.56	25.56	7'-8"	3'-11 1/2"	24'
2+75 R. Summer St.	31	30.56	25.56	7'-8"	3'-11 1/2"	15'

\* Approximate. Use existing pipe if approved.

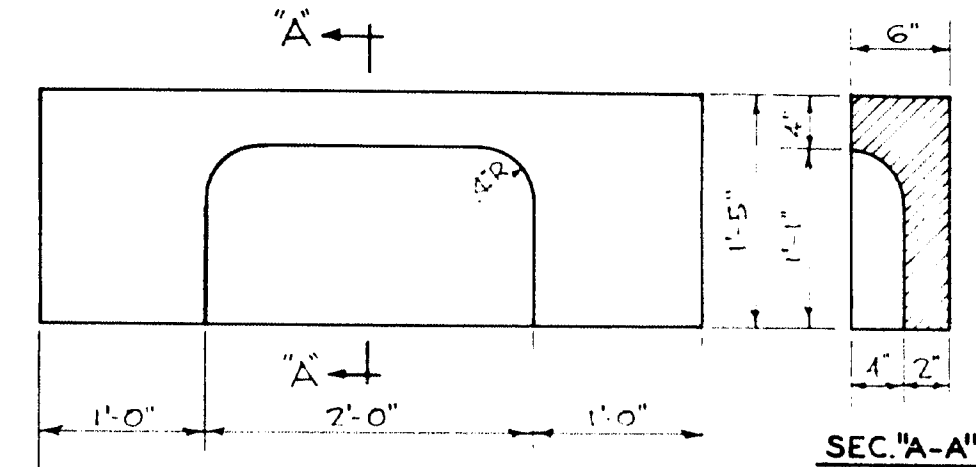


**DETAIL OF STANDARD GRANITE CURB INLET**

14 Req'd.

Scale: 1" = 1'-0"

**TYPE "C" CATCH BASIN**

14 Req'd.

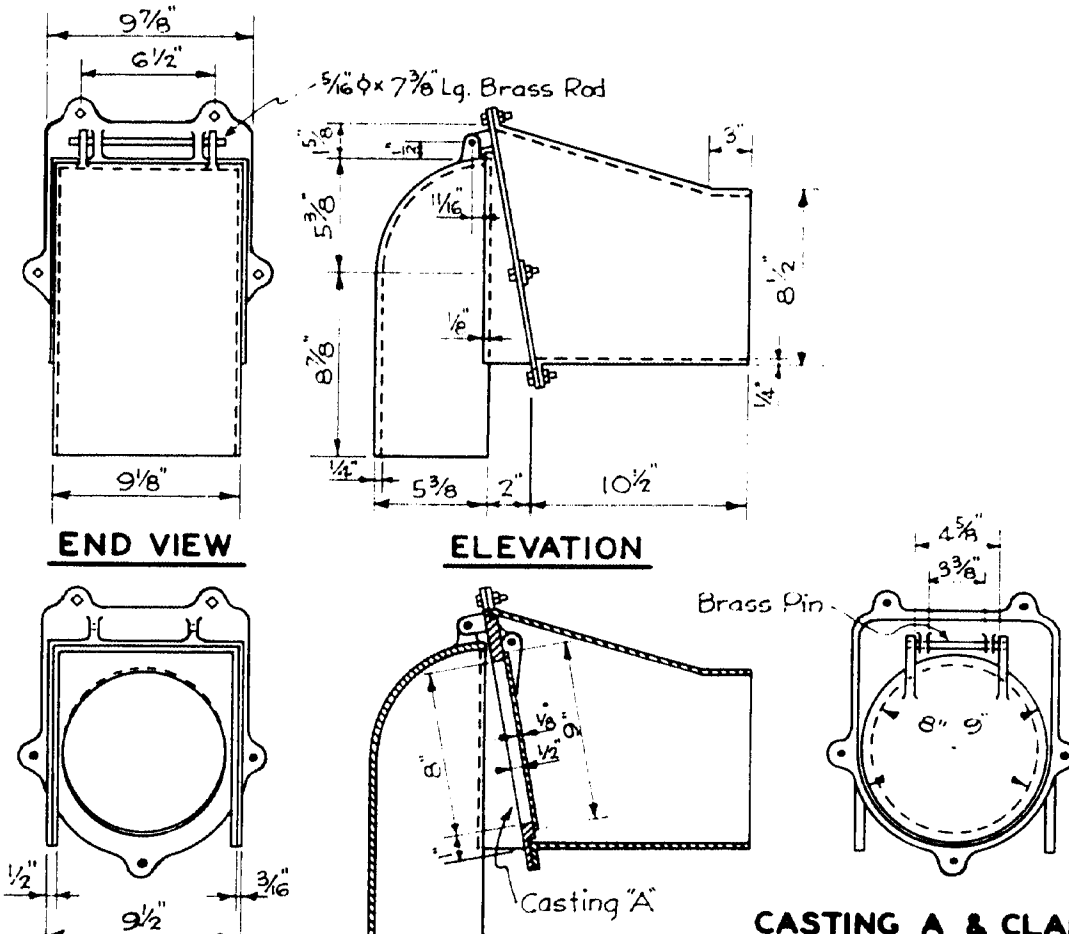

**END VIEW WITH HOOD & CLAPPER REMOVED**

**SECTION THROUGH CENTER**

**TRAP**

17 Req'd


Scale: 1" = 1'-0"

**GENERAL NOTES**

Manholes, Catch Basins, Trap, & Grate to Conform to Maine State Highway Commission Standards.  
Manholes & Catch Basins may be Constructed of Brick, Concrete Blocks, or Granite Blocks. Plaster Exterior with Portland Cement Mortar.

See Sh. No. 31 & 32 for elevations of manholes at Summer St. parking lot & relocation.


As Built Revisions 8-6-52

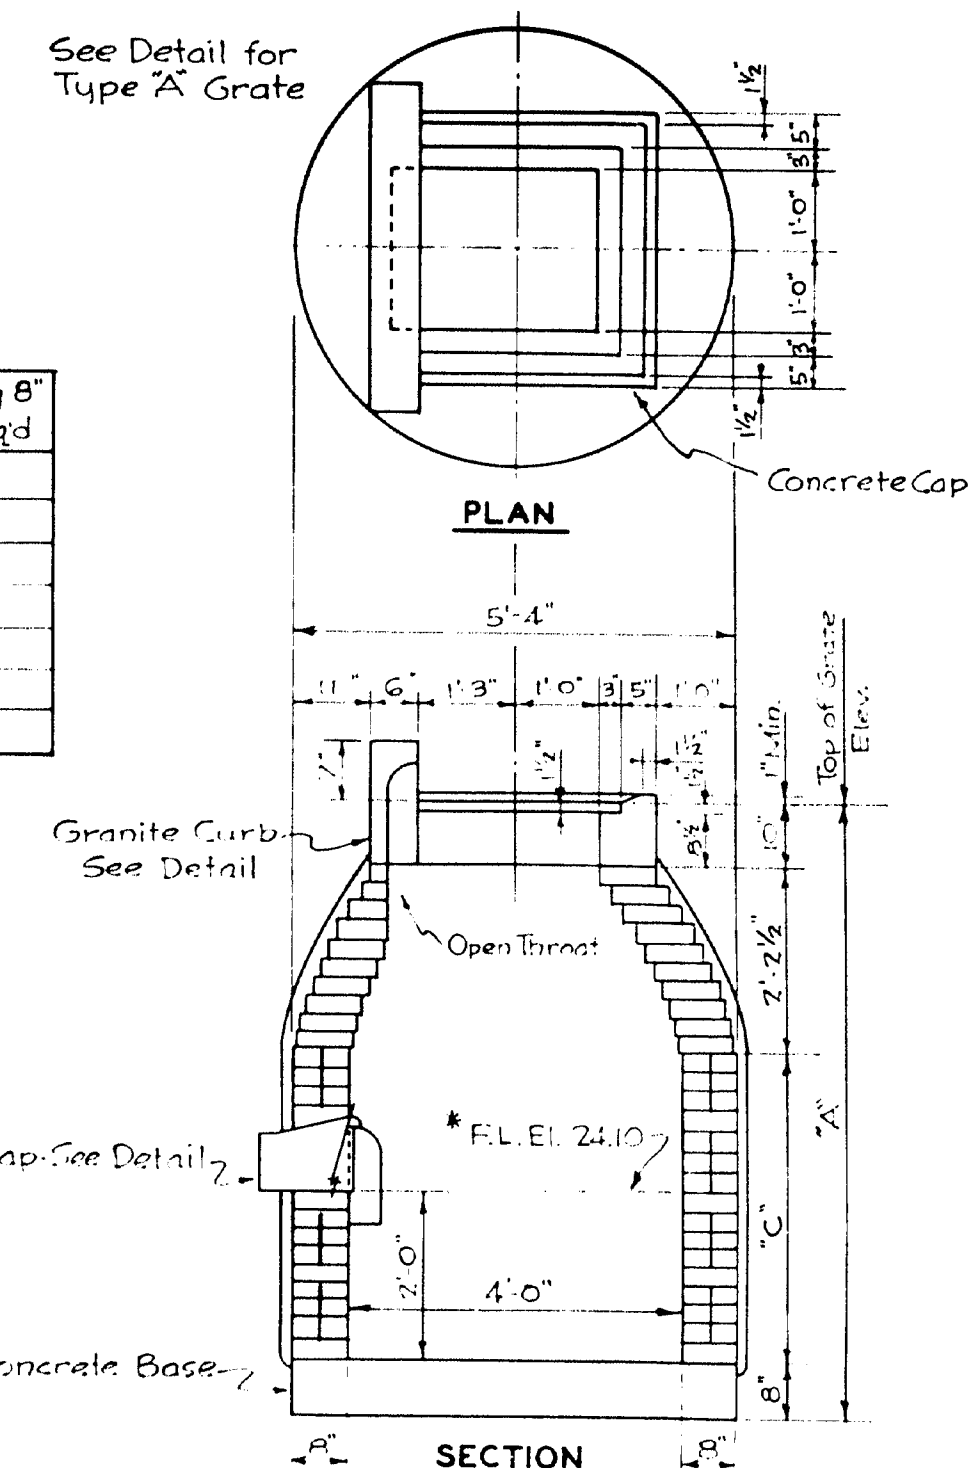

**TYPE "C" CATCH BASIN**

14 Req'd.

Scale: 1" = 1'-0"

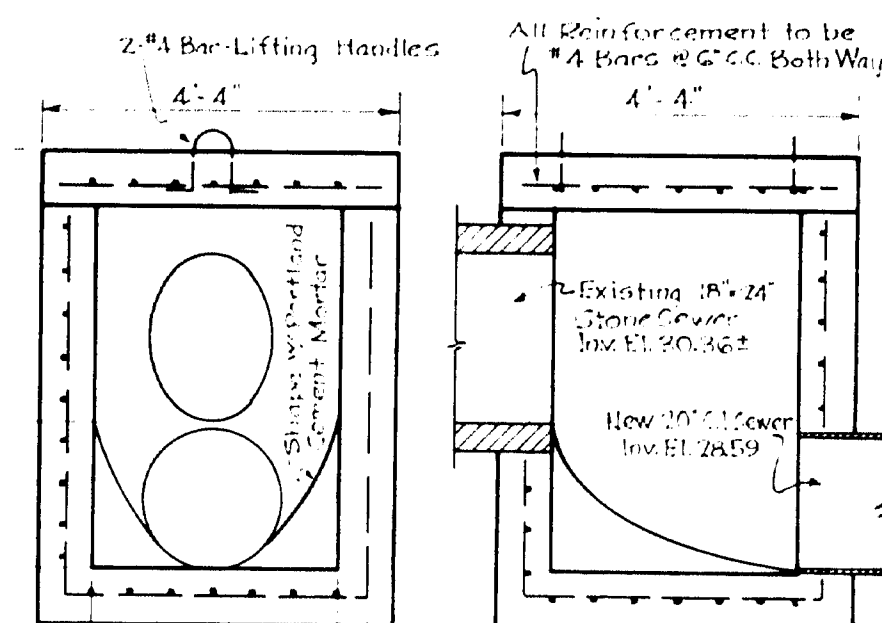

**DETAIL OF SEWER BOX AT STA. 23+85**

See Sh. No. 31

STATE OF MAINE  
STATE HIGHWAY COMMISSION  
**BANGOR-BREWER BRIDGE  
OVER PENOBSCOT RIVER  
BANGOR, MAINE**


**DRAINAGE DETAILS**

HARRINGTON AND CORTELYOU  
CONSULTING ENGINEERS  
KANSAS CITY, MO.


DETAILED H.J.K. 10-3-52  
TRACED H.J.K. 10-8-52  
CHECKED E.M.V. 1-18-53

SCALE: 1" = 1'-0"  
& AS NOTED


SHEET NO. 47

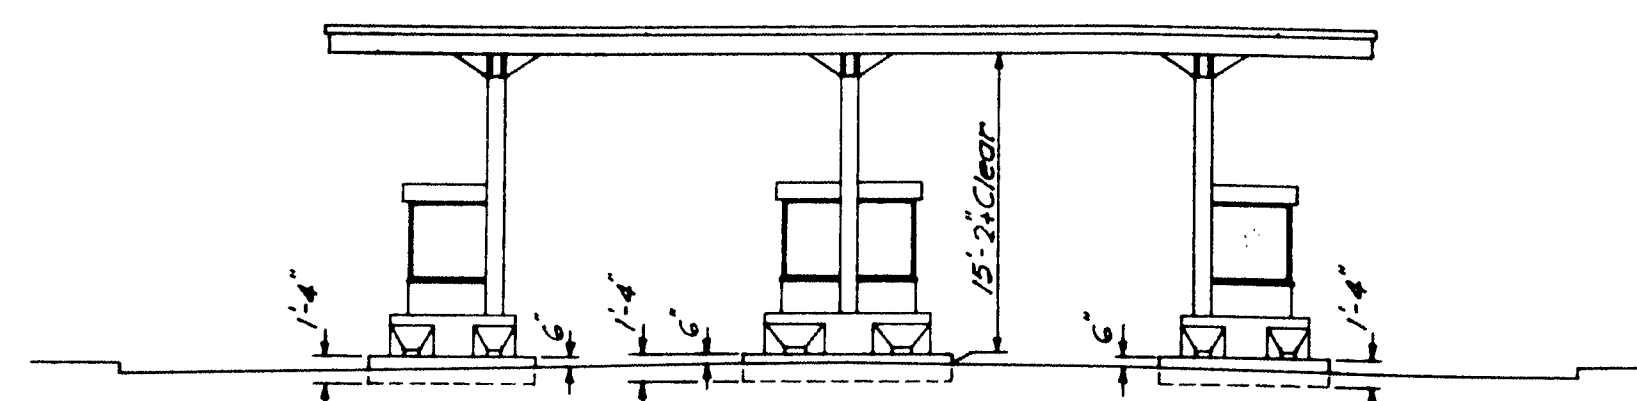


ELEVATION

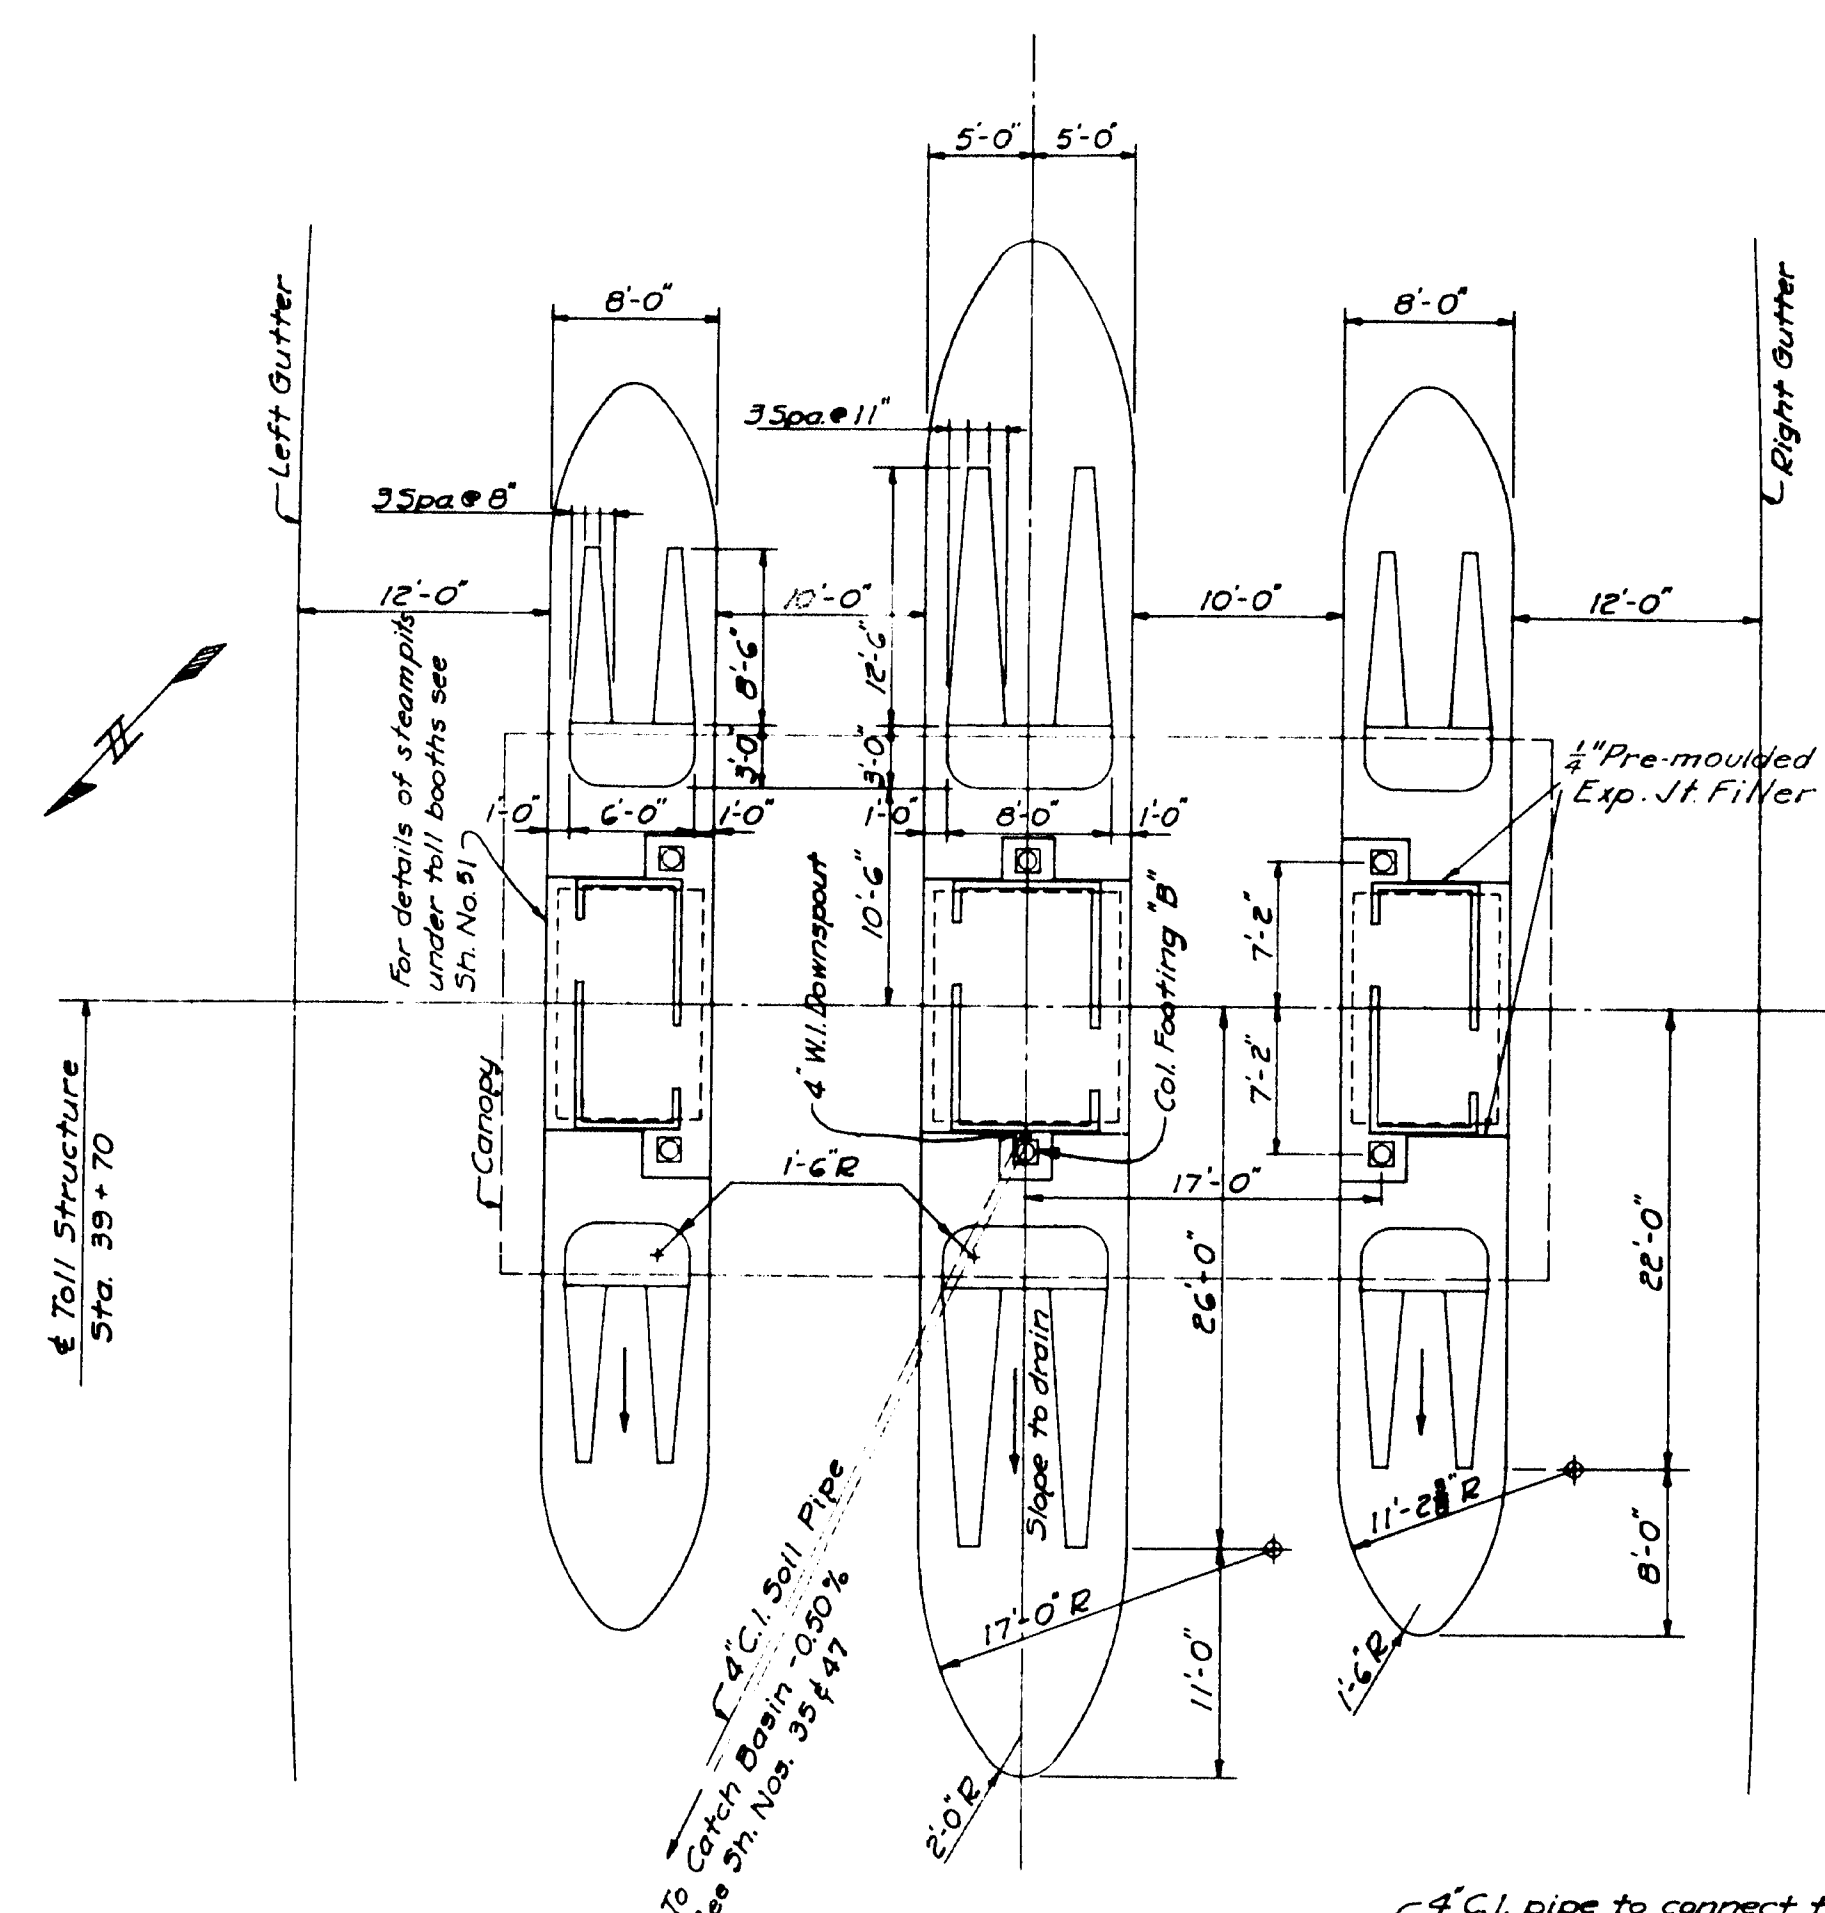

PLAN

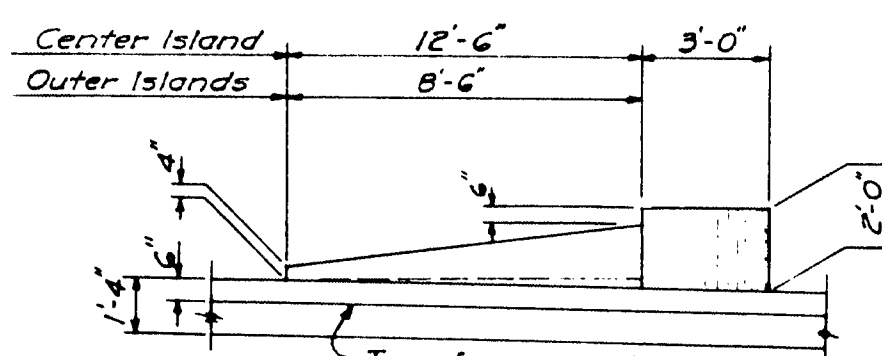


CONCRETE BUMPER  
Scale: 1/2" = 1'-0"

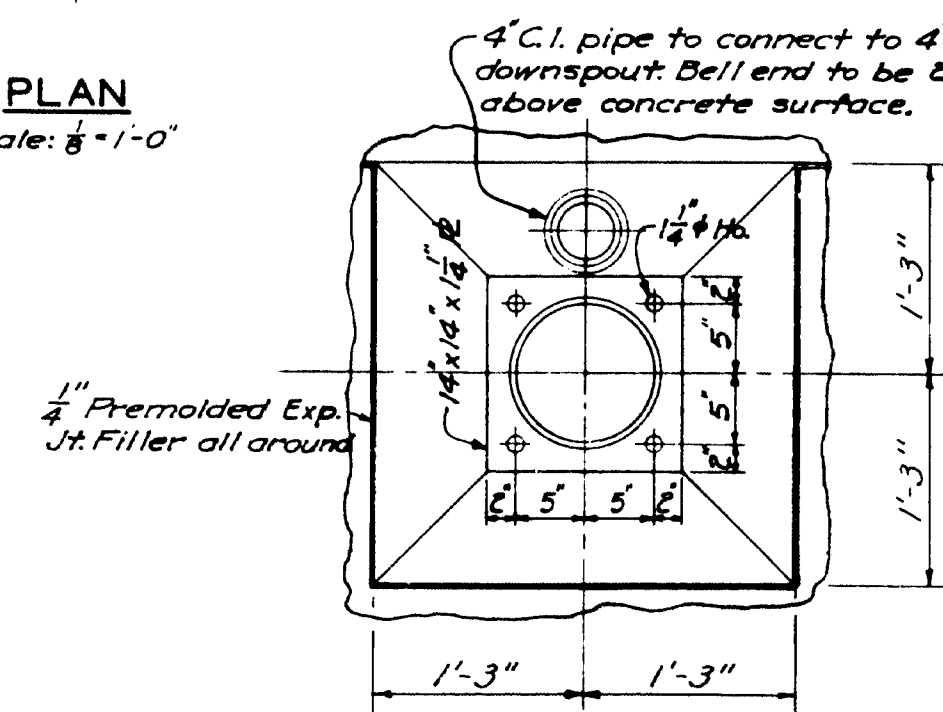


COLUMN FOOTING "B"  
Scale: 1" = 1'-0"


Details shown are typical for all footings except for footing size & C.I. pipe.

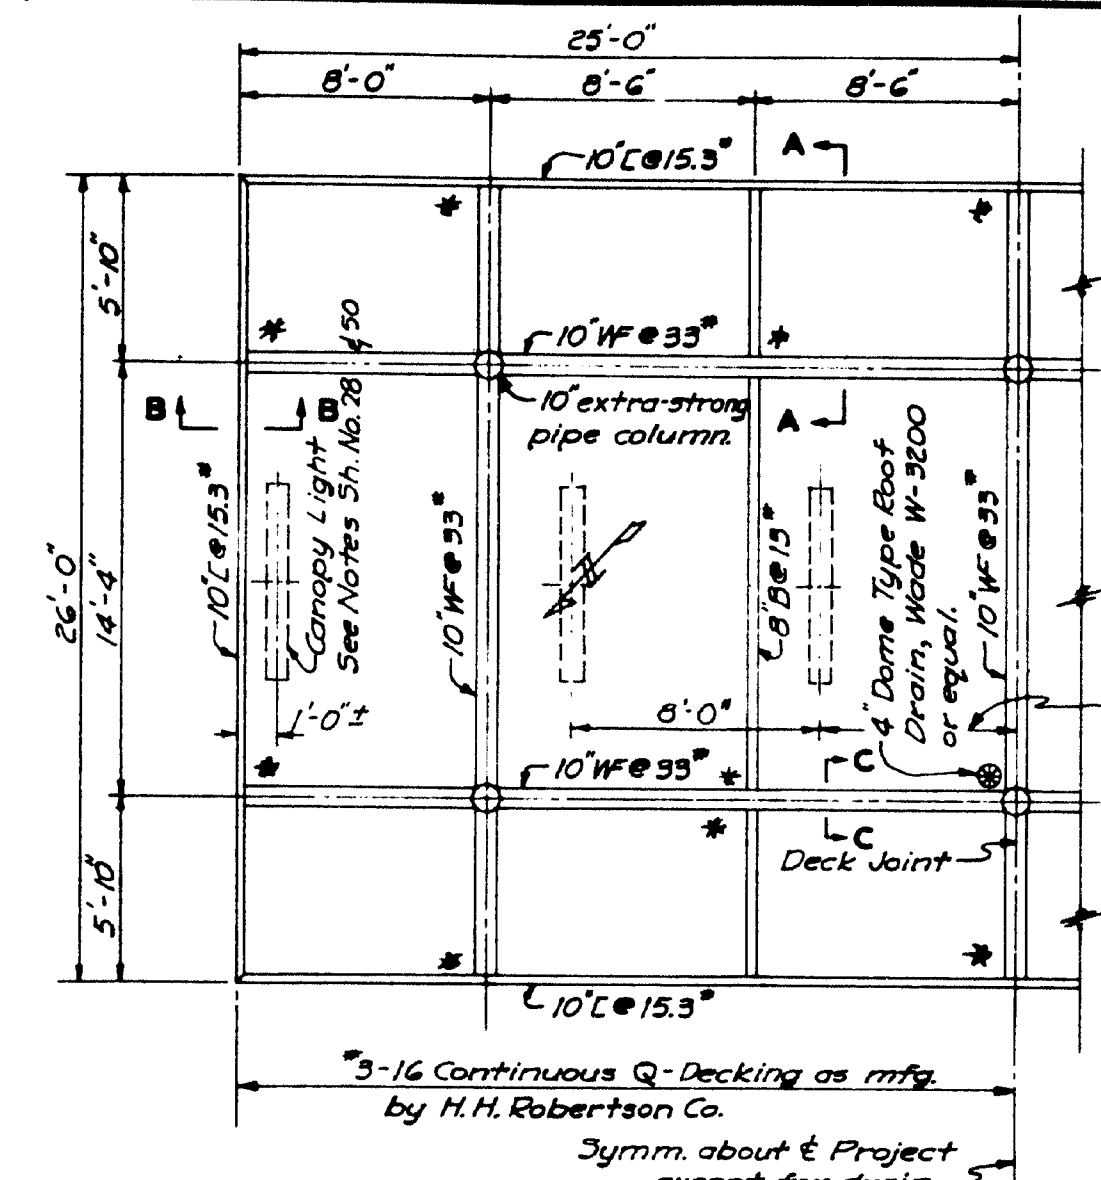

FRAMING PLAN  
Scale: 1/8" = 1'-0"

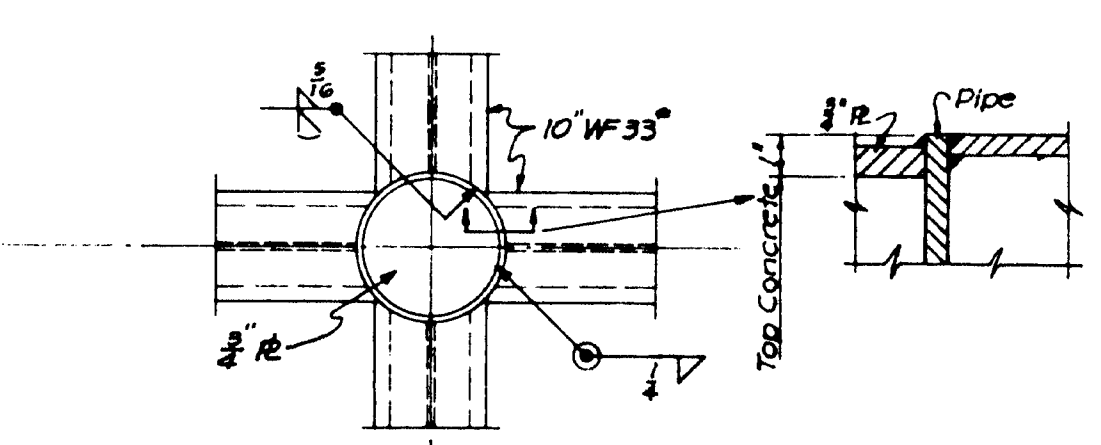


TYPICAL COLUMN AND FOOTING  
Scale: 1" = 1'-0"

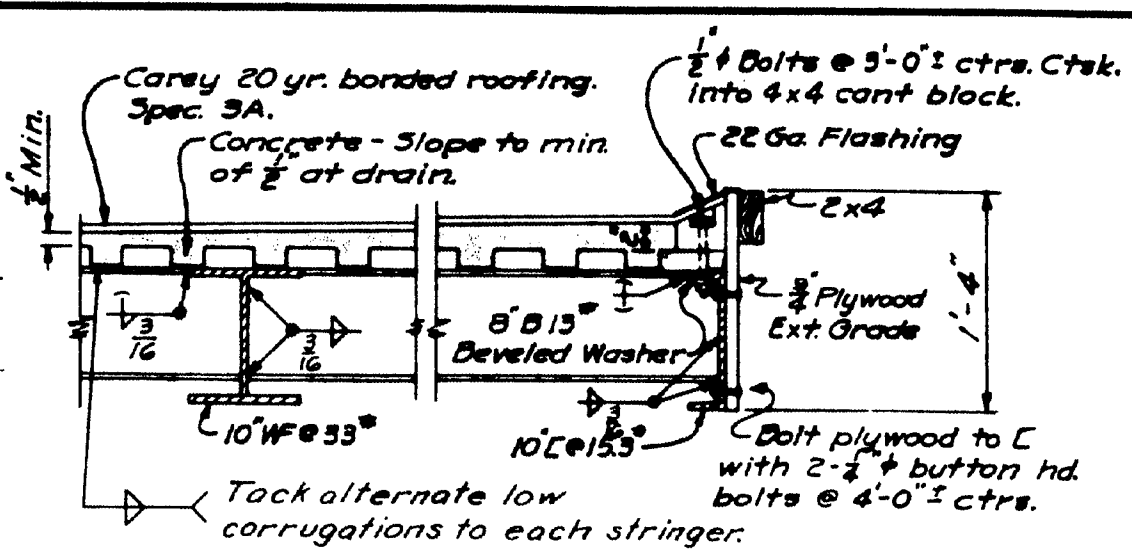


SECTION A-A  
Scale: 1" = 1'-0"


\* Steel not fabricated according to plans. Extra plates welded in field for connections.

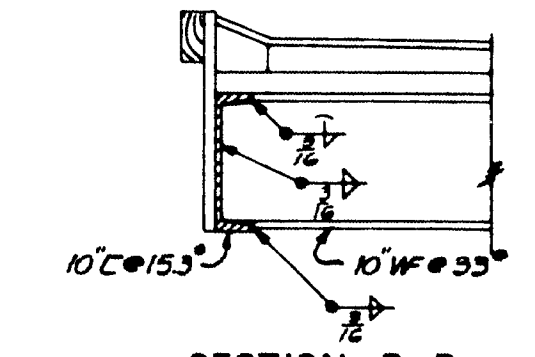


SECTION B-B  
Scale: 1" = 1'-0"

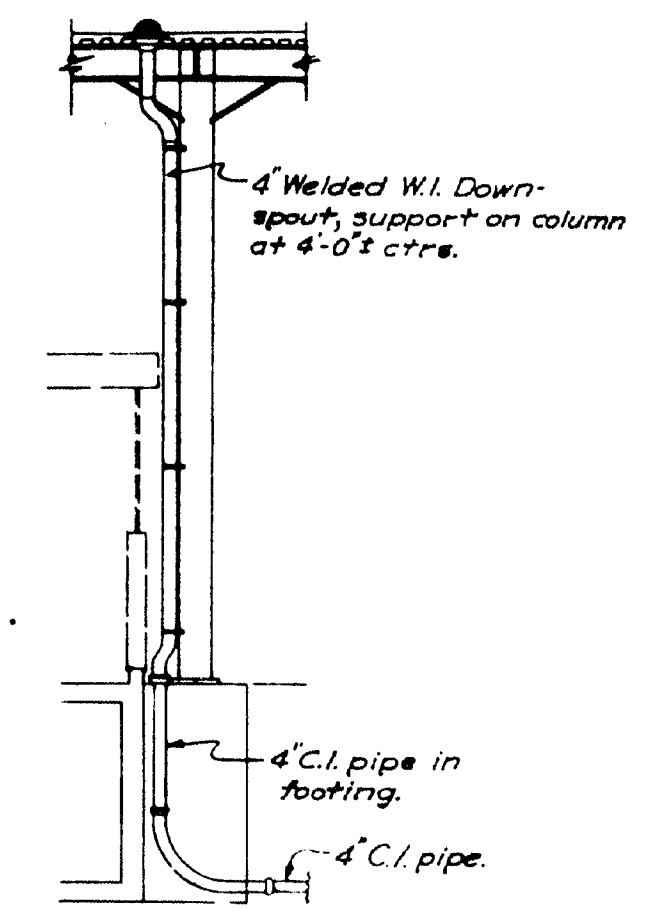


SECTION C-C  
Scale: 1/4" = 1'-0"

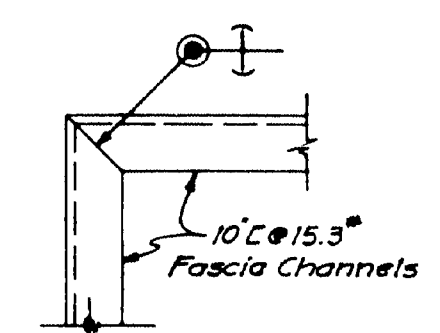

WELDING DETAIL

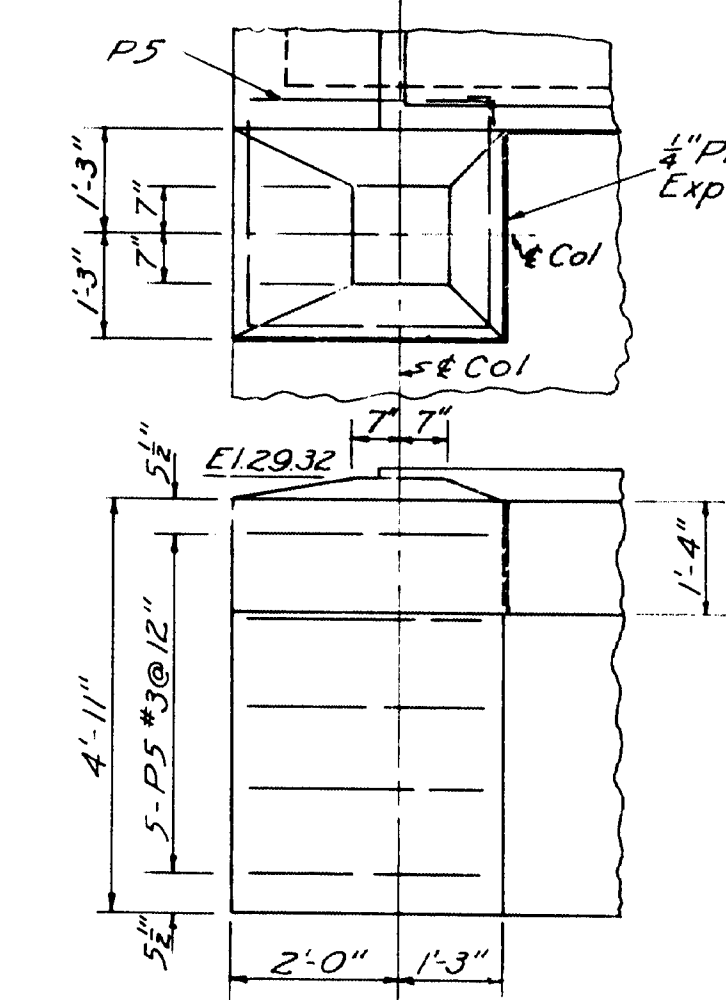

EXT. COLUMN FOOTING DETAILS  
Scale: 1/2" = 1'-0"

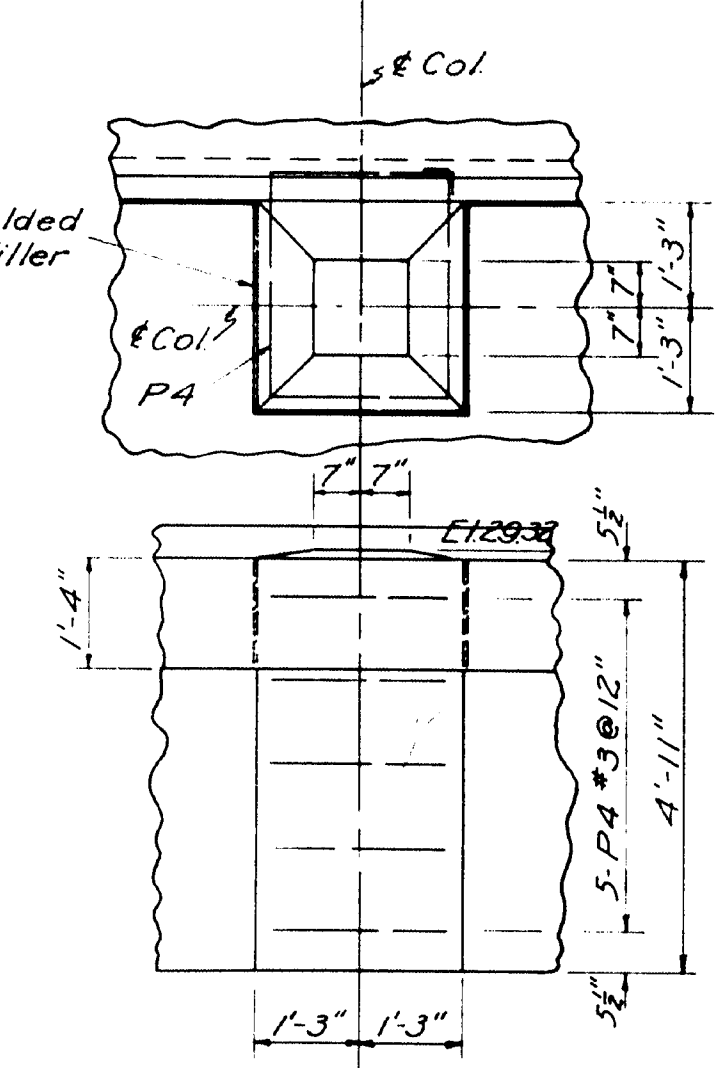

INT. COLUMN FOOTING DETAILS  
Scale: 1/2" = 1'-0"





NOTES:

For additional details see Sheet Nos. 40 and 51.  
For lighting details see Sheet No. 20 and 50.  
All concrete in Toll House islands, bumpers and canopy footings shall be Class "B" Concrete bumpers shall be rubbed to present a uniformly smooth, white appearance. Concrete in canopy roof shall be sloped to a roof drain as shown. See Specifications for type of concrete in canopy roof.

STATE OF MAINE  
STATE HIGHWAY COMMISSION  
BANGOR-BREWER BRIDGE  
OVER PENOBSCOT RIVER  
BANGOR, MAINE  
TOLL ISLANDS & CANOPY  
HARRINGTON AND CORTELYOU  
CONSULTING ENGINEERS  
KANSAS CITY, MO.  
DETAILED G.E.G. 12-13-52  
TRACED B.R.C. 1-18-53  
CHECKED G.H.K. 1-20-53  
SCALE: AS NOTED  
SHEET NO. 48











'As Built' Revisions 8-10-55 ZEW.



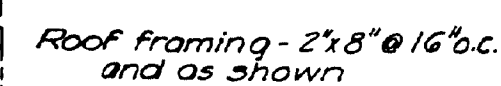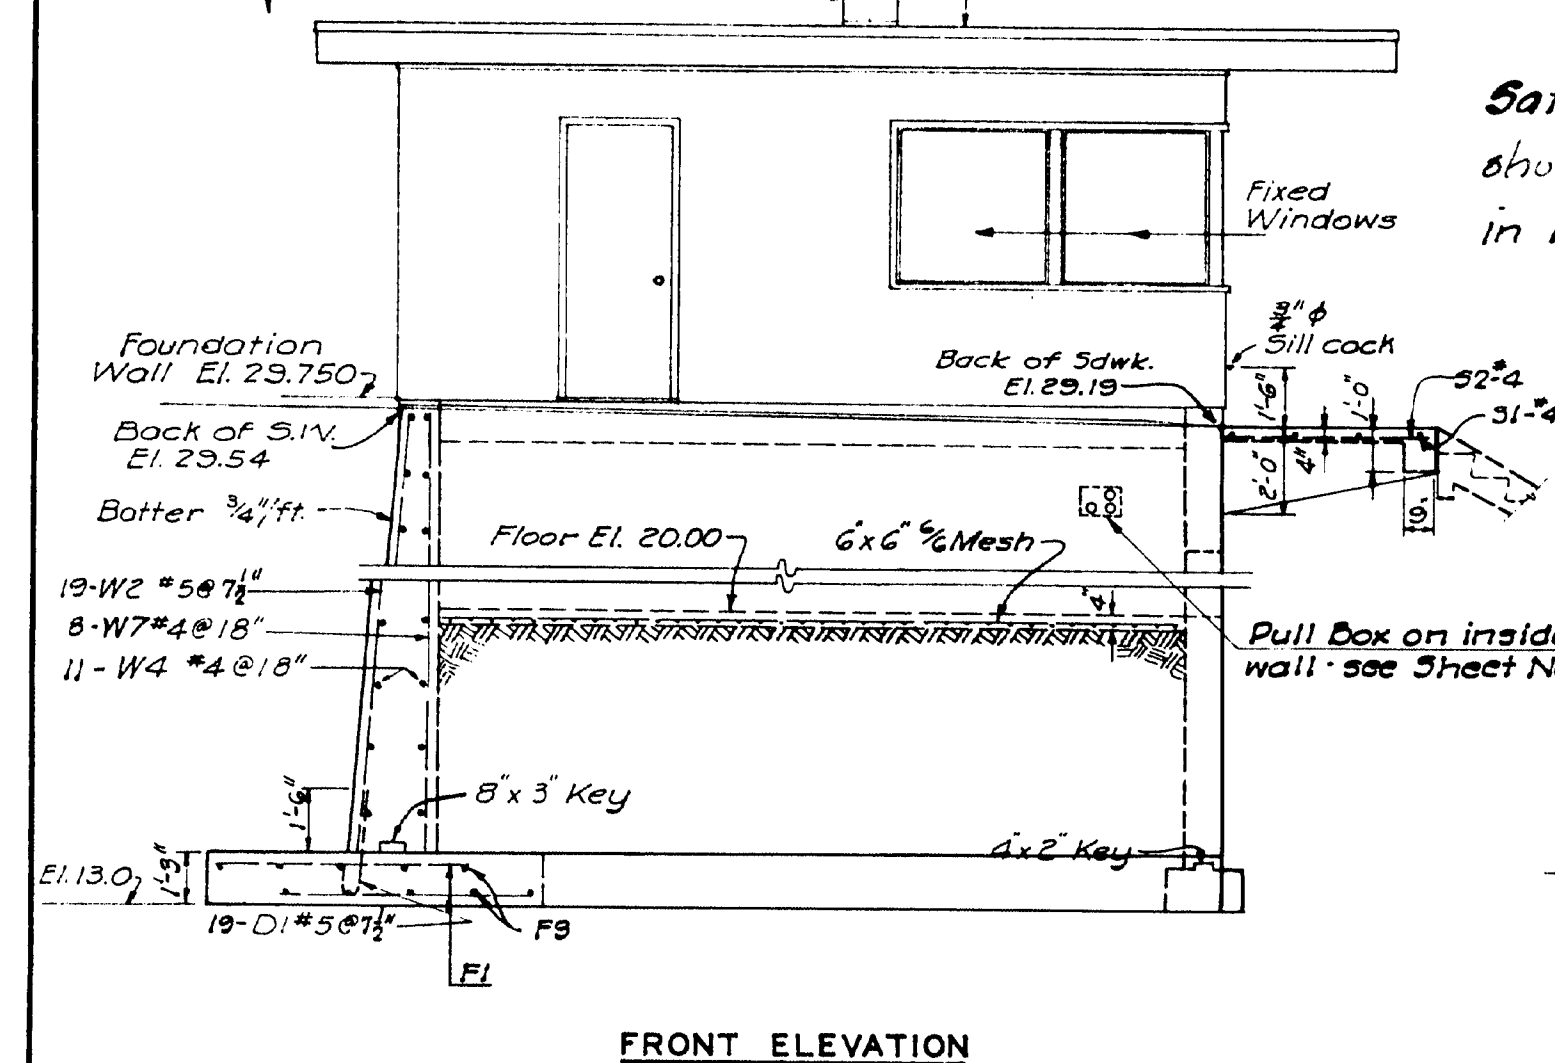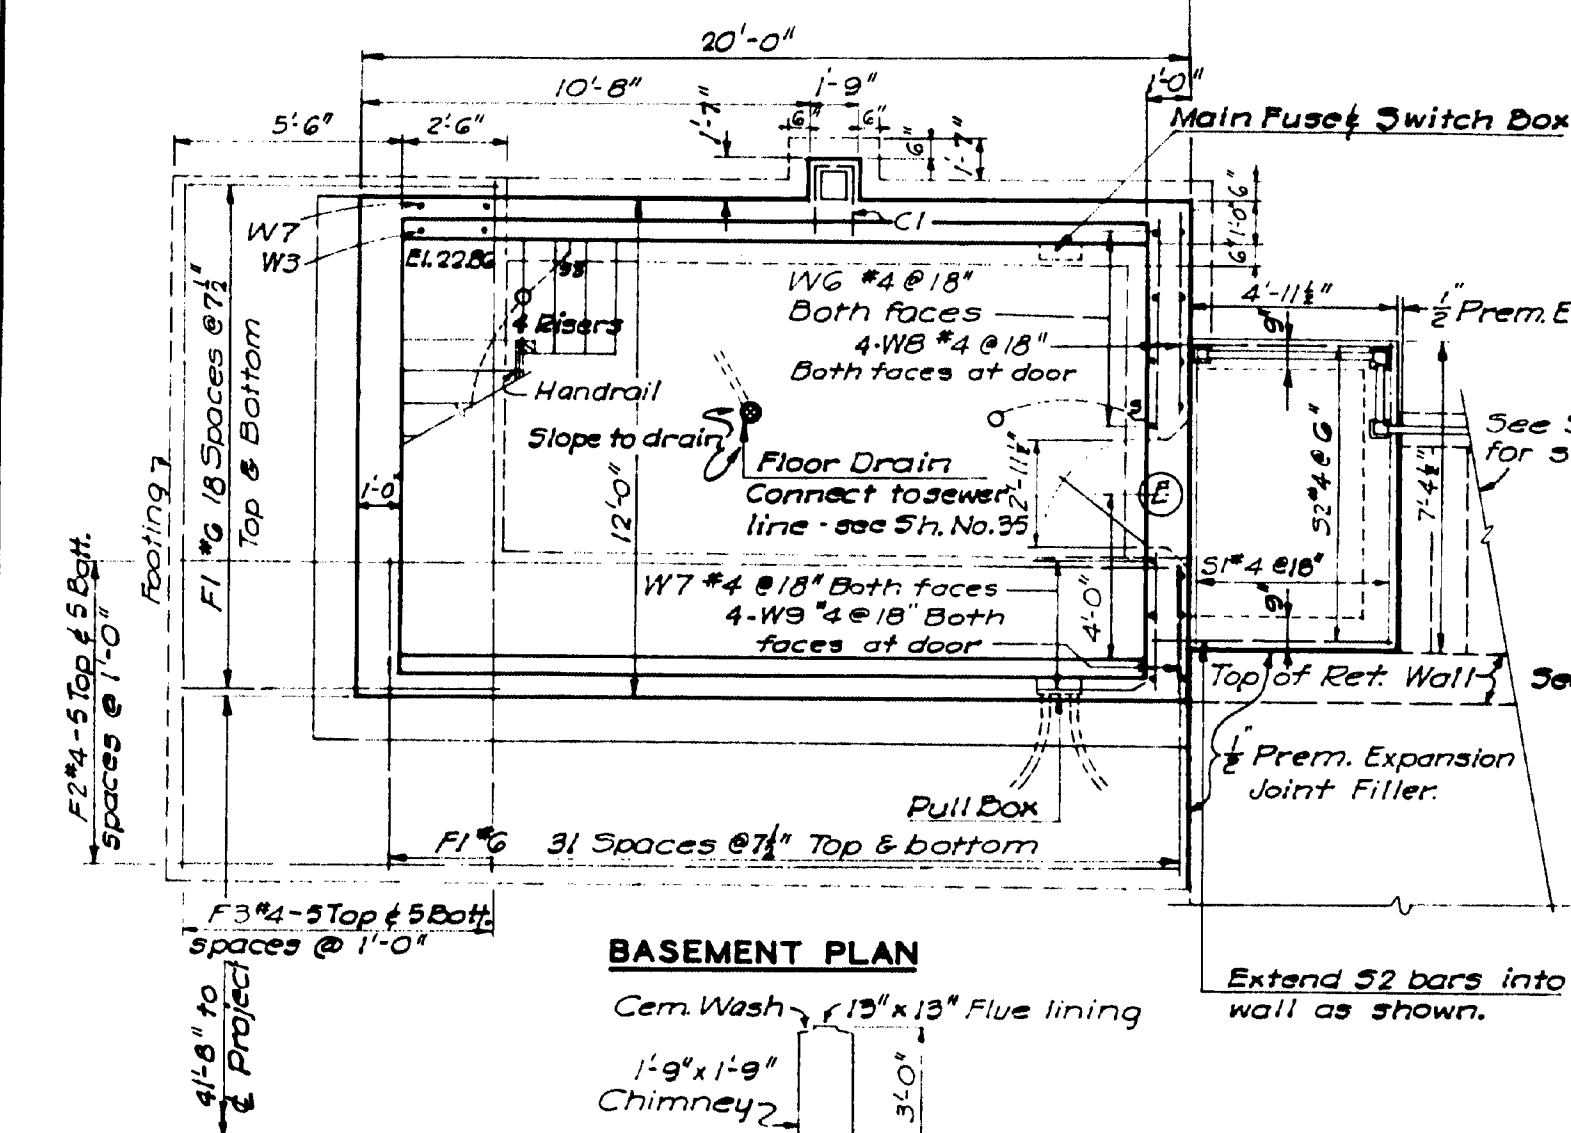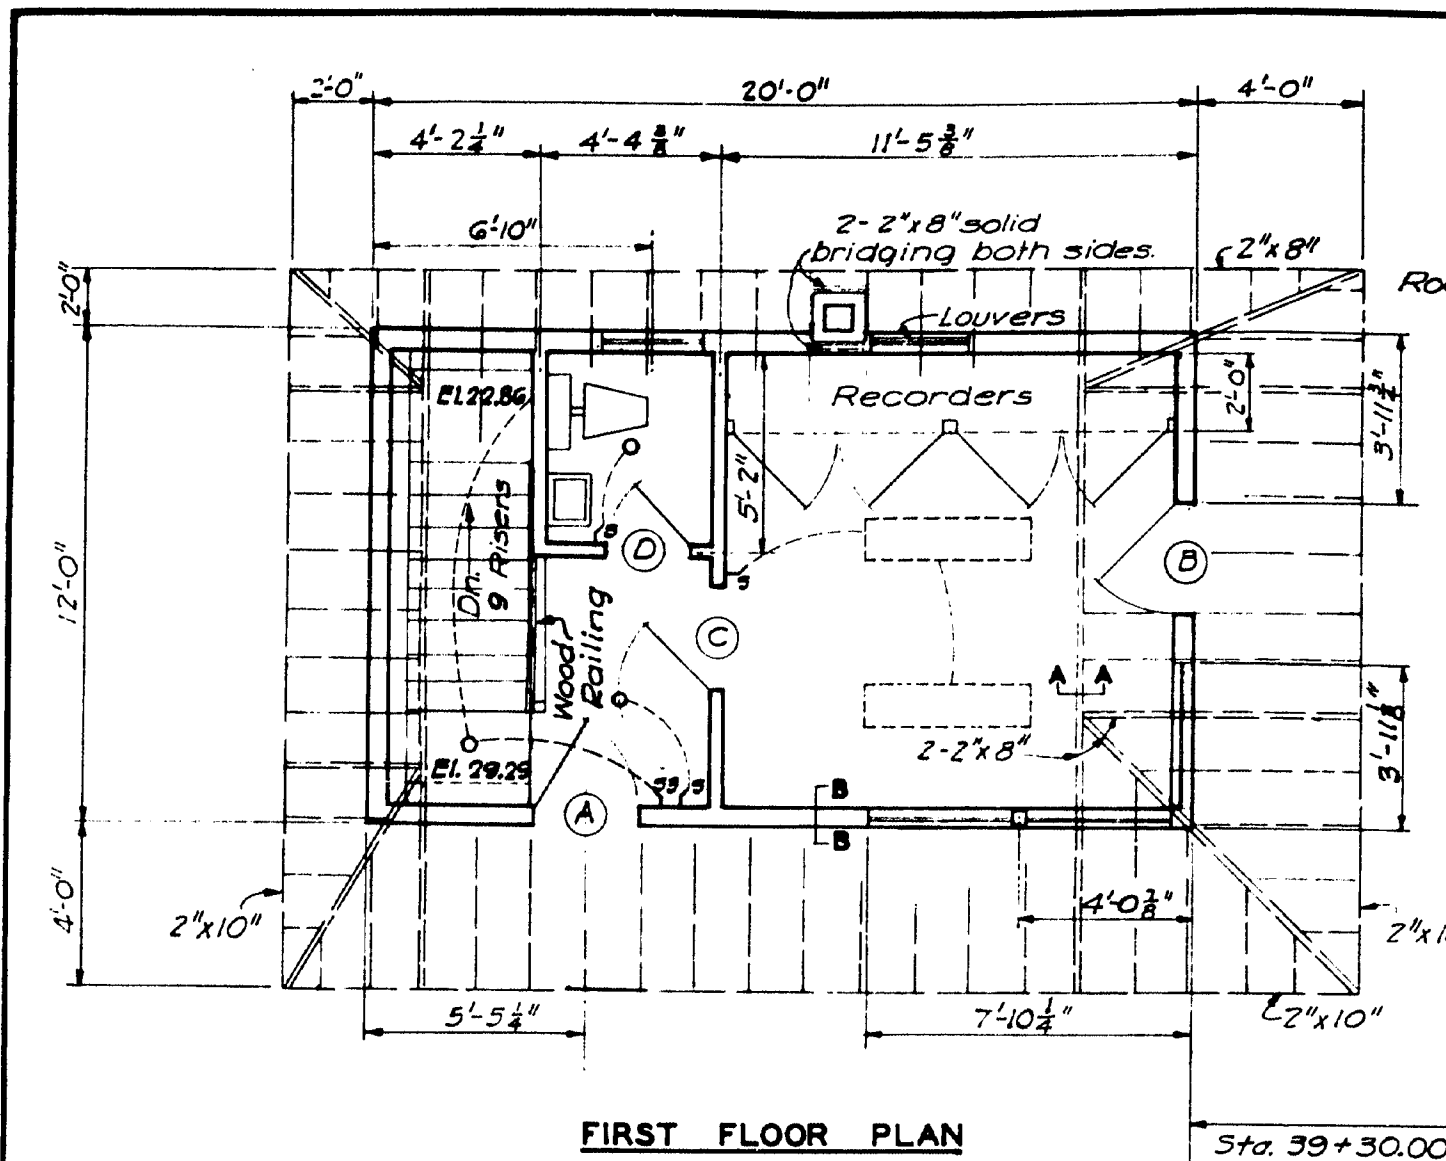

DOOR SCHEDULE		
Door	Type	Size
A	Flush	2'-8" x 6'-8"
B	do	do
C	do	2'-6" x 6'-6"
D	do	2'-0" x 6'-6"
E	2-Panel	2'-8" x 6'-8"

Note:  
Framing of exterior walls and interior partitions shall be 2"x4" studs @ 16" o.c.. The stairs shall be 8 1/2" risers and 9" treads with 2 x 10" treads and 2 - 2"x12" stringers.

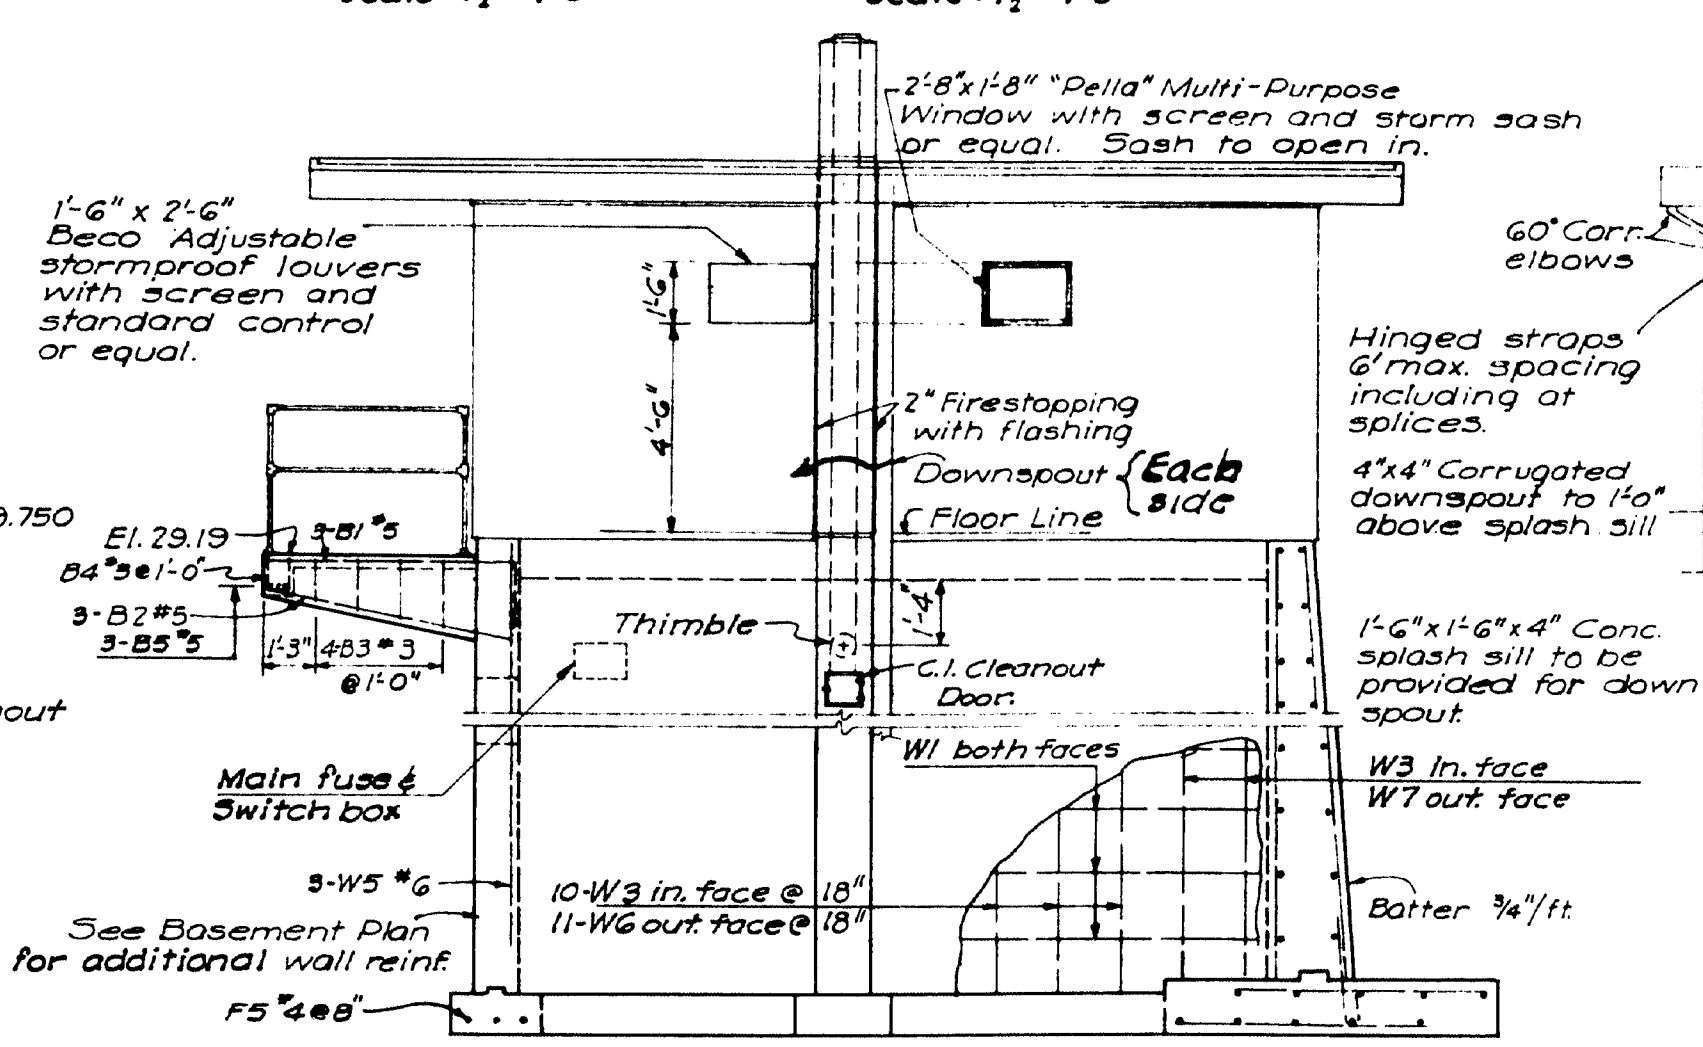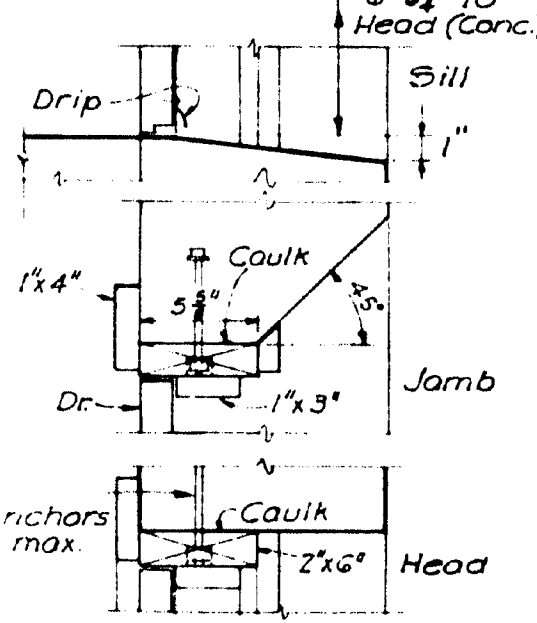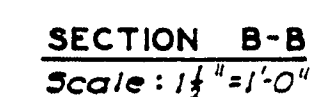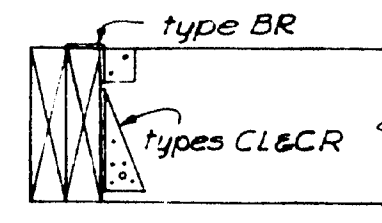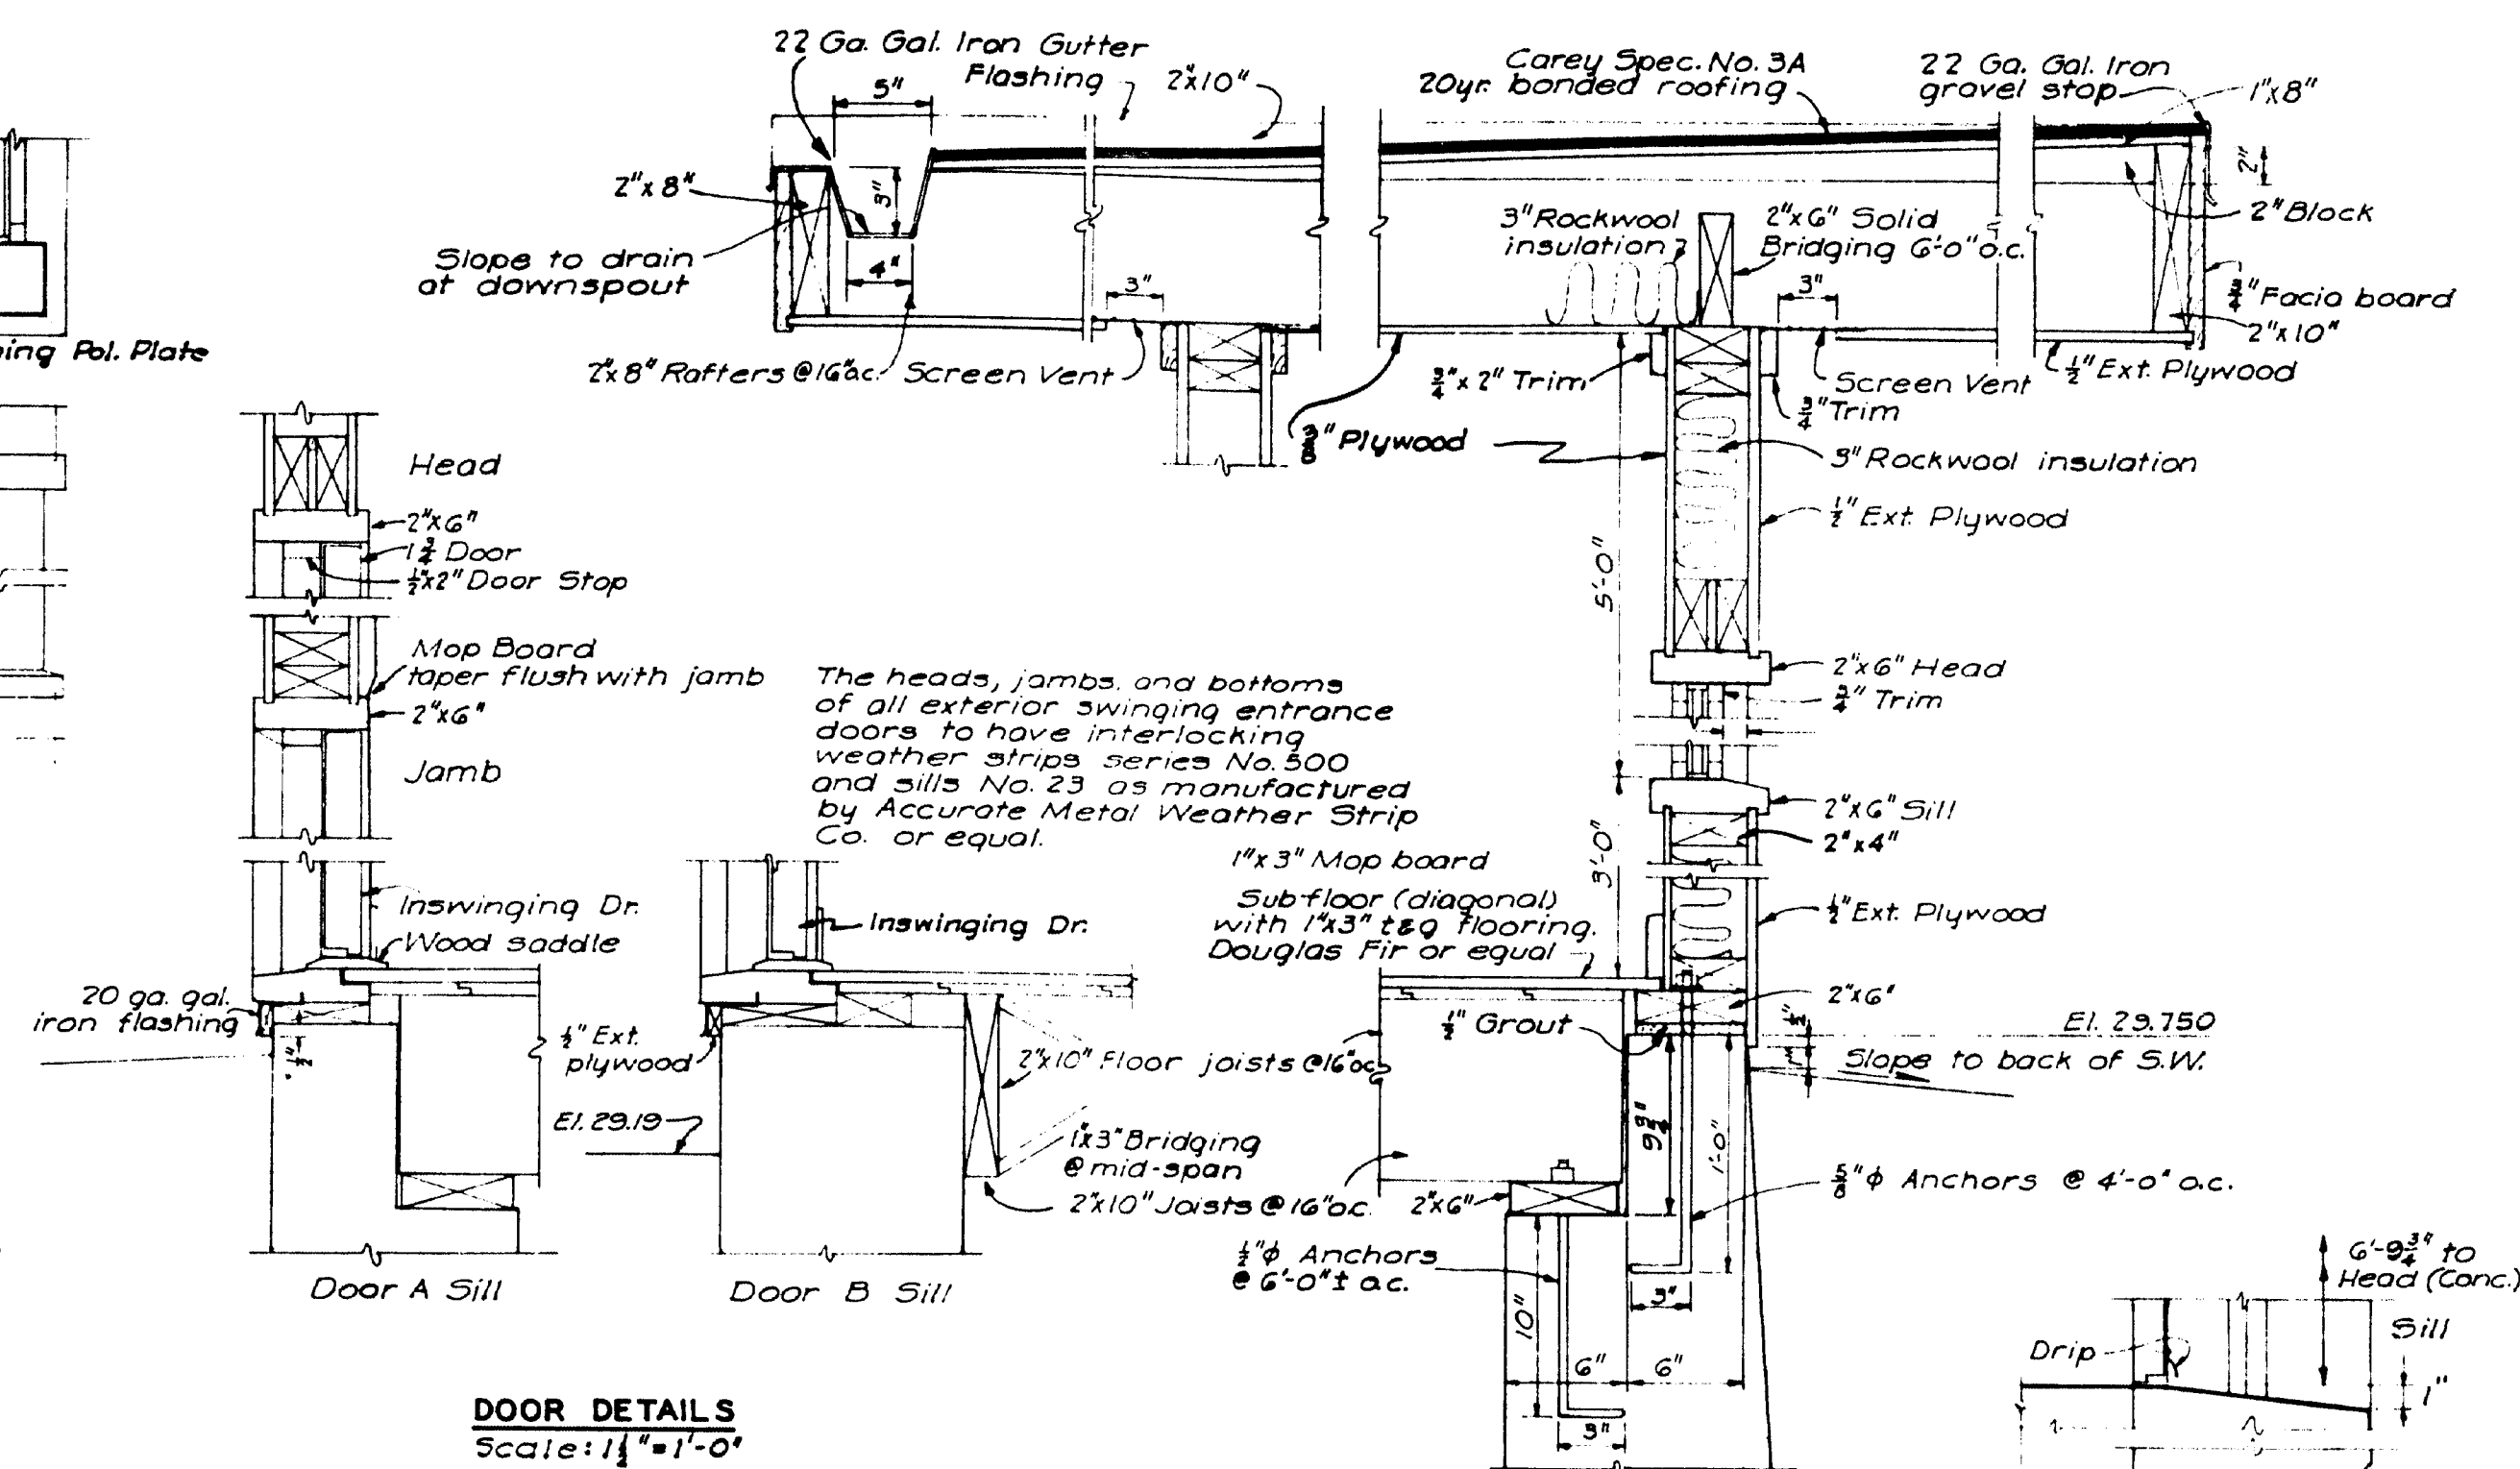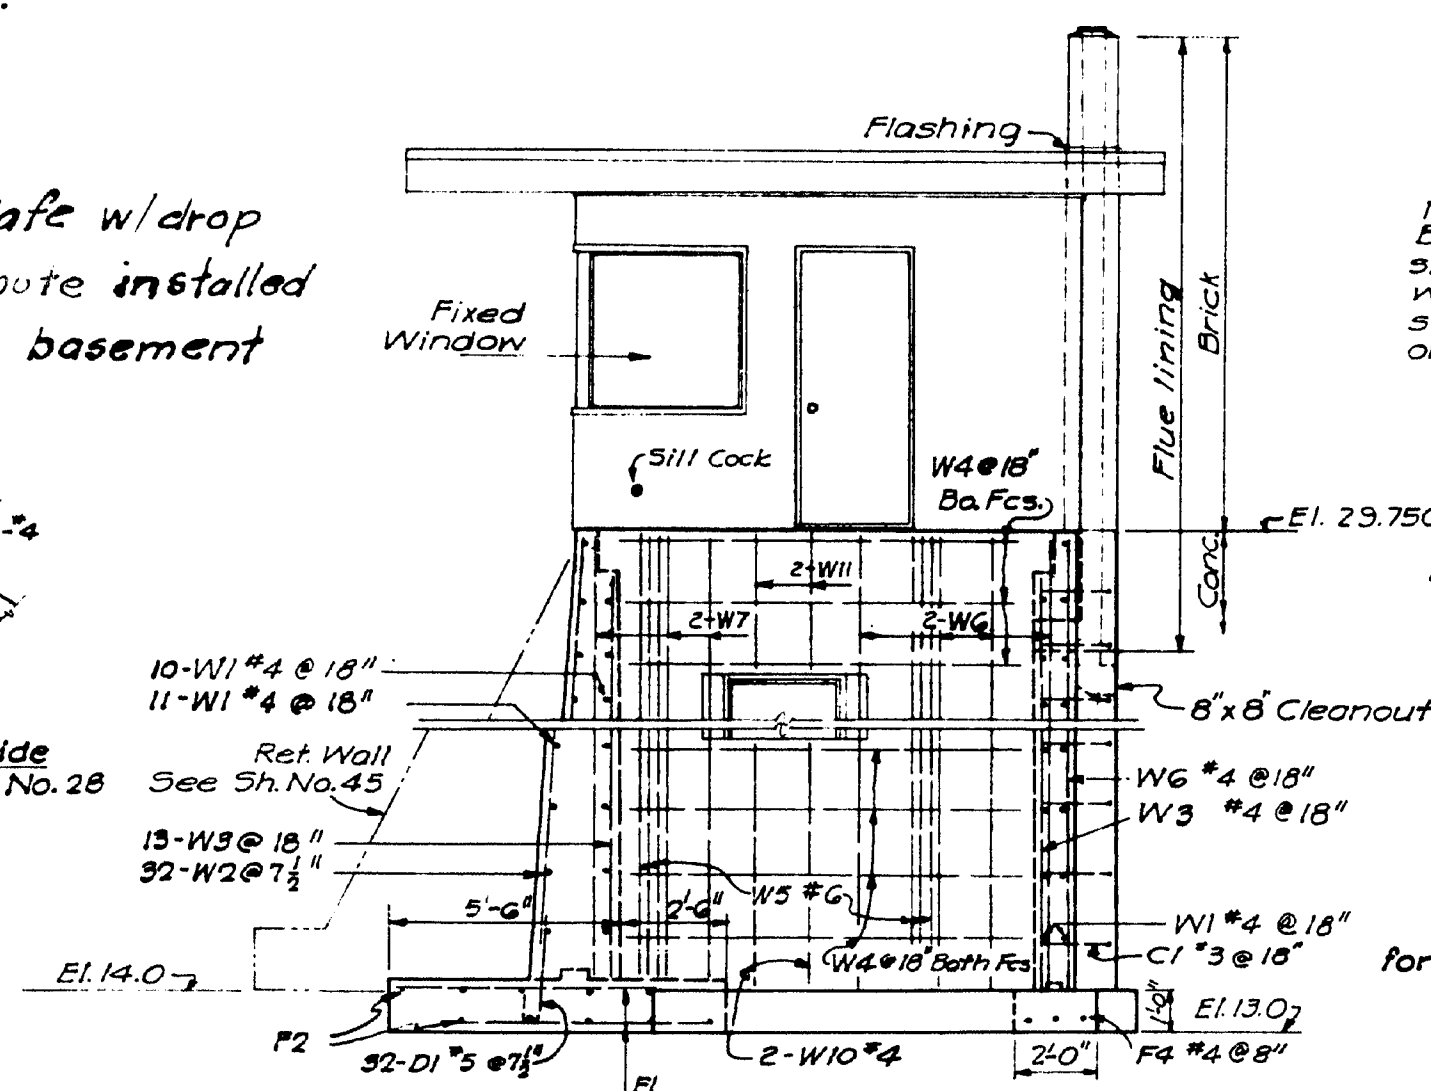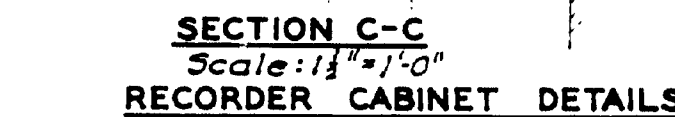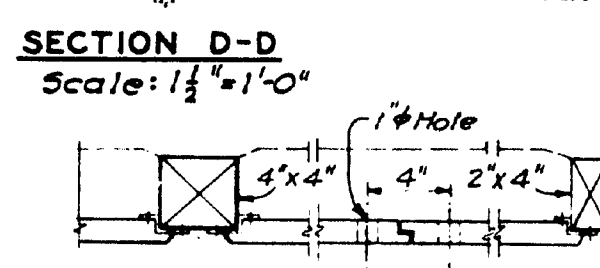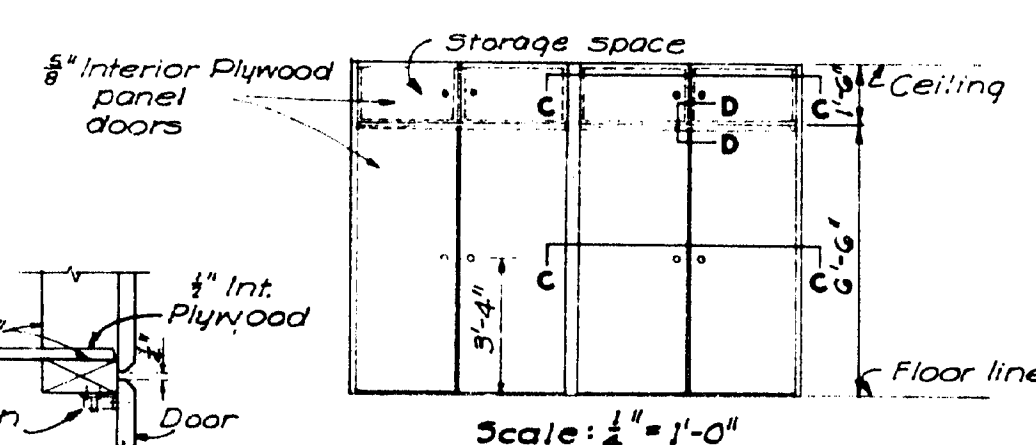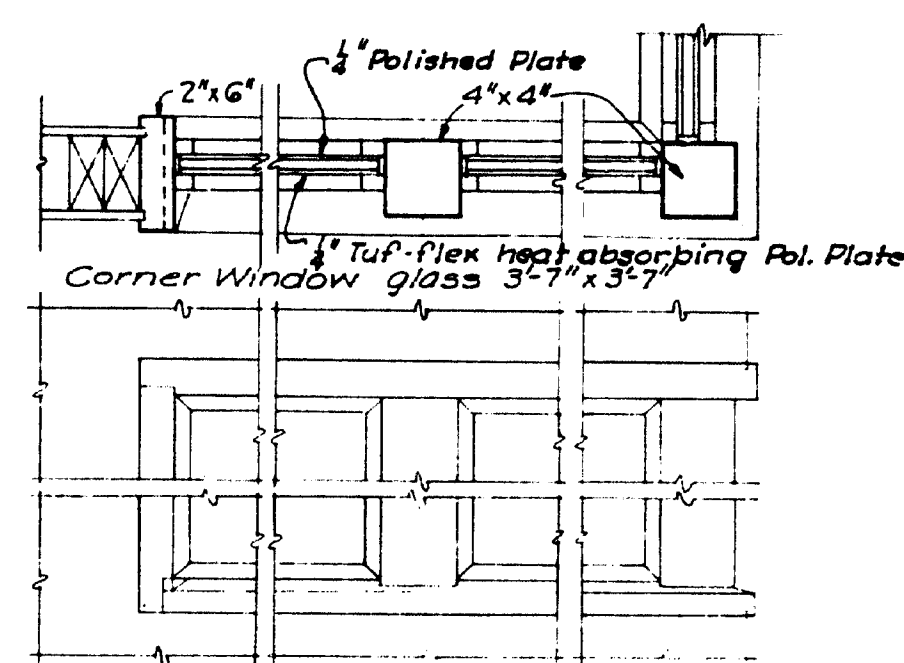


STATE OF MAINE  
STATE HIGHWAY COMMISSION  
**BANGOR-BREWER BRIDGE**  
**OVER PENOBSCOT RIVER**  
BANGOR, MAINE








UTILITY BUILDING

HARRINGTON AND CORTELYOU  
CONSULTING ENGINEERS  
KANSAS CITY, MO.


DETAILED E.R.Jr. 12-6-52 SCALE:  $\frac{1}{4}'' = 1' - 0''$   
 TRACED Repra 1-19-53 AND AS NOTED  
 CHECKED G.H.K. 1-20-53 SHEET NO. 49

"As Built" Revisions 8-8-55 ZEW

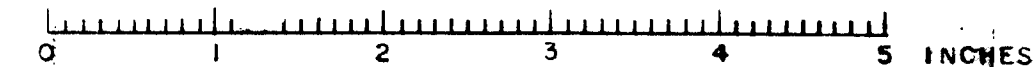


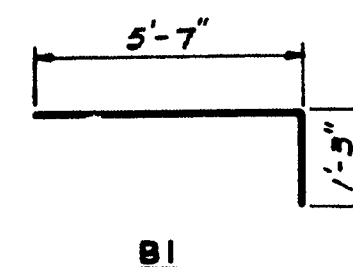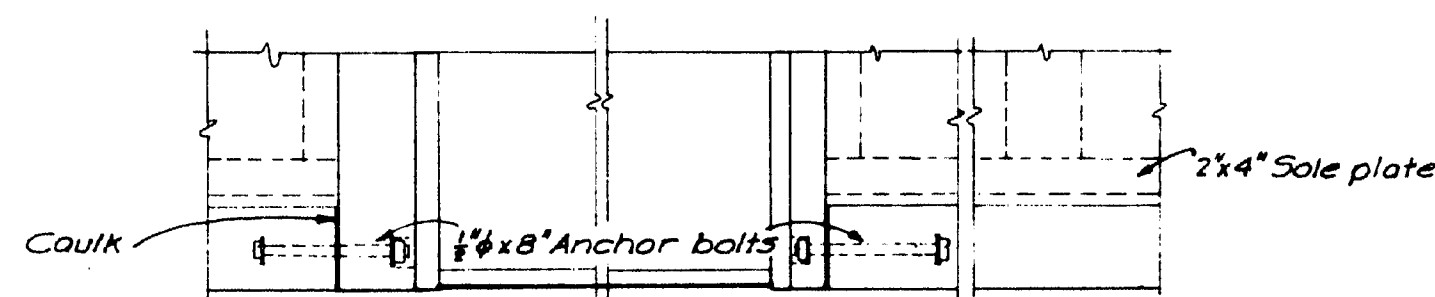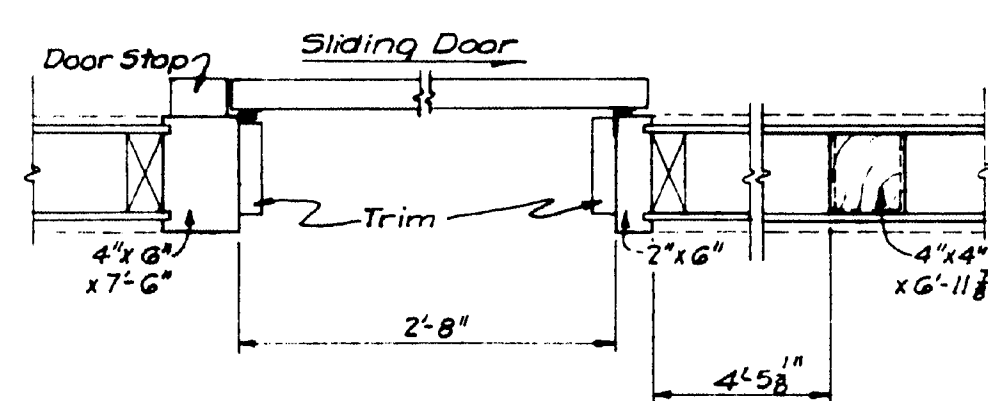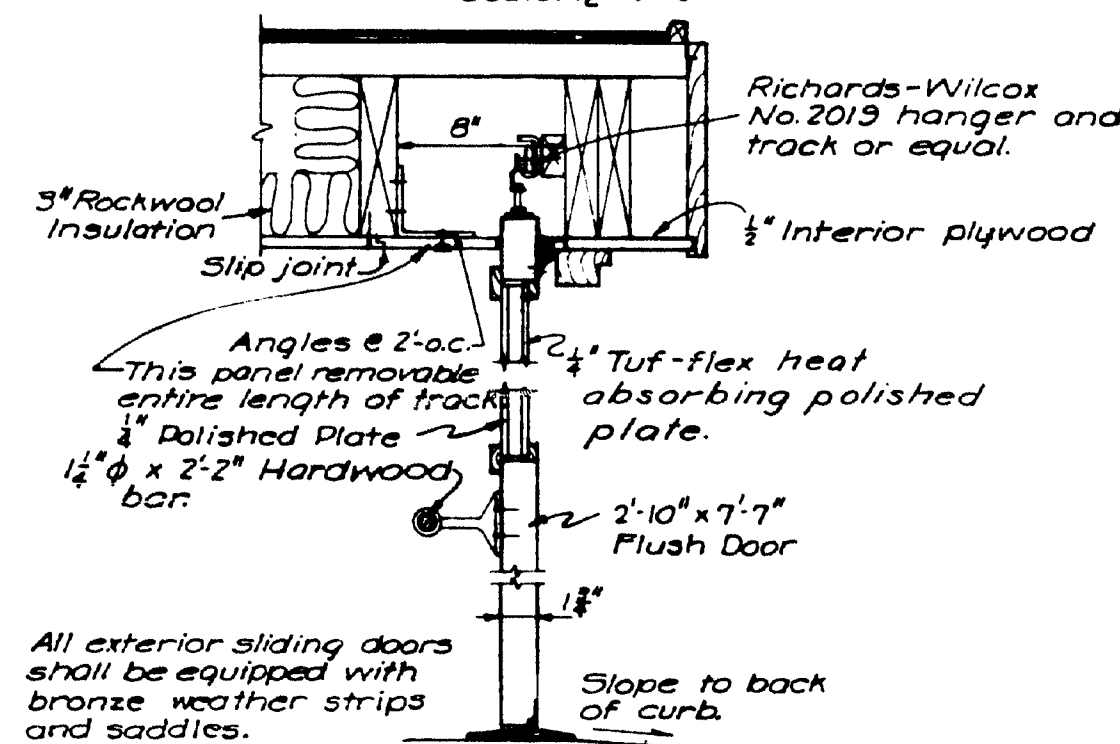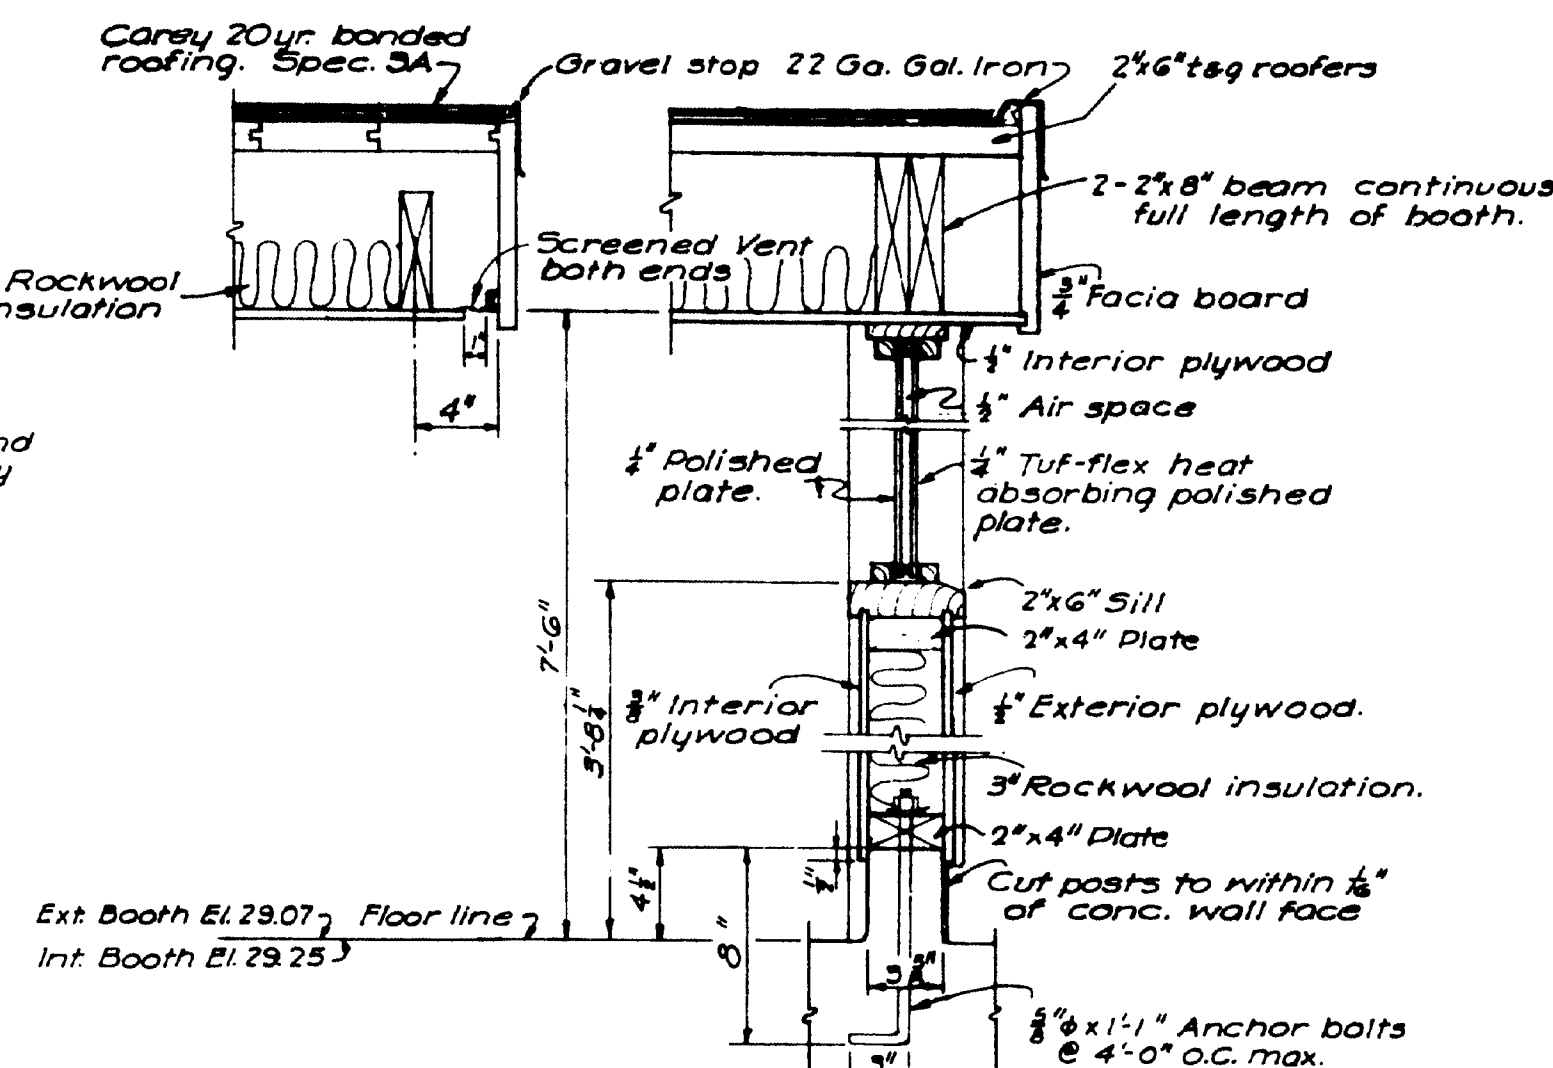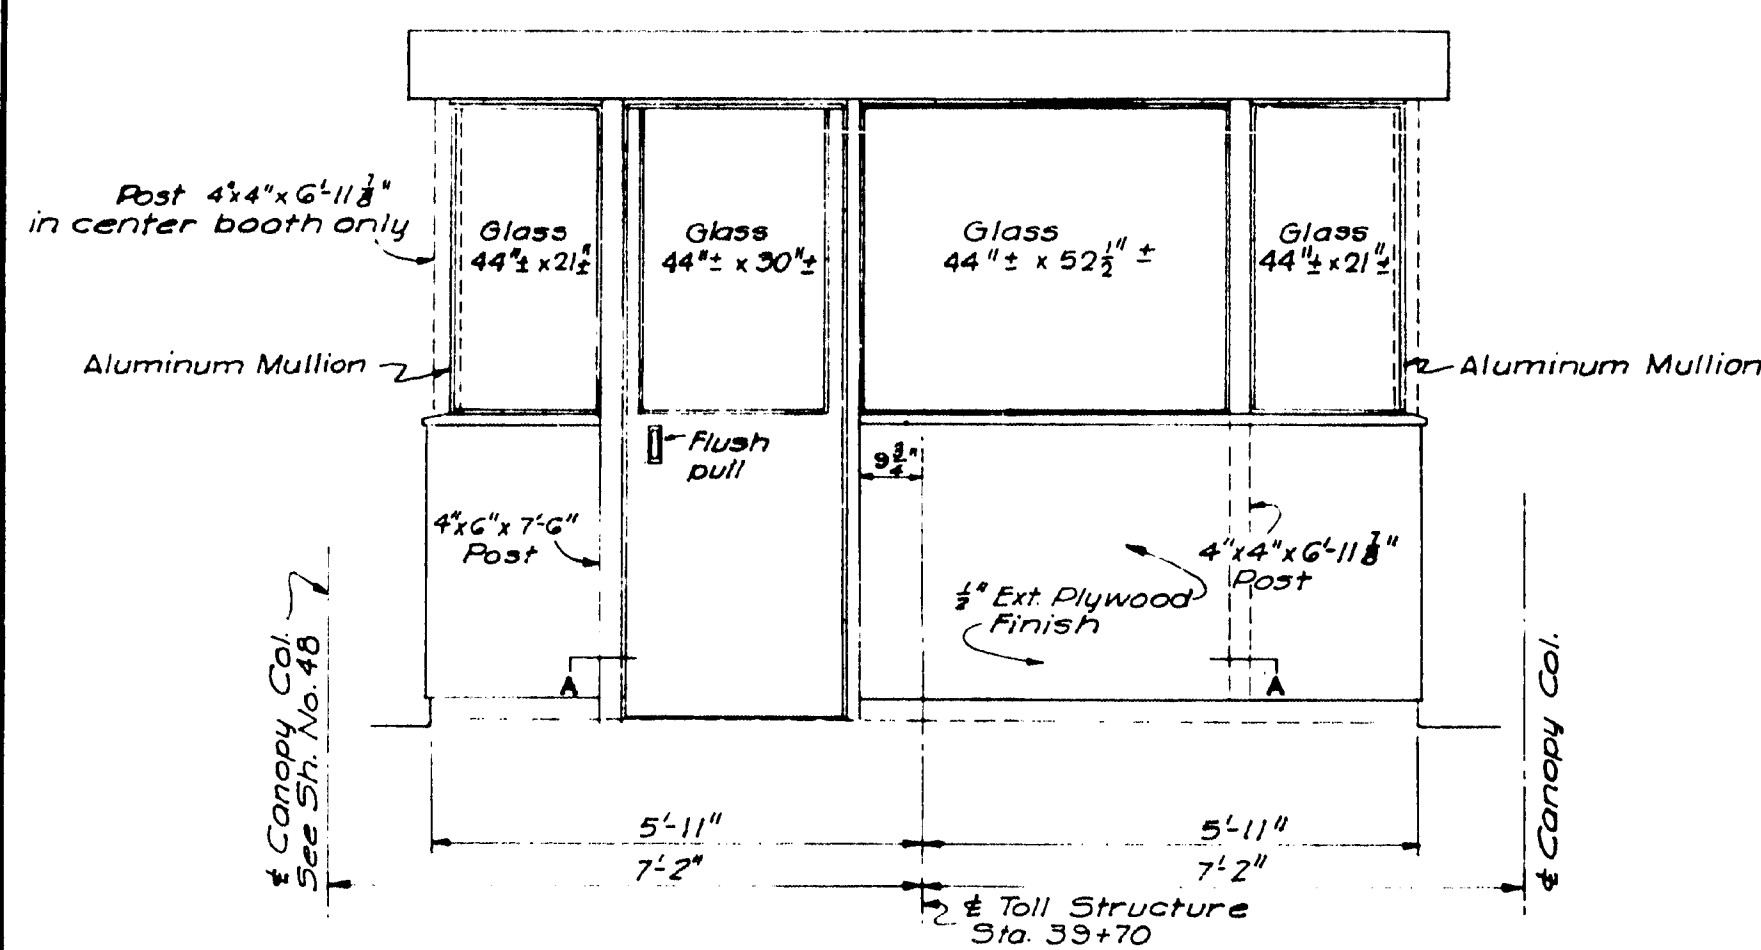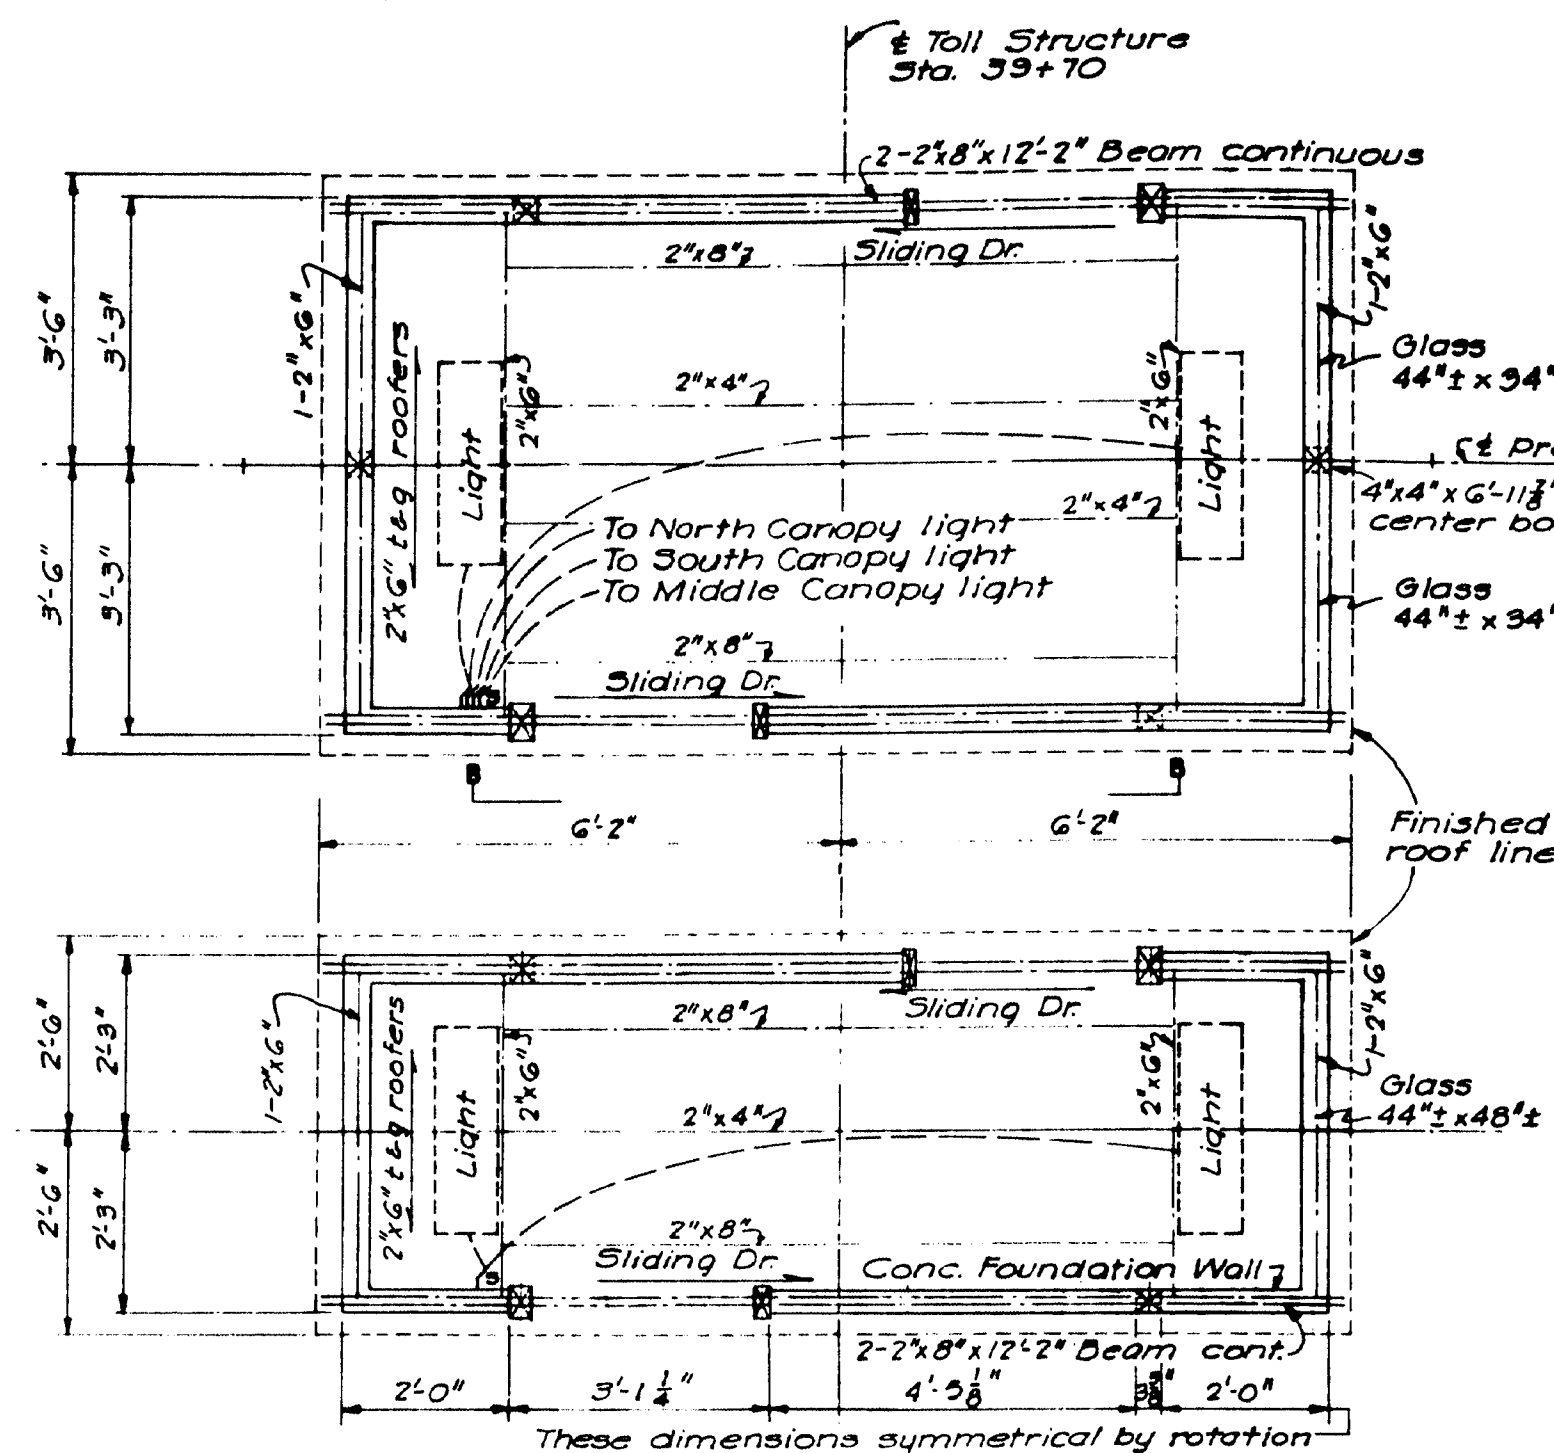


All dimensions are out to out of bar.

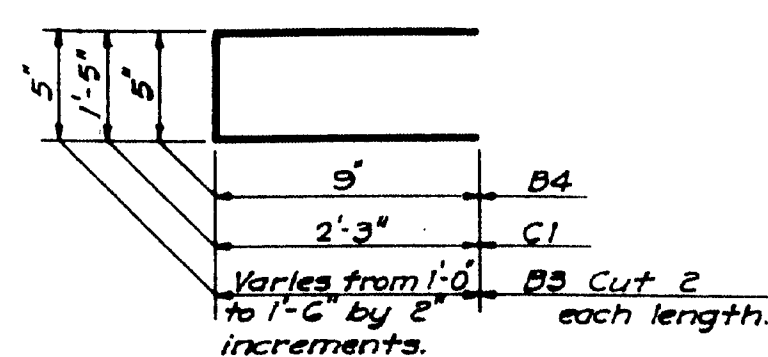

B3-B4-C1

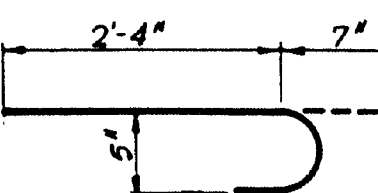

D1

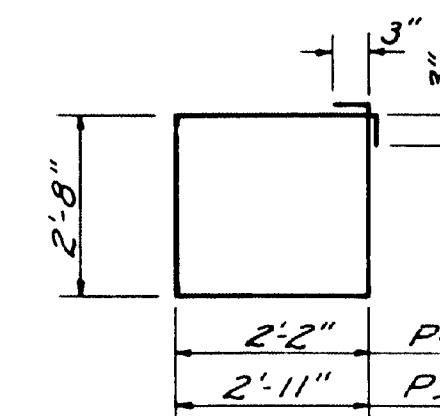

P4-P5

See MSHC Toll Recording Equipment Installation plans  
See Plan Sh. No. R10 & letter 7-14-55 for toll booth door revisions.

BILL OF REINFORCING				
MA.	No.	Size	Shape	Length
B1	6	5		6' 10"
B2	6	5		5' 9"
B3	8	3		2' 11"
B4	5	3		1' 11"
B5	3	5		7' 2"
C1	10	3		5' 11"
D1	51	5		2' 11"
F1	102	6		6' 0"
F2	10	4		24' 0"
F3	10	4		16' 6"
F4	3	4		19' 0"
F5	3	4		10' 0"
W1	42	4		19' 6"
W2	51	5		15' 3"
W3	25	4		14' 3"
W4	36	4		11' 6"
W5	6	6		15' 0"
W6	19	4		15' 6"
W7	16	4		15' 3"
W8	8	4		5' 0"
W9	8	4		3' 0"
W10	4	4		5' 9"
W11	4	4		2' 6"
S1	4	4		7' 2"
S2	15	4		5' 8"
P1	76	3		9' 8"
P2	76	3		11' 6"
P3	152	3		7' 8"
P4	10	3		10' 2"
P5	20	3		11' 8"
P6	118	3		4' 7"

This reinforcing for utility building walls Sh. No. 49, except \* bars are for steam pits Sh. No. 51.  
\* Average length

#### NOTES:

Framing not shown shall be 2x4 studs at 16" o.c.  
For heating and steam pit details see Sheet No. 51.  
For additional details see Sheet No. 48.  
For lighting details see Sheet No. 28.

STATE OF MAINE  
STATE HIGHWAY COMMISSION  
BANGOR-BREWER BRIDGE  
OVER PENOBSCOT RIVER  
BANGOR, MAINE

#### TOLL BOOTH DETAILS





HARRINGTON AND CORTELYOU  
CONSULTING ENGINEERS  
KANSAS CITY, MO.

DETAILED E.B. Jr. 12-9-52 SCALE: AS NOTED  
TRACED Repro. 1-19-53  
CHECKED G.H.K. 1-20-53 SHEET NO. 50

"As Built" Revisions 8-9-55 ZEW.

62-51



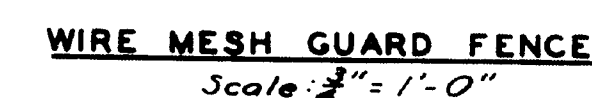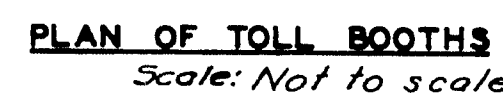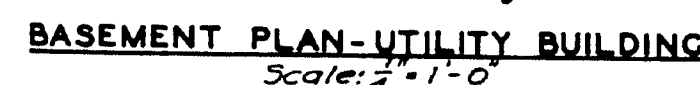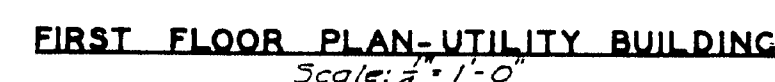

**NOTES:**

All concrete shall be Class "P".  
See Sheet Nos. 40, 49, 50 for additional details.  
See Specifications for equipment requirements.  
See Sheet No. 50 for Bill of Reinforcing.  
One oil fired - 20 gallon-jacketed-hot water tank, with connections to fuel oil tank, shall be installed in basement.



Use curved end fitting at No. end of guard rail as shown.

**PLAN**

Cut rail flush with post. Grind and smooth edges.

Guard rail, No. 10 gauge corrugated steel section

Ground line

12'-6"

3'-6" ±

12'-6"

18"

2'-3"

8" x 6" Creosoted Wood Posts

3'-0"

**ELEVATION**

See Sheet No. 31 for location.

[illegible][illegible]

STONE GUTTER

VAR. 4'-0" 2'-0" 2:1

AREA = 0.71 SQ YDS PER LIFT

VARIES 2" TO 4" VARIES 0" TO 2" DOWNLINE VAR GRADE

AREA = 0.67 SQ YDS PER LIFT

VAR. 2'-0" 1'-4" 2:1

AREA = 0.30 SQ YDS PER LIFT ONLY

GRAVEL BED FOR GROUTED STONE GUTTER ONLY.

[illegible][illegible]

Diagram showing the transition for driveway approach for 6 inch curb. The diagram is crossed out with a large X.

STANDARD

TRANSITION FOR DRIVEWAY APPROACH FOR 6" CURB

CONSTRUCTION & EXPANSION JOINTS, THE SAME AS FOR CONCRETE CURB & GUTTER.

DOWELS 2" x 2'-0" LONG  
REINFORCING STEEL 8" x 19'-8" LONG

DRIVEWAY

TO BE CONSTRUCTED IN 20' SECTIONS. CONSTRUCTION JOINTS TO BE PAINTED WITH BITUMINOUS MATERIAL. EXPANSION JOINTS EVERY 40' 1/2" THICK PRE-MOLDED MATERIAL SHALL BE PLACED IN EACH EXPANSION JOINT.

"A" BARS 1/2" X 10" @ 10" C/C. "B" BARS 1/2" X 4" @ 10" C/C. "A" BARS 3" FROM EACH END OF THE SECTION AND SPACING THEM 3'-6" C/C. THE REST OF THE SECTION DOWELS 3/4" X 10" @ 10" C/C, SPACED 1'-0" C/C.

CLASS "A" CONCRETE 5.49 CU YDS PER 100 LIN. FT.  
 STEEL 339.93 LBS. PER 100 LIN. FT.

6 MIN. L. LUG-O PLANK

8'-0"

8'-0"

6'-0"

6' x 8' LUG-O PLANK


6' x 8'

6' x 8'

BANGOR - BREWER BRIDGE

SHEET NO. 52



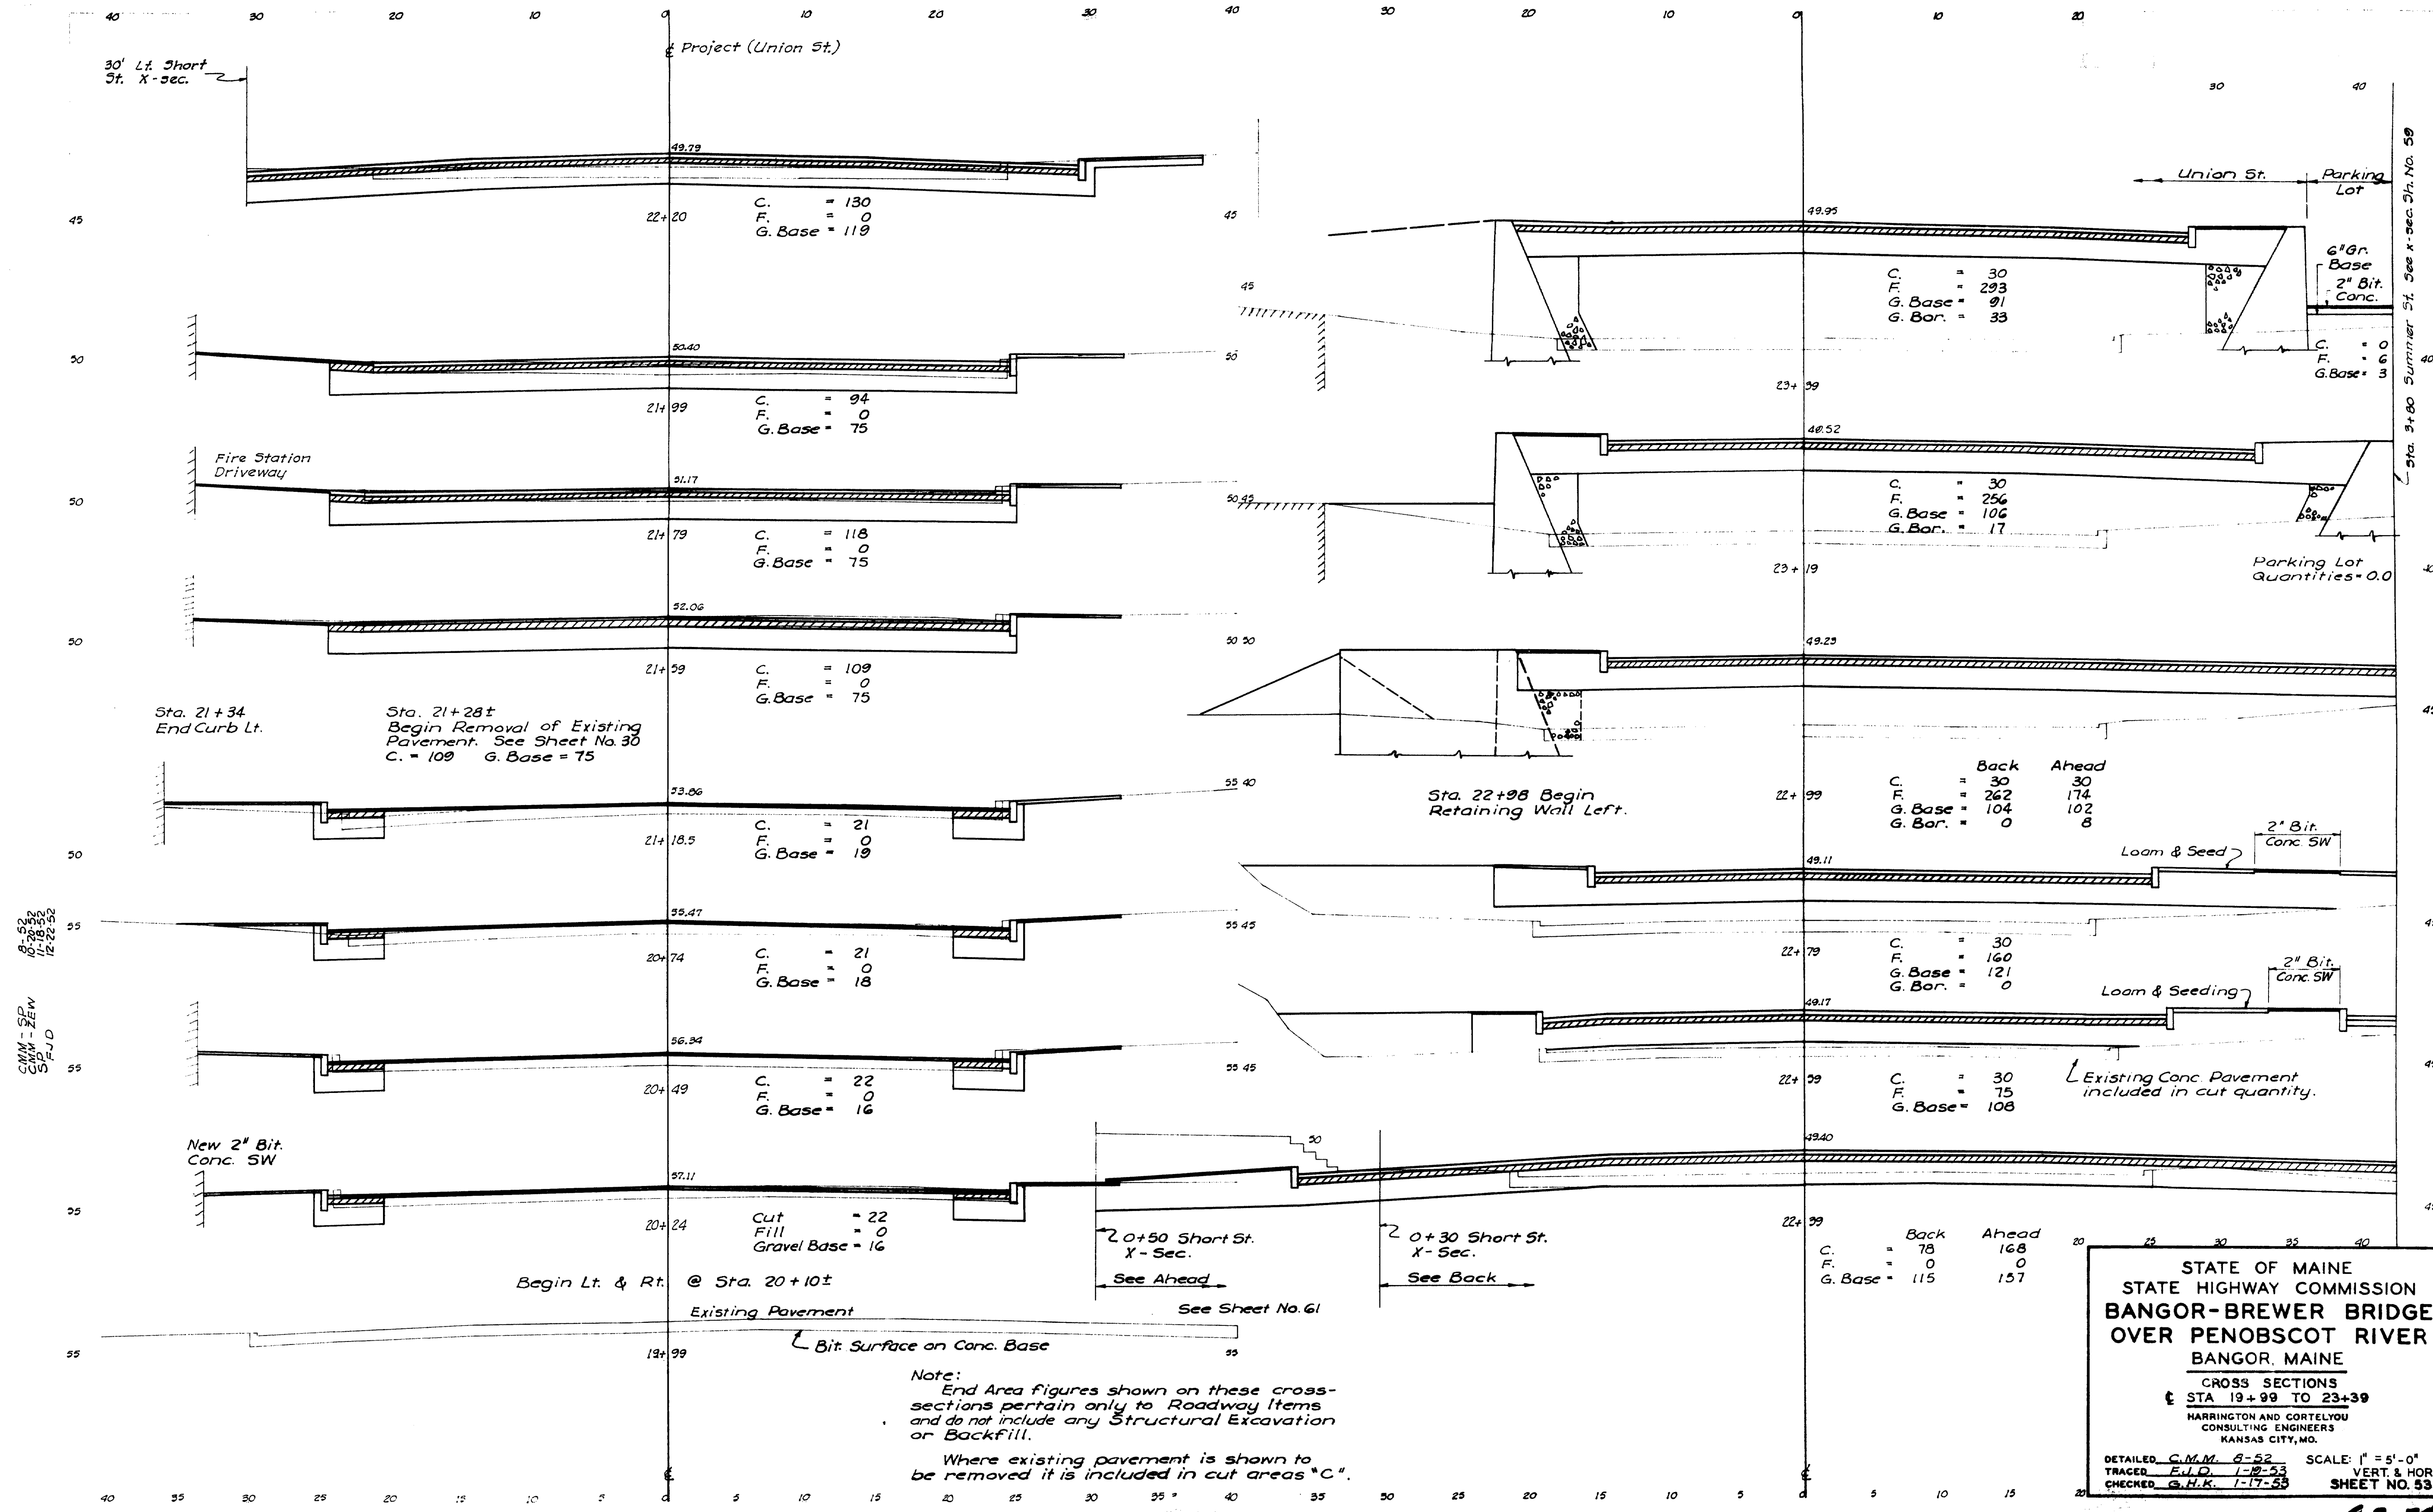



STATE OF MAINE  
STATE HIGHWAY COMMISSION  
**BANGOR-BREWER BRIDGE  
OVER PENOBSCOT RIVER  
BANGOR, MAINE**

CROSS SECTIONS  
STA 19+99 TO 23+39  
HARRINGTON AND CORTELYOU  
CONSULTING ENGINEERS  
KANSAS CITY, MO.

DETAILED C.M.M. 8-52 SCALE: 1" = 5'-0"  
TRACED F.J.D. 1-12-53 VERT. & HOR.  
CHECKED G.H.K. 1-17-53 SHEET NO. 53

62-54

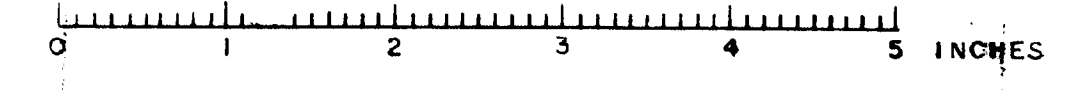

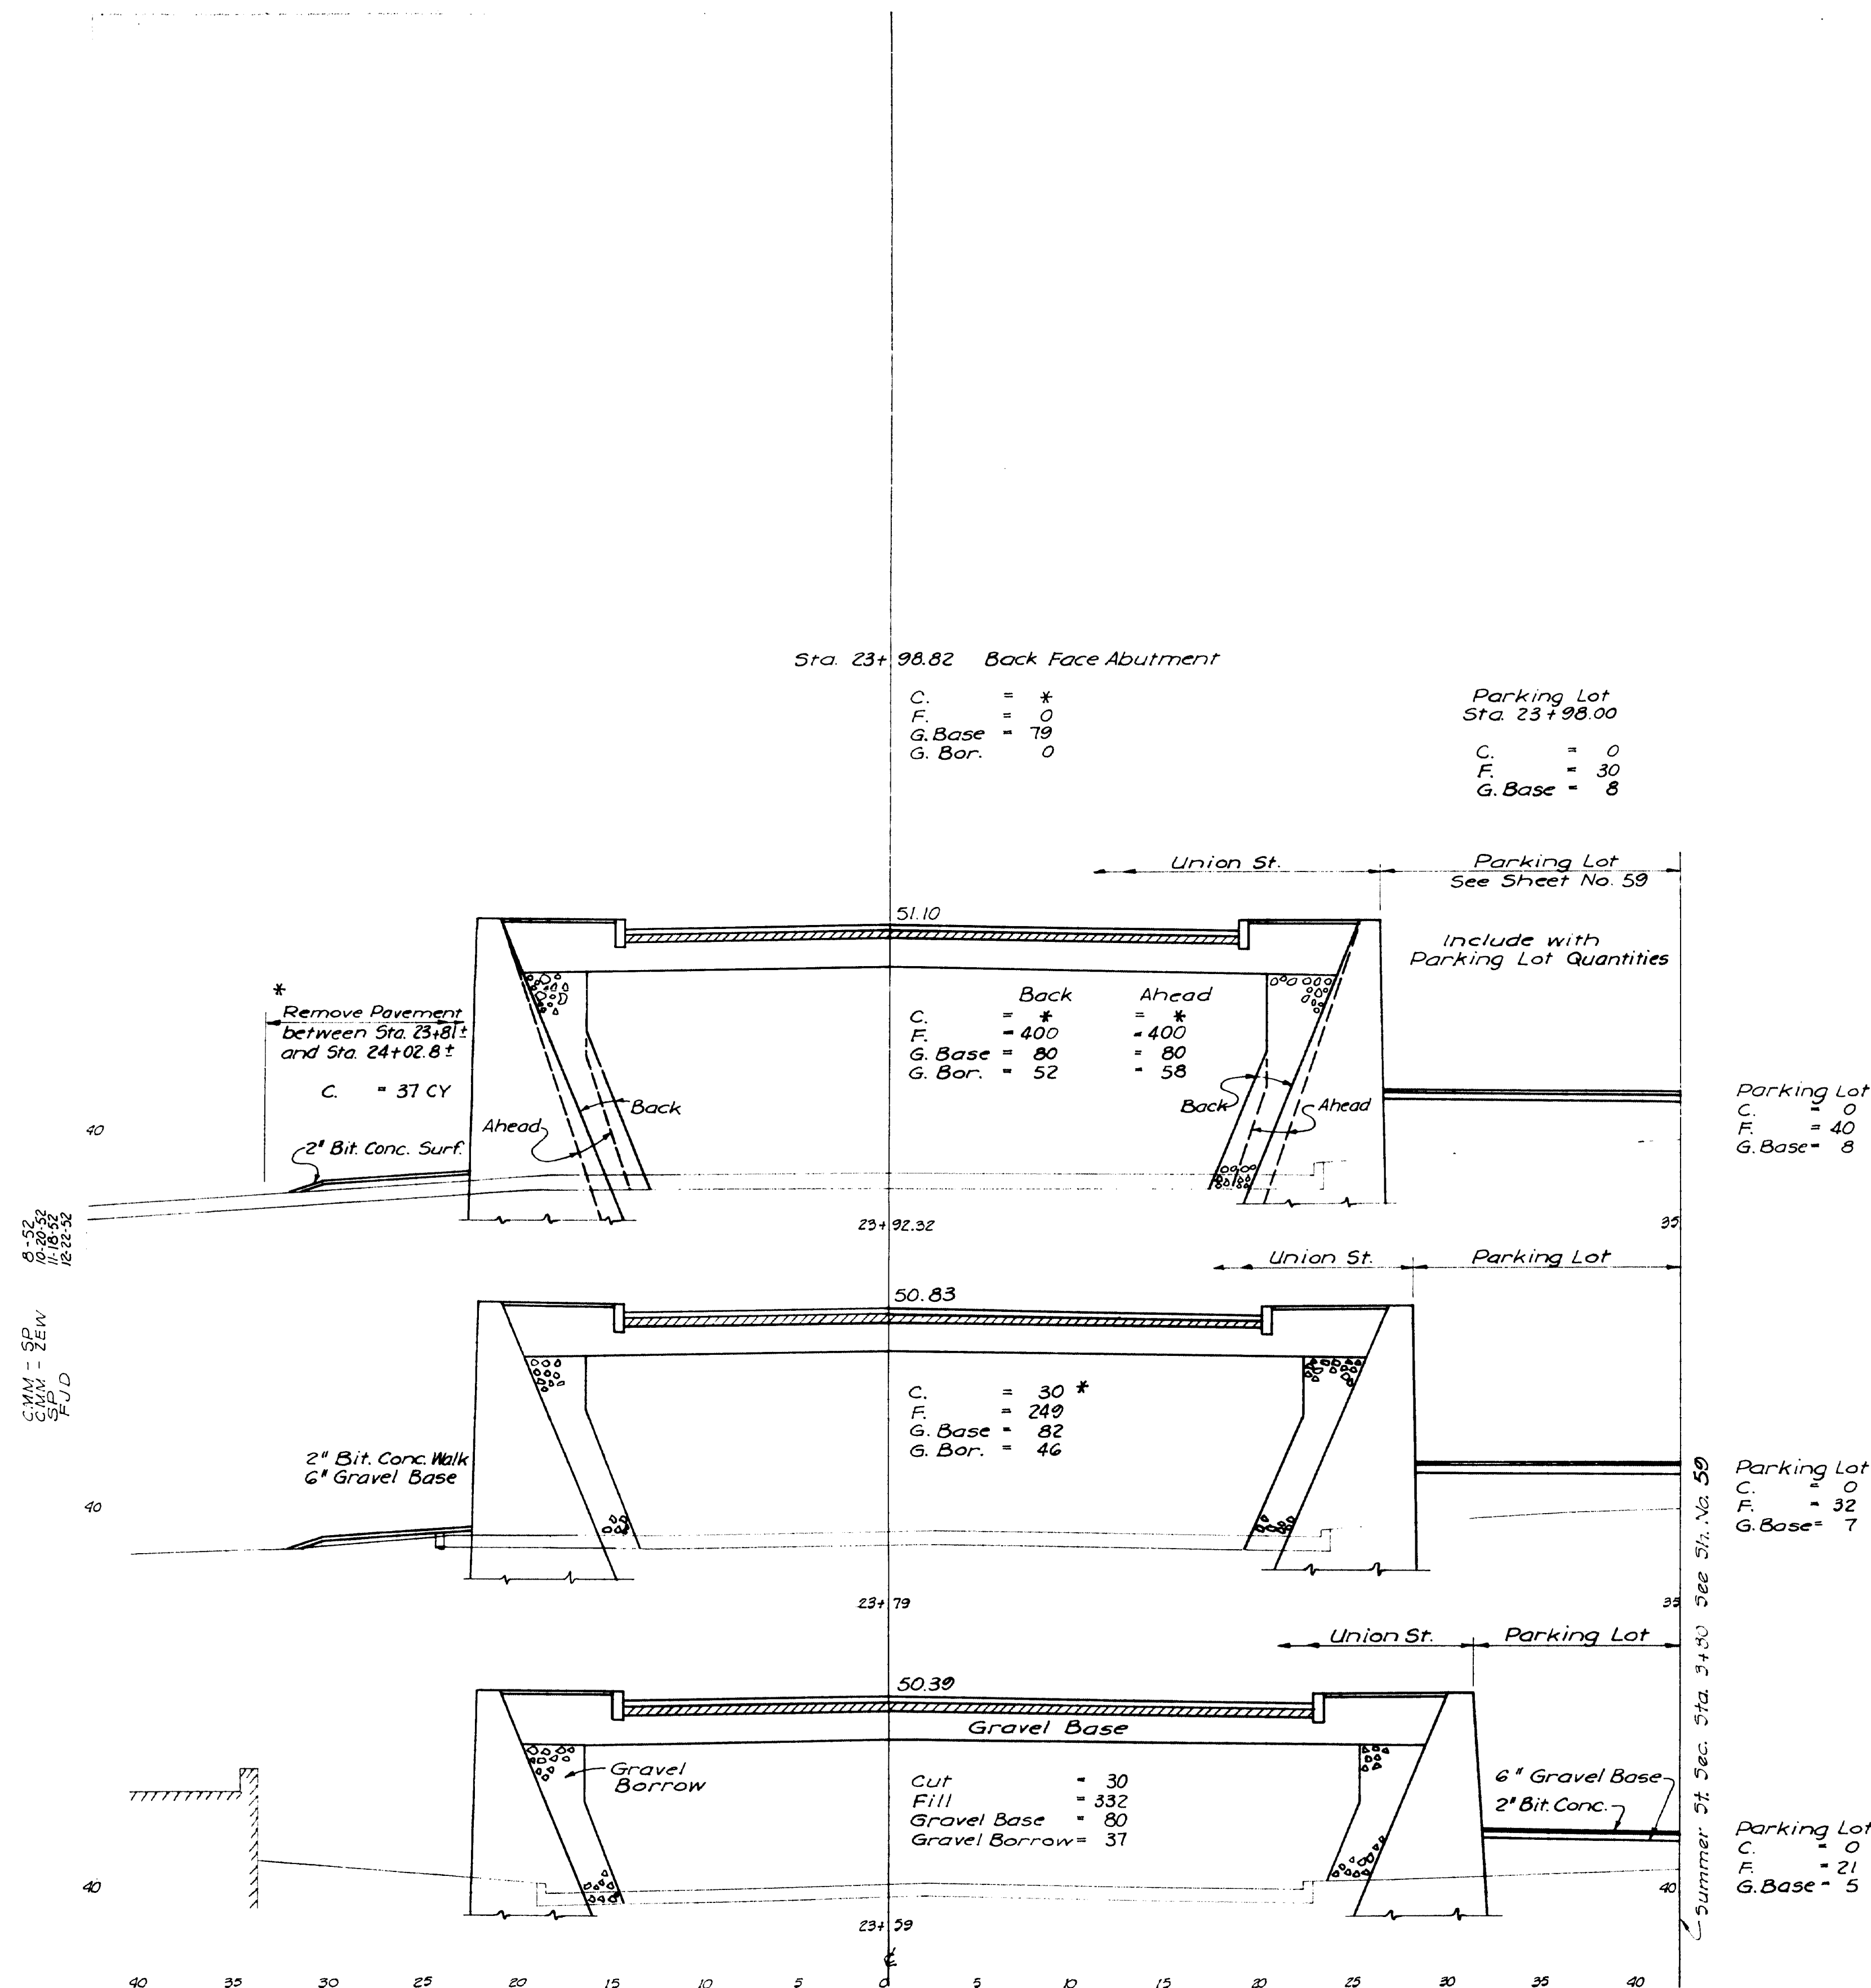

Note:  
End Area figures shown on these  
X-Sections pertain only to  
Roadway work and do not include  
any Structural Excavation or  
Backfill.

STATE OF MAINE  
STATE HIGHWAY COMMISSION  
**BANGOR-BREWER BRIDGE**  
**OVER PENOBSCOT RIVER**  
BANGOR, MAINE  
CROSS SECTIONS  
Sta. 23+59 TO 24+00  
HARRINGTON AND CORTELYOU  
CONSULTING ENGINEERS  
KANSAS CITY, MO.


DETAILED C.M.M. 8-52 SCALE: 1" = 5'-0"  
TRACED E.V.D. 1-17-52 VERT. & HOR.  
CHECKED G.H.K. 1-16-53 SHEET NO. 54

62-55



S.B. S.M.M.  
Z.E.W.  
J.C.O.  
11-18-52  
1-18-53  
1-22-53

Sta. 3+15.46 End Retaining Wall Lt.

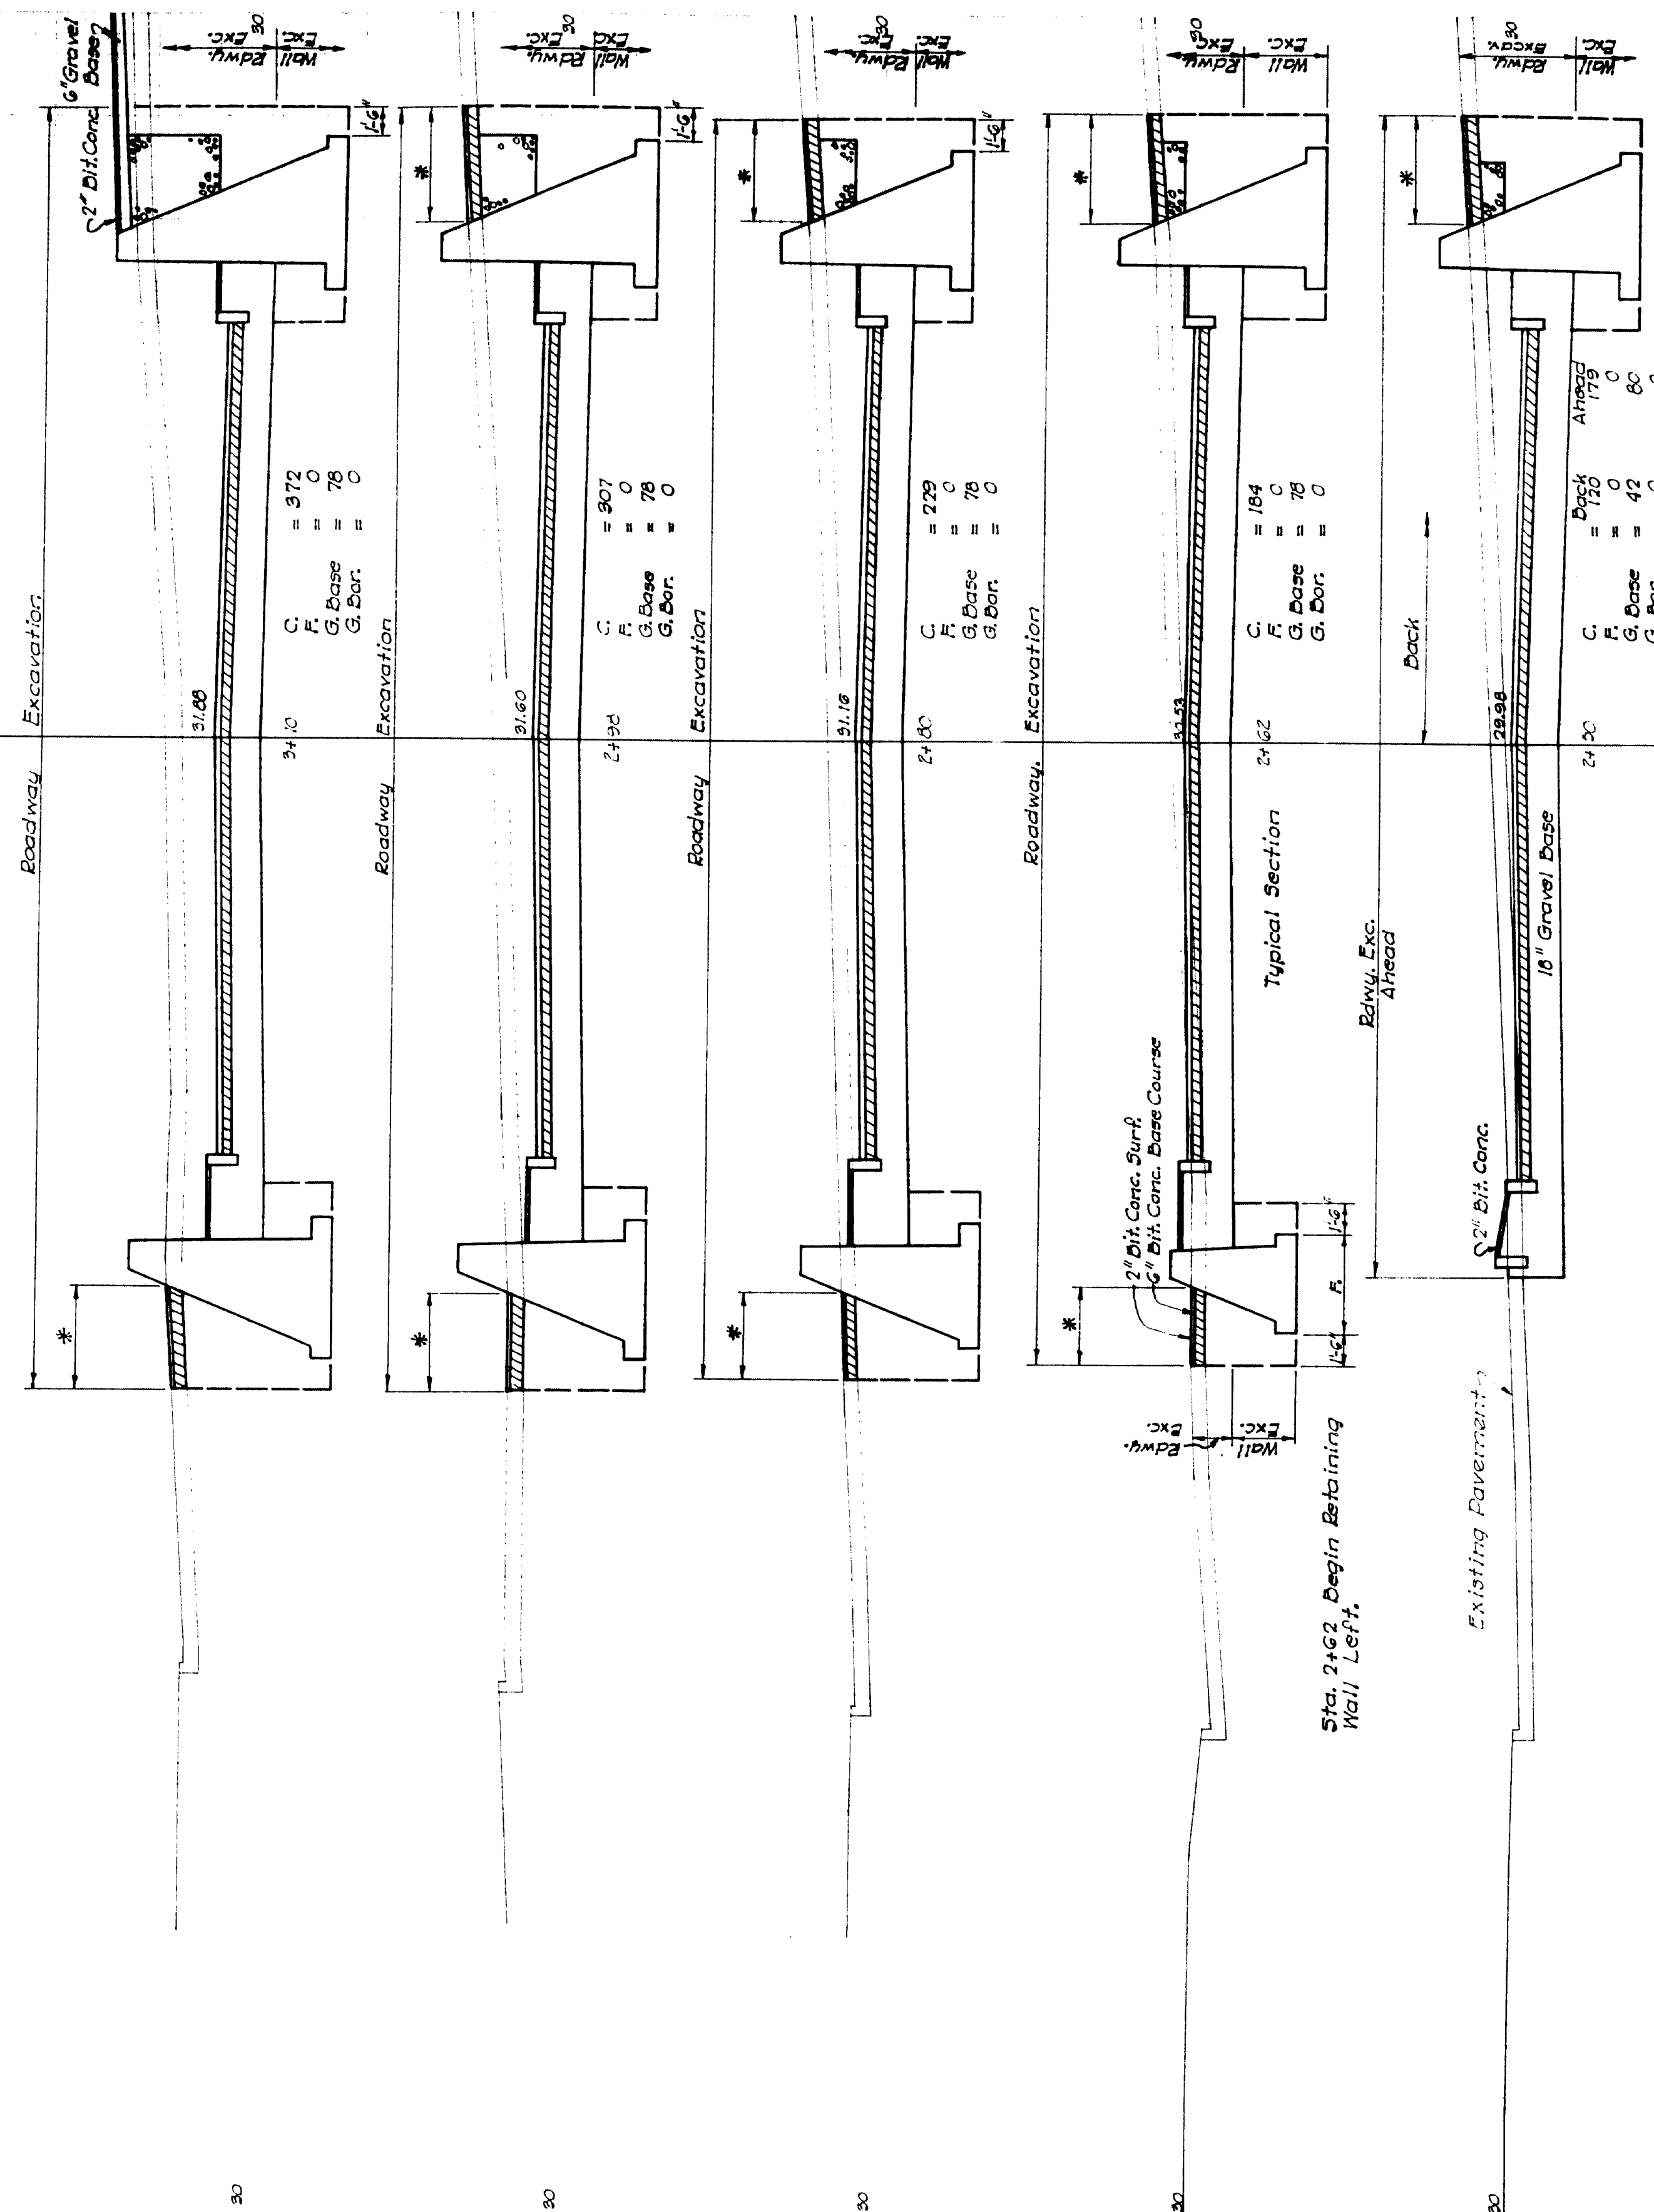

2+501 End of Pavement Removal and Gravel Base Lt. of Q.

\* Re-pave w/2' Bit. Conc. Surface and 6' Bit. Conc. Base Course. See Plan Sht. No. 31-32.

Note: End Area figures on these X-sections pertain only to roadway work and do not include Retaining Wall items.

Limits of Roadway Excavation as shown on Summer St. and Ramp 'A' are:  
Horizontal: 15' outside of footings of Retaining Walls or Front Face of Union St. Abutment.  
Vertical: Bottom of Gravel Base or existing pavement.

Existing Pavement


Quantities = 0.0  
Project Sta. 23+902

STATE OF MAINE  
STATE HIGHWAY COMMISSION  
**BANGOR-BREWER BRIDGE  
OVER PENOBSCOT RIVER**  
BANGOR, MAINE  
CROSS SECTIONS  
SUMMER ST. STA. 2+00 TO 3+00  
HARRINGTON AND CORTELYOU  
CONSULTING ENGINEERS  
KANSAS CITY, MO.  
DETAILED Z.E.W. 11-17-52  
TRACED S.B. 1-20-52  
CHECKED G.H.K. 1-18-53  
SCALE: 1" = 5'-0"  
VERT. & HOR.  
SHEET NO. 55

62-56

G.M.M. - S.P. 8-52  
S.P. - Z.E.W. 11-17-52  
S.P. 11-18-52  
F.J.D. 12-22-52

£ 570. 23 + 28 —  
See Sh. No. 54 & 59

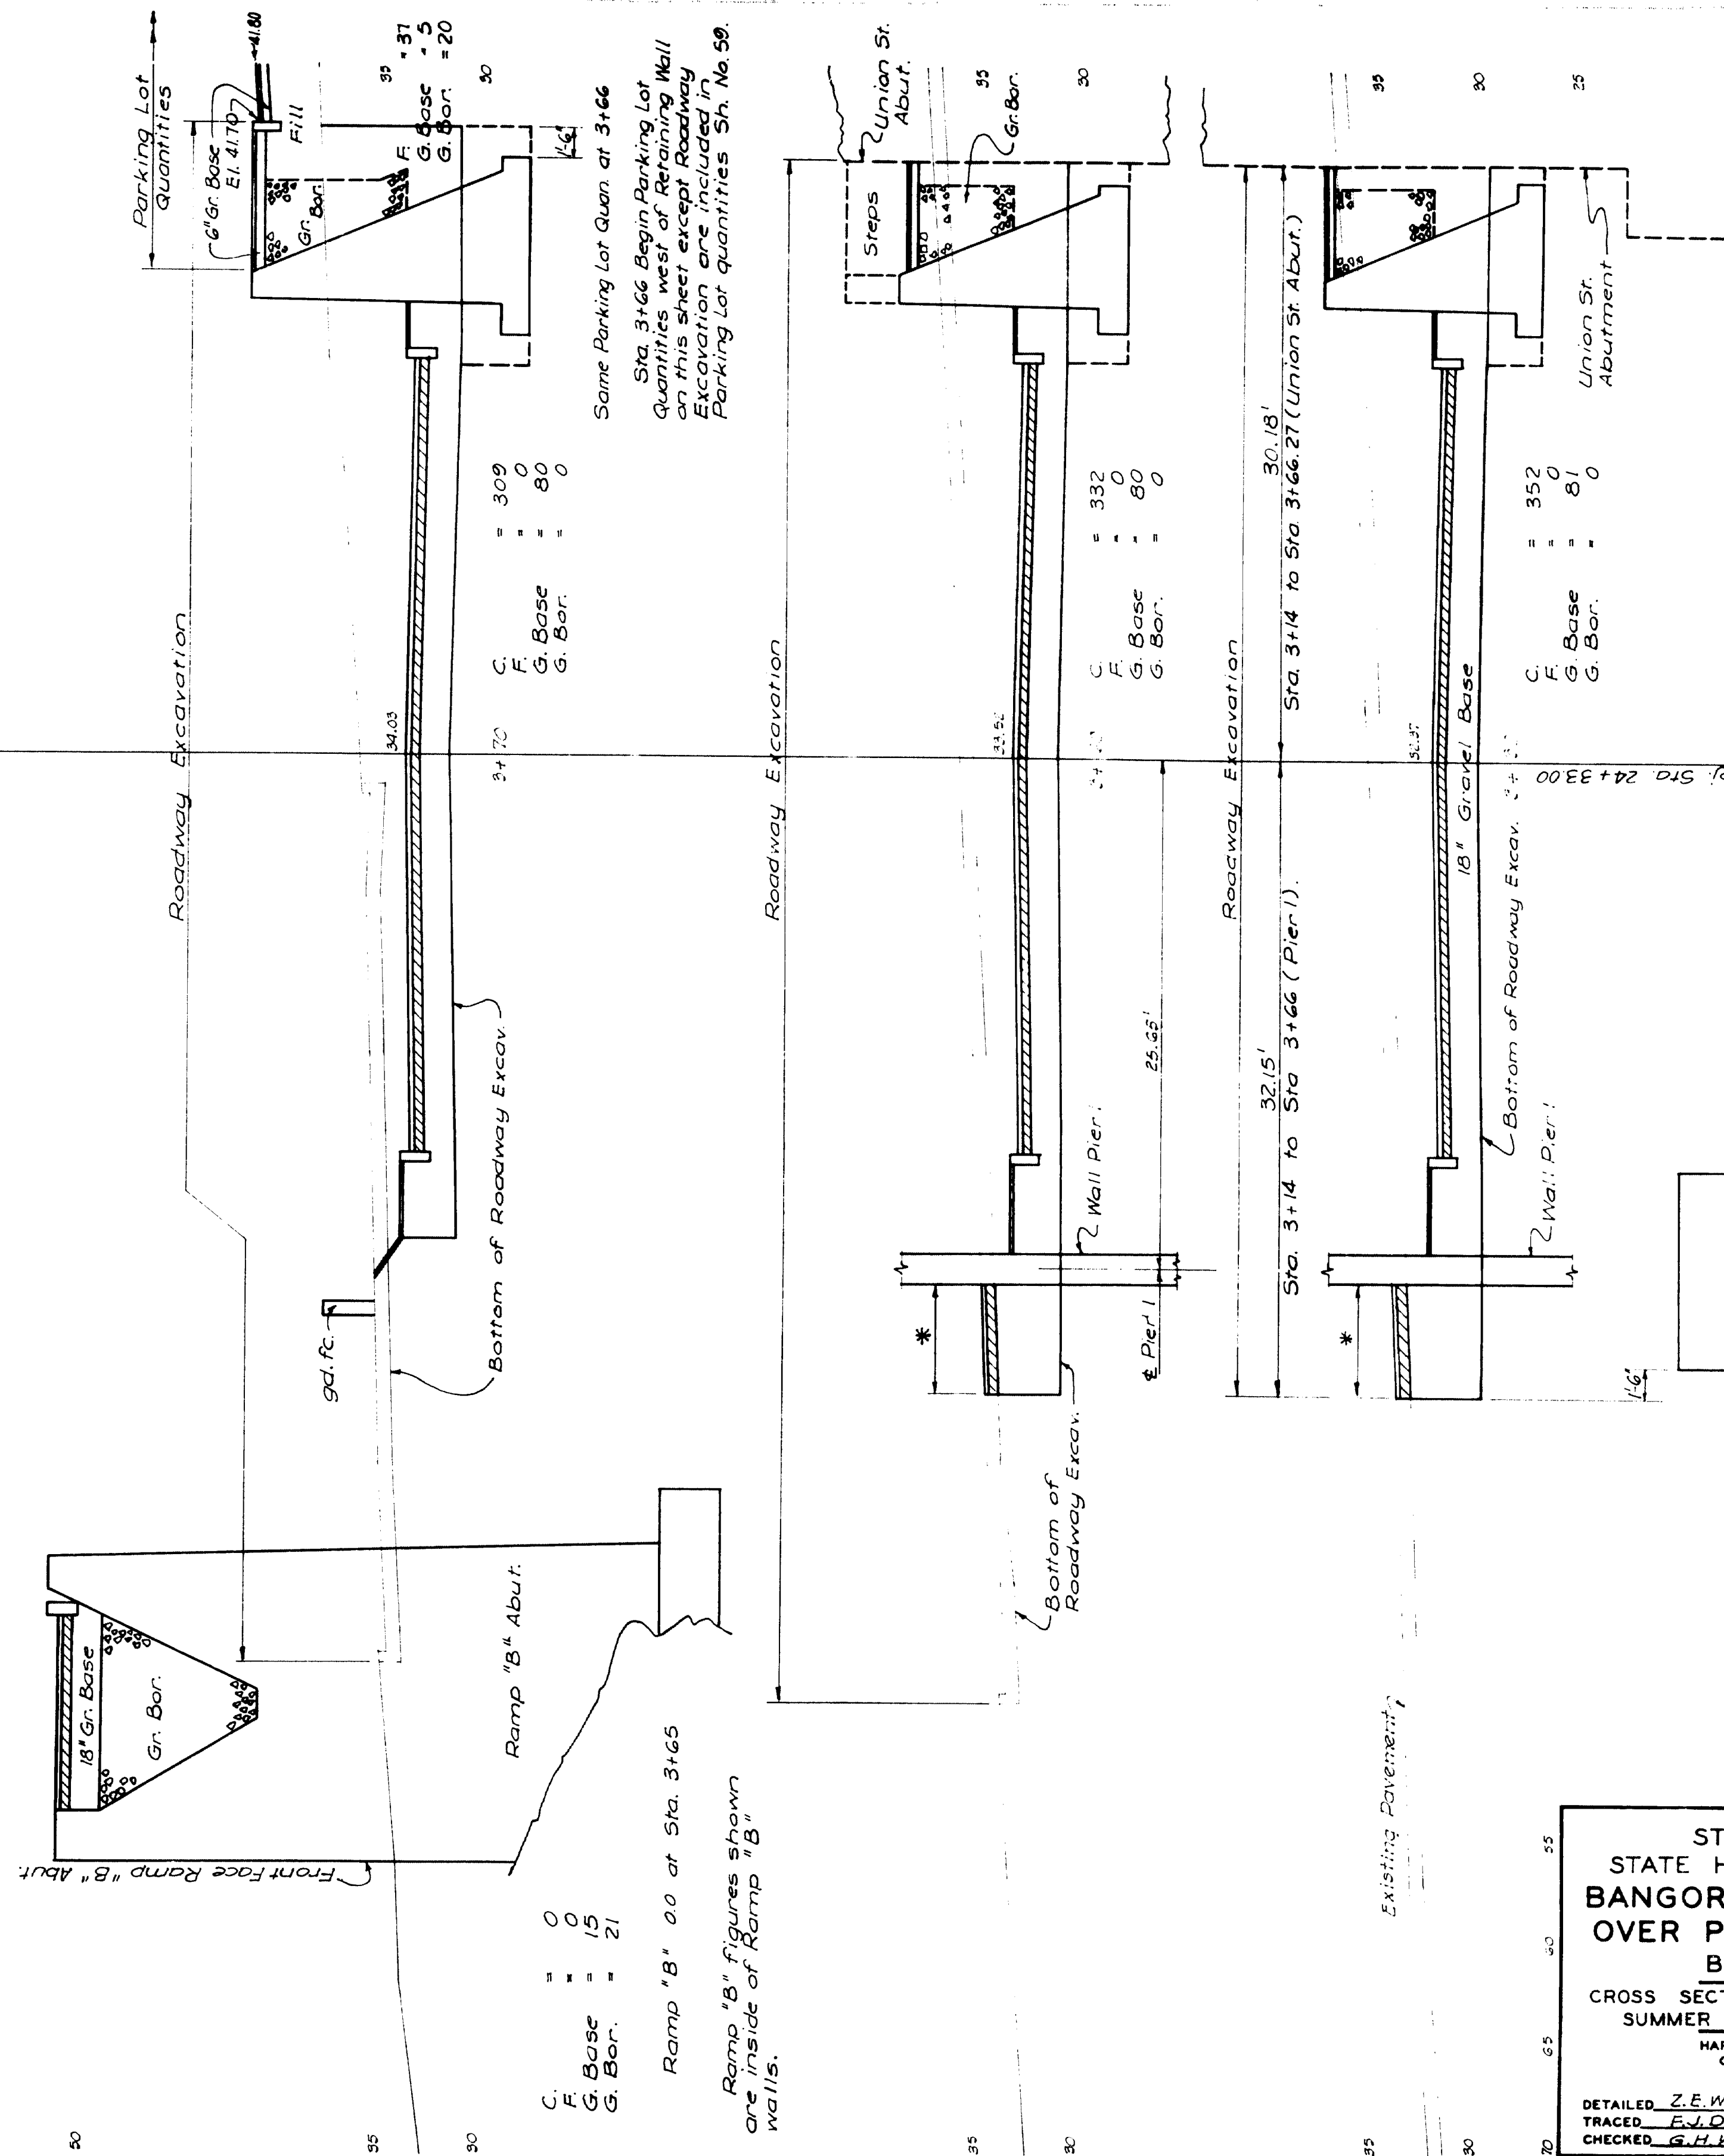

\* See Note Sn. No 55

STATE OF MAINE  
STATE HIGHWAY COMMISSION  
BANGOR-BREWER BRIDGE  
OVER PENOBSCOT RIVER  
BANGOR, MAINE  
CROSS SECTIONS SUMMER ST.-RAMP "B"  
SUMMER ST. STA. 3+30 TO 3+70  
HARRINGTON AND CORTELYOU  
CONSULTING ENGINEERS  
KANAS CITY, MO.  
DETAILED Z.E.W. 11-17-52  
TRACED F.J.D. 1-20-53  
CHECKED G.H.K. 1-16-53  
SCALE: 1" = 5'-0"  
VERT. & HOR.  
SHEET NO. 58

**6257**



S.M.M. - S.P.  
 8-52  
 C.D. - S.E.W.  
 11-18-52  
 E.J.D.  
 12-22-52

C. = 0  
 F. = 199  
 G. Base = 57  
 G. Bor. = 39

C. = 0  
 F. = 295  
 G. Base = 65  
 G. Bor. = 54

C. = 0  
 F. = 328  
 G. Base = 71  
 G. Bor. = 87

C. = 0  
 F. = 176  
 G. Base = 44  
 G. Bor. = 82

RAMP "B" AREAS

Summer St.

Roadway Excavation

Parking Lot  
 Elev. 41.45  
 Elev. 41.55

4+20  
 C. = 297  
 F. = 0  
 G. Base = 73  
 G. Bor. = 0

C. = 4  
 F. = 22  
 G. Base = 5  
 G. Bor. = 15

Roadway Excavation

Parking Lot  
 Elev. 41.55  
 Elev. 41.65

4+00  
 C. = 338  
 F. = 0  
 G. Base = 80  
 G. Bor. = 0

F. = 25  
 G. Base = 5  
 G. Bor. = 18

See St. No. 20

Roadway Excavation

Parking Lot  
 El. 41.60  
 El. 41.70

3+90  

C.	=	Back	Ahead
F.	=	303	363
G. Base	=	0	0
G. Bor.	=	80	80
		0	0

F. = 28  
 G. Base = 5  
 G. Bor. = 20

Roadway Excavation

Parking Lot  
 6" Gravel Base  
 El. 41.65  
 El. 41.75

3+80  

Cut	=	311
Fill	=	0
Gravel Base	=	80
Gravel Borrow	=	0

F. = 33  
 G. Base = 5  
 G. Bor. = 22

STATE OF MAINE  
 STATE HIGHWAY COMMISSION  
**BANGOR-BREWER BRIDGE  
 OVER PENOBSCOT RIVER**  
 BANGOR, MAINE


CROSS SECTIONS SUMMER ST.-RAMP "B"  
 SUMMER ST. STA. 3+80 TO 4+20

HARRINGTON AND CORTELYOU  
 CONSULTING ENGINEERS  
 KANSAS CITY, MO.

DETAILED Z.E.W. 11-18-52  
 TRACED E.J.D. 1-10-53  
 CHECKED G.H.K. 1-21-53

SCALE: 1" = 5'-0"  
 VERT. & HOR.  
 SHEET NO. 57

62-58

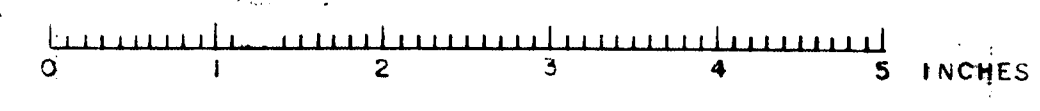

8-32  
11-83  
11-83  
11-83

COMM - SP  
CMM - SP  
F.D.

Sta 6+07  
C = 58  
F = 0  
G.B. = 32

Bit. Conc. Surface only  
warp to existing grade  
see Sta. No. 33

C = 60  
F = 0  
G.B. = 32

Bit. Conc. Surface Only  
Ahead of Sta. 5+85 ±

End of Pavement Removal and 18" Gravel Base  
Sta. 5+85 ±

C = 107  
F = 0  
G.B. = 66

Back Ahead  
C = 208 101  
F = 0 0  
G.B. = 140 74

C = 222  
F = 0  
G.B. = 151

C = 254  
F = 0  
G.B. = 131  
Gr. Bor. = 0

C = 222  
F = 0  
G.B. = 132  
Gr. Bor. = 0

Back on Fill = 0  
C = 0  
F = 0  
G.B. = 39  
Gr. Bor. = 0

Back on Summer St.  
C = 195  
F = 0  
G.B. = 81  
Gr. Bor. = 0

Back Ahead  
C = 245  
F = 0  
G.B. = 120  
Gr. Bor. = 0

End of Wall Ramp "B"  
Sta. 4+7983 (Summer St.)  
= Sta. 23+9747 (Ramp B)

C = 214  
F = 0  
G.B. = 73  
Gr. Bor. = 0

C = 0  
F = 134  
G.B. = 53  
Gr. Bor. = 30

C = 266  
F = 0  
G.B. = 73 (Gravel Base)  
Gr. Bor. = 0 (Gravel Borrow)

STATE OF MAINE  
STATE HIGHWAY COMMISSION  
BANGOR-BREWER BRIDGE  
OVER PENOBSCOT RIVER  
BANGOR, MAINE  
CROSS SECTIONS SUMMER ST. - RAMP "B"  
SUMMER ST. STA. 4+40 TO 5+98  
HARRINGTON AND CORTELYOU  
CONSULTING ENGINEERS  
KANSAS CITY, MO.  
DETAILED J.E.W. 11-18-52  
TRACED M.P.H. 1-20-53  
CHECKED G.H.K. 1-21-53  
SCALE: 1" = 5'-0"  
VERT. & HOR.  
SHEET NO. 58

Ramp "B" Areas

Summer St. Areas

6259










8-52  
 10-20-52  
 12-22-52  
 C.M.M.  
 Z.E.W.  
 S.P.  
 S.F.L.

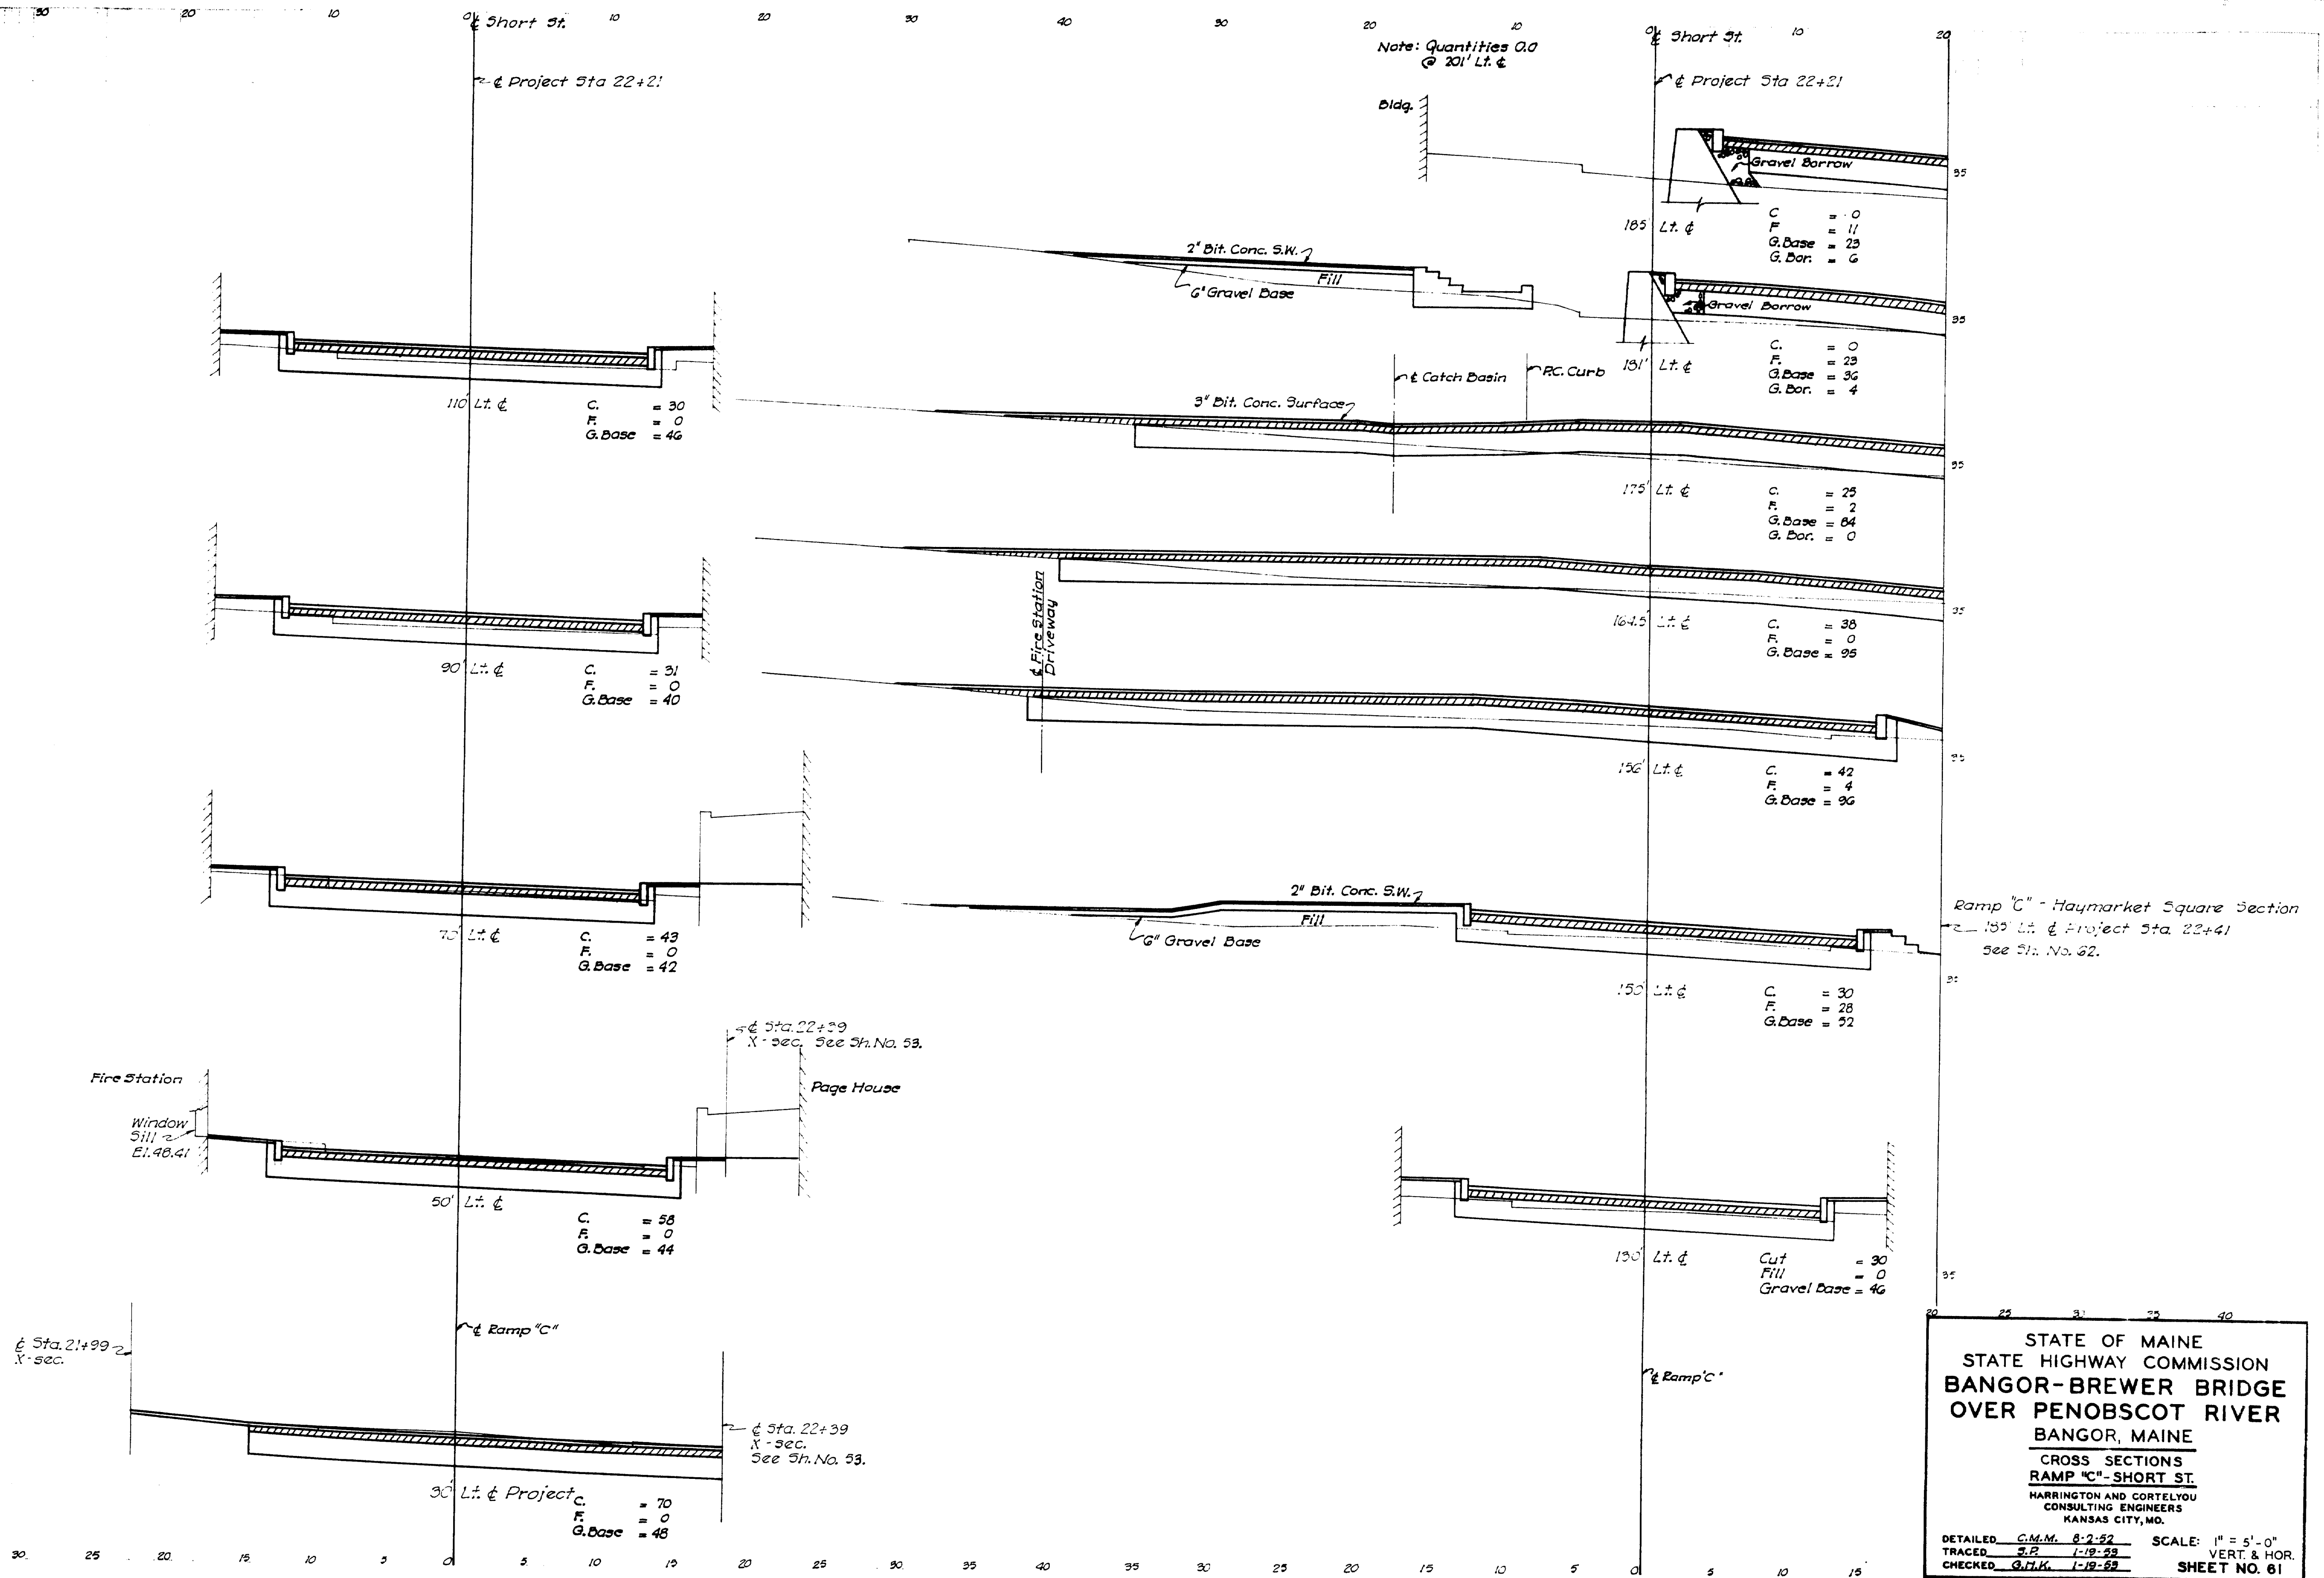




STATE OF MAINE  
 STATE HIGHWAY COMMISSION  
**BANGOR-BREWER BRIDGE**  
**OVER PENOBSCOT RIVER**  
 BANGOR, MAINE  
 CROSS SECTIONS  
 RAMP "C" - SHORT ST.  
 HARRINGTON AND CORTEYOU  
 CONSULTING ENGINEERS  
 KANSAS CITY, MO.

DETAILED C.M.M. 8-2-52  
 TRACED S.P. 1-19-53  
 CHECKED G.H.K. 1-19-53

SCALE: 1" = 5'-0"  
 VERT. & HOR.  
 SHEET NO. 61

62-62

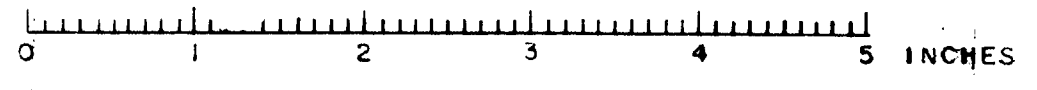


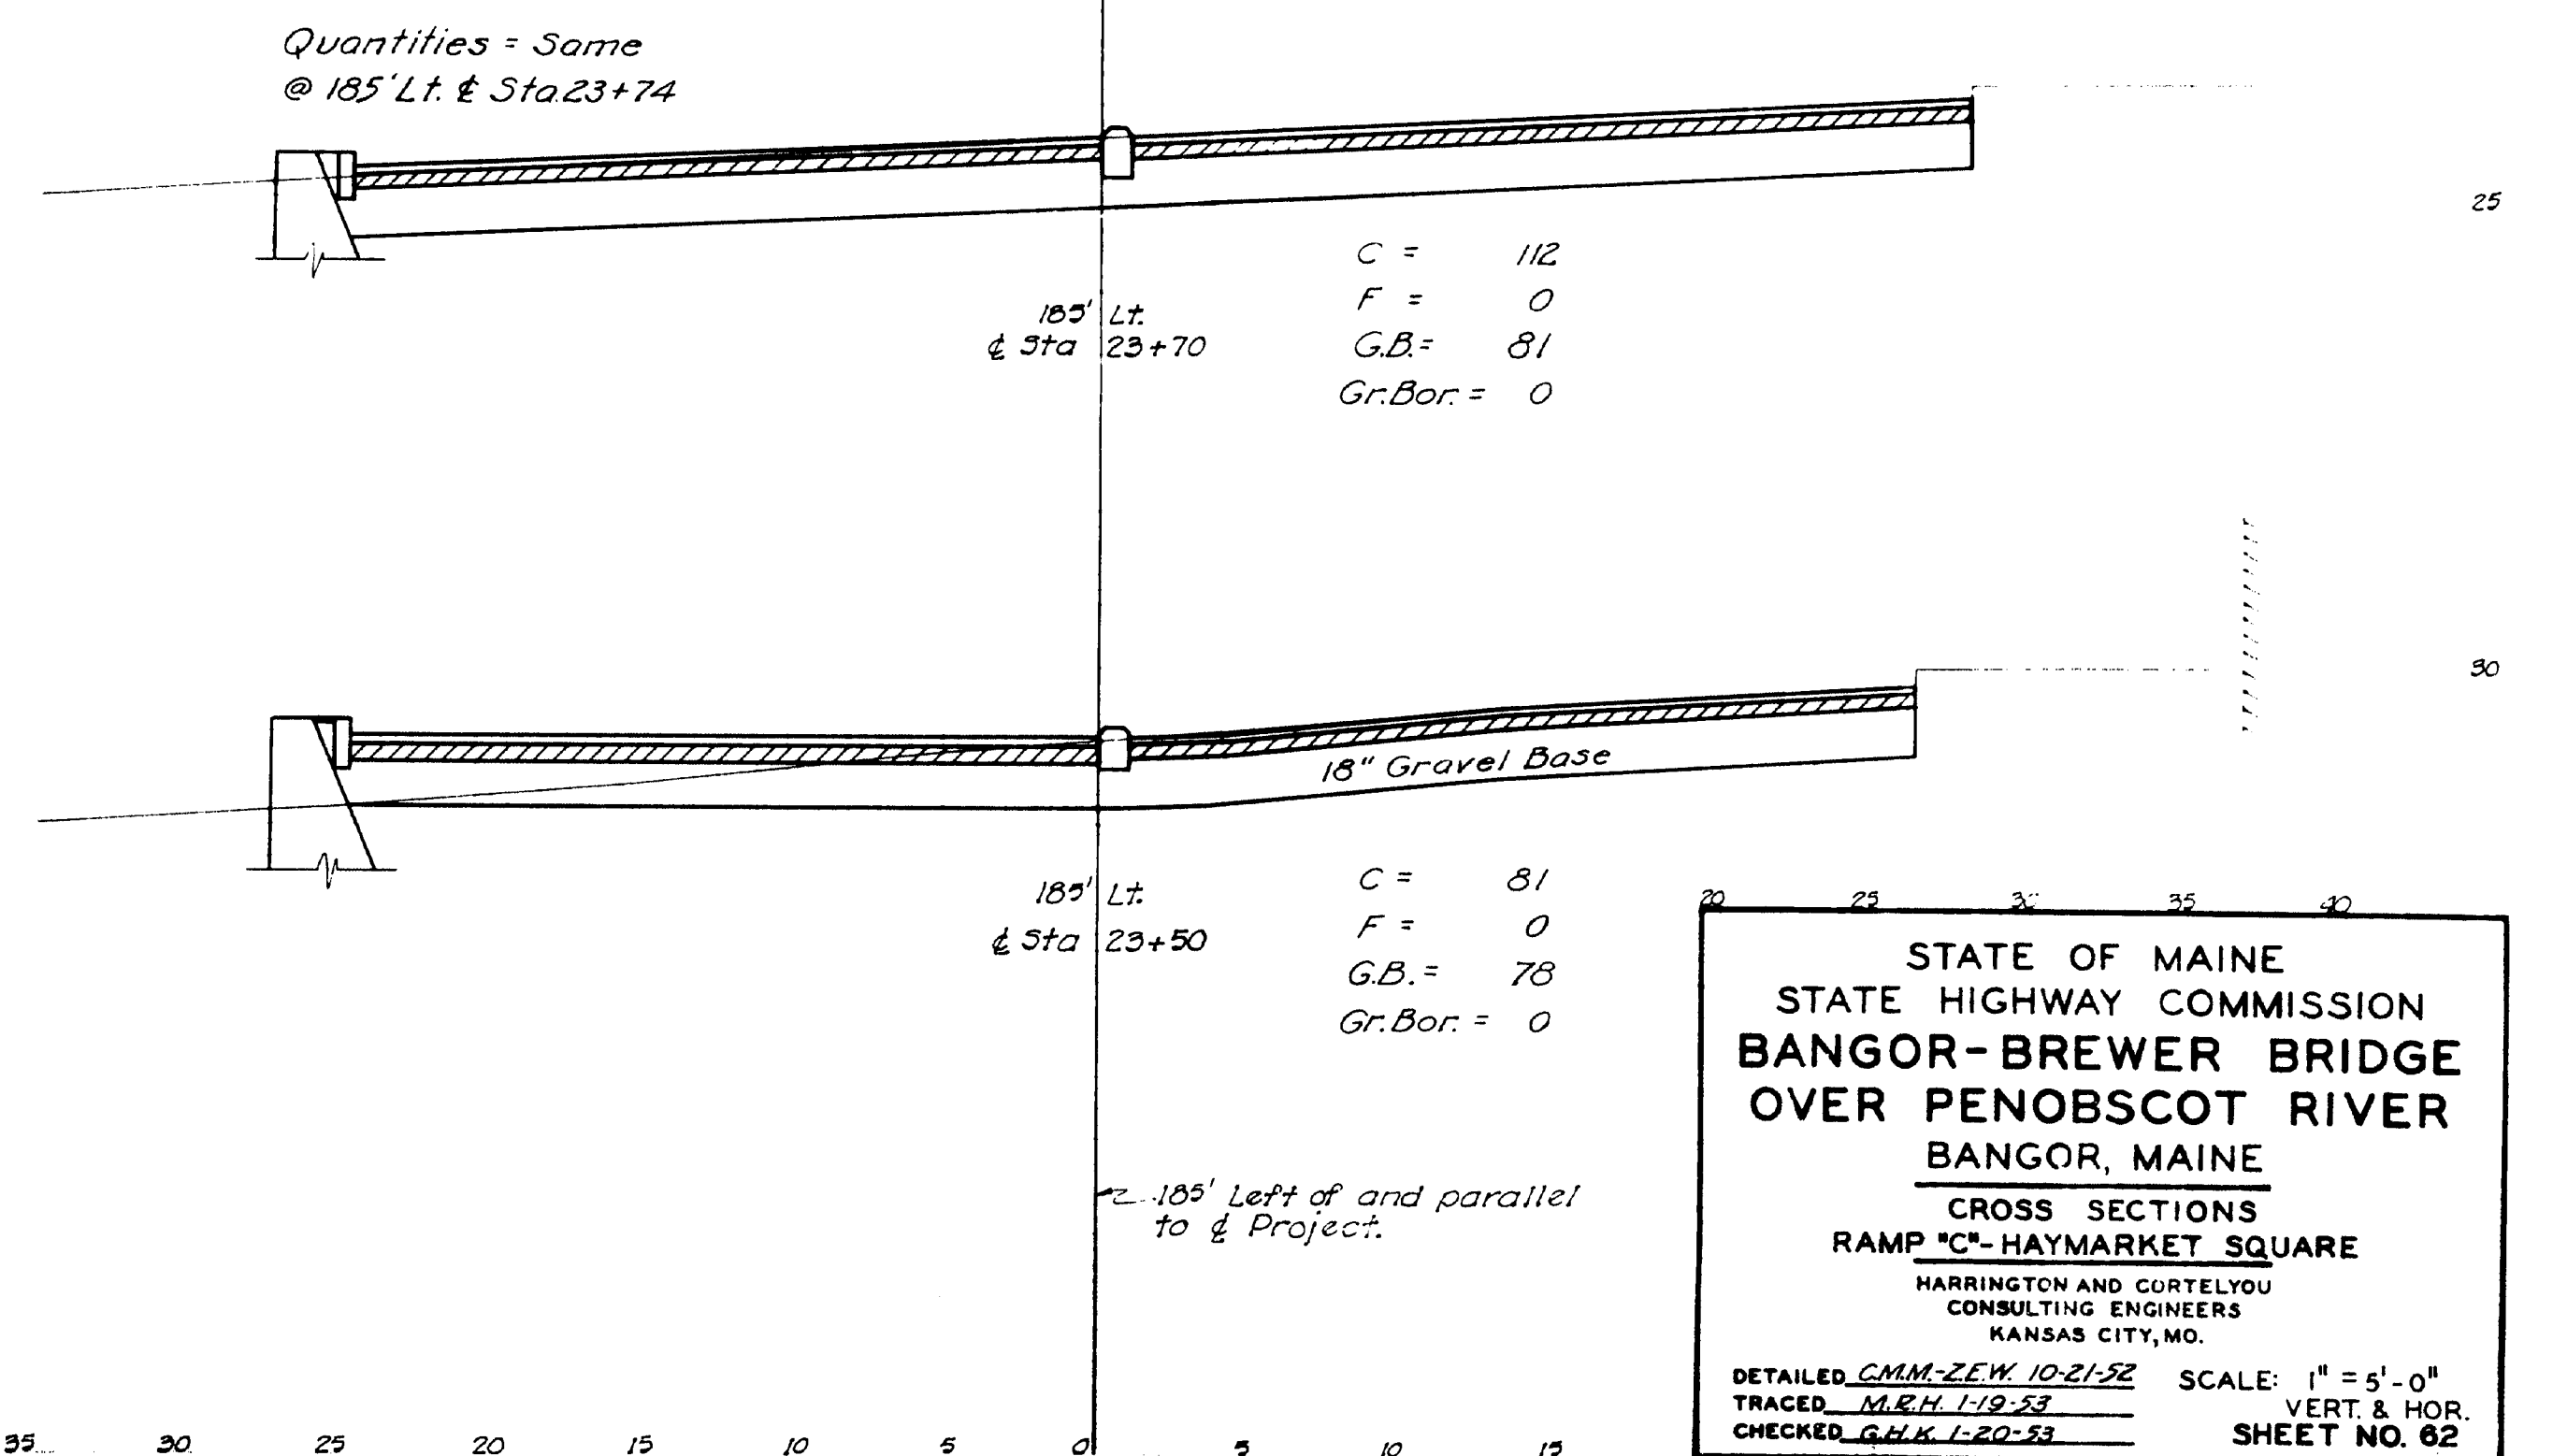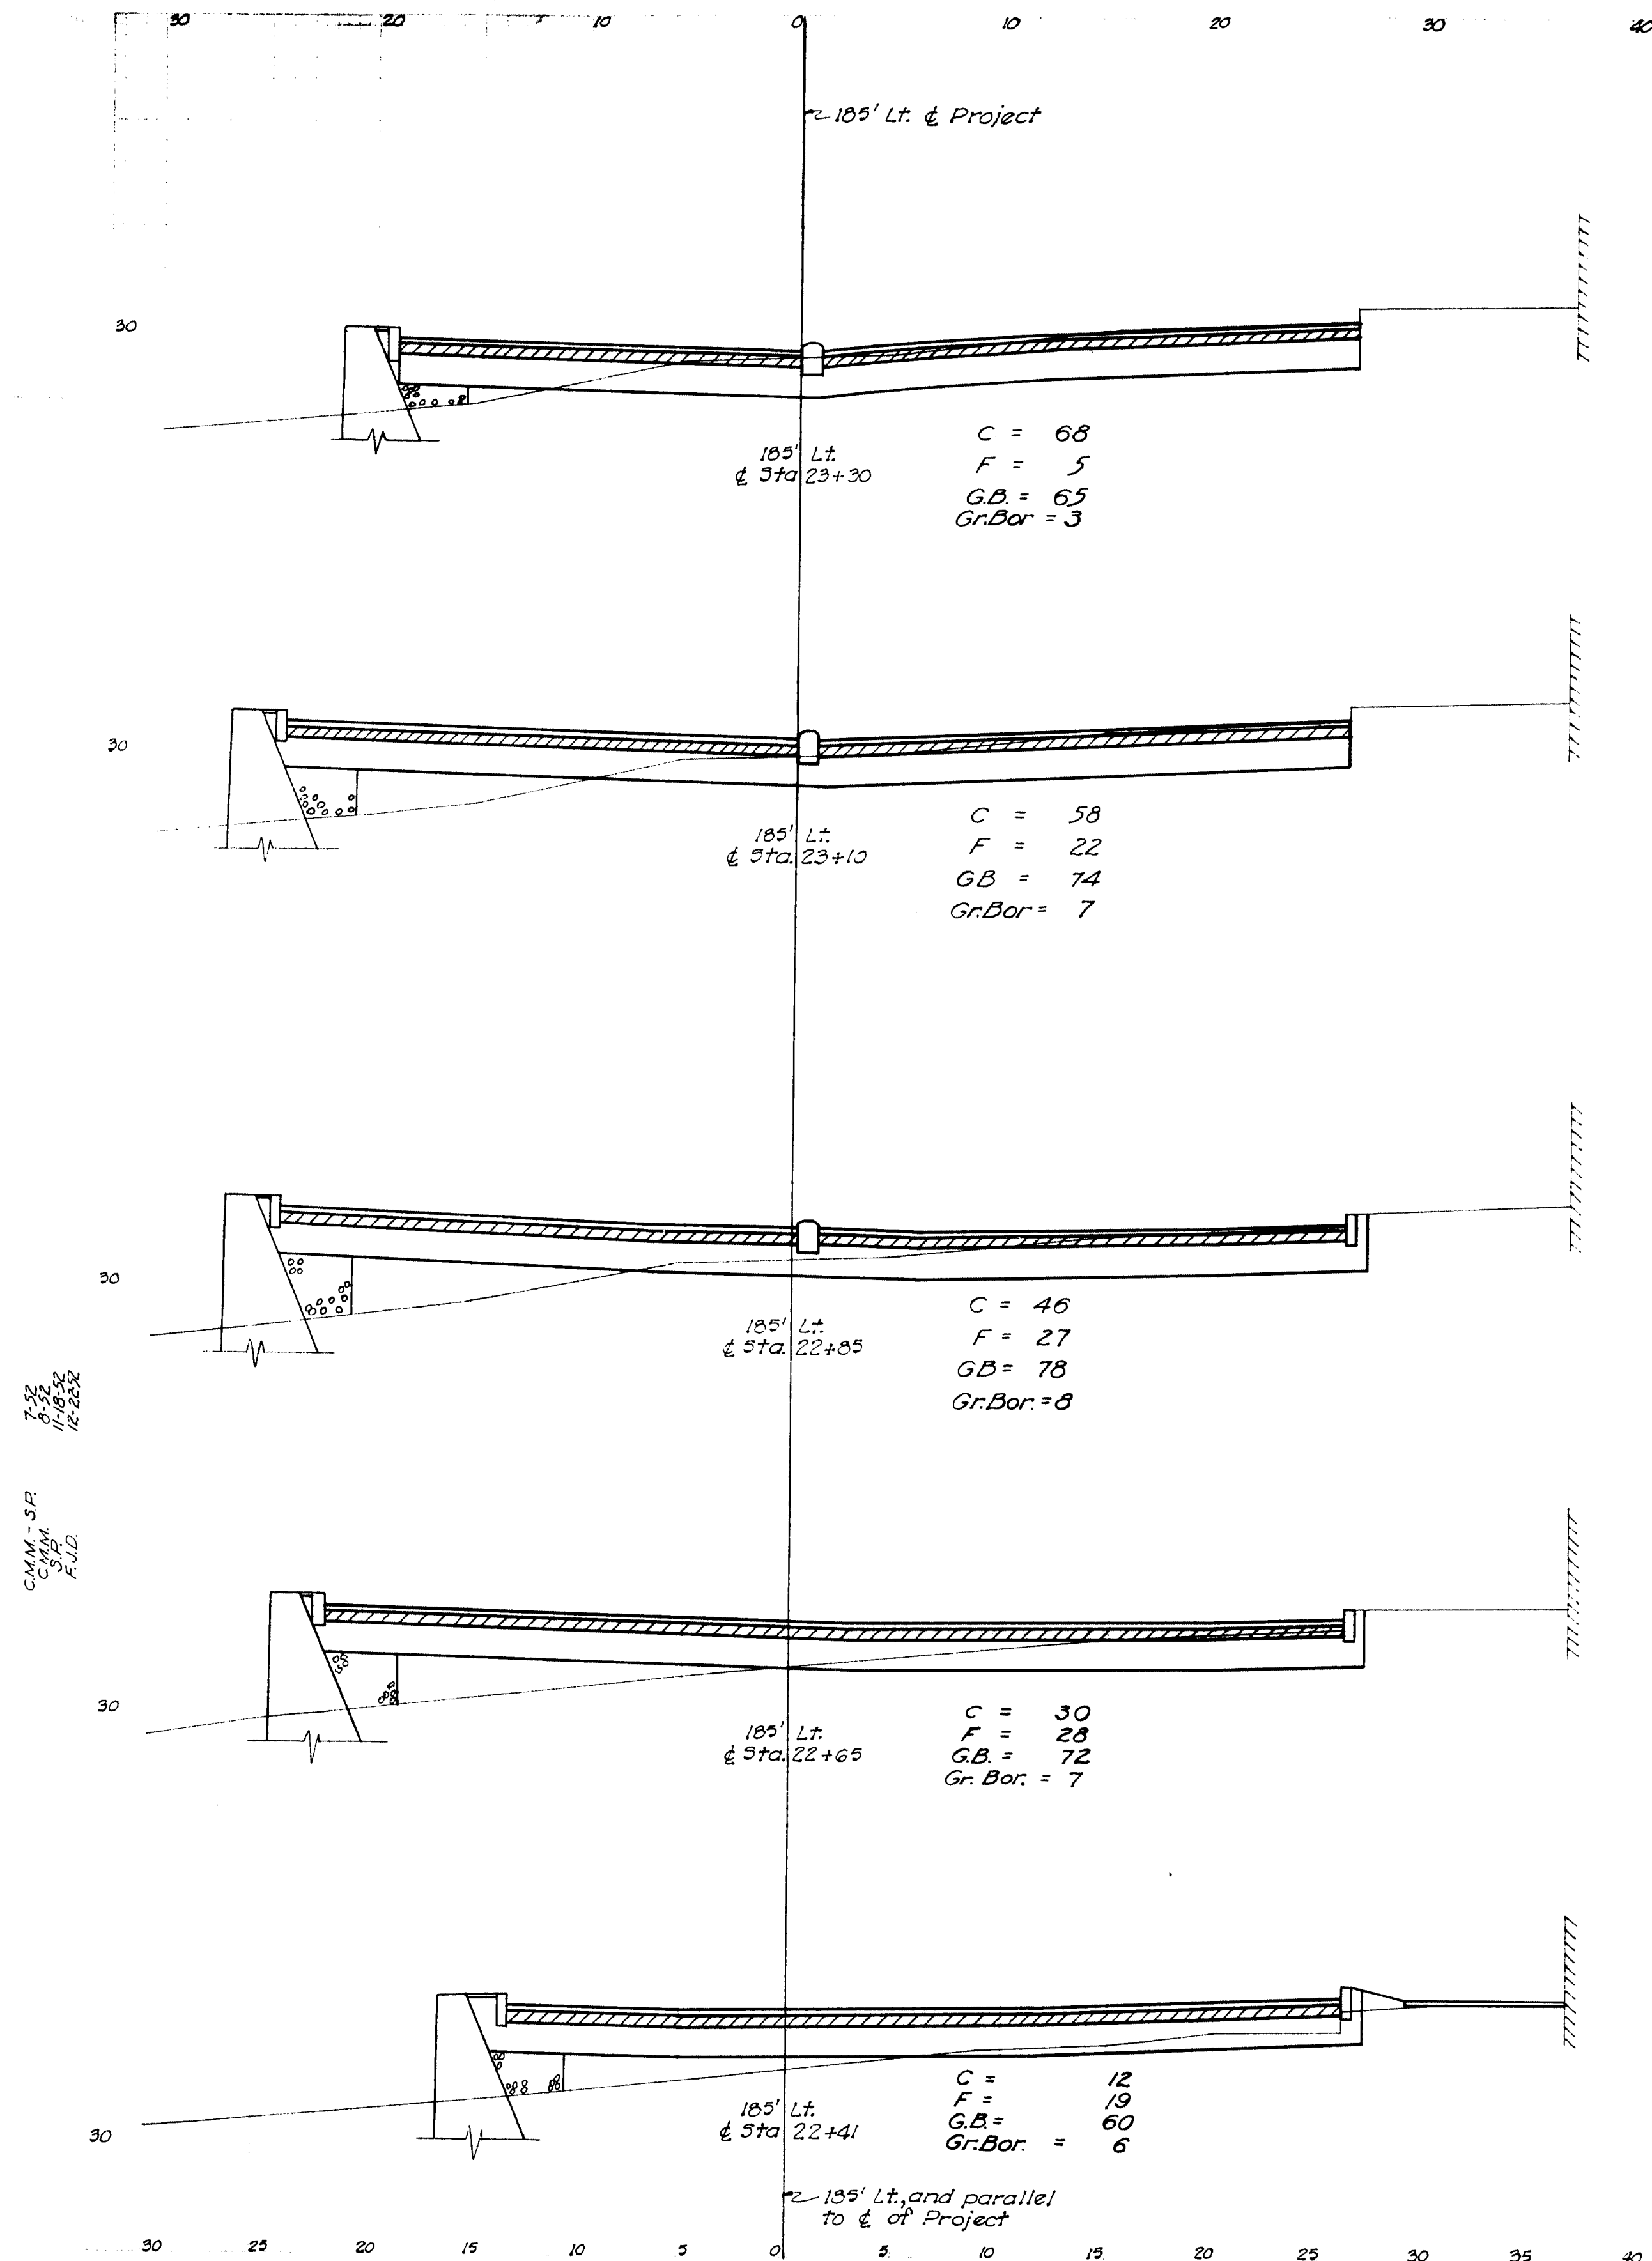

0 1 2 3 4 5 INCHES


62-63



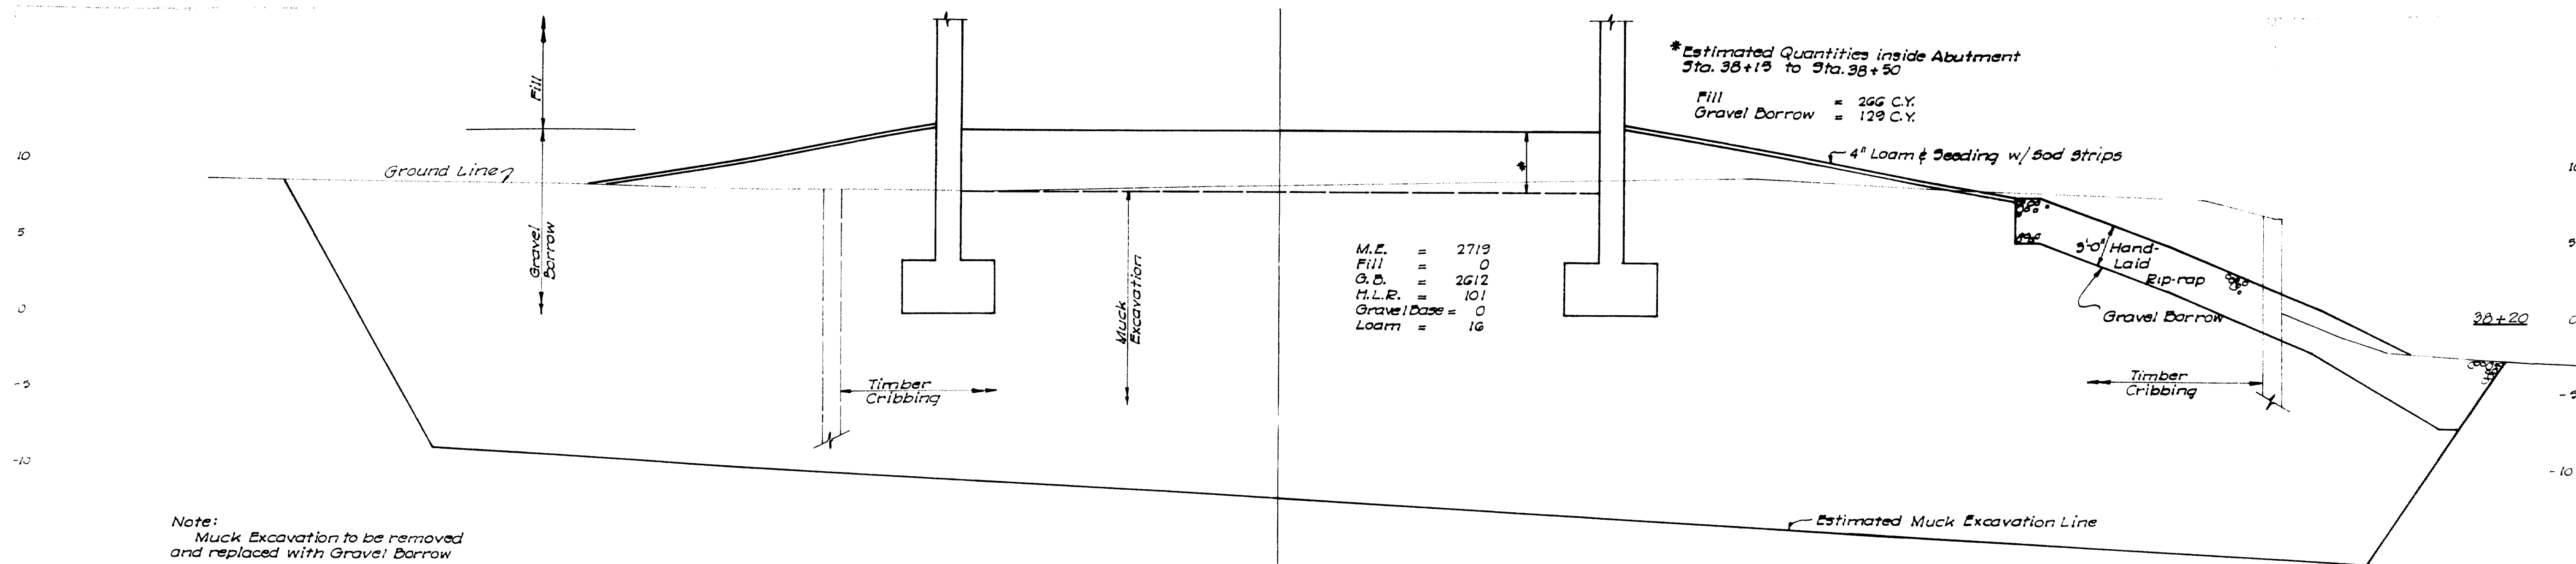

Note:  
Muck Excavation to be removed  
and replaced with Gravel Borrow

See Sh. No. 41 for Typical Sections  
of Brewer Abutment.

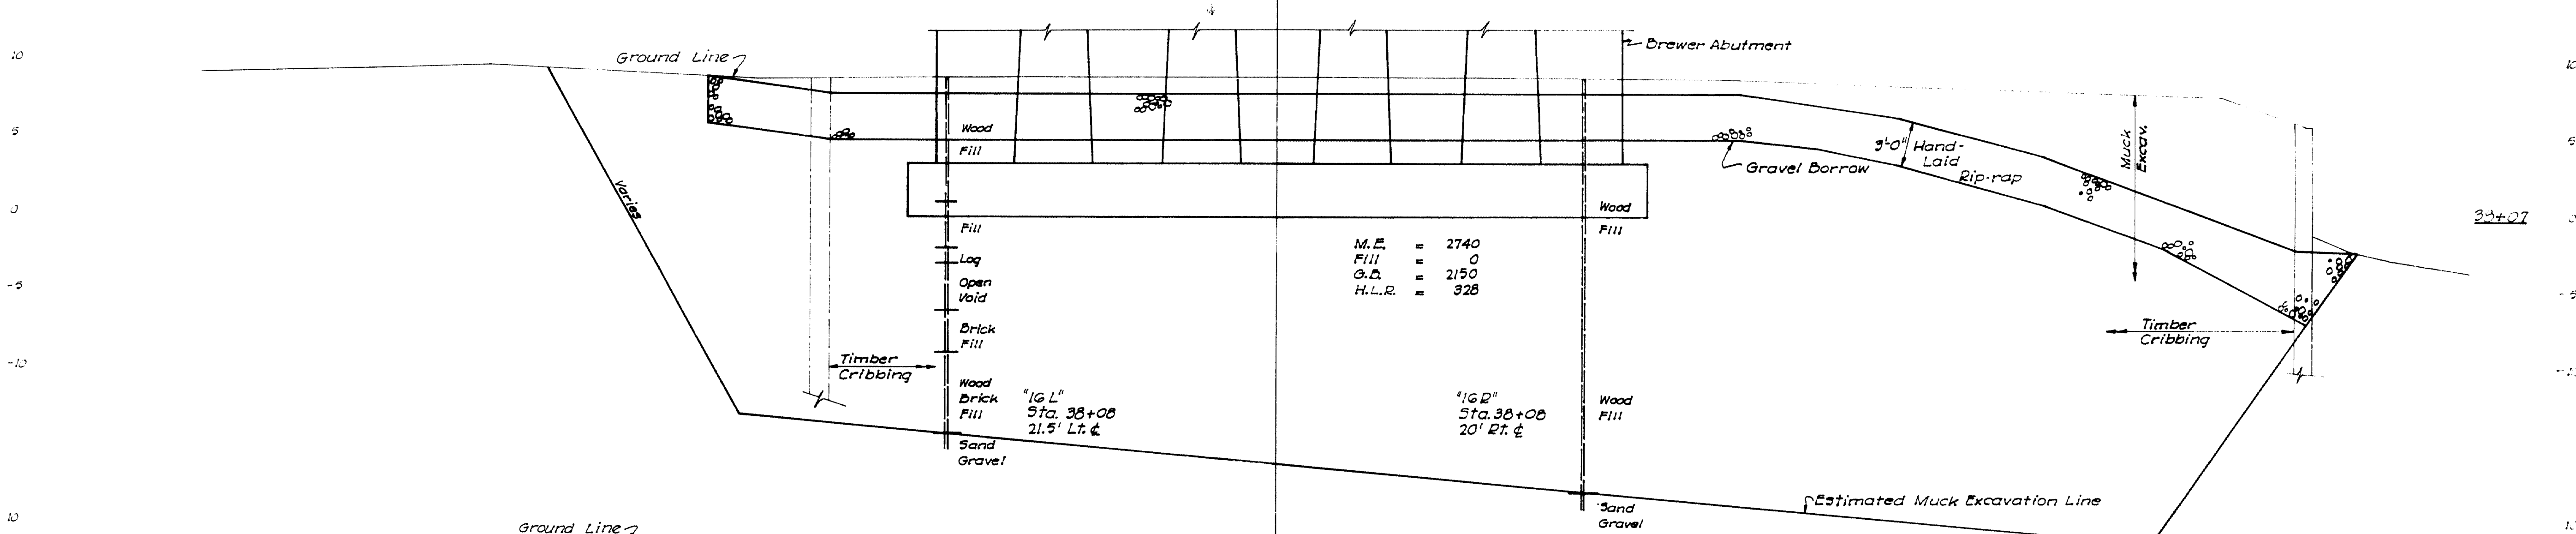

Note:  
The limits of "Muck Excavation"  
to be determined by the Engineer  
during construction.

Estimated Quantities between  
Sta. 37+75 and Sta. 38+00

M.E.	= 1100 C.Y.
G.B.	= 480 C.Y.
H.L.R.	= 340 C.Y.


Muck Excavation	= 2550 CY
Fill	= 0 CY
Gravel Borrow	= 1754 CY
Hand-Laid Rip-rap	= 340 CY

STATE OF MAINE  
STATE HIGHWAY COMMISSION  
**BANGOR-BREWER BRIDGE**  
**OVER PENOBSCOT RIVER**  
BANGOR, MAINE  
CROSS SECTIONS  
STA. 38+00 TO 38+20  
HARRINGTON AND CORTELYOU  
CONSULTING ENGINEERS  
KANSAS CITY, MO.  
DETAILED Z.E.W. 10-10-52  
TRACED S.R. 12-31-52  
CHECKED G.H.K. 1-20-53  
SCALE: 1" = 1'-0"  
VERT. & HOR.  
SHEET NO. 83

62-64


0 1 2 3 4 5 INCHES

6-52  
 10-11-52  
 11-7-52  
 12-2-52  
 S.R. C.M.M.  
 Z.E.W.  
 P.U.O.

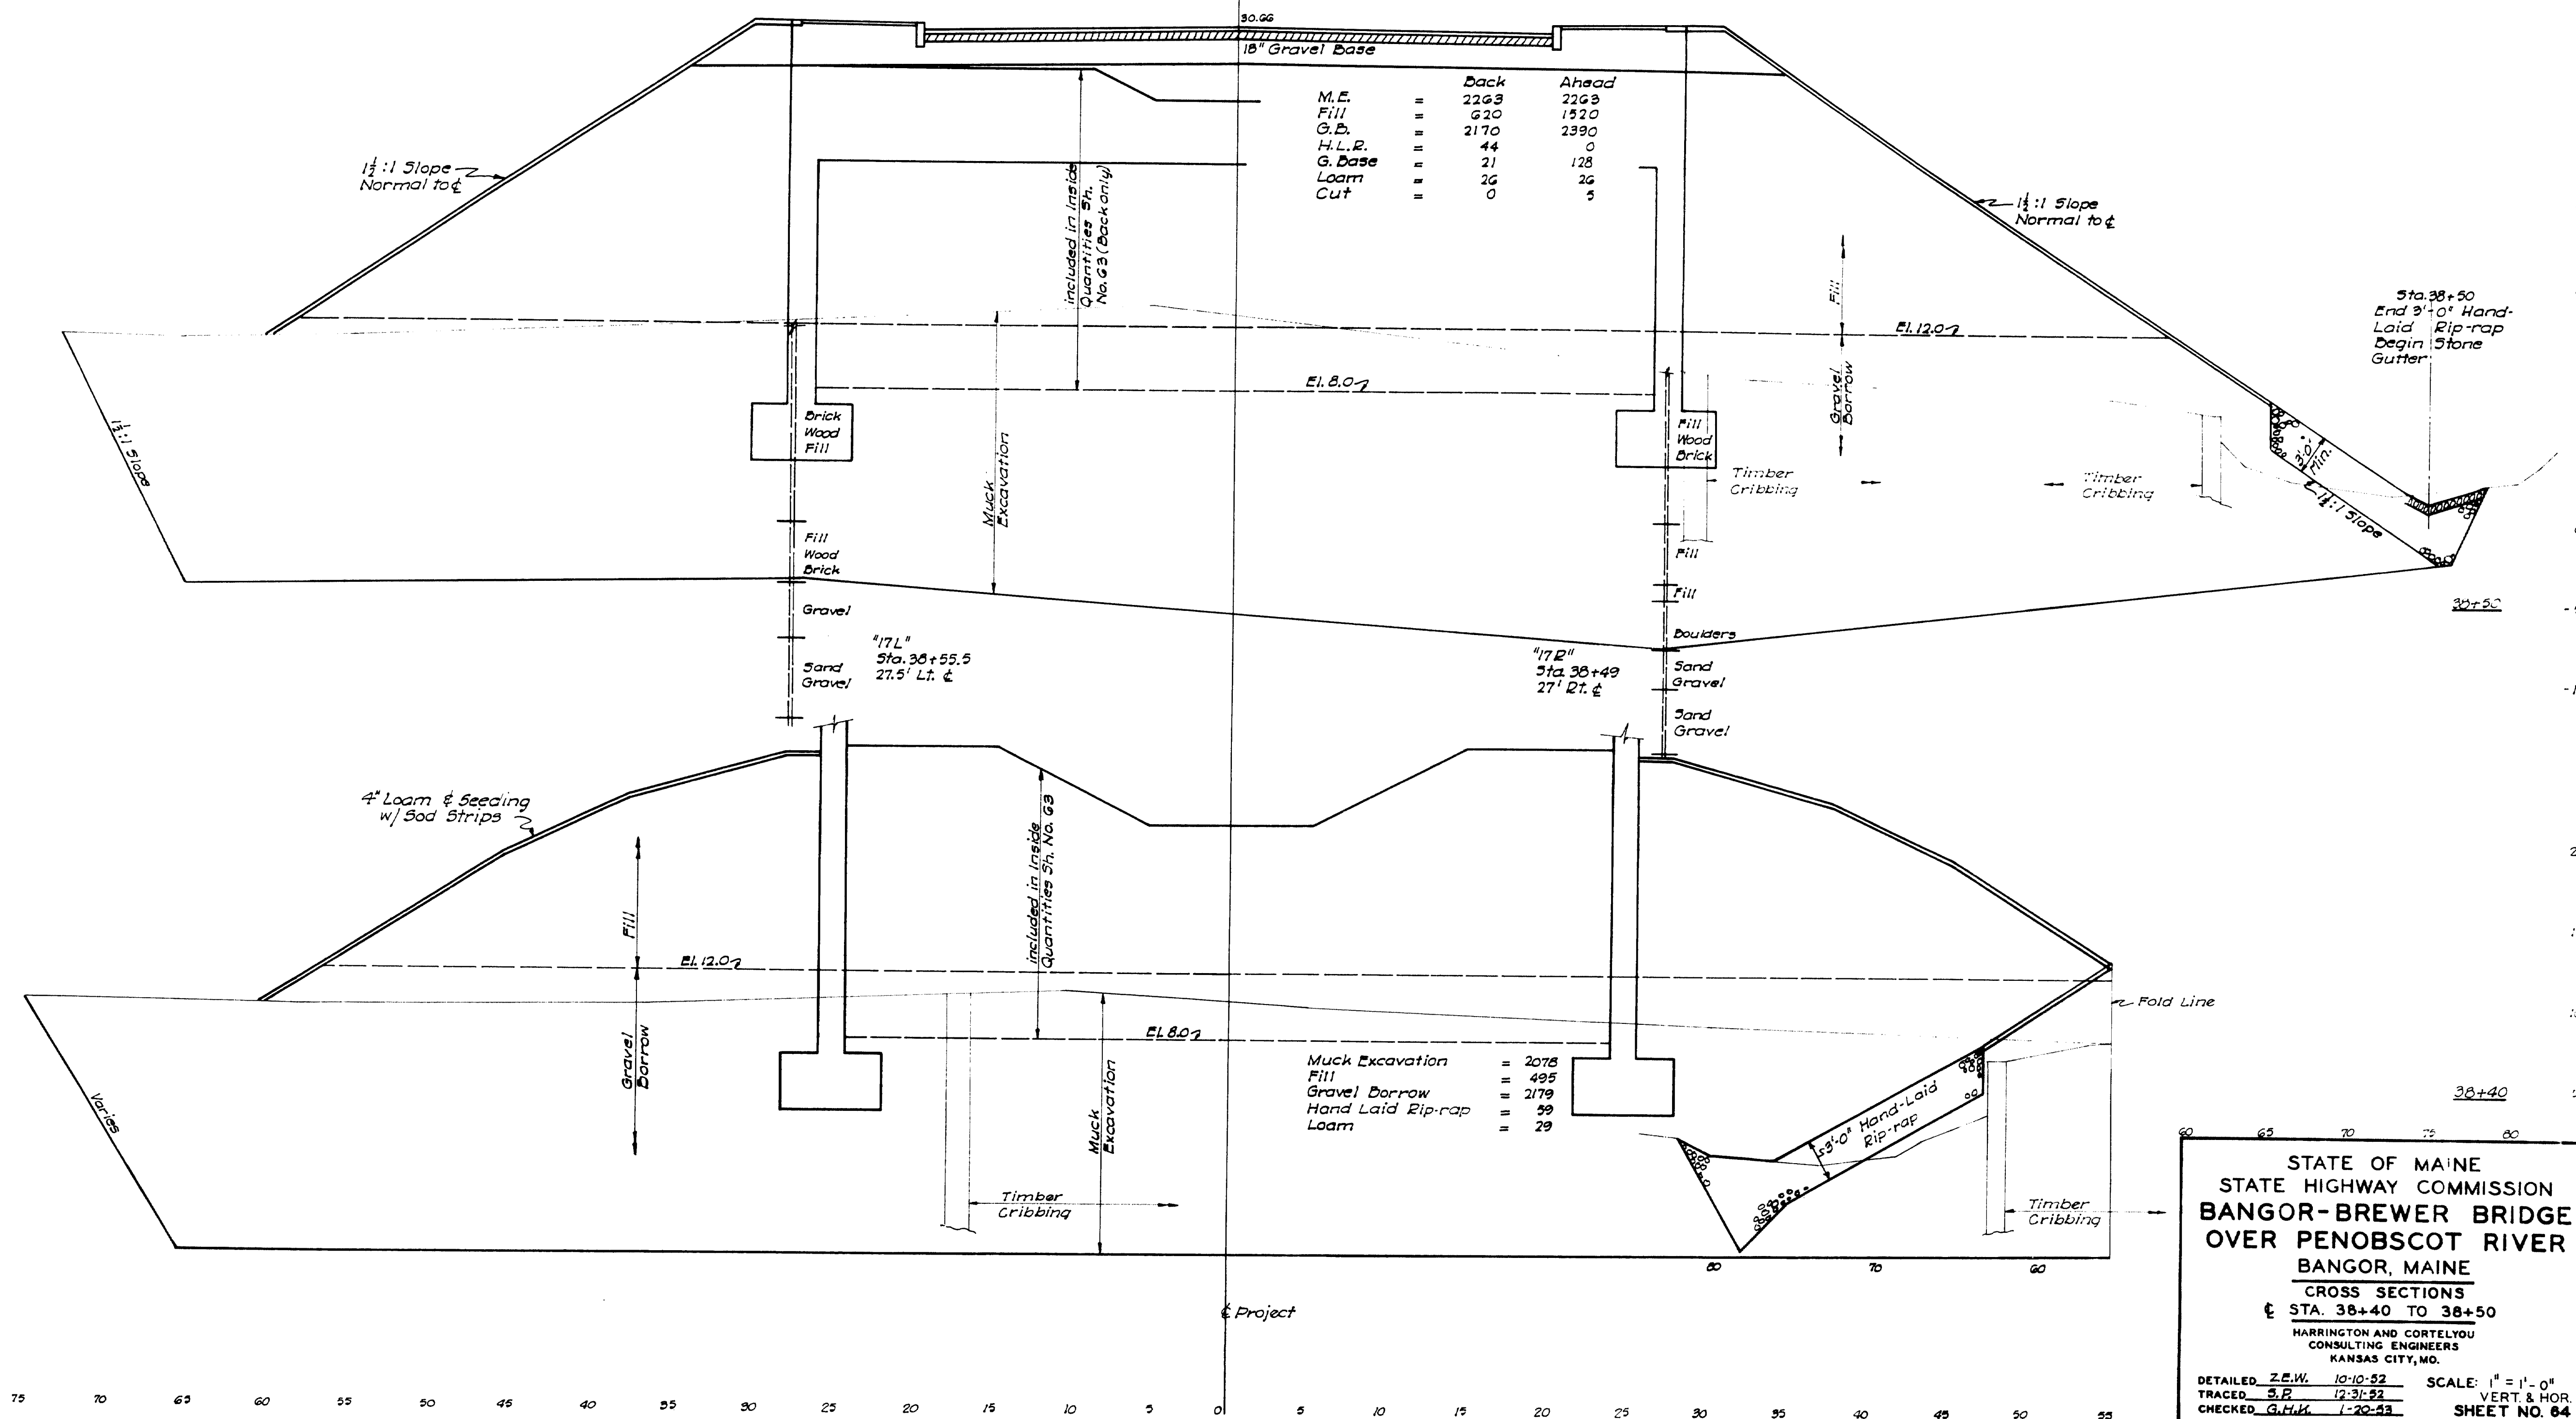

STATE OF MAINE  
 STATE HIGHWAY COMMISSION  
**BANGOR-BREWER BRIDGE**  
**OVER PENOBSCOT RIVER**  
 BANGOR, MAINE  
 CROSS SECTIONS  
 STA. 38+40 TO 38+50  
 HARRINGTON AND CORTELYOU  
 CONSULTING ENGINEERS  
 KANSAS CITY, MO.  
 DETAILED Z.E.W. 10-10-52  
 TRACED S.R. 12-31-52  
 CHECKED G.H.K. 1-20-53  
 SCALE: 1" = 1'-0"  
 VERT. & HOR.  
 SHEET NO. 64

62-65

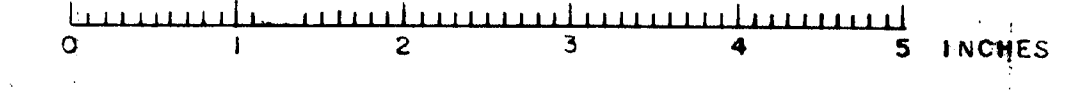



6.59  
 10.7.52  
 11.7.52  
 12.22.52  
 S.E.W.  
 C.M.M.  
 S.B.  
 S.J.D.

Estimated Limit of  
Muck Excavation = Sta. 39+05

C.	=	5
M.E.	=	401
Fill	=	1729
G. Bor.	=	28
G. Base	=	150
L.	=	19

C.	=	5
M.E.	=	900
Fill	=	1717
G. Bor.	=	744
G. Base	=	143
L.	=	23

Cut	=	5
Muck Excavation	=	1610
Fill	=	1641
Gravel Borrow	=	1980
Gravel Base	=	135
Loam	=	27


"TIP"  
Sta. 38+88  
34' Rd


STATE OF MAINE  
 STATE HIGHWAY COMMISSION  
**BANGOR-BREWER BRIDGE  
 OVER PENOBSCOT RIVER**  
 BANGOR, MAINE  
 CROSS SECTIONS  
 STA. 38+70 TO 39+00  
 HARRINGTON AND CORTELYOU  
 CONSULTING ENGINEERS  
 KANSAS CITY, MO.

DETAILED Z.E.W. 10-11-52  
 TRACED S.B. 1-2-52  
 CHECKED G.H.K. 1-20-52

SCALE: 1" = 1'-0"  
 VERT. & HOR.  
 SHEET NO. 65

62-66

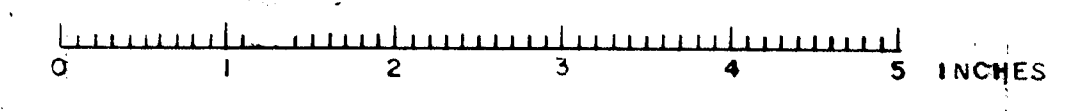

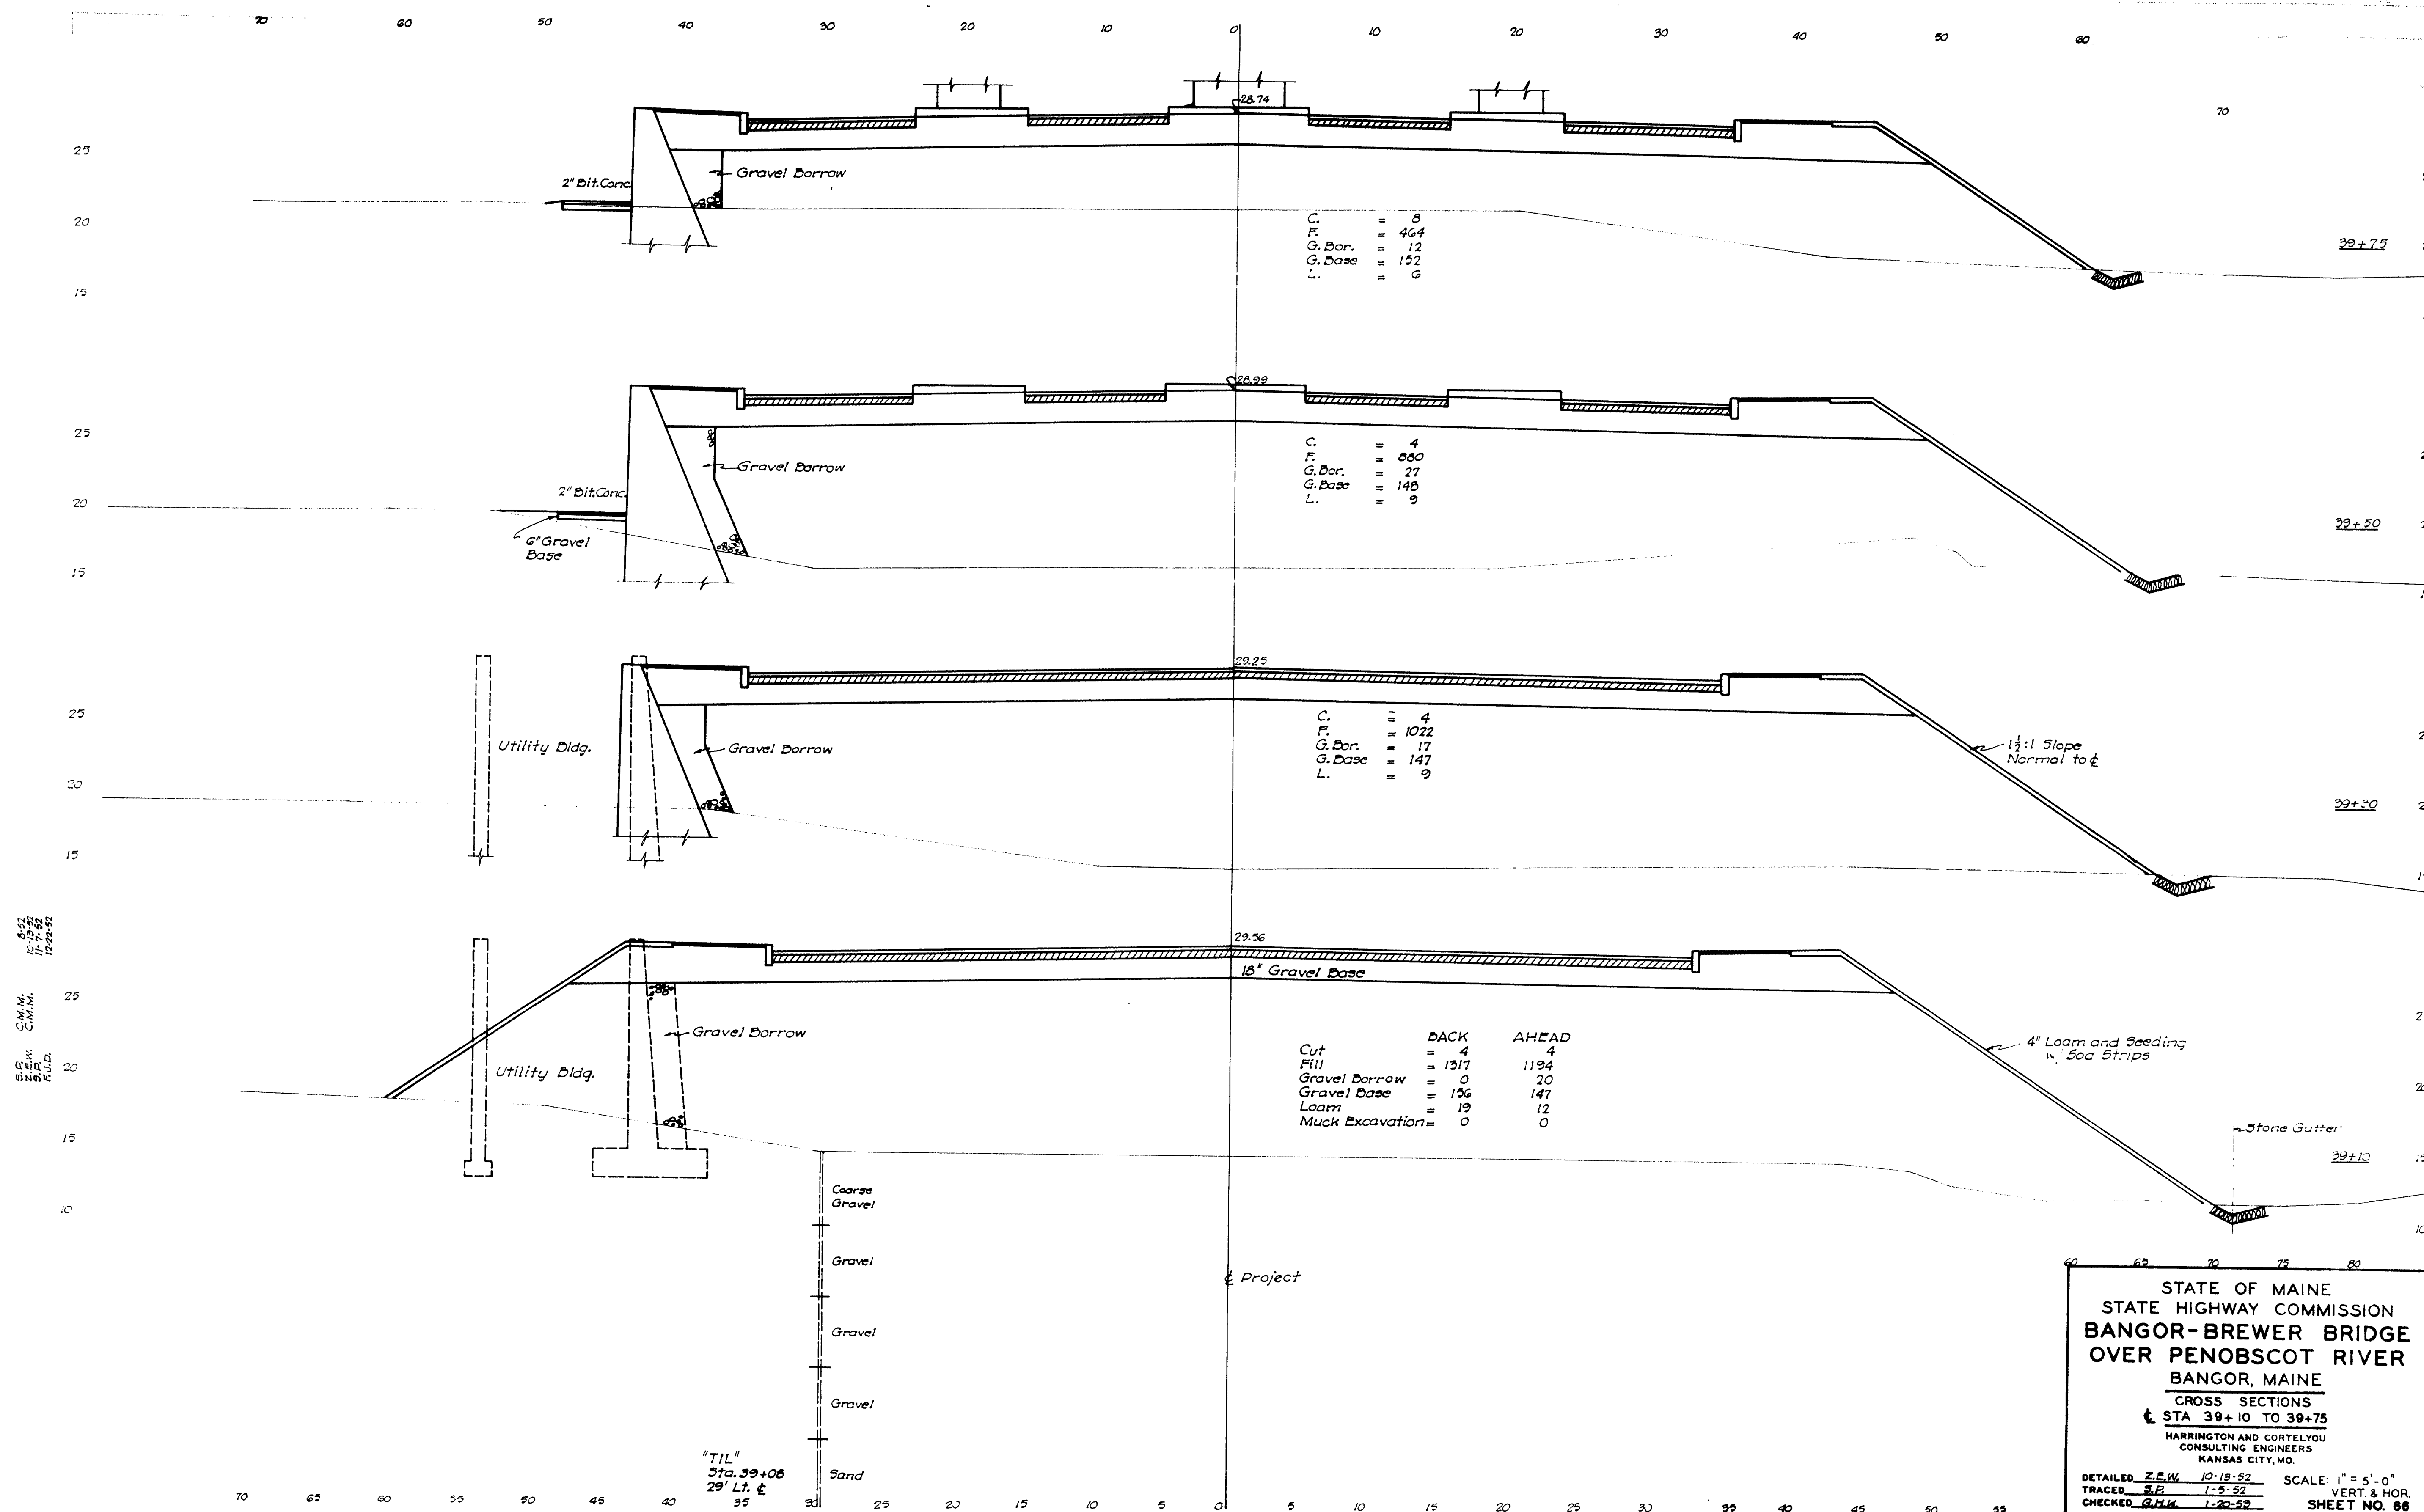


STATE OF MAINE  
STATE HIGHWAY COMMISSION  
**BANGOR-BREWER BRIDGE**  
OVER PENOBSCOT RIVER  
BANGOR, MAINE  
CROSS SECTIONS  
STA 39+10 TO 39+75  
HARRINGTON AND CORTELYOU  
CONSULTING ENGINEERS  
KANSAS CITY, MO.  
DETAILED Z.E.W. 10-18-52  
TRACED S.P. 1-5-52  
CHECKED G.H.W. 1-20-52  
SCALE: 1" = 5'-0"  
VERT. & HOR.  
SHEET NO. 66

62-67



S.B. C.M.M.  
10/25/52  
12/22/52

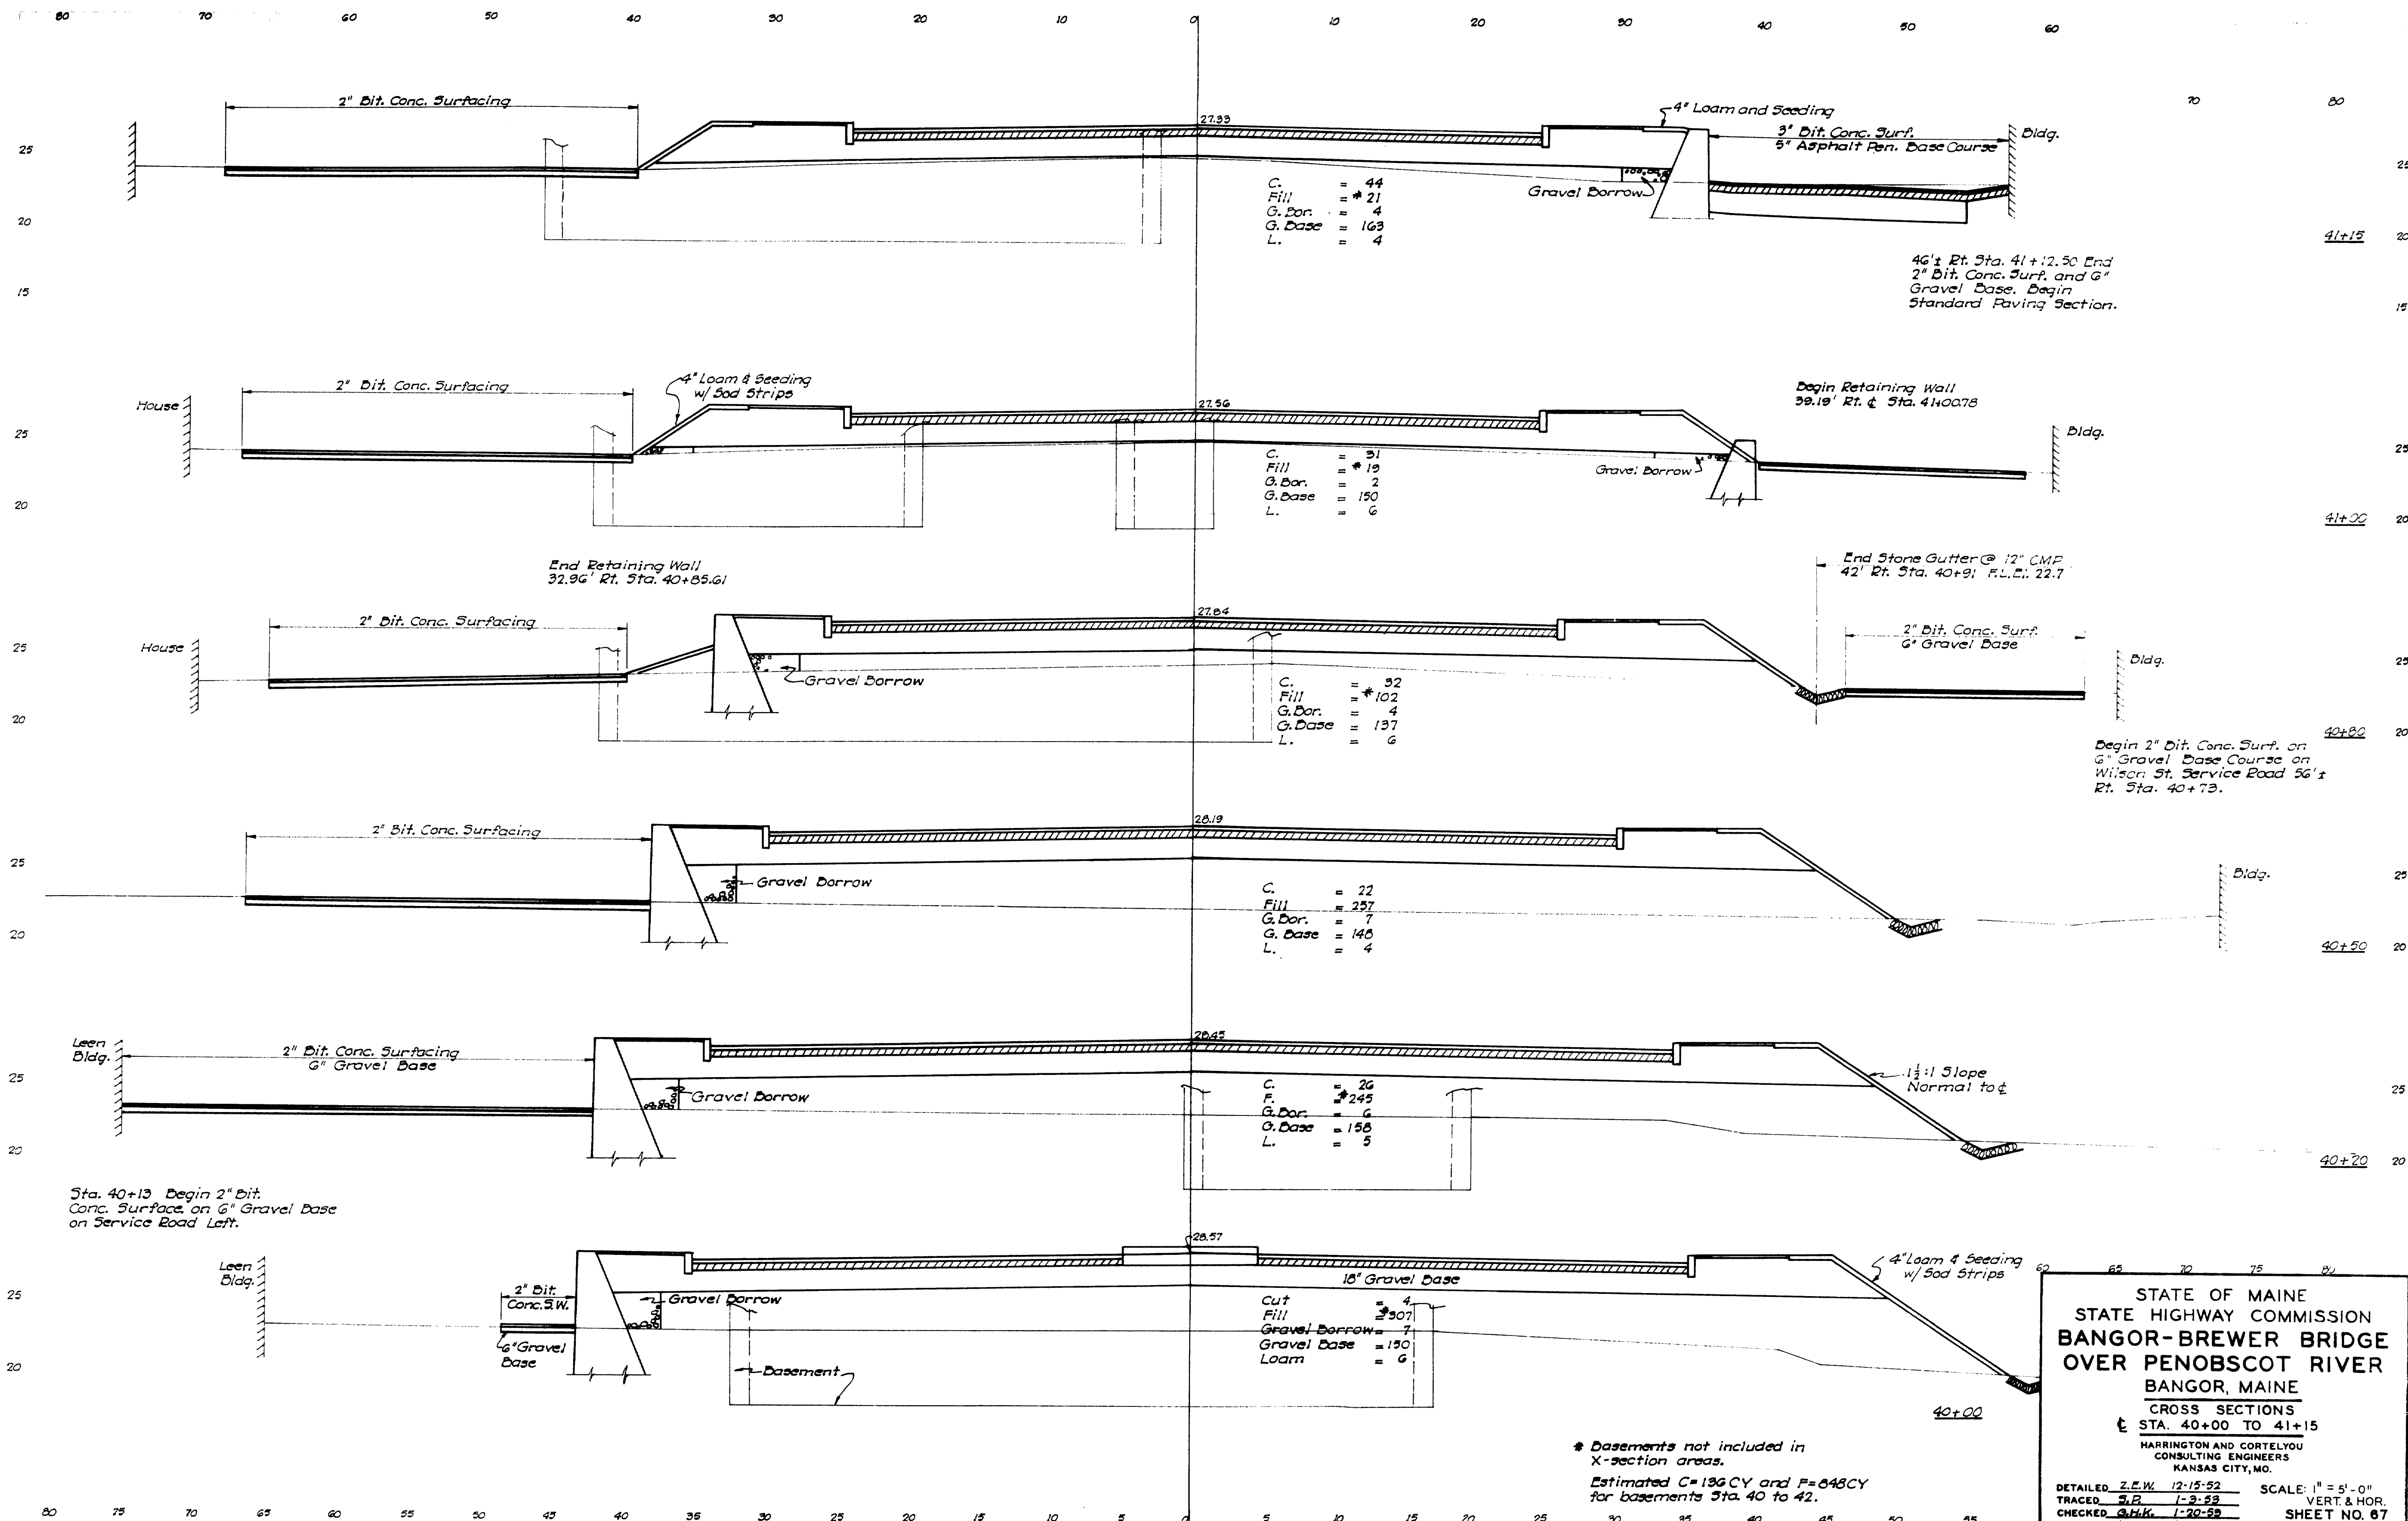

STATE OF MAINE  
STATE HIGHWAY COMMISSION  
**BANGER-BREWER BRIDGE**  
OVER PENOBSCOT RIVER  
BANGOR, MAINE

CROSS SECTIONS  
STA. 40+00 TO 41+15


HARRINGTON AND CORTELYOU  
CONSULTING ENGINEERS  
KANSAS CITY, MO.

DETAILED Z.E.W. 12-15-52  
TRACED S.B. 1-3-53  
CHECKED G.H.K. 1-20-53

SCALE: 1" = 5'-0"  
VERT. & HOR.  
SHEET NO. 67

62-68


0 1 2 3 4 5 INCHES

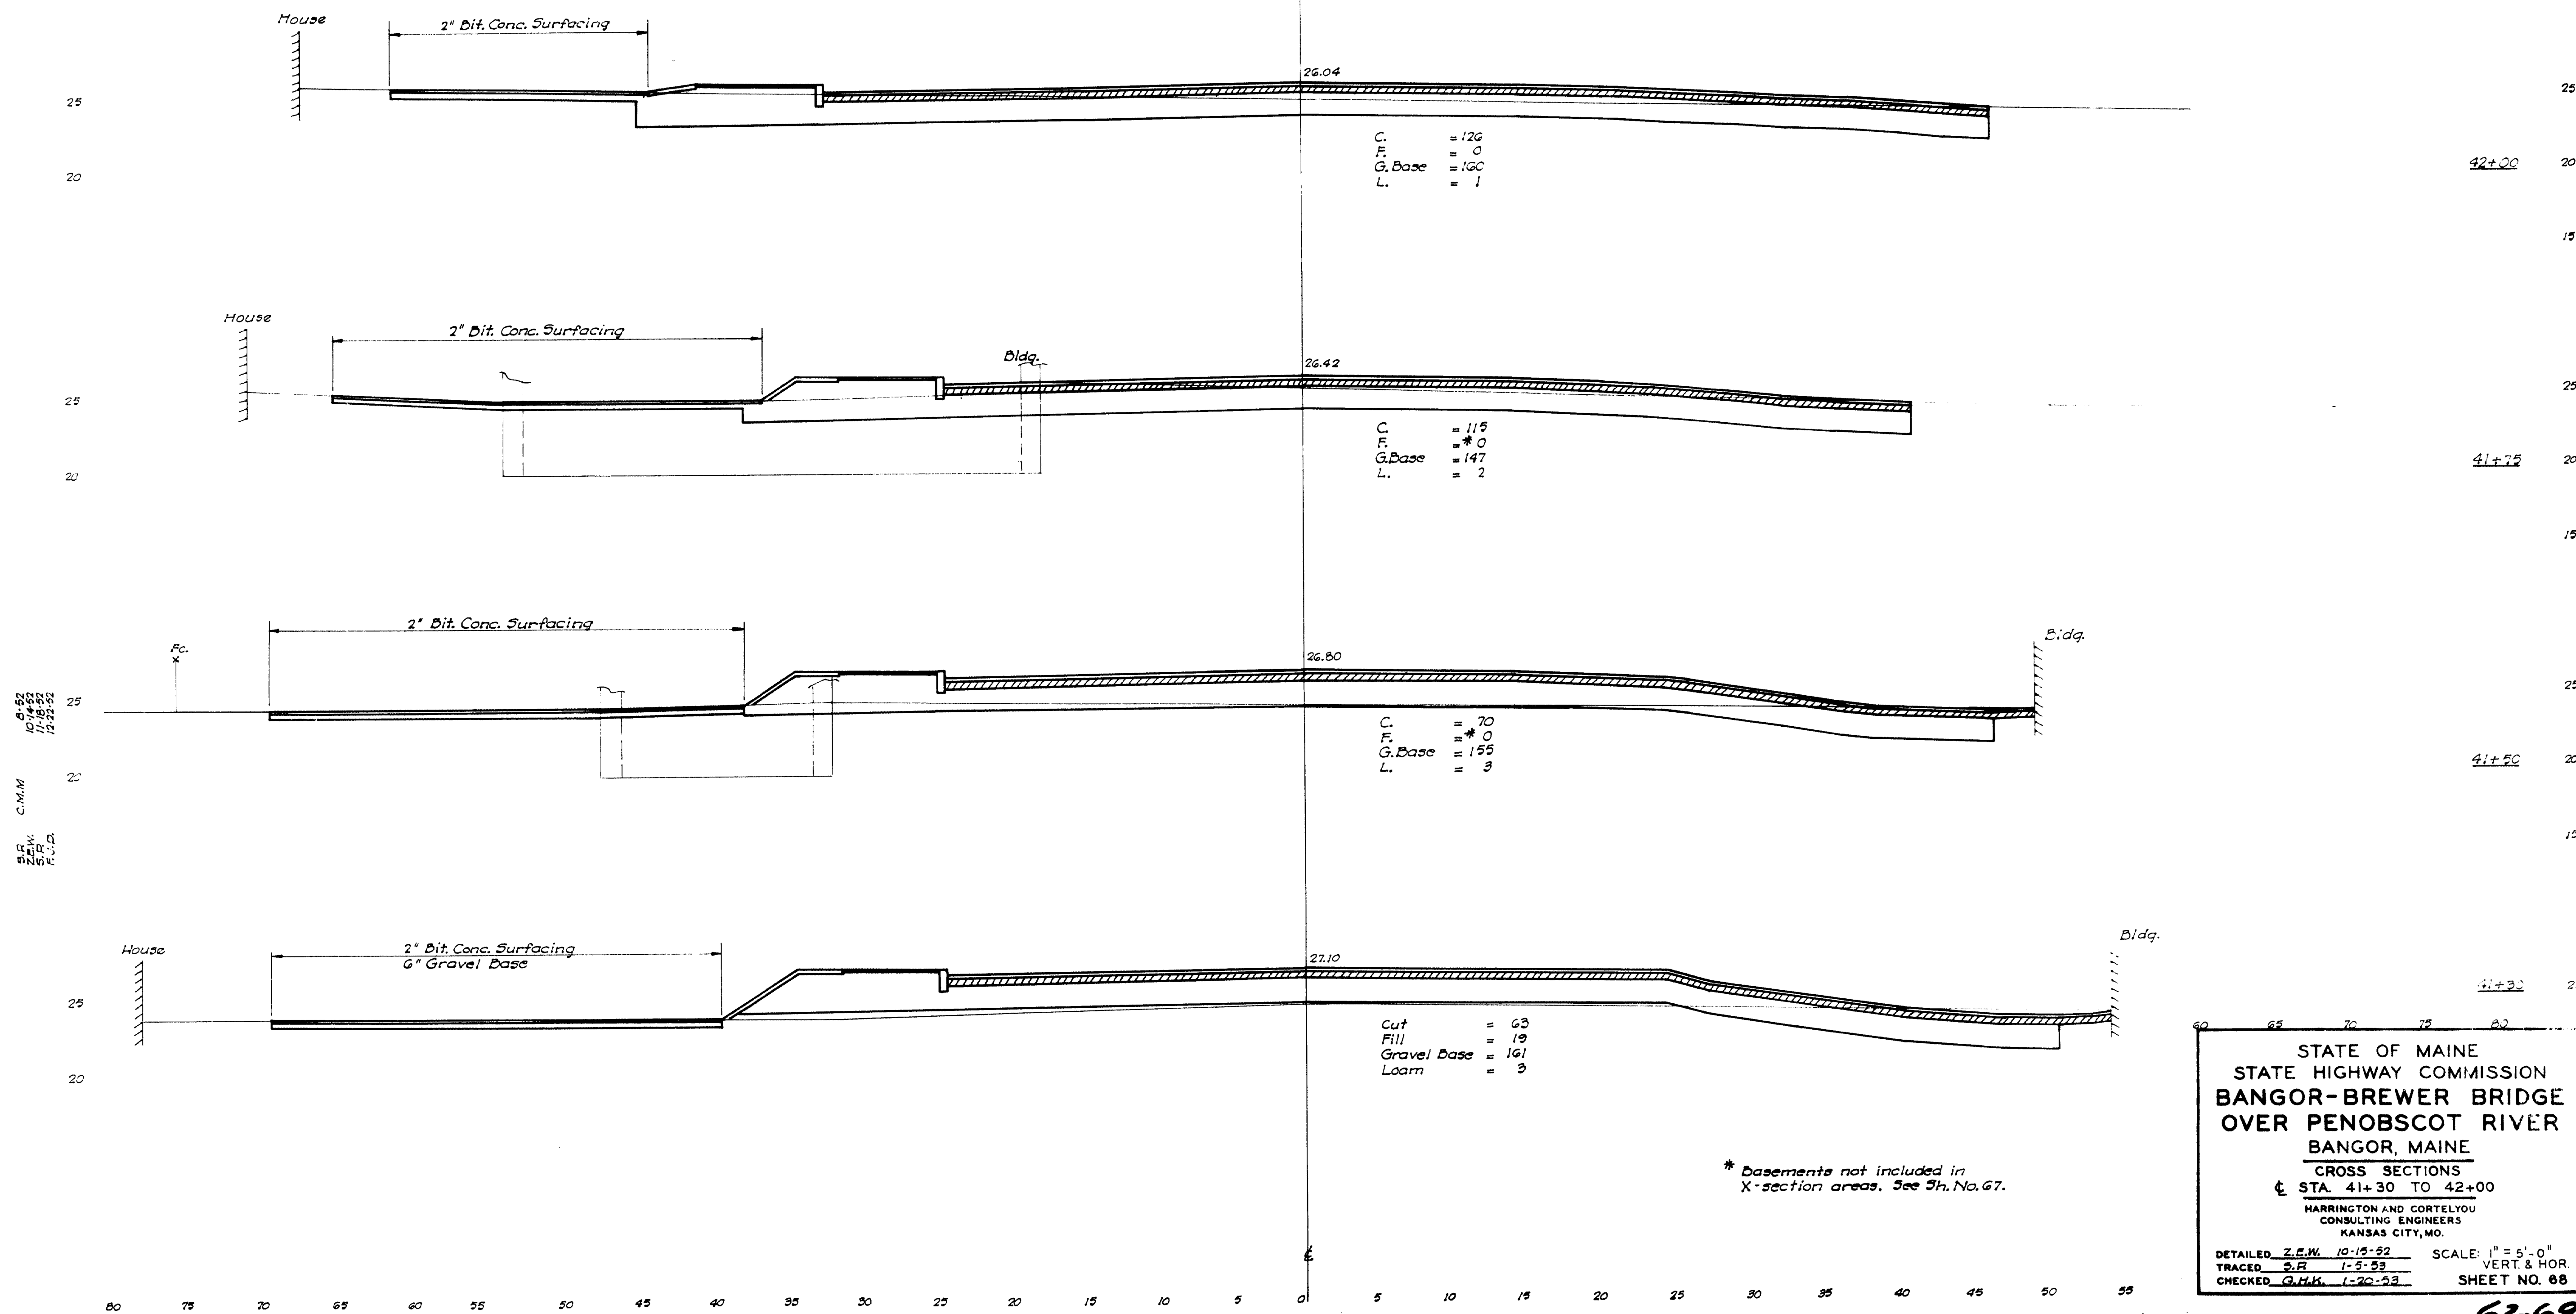


STATE OF MAINE  
STATE HIGHWAY COMMISSION  
**BANGOR-BREWER BRIDGE  
OVER PENOBSCOT RIVER**  
BANGOR, MAINE  
CROSS SECTIONS  
STA. 41+30 TO 42+00  
HARRINGTON AND CORTELYOU  
CONSULTING ENGINEERS  
KANSAS CITY, MO.  
DETAILED Z.E.W. 10-15-52 SCALE: 1" = 5'-0" VERT. & HOR.  
TRACED S.R. 1-5-53  
CHECKED G.H.K. 1-20-53  
SHEET NO. 68





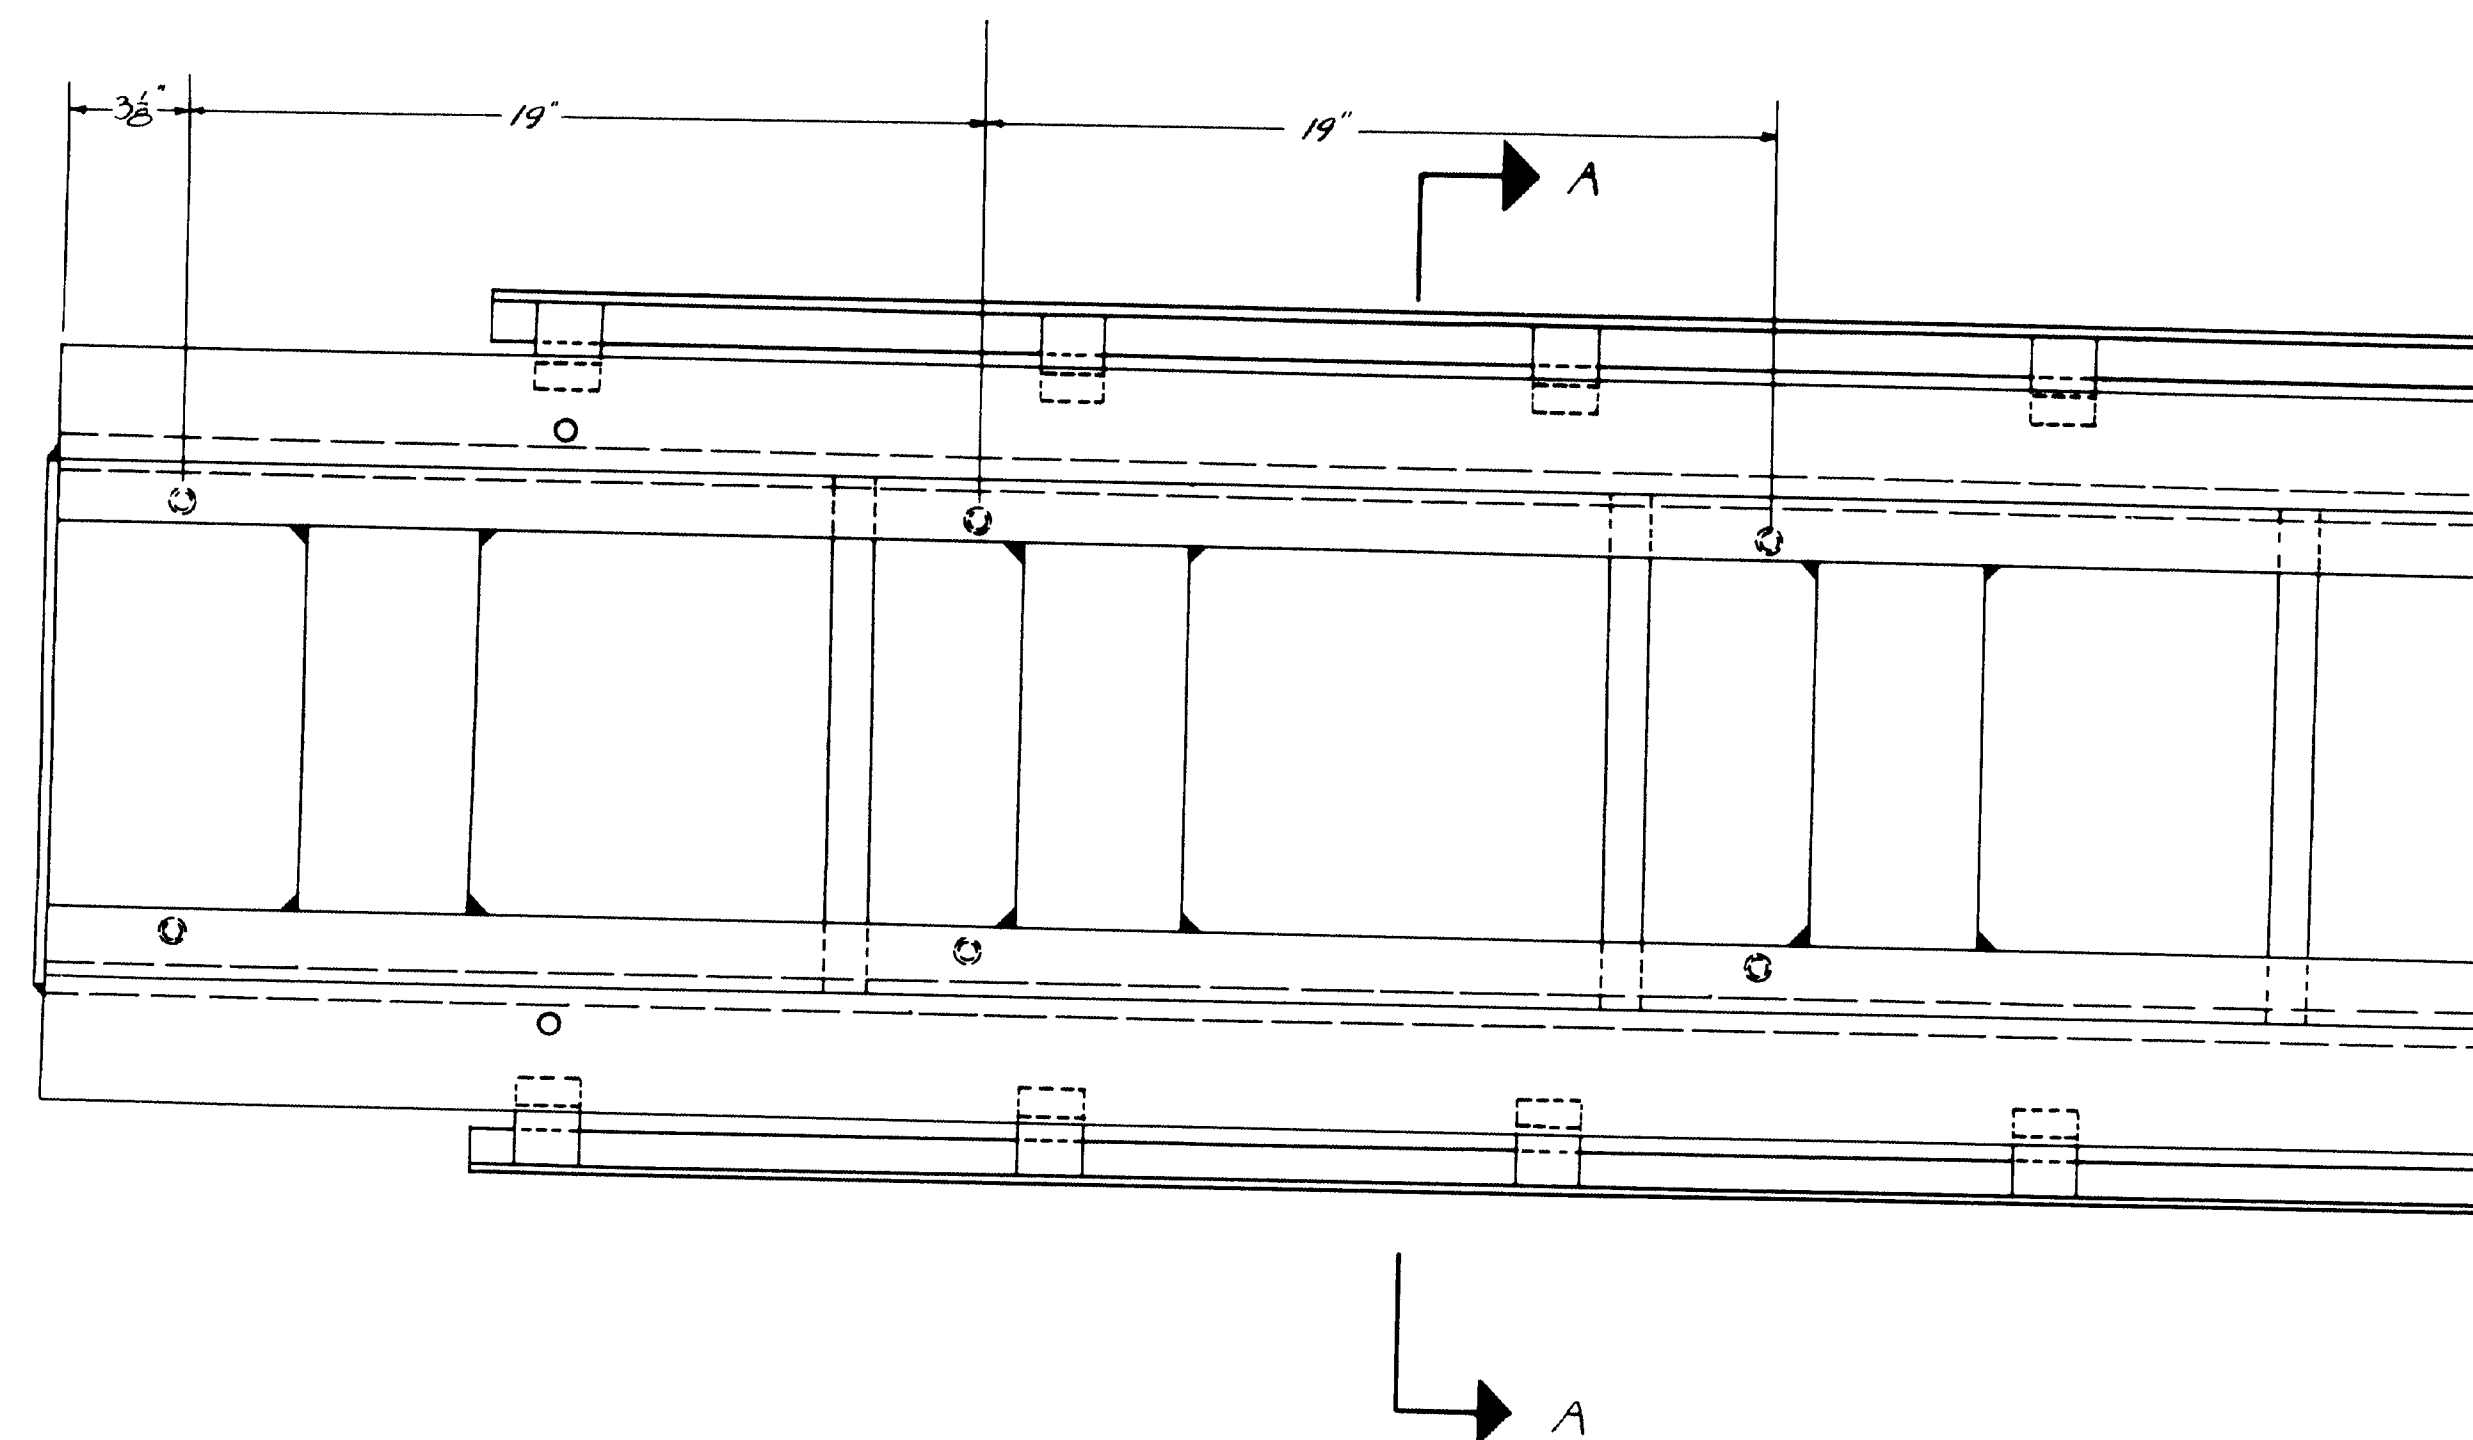

HALF PLAN VIEW

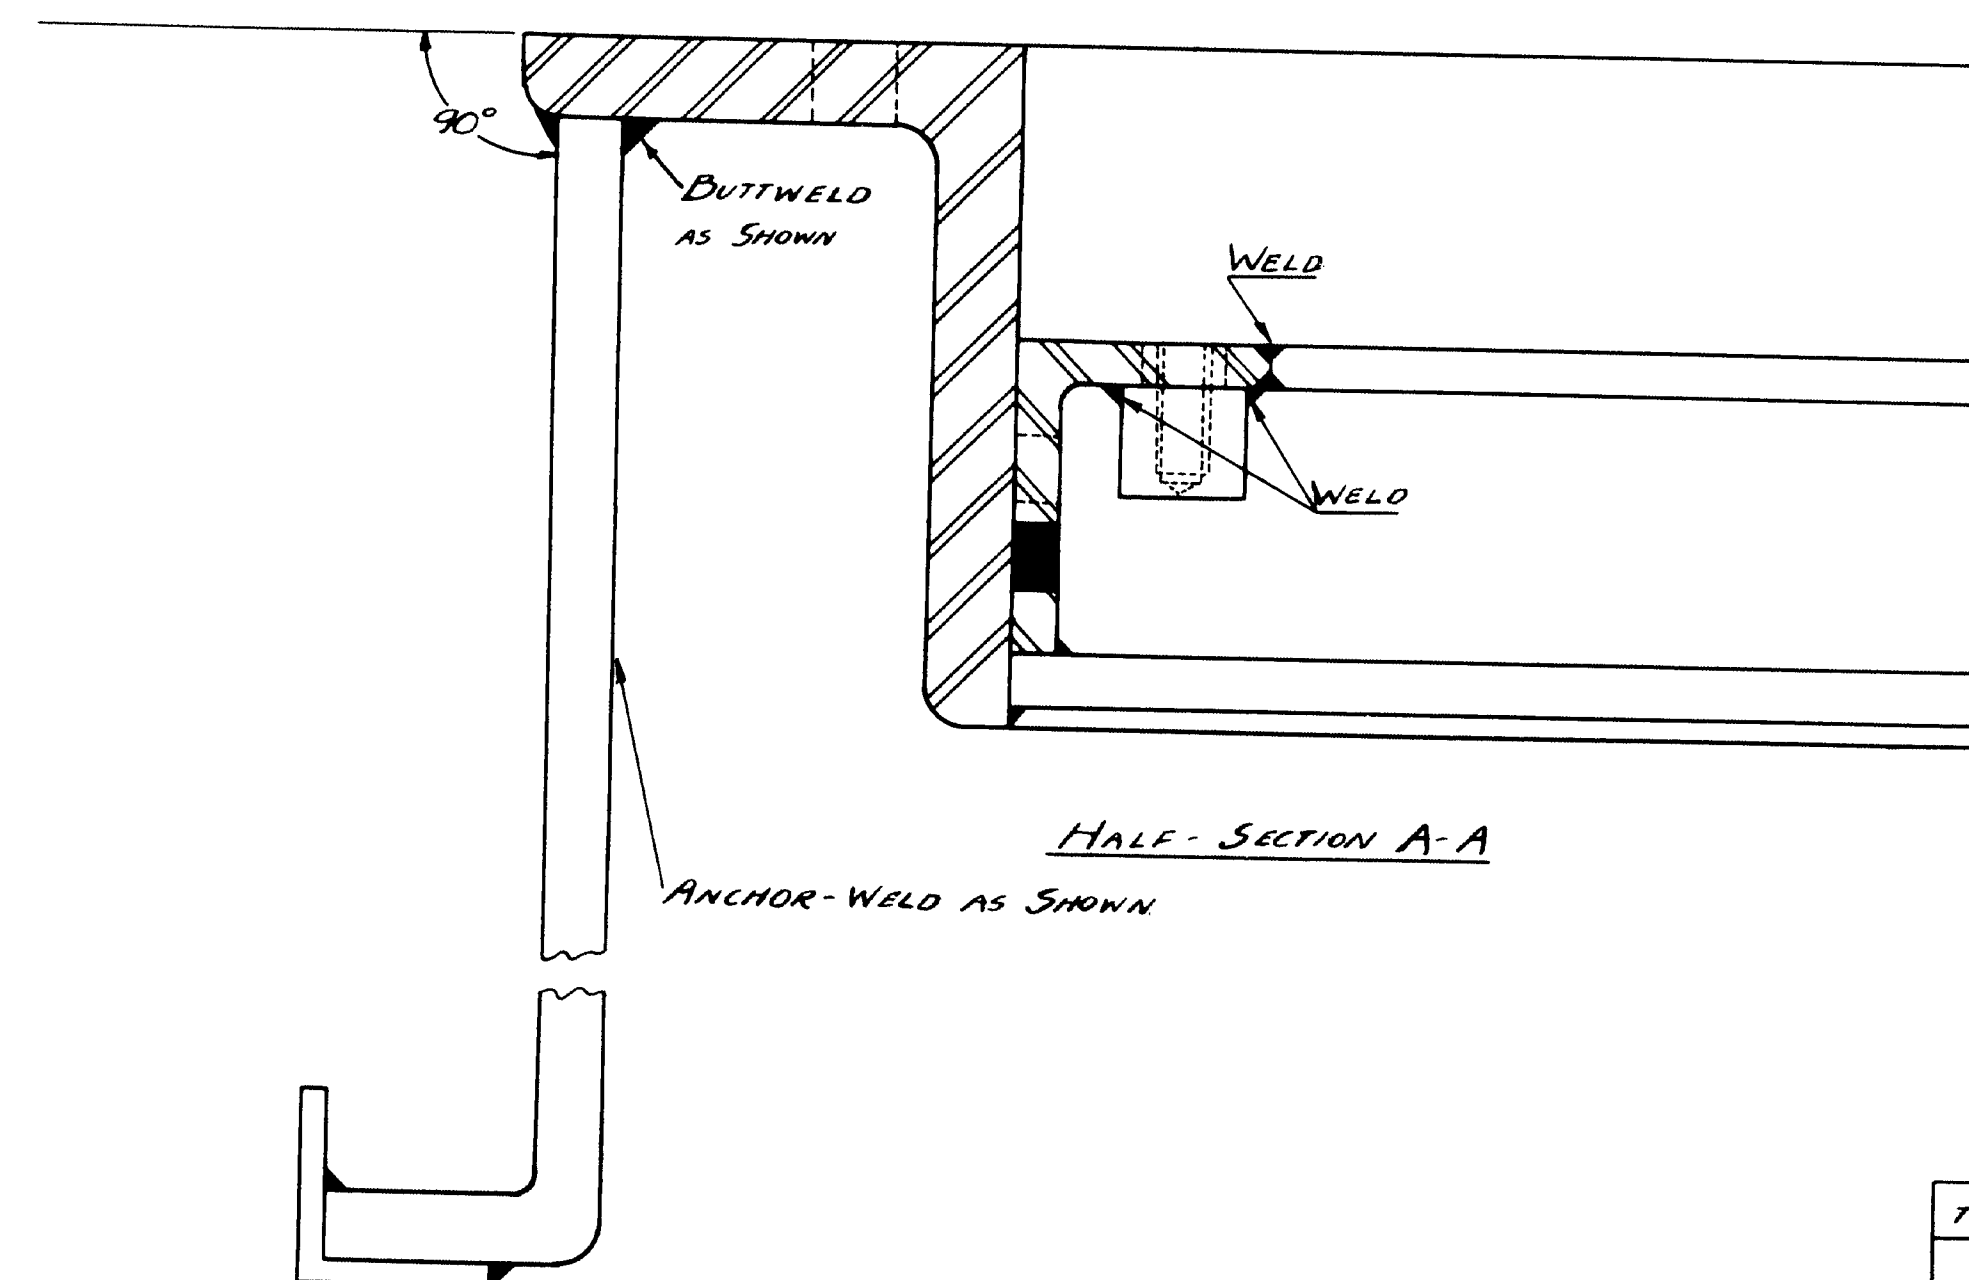


HALF SECTION A-A

TRICE-MARRELL  
TREADLE FRAME  
(REVISION OF TALLER & COOPER  
DESIGN)  
JAN. 1954


62-71

0 1 2 3 4 5 INCHES



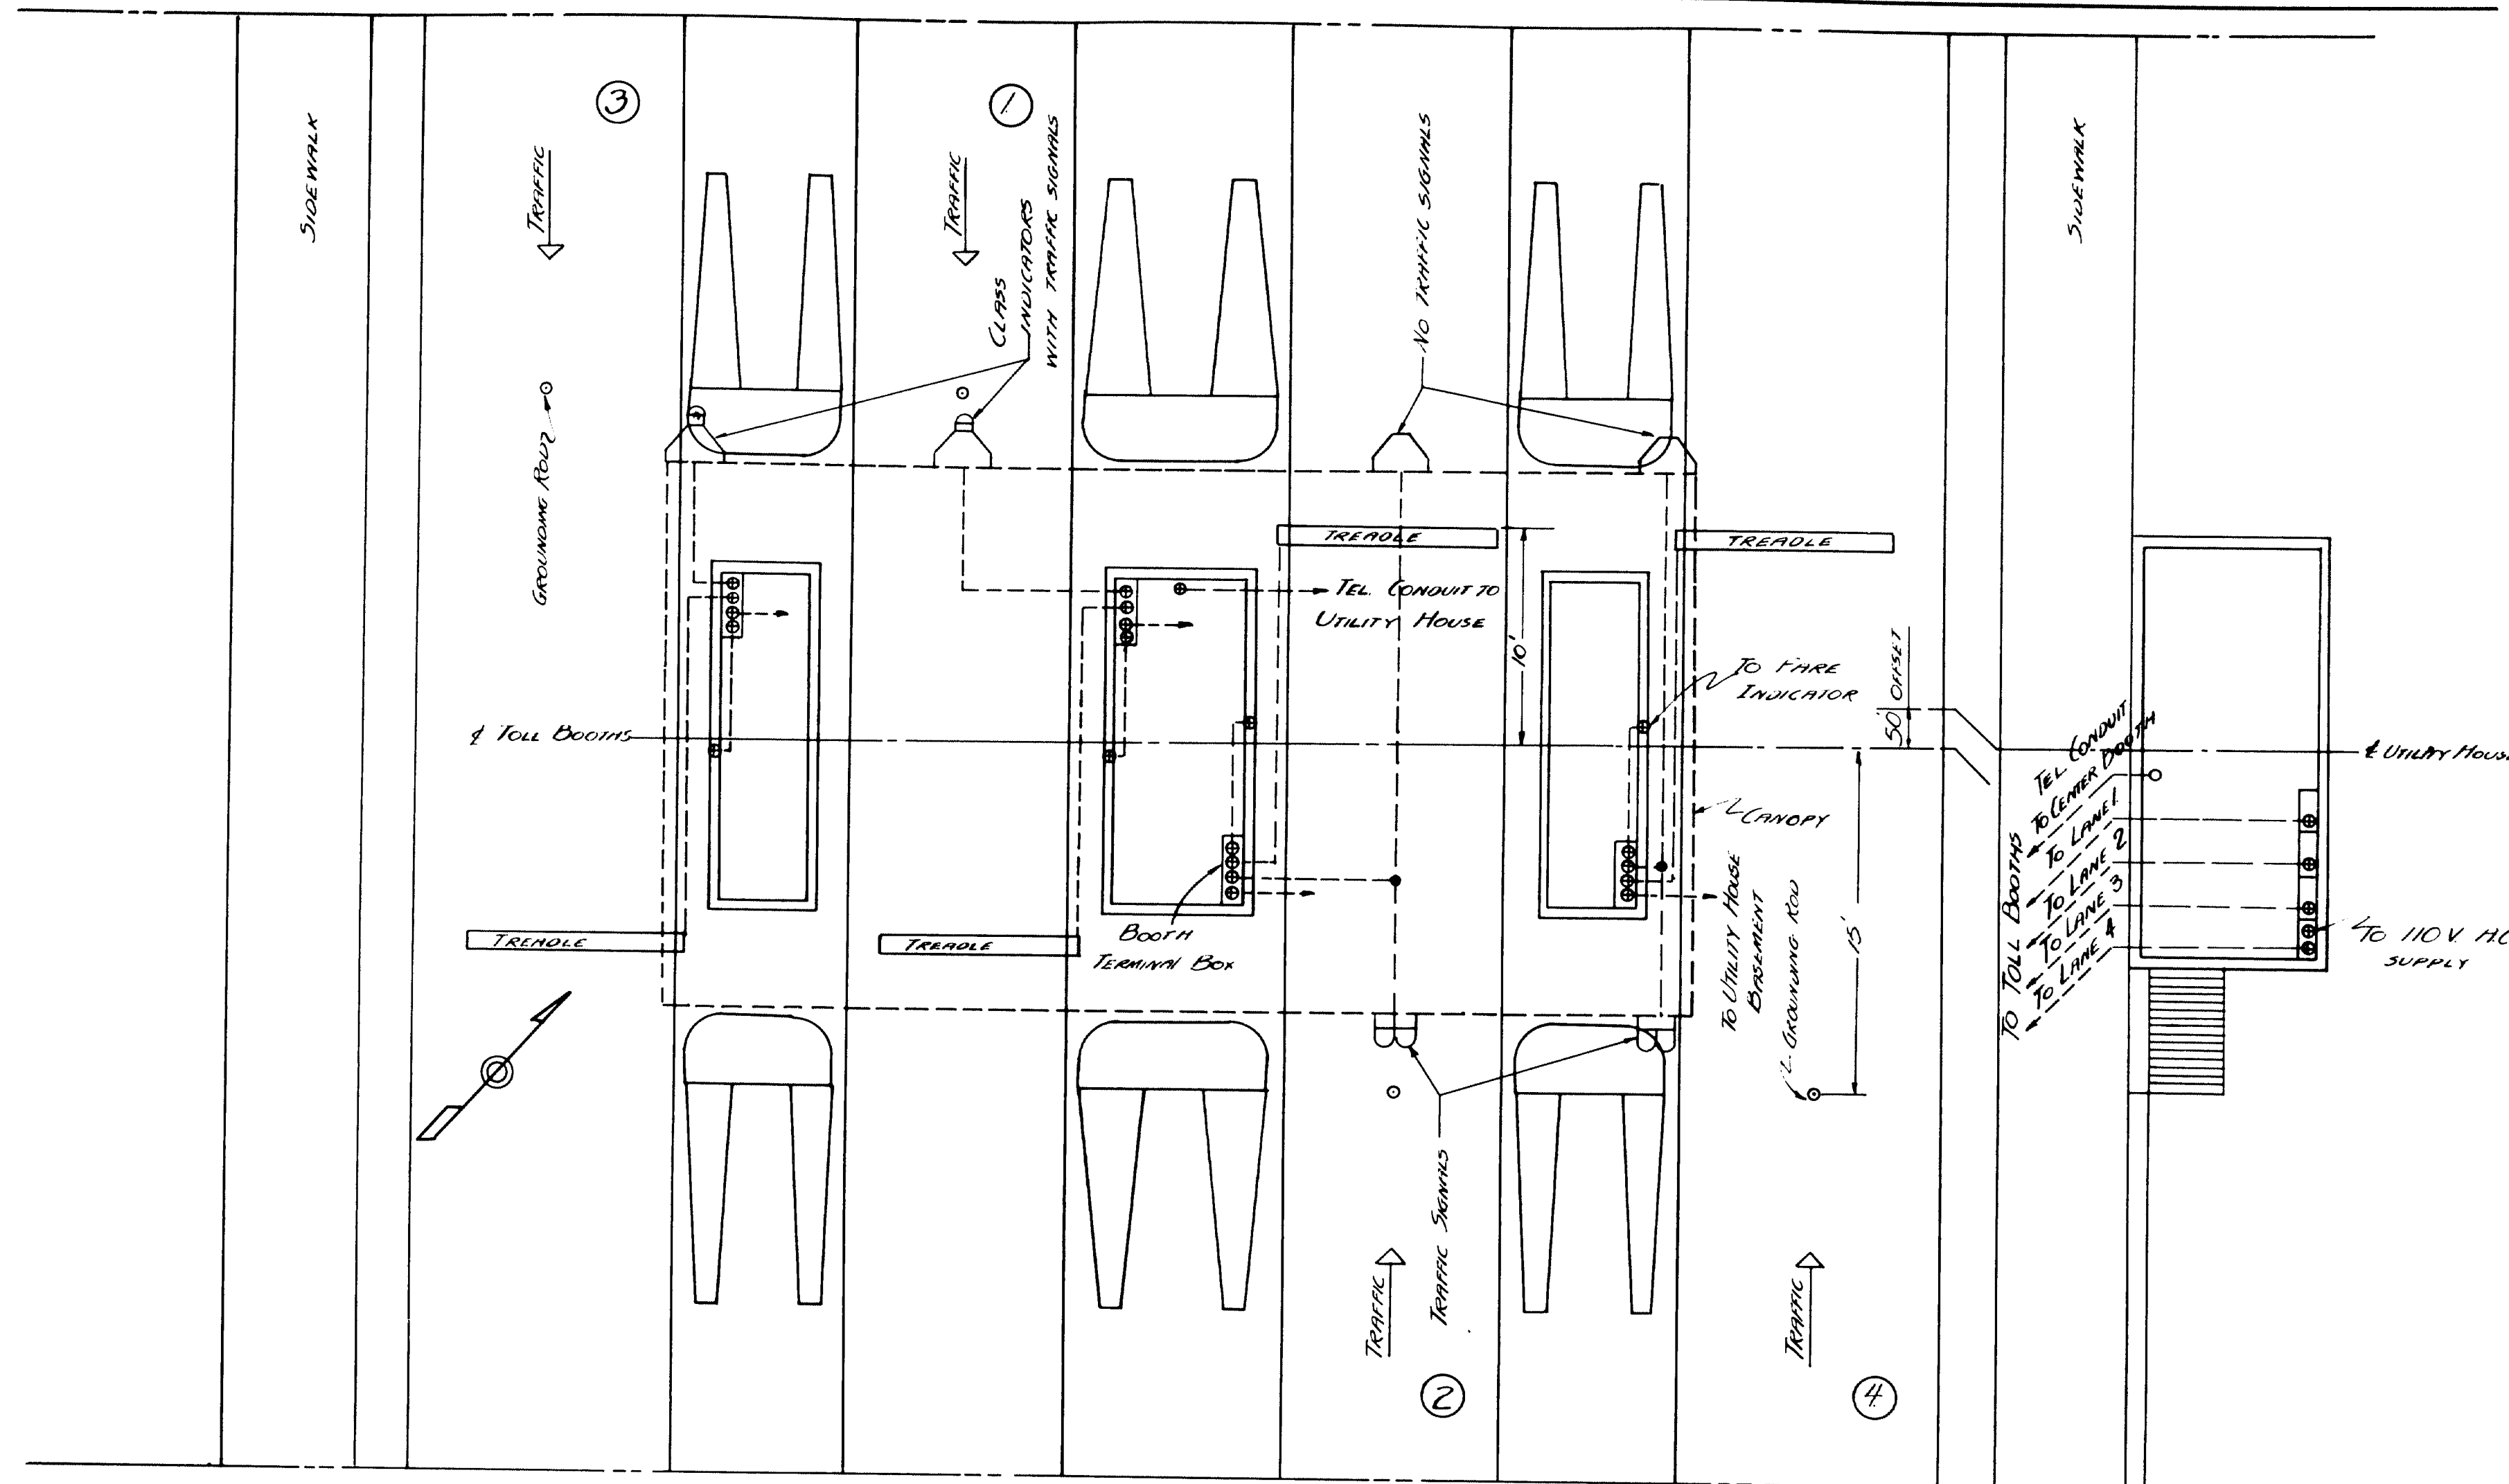


GENERAL PLAN

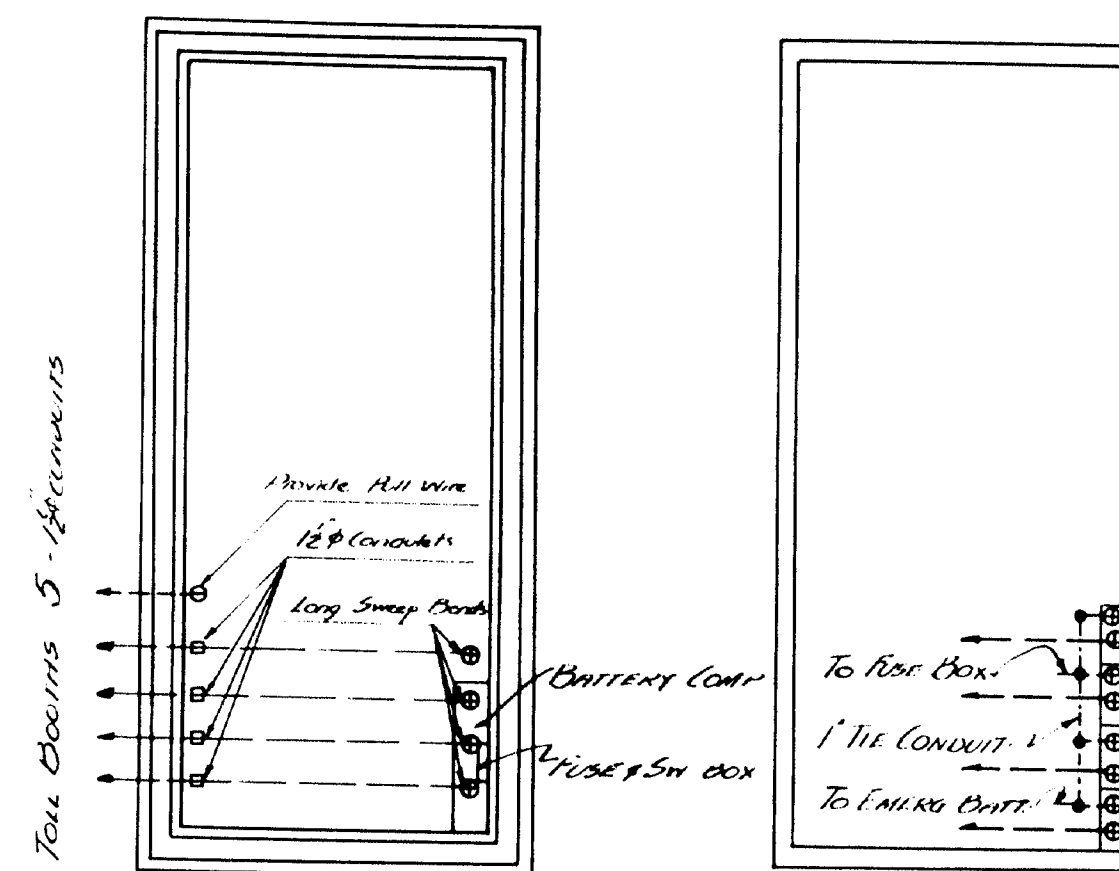

UTILITY HOUSE  
FOUNDATION PLAN FLOOR PLAN

NOTES

CONDUIT SIZE  
 1 1/2" UTILITY HOUSE TO BOOTH TERMINAL BOX  
 1 1/2" TREADLE TO BOOTH TERMINAL BOX  
 ALL OTHER CONDUIT FOR TOLL EQUIPMENT TO  
 BE 1" MINIMUM SIZE  
 PROVIDE PULL BOXES AS NECESSARY  
 TOLL WIRING MAY BE INDIVIDUAL CONDUCTORS  
 OR A CABLE FOR 120 V SERVICE  
 1/2" TELEPHONE CONDUIT FROM UTILITY HOUSE  
 TO CENTER TOLL BOOTH  
 PROVIDE 4'-5'x5' CONCRETE WELD GROUND  
 RODS SEE SHEET 3 FOR INSTALLATION METHOD  
 SEE SHEETS 28, 49, AND 50 FOR LIGHTING DETAILS  
 1/32" LONG SWEEP BENDS WHERE EVER FEASIBLE

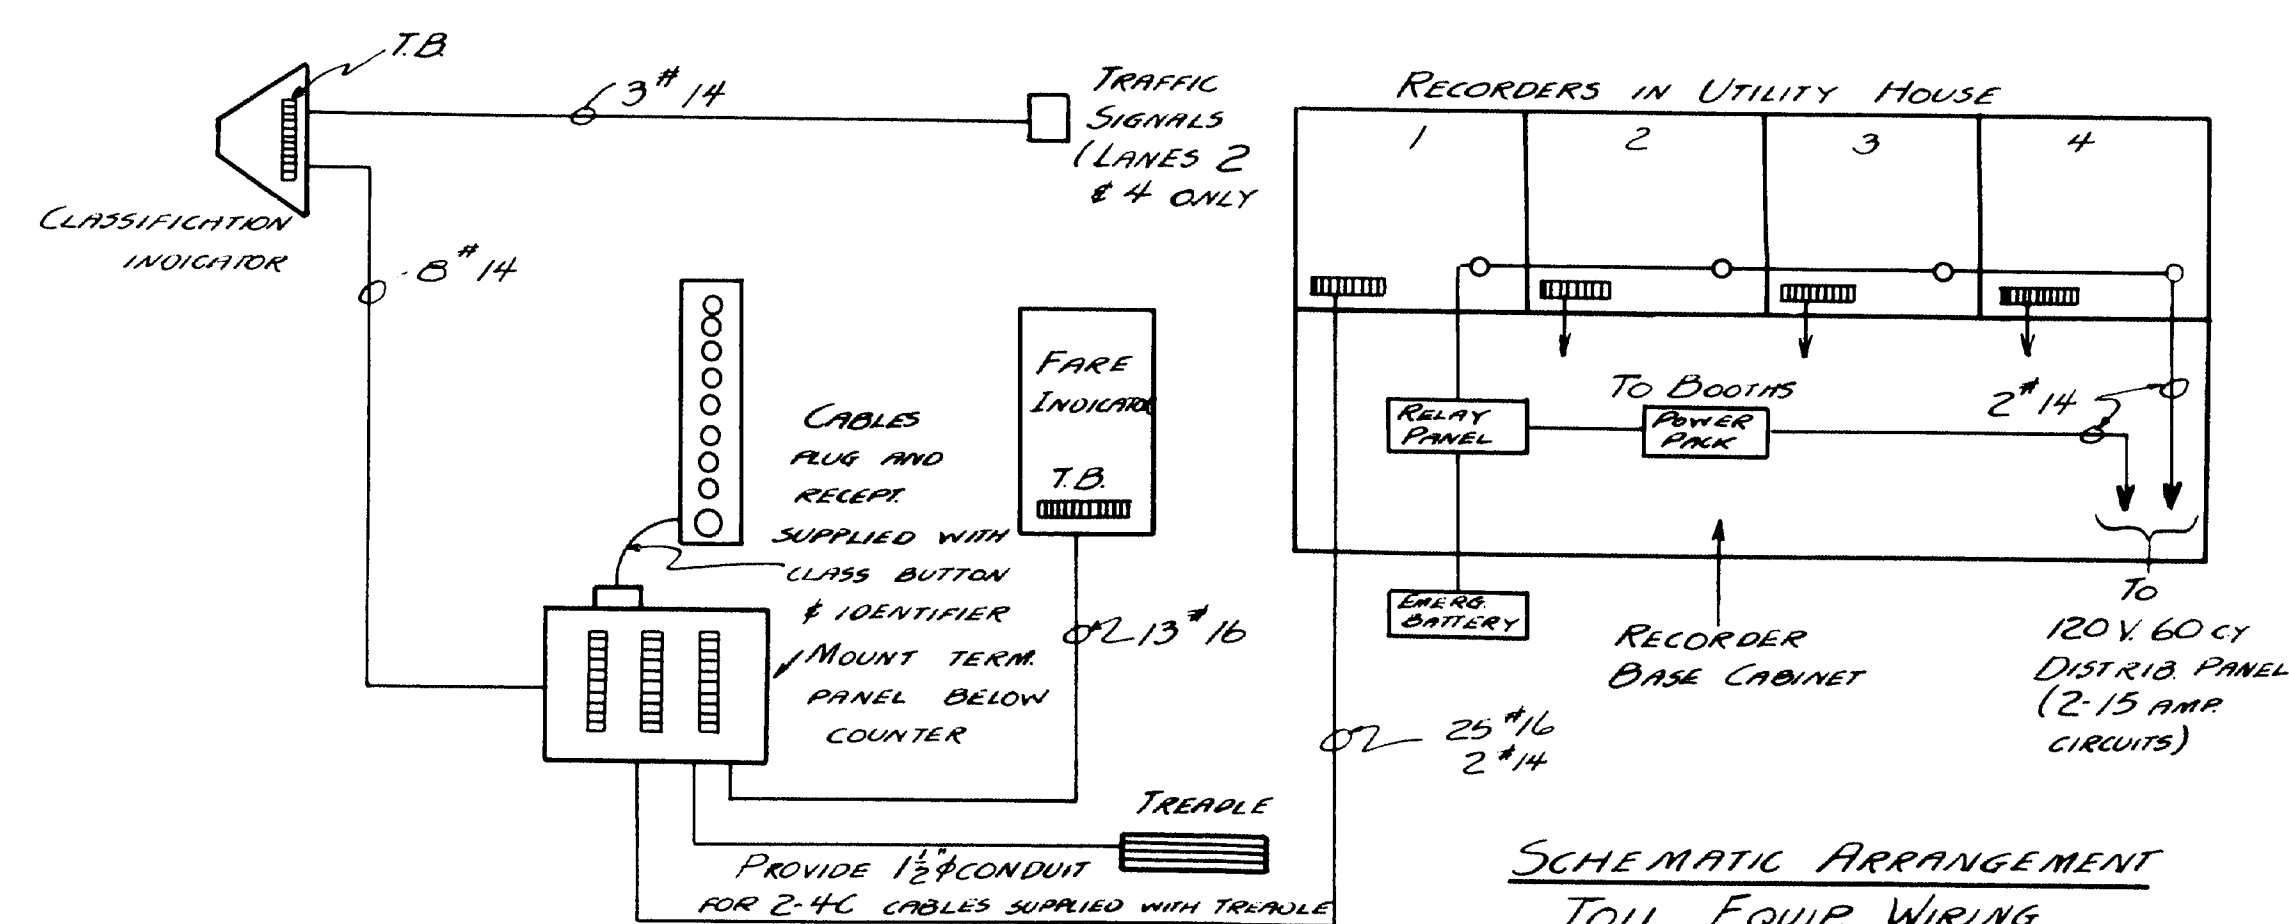


SCHEMATIC ARRANGEMENT  
TOLL EQUIP WIRING

TYPICAL TOLL WIRING FOR EACH LANE


Revised 3/1954

PLAN - MURRELL  
 CHECK -  
 BRIDGE  
 STATE HIGHWAY COMMISSION  
 BRIDGE DIVISION  
**BANGOR-BREWER BRIDGE**  
 OVER THE  
**PENOBSCOT RIVER**  
 IN THE CITY OF  
**BANGOR**  
**PENOBSCOT COUNTY**  
 ELECTRICAL LAYOUT

SHEET 1 OF 4 AUGUSTA, MAINE JAN. 1954




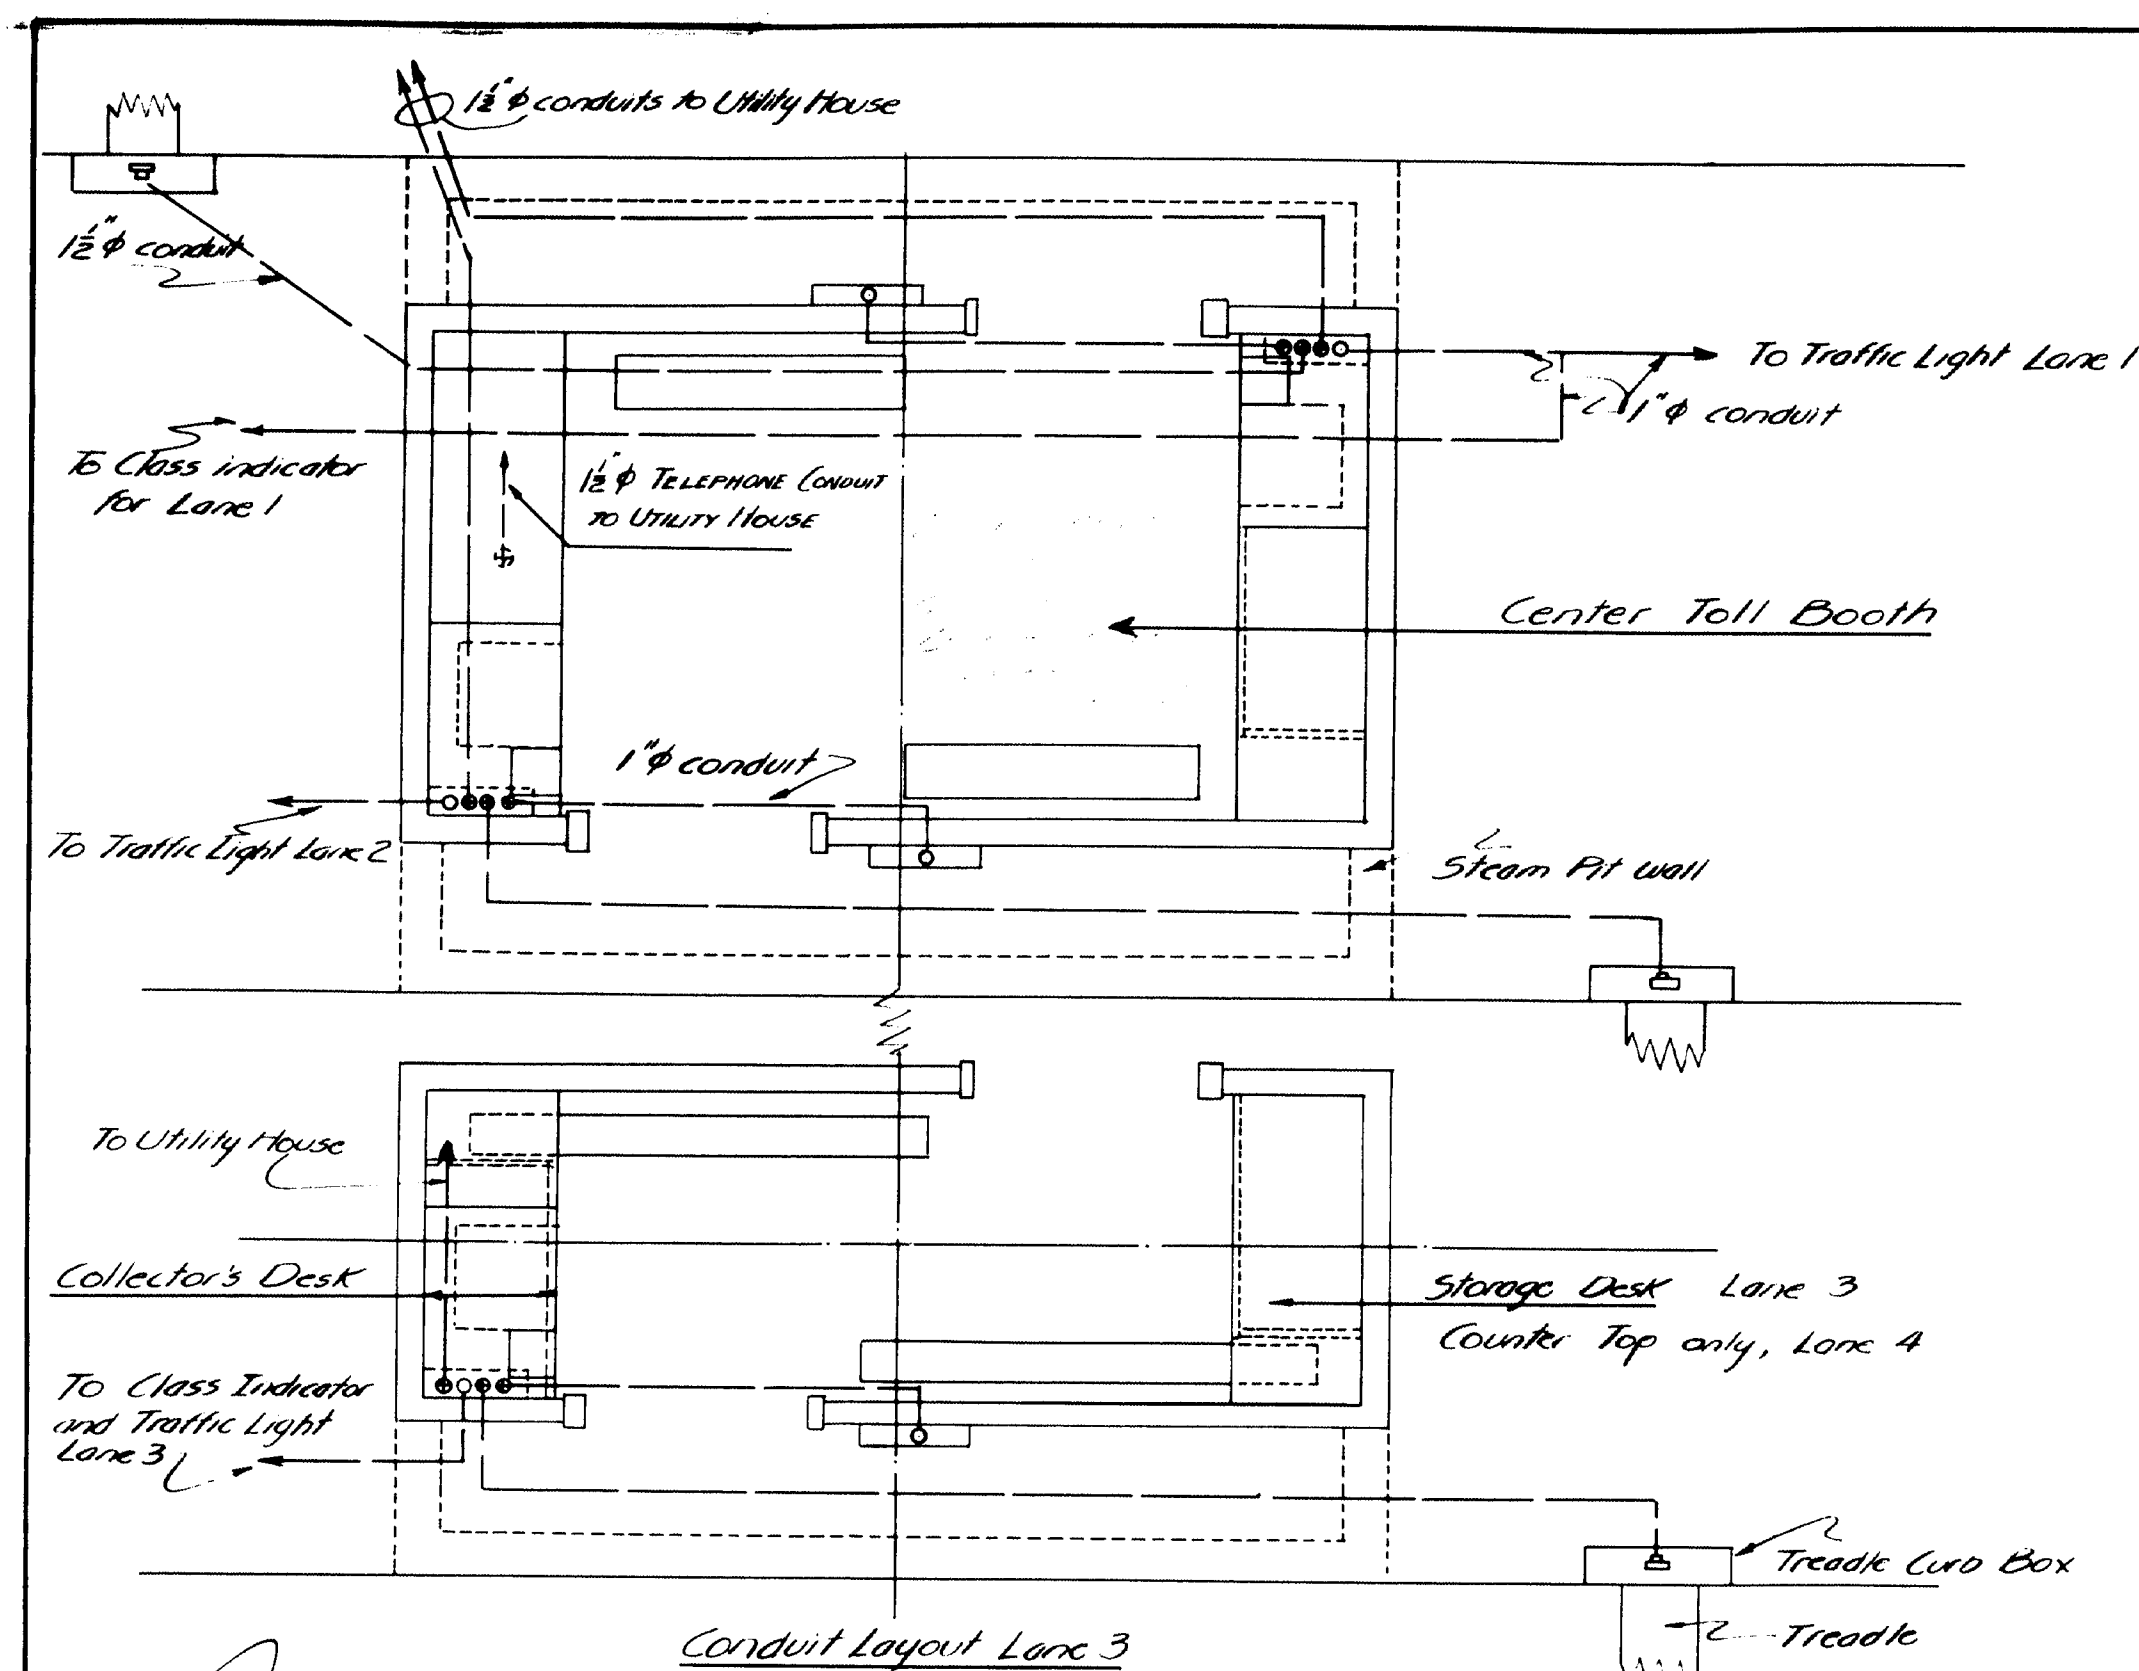


Conduit Layout Lane 3

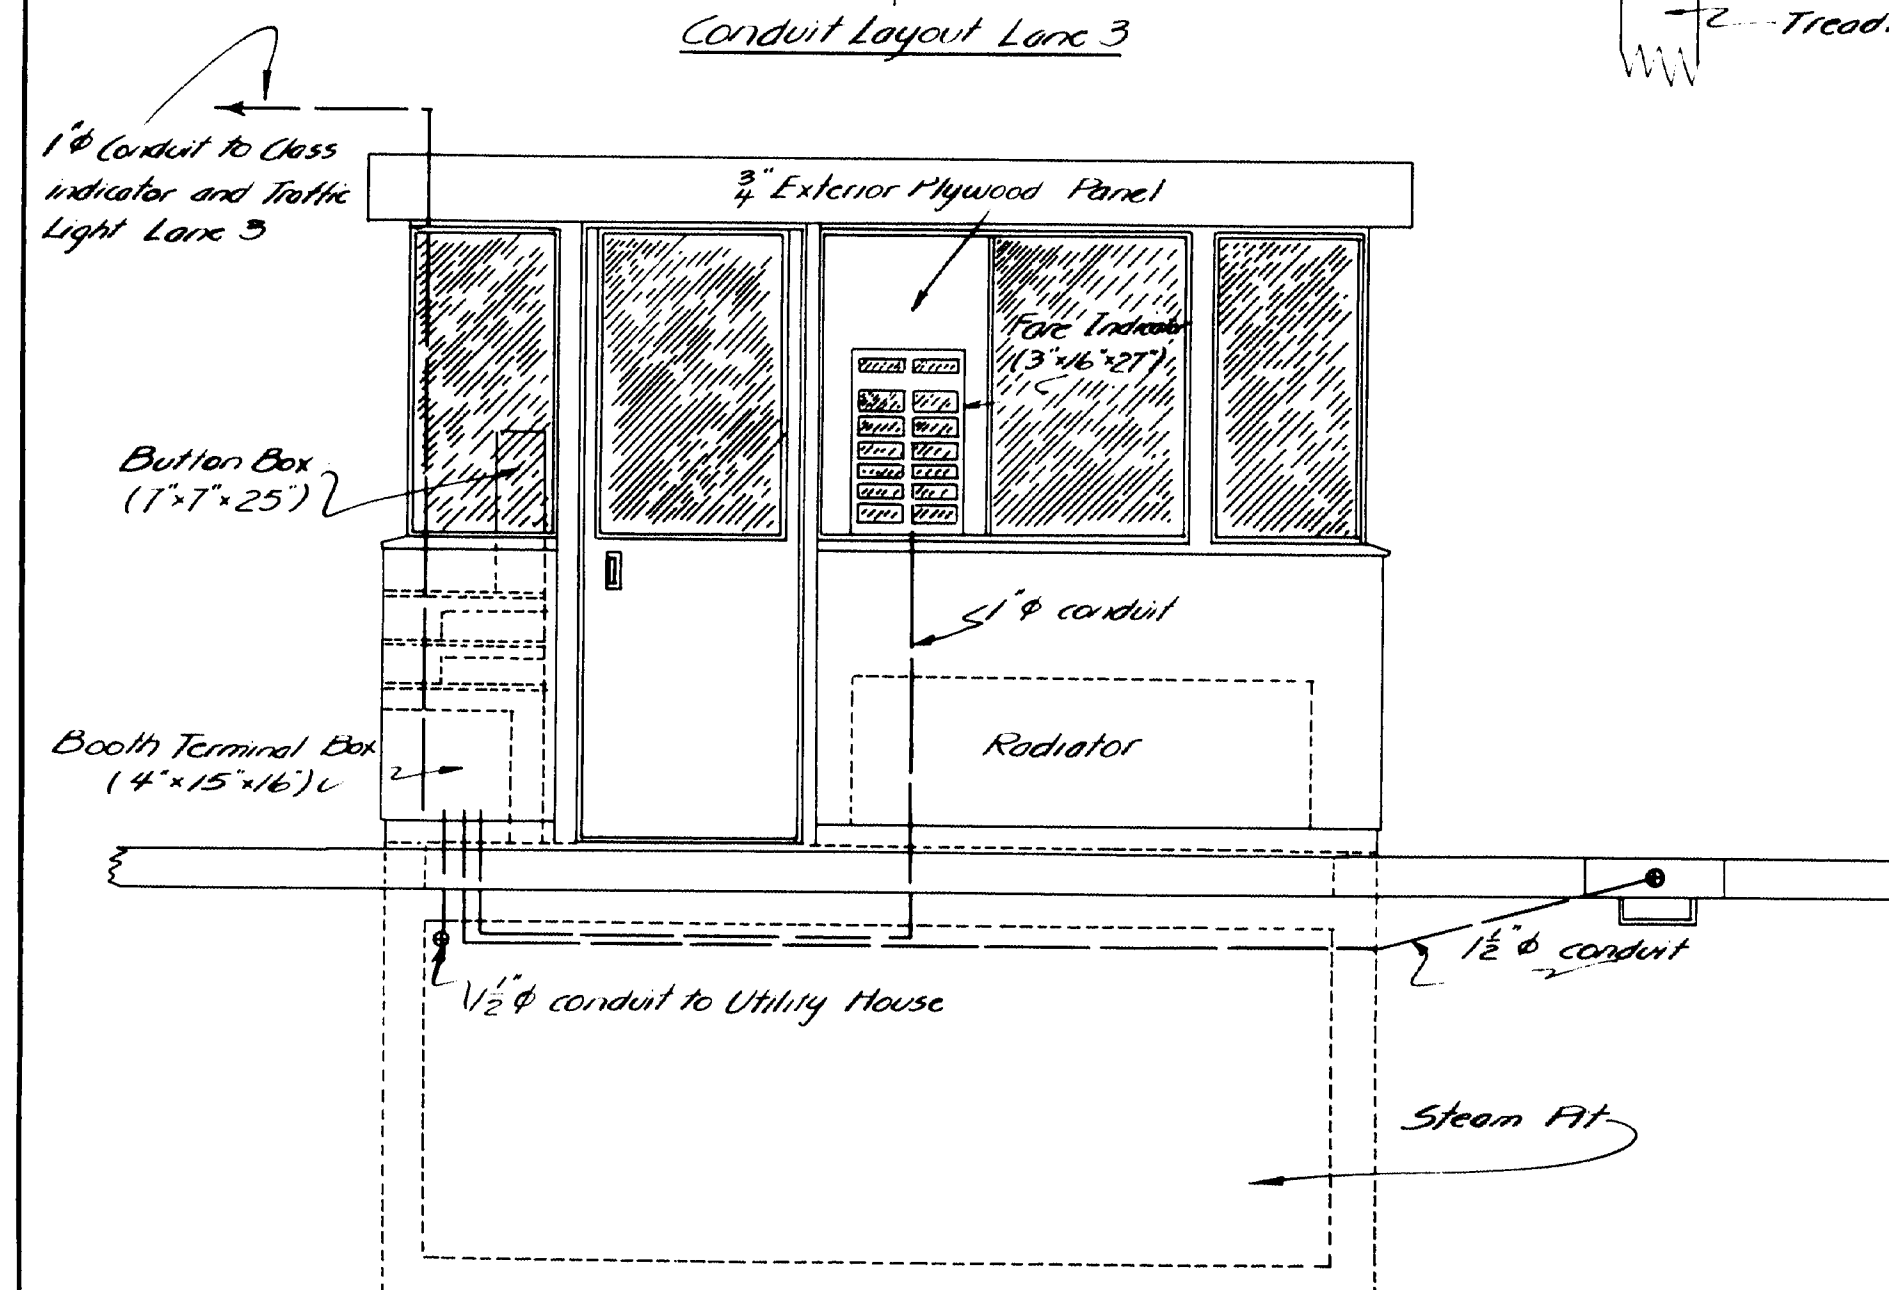


Typical Conduit layout for outside booths (Lanes 3 & 4)

Note for Lane 4: Lane 4 booth rotated 180°. Additional conduit required for traffic light.

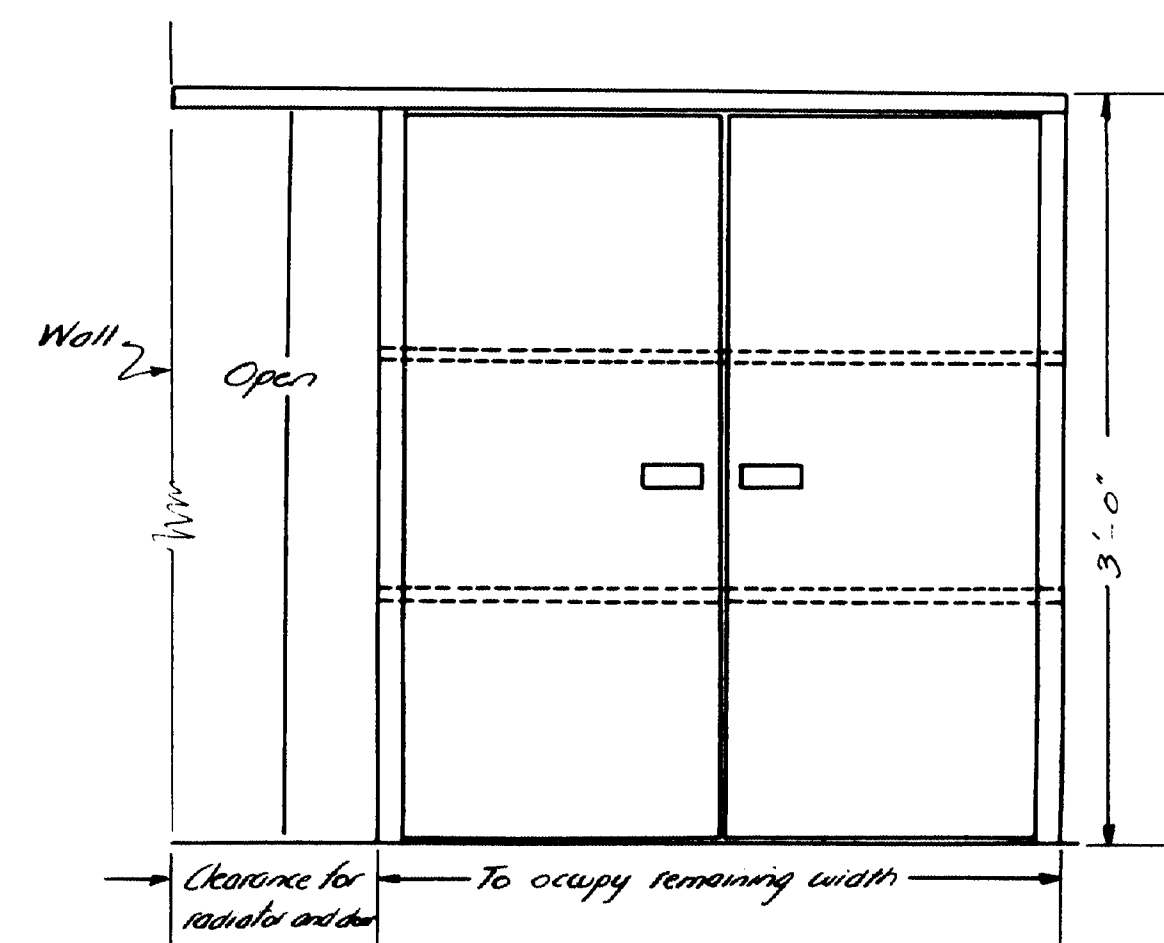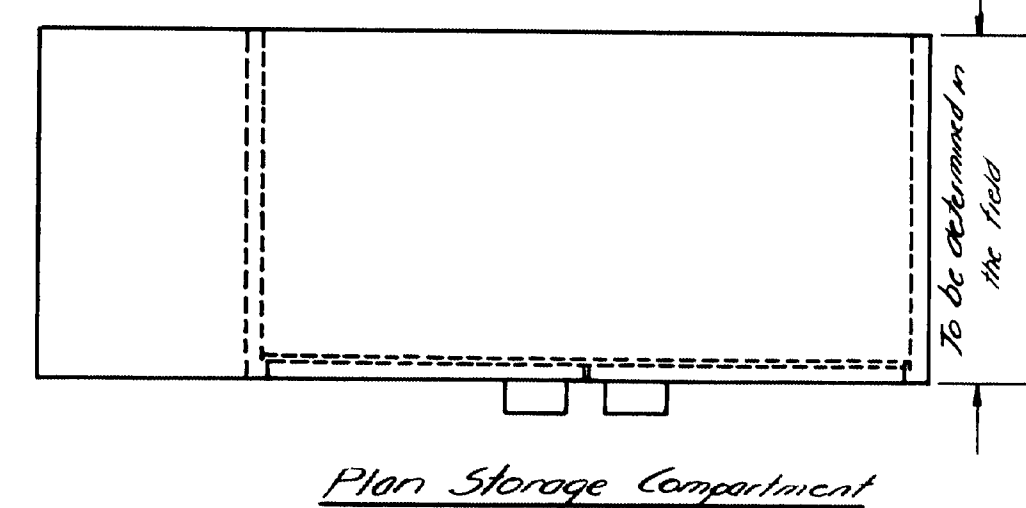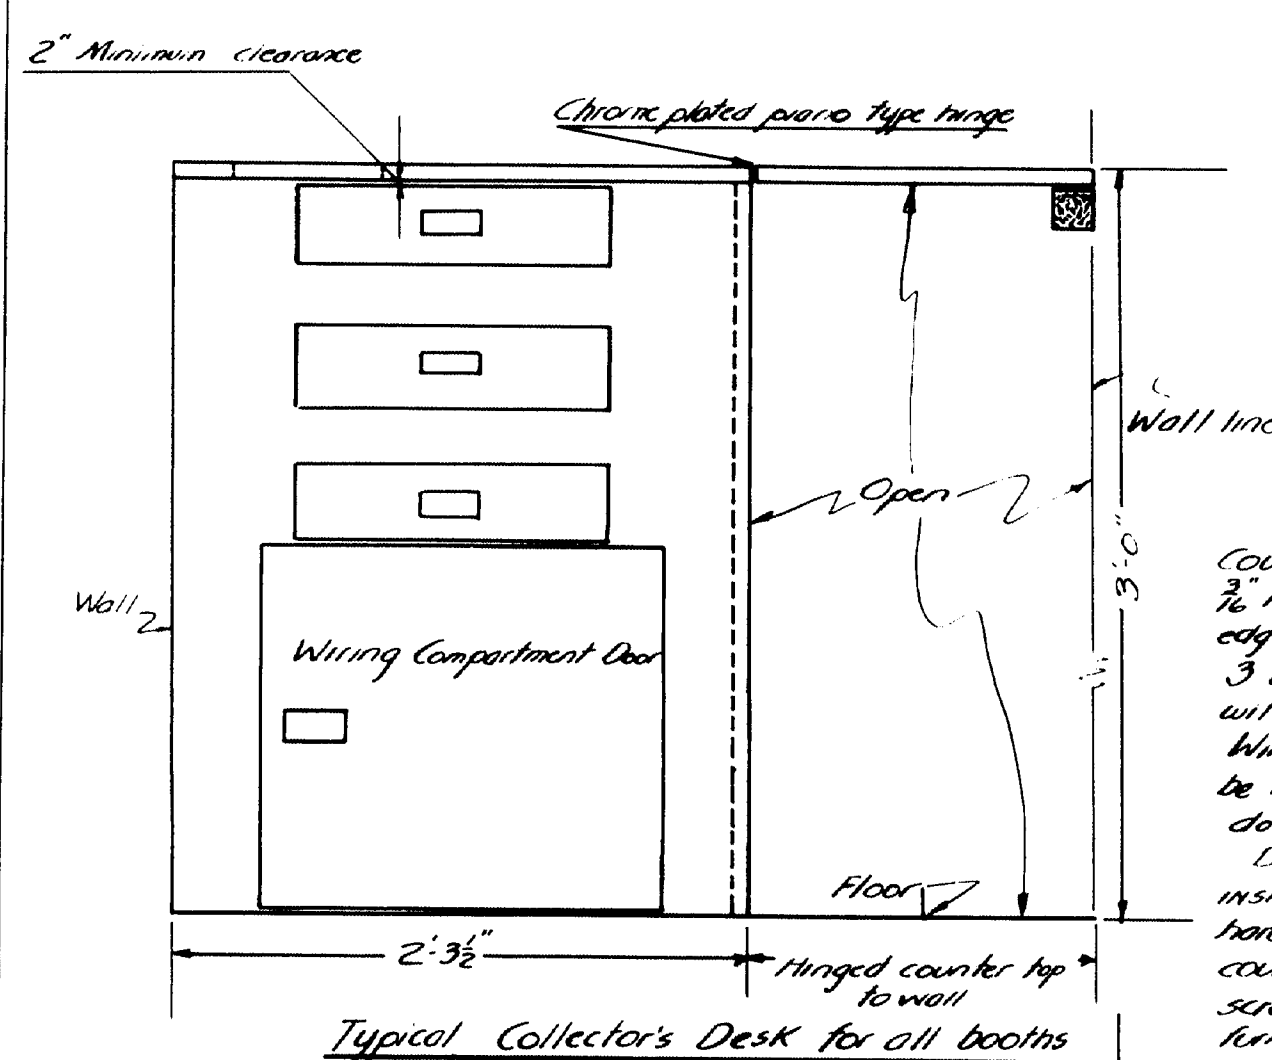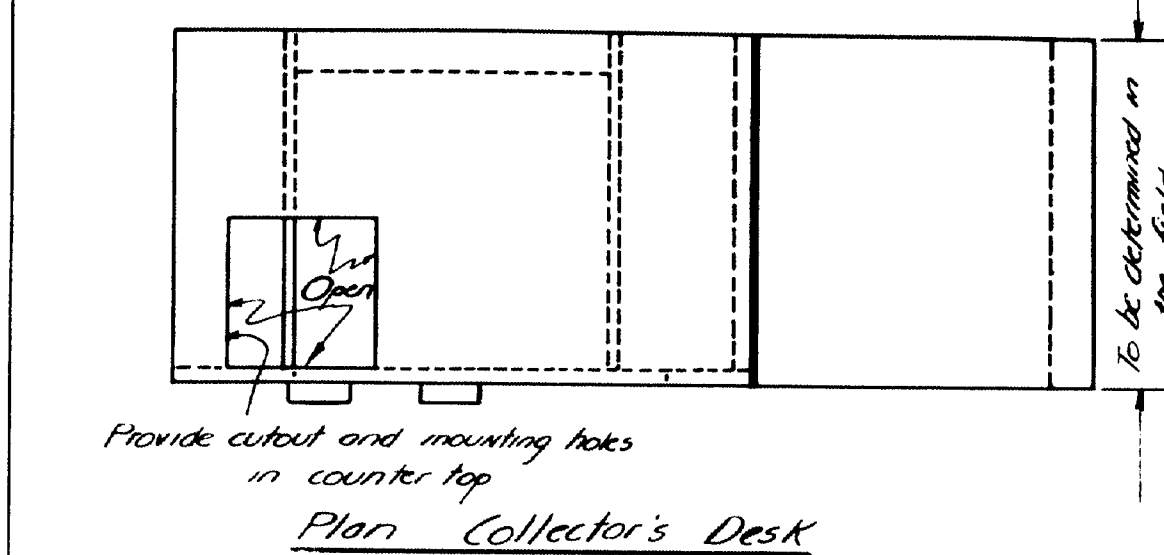

Use 3/4" plywood for compartments

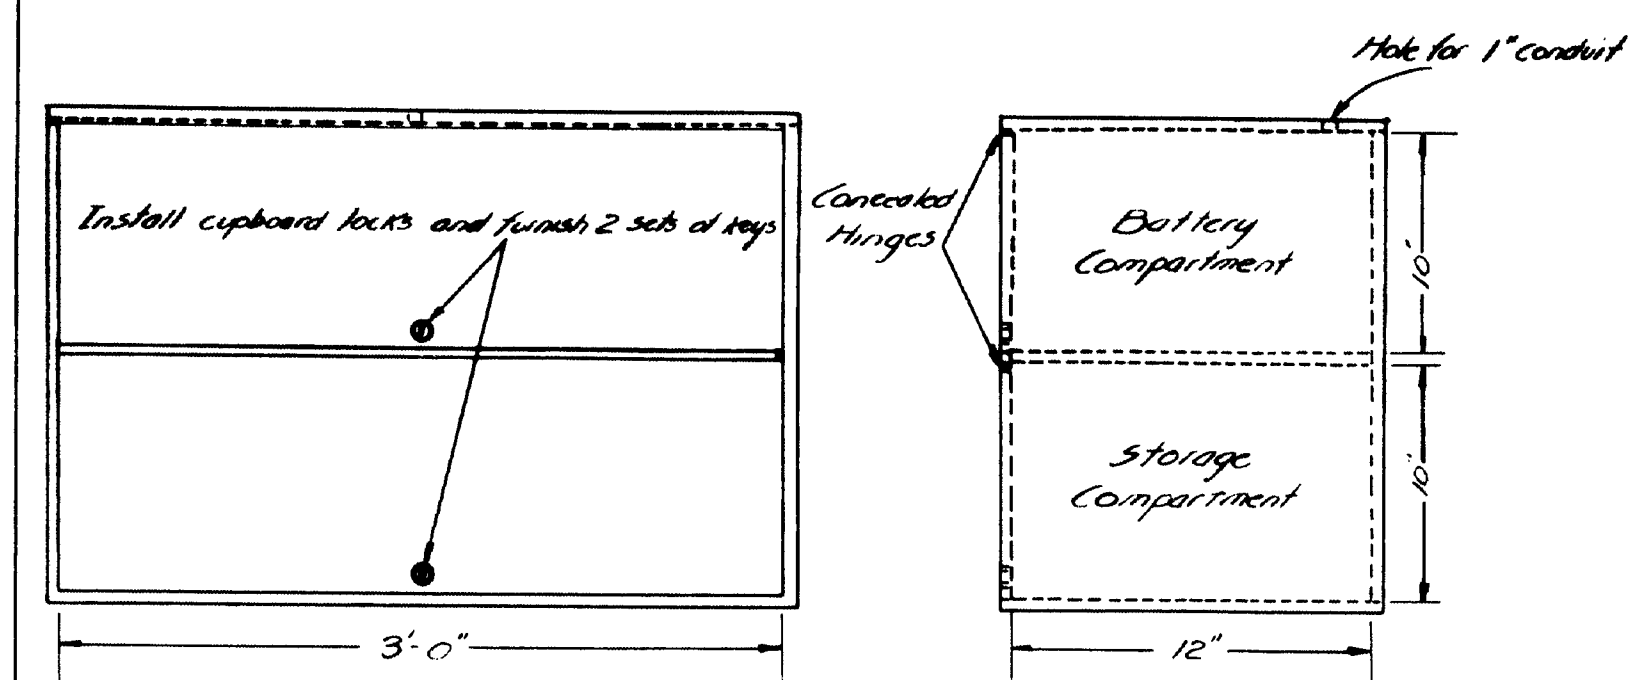

Battery and Storage Compartment


Note

Fasten to rear wall in Basement of Utility House below Race Box and Main Sinks.

Note

Counter top 3/4" Plywood with 3/16" linoleum covering and chrome edging.  
3 drawers to be 4' x 1 1/4" x 1 1/2" with drawer pulls.  
Wiring compartment door to be hinged and provided with door pull and friction clip.  
Drawers to be 3 1/2" x 15" x 15" inside dimensions, made of hardwood, assembled with countersunk flathead wood screws, with metal glides, and finished with step at back.

Use 2x4's D25 #2 E set on edge

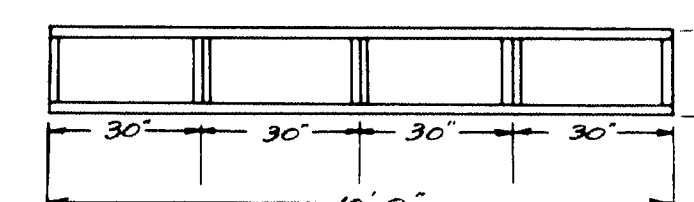



Platform for Recorders

Note

Shelves and counter top 3/4" Plywood Counter top covering 3/16" linoleum with chrome edging.  
Doors to be provided with hinges, door pulls, and friction clips.


DETAILS-MURRELL	CHECK-	BRIDGE
STATE HIGHWAY COMMISSION		
BRIDGE DIVISION		
BANGOR-BREWER BRIDGE		
OVER THE		
PENOBSCOT RIVER		
IN THE CITY OF		
BANGOR		
PENOBSCOT COUNTY		
DETAILS FOR TOLL EQUIPMENT INSTALLATION		
SHEET 2 OF 4 AUGUSTA, MAINE JAN. 1954		

REVISED 3/1954

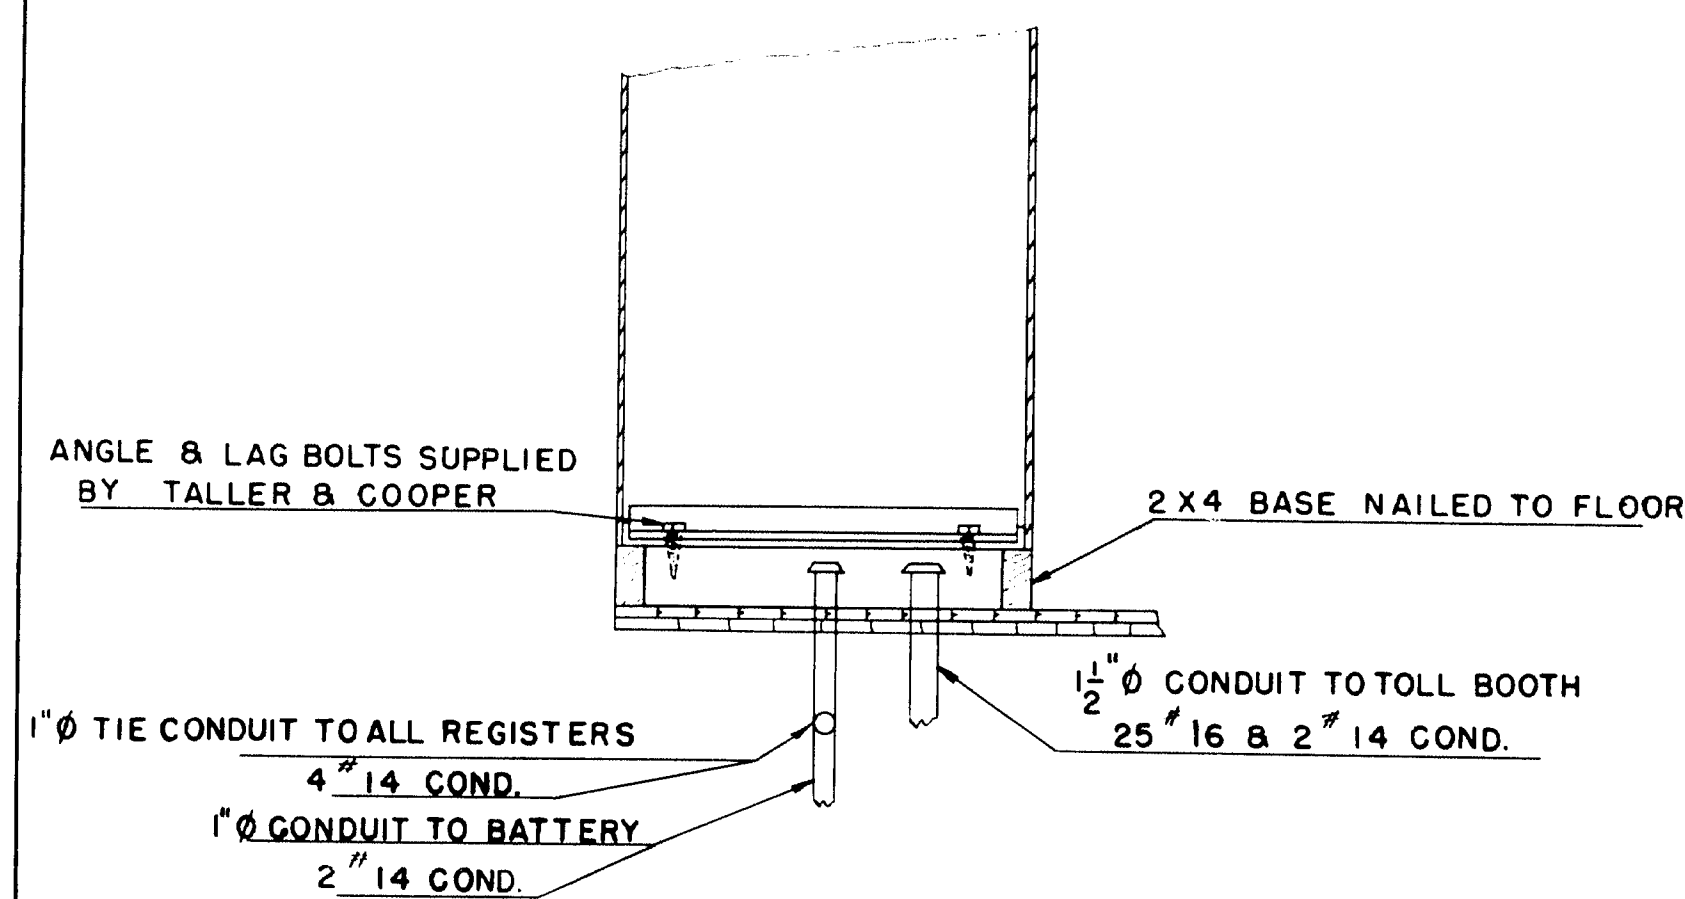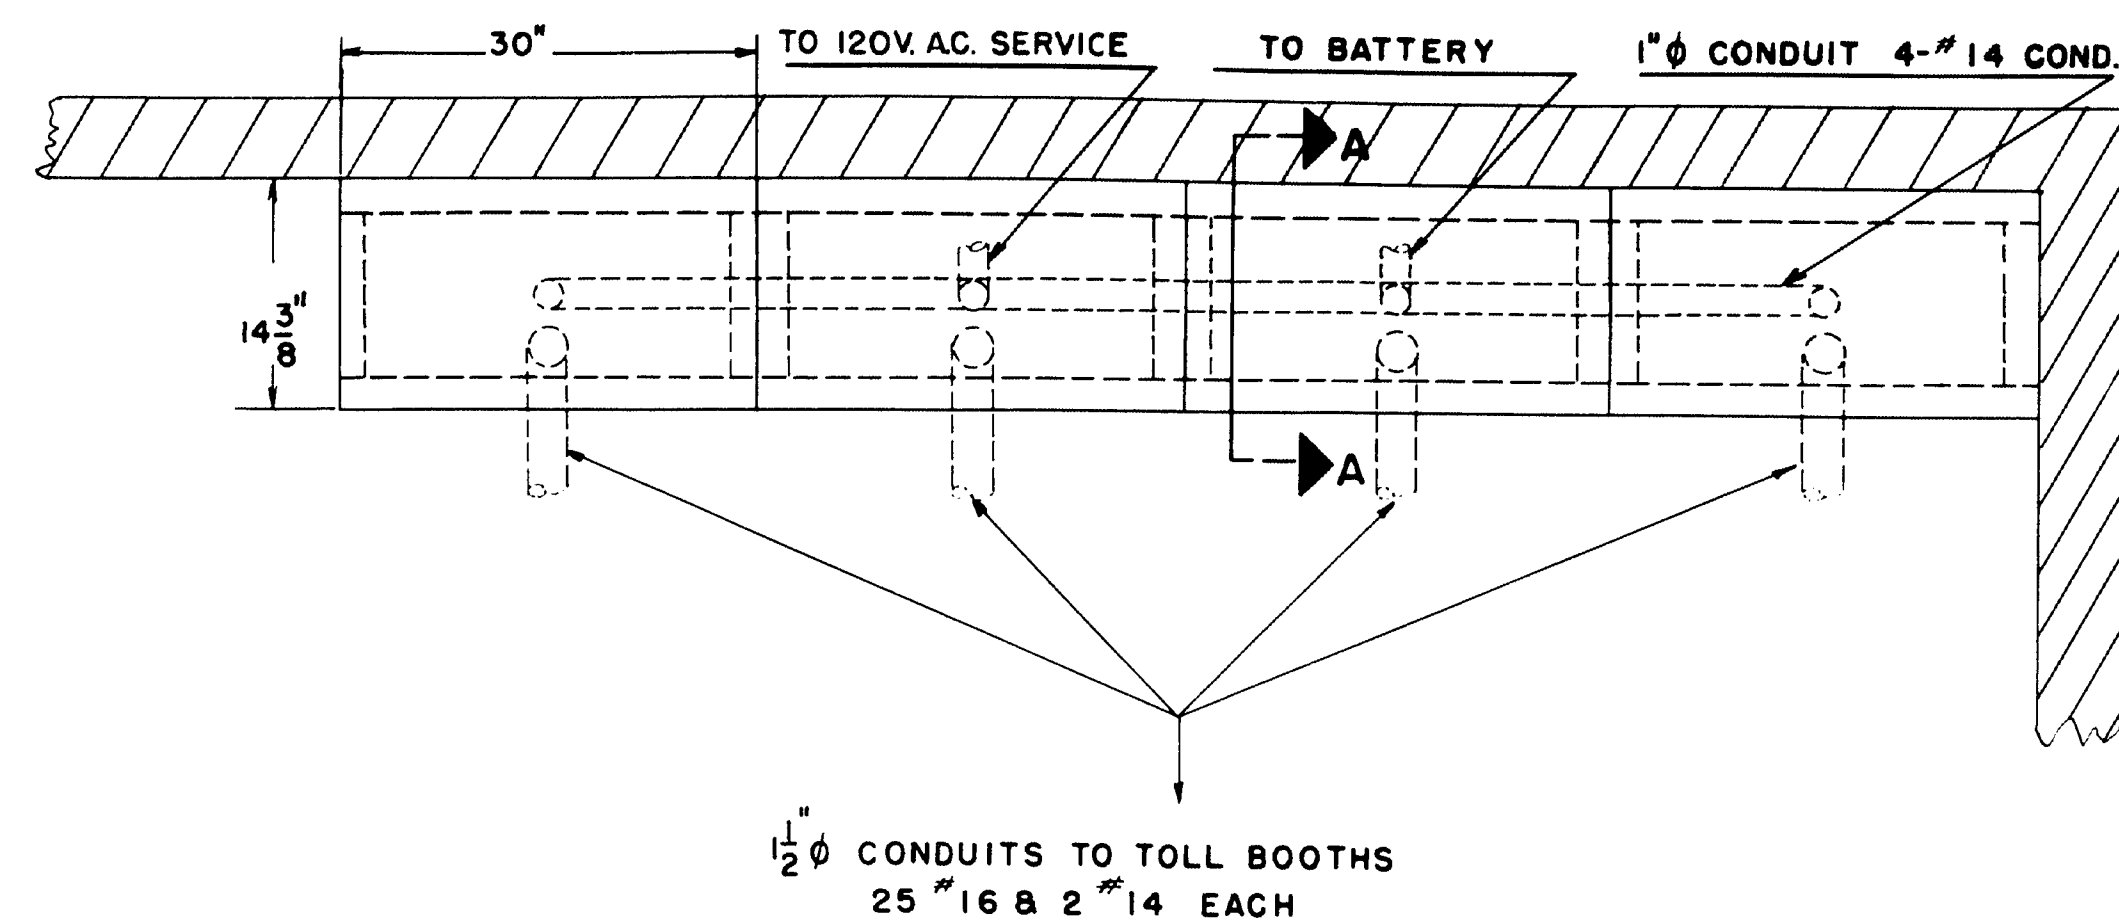

SECTION A-A

LAYOUT OF REGISTERS IN UTILITY HOUSE

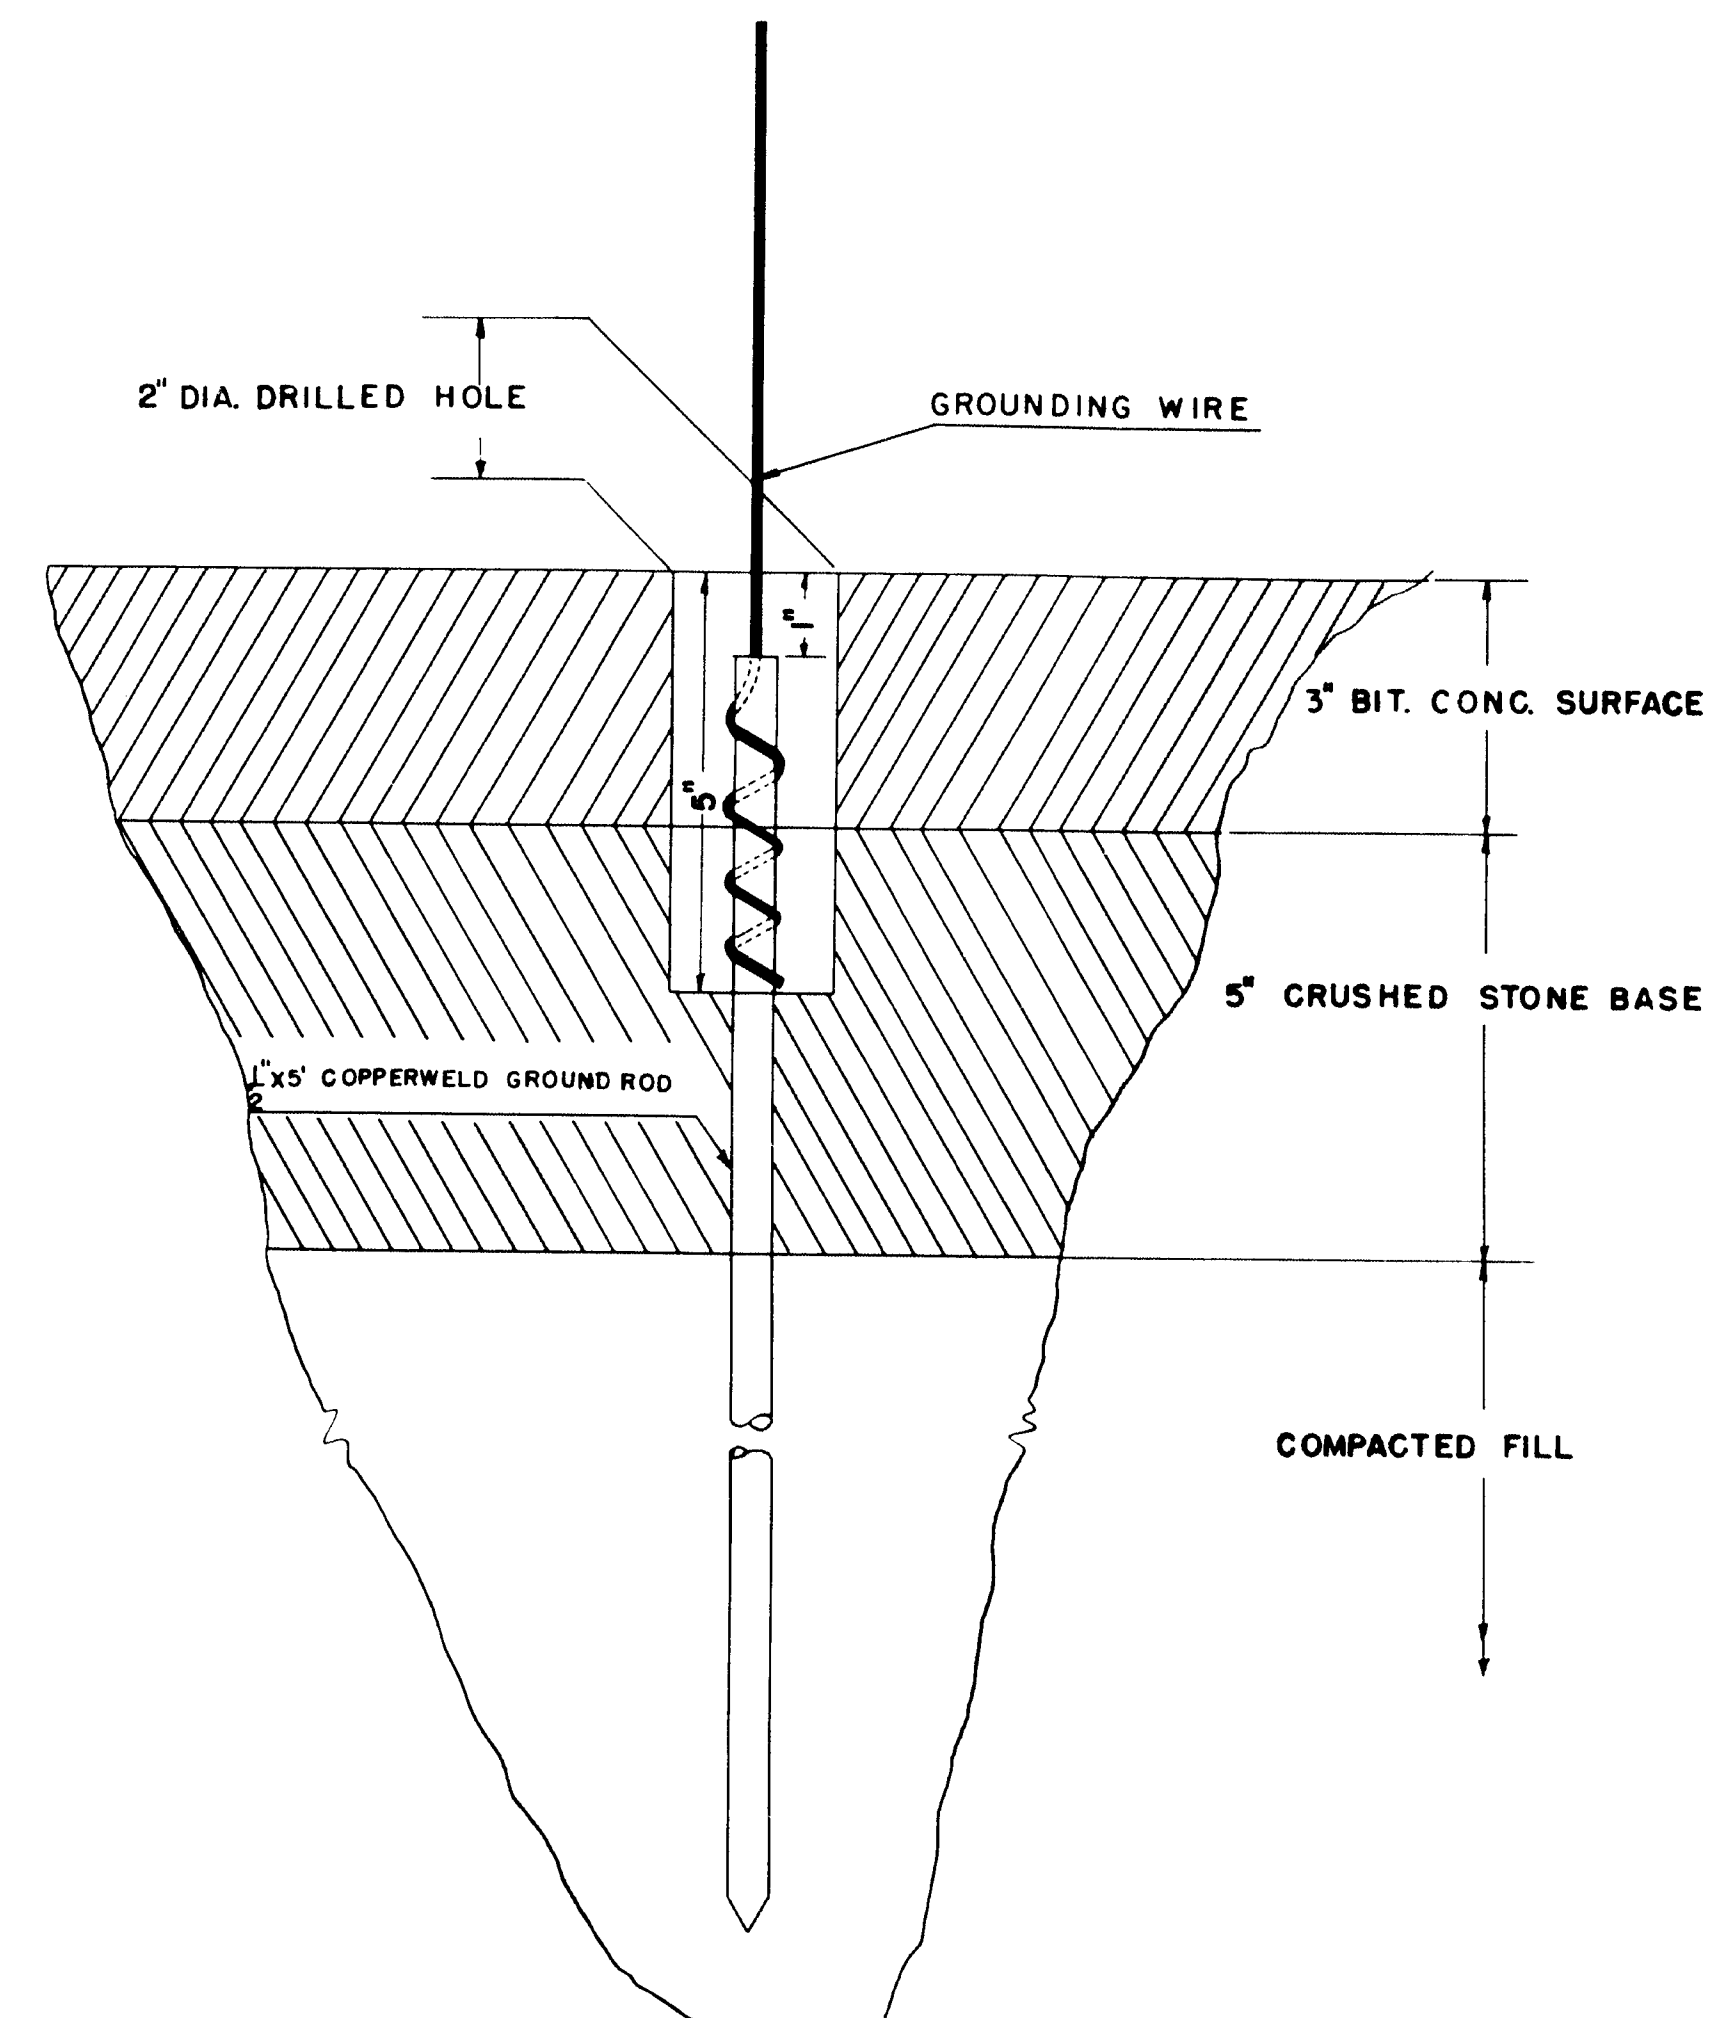

NOTE  
INSTALLATION OF GROUND ROD




DRILL 2" DIA. HOLE 5" DEEP ON CENTER LINE OF EACH LANE AND 15' FROM CENTER LINE OF TOLL BOOTHS AS SHOWN ON PLAN. DRIVE COPPERWELD GROUND ROD UNTIL TOP OF ROD IS 1" BELOW TOP OF WEARING SURFACE. GROUNDING WIRE WILL BE SUPPLIED BY THE STATE HIGHWAY COMMISSION.

GROUND ROD INSTALLATION

DETAILED—MURRELL	BRIDGE
TRACE—MURRELL	
STATE HIGHWAY COMMISSION BRIDGE DIVISION	
BANGOR—BREWER BRIDGE	
OVER THE	
PENOBSCOT RIVER	
IN THE CITY OF	
BANGOR	
PENOBSCOT COUNTY	
REGISTER LAYOUT & GROUND ROD	
SHEET 3 OF 4 AUGUSTA, MAINE FEB. 1954	

62-74



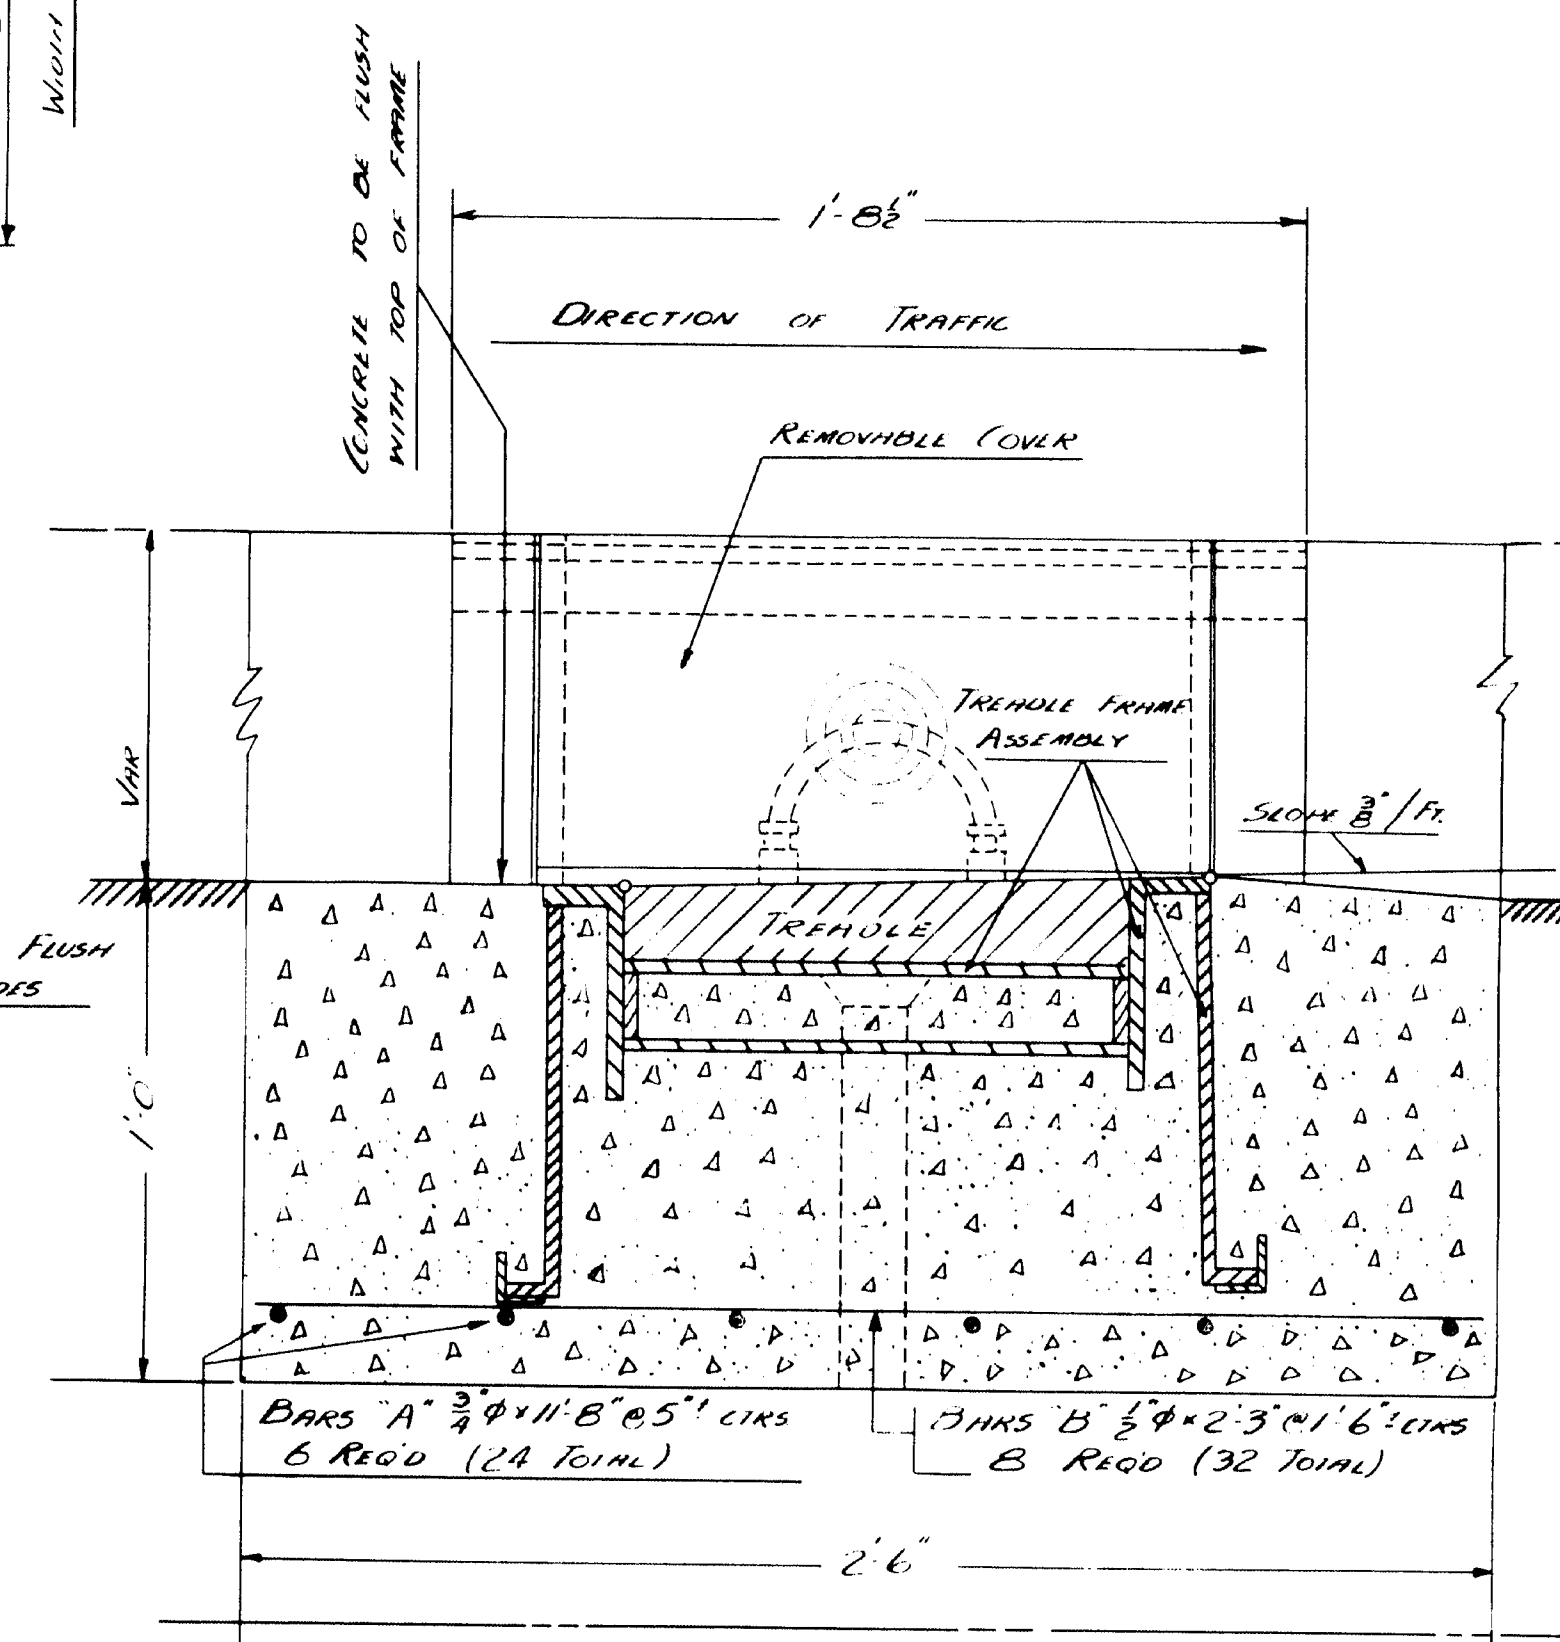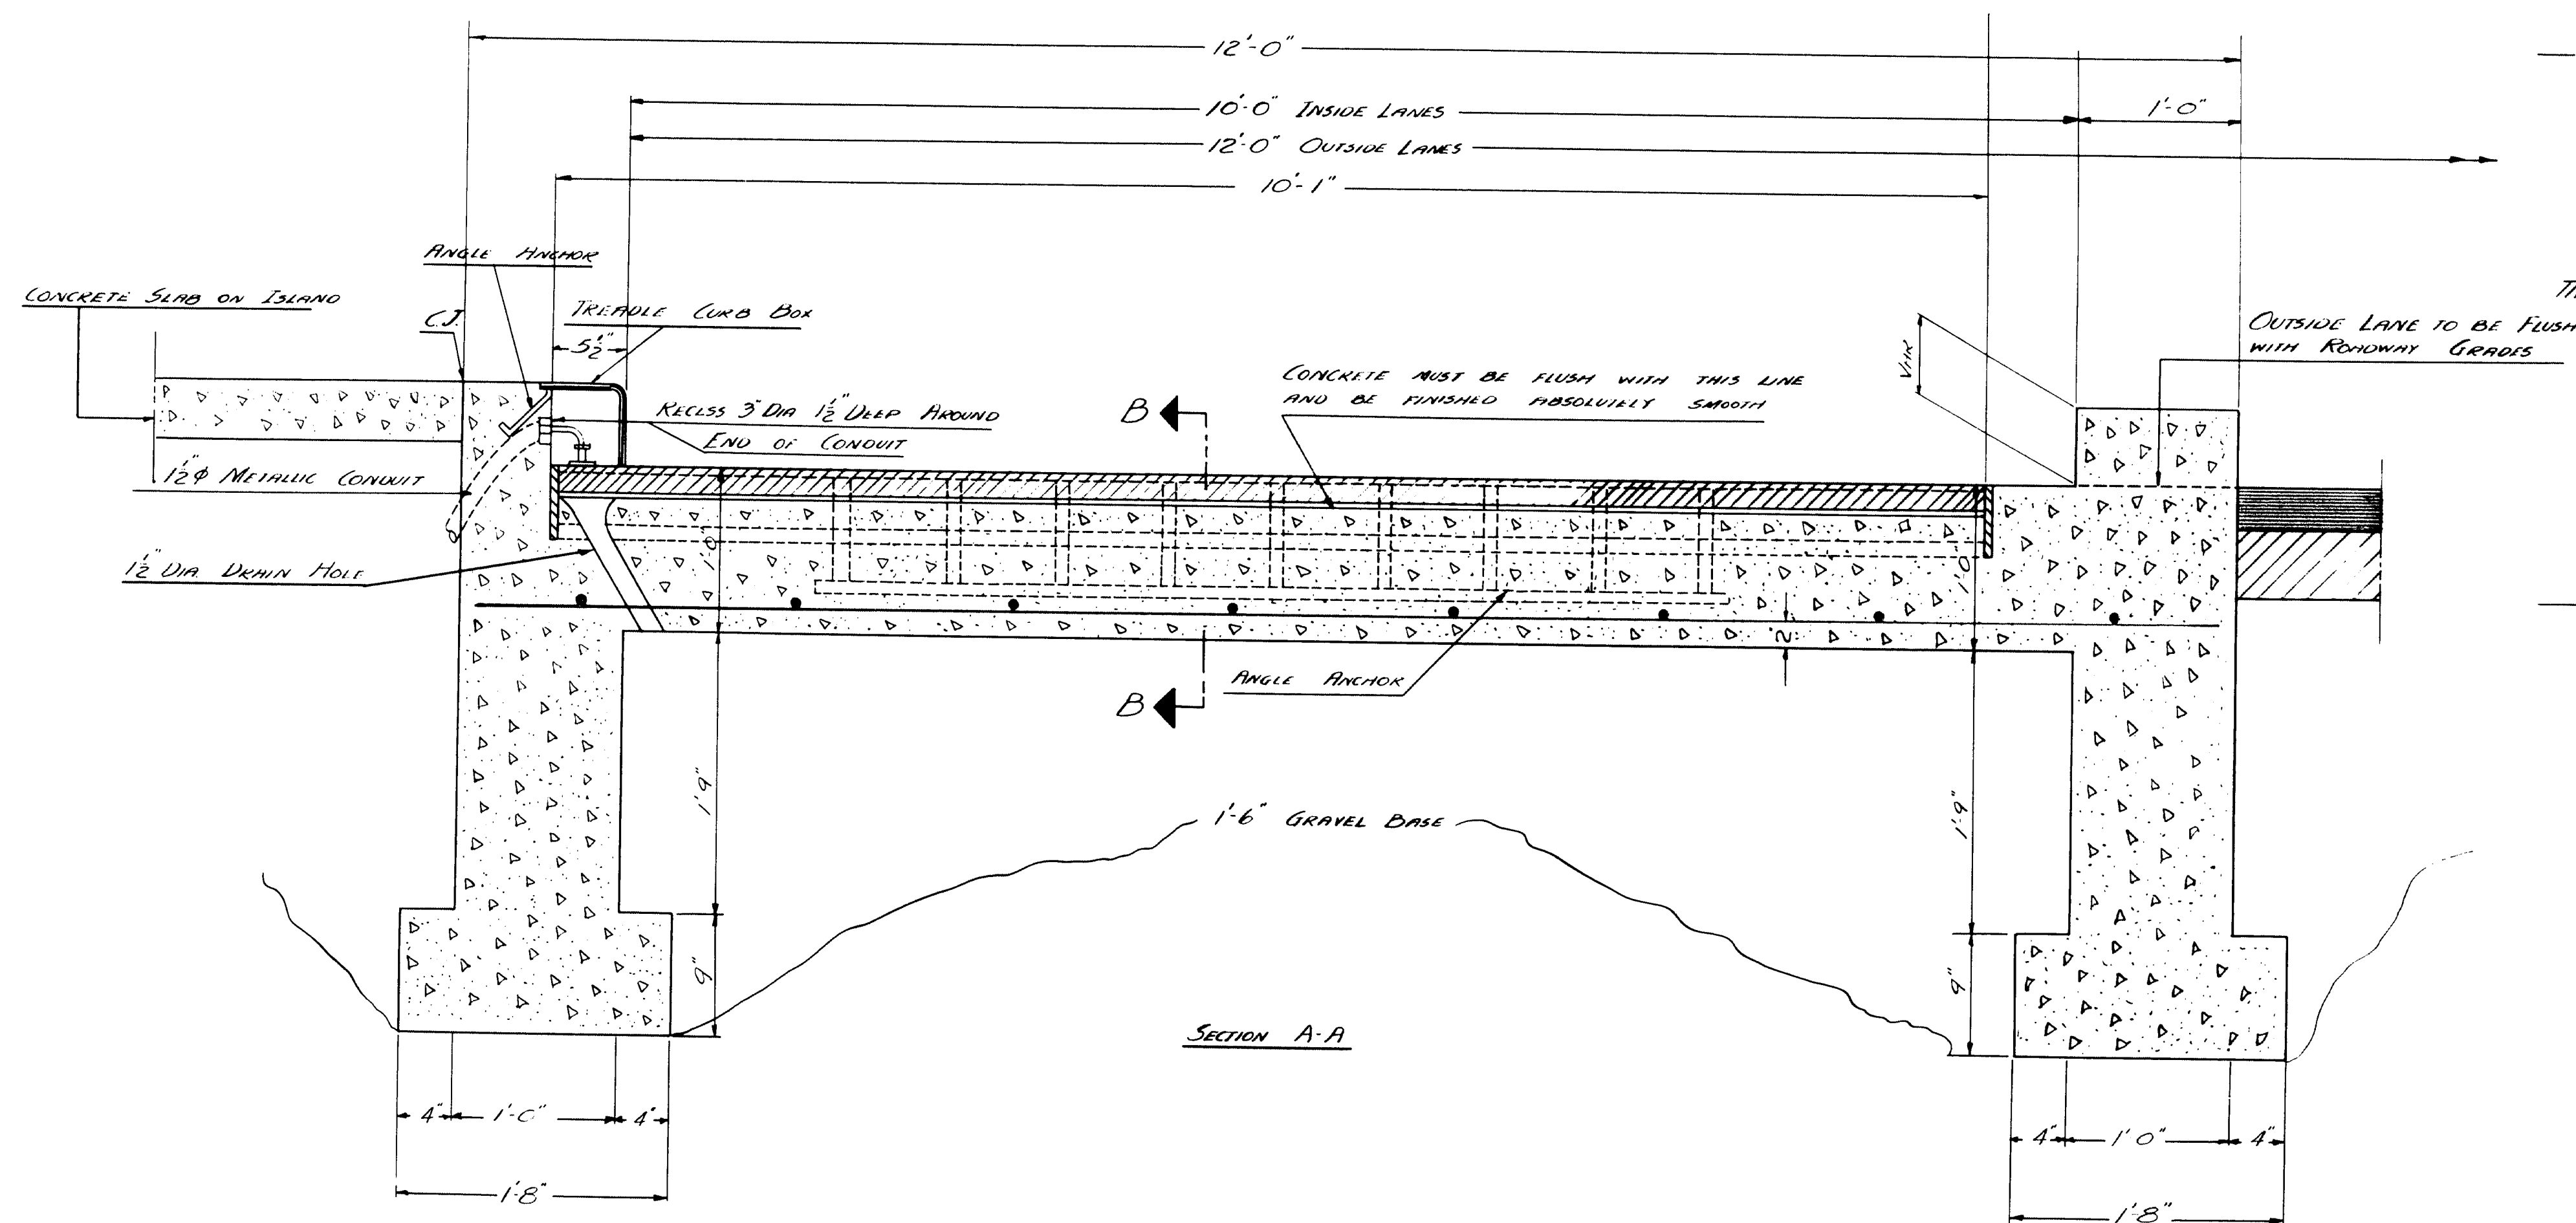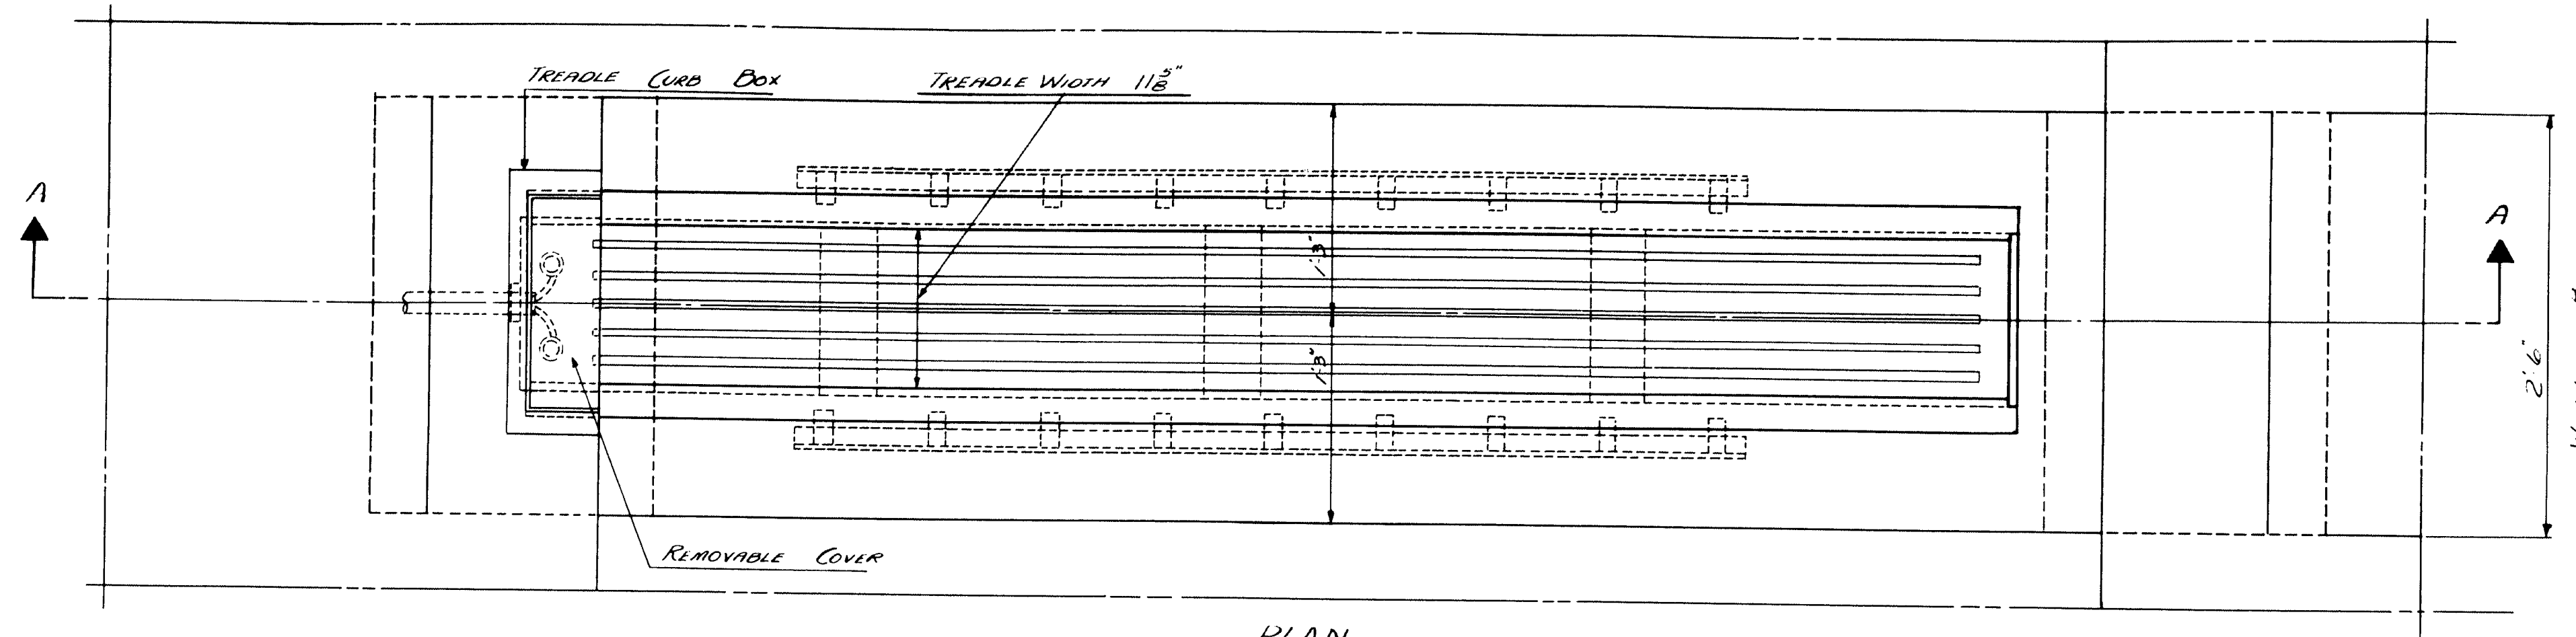

GENERAL NOTES

TREADLE, TREADLE FRAME, ETC TO BE FURNISHED BY THE STATE HIGHWAY COMMISSION.

INSTALL TREADLE FRAME DURING DIRECTION TO PREVENT TRAPPED H2O.

FROM AUGUSTA BRIDGE PLANS

TRACE-MURRELL

BRIDGE

STATE HIGHWAY COMMISSION

BRIDGE DIVISION

BANGOR- BREWER BRIDGE

OVER THE

PENOBSCOT RIVER

IN THE CITY OF

BANGOR


PENOBSCOT COUNTY

CONCRETE TREADLE BASE


SHEET 4 OF 4 AUGUSTA, MAINE FEB. 1934

68-75

0 1 2 3 4 5 INCHES

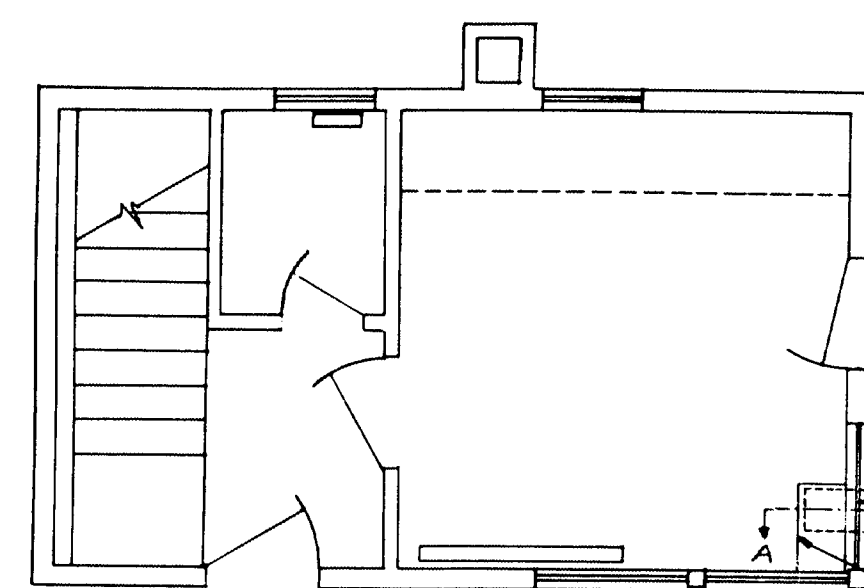

FIRST FLOOR PLAN-UTILITY BUILDING

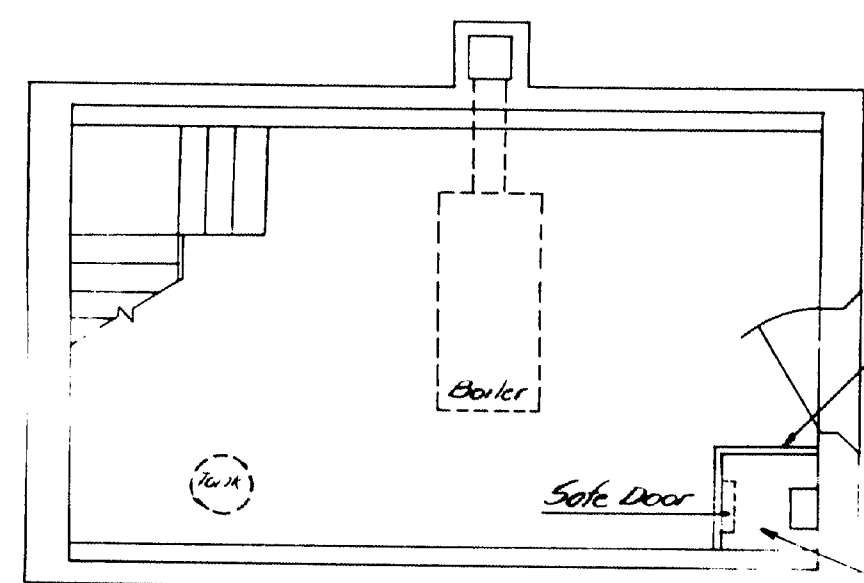


BASEMENT PLAN-UTILITY BUILDING

Night Safe Deposit Door


Plywood Boxings to encase drop chute

Plywood Door hung at top with post and catch

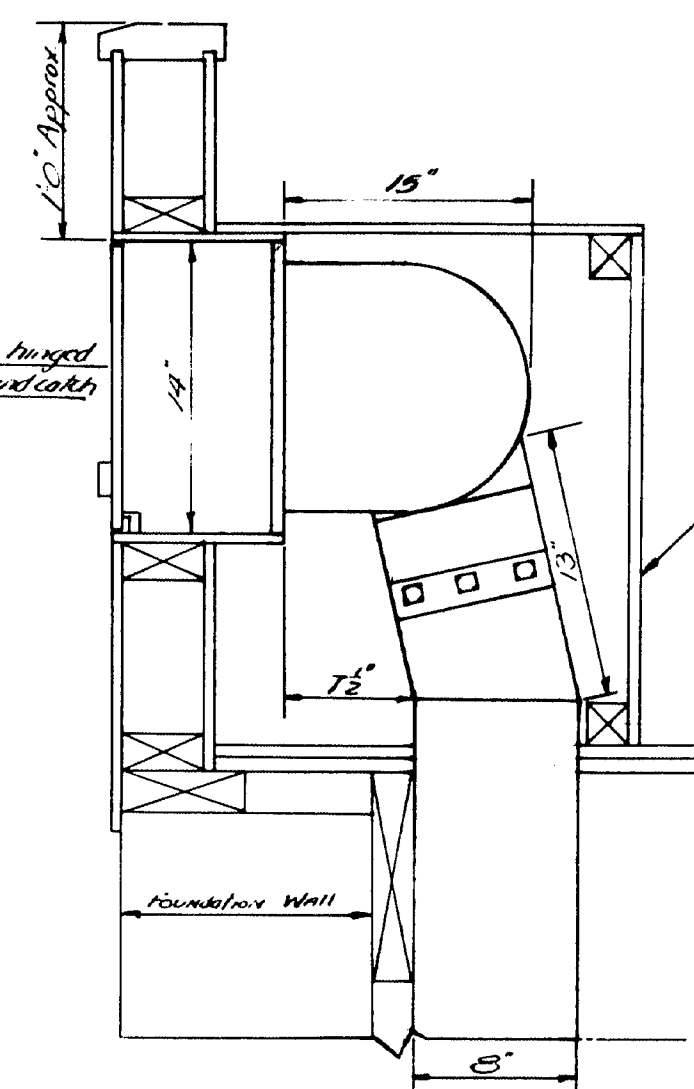


SECTION A-A (Enlarged)

3/4" Plywood box to fully encase chute

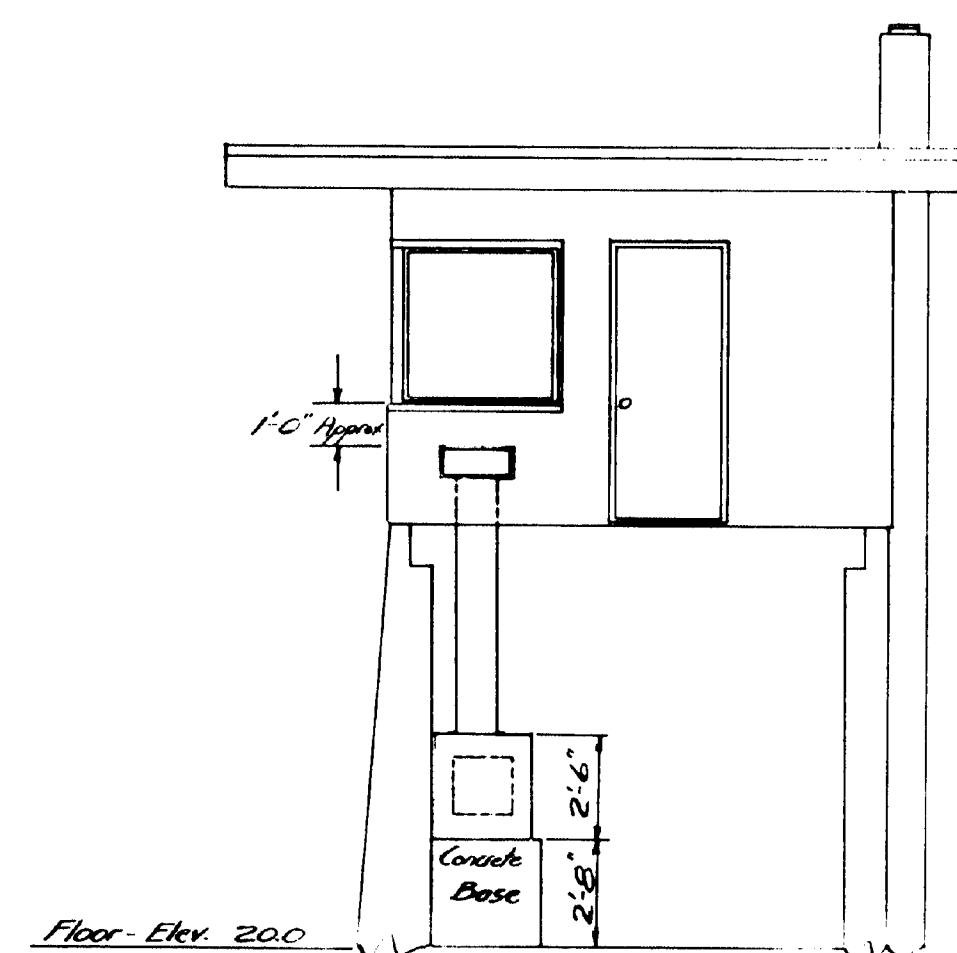

END ELEVATION

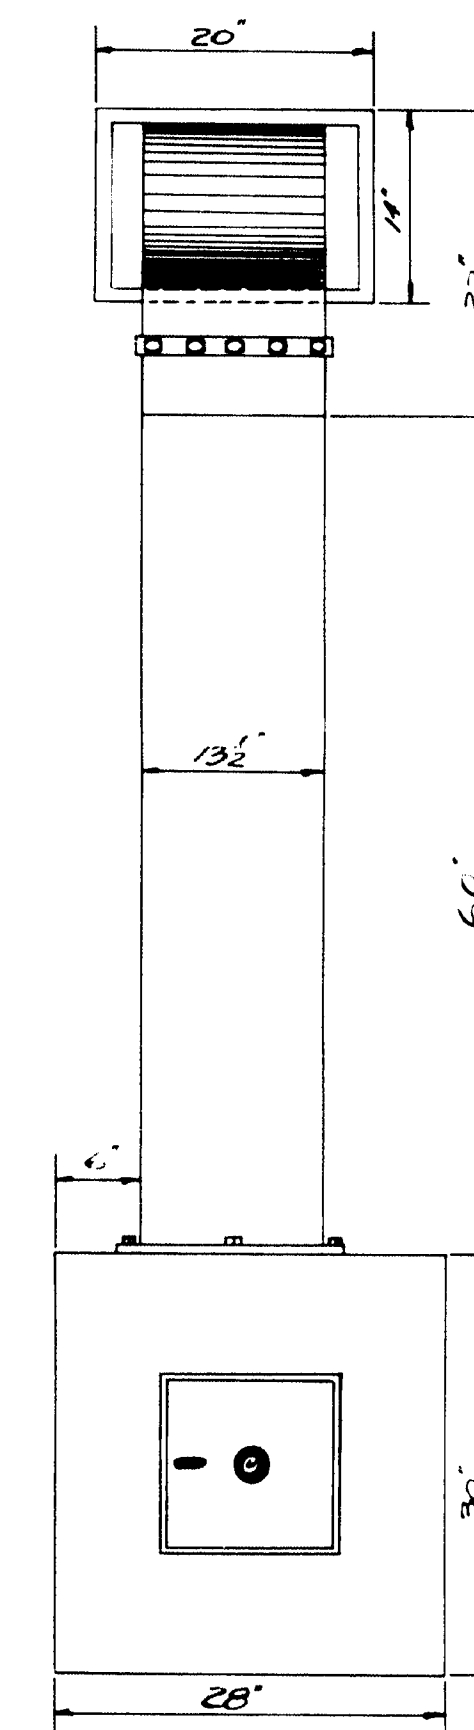


FRONT ELEVATION - SAFE


NOTE

The safe will be furnished and delivered to the job site by The Maine State Highway Commission.

DETAIL - MURRELL	BRIDGE
CHECK -	
STATE HIGHWAY COMMISSION	
BRIDGE DIVISION	
BANGOR-BREWER BRIDGE	
OVER THE	
PENOBSCOT RIVER	
IN THE CITY OF	
BANGOR	
PENOBSCOT COUNTY	
DROPSAFE DETAILS	
SHEET OF	AUGUSTA, MAINE MARCH 1954

62-76

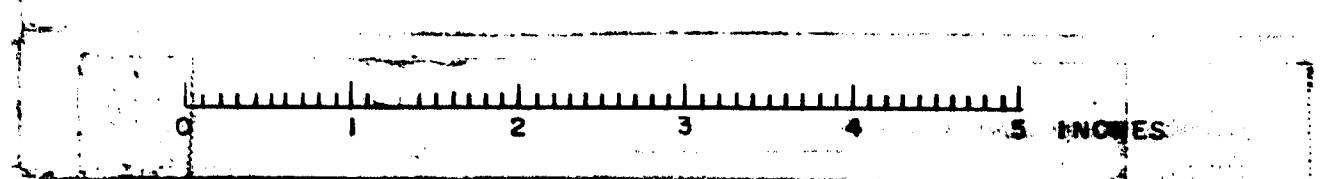


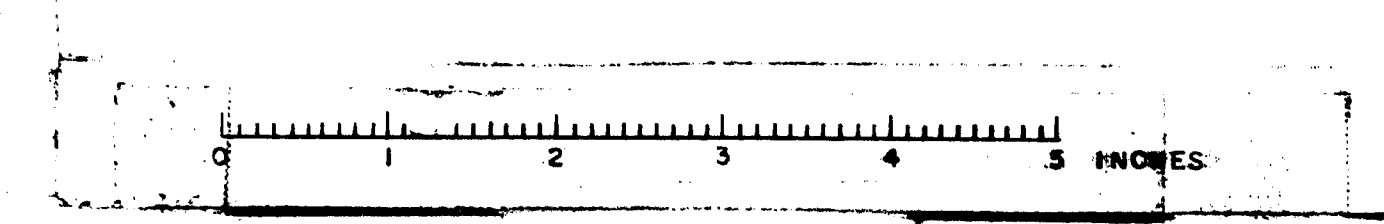[illegible][illegible]













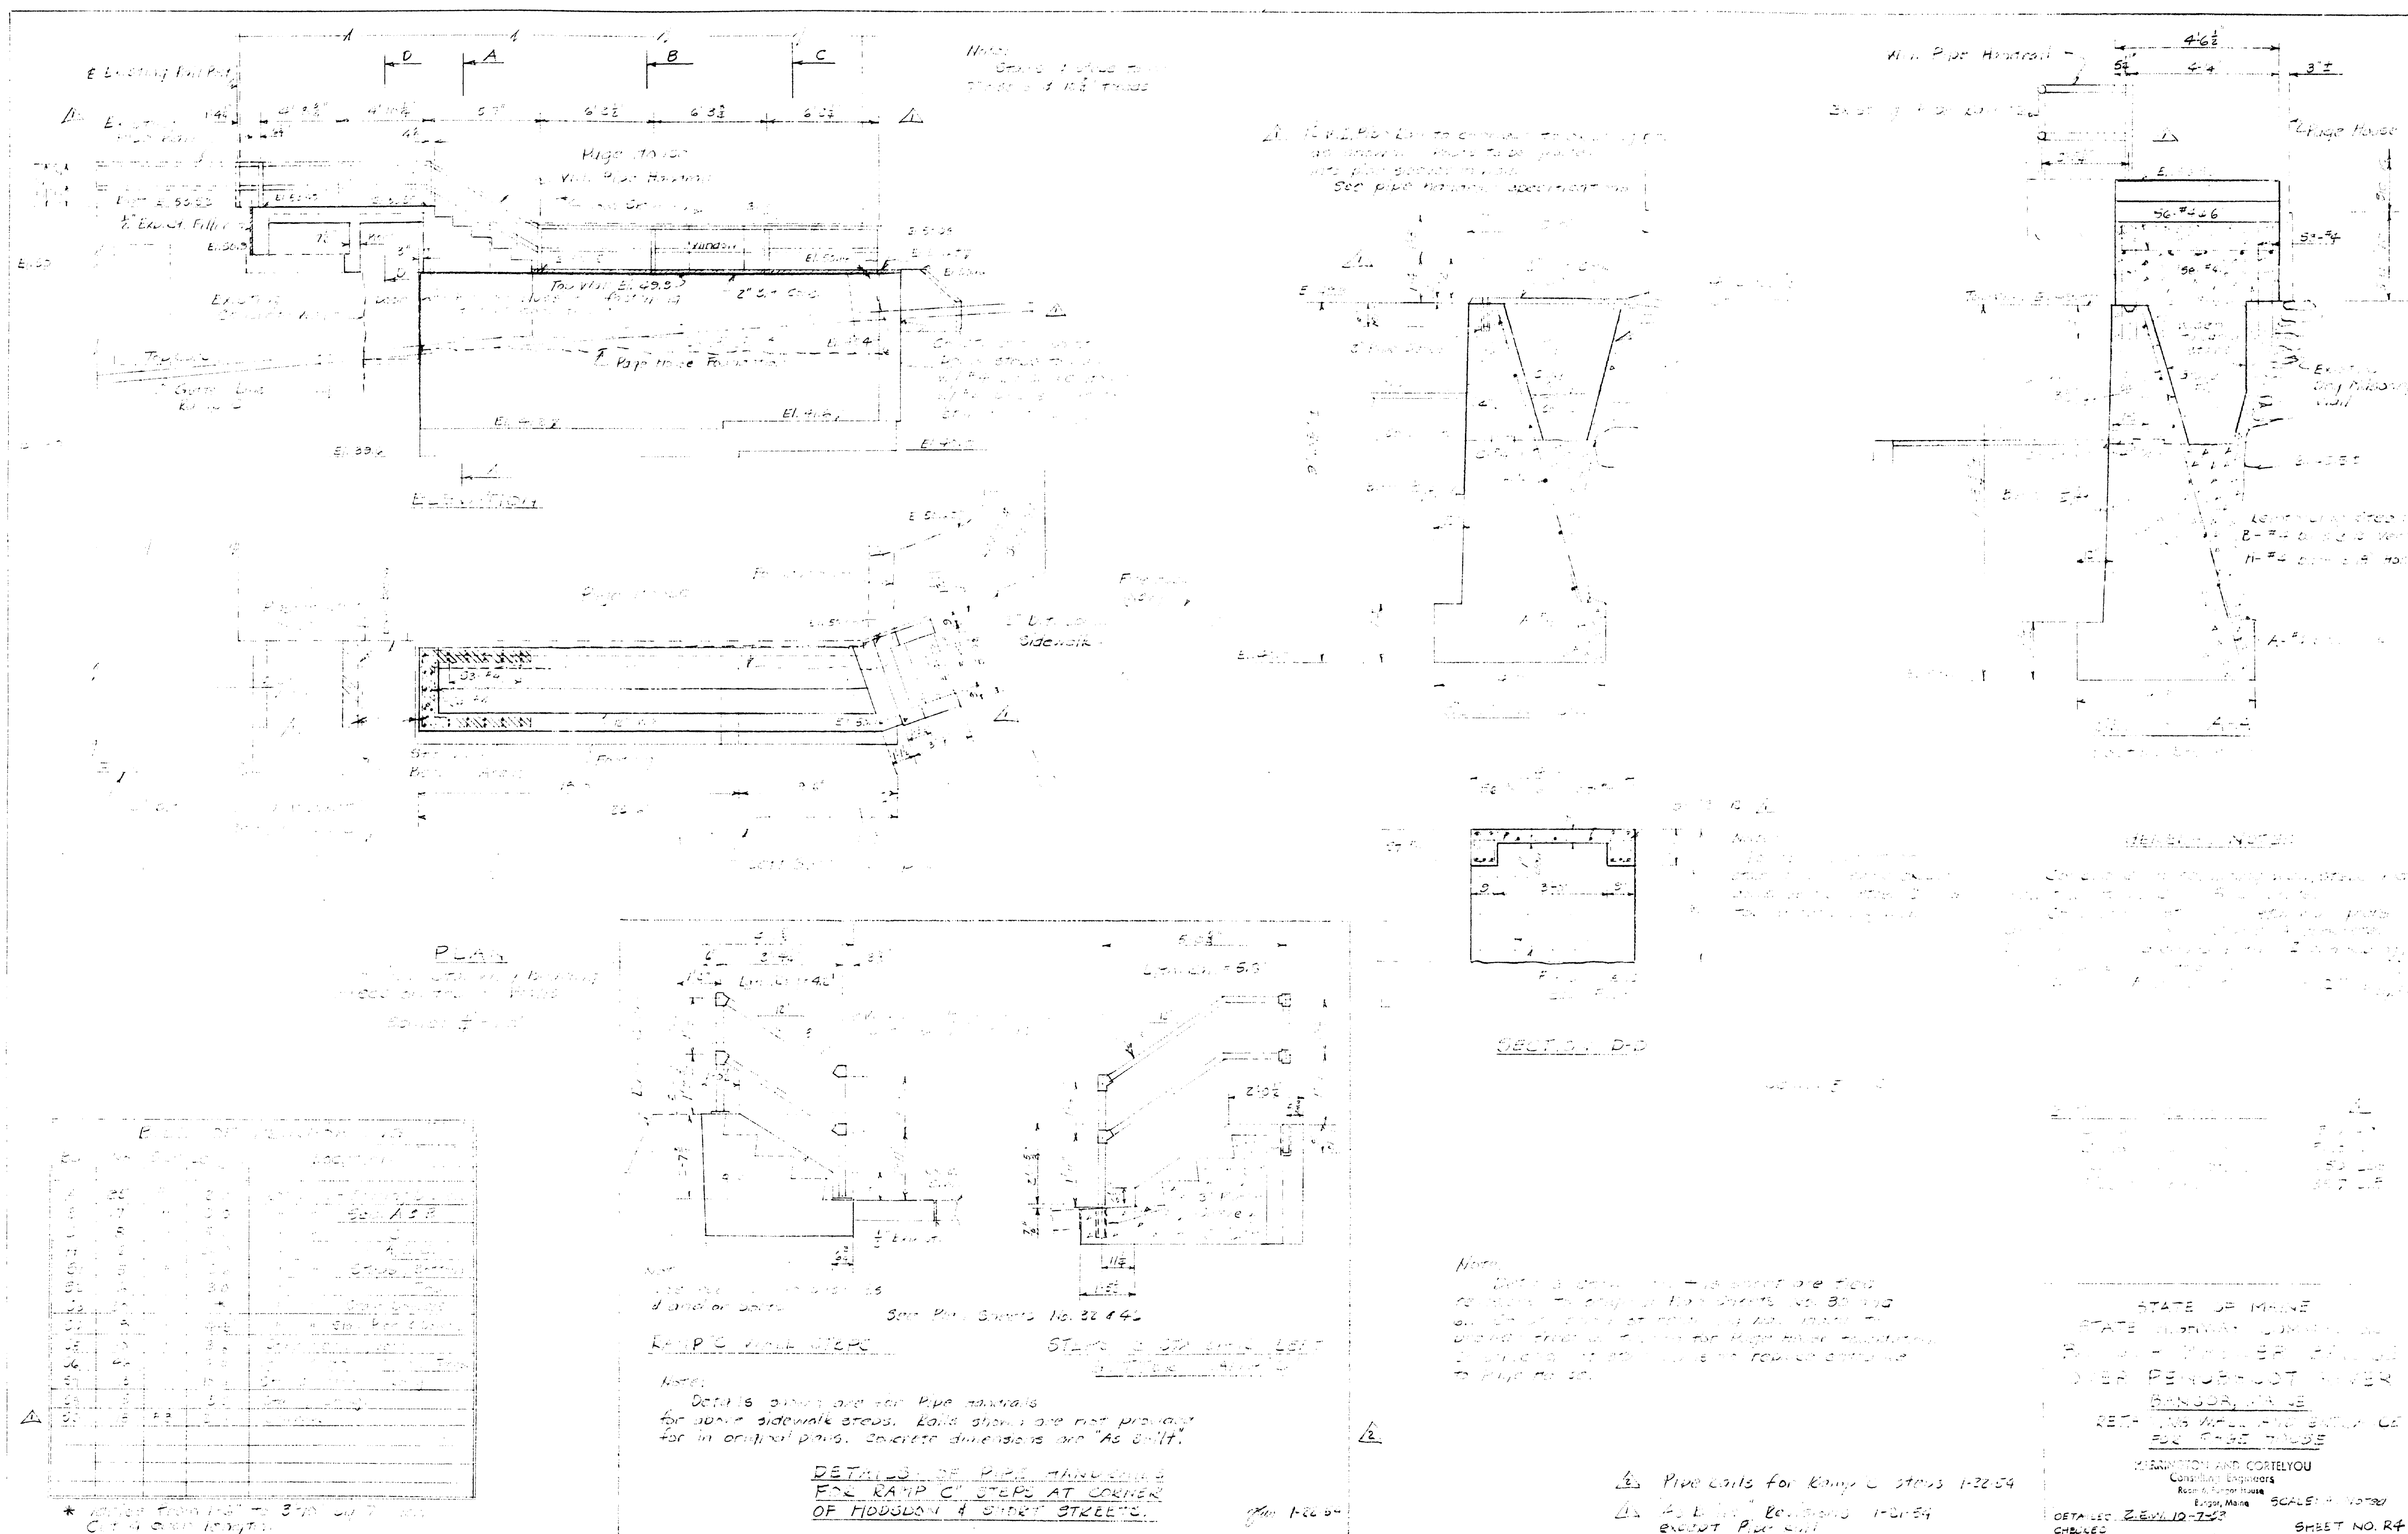




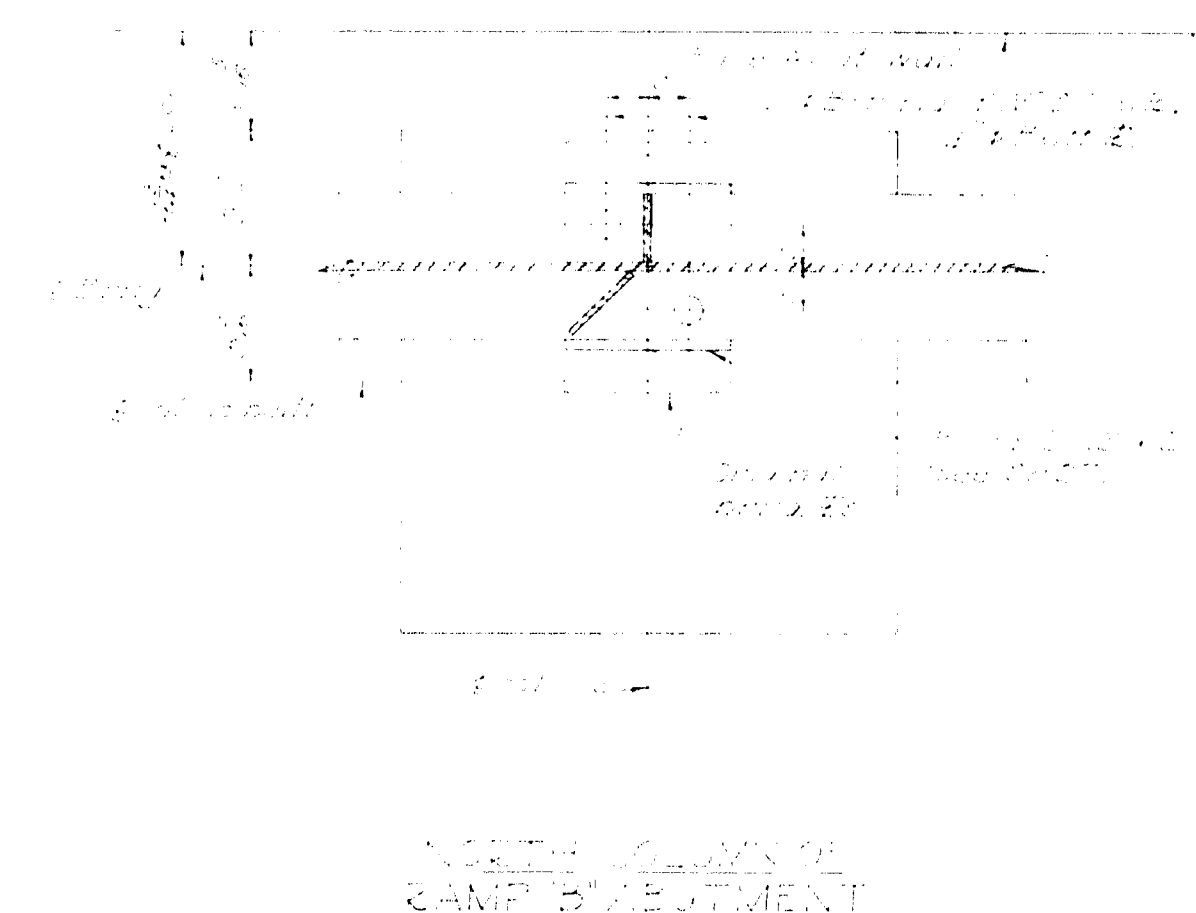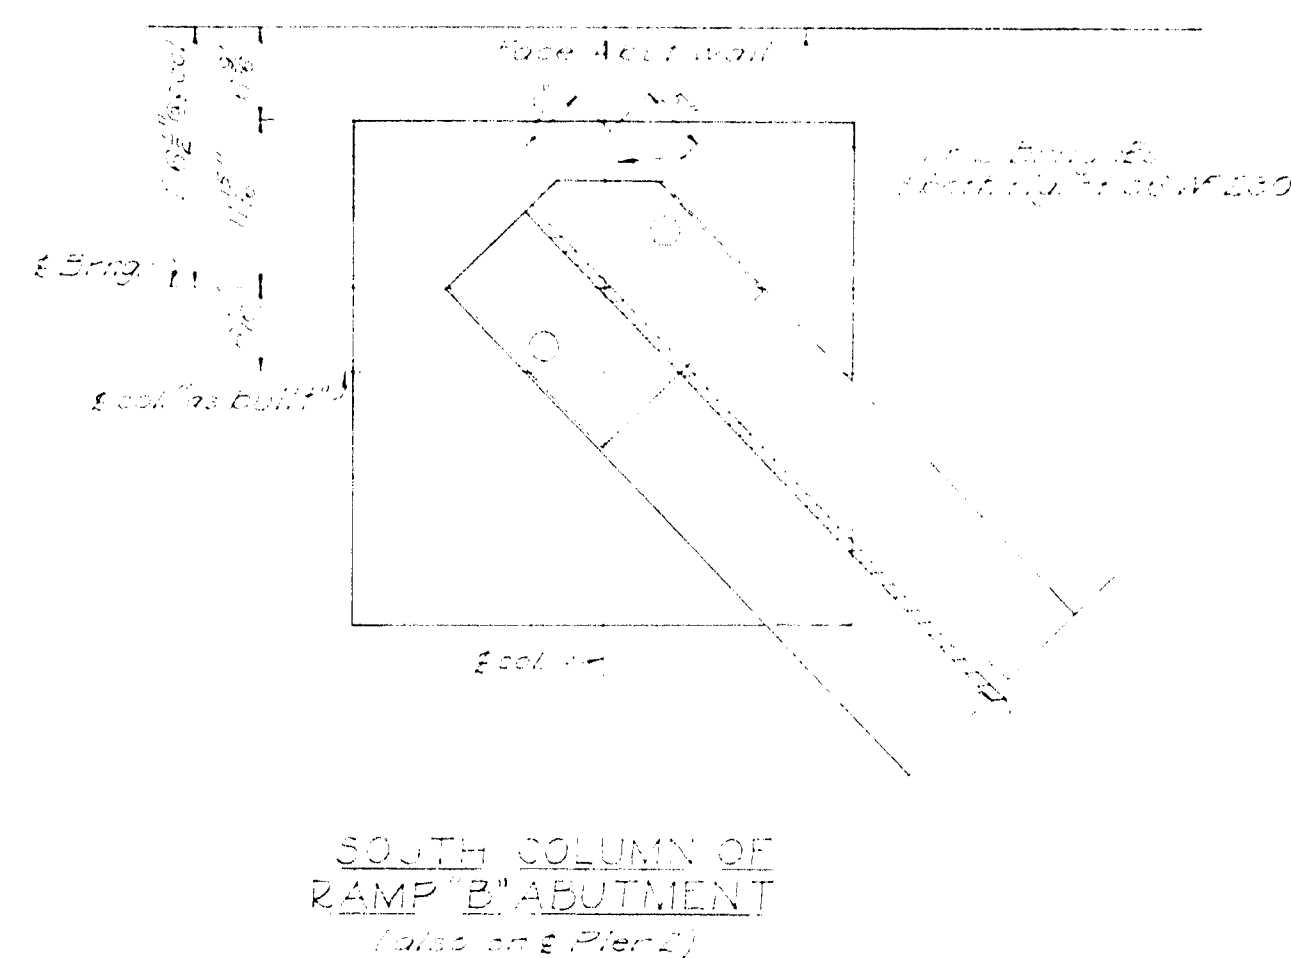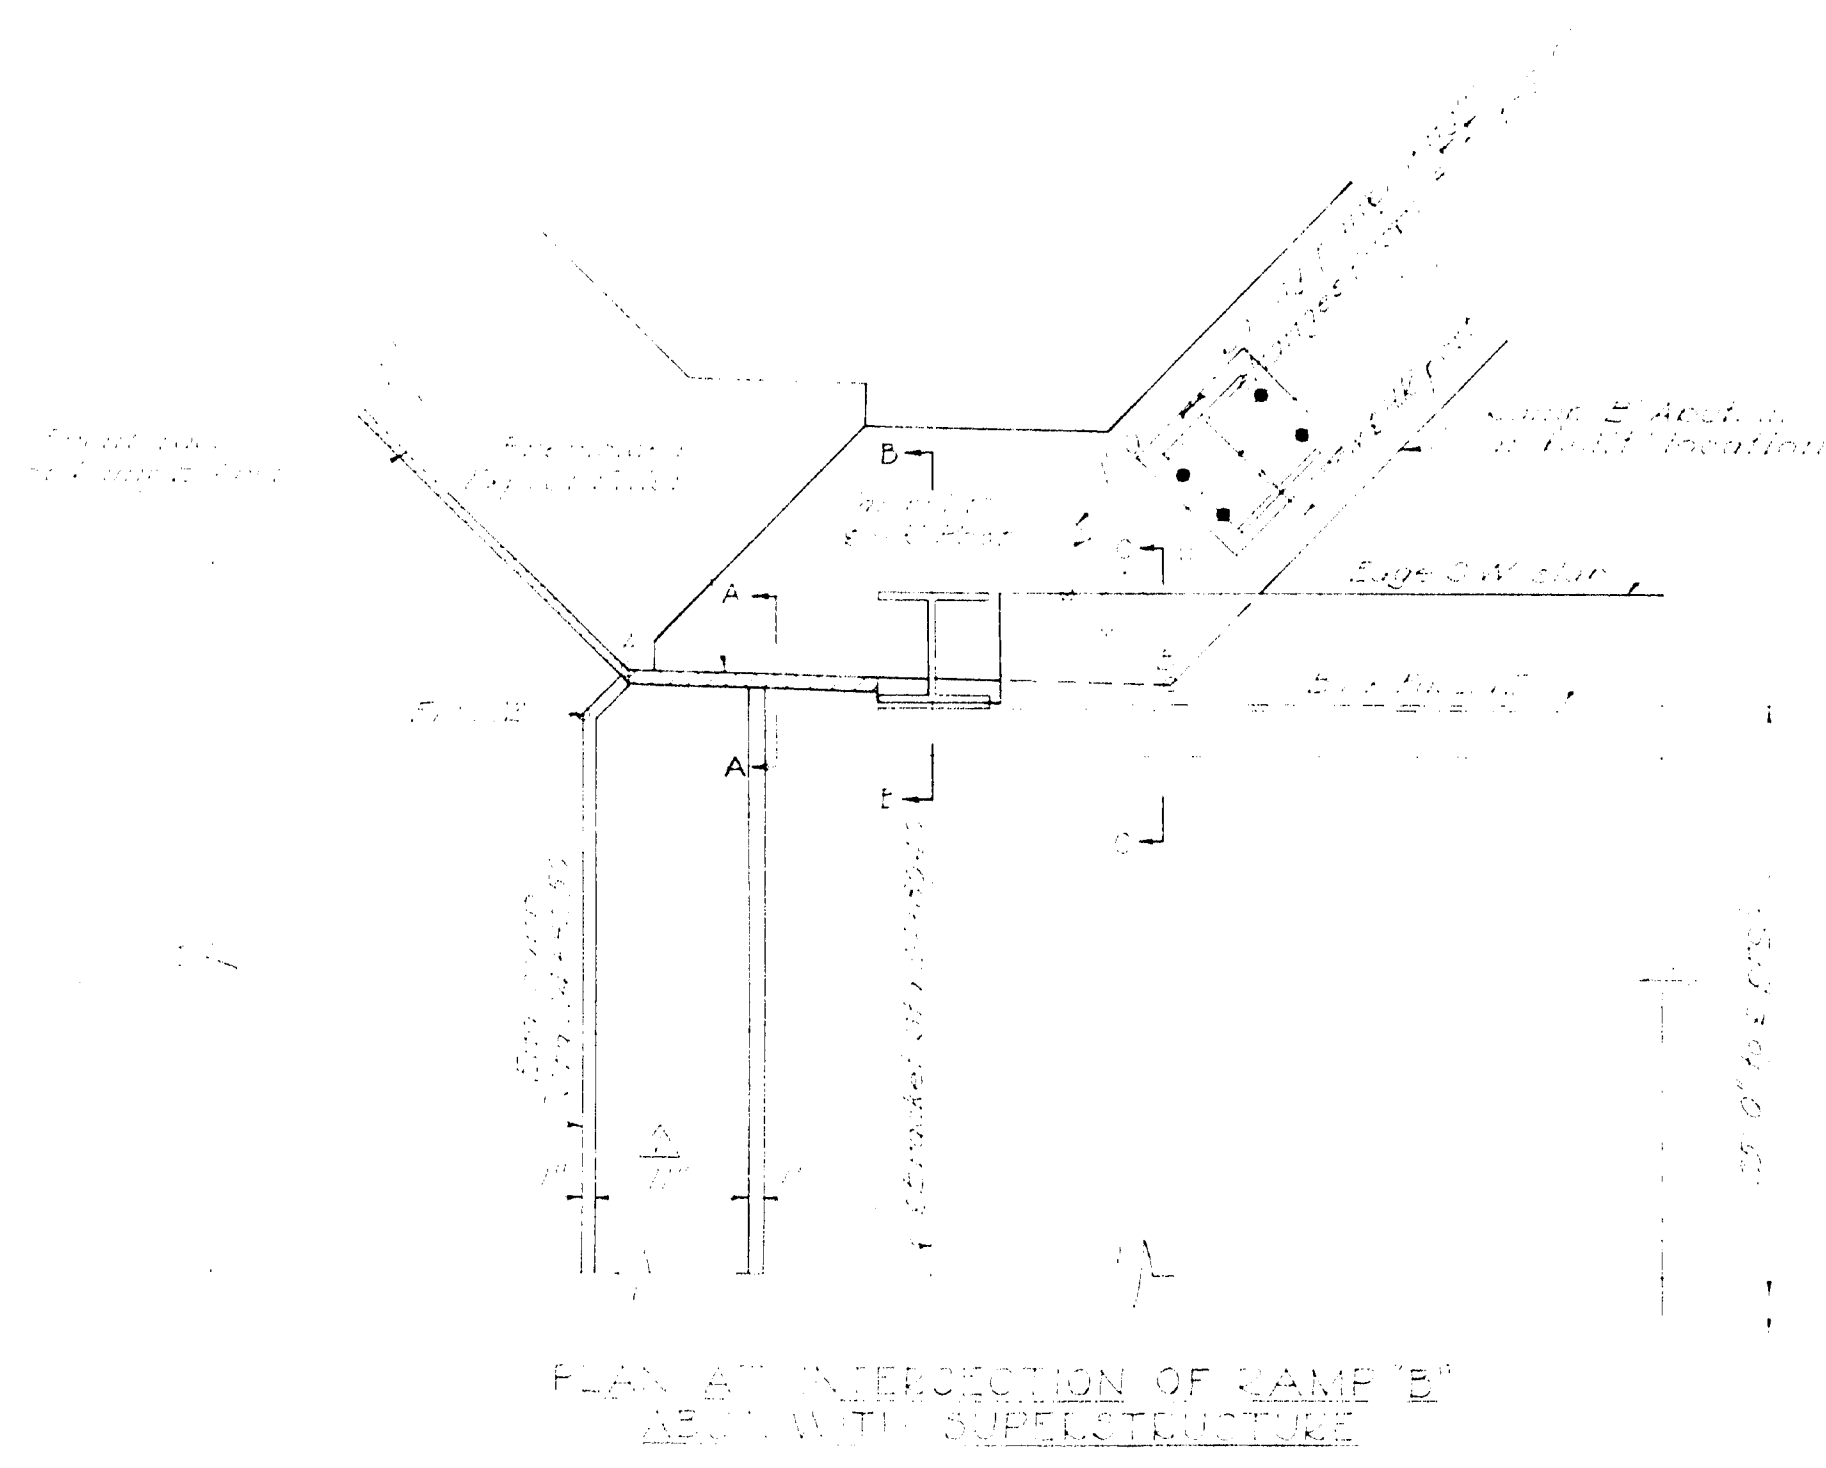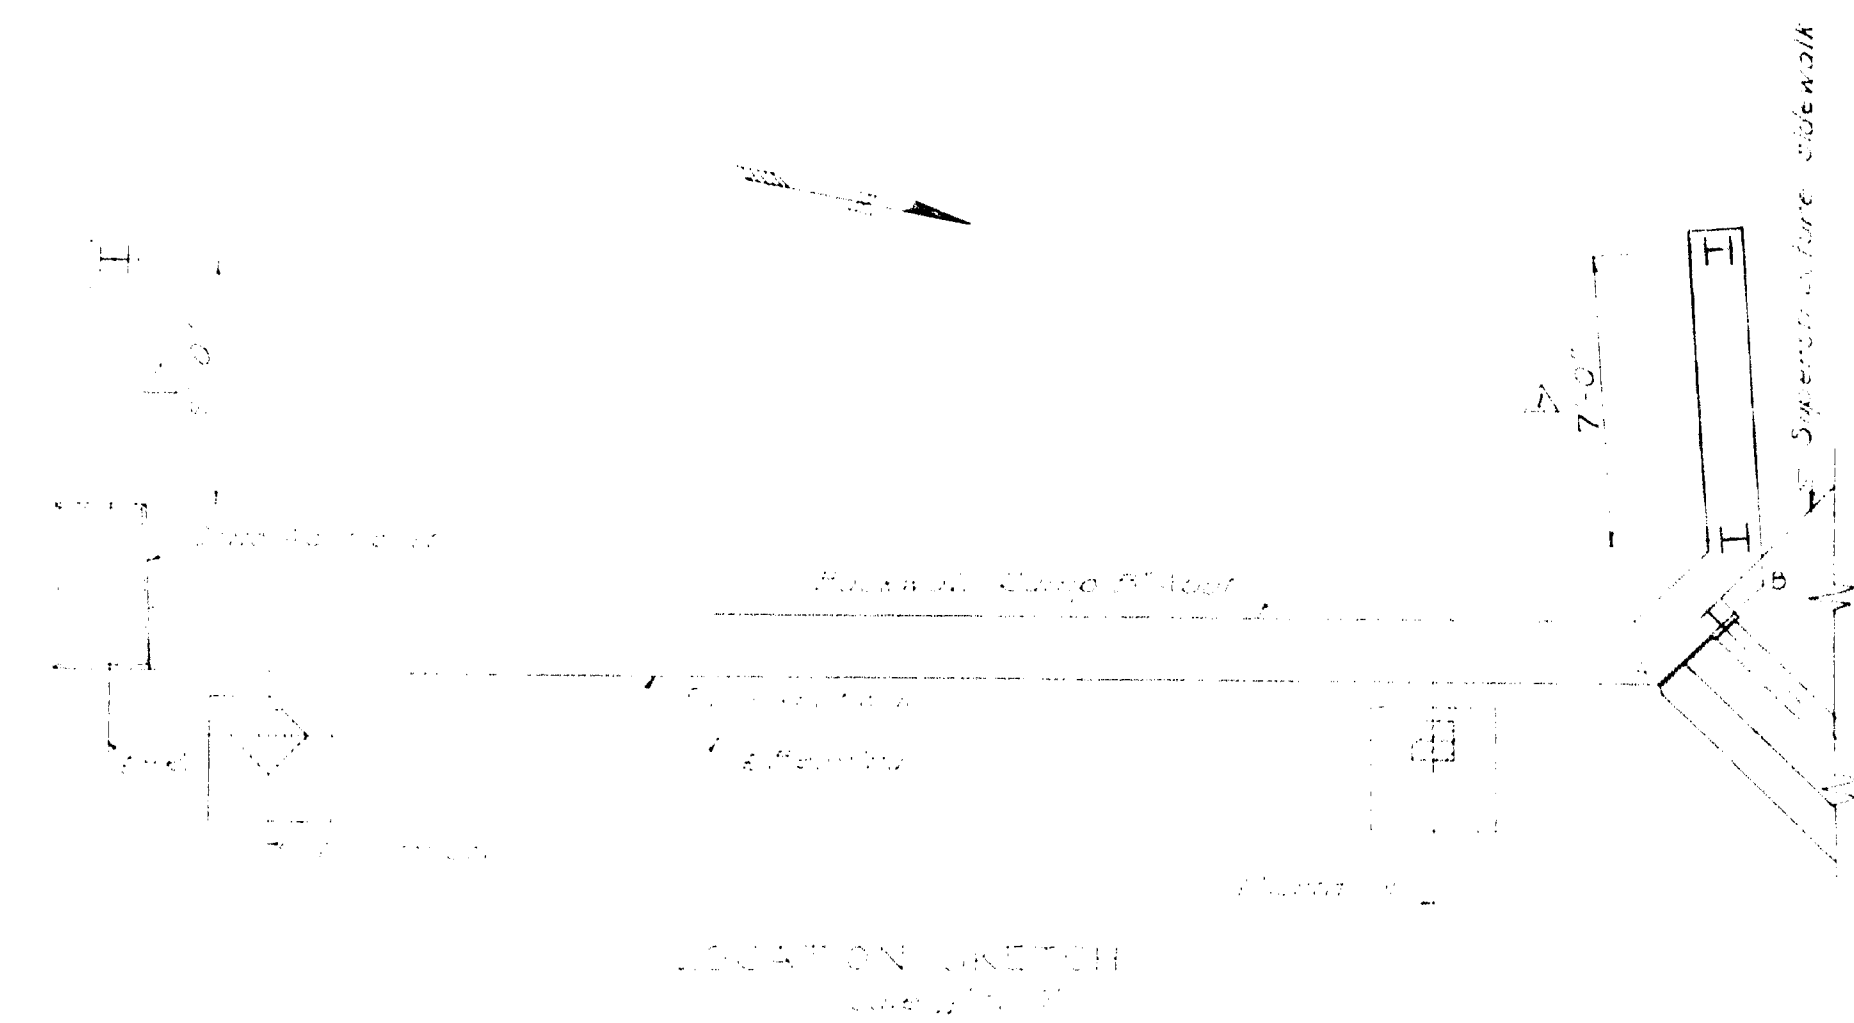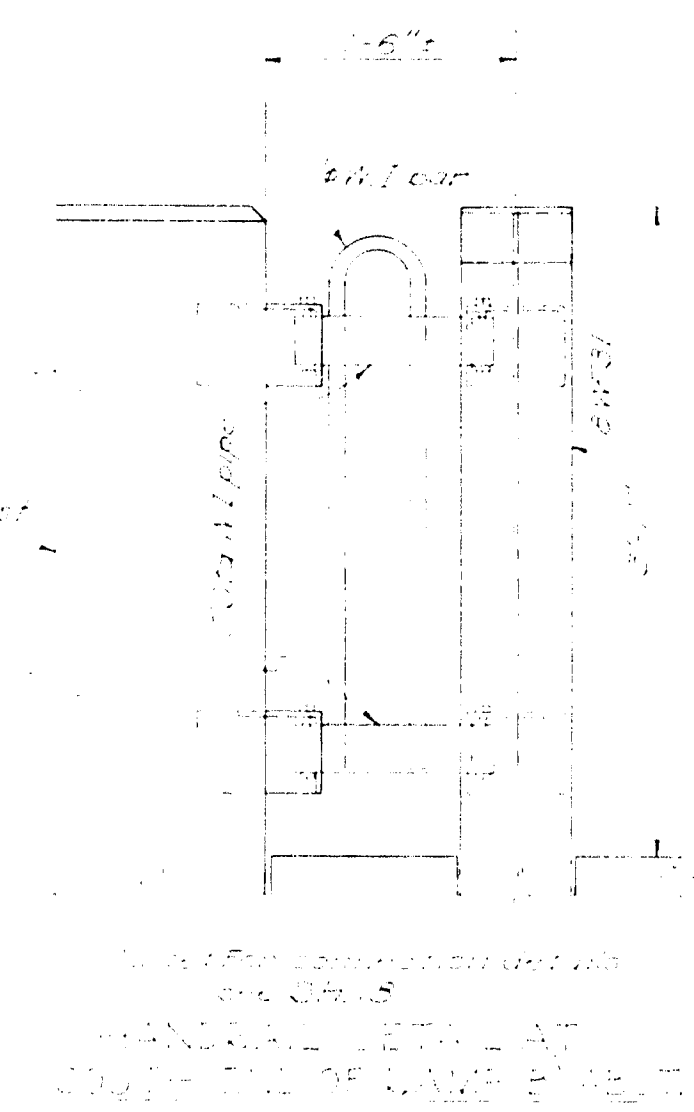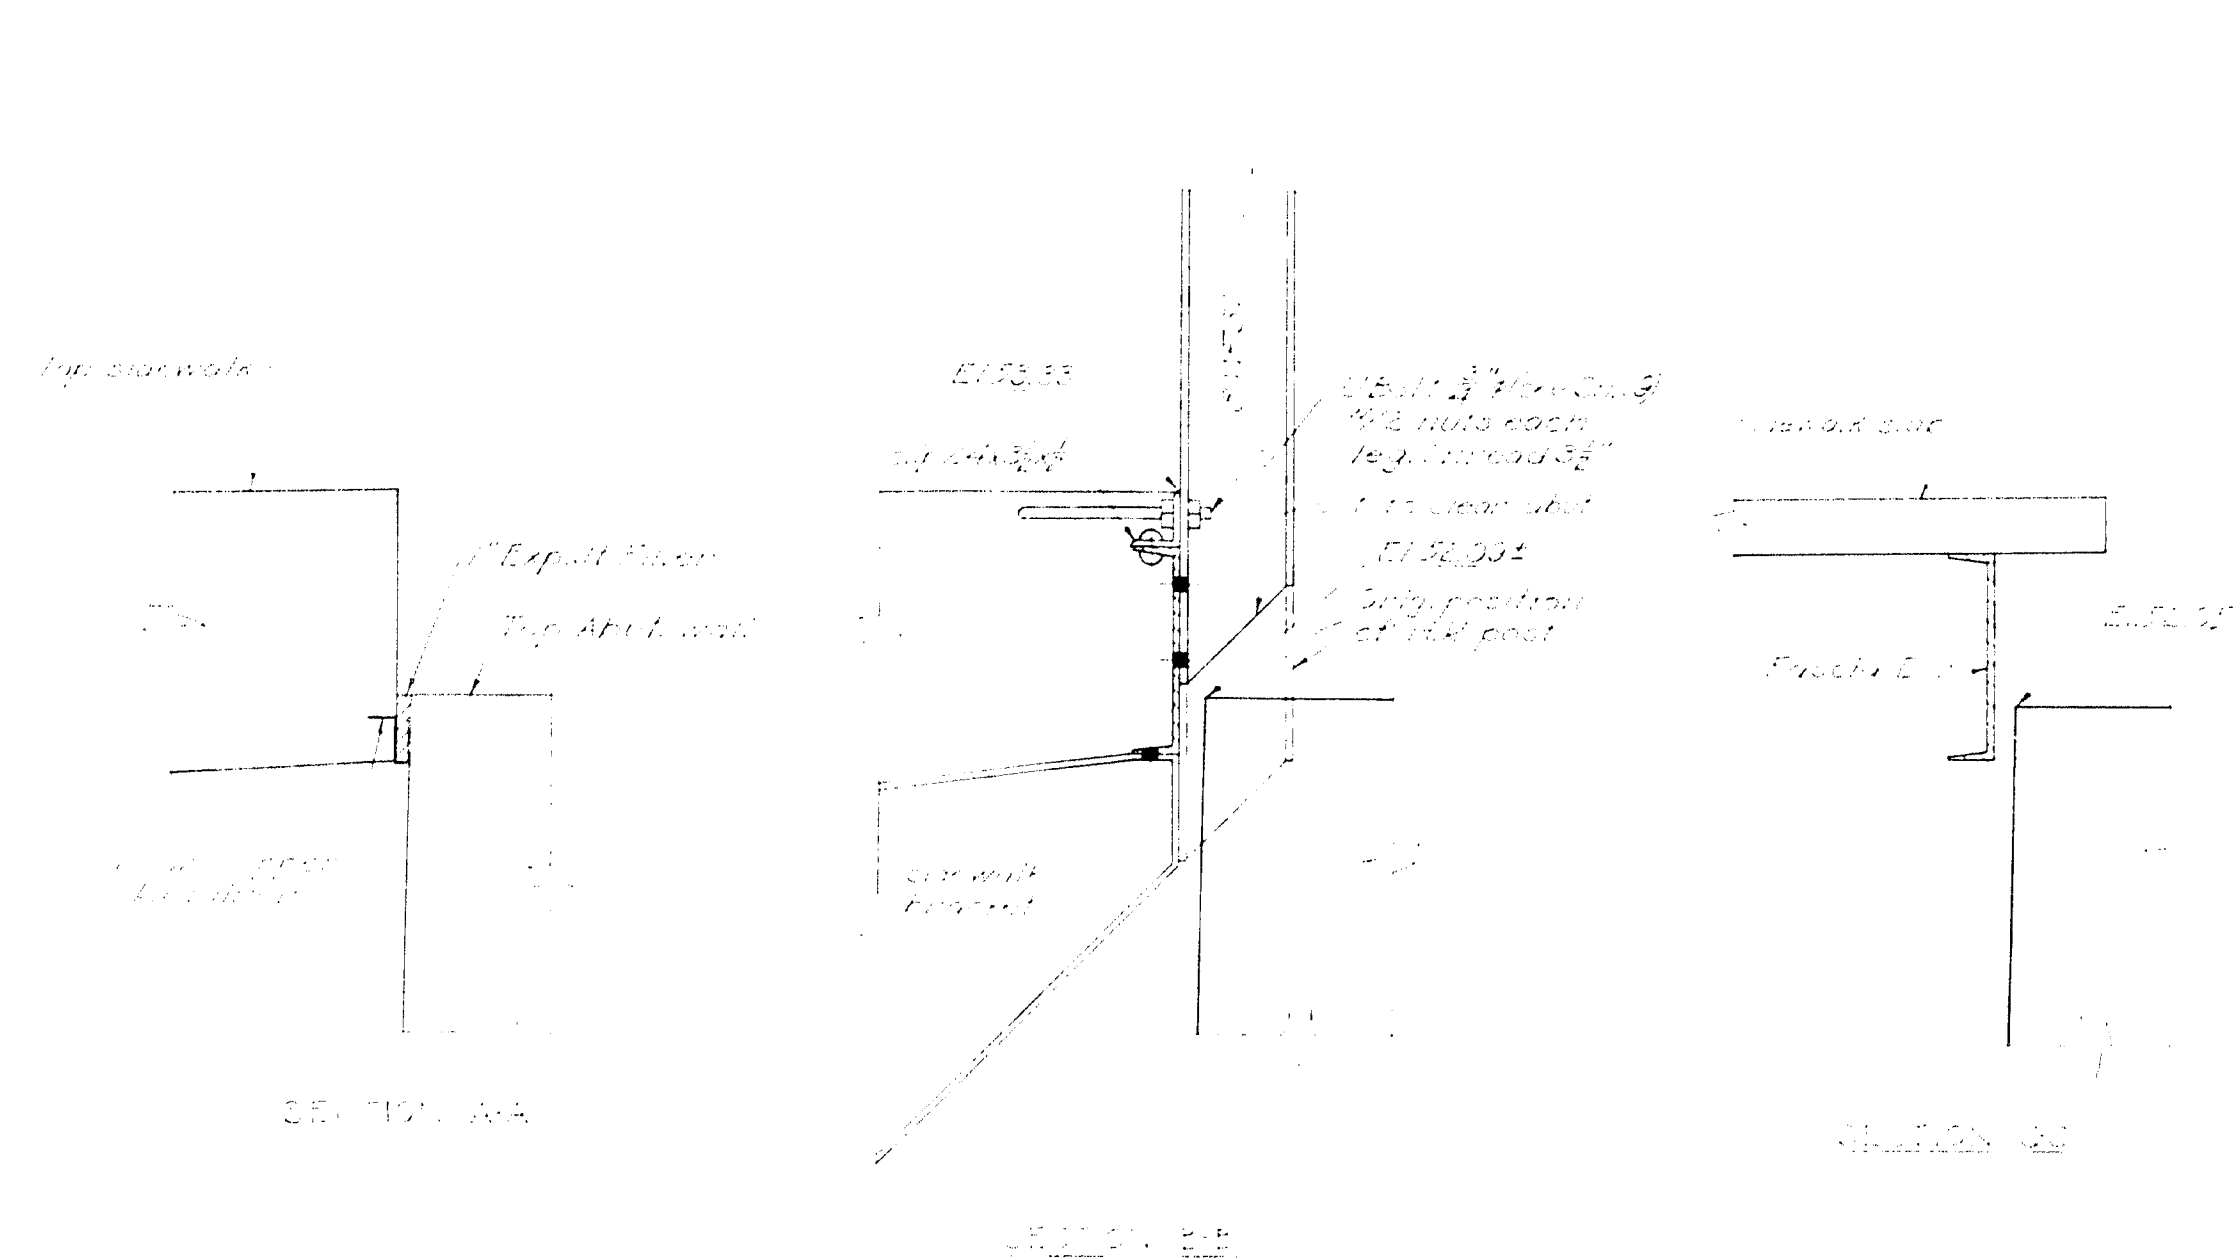


Details on this sheet supersede corresponding details on SH. No. 3, 10, 12, 17, 18, 21, 22, 23, 99, 100.

Revised 12-25-53


STATE OF MAINE  
STATE HIGHWAY COMMISSION  
BANGOR-BREWER BRIDGE  
OVER PENOBSCOT RIVER  
BANGOR, MAINE  
RAMP "B" ABUTMENT REVISION  
HARRINGTON AND CORTELYOU  
CONSULTING ENGINEERS  
KANSAS CITY, MO.  
SCALE: 1"=1'-0"  
AS NOTED  
SH. NO. 26  
DETAILED M.E.H. 12-15-53  
CHECKED G.H.K. 12-25-53

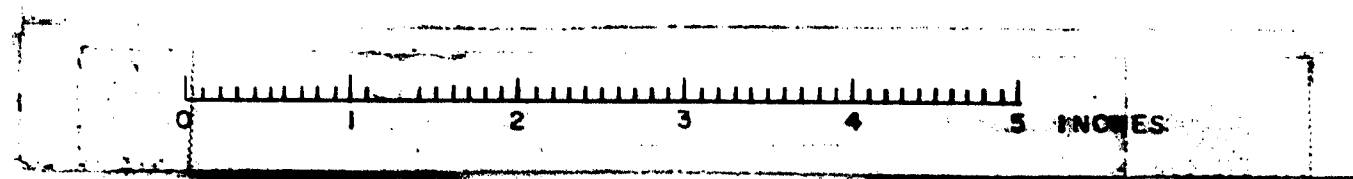

8-13-35 62-81

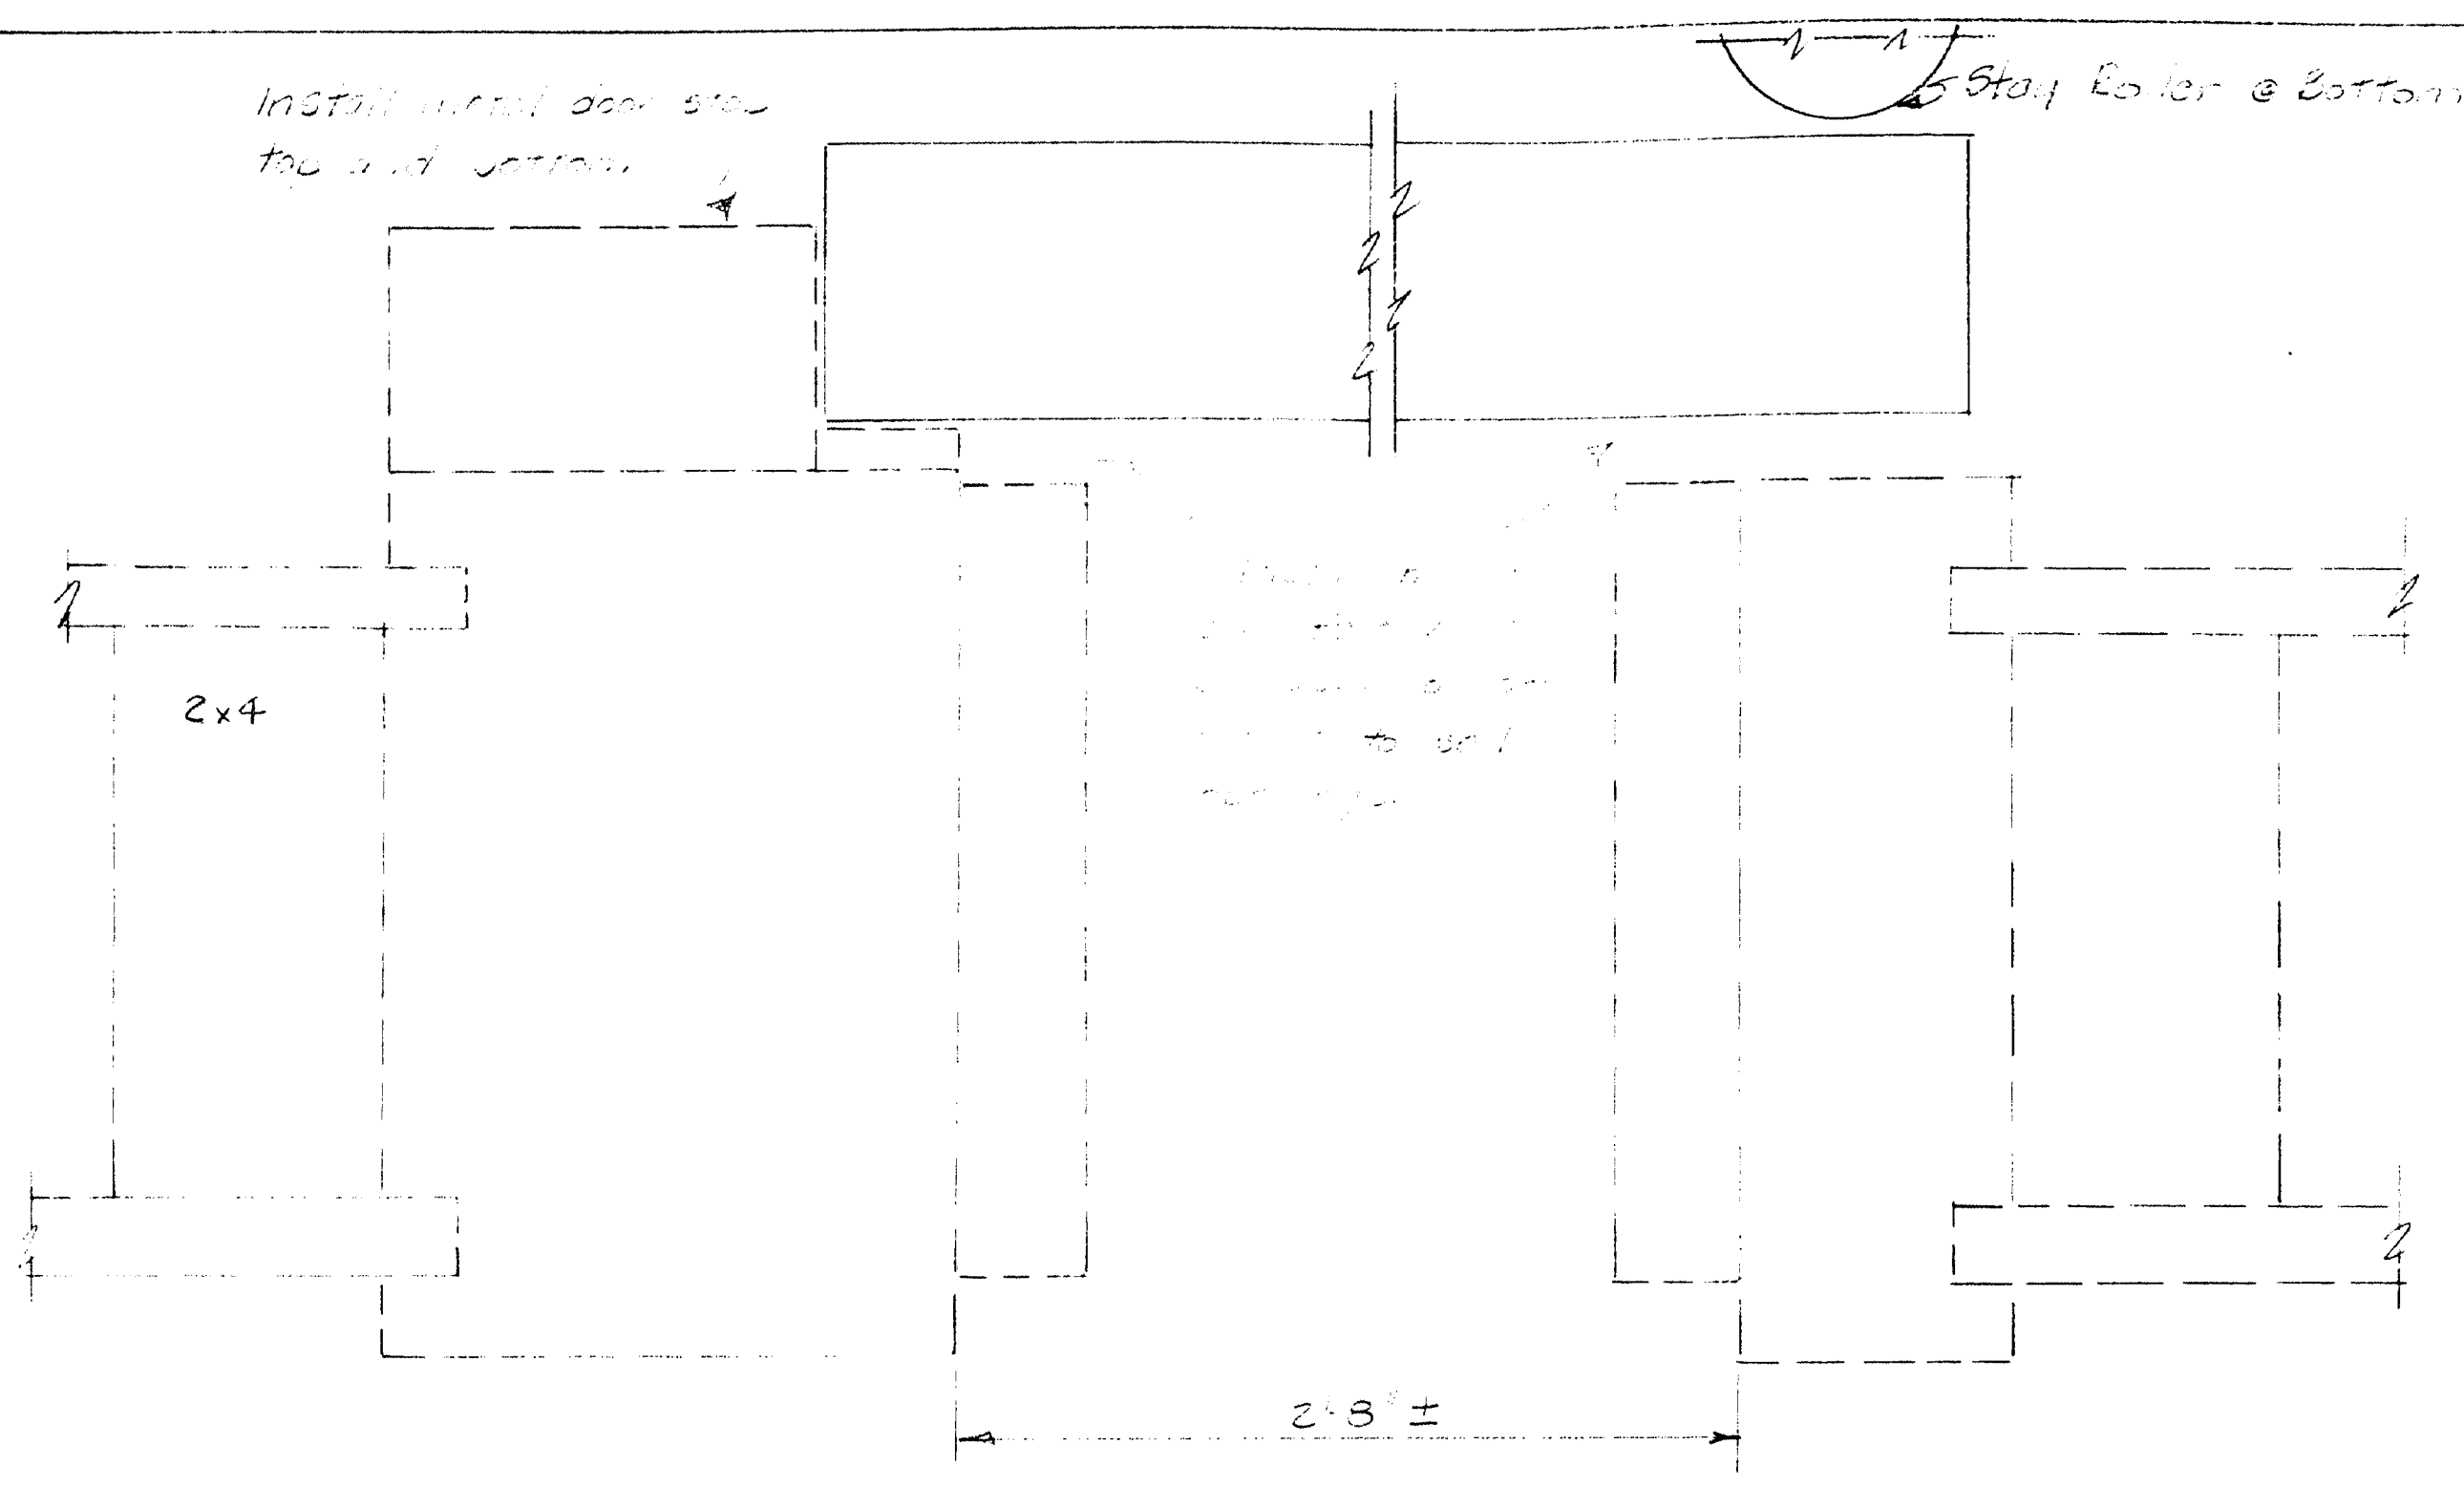

TYPICAL HORIZONTAL SECTION

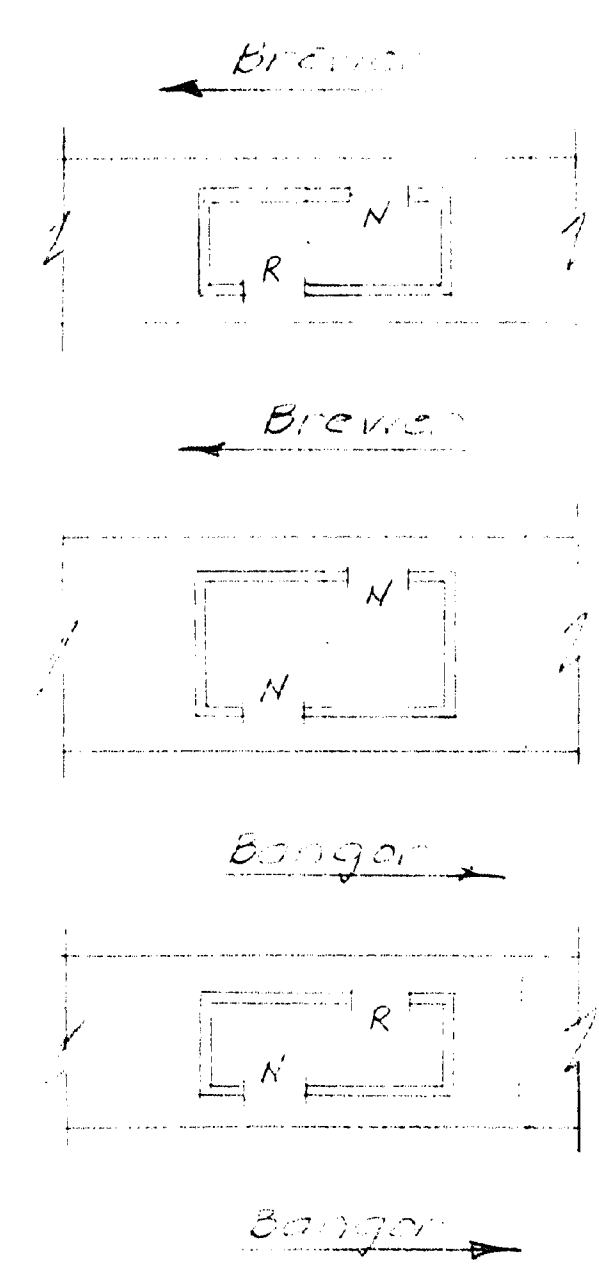


PART PLAN  
Showing Door Locations

GENERAL NOTES:  
The work required by this sheet shall consist of the following:

1. For all openings: New door tracks, hangers, stay rollers, and stops and weatherstripping shall be provided and installed as shown on this sheet and set forth herein. Existing door and window frames shall be strengthened, true'd up, and reinforced where necessary to provide and maintain clear traveling for all doors. Metal end stops shall be a new, solid standard type and will replace the old ones with some. An existing weatherstripping, except at openings of doors "R", shall be removed and replaced with a new, solid standard type and will replace the old ones with some. All end stops in the lower section.


2. For openings marked "N": New threshold, exterior finish as shown on this sheet. Existing door frame and stop shall be removed and replaced with a new, solid standard type and will replace the old ones with some. Existing finish shall be removed and replaced with a new, solid standard type and will replace the old ones with some. Existing finish shall be removed and replaced with a new, solid standard type and will replace the old ones with some.
3. For openings marked "R": The two doors now in place may be strengthened, true'd up, and reinforced as necessary to move and/or repair. Existing door and window frames shall be strengthened, true'd up, and reinforced where necessary to provide and maintain clear traveling for all doors. Metal end stops shall be a new, solid standard type and will replace the old ones with some. An existing weatherstripping, except at openings of doors "R", shall be removed and replaced with a new, solid standard type and will replace the old ones with some.



Remove existing threshold and plug bolt holes at door "N"

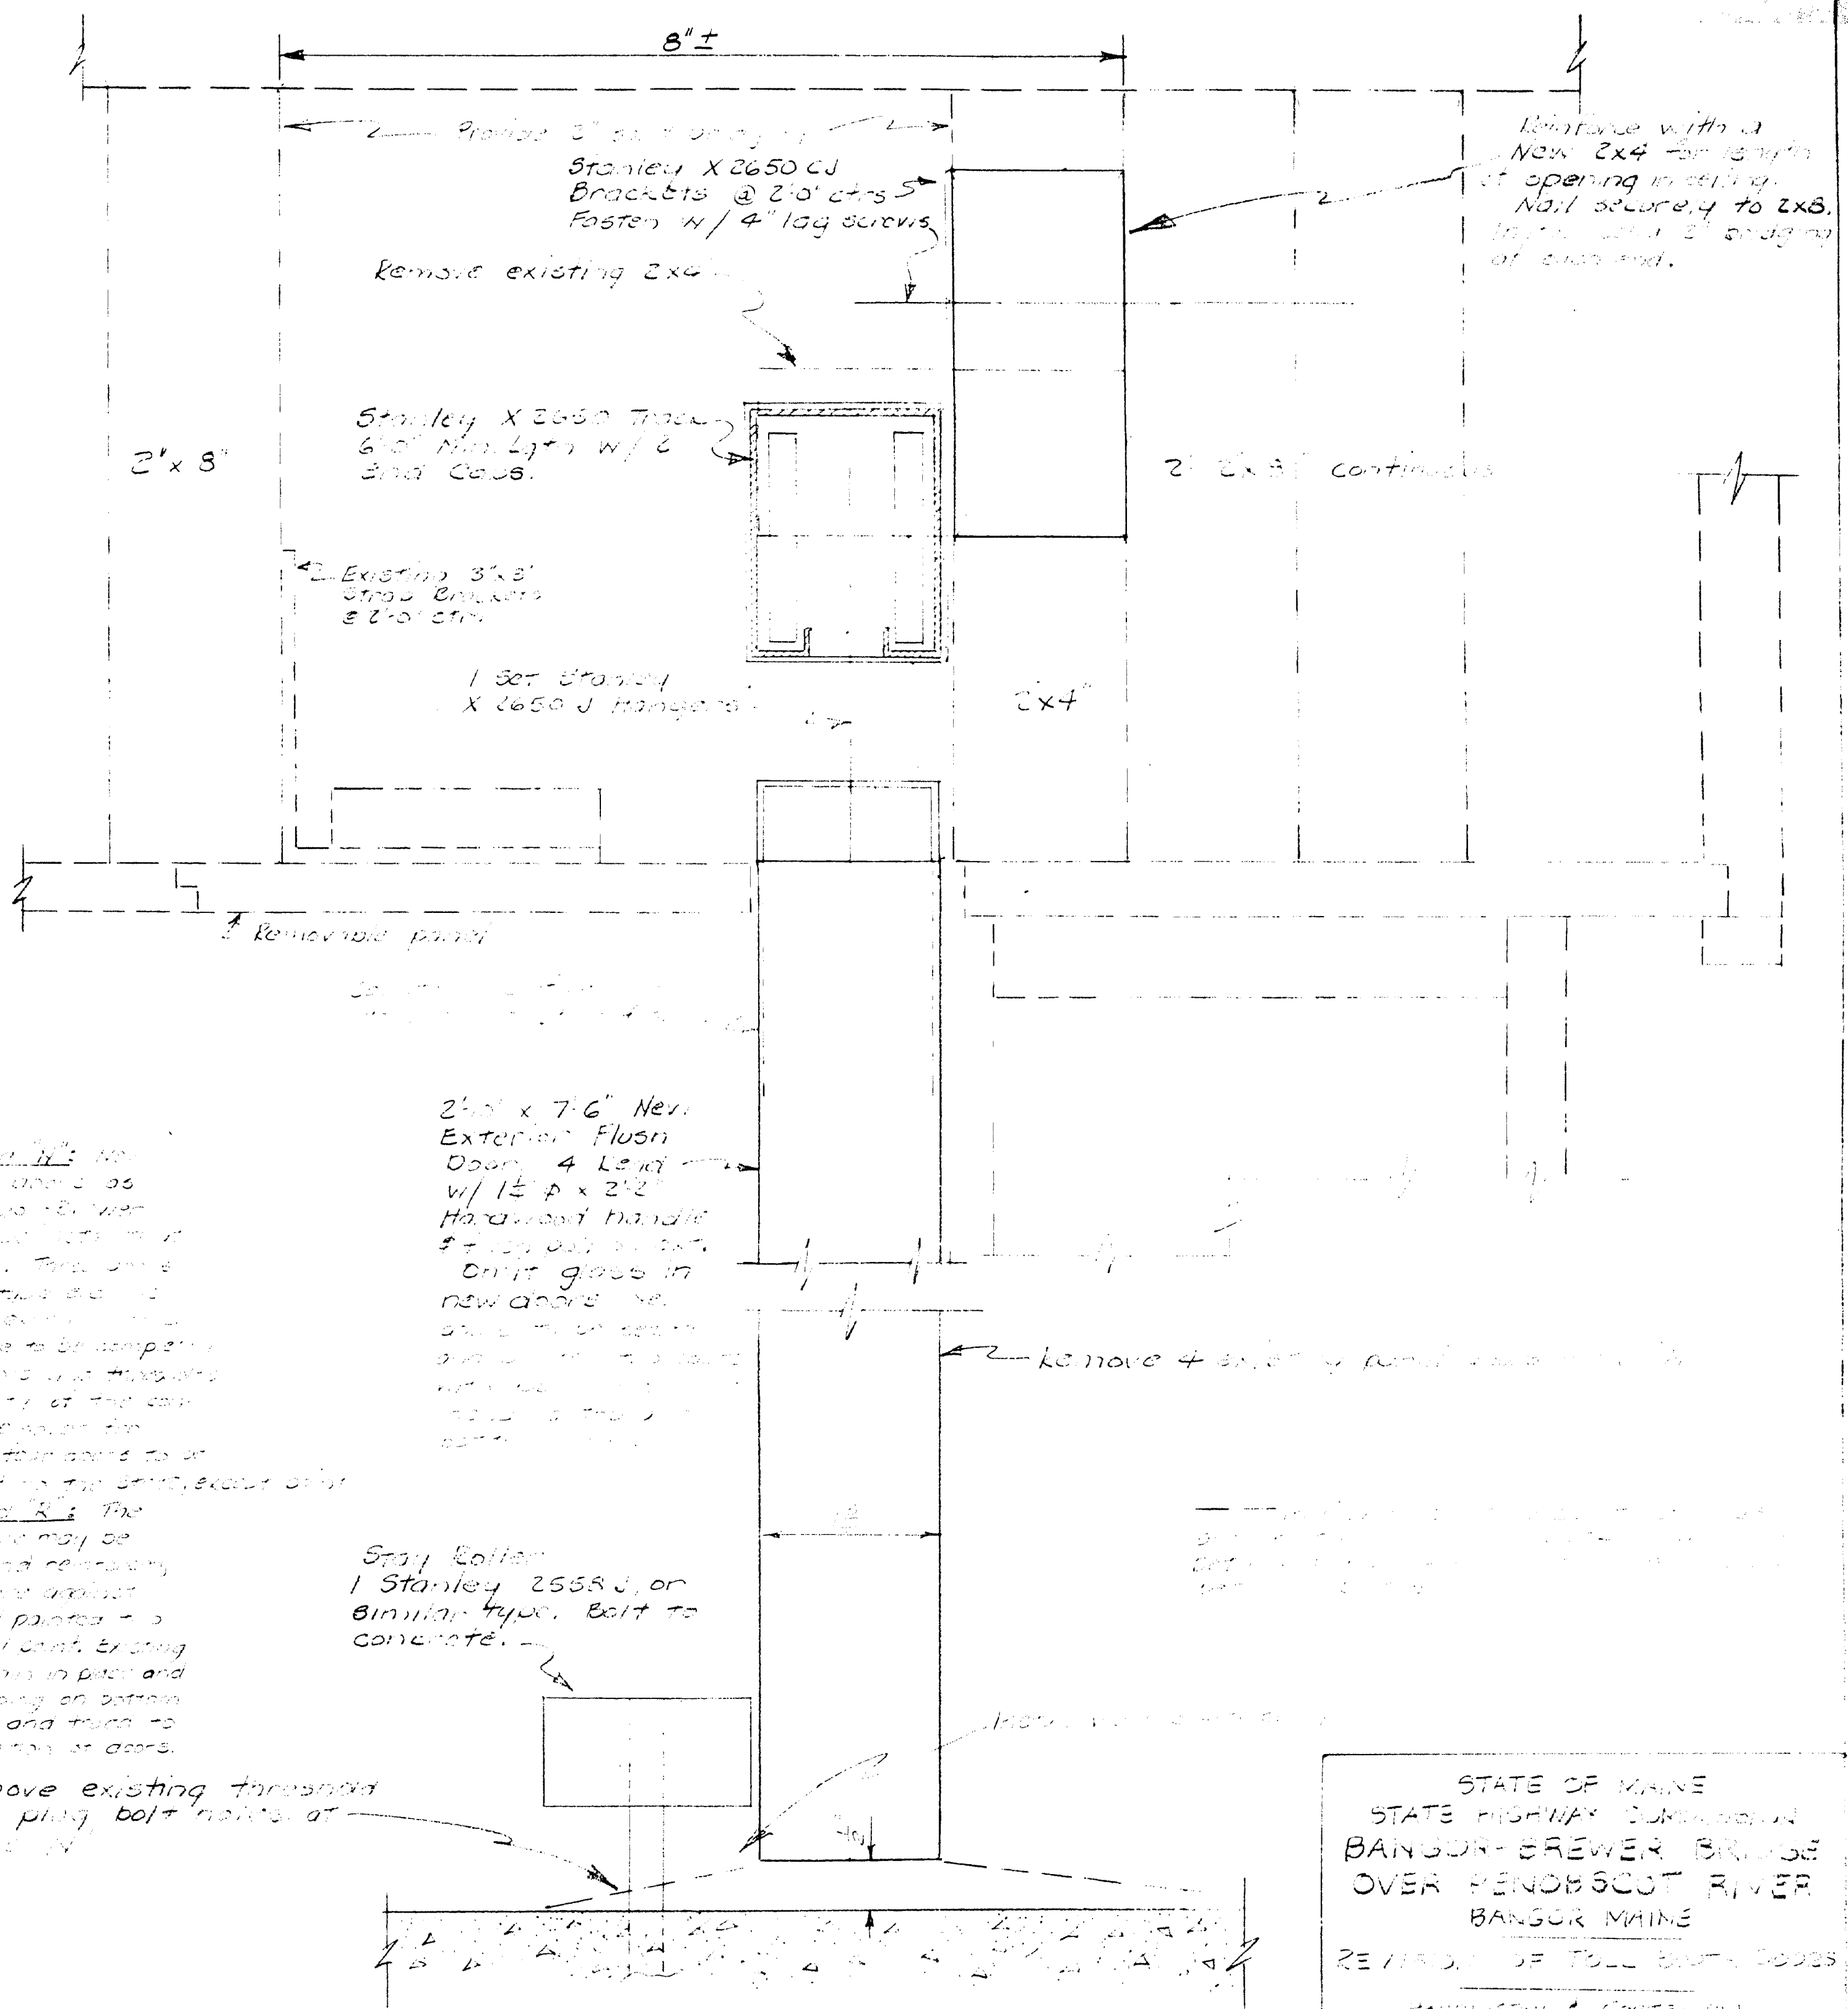



TYPICAL SECTION @ DOOR "N"

STATE OF MAINE  
STATE HIGHWAY COMMISSION  
BANGOR-BREWER BRIDGE  
OVER PENOBSCOT RIVER  
BANGOR MAINE  
REVISION OF TOLL BOOK BOOKS  
MAINTENANCE & REPAIR  
CONSTRUCTION ENGINEERS  
CONSULTING ENGINEERS  
MADE BY ZEW 7-14-65 SH 10 610

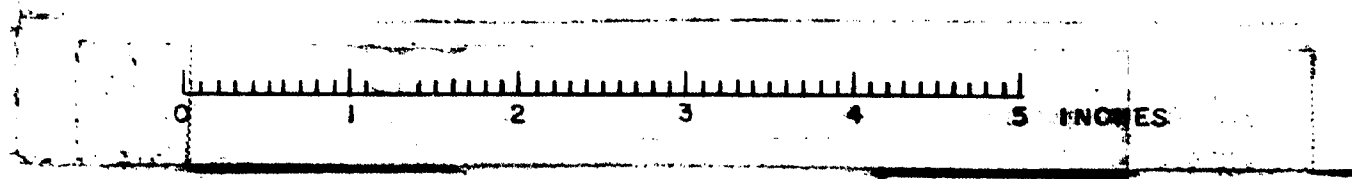


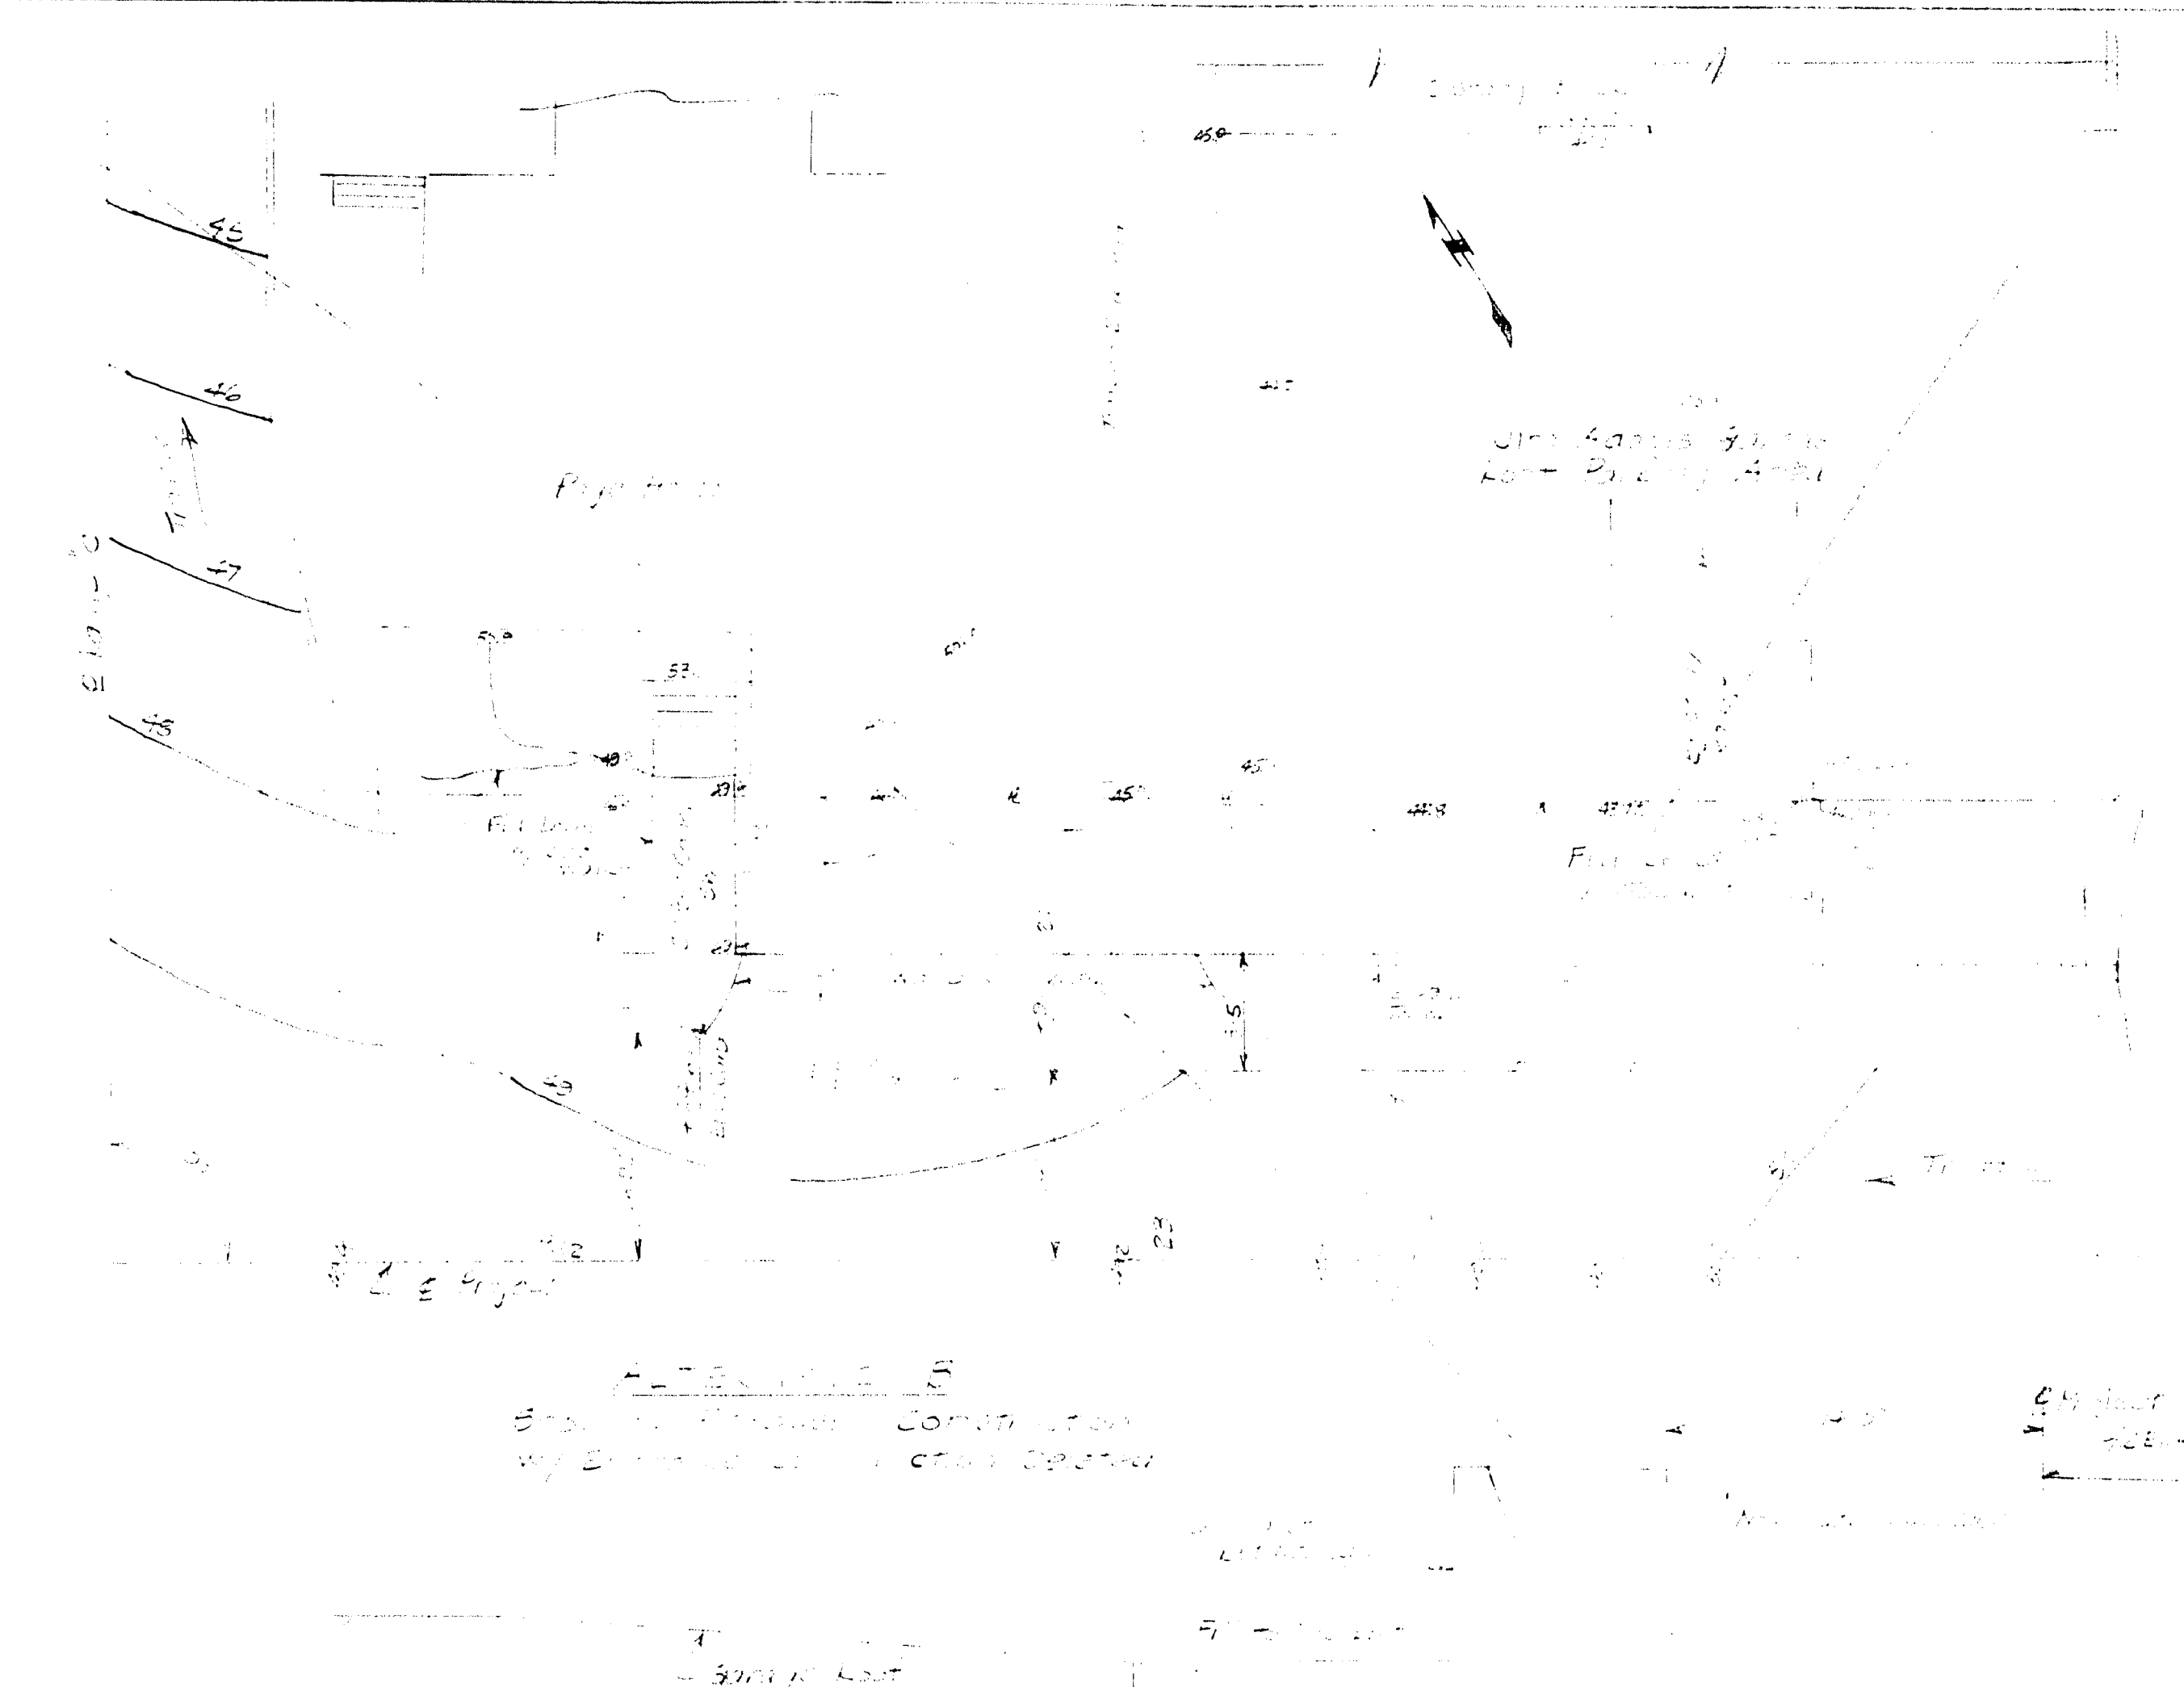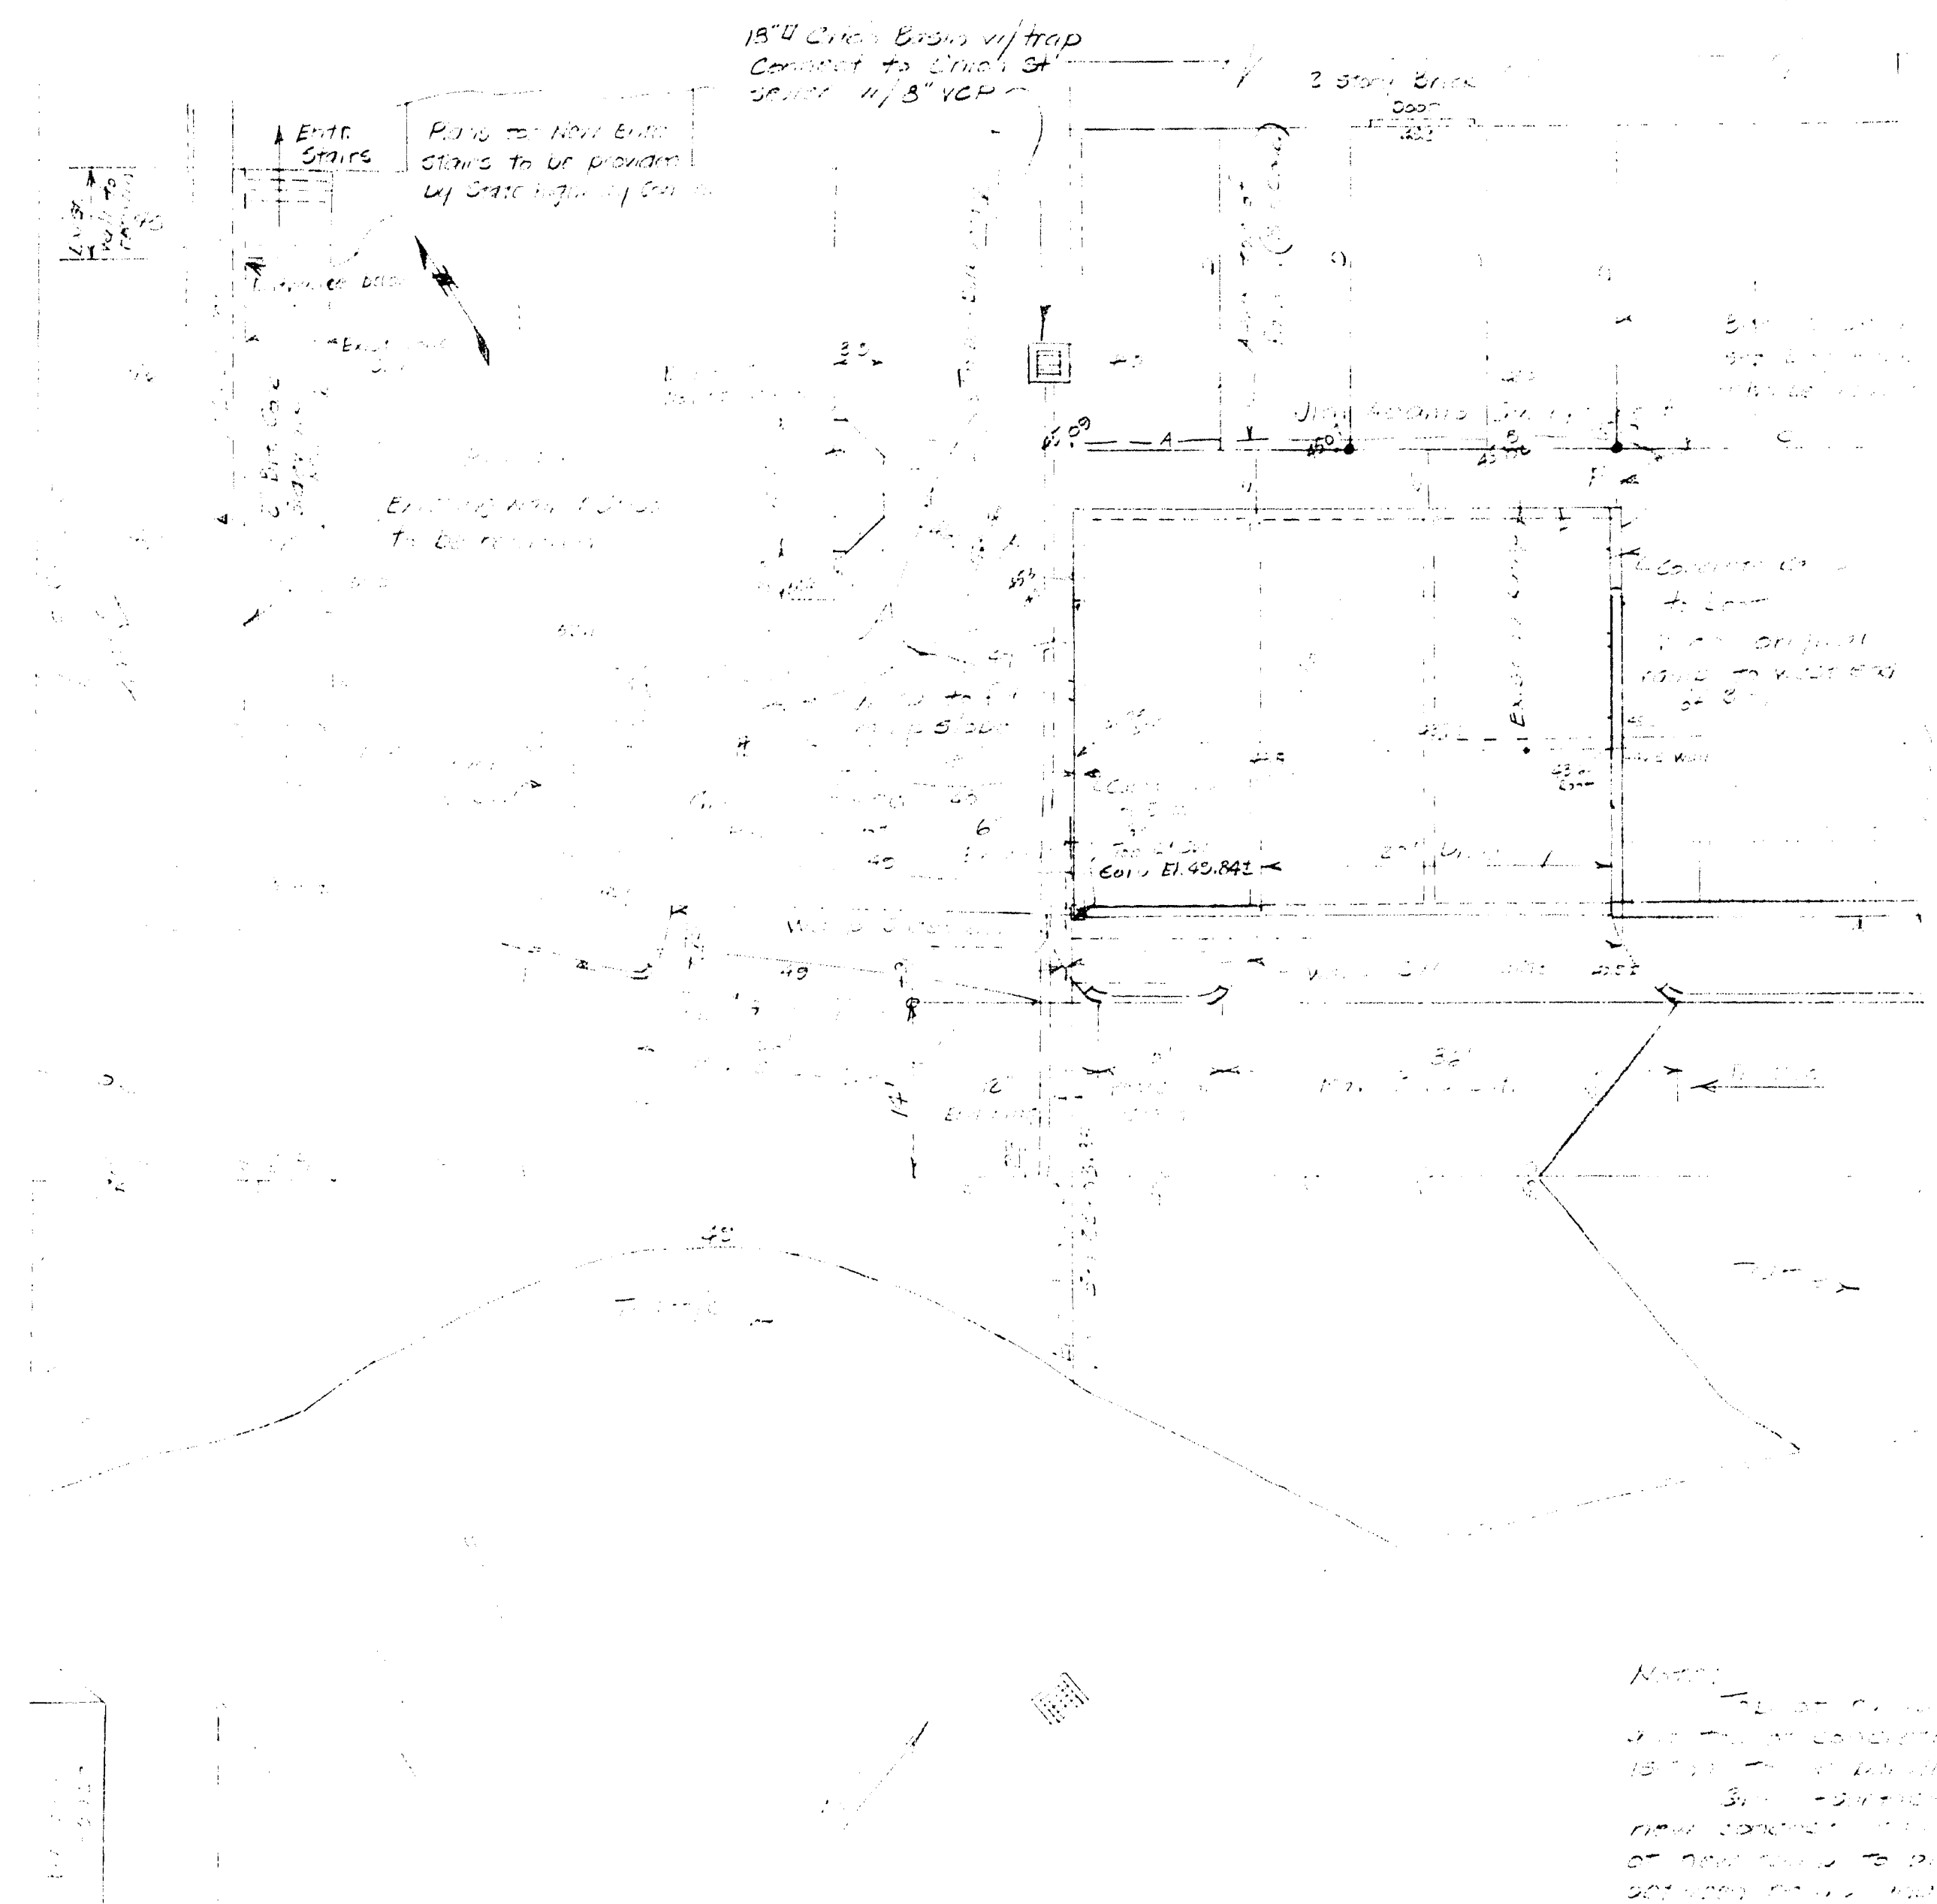

Notes:  
 1. At all times, keep the road clear of any obstructions.  
 2. The proposed road should be constructed to a minimum width of 18 feet.  
 3. The proposed road should be constructed to a minimum width of 18 feet.  
 4. The proposed road should be constructed to a minimum width of 18 feet.  
 5. The proposed road should be constructed to a minimum width of 18 feet.

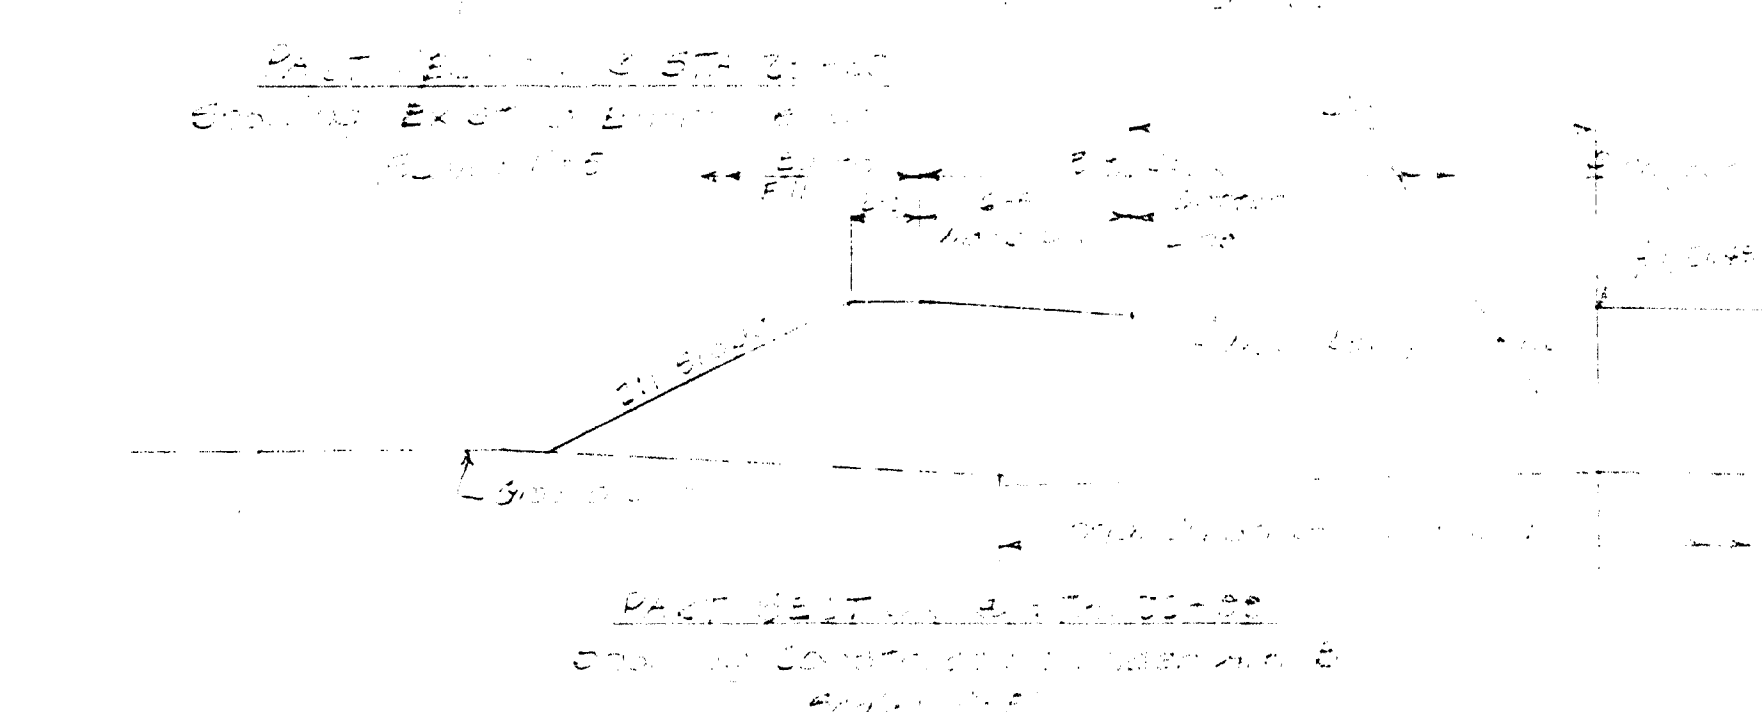
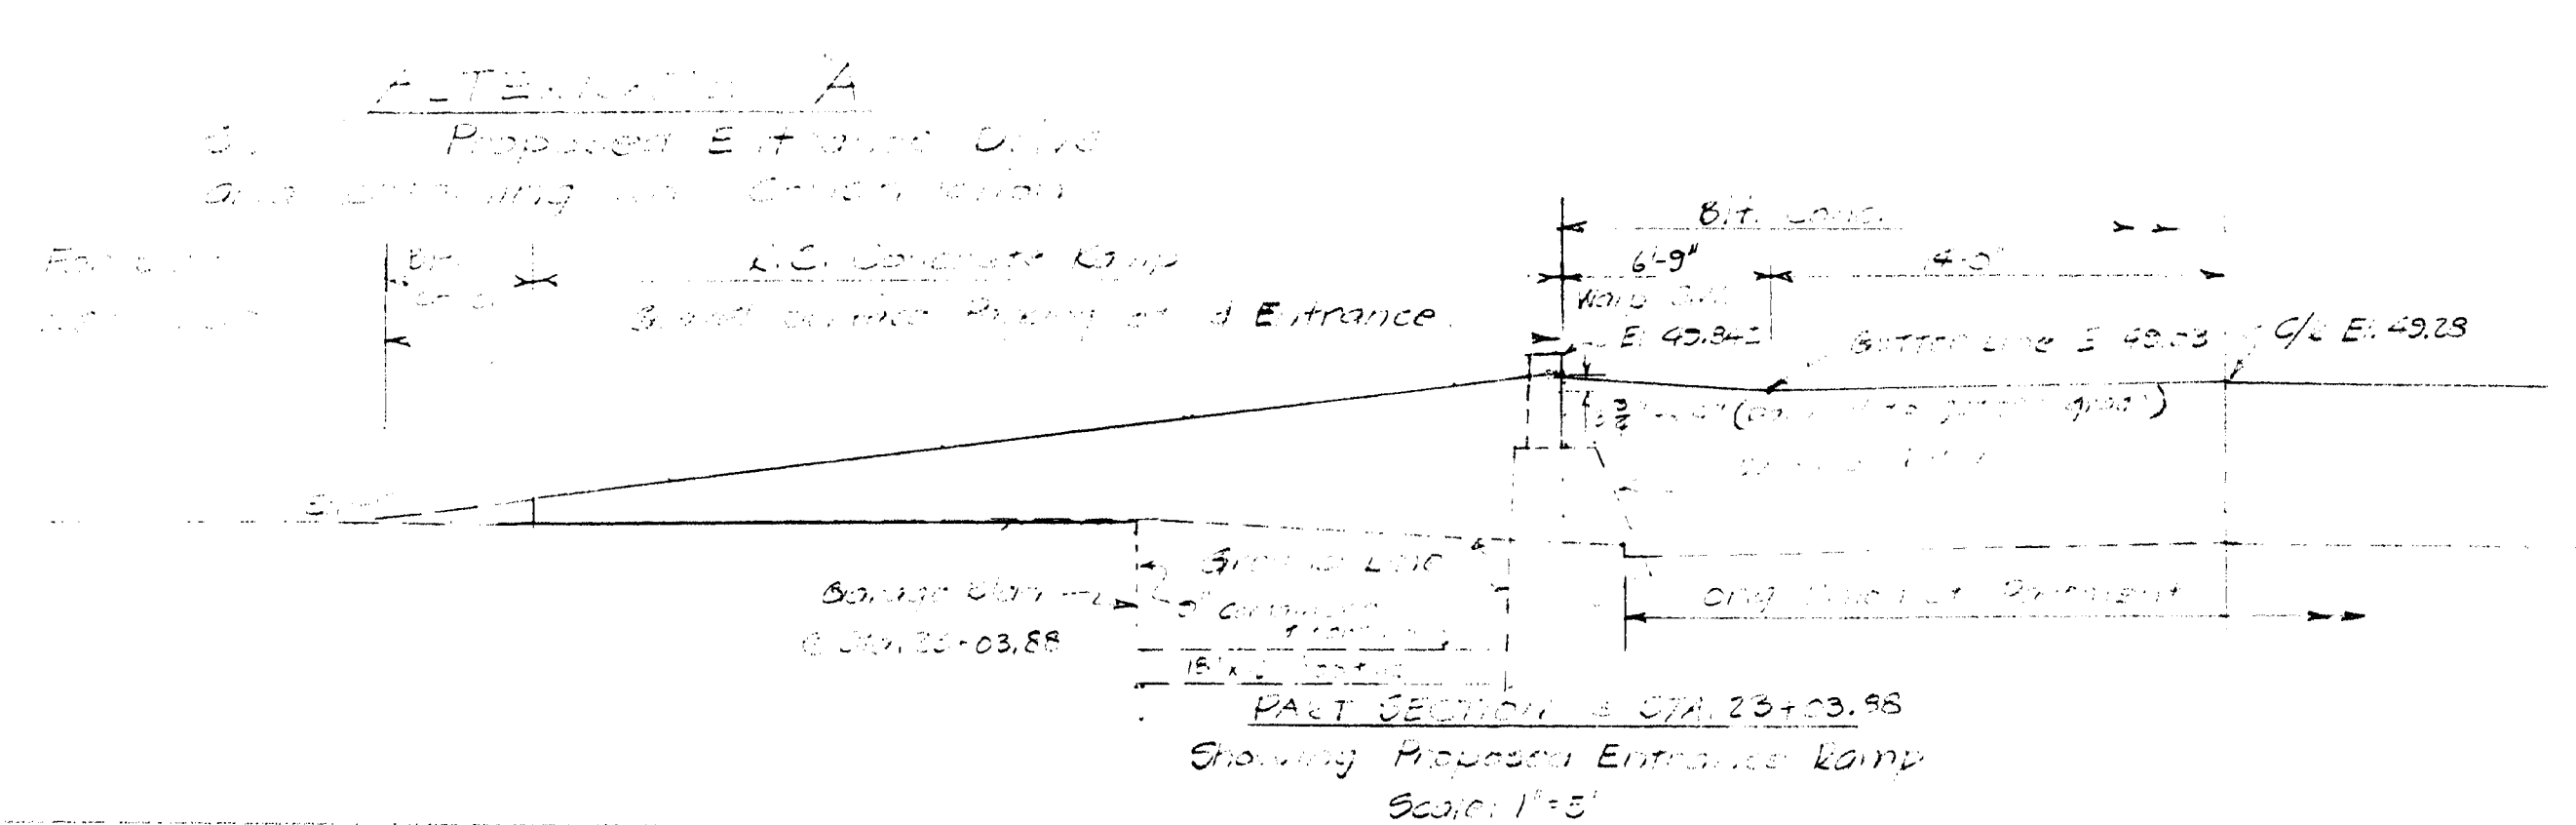


STATE OF MAINE  
 STATE HIGHWAY DEPARTMENT  
 BANGOR-PENOBSCOT BRIDGE  
 OVER PENOBSCOT RIVER  
 BANGOR, MAINE  
 SKETCHED - ADAMS STONE AREA  
 HAZARD ENGINEERING  
 BANGOR, MAINE  
 BANGOR FIELD OFFICE  
 DETAILED D.W. 7-20-53  
 SHEET 50  
 SCALE 1/4" = 1'-0"  
 SKETCH NO. JA


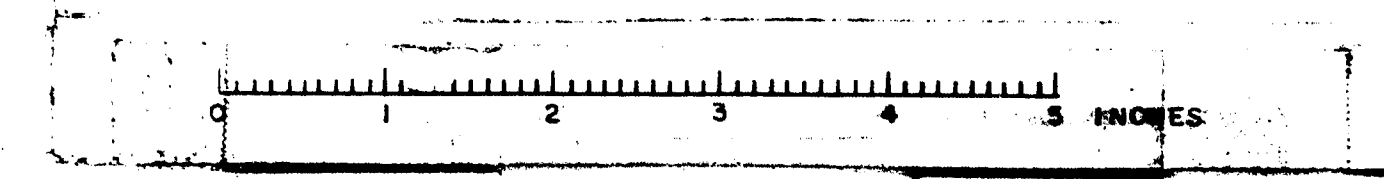






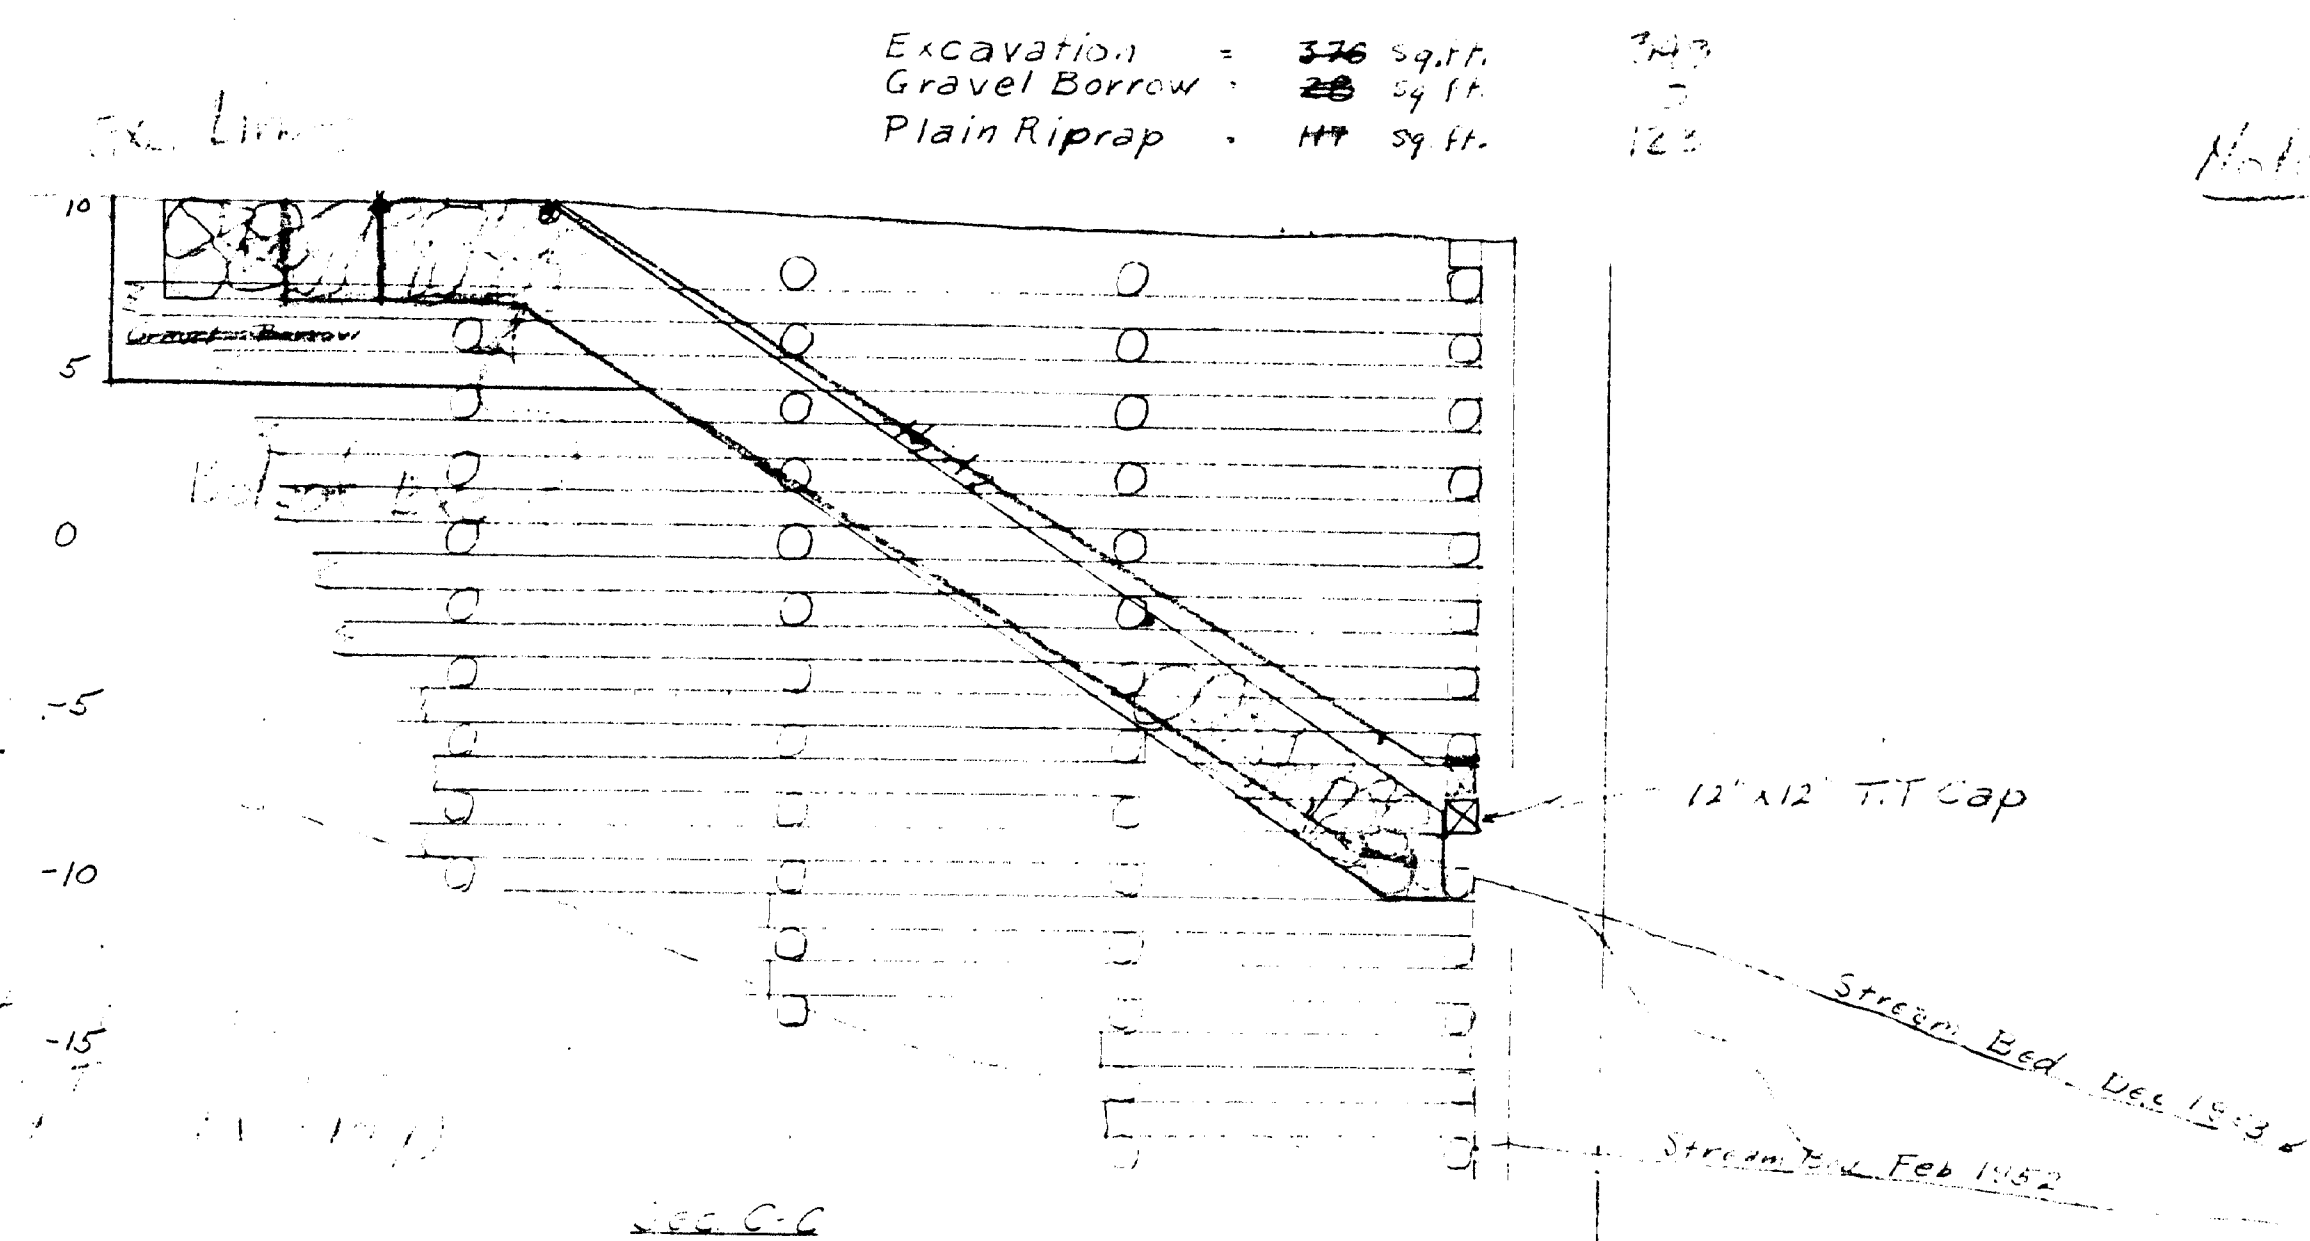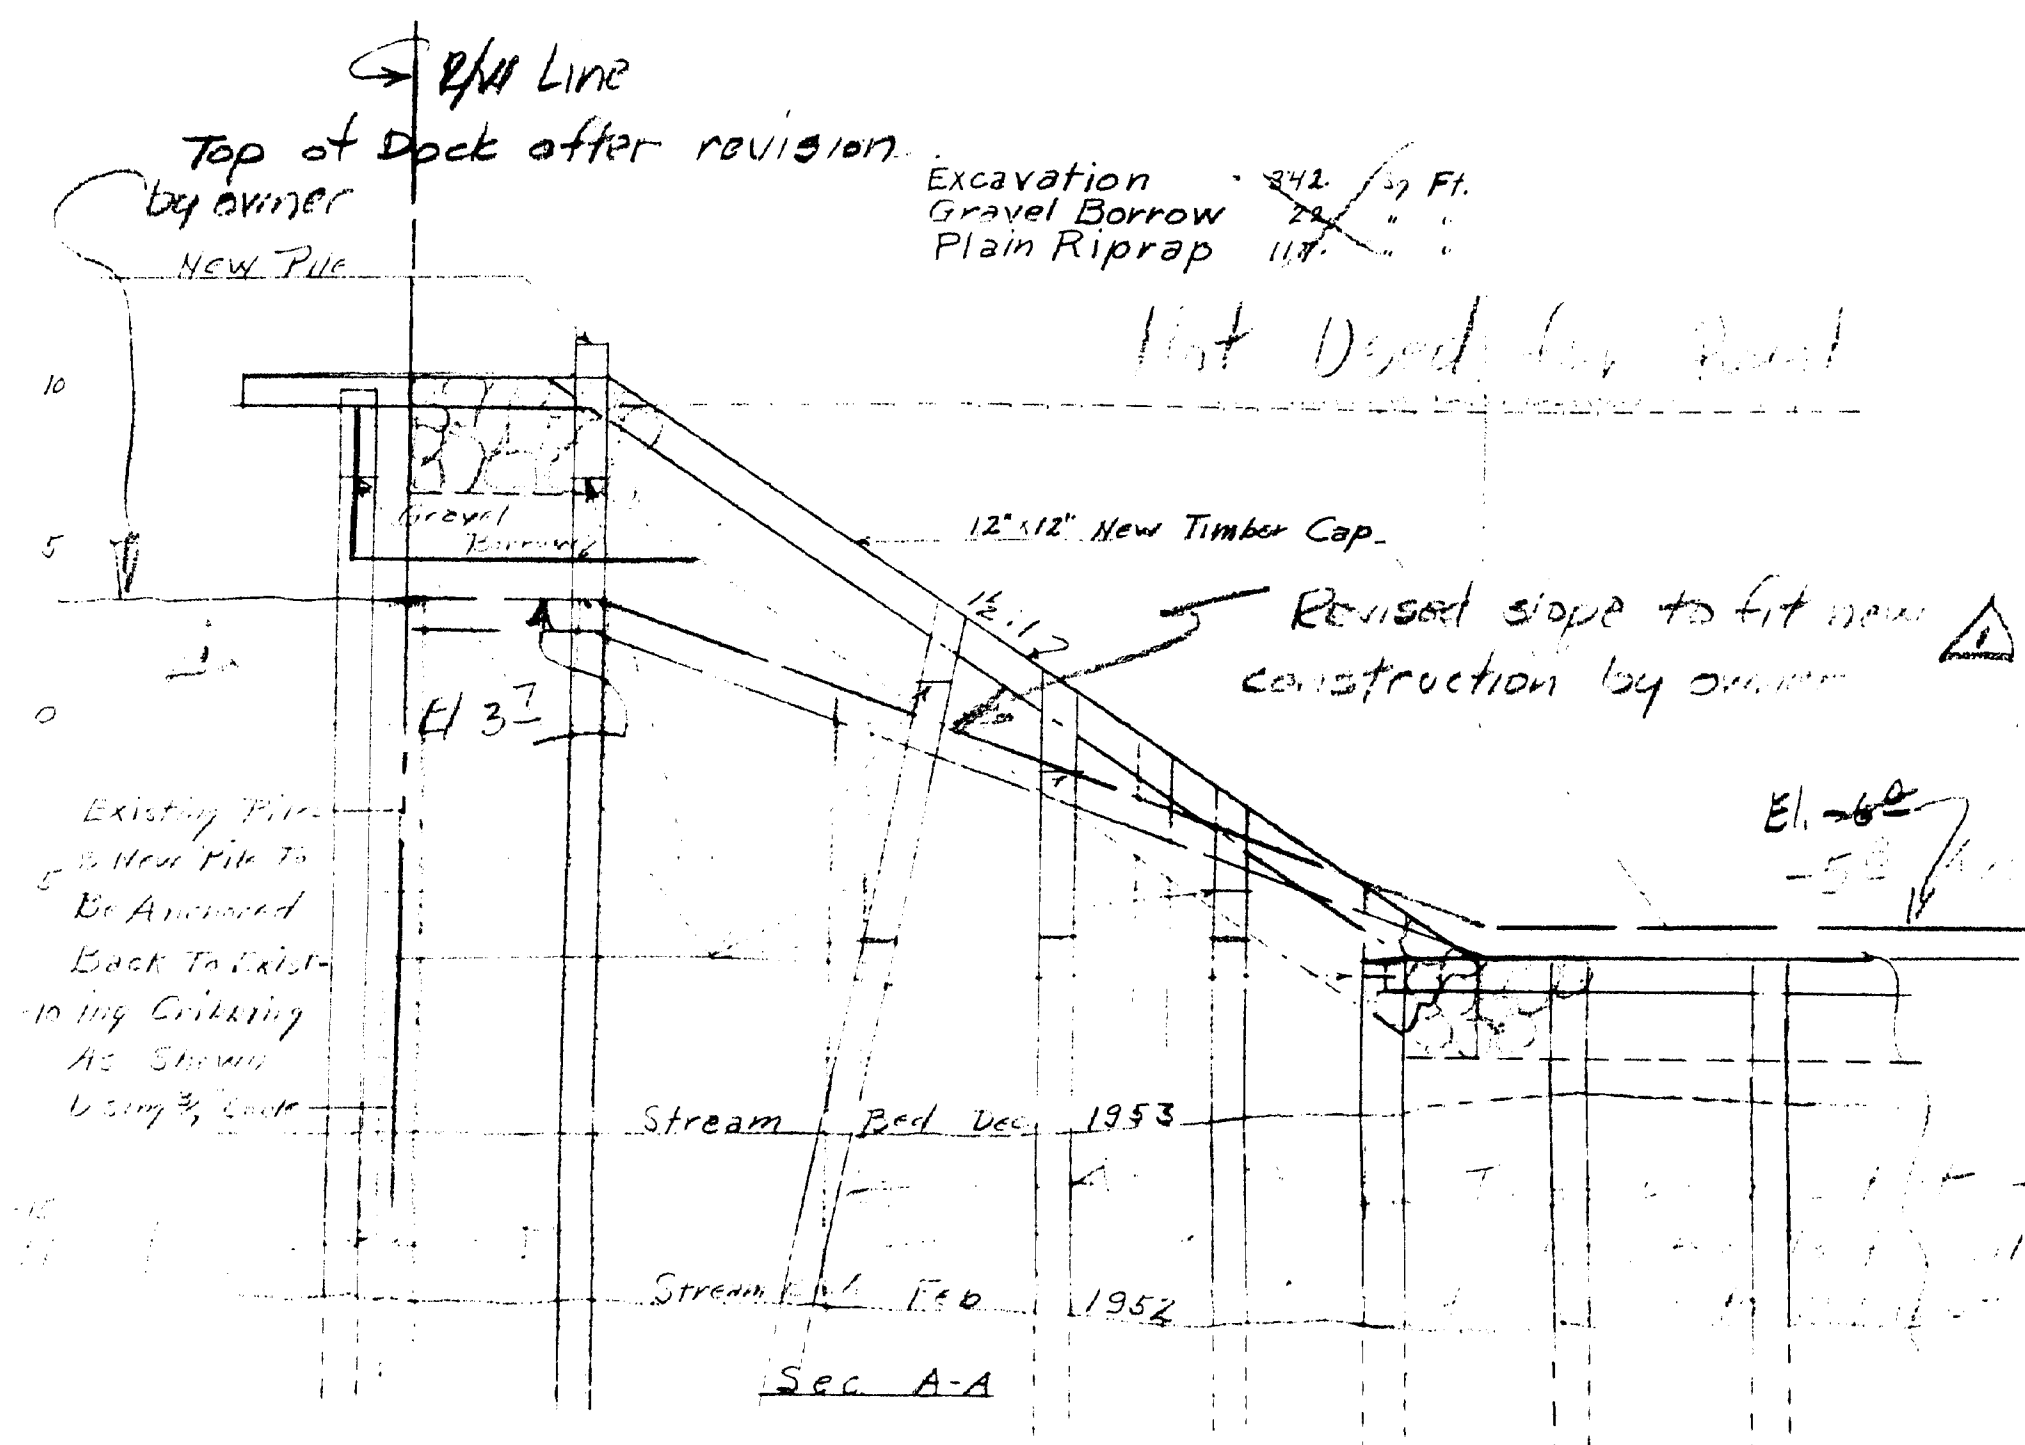

Note: Gravel Borrow not used under rip rap as shown on original contract because the 12" x 12" T.T. Cap was used out and for rip rap.

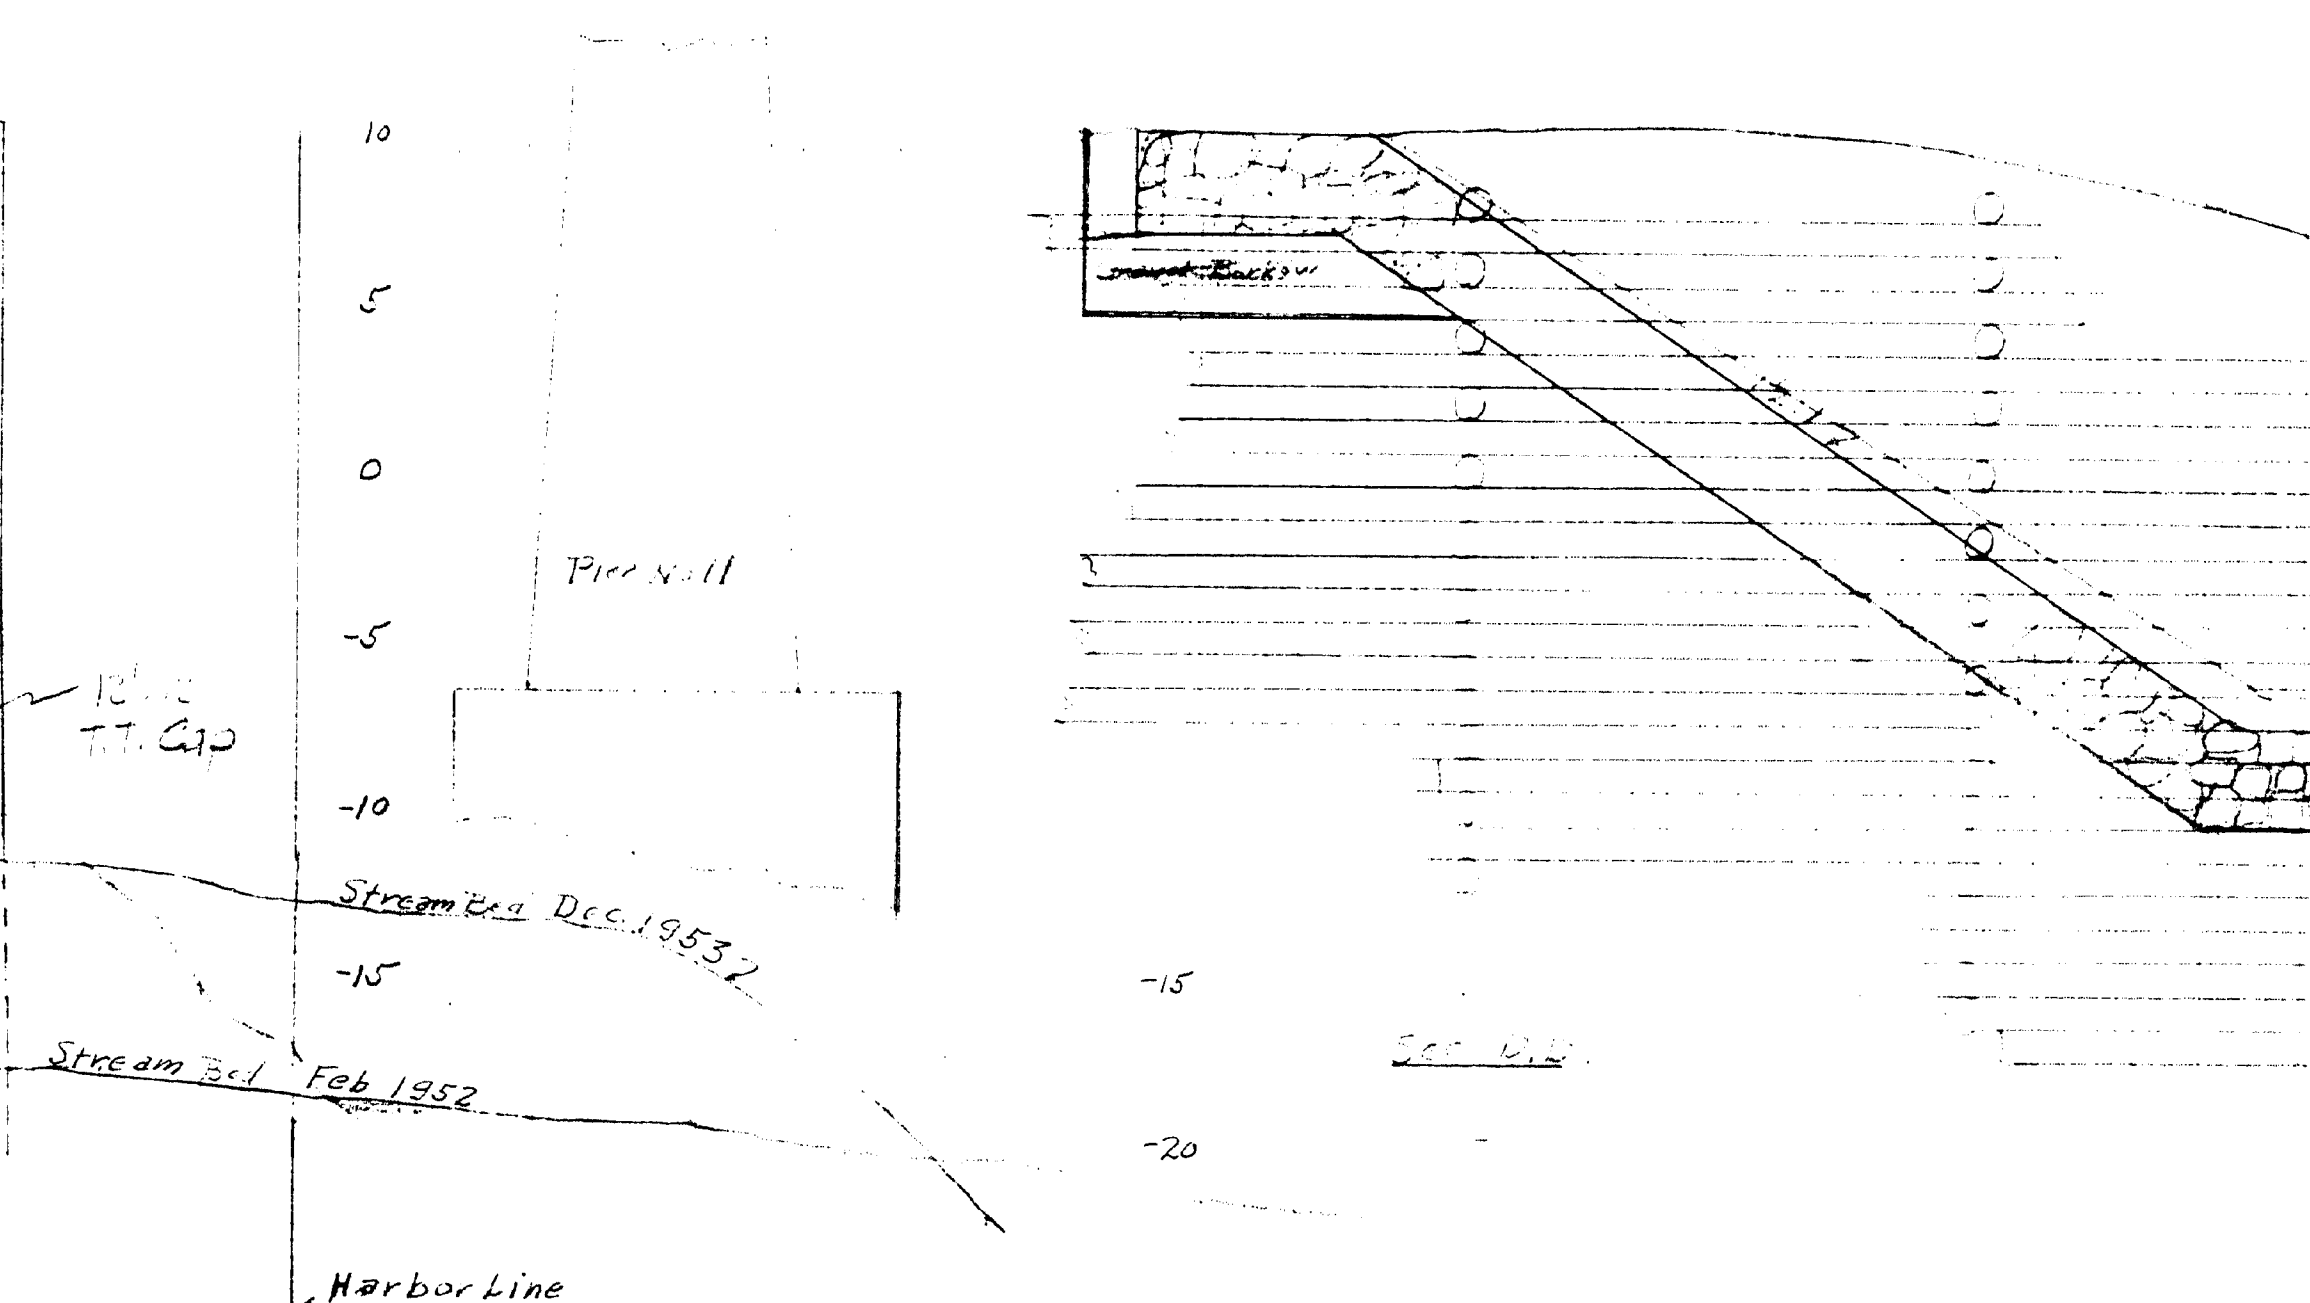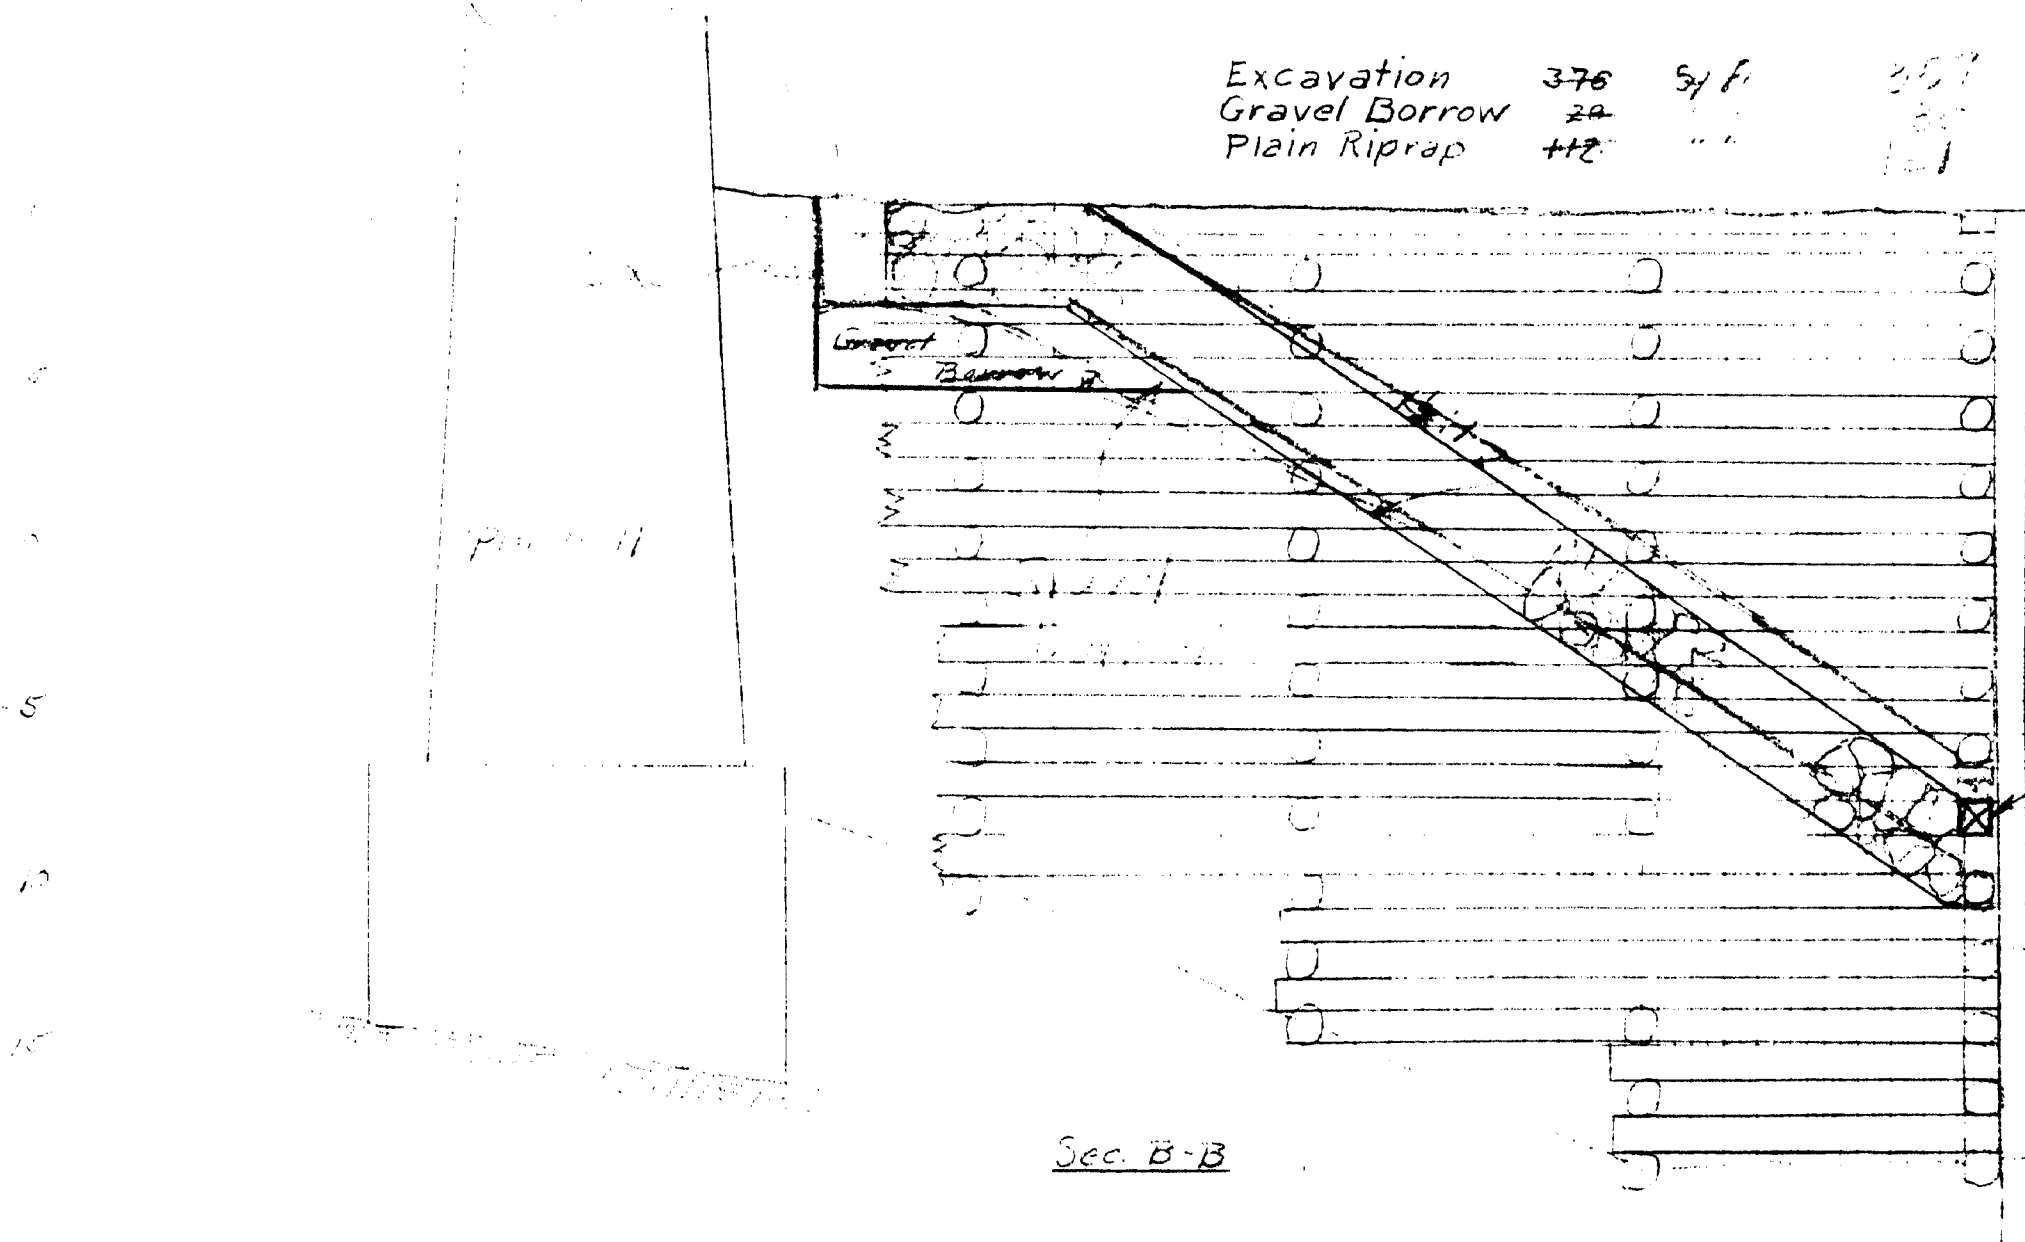

Excavation 376 sq. ft.  
Gravel Borrow 24  
Plain Riprap 117

12"x12" T.T. Cap

Stream Bed Dec. 1953

Stream Bed Feb. 1952

Harbor Line

Sec. E-E





Revised to fit owners revision of 7-6-55 dock downstream.

As Built Revisions & Quantities  
ZEN 3-12-57

STATE OF MAINE  
STATE HIGHWAY COMMISSION  
BANGOR-BREWER BRIDGE  
OVER PENOBSCOT RIVER  
BANGOR, MAINE  
CROSS-SECTIONS  
BANGOR SHORE RIPPAP  
HARRINGTON AND COMPANY  
Consulting Engineers  
Room 6, Bangor, Maine  
SCALE: 1" = 5'-0"  
VERTICAL  
SHEET NO. A-2


62-85

0 1 2 3 4 5 FEET

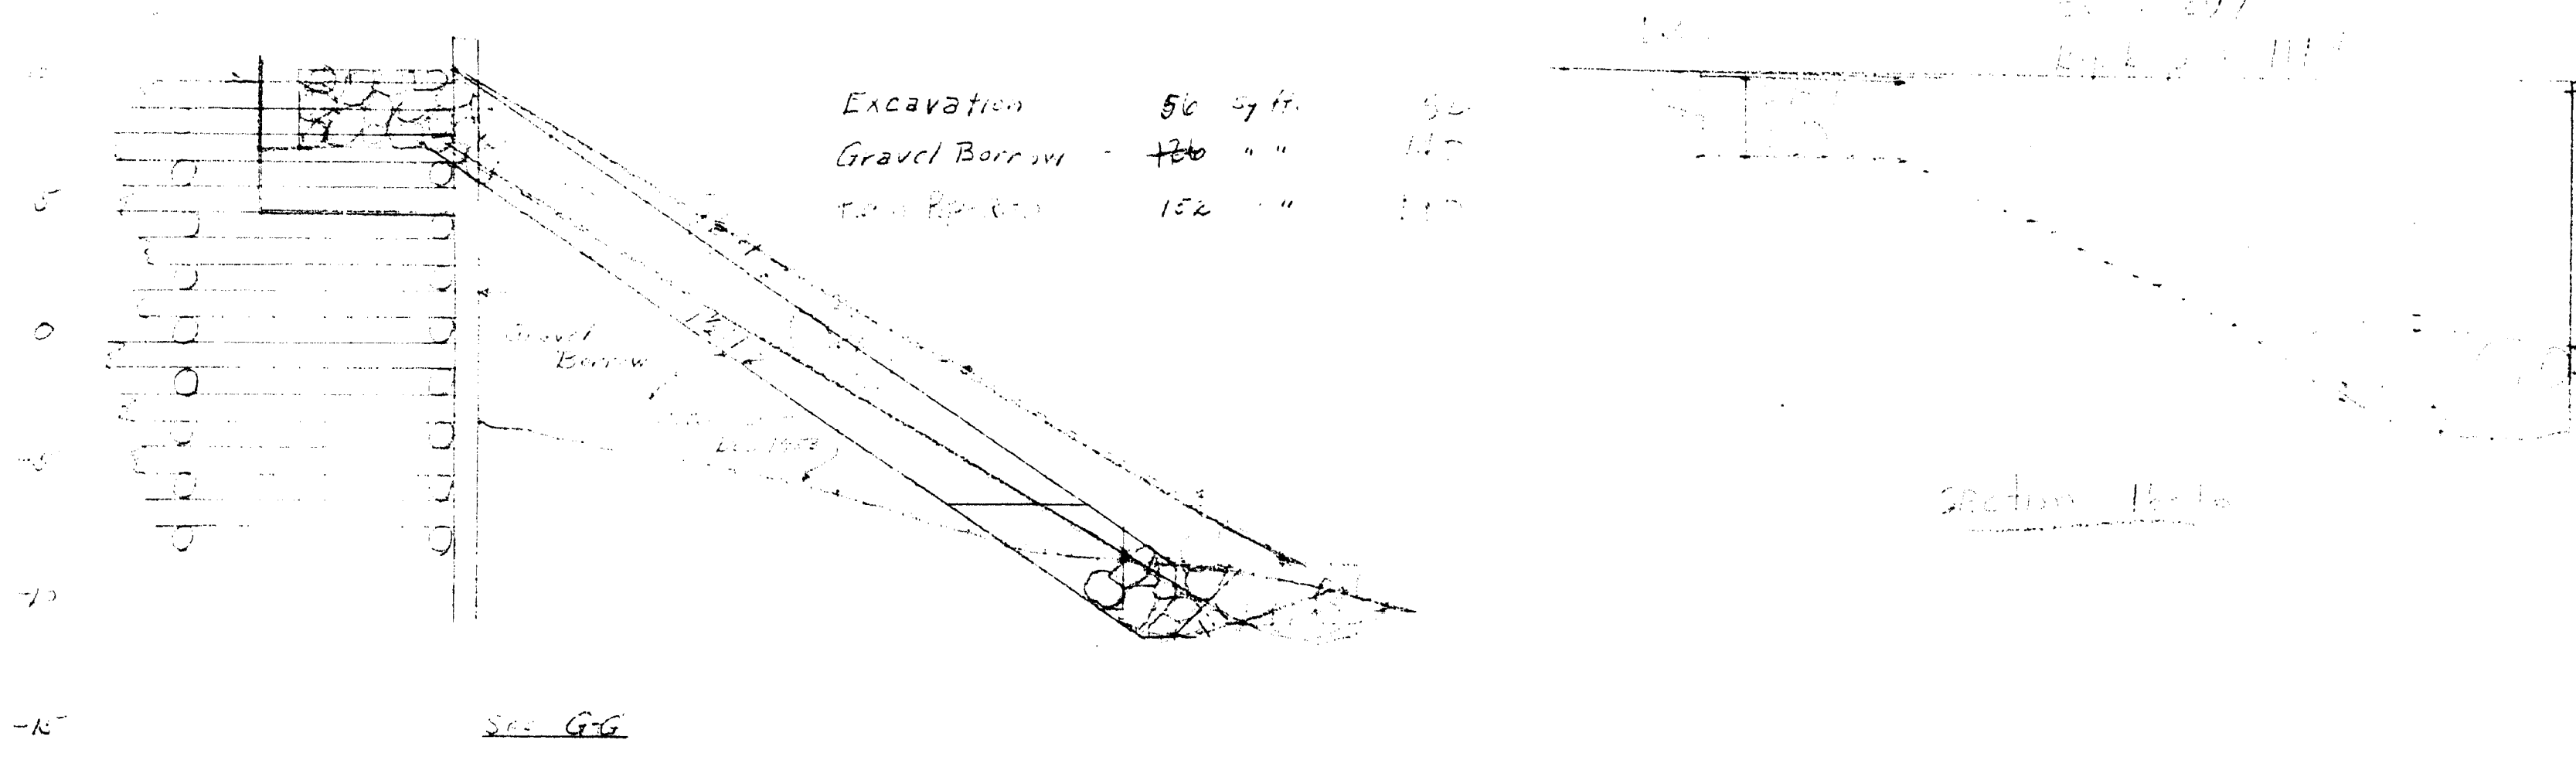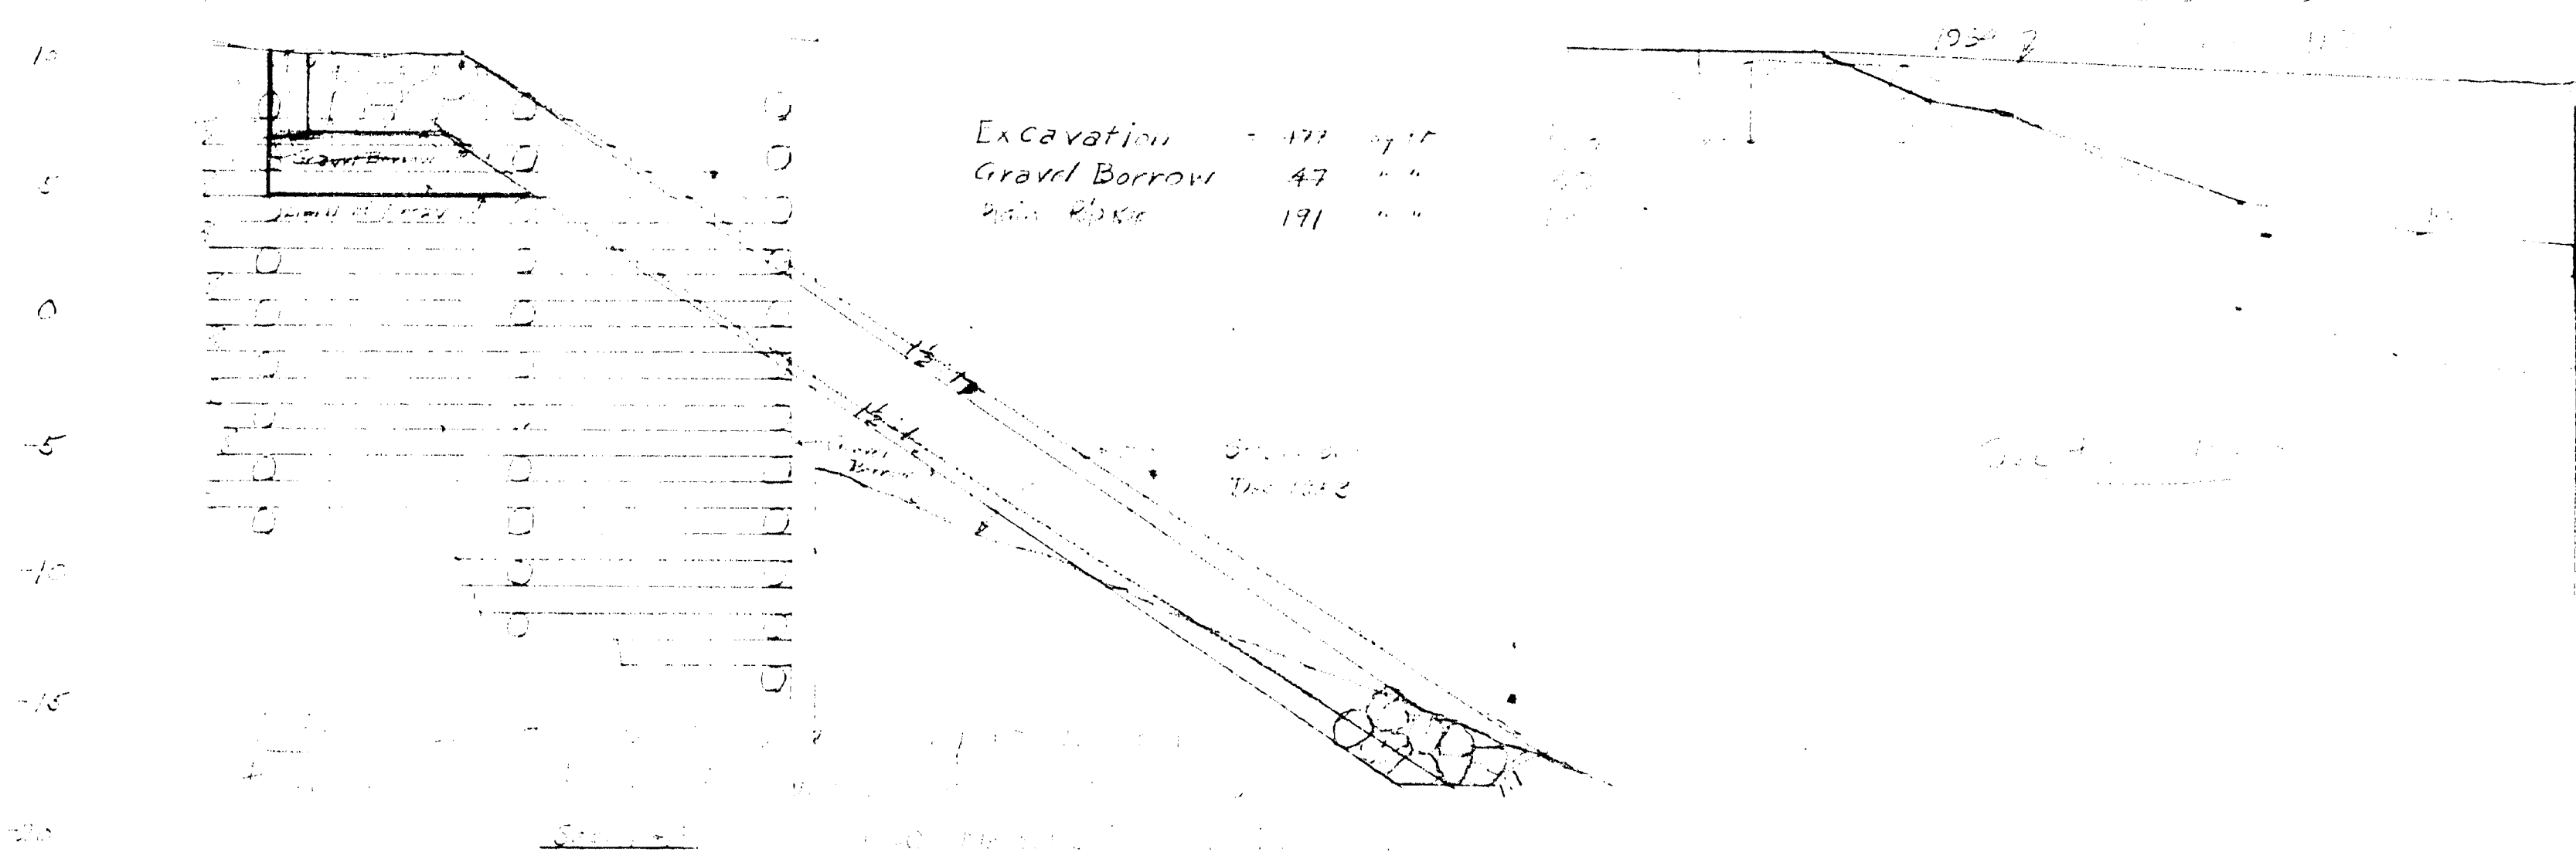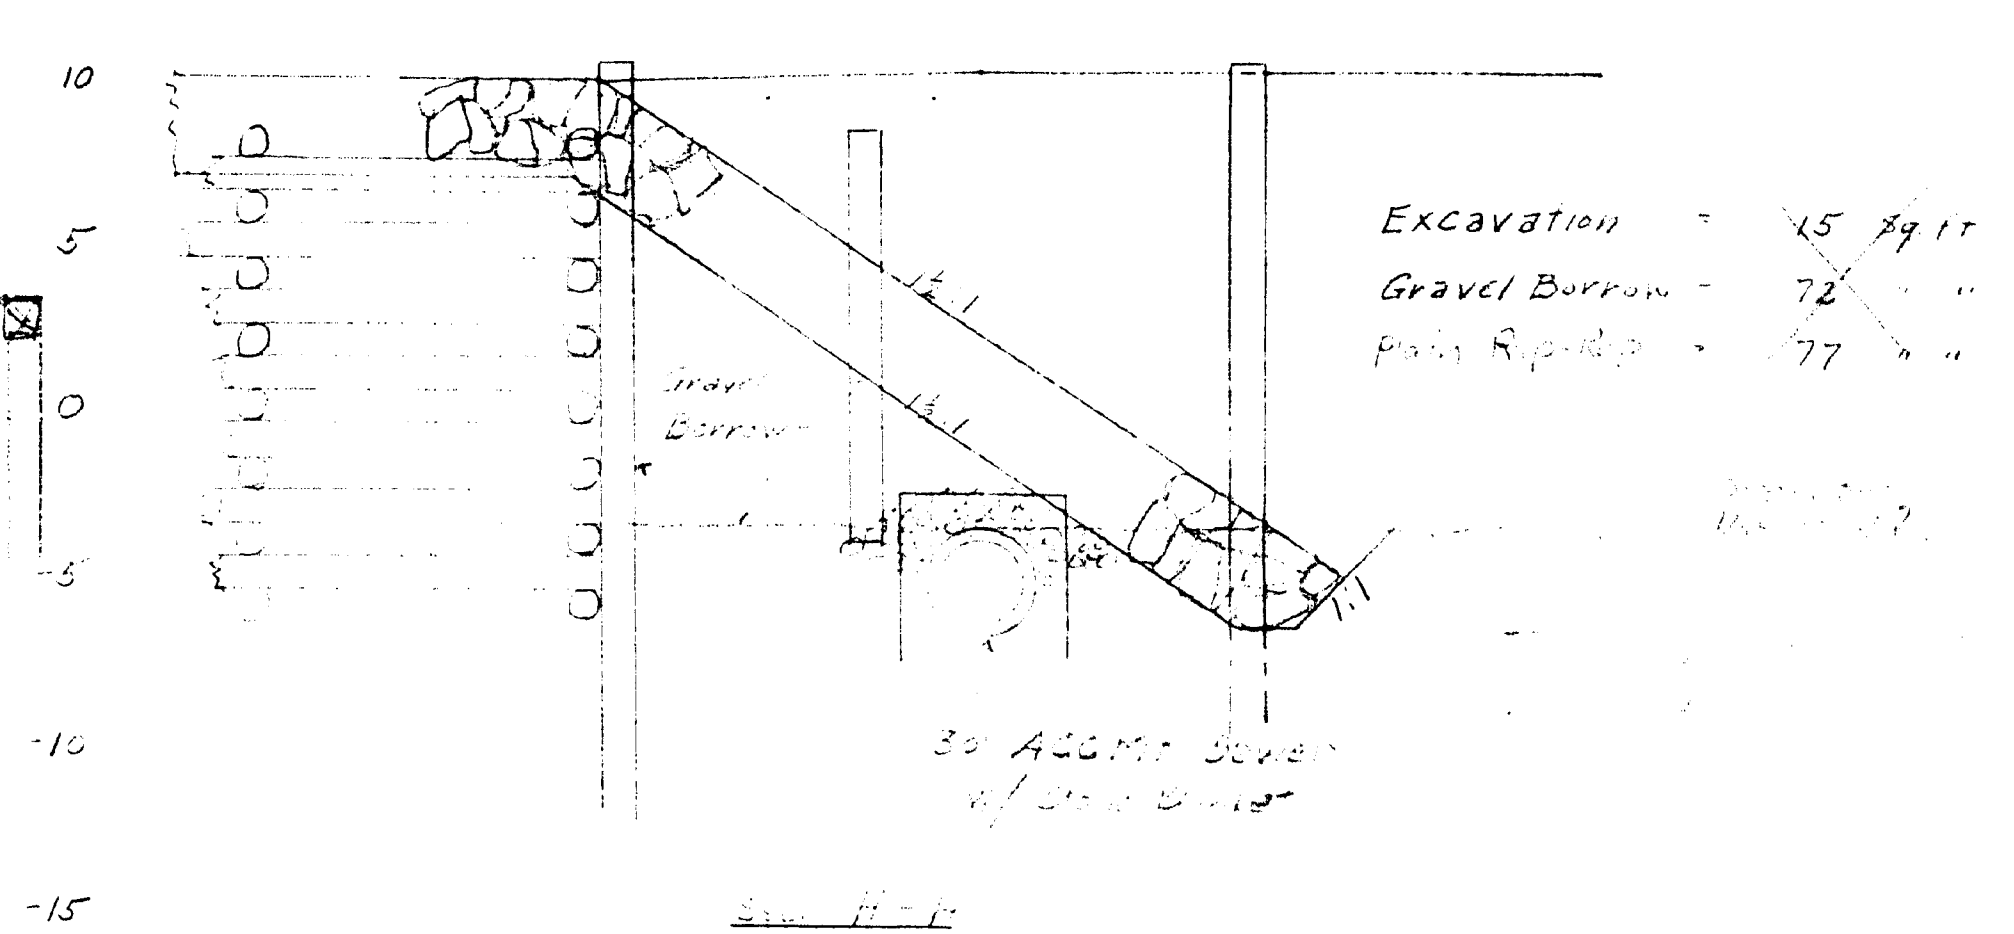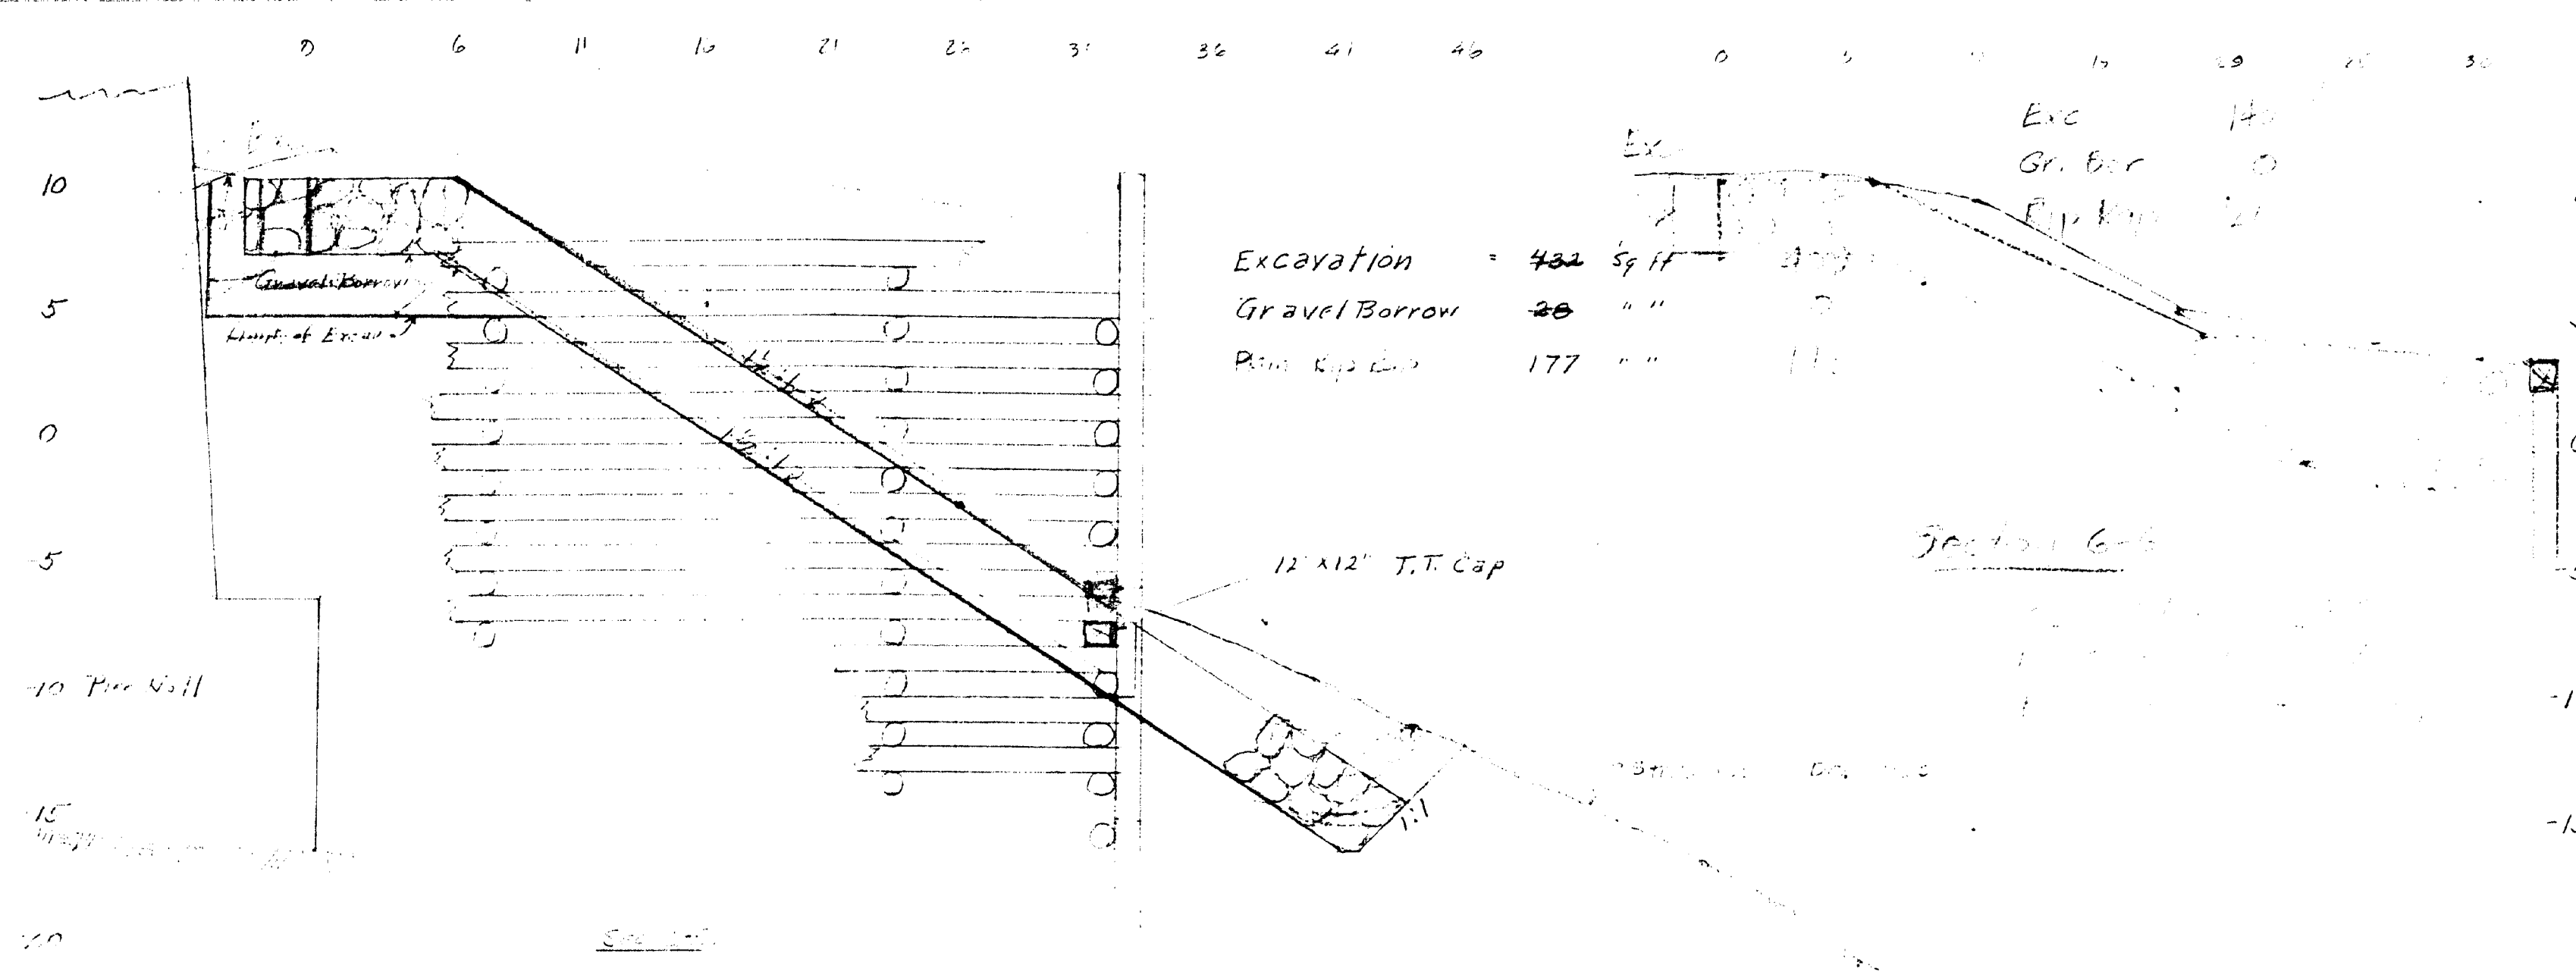


STATE OF MAINE  
STATE HIGHWAY COMMISSION  
BANGOR-BREWSTER BRIDGE  
OVER PENOBSCOT RIVER  
BANGOR MAINE  
CROSS-SECTIONS  
BANGOR CHORD RIPRAP  
HARRINGTON AND CORTELYOU  
Consulting Engineers  
Room 6, Bangor House  
Bangor, Maine  
DETAILED GFW 2257 SCALE: 1" = 5'-0"  
T.M.S. VERT. & HOR.  
CHECKED SHEET NO A-3

As Built Condition 1 and 2  
ZBM 8-15-05

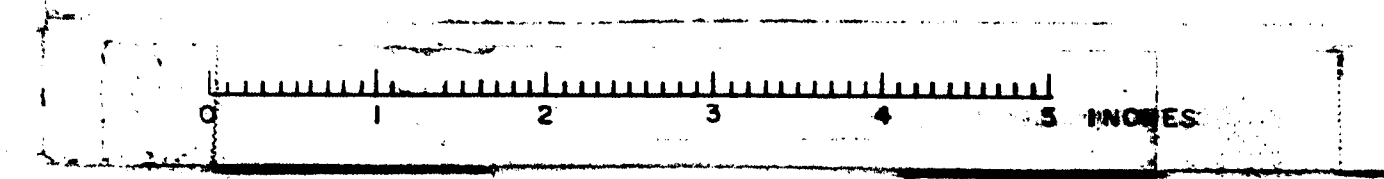


62-86  
3




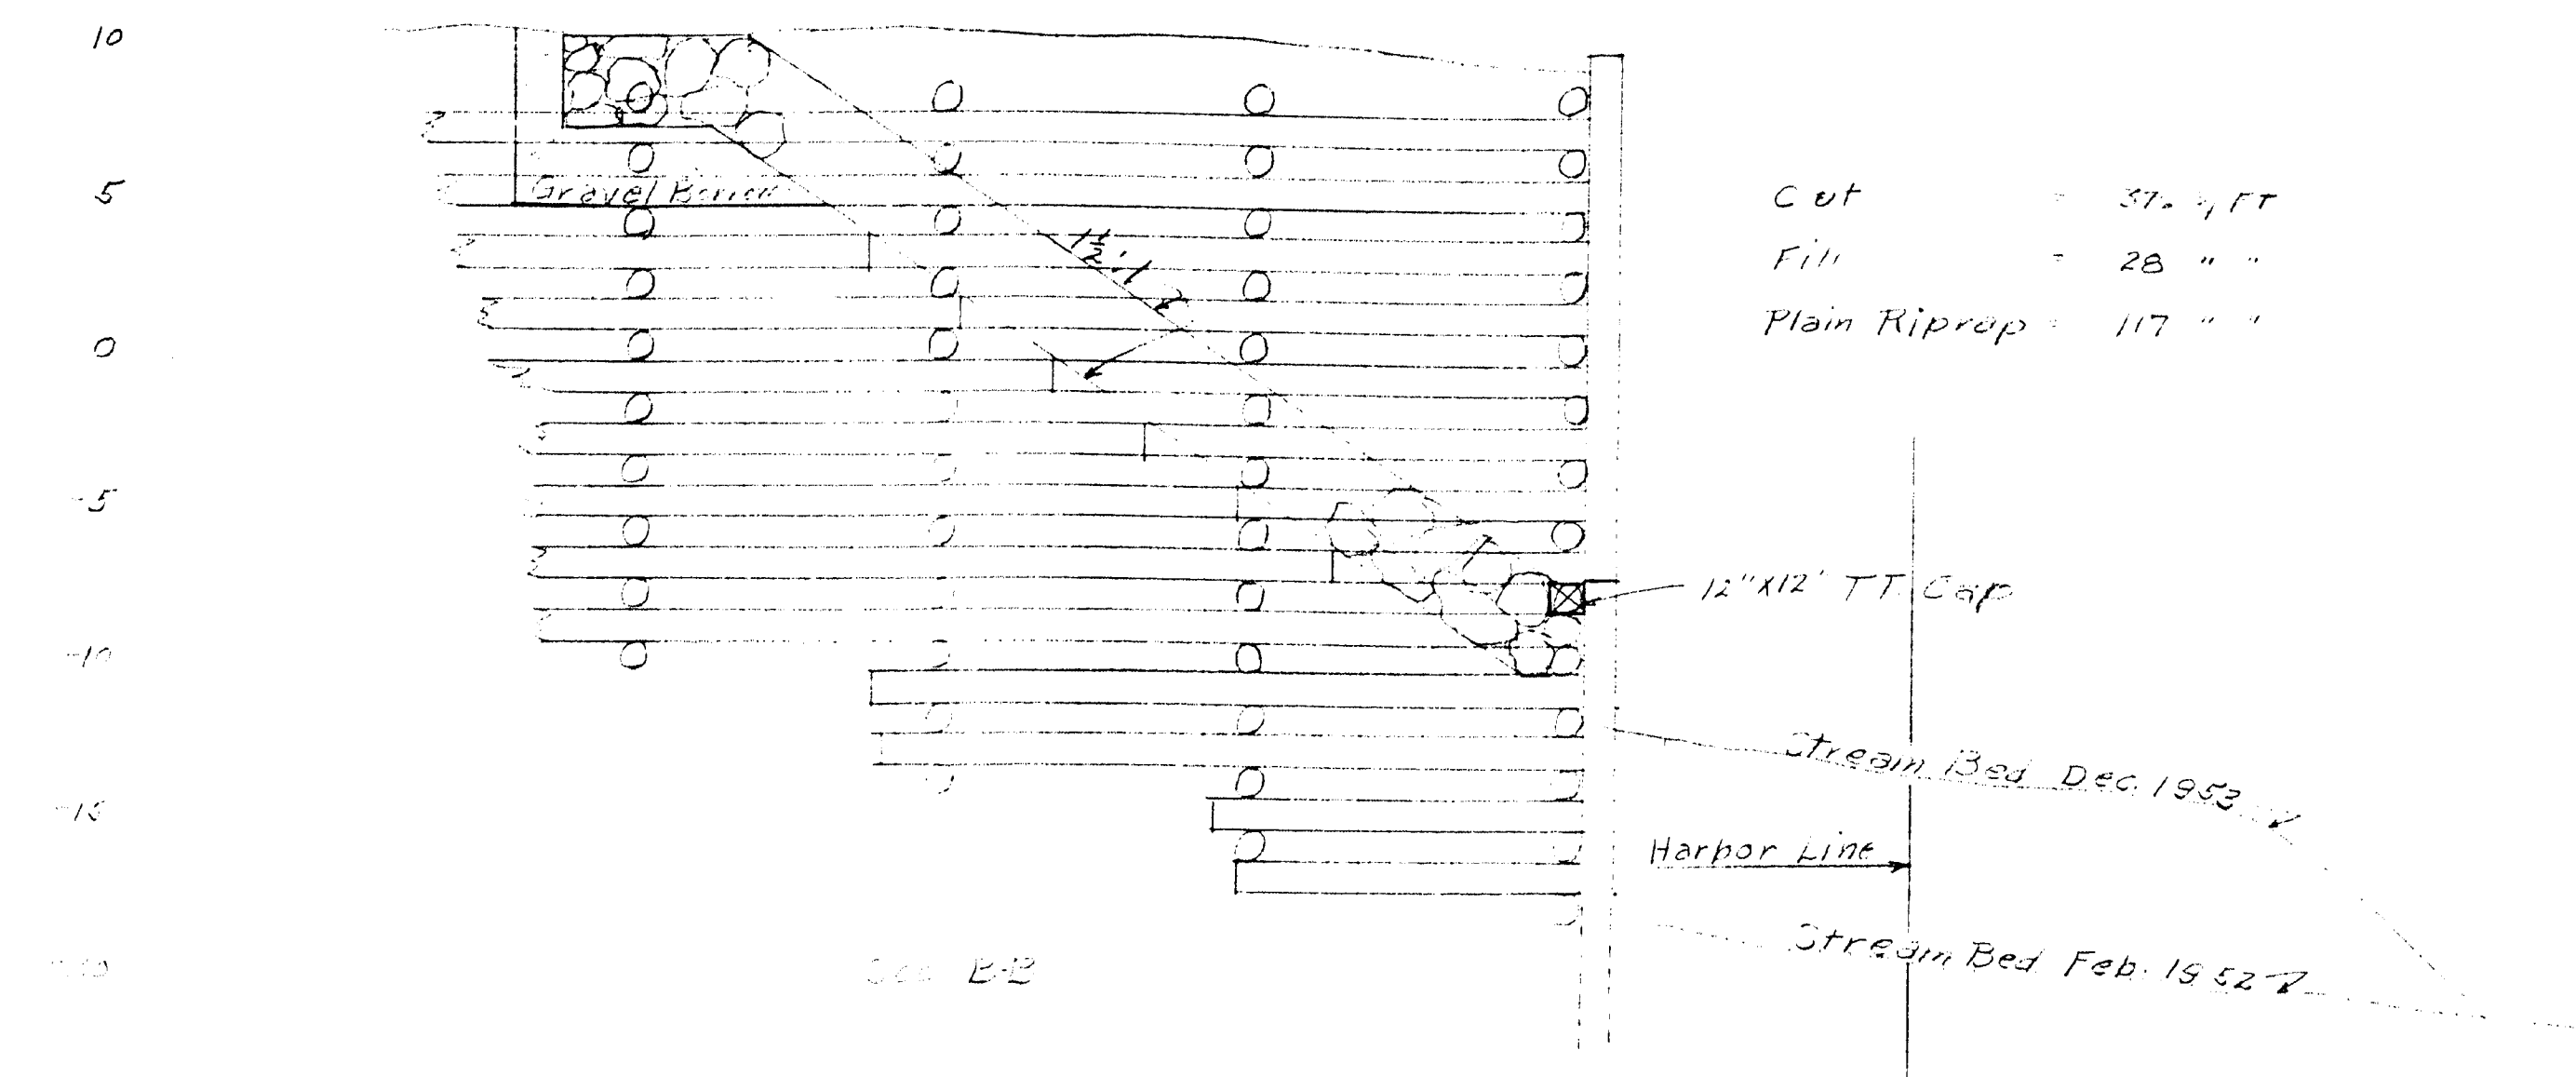


Cut = 37.4 FT  
 Fill = 28 " "  
 Plain Riprap = 117 " "

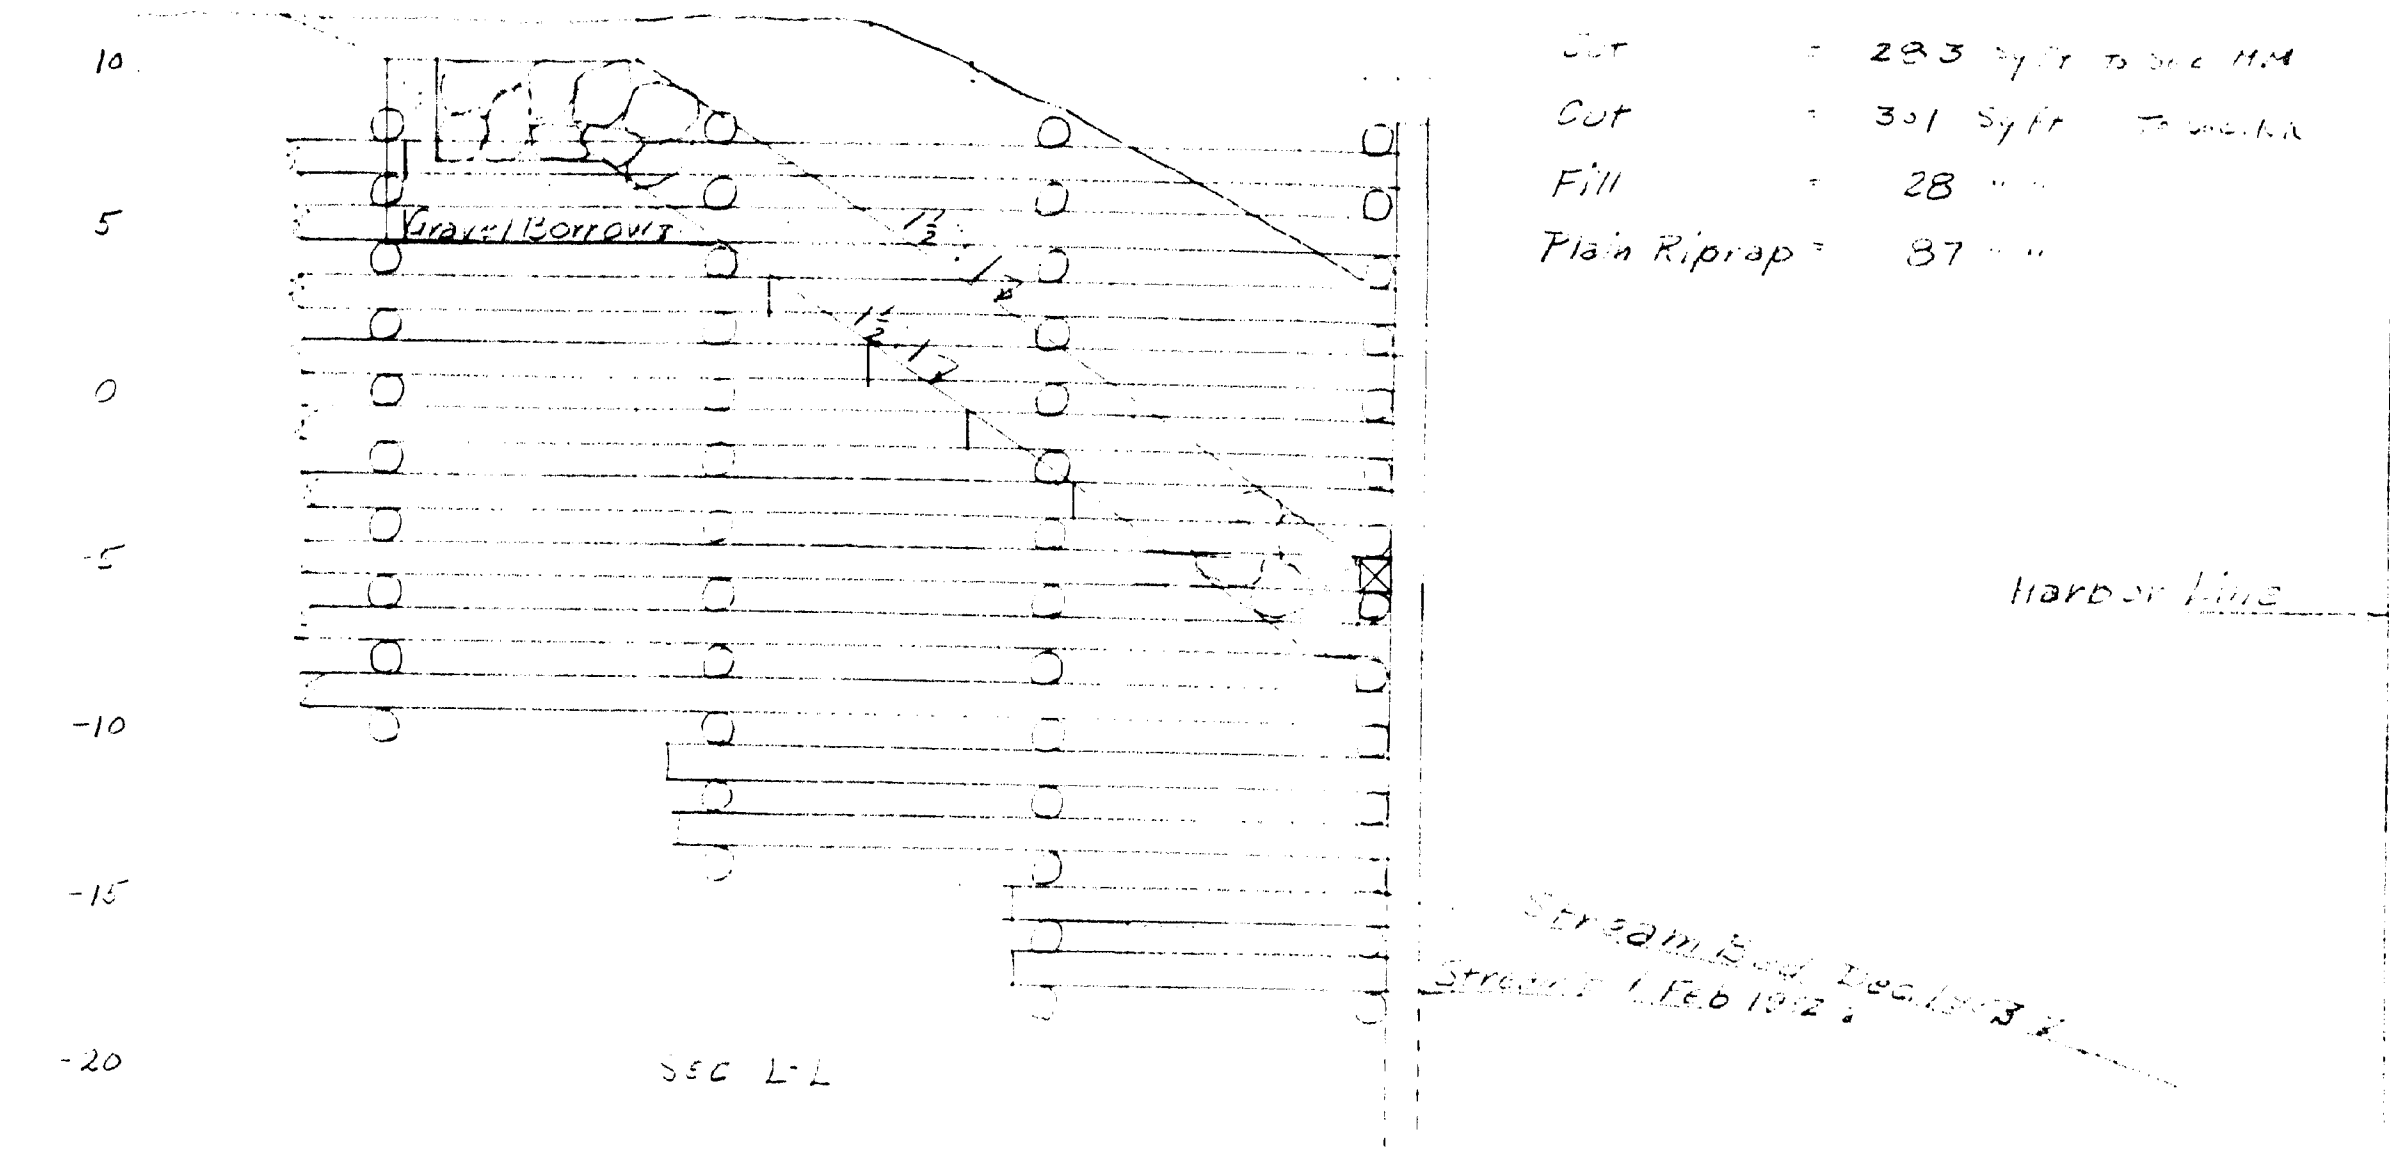


Cut = 28.3 Sg ft to Dec 1953  
 Cut = 30.1 Sg ft to Feb 1952  
 Fill = 28 " "  
 Plain Riprap = 37 " "

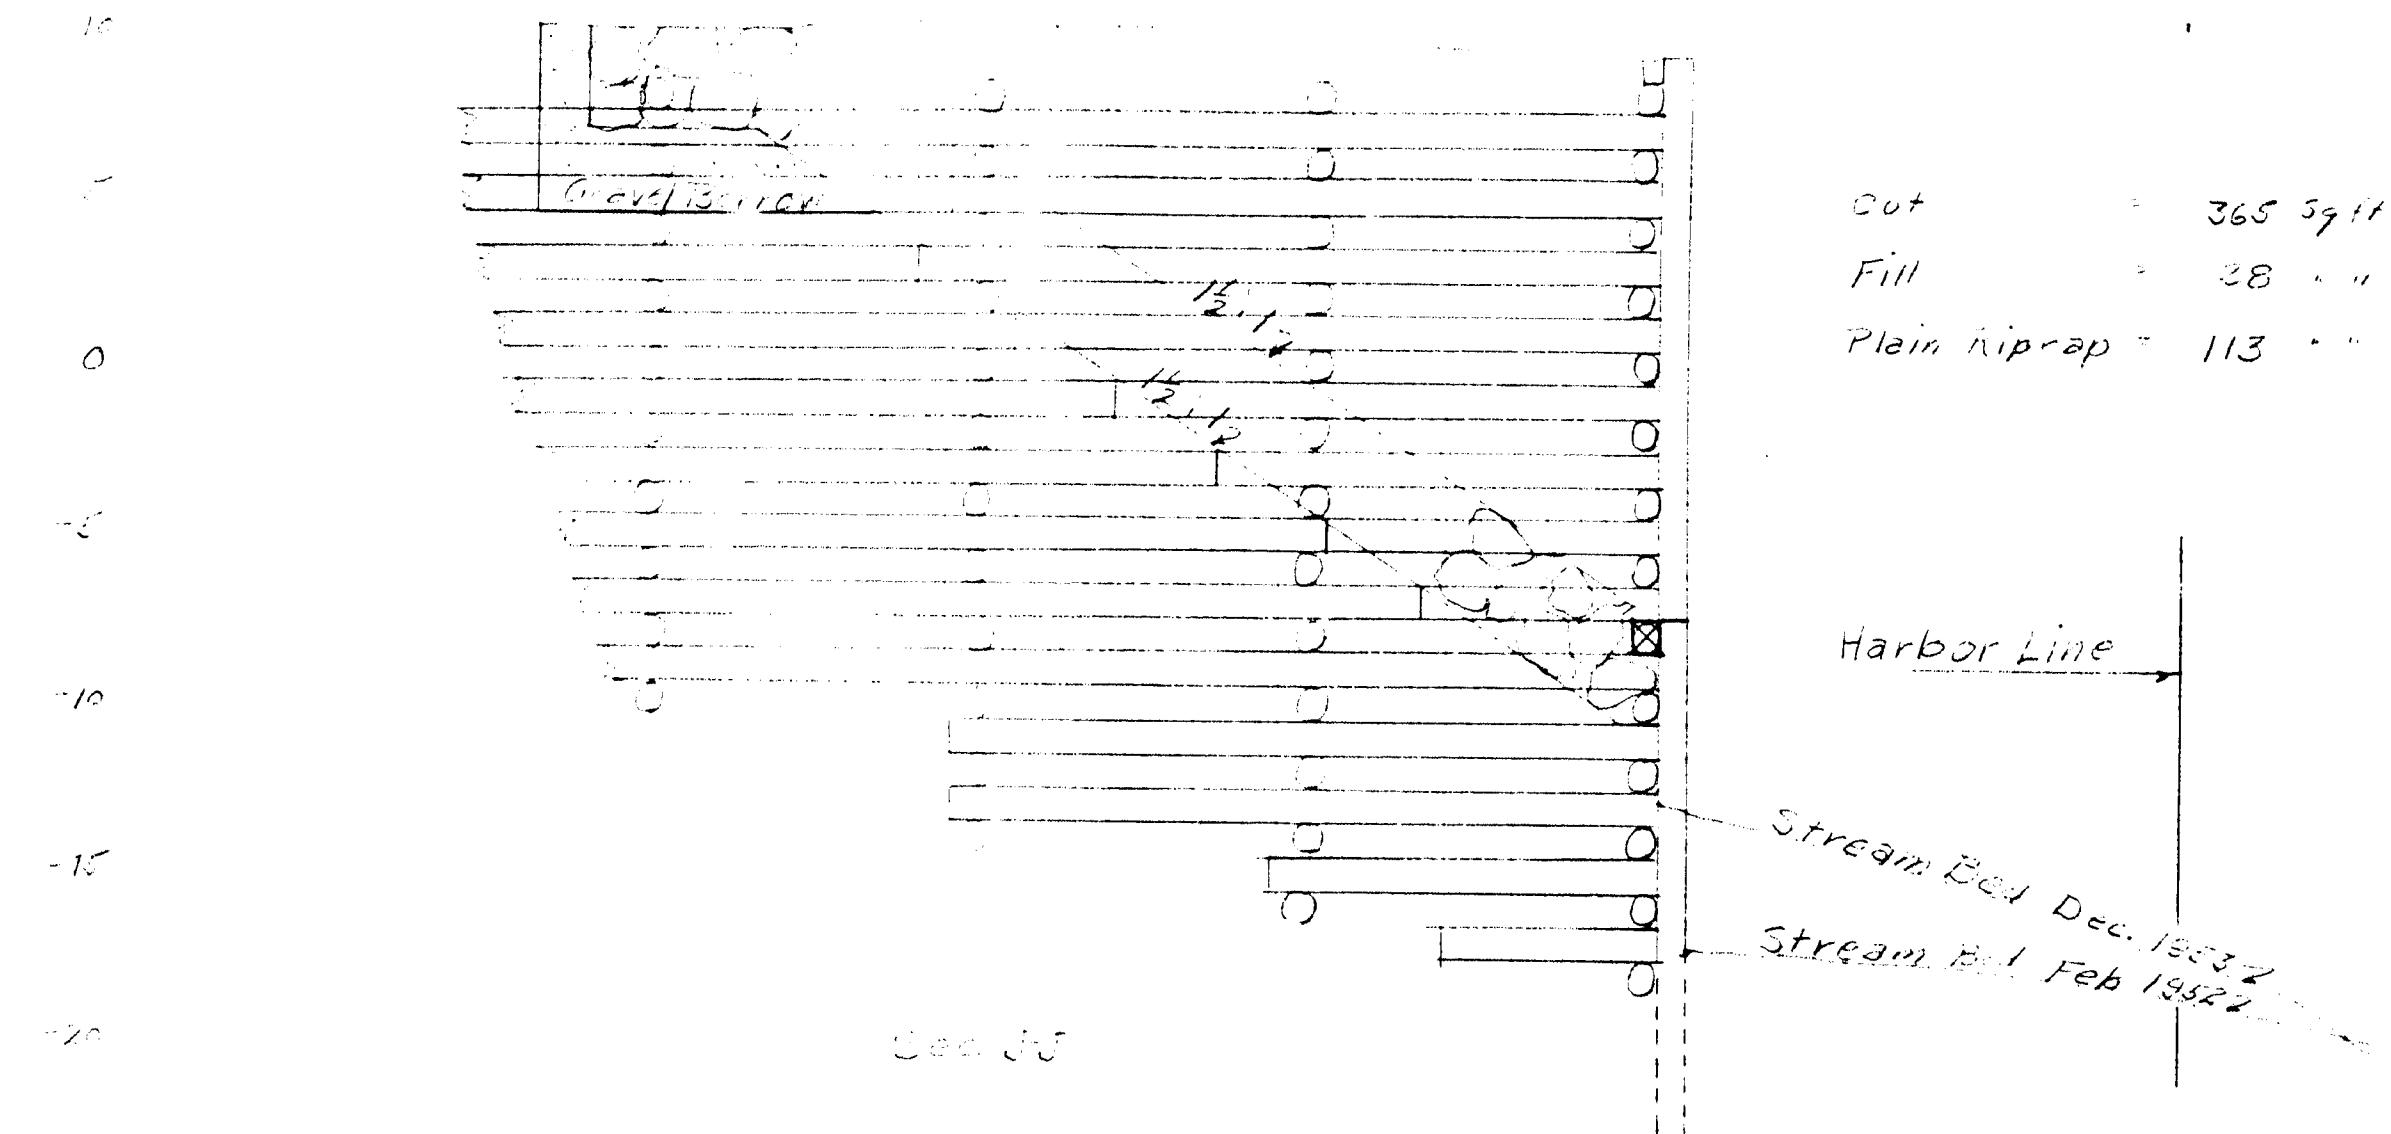


Cut = 36.5 Sg ft  
 Fill = 28 " "  
 Plain Riprap = 113 " "

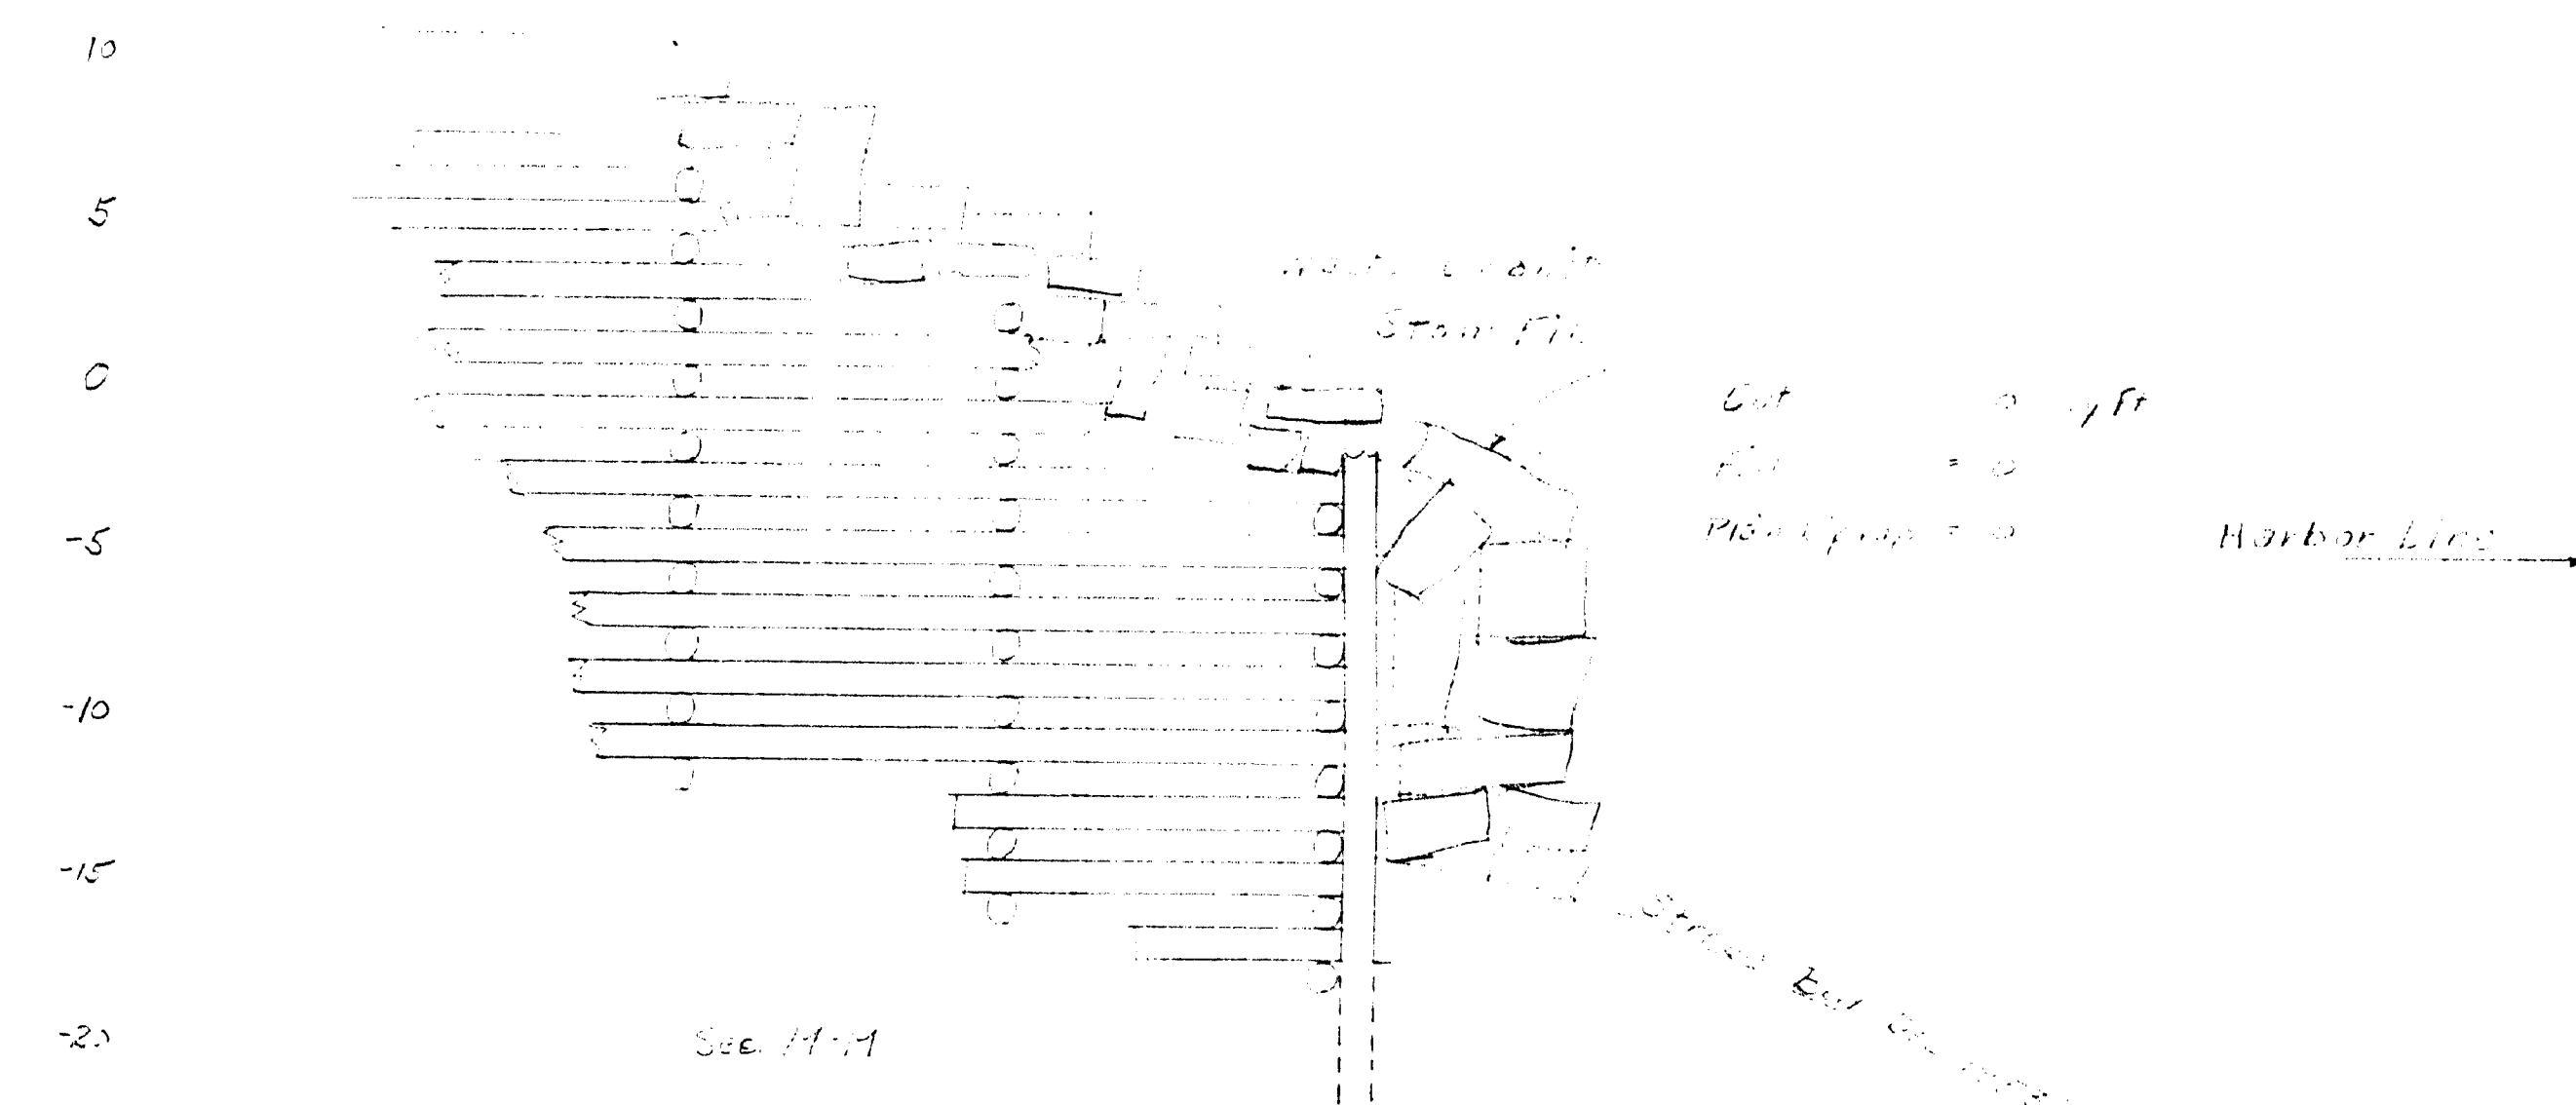

Cut = 0 Sg ft  
 Fill = 0 " "  
 Plain Riprap = 0 " "

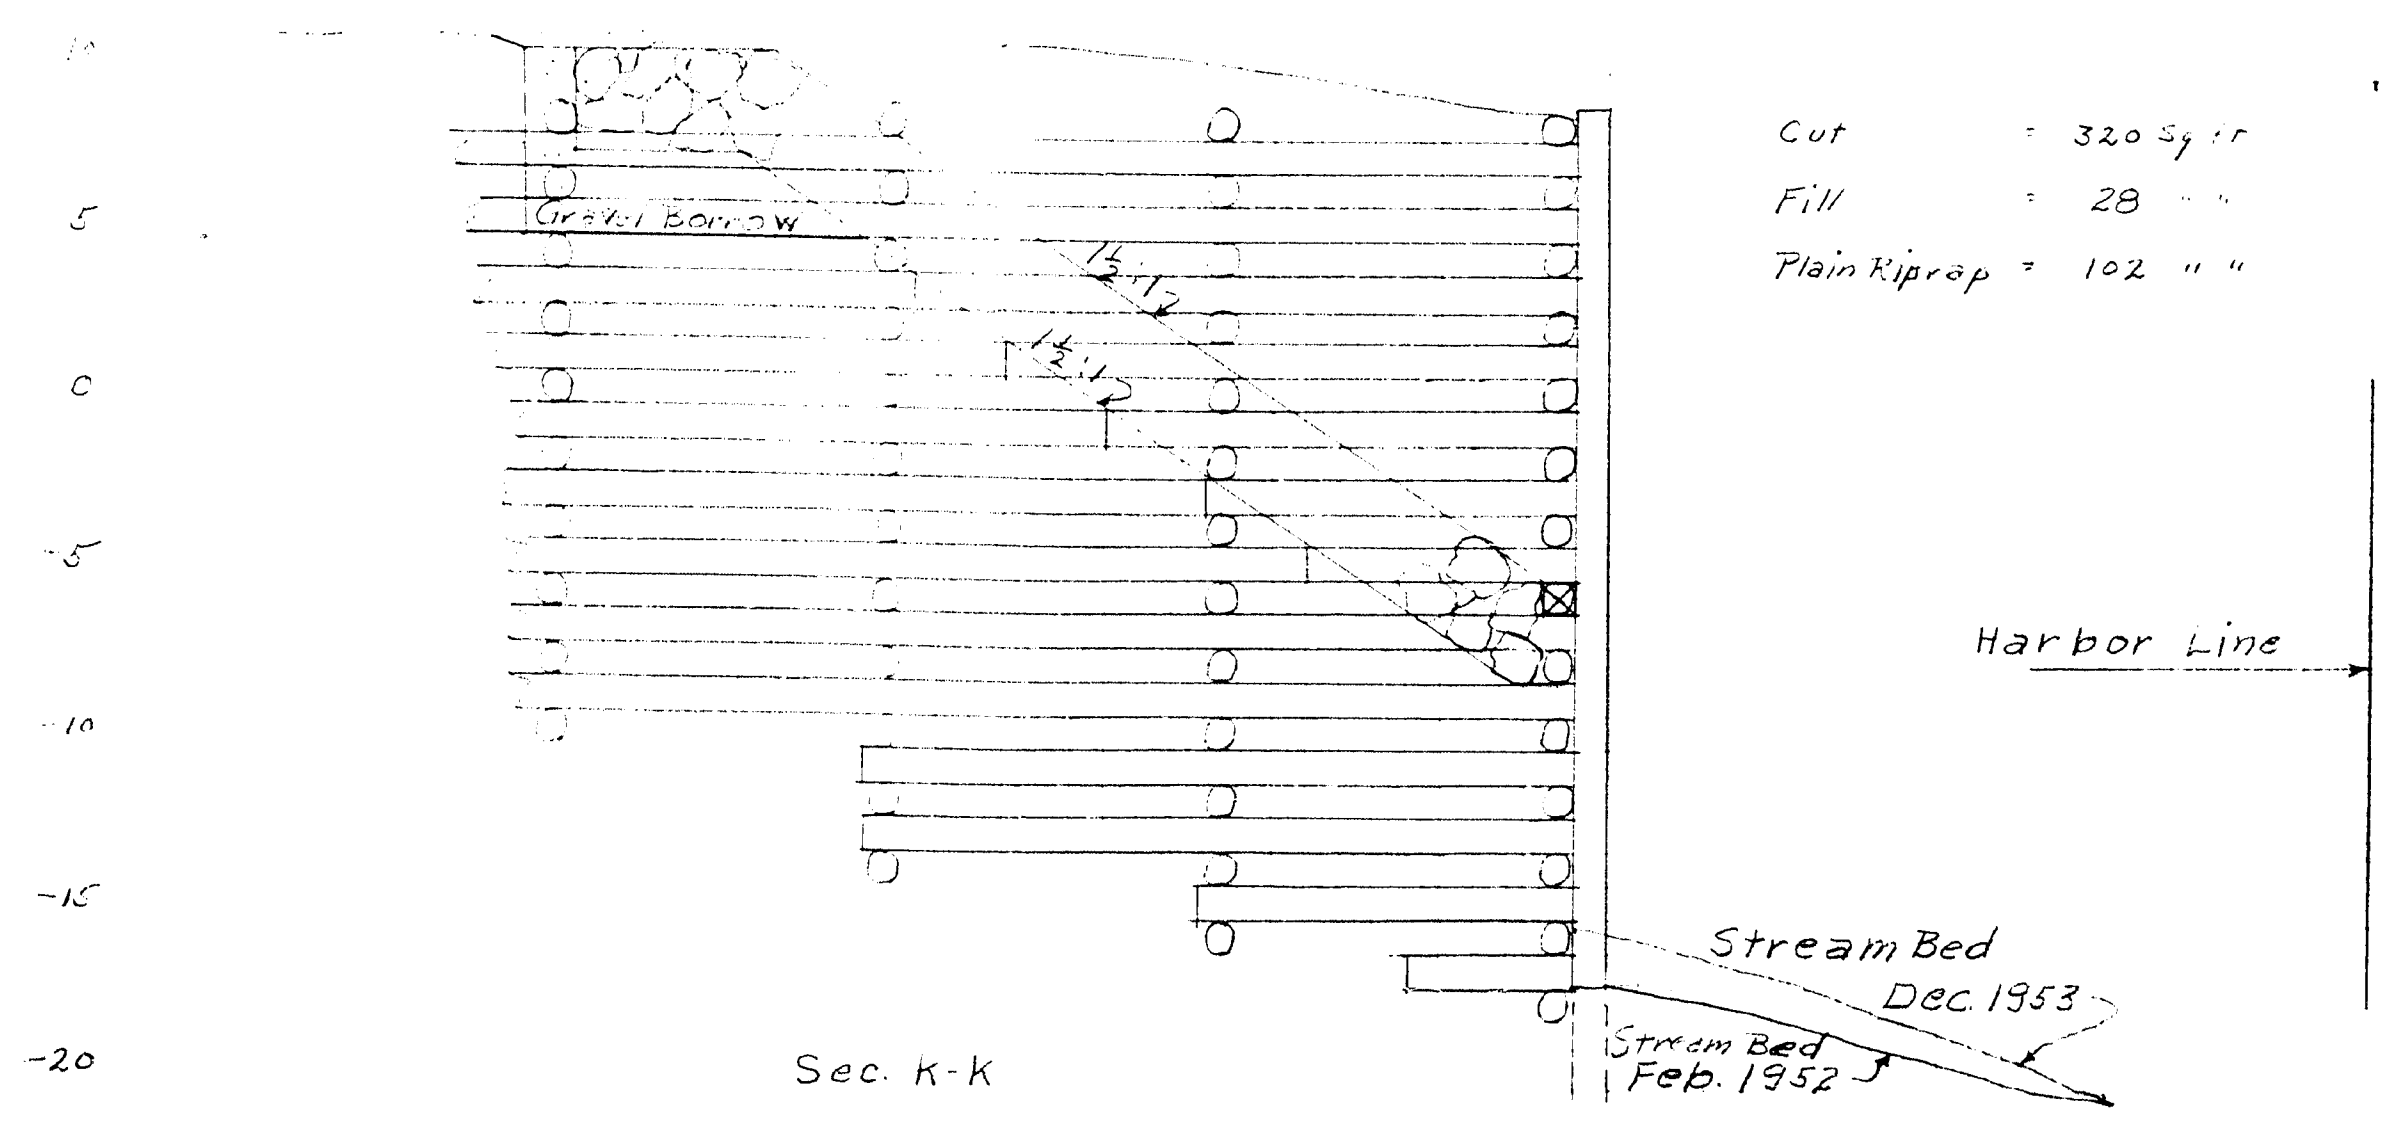



Cut = 32.0 Sg ft  
 Fill = 28 " "  
 Plain Riprap = 102 " "

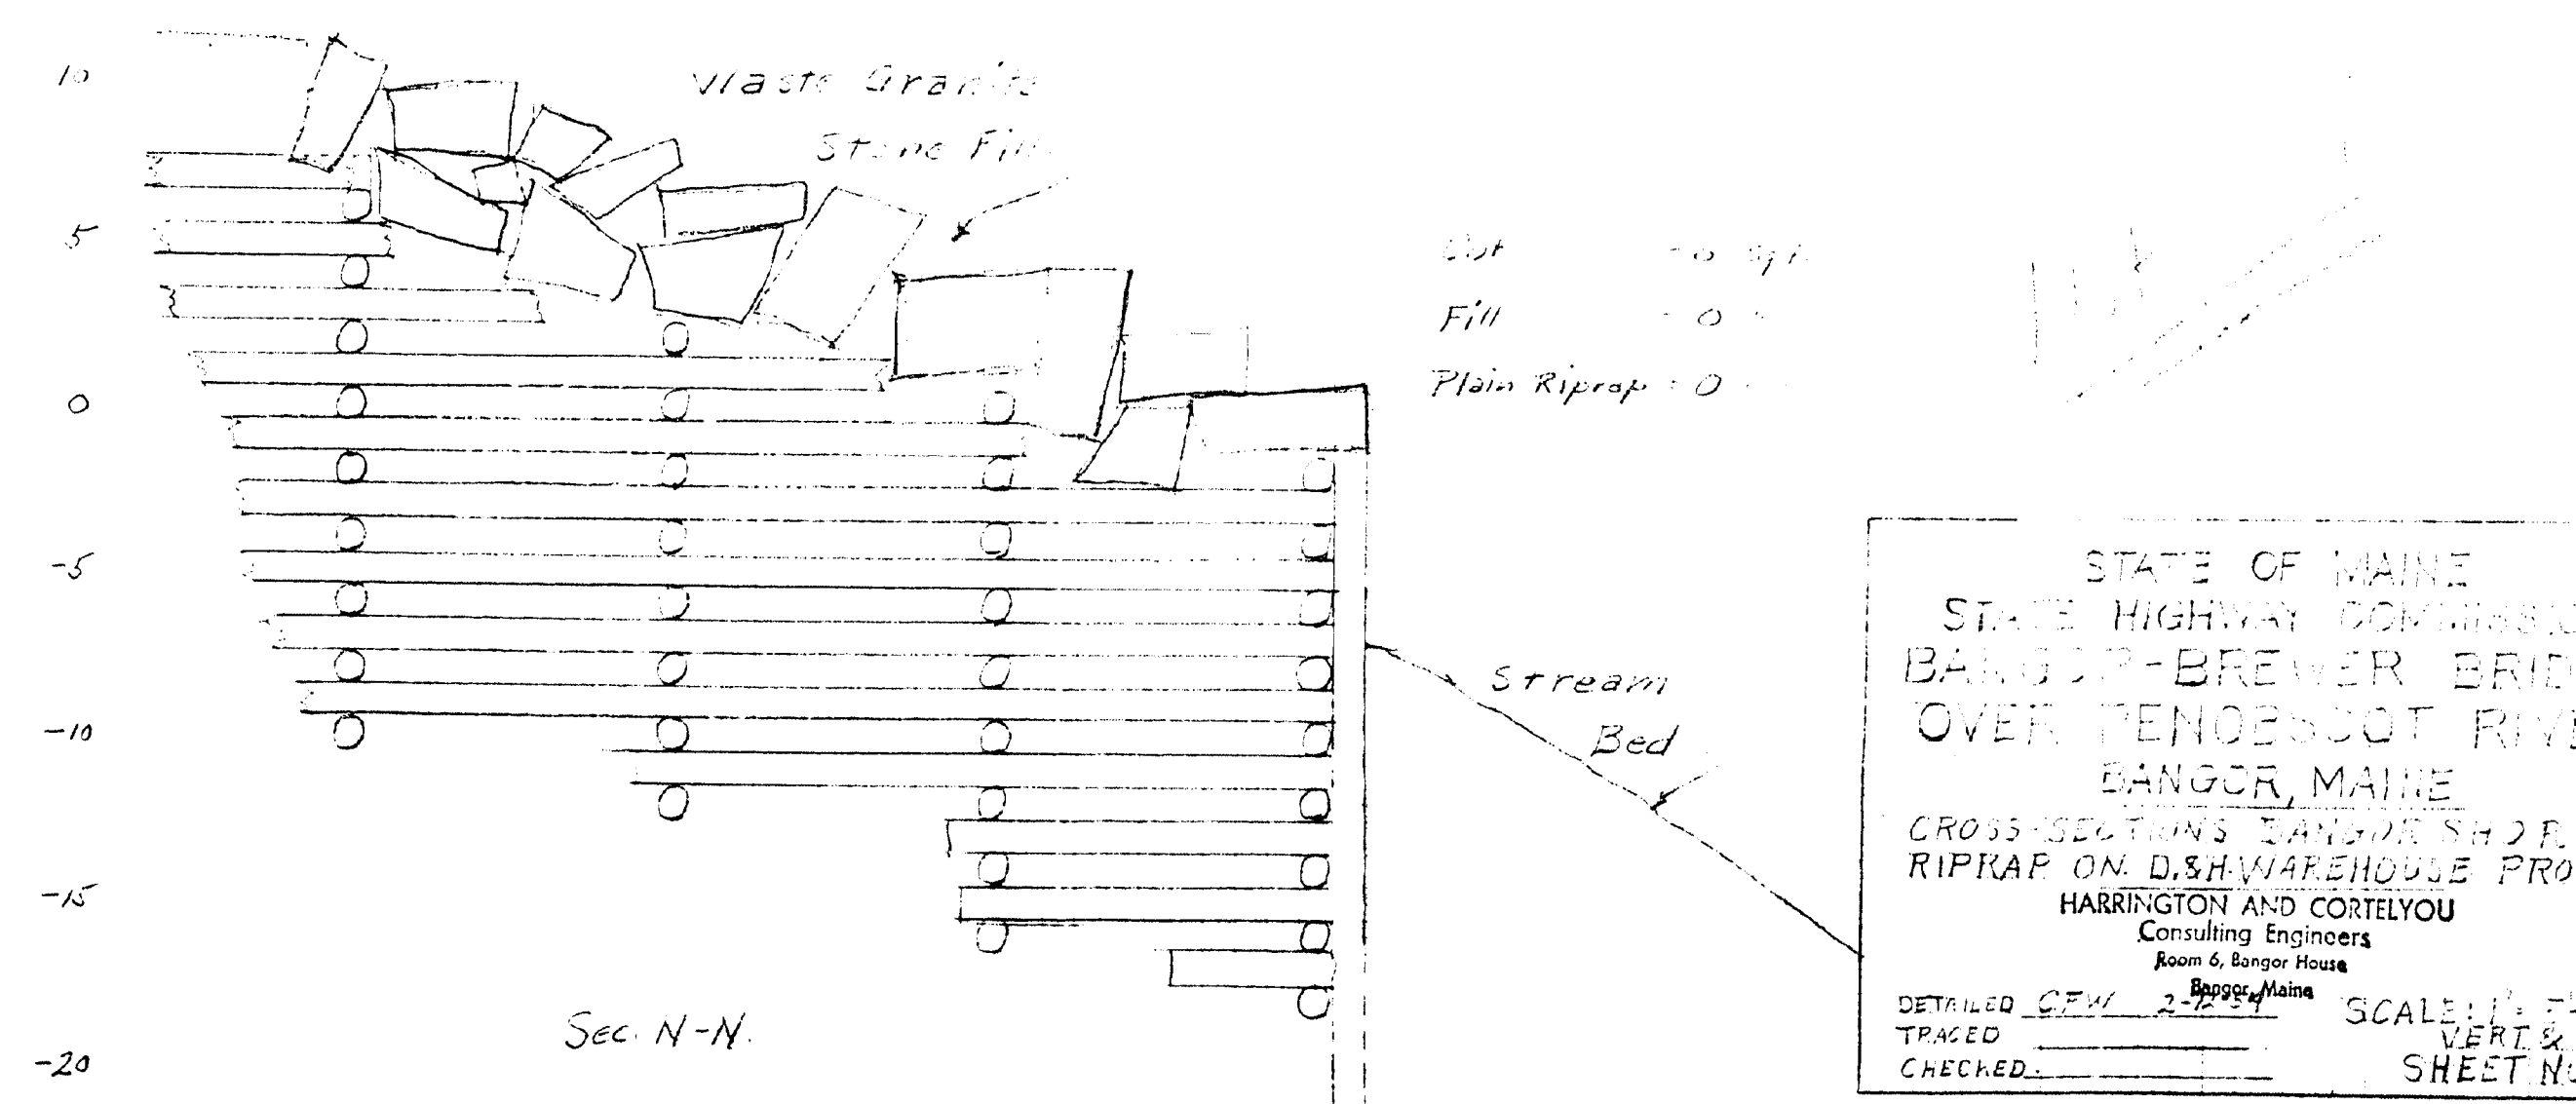

Cut = 0 Sg ft  
 Fill = 0 " "  
 Plain Riprap = 0 " "

STATE OF MAINE  
 STATE HIGHWAY COMMISSION  
 BANGOR-BREWER BRIDGE  
 OVER PENOBSCOT RIVER  
 BANGOR, MAINE  
 CROSS-SECTIONS TYPICAL SHORE  
 RIPRAP ON D.S. WAREHOUSE PROPERTY  
 HARRINGTON AND CORTELYOU  
 Consulting Engineers  
 Room 6, Bangor House  
 Bangor, Maine  
 DETAILED BY 2-2-53  
 TRACED  
 CHECKED  
 SCALE: 1\"/>

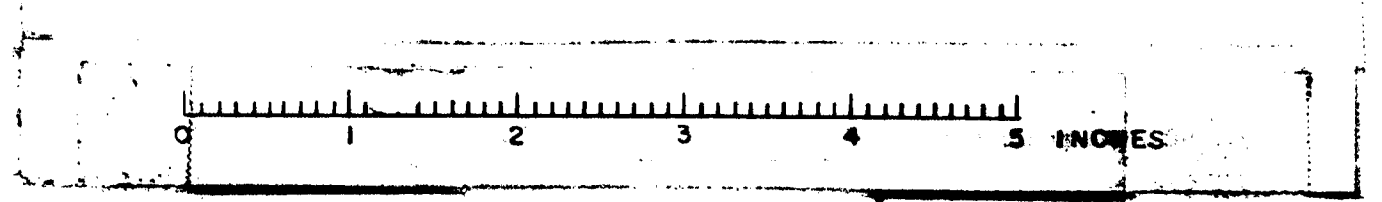

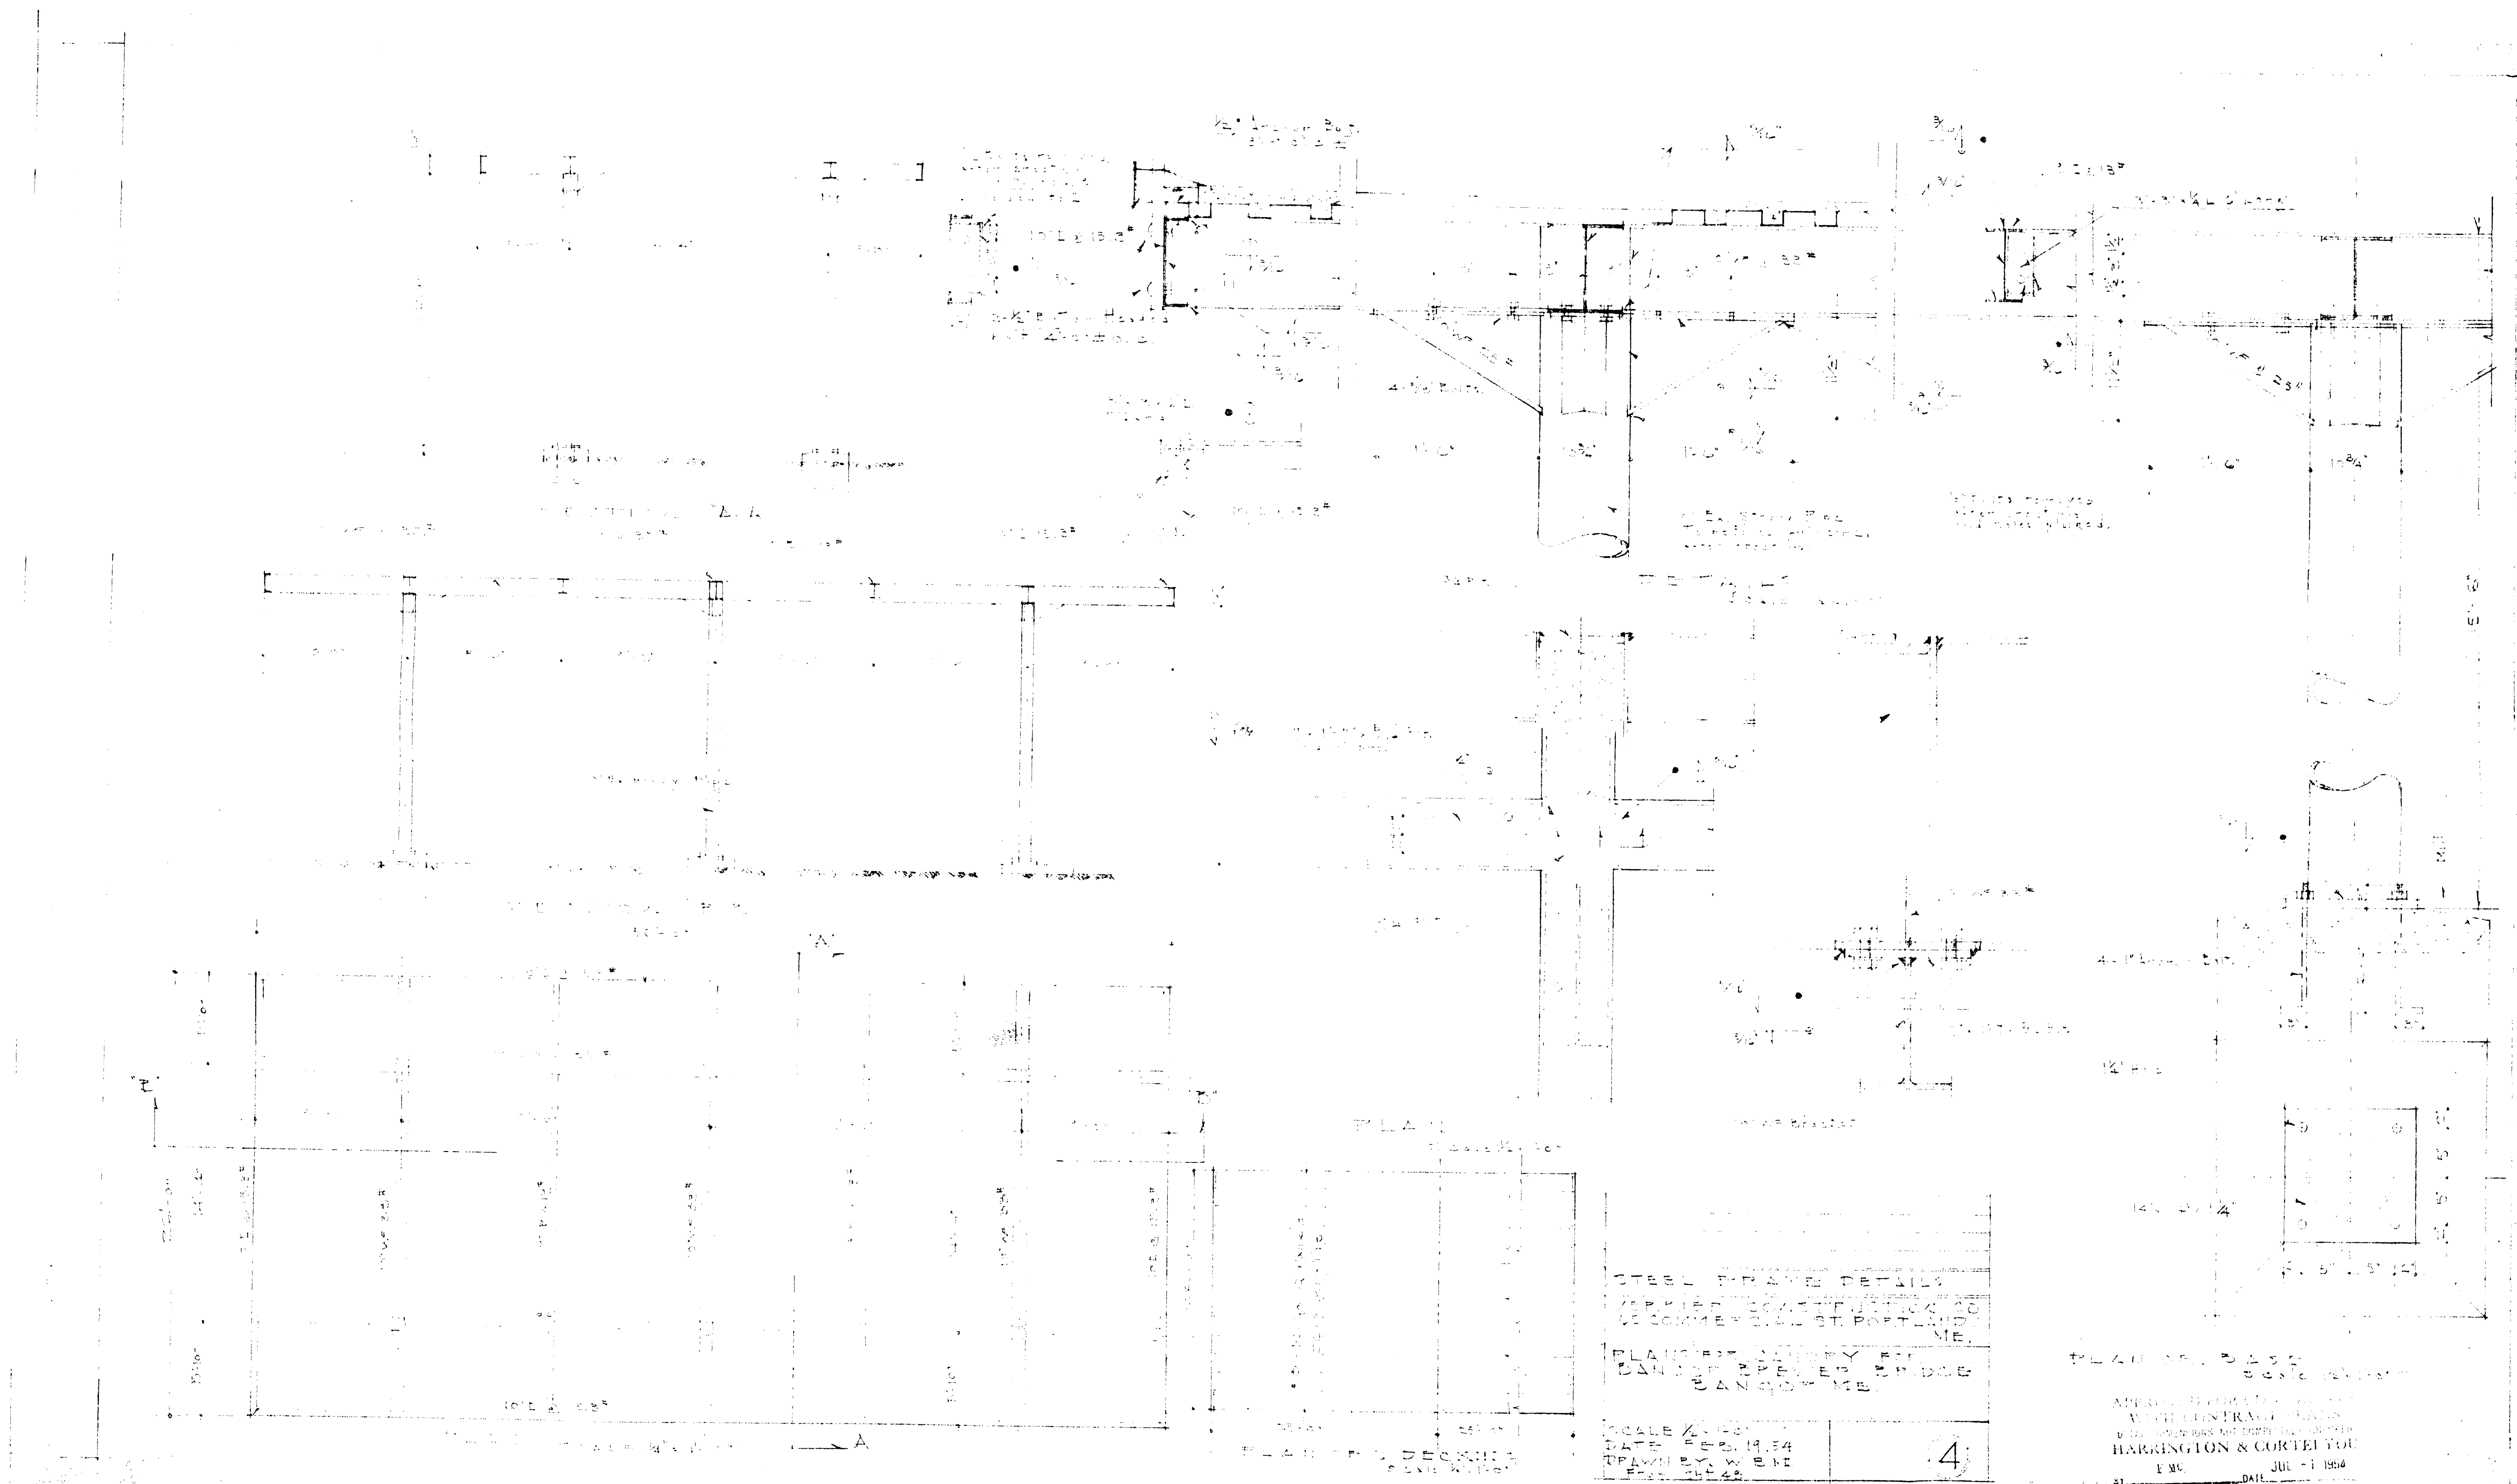

STEEL FRAME DETAILS  
 HERRING & CORTELL  
 100 COMMERCIAL ST. PORTLAND, ME.  
 PLAN OF BRIDGE  
 HERRING & CORTELL  
 100 COMMERCIAL ST. PORTLAND, ME.  
 SCALE 1/4" = 1'-0"  
 DATE FEB. 1954  
 DRAWN BY W. E. H.  
 CHECKED BY H. E. H.

PLAN OF BRIDGE  
 HERRING & CORTELL  
 100 COMMERCIAL ST. PORTLAND, ME.  
 APPROVED FOR CONSTRUCTION  
 HERRING & CORTELL  
 100 COMMERCIAL ST. PORTLAND, ME.  
 JUL - 1 1954

U.S. COURT  
HOUSE

1/2 Exterior  
Veneer

Ballot Room

Ballot Room

MULLING  
ROOM

Heavy Iron

Area for new building  
on lot 10 and 11

Area for new building  
on lot 10 and 11

Area for new building  
on lot 10 and 11

Area for new building  
on lot 10 and 11

APPROVED BY  
WILLIAM H. HARRINGTON  
HARRINGTON & CORTELYOU  
F.M.C. DATE JUL 1 1964

Area for new building  
on lot 10 and 11

Area for new building  
on lot 10 and 11

62-89

0 1 2 3 4 5 INCHES



HEAD & JAMB

8' x 10'  
all window  
2' 9" x 1' 10"

SILL

ONE LIKE THIS

WILLIAM W. LLOYD  
ARCHITECT  
HARRINGTON & CURTIS  
JULY 1 1954


WILLIAM W. LLOYD ARCHITECT  
25 COMMERCIAL ST. PORTLAND, ME

DETAIL FOR SILL WORK FOR  
UTILITY BUILDING - DANGER,  
SEWER BRIDGE




SEE LPP-10-54  
DATE LPP-10-54  
DRAWN BY W. W. LLOYD SHEET 11

62-90

0 1 2 3 4 5 INCHES

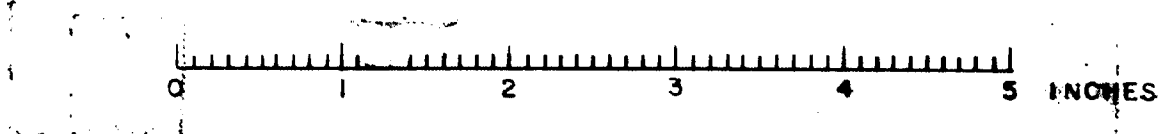


APPROVED FOR CONSTRUCTION  
 WITH CONTRACT NO. 62-91  
 HARRINGTON & CORTELYOU  
 DATE JUL - 1 1964

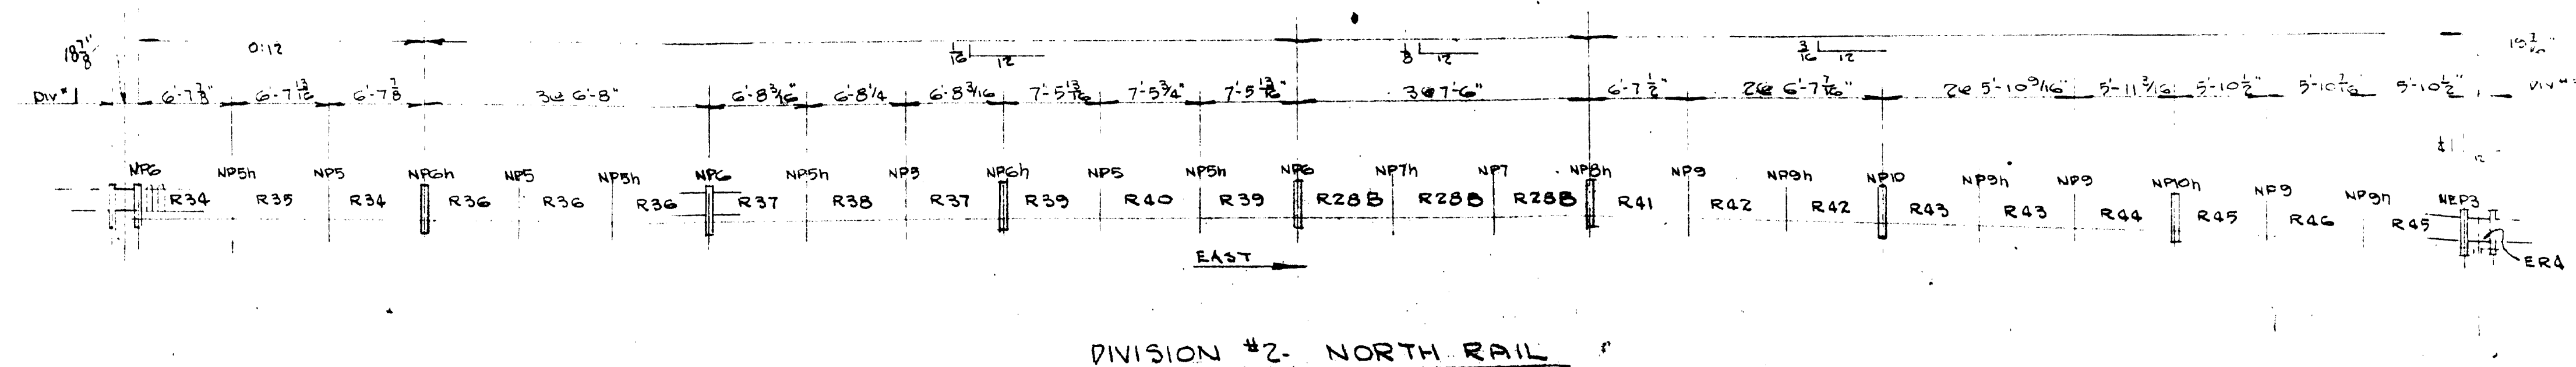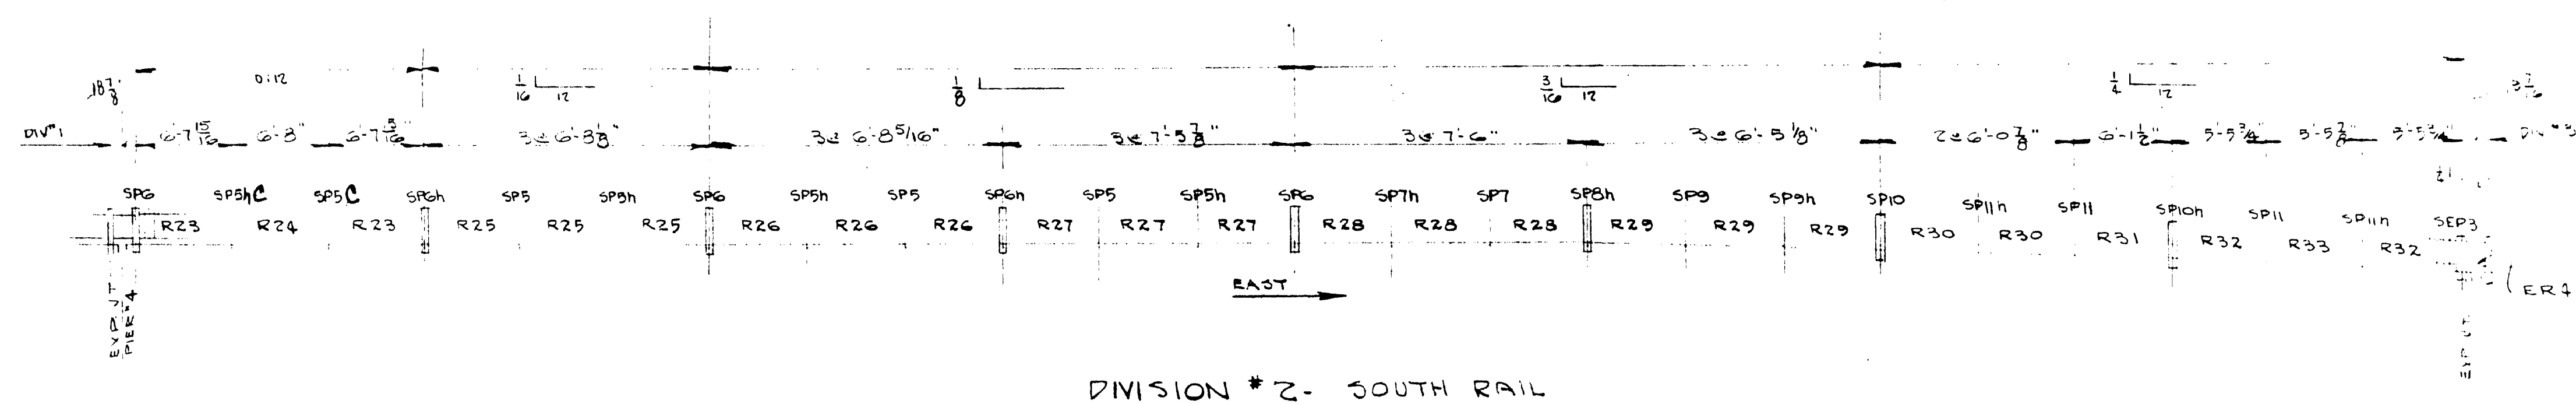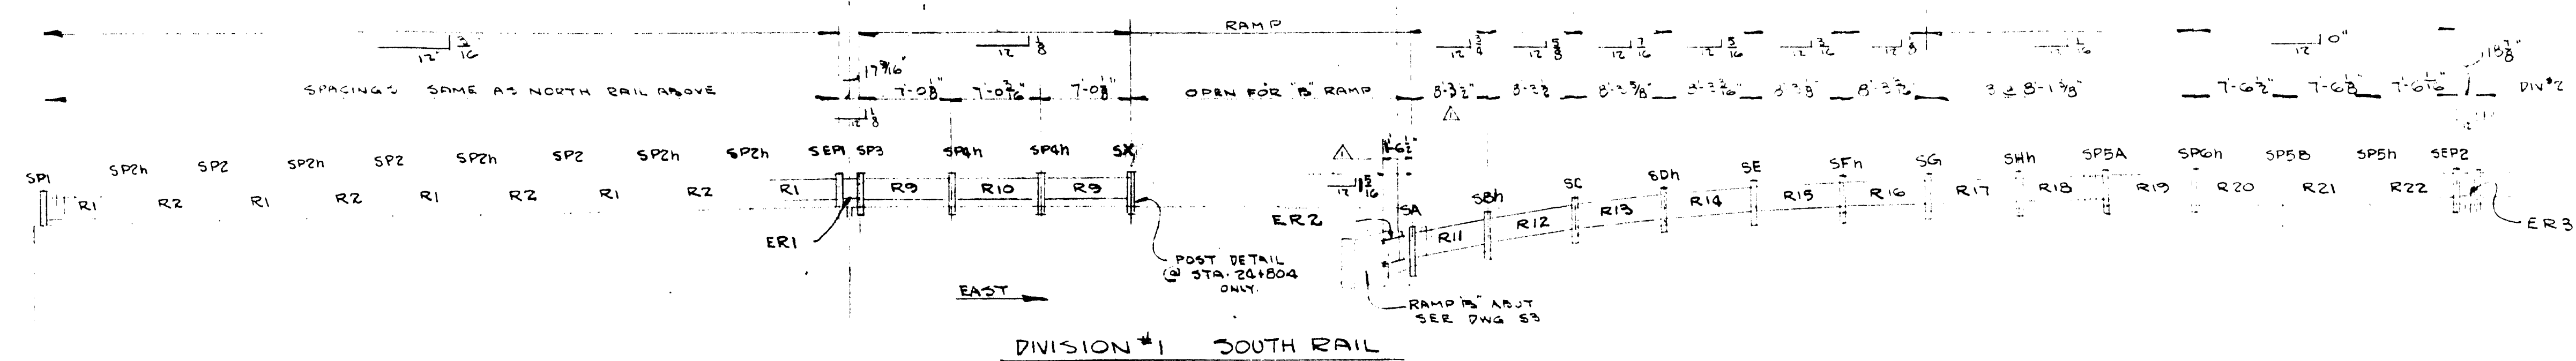

GEN. NOTES:  
SEE TYPICAL DETAIL DWG 293-S1  
RAIL & POST TO BE PAINTED-RED LEAD.

AS BANGOR-BREWER BRIDGE RAIL  
DIVISION #1 & 2 - ERECTION PLAN  
CUSTOMER: VERRIER CONST CO.  
ADDRESS: 100 W. 1ST ST. H. & CORTLEYOU  
CITY: 4-1-54 DATE: 5-7-54  
BY: R.L.B. DESIGNED BY: R.L.B. 62-2  
CUMMINGS & HAMILTON ENGINEERS & ARCHT. LSC00. 293 F


GENERAL REVISIONS - 5-7-54 FOR PLOTS 3 3-24-54 3 6-25-54  
FOR RAIL FINAL 3 4-1-54 7 7-25-54  
① @ RAMP "B" - REVISED RAIL DIM. TO 3 5-7-54  
QUIT H&C DWG RG OF 3/28/53  
H&C LET 7-1-54  
TANAGER

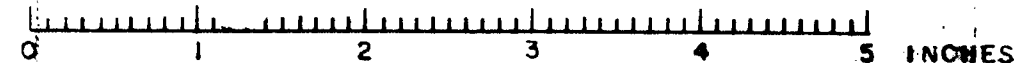








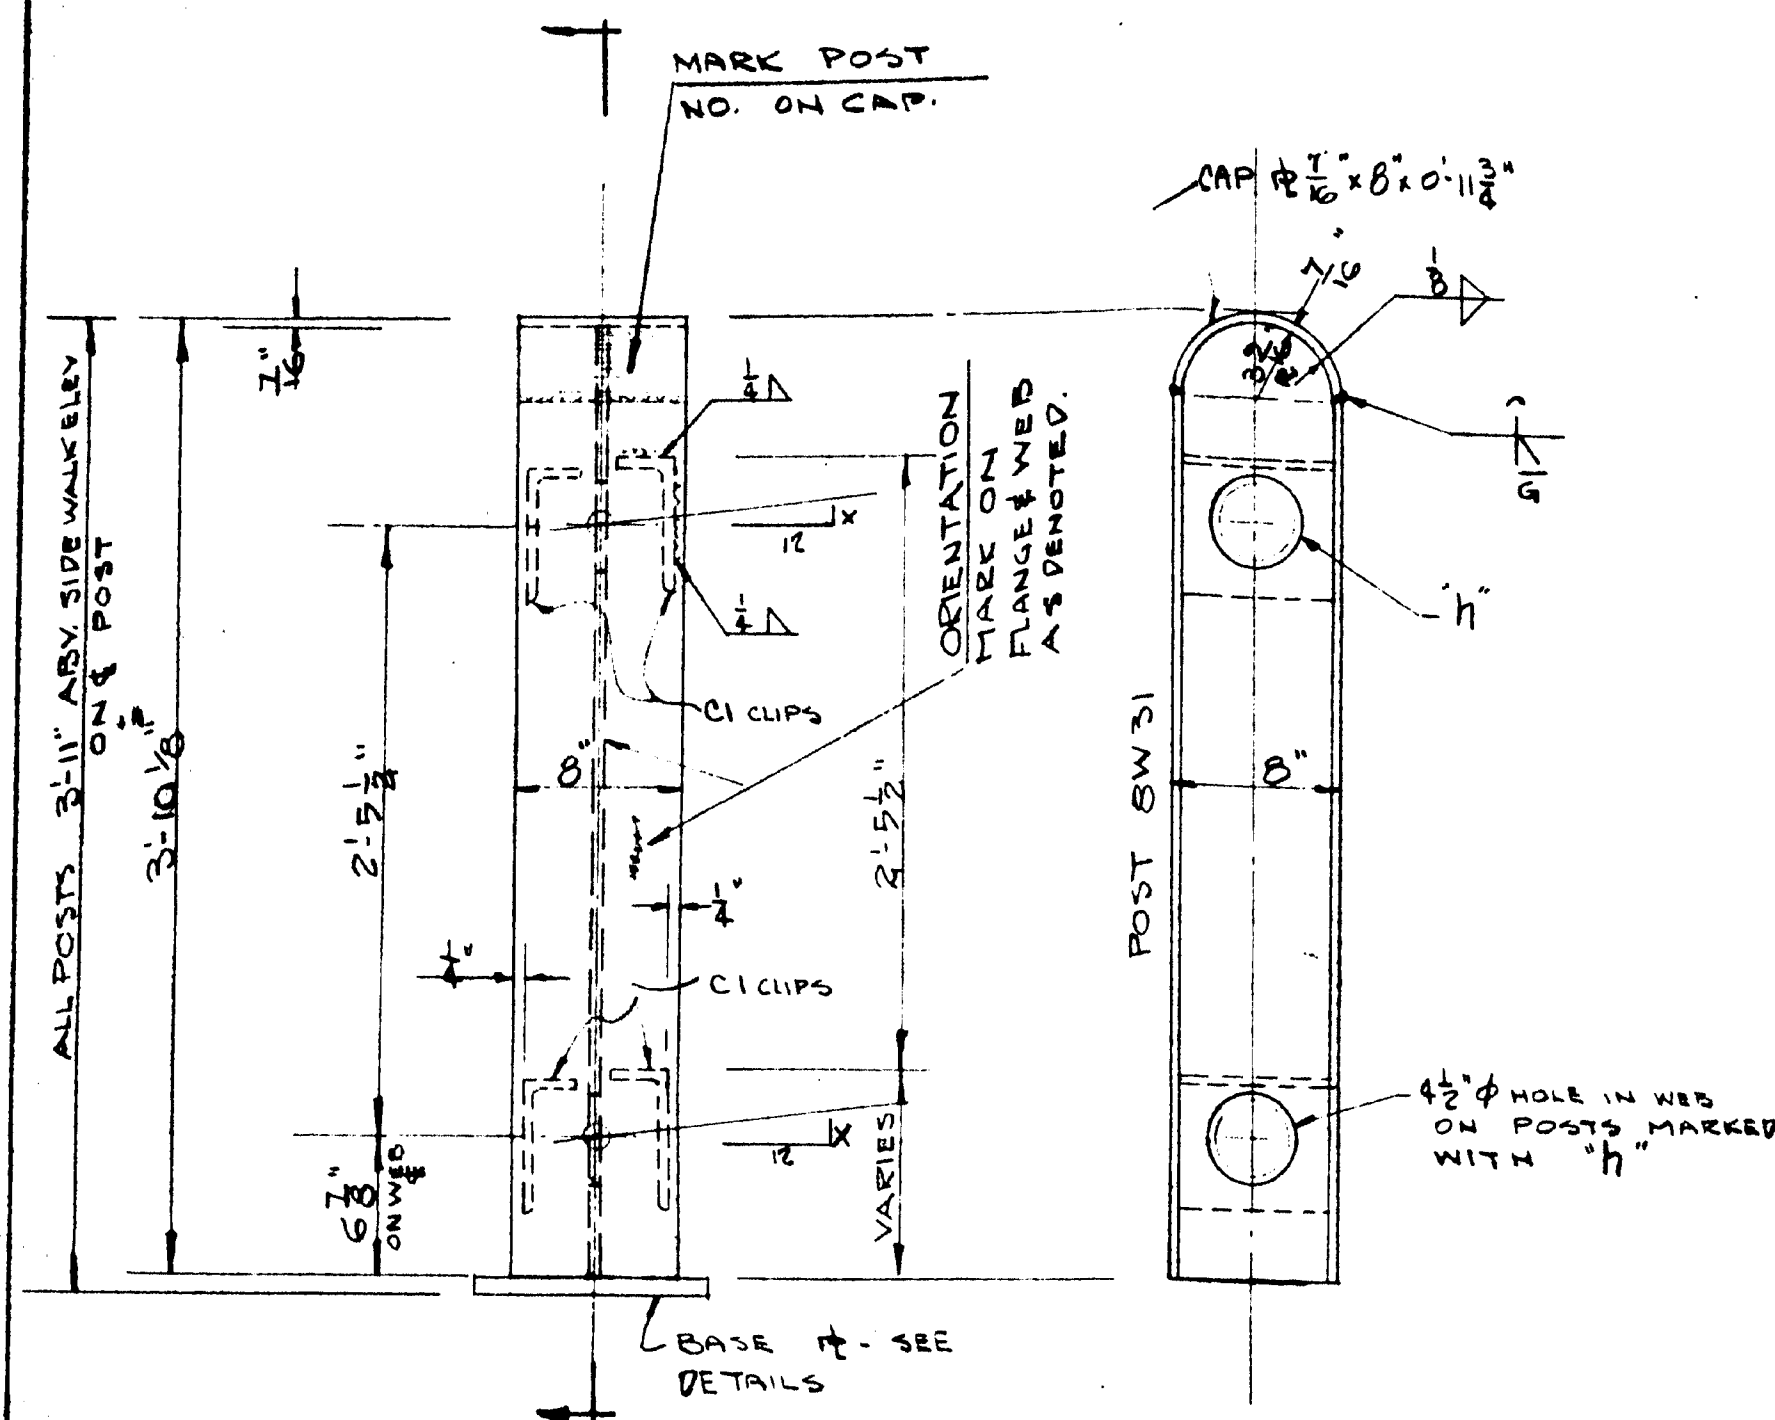


TYPICAL POST FOR WALLS, ABUTMENTS  
# SPAN 1

SPANS 2-16 SIMILAR EXCEPT THEY  
CONNECT TO 15" FACIA BELOW SIDEWALK

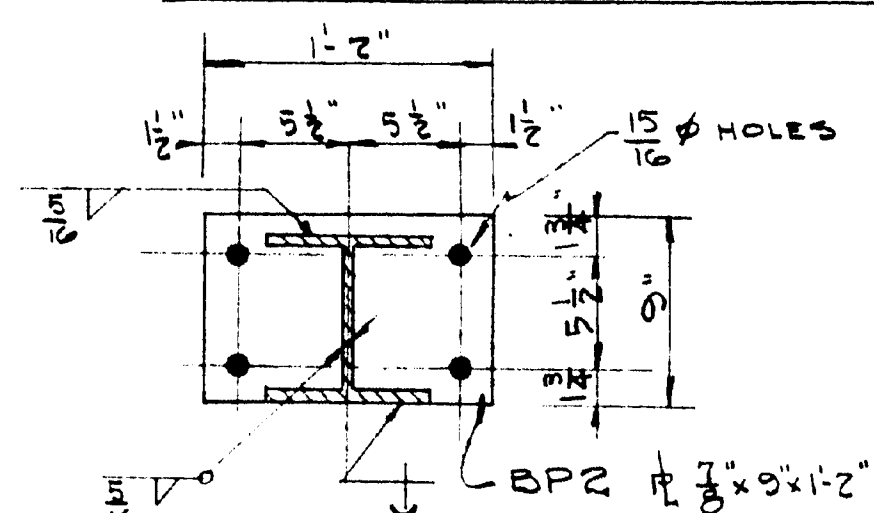


BP2 - FOR SPAN# POSTS

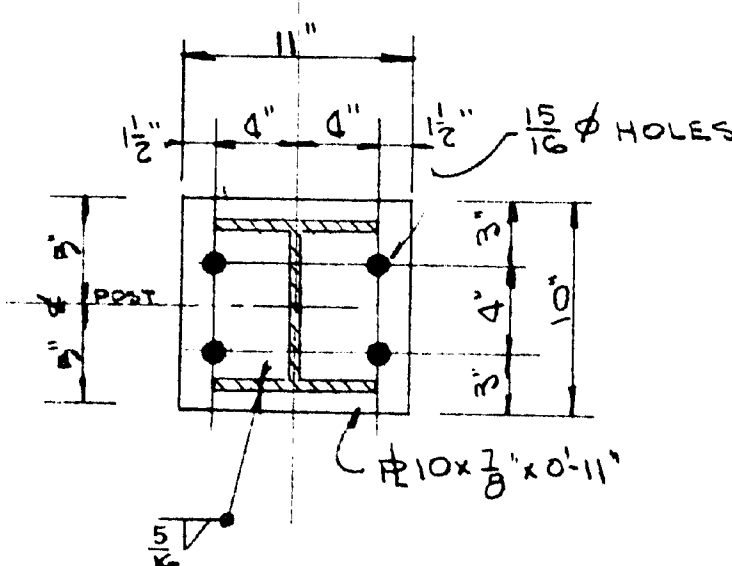

BP1 - FOR WALLS & ABUTMENT POSTS

1-BP1A: SEE DWG 513

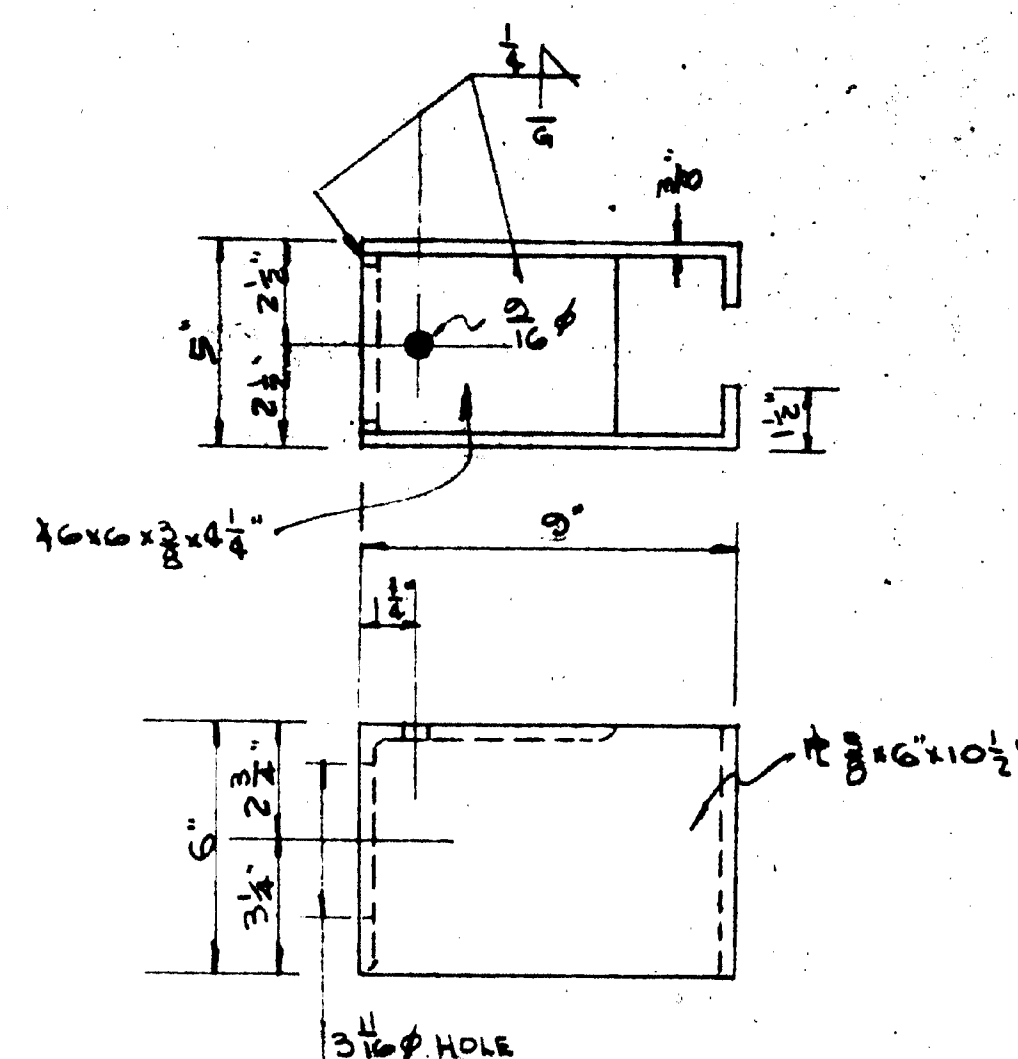


CH1 - FOR CONCRETE POSTS


18 - REQD.

WROUGHT IRON

10 - 1/2\"/>

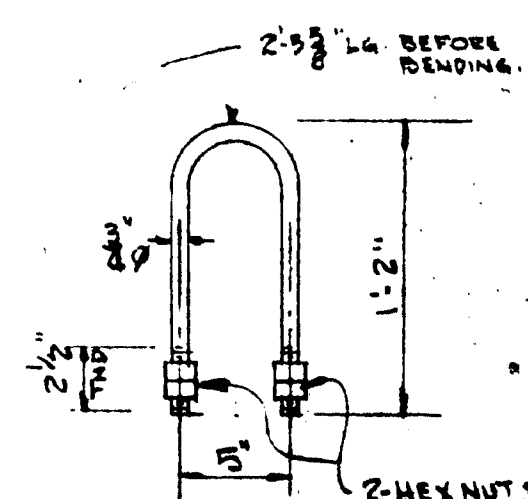


U BOLTS FOR  
POST CONN. SPAN  
2 TO 16  
TOTAL REQD - 27

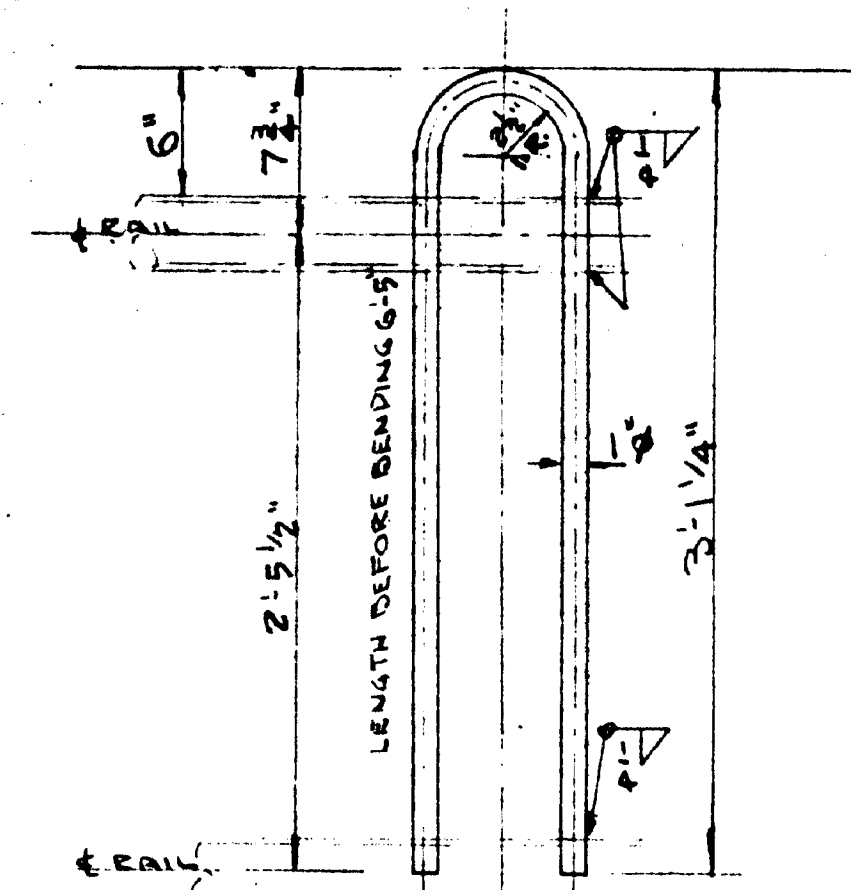

MATERIAL - WROUGHT  
IRON BAR

TYPICAL PALE DET.


(TOTAL QUANTITY TAKEN FROM  
RAILING DETAILS)

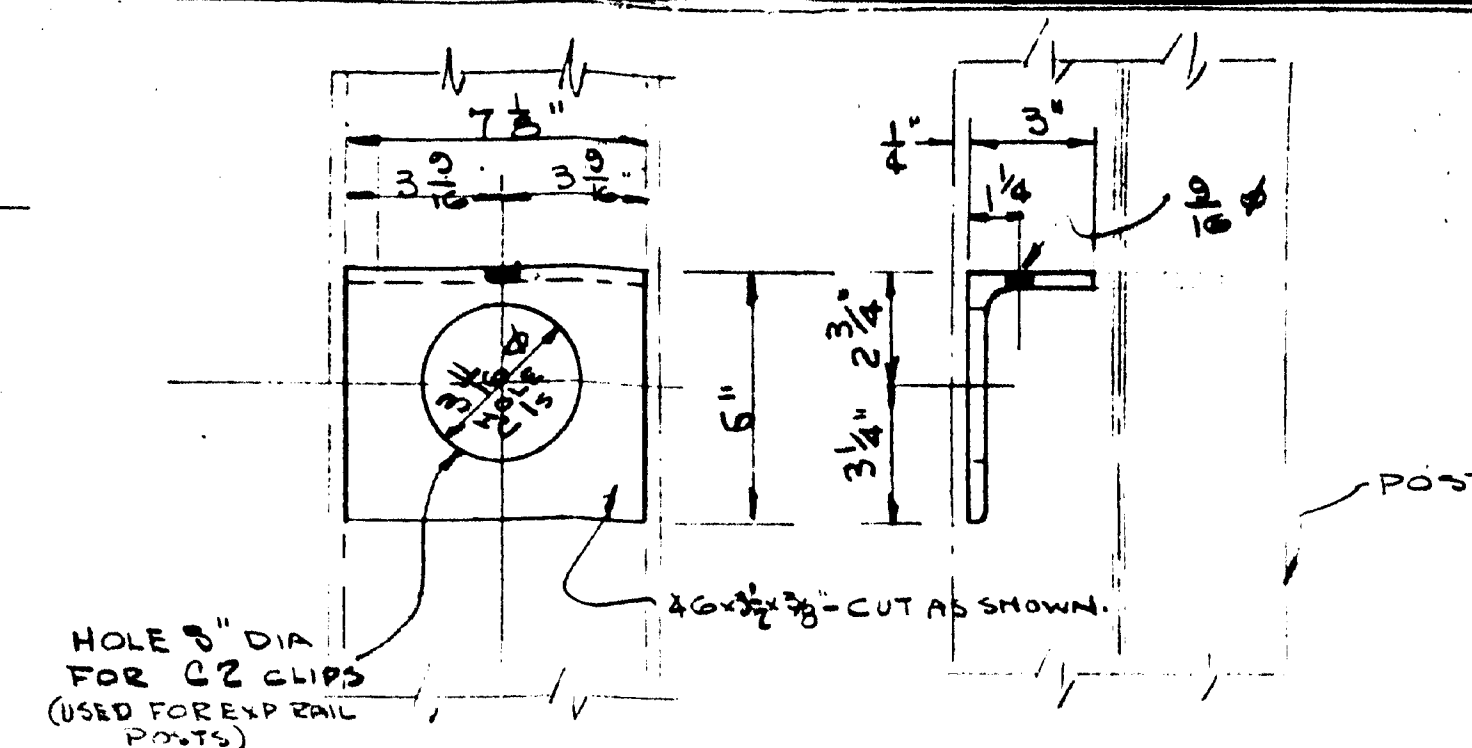

C1 & C2 CLIPS - FOR ALL POSTS

2140 - C1s - REQD.

26 - C2s - REQD.

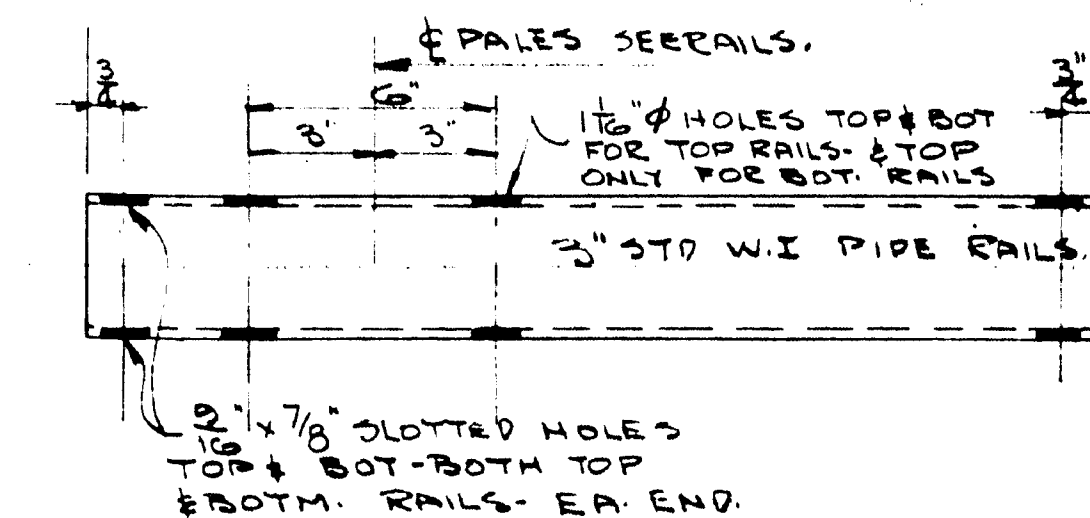

TYPICAL RAIL DETAIL

UNLESS OTHERWISE SHOWN - RAIL SHALL  
BE DRILLED AS THIS DETAIL

# NOTES

RAILS & POSTS TO BE FABRICATED  
AS SHOWN ON TYPICAL DETAILS  
EXCEPT AS OTHERWISE NOTED  
AT PIECE DETAILS.  
PAINT RED LEAD  
FIELD BOLTS FOR SPAN 2-16  
1900 - 3/4\"/>





REV.	DATE	BY	CHKD.
1	5-7-54	3	6-29-54
2	5-24-54	3	7-7-54
3	5-7-54	3	7-25-54

BANGOR-BREWER BRIDGE RAIL  
TYPICAL DETAILS  
VERRIER CONST. CO.  
H. & CORTLEYOU

5-7-54  
6-29-54  
7-7-54  
7-25-54  
R.L.B.  
MOUNTAIN FOLLING MILLS CO. 223-51

0 1 2 3 4 5 INCHES



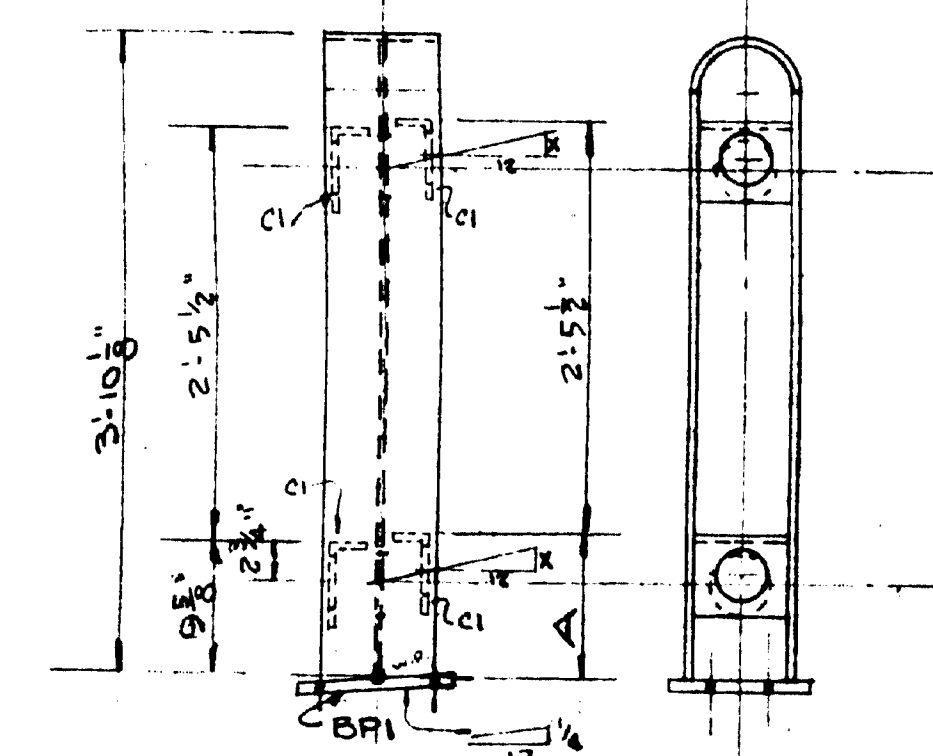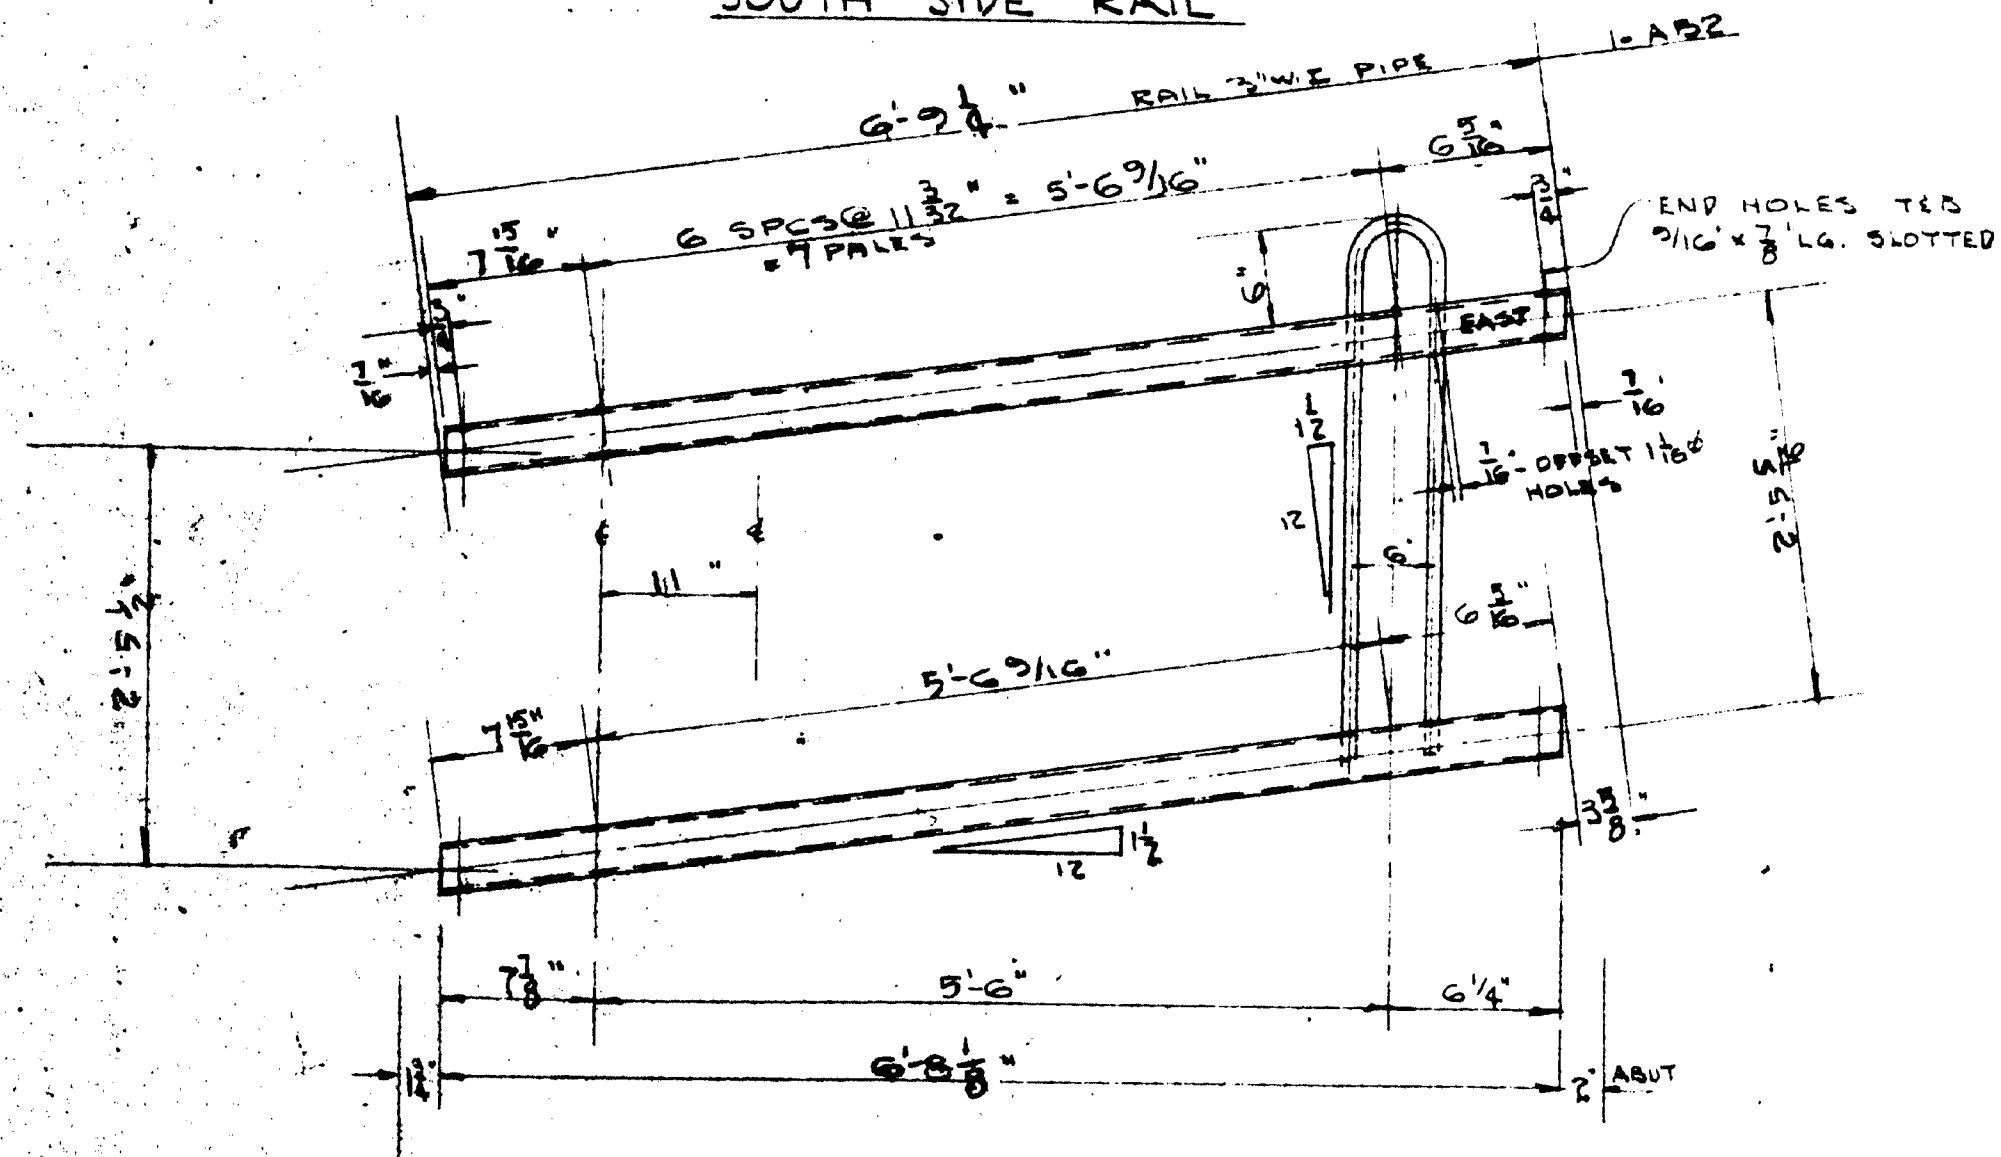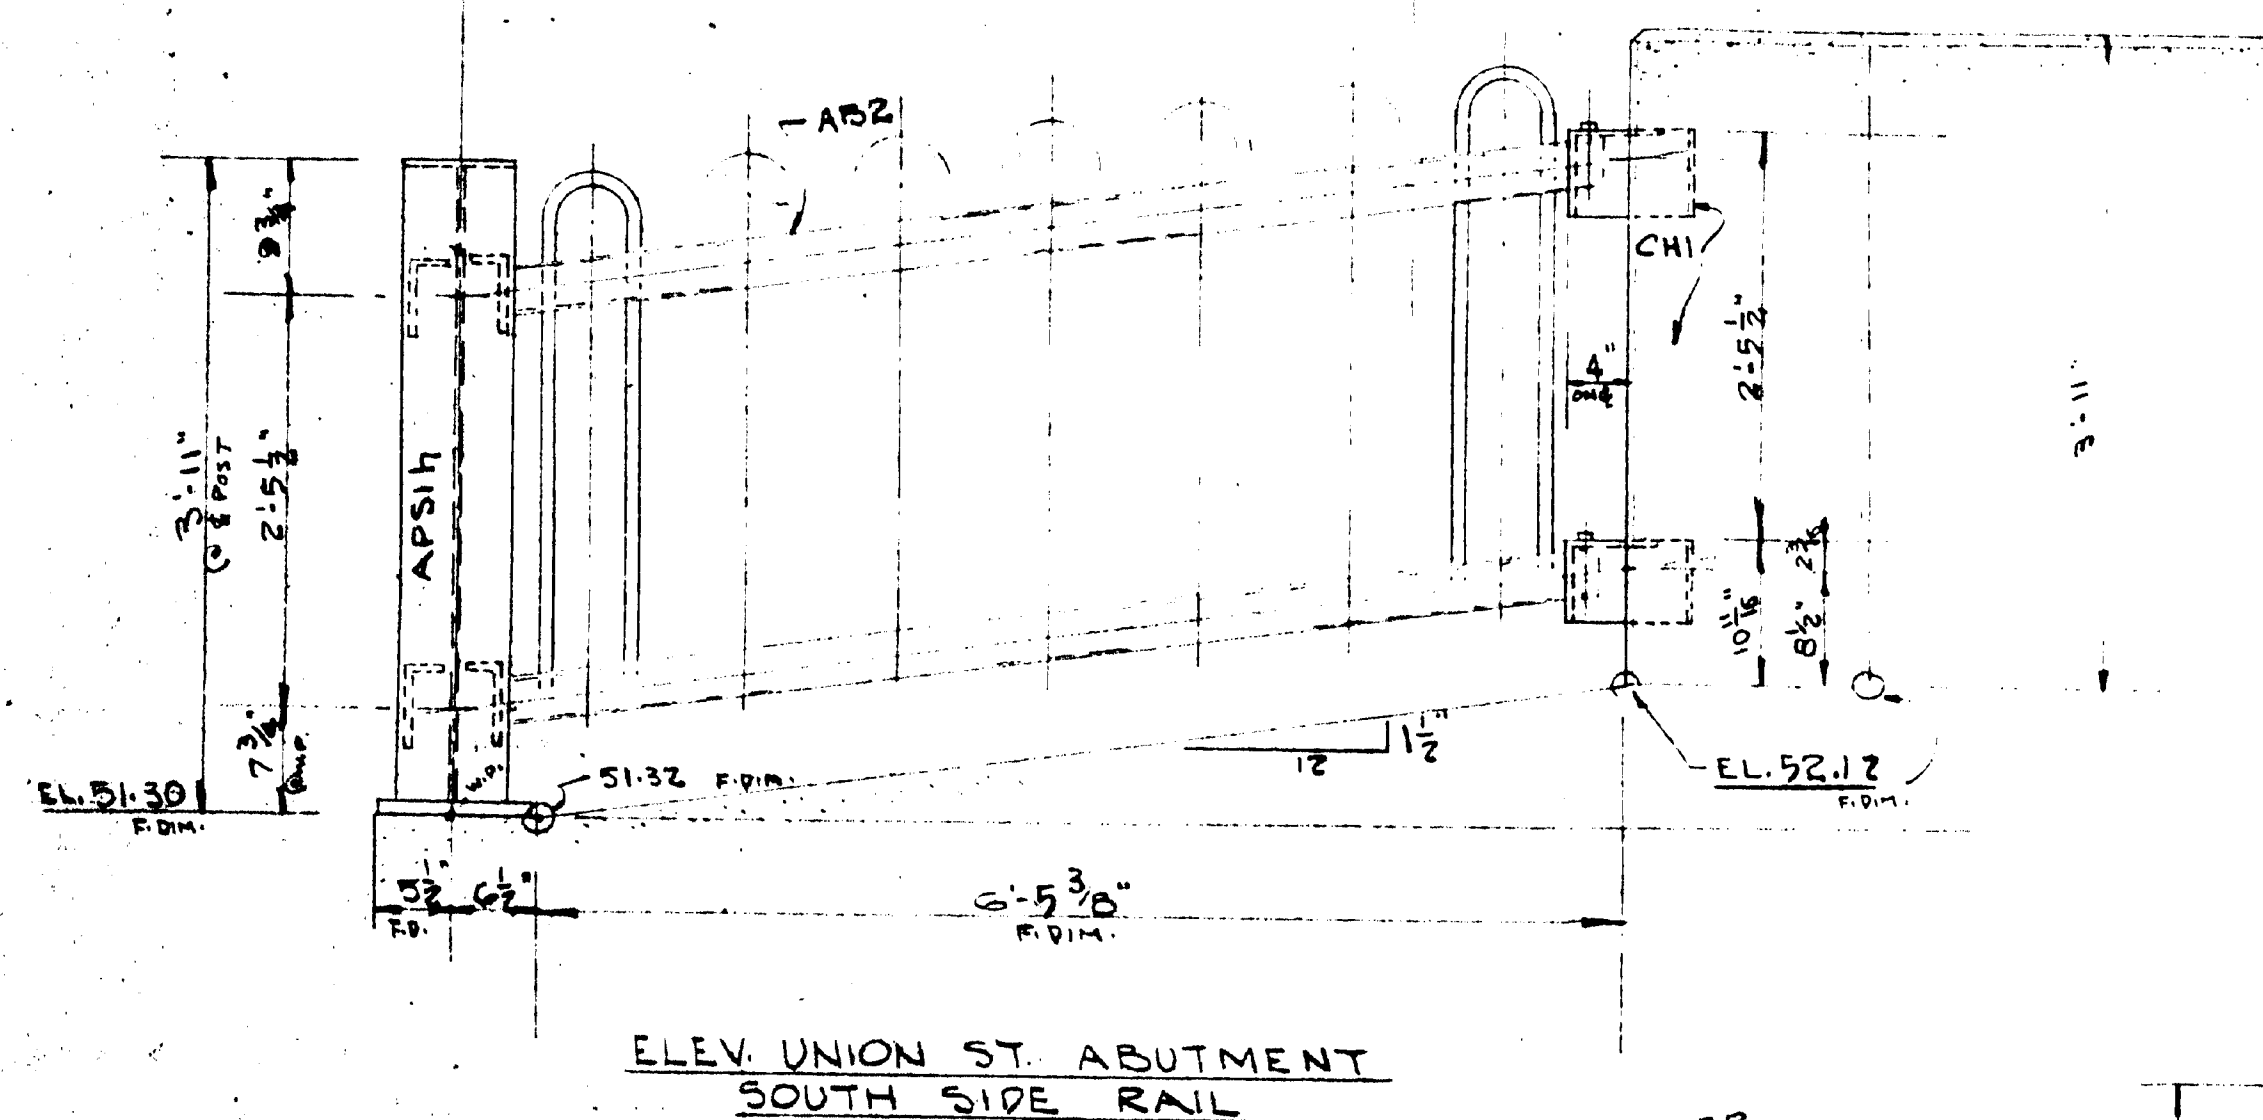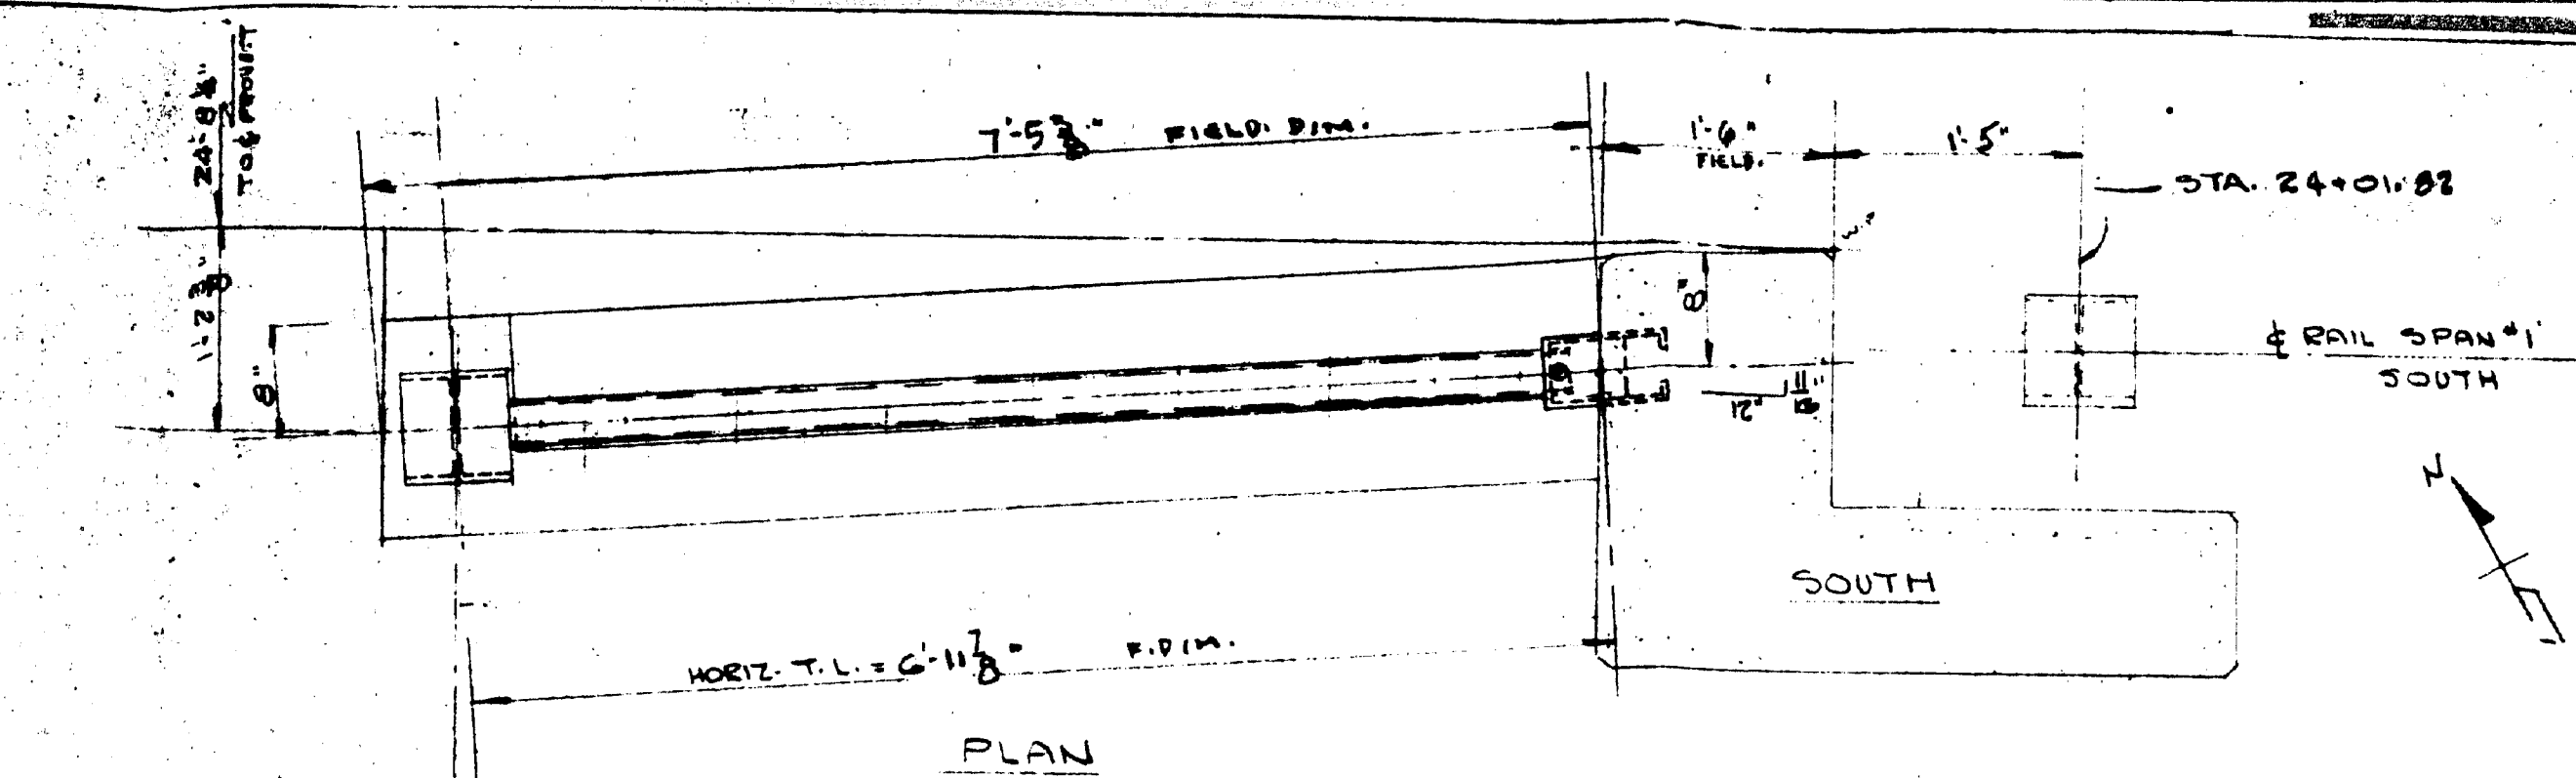


$$X = \begin{bmatrix} 12'' & \text{FOR APN11H} \\ 12'' & \text{FOR APS11H} \end{bmatrix} \quad A = \begin{bmatrix} 10\frac{1}{2}'' & \text{FOR APN11H} \\ 10\frac{1}{2}'' & \text{FOR APS11H} \end{bmatrix}$$


$$1 - \text{APN11H} \quad \frac{1}{2} \quad 1 - \text{APS11H} \quad \text{REQD.}$$

SEE DWG. 91 FOR TYPICAL DETAILS  
AND COMPONENT PARTS


BANGOR BREWER BRIDGE RAIL  
UNION ST ABUTMENT  
VERRIER CONSTCO.  
HARRINGTON, CORTLAND  
DATE 5-7-54  
R.L.P.  
62-96  
BANGOR CITY MANUFACTURING MILLS CO 220-52

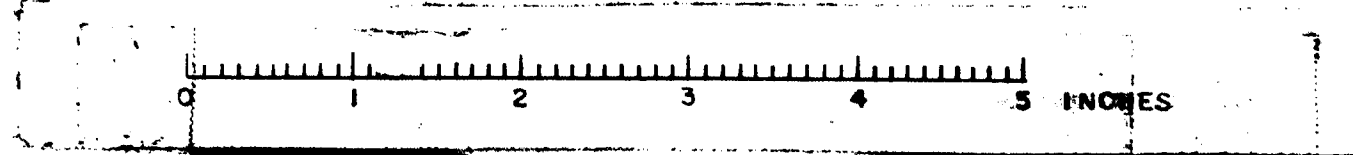






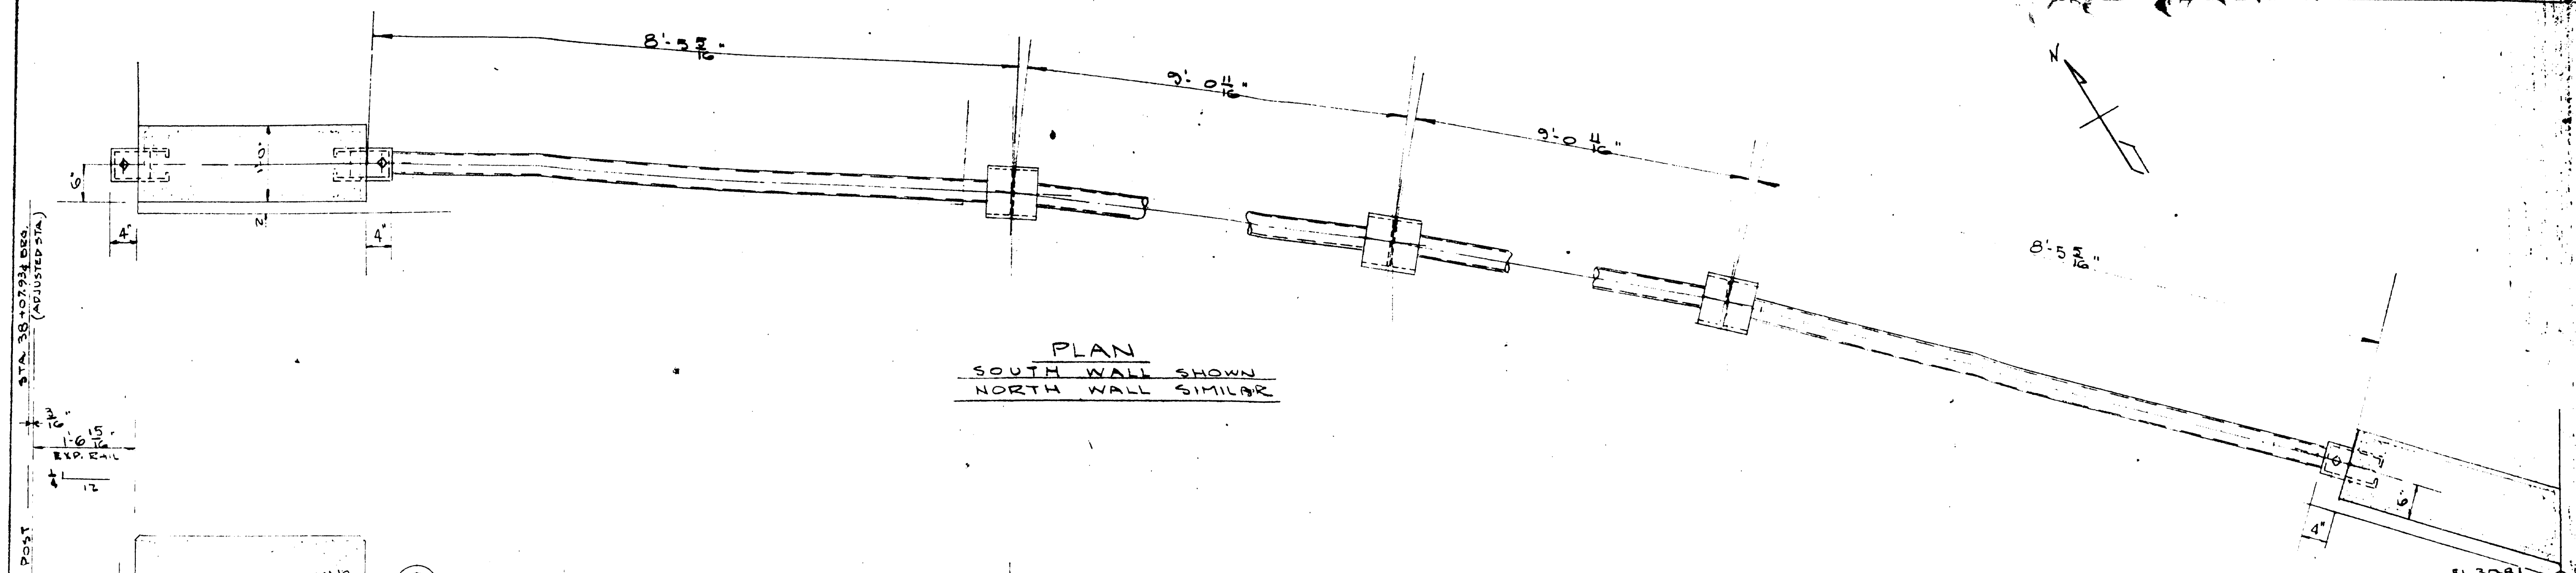


PLAN  
SOUTH WALL SHOWN  
NORTH WALL SIMILAR

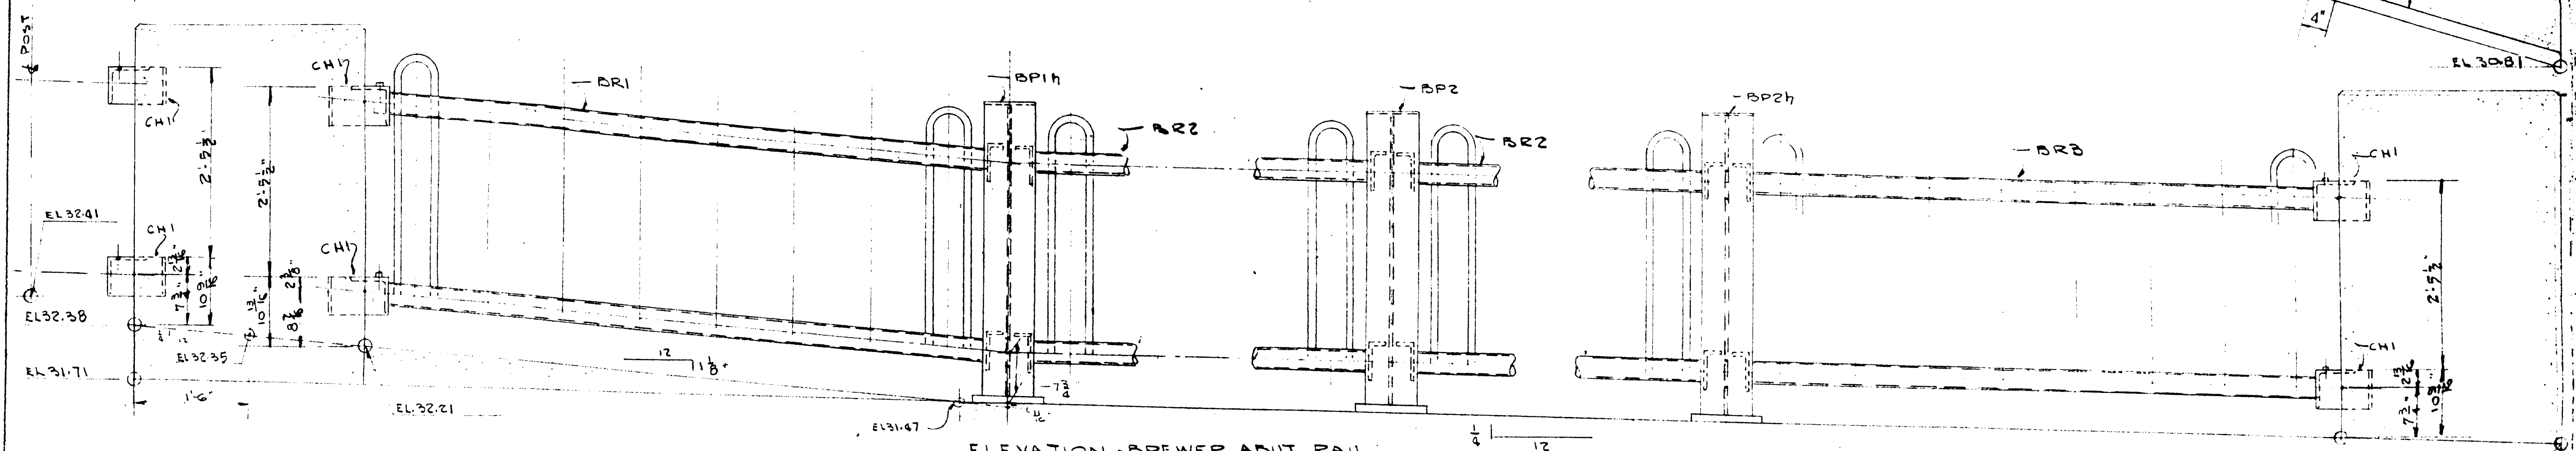

ELEVATION - BREWER ABUT. RAIL

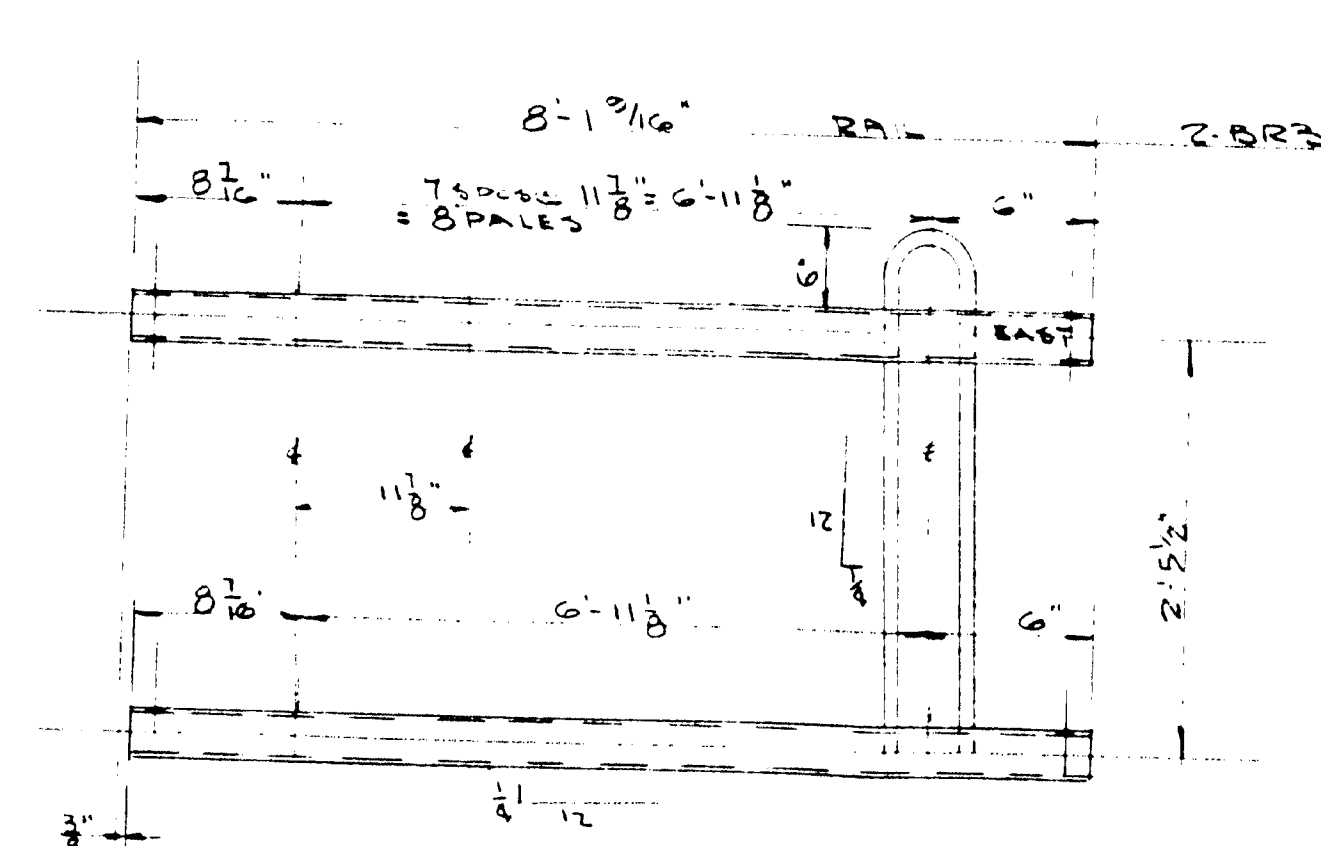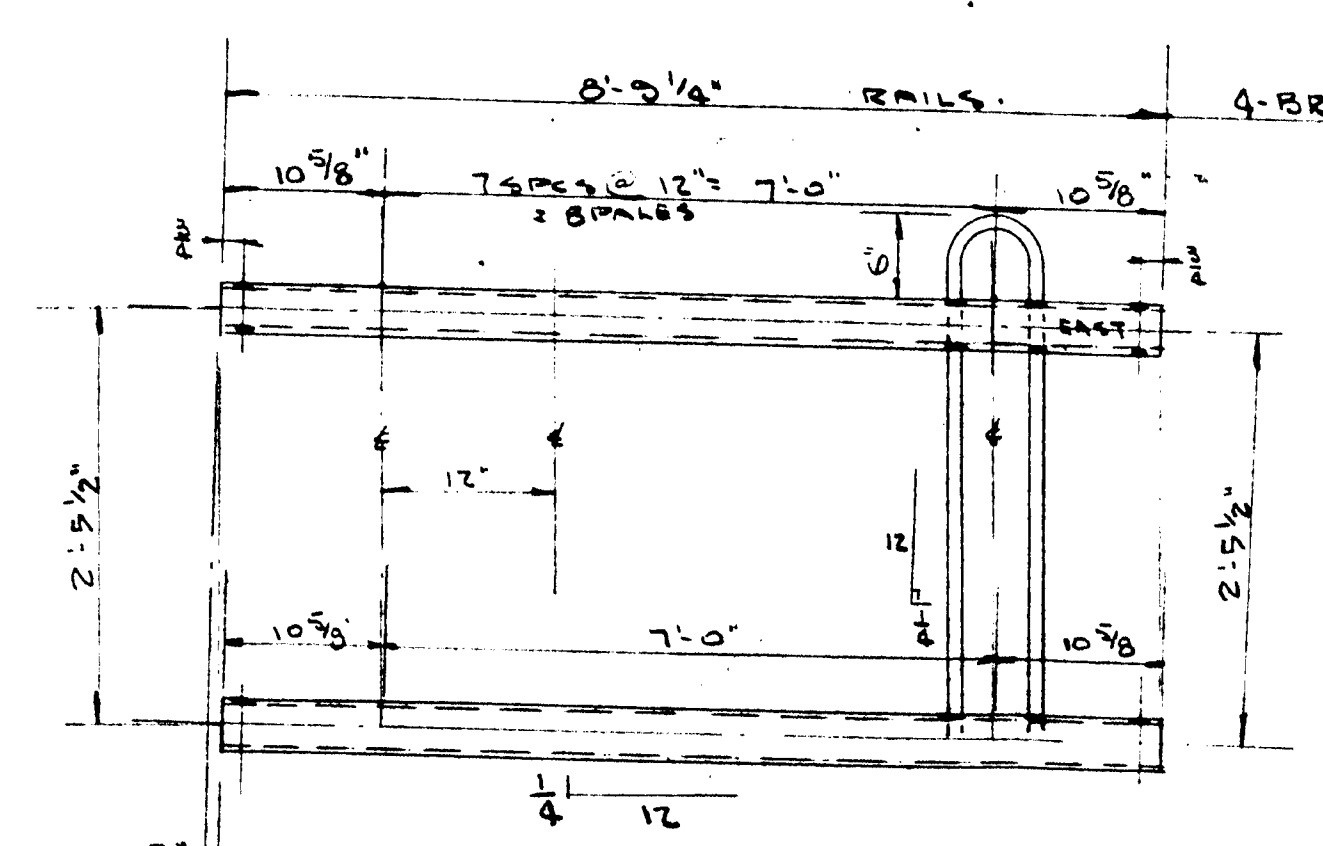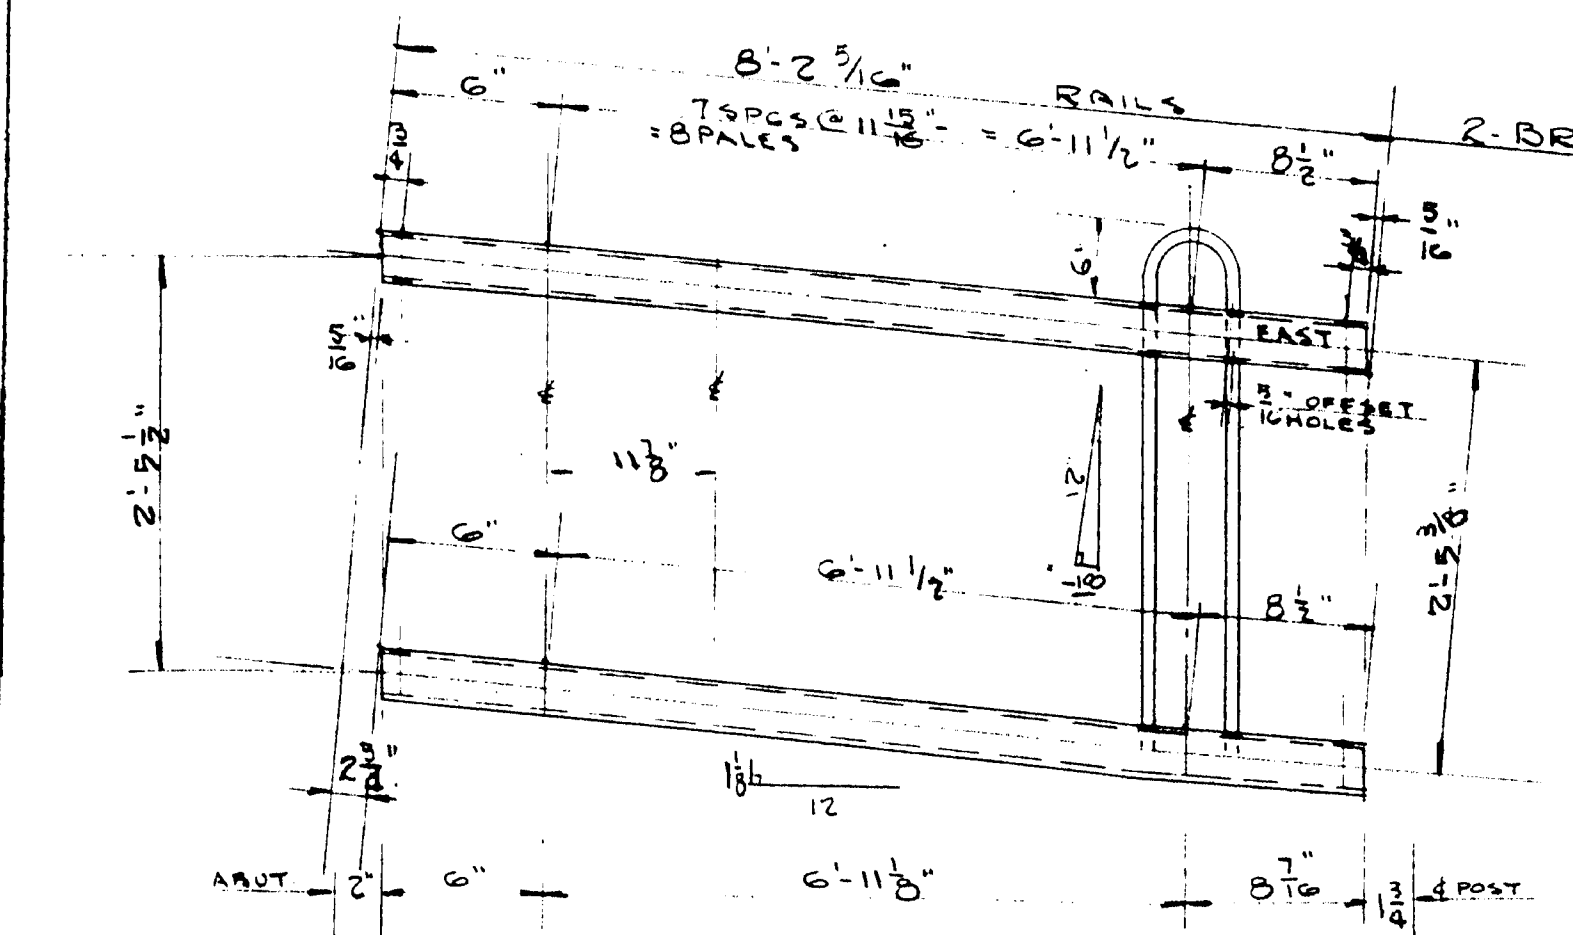








REFERENCES  
SEE TYPICAL DETAILS DWG 51

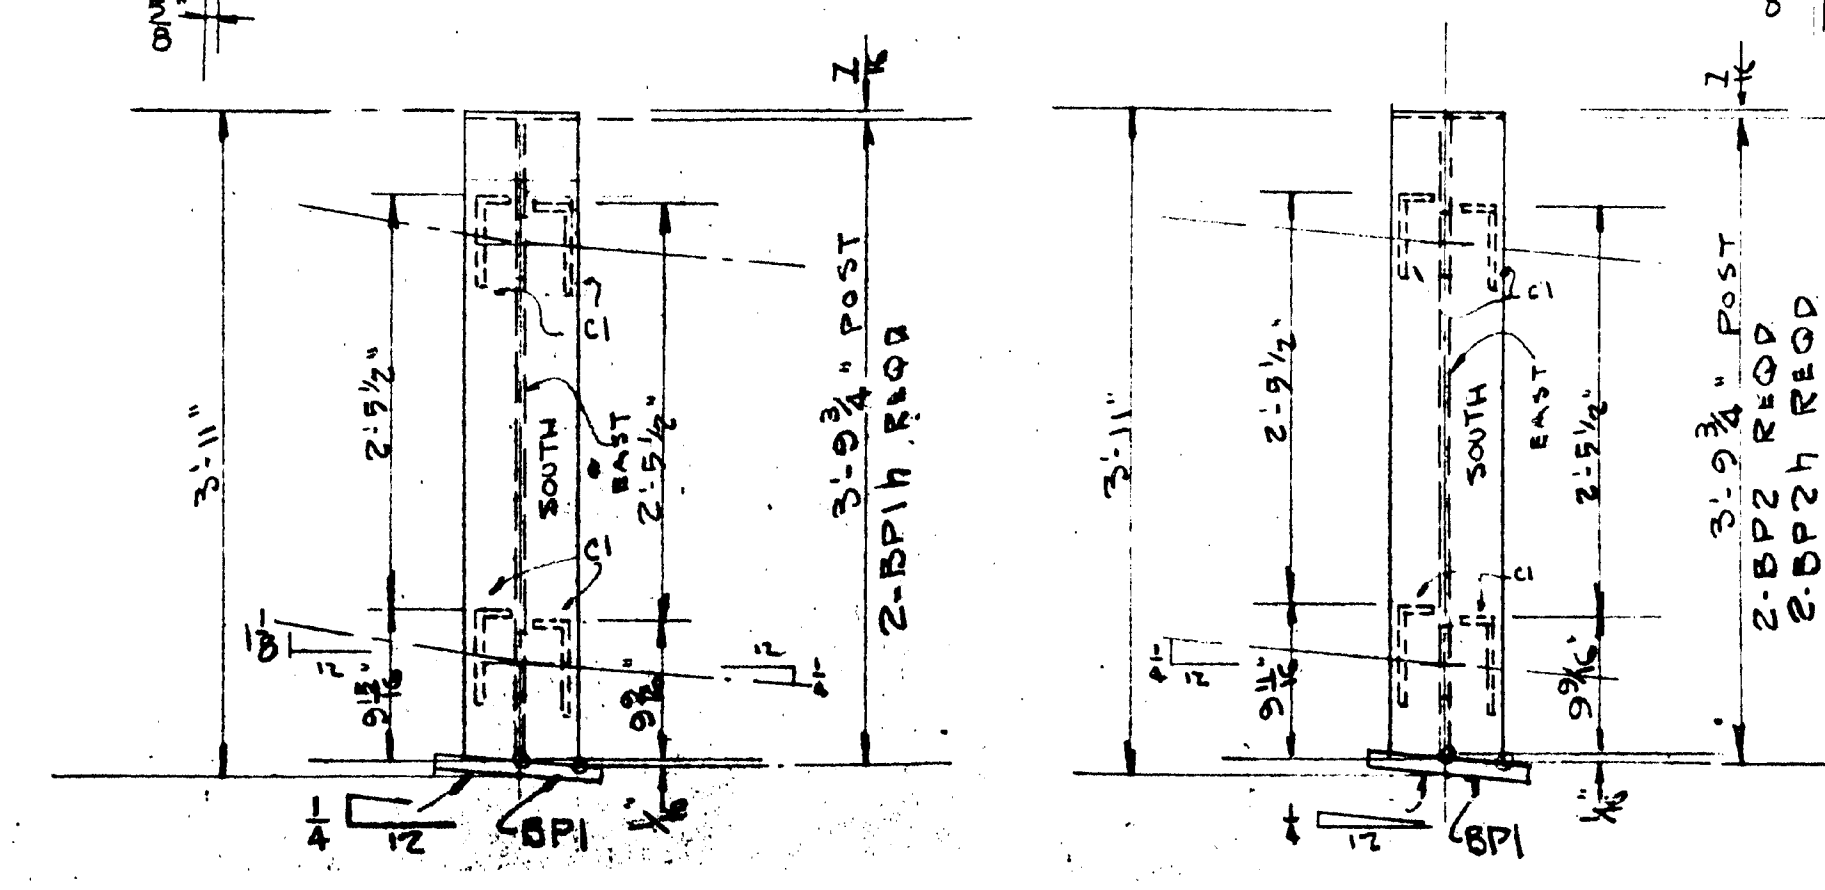

10-BANGOR-BREWER BRIDGE RAIL BREWER ABUTMENT			
DESIGNED BY VERRIER CONST CO.			
APPROVED BY ENGINEER H. & CORTELYOU			
DATE	REVISED	DATE	REVISED
3-5-54	3	6-25-54	5-7-54
BY R.L.B.		BY R.L.B.	
BANGOR & MARTIN ROLLING MILLS CO. 293-54		BANGOR & MARTIN ROLLING MILLS CO. 293-54	





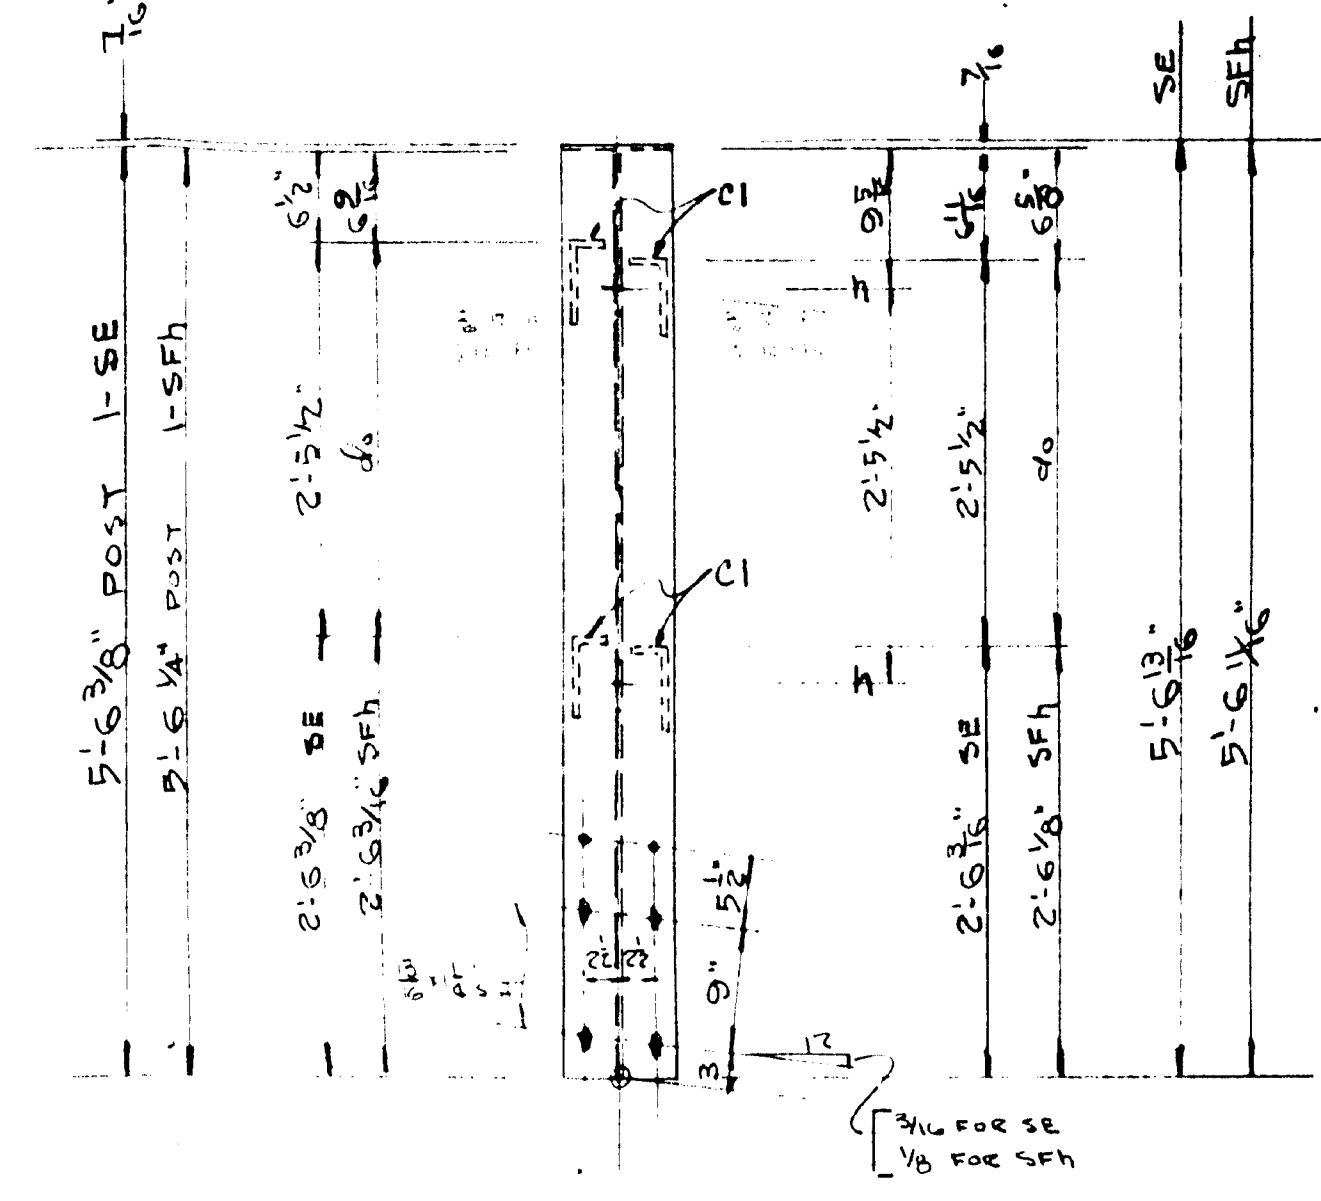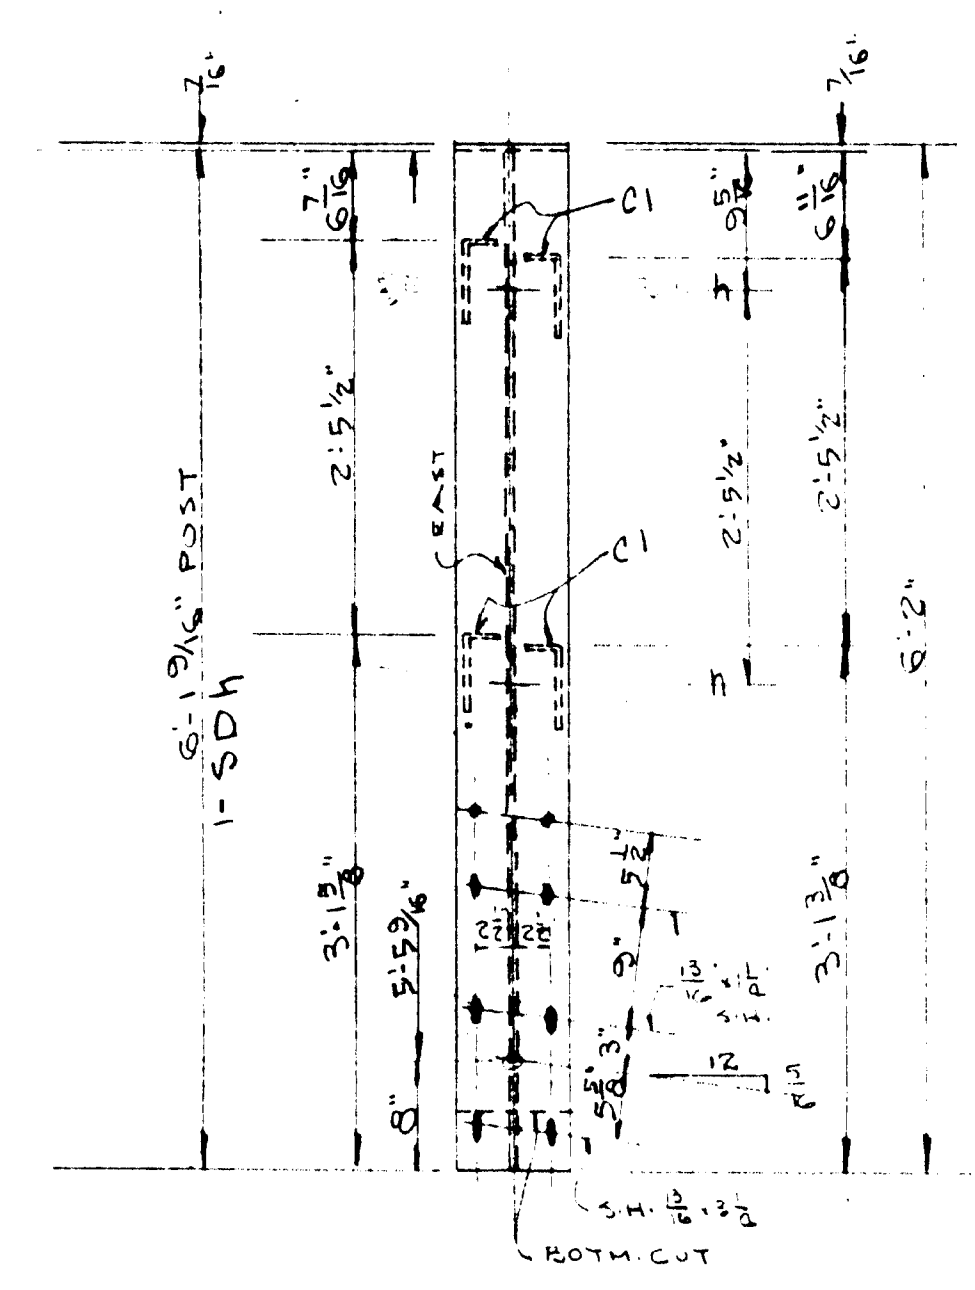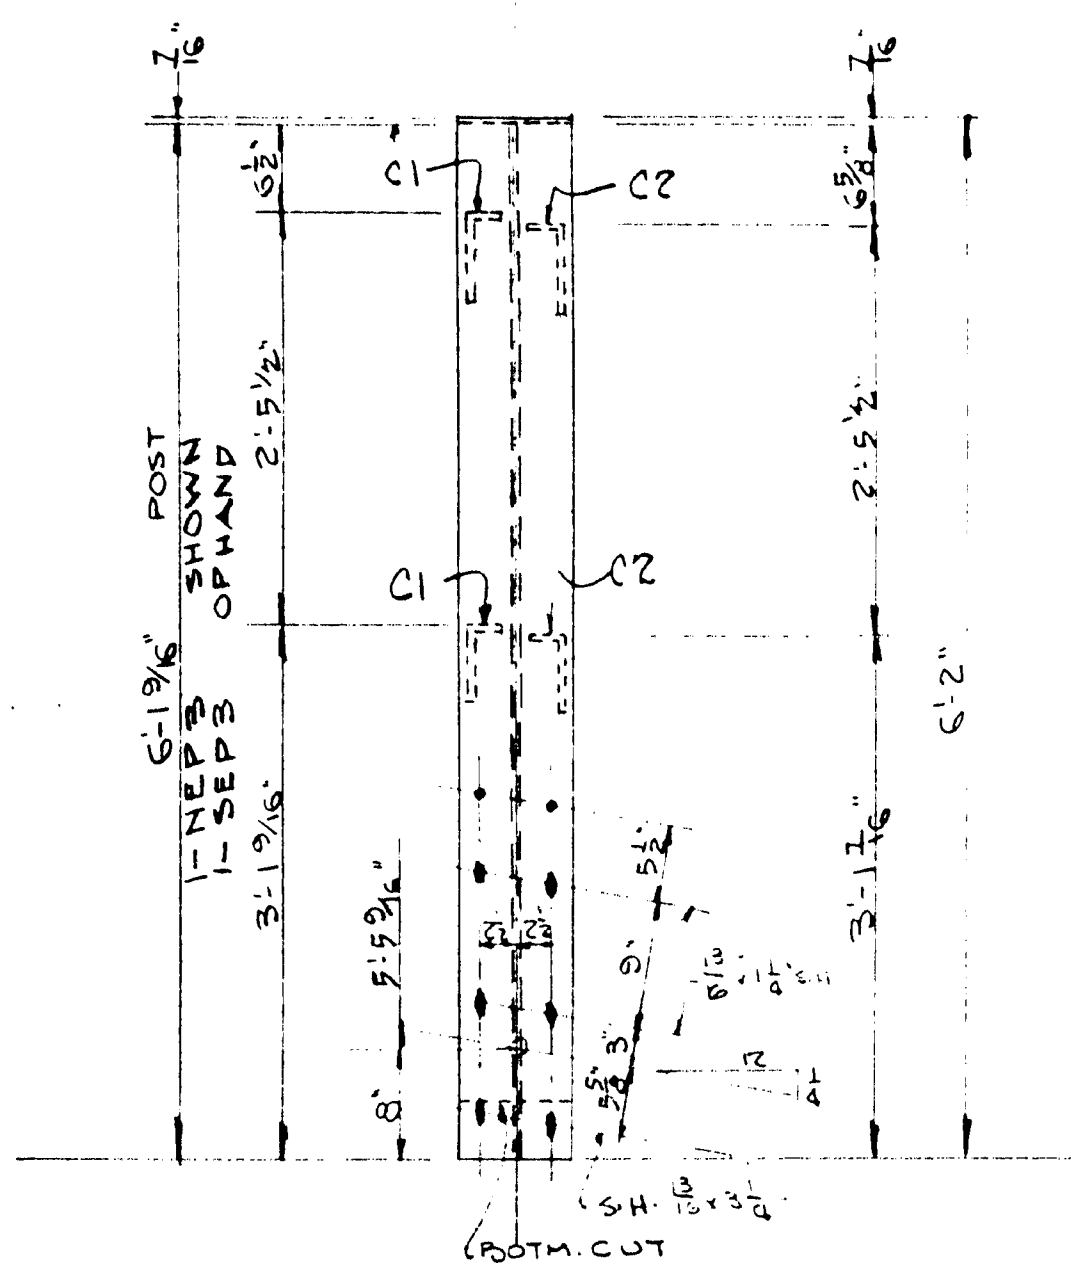
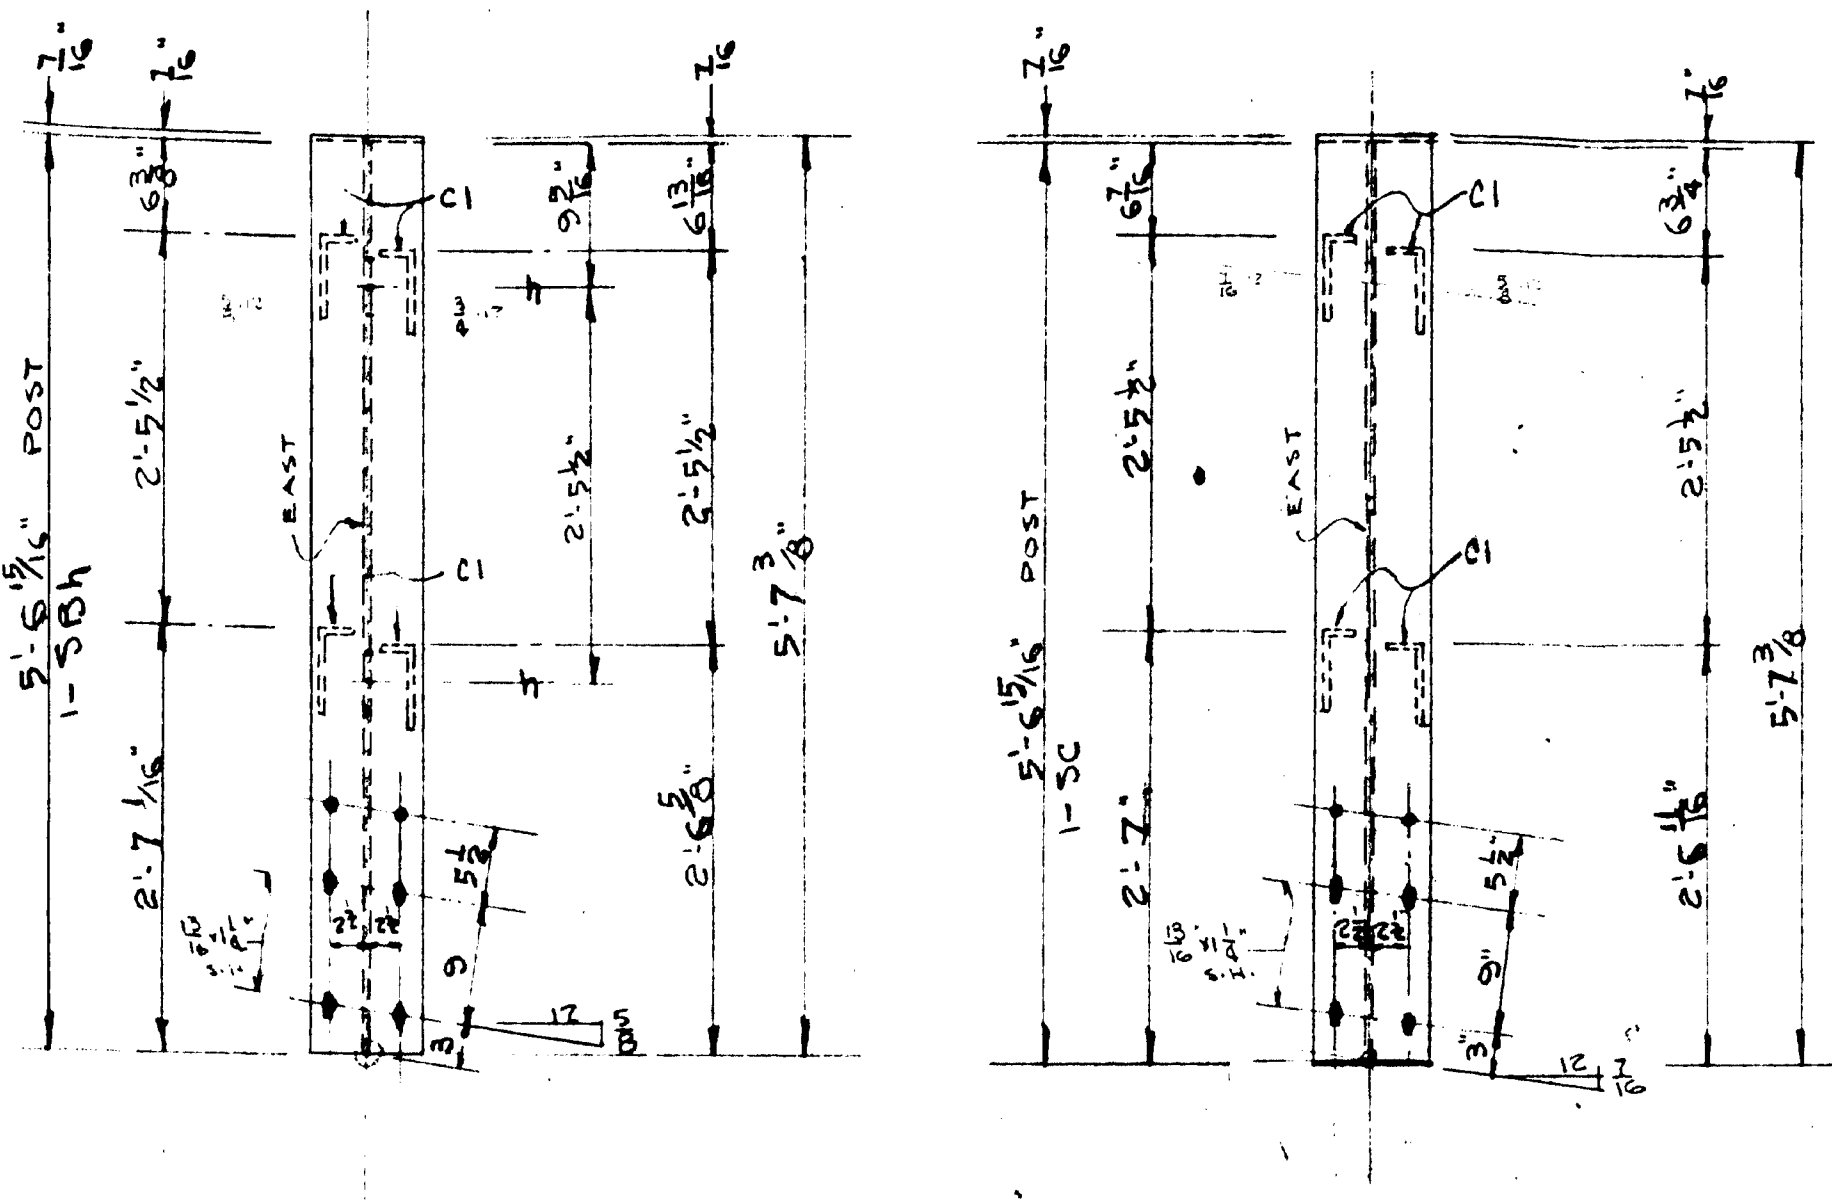
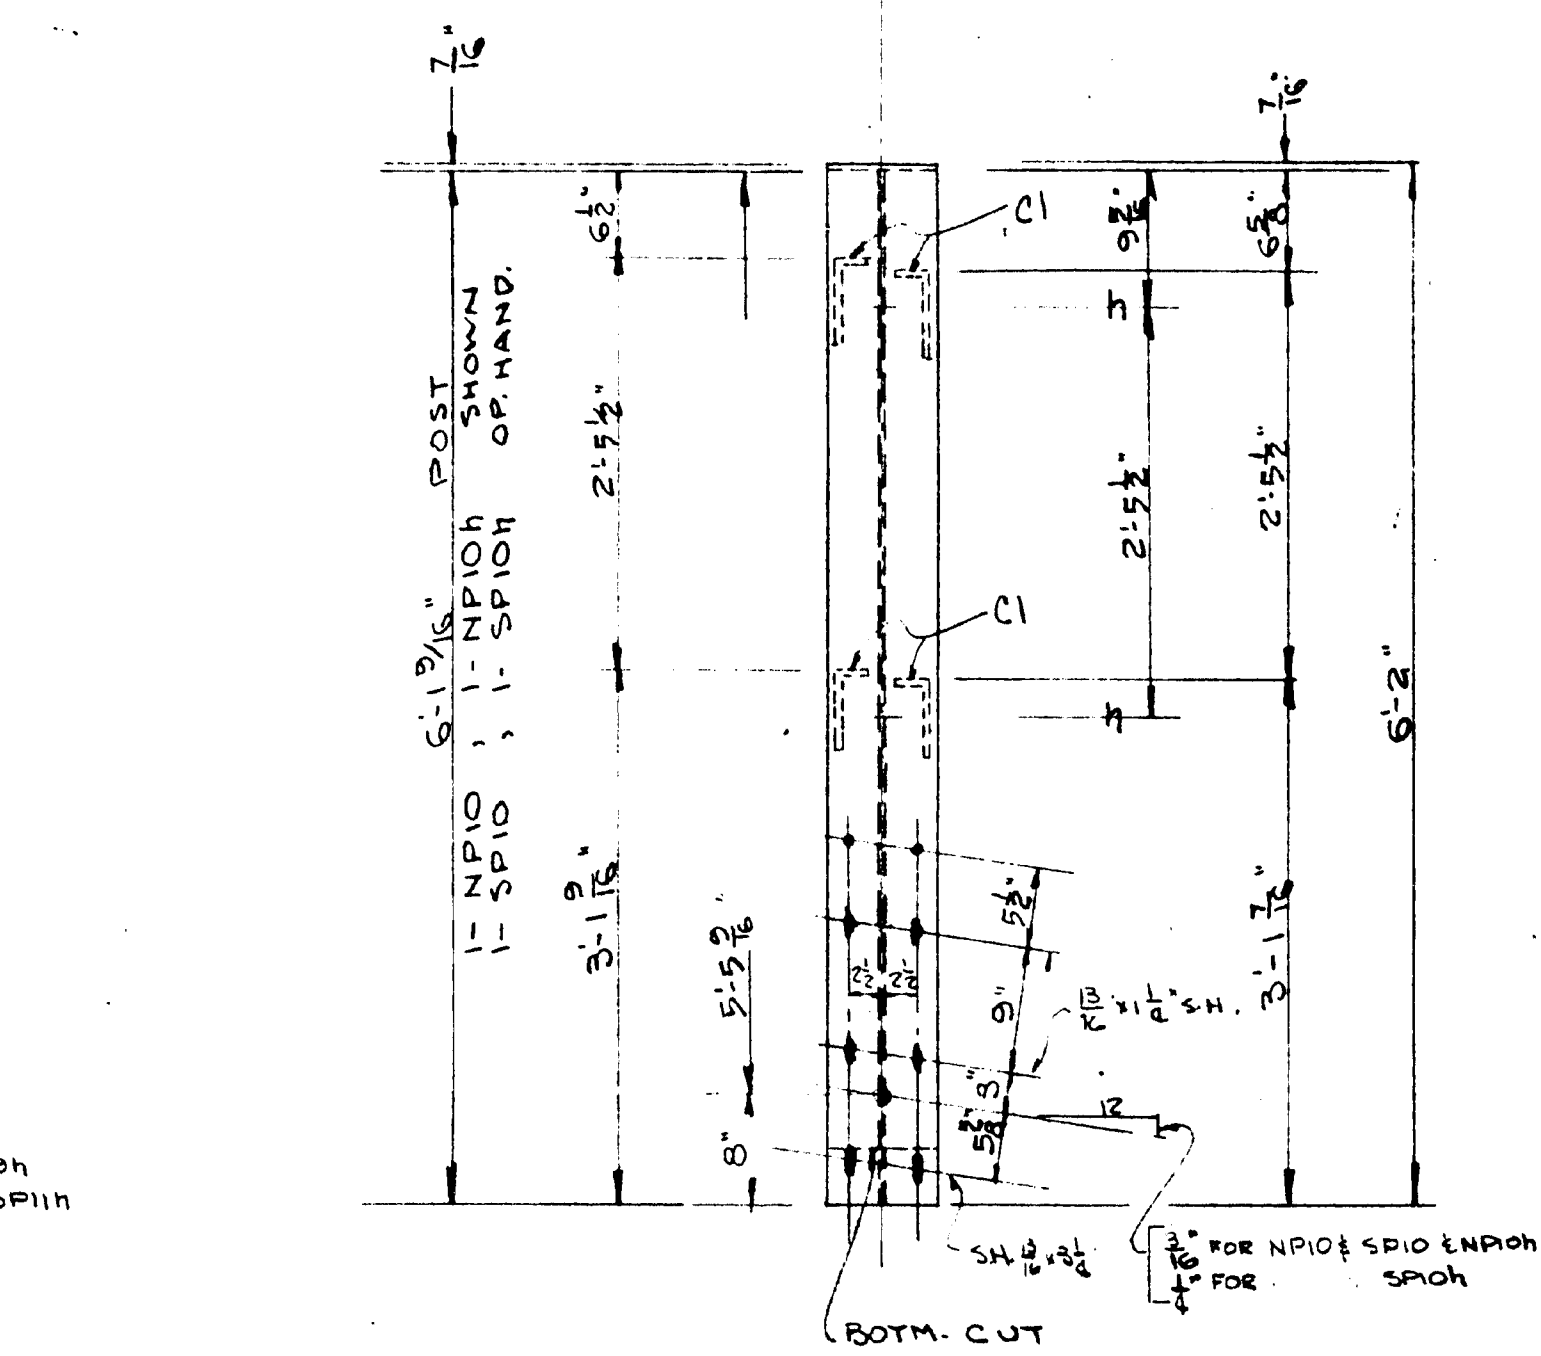
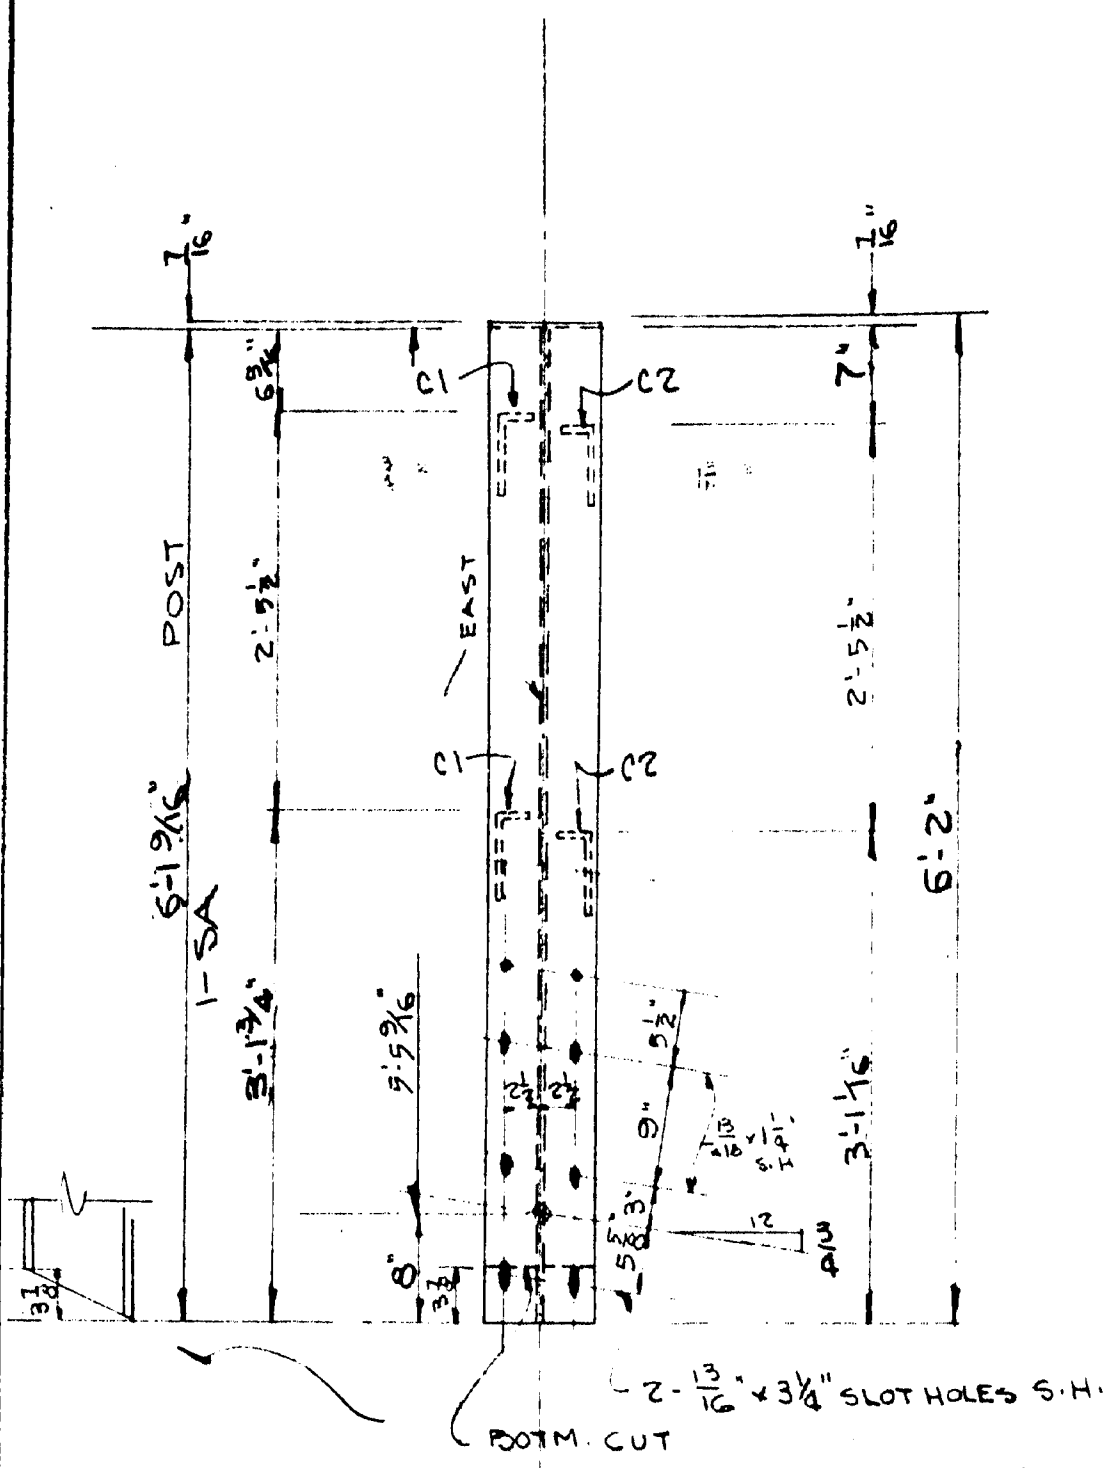
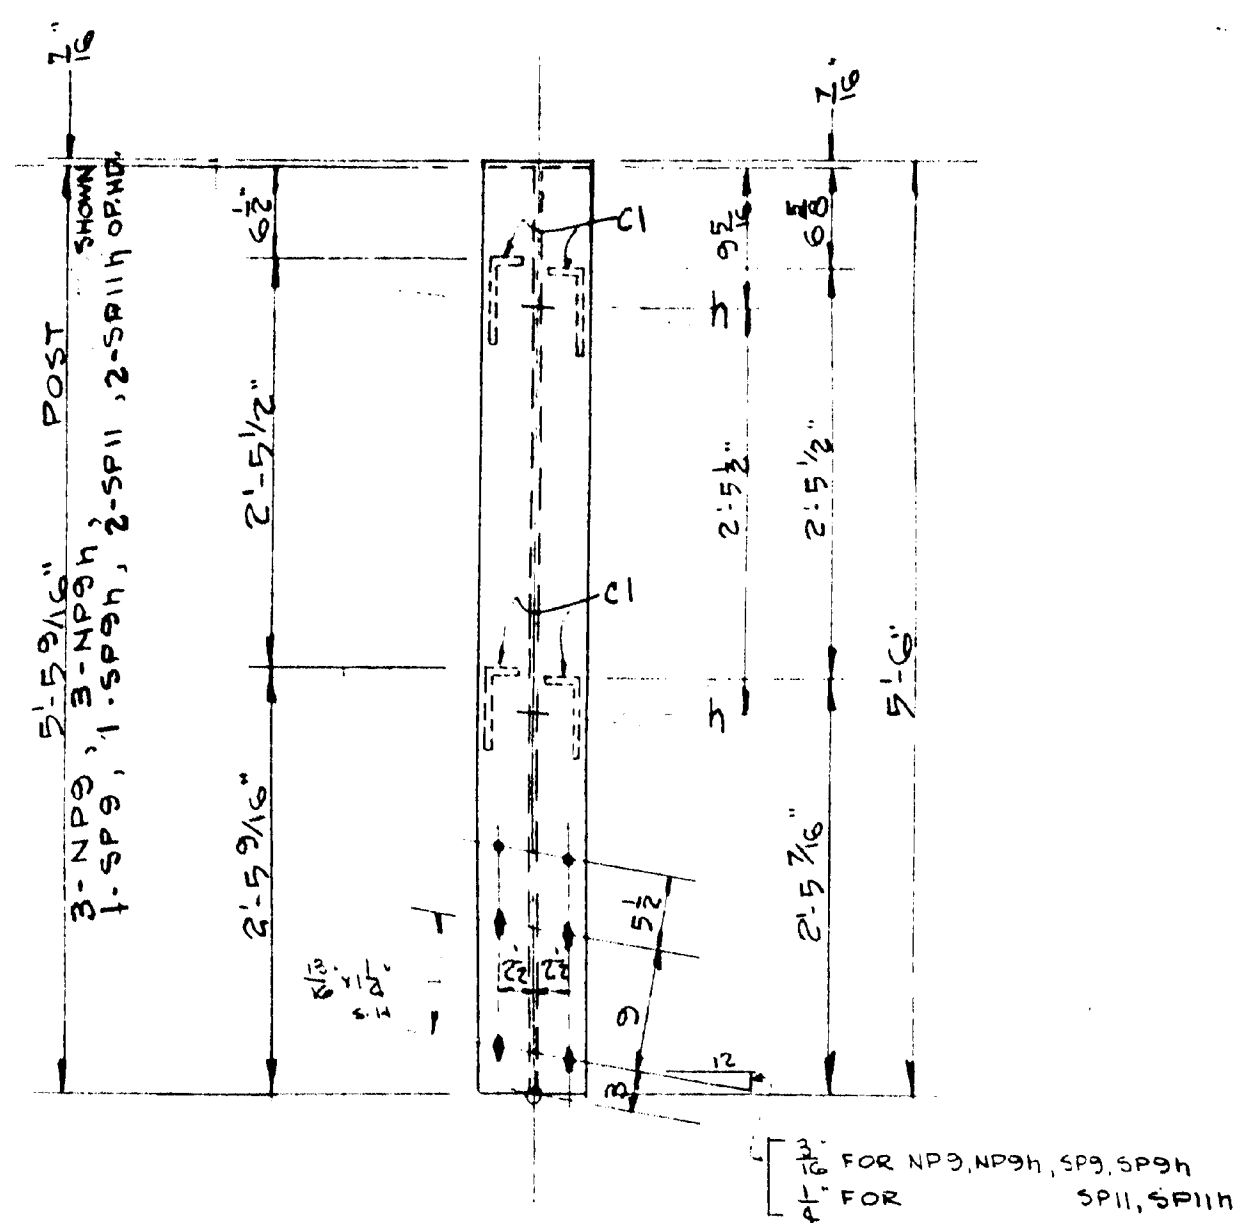


SEE TYPICAL DETAIL DNG 31.  
HOLES 1/2" Ø UNLESS NOTED.  
POSTS 8WF31

DIVISION #1 & 2 POSTS

BANGOR-BREWER BRIDGE RAIL  
POST DETAILS SH#2  
VERRIER CONST. CO.  
REVISION 5-7-54  
R.L.B. 62-24-34  
VERRIER  
BANGOR-BREWER BRIDGE RAIL  
POST DETAILS SH#2  
VERRIER CONST. CO.  
REVISION 5-7-54  
R.L.B. 62-24-34  
VERRIER  
BANGOR-BREWER BRIDGE RAIL  
POST DETAILS SH#2  
VERRIER CONST. CO.  
REVISION 5-7-54  
R.L.B. 62-24-34  
VERRIER

0 1 2 3 4 5 INCHES

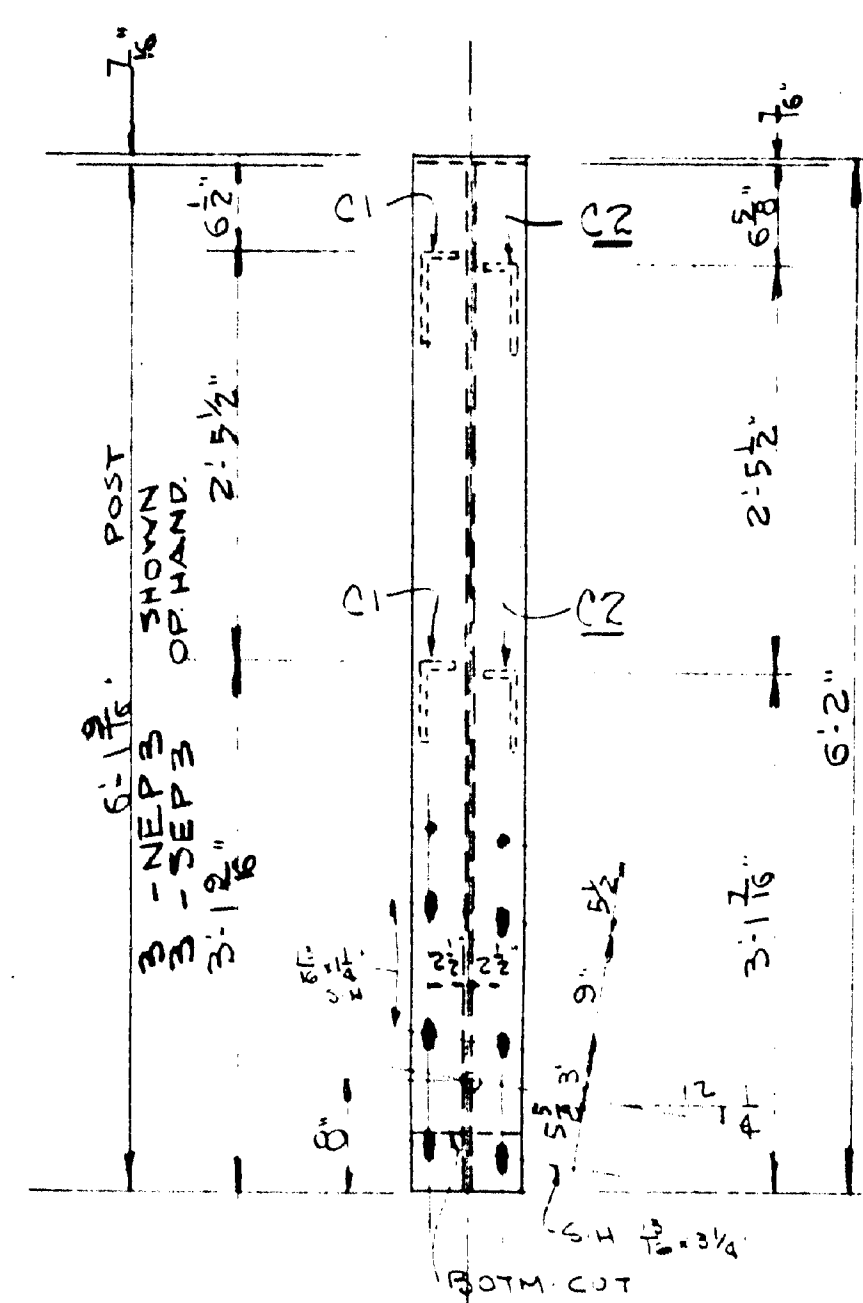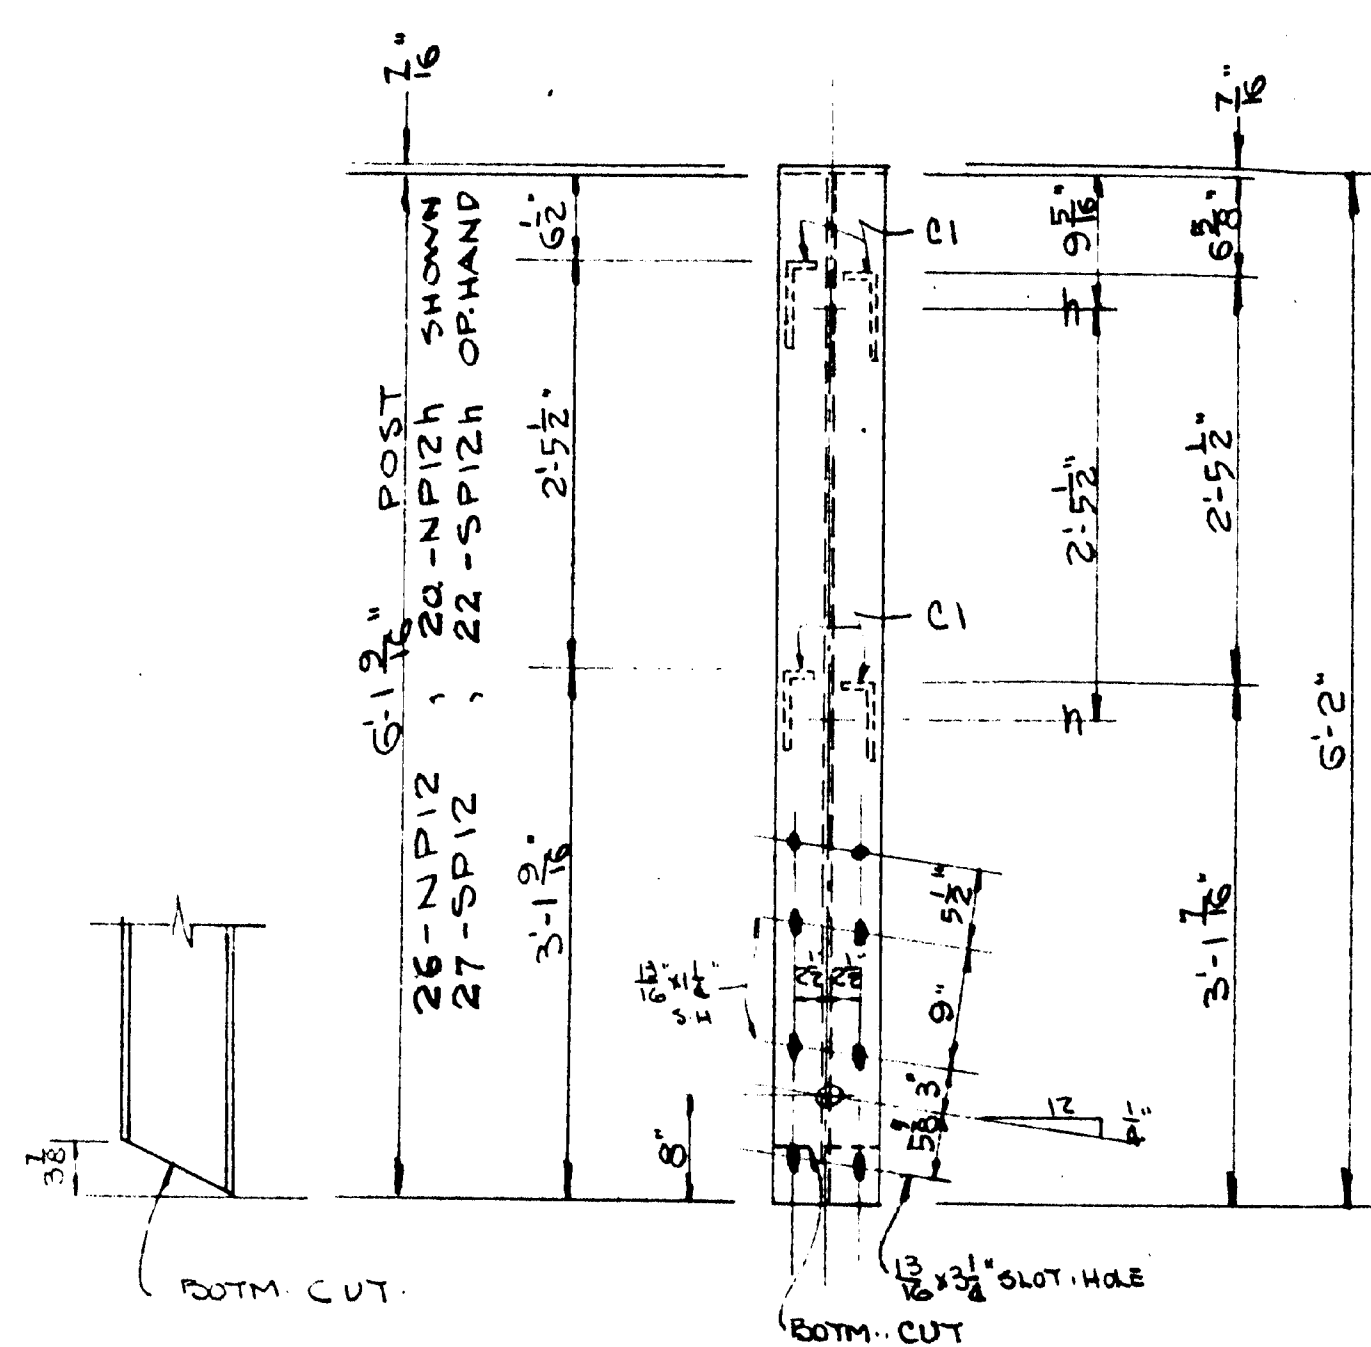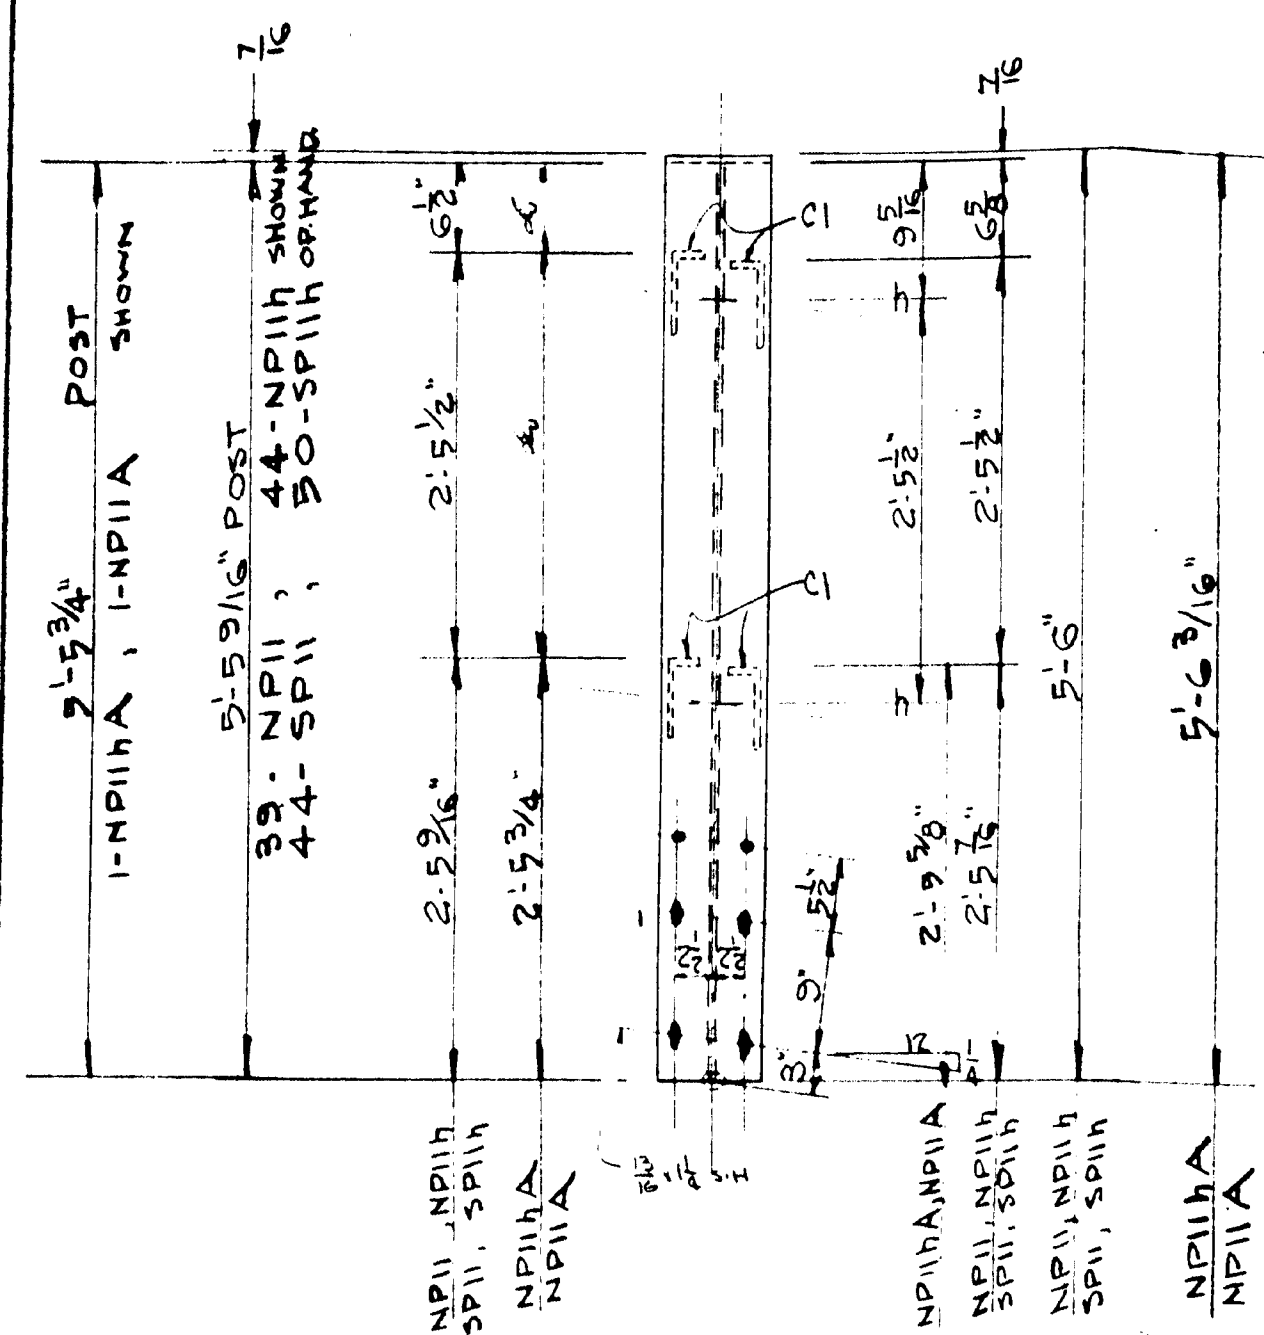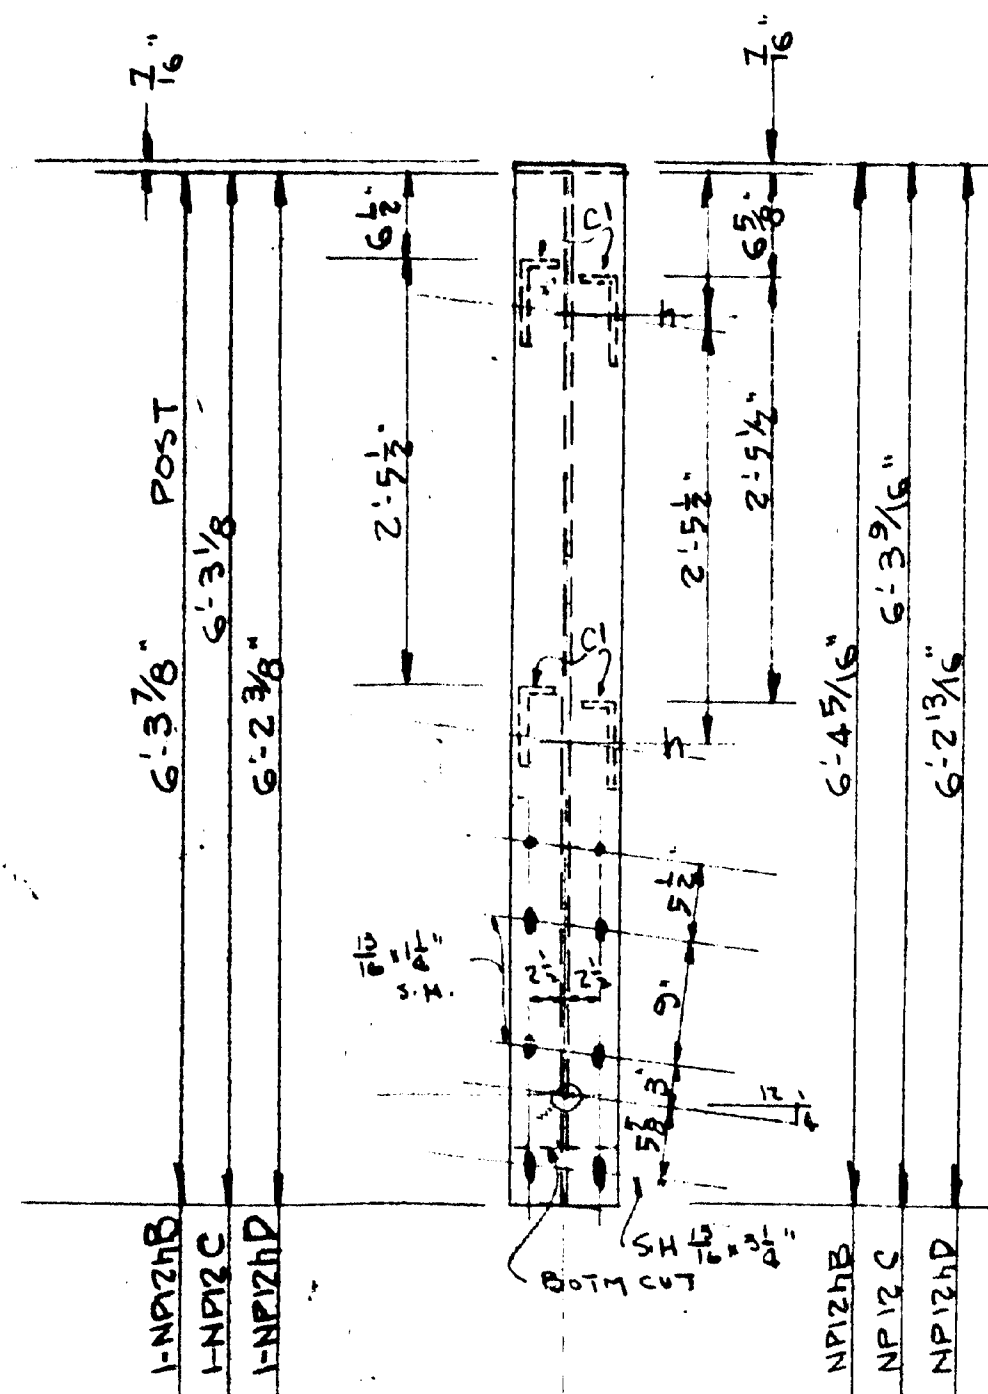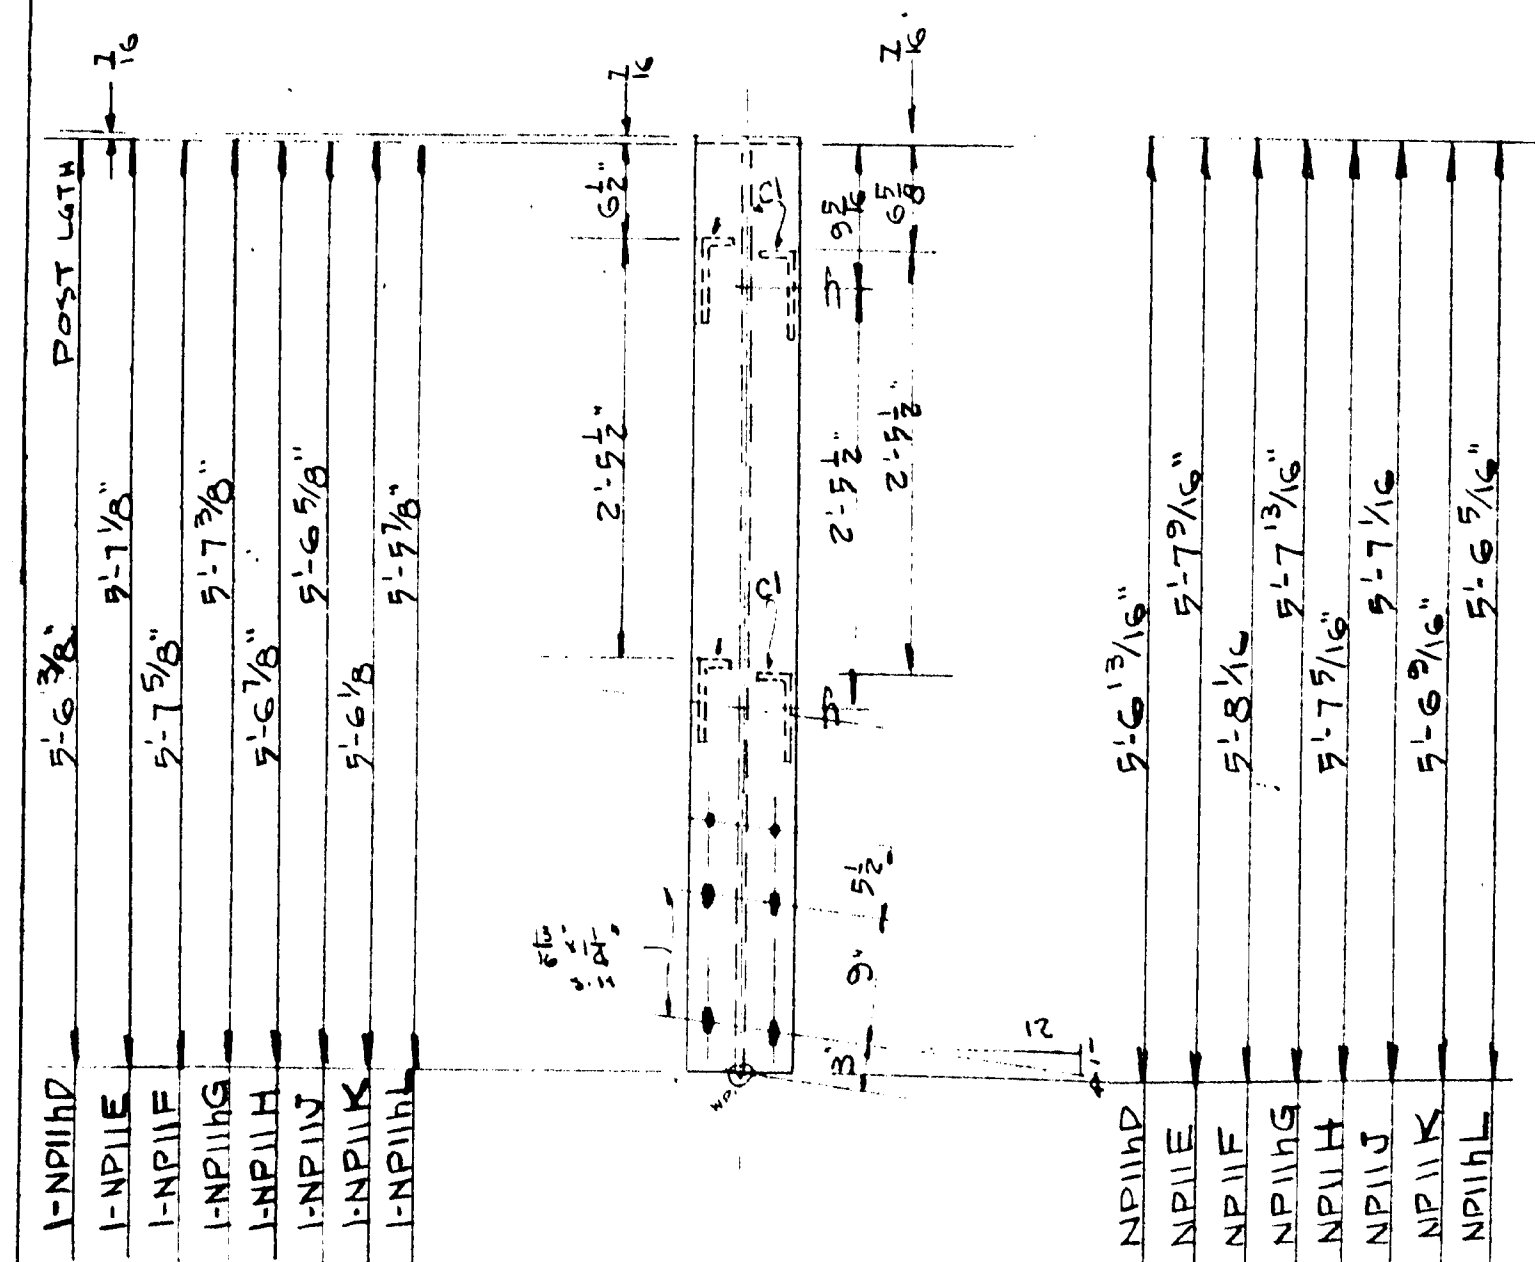




SEE TYPICAL DETAILS DWG 51  
HOLES 1/8" UNLESS NOTED.  
D.P. CUT RED LEAD.

PRINTS ISSUED			
NO.	DATE	BY	REASON
3	4-1-54	3	6-25-54
3	7-7-54	3	7-23-54


CUSTOMER ORDER NO. VERMONT  
APPROVAL DATE: 7-1-54




JOB BANGOR-BREWER BRIDGE RAIL  
POST DETAILS  
CUSTOMER VERRIER CONST. CO.  
ARCHITECT OR ENGINEER H. & CORTELYOU  
DATE 4-1-54 REVISED 7-7-54  
BY R. C. S. BY 62-100A  
BANCROFT & MARTIN ROLLING MILLS CO. 293-57



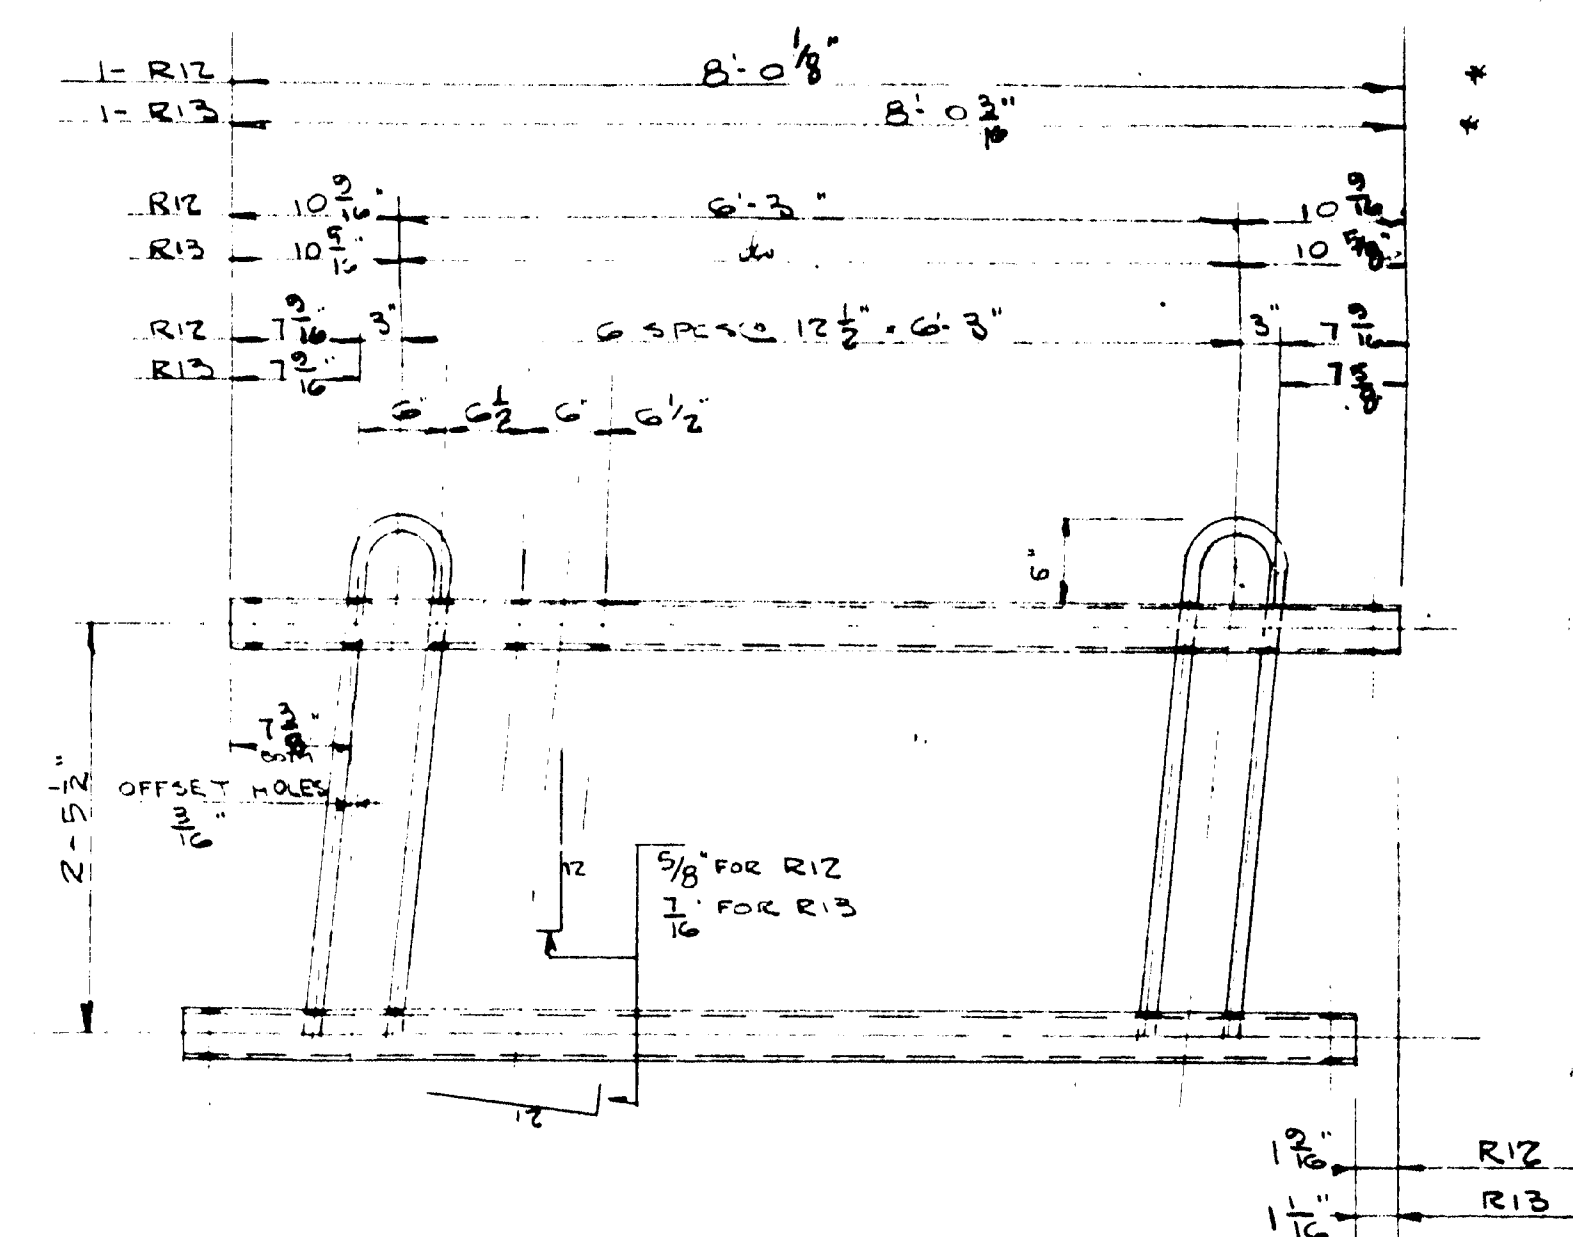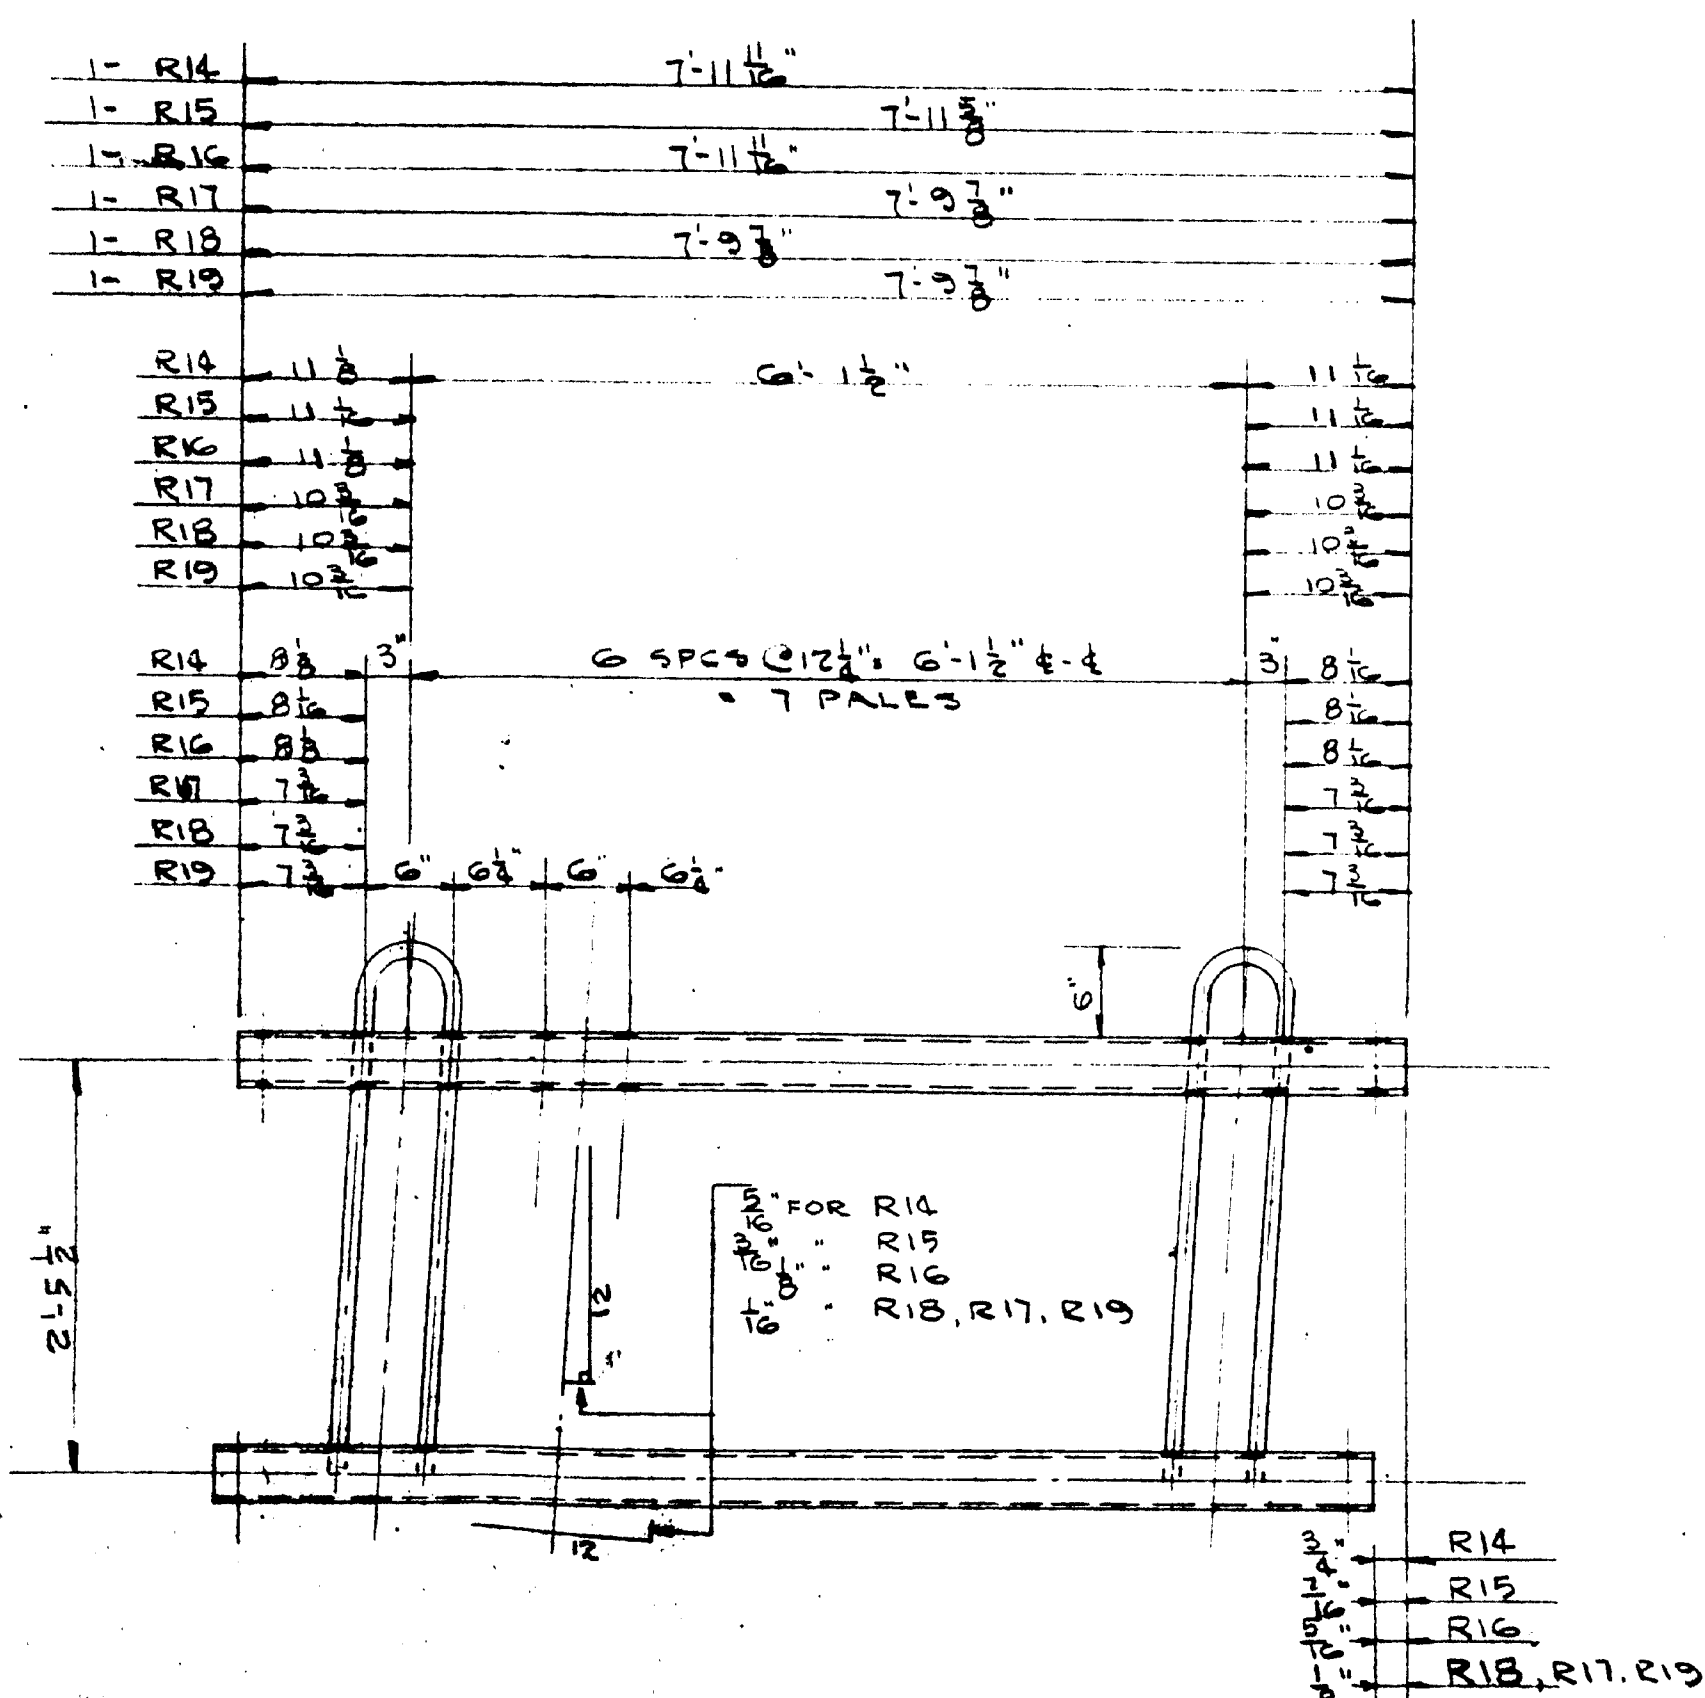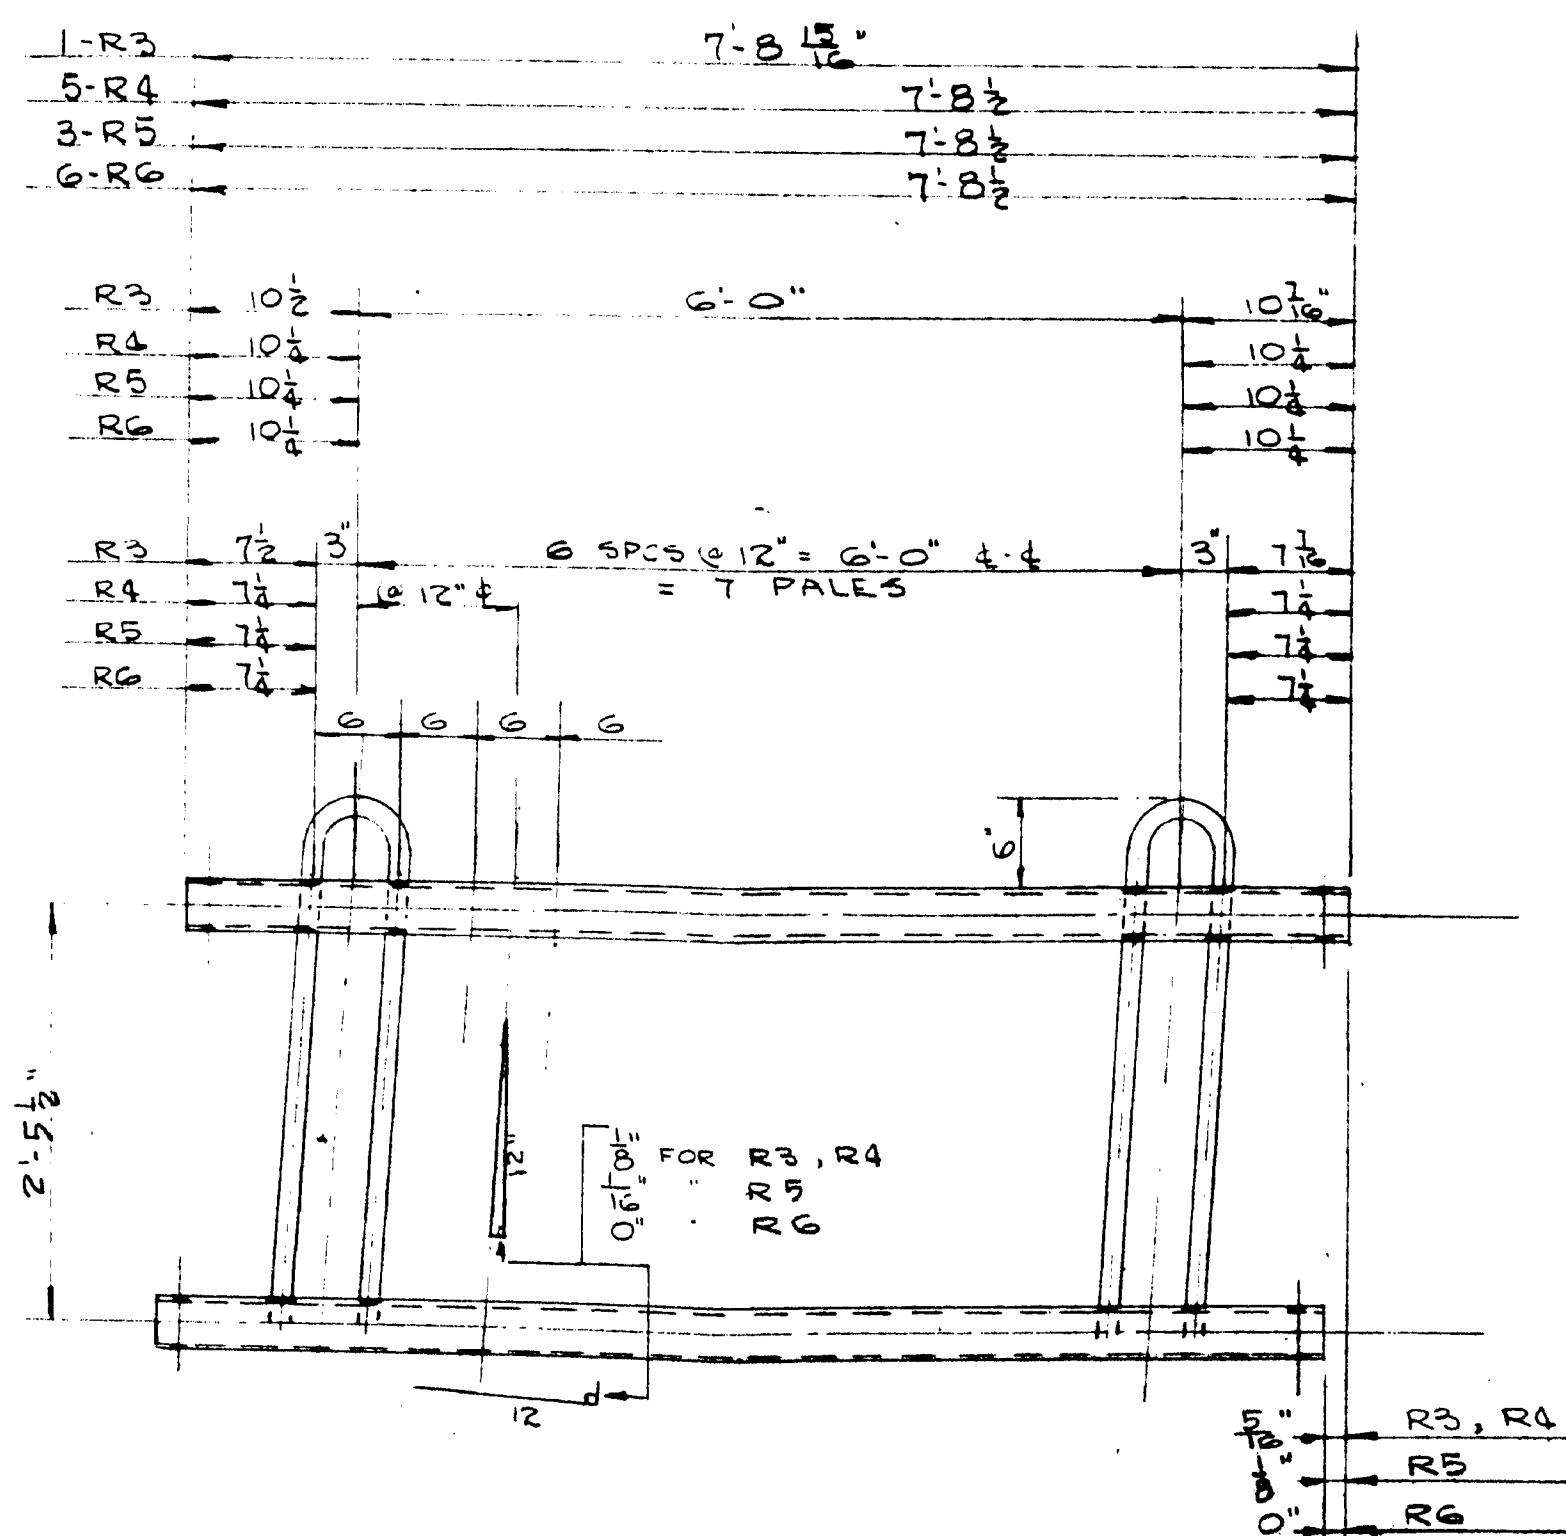

BANGOR-BREWER BRIDGE RAIL  
RAIL DETAILS SH#1  
VERRIER CONST. CO.  
H. & CORTELOU  
DATE 4-1-54 REVISED 7-7-54  
BY R.L.D. BY 628-1001  
BANDROFF & MARTIN ROLLING MILLS CO. 293-54

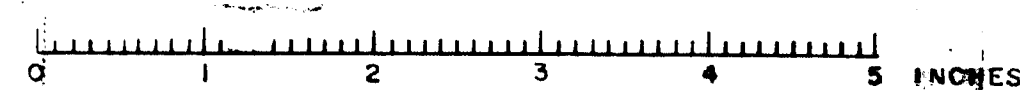

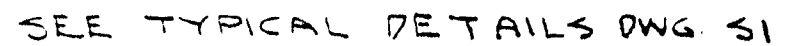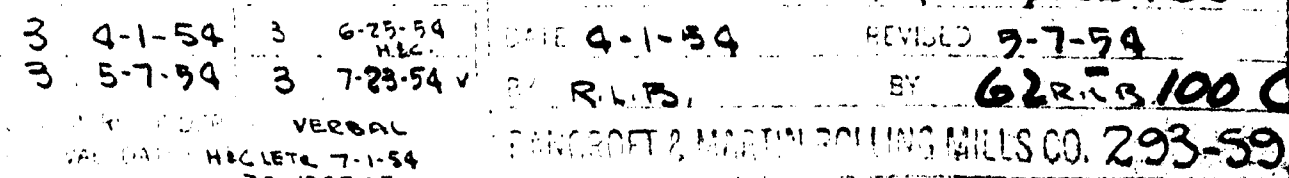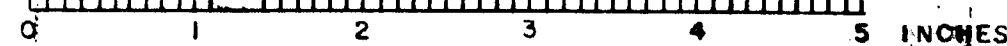


BANGOR-BREWER BRIDGE RAIL  
RAIL DETAILS 3H42  
COLUMBIA VERRIER CONST. CO.  
ARCHITECT & ENGINEER H. & CORTLEYOU  
DATE 4-1-54 REVISED 7-7-54  
BY R.L.B. 62-5100  
BANGOR & MARTIN ROLLING MILLS CO. 293-5

2-R45	5'-7"
1-R46	5'-6 $\frac{13}{16}$ "
2-R50	5'-11 $\frac{13}{16}$ "
1-R51	5'-11 $\frac{3}{8}$ "
2-R63	5'-6 $\frac{7}{8}$ "
1-R64	5'-6 $\frac{13}{16}$ "
1-R68	5'-10 $\frac{3}{16}$ "
1-R69	5'-10 $\frac{1}{8}$ "
3-R70	5'-11 $\frac{1}{2}$ "
3-R72	5'-6"
4-R74	6'-0 $\frac{13}{16}$ "
2-R75	6'-0 $\frac{7}{8}$ "
6-R76	6'-0 $\frac{11}{16}$ "

R45	9"	4'-1 $\frac{1}{4}$ "	9"
R46	9"		8 $\frac{15}{16}$ "
R50	11 $\frac{3}{8}$ "		11 $\frac{7}{16}$ "
R51	11 $\frac{3}{8}$ "		11 $\frac{3}{8}$ "
R63	8 $\frac{15}{16}$ "		8 $\frac{3}{8}$ "
R64	8 $\frac{15}{16}$ "		8 $\frac{3}{8}$ "
R68	10 $\frac{3}{8}$ "		10 $\frac{3}{16}$ "
R69	10 $\frac{3}{8}$ "		10 $\frac{1}{2}$ "
R70	11 $\frac{1}{2}$ "		11 $\frac{1}{2}$ "
R72	8 $\frac{1}{2}$ "		8 $\frac{1}{2}$ "
R74	11 $\frac{15}{16}$ "		11 $\frac{1}{8}$ "
R75	11 $\frac{15}{16}$ "		11 $\frac{15}{16}$ "
R76	11 $\frac{1}{8}$ "		11 $\frac{15}{16}$ "

R45	6"	4 SPCS @ 12 $\frac{1}{2}$ " = 4'-1" ±	3' 6"
R46	6"	= 9 PALES	5 $\frac{15}{16}$ "
R50	8 $\frac{3}{8}$ "		8 $\frac{7}{8}$ "
R51	8 $\frac{3}{8}$ "		8 $\frac{3}{8}$ "
R63	5 $\frac{13}{16}$ "		5 $\frac{15}{16}$ "
R64	5 $\frac{13}{16}$ "		5 $\frac{3}{8}$ "
R68	7 $\frac{3}{8}$ "		7 $\frac{7}{8}$ "
R69	7 $\frac{3}{8}$ "		7 $\frac{1}{2}$ "
R70	8 $\frac{1}{4}$ "		8 $\frac{1}{2}$ "
R72	5 $\frac{1}{2}$ "		5 $\frac{1}{2}$ "
R74	8 $\frac{15}{16}$ "		8 $\frac{3}{8}$ "
R75	8 $\frac{15}{16}$ "		8 $\frac{15}{16}$ "
R76	8 $\frac{1}{8}$ "		8 $\frac{3}{8}$ "

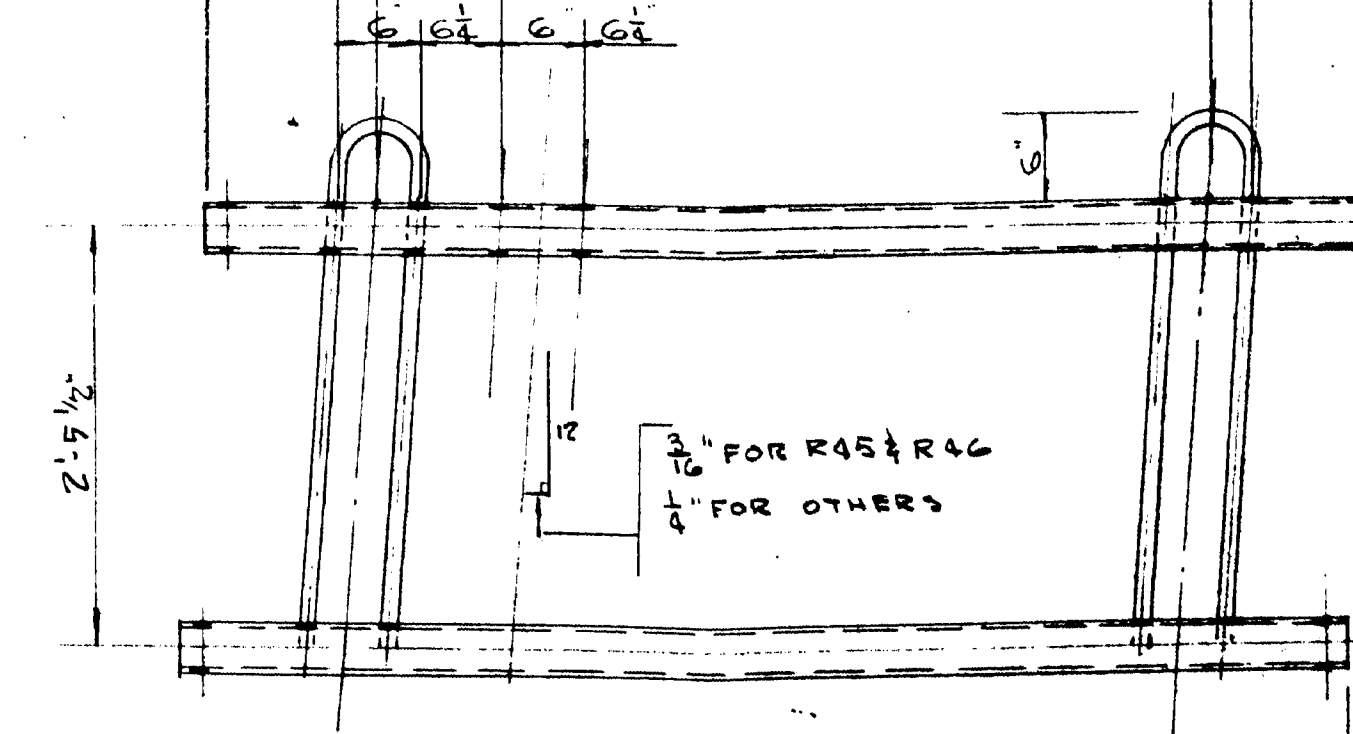


5" - ALL OTHERS  
7" - R45, R46

2-R47	6'-11 $\frac{1}{2}$ "
2-R48	6'-11 $\frac{15}{16}$ "
2-R56	6'-11 $\frac{1}{16}$ "
3-R57	6'-9 $\frac{7}{8}$ "
2-R58	6'-9 $\frac{11}{16}$ "
1-R59	6'-9 $\frac{3}{8}$ "
1-R60	7'-0"
2-R65	6'-10"
2-R66	6'-10 $\frac{11}{16}$ "
2-R67	7'-0 $\frac{3}{16}$ "
23-R71	6'-8 $\frac{3}{16}$ "
2-R77	6'-8"
3-R80	6'-6 $\frac{1}{2}$ "

R47	11"	5'-1 $\frac{1}{2}$ "	11"
R48	11 $\frac{3}{8}$ "		11 $\frac{3}{8}$ "
R56	10 $\frac{15}{16}$ "		10 $\frac{13}{16}$ "
R57	10 $\frac{5}{8}$ "		10 $\frac{3}{8}$ "
R58	10 $\frac{3}{8}$ "		10 $\frac{3}{16}$ "
R59	10 $\frac{1}{2}$ "		10 $\frac{1}{8}$ "
R60	11 $\frac{3}{8}$ "		11 $\frac{3}{8}$ "
R65	10 $\frac{3}{8}$ "		10 $\frac{3}{8}$ "
R66	10 $\frac{3}{8}$ "		10 $\frac{11}{16}$ "
R67	11 $\frac{1}{2}$ "		11 $\frac{7}{16}$ "
R71	9 $\frac{11}{16}$ "		9 $\frac{5}{8}$ "
R77	9 $\frac{3}{8}$ "		9 $\frac{3}{8}$ "
R80	8 $\frac{5}{8}$ "		8 $\frac{5}{8}$ "


R47	8"	5 SPCS @ 12 $\frac{1}{2}$ " = 5'-1 $\frac{1}{2}$ " ±	3' 8"
R48	8 $\frac{3}{8}$ "	= 6 PALES	8 $\frac{5}{8}$ "
R56	7 $\frac{15}{16}$ "		7 $\frac{1}{2}$ "
R57	7 $\frac{7}{8}$ "		7 $\frac{13}{16}$ "
R58	7 $\frac{1}{2}$ "		7 $\frac{1}{8}$ "
R59	7 $\frac{1}{2}$ "		7 $\frac{1}{8}$ "
R60	8 $\frac{3}{8}$ "		8 $\frac{3}{8}$ "
R65	7 $\frac{3}{8}$ "		7 $\frac{3}{8}$ "
R66	7 $\frac{1}{2}$ "		7 $\frac{11}{16}$ "
R67	8 $\frac{1}{2}$ "		8 $\frac{1}{2}$ "
R71	6 $\frac{11}{16}$ "		6 $\frac{5}{8}$ "
R77	6 $\frac{5}{8}$ "		6 $\frac{5}{8}$ "
R80	5 $\frac{5}{8}$ "		5 $\frac{5}{8}$ "

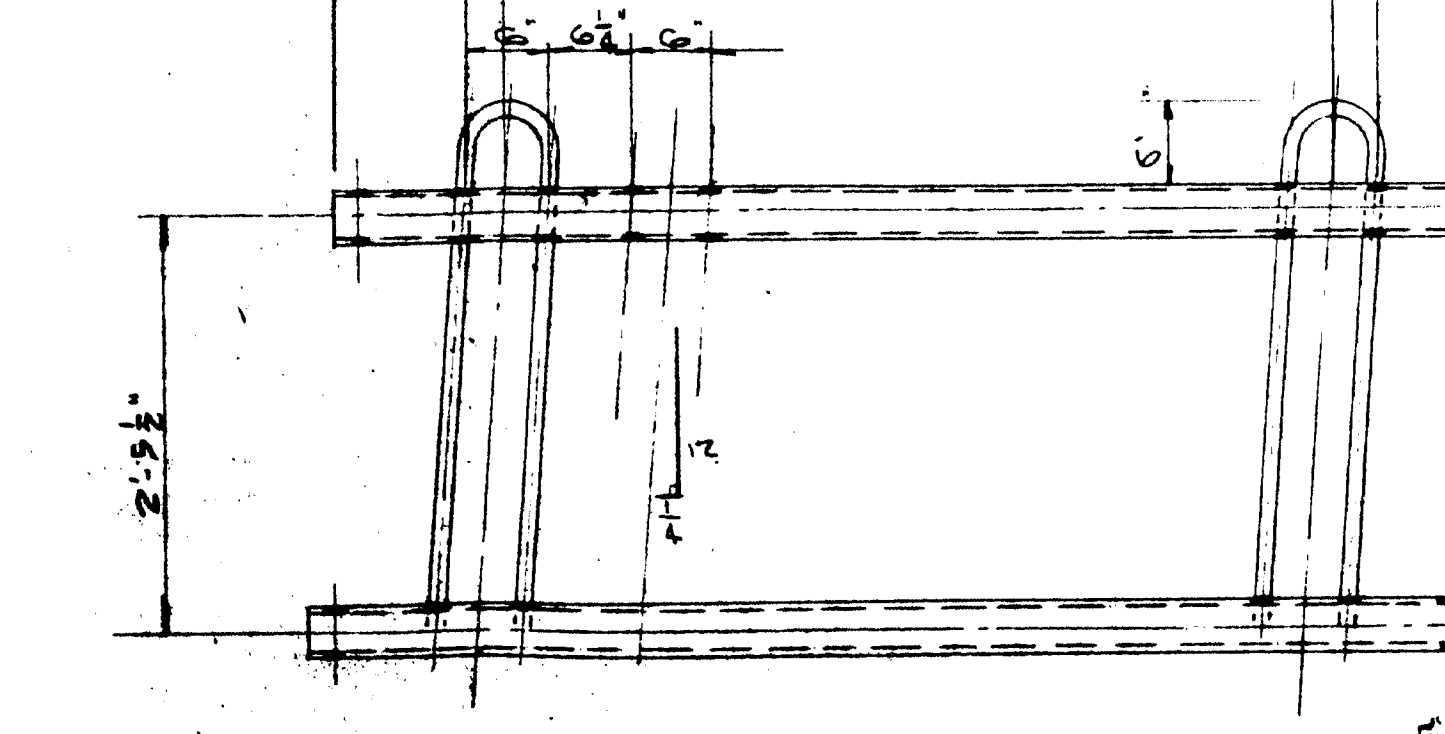

7-754  
\*REVISED QUANTITIES OF  
R47 FROM 4 TO 5


16-R84	6'-8 $\frac{7}{16}$ "
32-R85	6'-10 $\frac{13}{16}$ "
16-R86	6'-10 $\frac{3}{8}$ "
8-R87	6'-11 $\frac{1}{8}$ "
4-R90	6'-8 $\frac{5}{8}$ "
4-R91	6'-8 $\frac{11}{16}$ "
4-R92	6'-8 $\frac{7}{16}$ "

R84	9 $\frac{1}{8}$ "	5'-1 $\frac{1}{2}$ "	9 $\frac{1}{8}$ "
R85	10 $\frac{13}{16}$ "		10 $\frac{3}{4}$ "
R86	10 $\frac{13}{16}$ "		10 $\frac{13}{16}$ "
R87	10 $\frac{15}{16}$ "		10 $\frac{15}{16}$ "
R90	9 $\frac{1}{2}$ "		9 $\frac{1}{2}$ "
R91	9 $\frac{1}{2}$ "		9 $\frac{1}{2}$ "
R92	9 $\frac{1}{2}$ "		9 $\frac{1}{2}$ "







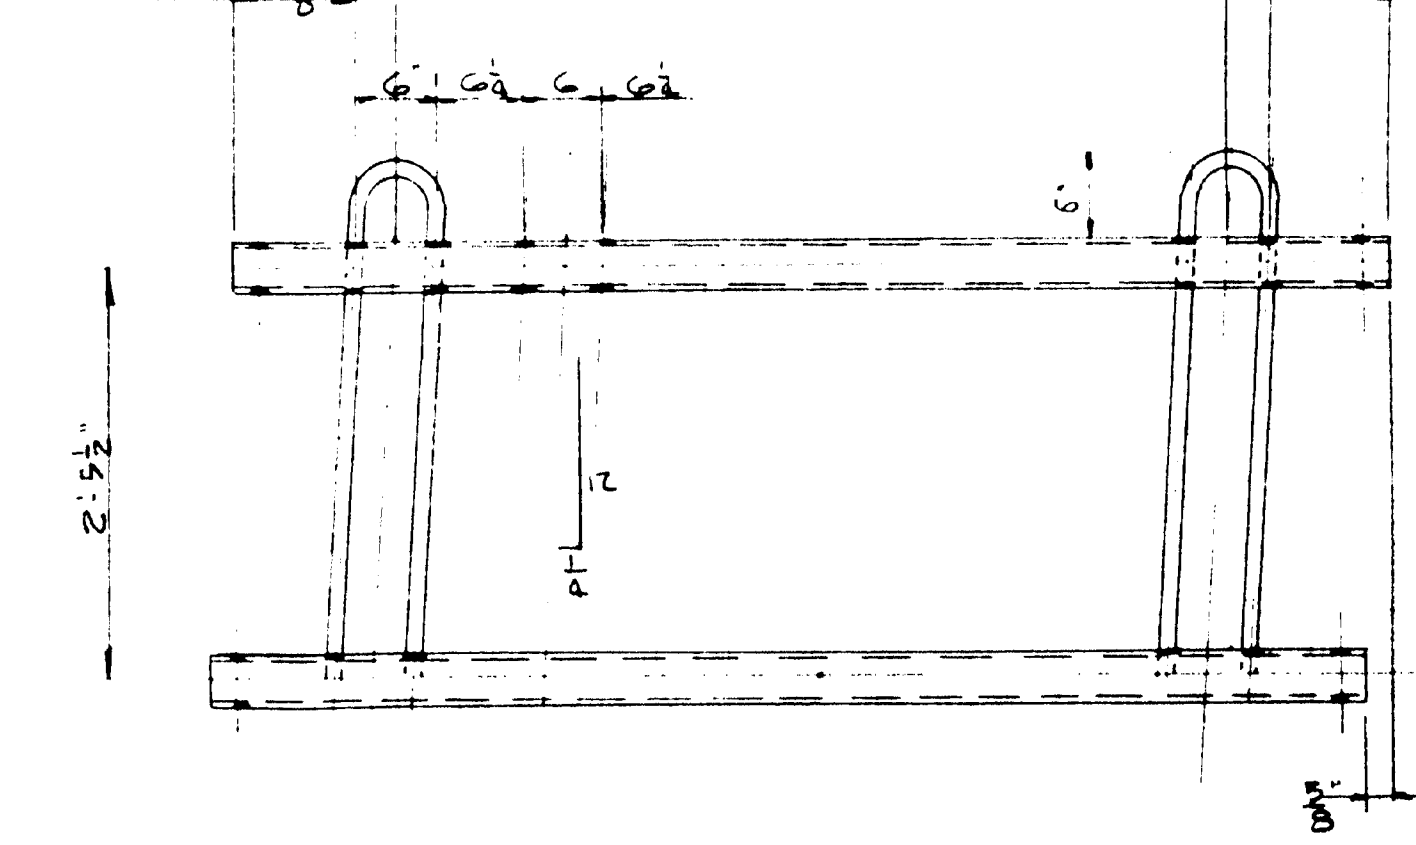


SEE TYPICAL DETAILS DWG 51

BANGOR-BREWER BRIDGE- RAIL  
RAIL DETAILS SH#3  
VERRIER CONST. CO  
H. # CORTELYOU  
7-754  
4-1-54  
5-7-54  
7-23-54  
H.C. LEBER 7-1-54  
BANGOR & MARTIN ROLLING MILLS CO. 293-500

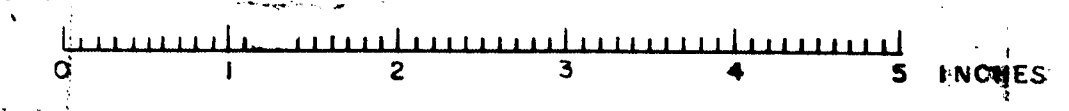









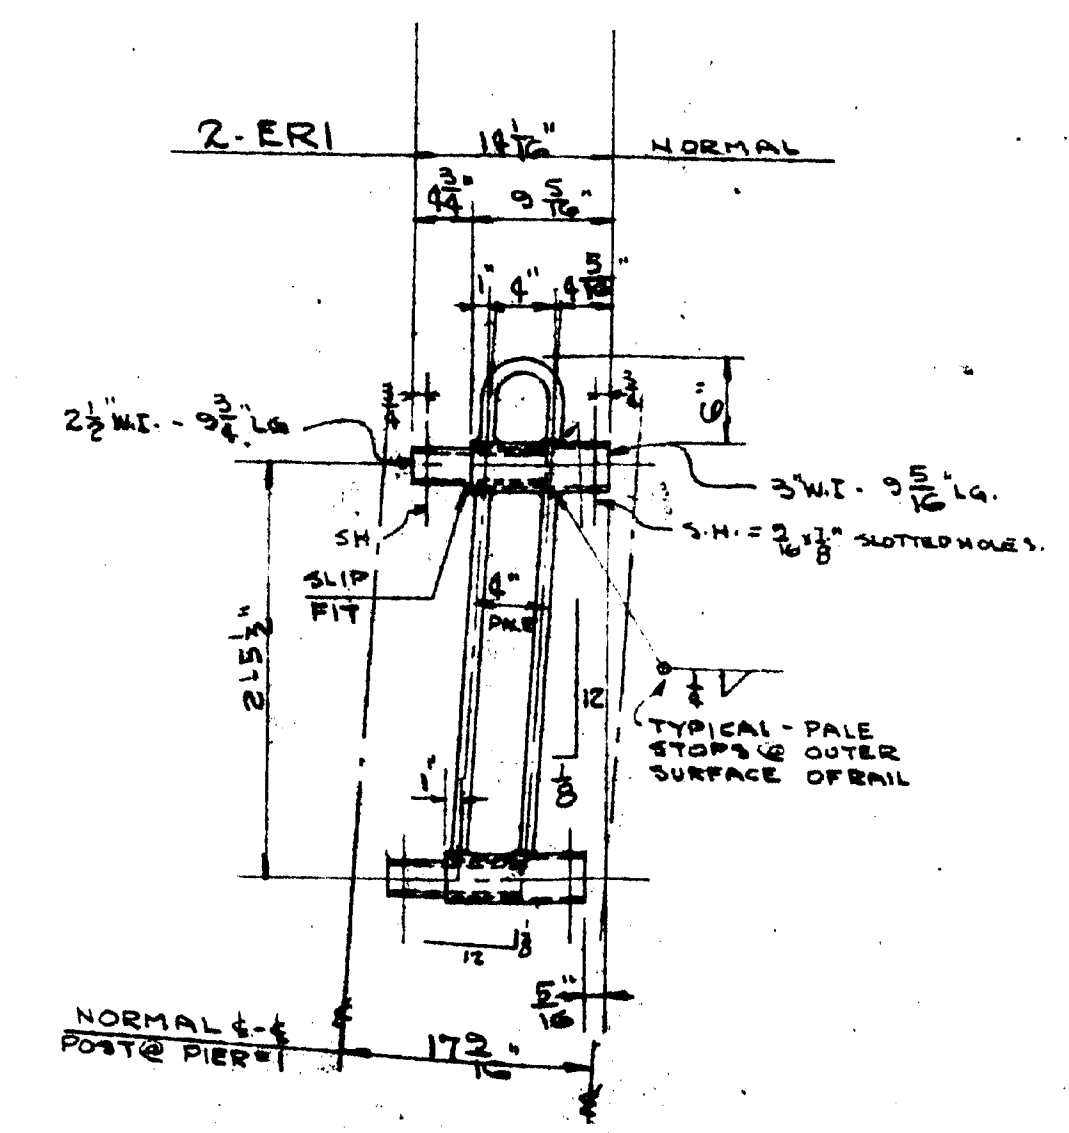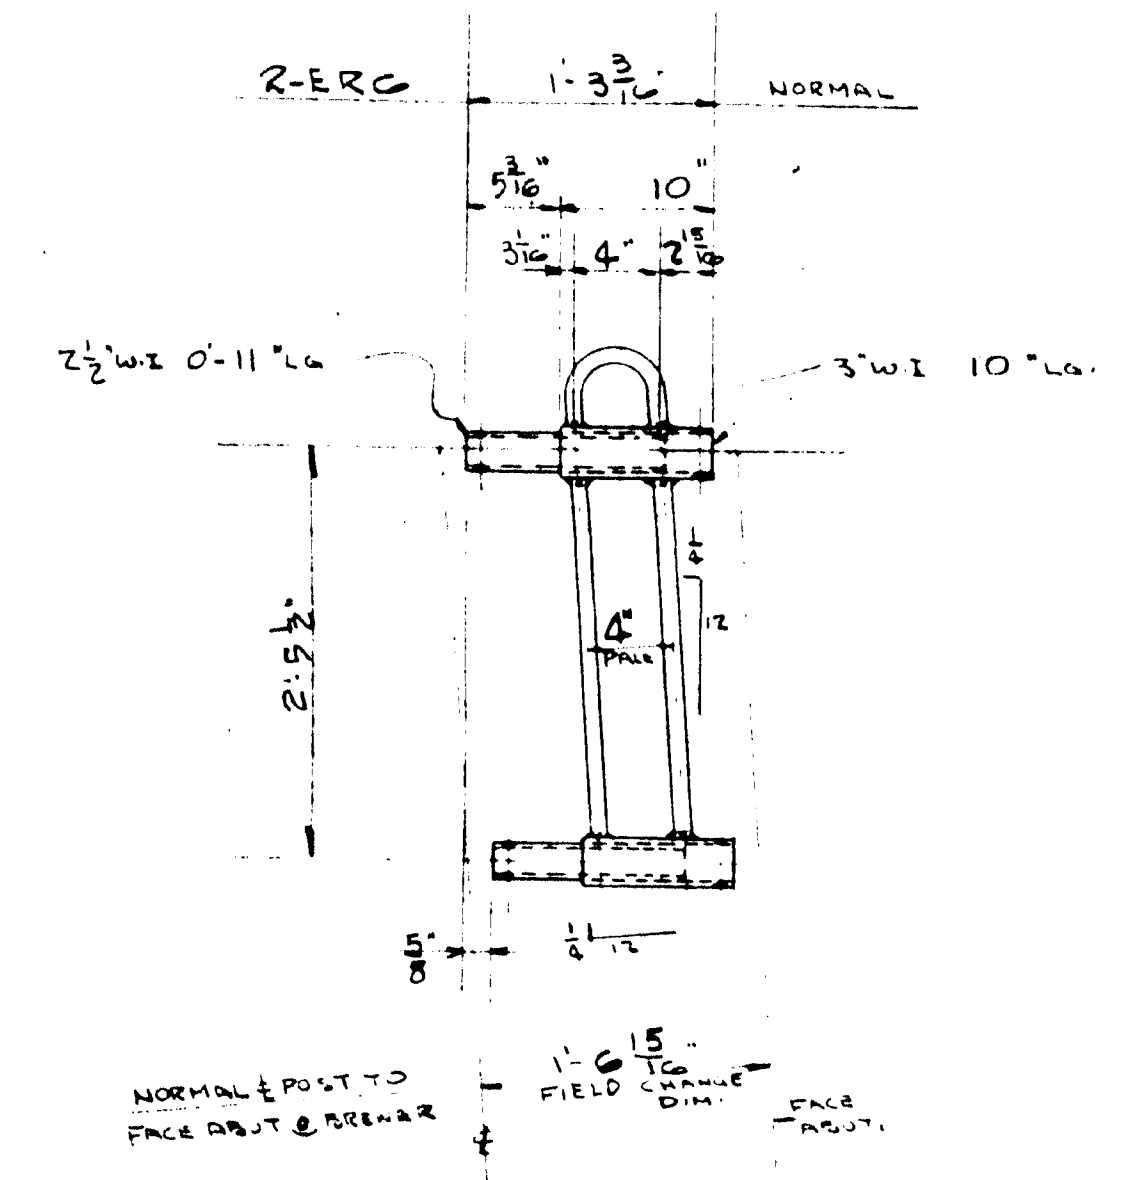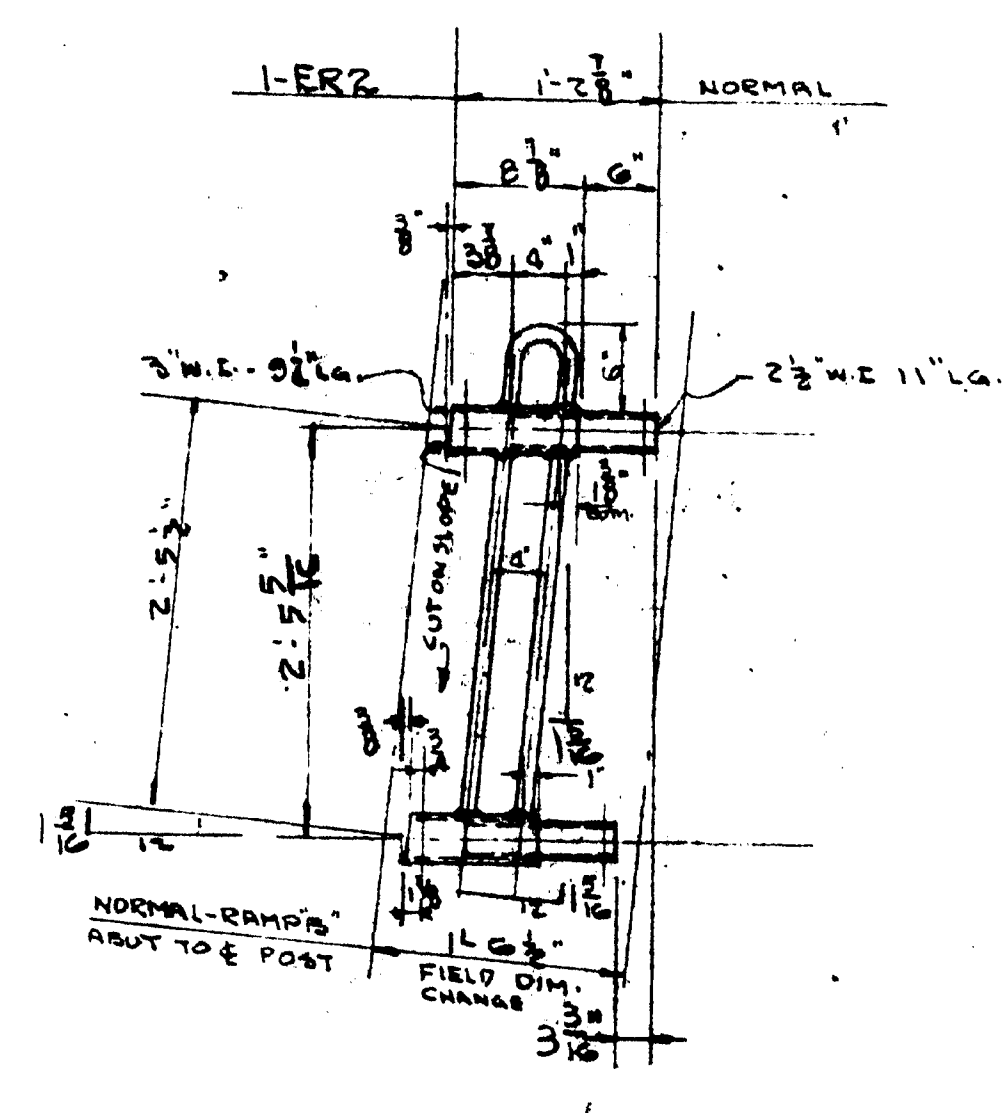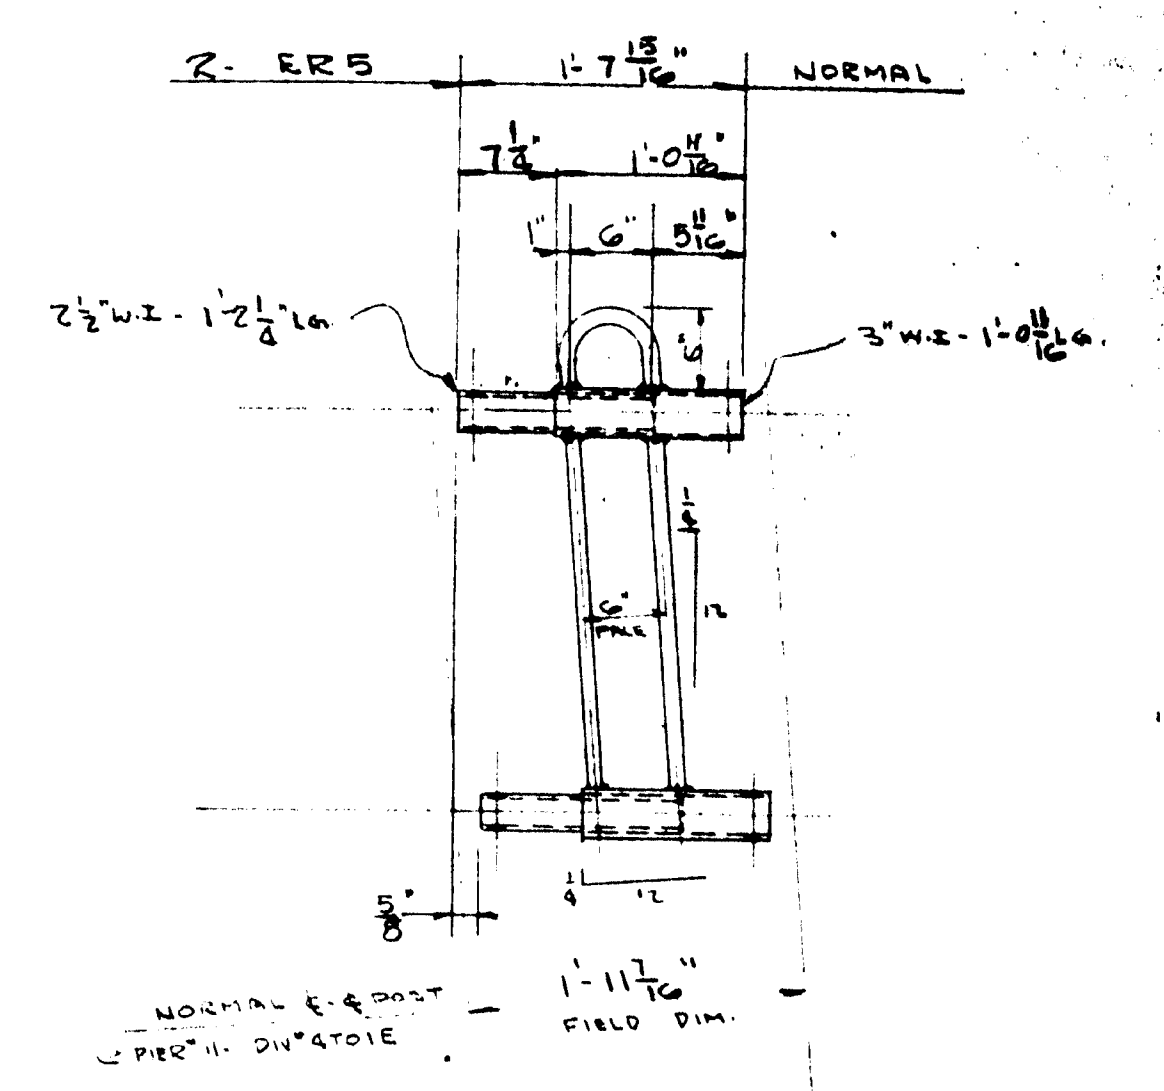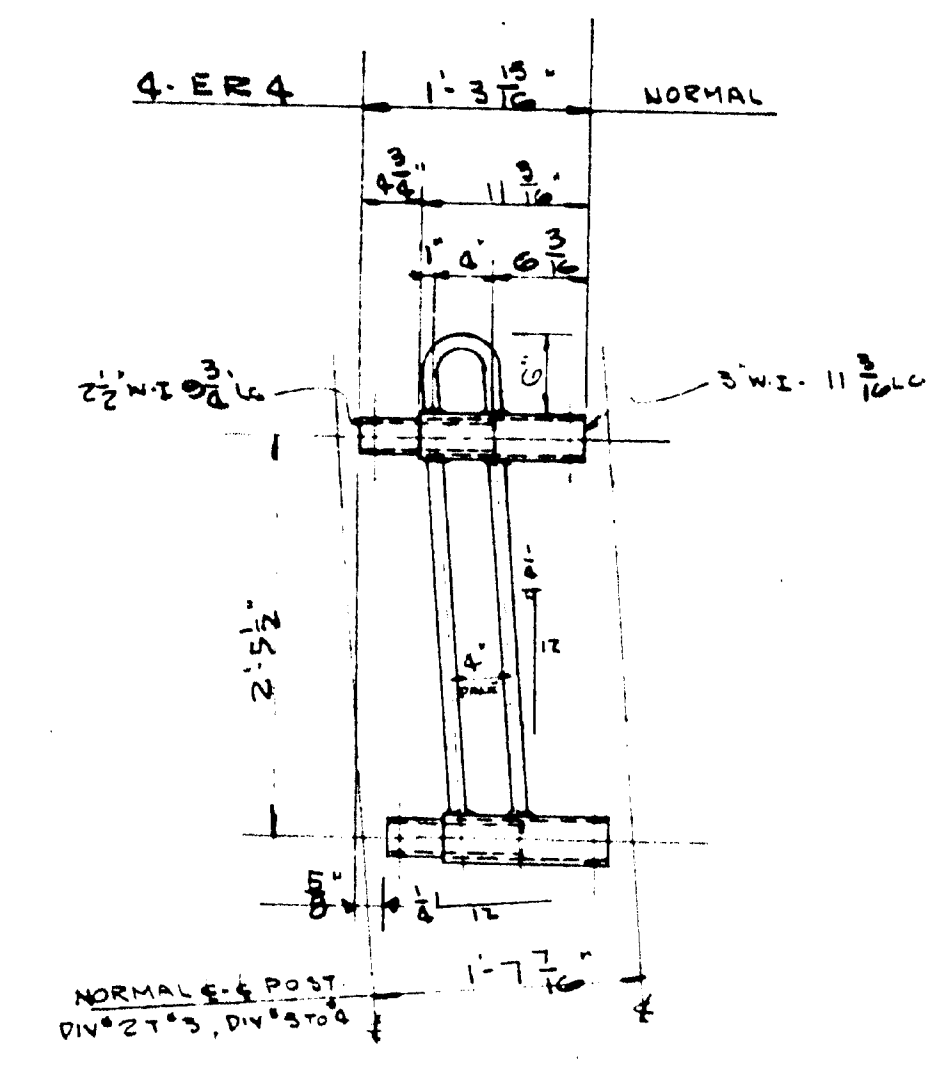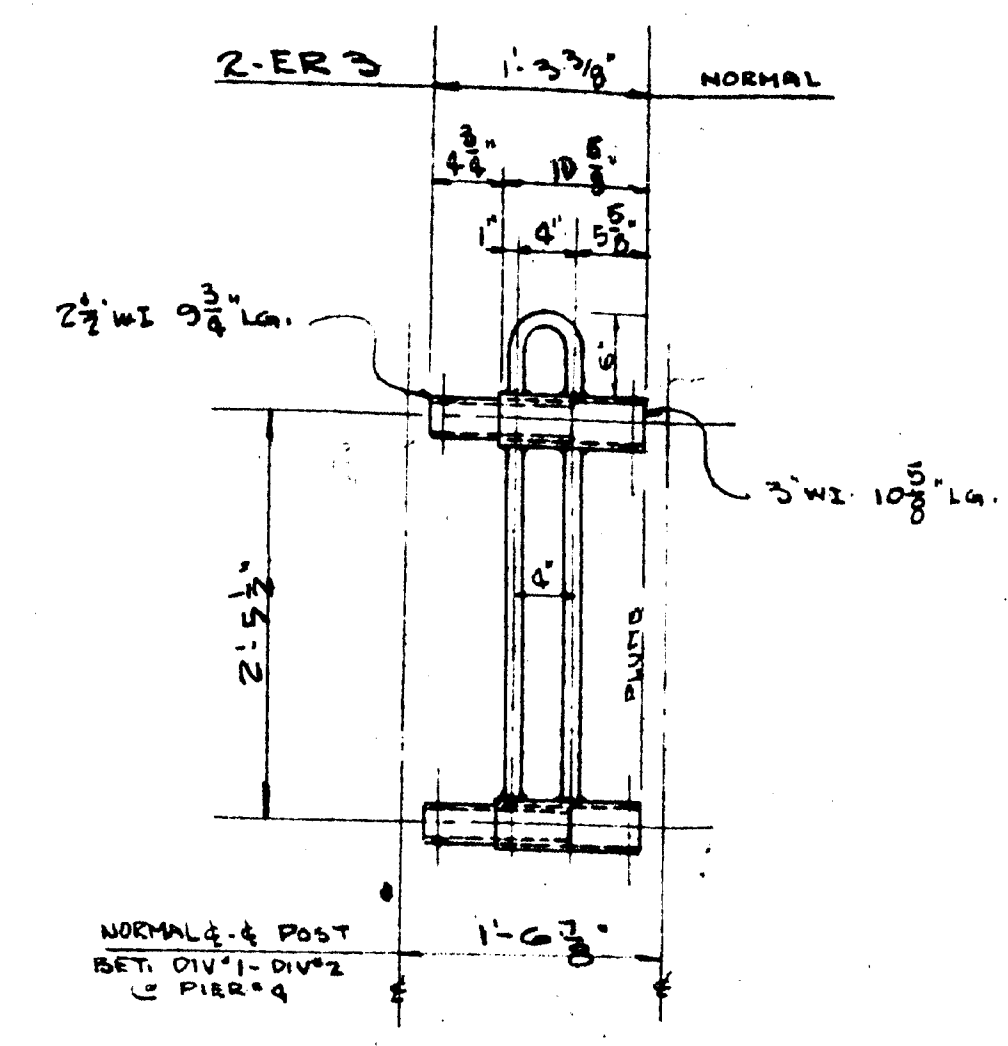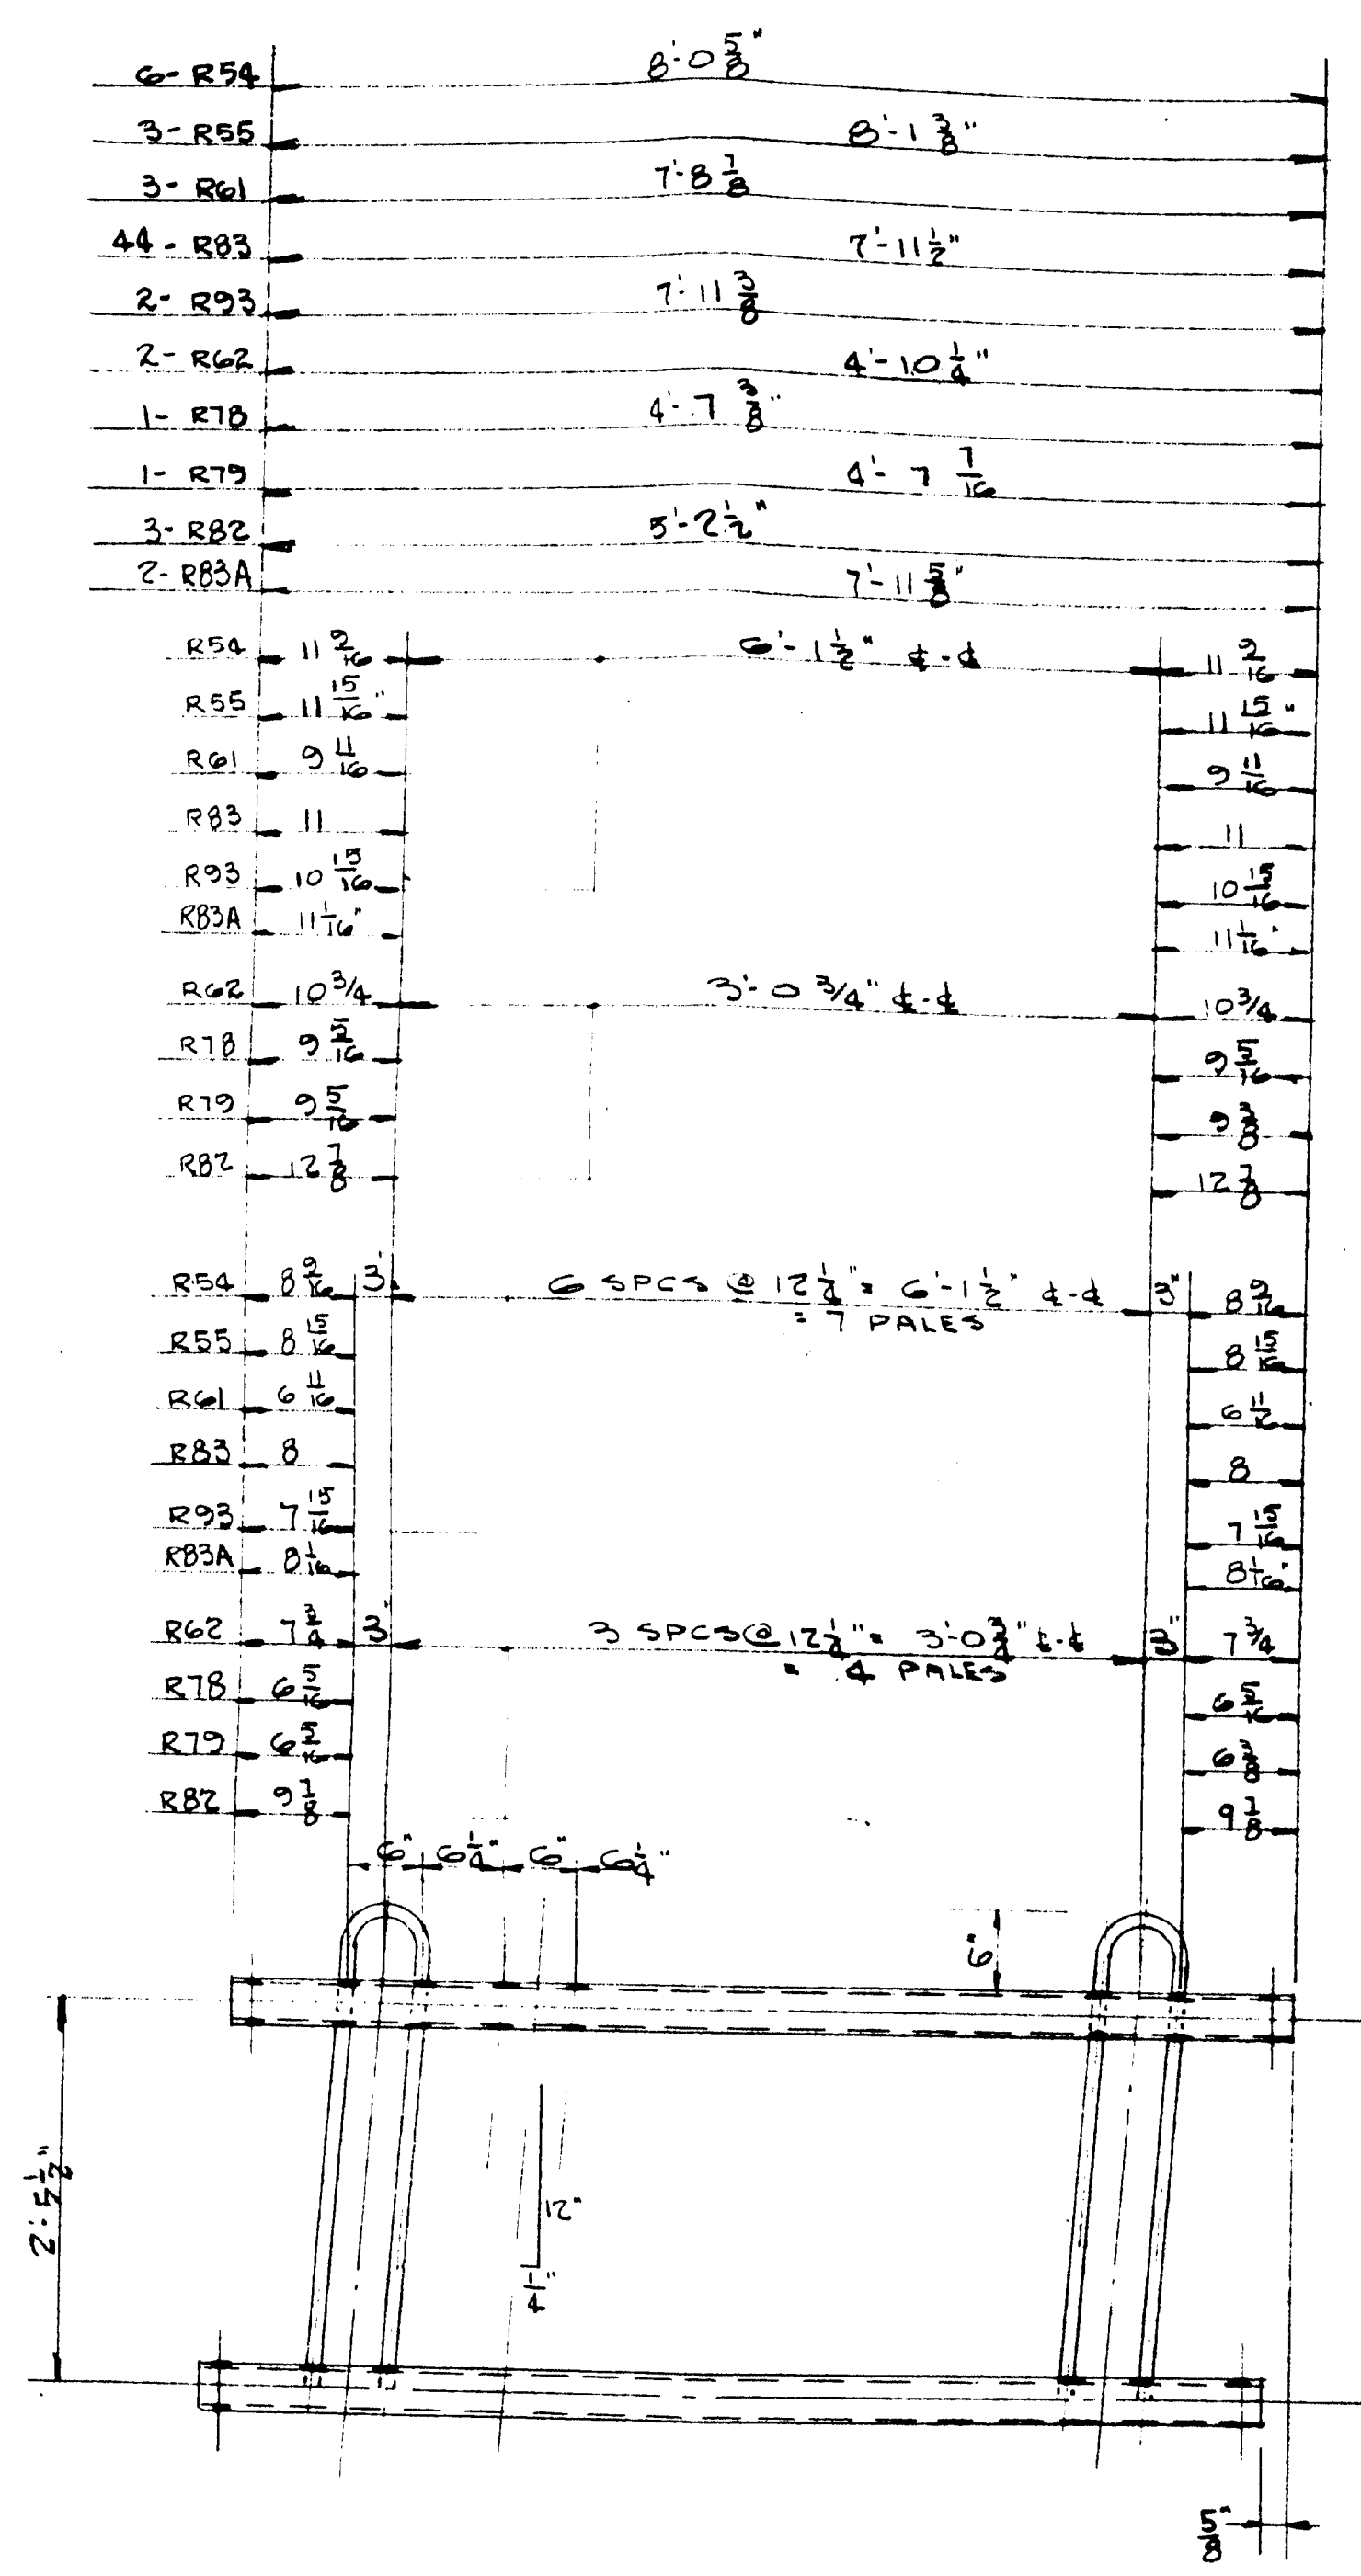

SEE TYPICAL DETAILS - DWG 31


BANGOR-BREWSTER BRIDGE RAIL  
RAIL DETAILS & EXPANSION RAIL MOD  
VERRIER CONST CO  
H. & CORTELYOU  
4-1-54 5-7-54  
R.L.B. 62 R.T. 100 E  
APPROVAL DATE 5-22-54


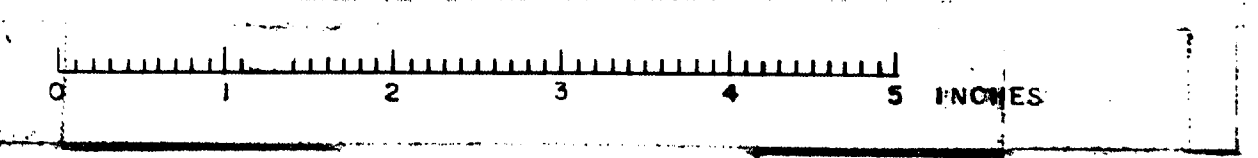


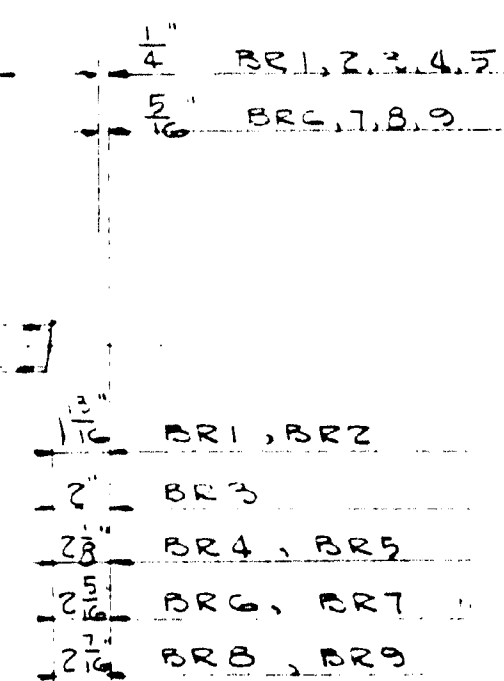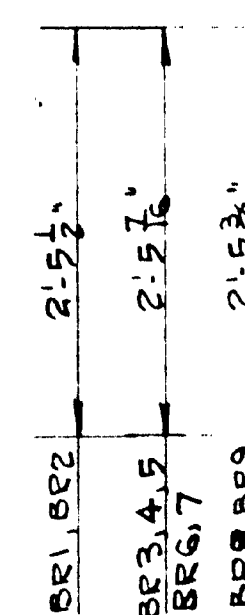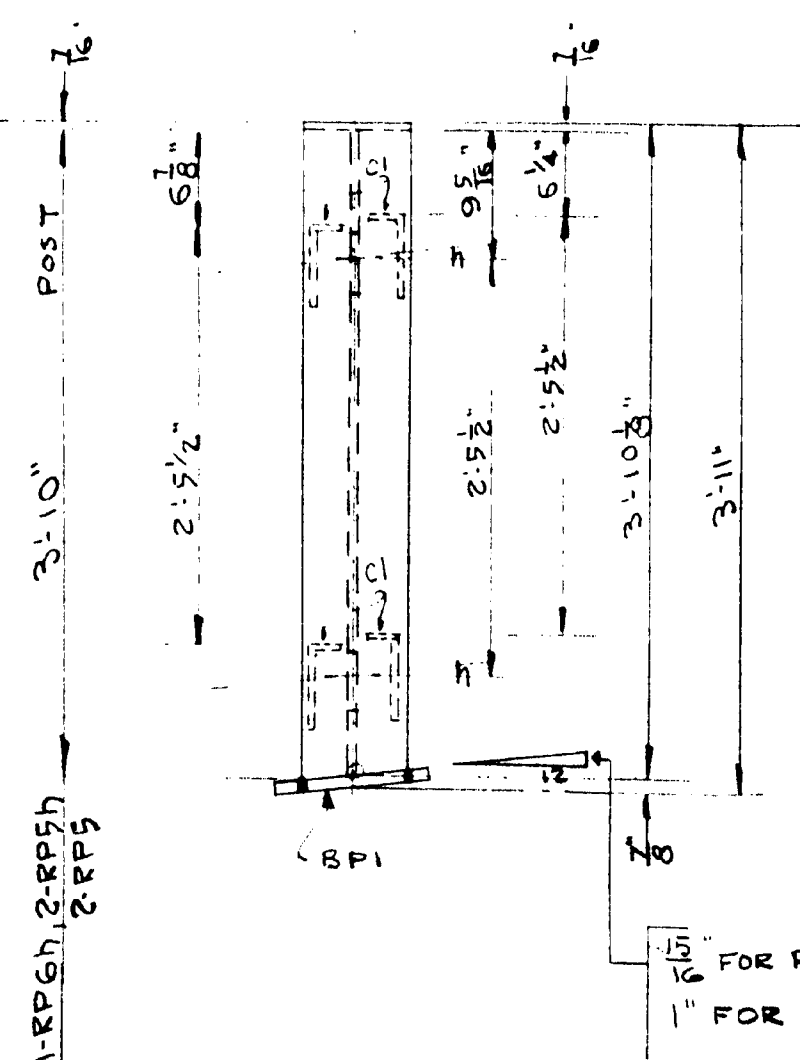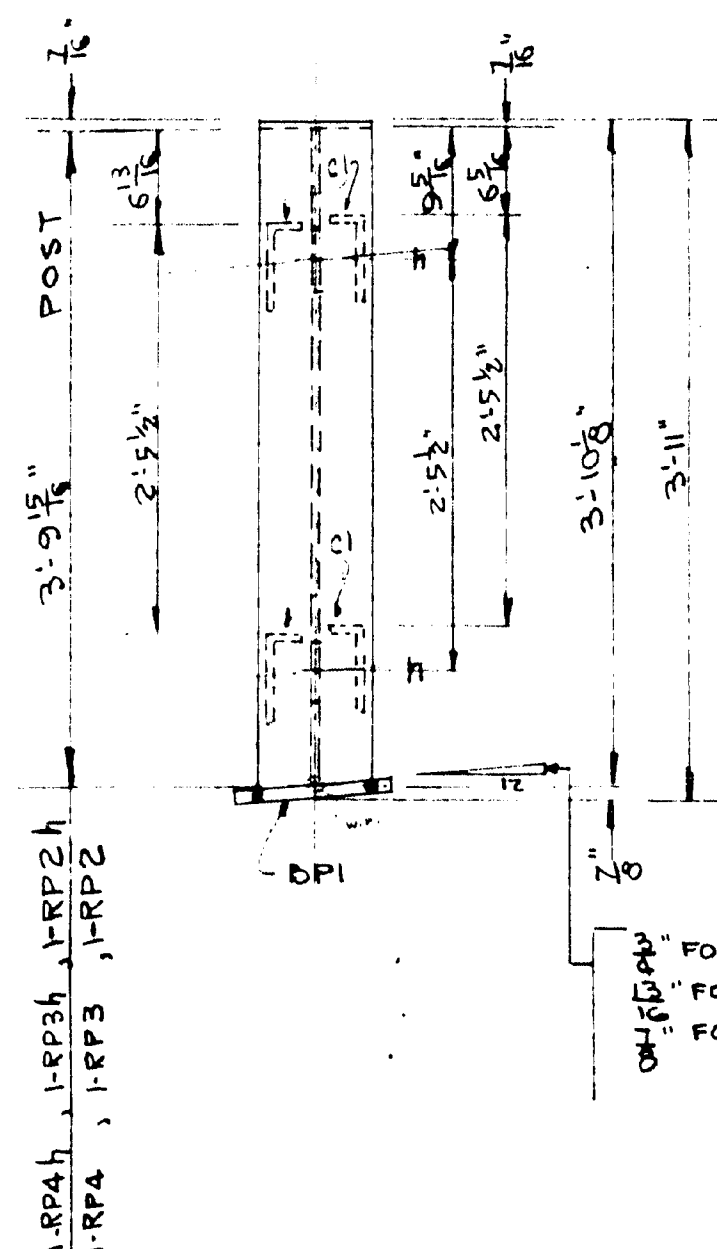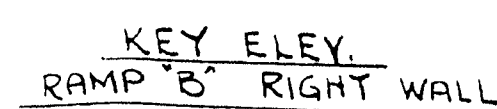

SEE TYPICAL DETAIL DWG  
293-S1



PRINTS ISSUED				CUSTOMER VERIFIER CONST Gd	
NO.	APPROVAL	NO.	FINAL	ARCHITECT OR ENGINEER	H. C. CORTELYOU
3	5-19-54	3	6-23-54	DATE 5-17-54	REVISED
		3	7-23-54 ✓	BY R.L.D.	62-100 F
CUSTOMERS ORDER NO. VERBAL				BANCROFT & MARTIN ROLLING MILLS CO. 2935	
APPROVAL DATE 5-27-54					

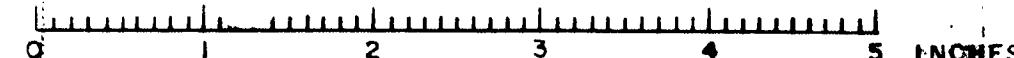

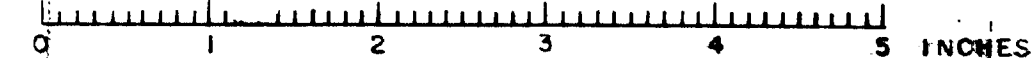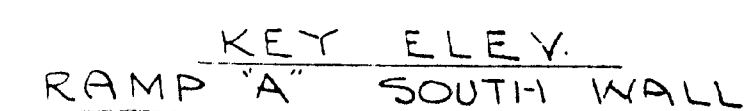




ARCHITECT OR ENGINEER H. E. CORTLYOU  
DATE 5-14-54 REVISED \_\_\_\_\_  
BY R. L. B. 62-100 G  
FIRM HART ROFT & MARTIN ROLLING MILLS CO. 293 S. 13



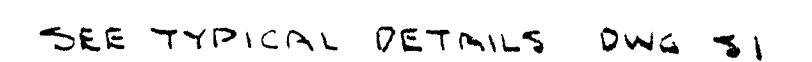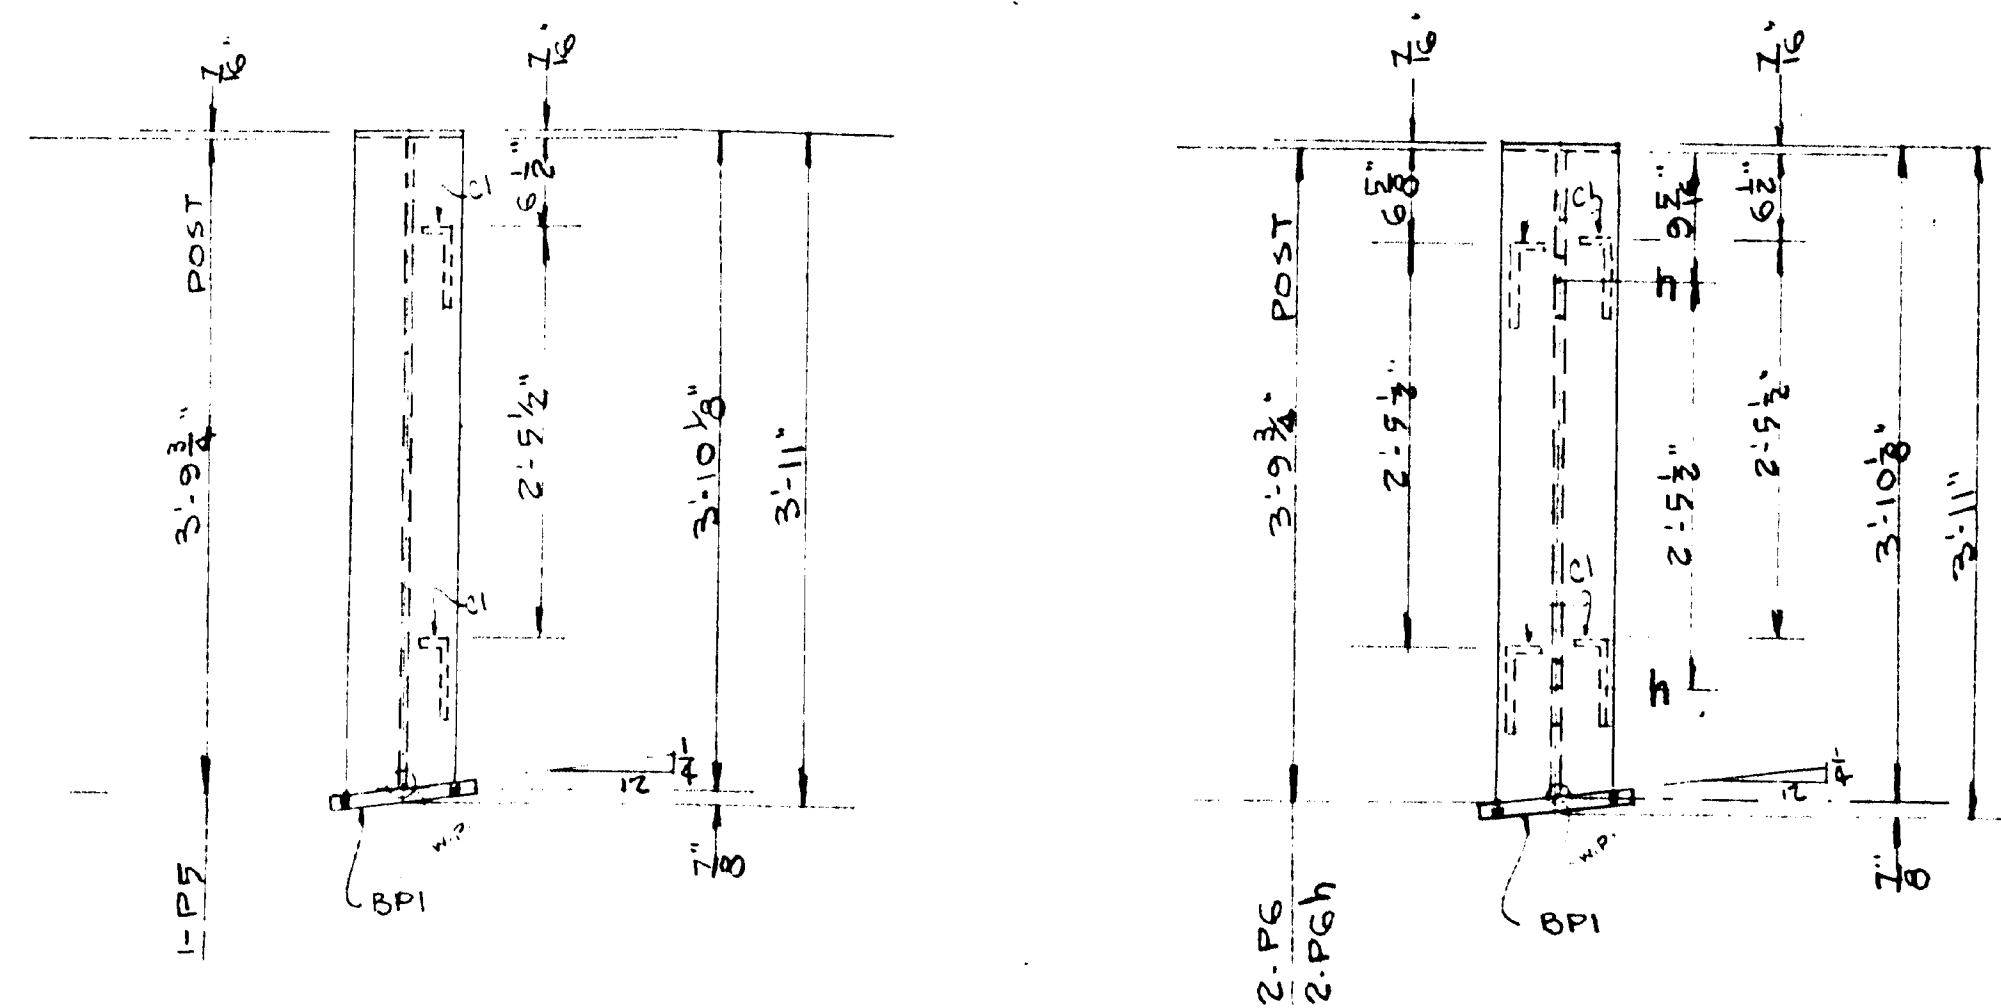

100. BANGOR-BREWER BRIDGE RAIL  
RAIL&POST DETAILS-RAMP 'A' NORTH  
STUMPF VERZIER CONST CO.  
ARCHITECT OR ENGINEER H. & CORTLEYOU  
DATE 5-14-24 REVISED  
BY 62-100 M  
BANCROFT & MARTIN ROLLING MILLS CO. 293-S14

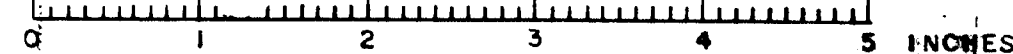

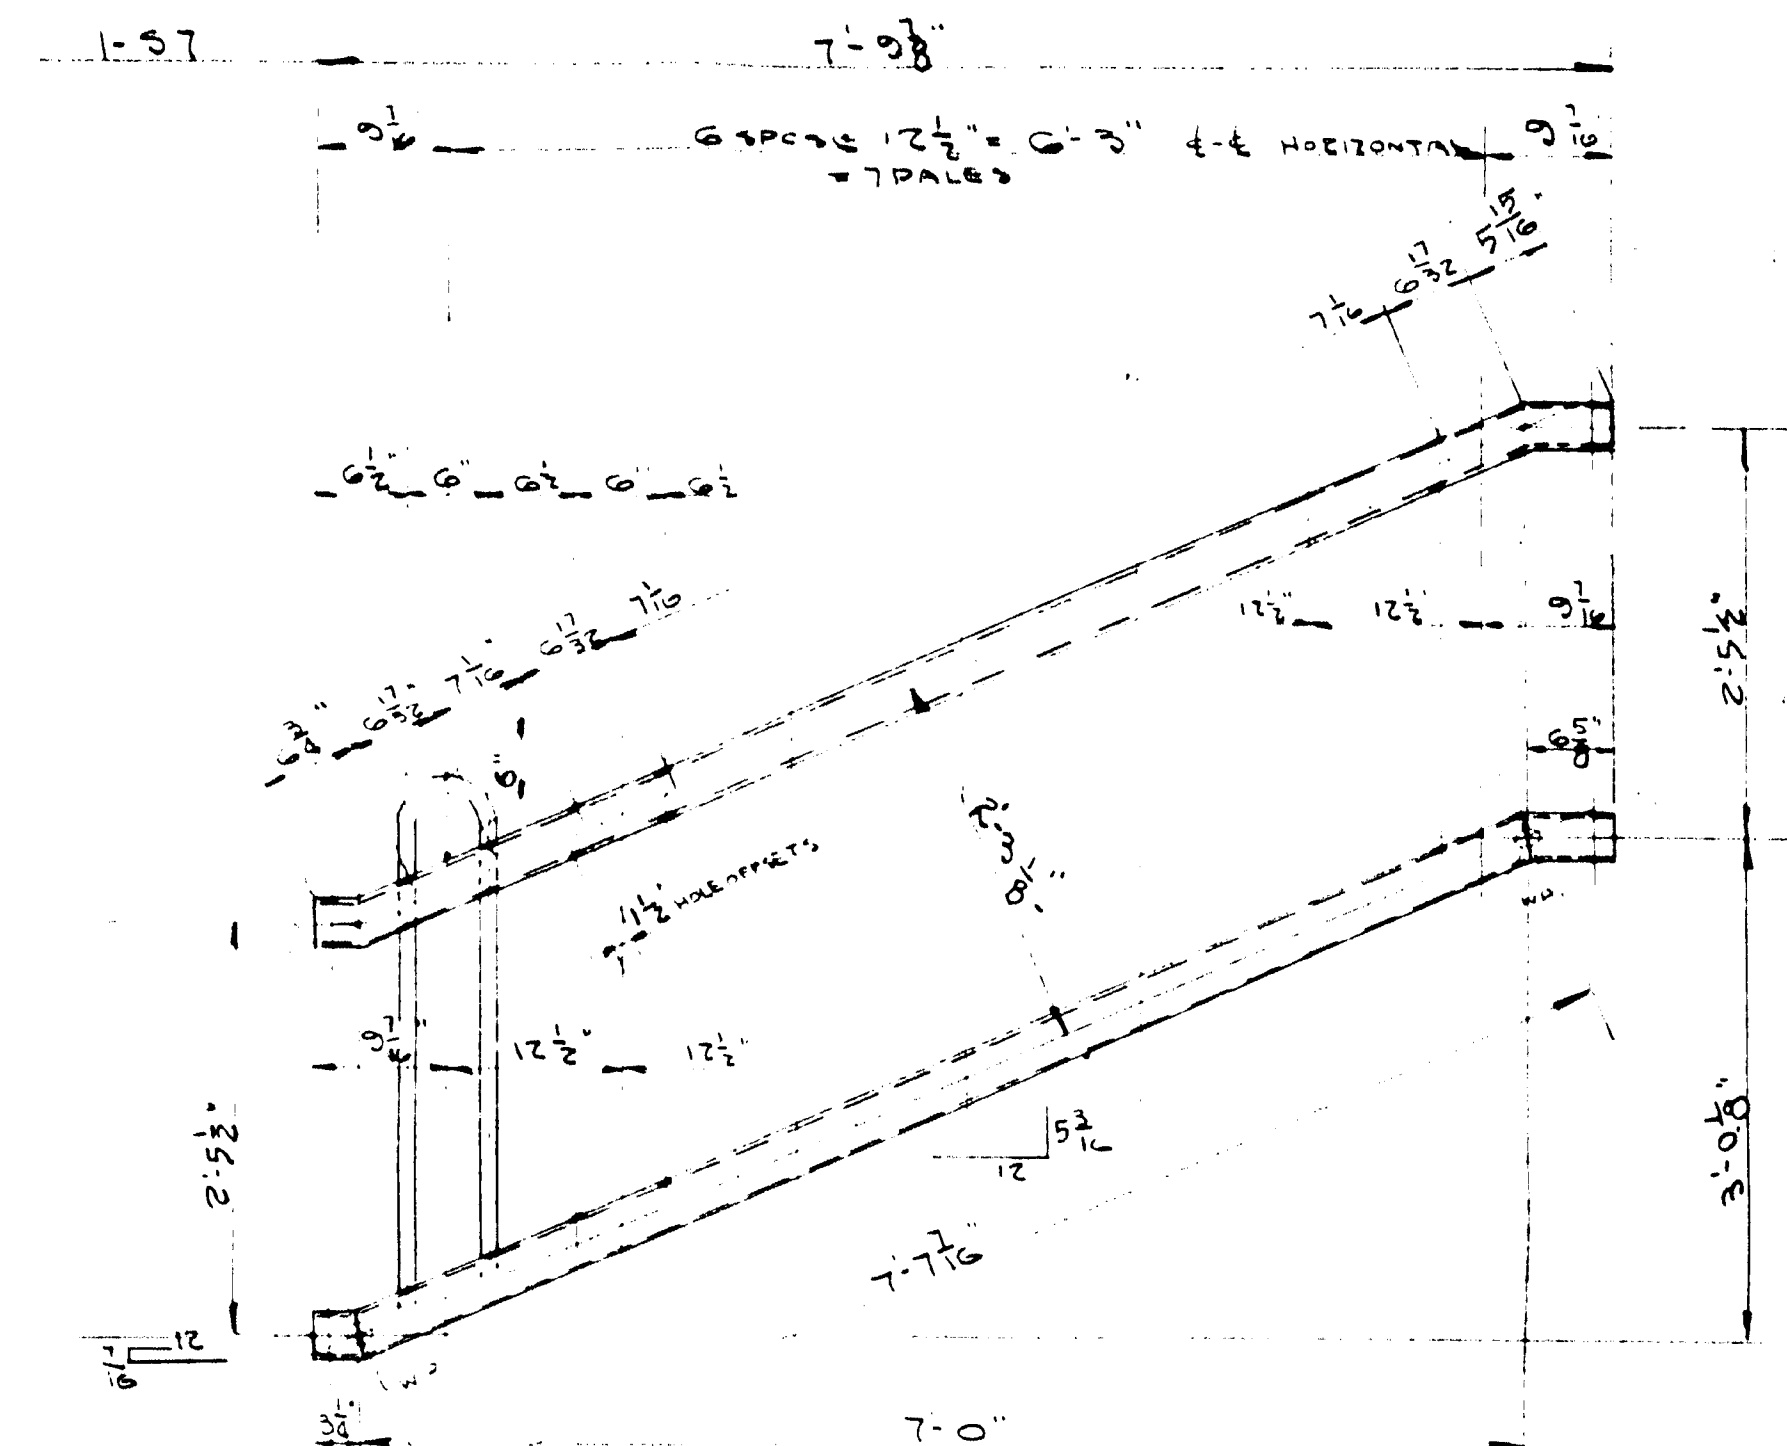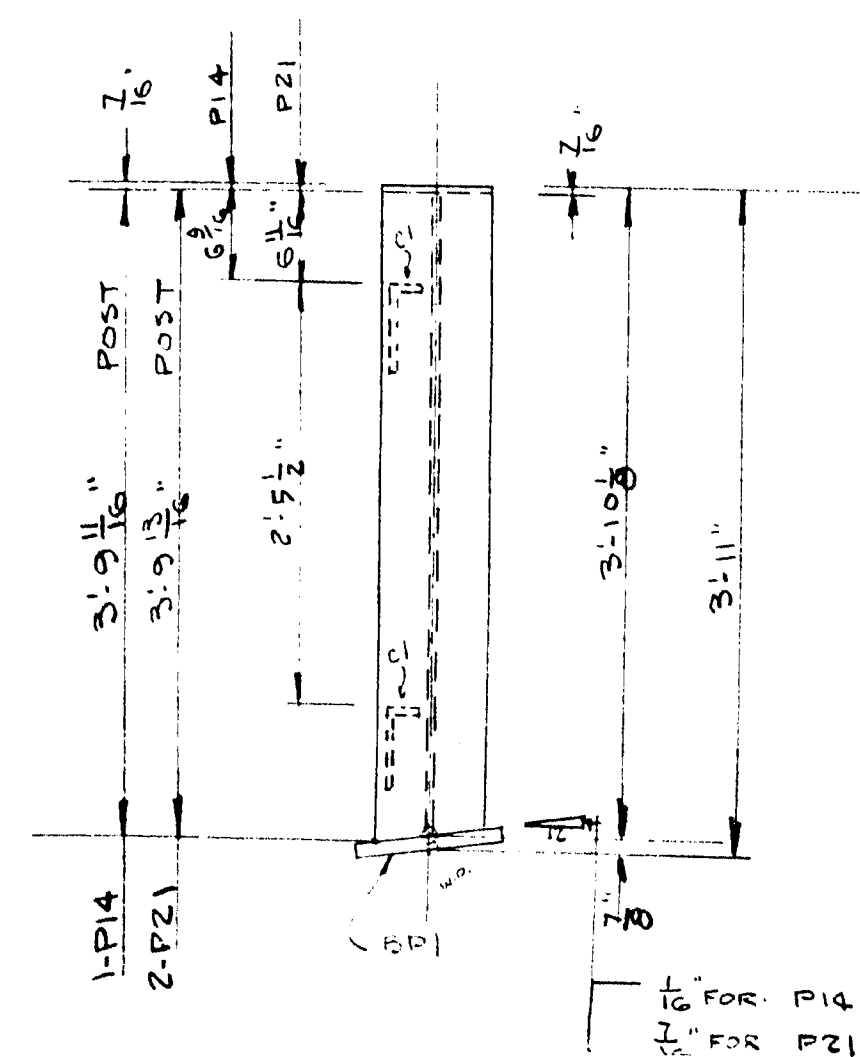


SEE TYPICAL DETAILS DWG S1  
SEE DWG 293-SIG FOR RAIL  
DETAILS OF THIS SHEET.

PRINTS ISSUED

NO.	REMOVAL	NO.	REMARKS
3	5-10-54	3	6-25-54 nfc
		3	7-23-54 v


ALL MEMS SHOWN ARE VERBALLY  
APPROVED DATE 5-27-54

AT BANGOR-BREWER BRIDGE RAIL  
RAILPOST DETAILS: SUMMER ST. RIGHT.  
CUSTOMER VERRIER CONST CO  
ADDRESS: 445 SUMMER H FORTCORTLYOU  
DATE 5-17-54  
BY R.L.A. 62-100 I  
BANDSON & MARTIN ROLLING MILLS CO. 293-51

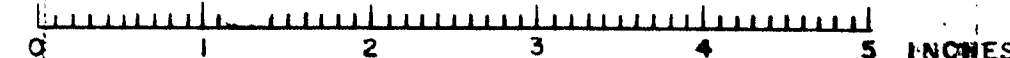


2-51	7'-0 5/8"
1-52	7'-0 3/8"
1-53	7'-10 1/4"
1-54	7'-10 1/8"
1-55	7'-9 5/8"
1-56	7'-10 5/8"
3-58	7'-0 3/8"
1-59	7'-10 1/4"
2-60	7'-10"
1-61	7'-9 3/4"
1-515	7'-8 3/8"
1-518	7'-8 1/8"
1-519	7'-8"

51	9 1/16"
52	9 1/16"
53	9 1/16"
54	9 1/16"
55	9 1/16"
56	9 1/16"
58	9 1/16"
59	9 1/16"
60	9 1/16"
61	9 1/16"
615	8 1/16"
618	8 1/16"
619	8 1/16"

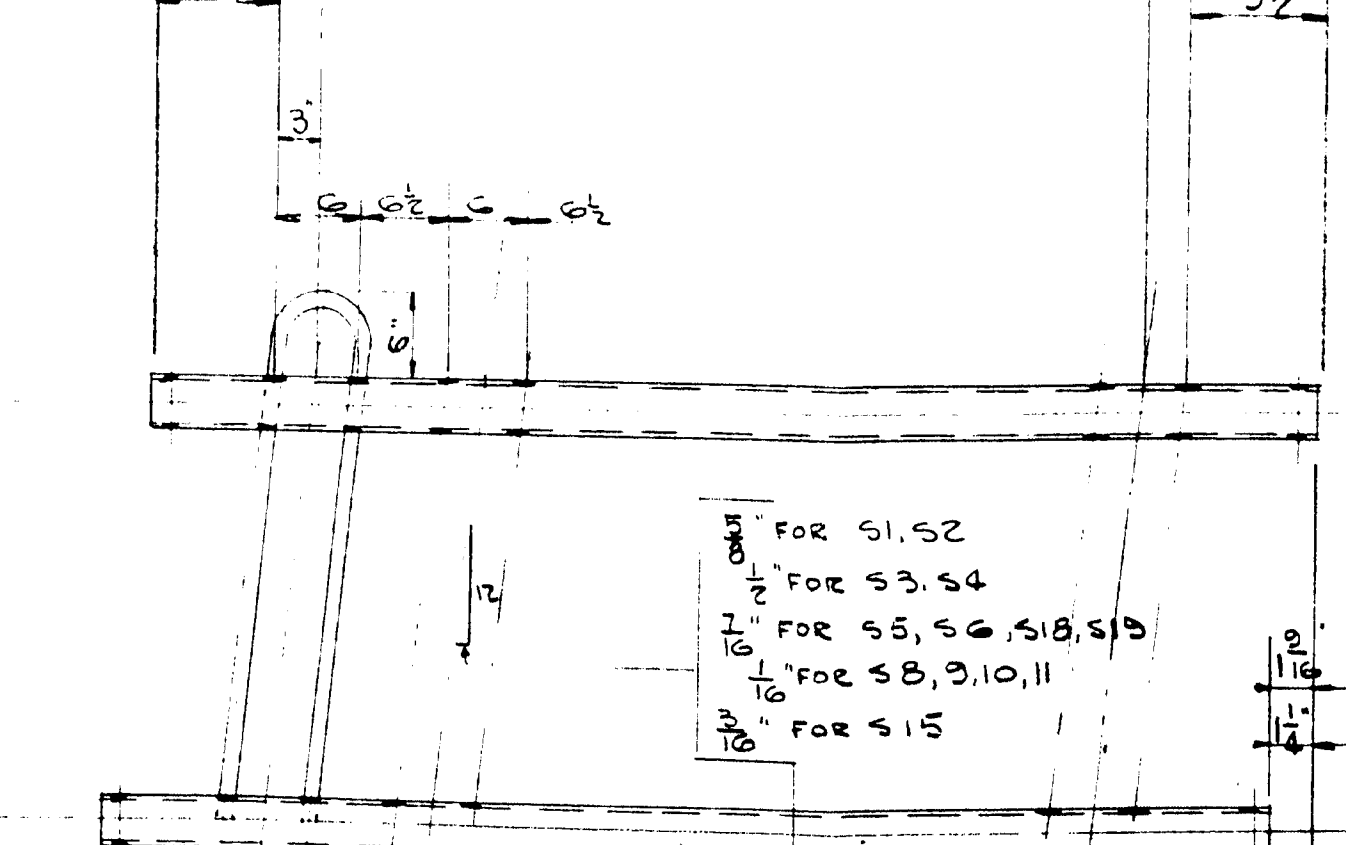


51, 52
53, 54
55, 56, 58, 59
60, 61, 615, 618, 619

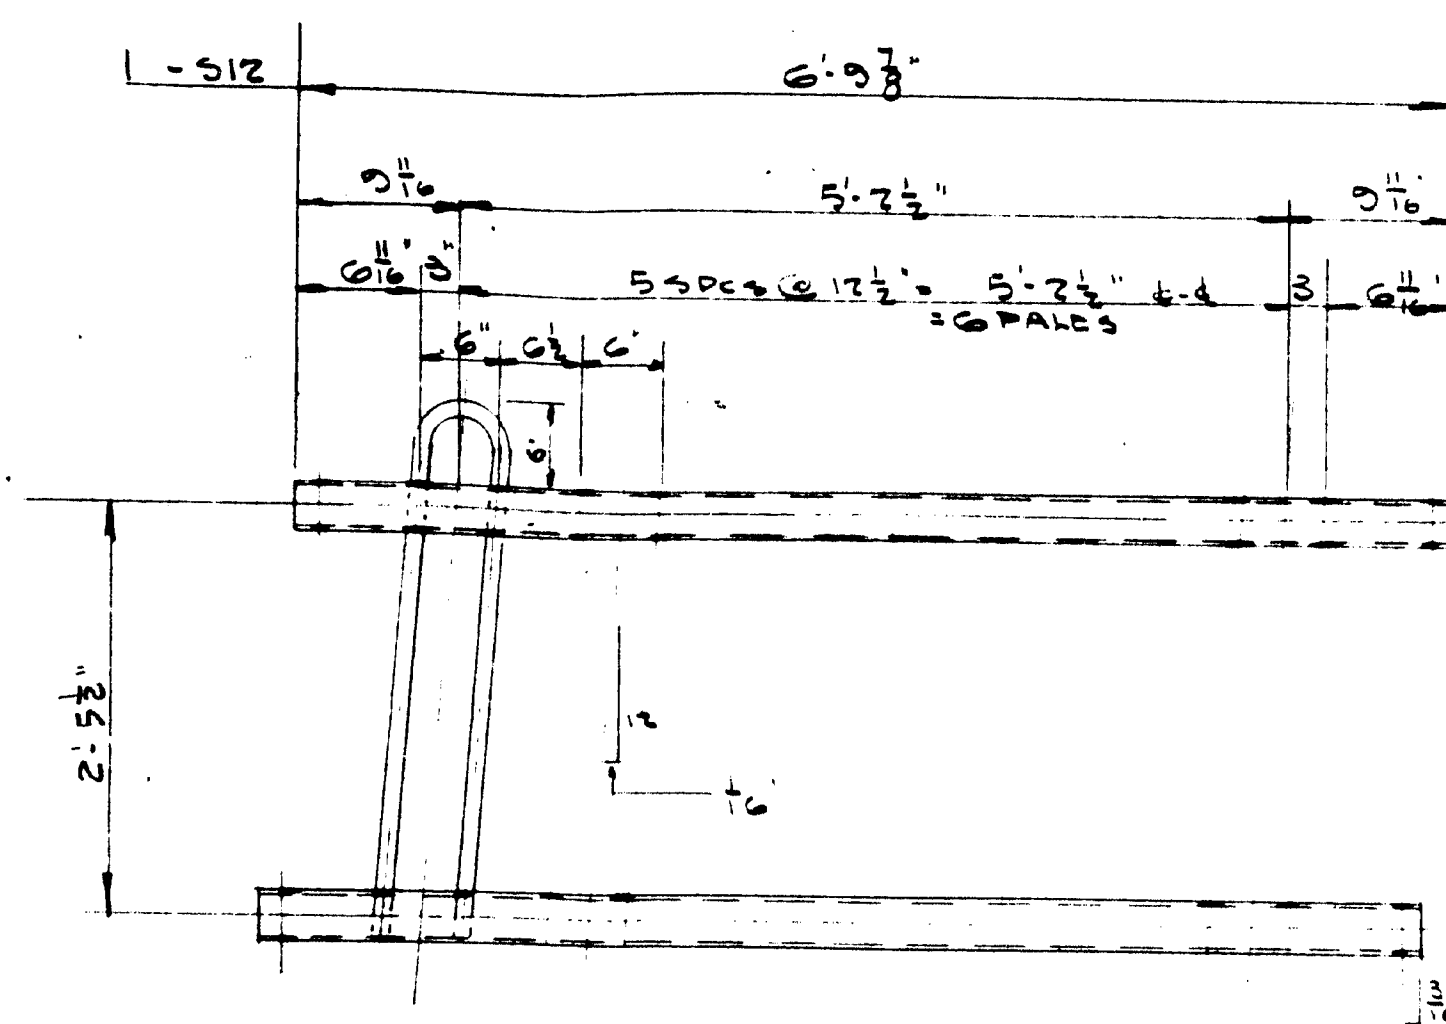

1-513	7'-7 3/4"
1-514	7'-7 3/4"
1-516	7'-7 3/4"
1-517	7'-7 3/8"
2-520	7'-7 1/2"
2-521	7'-7 1/2"
1-522	7'-7 3/8"




513	9 1/8"
514	9 1/8"
516	9 1/8"
517	9 1/8"
520	9"
521	8 7/8"
522	8 15/16"

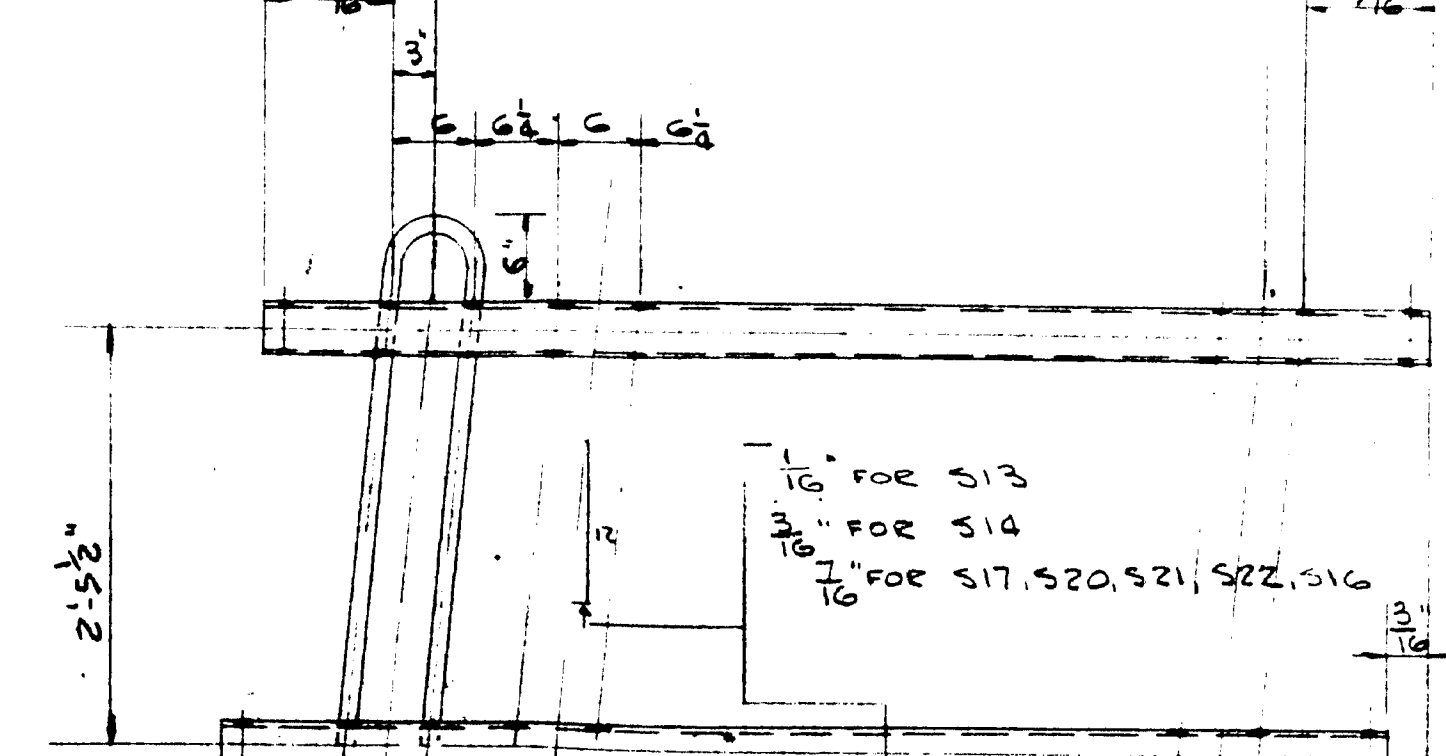

FOR 513
514
517, 520, 521, 522, 516

1-527	5'-8" CHORD LENGTH
527	4'-2"
527	4 SPCS @ 12 1/2" = 4'-2" ± 4" = 5 PALES
1-523	7'-6 3/8"
1-524	7'-7 3/8"
2-525	7'-7 3/8"
1-526	7'-7 3/8"

523	8 1/16"
524	8 1/16"
525	8 1/16"
526	8 1/16"
523	5 1/16"
524	5 1/16"
525	5 1/16"
526	5 1/16"

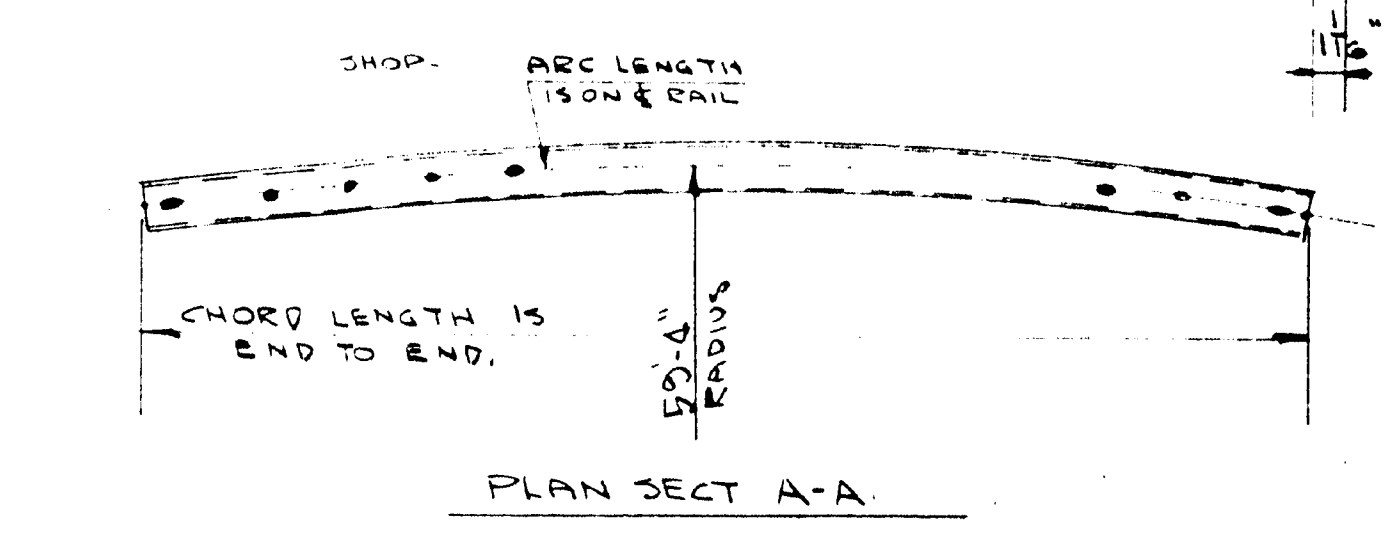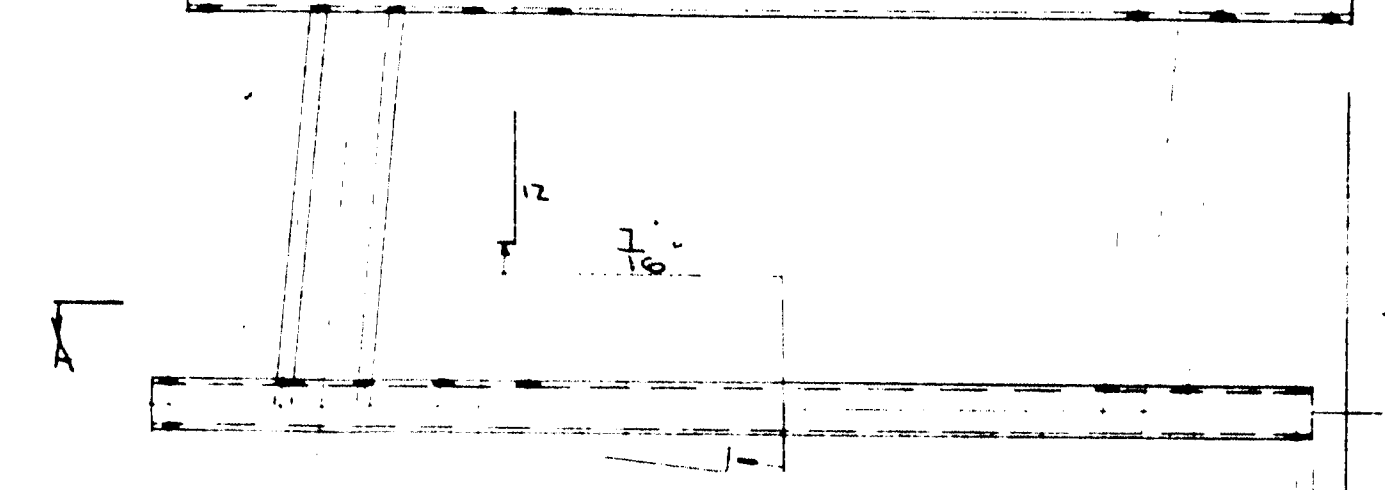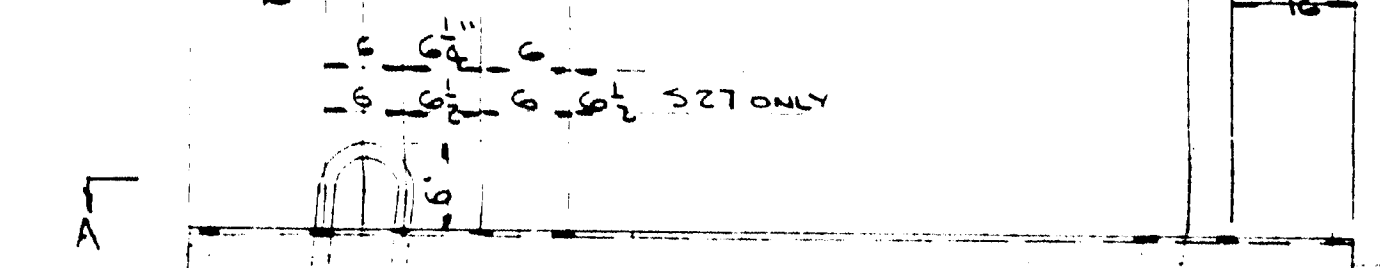


SEE TYPICAL DETAILS 51  
SEE DWG 253-519 FOR KEY PLAN & POSTS

34-2002




JOB BANGOR BREWER BRIDGE RAIL  
RAIL DETAILS FOR SUMMER ST. RIGHT  
OWNER VERRIER CONST CO  
ARCHITECT ENGINEER H. & CORTLYOU  
DATE 5-17-54  
REVISED BY 62-100 J  
BANGOR & MARTIN ROLLING MILLS CO. 253-519

APPROVAL DATE: 5-27-54

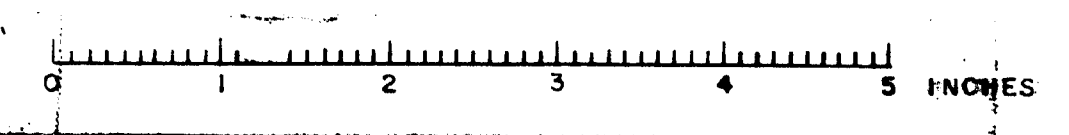





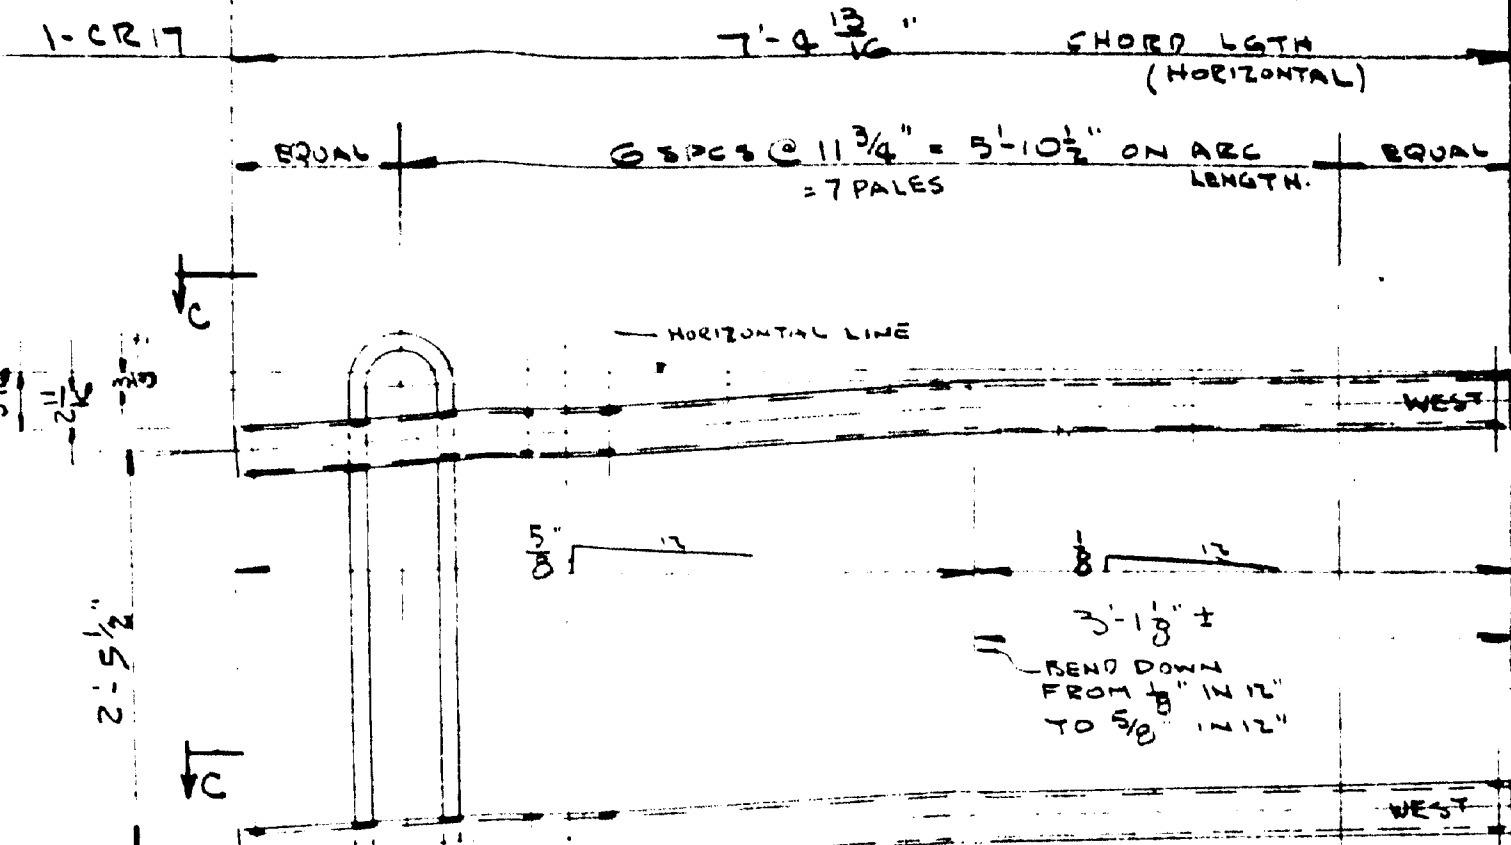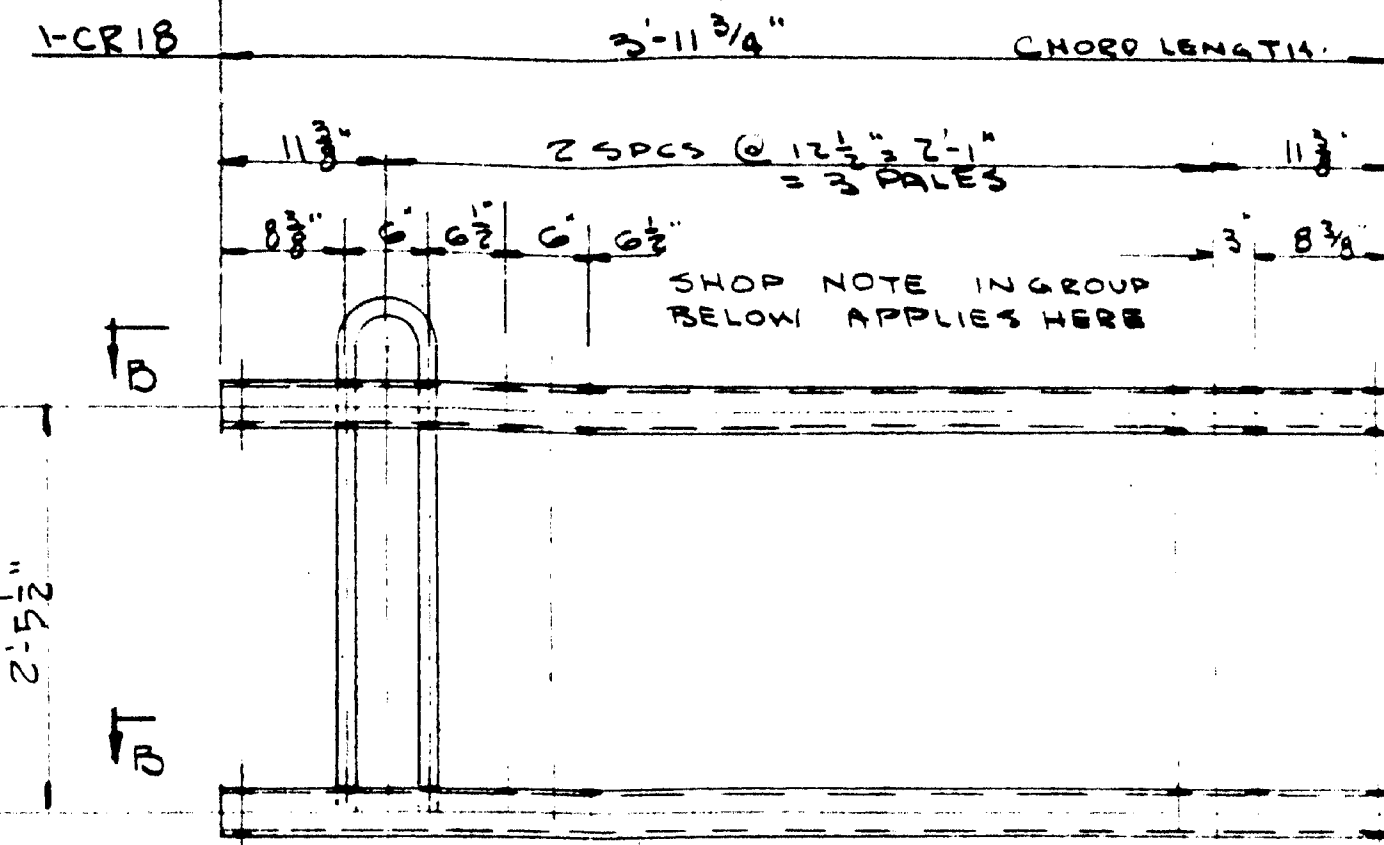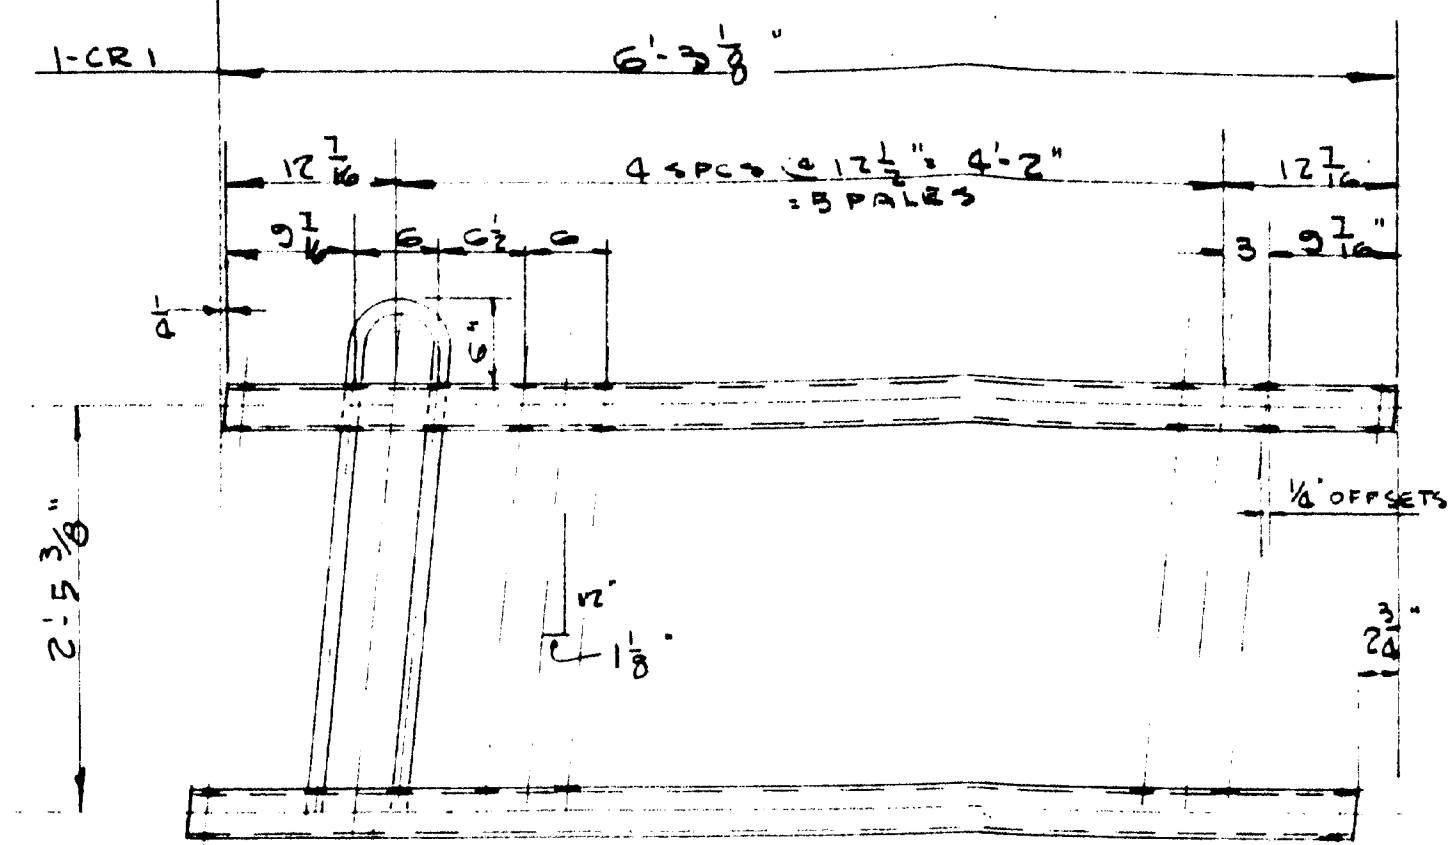


1-CR10	7'-2 1/16"
6-CR2	7'-3 3/8"
1-CR3	7'-3"
1-CR4	7'-3 1/4"
1-CR5	7'-3 5/16"
1-CR6	7'-3 7/16"
1-CR7	7'-2 7/16"
1-CR8	7'-2 1/16"
1-CR9	7'-2 13/16"


1-CR11	7'-2 1/4"
1-CR12	7'-1 3/4"
1-CR13	7'-1 7/8"
4-CR14	7'-1 2/16"
1-CR15	7'-1 13/16"
1-CR16	7'-2"

1" ALL RAIL	
CR2	12 3/16"
CR3	12 3/8"
CR4	12 1/4"
CR5	12 1/8"
CR6	12 3/16"
CR7	11 1/8"
CR8	11 5/8"
CR9	12"
CR10	11 1/2"
CR2	9 1/16"
CR3	9 3/8"
CR4	9 1/4"
CR5	9 1/2"
CR6	9 3/4"
CR7	8 1/2"
CR8	8 1/8"
CR9	9"
CR10	8 1/2"




1" ALL RAIL	
CR11	11 3/4"
CR12	11 1/2"
CR13	11 1/8"
CR14	11 1/16"
CR15	11 1/4"
CR16	11 1/8"

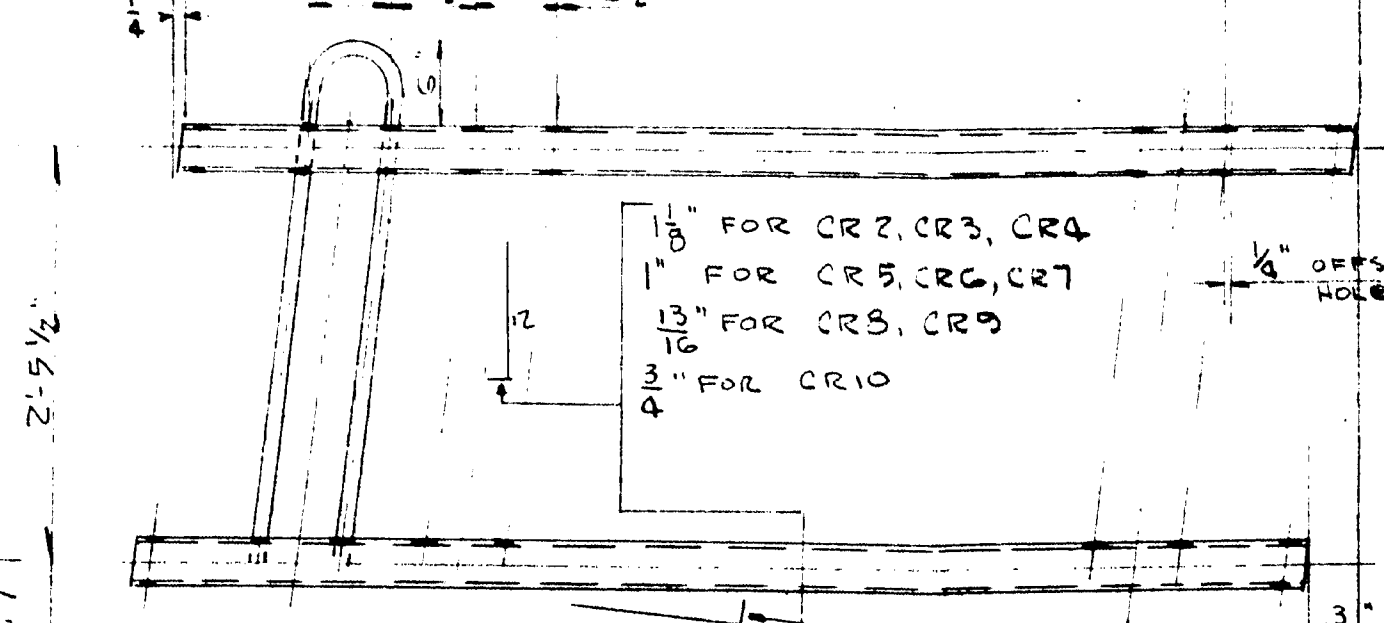

CR11	8 3/4"
CR12	8 1/2"
CR13	8 1/8"
CR14	8 1/16"
CR15	8 1/4"
CR16	8 1/8"

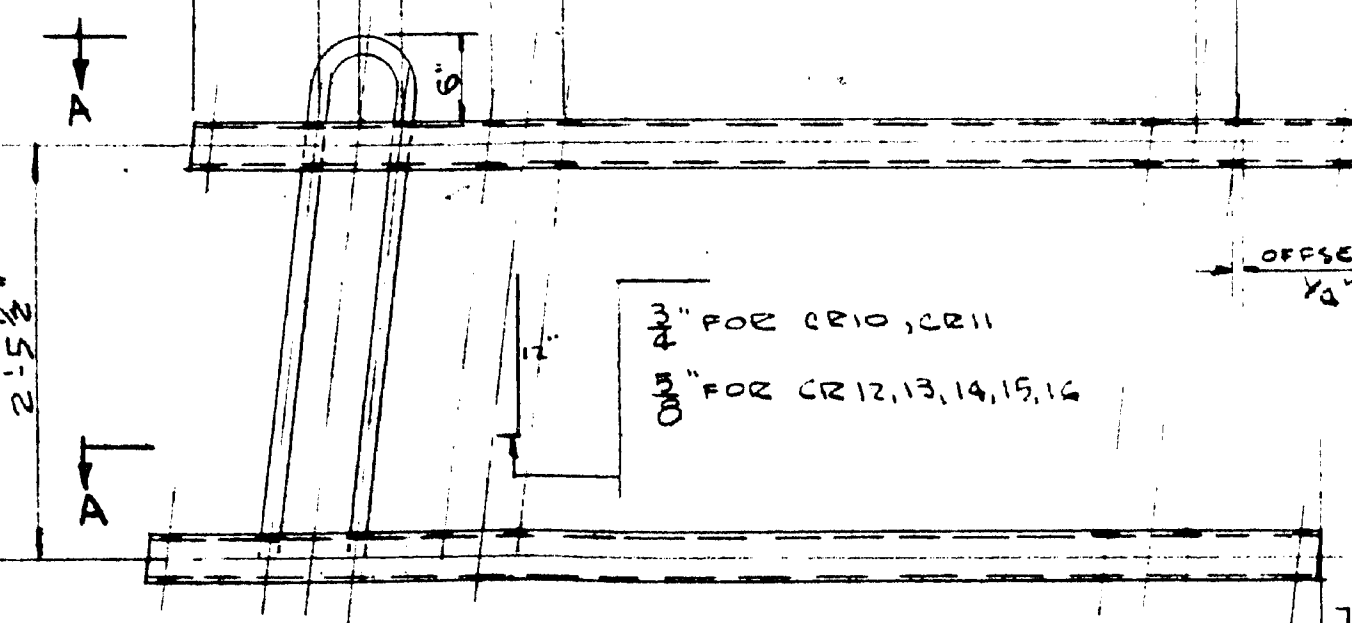


CR2, CR3, CR4	2 3/4"
CR5, CR6, CR7	2 1/2"
CR8, CR9	2"
CR10	1 1/2"

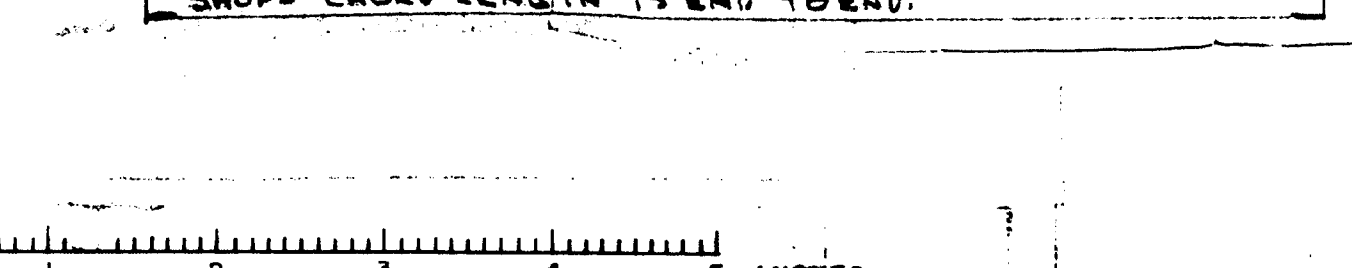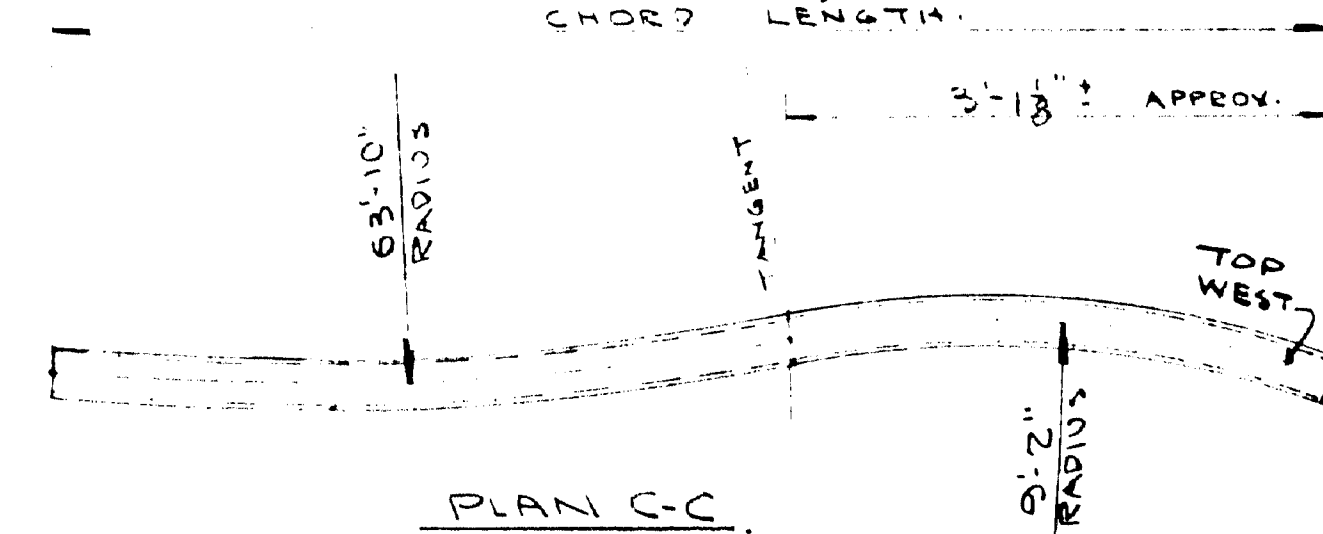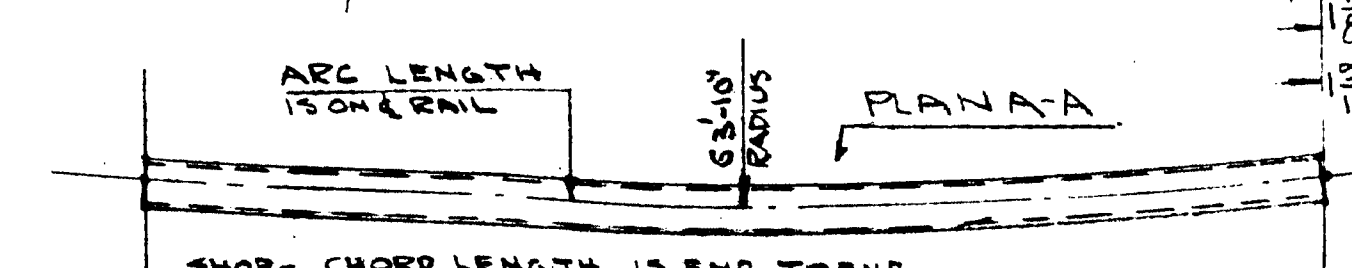


SEE TYPICAL DETAILS DWG 51  
SEE DWG 293-517 FOR KEYPLAN  
& POST DETAILS



108 BANGOR BREWER BRIDGE RAIL  
RAIL DETAILS FOR RAMP WALL  
VERRIE CONST CO.  
H. & CORTLEYOU  
R.D.  
62-1002  
VERBAL  
REC'D 7-1-54  
6-24-54 3 17-23-54  
3-18-54  
6-24-54 3 17-23-54  
3-18-54  
62-1002

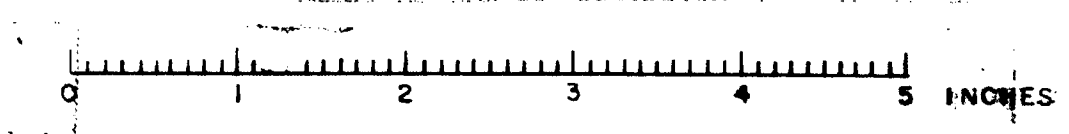

NORTH

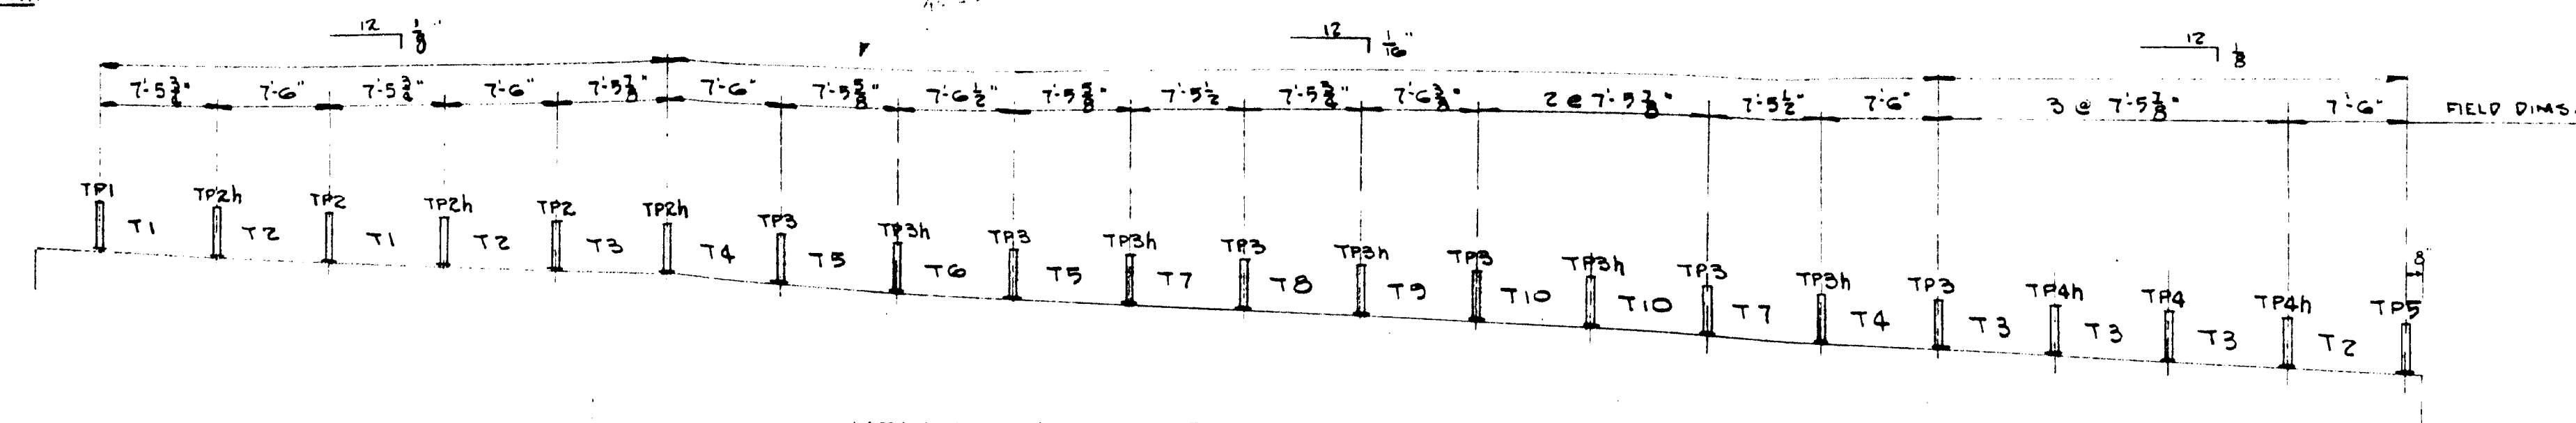


KEY ELEV. TOLL PLAZA WALL

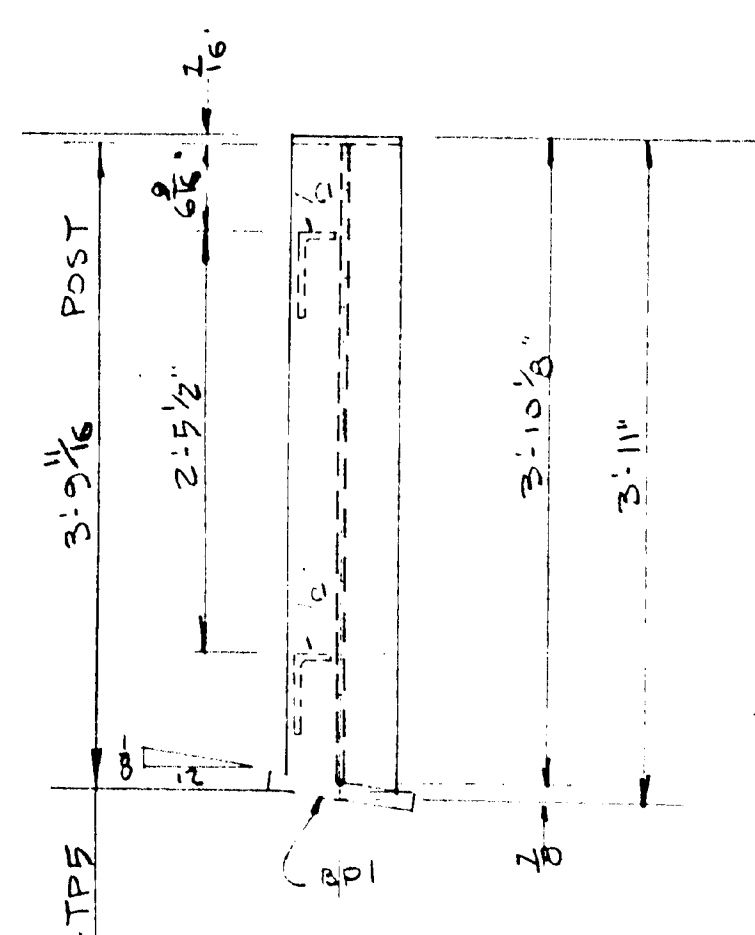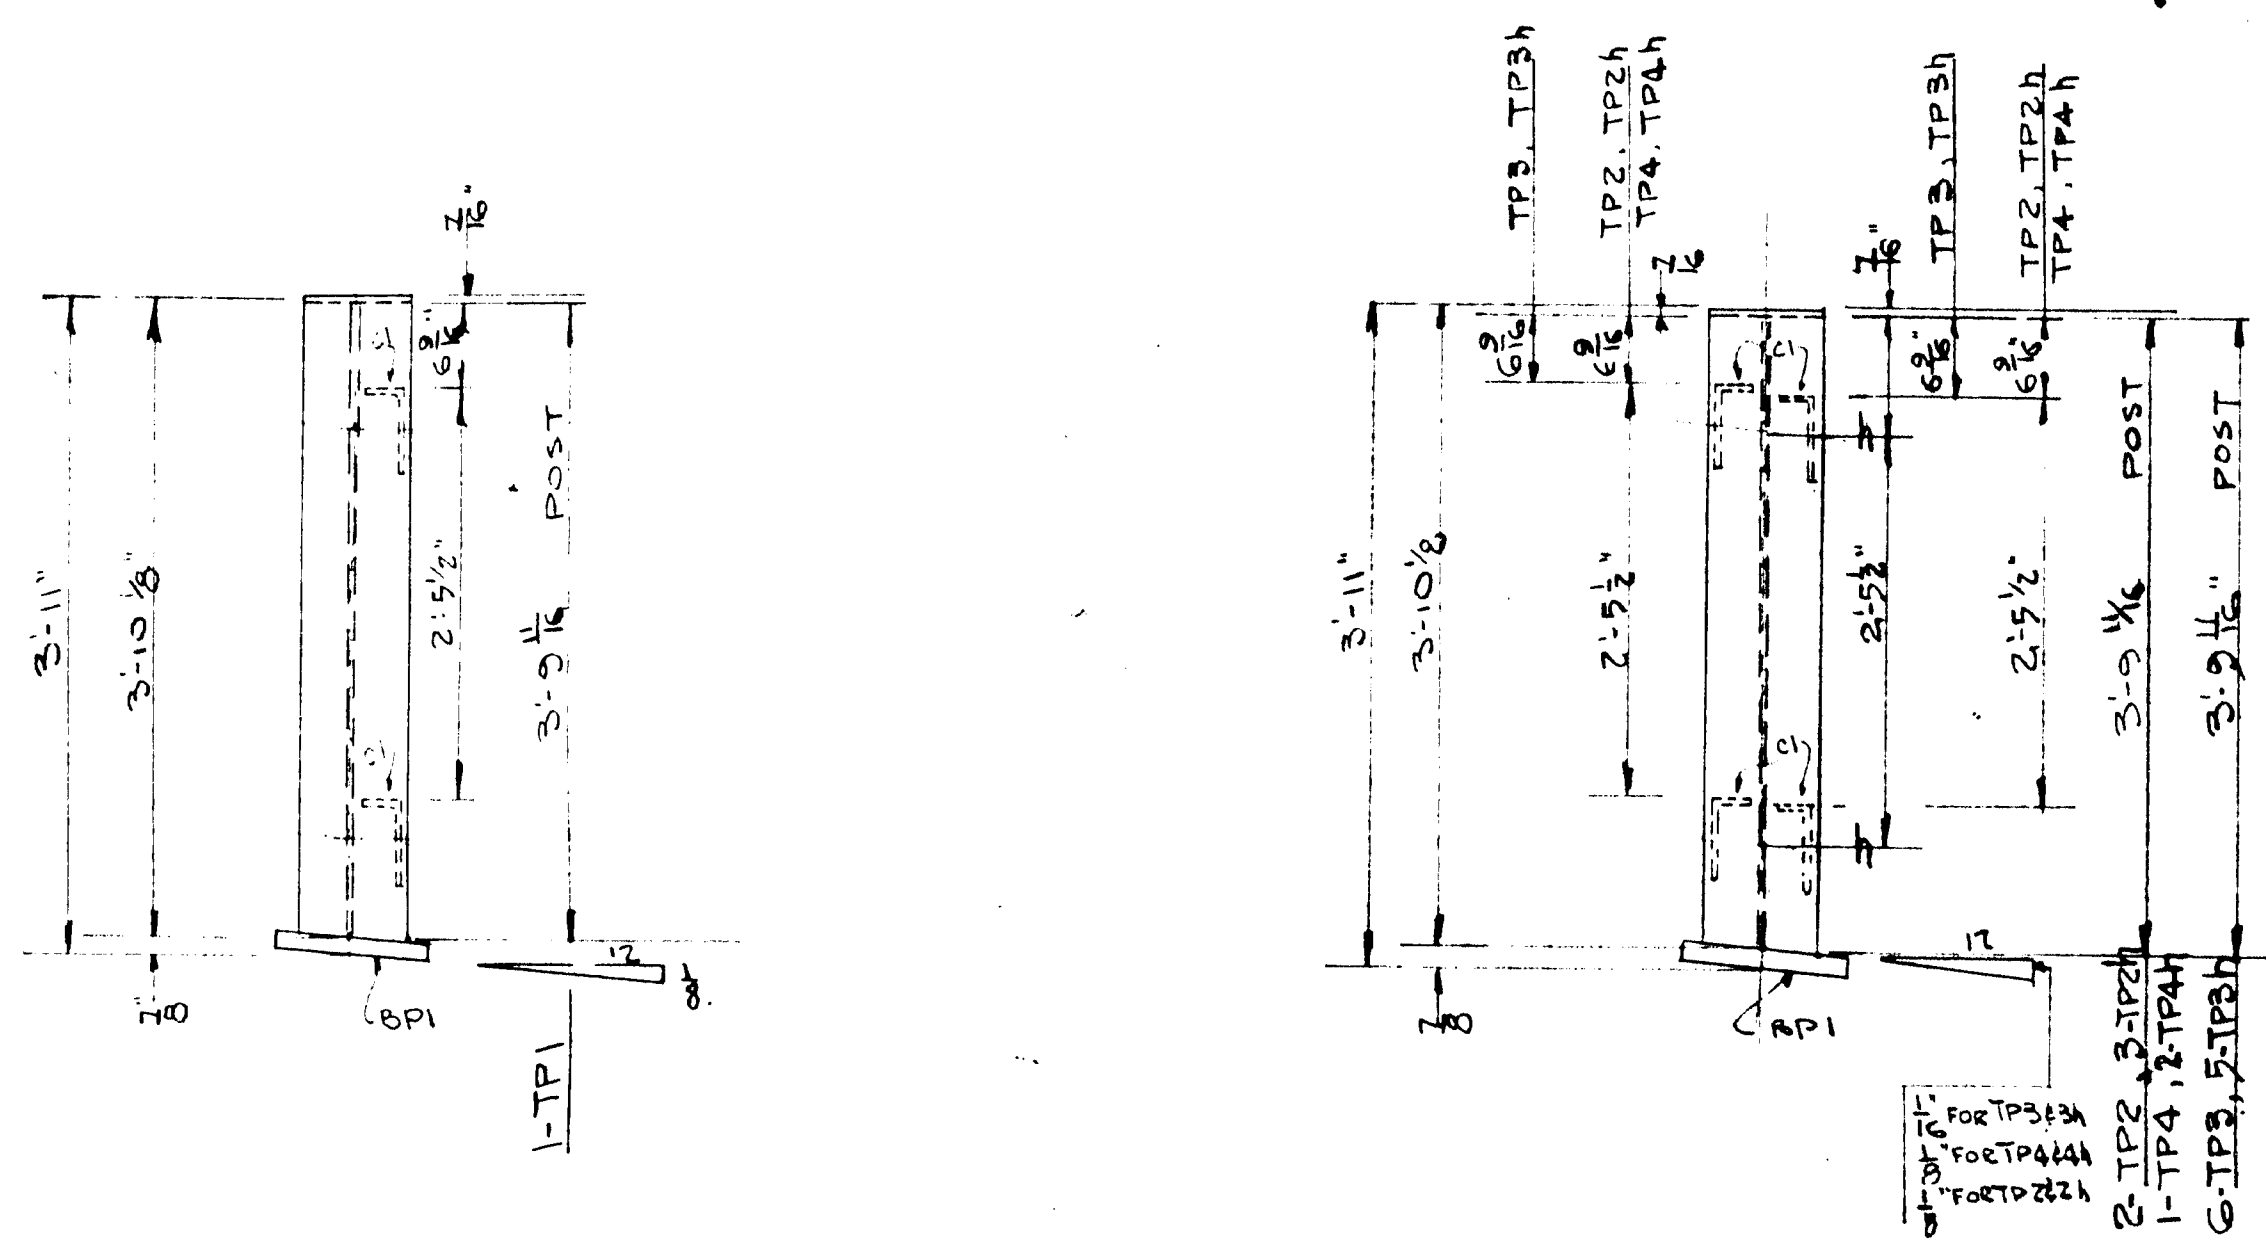

2-T1	7'-2 1/4"	
3-T2		7'-2 1/2"
4-T3	7'-2 3/8"	
2-T4		7'-2 1/2"
2-T5	7'-2 3/8"	
1-T6		7'-3"
2-T7	7'-2"	
1-T8		7'-2 1/2"
1-T9	7'-2 3/8"	
2-T10		7'-2 3/8"

T1	11 7/8"	5'-2 1/2"	11 7/8"
T2	12 1/8"		12 1/8"
T3	11 5/8"		11 5/8"
T4	12"		12"
T5	11 5/8"		11 5/8"
T6	12 1/8"		12 1/8"
T7	11 3/4"		11 3/4"
T8	11 7/8"		11 7/8"
T9	12 3/16"		12 3/16"
T10	11 5/8"		11 5/8"

T1	8 3/8"	5 SPACES @ 12 1/2" = 5'-2 1/2"	8 3/8"
T2	9"	16 PALES	9"
T3	8 5/8"		8 5/8"
T4	9"		9"
T5	8 5/8"		8 5/8"
T6	9 1/2"		9 1/2"
T7	8 3/4"		8 3/4"
T8	8 5/8"		8 5/8"
T9	9 1/2"		9 1/2"
T10	8 5/8"		8 5/8"

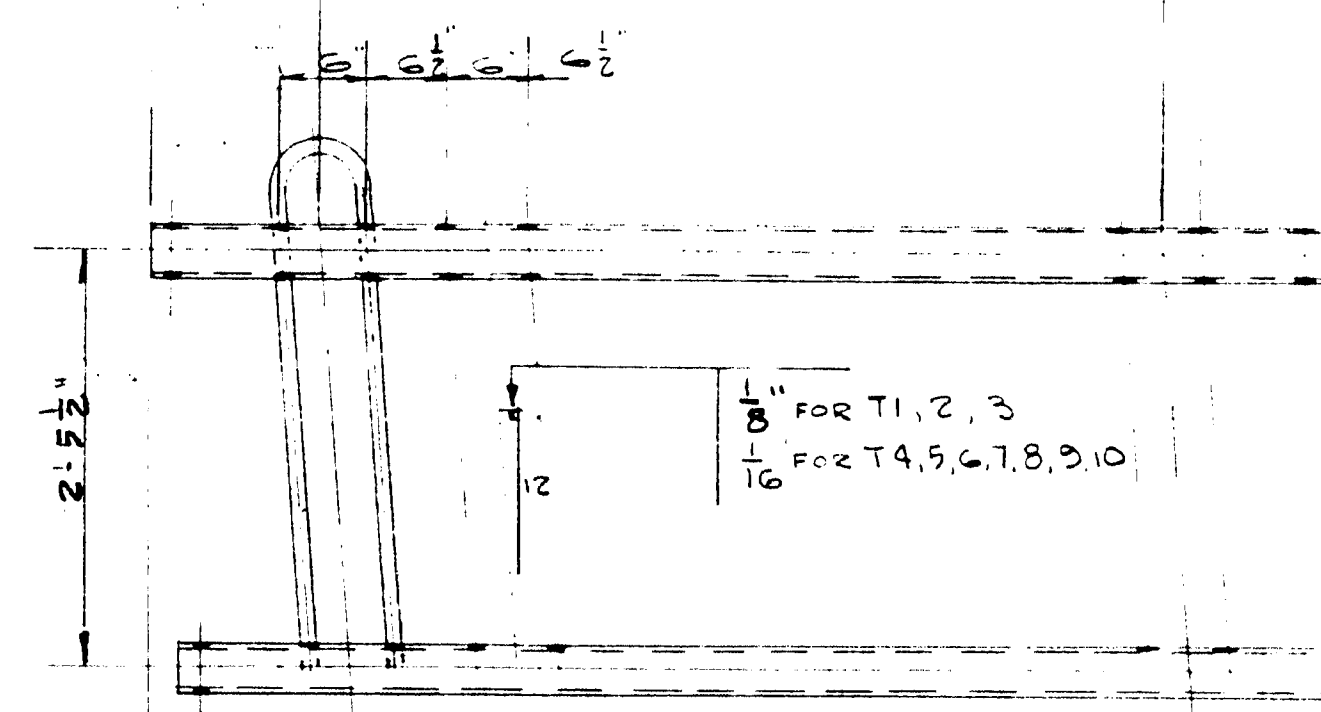


T1, T2, T3	5 1/16"
T4, T5, T6, T7, T8, T9, T10	1 1/8"

SEE TYPICAL DETAIL DWG 51

405 BANGOR BREWER BRIDGE RAIL			
TOLL PLAZA WALL			
CUSTOMER: VERRIER CONST. CO.			
ARCHITECT OR ENGINEER: H. & CORTELYOU			
DATE: 5-28-54		REVISED:	
BY: R.L.D.		62-100 M	
BANGOR & MARTIN ROLLING MILLS CO. 293-519			

NO.	APPROVAL	NO.	FINAL
9-28-54	3	6-29-54	
2-20-54	3	7-23-54	

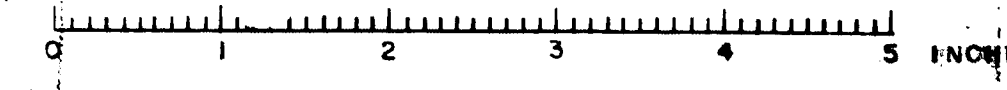





0 1 2 3 4 5 INCHES





0 1 2 3 4 5 INCHES



AMERICAN BRIDGE  
DIVISION  
UNITED STATES STEEL COMPANY

LINE	ITEM	MATERIAL	SHAPE	LENGTH	ASSEMBLY	REMARKS	ORDERED	ITEM	CALCULATED
1									
2									
3		ONE EXPANSION DAM-ED3		120'					
4		ONE EXPANSION DAM-ED7							
5		10 3/4 6 7/8	PA	5300	ED17			5	92
6		10 3/4 6 7/8	PA	5300	ED13			5	92
7		10 3/4 6 7/8	PA	5300				5	92
8		10 3/4 6 7/8	PW	5300				5	92
9		10 3/4 6 7/8	PW	5300				5	92
10		10 3/4 6 7/8	PW	5300				5	92
11		10 3/4 6 7/8	PW	5300				5	92
12		ONE EXPANSION DAM-ED4		104'					
13		ONE EXPANSION DAM-ED8							
14									
15		2 R	12 3/4 6 7/8	PA				20-0	M419
16		2 R	12 3/4 6 7/8	PA				45-0	M418
17		2 R	12 3/4 6 7/8	PA				45-0	M418
18		2 R	12 3/4 6 7/8	PA				20-0	M417
19		2 R	12 3/4 6 7/8	PA					
20		2 R	12 3/4 6 7/8	PA					
21		2 R	12 3/4 6 7/8	PA					
22		2 R	12 3/4 6 7/8	PA					
23		2 R	12 3/4 6 7/8	PA					
24		20 10 3/4 6 7/8	PA	1 9	M2301	BENT		20-0	M419
25									
26									
27		ONE EXPANSION DAM-ED5		912'					
28		1 R	14 1/2 8 2	PA				20-0	M419
29		1 R	14 1/2 8 2	PA				45-0	M418
30		1 R	14 1/2 8 2	PA				30-0	M418
31		1 R	14 1/2 8 2	PA				30-0	M418
32		1 R	14 1/2 8 2	PA				30-0	M418
33		1 R	14 1/2 8 2	PA				30-0	M418
34									
35									
36									
37		ONE EXPANSION DAM-ED6		942'					
38									
39		1 R	14 1/2 8 2	PA				20-0	M419
40		1 R	14 1/2 8 2	PA				45-0	M418
41		1 R	14 1/2 8 2	PA				30-0	M418
42		1 R	14 1/2 8 2	PA				30-0	M418
43		1 R	14 1/2 8 2	PA				30-0	M418
44		1 R	14 1/2 8 2	PA				30-0	M418
45									
46									
EXPANSION DAMS ED3, ED4, ED5, ED6, ED7 & ED8

STATE OF MAINE  
STATE HIGHWAY COMMISSION  
BANGOR-BREWER BRIDGE  
OVER THE PENOBSCOT RIVER  
BANGOR, MAINE

AMERICAN BRIDGE

DRAWINGS MADE AT TRENTON PLANT  
WORK FABRICATED AT TRENTON PLANT  
IN CHARGE OF E. B. MARKS  
DRAW. MADE BY E. A. B. DATE 10-6-53  
DRAW. CHECKED BY FRY DATE 11-2-53

F	
E	
D	
C	
B	
A	


ORDER No. Q4149  
SHEET No. 301

REVISIONS

304

WELD

62-101A

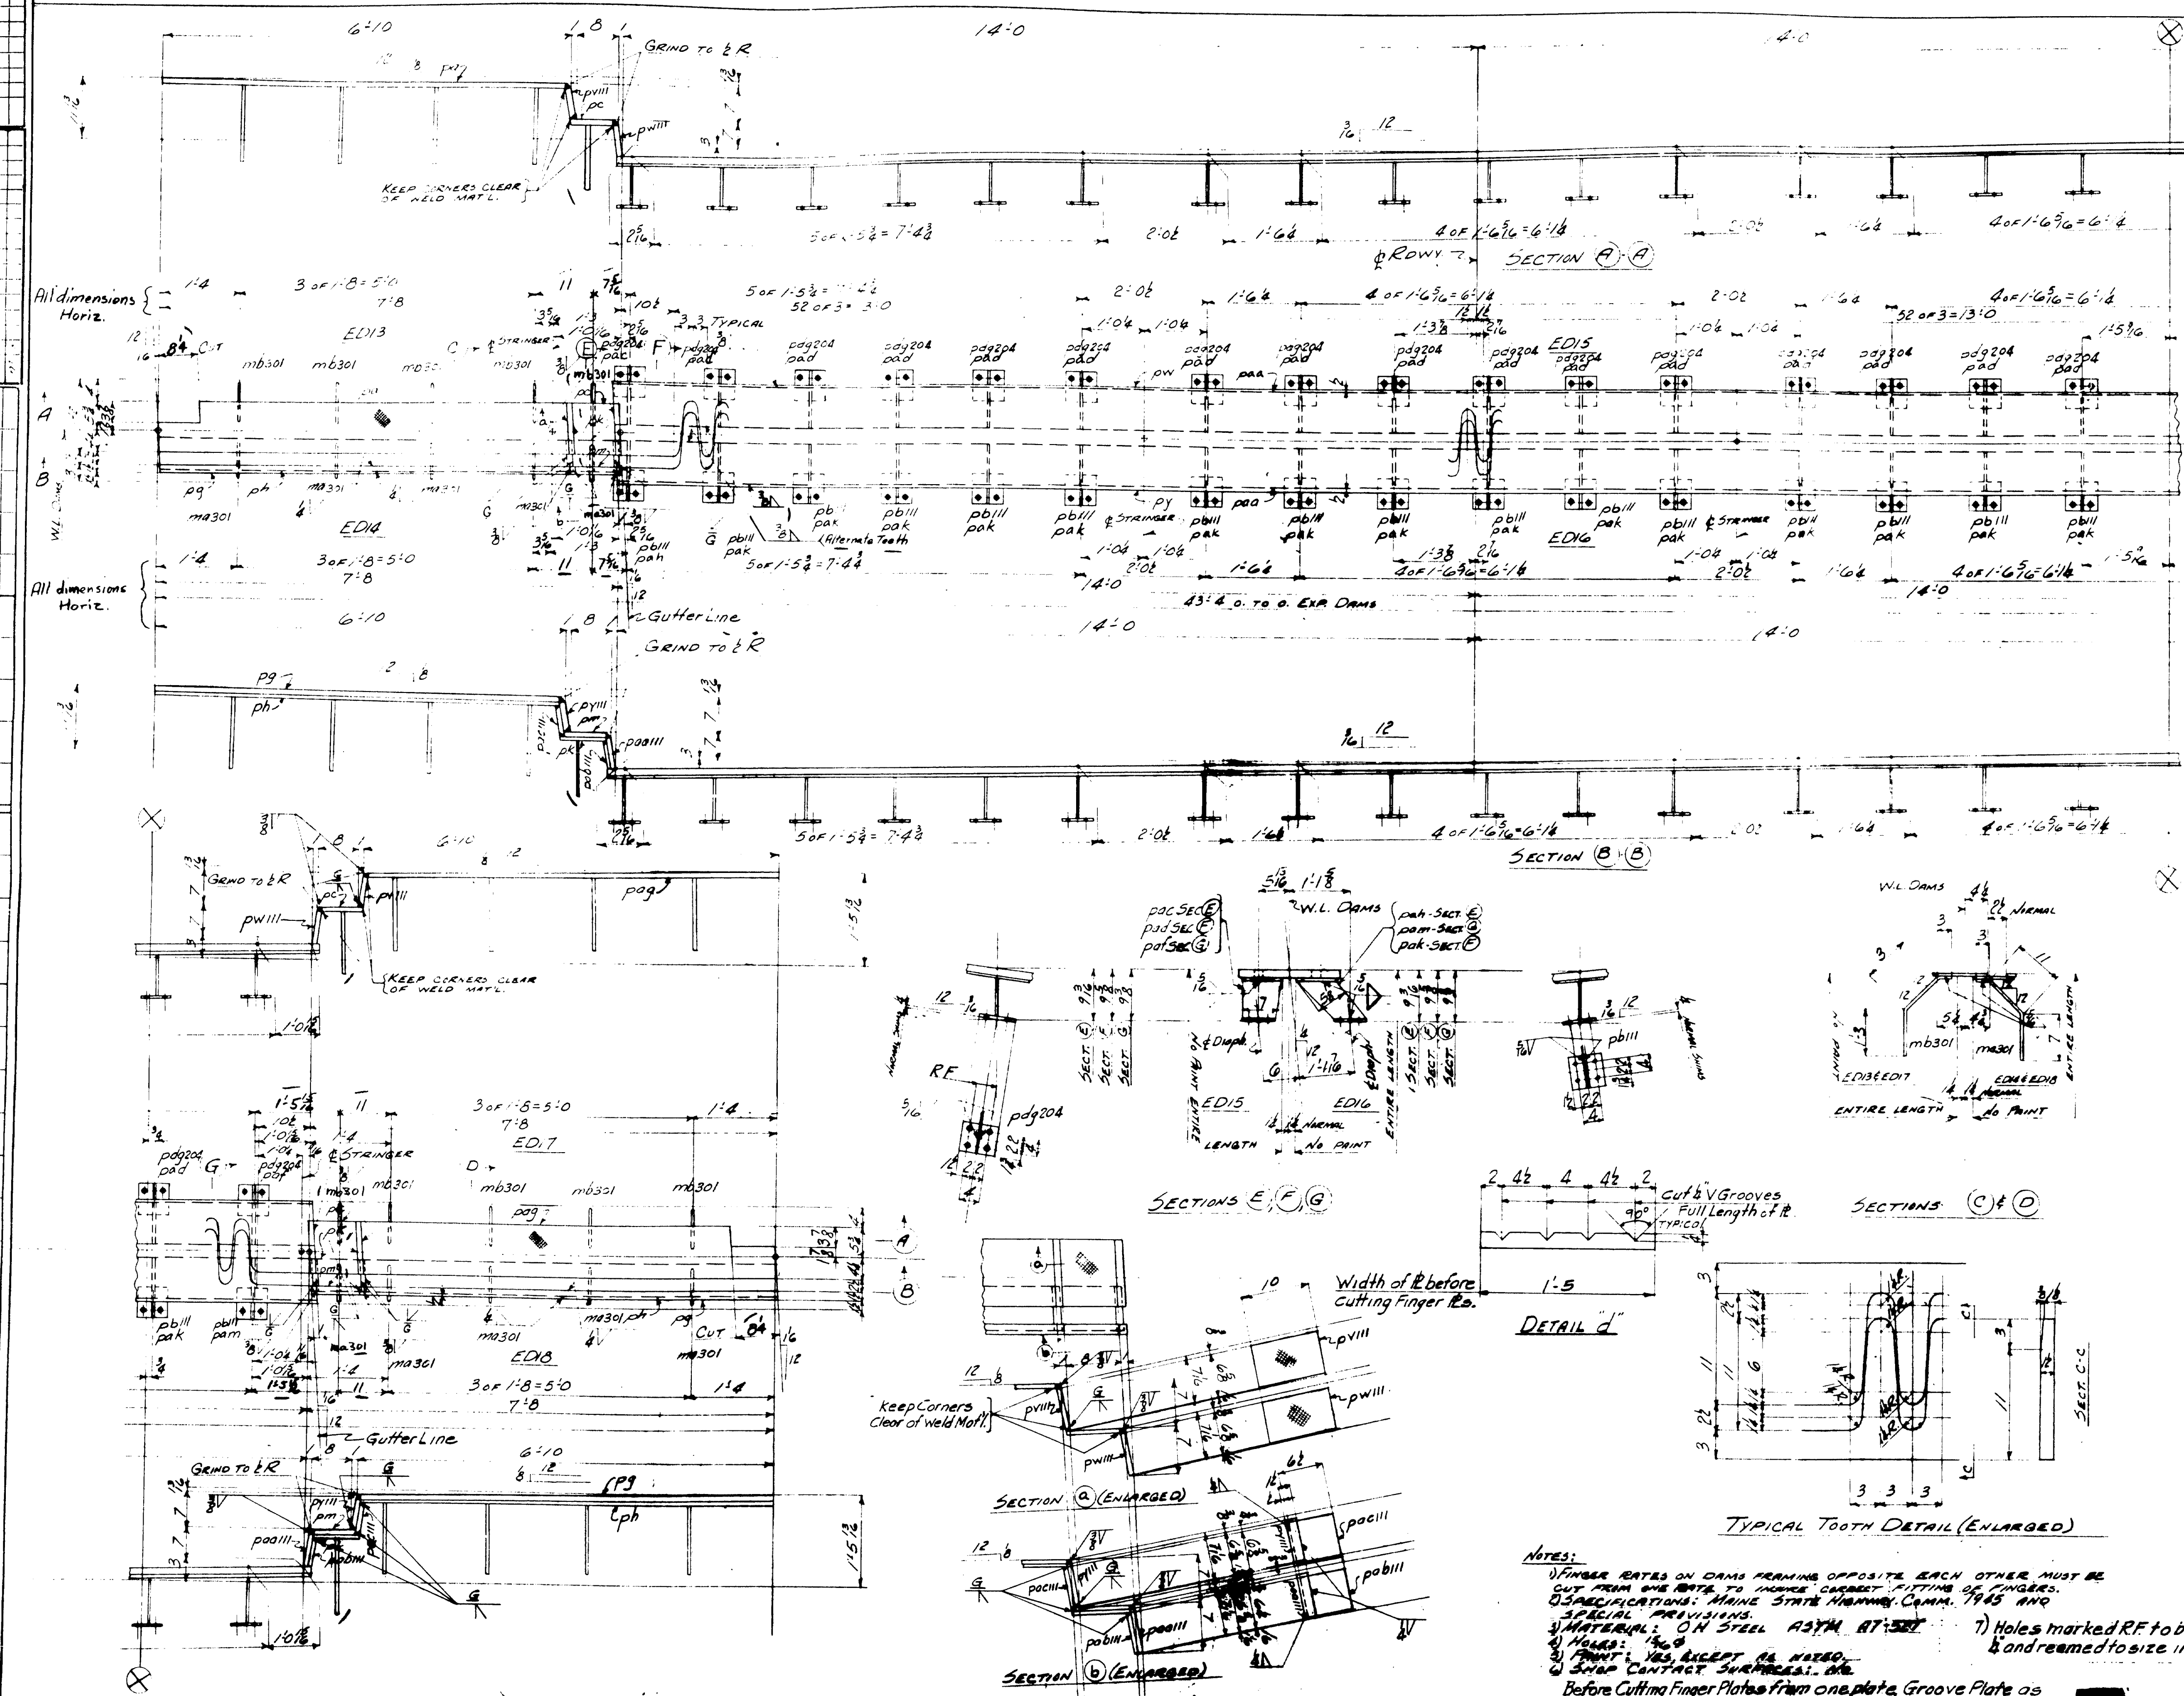

NOTES:  
1) FINGER RATES ON DAMS FRAMING OPPOSITE EACH OTHER MUST BE CUT FROM ONE END TO INSURE CORRECT FITTING OF FINGERS.  
2) SPECIFICATIONS: MAINE STATE HIGHWAY COMMISSION, 1945 AND 1946.  
3) MATERIAL: ON STEEL ASTM A36 AT 50°F.  
4) HOLES: 1/2" DIA.  
5) HOLES: 1/2" DIA.  
**DIVISION**  
**UNITED STATES COAST GUARD**

	63	RIV
1	28	cut
	68	hole
	55	W
	87	P

LIFTING WT. = 14 TONS

301, 302

62-101B

# DRAWING WITH BILL AMERICAN BRIDGE

LINE	ITEM	MATERIAL	LENGTH	ASSEMBLY	REMARKS	ORDERED	CALCULATED
		SHAPE	Feet	MARK		ITEM	WEIGHT FOR ONE
							SPAN - PIER
1					90' 1"		
2					253' 04148		
3					24543' 04149		
4	ONE BEAM	B38					
5							
6							
7	1 2G CB170	44 5 9			Fin 1 - 11	44 5 2	3116
8	1 2G CB 300	43 4 16			Fin 2 - 18	43 5 4	3068
9							
10	2 2 12 1/2	4 2 3					255
11	2 2 5 1/2	3 2 3					16
12	2 2 5 1/2	3 2 3					15
13	2 2 10 1/2	4 9					50 1
14	4 1 1/2	4 9					2 1/2
15	2 2 10 1/2	4 9					2 1/2
16	2 2 10 1/2	4 9					2 1/2
NOTES:  
 SPECIFICATIONS: Maine State Highway Comm. 1948 & Special Provisions  
 MATERIAL: O.H. Steel A513, A7-52  
 RIVETS: 3" HOLES: 1/2" unless noted  
 WORKMANSHIP:  
 Holes in material thicker than the diameter of the rivet shall be drilled  
 All holes for Shop Rivets to be Subpunched or Subdrilled 1/4" and Reamed to size with connecting parts assembled.  
 Holes marked RT to be Subpunched or subdrilled 1/4" and reamed to size to a metal template  
 Holes marked RA to be subpunched & subdrilled 1/4" & reamed to size while connecting members are assembled. Connecting members to be matchmarked.  
 BE indicates bearing end of stiffeners.  
 In assembling TPI care must be taken to have axis of bore normal to & of beam.  
 Shop to fabricate beams with mill camber up.  
 For assembling & reaming diagrams see Sht. 3/2  
 Work Sht. 3/2 with this sheet.  
 PAINT: Yes, except as noted  
 SHOP CONTACT SURFACES: No

STRINGER B38  
 DIV. 3  
 STATE OF MAINE  
 STATE HIGHWAY COMMISSION  
 BANGOR BREWER BRIDGE  
 OVER PENOBSCOT RIVER  
 BANGOR, MAINE  
 ESTABLISHED 19-21 OCT 1948  
 AMERICAN BRIDGE  
 DIVISION  
 UNITED STATES STEEL COMPANY

DRAWINGS MADE AT TRENTON PLANT  
 WORK FABRICATED AT TRENTON PLANT  
 IN CHARGE OF E.B. MARKS  
 DRAW. MADE BY S.E.K. DATE 10-12-53  
 DRAW. CHECKED BY P.R.Y. DATE 1-14-54  
 ORDER NO. Q4149  
 SHEET NO. 303



# AMERICAN BRIDGE

LINE	ITEM	MATERIAL	LENGTH	ASSEMBLY	REMARKS	ORDERED	CALCULATED
						ITEM	WEIGHT
1					91'3"		
2							
3					244		
4	ONE BEAM	B36			2690' Q4148		
5	ONE BEAM	B37			26812' Q4149		
6							
7	1 3G CB 230	43 03 (FIN)			45-02	3011	103.64
8	1 3G CB 230	43 11 1/2 (FIN)			44-02	3006	131.91
9	1 3G CB 230	44 9 1/4 (FIN)			44-9	3012	102.97
10	1 3G CB 230	42 8 1/4 (FIN)			42-9	3007	131.10
11							
12	4 1/2 16 1/2	4 9			40 1/2 25-0	3022	6.11
13	4 1/2 16 1/2	2 9					
14	4 1/2 16 1/2	2 9					
15	4 1/2 16 1/2	2 9					
16	4 1/2 16 1/2	2 9					
17	4 1/2 16 1/2	2 9					
18	4 1/2 16 1/2	2 9					
19	4 1/2 16 1/2	2 9					
20	4 1/2 16 1/2	2 9					
21							
22	2 1/2 16 1/2	2 9					
23	2 1/2 16 1/2	2 9					
24	4 1/2 16 1/2	2 9					
25	4 1/2 16 1/2	2 9					
26	2 1/2 16 1/2	2 9					
27	2 1/2 16 1/2	2 9					
28	2 1/2 16 1/2	2 9					
29	2 1/2 16 1/2	2 9					
30	2 1/2 16 1/2	2 9					
31	2 1/2 16 1/2	2 9					
32	2 1/2 16 1/2	2 9					
33	4 1/2 16 1/2	2 9					
34	4 1/2 16 1/2	2 9					
35	2 1/2 16 1/2	2 9					
36	2 1/2 16 1/2	2 9					
37	2 1/2 16 1/2	2 9					
38	2 1/2 16 1/2	2 9					
39	2 1/2 16 1/2	2 9					
40							
41							
42	2 1/2 16 1/2	2 9					
43	2 1/2 16 1/2	2 9					
44	4 1/2 16 1/2	2 9					
45	4 1/2 16 1/2	2 9					
46	4 1/2 16 1/2	2 9					
47	4 1/2 16 1/2	2 9					
48	4 1/2 16 1/2	2 9					
49	4 1/2 16 1/2	2 9					
50	4 1/2 16 1/2	2 9					
51							
52							
## NOTES:

SPECIFICATIONS: Maine State Highway Comm. 1945 & Special Provisions  
 MATERIAL: O.H. Steel ASTM A7-52T  
 RIVETS: 3/4" HOLES: 1/2" unless noted  
 WORKMANSHIP:  
 Holes in material thicker than the diameter of the rivet shall be drilled.  
 All holes for Shop Rivets to be Subpunched or Subdrilled & reamed to size with connecting parts assembled.  
 B.E. indicates bearing end of stiffeners.  
 In assembling TP3 care must be taken to have axis of bore normal to & of beam.  
 Shop to fabricate beams with mill camber up.

Holes marked RA to be subpunched or subdrilled & reamed to size while connecting members are assembled. Connecting members to be match marked.  
 B.E. indicates bearing end of stiffeners.  
 In assembling TP3 care must be taken to have axis of bore normal to & of beam.  
 Shop to fabricate beams with mill camber up.

For assembling & reaming diagrams see sht #312  
 Work sht #312 with this sheet.


LIFTING WT. - 15 TONS.

PAINT: Yes, except as noted  
 SHOP CONTACT SURFACES: No

F	DRAWINGS MADE AT	TERRELL	PLANT
E	WORK FABRICATED AT	TERRELL	PLANT
D	IN CHARGE OF	E.B. MARKS	
C	DRAW. MADE BY	SEK.	DATE 10-16-53
B	DRAW. CHECKED BY	PRY	DATE 1-13-54
A	REVISIONS		
	ORDER NO.	Q4149	SHEET NO. 304

301, 302

62-101D

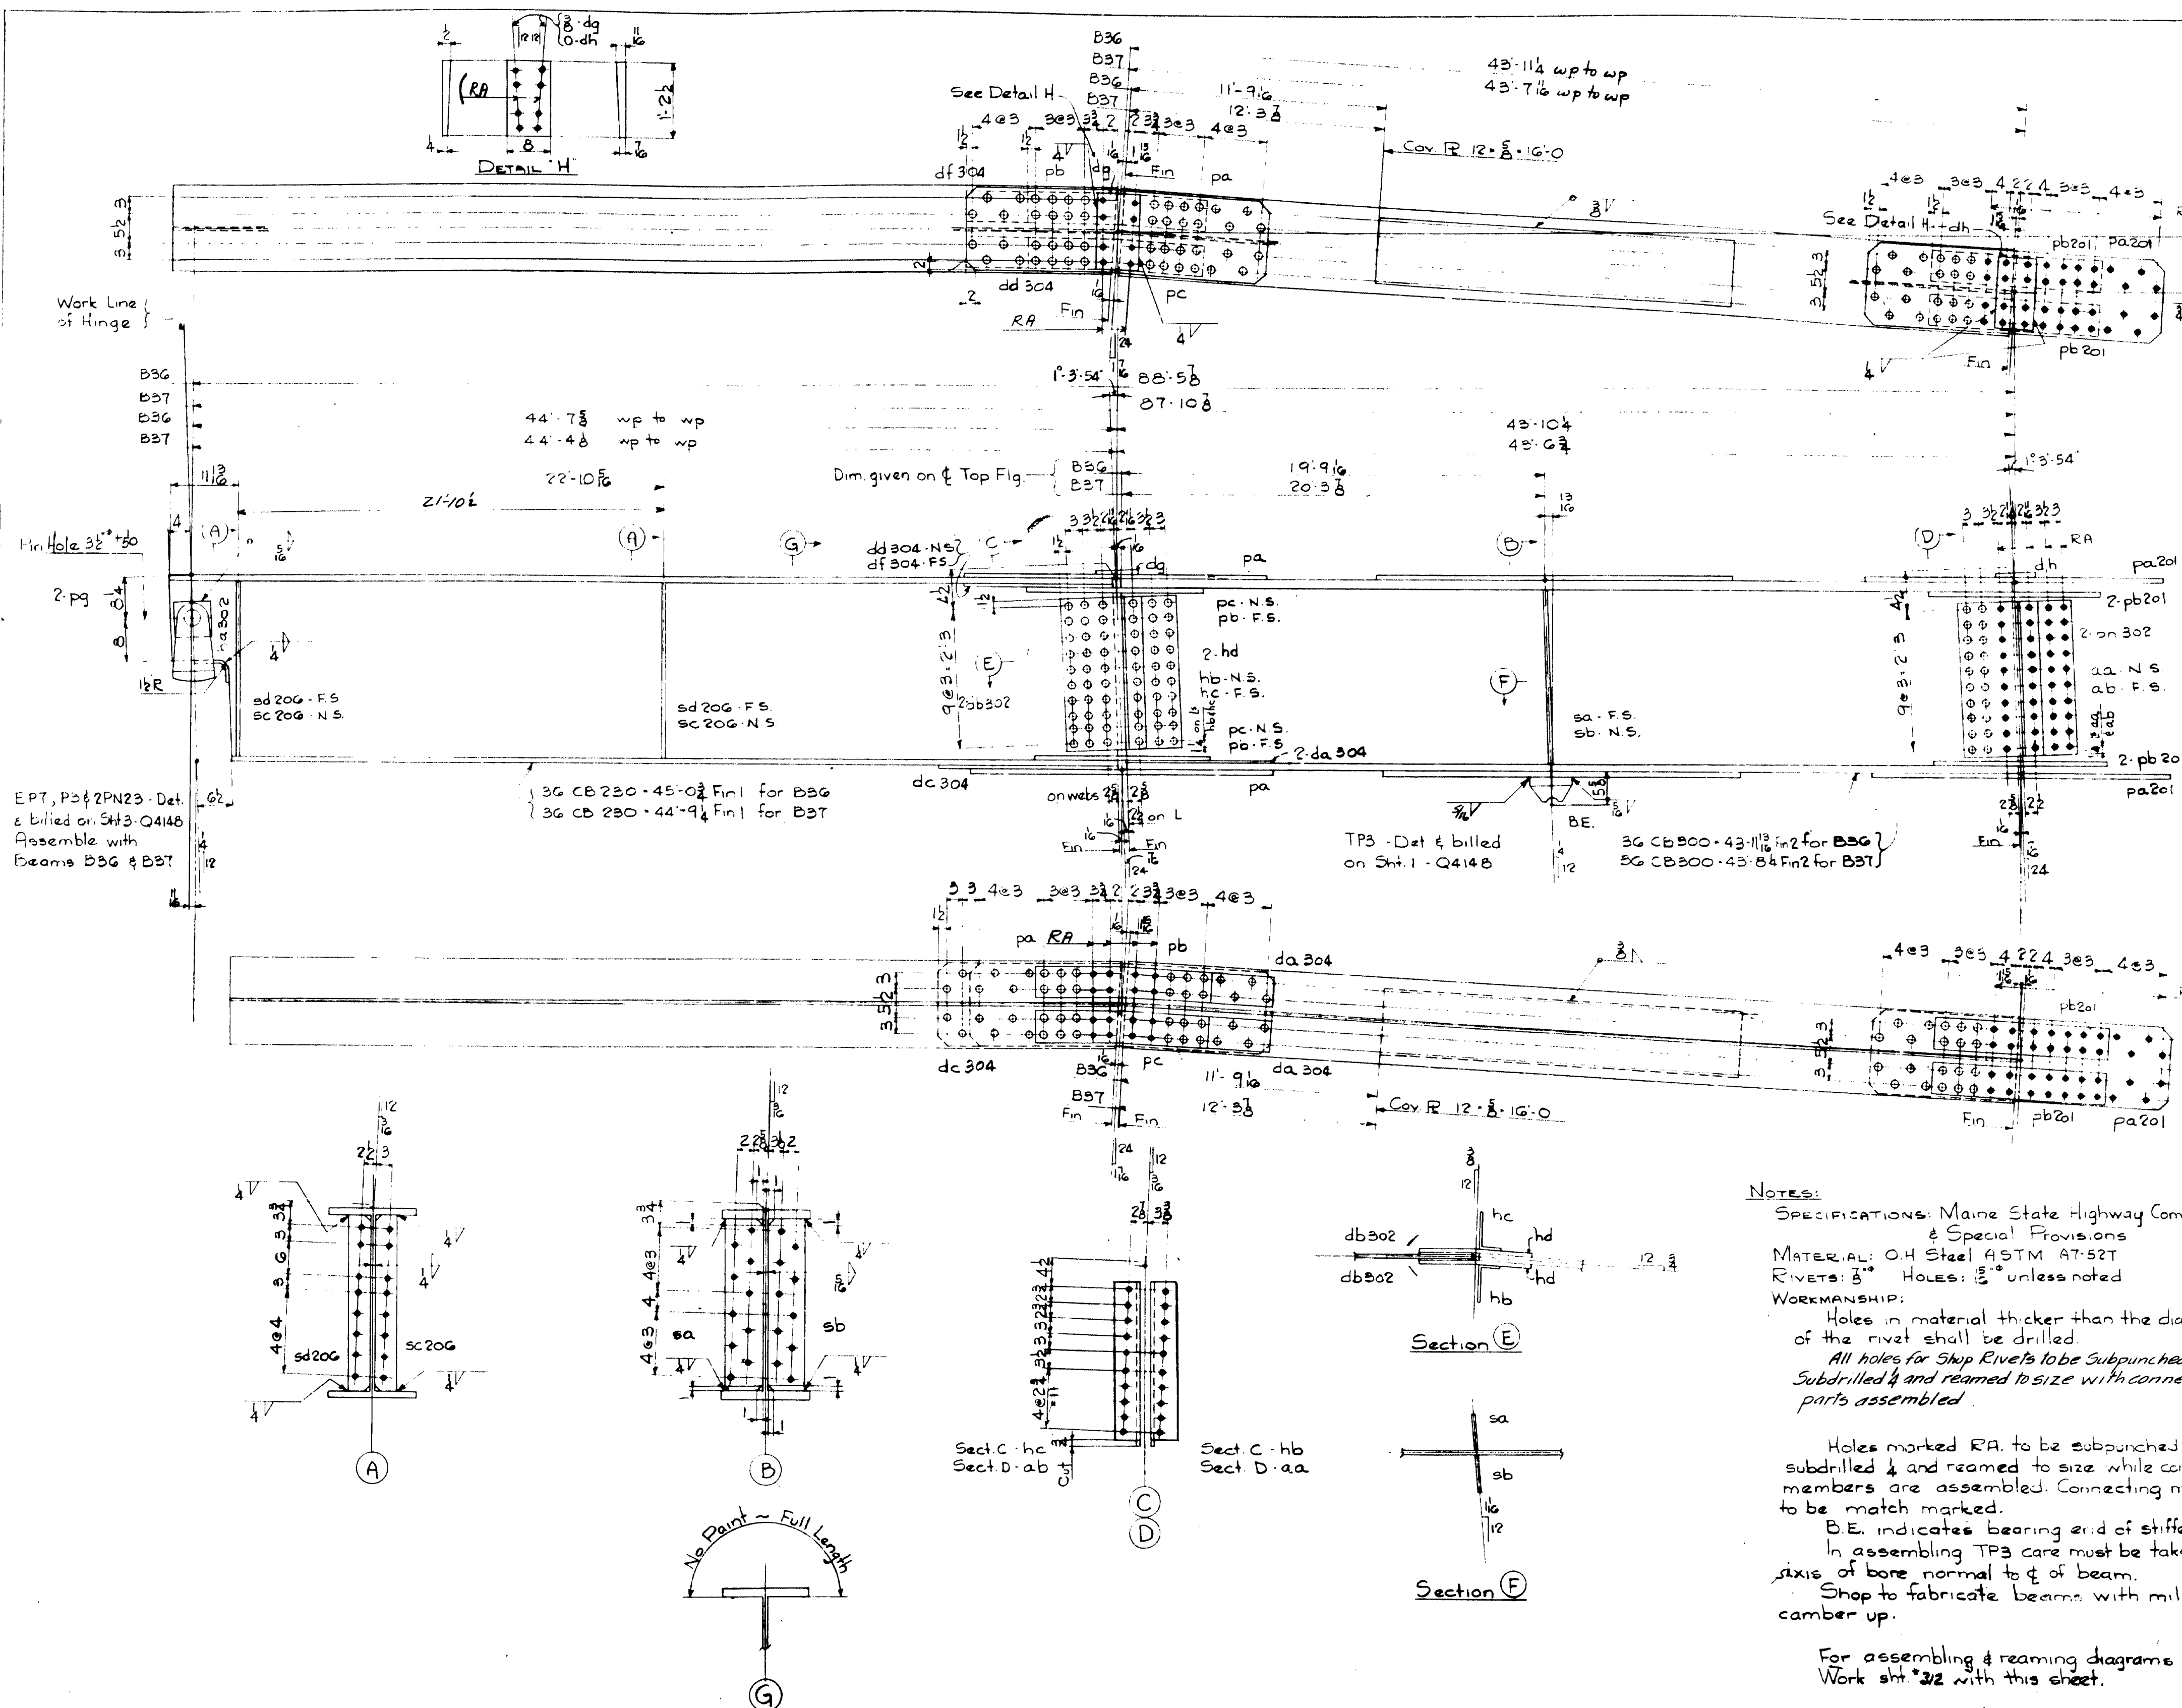



## DRAWING WITH BILL AMERICAN BRIDGE

LINE	ITEM No. of Piece	MATERIAL	SHAPE	LENGTH		ADDRESS BLANK MARK	REMARKS	ORDERED		CALCULATED WEIGHT FOR ONE SHIP PIECE
				Feet	Inches			ITEM		
1										
2										
3							80'2"			
4							122' 24" 241188 ✓			
5		ONE BEAM				D29	24044" 241188 ✓			
6										
7	1	3G CB 300		50	1 1/2		Fin 2 -18	50'-2	3401	150.48
8	1	3G CB 245		30	1 1/2		Fin 1 -185	30'-2	3409	73.87
9										
10	4	2 R 16 3/4 A		4	9	pa305	-5	44 1/2 35'-0	2022	6.29
11	4	2 R 16 3/4 B		2	0 1/2	pb305			S	1.20
12	4	2 R 16 3/4 C		2	9	pc305			S	1.22
13	8	2 R 30 1/2		1	9 1/2	nd305	Bent		S	1.32
14	1	F1 9 (3/4) 1		1	4	df305			S	1.71
15	2	F1 8 (3/4) 1		1	3	dg305			S	1.4
16	2	F1 6 (3/4) 1		1	4 1/2	da305			S	1.7
17	2	F1 6 (3/4) 1		2	4 1/2	db305			S	3.0
18	2	F1 16 (3/4) 1		2	10 1/2	dc305			S	9.7
19	2	F1 6 (3/4) 1		1	4 1/2	dd305			S	1.4
20										
21	1	R 7 1/2 A		2	9 1/2	sa		45'-0	M618	
22	1	R 7 1/2 B		2	9 1/2	sg		45'-0	M618	
23	1	R 7 1/2 C		2	9 1/2	sc202	Fin 1			25
24	1	R 7 1/2 D		2	9 1/2	sd202	Fin 1			5 1/2
25	1	R 7 1/2 E		2	9 1/2	se202				5 1/2
26	1	R 7 1/2 F		2	9 1/2	sf202				25
27	2	R 3 1/2 A		1	0 1/2	sg202	Fin 1			1 1/2
28	2	R 3 1/2 B		1	0 1/2	sh202	Fin 1			1 1/2
29	2	R 3 1/2 C		1	0 1/2	sk202	Fin 1			1 1/2
30										
31										
32	2	B 7 1/4 A		2	6	ha	Bent	60'-0	M619	6 1/2
33	2	B 7 1/4 B		2	5 1/2	hb	Bent	60'-0	M619	6 1/2
34	1	R 6 1/2			5 1/2	hc202	Bent			4
35										
36	4	R 7 1/2 A		1	1	ha103	Bent			3 1/2
37	2	R 7 1/2 B		1	1	hb103	Bent			1 1/2
38										
39	1	TOP PLATE				TP2	Det & bulled on Sh 2 Q440			9
40										
41	1	BASE PLATE				BP11	Det & bulled on Sh 2 Q440			2 1/2
42										
43										
44										
45	2	SB 7 1/2							Stores	
46										5 1/2
47										4 1/2
48										6 1/2
49										2 1/2
50										8 1/2
51										
52										
53										
54										
55										
56										
57										

STRINGER B39  
DIV. 3

STATE OF MAINE  
STATE HIGHWAY COMMISSION  
BANGOR-BREWER BRIDGE  
OVER PENOBSCOT RIVER  
BANGOR, MAINE  
ESTABLISHED 19-11-00 18-01 18-0  
AMERICAN BRIDGE  
MADE IN  
UNITED STATES OF AMERICA COMPANY

DRAWINGS MADE AT TRENTON PLANT  
WORK FABRICATED AT TRENTON PLANT  
IN CHARGE OF E.D. MARKS  
DRAW. MADE BY S.E.K. DATE 10-20-51  
DRAW. CHECKED BY PRY DATE 1-18-54

ORDER No. \_\_\_\_\_  
Q4149 \_\_\_\_\_

SHOOT No. \_\_\_\_\_  
305 \_\_\_\_\_

PAINT: Yes, except as noted  
SHOP CONTACT SURFACES: No

F	
E	
D	
C	
B	
X	2-8-54
REVISIONS:	


ORDER No  
Q4149

**SHEET No.**  
305

301, 302

**62-101 E**

LINE	ITEM	QUANTITY	UNIT	REMARKS	ORDERED	ITEM	QUANTITY	UNIT	REMARKS
1				78'7"					
2				122'24"48					
3				23627'0449					
4	ONE BEAM	B42							
5									
6									
7	1 3G CB 300	49'4 1/2		Fin 2 -18	49'4 1/2	3004	1	48'17	
8	1 3G CB 245	29'4 1/2		Fin 1 -12	29'4 1/2	3010	1	71'13	
9									
10									
11	2 R 10 1/2	4 9		pa305				60'9	
12	2 R 10 1/2	2 8 1/2		pb305				12'0	
13	2 R 10 1/2	2 9		pc305				12'2	
14	2 R 10 1/2	1 9 1/2		pd305				18'2	
15	1 R 10 1/2	1 4 1/2		pe305				9'	
16	2 R 10 1/2	1 1		hd108				16'	
17	1 R 10 1/2	1 4 1/2		da305				9'	
18	2 R 10 1/2	2 4 1/2		db305				30'	
19	1 R 10 1/2	2 10 1/2		dc305				97'	
20	5 R 7 1/2	1 1		hb103				40'	
21	2 R 7 1/2	2 6		ha8				60'0	M619
22	2 R 7 1/2	2 5 1/2		hb8				60'0	M619
23	1 R 6 1/2	5 4		hc202				4'	
24									
25	1 R 7 1/2	2 9 1/2		sa				45'0	M618
26	1 R 7 1/2	2 9 1/2		sg				45'0	M618
27	1 R 7 1/2	2 9 1/2		sc202				58'	
28	1 R 7 1/2	2 9 1/2		sd205				58'	
29	1 R 7 1/2	2 9 1/2		se202				25'	
30	1 R 7 1/2	2 9 1/2		sf205				25'	
31	2 R 7 1/2	1 0 1/2		sh202				16'	
32	2 R 7 1/2	1 0 1/2		sk202				16'	
33	2 R 7 1/2	1 0 1/2		sl202				16'	
34	1 R 7 1/2	1 4		df305				17'	
35	1 R 7 1/2	1 3		dg305				14'	
36	1 R 7 1/2	1 1 1/2		dh305				91'	
37									
38									
39	1 CASE PLATE	BPII		Let & welded on Sh 3 Q4148				31'	
40									
41									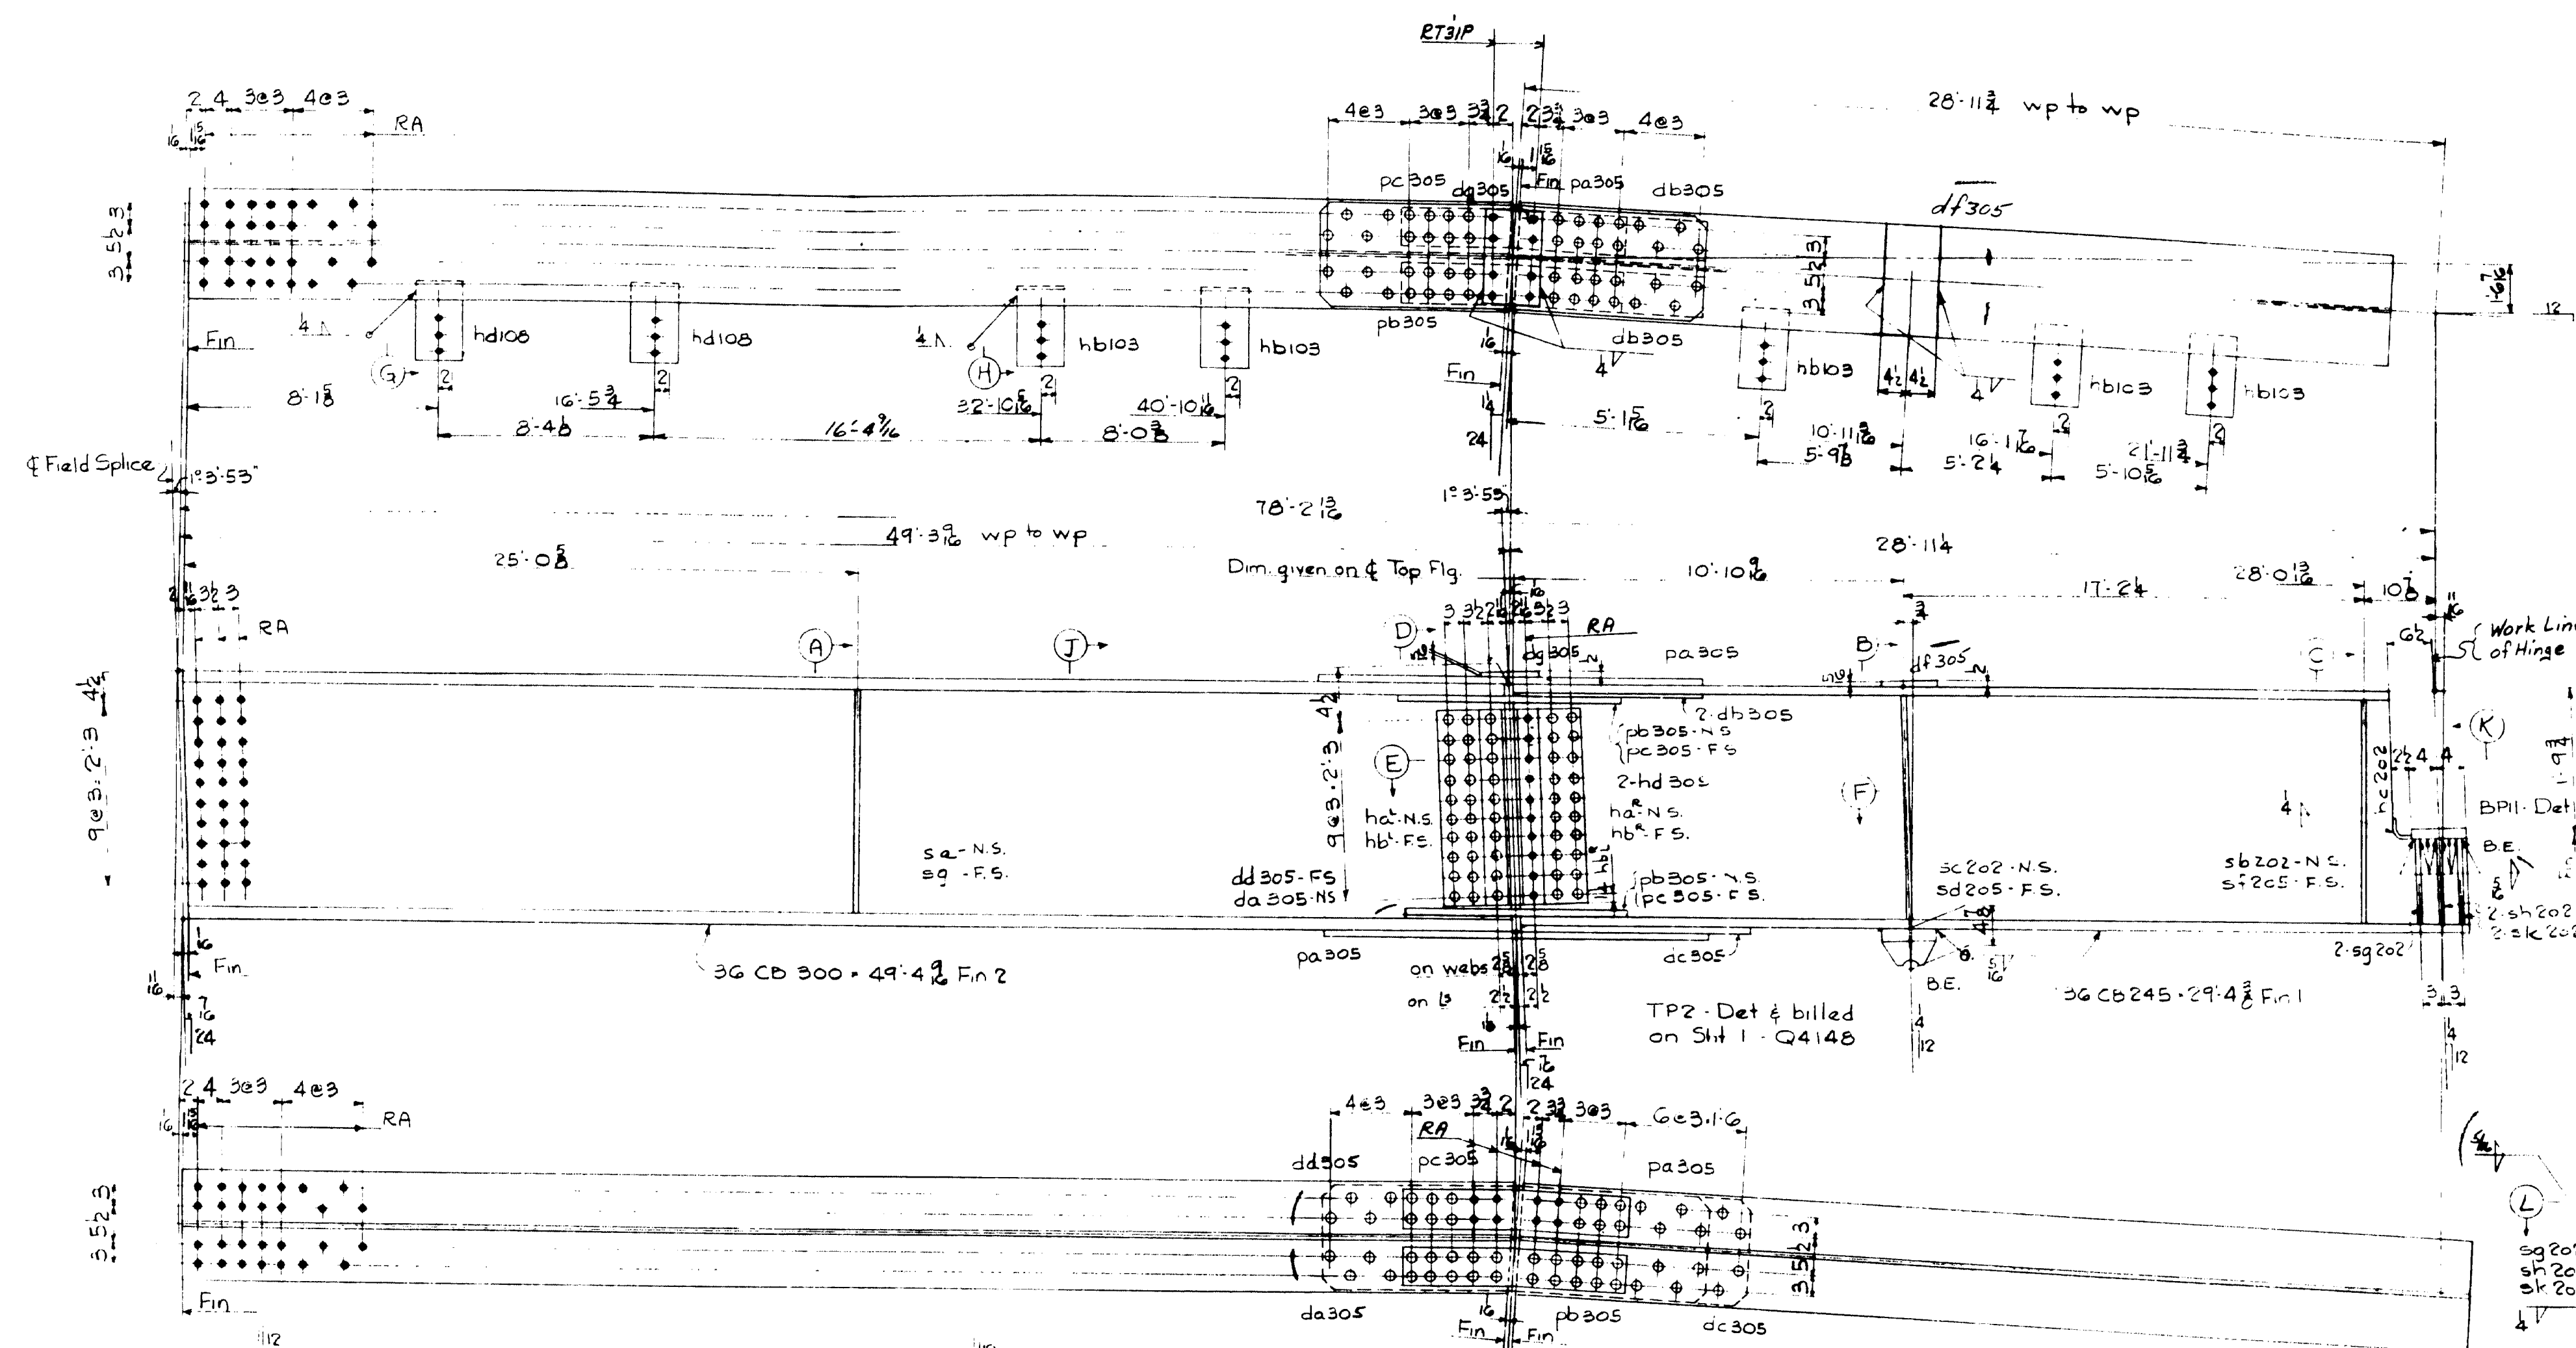
NOTES:  
SPECIFICATIONS: Maine State Highway Commission, 1945 and Special Provisions  
MATERIAL: OH. Steel ASTM A7-52T  
RIVETS: 8" Holes: 1 1/2"  
WORKMANSHIP:  
Holes in material thicker than the diameter of the rivet shall be drilled.  
All holes for Shop Rivets to be Subdrilled or subpunched & reamed to size with connecting parts assembled.  
Holes marked R.T. to be Subpunched or Subdrilled & reamed to size to a metal template.  
Holes marked R.A. to be subpunched or subdrilled & reamed to size while connecting members are assembled. Connecting members to be matchmarked.  
B.E. indicates bearing end of stiffeners.  
In assembling TP2 care must be taken to have axis of bore normal to & of beam.  
Shop to fabricate beams with mill camber up.  
For assembling & reaming diagrams see sht. #312  
Work sht. #312 with this sheet.  
LIFTING WT. = 13 Tons

STRINGER: B42  
DIV. 3  
STATE OF MAINE  
STATE HIGHWAY COMMISSION  
DANGOR-BREWER BRIDGE  
OVER PENOBSCOT RIVER  
DANGOR, MAINE

AMERICAN BRIDGE  
DRAWINGS MADE AT TRENTON PLANT  
WORK FABRICATED AT TRENTON PLANT  
IN CHARGE OF E.D. MARKS  
DRAW. MADE BY S.E.K. DATE 10-22-53  
DRAW. CHECKED BY F.R.V. DATE 11-2-54  
ORDER No. Q4149  
SHEET No. 306


PAINT: Yes, except as noted  
SHOP CONTACT SURFACES: No

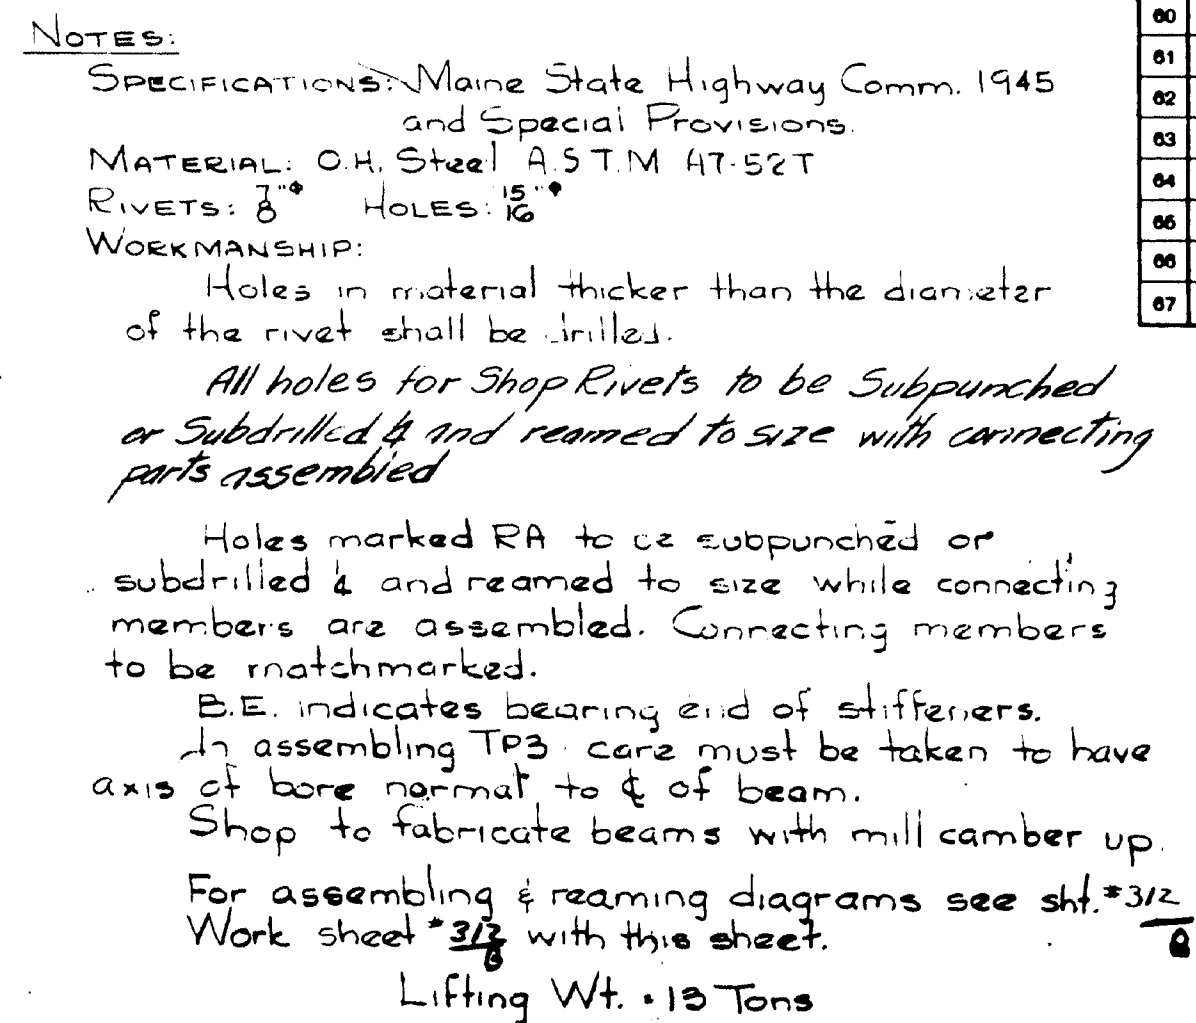

[illegible]

SIKINGERS B40 #541  
DIV. 3  
STATE OF MAINE  
STATE HIGHWAY COMMISSION  
BANGOR BREWER BRIDGE  
OVER PENOBSCOT RIVER  
BANGOR, MAINE  
RETIRED 10-31-1981 10081 10-80  
AMERICAN BRIDGE  
DIVISION  
UNITED STATES STEEL COMPANY  
DRAWINGS MADE AT TRENTON PLANT  
WORK FABRICATED AT TRENTON PLANT  
IN CHARGE OF E.B. MARKS  
DRAW. MADE BY SEK DATE 10-26-53  
DRAW. CHECKED BY PRY DATE 1-18-54  
ORDER NO. SHEET NO.  
Q3419 307



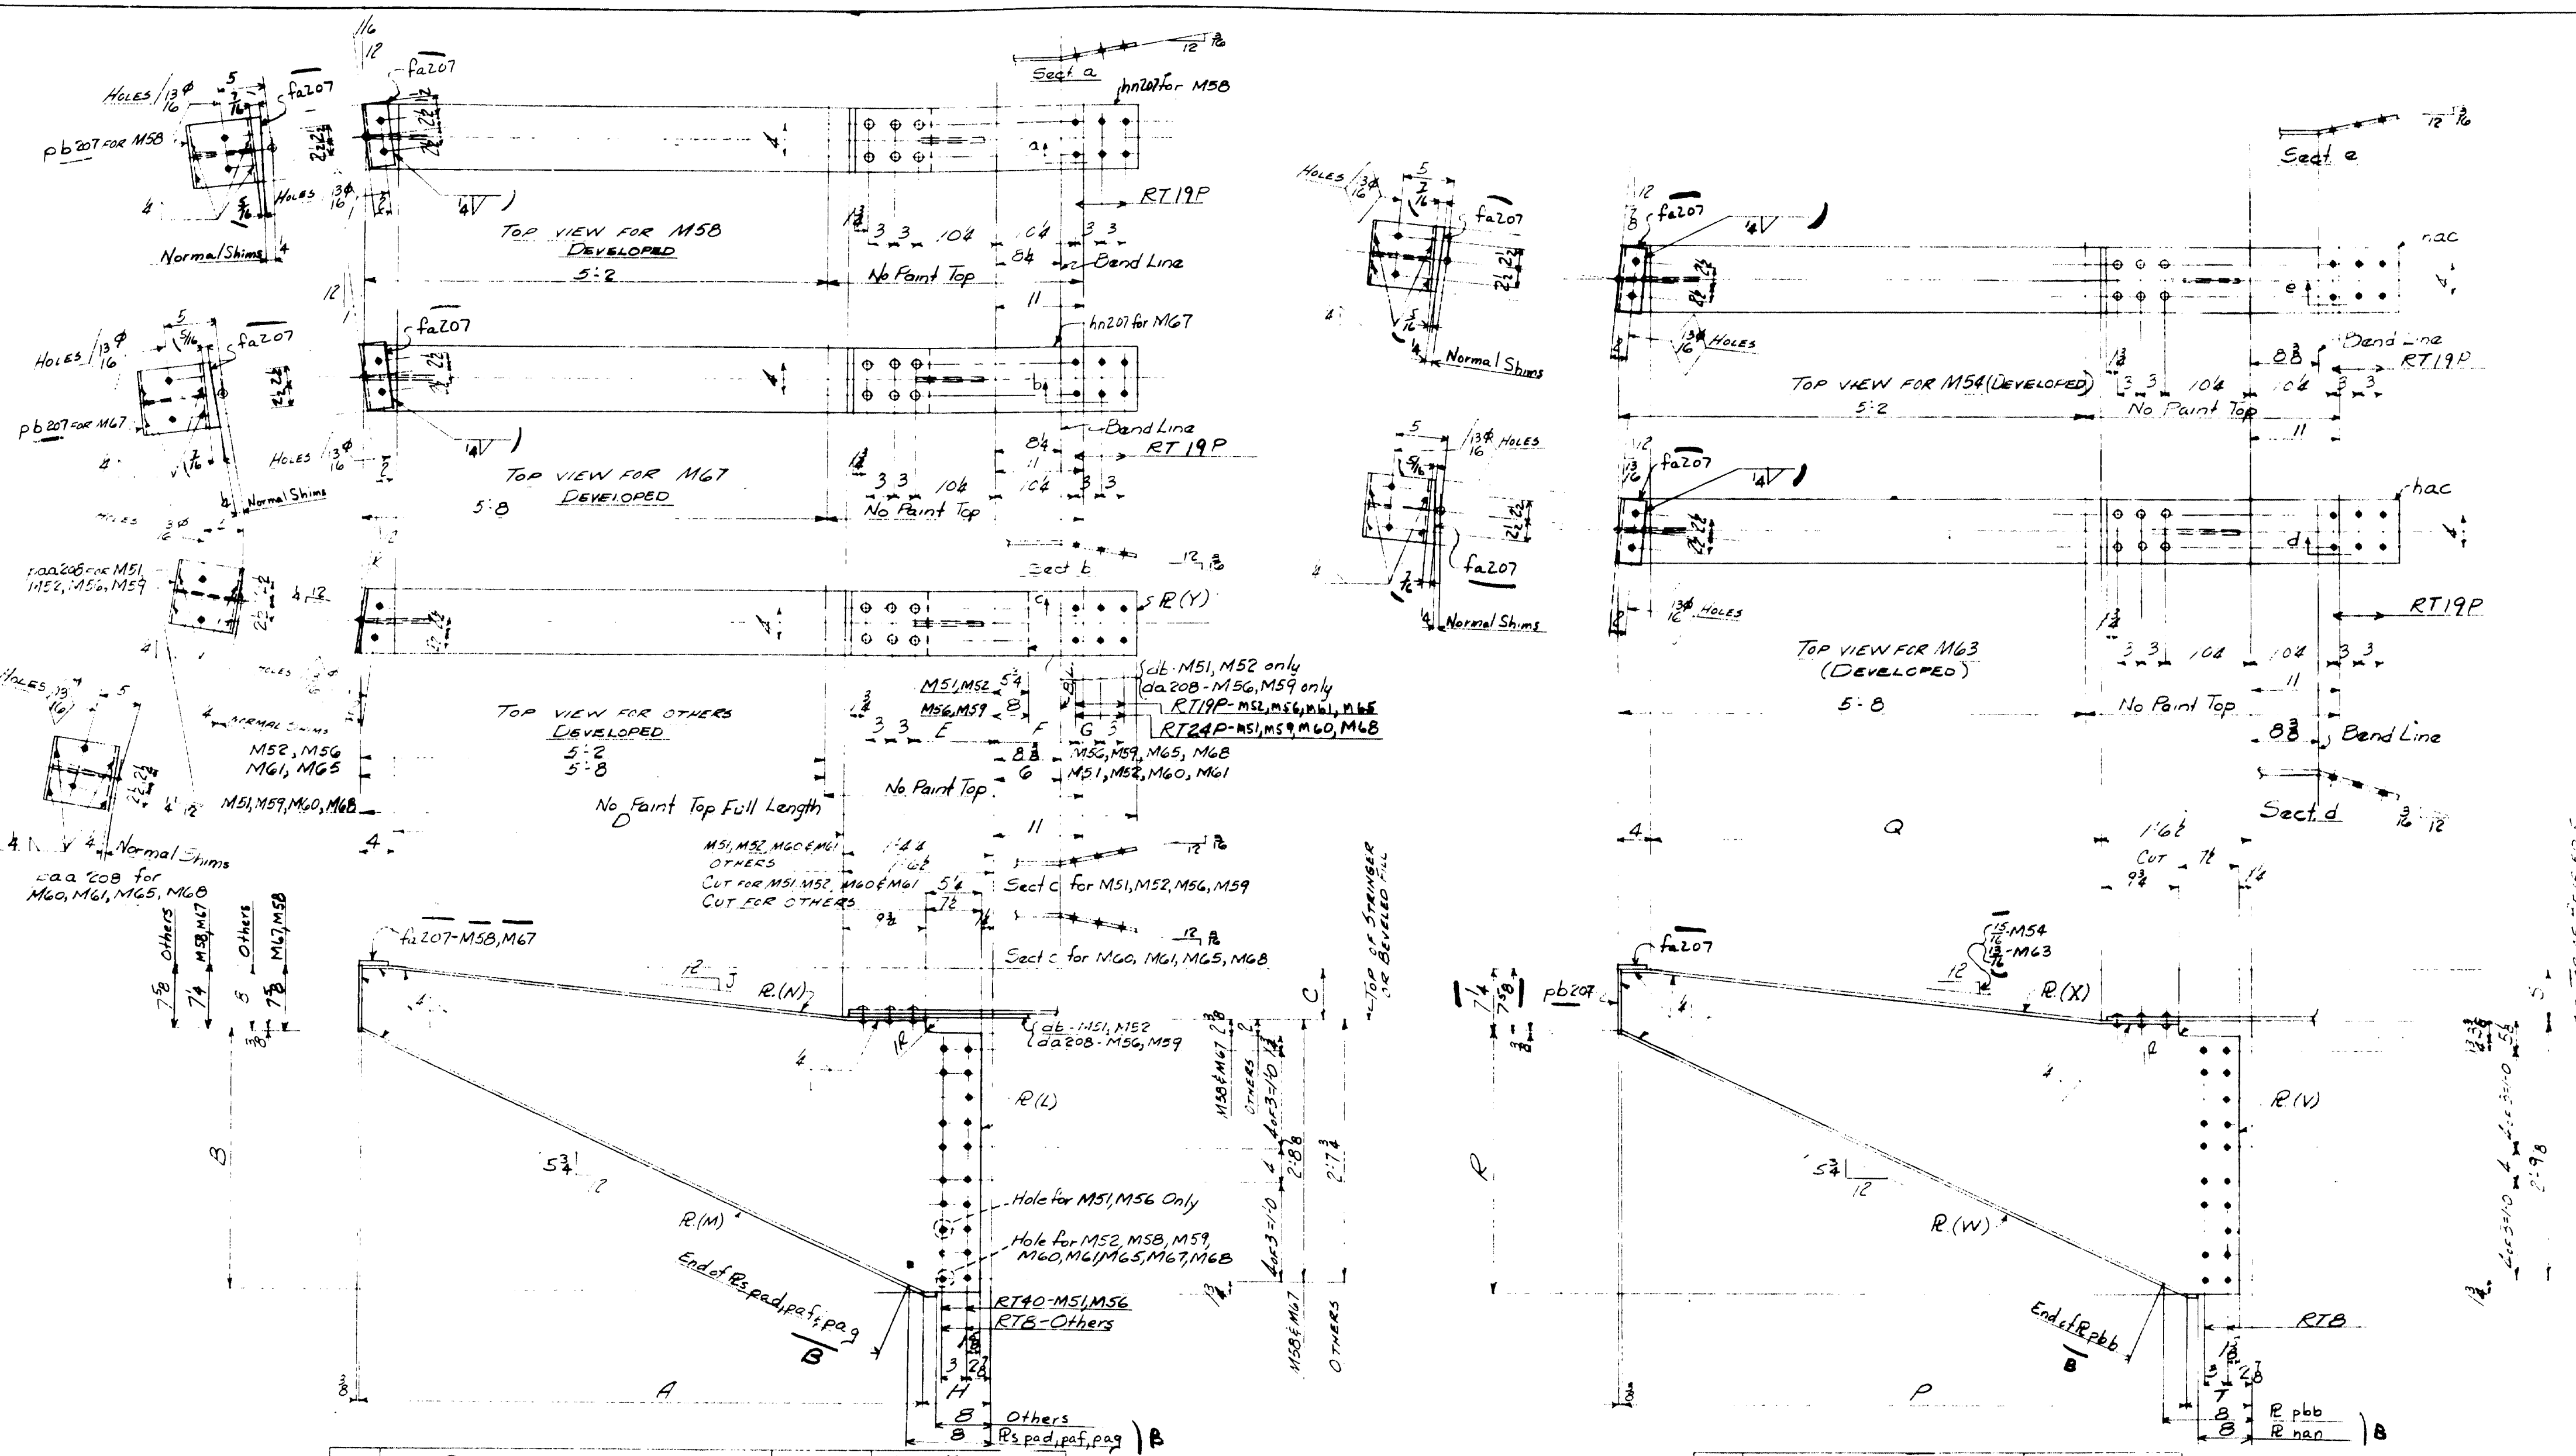

BRKT.	DIMENSIONS					PIECE MARKS		
	P	Q	R	S	T	V	W	X
M54	5:52	4:14	2:78	3:34	5:8	pay	pbb	hp
M63	5:63	5:15	2:18	4:34	1:53	pba	han	ht

F		DRAWINGS MADE AT <u>TRENTON</u>	PLANT
E		WORK FABRICATED AT <u>TRENTON</u>	PLANT
D		IN CHARGE OF <u>E. B. MARKS</u>	
C		DRAW. MADE BY <u>E.B.</u>	DATE <u>11-5-53</u>
B	<u>3-15-54</u>	DRAW. CHECKED BY <u>PRY</u>	DATE <u>1-20-54</u>
X	<u>2-9-54</u>	ORDER NO.	SHEET NO.
	REVISIONS	<u>Q4149</u>	<u>502</u>

[illegible]

STATE OF MAINE  
STATE HIGHWAY COMMISSION  
BANGOR BREWES BRIDGE  
OVER THE PENOBSCOT RIVER  
BANGOR, MAINE

DEM 1500-2-51 PENCILTEX  
**AMERICAN BRIDGE COMPANY**  
UNITED STATES STEEL CORPORATION SUBSIDIARY

F		DRAWINGS MADE AT <u>TRENTON</u>	PLANT
E		WORK FABRICATED AT <u>TRENTON</u>	PLANT
D		IN CHARGE OF <u>E. B. MARKS</u>	
C		DRAW. MADE BY <u>E.B.</u>	DATE <u>11-5-53</u>
B	<u>3-15-54</u>	DRAW. CHECKED BY <u>PRY</u>	DATE <u>1-20-54</u>
X	<u>2-9-54</u>	ORDER NO.	SHEET NO.
	REVISIONS	<u>Q4149</u>	<u>502</u>

# AMERICAN BRIDGE COMPANY

LINE	ITEM	SHAPE	LENGTH	ASSEMBLY	REMARKS	ORDERED	ITEM	CALCULATED
1								
2								
3								
4								
5	ONE BRACKET-M55				377'			
6	ONE BRACKET-M57				435'			
7	ONE BRACKET-M62				479'			
8	ONE BRACKET-M66				426'			
9								
10	4 R	3 1/2	7 1/2	pb207				
11	1 R	3 1/2	7 1/2	pb207				
12	1 R	5 1/2	3	hh	FOR M57 Bent	45-0	M618	
13	1 R	5 1/2	3	hh	FOR M55 Bent	45-0	M618	
14	1 R	5 1/2	3	hh	FOR M55 Bent	45-0	M618	
15	1 R	5 1/2	3	hh	FOR M57 Bent	45-0	M618	
16	1 R	5 1/2	3	hh	FOR M57 Bent	45-0	M618	
17	1 R	5 1/2	3	hh	FOR M55 Bent	45-0	M618	
18	1 R	5 1/2	3	hh	FOR M57 Bent	45-0	M618	
19	1 R	5 1/2	3	hh	FOR M57 Bent	45-0	M618	
20	1 R	5 1/2	3	hh	FOR M57 Bent	45-0	M618	
21	1 R	5 1/2	3	hh	FOR M57 Bent	45-0	M618	
22	1 R	5 1/2	3	hh	FOR M57 Bent	45-0	M618	
23	1 R	5 1/2	3	hh	FOR M57 Bent	45-0	M618	
24	1 R	5 1/2	3	hh	FOR M57 Bent	45-0	M618	
25	1 R	5 1/2	3	hh	FOR M57 Bent	45-0	M618	
26	1 R	5 1/2	3	hh	FOR M57 Bent	45-0	M618	
27	1 R	5 1/2	3	hh	FOR M57 Bent	45-0	M618	
28	1 R	5 1/2	3	hh	FOR M57 Bent	45-0	M618	
29	1 R	5 1/2	3	hh	FOR M57 Bent	45-0	M618	
30	ONE BRACKET-M55				388'			
31	ONE BRACKET-M62				387'			
32								
33	2 R	3 1/2	7 1/2	pb207				
34	1 R	3 1/2	7 1/2	pb207				
35	1 R	3 1/2	7 1/2	pb207				
36	1 R	3 1/2	7 1/2	pb207				
37	1 R	3 1/2	7 1/2	pb207				
38	1 R	3 1/2	7 1/2	pb207				
39	1 R	3 1/2	7 1/2	pb207				
40	1 R	3 1/2	7 1/2	pb207				
41	1 R	3 1/2	7 1/2	pb207				
42	2 R	3 1/2	7 1/2	pb207				
43								
44								
SIDEWALK BRACKET M53, M55, M57, M62, M64 & M66  
DIV. 3


STATE OF MAINE  
STATE HIGHWAY COMM. 3311N  
BANGOR - BREWER BRIDGE  
OVER THE PENOBSCOT RIVER  
BANGOR, MAINE

AMERICAN BRIDGE COMPANY  
MADE IN U.S.A.

DRAWINGS MADE AT TRENTON PLANT  
WORK FABRICATED AT TRENTON PLANT  
IN CHARGE OF E. B. MARKS  
DRAW. MADE BY E. A. B. DATE 11-19-53  
DRAW. CHECKED BY PRY DATE 1-21-54  
ORDER NO. Q4149 SHEET NO. 309

303

62-101 I

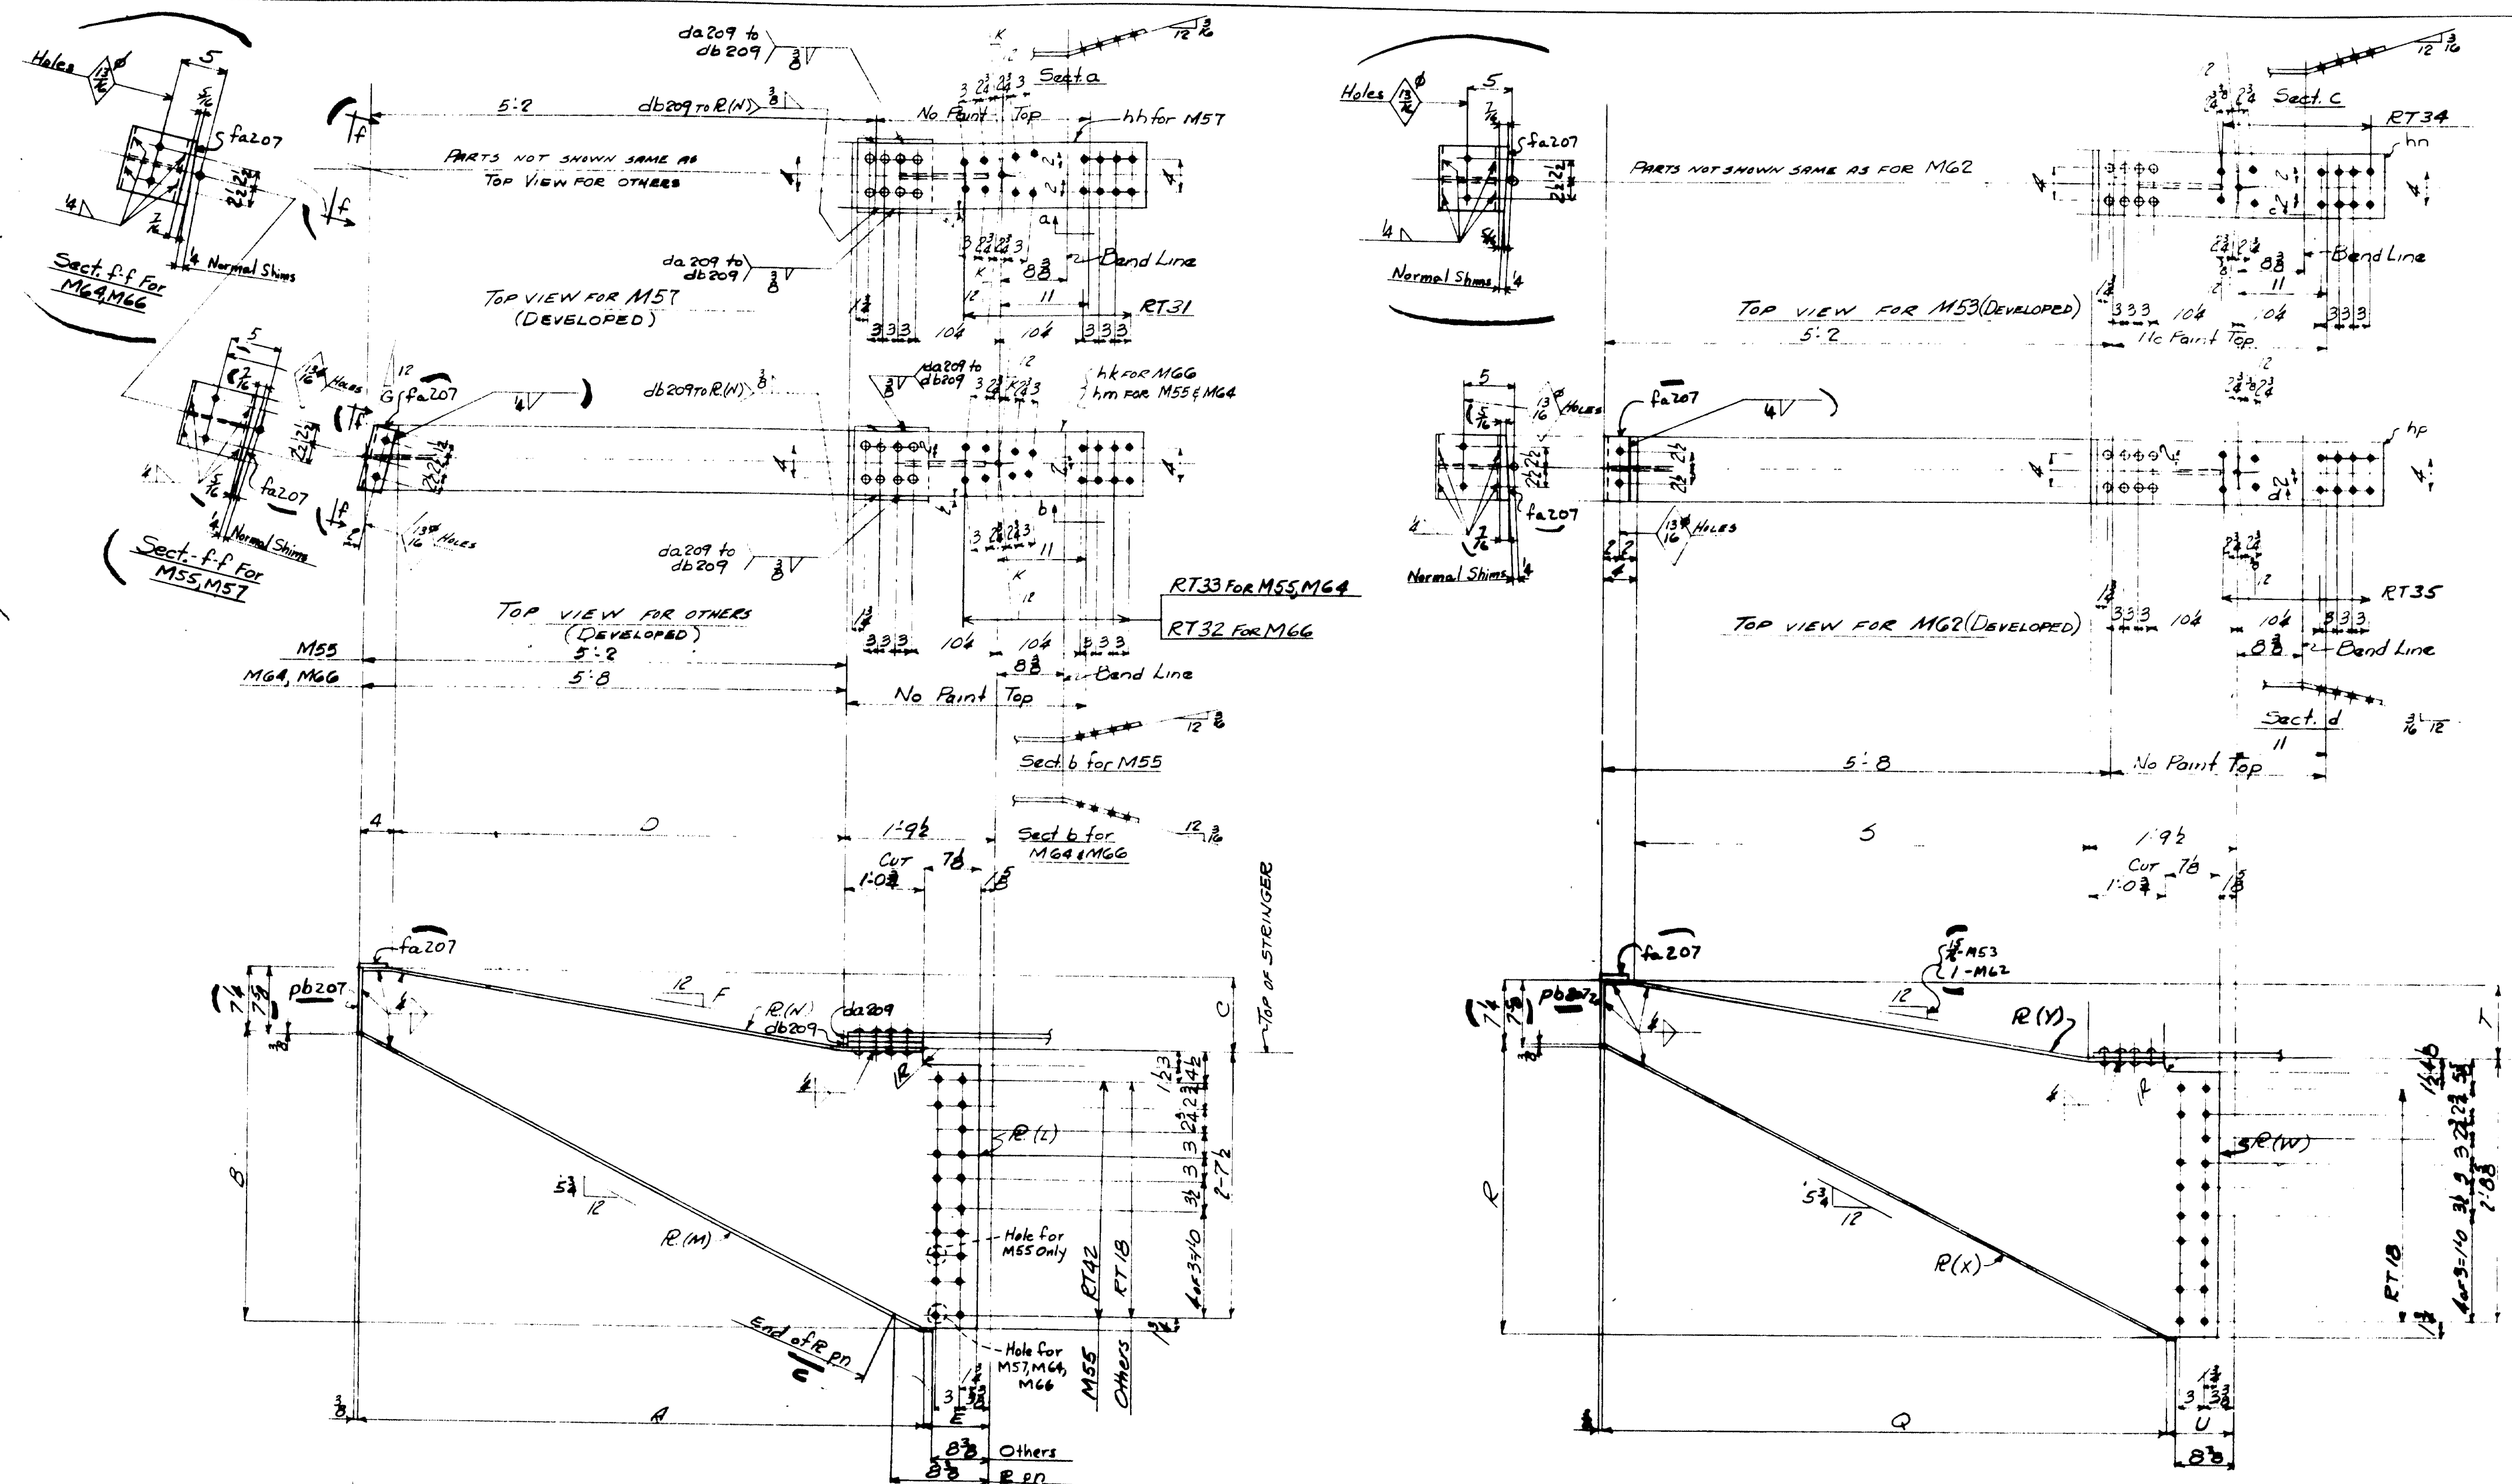

DRY	DIMENSIONS	BEVELS	PIECE MARKS
	A B C D E	F G	K L M N
M55	5'-5 1/2" 2'-7 1/2" 5'-7 1/2" 3'-7 1/2"	1'-0" 0	0 0 0 0
M57	5'-5 1/2" 2'-7 1/2" 5'-7 1/2" 3'-7 1/2"	1'-0" 0	0 0 0 0
M62	5'-5 1/2" 2'-7 1/2" 5'-7 1/2" 3'-7 1/2"	1'-0" 0	0 0 0 0
M64	5'-5 1/2" 2'-7 1/2" 5'-7 1/2" 3'-7 1/2"	1'-0" 0	0 0 0 0
M66	5'-5 1/2" 2'-7 1/2" 5'-7 1/2" 3'-7 1/2"	1'-0" 0	0 0 0 0


DRY	DIMENSIONS	PIECE MARKS
	Q R S T U	W X Y
M53	5'-5 1/2" 2'-7 1/2" 5'-7 1/2" 3'-7 1/2"	1'-0" 0 0 0 0
M62	5'-5 1/2" 2'-7 1/2" 5'-7 1/2" 3'-7 1/2"	1'-0" 0 0 0 0

NOTES:  
1) SPECIFICATIONS: MAINE STATE  
HIGHWAY COMM. 1795 AND SPECIAL  
PROVISIONS.  
2) MATERIAL: OH STEEL 15TH AT-52T  
3) RIVETS: 69  
4) Holes: 1/2" UNLESS NOTED  
5) PAINT: YES, EXCEPT AS NOTED  
6) SHOP CONTACT SURFACES: NO  
7) MARKING: HOLES MARKED RT TO BE  
SUBPUNCHED OR SUBDRILLED 1/4" AND REAMED  
TO SEE FOR METAL TEMPLATE.  
ALL HOLES FOR SUBA RIVETS TO BE  
SUBPUNCHED OR SUBDRILLED 1/4" AND REAMED  
TO SEE WITH CONNECTING PARTS ASSEMBLED.



LINE	ITEM	QTY	UNIT	PRICE	TOTAL
1					
2					
3					
Div.3	BEVELS			DIMENSIONS			ASSEMBLY MARKS		BEVELS	
MARK	A	B	C	D	E	F	G	H	J	K
M119	2 1/2	0	0	2 1/2	6'-4 1/2	6'-7 1/2	aa	mf310	1	1
M120	2 1/2	0	0	2 1/2	6'-4 1/2	6'-6 1/2	aa	ma310	1	1
M121	2 1/2	0	0	2 1/2	6'-2	6'-4 1/2	ah213	mb310	1	1
M122	2 1/2	0	0	2 1/2	6'-0	6'-2 1/2	ad	mq	1	1
M123	2 1/2	0	0	2 1/2	5'-10	6'-0 1/2	ad	mb213	1	1
M124	2 1/2	0	0	2 1/2	6'-0	6'-2 1/2	ad	mb213	1	1
M125	2 1/2	0	0	2 1/2	6'-3 1/2	6'-6 1/2	am	mh310	1	1
M126	2 1/2	0	0	2 1/2	6'-4 1/2	6'-1 1/2	aa	md310	1	1
M127	2 1/2	0	0	2 1/2	6'-4 1/2	6'-1 1/2	ak	ma310	1	1
M128	2 1/2	0	0	2 1/2	6'-4 1/2	6'-7	aa	mc	1	1
M129	2 1/2	0	0	2 1/2	6'-1 1/2	6'-4	ag213	mq	1	1
M130	2 1/2	0	0	2 1/2	5'-11	6'-1 1/2	af213	md	1	1
M131	2 1/2	0	0	2 1/2	5'-9 1/2	6'-0 1/2	ad213	mh310	1	1
M132	2 1/2	0	0	2 1/2	5'-11	6'-2	af213	mf213	1	1
M133	2 1/2	0	0	2 1/2	5'-3 1/2	5'-6 1/2	at	mk310	1	1
M134	2 1/2	0	0	2 1/2	5'-3 1/2	5'-6 1/2	at	mn310	1	1
M135	2 1/2	0	0	2 1/2	5'-6	5'-8 1/2	ab213	mn310	1	1
M136	2 1/2	0	0	2 1/2	5'-8	5'-10 1/2	ac213	mp	1	1
M137	2 1/2	0	0	2 1/2	5'-5 1/2	5'-8 1/2	ay	mn213	1	1
M138	2 1/2	0	0	2 1/2	5'-3 1/2	5'-6 1/2	an	mp213	1	1
M139	2 1/2	0	0	2 1/2	5'-0 1/2	5'-3 1/2	aa	mt213	1	1
M140	2 1/2	0	0	2 1/2	4'-11 1/2	5'-2 1/2	aac	mn213	1	1
M141	2 1/2	0	0	2 1/2	4'-11	5'-1 1/2	aad	mm310	1	1
M142	2 1/2	0	0	2 1/2	4'-11 1/2	5'-2 1/2	aac	mt	1	1
M143	2 1/2	0	0	2 1/2	5'-2 1/2	5'-5 1/2	aag	mp	1	1
M144	2 1/2	0	0	2 1/2	5'-5 1/2	5'-7 1/2	ay	mv	1	1
M145	2 1/2	0	0	2 1/2	5'-6 1/2	5'-9 1/2	aak	mn310	1	1
M146	2 1/2	0	0	2 1/2	5'-5 1/2	5'-7 1/2	ay	mt213	1	1
M147	2 1/2	0	0	2 1/2	5'-4 1/2	5'-7 1/2	aab213	mv213	1	1

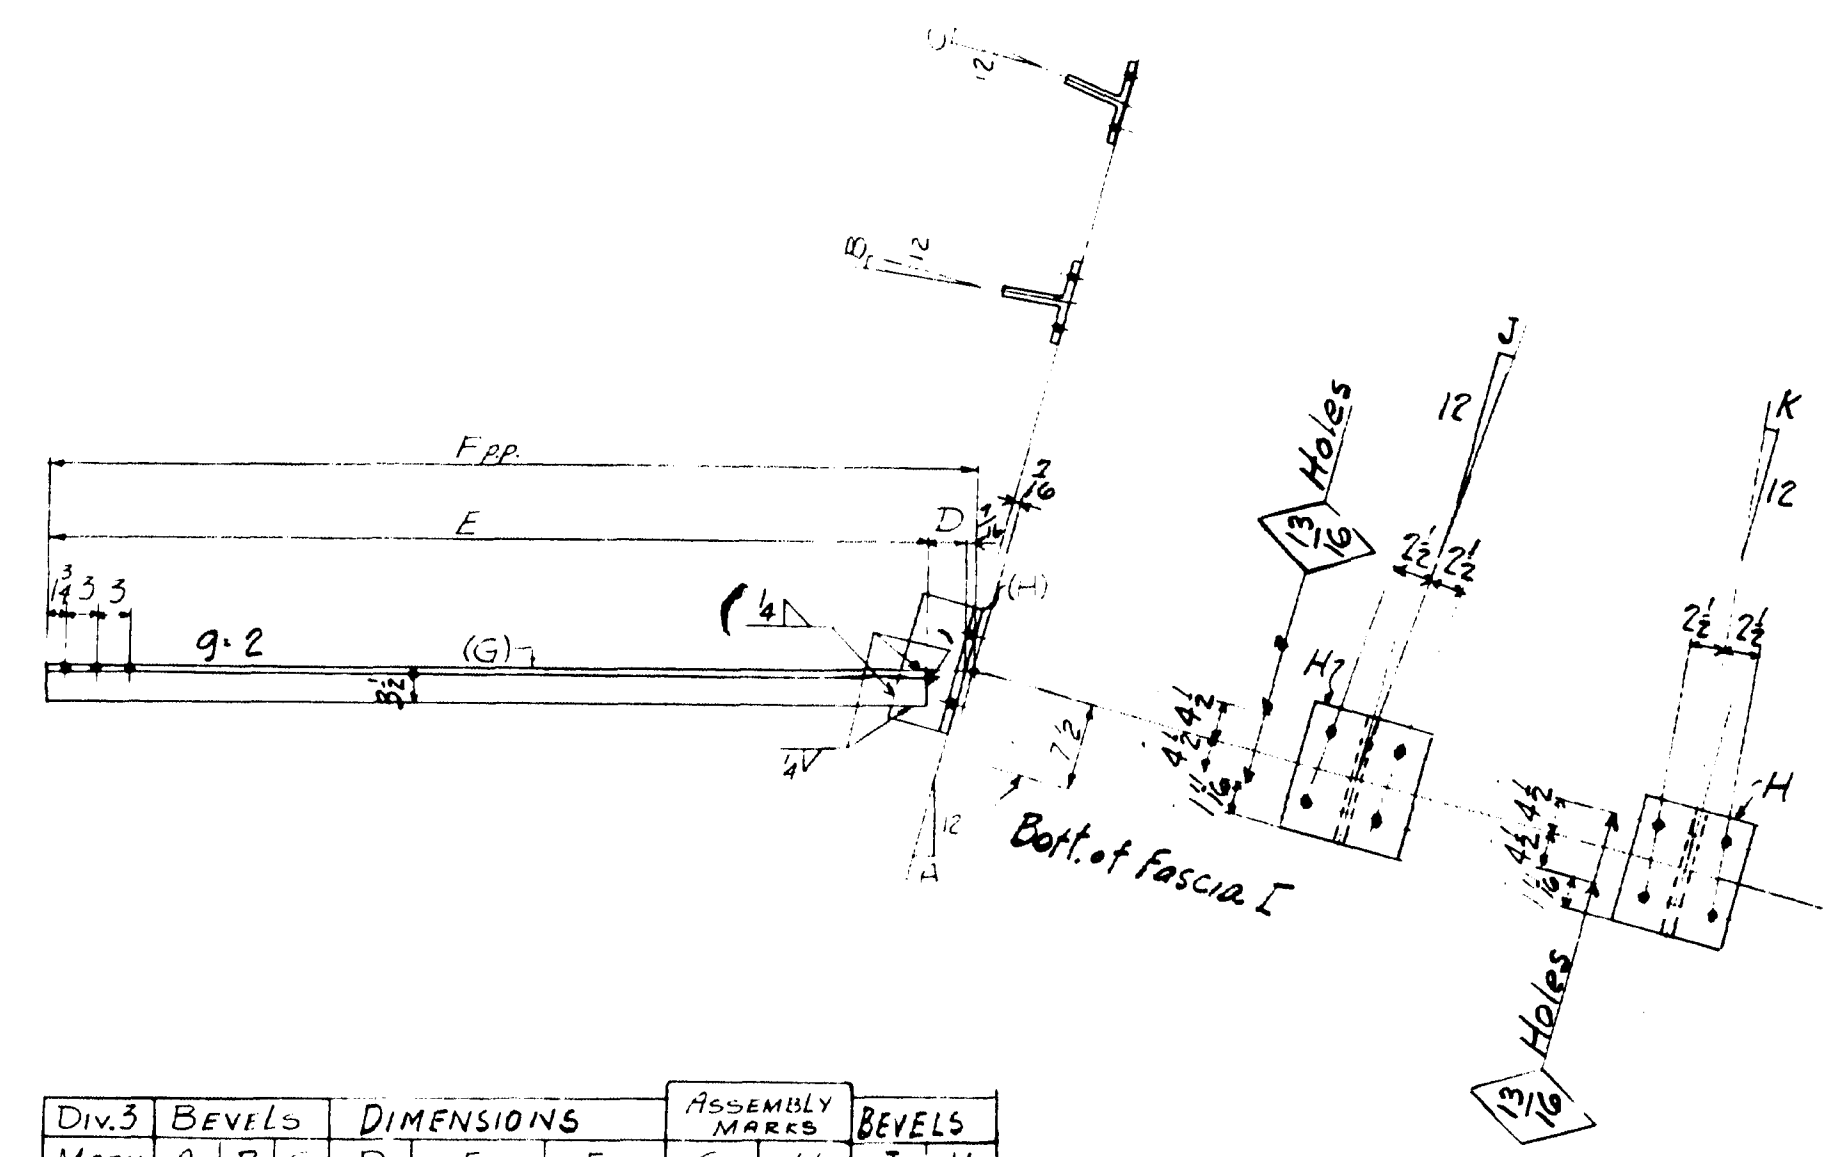

M119-66"  
M120-66"  
M121-65"  
M122-63"  
M123-62"  
M124-63"  
M125-66"  
M126-66"  
M127-66"  
M128-66"  
M129-64"  
M130-63"  
M131-62"  
M132-63"  
M133-58"  
M134-57"  
M135-57"  
M136-57"  
M137-57"  
M138-58"  
M139-56"  
M140-55"  
M141-55"  
M142-57"  
M143-57"  
M144-59"  
M145-60"  
M146-59"  
M147-58"

LINE	ITEM	QTY	UNIT	PRICE	TOTAL
1					
2					
NOTES:-  
SPECIFICATIONS: MAINE STATE HIGHWAY  
Comm 1945 and SPECIAL PROVISIONS.  
MATERIAL: D.H STEEL ASTM A7-52T  
HOLES 1/2" DIA

SIDE WALK STRUTS DIV 3  
STATE OF MAINE  
STATE HIGHWAY COMMISSION  
BANGOR-BREWER BRIDGE  
OVER PENOBSCOT RIVER  
BANGOR, MAINE

AMERICAN BRIDGE  
DRAWINGS MADE AT TRENTON PLANT  
WORK FABRICATED AT TRENTON PLANT  
IN CHARGE OF E.B. MARKS  
DRAW. MADE BY RIG. DATE 12-9-53  
DRAW. CHECKED BY PRY DATE 1-23-54  
ORDER No. Q4149 SHEET No. 310

PAINT: Y-25  
SHOP CONTACT SURFACES: NO



# AMERICAN BRIDGE COMPANY

LINE	ITEM	SHAPE	LENGTH	REMARKS	ORDERED	CALCULATED
					ITEM	WEIGHT FOR ONE SHIP PIECE
1	ONE DIAPHRAGM	D43	642"			
2	ONE DIAPHRAGM	D64	628"			
3	ONE DIAPHRAGM	D73	643"			
4	3 BCB50	9 4 3/4			3019	470
5	2 BCB50	2 3/4				
6	2 BCB50	2 2 1/2				
7	2 BCB50	2 3/4				
8	2 BCB50	2 2 1/2				
9	2 BCB50	2 3/4				
10	2 BCB50	2 2 1/2				
11	2 BCB50	2 3/4				
12	2 BCB50	2 2 1/2				
13	2 BCB50	2 3/4				
14	2 BCB50	2 2 1/2				
15	2 BCB50	2 3/4				
16	2 BCB50	2 2 1/2				
17	2 BCB50	2 3/4				
18	2 BCB50	2 2 1/2				
19	2 BCB50	2 3/4				
20	2 BCB50	2 2 1/2				
21	2 BCB50	2 3/4				
22	2 BCB50	2 2 1/2				
23	ONE DIAPHRAGM	D70	644"			
24	ONE DIAPHRAGM	D71	645"			
25	ONE DIAPHRAGM	D72	643"			
26	3 BCB50	9 4 3/4			3019	470
27	2 BCB50	2 3/4				
28	2 BCB50	2 2 1/2				
29	2 BCB50	2 3/4				
30	2 BCB50	2 2 1/2				
31	2 BCB50	2 3/4				
32	2 BCB50	2 2 1/2				
33	2 BCB50	2 3/4				
34	2 BCB50	2 2 1/2				
35	2 BCB50	2 3/4				
36	2 BCB50	2 2 1/2				
37	2 BCB50	2 3/4				
38	2 BCB50	2 2 1/2				
39	ONE DIAPHRAGM	D42	651"			
40	ONE DIAPHRAGM	D44	649"			
41	ONE DIAPHRAGM	D65	636"			
42	3 BCB50	9 4 3/4			3019	470
43	2 BCB50	2 3/4				
44	2 BCB50	2 2 1/2				
45	2 BCB50	2 3/4				
46	2 BCB50	2 2 1/2				
47	2 BCB50	2 3/4				
48	2 BCB50	2 2 1/2				
49	2 BCB50	2 3/4				
50	2 BCB50	2 2 1/2				
51	2 BCB50	2 3/4				
52	2 BCB50	2 2 1/2				
53	2 BCB50	2 3/4				
54	2 BCB50	2 2 1/2				
55	2 BCB50	2 3/4				
56	2 BCB50	2 2 1/2				
57	2 BCB50	2 3/4				
58	2 BCB50	2 2 1/2				
59	2 BCB50	2 3/4				
60	2 BCB50	2 2 1/2				
61	1 1/2 BCB50	14 6				
62	1 1/2 BCB50	10 2 1/2				
63	1 1/2 BCB50	14 6 1/2				
64	1 1/2 BCB50	12 2				
65	1 1/2 BCB50	13 10				
66	1 1/2 BCB50	9 9				
67						


DIAPHRAGMS-D43  
FASCIA BEAMS-D43 & 4  
STATE OF MAINE  
STATE HIGHWAY COMMISSION  
BANGOR-BREWER BRIDGE  
OVER PENOBSCOT RIVER  
BANGOR, MAINE

AMERICAN BRIDGE COMPANY  
TRENTON, N.J.

F	2-10-54	DATE	1-14-54
E	2-17-54	DATE	2-2-54
C	2-10-54	DATE	2-2-54
B	2-2-54	DATE	2-2-54
X	2-2-54	DATE	2-2-54
REVISIONS			

ORDER No. 04199  
SHEET No. 311


MA 303, 402  
62-101 K Welding

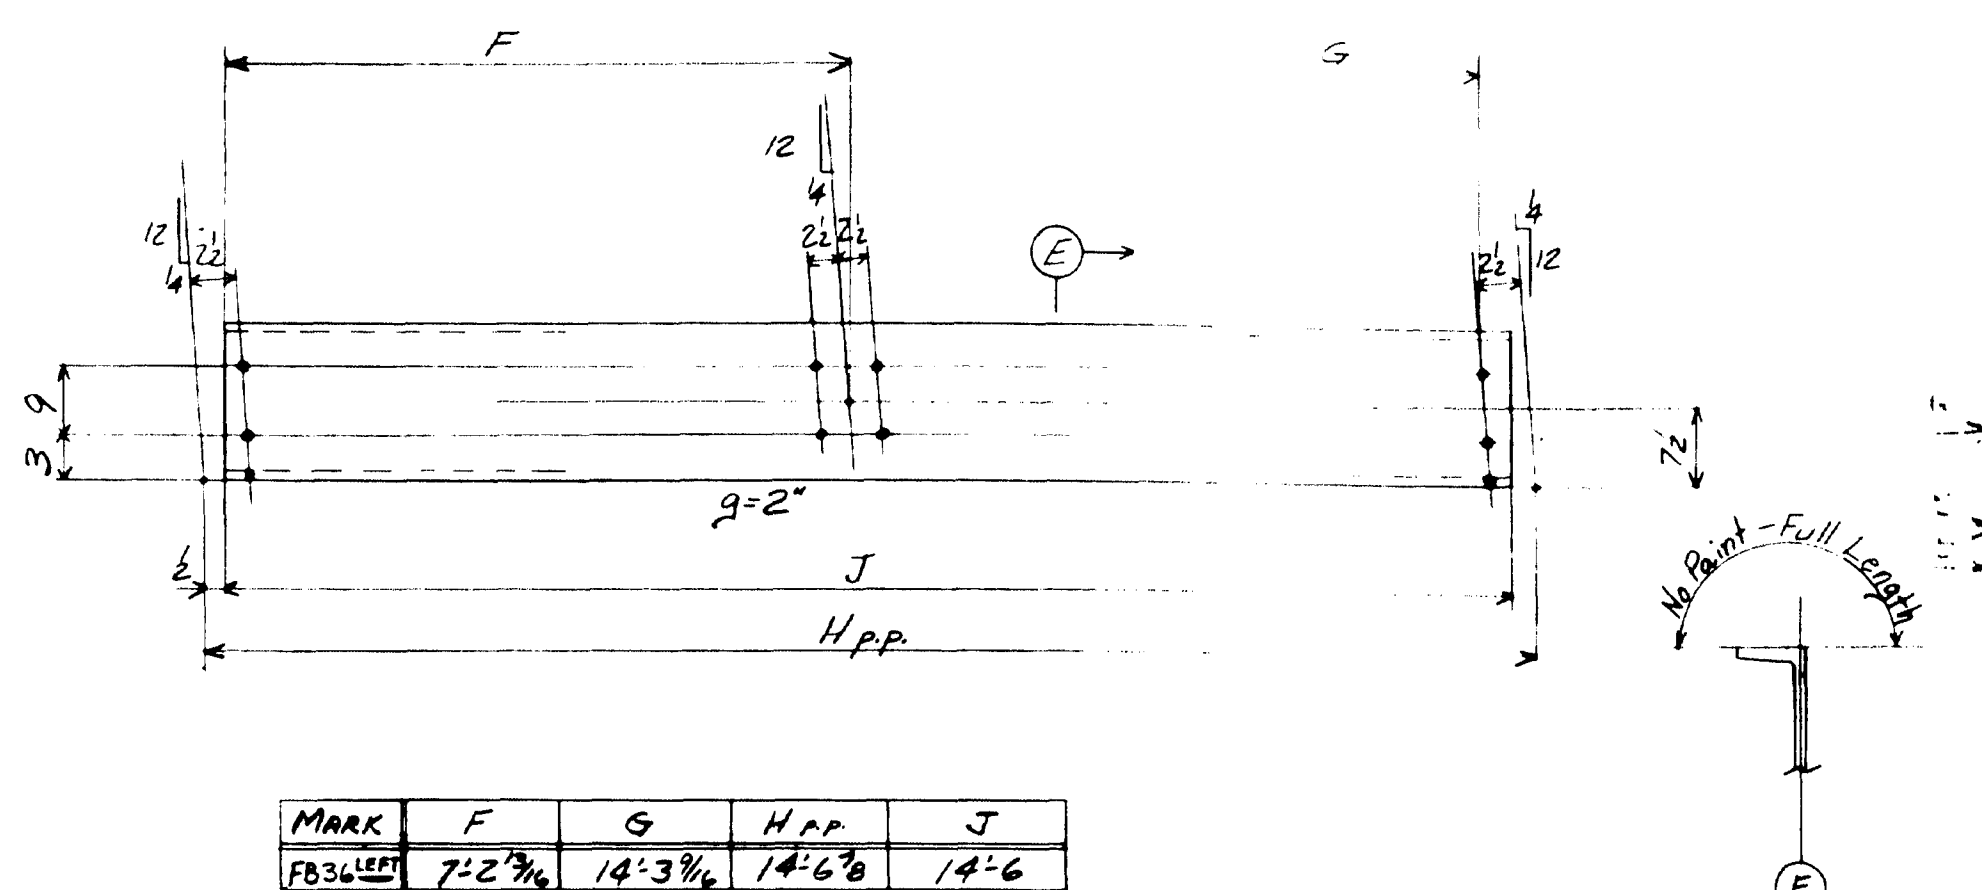


MARK	F	G	H	J
FB36	7-2 3/4	14-3 3/4	14-6 3/4	14-6
FB44	5-1 1/8	10-0 3/4	10-3 1/2	10-2 1/2
FB47	7-3 1/4	14-4 1/4	14-7 3/4	14-6 1/2
FB48	6-1 1/4	12-0	12-3 3/4	12-2
FB56	6-10 3/8	13-7 3/4	13-11	13-10
FB57	4-10 1/4	9-6 1/2	9-9 3/4	9-9

NOTE:  
All Holes in Fascia Beams  
to be 1 3/8"


dg210-D43,D44,D73  
dg211-D42,D44,D65  
dg211-All

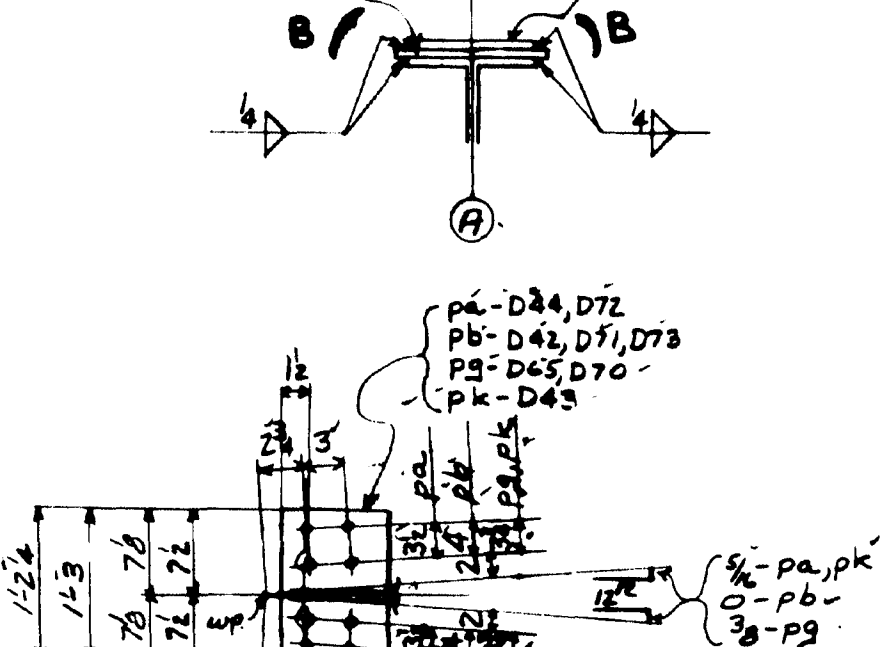


Sect. C for D42, D43, D44, D65, D70, D71, D72, D73

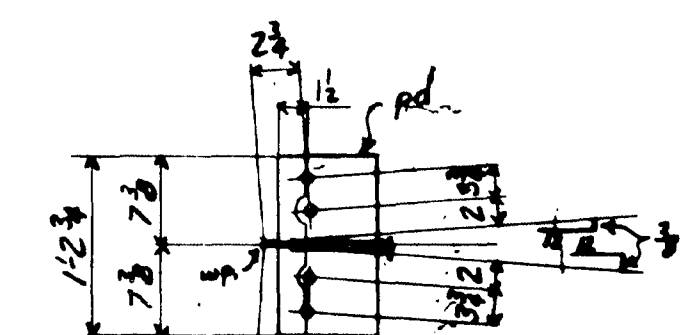

Sect. C for D64



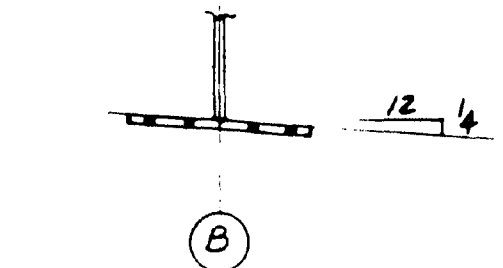






Sect. D for D42, D43, D44, D64, D70, D71, D72, D73

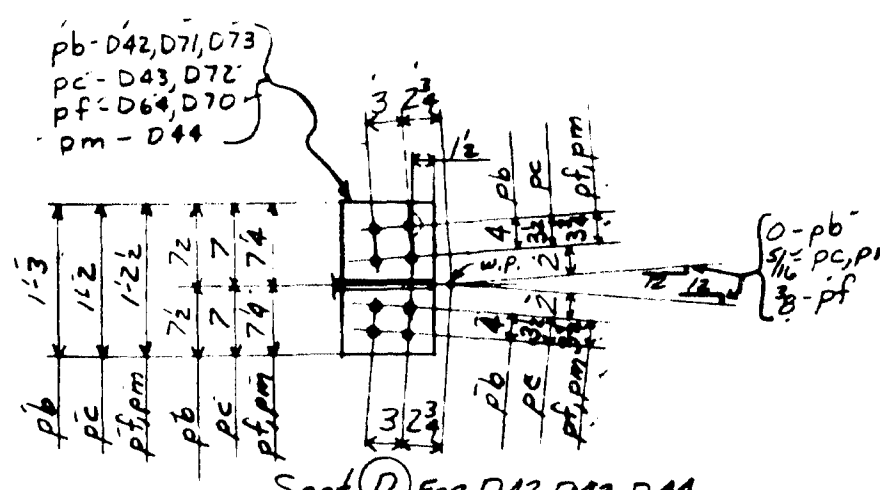

Sect. D for D65

NOTES:  
SPECIFICATIONS-MAINE STATE HIGHWAY COMM. 1945  
AND SPECIAL PROVISIONS  
MATERIAL-O.H. STEEL ASTM A7-52T  
HOLES-1 3/8" UNLESS NOTED  
PAINT-YES, EXCEPT AS NOTED  
SHOP CONTACT SURFACES-NO  
HOLES MARKED RT TO BE SUBPUNCHED OR SUBDRILLED  
4 AND REAMED TO SIZE TO A METAL TEMPLAT

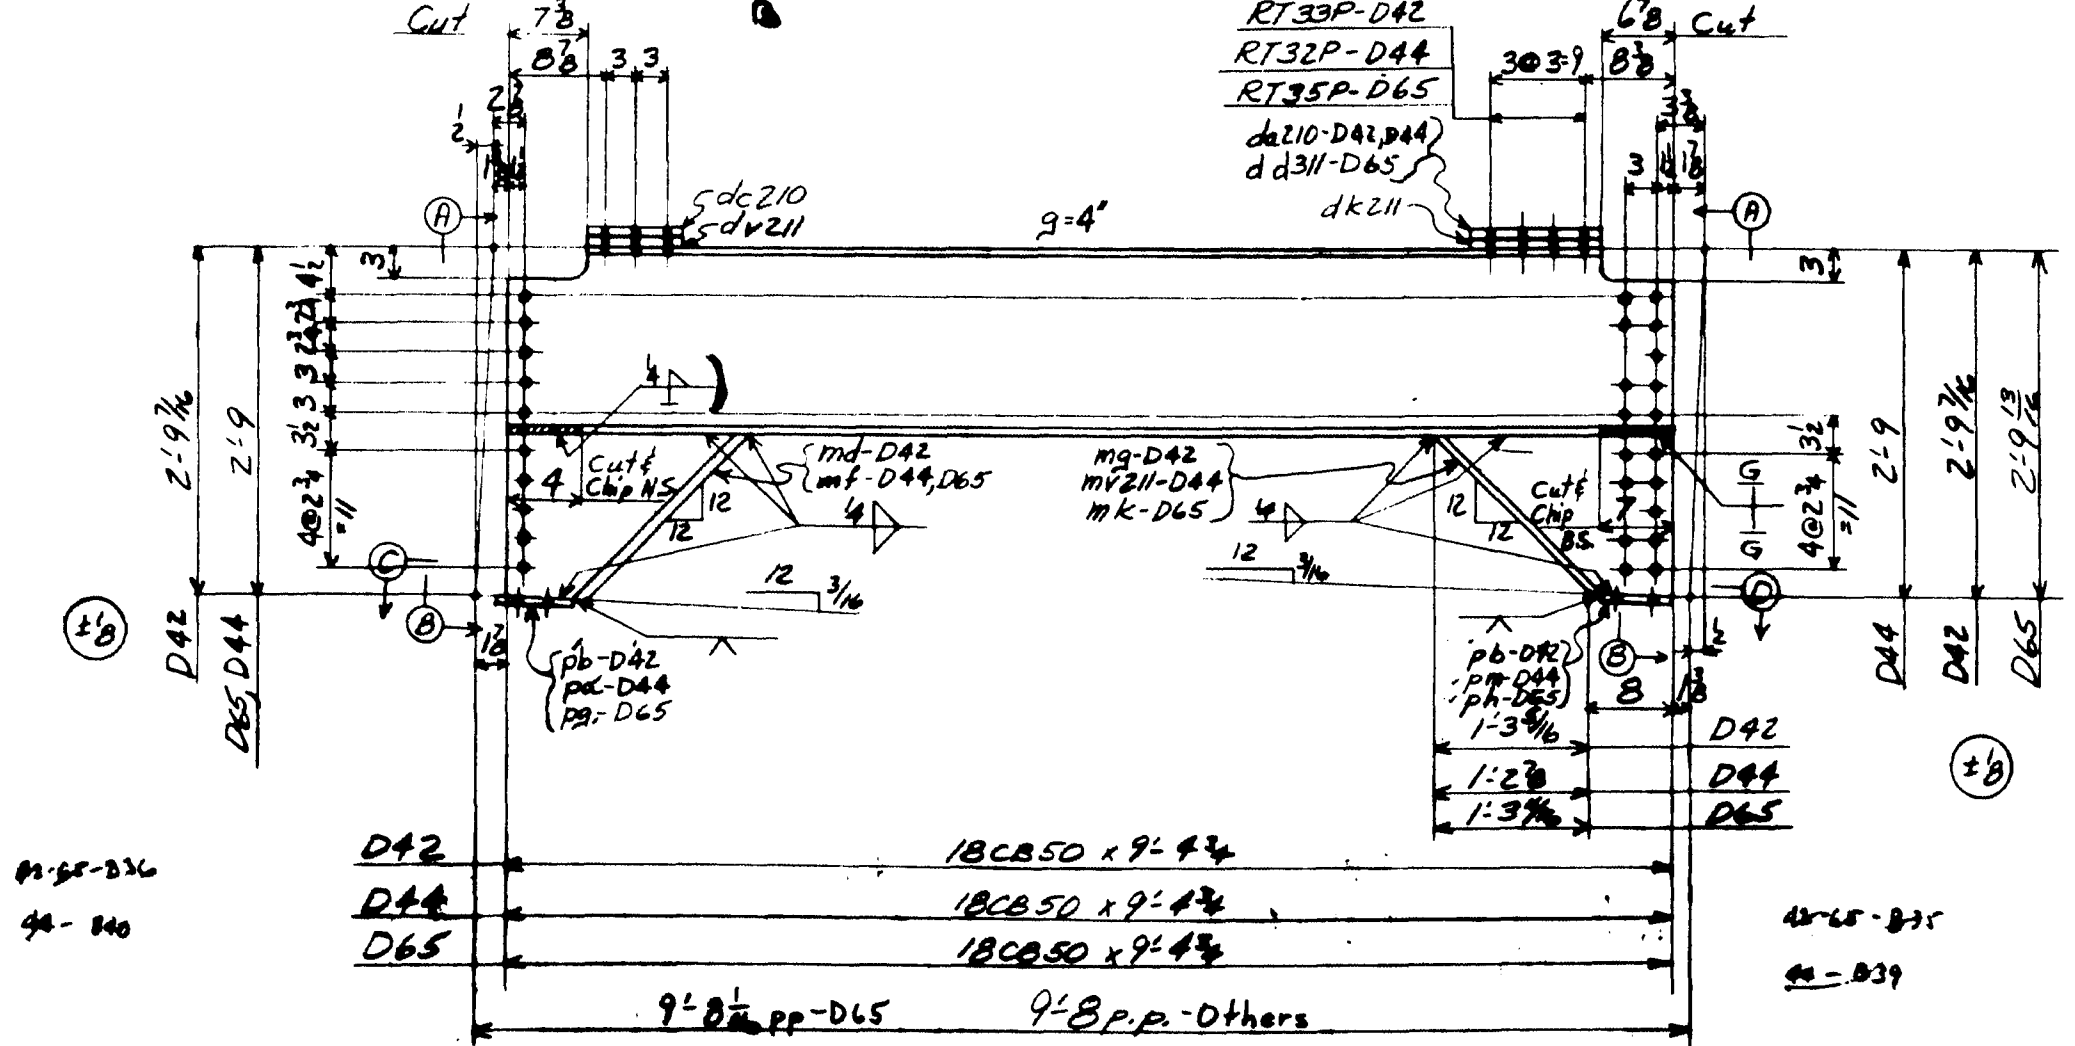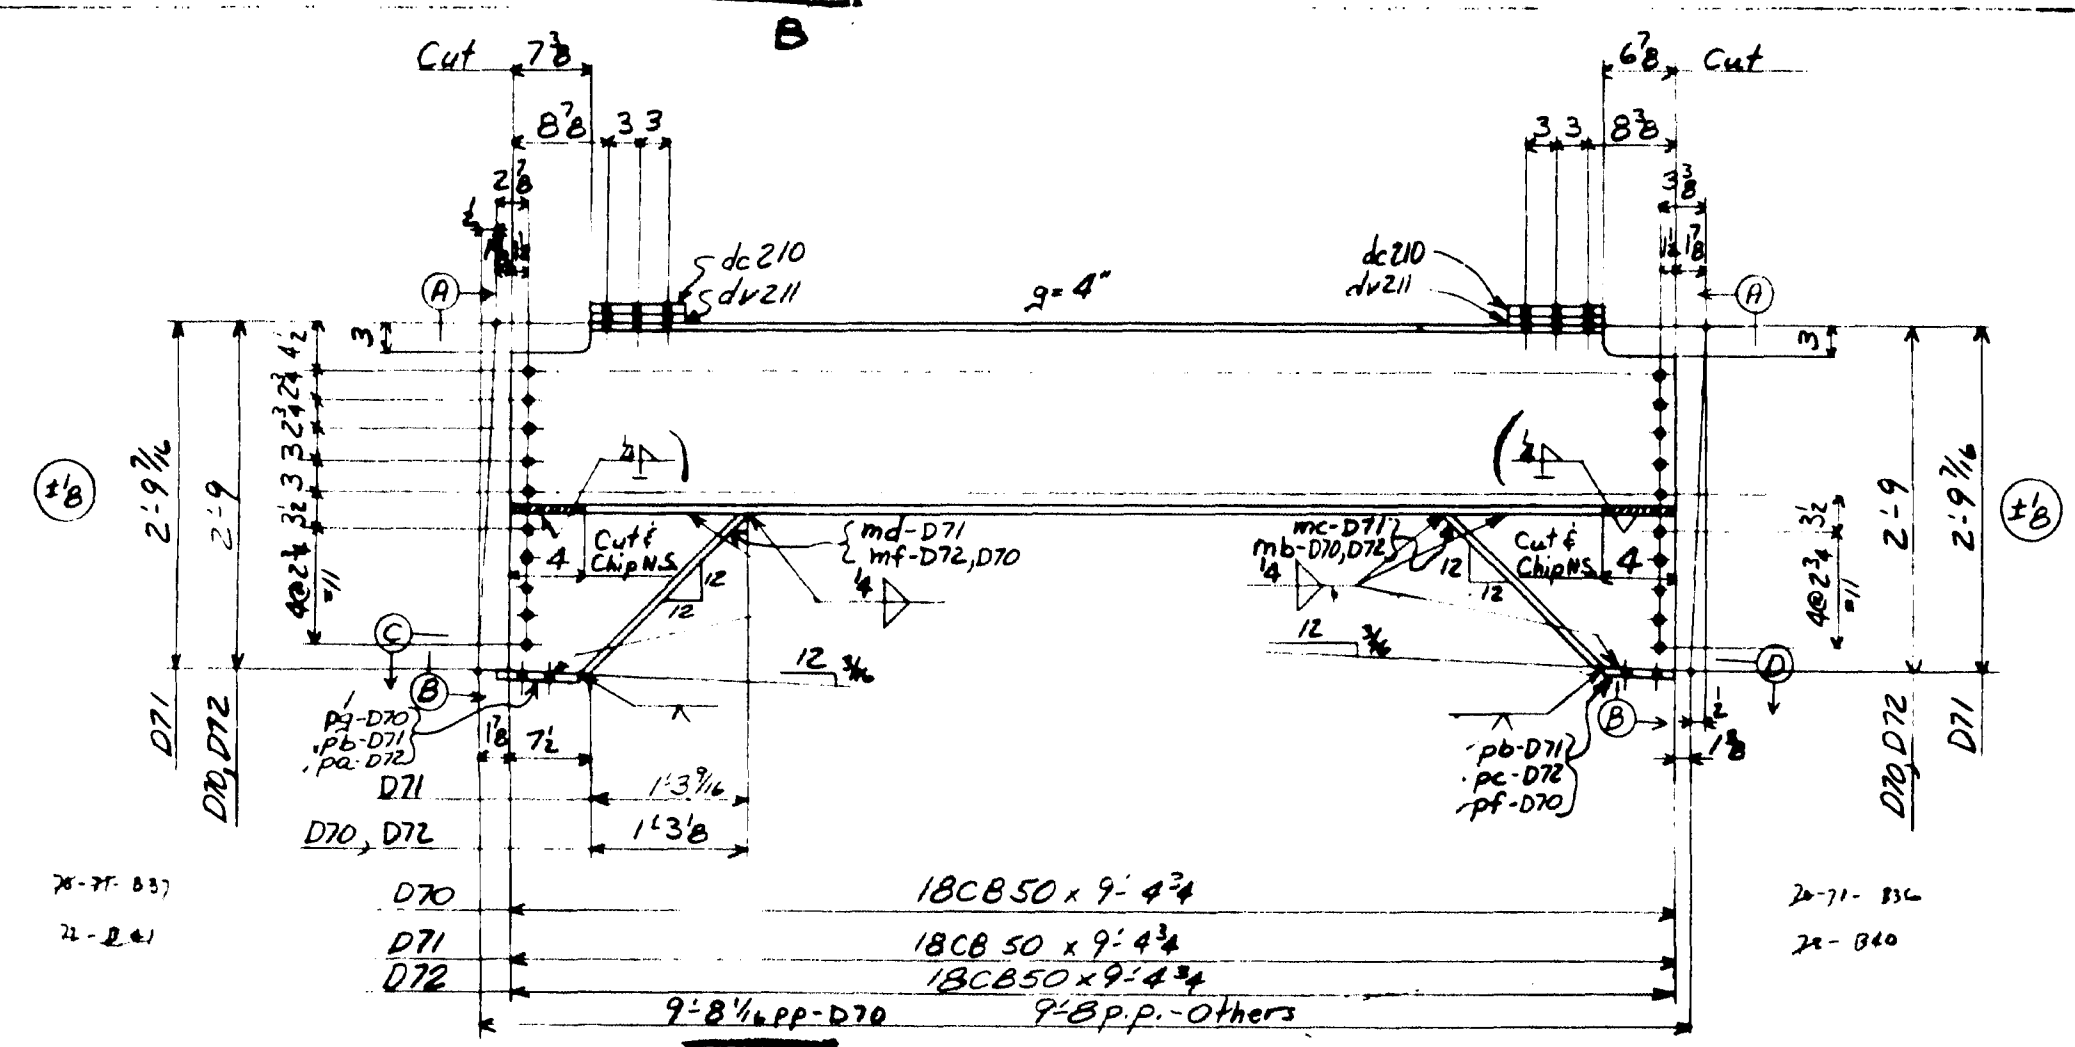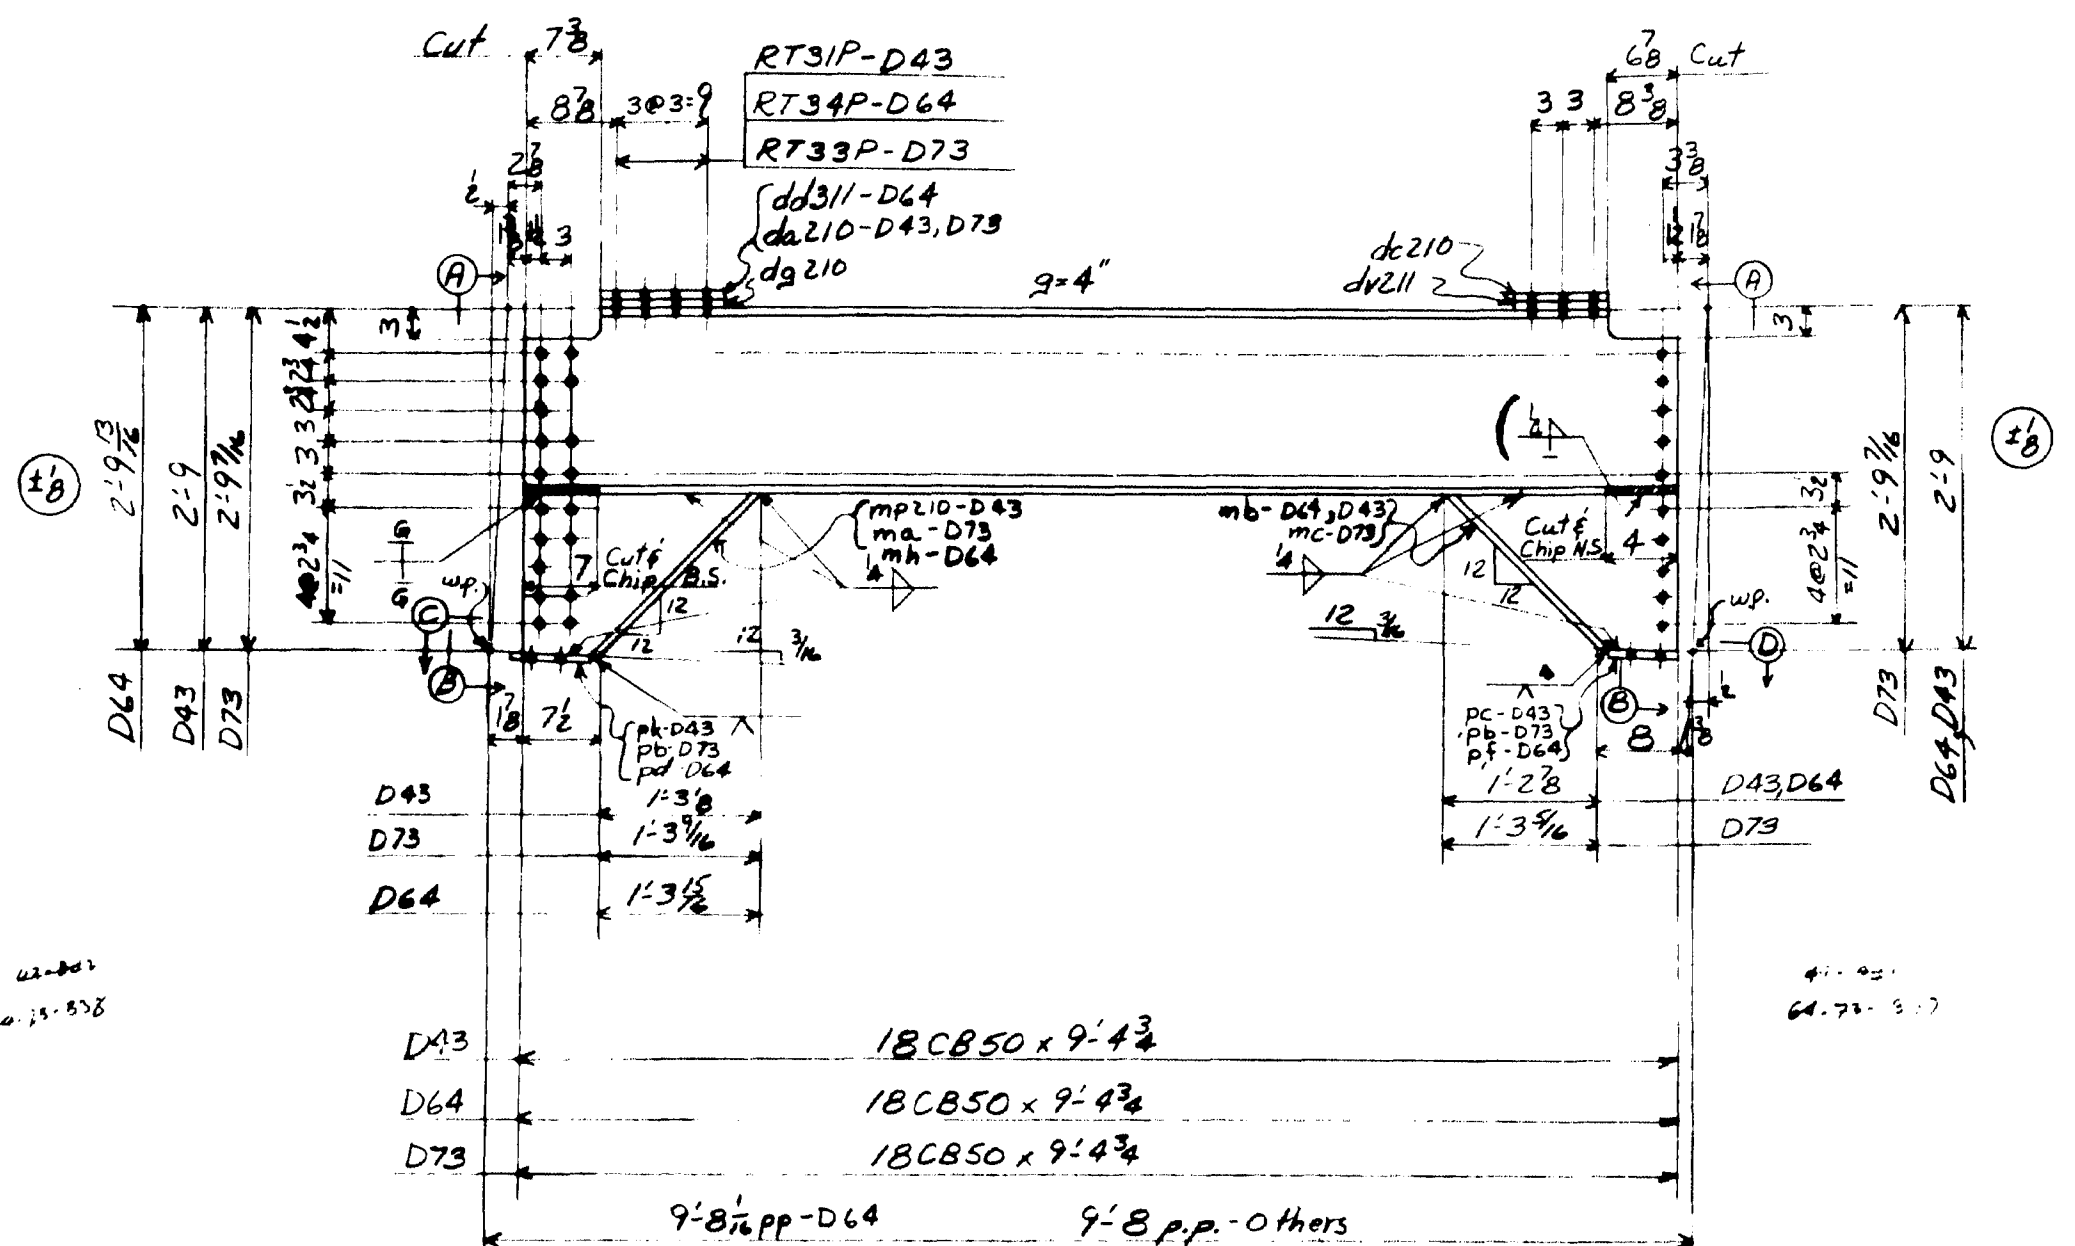

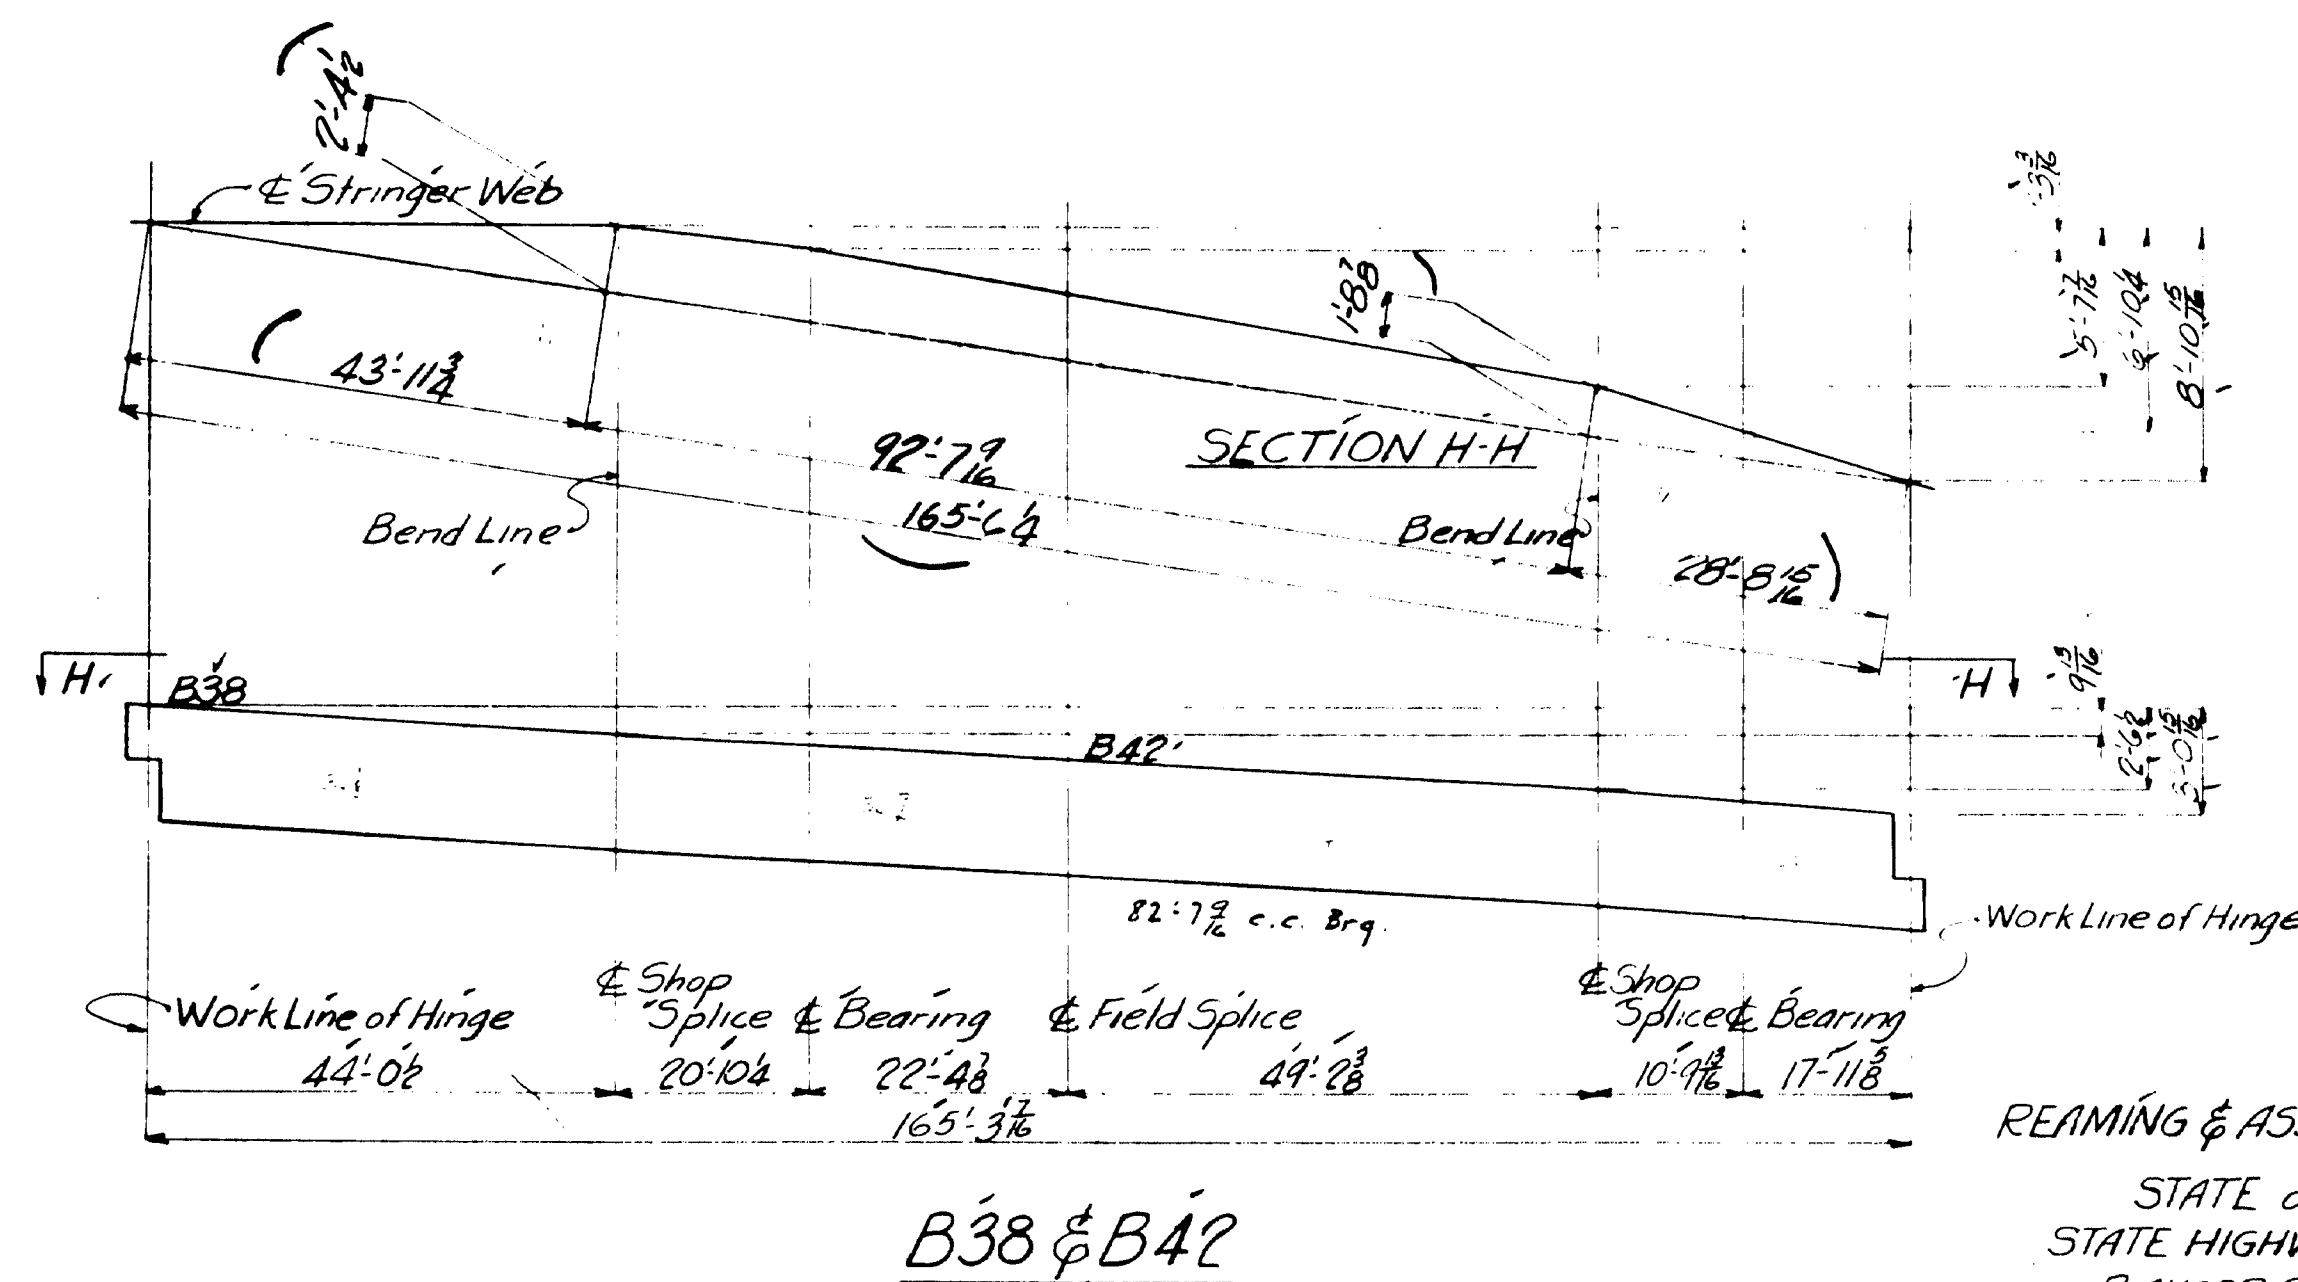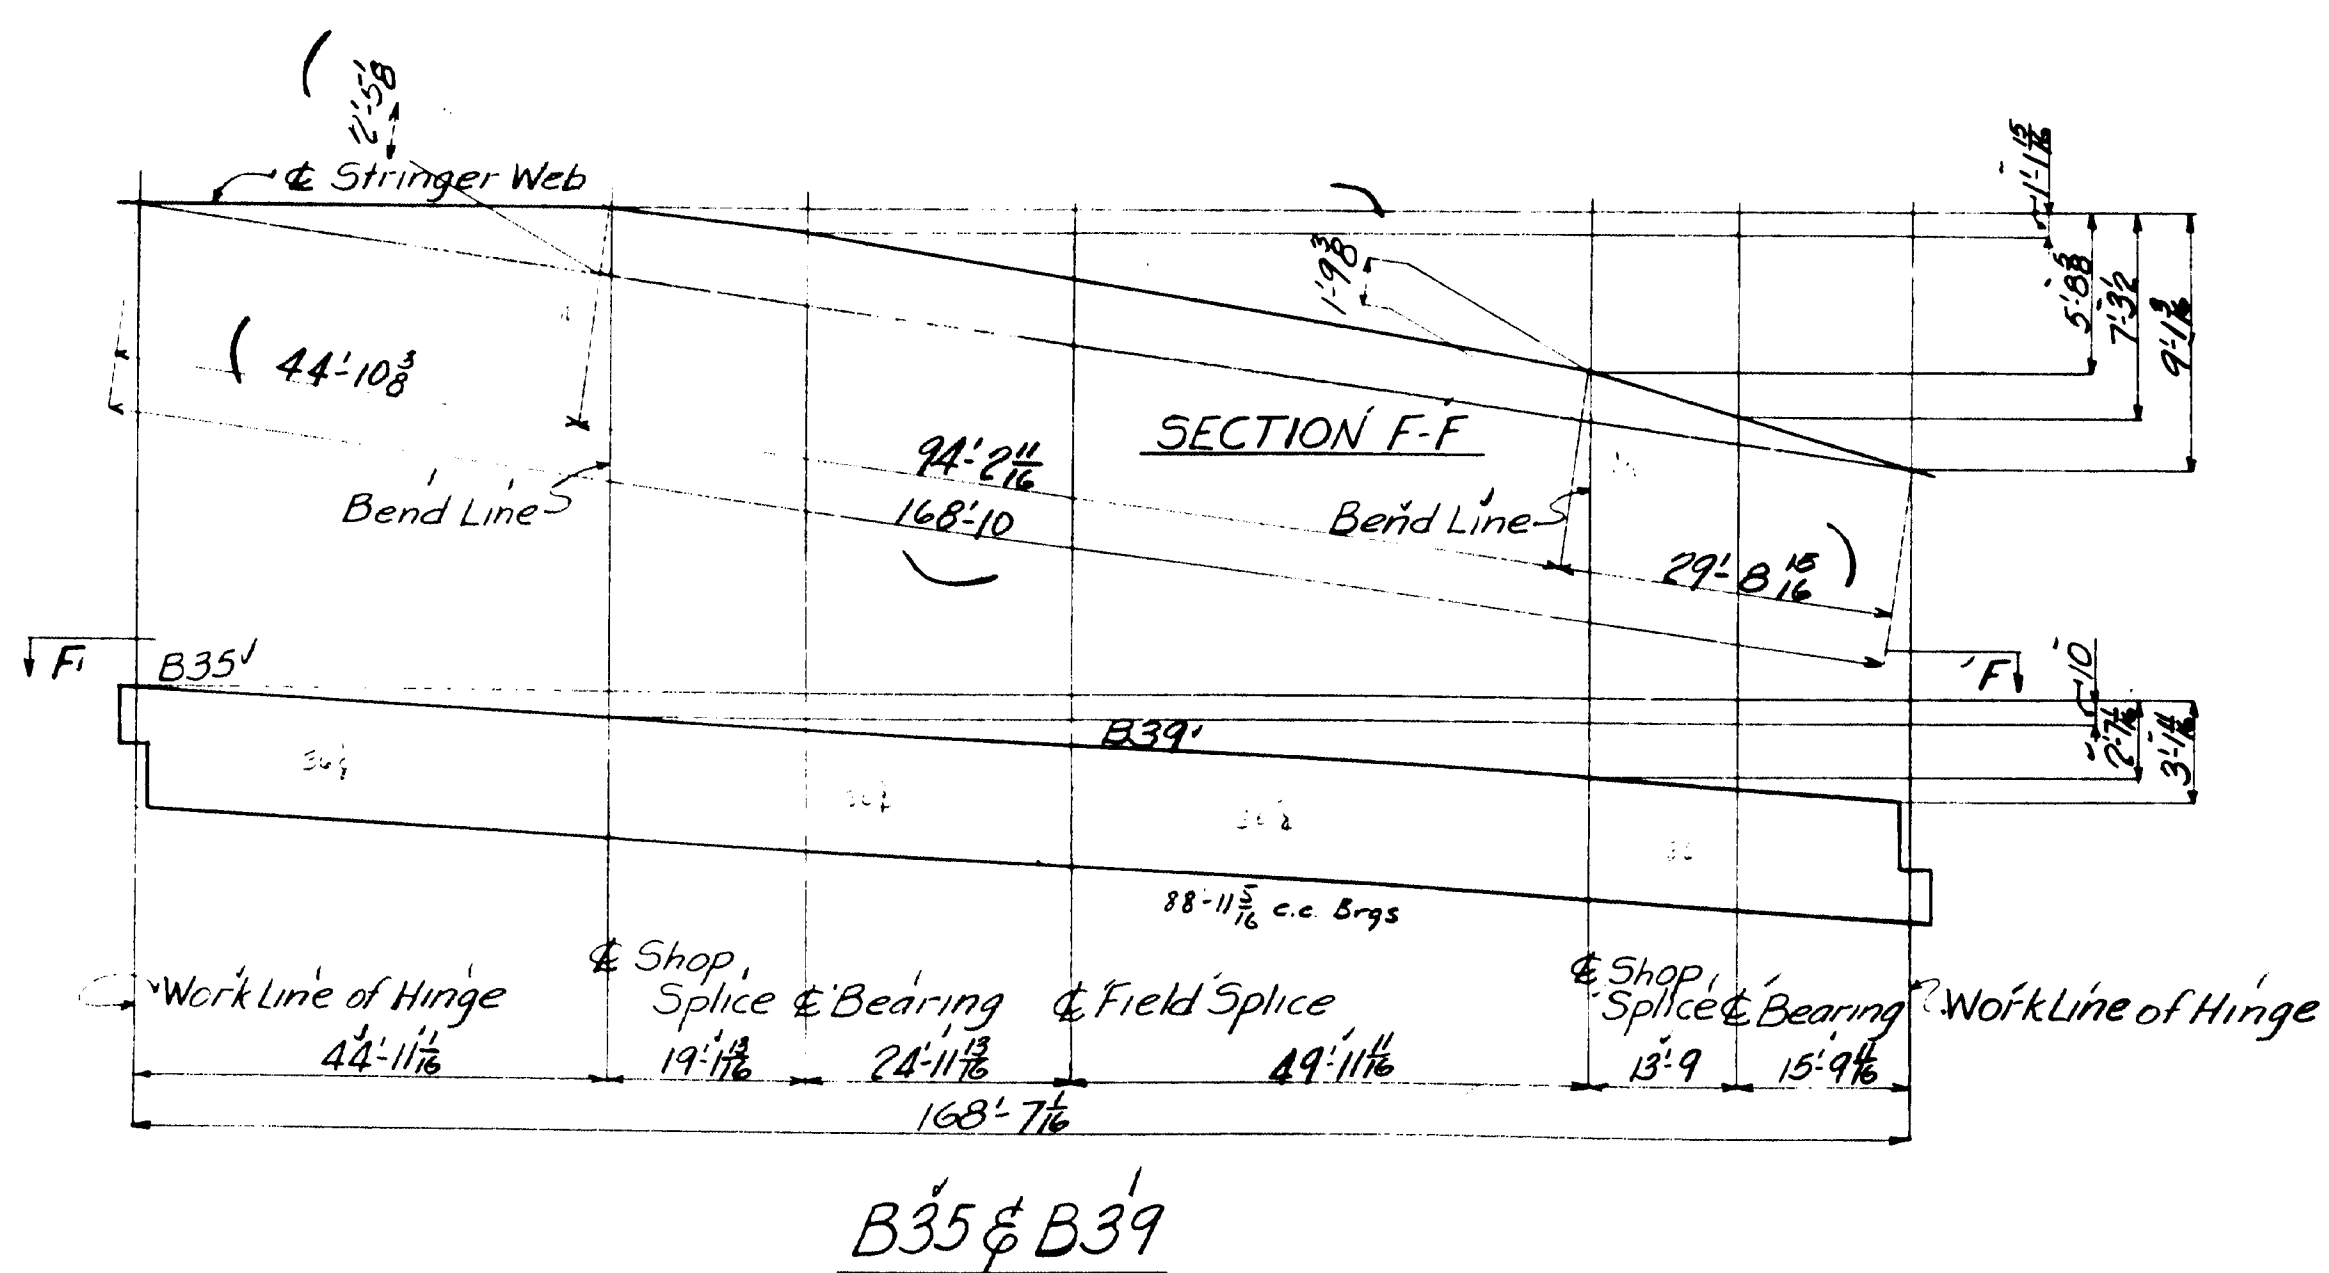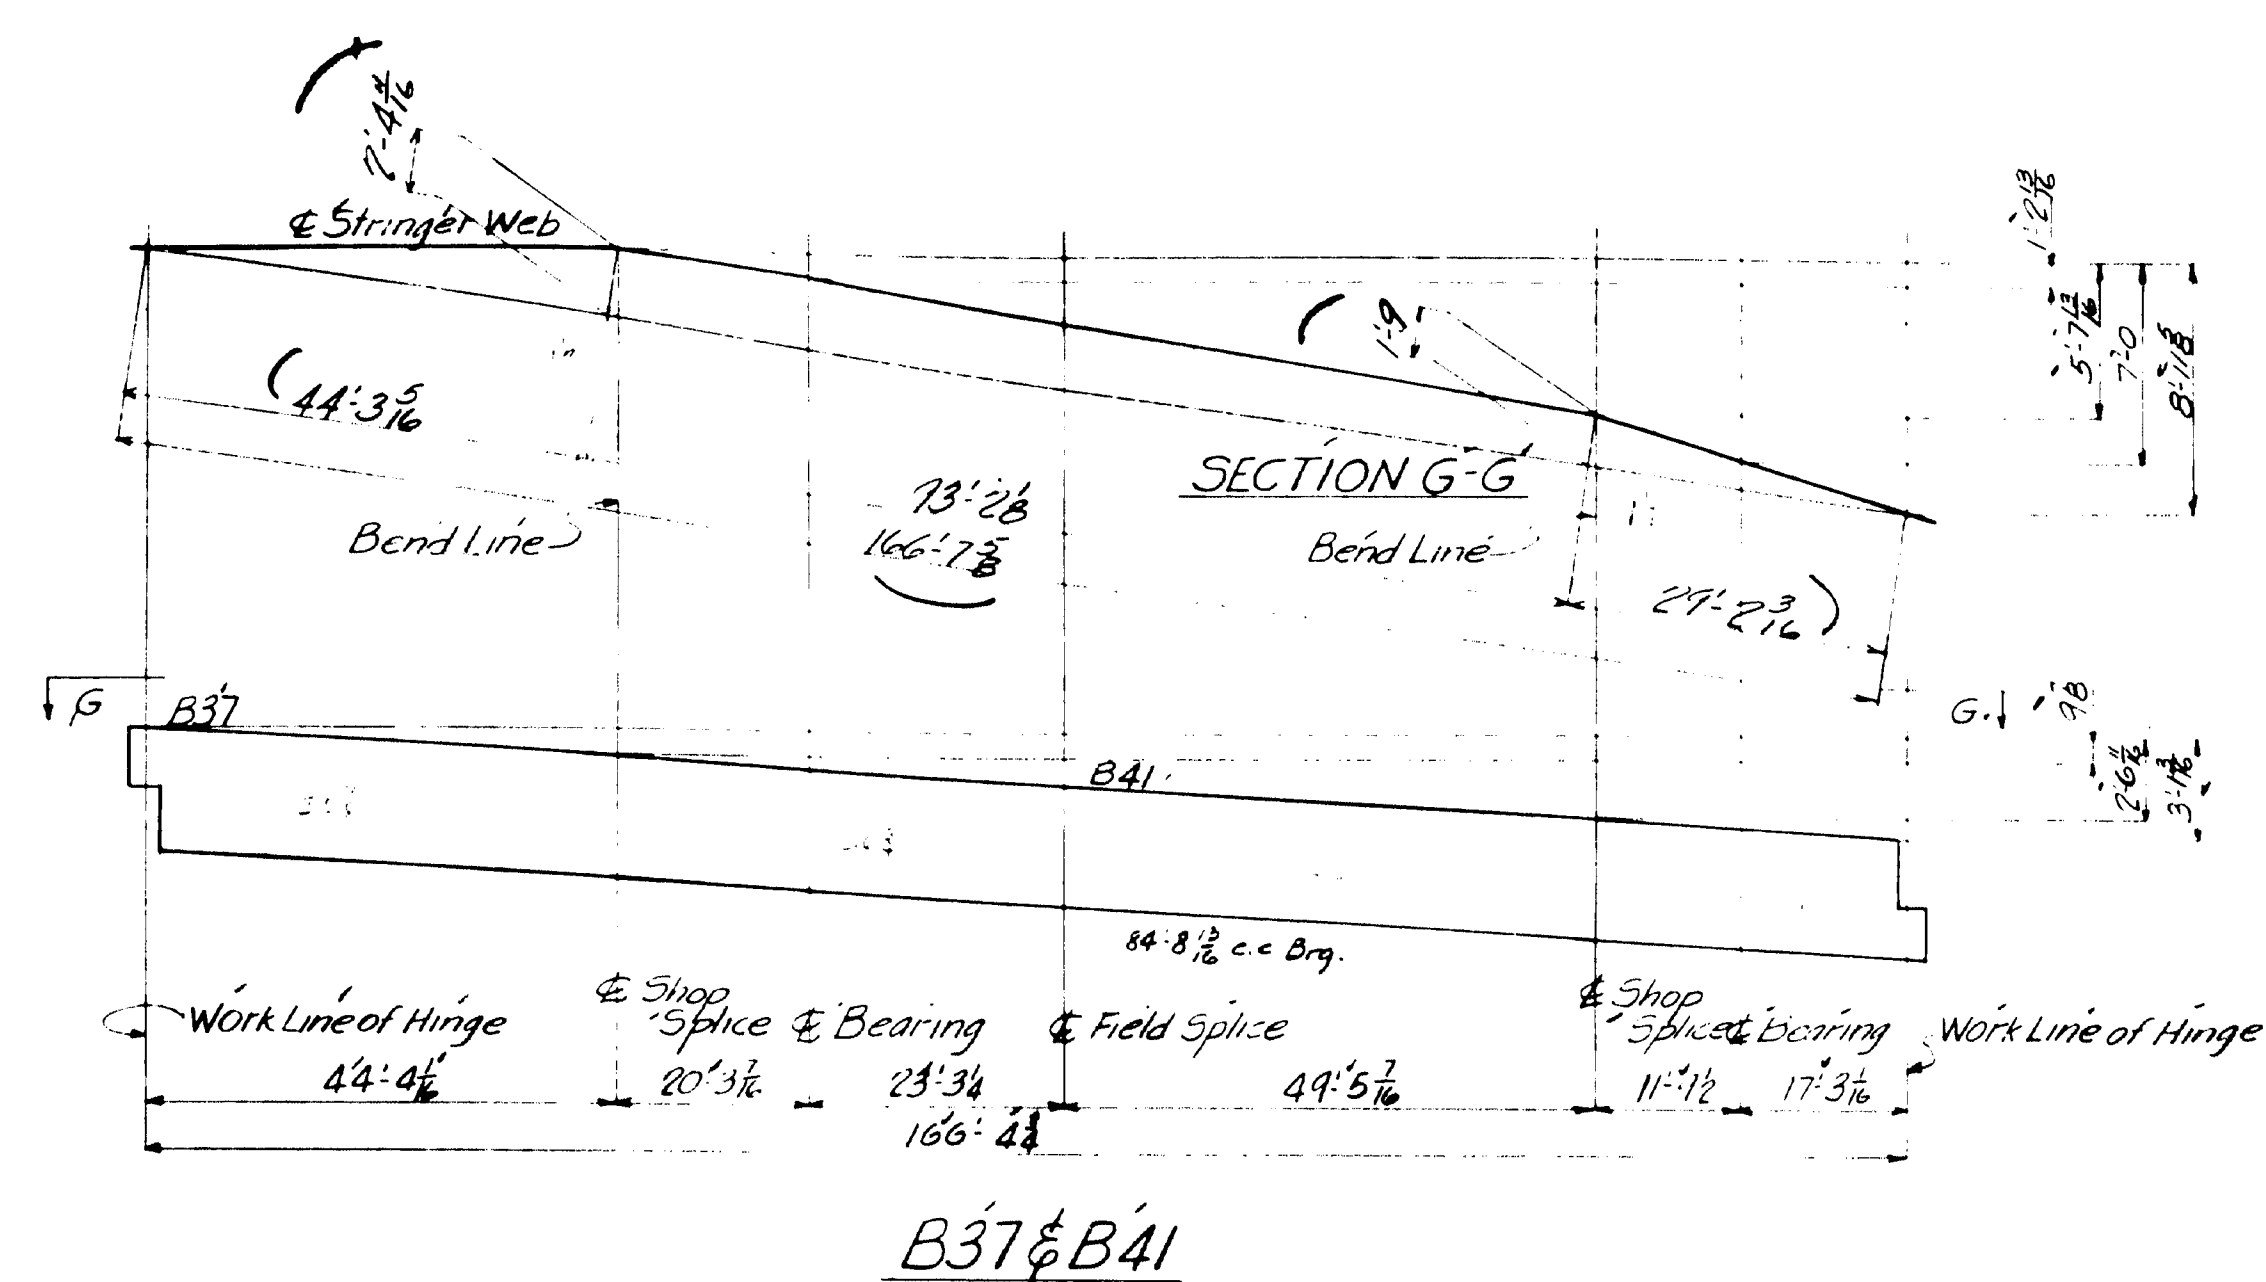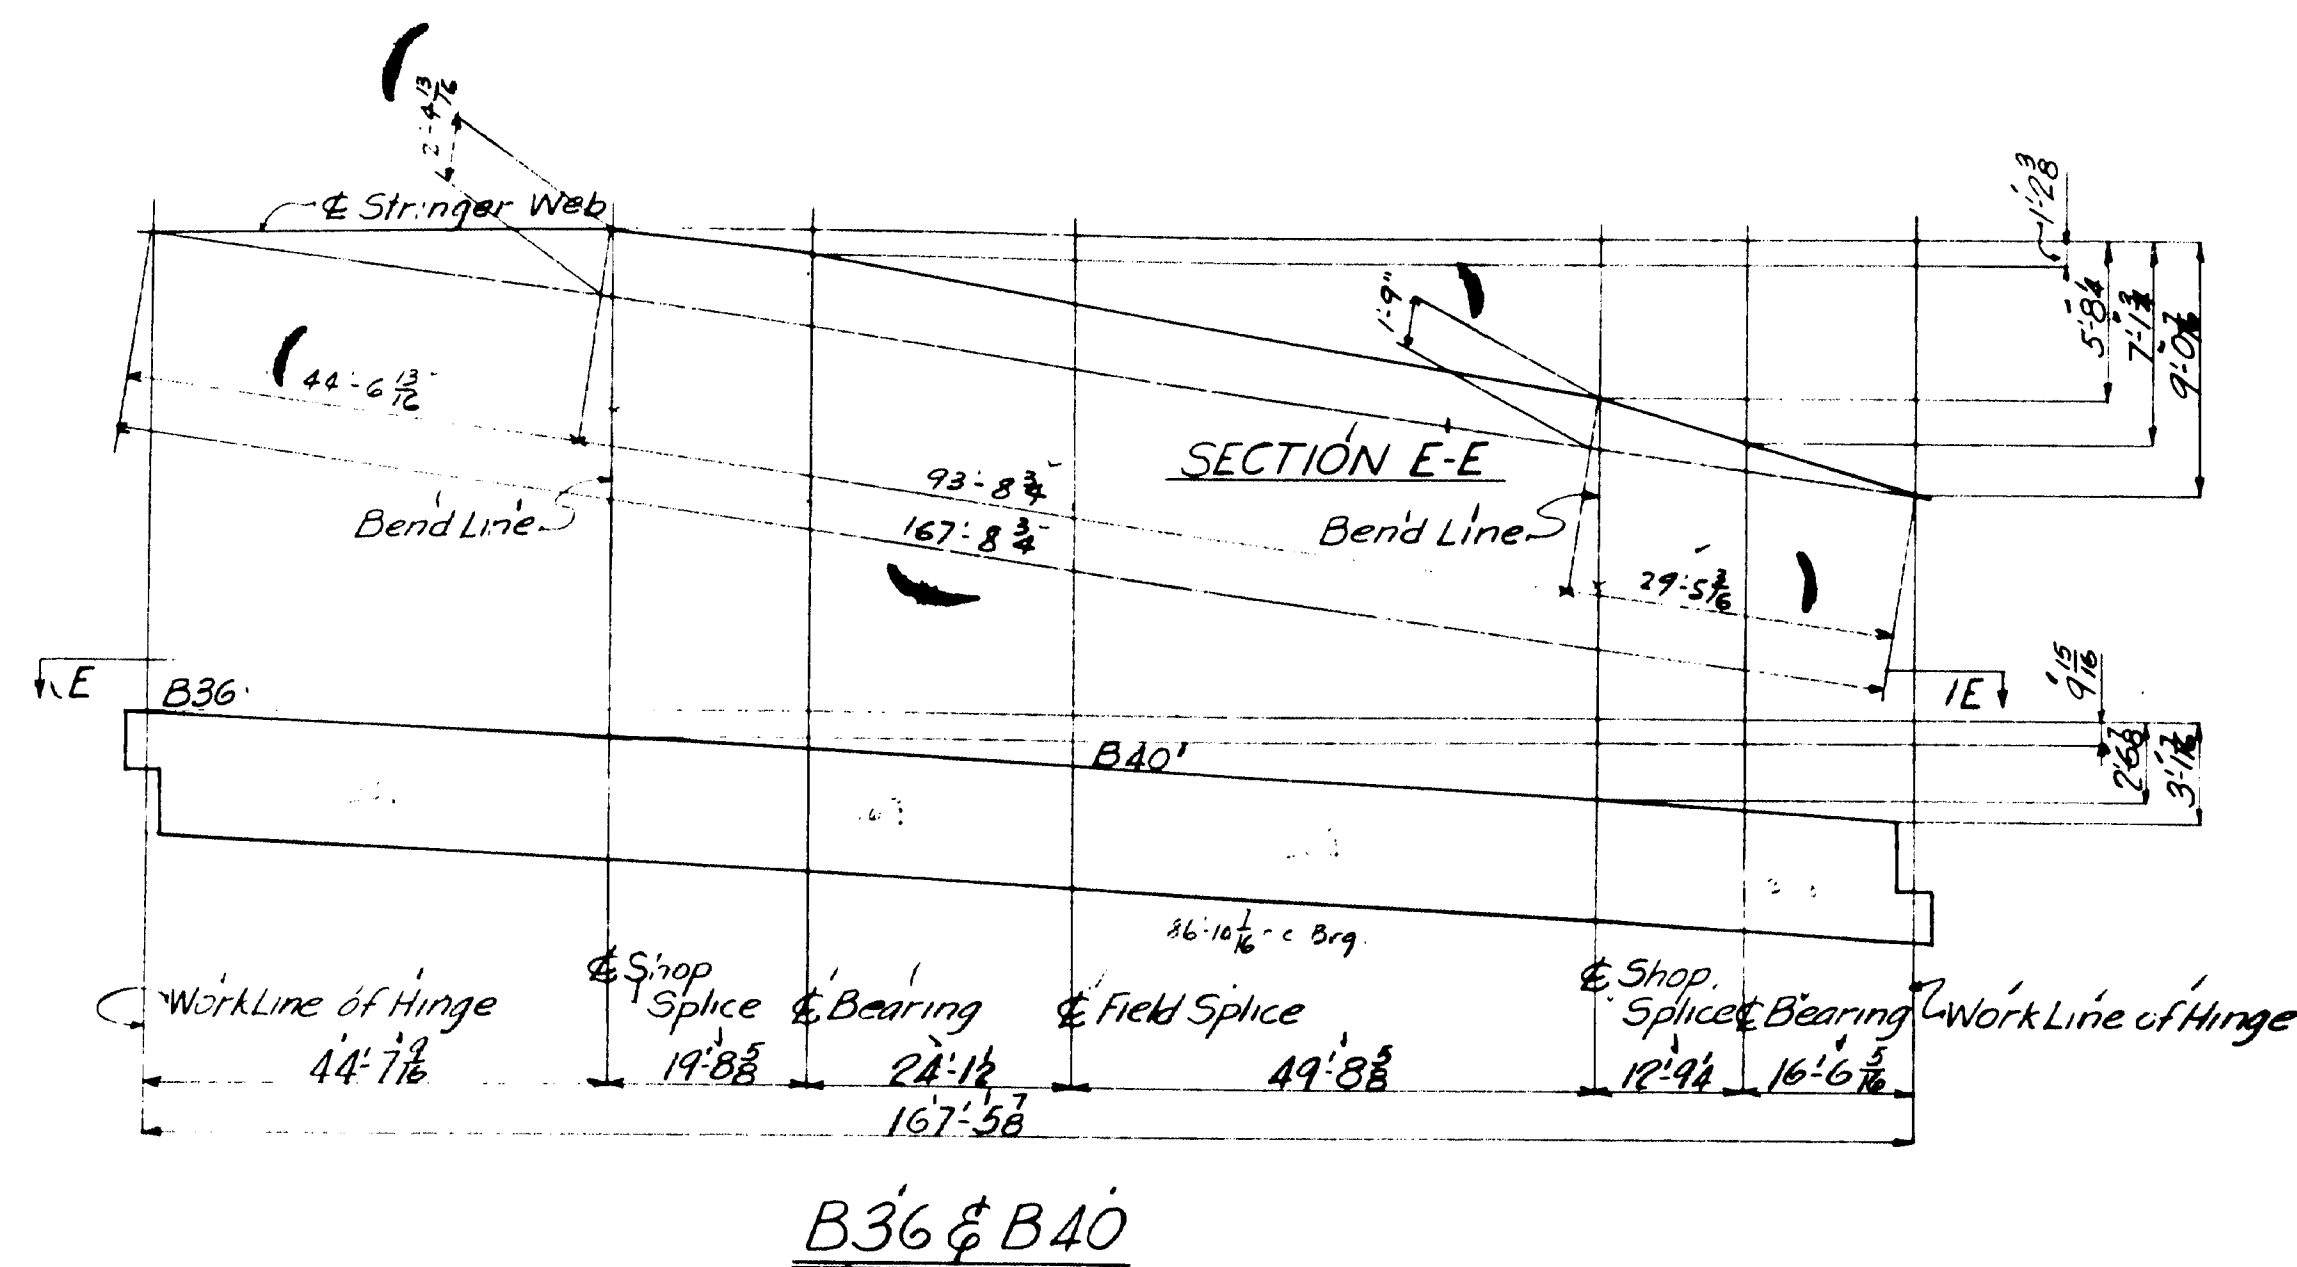

REARMS & ASSEMBLY DIAGRAMS

STATE OF MAINE  
STATE HIGHWAY COMMISSION  
BANGOR BREWER BRIDGE  
OVER PENOBSCOT RIVER  
BANGOR, MAINE

D-63 1M-8-51 PENCILTEX DIV. 3  
AMERICAN BRIDGE COMPANY  
UNITED STATES STEEL CORPORATION SUBSIDIARY

DRAWINGS MADE AT TRENTON PLANT  
WORK FABRICATED AT TRENTON PLANT  
IN CHARGE OF E.B. MARKS  
DRAW. MADE BY L.H.T. DATE 1-27-54  
DRAW. CHECKED BY J.C.P. DATE 2-1-54

ORDER No. Q4149 SHEET No. 312

PAINT:  
SHOP CONTACT SURFACES:

REVISIONS
1
2
3
4
5
6
7
8
9
10

62-101.L





LINE	ITEM	MATERIAL	LENGTH	REMARKS	ORDERED	CALCULATED
NO.	NO.	SHAPE	Feet		ITEM	WEIGHT FOR ONE SHIP PILE
1	8	8 Top Pedestals	TP1	Patt. T-2463-AH		
2	8	8 Casting B.4A	1 2	Shop weld (See Sketch)	Eg. 50382	9.8
3	7	9 Top Pedestals	TP2	Patt. T-2463		
4	7	9 Casting B.4A	1 2	Shop weld (See Sketch)	Eg. 50382	9.1
5	20	20 Top Pedestals	TP3	Patt. T-2463-AH		
6	20	20 Casting B.4A	1 2	Shop weld (See Sketch)	Eg. 50382	9.4
7	2	2 Top Pedestals	TP4	Patt. T-2463-AH		
8	2	2 Casting B.4A	1 2	Shop weld (See Sketch)	Eg. 50382	9.8
9	5	5 Top Pedestals	TP5	Patt. T-2463-AH		
10	5	5 Casting B.5A	1 2	Shop weld (See Sketch)	Eg. 50382	11.3
11	2	2 Top Pedestals	TP6	Patt. T-2463-AH		
12	2	2 Casting B.5A	1 2	Shop weld (See Sketch)	Eg. 50382	10.4
13	1	1 One Top Pedestals	TP7	Patt. T-2463-AH		
14	1	1 Casting B.4A	1 2	Shop weld (See Sketch)	Eg. 50382	9.4
15	1	1 Top Pedestals	TP8	Patt. T-2463-AH		
16	1	1 Casting B.5A	1 2	Shop weld (See Sketch)	Eg. 50382	10.7
17	1	1 One Top Pedestals	TP17	Patt. T-2463-AH		
18	1	1 Casting B.5A	1 2	Shop weld (See Sketch)	Eg. 50382	10.4
19	8	8 Top Pedestals	TP9	Patt. T-2463-AH		
20	8	8 Casting B.4A	1 2	Shop weld (See Sketch)	Eg. 50382	9.4
21	8	12 Eye Pedestals	EP1	Patt. T-2463		
22	8	12 Casting B.5A	1 7	Shop weld (See Sketch)	Eg. 50382	23.8
23	8	8 Eye Pedestals	EP2A	Patt. T-2463		
24	8	8 Casting B.5A	1 10	Shop weld (See Sketch)	Eg. 50382	25.5
25	25	25 Eye Pedestals	EP3A	Patt. T-2463		
26	25	25 Casting B.7A	1 7	Shop weld (See Sketch)	Eg. 50382	15.5
27	8	8 Base Plates	BP1	91"		
28	8	8 R 10 1/2	1 7			
29	4	4 Base Plates	BP2	103"		
30	4	4 R 10 1/2	1 7			
31	8	8 Base Plates	BP3	183"		
32	8	8 R 12 22	1 10			
33	25	25 Base Plates	BP4	61"		
34	25	25 R 8 1/2	1 7			
35	25	25 R 8 1/2	1 7			
TO BE SHOP ASSEMBLED AS NOTED ON JNT 4

Mark	Dim. A	Dim. B	Dim. C
TP1	1 1/2	1 1/2	5 1/2
TP2	1 1/2	1 1/2	4 1/2
TP3	1 1/2	1 1/2	5
TP4	1 1/2	1 1/2	5 1/2
TP5	2 1/2	2 1/2	5 1/2
TP6	1 1/2	1 1/2	5 1/2
TP7	1 1/2	1 1/2	5
TP8	1 1/2	1 1/2	5 1/2
TP9	1 1/2	1 1/2	5
TP17	1 1/2	1 1/2	5 1/2

To be painted after assembly to beams.

- TP17 { PATT. No. T-2463-AH  
WT. 104" } To be shop welded to Beams on Sheets-103-Q4149
- TP1 { PATT. No. T-2463-AH  
WT. 98" } To be shop welded to Beams on Sheets-101,303,405,406-Q4149
- TP2 { PATT. No. T-2463  
WT. 91" } To be shop welded to Beams on Sheets-101,202,205,305,306,407-Q4149
- TP3 { PATT. No. T-2463-AH  
WT. 94" } To be shop welded to Beams on Sheets-101,201,203,206,302,304,307,403,404,405,406,407-Q4149
- TP4 { PATT. No. T-2463-AH  
WT. 98" } To be shop welded to Beams on Sheets-103,109-Q4149
- TP5 { PATT. No. T-2463-AH  
WT. 113" } To be shop welded to Beams on Sheets-103,109-Q4149
- TP6 { PATT. No. T-2463-AH  
WT. 104" } To be shop welded to Beams on Sheet-201-Q4149
- TP7 { PATT. No. T-2463-AH  
WT. 94" } To be shop welded to Beam on Sheet-103-Q4149
- TP8 { PATT. No. T-2463-AH  
WT. 107" } To be shop welded to Beam on Sheet-110-Q4149
- TP9 { PATT. No. T-2463-AH  
WT. 94" }

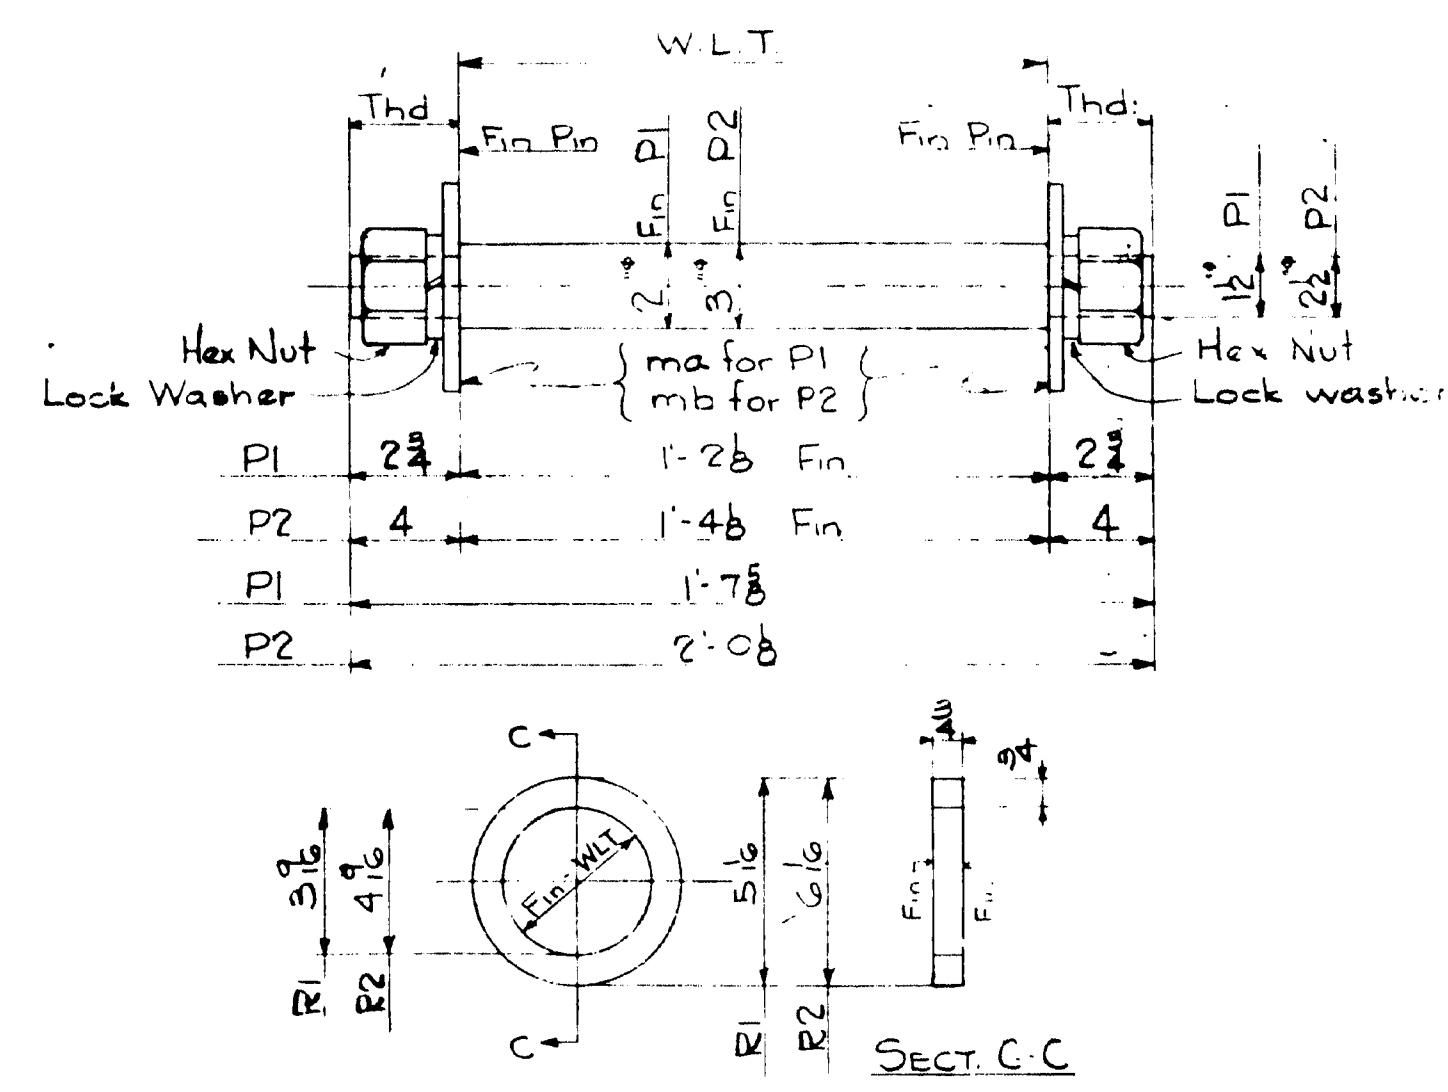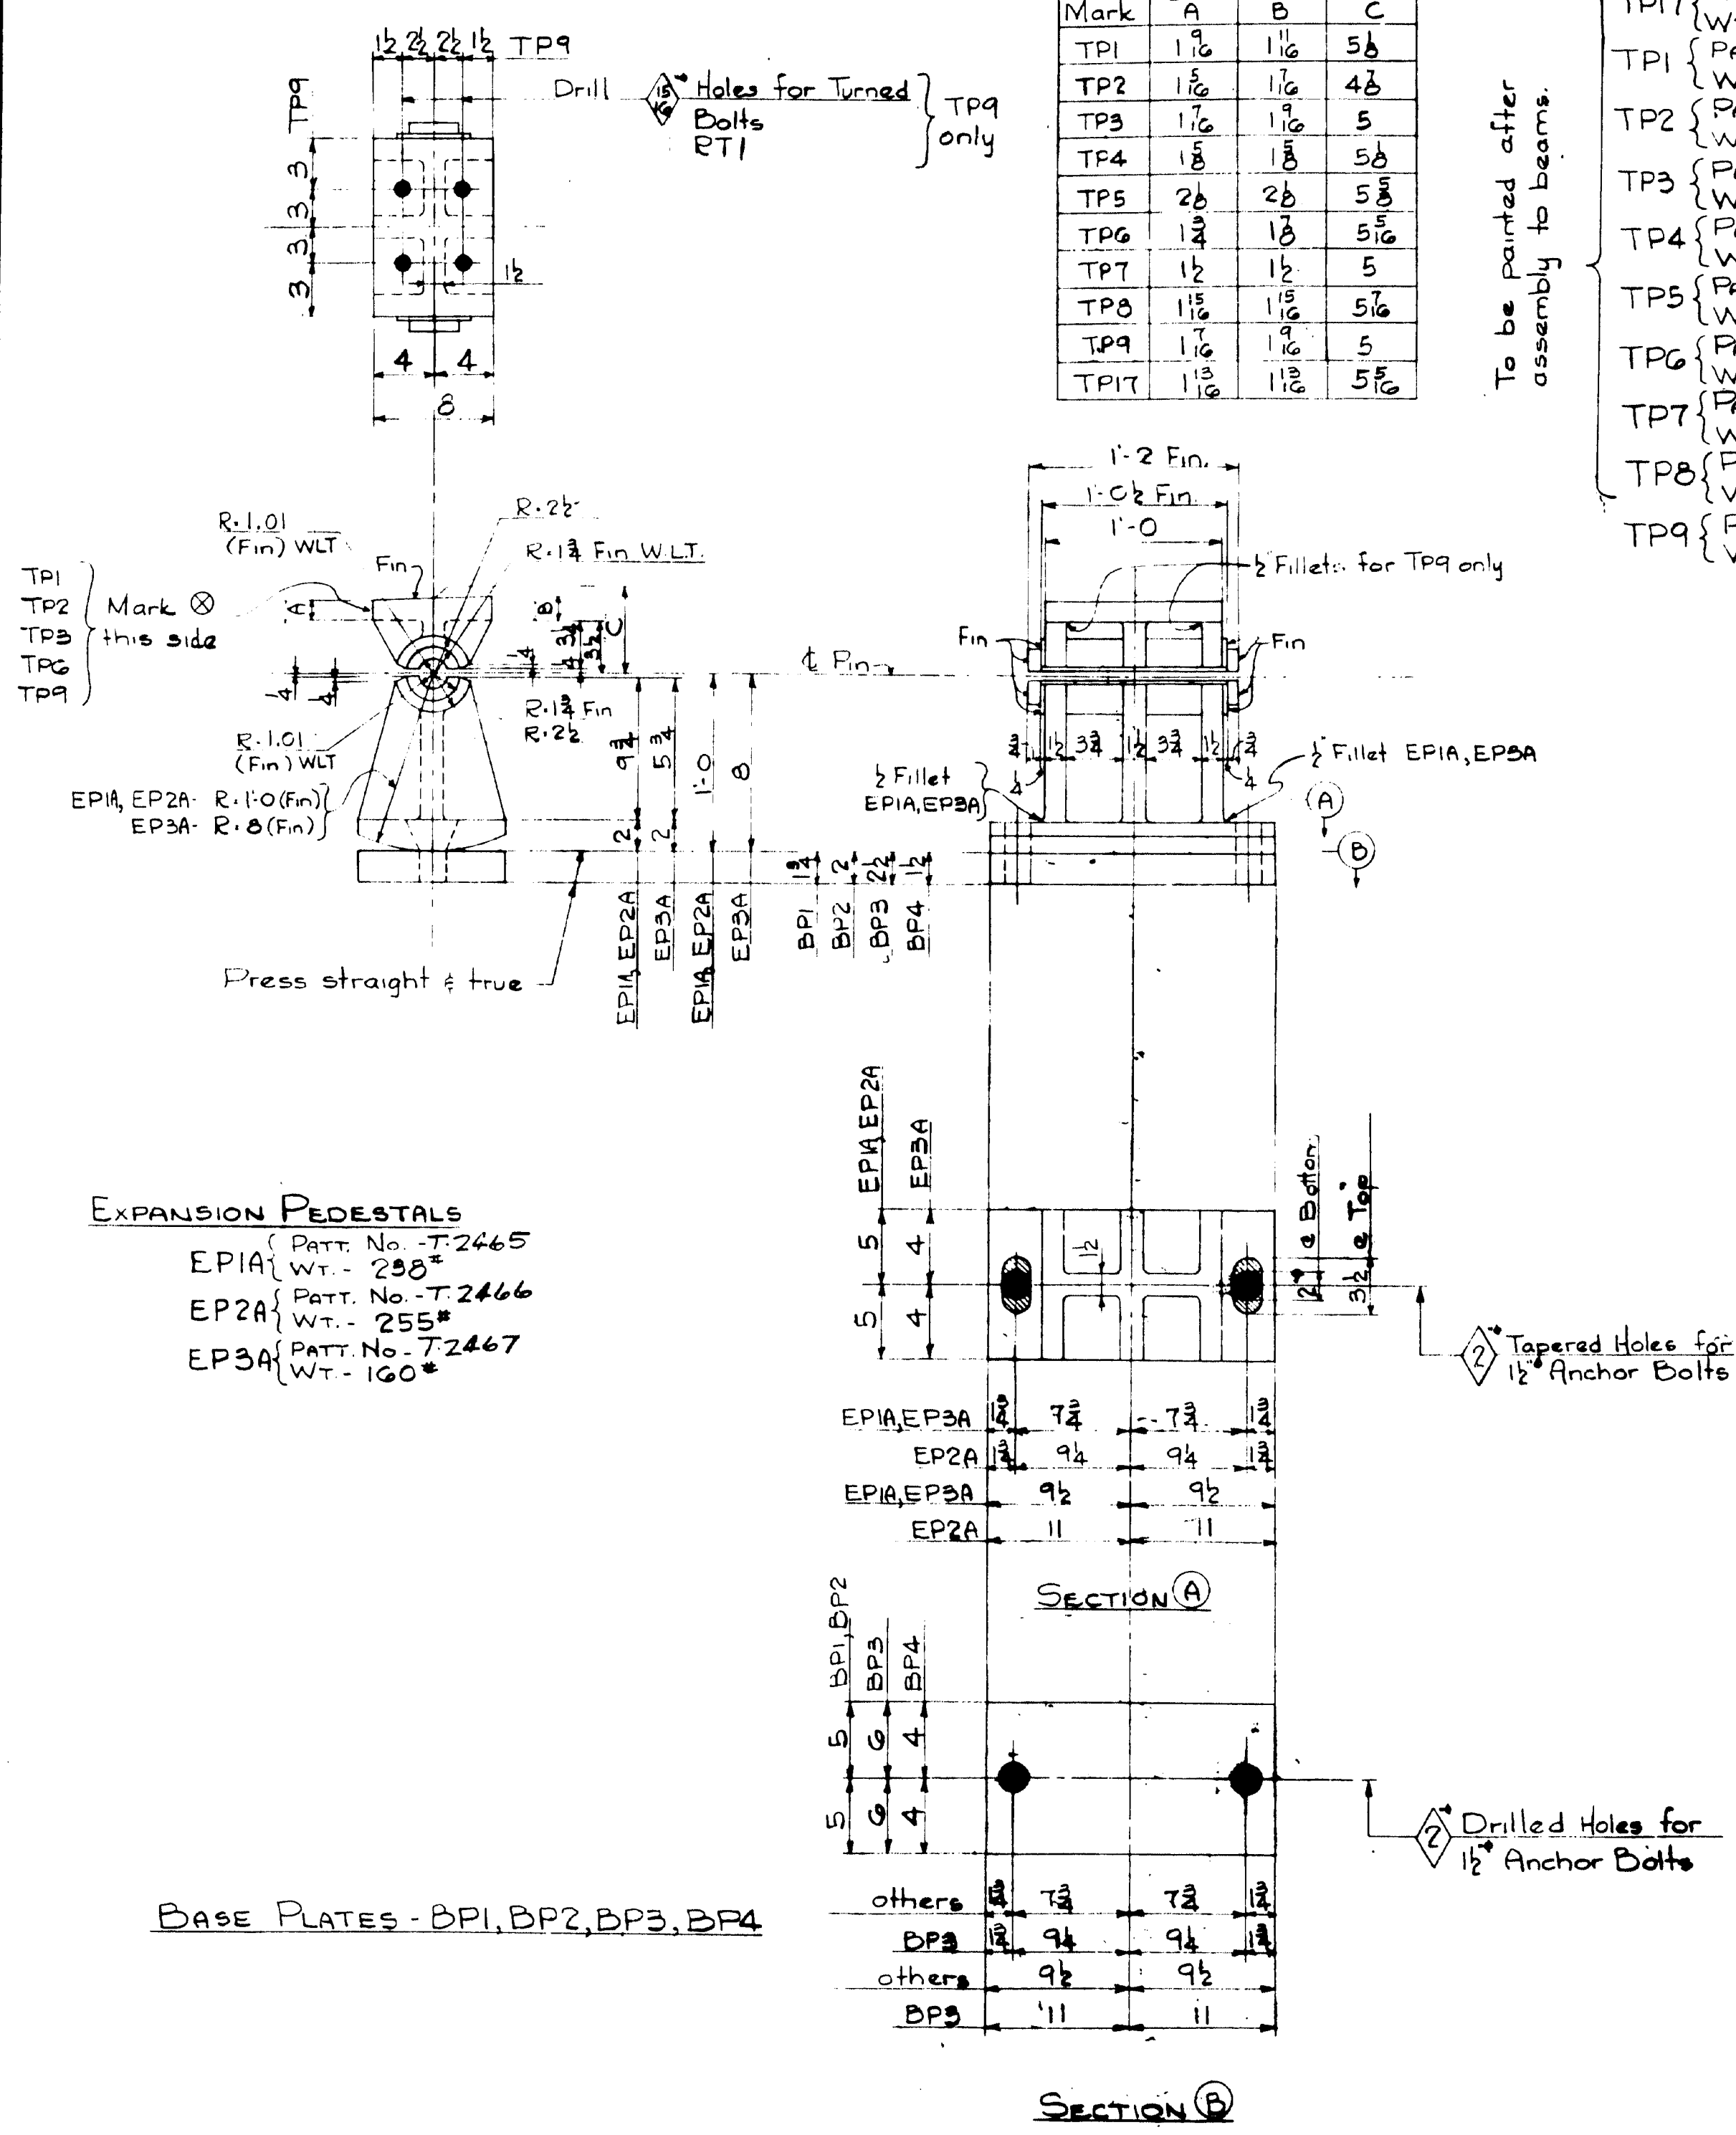

NOTES:

Material: Cast Steel - A.S.T.M. A27, Grade 65-35

O.H. Steel - A.S.T.M. A7-82T.

Specifications: Maine State Highway Comm. 1945

& special provisions.

Paint: One coat red lead & oil except surfaces marked W.L.T. to receive white lead & tallow

Scribe longitudinal & transverse center lines on sides of base plates.

All fillets on castings to be 1" unless noted.

Holes marked RT. to be drilled full size to a metal template.

NOTE TO SHOP:

SAVE REMAINING TEMPLATE FOR USE ON Q4150.

BANGOR BREWER BRIDGE  
OVER FENOSCOT RIVER  
STATE OF MAINE

AMERICAN BRIDGE

DRAWINGS MADE AT TRENTON PLANT

WORK FABRICATED AT TRENTON PLANT

IN CHARGE OF E. F. MARKS

DRAW. MADE BY E. F. MARKS DATE 7-2-33

DRAW. CHECKED BY E. F. MARKS DATE 7-2-33

ORDER NO. Q4148

SHEET NO. 1


MA 10, 1/2

62-101



AMERICAN BRIDGE

LINE	ITEM	MATERIAL	QUANTITY	REMARKS	ORDERED	CALCULATED
1	2	2 TOP PEDESTALS TPI1 (PATT. NO. T-2464)	2			
2	2	2 CASTING 14 7/8 1 4	2			
3	2	2 TOP PEDESTALS TPI2 (PATT. NO. T-2464)	2			
4	2	2 CASTING 14 7/8 1 4	2			
5	4	4 FIXED PEDESTALS FPIA (PATT. NO. T-2470)	4			
6	12	12 FIXED PEDESTALS FPIB (PATT. NO. T-2471)	12			
7	6	6 FIXED PEDESTALS FPI3 (PATT. NO. T-2472)	6			
8	2	2 TOP PLATES TPI3 (To be shop welded to Bm on SH. 113-Q4149)	2			
9	2	2 TOP PLATES TPI4 (To be shop welded to Bm on SH. 113-Q4149)	2			
10	1	ONE TOP PLATE TPI5 (To be shop welded to Bm on SH. 102-Q4149)	1			
11	1	ONE TOP PLATE TPI6 (To be shop welded to Bm on SH. 107-Q4149)	1			
12	2	2 BASE PLATES BPI1	2			
13	2	2 BASE PLATES BPI2	2			
14	2	2 BASE PLATES BPI3	2			
15	1	ONE BASE PLATE BPI4	1			
16	1	ONE BASE PLATE BPI5	1			

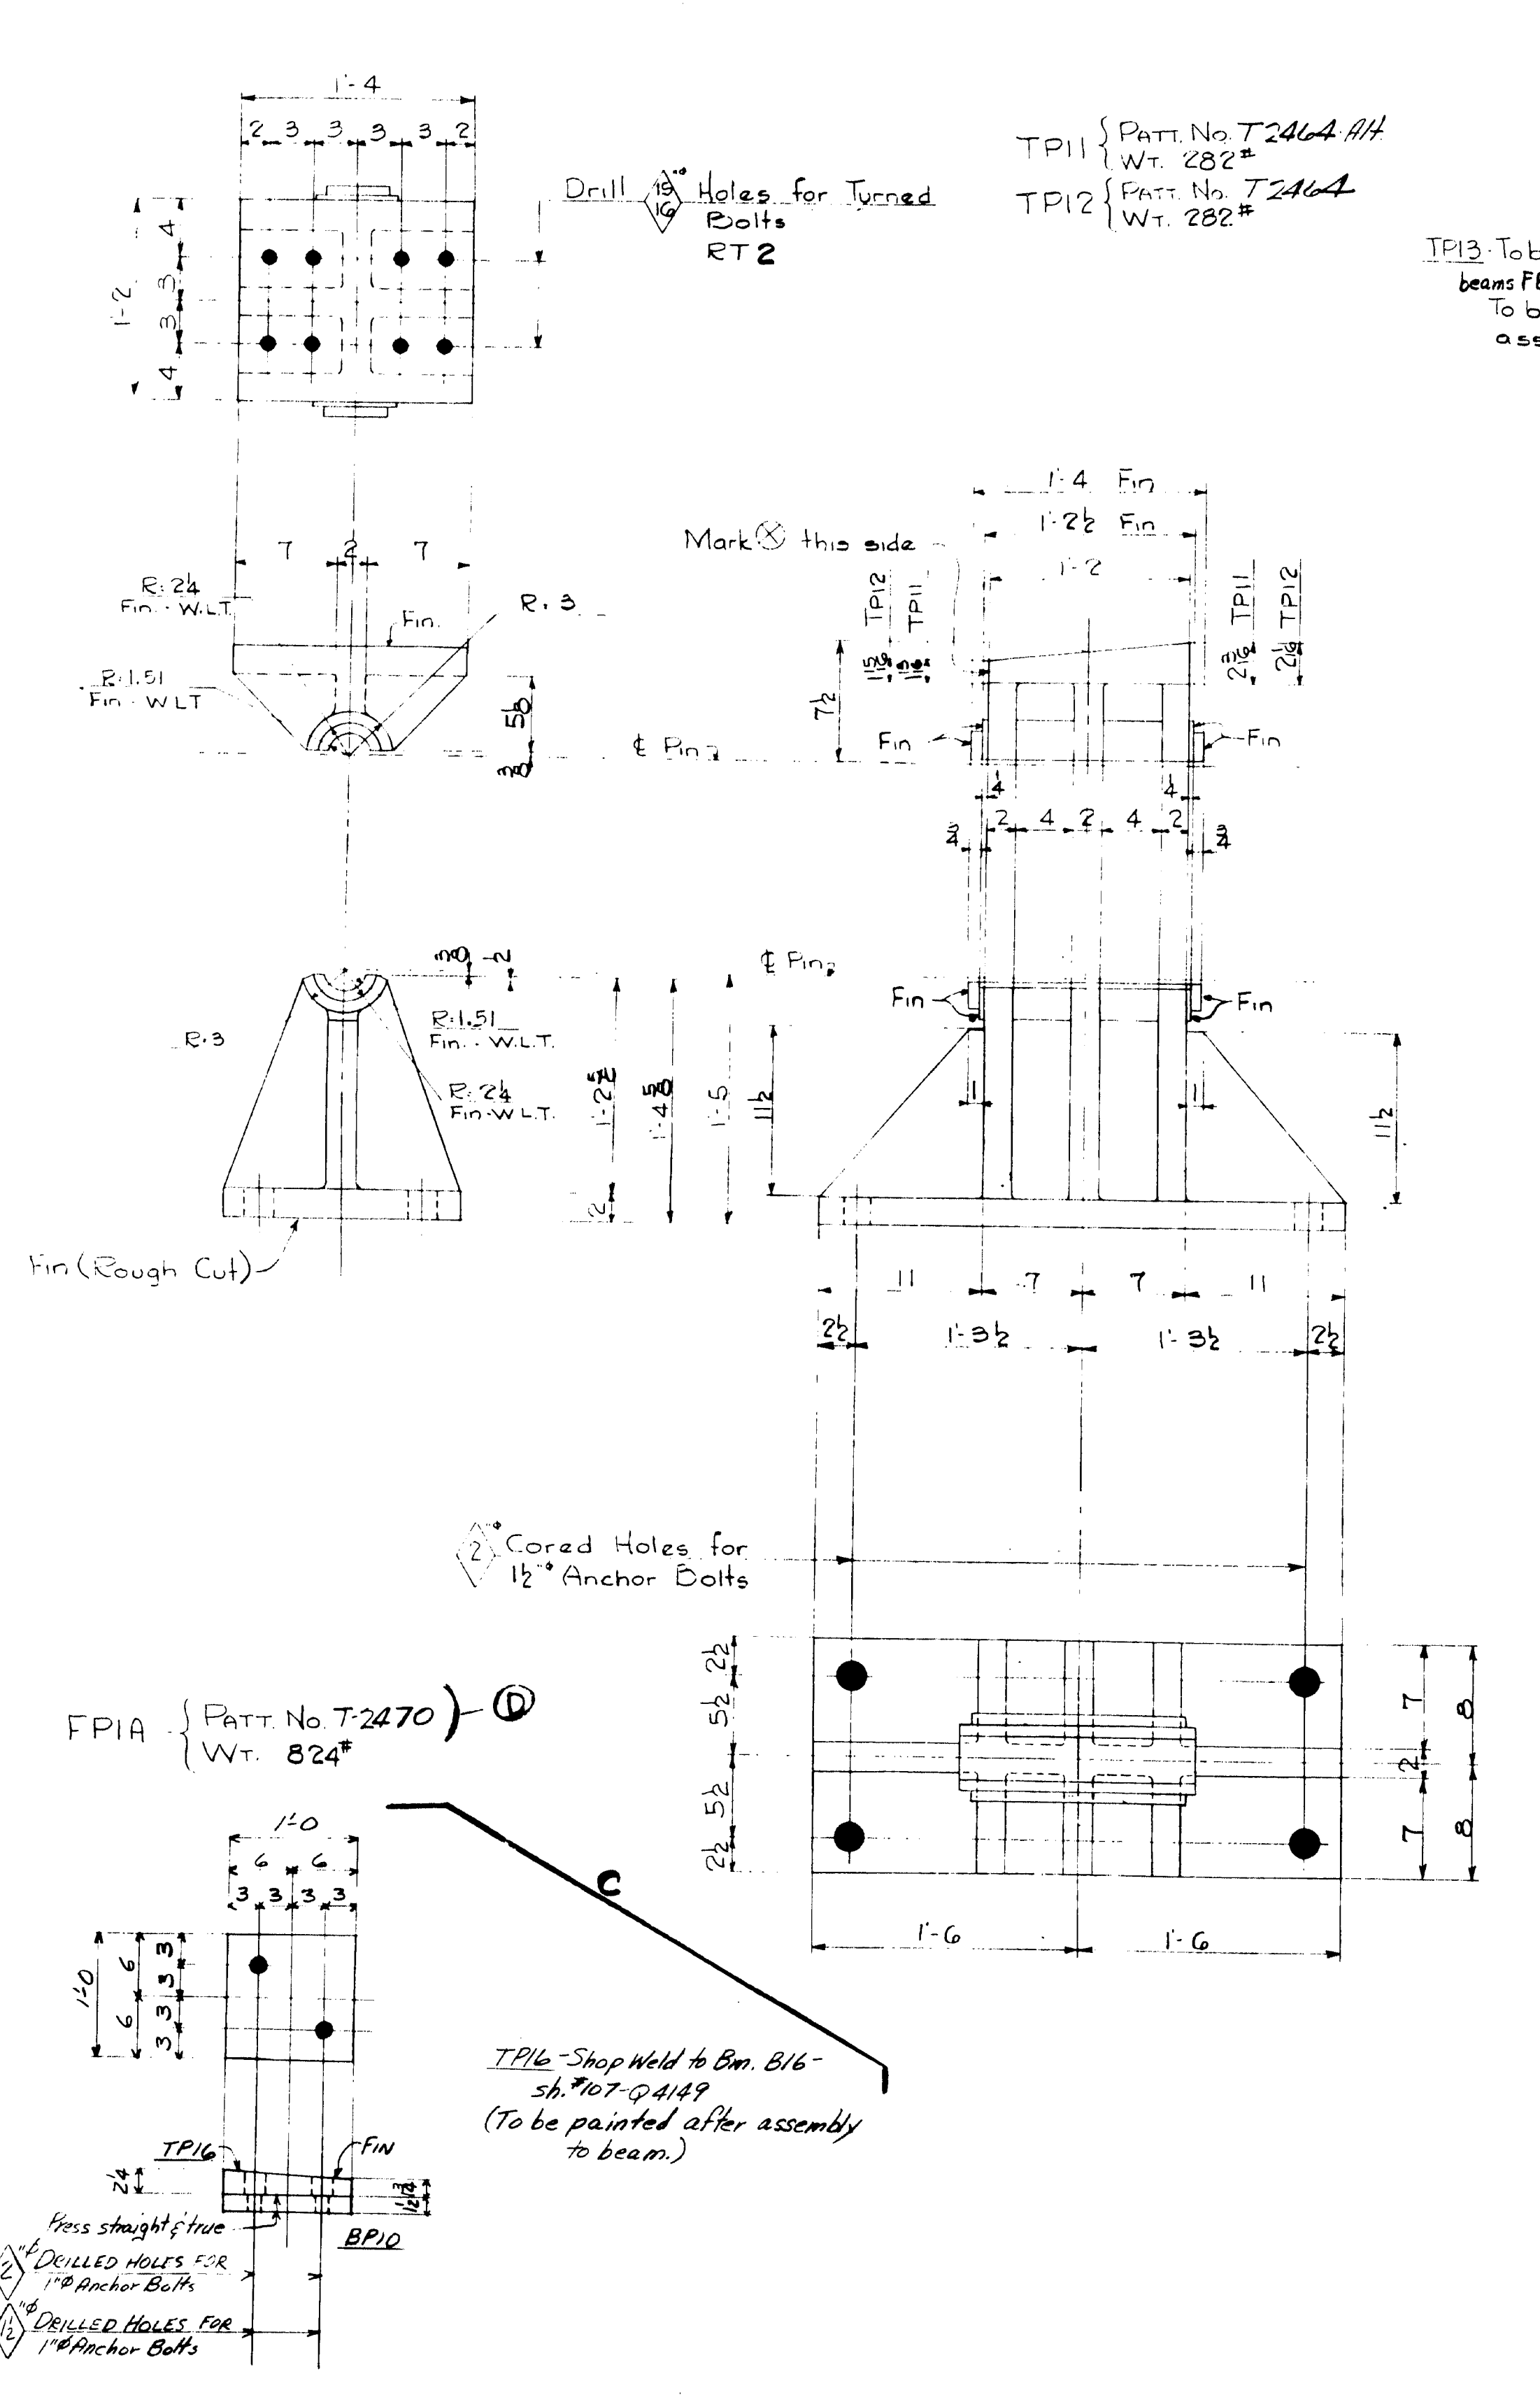

**NOTES:**

Material: Cast Steel - A.S.T.M. A27, Grade GS-35.  
O.H. Steel - A.S.T.M. A7-52T.  
Specifications: Maine State Highway Comm 1945 & special provisions.

Paint: One coat red lead & oil except surfaces marked W.L.T. to receive white lead & tallow.

Scribe longitudinal & transverse center lines on sides of pedestals.

All fillets on castings to be 1" unless noted.

Holes marked RT to be drilled full size to a metal templet.

**NOTE TO SHOP:**  
SAVE REAMING TEMPLET FOR USE ON Q4149.

DANFOR-BREWER BRIDGE  
OVER PENOBSCOT RIVER  
STATE OF MAINE

REVISIONS


1	1-21-54	1
2	12-31-53	1
3	12-7-53	1
4	11-4-53	1

ORDER NO. Q4148  
SHEET NO. 2

# AMERICAN BRIDGE

LINE	ITEM	MATERIAL	ASSEMBLY MARK	REMARKS	ORDERED	CALCULATED
					ITEM	WEIGHT FOR ONE SHIP PIECE
1						
2						
3						
4						
5						
6						
7						
8						
9						
10						
11	14	EXP. PEDESTAL EP4A (Part T-2448)				6.08
12	14	Casting 12 1/4" x 20"				
13						
14	12	BASE PLATES BPE	475			
15	12	1/2" x 16" x 20"			5	49.0
16						
17						
18	12	1/2" x 16" x 20"	435		5	44.9
19						
20						
21						
22						
23	8	EXP. PEDESTAL EP7	125			12.4
24						
25						
26						
27						
28	8	EXP. PEDESTAL EP7	125			12.4
29						
30						
31						
32	8	EXP. PEDESTAL EP7	125			12.4
33						
34						
35						
36						
37						
38						
39						
40						
41	ONE	TOP PEDESTAL TP10A				
42	ONE	TOP PEDESTAL TP10B				
43	ONE	TOP PEDESTAL TP10D				
44	ONE	TOP PEDESTAL TP10E				
45	ONE	TOP PEDESTAL TP20A				
46	ONE	TOP PEDESTAL TP20B				
47	ONE	TOP PEDESTAL TP20D				
48	ONE	TOP PEDESTAL TP20E				
49	ONE	TOP PEDESTAL TP30A				
50	ONE	TOP PEDESTAL TP30B				
51	ONE	TOP PEDESTAL TP30D				
52	ONE	TOP PEDESTAL TP30E				
53	ONE	TOP PEDESTAL TP40A				
54	ONE	TOP PEDESTAL TP40B				
55	ONE	TOP PEDESTAL TP40D				
56	ONE	TOP PEDESTAL TP40E				
57						
58	16	Castings 16 1/8" x 20"				4.12
59						
60						
61						
62						
63						
64						
65						
66						
67						

TOP PEDESTALS							
MARK	GIRDER	PART. No.	WT.	MARK	GIRDER	PART. No.	WT.
TP10A	G1A-SH101	T-2473	599	TP30A	G3A-SH101	T-2473	599
TP10B	G1B-SH201			TP30B	G3B-SH201		
TP10D	G1D-SH401			TP30D	G3D-SH401		
TP10E	G1E-SH301			TP30E	G3E-SH301		
TP20A	G2A-SH101			TP40A	G4A-SH101		
TP20B	G2B-SH201			TP40B	G4B-SH201		
TP20D	G2D-SH401			TP40D	G4D-SH401		
TP20E	G2E-SH301			TP40E	G4E-SH301		

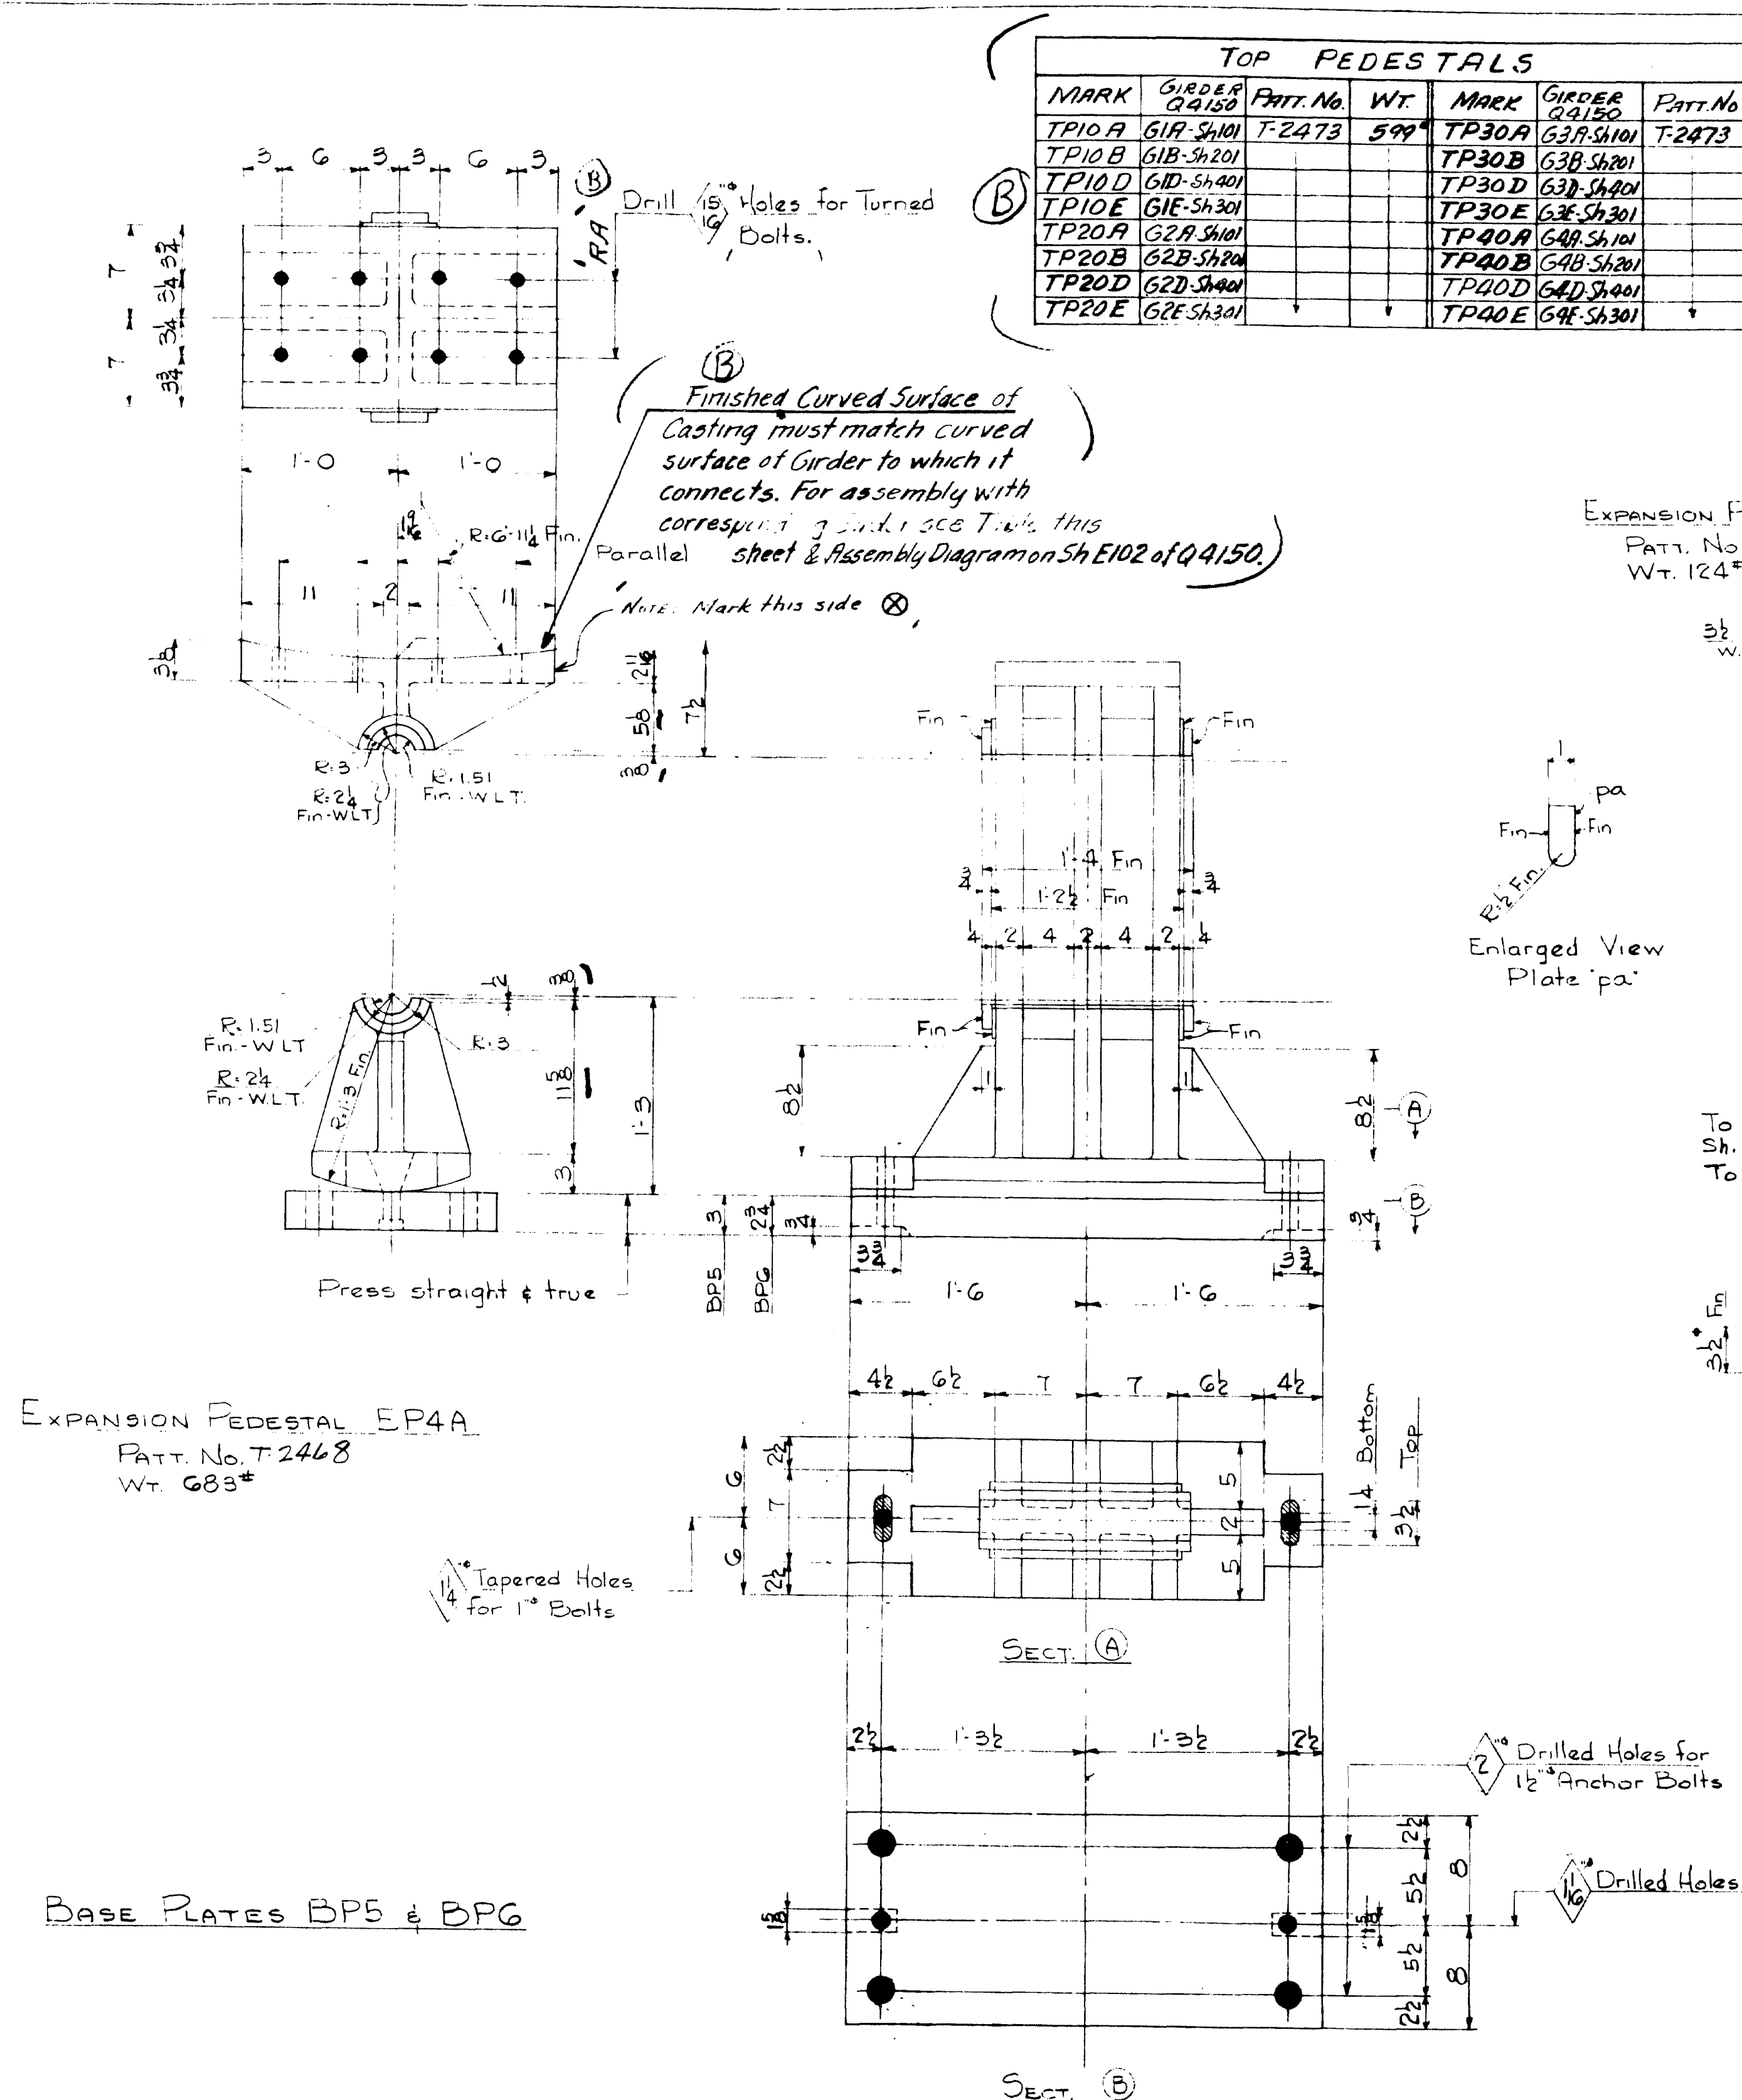

- NOTES:**
- Material: Cast Steel - A.S.T.M. A27, Grade G5-35.
  - O.H. Steel - A.S.T.M. A7-52T.
  - Specifications: Maine State Highway Comm. 1945 & special provisions.
  - Paint: One coat red lead & oil except surfaces marked W.L.T. to receive white lead & talow.
  - Scribe longitudinal & transverse center lines on sides of base plates.
  - All fillets on castings to be 1" unless noted.
  - Holes marked RA to be subdrilled 4" and reamed to size while assembled to connecting Girder. See Assembly Diagram SH E102, Contract Q4150.

BANKS - BREWER  
OVER FINESTON LIVER  
STATE OF MAINE

REVISIONS

F	
E	
D	
C	
B	12-31-53
A	12-7-53

REVISIONS

DRAWINGS MADE AT TRENTON PLANT

WORK FABRICATED AT TRENTON & AMB PLANT

IN CHARGE OF E.D. MORSE


DRAW. MADE BY S.E.K. DATE 7-9-53

DRAW. CHECKED BY E.D.M. DATE 9-4-53

ORDER No. Q4148

SHEET No. 3



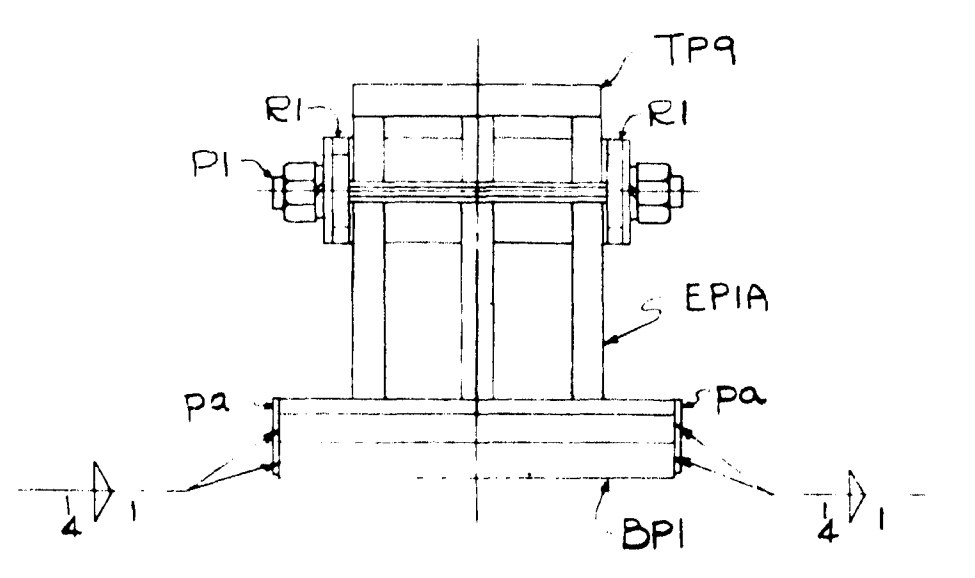

EXPANSION PEDISTAL ASSEMBLY

## EXPANSION PEDISTAL ASSEMBLY

### EP5

68	ONE EXPANSION PEDESTAL	EP10A	1573
70	ONE EXPANSION PEDESTAL	EP10B	
71	ONE EXPANSION PEDESTAL	EP10C	
72	ONE EXPANSION PEDESTAL	EP20A	
73	ONE EXPANSION PEDESTAL	EP20B	
74	ONE EXPANSION PEDESTAL	EP20C	
75	ONE EXPANSION PEDESTAL	EP30A	
76	ONE EXPANSION PEDESTAL	EP30B	
77	ONE EXPANSION PEDESTAL	EP30C	
78	ONE EXPANSION PEDESTAL	EP40A	
79	ONE EXPANSION PEDESTAL	EP40B	
80	ONE EXPANSION PEDESTAL	EP40C	
81			
82	12 Castings	EP2A	408
83	12 Base Plates	SP5	475
84	1 Casting	TP10A EP10A	412
85	1 Casting	TP10B EP10B	
86	1 Casting	TP10C EP10C	
87	1 Casting	TP20A EP20A	
88	1 Casting	TP20B EP20B	
89	1 Casting	TP20C EP20C	
90	1 Casting	TP30A EP30A	
91	1 Casting	TP30B EP30B	
92	1 Casting	TP30C EP30C	
93	1 Casting	TP40A EP40A	
94	1 Casting	TP40B EP40B	
95	1 Casting	TP40C EP40C	
96	12 Pins	P2	59
97	24 Rings	R2	56
98	24 Bolts 1"		5
99	24 Wash 2 1/8"		1 7/8
100			
101			
102			
103			
104			
105	ONE FIXED PEDESTAL	FP10D	1296
106	ONE FIXED PEDESTAL	FP20D	
107	ONE FIXED PEDESTAL	FP30D	
108	ONE FIXED PEDESTAL	FP40D	
109			
110	4 Castings	FP1A Det & billed on Sht. 2	812
111	1 Casting	TP10D FP10D Det &	412
112	1 Casting	TP20D FP20D billed	
113	1 Casting	TP30D FP30D Sht. 3	
114	1 Casting	TP40D FP40D	59
115	4 Pins	P2 Det & billed	6
116	8 Rings	R2 on Sht. 1	60
117			
118			

TRENTON  
ASSEMBLY

<sup>p</sup> AMBRIDGE  
ASSEMBLY

TRENTON  
ASSEMBLY

# DRAWING WITH BILL AMERICAN BRIDGE

UNITED STATES STEEL COMPANY  
DIVISION

LINE	Steel Type Part Order	No. of Parts Order	MATERIAL		ASSEMBLING MARK	REMARKS	ORDERED		CALCULATED WEIGHT FOR ONE BRIDGE PIECE
			SHAPE	LENGTH Feet Inches				ITEM	
1									
2									
3									
4			4 EXPANSION PEDESTALS		EPI		342	2' No Change	
5	58	8	R 12	4	32 pa			5	1.1
6	58	8	R 12	4	32 pb			5	1.1
7			4 Castings		EPIA	Det & billed			2.32
8			4 Base Plates		BP2	on Sh. 1			1.03
9									
10									
11			8 EXPANSION PEDESTALS		EP2		439	2' No Change	
12			16 R		pa				1
13			16 R		pb				1
14			8 Castings		EP2A	Det & billed			2.55
15			8 Base Plates		BP3	on Sh. 1			1.83
16									
17									
18			25 EXPANSION PEDESTALS		EP3		282	2' No Change	
19	58	8	R 12		pa				1
20	58	8	R 12		pb				1
21			25 Castings		EP3A	Det & billed			1.60
22			25 Base Plates		BP4	on Sh. 1			6.1
23									
24			2 EXPANSION PEDESTALS		EP4		402		
25			2 Castings		EP4A	Det & billed			4.08
26			2 Castings		TP12	Det & billed			2.82
27			2 Base Plates		BP6	Det & billed			4.35
28			2 Pins		P2	Det & billed			5.9
29			4 Rings		R2	on Sh. 1			6
30			4 bolts 1" x 7			Sn Hd & Hex Nut		Stops	5
31			4 Wash 2" x 2			(1/4" Hole)		5	1.4
32									
33			8 EXPANSION PEDESTALS		EP5		452		
34			16 R 12	4	32 pa			AS	1
35			8 Castings		EPIA				2.32
36			8 Castings		TP9	Det & billed			9.4
37			8 Base Plates		BP1	on Sh. 1			9.1
38			8 Pins		P1				2.4
39			16 Rings		R1				4
40									
41									
42									
43									
44									
45									
46									
47									
48									
49									
50			2 FIXED PEDESTALS		FPI		1165		
51			2 Castings		FFIA	Det & billed			2.13
52			2 Castings		TP11	on Sh. 1			2.82
53			2 Pins		P2	Det & billed			5.9
54			4 Rings		R2	on Sh. 1			6
55									5.0
56									
57									
58									
59									
60									
61									
62									
63									
64									
65									
66									
67									

PEDESTAL ASSEMBLIES

BANGOR - BREWER BRIDGE  
OVER PENOBSCOT RIVER  
STATE OF MAINE

AMERICAN BRIDGE

F	DRAWINGS MADE AT <u>TRENTON</u> PLANT
E	WORK FABRICATED AT <u>TRENT &amp; AMB</u> PLANT
D	IN CHARGE OF <u>E.D. MARKS</u>
C	DRAW. MADE BY <u>SELK</u> DATE <u>7-12-53</u>
B	DRAW. CHECKED BY <u>PRY</u> DATE <u>9-17-53</u>
X	12-31-53
REVISIONS	ORDER No. <u>Q4148</u> SHEET No. <u>4</u>

~~PAINT:~~  
~~SHOP CONTACT SURFACES~~



44 45

WELD

62-104



REV	DATE	BY	CHK	DESCRIPTION
1				
2				
3				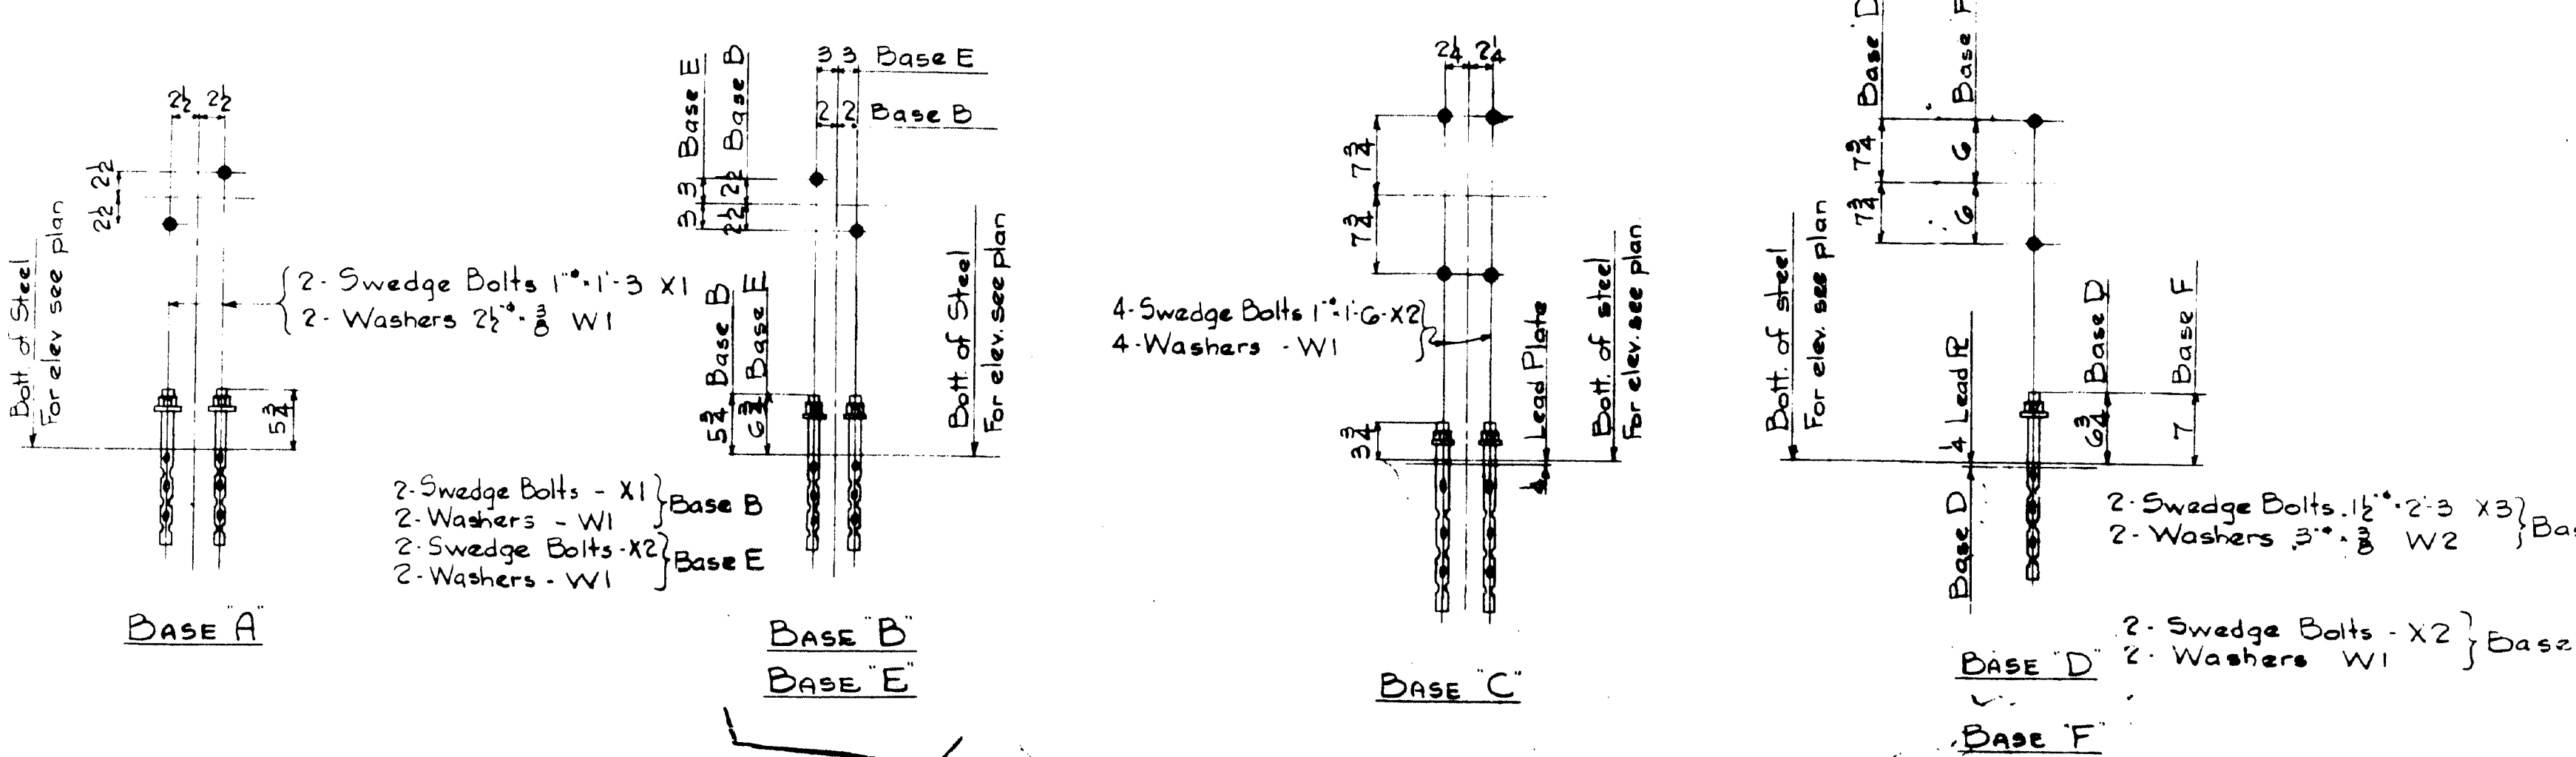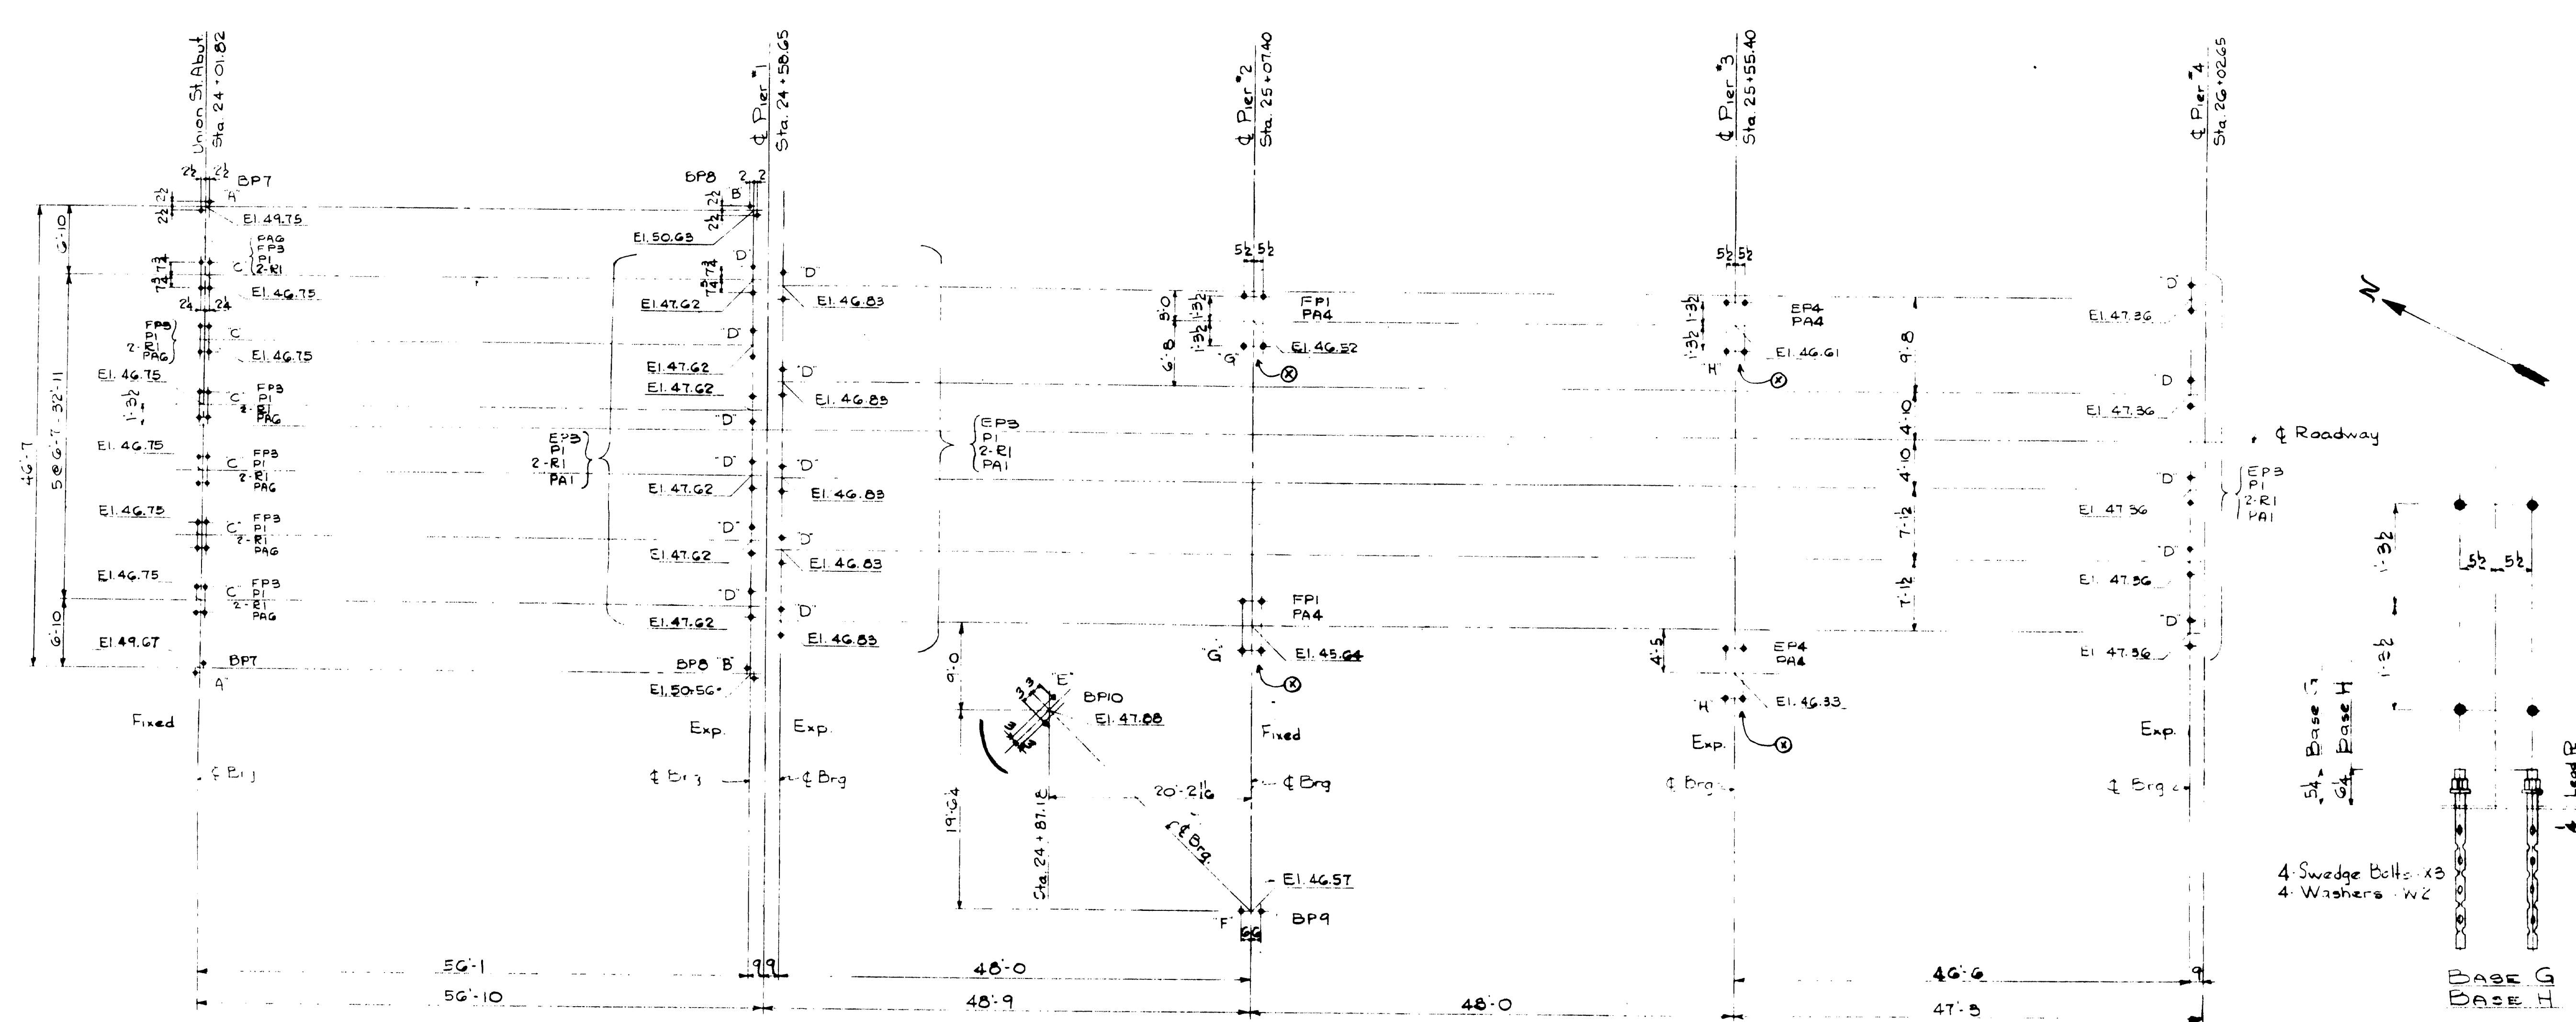
Anchor Bolts furnished by A.B. Div.  
Anchor Bolts set by A.B. Div.

NOTE - Pedestals to be erected with sides marked @ as shown.

THE DIMENSIONS ON THIS PLAN  
SHALL BE STRICTLY ADHERED TO IN  
ALL MASONRY CONSTRUCTION AND  
CONSTRUCTION OR THE SPECIAL WORK  
ANY ERRORS OR MISUNDERSTANDINGS AT ONCE.

# ANCHOR BOLT PLAN




BANGOR - BREWER BRIDGE  
OVER PENOBSCOT RIVER  
STATE OF MAINE

AMERICAN BRIDGE  
UNITED STATES STEEL CORPORATION

DRAWINGS MADE AT: TRENTON PLANT  
WORK FABRICATED AT: TRENTON PLANT  
IN CHARGE OF: E.D. MAEKE  
DRAWN BY: E.E.K. DATE: 6-12-53  
CHECKED BY: PRY DATE: 9-17-53  
ORDER No. Q4148 SHEET No. E1

F	
E	
D	
C	
B	
A	

REV.	DATE	BY	CHK.	DESCRIPTION
1				
2				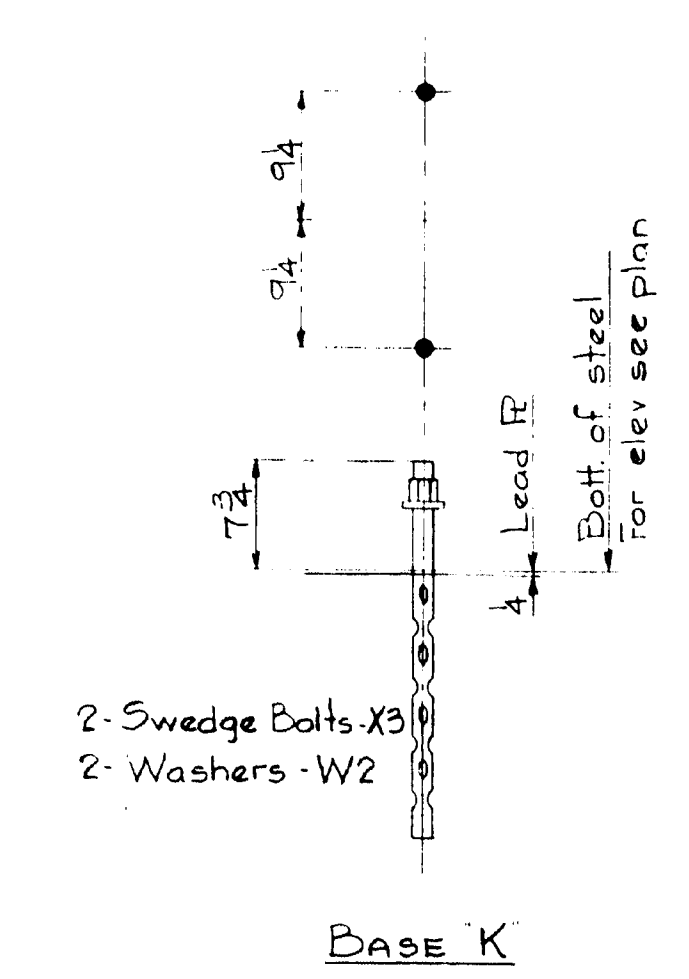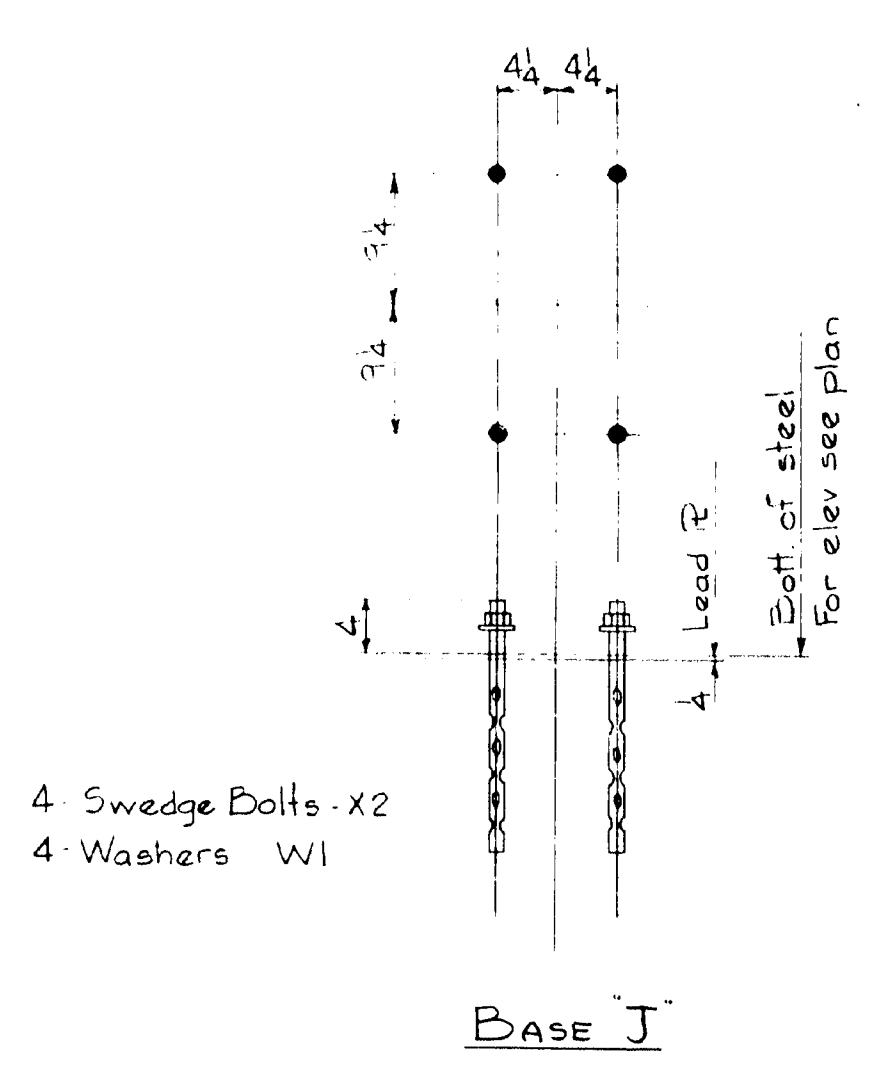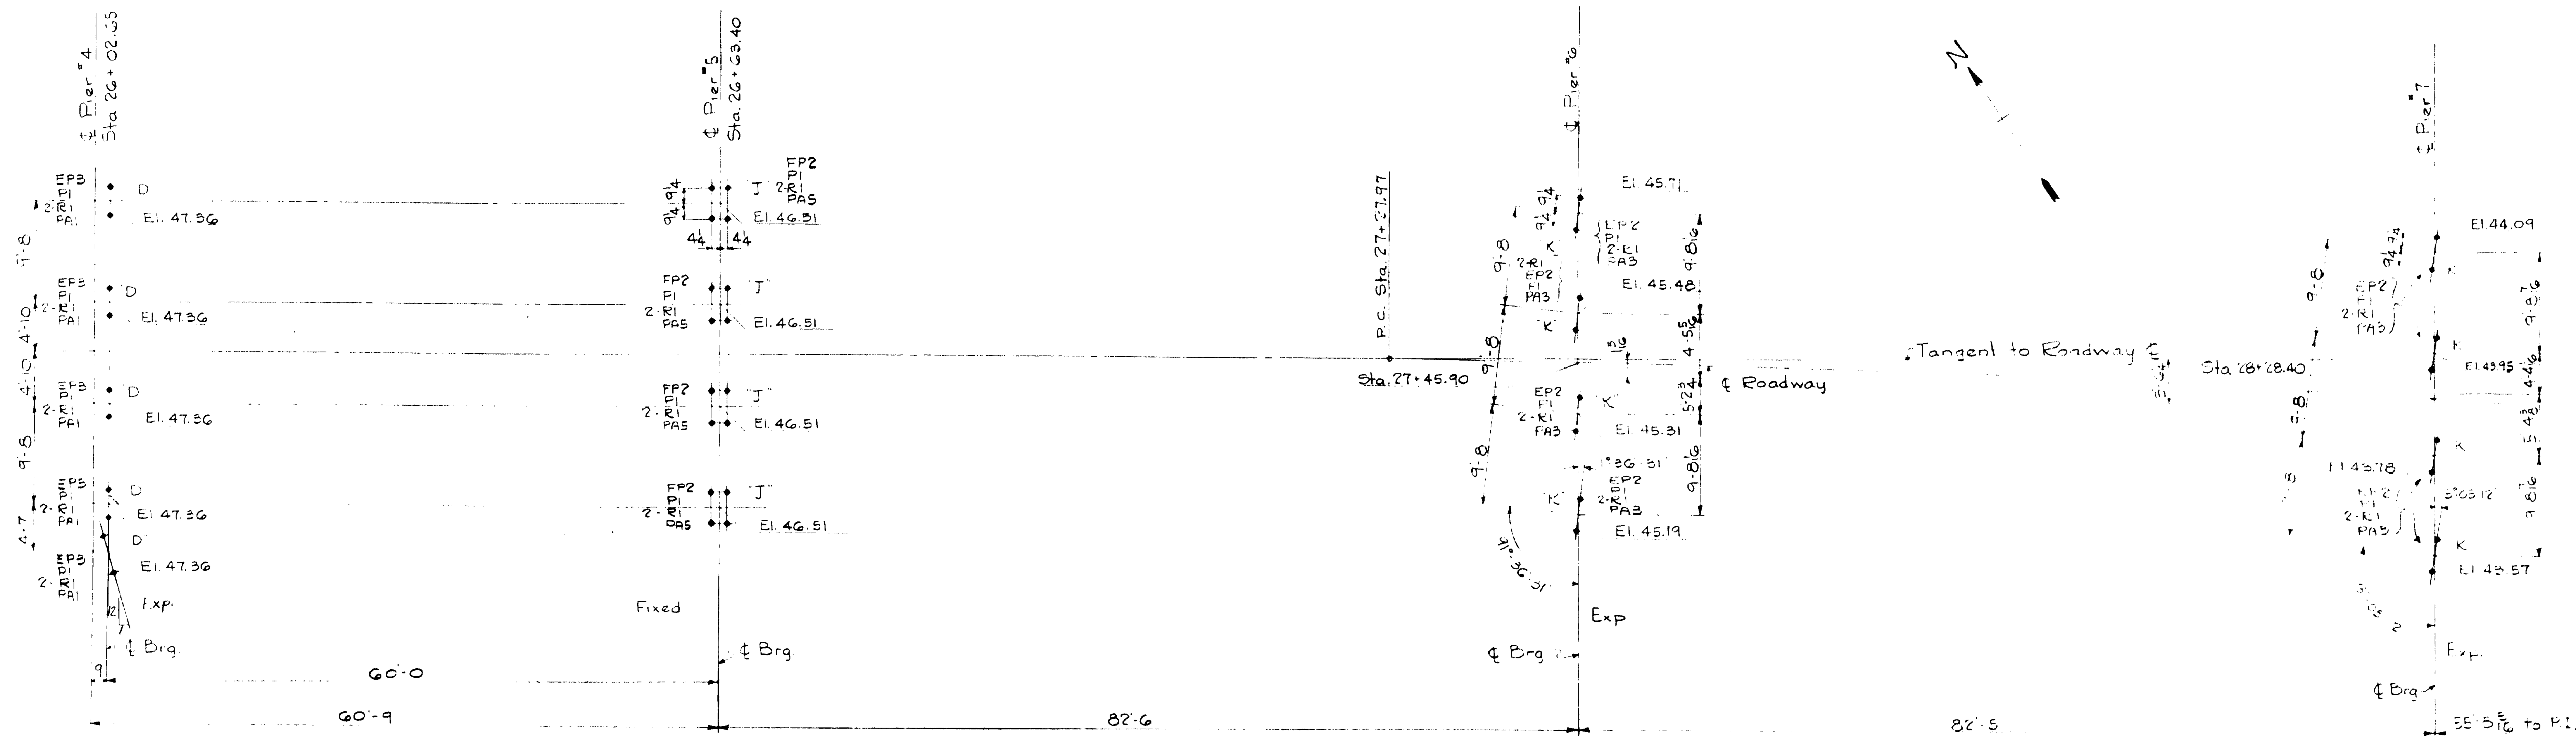
Anchor Bolts furnished by A.B. Div.  
Anchor Bolts set by A.B. Div.

For Base "D" see sheet E1.

ANCHOR BOLT PLAN  
DANFORTH-BREWER BRIDGE  
OVER PISCATAQUA RIVER  
STATE OF MAINE

THE DIMENSIONS GIVEN ON THIS PLAN  
SHALL BE STRICTLY ADHERED TO IN  
ALL MASONRY, STEEL, AND WOODWORK  
CONSTRUCTION OR THE WORK WILL NOT BE  
ACCEPTED. ANY ERRORS OR MISUNDERSTANDINGS  
AT ONCE.  
DATE 9-17-53

REV.	DATE	BY	CHK.	DESCRIPTION
1				
2				
3				
DATE 9-17-53

DRAWING MADE AT TRENTON PLANT  
WORK FABRICATED AT TRENTON & AMB PLANT  
IN CHARGE OF E.B. MARKS  
DRAW. MADE BY S.E.K. DATE 9-17-53  
DRAW. CHECKED BY PRY DATE 9-17-53  
ORDER No. Q4148 SHEET No. E2

**Anchor Bolt Plan**

**BANGOR BREWER BRIDGE**  
OVER PENOBSCOT RIVER  
STATE OF MAINE

Anchor Bolts furnished by A.B. Div.  
Anchor Bolts set by A.B. Div.

For Base "D" see sheet E1.  
For Base "J" see sheet E2.

NO.	DESCRIPTION	QUANTITY
1	2" Swedge Bolt - X3	10
2	2" Washers - W2	10

**BASE "L"**

2" Swedge Bolt - X3  
2" Washers - W2

For elev. see plan

BASE L

For Base "D" see sheet E1.  
For Base "J" see sheet E2.

DATE 9-17-5

D-63 1600 3-53 PENCILTEX  
**AMERICAN BRIDGE**  
 DIVISION  
 UNITED STATES  STEEL CORPORATION


F	
E	
D	
C	
B	
X	
REVISION:	

42. 100

62-107



ITEM	QTY	UNIT	DESCRIPTION
1			
2			
3			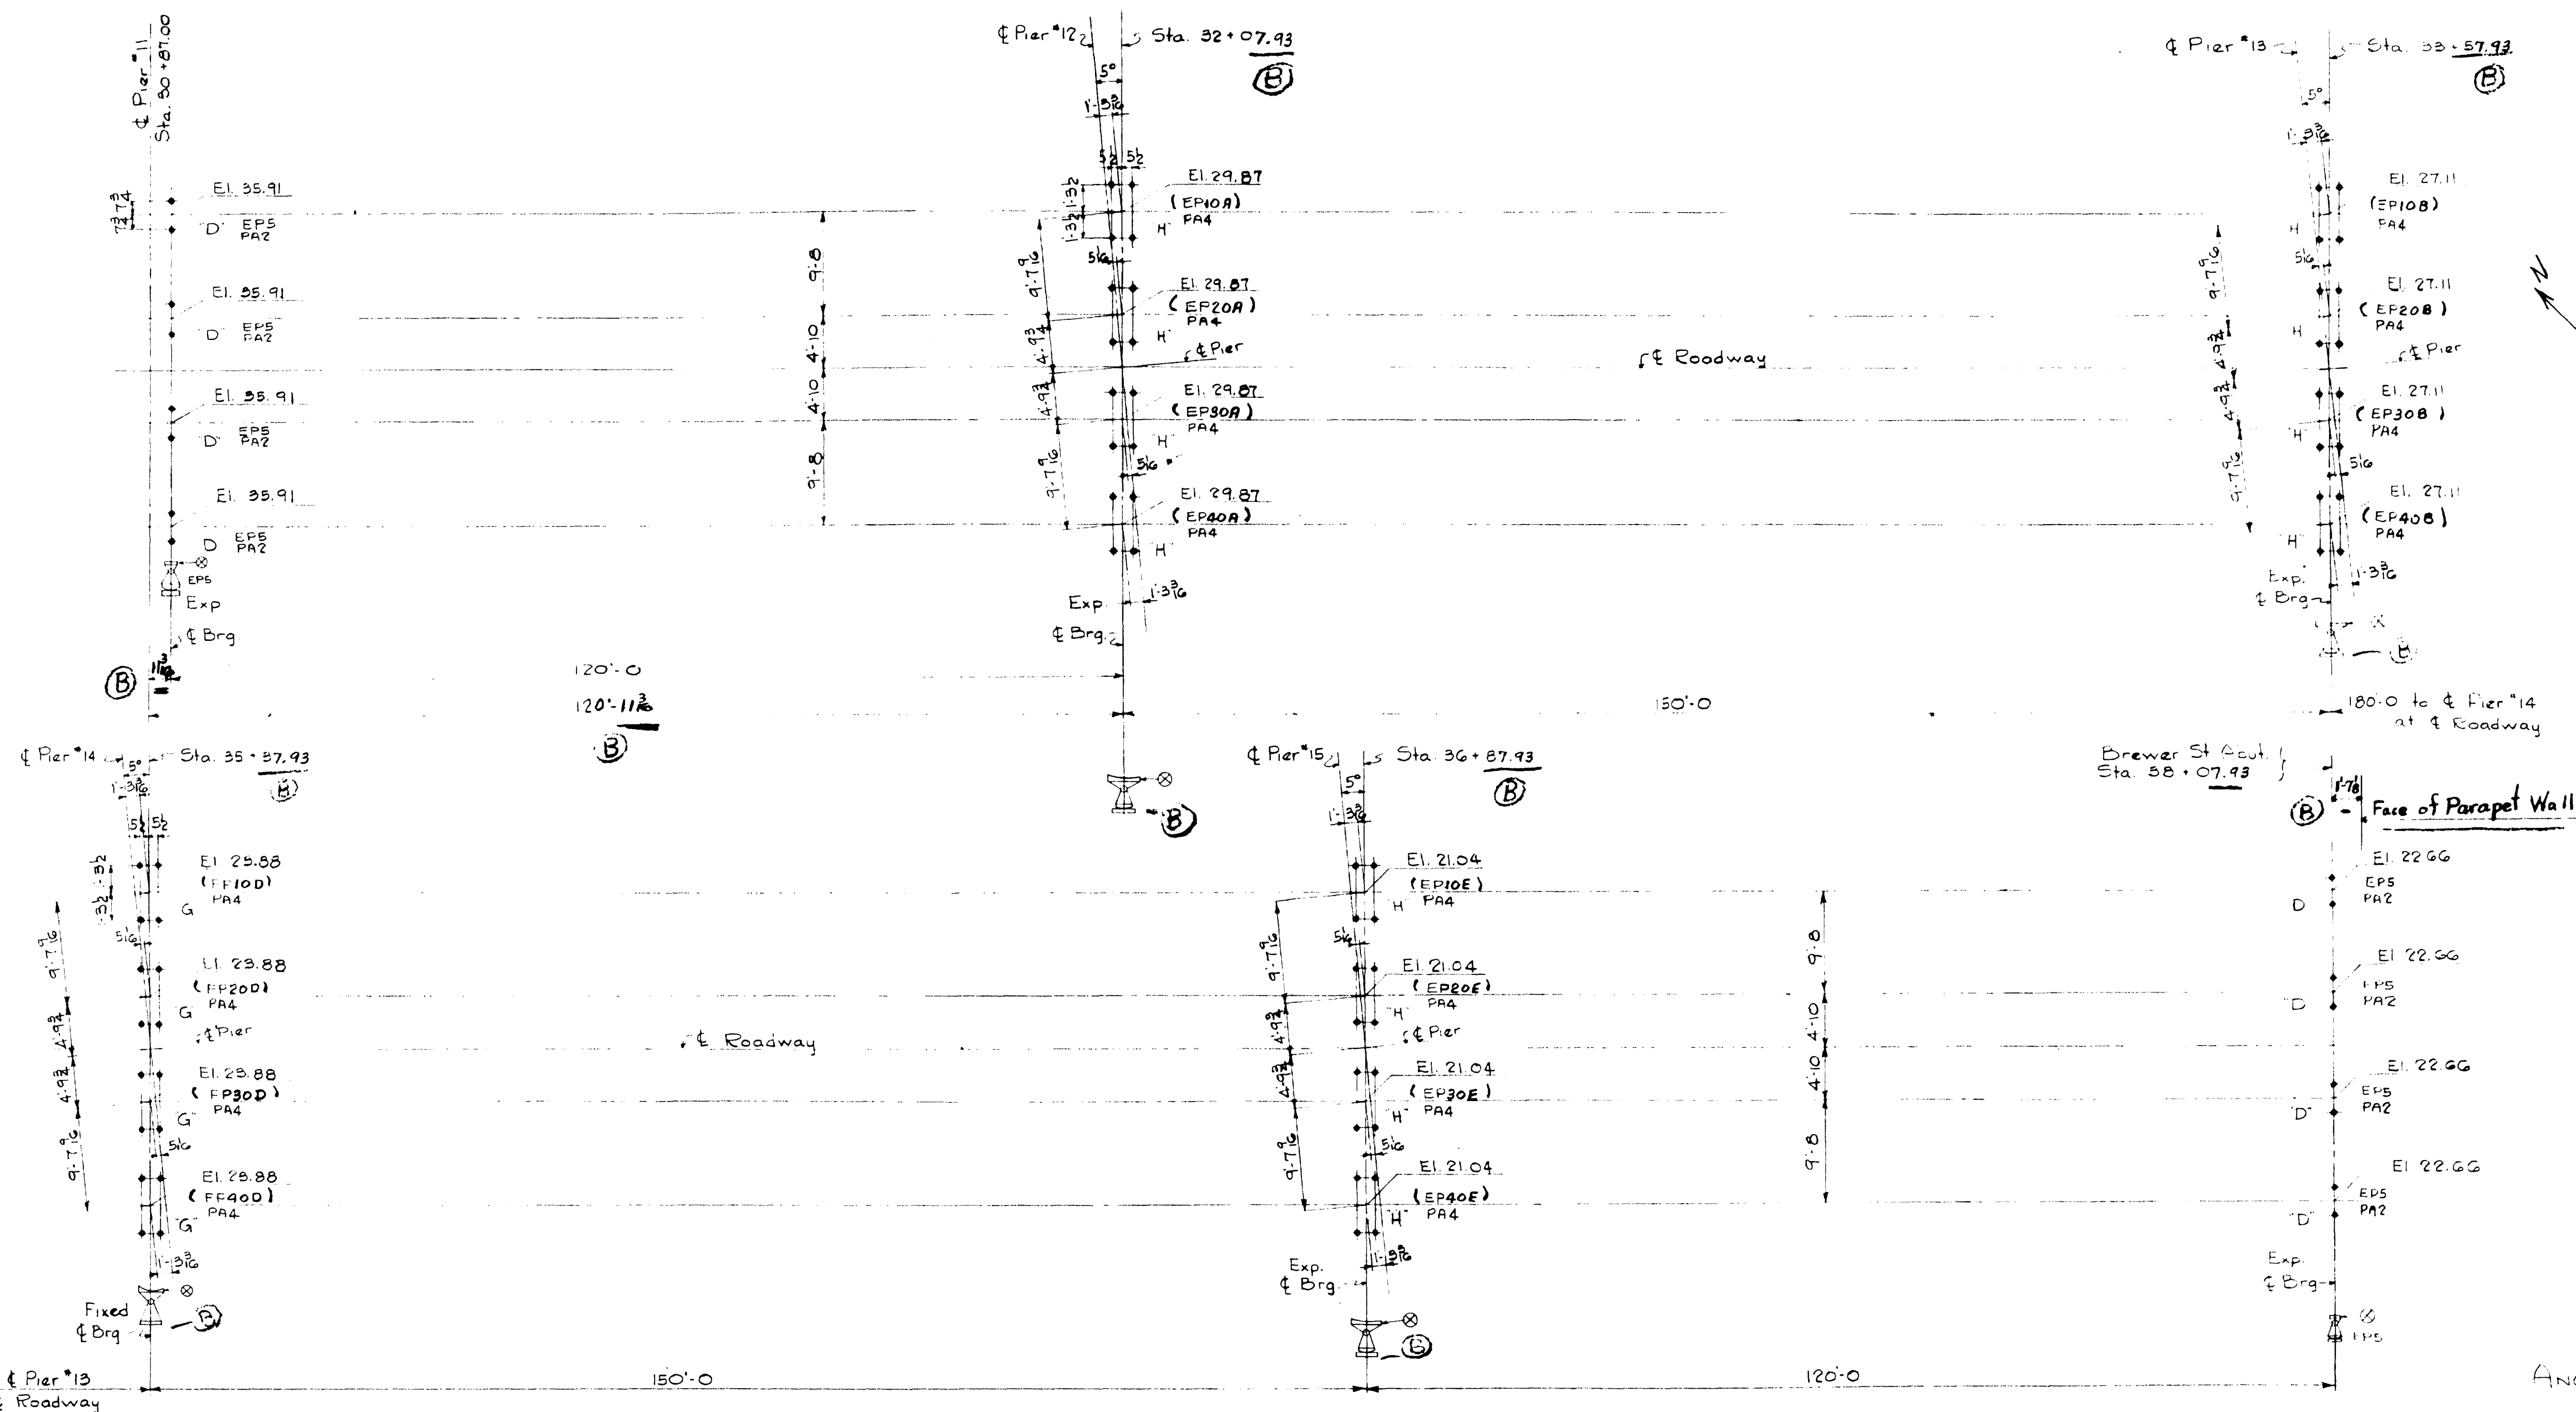
Pedestals to be erected with side  
marked  $\otimes$  in position shown.

Anchor Bolts furnished by A.B. Div.  
Anchor Bolts set by A.B. Div.

For detail of Bases see sht. E1.

THE DIMENSIONS GIVEN ON THIS PLAN  
MUST BE STRICTLY ADHERED TO IN  
ALL MASONRY CONCRETE AND BUILDING CONSTRUCTION  
ON THE STEEL WORK WILL NOT BE RESPONSIBLE  
FOR ERRORS OR MISUNDERSTANDINGS AT ONCE.

DATE 9-17-53


DRAWINGS MADE AT TRENTON PLANT  
WORK FABRICATED AT TRENTON AND PLANT  
IN CHARGE OF E.B. MARKS  
DRAWN BY SEK DATE 6-23-53  
CHECKED BY PRY DATE 9-17-53  
ORDER No. 04148  
SHEET No. E4

MA. 11

62-108



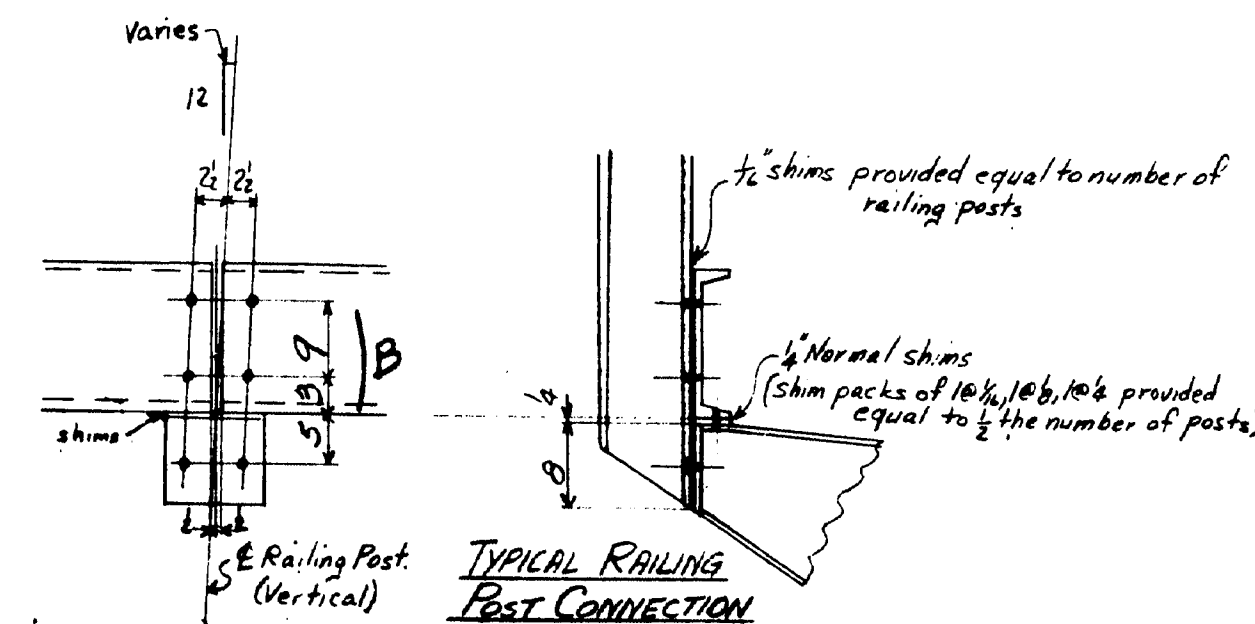

[illegible]

- 1) ELEVATIONS GIVEN ONLY & ITS ARE  
OF SPINDLES BEHIND HT & BGR  
OR INTERSECTING OF BSS BEING
- 2) ELEVATIONS GIVEN THAT IS HT ARE  
FIXED SIDING ELEVATIONS ON BANK  
OF FASCIA IN OF SPINDLE POSTS.
- 3) ELEVATIONS GIVEN THAT IS HT  
CHANGES IN THE FIXED SIDING  
IN BACK OF FASCIA IN OF SPINDLE  
POSTS TO BOTTOM OF FASCIA IN  
DOWN LOAD DEFLECTION.
- 4) DIMENSIONS GIVEN ARE INCIDENTAL  
EXCEPT THOSE GIVEN THAT ARE  
& SPLICE TO & BGR IN SLEPE & 10.

16-51-MB-AEEO  
**AMERICAN BRIDGE**  
DIVISION  
UNITED STATES  STEEL COMPANY

DRAWINGS MADE AT TRENTON PLANT  
WORK FABRICATED AT TRENTON PLANT  
IN CHARGE OF MAKES  
DRAW. MADE BY EAB DATE 6-19-53  
DRAW. CHECKED BY PRY DATE 9-18-53

ORDER No. 21149 SHEET No. 50

E2  
Formerly D2


62-110




Hand-drawn structural plan of a bridge deck. The plan shows a grid of girders (G1 to G14) and floor beams (FB1 to FB13). Key dimensions and labels include:

- Dimensions:** 56'-10" c.c. Piers, 48'-9" c.c. Piers, 48'-0" c.c. Piers, 47'-3" c.c. Piers.
- Labels:** FB1, FB2, FB3, FB4, FB5, FB6, FB7, FB8, FB9, FB10, FB11, FB12, FB13.
- Notes:** "Field connect to sidewalk E Use Dardelot Expansion Dams and Bracket M Bolts for..."
- Scale:** 1" = 32'
- North Arrow:** Indicated by an arrow pointing towards the top left.


Project

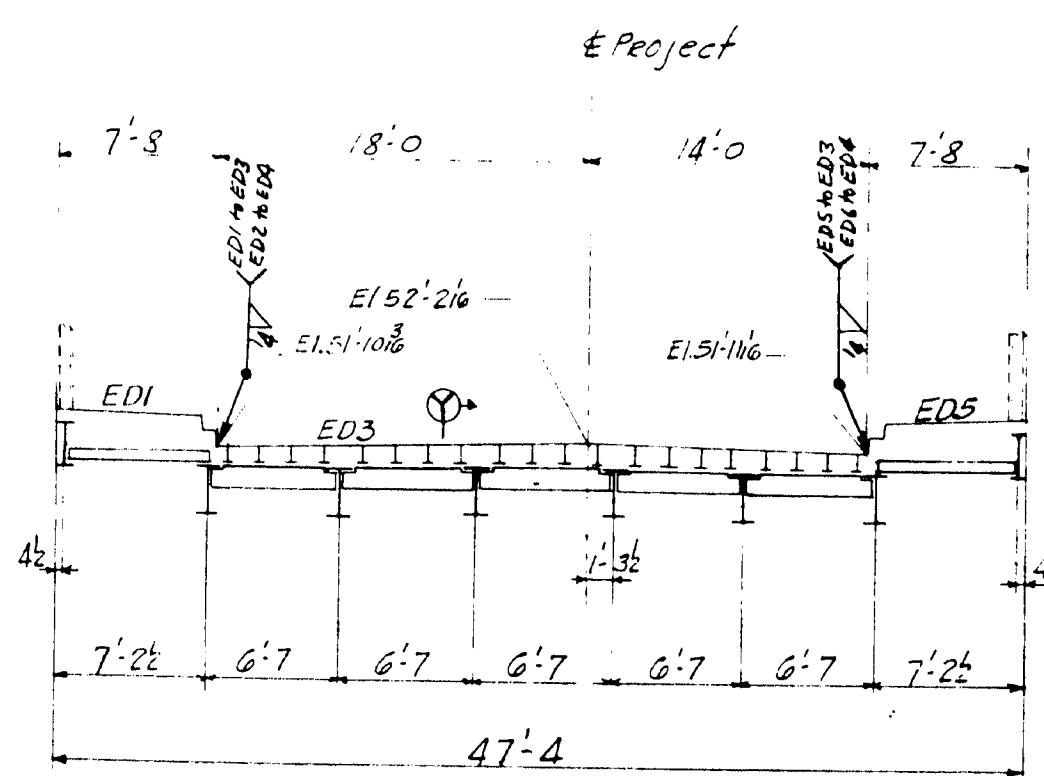


SECTION  

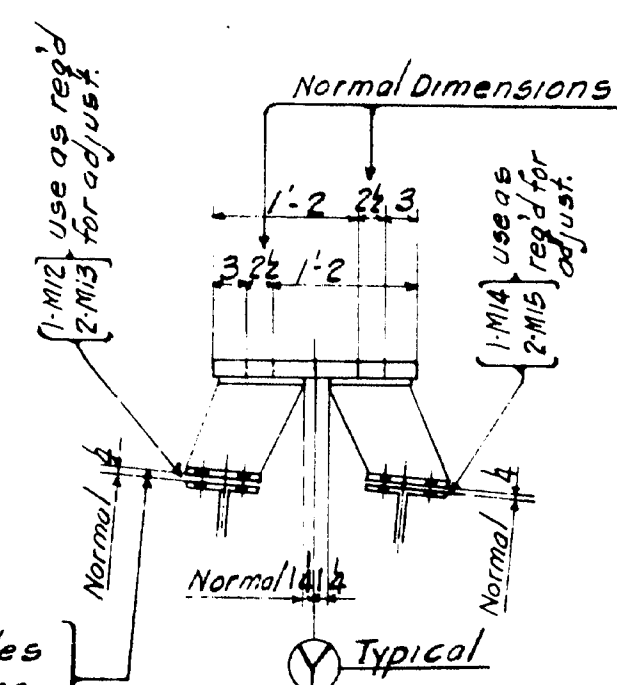

NOTE: Ream holes  
to 15" after Dams  
are properly aligned

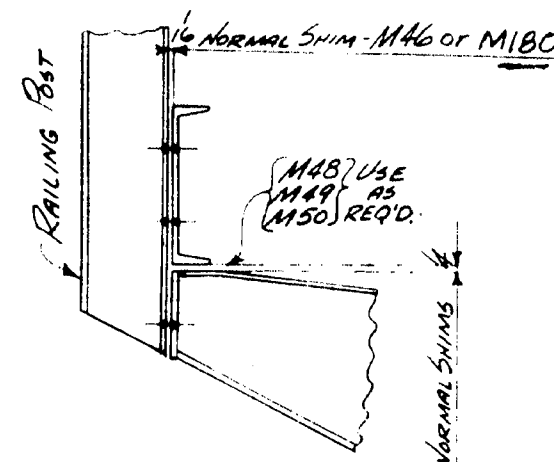

TYPICAL RAILING POST CONN. AT SIDEWALK BRK'TS

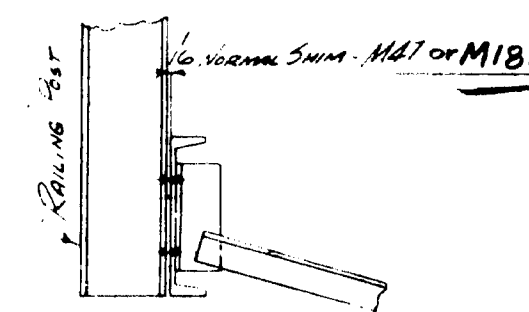

TYPICAL RAILING POST CONN. AT INTERMEDIATE STRUTS

Field connections riveted except Fucbia 13 to Sidewalk Cracks to be bolted.  
Use Dardelot Rivet Bolts in the connection of Expansion Dams to Diaphragms, and Beam B16 and Bracket M3 to Cross Beam H.  
Bolts for Railing Post Connections supplied by others.

2-Wash. 2"x 6" (1/4" hole)  
1-Wash. 2"x 6" (1/4" hole) } To be used for Expansion Dams where necessary under nut of Dardelot Rivet Bolts to build up required grip.

ERECTION PLAN  
Div. 1

BANGOR - BREWER BRIDGE  
OVER PENOBSCOT RIVER  
STATE OF MAINE

D-63 1600 3-63 PENCILTEX  
**AMERICAN BRIDGE**  
 DIVISION  
 UNITED STATES  STEEL CORPORATION

DRAWINGS MADE AT TRENTON PLANT  
WORK FABRICATED AT TRENTON PLANT  
IN CHARGE OF E.B. MARKS  
DRAW. MADE BY S.E.K. DATE 7-29-52  
DRAW. CHECKED BY BR DATE 1-6-54

ORDER No  
04149

**SHEET No**  
E101


F	
E	
D	
C	
B	4-12-5
X	2-8-54
REVISION	

STRINGERS - SPAN / DIV.

DRAWINGS MADE AT TRENTON PLANT  
WORK FABRICATED AT TRENTON PLANT  
IN CHARGE OF E.B. YARKE  
DRAW. MADE BY ELC DATE 8-11-53  
DRAW. CHECKED BY G.L.R. DATE 1-4-53  
ORDER NO. Q4149 SHEET NO. 101

地圖 101

Weld  
62-1

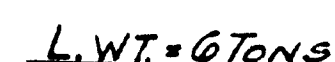

NOTES:  
SPECIFICATIONS: MAIN STATE HIGHWAY COMM. 1945 or it's SPECIAL PROVISIONS  
MATERIAL: OH STEEL ASTM A7-52T  
HOLES:  $\frac{1}{8}"$  <sup>φ</sup> Unless Noted  
WORKMANSHIP: Holes in material thicker than  $\frac{3}{8}"$  to be drilled.  
 Place Top Plates TP1, TP2 & TP3 on Beams with the  
 Face marked ⊗ as indicated.  
 Shop to Fabricate Beams with MILL CAMBER UP  
BE Indicates Bearing End of Stiffeners  
 In assembling TP1, TP2 & TP3 to Beams care  
 must be taken to have axis of bore normal to E of Beam.

PAINT: Yes, Except Top as not  
SHOP CONTACT SURFACES: No







# AMERICAN BRIDGE

LINE	ITEM	QUANTITY	UNIT	REMARKS	ORDERED	CALCULATED
1						
2						
3						
4	1	36CB182	48'4 1/2 B4	98' Q4148	1009	88.09
5	1	R	7 3/4 2 9/16	50103	450	25
6	1	R	7 3/4 2 9/16	50103	450	25
7	1	R	7 3/4 2 9/16	50103	450	25
8	1	R	7 3/4 2 9/16	50103	450	25
9	1	R	7 3/4 2 9/16	50103	450	25
10	1	R	7 3/4 2 9/16	50103	450	25
11	1	Top Plate	TP4	48'5"		
12	1	36CB230	48'4 1/2 B5	98' Q4148	1015	111.32
13	1	36CB230	48'4 1/2 B6	98' Q4148	1015	111.32
14	1	R	6 5/8 2 9/16	50103	350	57
15	1	R	6 5/8 2 9/16	50103	350	57
16	1	R	6 5/8 2 9/16	50103	350	57
17	1	R	6 5/8 2 9/16	50103	350	57
18	1	Top Plate	TP5	48'5"		
19	1	36CB170	48'4 1/2 B7	98' Q4148	1012	82.28
20	1	R	6 5/8 2 9/16	50103	350	57
21	1	R	6 5/8 2 9/16	50103	350	57
22	1	Top Plate	TP6	48'5"		
23	1	36CB194	48'4 1/2 B8	98' Q4148	1008	93.90
24	1	R	6 5/8 2 9/16	50103	350	57
25	1	R	6 5/8 2 9/16	50103	350	57
26	1	R	6 5/8 2 9/16	50103	350	57
27	1	R	6 5/8 2 9/16	50103	350	57
28	1	R	6 5/8 2 9/16	50103	350	57
29	1	R	6 5/8 2 9/16	50103	350	57
30	1	R	6 5/8 2 9/16	50103	350	57
31	1	Top Plate	TP3	48'5"		
32	1	Top Plate	TP3	48'5"		
33						
34						
STRINGERS - SPAN 2 - DIV. 1

STATE OF MAINE  
STATE HIGHWAY COMMISSION  
BANGOR-BREWER BRIDGE  
OVER PENOBSCOTT RIVER  
BANGOR, MAINE

AMERICAN BRIDGE  
UNITED STATES STEEL COMPANY

DRAWINGS MADE AT TRENTON PLANT  
WORK FABRICATED AT TRENTON PLANT  
IN CHARGE OF E.B. MARKS  
DRAW. MADE BY J.P.C. DATE 8-14-53  
DRAW. CHECKED BY J.P.C. DATE 1-4-54


REVISIONS  
2-5-54  
2-1-54

ORDER NO. Q4149  
SHEET NO. 103


PAINT: Yes, Except Top and Sides  
SHOP CONTACT SURFACES: No

102


62-114 Weld

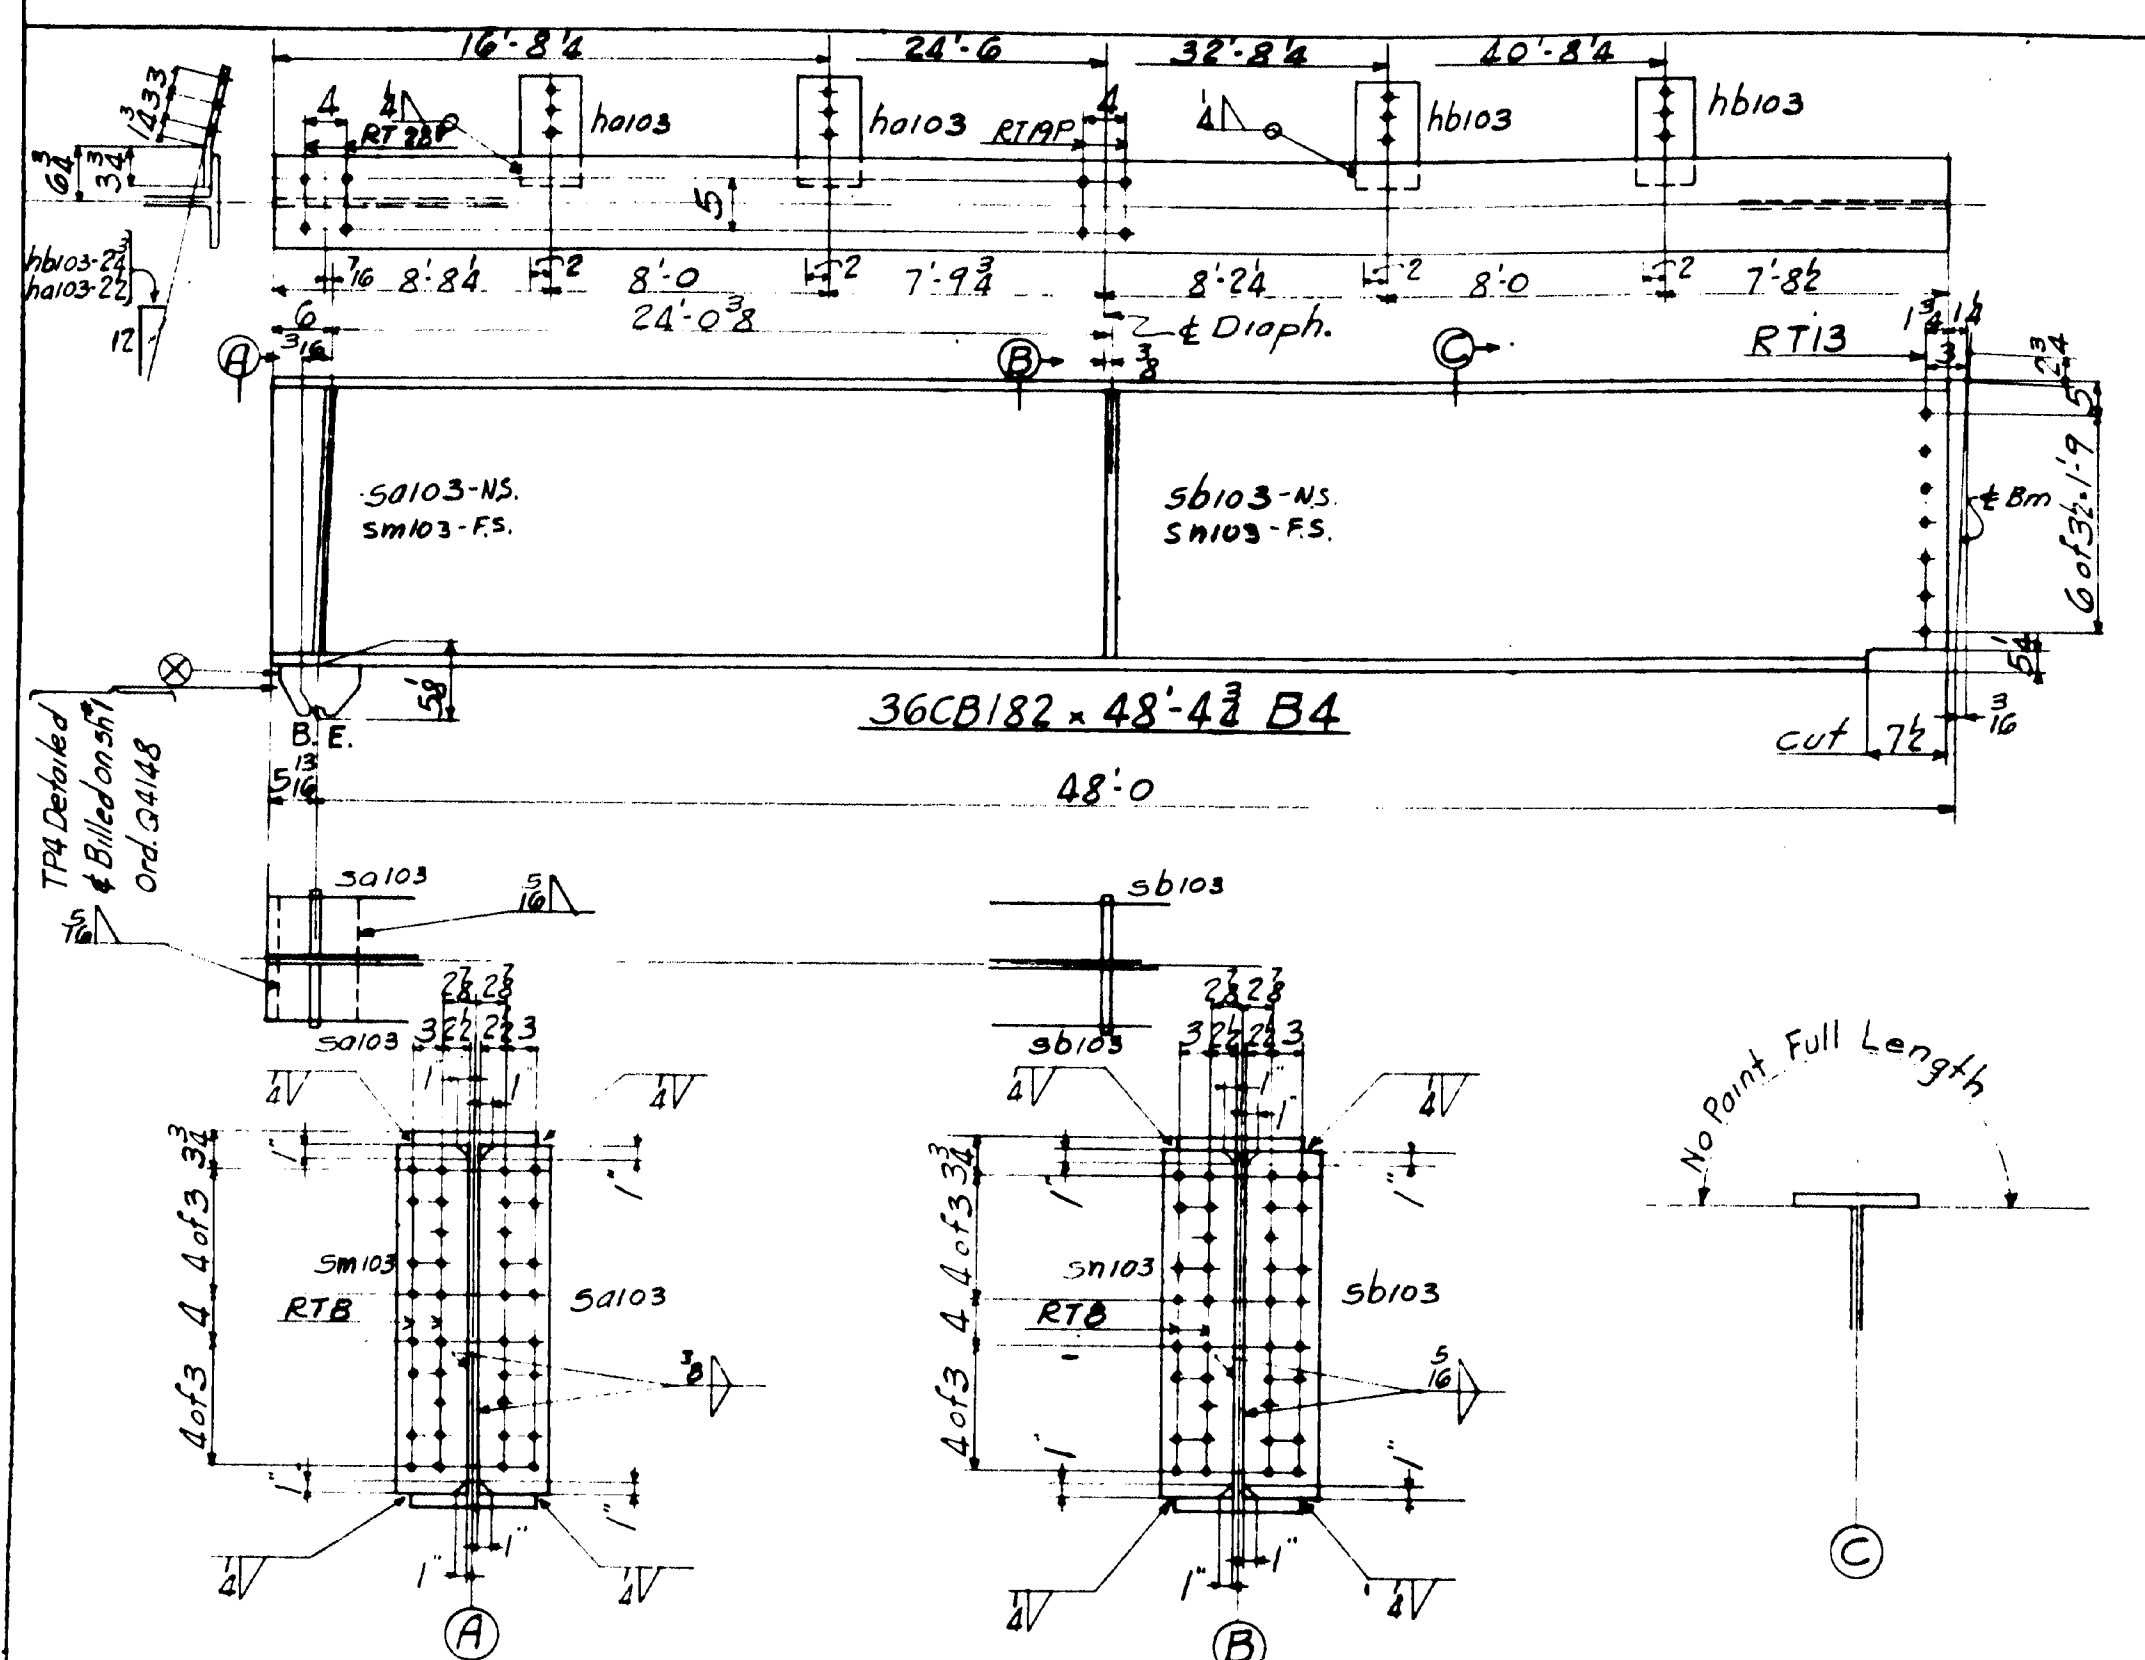


L.W.T. = 5 TONS

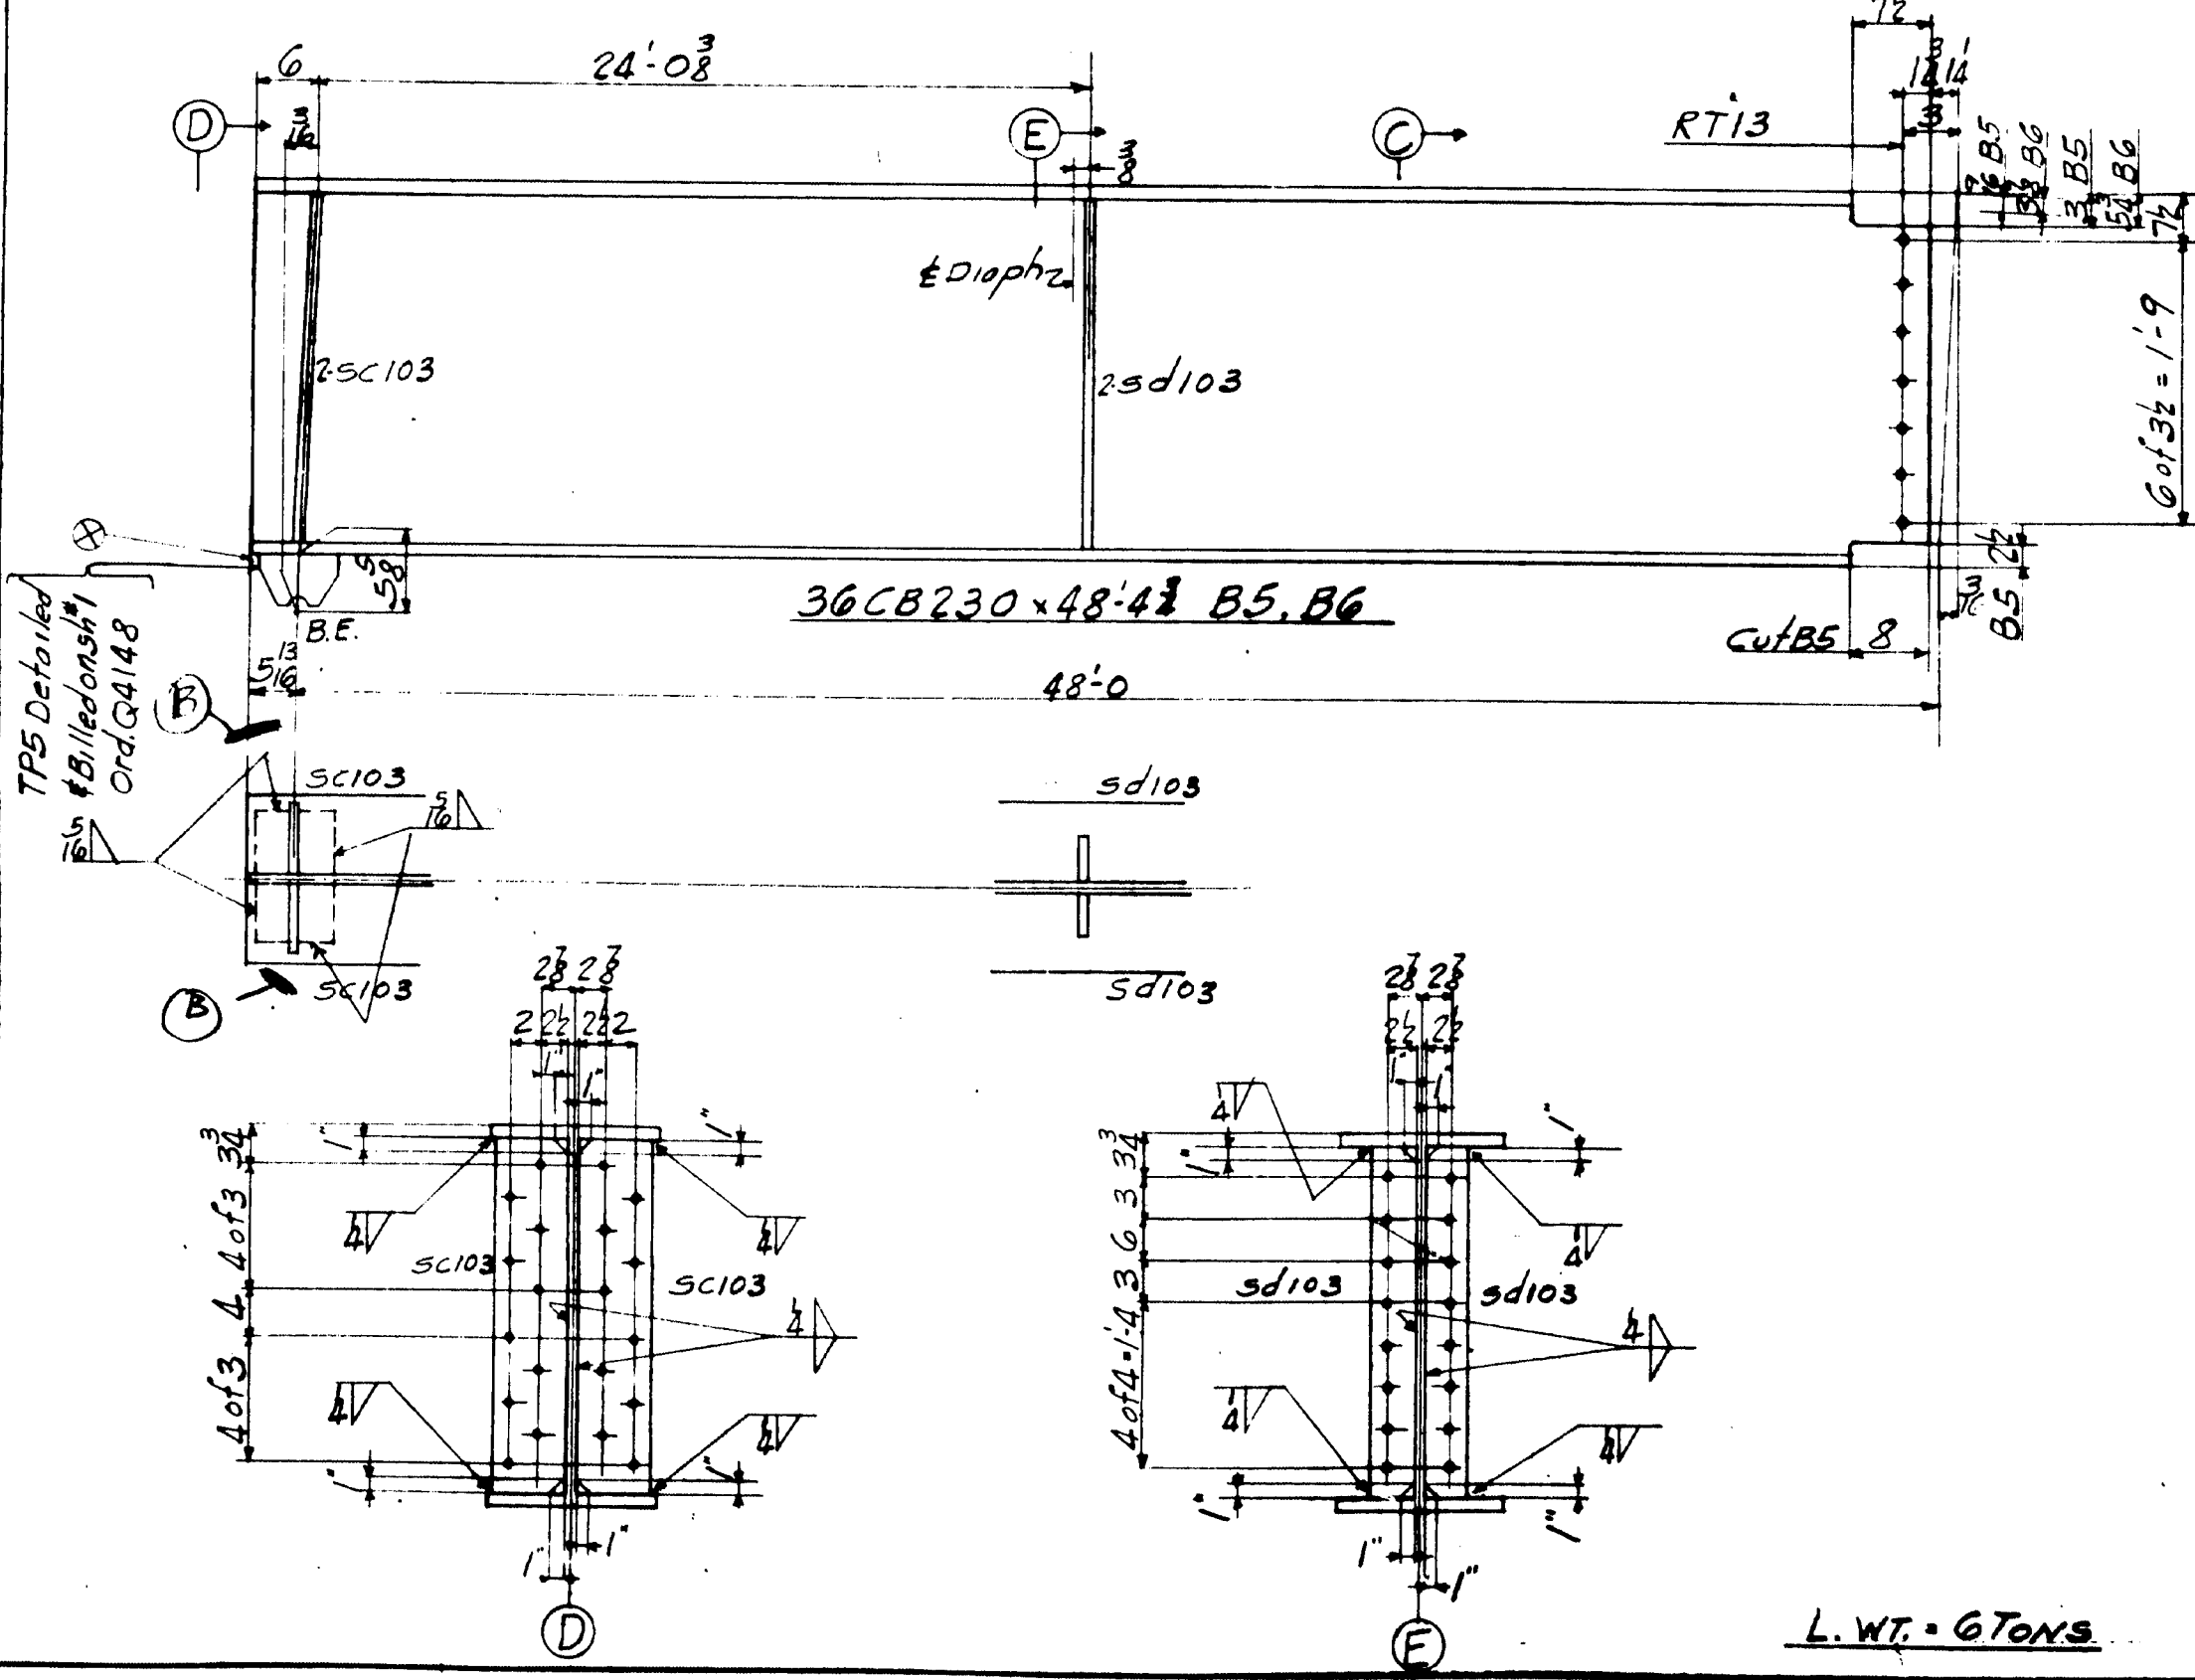

L.W.T. = 6 TONS

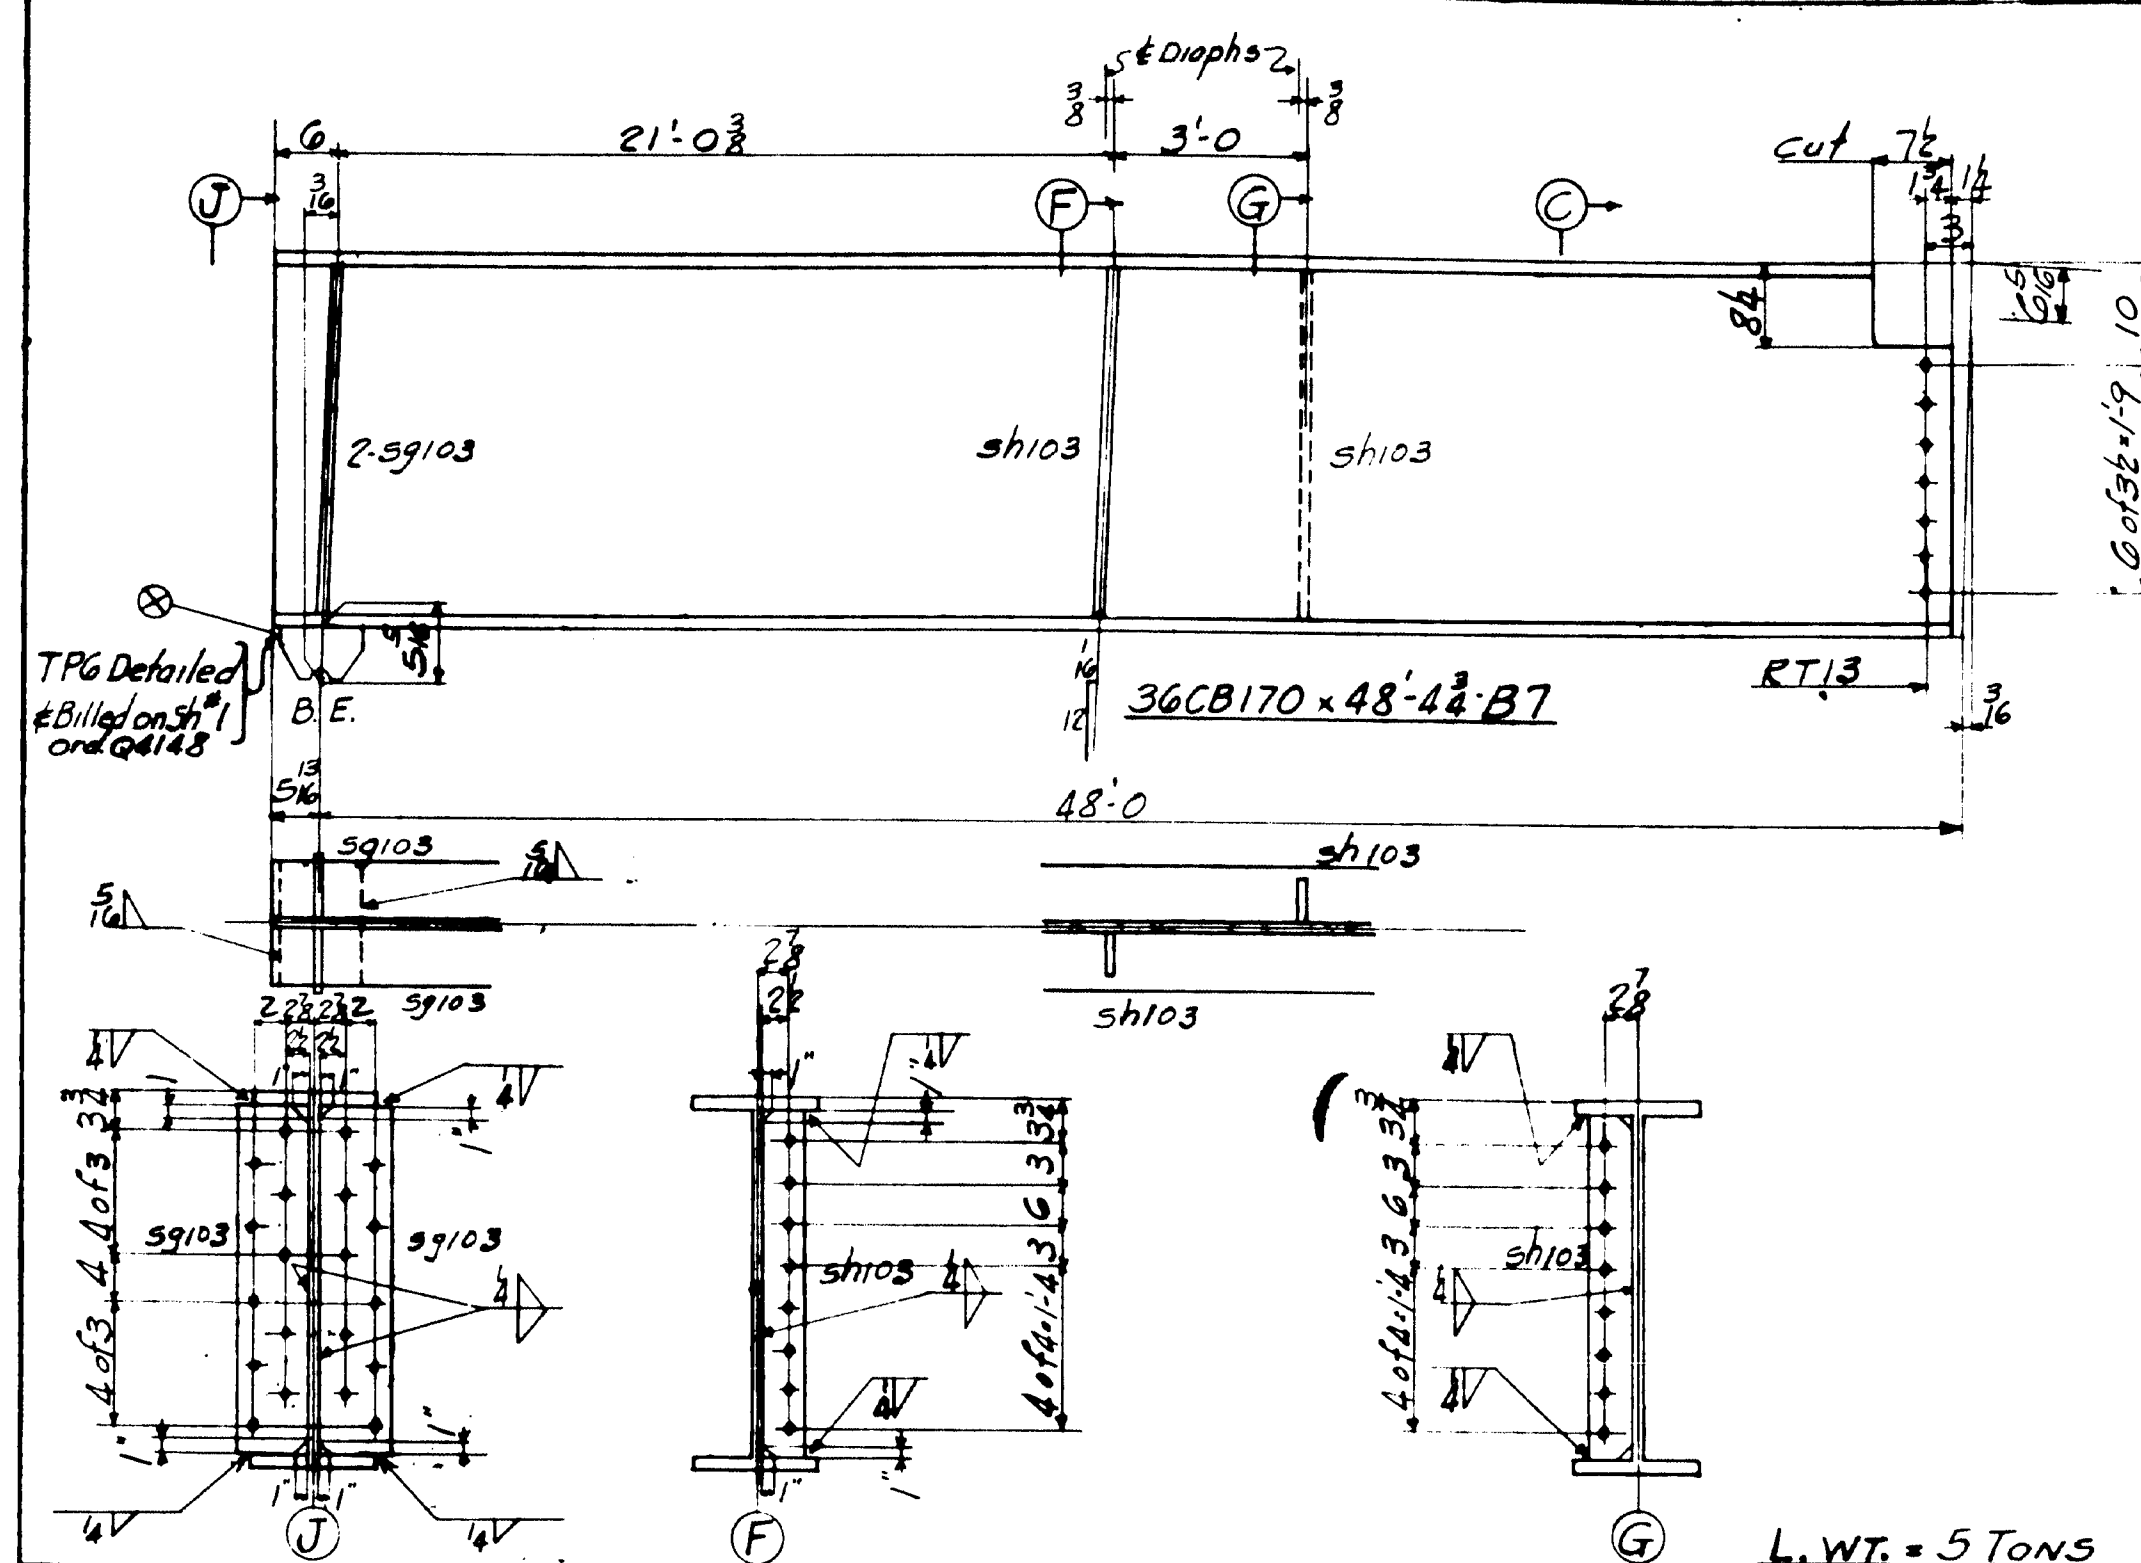

L.W.T. = 5 TONS

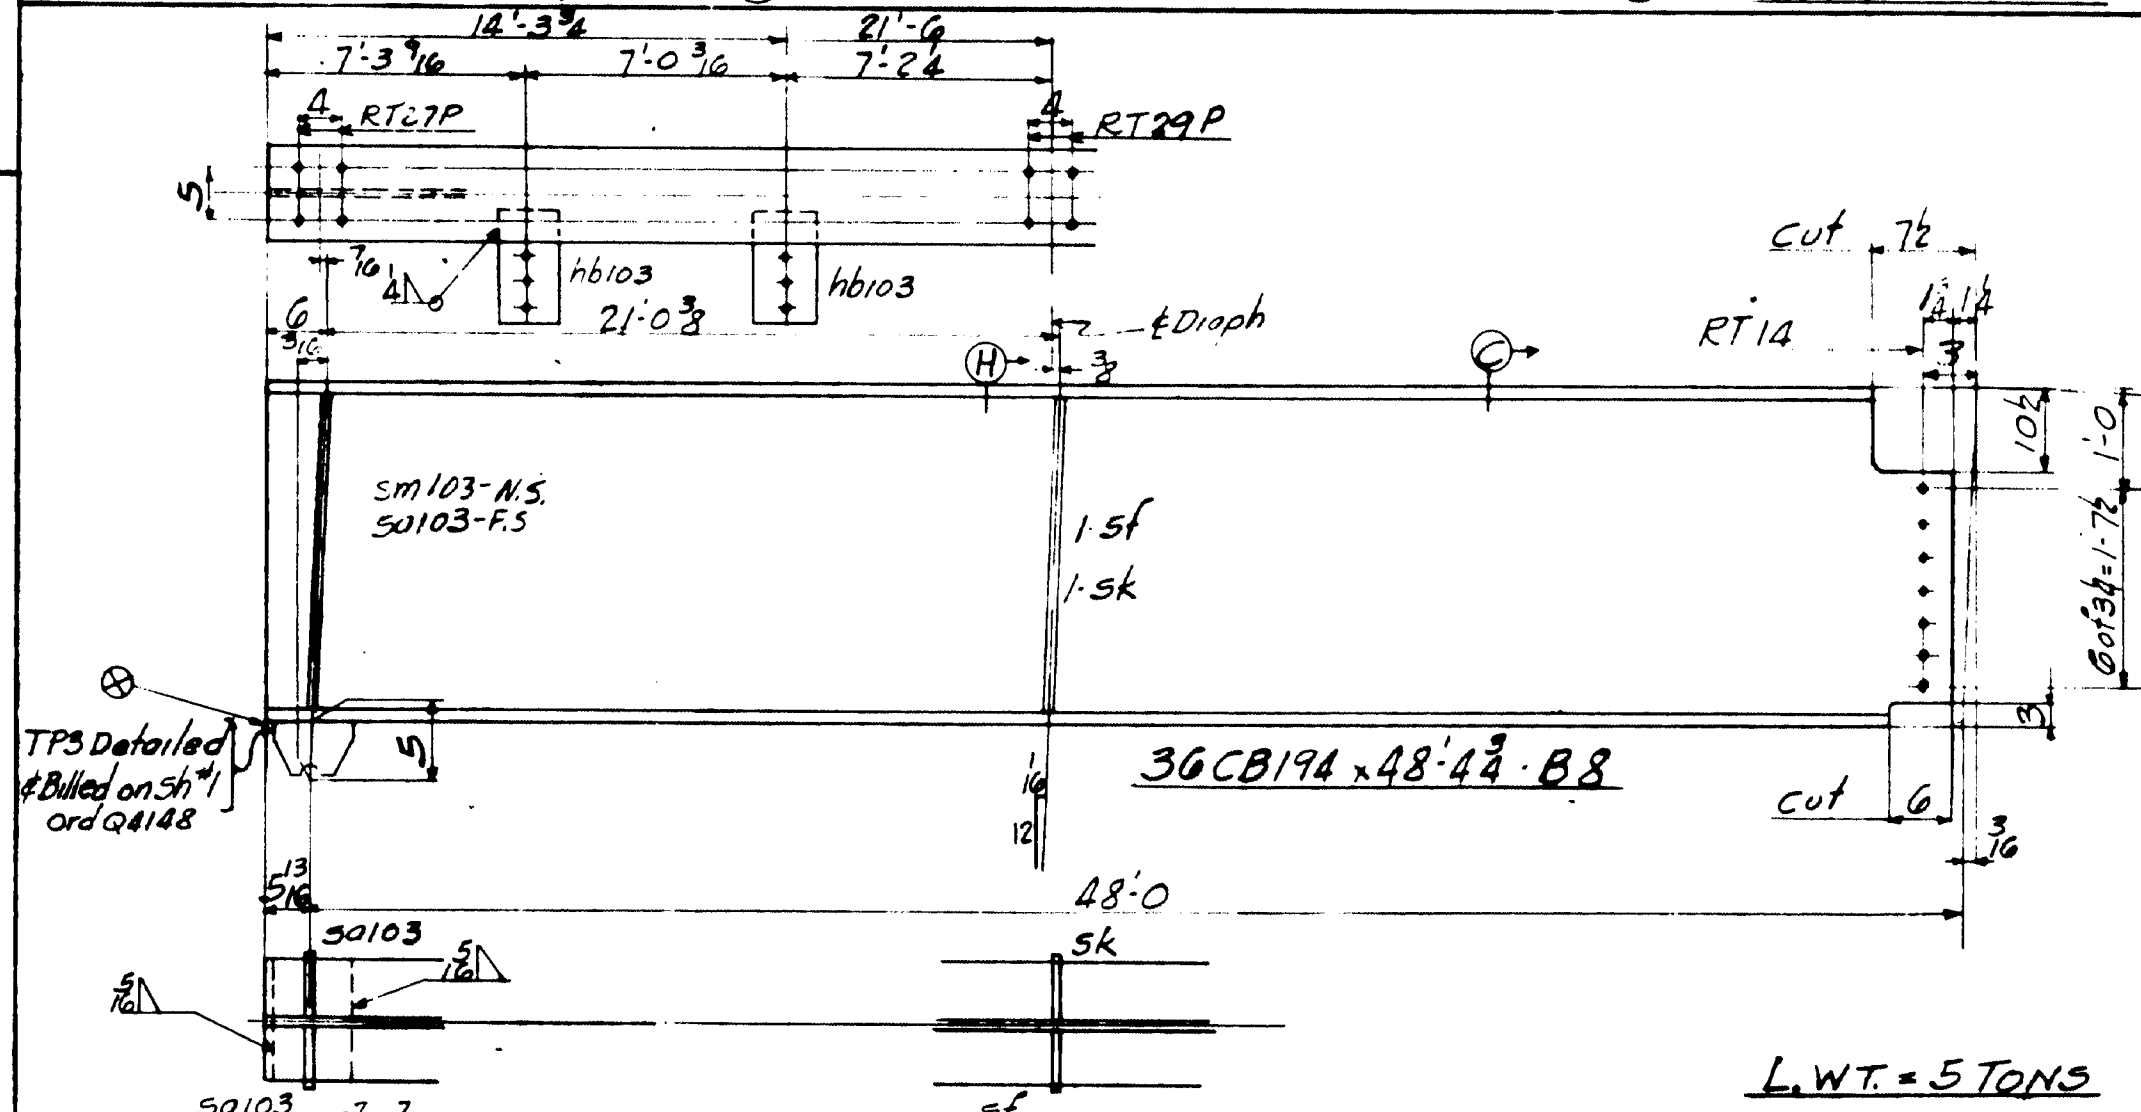

L.W.T. = 5 TONS

## NOTES:

SPECIFICATIONS: MAIN STATE HIGHWAY COMM. 1945 and SPECIAL PROVISIONS.  
MATERIAL: Q.H. STEEL ASTM A7-52T

HOLES: 1/8"

WORKMANSHIP: Holes in material thicker than 1/8" to be drilled.  
Holes marked RT to be subpunched 1/4" and reamed to size, to a metal template.  
Place Top Plates TP3, 4, 5 #16 on beams with the face marked B as indicated.  
Shop to Fabricate Beams with Mill Camber UP.

B.E. Indicates Bearing End of Stiffeners.  
In Assembling TP3, TP4, TP5 #TP6 to Beams, care must be taken to have axis of bore normal to E of Beam.

# DRAWING WITH BILL AMERICAN BRIDGE

UNITED STATES STEEL COMPANY

LINE	ITEM	MATERIAL	LENGTH	ASSEMBLY	REMARKS	ORDERED	CALCULATED
		SHAPE	Feet	MARK		ITEM	WEIGHT FOR ONE SHIP DEL.
1					52'9"		
2							
3							
4		ONE TRANSVERSE BEAM	F2		1655'		
5							
6	1	36 CB 300	41	1		41'3	1001
7	2	R 14	20	6	UM	45'0	M618
8	4	R 6	9	2	Final UM	39'9	M618
9	4	R 6	34	2	Final UM	39'9	M618
10	1	R 10	2	3	ha		S
11	1	R 14	2	3	ha		S
12	1	L 5	4	2	4d1 cut 6-4		S
13	1	L 4	4	2	1 3 ha	50'0	M618
14	1	R 8	2	5	94 ha		S
15	1	R 8	2	6	38 ha		S
16	1	R 8	2	5	114 ha		S
17	1	R 8	2	5	64 ha		S
18	1	R 8	2	5	125 ha	42'x40'0	1029
19	1	R 8	2	5	125 ha	45'0	M618
20	1	R 40	1	5	125 ha	42'x44'0	1429
21	1	L 4	4	2	2 34 ab	50'0	M618
22	1	L 4	4	2	2 34 ac		29
23	1	L 4	4	2	2 34 ad		29
24	1	L 4	4	2	2 34 ae		29
25	1	L 4	4	2	2 34 af		29
26	1	L 4	4	2	2 34 ag		29
27	1	L 4	4	2	2 34 ah		29
28	1	L 4	4	2	2 34 ai		29
29	1	L 4	4	2	2 34 aj		29
30	1	L 4	4	2	2 34 ak		29
31	1	L 4	4	2	2 34 al		29
32	1	L 4	4	2	2 34 am		29
33	1	L 4	4	2	2 34 an		29
34	1	L 4	4	2	2 34 ao		29
35	1	L 4	4	2	2 34 ap		29
36	1	L 4	4	2	2 34 aq		29
37	1	L 4	4	2	2 34 ar		29
38	1	L 4	4	2	2 34 as		29
39	1	L 4	4	2	2 34 at		29
40	1	L 4	4	2	2 34 au		29
41	1	L 4	4	2	2 34 av		29
42	1	L 4	4	2	2 34 aw		29
43	1	L 4	4	2	2 34 ax		29
44	1	L 4	4	2	2 34 ay		29
45	1	L 4	4	2	2 34 az		29
46	1	L 4	4	2	2 34 ba		29
47	1	L 4	4	2	2 34 bb		29
48	1	L 4	4	2	2 34 bc		29
49	1	L 4	4	2	2 34 bd		29
50	1	L 4	4	2	2 34 be		29
51	1	L 4	4	2	2 34 bf		29
52	1	L 4	4	2	2 34 bg		29
53	1	L 4	4	2	2 34 bh		29
54	1	L 4	4	2	2 34 bi		29
55	1	L 4	4	2	2 34 bj		29
56	1	L 4	4	2	2 34 bk		29
57	1	L 4	4	2	2 34 bl		29
58	1	L 4	4	2	2 34 bm		29
59	1	L 4	4	2	2 34 bn		29
60	1	L 4	4	2	2 34 bo		29
61	1	L 4	4	2	2 34 bp		29
62	1	L 4	4	2	2 34 bq		29
63	1	L 4	4	2	2 34 br		29
64	1	L 4	4	2	2 34 bs		29
65	1	L 4	4	2	2 34 bt		29
66	1	L 4	4	2	2 34 bu		29
67	1	L 4	4	2	2 34 bv		29

TRANSVERSE BEAM - DIV. 1

LIFTING WT. 9 TONS

## NOTES:

SPECIFICATIONS: MAINE STATE HIGHWAY COMM. 1945 AND SPECIAL PROVISIONS  
MATERIAL: O.H. STEEL A.S.T.M. A7-52T  
RIVETS: 7/8" HOLES 1/2" P.U.N.  
WORKMANSHIP: HOLES MARKED RT TO BE SUBPUNCHED OR SUBDRILLED & REAMED TO SIZE TO A METAL TEMPLATE.  
HOLES MARKED RA TO BE SUBPUNCHED OR SUBDRILLED & REAMED TO SIZE WITH CONNECTING PARTS ASSEMBLED.  
HOLES IN MATERIAL OVER 3/8" THICK TO BE DRILLED BE. INDICATES BEARING END OF STIFFENERS.  
SHOP TO FABRICATE BEAM WITH MILL CABLES.  
ALL HOLES FOR SHOP RIVETS TO BE SUBPUNCHED OR SUBDRILLED AND REAMED TO SIZE WITH CONNECTING PARTS ASSEMBLED.  
PAINT: YES (EXCEPT AS NOTED)  
SHOP CONTACT SURFACES: NO

STATE OF MAINE  
STATE HIGHWAY COMMISSION  
BANGOR-BREWER BRIDGE  
Over PENOBSCOT RIVER  
BANGOR, MAINE  
DRAWINGS MADE AT TRENTON PLANT  
WORK FABRICATED AT TRENTON PLANT  
IN CHARGE OF E.B. MARKS  
DRAWN BY RIG DATE 8/24/53  
DRAWN CHECKED BY bcl DATE 1-13-54  
ORDER NO. Q4149 SHEET NO. 104





WELDING  
62-115






LINE	ITEM	MATERIAL		LENGTH	ASSEMBLY MARK	REMARKS	ORDERED	CALCULATED
		SHAPE	SIZE					
1								
2								
AMERICAN BRIDGE


LINE	ITEM	MATERIAL	LENGTH	ASSEMBLY MARK	REMARKS	ORDERED	CALCULATED
1							
2							
3							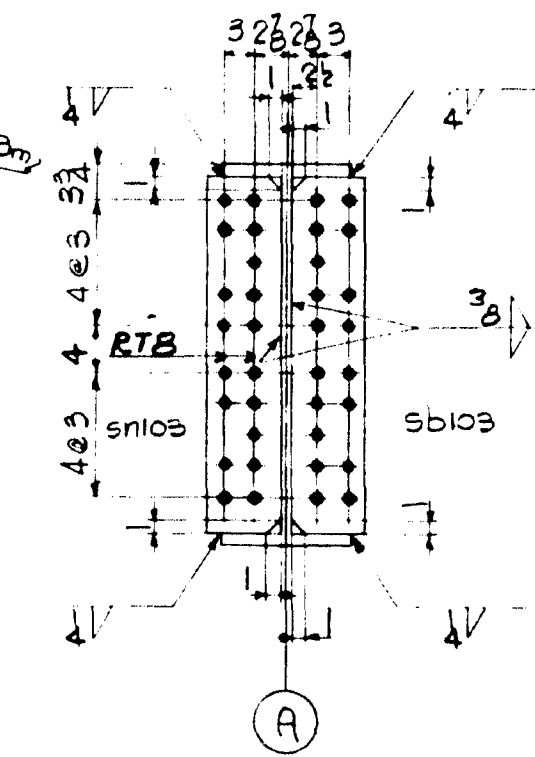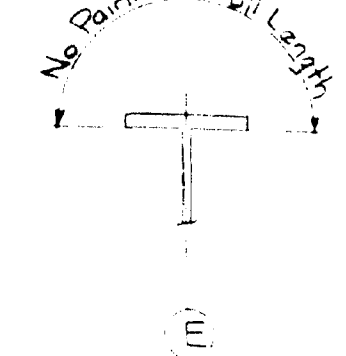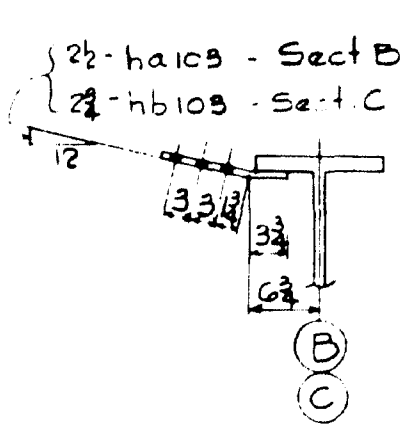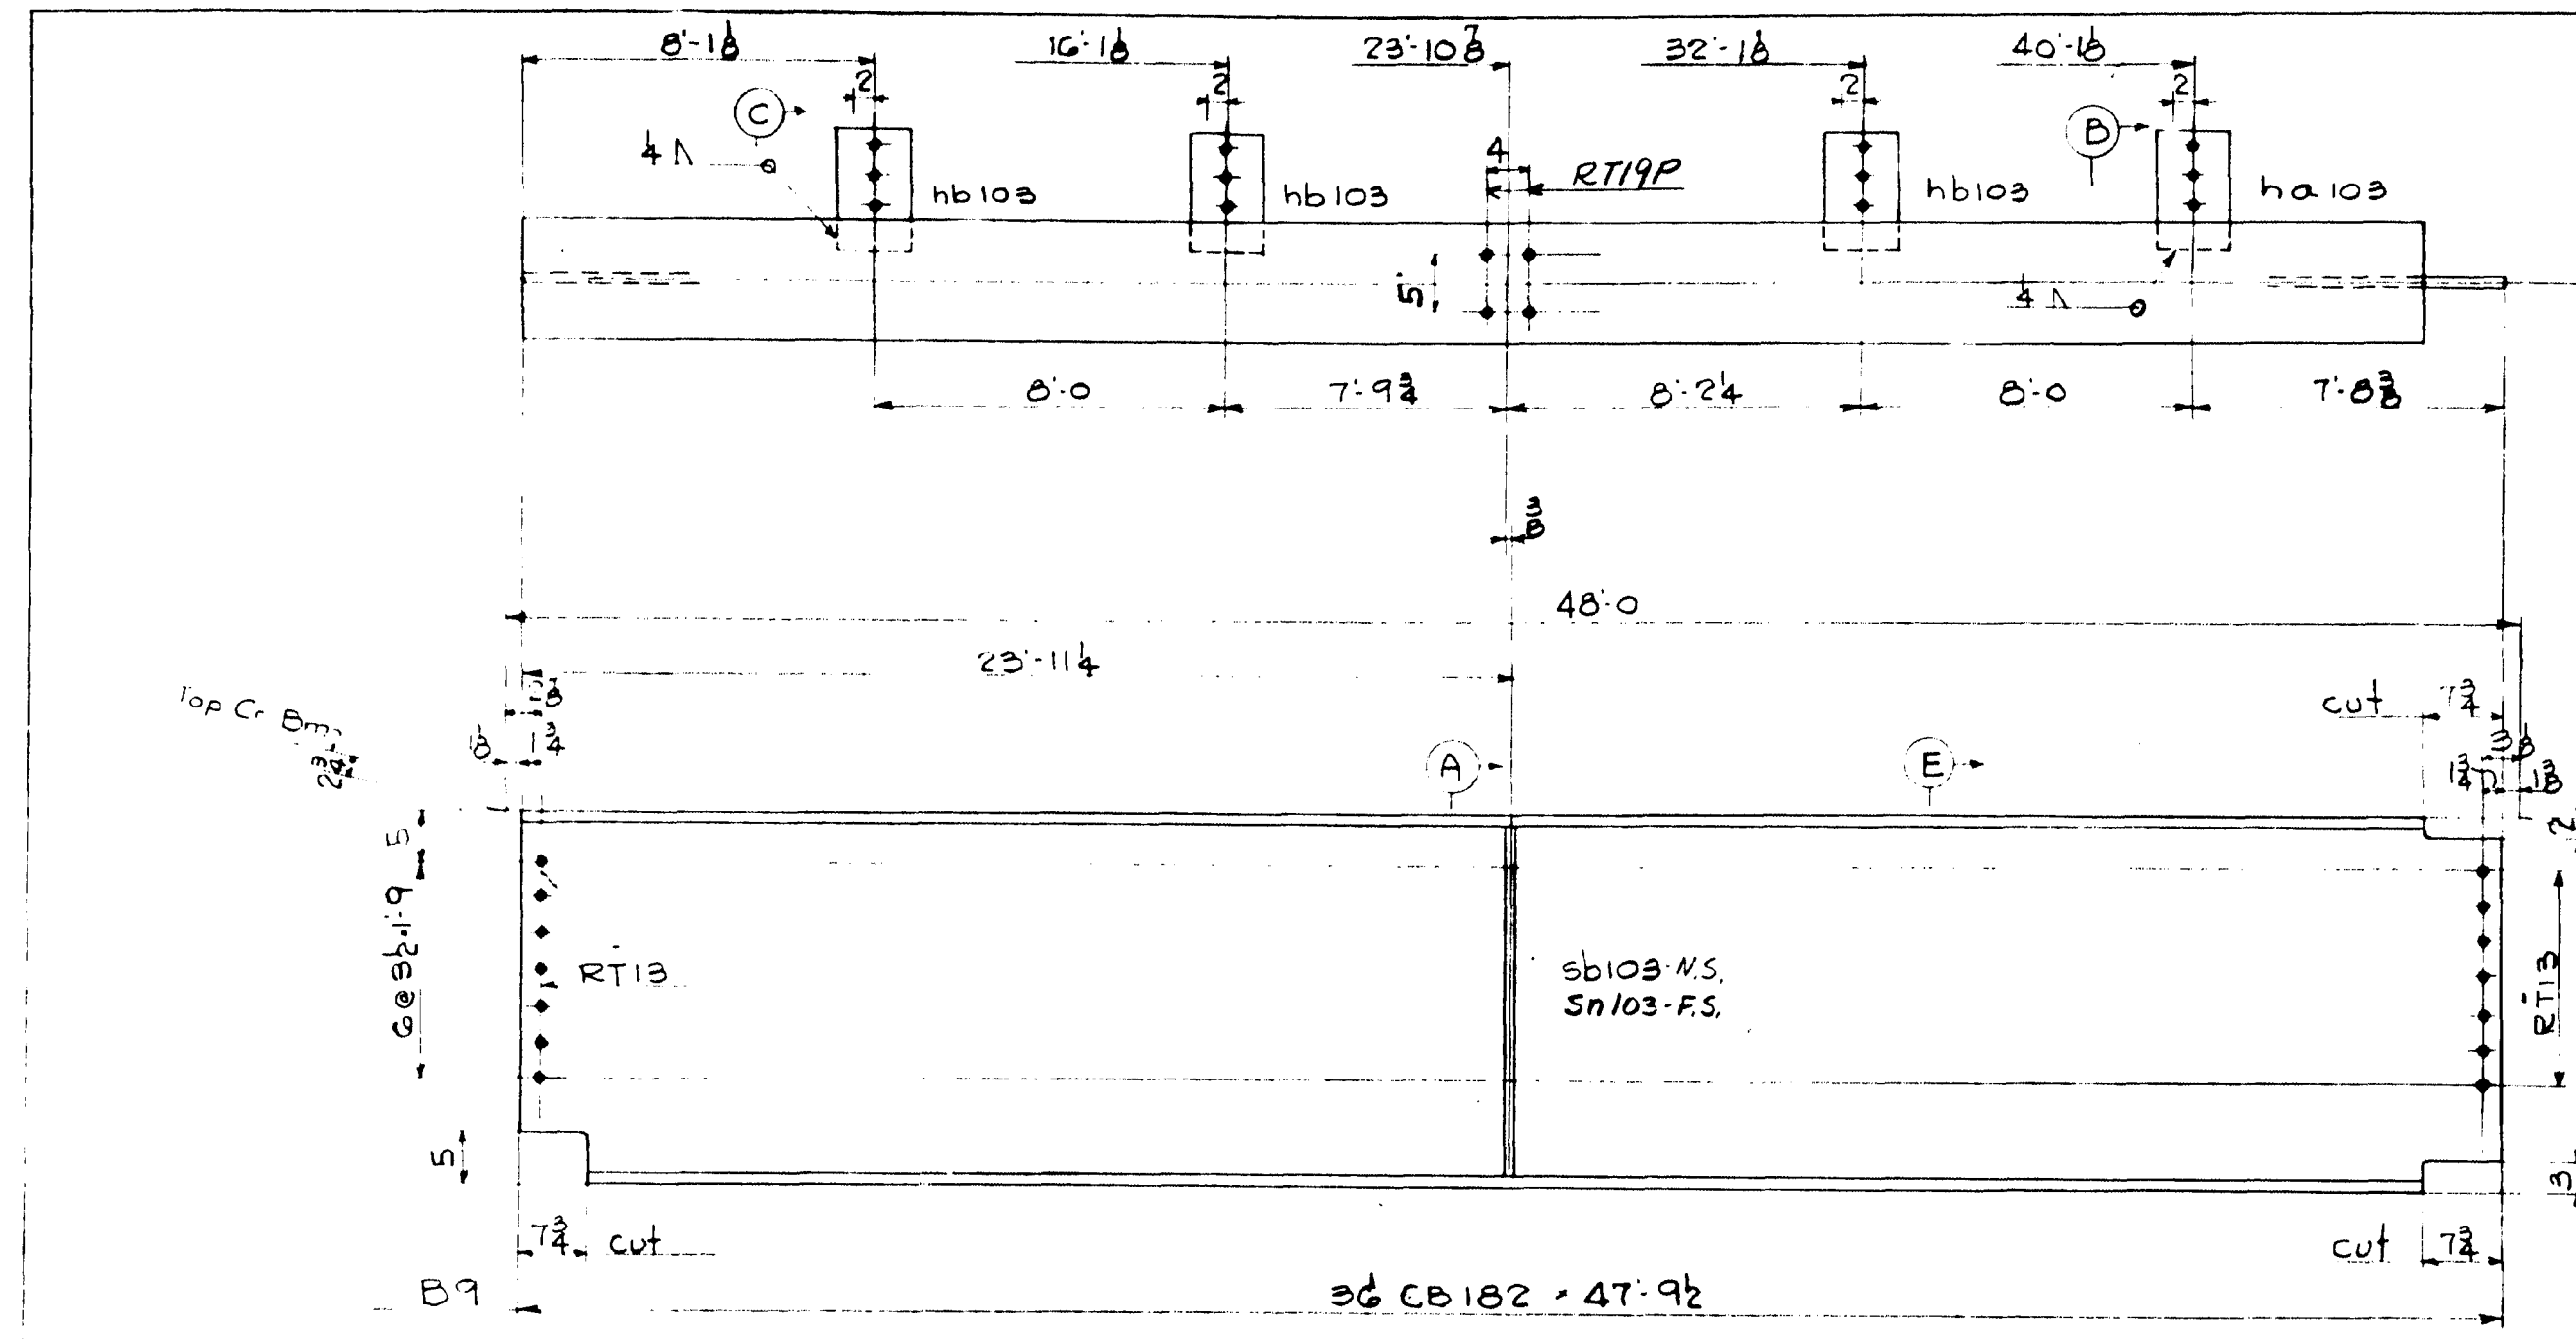
LIFTING WT - 5 TONS

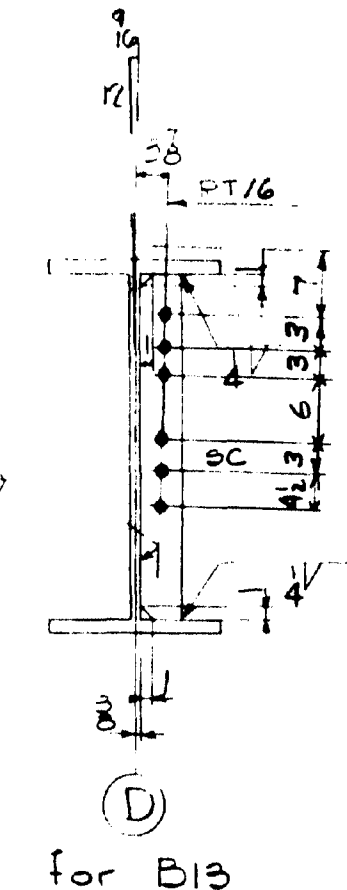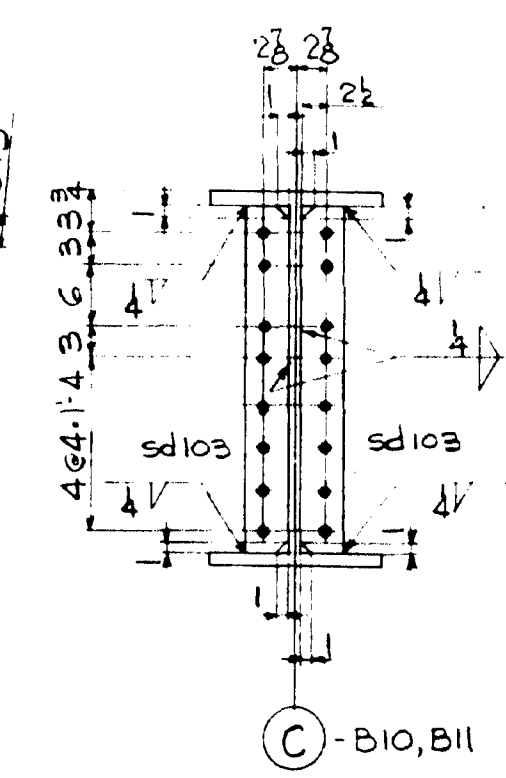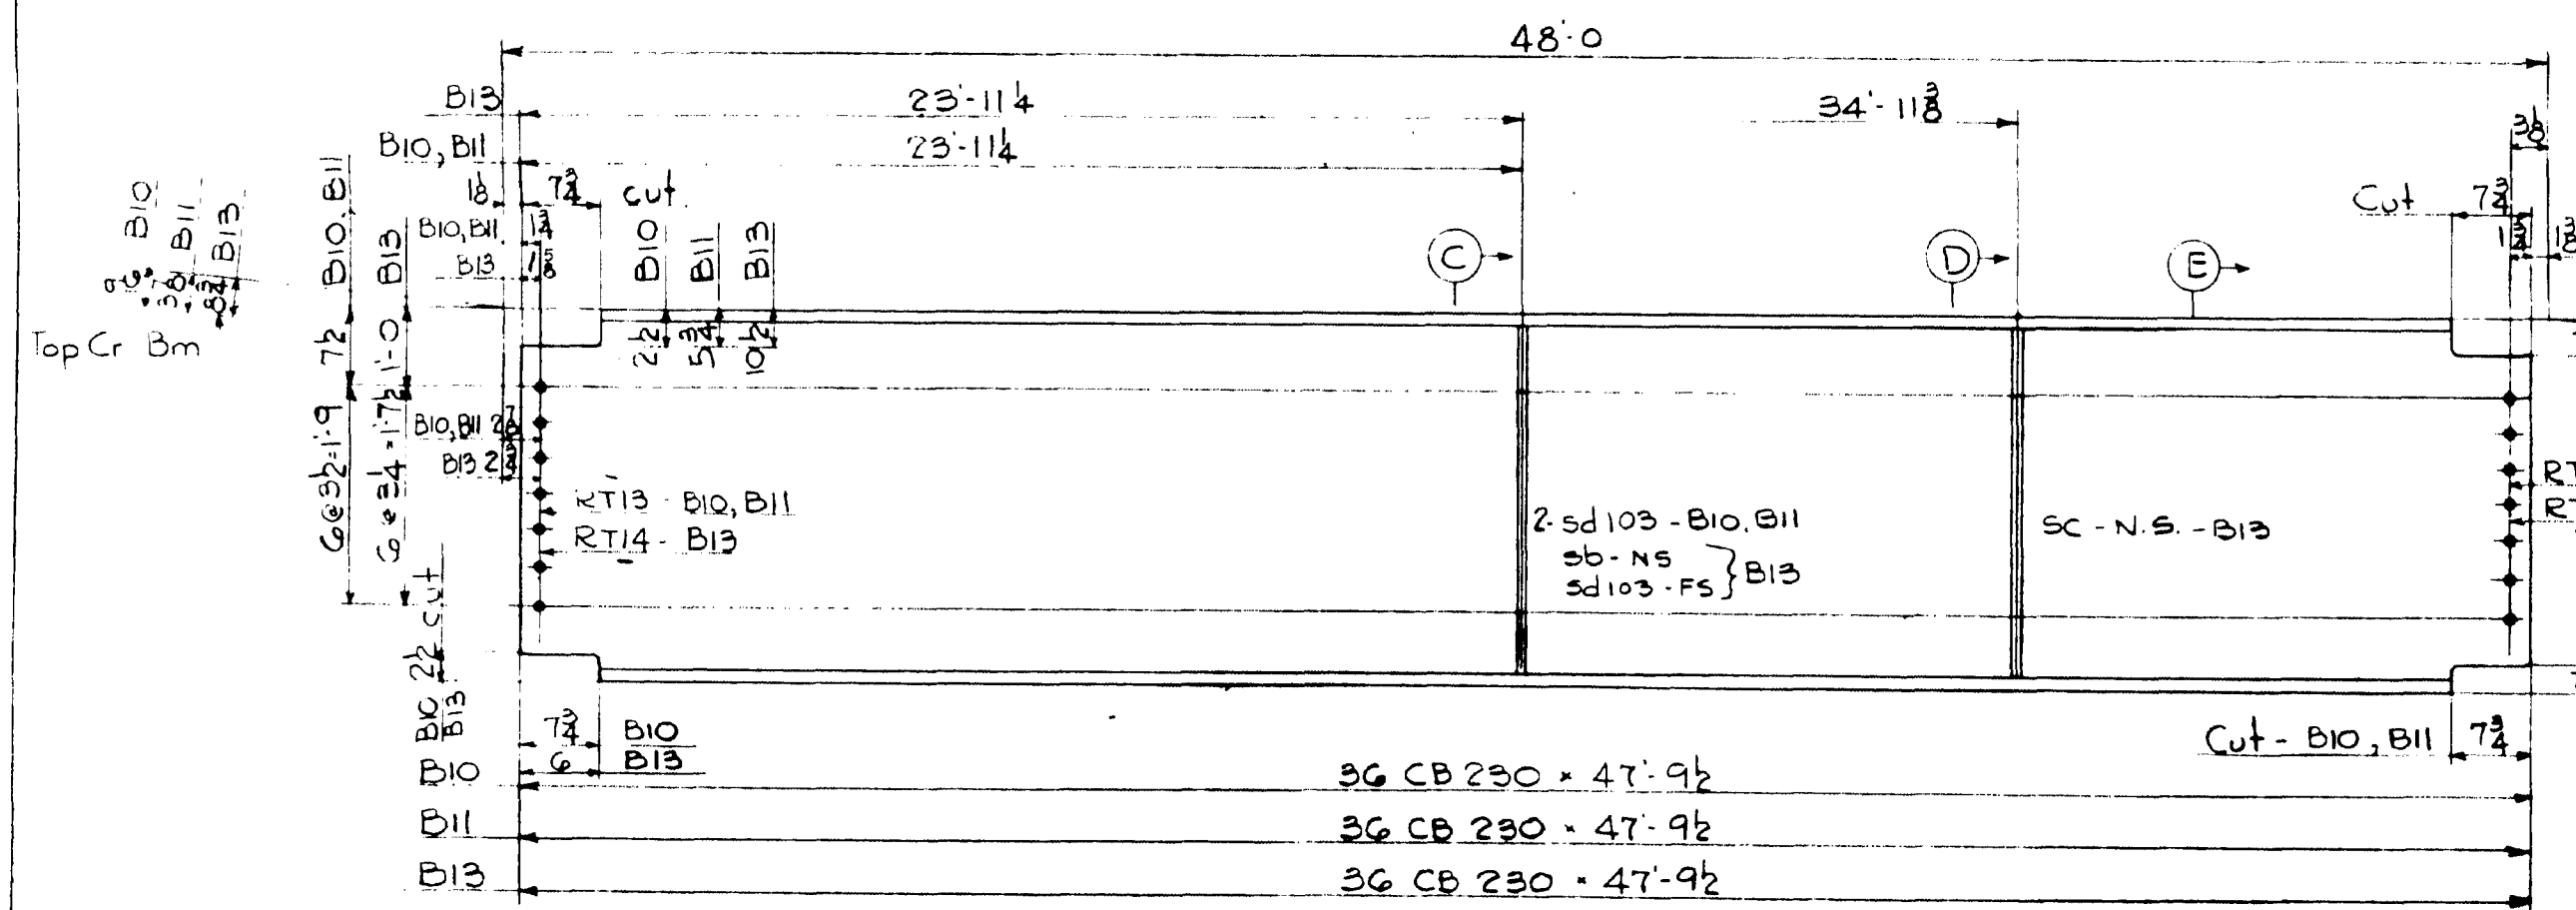

LIFTING WT - 6 TONS

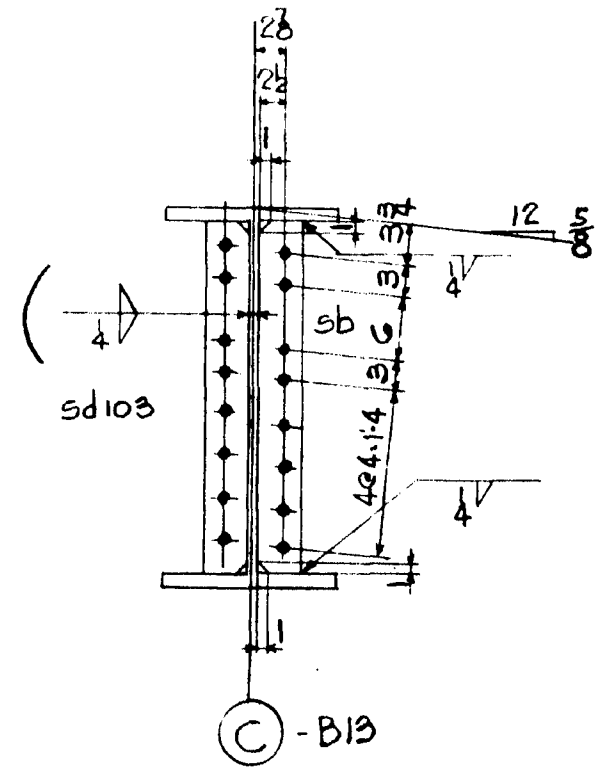

NOTES:  
 SPECIFICATIONS: Maine State Highway Comm. 1945 & Special Provisions  
 MATERIAL: QH Steel A.S.T.M. A7-52T  
 HOLES: 1/8"  
 WORKMANSHIP:  
 Holes in material thicker than the diameter of the rivet shall be drilled.  
 Holes marked RT to be subpunched or subdrilled & reamed to size to a metal template.  
 Shop to fabricate beams with the natural mill camber up.

STRINGERS - SPAN 3 - DIV 1

STATE OF MAINE  
 STATE HIGHWAY COMMISSION  
 BANGOR - FLEWEE BRIDGE  
 OVER PENOBSCOT RIVER  
 BANGOR, MAINE  
 ESTABLISHED 18-51 OVER 18-0  
 AMERICAN BRIDGE  
 UNITED STATES STEEL COMPANY

DRAWINGS MADE AT TRENTON PLANT  
 WORK FABRICATED AT TRENTON PLANT  
 IN CHARGE OF E.B. MARKS  
 DRAW. MADE BY S.E.K. DATE 8-24-53  
 DRAW. CHECKED BY S.E.K. DATE 1-4-54

F	
E	
D	
C	
B	
A	

PAINT: Yes, except top as noted  
 SHOP CONTACT SURFACES: No

ORDER NO. Q4149  
 SHEET NO. 105

REVISIONS

2-27-54




104

62-116



# AMERICAN BRIDGE

LINE	ITEM	MATERIAL	SHAPE	LENGTH	ASSEMBLY	REMARKS	ORDERED		CALCULATED	
							QTY	WT	QTY	WT
1										
2						47'10"				
3										
4	1	36 CB 170	47'9 1/2"	B12		8076#	47'9 1/2"	1013	81	24
5	2	R	4 3/8"	29 3/4"	sh103					
6										
7										
8		ONE BEAM			B14	1516#				
9	1	24 CB 76	19'9 1/2"				20'-0"	4618	15	504
10	1	L 8 4 1/2	13	aa				5		25
11	1	L 8 4 1/2	13	ac				5		25
12										
13		ONE BEAM			B15	538#				
14	1	10 CB 50	10'5 1/2"				4'65'-0"	1618	52	4
15	1	L 8 4 1/2	10	ab				5		20
16	1	L 8 4 1/2	10	ad				5		20
17										
18										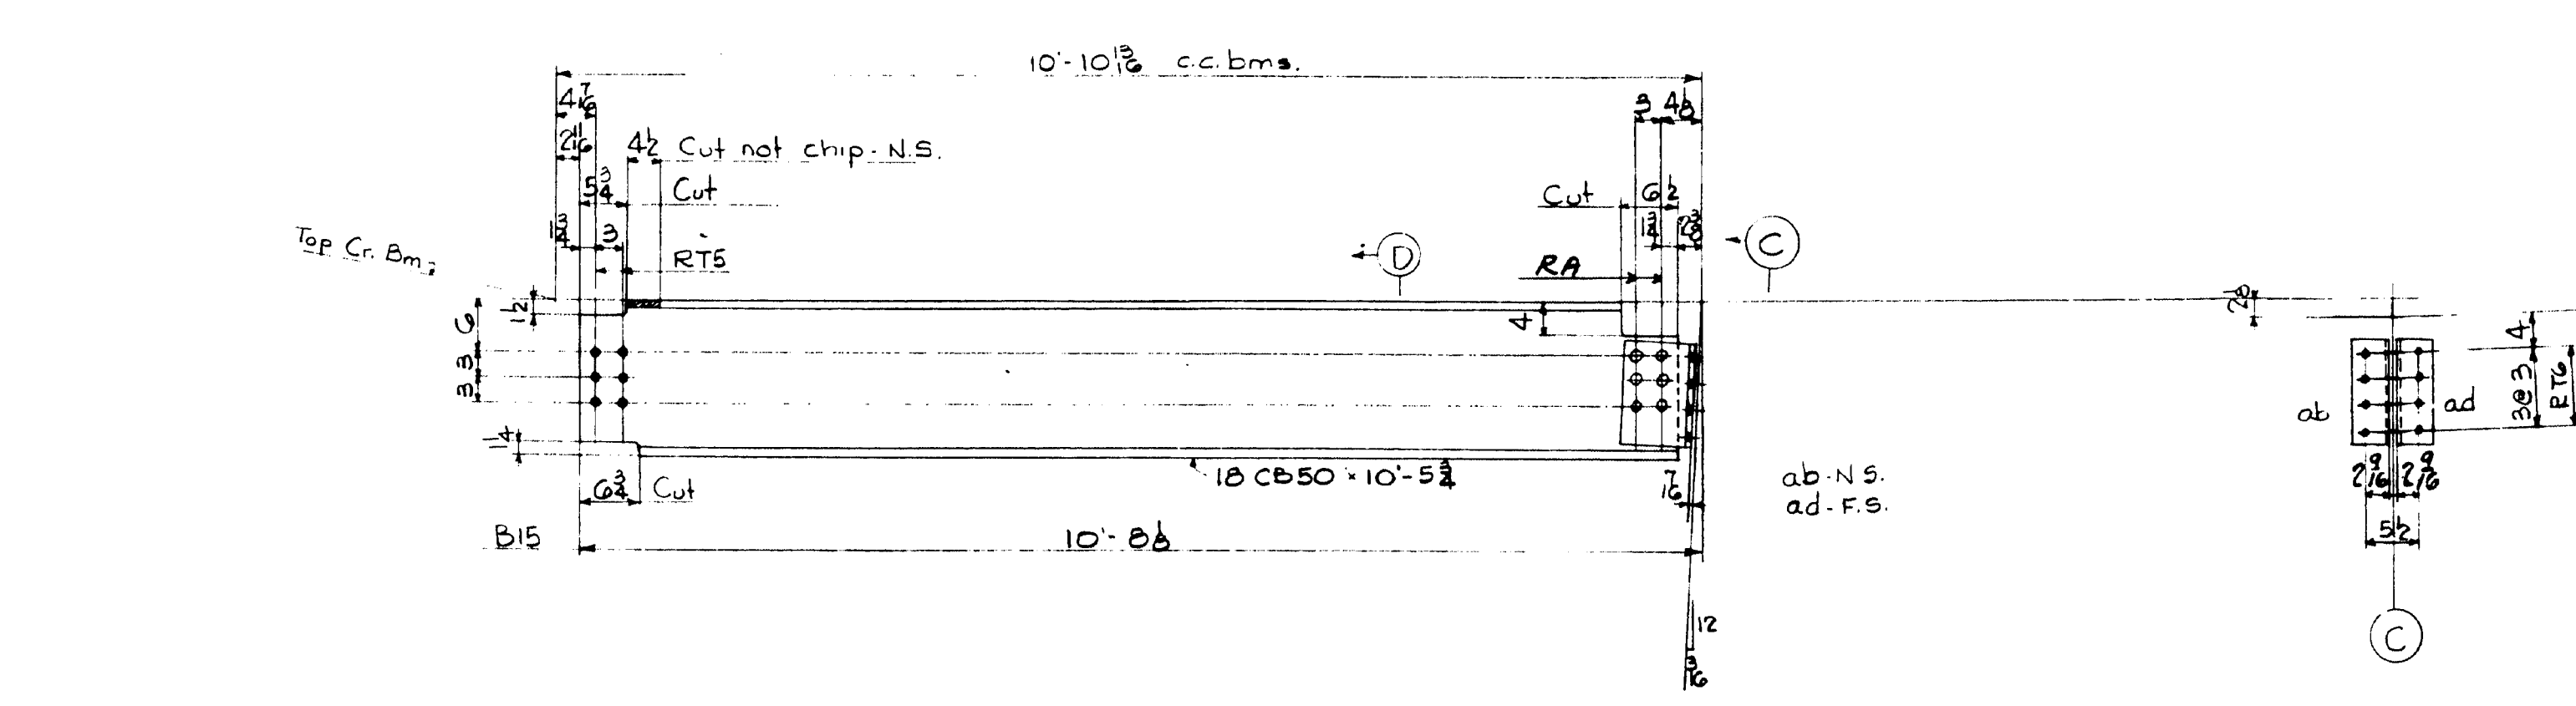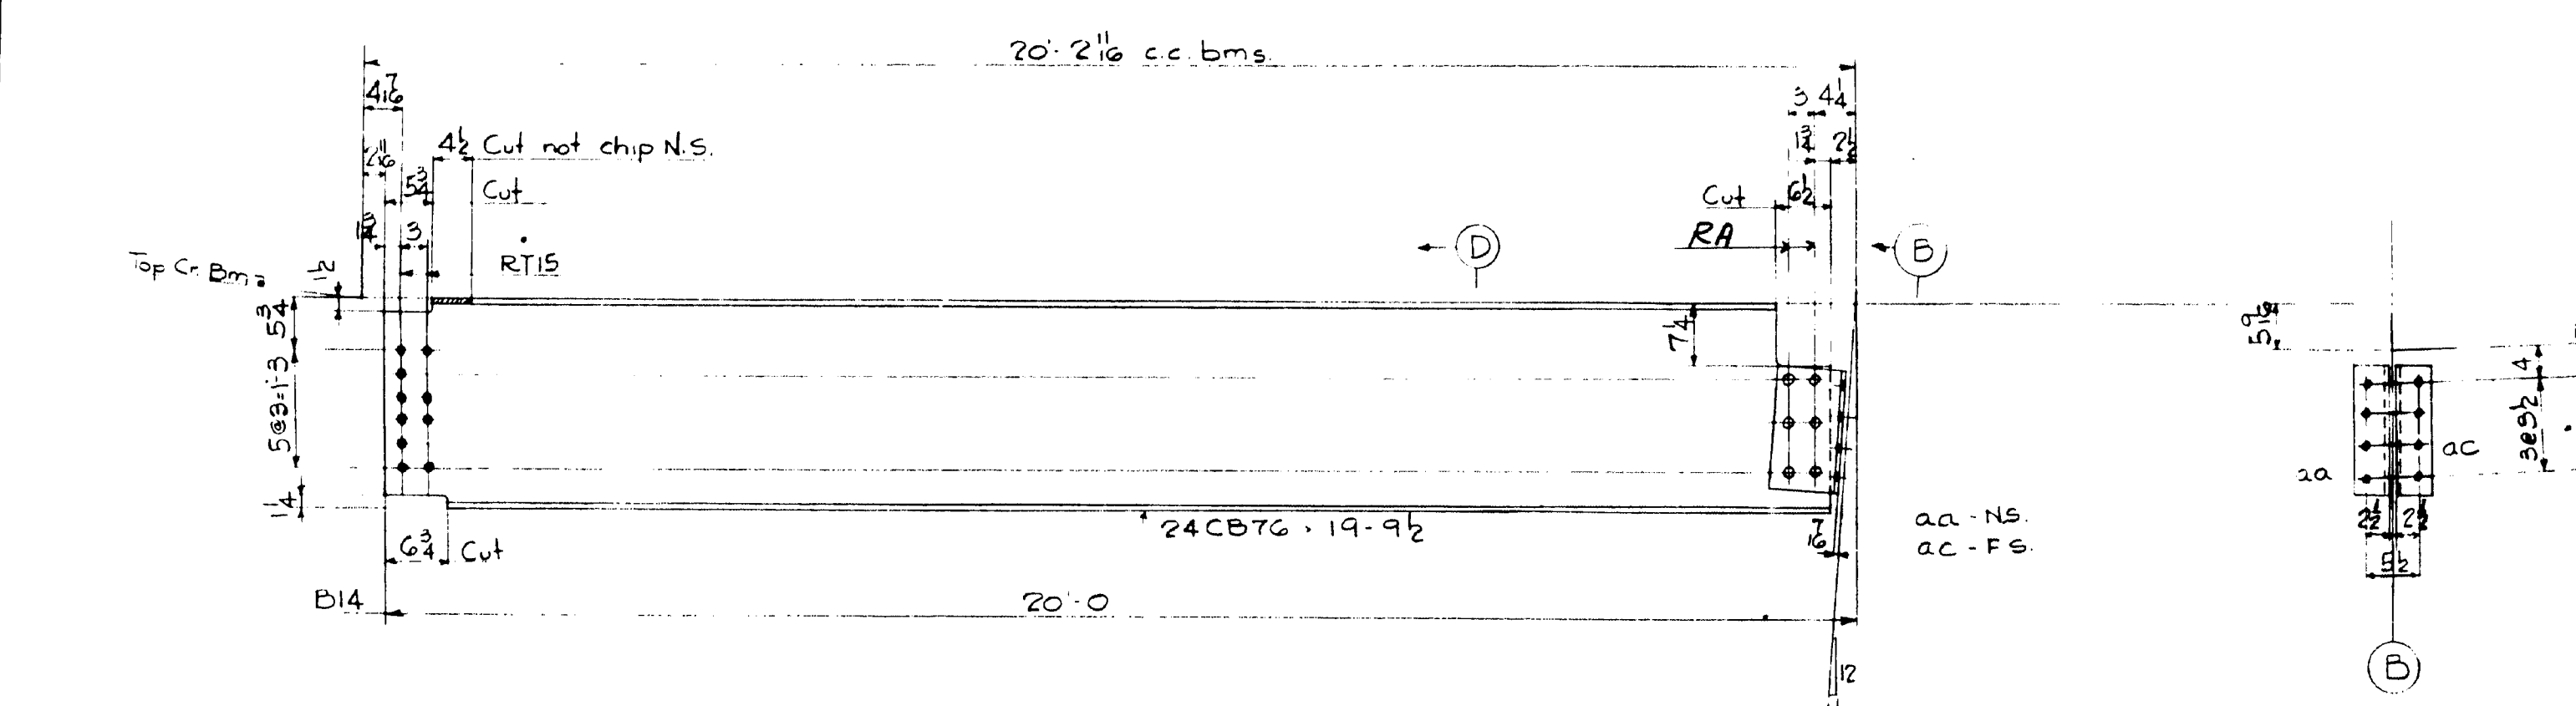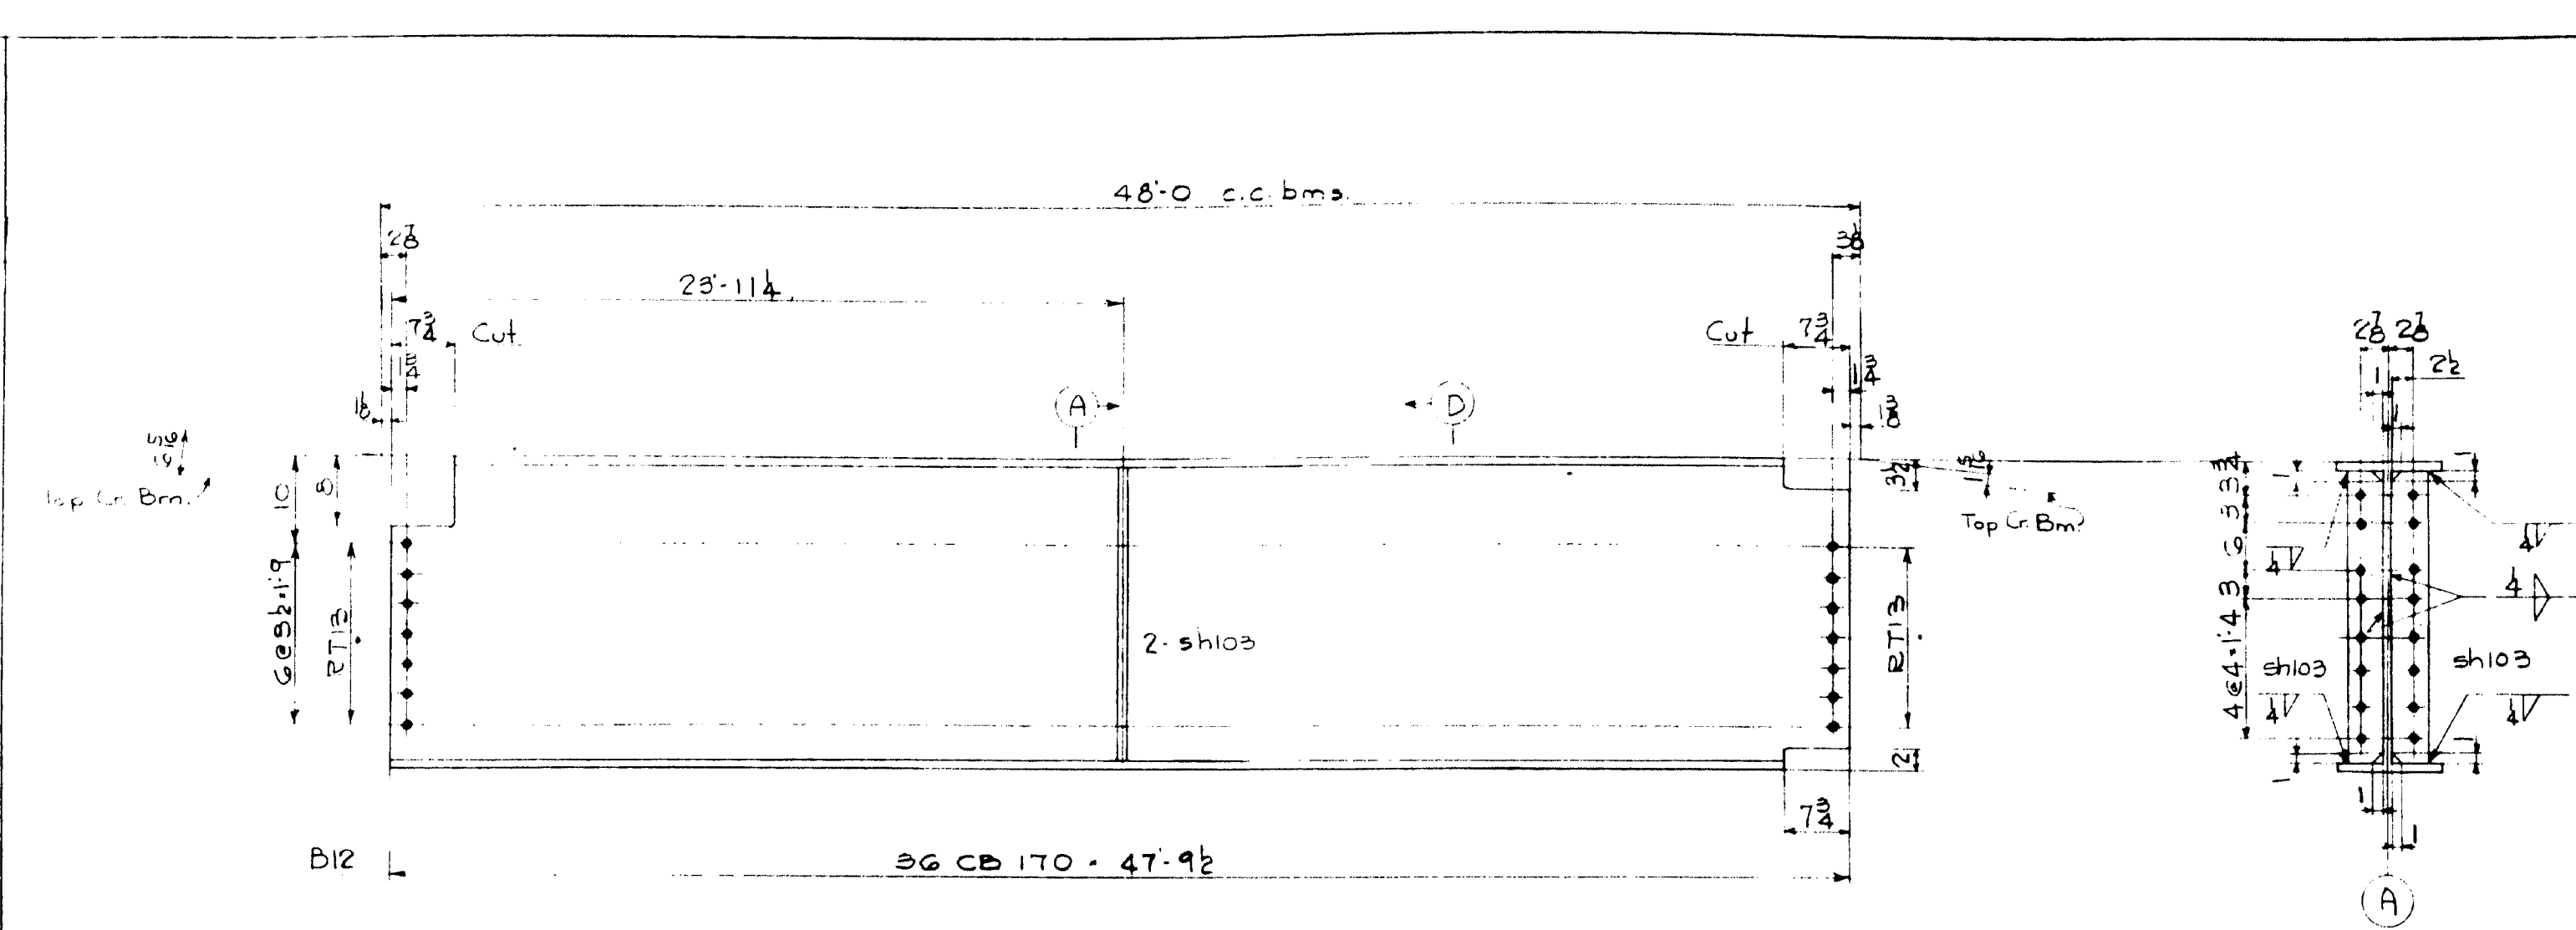
NOTES:  
 SPECIFICATIONS: Maine State Highway Comm 1945  
 & Special Provisions  
 MATERIAL: C.H. Steel ASTM. A7-52T  
 HOLES: 5/8" Rivets 3/4"  
 WORKMANSHIP:  
 Holes marked RT to be subpunched or subdrilled 1/4" and reamed to size to a metal template.  
 Shop to fabricate beams with natural mill camber up.  
 Holes marked RA to be subpunched or subdrilled 1/4" and reamed to size with connecting parts assembled.

DIV. 1  
 STATE OF MAINE  
 STATE HIGHWAY COMMISSION  
 BANGOR: BREWER BRIDGE  
 OVER PENOBSCOT RIVER  
 BANGOR, MAINE  
 ESTABLISHED 19-21 DOB 19-21  
 AMERICAN BRIDGE  
 UNITED STATES STEEL COMPANY











DRAWINGS MADE AT TRENTON PLANT  
 WORK FABRICATED AT TRENTON PLANT  
 IN CHARGE OF E.D. MARKS  
 DRAW. MADE BY SEK DATE 8-27-53  
 DRAW. CHECKED BY HLR DATE 1-4-54  
 REVISIONS  
 ORDER No. Q4149 SHEET No. 106

PAINT: Yes, Except Top as noted  
 SHOP CONTACT SURFACES: No



# DRAWING WITH BILL AMERICAN BRIDGE

LINE	ITEM	QUANTITY	UNIT	REMARKS	ORDERED	WEIGHT	FOR ONE	PIECE
1								
2								
3								
4				49'10"				
5								
6	ONE BEAM			B18				
7	1 SCB230	49.94			49-10 1/2	1004	11.4	7
8	1 R 7 1/2	2.94	ea		45-0	M618	25	
9	1 R 5 1/2	2.94	ea		45-0	M618	10	
10	1 R 7 1/2	1	ea		45-0	M618	8	
11	1 R 7 1/2	1	ea		45-0	M618	8	
12	1 R 7 1/2	1	ea		45-0	M618	8	
13	1 R 7 1/2	2.94	ea		45-0	M618	25	
14								
15	1 SCB55	24.2	B20	1327"	25-6	M618	132.3	
16	2 R 7 1/2	1	ea		45-0	M618	16	
17								
18								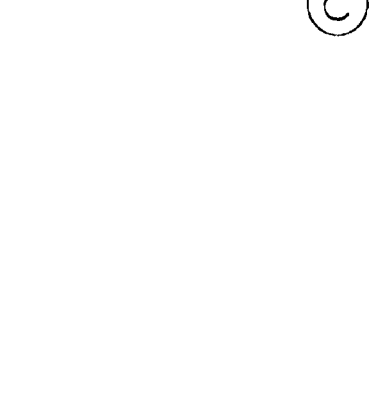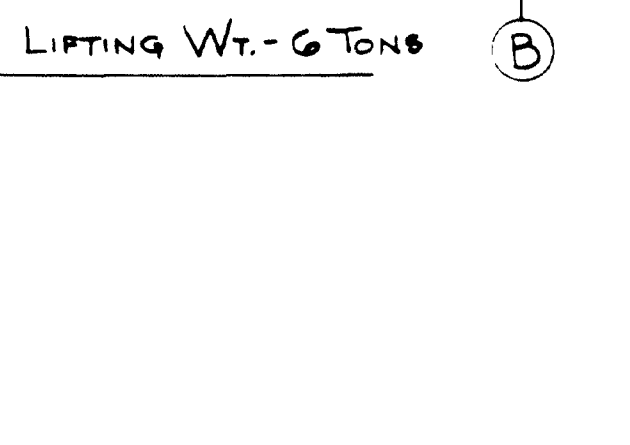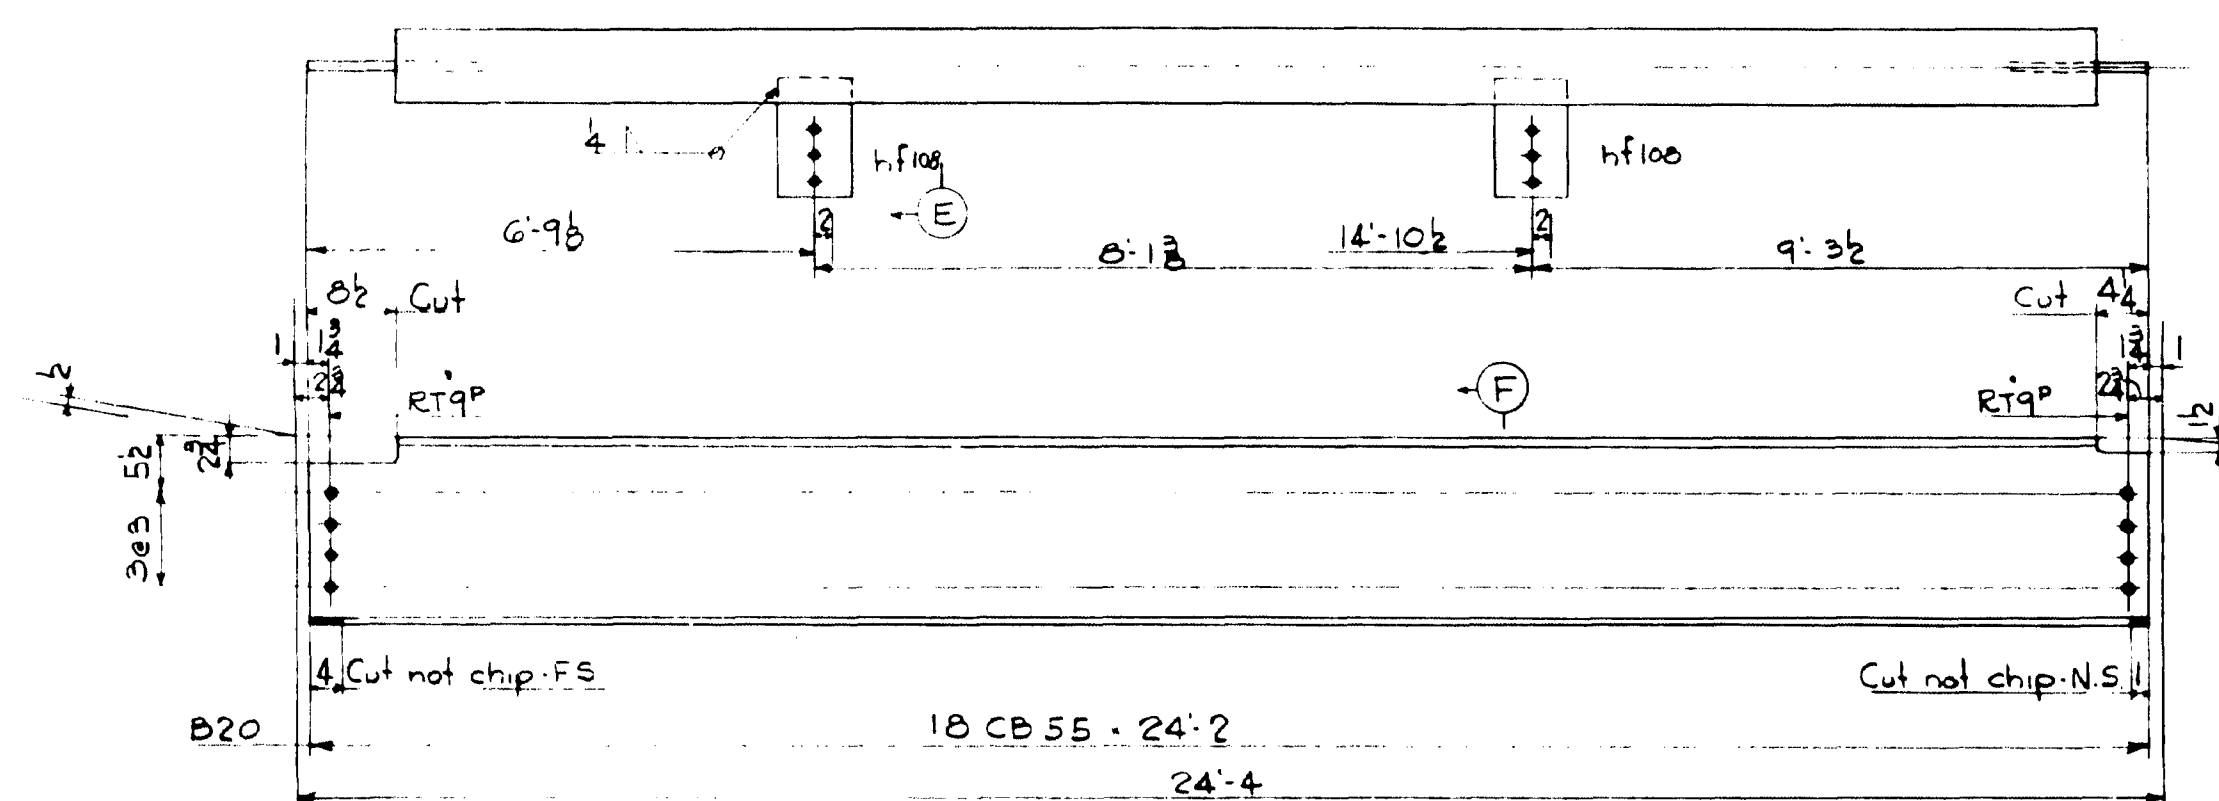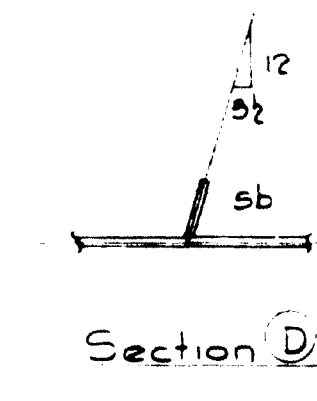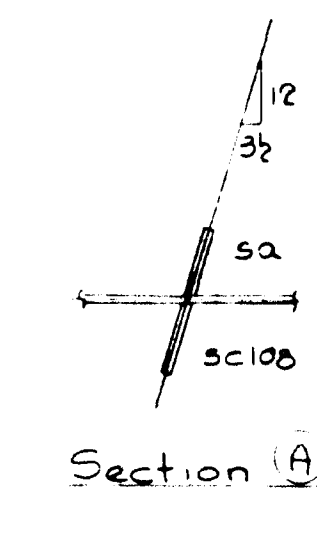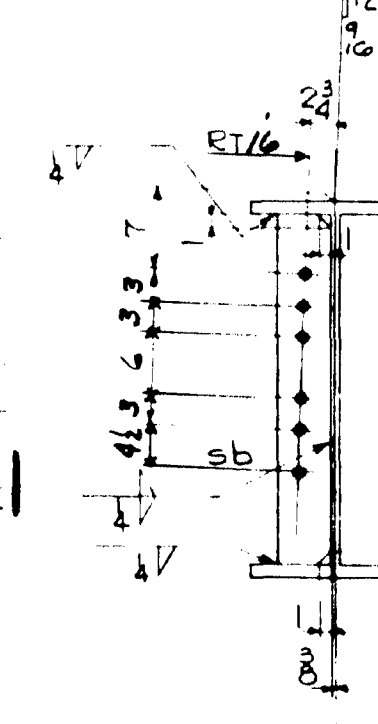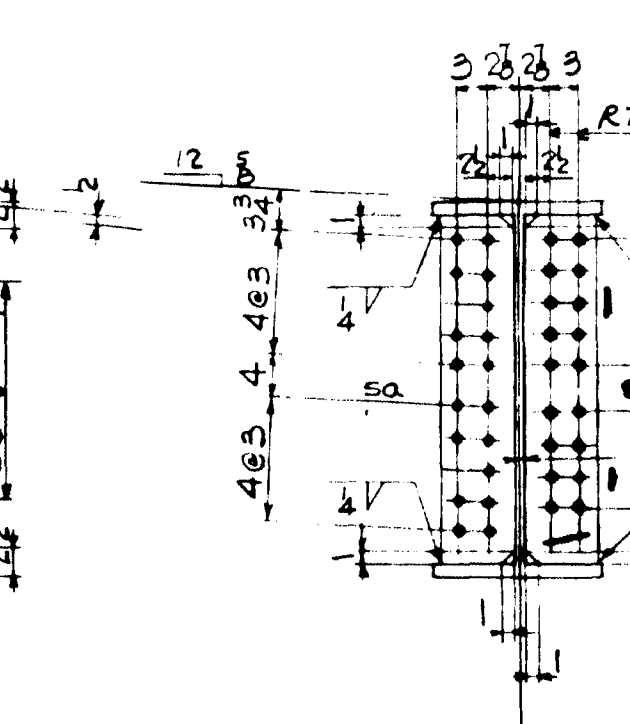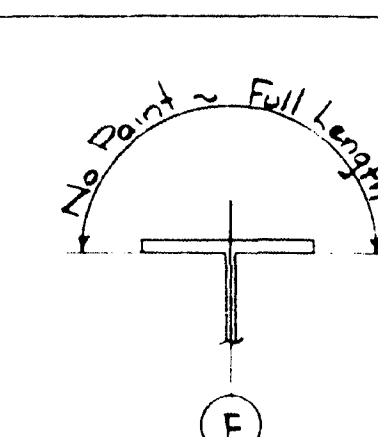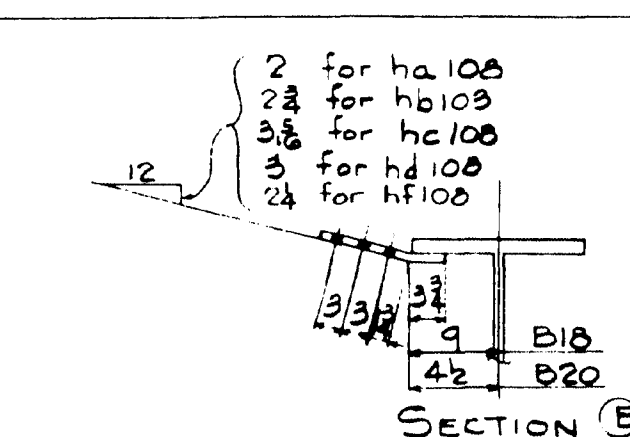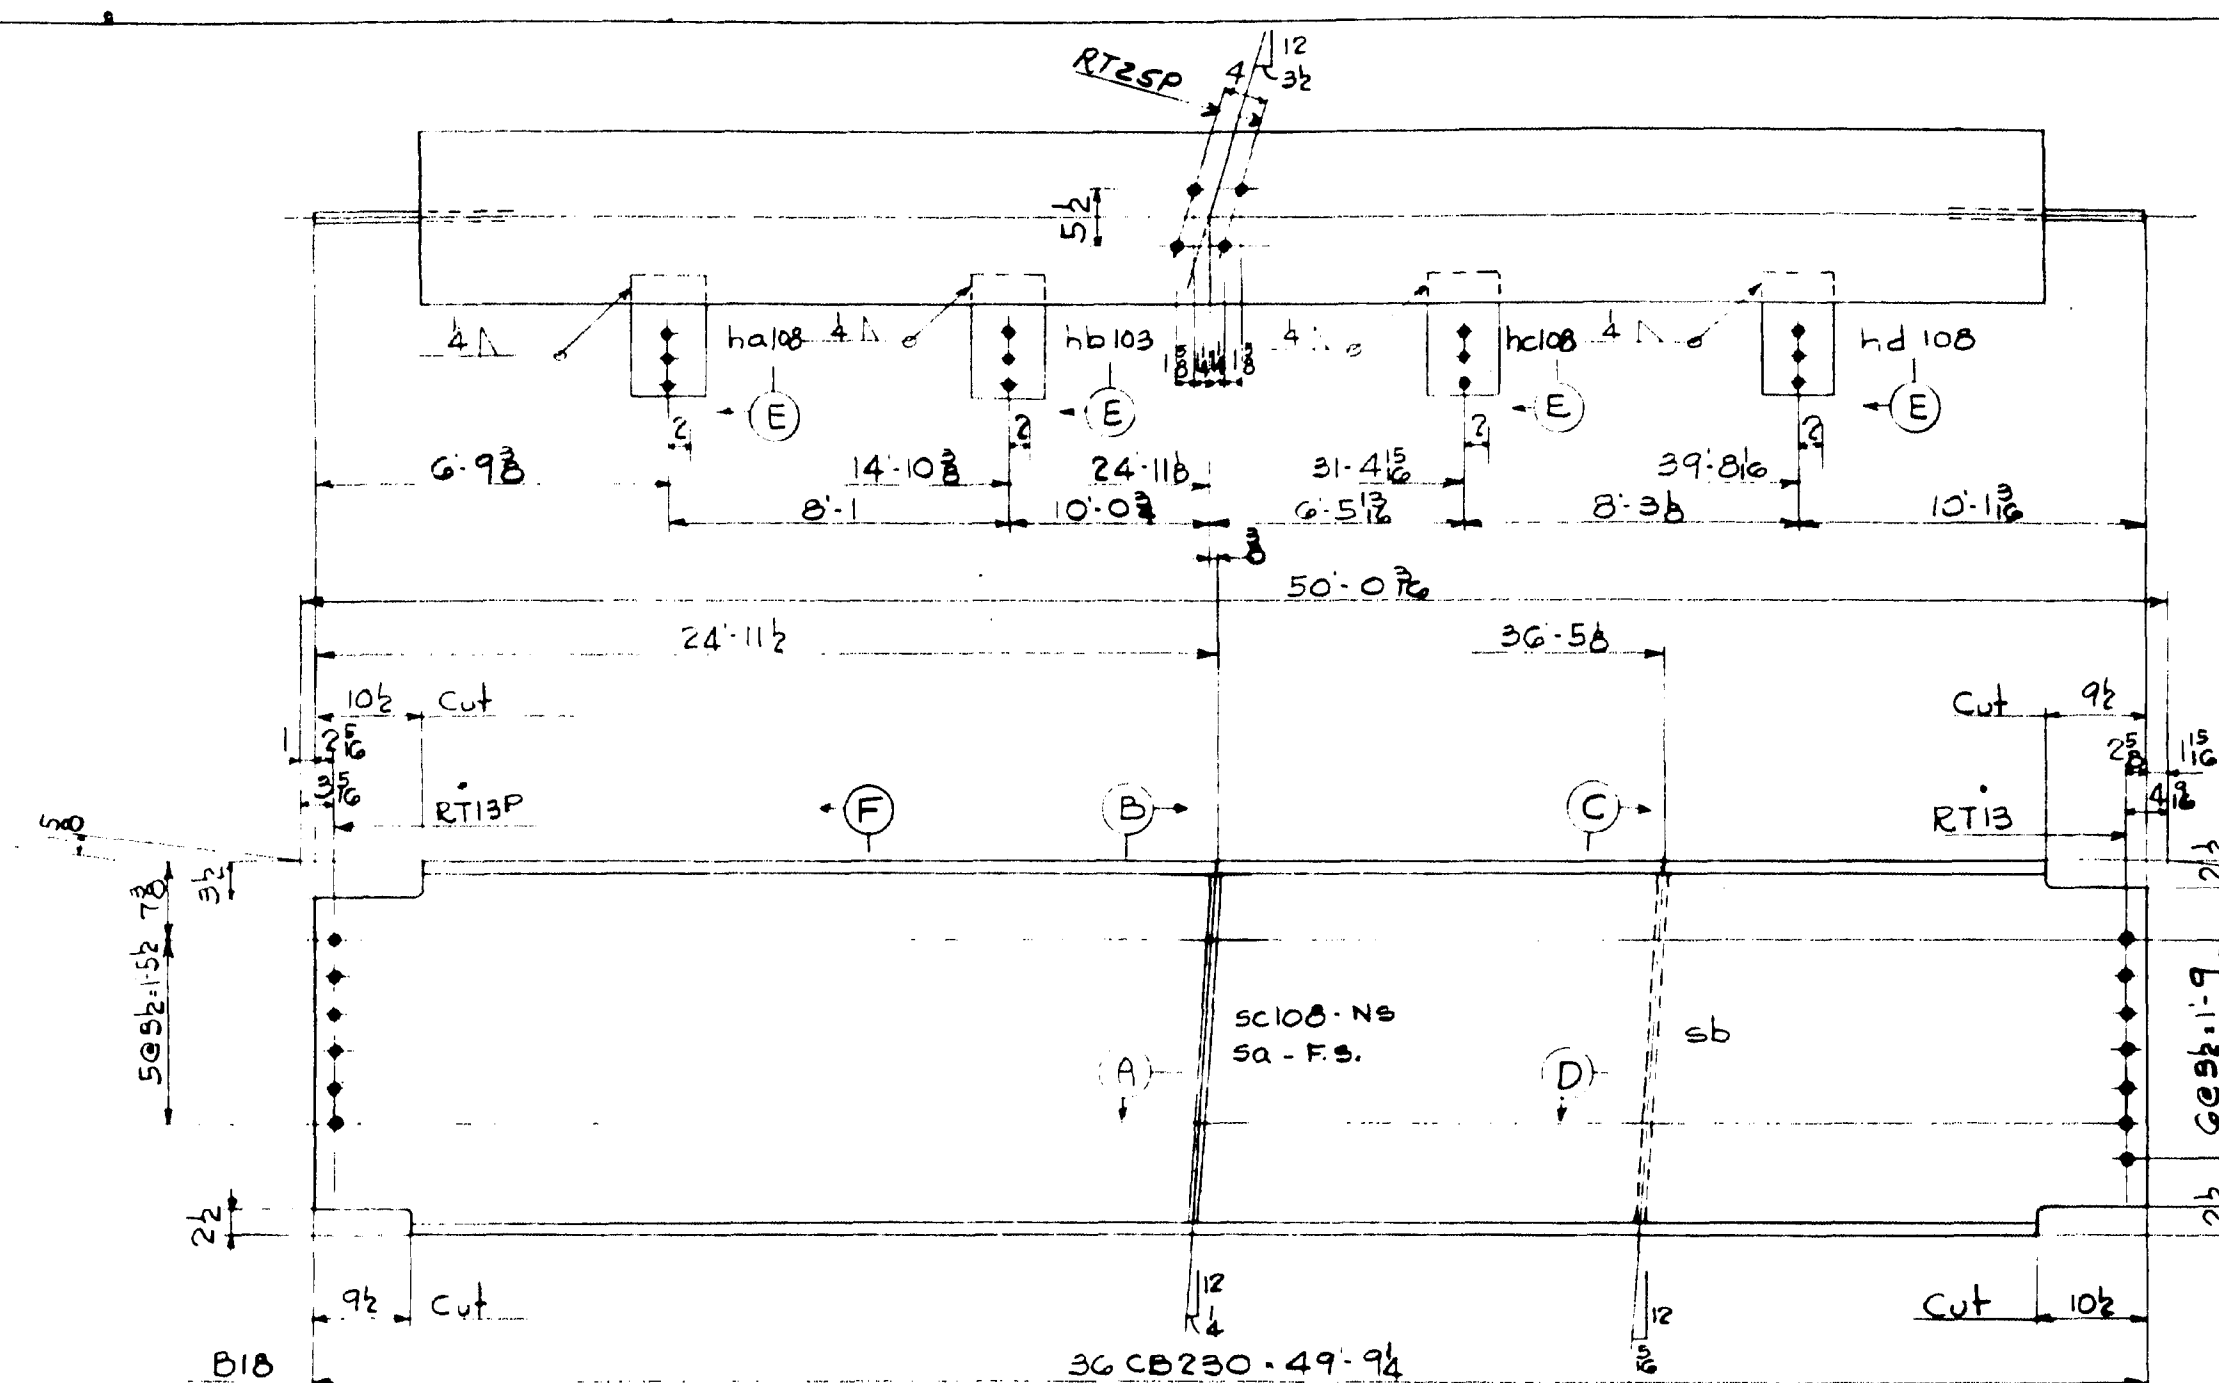
NOTES:  
SPECIFICATIONS: Maine State Highway Commission 1945  
and Special Provisions  
MATERIAL: O.H. Steel ASTM A7-52T  
HOLES: 1 1/2"  
WORKMANSHIP:  
Holes in material thicker than the diameter  
of the rivet shall be drilled.  
Holes marked RT to be subpunched or subdrilled  
and reamed to size to a metal template.  
Shop to fabricate beams with natural mill  
camber up.

STATE OF MAINE  
STATE HIGHWAY COMMISSION  
BANGOR-BREWER BRIDGE  
OVER PENOBSCOT RIVER  
BANGOR, MAINE  
127 JIMMIE IS ST COPI 1945  
AMERICAN BRIDGE  
DIVISION  
UNITED STATES STEEL COMPANY

DRAWINGS MADE AT TRENTON PLANT  
WORK FABRICATED AT TRENTON PLANT  
IN CHARGE OF E.D. MARKS  
DRAW. MADE BY S.E.K. DATE 7-5-53  
DRAW. CHECKED BY J.E.E. DATE 7-5-54  
REVISIONS  
F 1-26-54  
E 1-26-54  
D 1-26-54  
C 1-26-54  
B 1-26-54

PAINT: Yes, except top as noted  
SHOP CONTACT SURFACES: No

ORDER No. Q4149  
SHEET No. 108

104, 105




62-119 WELD






ITEM	QTY	UNIT	DESCRIPTION	REMARKS
1				
2				
3				
DRAWING WITH BILL  
AMERICAN BRIDGE  
UNITED STATES STEEL COMPANY



LINE	ITEM	MATERIAL	QUANTITY	REMARKS	ORDERED	CALCULATED
1				46"11"		
2						
3				98" 2448		
4	ONE BEAM	B21	8653' 4149			
5	1 36 CB 182	46' 10 3/4	1011	8536		
6	1 R 7 1/2	2 934 sm 103	Fin 1			33
7	1 R 7 1/2	2 934 sm 103	Fin 1			25
8	1 R 7 1/2	2 934 sm 103	Fin 1			33
9	2 R 7 1/2	1 1 ha 103				16
10	1 Top Plate	1 1 TPA	Det & Filled on Sht. 1, 2448			98
11						
12	2 R 7 1/2	1 1 h 103				16
13	1 R 7 1/2	2 934 sm 103				25
14	2 BEAMS	B22	103' 2448	46' 11"		
15	2 36 CB 230	46' 10 3/4	1007	10787		
16	4 R 4 1/2	2 94 sc 103				28
17	4 R 6 1/2	2 94 sc 103	Fin 1			57
18	1 Top Plate	1 1 TPA	Det & Filled on Sht. 1, 2448			98
19						
20						
21						
22	ONE BEAM	B23	103' 2448	46' 11"		
23	1 36 CB 150	46' 10 3/4	1014	7085		
24	2 R 4 1/2	2 94 sh 103				29
25	2 R 6 1/2	2 94 sh 103	Fin 1			57
26	1 Top Plate	1 1 TPA	Det & Filled on Sht. 1, 2448			98
27						
28						
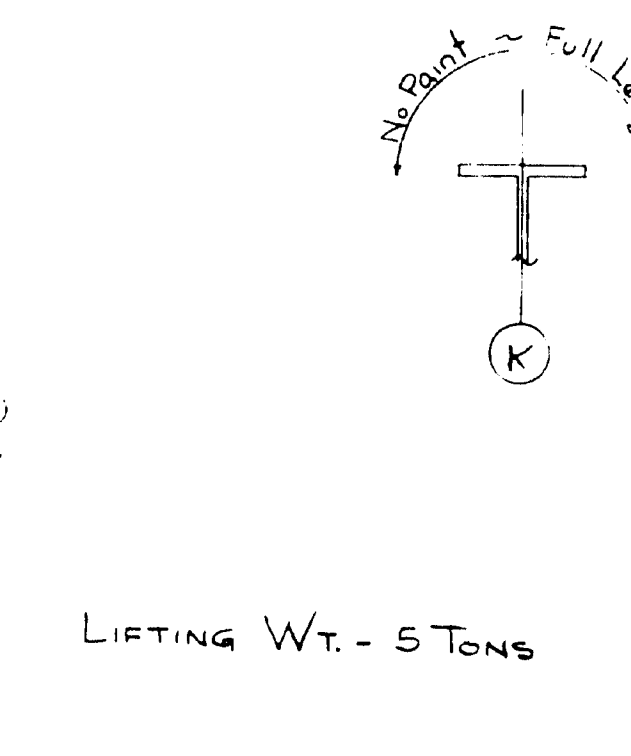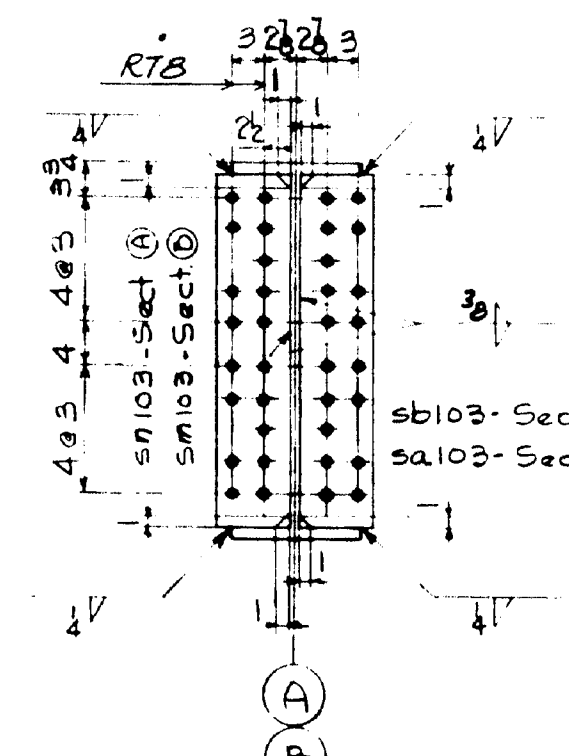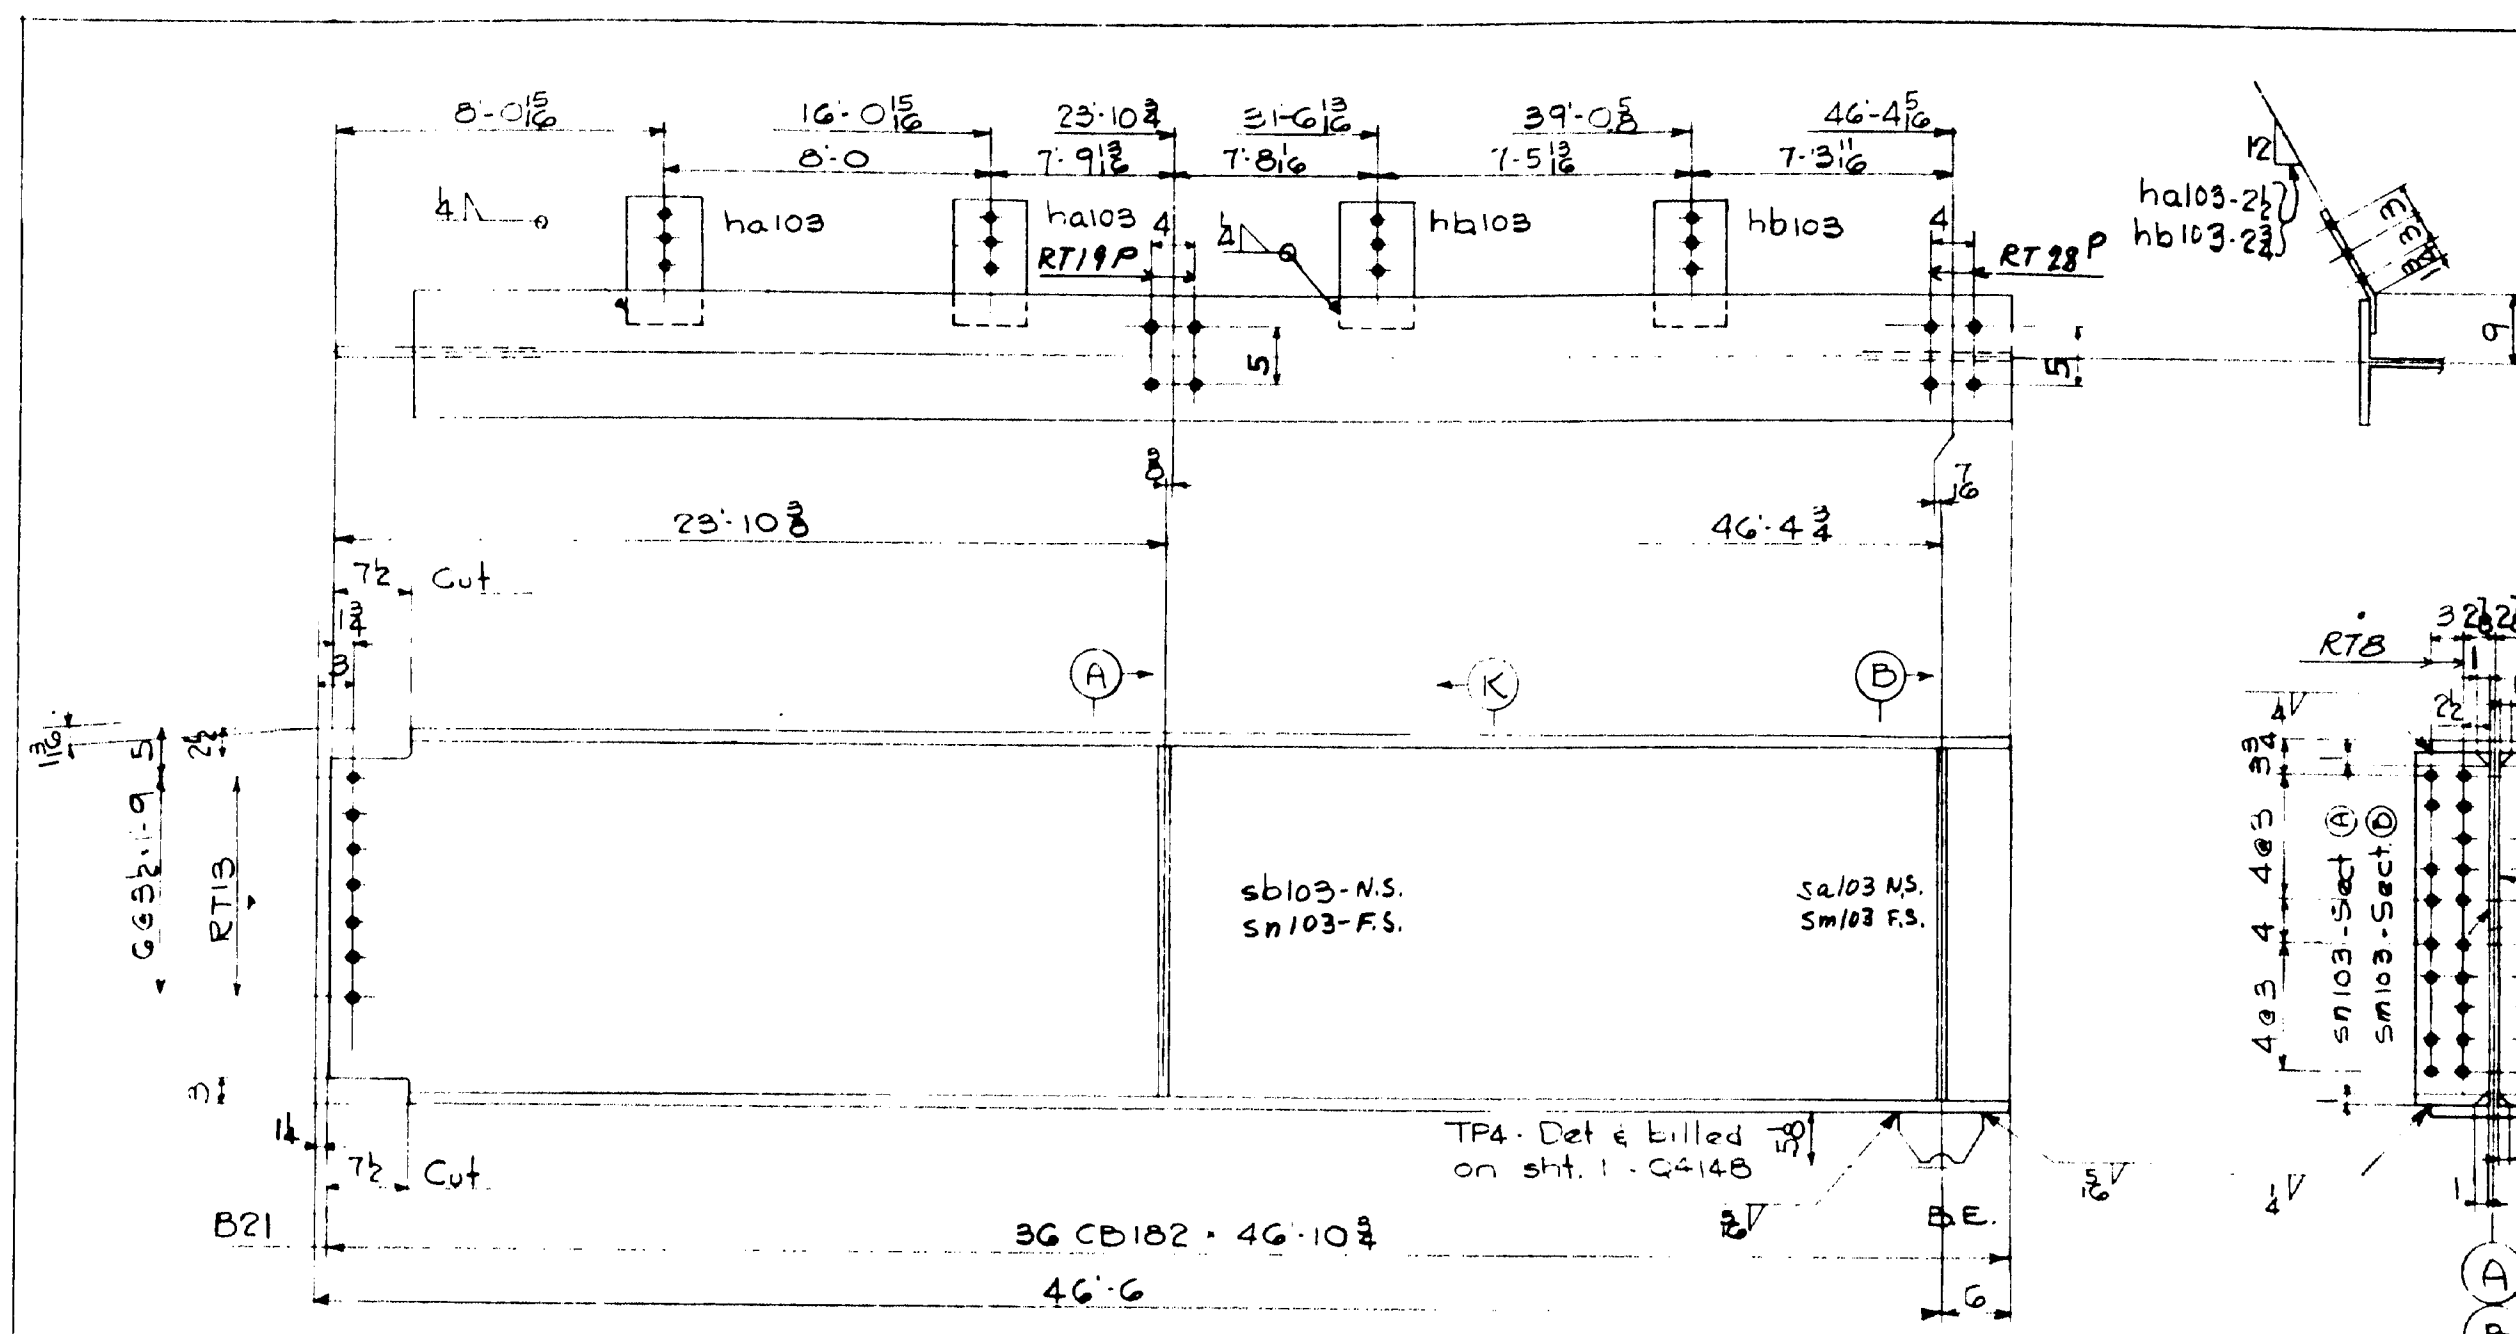

LIFTING WT. - 5 TONS

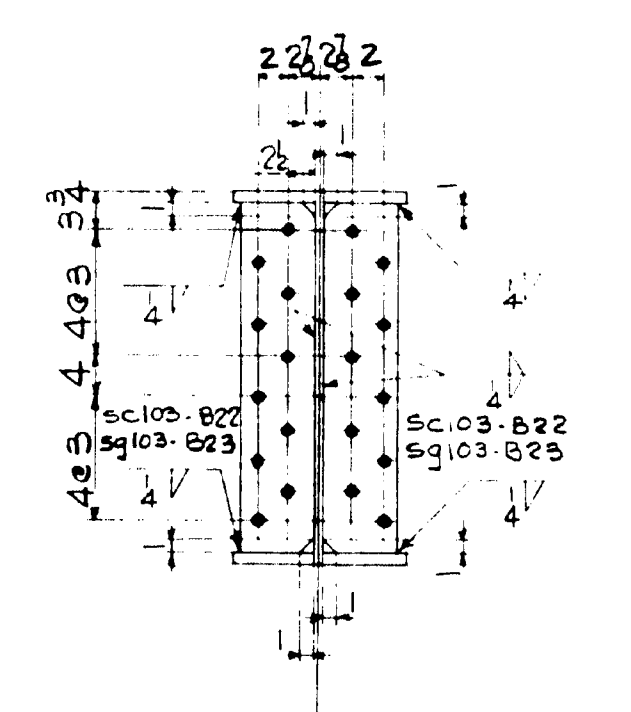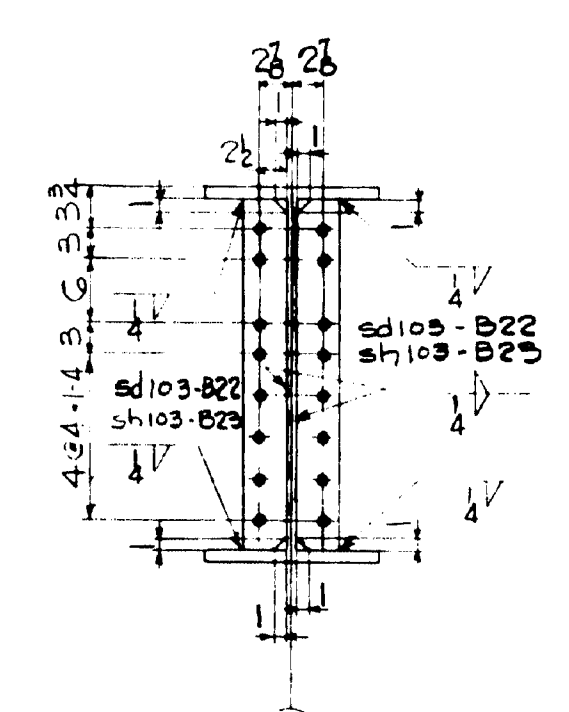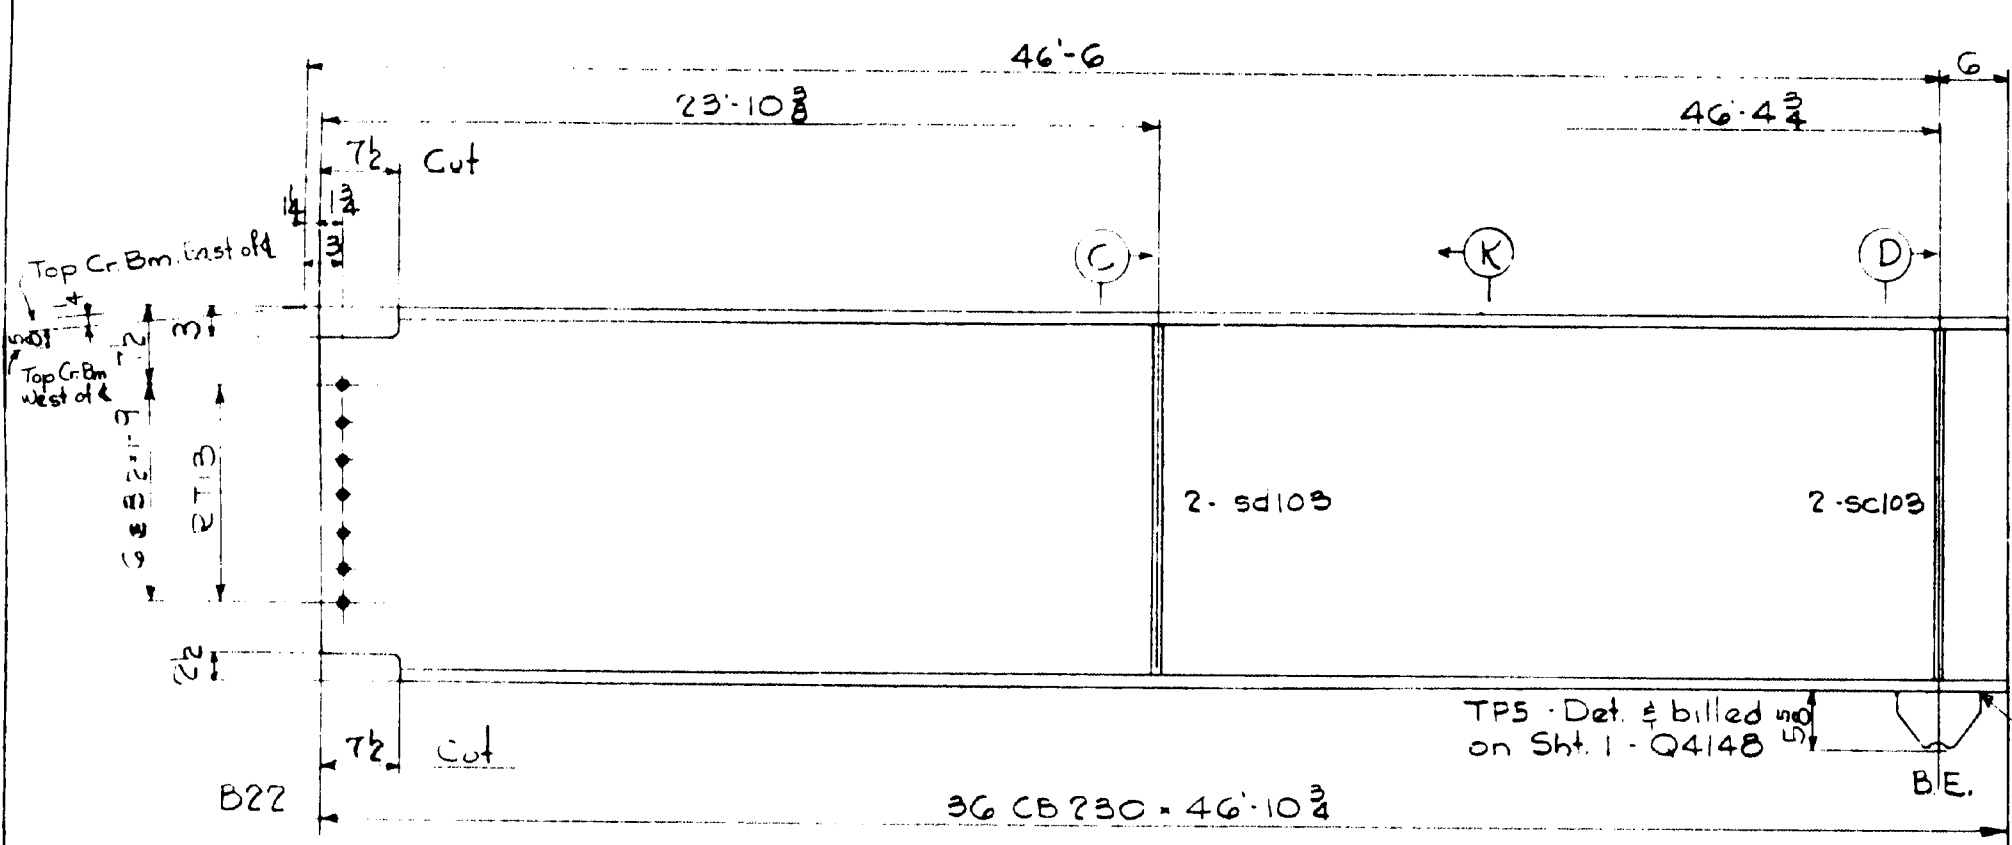

LIFTING WT. - 6 TONS

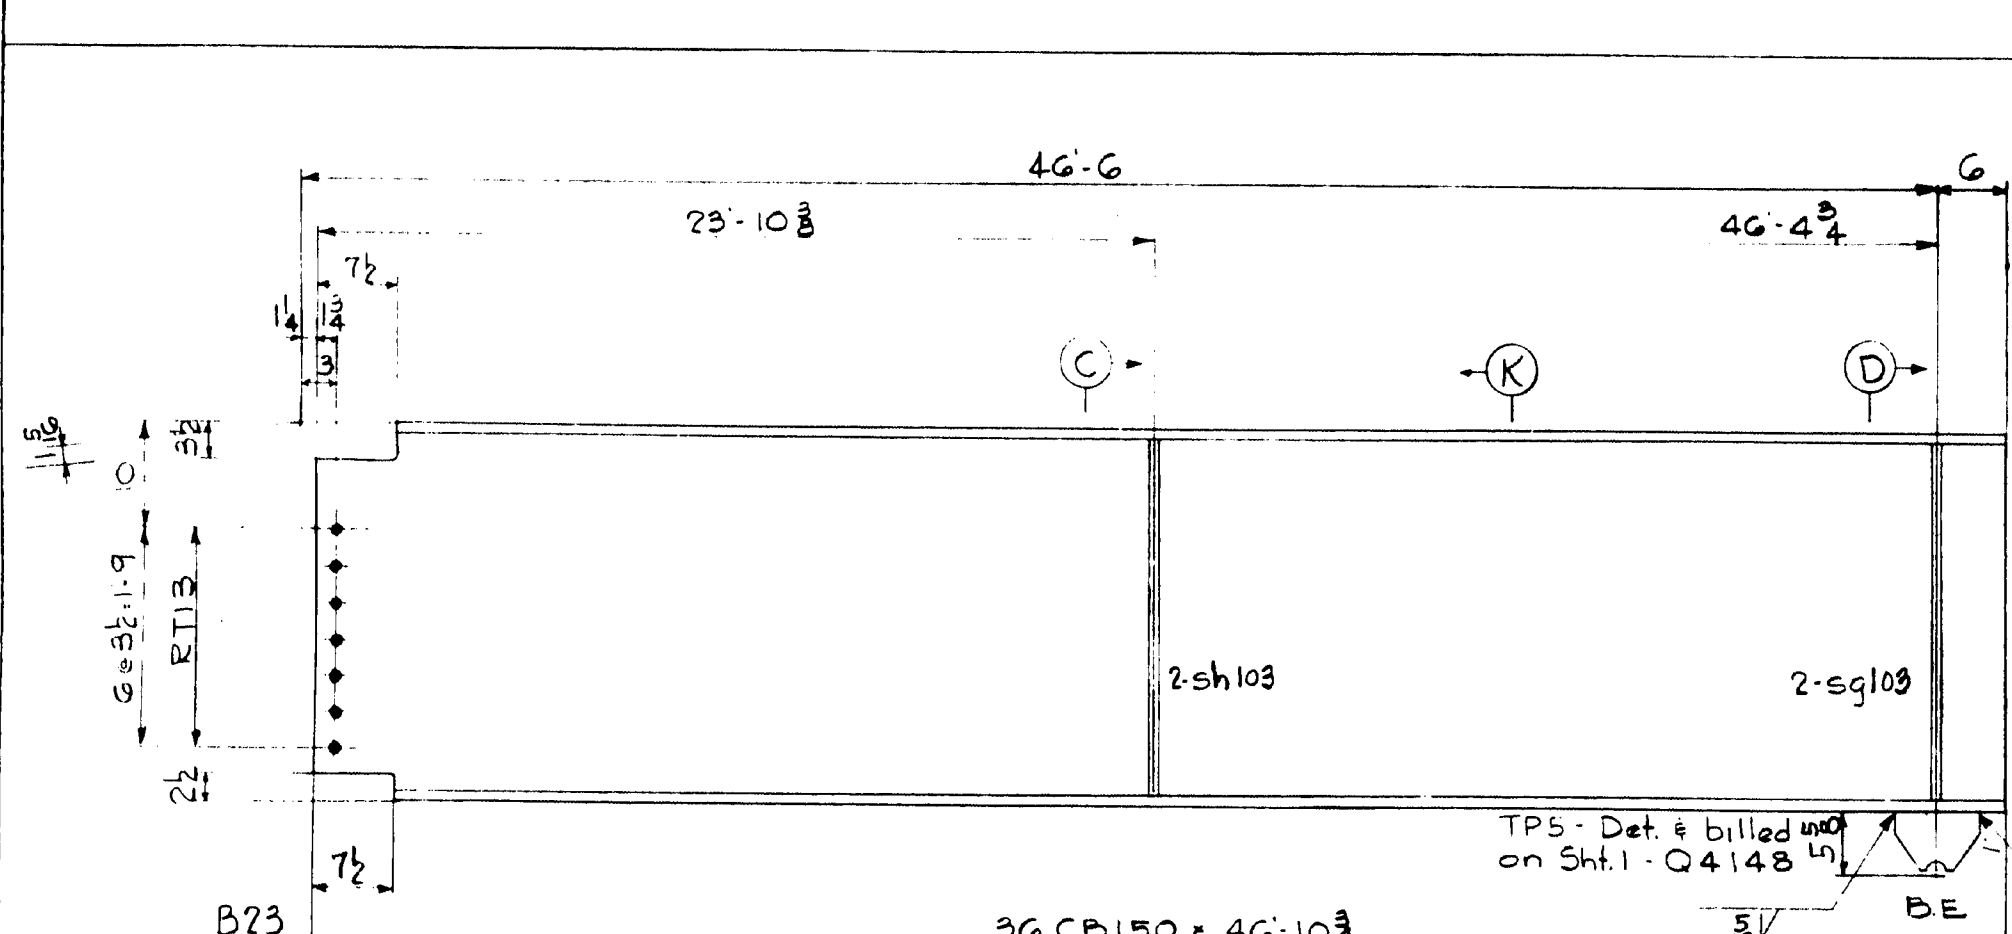 

LIFTING WT. - 4 TONS

NOTES:  
SPECIFICATIONS: Maine State Highway Comm. 1945 and Special Provisions.  
MATERIAL: OH Steel ASTM A7-52T  
HOLES: 1/2"  
WORKMANSHIP:  
Holes in material thicker than the diameter of the rivet shall be drilled.  
Holes marked RT to be subpunched or subdrilled 1/4" and reamed to size to a metal template.  
Shop to fabricate beams with natural mill camber up.  
BE indicates bearing end of stiffener.  
In assembling TP4 & TP5 to beams care must be taken to have axis of bore normal to & of beam.

STATE OF MAINE  
STATE HIGHWAY COMMISSION  
BANGOR BREWER BRIDGE  
OVER PENOBSCOT RIVER  
BANGOR, MAINE  
AMERICAN BRIDGE  
DIVISION  
UNITED STATES STEEL COMPANY

DRAWINGS MADE AT TRENTON PLANT  
WORK FABRICATED AT TRENTON PLANT  
IN CHARGE OF E.B. MARKS  
DRAW. MADE BY S.F.K. DATE 9-10-53  
DRAW. CHECKED BY R.R. DATE 1-5-54  
ORDER No. Q4149  
SHEET No. 109

PAINT: Yes, except top as noted  
SHOP CONTACT SURFACES: No





MOBILE 1000


EXPANSION DAMS ED1 ED2 ED3 ED4 ED5 ED6

AMERICAN BRIDGE  
DIVISION  
UNITED STATES STEEL COMPANY

ORDER No.	SHEET No.
Q4149	111

107

66-122 WELD

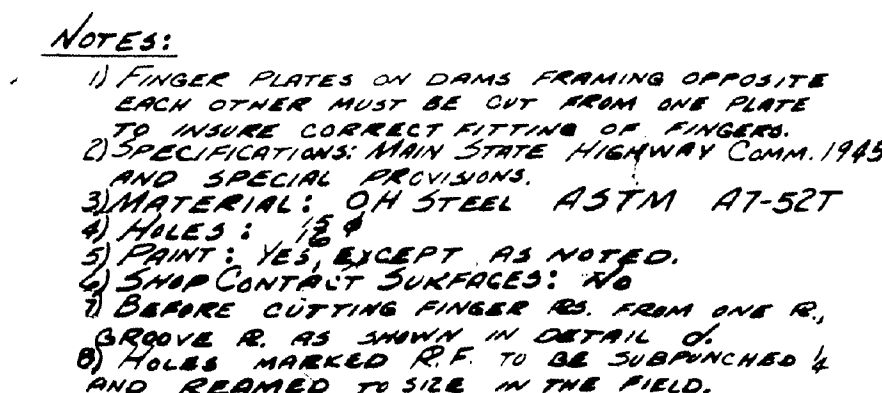




STATE OF MAINE  
STATE HIGHWAY COMMISSION  
BANGOR-BREWER BRIDGE  
OVER PENOBSCOT RIVER  
BANGOR, MAINE

AMERICAN BRIDGE  
DIVISION  
UNITED STATES STEEL CORP.

DRAWINGS MADE AT TRENTON PLANT  
WORK FABRICATED AT TRENTON  
IN CHARGE OF E.B. MARKS  
DRAW. MADE BY R.T.G. DATE 10-7-53  
DRAW. CHECKED BY b.e.f. DATE 1-11-54

ORDER No. **Q4149** SHEET No. **112**





Mr. Dill **62-123** WELDING

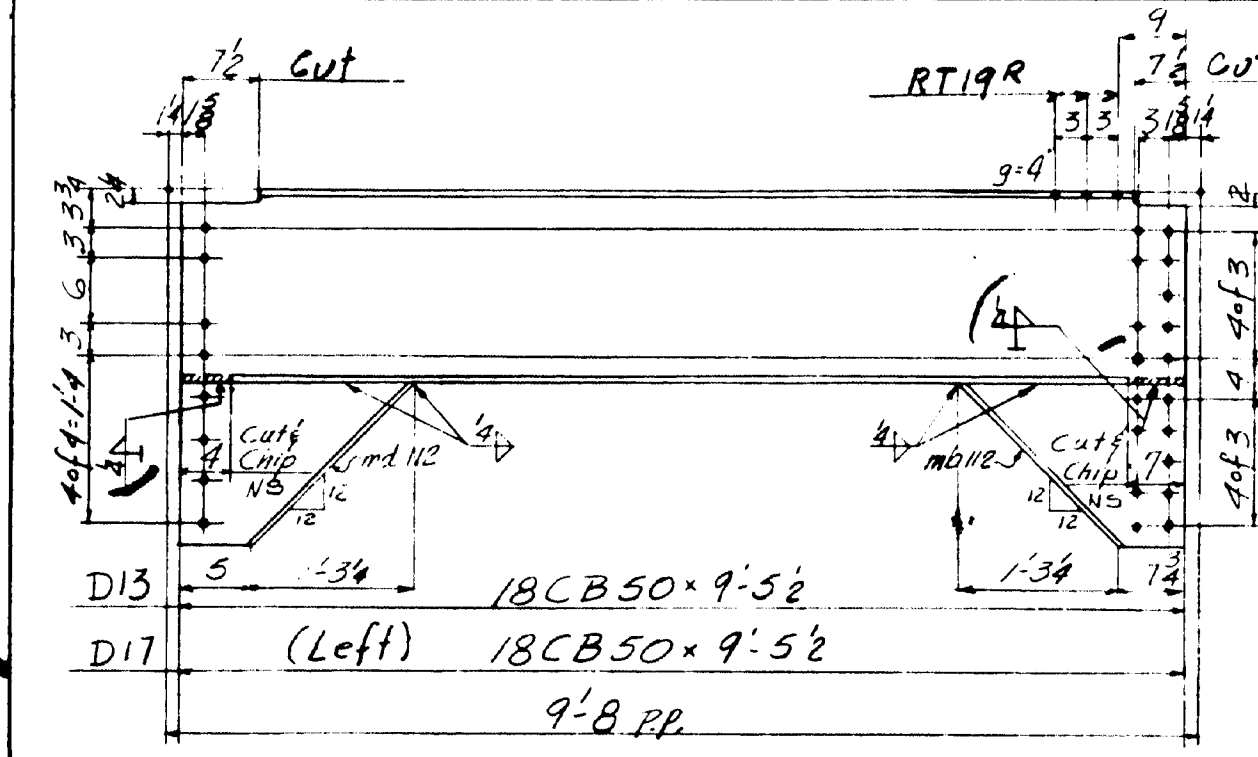

SPECIFICATIONS: - MAINE STATE HIGHWAY COMM. 1945 AND SPECIAL PROVISIONS  
MATERIAL: - Q.H. STEEL A.S.T.M. A7-52T

HOLES : - 15/16"  $\phi$  U.N

PAINT: YES - EXCEPT AS NOTED  
SHOP CONTACT SURFACES: NO

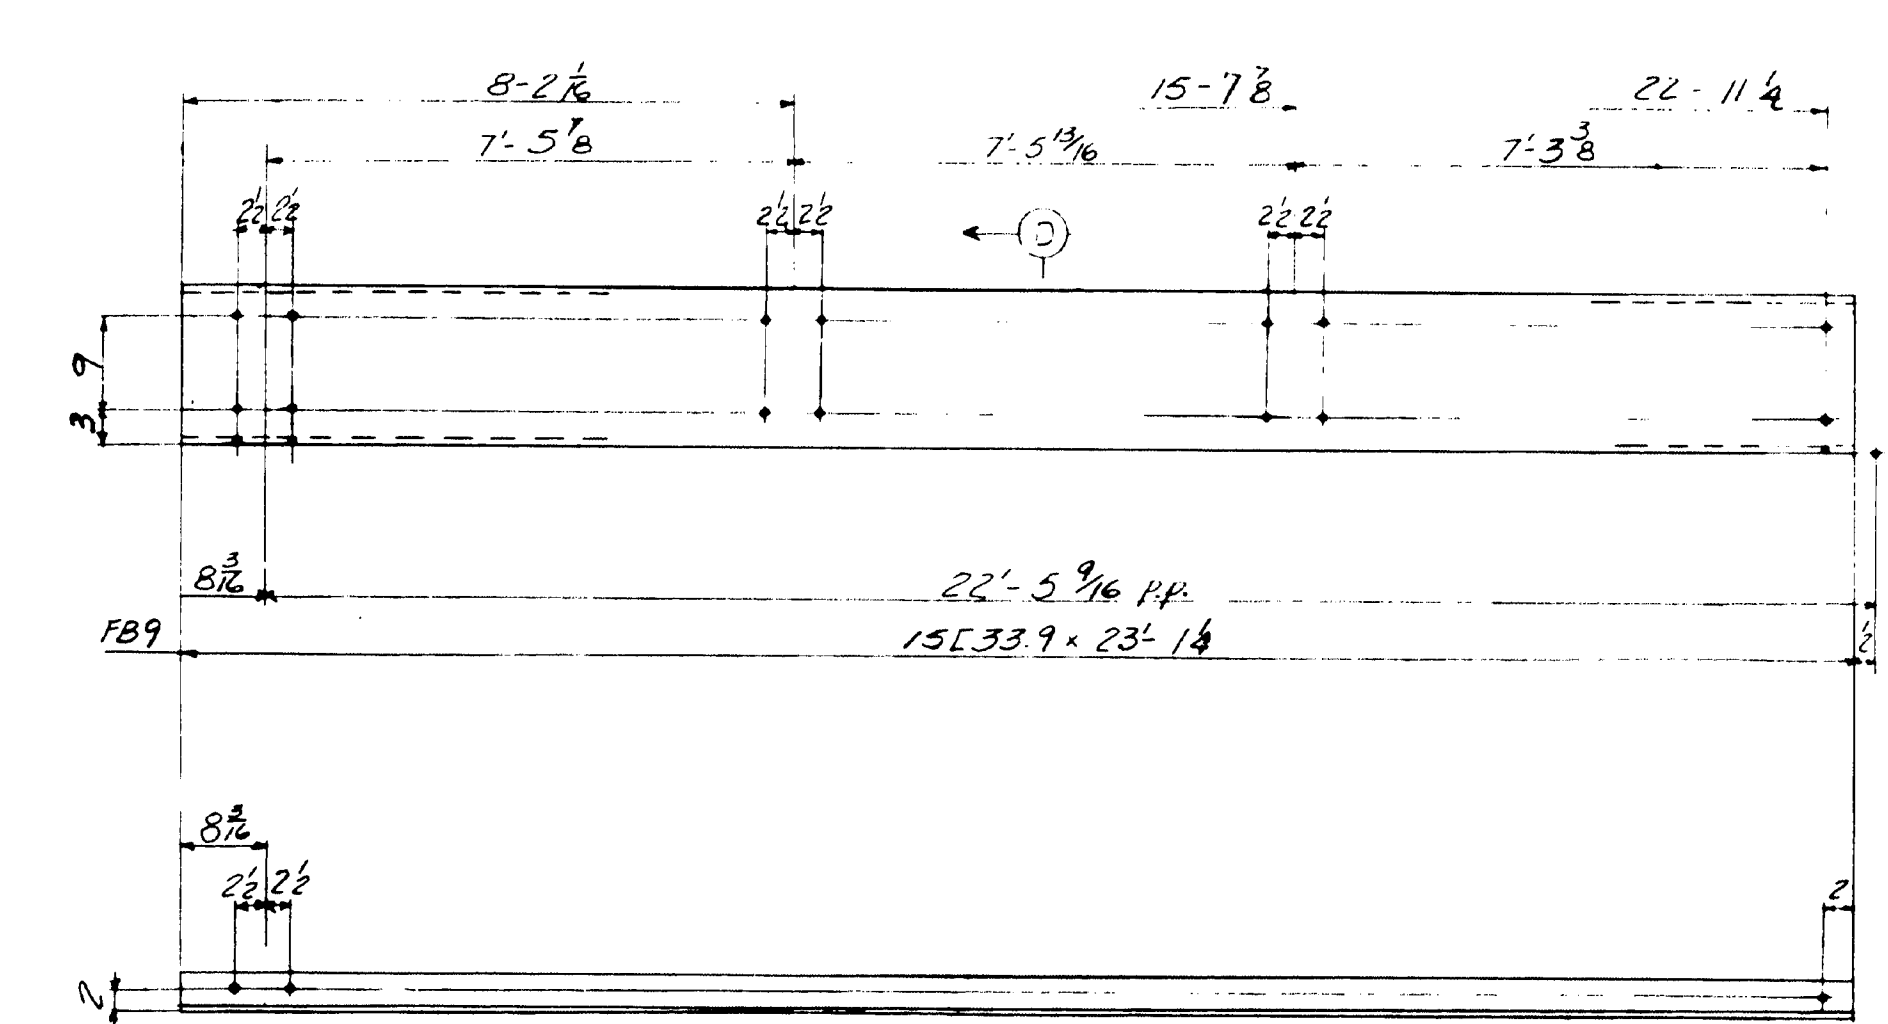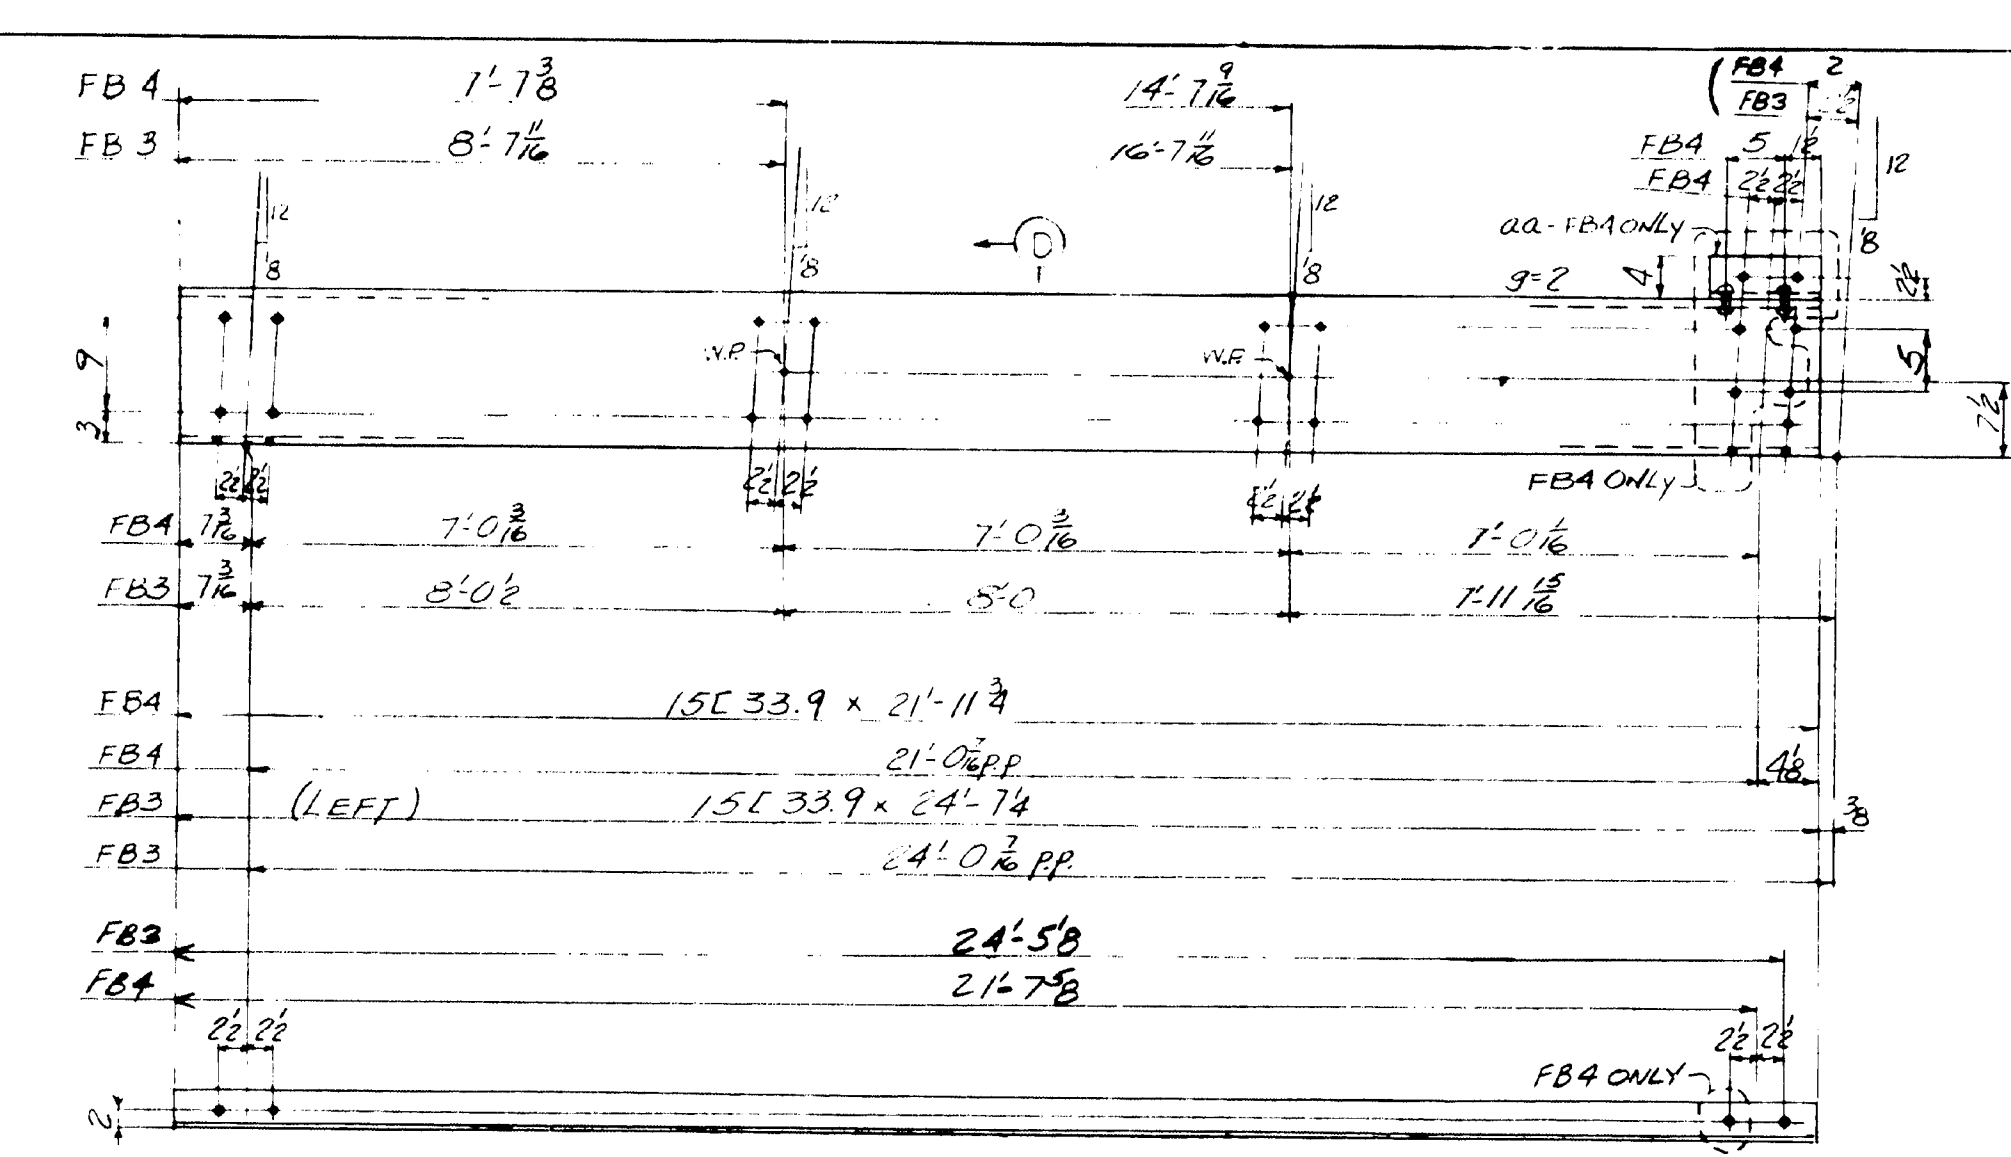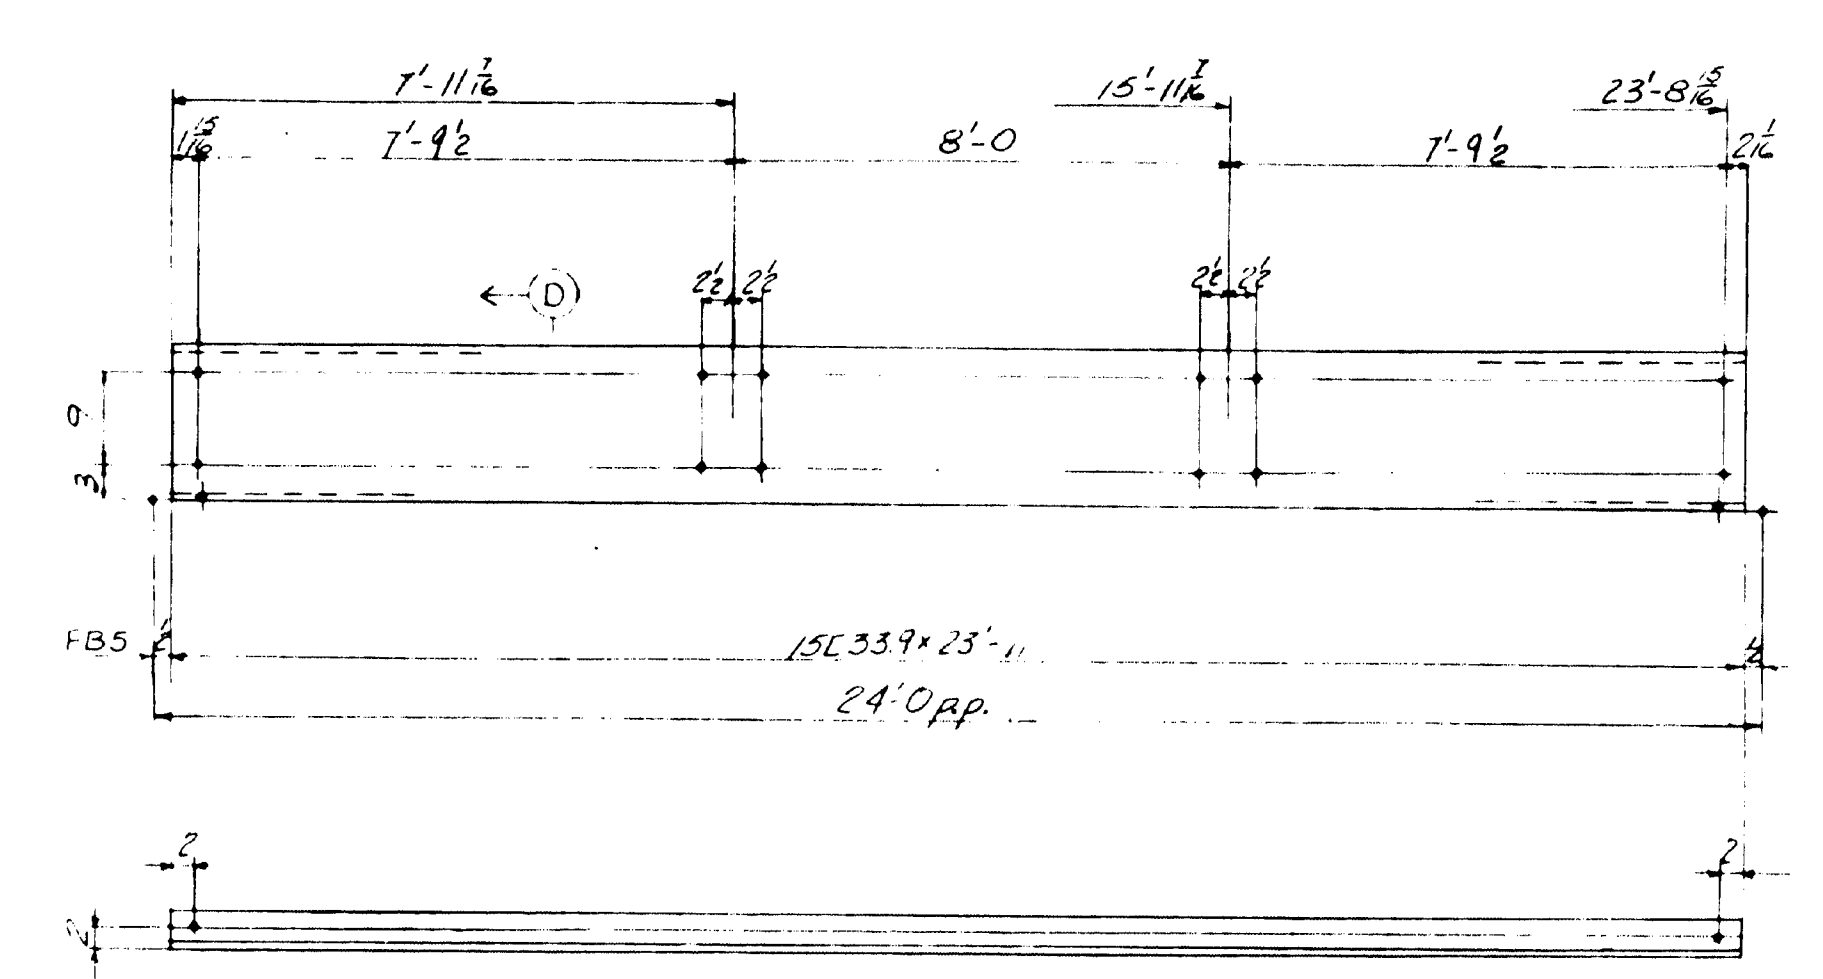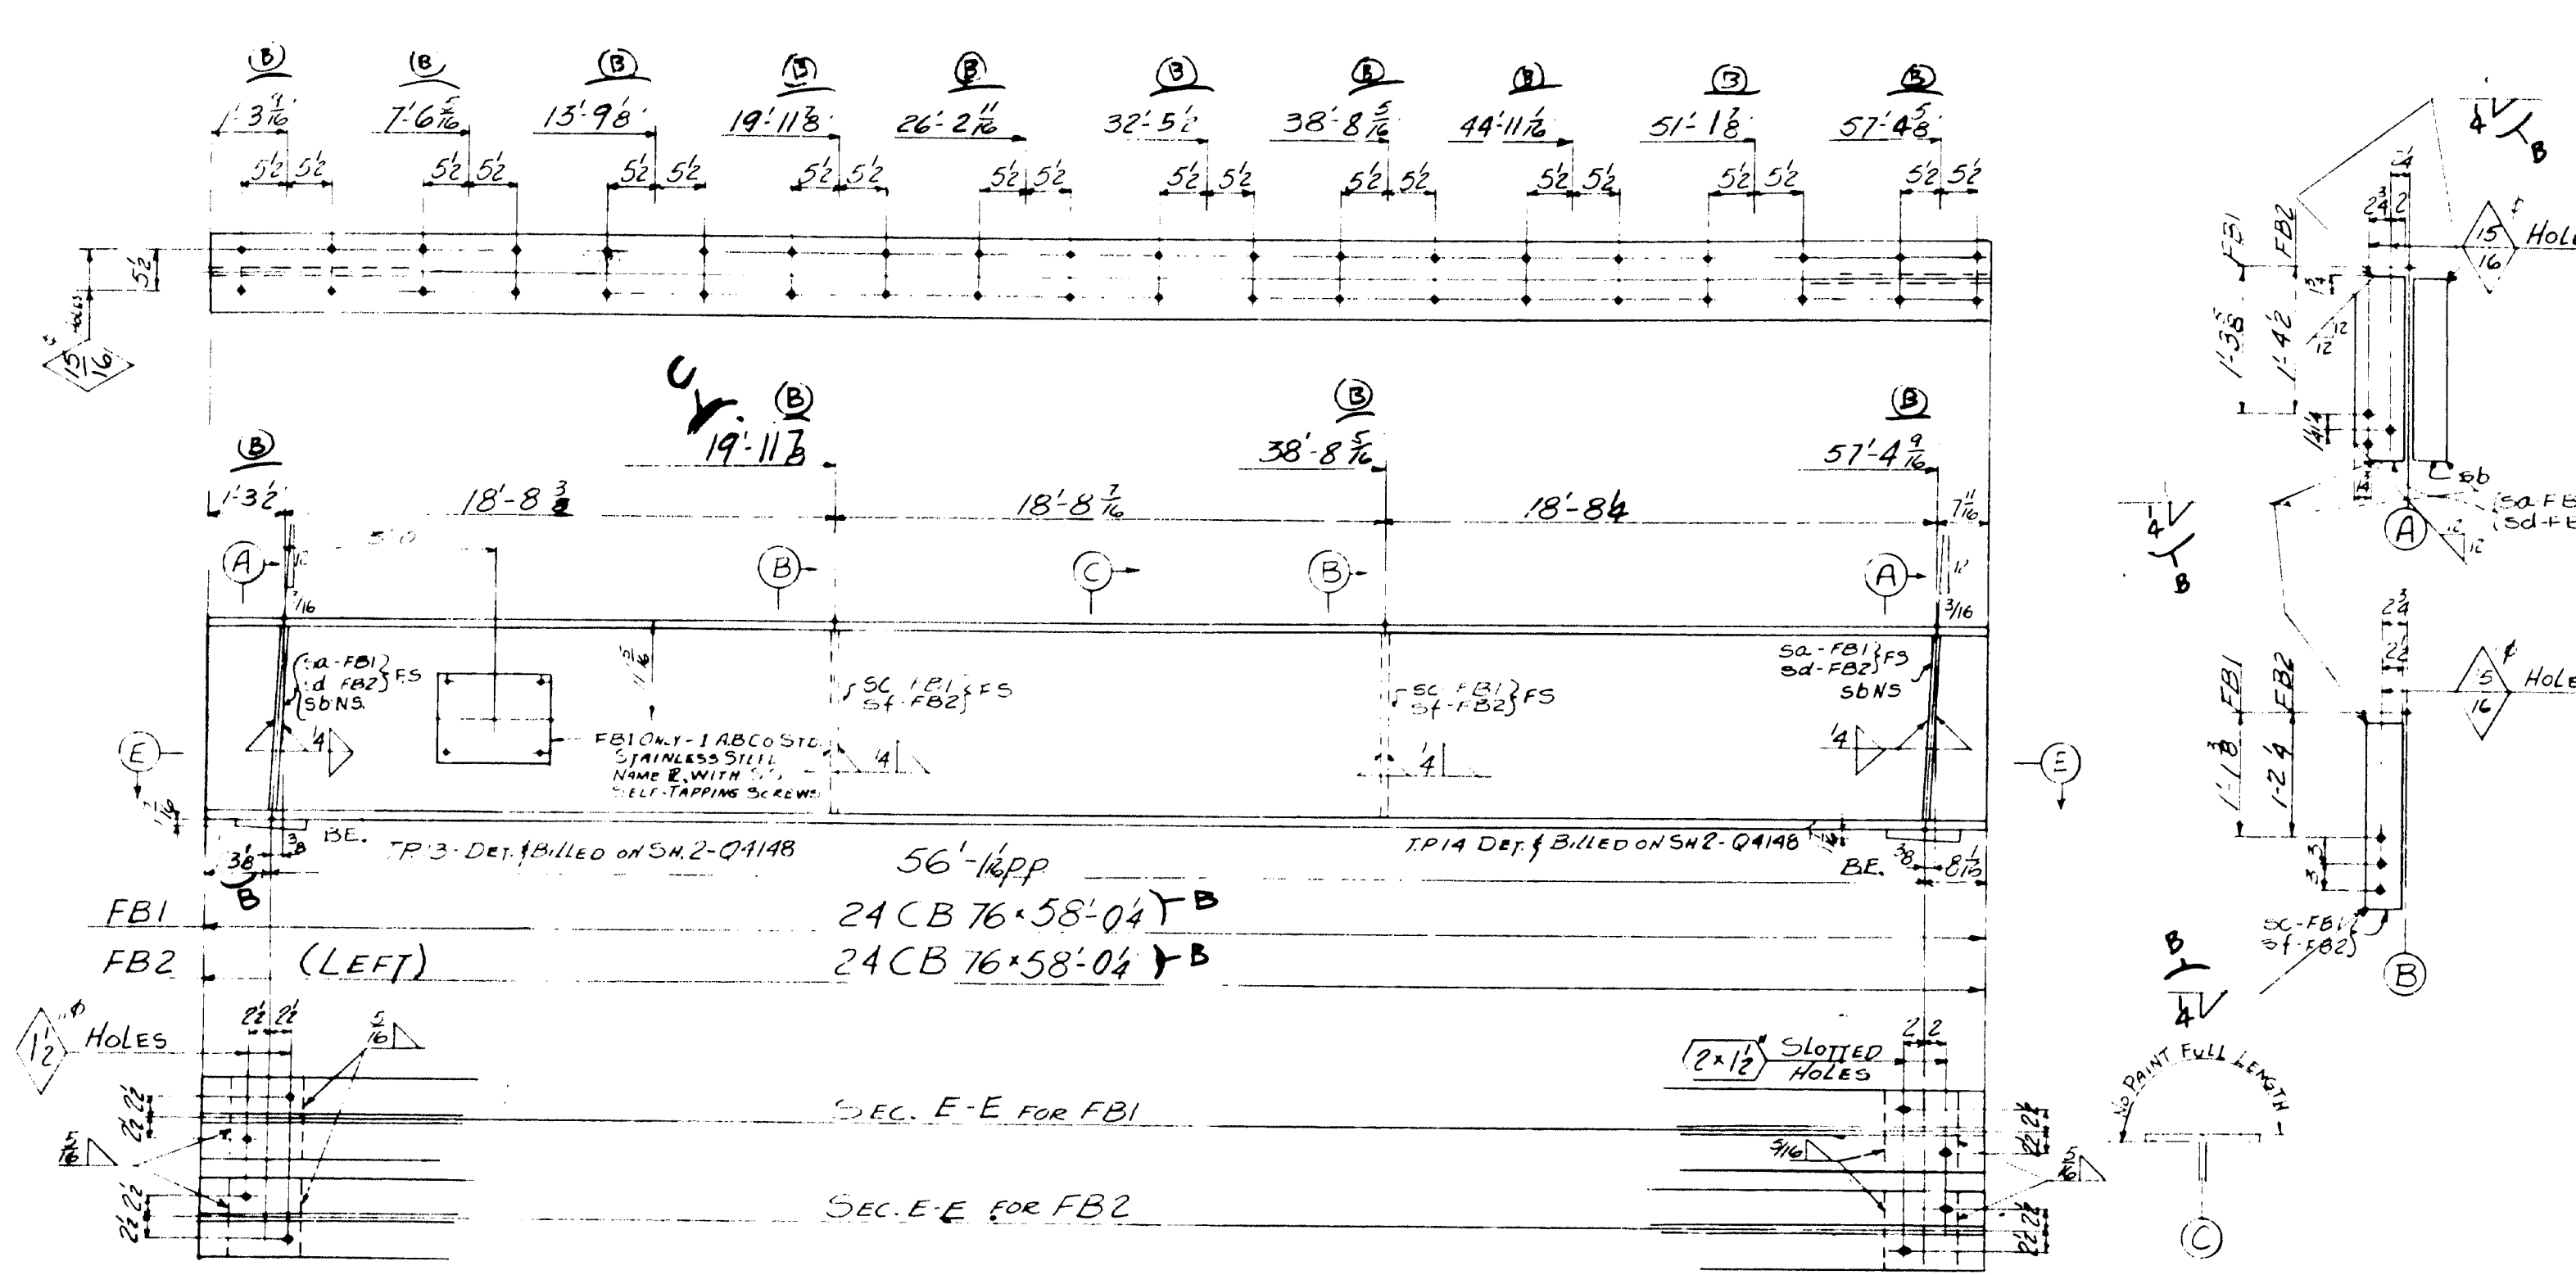

**NOTES:**  
 SPECIFICATIONS: MAINE STATE HIGHWAY COMM. 1745  
 AND SPECIAL PROVISIONS  
 MATERIAL: A.H. STEEL A588M A1-52T  
 RIVETS: 3/4\"/>

LINE	ITEM	MATERIAL			ABR. BLIND MARK	REMARKS	CALCULATED WEIGHT FOR ONE SHOP PIECE	ORDERED	ITEM	LINE	ITEM	MATERIAL			ABR. BLIND MARK	REMARKS	CALCULATED WEIGHT FOR ONE SHOP PIECE	ORDERED	ITEM	LINE	ITEM	MATERIAL			ABR. BLIND MARK	REMARKS	CALCULATED WEIGHT FOR ONE SHOP PIECE	ORDERED	ITEM
		SHAPE	LENGTH	Feet								Feet	Feet	Feet								Feet	Feet	Feet					
1	ONE FASCIA BEAM	FB1	44'-0"	1 1/2"	FB1	44'-0"	1 1/2"	FB1	1	16	ONE FASCIA BEAM	FB4	7'-5 1/2"	1 1/2"	FB4	7'-5 1/2"	1 1/2"	FB4	1	31									
2	ONE FASCIA BEAM	FB2	(LEFT) 44'-0"	1 1/2"	FB2	(LEFT) 44'-0"	1 1/2"	FB2	2	17	ONE FASCIA BEAM	FB3	8'-2 1/2"	1 1/2"	FB3	8'-2 1/2"	1 1/2"	FB3	2	32									
3									3	18									3	33									
4	2 24 CG 7/8	SC	30	1 1/2"	SC	30	1 1/2"	SC	4	19	1 15 L 3/8	21 1/8	FB4	7'-4 1/2"	21 1/8	1024		4	34										
5	2 R 6 3/8	SC	1 1/2"	SC	FB1	29 1/2	35-0	MB18	5	20	1 15 L 3/8	24 7/8	FB3	8'-4 1/4"	24 7/8	1024		5	35										
6	4 R 4 3/8	SC	1 1/2"	SC	FB1	16 1/2			6	21	1 L 4 3/8	2	8	FB4	8			6	36										
7	2 R 4 3/8	SC	1 1/2"	SC	FB1	16 1/2			7	22								7	37										
8	2 R 6 3/8	SC	1 1/2"	SC	FB1	29 1/2			8	23	4 FASCIA BEAMS	FB5	8'-13 1/2"					8	38										
9	2 R 4 3/8	SC	1 1/2"	SC	FB1	16 1/2			9	24								9	39										
10									10	25	4 15 L 3/8	23 1/8		8'-11 1/2"	23 1/8	1024		10	40										
11	1 S.S. AB CG STR. NAME P	FB1	3		FB1	3			11	26								11	41										
12									12	27	ONE FASCIA BEAM	FB9	7'-8 1/2"					12	42										
13	2 TOP PLATES	TP13	DESIGNED		TP13	DESIGNED			13	28								13	43										
14	2 TOP PLATES	TP4	ON S.W. P		TP4	ON S.W. P			14	29	1 15 L 3/8	23 1/4		7'-8 1/2"	23 1/4	1024		14	44										
15									15	30								15	45										

**FASCIA BEAMS-DIV. I**  
 STATE OF MAINE  
 STATE HIGHWAY COMMISSION  
 BANGOR-BREWER BRIDGE  
 OVER PENOBSCOT RIVER,  
 BANGOR, MAINE

AMERICAN BRIDGE COMPANY  
 DRAWINGS MADE AT TRENTON PLANT  
 WORK FABRICATED AT TRENTON PLANT  
 IN CHARGE OF E.B. MARKS  
 DRAW. MADE BY RIG DATE 10-14-54  
 DRAW. CHECKED BY PRY DATE 11-14-54  
 ORDER No. Q4149 SHEET No. 113



AMERICAN BRIDGE COMPANY

LINE	ITEM	MATERIAL	SHAPE	SIZE	LENGTH	REMARKS	ORDERED	ITEM	QUANTITY	FOR ONE	FOR ONE
1											
2											
3											
CURVED FASCIA BMS. & SIDEWALK BKTS. - DIV 1

STATE OF MAINE  
STATE HIGHWAY COMMISSION  
BANGOR BREWER BRIDGE  
OVER PENOBSCOT RIVER  
BANGOR, MAINE

AMERICAN BRIDGE COMPANY  
MADE IN U.S.A.

DRAWINGS MADE AT TRENTON PLANT  
WORK FABRICATED AT TRENTON PLANT  
IN CHARGE OF E.B. MARKS  
DRAWN BY R.J.G. DATE 10.21.53  
CHECKED BY R.J.G. DATE 1.19.54  
ORDER NO. 94149 SHEET NO. 114



NOTES  
SPECIFICATIONS: MAINE STATE HIGHWAY COMM. 1945 AND  
SPECIAL PROVISIONS  
MATERIAL: A572 STEEL ASTM A7-52T  
RIVETS: 5/8" HOLES 3/4" U.N.

WORKMANSHIP: HOLES IN MATERIAL THICKER THAN THE  
DIAMETER OF THE RIVET SHALL BE DRILLED  
HOLES MARKED RT TO BE SUBPUNCHED  
OR SUBDRILLED 1/4" AND REAMED TO SIZE  
TO METAL TEMPLATE.  
All holes for shop rivets to be subpunched  
or subdrilled 1/4" and reamed to size with corners  
parts assembled.  
PAINT: YES - EXCEPT AS NOTED  
SHOP CONTACT SURFACES: NO

REVISIONS  
F 4-9-54  
E 4-8-54  
D 2-5-54  
C 2-5-54  
B 2-5-54  
A 2-5-54

MA 11

68-125 W&K

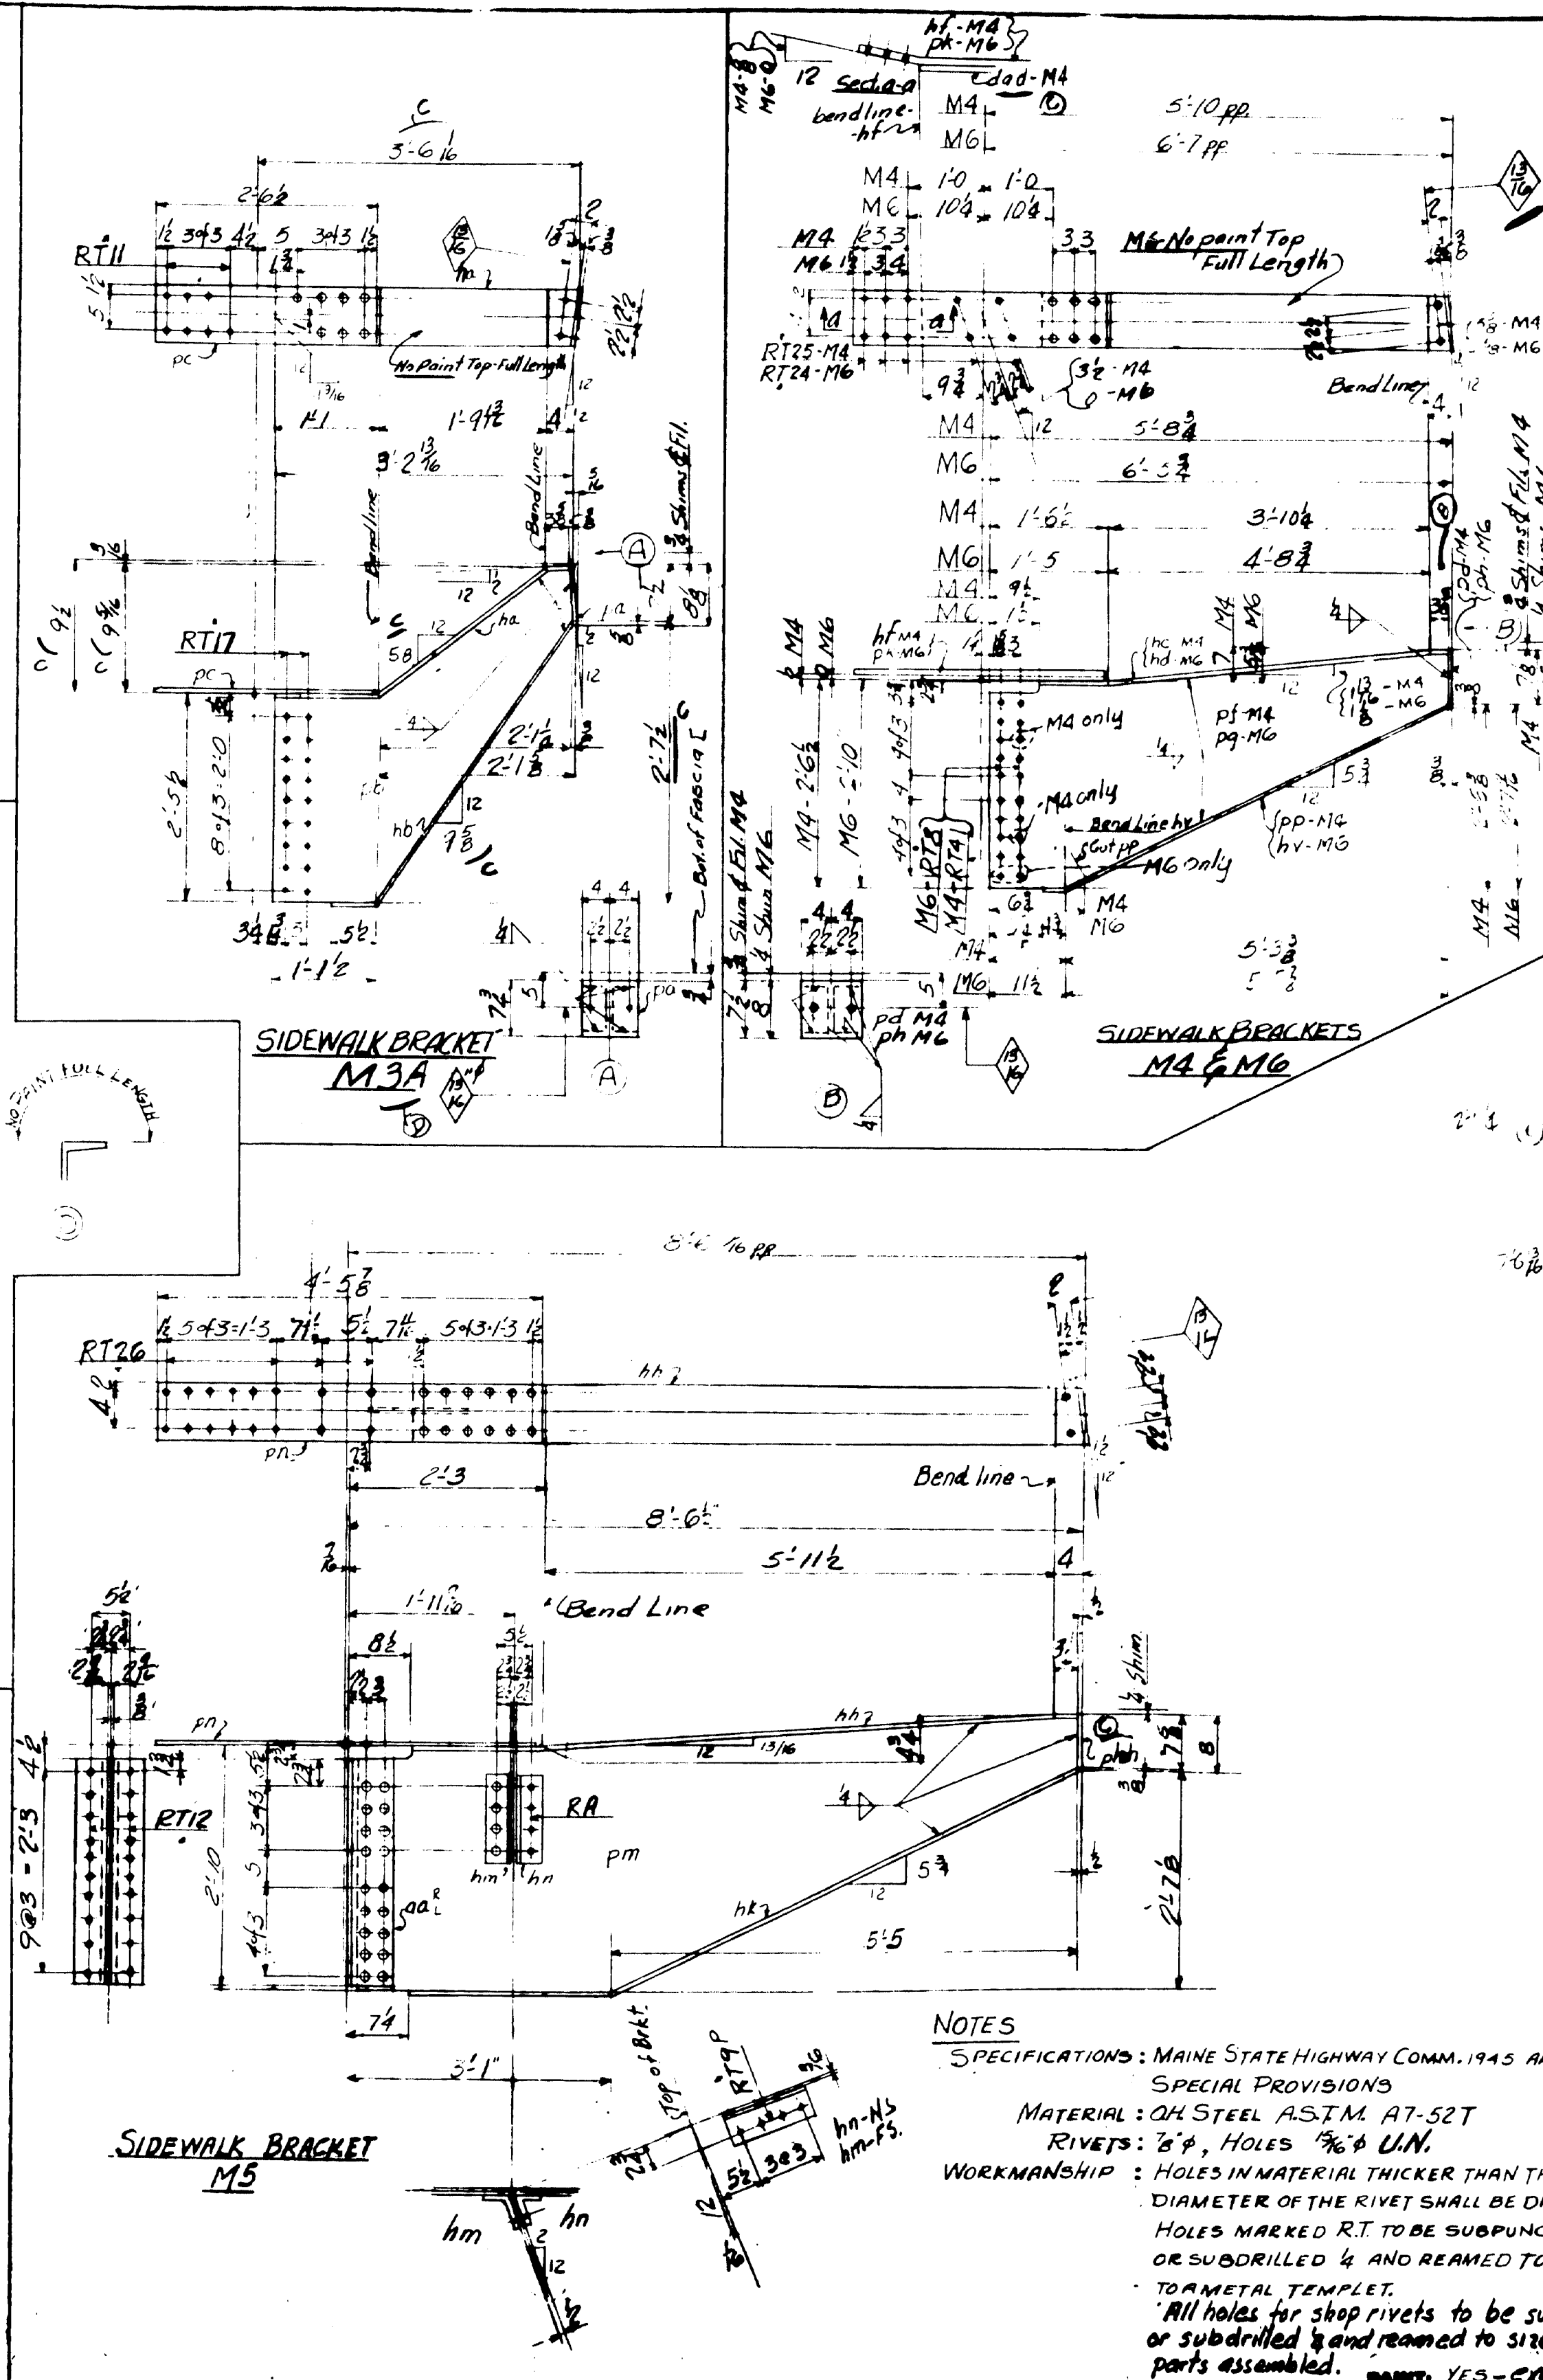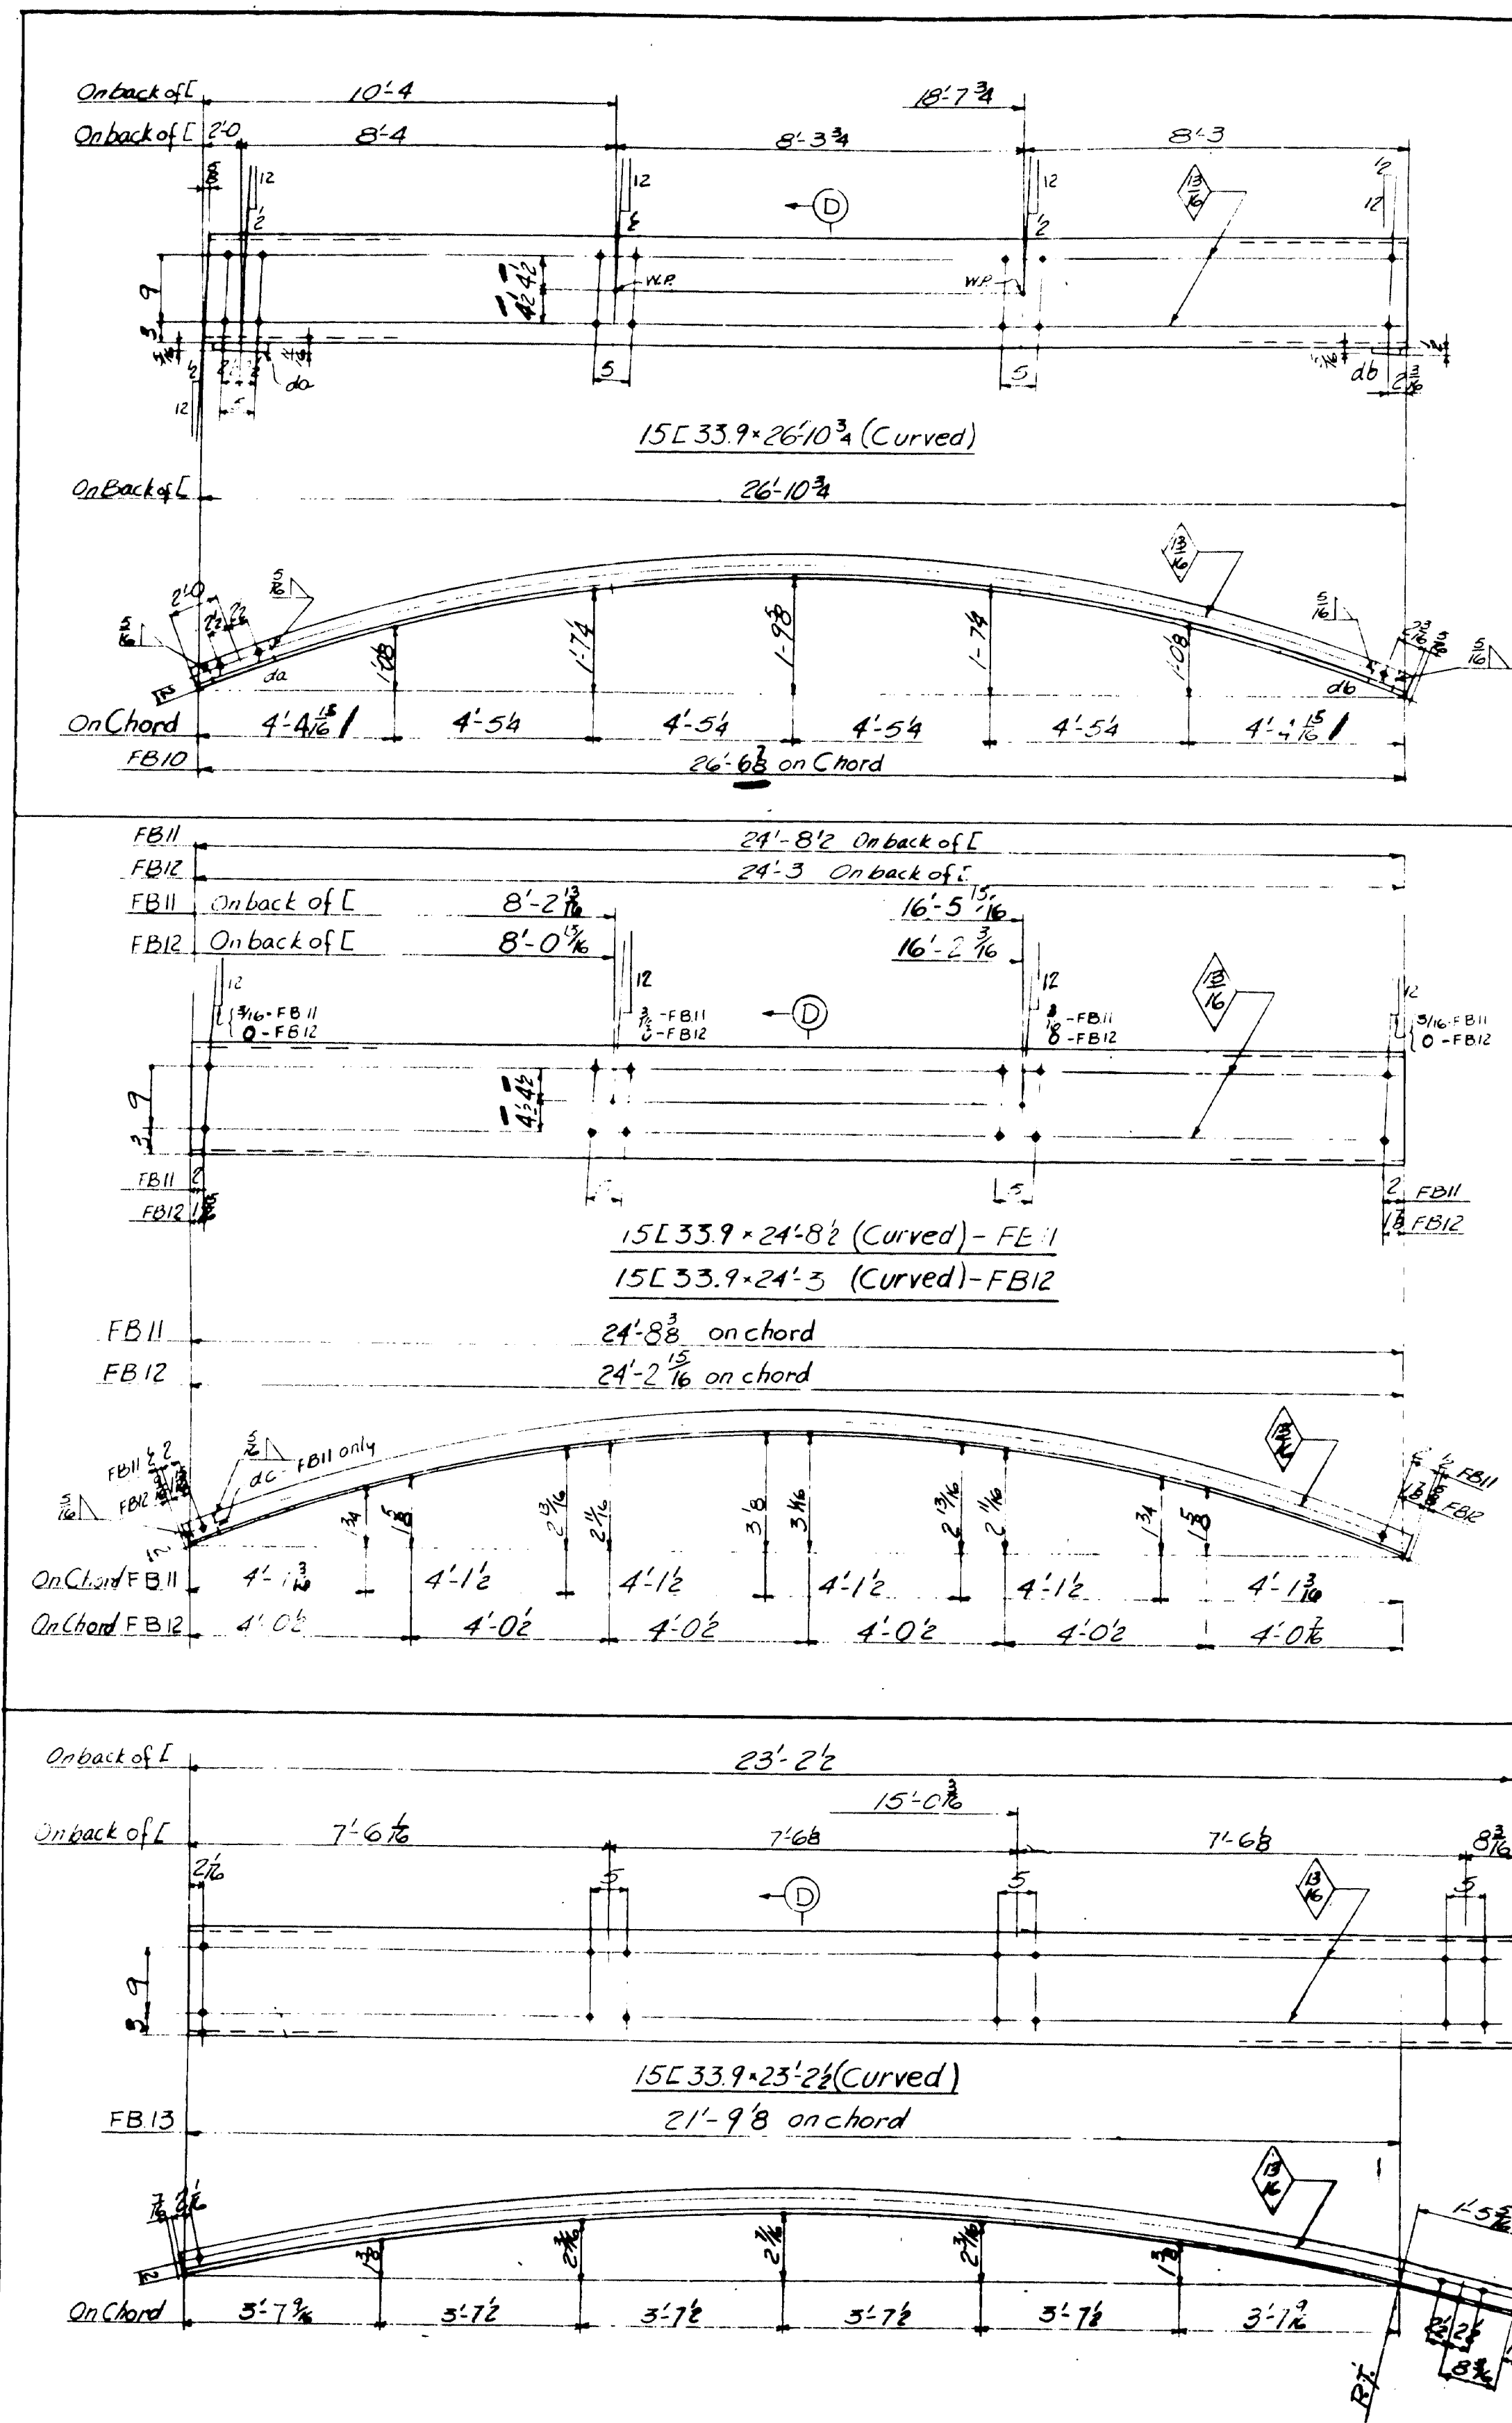



# DRAWING WITH BILL AMERICAN BRIDGE

UNITED STATES STEEL COMPANY

LINE	ITEM	MATERIAL	LENGTH	REMARKS	ORDERED	ITEM	QUANTITY	WEIGHT	FOR ONE
1									
2									
3									
4	ONE DIAPHRAGM	D14	371"						
5									
6	1 18 CB 50	6 4 1/2						60 1/2-0	10 1/8
7	1 18 CB 50	6 4 1/2						60 1/2-0	10 1/8
8	1 18 CB 50	6 4 1/2						60 1/2-0	10 1/8
9	ONE DIAPHRAGM	D15	373"						
10									
11	1 18 CB 50	6 4 1/2						60 1/2-0	10 1/8
12	1 18 CB 50	6 4 1/2						60 1/2-0	10 1/8
13	1 18 CB 50	6 4 1/2						60 1/2-0	10 1/8
14	ONE DIAPHRAGM	D16	611"						
15									
16	1 12 CB 64	6 1/2						45-0	4 4/3
17	1 12 CB 64	6 1/2						45-0	4 4/3
18	1 12 CB 64	6 1/2						45-0	4 4/3
19	2 1/2 7 4 3/8	2 7	99"						7 9
20	ONE SIDEWALK BRACKET	M2	347"						
21									
22	1 1/2 8 3/8	6 1/2		Bent				45-0	M618
23	1 1/2 8 3/8	6 1/2		Bent				45-0	M618
DIAPHRAGMS, SIDEWALK BRACKETS & STRUTS

DIV. 1

STATE OF MAINE  
STATE HIGHWAY COMMISSION  
BANGOR-BREWER BRIDGE  
OVER PENOBSCOT RIVER  
BANGOR MAINE

## NOTES

SPECIFICATIONS: MAINE STATE HIGHWAY  
1945 AND SPECIAL PROVISIONS  
MATERIAL: Q.H. STEEL ASTM. A7-52T  
RIVETS: 7/8" HOLES 7/8" U.N.  
WORKMANSHIP: HOLES MARKED R.I. TO  
BE SUBPUNCHED OR SUBDRILLED  
4 AND REAMED TO SIZE TO A METAL  
TEMPLET.



All holes for shop rivets to be  
subpunched or subdrilled 1/4 and reamed  
to size with connecting parts assembled.

F 3-2-54	DRAWINGS MADE AT	TRENTON	PLANT
E 2-22-54	WORK FABRICATED AT	TRENTON	PLANT
D 2-17-54	IN CHARGE OF	E.B. MARKS	
C 2-9-54	DRAW. MADE BY	R.G.	DATE 10-29-53
B 2-5-54	DRAW. CHECKED BY	R.R.	DATE 1-17-54
X 2-1-54	ORDER NO.	Q4149	SHEET NO.
REVISIONS			115

PAINT: YES - EXCEPT AS NOTED  
SHOP CONTACT SURFACES: NO



104,105,106

62-126 Weld

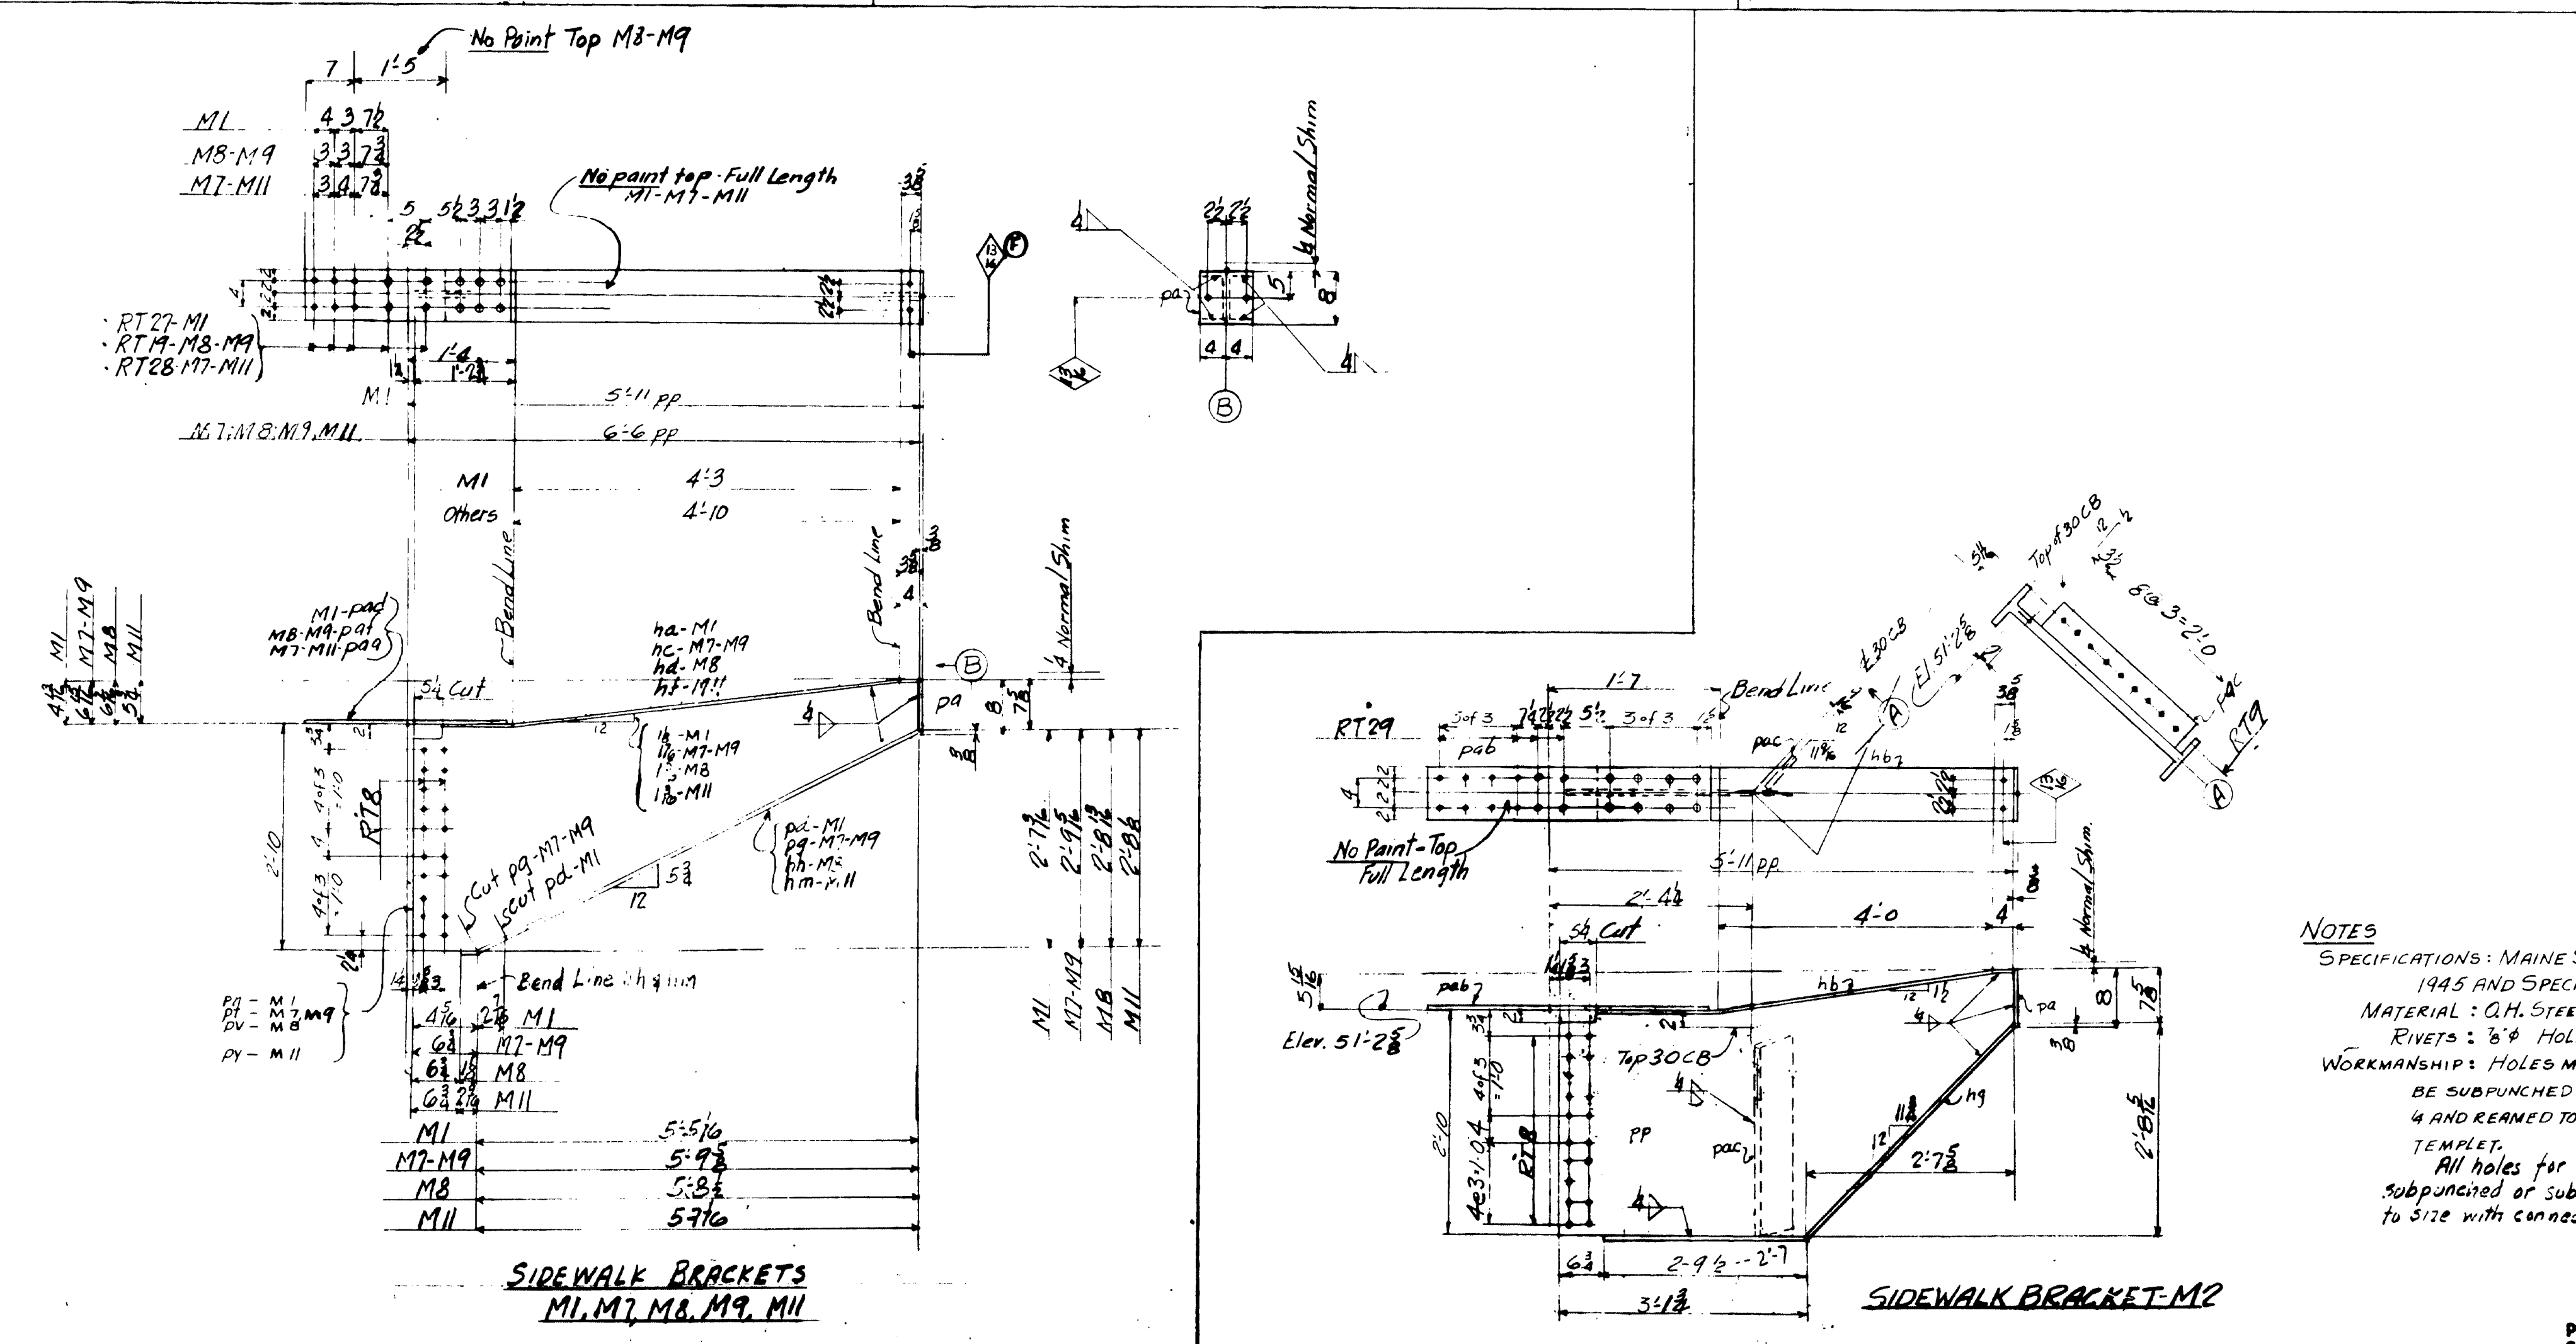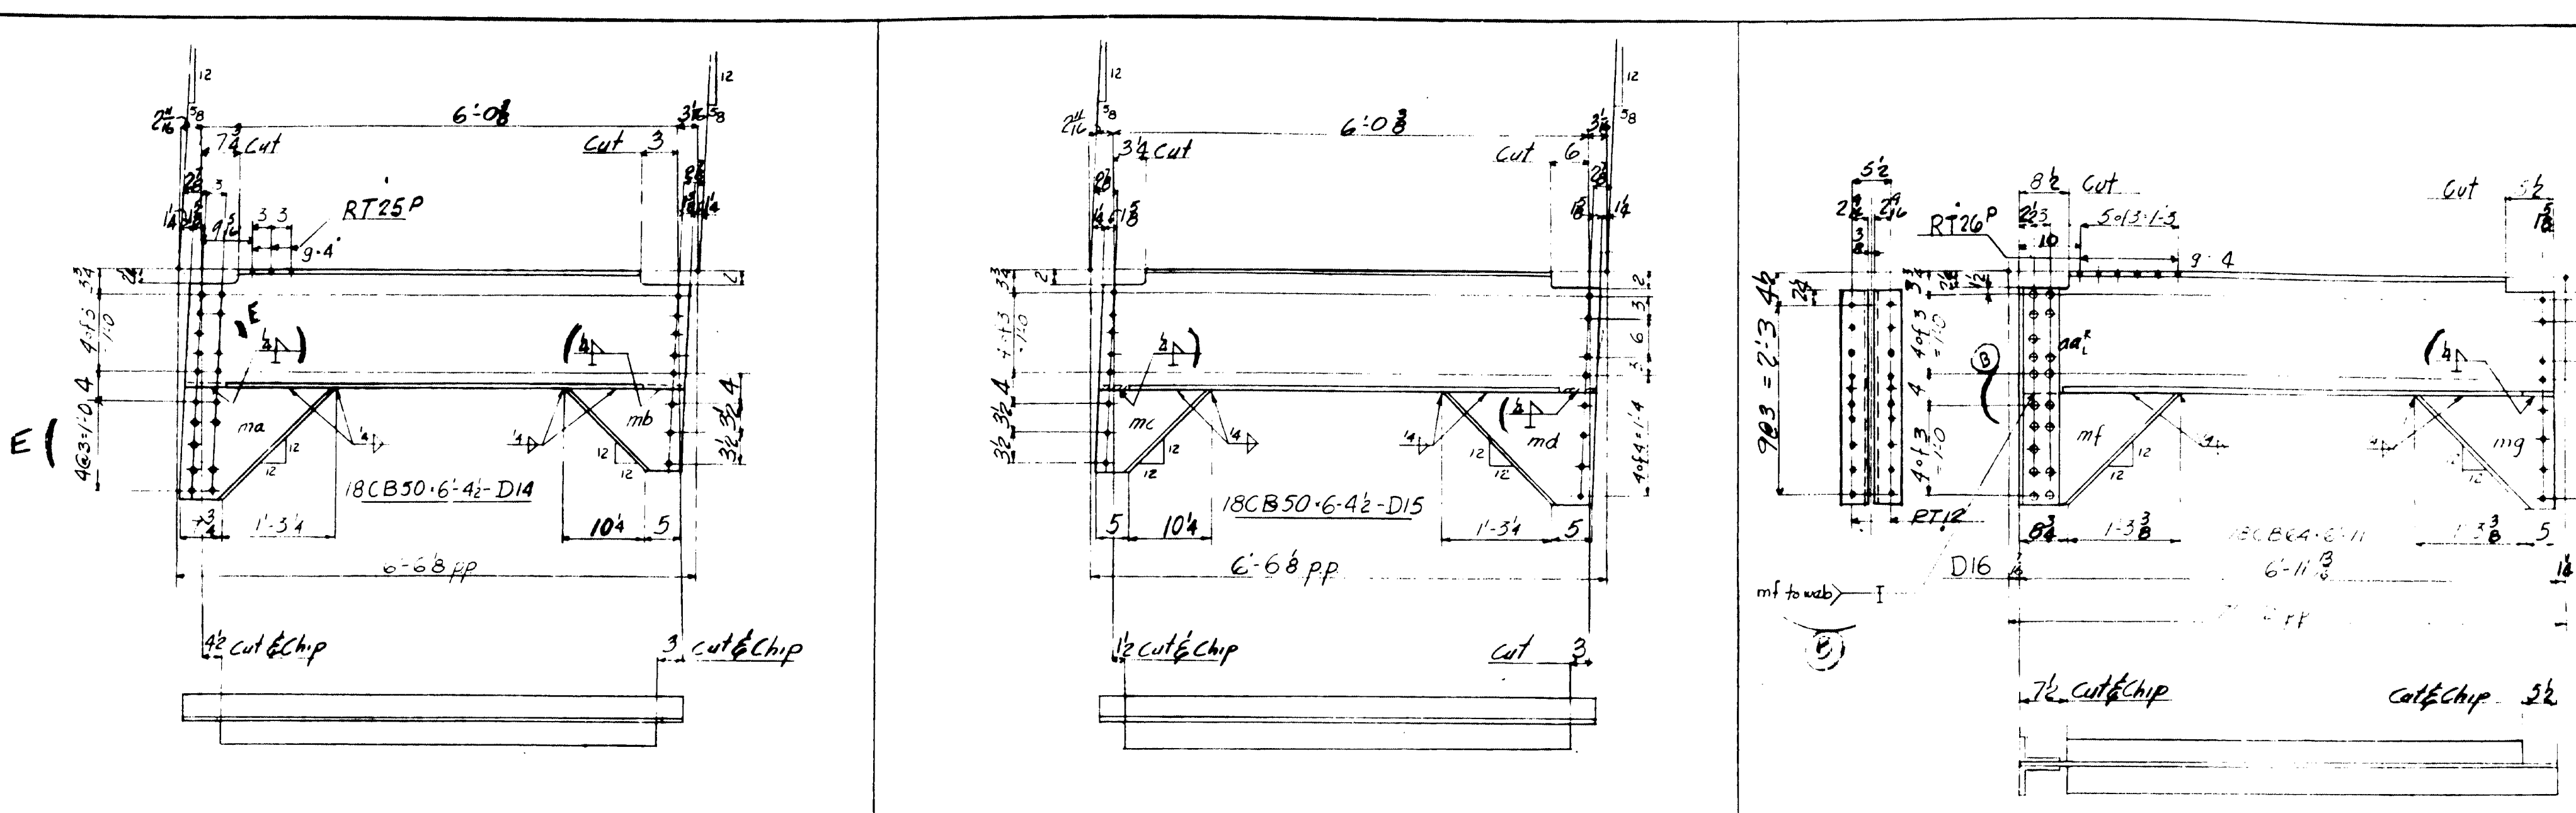



SIDEWALK BRACKETS  
M1, M2, M3, M99, M100



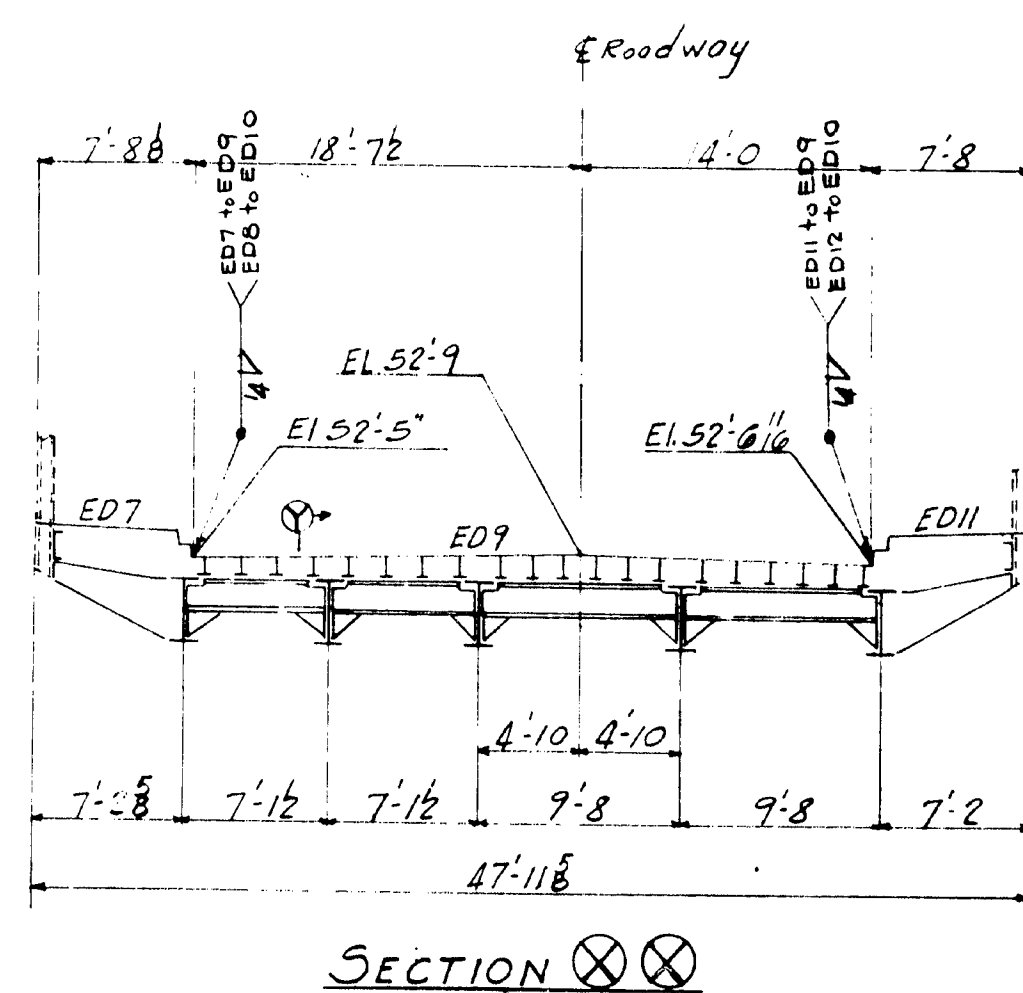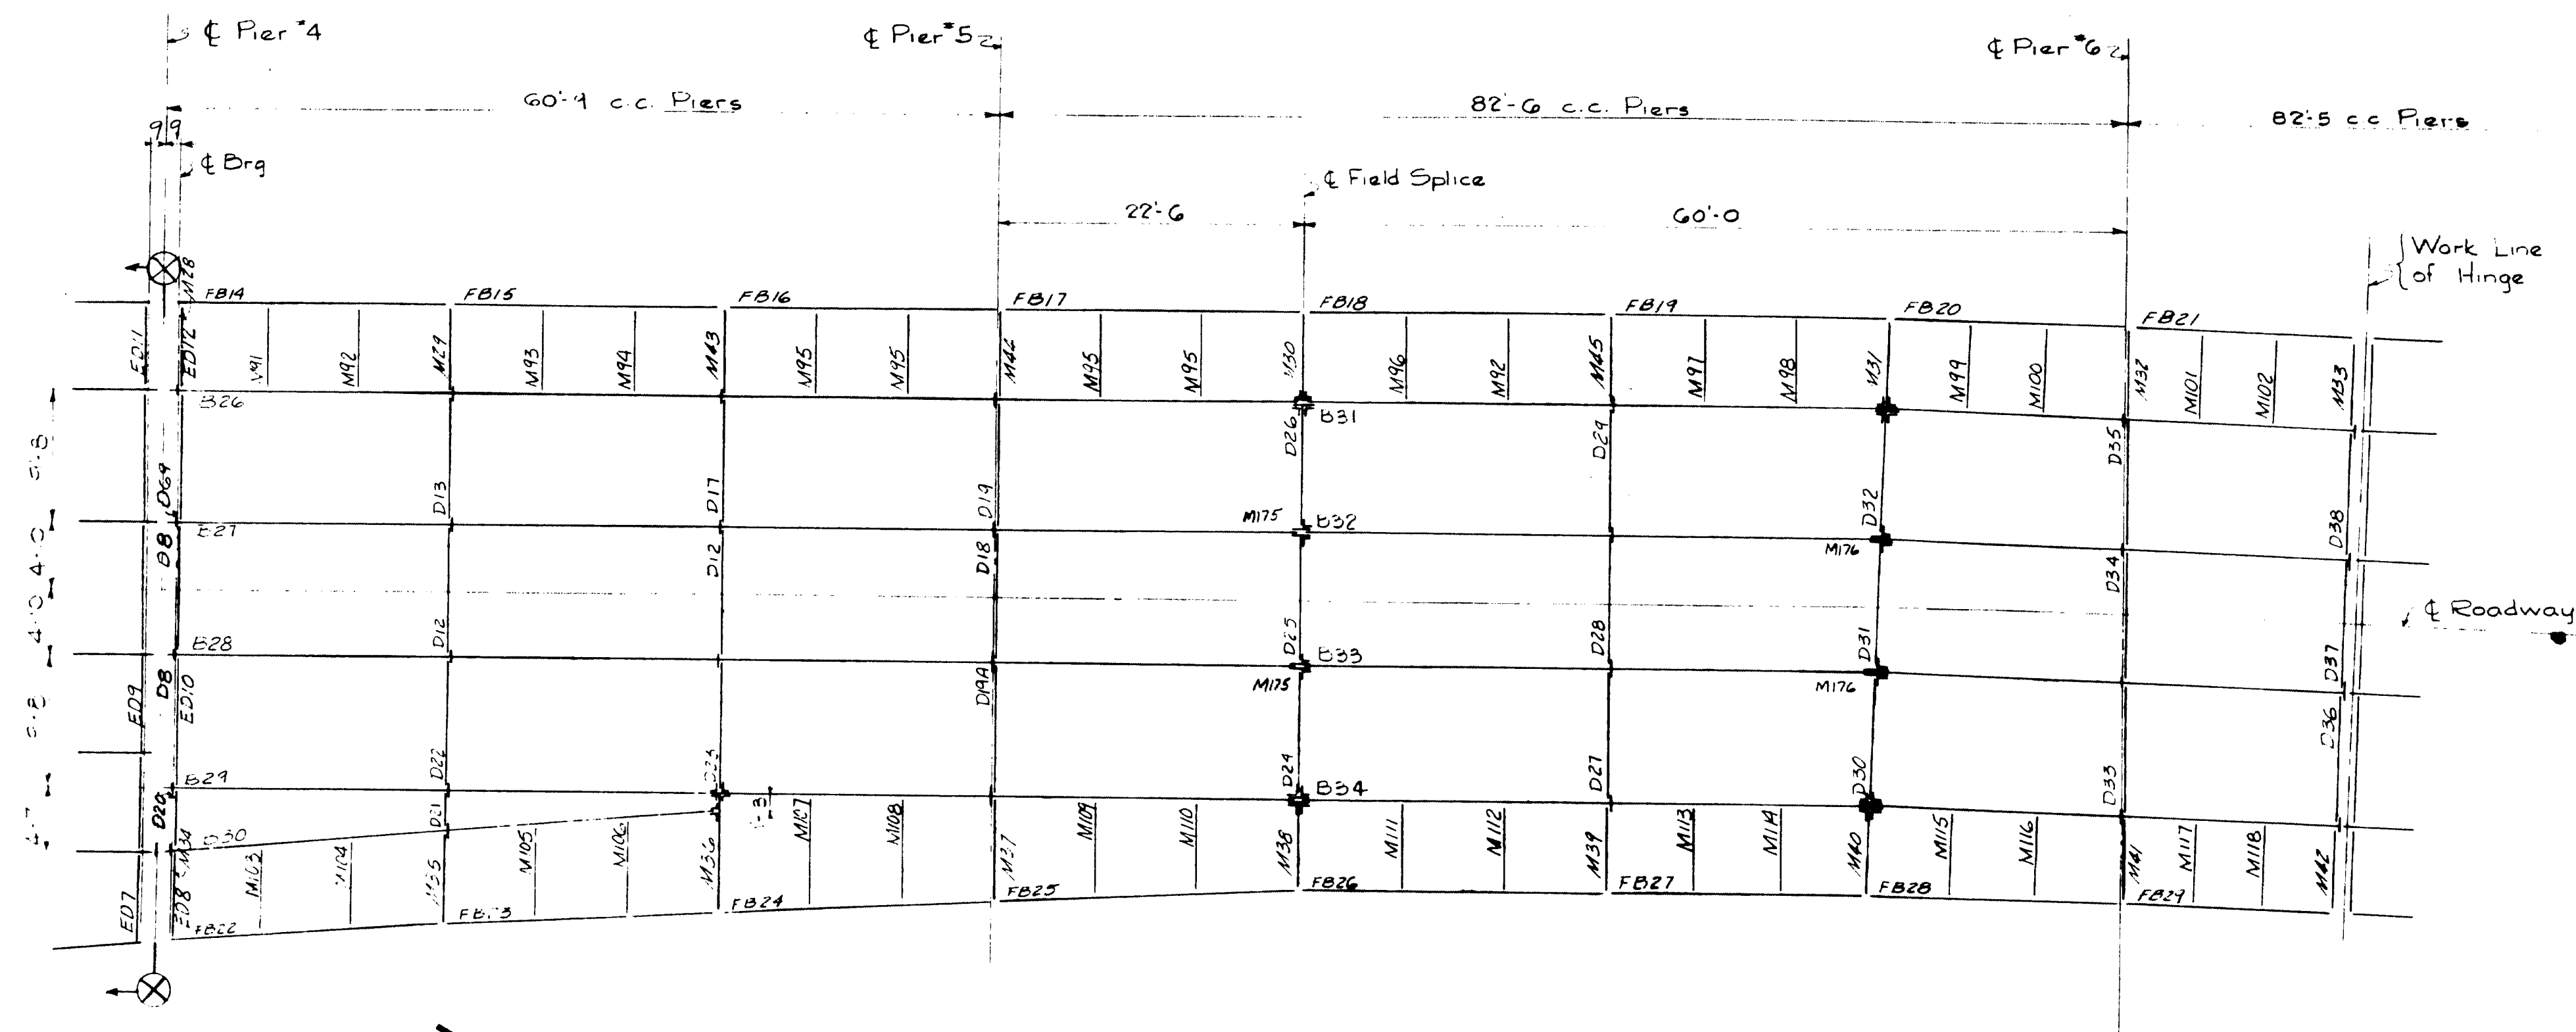


SECTION X-X


NOTE:  
Ream holes to 1/8"  
after dams are  
properly aligned

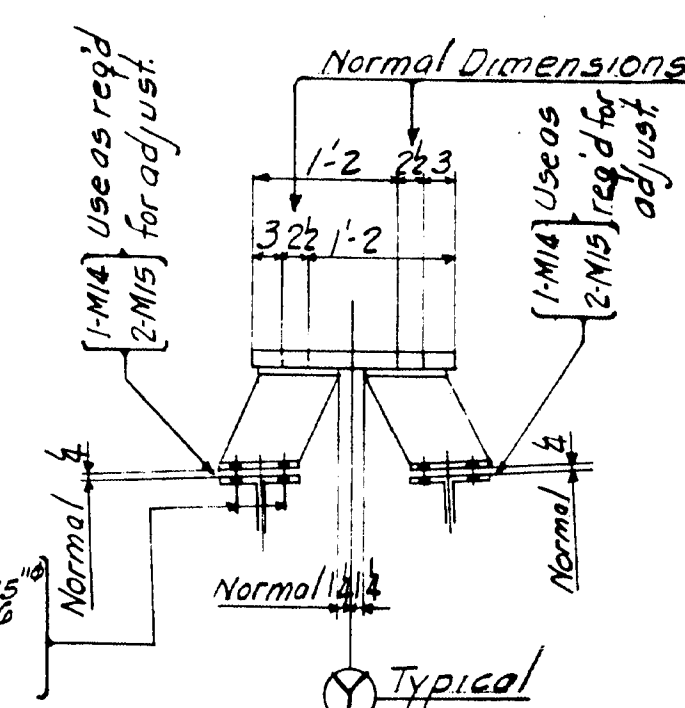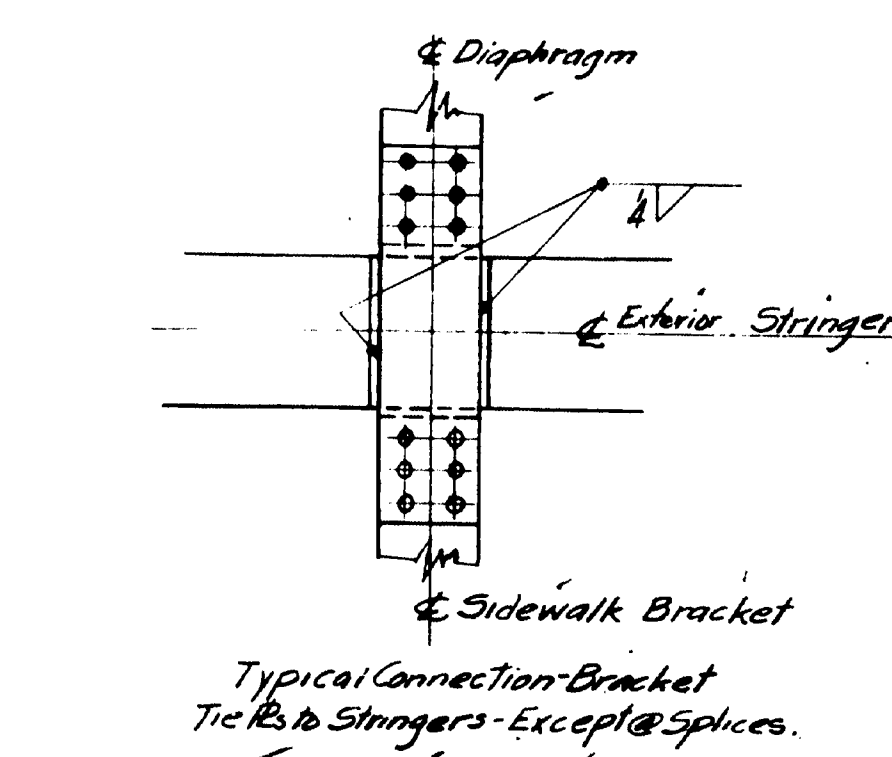

Typical

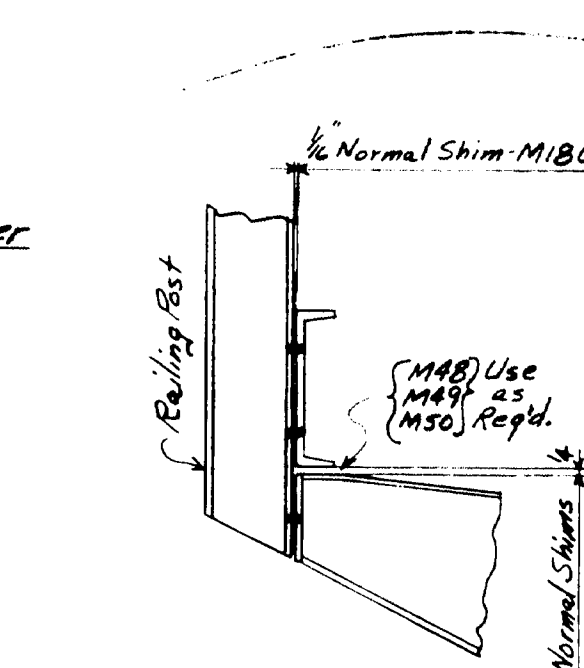

Typical Railing Post Conn. at Sidewalk Bracket.

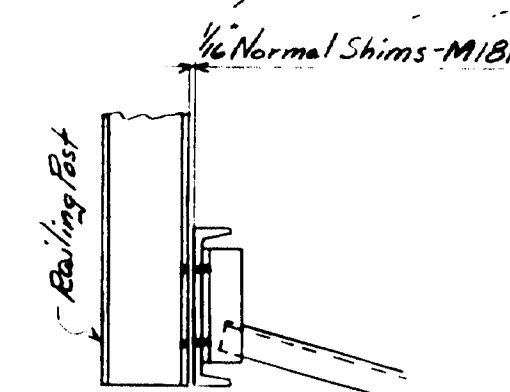

Typical Railing Post Conn. at Intermediate Struts.

All connections riveted except for expansion dams to diaphragms use Dardelot Rivet Bolts and Fascia Channels to sidewalk brackets use ordinary bolts.  
Bolts for Railing Post connections supplied by others.  
2-Wash. 2 1/2 x 8 (1/4 hole) } To be used where necessary under nut of  
1-Wash. 2 1/2 x 4 (1/4 hole) } Dardelot Rivet Bolts to build up required grip.

ERECTION PLAN  
DIV. 2  
BANGOR BREWER BRIDGE  
OVER PENOBSCOT RIVER  
STATE OF MAINE

AMERICAN BRIDGE  
DIVISION  
UNITED STATES STEEL CORPORATION

REVISIONS	DRAWINGS MADE AT TRENTON PLANT
	WORK FABRICATED AT TRENTON PLANT
	IN CHARGE OF E.D. MARKS
	DRAW. MADE BY S.E.K. DATE 7-31-53
	DRAW. CHECKED BY PRY DATE 1-5-53
	ORDER No. Q4149
	SHEET No. E201

62-128



LINE	ITEM No. or Name	MATERIAL		ASSEMBLY WEIGHT	REMARKS	ORDERED		CALCULATED	
		Qty. of Pieces	Weight			ITEM	WEIGHT SHIP PLS		
1					85.5"				
2					138° Q4148 ✓				
3		ONE BEAM	B26		21806 Q4149 ✓				
4		1 36 CB 230	B30		FINI - 2	83:14	2009	19.09	
5		2 COW 6 1 1/2	1 1/2		U/M		2025		
6		1 R 7 1/2	2 94	56110	FINI				
7		1 R 7 1/2	2 94	56110	FINI				
8		1 R 7 3/8	2 94	56110	FINI				
9		2 R 7 3/8	2 94	56110		45:0	M618		
10		6 R 7 3/8	1 1	ACUB	BENT				
11		2 R 7 3/8	1 1	ACUB	BENT				
12		2 R 10 1/8	4 9	ACUB	BENT - 11	60:16:25:0	2022		
13		4 R 6 1	2 9	ACUB	BENT	32:0	M619		
14		2 FIA 6 3	1 42	ACUB			S		
15		2 FIA 16 3	2 42	ACUB			S		
16		2 R 30 2	1 1	ACUB			S		
17		2 R 7 4 3/8	2 54	ACUB		60:0	M619		
18		2 R 7 4 3/8	2 6	ACUB		60:0	M619		
19		2 FIA 9 (3 3/8)	1 0	ACUB			S		
20		4 FIA 8 (3 3/8)	1 22	ACUB			S		
21		2 TOP PLATES	TP3		DEL. BILLED				
22		2 R 7 3/8	2 94	56110	FINI		S		
23		2 R 7 3/8	2 94	56110		45:0	M618		
24		4 85.5"					Stored		
25		ONE BEAM	B27		ALINE BEFORE	148°	964		
26		ONE BEAM	B28		REMARKS				
27									
28		2 36 CB 230	B30		FINI - 2	83:14	2009	19.09	
29		4 COW 12 2	12 0		U/M	45:0	M619		
30		4 R 6 2	2 94	56103	FINI				
31		4 R 6 3/8	2 94	56103	FINI		S		
32		8 R 4 3/8	2 94	56103					
33		4 R 16 1/8	4 4	ACUB		60:16:25:0	2022		
34		8 R 6 1	2 9	ACUB		32:0	M619		
35		4 R		ACUB					
36		4 FIA 6 3/8	1 42	ACUB			S		
37		2 FIA 16 3/8	2 42	ACUB			S		
38		4 R 4 4 3/8	2 54	ACUB			S		
39		2 FIA 6	ACUB						
40		2 TOP PLATES	TP3		DEL. BILLED				
41		2 TOP PLATES	TP6		SN: Q4148				
42									
43		8 3 3/8 5/8			40"7"		Shore		
44					94° Q4148 ✓				
45		ONE BEAM	B30		13200 Q4149 ✓				
46									
47		1 36 CB 150	40 7		-5	40:7	2010	6.08	
48		1 R 1 3/8	2 94	56103	FINI				
49		1 R 7 3/8	2 94	56103					
50		1 L 4 3/8 3/8	2 3	AC	BENT		S		
51		1 L 4 3/8 3/8	2 3	AC	BENT		S		
52		2 R 7 3/8	1 1	ACUB	BENT				
53		2 R 7 3/8	1 1	ACUB	BENT				
54		1 FIA	ACUB						
55		1 TOP PLATE	TP3		DEL. BILLED				
56					SN: Q4148				
57		1 R 7 1/2	2 94	56110	FINI				
58		1 R 7 3/8	2 94	56110					
59									
60									
61									
62									
63									
64									
65									
66									
67									

NOTE TO SHOP!  
For assembling & reaming diagrams  
see sheet #214  
WORK SHEET #214 WITH THIS SHEET.

SPECIFICATIONS: MAINE STATE HIGHWAY COMM.  
1945 AND SPECIAL PROVISIONS.  
MATERIAL: Q.H. STEEL A.S.T.M. A7-52T  
RIVETS: 8 Ø HOLES 1/8 Ø  
WORKMANSHIP: HOLES IN MATERIAL THICKER THAN  
THE DIAMETER OF THE RIVET SHALL BE DRILLED.  
ALL HOLES FOR SHOP RIVETS TO BE SUBBUNCHED  
OR SUBDRILLED & REAMED TO SIZE WITH  
CONNECTING PARTS ASSEMBLED

STRINGERS - B26, B27, B28 & B30  
DIV. 2  
STATE OF MAINE  
STATE HIGHWAY COMMISSION  
BANGOR - BREWER BRIDGE  
Over PENOBSCOT RIVER  
BANGOR, MAINE


AMERICAN BRIDGE  
DIVISION  
UNITED STATES STEEL COMPANY

DRAWINGS MADE AT TRENTON PLANT  
WORK FABRICATED AT TRENTON PLANT  
IN CHARGE OF E.B. MARKS  
DRAW. MADE BY R.T.G. DATE 9-15-53  
DRAW. CHECKED BY PRY DATE 12-18-53

ORDER No.  
Q4149

地圖 201, 202


WELDING  
2-129

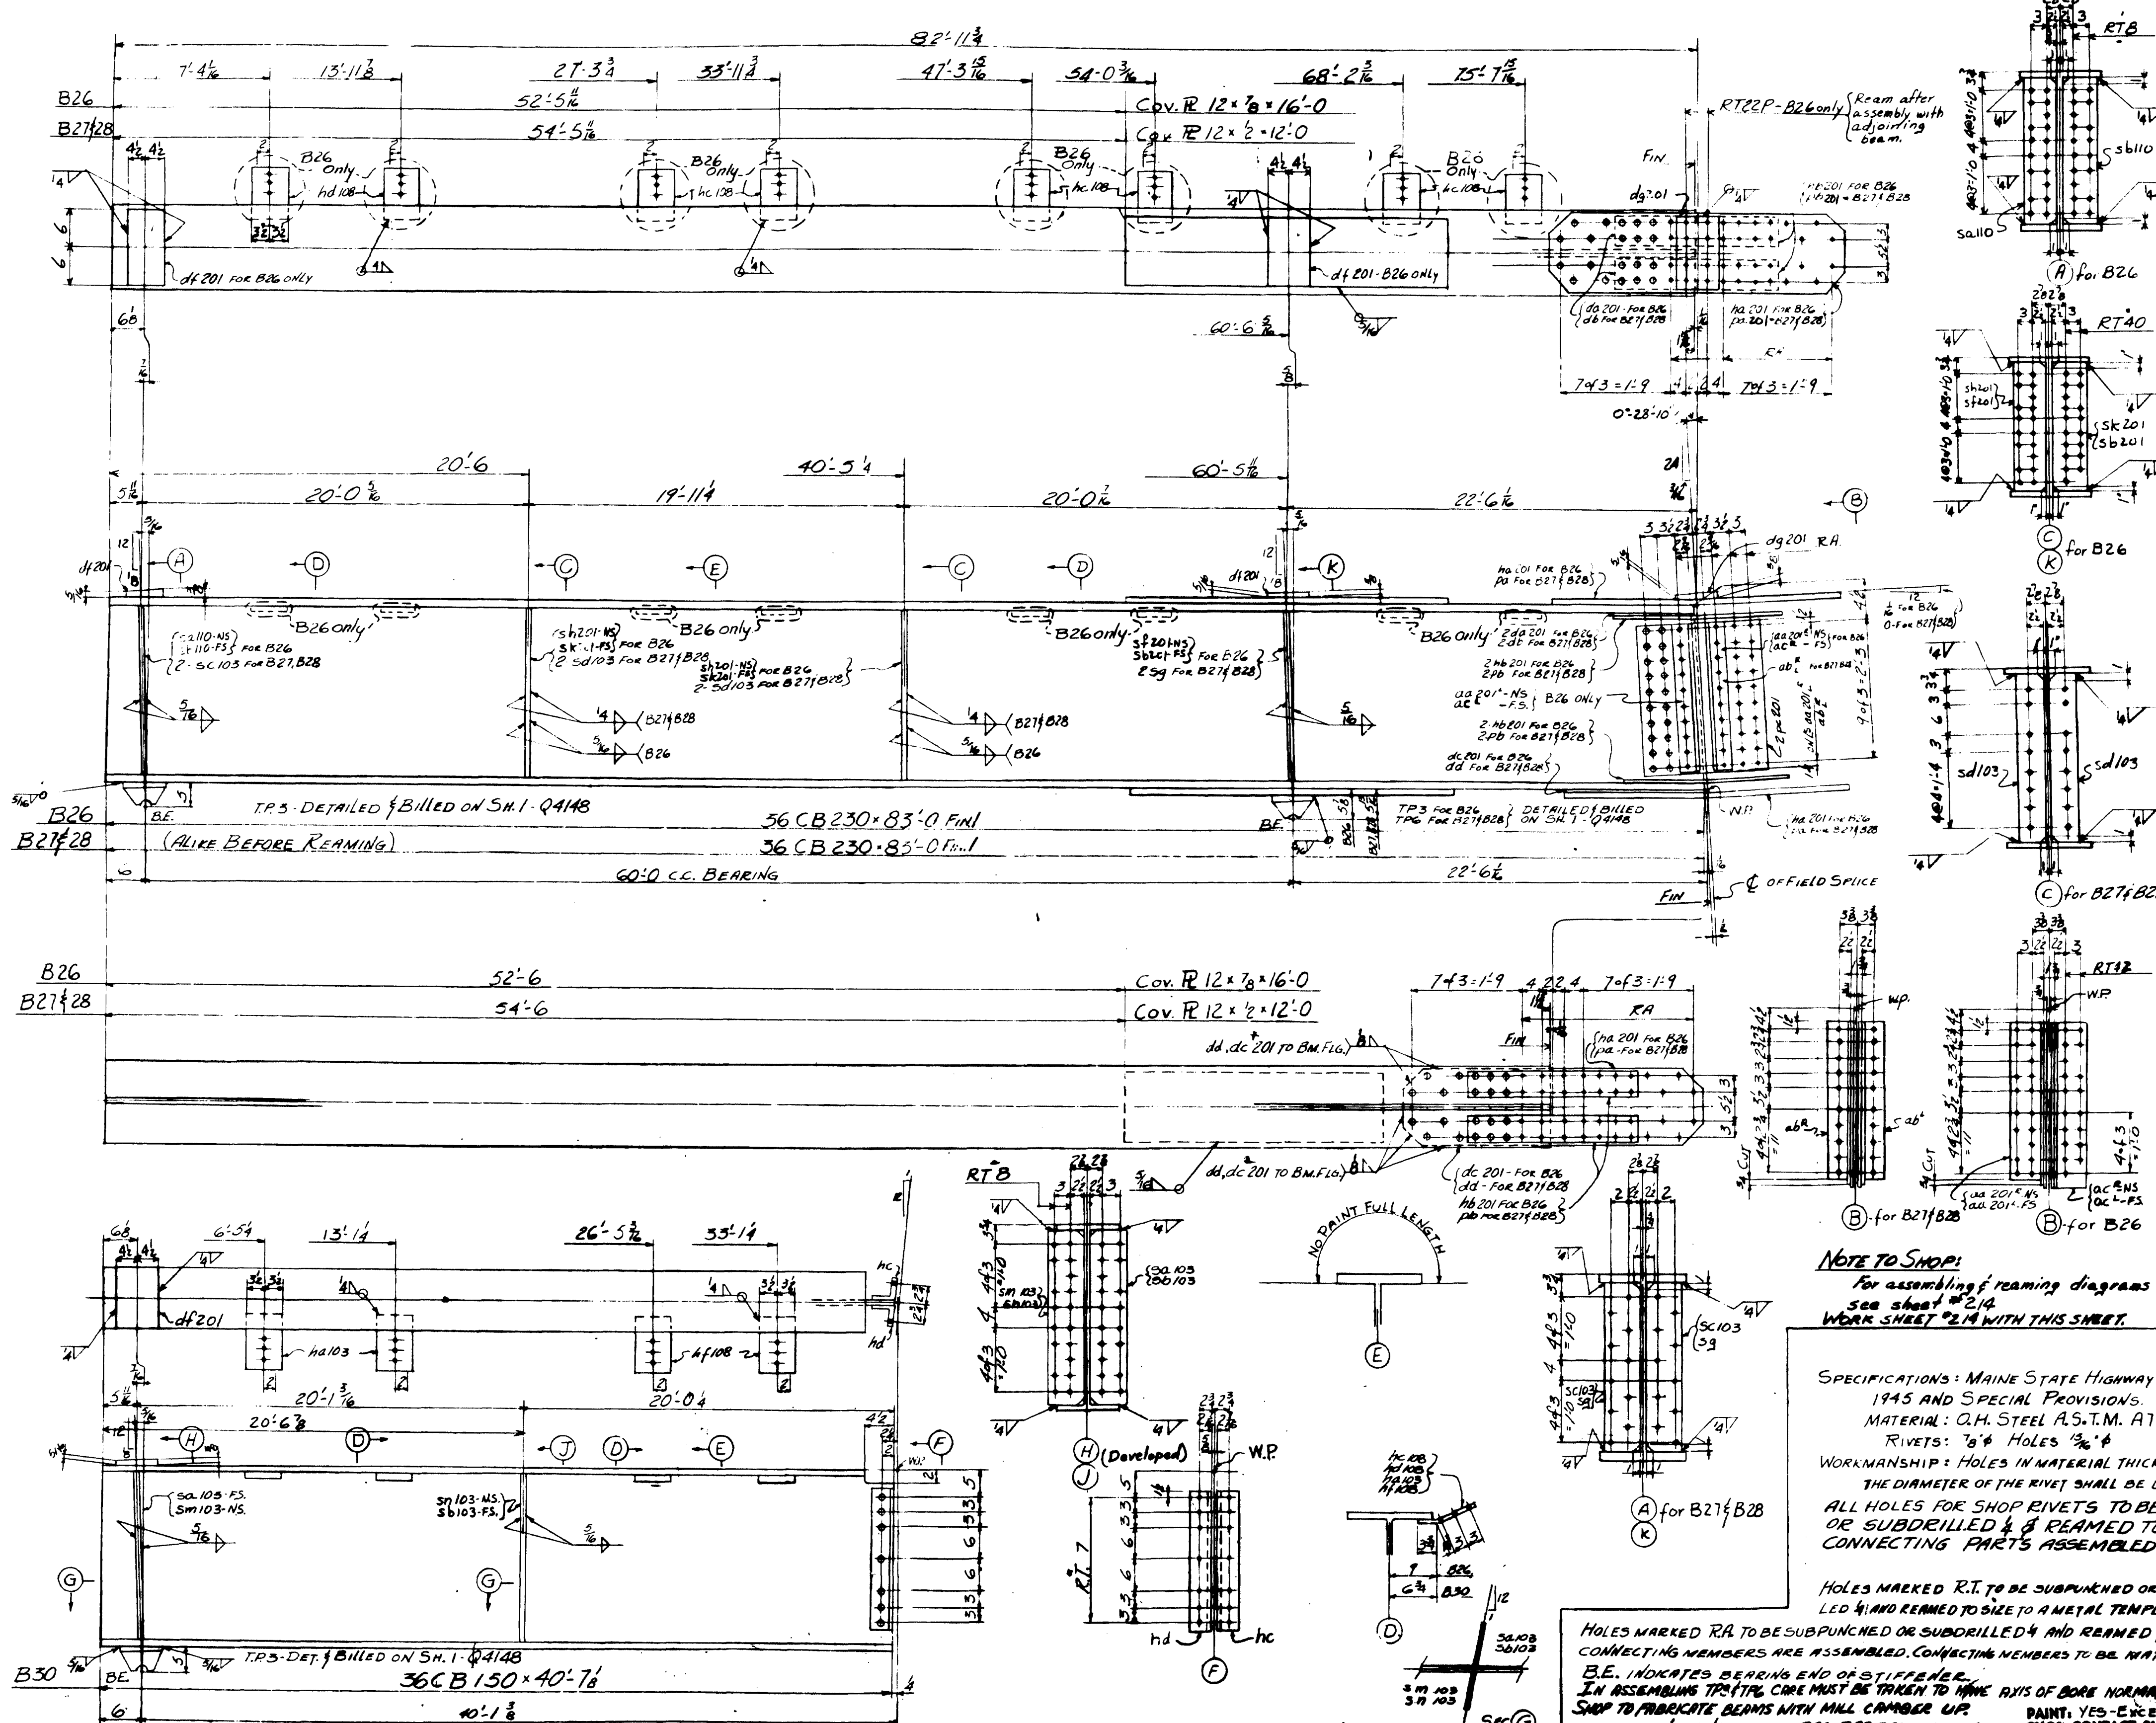



# AMERICAN BRIDGE


LINE	ITEM	MATERIAL	LENGTH	ASSEMBLY MARK	REMARKS	ORDERED	CALCULATED WEIGHT
		SHAPE	Feet			ITEM	FOR ONE PAIR
1					78'10"		
2							
3							
4					122'-24148		
5	ONE BEAM	B31			21931-24149		
6							
7	1	3G CB245	42'3 1/2"		Fin 2	2405	1103.6
8	1	3G CB245	36'6 3/4"		Fin 1-117	2407	89.50
9	2	R 10 1/2 x 1/2	4'9"	ha	Bent -5	24150	600
10	2	R 6 1/2 x 1/2	2'8 3/4"	hg	Bent		11.15
11	2	R 6 1/2 x 1/2	2'8 3/4"	hg	Bent		11.15
12	2	R 20 x 1/2	1'10"	hb202			18.17
13	2	Cov R 12 x 1/2	10'0"		UM	45-0	11.012
14	2	1 Fl 9 x 3/8	1'0"	da202			11.13
15	2	1 Fl 8 x 3/8	1'2 1/2"	db202			11.1
16	2	L 7 x 4	2'5 1/2"	hd 1	Bent	60-0	6.7
17	2	L 7 x 4	2'5 1/2"	hd 1	Bent	60-0	6.8
18	1	R 7 x 3/8	2'9 1/4"	sa		45-0	2.5
19	5	2 R 7 x 3/8	2'9 1/4"	sb202		45-0	4.9
20	4	1 R 7 x 3/8	2'9 1/4"	sc202	Fin 1		3.8
21	2	1 R 7 x 3/8	2'9 1/4"	sd202	Fin 1		5.8
22	2	1 R 7 x 3/8	2'9 1/4"	sf202		45-0	2.5
23	12	2 R 32 x 3/8	1'0 1/2"	sg202	Fin 1		1.6
24	12	2 R 32 x 3/8	1'0 1/2"	sh202	Fin 1		1.6
25	12	2 R 32 x 3/8	1'0 1/2"	sk202	Fin 1		1.6
26	2	R 7 x 3/8	1'1"	hd108			1.6
27	2	R 7 x 3/8	1'1"	hb108			1.6
28	1	R 6 1/2 x 3/8	5 1/4"	hc202			4
29	2	R 7 x 3/8	1'1"	ha108			1.6
30	2	R 7 x 3/8	1'1"	hf108			1.6
31	1	Top PLATE		TP2	Det & billed on Sh. 3-Q4148		9.1
32							
33							
34	1	BASE PLATE		BPI1	Det & billed on Sh. 3-Q4148		2.1
35							
36							
37							
38	2	SB 6"					5.4 RV
39							17.2 Cuts
40							5.3 Holes
41							5.9 W
42							72.9
43							
44							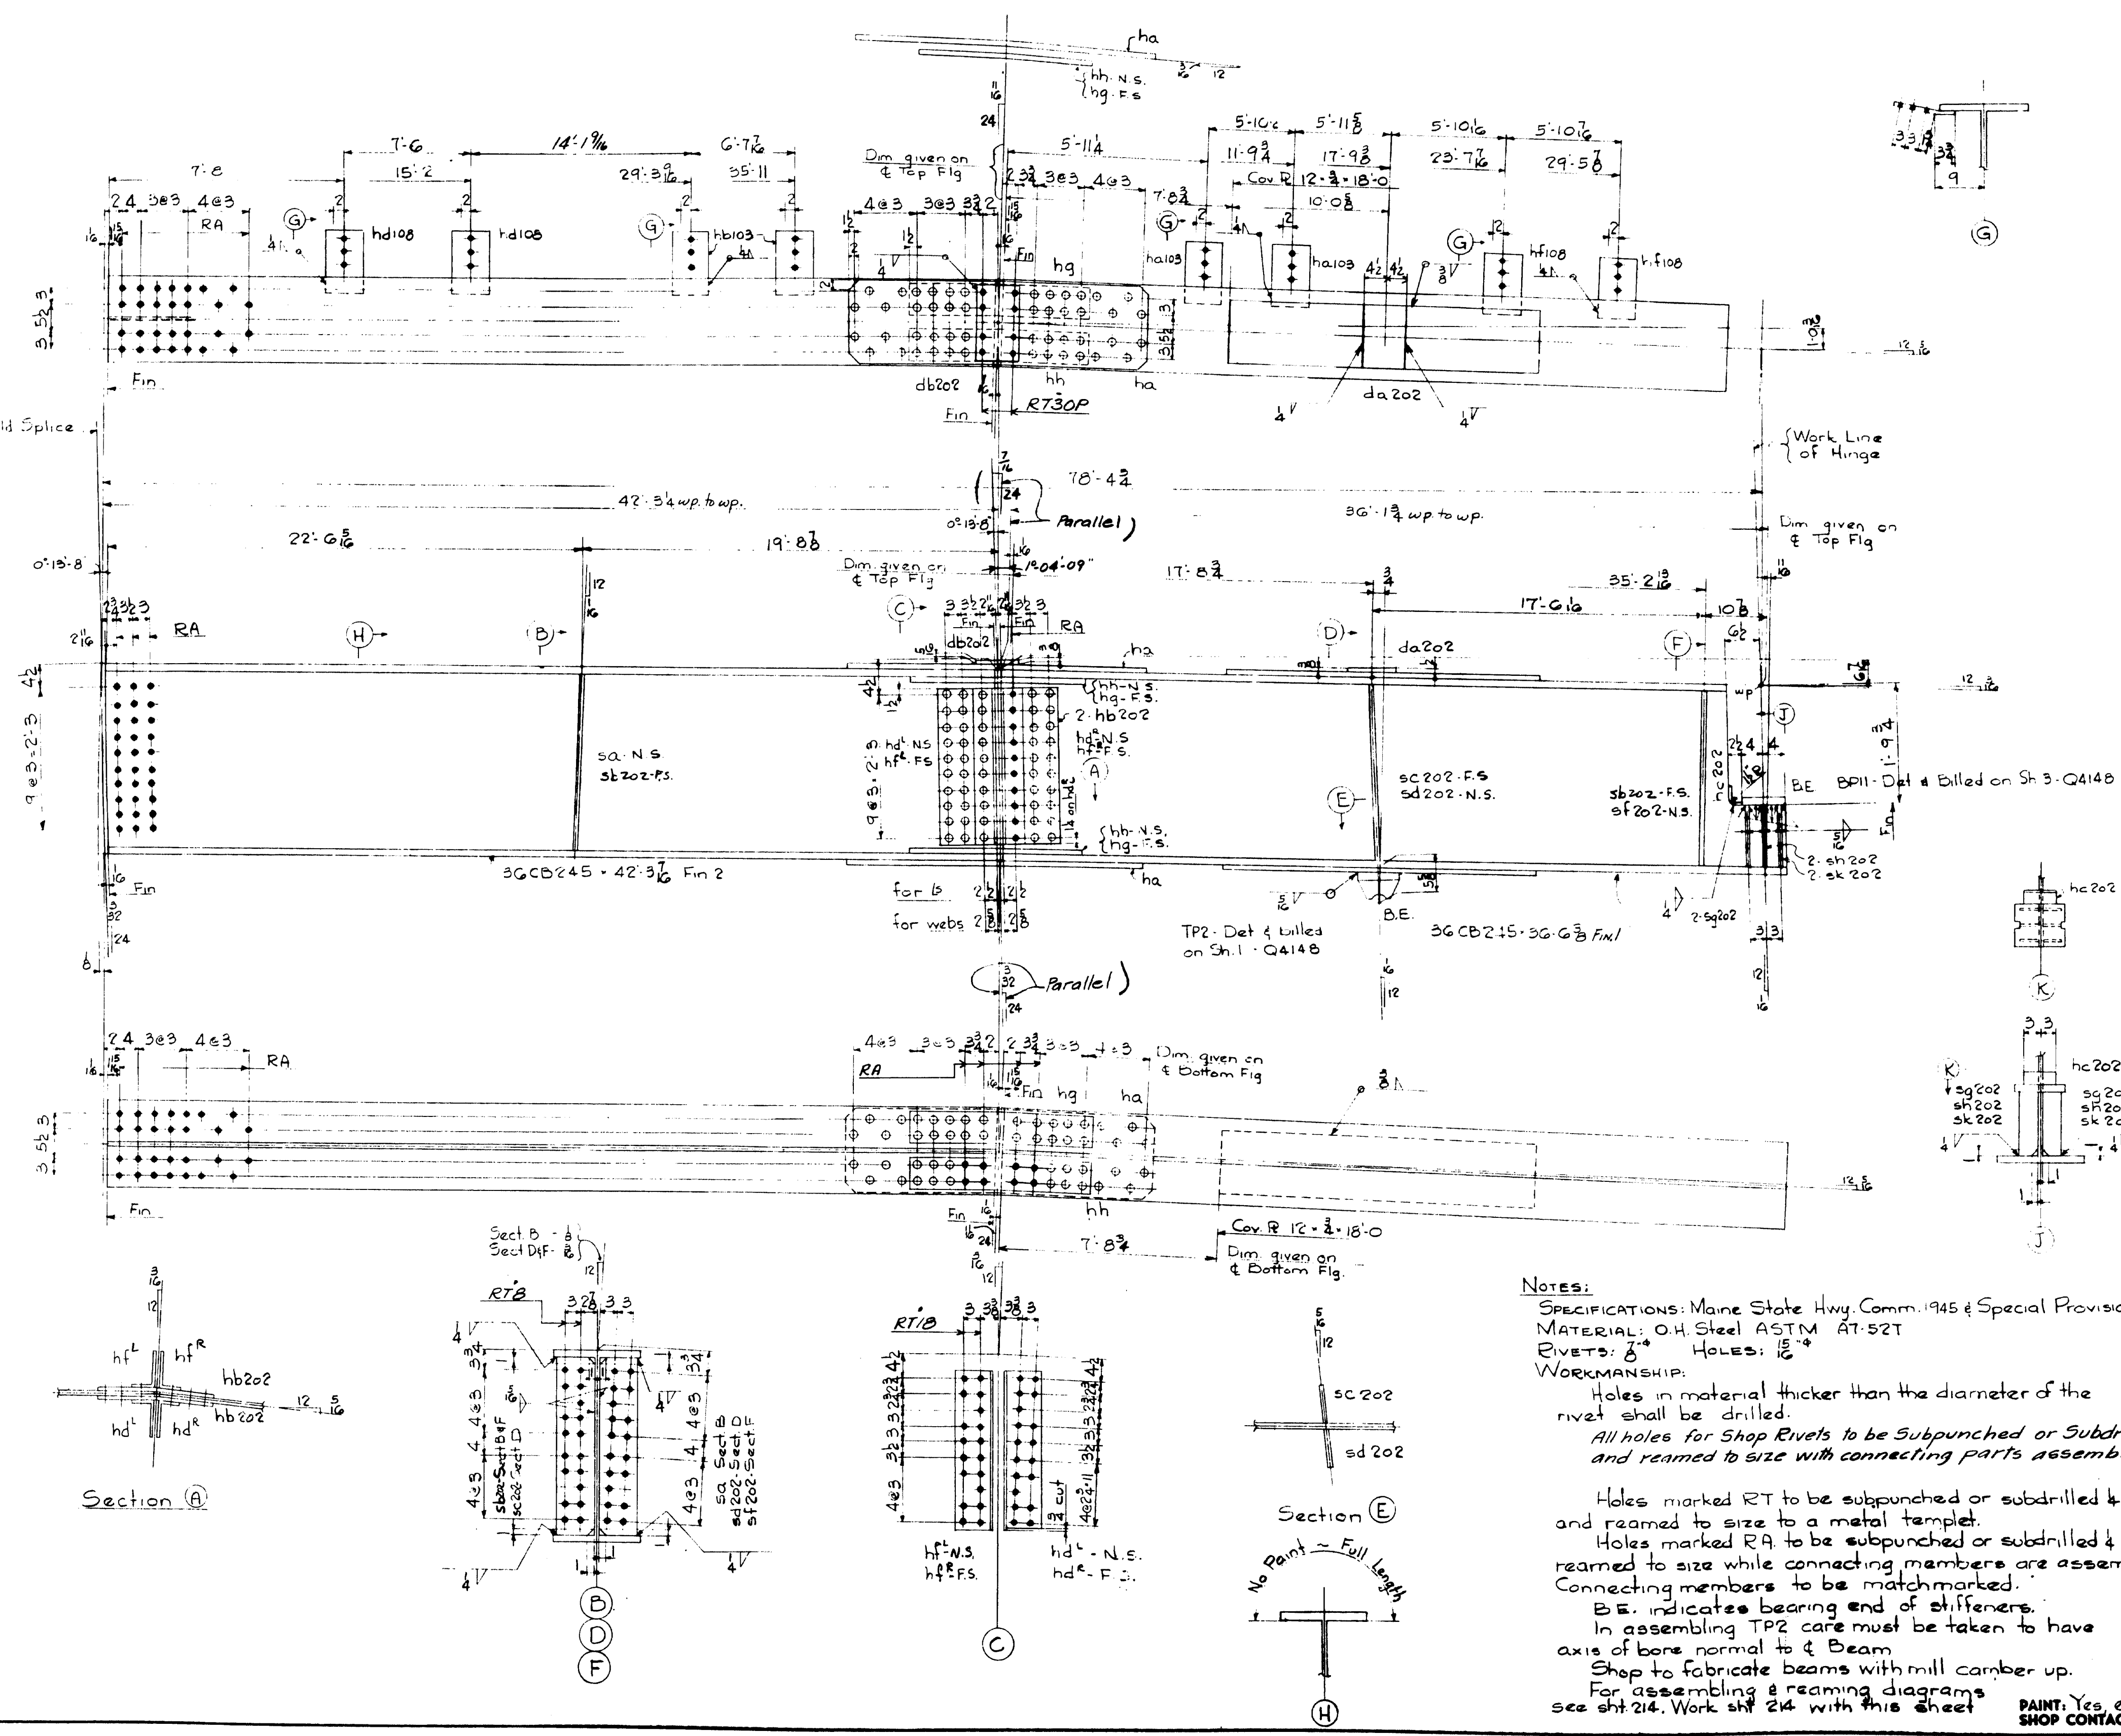
**NOTES:**  
 SPECIFICATIONS: Maine State Hwy. Comm. 1945 & Special Provisions  
 MATERIAL: O.H. Steel ASTM A7-52T  
 RIVETS: 3" HOLES: 1 1/2"  
 WORKMANSHIP:  
 Holes in material thicker than the diameter of the rivet shall be drilled.  
 All holes for Shop Rivets to be Subpunched or Subdrilled 1/4" and reamed to size with connecting parts assembled.  
 Holes marked RT to be subpunched or subdrilled 1/4" and reamed to size to a metal template.  
 Holes marked RA to be subpunched or subdrilled 1/4" and reamed to size while connecting members are assembled.  
 Connecting members to be matchmarked.  
 B.E. indicates bearing end of stiffeners.  
 In assembling TP2 care must be taken to have axis of bore normal to & Beam.  
 Shop to fabricate beams with mill camber up.  
 For assembling & reaming diagrams see sh. 214. Work sh. 214 with this sheet.  
 PAINT: Yes, except as noted  
 SHOP CONTACT SURFACES: No

LIFTING WT.-12 TONS STRINGER B31  
 DIV. 2  
 STATE OF MAINE  
 STATE HIGHWAY COMMISSION  
 BANGOR-BREWER BRIDGE  
 OVER PENOBSCOT RIVER  
 BANGOR, MAINE  
 127.12044 12-31 0001 12-0  
 AMERICAN BRIDGE  
 UNITED STATES STEEL COMPANY  
 DRAWINGS MADE AT TRENTON PLANT  
 WORK FABRICATED AT TRENTON PLANT  
 IN CHARGE OF E.D. MARKS  
 DRAW. MADE BY S.E.K. DATE 9-24-53  
 DRAW. CHECKED BY P.R.V. DATE 12-30-53  
 REVISIONS  
 1 3-2-54  
 ORDER NO. Q4149  
 SHEET NO. 202

UNITED STATES STEEL COMPANY									
LINE	ITEM NO. OF THIS SHEET	MATERIAL		JASPER- BLIND NAME	REMARKS	ORDERED		CALCULATED WEIGHT FOR ONE SHEAF-PIECE	
		SHAPE	LENGTH Feet INCHES			QTY	UNIT		
1					RS'S"				
2					188"	Q4148	✓		
3		ONE BEAM		B29	21860"	Q4149	✓		
4									
5		1 36 CB230	83.0		FIN 1 -2	83'-14	2009	19.09	
6		2 COR PL 12" x 1/2"	16.0		UM		2025	11.42	
7		2 RP 6" x 1/2"	2.94	2X108	FIN 1			5.7	
8		1 RP 7" x 1/2"	2.94	5d	FIN 1		S	5.8	
9		2 RP 4" x 3/8"	2.94	5d		35'-0	M618	2.9	
10		1 1/2 7" x 4" x 3/8"	2.94	5d		60'-0	M619	7.5	
11		2 1/2 7" x 4" x 3/8"	2.94	5d		60'-0	M619	7.5	
12		2 RP 7" x 1/2"	1.1	1008	BENT			1.0	
13		2 1/2 1" x 1/2"	1.1	1008	BENT			1.0	
14		2 1/2 1" x 1/2"	1.1	1008	BENT -11			58.1	
15		4 RP 6" x 1"	2.94	1008	BENT			22.4	
16		2 1/2 1" x 1/2"	1.1	1008				1.0	
17		2 1/2 1" x 1/2"	1.1	1008				1.0	
18		2 RP 30" x 1"	1.10	25301				18.7	
19		2 1/2 7" x 4" x 3/8"	2.53	1008				6.7	
20		1 1/2 9" x 4" x 3/8"	1.0	11201				1.1	
21		1 1/2 5" x 3" x 3/8"	1.84	1008				1.1	
22		2 1/2 7" x 4" x 3/8"	2.53	1008		60'-0	M619	6.8	
23		2 7/8 RP 8"		1008	DETAINED			18.5	
24				1008	CH 1 Q4149				
25		1 E 7" x 1/2"	2.94	1008	FIN 1			58	
26									
27		6 7/8 2" x 3/8"					Stress		
28								27	
29								13	
30								61	
31								44	
32								70	
33									
34									
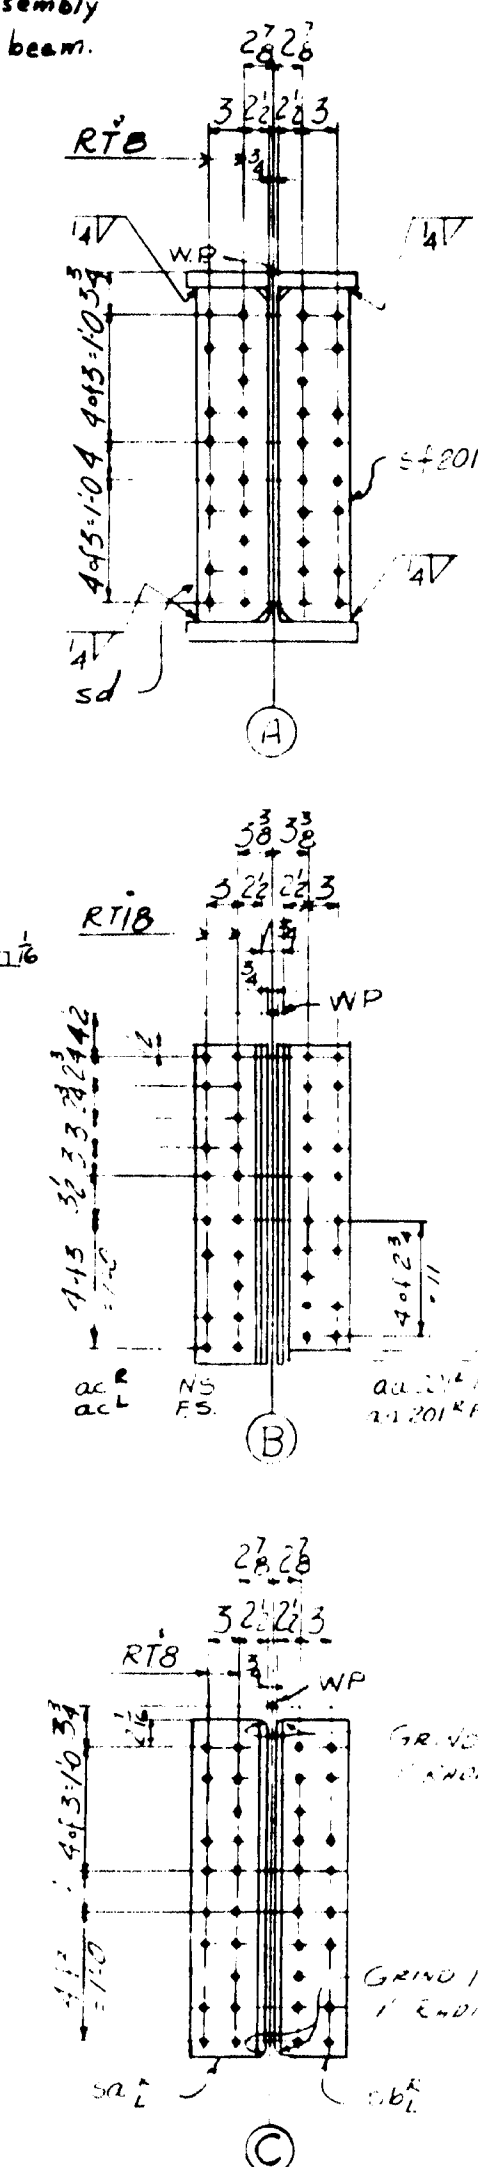

A diagram of a semi-circular arch. The arch is supported by a central vertical post. A downward force  $F$  is applied at the base of the post. The arch is labeled "No PAINT FULL LENGTH" along its top curve.

HOLES MARKED R.T. TO BE SUBPUNCHED OR SUBDRILLED  
4 AND REAMED TO SIZE TO A METAL TEMPLET.  
HOLES MARKED R.A. TO BE SUBPUNCHED OR SUBDRILLED 4 AND  
REAMED TO SIZE WHILE CONNECTING MEMBERS ARE ASSEMBLED.  
CONNECTING MEMBERS TO BE MATCHMARKED.  
B.E. INDICATES BEARING END OF STIFFENER.  
IN ASSEMBLING TIPS CARE MUST BE TAKEN TO HAVE AXIS OF BORE AXIAL TO  
OF BEAM.  
SHOP TO FABRICATE BEAM WITH MILL CAMBER UP.  
PAINT: YES. EXCEPT AS NOTED  
SHOP CONTACT SURFACES: NO.  
LIFTING WT. 12 TONS

137-103739N 18 21 0051 18 G  
**American STEEL COMPANY**  
 DIVISION  
 UNITED STATES STEEL COMPANY

DRAWINGS MADE AT TRENTON PLANT  
 WORK FABRICATED AT TRENTON PLANT  
 IN CHARGE OF E.B. MARKS  
 DRAW. MADE BY R.L.G. DATE 9-21-53  
 DRAW. CHECKED BY PRY DATE 12-18-53

ORDER NO. Q4149 SHEET NO. 203

NOTE TO SHOP:  
For assembling & reaming diagrams  
see sheet #214.  
WORK SHEET #214 WITH THIS SHEET.

施 訓 201, 202

## WELDING

**62-131**



[illegible]

**62-132**

UNITED STATES STEEL COMPANY

68	/ R	7 2 /	24	pcw	-2	30-0	1035
69	/ R	7 2 /	26	poy	-2		
70	/ R	7 2 /	28	oda	-2		
71	/ R	7 2 /	28	oda	-2		
72	/ R	7 2 /	28	oda	-2		
73	/ R	7 2 /	110	pdf	-2	30-0	1035
74							
75	/ R	7 2 /	8	pdh	-2	30-0	1035
76							
77							
78	/ R	8 2 32	7/8	pb	BENT	45-0	M68 W Hides BT
79							
80							
81	ONE EXPANSION JAMMED!!				129*	R	
82							
83	/ R	10 3 6	95	da20g	2300	} Raised Pattern	S
84	/ R	10 3 8	8	pa11	2300		
85	/ R	10 3 8	10 3 8	pa11	2300		
86	/ R	10 3 8	8	pa11	2300		
87	S Ro			ma11	BENT		Nat
88							
89							
90	ONE EXPANSION JAMMED?				102*	/	
91							
92	/ R	12 3 6	95	ad20g		45-0	M68
93	/ R	12 3 8	8	pa11			
94	/ R	12 3 8	8	oc11			
95	/ R	12 3 8	10 3 8	cy111			
96	/ R	12 3 8	10 3 8	ada11			
97	/ R	12 3 8	10 3 8	pa111			
98	/ R	12 3 8	10 3 8	pa111			
99	S Ro			ma11	BENT		
100	/ R	12 3 6	10 3 8	pc20d		20-0	M68 Coke N
101							
102							
STATE OF MAINE  
STATE HIGHWAY COMMISSION  
BANGOR-BREWER BRIDGE  
OVER THE PENOBSCOT RIVER  
BANGOR, MAINE

AMERICAN BRIDGE  
DIVISION  
UNITED STATES STEEL COMPANY

1 WELD

WELD

62-133

1) SPECIFICATIONS: MAINE STATE HIGHWAY COMM.  
1985 AND SPECIAL PROVISIONS.

2) MATERIAL: OH STEEL ASTM A7-52T

3) HOLES: 12 Ø

4) PAINT: YES, EXCEPT AS NOTED.


5) SHOP CONTACT SURFACES: NO

6) WORKMANSHIP: HOLES MARKED RF TO  
BE SUBPUNCHED 4 AND REAMED TO SIZE  
IN THE FIELD.



AMERICAN BRIDGE

LINE	ITEM	DESCRIPTION	QUANTITY	UNIT	REMARKS	ORDERED	CALCULATED
1					78'1"		
2							
3							
4					122' 2 1/2" ✓		
5					21752' 64149 ✓		
6		ONE BEAM	B34				
7	1	3G CB 245	41	11 1/2"	Fin 2	42-04	2006
8	1	3G CB 245	36	12"	Fin 1-117	36-24	2008
9	2	R 10 1/2	4	9"	hc	Bent -5	44-25-0
10	2	R 10 1/2	1	2 1/2"	hf	Bent	5
11	2	R 10 1/2	1	2 1/2"	hd	Bent	5
12	2	R 10 1/2	1	10"	hb202	Bent	187
13	2	Cov R 12 3/4	12	0"	U.M.	45-0	M619
14							
15	1	R 7 3/8	2	94"	sk201		25
16	2	R 7 3/8	2	6"	hc	Bent	60-0
17	2	R 7 3/8	2	5 1/2"	hf	Bent	60-0
18	1	R 7 3/8	1	5 1/2"	hf		4
19	4	R 7 3/8	1	1	ha103		32
20	4	R 7 3/8	1	1	hb103		32
21	1	R 7 3/8	2	14"	ez	45-0	M618
22	1	R 7 3/8	2	94"	sk201		25
23	1	R 7 3/8	2	14"	ez		25
24	1	R 7 3/8	2	14"	ez		25
25	2	R 7 3/8	2	94"	sk201	45-0	M618
26	1	R 7 3/8	1	10 1/2"	ez		16
27	2	R 7 3/8	1	10 1/2"	ez		16
28	2	R 7 3/8	1	10 1/2"	ez		16
29	1	Fin 9 (8-1)	1	0"	da202		11
30	1	Fin 8 (8-2)	1	22"	db202		11
31	1	Base Plate	1		Det & billed on Sh. 3-Q4148		31
32							
33							
34	1	Top Flange	1		Det & billed on Sh. 3-Q4148		91
35							
36							
37							
38	2	SB 8"					
39							
40							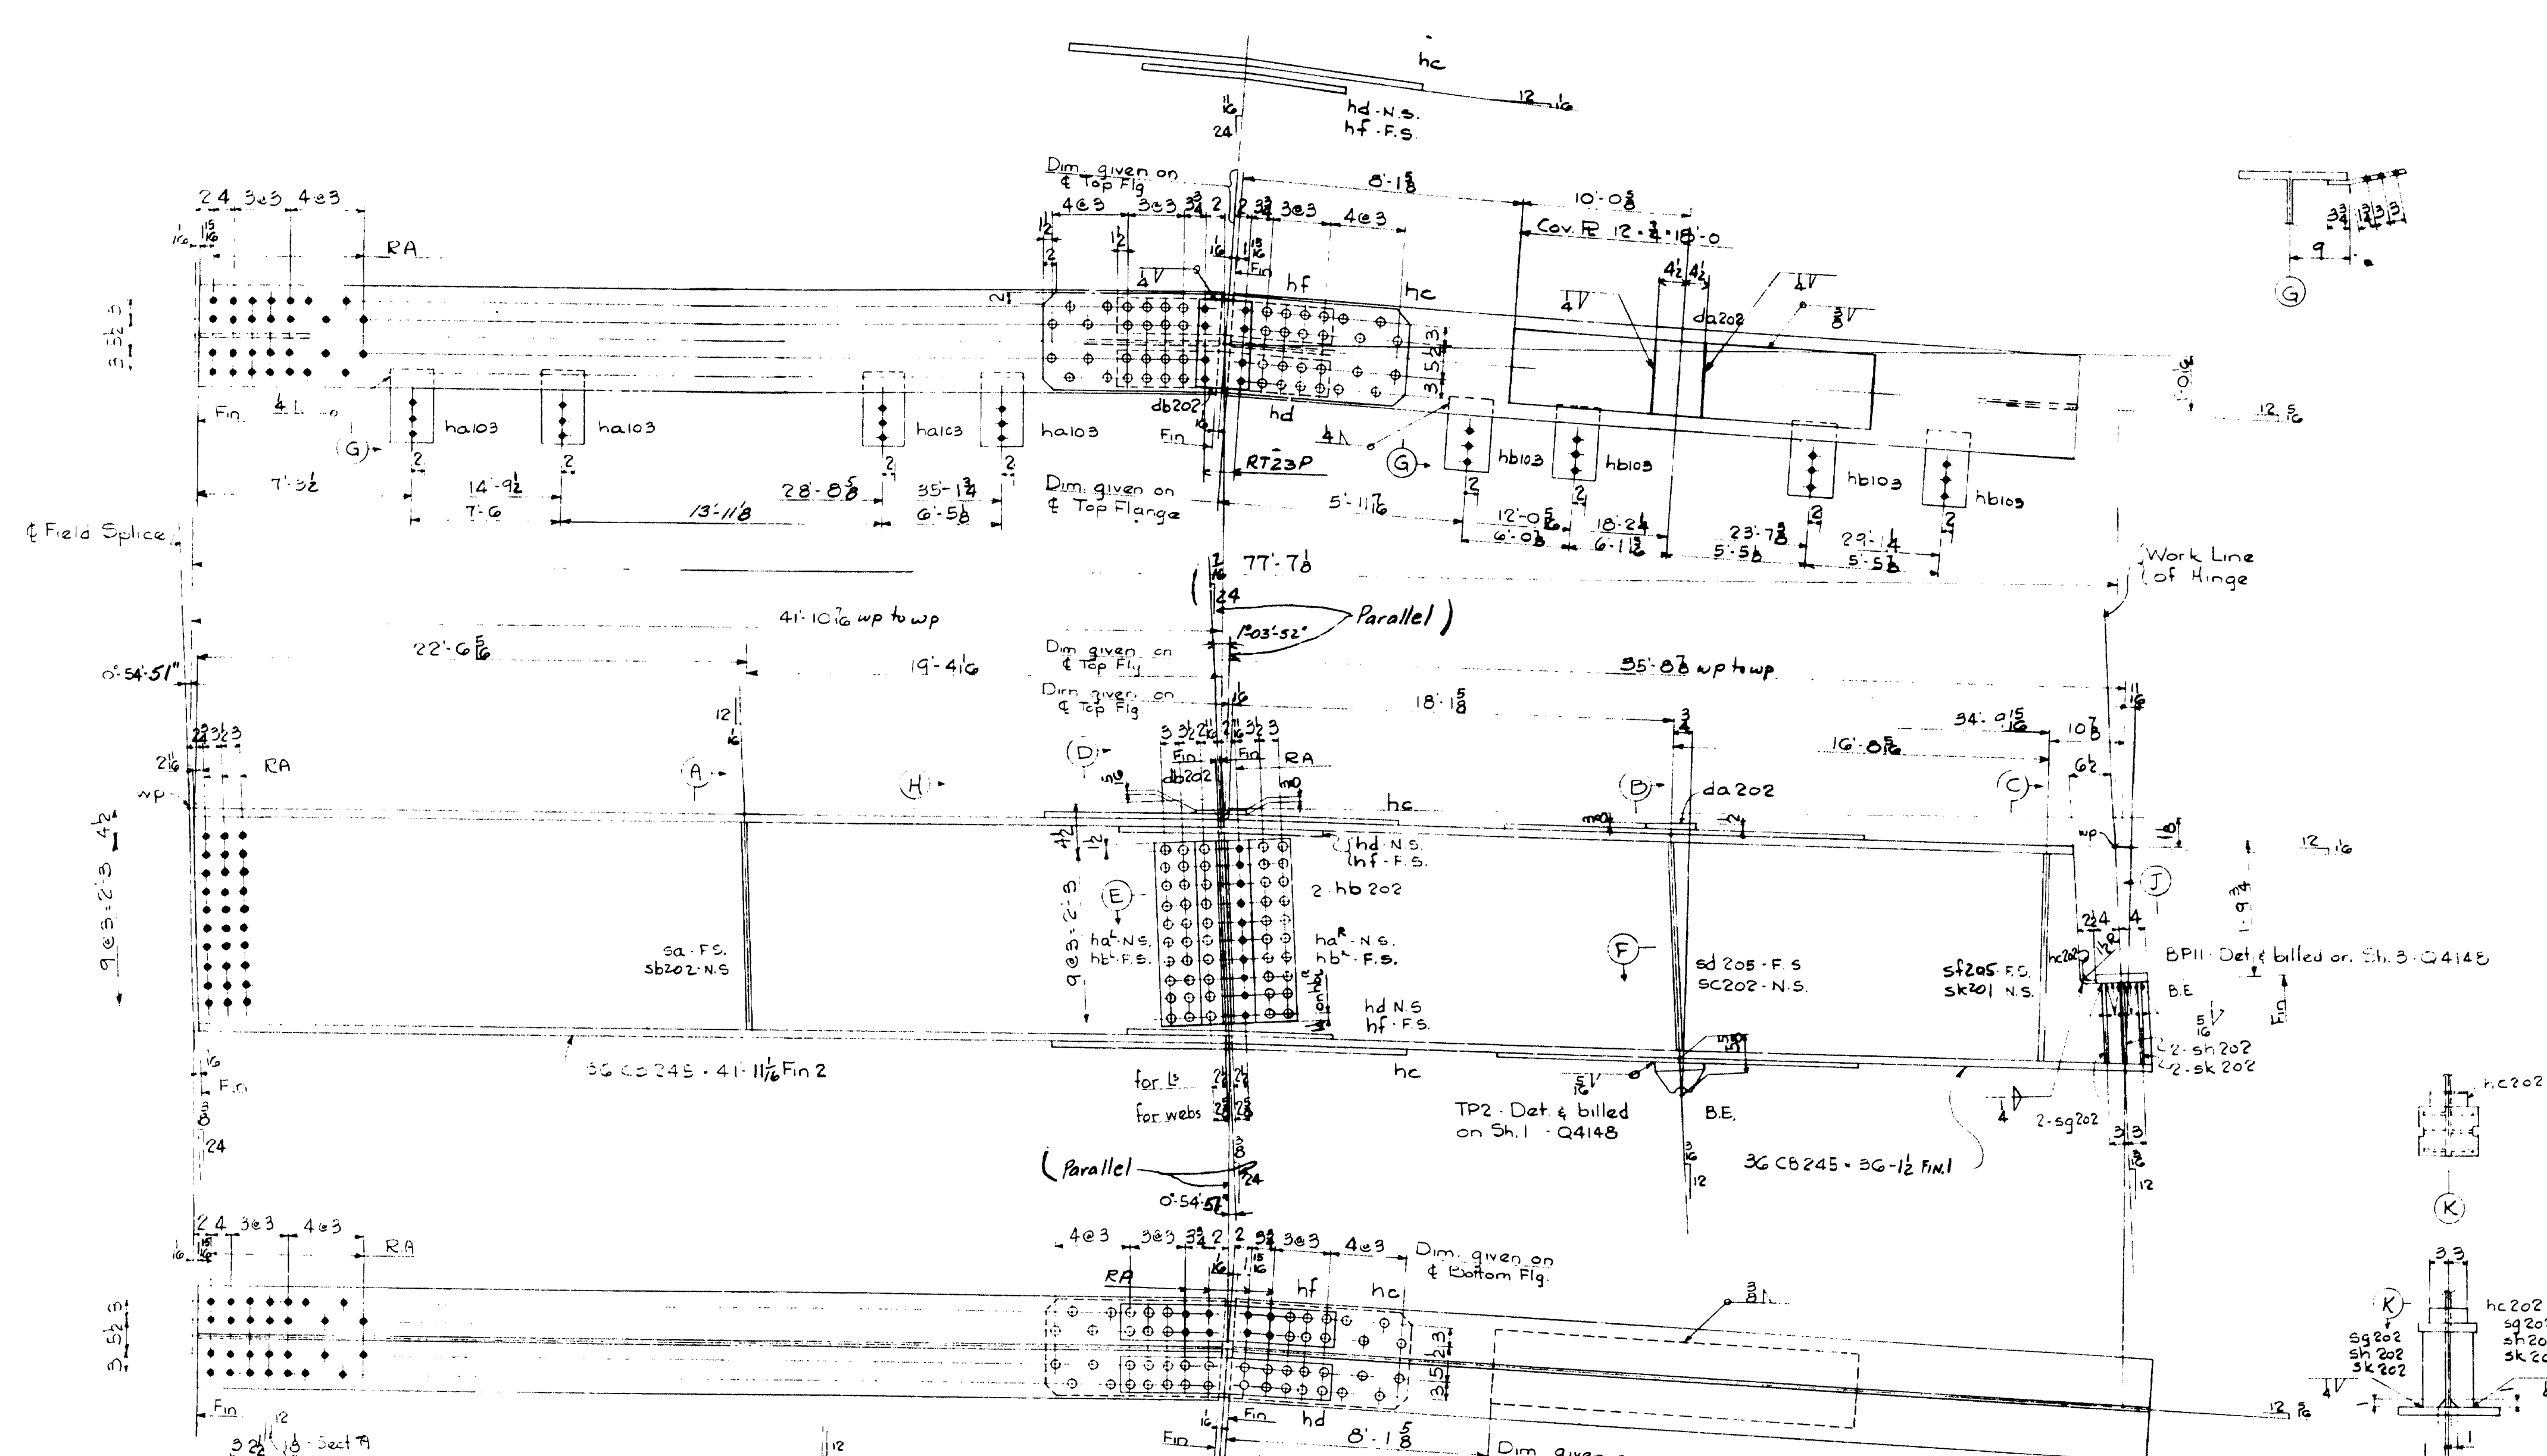
NOTES:  
 SPECIFICATIONS: Maine State Highway Commission 1945 and Special Provisions  
 MATERIAL: OH Steel A.S.T.M. A7-52T  
 RIVETS: 3" Holes: 1 1/2"  
 WORKMANSHIP:  
 Holes in material thicker than the diameter of the rivet shall be drilled.  
 All holes for Shop Rivets to be Subpunched or Subdrilled & reamed to size with connecting parts assembled.  
 Holes marked RT to be subpunched or subdrilled & reamed to size to a metal template.  
 Holes marked RA to be subpunched or subdrilled & reamed to size while connecting members are assembled. Connecting members to be matchmarked.  
 Shop to fabricate beams with mill camber up.  
 B.E. indicates bearing end of stiffeners.  
 In assembling TP2 care must be taken to have axis of bore normal to E Beam.  
 For assembling & reaming diagrams see sht. 214. Work sht. 214 with this sheet.

STRINGER B34  
 DIV. 2  
 STATE OF MAINE  
 STATE HIGHWAY COMMISSION  
 BANGOR-BREWER BRIDGE  
 OVER PENOBSCOT RIVER  
 BANGOR, MAINE  
 DIVISION OF HIGHWAYS  
 AMERICAN BRIDGE  
 DIVISION  
 UNITED STATES STEEL COMPANY

DRAWINGS MADE AT TEENTON PLANT  
 WORK FABRICATED AT TEENTON PLANT  
 IN CHARGE OF E.B. MARKS  
 DRAW. MADE BY S.E.K. DATE 9-28-53  
 DRAW. CHECKED BY PRY DATE 12-31-53  
 ORDER No. Q4147  
 SHEET No. 205

LIFTING WT. - 12 TONS





[illegible][illegible]

DREF.	DIMENSIONS					BEVELS		PIECE NAMES			
	J	L	Q	R	S	T	U	W	X	Y	Z
M32	5'-5"	2'-7"	5'6"	5'-0"	1'-4"	1'-1"	1/2	py	hw	ag	pb2207
M37	5'-5"	2'-8"	5'6"	4'-11"	2'-5"	1'-6"	3/4	pac	py	ah	pb2207
M41	5'-5"	2'-8"	5'6"	4'-11"	2'-5"	1'-4"	1/2	pac	py	ah	pb2207
M44	6'-1/2"	2'-11"	9'	4'-7"	3'-6"	2'-6"	1/2	pac	pb207	hk	pb2207

DRAWING WITH BILL											
AMERICAN BRIDGE COMPANY											
LINE	QUANTITY	MATERIAL	SHAPE	LENGTH		ASSEMBLY NAME	REMARKS	ORDERED		CALCULATED WEIGHT FOR ONE SHIP PRICE	
				Feet	Inches			ITEM			
1											
2											
3											
4											
5		ONE BRACKET-M29					349* ✓				
6		ONE BRACKET-M35					398* ✓				
7		ONE BRACKET-M39					367* ✓				
8		ONE BRACKET-M43					345* ✓				
9		ONE BRACKET-M45					253* ✓				
10											
11	6	4 R	8 7/8	3	0	pa207	M29,39,43,45	30-0	1034	3 6	
12	1	R	4 1/2	6	4 1/2	pc	FOR M29,43,45	42x40-0	1029	3 4 1/2	
13	1	R	4 0	6	1 1/8	pd	FOR M35,54			3 3 1/2	
14	1	R	3 3/8	6	6	pf	FOR M39,(41)			3 3 1/2	
15	1	R	4 1/2	6	6 1/8	pg	FOR M43,12			3 3 1/2	
16	1	R	4 0 3/8	6	4 1/2	ph	FOR M45,59	42x40-0	1029	3 3 1/2	
17	5	3 R	8 3/8	0	5 1/2	pk207	FOR M31, M43	45-0	M618	6 6	
18	1	R	8 1/4	2	9 1/2	pm	FOR M35	30-0	1034	3 3 1/2	
19	1	R	8 3/8	7	0 1/2	ht	FOR M35-BENT	45-0	M618	7 1/2	
20	1	R	8 3/8	6	6 1/2	hv	FOR M37-BENT	45-0	M618	6 7	
21											
22	16	5 R	8 3/8	8		pv207		45-0	M618	7	
23											
24	1	R	8 3/8	5	1 1/8	na	FOR M45-BENT	45-0	M618	5 9	
25	1	R	8 3/8	6	6 1/2	nb	FOR M31-BENT			4 7	
26	1	R	8 3/8	5	10 1/8	nc	FOR M37-BENT			6 0	
27	1	R	8 3/8	5	9 1/2	nd	FOR M43-BENT			5 9	
28	1	R	8 3/8	5	9 1/2	nf	FOR M45-BENT	45-0	M618	5 9	
29											
30											
31		ONE BRACKET-M32					417* ✓				
32		ONE BRACKET-M37					486* ✓				
33		ONE BRACKET-M41					362* ✓				
34		ONE BRACKET-M44					372* ✓				
35											
36	4	FWS	9 3/8		9 1/4	da			S	1 1/8	
37	4	FWS	8 3/8		9 1/4	db		45-0	M618	1 1/8	
38	4	2 R	8 7/8	3	0	ha207	FOR M32, M41	30-0	1034	3 6	
39	1	R	3 3/8	6	9	py	FOR M32,134	42x40-0	1029	3 3 1/2	
40	1	R	3 3/8	7	10 1/8	pa	FOR M37-155	do		4 2 1/2	
41	1	R	3 3/8	5	1 1/8	pab	FOR M41-133	do	1029	2 9 1/2	
42	1	R	4 1/2	6	4 1/2	pac	FOR M43,141	do	1029	3 5 1/2	
43	1	R	8 3/8	6	9 1/2	hw	FOR M32-BENT	45-0	M618	6 9	
44	1	R	8 3/8	7	10 1/2	hy	FOR M37-BENT	45-0	M618	6 1 1/2	
45</											

F			
E			
D			
C	3-15-54		
B	2-9-54		
X	2-3-54		

DRAWINGS MADE AT TRENTON PLANT  
 WORK FABRICATED AT TRENTON PLANT  
 IN CHARGE OF E. B. MARKS  
 DRAW. MADE BY E. A. B DATE 11-11-53  
 DRAW. CHECKED BY PRV DATE 12-22-53  
 ORDER No. Q4149 SHEET No. 207



Hand-drawn technical drawings of a ship's hull structure, showing top and side views of a deck section. The drawings include dimensions, labels for various parts (e.g., M2B, M33, M34, M42), and notes like "No PAINT TOP" and "RT24P". The top view is labeled "TOP VIEW (DEVELOPED)" and the side view is labeled "SIDE VIEW". The drawings are oriented vertically on the page.

NOTES:

- 1) SPECIFICATIONS: MARINE STATE HIGHWAY COMM. 1965 AND SPECIAL PROVISIONS.
- 2) MATERIAL: ON STEEL ASTM A7-52T
- 3) RIVETS: 5/8"
- 4) HOLES: 1 1/8" UNLESS NOTED
- 5) SNIP: YES, EXCEPT AS NOTED.
- 6) SNIP CONTACT SURFACES: NO
- 7) WELDING: HOLES MARKED RT TO BE SUBRIPPED OR SUBDRILLED & REAMED TO SIZE TO A METAL TEMPLATE.


HOLES FOR SNIP RIVETS TO BE SUBRIPPED OR SUBDRILLED & REAMED TO SIZE WITH CONNECTING PARTS ASSEMBLED.

SIDEWALK BRACKETS - M28, M33, M34, M36 & M46  
DIV. 2  
STATE OF MAINE  
STATE HIGHWAY COMMISSION  
BANGOR - BREWER BRIDGE  
OVER PENOBSCOT RIVER  
BANGOR, MAINE

F		DRAWINGS MADE AT <u>TRENTON</u>	PLANT
E		WORK FABRICATED AT <u>TRENTON</u>	PLANT
D		IN CHARGE OF <u>E.B. MARKS</u>	
C		DRAW. MADE BY <u>E.B.B.</u>	DATE <u>11-1-53</u>
B		DRAW. CHECKED BY <u>PRY</u>	DATE <u>12-22-53</u>
X	3-15-54	ORDER No.	SHEET No.
REVISIONS		Q4149	208



AMERICAN BLUE PRINTING CO., BOSTON, MA

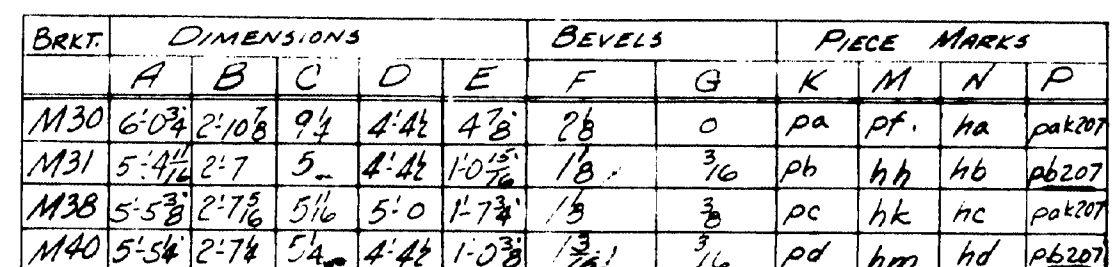

- 1) SPECIFICATIONS: MARINE STATE HIGHWAY COMM. 1985 AND SPECIAL PROVISIONS.
- 2) MATERIAL: ON STEEL ASTM A7-52T
- 3) RIVETS:  $\frac{7}{8}$ "
- 4) HOLES:  $\frac{13}{16}$ " UNLESS NOTED
- 5) PAINT: YES, EXCEPT AS NOTED.
- 6) SHOP CONTRACT: 2000
- 7) WORKMANSHIP: HOLES MARKED RT TO BE SUBPUNCHED OR SUBDRILLED  $\frac{1}{4}$  AND REAMED TO SIZE TO A METAL TEMPLET.
- 8) ALL HOLES FOR SHOP RIVETS TO BE SUBPUNCHED OR SUBDRILLED  $\frac{1}{4}$  AND REAMED TO SIZE WITH CONNECTING PARTS ASSEMBLED.

WELD

AMERICAN BRIDGE

LINE	ITEM	MATERIAL	LENGTH	REMARKS	ORDERED	CALCULATED
1						
2						
3						
4	ONE DIAPHRAGM	D22	301'			
5						
6	1 18 CB 50	4 43		-28	60/65-0	1018
7	1 18 CB 50	2 36		-63	60/65-0	1018
8	1 18 CB 50	2 36		-63	60/65-0	1018
9	2 18 CB 50	104				
10	ONE DIAPHRAGM	D21	306'			
11						
12	ONE DIAPHRAGM	D22	543'			
13	1 18 CB 50	9 54		-25	9:54	2011
14	1 18 CB 50	2 18		-59	60/65-0	1018
15	1 18 CB 50	2 18		-59	60/65-0	1018
16	ONE DIAPHRAGM	D23	539'			
17	1 18 CB 50	9 54		-25	9:54	2011
18	1 18 CB 50	2 36		-63	60/65-0	1018
19	1 18 CB 50	2 36		-63	60/65-0	1018
20	2 DIAPHRAGMS	D27	543'			
21	2 DIAPHRAGMS	D27 (LEFT)				
22	2 DIAPHRAGMS	D27 (LEFT)				
23	2 DIAPHRAGMS	D27 (LEFT)				
24	2 DIAPHRAGMS	D27 (LEFT)				
25	2 DIAPHRAGMS	D27 (LEFT)				
26	ONE DIAPHRAGM	D27	544'			
27	ONE DIAPHRAGM	D27 (LEFT)				
28						
29	1 18 CB 50	9 54		-25	9:54	2011
30	1 18 CB 50	2 36		-63	60/65-0	1018
31	1 18 CB 50	2 36		-63	60/65-0	1018
32	ONE DIAPHRAGM	D25	636'			
33						
34	1 18 CB 50	9 43		-25	60/65-0	1018
35	1 18 CB 50	2 36		-63	60/65-0	1018
36	1 18 CB 50	2 36		-63	60/65-0	1018
37	2 18 CB 50	104				
38	2 18 CB 50	104				
39	2 18 CB 50	104				
40	2 18 CB 50	104				
41	ONE DIAPHRAGM	D21	640'			
42	ONE DIAPHRAGM	D26 (LEFT)				
43						
44	1 18 CB 50	9 43		-25	60/65-0	1018
45	2 18 CB 50	2 36		-63	60/65-0	1018
46	2 18 CB 50	2 36		-63	60/65-0	1018
47	2 18 CB 50	104				
48	2 18 CB 50	104				
49	2 18 CB 50	104				
50	2 18 CB 50	104				
51	2 18 CB 50	104				
52	3 DIAPHRAGMS	D28	543'			
53	2 DIAPHRAGMS	D28 (LEFT)	543'			
54	2 DIAPHRAGMS	D28 (LEFT)				
55	2 DIAPHRAGMS	D28 (LEFT)				
56	1 18 CB 50	9 54		-25	9:54	2011
57	ONE DIAPHRAGM	D30	642'			
58						
59	1 18 CB 50	9 43		-25	9:54	2011
60	2 18 CB 50	2 36		-63	60/65-0	1018
61	2 18 CB 50	2 36		-63	60/65-0	1018
62	3 18 CB 50	104				
63	3 18 CB 50	104				
64	1 18 CB 50	9 54		-25	9:54	2011
65	1 18 CB 50	2 36		-63	60/65-0	1018
66	1 18 CB 50	2 36		-63	60/65-0	1018
67	6 18 CB 50	104				

DIAPHRAGMS-DIV. 2,3,4

STATE OF MAINE  
STATE HIGHWAY COMMISSION  
BANGOR-BREWER BRIDGE  
OVER PENOBSCOT RIVER  
BANGOR, MAINE

NOTES

SPECIFICATIONS - MAINE STATE HIGHWAY COMM. 1745 AND SPECIAL PROVISIONS

MATERIAL : QH STEEL A.S.T.M. A7-52T


HOLES: 7/8"

Holes marked RT to be subpunched or subdrilled 1/4" and reamed to size to a metal template.

F	DRAWINGS MADE AT	TRENTON	PLANT
E	WORK FABRICATED AT	TRENTON	PLANT
D	IN CHARGE OF	E.B. MARKS	
C	DRAWN BY	R.G.	DATE 1-11-55
B	DRAWN CHECKED BY	PRY	DATE 1-20-54
A	REVISIONS		
	Q4/49		
	ORDER NO.		SHEET NO.
			210

PAINT: YES-EXCEPT AS NOTED  
SHOP CONTACT SURFACES: NO

203, 303, 403 62-139 WELDING

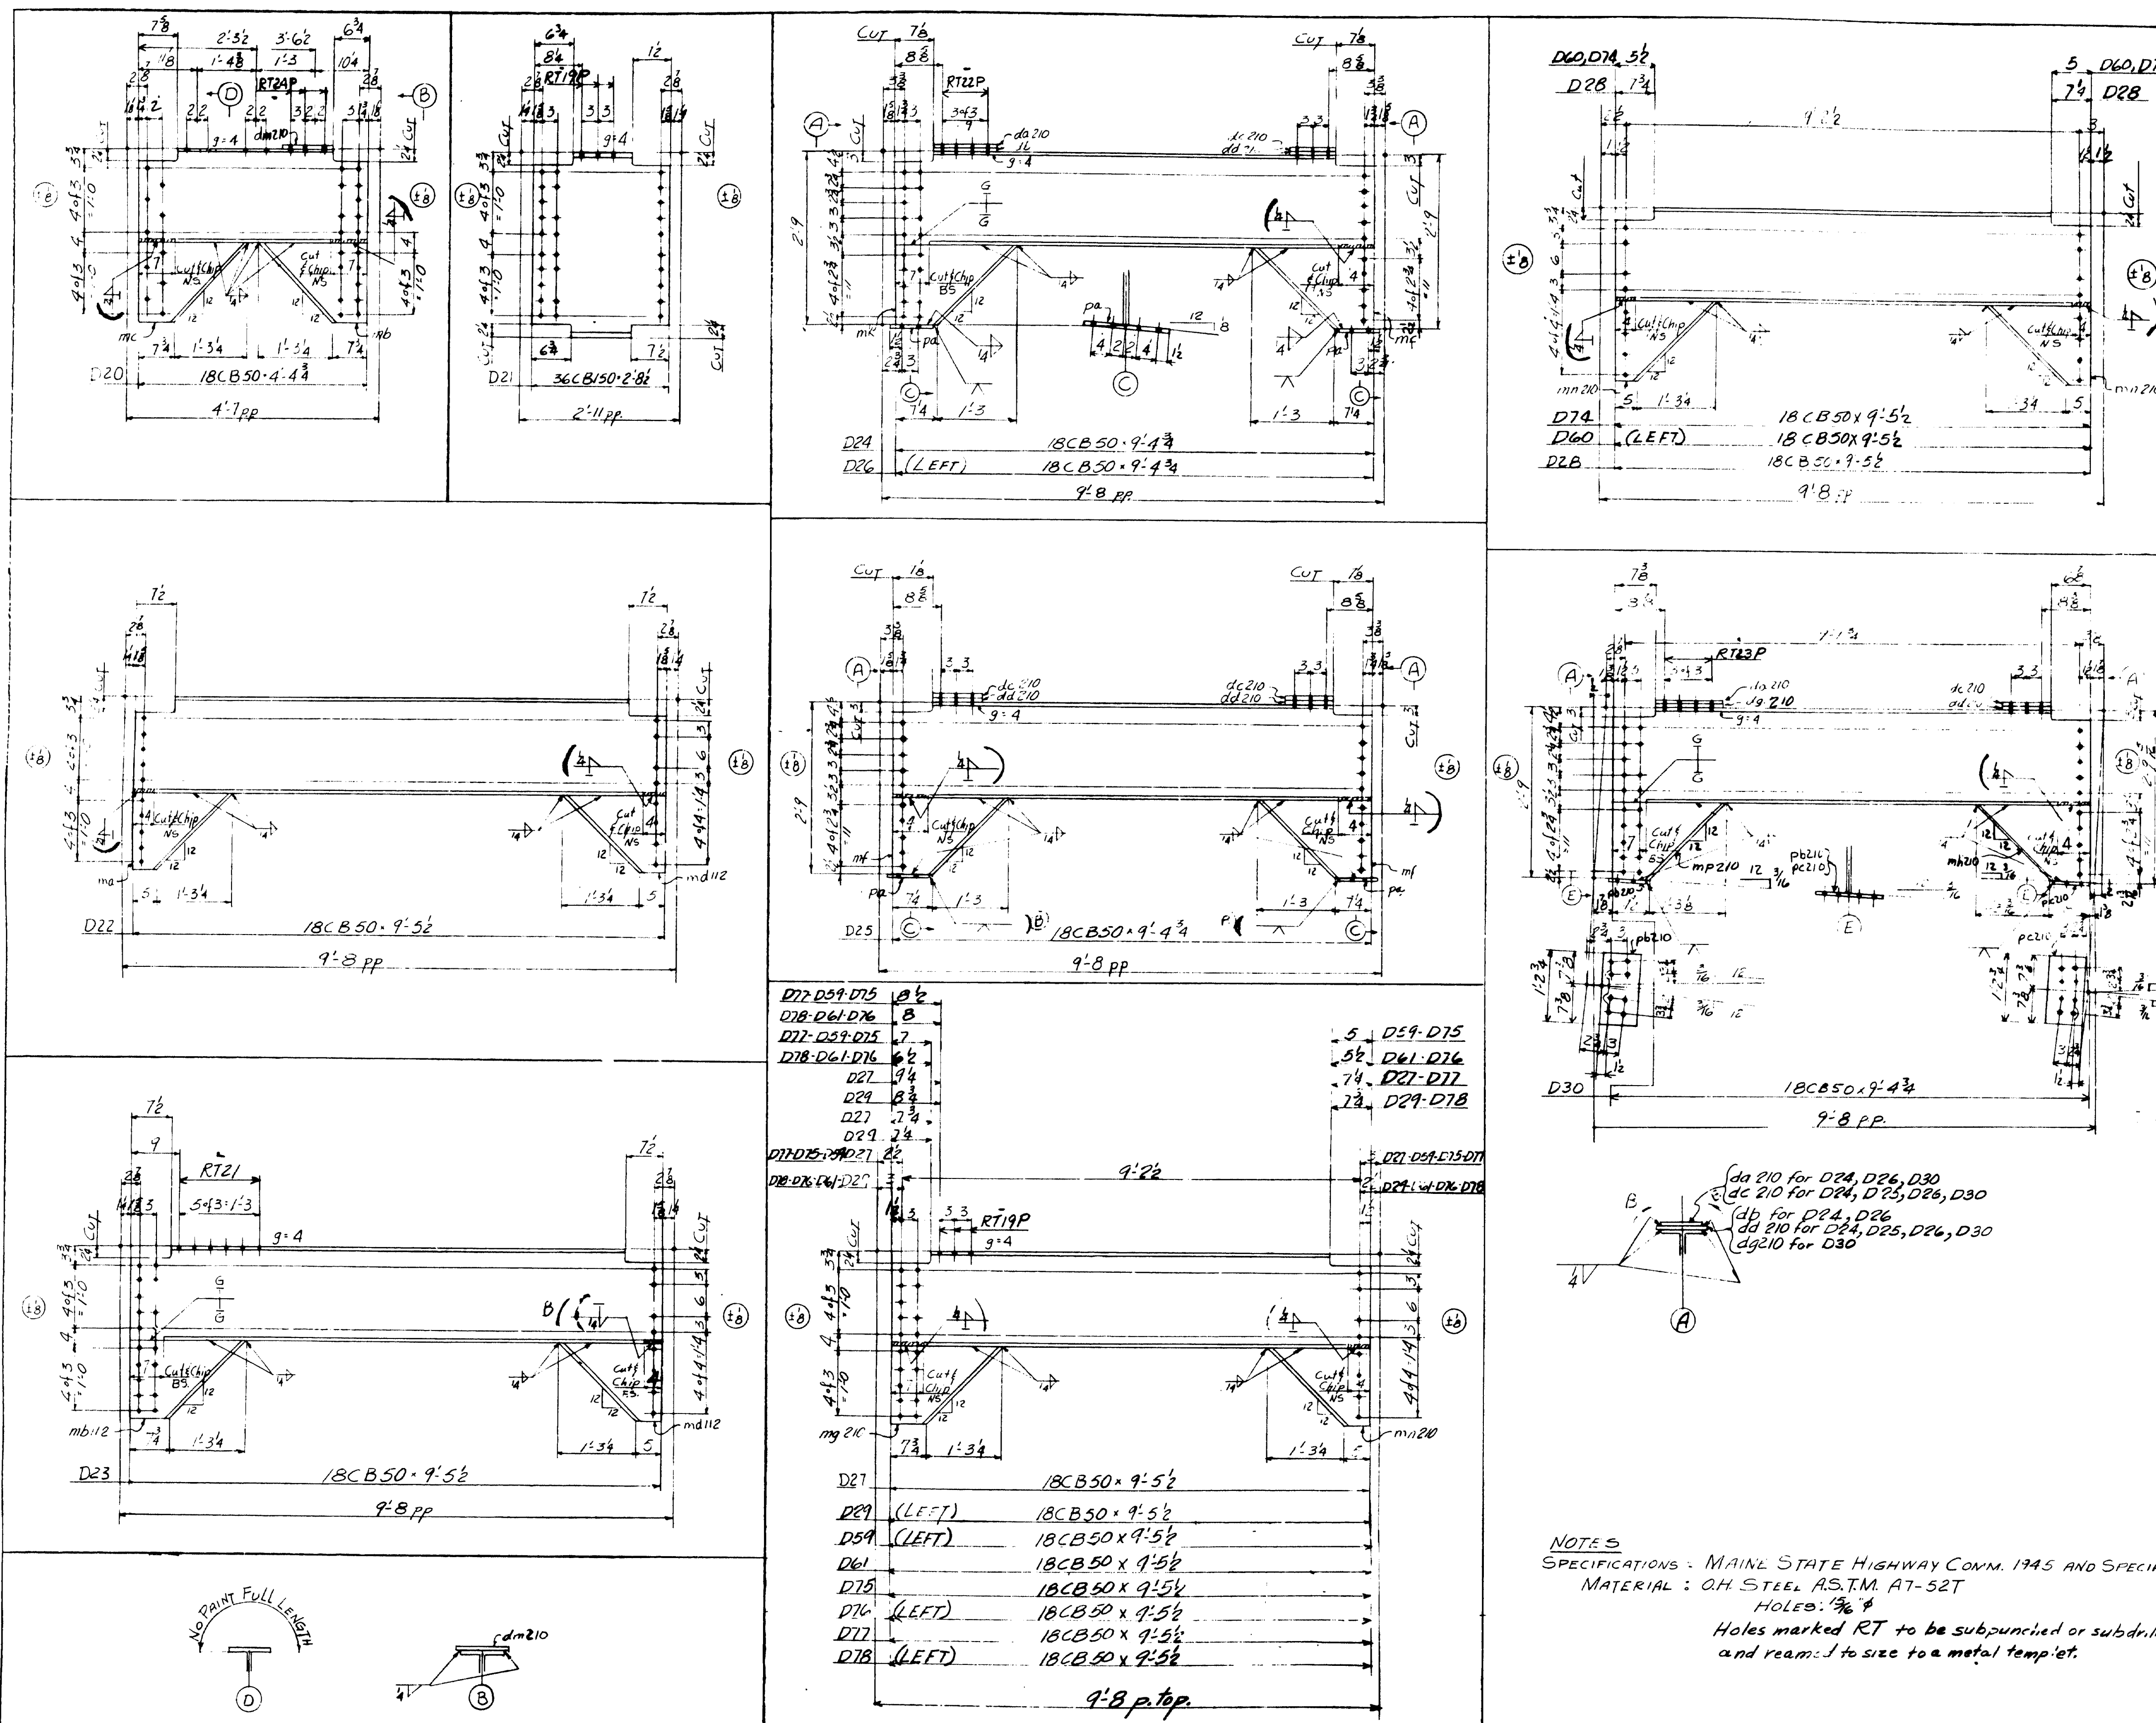



# AMERICAN BRIDGE


UNITED STATES STEEL COMPANY

LINE	ITEM	MATERIAL	ASSEMBLY MARK	REMARKS	ORDERED	CALCULATED WEIGHT FOR ONE
1	2	3	4	5	6	7
1	1	ONE DIAPHRAGM	D18	548'		
2	1	16 CB 50	7 5/8		9' 5 1/2	2011
3	2	16 CB 50	2 3/8			473
4	1	ONE DIAPHRAGM	D31	641'		
5	1	16 CB 50	9 4/3		9' 5 1/2	2011
6	2	16 CB 50	2 3/8			473
7	1	ONE DIAPHRAGM	D33	651'		
8	1	16 CB 50	9 4/3		9' 5 1/2	2011
9	2	16 CB 50	2 3/8			473
10	1	ONE DIAPHRAGM	D34	547'		
11	1	16 CB 50	9 4/3		9' 5 1/2	2011
12	2	16 CB 50	2 3/8			473
13	1	ONE DIAPHRAGM	D35	542'		
14	1	16 CB 50	9 4/3		9' 5 1/2	2011
15	2	16 CB 50	2 3/8			473
16	1	ONE DIAPHRAGM	D36	548'		
17	1	16 CB 50	9 4/3		9' 5 1/2	2011
18	2	16 CB 50	2 3/8			473
19	1	ONE DIAPHRAGM	D37	542'		
20	1	16 CB 50	9 4/3		9' 5 1/2	2011
21	2	16 CB 50	2 3/8			473
22	1	ONE DIAPHRAGM	D38	541'		
23	1	16 CB 50	9 4/3		9' 5 1/2	2011
24	2	16 CB 50	2 3/8			473
25	1	ONE DIAPHRAGM	D39	542'		
26	1	16 CB 50	9 4/3		9' 5 1/2	2011
27	2	16 CB 50	2 3/8			473
28	1	ONE DIAPHRAGM	D40	548'		
29	1	16 CB 50	9 4/3		9' 5 1/2	2011
30	2	16 CB 50	2 3/8			473
31	1	ONE DIAPHRAGM	D41	542'		
32	1	16 CB 50	9 4/3		9' 5 1/2	2011
33	2	16 CB 50	2 3/8			473
34	1	ONE DIAPHRAGM	D42	541'		
35	1	16 CB 50	9 4/3		9' 5 1/2	2011
36	2	16 CB 50	2 3/8			473
37	1	ONE DIAPHRAGM	D43	542'		
38	1	16 CB 50	9 4/3		9' 5 1/2	2011
39	2	16 CB 50	2 3/8			473
40	1	ONE DIAPHRAGM	D44	548'		
41	1	16 CB 50	9 4/3		9' 5 1/2	2011
42	2	16 CB 50	2 3/8			473
43	1	ONE DIAPHRAGM	D45	542'		
44	1	16 CB 50	9 4/3		9' 5 1/2	2011
45	2	16 CB 50	2 3/8			473
46	1	ONE DIAPHRAGM	D46	541'		
47	1	16 CB 50	9 4/3		9' 5 1/2	2011
48	2	16 CB 50	2 3/8			473
49	1	ONE DIAPHRAGM	D47	542'		
50	1	16 CB 50	9 4/3		9' 5 1/2	2011
105	2	16 CB 50	2 3/8			473
106	1	ONE DIAPHRAGM	D66	541'		
107	1	16 CB 50	9 4/3		9' 5 1/2	2011
108	2	16 CB 50	2 3/8			473
109	1	ONE DIAPHRAGM	D67	542'		
110	1	16 CB 50	9 4/3		9' 5 1/2	2011
111	2	16 CB 50	2 3/8			473
112	1	ONE DIAPHRAGM	D68	548'		
113	1	16 CB 50	9 4/3		9' 5 1/2	2011
114	2	16 CB 50	2 3/8			473
115	1	ONE DIAPHRAGM	D69	542'		
116	1	16 CB 50	9 4/3		9' 5 1/2	2011
117	2	16 CB 50	2 3/8			473
118	1	ONE DIAPHRAGM	D70	541'		
119	1	16 CB 50	9 4/3		9' 5 1/2	2011
120	2	16 CB 50	2 3/8			473
121	1	ONE DIAPHRAGM	D71	542'		
122	1	16 CB 50	9 4/3		9' 5 1/2	2011
123	2	16 CB 50	2 3/8			473
124	1	ONE DIAPHRAGM	D72	548'		
125	1	16 CB 50	9 4/3		9' 5 1/2	2011
126	2	16 CB 50	2 3/8			473
127	1	ONE DIAPHRAGM	D73	542'		
128	1	16 CB 50	9 4/3		9' 5 1/2	2011
129	2	16 CB 50	2 3/8			473
130	1	ONE DIAPHRAGM	D74	541'		
131	1	16 CB 50	9 4/3		9' 5 1/2	2011
132	2	16 CB 50	2 3/8			473
133	1	ONE DIAPHRAGM	D75	542'		
134	1	16 CB 50	9 4/3		9' 5 1/2	2011
135	2	16 CB 50	2 3/8			473
136	1	ONE DIAPHRAGM	D76	548'		
137	1	16 CB 50	9 4/3		9' 5 1/2	2011
138	2	16 CB 50	2 3/8			473
139	1	ONE DIAPHRAGM	D77	542'		
140	1	16 CB 50	9 4/3		9' 5 1/2	2011
141	2	16 CB 50	2 3/8			473
142	1	ONE DIAPHRAGM	D78	541'		
143	1	16 CB 50	9 4/3		9' 5 1/2	2011
144	2	16 CB 50	2 3/8			473
145	1	ONE DIAPHRAGM	D79	542'		
146	1	16 CB 50	9 4/3		9' 5 1/2	2011
147	2	16 CB 50	2 3/8			473
148	1	ONE DIAPHRAGM	D80	548'		
149	1	16 CB 50	9 4/3		9' 5 1/2	2011
150	2	16 CB 50	2 3/8			473
151	1	ONE DIAPHRAGM	D81	542'		
152	1	16 CB 50	9 4/3		9' 5 1/2	2011
153	2	16 CB 50	2 3/8			473
154	1	ONE DIAPHRAGM	D82	541'		
155	1	16 CB 50	9 4/3		9' 5 1/2	2011
156	2	16 CB 50	2 3/8			473
157	1	ONE DIAPHRAGM	D83	542'		
158	1	16 CB 50	9 4/3		9' 5 1/2	2011
159	2	16 CB 50	2 3/8			473
160	1	ONE DIAPHRAGM	D84	548'		
161	1	16 CB 50	9 4/3		9' 5 1/2	2011
162	2	16 CB 50	2 3/8			473
163	1	ONE DIAPHRAGM	D85	542'		
164	1	16 CB 50	9 4/3		9' 5 1/2	2011
165	2	16 CB 50	2 3/8			473
166	1	ONE DIAPHRAGM	D86	541'		
167	1	16 CB 50	9 4/3		9' 5 1/2	2011
168	2	16 CB 50	2 3/8			473
169	1	ONE DIAPHRAGM	D87	542'		
170	1	16 CB 50	9 4/3		9' 5 1/2	2011
171	2	16 CB 50	2 3/8			473
172	1	ONE DIAPHRAGM	D88	548'		
173	1	16 CB 50	9 4/3		9' 5 1/2	2011
174	2	16 CB 50	2 3/8			473
175	1	ONE DIAPHRAGM	D89	542'		
176	1	16 CB 50	9 4/3		9' 5 1/2	2011
177	2	16 CB 50	2 3/8			473
178	1	ONE DIAPHRAGM	D90	541'		
179	1	16 CB 50	9 4/3		9' 5 1/2	2011
180	2	16 CB 50	2 3/8			473
181	1	ONE DIAPHRAGM	D91	542'		
182	1	16 CB 50	9 4/3		9' 5 1/2	2011
183	2	16 CB 50	2 3/8			473
184	1	ONE DIAPHRAGM	D92	548'		
185	1	16 CB 50	9 4/3		9' 5 1/2	2011
186	2	16 CB 50	2 3/8			473
187	1	ONE DIAPHRAGM	D93	542'		
188	1	16 CB 50	9 4/3		9' 5 1/2	2011
189	2	16 CB 50	2 3/8			473
190	1	ONE DIAPHRAGM	D94	541'		
191	1	16 CB 50	9 4/3		9' 5 1/2	2011
192	2	16 CB 50	2 3/8			473
193	1	ONE DIAPHRAGM	D95	542'		
194	1	16 CB 50	9 4/3		9' 5 1/2	2011
195	2	16 CB 50	2 3/8			473
196	1	ONE DIAPHRAGM	D96	548'		
197	1	16 CB 50	9 4/3		9' 5 1/2	2011
198	2	16 CB 50	2 3/8			473
199	1	ONE DIAPHRAGM	D97	542'		
200	1	16 CB 50	9 4/3		9' 5 1/2	2011
201	2	16 CB 50	2 3/8			473
202	1	ONE DIAPHRAGM	D98	541'		
203	1	16 CB 50	9 4/3		9' 5 1/2	2011
204	2	16 CB 50	2 3/8			473
205	1	ONE DIAPHRAGM	D99	542'		
206	1	16 CB 50	9 4/3		9' 5 1/2	2011
207	2	16 CB 50	2 3/8			




# AMERICAN BRIDGE


LINE	ITEM	MATERIAL		ASSEMBLY MARK	REMARKS	ORDERED	CALCULATED
		MARK	LENGTH				
1							
2							
3							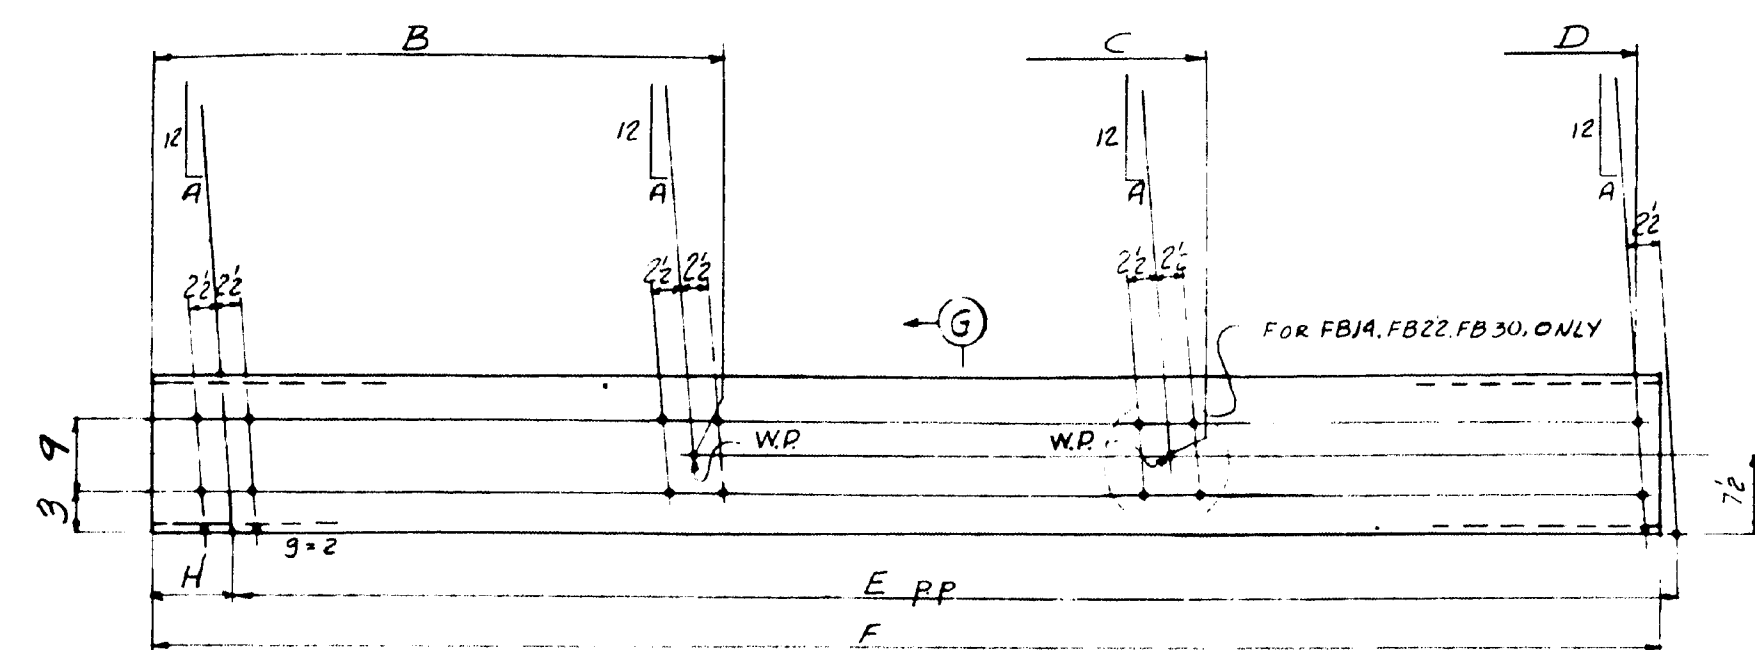
MARK	A	H	B	C	D	E PP	F
FB14 LEFT	8	8 1/2	7 1/4	13 1/8	20 5/8	19 11/16	20 7/8
FB22	8	8 1/2	7 1/4	14 0/8	20 5/8	19 11/8	20 7/8
FB30	4	1 0/8	8 3/16	15 6/8	22 7/8	21 9/16	22 9/8
FB46	4	1 0/8	8 2	—	15 1/2	14 3/8	15 3/8

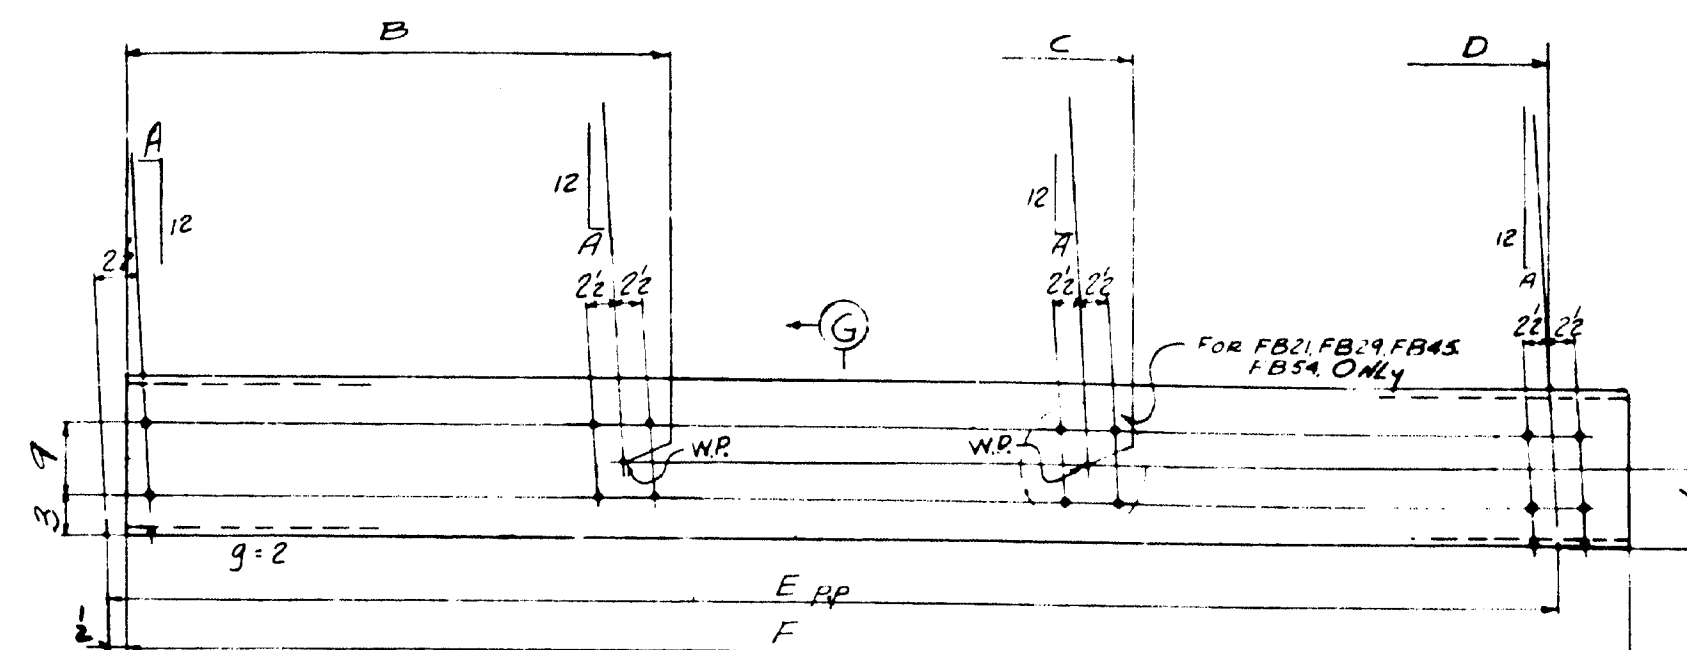

MARK	A	B	C	D	E PP	F
FB21 LEFT	4	5 9/8	11 8/8	17 6/8	17 7/8	17 11/8
FB29	4	5 5/8	10 1/8	16 4/8	16 5/8	16 9/4
FB37 LEFT	4	7 1/8	—	14 4/8	14 5/8	14 9
FB45	4	5 9/8	11 8/8	17 6/8	17 7/8	17 11
FB54	4	6 3/8	12 7/8	18 11/8	19 0/8	19 9/8

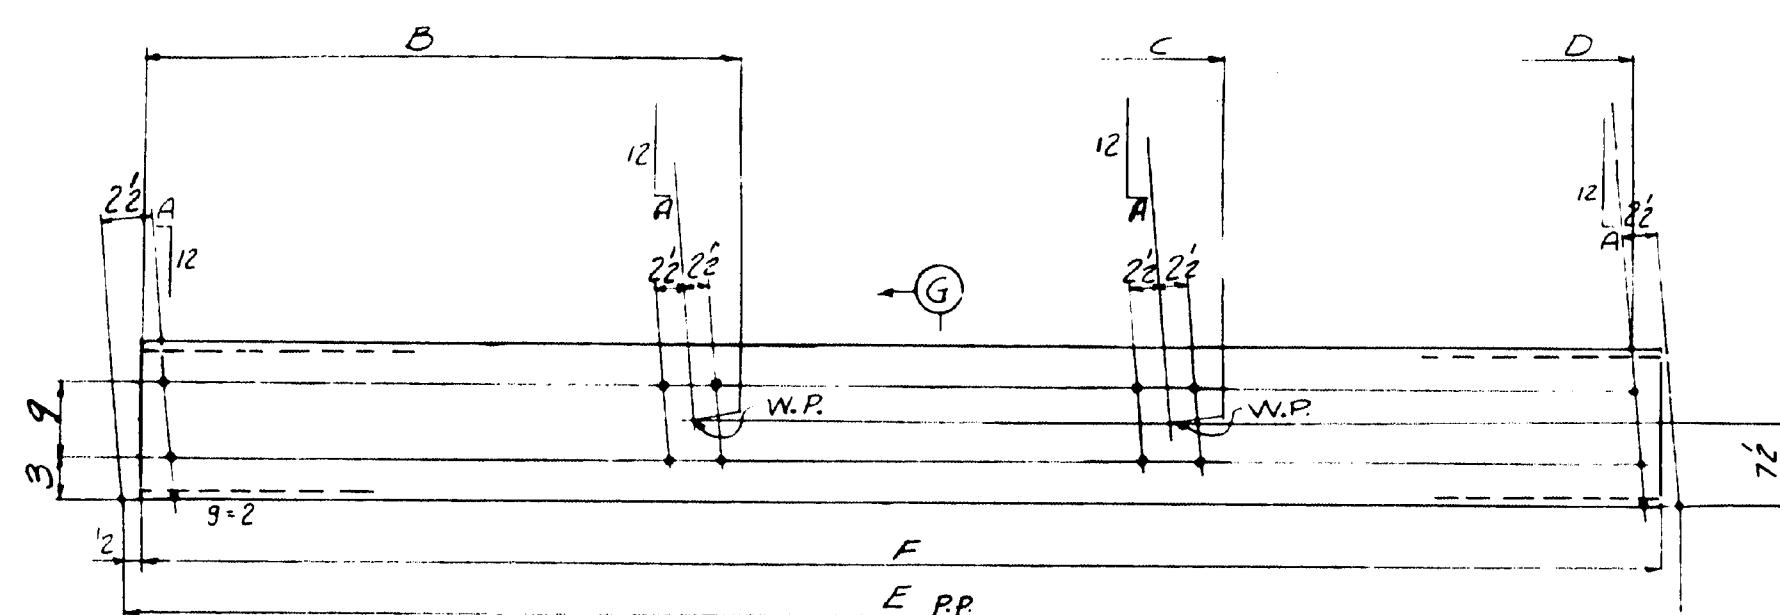

MARK	A	B	C	D	E PP	F
FB15 LEFT	8	6 7/8	13 3/8	19 8/8	20 0	19 11
FB16 LEFT	8	6 7/8	13 3/8	19 9/8	20 0/8	19 11/2
FB17 LEFT	8	7 5/4	14 1/1	22 2/4	22 5/8	22 4/2
FB20 LEFT	4	5 9/8	11 8/8	17 5	17 8/8	17 7/2
FB23	8	6 7/8	13 3/8	19 9/4	20 0/8	19 11
FB24	8	6 7/8	13 3/8	19 9/16	20 0/8	20 0
FB25	8	7 5/8	14 1/8	22 2/8	22 5/8	22 4/2
FB26	4	7 5/8	14 1/8	22 2/8	22 6	22 5
FB27	4	6 4/8	12 9/8	19 0/8	19 3/8	19 2/2
FB28	4	6 0/4	12 1/8	17 11/8	18 3/4	18 2/2
FB31 LEFT	4	7 5/8	15 0/8	22 4/4	22 7/8	22 6/2
FB32 LEFT	4	6 2/8	12 5/8	18 6/8	18 9/8	18 9
FB33 LEFT	4	8 5/8	17 0/8	25 3/8	25 7/4	25 6/4
FB34 LEFT	4	8 3/8	16 7/8	24 9/8	25 0/8	24 11/2
FB35 LEFT	4	8 4/4	16 9/8	24 11/8	25 2/4	25 2
FB39	4	7 0/8	14 2/8	21 0/8	21 3/8	21 3/4
FB40	4	7 0/8	14 1/8	21 0/4	21 3/8	21 2/2
FB41	4	7 2/8	14 6/8	21 7/8	21 10/8	21 9/2
FB42	4	8 3/8	16 7/8	24 9/8	25 0/8	24 11/2
FB43	4	7 11/8	16 0/8	23 9/8	24 1/8	24 0/4
FB44 LEFT	4	6 2/8	12 5/8	18 5/8	18 9/8	18 8
FB50 LEFT	4	6 11/8	13 11/2	20 8/8	21 0/4	20 11/4
FB51 LEFT	4	5 8/8	11 6/8	17 1/4	17 4/8	17 3/2
FB52	4	6 3/8	12 8/8	18 10/4	19 1/8	19 0/2
FB53	4	6 3/8	12 8	18 9/8	19 1/4	19 0
FB58	4	6 9/8	13 7/8	20 2/8	20 6/8	20 5
FB59	4	6 7/8	13 4/8	19 10/8	20 1/8	20 0/8
FB60	4	5 5/8	10 11/8	16 2/8	16 6/8	16 5
FB18 LEFT	8	7 5/8	14 1/8	22 2/16	22 6	22 5
FB19 LEFT	8	6 6/8	13 2/8	19 7/8	19 10/8	19 9/2

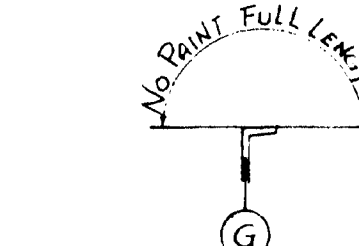

## FASCIA BEAMS DIV. 2,3,4


STATE OF MAINE  
STATE HIGHWAY COMMISSION  
BANGOR-BREWER BRIDGE  
OVER PENOBSCOT RIVER  
BANGOR, MAINE

NOTES  
SPECIFICATIONS: MAINE STATE  
HIGHWAY COMM. 1945  
AND SPECIAL PROVISIONS.  
MATERIAL: A.H. STEEL A.S.T.M. A7-52T  
HOLES: 1/16"

AMERICAN BRIDGE  
UNITED STATES STEEL COMPANY

DRAWINGS MADE AT TRENTON PLANT  
WORK FABRICATED AT TRENTON PLANT  
IN CHARGE OF E.B. MARKS  
DRAW. MADE BY R.G. DATE 11-25-53  
DRAW. CHECKED BY PRY DATE 12-23-53  
ORDER NO. 94149 SHEET NO. 212

PART: YES-EXCEPT AS NOTED  
SHOP CONTACT SURFACES: NO.

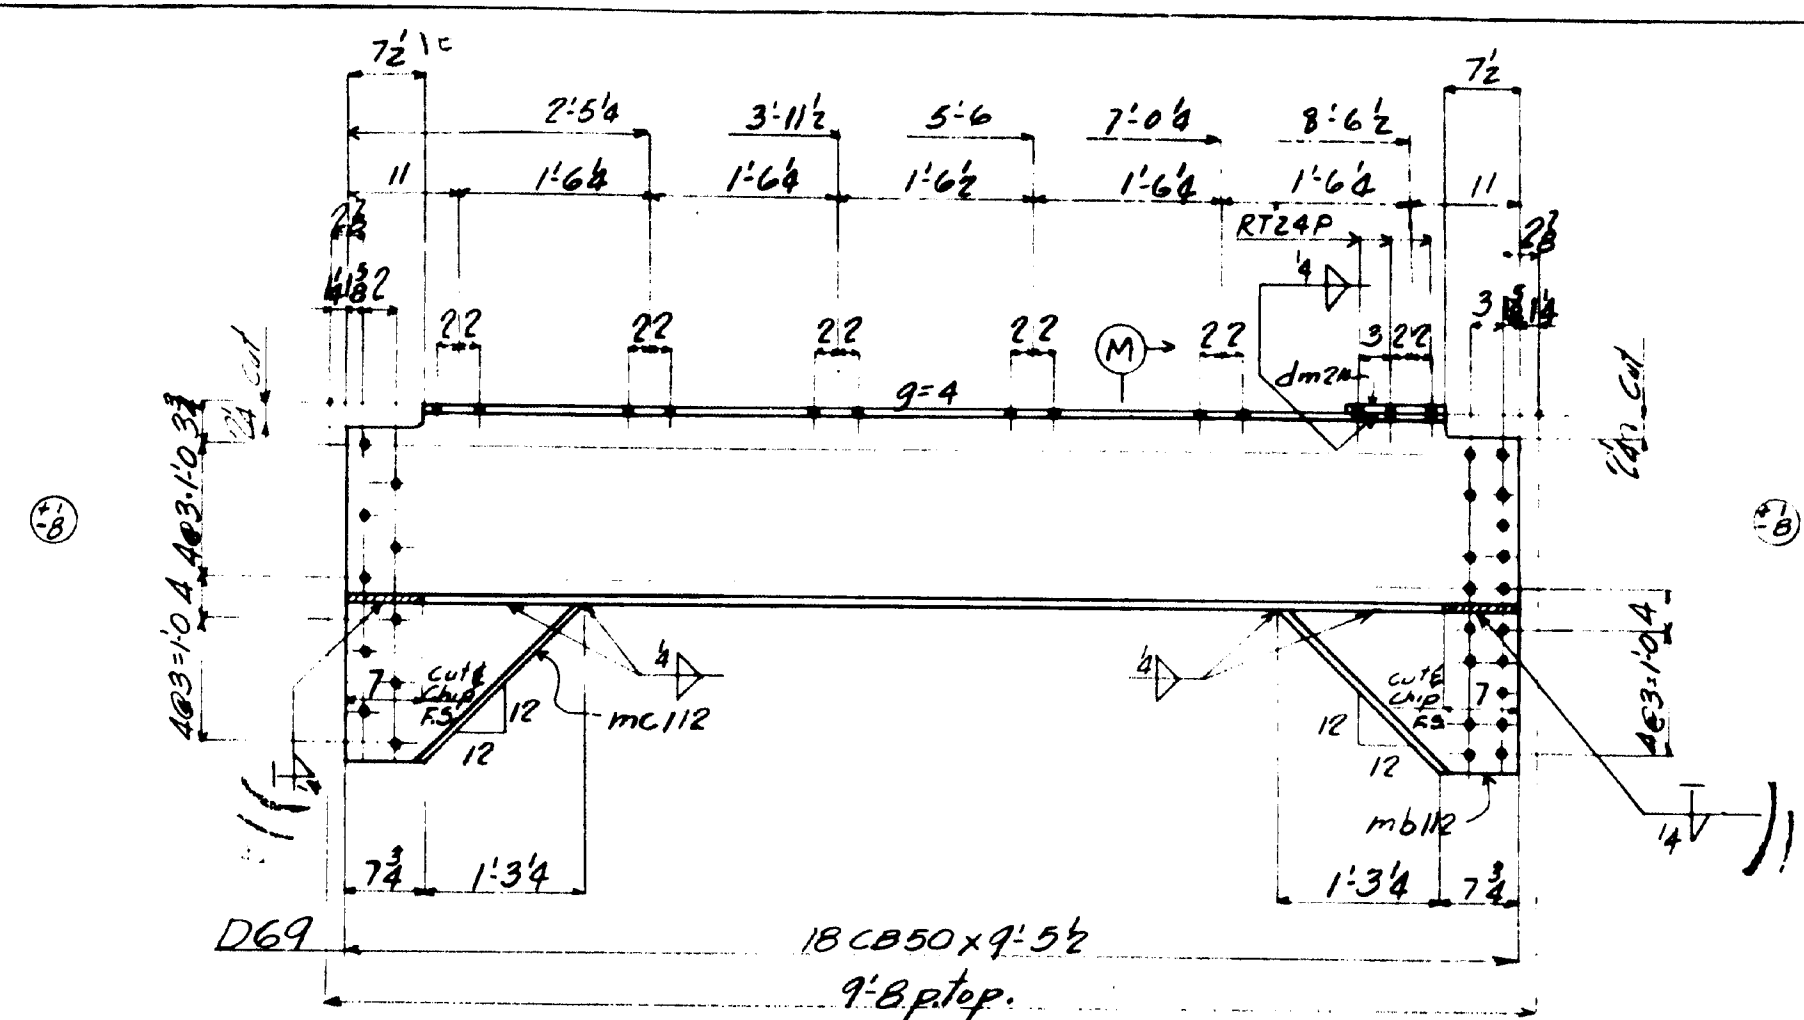

A diagram showing a horizontal beam supported by a central vertical post. A circular load labeled 'M' is suspended from the center of the beam. Above the beam, a curved line with arrows at both ends is labeled 'No Point ~ Full Length'.

SIDEWALK STRUTS - DIV.  
DIAPHRAGM D69 - DIV.2  
STATE OF MAINE  
STATE HIGHWAY COMMISSION  
BANGOR-BREWER BRIDGE  
(OVER PENOBSCOT RIVER  
BANGOR, MAINE




203

203





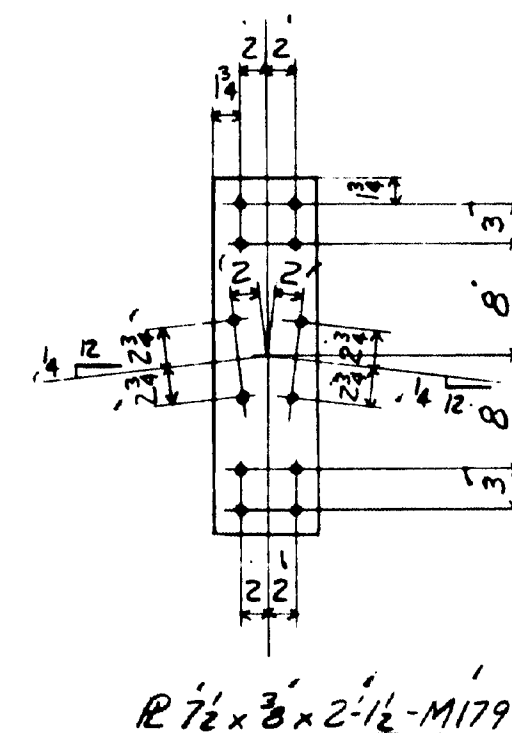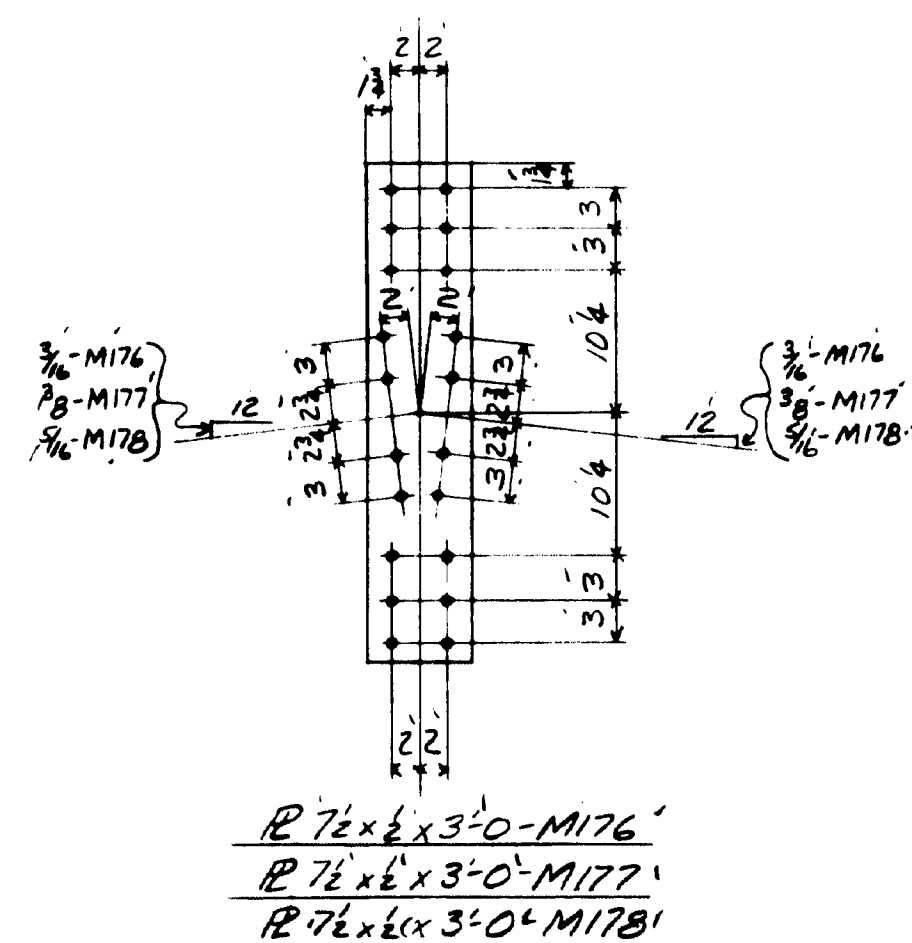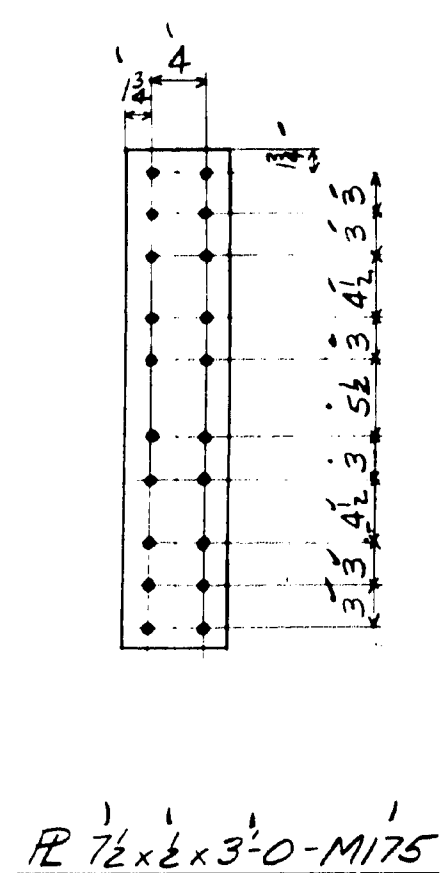

[illegible]

NOTES:

SPECIFICATIONS: 'MAINE STATE' HIGHWAY COMM. 1945  
& SPECIAL PROVISIONS  
MATERIAL: C.H. STEEL ASTM A7-52T  
HOLES - 1 7/8" Ø  
PAINT - YES,  
SHOP CONTACT SURFACES - NO

DRAWING WITH BILL  
**AMERICAN BRIDGE COMPANY**

[illegible]

TIE PLATES - M175, M176, M177, M178, M179  
DIV. 2, 3, & 4  
 STATE OF MAINE  
 STATE HIGHWAY COMMISSION  
 BANGOR-BREWER BRIDGE  
 OVER PENOBSCOT RIVER  
 BANGOR, MAINE

DN 1500-2-54 PENCILTEX  
**AMERICAN BRIDGE COMPANY**  
 UNITED STATES STEEL CORPORATION SUBSIDIARY

DRAWINGS MADE AT TRENTON PLANT  
WORK FABRICATED AT TRENTON PLANT  
IN CHARGE OF E.B. Marks  
DRAW. MADE BY PRY DATE 1-28-54  
DRAW. CHECKED BY hlp DATE 1-29-54

ORDER No. 04149 SHEET No. 215-






F	
E	
D	
C	
B	
X	
REVISIONS	

~~PANTS~~  
~~SHOE CONTACT SURFACES~~

組別

62-144

REV.	BY	DATE	BOLTS		RIVETS	
			Qty	Size	Qty	Size
1						
2						
3						
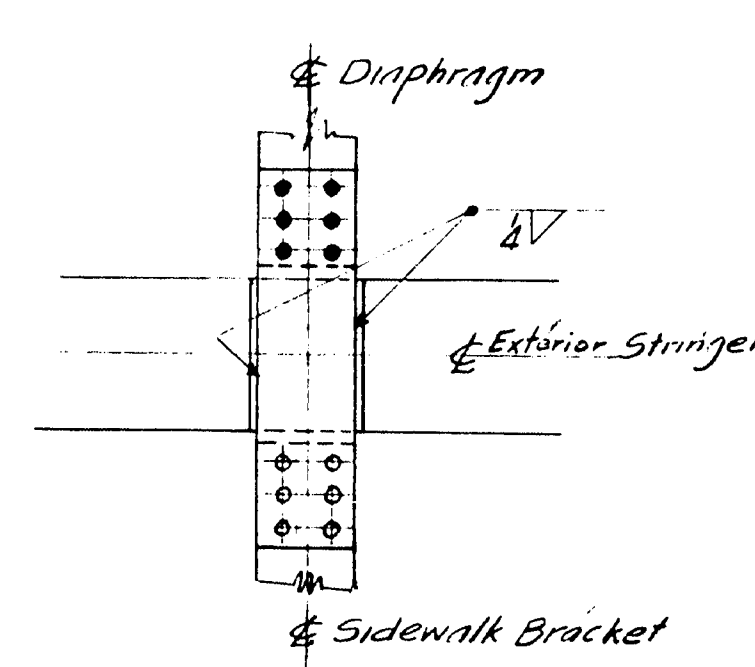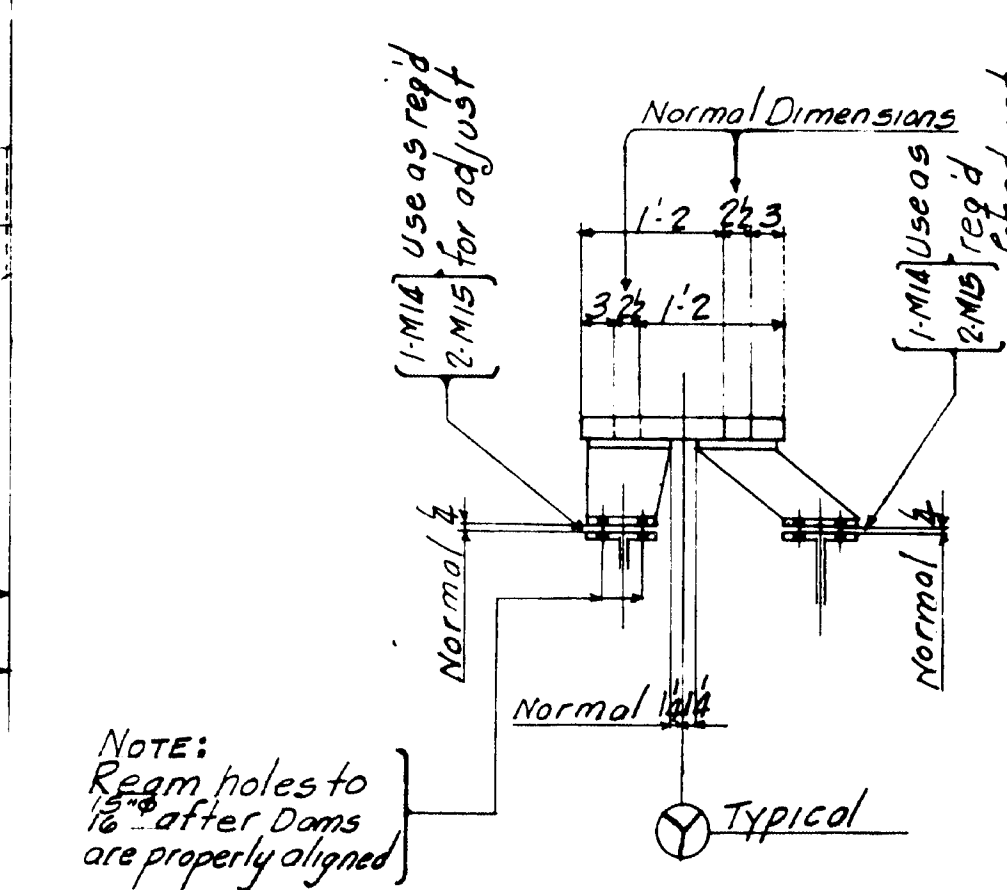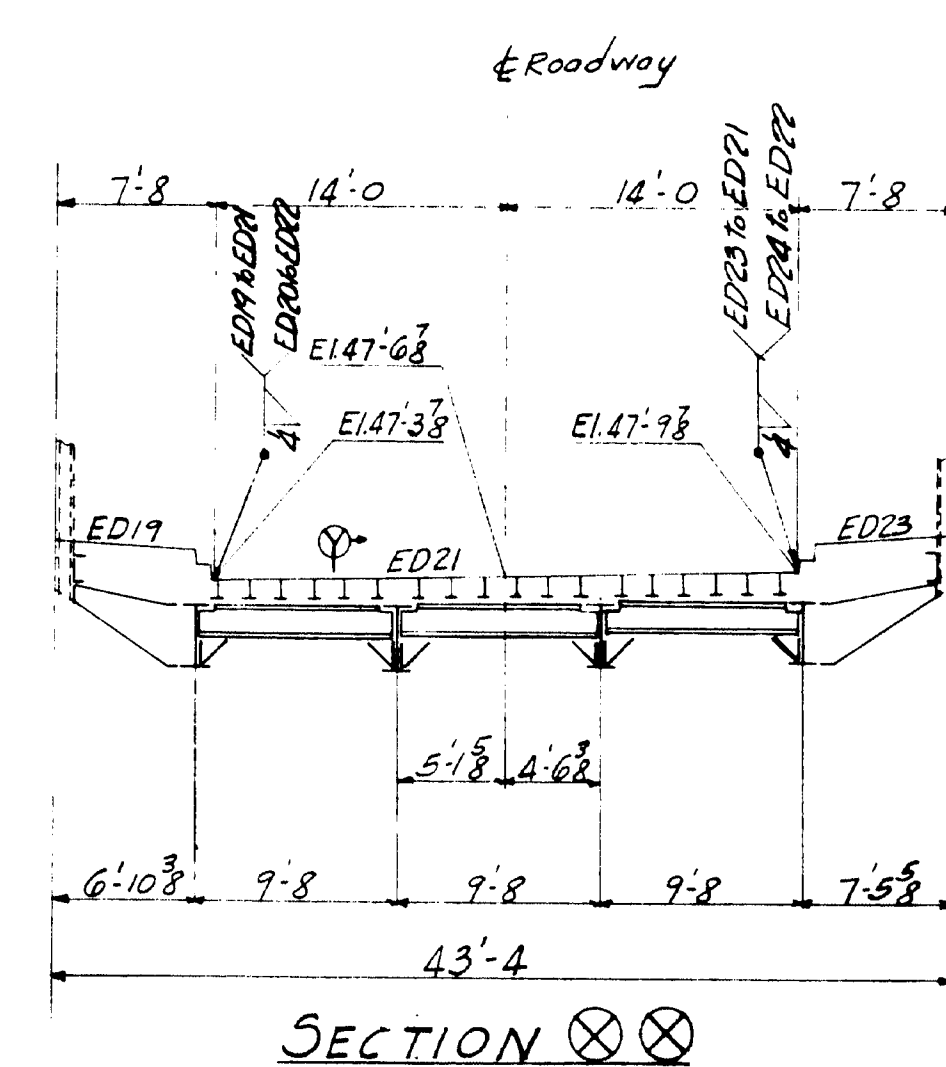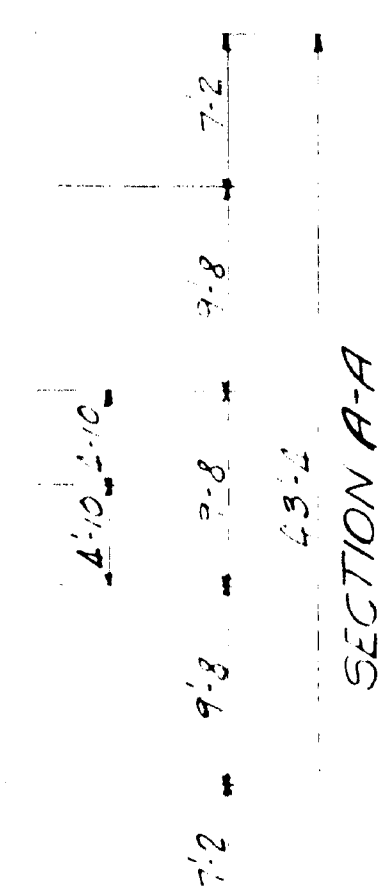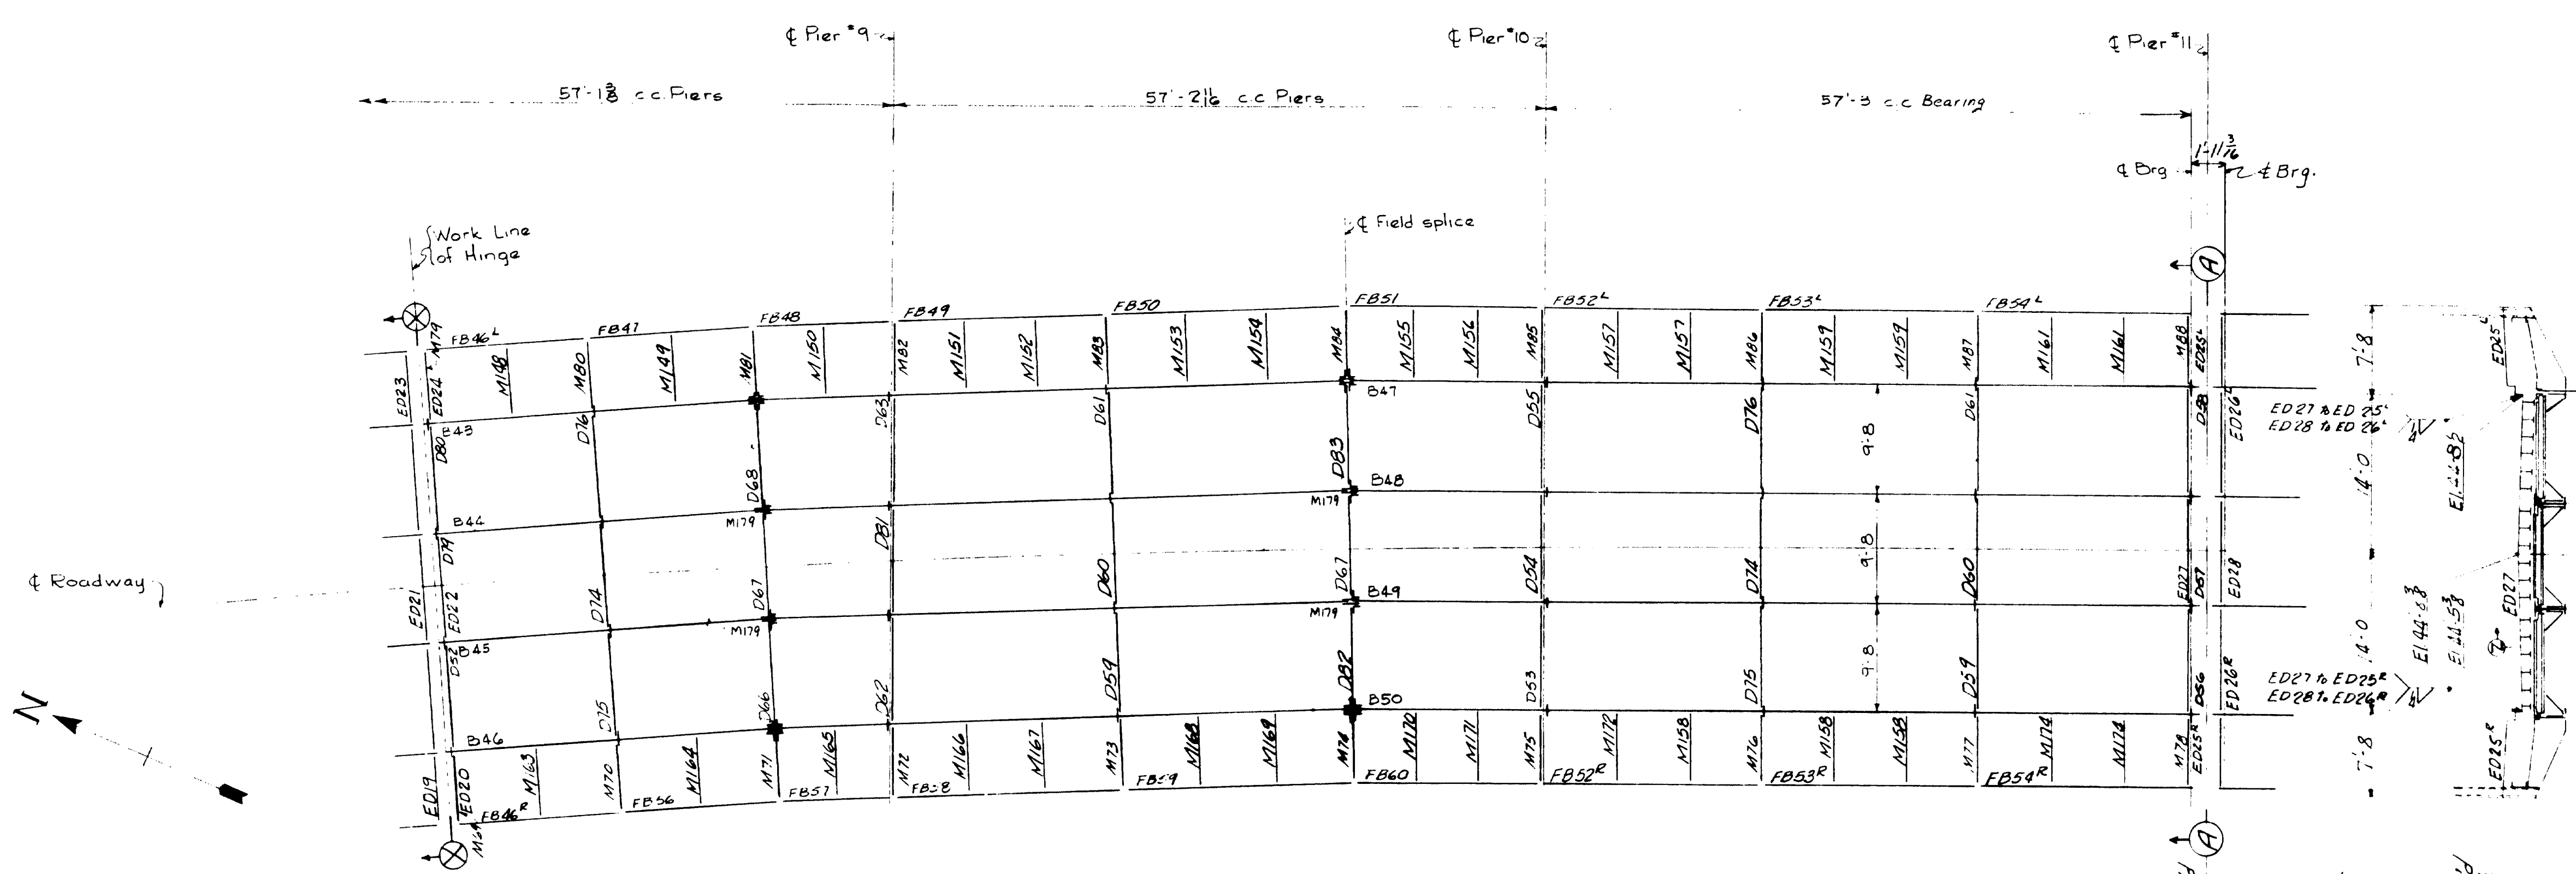


Typical Connection Bracket Tie Rts. to Stringers - Except at Splices.

FOR CONNECTIONS OF RAILING PILES AND THE NECESSARY SHIMS AT BOTH THE SIDEWALK BRACKETS AND THE INTERMEDIATE STRUTS SEE SKETCHES ON SHEET E201

All connections riveted, except for expansion dams to diaphragms use Dardelot Rivet Bolts and Fascia Channels to sidewalk brackets use ordinary bolts.

Bolts for Railing Fast Connections supplied by others for the Assembly Diagrams and Match Marks at the Field Splices of the Stringer Beams see Sh. 412

2-Wash. 2x8 (1/4 hole) to be used where necessary under nut of Dardelot Rivet Bolts to build up required grip.

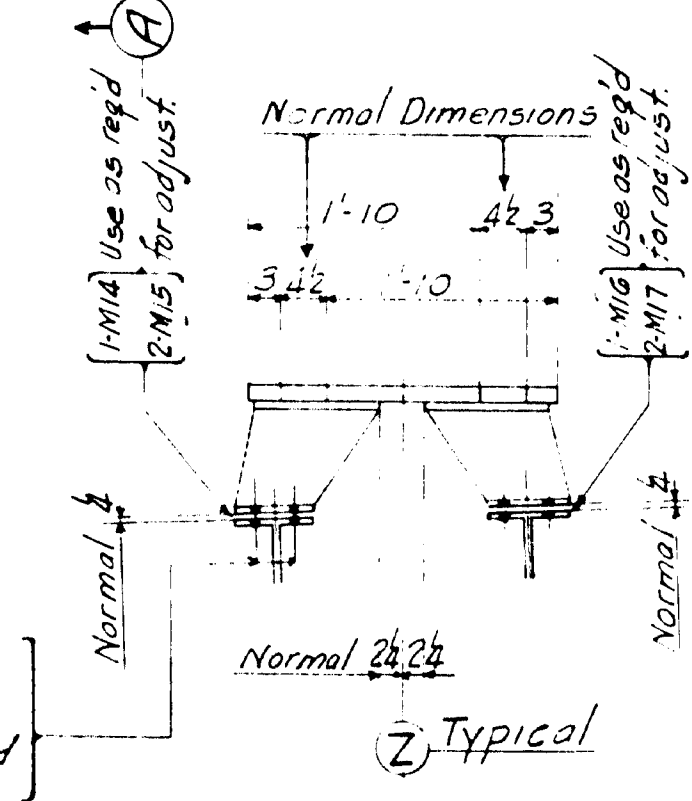

Typical

ERECTION PLAN  
DIV. 4  
BANGOR - BROWER BRIDGE  
OVER PENOBSCOT RIVER  
STATE OF MAINE

AMERICAN BRIDGE  
UNITED STATES STEEL CORPORATION

REVISED	DATE	BY
1	2-5-54	PRV
2	2-5-54	PRV
# AMERICAN BRIDGE

UNITED STATES STEEL COMPANY

LINE	NO. OF PLATES	MATERIAL	LENGTH	ASSEMBLY MARK	REMARKS	ORDERED	CALCULATED
						ITEM	WEIGHT FOR ONE BAY
1							
2							
3		ONE EXPANSION DAM - ED19	126'				
4		ONE EXPANSION DAM - ED23 (LEFT)					
5	2	R 10 3/4 6 9/16	3300			92	
6	2	R 10 3/4 6 9/16	3300			92	
7	2	R 10 3/4 6 9/16	3300			92	
8	2	R 10 3/4 6 9/16	3300			92	
9	10	R 10 3/4 6 9/16	3300			13	
10		ONE EXPANSION DAM - ED20	104'				
11		ONE EXPANSION DAM - ED24 (LEFT)					
12	2	R 12 3/4 6 9/16	3300			13	
13	2	R 12 3/4 6 9/16	3300			13	
14	2	R 12 3/4 6 9/16	3300			13	
15	2	R 12 3/4 6 9/16	3300			13	
16	2	R 12 3/4 6 9/16	3300			13	
17	2	R 12 3/4 6 9/16	3300			13	
18	2	R 12 3/4 6 9/16	3300			13	
19	2	R 12 3/4 6 9/16	3300			13	
20	2	R 12 3/4 6 9/16	3300			13	
21	10	R 12 3/4 6 9/16	3300			13	
22		ONE EXPANSION DAM - ED21	1882'				
23	2	R 12 3/4 6 9/16	3300			20	
24	2	R 12 3/4 6 9/16	3300			20	








EXPANSION DAMS - ED19, ED20, ED21, ED22, ED23 & ED24

STATE OF MAINE  
STATE HIGHWAY COMMISSION  
BANGOR - BREWER BRIDGE  
OVER THE PENOBSCOT RIVER  
BANGOR, MAINE

AMERICAN BRIDGE


DRAWINGS MADE AT TRENTON PLANT  
WORK FABRICATED AT TRENTON PLANT  
IN CHARGE OF E. B. MARKS  
DRAWN BY E. A. B. DATE 10-10-53  
DRAWN CHECKED BY P. R. Y. DATE 1-22-54  
ORDER NO. Q4149 SHEET NO. 401

REVISIONS	DATE	BY	REASON
1	10-10-53	E. A. B.	INITIAL DESIGN
2	1-22-54	P. R. Y.	REVISIONS

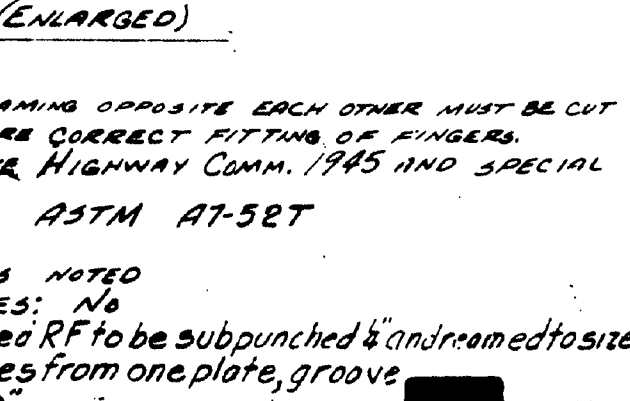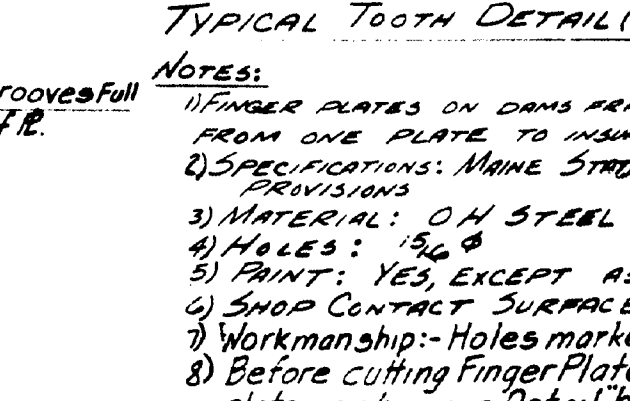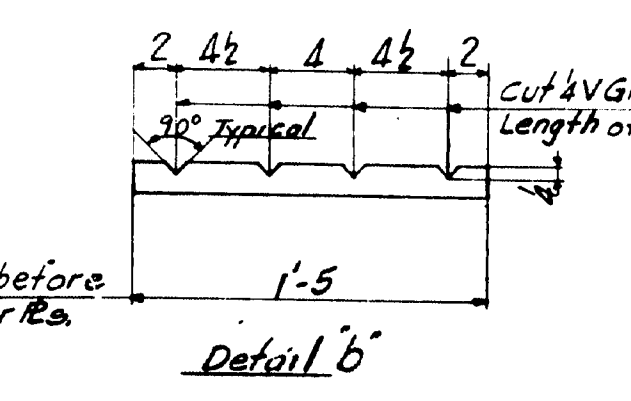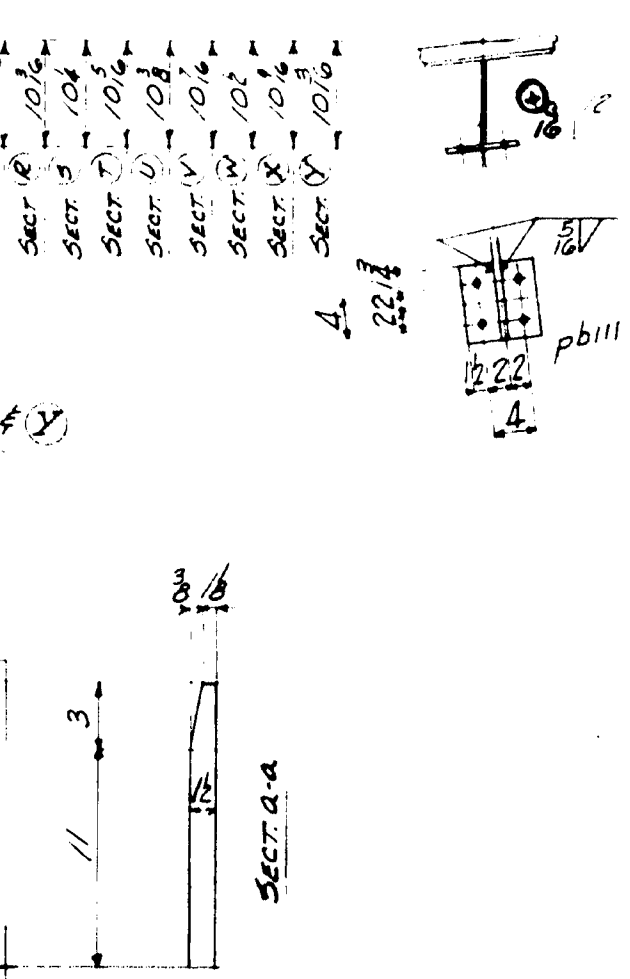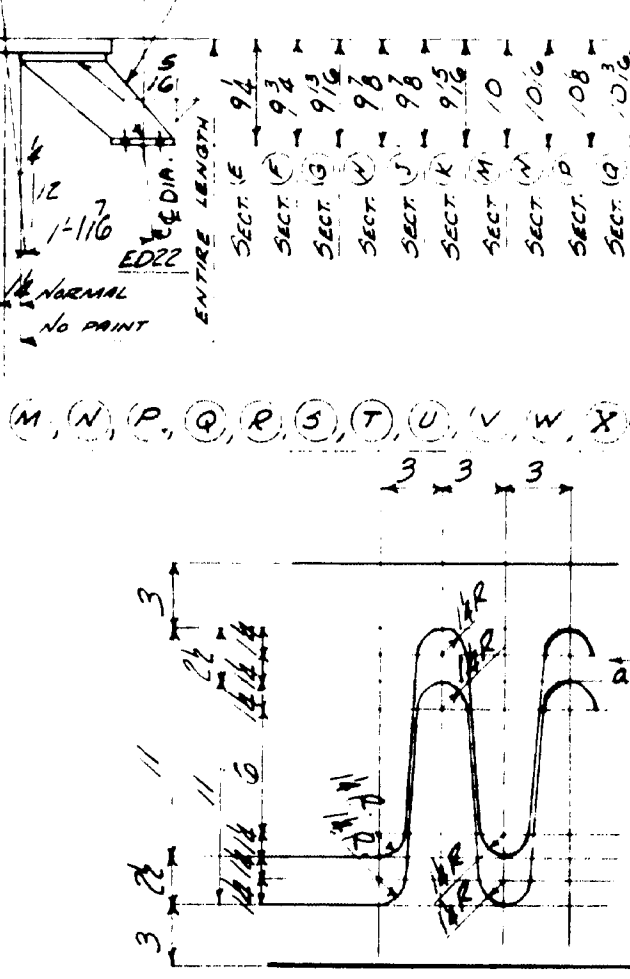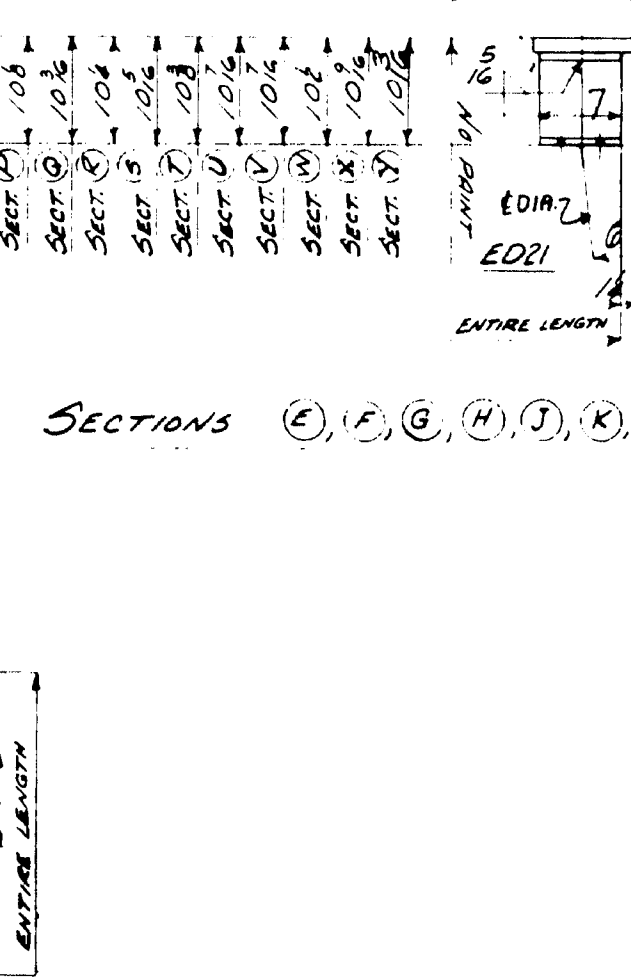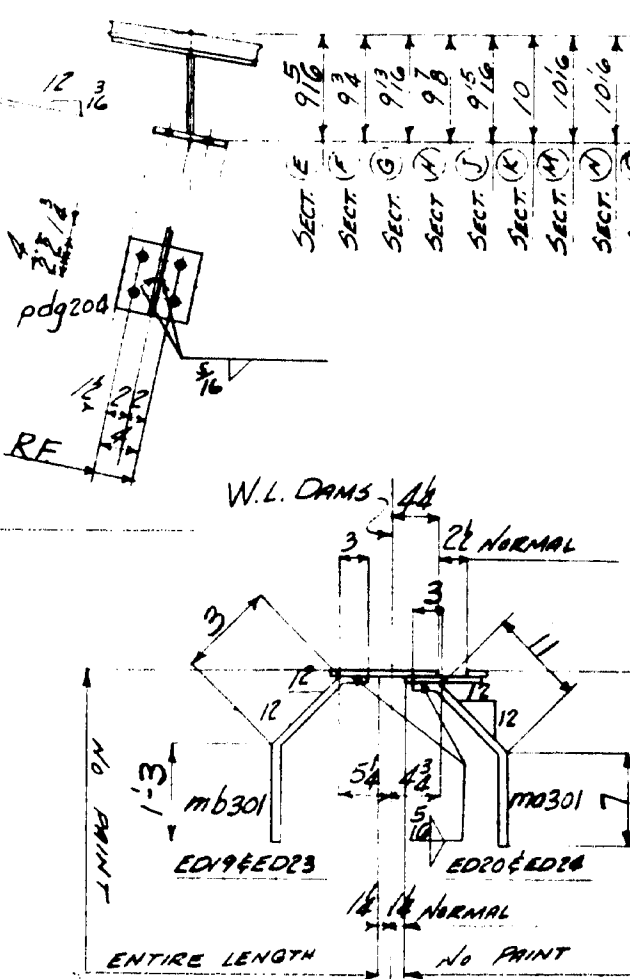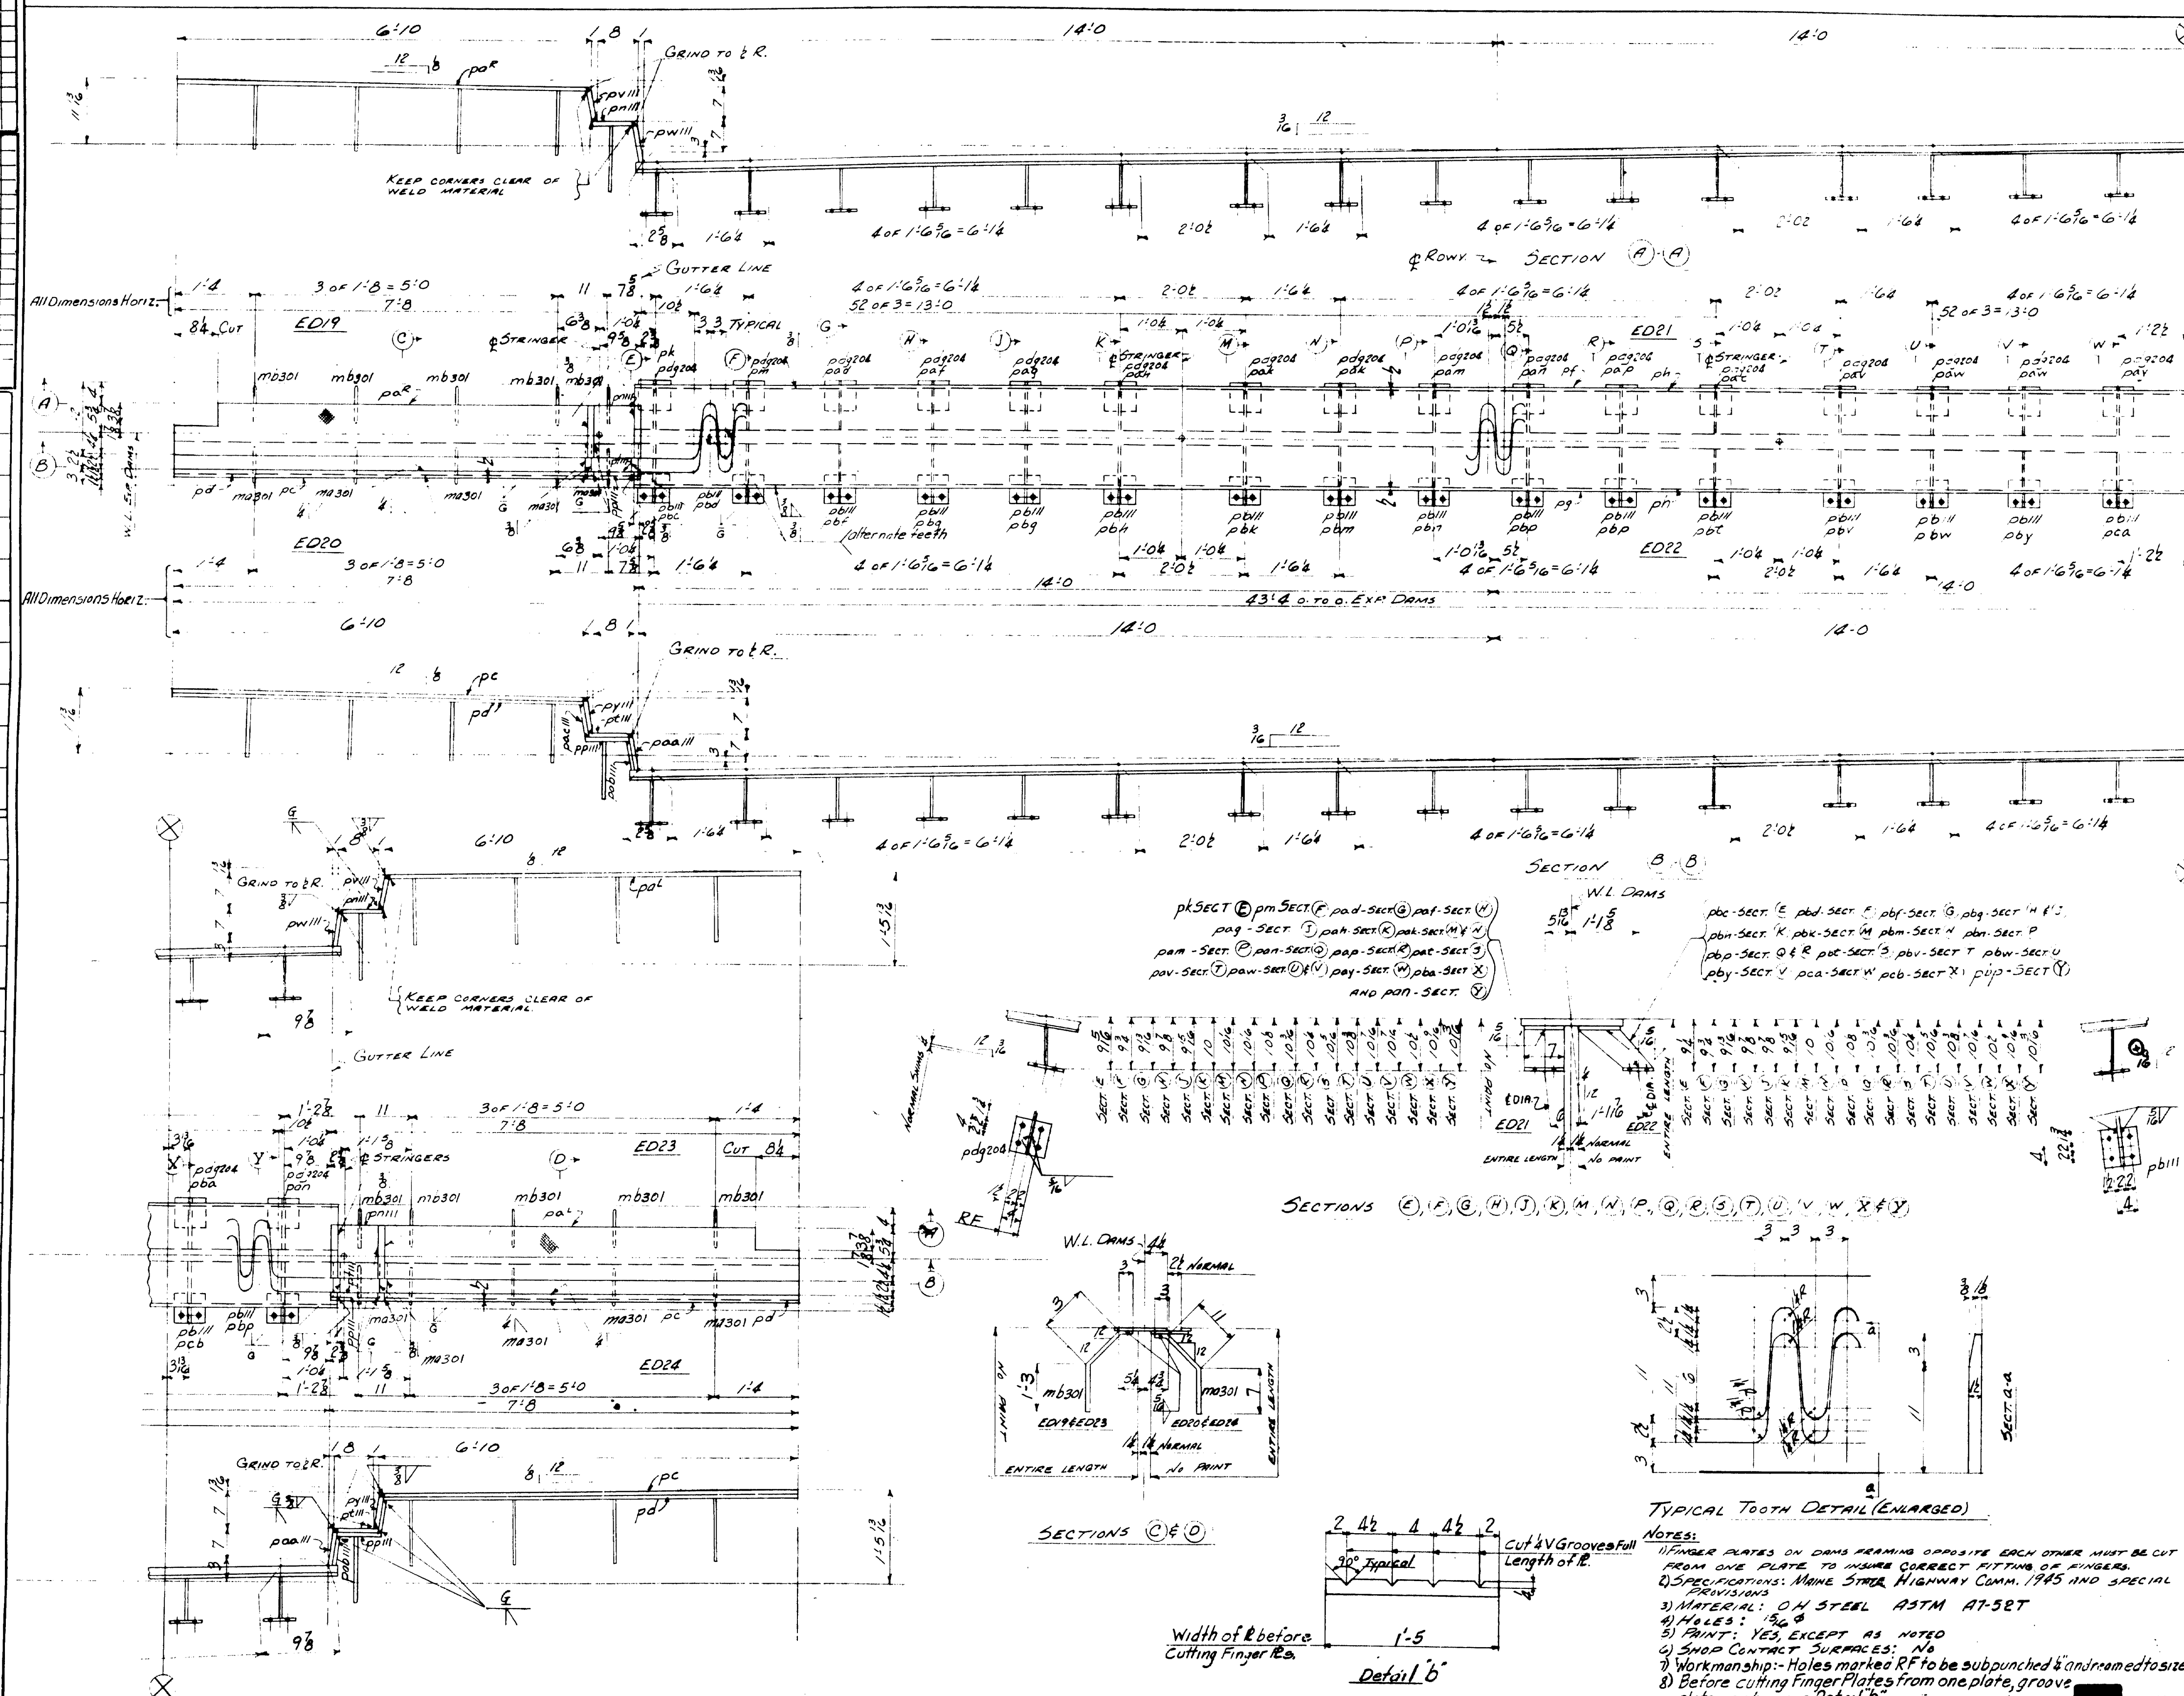

NOTES:  
1) FINGER PLATES ON DAMS FRAMING OPPOSITE EACH OTHER MUST BE CUT FROM ONE PLATE TO INSURE CORRECT FITTING OF FINGERS.  
2) SPECIFICATIONS: MAINE STATE HIGHWAY COMM. 1945 AND SPECIAL PROVISIONS.  
3) MATERIAL: A572 STEEL A572 AT 50T  
4) RIVETS: A502  
5) PAINT: YES, EXCEPT AS NOTED  
6) SHOP CONTRACT SURFACES: NO  
7) WORKMANSHIP: HOLES MARKED RF TO BE SUBPUNCHED & DRILLED TO SIZE IN FIELD  
8) BEFORE CUTTING FINGER PLATES FROM ONE PLATE, GROOVE PLATE AS SHOWN IN DETAIL 'b'



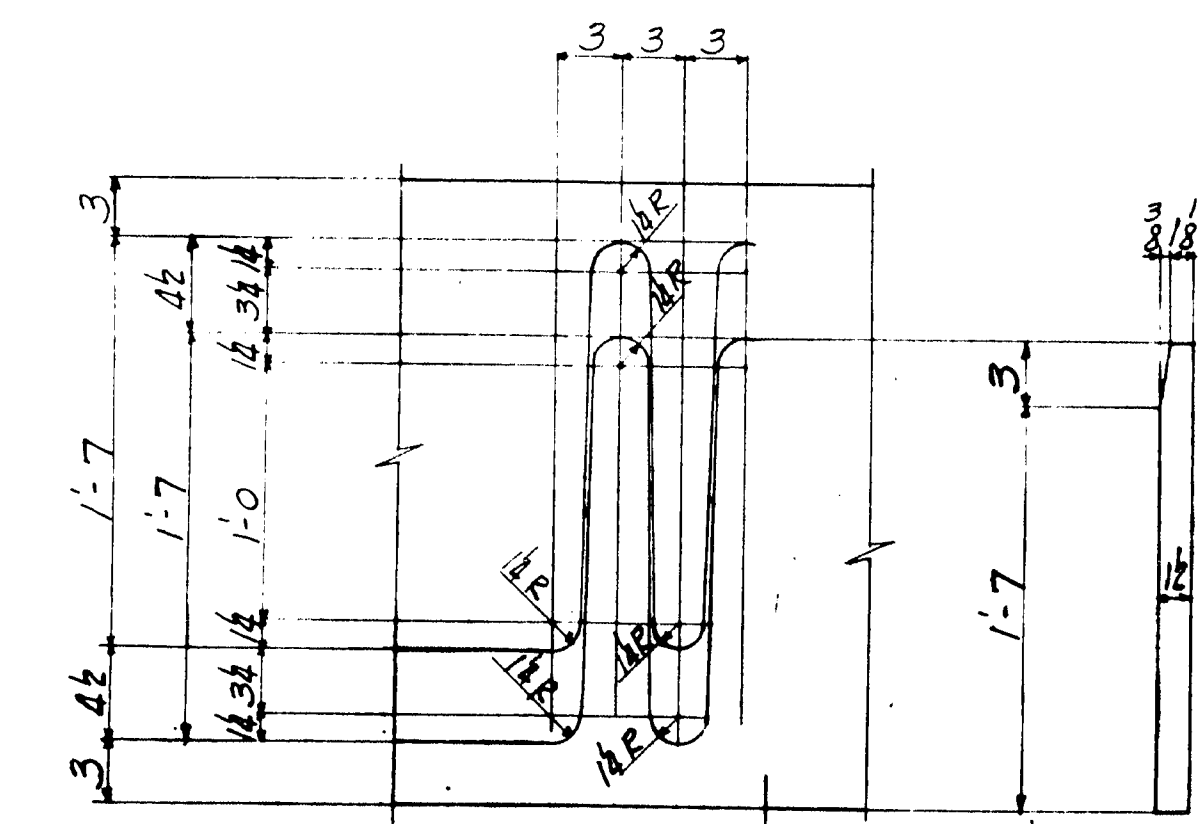

2 4 1/2 4 4 4 4 1/2 2

40° Typical

Cut 1/2 V Grooves full Length of Plate

2'-1"

Detail "a"

ORDER No. Q4149 SHEET No. 402AB

~~PAINT:~~  
~~SHOP CONTACT SURFACES:~~

62-147

# AMERICAN BRIDGE

UNITED STATES STEEL COMPANY

LINE	ITEM	MATERIAL	ASSEMBLY MARK	REMARKS	ORDERED	CALCULATED
		SHAPE	LENGTH		ITEM	WEIGHT
			Feet			Per Piece
1						
2						
3						
4						
5						
6						
7						
8		ONE EXPANSION DAM	ED 25	176		
9		ONE EXPANSION DAM	ED 25			
10						
11	2	14	3/4	6	93	5300
12	2	14	3/4	6	93	5300
13	2	14	3/4	6	93	5300
14	2	14	3/4	6	93	5300
15	10	14	3/4	6	93	5300
16						
17		ONE EXPANSION DAM	ED 26	142		
18		ONE EXPANSION DAM	ED 26			
19						
20						
21	2	10	3/4	6	93	5300
22	2	10	3/4	6	93	5300
23	2	10	3/4	6	93	5300
24	2	10	3/4	6	93	5300
25	2	10	3/4	6	93	5300
26	2	10	3/4	6	93	5300
27	2	10	3/4	6	93	5300
28	2	10	3/4	6	93	5300
29	10	10	3/4	6	93	5300
30						
31		ONE EXPANSION DAM	ED 27	2830		
32						
33						
34	1	22	12	13	112	428
35	1	22	12	13	112	428
36	2	11	2	112	428	159
37	2	11	2	112	428	36
38	1	11	2	112	428	38
39	1	11	2	112	428	19
40	2	11	2	112	428	19
41	1	11	2	112	428	39
42	1	11	2	112	428	19
43	2	11	2	112	428	20
44	1	11	2	112	428	39
45	1	11	2	112	428	19
46	1	11	2	112	428	18
47	1	11	2	112	428	18
48	1	11	2	112	428	18
49	1	11	2	112	428	16
50	2	11	2	112	428	16
51	18	7	2	72	239	57
52						
53		ONE EXPANSION DAM	ED 28	2843		
54						
55						
56	1	22	12	13	112	428
57	1	22	12	13	112	428
58	1	22	12	13	112	428
59	18	7	2	72	239	57
60	1	11	2	112	428	6
61	1	11	2	112	428	7
62	1	11	2	112	428	8
63	1	11	2	112	428	8
64	1	11	2	112	428	8
65	1	11	2	112	428	8
66	1	11	2	112	428	8
67	2	11	2	112	428	10
68	1	11	2	112	428	20
69	5	11	2	112	428	10
70	3	11	2	112	428	10




EXPANSION DAMS ED 25, ED 26, ED 27, ED 28  
STATE HIGHWAY COMMISSION  
BANGOR, BREWER BRIDGE  
OVER PENOBSCOT RIVER  
BANGOR, MAINE

NOTES:  
SPECIFICATIONS: MAINE STATE HIGHWAY COMM. 1945  
and special provisions  
MATERIAL: O.H. Steel ASTM A7-52T  
HOLES: 1/2"  
WORKMANSHIP: Holes marked RF to be sub-  
punched and reamed to size in field.  
PAINT: Yes, except as noted  
SHOP CONTACT SURFACES: No

DRAWINGS MADE AT TRENTON PLANT  
WORK FABRICATED AT TRENTON PLANT  
IN CHARGE OF E.B. MARKS  
DRAW. MADE BY S.K.C. DATE 10-15-53  
DRAW. CHECKED BY P.R.Y. DATE 1-22-54  
ORDER No. Q4149 SHEET No. 102B

404

62-148 Weld

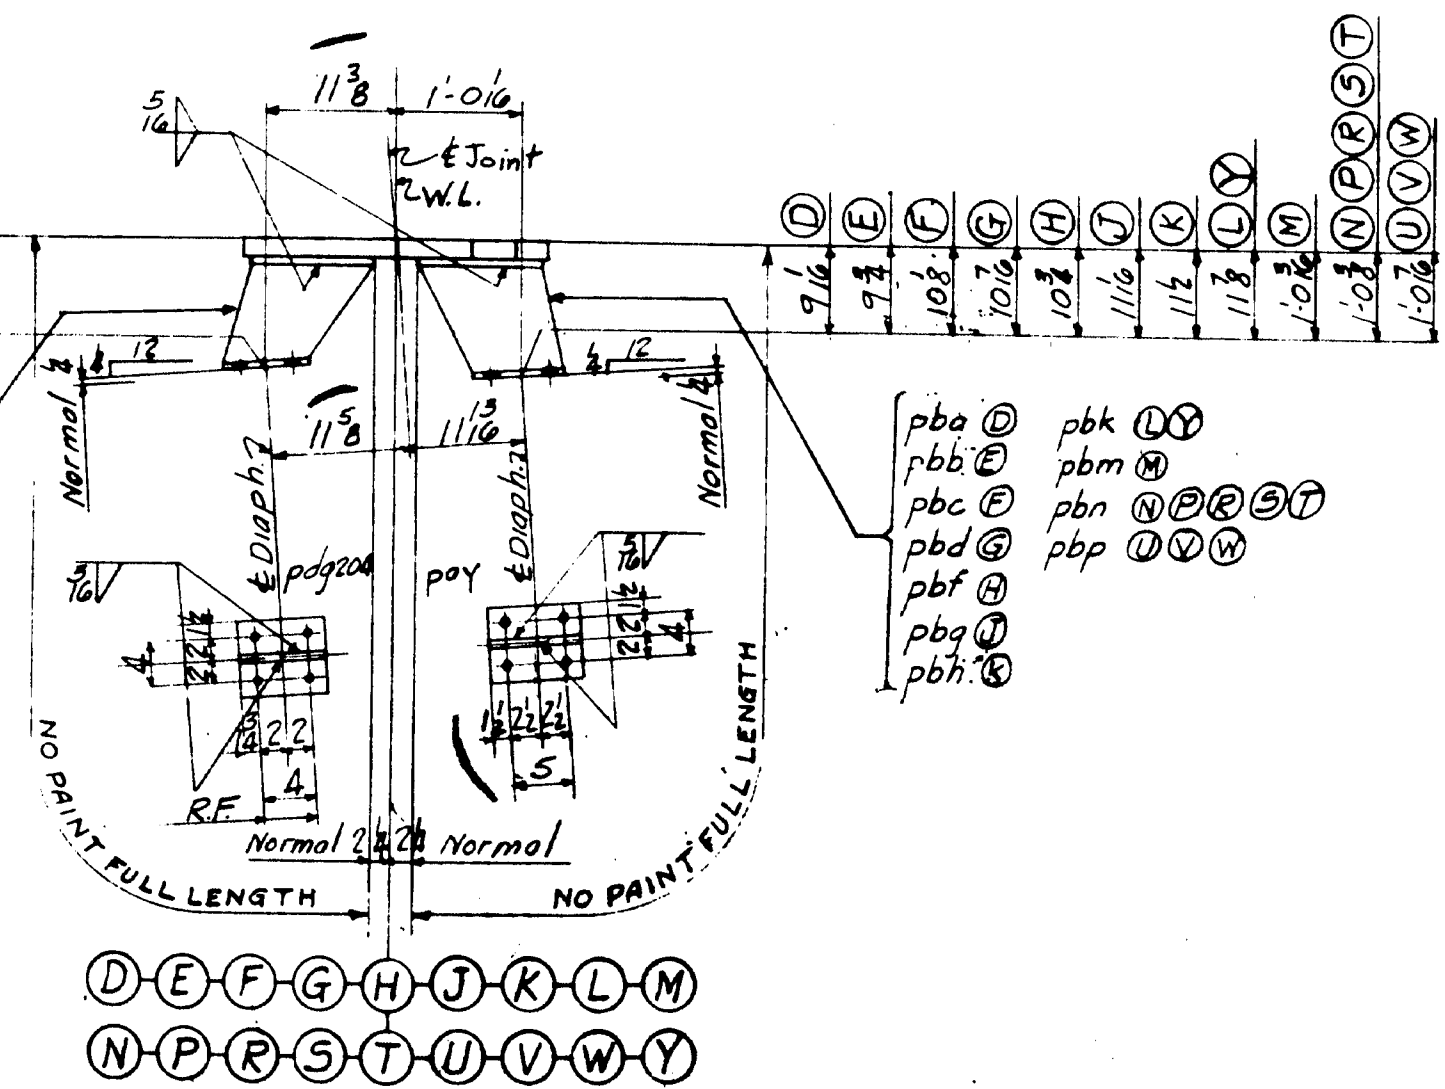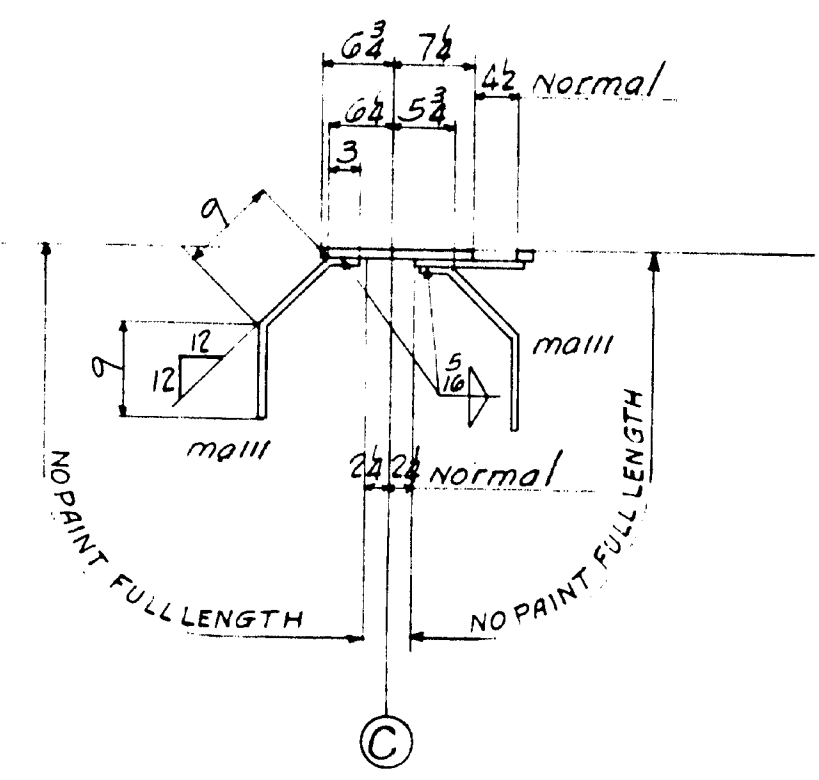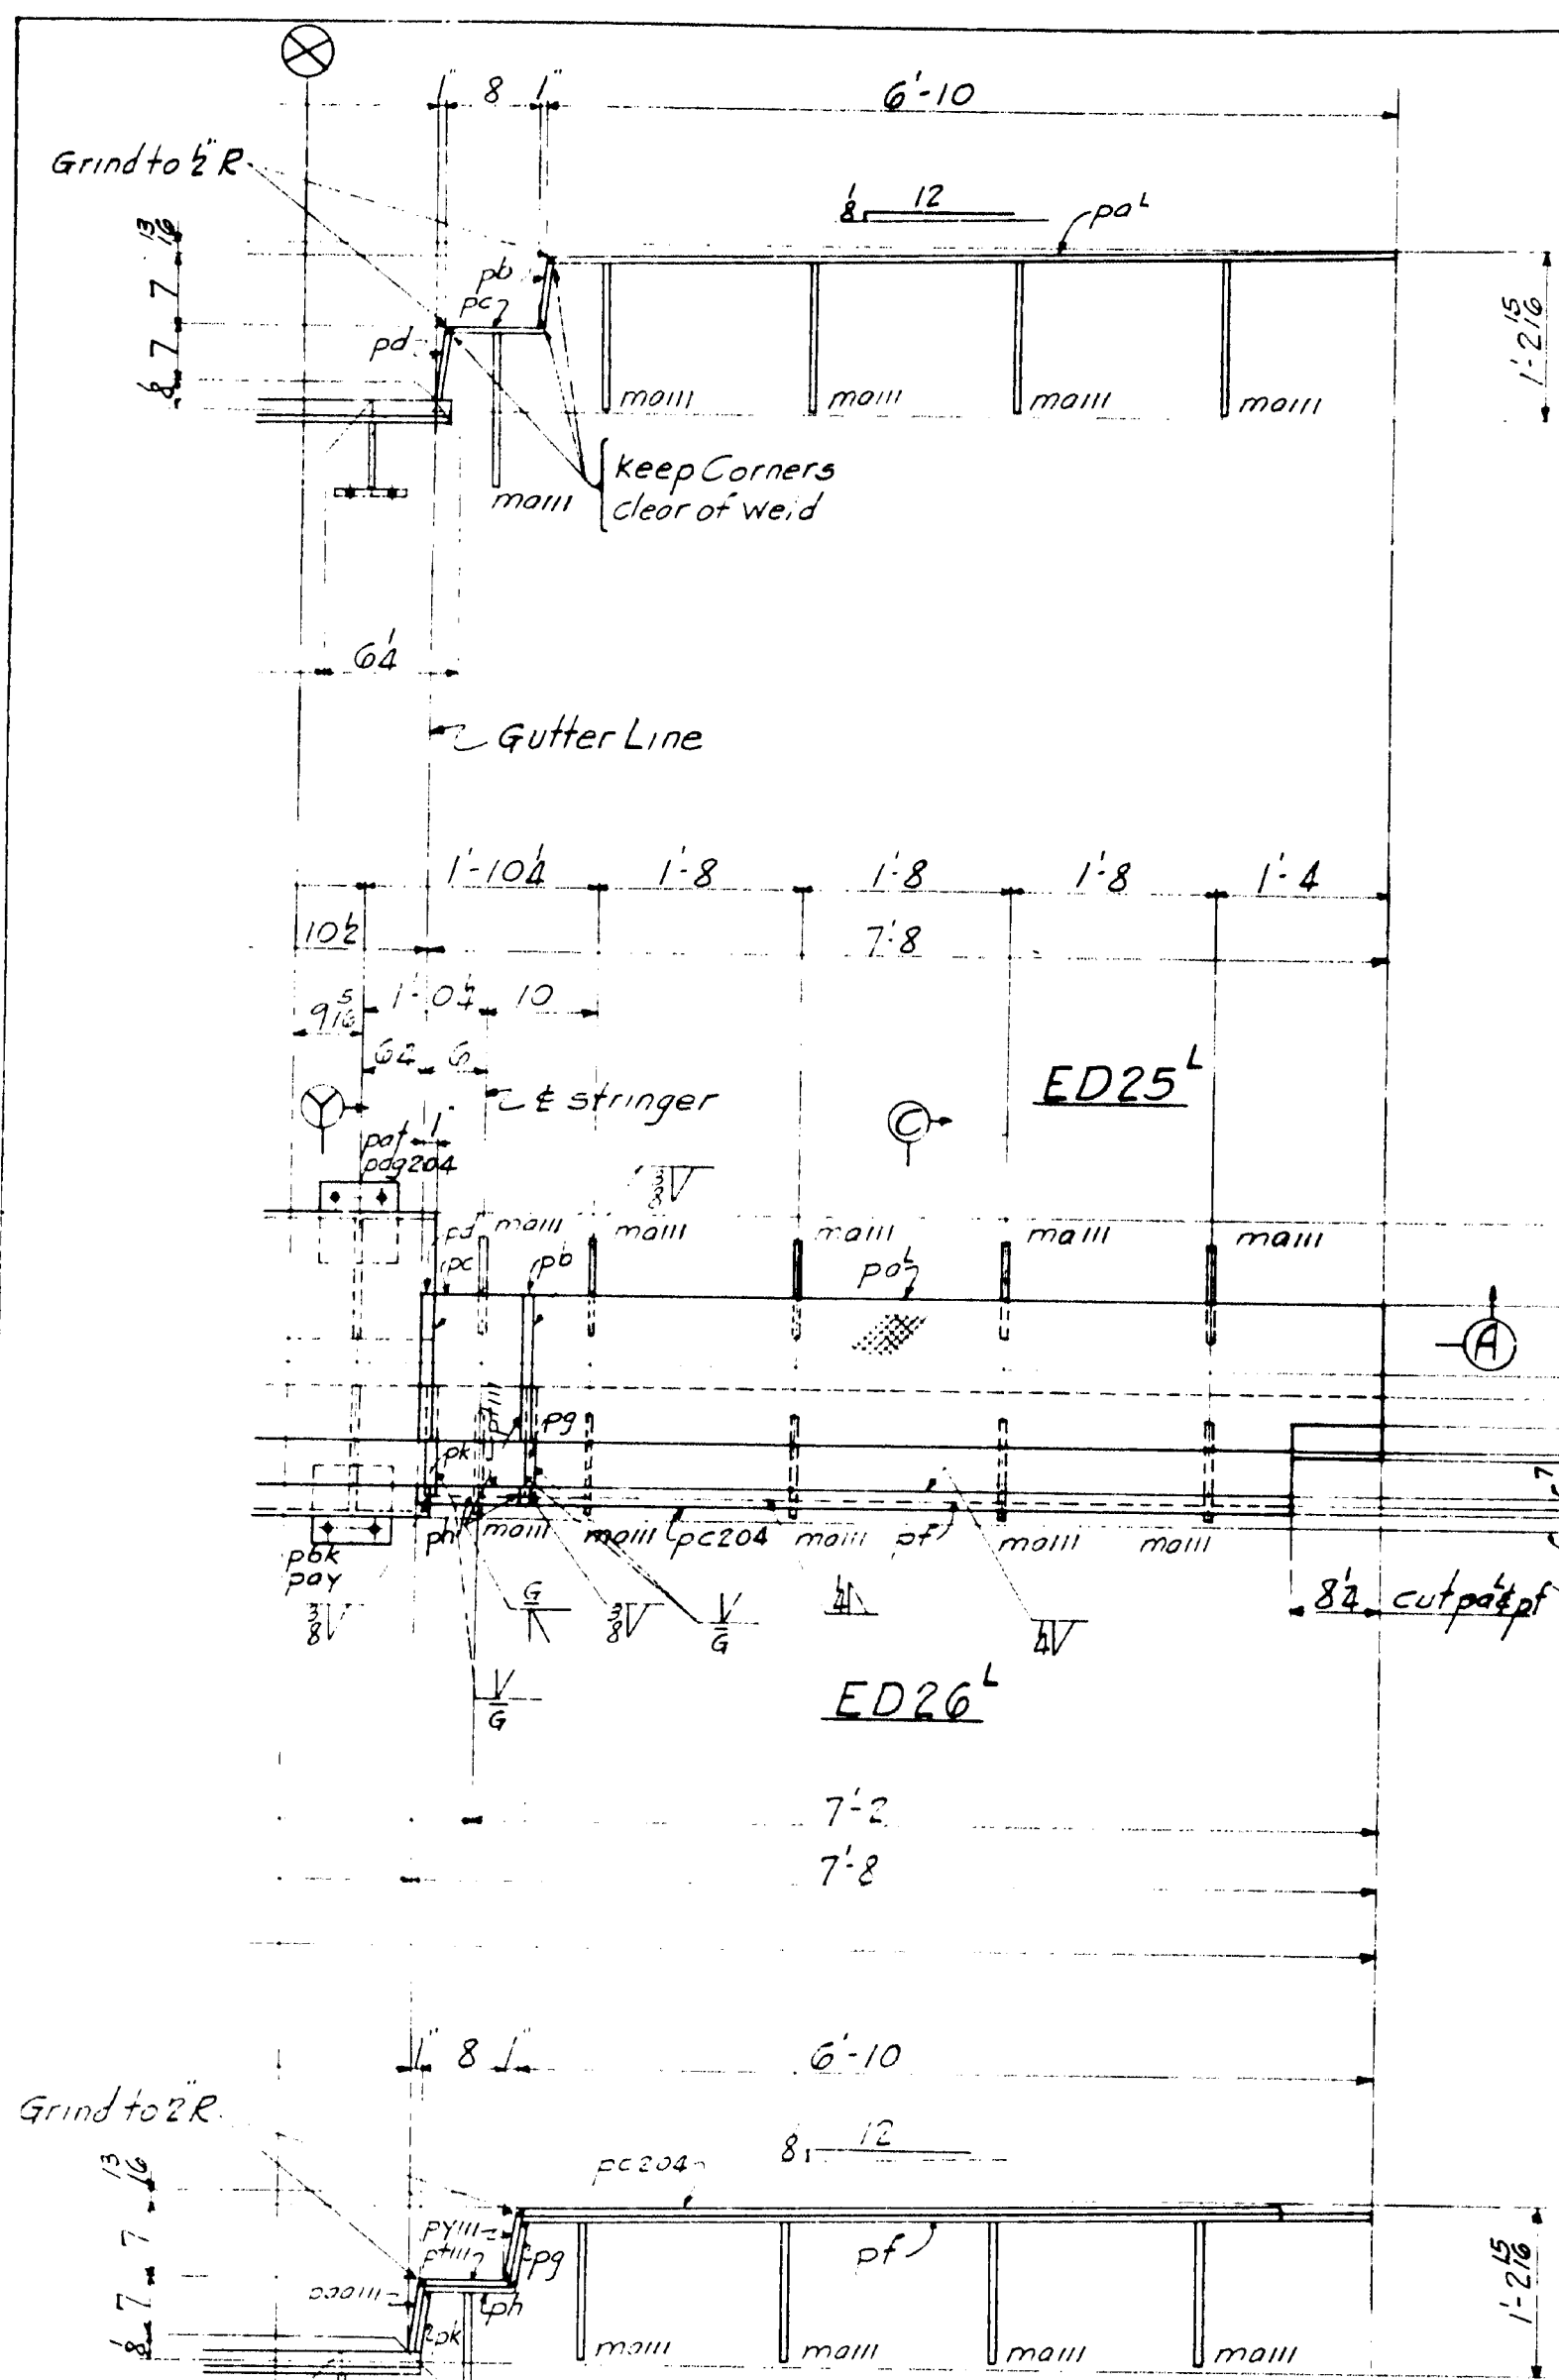

pw-00 pag-00  
py-00 pah-00  
pa-00 pak-00  
pab-00 pam-00  
pac-00 pap-00  
pad-00 pas-00  
paf-00 pat-00

pba-00 pbk-00  
pbb-00 pbm-00  
pbc-00 pbn-00  
pbd-00 pbp-00  
pbf-00  
pbg-00  
pbh-00

DEF G H J K L M  
N P R S T U V W Y



# AMERICAN BRIDGE

LINE	ITEM	MATERIAL	LENGTH	REMARKS	ORDERED	CALCULATED
		SHAPE	Feet-Inches		ITEM	WEIGHT FOR ONE ROAD PLATE
1				8'10"		
2						
3						
4				244	Q4148	
5	ONE BEAM	B43		14045	Q4149	
6						
7	1 BG WF 150	29'10"	Beth	Fin 1 - 75	29'11"	B4009 44.07
8	1 BG WF 150	51'10"	Beth	Fin 2 - 9	51'11"	B4005 77.85
9						
10	8 2 F	4 2 1/2	pa403	-3	13 1/2 x 4 1/2	3032 2.52
11	8 2 F	3 2 1/2	pb403			S 1.7
12	8 2 F	3 2 1/2	pc403			S 1.7
13	8 2 F	4 2 1/2	ph403			S 1.54
14	8 2 F	4 2 1/2	pd403	-3	41'9"	3032 2.57
15	8 2 F	3 2 1/2	pe403			S 1.7
16	8 2 F	3 2 1/2	pf403			S 1.7
17	8 2 F	3 2 1/2	pg403			S 1.54
18	2 1 F	7 4	ph403			S 3.0
19	2 1 F	7 4	pd403			S 3.0
20	2 1 F	7 4	pe403			S 2.7
21	24 6 F	1 1	ha403		45'0"	M618 4.8
22	2 1 F	7 4	ha403			S 4
23	6 1 F	7 4	hg403		45'0"	M618 2.8
24	2 1 F	7 4	hg403			S 2.8
25	2 1 F	7 4	hd403		66'6"	M619 4.1
26	2 1 F	7 4	hd403		66'6"	M619 4.1
27	2 1 F	7 4	hf403		60'0"	M619 3.5
28	2 1 F	7 4	hf403		60'0"	S 3.5
29	6 3 F	7 4	ha403		45'0"	M618 7.6
30	2 1 F	7 4	ha403		45'0"	M618 7.6
31	2 1 F	7 4	hg403	Fin 1	36'0"	4432 5.1
32	1 F	7 4	hg403			S 5.1
33						
34						
35	1 R	7 4	ha403	Det. & billed		1.85
36	1 F	7 4	ha403	on Sh 3		2.4
37	2 1 F	7 4	ha403	PN23 Q4148		6
38						
39	1 TOP PLATE	1 F	7 4	Det. & billed		1.4
40				on Sh 1		
41				Q4148		
42						
43						
44	16 SB 2"					Terms
45						
46	4 2 B	1 0	db403			S 1.2
47	2 1 B	1 0	dc403			S 1.2
48						
49						
STEINGER B43  
Div. 4

STATE OF MAINE  
STATE HIGHWAY COMMISSION  
BANGOR-BREWER BRIDGE  
OVER PENOBSCOT RIVER  
BANGOR, MAINE  
ESTABLISHED 18-87 18-87 18-87  
AMERICAN BRIDGE  
UNITED STATES STEEL COMPANY

WORK MADE AT TRENTON	PLANT
WORK FABRICATED AT TRENTON	PLANT
IN CHARGE OF E.B. MARKS	
DRAW. MADE BY S.E.K.	DATE 10-31-53
DRAW. CHECKED BY J.E.L.	DATE 1-25-54
REVISIONS	ORDER NO. Q4149
	SHEET NO. 403

NOTES:  
SPECIFICATIONS: Maine State Highway Comm. 1945 & Special Provisions  
MATERIAL: O.H. Steel ASTM A7-52T  
RIVETS: 3/4" HOLES: 1/2" unless noted.  
WORKMANSHIP:  
Holes in material thicker than the diameter of the rivet shall be drilled.  
All holes for Shop Rivets to be Subpunched or Subdrilled & reamed to size with connecting parts assembled.



Holes marked RT to be subpunched or subdrilled & reamed to size to a metal template.  
Holes marked RA to be subpunched or subdrilled & reamed to size while connecting members are assembled.  
Connecting members to be marked marked.  
B.E. indicates bearing end of stiffeners.  
Shop to fabricate beam with mill camber up.  
For assembly & reaming diagrams see Sht. #412.  
Work sheet #412 with this sheet.

LIFTING Wt. = 7 Tons

PAINT: Yes, except as noted  
SHOP CONTACT SURFACES: No



M. 401,402

68-119 WELD

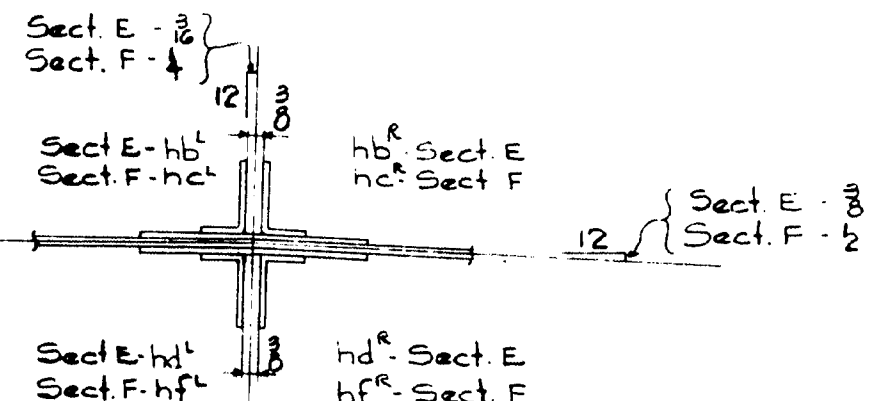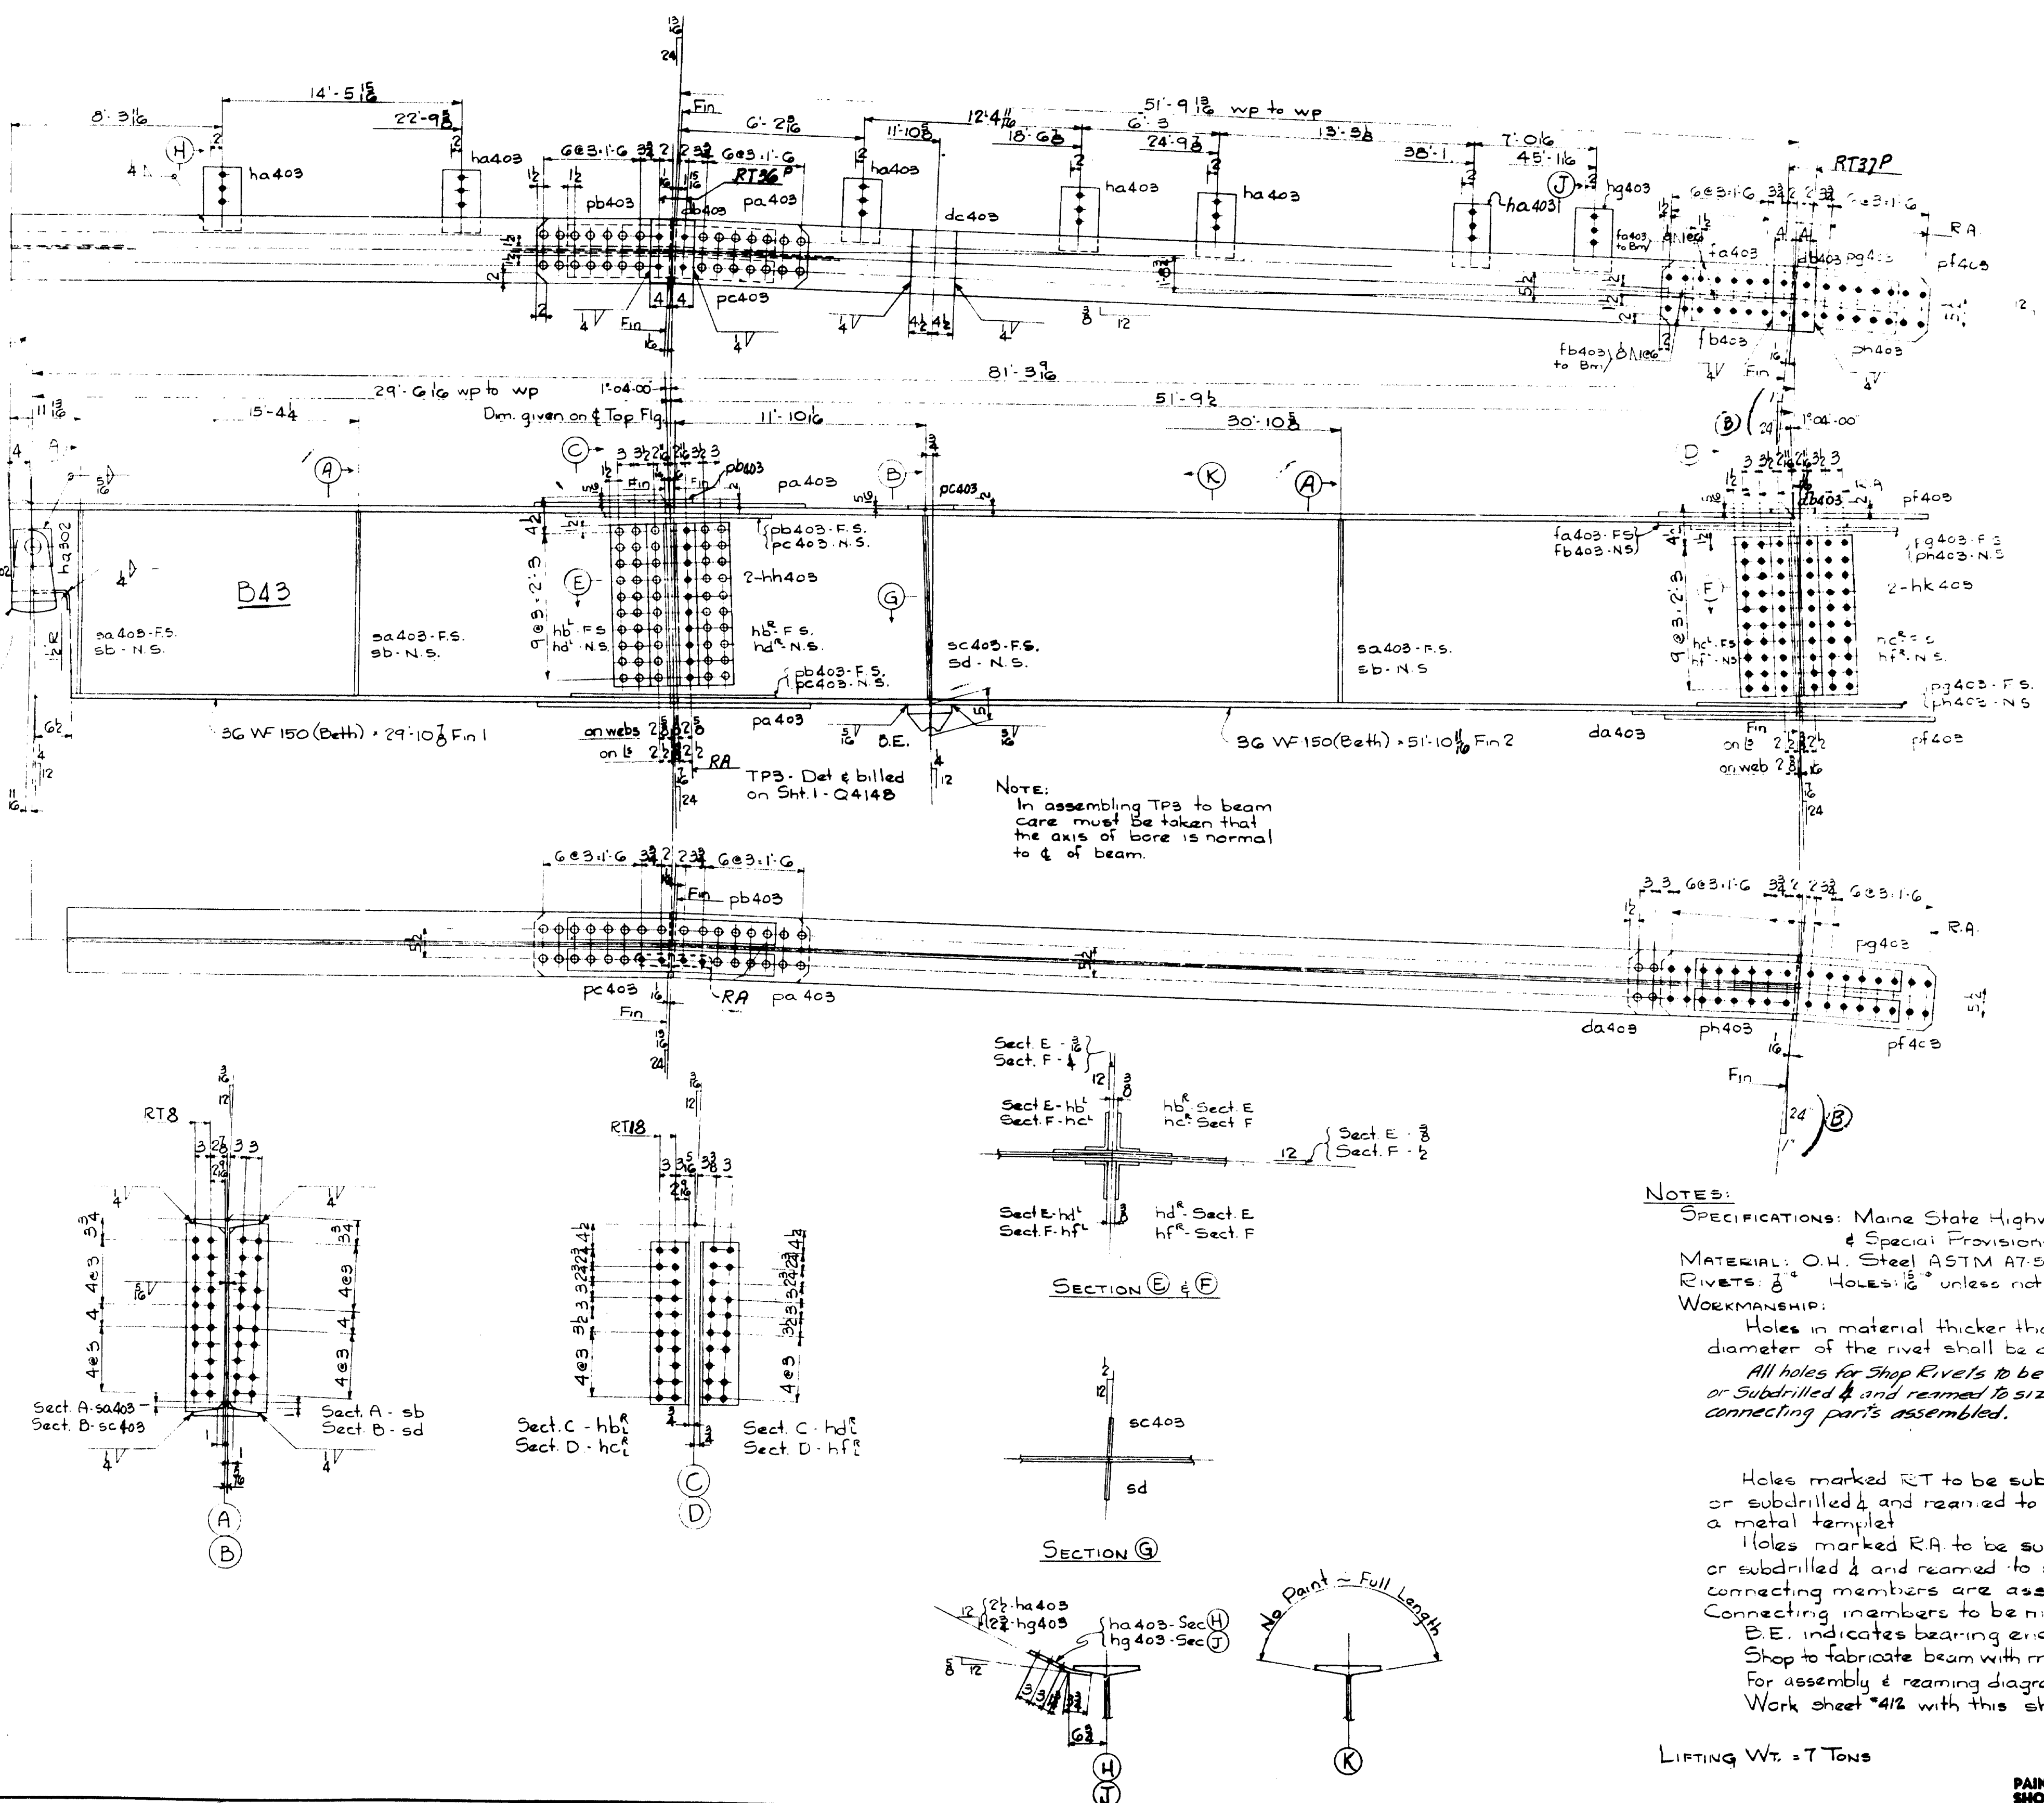

SECTION E & F

SECTION G

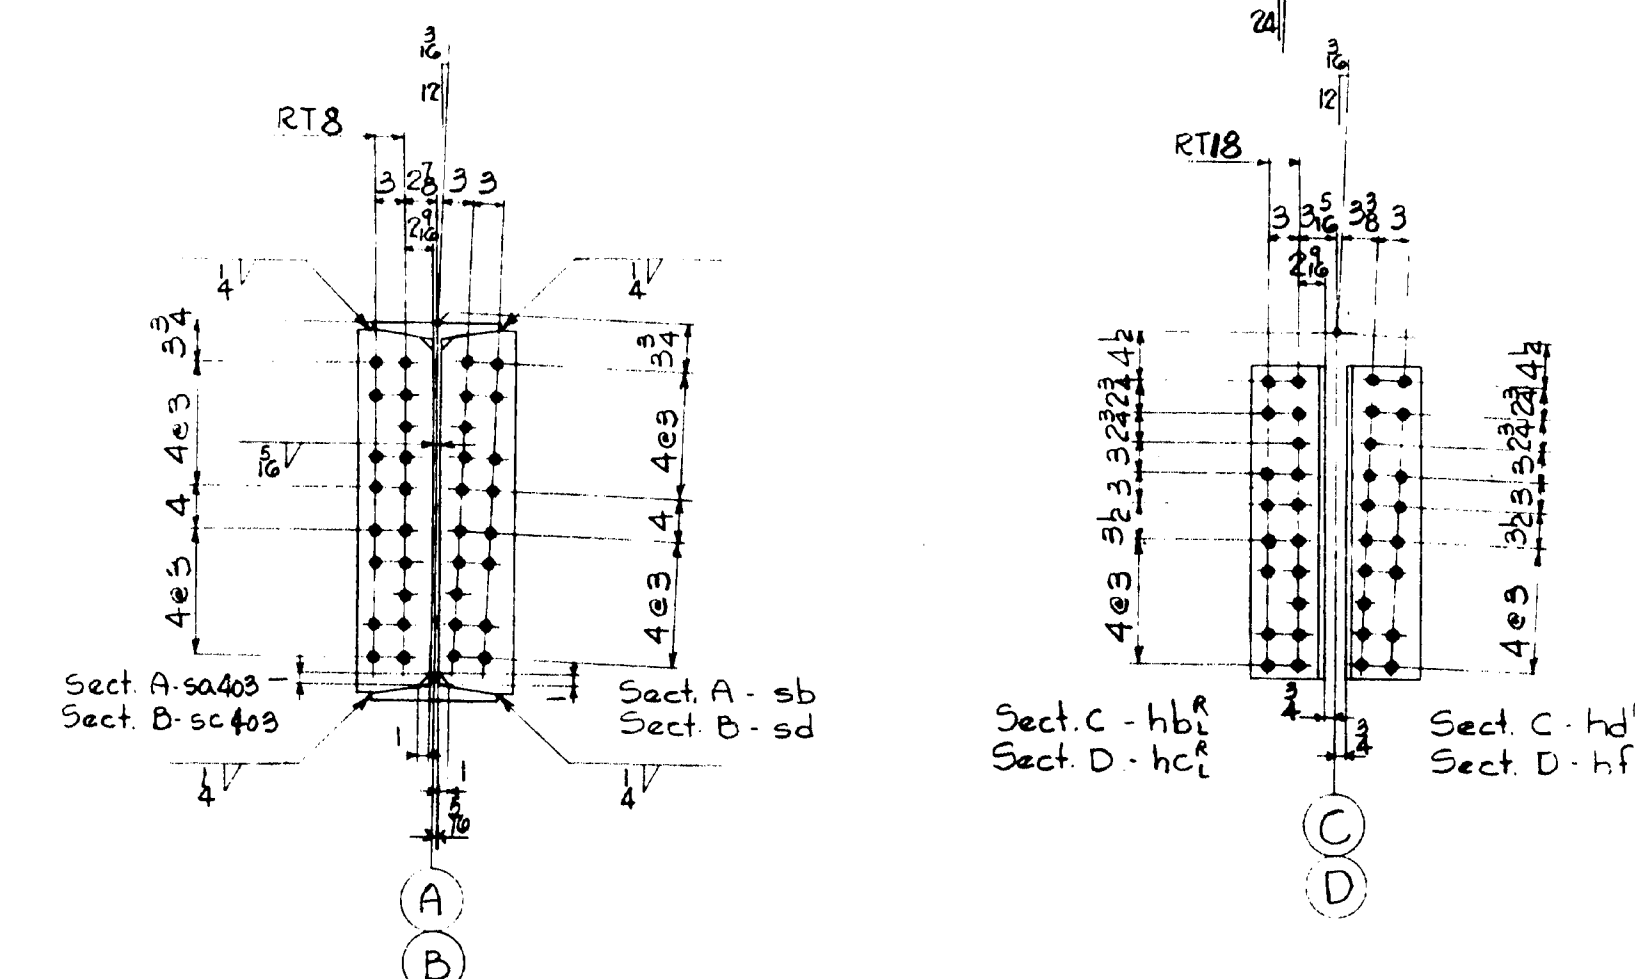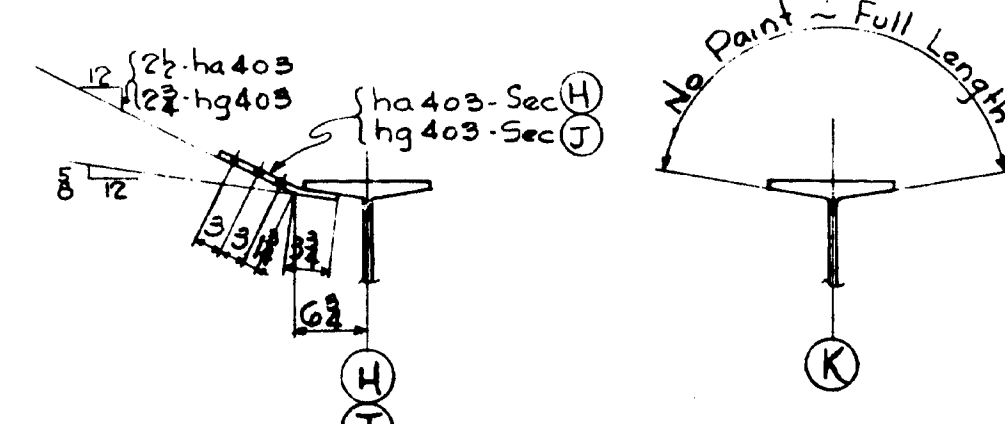


SECTION H



# AMERICAN BRIDGE

LINE	ITEM	MATERIAL	LENGTH	ASSEMBLY	REMARKS	ORDERED	CALCULATED
1					80' 3"		
2							
3							
4					24" 4x14 1/2		
5	ONE BEAM	B4G			13806 4x14 1/2		
6							
7	1 3G WF 150	29' 5 1/2"	29' 5 1/2"	Fin 1	ns	29' 5"	44' 15"
8	1 3G WF 150	50' 9 1/2"	50' 9 1/2"	Fin 2	-1	50' 10"	76' 18"
9							
10	2 R 12 1/2	4	2 1/2"	pa403			25' 2"
11	2 R 5 1/2	3	2 1/2"	pb403			17'
12	2 R 5 1/2	3	2 1/2"	pc403			17'
13	2 R 20	1	9 1/2"	ha403			15' 9"
14	2 R 13	4	2 1/2"	pf403			25' 7"
15	2 R 5 1/2	3	2 1/2"	pg403			80'
16	2 R 5 1/2	3	2 1/2"	ph403			80'
17	2 R 30	1	9 1/2"	pb403			15' 9"
18	2 R 7 1/2	7	7 1/2"	pk302			30'
19							
20	7 R 7 1/2	1	7 1/2"	na403			5' 9"
21	1 R 3	3	3"	na302			4'
22							
23	1 Fin 4 1/2	2	1 1/2"	fa403			4'
24	1 Fin 12 1/2	2	1 1/2"	da403			27'
25	1 Fin 4 1/2	2	1 1/2"	fb403			4'
26	2 R 7 1/2	2	7 1/2"	na		60' 0"	48'
27	2 R 7 1/2	2	7 1/2"	hb		60' 0"	48'
28	2 R 7 1/2	2	7 1/2"	hc		60' 0"	48'
29	2 R 7 1/2	2	7 1/2"	hd		60' 0"	48'
30							
31	3 R 7 1/2	2	10 1/2"	sa403		45' 0"	76'
32	2 R 7 1/2	2	10 1/2"	sb			76'
33	1 R 7 1/2	2	10 1/2"	sc403	Fin 1		51'
34	1 R 7 1/2	2	10 1/2"	sd	Fin 1	30' 0"	51'
35							
36							
37	1 R 6 1/2			Fin 1	Det & billed on Sh 1-Q4148		13'
38	1 R 12 1/2			Fin 1	Det & billed on Sh 1-Q4148		24'
39	2 R 12 1/2			Fin 1	Det & billed on Sh 1-Q4148		4'
40							
41	1 Top Plate			Fin 1	Det & billed on Sh 1-Q4148		9' 4"
42							
43							
44	10 3 1/2"						Stress
45							
46	2 R 12 1/2	1	10 1/2"	db403			22'
47	1 R 12 1/2	1	10 1/2"	dc403			12'
48							4' 1/2"
49							9' 6"
50							7' 3"
51							2' 4"
52							5' 0"
53							
54							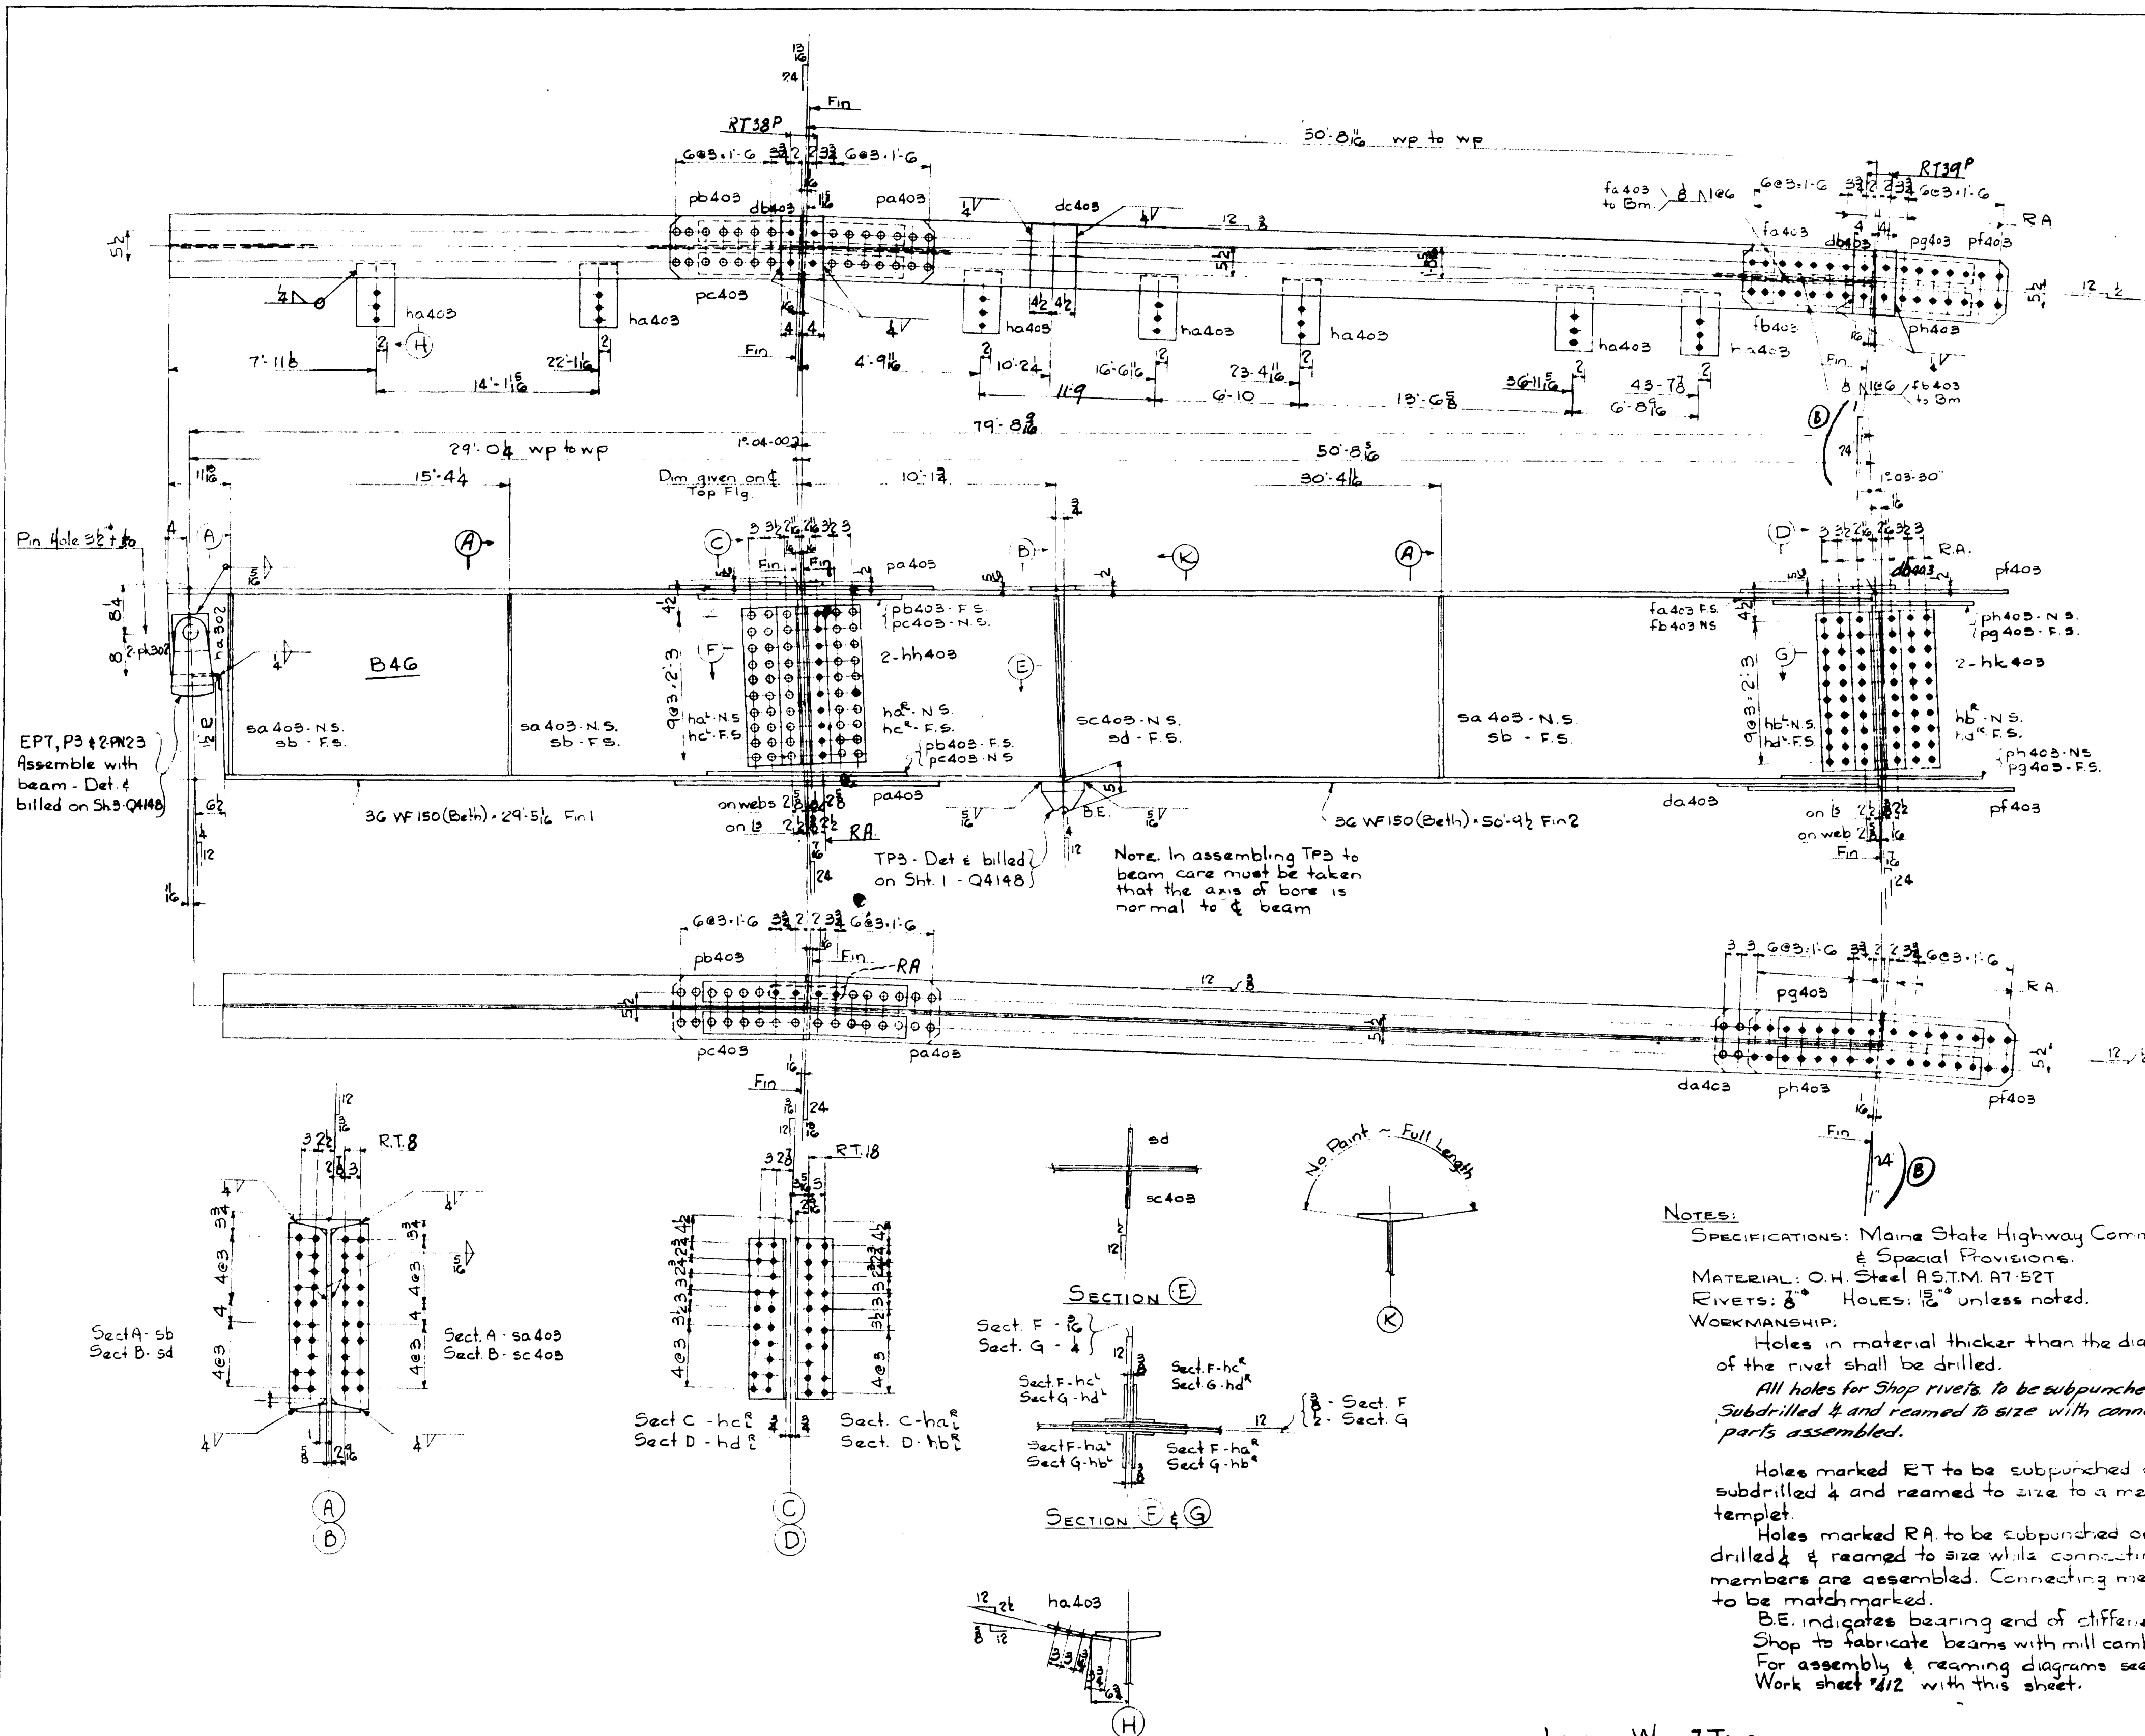
NOTES:  
 SPECIFICATIONS: Maine State Highway Comm., 1945 & Special Provisions.  
 MATERIAL: O.H. Steel A.S.T.M. A7-52T  
 RIVETS: 3" HOLES: 1 1/2" unless noted.  
 WORKMANSHIP:  
 Holes in material thicker than the diameter of the rivet shall be drilled.  
 All holes for shop rivets to be subpunched or subdrilled & reamed to size with connecting parts assembled.  
 Holes marked RT to be subpunched or subdrilled & reamed to size to a metal template.  
 Holes marked RA to be subpunched or subdrilled & reamed to size while connecting members are assembled. Connecting members to be matchmarked.  
 BE indicates bearing end of stiffener.  
 Shop to fabricate beams with mill camber up.  
 For assembly & reaming diagrams see sheet 412 with this sheet.

LIFTING Wt. = 7 Tons

PAINT: Yes, except as noted  
 SHOP CONTACT SURFACES: No

REVISIONS	DATE	BY	CHECKED	DATE
1	3-24-54	SEK	SEE	3-25-54
2	2-15-54			
3				
4				
STRINGER - B4G  
 DIV. 4  
 STATE OF MAINE  
 STATE HIGHWAY COMMISSION  
 BANGOR - BREWER BRIDGE  
 OVER PENOBSCOT RIVER  
 BANGOR, MAINE  
 AMERICAN BRIDGE  
 DIVISION  
 UNITED STATES STEEL COMPANY

DRAWINGS MADE AT TRENTON PLANT  
 WORK FABRICATED AT TRENTON PLANT  
 IN CHARGE OF E.D. MARKS  
 DRAW. MADE BY SEK DATE 11-4-53  
 DRAW. CHECKED BY SEE DATE 1-5-54  
 ORDER NO. Q4149 SHEET NO. 404

MA 401, 402

68-150 WELD

# AMERICAN BRIDGE

UNITED STATES STEEL COMPANY

LINE	ITEM	MATERIAL	LENGTH	ASSEMBLY MARK	REMARKS	ORDERED	CALCULATED
1					31'4"		
2							
3							
4	ONE BEAM	B44			29'7 1/2" B44		
5	ONE BEAM	B45			29'7 1/2" B45		
6							
7	1 36 WF 150	29'8 1/2" BETH	FIN 1	B44	29'9" B44	44'43"	
8	1 36 WF 150	51'6 1/2" BETH	FIN 2	B45	51'6 1/2" B45	77'28"	
9							
10	1 36 WF 150	29'7 1/2" BETH	FIN 1	B44	29'7" B44	44'43"	
11	1 36 WF 150	51'6 1/2" BETH	FIN 2	B45	51'6 1/2" B45	77'28"	
12	4 L 12	11'6"	UM		45'0"	32'3"	
13	4 R 12	11'6"				25'2"	
14	4 R 5 1/2	11'6"				7'7"	
15	4 R 5 1/2	11'6"				7'7"	
16	4 R 30	11'6"				1'59"	
17	4 R 13	11'6"				2'57"	
18	4 R 5 1/2	11'6"				8'0"	
19	4 R 5 1/2	11'6"				8'0"	
20	4 R 30	11'6"				1'59"	
21							
22	4 R 7 1/2	11'6"				3'0"	
23							
24	2 R 3	11'6"				4'	
25							
26	2 L 4 1/2	11'6"				2'5"	
27	2 L 4 1/2	11'6"				2'5"	
28	2 L 4 1/2	11'6"				2'5"	
29	2 L 4 1/2	11'6"				2'5"	
30							
31	6 F 4	11'6"				35'0"	4'3"
32	6 F 4	11'6"				35'0"	4'3"
33	2 F 6	11'6"					4'3"
34	2 F 6	11'6"					4'3"
35	4 R 12	11'6"					2'4"
36	2 F 12	11'6"					1'0"
37	2 F 12	11'6"					6'7"
38	2 F 12	11'6"					1'0"
39	4 F 12	11'6"					2'2"
40	2 RACKERS						
41	2 PINS						
42	4 PIN NUTS						
43							
44	1 TOP PLATE						9'8"
45	1 TOP PLATE						9'8"
46							
47							
48	4 SB A						
49							
50							
STRINGERS B44 & B45  
Div. 4

STATE OF MAINE  
STATE HIGHWAY COMMISSION  
BANGOR - BREWER BRIDGE  
OVER PENOBSCOT RIVER  
BANGOR, MAINE  
ESTABLISHED 18-21 ROAD 18-21  
AMERICAN BRIDGE

DRAWINGS MADE AT TRENTON PLANT  
WORK FABRICATED AT TRENTON PLANT  
IN CHARGE OF E.P. MARKS  
DRAW. MADE BY S.B.K. DATE 11-6-53  
DRAW. CHECKED BY L.P. DATE 1-15-54  
ORDER NO. Q4149 SHEET NO. 405

PAINT: Yes, except as noted  
SHOP CONTACT SURFACES: No

LIFTING WT. 7 TONS

NOTES:  
SPECIFICATIONS: Maine State Highway Comm. 1945  
and Special Provisions.  
MATERIAL: O.H. Steel A.S.T.M. A7-52T  
RIVETS: 8" HOLES 1/2" unless noted  
WORKMANSHIP:  
Holes in material thicker than the diameter  
of the rivet shall be drilled.  
All holes for Shop Rivets to be subpunched or  
subdrilled & reamed to size with connecting  
parts assembled.  
Holes marked R.A. to be subpunched or subdrilled  
& reamed to size while connecting members are  
assembled. Connecting members to be matchmarked.  
B.E. indicates bearing end of stiffener.  
Shop to fabricate beams with Mill Camber up  
for assembly & reaming diaphragms see Sh. #412  
Work Sh. #412 with this Sheet.

SECTION E & F

No Paint - Full Length

Sect. C - hb  
Sect. D - hd


Sect. C - ha  
Sect. D - hc

36 WF 150 Beth. X 29'8 1/2" Fin 1-B44  
36 WF 150 Beth. X 29'7 1/2" Fin 1-B45

36 WF 150 Beth. X 51'6 1/2" Fin 2-B44  
36 WF 150 Beth. X 51'18" Fin 2-B45

NOTE:  
In assembling TPI & TP3  
to Beams care must be taken  
that axis of bore is normal to the  
face of Beam

TP1 for B44/  
TP1 for B45  
& billed on Sh. 1-Q4148

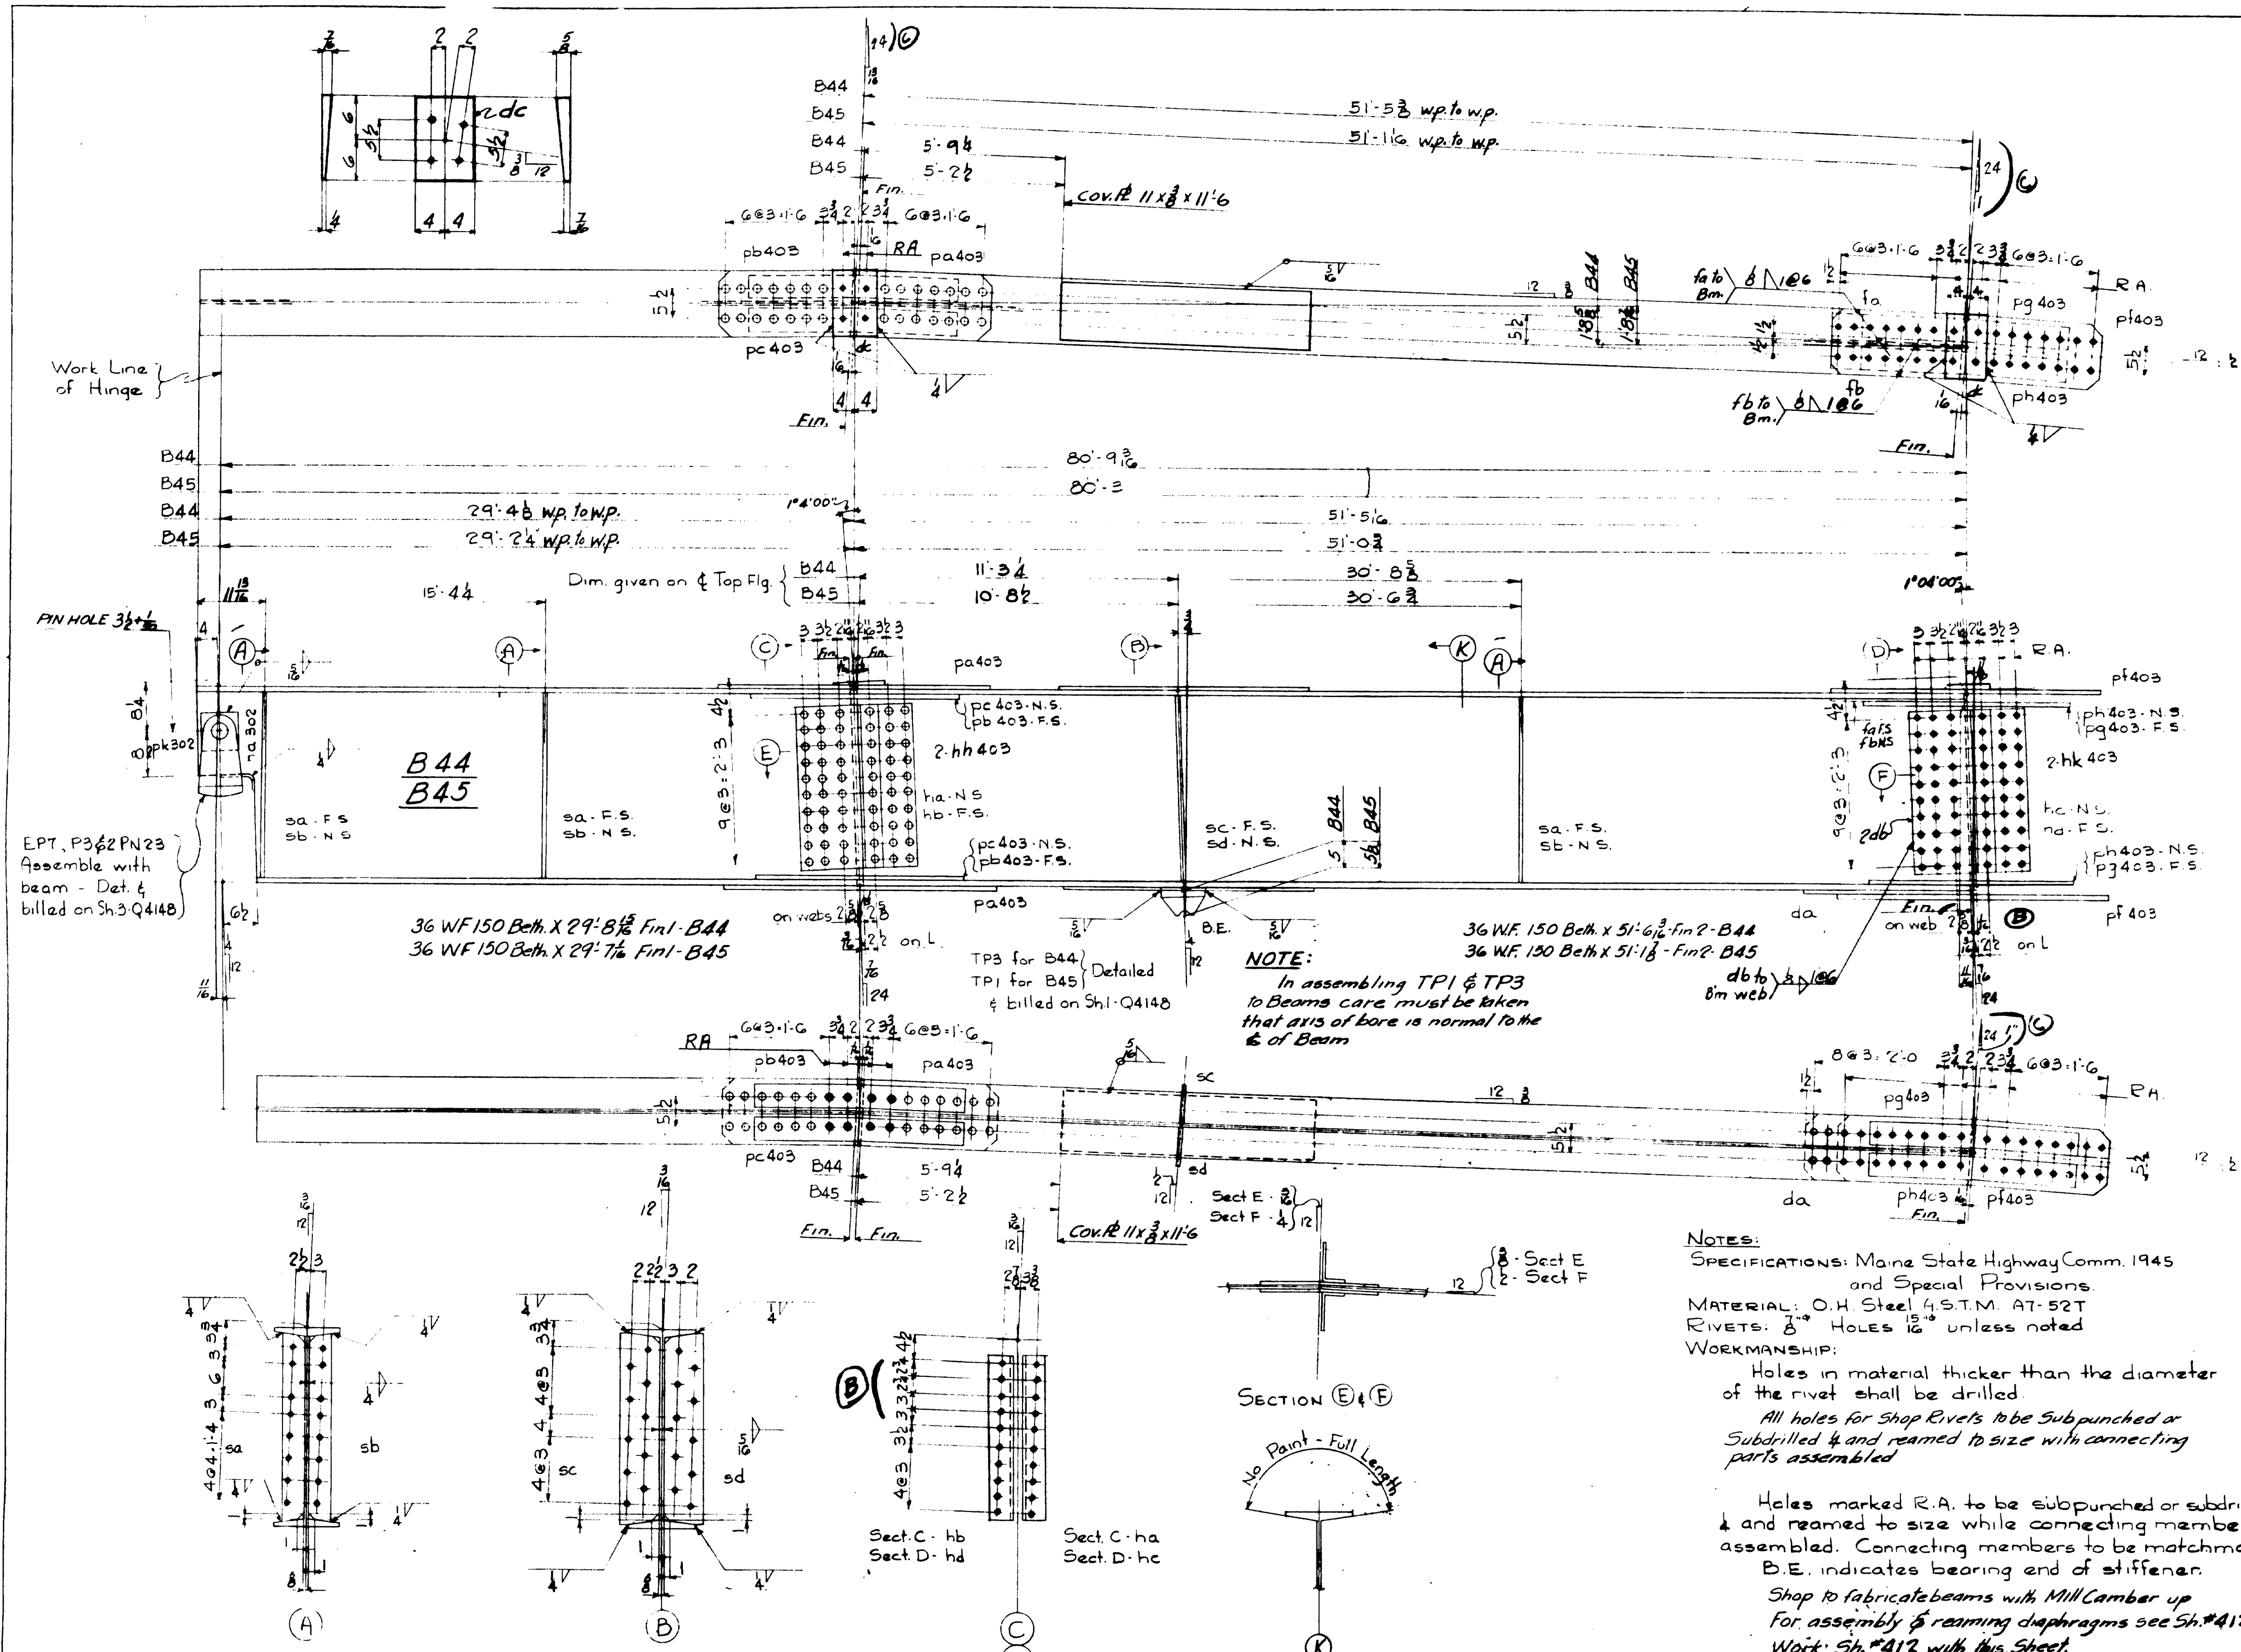

EPT, P3 & P23  
Assemble with  
beam - Det. &  
billed on Sh. 3-Q4148

Work Line  
of Hinge

FIN HOLE 3 1/2"

EPT, P3 & P23  
Assemble with  
beam - Det. &  
billed on Sh. 3-Q4148


Work Line  
of Hinge

FIN HOLE 3 1/2"



# AMERICAN BRIDGE

LINE	ITEM	MATERIAL	QUANTITY	REMARKS	ORDERED	CALCULATED
1						
2						
3						
4	ONE BEAM	B48	15138	192" 2448 - 11' 11"		74' 11"
5	ONE BEAM	B49	15100	192" 2448 - 11' 9"		74' 9"
6						
7	1 36 WF 194	74 11 BETH	FINL B48	75-12 64001		14534
8	1 36 WF 194	74 11 BETH	FINL B49	74-11 64002		14496
9						
10	4 R 11 A	11 G	11M	45-0 M619		323
11						
12	2 R 6 3/4	2 106 sc	Finl		5	43
13	2 R 6 3/4	2 106 sd	Finl		5	43
14	4 R 4 3/4	2 10 sq		35-0 M618		29
15	4 R 4 3/4	2 10 sb		35-0 M618		29
16	2 R 6 3/4	2 108 sf			5	29
17	2 R 6 3/4	2 108 sq			5	29
18	4 R 4 3/4	2 108 sf			5	29
19						
20	2 Top Plates	TPI	Det & billed			9.8
21	2 Top Plates	TPS	Det & billed on			9.4
22						
23						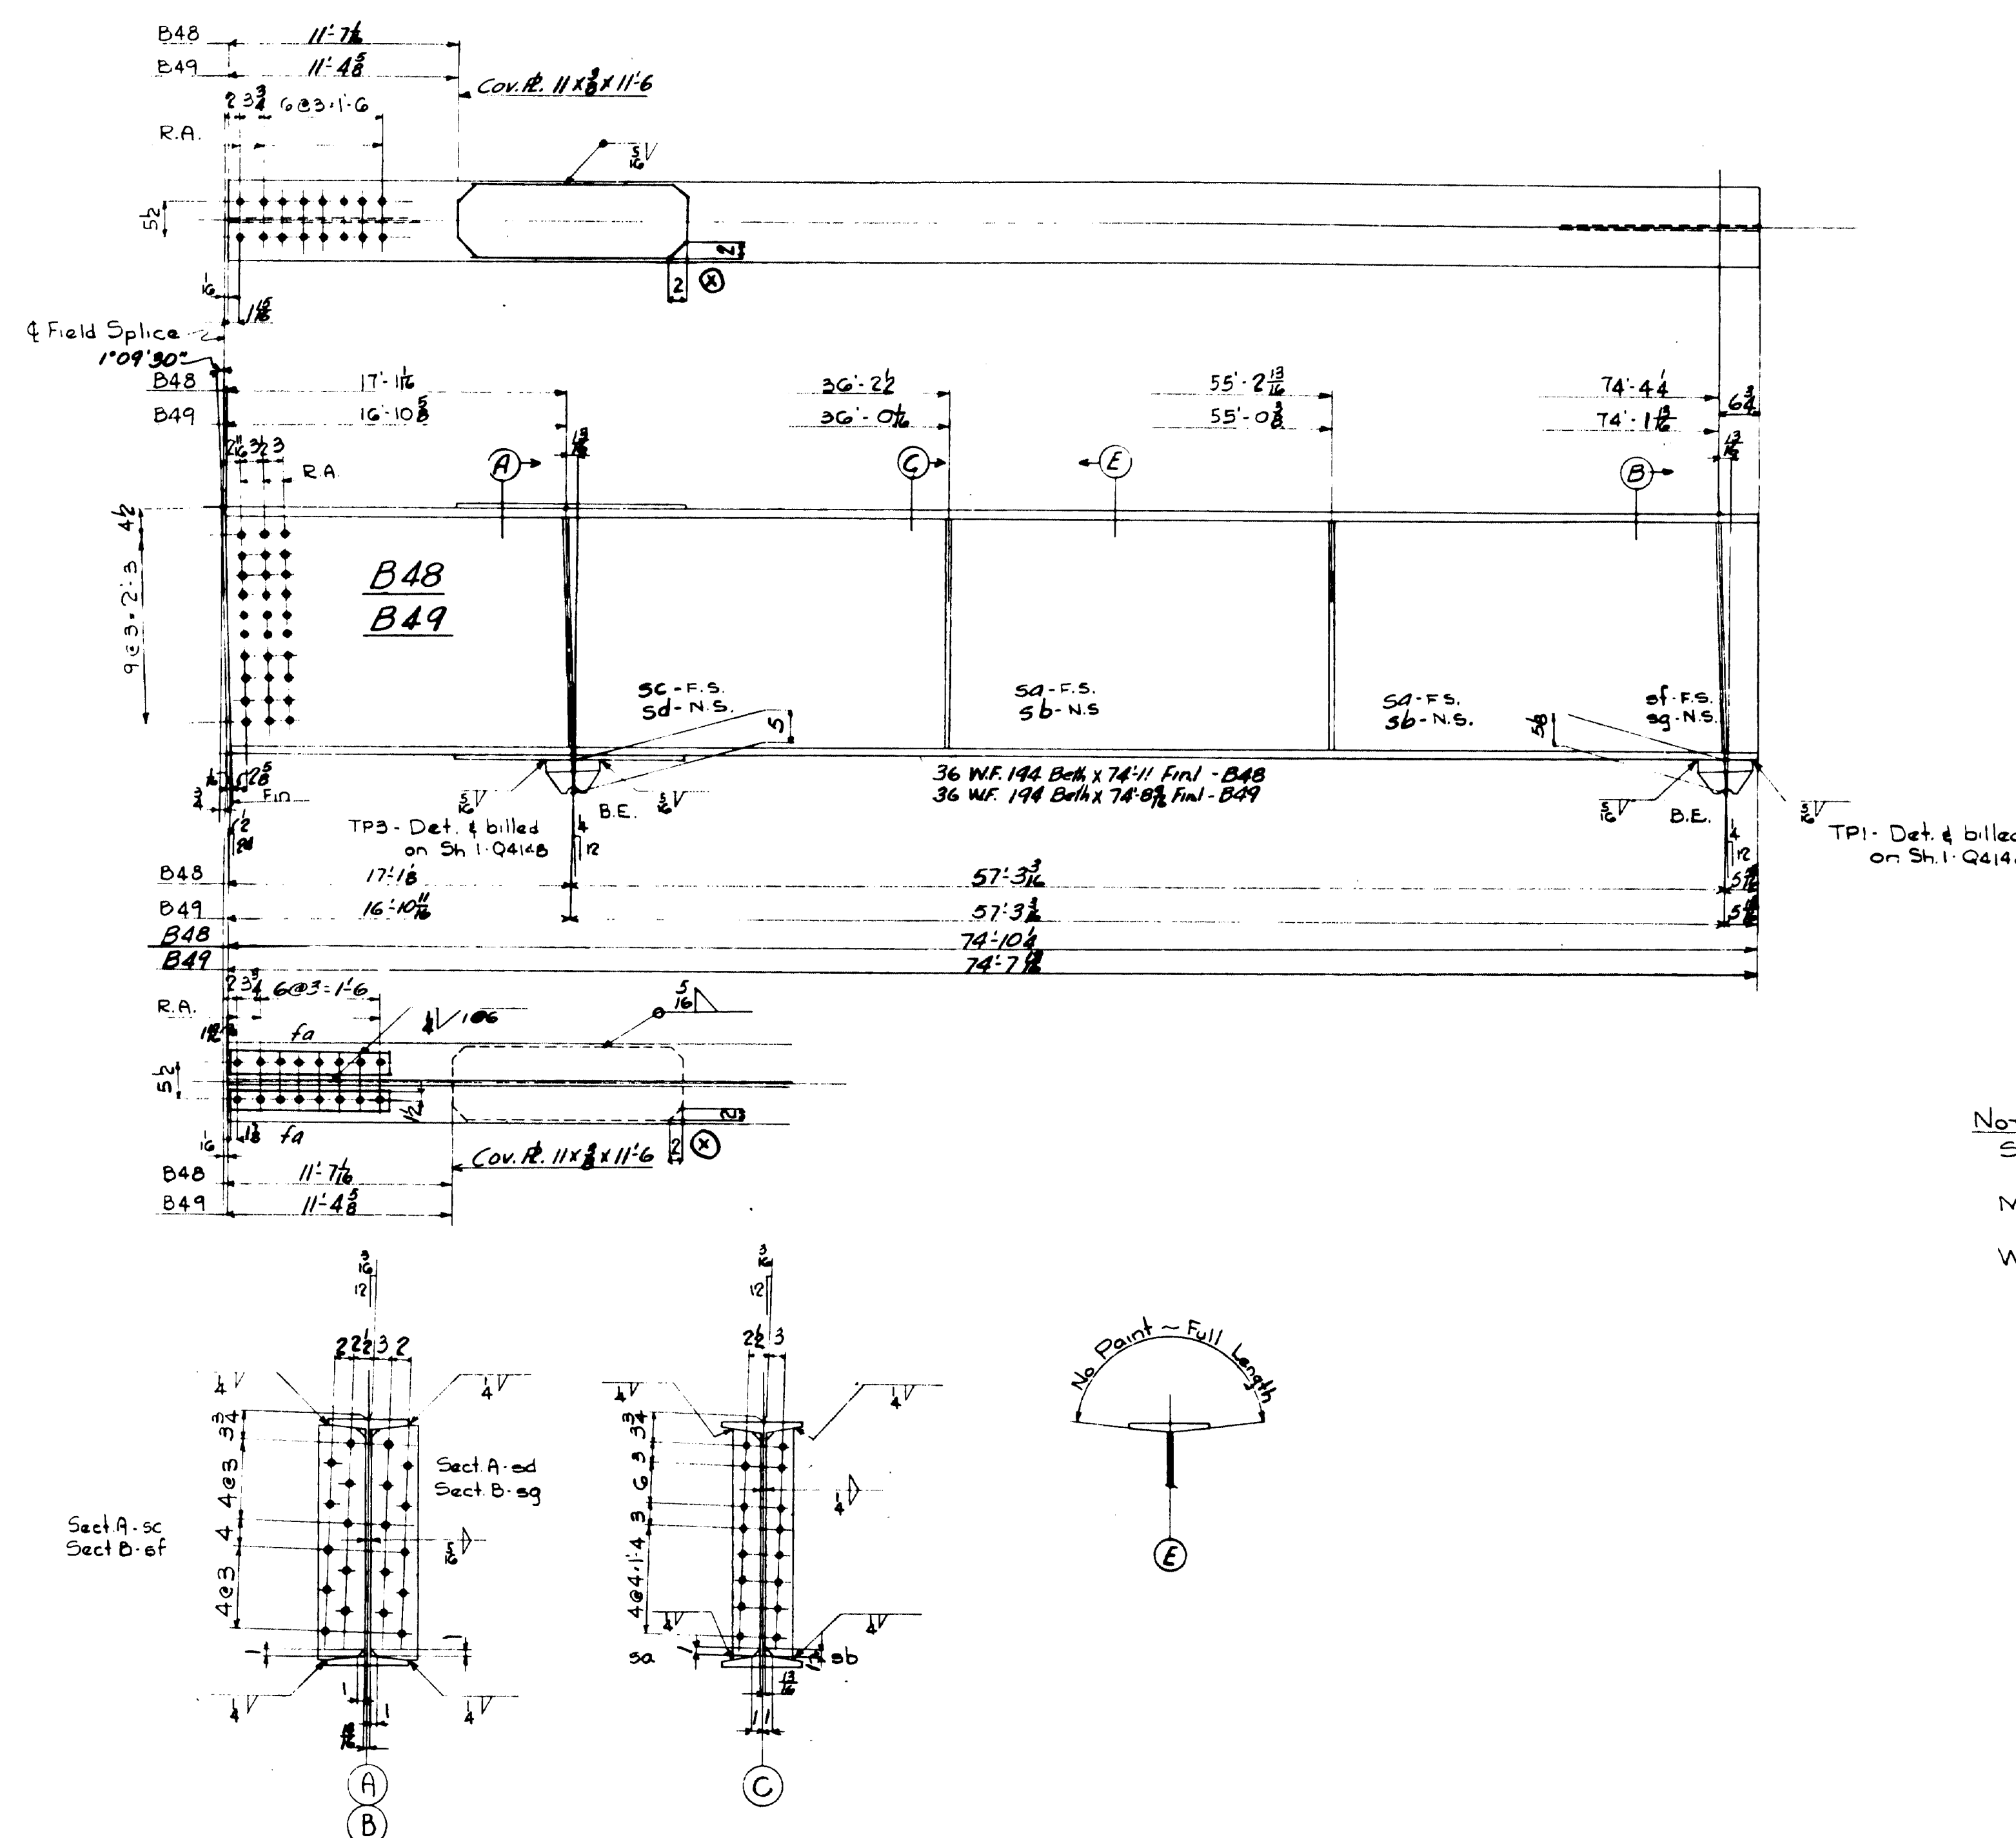
NOTES:  
 SPECIFICATIONS: Maine State Highway Comm. 1945  
 & Special Provisions.  
 MATERIAL: O.K. Steel A S.T.M. A7-52T.  
 Holes - 1 1/8\"/>

WORKMANSHIP:  
 Holes in material thicker than the diameter of the rivet shall be drilled

Holes marked R.A. to be subpunched or subdrilled 1/2\"/>

Connecting members to be matchmarked.  
 B.E. indicates bearing end of stiffener.  
 Shop to fabricate Beam with Mill Camber up.  
 In assembling TPI & TPS to Beams, care must be taken that the axis of bore is normal to 1/2\"/>

For Assembly and Reaming Diagrams See Sh. 412 Work Sh. 412 with this Sheet.

STRINGERS B48 & B49  
 DIV. 4  
 STATE OF MAINE  
 STATE HIGHWAY COMMISSION  
 BANGOR-BREWER BRIDGE  
 OVER PENOBSCOT RIVER  
 BANGOR, MAINE

AMERICAN BRIDGE

DRAWINGS MADE AT JERINTON PLANT  
 WORK FABRICATED AT JERINTON PLANT  
 IN CHARGE OF E.D. MARKS  
 DRAW. MADE BY S.B.K. DATE 11-9-52  
 DRAW. CHECKED BY H.S. DATE 1-15-54  
 ORDER NO. Q4149 SHEET NO. 406

LIFTING WT. = 8 TONS

PAINT: Yes, except as noted  
 SHOP CONTACT SURFACES: No

401, 402

WELD



# AMERICAN BRIDGE COMPANY

LINE	ITEM	QUANTITY	UNIT	REMARKS	ORDERED	ITEM	QUANTITY	UNIT	REMARKS
1	ONE BEAM	B47		18' 0" x 11' 6"					
2	ONE BEAM	B50		17' 3 1/2" x 16' 8 1/2"					
3	3G WF 170	75	1/2	18' 0" x 11' 6"					
4	3G WF 170	74	1/2	17' 3 1/2" x 16' 8 1/2"					
5	4 R 11 3/8	11	6	U.M.					
6	4 R 7 3/8	2	10	sa	Finl				
7	4 R 7 3/8	2	10	sb	Finl				
8	4 R 7 3/8	2	10	sc	Finl				
9	4 R 7 3/8	2	10	sd	Finl				
10	4 R 7 3/8	2	10	sf	Finl				
11	4 R 7 3/8	2	10	sg	Finl				
12	4 R 7 3/8	2	10	sh	Finl				
13	4 R 7 3/8	2	10	sk	Finl				
14	4 R 7 3/8	2	10	sm	Finl				
15	11 R 7 3/8	1	1	ha403	4.850				
16	5 R 7 3/8	1	1	hg403	4.850				
17	2 R 7 3/8	1	1	da					
18	2 R 7 3/8	1	1	db					
19	3 TOP PLATE	TP2		3.850 Det					
20	1 TOP PLATE	TP2		B50 & E					
21				Sh. 1-0414B					
22	4 FIB 4 1/2	2	18	fa					

STRINGERS B47 & B50  
Div. 4

STATE OF MAINE  
STATE HIGHWAY COMMISSION  
BANGOR-BREWER BRIDGE  
OVER PENOBSCOT RIVER  
BANGOR, MAINE

AMERICAN BRIDGE COMPANY  
UNITED STATES STEEL CORPORATION SUBSIDIARY

DRAWINGS MADE AT TRENTON PLANT  
WORK FABRICATED AT TRENTON PLANT  
IN CHARGE OF E.B. MARKS  
DRAW. MADE BY S.S.K. DATE 11-10-53  
DRAW. CHECKED BY H.R. DATE 1-15-54

ORDER No. 407  
SHEET No. 407





REVISIONS  
F  
E  
D  
C  
B  
A

PAINT: Yes, except as noted.  
SHOP CONTACT SURFACES: No.


LIFTING WT. 7 TONS

NOTE:  
In assembling TP2 & TP3 to beam care must be taken that the axis of bore is normal to & of beam.

NOTES:  
SPECIFICATIONS: Maine State Highway Comm. 1945 & Special Provisions  
MATERIAL: O.H. Steel A.S.T.M. A7-S2T  
RIVETS: 3" HOLES: 1 1/2"  
WORKMANSHIP:  
Holes in material thicker than the diameter of the rivet shall be drilled  
Holes in main material & splice pls. to be subpunched or subdrilled & and corresponding holes in shop assembled members subpunched & and reamed to size after assembly.  
Holes marked RT to be subpunched or subdrilled & and reamed to size to a metal template.  
Holes marked R.A. to be subpunched or subdrilled & and reamed to size while connecting members are assembled.  
Connecting members to be matchmarked.  
B.E. indicates bearing end of stiffener.  
Shop to fabricate Beams with Mill Camber up.  
For assembly & reaming diagrams see Sh. 412  
Work Sh. 412 with this Sheet.

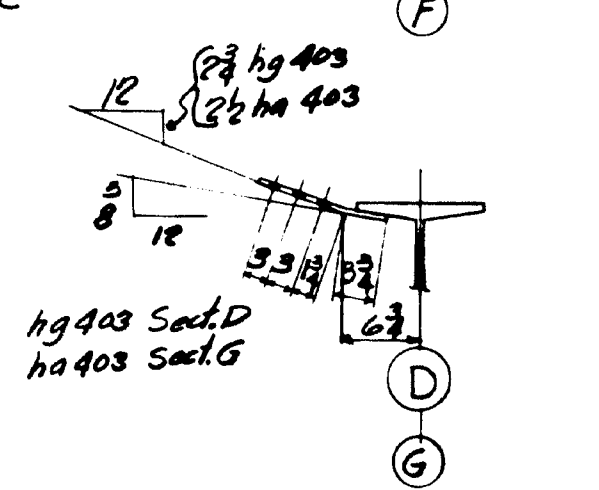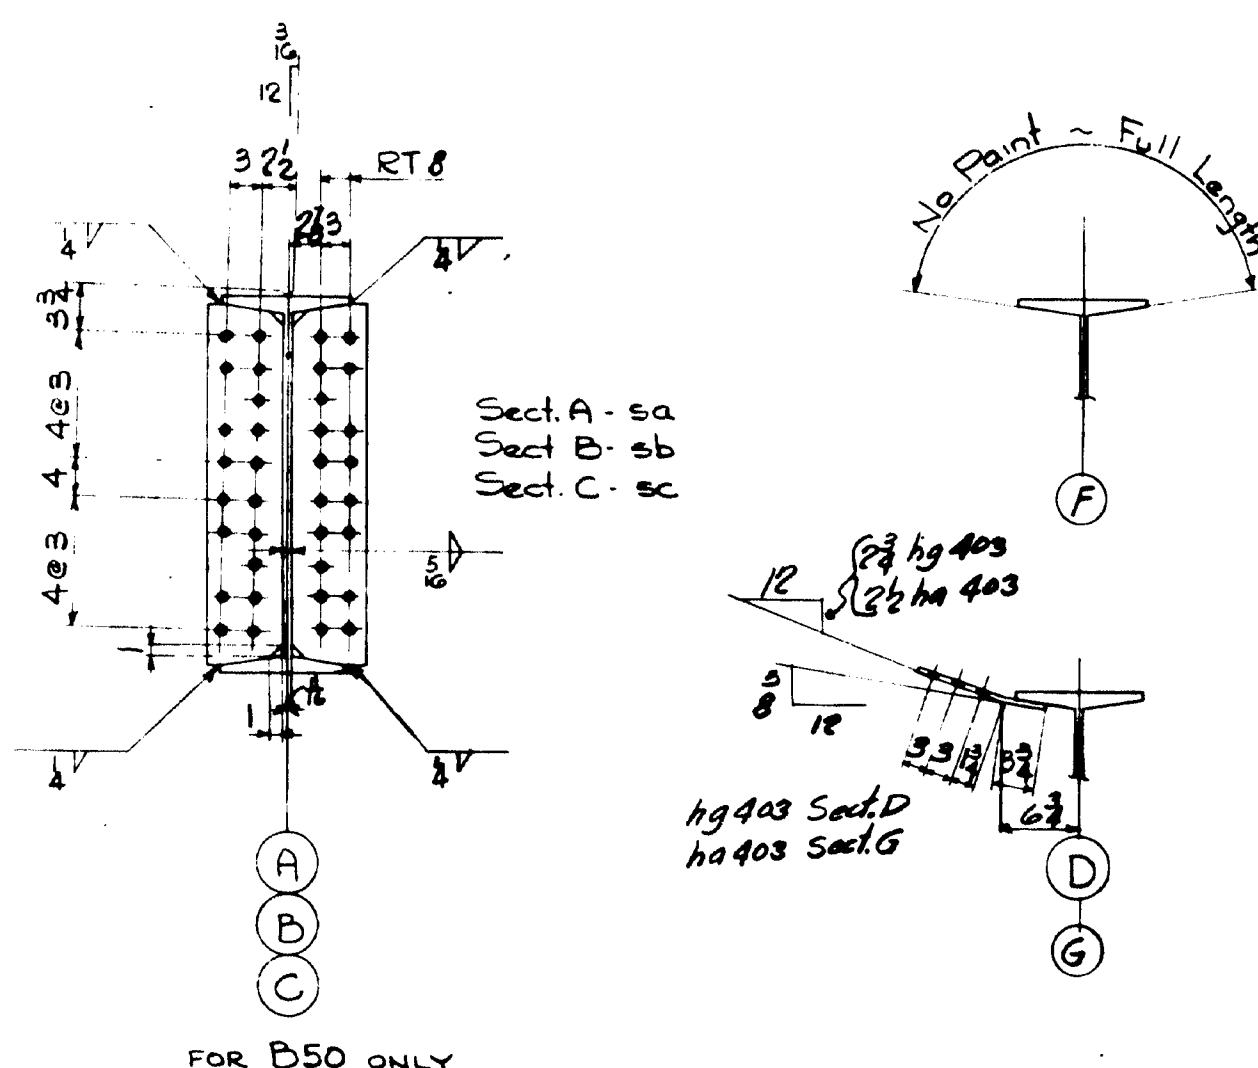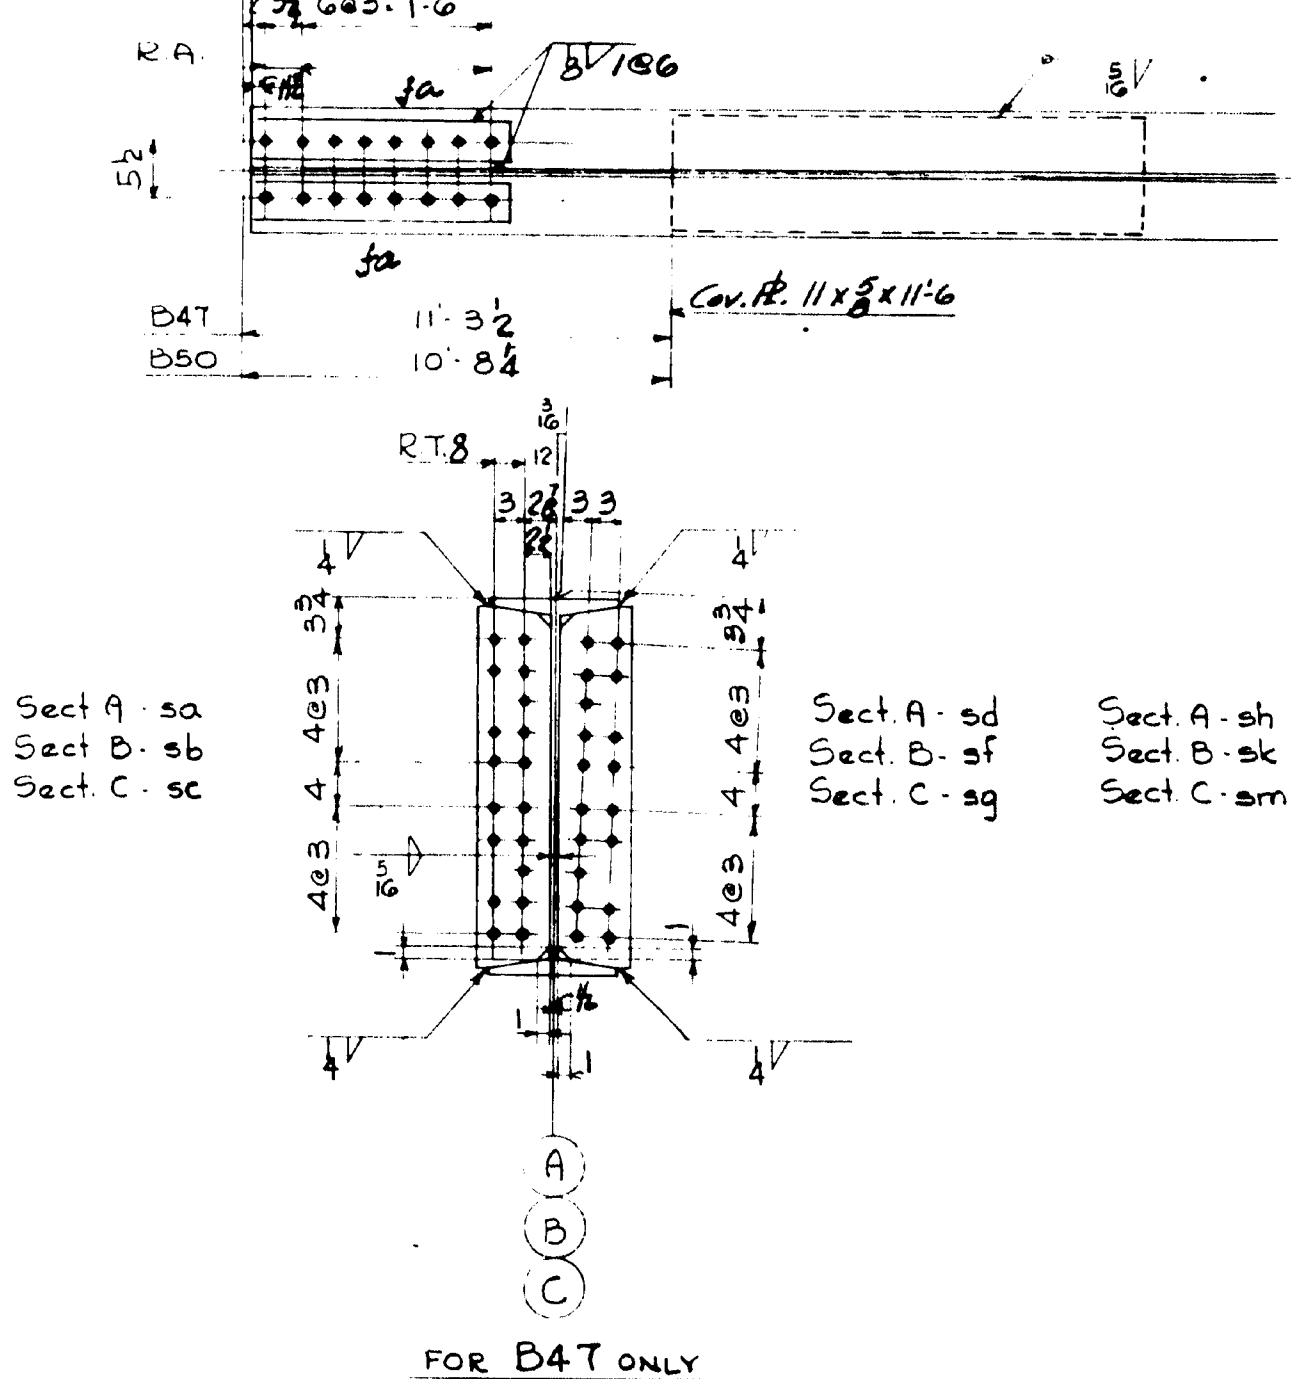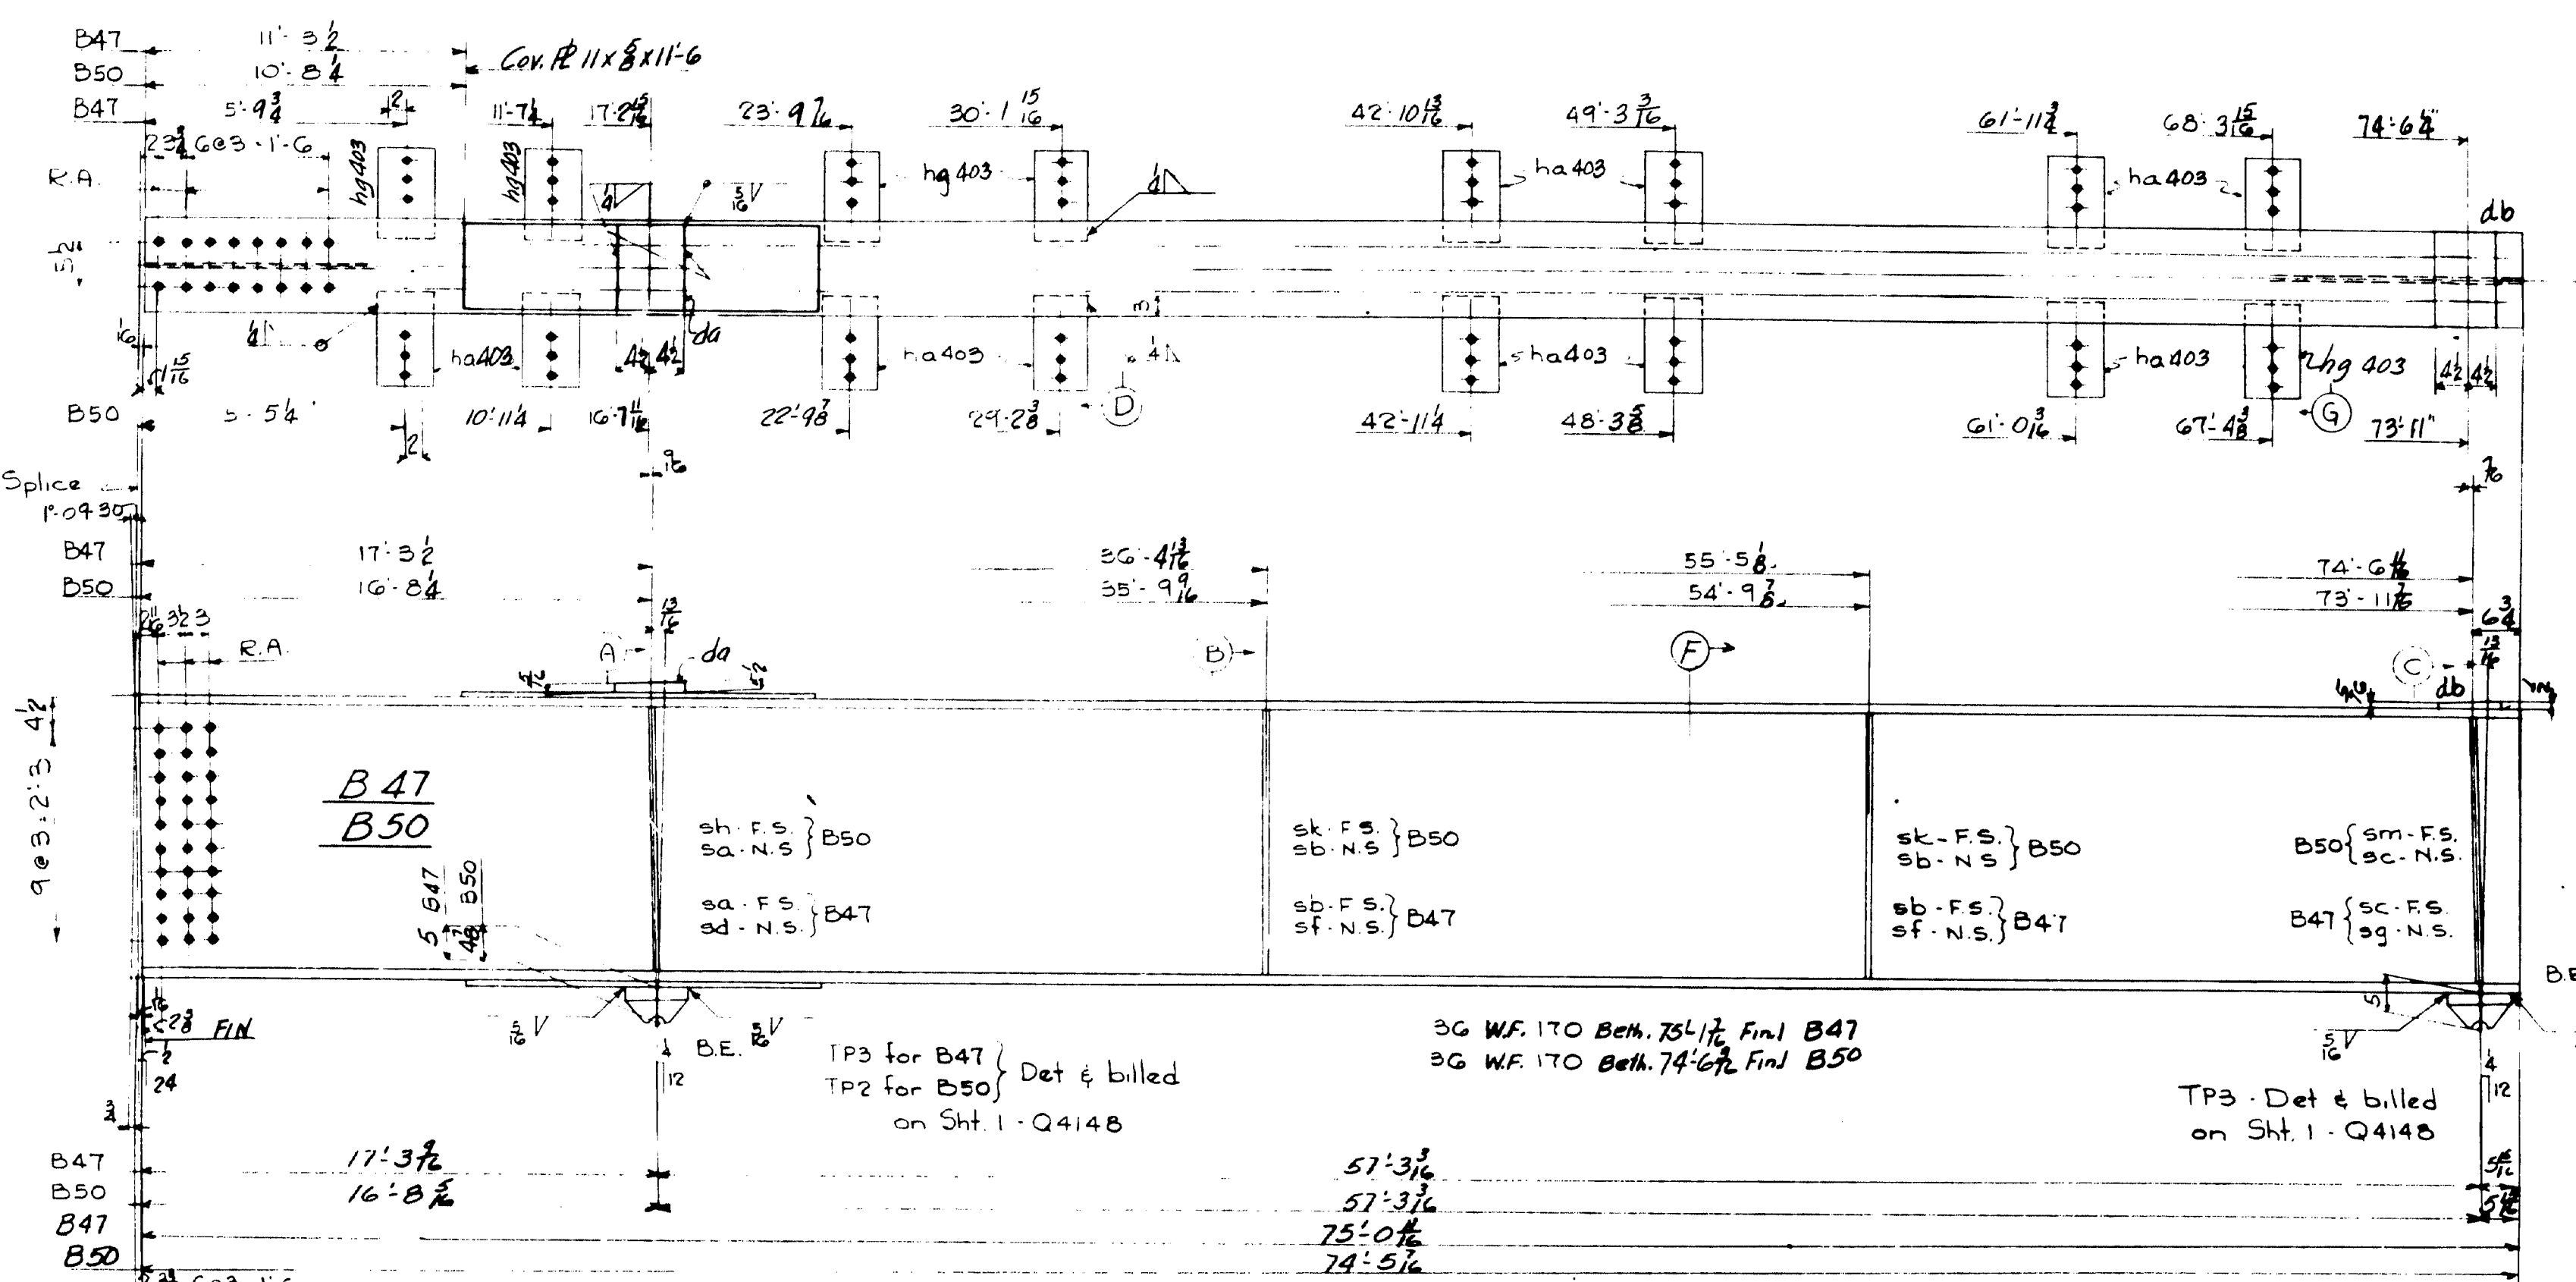

ITEM	QTY	UNIT	DESCRIPTION	REMARKS
1				
2				
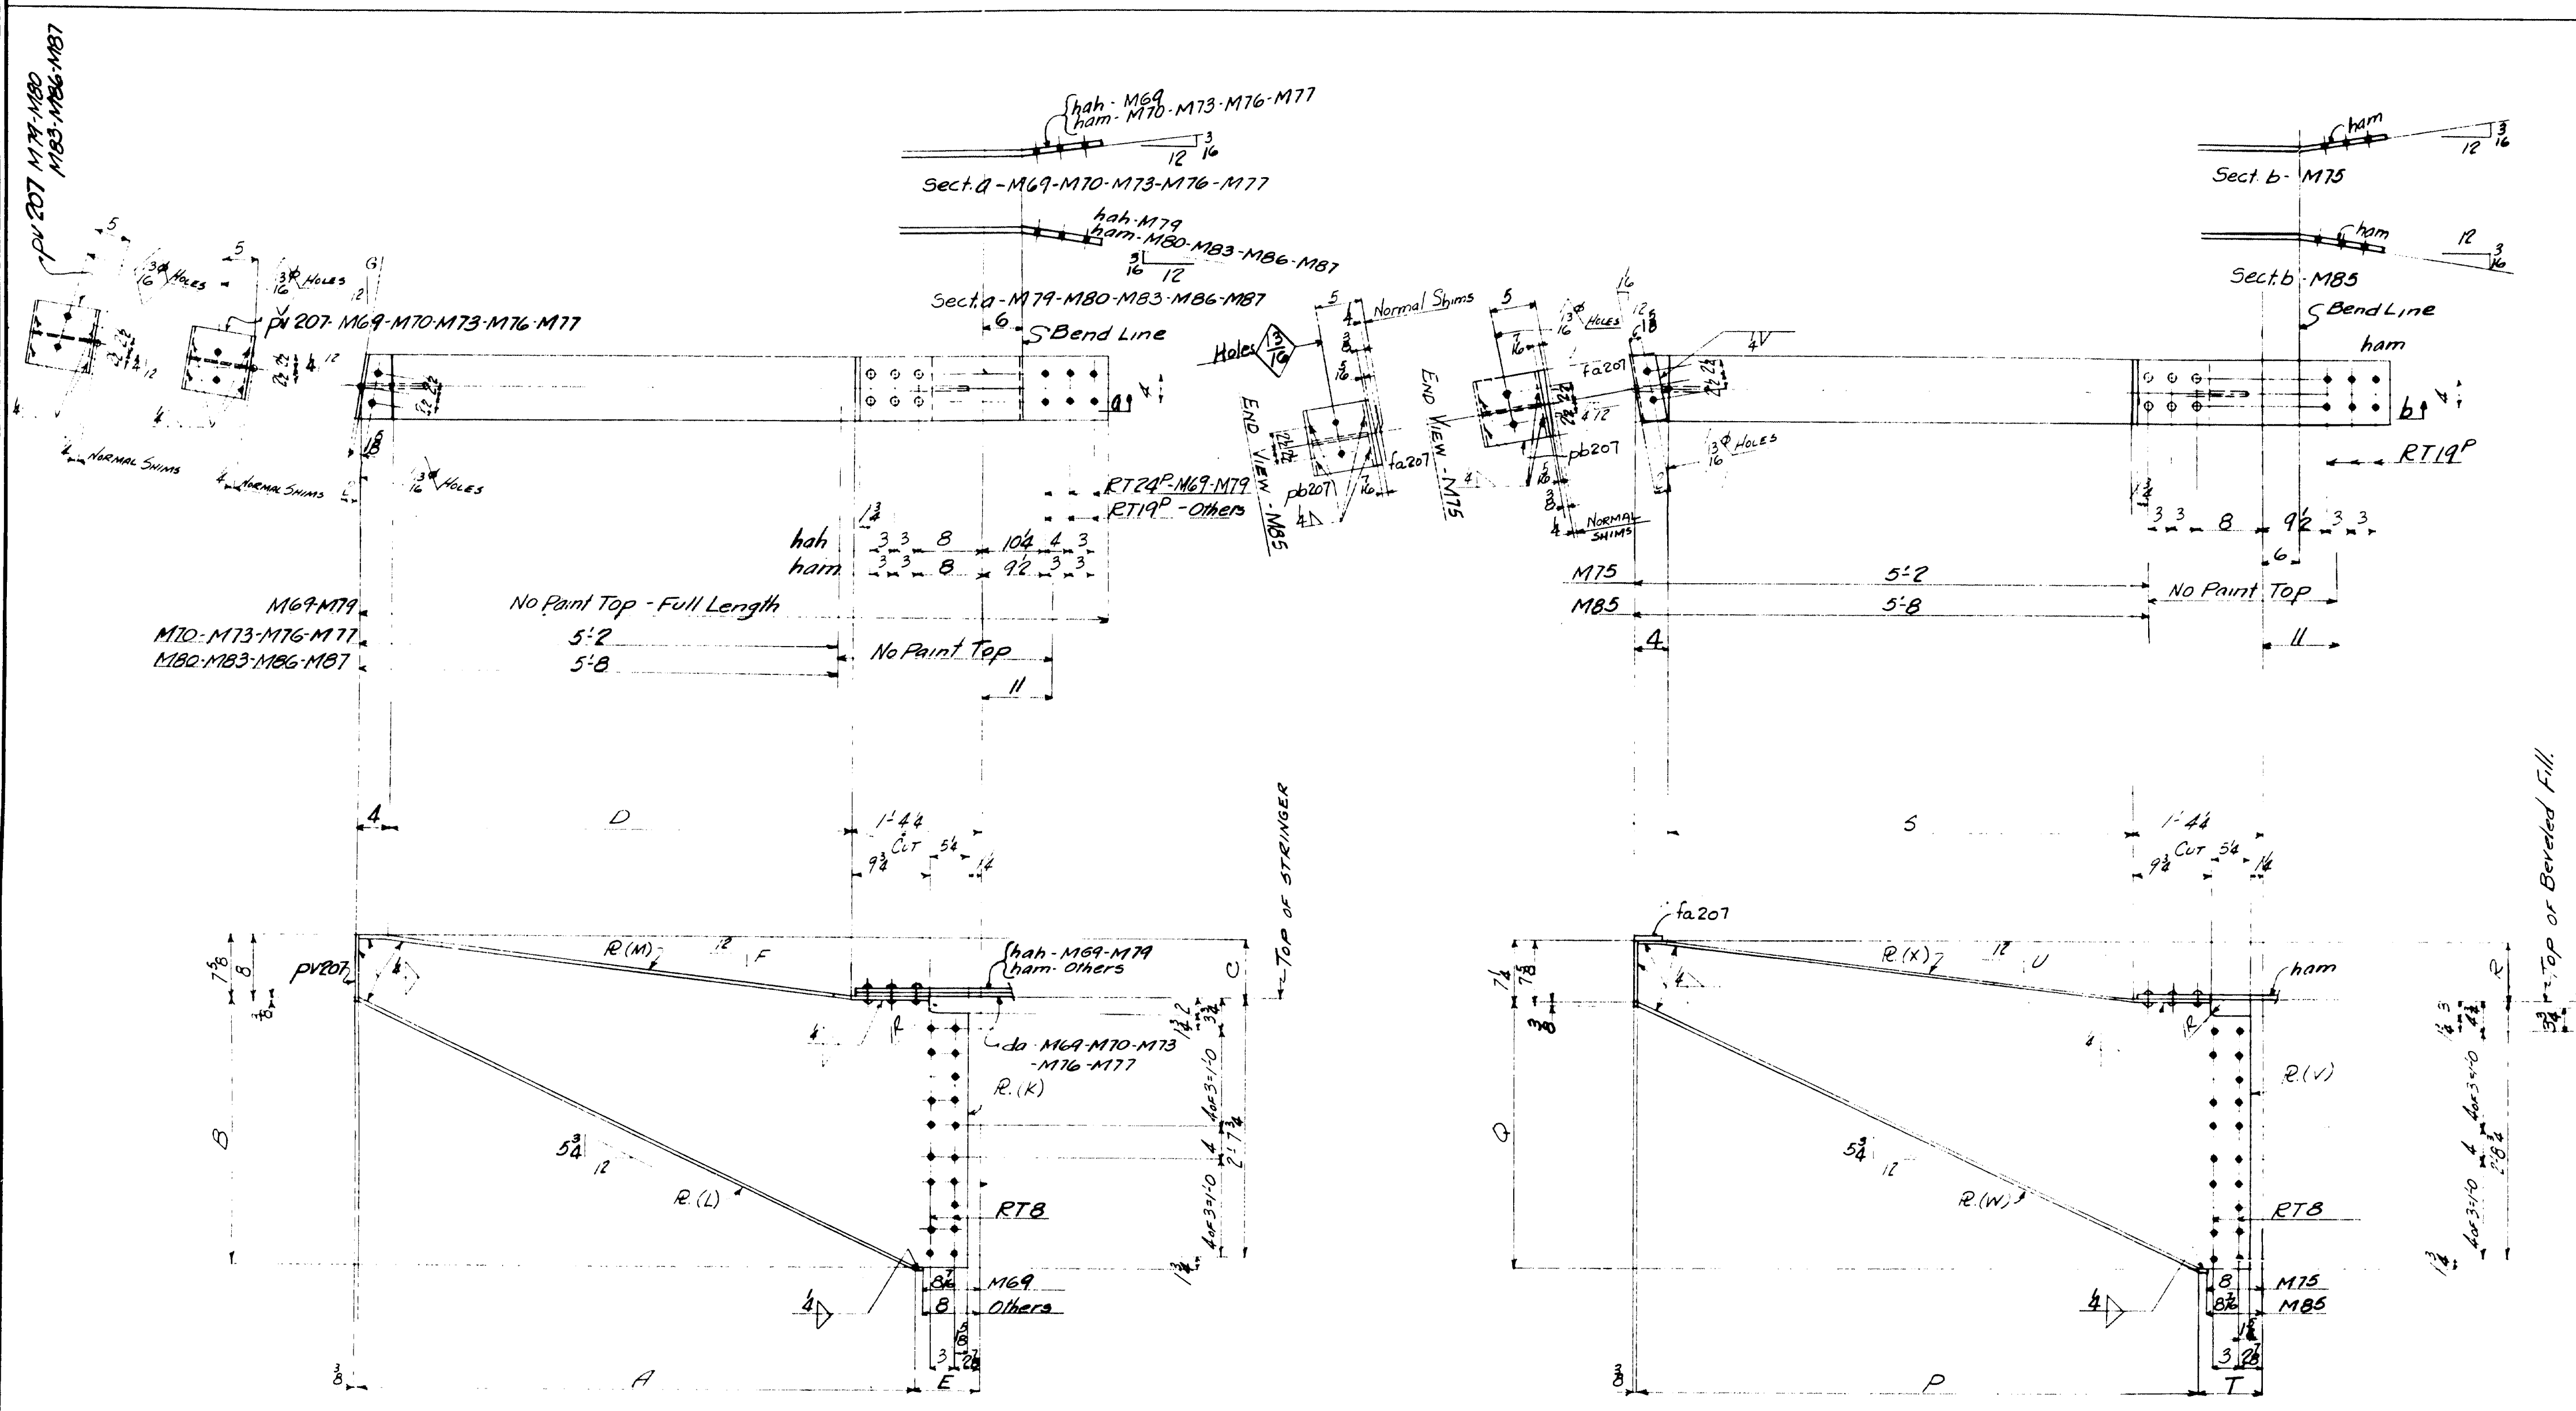

BRKT.	DIMENSIONS							SEVELS			PIECE MARK		
	A	B	C	D	E	F	G	K	L	M	N	O	
M69	5'-5 1/2"	2'-7 1/2"	5 1/2"	4'-0 1/2"	8 1/2"	1 1/4"	0	pc	pab	ha			
M70	5'-5 1/2"	2'-7 1/2"	5 1/2"	4'-7 1/2"	9 1/2"	1 1/2"	0	pc	ay	hb			
M73	5'-5 1/2"	2'-7 1/2"	5 1/2"	4'-8 1/2"	11 1/2"	1 1/2"	0	pc	ay	hc			
M76	5'-7 1/2"	2'-8 1/2"	6 1/2"	4'-9 1/2"	10 1/2"	1 1/2"	0	pk	hy	hd			
M77	5'-7 1/2"	2'-8 1/2"	6 1/2"	4'-9 1/2"	9 1/2"	1 1/2"	0	pm	hag	hf			
M79	5'-7 1/2"	2'-8 1/2"	6 1/2"	5'-0 1/2"	1 1/2"	0	0	pm	hab	hg			
M80	5'-7 1/2"	2'-8 1/2"	6 1/2"	5'-0 1/2"	1 1/2"	0	0	pp	hac	hh			
M83	5'-7 1/2"	2'-8 1/2"	6 1/2"	4'-10 1/2"	10 1/2"	1 1/2"	0	PT	hard	hk			
M86	5'-8 1/2"	2'-8 1/2"	7 1/2"	4'-9 1/2"	9 1/2"	1 1/2"	0	PT	hvt	hm			
M87	5'-7 1/2"	2'-8 1/2"	6 1/2"	4'-9 1/2"	10 1/2"	1 1/2"	0	pk	hy	hd			

BRKT.	DIMENSIONS					S.I.E.L. PIECE MARKS				
	P	Q	R	S	T	U	V	W	X	
M75	5'-6 1/2"	2'-7 1/2"	4 1/2"	4'-10 1/2"	11 1/2"	1 1/2"	pat	haz	hp	
M85	5'-8 1/2"	2'-8 1/2"	5 1/2"	4'-9 1/2"	8 1/2"	1 1/2"	pav	pay	ht	

NOTES:  
 1) SPECIFICATIONS: MAINE STATE HIGHWAY COMM. 1945 AND SPECIAL PROVISIONS.  
 2) MATERIAL: ON STEEL ASTM A7-52T.  
 3) RIVETS: 7/8" 150-54 UNLESS NOTED.  
 4) HOLES: 1 1/2" UNLESS NOTED.  
 5) PAINT: YES, EXCEPT AS NOTED.  
 6) SHOP CONTACT SURFACES: NO.  
 Holes marked R.T. to be subpunched & reamed to size to a metal template.  
 All holes for Shop Rivets to be subpunched & reamed to size with connecting parts assembled.

AMERICAN BRIDGE COMPANY

LINE	ITEM	SHAPE	LENGTH	ASSEMBLY NAME	REMARKS	ORDERED	ITEM	CALCULATED FOR ONE BRIDGE
1								
2								
3								
4								
5	ONE BRACKET-M69		348"					
6	ONE BRACKET-M70		351"					
7	ONE BRACKET-M73		363"					
8	ONE BRACKET-M76							
9	ONE BRACKET-M77							
10	ONE BRACKET-M79		381"					
11	ONE BRACKET-M80		373"					
12	ONE BRACKET-M83		362"					
13	ONE BRACKET-M86		356"					
14	ONE BRACKET-M87		357"					
15								
16	1 R	308"	6 1/2"	pc	FOR M69	42x14x0	1029	30.6
17	2 R	308"	6 1/2"	pc	FOR M70	42x14x0	1029	30.6
18	10 B	8 3/8"	6 1/2"	ay	FOR M73	42x14x0	1029	31.0
19	1 R	308"	6 1/2"	pc	FOR M76	42x14x0	1029	31.0
20	1 R	308"	6 1/2"	pc	FOR M77	42x14x0	1029	31.0
21	2 R	308"	6 1/2"	pc	FOR M79	42x14x0	1029	31.0
22	1 R	308"	6 1/2"	pc	FOR M80	42x14x0	1029	31.0
23	1 R	308"	6 1/2"	pc	FOR M83	42x14x0	1029	31.0
24	1 R	308"	6 1/2"	pc	FOR M86	42x14x0	1029	31.0
25	10 B	8 3/8"	6 1/2"	ay	FOR M87	42x14x0	1029	31.0
26								
27								
28	1 R	308"	6 1/2"	pc	FOR M89	42x14x0	1029	31.0
29								
30	1 R	308"	6 1/2"	pc	FOR M90	42x14x0	1029	31.0
31	1 R	308"	6 1/2"	pc	FOR M93	42x14x0	1029	31.0
32	1 R	308"	6 1/2"	pc	FOR M96	42x14x0	1029	31.0
33	2 R	308"	6 1/2"	pc	FOR M97	42x14x0	1029	31.0
34	1 R	308"	6 1/2"	pc	FOR M99	42x14x0	1029	31.0
35	1 R	308"	6 1/2"	pc	FOR M100	42x14x0	1029	31.0
36	1 R	308"	6 1/2"	pc	FOR M103	42x14x0	1029	31.0
37	1 R	308"	6 1/2"	pc	FOR M106	42x14x0	1029	31.0
38	1 R	308"	6 1/2"	pc	FOR M107	42x14x0	1029	31.0
39								
40	1 R	308"	6 1/2"	pc	FOR M109	42x14x0	1029	31.0
41	1 R	308"	6 1/2"	pc	FOR M110	42x14x0	1029	31.0
42	1 R	308"	6 1/2"	pc	FOR M113	42x14x0	1029	31.0
43	1 R	308"	6 1/2"	pc	FOR M116	42x14x0	1029	31.0
44	1 R	308"	6 1/2"	pc	FOR M117	42x14x0	1029	31.0
45	1 R	308"	6 1/2"	pc	FOR M119	42x14x0	1029	31.0
46	1 R	308"	6 1/2"	pc	FOR M120	42x14x0	1029	31.0
47	1 R	308"	6 1/2"	pc	FOR M123	42x14x0	1029	31.0
48	1 R	308"	6 1/2"	pc	FOR M126	42x14x0	1029	31.0
49	5 Fib	8 3/8"	1 1/2"	da	FOR M127	42x14x0	1029	31.0
50								
51								
52	ONE BRACKET-M75		368"					
53	ONE BRACKET-M85		354"					
54								
55								
56	2 R	8 3/8"	7 1/2"	pc	FOR M75	42x14x0	1029	31.0
57								
58	1 R	308"	6 1/2"	pc	FOR M85	42x14x0	1029	31.0
59	1 R	308"	6 1/2"	pc	FOR M75	42x14x0	1029	31.0
60	1 R	308"	6 1/2"	pc	FOR M85	42x14x0	1029	31.0
61	1 R	308"	6 1/2"	pc	FOR M75	42x14x0	1029	31.0
62	1 R	308"	6 1/2"	pc	FOR M85	42x14x0	1029	31.0
63	1 R	308"	6 1/2"	pc	FOR M75	42x14x0	1029	31.0
64	1 R	308"	6 1/2"	pc	FOR M85	42x14x0	1029	31.0
65	2 F	1 3/4"	1 1/2"	8	FOR M75	42x14x0	1029	31.0
66								
67								

STATE OF MAINE  
 STATE HIGHWAY COMMISSION  
 BANGOR-BREWER BRIDGE  
 OVER THE PENOBSCOT RIVER  
 BANGOR, MAINE

AMERICAN BRIDGE COMPANY  
 UNITED STATES OF AMERICA


DRAWINGS MADE AT TRENTON PLANT  
 WORK FABRICATED AT TRENTON PLANT  
 IN CHARGE OF E. B. MARKS  
 DRAW. MADE BY E. B. MARKS DATE 11-10-53  
 DRAW. CHECKED BY W. L. L. DATE 2-1-54  
 ORDER No. Q4149 SHEET No. 408



ITEM	QTY	UNIT	PRICE	TOTAL
1				
2				
3				
# AMERICAN BRIDGE COMPANY

LINE	ITEM	QTY	UNIT	PRICE	TOTAL
1					
2					
3					
4	ONE BRACKET-M72	359			
5	ONE BRACKET-M78	362			
6	ONE BRACKET-M82	370			
7	ONE BRACKET-M88	365			
8					
9					
10	4 R	8 3/4	1/8	pb207	
11	4 F	3 1/2	3/8	fa207	
12	2 R	8 1/2	1/4	hp	
13	2 R	8 1/2	1/4	hp	
14	1 R	20 3/4	1/4	hp	
15	1 R	29 1/2	1/4	hp	
16	1 R	29 1/2	1/4	hp	
17	1 R	29 1/2	1/4	hp	
18	1 R	29 1/2	1/4	hp	
19	1 R	29 1/2	1/4	hp	
20	1 R	29 1/2	1/4	hp	
21	1 R	29 1/2	1/4	hp	
22	1 R	29 1/2	1/4	hp	
23	1 R	29 1/2	1/4	hp	
24	1 R	29 1/2	1/4	hp	
25	1 R	29 1/2	1/4	hp	
26	1 R	29 1/2	1/4	hp	
27	ONE BRACKET-M71	386			
28	ONE BRACKET-M74	402			
29	ONE BRACKET-M81	387			
30	ONE BRACKET-M84	363			
31					
32					
33	4 R	8 3/4	1/8	pb207	
34	1 R	36 1/2	1/4	hp	
35	1 R	36 1/2	1/4	hp	
51	4 F	3 1/2	3/8	fa207	
52					
53					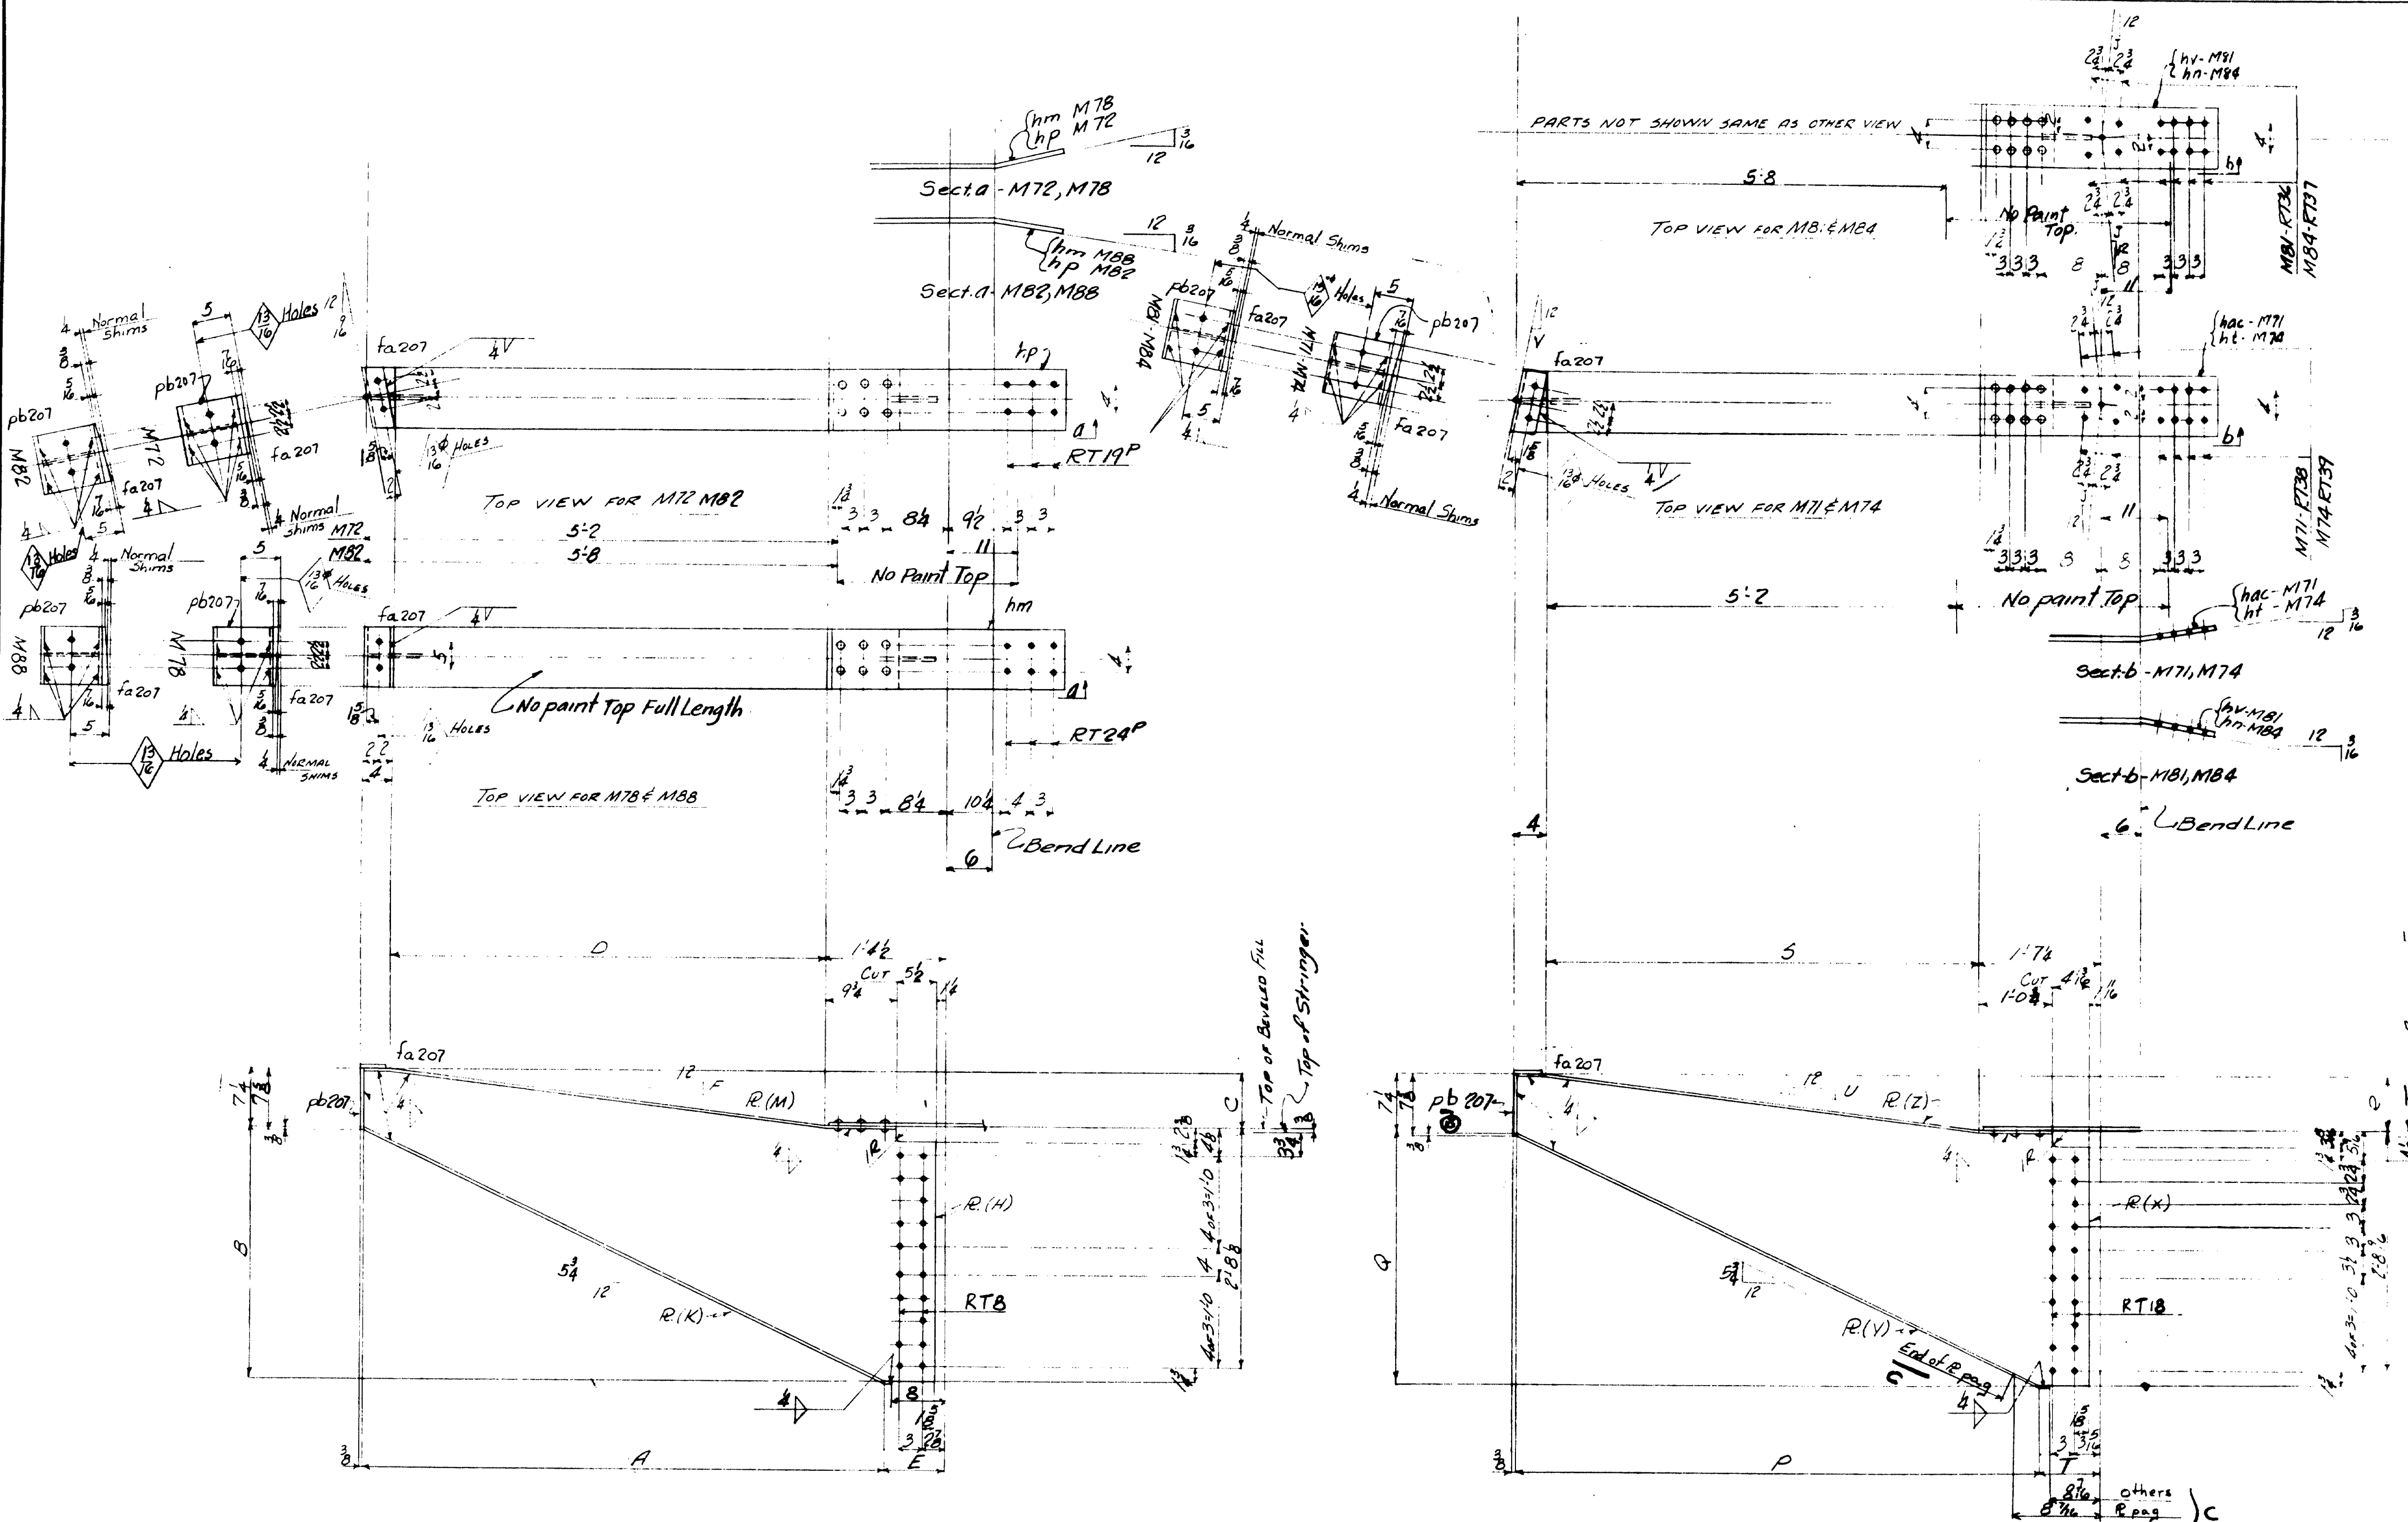
BEKT	DIMENSIONS	BEVEL	PIECE MARKS
M72	5'5 1/2" x 2'7 1/2" x 4'8" x 10'1 1/2" x 1'6"	1/4"	pg hw ha
M78	5'8 1/2" x 2'8 1/2" x 6'1 1/2" x 10'2 1/2" x 1'6"	1/4"	ph hy hb
M82	5'7 1/2" x 2'8 1/2" x 5'1 1/2" x 10'2 1/2" x 1'6"	1/4"	pk hag hc
M88	5'5 1/2" x 2'7 1/2" x 4'8" x 10'1 1/2" x 1'6"	1/4"	pm hab hd

BEKT	DIMENSIONS	BEVELS	PIECE MARKS
M71	5'5 1/2" x 2'7 1/2" x 4'8" x 10'1 1/2" x 1'6"	1/4"	pw had hf
M74	5'5 1/2" x 2'7 1/2" x 4'8" x 10'1 1/2" x 1'6"	1/4"	py bat pg
M81	5'7 1/2" x 2'8 1/2" x 5'1 1/2" x 10'2 1/2" x 1'6"	1/4"	paq hah ha
M84	5'7 1/2" x 2'8 1/2" x 5'1 1/2" x 10'2 1/2" x 1'6"	1/4"	pab pag hk


NOTES:  
 1) SPECIFICATIONS: MAINE STATE HIGHWAY  
 COMM. 1945 AND SPECIAL PROVISIONS  
 2) MATERIAL: QU. STEEL ASTM A7-52T  
 3) RIVETS: 3/4"  
 4) HOLES: 1/8" UNLESS NOTED.  
 5) PAINT: YES, EXCEPT AS NOTED.  
 6) SHOP CONTACT SURFACES: NO  
 Holes marked RT to be subpunched &  
 reamed to size to a metal template  
 All holes for Shop Rivets to be subpunched  
 and reamed to size with connecting  
 parts assembled.

STATE OF MAINE  
 STATE HIGHWAY COMMISSION  
 BANGOR-BREWSTER BRIDGE  
 OVER THE PENOBSCOT RIVER  
 BANGOR, MAINE

AMERICAN BRIDGE COMPANY  
 DRAWINGS MADE AT TRENTON PLANT  
 WORK FABRICATED AT TRENTON PLANT  
 IN CHARGE OF E.B. MARKS  
 DRAW. MADE BY E.B. MARKS DATE 11-20-53  
 DRAW. CHECKED BY J.P.P. DATE 2-2-54  
 ORDER NO. 46149  
 SHEET NO. 409



DIV 4 BEVELS			DIMENSIONS			ASSEMBLY MARKS		BEVELS	
MARK	A	B C	D	E	F	G	H	I	K
M148	2 1/2	1/2	2 1/2	5'-14"	6'-4 1/2"	ac	21	mk30	4
M149	2 1/2	1/2	2 1/2	5'-11 1/2"	6'-2 1/2"	ac	aa	mk30	4
M150	2 1/2	1/2	2 1/2	5'-11"	6'-2 1/2"	ac	af23	mk23	4
M151	2 1/2	0	0	2 1/2	5'-11 1/2"	6'-1 1/2"	ac	mk30	4
M152	2 1/2	1/2	2 1/2	5'-11 1/2"	6'-2 1/2"	ac	2P	mk30	4
M153	2 1/2	1/2	2 1/2	5'-10 1/2"	6'-0 1/2"	ac	ac	mk30	4
M154	2 1/2	1/2	2 1/2	5'-8 3/4"	5'-11 1/2"	ac	af23	mk30	4
M155	2 1/2	1/2	2 1/2	5'-8 3/4"	5'-11 1/2"	ac	ac	mk30	4
M156	2 1/2	1/2	2 1/2	5'-9 1/2"	5'-0"	ac	af23	mk23	4
M157	2 1/2	0	0	2 1/2	5'-10 1/2"	6'-0 1/2"	ac	mk30	4
M158	2 1/2	0	0	2 1/2	5'-10 1/2"	6'-0"	ac	mk30	4
M159	2 1/2	0	0	2 1/2	5'-10 1/2"	6'-0 1/2"	ac	mk30	4
M161	2 1/2	0	0	2 1/2	5'-10 1/2"	6'-0 1/2"	ac	mk30	4
M163	2 1/2	1/2	2 1/2	5'-6 3/4"	5'-9 1/2"	ac	aw	mk30	4
M164	2 1/2	1/2	2 1/2	5'-8 1/2"	5'-11 1/2"	ac	ad	mk30	4
M165	2 1/2	1/2	2 1/2	5'-9 1/2"	6'-0 1/2"	ac	af23	mk23	4
M166	2 1/2	0	0	2 1/2	5'-8 1/2"	5'-11 1/2"	ac	mk30	4
M167	2 1/2	1/2	2 1/2	5'-8 1/2"	5'-11 1/2"	ac	ad	mk30	4
M168	2 1/2	1/2	2 1/2	5'-10 1/2"	6'-0 1/2"	ac	ac	mk30	4
M169	2 1/2	1/2	2 1/2	5'-11 1/2"	6'-2 1/2"	ac	ac	mk30	4
M170	2 1/2	1/2	2 1/2	5'-11 1/2"	6'-2 1/2"	ac	af23	mk30	4
M171	2 1/2	1/2	2 1/2	5'-11"	6'-1 1/2"	ac	af23	mk23	4
M172	2 1/2	1/2	2 1/2	5'-11"	6'-0 1/2"	ac	af23	mk23	4
M174	2 1/2	0	0	2 1/2	5'-10 1/2"	6'-1"	ac	mk30	4

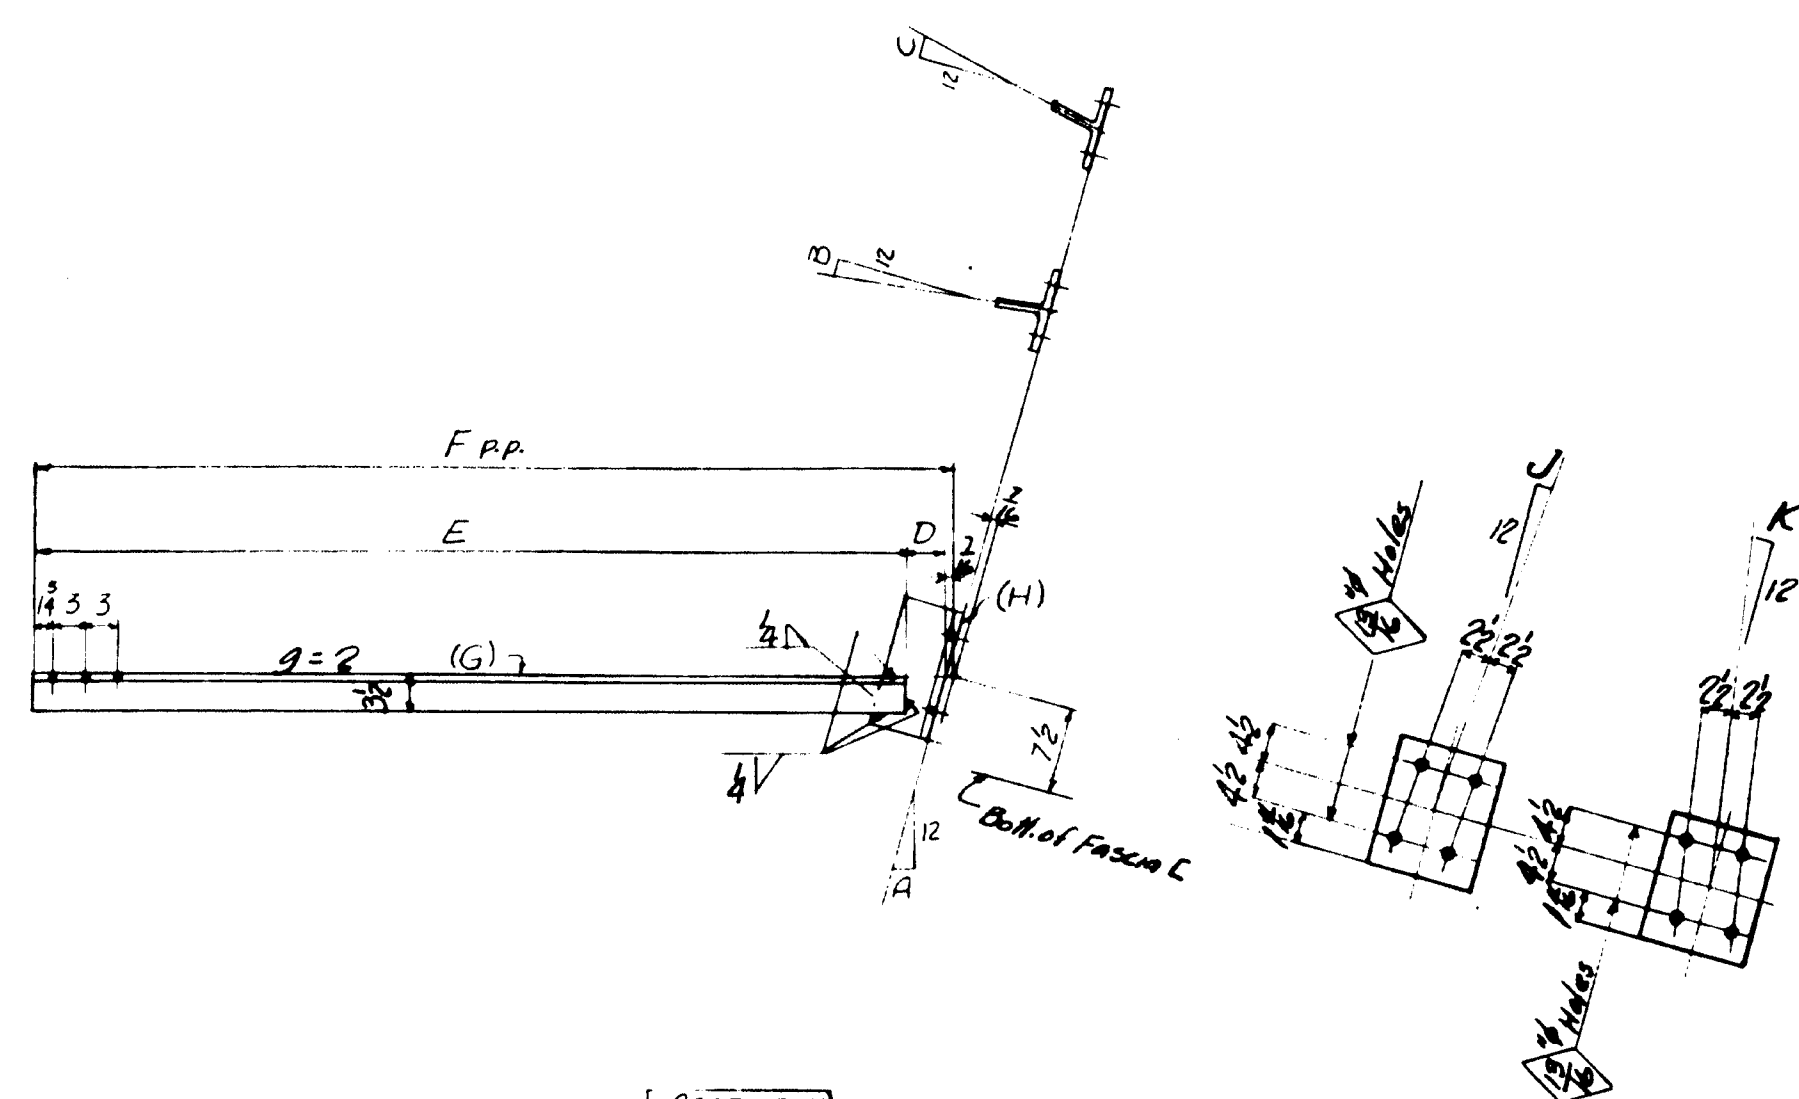

NOTES:  
Specifications - Maine State Highway Commission 1954  
and Special Provisions.  
Material - Q.H. Steel A.S.T.M. A7-52T  
Holes -  $\frac{15}{16}$  Unless Noted

[illegible]

SIDEWALK STRUTS  
STATE OF MAINE  
STATE HIGHWAY COMMISSION  
BANGOR - BREWER BRIDGE  
OVER PENOBSCOT RIVER  
BANGOR, MAINE

Div. 4

DE 1000-2-01 PENCILTEX  
**AMERICAN BRIDGE COMPANY**  
 UNITED STATES STEEL CORPORATION CHICAGO

DRAWINGS MADE AT TRENTON PLANT  
WORK FABRICATED AT TRENTON PLANT  
IN CHARGE OF E. B. MARKS  
DRAW. MADE BY R.J.G. DATE 12-10-53  
DRAW. CHECKED BY R.G.P. DATE 1-25-54

PAINT: *Yes*  
SNOP CONTACT SURFACES: *No*

F	
E	
D	
C	
B	
X	2-15-54
REVISIONS	











ORDER No. **Q 4149** SHEET No. **410**

405

6456

# AMERICAN BRIDGE COMPANY

LINE	ITEM	QUANTITY	UNIT	REMARKS	ORDERED	ITEM	QUANTITY	UNIT	REMARKS
1	ONE DIAPHRAGM	D66	Like before	619"					
2	ONE DIAPHRAGM	D67	Reaming	619"					
3	2 18CB50	9 4/8	mb	9'-4 3/4"	84014		470		
4	2 18CB50	2 3/8	ma	615-0	1018		116		
5	2 18CB50	2 3/8	mb	615-0	1018		117		
6	2 18CB50	2 3/8	pa				12		
7	2 18CB50	2 3/8	pb				12		
8	2 18CB50	2 3/8	da				12		
9	2 18CB50	2 3/8	db				12		
10	2 18CB50	2 3/8	dd311				12		
11	2 18CB50	2 3/8	dd310				12		
12	2 18CB50	2 3/8	mc211				12		
13	2 18CB50	2 3/8	mc210				12		
14	2 18CB50	2 3/8	mc211				12		
15	2 18CB50	2 3/8	mc210				12		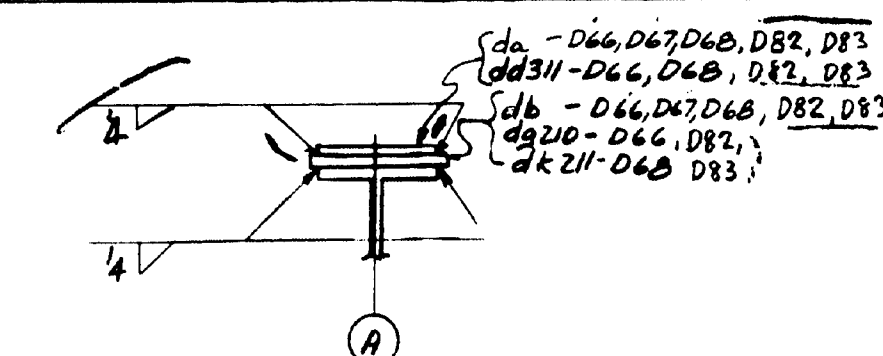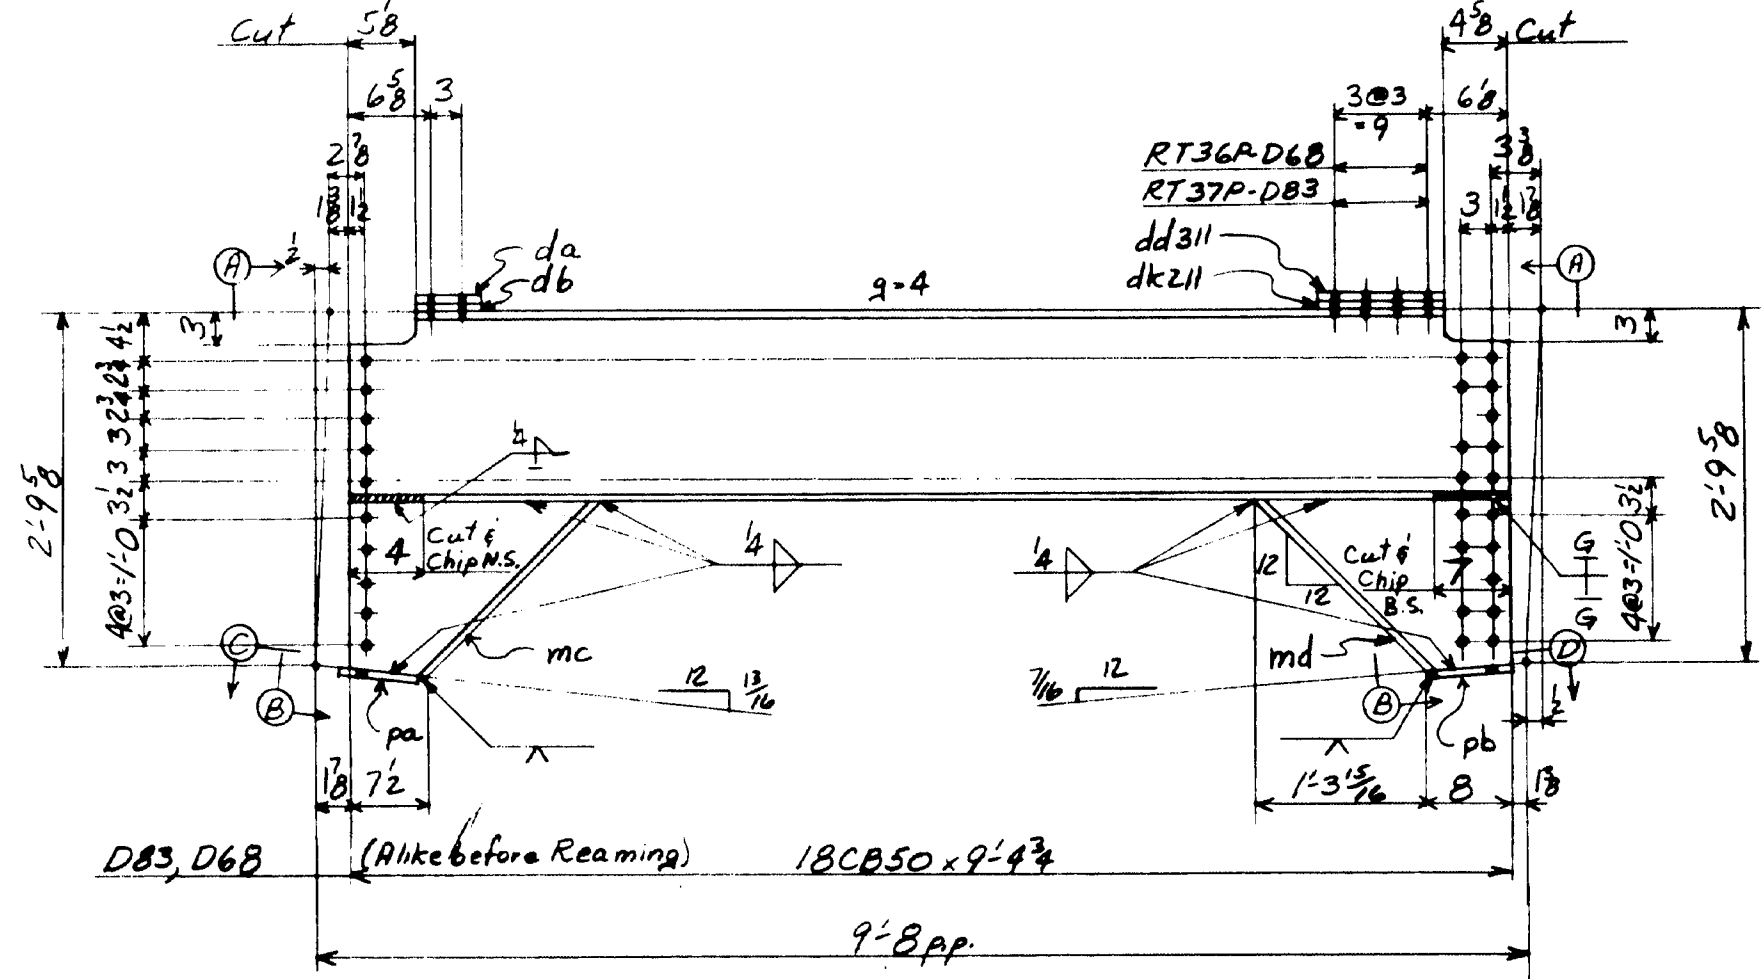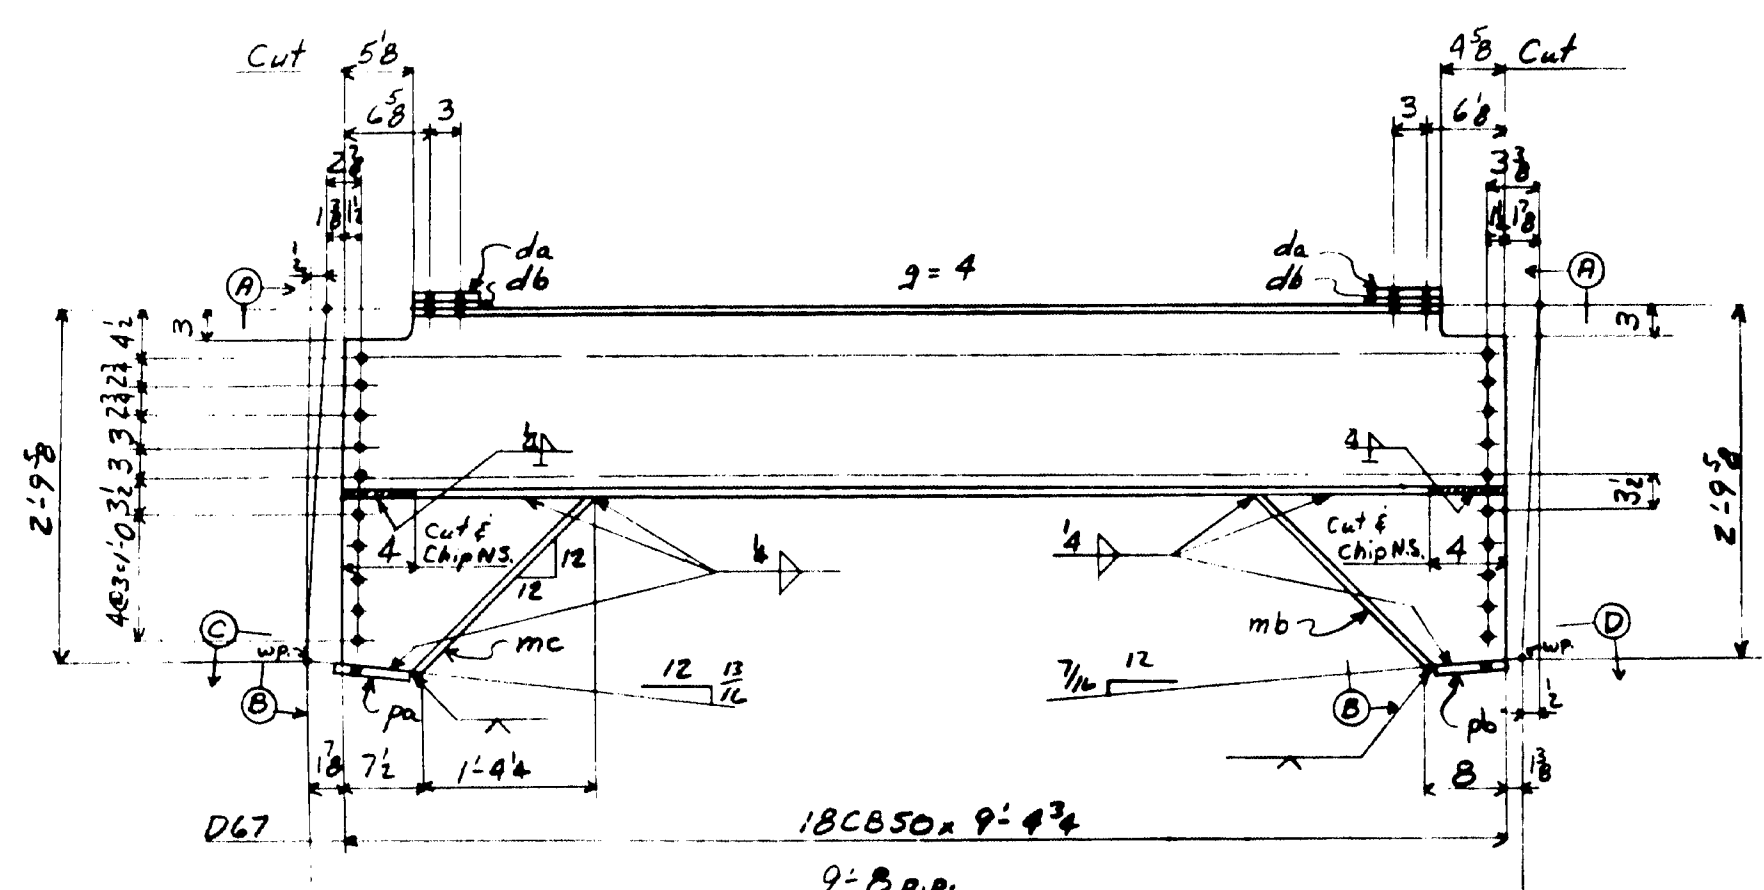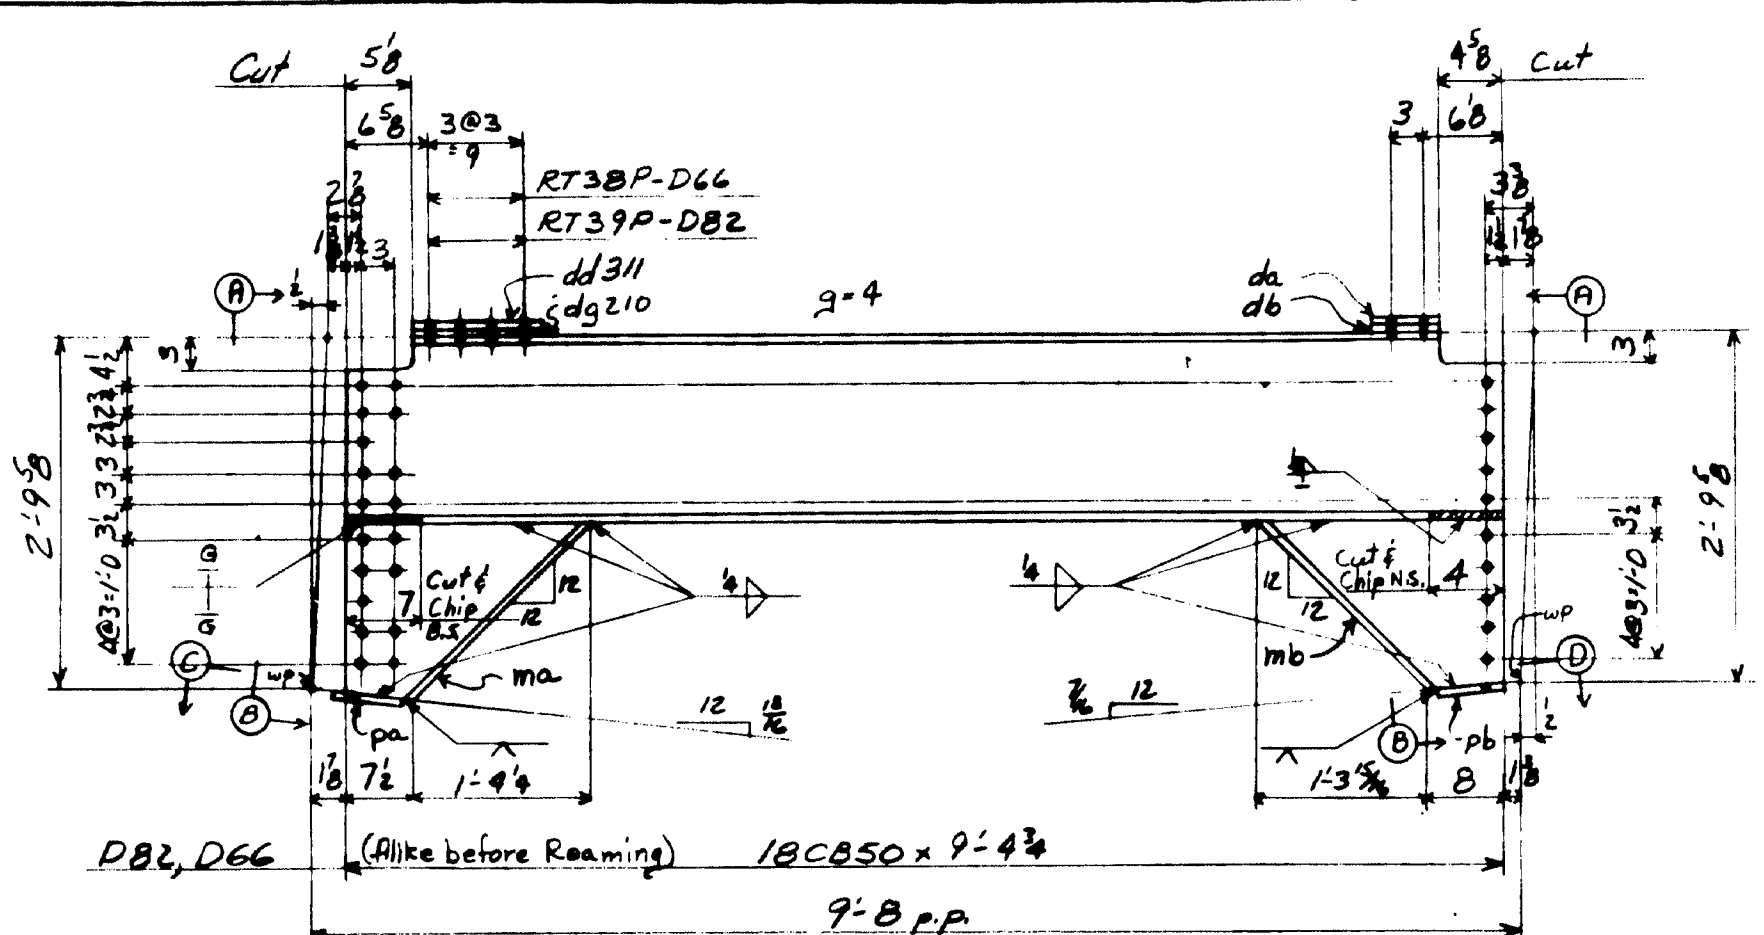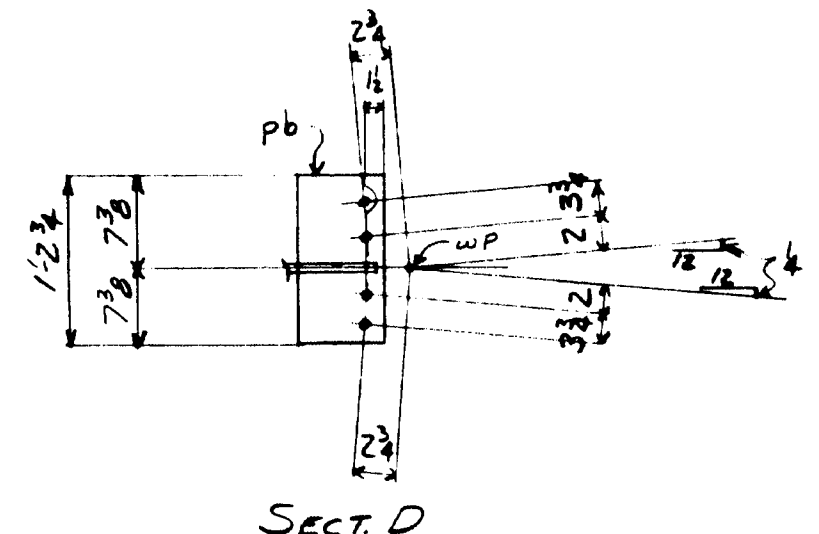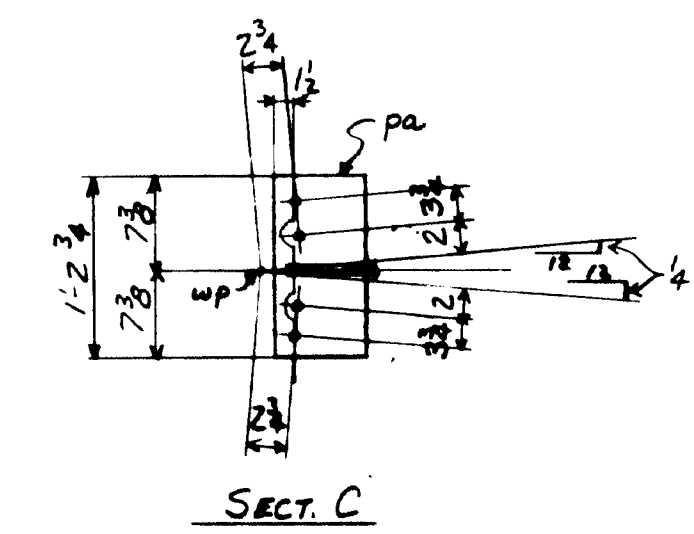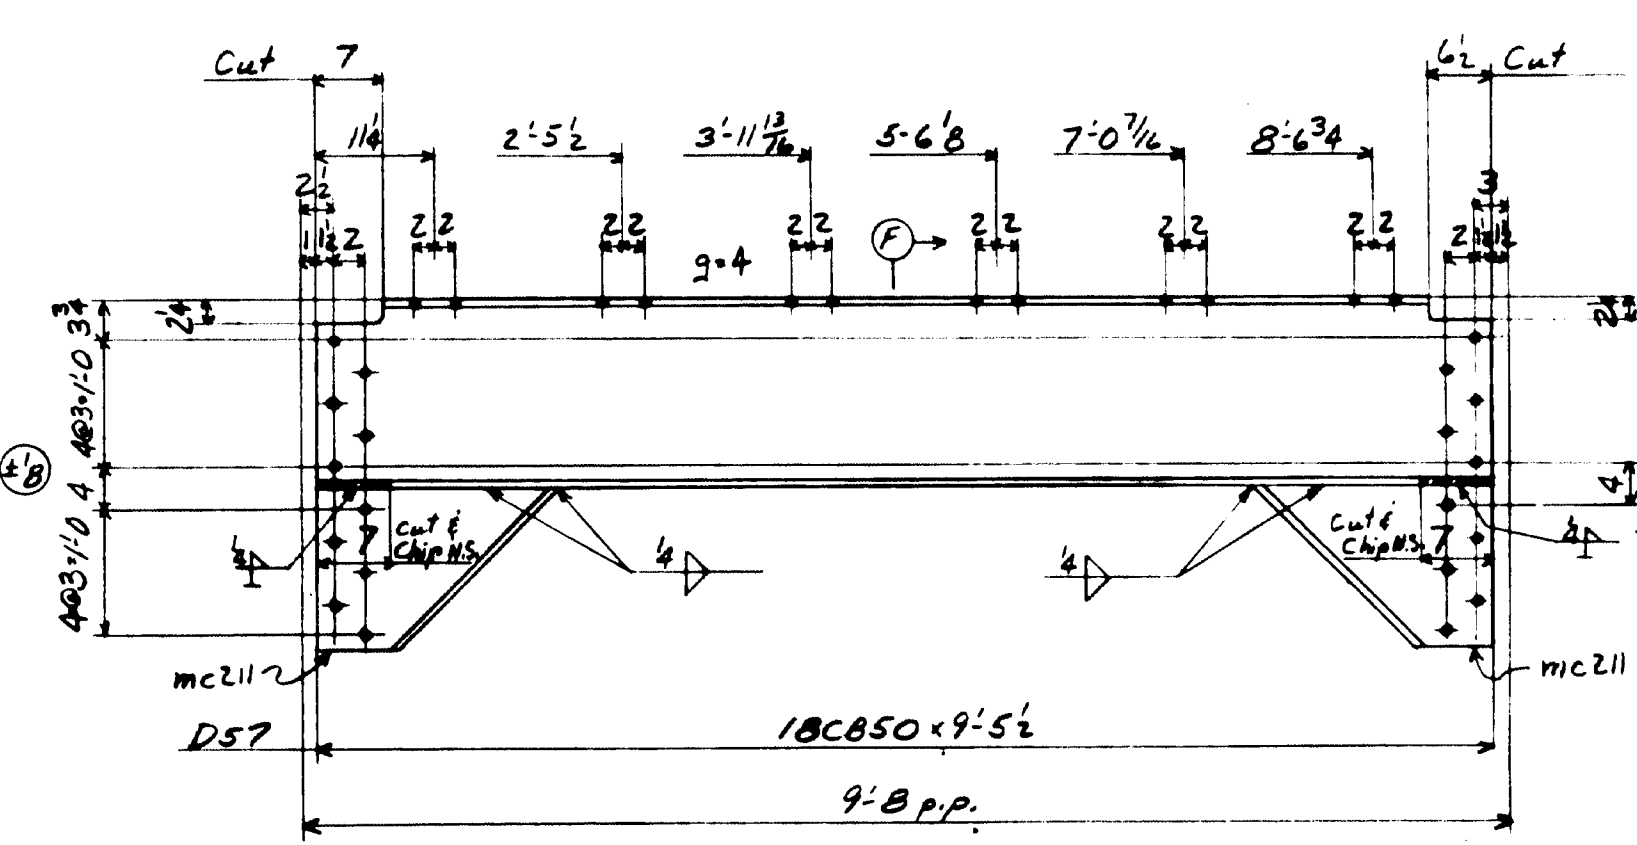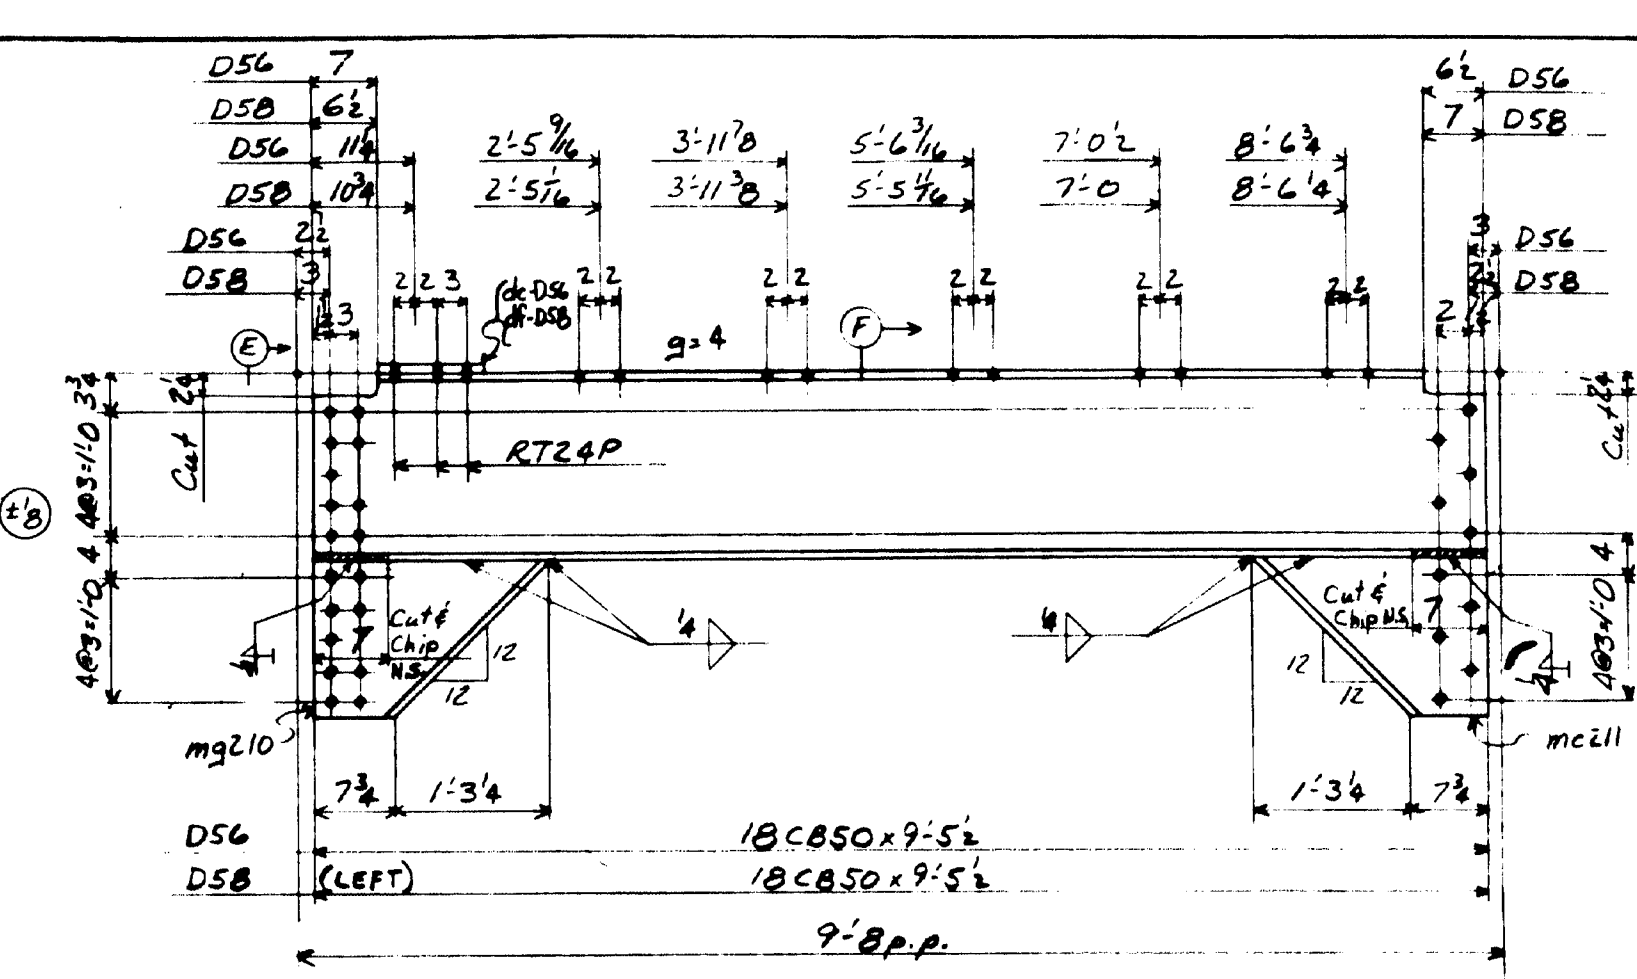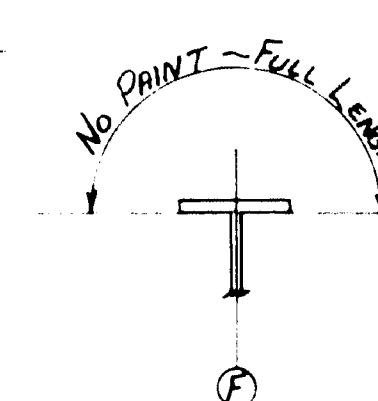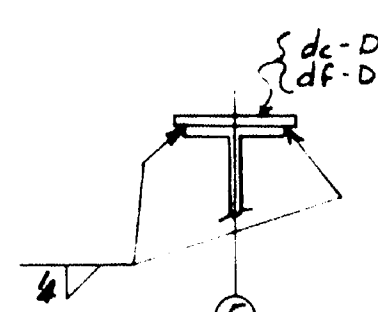
NOTES:  
 SPECIFICATIONS - Maine State Highway Comm. 1945  
 & Special Provisions  
 MATERIAL - O.H. Steel - ASTM - A7-52T  
 HOLES - 1 1/2"  
 PAINT - Yes, Except as Noted  
 SHOP CONTACT SURFACES - No  
 Holes marked RT to be subpunched or subdrilled  
 1/4 and reamed to size to a metal template.


DIAPHRAGMS - D11.4  
 STATE OF MAINE  
 STATE HIGHWAY COMMISSION  
 BANGOR-BREWER BRIDGE  
 OVER PENOBSCOT RIVER  
 BANGOR, MAINE

F	REVISIONS
E	
D	
C	
B	
A	


ORDER NO. 411  
 SHEET NO. 411

62-157 Welding




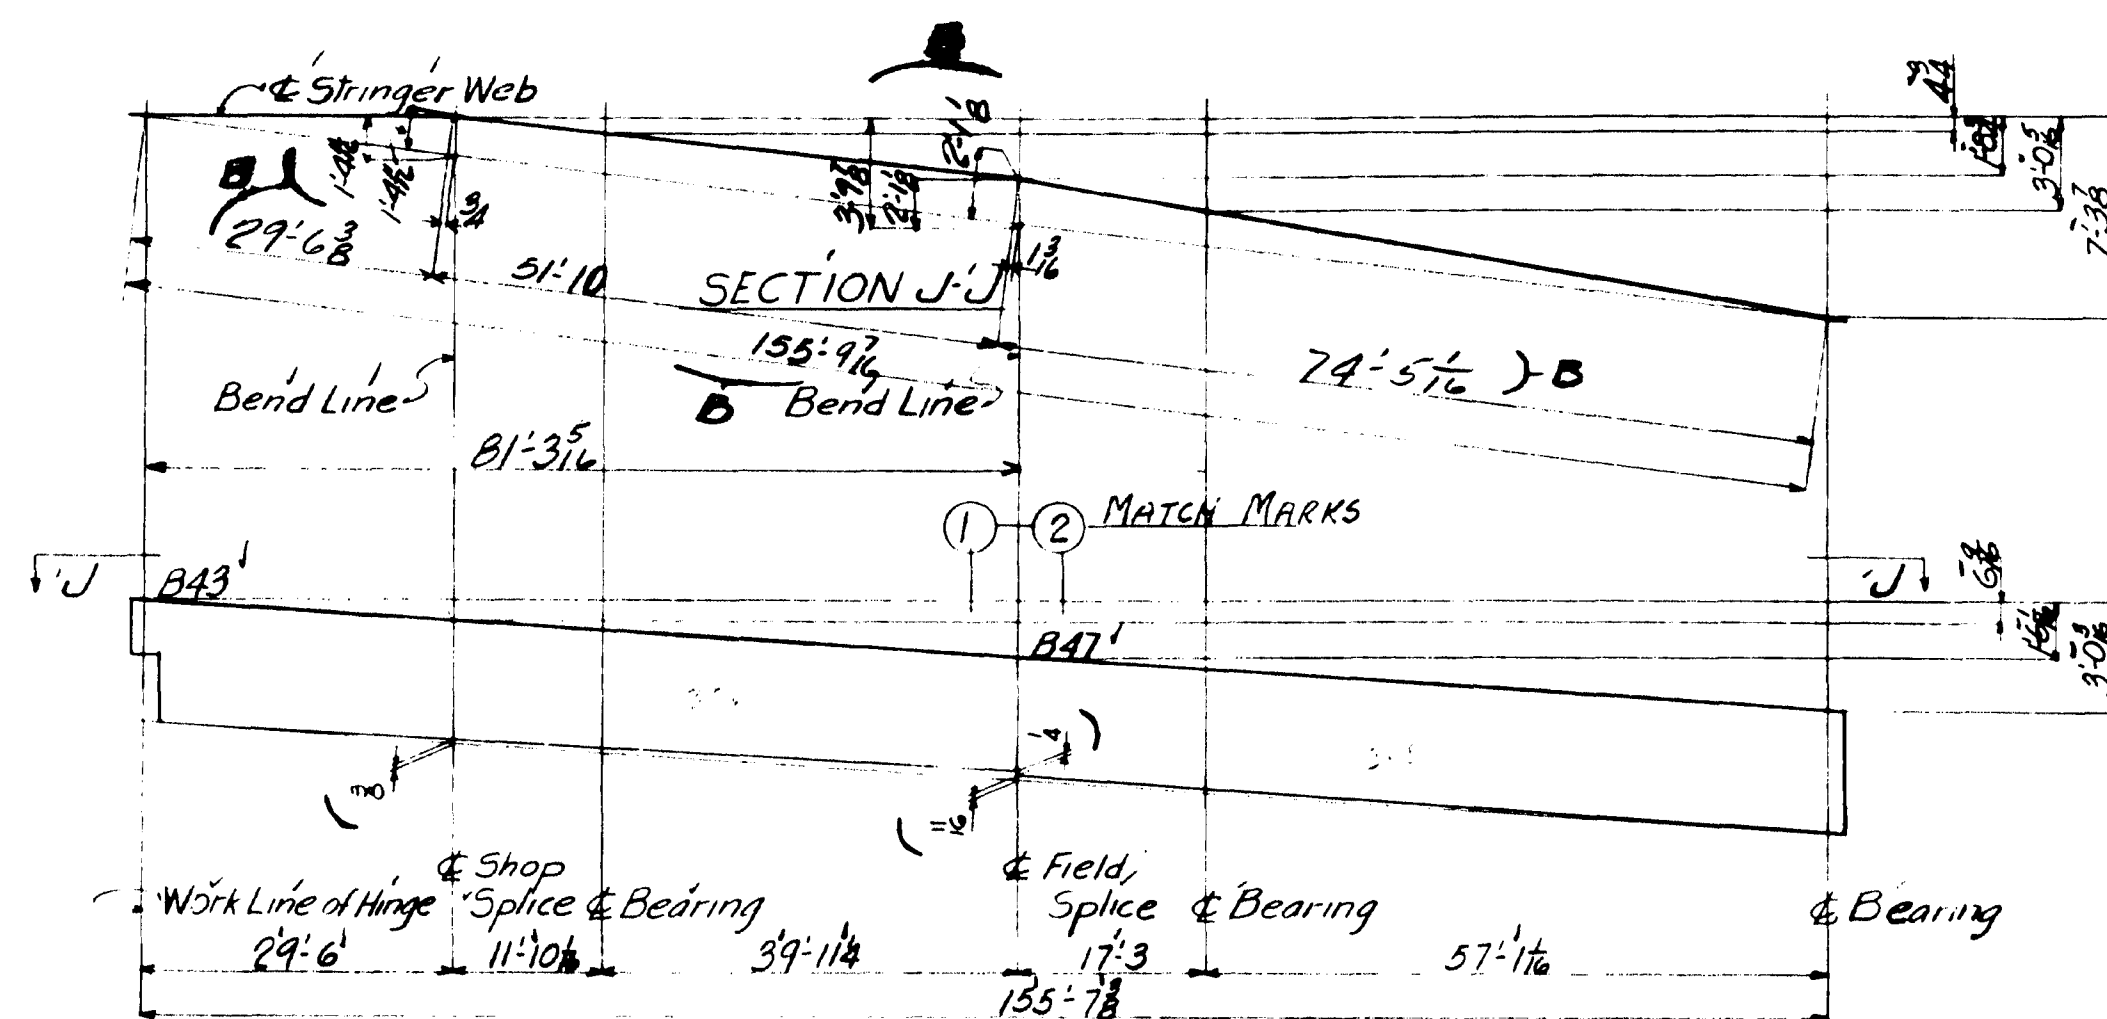


B43 & B47

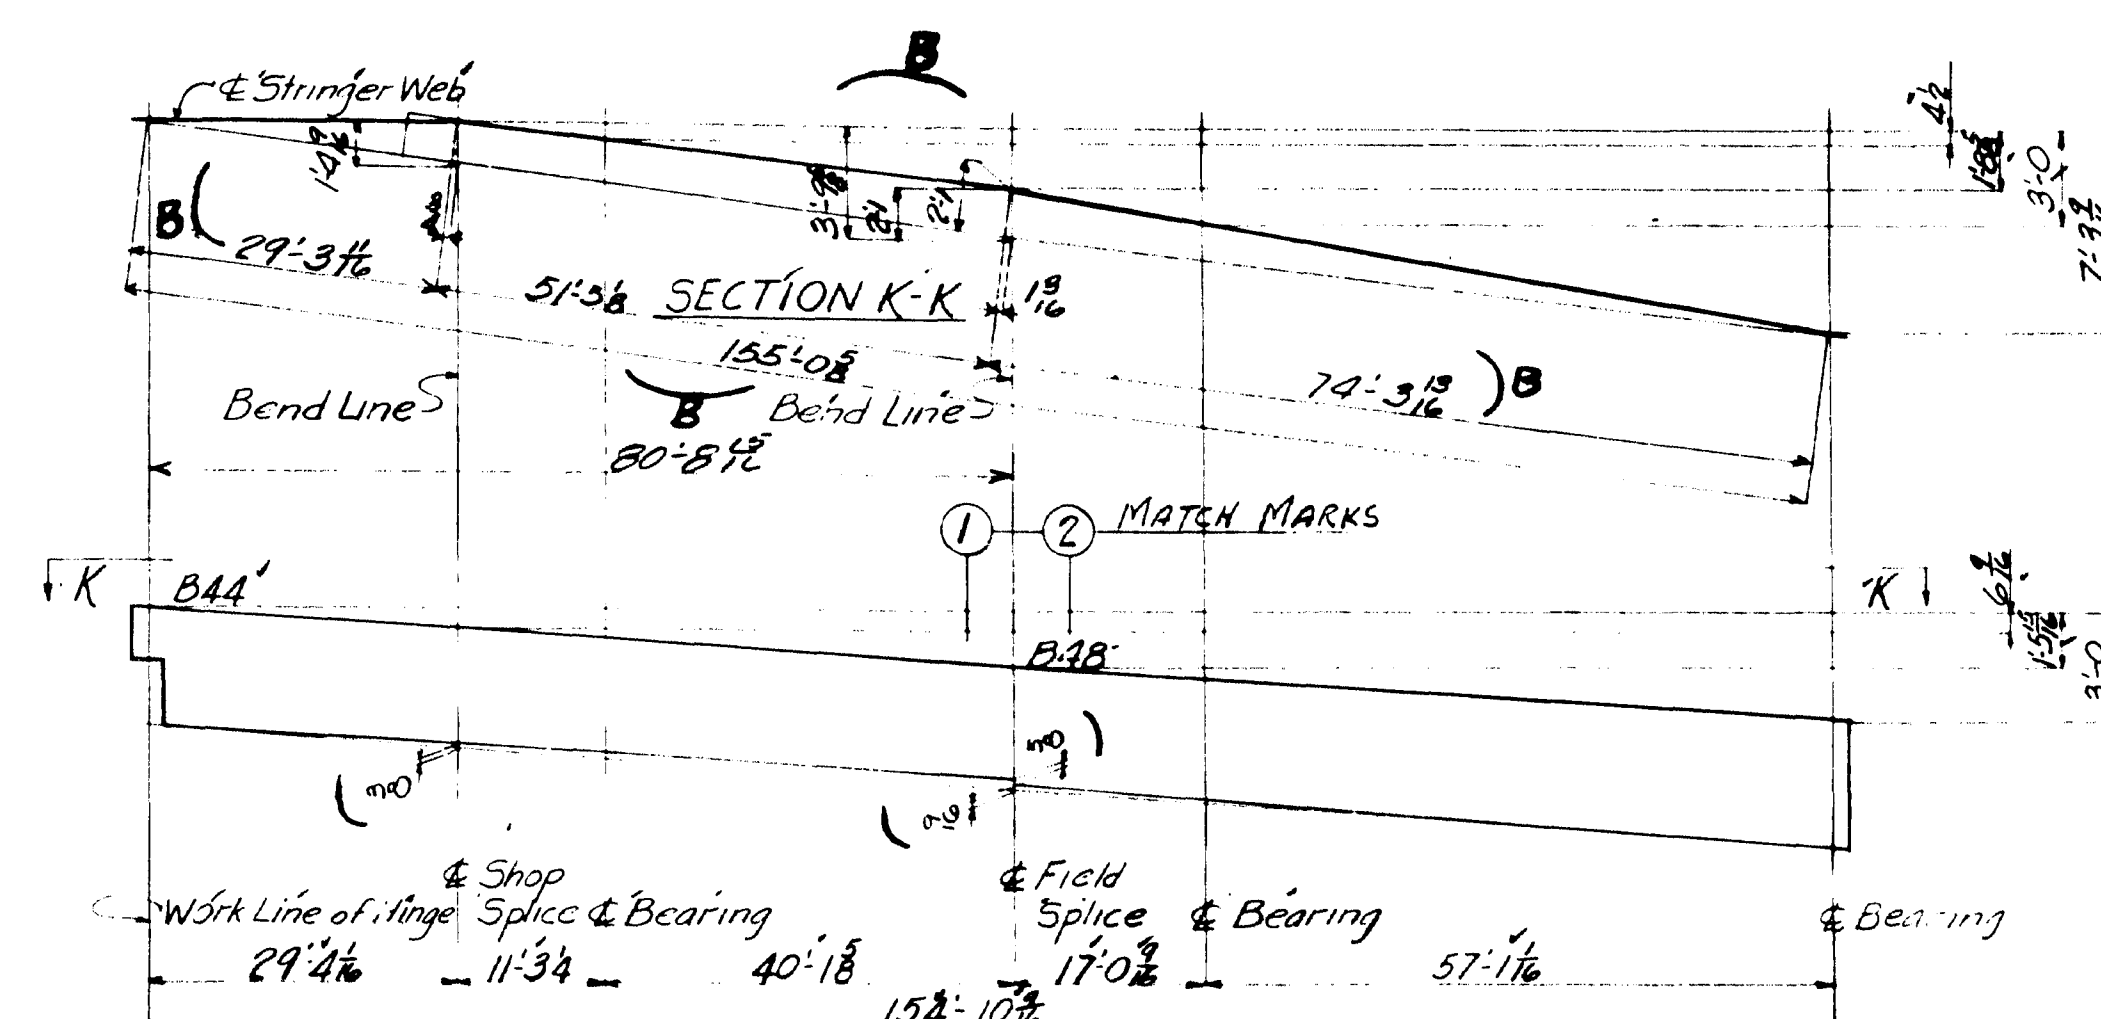

B44 & B48

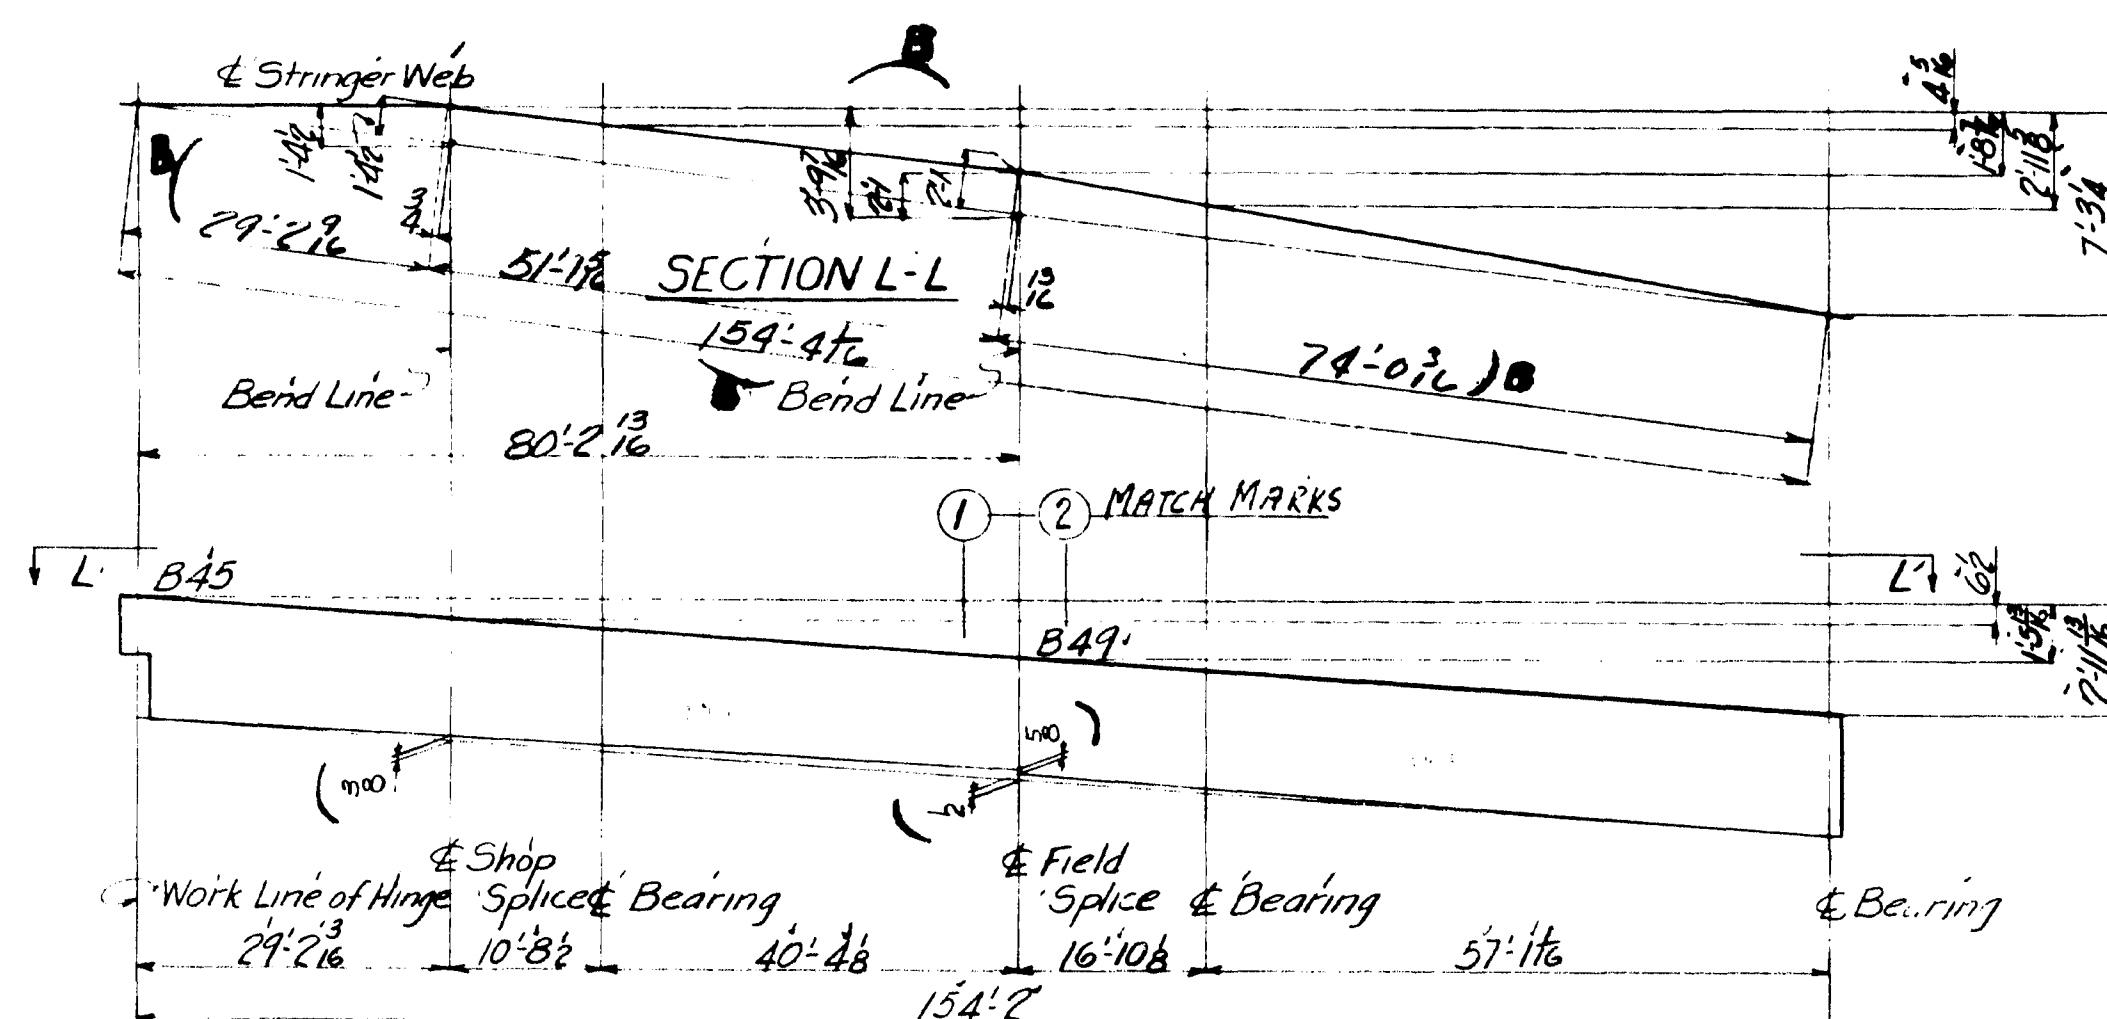

B45 & B49

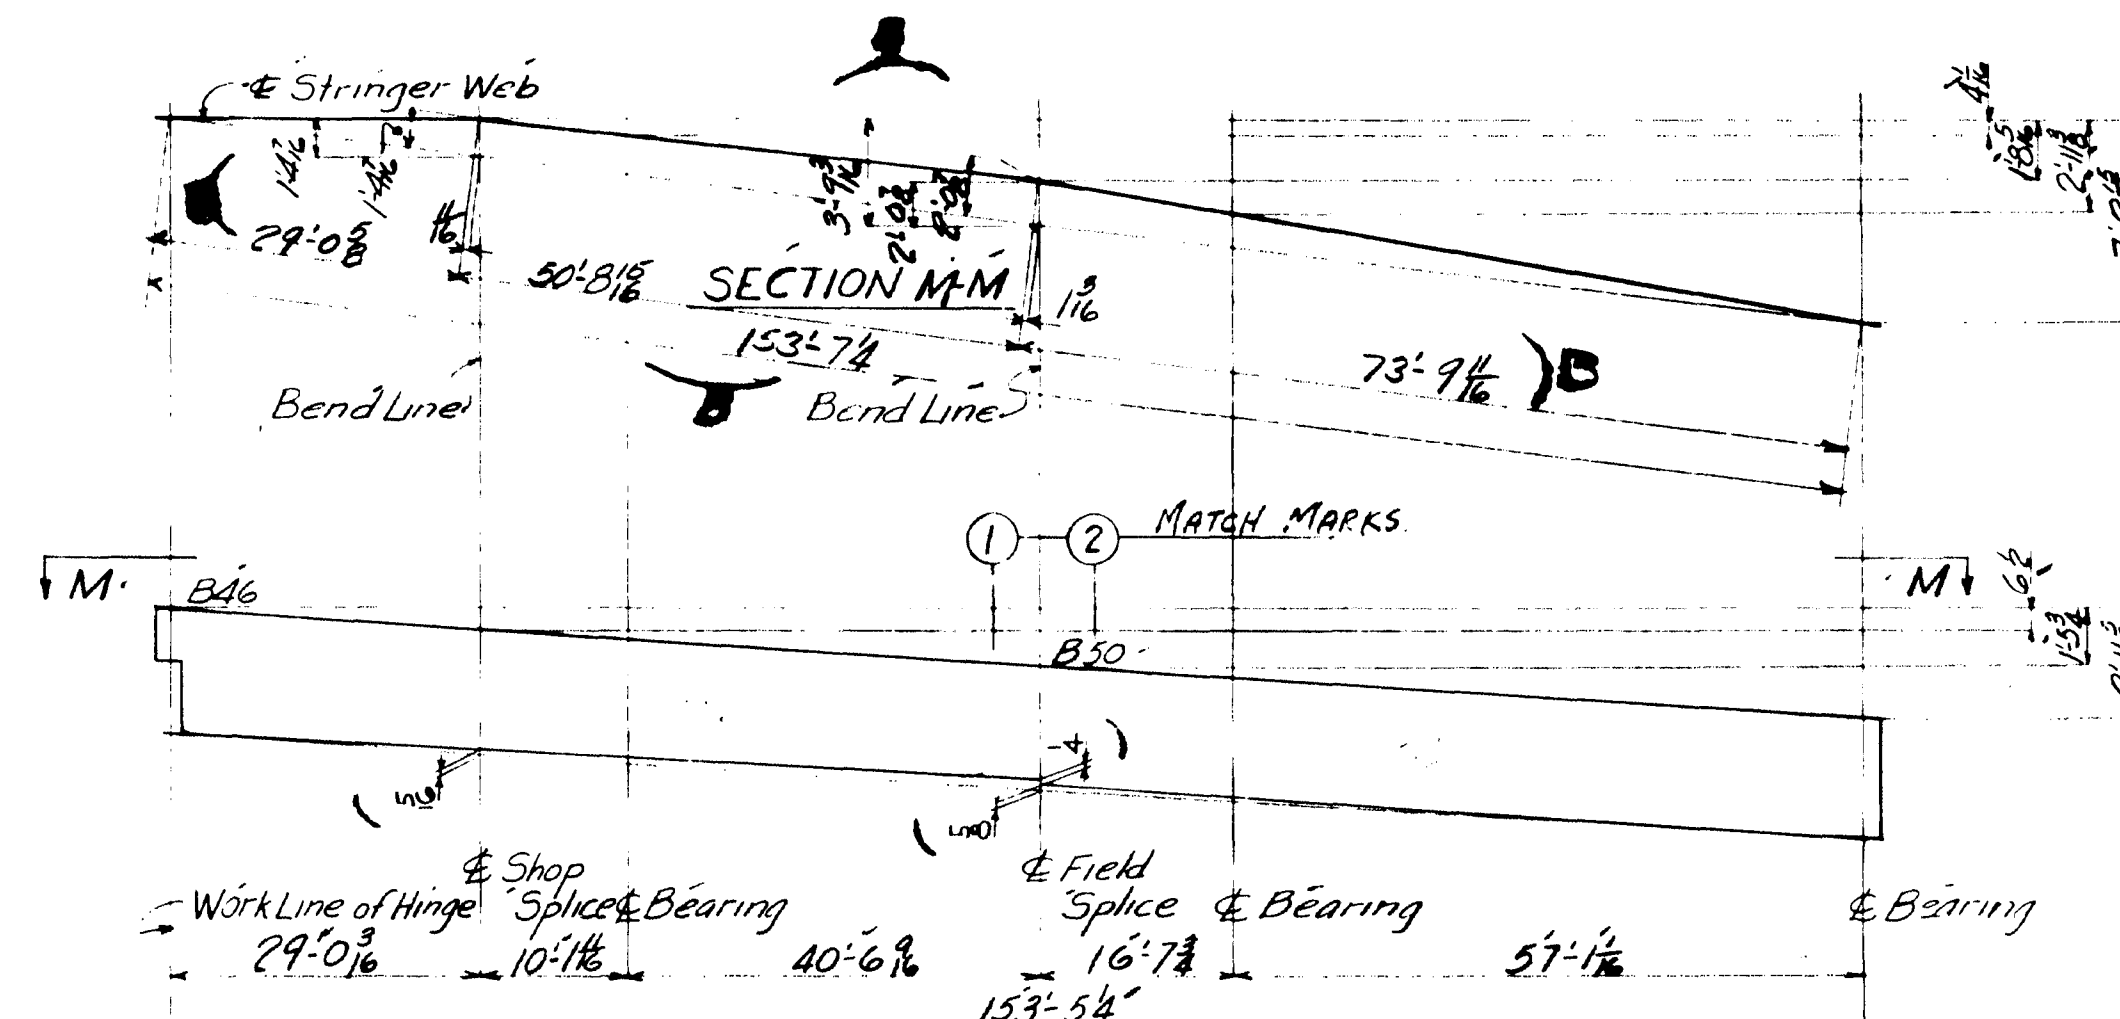

B46 & B50

REAMING & ASSEMBLY DIAGRAM

STATE OF MAINE  
STATE HIGHWAY COMMISSION  
BANGOR BREWER BRIDGE  
OVER PENOBSCOT RIVER  
BANGOR, MAINE

The ERECTOR must see that all pieces are placed in position in accordance with the match marks shown on the Assembly diagrams.

REVISIONS	DATE	BY
1	5-15-54	J. J. T.

DRAWINGS MADE AT TRENTON PLANT  
WORK FABRICATED AT TRENTON PLANT  
IN CHARGE OF E. B. MARKS  
DRAW. MADE BY J. J. T. DATE 1-27-54  
DRAW. CHECKED BY J. J. T. DATE 2-1-54  
ORDER No. Q 4149  
SHEET No. 412


PAINT:  
SHOP CONTACT SURFACES:

AM. B.




62-158

RIVETS		RIVETS		RIVETS		RIVETS		BOLTS		BOLTS		--------	--	--------	--	--------	--	--------	--	-------	--	-------	--	--	--

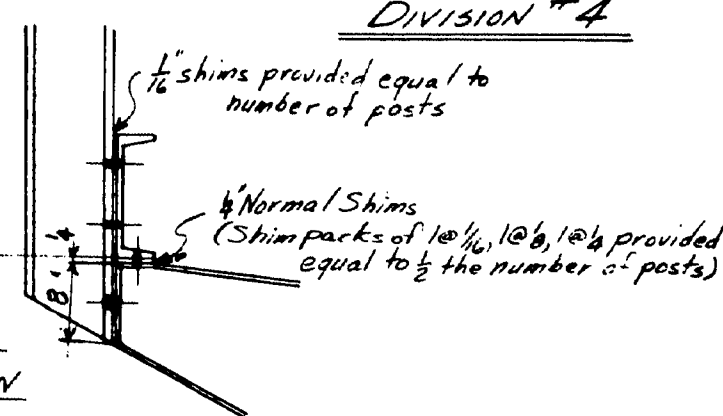

[illegible]

REV.	DATE	BY	CHK.	DESCRIPTION
1				
2				
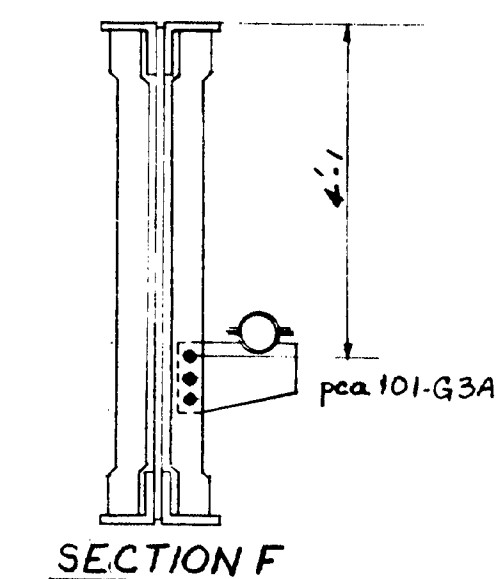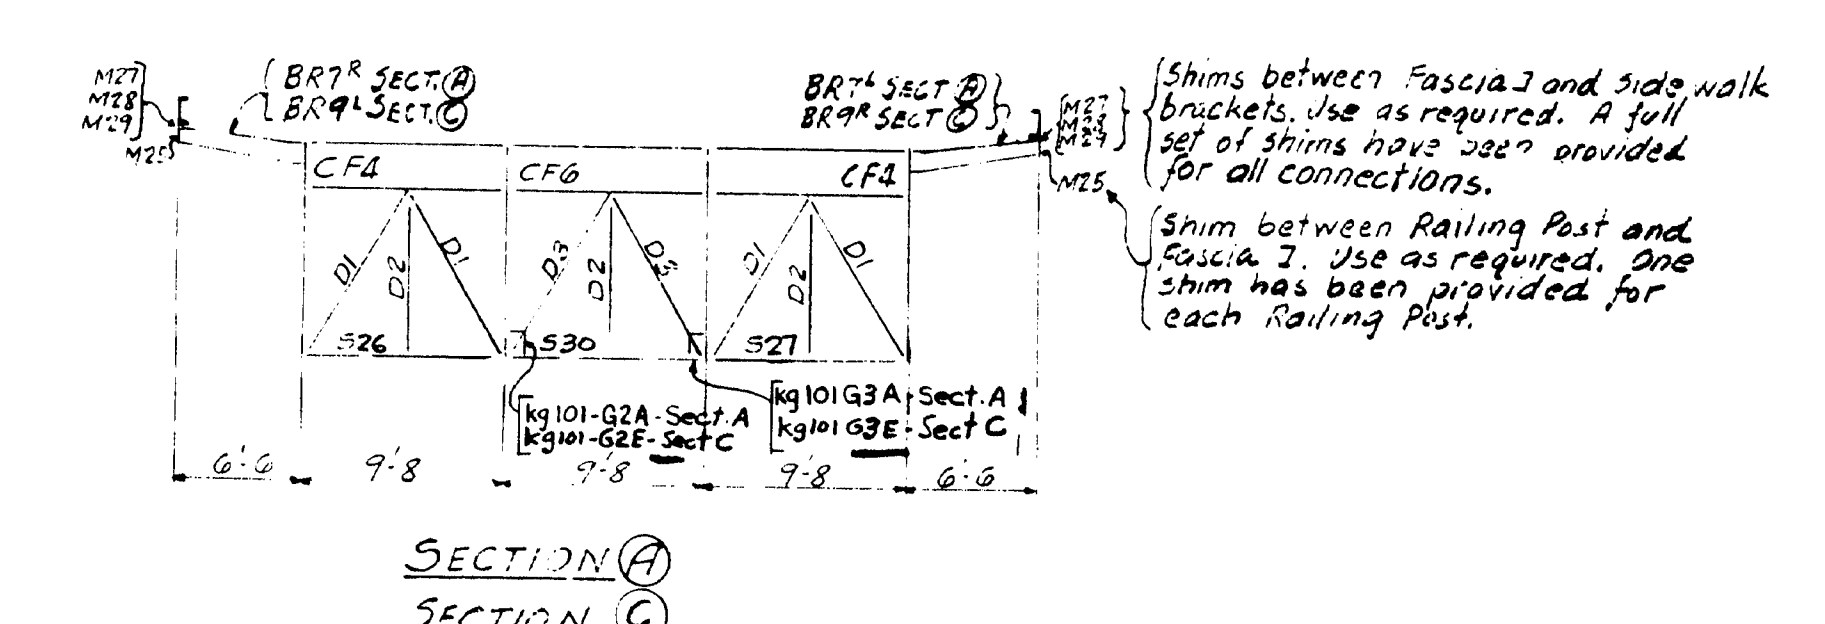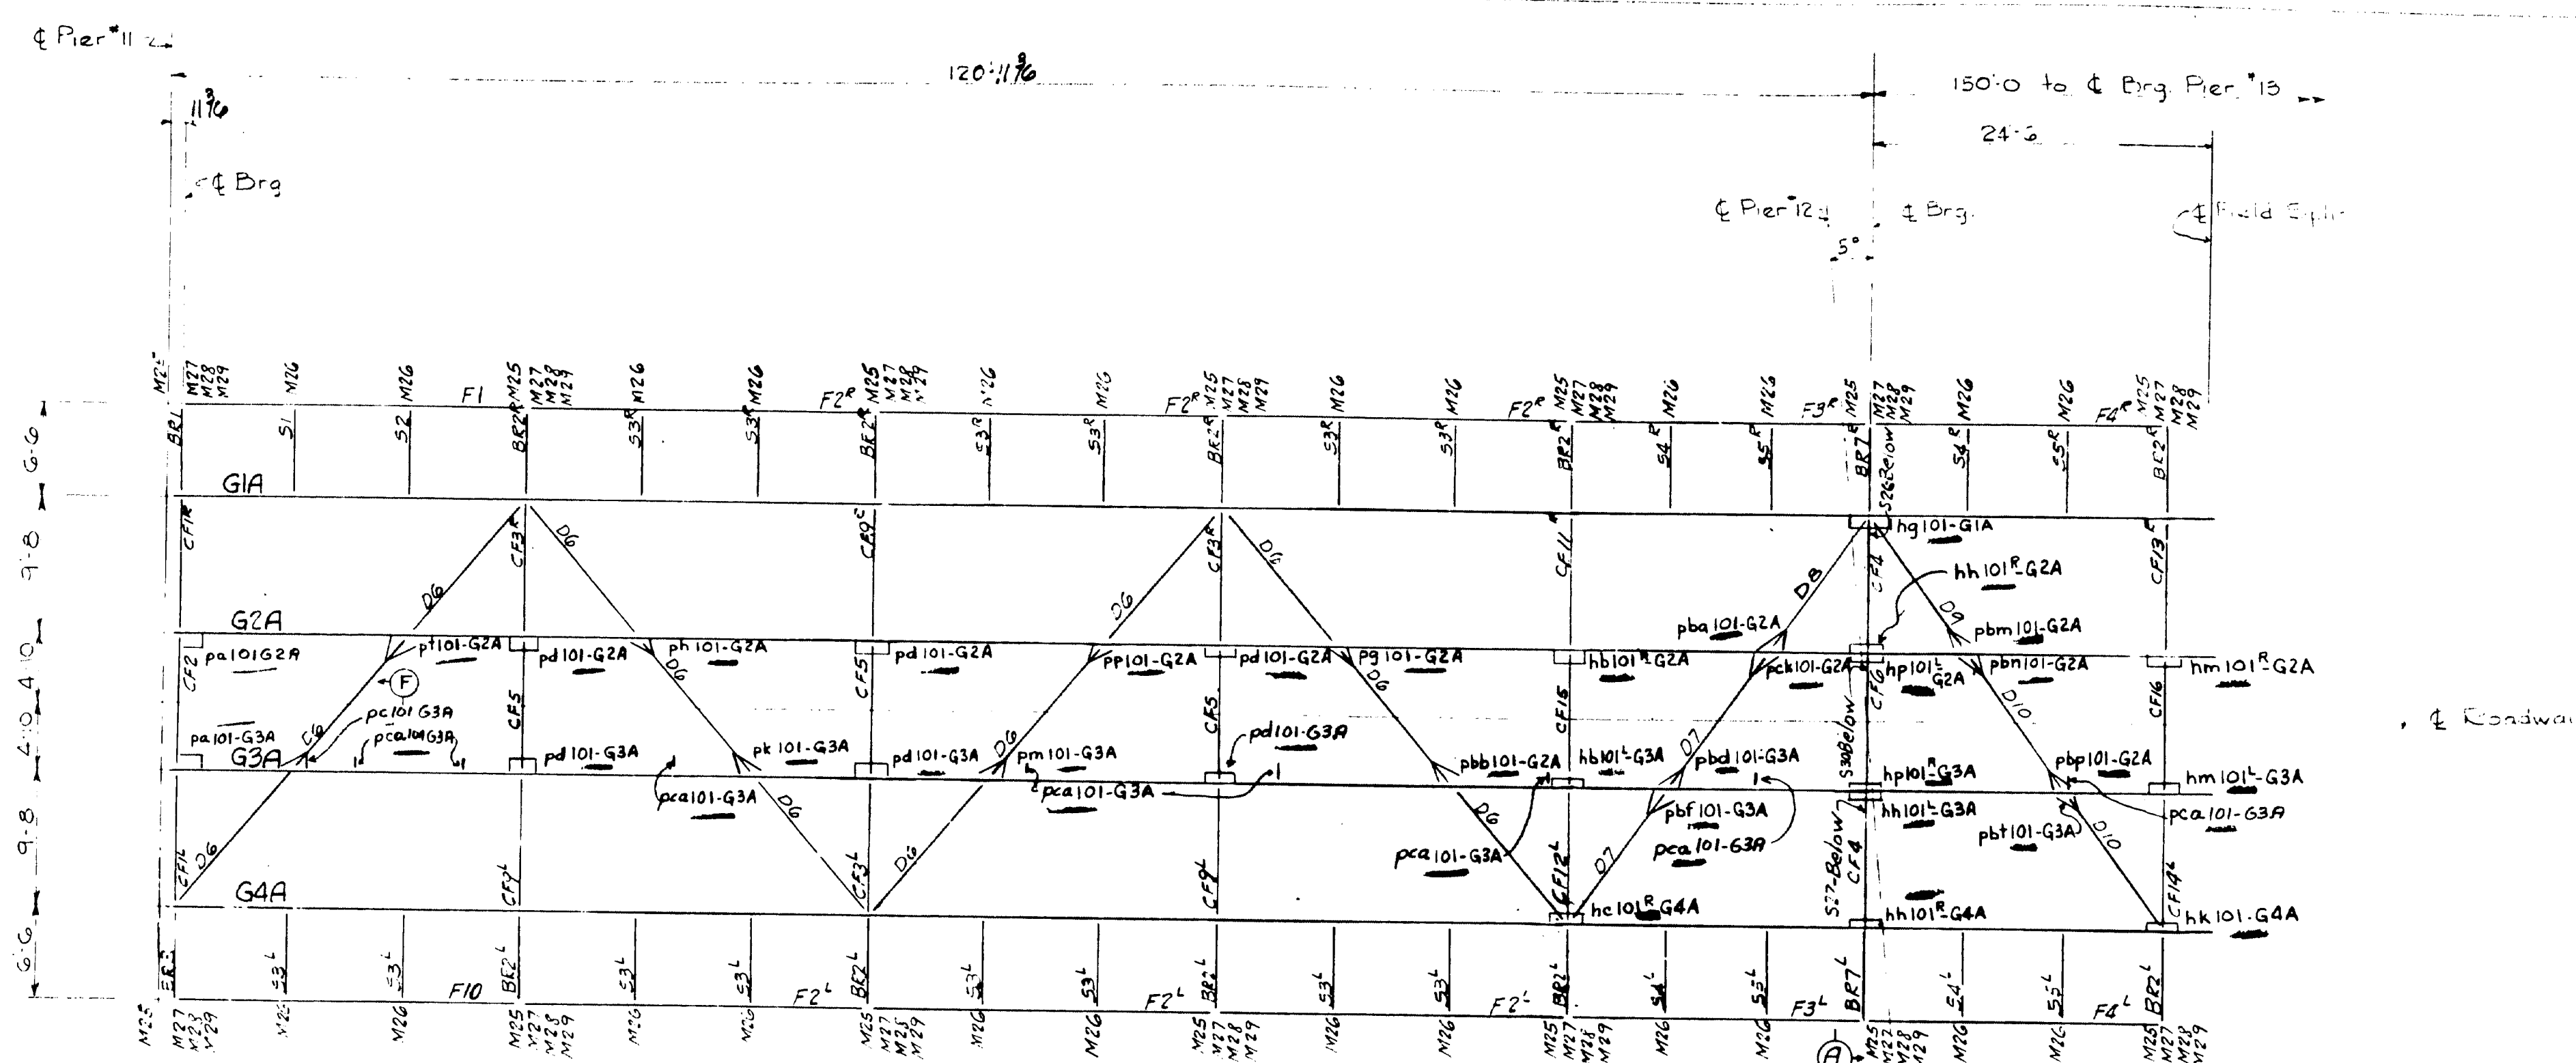

Field Connections riveted except Fascia is to Side Walk Brackets bolted. Bolts for Railing Post connections supplied by others.

ERECTION PLAN  
Div. 1  
BANGOR BREWER BRIDGE  
OVER PENOBSCOT RIVER  
STATE OF MAINE

AMERICAN BRIDGE  
DIVISION  
UNITED STATES STEEL CORPORATION

REVISED	5-13-54	ORDER No.	Q4150	SHEET No.	E101
REVISIONS					

AMERICAN BLUE PRINTING CO., PGH., PA.



Top Plates to be assembled to Girders with side marked thus  $\otimes$  in direction shown.

MATCH MARKING AND  
ASSEMBLY DIAGRAM  
STATE OF MAINE  
STATE HIGHWAY COMMISSION  
BANGOR - BREWER BRIDGE  
PENOBSCOT RIVER  
BANGOR, MAINE




9-62 1000 3-62 PERCUTEX  
**AMERICAN BRIDGE**  
DIVISION  
UNITED STATES STEEL CORPORATION

DRAWINGS MADE AT TRENTON PLANT  
WORK FABRICATED AT AMBRIDGE PLANT  
IN CHARGE OF E. B. MARKS  
DRAW. MADE BY W. J. P. DATE 10-24-53  
DRAW. CHECKED BY FEL DATE 2-18-54

ORDER No. Q4150

**62-161**

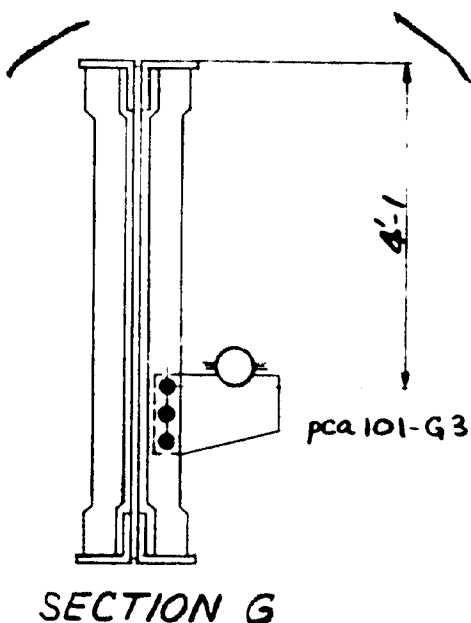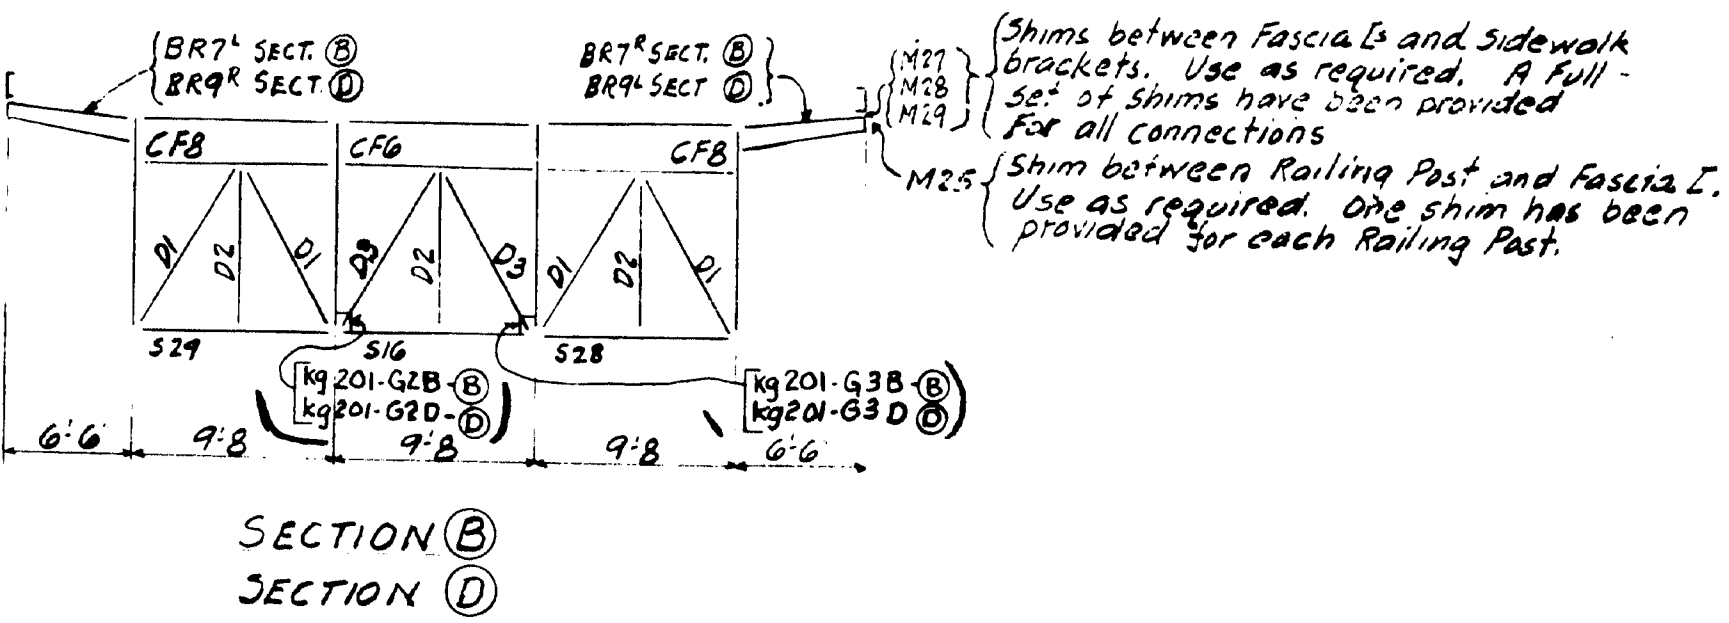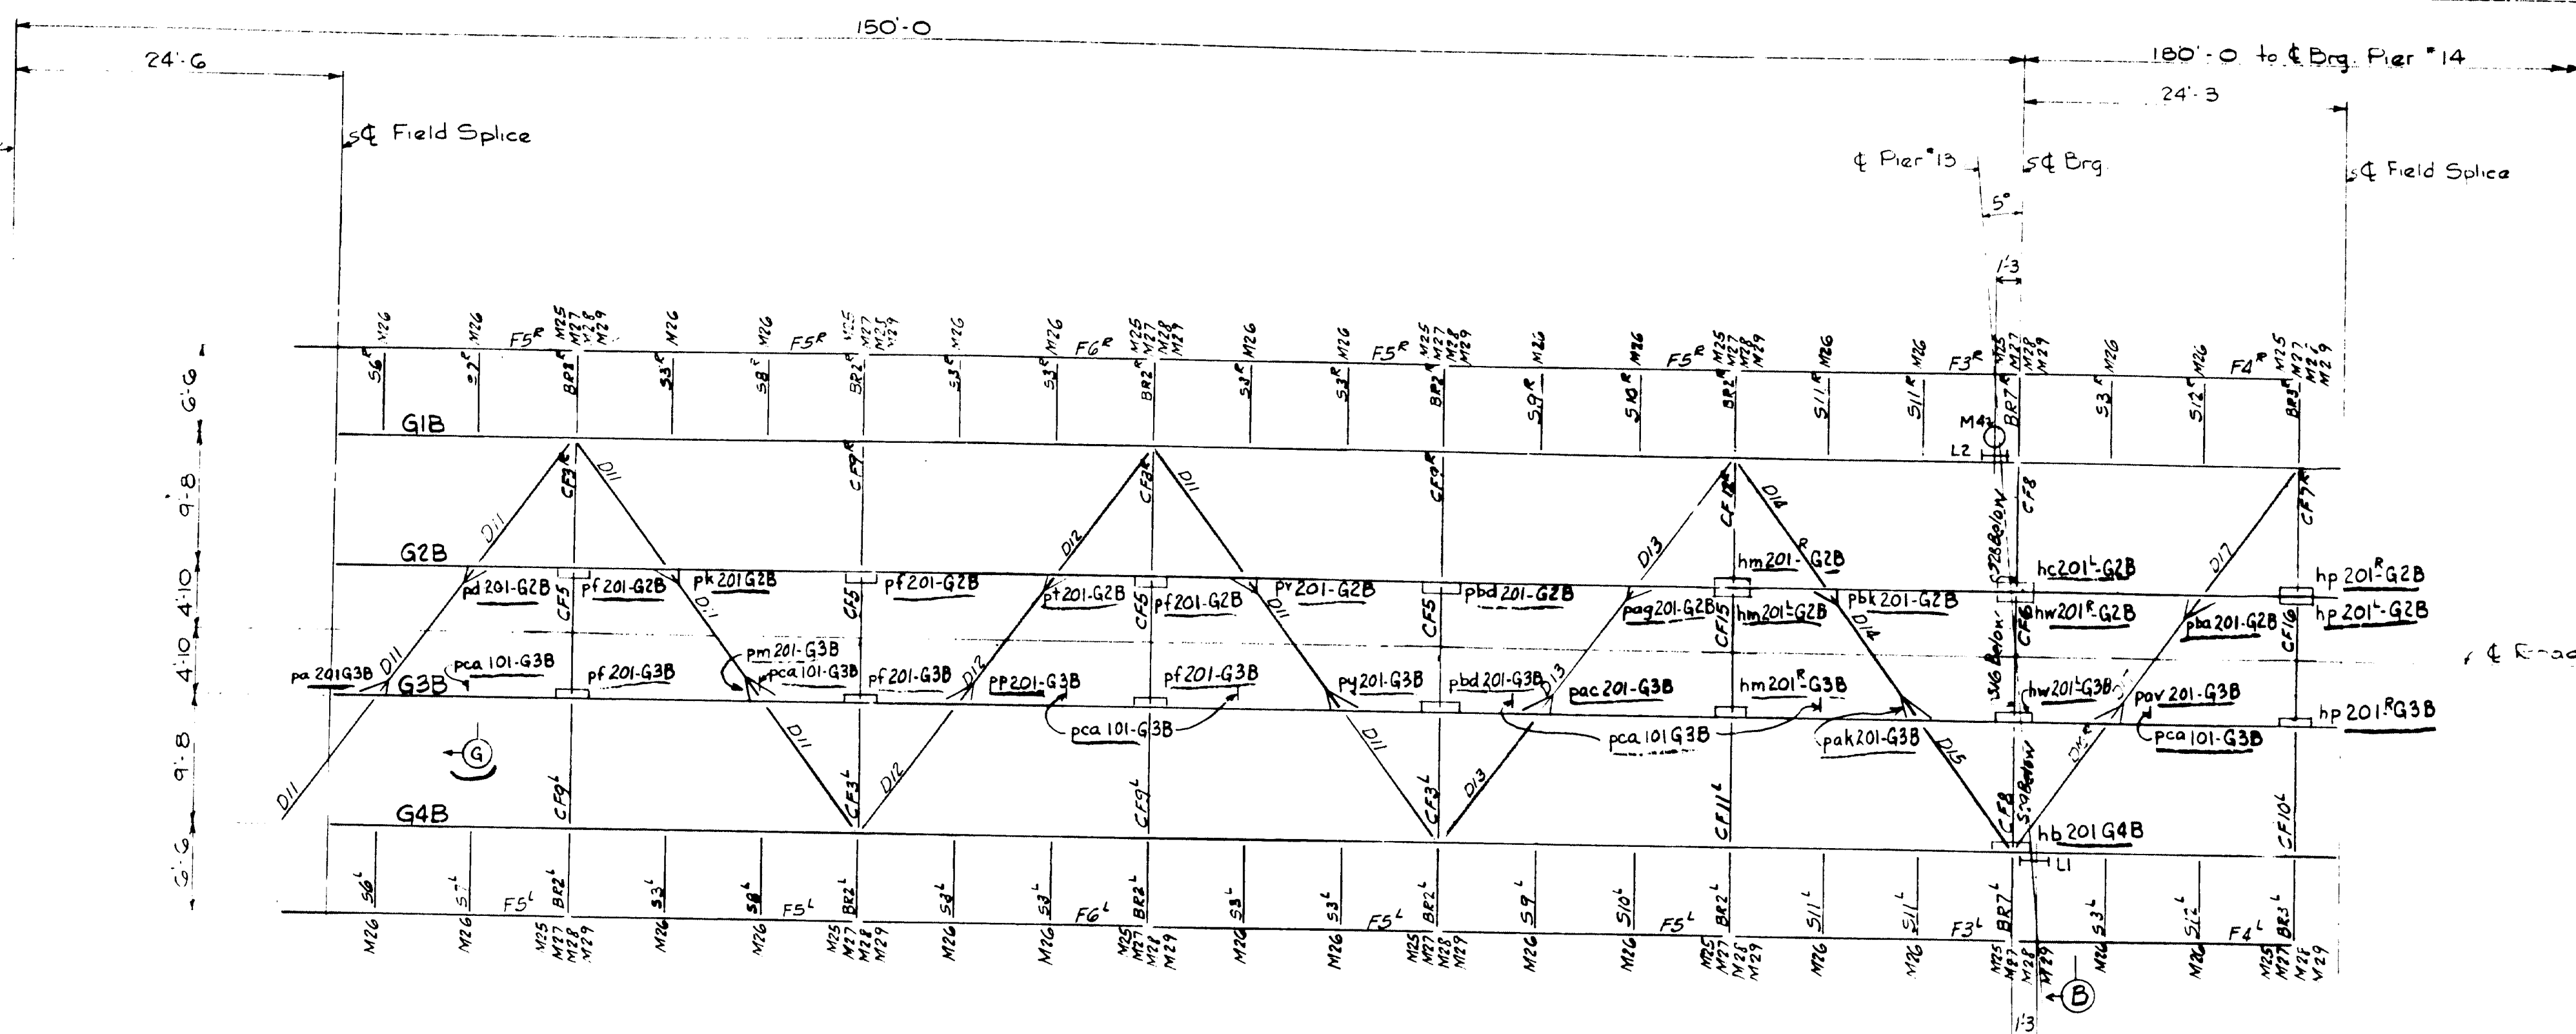

[illegible]

Field Connections riveted except Fascia E's to  
sidewalk Brackets bolted  
Bolts For Railing Post connections supplied  
by others.

ERECTION PLAN  
DIV. 2  
BANGOR - BREWER BRIDGE  
OVER PENOBSCOT RIVER  
STATE OF MAINE

D-63 1500 3-63 PENCILTUX  
AMERICAN BRIDGE  
DIVISION  
UNITED STATES STEEL CORPORATION

DRAWINGS MADE AT TRENTON PLANT  
WORK FABRICATED AT AMBRIDGE PLANT  
IN CHARGE OF E. B. MARKS  
DRAW. MADE BY S. E. K. DATE 8-6-55  
DRAW. CHECKED BY \_\_\_\_\_ DATE \_\_\_\_\_

**ORDER No.**  
Q4150

**SHEET No.**  
E201




62-164





ITEM	QTY	UNIT	DESCRIPTION
1	1	EA	SC101
2	1	EA	SC101
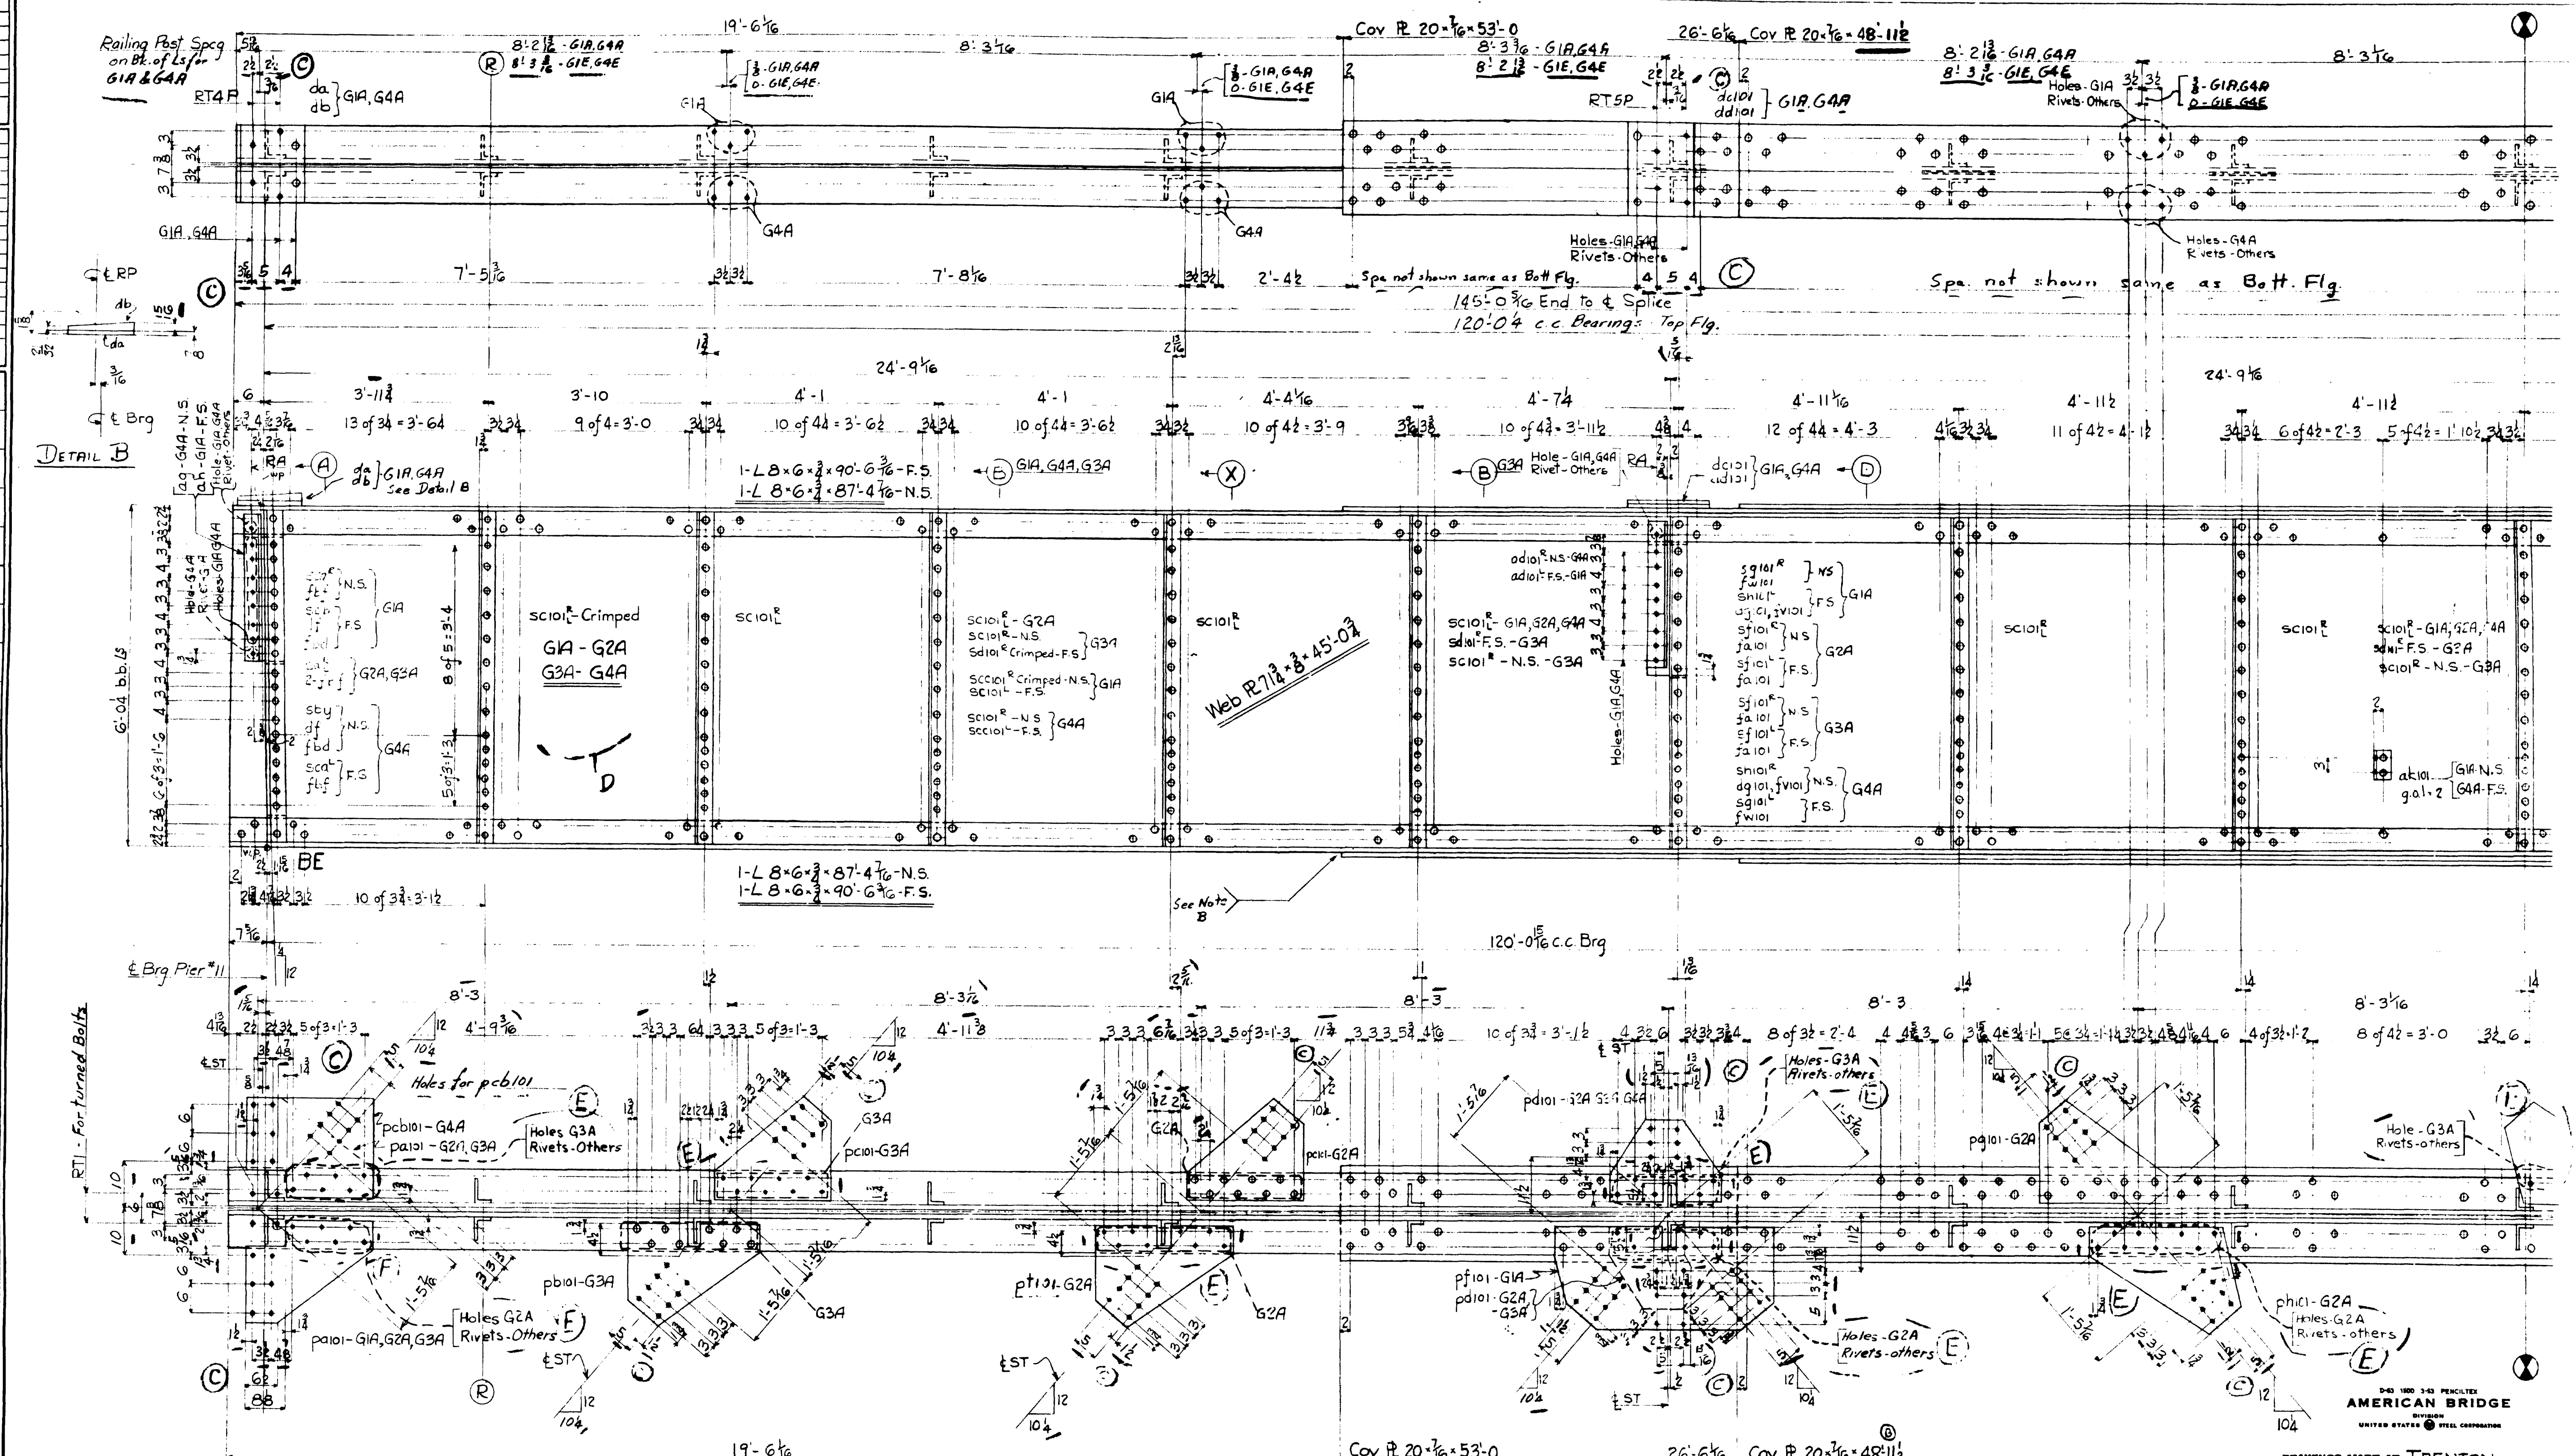

NOTE B - Seal opening between Cover Plate and Girder Web with weld metal.

STATE OF MAINE  
STATE HIGHWAY COMMISSION  
BANGOR - BREWER BRIDGE  
PENOBSCOT RIVER  
BANGOR, MAINE


REVISIONS	DATE	BY	CHKD	APP'D
F	5-17-54			
E	3-12-54			
C	2-20-54			
B	2-18-54			
X	2-12-54			

ORDER NO. Q4150  
SHEET NO. 101AF

62-166 WELDING



REV.	DATE	BY	CHKD.	DESCRIPTION
1	5-17-54	W.J.P.		Initial Design
2	6-18-54	FEL		Revised Design
3	8-20-54			Final Design
4	12-12-54			Revised Design

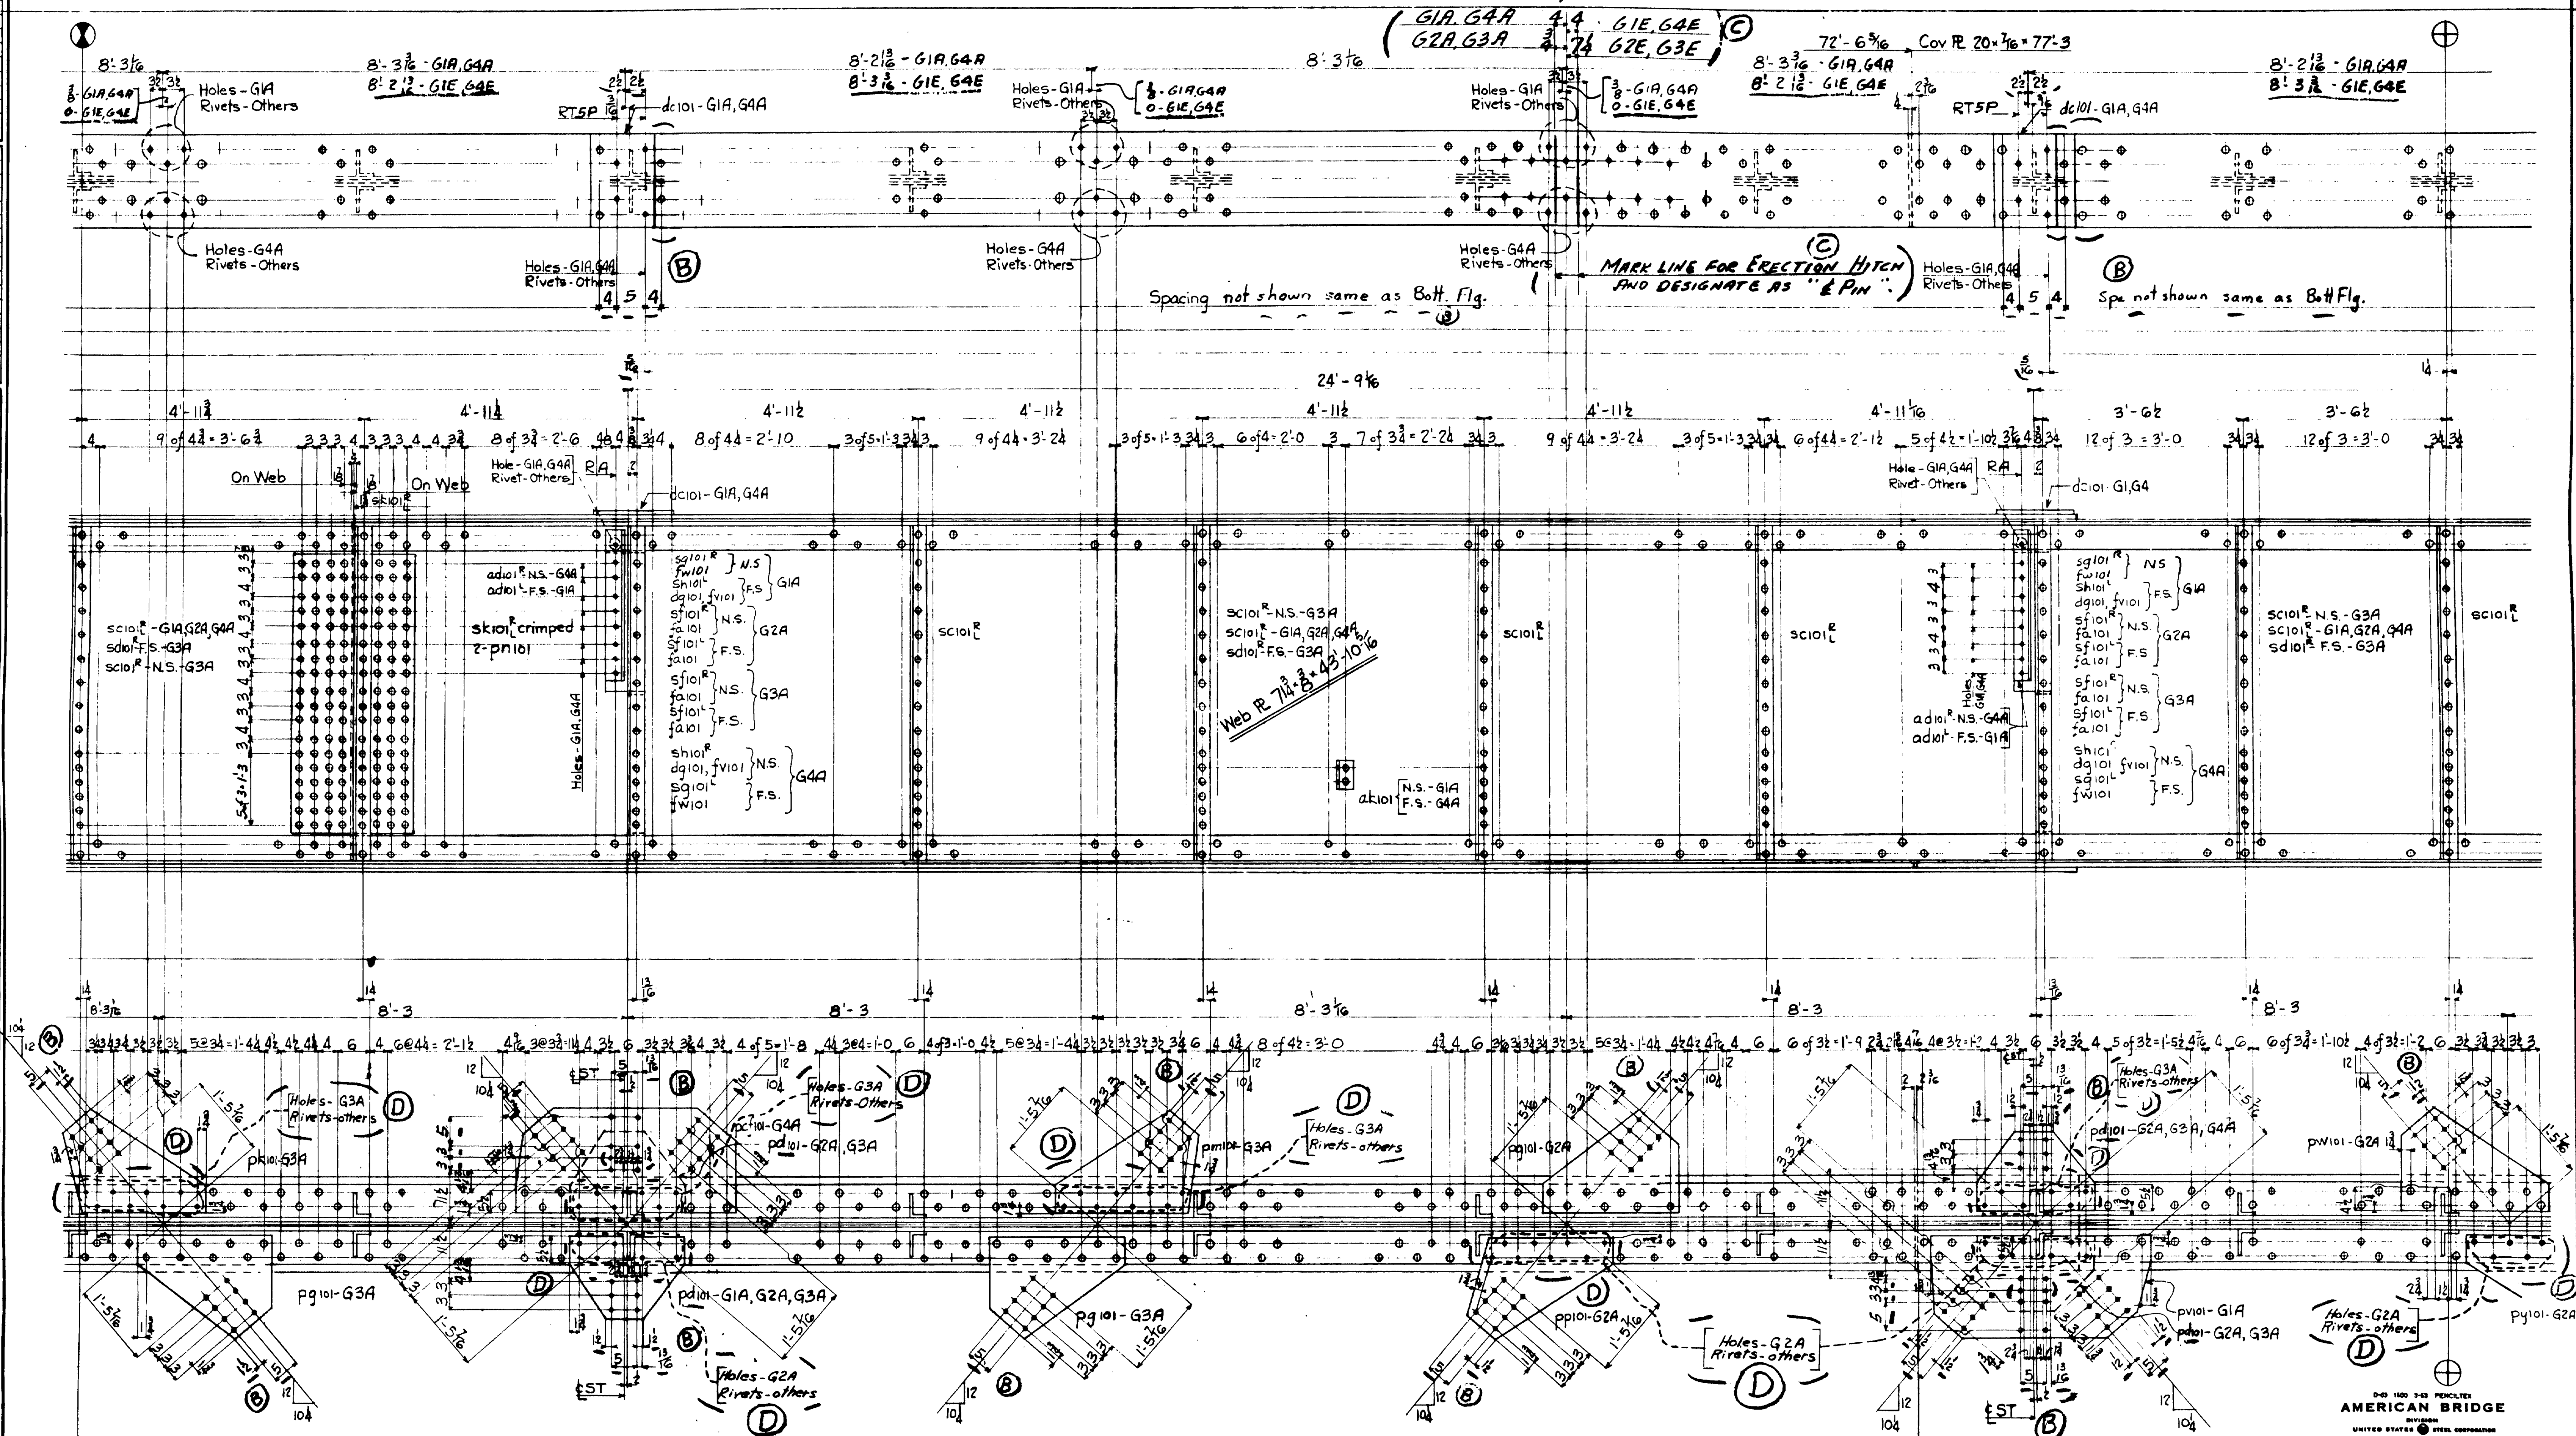

STATE OF MAINE  
STATE HIGHWAY COMMISSION  
BANGOR - BREWER BRIDGE  
PENOBSCOT RIVER  
BANGOR, MAINE

F E D 5-17-54 C 6-18-54 B 8-20-54 X 12-12-54 REVISIONS	DRAWINGS MADE AT TRENTON WORK FABRICATED AT AMBRIDGE IN CHARGE OF E.B. MARKS DRAWN BY W.J.P. CHECKED BY FEL ORDER NO. Q4150 SHEET NO. 101 BF	DATE 7-22-53 DATE 1-28-54
--	--	------------------------------

62-167





DRAWINGS MADE AT TRENTON PLANT FLA  
WORK FABRICATED AT AMBRIDGE PLANT FLA  
IN CHARGE OF E.B. MARKS  
DRAW. MADE BY W.J.P. DATE 7-22-50  
DRAW. CHECKED BY FEL DATE 1-28-51

ORDER No. Q4150 SHEET No. 101CE

**62-168**