
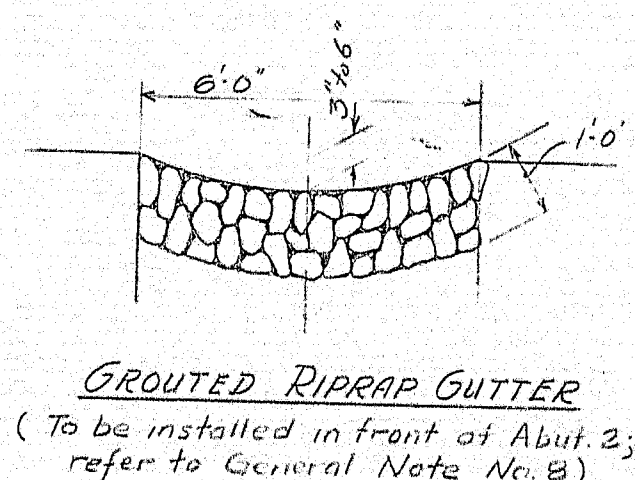
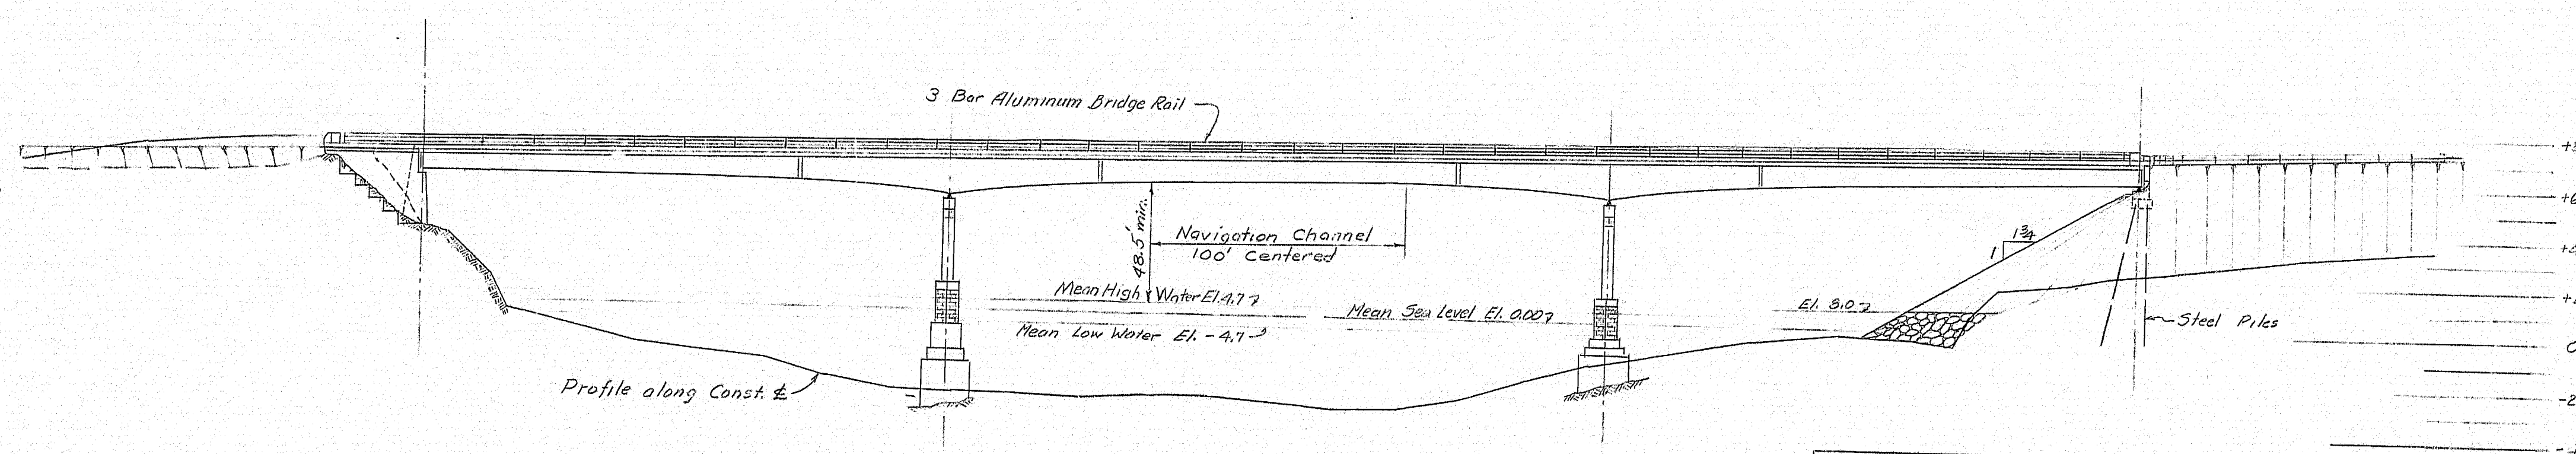


F.R.M. No.	STATE	PROJECT NUMBER	SHEET NO.	TOTAL SHEETS
1	MAINE	90118	14	105

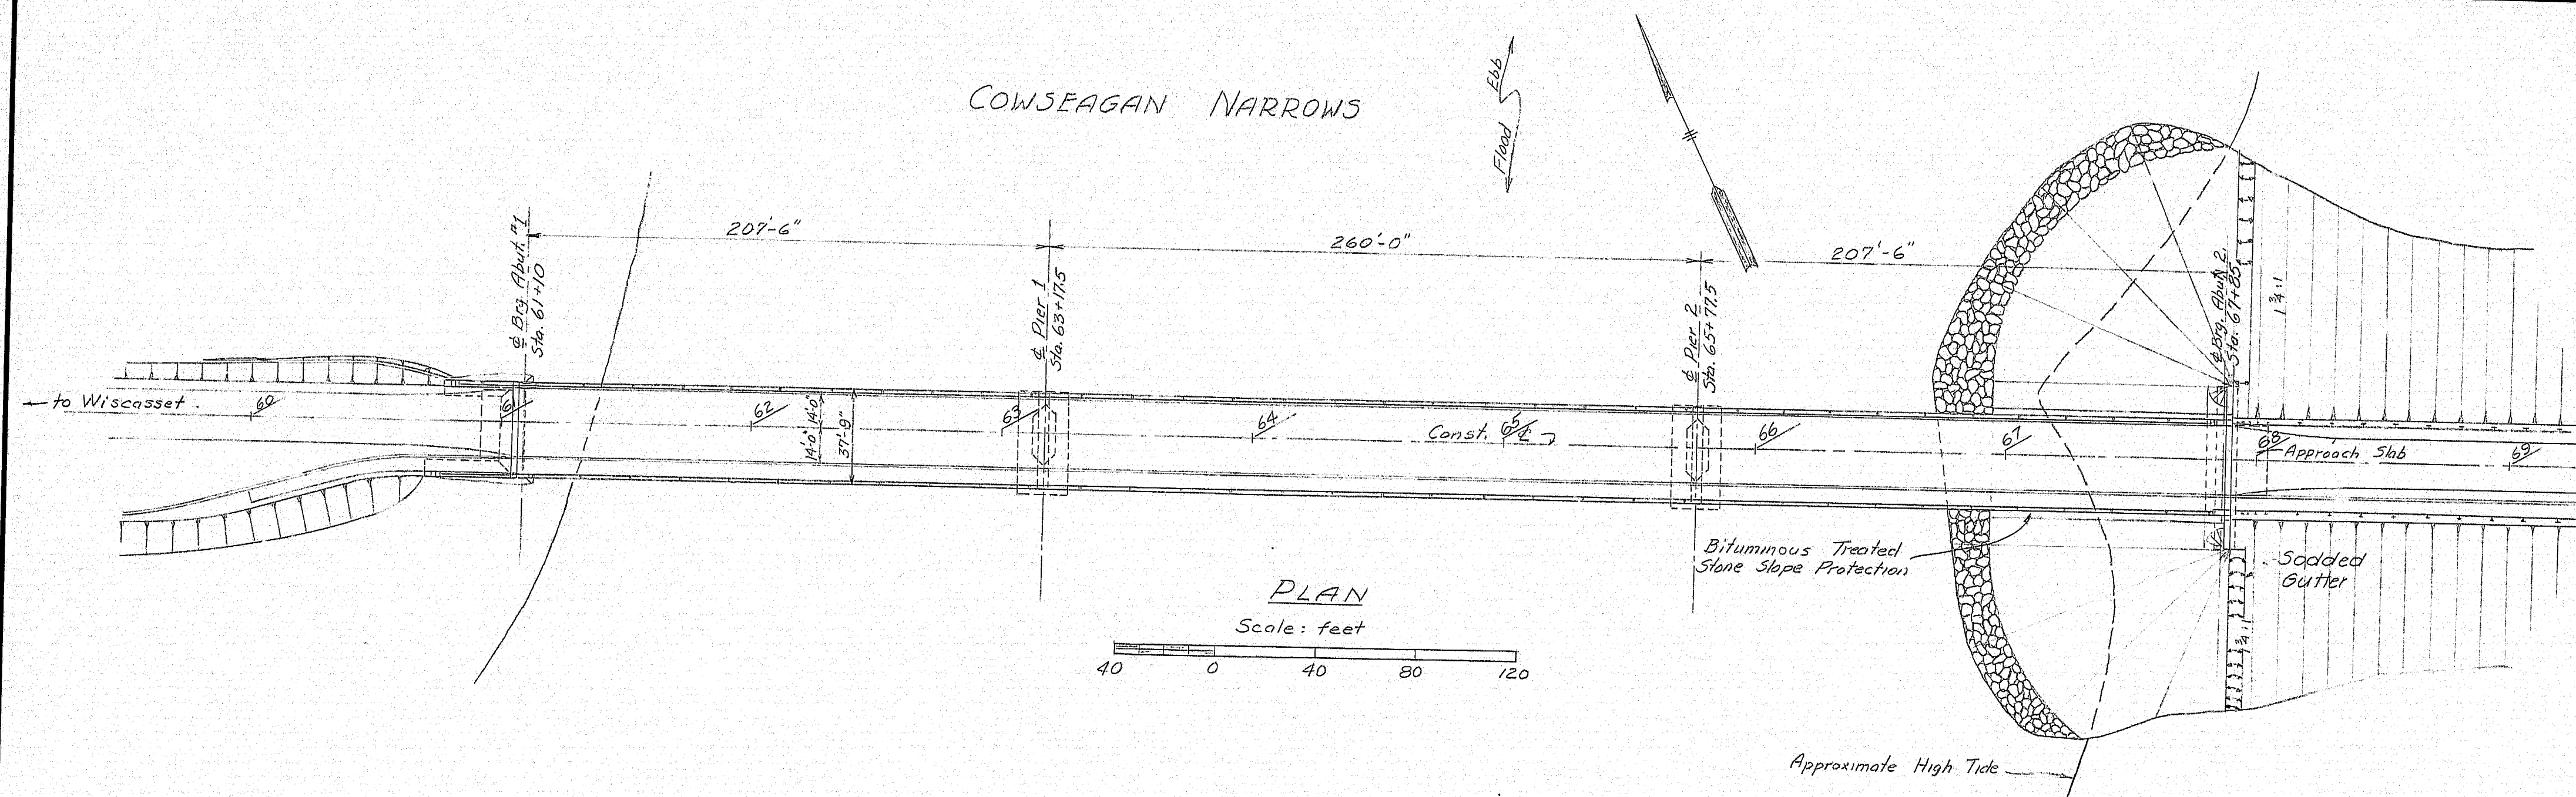

SPECIFICATIONS

DESIGN - AASHTO standard specifications for Highway Bridges 1969 and interim specifications 1970, 1971 & 1972.
CONTRACT - State of Maine, State Highway Commission, Standard Specifications, Highways & Bridges, Revision of June 1968.

DESIGN LOADING

LIVE LOAD - HS20-44

MATERIALS

CONCRETE - Seals - - - - Class S
All other - - - - Class A
REINFORCING STEEL - ASTM A615 Grade 60
STRUCTURAL STEEL - ASTM A572 Grade 50 & A36 as shown

BASIC ALLOWABLE STRESSES

CONCRETE - $f_c = 1200$ psi. $n = 10$
REINFORCING STEEL - $f_s = 24,000$ psi.
STRUCTURAL STEEL - ASTM A572 Grade 50 - $f_s = 27,000$ psi.
ASTM A36 - $f_s = 20,000$ psi.
ASTM A325 - $f_s = 13,000$ psi.

INDEX OF BRIDGE PLANS	
General Plan	1
Estimate of Bridge Quantities	2
Survey	3-4
Profile	5-6
Abutment 1	7
Abutment 1 Wings	8
Abutment 2 Footing	9
Abutment 2	10
Pier 1	11
Pier 2	12
Framing Plan	13
Steel Details	14
Armored Joint	15
Camber Diagram - Pedestals	16
Bottom of Slab Elevations	17
Superstructure Slab	18
Superstructure Details	19
End Posts, Curbs, Expansion Dam	20
Safety Barrier, Approach Slabs	21
Navigation Light Details	22
Reinforcing Steel	23-25

REFERENCES

Highway Plans
Bridge Standards
BD 100-71
BD 104-71
BD 105-64
BD 113-72
BD 115-73
BD 116-73
Soils Survey
Foundation Survey
Boring Details

GENERAL NOTES

- All utility plant shall be adjusted by respective utility unless otherwise noted.
- Refer to highway plans for Construction limits, Right of Way and additional utility plant details.
- Bituminous treated stone slope protection shall be placed in front of Abut. #2. The exact limits and elevations will be determined in the field by the Engineer.
- A layer of granular borrow 2'-3" thick shall be placed under the slope protection, except if in the opinion of the Engineer the existing embankment material is suitable.
- The material used to construct embankments in areas where piles are to be driven shall meet the requirements of sub-section 501.07 of the Standard Specifications.
- Where granular borrow is required, the material shall meet the requirements for Underwater Backfill given in sub-section 703.19 of the Standard Specifications.
- A strip of sod 4'-0" wide shall be placed behind abut. #2 wings as shown. The center of the strip shall be recessed 3 to 6 inches to form a gutter. Two inches of loam shall be placed under the sod.
- A grouted riprap gutter shall be constructed under bridge drains at abut. 2 & shall extend to Elev. 0.

Microfilmed on Highway Reel 185

Project Design Engineer: J. Chandler

STATE OF MAINE
DEPARTMENT OF TRANSPORTATION
WESTPORT-WISCASSET BRIDGE
OVER
COWSEAGAN NARROWS
BETWEEN THE TOWNS OF
WESTPORT WISCASSET
LINCOLN COUNTY
GENERAL PLAN

SHEET 1 OF 25 AUGUSTA, MAINE APRIL 1973

153-119

touraine paints TRUFLEX ★ SILKY ★ TRIPLE WHITE ★ RYPLEX

PLANS	DESIGN - DETAILED	BY	DATE
	CHECKED		
	REVISIONS		
	FIELD CHANGES		

ESTIMATED BRIDGE QUANTITIES			
ITEM NO.	DESCRIPTION	QUANTITY	UNIT
203.25	Granular Borrow	1300	Cu. Yd.
206.08	Structural Earth Excavation, Abuts. & Ret. Walls	10	Cu. Yd.
206.09	Structural Rock Excavation, Abuts. & Ret. Walls	120	Cu. Yd.
206.10	Structural Earth Excavation, Piers	355	Cu. Yd.
206.11	Structural Rock Excavation, Piers	50	Cu. Yd.
403.09	Hot Bituminous Pavement, Grading C	234	Tons
501.216	Steel H-Beam Piles, 73 lbs/ft	840	L.F.
502.21	Structural Concrete, Abuts. & Retaining Walls	560	Cu. Yd.
502.23	Structural Concrete, Piers	638	Cu. Yd.
502.24	Structural Concrete, Piers (placed under water)	1017	Cu. Yd.
502.26	Structural Concrete, Rdwy. & Sidw. Slabs on Steel Bridges	1	L.S.
502.31	Structural Concrete, Approach Slabs	1	L.S.
503.12	Reinforcing Steel, Fab. & Delivered	240,000	Lb.
503.13	Reinforcing Steel, Pacing	240,000	Lb.
504.70	Structural Steel, Fab. & Delivered	1	L.S.
504.71	Structural Steel, Erection	1	L.S.
505.08	Shear Connectors	1	L.S.
506.14	Field Painting, Structural Steel	1	L.S.
507.142	Aluminum Bridge Railing, Type B	702	L.F.
507.143	Aluminum Bridge Railing, Type C	709	L.F.
508.10	Membrane Waterproofing	2106	S.Y.
511.0701	Cofferdam, Pier 1	1	L.S.
511.0702	Cofferdam, Pier 2	1	L.S.
512.07	French Drains (Stones only)	20	Cu. Yd.
513.10	Slope Protection, Bituminous Treated Stone	430	Sq. Yd.
514.06	Curing Box for Concrete Cylinders	1	Each
515.20	Protective Coating for Concrete Surfaces	2000	Sq. Yd.
525.06	Granite Masonry	1620	S.F.
609.13	Vertical Bridge Curb, Type 1	711	L.F.
609.17	Sloped Bridge Curb, Type 1	676	L.F.
610.09	Hand Laid Riprap	40	Cu. Yd.
610.12	Portland Cement for Riprap Grout	16	Barrel
616.08	Sodding	90	S.Y.
634.176	Bituminous Fibre Junction Box	3	Each
634.184	2" Steel Conduit Exposed or in Trench	50	L.F.
634.191	2" Non-Metallic Conduit	350	L.F.
638.02	Navigation Lights	1	L.S.



F.H.W.A. REG. NO.	STATE	PROJECT NUMBER	SHEET NO.	TOTAL SHEETS
1	MAINE	90118	15	105

ESTIMATED QUANTITIES FOR LUMP SUM ITEMS		
502.26	Structural Concrete, Rdwy. & Sidw. Slab on Steel Bridge (including all end post concrete)	902
502.31	Structural Concrete, Approach Slabs	20
504.70 & 71	Structural Steel	1,467,500
505.08	Shear Connectors	3650

STATE OF MAINE
DEPARTMENT OF TRANSPORTATION
WESTPORT-WISCASSET BRIDGE
OVER
COWSEAGAN NARROWS
BETWEEN THE TOWNS OF
WESTPORT-WISCASSET
LINCOLN COUNTY
ESTIMATED BRIDGE QUANTITIES
SHEET 2 OF 25 AUGUSTA, MAINE APRIL 1973

153-120

Touraine Paints TRUFLEX ★ SILKY ★ TRIPLE WHITE ★ RYPLEX

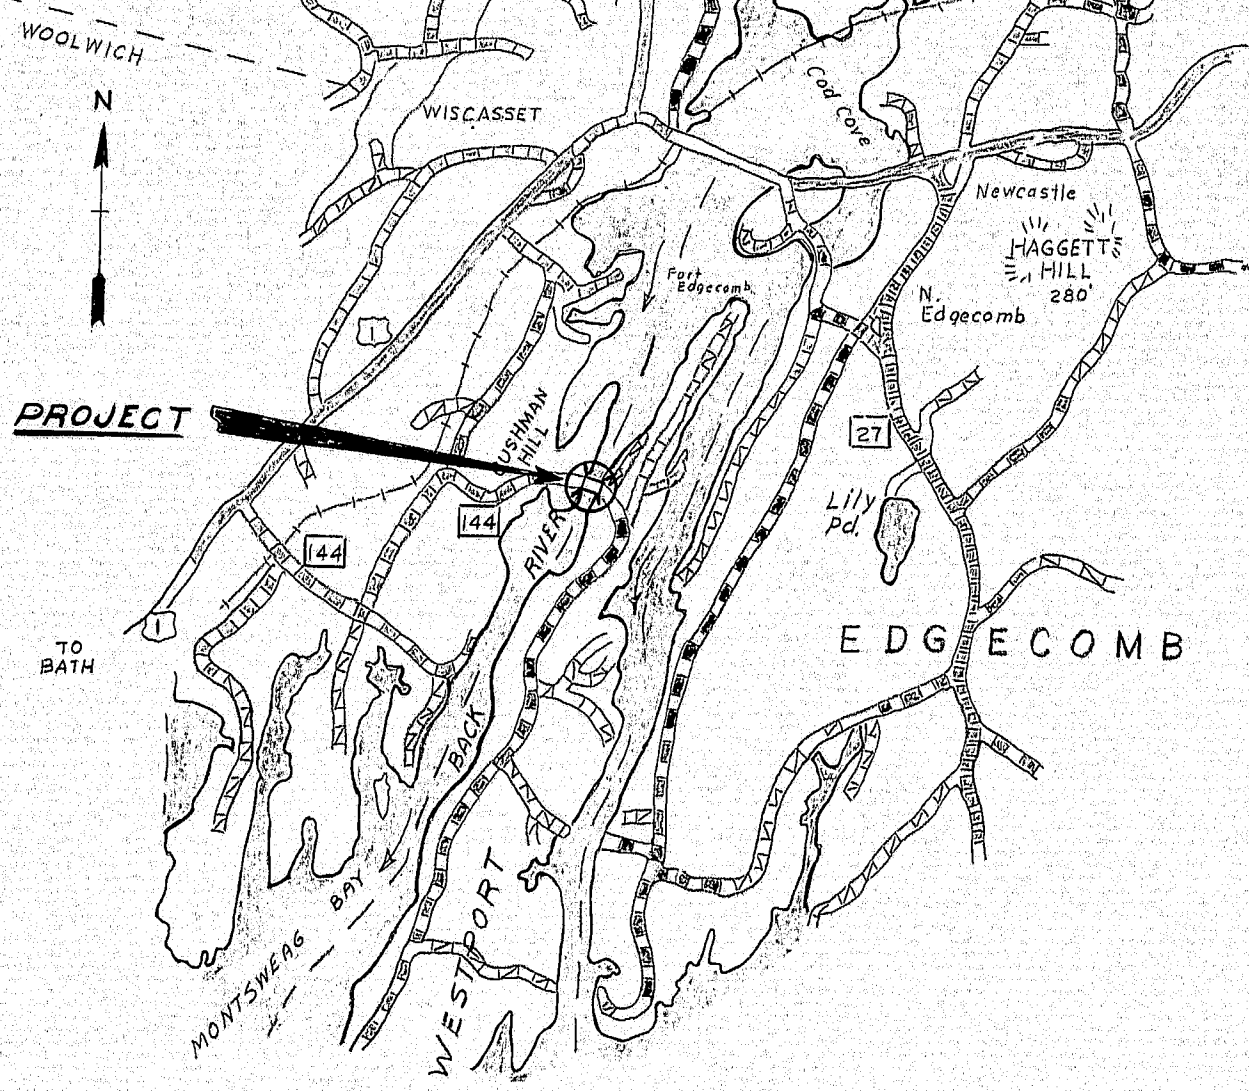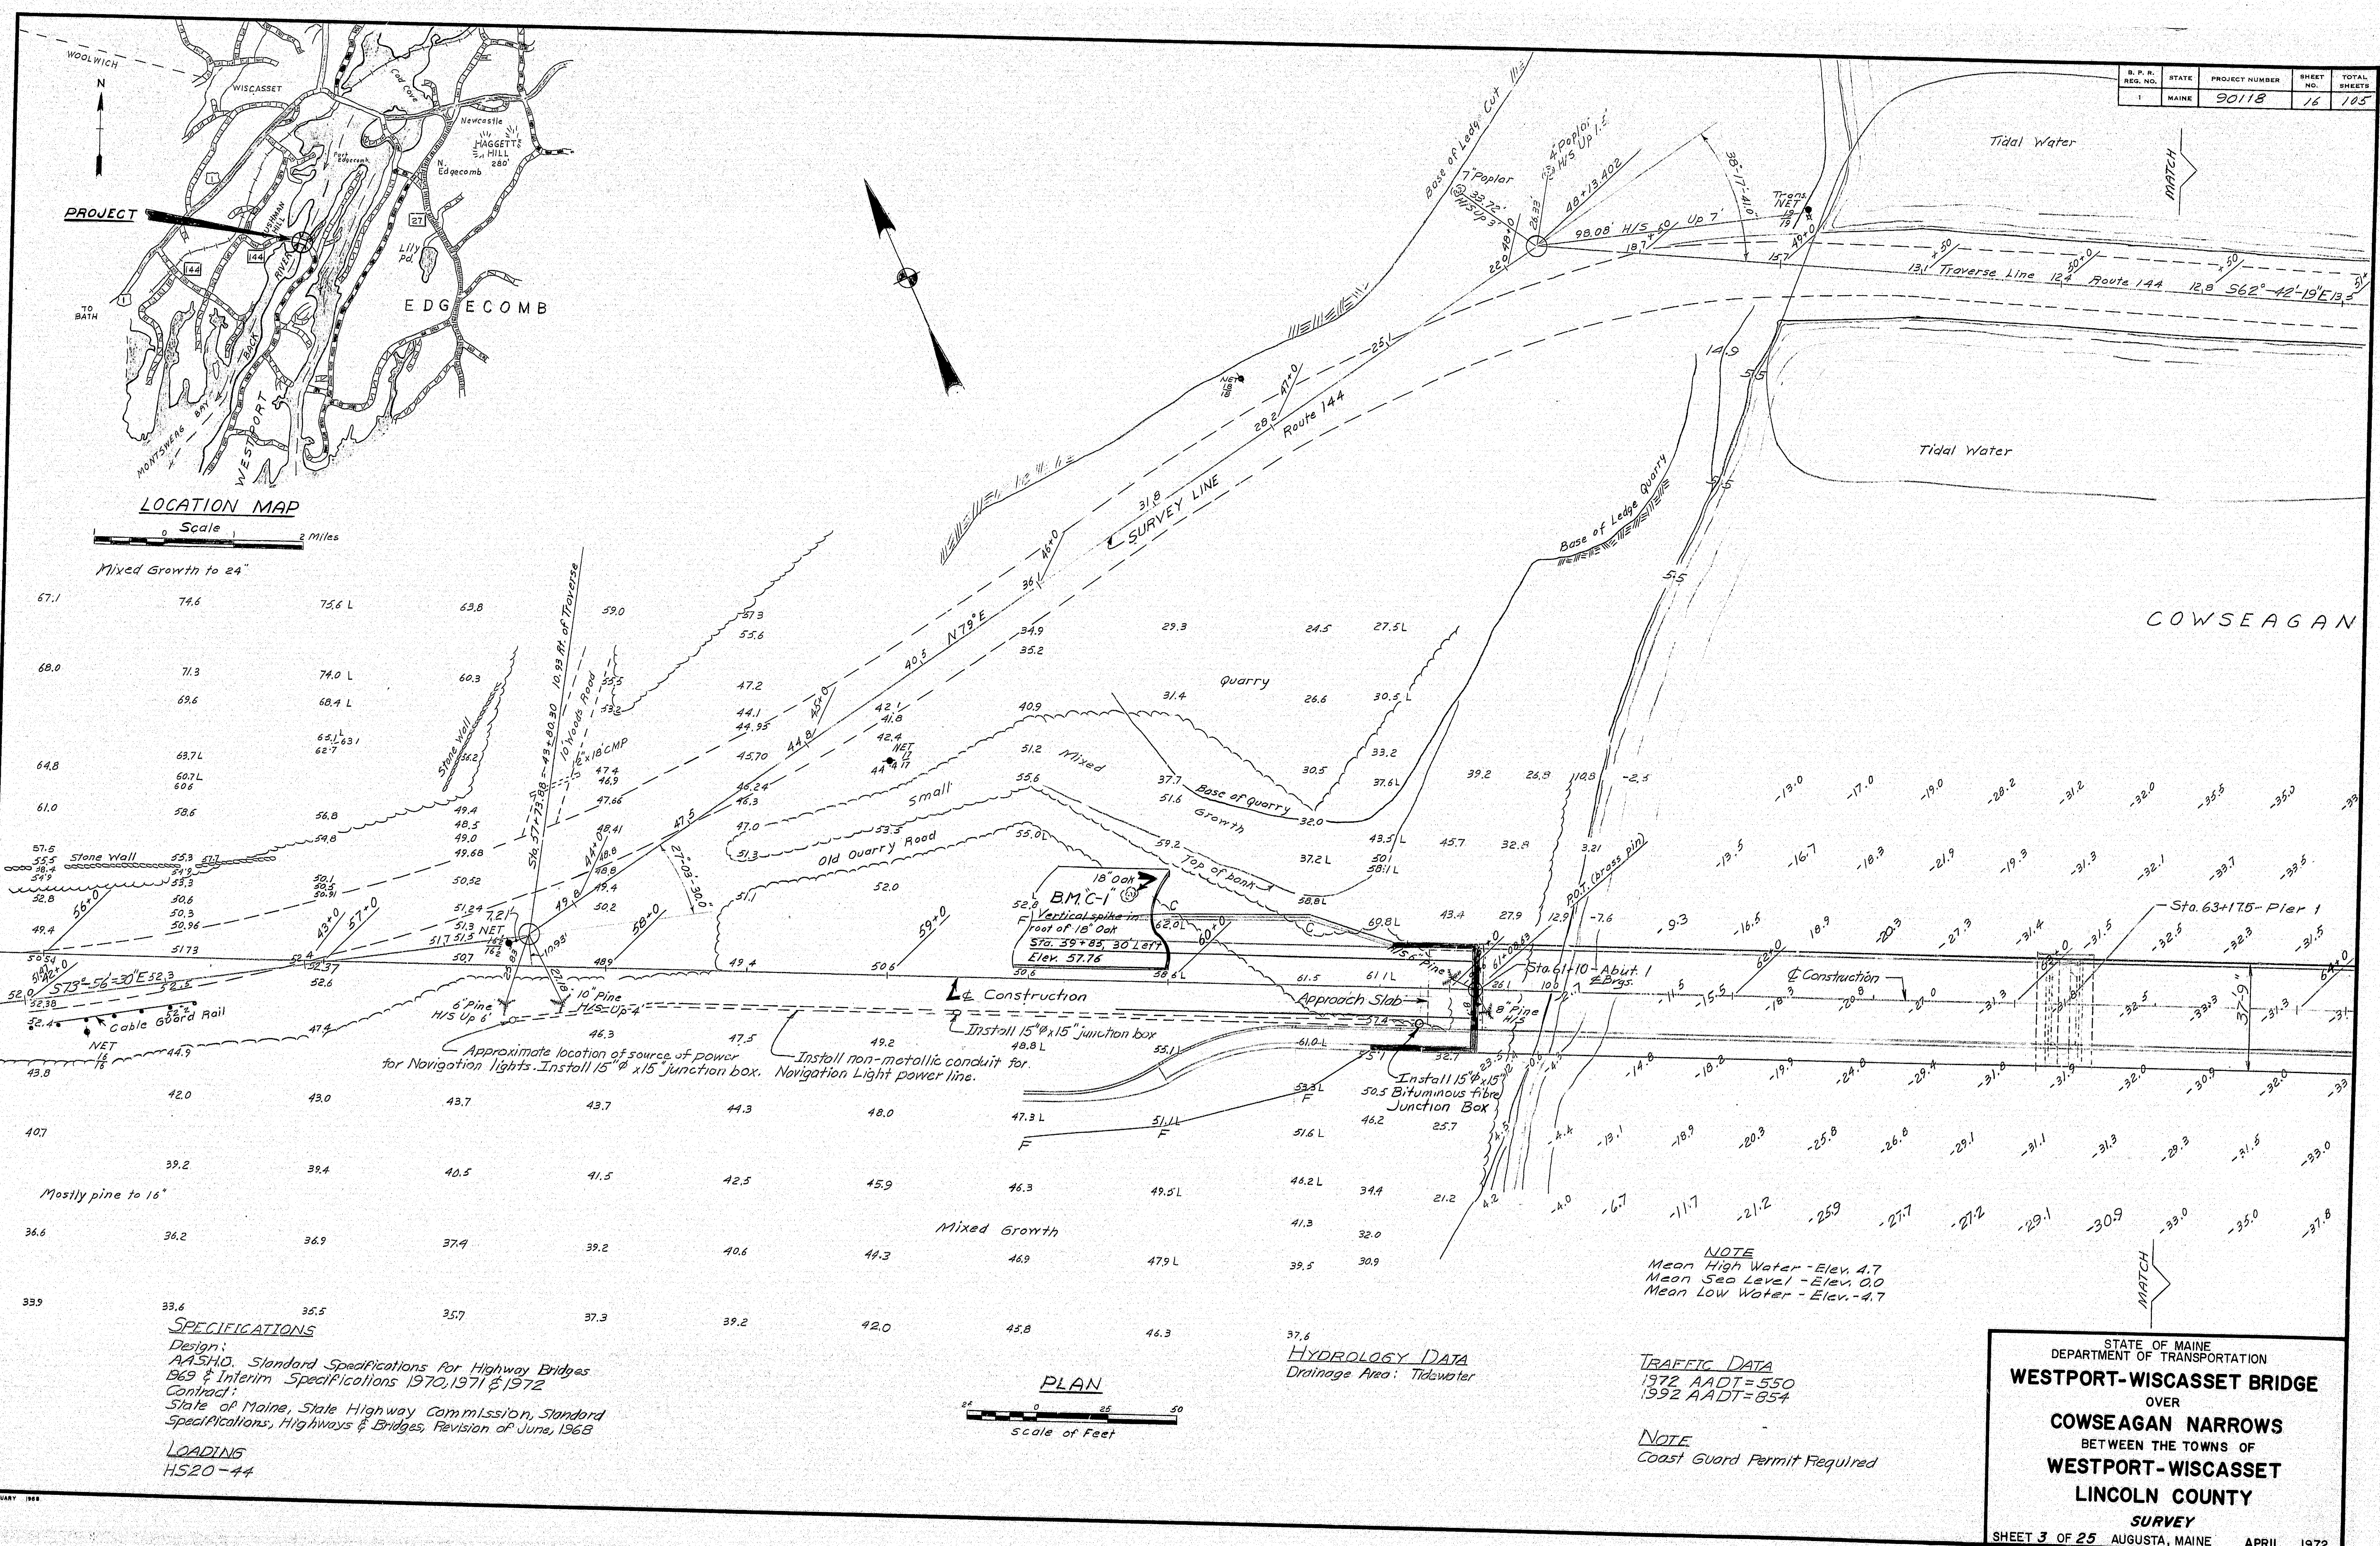

B. P. R.	STATE	PROJECT NUMBER	SHEET NO.	TOTAL SHEETS
1	MAINE	90118	16	105

PLANS	DESIGN - DETAILED	DATE	BY
	CHECKED	5-10-72	C.F.H.
	REVISIONS	7/13/73	G.O.T.
	FIELD CHANGES		

SPECIFICATIONS
Design:
AASHTO, Standard Specifications for Highway Bridges
609 & Interim Specifications 1970, 1971 & 1972
Contract
State of Maine, State Highway Commission, Standard
Specifications, Highways & Bridges, Revision of June, 1968
LOADING
HS20-44

HYDROLOGY DATA
Drainage Area: Tidewater


TRAFFIC DATA
1972 AADT=550
1992 AADT=854

NOTE
Coast Guard Permit Required

STATE OF MAINE
DEPARTMENT OF TRANSPORTATION
WESTPORT-WISCASSET BRIDGE
OVER
COWSEAGAN NARROWS
BETWEEN THE TOWNS OF
WESTPORT-WISCASSET
LINCOLN COUNTY
SURVEY
SHEET 3 OF 25 AUGUSTA, MAINE APRIL 1972

153-121

D. P. R.	STATE	PROJECT NUMBER	SHEET NO.	TOTAL SHEETS
1	MAINE	30118	18	105

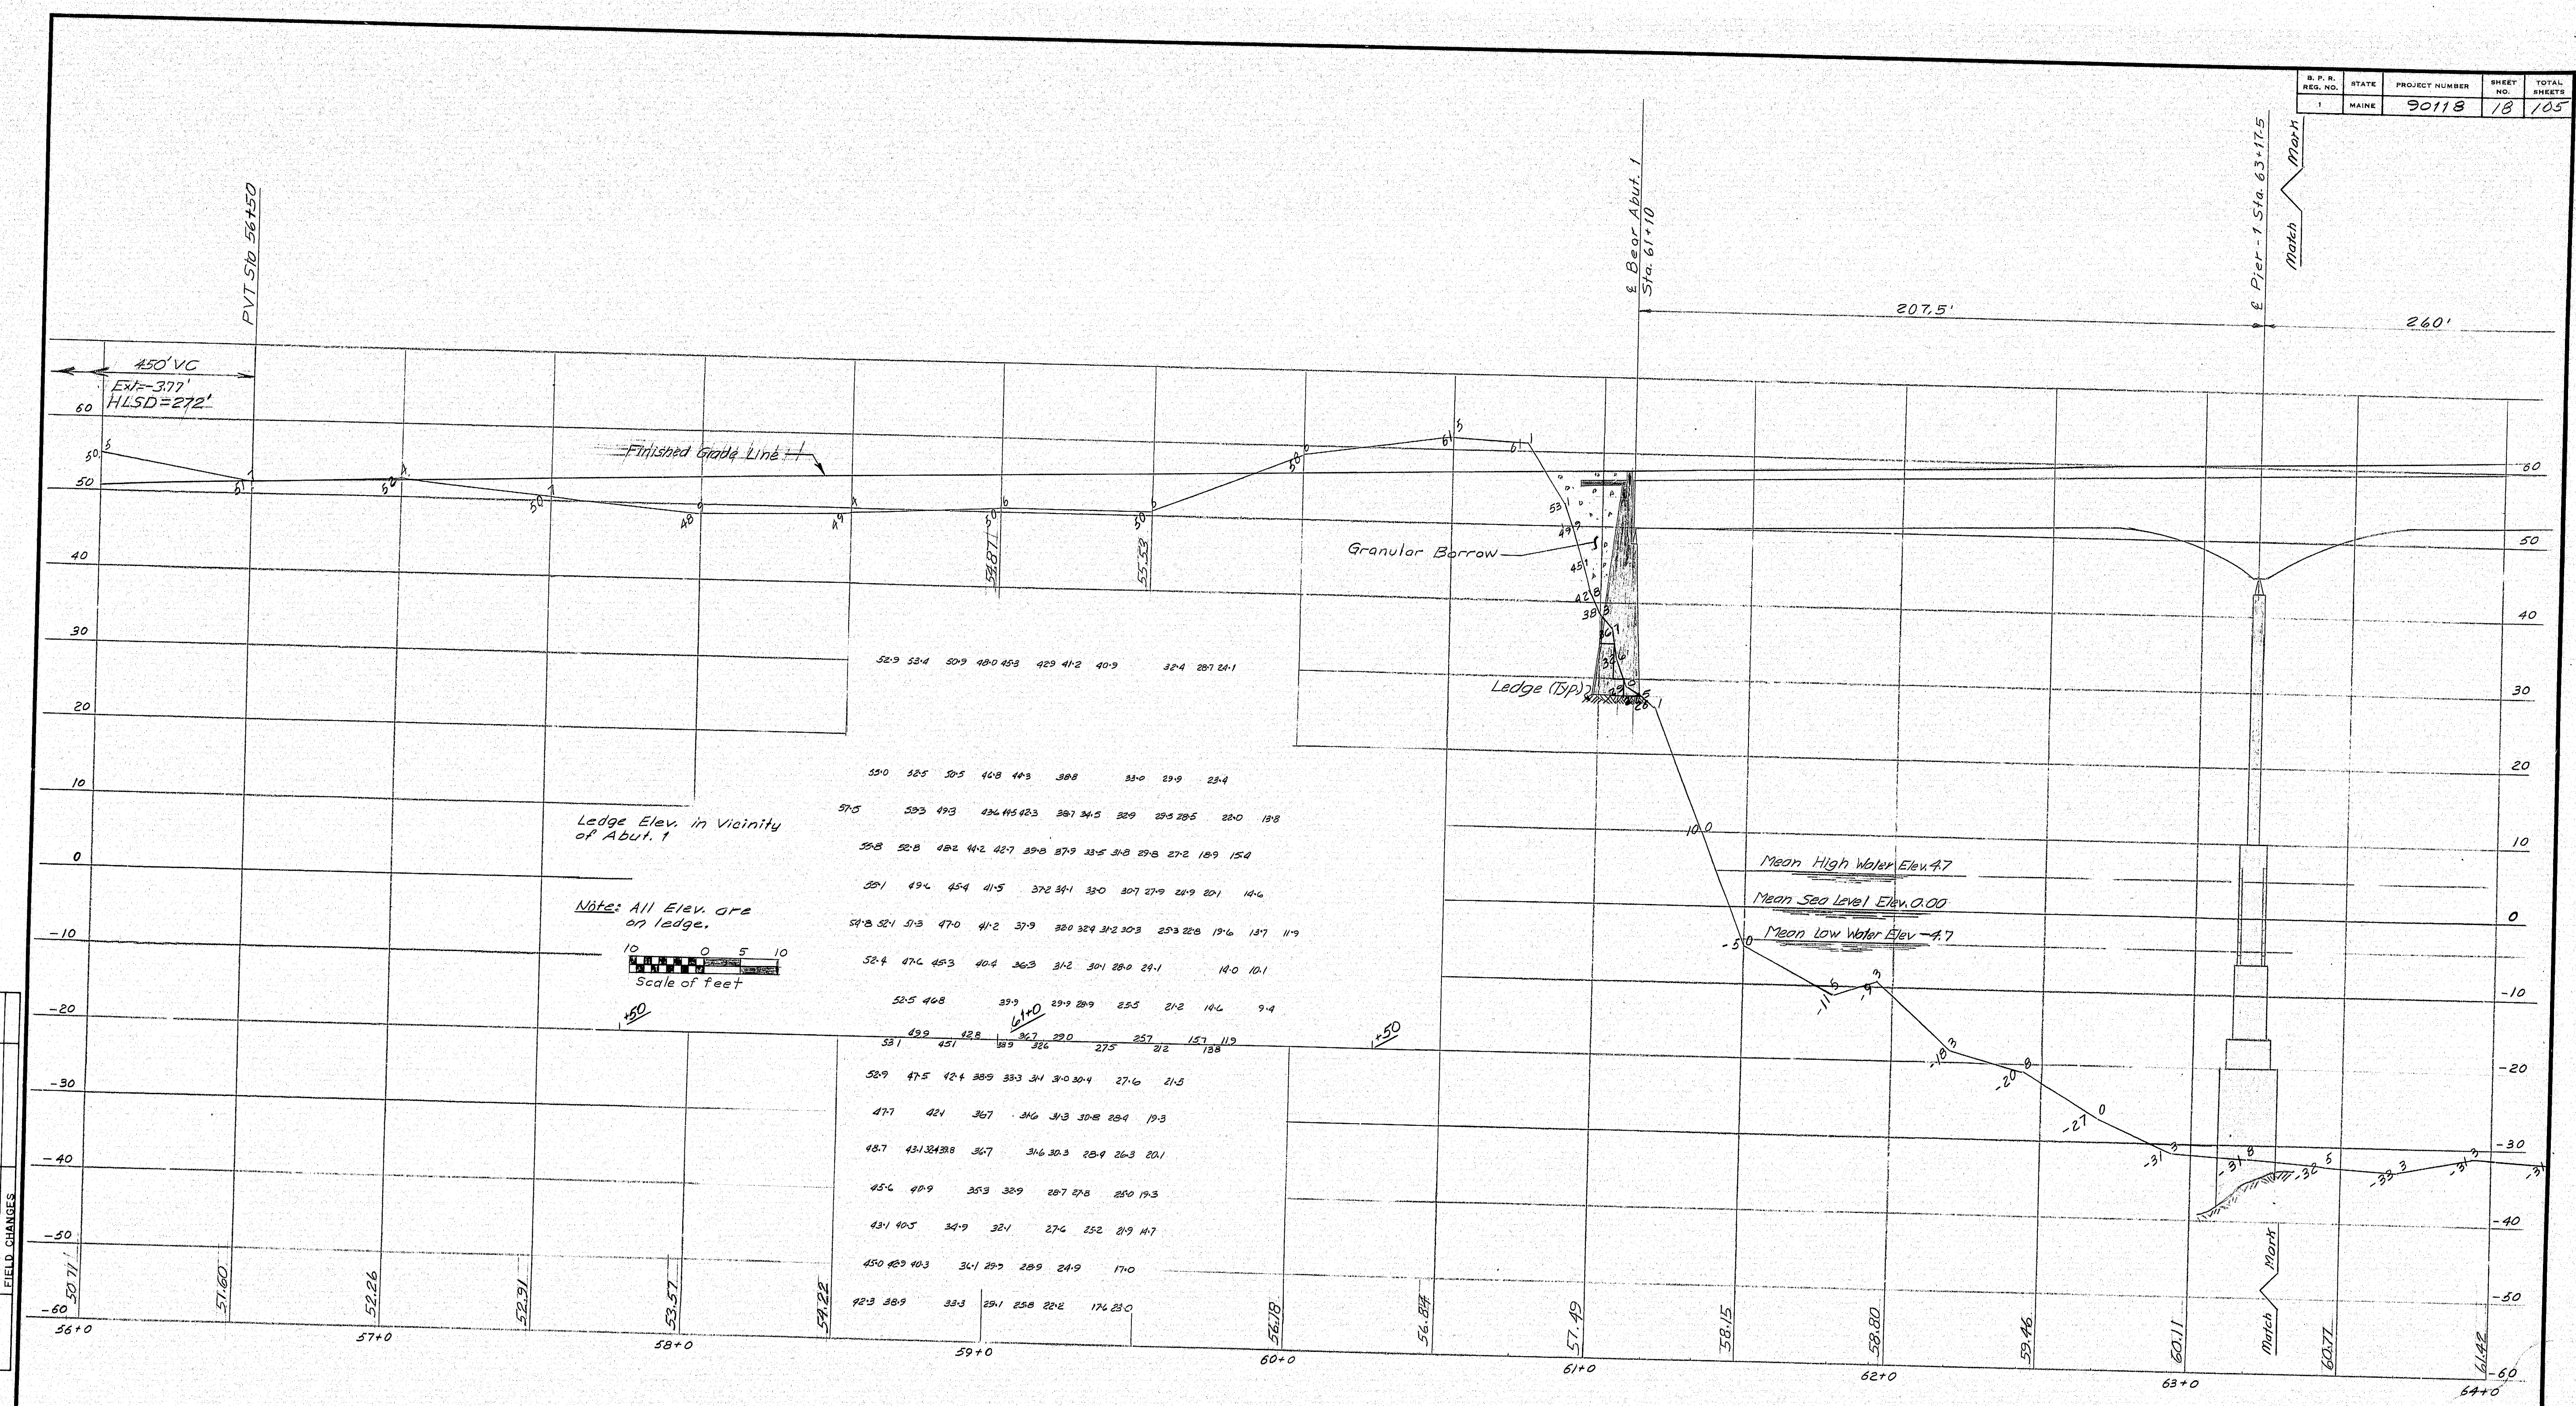

Ledge Elev. in Vicinity of Abut. 1


Note: All Elev. are on ledge.

Scale of feet

10 0 5 10

52.9	53.4	53.9	54.0	54.3	54.8	54.9	54.2	40.9	40.9	40.9	32.4	287.26.1
55.0	55.5	55.5	40.8	40.8	38.8	33.0	23.9	23.4				
55	53.3	49.3	43.4	44.5	45.3	38.7	34.3	32.9	23.5	28.5	28.5	100.0
55.8	55.8	48.2	44.2	42.7	39.0	37.9	23.5	31.8	27.8	18.9	15	
55.1	49.4	45.4	41.5	37.2	34.1	33.0	30.7	27.9	24.9	20.1		
54.8	52.1	51.3	47.0	41.2	37.9	32.0	32.4	31.2	30.3	23.2	22.8	19.6
52.4	47.6	45.3	40.4	36.3	31.2	30.1	28.0	24.1				14.0
52.5	46.8											
				33.9	27.9	23.9	23.5	21.2	14.4			
				61.0								
53.1	45.1	42.8		34.7	29.0		25.7	21.2	15.1	11.9		
				38.9	32.6		27.3	21.2				
52.9	47.5	42.4	38.9	33.3	34.1	31.0	30.4	27.6	21.5			
47.7	42.4	36.7	31.6	31.3	30.8	28.4	19.3					
48.7	43.1	34.3	34.8	36.7	31.4	30.3	28.4	26.3	22.1			
45.4	40.9	35.3	32.9	28.7	27.8	25.0	19.3					
43.1	40.5	34.9	32.1	27.6	25.2	21.9	14.7					
45.0	42.9	40.3	34.1	29.7	28.9	24.9	17.0					
42.3	38.9	33.3	29.1	25.8	22.2	17.4	23.0					

S. P. N.	STATE	PROJECT NUMBER	SHEET NO.	TOTAL SHEETS
1	MAINE	90115	19	105

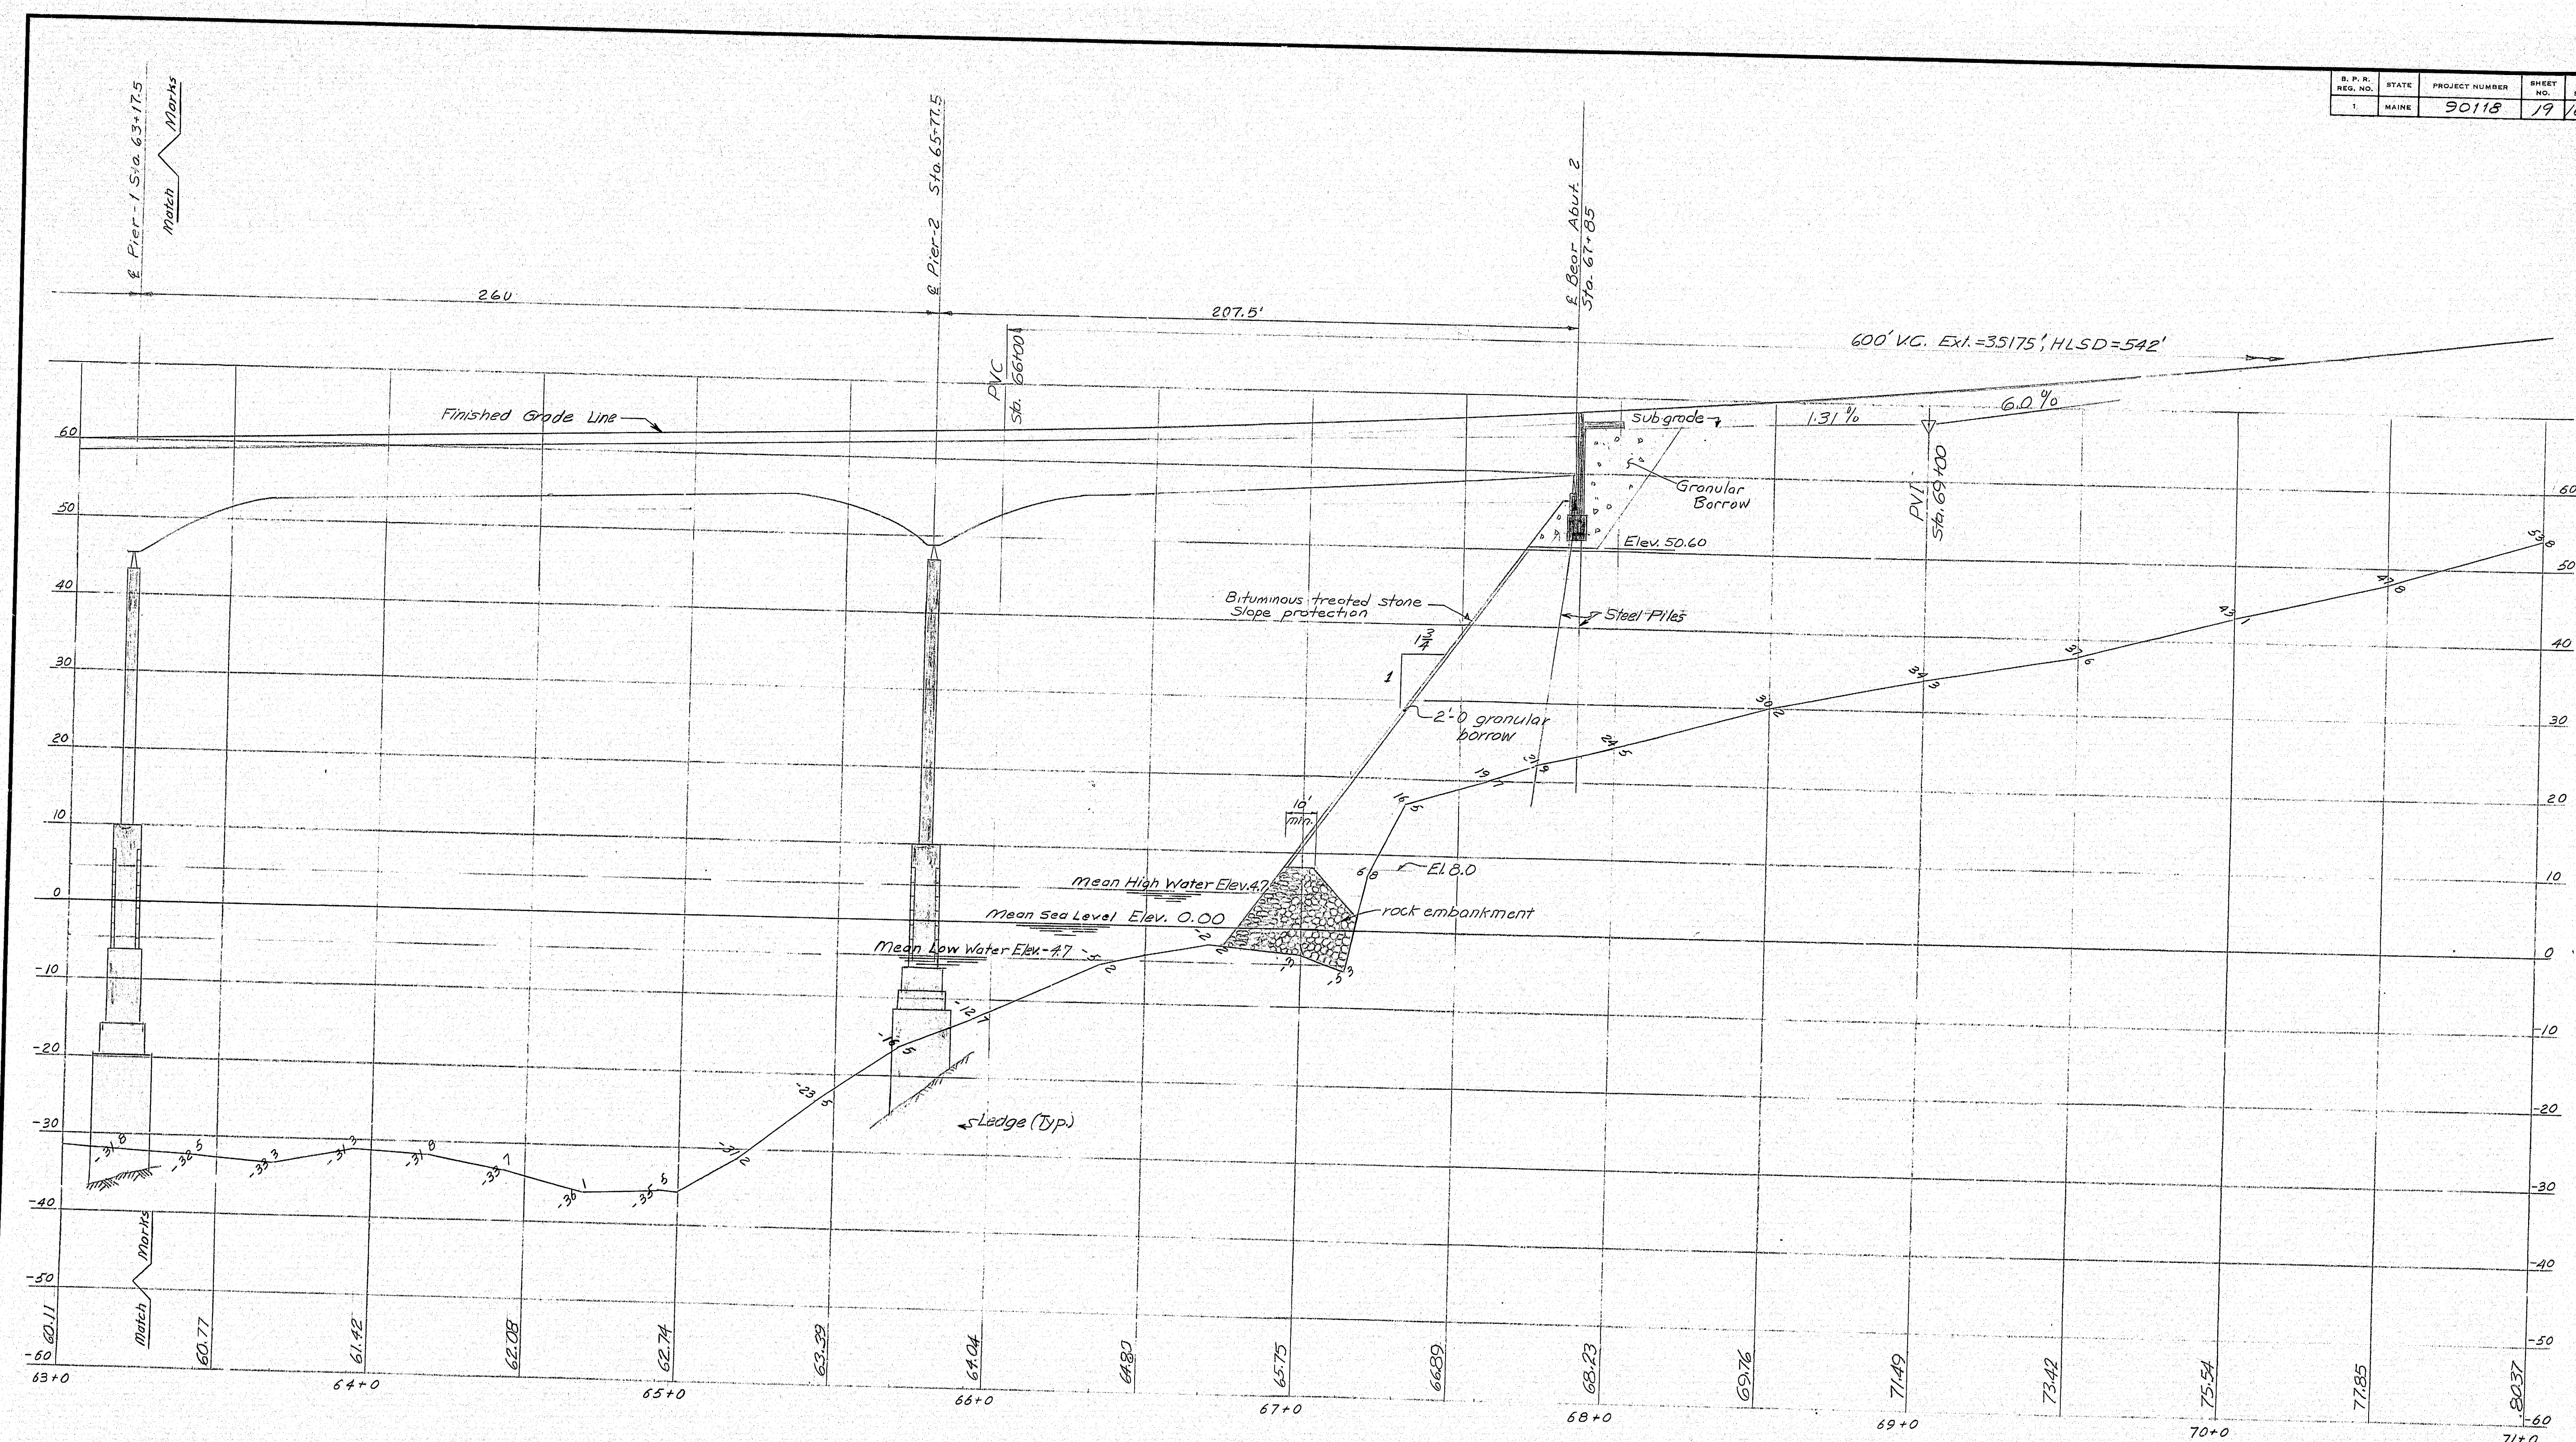


PROFILE


STATE OF MAINE
DEPARTMENT OF TRANSPORTATION
WESTPORT-WISCASSET BRIDGE
OVER
COWSEAGAN NARROWS
BETWEEN THE TOWNS OF
WESTPORT-WISCASSET
LINCOLN COUNTY
PROFILE
SHEET 6 OF 25 AUGUSTA, MAINE APRIL 1972

153-124

DESIGN - DETAILED	DATE
CHECKED	BY
REVISIONS	7/10/72
FIELD CHANGES	9/10/72

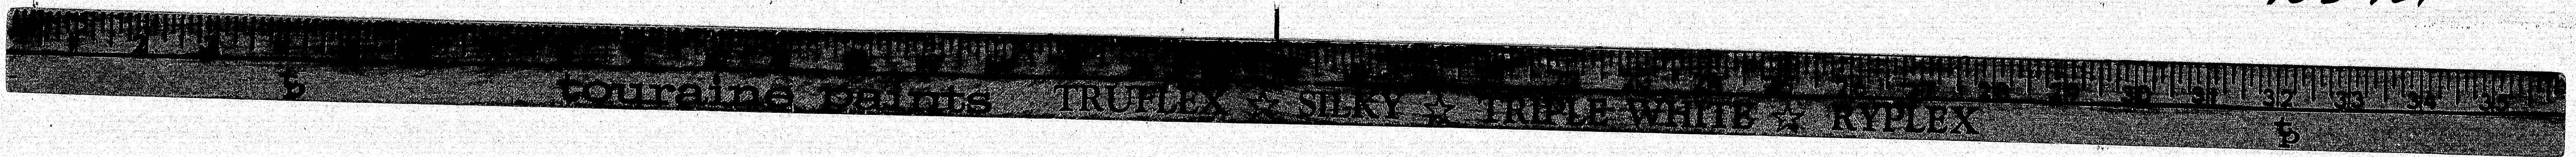


R. P. R. REV. NO.	STATE	PROJECT NUMBER	SHEET NO.	TOTAL SHEETS
1	MAINE	90/18	20	105

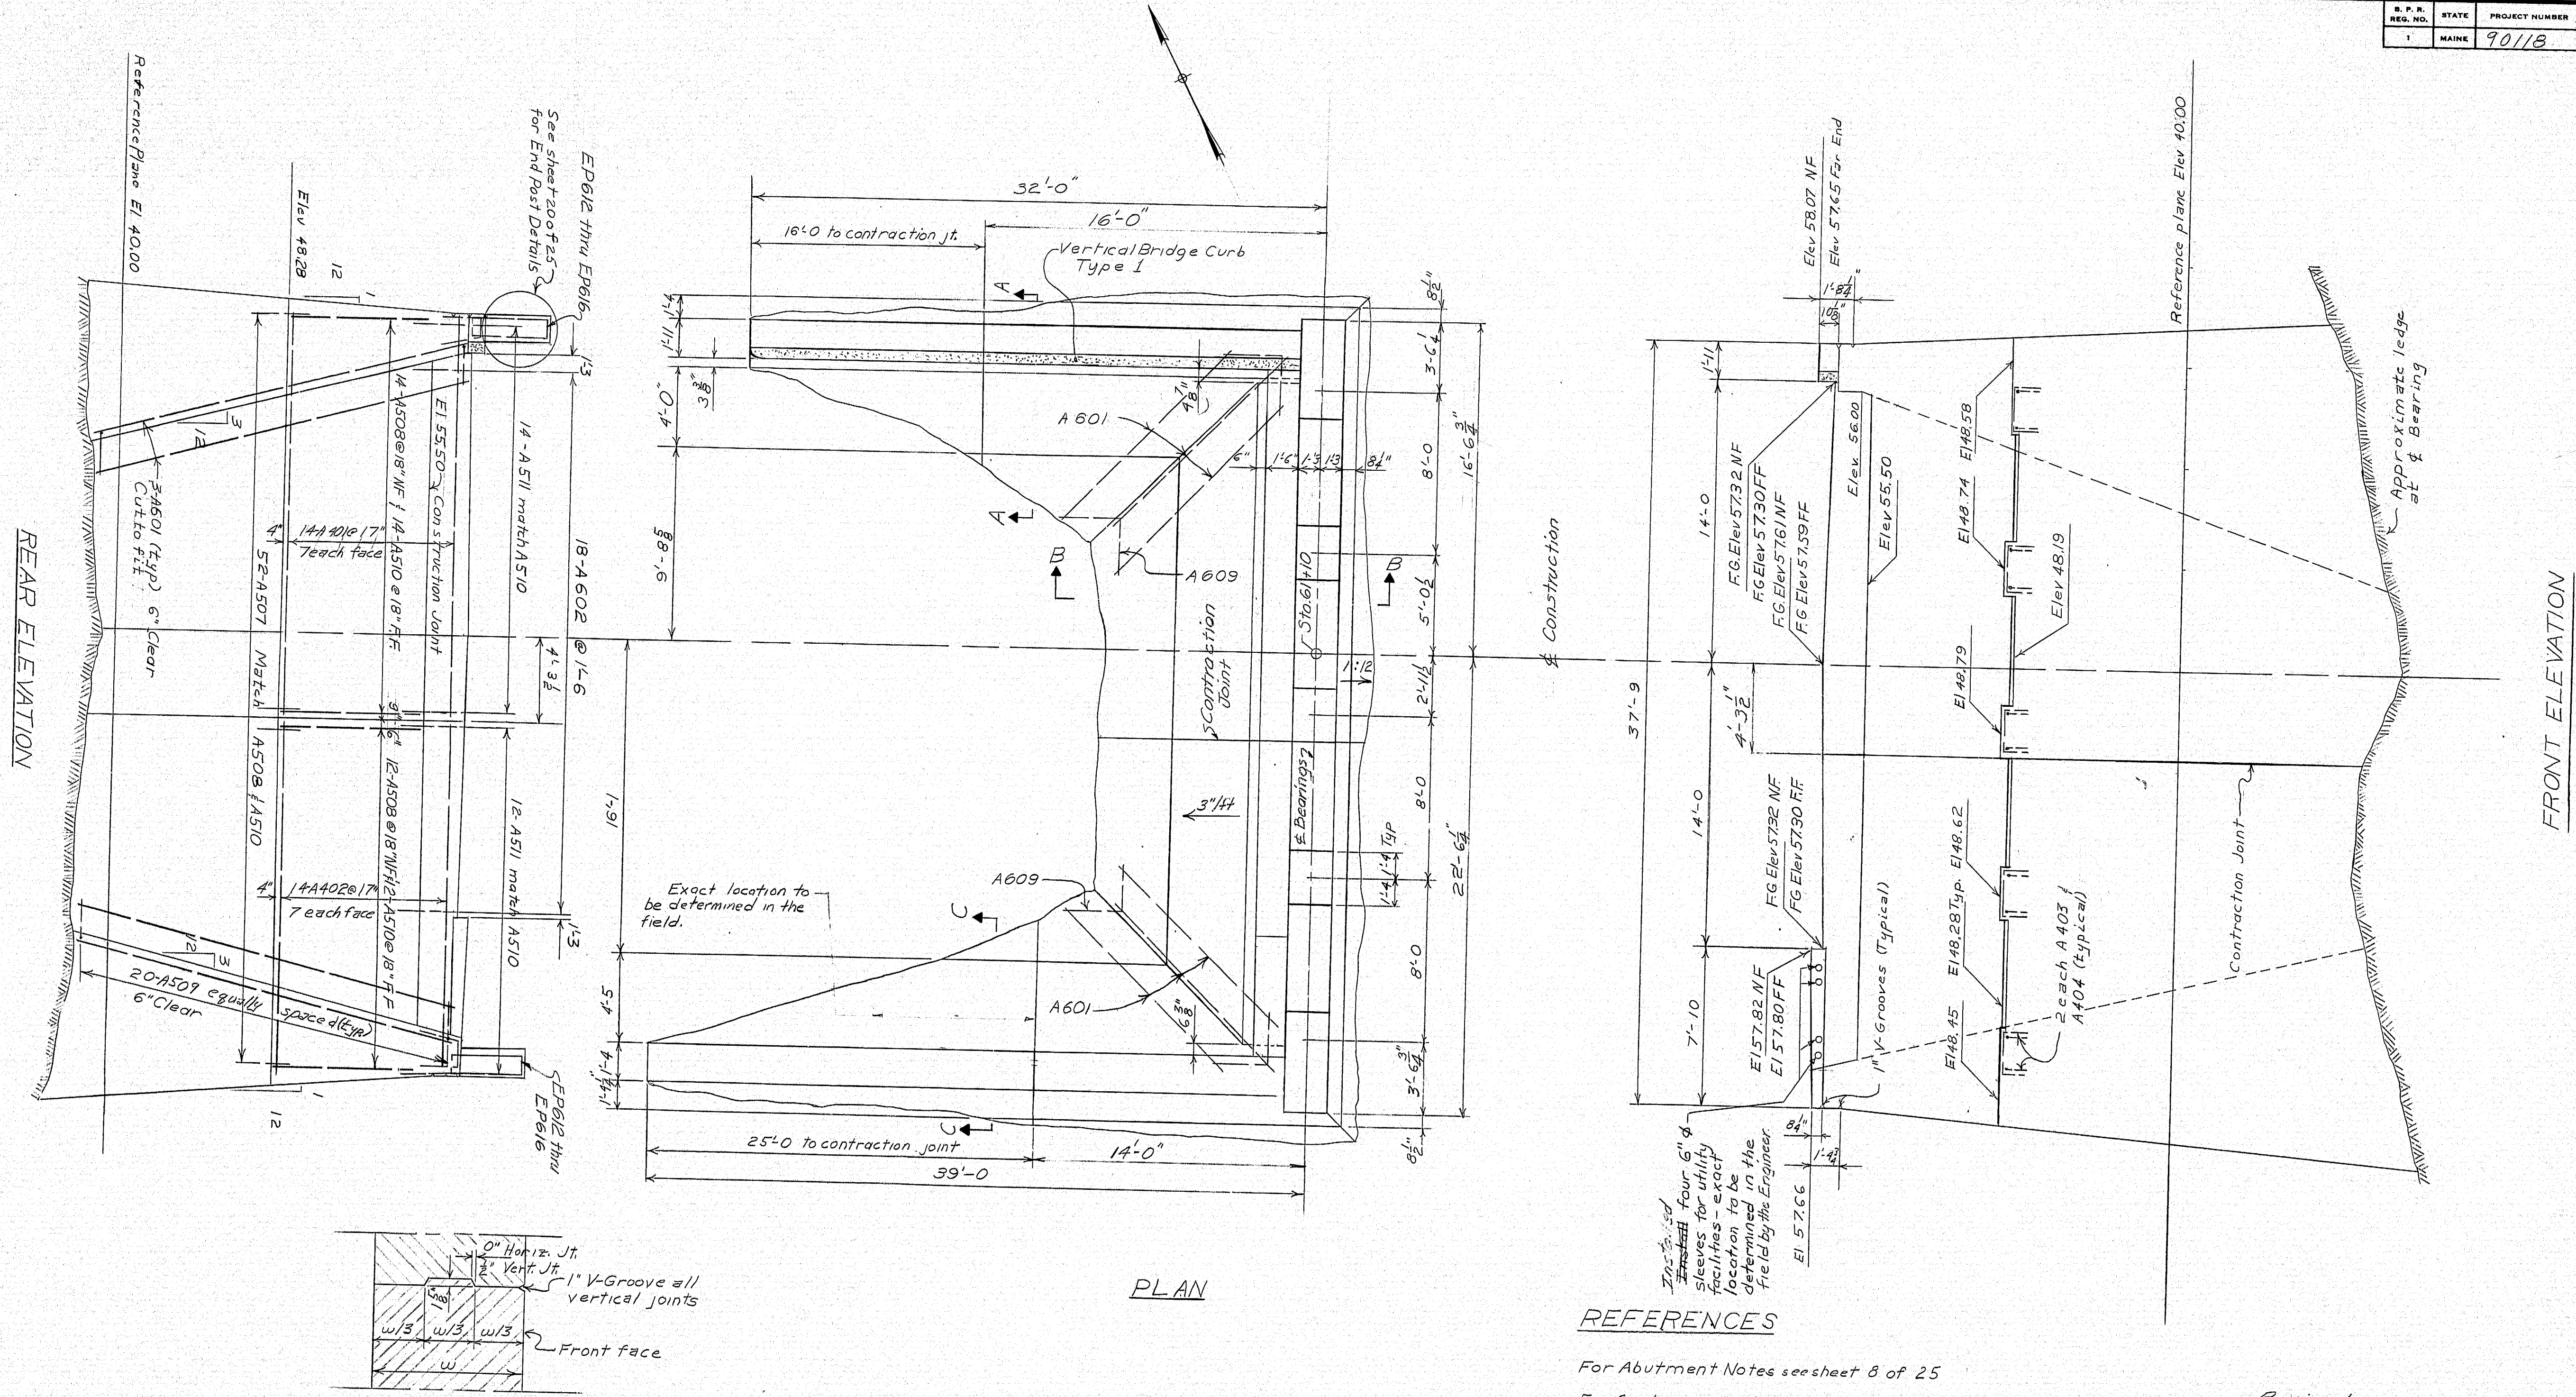


STATE OF MAINE
 DEPARTMENT OF TRANSPORTATION
WESTPORT-WISCASSET BRIDGE
 OVER
COWSEAGAN NARROWS
 BETWEEN THE TOWNS OF
WESTPORT-WISCASSET
 LINCOLN COUNTY
ABUTMENT 1
 SHEET 7 OF 25 AUGUSTA, MAINE APRIL 1973

153-125

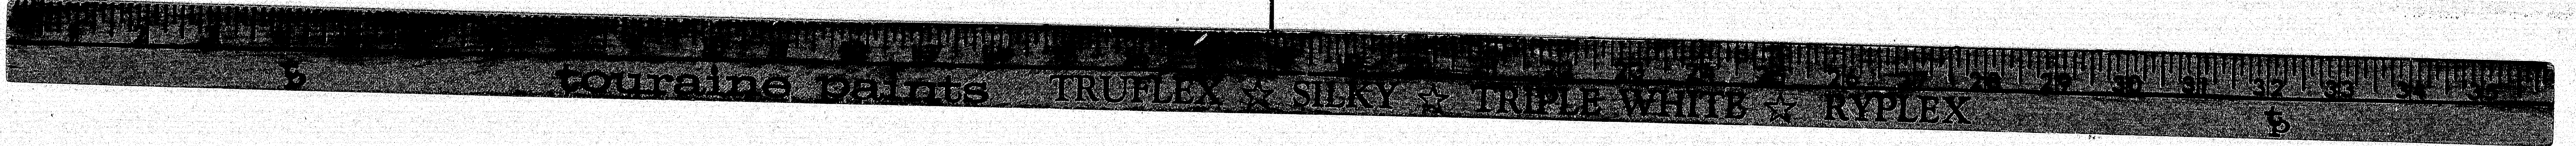


S. P. R.	STATE	PROJECT NUMBER	SHEET NO.	TOTAL SHEETS
1	MAINE	90118	21	105

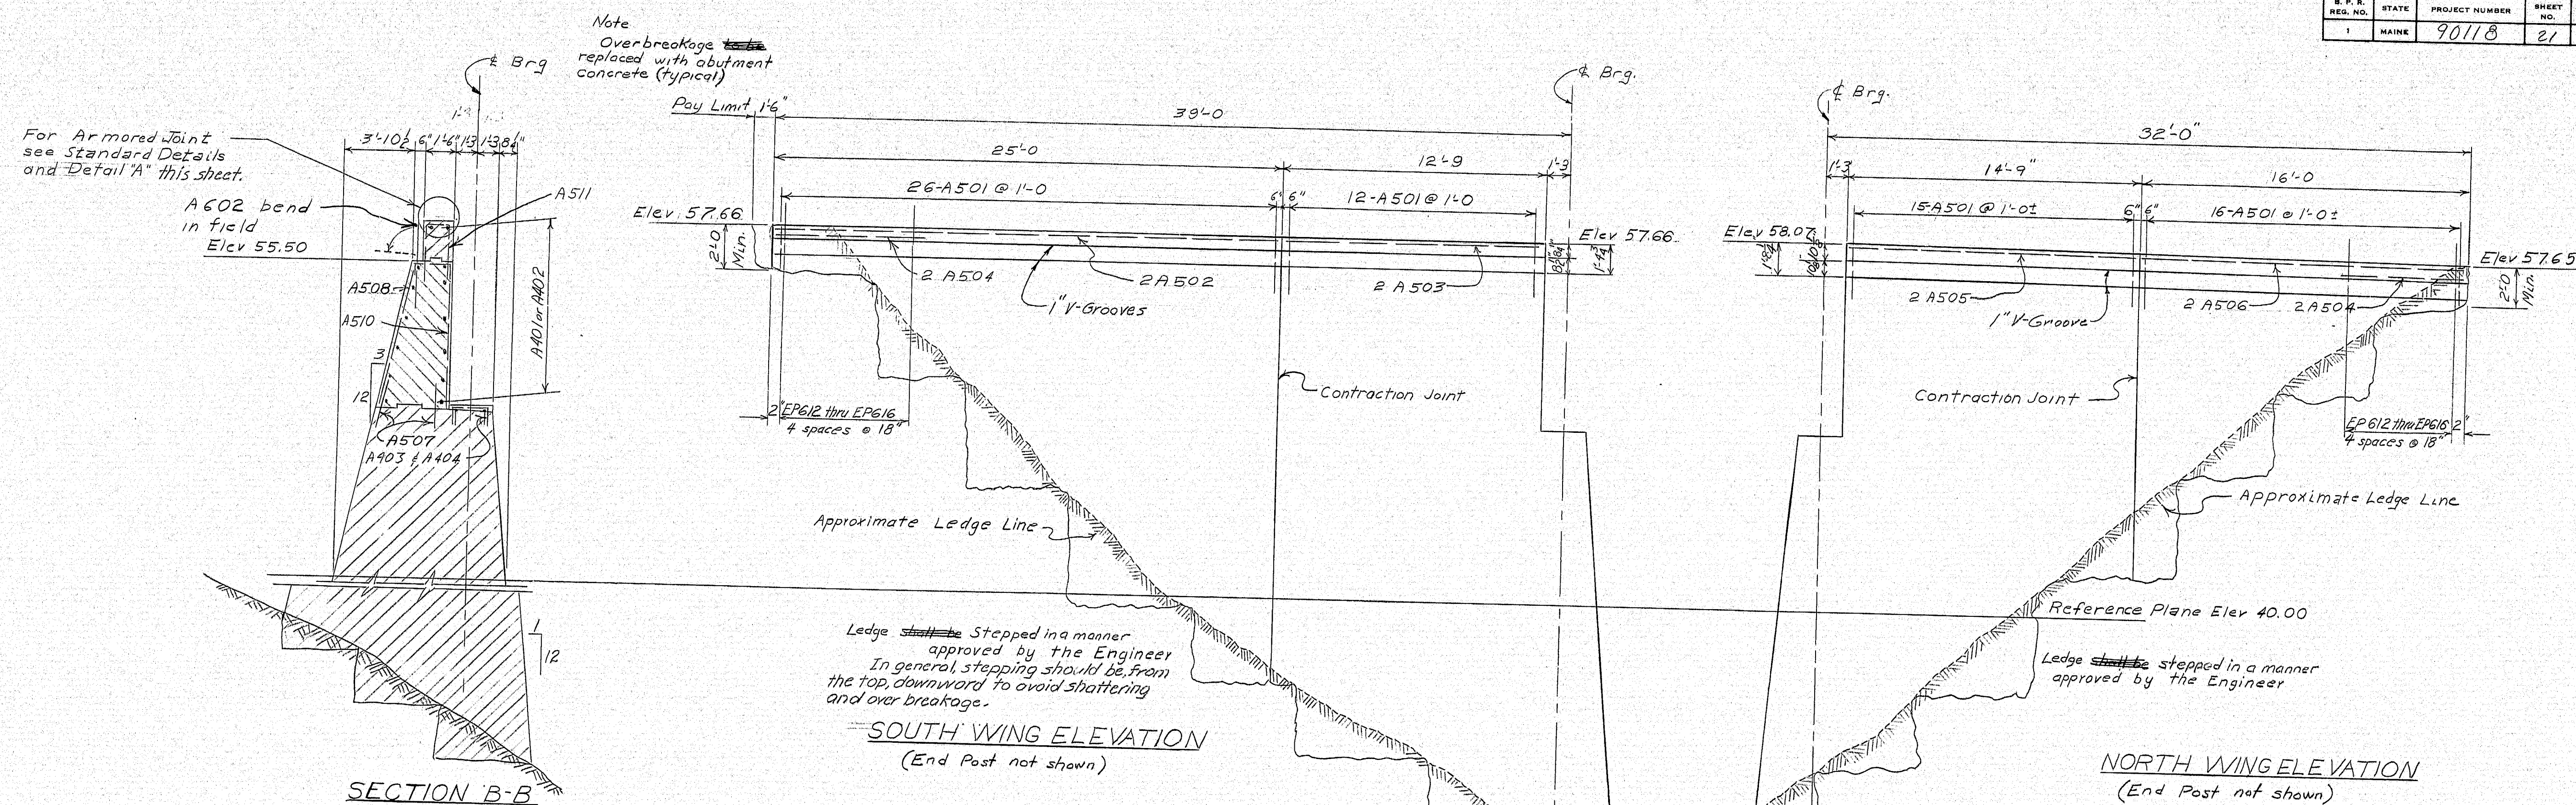

SECTION B-B
ABUTMENT NOTES

1. ~~Chamfered~~ all exposed edges of concrete $\frac{1}{2}$ inch unless otherwise indicated.
2. All reinforcing steel splices and embedments shall be a minimum of 24 bar diameters unless otherwise indicated. Tension splices approved during construction and not shown on plans shall have a 36 bar diameter lapped length.
3. Reinforcing steel shall have 2 inches cover unless otherwise indicated.
4. Place reinforcing steel in bridge seats to clear anchor bolts.
5. ~~Break~~ bond at vertical contraction joints by a method approved by the Engineer.
6. Place concrete in top of abutment backwalls after the superstructure slab has been placed.
7. Waterstops are not required in vertical and horizontal joints.
8. Protective Coating for Concrete Surfaces ~~shall be~~ applied to the following areas: all exposed surfaces of wing walls, and Abutment 2 backwall and breastwall.
9. All structural earth excavation required at abutment #1 in order to reach the ledge foundation ~~shall be~~ paid for at 100% of the contract unit price for Item 206.03.
10. Place 4 inch diameter drains in breastwall and wings at 20 ft maximum spacing and at all low points in ledge. Exact number and location ~~to be~~ determined by Engineer in the field. French Drain (stones only) ~~shall be~~ constructed according to Section 512.
11. Provide joints in the Vertical Bridge Curb, Type 1 at each contraction joint in the wing walls.

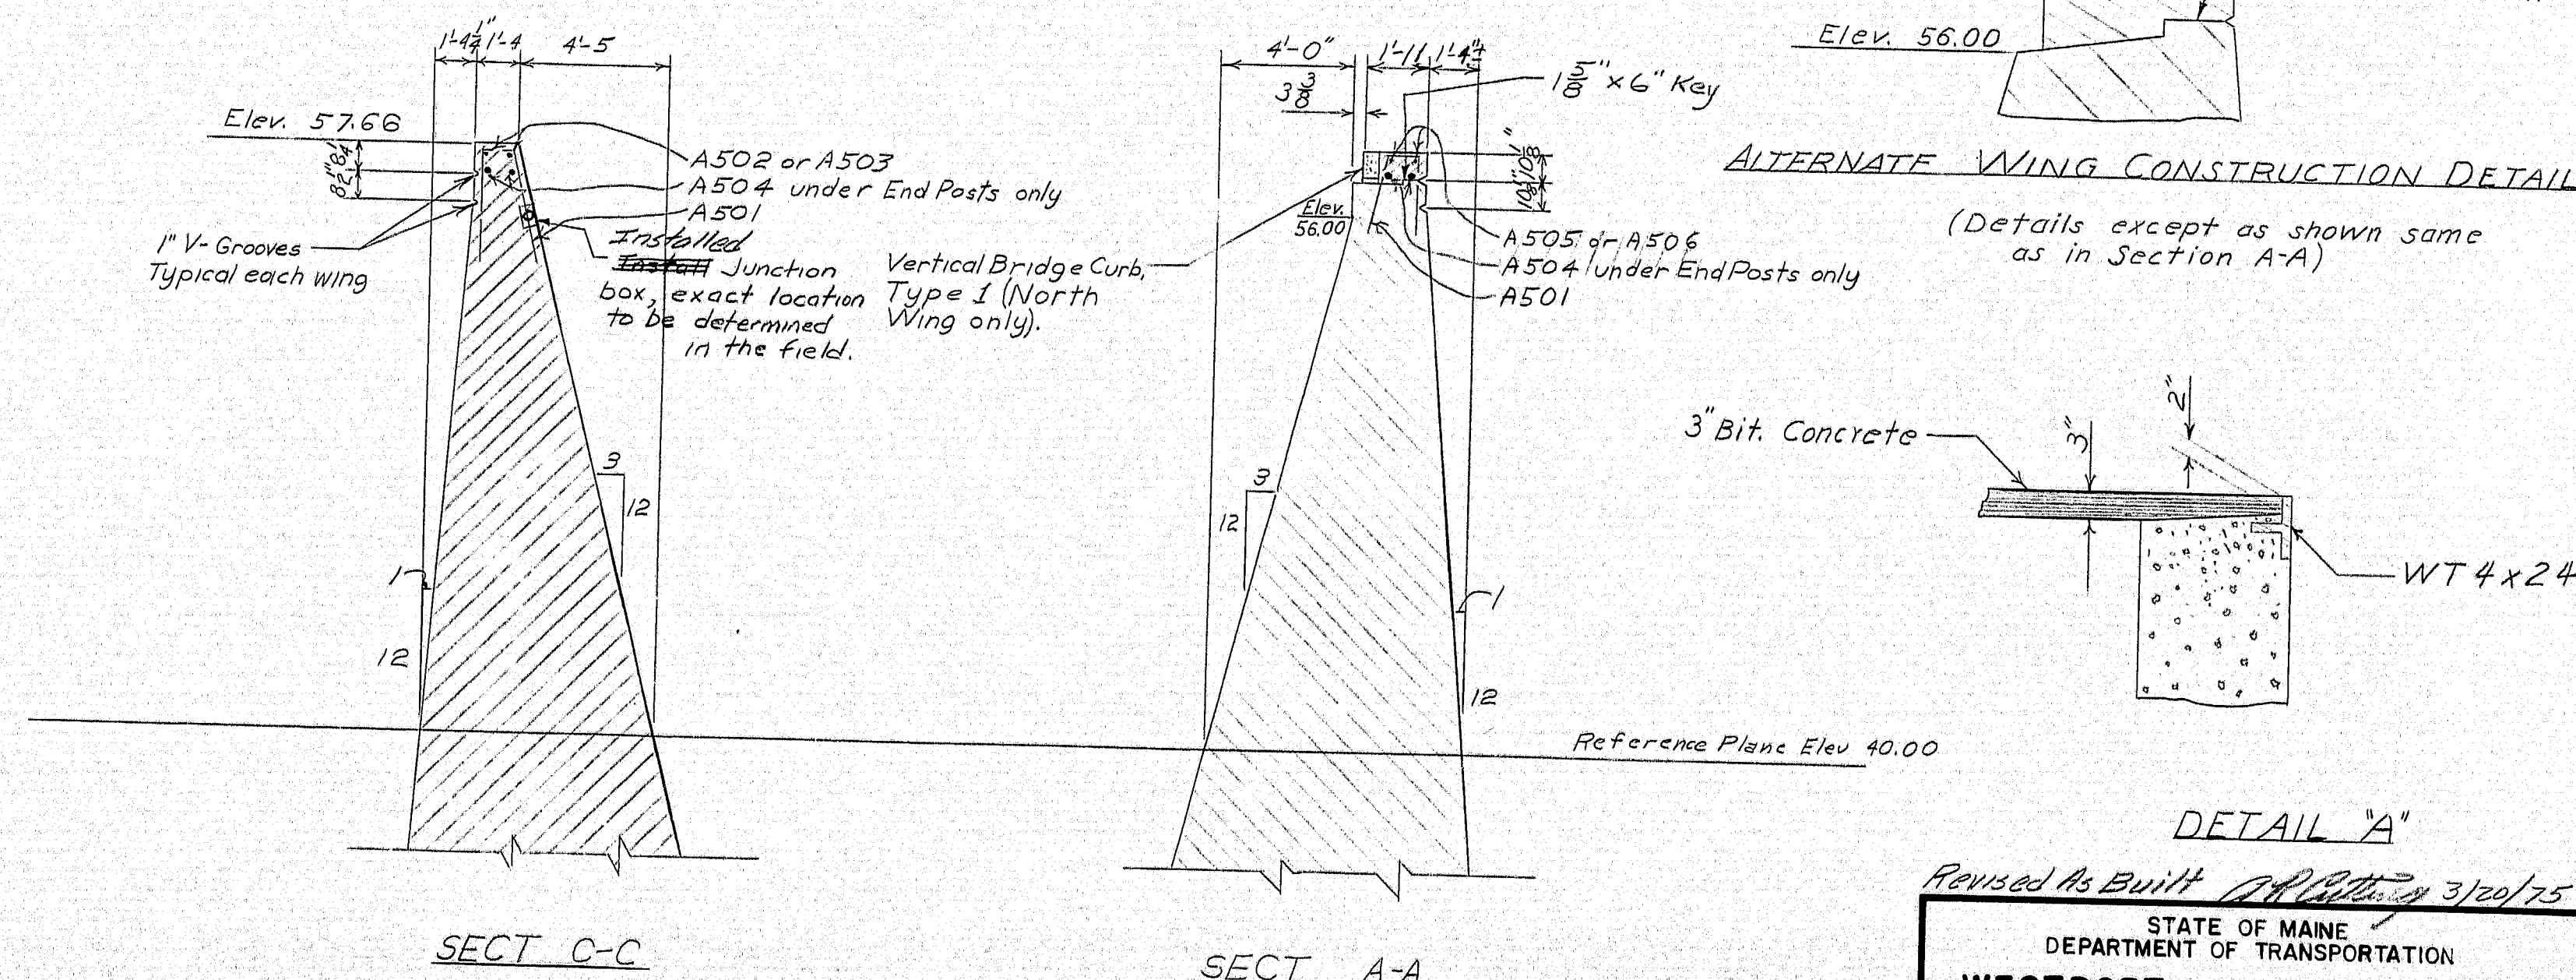




STATE OF MAINE
DEPARTMENT OF TRANSPORTATION
WESTPORT-WISCASSET BRIDGE
OVER
COWSEAGAN NARROWS
BETWEEN THE TOWNS OF
WESTPORT-WISCASSET
LINCOLN COUNTY
ABUTMENT 1 - WINGS
SHEET 8 OF 25 AUGUSTA, MAINE APRIL 1973

153-126

DESIGN - DETAILED	CHECKED	DATE
EDC	Pinkham	Dec 72
REVISIONS	FIELD CHANGES	
1	G.O.W.	1/15/73

PLANS

PLANS	DESIGN - DETAILED	BY	DATE
	CHECKED	MMS	Dec 72
	REVISIONS	S.O.T	4/13/73
	FIELD CHANGES		

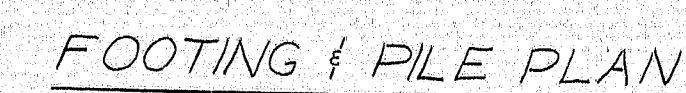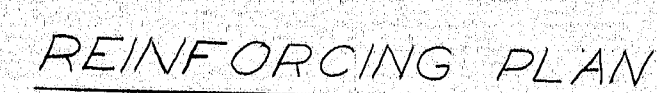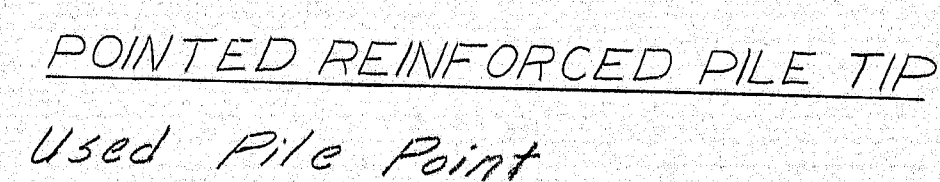


1. Piles ~~shall be~~ driven to ledge or practical refusal.
2. All piles shall have pointed reinforced tips.
- used 3. Alternate types of pointed reinforced pile tips may be used if they are approved by the Engineer.
4. Estimated driven lengths of piles are determined from available soils information with no allowance for pile cut-offs and no allowance for uncertain pile penetration.
5. Piles marked thus, ~~shall be~~ ^{WP29} battered $1\frac{1}{2}$ inches per foot in the direction of the arrow.
6. Maximum pile load equals: 96 tons.
7. Following are pile locations, number of piles required, size of piles and estimated driven lengths:
Abutment No. 2 8-HP14x73@50ft
 8-HP14x73@55ft

STATE OF MAINE
DEPARTMENT OF TRANSPORTATION
WESTPORT-WISCASSET BRIDGE
OVER
COWSEAGAN NARROWS
BETWEEN THE TOWNS OF
WESTPORT-WISCASSET
LINCOLN COUNTY
ABUTMENT 2 FOOTING

SHEET 9 OF 25 AUGUSTA, MAINE APRIL 1973


153-127

PLANS	DESIGN - DETAILED	CHECKED	REVISIONS	FIELD CHANGES
	MM/2	MM/2	MM/2	MM/2
	CDH	CDH	CDH	CDH

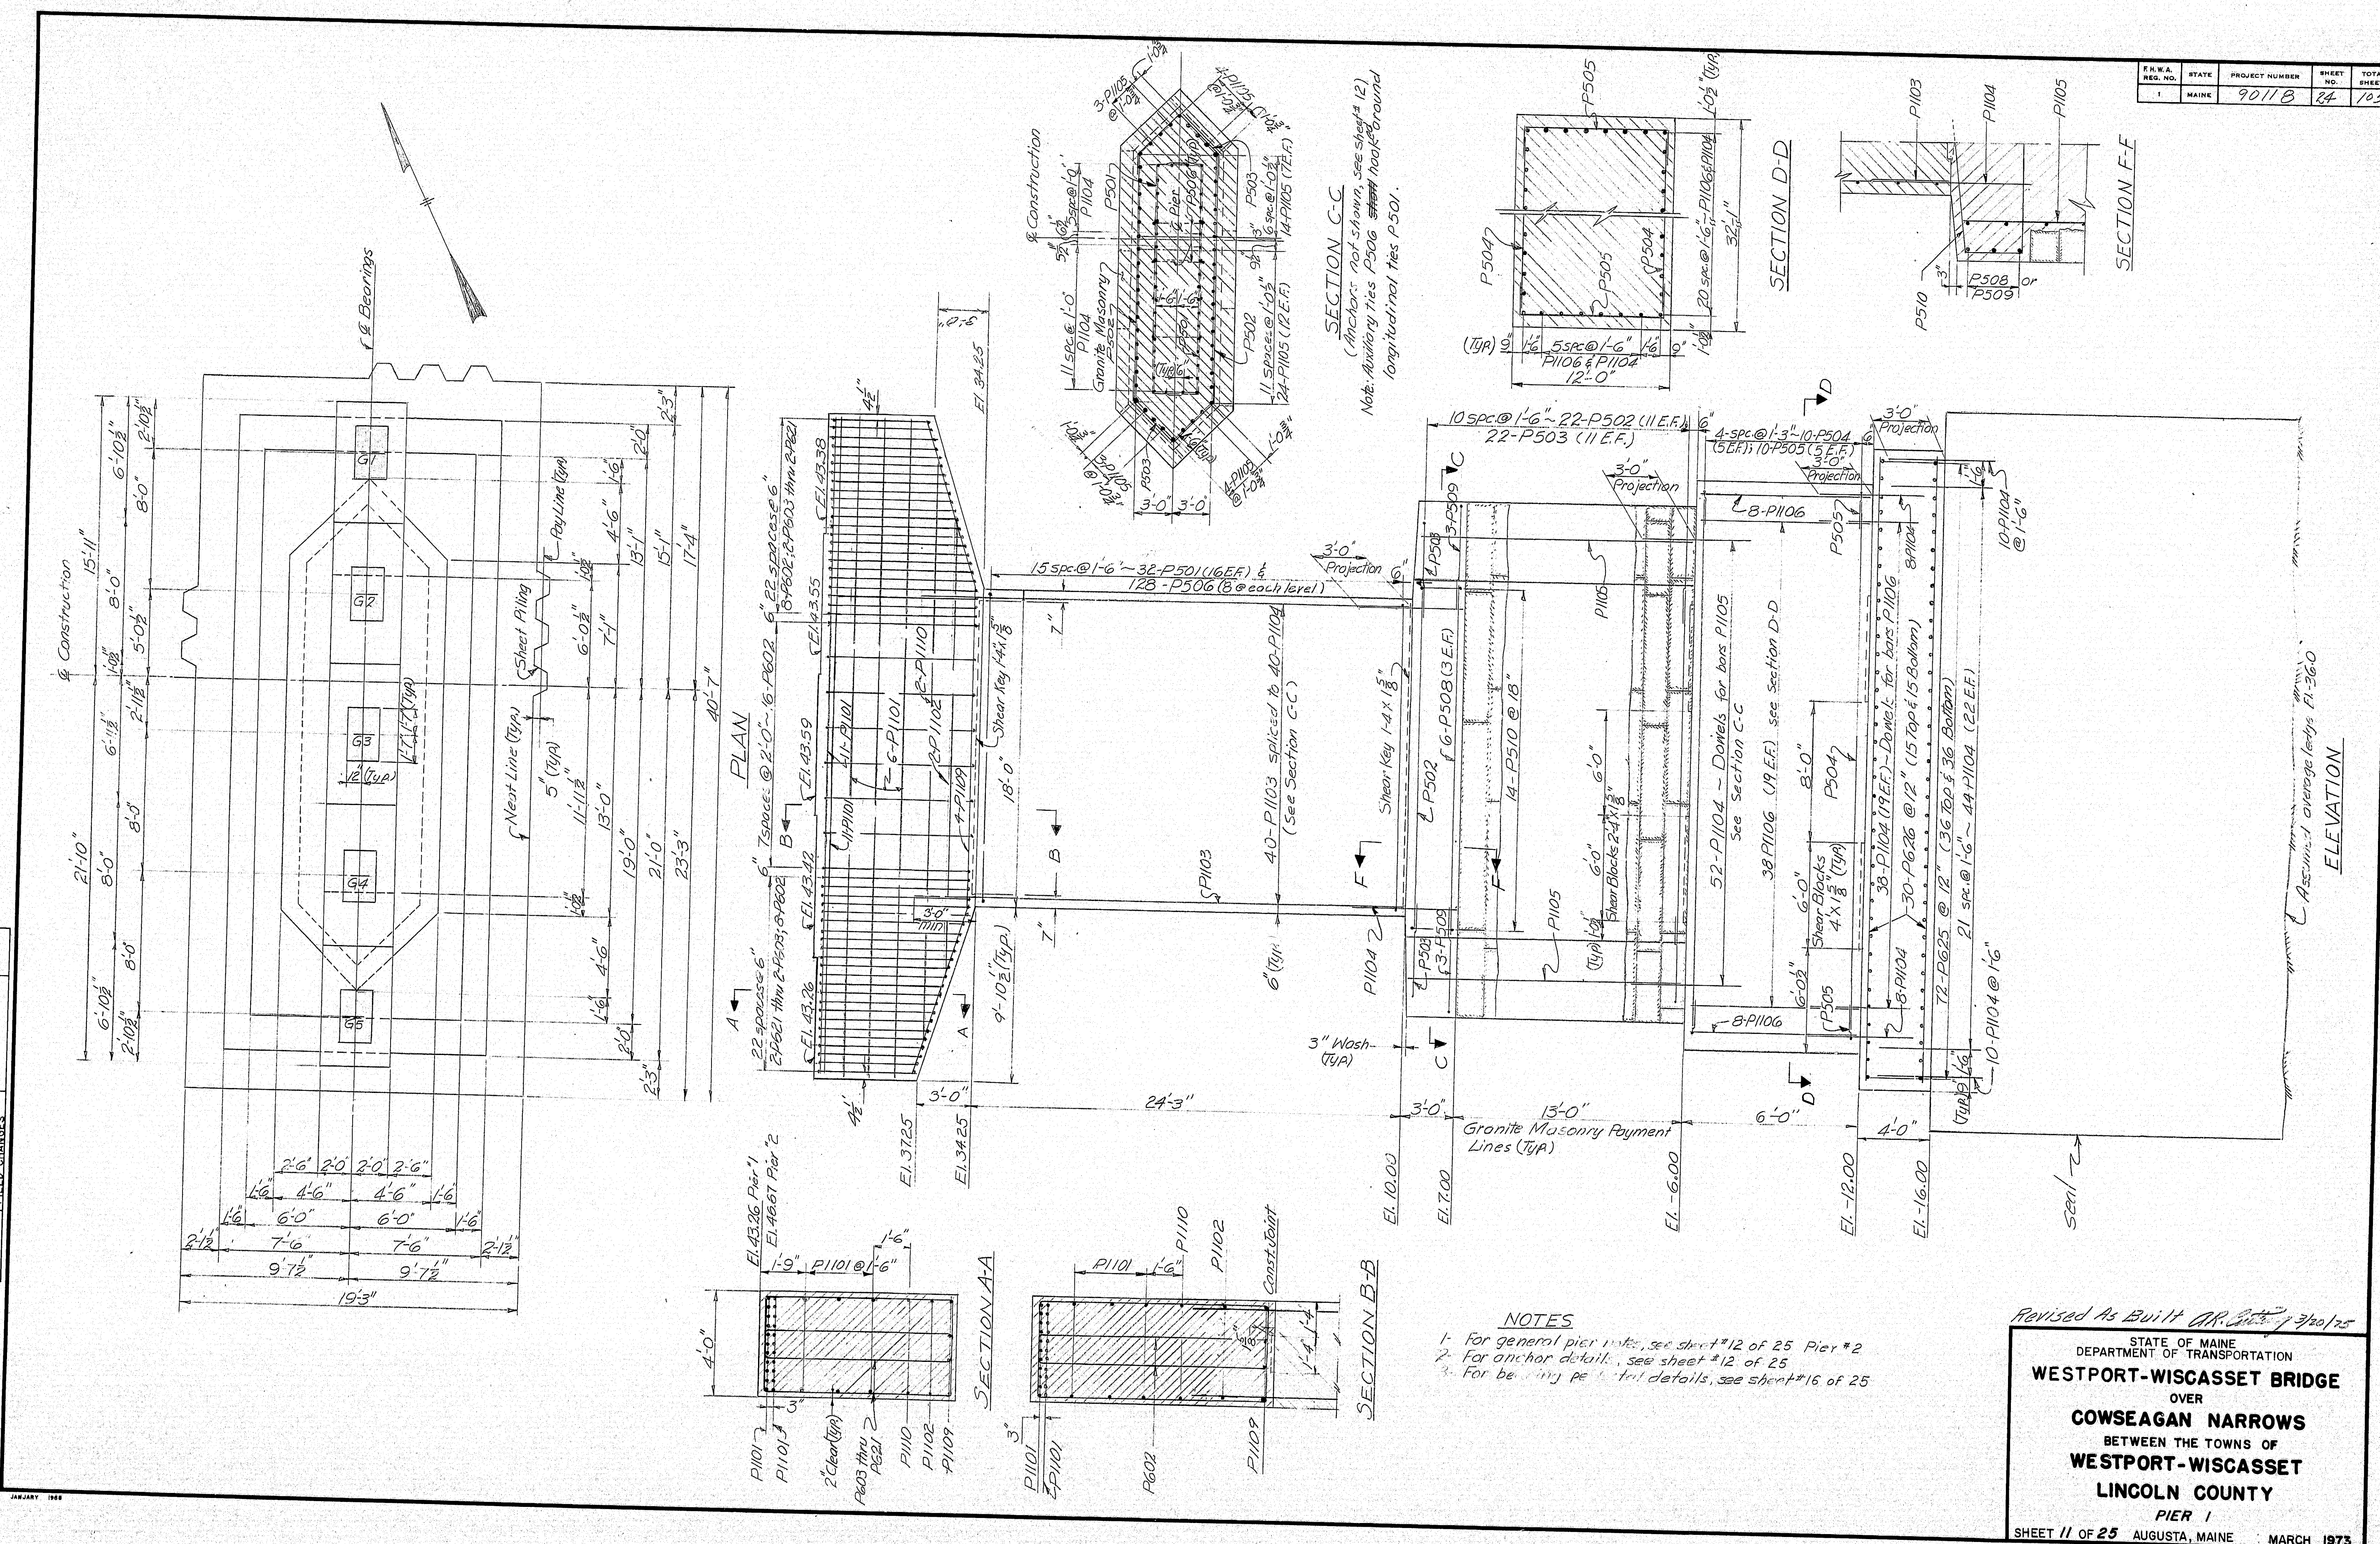

153-129

^aNote: The ledge shall be excavated in the area where seal one is to be placed such that the ledge on the ledge will be not more than 4 feet vertical to the top of the 20% of the Standard Specifications. Payment will be according to section 601.07. Payment shall not extend below a horizontal plane thru the bottom point of existing ledge inside the neat lines of the seal. Typical for both pier.

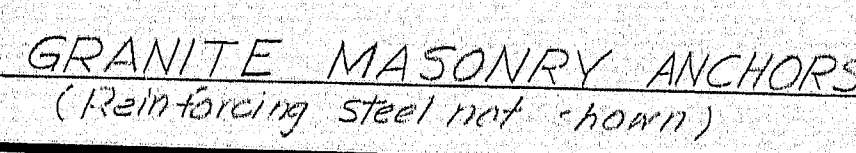

- REFERENCES
- 1- For bearing pedestal details, see sheet # 16
 - 2- For Sections A-A, B-B & C-C, see sheet # 11 Pier #1
 - 3- For Section F-F see sheet #11 Pier #1

Revised As Built CR. 3/20/75

STATE OF MAINE
DEPARTMENT OF TRANSPORTATION

WESTPORT-WISCASSET BRIDGE

OVER

COWSEAGAN NARROWS


BETWEEN THE TOWNS OF

WESTPORT-WISCASSET

LINCOLN COUNTY



PIER 2

SHEET 12 OF 25 AUGUSTA, MAINE MARCH 1973



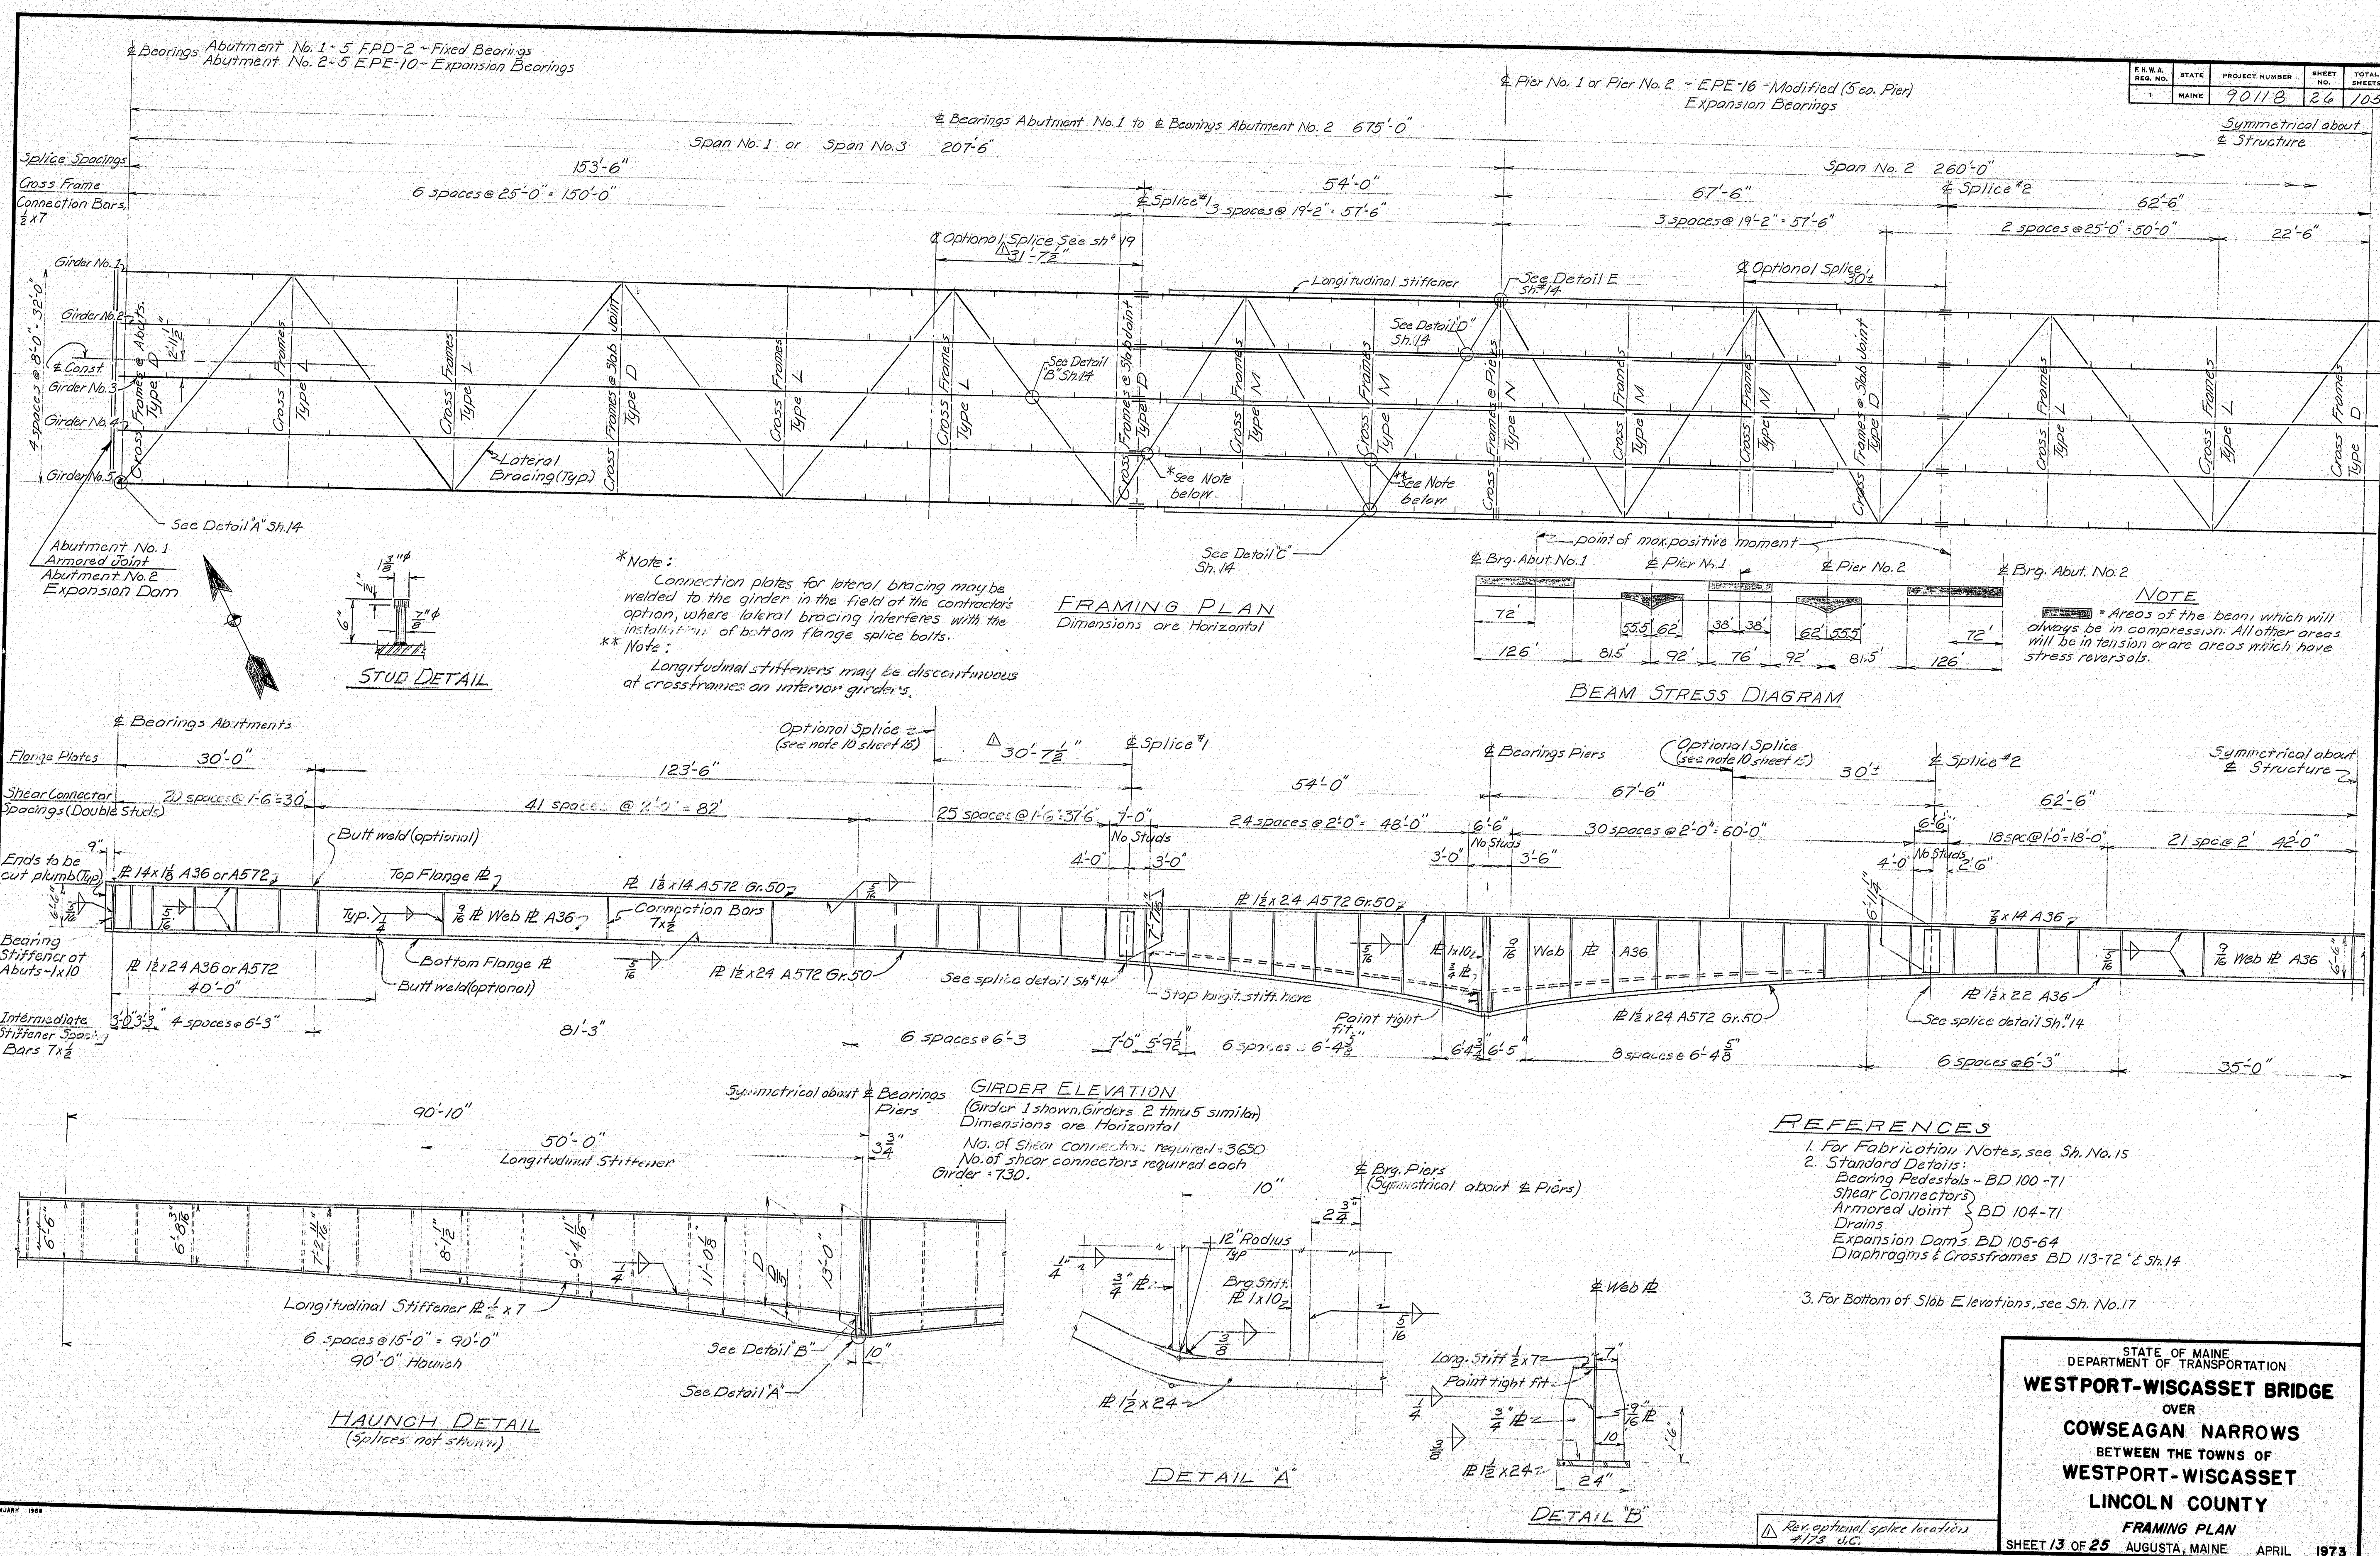


153-131




F.H.W.A. REV. NO.	STATE	PROJECT NUMBER	SHEET NO.	TOTAL SHEETS
1	MAINE	90118	27	105

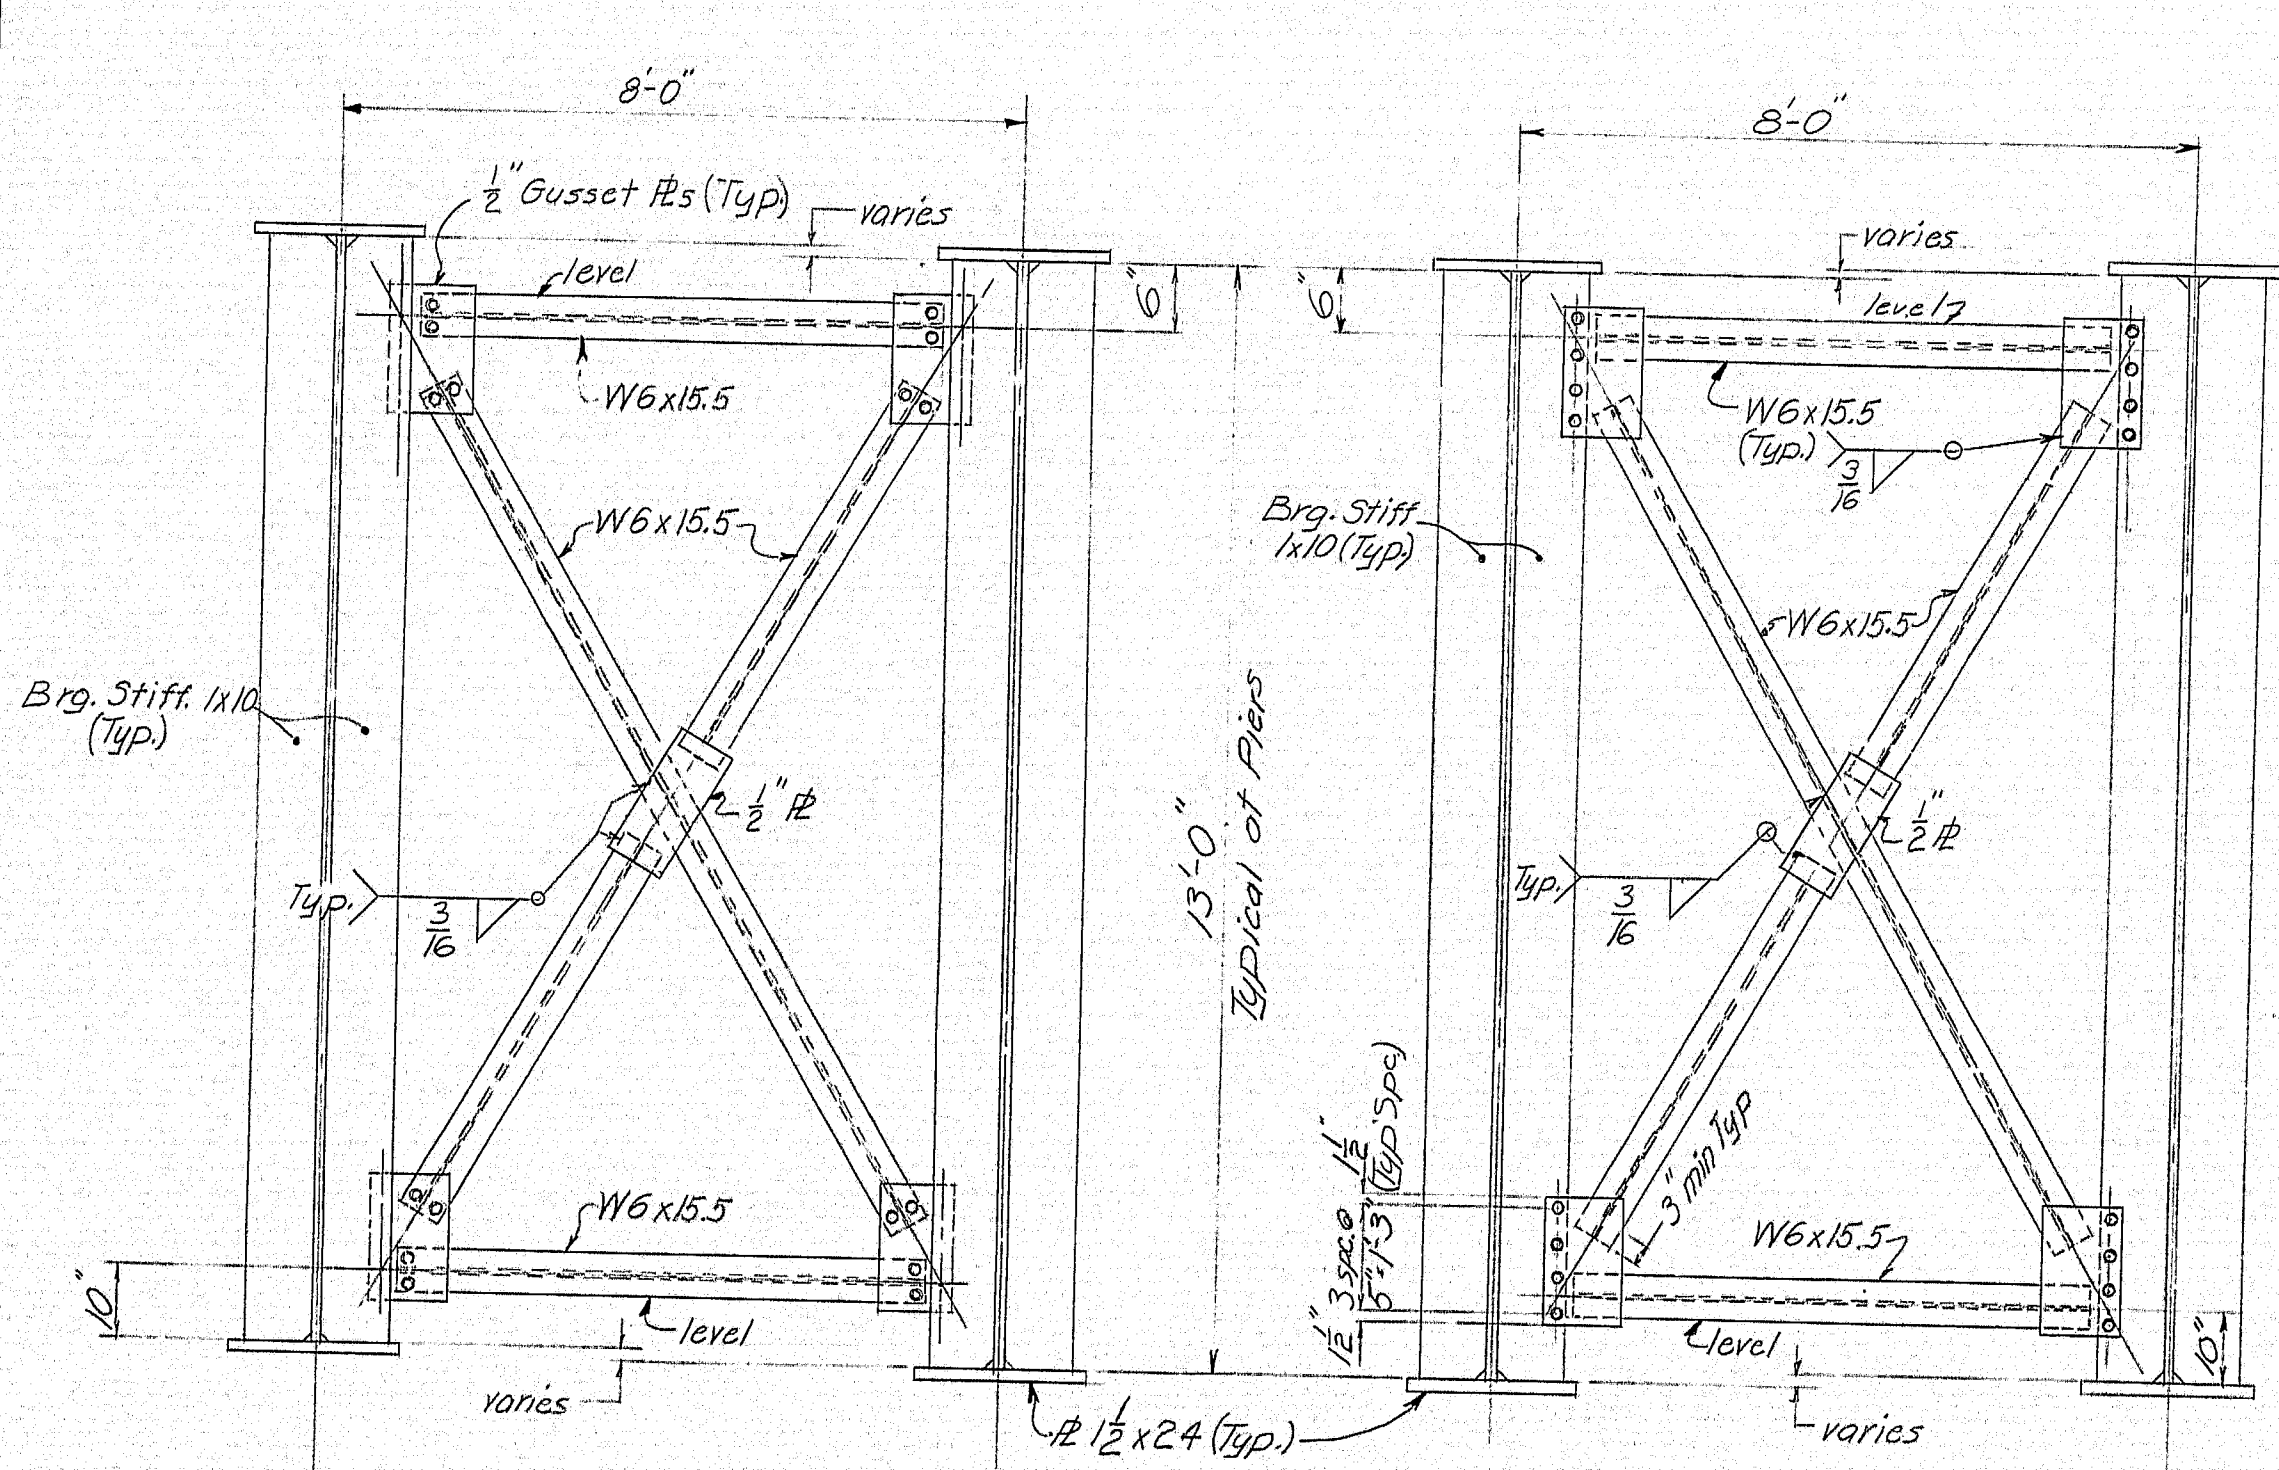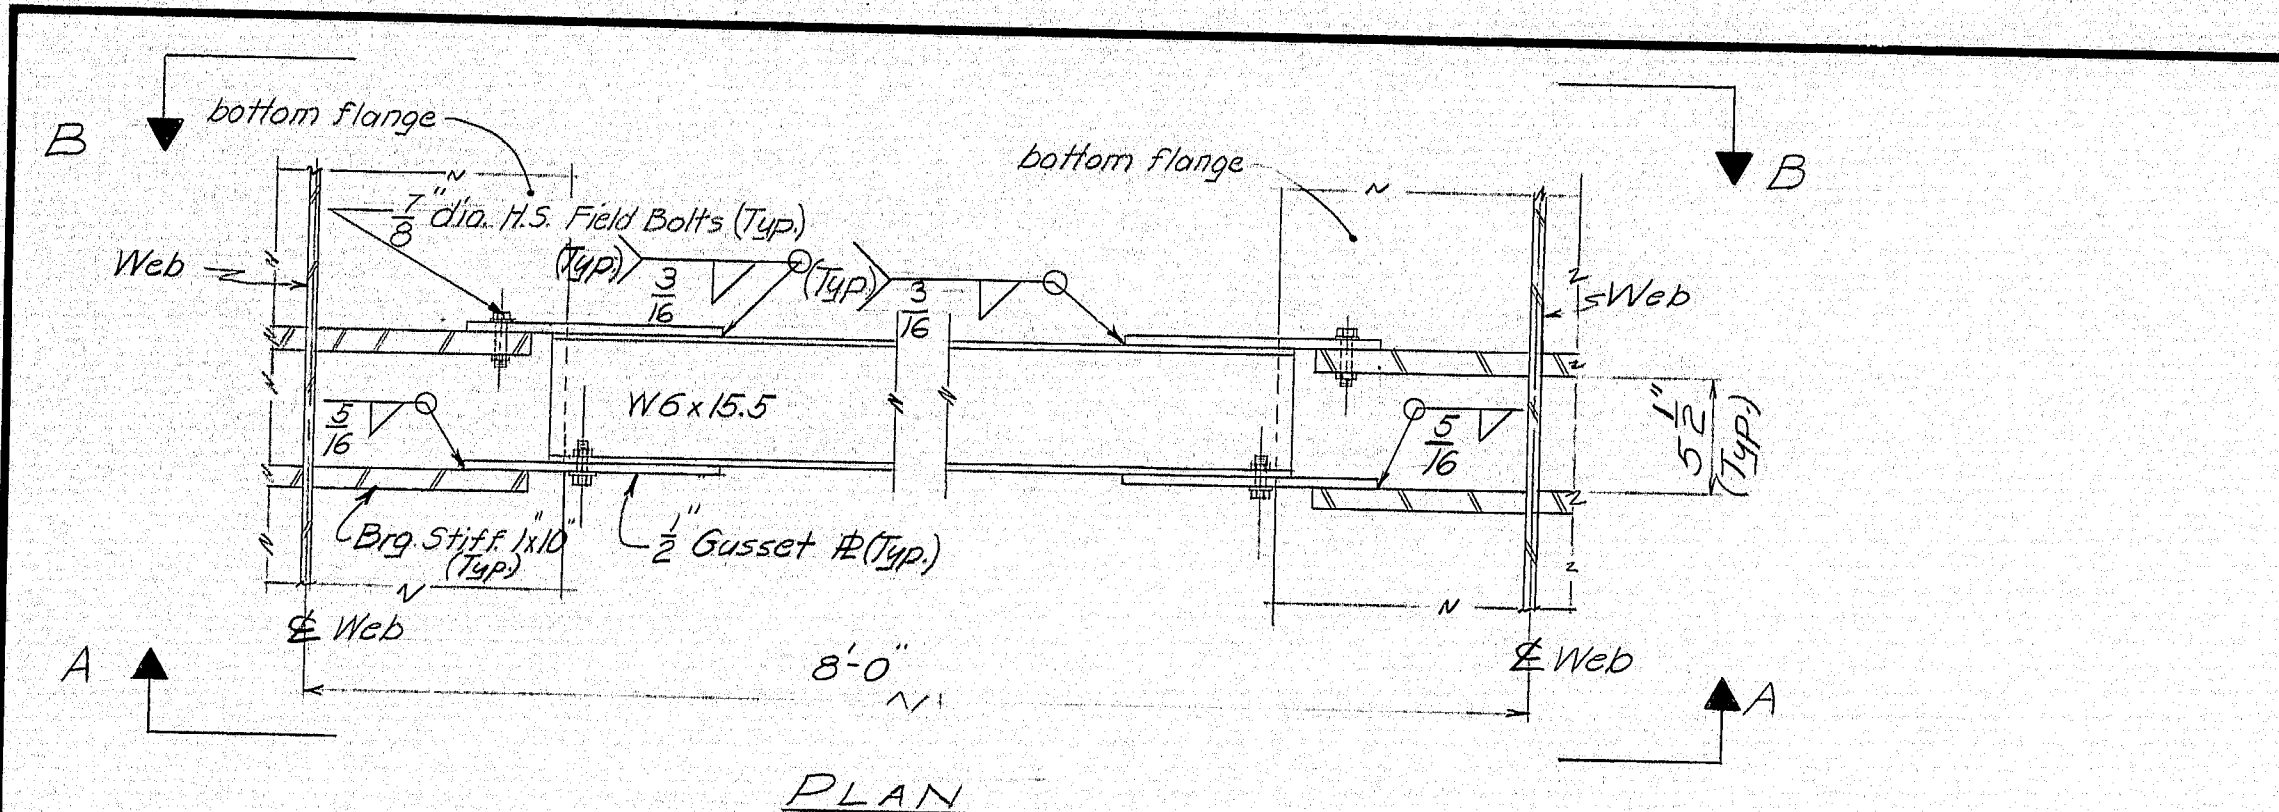

TYPE N CROSSFRAME DETAILS

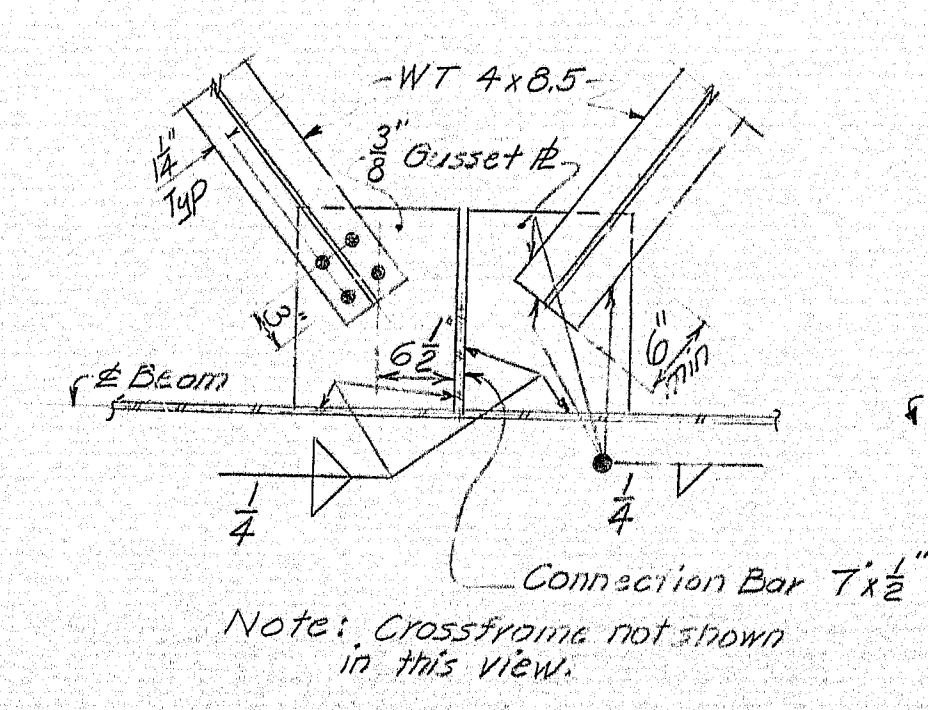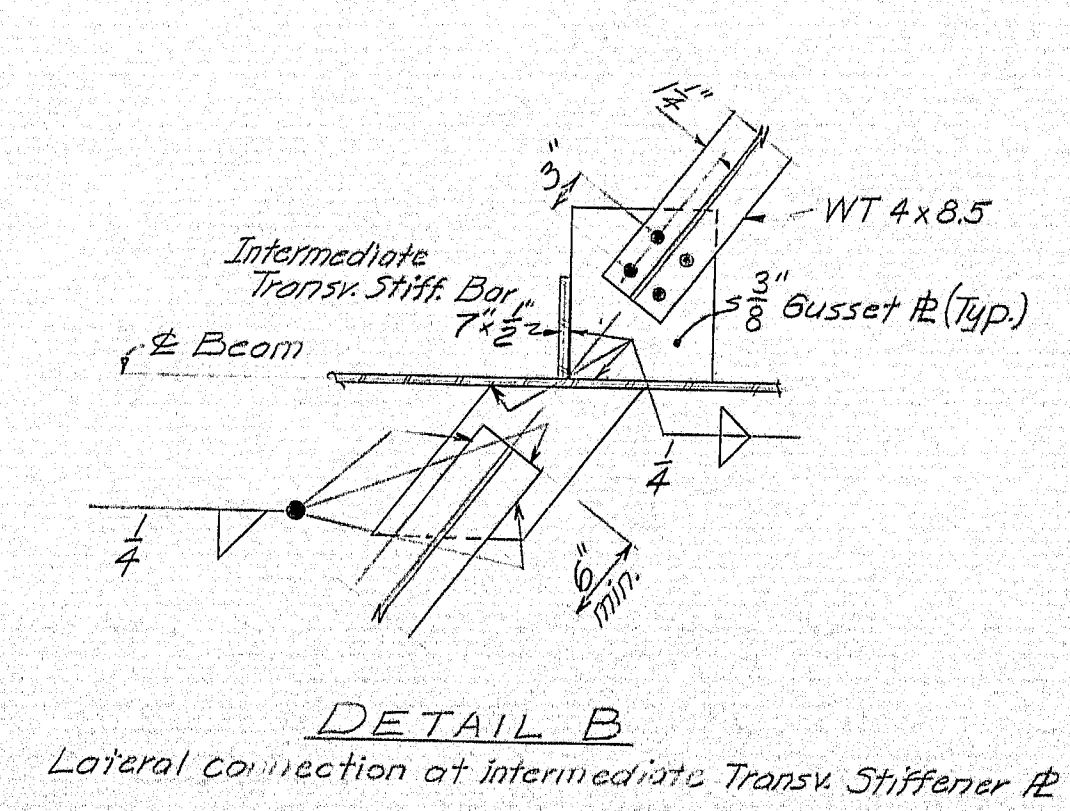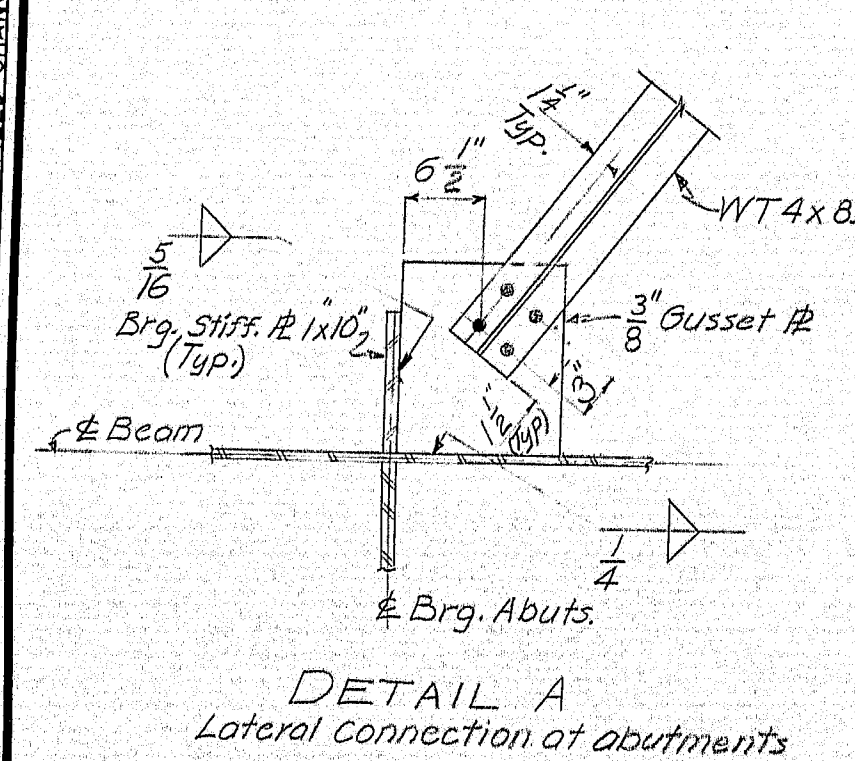


DETAIL C-PLAN
Lateral connection at Cross Frame (Ext. beam)

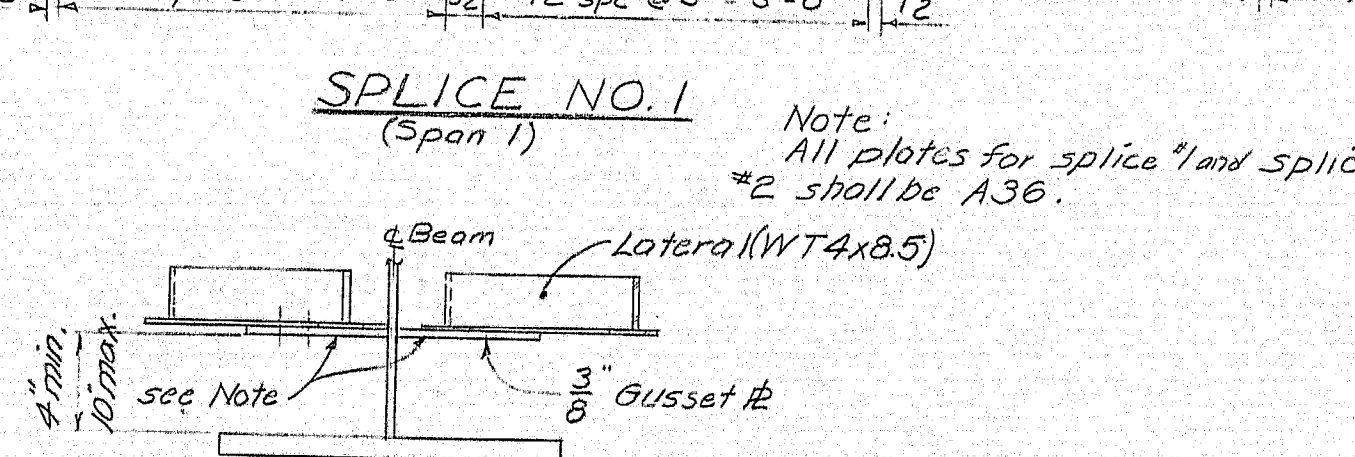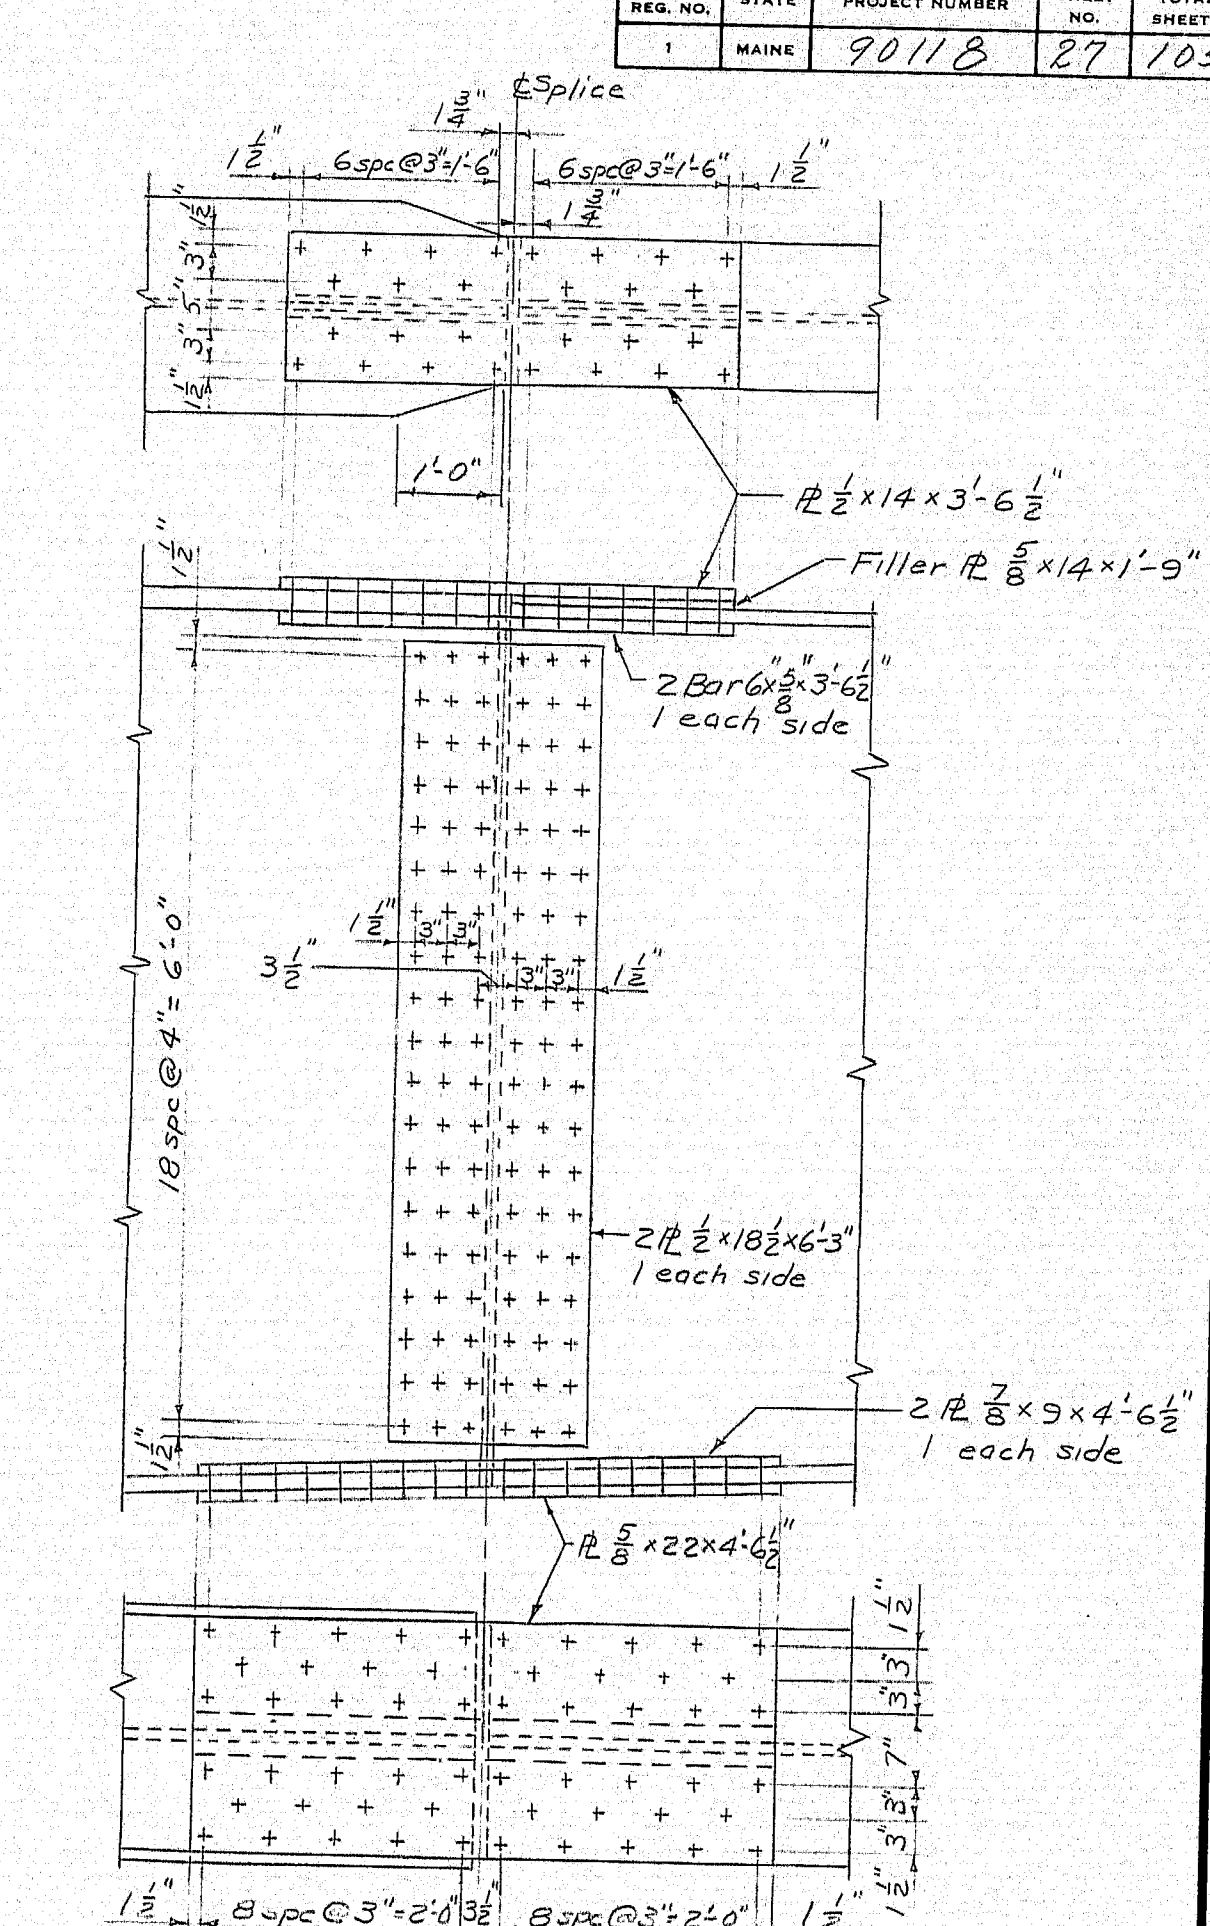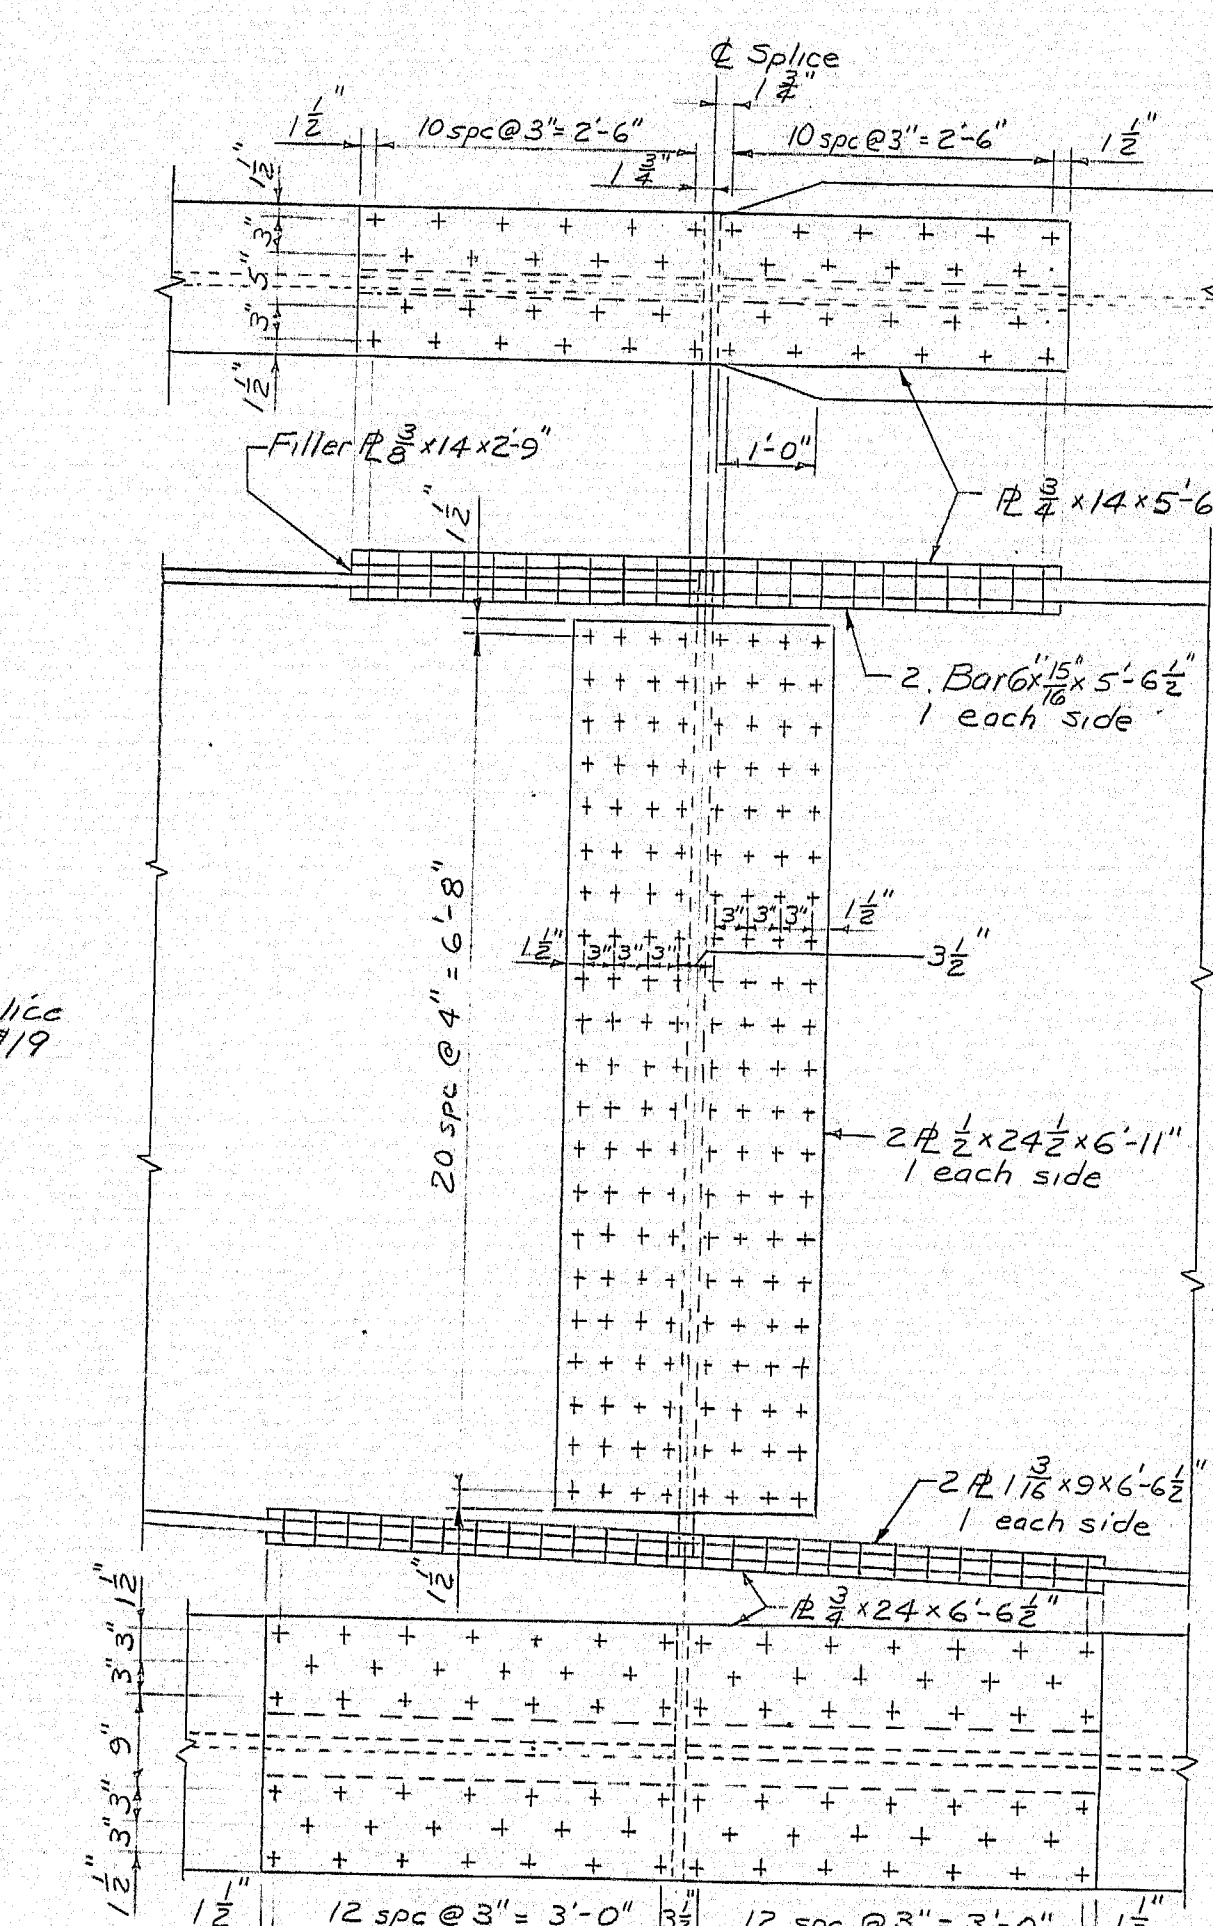

NOTE: The lateral members being connected to a common beam shall be attached at the same elevation as shown in above detail. (Typical at all connection points)

DETAIL D-PLAN
Lateral connection at location with no transverse stiffener or connection (Int. beam)

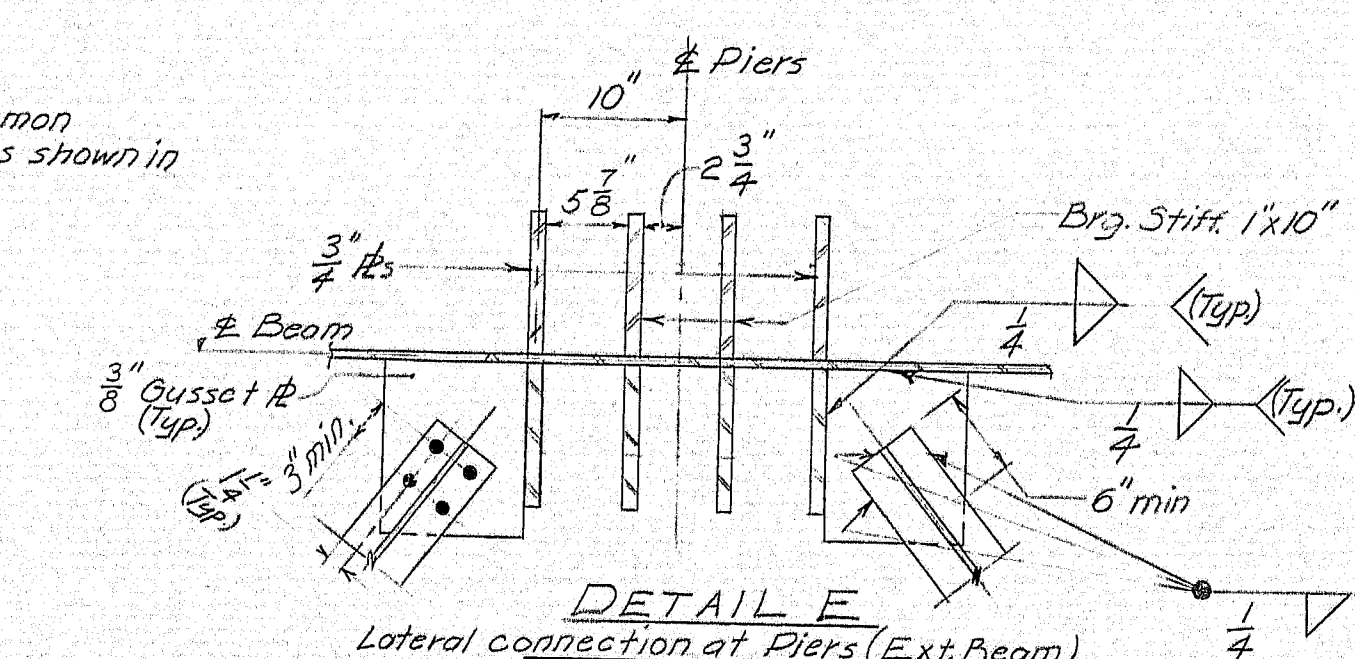


STATE OF MAINE
DEPARTMENT OF TRANSPORTATION
WESTPORT-WISCASSET BRIDGE
OVER
COWSEAGAN NARROWS
BETWEEN THE TOWNS OF
WESTPORT-WISCASSET
LINCOLN COUNTY
STEEL DETAILS
SHEET 14 OF 25 AUGUSTA, MAINE APRIL 1973

153-132


DESIGN - DETAILED	DATE
CHECKED	BY
REVISIONS	REVISIONS
FIELD CHANGES	FIELD CHANGES

FABRICATION NOTES


1. No transverse butt weld splices will be allowed in the flange plates or web plates within 10 feet from the points of maximum negative moment at pier or maximum positive moment (See sh# 13).
2. Sections of flange plates or web plates between transverse butt weld splices or from field splices shall be not less than 10 feet in length unless otherwise shown on the plans.
3. Butt weld splices in flanges shall be not closer than one foot from transverse welds in the web plates.
4. One longitudinal butt weld splice in the web will be allowed in the trunched sections of the girders. Feather edges between the longitudinal welds and the bottom flanges will not be allowed.
5. Bearing stiffeners shall be plumb after erection and dead loading of the structure. Intermediate web stiffeners may be either plumb or normal to the top flange.
6. Crossframe connection plates may be either plumb or normal to the top flange.
7. Filler plates may be ASTM A36 steel and mill tests for filler plate material will not be required.
8. Intermediate stiffeners and crossframe connection plates shall extend to the top and bottom flanges, and shall have a "point tight fit", except intermediate stiffeners adjacent to abutments (6 per beam section) shall be attached to the top flange with a $\frac{5}{16}$ " double fillet weld; and intermediate stiffeners adjacent to piers (15 each side of each pier) shall be attached to the bottom flange with a $\frac{5}{16}$ " double fillet weld.
9. Bearing stiffeners shall be attached to both sides of webs at all abutments and piers, and shall have a point tight fit at the top flange and shall be ground to bear at the bottom flange or attached with a full penetration groove weld.
10. At the contractor's option additional bolted field splices may be utilized at locations shown on the plans. Design details will be provided upon written request by the contractor.
11. All structural steel except as otherwise indicated shall conform to ASTM A36. Girder flange plates shall conform to ASTM A572 Gr 50 where shown on framing plan. Bolts shall conform to ASTM A325.

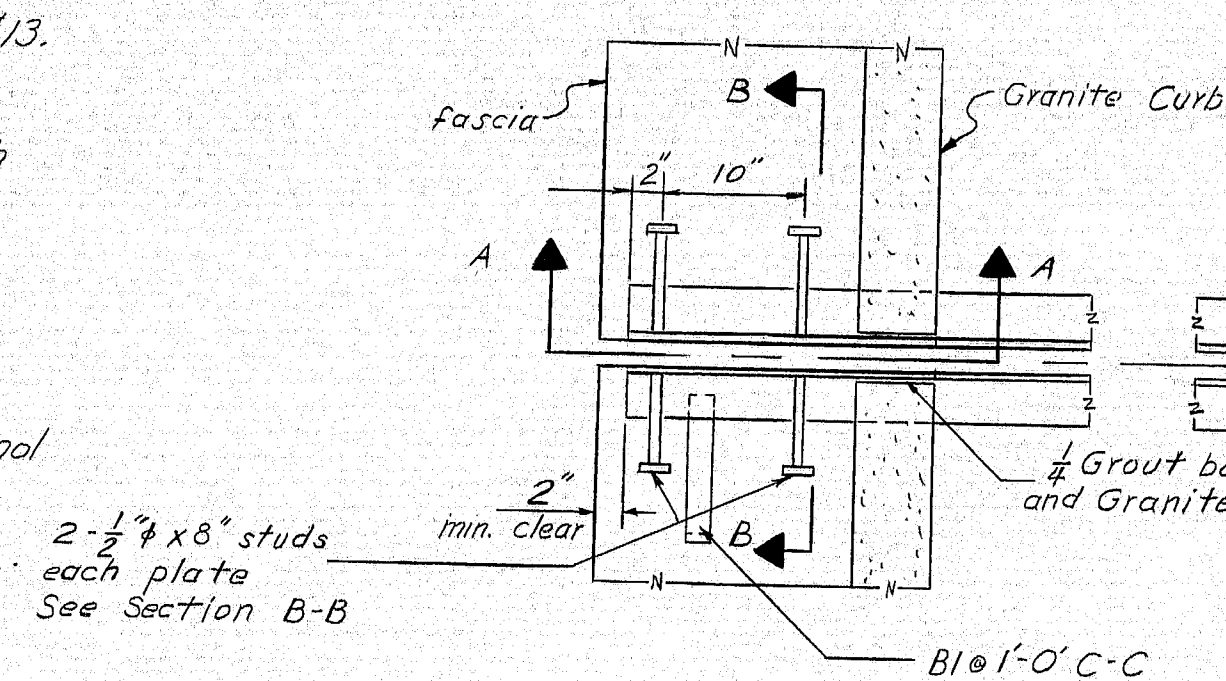

ABUTMENT NO. 1
ARMORED JOINT
PLAN

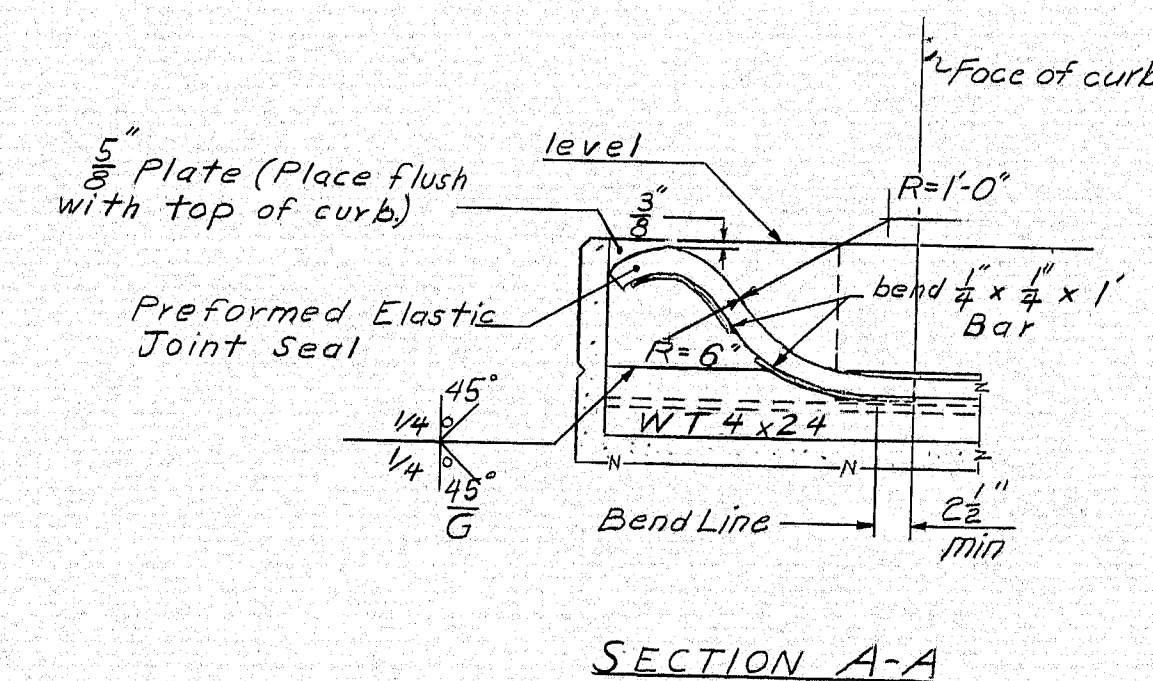


SECTION A-A

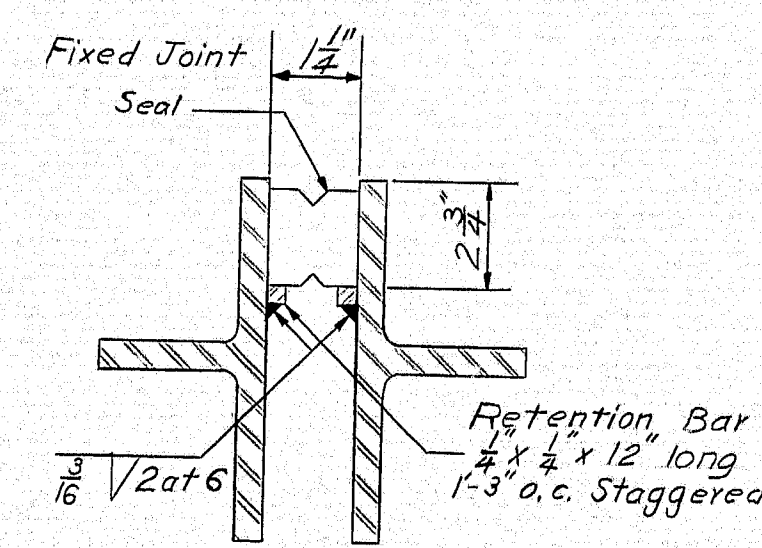


SEAL ARRANGEMENT

NOTES:


- 1) The seal furnished shall be type A or type B and shall have a movement rating of $\frac{1}{2}$ inch.
- 2) The joint opening shown is for design only and is subject to change due to differences in seals as supplied by various manufacturers. Do not use for setting of joint opening during construction.
- 3) The seal characteristics shall be submitted to the engineer for approval prior to the fabrication of the armored joint.
- 4) A movement of $\frac{1}{2}$ inch, due to dead loads (slab, curb, and wearing surface), shall be taken into account when setting the armored joint.

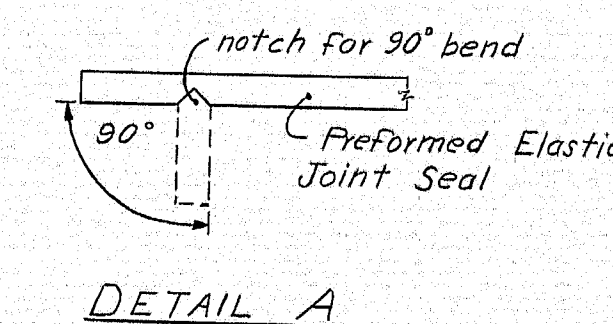

DETAIL A

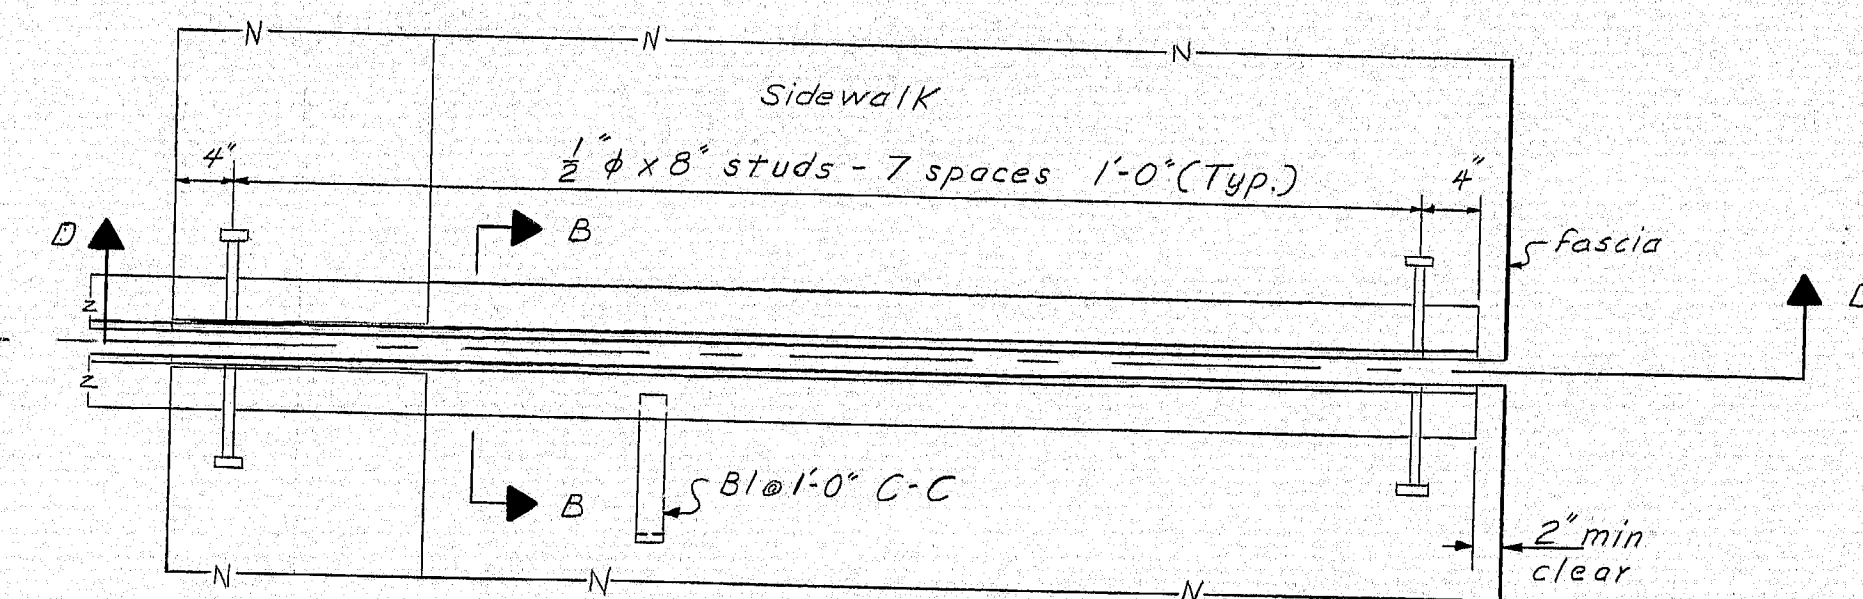

SECTION D-D

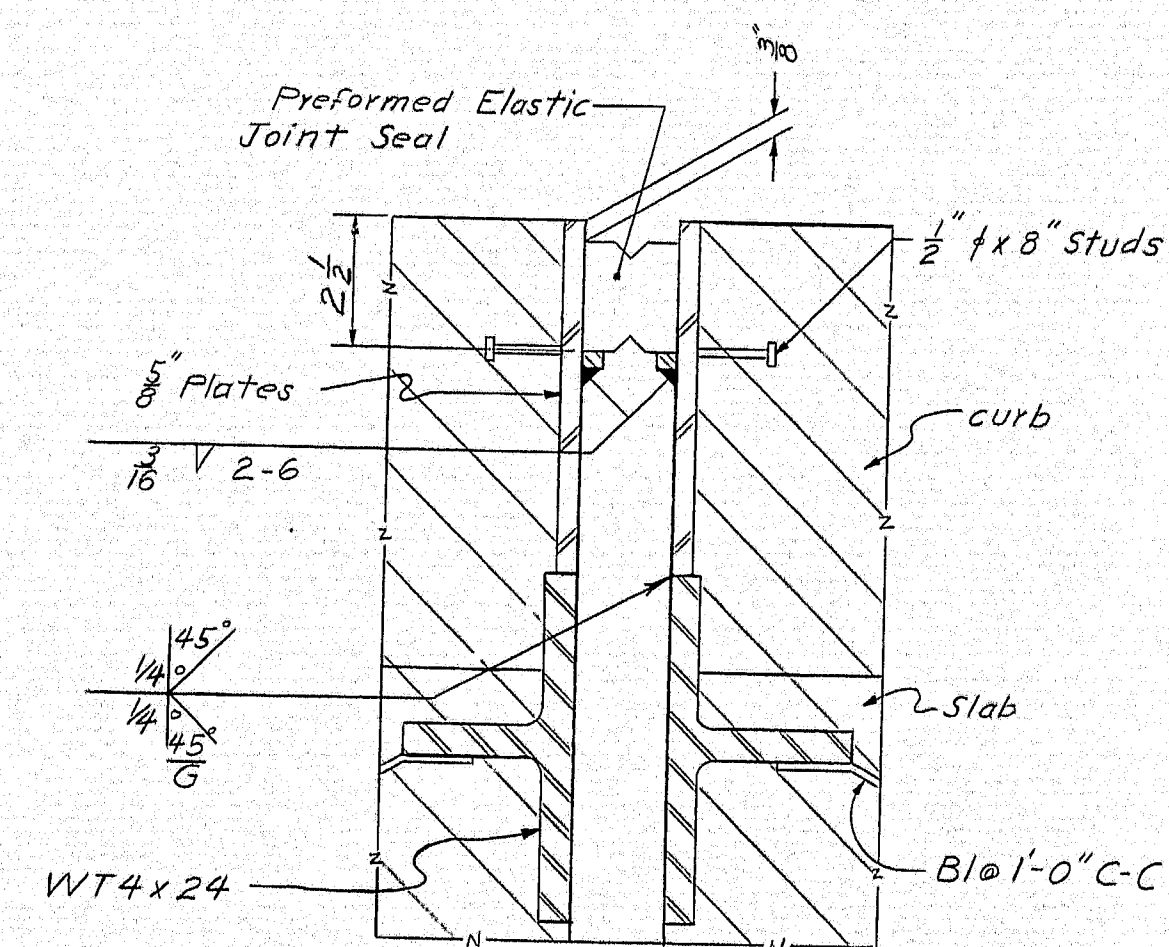

SECTION B-B


NOTE:

For armored joint details not shown, refer to Bridge Standard Details BD 104-71.

STATE OF MAINE
DEPARTMENT OF TRANSPORTATION
WESTPORT-WISCASSET BRIDGE
OVER
COWSEAGAN NARROWS
BETWEEN THE TOWNS OF
WESTPORT-WISCASSET
LINCOLN COUNTY
ARMORED JOINT
SHEET 15 OF 25 AUGUSTA, MAINE APRIL 1973


153-133

F.H.W.A. RES. NO.	STATE	PROJECT NUMBER	SHEET NO.	TOTAL SHEETS
1	MAINE	90118	29	105

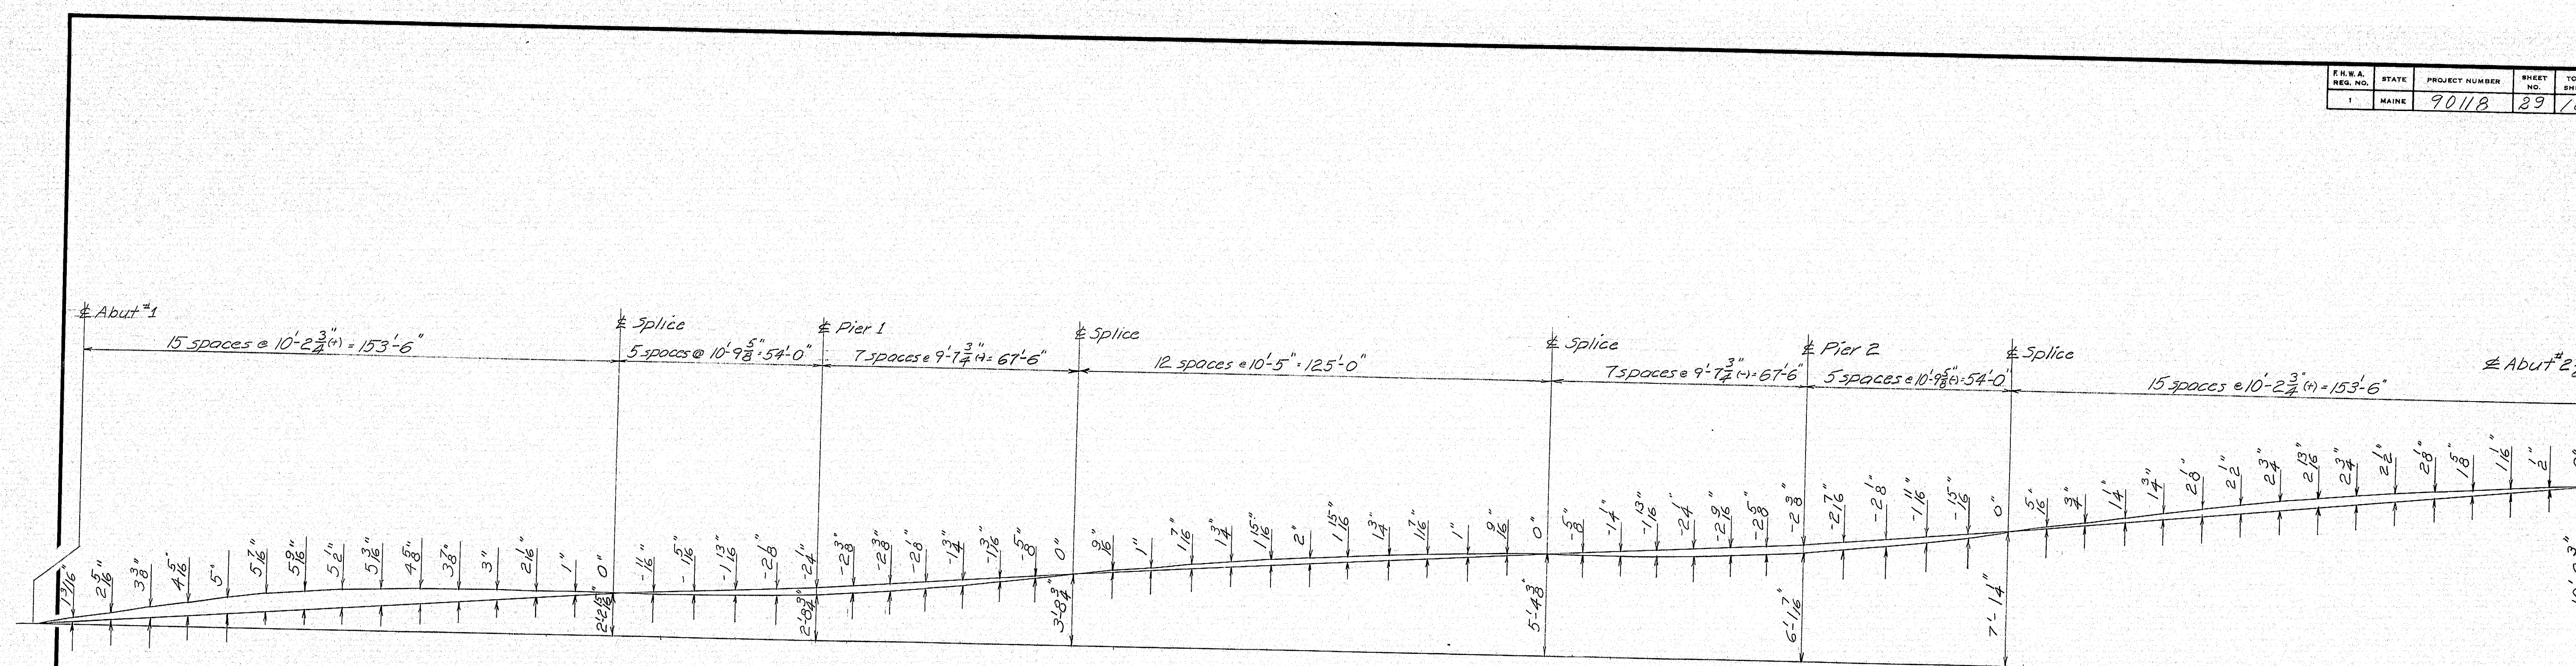


Note:
Camber ordinates shown are computed to
compensate for all dead load deflections and
for the curvature of the finish grade profile.


CAMBER DIAGRAM

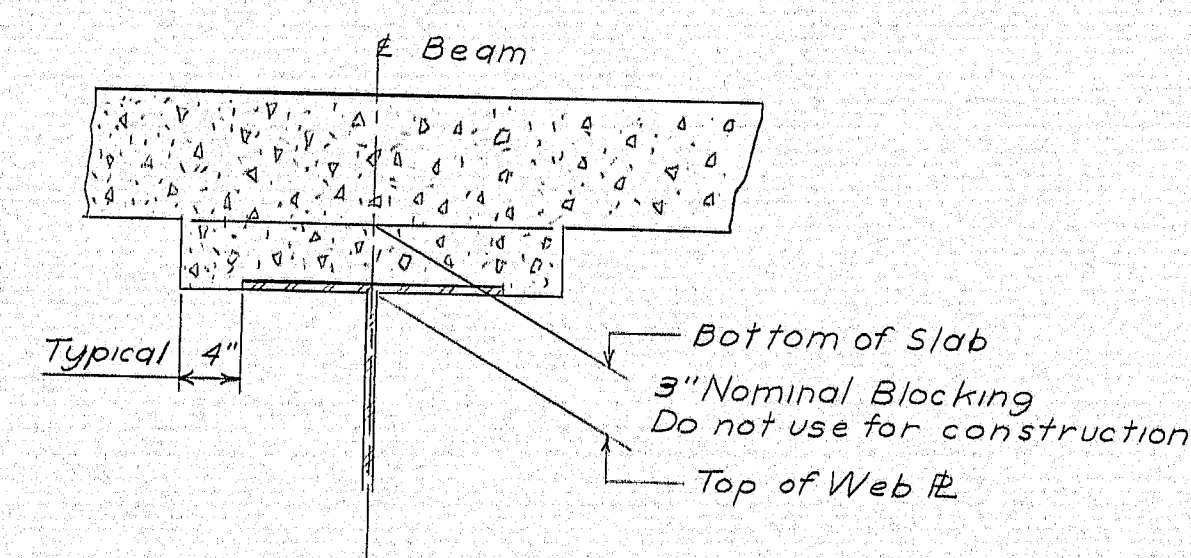

BLOCKING DETAIL

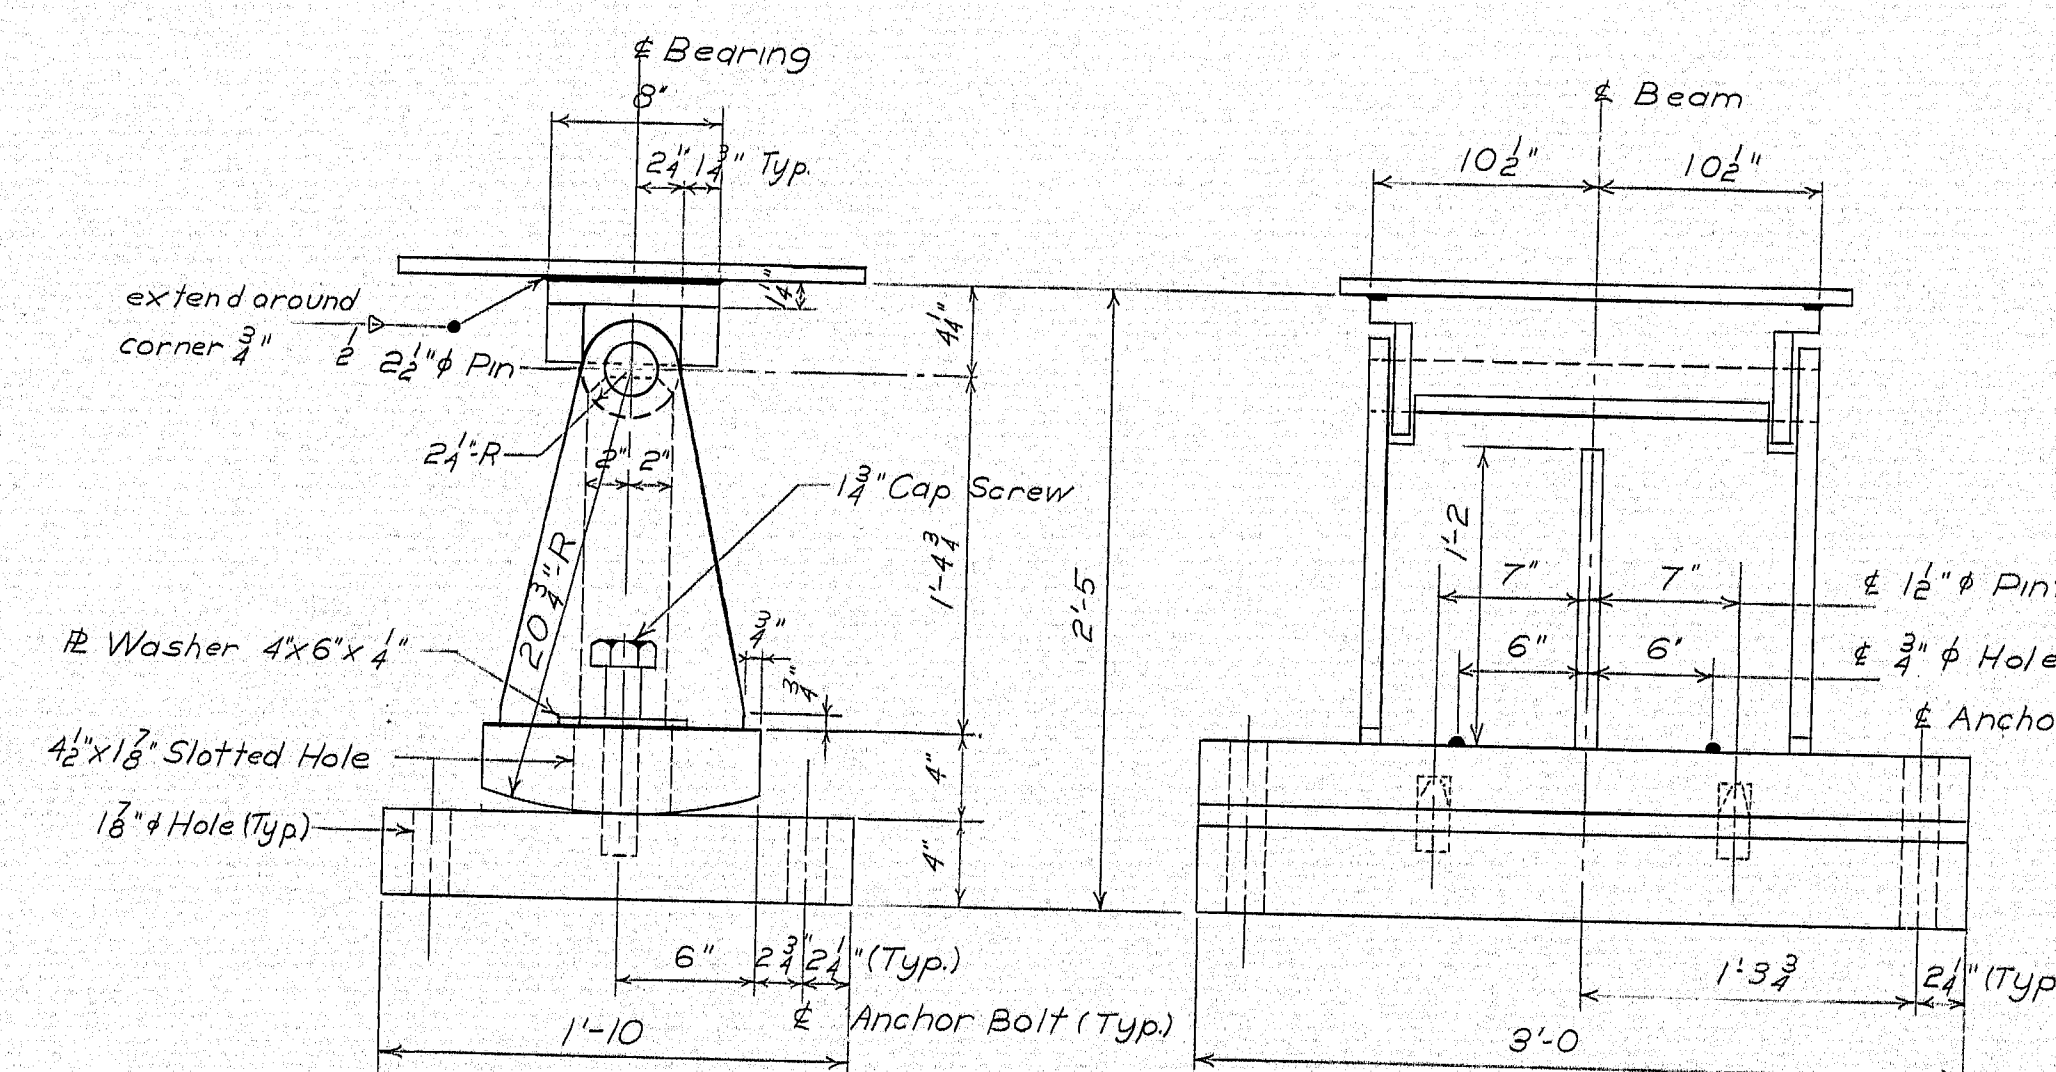

BEARING PEDESTAL AT PIERS
(EPE 16 Modified, 10 Required)

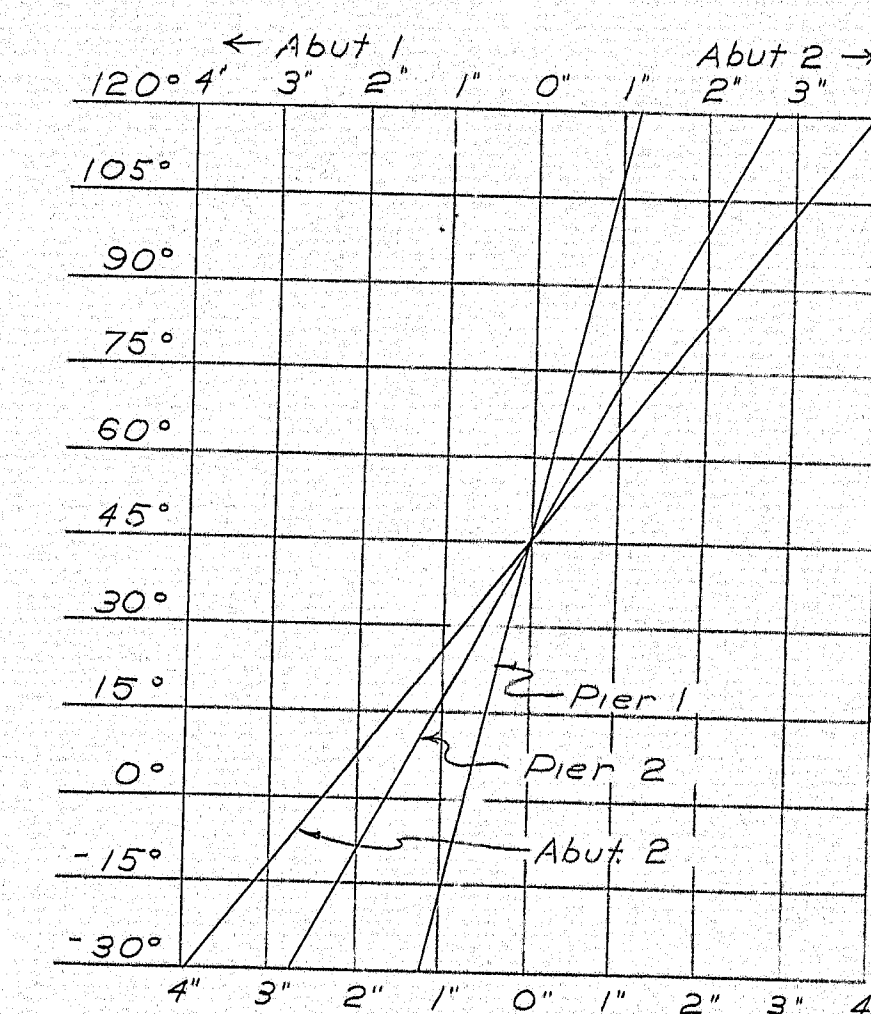

PEDESTAL SETTING DIAGRAM
(Final Positions Shown)

STATE OF MAINE
DEPARTMENT OF TRANSPORTATION
WESTPORT-WISCASSET BRIDGE
OVER
COWSEAGAN NARROWS
BETWEEN THE TOWNS OF
WESTPORT-WISCASSET
LINCOLN COUNTY
CAMBER DIAGRAM - PEDESTALS
SHEET 16 OF 25 AUGUSTA, MAINE APRIL 1973

153-134

DESIGN - DETAILED	BY	DATE
MMG	Pinham	Dec 72
REVISIONS	BY	DATE
1	MMG	10/73
FIELD CHANGES	BY	DATE


PLANS

JANUARY 1988

F.H.W.A. NO.	STATE	PROJECT NUMBER	SHEET NO.	TOTAL SHEETS
1	MAINE	90118	30	105

BOTTOM OF SLAB ELEVATIONS																											
SPAN No. 1																	SPAN No. 2										
POINT	± Brg. Abut. 1	1	2	3	4	5	6	7	8	9	10	11	12	13	14	15	± Brg. Pier #1	1	2	3	4	5	6	7	8	9	10
Beam 1	56.46	56.74	57.02	57.28	57.53	57.74	57.93	58.10	58.24	58.36	58.47	58.57	58.67	58.78	58.90	59.03	59.18	59.32	59.50	59.69	59.90	60.12	60.33	60.54	60.75	60.94	61.11
Beam 2	56.62	56.91	57.19	57.45	57.69	57.91	58.10	58.26	58.40	58.52	58.63	58.74	58.84	58.94	59.06	59.20	59.34	59.49	59.66	59.86	60.07	60.29	60.50	60.71	60.91	61.10	61.28
Beam 3	56.67	56.95	57.23	57.49	57.74	57.95	58.14	58.31	58.45	58.57	58.68	58.78	58.88	58.99	59.11	59.24	59.39	59.53	59.71	59.90	60.11	60.33	60.54	60.75	60.96	61.15	61.32
Beam 4	56.50	56.78	57.06	57.33	57.57	57.79	57.98	58.14	58.28	58.40	58.51	58.61	58.71	58.82	58.94	59.07	59.22	59.37	59.54	59.74	59.95	60.16	60.38	60.59	60.79	60.98	61.16
Beam 5	56.33	56.62	56.90	57.16	57.40	57.62	57.81	57.97	58.11	58.23	58.34	58.45	58.55	58.65	58.77	58.91	59.05	59.20	59.37	59.57	59.78	60.00	60.21	60.42	60.62	60.81	60.99
①	.0000	.0321	.0617	.0869	.1065	.1196	.1257	.1248	.1173	.1042	.0870	.0671	.0471	.0291	.0148	.0050	.0000	-.0008	-.0033	.0119	.0245	.0400	.0564	.0716	.0836	.0919	.0940
②	.0000	.0355	.0681	.0956	.1168	.1307	.1370	.1355	.1270	.1125	.0937	.0730	.0528	.0345	.0192	.0076	.0000	-.0031	-.0024	.0020	.0098	.0204	.0329	.0454	.0558	.0626	.0650
③	.0000	.0866	.1659	.2325	.2835	.3166	.3307	.3261	.3042	.2681	.2219	.1715	.1229	.0796	.0439	.0171	.0000	-.0093	-.0035	-.0001	.0177	.0425	.0728	.1034	.1290	.1459	.1518

BOTTOM OF SLAB ELEVATIONS																										
SPAN No. 2 CONT'D											SPAN No. 3															
POINT	11	12	13	14	15	16	17	18	19	± Brg. Pier #2	1	2	3	4	5	6	7	8	9	10	11	12	13	14	15	± Brg. Abut. #2
Beam 1	61.28	61.43	61.57	61.70	61.82	61.95	62.08	62.22	62.39	62.58	62.77	62.98	63.21	63.47	63.75	64.04	64.33	64.62	64.91	65.19	65.46	65.71	65.95	66.18	66.41	66.64
Beam 2	61.44	61.59	61.73	61.86	61.99	62.11	62.25	62.39	62.56	62.75	62.94	63.15	63.38	63.64	63.91	64.20	64.50	64.79	65.08	65.36	65.63	65.88	66.12	66.35	66.58	66.81
Beam 3	61.49	61.64	61.78	61.91	62.03	62.16	62.29	62.43	62.60	62.79	62.98	63.19	63.42	63.68	63.96	64.25	64.54	64.83	65.12	65.40	65.67	65.92	66.16	66.39	66.62	66.85
Beam 4	61.32	61.47	61.61	61.74	61.87	61.99	62.12	62.27	62.43	62.63	62.82	63.02	63.26	63.51	63.79	64.08	64.37	64.67	64.96	65.24	65.50	65.76	65.99	66.23	66.45	66.68
Beam 5	61.15	61.30	61.44	61.57	61.70	61.82	61.96	62.10	62.27	62.46	62.65	62.86	63.09	63.35	63.62	63.91	64.21	64.50	64.79	65.07	65.34	65.59	65.83	66.06	66.29	66.52
①	.0913	.0836	.0716	.0564	.0400	.0245	.0119	.0033	-.0008	.0000	.0050	.0148	.0291	.0471	.0671	.0870	.1042	.1173	.1248	.1257	.1196	.1065	.0869	.0617	.0321	.0000
②	.0626	.0558	.0454	.0329	.0204	.0098	.0020	-.0024	-.0031	.0000	.0076	.0192	.0345	.0528	.0730	.0937	.1125	.1270	.1355	.1370	.1307	.1168	.0958	.0681	.0355	.0000
③	.1459	.1290	.1034	.0728	.0425	.0177	-.0001	-.0095	-.0093	.0000	.0171	.0439	.0796	.1229	.1715	.2219	.2681	.3042	.3261	.3307	.3166	.2835	.2325	.1659	.0866	.0000

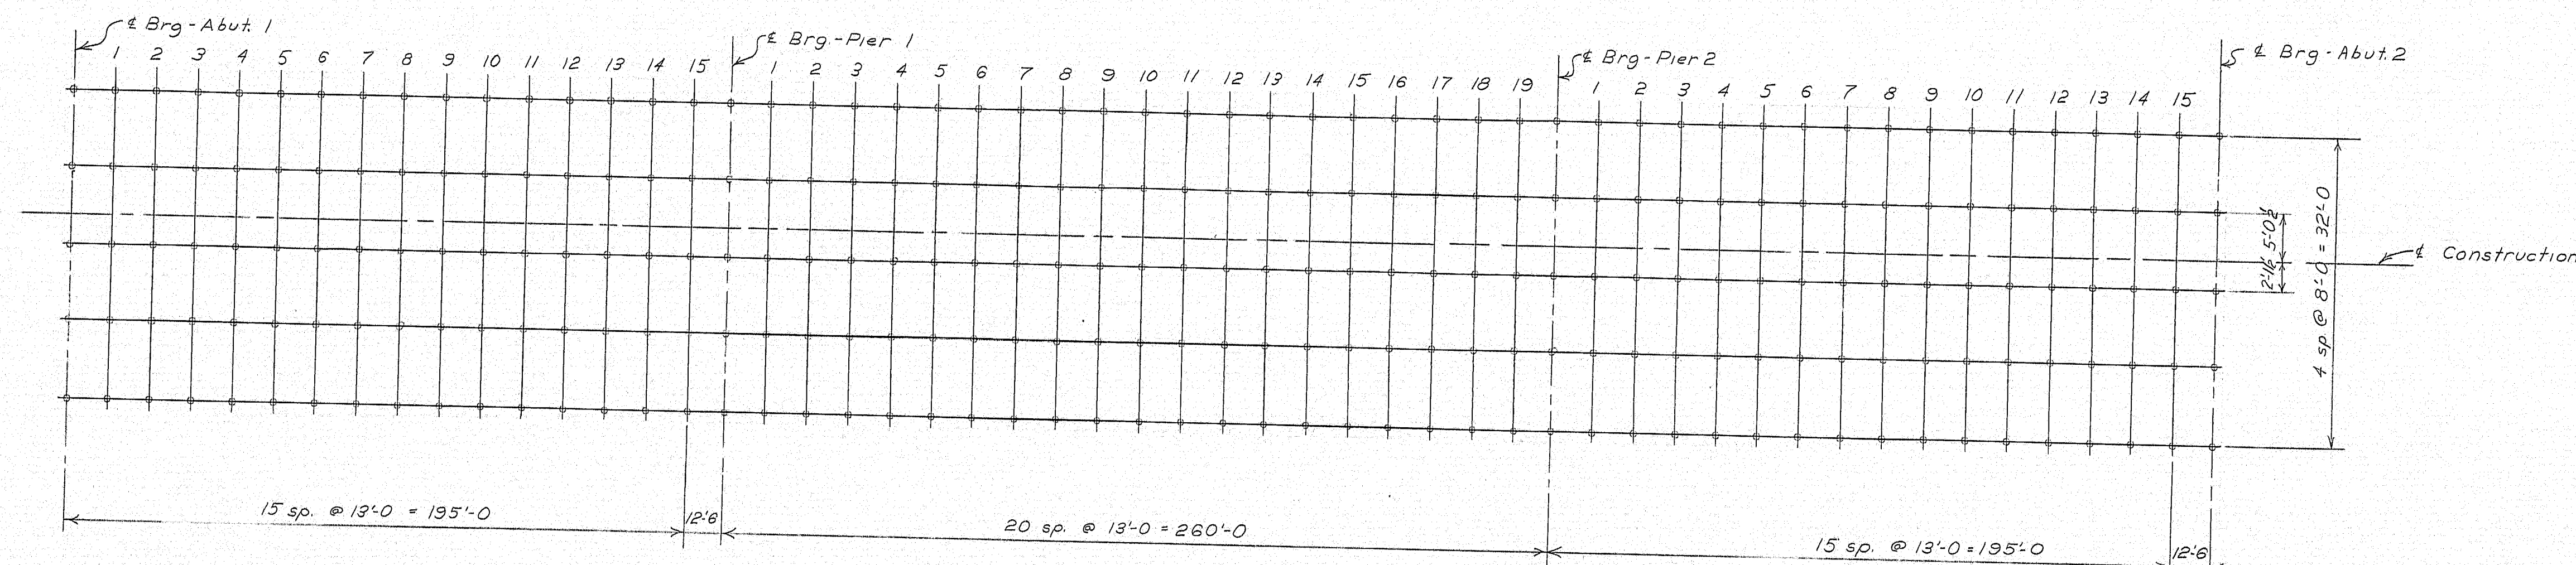

- ① Superimposed Dead Load Deflection
 - ② Steel Dead Load Deflection
 - ③ Fluid Dead Load Deflection
- For Blocking Detail see sheet 16 of 25

Note: Bottom of slab elevations have been adjusted to compensate for concrete dead load deflections (fluid and superimposed). Use in conformance with subsection 502.10 (a) of the specifications.


STATE OF MAINE
DEPARTMENT OF TRANSPORTATION
WESTPORT-WISCASSET BRIDGE
OVER
COWSEAGAN NARROWS
BETWEEN THE TOWNS OF
WESTPORT-WISCASSET
LINCOLN COUNTY
BOTTOM OF SLAB ELEVATIONS
SHEET 17 OF 25 AUGUSTA, MAINE APRIL 1973

153-135


DATE	BY
12/12/72	MAK/Pinkham
DESIGN	CHECKED
REVISIONS	REVISIONS
FIELD CHANGES	FIELD CHANGES

JANUARY 1988


Louaine paints TRUFLEX & SILKY & TRIPLE WHITE & RYPLEX

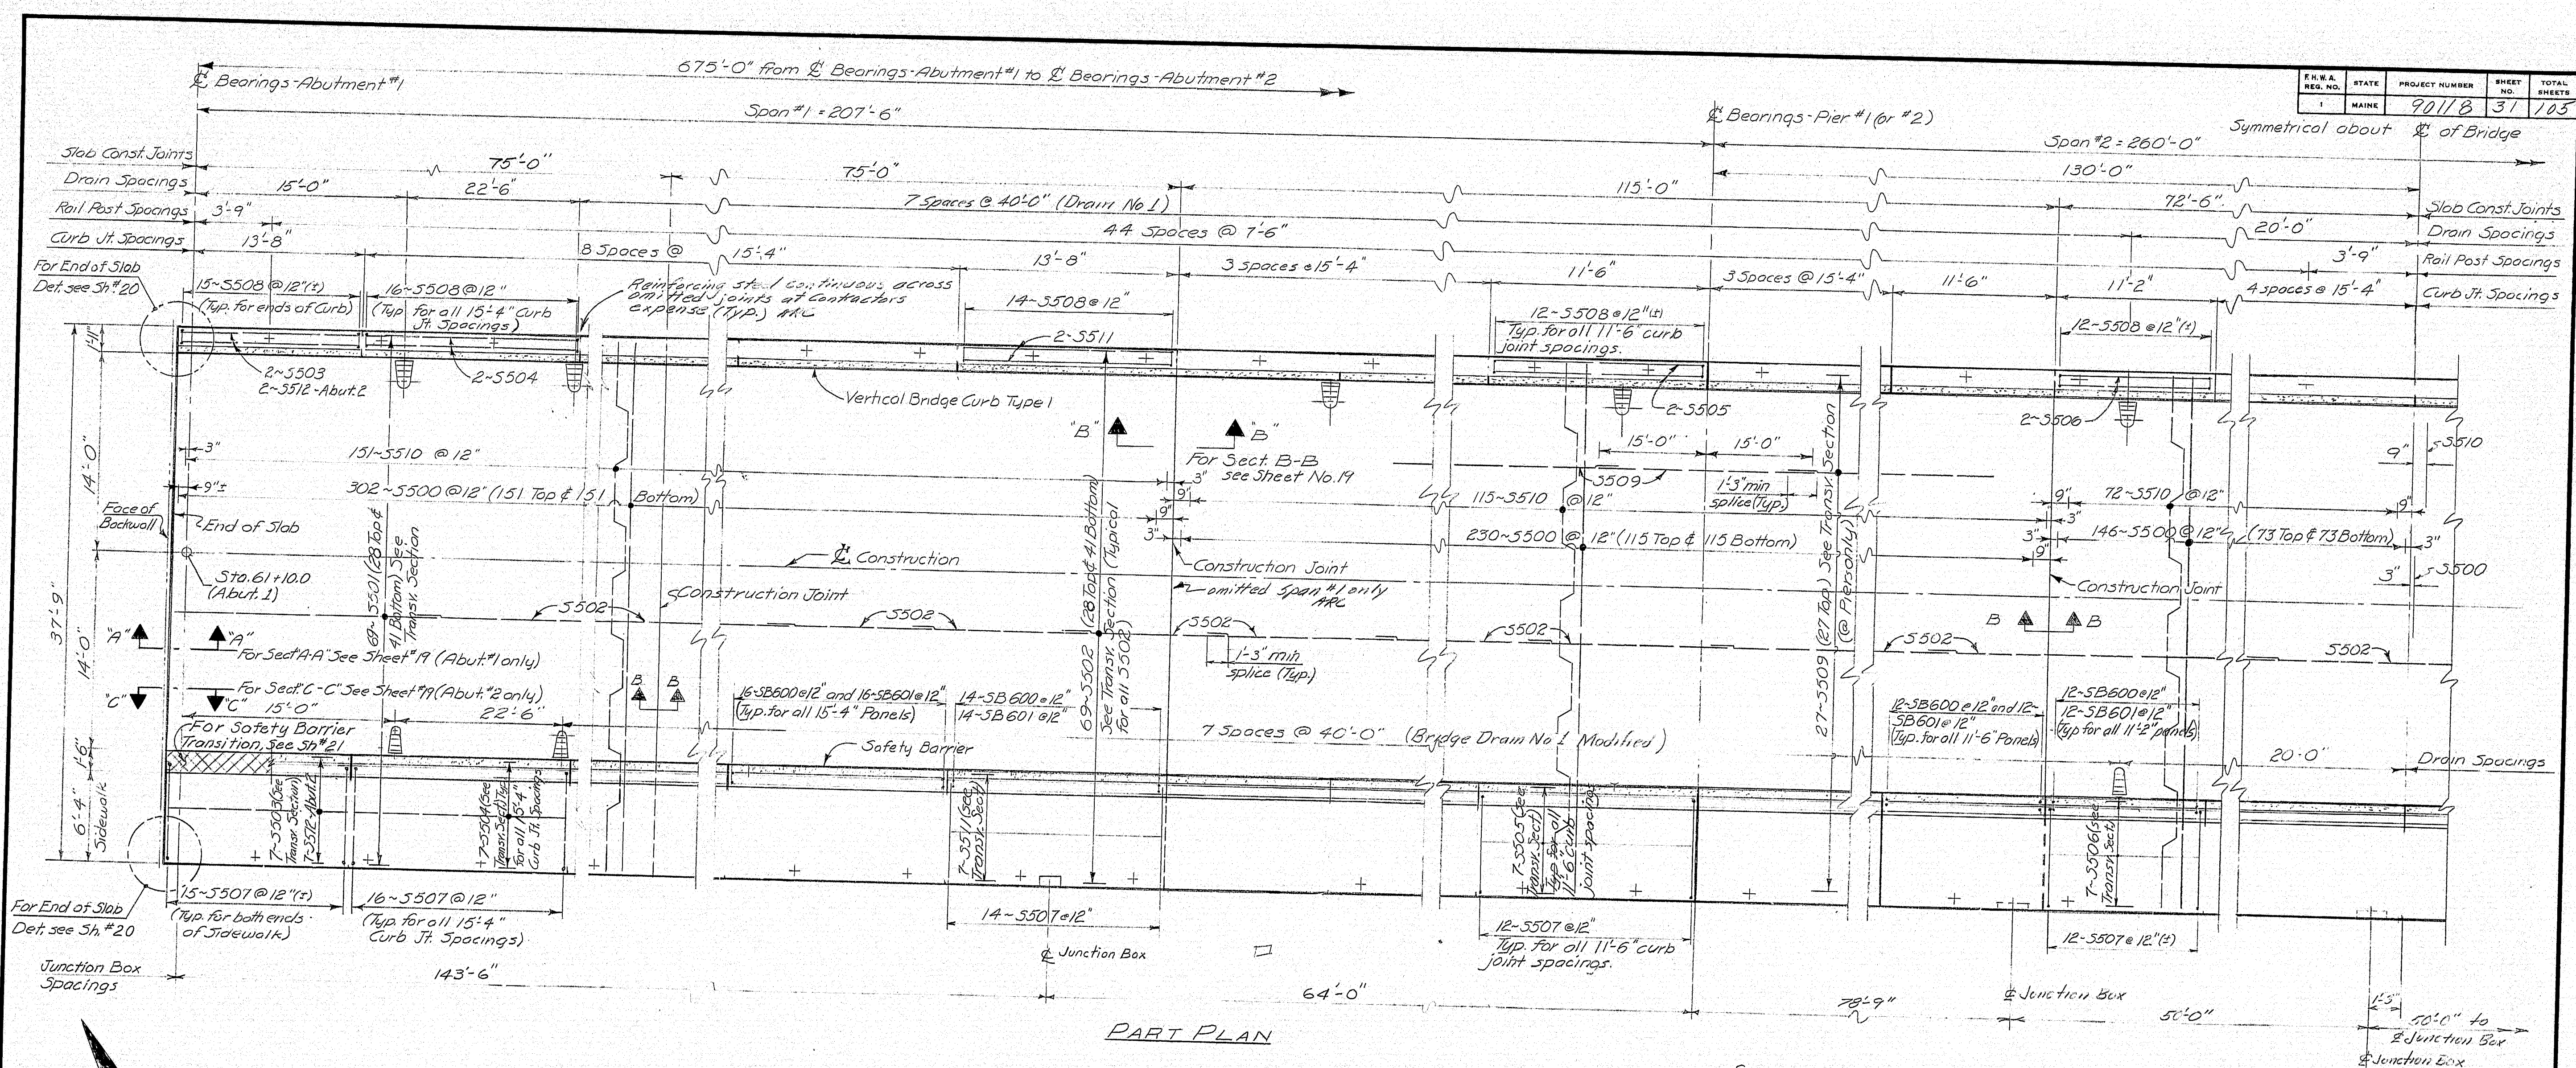

F.H.W.A. REG. NO.	STATE	PROJECT NUMBER	SHEET NO.	TOTAL SHEETS
1	MAINE	70118	32	125

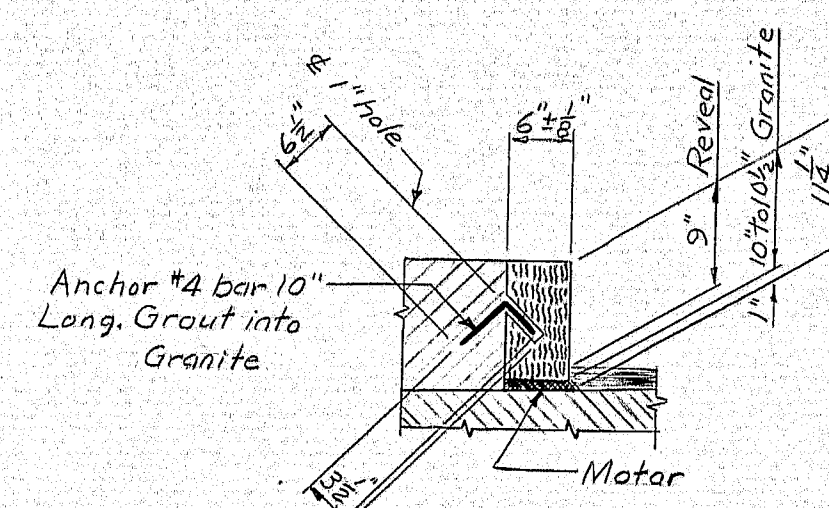


VERTICAL BRIDGE CURB TYPE I
TYPICAL SECTION

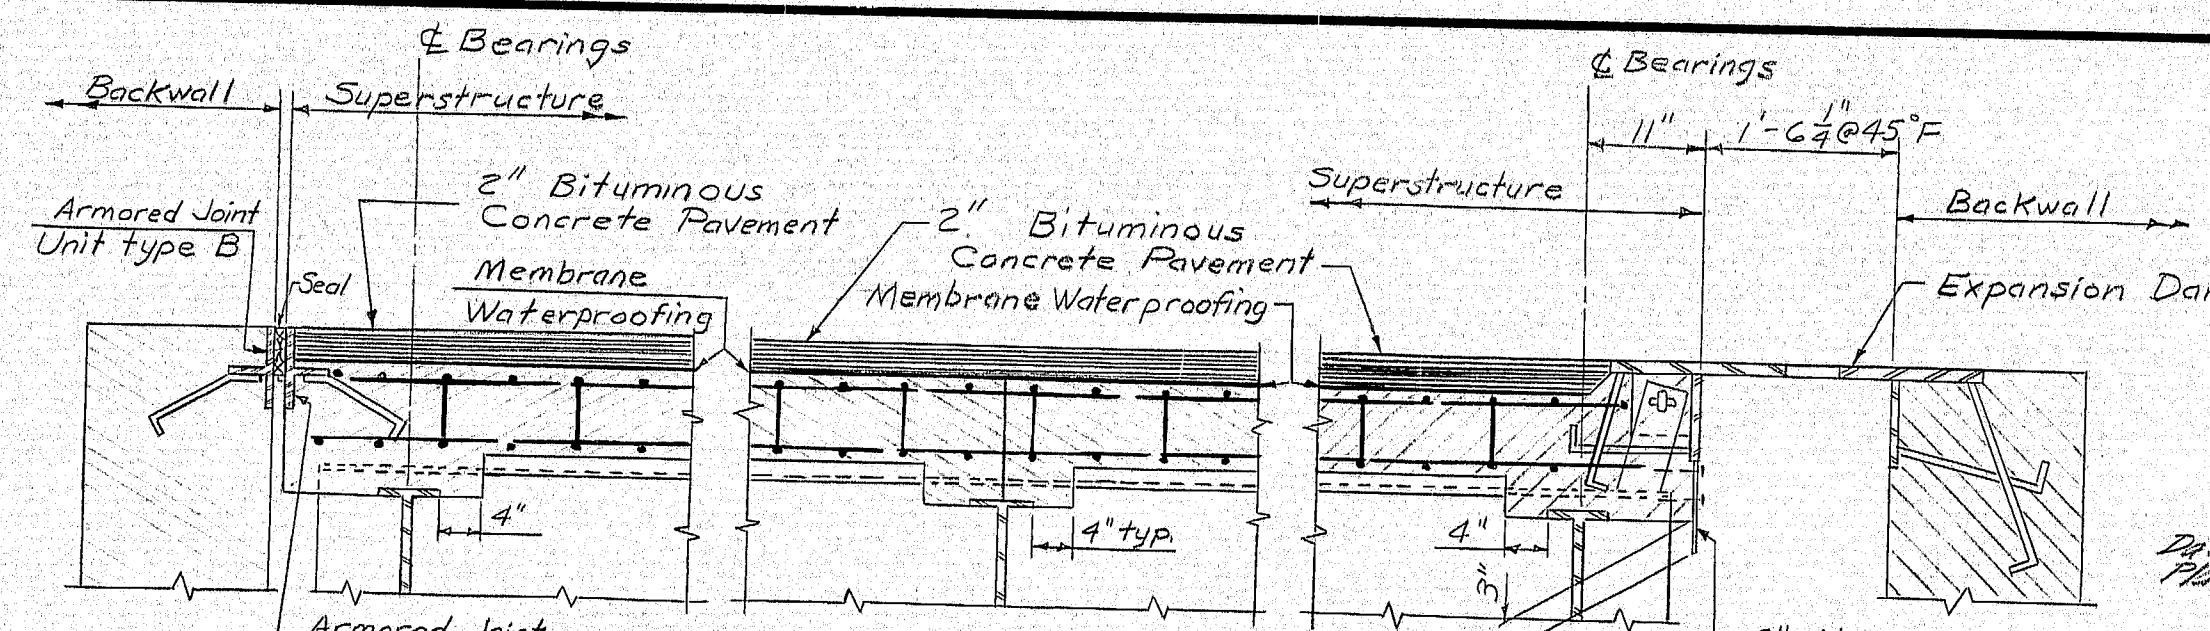


SECTION A-A
at Abutment 1

SECTION B-B
at Slab Construction Joints


SECTION C-C
at Abutment 2

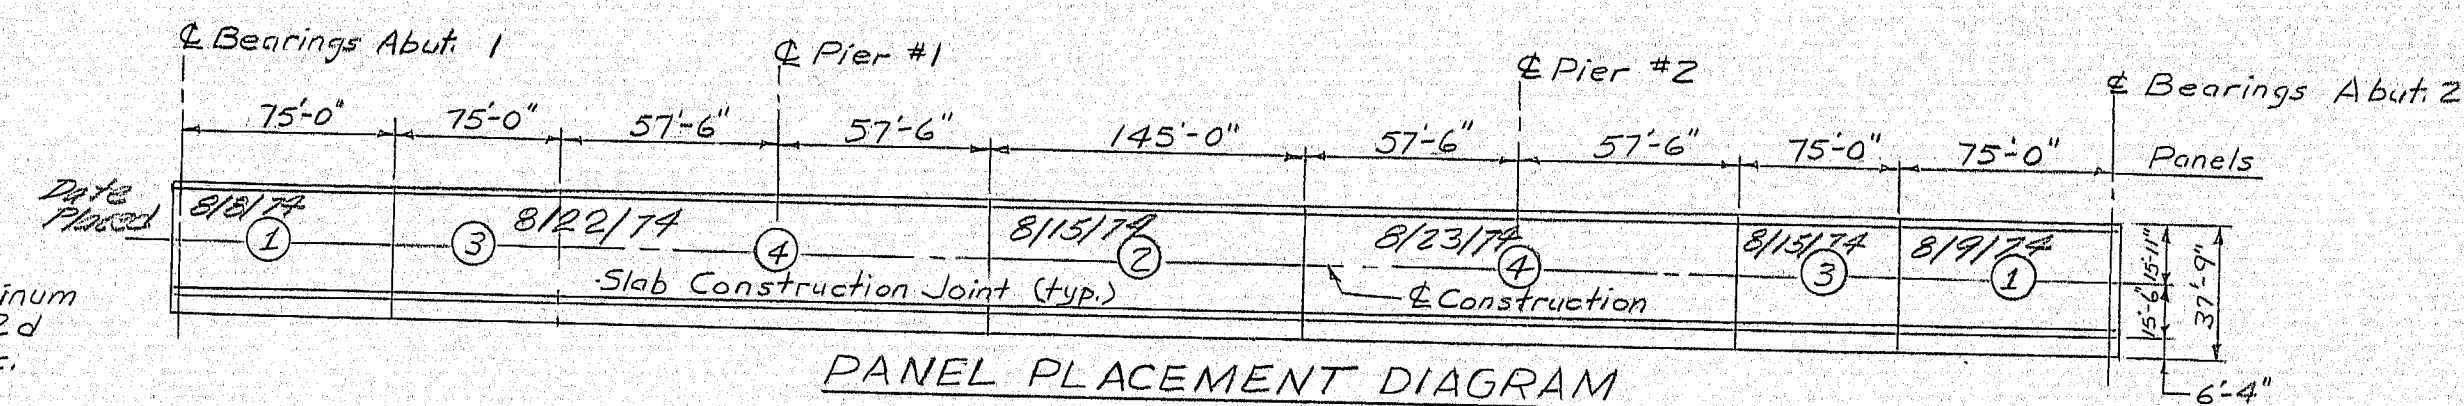


PANEL PLACEMENT DIAGRAM

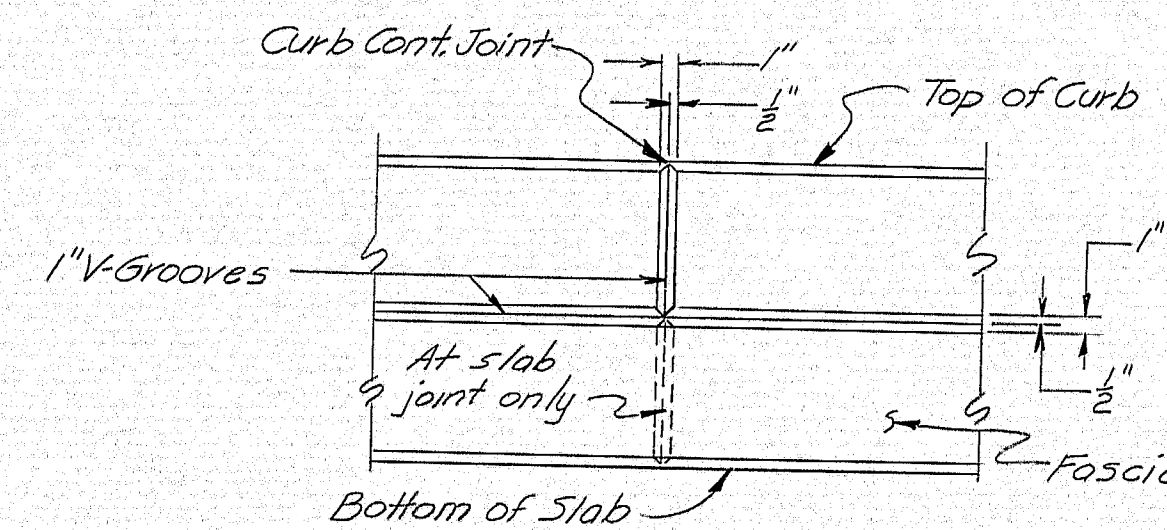

1" V-GROOVE DETAIL

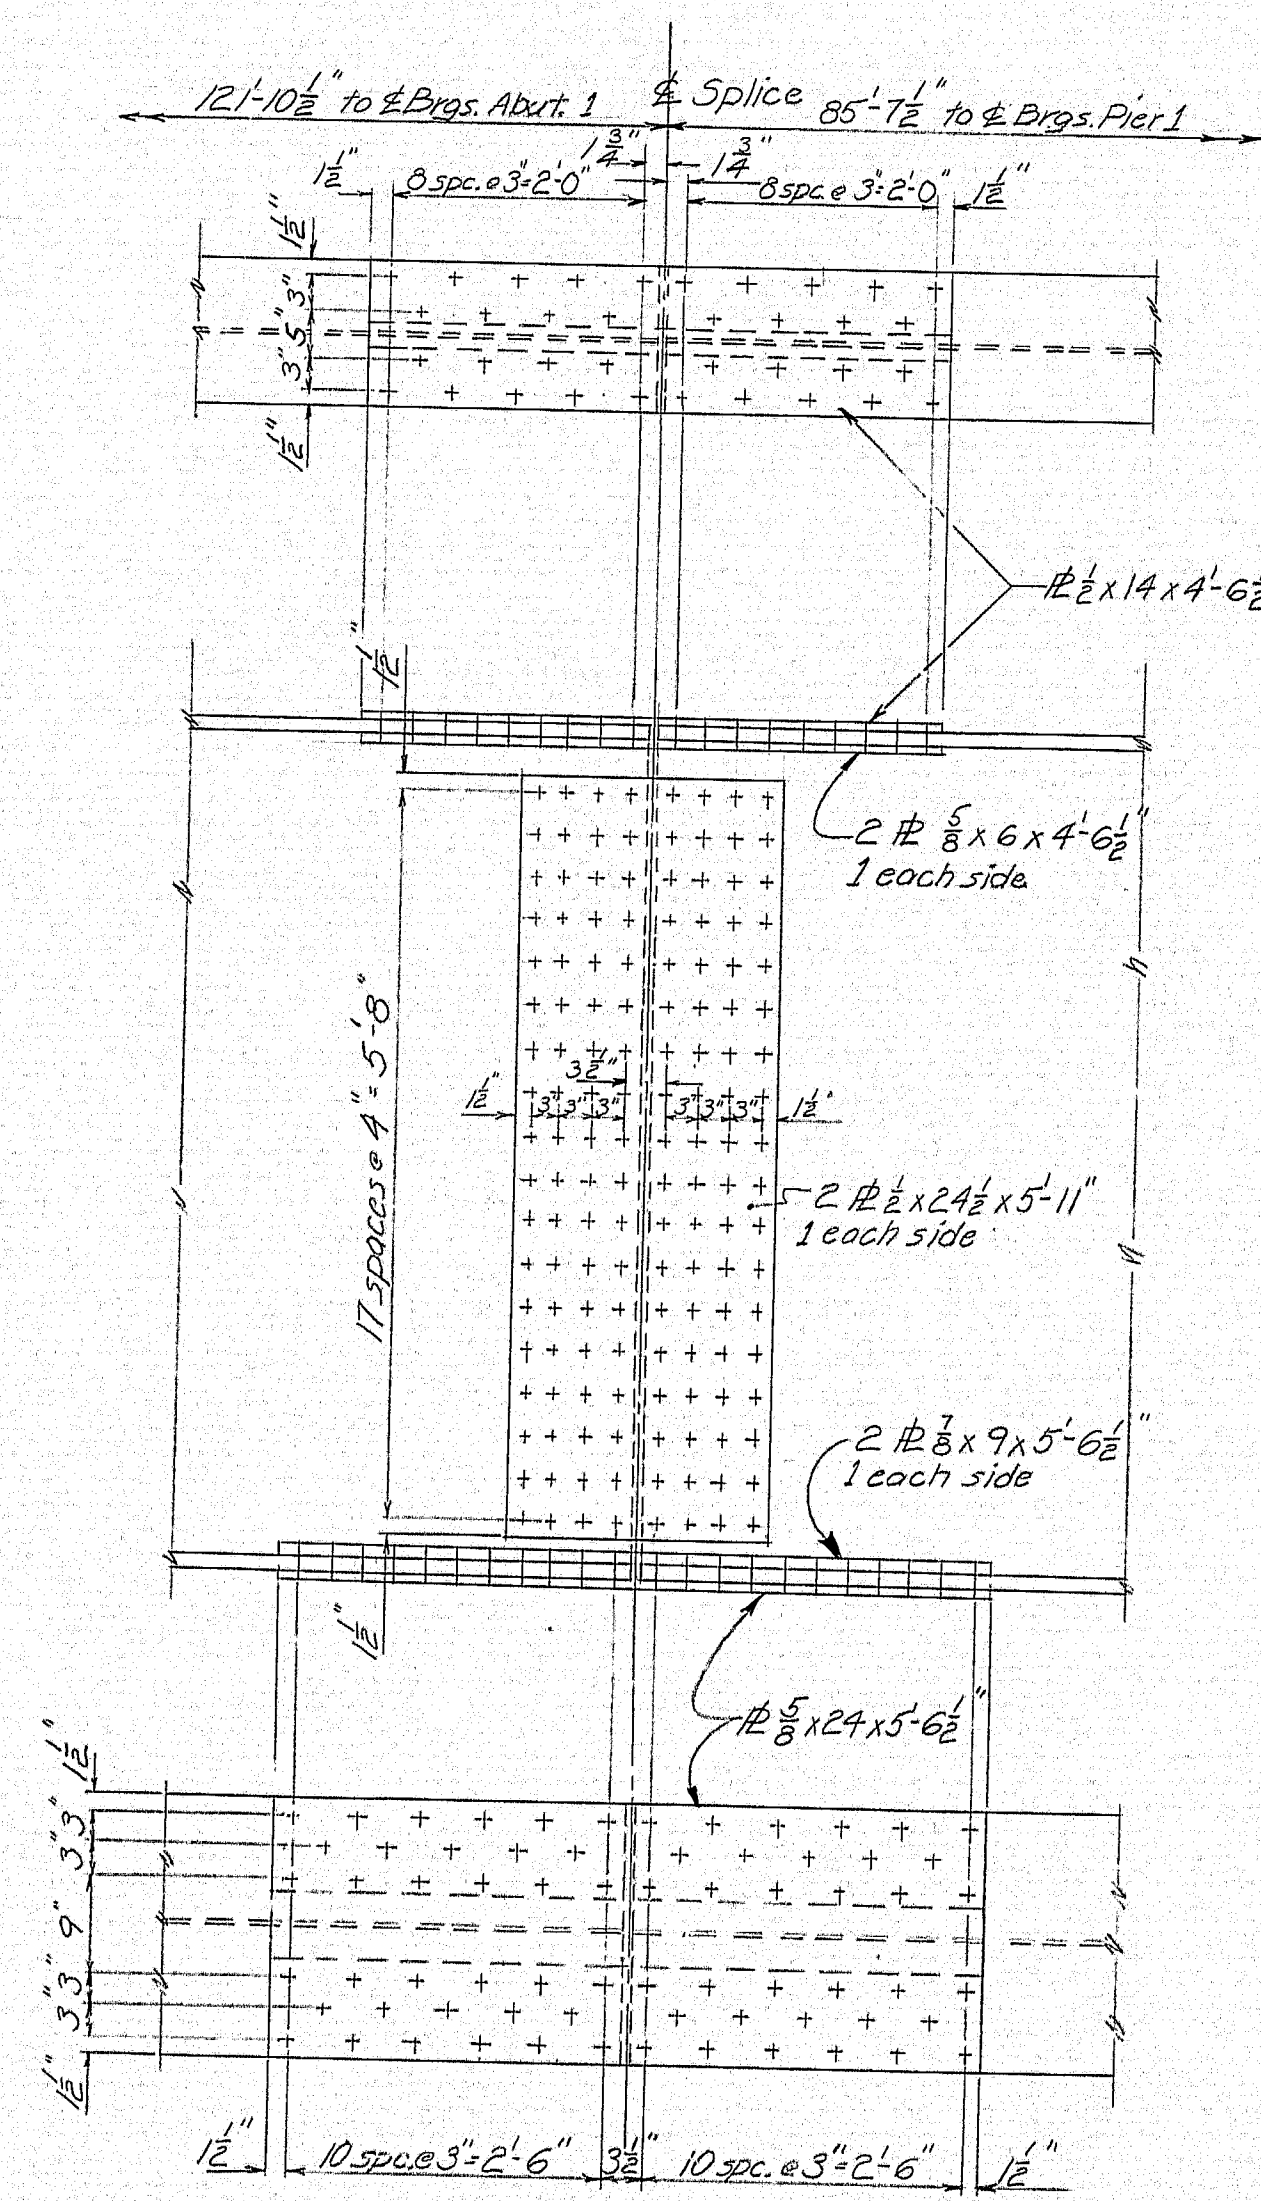

OPTIONAL SPLICE
Span 1 & Span 3

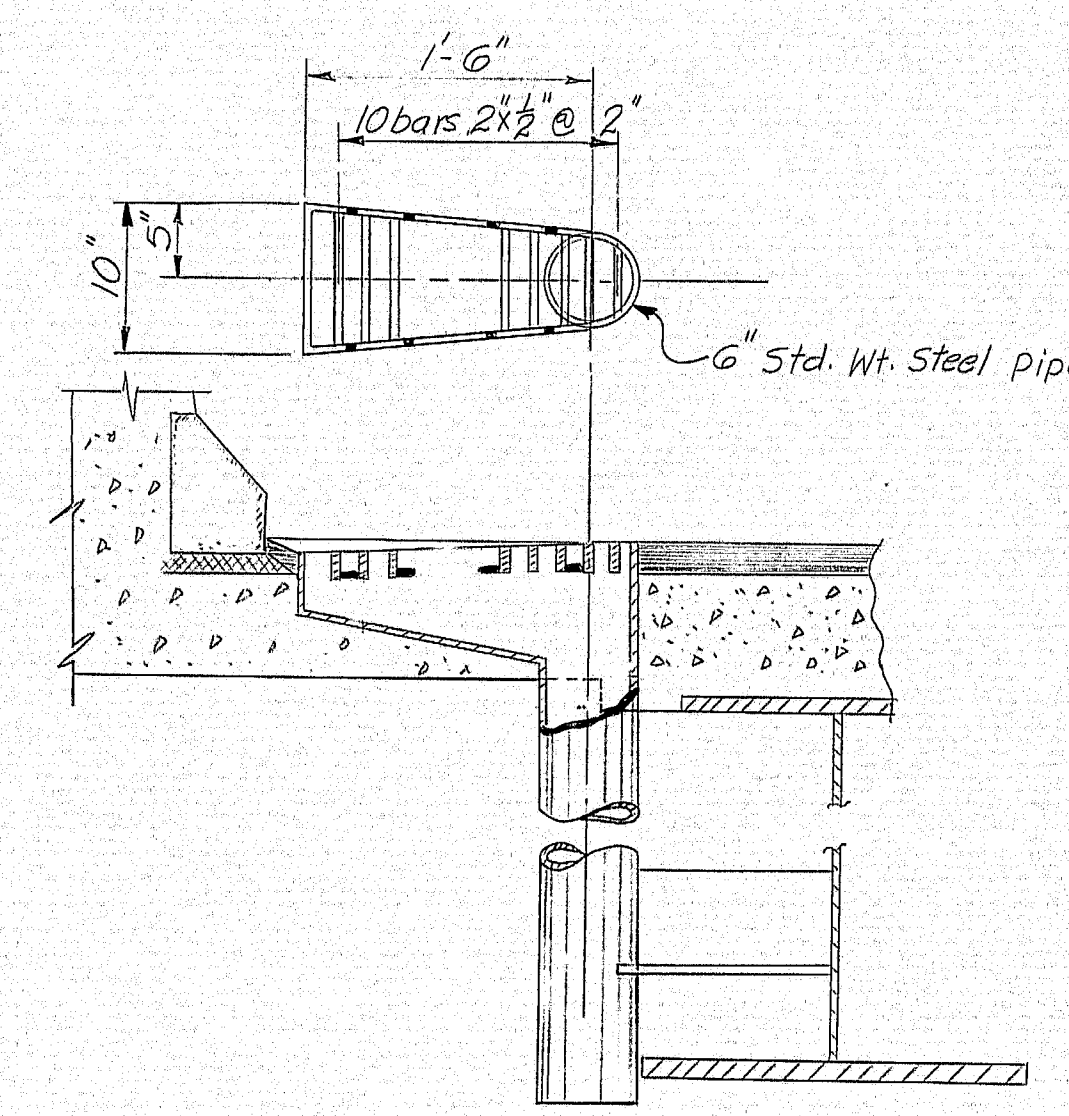

DRAIN NO. 1 (MODIFIED)
Note: For details not shown, see Standard Details, BD 104-71.










PLANS	DESIGN - DETAILED	CHECKED	REVISIONS	FIELD CHANGES
	Pham/11	G.O.T.		

Revised As Built on 3/20/75
Added optional splice. 4/1/73 D.M.P. G.O.T.

STATE OF MAINE
DEPARTMENT OF TRANSPORTATION
WESTPORT-WISCASSET BRIDGE
OVER
COWSEAGAN NARROWS
BETWEEN THE TOWNS OF
WESTPORT-WISCASSET
LINCOLN COUNTY
SUPERSTRUCTURE DETAILS
SHEET 19 OF 25 AUGUSTA, MAINE APRIL 1973

153-137

F.H.W.A. REV. NO.	STATE	PROJECT NUMBER	SHEET NO.	TOTAL SHEETS
1	MAINE	90118	34	105

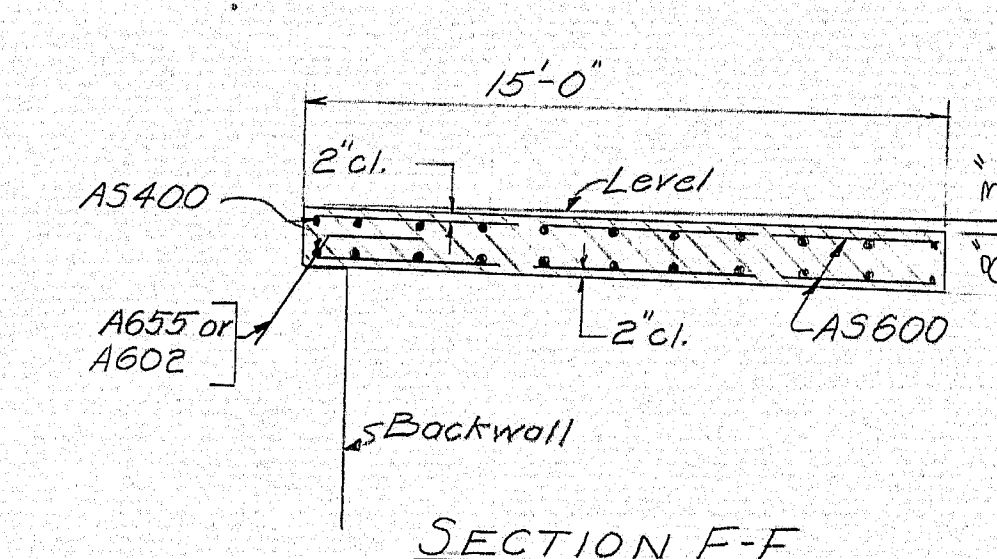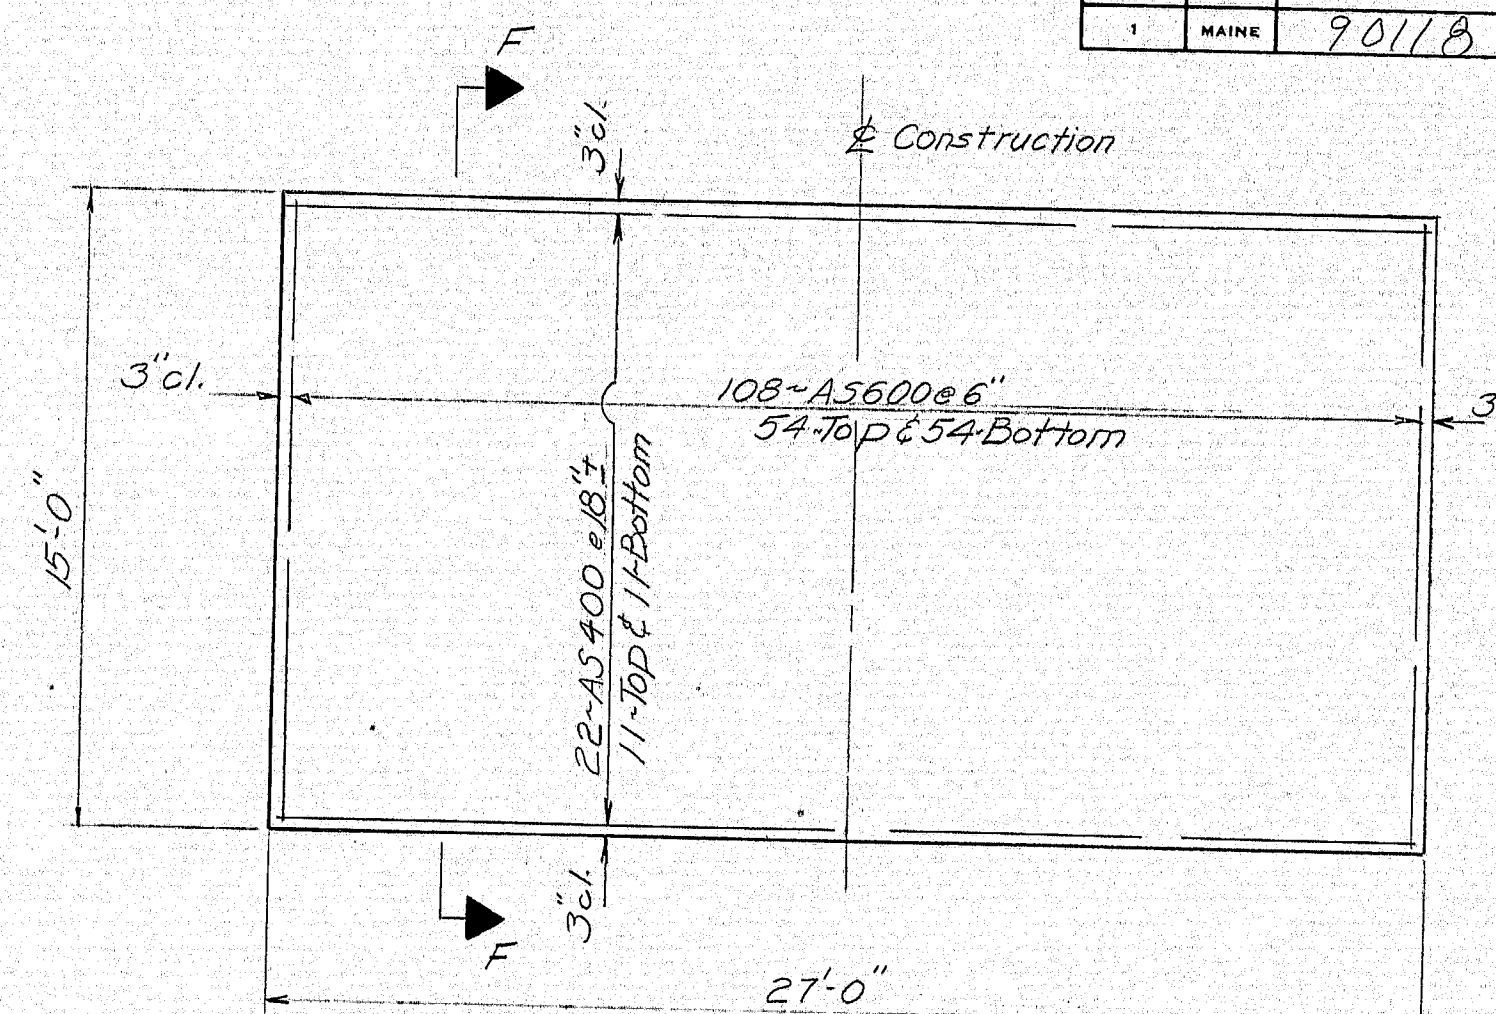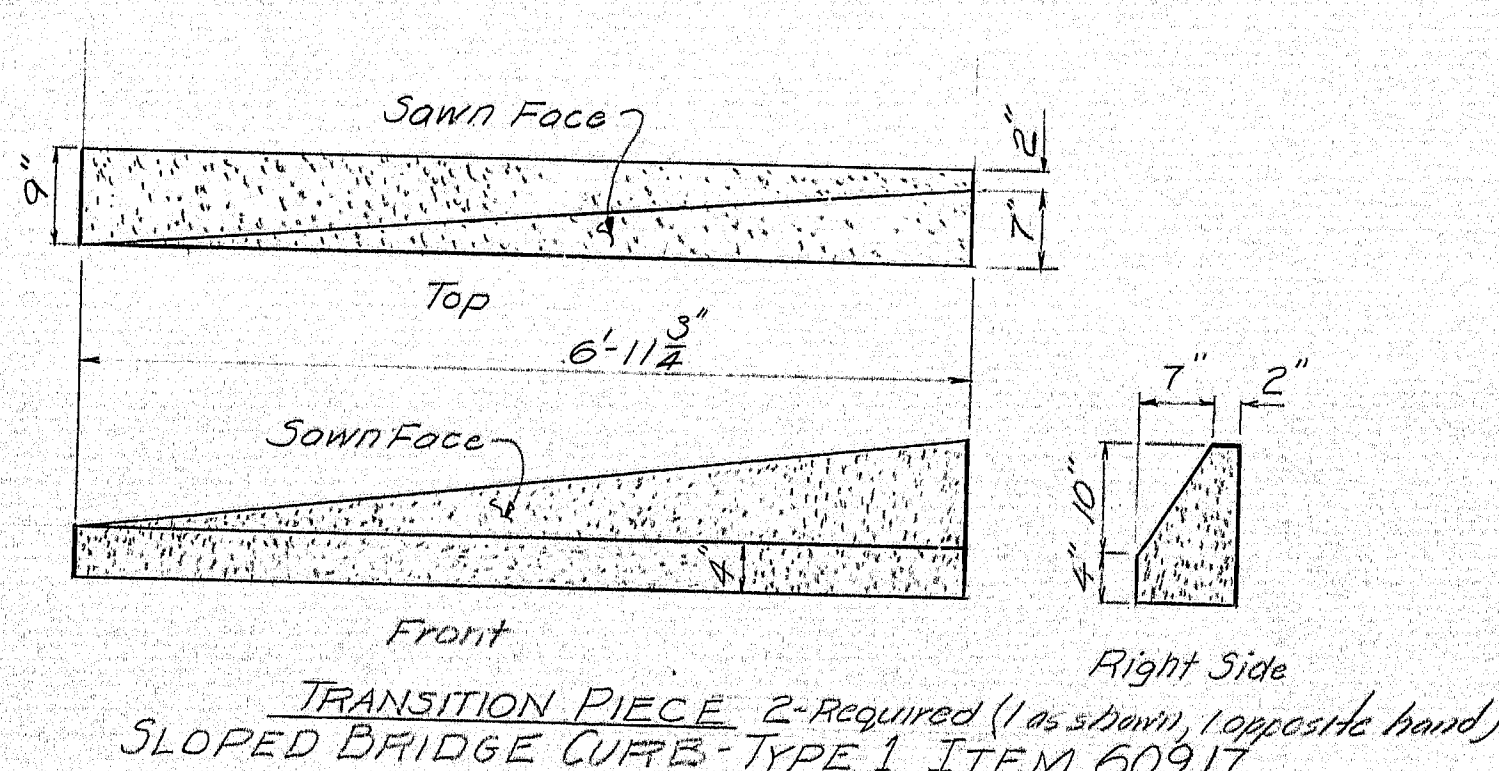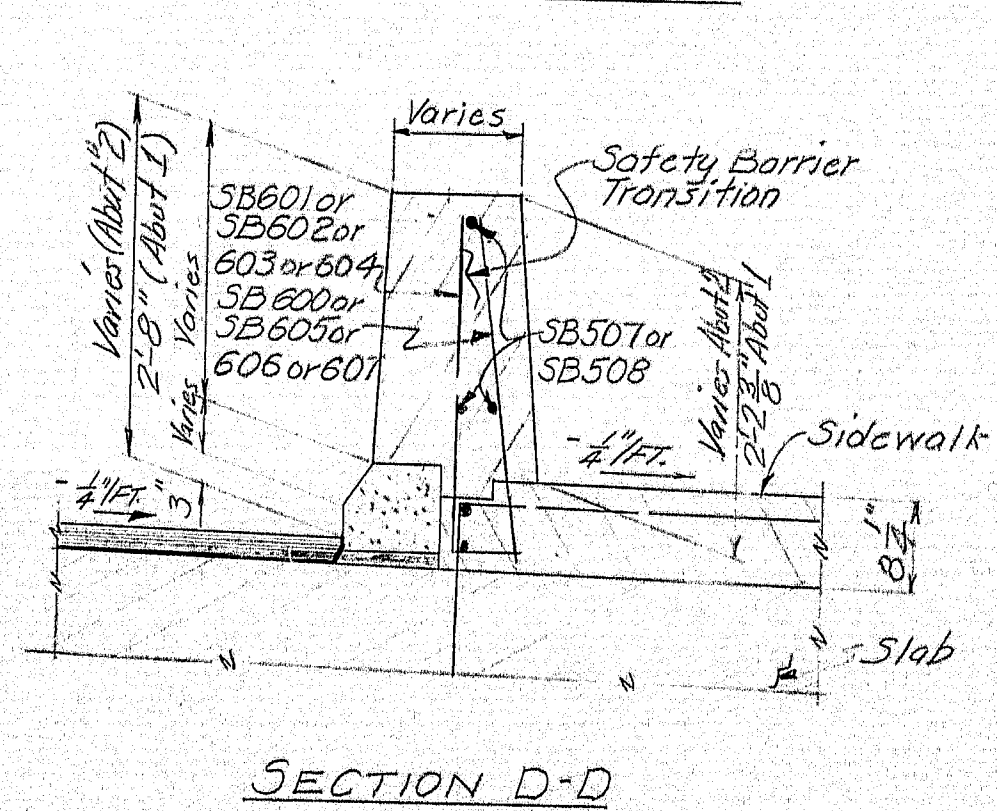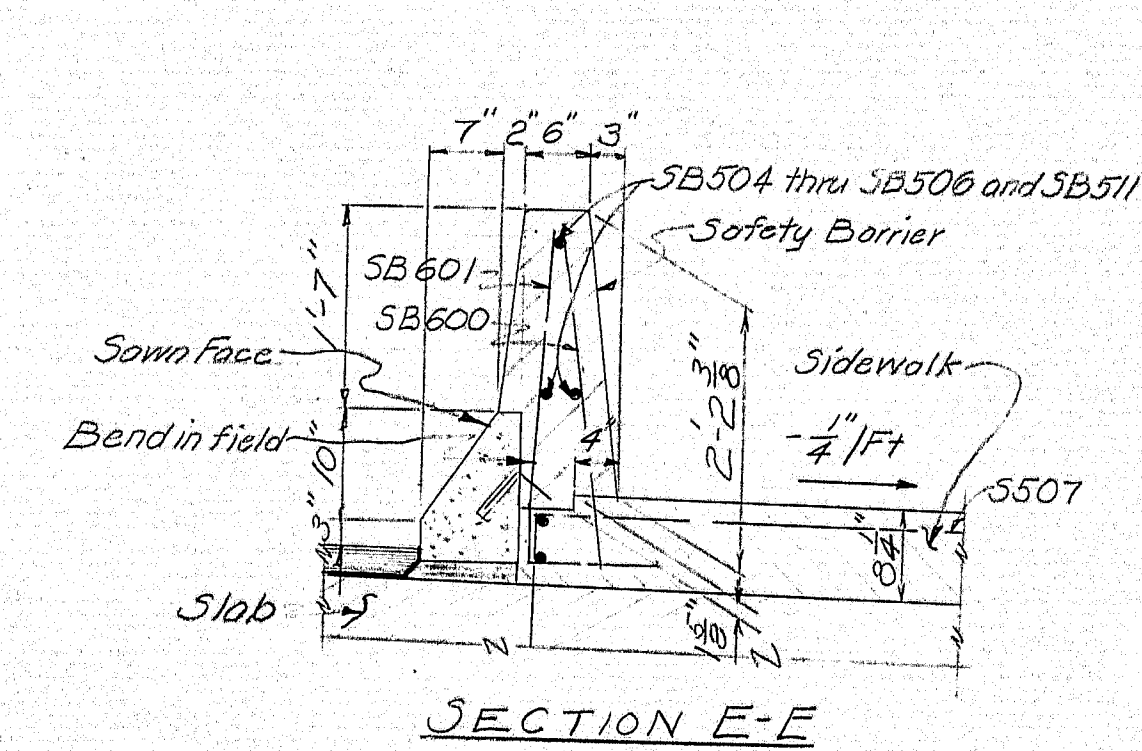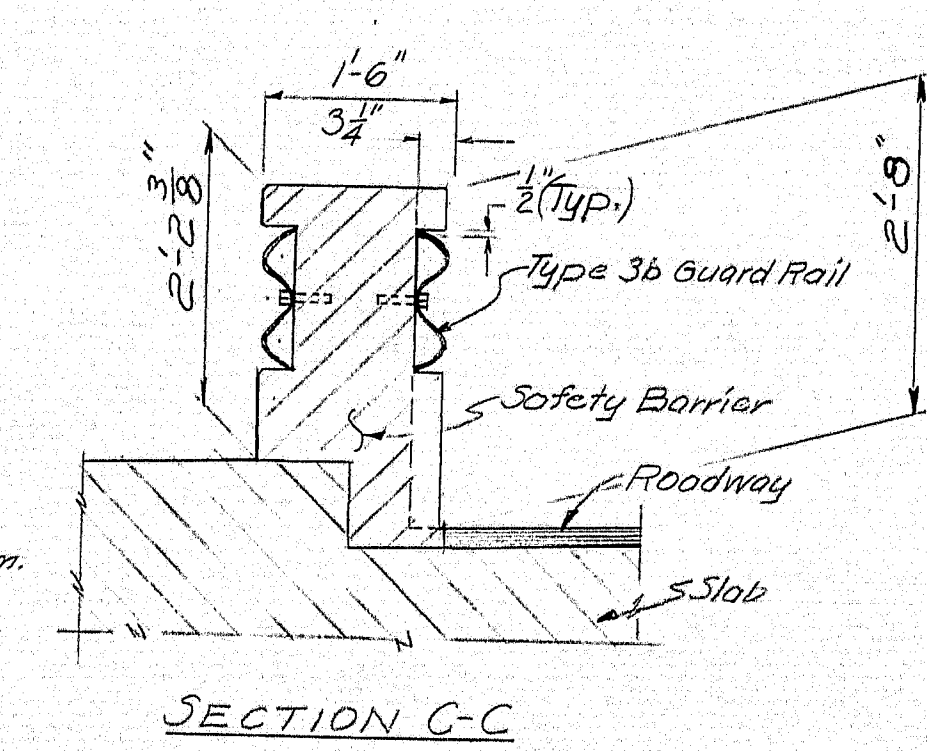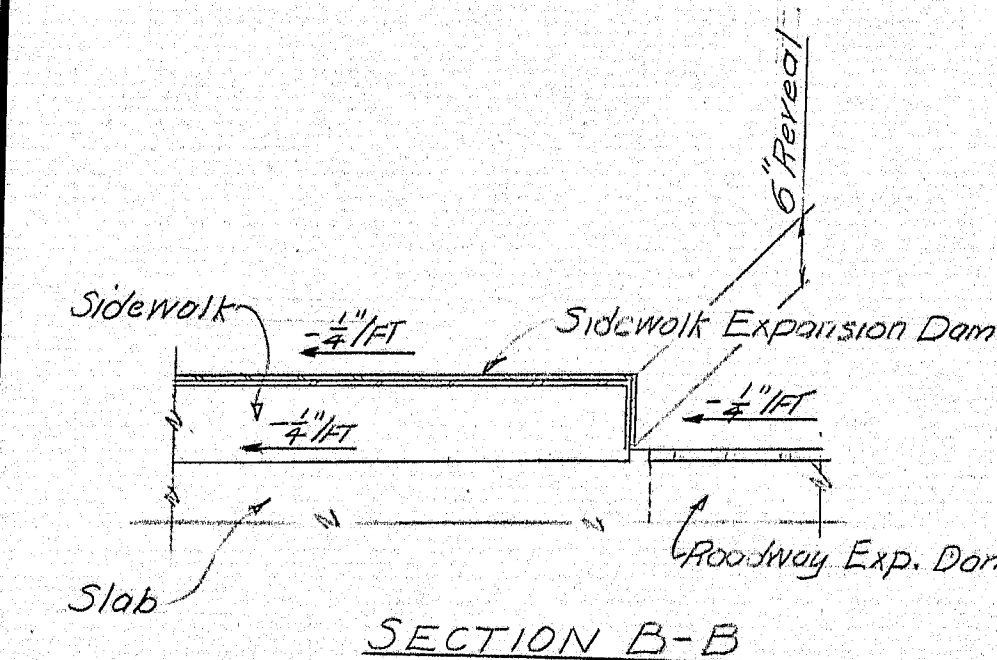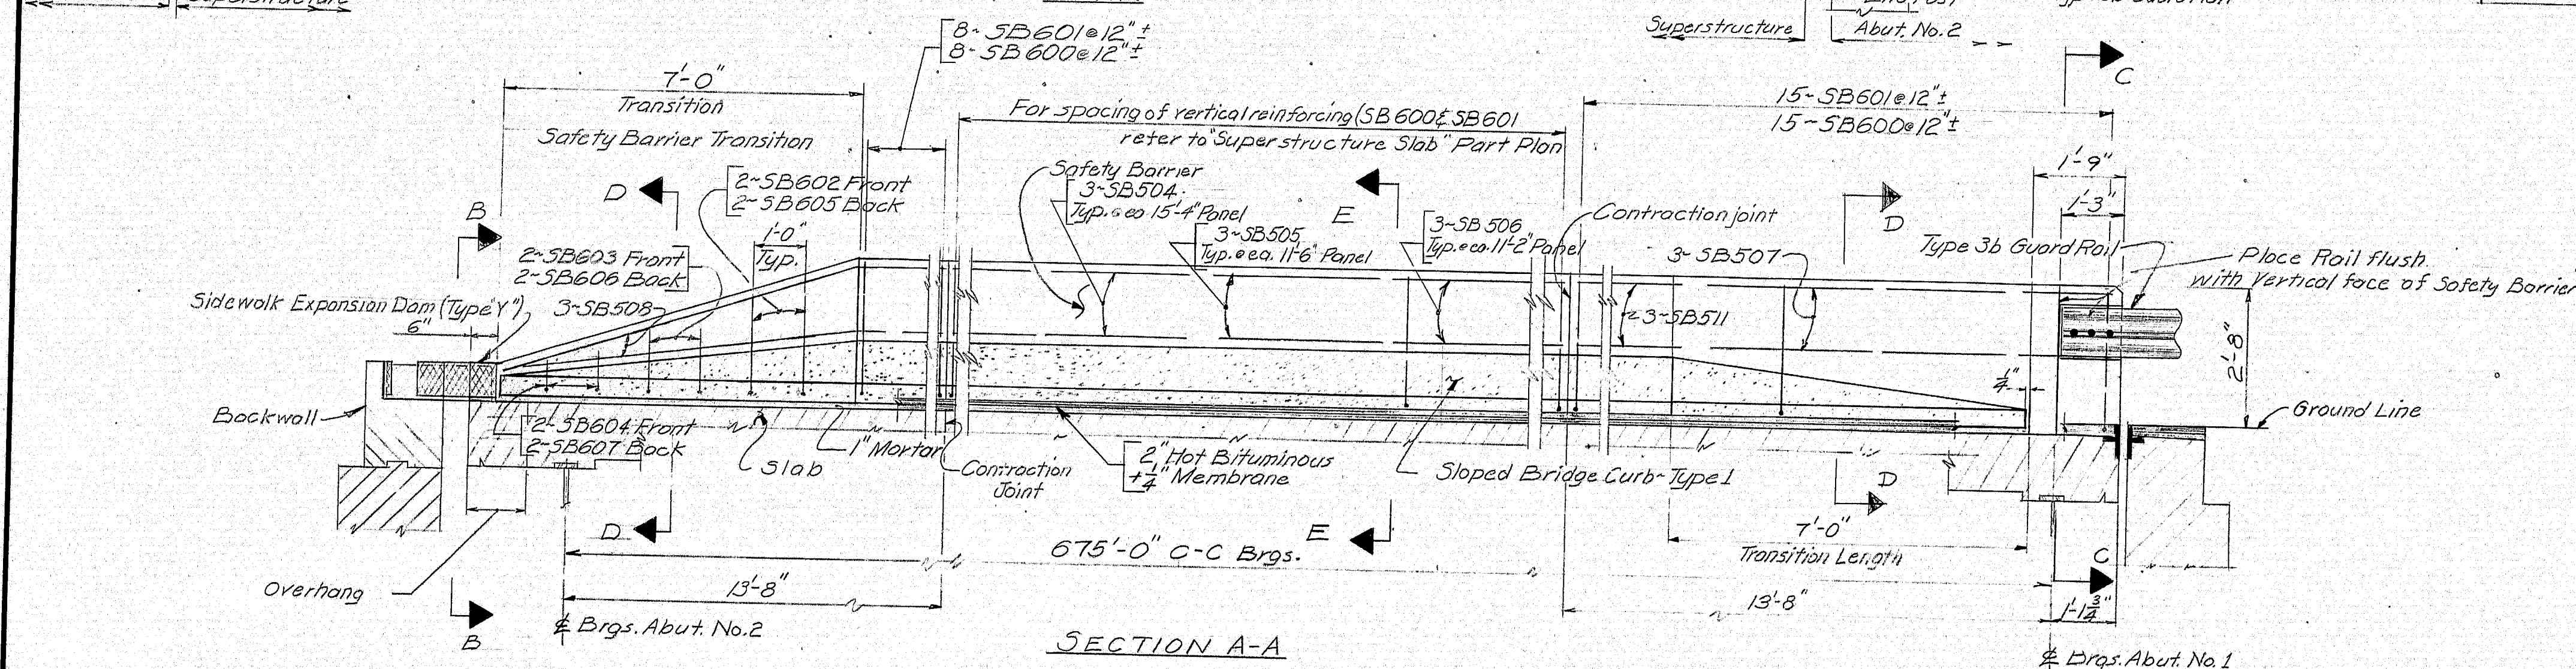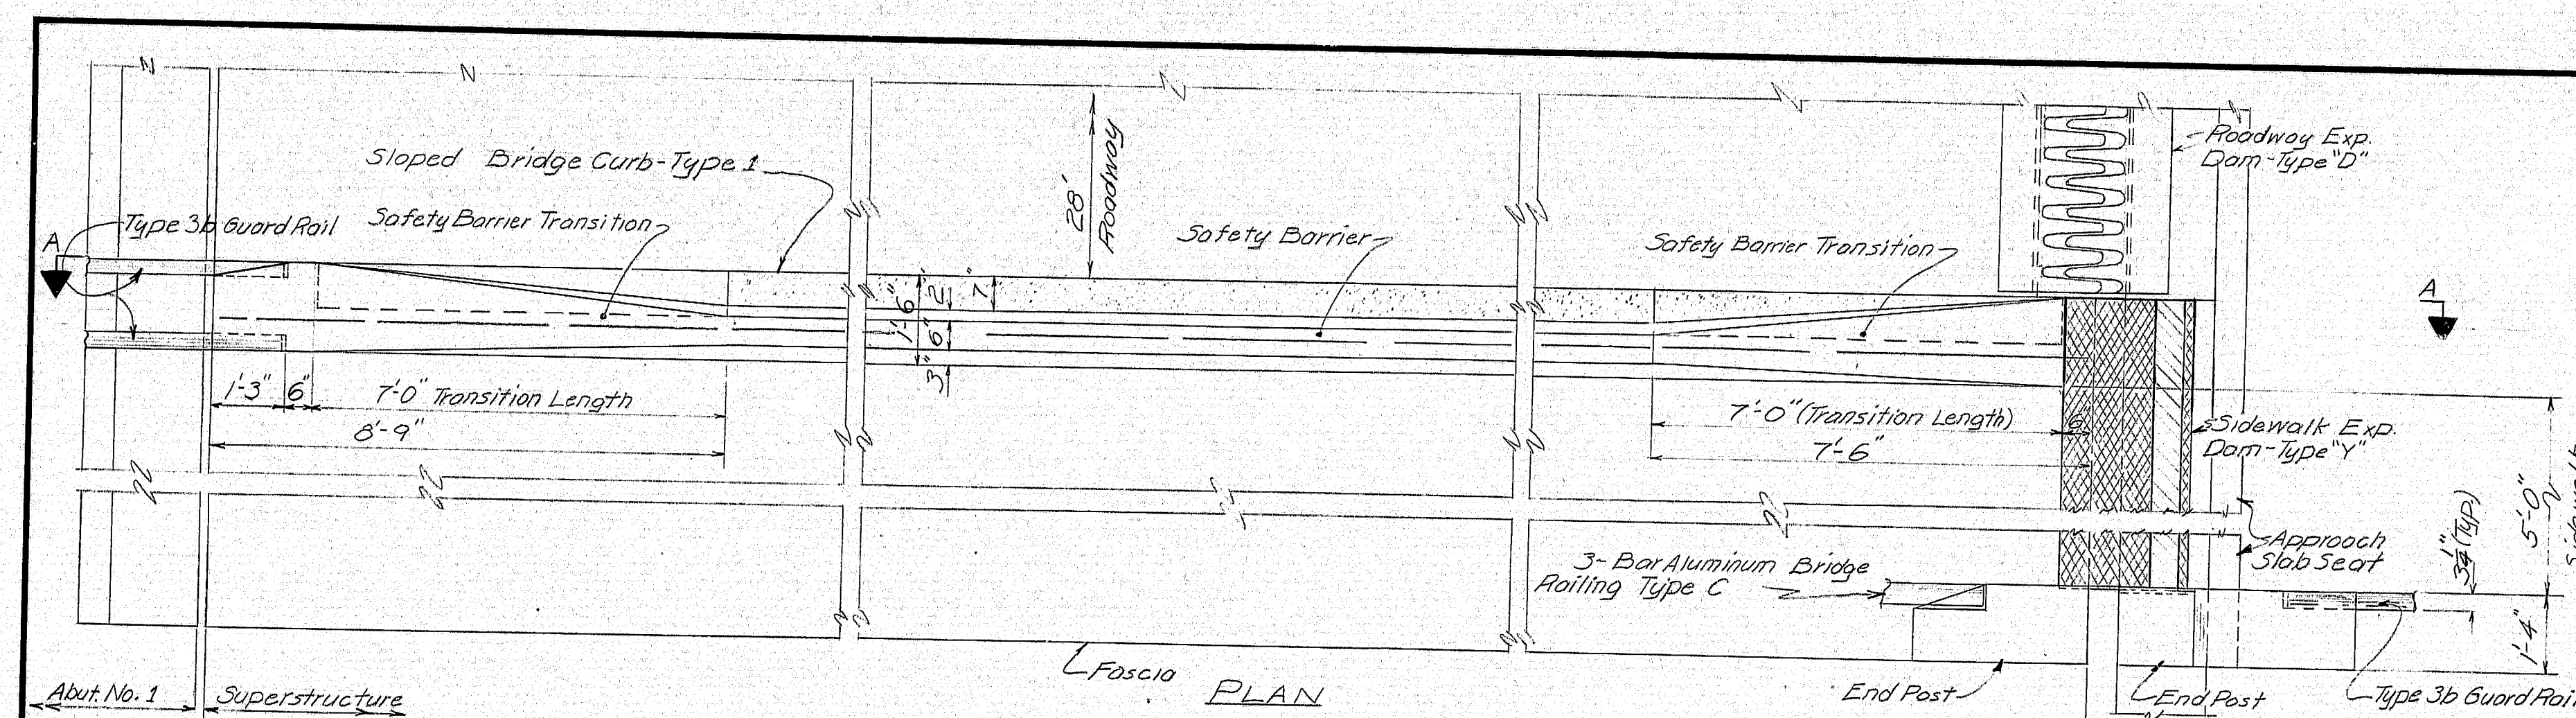

GENERAL NOTES


1. Chamfer all exposed edges of concrete 1/4 inch unless otherwise indicated.
2. Reinforcing Steel in all 2" cover unless otherwise indicated.
3. Anchor bars were installed in sloped curb in the same manner as installed in vertical bridge curb (see sheet 19).

REFERENCES


For Expansion Dam details not shown, see Standard Detail BD 105-64

Revised As Built 10/25/75
STATE OF MAINE
DEPARTMENT OF TRANSPORTATION
WESTPORT-WISCASSET BRIDGE
OVER
COWSEAGAN NARROWS
BETWEEN THE TOWNS OF
WESTPORT-WISCASSET
LINCOLN COUNTY
SAFETY BARRIER & APPROACH SLABS
SHEET 21 OF 25 AUGUSTA, MAINE APRIL 1973


153-139

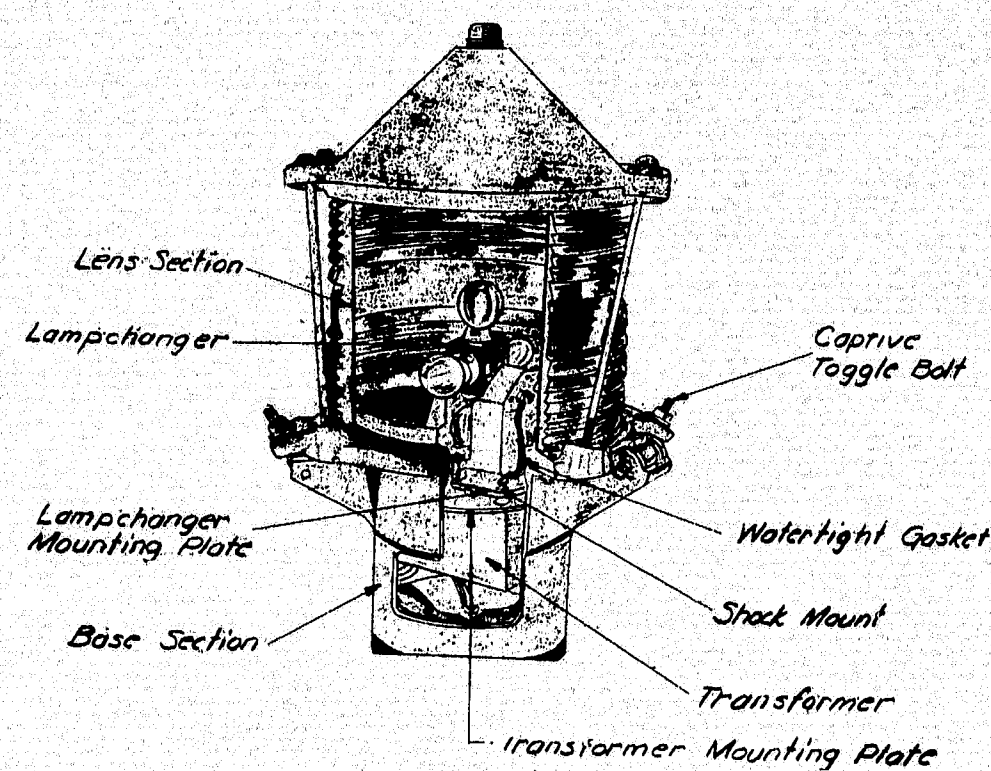


CUT-AWAY VIEW OF NAVIGATION LIGHT

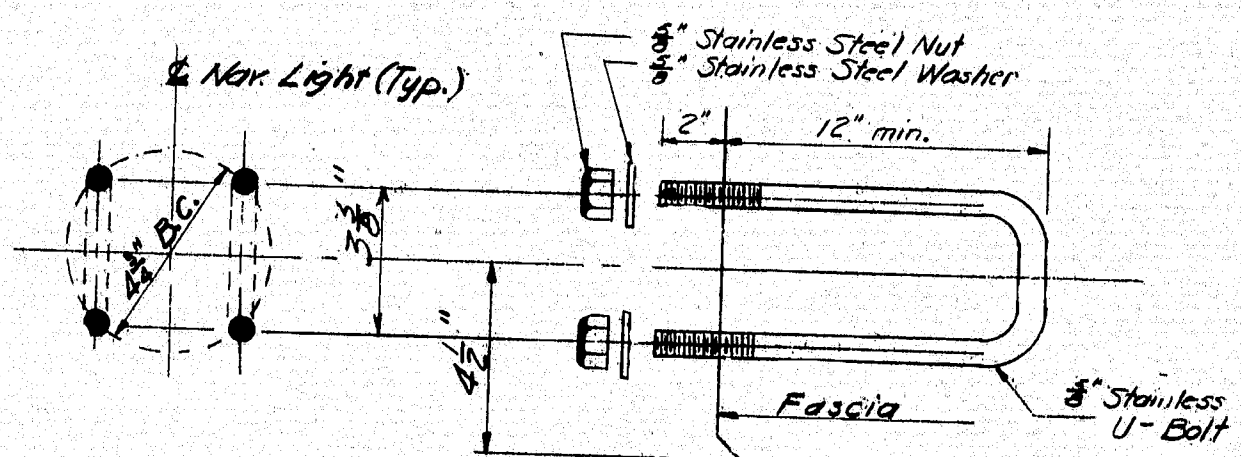


NAVIGATION LIGHT ANCHORAGE
12 - Required

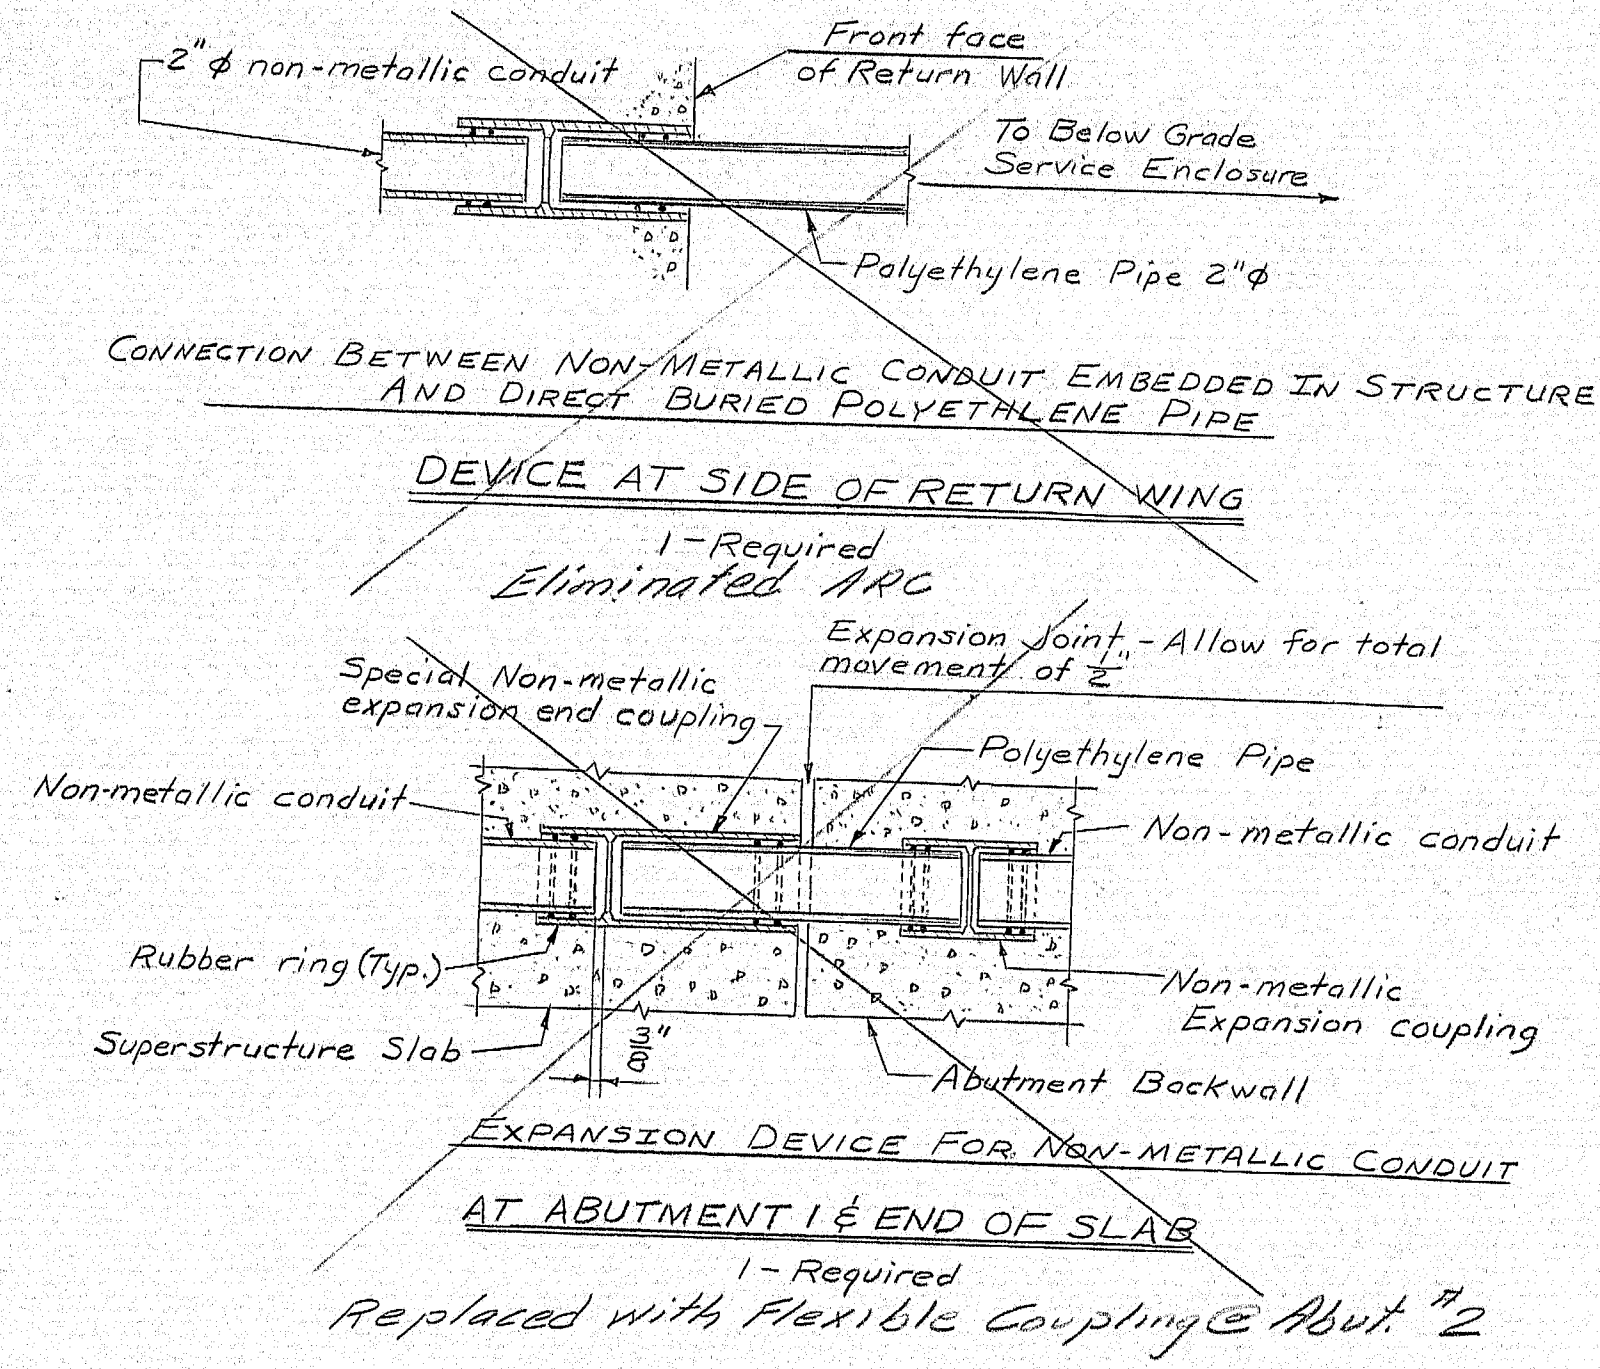


DEVICE AT SIDE OF RETURN WING

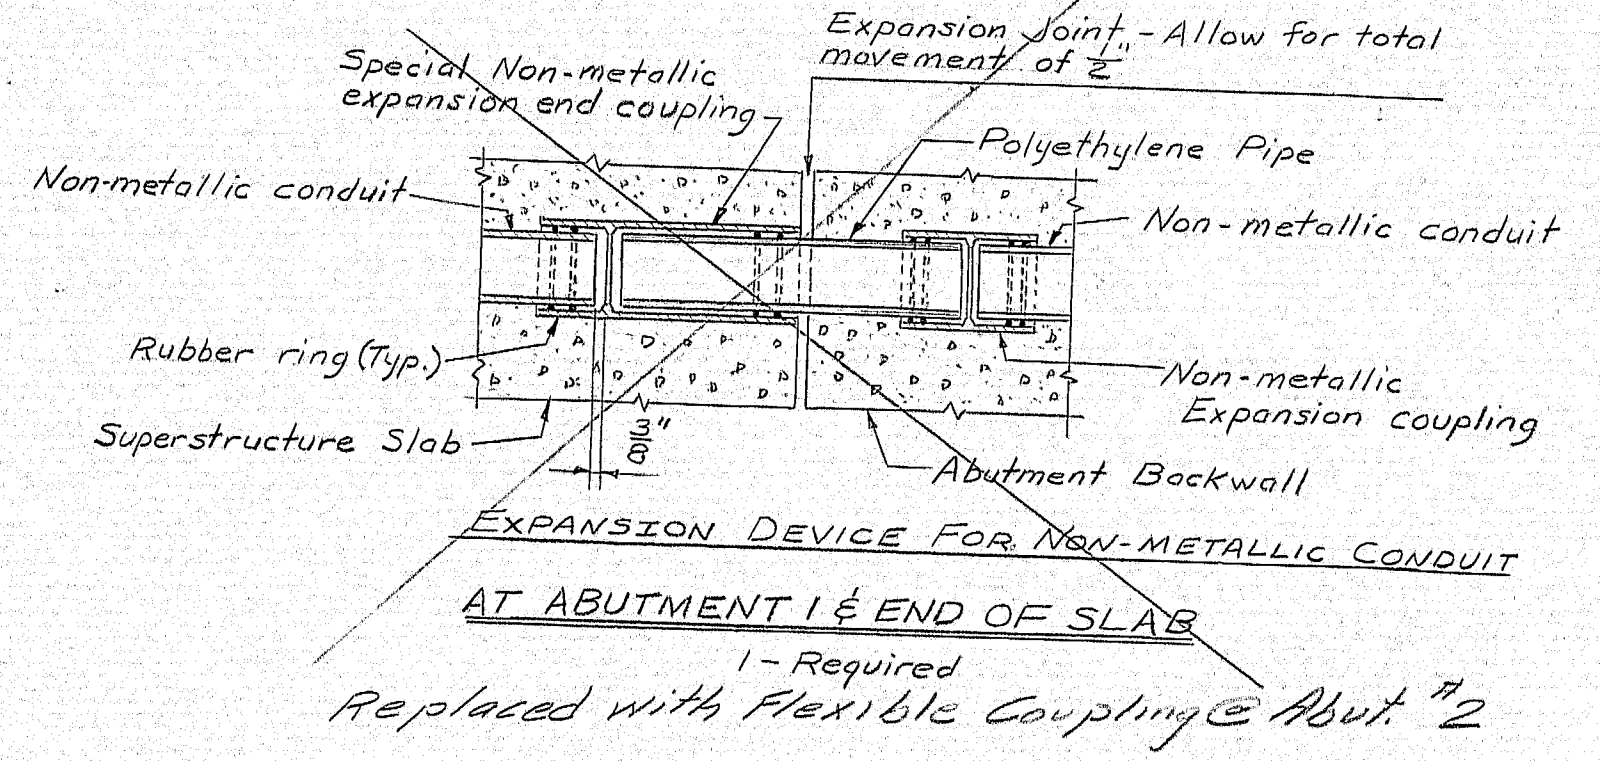


EXPANSION DEVICE FOR NON-METALLIC CONDUIT AT ABUTMENT 1 & END OF SLAB
1 - Required
Replaced with Flexible Coupling @ Abut #2

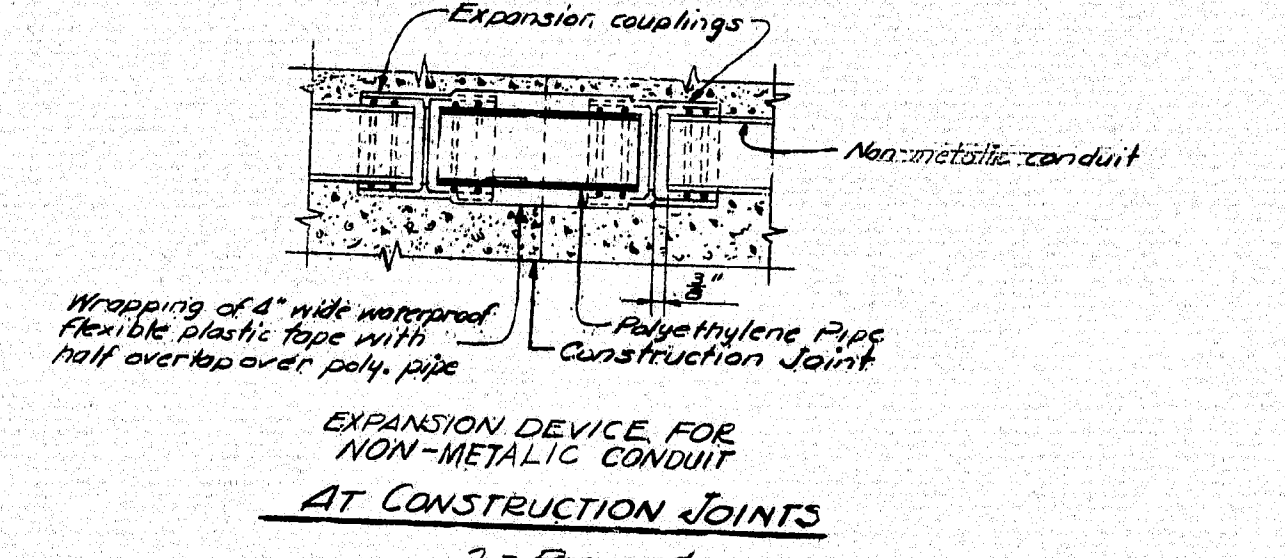


EXPANSION DEVICE FOR NON-METALLIC CONDUIT AT CONSTRUCTION JOINTS
3 - Required

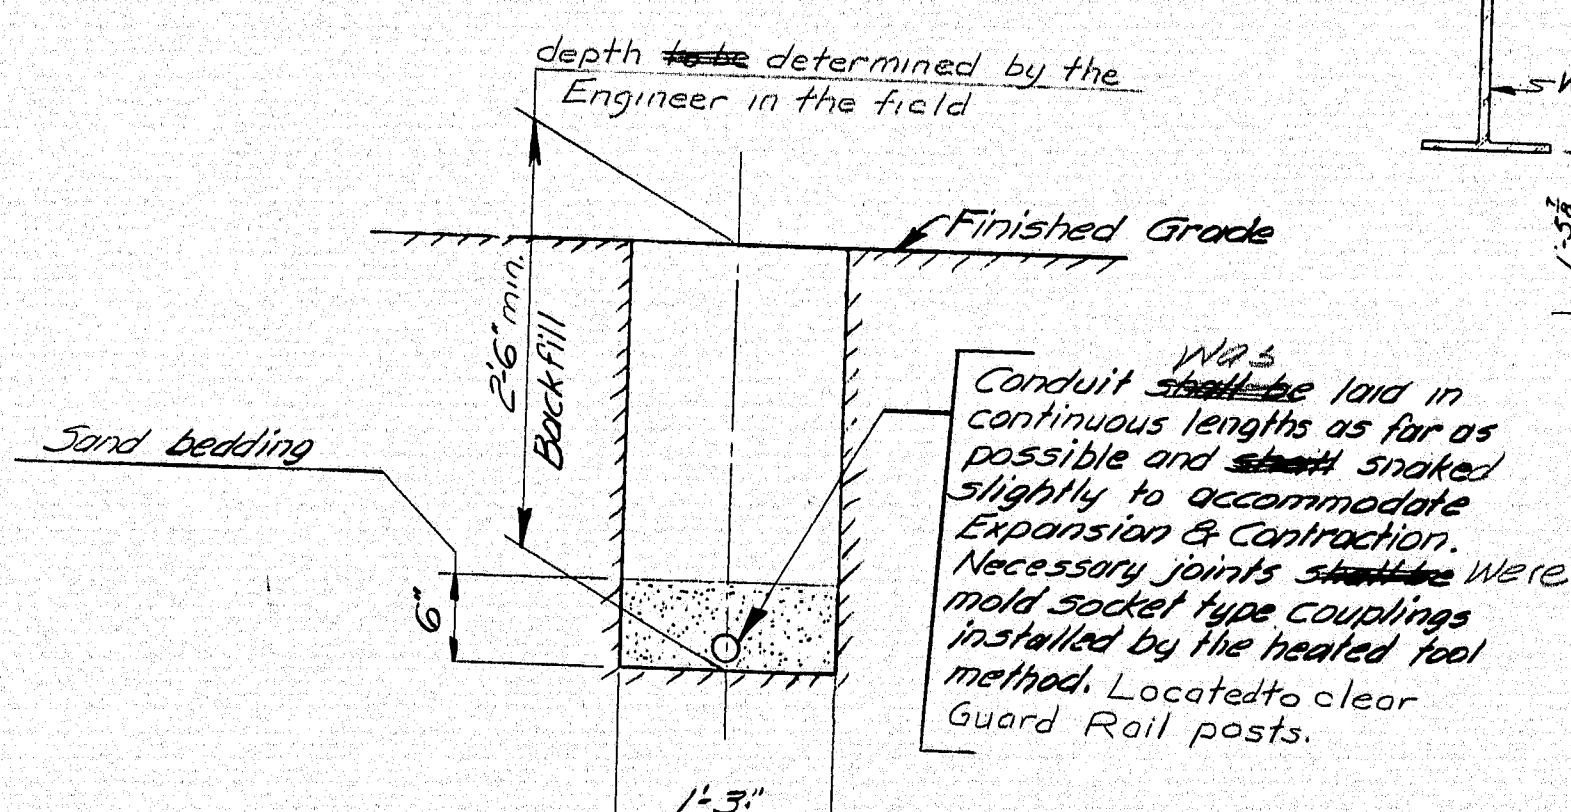

NON-METALLIC CONDUIT INSTALLATION
Typical for Approaches

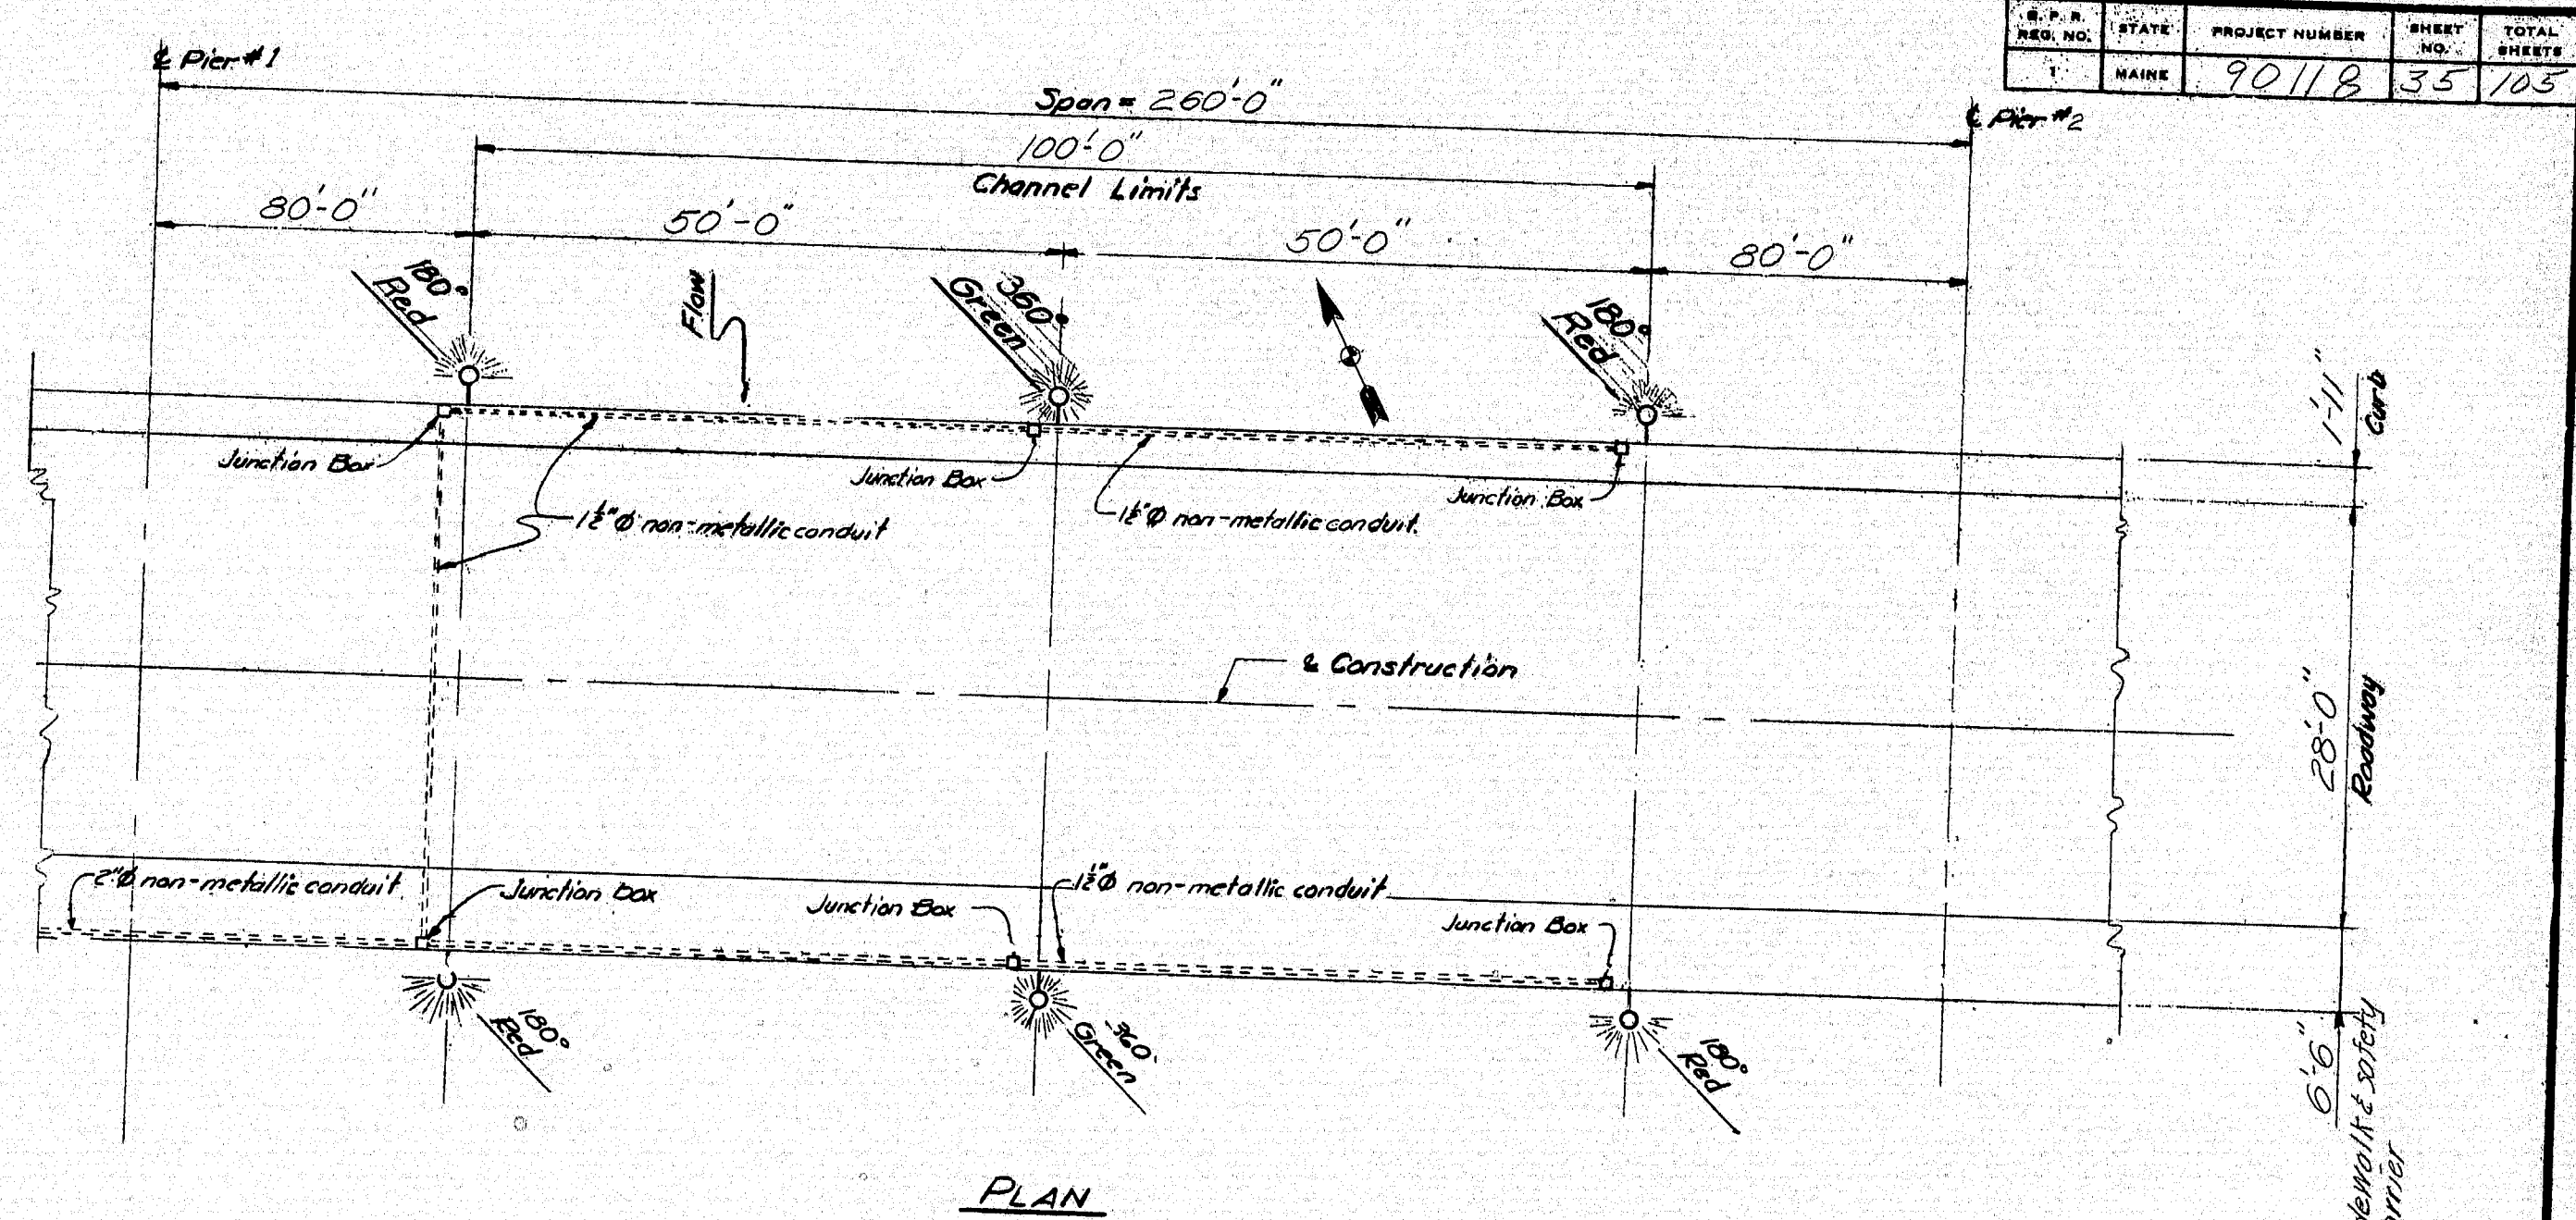

PLAN

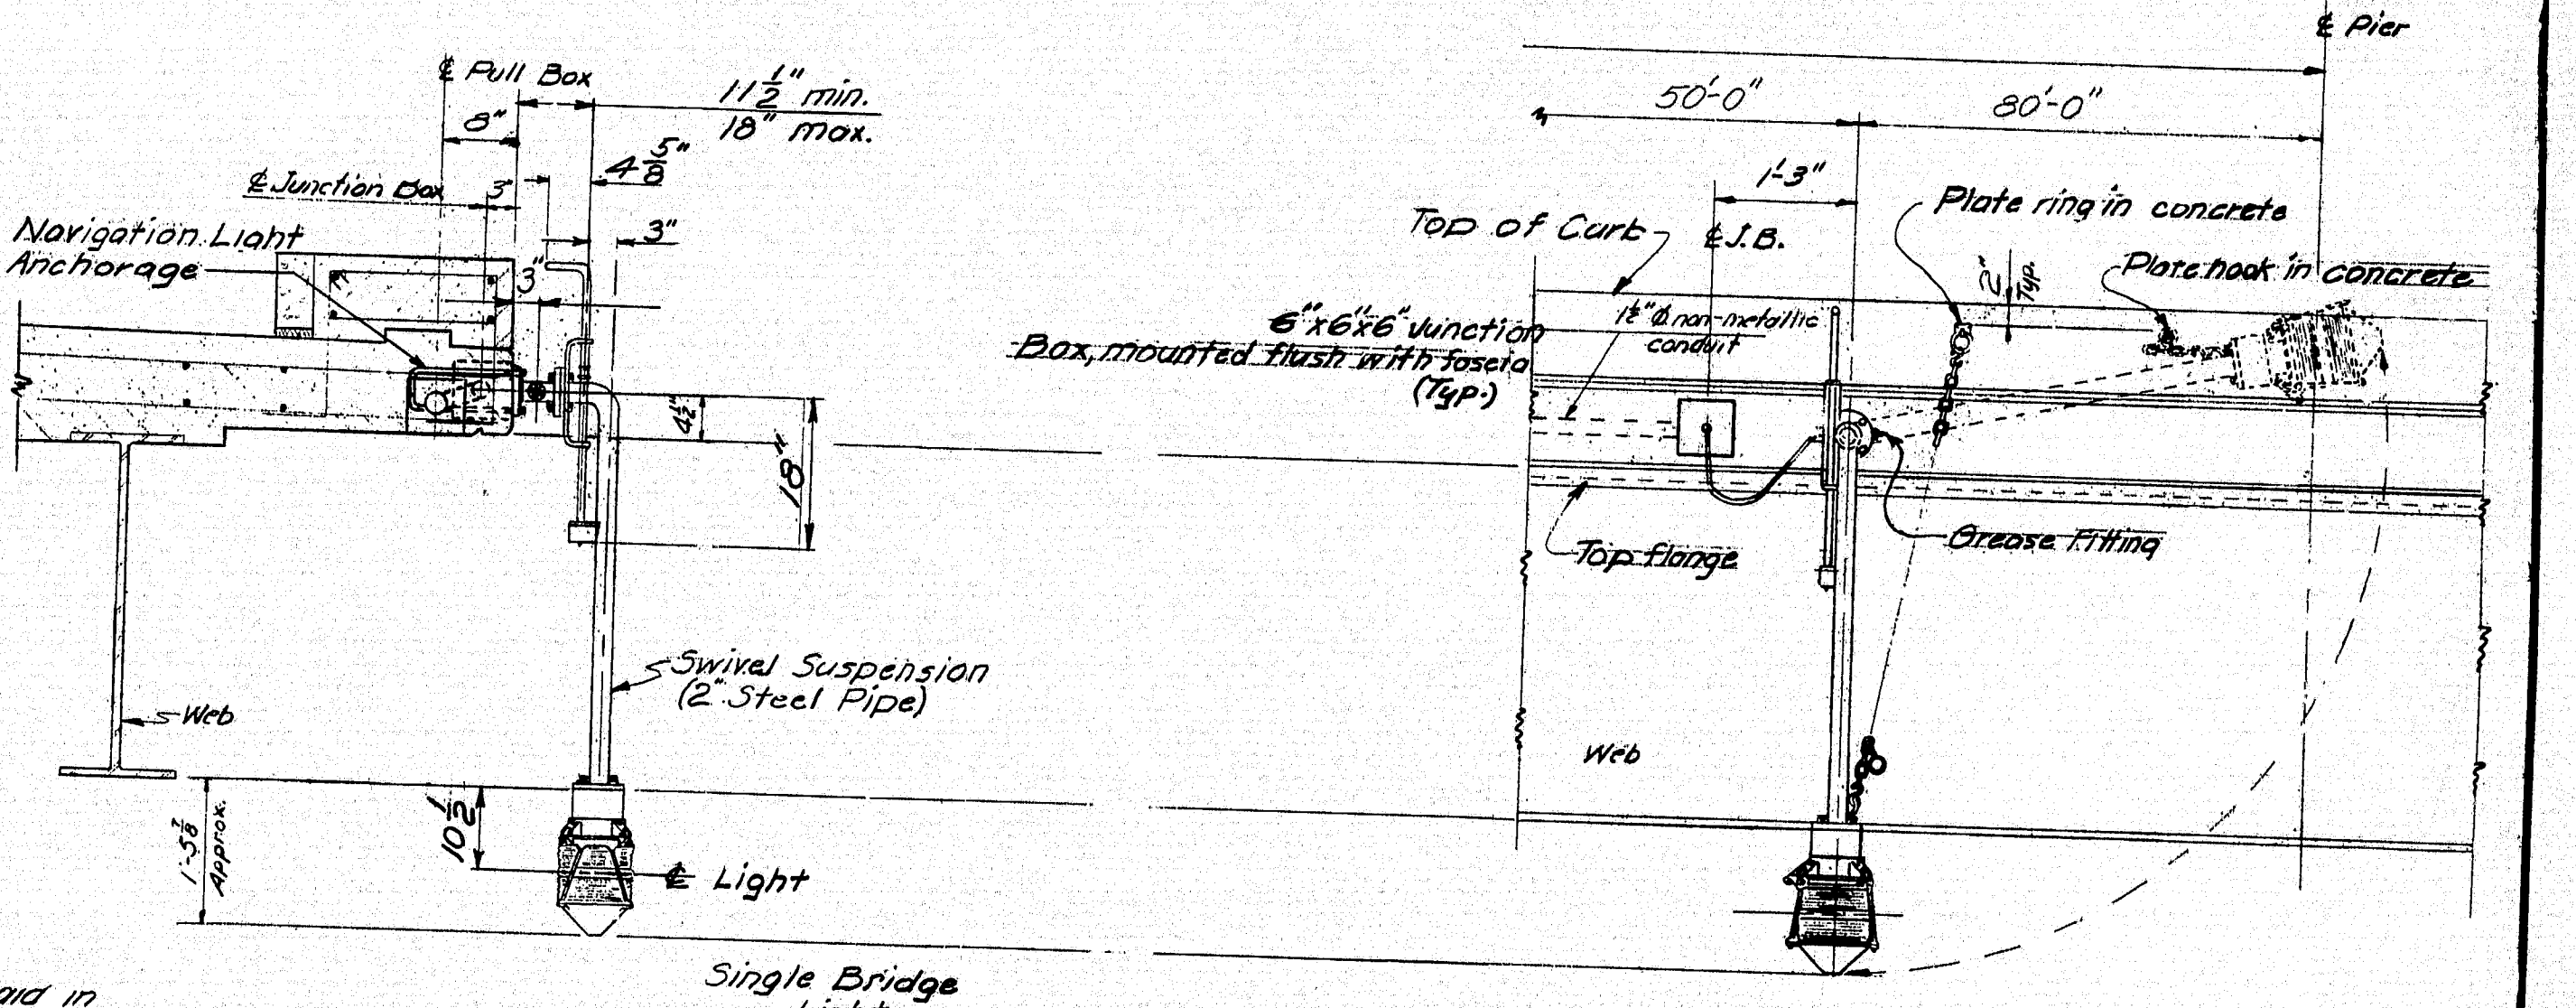

SIDE VIEW

PART ELEVATION

- NOTES:
1. All conduit except as otherwise shown shall be PVC Schedule 40, and shall be U.L. approved.
 2. Junction boxes shall be installed where shown on this sheet and sheets 7 and 18. 3 Required (flush mounted).
 3. Provisions shall be made to drain the conduit system in a manner approved by the Engineer.
 4. Three 15 x 15 x 1/8 inch brass union bolts with cast iron covers shall be installed below grade on Wiscasset approach. Exact location shall be determined in the field. The cover shall be at least 18\"/>
 - 5. Six navigation lights are required - four (4) 180° red & two (2) 360° green.
 - 6. Payment for all work and materials embedded in structures shall be paid for under item 638.02. Payment for furnishing and installing conduit and junction boxes in approaches shall be paid for at the contract unit price for the appropriate item.

Revised As Built 3/10/75
STATE OF MAINE
DEPARTMENT OF TRANSPORTATION
WESTPORT-WISCASSET BRIDGE
OVER
COWSEAGAN NARROWS
BETWEEN THE TOWNS OF
WESTPORT-WISCASSET
LINCOLN COUNTY
NAVIGATION LIGHTING DETAILS
SHEET 22 OF 25 AUGUSTA, MAINE APRIL 1973

153-140


PLANS	BY	DATE
DESIGN - DETAILED	CHANDLER/DEWITT	7/73
REVISIONS		
FIELD CHANGES		

REINFORCING STEEL SCHEDULE

REINFORCING STEEL SCHEDULE																											
STRAIGHT BARS													BENT BARS														
MARK	NO.	LENGTH	LOCATION	MARK	NO.	LENGTH	LOCATION	MARK	NO.	LENGTH	LOCATION	MARK	NO.	LENGTH	TYPE	A	B	C	D	E	F	G	H	O	R	LOCATION	
ABUTMENT No. 1				ABUTMENT No. 2 (CONT)								ABUTMENT No. 1															
A401	14	19'-10"	Backwall	A561	2	9'-11"						A403	10	4'-2"	S	~	1'-0"	2'-2"	1'-0"			~					Bridge Seats
A402	14	17'-2"	Backwall	A562	2	10'-9"						A404	10	4'-4"	S	~	1'-0"	2'-4"	1'-0"			~					Bridge Seats
				A563	2	11'-8"						A405	2	10'-6"	S		0'-6"	1'-0"	7'-6"	1'-0"			0'-6"				Sidewalk
A502	2	24'-8"	So. wing wall	A564	2	12'-5"	No. & So. wing wall					A501	69	7'-6"	S	~	3'-3"	1'-0"	3'-3"			~					Wing wall - curbs
A503	2	12'-5"	So. wing wall	A565	2	13'-2"	So. wing wall																				
A504	4	6'-6"	Wing walls	A566	1	13'-7"	So. wing wall																				
A505	2	14'-5"	No. wing wall	A581	2	3'-6"	No. & So. wing wall - Vert					A510	26	9'-11"	S	~	1'-3"	1'-8"	7'-0"			~					Breastwall
A506	2	15'-8"	No. wing wall	A582	2	4'-4"						A511	26	8'-2"	S	~	3'-6"	1'-2"	3'-6"			~					Backwall Stirrup
A507	52	4'-0"	Breastwall-Dowel	A583	2	5'-2"						A609	40	10'-0"	L		5'-0"	5'-0"									Breastwall
A508	26	7'-0"	Backwall	A584	2	6'-0"						EP410	2	10'-7"	U	1'-7"	0'-8 3/4"	6'-2"	0'-7"	1'-6"							End Post - Slant
				A585	2	6'-10"						EP411	4	10'-4"	U	1'-5"	0'-8 3/4"	6'-2"	0'-7"	1'-5"							End Post - Hor.
A601	6	20'-0"	Breastwall & Backwall	A586	2	7'-8"						EP415	2	5'-0"	S	~	0'-6"	3'-8 1/2"	0'-8"			~					End Post - Slant
A602	18	4'-6"	Approach slab seat-Dowel	A587	2	8'-6"						EP416	4	4'-11"	S	~	0'-6"	3'-8 1/2"	0'-8"			~					End Post - Hor.
				A588	2	9'-4"																					
				A589	2	10'-2"	No. & So. wing wall - Vert																				
				A590	1	10'-6"	So. wing wall																				
ABUTMENT No. 2				A651	16	33'-0"	Footings					EP612	2	6'-1"	SC	0'-6"	2'-2"	0'-7 1/2"	2'-2"			0'-6"					Abut-End Post-Vert.
A451	21	20'-0"	Backwall+Breastwall-Hor.	A652	16	36'-0"	Footings					EP613	2	7'-4"	SC	0'-6"	2'-8 1/2"	0'-11"	2'-8 1/2"			0'-6"					
A452	21	17'-0"	Backwall+Breastwall-Hor.	A653	132	7'-0"	Footings					EP614	2	8'-4"	SC	0'-6"	3'-2 1/2"	0'-11"	3'-2 1/2"			0'-6"					
A453	10	14'-2"	No. wing wall-Hor.	A654	36	7'-3"	Wing					EP615	2	9'-4"	SC	0'-6"	3'-8 1/2"	0'-11"	3'-8 1/2"			0'-6"					
A454	2	11'-6"		A655	22	4'-6"	Approach slab seat-Dowel					EP616	4	8'-11"	SC	0'-6"	3'-8 1/2"	0'-6"	3'-5 1/2"			0'-6"					Abut-End Post-Vert.
A455	2	8'-9"																									
A456	2	6'-10"										ABUTMENT No. 2															
A457	2	3'-6"	No. wing wall - Hor.									A458	2	10'-6"	S	0'-6"	1'-0"	7'-6"	1'-0"			0'-6"					Sidewalk
												A473	10	4'-8"	S	~	1'-0"	2'-8"	1'-0"			~					Bridge Seats
												A474	10	5'-8"	S	~	1'-0"	3'-8"	1'-0"			~					Bridge Seats
A467	10	15'-3"	So. wing wall-Hor.									A552	26	8'-3"	L	2'-7"	5'-8"										Breastwall
A468	2	12'-7"	So. wing wall-Hor.									A556	26	10'-11"	S	~	8'-0"	1'-8"	1'-3"			~					Backwall
A469	2	10'-1"										A591	26	9'-2"	S	~	4'-0"	1'-2"	4'-0"			~					Backwall Stirrup
A470	2	7'-8"																									
A471	2	5'-2"	So. wing wall-Hor.									EP412	2	10'-3"	EP	0'-6"	2'-6 3/4"	1'-0"	3'-10 3/4"	0'-8 3/4"	1'-6"						End Post - Slant
												EP413	4	9'-10"	EP	0'-6"	2'-5"	1'-0"	3'-8"	0'-8 3/4"	1'-6"						End Post - Hor.
A475	2	14'-0"	No. wing wall - Slant									EP617	2	7'-4"	SC	0'-6"	2'-10"	0'-7 1/2"	2'-10"			0'-6"					End Post haunch-Vert.
A476	2	15'-6"	So. wing wall - Slant									EP618	2	10'-4"	SC	0'-6"	4'-2 1/2"	0'-10 1/2"	4'-2 1/2"			0'-6"					End Post haunch-Vert.
A550	76	4'-0"	Dowels									EP619	4	12'-7"	SC	0'-6"	5'-4"	0'-10 1/2"	5'-4"			0'-6"					Abut-End Post-Vert.
A551	26	2'-6"	Dowels									EP620	2	10'-4"	H	0'-6"	1'-0"	3'-8"	1'-0"	3'-8"		0'-6"					Abut-Back wall haunch
A554	26	11'-0"	Backwall																								
A557	2	6'-6"	No. & So. wing wall																								
A558	2	7'-5"																									
A559	2	8'-4"																									
A560	2	9'-2"																									
													MARK	NO.	LENGTH	TYPE	A	B	C	D	E	F	G	H	O	R	LOCATION

FWA RES. NO.	STATE	PROJECT NUMBER	SHEET NO.	TOTAL SHEETS
1	MAINE	90110	36	105

TYPE-BENDING DIAGRAMS

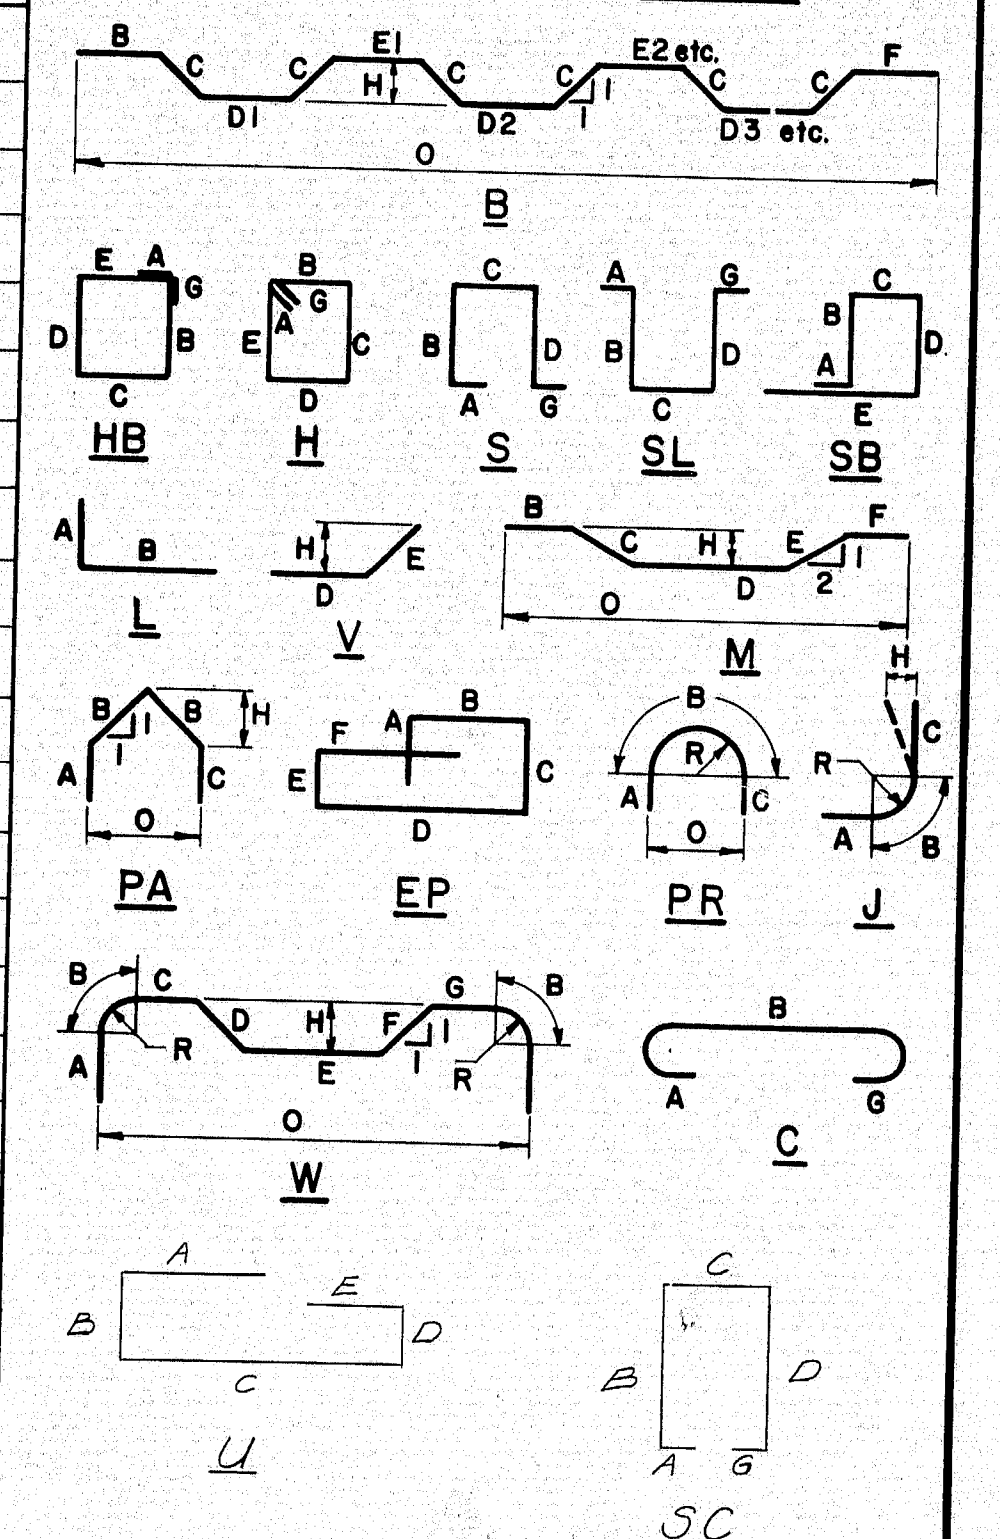

All dimensions are out to out of reinf. bar
 Bending details and hooks shall conform to the
 recommendations of ACI Standard 315-65.
 Reinforcing Bar: ASTM A615 Grade 60

GENERAL NOTES

- First digit(s) following the letter of the Mark indicates size of reinf. bar.
 Mark (A 502) bar size - #5
 Mark (P 1001) bar size - #10
 Mark (S 603) bar size - #6
- Letter of Marks A, P & S locates bars of Abutments, Piers, and Superstructure parts respectively.

STATE OF MAINE
 DEPARTMENT OF TRANSPORTATION

WESTPORT-WISCASSET BRIDGE
 OVER
COWSEAGAN NARROWS
 BETWEEN THE TOWNS OF
WESTPORT WISCASSET
LINCOLN COUNTY
 REINFORCING STEEL

SHEET 23 OF 25 AUGUSTA, MAINE APRIL 1973

153-141

[illegible]

STATE OF MAINE
DEPARTMENT OF TRANSPORTATION

WESTPORT-WISCASSET BRIDGE
OVER
COWSEAGAN NARROWS
BETWEEN THE TOWNS OF
WESTPORT WISCASSET
LINCOLN COUNTY
REINFORCING STEEL

SHEET 24 OF 25 AUGUSTA, MAINE APRIL 1973

153-142

REINFORCING STEEL SCHEDULE																															
				STRAIGHT BARS								BENT BARS																			
MARK	NO.	LENGTH	LOCATION	MARK	NO.	LENGTH	LOCATION	MARK	NO.	LENGTH	LOCATION	MARK	NO.	LENGTH	TYPE	A	B	C	D	E	F	G	H	O	R	LOCATION					
	<u>PIER No. 1</u>				<u>PIER No. 2</u>											<u>PIER No. 1</u>															
P502	22	20'-0"	Middle Shaft	P502	22	20'-0"	Middle Shaft					P501	32	22'-4"	S	~	2'-6"	17'-4"	2'-6"												
P504	10	30'-0"	Lower Shaft									P503	22	11'-4"	PA	1'-3"	4'-4 $\frac{3}{4}$ "	1'-3"						3'-1 $\frac{1}{2}$ "			Upper Shaft				
P508	38	20'-0"	Middle Shaft	P508	38	20'-0"	Middle Shaft					P505	10	13'-3"	S	~	1'-3"	10'-8 $\frac{1}{2}$ "	1'-3"				~			Middle Shaft					
												P506	128	3'-3"	CI	0'-7"	2'-8"										Lower Shaft				
																<u>PIER No. 2</u>															Upper Shaft
P625	72	14'-4"	Distribution Slab	P627	64	11'-4"	Distribution slab					P501	38	22'-4"	S	~	2'-6"	17'-4"	2'-6"				~				Upper Shaft				
P626	30	35'-5"	Distribution slab	P628	24	31'-5"	Distribution slab					P503	22	11'-4"	PA	1'-3"	4'-4 $\frac{3}{4}$ "	1'-3"						3'-1 $\frac{1}{2}$ "			Middle Shaft				
												P506	152	3'-3"	CI	0'-7"	2'-8"										Upper Shaft				
P1101	28	37'-5"	Cap	P1101	28	37'-5"	Cap									<u>PIER No. 1 & PIER No. 2</u>															
P1102	2	25'-8"	Cap	P1102	2	25'-8"	Cap					(Total No.)																			
P1103	40	29'-0"	Upper Shaft	P1104	92	6'-0"	Dowels																			(Pier 1)	(Pier 2)				
P1104	2128 2128	6'-0"	Dowels	P1105	52	15'-5"	Middle Shaft					P602	64	23'-1"	HB	0'-6 $\frac{1}{2}$ "	8'-8"	2'-4"	8'-8"	2'-4"			0'-6 $\frac{1}{2}$ "				Cap	32	32		
P1105	52	15'-5"	Middle Shaft	P1107	40	31'-0"	Upper Shaft					P603	8	22'-10"			8'-6 $\frac{1}{2}$ "		8'-6 $\frac{1}{2}$ "												
P1106	54	5'-8"	Lower Shaft	P1108	54	5'-9"	Lower Shaft					P604	8	22'-6"			8'-4 $\frac{1}{2}$ "		8'-4 $\frac{1}{2}$ "								4	4			
P1110	2	27'-8"	Cap	P1110	2	27'-8"	Cap					P605	8	22'-2"			8'-2 $\frac{1}{2}$ "		8'-2 $\frac{1}{2}$ "								4	4			
												P606	8	21'-11"			8'-0 $\frac{3}{4}$ "		8'-0 $\frac{3}{4}$ "								4	4			
												P607	8	21'-7"			7'-10 $\frac{3}{4}$ "		7'-10 $\frac{3}{4}$ "								4	4			
												P608	8	21'-3"			7'-9"		7'-9"								4	4			
												P609	8	21'-0"			7'- $\frac{1}{2}$ "		7'- $\frac{1}{2}$ "								4	4			
												P610	8	20'-8"			7'- $\frac{1}{4}$ "		7'- $\frac{1}{4}$ "								4	4			
												P611	8	20'-4"			7'- $\frac{3}{8}$ "		7'- $\frac{3}{8}$ "								4	4			
			</																												

[illegible]

GENERAL NOTES

1. First digit(s) following the letter of the Mark indicates size of reinf. bar.
Mark (A 502) bar size - #5
Mark (P 1001) bar size - #10
Mark (S 603) bar size - #6
2. Letter of Marks A, P & S locates bars of Abutments, Piers, and Superstructure parts respectively.



Revised As Built OK *Auth* 3/20/25

STATE OF MAINE
DEPARTMENT OF TRANSPORTATION



WESTPORT-WISCASSET BRIDGE
OVER
COWSEAGAN NARROWS
BETWEEN THE TOWNS OF
WESTPORT WISCASSET
LINCOLN COUNTY
REINFORCING STEEL

SHEET 25 OF 25 AUGUSTA, MAINE MARCH 1973



153-145

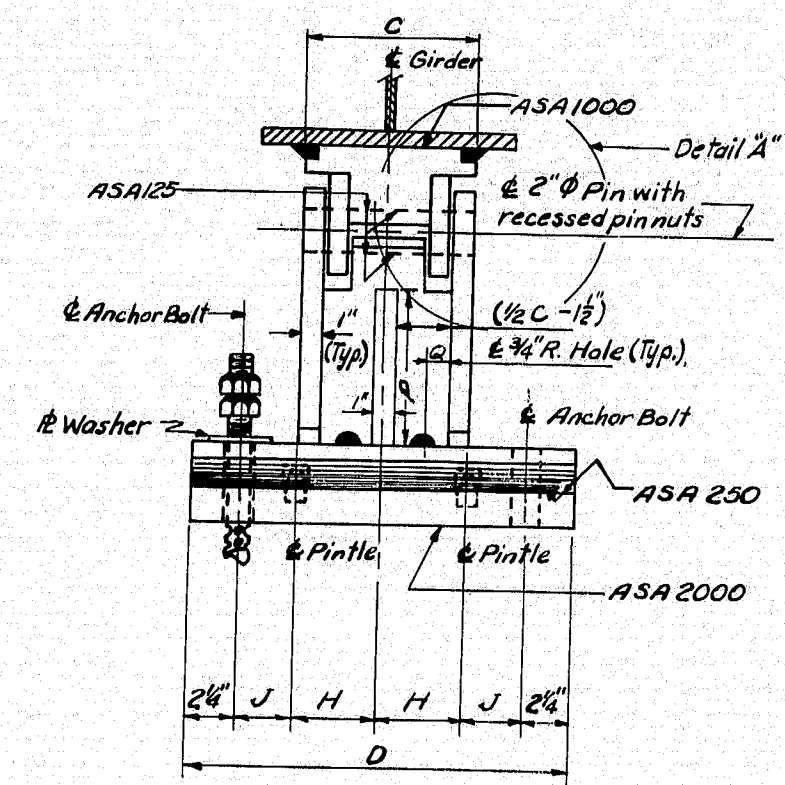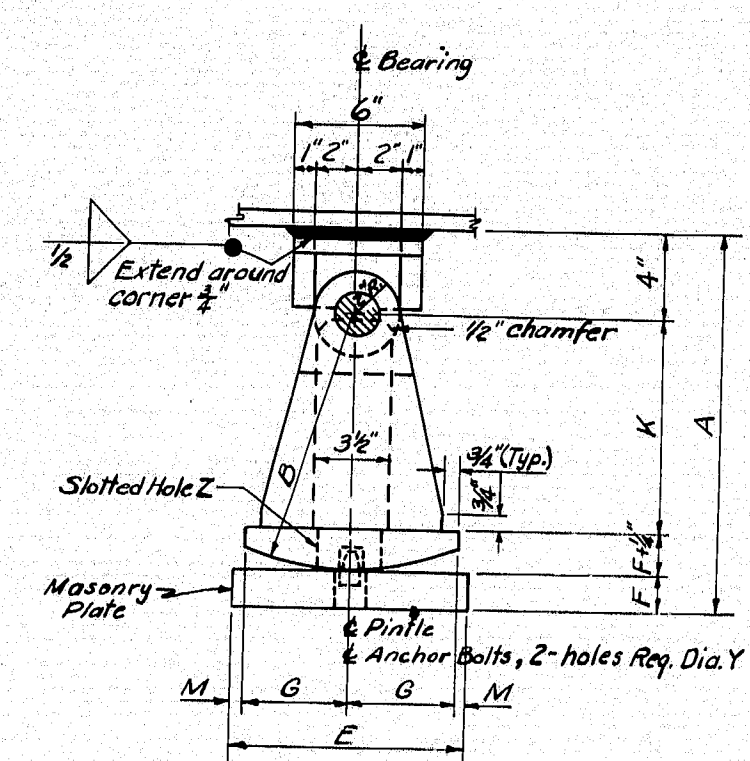

EXPANSION PEDESTAL — EPD

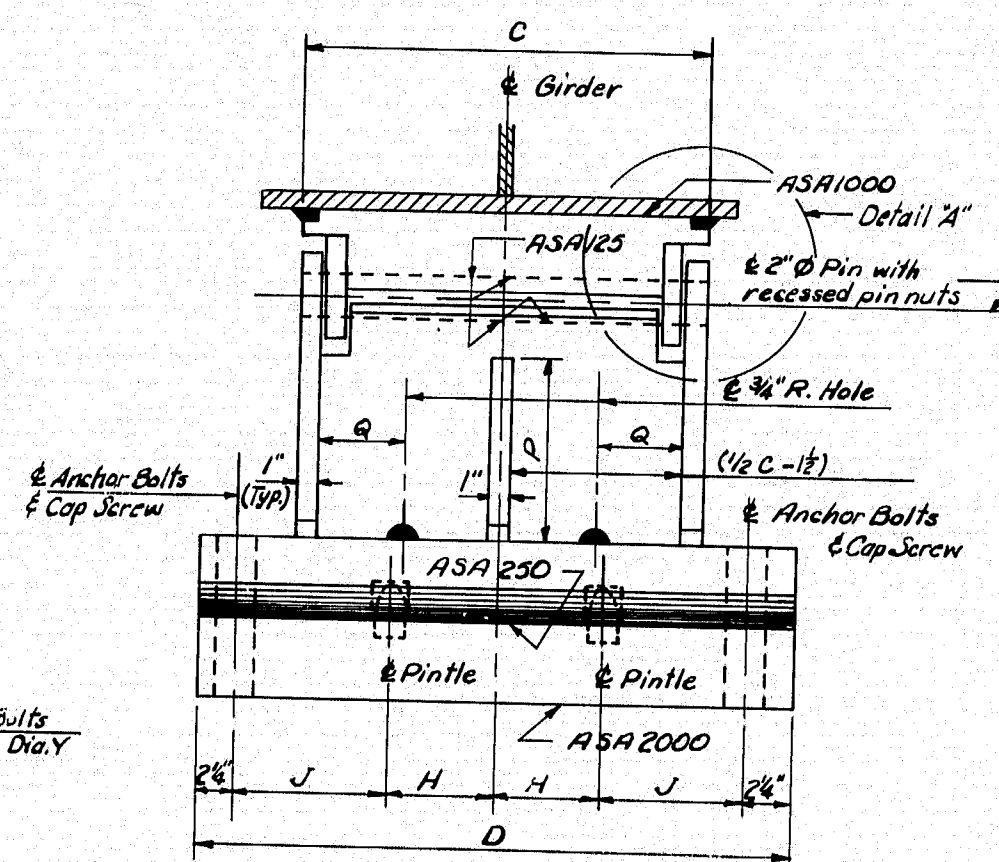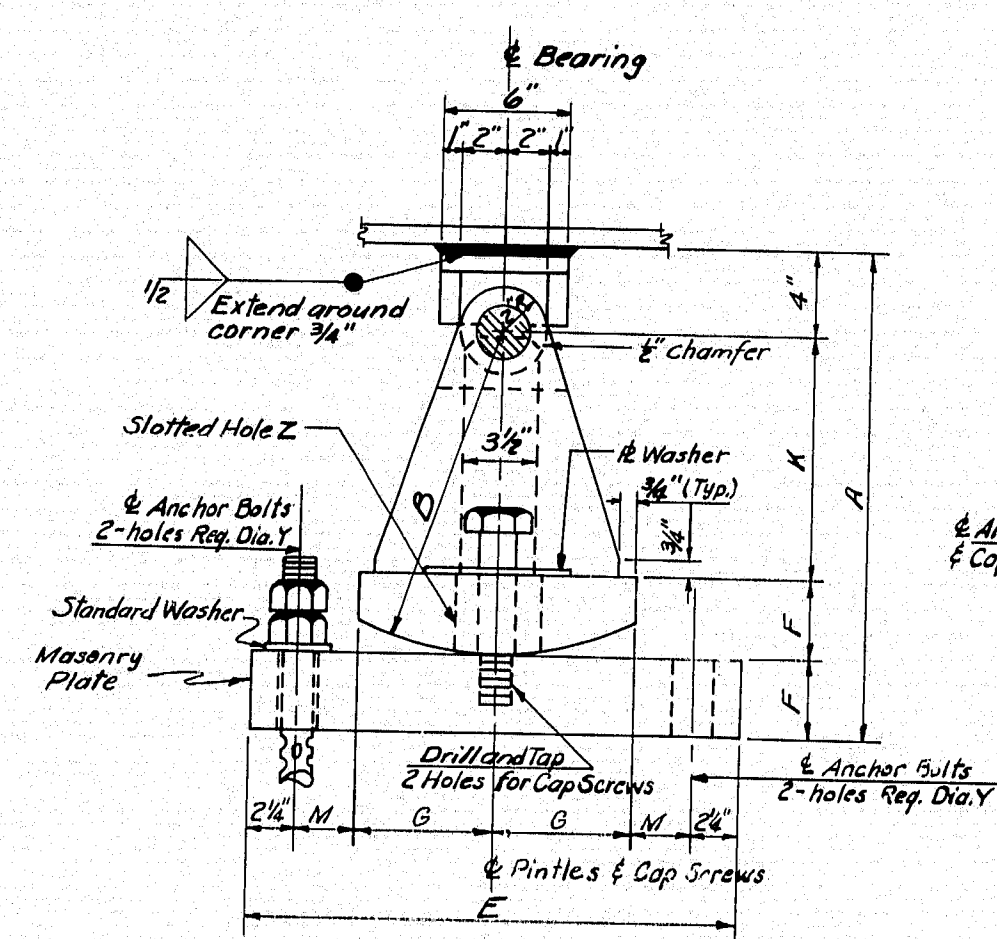


EXPANSION PEDESTAL — EPE

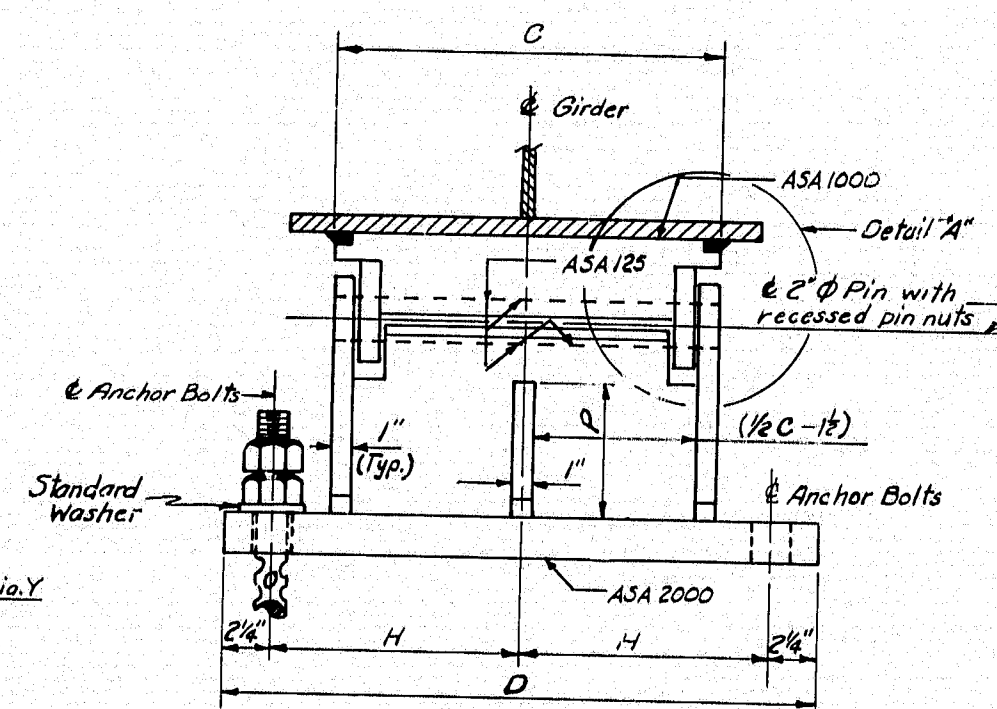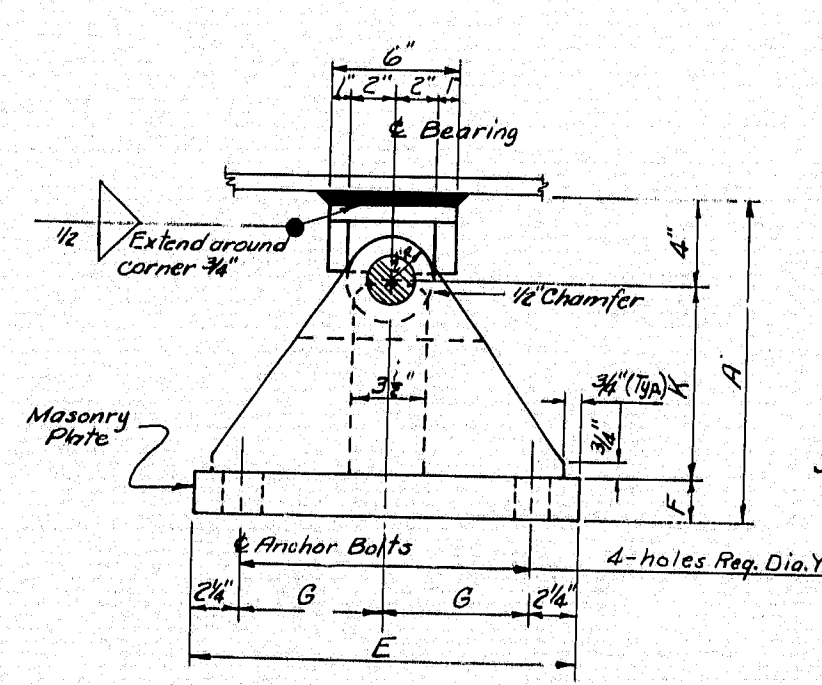


FIXED PEDESTAL — FPD

MARK	LOAD	A	B	C	D	E	F	G	H	J	K	M	P	Q	R	S	T	V	X-Anchor Bolt Diameter	Y-Masonry Plate Hole Size	Number Anchor Bolts Required	Z- Slotted Hole for Anchor Bolts or Cap Screws	W-Washer Size for Anchor Bolts or Cap Screws	A1 Embedment Depth	MARK
EPD-1	100K	1'-2 1/2"	9"	8"	1'-6"	8"	1 1/2"	3 1/2"	4"	2 1/2"	7"	4"	—	3"	1'-4 1/2"	3"	4 1/2"	—	1"	1 1/2"	2	3" x 1 1/2"	3" x 5" x 1/2"	10"	EPD-1
EPD-2	100K	1'-2 1/2"	9"	8"	1'-6"	9"	1 1/2"	4"	4"	2 1/2"	7"	4"	—	3"	1'-4 1/2"	3"	4 1/2"	—	1"	1 1/2"	2	3" x 1 1/2"	3" x 5" x 1/2"	10"	EPD-2
EPD-3	100K	1'-2 1/2"	9"	8"	1'-6"	10"	1 1/2"	4 1/2"	4"	2 1/2"	7"	4"	—	3"	1'-4 1/2"	3"	4 1/2"	—	1"	1 1/2"	2	3" x 1 1/2"	3" x 5" x 1/2"	10"	EPD-3
EPD-4	100K	1'-5 1/2"	1'-0"	8"	1'-6"	11"	1 1/2"	5"	4"	2 1/2"	10"	4"	—	3"	1'-5 1/2"	3"	4 1/2"	—	1"	1 1/2"	2	3" x 1 1/2"	3" x 5" x 1/2"	10"	EPD-4
EPD-5	200K	1'-9 1/2"	1'-3"	10"	1'-8"	1'-0"	2 1/2"	5 1/2"	4"	3 1/2"	1'-0 1/2"	4"	—	4"	2'-0 1/2"	4"	6 1/2"	—	1 1/2"	1 1/2"	2	4" x 1 1/2"	4" x 7" x 1/2"	1'-3"	EPD-5
EPD-6	200K	1'-9 1/2"	1'-3"	10"	1'-8"	1'-1"	2 1/2"	6"	4"	3 1/2"	1'-0 1/2"	4"	—	4"	2'-1"	4"	6 1/2"	—	1 1/2"	1 1/2"	2	4" x 1 1/2"	4" x 7" x 1/2"	1'-3"	EPD-6
EPD-7	200K	1'-9 1/2"	1'-3"	10"	1'-8"	1'-2"	2 1/2"	6 1/2"	4"	3 1/2"	1'-0 1/2"	4"	—	4"	2'-1"	4"	6 1/2"	—	1 1/2"	1 1/2"	2	4" x 1 1/2"	4" x 7" x 1/2"	1'-3"	EPD-7
EPD-8	200K	1'-9 1/2"	1'-3"	10"	1'-8"	1'-3"	2 1/2"	7"	4"	3 1/2"	1'-0 1/2"	4"	—	4"	2'-1"	4"	6 1/2"	—	1 1/2"	1 1/2"	2	4" x 1 1/2"	4" x 7" x 1/2"	1'-3"	EPD-8
EPD-9	300K	1'-10"	1'-3"	1'-2"	2'-0"	1'-4"	3"	7 1/2"	5"	4 1/2"	1'-1 1/2"	4"	—	6"	2'-2 1/2"	4"	8"	—	1 1/2"	1 1/2"	2	5" x 1 1/2"	4" x 8" x 1/2"	1'-3"	EPD-9
EPD-10	400K	1'-10 1/2"	1'-3"	1'-6"	2'-4"	1'-6"	3 1/2"	8 1/2"	6"	5 1/2"	1'-1 1/2"	4"	—	6"	2'-3"	4"	8 1/2"	—	1 1/2"	1 1/2"	2	5" x 1 1/2"	4" x 8" x 1/2"	1'-3"	EPD-10
EPE-11	400K	1'-10 1/2"	1'-3"	1'-7"	2'-4"	1'-7"	3 1/2"	4 1/2"	5"	4 1/2"	1'-1 1/2"	3 1/2"	—	6"	1'-10 1/2"	4 1/2"	—	5"	1 1/2"	1 1/2"	4	5" x 1 1/2"	3 1/2" x 7" x 1/2"	1'-3"	EPE-11
EPE-12	400K	1'-10 1/2"	1'-3"	1'-7"	2'-4"	1'-11"	3 1/2"	6 1/2"	5"	4 1/2"	1'-1 1/2"	3 1/2"	—	6"	1'-10 1/2"	4 1/2"	—	5"	1 1/2"	1 1/2"	4	4" x 1 1/2"	3 1/2" x 5" x 1/2"	1'-3"	EPE-12
EPE-13	400K	1'-11"	1'-3"	1'-7"	2'-4"	2'-4"	4"	8 1/2"	5"	4 1/2"	1'-1 1/2"	3 1/2"	—	6"	1'-11"	4 1/2"	—	5 1/2"	1 1/2"	1 1/2"	4	5" x 1 1/2"	3 1/2" x 6" x 1/2"	1'-3"	EPE-13
EPE-14	600K	2'-1 1/2"	1'-6"	1'-11"	3'-0"	1'-10"	3 1/2"	6"	7"	8 1/2"	1'-2 1/2"	3 1/2"	—	6"	1'-10 1/2"	4 1/2"	—	6 1/2"	1 1/2"	1 1/2"	4	6 1/2" x 1 1/2"	3 1/2" x 8" x 1/2"	1'-3"	EPE-14
EPE-15	600K	2'-2 1/2"	1'-6"	1'-11"	3'-0"	2'-3"	4 1/2"	9"	7"	8 1/2"	1'-2 1/2"	3 1/2"	—	6"	1'-10 1/2"	4 1/2"	—	6 1/2"	1 1/2"	1 1/2"	4	4 1/2" x 1 1/2"	4" x 5 1/2" x 1/2"	1'-3"	EPE-15
EPE-16	800K	2'-2 1/2"	1'-6"	2'-6"	3'-10"	1'-11"	4"	10"	10 1/2"	1'-2 1/2"	3 1/2"	3 1/2"	—	8"	1'-11"	4 1/2"	—	5"	1 1/2"	1 1/2"	4	6 1/2" x 1 1/2"	4" x 8" x 1/2"	1'-3"	EPE-16
EPE-17	800K	2'-2 1/2"	1'-6"	2'-6"	3'-10"	2'-5"	4 1/2"	9"	10"	10 1/2"	1'-2 1/2"	3 1/2"	—	8"	1'-11"	4 1/2"	—	5"	1 1/2"	1 1/2"	4	4 1/2" x 1 1/2"	4" x 6" x 1/2"	1'-3"	EPE-17
FPD-1	100K	1'-0"	—	8"	1'-6"	9"	2"	2 1/2"	6 1/2"	—	6"	—	—	—	1'-3"	3 1/2"	—	—	1"	1 1/2"	4	—	Standard	10"	FPD-1
FPD-2	200K	1'-0"	—	10"	1'-8"	1'-2"	2"	4 1/2"	7 1/2"	—	6"	—	—	—	1'-8"	4"	—	—	1"	1 1/2"	4	—	Standard	1'-3"	FPD-2
FPD-3	300K	1'-0"	—	1'-2"	2'-0"	1'-4"	2"	3 1/2"	9 1/2"	—	6"	—	—	—	1'-8"	4"	—	—	1"	1 1/2"	4	—	Standard	1'-3"	FPD-3
FPD-4	400K	1'-3"	—	1'-6"	2'-4"	1'-6"	2"	6 1/2"	11 1/2"	—	9"	—	—	—	1'-8"	4"	—	—	1"	1 1/2"	4	—	Standard	1'-3"	FPD-4
FPD-5	600K	1'-3"	—	1'-11"	3'-0"	1'-10"	3"	8 1/2"	1'-3 1/2"	—	8"	—	—	—	1'-9"	4"	—	—	1"	1 1/2"	4	—	Standard	1'-3"	FPD-5
FPD-6	800K	1'-3"	—	2'-6"	3'-10"	1'-11"	3"	8 1/2"	1'-8 1/2"	—	8"	—	—	—	1'-9"	4"	—	—	1"	1 1/2"	4	—	Standard	1'-3"	FPD-6

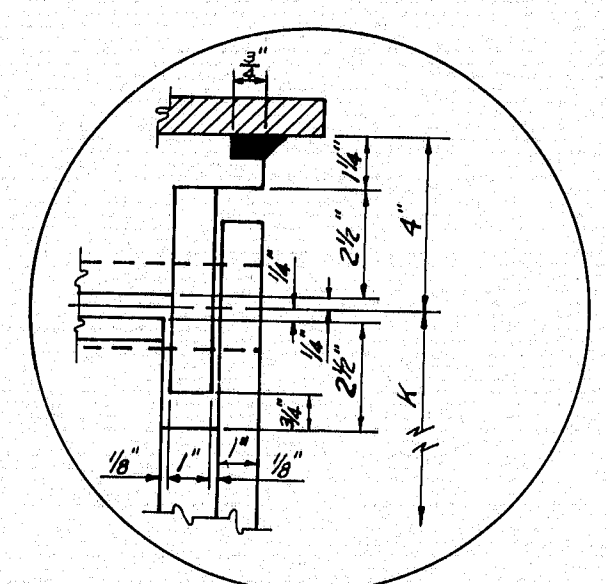


DETAIL "A"

CAP SCREW DETAIL

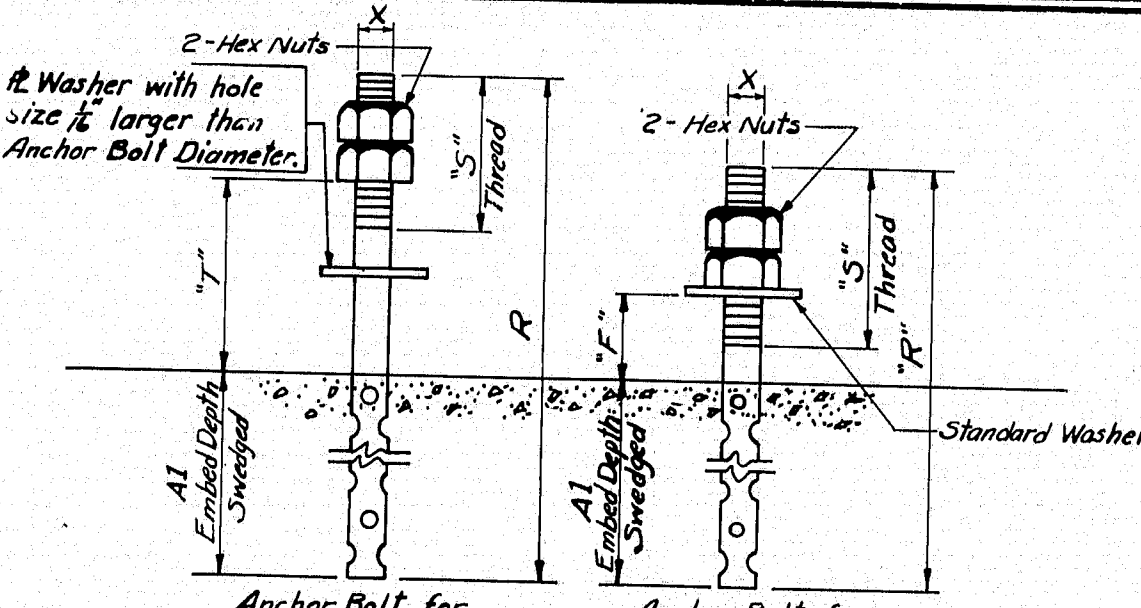

ANCHOR BOLT DETAILS

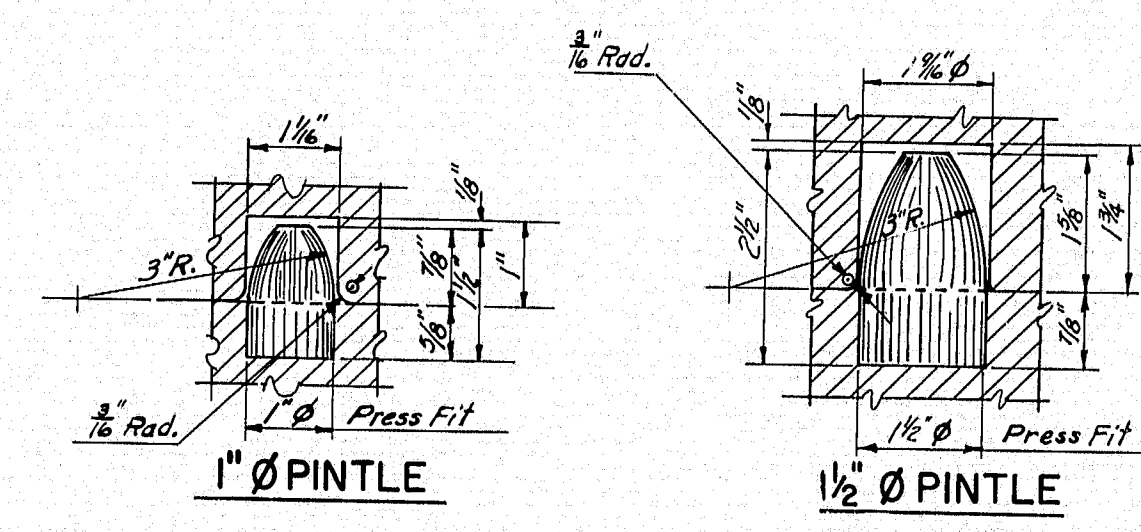

PINTLE DETAILS

GENERAL NOTES:

At the location of bearing pedestals the concrete bridge seats shall be dressed one inch larger all around than size of masonry pintoles and to exact elevations shown on the plans. If dressed areas are below the surface of the surrounding bridge seat a small channel shall be cut to the edge of the bridge seat for drainage where required by the Engineer. Channels shall have a min. width of 2" and a min. slope of 1/4 inch per foot. No separate payment for this work will be made as it shall be considered incidental to contract items.

Fabricate pedestals with 1/2" fillet welds. The diameter of the pin hole shall not exceed that of the pin by more than 1/8 inch.

Pedestals EPD-1 thru EPD-9 and EPE-1 thru EPE-10 have no center stiffeners and have only one drainage hole.

Pedestals EPD-10 and EPE-11 thru EPE-17 have a center stiffener and have two drainage holes.

Pedestals FPD-1 thru FPD-3 have no center stiffeners and have no drainage holes.

Pedestals FPD-4 thru FPD-6 have a center stiffener and no drainage holes.

DESIGN SPECIFICATIONS

A.A.S.H.O. Standard Specifications for Highway Bridges, 1969

A.S.T.M. STEEL CLASSIFICATION

All structural steel shall be A-36 except the following:
2" Ø Pin - A-36; A-233, Class E or A-108, Grade 1016 - 1030 inclusive.

NOTE:
Use 1" Ø Pintles with 1" Ø Anchor Bolts & 1 1/2" Ø Pintles with 1 1/2" Ø Anchor Bolts.


MAINE STATE HIGHWAY COMMISSION
AUGUSTA, MAINE

STANDARD DETAILS
(BD 100-71)


BEARING PEDESTALS

JULY 1971

153-144

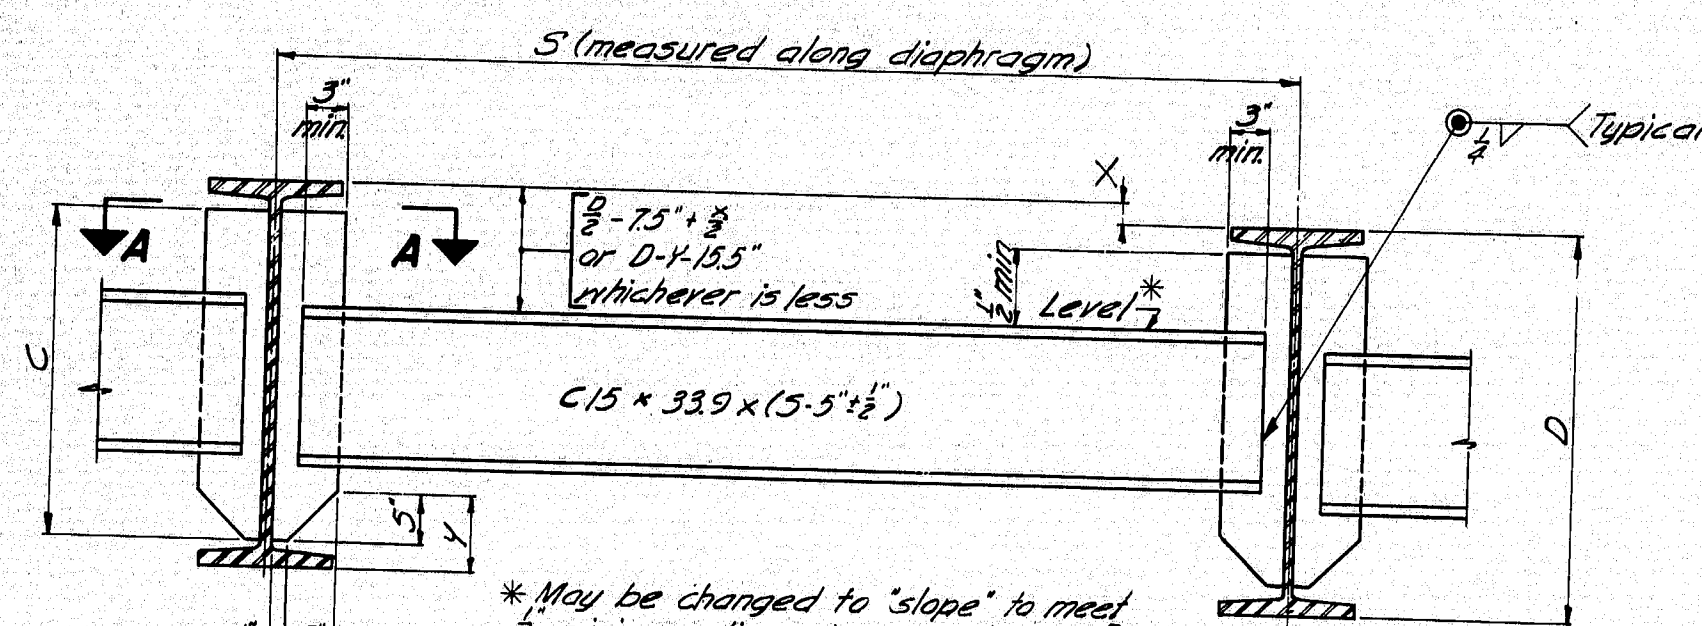


TYPE A DIAPHRAGM

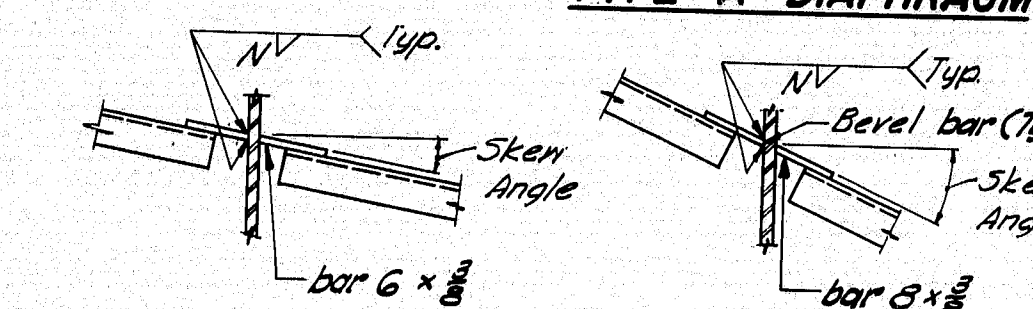

SECTION A-A
Skew Angle 0° to 10°00'


SECTION A-A
Skew Angle over 10°00' to 20°00'

BEAM	C	N
W27 x 84 to 114 incl.	1'-11"	1/2"
W30 x 99 to 132 incl.	2'-2"	1/2"
W33 x 118 to 152 incl.	2'-5"	1/2"
W36 x 135 to 184 incl.	2'-7"	1/2"
W36 x 230 to 300 incl.	2'-6"	1/2"

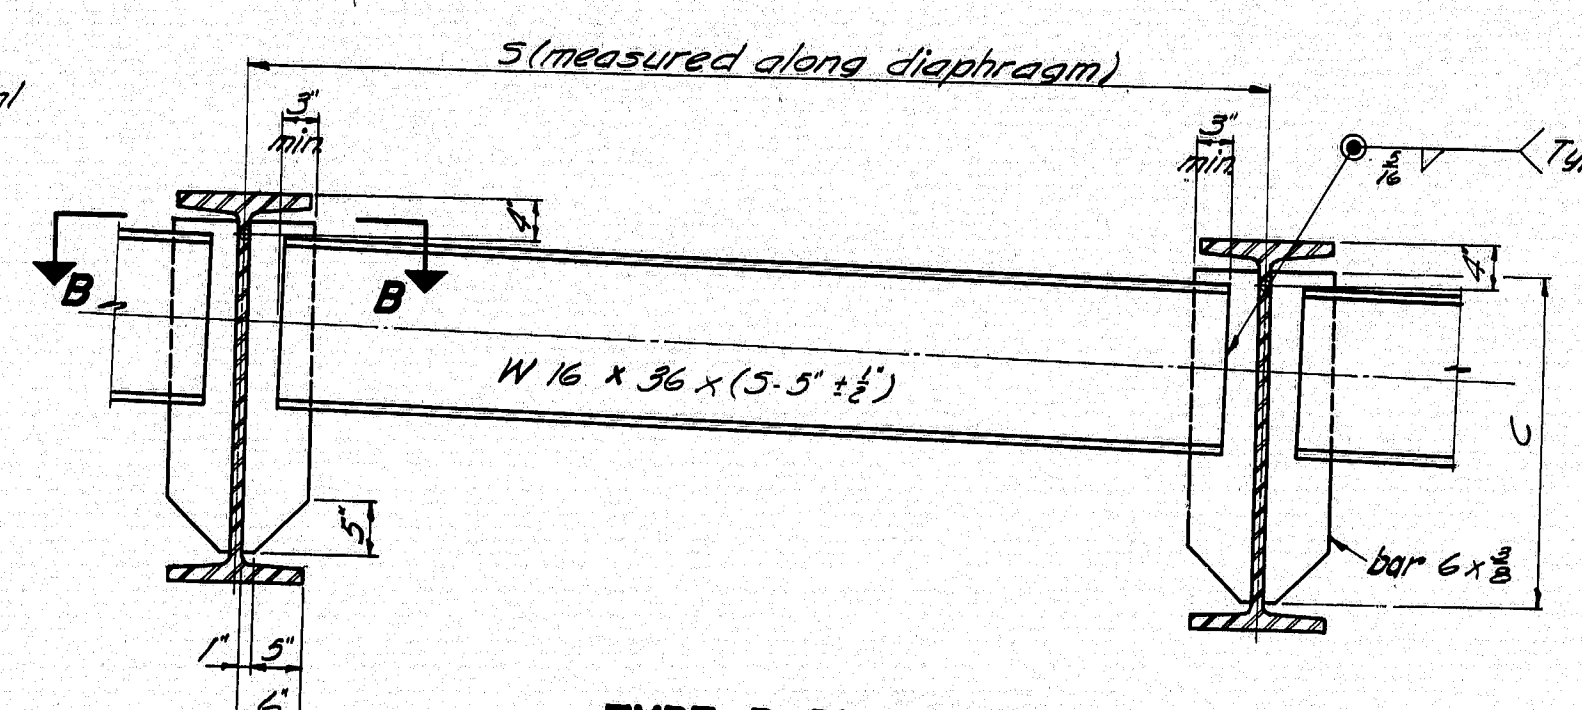

TYPE B DIAPHRAGM

Welding 6 x 8 bars to web same as for Type A Diaphragm.

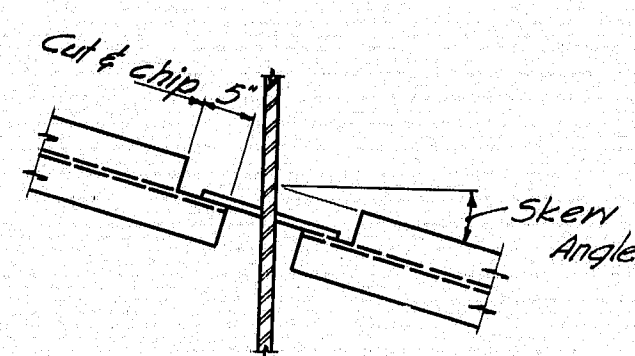


SECTION B-B
Skew Angle 0° to 10°00'


SECTION B-B
Skew Angle over 10°00'

NOTE
See design details for diaphragm type, location and skew.

DIAPHRAGMS

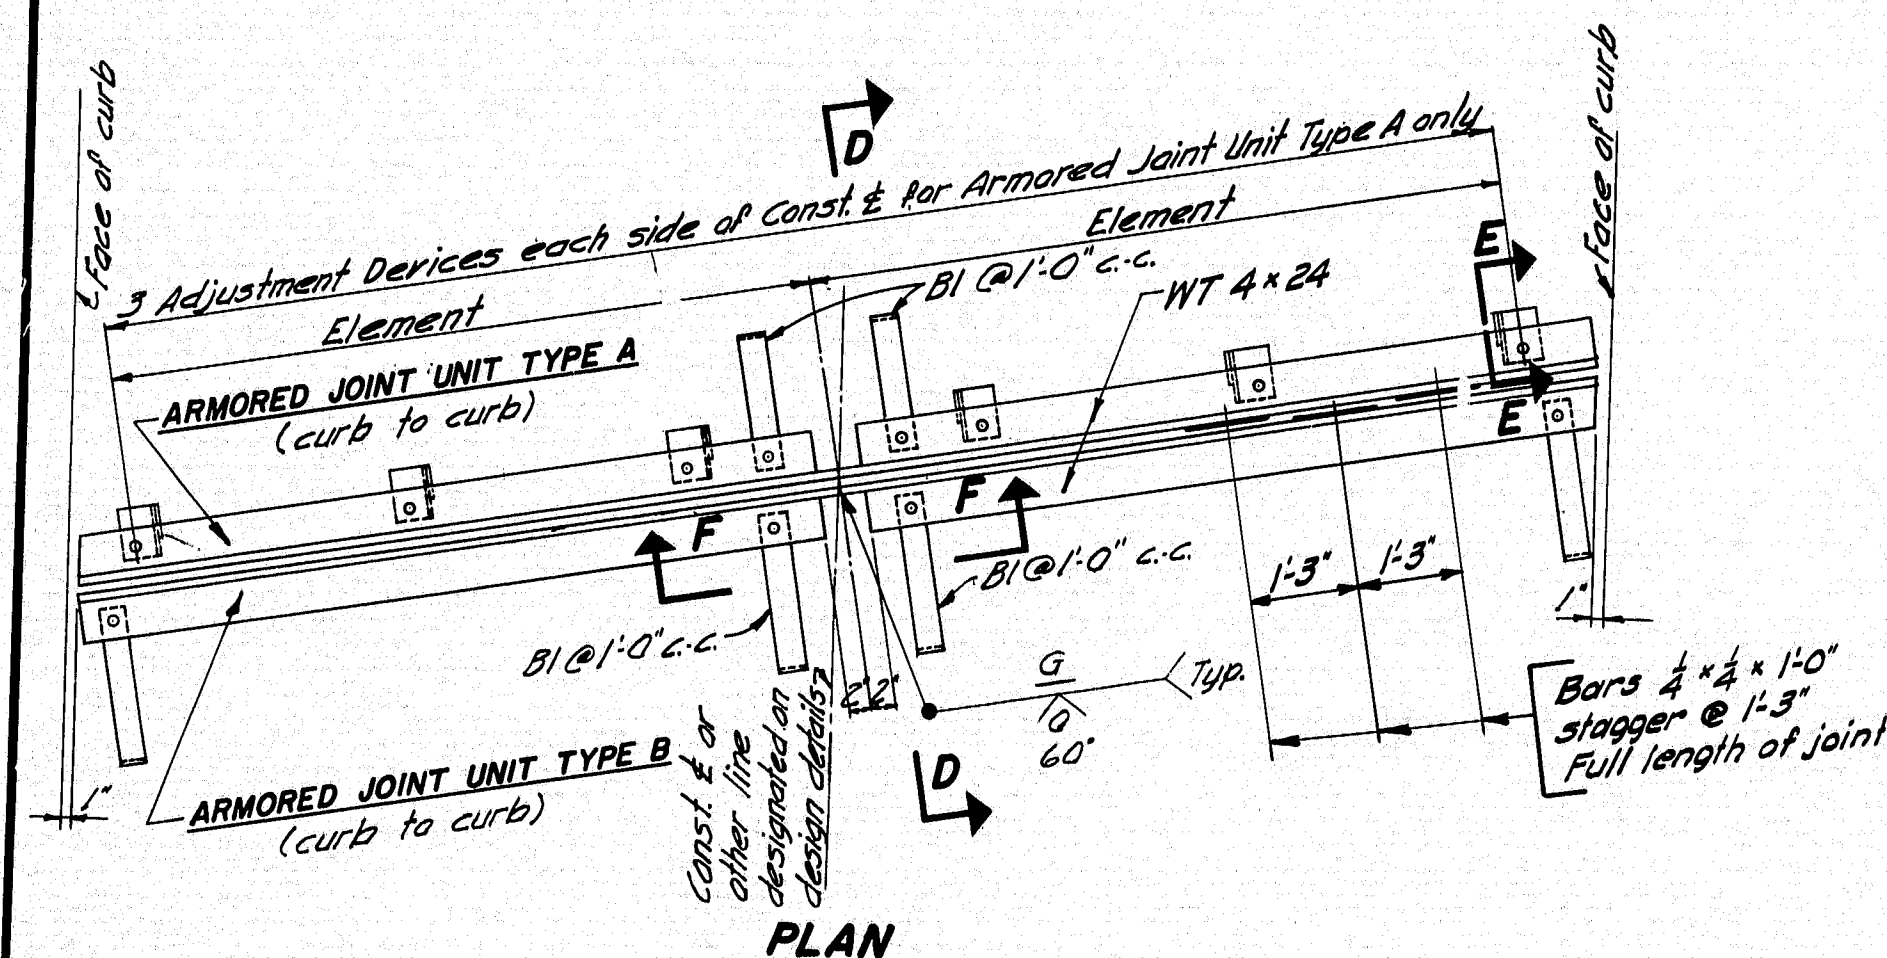

PLAN

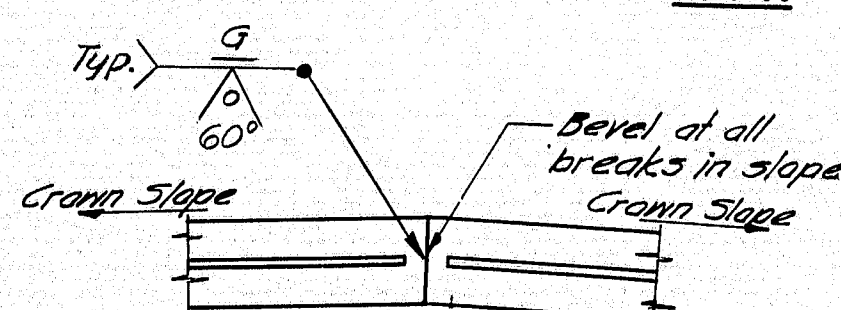

SECTION F-F


Note: See design details for constr. to curb dimensions, skew, crown slope, slab thickness, other dimensions necessary to complete the fabrication details, and location.

NOTE

1. Type A Armored Joint Units are intended to be used for attachment to superstructures. Type B Armored Joint Units are intended to be used for attachment to abutments. All armored joints over piers, two (2) Type A Armored Joint Units shall be used.
2. If more elements than the two shown in the 'Plan' are required by the design details, there shall be three adjustment devices for each element for Armored Joint Unit Type A and the elements of both units shall be field welded together in the same manner as shown in the 'Plan'.
3. Armored Joints to be paid for as Structural Steel.

ARMORED JOINT


An armored joint consists of two armored joint units. See note 1.

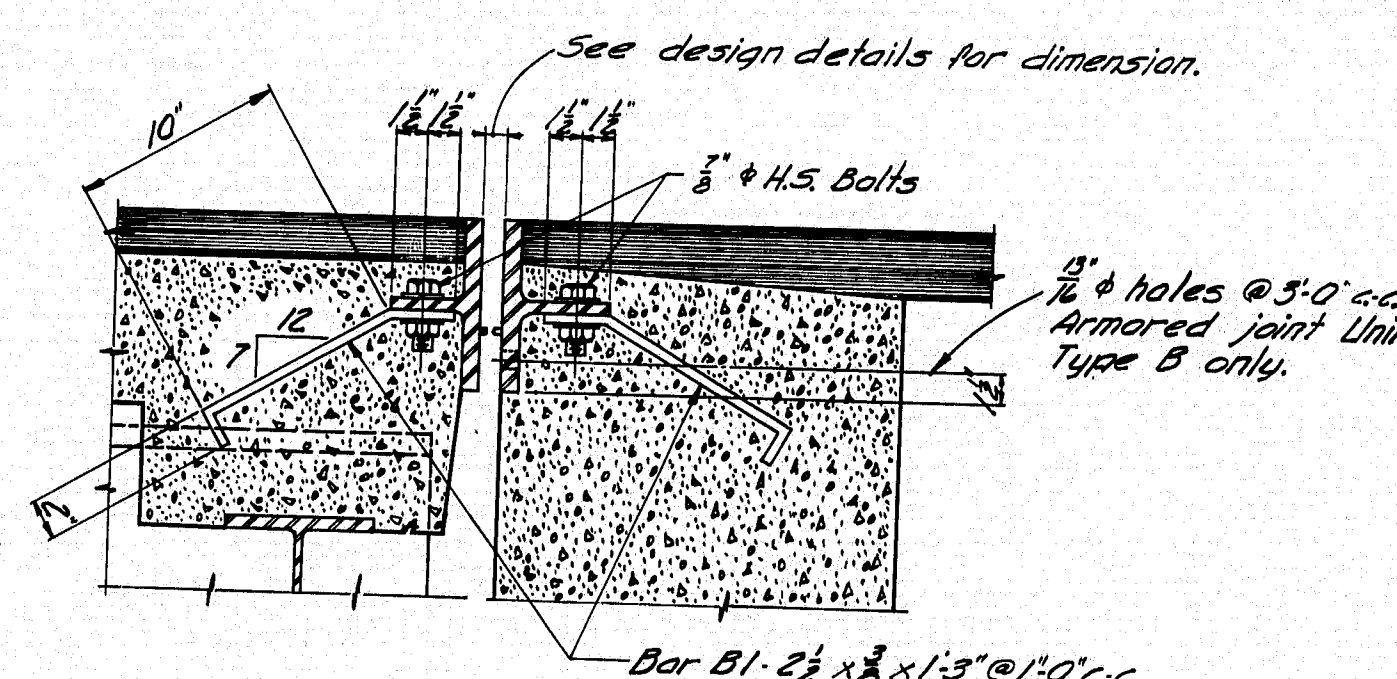

ARMORED JOINT UNIT TYPE A


ARMORED JOINT UNIT TYPE B

SECTION D-D

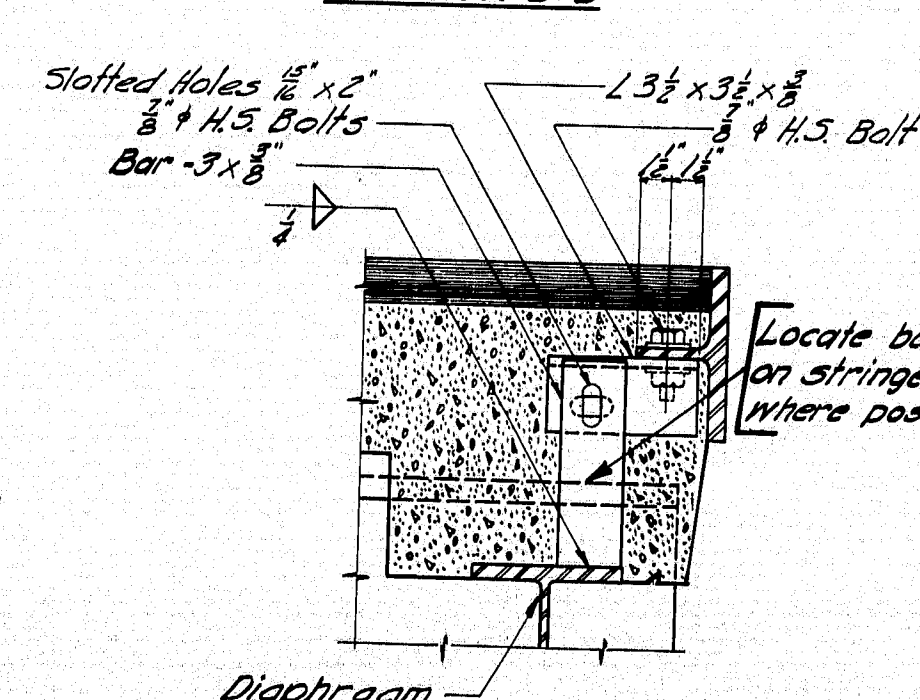

SECTION E-E


Showing Adjustment Device Armored Joint Unit Type A only - After Unit is in final position weld 8 bars to angle with 1/2" fillet

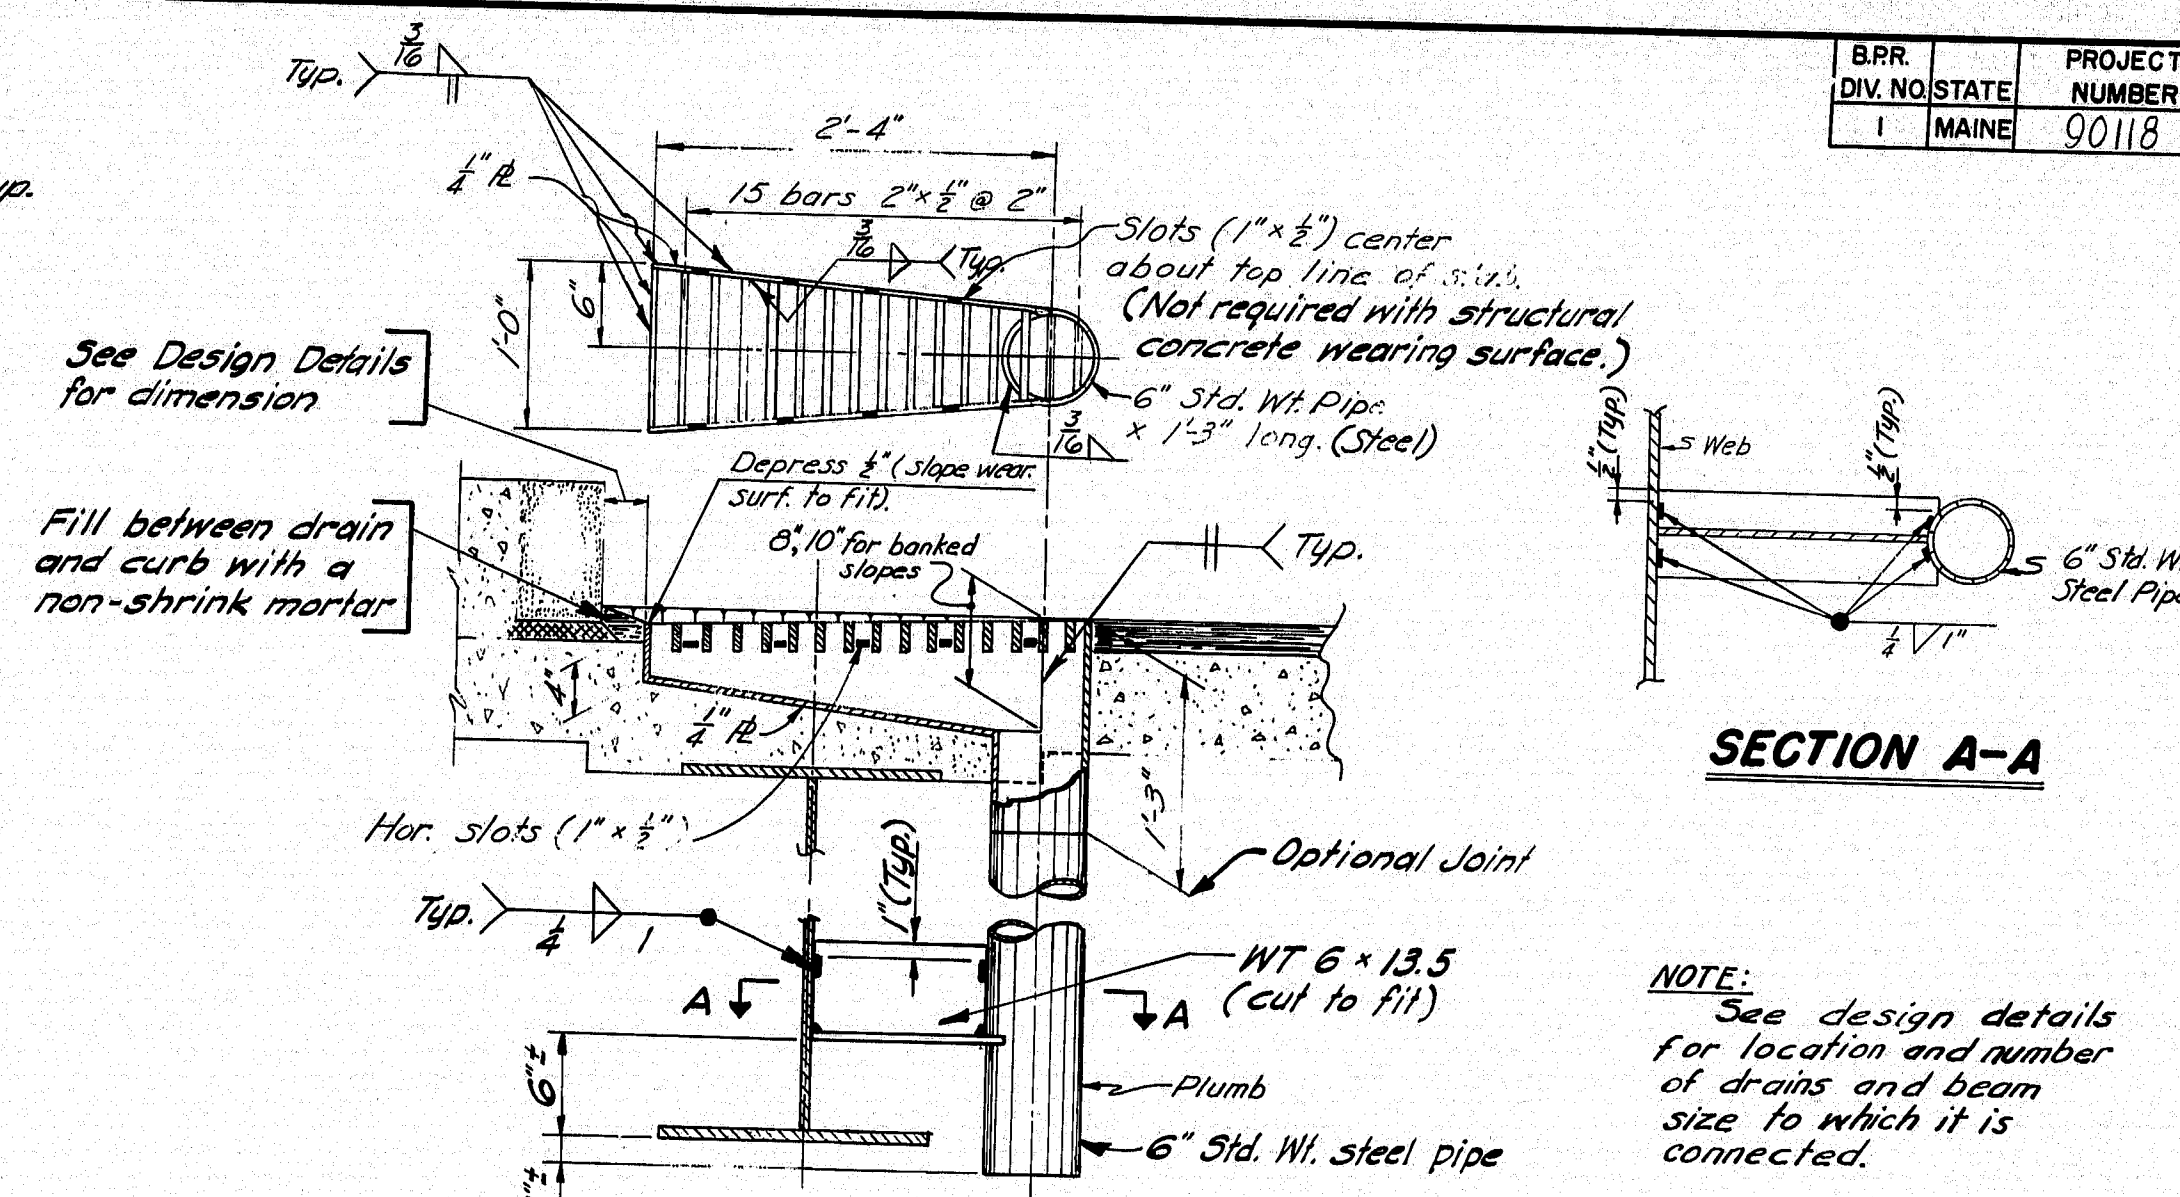

SECTION A-A

NOTE:
See design details for location and number of drains and beam size to which it is connected.

DRAIN NO. 1

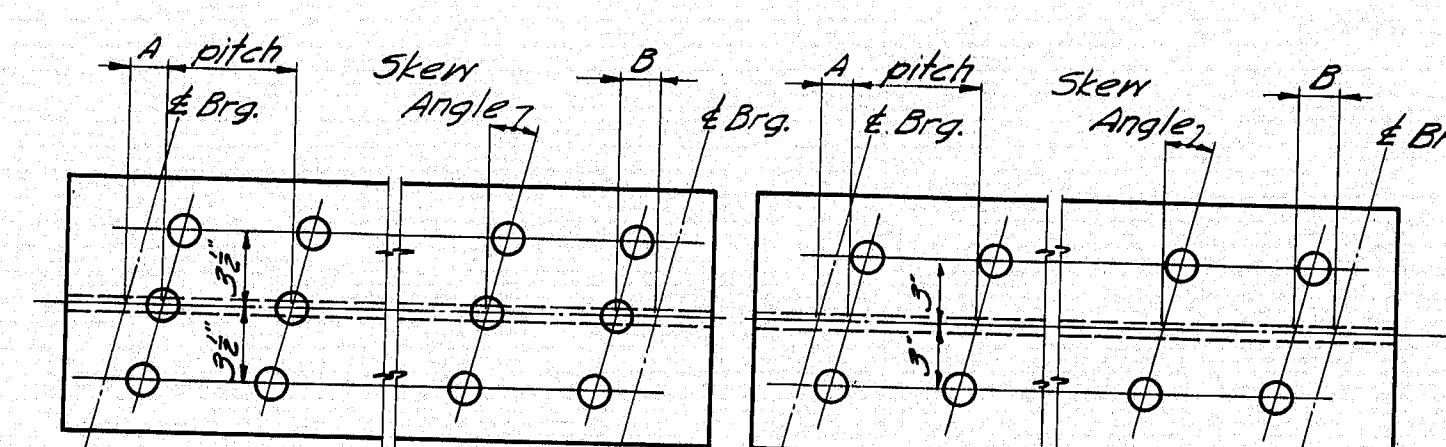

TRIPLE STUDS


DOUBLE STUDS

STUD DETAIL

NOTE

1. Studs shall be granular or solid flux filled and automatically welded to top flange in the shop or field.
2. See the design details for Dimensions 'A' & 'B', stud pitch and skew angle for studs.

SHEAR CONNECTORS

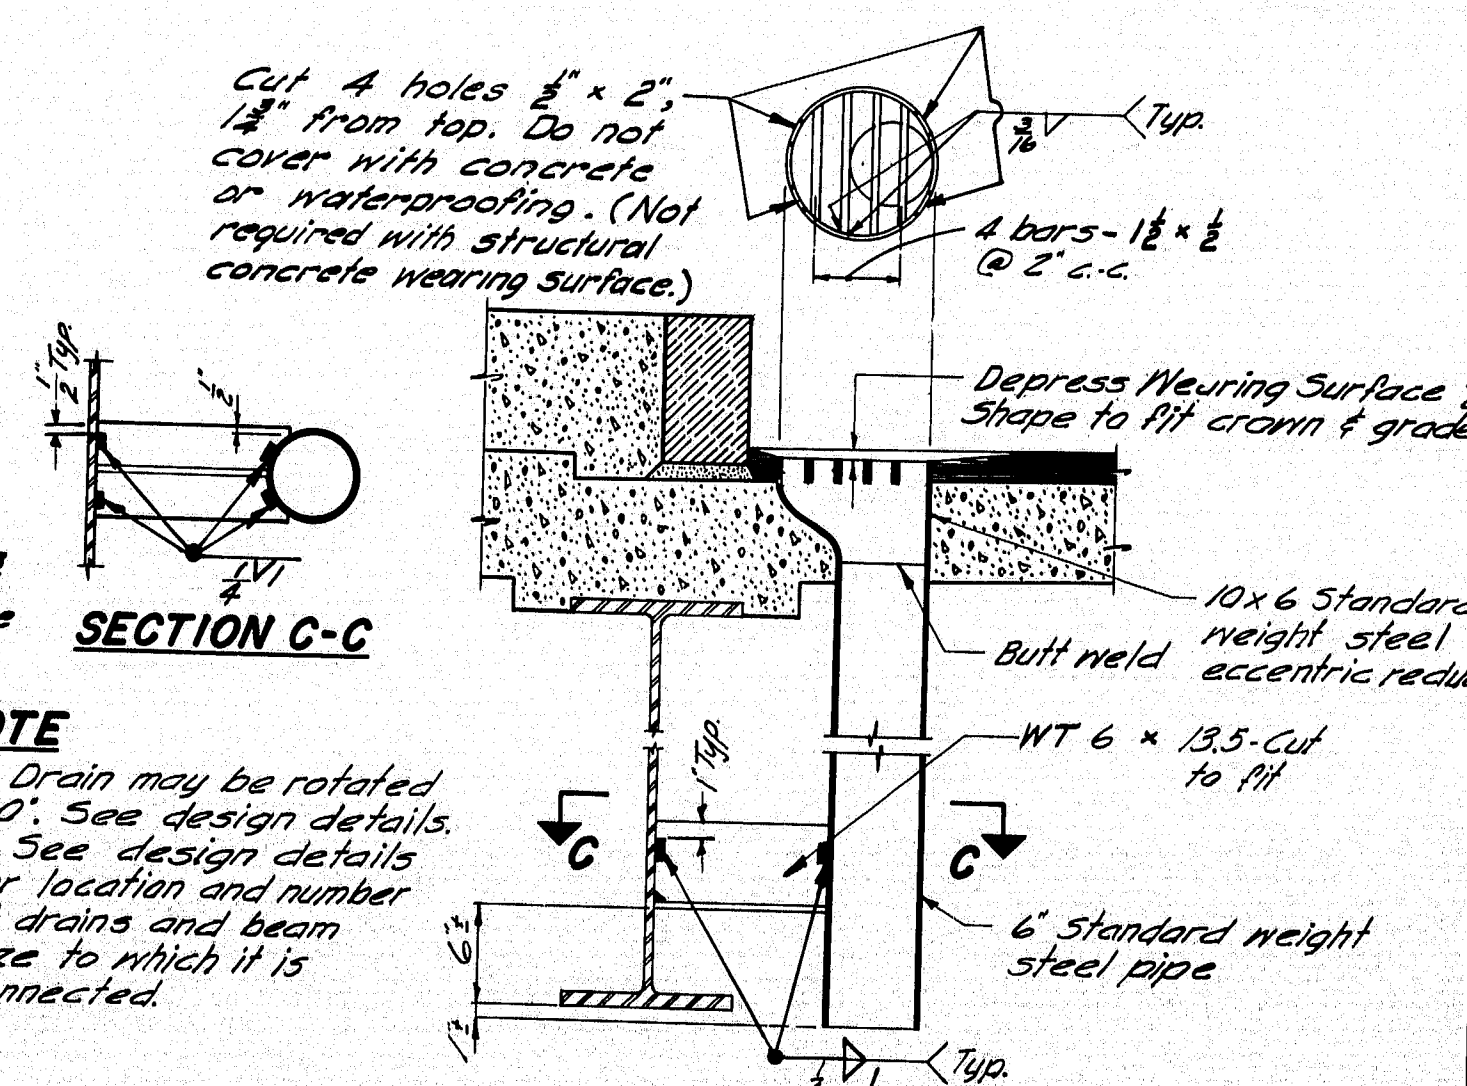

SECTION C-C

NOTE

1. Drain may be rotated 180°. See design details.
2. See design details for location and number of drains and beam size to which it is connected.

DRAIN NO. 2

GENERAL NOTE

Use only those items called for on design details. In case of conflict between these Standard Details and the design details, the requirements of the design details shall be followed.

Drains to be incidental, see Section 502.20

STATE OF MAINE
DEPARTMENT OF TRANSPORTATION
AUGUSTA, MAINE








STANDARD DETAILS

(BD 104-71)

DIAPHRAGMS, ARMORED JOINT,
SHEAR CONNECTORS, DRAIN

DECEMBER 1971

153-145

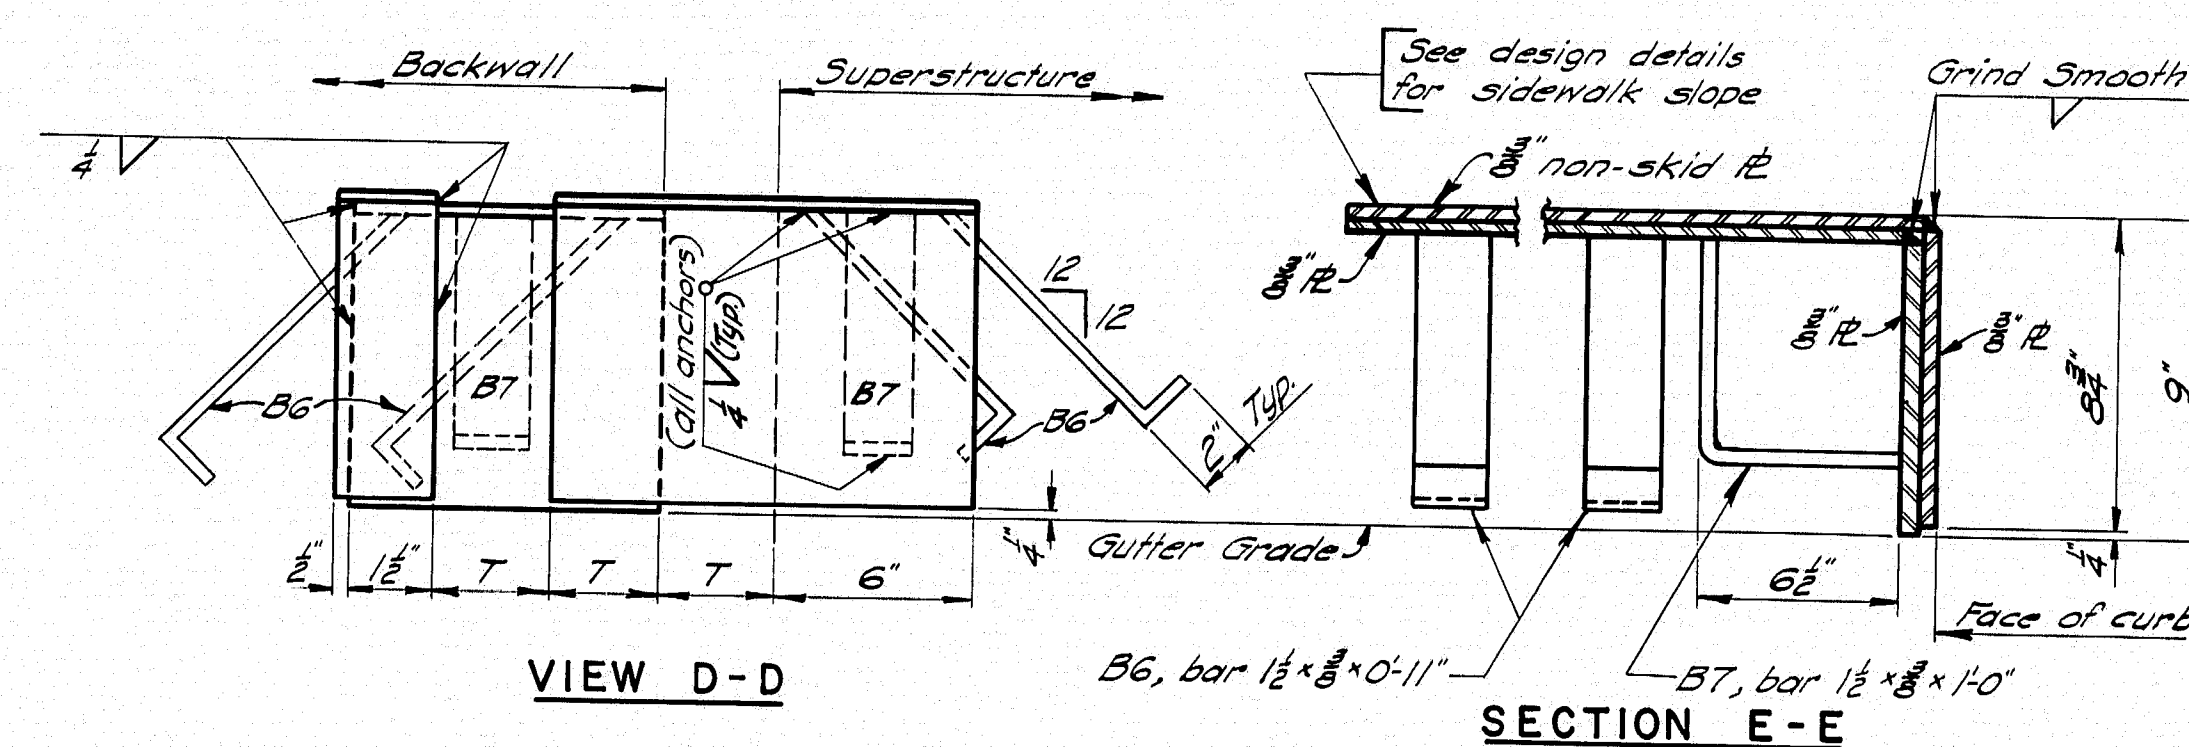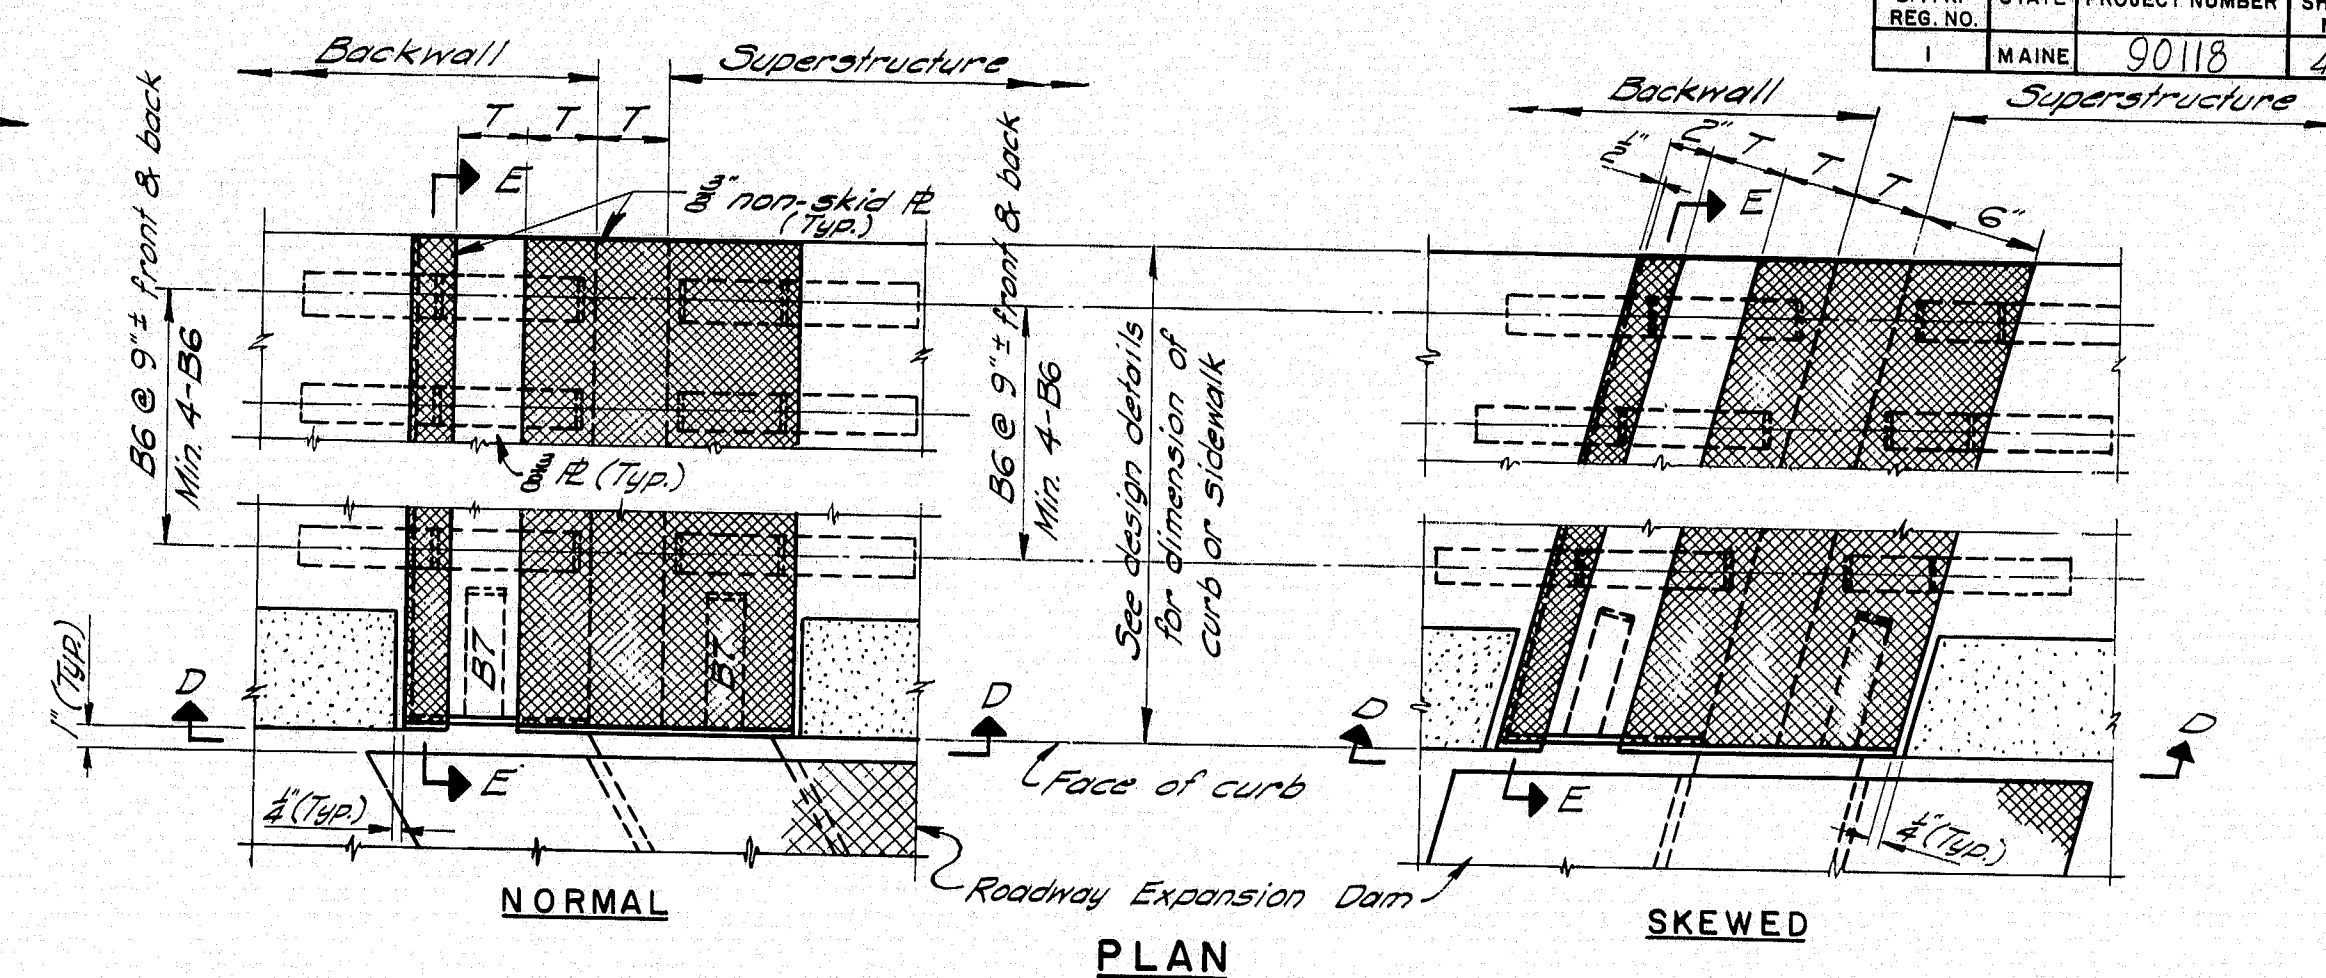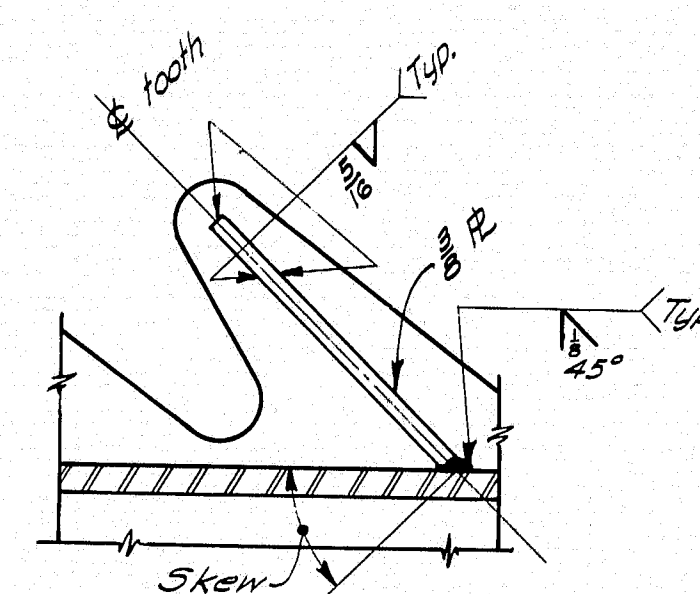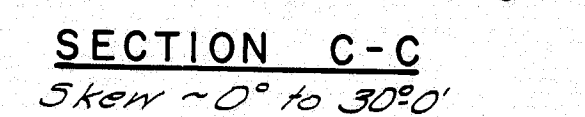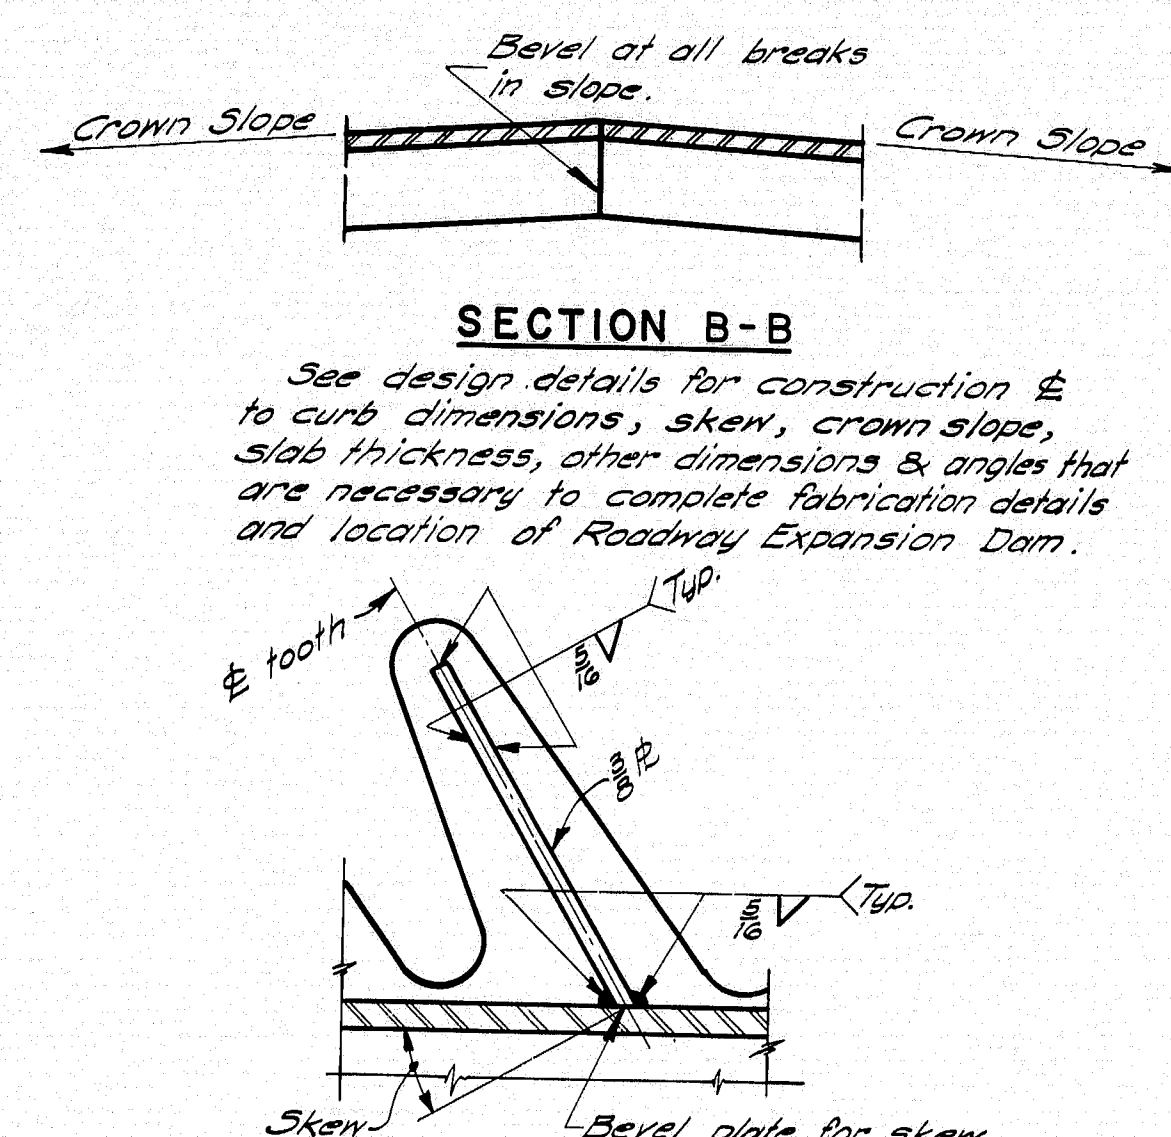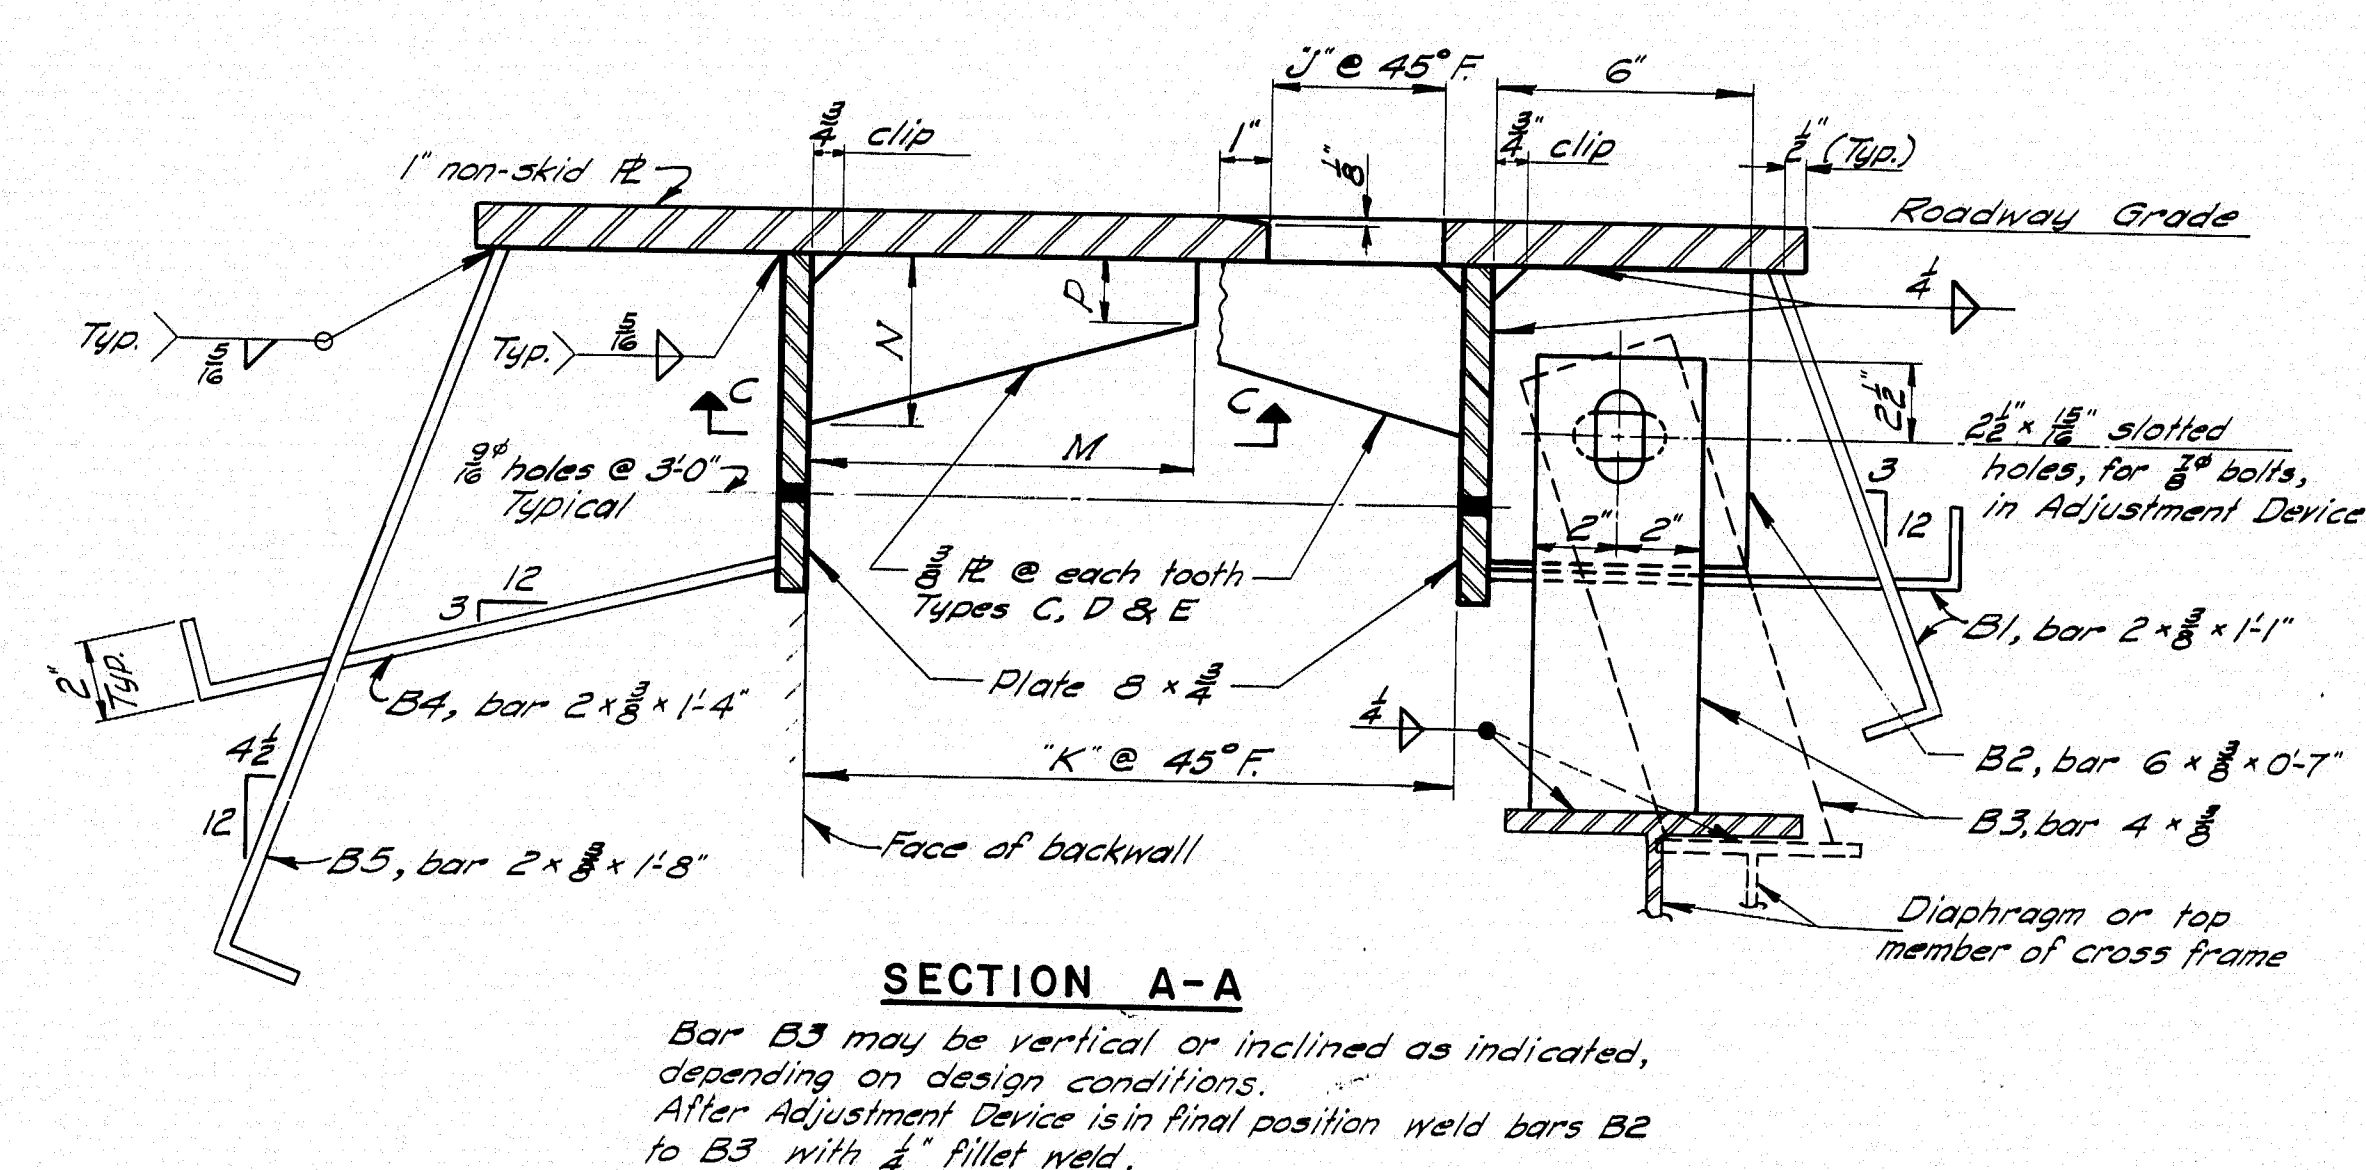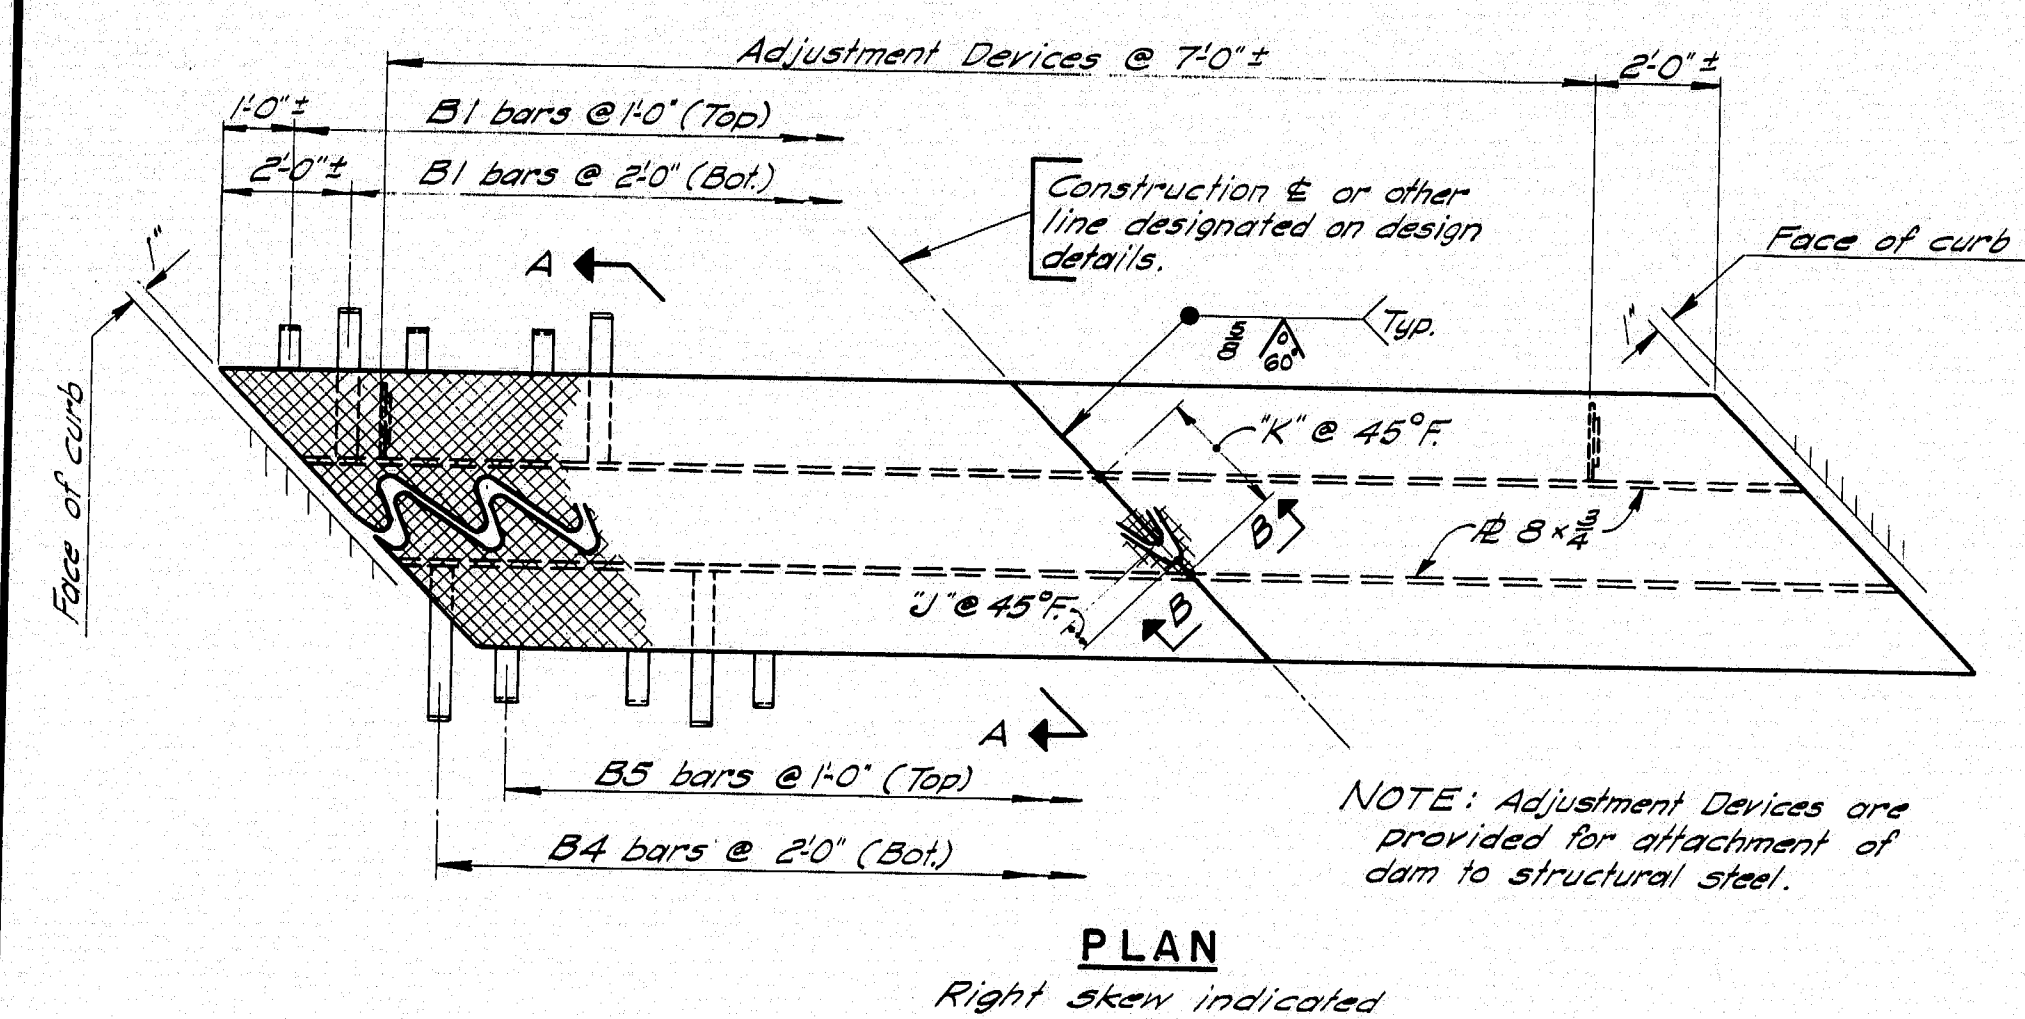

TYPE	V	W	X	Y	Z
Exp. Length	100'-280'	280'-440'	440'-600'	600'-760'	760'-920'
T	3"	4"	5"	6"	7"

TABLE OF DIMENSIONS												
Type	Exp. Length	Skew	# K	L	G	H	Kx45°	Vx45°	M	N	P	Q
A	100'-280'	0°-5° incl.	7"	4"	3"	3"	9"	2½"	—	—	—	21"
		5°/10°	7½"	4½"	2½"	3½"	9½"	2½"	—	—	—	22"
		10°/20°	8"	4½"	2½"	3½"	10"	2½"	—	—	—	22"
		20°/30°	8½"	5"	2½"	3½"	10½"	2½"	—	—	—	23"
		30°/40°	9½"	5½"	2½"	3½"	11½"	2½"	—	—	—	23"
B	280'-440'	40°/50° incl.	11½"	6½"	2½"	3½"	13½"	2½"	—	—	—	23"
		0°-5° incl.	9"	6"	3"	3"	12"	3½"	—	—	—	23"
		5°/10°	9½"	6½"	2½"	3½"	12½"	3½"	—	—	—	24"
		10°/20°	10"	6½"	2½"	3½"	13"	3½"	—	—	—	24"
		20°/30°	10½"	7"	2½"	3½"	13½"	3½"	—	—	—	25"
C	440'-600'	30°/40°	12"	8"	2½"	3½"	15"	3½"	—	—	—	25"
		40°/50° incl.	13½"	8½"	2½"	3½"	16½"	3½"	—	—	—	25"
		0°/10° incl.	11½"	8½"	3"	3"	15½"	4½"	9"	4"	1½"	26"
		10°/20°	12"	9"	2½"	3½"	16"	4½"	10"	4"	1½"	26"
		20°/30°	12½"	9½"	2½"	3½"	16½"	4½"	11"	4"	1½"	26"
D	600'-760'	30°/40°	14"	10"	2½"	3½"	18"	4½"	11"	4"	1½"	26"
		40°/50° incl.	15½"	10½"	2½"	3½"	19½"	4½"	12"	4"	1½"	26"
		0°/10° incl.	13½"	10½"	3"	3"	18½"	5½"	11"	5"	2"	30"
		10°/20°	14"	10½"	2½"	3½"	19"	5½"	12"	5"	2"	30"
		20°/30°	14½"	11"	2½"	3½"	19½"	5½"	13"	5"	2"	30"
E	760'-920'	30°/40°	16"	12"	2½"	3½"	21"	5½"	13"	5"	2"	30"
		40°/50° incl.	17½"	13"	2½"	3½"	22½"	5½"	15"	5"	2"	30"
		0°/10° incl.	15½"	12½"	3"	3"	21½"	6½"	13"	6"	2½"	36"
		10°/20°	16"	12½"	2½"	3½"	22"	6½"	14"	6"	2½"	36"
		20°/30°	16½"	13"	2½"	3½"	22½"	6½"	15"	6"	2½"	36"
		30°/40°	18"	14"	2½"	3½"	24"	6½"	15"	6"	2½"	36"
		40°/50° incl.	19½"	15"	2½"	3½"	25½"	6½"	17"	6"	2½"	36"

GENERAL NOTES

GENERAL NOTES

Expansion Dams to be paid for as Structural Steel.

If there is conflict between this Standard Detail and the design details, the requirements of the design details shall be followed.

Steel Classification : A.S.T.M. A36

MAINE STATE HIGHWAY COMMISSION
AUGUSTA, MAINE

AUGUSTA, MAINE

STANDARD DETAILS
(BD 105 - 64)

EXPANSION DAMS

APRIL 1964

153-176

F.R.W.A.	STATE	PROJECT NUMBER	SHEET NO.	TOTAL SHEETS
1	MAINE	90118	42	105

FABRICATION NOTES


1. For location and type of diaphragm or crossframe see design details.
 2. Holes for $\frac{3}{8}$ " diameter bolts shall be $\frac{15}{16}$ " dia. and edge distances shall be $\frac{1}{2}$ " minimum unless otherwise shown.
 3. Connection plates and gusset plates shall have a minimum thickness of $\frac{3}{8}$ " and shall have sufficient width to provide erection clearances. When bearing stiffeners or intermediate stiffeners are used as connection plates, the plate size will be given on the design details.
 4. Connection plates shall be fastened to beam and girder webs as follows:
0° to 30° skew... fillet weld both sides.
Over 30° skew... full penetration groove weld (see Detail B) except as indicated in Note 5.
Over 45° skew... weld prequalification will be required.
- The skew angle is the angle between the connection plate and a line normal to the beam.
5. Bearing stiffeners shall be used as connection plates when the skew is not over 30°. When the skew is over 30° a bent connection plate shall be attached to the web adjacent to the bearing stiffener as shown in Detail A.
 6. All fillet weld sizes shall be the minimum for the thickness of metal being joined according to AWS Specifications for Welded Highway & Railway Bridges.
 7. Connection plates on welded beams and girders shall extend to the top flange in areas where the top flange is always in compression or when used as a bearing stiffener or intermediate stiffener.
 8. Connection plates shall extend to the bottom flange when used as a bearing stiffener, at points where lateral bracing is attached & on welded beams and girders in areas where the bottom flange is always in compression.
 9. When a conn. plate is extended to a flange it shall be a paint tight fit except as otherwise indicated on design details.
 10. Conn. plates shall be 2" clear from flanges, except as indicated by Notes 7 & 8.
 11. Use only those items called for on the design details. In case of conflict between these standard details and the design details, the design details shall be followed.

STATE OF MAINE
DEPARTMENT OF TRANSPORTATION
STANDARD DETAILS
(BD 113 - 72)
DIAPHRAGMS & CROSSFRAMES


SHEET OF AUGUSTA, MAINE SEPT. 1972

153-147


NOTE A This dimension may be varied ($\pm 1"$) to allow a series of diagonals to have the same slope.

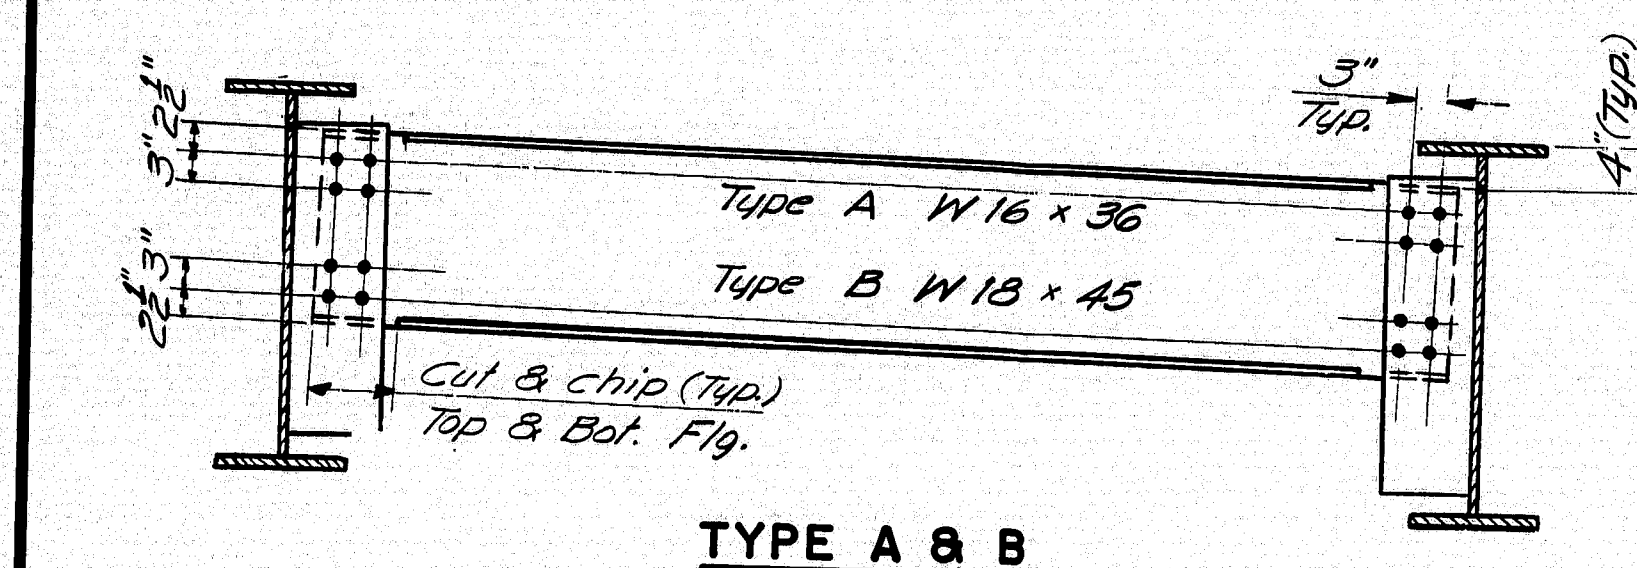


TYPE A & B

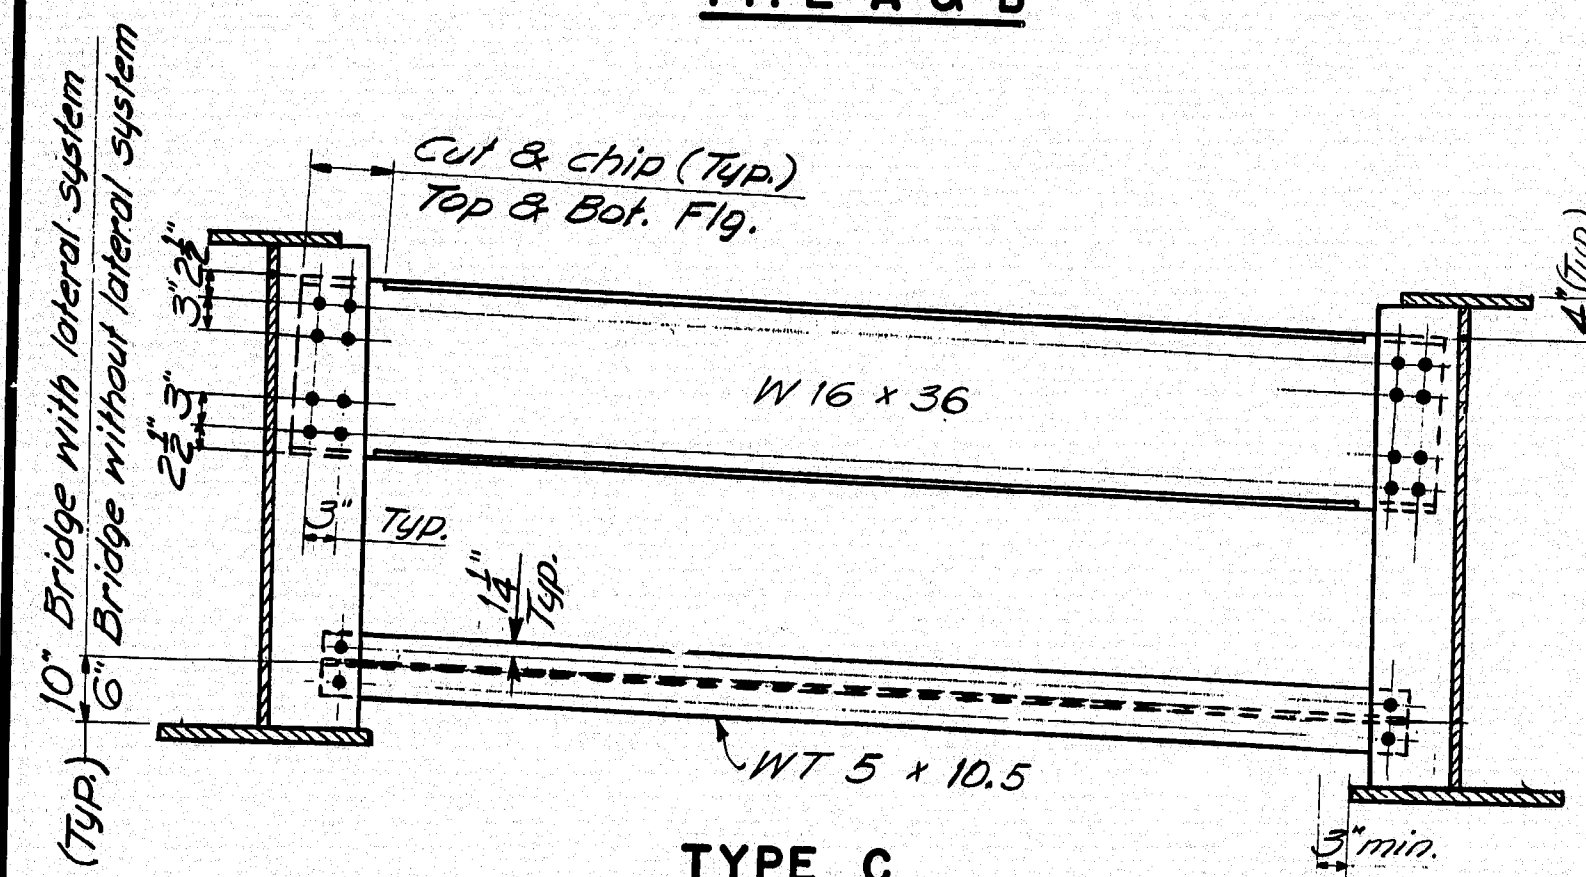


TYPE C

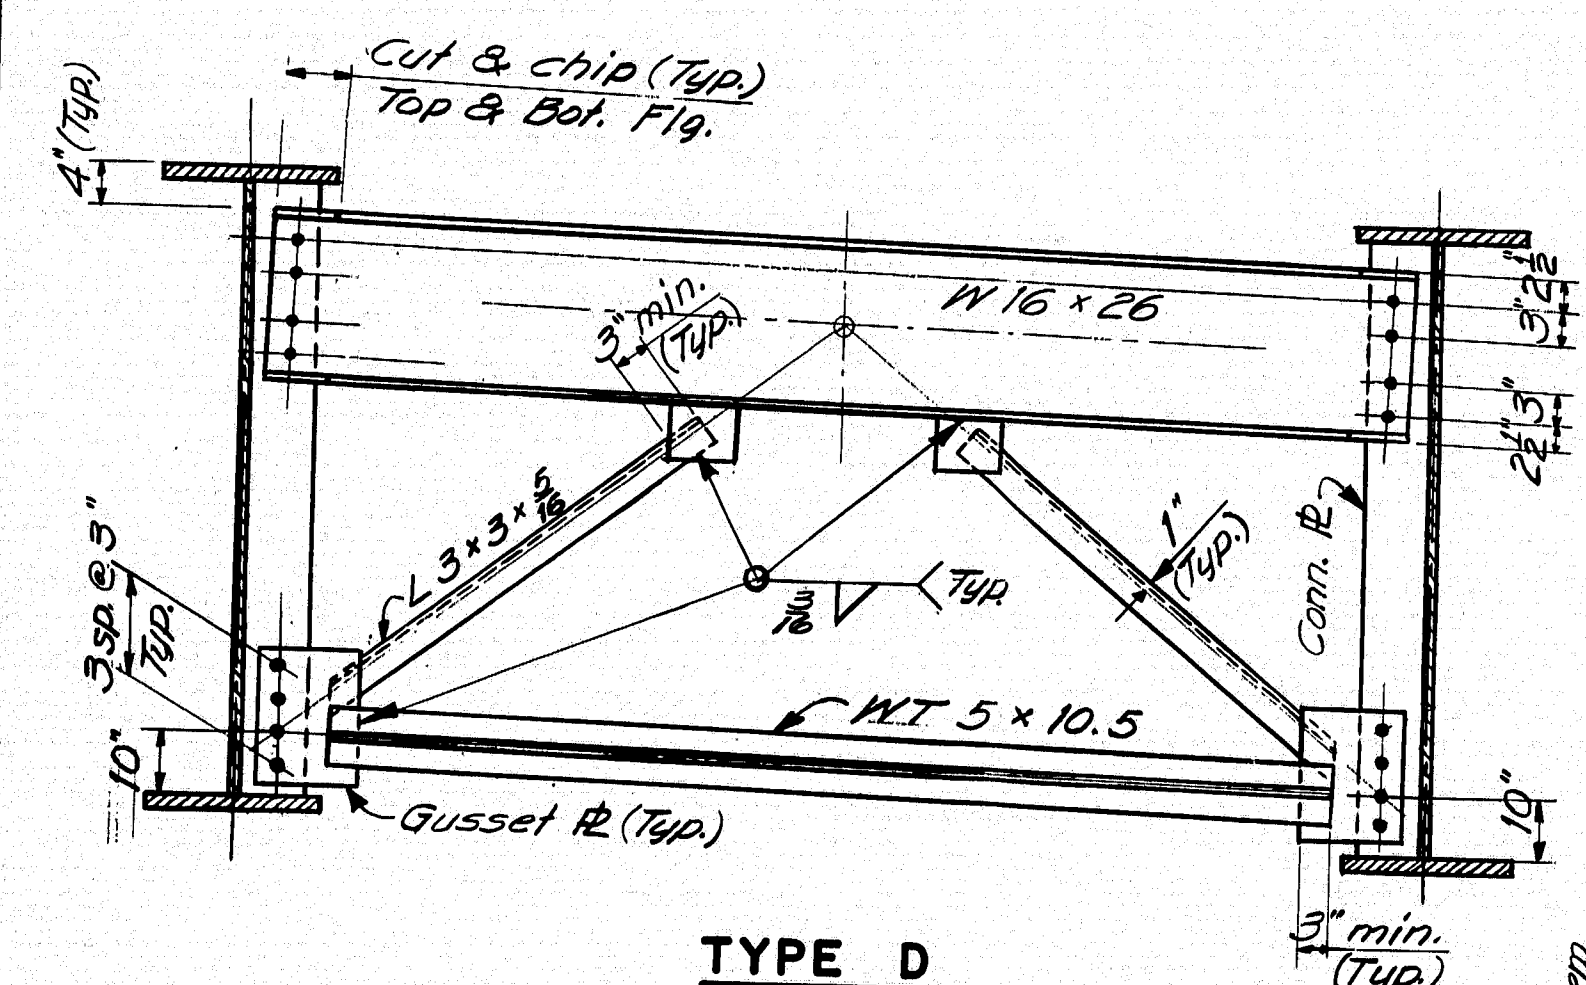


TYPE D

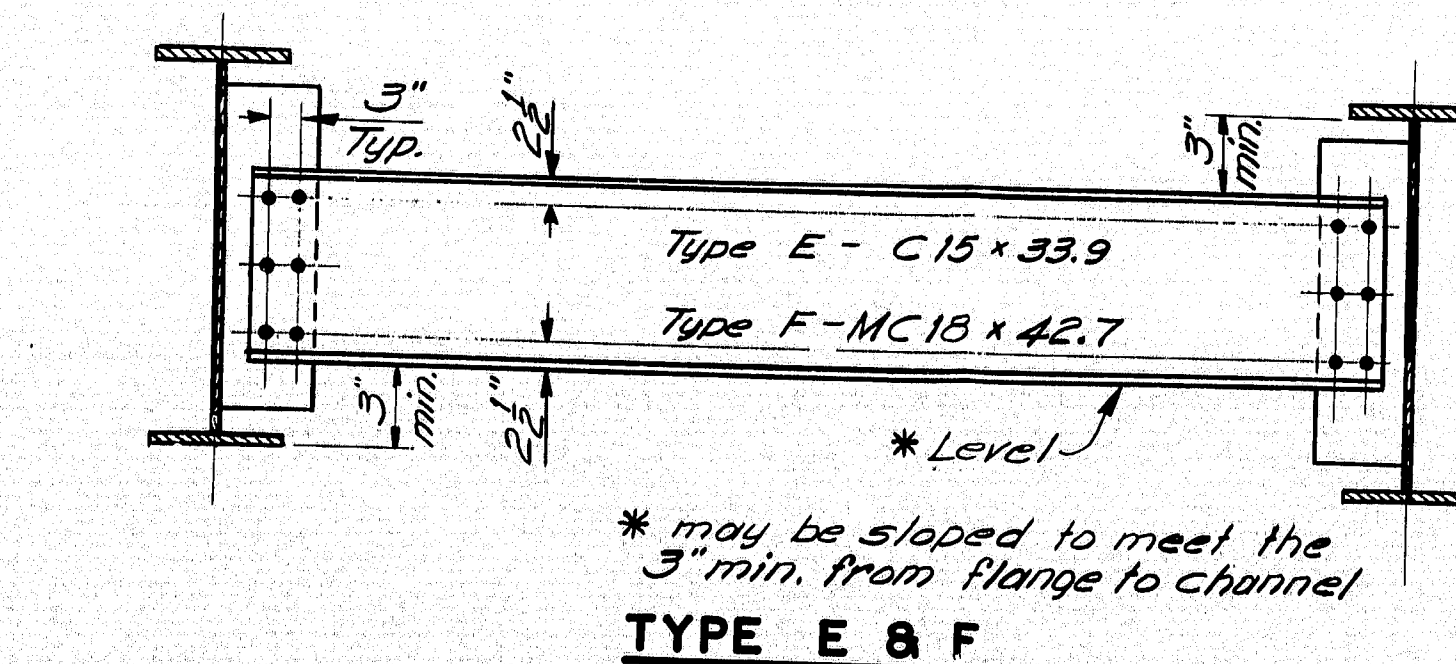


TYPE E & F

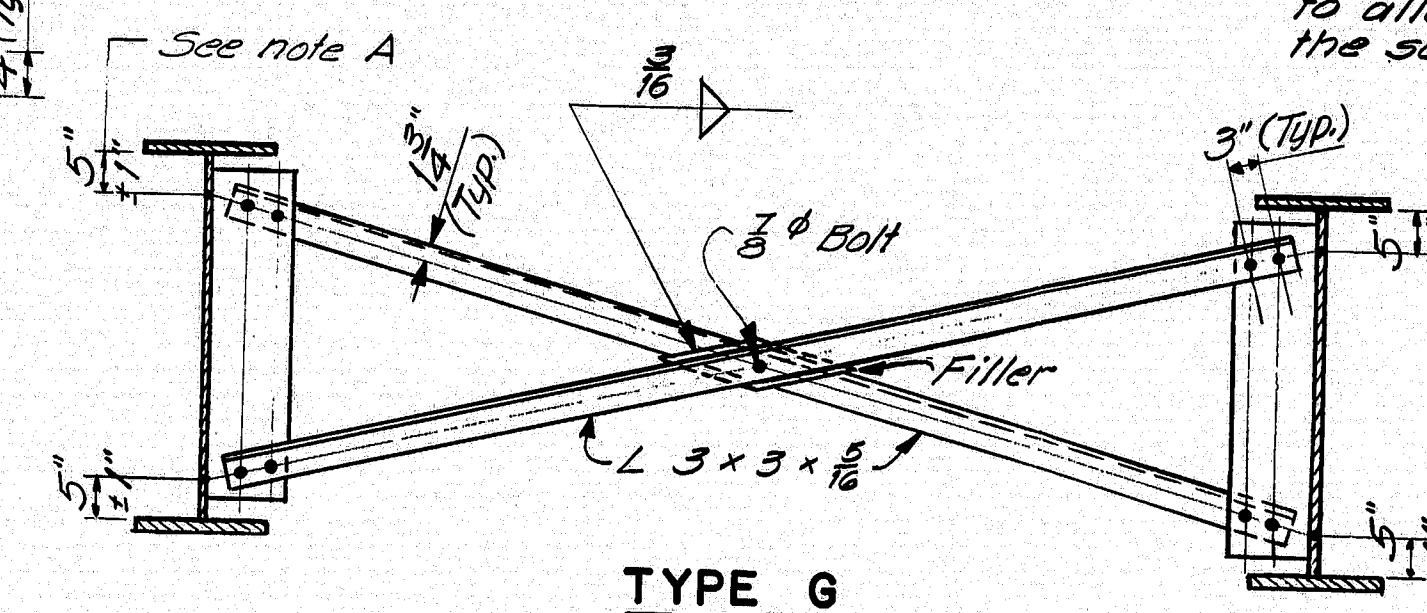


TYPE G

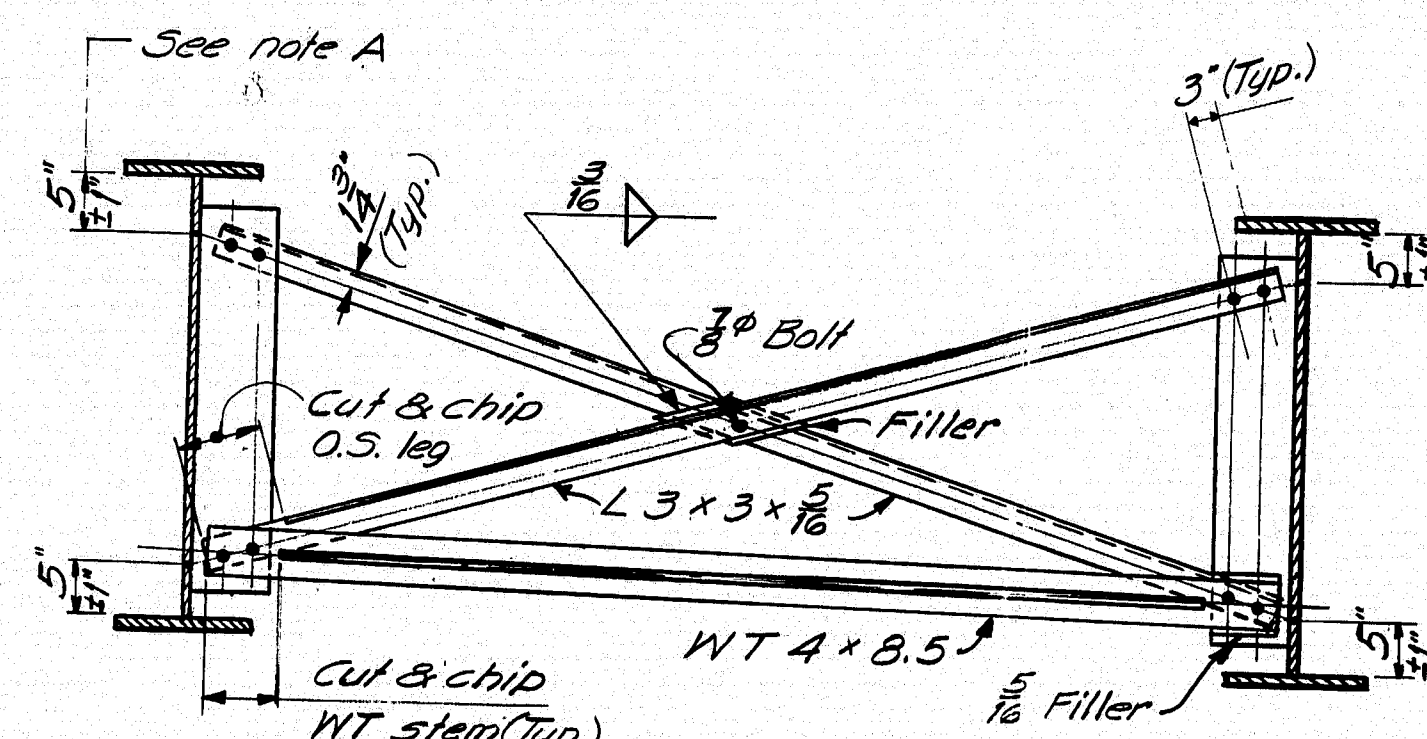


TYPE H

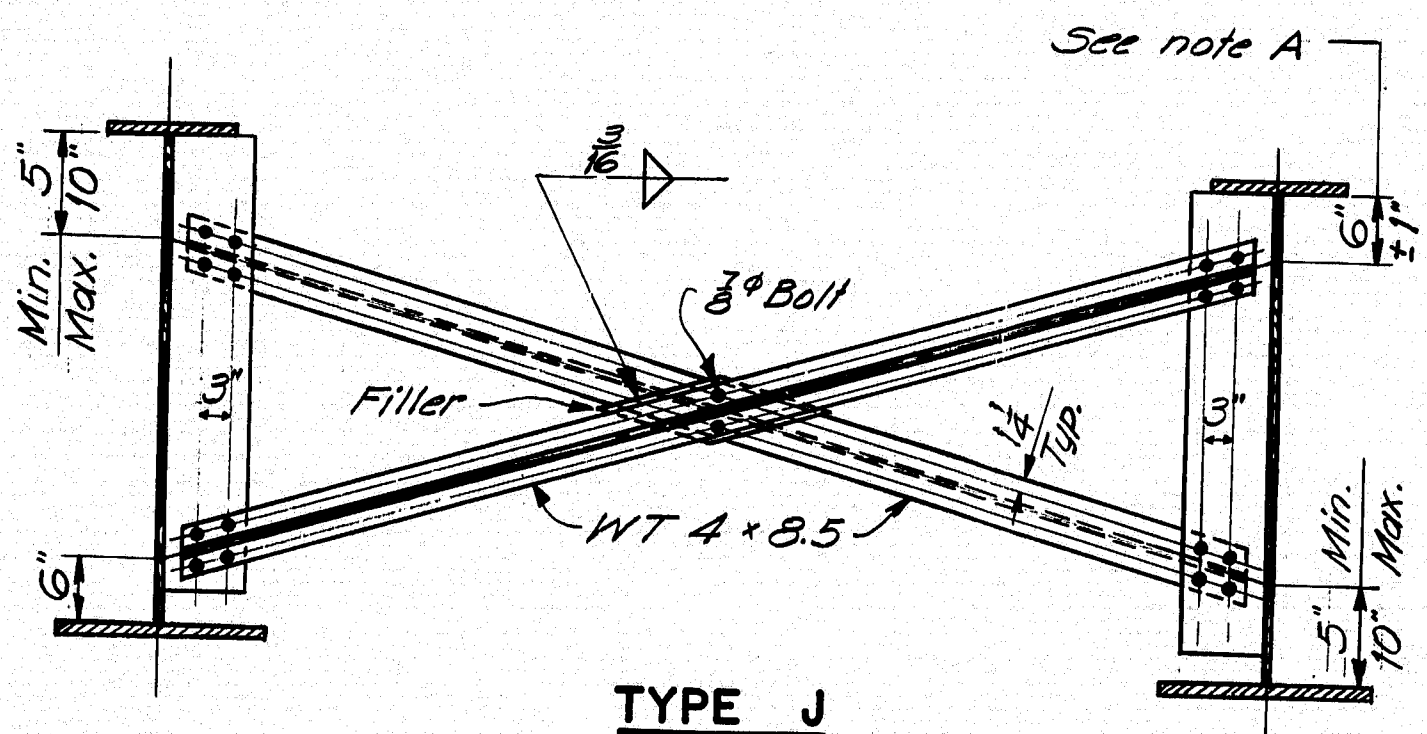


TYPE J

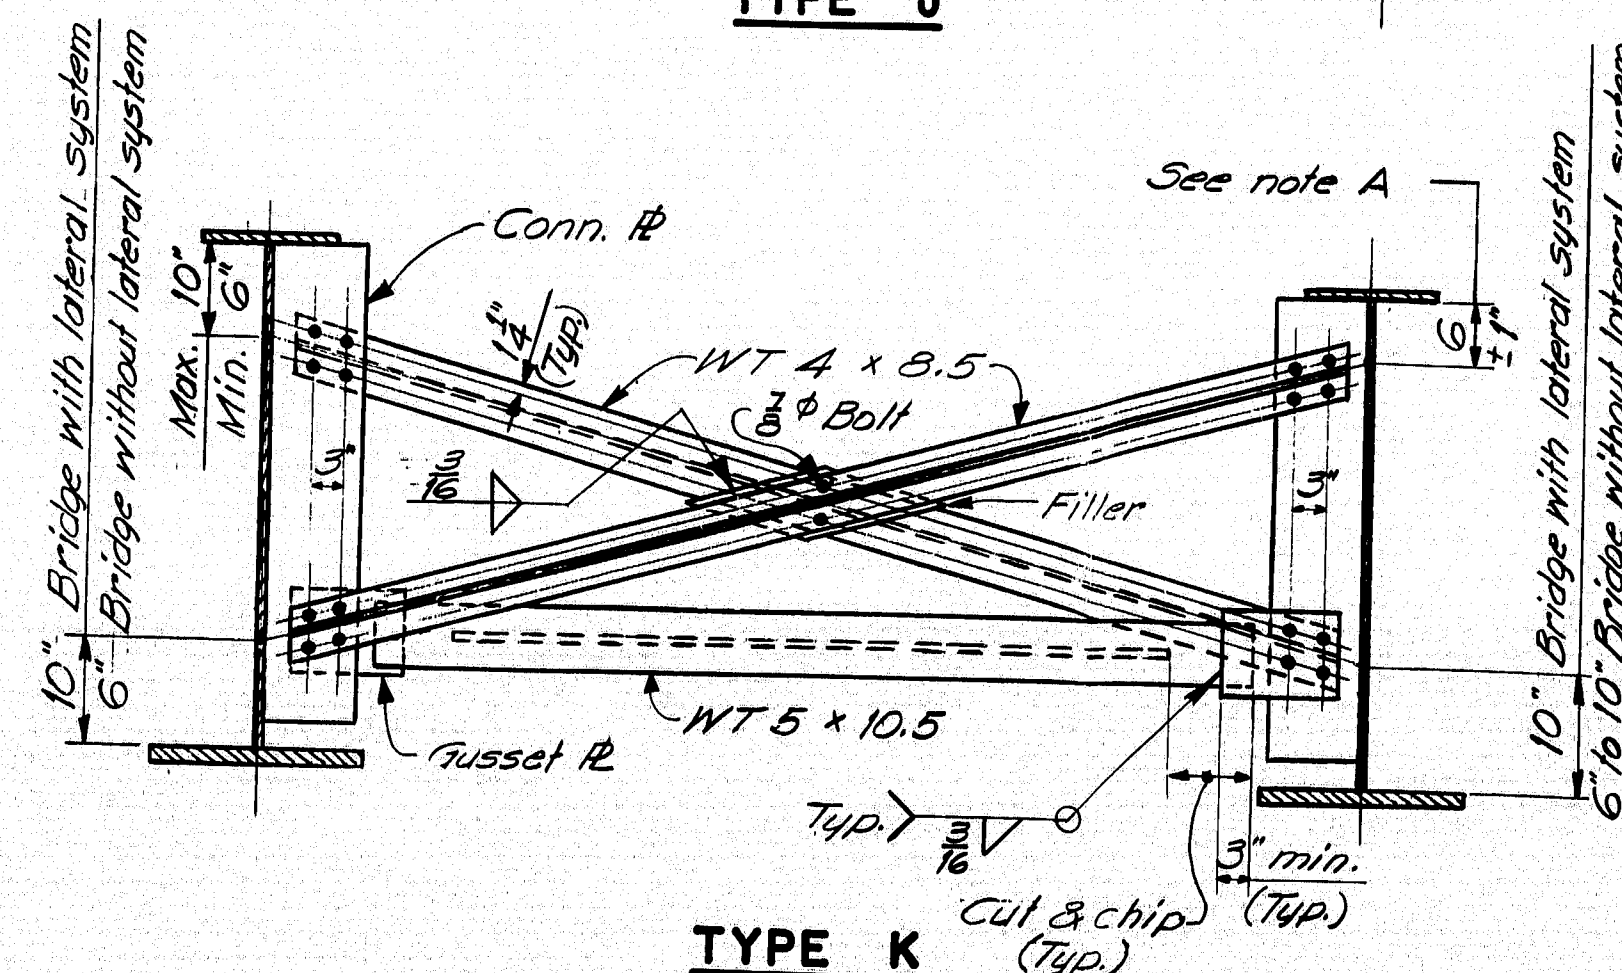


TYPE K

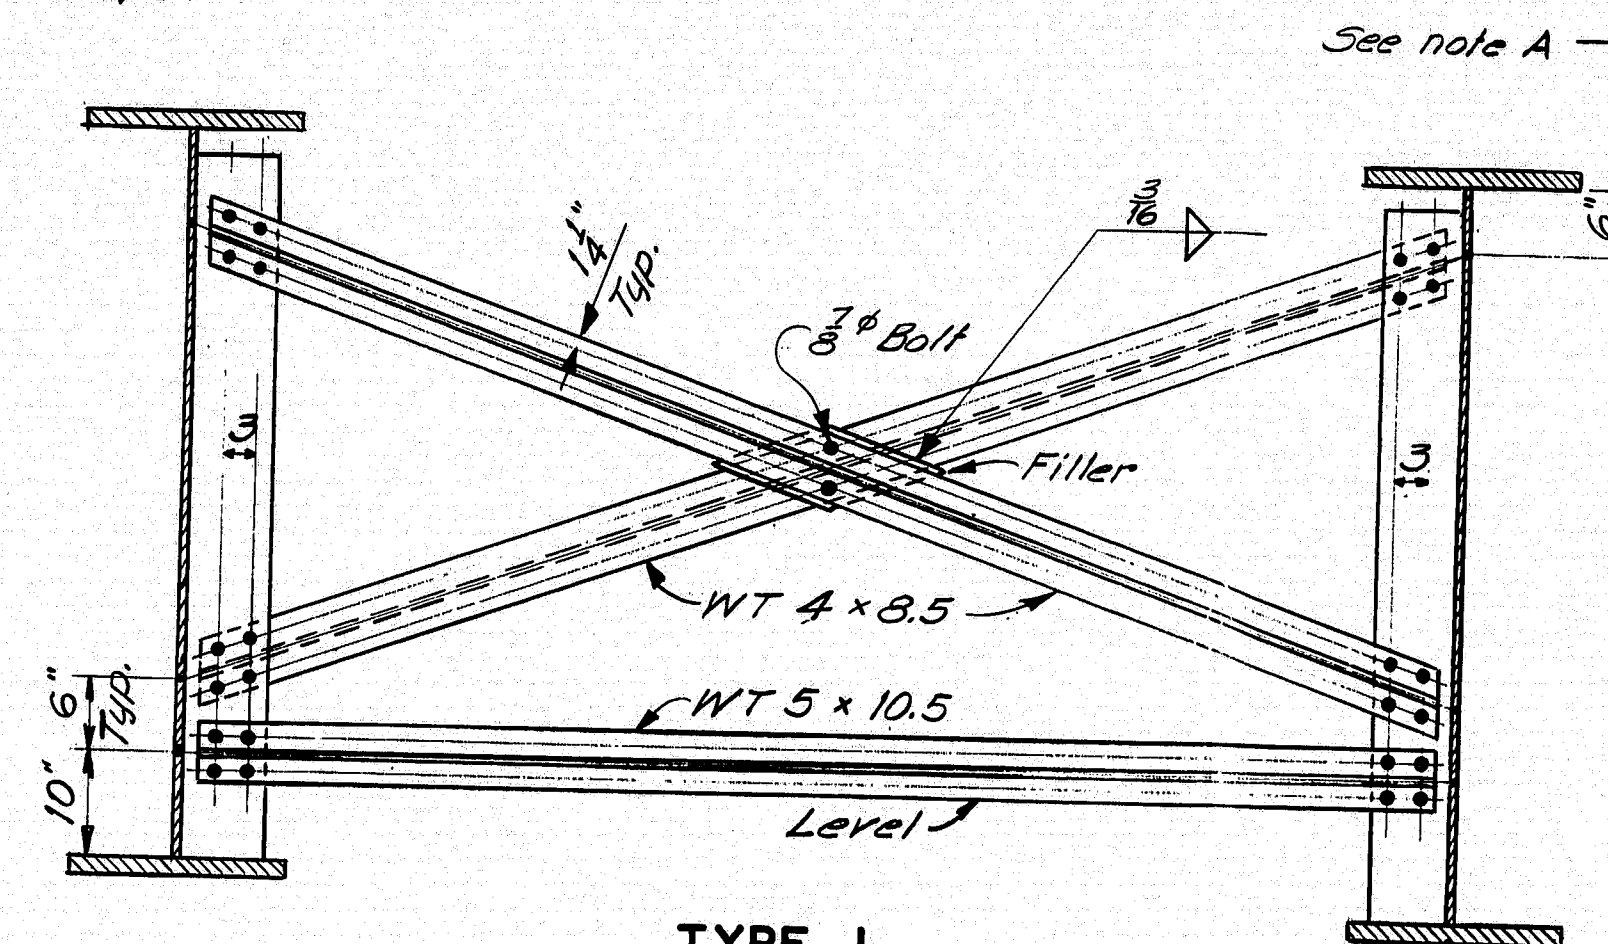

TYPE L

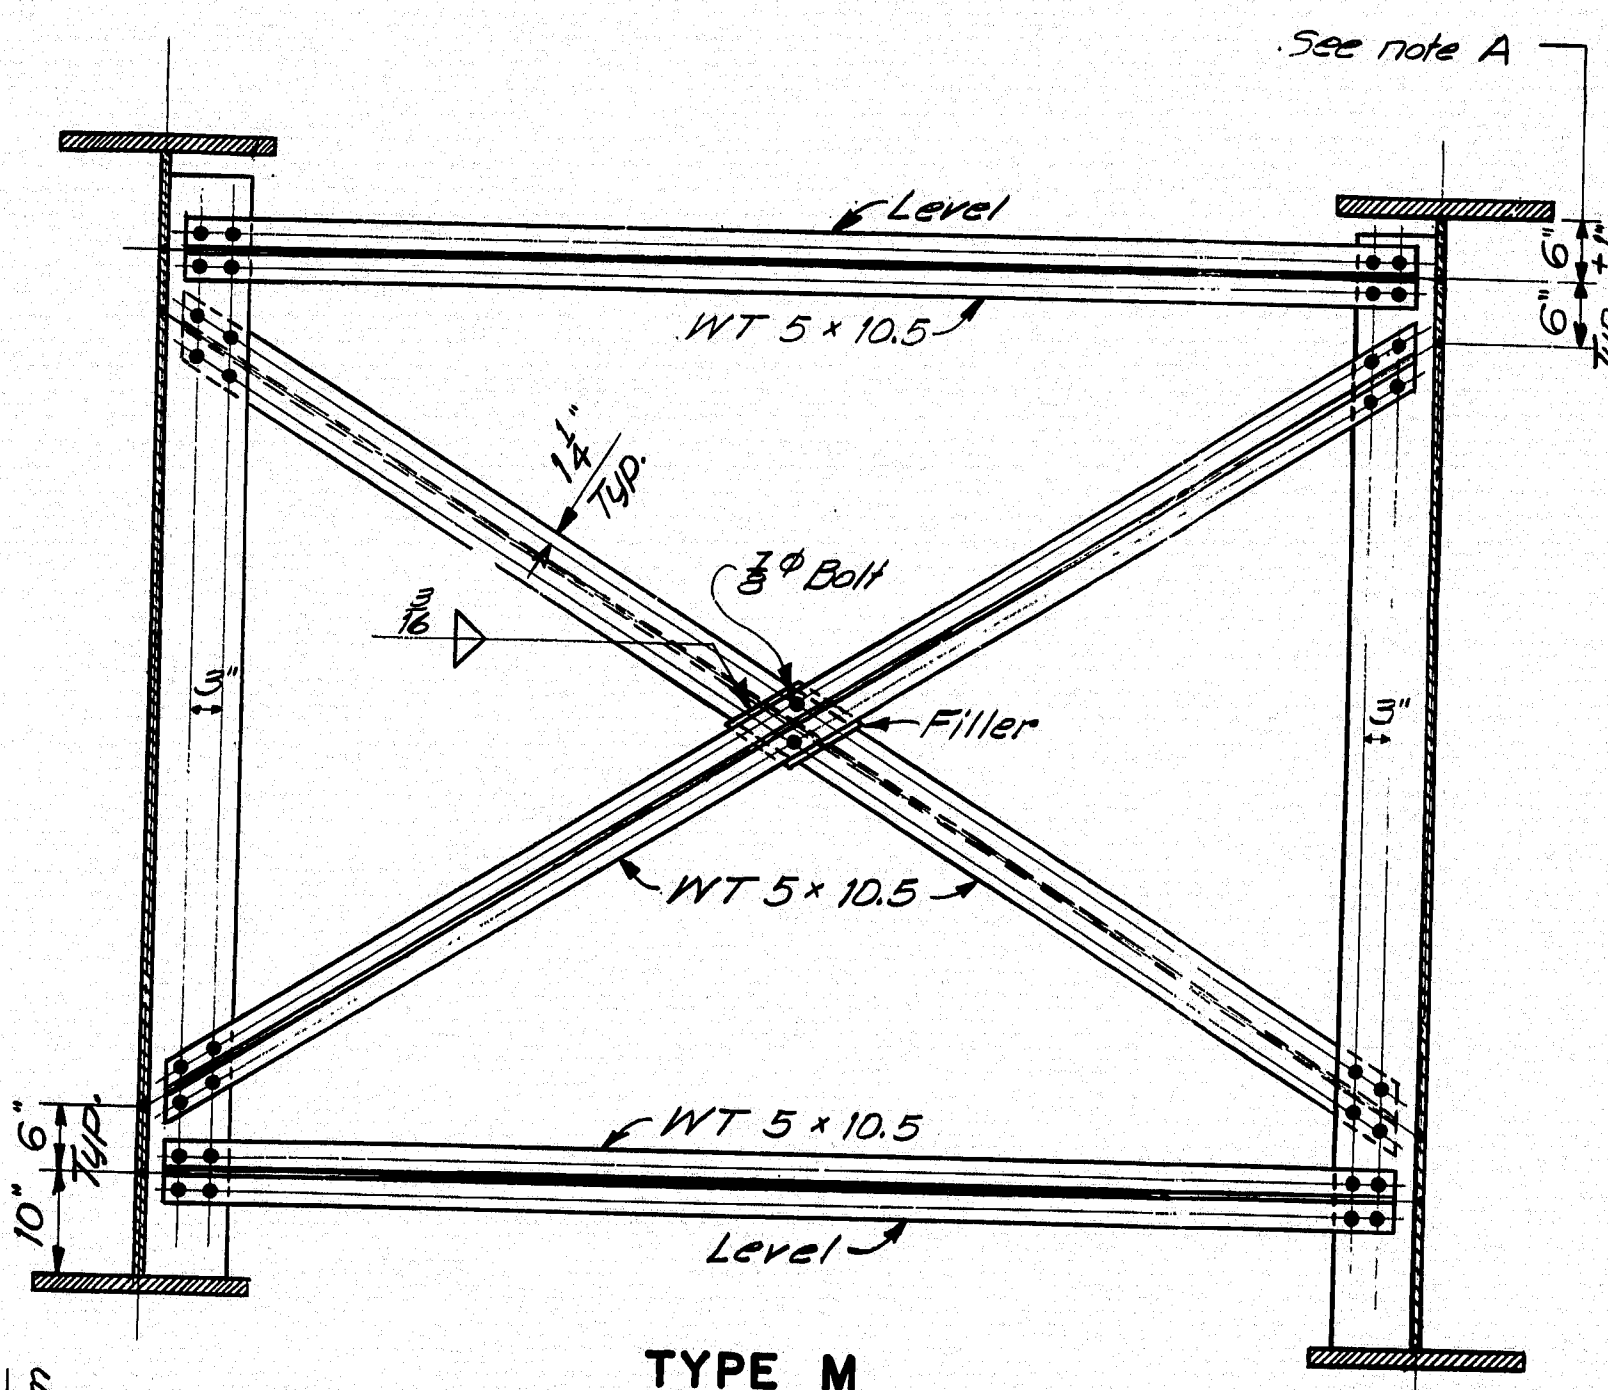


TYPE M

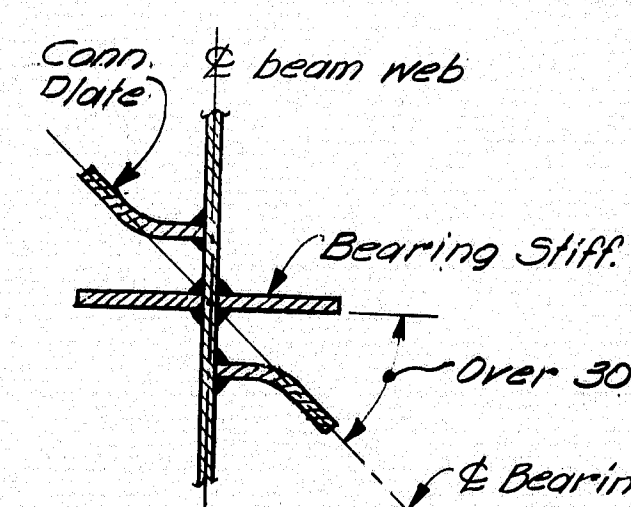

DETAIL A

Referenced from Note 5

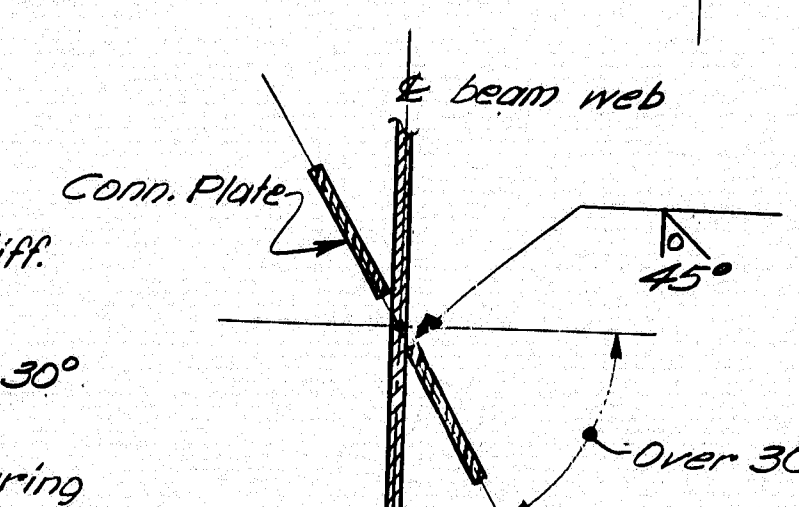

DETAIL B

Referenced from Note 4

MATERIALS


Diaphragms, Crossframes and All Plates (Filler, gusset, and connection) ASTM A36
High Strength Bolts $\frac{3}{8}$ " diameter — — — ASTM A325

DATE	BY
DESIGN - DETAILER	
CHECKED	
REVISIONS	
FIELD CHANGES	


PLANS

touraine paints TRUFLEX * SILKY * TRIPLE WHITE * RYPLEX

DESIGN - DETAILED	BY	DATE
CHECKED	K. Lewis	10/1/73
REVISIONS		
FIELD CHANGES		
PLANS		

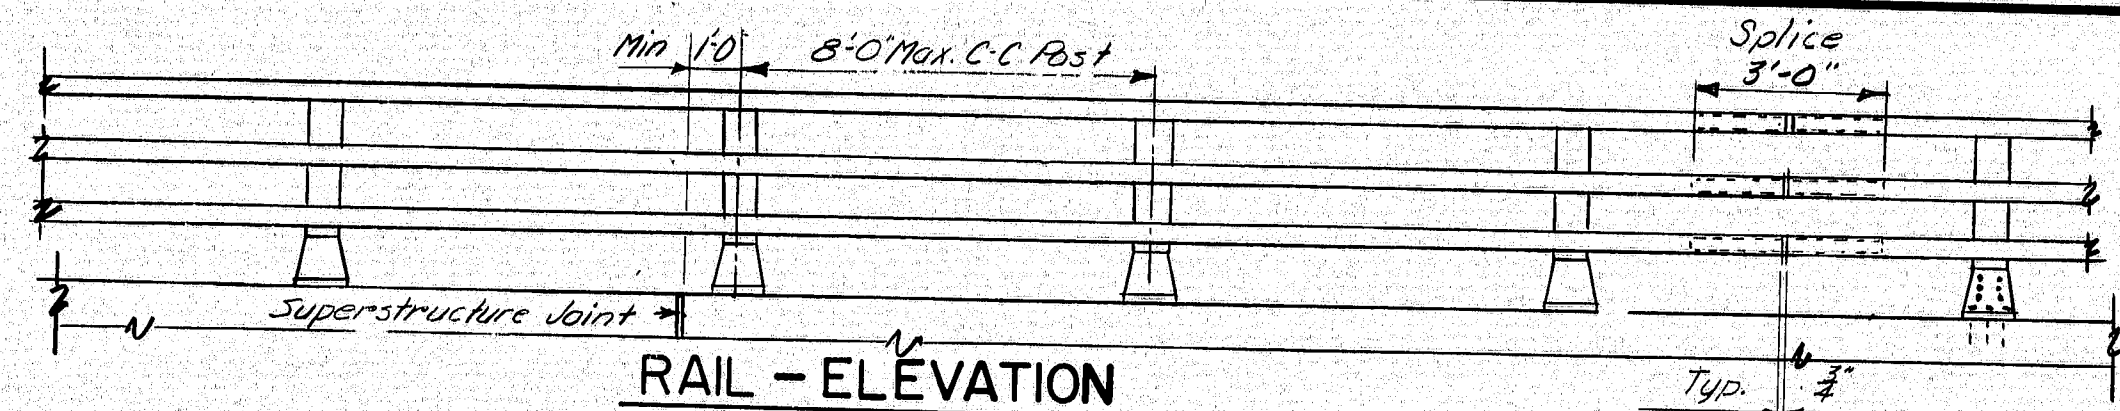


Lengths of rail shall be attached to a minimum of four (4) rail posts, wherever possible, and in any case never less than two (2). Rail posts are to be set normal to grade unless otherwise shown on Bridge Plans.

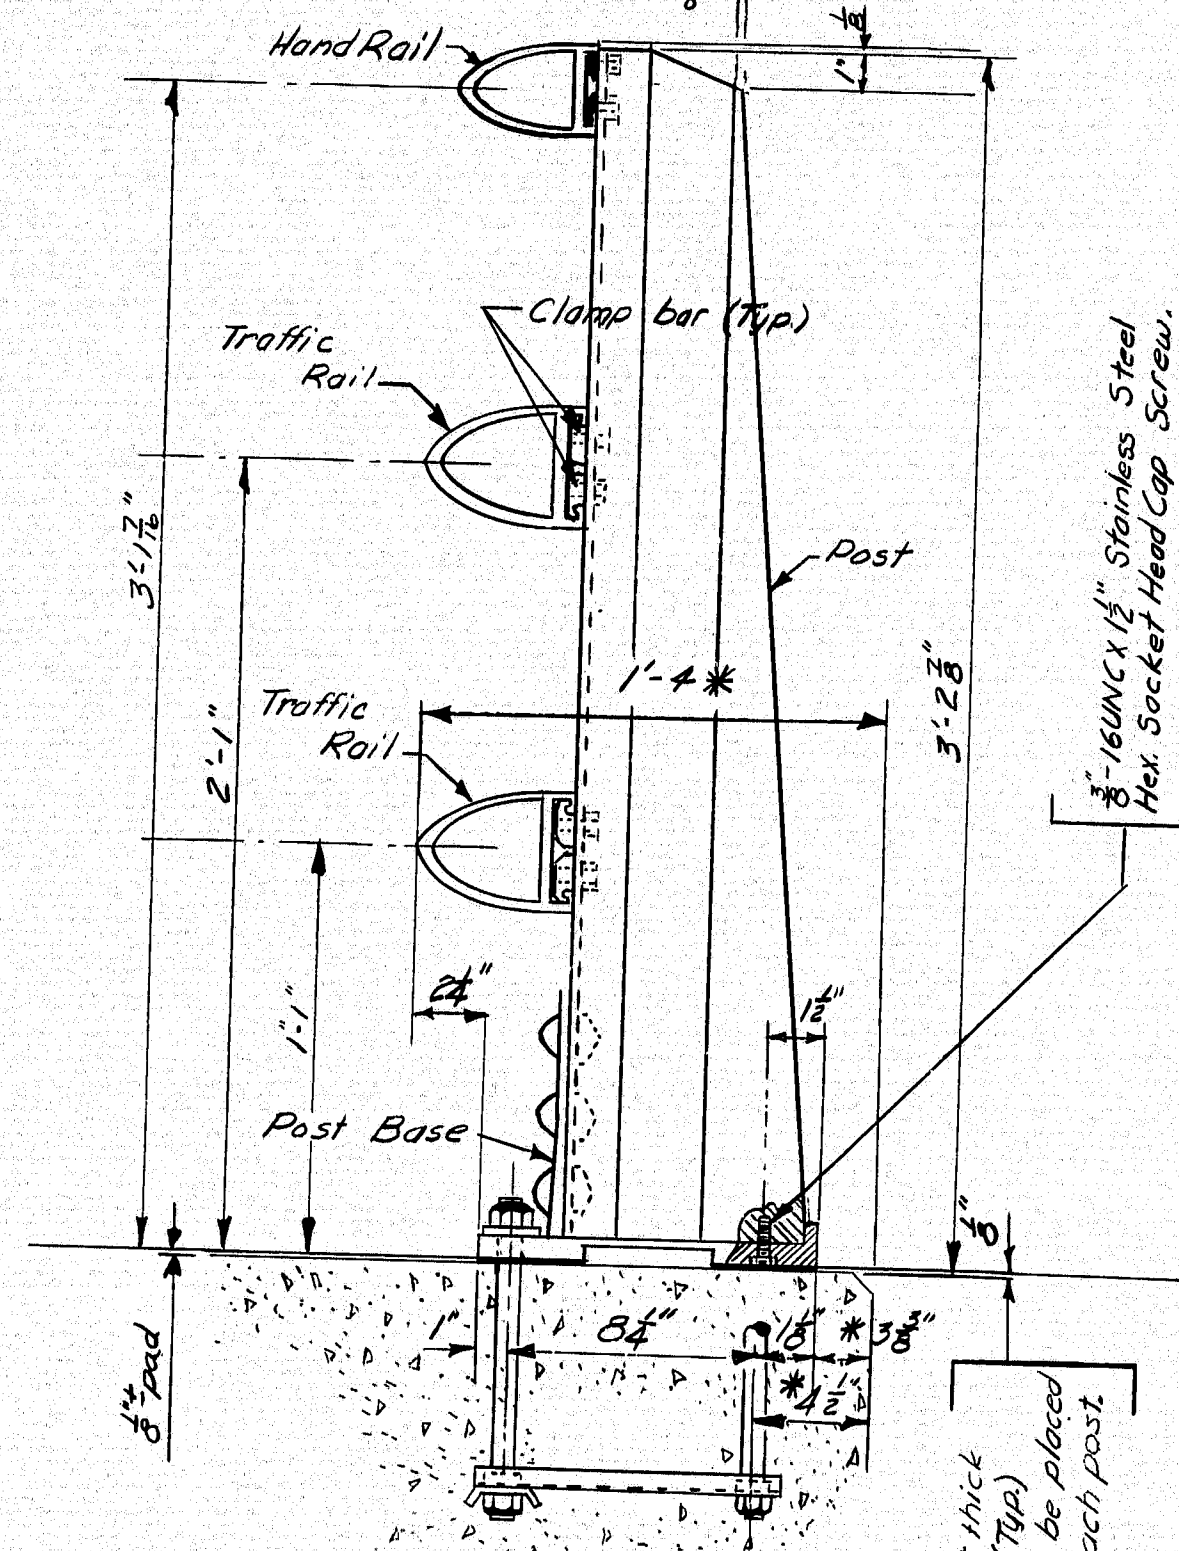

BRIDGE RAIL


(Assembly)

* Preferable minimum dimensions. For actual dimensions - see Bridge Plan.

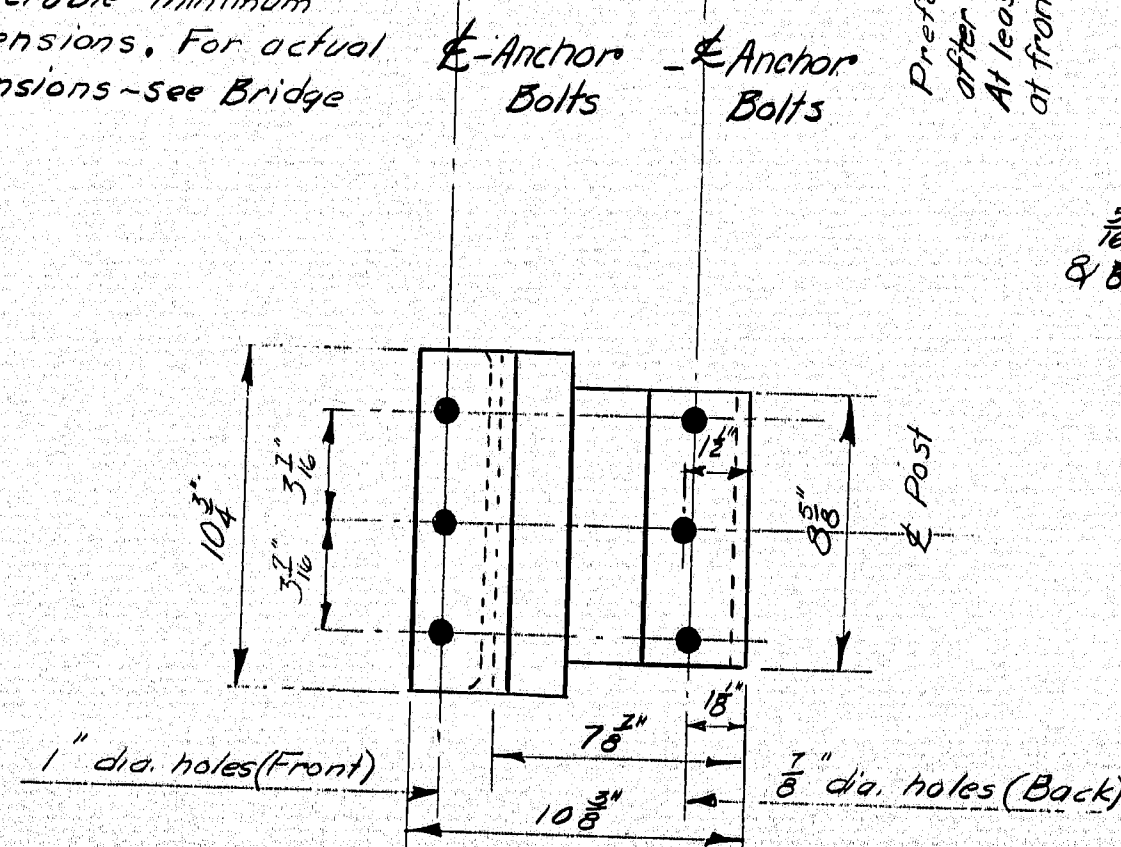


POST BASE


(Bottom View)

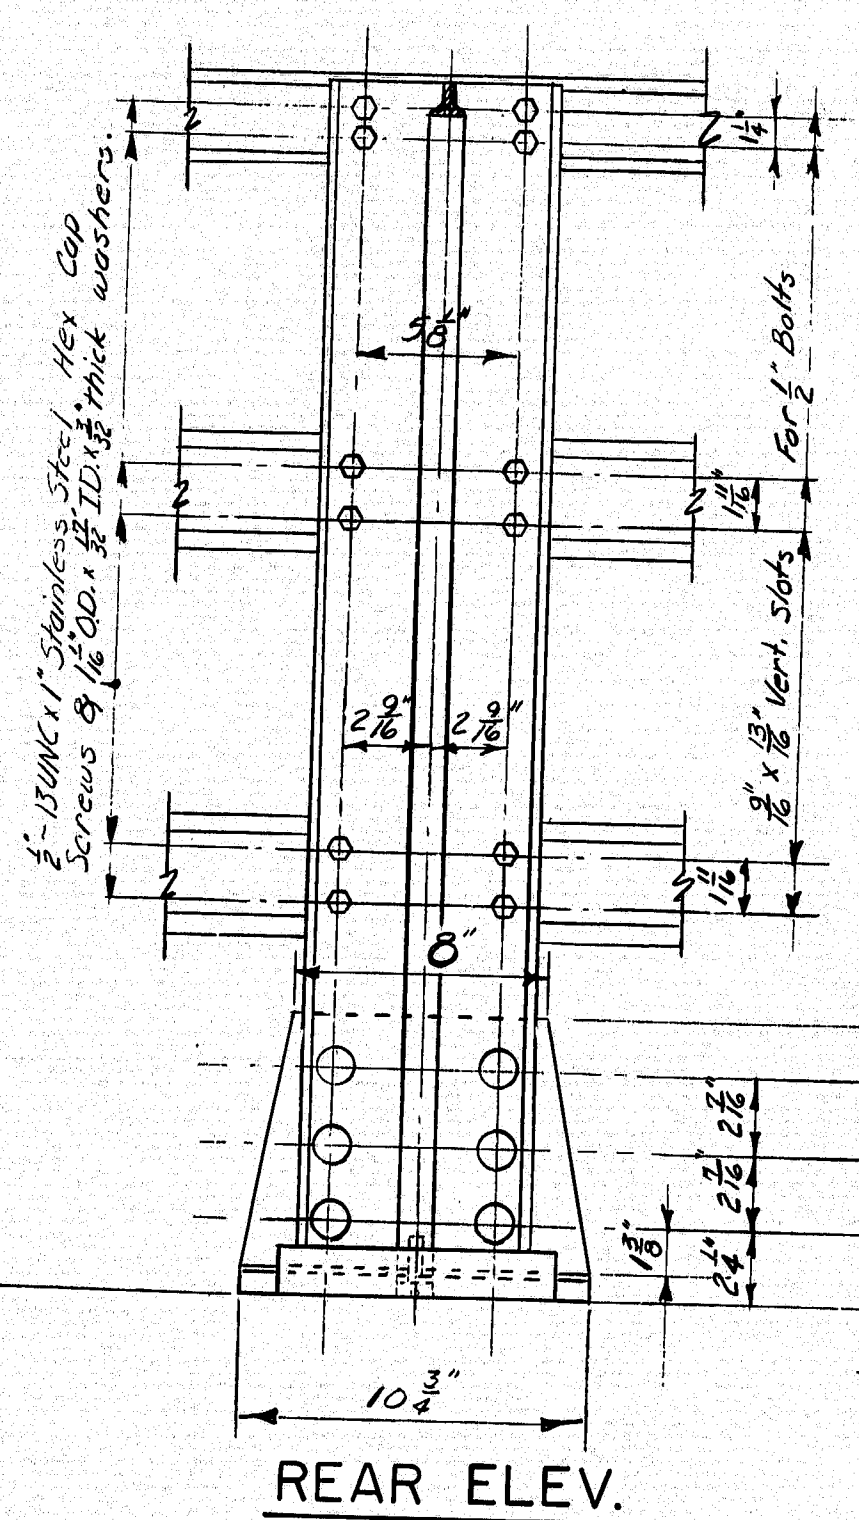


REAR ELEV.

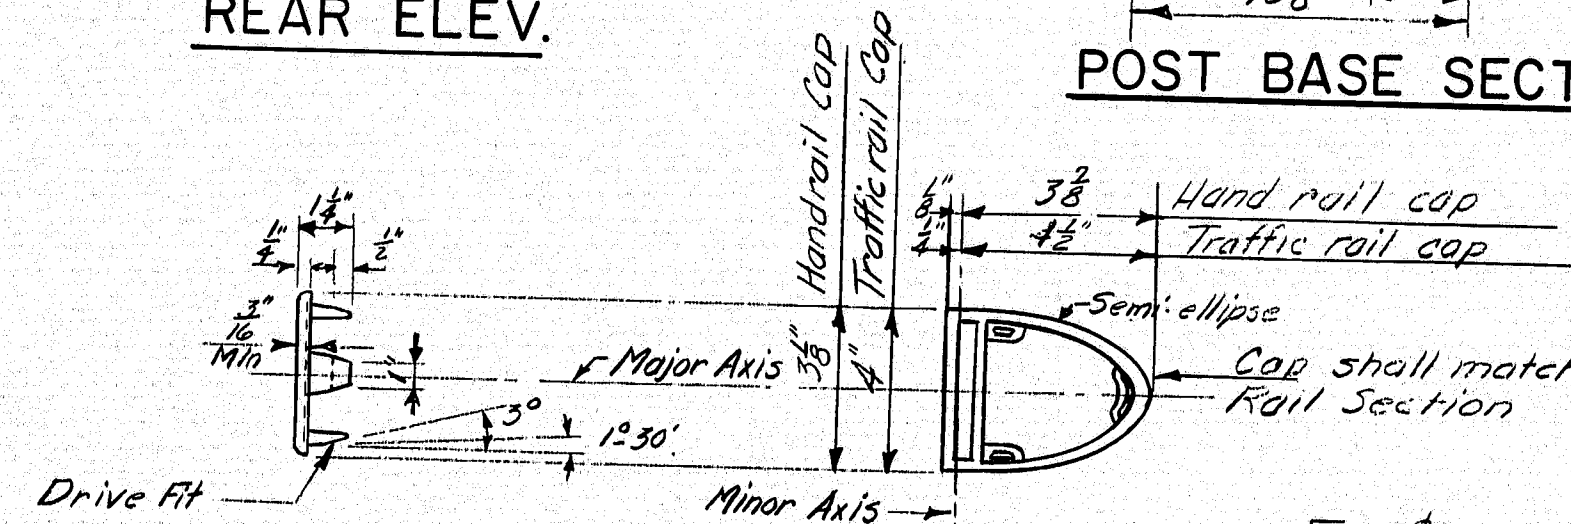

RAIL CAP

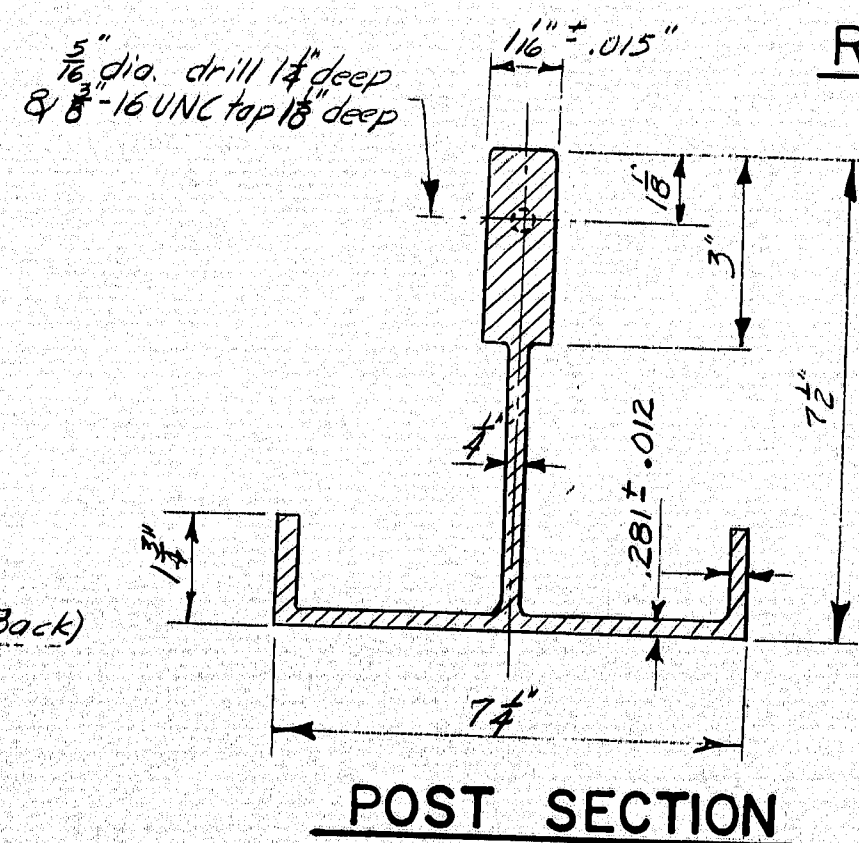


RAIL POST ANCHORAGE

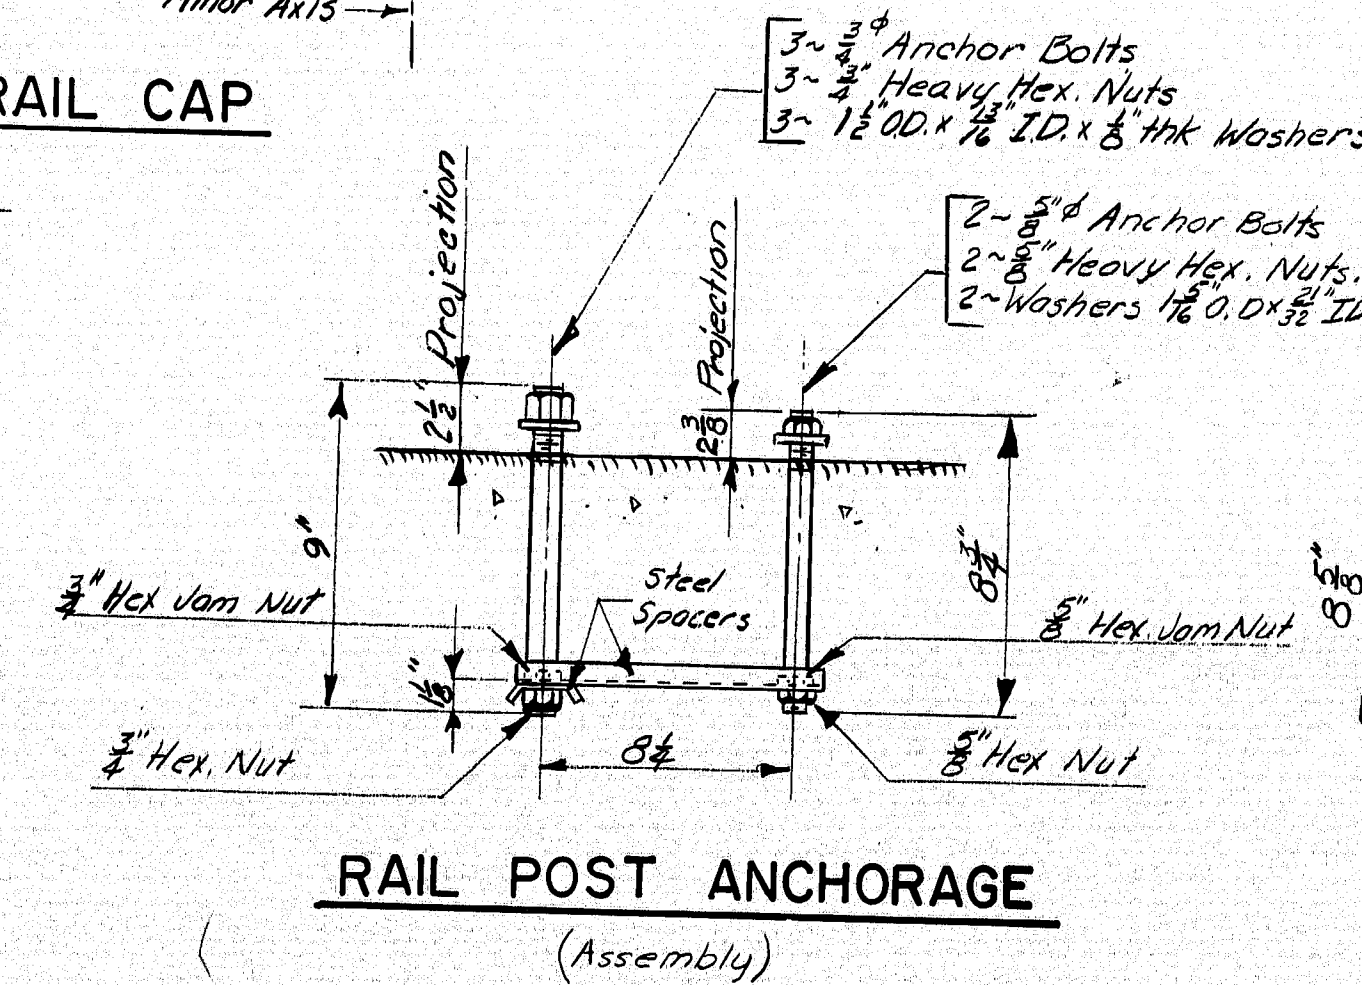


SECTION B-B

TRAFFIC RAIL

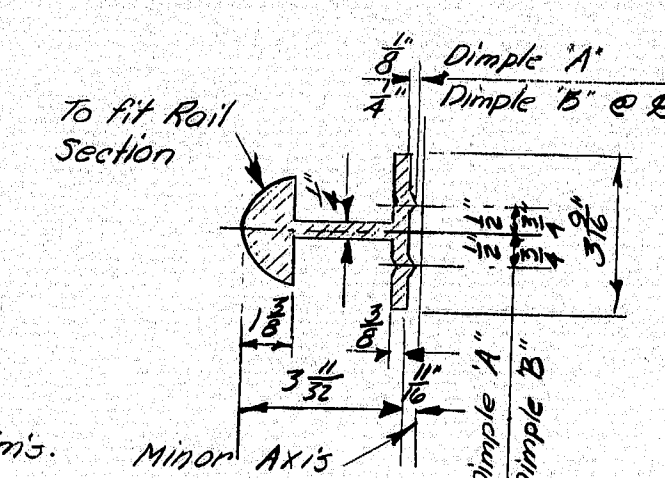


SPLICE BAR

Note - An alternate to the dimple system for holding the splice bar in position may be used if approved by the Engineer.

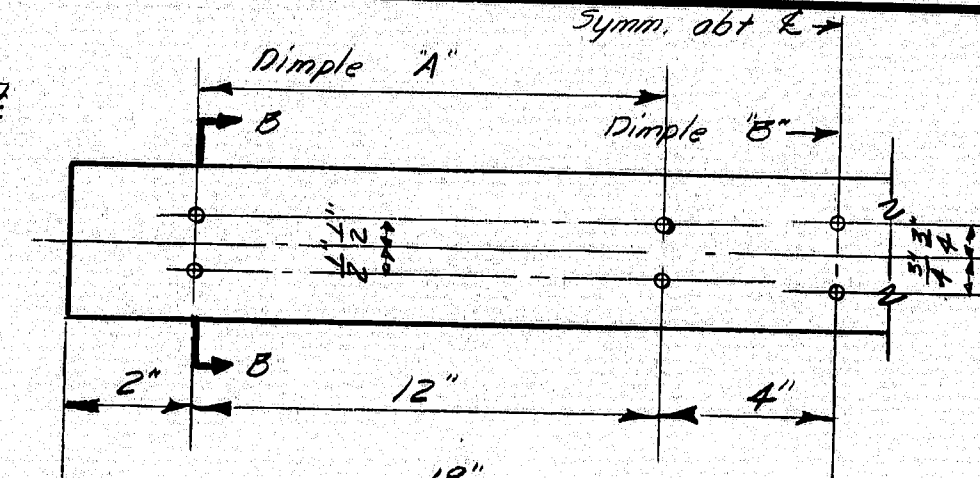


SECTION A-A

TRAFFIC RAIL

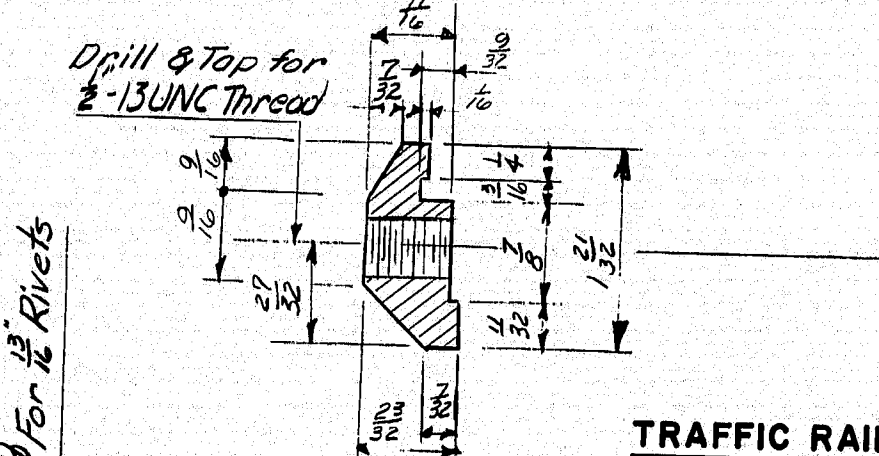


SECTION B-B


HAND RAIL

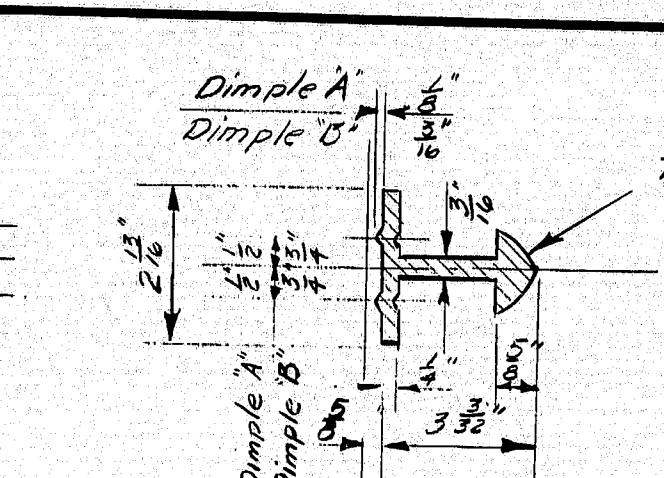


PREFORMED PADS

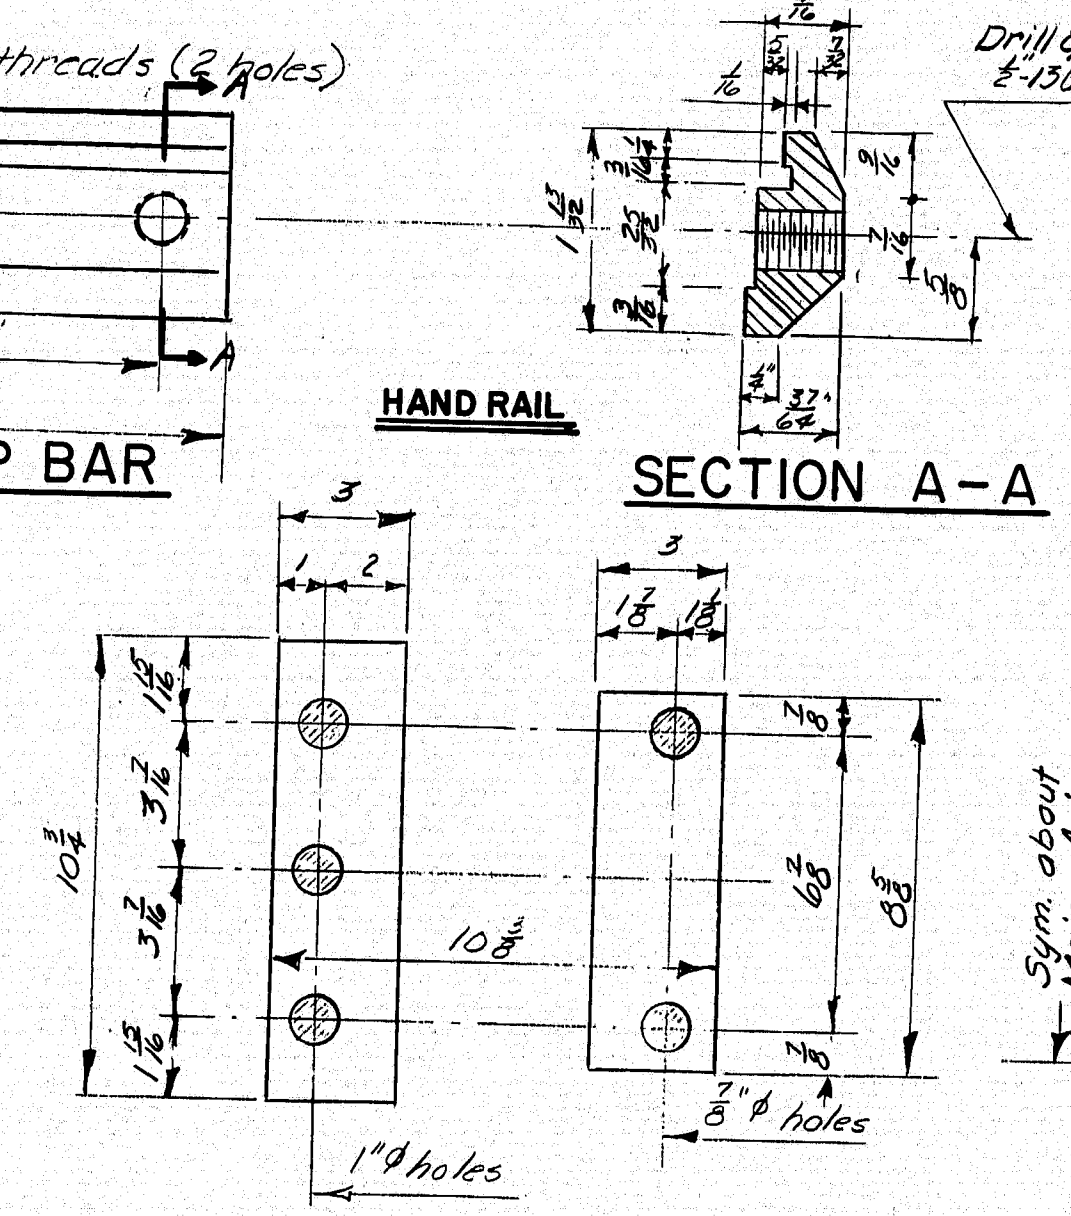

RAIL DETAILS

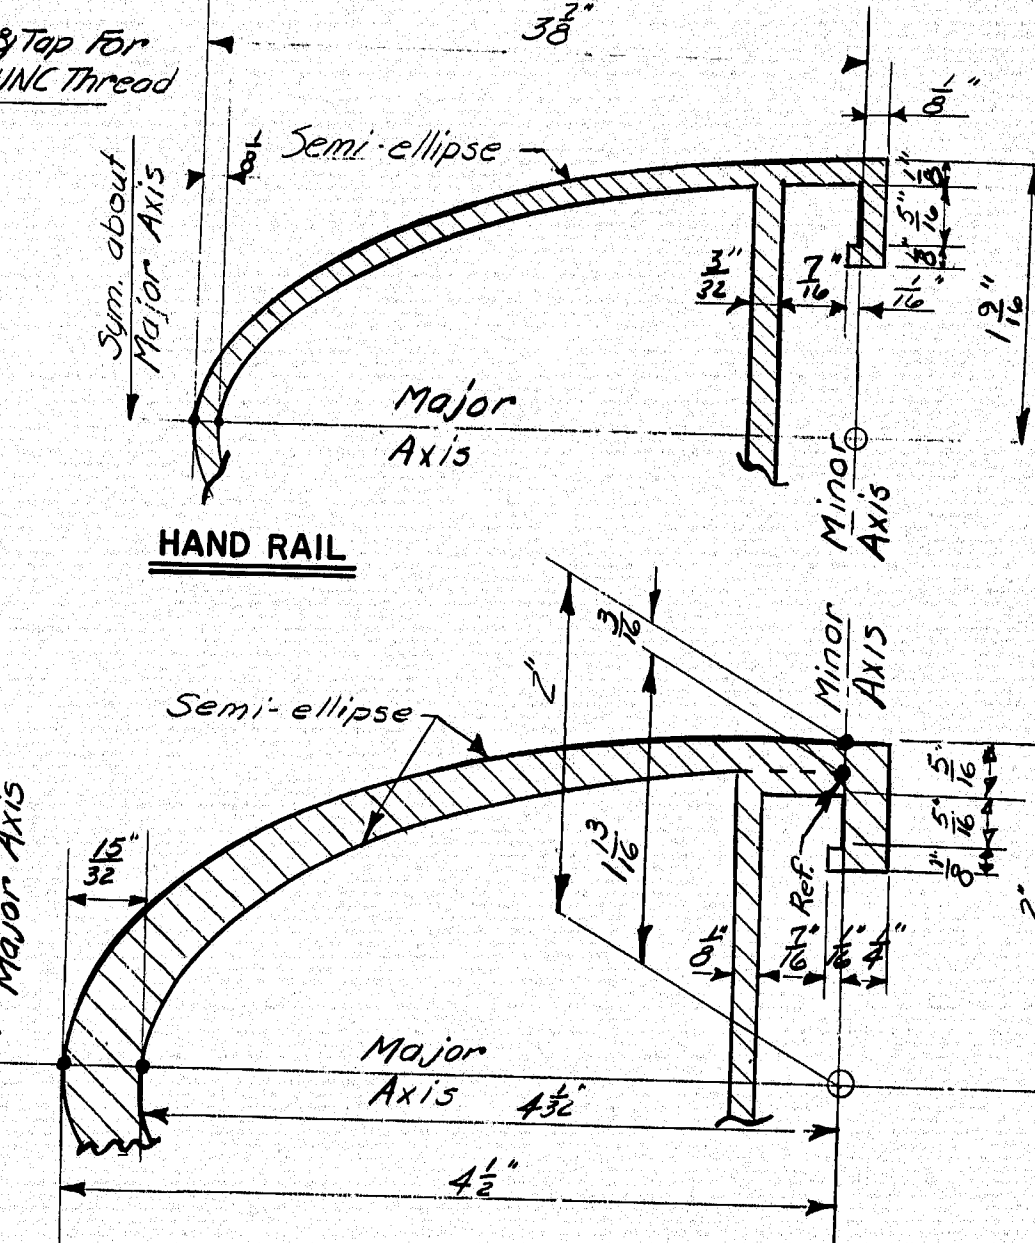


ANCHOR BOLTS

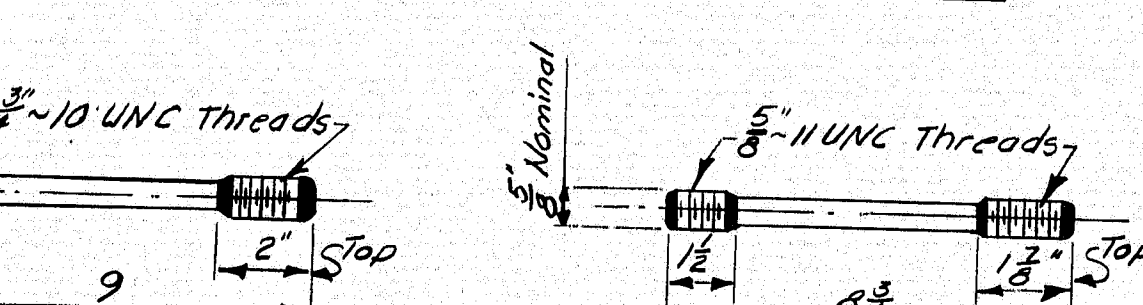

STEEL SPACERS

(For Anchorage)

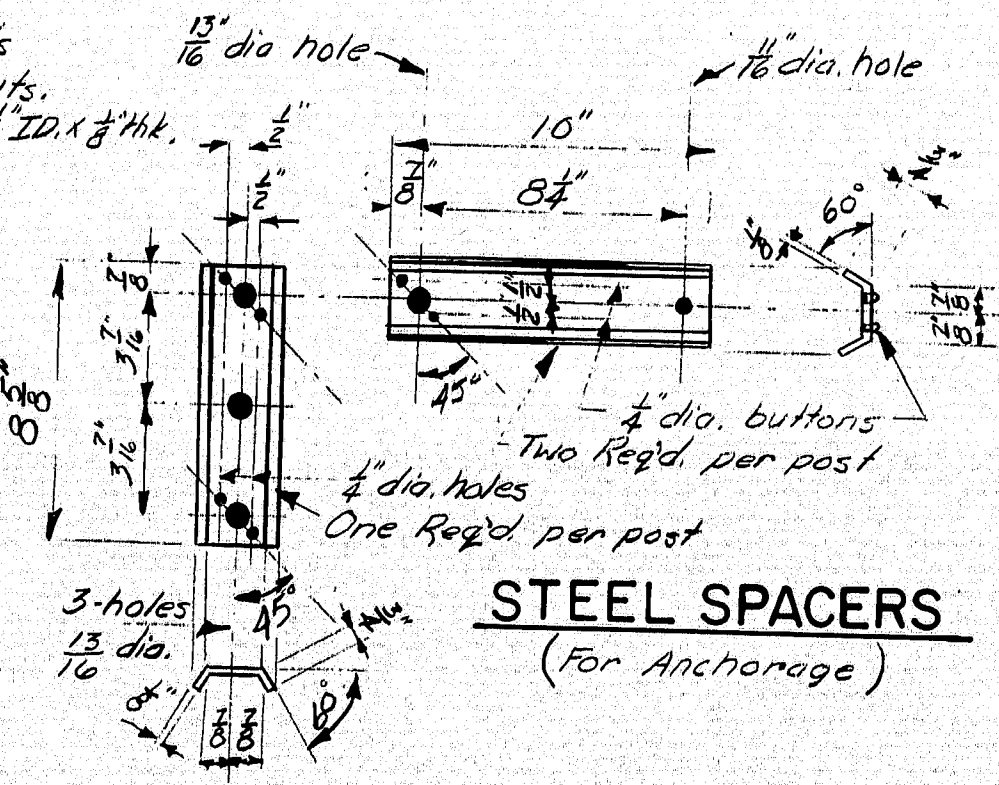


F.W.A. REG. NO.	STATE	PROJECT NUMBER	SHEET NO.	TOTAL SHEETS
1	MAINE	90118	43	105

DESIGN SPECIFICATIONS
AASHTO - Standard Specification for Highway Bridges 1969 and Interim Specifications


STATE OF MAINE
DEPARTMENT OF TRANSPORTATION
STANDARD DETAILS
(BD 115 - 73)
ALUMINUM RAILING
3 - BAR (SEMI-ELLIPSE)
EXTRUDED POST

SHEET OF AUGUSTA, MAINE FEBRUARY 1973

153-148

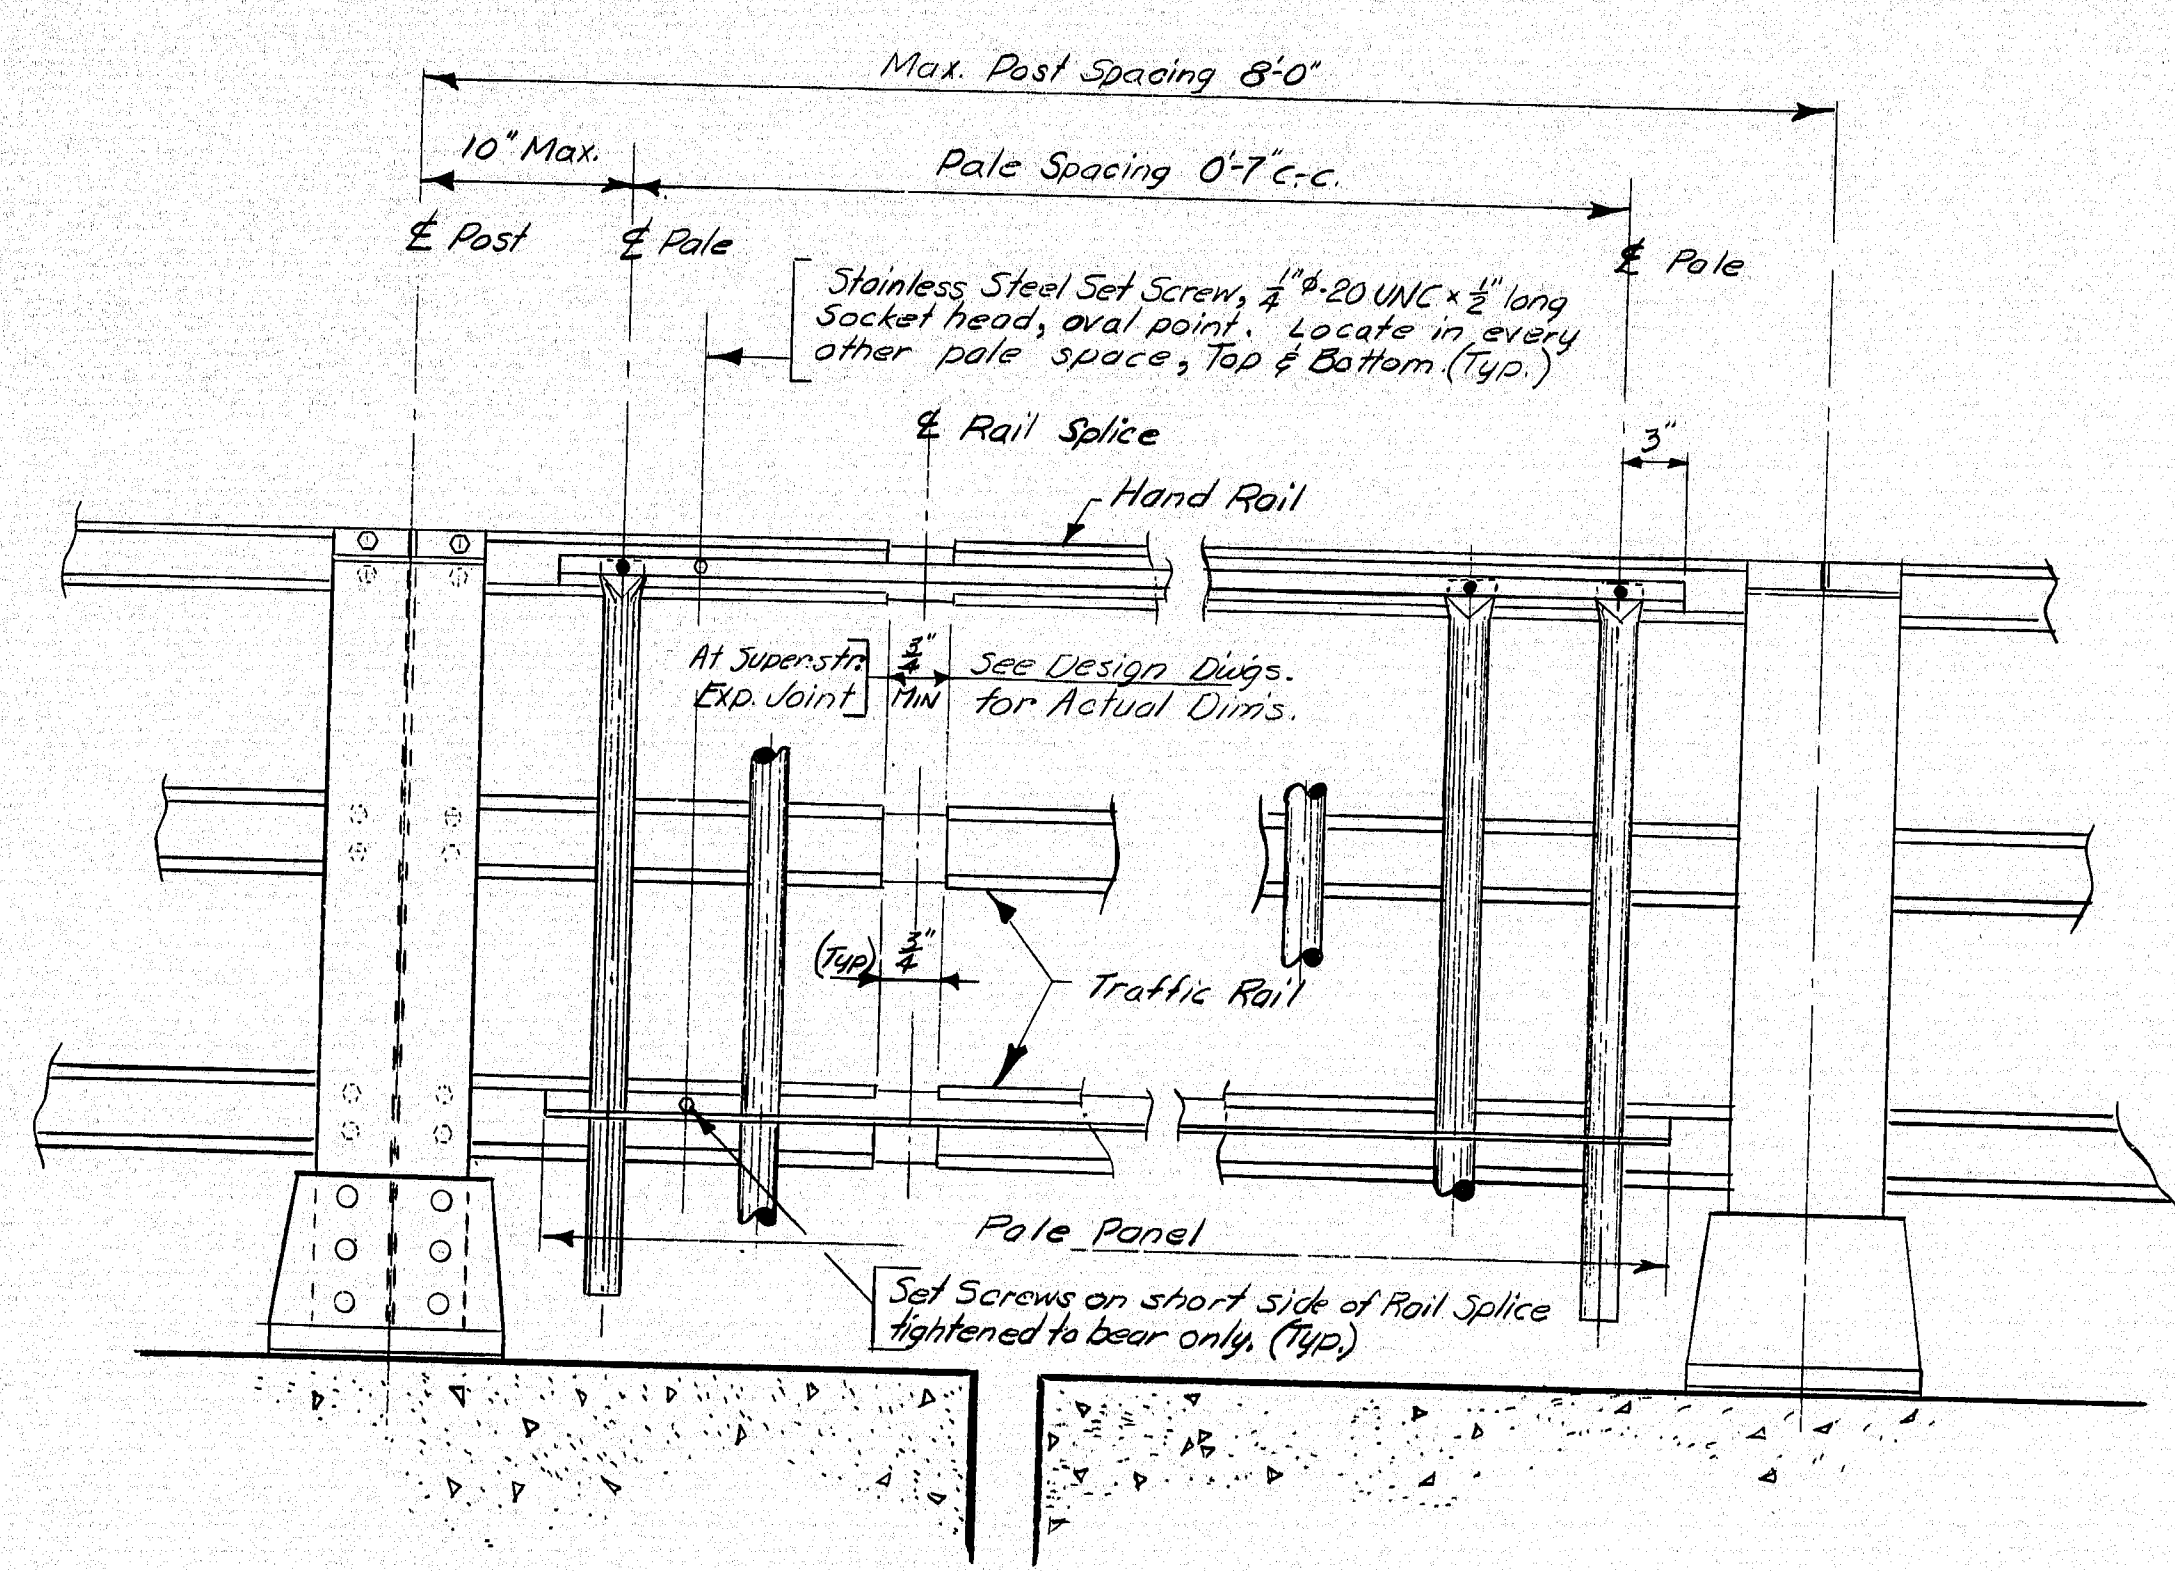


REAR ELEVATION

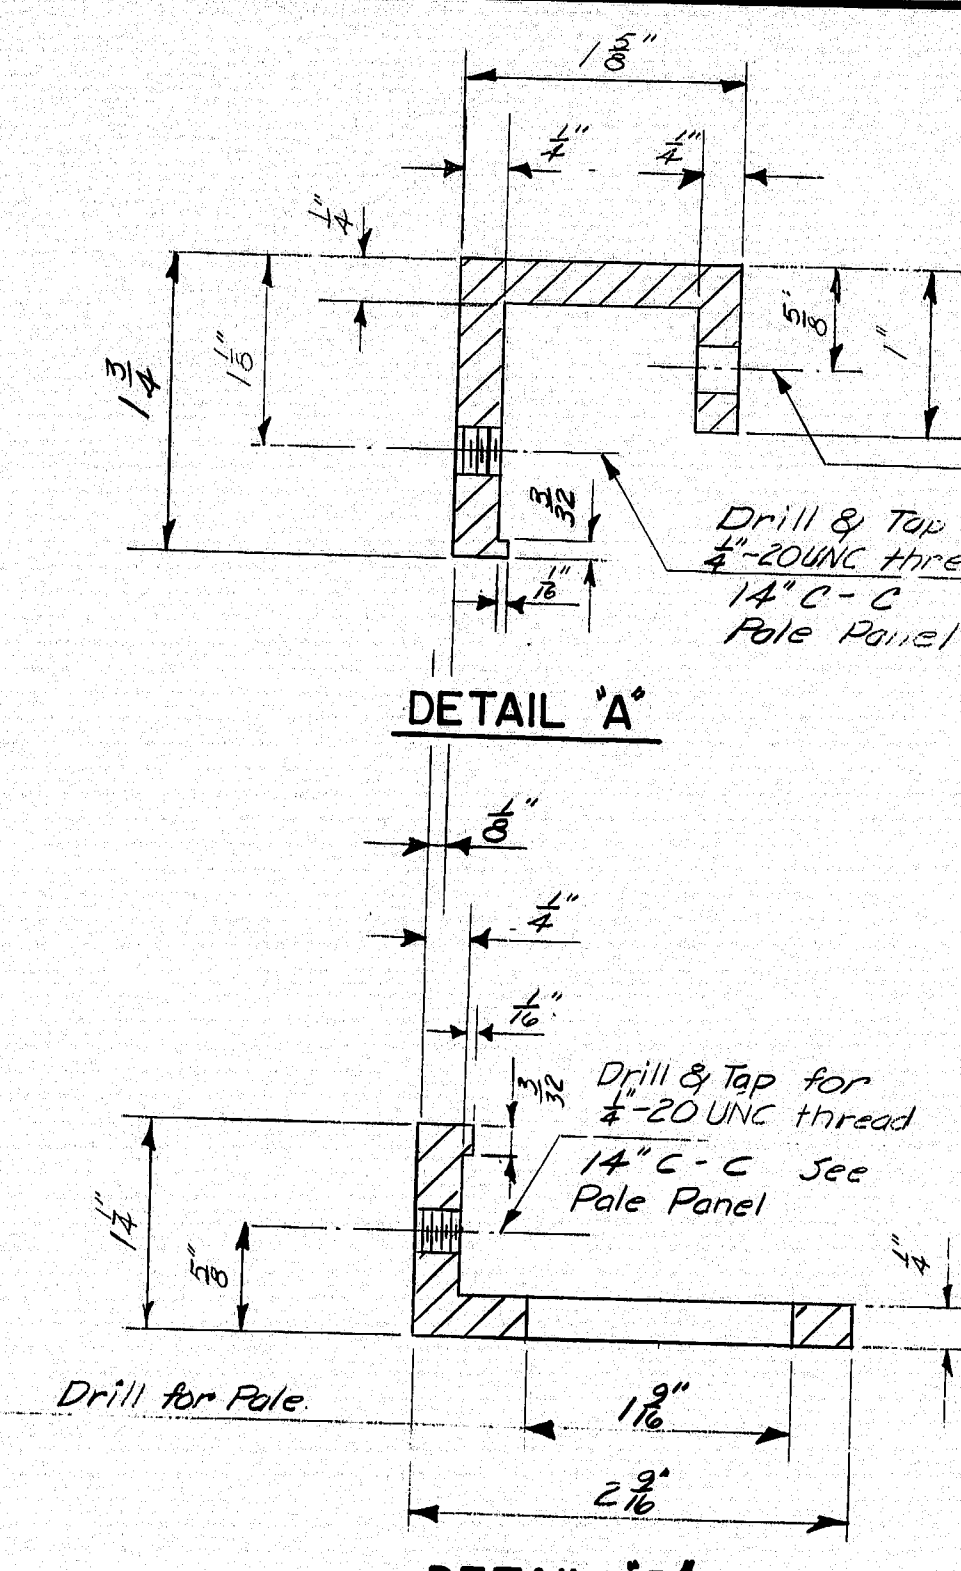

DETAIL 'A'


DETAIL 'B'

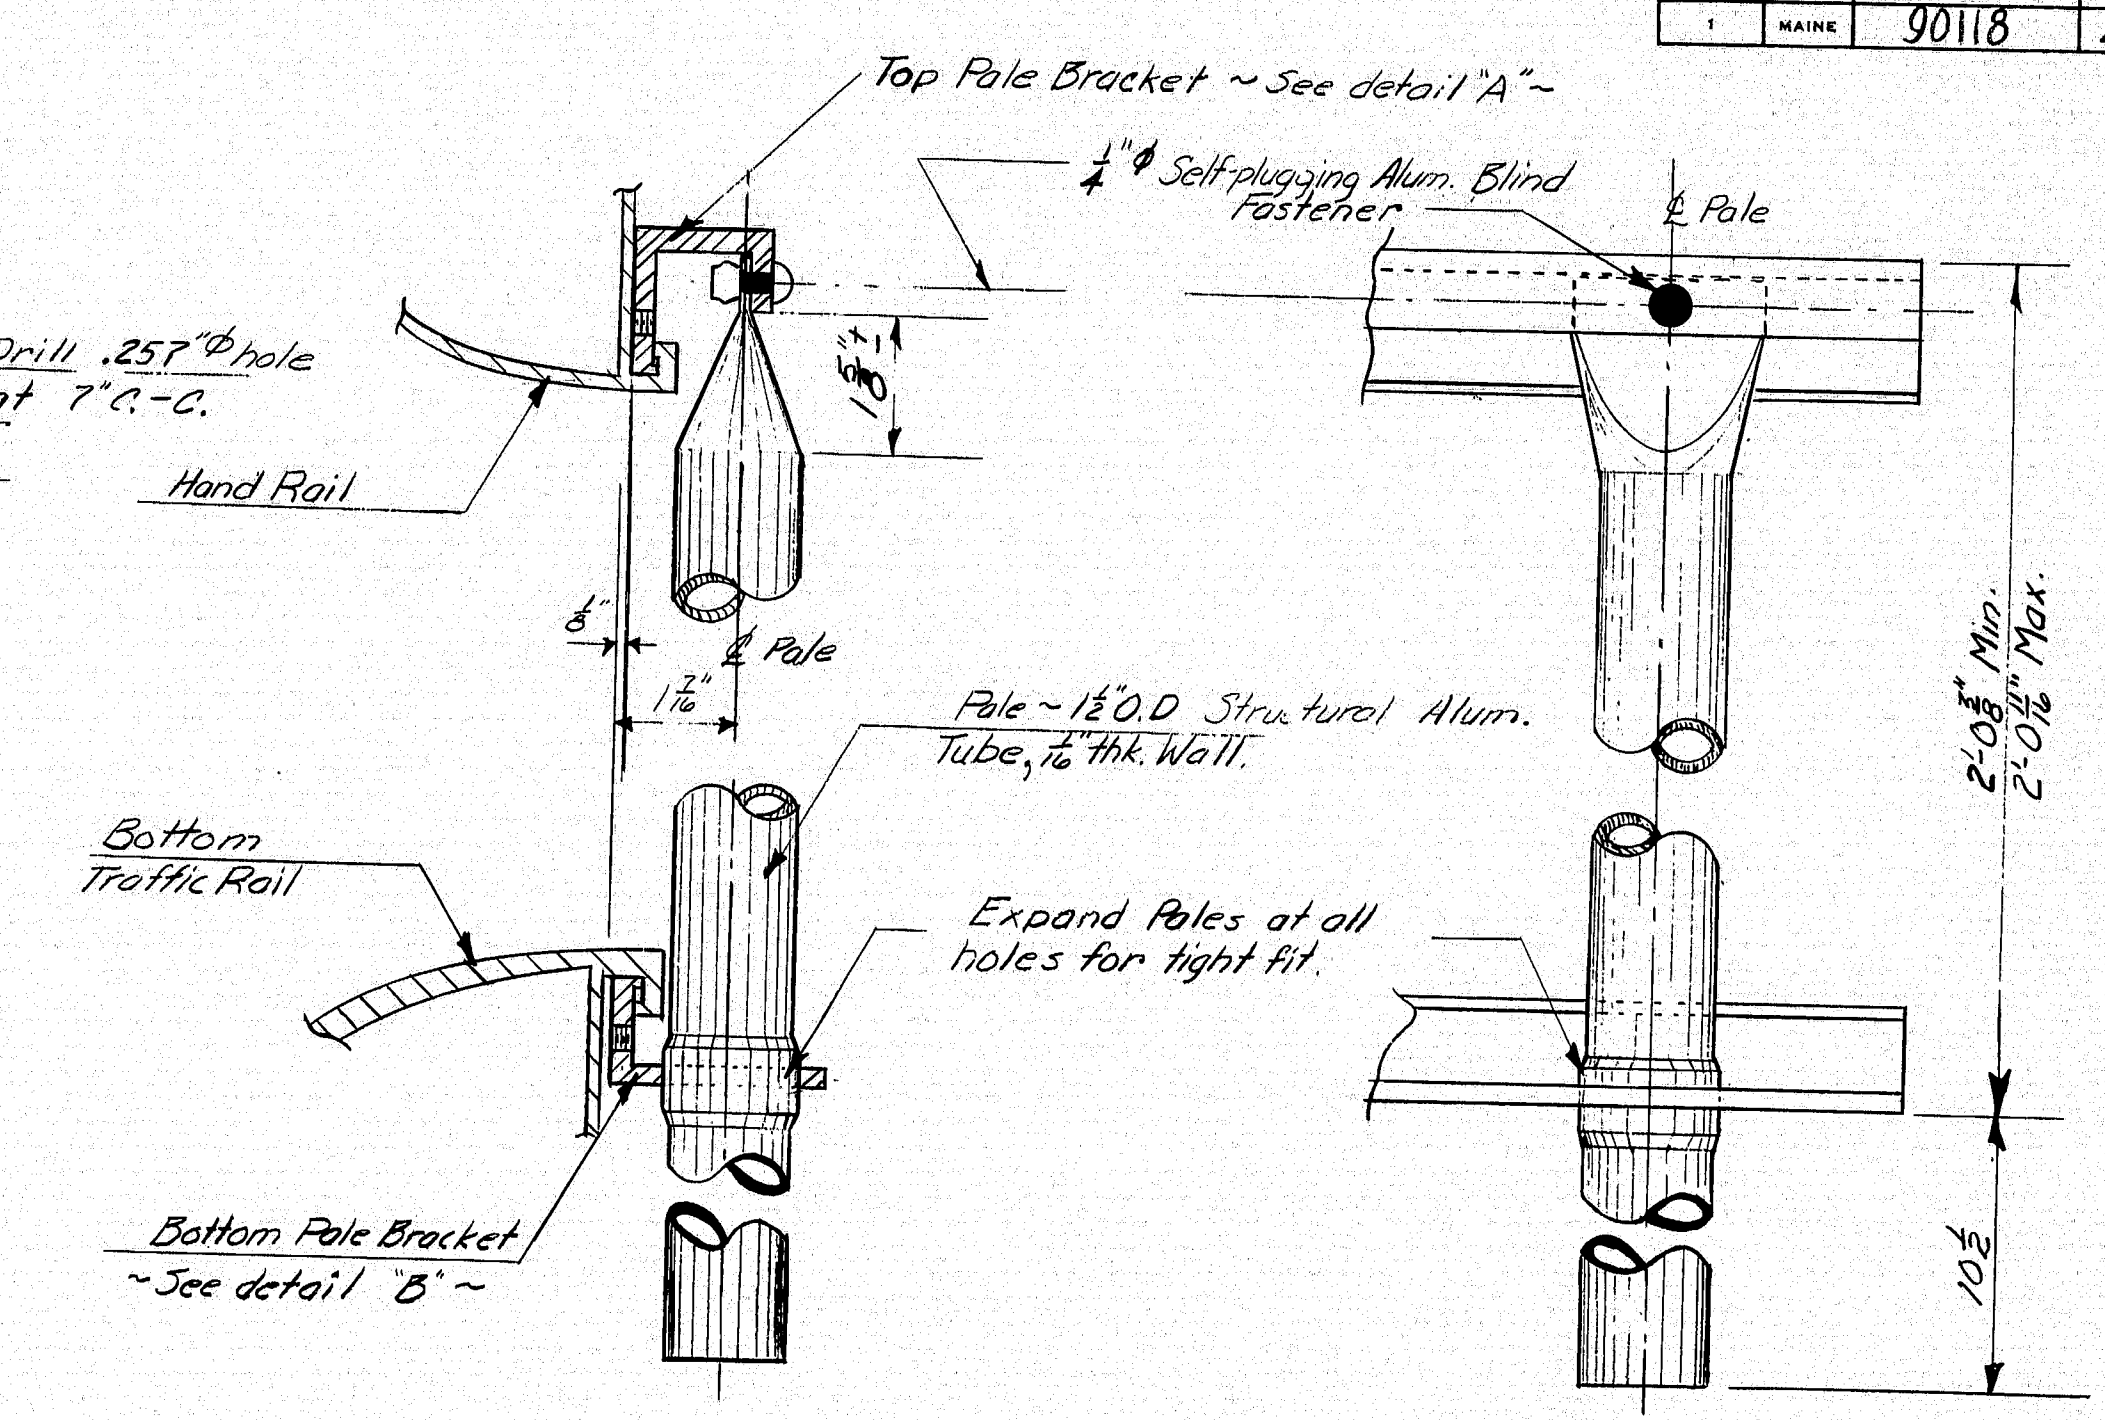

PALE PANEL DETAILS

PALES


For use with 3-Bar Aluminum Rail

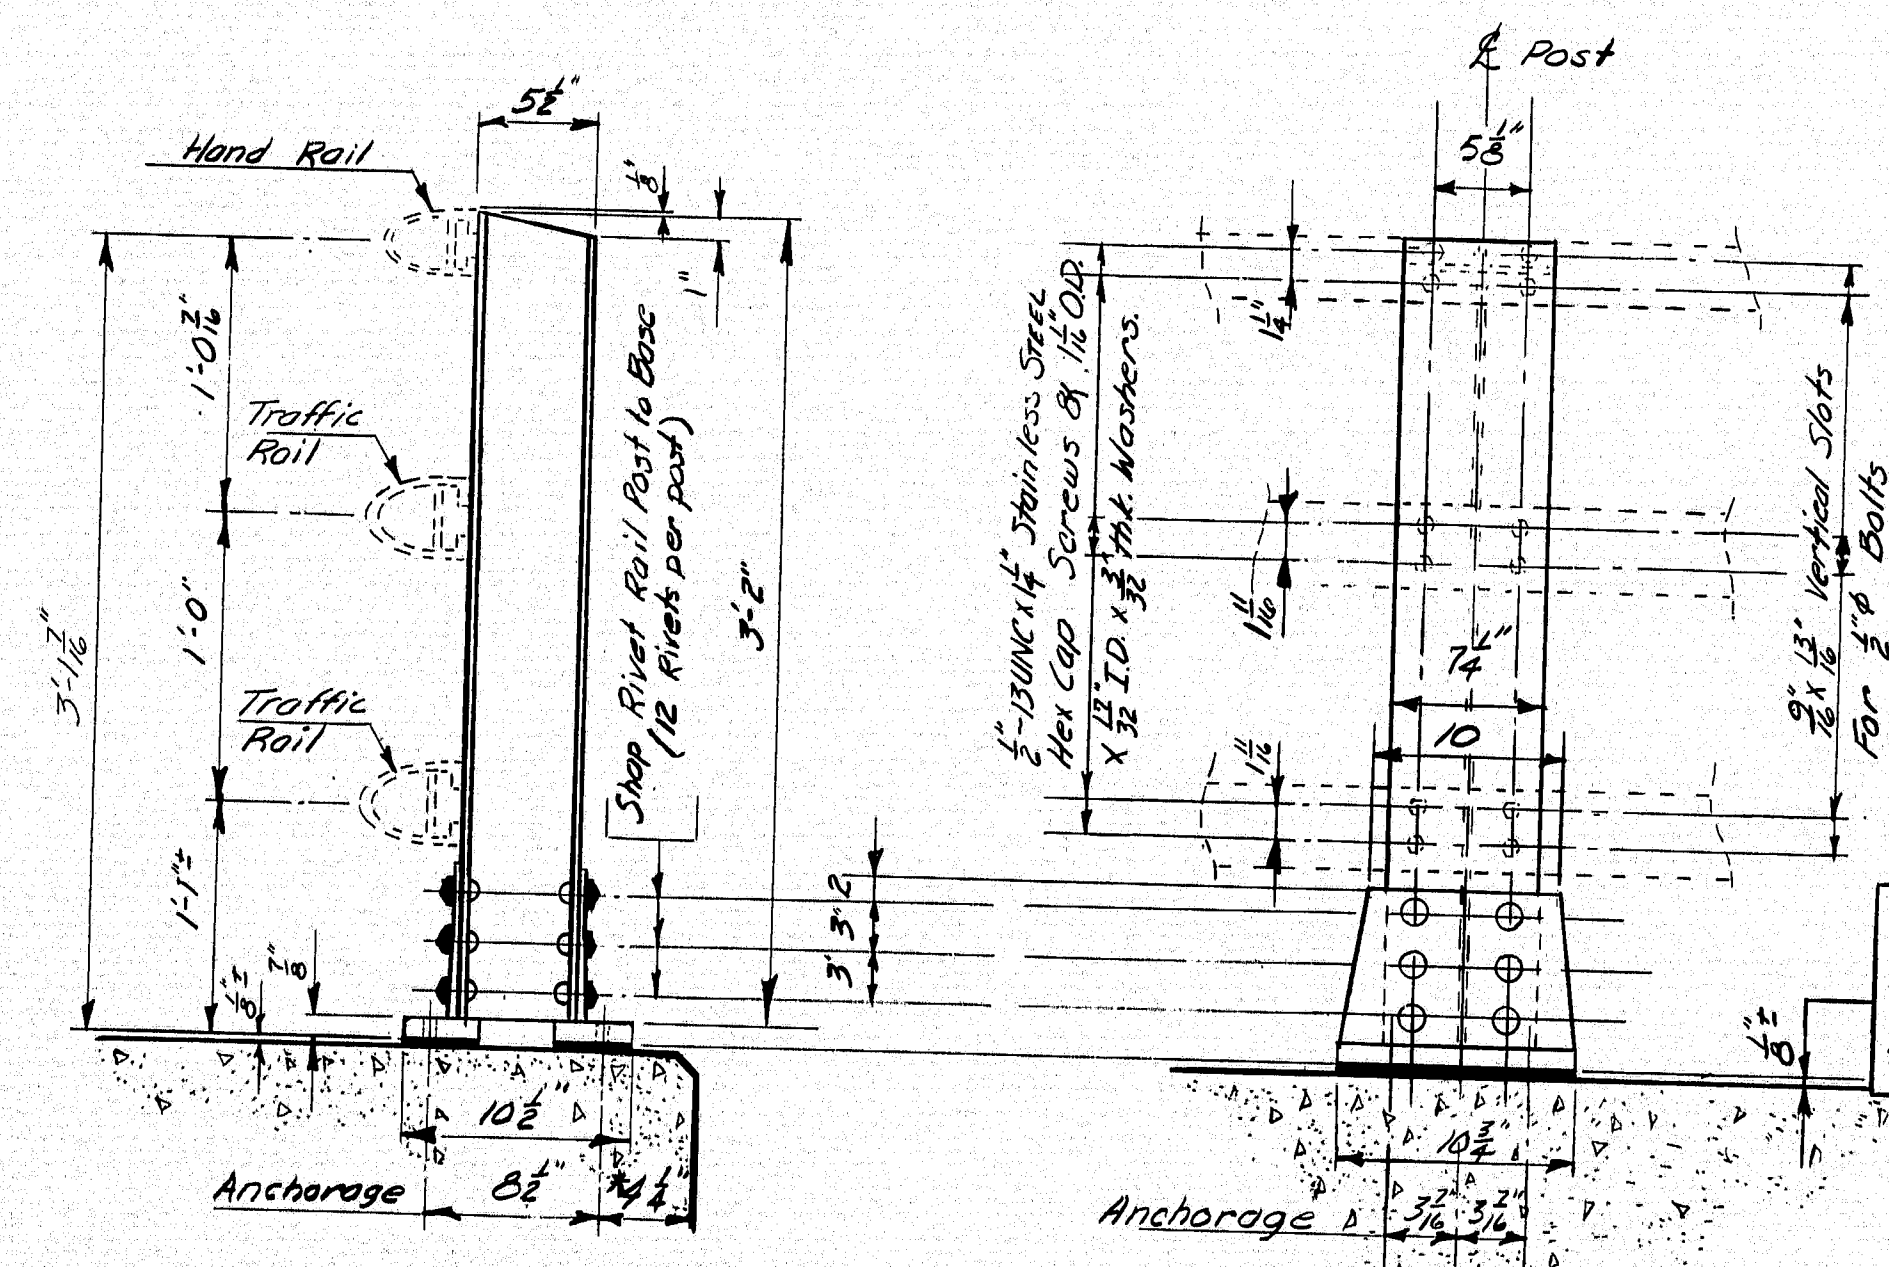

SIDE ELEV.


FRONT ELEV.

RAIL POST

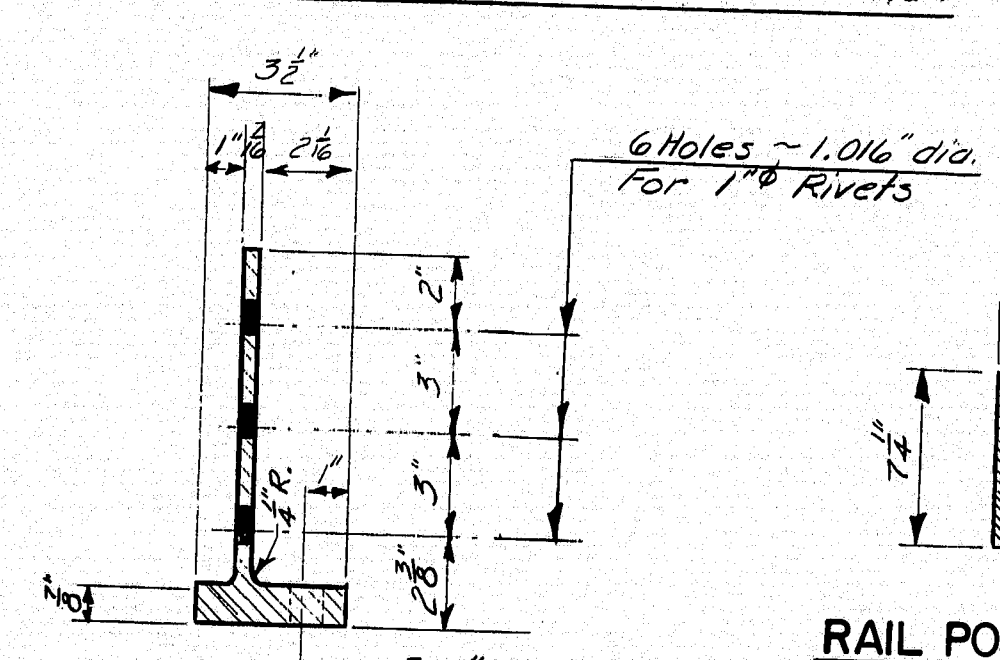


POST BASE SECTION
(2 Required per post)

RAIL POST SECTION

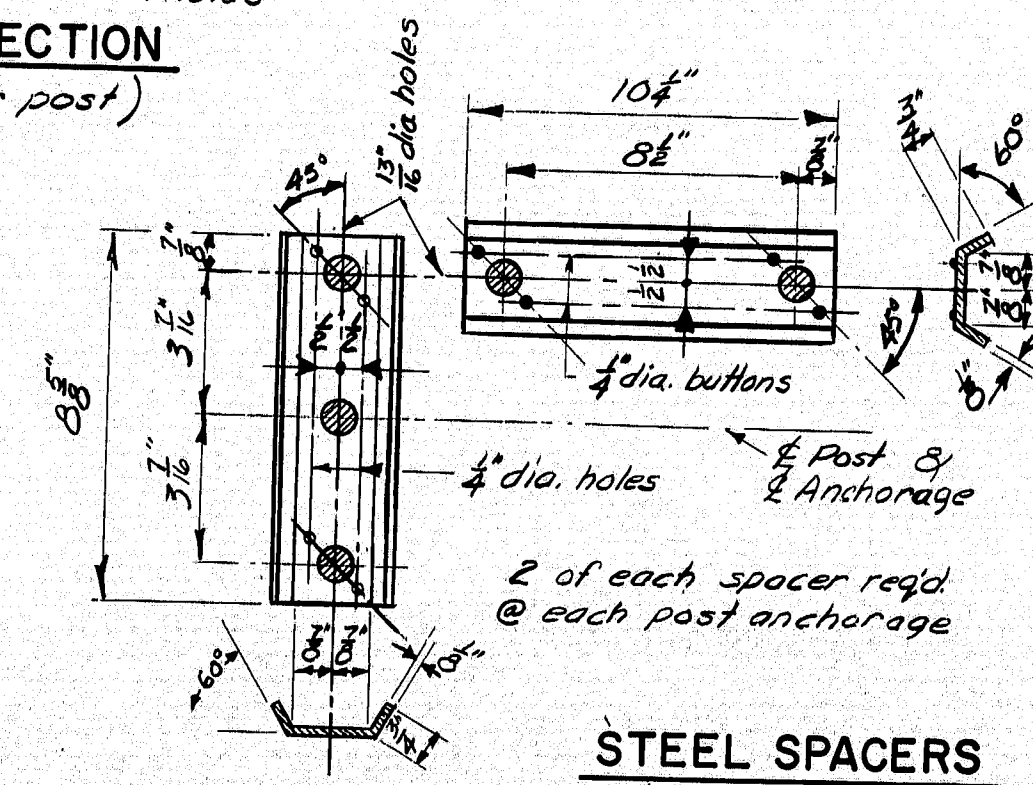


STEEL SPACERS

HEAVY DUTY POST (3-BAR RAIL)

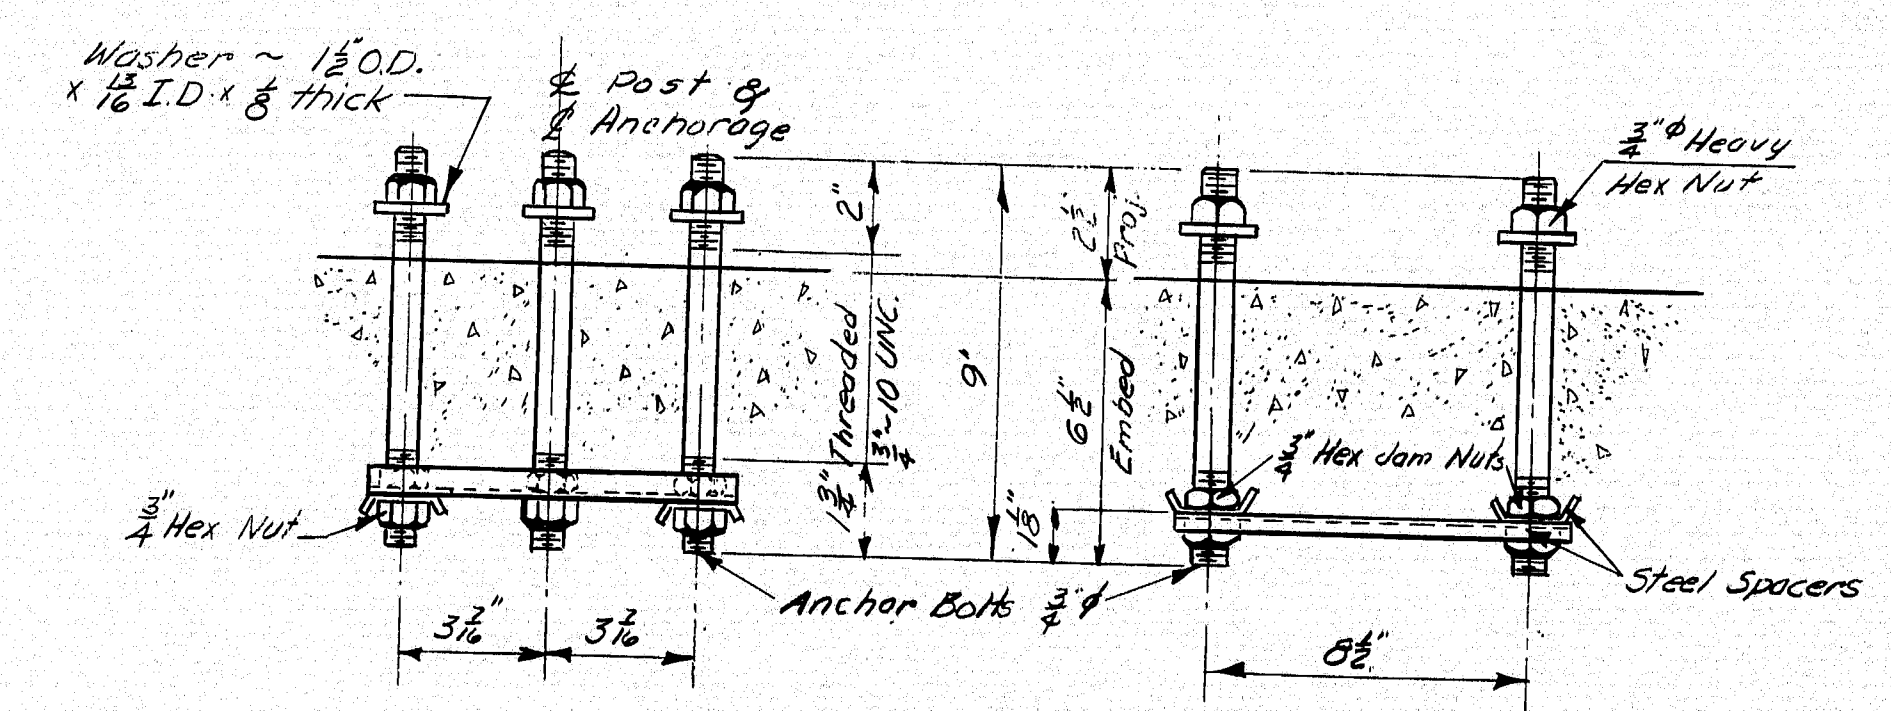

RAIL POST ANCHORAGE

If cut threads are used, body diameter shall be not less than nominal diameter.
If rolled threads are used, body diameter shall be not less than the root diameter of the threads.

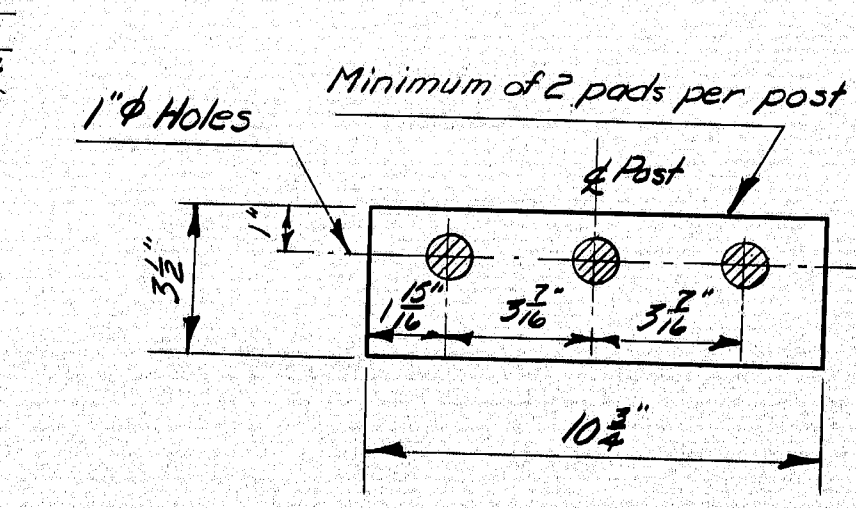

PREFORMED PAD

STATE OF MAINE
DEPARTMENT OF TRANSPORTATION
(SHEET BD115-73 SHALL ACCOMPANY THIS SHEET)

STANDARD DETAILS
(BD 116-73)


PALE PANELS
HEAVY DUTY POST

SHEET OF AUGUSTA, MAINE FEBRUARY 1973

153-149

DATE	BY	DESIGN	CHECKED	REVISIONS	FIELD CHANGES
10/1/73	K.L. Leach	DESIGNED	CHECKED		


* Preferable minimum dimension.
For actual dimension - See Bridge Plans.

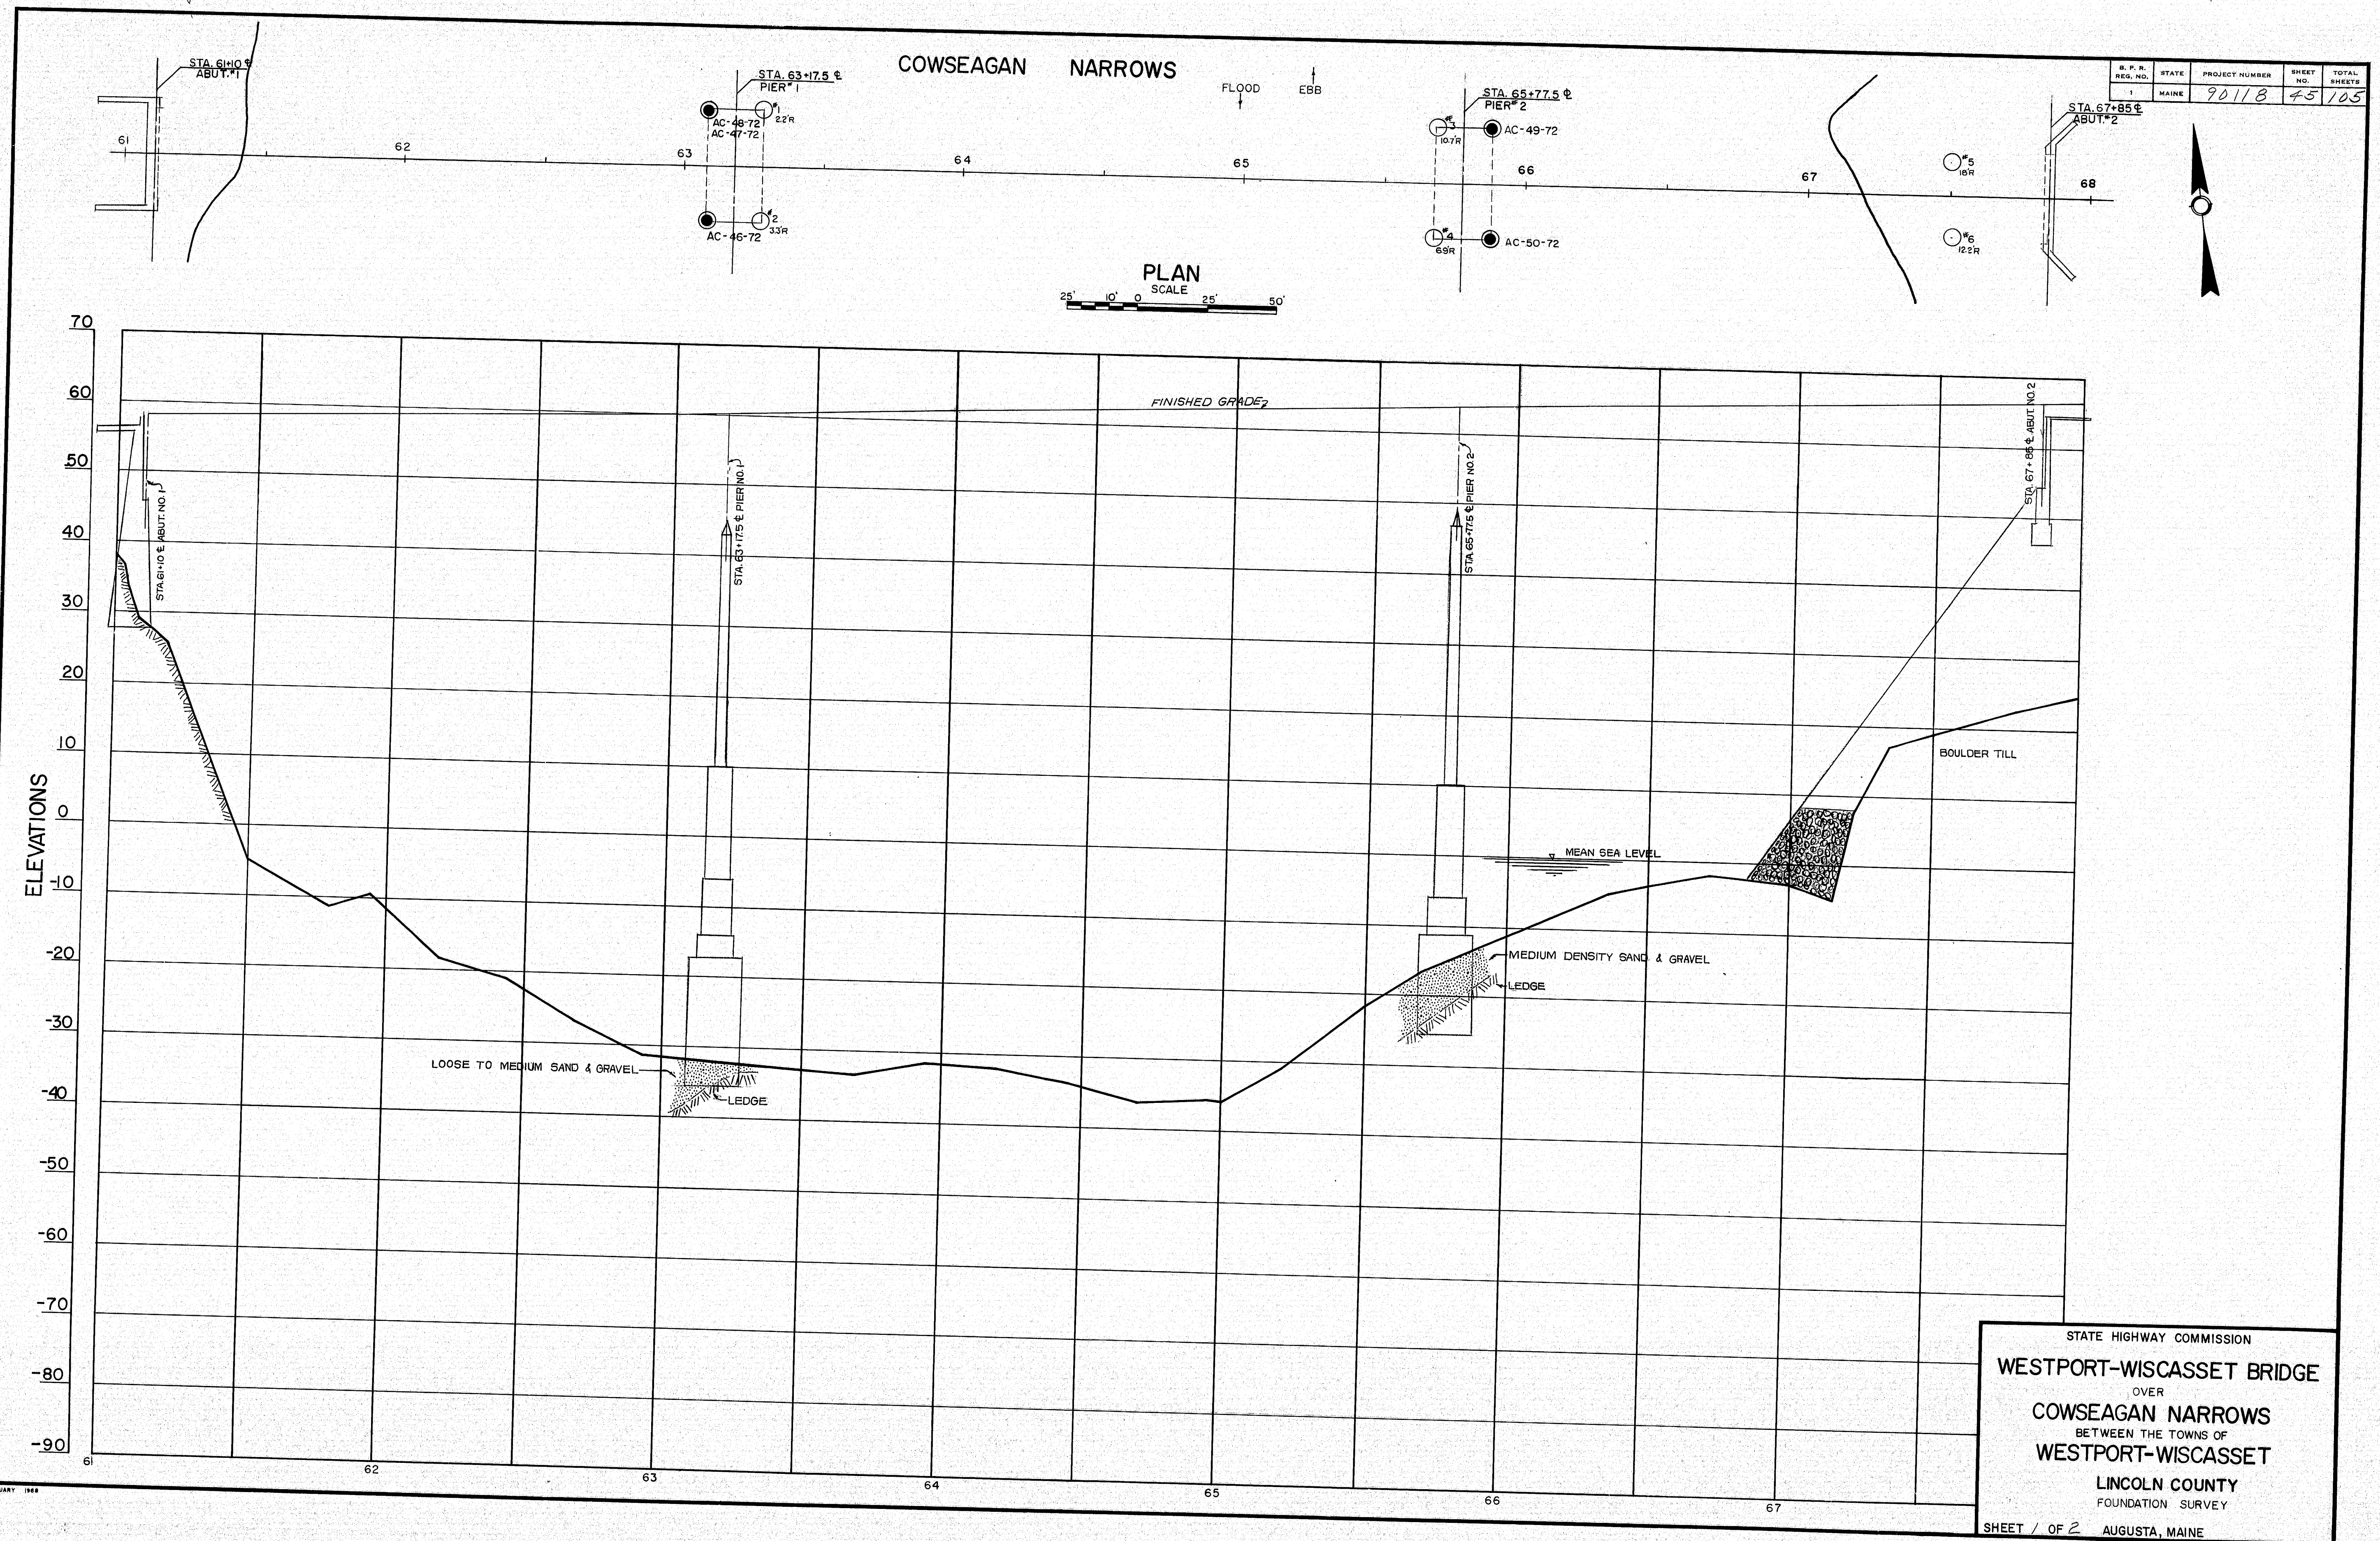


PLANS	BY	DATE
DESIGN - DETAILED		
REVISIONS		
FIELD CHANGES		

STATE HIGHWAY COMMISSION
WESTPORT-WISCASSET BRIDGE
 OVER
COWSEAGAN NARROWS
 BETWEEN THE TOWNS OF
WESTPORT-WISCASSET
 LINCOLN COUNTY
 FOUNDATION SURVEY
 SHEET 1 OF 2 AUGUSTA, MAINE

153-150


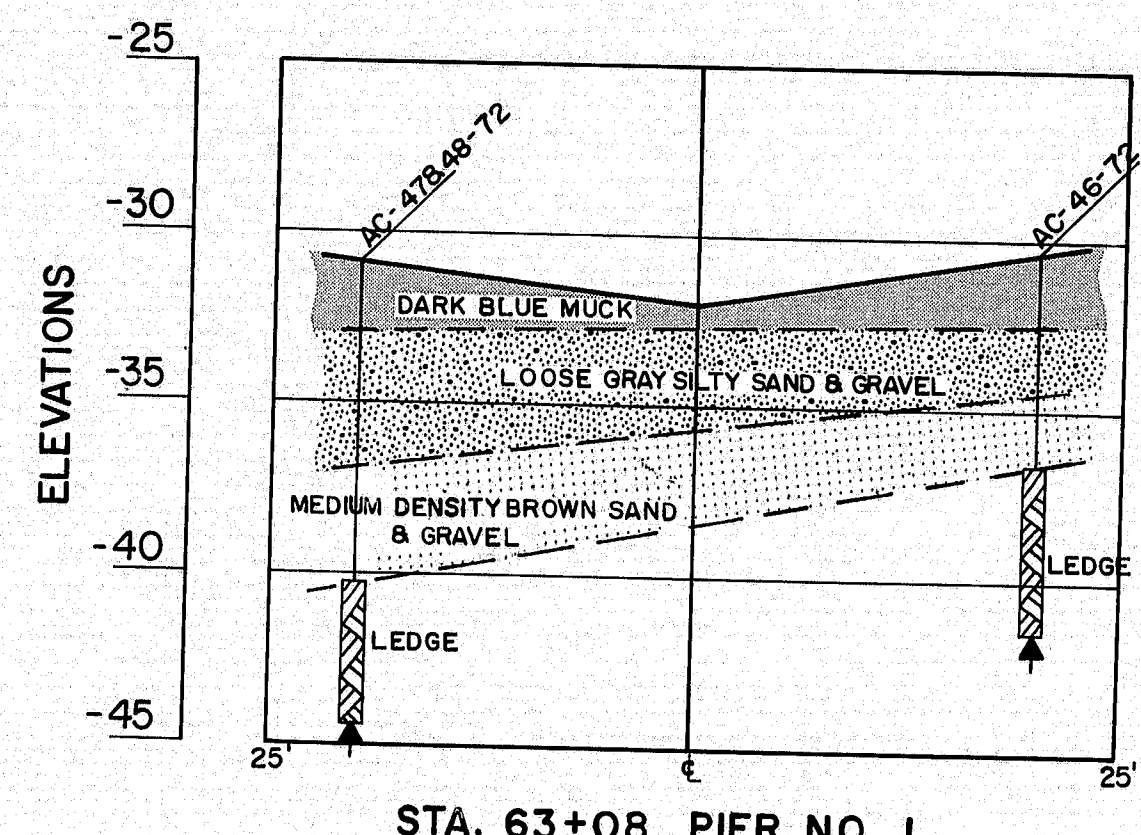


STA. 63+08 PIER NO. 1

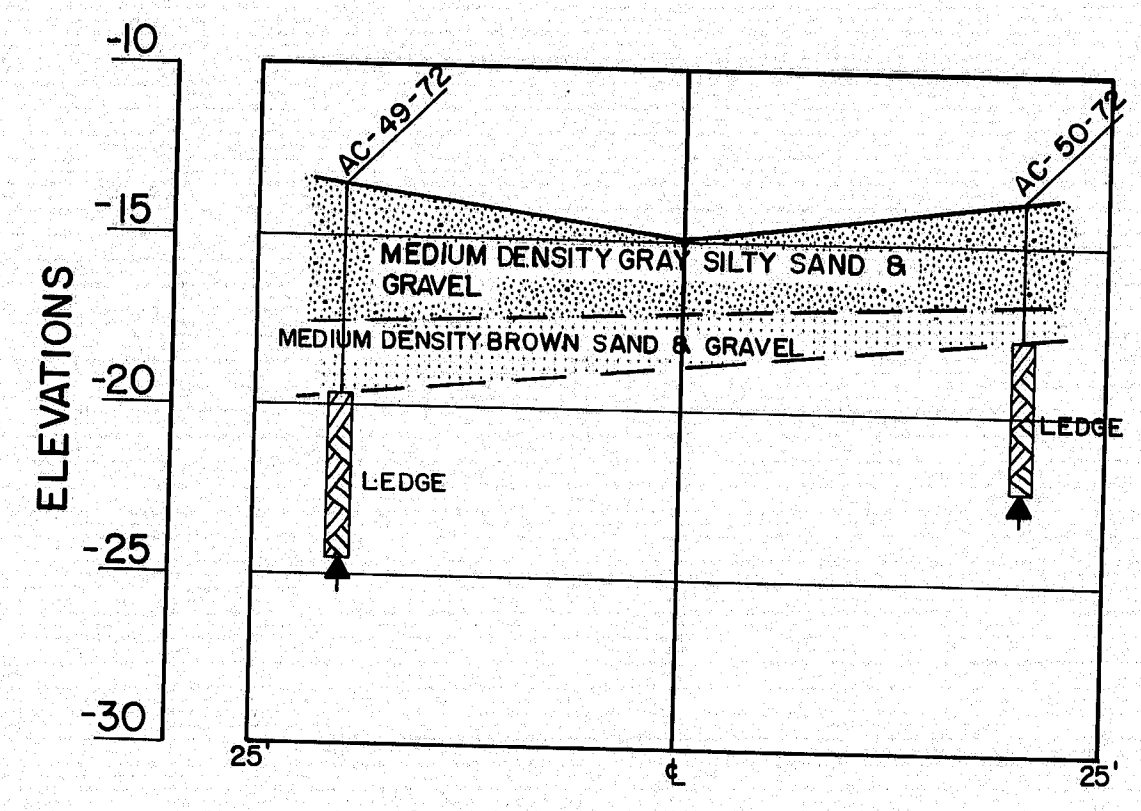


STA. 65+88 PIER NO. 2

TRANSVERSE SECTIONS

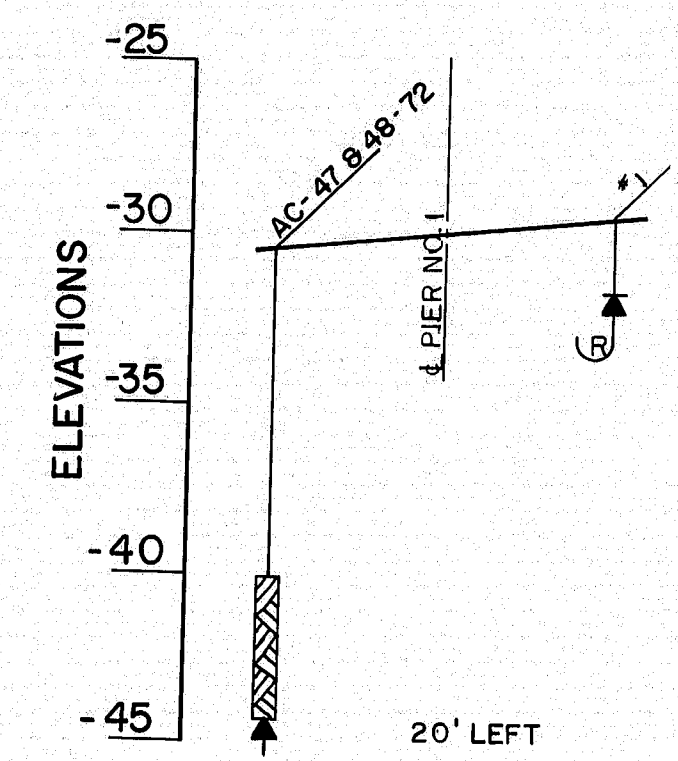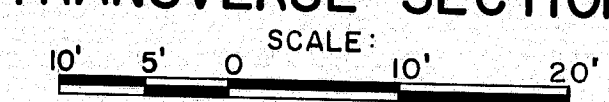


20' LEFT

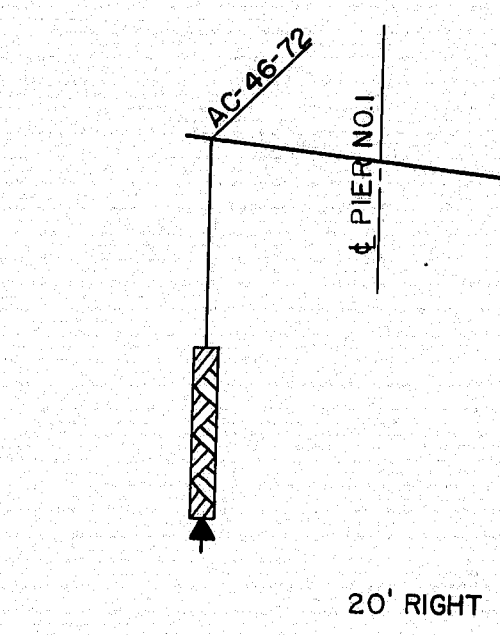


20' RIGHT

PROFILES PIER NO. 1





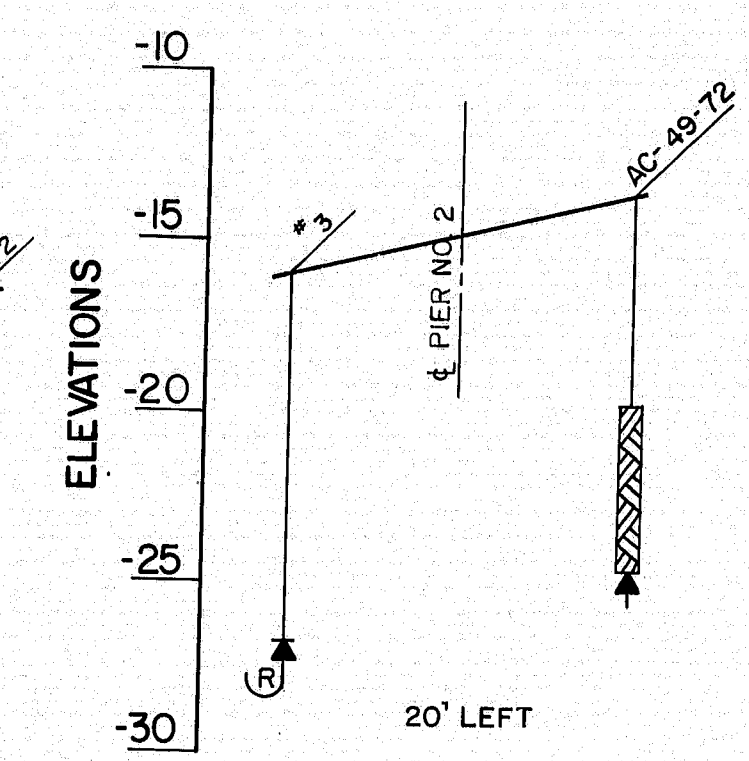


20' LEFT

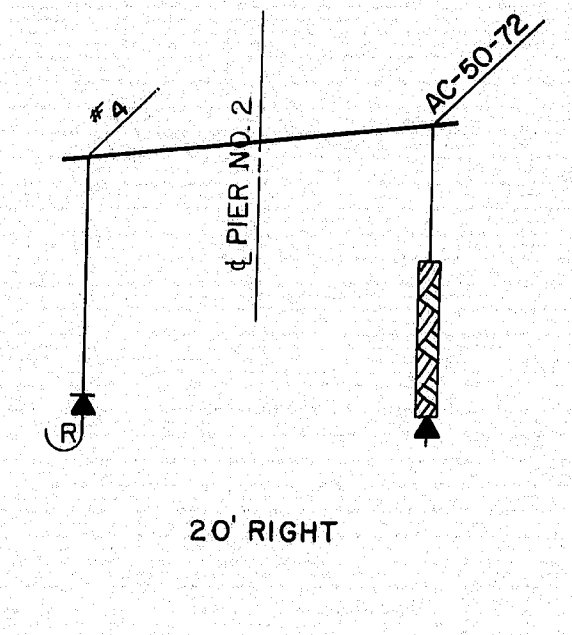

20' RIGHT

PROFILES PIER NO. 2

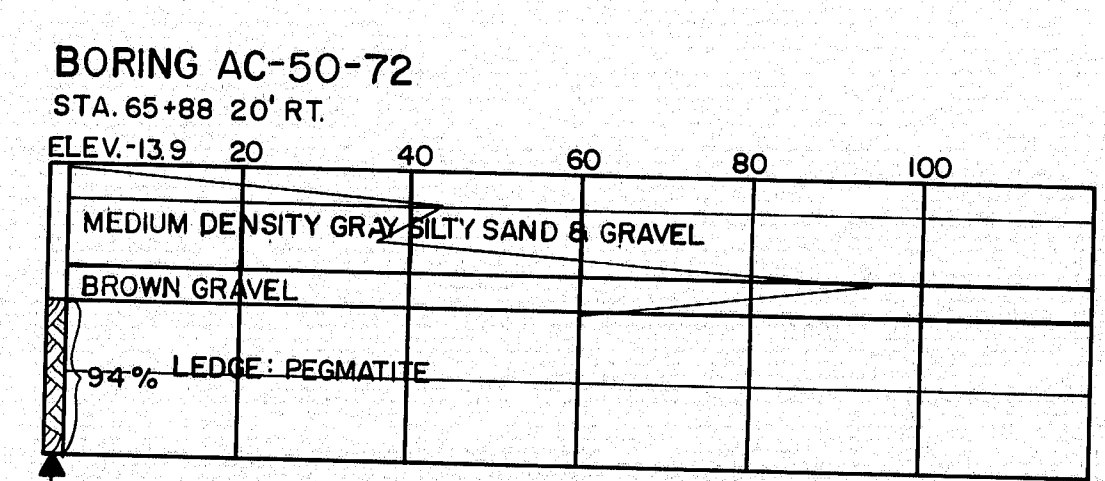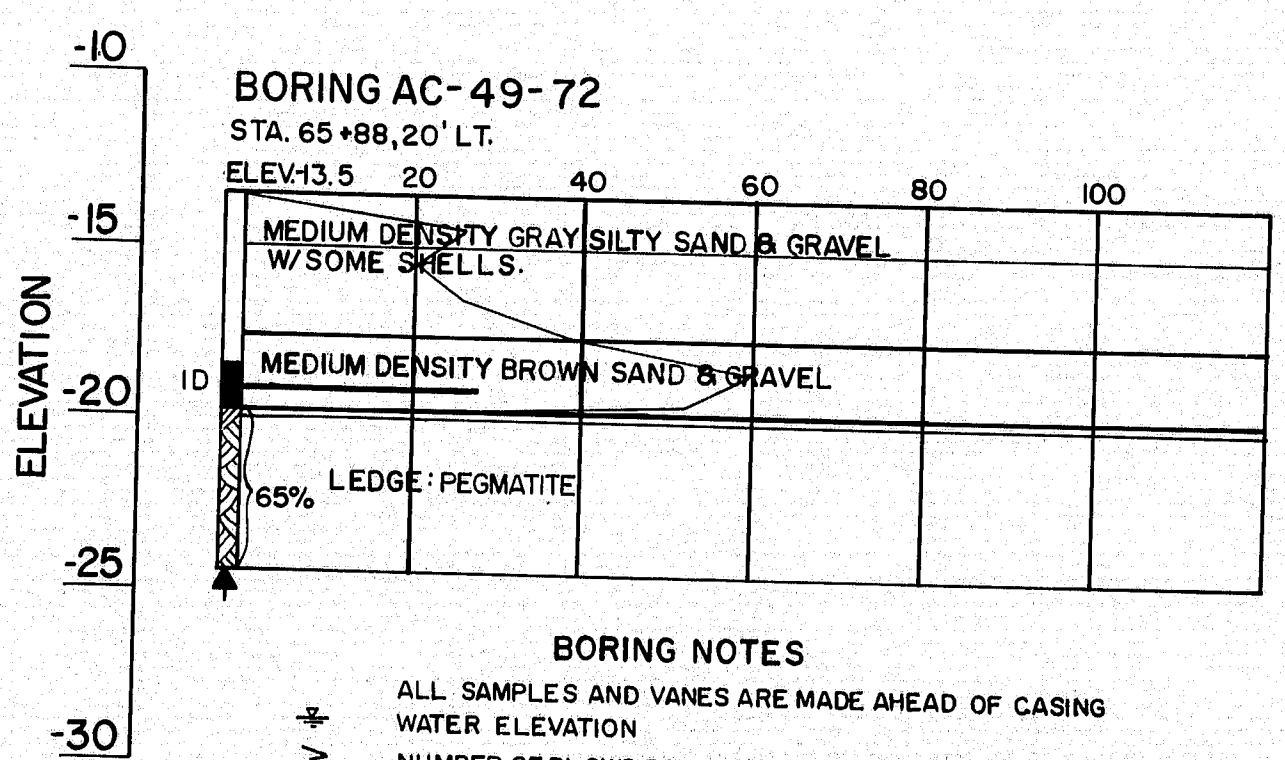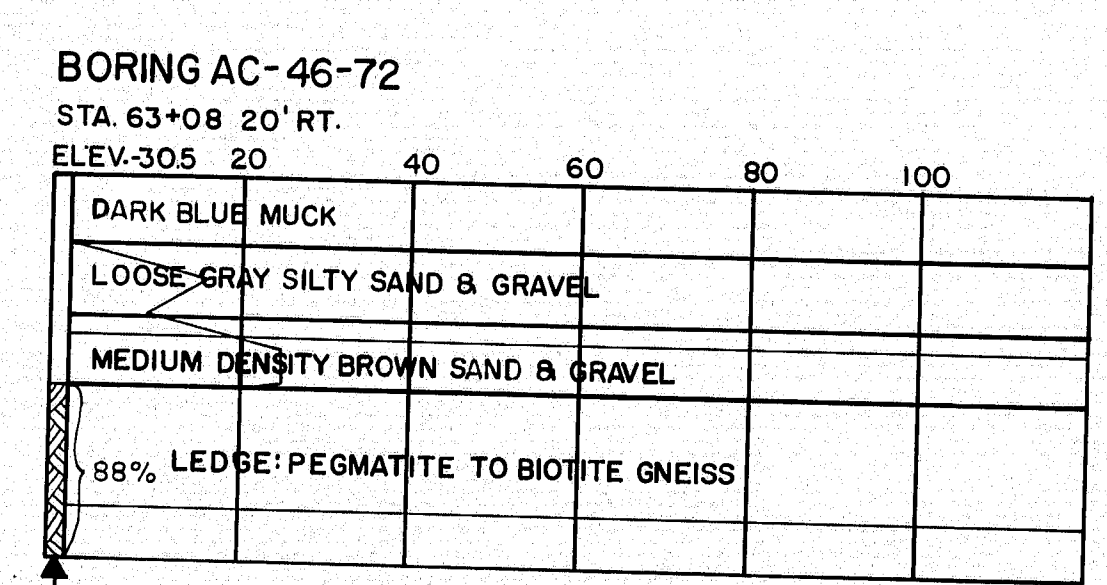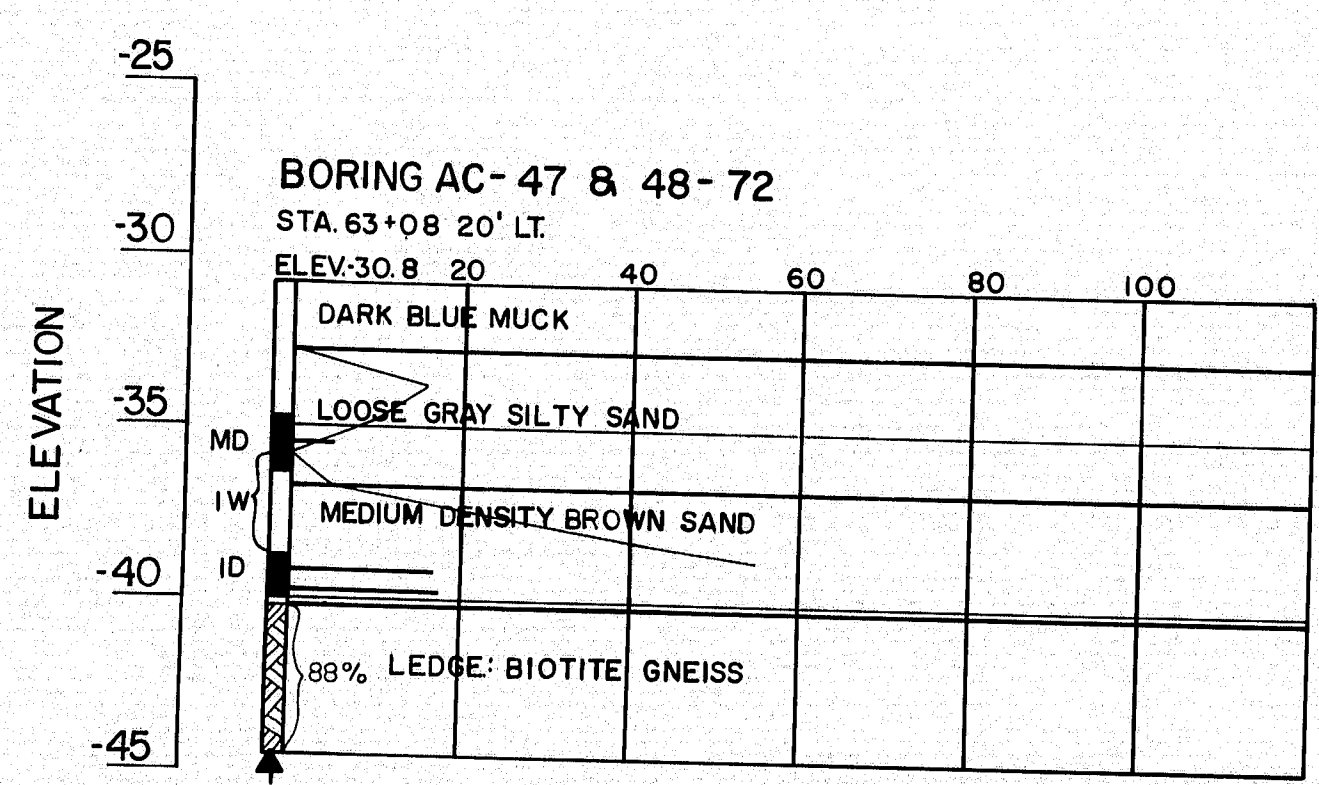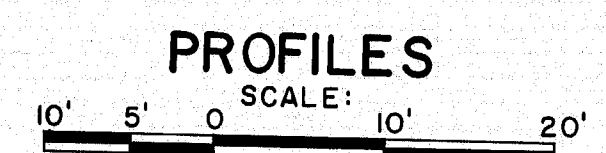








BORING NOTES

- ALL SAMPLES AND VANS ARE MADE AHEAD OF CASING
- WATER ELEVATION
- NUMBER OF BLOWS REQUIRED TO DRIVE EXTRA HEAVY CASING ONE FOOT WITH 400 FT. LBS. OF ENERGY PER BLOW
- LOCATION OF SAMPLE OR SAMPLE ATTEMPT
- NUMBER AND TYPE OF DRY SAMPLE
- S&H SAMPLER 1290'S
- WASH SAMPLE AND NUMBER
- UNSUCCESSFUL SAMPLE ATTEMPT AND TYPE OF SAMPLER
- NUMBER OF BLOWS REQUIRED TO DRIVE SPOON OR TUBING ONE FOOT WITH 350 FT. LBS. OF ENERGY PER BLOW
- BOTTOM OF BORING (MAY NOT BE BOTTOM OF SOIL STRATA)
- REFUSAL OF DRILL RODS OR CASING (MAY NOT BE LEDGE)
- LOCATION CORED BY DIAMONDBIT AND PER CENT RECOVERY OF ROCK
- 2 1/2" CASING USED ON ALL BORINGS

STATE HIGHWAY COMMISSION
WESTPORT-WISCASSET BRIDGE
 OVER
COWSEAGAN NARROWS
 BETWEEN THE TOWNS OF
WESTPORT-WISCASSET
 LINCOLN COUNTY
 BORING DETAILS
 SHEET 2 OF 2 AUGUSTA, MAINE

153-151




PLANS	DESIGN - DETAILED	CHECKED	REVISIONS	FIELD CHANGES
BY				
DATE				

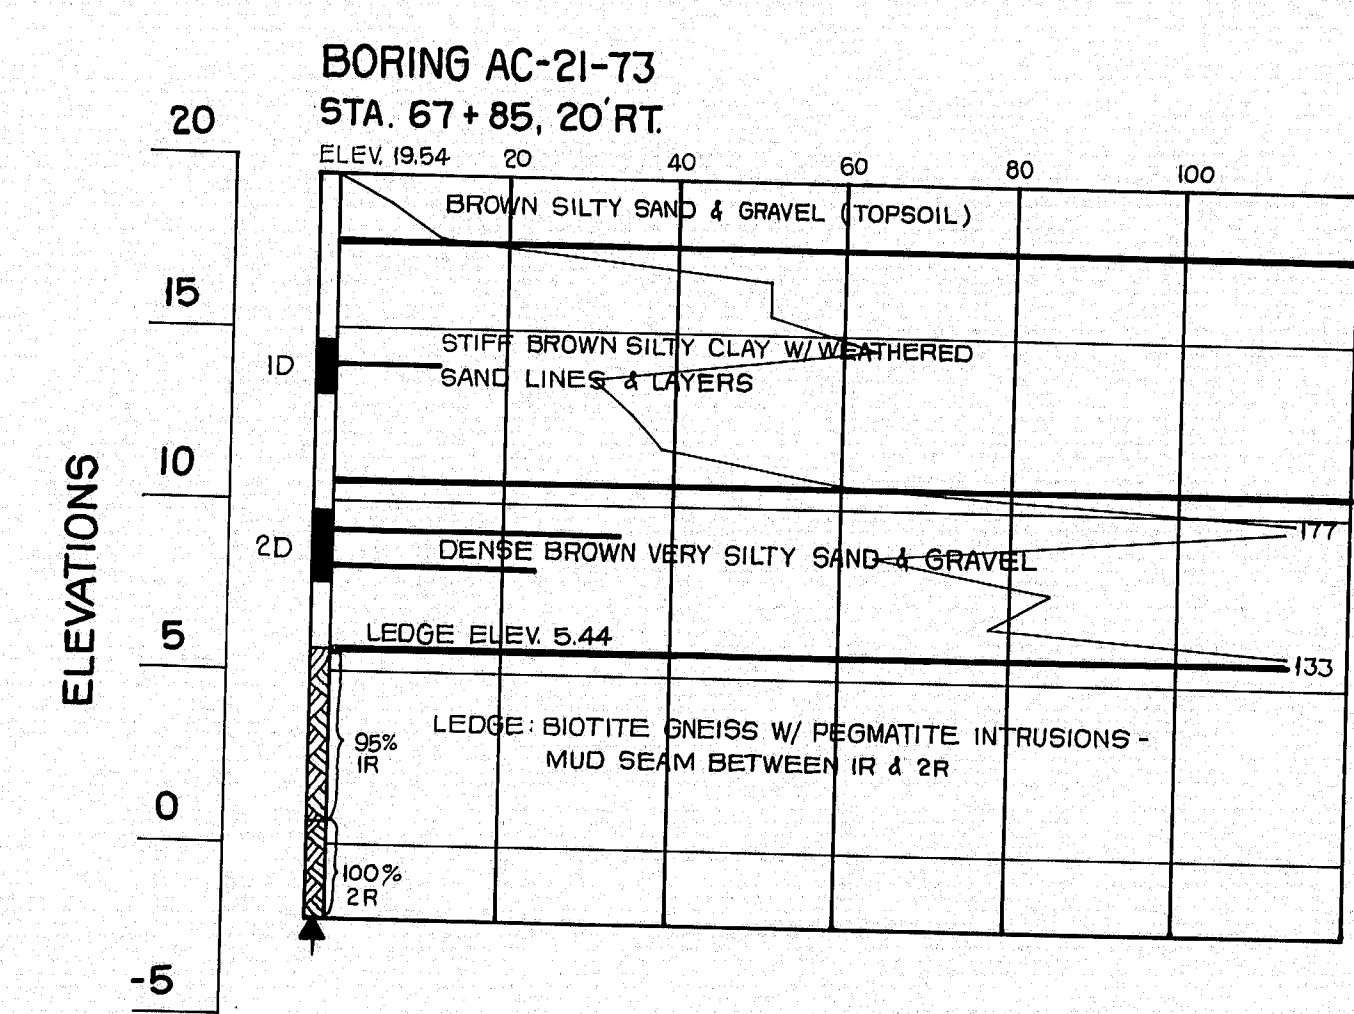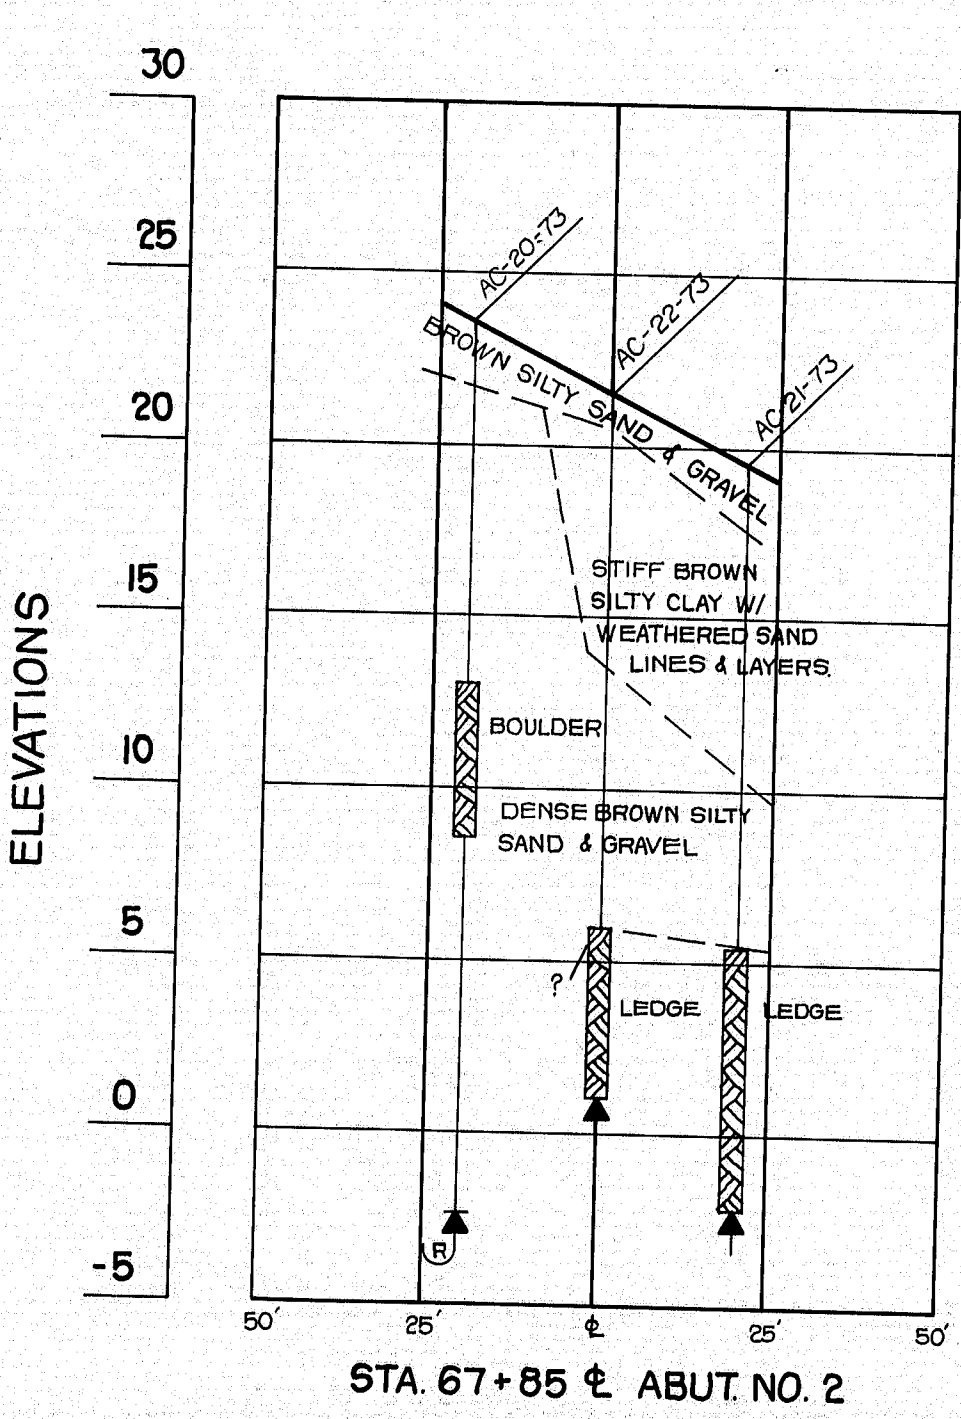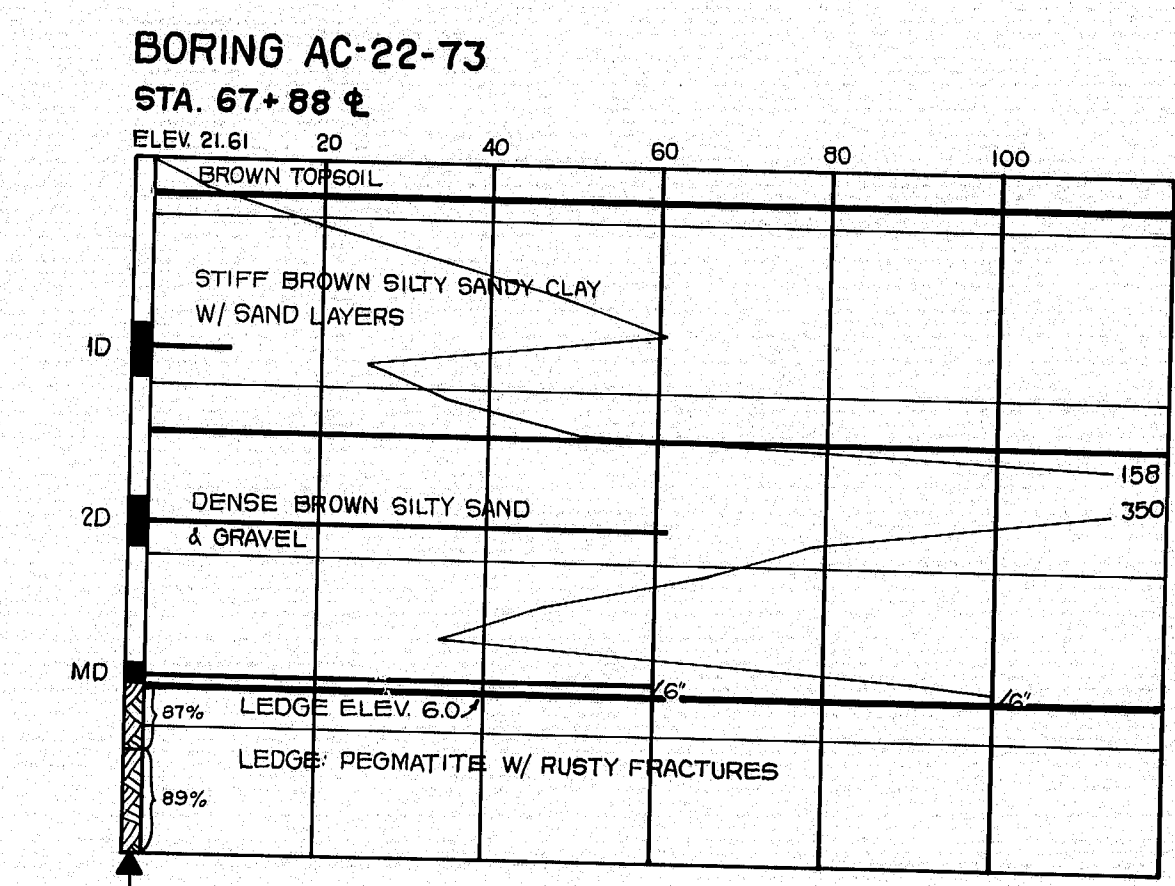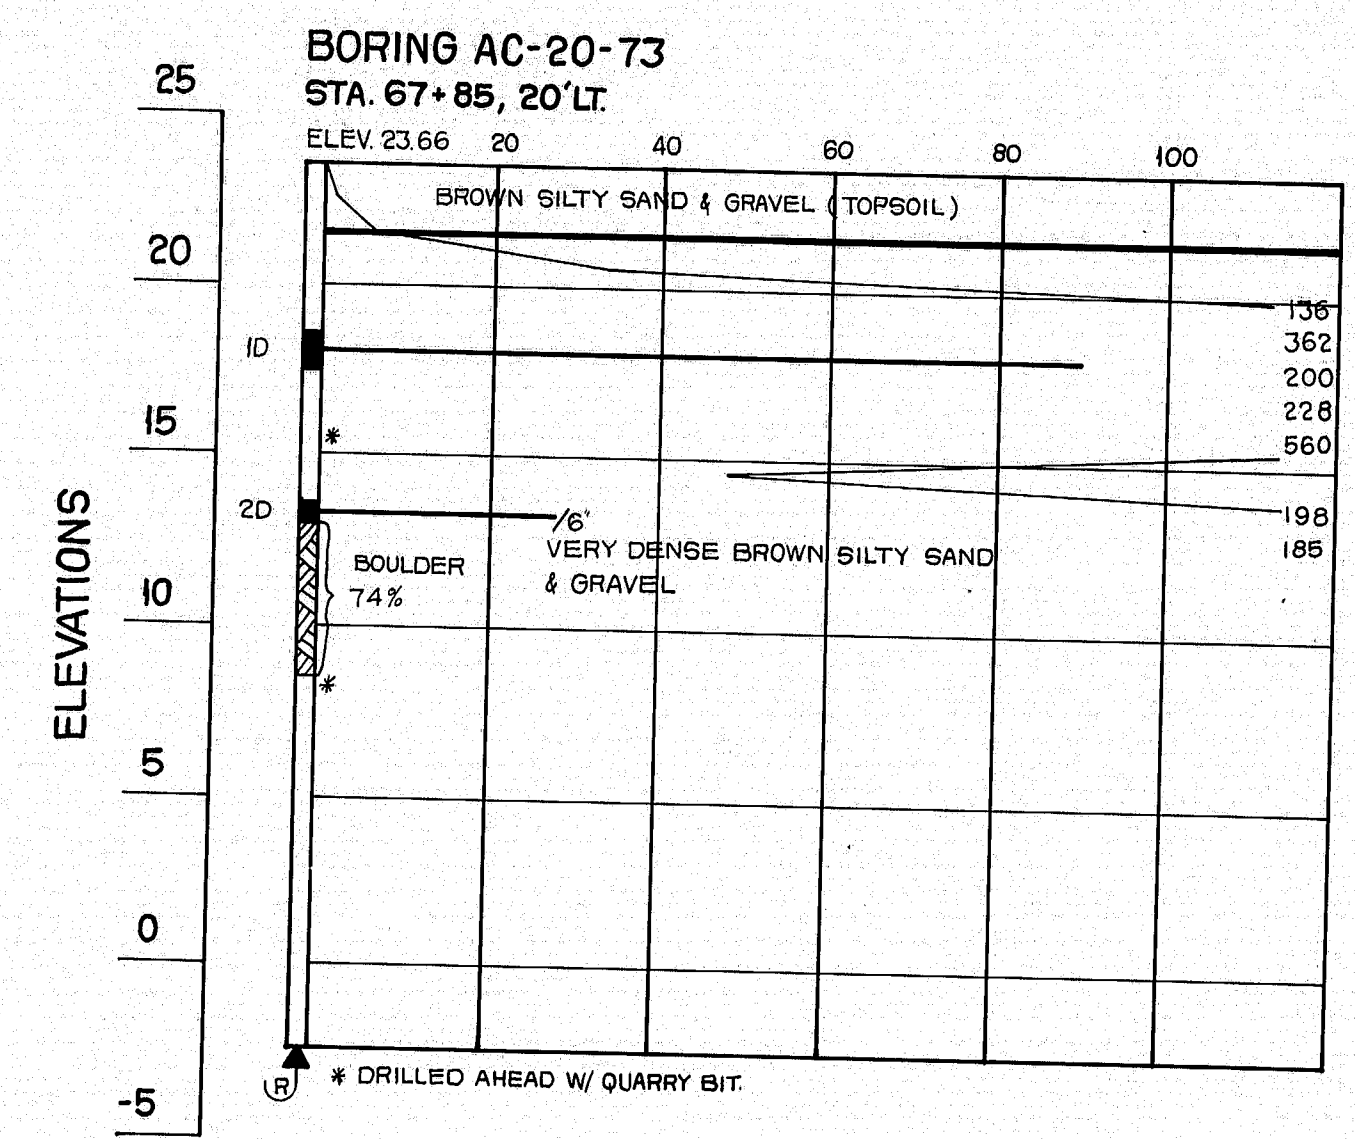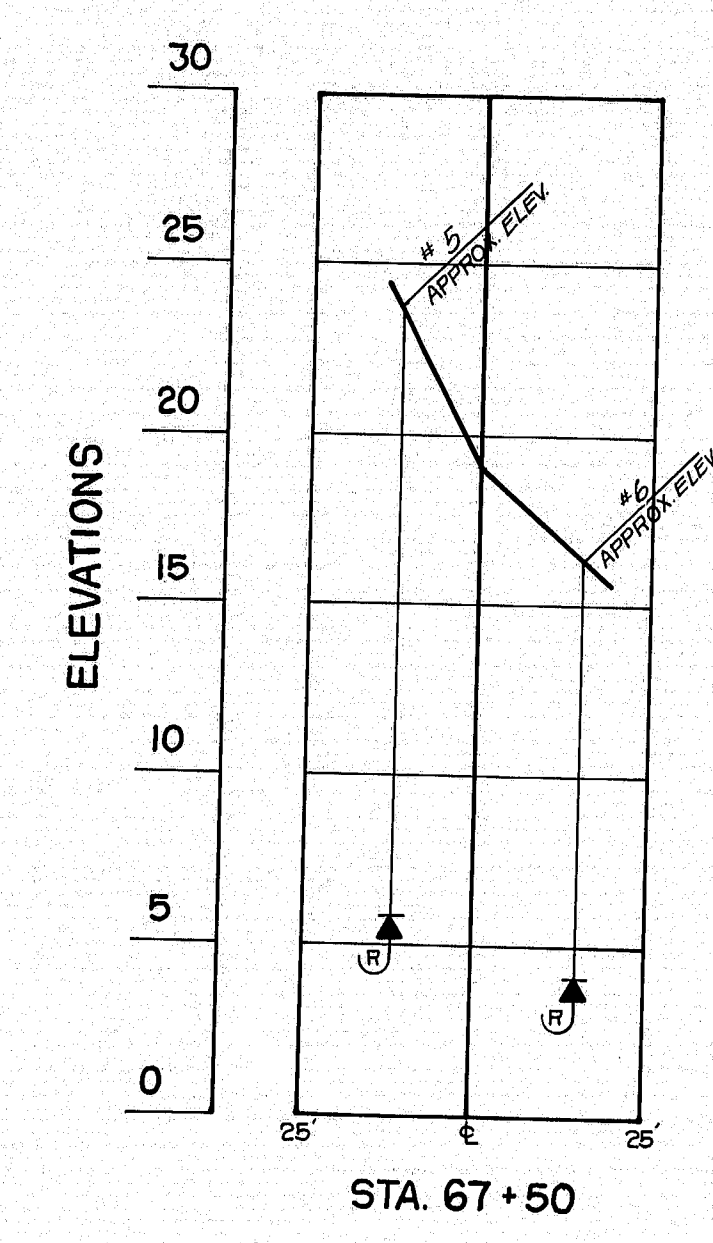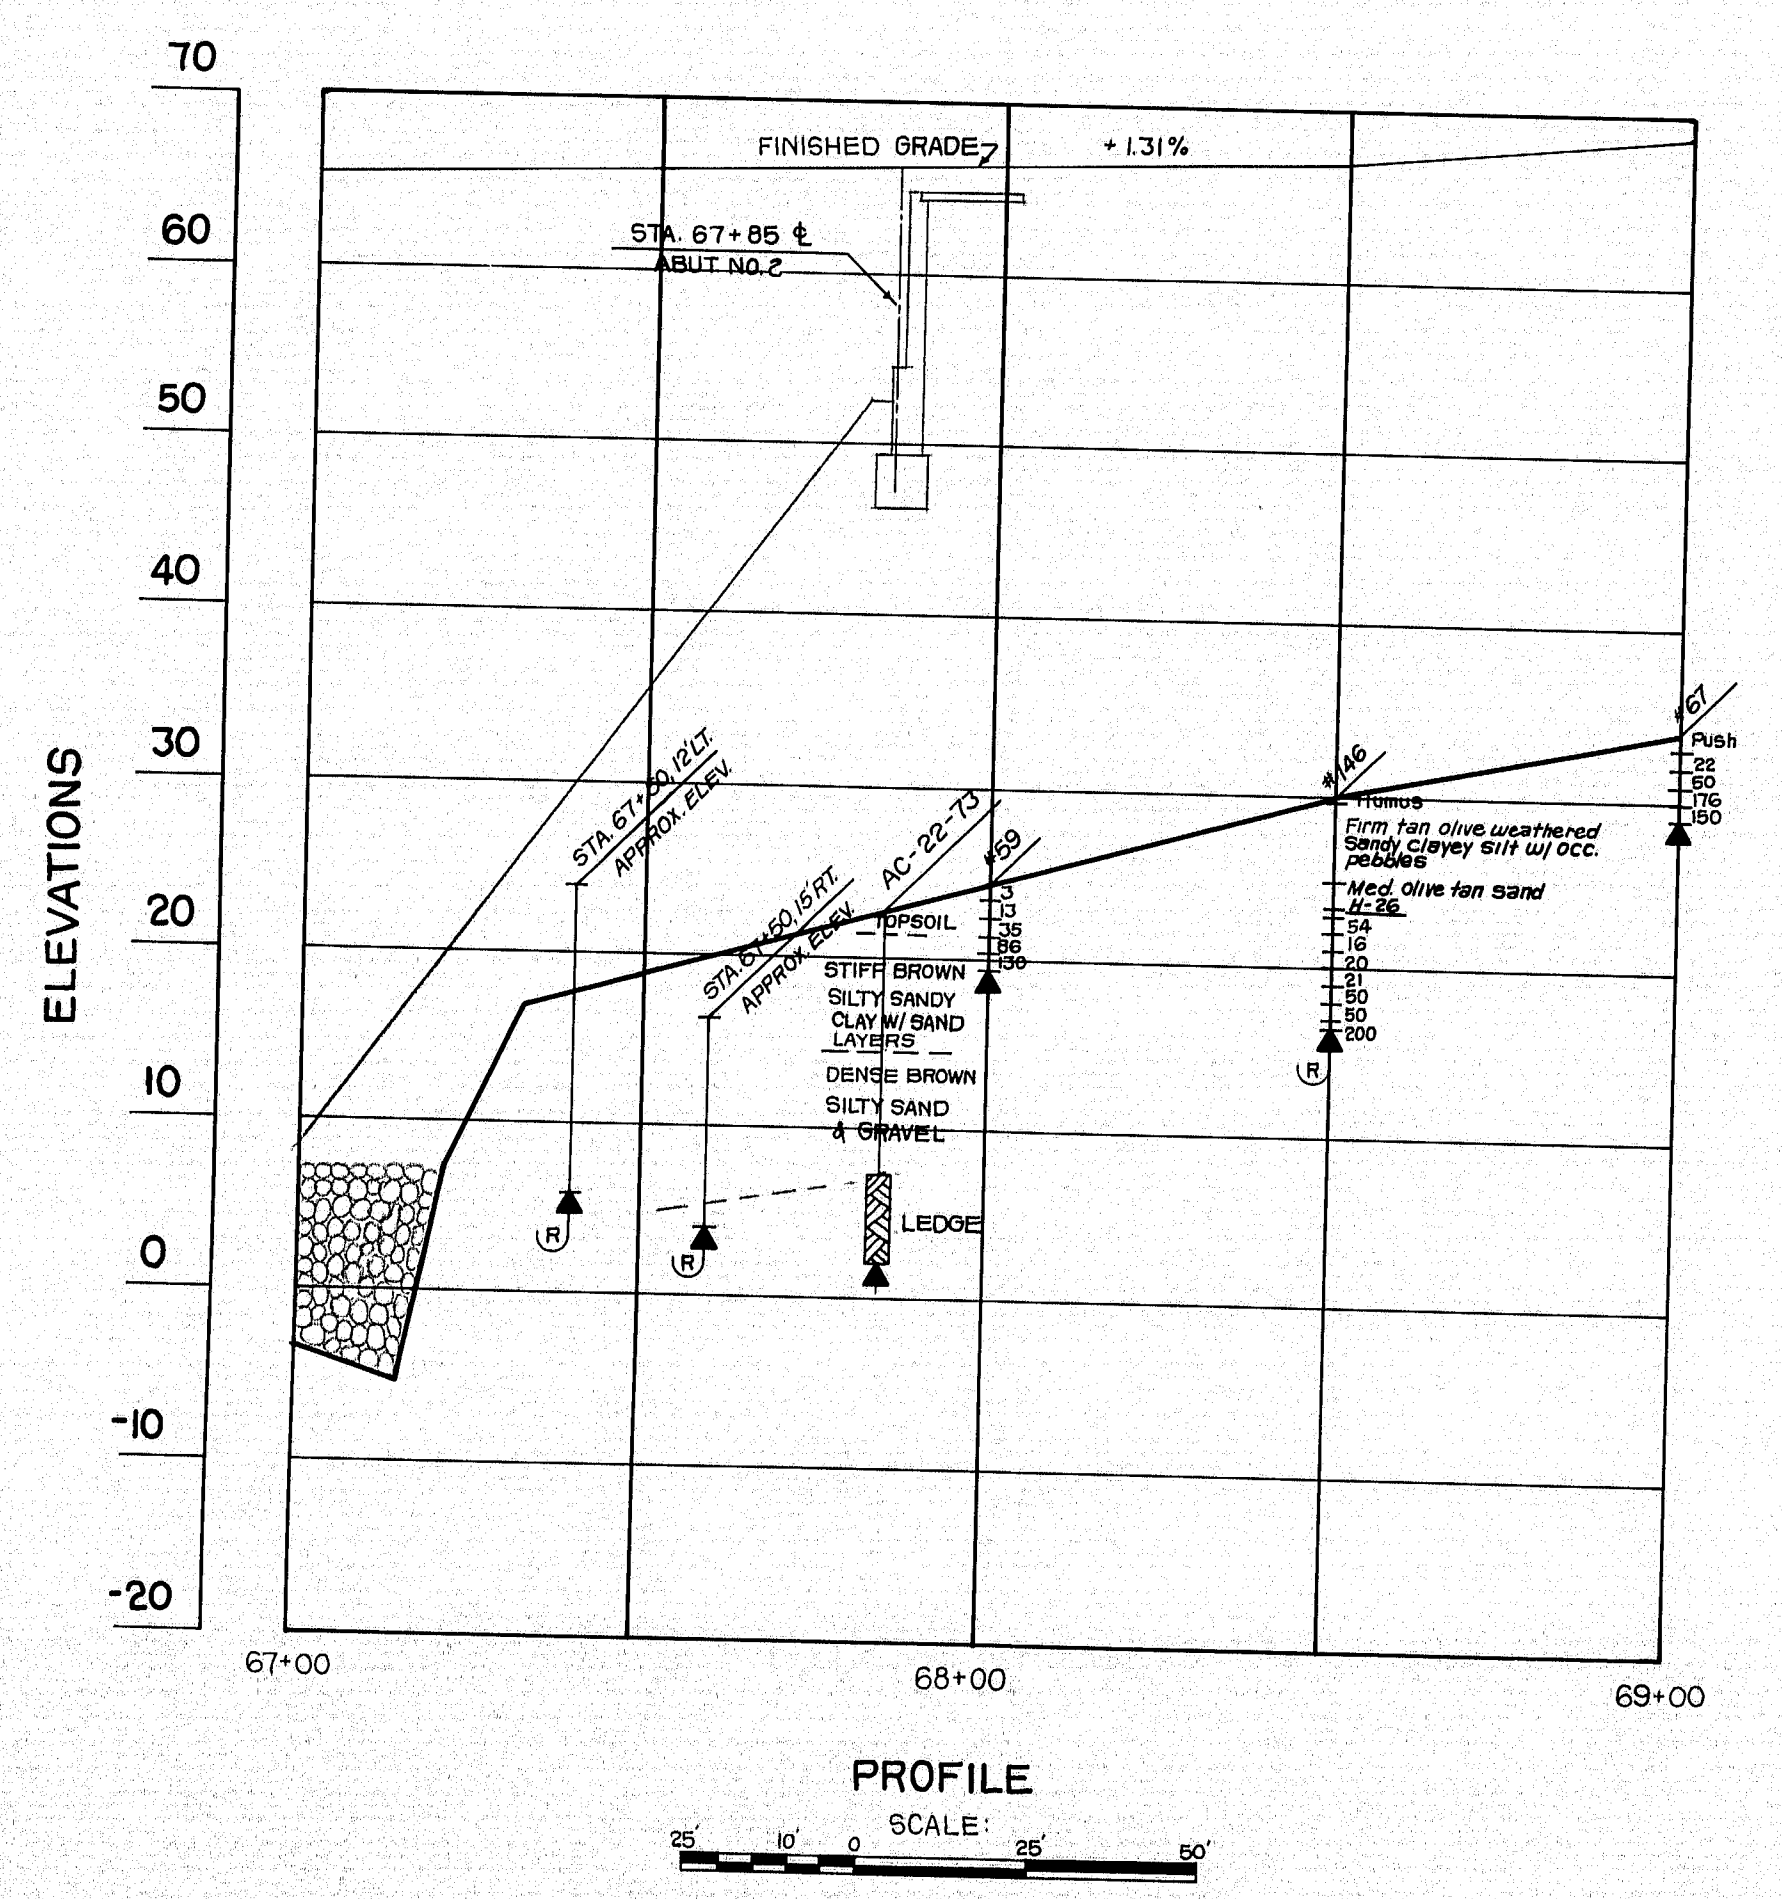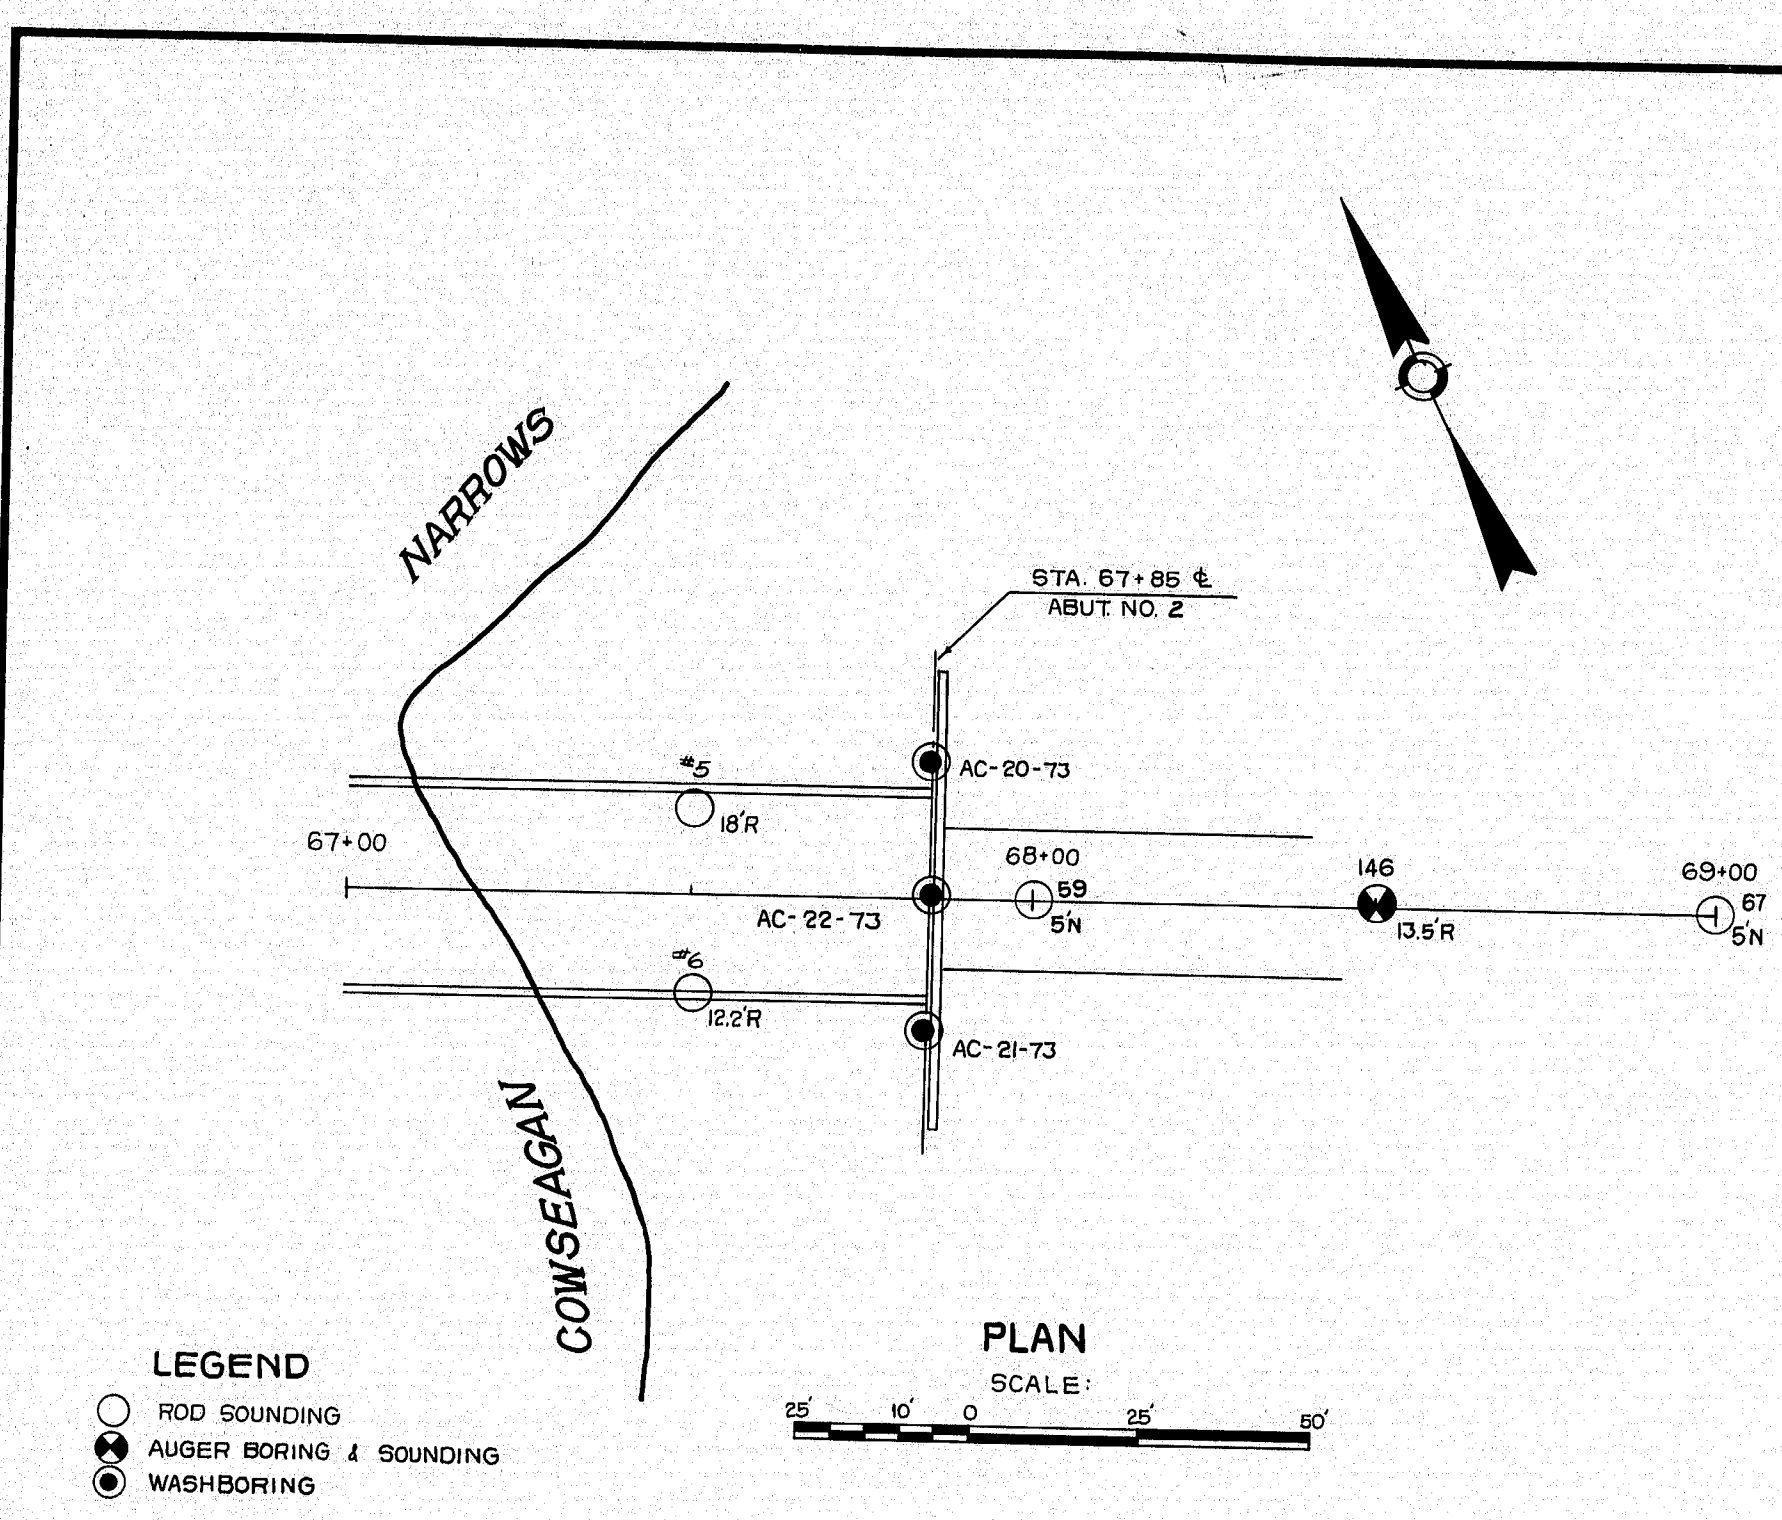

- BORING NOTES**
- All samples and vials are made ahead of casing.
 - Water content
 - Number of blows required to drive extra heavy casing one foot with 400 ft. lbs. of energy per blow
 - Location of sample or sample attempt
 - Number and type of dry sample
 - 5.4H sampler #1290's
 - Unsuccessful sample attempt and type of sampler
 - Number of blows required to drive spoon or tubing one foot with 350 ft. lbs. of energy per blow
 - Bottom of boring (may not be bottom of soil strata)
 - Refusal of drill rods or casing (may not be ledge)
 - Locations cored by diamond bit and per cent recovery of rock

STATE OF MAINE
DEPARTMENT OF TRANSPORTATION
WESTPORT-WISCASSET BRIDGE
OVER
COWSEAGAN NARROWS
BETWEEN THE TOWNS OF
WESTPORT - WISCASSET
LINCOLN COUNTY
FOUNDATION SURVEY
SHEET OF AUGUSTA, MAINE

153-152

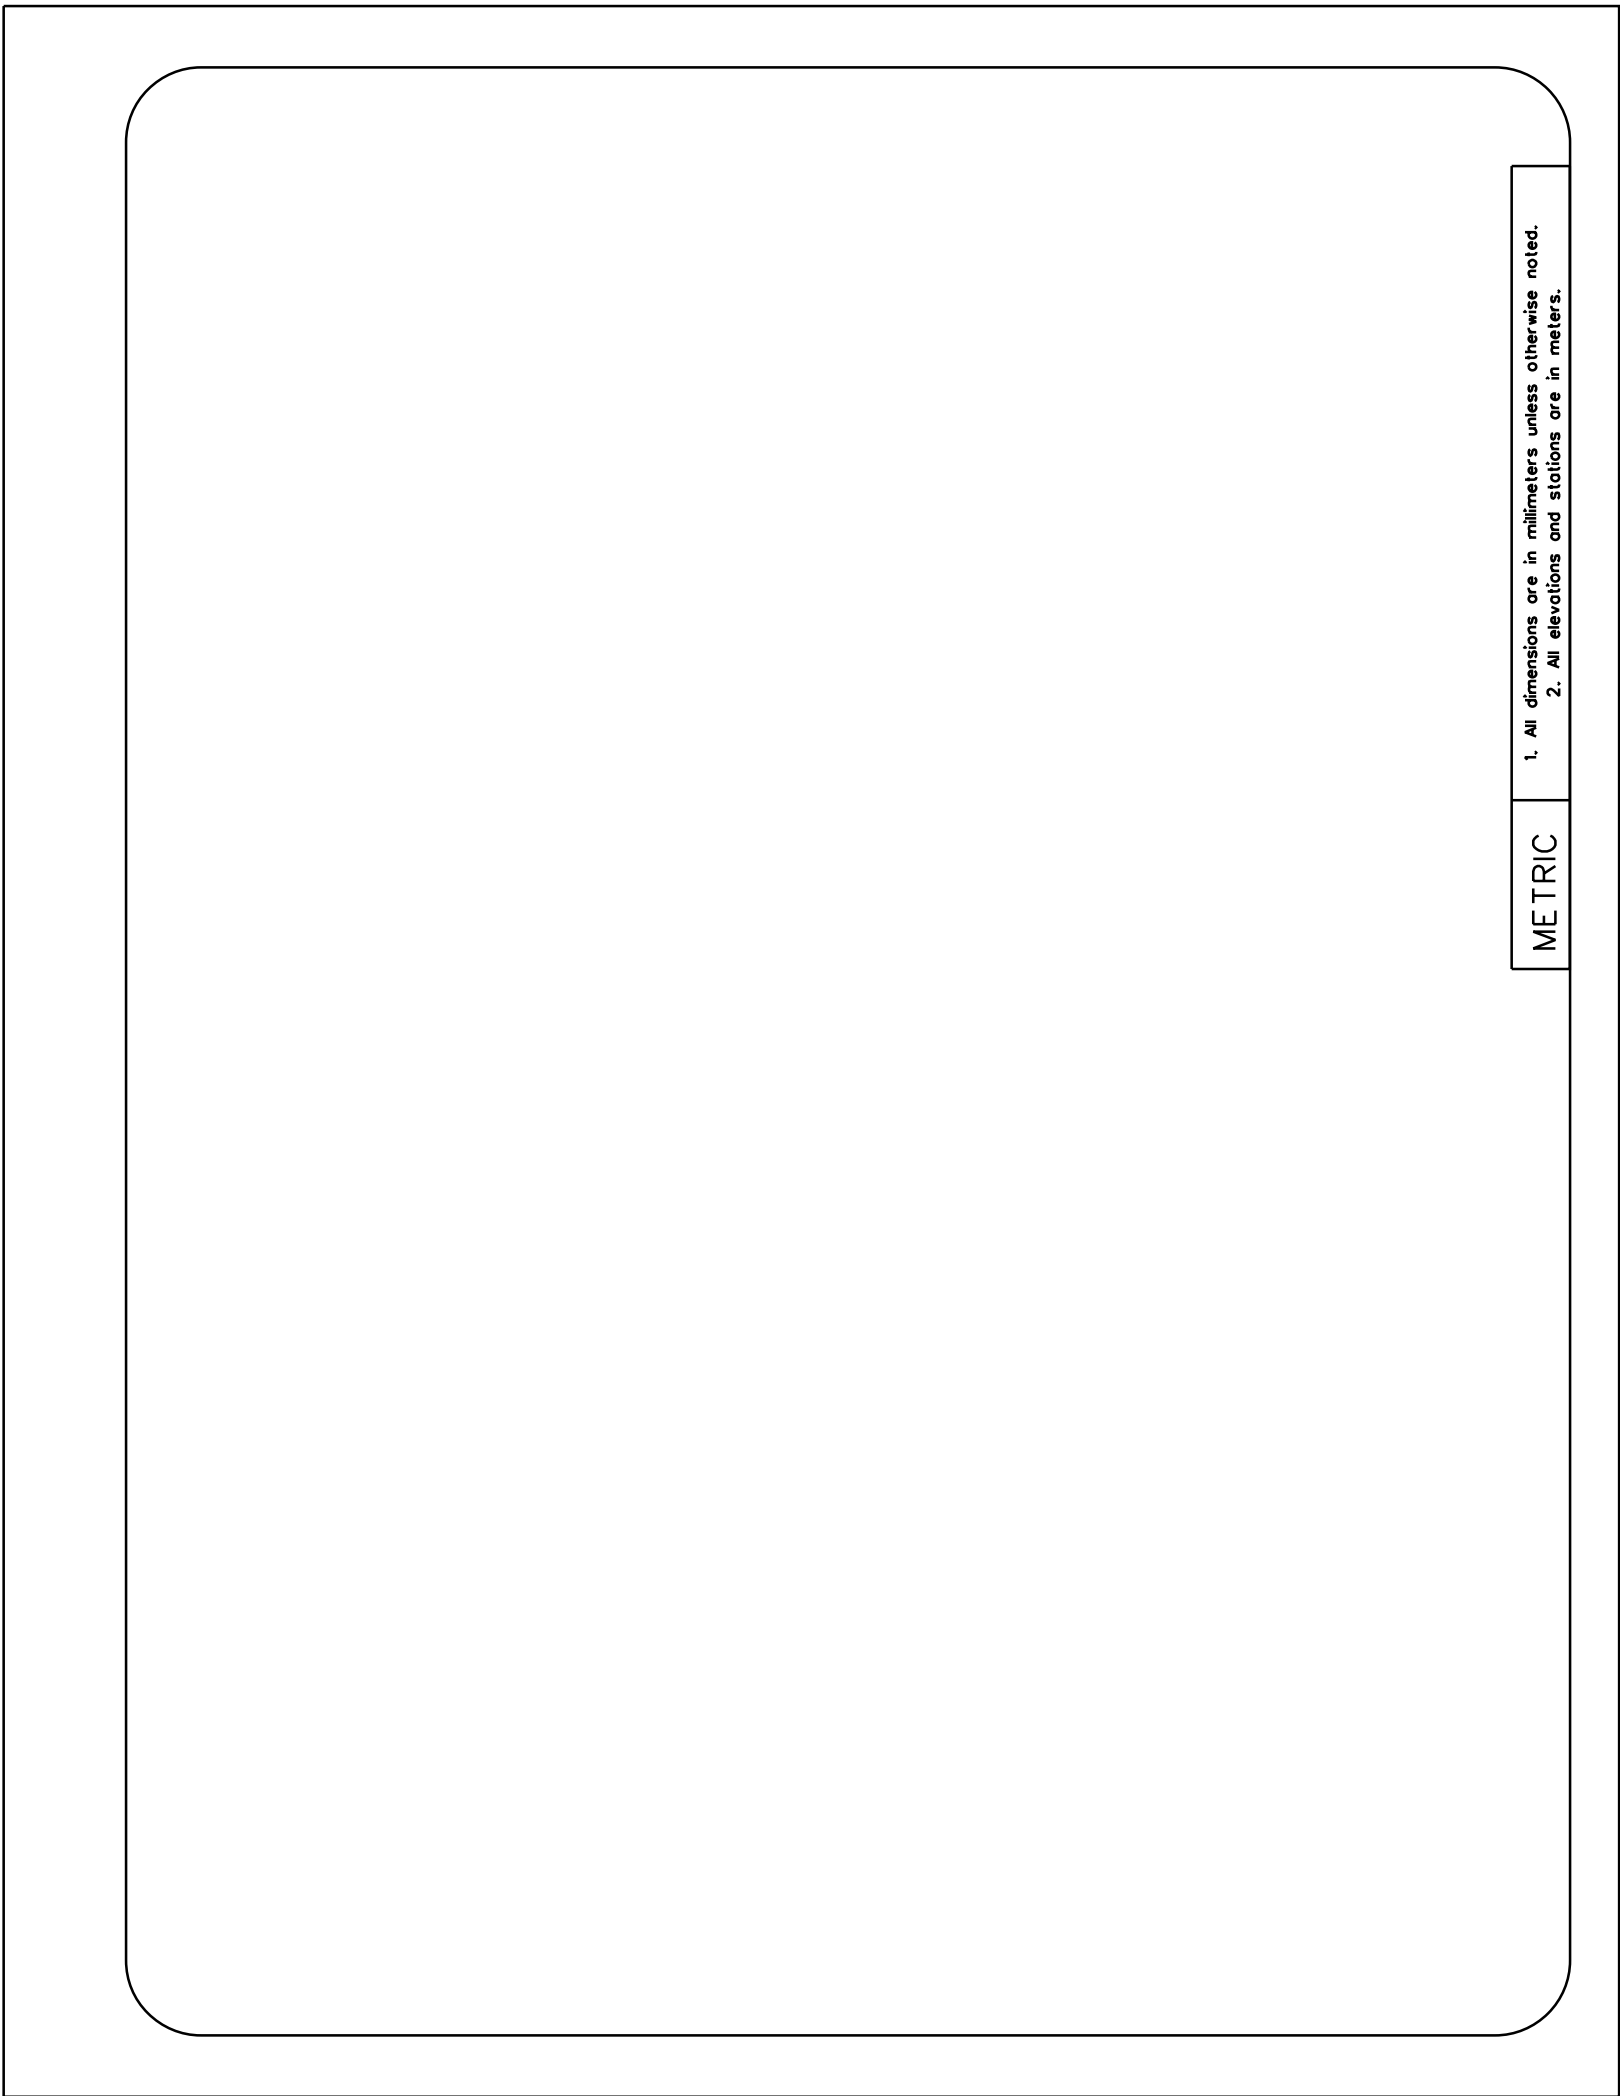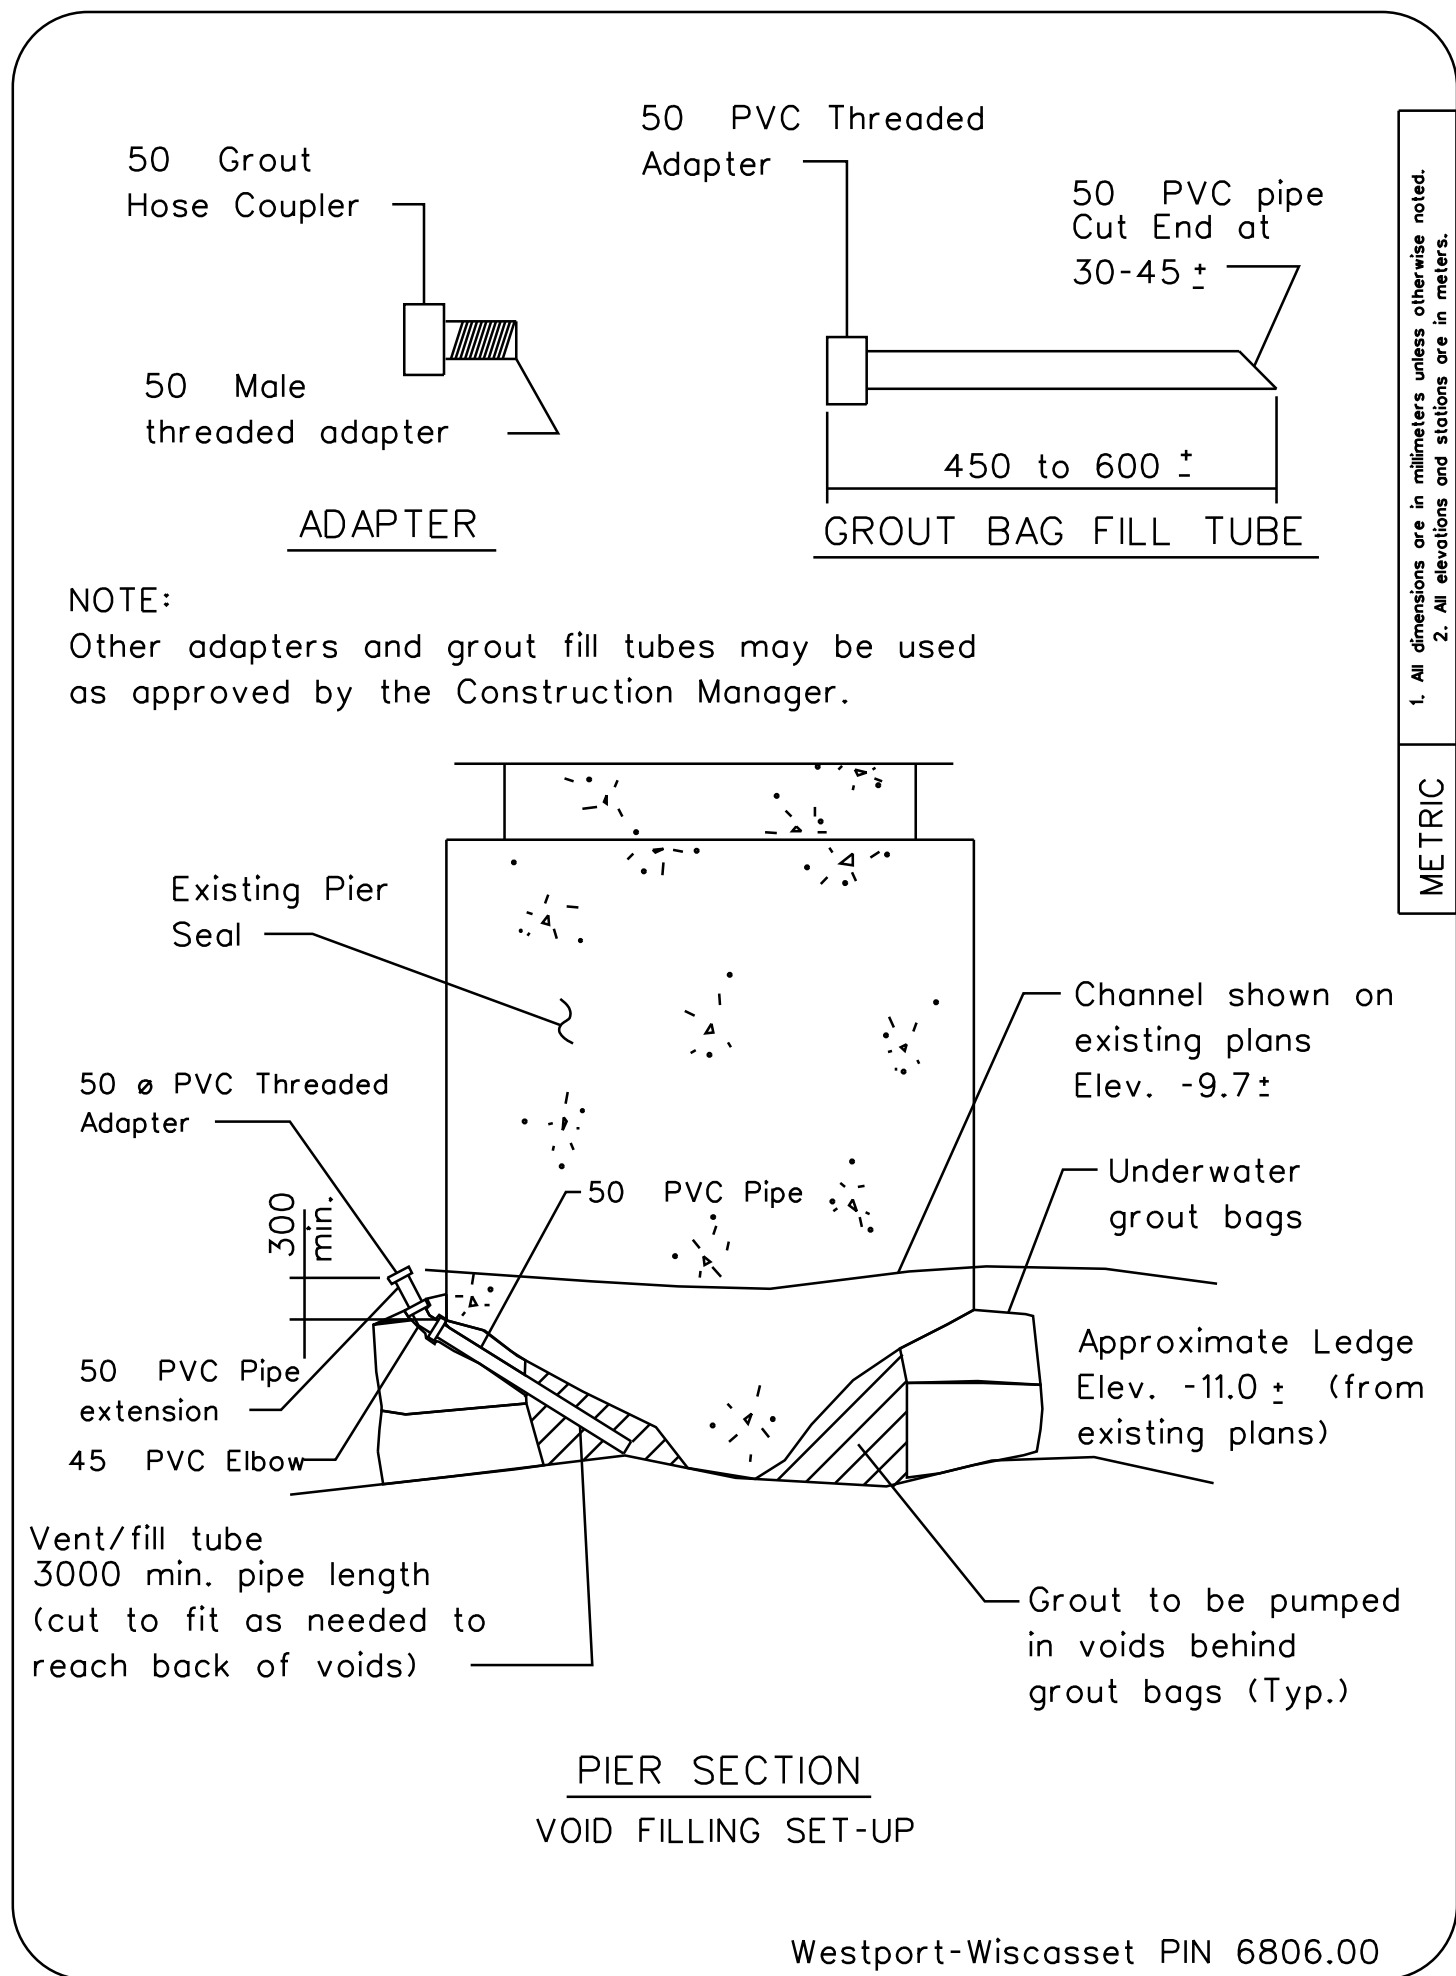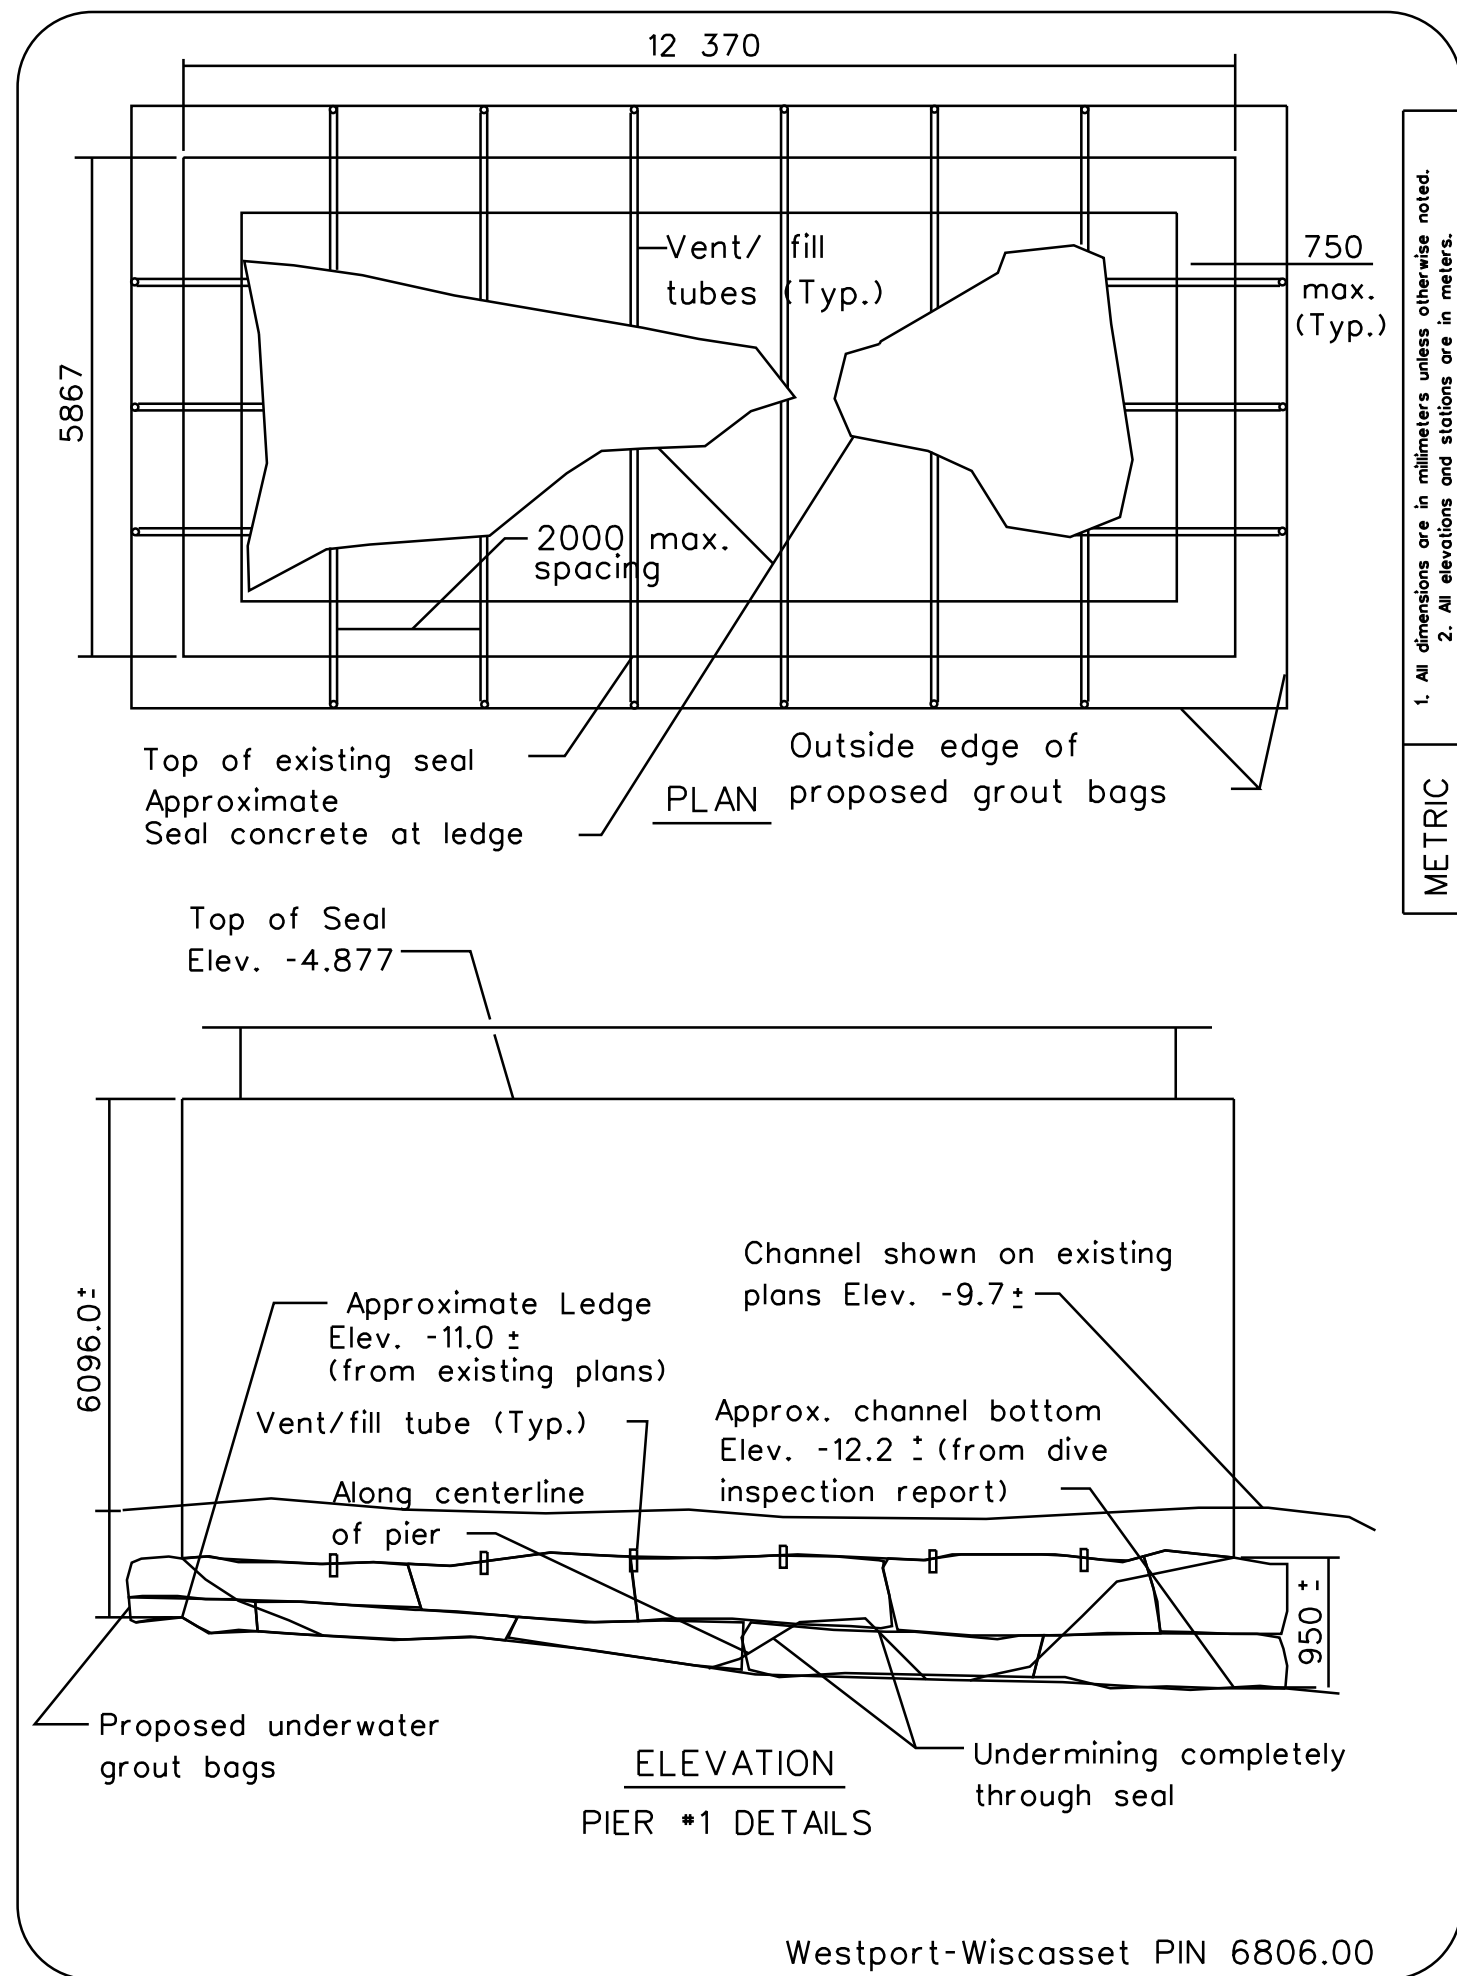

- 1.- The Construction Engineer and Divers from the Department shall be ferried from shore (Wiscasset Public Landing) to the site upon request. This item shall be considered incidental to Item 659.10, Mobilization.
- 2.- All work, materials and payment involved in the underwater pier repair shall conform to Special Provision Section 502, Structural Concrete (Underwater Grout Bags).
- 3.- Disturbance to the seabed shall be limited to installation of Underwater Grout Bags. No dredging or dumping of material is authorized.
- 4.- Barges and boats shall be moored to the seabed independent of the existing bridge structure under Span #1.
- 5.- Item 629.06, Diver/Hand Labor shall cover unanticipated work activities authorized by the Construction Manager that are not part of the placement of Underwater Grout Bags.
- 6.- Travel by marine vessels in and out of the bridge channel shall not be impeded by construction activities. Barges shall be marked with lights at night as an aid to navigation. Signs shall be provided on barges in the bridge channel notifying marine traffic of construction activities above and below the water. These items shall be considered incidental to Item 659.10, Mobilization.
- 7.- Unstable material along the bottom of the undermined area shall be removed prior to grouting the bags. All bags are to be placed on ledge.
- 8.- All vent/fill tubes shall be spaced at no more than 2 m and shall be field cut to length. The length shall be to the back of the void and no more than the outer edge of the grout bags.
- 9.- All vent/fill tube connections shall be threaded or other attachment approved by the Construction Manager.
- 9.- Grout bags shall not be tied together with reinforcing steel or by any other means. Grout bags shall be allowed to settle to a state of equilibrium individually to fit the contours of the ledge and concrete pier seal.
- 10.- The grout bags shall be overlapped both horizontally and vertically to prevent any gaps between the bags. The grout bags act as a stay-in-place form.

- PIER REPAIR NOTES CONT.
- 11.- A liquid anti-washout admixture, such as RHEOMAC UW 450 or an equal product shall be added to the concrete on site as per manufacturer's recommendations. Any remaining product after the grouting operation is complete shall become the property of the Department. Bridge Maintenance Office in Augusta shall be notified to pick up the remaining product.
 - 12.- The grout bags shall not be filled more than 300 mm average thick except the top bag which can be greater to ensure a good seal.
 - 13.- After the grout bags and vent/fill tubes are installed, The void shall be pressure filled by starting at the lowest end and continuing around the pier. The grout shall be pumped at each vent/fill tube until it exits from the adjacent one. Rags or other flexible material shall be used to plug the vent/fill tubes after pumping operation is complete.
 - 14.- An Underwater Inspection Report is available for the Contractors reference at the Bridge Maintenance Office in Augusta.



METRIC