

REEL 305

PIN. 004220.00


F.H.W.A. REG. NO.	STATE	PROJECT NUMBER	SHEET NO.	TOTAL SHEETS
1	MAINE	BR-034P(1)X	1	31

STATE OF MAINE DEPARTMENT OF TRANSPORTATION



PLANS

HOTEL BRIDGE OVER DAVIS STREAM IN THE TOWN OF JEFFERSON LINCOLN COUNTY PROJECT NO. BR-034P(1)X PROJECT LENGTH 0.0237 MILES

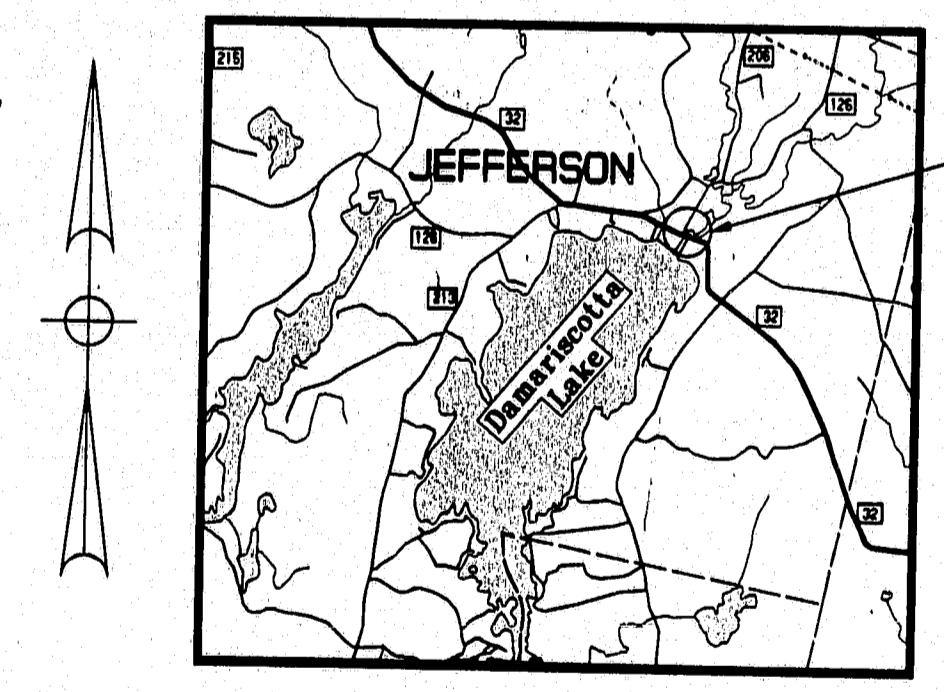

LOCATION MAP
Scale in Miles

As BUILT
BY
11/10/94

SPECIFICATIONS

DESIGN: Load Factor Design per AASHTO Standard Specifications for Highway Bridges 1992.
CONTRACT: State of Maine, Department of Transportation, Standard Specifications, Highways and Bridges, Revision of October 1990.

DESIGN LOADING

LIVE LOAD: HS25

Materials

CONCRETE: Precast Class P
Structural Concrete Slab Class A
All Other Class A

STRUCTURAL STEEL: ASTM A36 STEEL

REINFORCING STEEL: ASTM A615 Grade 60

PRESTRESSING STRANDS: ASTM A416 Grade 270, 1/2 inch, Uncoated, 7 Wire Low Relaxation Strand

Basic Design Stresses

CONCRETE: Precast: $f'_c = 6,000$ psi
Cast in Place: $f'_c = 3,000$ psi

REINFORCING STEEL: $f_y = 60,000$ psi

PRESTRESSING STRANDS: $f_y = 270,000$ psi

STRUCTURAL STEEL: H-Piles $F_y = 36,000$ psi

Hydrologic Data

Drainage Area (square miles) 26.2
Design Discharge (Q50) 2670 cfs
Check Discharge (Q100) 3160 cfs
Headwater Elevation (Q50) 57.33
Headwater Elevation (Q100) 58.81
Discharge Velocity (Q50) 6.2 fps
Discharge Velocity (Q100) 6.9 fps

Plans of the reconstruction of the existing superstructure and addition of concrete caps to the existing abutments and wing walls and a hydrologic report of the bridge site are available for the Contractor's reference at the Bridge Design Office in Augusta. The plans are reproductions of original drawings as prepared for the construction of the bridge and it is very unlikely that the plans will show any construction field changes or any alterations which may have been made to the bridge during its life span. The hydrologic report is based on the interpretation by the Department of Information obtained for the subject site and no assurance is given that the information or the conclusions of the report will be representative of actual conditions at the time of construction.

Traffic Data

A.A.D.T. (1990)	2280
A.A.D.T. (2010)	3160
D.H.V.	383
T.(S.D.H.V.)	6
D.(S.D.H.V.)	60
V.	35 MPH
P.S.D.(X)	N/A
18 KIPS P20	78
P25	77

NOTE
ALL WORK CONTEMPLATED UNDER THIS CONTRACT TO BE GOVERNED BY AND IN CONFORMITY WITH THE STANDARD SPECIFICATIONS (REVISION OF OCTOBER 1990) AND SUPPLEMENTALS THERETO AS MODIFIED ON THE PLANS AND IN THE SPECIAL PROVISIONS.

INDEX OF SHEETS

SHEET NO.	DESCRIPTION
1	TITLE SHEET
2	ESTIMATED QUANTITIES
3	GENERAL PLAN & PROFILE
4-5	CROSS SECTIONS
6	FOUNDATION SURVEY
7	STAGE CONSTRUCTION DETAILS
8	ABUTMENT #1
9	ABUTMENT #2
10-11	PRECAST BOX BEAM DETAILS
12	SUPERSTRUCTURE
13	GUARDRAIL LAYOUT & FASCIA OFFSETS
14	REINFORCING STEEL SCHEDULE
15-21	BRIDGE STANDARD DETAILS
22-30	HIGHWAY STANDARDS
31	RIGHT-OF-WAY MAP

BRIDGE STANDARD DETAILS

BD 202-93	REV. 7/93	3 BAR CONCRETE END POST
BD 203-93	REV. 7/93	4 BAR CONCRETE END POST
BD 402-93	REV. 7/93	ALUMINUM BRIDGE RAILING 3-BAR
BD 405-93	REV. 7/93	PALE PANEL DETAILS 3-BAR
BD 406-93	REV. 7/93	ALUMINUM BRIDGE RAILING 4-BAR
BD 407-93	REV. 7/93	PALE PANEL DETAILS 4-BAR
BD 501-93	REV. 7/93	SUBSTRUCTURE DETAILS


HIGHWAY STANDARDS

HD-4	REV. 10/92	MUCK EXCAVATION
HD-5	REV. 10/92	DRIVES & ENTRANCES
HD-6	REV. 10/92	TYPE 3 GUARDRAIL
HD-7	REV. 10/92	EROSION CONTROL
HD-10	REV. 10/92	MAINTENANCE OF TRAFFIC
HD-11	REV. 10/92	MAINTENANCE OF TRAFFIC
HD-12	REV. 10/92	MAINTENANCE OF TRAFFIC
HD-14	REV. 10/92	PEDESTRIAN RAMPS
HD-15	REV. 10/92	GEOTEXTILES

FD
SR INTZ

109-251 102

APPROVED:
STATE OF MAINE
DEPARTMENT OF TRANSPORTATION

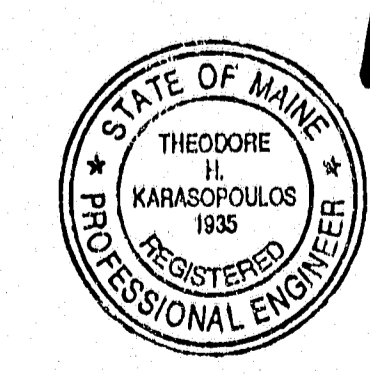

COMMISSIONER
DATE 12-21-93
CHIEF ENGINEER
DATE 12-21-93

UNITED STATES
DEPARTMENT OF TRANSPORTATION
FEDERAL HIGHWAY ADMINISTRATION
REGION 1
APPROVED: _____
DIVISION ADMINISTRATOR DATE

MAINE-010120

ESTIMATED QUANTITIES			
ITEM NO.	DESCRIPTION	QUANTITY	UNIT
201.23	REMOVING SINGLE TREE TOP ONLY	3	EACH
201.24	REMOVING STUMP	5	EACH
202.19	REMOVING EXISTING BRIDGE (CY)	1	LS
203.20	COMMON EXCAVATION		
203.24	COMMON BORROW	415	CY
203.25	GRANULAR BORROW	95	CY
206.082	STRUCTURAL EARTH EXCAVATION-MAJOR STRUCTURES	165	CY
301.09	PLANT MIX BITUMINOUS BASE COURSE, GRADING B	350	CY
304.10	AGGREGATE SUBBASE COURSE-GRAVEL	46	TONS
		498	CY
403.07	HOT BITUMINOUS PAVEMENT, GRADING B	66	TONS
403.10	HOT BITUMINOUS PAVEMENT, GRADING D	87	TONS
403.101	HOT BIT. PVMT., GRD D (SIDEWALKS, SHIMS, DRIVES, INCIDENTALS)	16	TONS
409.15	BITUMINOUS TACK COAT, APPLIED	6	GAL
501.46	STEEL H-BEAM PILES 73 LBS/FT, DELIVERED	800	LF
501.461	STEEL H-BEAM PILES 73 LBS/FT, IN PLACE	1 800	LF
501.90	PILE TIPS	16	EACH
501.92	PILE MOBILIZATION	1	LS
502.21	STRUCTURAL CONCRETE, ABUTMENTS & RETAINING WALLS	73	CY
502.25	STRUCTURAL CONCRETE SUPERSTRUCTURE SLABS (CY)	1	LS
502.4711	SILICA FUME ADDITIVE (LB)	1	LS
503.12	REINFORCING STEEL FABRICATED & DELIVERED	10,930	LB
503.13	REINFORCING STEEL PLACING	10,900	LB
503.17	MECHANICAL/WELDED SPLICE	50	EACH
507.0941	ALUMINUM BRIDGE RAILING, 3 BAR, WITH PALES ANODIZED	67	LF
507.0946	ALUMINUM BRIDGE RAILING, 4 BAR, WITH PALES ANODIZED	76	LF
508.13	MEMBRANE WATERPROOFING (SY)	1	LS
510.10	SPECIAL DETOUR, 11' RDWY WIDTH VEH. & PED. TRAF. NOT SEP.	1	LS
515.21	PROTECTIVE COATING FOR CONCRETE SURFACES	1	LS
525.34	GRANITE MASONRY FACING	77	SF
526.301	TEMPORARY CONCRETE BARRIER TYPE I	1	LS
527.32	PORTABLE CRASH BARRELS	7	EACH
535.62	PRESTRESSED STRUCTURAL CONCRETE BOX BEAMS (CY)	1	LS
606.151	GUARD RAIL TYPE 3ee-SINGLE RAIL	75	LF
606.191	GUARD RAIL TYPE 3ee--15 FOOT RADIUS AND LESS	96	LF
606.25	TERMINAL CONNECTOR	4	EACH
606.266	TERMINAL END--SINGLE RAIL--CORROSION RESISTANT STEEL	3	EACH
606.35	GUARD RAIL DELINEATOR POST	4	EACH
606.77	BREAKAWAY CABLE TERMINAL	1	EACH
609.31	CURB TYPE 3	20	LF
610.08	PLAIN RIPRAP	480	CY
610.18	STONE DITCH PROTECTION	5	CY
615.07	LOAM	16	CY
616.08	SODDING	16	SY
618.13	SEEDING METHOD NUMBER 1	3	UNIT
618.15	TEMPORARY SEEDING	3	LB
618.25	APPLIED WATER	1	MG
619.12	MULCH	4	UNIT
620.58	EROSION CONTROL GEOTEXTILE	18	SY
627.61	4 INCH SOLID WHITE PAVEMENT MARKING LINE	500	LF
627.63	4 INCH SOLID YELLOW PAVEMENT MARKING LINE	500	LF

ESTIMATED QUANTITIES			
ITEM NO.	DESCRIPTION	QUANTITY	UNIT
627.65	WHITE OR YELLOW PAVEMENT AND CURB MARKING	50	SF
627.67	REMOVING PAVEMENT MARKINGS	550	SF
627.68	TEMP. 4" PAINTED PAVEMENT MARKING LINE, YELLOW OR WHITE	1500	LF
629.05	HAND LABOR, STRAIGHT TIME	210	MH
631.12	ALL PURPOSE EXCAVATOR (INCLUDING OPERATOR)	10	HDUR
631.172	TRUCK--LARGE (INCLUDING OPERATOR)	10	HDUR
637.07	SPRINKLING	10	MG
637.08	CALCIUM CHLORIDE	1	TONS
639.19	FIELD OFFICE TYPE B	1	EACH
639.23	TESTING FACILITIES CONCRETE	1	LS
643.72	TEMPORARY TRAFFIC SIGNAL: XX	1	LS
652.31	TYPE I BARRICADE	10	EACH
652.311	TYPE II BARRICADE	5	EACH
652.33	DRUM	10	EACH
652.34	CDNE	10	EACH
652.35	CONSTRUCTION SIGNS	510	SF
652.361	MAINTENANCE OF TRAFFIC CONTROL DEVICES	1	LS
652.38	FLAGGER	200	MH
656.50	BALED HAY, IN PLACE	18	EACH
656.51	SANDBAG, IN PLACE	18	EACH
656.632	30" TEMPORARY SILT FENCE	500	LF
657.24	SEEDING PITS	1	UNIT
659.10	MOBILIZATION	1	LS

FED. AID RES. NO.	STATE	PROJECT NUMBER	SHEET NO.	TOTAL SHEETS
	MAINE	BR-034P(1)X	2	31
Pin 004220.00				

General Construction Notes

- All utility facilities shall be adjusted by the respective utilities unless noted.
- For easements, construction limits and right-of-way lines refer to Right of Way Map.
- Place a 1'-6" wide strip of sod on the side slopes along the top of the riprap.
- All embankment material, except as otherwise shown, placed below water, shall be granular borrow meeting the requirements of Subsection 703.19. Material for Underwater Backfill.
- The clearing limits as shown on the plans are approximate. The exact limits shall be established in the field by the Engineer. Payment for clearing shall be incidental to related contract items.
- Place Loam, 2" deep, on slopes between Station 205+50 and 208+00.
- Do not excavate for Aggregate Subbase Course where existing material is suitable as determined by the Engineer. Payment for shaping and compacting of the existing subbase and layers of new subbase 6" or less thick, in areas where the Engineer directs the Contractor not to excavate to the subgrade line shown on the plans, will be made in accordance with subsection 104.03, Extra Work.
- One guardrail delineator post and one terminal end shall be installed at each guardrail end.
- OMITTED
- Sodded gutters shall be constructed, after paving and shoulder work is completed, where it is apparent that runoff will cause continual erosion.
- OMITTED
- Boat Traffic Control Officers shall be provided by the Contractor to allow for safe passage of boat traffic through the work area during construction hours when approved by the Engineer. The payment for furnishing the officer will be paid for under Item 629.05, Hand Labor, Straight Time.
- OMITTED
- During construction, the Contractor shall maintain the existing gauge station located on the south-westerly corner of the existing abutment in a manner approved by the Engineer. Upon completion of the project the gauge shall be permanently reset by the Contractor in a manner approved by the Engineer. Payment for maintaining and resetting the gauge shall be considered incidental to Item 202.19, Removing Existing Bridge.

109-252

15.- Where the proposed riprap slopes are to be constructed along the easterly bank of the stream (upstream and downstream), where stone walls now exist, the stone wall will be removed to clear for the riprap. The riprap will be blended to match the stone walls. The removed stones shall be stockpiled on the respective owners property. The work required to remove and stockpile the stones and blending to match stone walls will be considered incidental to Item 610.08, Plain Riprap.

STATE OF MAINE 103
DEPARTMENT OF TRANSPORTATION

HOTEL BRIDGE
OVER
DAVIS STREAM
IN THE TOWN OF
JEFFERSON
LINCOLN COUNTY

ESTIMATED QUANTITIES

SHEET OF AUGUSTA, MAINE Jan., 1994


REVISION	DESCRIPTION	DATE
1	Revised Rebar Quantity	2-9-94

DATE 10-93
BY MKD
DESIGN-DETAILED
CHECKED
REVISIONS
FIELD NOTES



PLANS

18 JUN 84 01:00:00

F.R.A. NO.	STATE	PROJECT NUMBER	SHEET NO.	TOTAL SHEETS
1	MAINE	BR-034P(0)X	3	3
Pin # 04220.00				

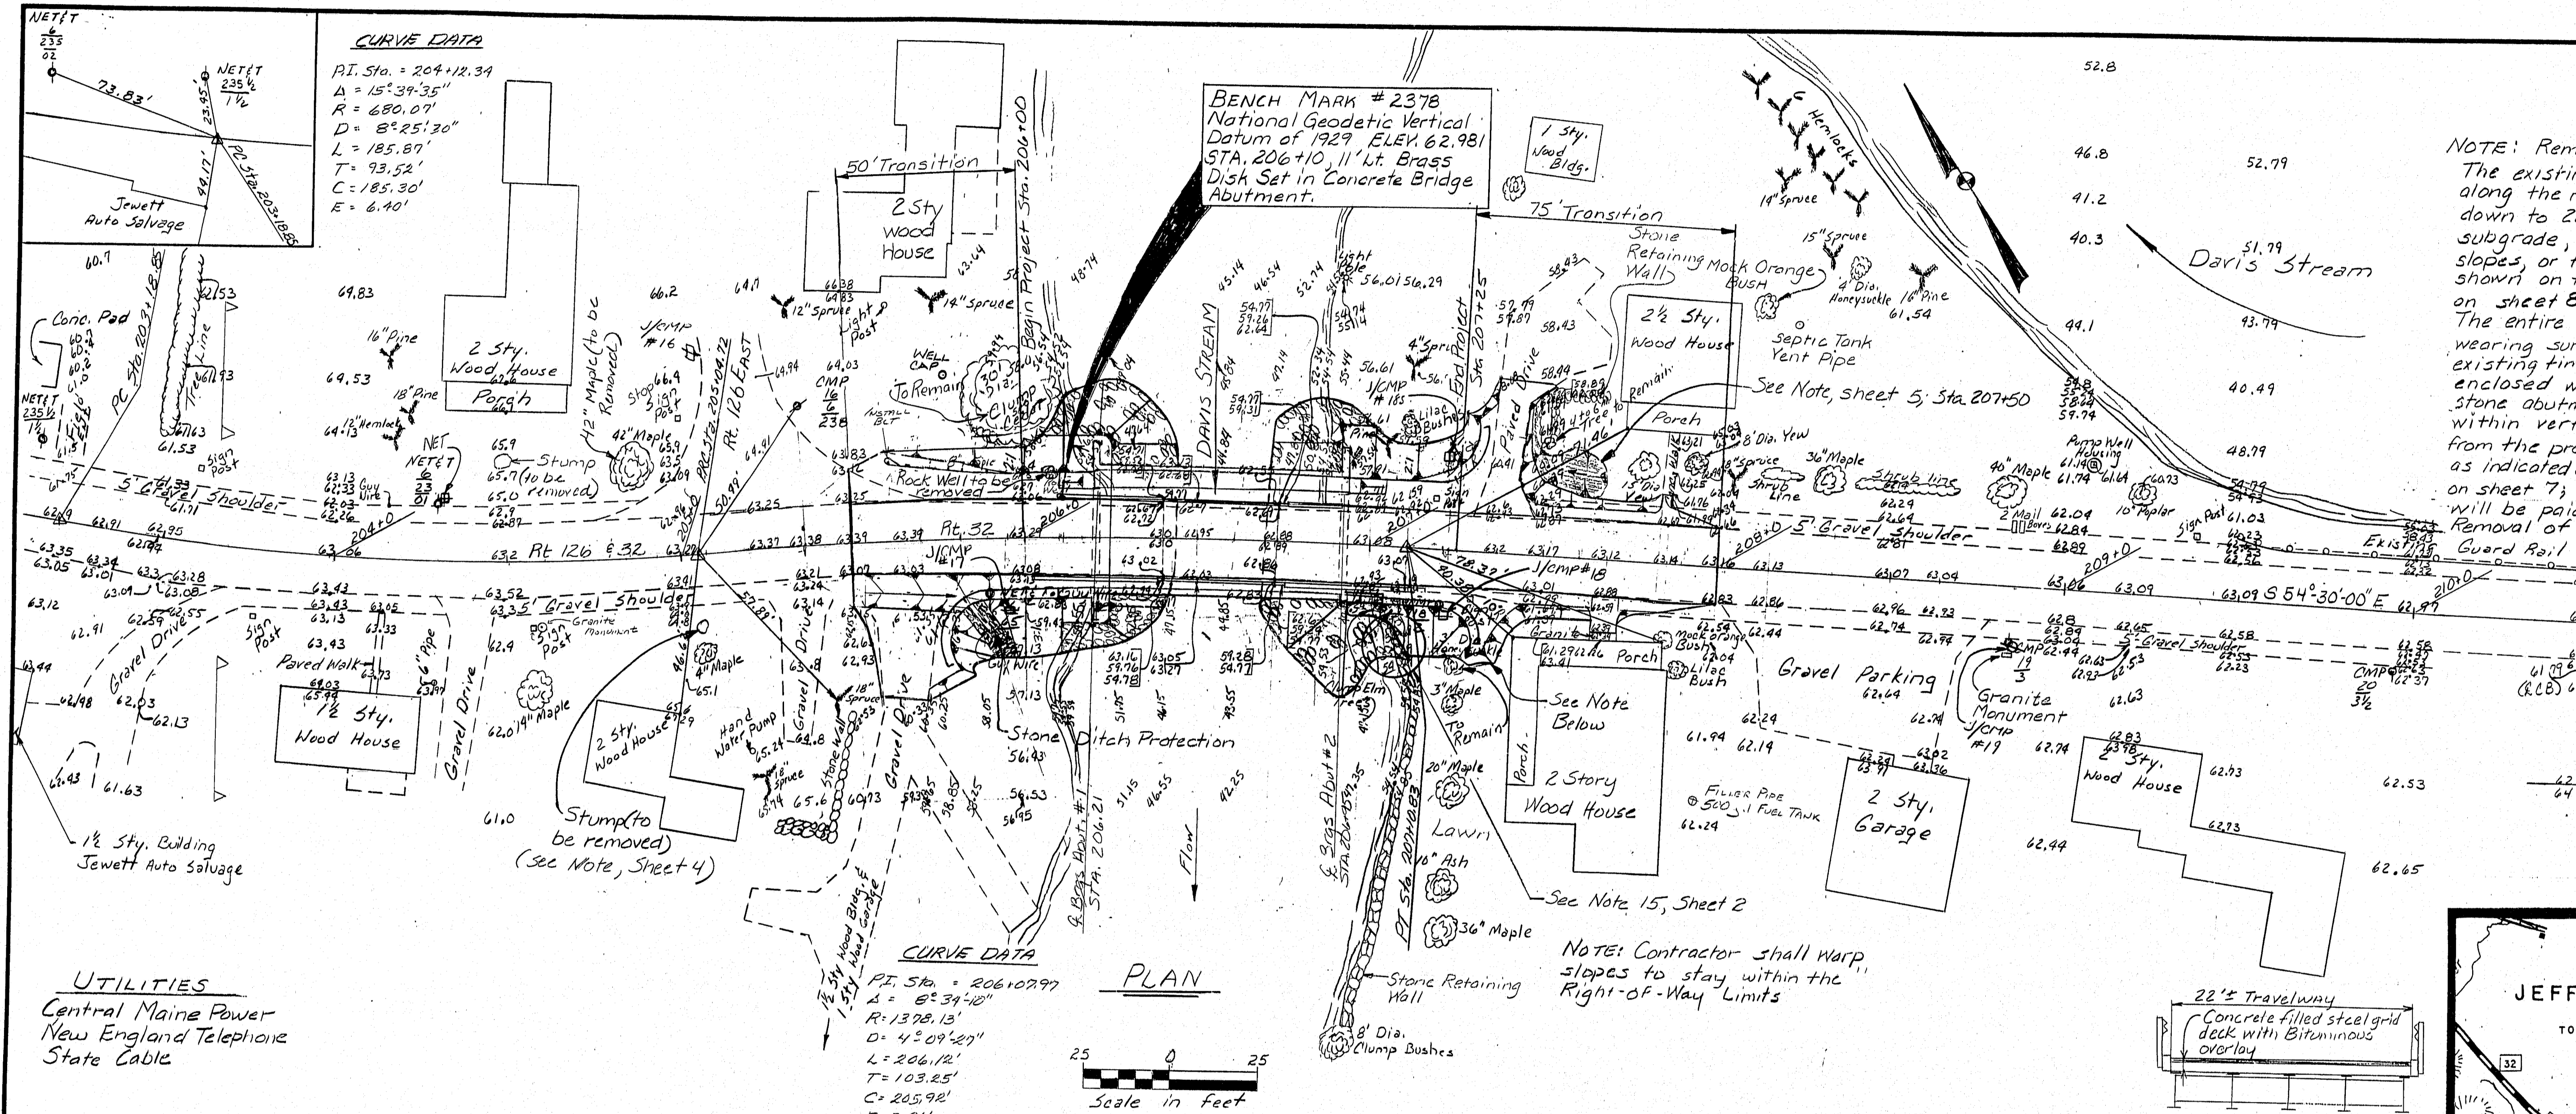

NOTE: Removal of the existing bridge:
 The existing stone retaining walls along the roadway shall be removed down to 2.0 ft. min. below roadway subgrade, 1.0 ft. below the finished slopes, or to the granular borrow limits shown on the Typical Abutment Section on sheet 8, whichever governs. The entire existing superstructure including wearing surface and bridge railing, the existing timber cribs and fill material enclosed within, and the supported stone abutments, and concrete caps within vertical planes measured 9'0" out from the proposed centerline of bearings as indicated on the Typical Abutment Section on sheet 7; shall be removed. This work will be paid for under Item 202.19, Removal of Existing Bridge.

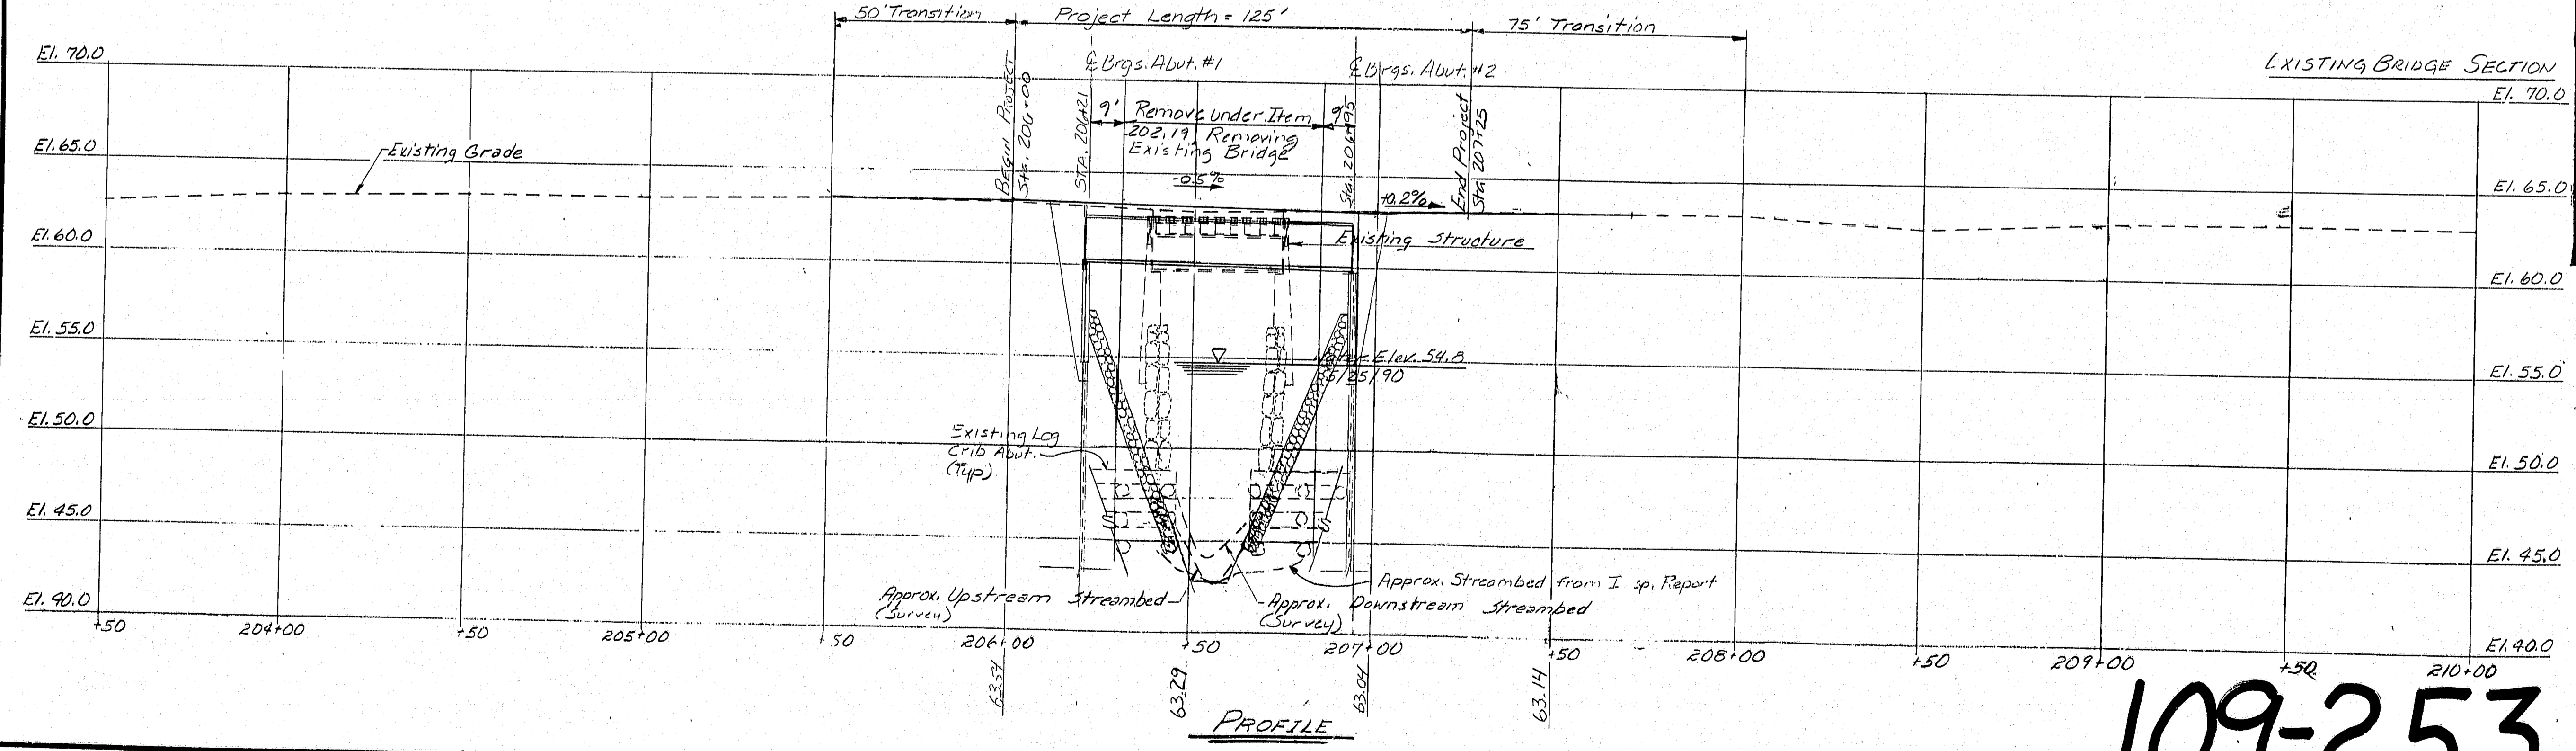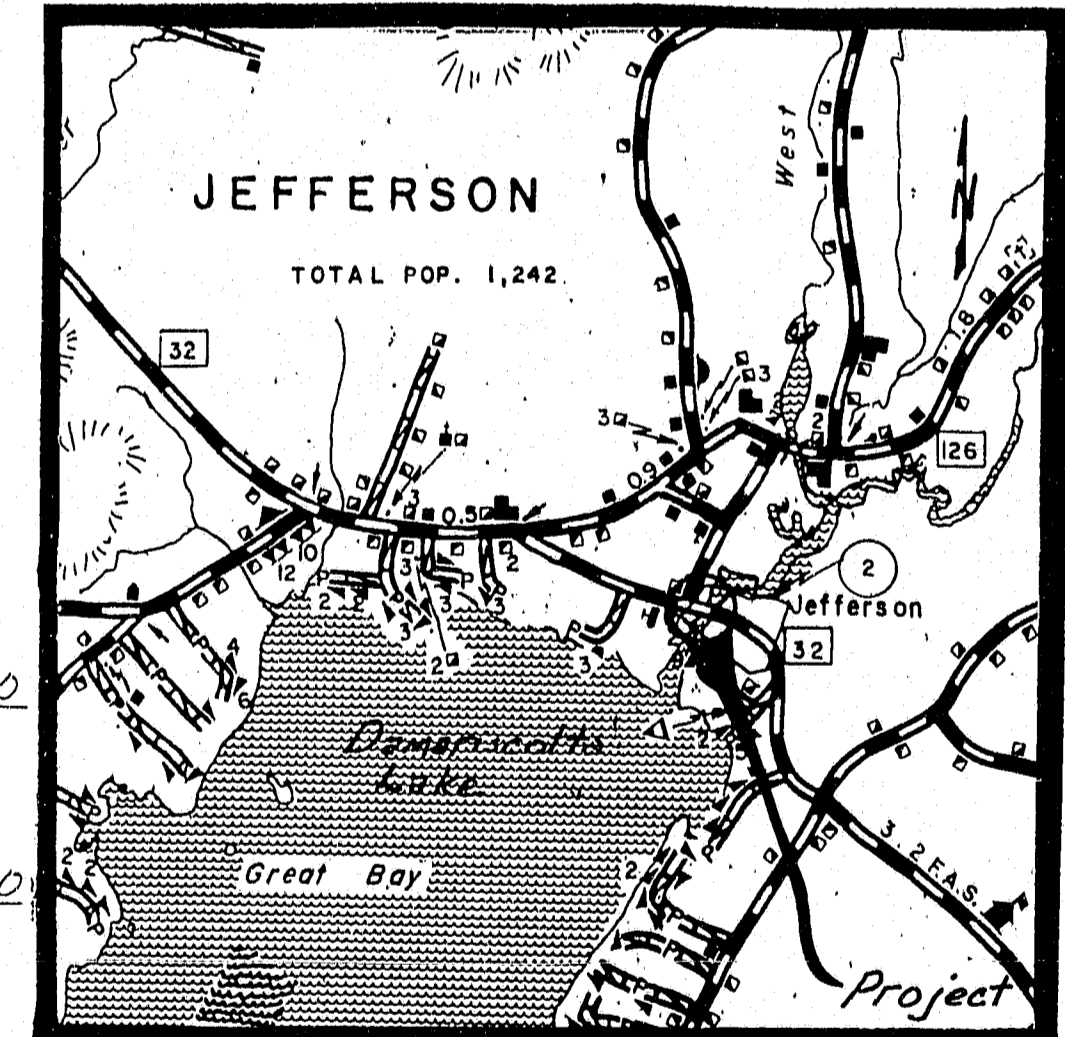

Bridge # 2376 Survey Book #
 STATE OF MAINE
 DEPARTMENT OF TRANSPORTATION 104
HOTEL BRIDGE
 OVER
DAVIS STREAM
 IN THE TOWN OF
JEFFERSON
 LINCOLN COUNTY
 GENERAL PLAN AND PROFILE
 SHEET OF AUGUSTA, MAINE

109-253




Survey Plotted by RTN 9.1.0

PROJECT DESIGN ENGINEER	DATE
DESIGN-DETAILED	
REVISIONS	
FIELD CHANGES	



BRUNING 45710-1

PIN. 4220.00

F.A.R.A. REG. NO.	STATE	PROJECT NUMBER	SHEET NO.	TOTAL SHEETS
1	MAINE	BR-034PDX	6	31

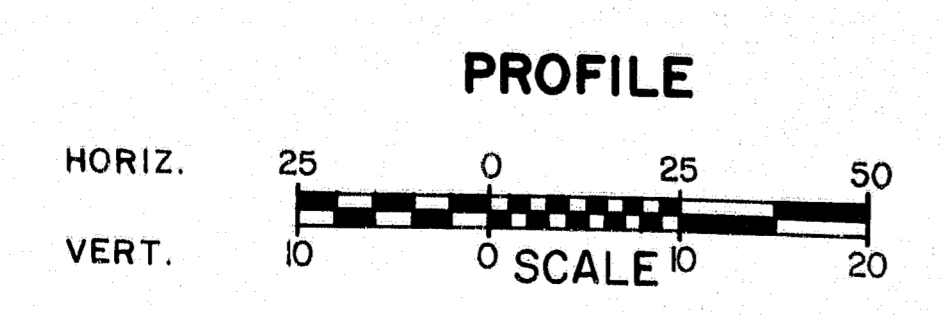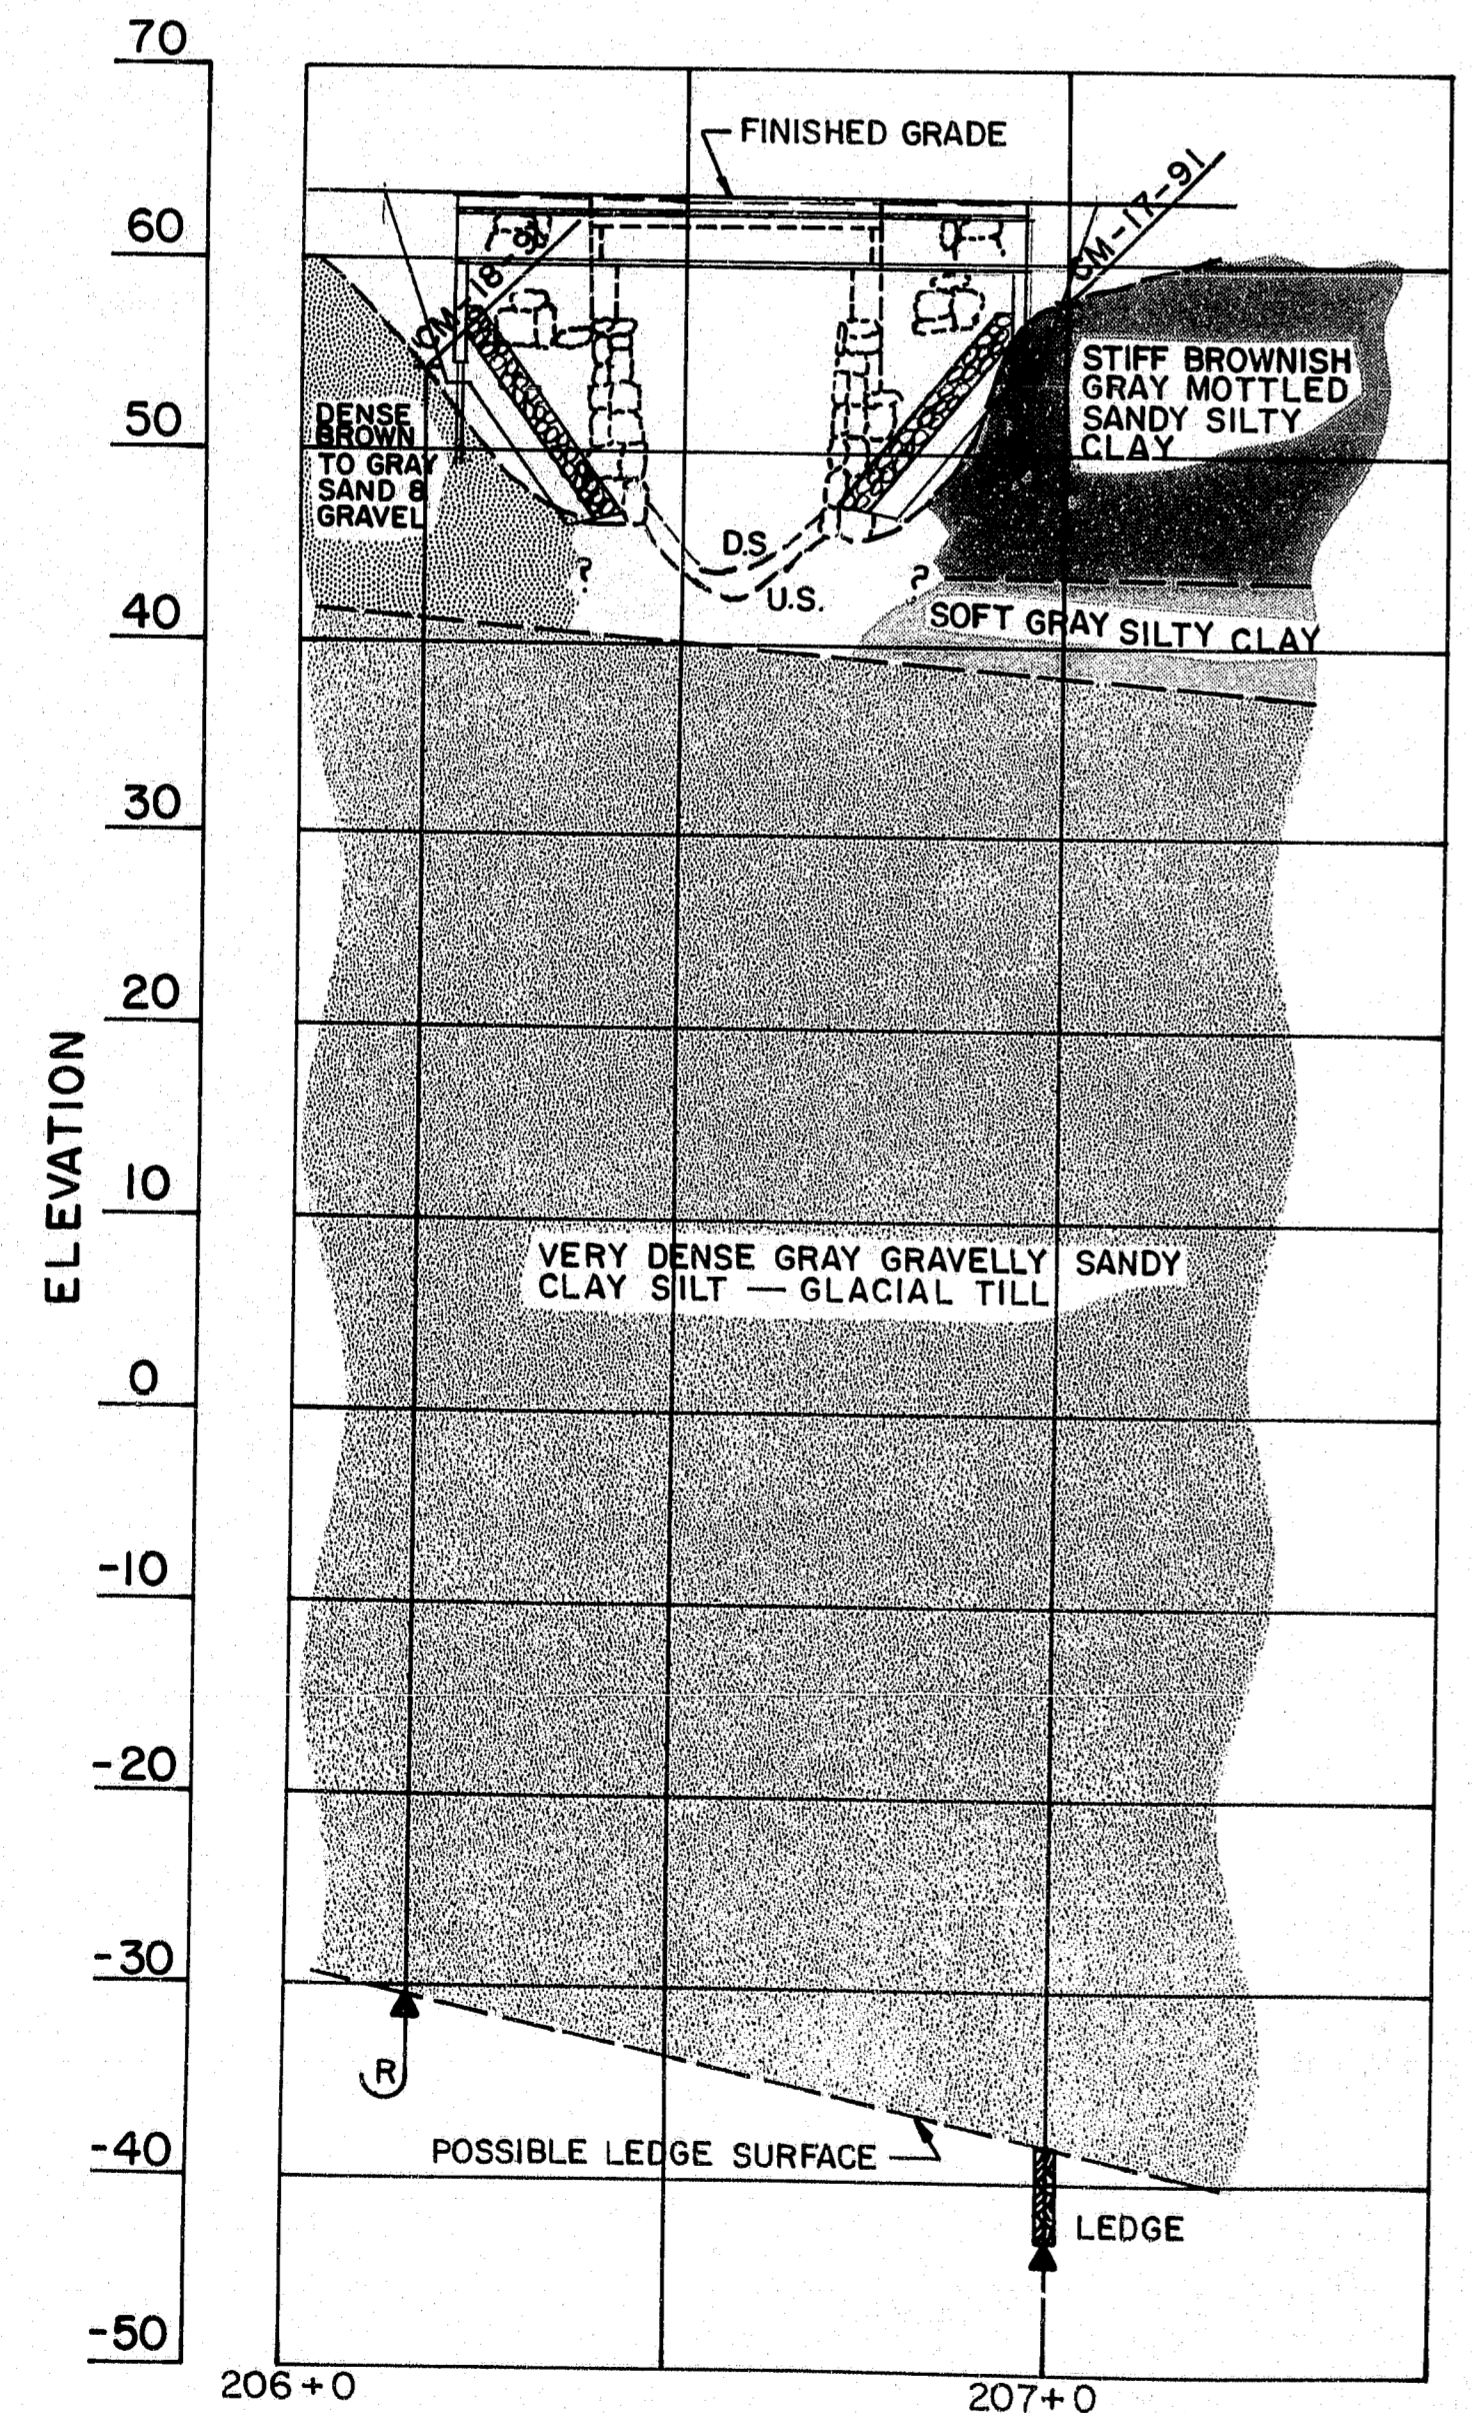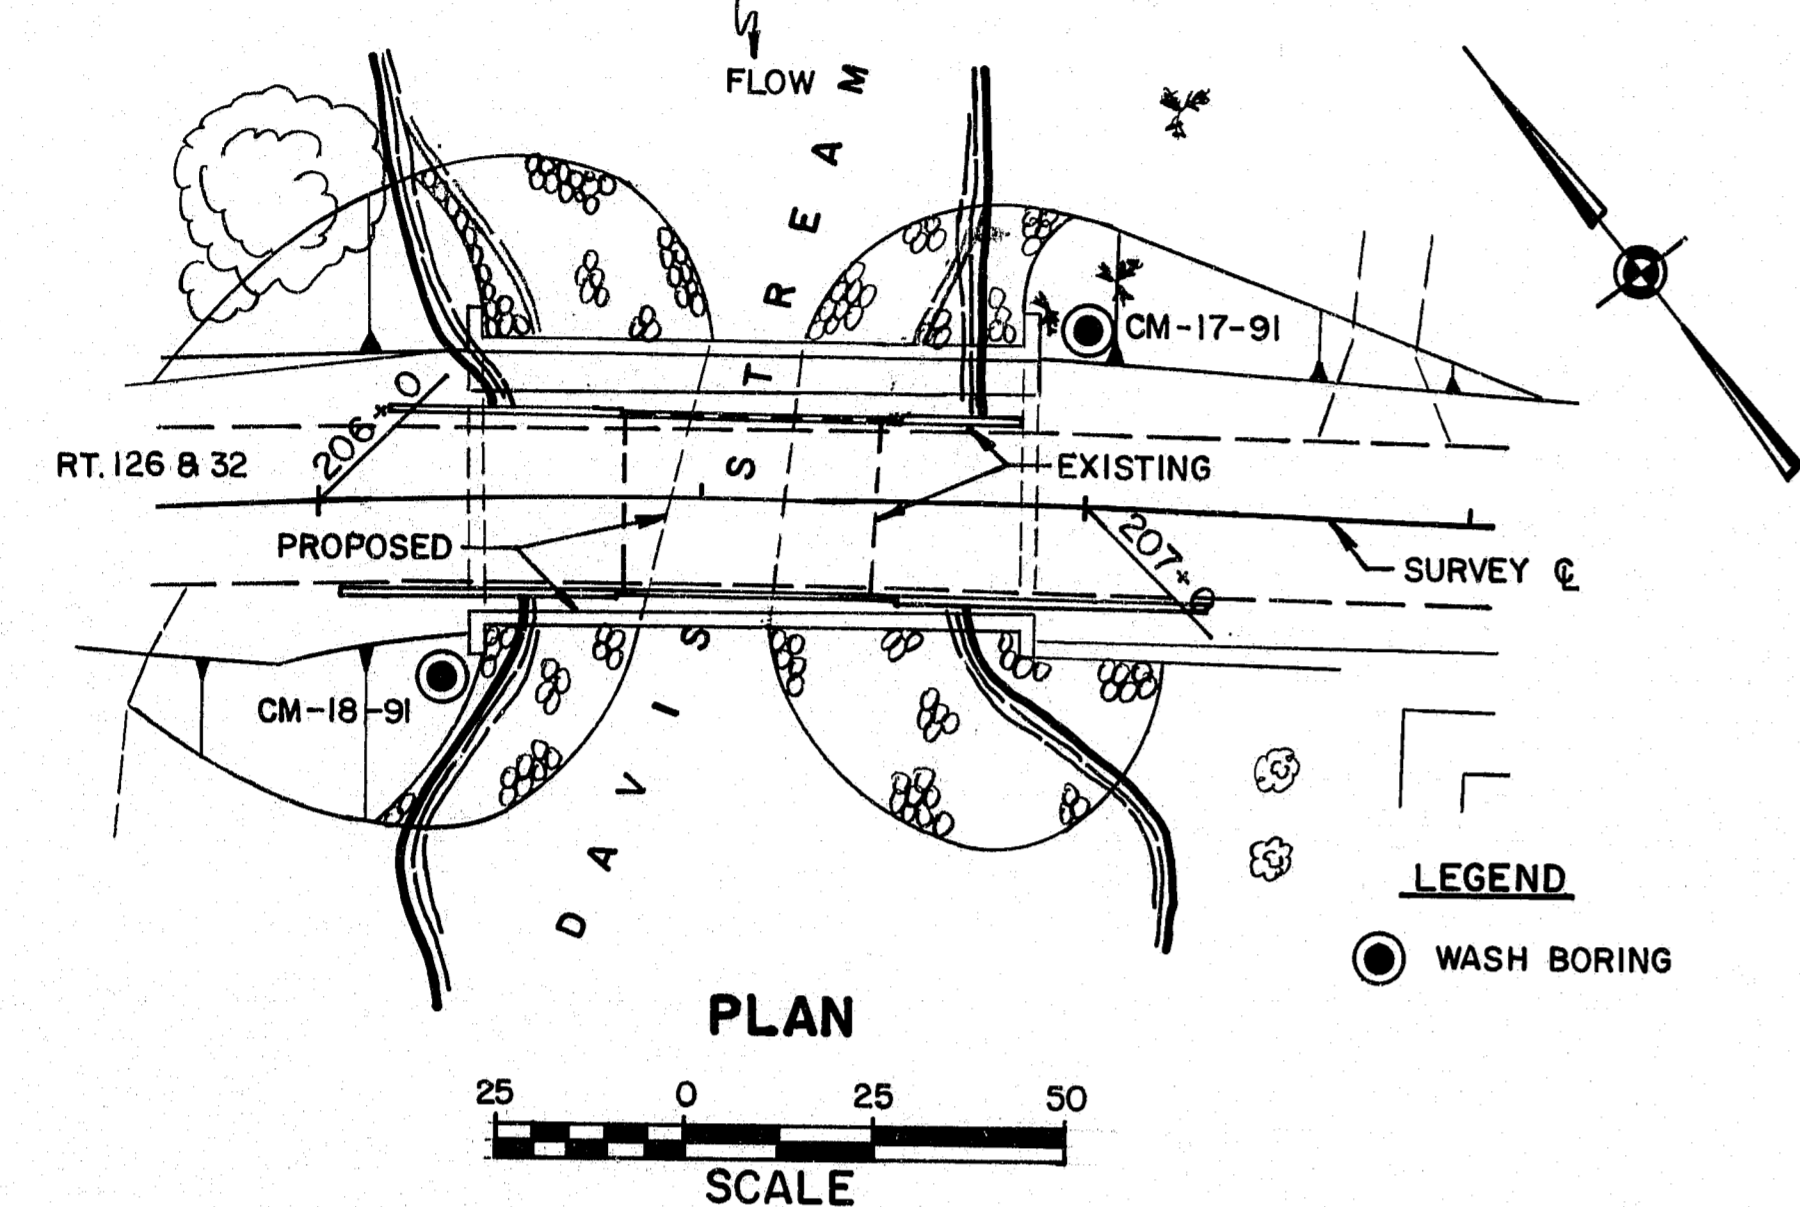

- BORING NOTES**
- 2 1/2" Casing
 - All samples and vane tests made ahead of casing
 - Number of blows required to drive extra heavy casing one foot with 400 ft. lbs. of energy per blow
 - Location of sample or sample attempt
 - Number and type of dry sample
 - S & H Sampler # 1290's
 - 2" O.D. 16 ga. seamless tubing
 - Unsuccessful sample attempt and type of sampler
 - Number of blows required to drive spoon or tubing one foot with 350 ft. lbs. of energy per blow
 - Sampling spoon or seamless tubing driven by static weight of drill rods and hammer
 - Field vane test
 - Bottom of boring (may not be bottom of soil strata)
 - Refusal of drill rods or casing (may not be ledge)
 - Locations cored by diamond bit and percent recovery of rock
- SHEAR NOTES**
- Field vane shear strengths
 - Laboratory vane shear strengths
- WATER CONTENT NOTES**
- Natural water contents, given as percent or dry weight

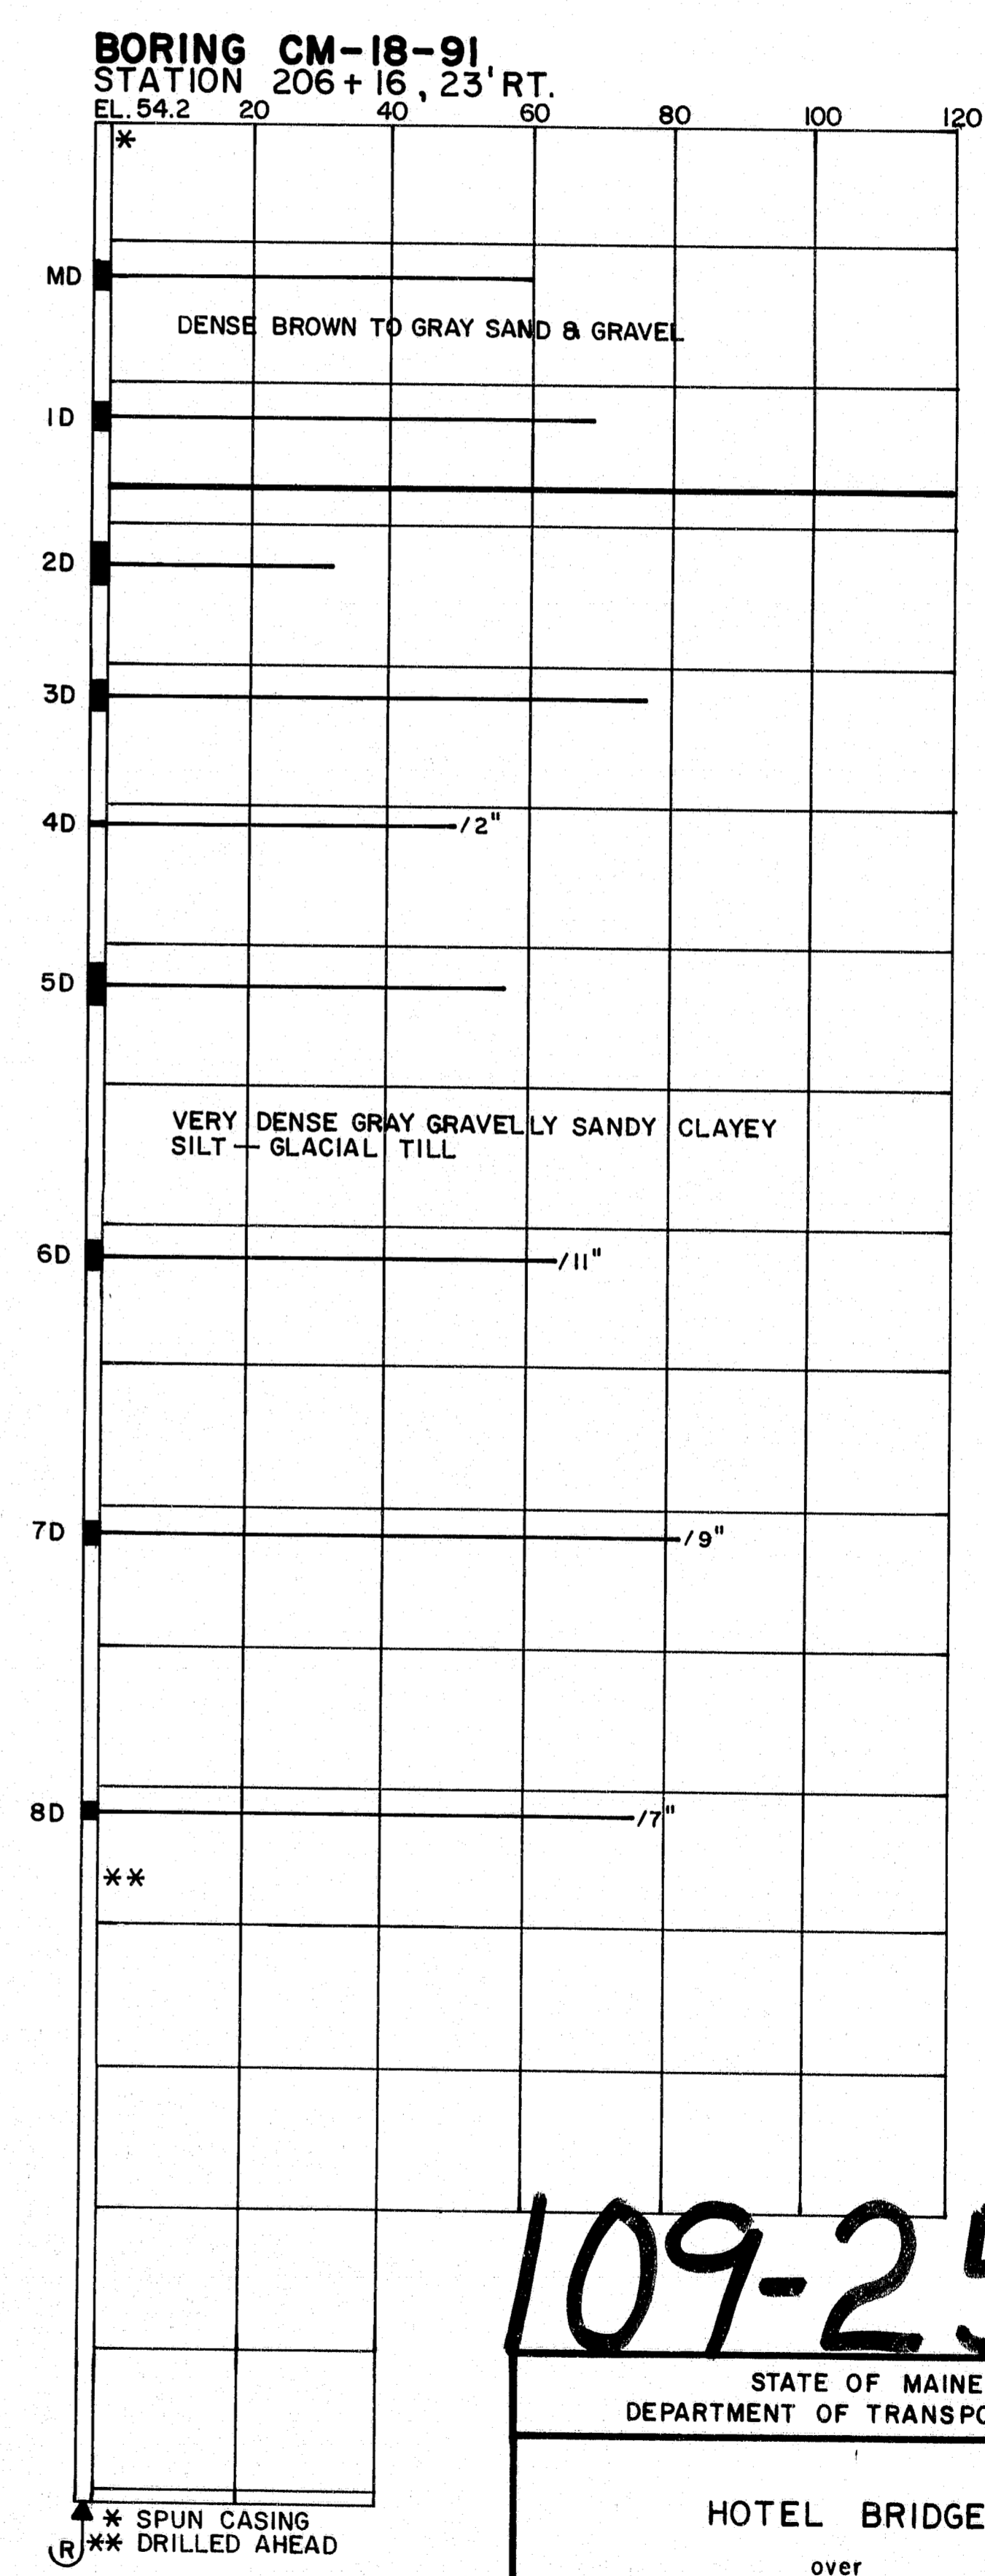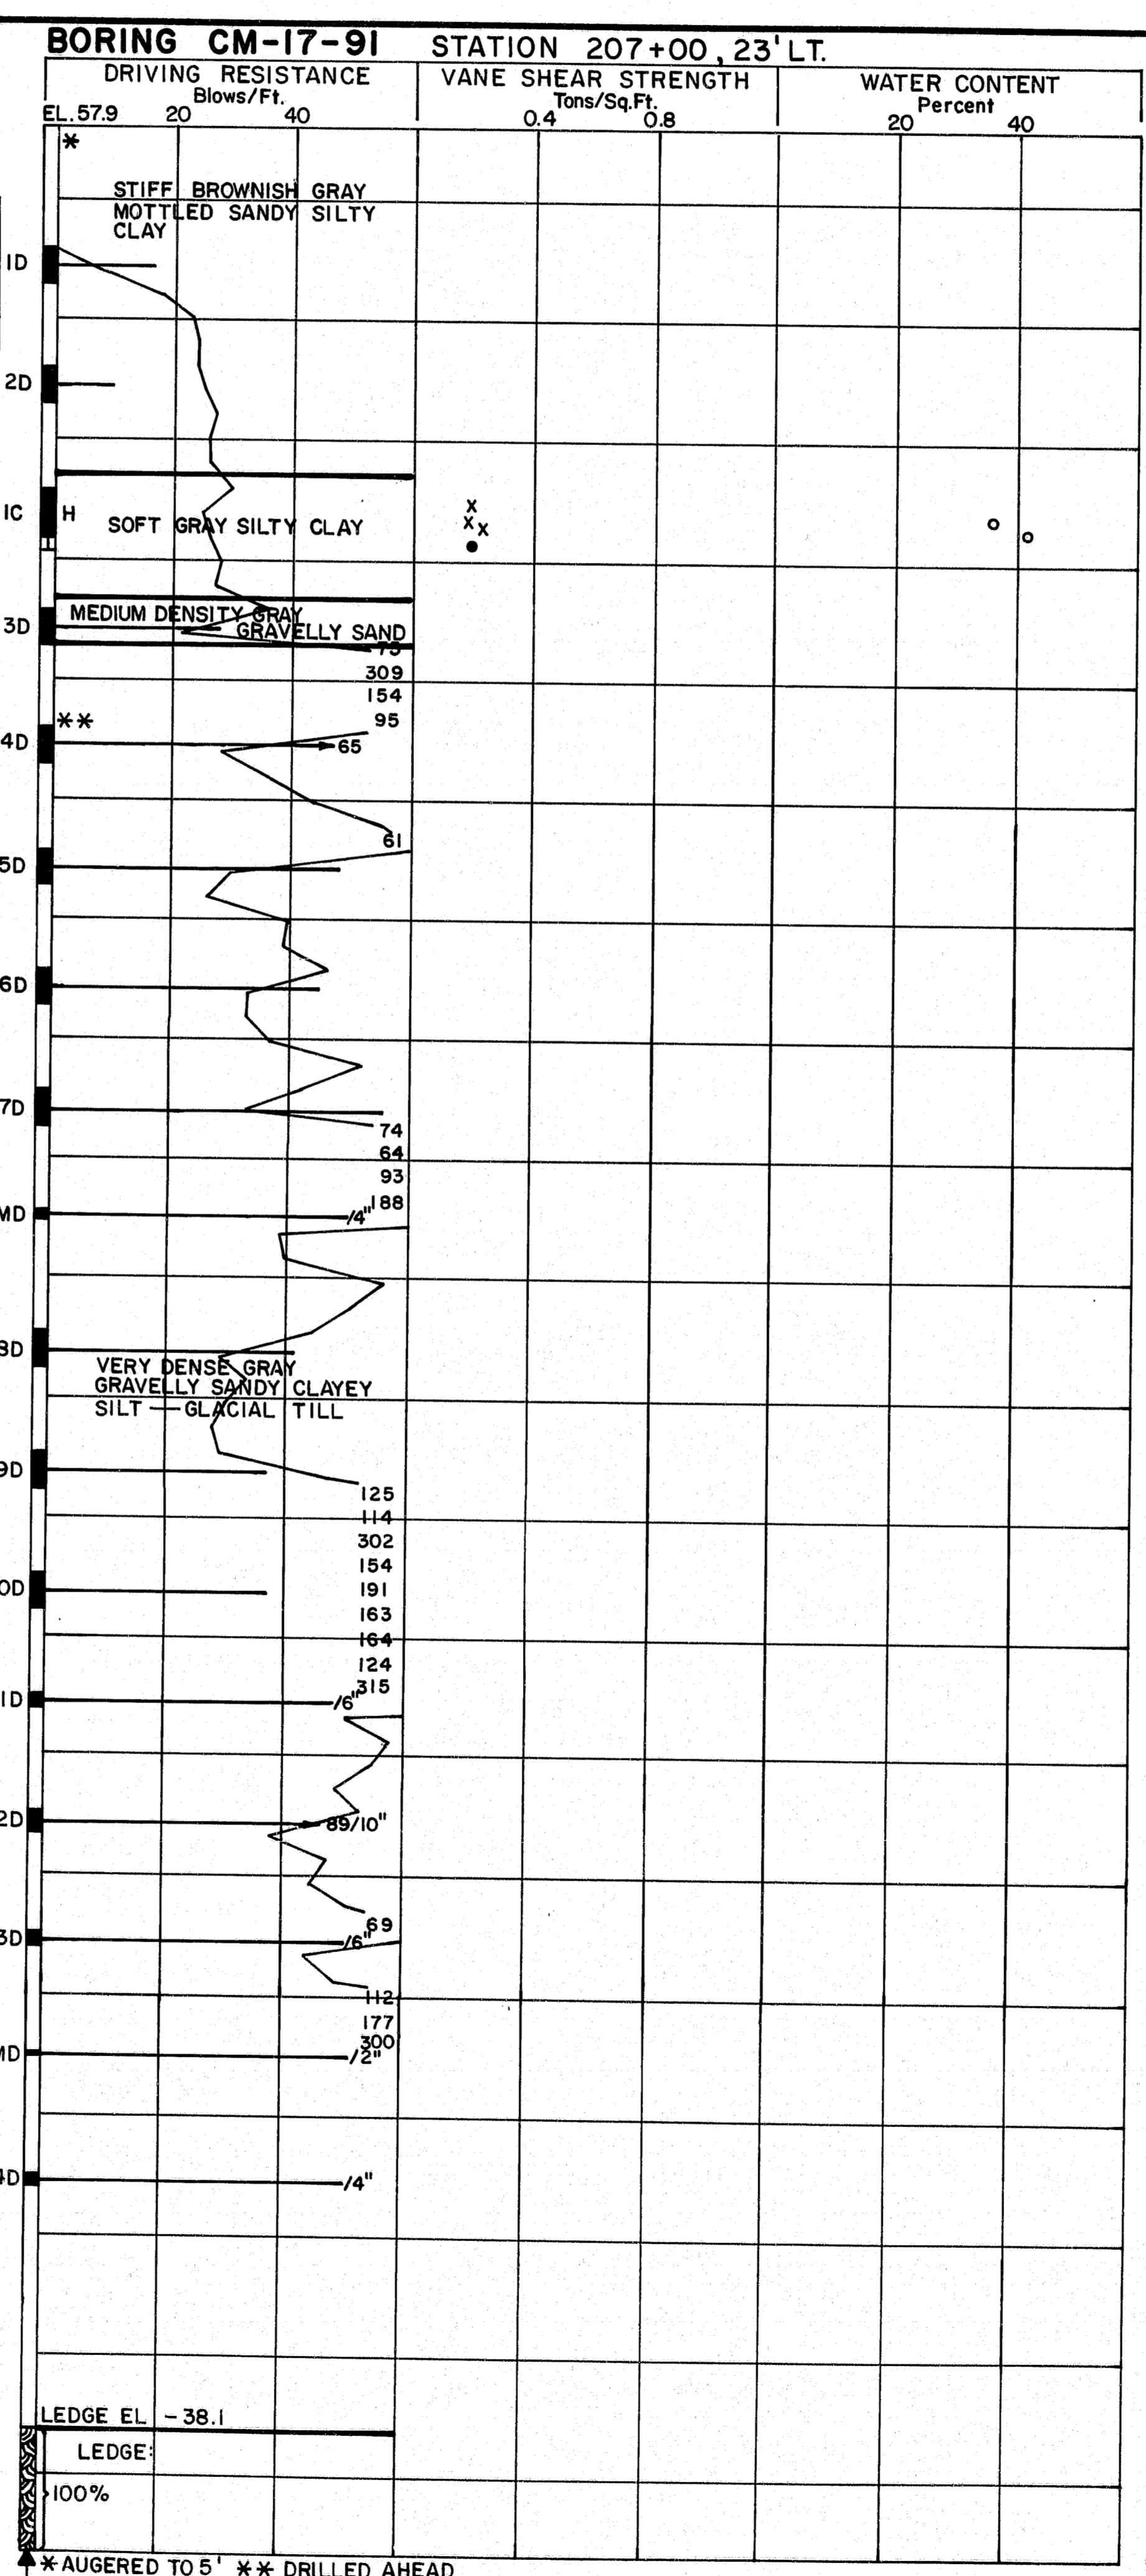

109-254


STATE OF MAINE
DEPARTMENT OF TRANSPORTATION

HOTEL BRIDGE 107
over
DAVIS STREAM
in the town of
JEFFERSON
LINCOLN COUNTY
FOUNDATION SURVEY
AUGUSTA, MAINE

SHEET OF

PROJECT DESIGN ENGINEER	BY	DATE
DESIGN - DETAILED		
CHECKED		
REVISIONS		
FIELD CHANGES		

BORING 44-132-45710-1

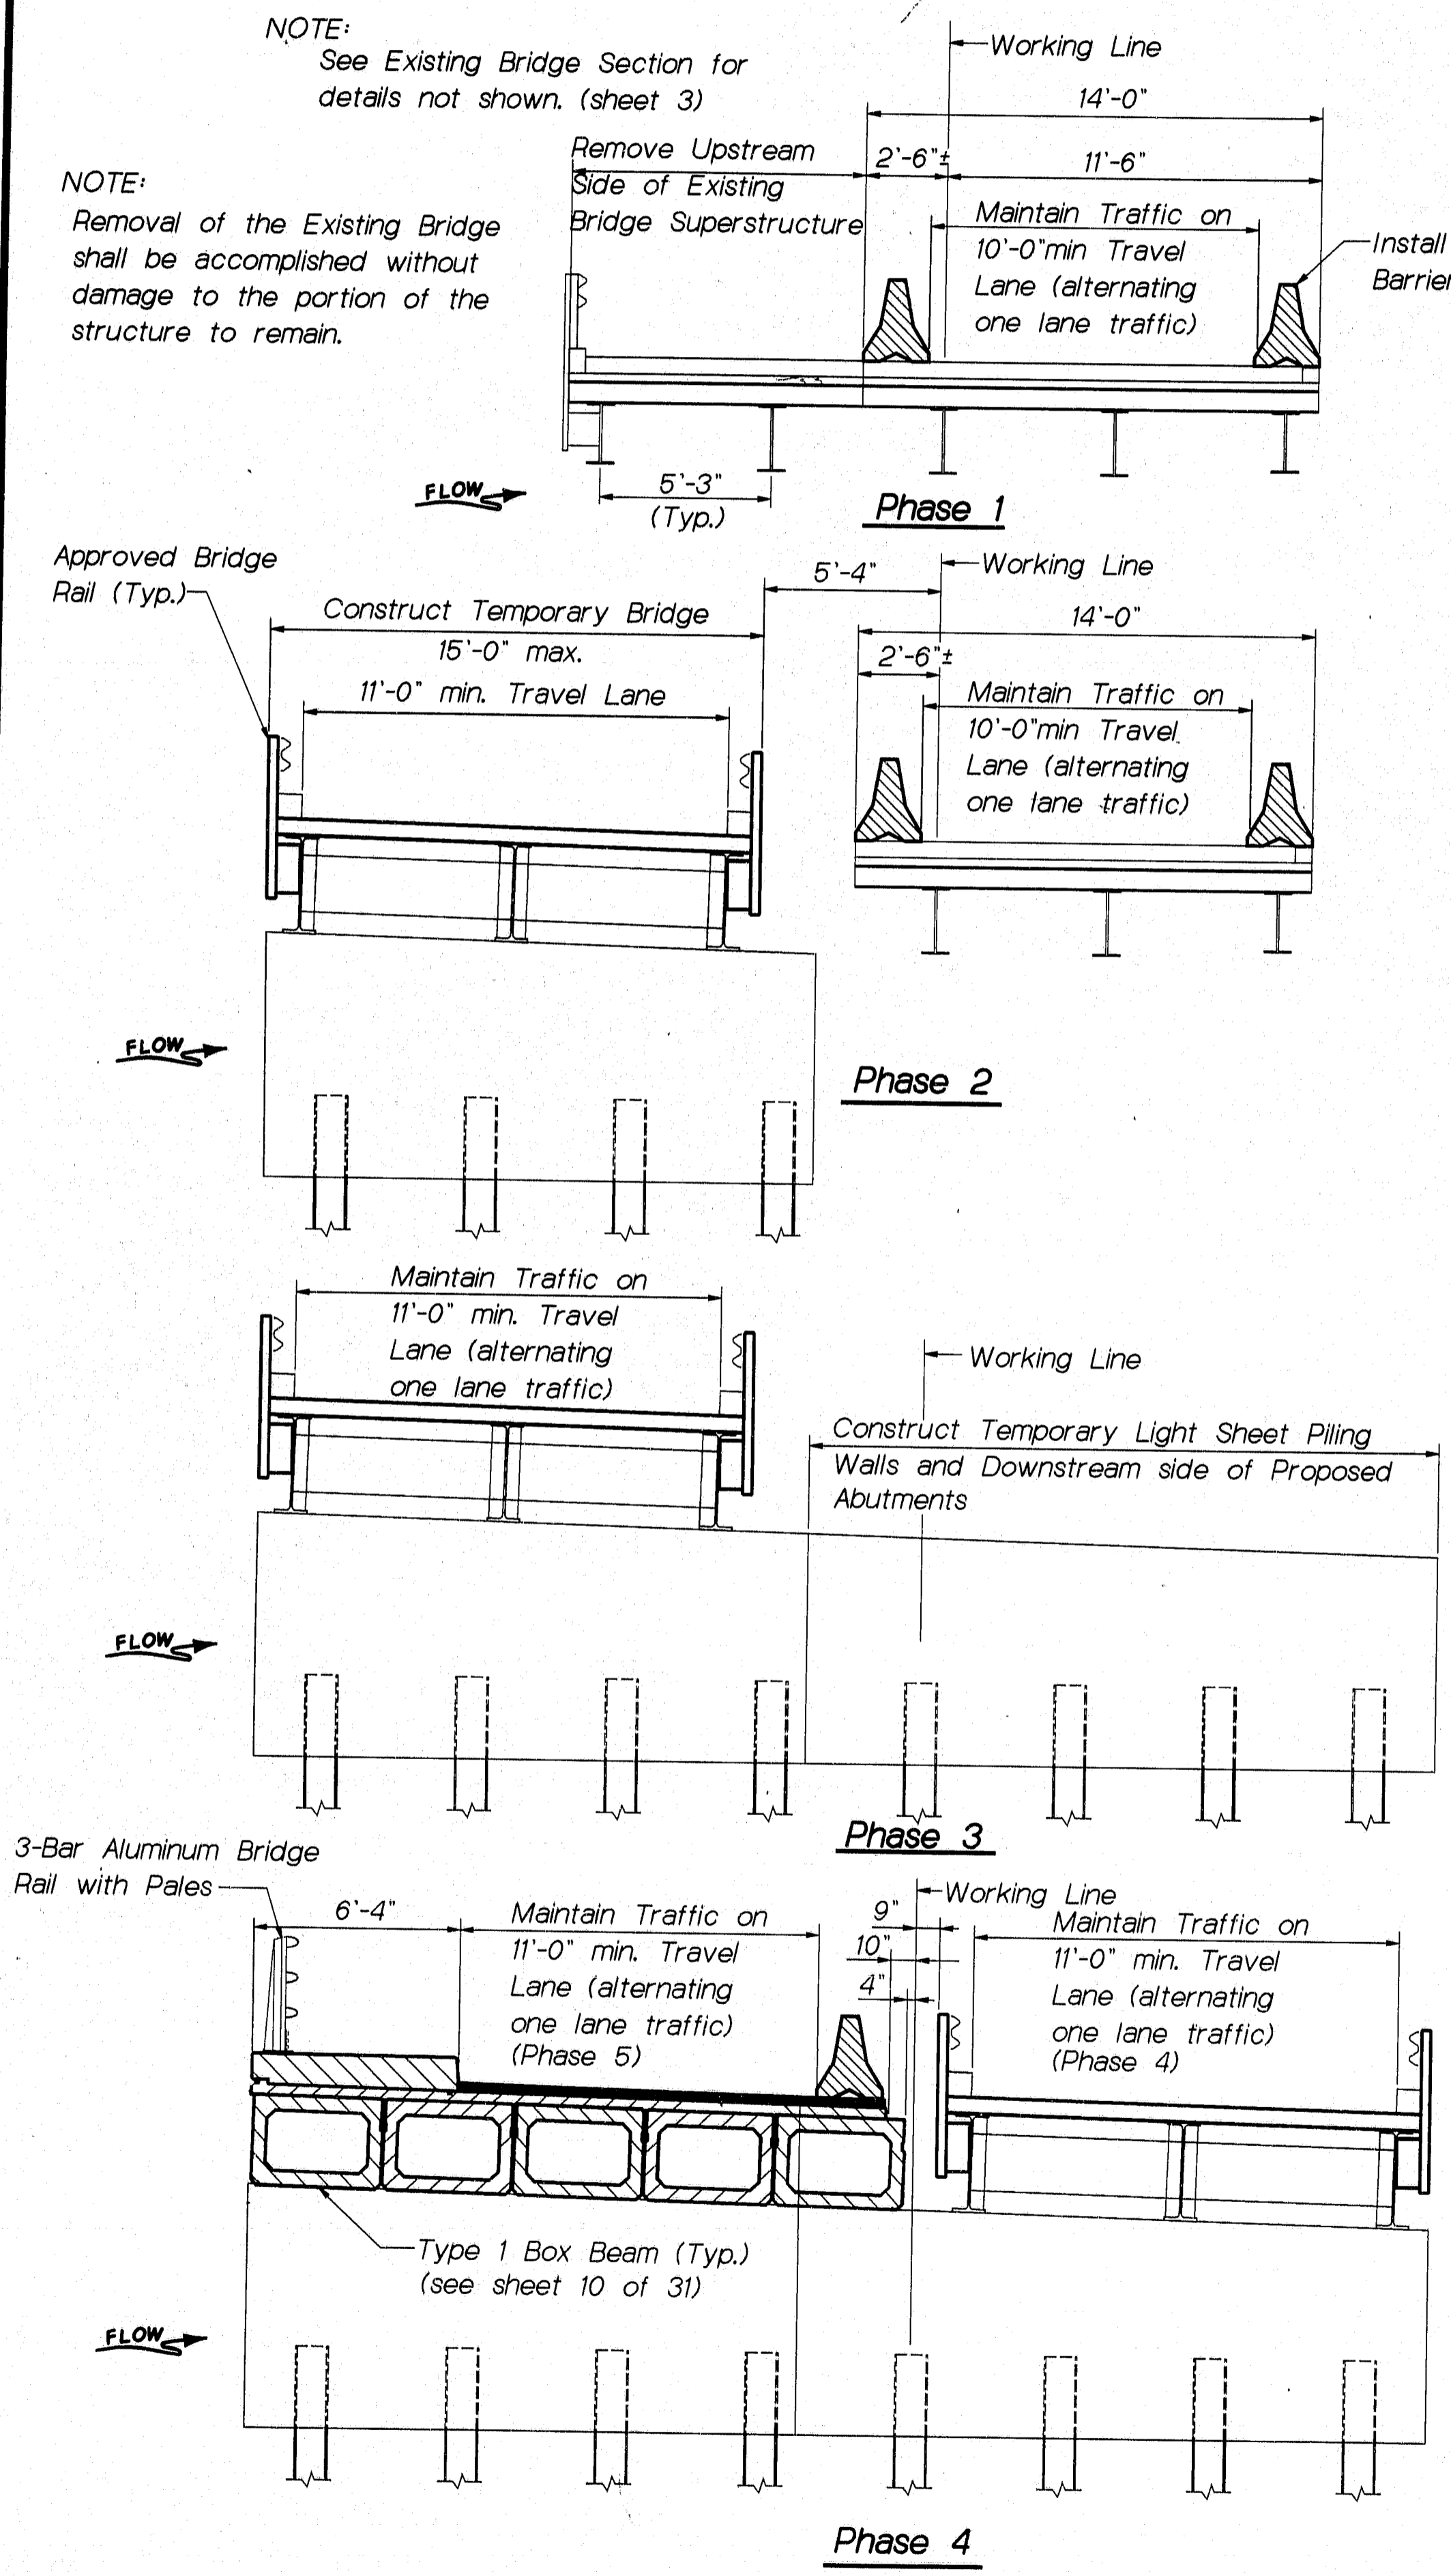

NOTE: See Existing Bridge Section for details not shown. (sheet 3)

NOTE: Removal of the Existing Bridge shall be accomplished without damage to the portion of the structure to remain.


Approved Bridge Rail (Typ.)

Construct Temporary Bridge

Maintain Traffic on 11'-0" min. Travel Lane (alternating one lane traffic)

3-Bar Aluminum Bridge Rail with Pales

Type 1 Box Beam (Typ.) (see sheet 10 of 31)

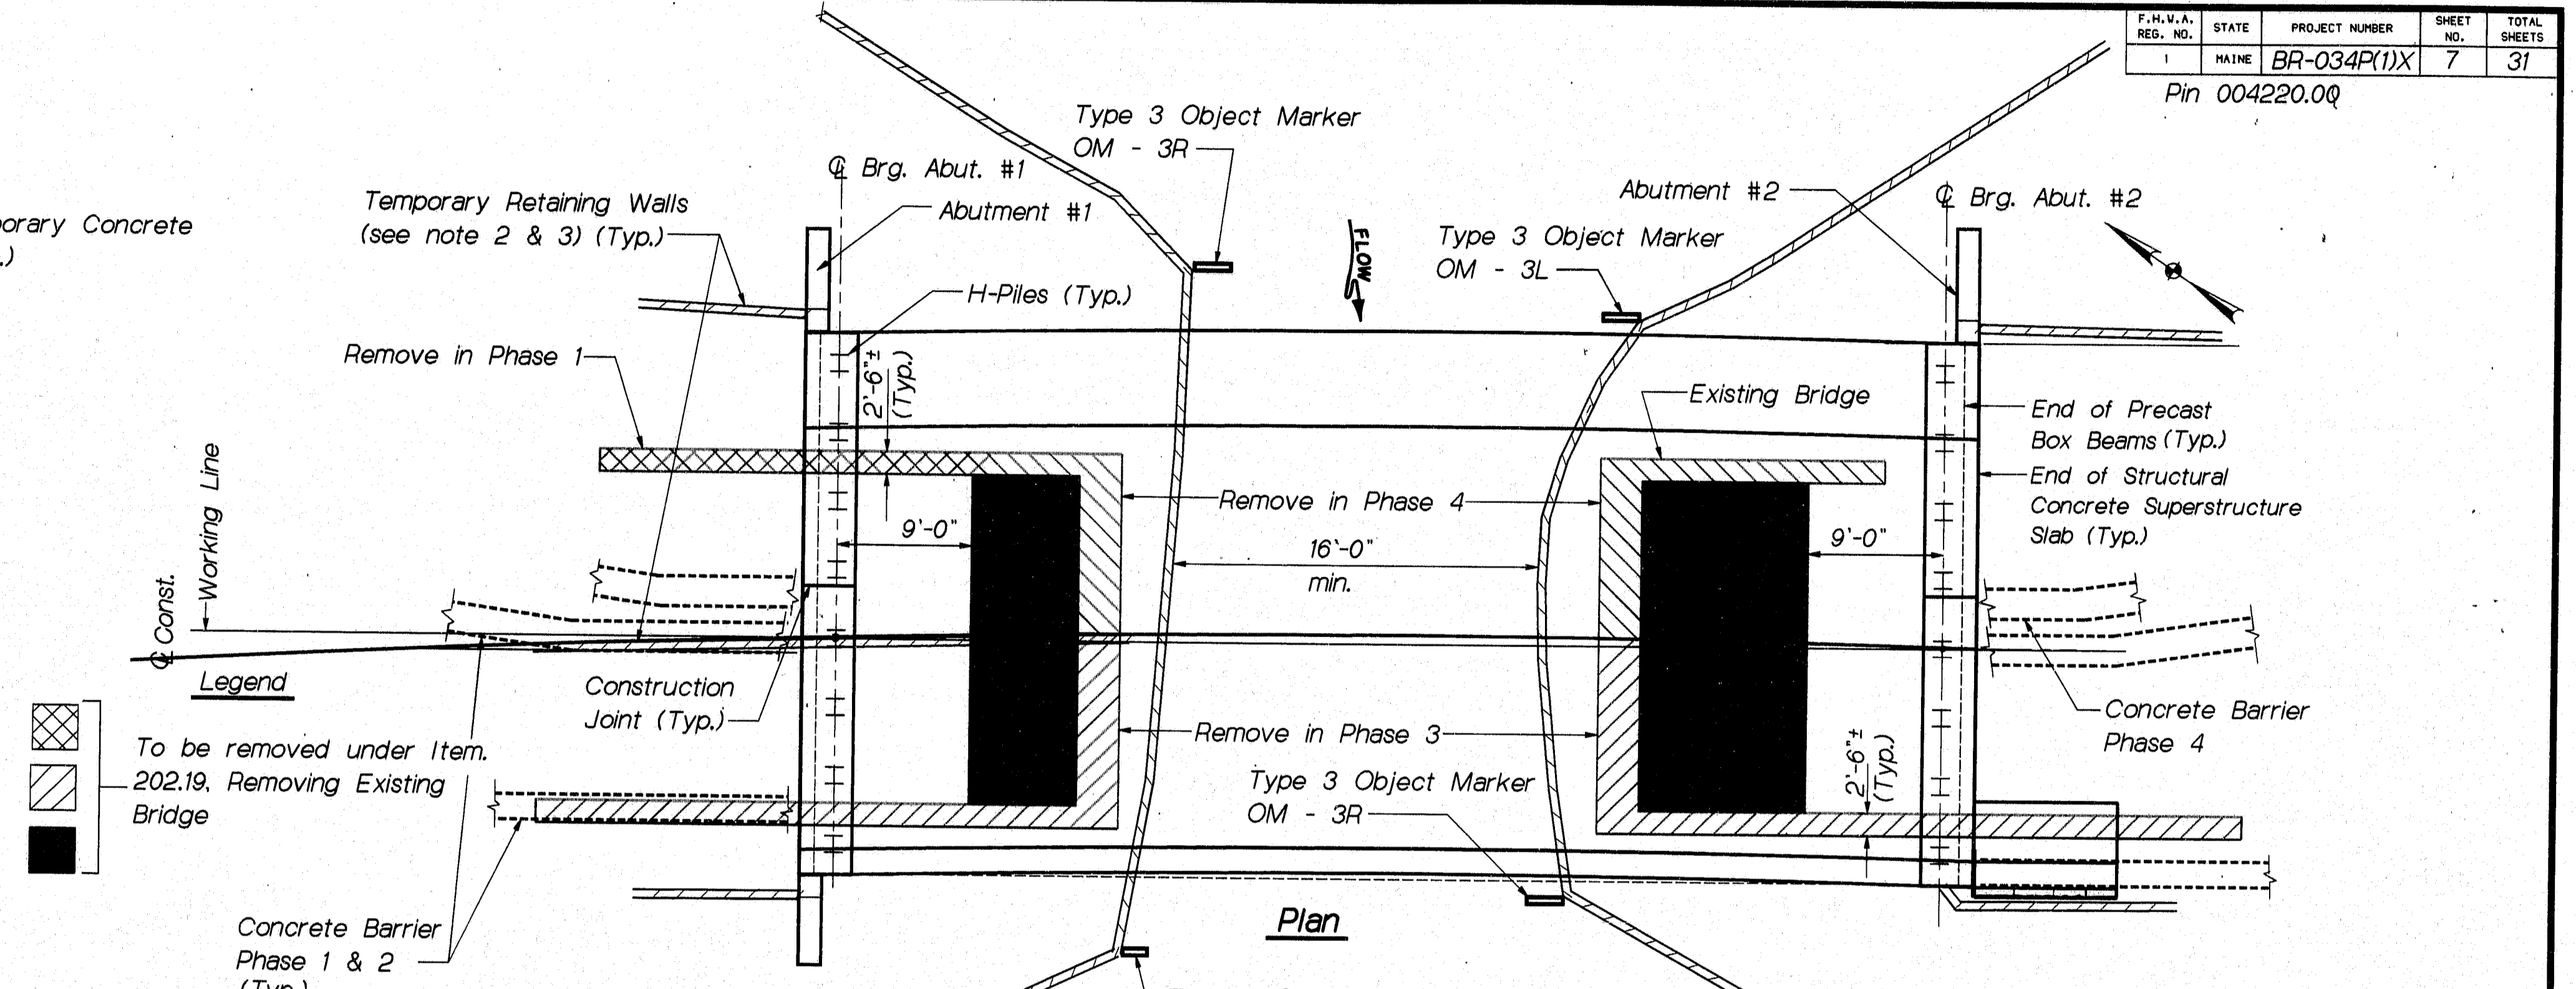

Sequence of Construction

Phase 1: Locate traffic on downstream side of bridge and maintain alternating two way traffic on a 10'-0" minimum travel lane with temporary lights. Remove the upstream portion of the existing bridge superstructure and wingwalls, northeast and southeast wings only.

Phase 2: Construct upstream portion of proposed abutments. Construct temporary bridge superstructure, with approved bridge rails, and temporary walls.

Phase 3: Locate traffic on temporary bridge on upstream side. Remove downstream side of existing bridge including existing abutments. Construct proposed slopes and riprap as far as practical. Construct temporary walls similar to Phase 2, and remaining portions of proposed abutments.

Phase 4: Move temporary bridge to downstream side. Relocate traffic to downstream side. Remove upstream portions of existing abutments and construct remaining portions of riprap slopes. Remove upstream portion of temporary walls. Construct upstream portion of superstructure.

Phase 5: Move traffic to new superstructure on upstream side. Remove temporary bridge, downstream temporary walls and complete superstructure.

Temporary Signals

The Temporary Signal Controller shall be a 3 phase fully actuated controller. Install presense loops on three approaches. Initial timing shown below: adjust as necessary.

	Rte. 32 (SB)	Rte. 32 (NB)	Rte. 126 (WB)
Initial	3	3	3
Extension	3	3	3
Maximum	12	12	8
Yellow	3	3	3
All Red	12	12	12
Recall	Soft		

Maintenance of Traffic Notes

- 1.- Temporary concrete barrier shall have a 6:1 taper on all flare backs.
- 2.- A temporary light sheet piling wall at a minimum of 2 feet above water level as approved by the Engineer, will be required to contain any sediment load in the water that may occur in excavating the existing log cribs, stone abutments and backfilling behind the existing walls. The temporary light sheet piling walls shall remain in place until the proposed riprap slopes have been completed to a minimum of 1 foot above the water level. It is anticipated that temporary earth retaining walls will be required to maintain traffic on widened roadway, and to maintain existing roadway during excavation for proposed bridge abutments. A temporary bridge superstructure with approved bridge rails will be required. At least one movement of the temporary bridge is anticipated. Some removal of concrete caps and approach fill on the existing abutments will be necessary to accommodate the temporary bridge beams. This work will be considered incidental to Item 510.10, Special Detour, 11 ft. Roadway Width Vehicle and Pedestrian Traffic Not Separated.
- 3.- The existing log cribbing to remain during Phase 1 & 2 of construction shall be adequately braced and supported in a manner approved by the Engineer. Underwater inspection reports can be found in the Bridge Maintenance Office Files in Augusta, and are available for inspection by the Contractor. Recent underwater inspection reports indicate some voids within the existing log cribbing. This work will be considered incidental to Item 510.10, Special Detour, 11 ft. Roadway Width Vehicle and Pedestrian Traffic Not Separate.
- 4.- Where approved by the Engineer, any voids created by the removal of the existing timber cribbing shall be filled with granular borrow suitable for underwater backfill. Payment will be made under Item 203.25, Granular Borrow.
- 5.- Other methods of maintenance of traffic and sequence of construction may be used as approved by the Engineer.
- 6.- Payment for all the work and materials required for the maintenance of traffic, such as temporary concrete barriers, maintenance of traffic control devices, cones, drums, and traffic lights as approved by the Engineer will be paid for under the applicable pay items.

109-255

STATE OF MAINE
DEPARTMENT OF TRANSPORTATION

HOTEL BRIDGE 108
OVER
DAVIS STREAM
IN THE TOWN OF
JEFFERSON
LINCOLN COUNTY

STAGE CONSTRUCTION DETAILS

SHEET OF AUGUSTA, MAINE Jan., 1994


PROJECT DESIGN ENGINEER	DATE
BY MKD	10-93
DESIGN-DETAILED	
CHECKED	
REVISIONS	
FIELD CHANGES	

04JAN94-010100

PLANS


F.H.W.A. RES. NO.	STATE	PROJECT NUMBER	SHEET NO.	TOTAL SHEETS
1	MAINE	BR-034R(1)X	8	31

Pin 004220.00

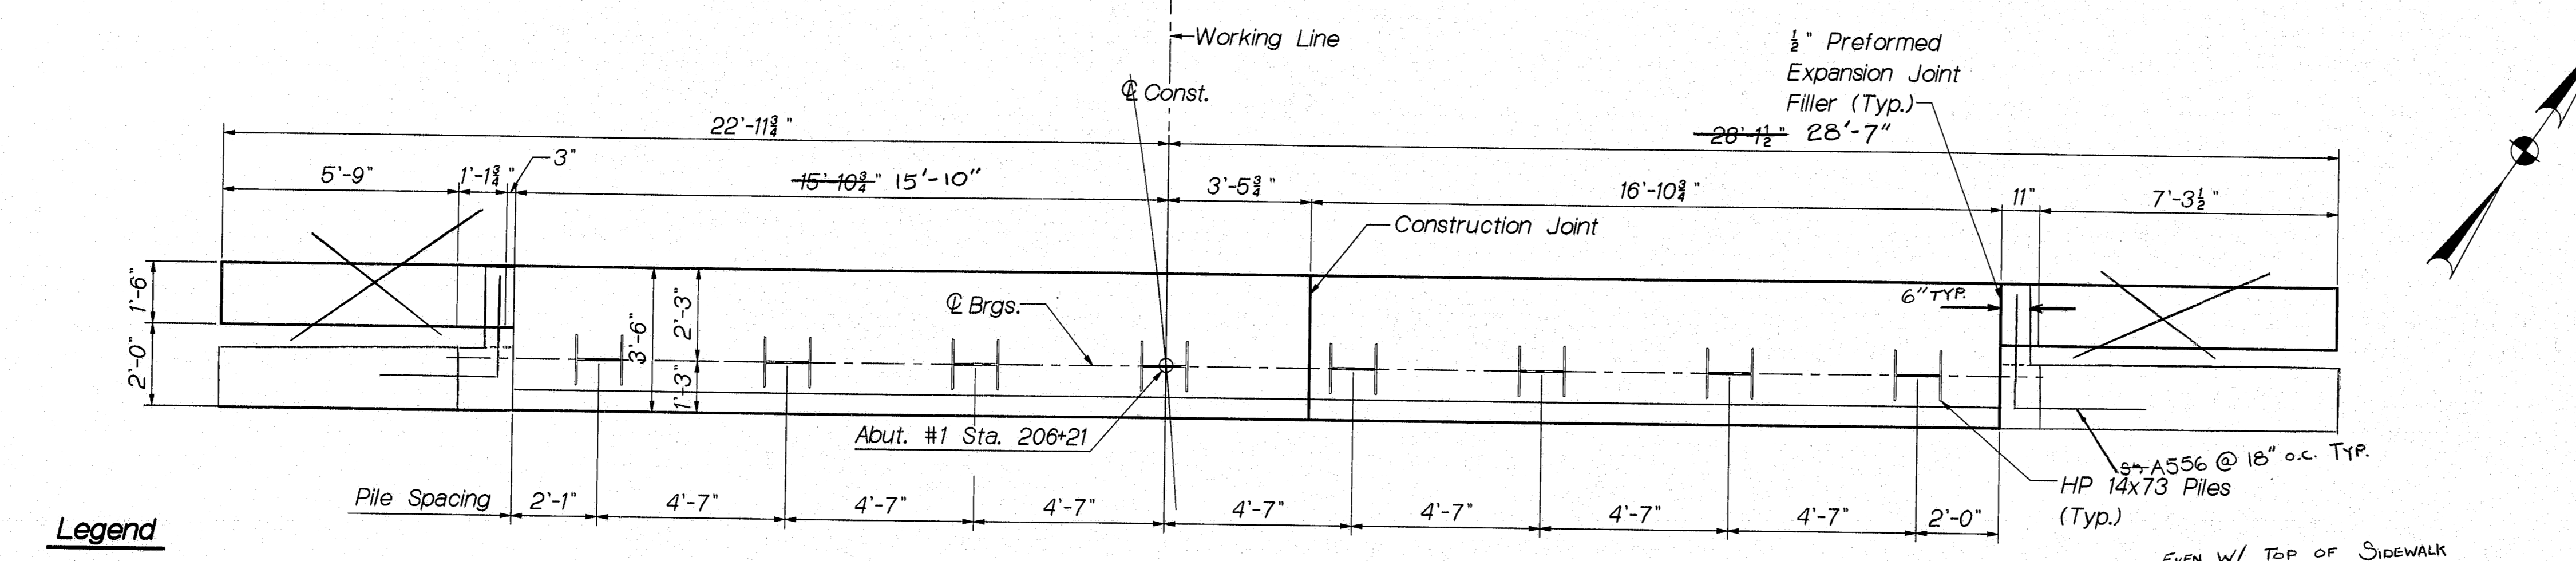

Legend
 NF - Near Face
 FF - Far Face
 EF - Each Face


Plan & Pile Layout

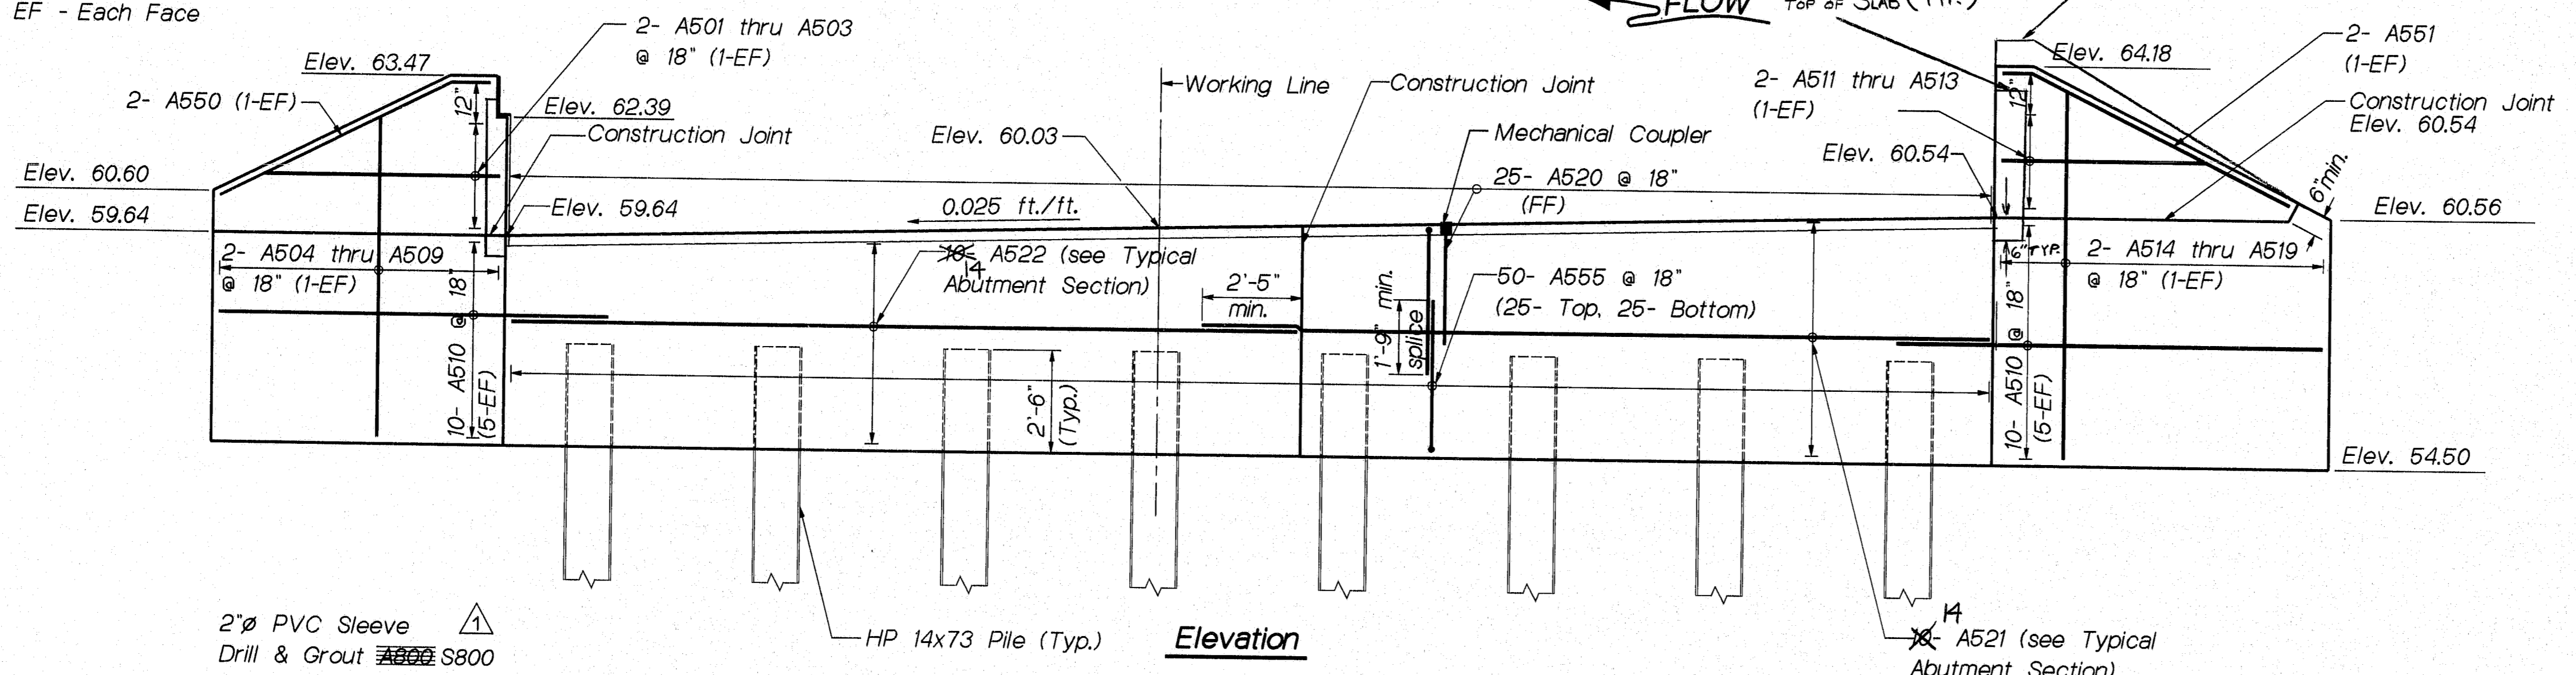


Elevation

- Abutment Notes**
- 1.- Reinforcing steel shall have two inches minimum cover unless otherwise noted.
 - 2.- All exposed edges of concrete shall be chamfered 1" except as noted.
 - 3.- Maximum calculated pile loads: 112 Kips per pile.
 - 4.- Estimate of piles required:
 Abutment #1 - 8~ HP14x73 @ 50 feet
 Abutment #2 - 8~ HP14x73 @ 50 feet
 - 5.- Piles shall not be out of position shown on plans by more than 3 inches.
 - 5.- For construction and contraction joint details see BD501-93 of the Standard Details.
 - 7.- The top portion of the wings shall be placed after the erection of the prestressed box beams.
 - 8.- Protective coating will be applied to all exposed surfaces of wings above finished grade.
 - 9.- Concrete retaining wall shall be faced with granite masonry within the limits shown on the plans and paid for under Item 525.34, Granite Masonry Facing.
 - 10.- For pile splice details see BD501-93 of the Standard Details.
 - 11.- The ultimate HP 14x73 pile capacity required is 336 kips.
 - 12.- Dynamic and static tests will not be required.
 - 13.- The wave equation analysis shall be performed as directed by the Engineer.
 - 14.- Removal of timber cribs and stones where necessary to drive piles shall be considered incidental to Item 202.19, Removing Existing Bridge.

NOTE:
 Grades parallel to
 Q Construction

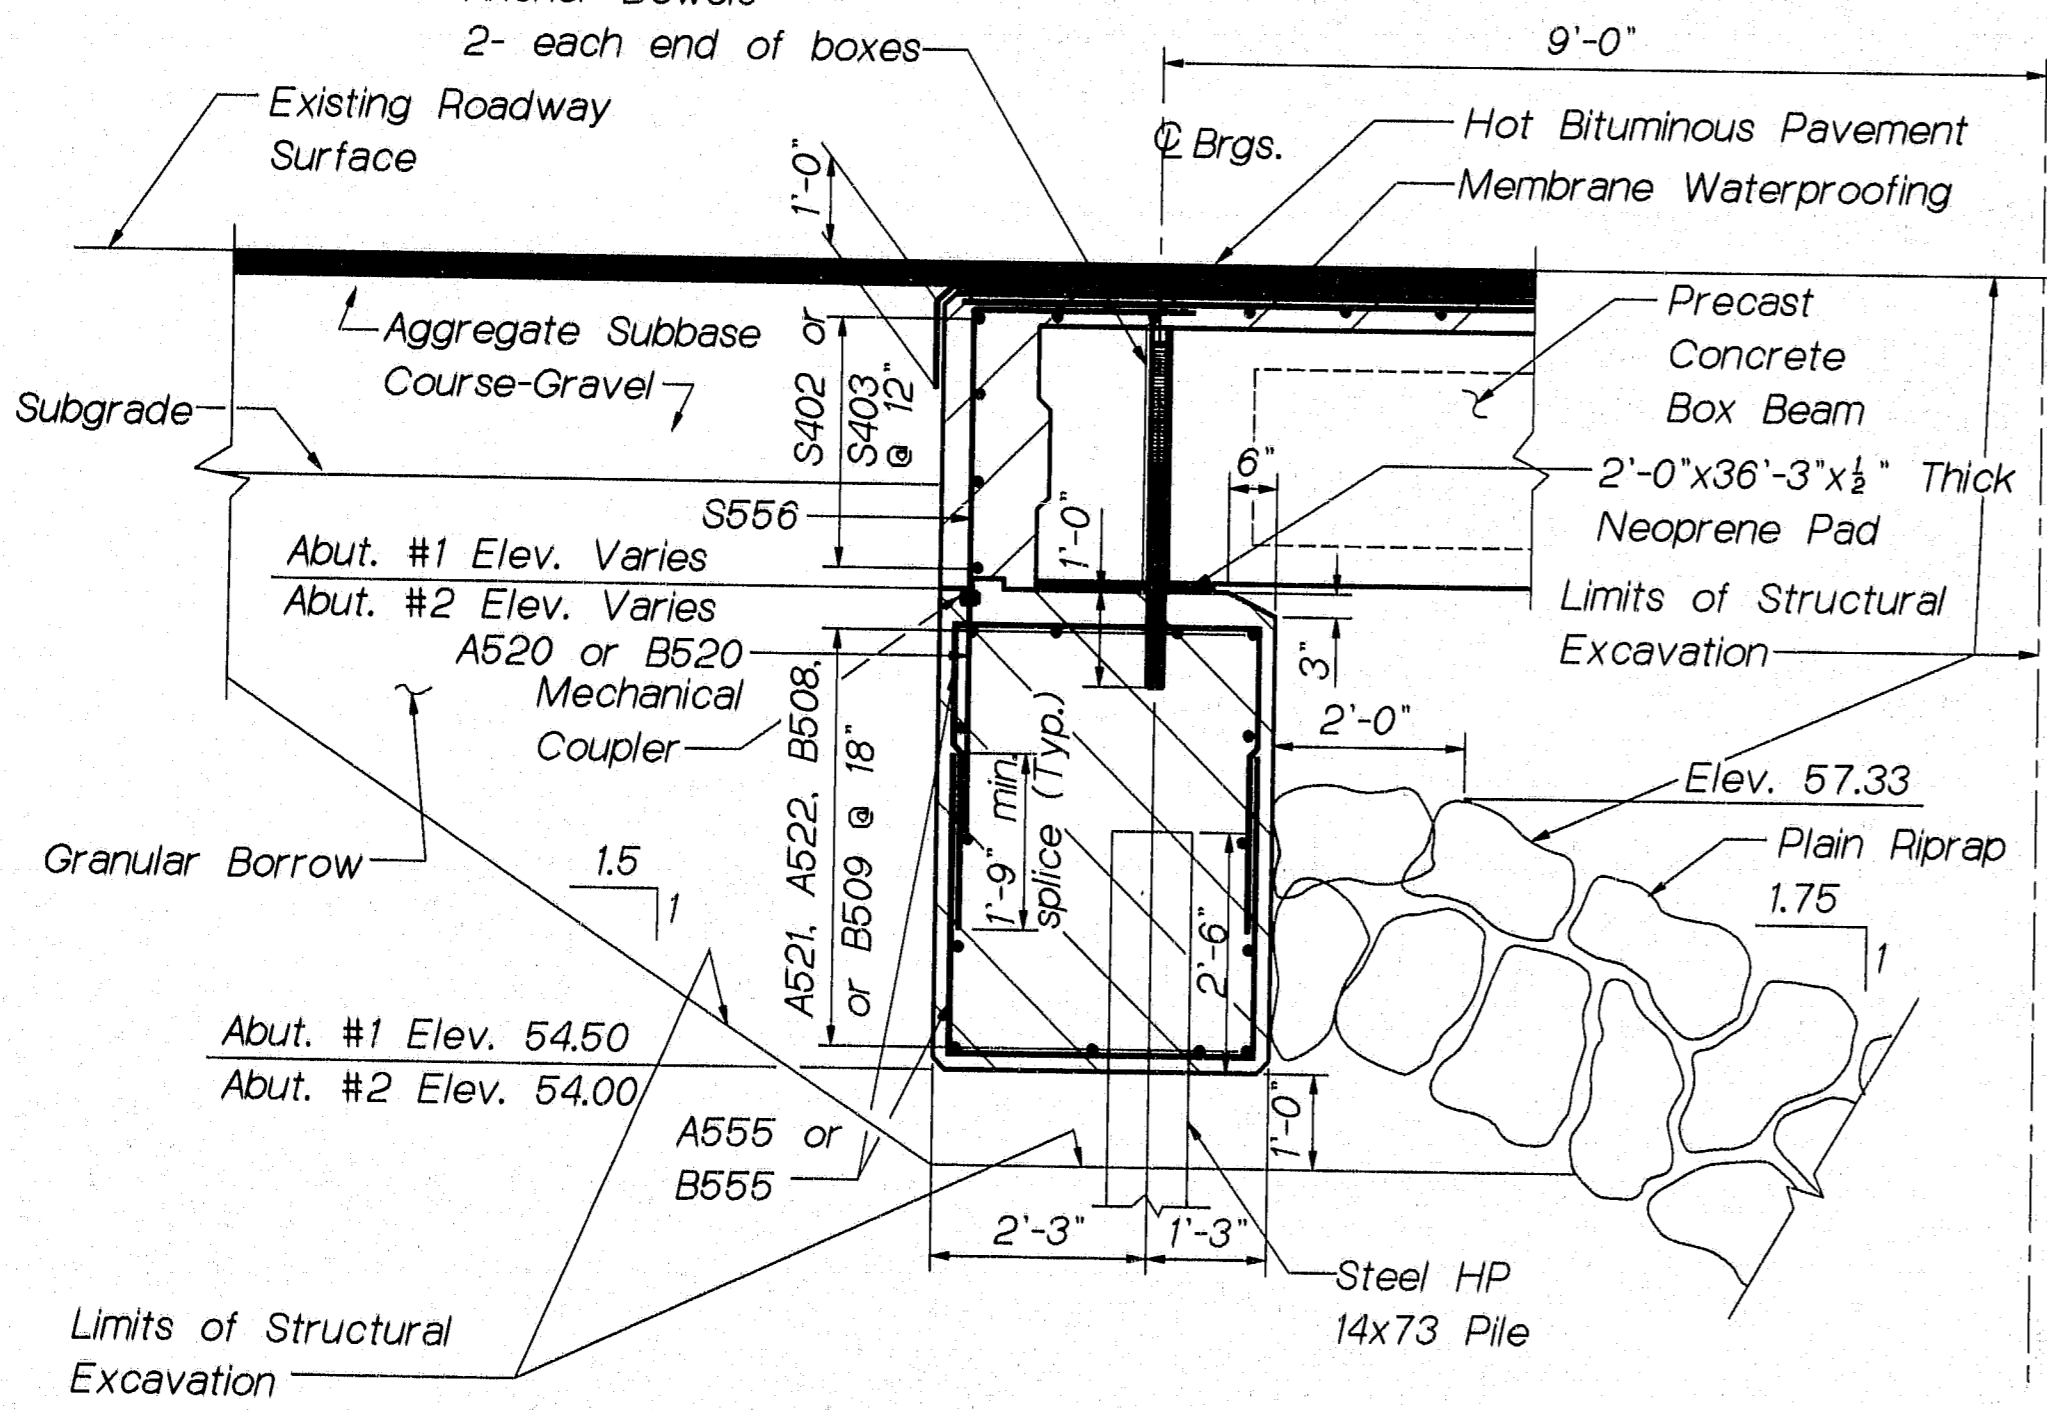


Typical Abutment Section
 (Abutment #1 shown)

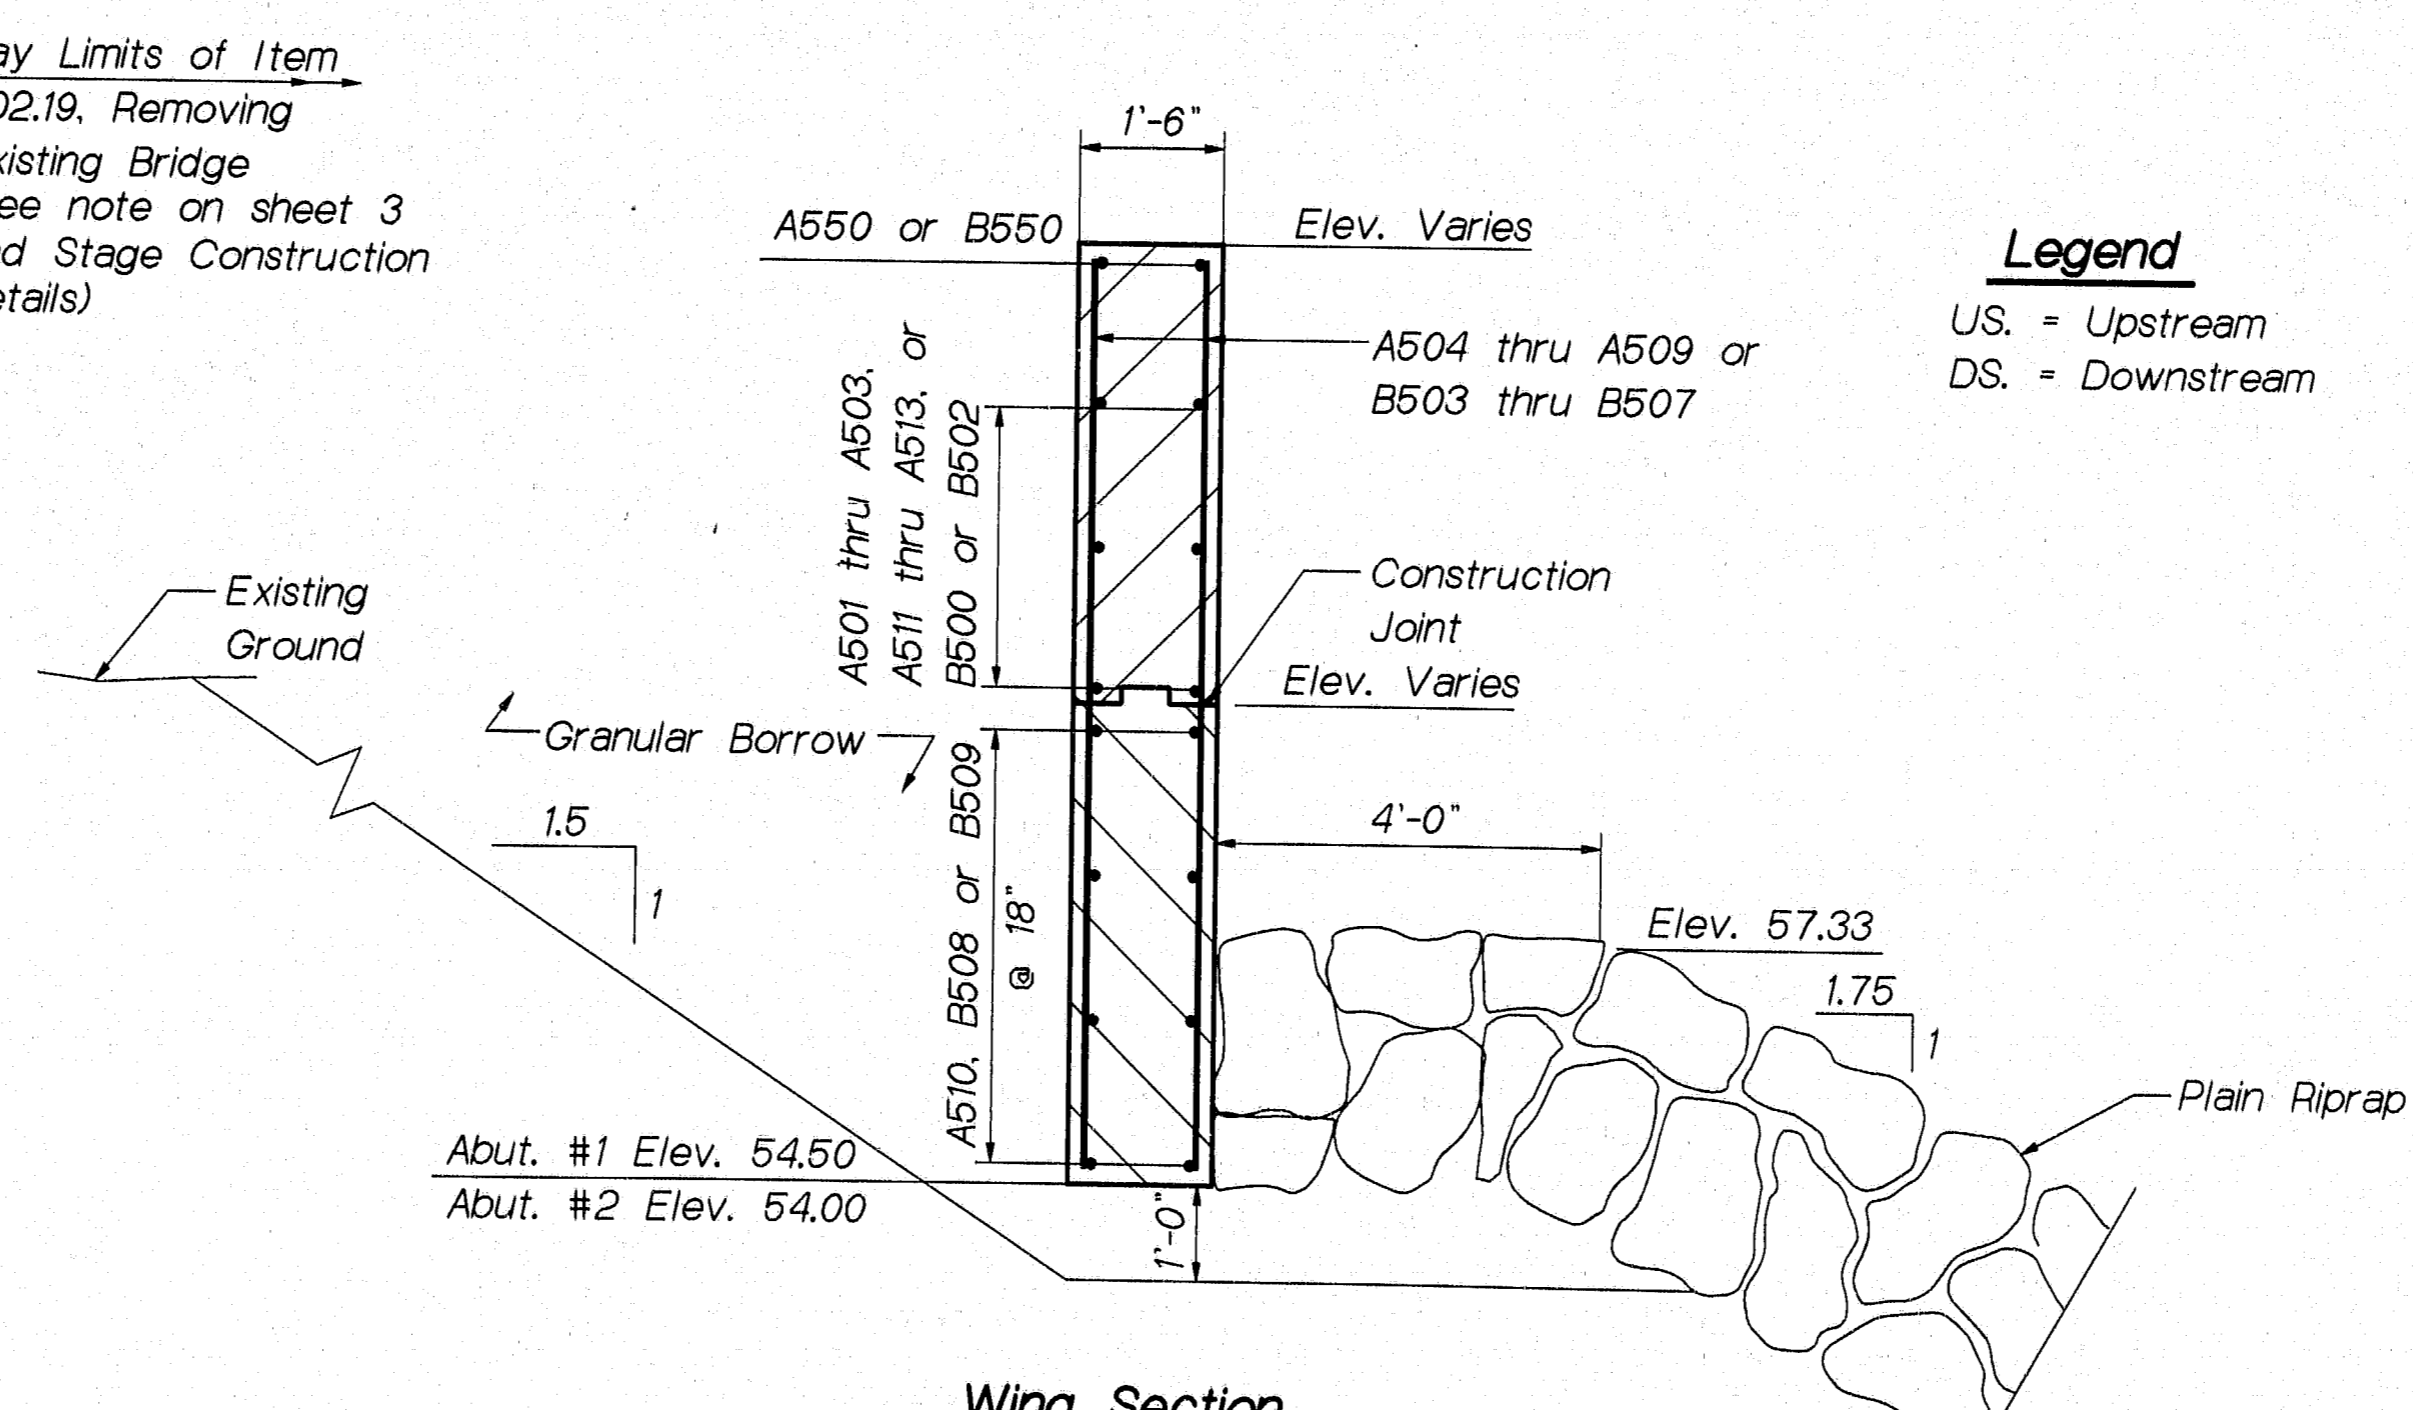

Wing Section
 (Abut. #1 DS. Wing shown,
 other wings similar)

Legend
 US. = Upstream
 DS. = Downstream

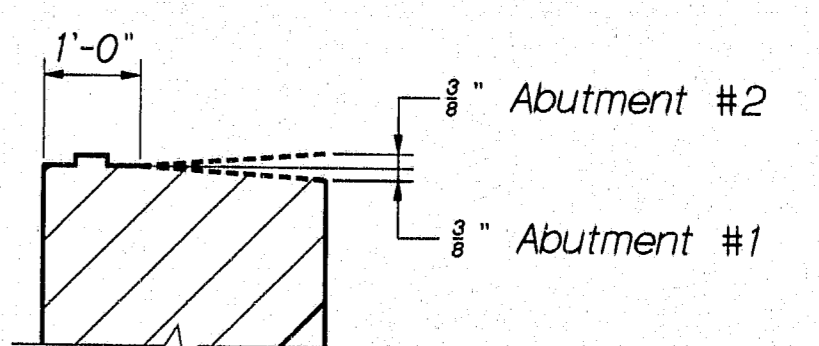

Bridge Seat Section

109-256

STATE OF MAINE
 DEPARTMENT OF TRANSPORTATION
 HOTEL BRIDGE 109
 OVER
 DAVIS STREAM
 IN THE TOWN OF
 JEFFERSON
 LINCOLN COUNTY
 ABUTMENT #1

REVISION	DESCRIPTION	DATE
1	Revised Reber Number	2-9-94





SHEET OF AUGUSTA, MAINE Jan., 1994

PROJECT ENGINEER	DATE
BY MKD	10-93
DESIGN-DETAILED	
CHECKED	
REVISIONS	
FIELD CHANGES	



18JAN94-010100

F.H.V.A. RES. NO.	STATE	PROJECT NUMBER	SHEET NO.	TOTAL SHEETS
1	MAINE	BR-034PX(1)X	9	37

Pin 004220.00

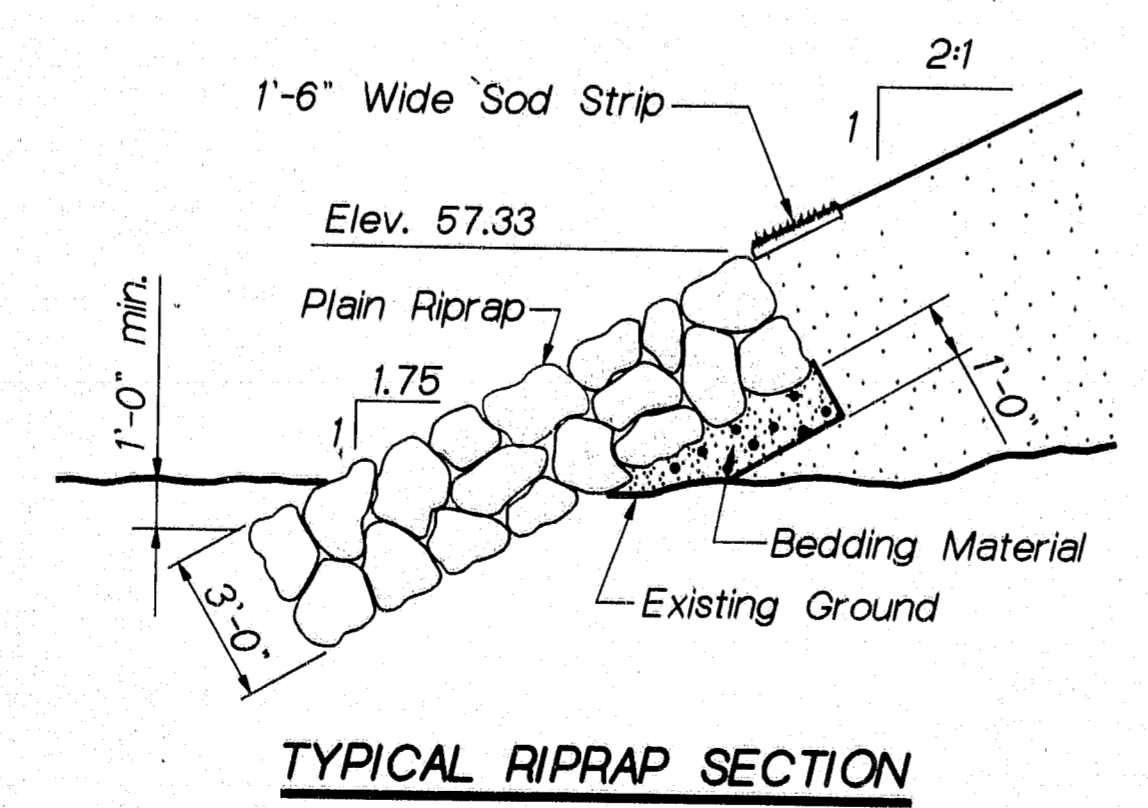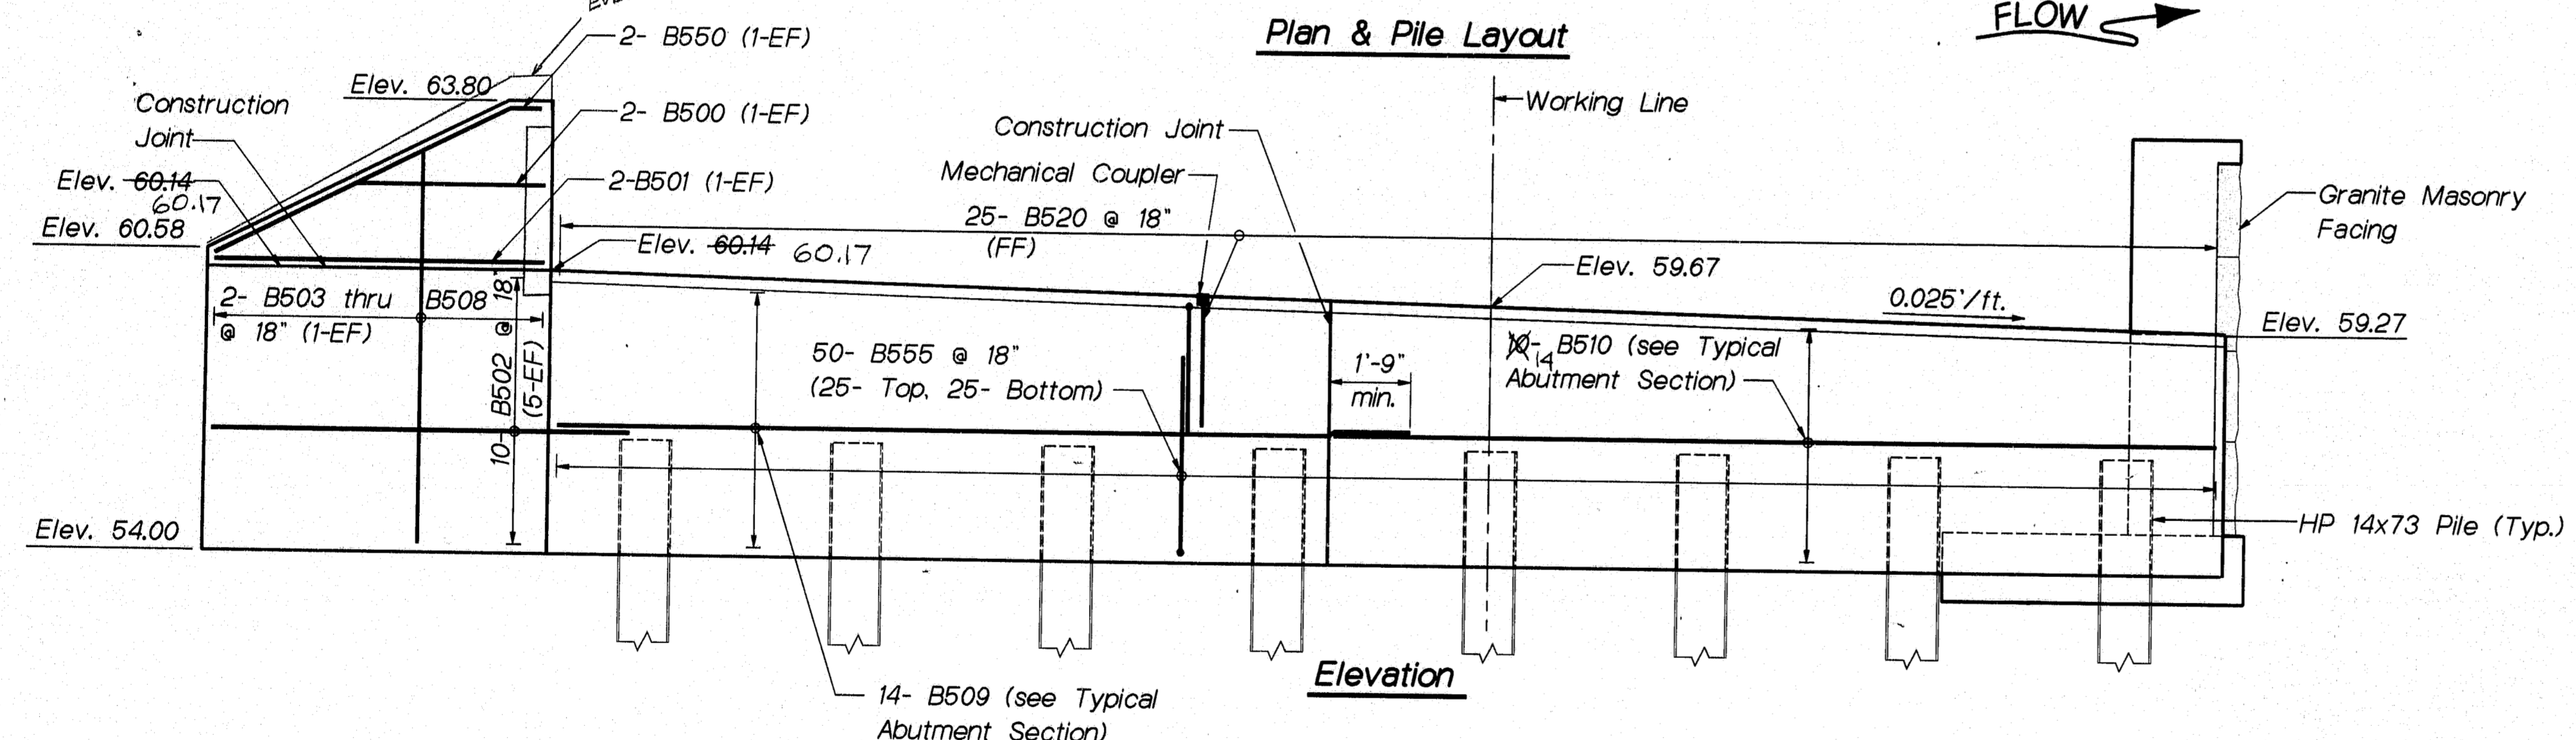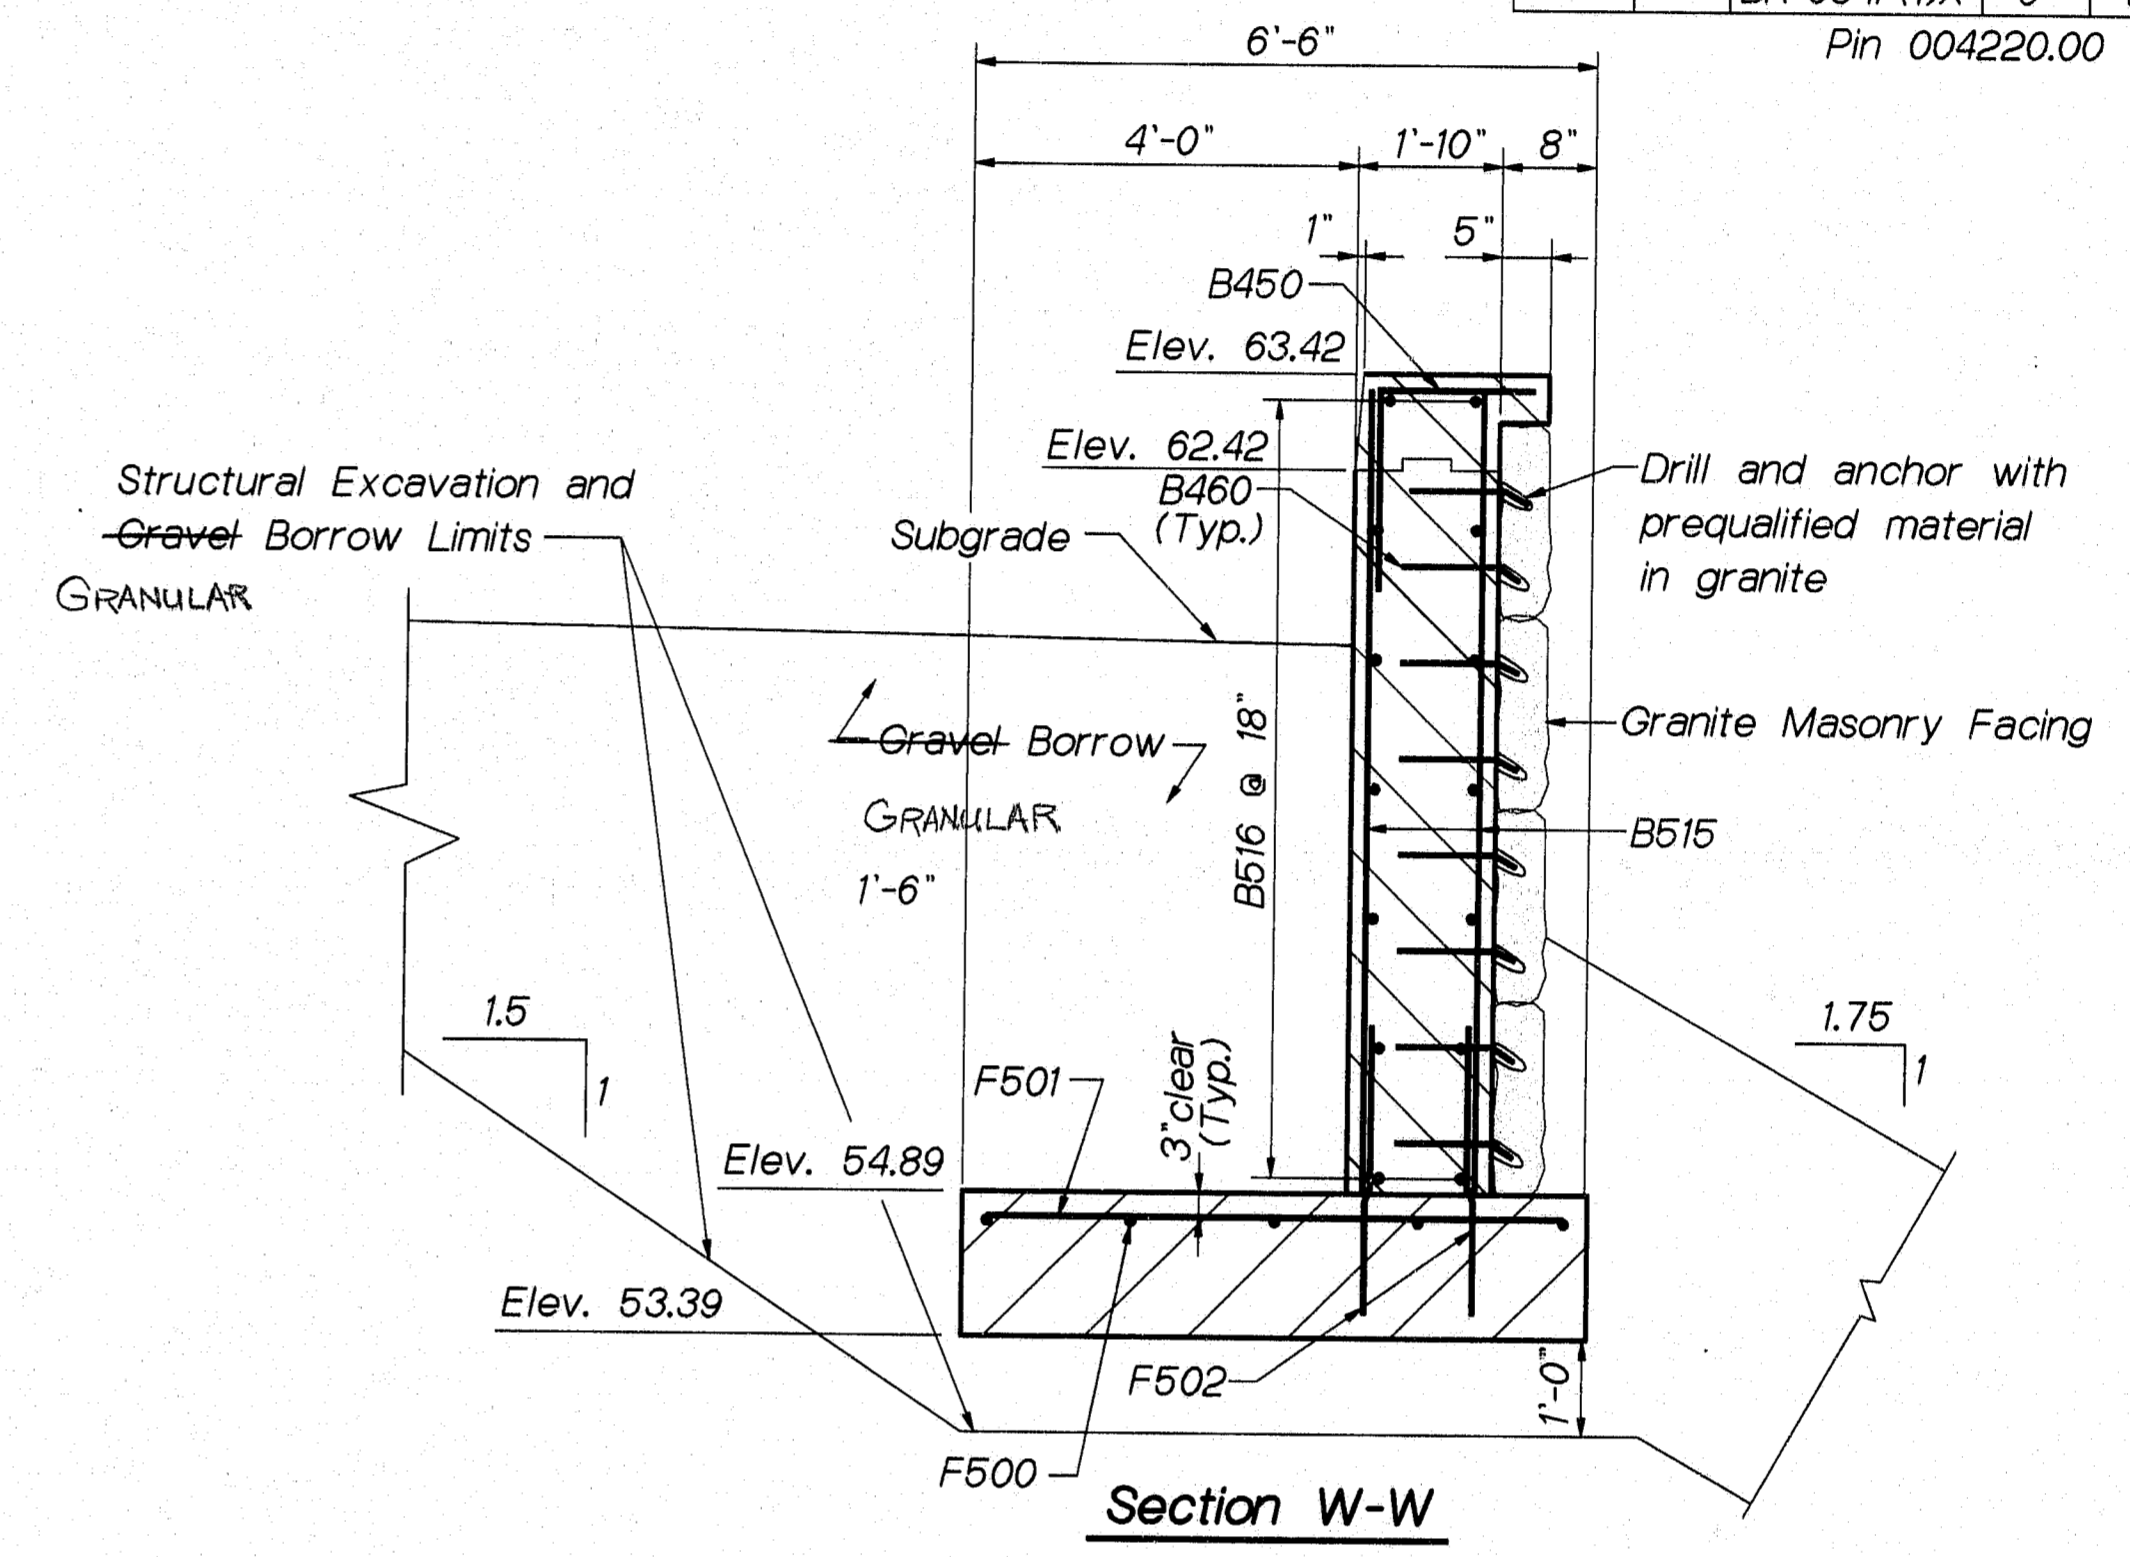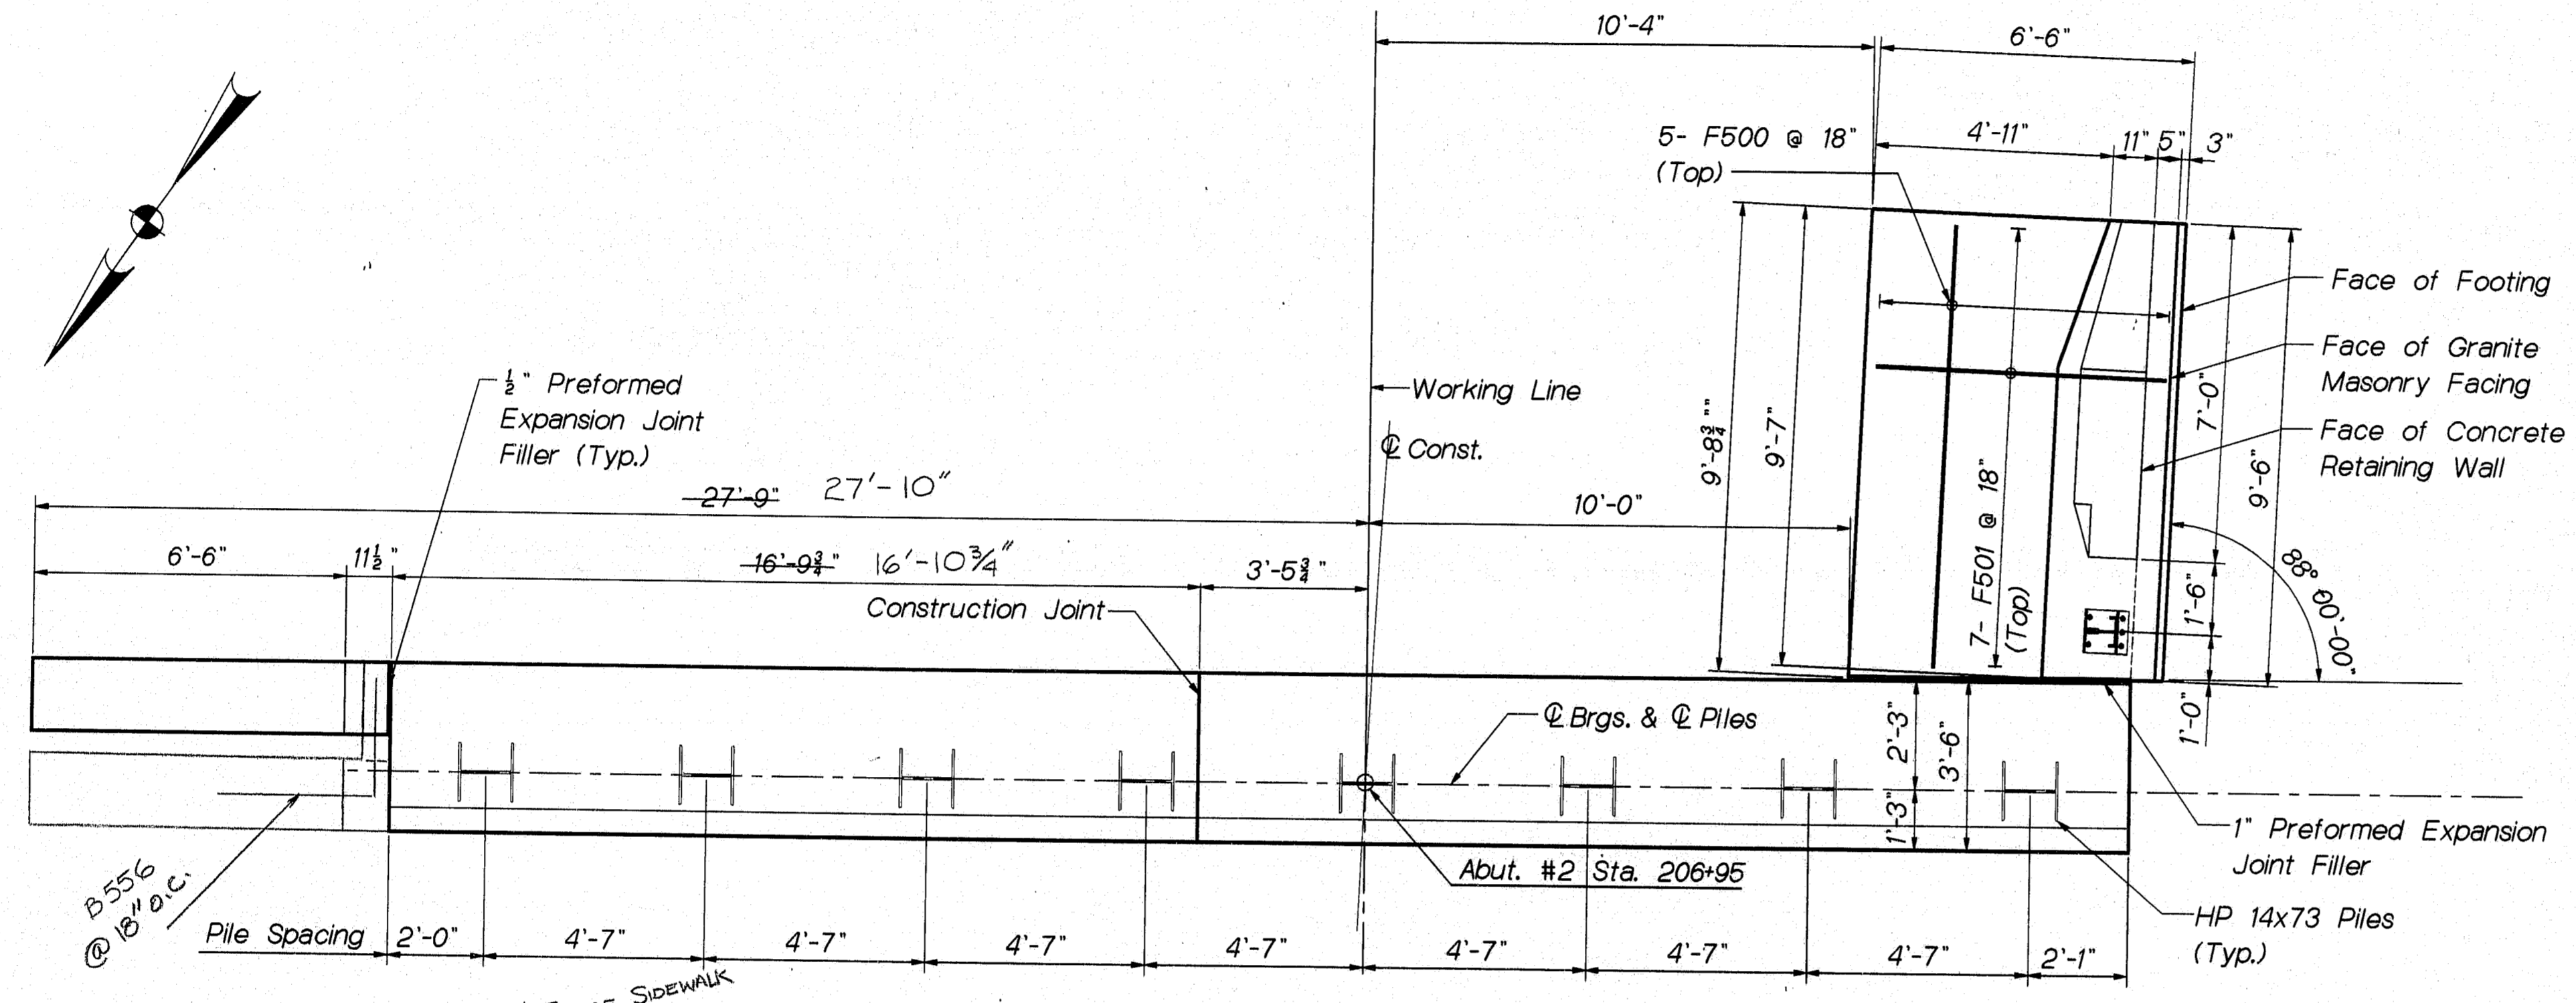

Legend
 NF - Near Face
 FF - Far Face
 EF - Each Face

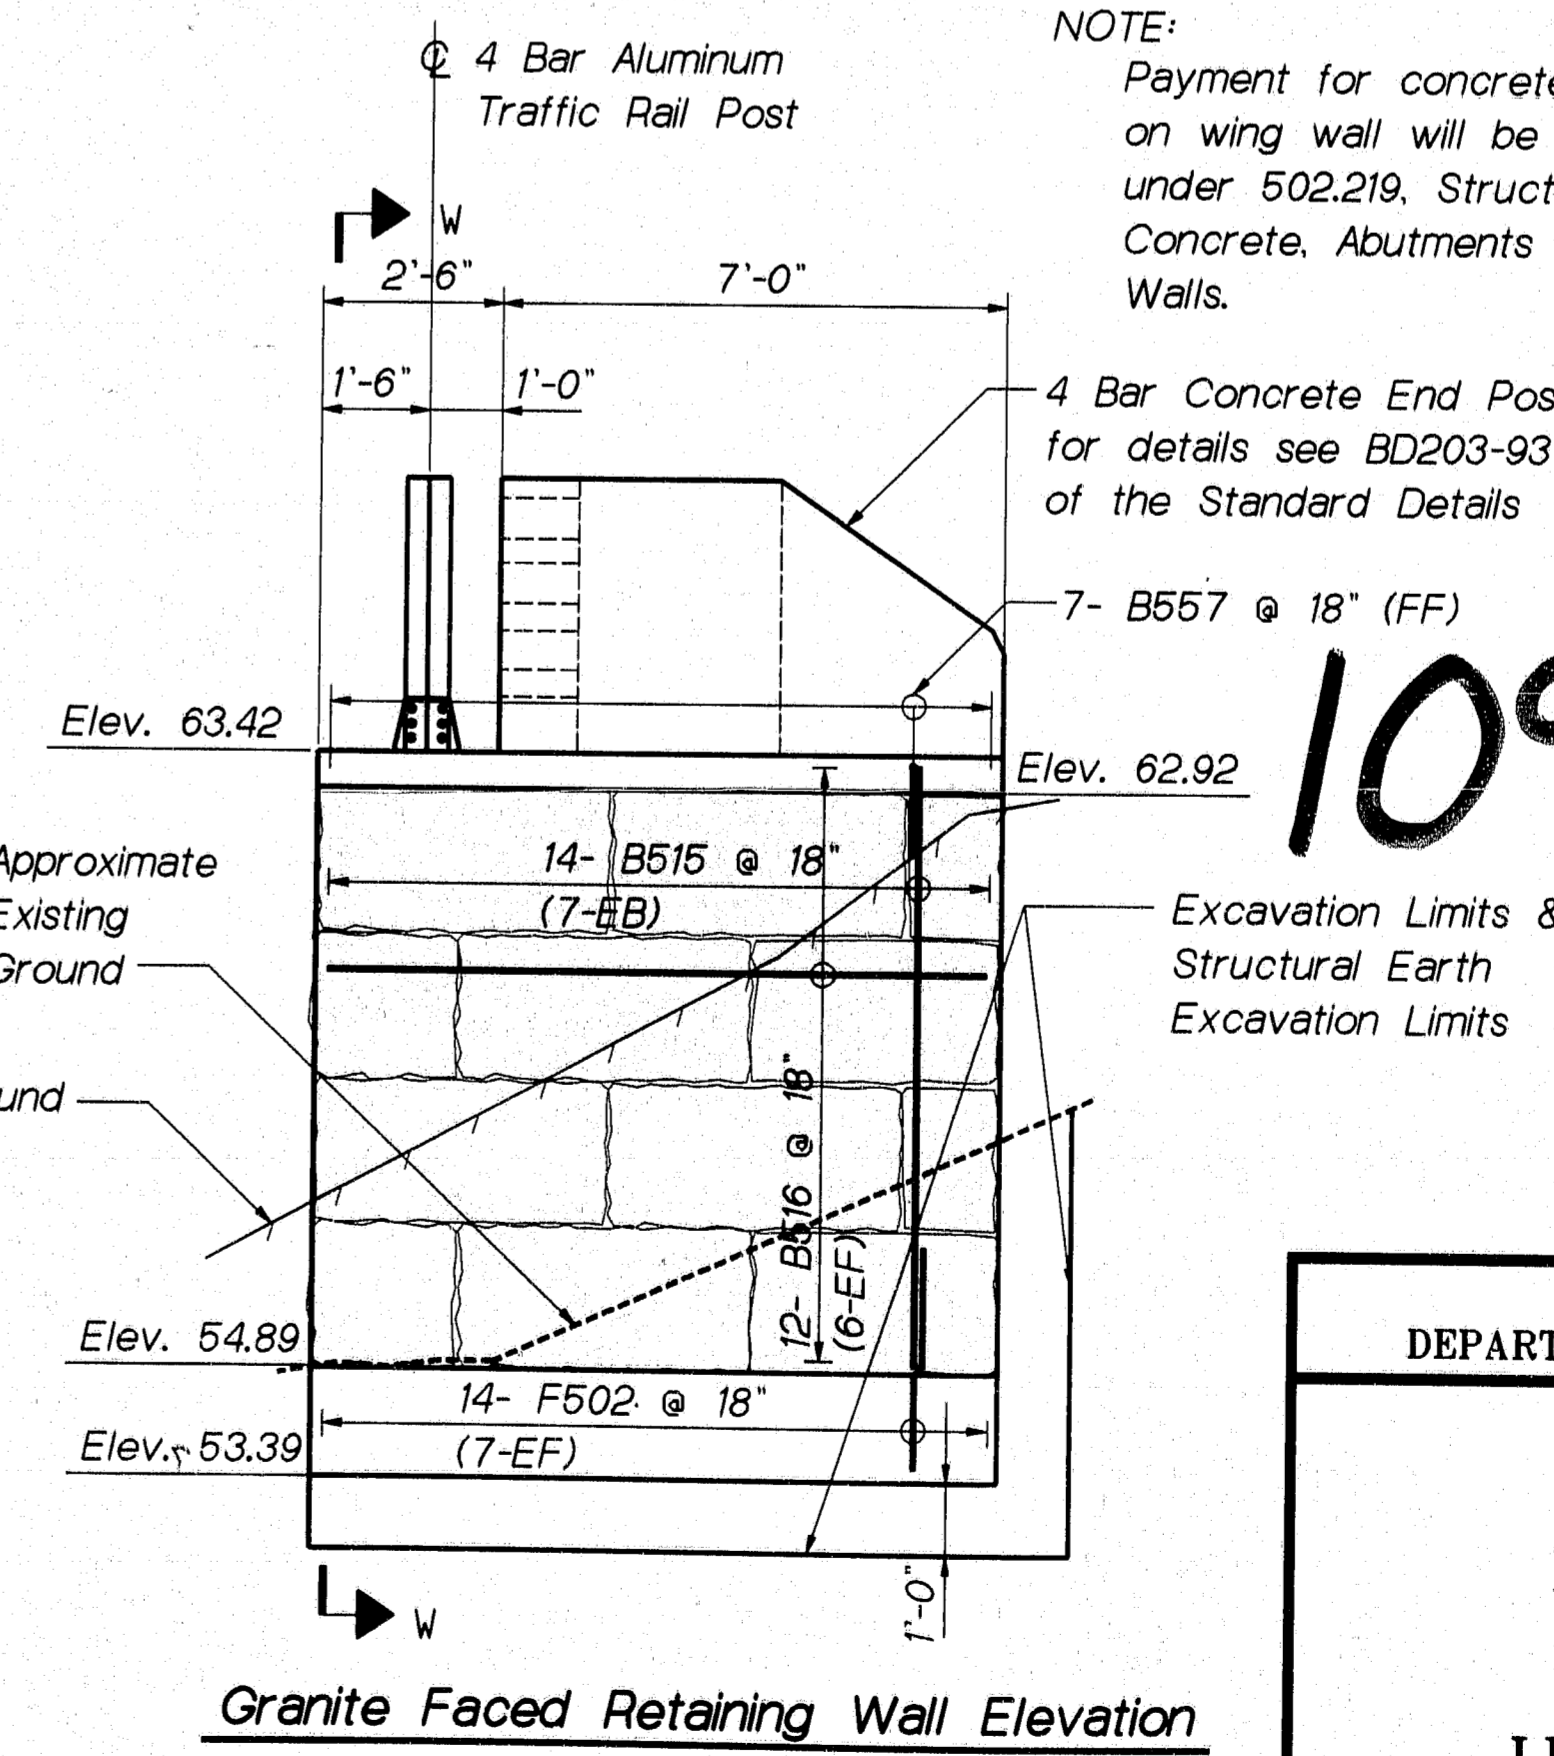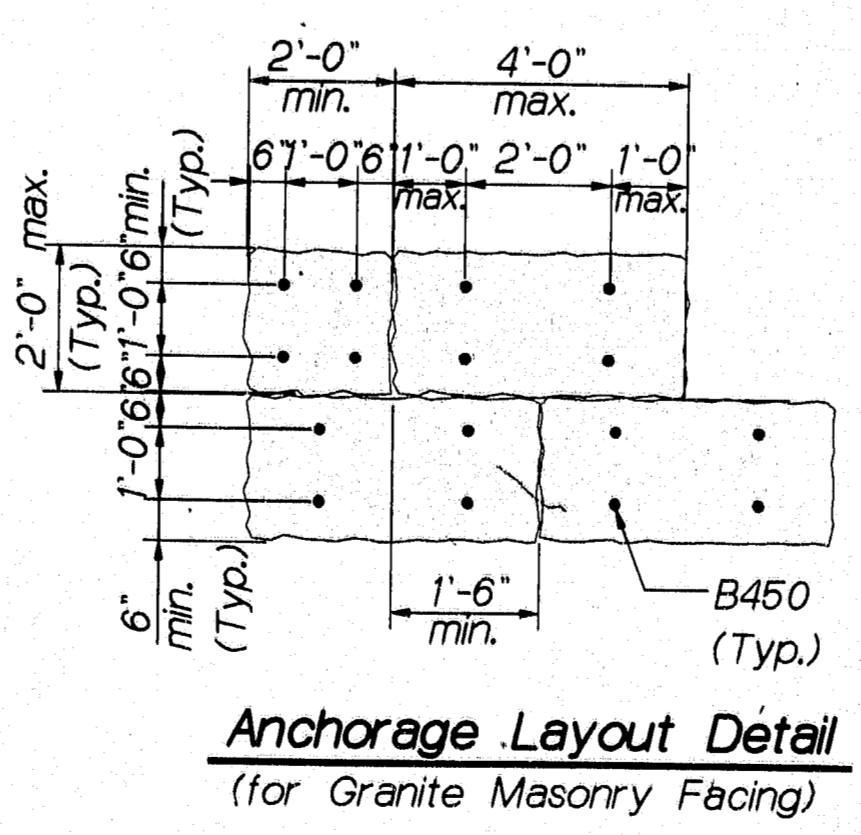

NOTE:
 Payment for concrete end post on wing wall will be paid for under 502.219, Structural Concrete, Abutments & Retaining Walls.

109-257

For Abutment Details not shown see sheet 8 of 31.

STATE OF MAINE
 DEPARTMENT OF TRANSPORTATION

HOTEL BRIDGE 110
 OVER
 DAVIS STREAM
 IN THE TOWN OF
 JEFFERSON
 LINCOLN COUNTY
 ABUTMENT #2

SHEET OF AUGUSTA, MAINE Jan., 1994


PROJECT DESIGN ENGINEER	DATE
BY MKD	10-88
DESIGN-DETAILED	
CHECKED	
REVISIONS	
FIELD CHANGES	

04JAN84-010.100

F.H.S.A. RES. NO.	STATE	PROJECT NUMBER	SHEET NO.	TOTAL SHEETS
1	MAINE	BR-034P(1)X	10	31
Pin 004220.00				


Prestressed Structural Concrete Box Beam Notes

- 1- The minimum compressive strength of prestressed concrete at the age of 28 days shall be 6000 psi. Minimum compressive strength at transfer of prestressing force shall be 4000 psi.
- 2- Pretensioning steel shall consist of Low Relaxation seven wire strands, Grade 270 with a nominal diameter of one-half inch. The initial tensile force applied to each strand shall be 31,000 lbs.
- 3- The debonding sheaths shall be as approved by the Engineer. Debonded strands will be sheathed for a length of 3'-6" from the end of beam.
- 4- Payment for reinforcing steel for concrete box beams shall be considered incidental to Item 535.62, Prestressed Structural Concrete Box Beams.

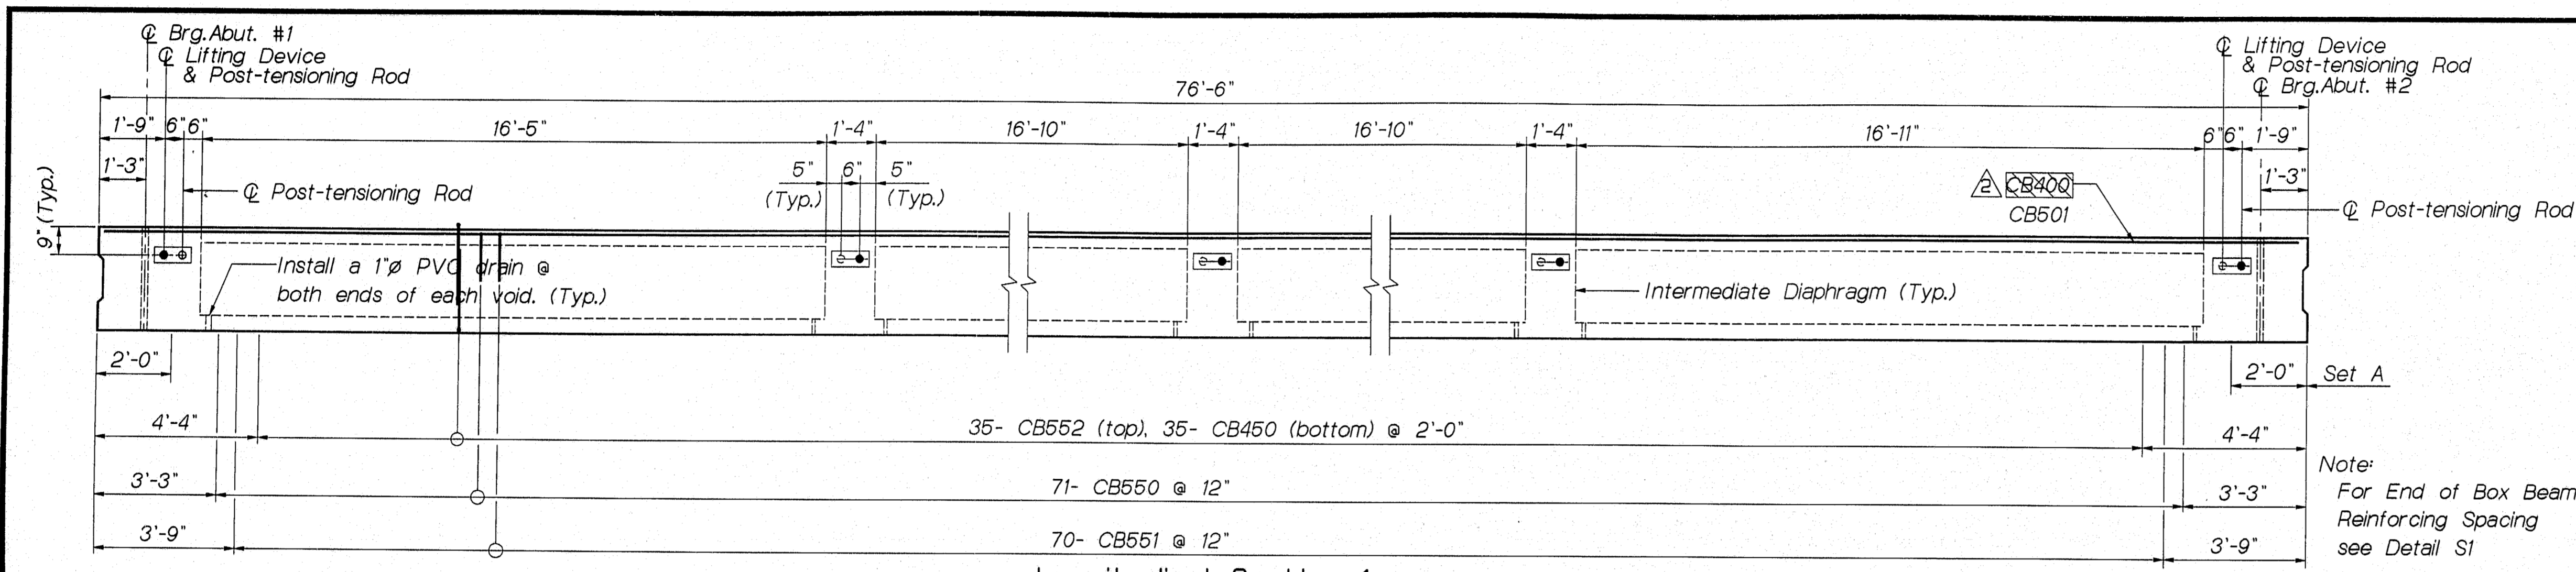


Longitudinal Section 1
Type 1 - Box Beams
(1- Exterior & 4- Interior Required)
76'-6"

•• Rods only through Type 1
• Rods through Type 1 & 2

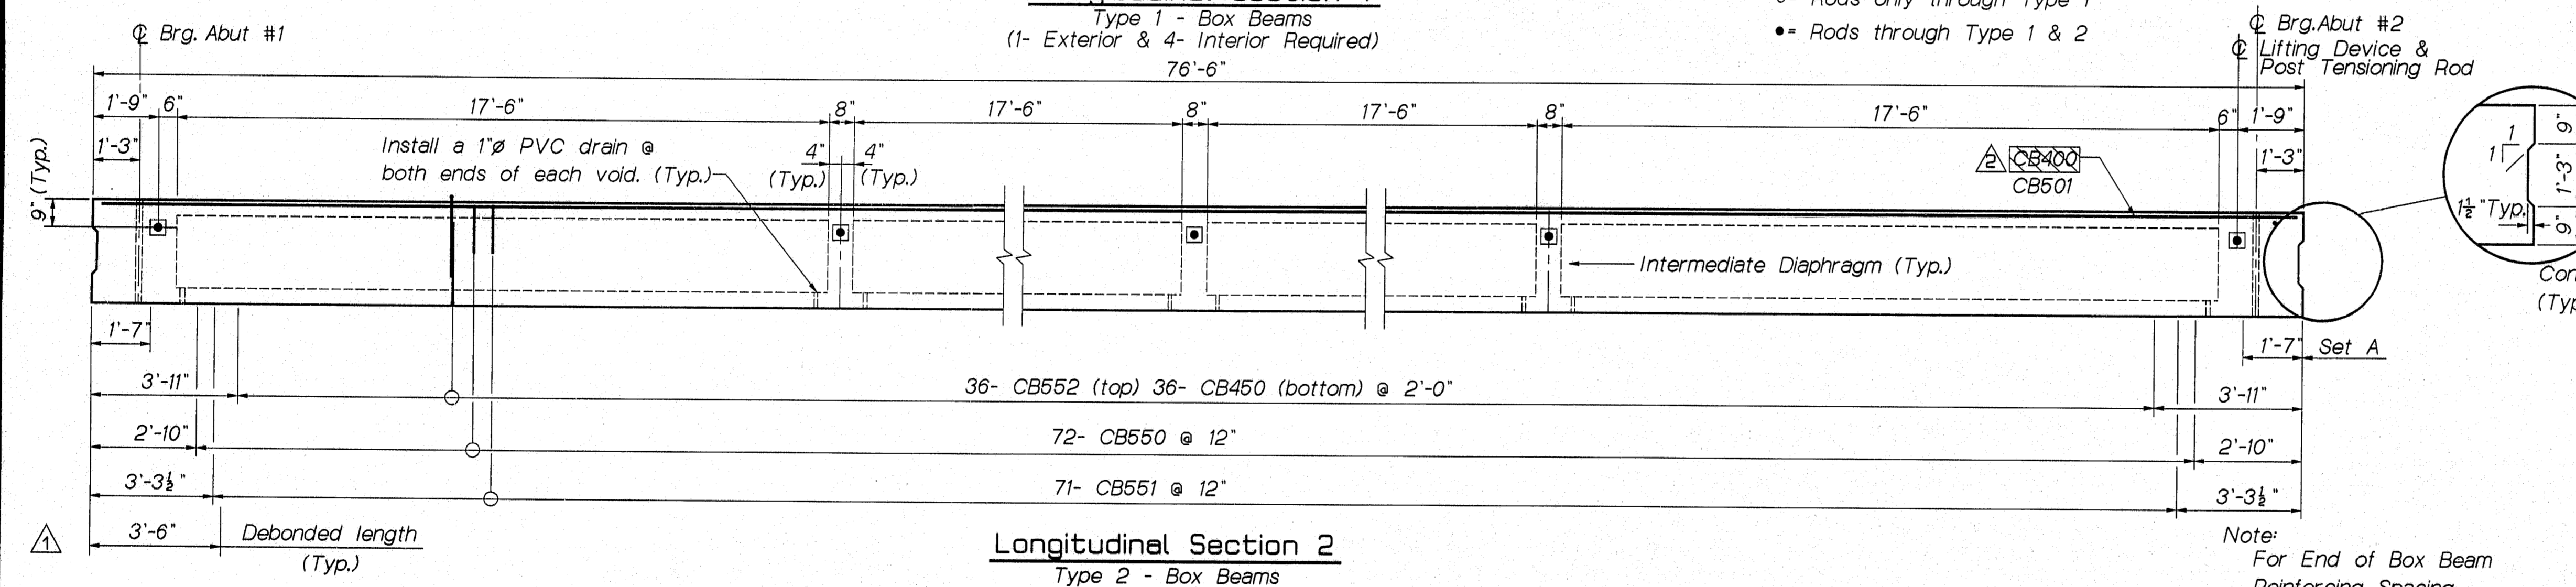


Longitudinal Section 2
Type 2 - Box Beams
(1- Exterior & 3- Interior Required)
76'-6"


Note:
For End of Box Beam
Reinforcing Spacing
see Detail S2

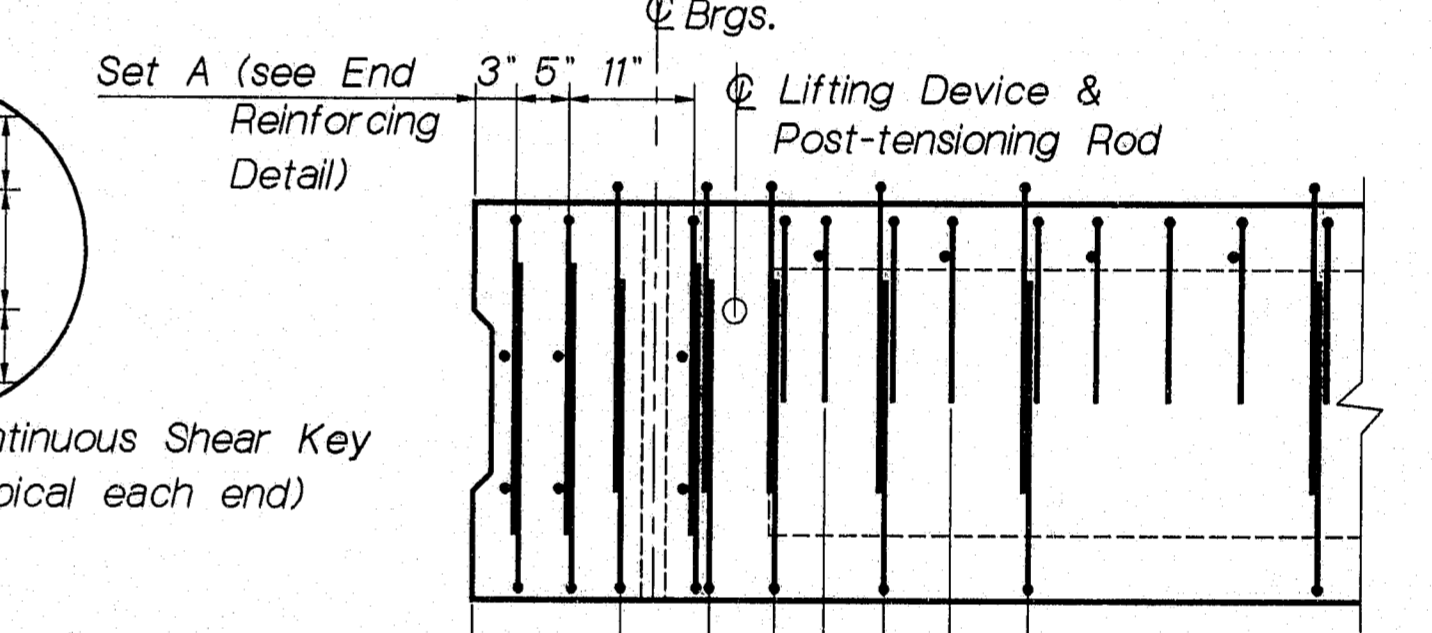


Spacing for CB552 & CB450 1'-0" 8" 6" 9" 1'-0" See Longitudinal Section Type 2 (Typ.)
Spacing for CB550 2'-1" 9"
Spacing for CB551 & CB500 2'-5" 10 1/2"

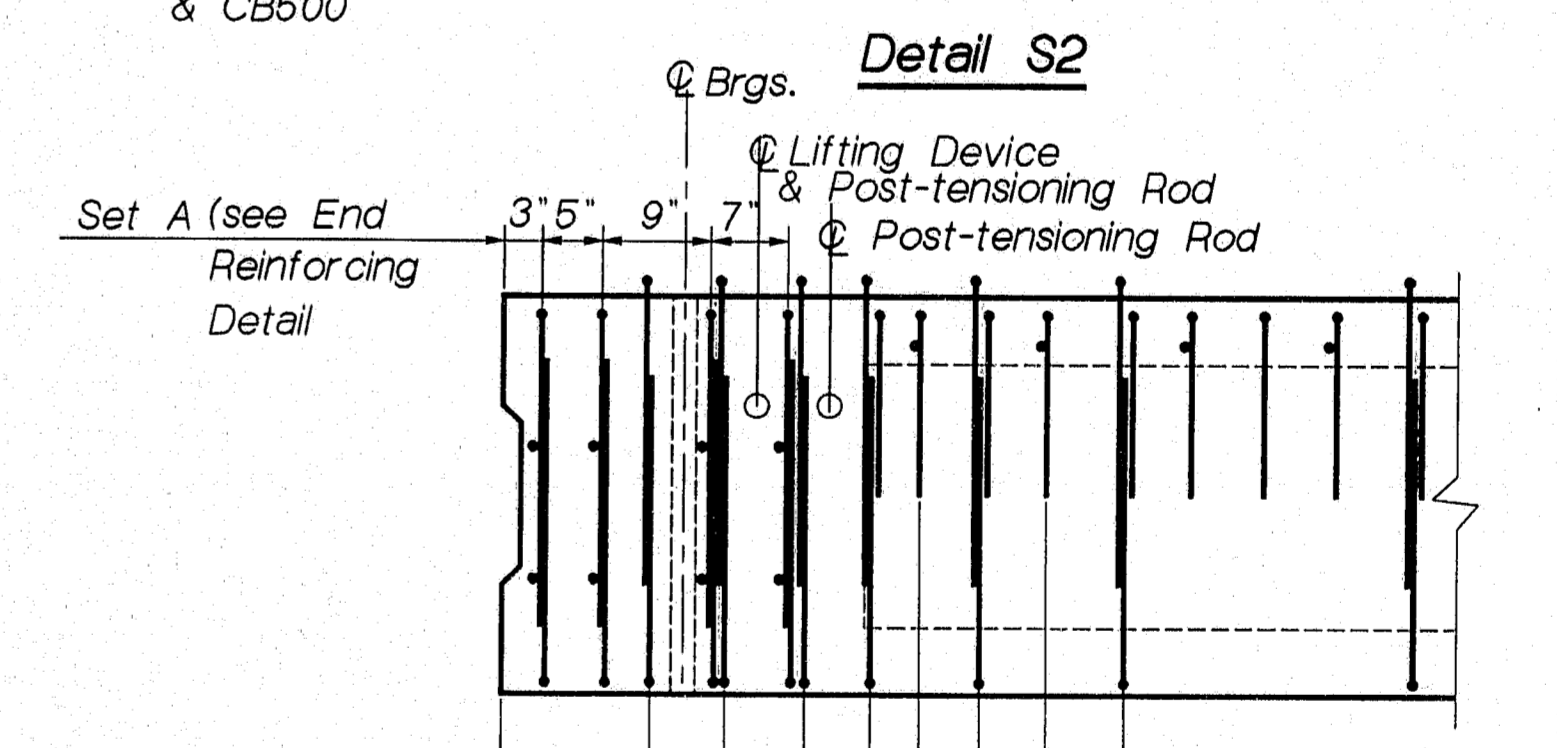


Spacing for CB552 & CB450 1'-0" 6 1/2" 6 1/2" 6" 9" 1'-0" See Longitudinal Section Type 1 (Typ.)
Spacing for CB550 2'-6" 9"
Spacing for CB551 & CB500 2'-10 1/2" 10 1/2"

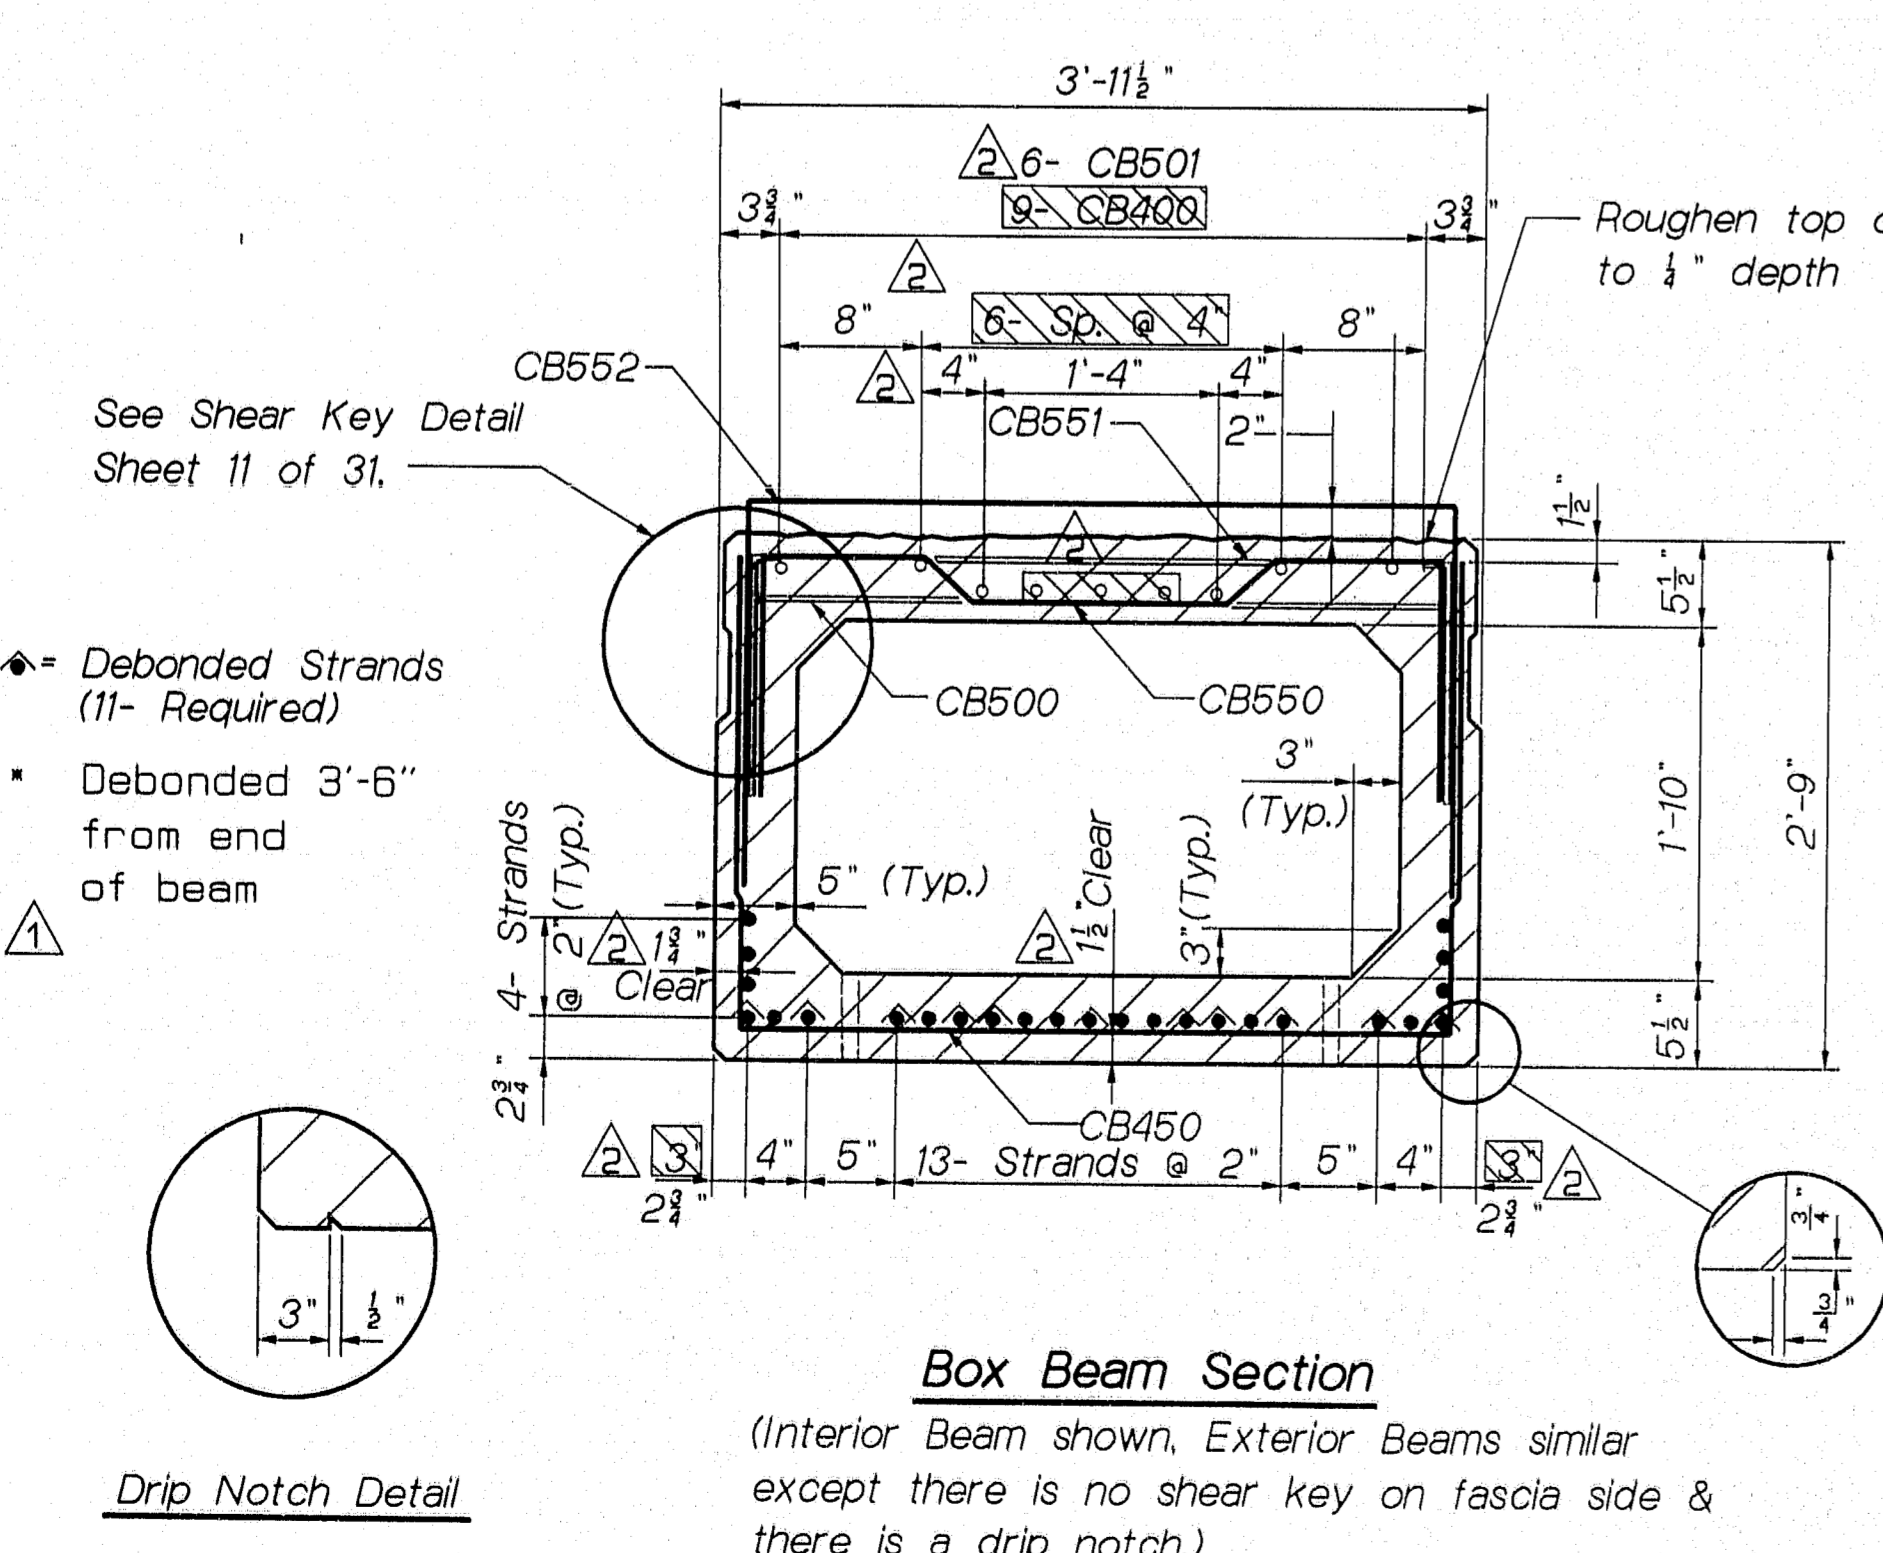

Box Beam Section
(Interior Beam shown, Exterior Beams similar except there is no shear key on fascia side & there is a drip notch.)

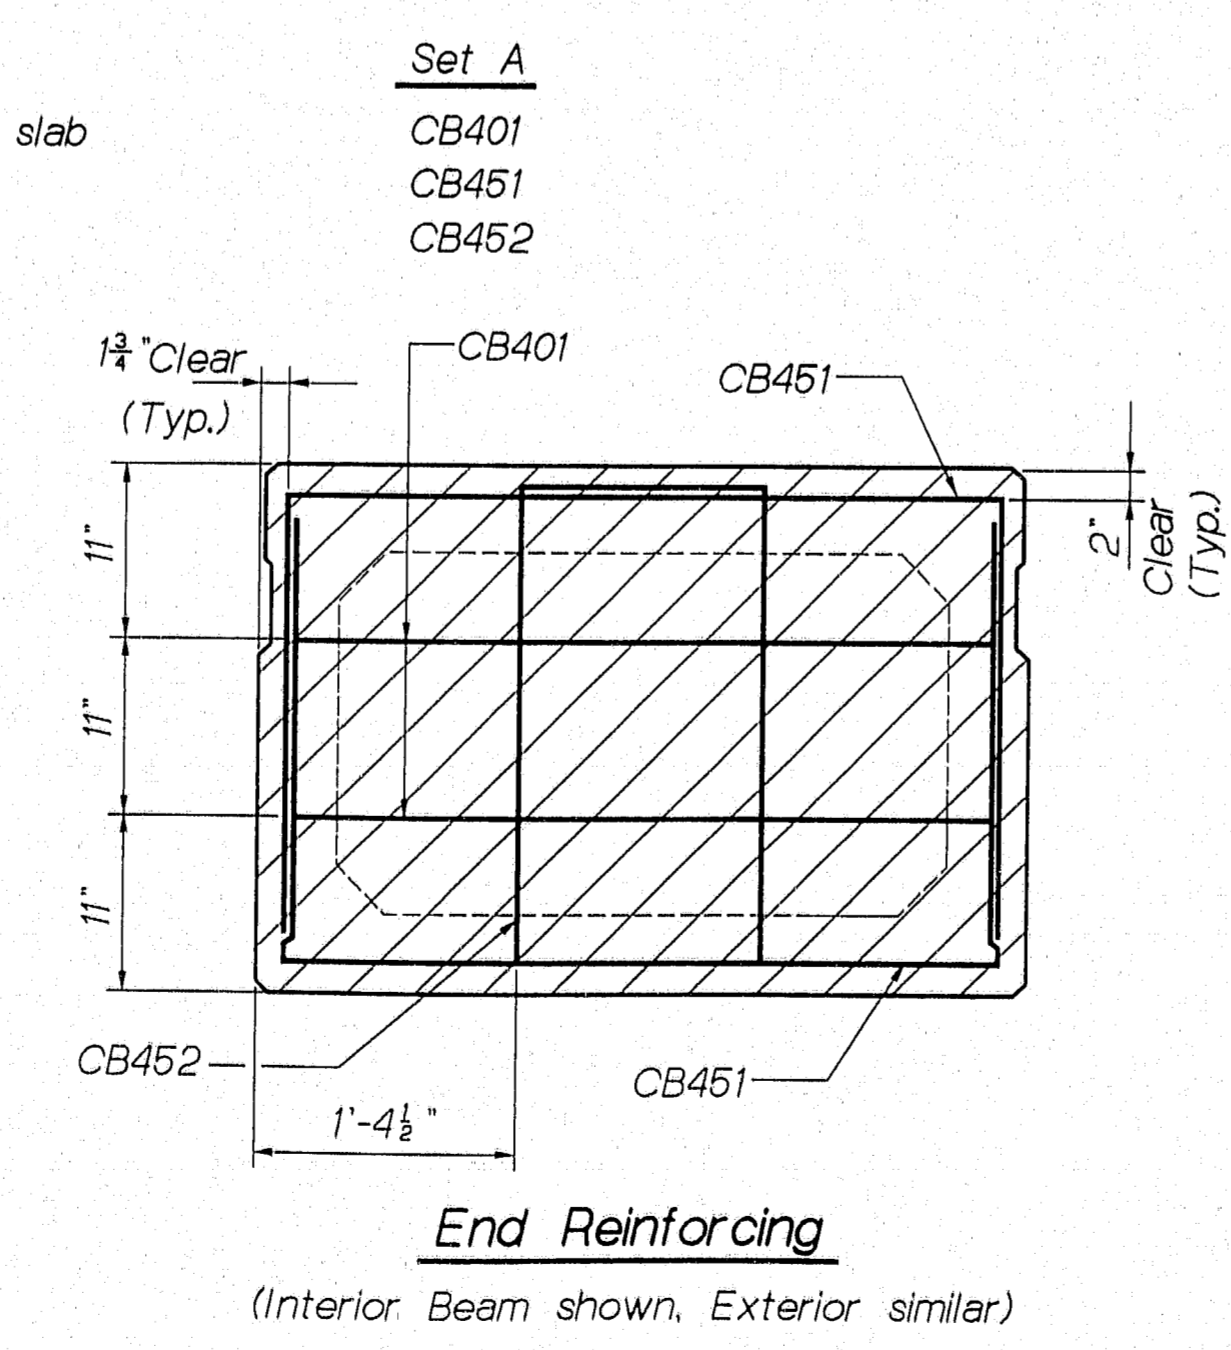

End Reinforcing
(Interior Beam shown, Exterior similar)

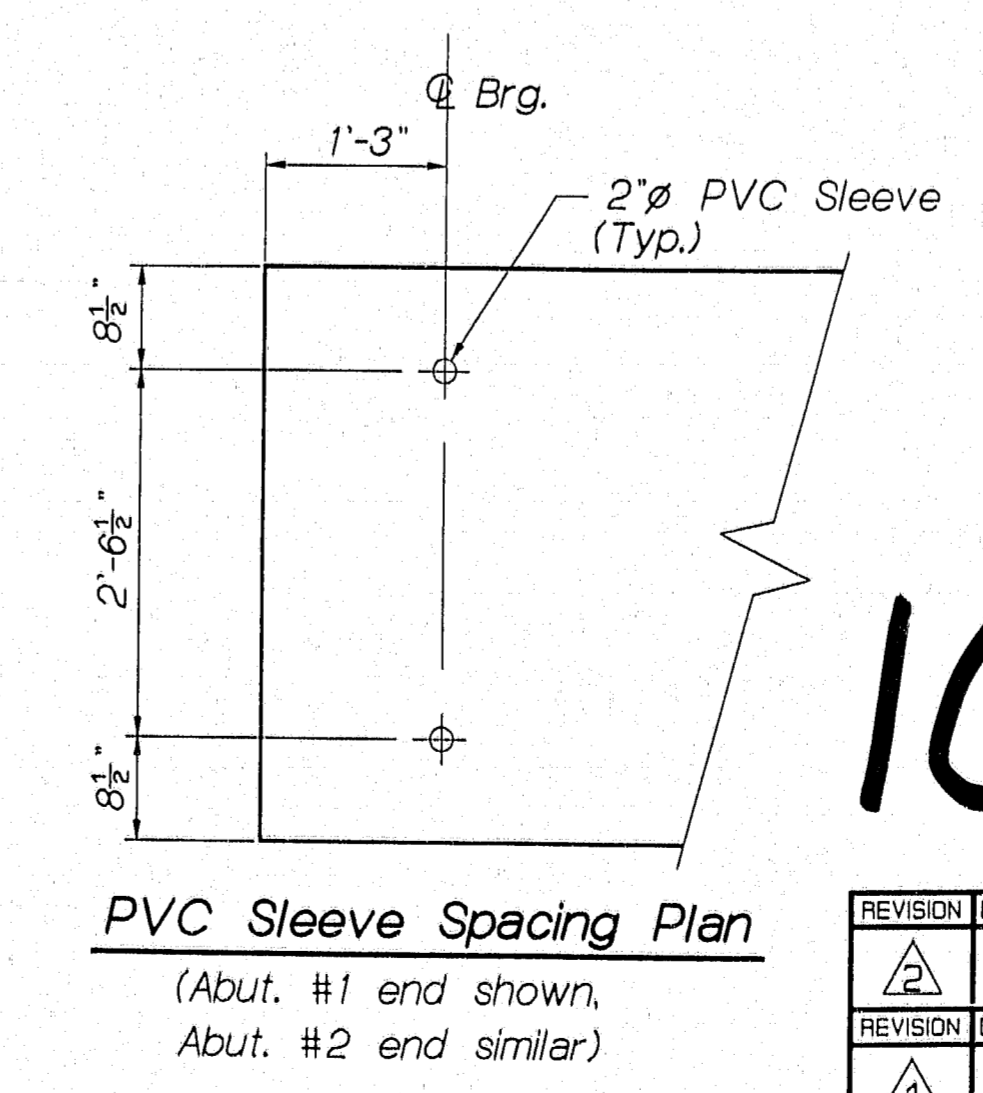

PVC Sleeve Spacing Plan
(Abut. #1 end shown, Abut. #2 end similar)

PROJECT DESIGN ENGINEER	DATE
BY MKO	10-93
DESIGN-DETAILED	
CHECKED	
REVISIONS	
FIELD CHANGES	

10JUNSA-0100050

109-258

STATE OF MAINE
DEPARTMENT OF TRANSPORTATION


HOTEL BRIDGE
OVER
DAVIS STREAM
IN THE TOWN OF
JEFFERSON
LINCOLN COUNTY
PRESTRESSED STRUCTURAL CONCRETE
BOX BEAMS

SHEET OF AUGUSTA, MAINE Jan, 1994
JEFFERSON Jun 94


REVISION	DESCRIPTION	DATE
△	REINFORCING & DIMENSIONS	6-8-94
△	NOTES AND DIMENSIONS	1-26-94

F.M.V.A. REG. NO.	STATE	PROJECT NUMBER	SHEET NO.	TOTAL SHEETS
1	MAINE	BR-034P(1)X	11	31


Pin 004220.00

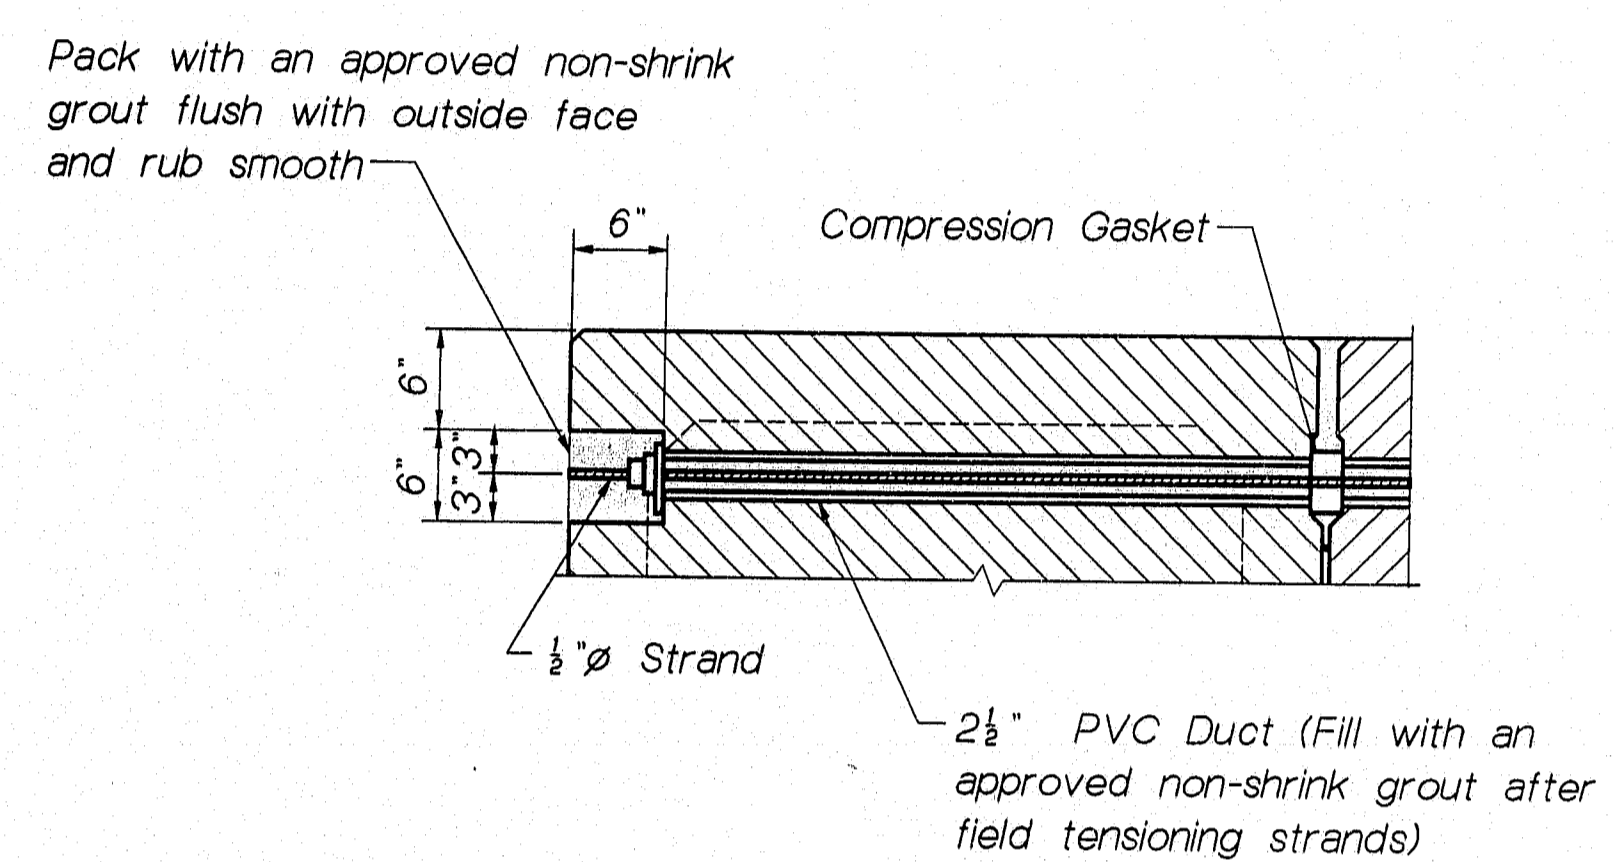


Post-Tensioning Detail

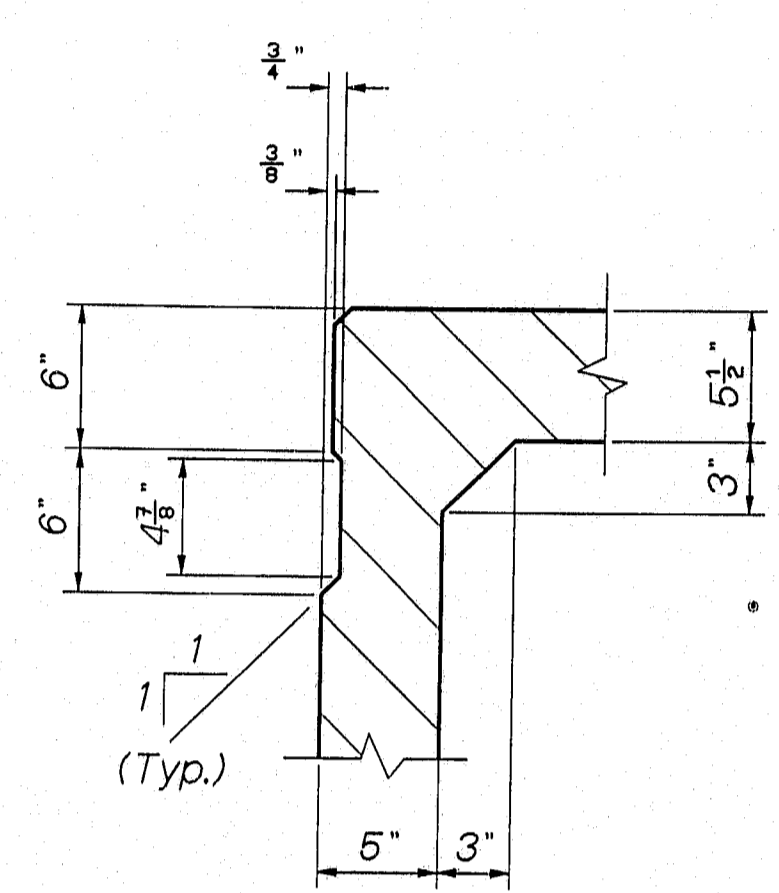

Shear Key Detail

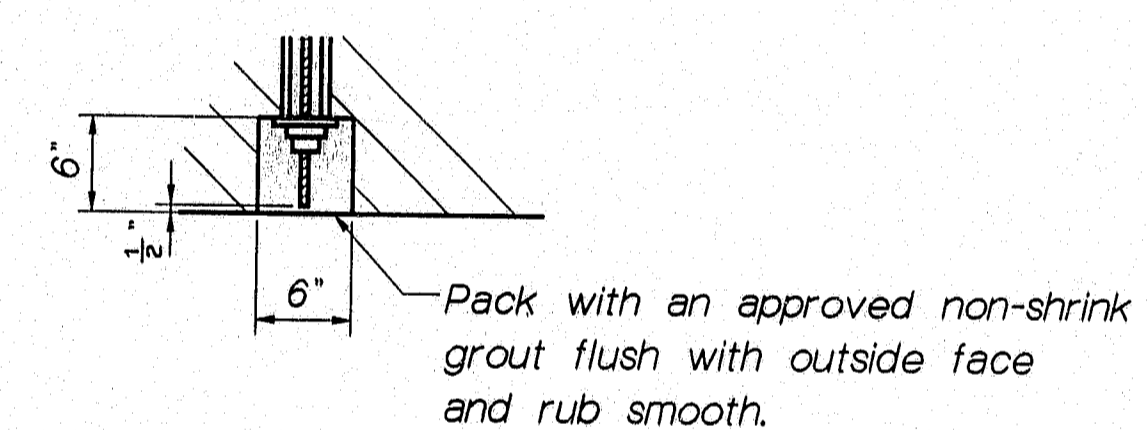

Post-Tensioning Duct Detail
(Type 2 Box Beams)

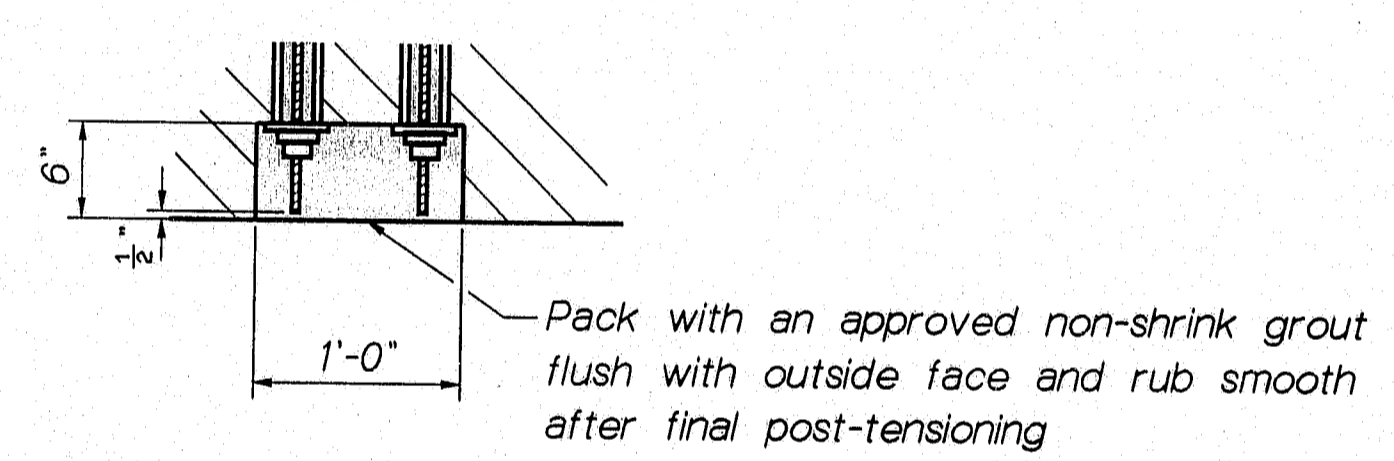


Stage Construction
Post-Tensioning Duct Detail
(Type 1 Box Beams)

STRAIGHT BARS			
MARK	NO.	LENGTH	LOCATION
△	CB400	81	78'-4" LONGITUDINAL
	CB401	128	3'-8" DIAPHRAGM MATS. END REINFORCING
	CB500	652	3'-8" TRANSVERSE
△	CB501	54	76'-4" LONGITUDINAL

BENT BARS														
MARK	NO.	LENGTH	TYPE	A	B	C	D	E	F	G	H	O	R	LOCATION
△	CB450	401	S	—	2'-8"	3'-8"	2'-8"							BOX BEAMS
△	CB451	128	S	—	2'-8"	3'-8"	2'-8"							END REINFORCING
	CB452	64	S	—	2'-5"	1'-2"	2'-5"							END REINFORCING
△	CB550	661	W	1'-3"	0'-11"	0'-5 1/2"	1'-0 1/2"	0'-5 1/2"	0'-11"	1'-3"	0'-2 3/4"	3'-8"		BOX BEAMS
△	CB551	652	S	—	1'-3"	3'-8"	1'-3"							BOX BEAMS
△	CB552	401	S	—	2'-9"	3'-8"	2'-9"							BOX BEAMS

109-259

TYPE - BENDING DIAGRAMS

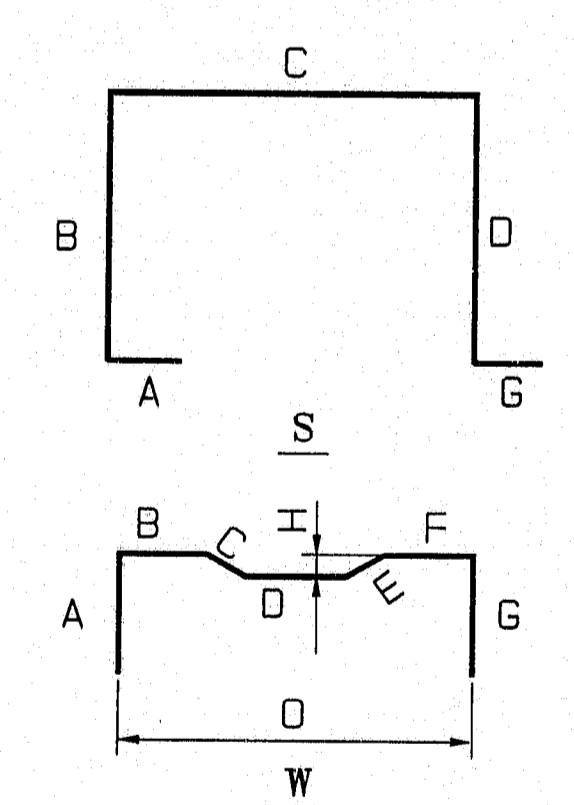

- Dimensions are out-to-out of bar
 - Bending details and hooks shall conform to the recommendations of the current revision of ACI Standard 318.
 - Reinforcing Bar: ASTM A615 Grade 60

STATE OF MAINE
 DEPARTMENT OF TRANSPORTATION
 HOTEL BRIDGE OVER DAVIS STREAM
 IN THE TOWN OF JEFFERSON
 LINCOLN COUNTY
 PRESTRESSED STRUCTURAL CONCRETE BOX BEAMS
 SHEET OF AUGUSTA, MAINE Jan., 1994
 JEFFERSON JUN 74

PROJECT DESIGN ENGINEER	DATE
DESIGN CHECKED	10-30
REVISIONS	BY MKD
FIELD CHANGES	

PLANS

10JUN94-010050





REVISION	DESCRIPTION	DATE
△	REINFORCING STEEL	6-8-94

F.R.V.A. RES. NO.	STATE	PROJECT NUMBER	SHEET NO.	TOTAL SHEETS
1	MAINE	BR-034P(1)	12	31

PIN 004220.00

Superstructure Notes

- 1.- Reinforcing steel shall have two inches minimum cover in curbs.
- 2.- Protective coating shall be applied to the following areas:
 - All exposed surfaces of concrete curbs, and end posts.
 - Fascias down to drip notch
- 3.- Form a 1" V-groove on the fascias at the horizontal joint between the curb and concrete slab.
- 4.- The surface of the Precast Prestressed Butted Box Beams shall be cleaned prior to the placement of the concrete leveling slab in accordance with the requirements of subsection 502.11. Payment will be considered incidental to related concrete items.
- 5.- All curb, sidewalk, end post and top part of granite masonry retaining wall down to Elevation 62.42 shall contain a silica fume additive.
- 6.- Tensioning of prestressing strands shall be done in accordance with Standard and Supplemental Specifications Section 535. The jacking force applied to the prestressing strands shall be 31,000 pounds.
- 7.- The approximate weight of a Precast Prestressed Butted Box Beam is 32 tons.
- 8.- The concrete curb and sidewalk will be cast in place. Concrete for curb, sidewalk, and end posts will be paid for under Item 502.25, Structural Concrete Superstructure Slab.
- 9.- Lateral post-tensioning strands shall have a tension of 29,000 pounds per strand applied.
- 10.- In accordance with subsection 535.36, the Contractor shall provide 36-S800 anchor dowels 2'-5" long. Drill and anchor, with an approved anchorage material, S800 dowels into abutments after prestressed box beams have been erected. All work and materials will be considered incidental to related contract items.

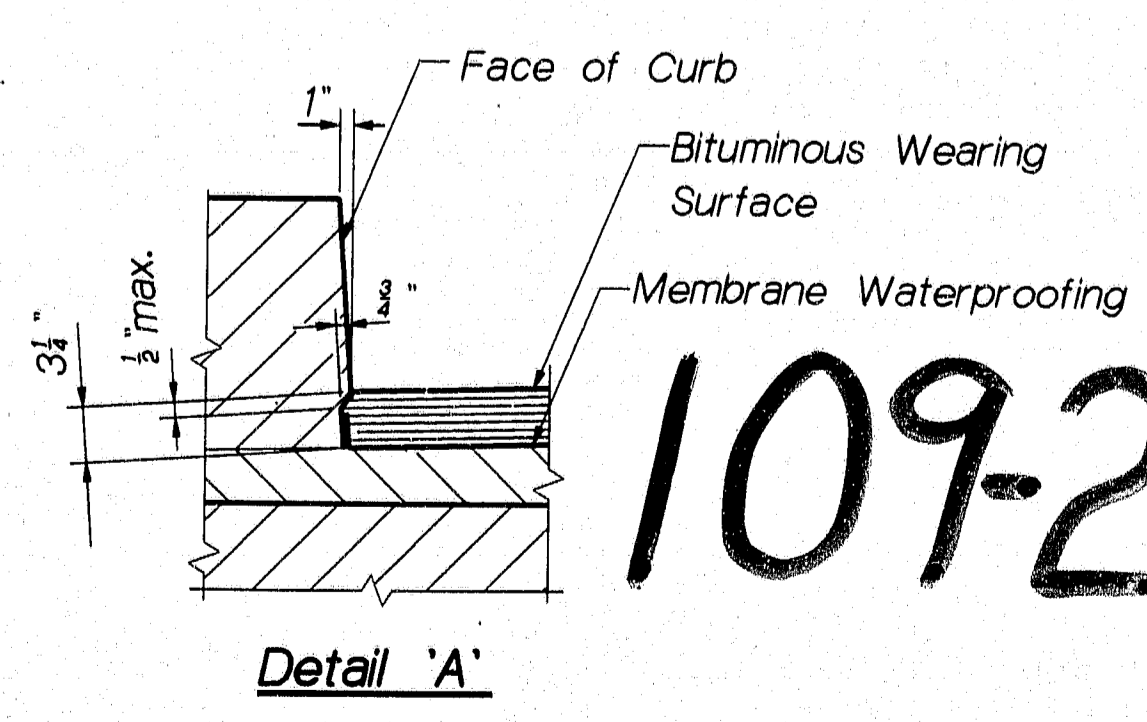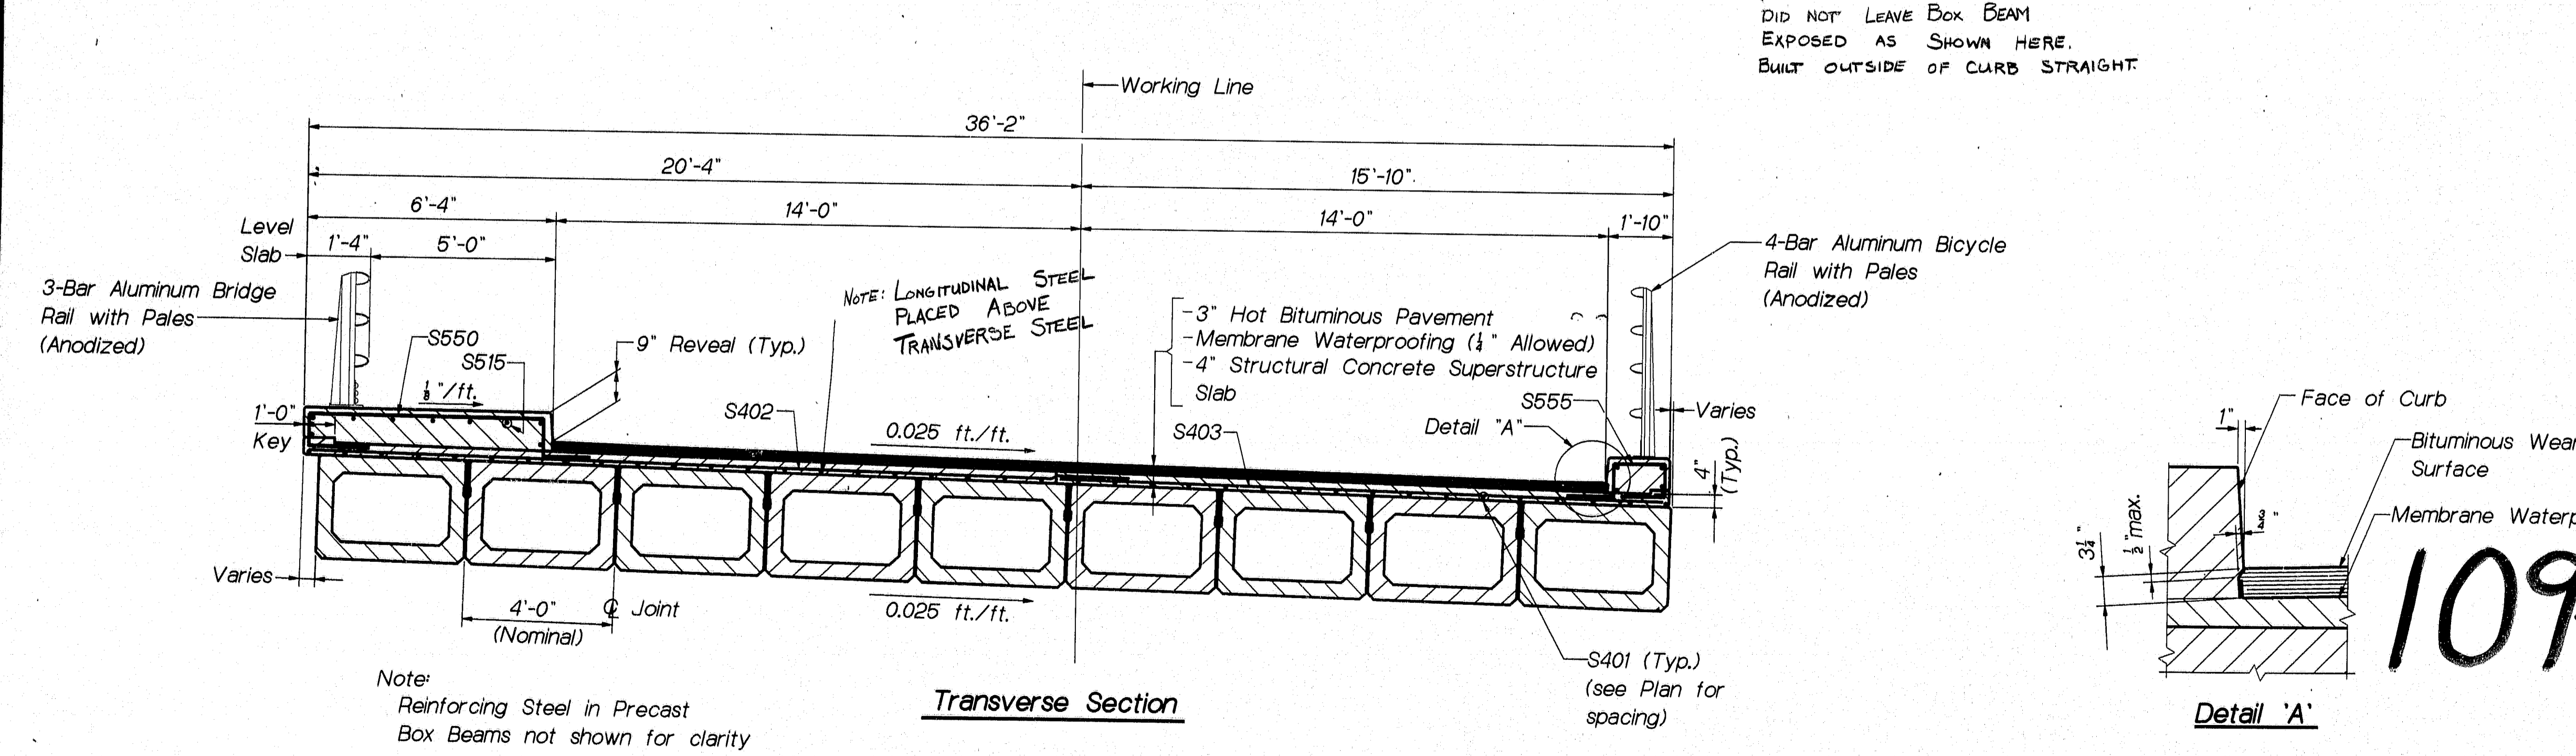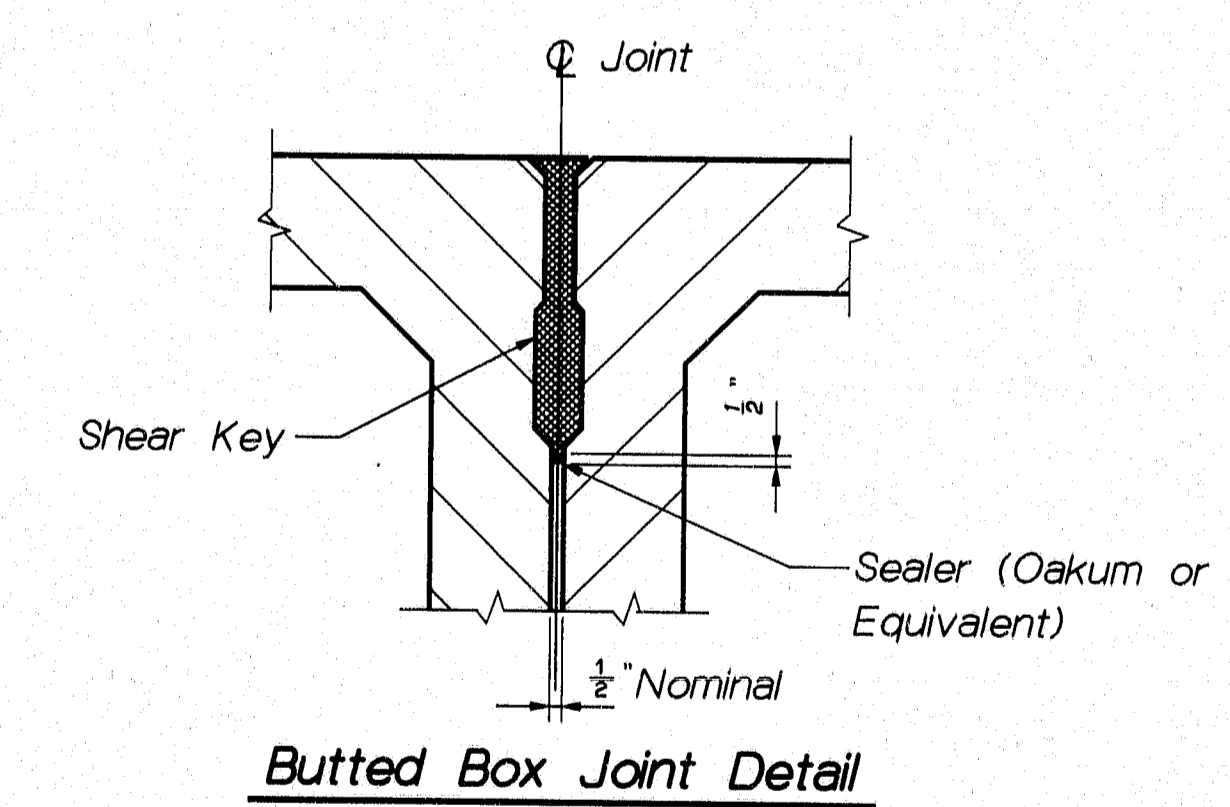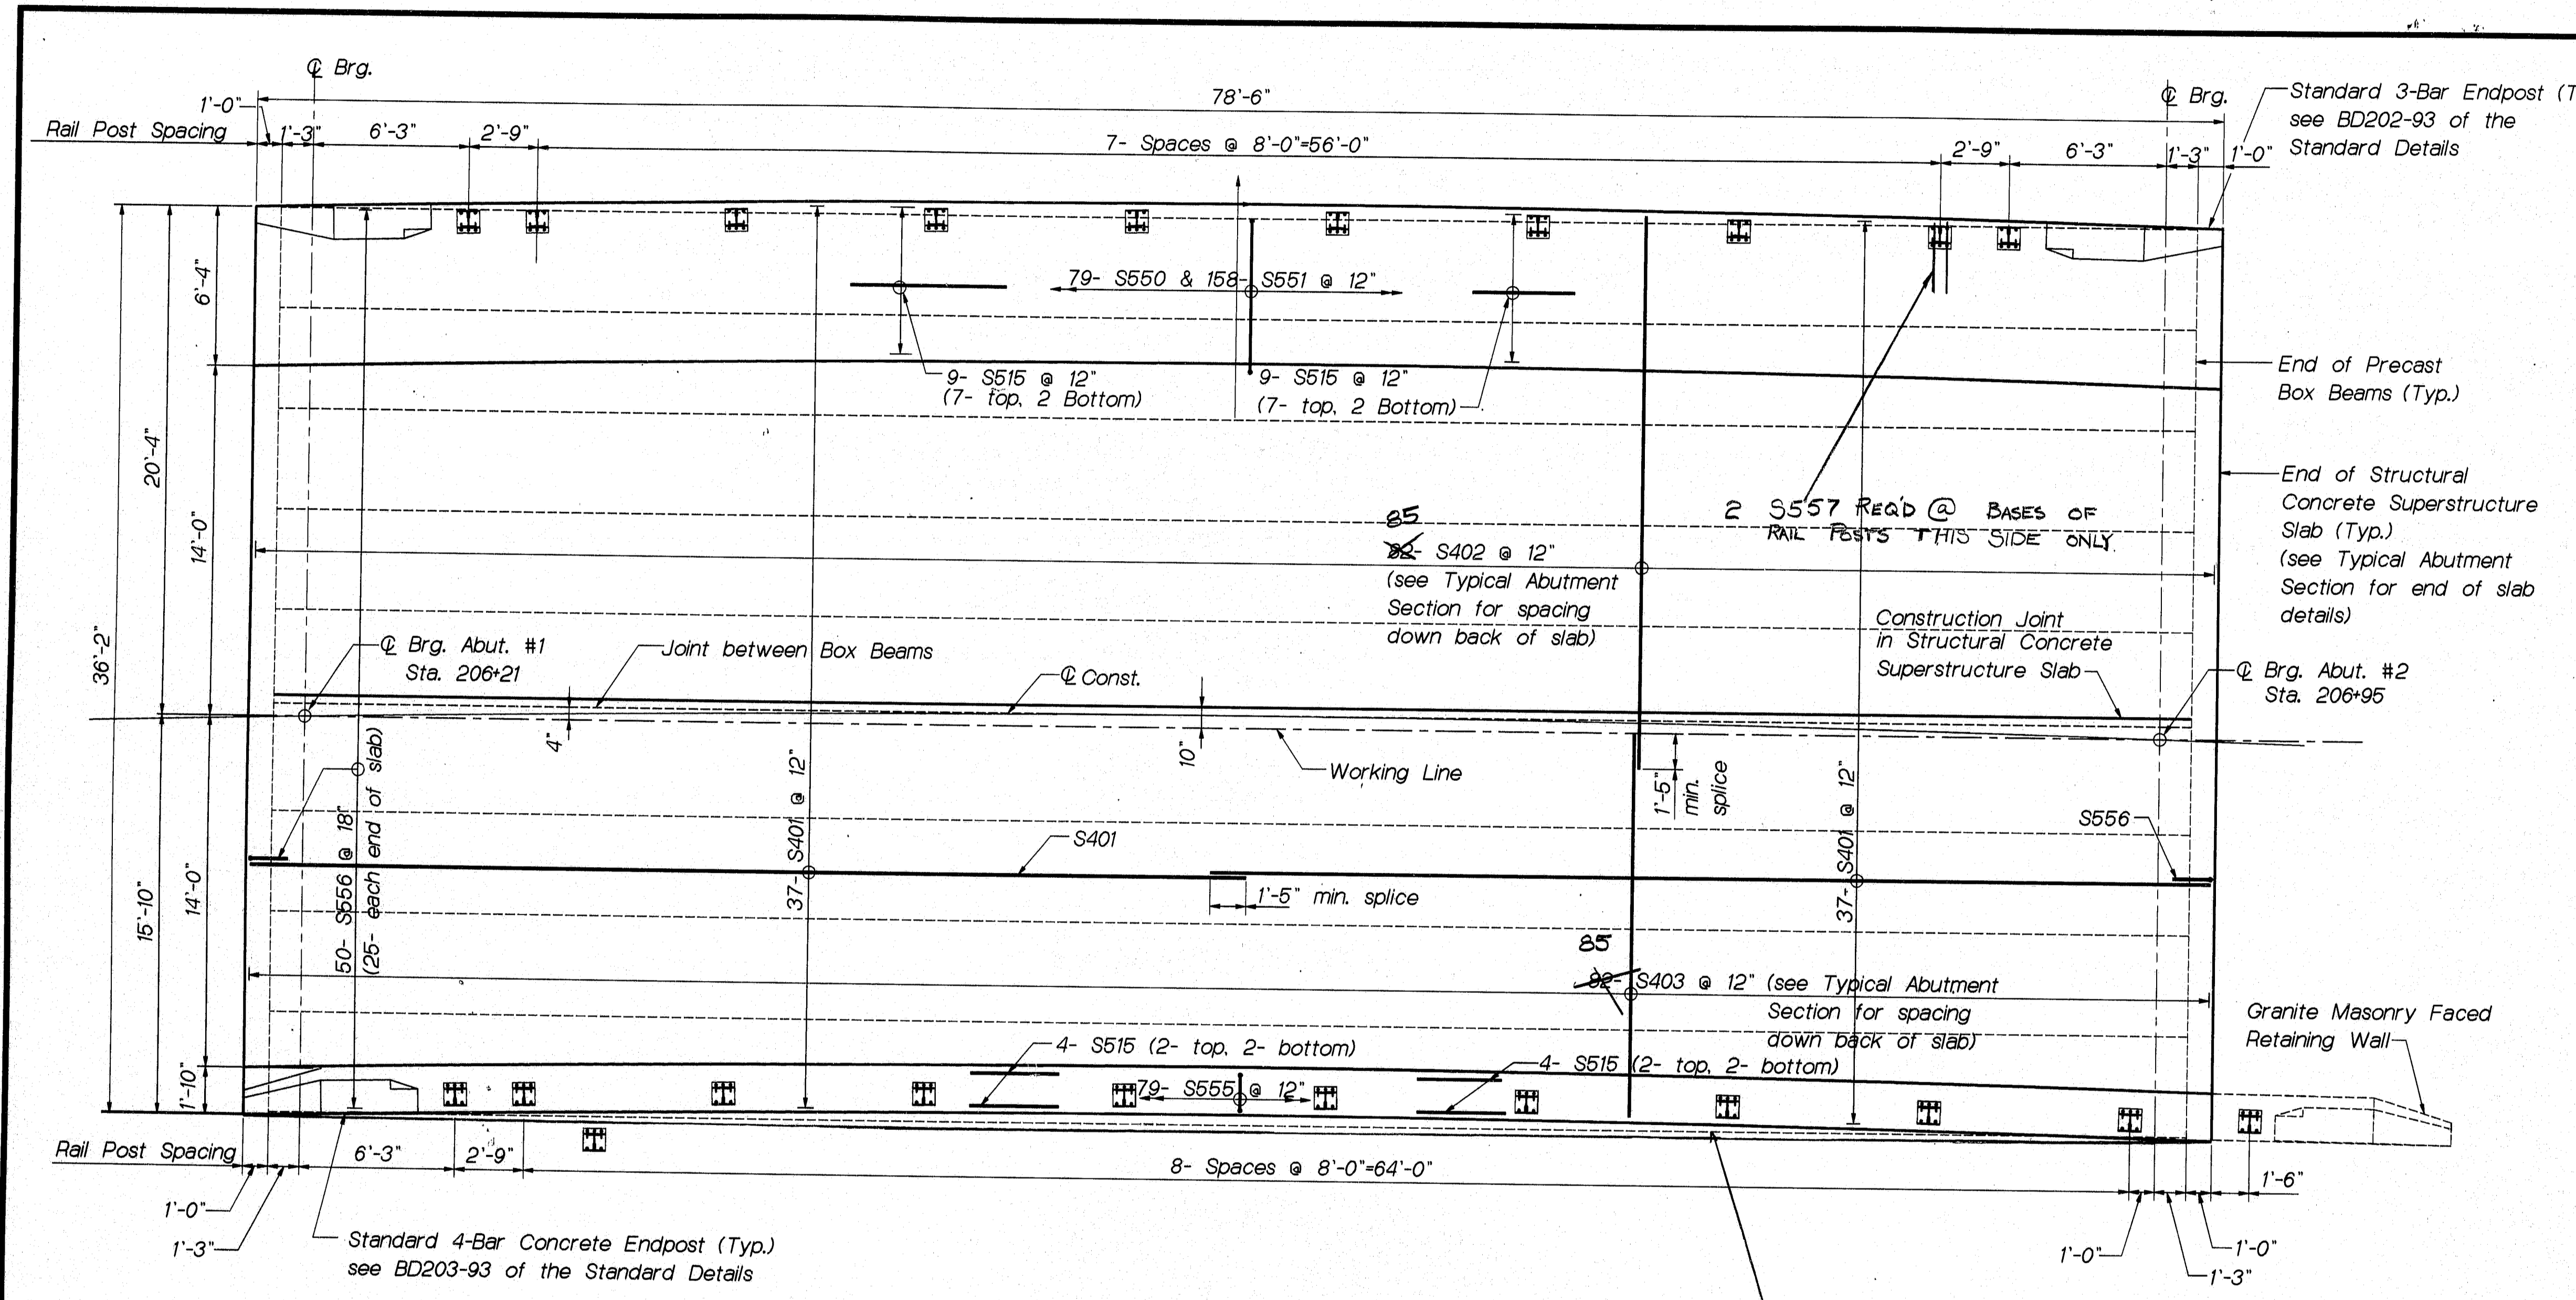

109-260


STATE OF MAINE
 DEPARTMENT OF TRANSPORTATION
 HOTEL BRIDGE 113
 OVER
 DAVIS STREAM
 IN THE TOWN OF
 JEFFERSON
 LINCOLN COUNTY
 SUPERSTRUCTURE
 SHEET OF AUGUSTA, MAINE Jan., 1992

PROJECT DESIGN NUMBER	DATE
PLANS	10-95
DESIGN DETAILED	BY MKD
REVISIONS	
FIELD CHANGES	

10JUN95-0100L40


F.I.R.V.A. REG. NO.	STATE	PROJECT NUMBER	SHEET NO.	TOTAL SHEETS
1	MAINE	BR-034P(1)X	13	31

Pin 004220.00

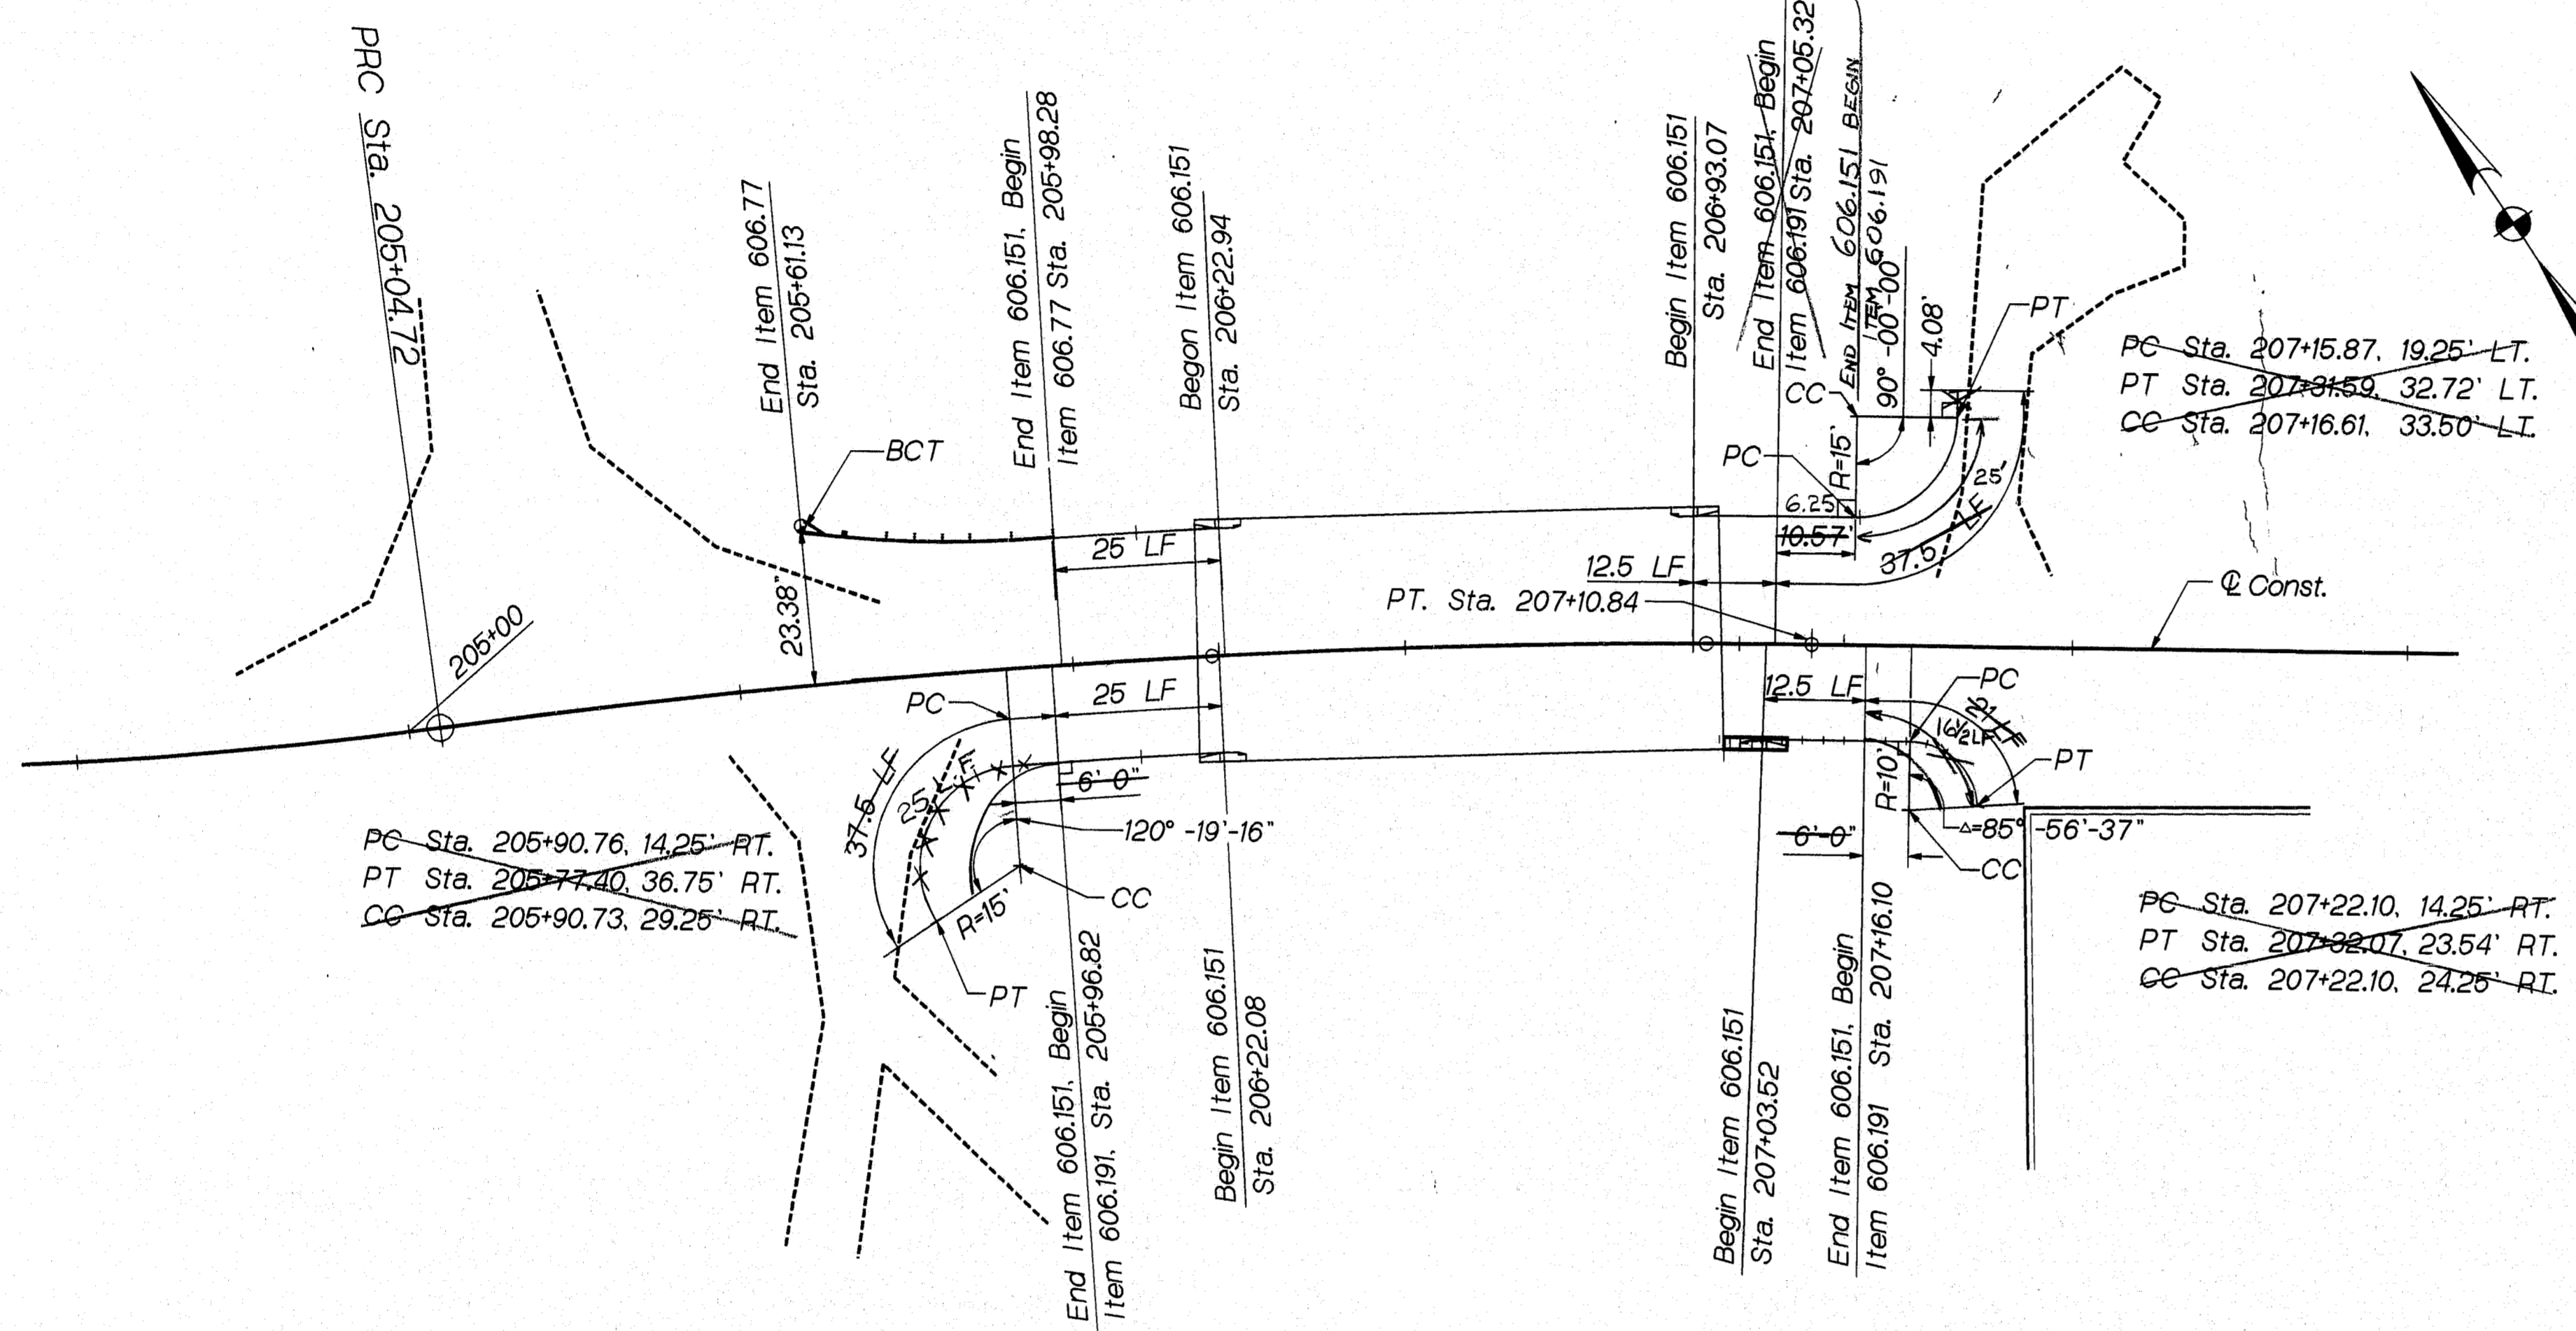

Modified Guardrail Post Detail
(Upstream side only)

NOTE:
1.- All guardrail posts shall be 7'-0" long and embedded 3'-9" min.
Modified guardrail posts shall be considered incidental to related contract items.

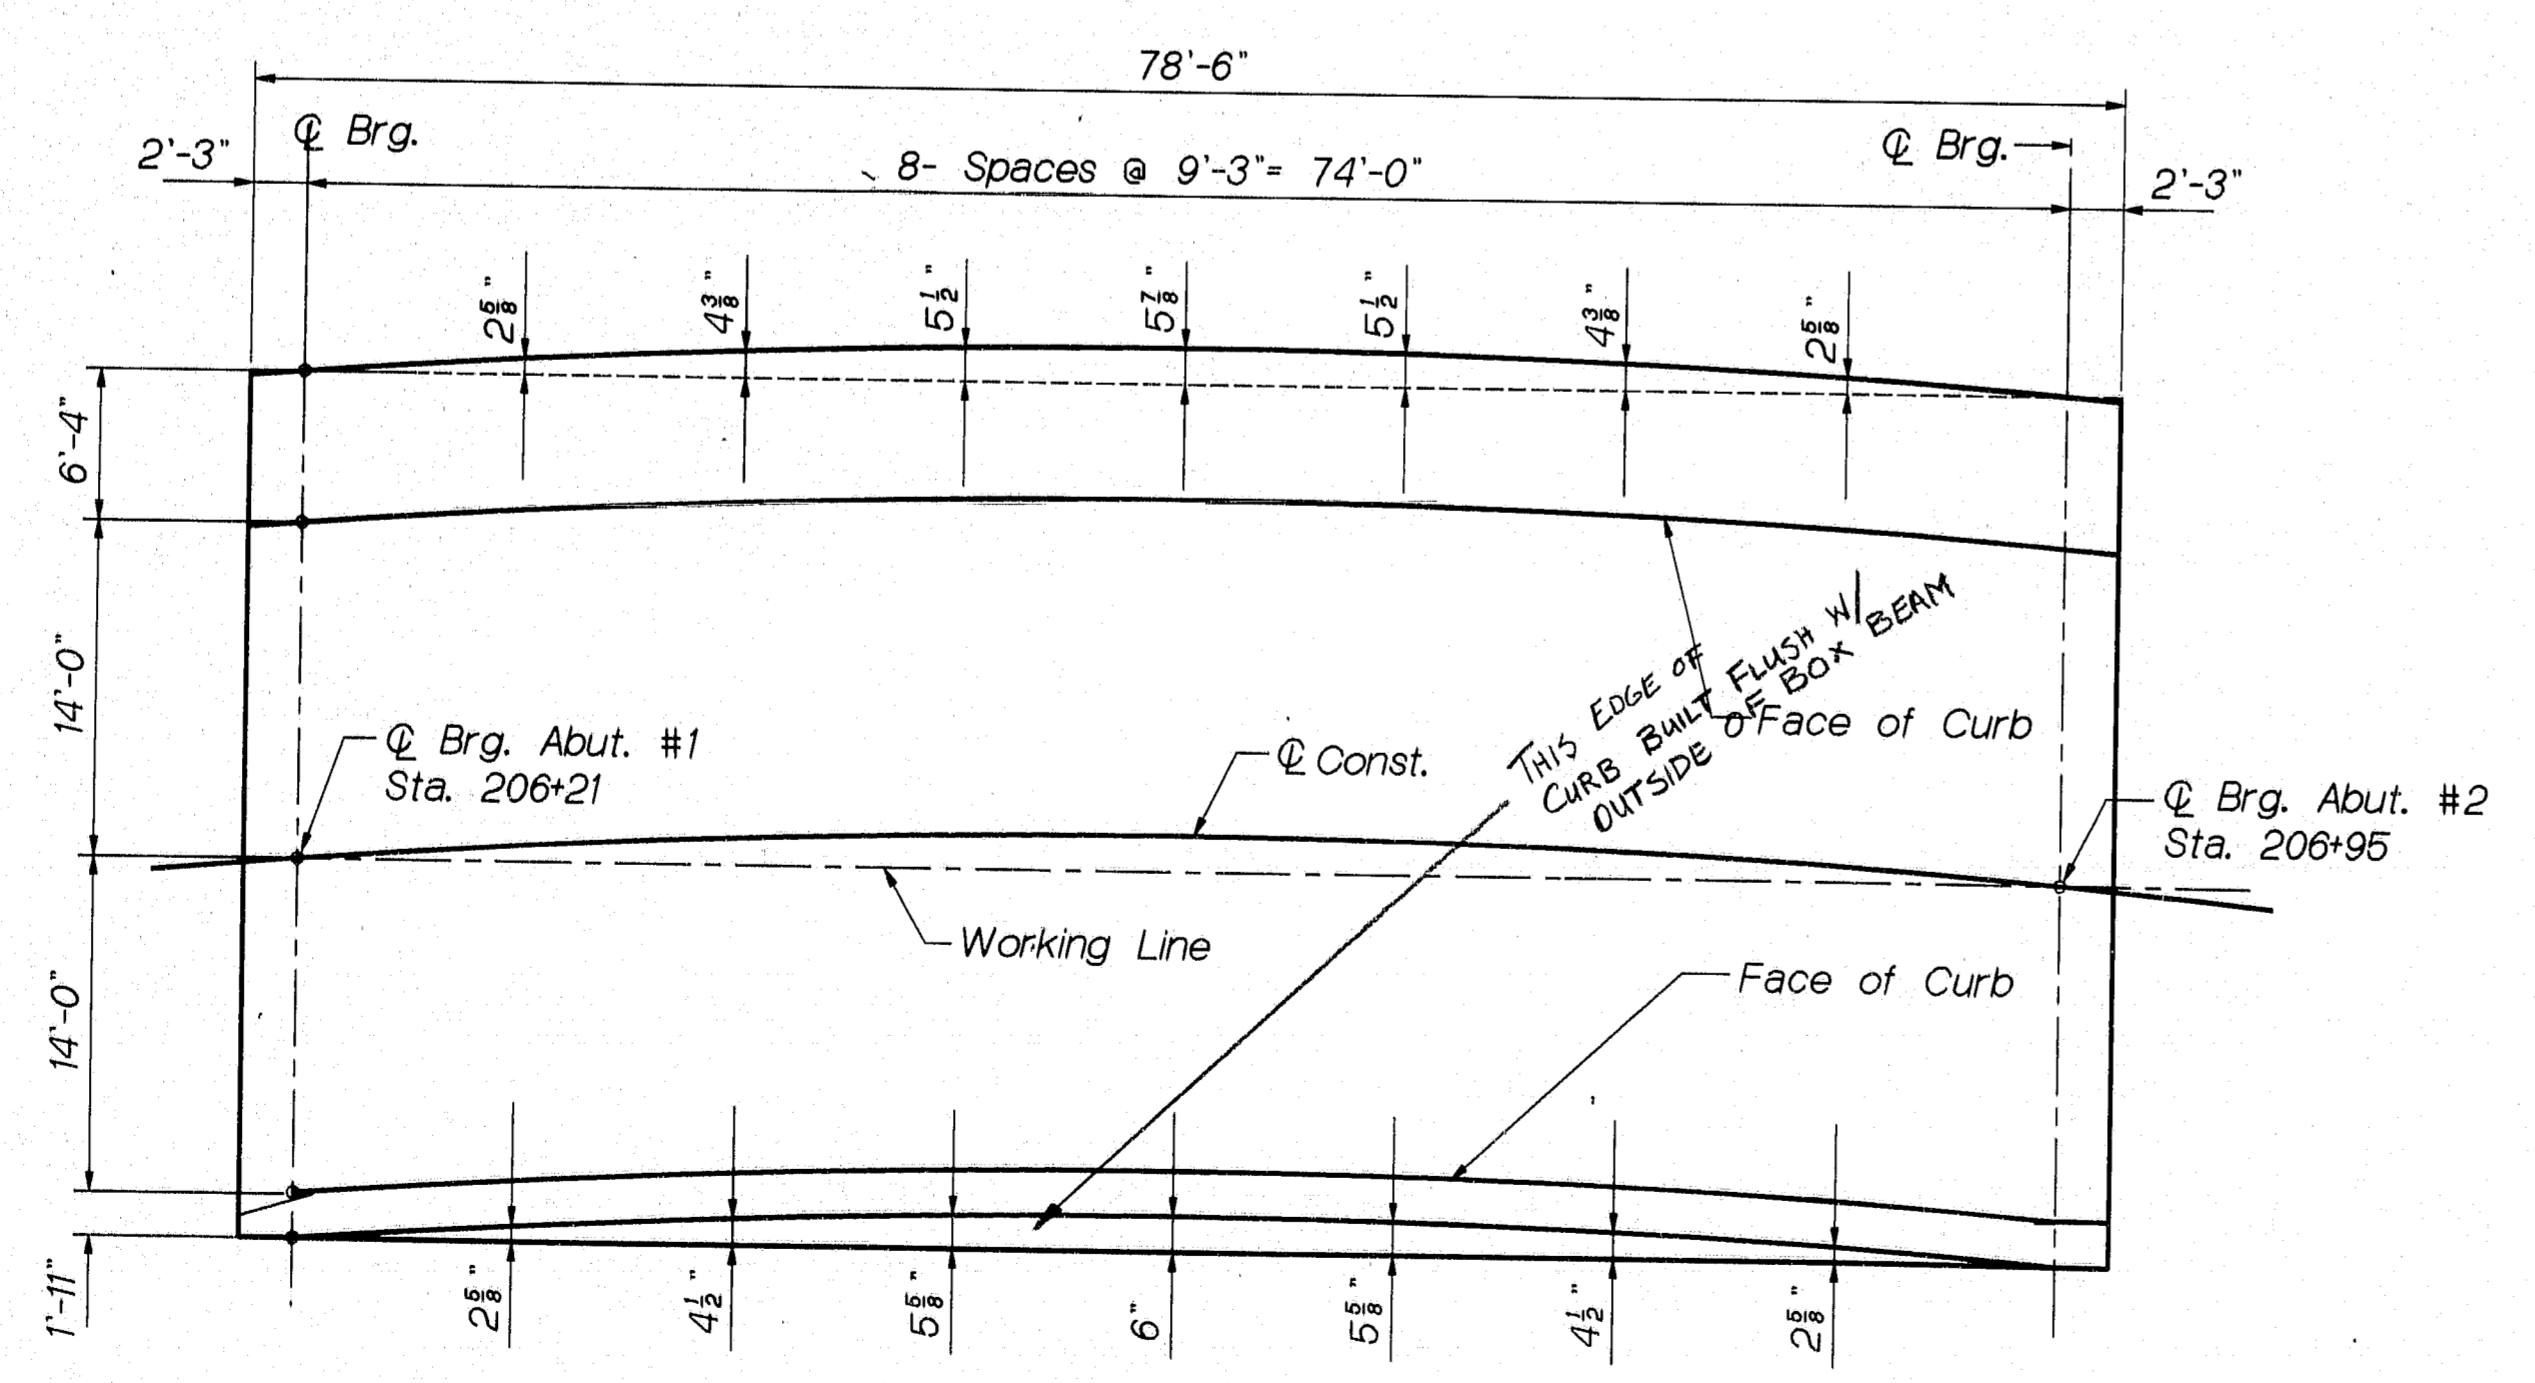

Curb Offsets
(not to scale)

109-261

STATE OF MAINE
DEPARTMENT OF TRANSPORTATION

HOTEL BRIDGE 11A
OVER
DAVIS STREAM
IN THE TOWN OF
JEFFERSON
LINCOLN COUNTY
GUARDRAIL LAYOUT &
FASCIA OFFSET LAYOUT

SHEET OF AUGUSTA, MAINE Jan., 1993


PROJECT DESIGN ENGINEER	DATE
BY MKD	10-93
DESIGN-DETAILED	
CHECKED	
FIELD CHANGES	

140EC93-010120

REINFORCING STEEL SCHEDULE

STRAIGHT BARS												BENT BARS											
MARK	NO.	LENGTH	LOCATION	MARK	NO.	LENGTH	LOCATION	MARK	NO.	LENGTH	TYPE	A	B	C	D	E	F	G	H	O	R	LOCATION	
ABUTMENT #1				SUPERSTRUCTURE				ABUTMENT #1															
A501	2	3'-2"	HORIZ. WING	S401	74	39'-7"	39'-10" LONG. SLAB	A550	2	7'-0"	V				6'-3"	0'-9"					0'-5"		WINGS
A502	2	5'-8"	HORIZ. WING	S402	82	24'-4"	21'-7" TRANS. SLAB	A551	2	7'-7"	V				6'-11"	0'-8"					0'-4"		WINGS
A503	2	6'-9"	HORIZ. WING	S403	85	46'-5"	15'-9" TRANS. SLAB	A555	50	11'-2"	S			4'-0"	3'-2"	4'-0"							BREAST WALL
A504	2	5'-10"	VERT. WING	S515	26	40'-0"	CURB & SIDEWALK	A556	6	4'-0"	L	2'-0"	2'-0"										CURTAIN WALLS
A505	2	6'-6"						ABUTMENT #2															
A506	2	7'-2"		S800	36	3'-5"	ANCHOR DOWELS	B450	7	4'-5"	L	2'-0"	2'-5"										RETAINING WALL
A507	2	7'-10"						B460**	50	1'-3"	V				1'-0"	0'-3"				△	0'-2"		GRANITE ANCHORAGE
A508	2	8'-6"		END POSTS				B550	2	7'-9"	V				7'-0"	0'-9"					0'-5"		WINGS
A509	2	7'-7"						B555	50	11'-2"	S			4'-0"	3'-2"	4'-0"							BREAST WALL
A510	20	10'-0"	HORIZ. WING					B556	3	4'-0"	L	2'-0"	2'-0"									CURTAIN WALLS	
A511	2	2'-8"		EP405	24	1'-10"	3 & 4 BAR	END POSTS															
A512	2	4'-11"		EP450	12	3'-3"	3 BAR	EP451	8	7'-5"	S		3'-3"	0'-11"	3'-3"								3 BAR
A513	2	7'-4"		EP453	12	3'-6"	4 BAR	EP452	4	7'-0"	S		3'-3"	0'-6"	3'-3"								3 BAR
A514	2	9'-4"	VERT. WING					EP454	8	7'-11"	S		3'-6"	0'-11"	3'-6"								4 BAR
A515	2	8'-11"						EP455	4	7'-6"	S		3'-6"	0'-6"	3'-6"								4 BAR
A516	2	8'-1"						EP500	20	7'-10"	S		5'-6"	0'-7"	1'-9"								3 & 4 BAR
A517	2	7'-3"						EP501	20	6'-8"	SJ		3'-1"	2'-7"	1'-0"						0'-8"		3 & 4 BAR
A518	2	6'-6"						EP502	16	4'-7"	S		1'-10"	0'-11"	1'-10"								3 & 4 BAR
A519	2	5'-10"						EP503	8	4'-2"	S		1'-10"	0'-6"	1'-10"								3 & 4 BAR
A520	25	3'-0"	DOWELS					SUPERSTRUCTURE															
A521	14	19'-2"	BREAST WALL					S550	79	10'-1"	S	1'-3"	0'-10"	5'-11"	0'-10"					1'-3"			SIDEWALK
A522	14	19'-0"	BREAST WALL					S555	79	6'-0"	S	1'-3"	1'-0"	1'-5"	1'-1"					1'-3"			CURB
ABUTMENT #2								S556	50	4'-4"	L	1'-3"	3'-1"										SLAB END
B500	2	4'-0"	HORIZ. WING					S557	20	5'-2"	S	1'-3"	8"	1'-4"	8"								SIDEWALK @ BASE OF RAIL POSTS
B501	2	7'-1"	HORIZ. WING					GENERAL NOTES															
B502	10	9'-1"	HORIZ. WING					1-First digit(s) following the letter of the mark indicates size of the bar: Mark (A502) bar size-#5 Mark (P1001) bar size-#10 Mark (S603) bar size-#6															
B503	2	6'-2"	VERT. WING					2-Each truss bar, Type B, may be replaced by two (2) straight bars (one top and one bottom) of the same bar size as the truss bar. Payment in either case shall be based on truss bars as scheduled on plans.															
B504	2	6'-11"						All dimensions are out to out of reinforcing bar Bending details and hooks shall conform to the recommendations of the current revision of ACI Standard 318 Reinforcing Bar: ASTM A615 Grade 60															
B505	2	7'-8"						GENERAL NOTES															
B506	2	8'-6"						1-First digit(s) following the letter of the mark indicates size of the bar: Mark (A502) bar size-#5 Mark (P1001) bar size-#10 Mark (S603) bar size-#6															
B507	2	9'-2"						2-Each truss bar, Type B, may be replaced by two (2) straight bars (one top and one bottom) of the same bar size as the truss bar. Payment in either case shall be based on truss bars as scheduled on plans.															
B508	2	9'-5"						All dimensions are out to out of reinforcing bar Bending details and hooks shall conform to the recommendations of the current revision of ACI Standard 318 Reinforcing Bar: ASTM A615 Grade 60															
B509	14	18'-6"	BREAST WALL					GENERAL NOTES															
B510	14	19'-1"	BREAST WALL					1-First digit(s) following the letter of the mark indicates size of the bar: Mark (A502) bar size-#5 Mark (P1001) bar size-#10 Mark (S603) bar size-#6															
B515	14	8'-4"	RETAINING WALL					2-Each truss bar, Type B, may be replaced by two (2) straight bars (one top and one bottom) of the same bar size as the truss bar. Payment in either case shall be based on truss bars as scheduled on plans.															
B516	12	9'-2"	RETAINING WALL					All dimensions are out to out of reinforcing bar Bending details and hooks shall conform to the recommendations of the current revision of ACI Standard 318 Reinforcing Bar: ASTM A615 Grade 60															
B520	25	3'-0"	DOWELS					GENERAL NOTES															
F500	5	9'-0"	FOOTING					1-First digit(s) following the letter of the mark indicates size of the bar: Mark (A502) bar size-#5 Mark (P1001) bar size-#10 Mark (S603) bar size-#6															
F501	7	6'-0"	FOOTING					2-Each truss bar, Type B, may be replaced by two (2) straight bars (one top and one bottom) of the same bar size as the truss bar. Payment in either case shall be based on truss bars as scheduled on plans.															
F502	14	3'-0"	DOWELS					All dimensions are out to out of reinforcing bar Bending details and hooks shall conform to the recommendations of the current revision of ACI Standard 318 Reinforcing Bar: ASTM A615 Grade 60															

F.M.V.A. REG. NO.	STATE	PROJECT NUMBER	SHEET NO.	TOTAL SHEETS
	MAINE	BR-034R(1)X	14	31

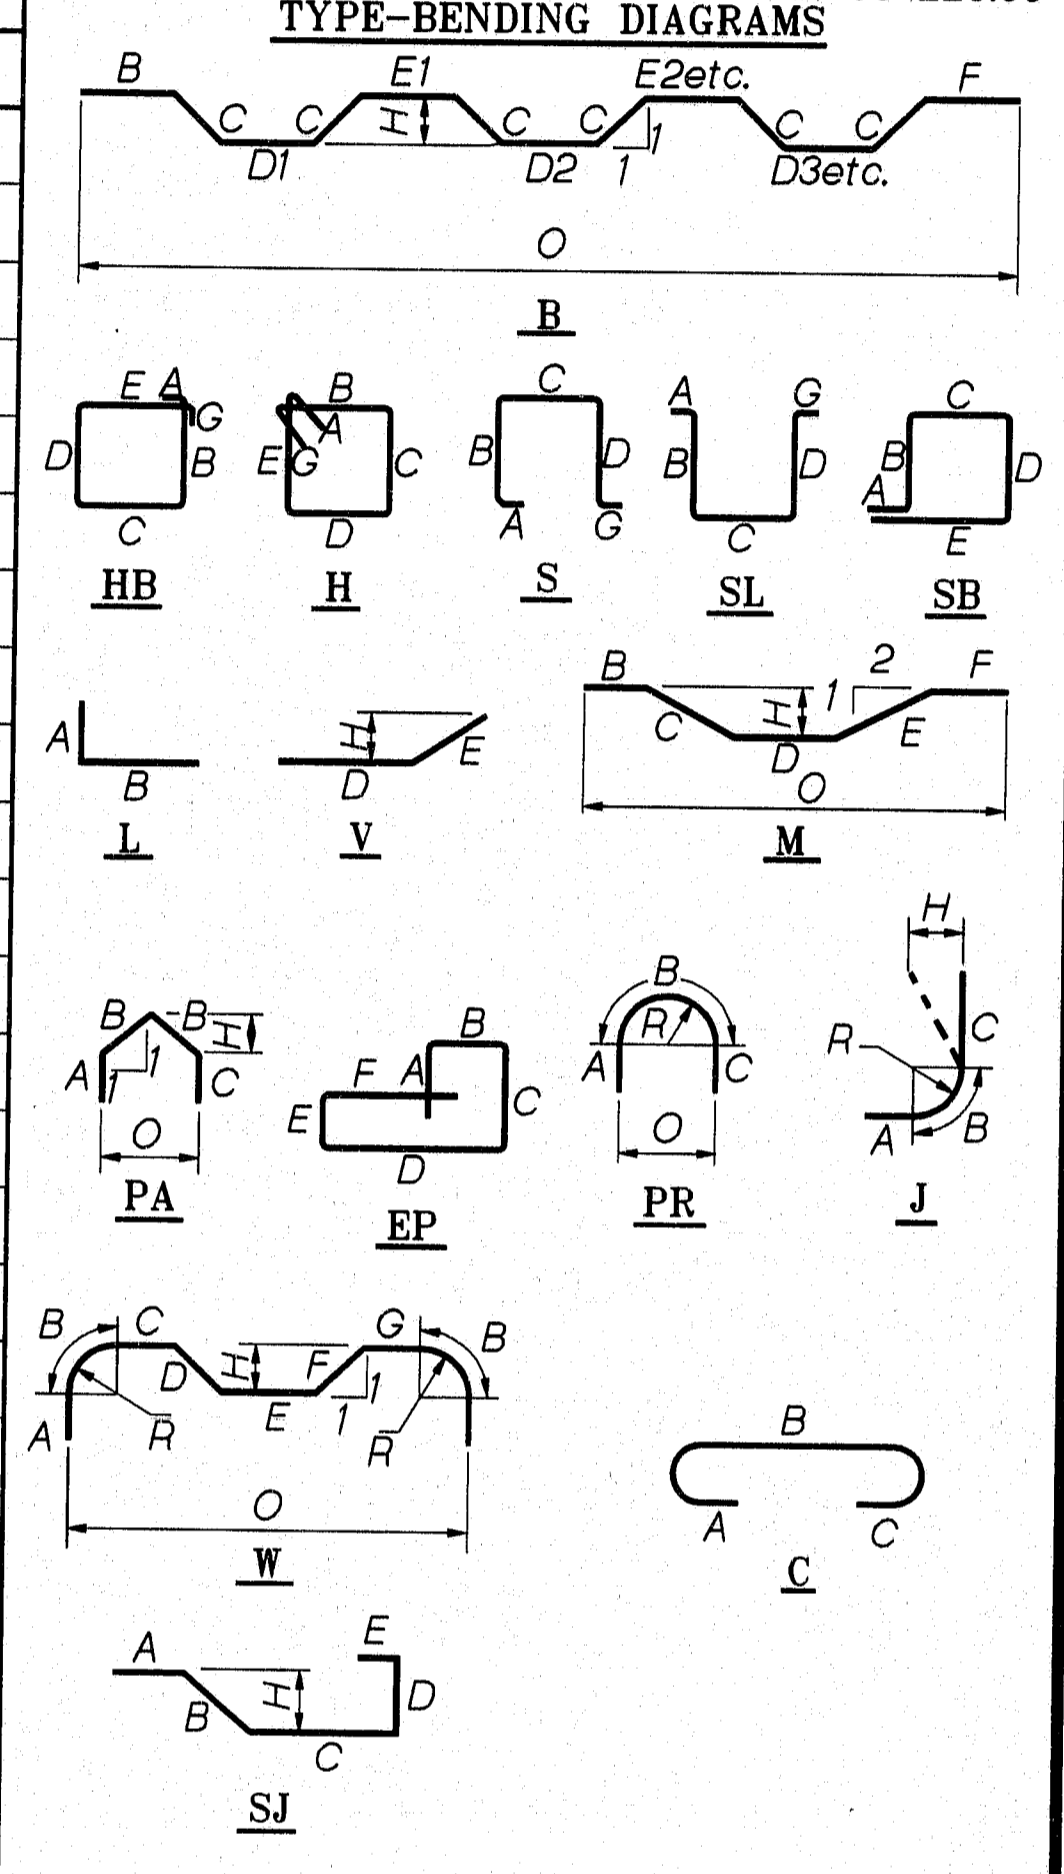

All dimensions are out to out of reinforcing bar
Bending details and hooks shall conform to the recommendations of the current revision of ACI Standard 318
Reinforcing Bar: ASTM A615 Grade 60

- GENERAL NOTES
- 1-First digit(s) following the letter of the mark indicates size of the bar:
Mark (A502) bar size-#5
Mark (P1001) bar size-#10
Mark (S603) bar size-#6
 - 2-Each truss bar, Type B, may be replaced by two (2) straight bars (one top and one bottom) of the same bar size as the truss bar. Payment in either case shall be based on truss bars as scheduled on plans.

△ Added 2" dimension to B460**	2-9-94
--------------------------------	--------

REVISIONS DATE

STATE OF MAINE
DEPARTMENT OF TRANSPORTATION

HOTEL BRIDGE
OVER
DAVIS STREAM
IN THE TOWN OF
JEFFERSON
LINCOLN COUNTY

REINFORCING SCHEDULE

SHEET OF AUGUSTA, MAINE Jan., 1994

109-262

DATE 0-99
BY MKD
DESIGN-DETAILED
CHECKED
FIELD CHANGES

PLANS

18JAN94-0101.00