

**STATE OF MAINE
STATE HIGHWAY COMMISSION**

PLANS

**GRAFTON NOTCH
OXFORD COUNTY**

MAINE STATE
PROJECT NO. 178 (504)

TOTAL LENGTH 0.322 MILES



SCALES { PLAN 1 IN. = 50 FT.
PROFILE { HOR. 1 IN. = 50 FT.
VER. 1 IN. = 5 FT.
CROSS SECTIONS 1 IN. = 5 FT.

PROJECT COMPLETED JUNE 20, 1968

Microfilm #7 on Reel 153

CONVENTIONAL SIGNS			
STATE OR NATIONAL LINE	-----	SURVEY LINE	
COUNTY LINE	-----	CULVERT	
TOWN LINE	-----	DROP INLET	
UNFENCED PROPERTY	-----	TROLLEY POLE	
FENCE	-----	POWER POLE	
RIGHT OF WAY LINE	-----	TEL. POLE	
TRAVELED WAY	-----	MARSH	
RAILROAD	-----	TREES	
RETAINING WALL	-----	STONE WALL	

INDEX OF SHEETS		
SHEET NO.	1	TITLE PAGE STA. 41+50 to 58+50
SHEET NO.	2	TYPICAL SECTIONS
SHEET NO.	3	QUANTITIES
SHEET NO.	4-11	STANDARD DETAILS
SHEET NO.	12-14	PLAN AND PROFILE STA. 41+50 to 58+50
SHEET NO.	15-24	CROSS-SECTIONS STA. 41+50 to 58+50
SHEET NO.		BRIDGES STA.
SHEET NO.		SPECIAL DETAILS

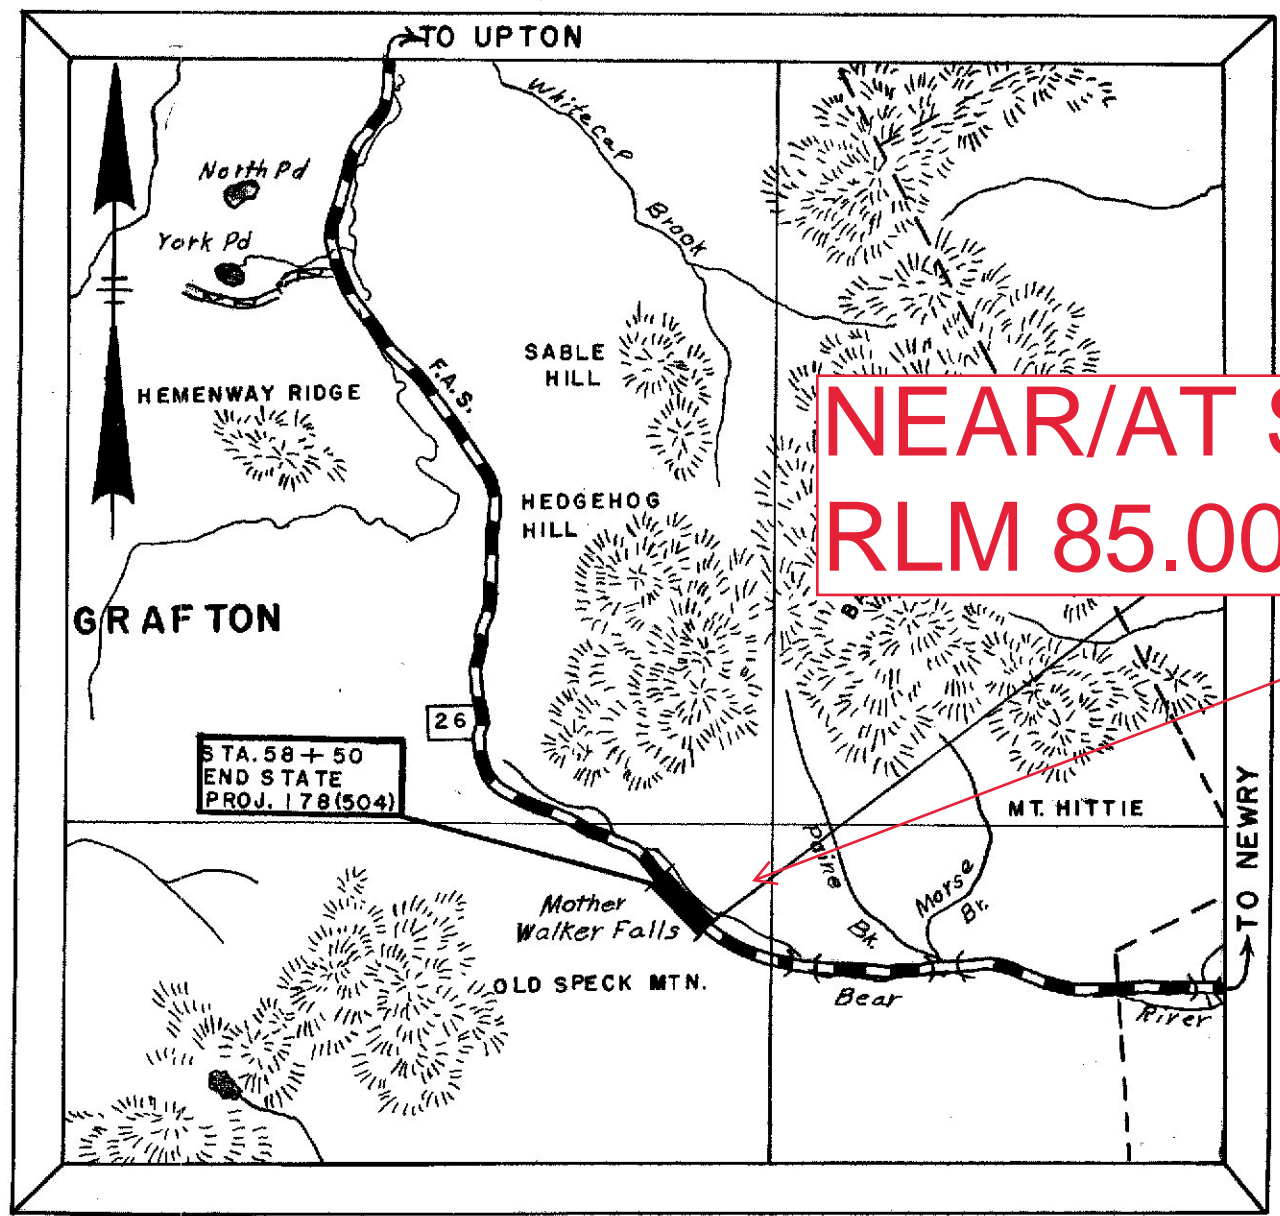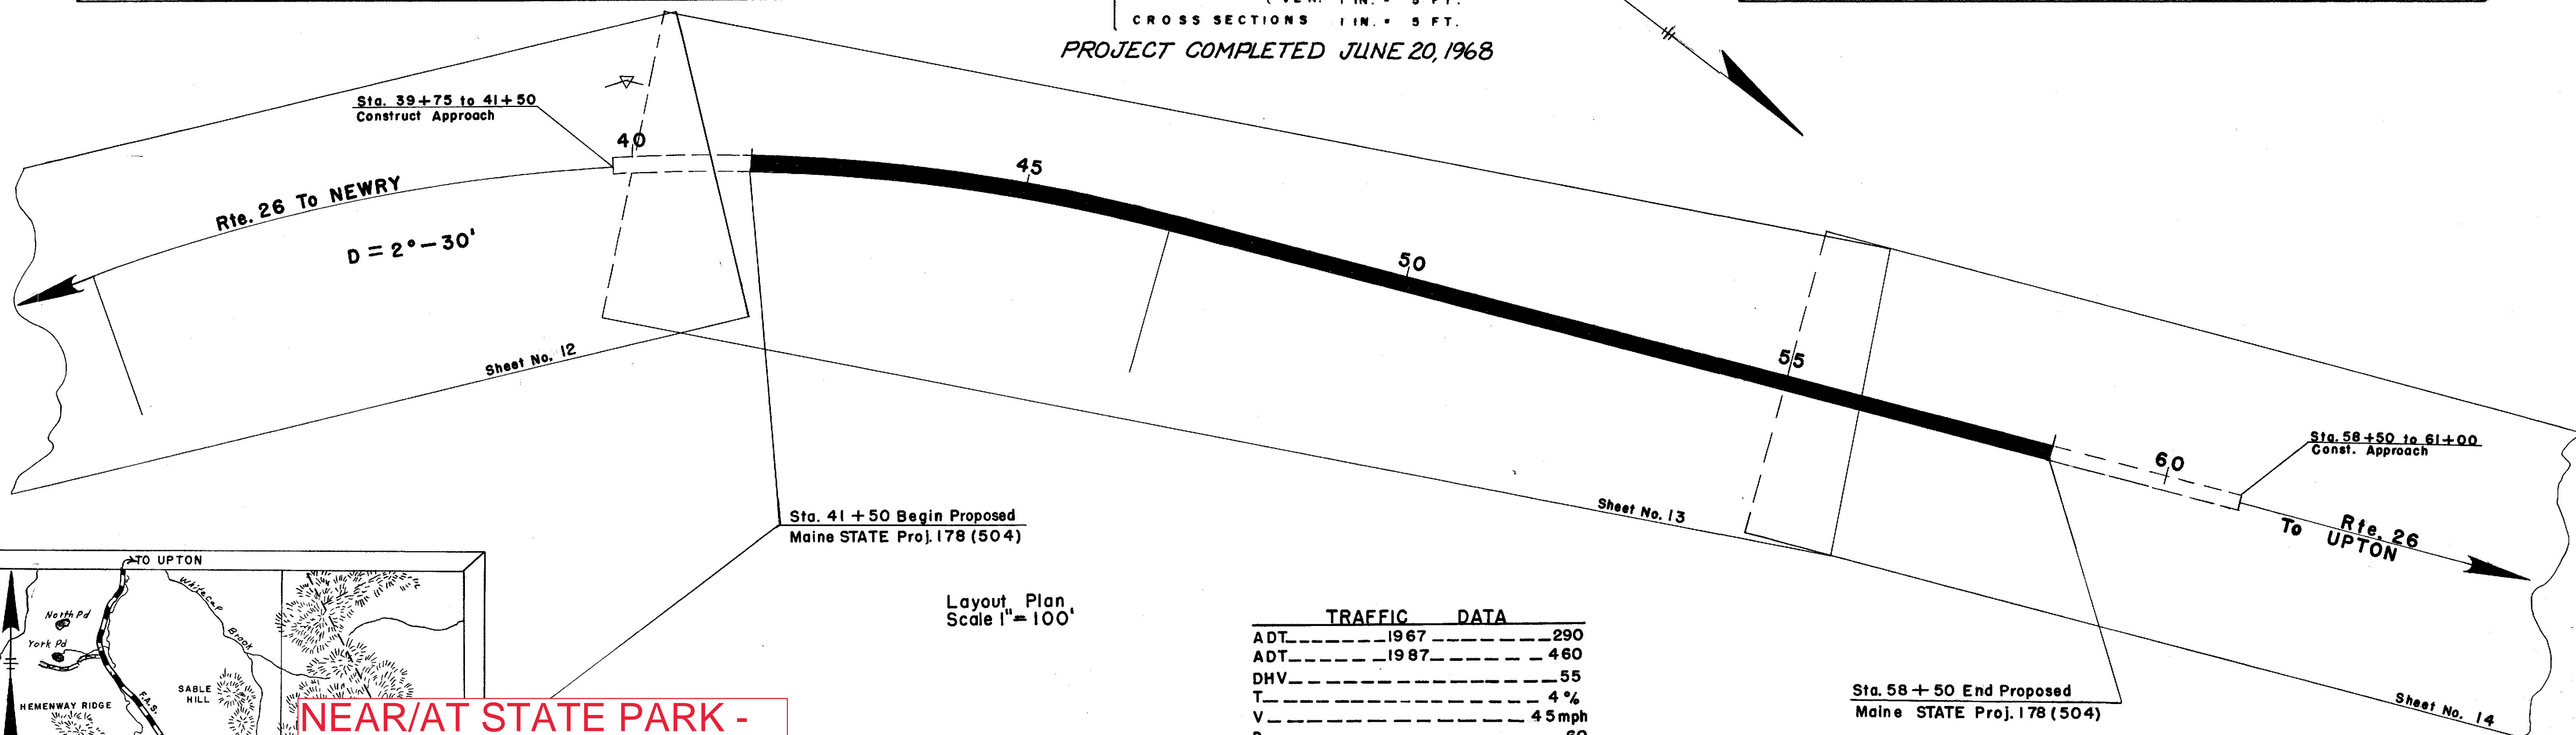

Layout Plan
Scale 1" = 100'

TRAFFIC DATA	
ADT.-----1967-----	290
ADT.-----1987-----	460
DHV-----	55
T-----	4 %
V-----	4.5 mph
D-----	60
18K-----	9

NOTE
All work contemplated under this contract to be governed by and in conformity with the STANDARD SPECIFICATIONS (revision of June 1965) and supplementals thereto, except as modified on the plans and in the special provisions.

APPROVED:
MAINE STATE HIGHWAY COMMISSION

<i>David W. Stearns</i>	DATE	JUNE 14, 1967
<i>Bernard G. Lechard</i>	DATE	JUNE 14, 1967
<i>Steven D. Shaw</i>	DATE	JUNE 14, 1967
<i>Sylvester L. Poor</i>	DATE	JUNE 14, 1967

CHIEF ENGINEER

DEPARTMENT OF COMMERCE
BUREAU OF PUBLIC ROADS
REGION 1

APPROVED:

_____ DIVISION ENGINEER	DATE
----------------------------	------

STANDARD SECTIONS - PROJ. NO. 178(504)


D. P. R. REG. NO.	STATE	PROJECT NUMBER	SHEET NO.	TOT SHE
1	MAINE	178(504)	2	2

L55-0178(1)

For all sections depth of ditch depends on local conditions. Depth of base as shown may be changed to meet local conditions.

Where "X" = 7 or less, "T" = X-2, otherwise "T" = 5.

To avoid property damage and to save shade trees, this formula may be modified by the engineer.

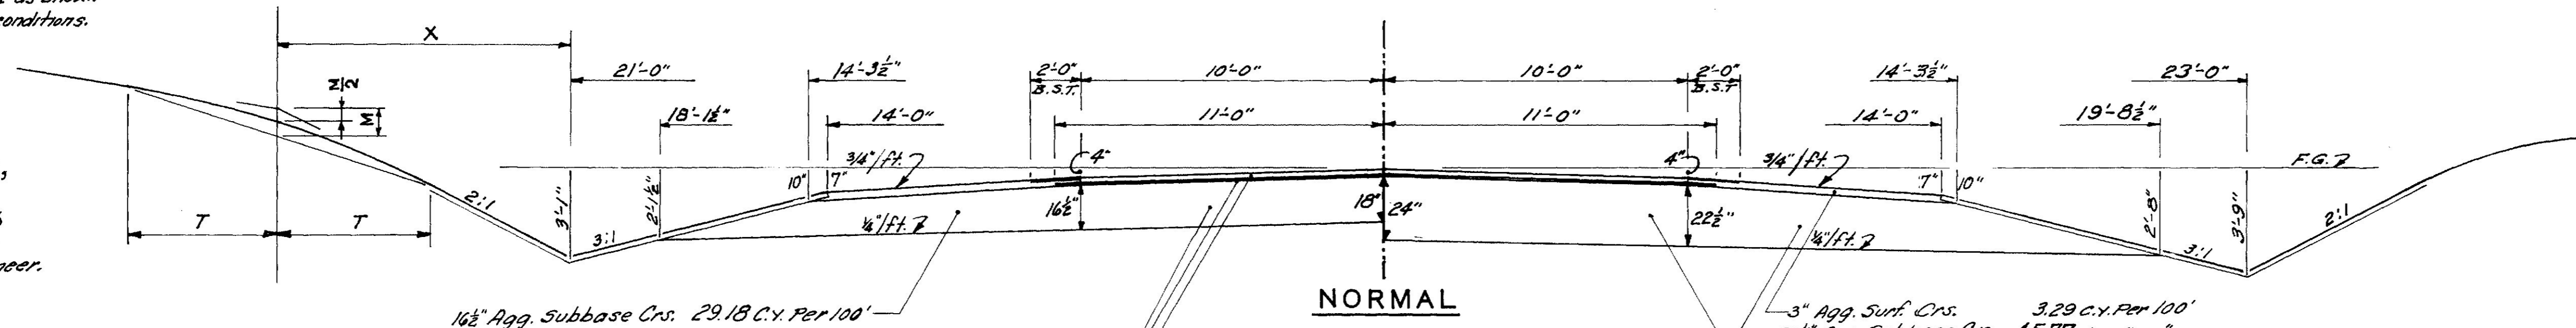


16" Agg. Subbase Crs. 29.18 C.Y. Per 100'

NORMAL


2" Road Mix Bit Pavc. 20' wide 12.35 C.Y. Per 100'
 1" Agg. Surf. Crs. Primed 22" " 6.79 " " "
 18" " Subbase Crs. 20" " 106.48 " " "
 24" " " " 20" " 143.52 " " "

3" Agg. Surf. Crs. 3.29 C.Y. Per 100'
 22" Agg. Subbase Crs. 45.77 " " "

Construct berm/ditch as shown or as directed by the engineer. Where a 2:1 slope is not practicable use a 1 1/2:1 slope in cuts.

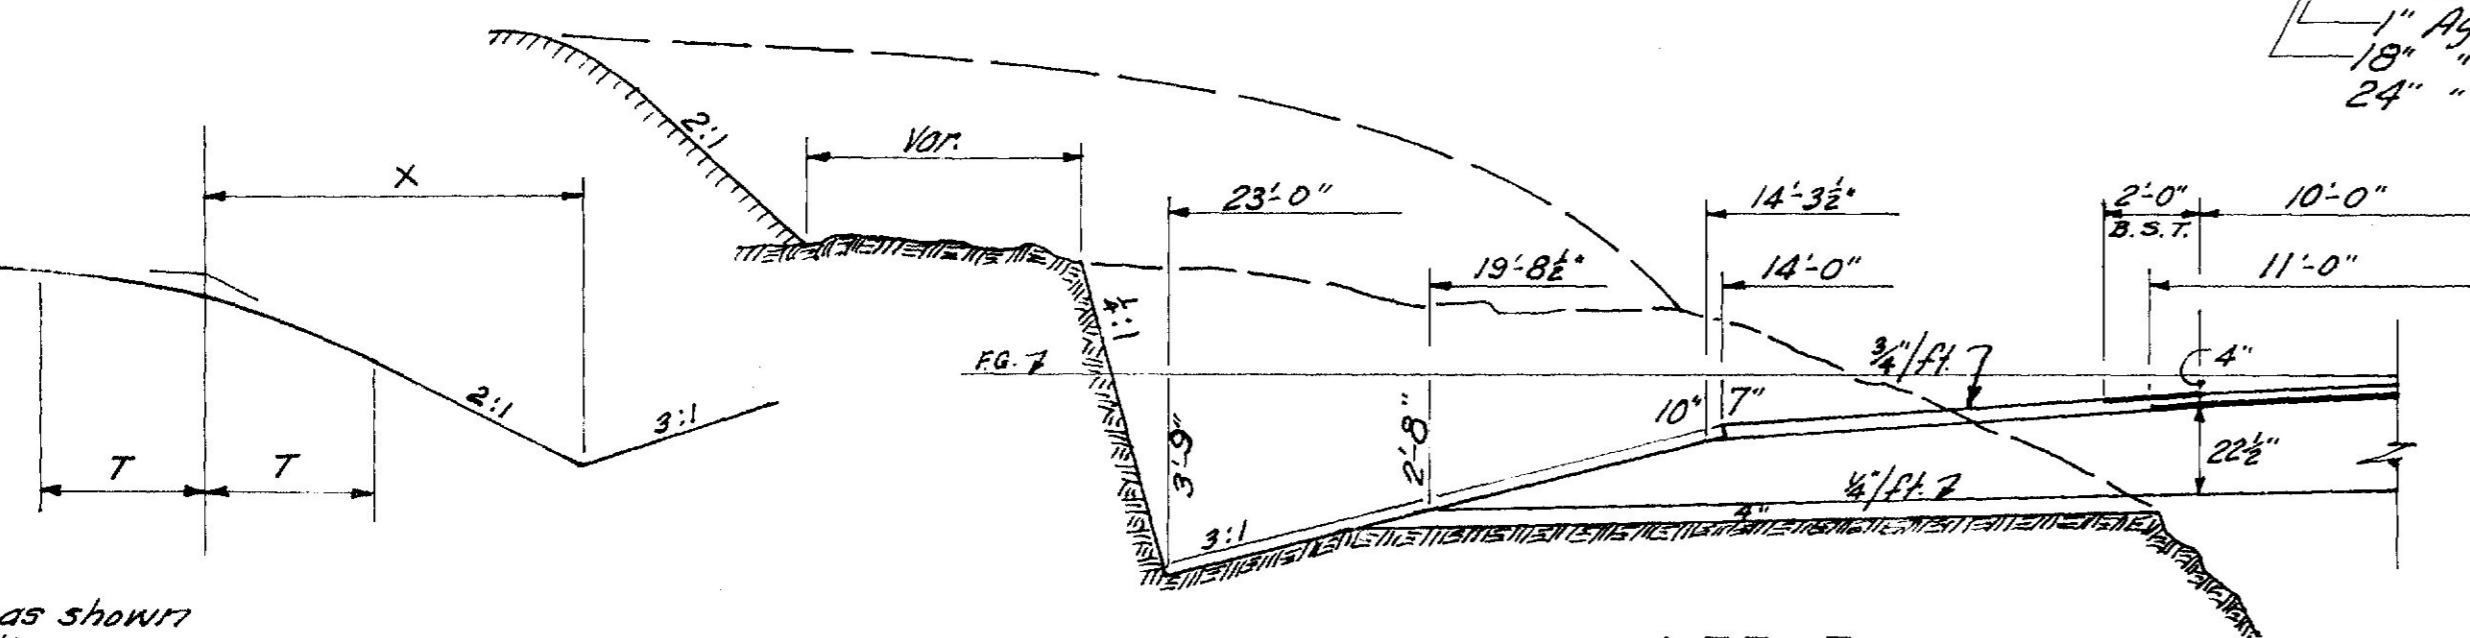

LEDGE

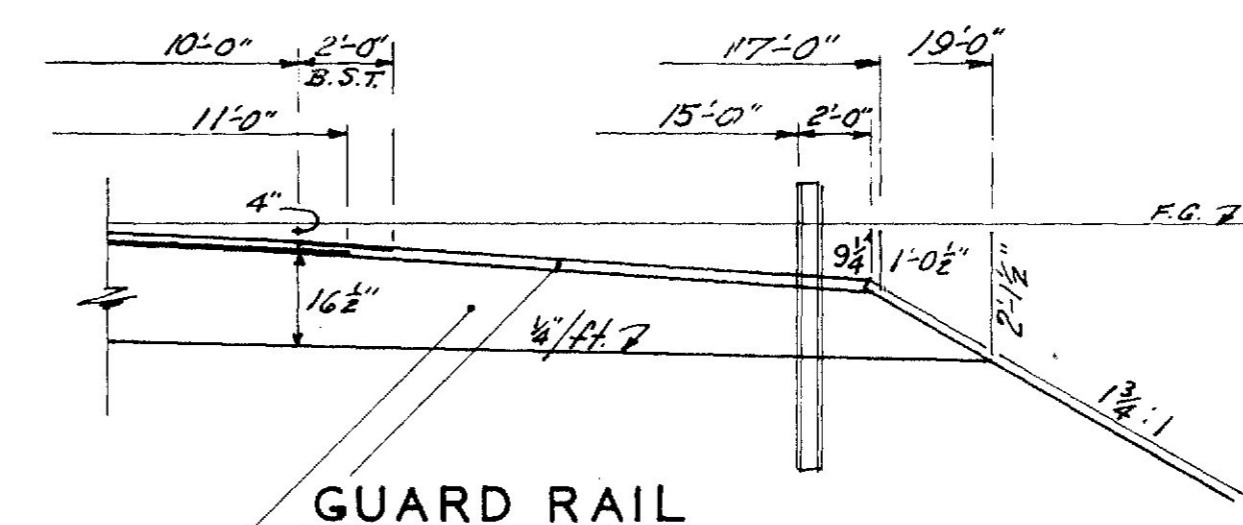


GUARD RAIL

3" Agg. Surf. Crs. 6.40 C.Y. Per 100'
 16" Agg. Subbase Crs. 35.26 " " "


Seeding Method No. 1 and Sodded areas shall require a max. depth of four (4) inches of loam unless otherwise specified.

All embankment slopes, ditches and back-slopes shall be seeded by Method No. 2 with a max. depth of two (2) inches of loam except where sodding or Seeding Method No. 1 is noted.

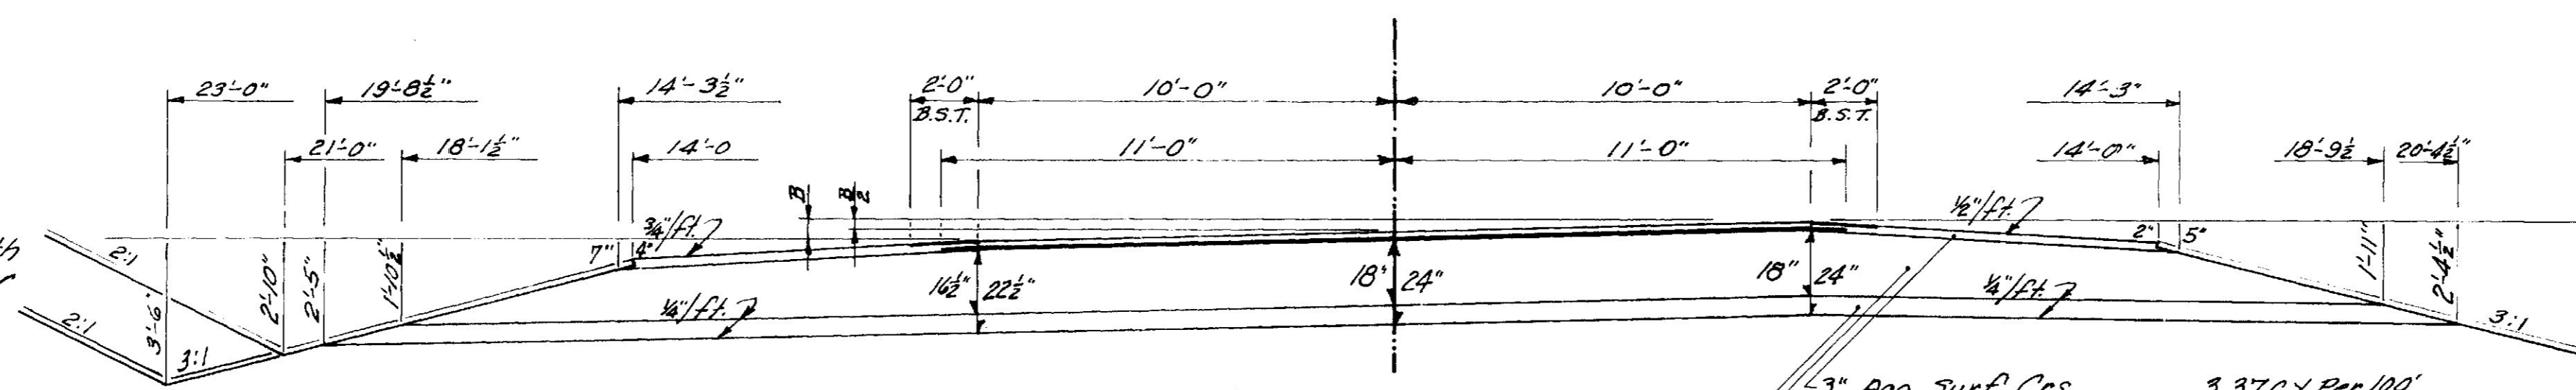

SUPER.

3" Agg. Surf. Crs. 3.37 C.Y. Per 100'
 18" Agg. Subbase Crs. 34.53 " " "
 24" " " " 52.60 " " "

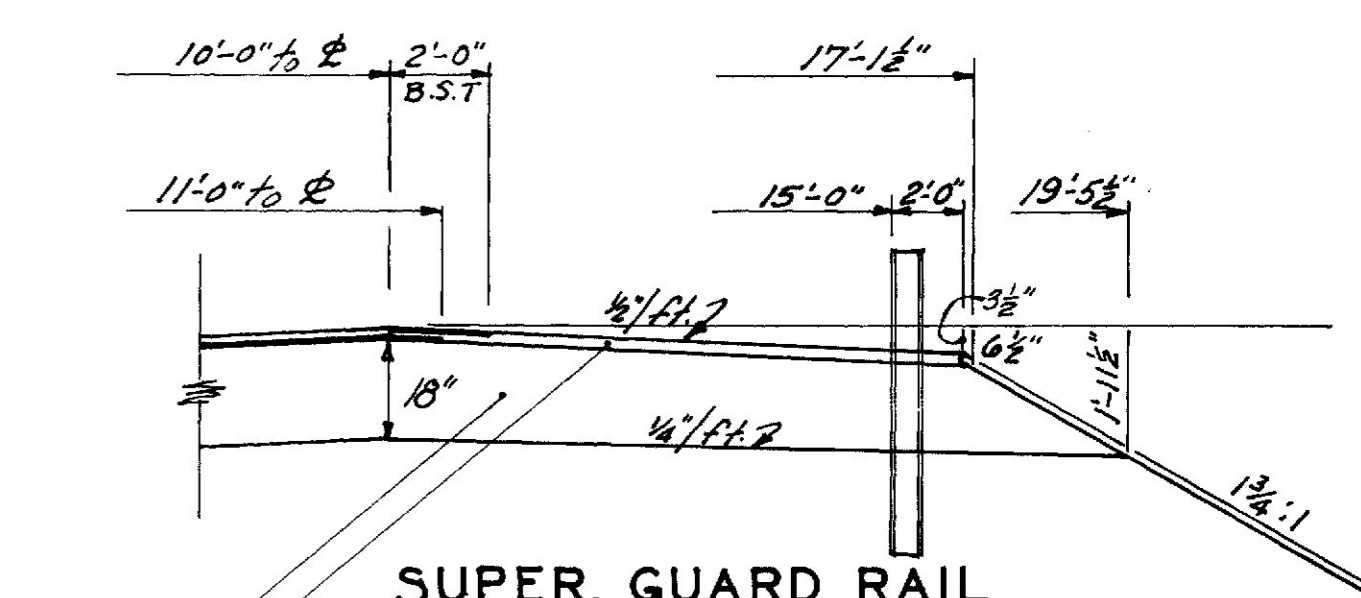


SUPER. GUARD RAIL

3" Agg. Surf. Crs. 6.09 C.Y. Per 100'
 18" Agg. Subbase Crs. 43.71 " " "

The pavement and base depths as shown are intended to be nominal.

The surface of all courses shall be straight crown.


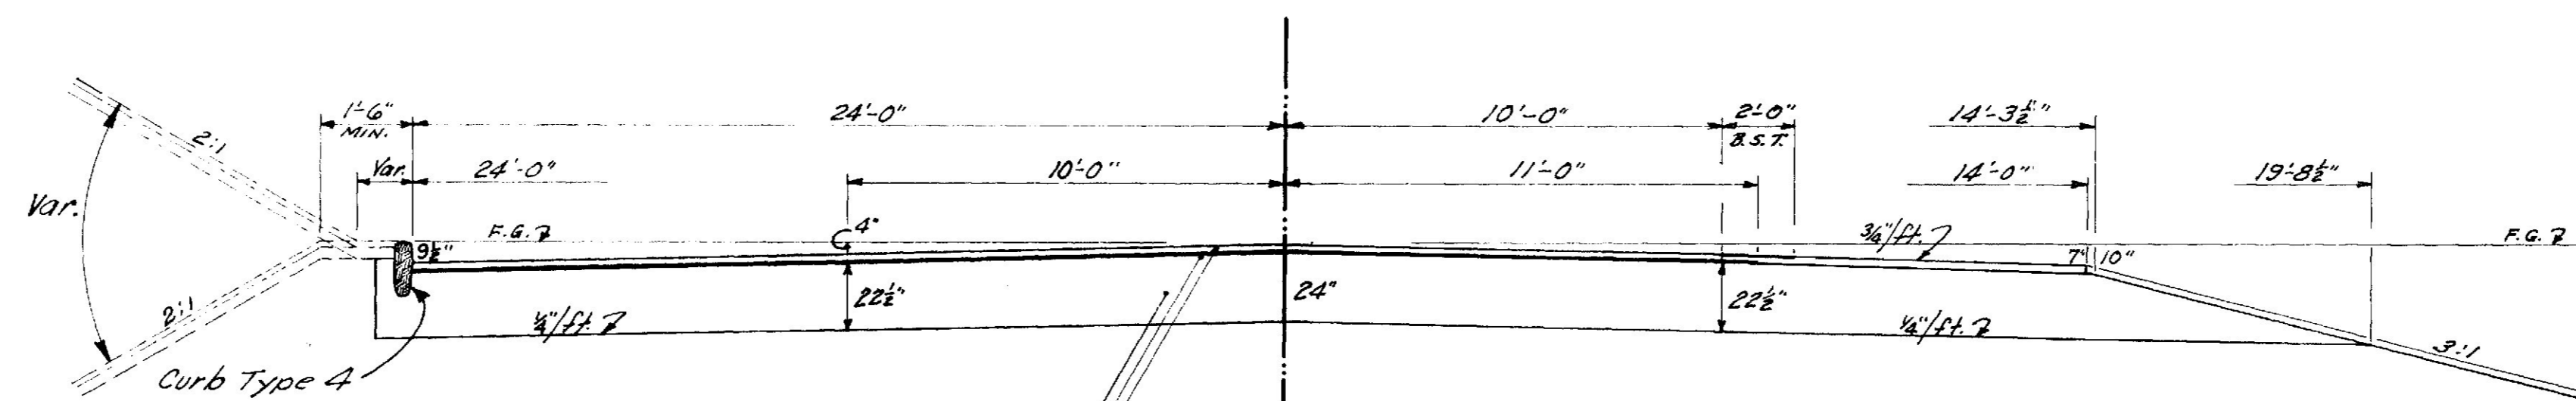


BOX

NORMAL

2" Road Mix Bit Pavc. 34' wide 20.99 C.Y. Per 100'
 1" Agg. Surf. Crs. Primed 35" " 10.80 " " "
 24" " Subbase Crs. 35" " 227.20 " " "

Curve Data
 P.I. = 40+20.24
 $\Delta = 34^\circ - 53' - 30''$ R+
 D = 2' - 30"
 T = 720.24'
 L = 1395.67'
 Ext. = 110.49'
 R = 2291'


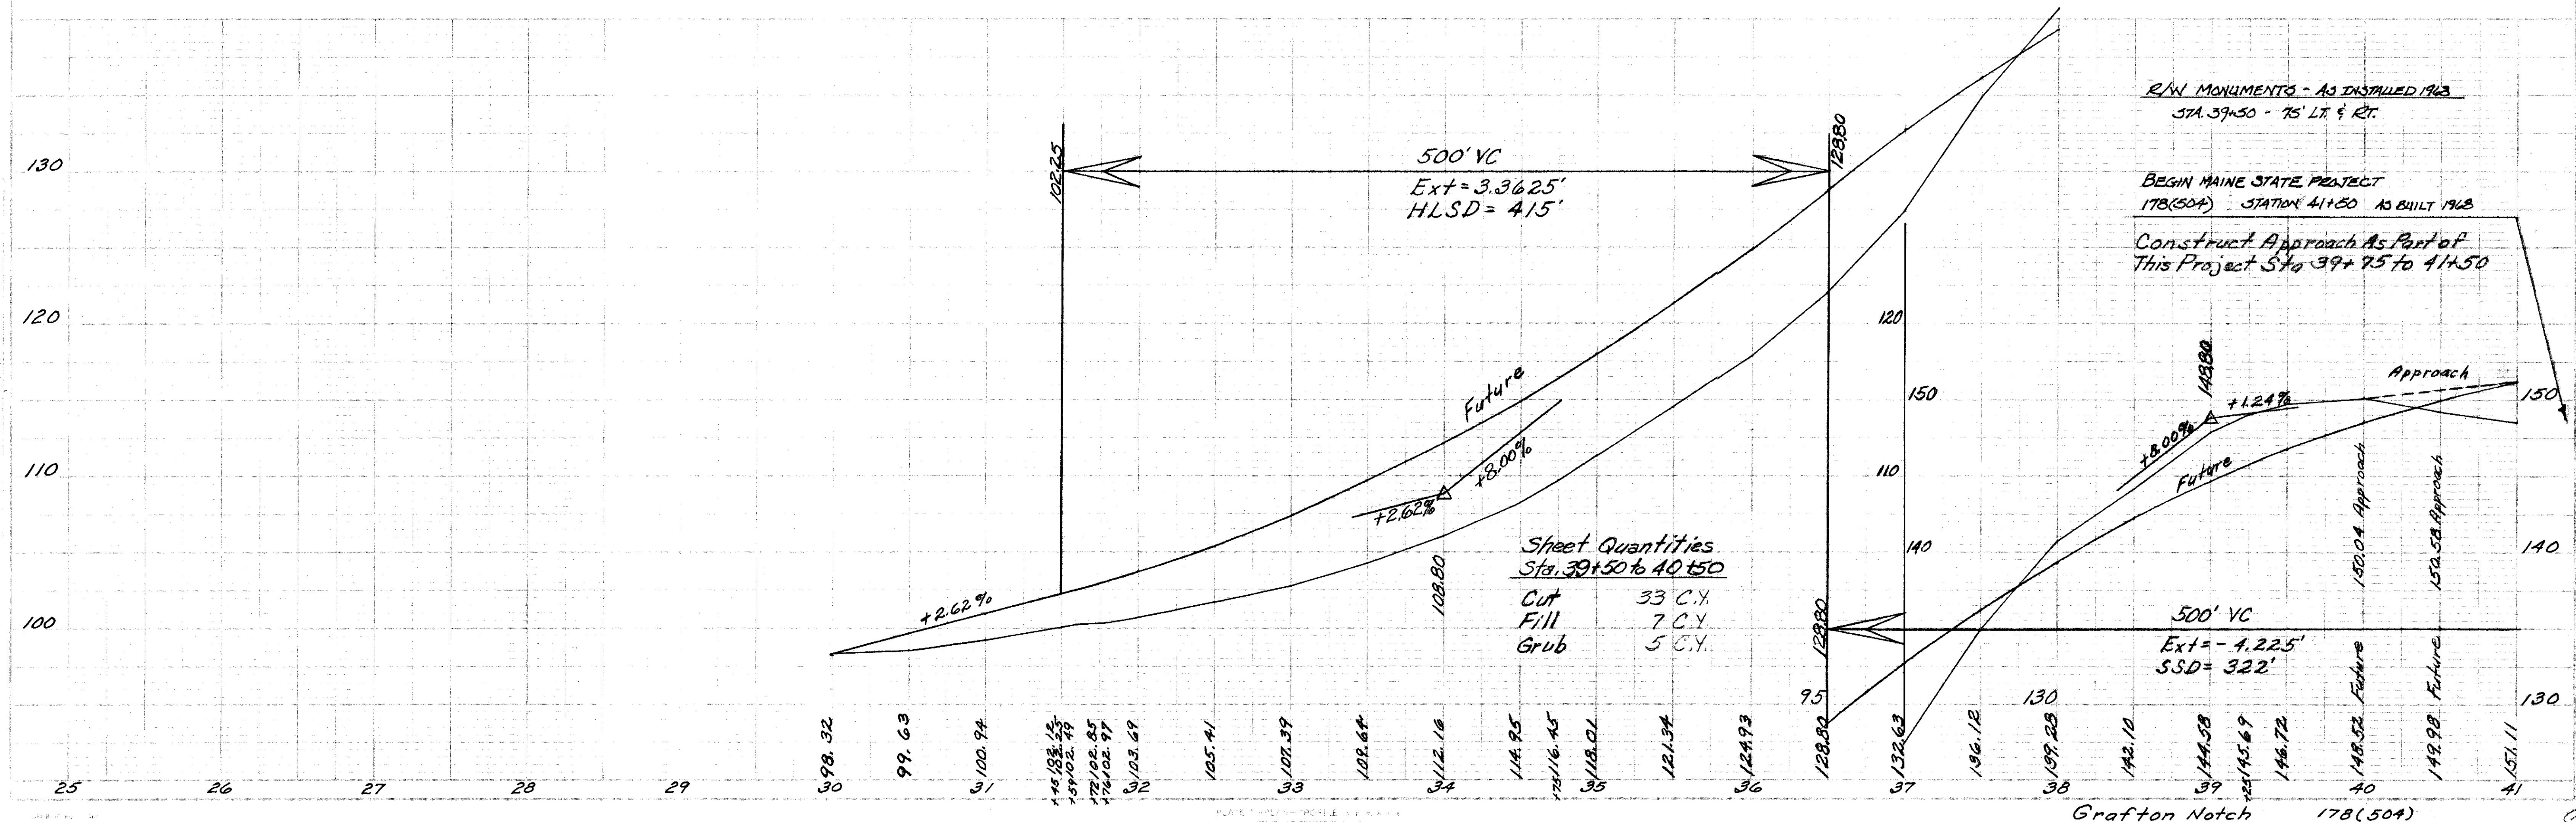
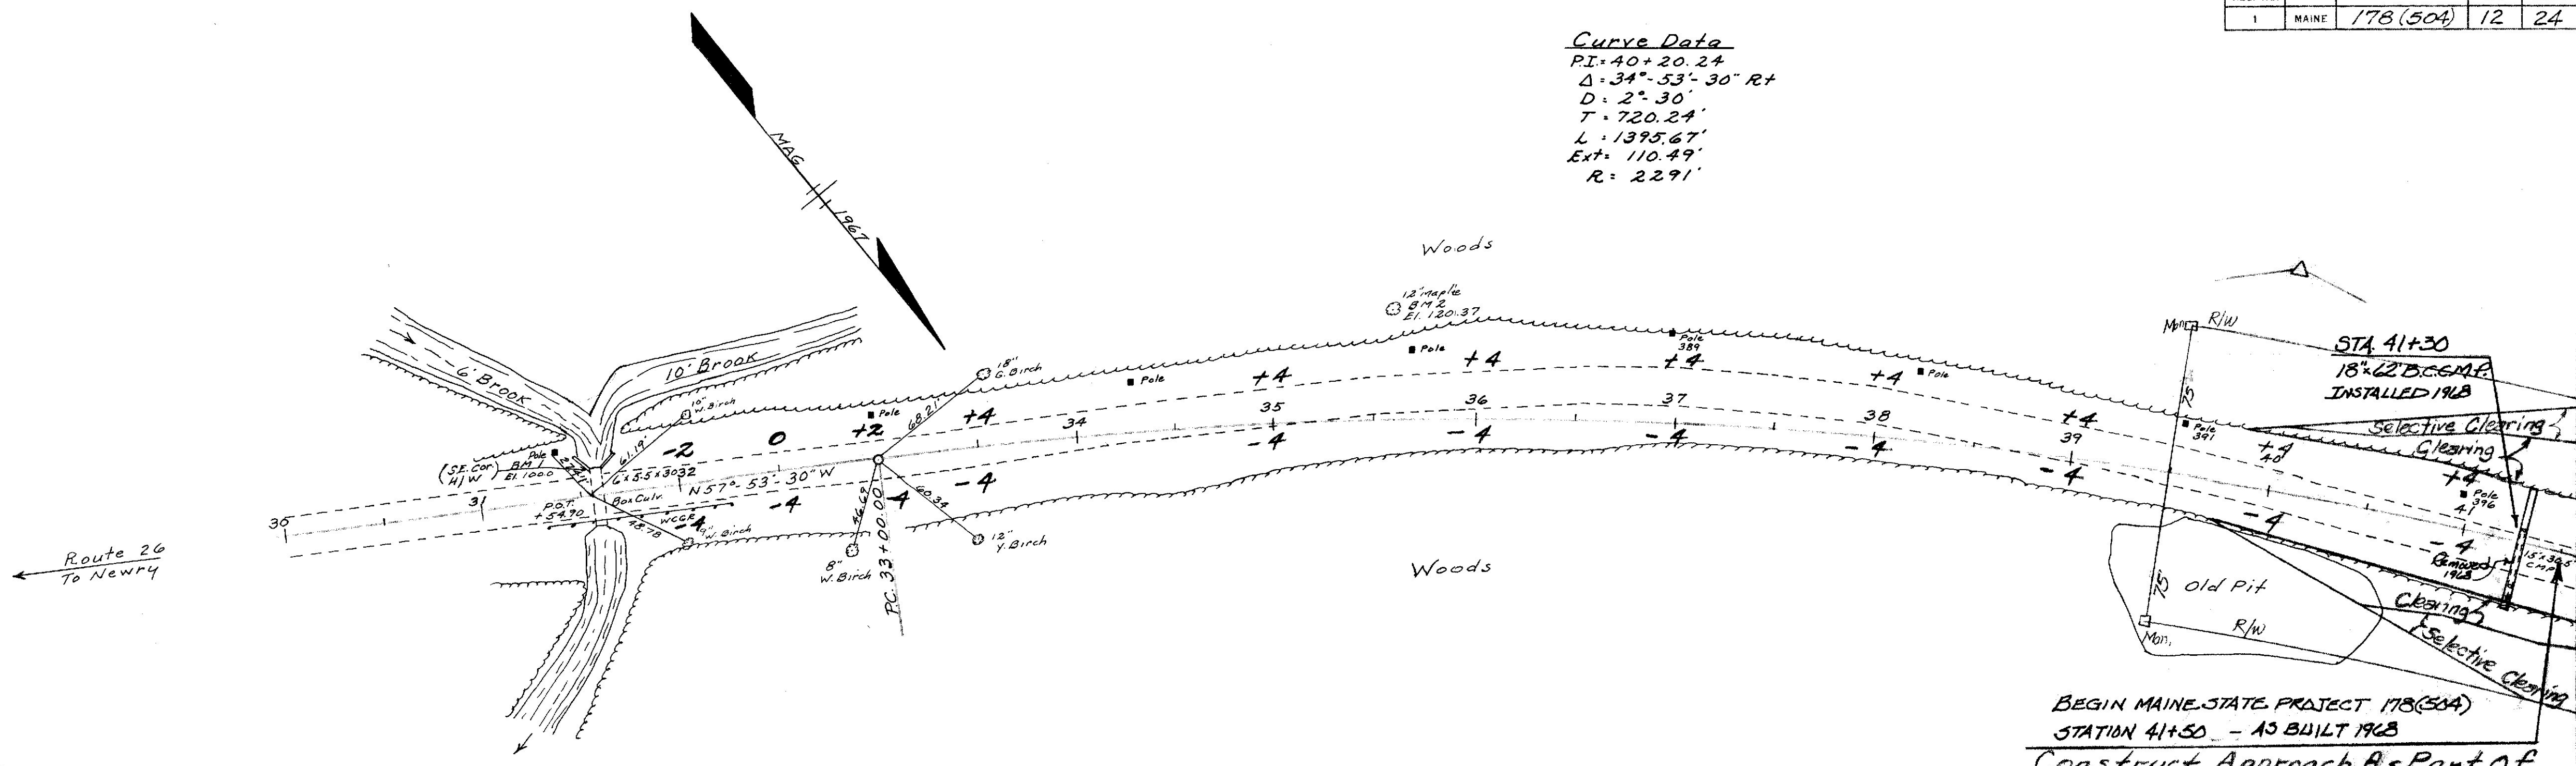


L. Hayward
 L. Hayward
 5-67
 5-67

L. Hayward
 L. Hayward
 5-67
 5-67

Curve Data
 P.I. 40+20.24
 $\Delta = 34^\circ - 53' - 30''$ R.T.
 $D = 2^\circ - 30'$
 $T = 720.24'$
 $L = 1395.67'$
 $Ext = 110.49'$
 $R = 2291'$

Note:
 Proposed Van Teld Tel.
 Lines on Trees at Selective
 Clearing Line

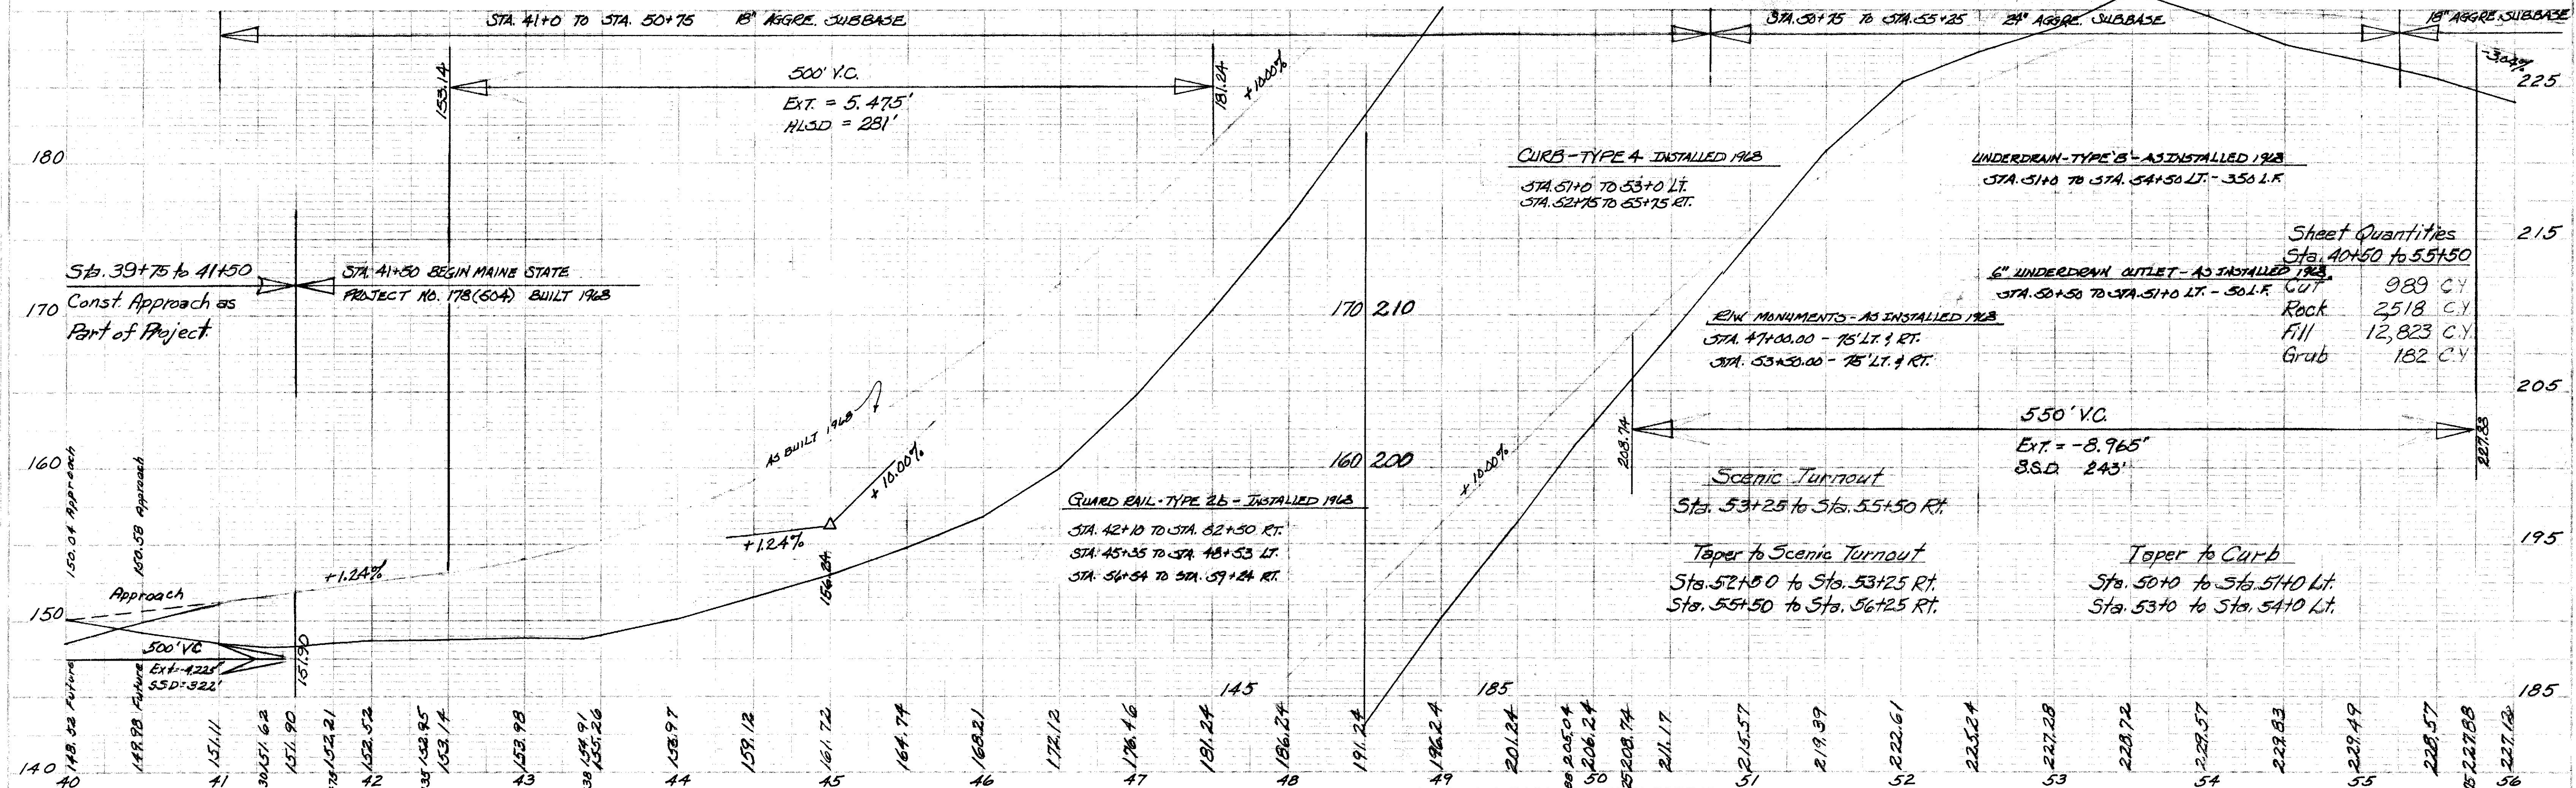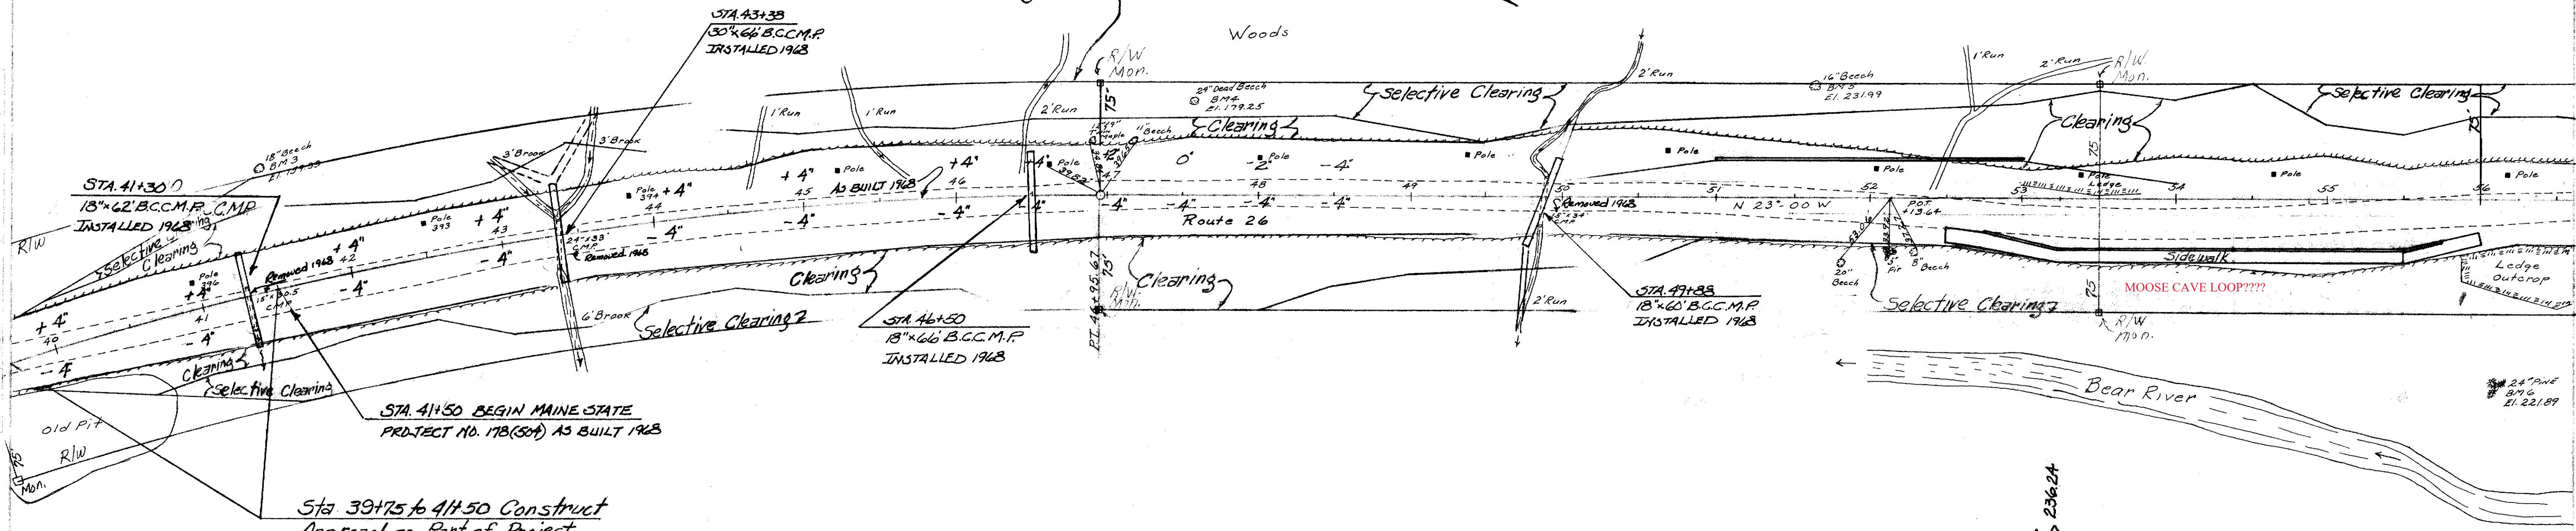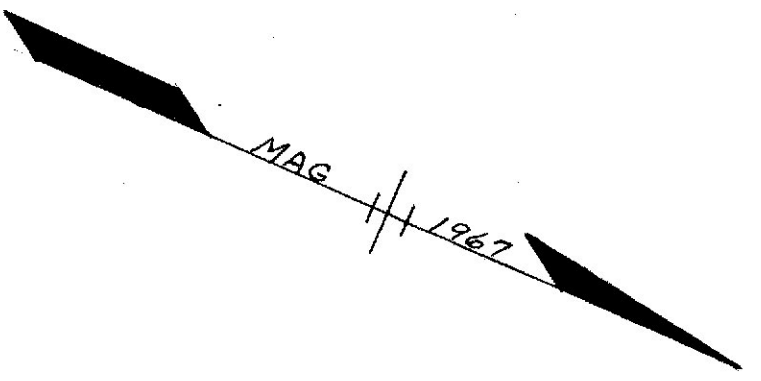




5-57
L. Hayward
5-57

5/67
L. Hayward
5/67

S. P. N.	STATE	PROJECT NUMBER	SHEET NO.	TOTAL SHEETS
I	MAINE	178(504)	14	24

Curve Data

PI = 67+65.07
 $\Delta = 07^{\circ} 37' 30''$ L.
 D = 3'-00"
 T = 127.27'
 L = 254.17'
 Ext = 4.24'
 R = 1909.853

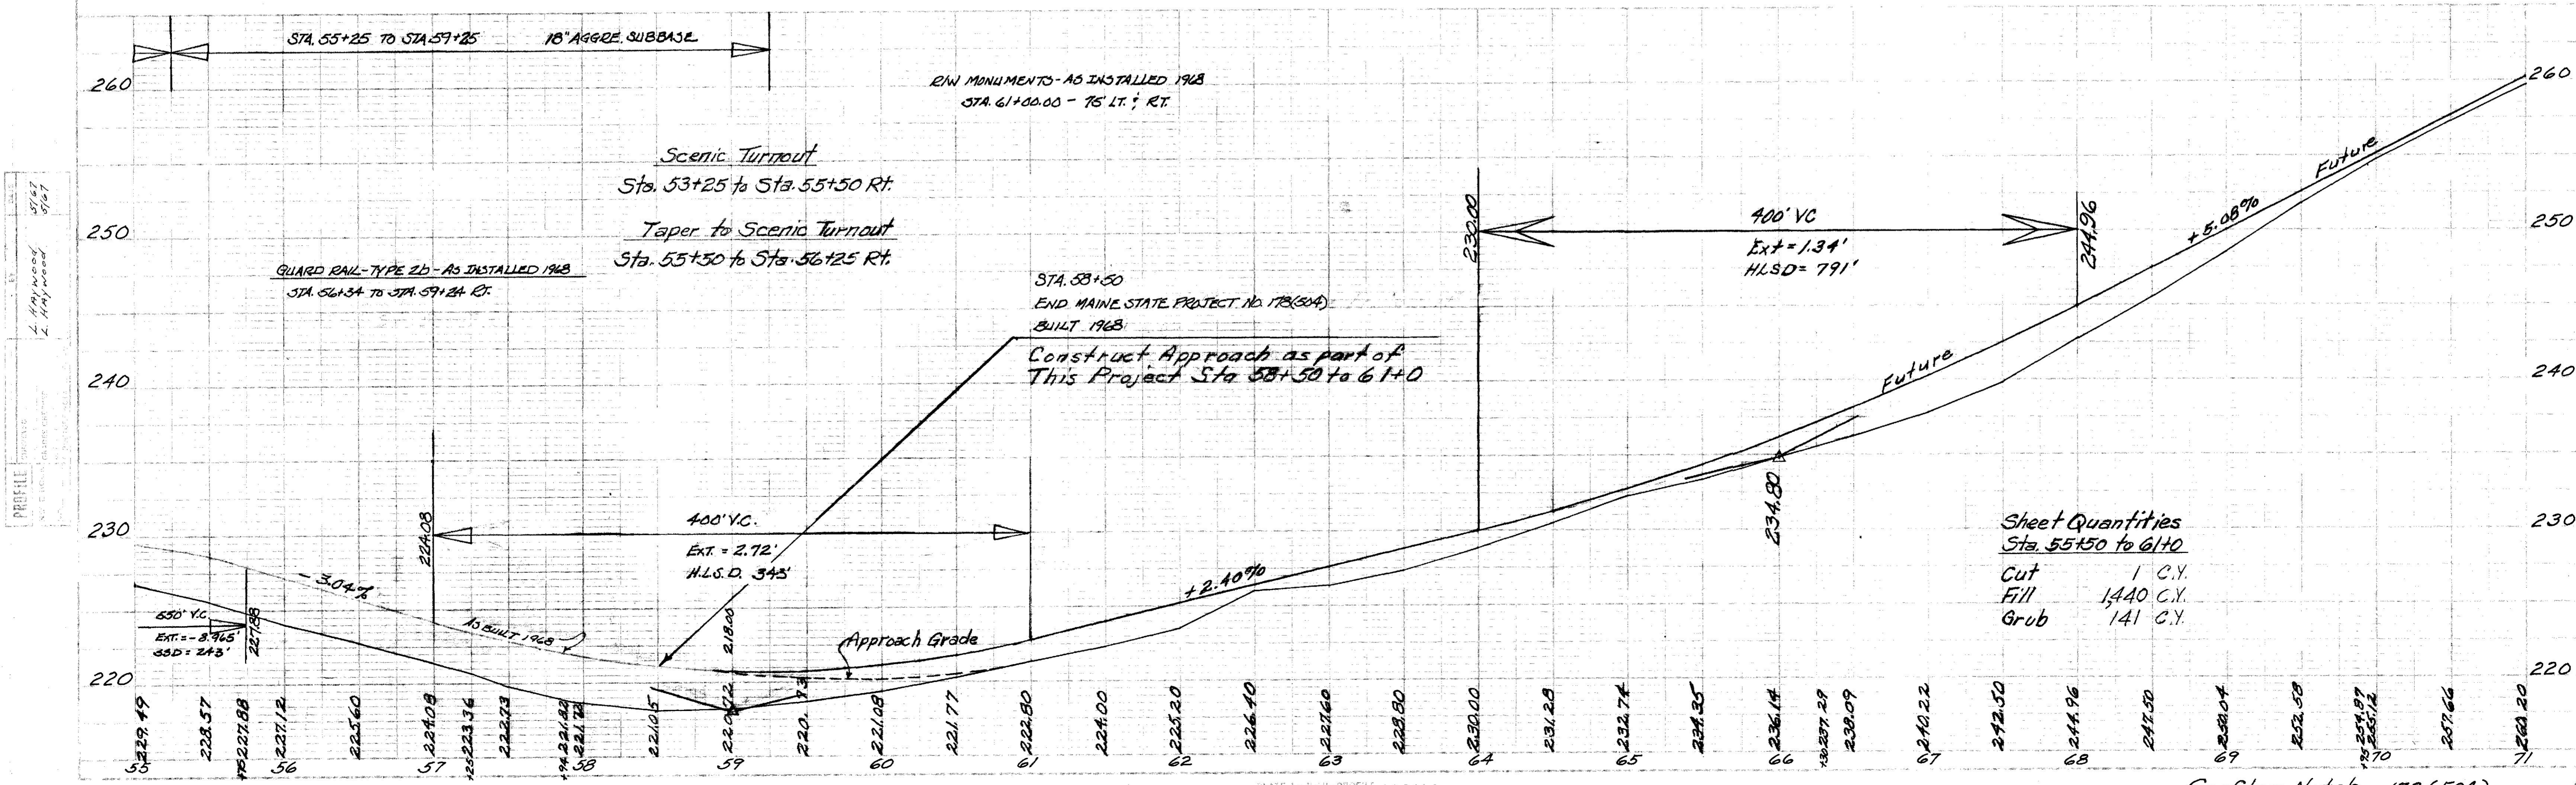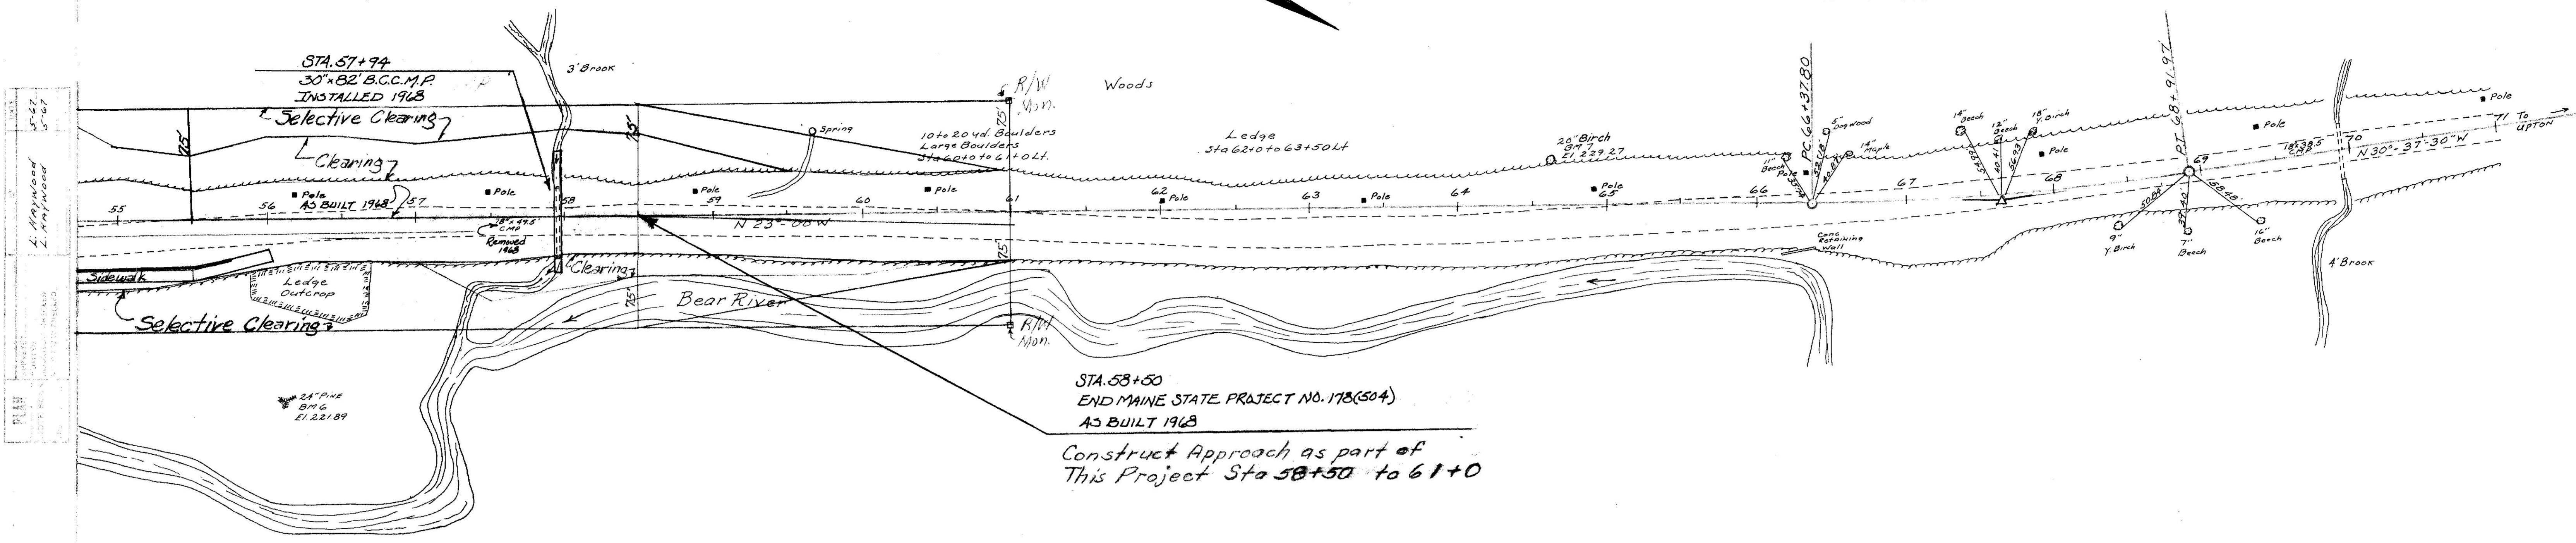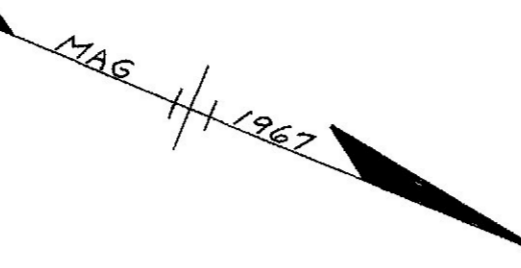

Sheet Quantities
 Sta. 55+50 to 61+0
 Cut 1 C.Y.
 Fill 1,440 C.Y.
 Grub 141 C.Y.

STATE OF MAINE DEPARTMENT OF TRANSPORTATION



BUREAU OF HIGHWAYS NEWRY OXFORD COUNTY MAINE FEDERAL AID SECONDARY PROJECT NO. RS-0178(3)

Microfilm Reel 123

CONVENTIONAL SIGNS	
COUNTY LINES	-----
TOWN LINES	-----
PROPERTY LINES	-----
R/W LINES - EXISTING	-----
R/W LINES - NEW - ACCESS CONTROL	-----
R/W LINES - NEW - NO ACCESS CONTROL	-----
CULVERT - EXISTING	-----
CULVERT - PROPOSED	-----
CURBING - EXISTING	-----
CURBING - PROPOSED	-----
TRAVELLED WAY - EXISTING	-----
TRAVELLED WAY - PROPOSED	=====
UNDERGROUND UTILITIES - EXISTING	-----
UNDERGROUND UTILITIES - PROPOSED	-----
RAILROAD - SINGLE TRACK	-----
RAILROAD - DOUBLE TRACK	-----
UTILITY POLE - EXISTING	◆
UTILITY POLE - JOINT OCCUPANCY	◆◆
PROPOSED UTILITY POLE - TEMPORARY	×
PROPOSED UTILITY POLE - PERMANENT	×
TREES	① hardwood ② softwood
WOODS	-----

SHEET NO.	DESCRIPTION
1	TITLE SHEET
2,3	TYPICAL SECTIONS
4	ESTIMATED QUANTITIES & SUMMARY OF EXCAVATION & BORROW
5	DRAINAGE SUMMARY & GENERAL NOTES
6-14	STANDARD DETAILS
15-17	PLAN & PROFILE
18-48	CROSS SECTIONS

TOTAL LENGTH .0625 MILES

SCALES

- PLAN: 0 50 100 FEET
- PROFILE: HOR. 0 50 100 FEET; VER. 0 5 10 FEET
- CROSS SECTIONS: 0 5 10 FEET

GRADING, DRAINAGE, BASE & PAVEMENT

**RLM
80.08**


**RLM
80.71**

**RLM
80.31**

**RLM
80.63**

STA. 50+50 BEGIN PROPOSED MAINE
F.A.S. PROJECT RS-0178(3)

STA. 83+50 END PROPOSED MAINE
F.A.S. PROJECT RS-0178(3)

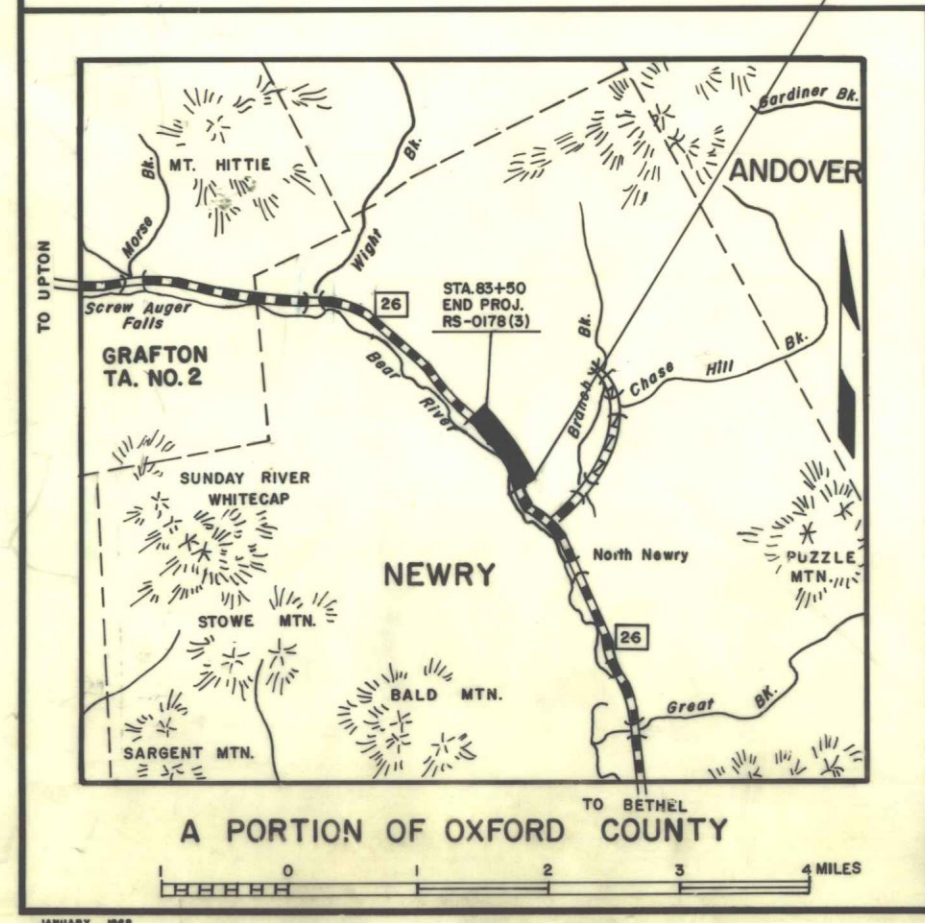

TRAFFIC DATA	
A.D.T. 1977	400
A.D.T. 1997	560
D.H.V.	112
T. (%)	10
D. (%)	60
V.	50
P.S.D. (%)	49.3
18 KIPS	20

NOTE

All work contemplated under this contract to be governed by and in conformity with the STANDARD SPECIFICATIONS (revision of June 1968) and supplementals thereto, except as modified on the plans and in the special provisions.

APPROVED:

STATE OF MAINE
DEPARTMENT OF TRANSPORTATION

Richard A. Luetich, Sr.
COMMISSIONER

DATE: JULY 11, 1977

Richard A. Luetich, Sr.
CHIEF ENGINEER & BUREAU DIRECTOR

DATE: JULY 11, 1977



UNITED STATES
DEPARTMENT OF TRANSPORTATION
FEDERAL HIGHWAY ADMINISTRATION
REGION 1

APPROVED:

DIVISION ADMINISTRATOR


DATE

As built 1978 E. Merrill

DD-35


3" HOT BIT. PAVEMENT *

F.R.W.A. REG. NO.	STATE	PROJECT NUMBER	SHEET NO.	TOTAL SHEETS
1	MAINE	RS-0178(3)	2	48

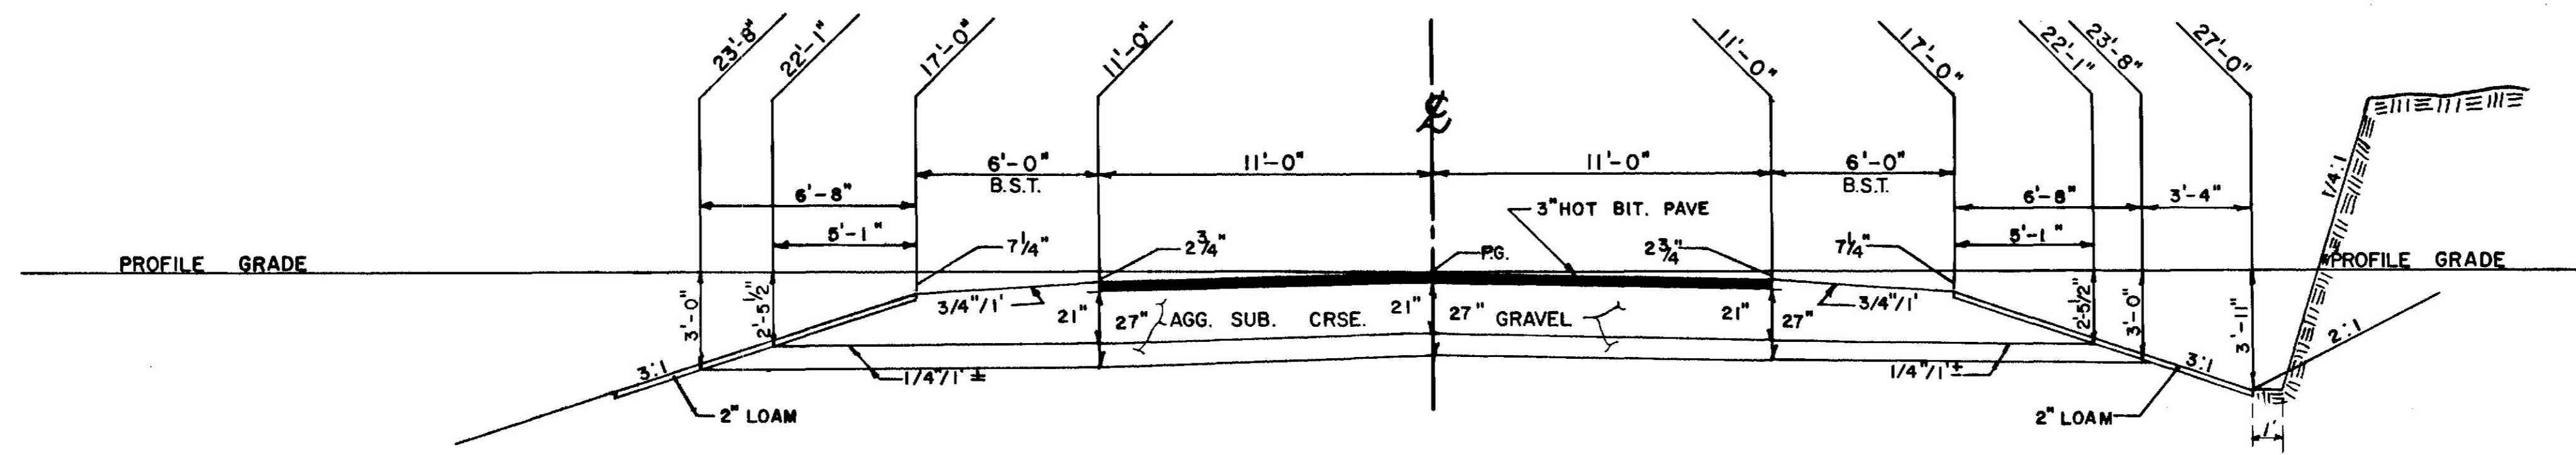


6 FT. SHLD. NORMAL
 21" AGG. SUBBASE CRSE. GRAVEL = 56.55 C.Y./100 L.F. STA. 71+00 TO 84+00 LT.
22 FT. PAVEMENT
 21" AGG. SUBBASE - 11" WIDE = 142.59 C.Y./100 L.F.
 27" AGG. SUBBASE - 11" WIDE = 183.33 C.Y./100 L.F.
 27" AGG. SUBBASE CRSE. GRAVEL = 78.57 C.Y./100 L.F. STA. 71+00 TO 84+00 RT.

NORMAL

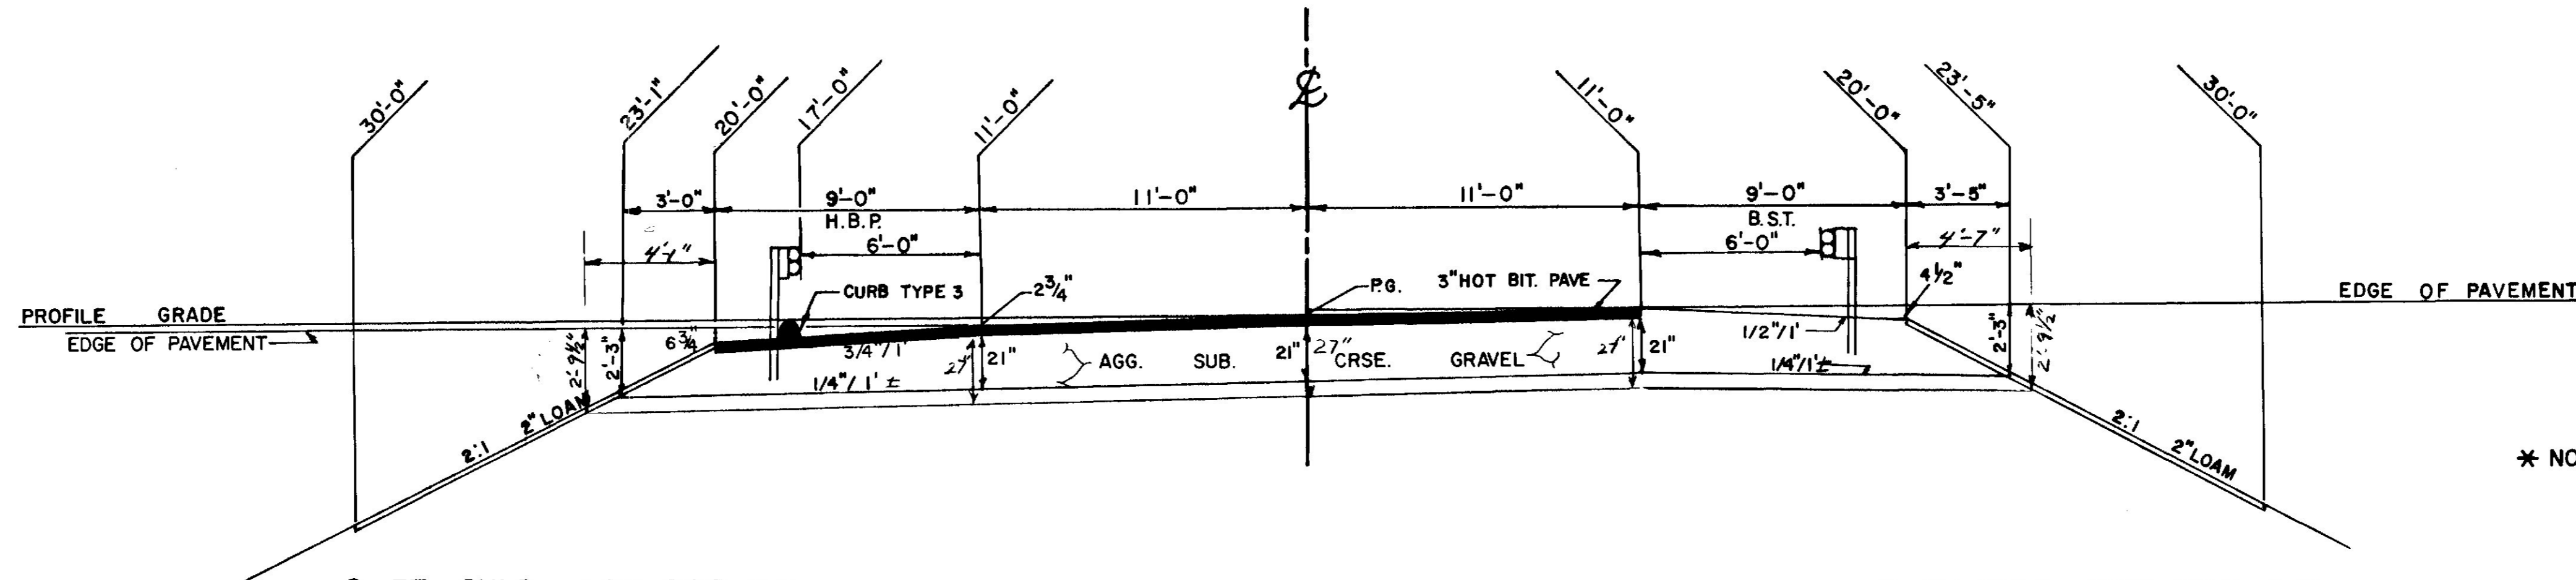

9 FT. SHLD. - LOW SIDE G.R.
 21" AGG. SUBBASE - GRAVEL = 60.65 C.Y./100 L.F. STA. 59+00 TO 61+00 LT.
 27" AGG. SUBBASE - GRAVEL = 83.88 C.Y./100 L.F. STA. 57+25 TO 59+00 LT.
 STA. 61+00 TO 62+00 LT.
9 FT. SHLD. - HIGH SIDE G.R.
 21" AGG. SUBBASE CRSE. GRAVEL = 73.81 C.Y./100 L.F.
 27" AGG. SUBBASE CRSE. GRAVEL = 98.27 C.Y./100 L.F. STA. 55+50 TO 57+25 LT.

SUPERELEVATED

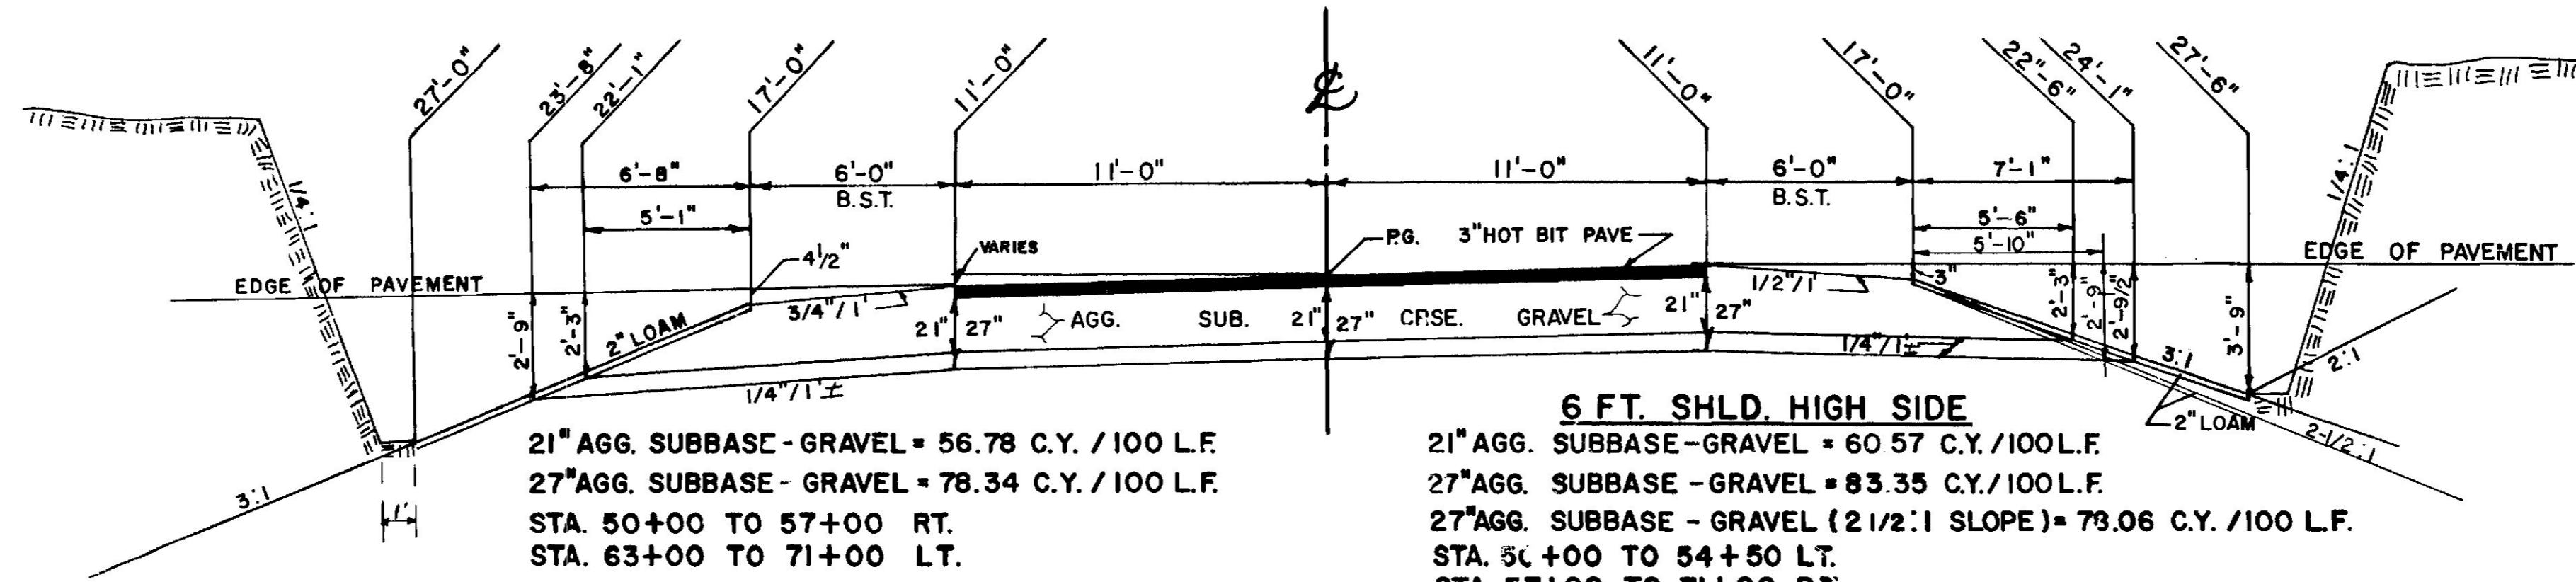

6 FT. SHLD. HIGH SIDE
 21" AGG. SUBBASE - GRAVEL = 56.78 C.Y./100 L.F. STA. 50+00 TO 57+00 RT.
 27" AGG. SUBBASE - GRAVEL = 78.34 C.Y./100 L.F. STA. 63+00 TO 71+00 LT.
 21" AGG. SUBBASE - GRAVEL = 60.57 C.Y./100 L.F.
 27" AGG. SUBBASE - GRAVEL = 83.35 C.Y./100 L.F.
 27" AGG. SUBBASE - GRAVEL (2 1/2:1 SLOPE) = 73.06 C.Y./100 L.F. STA. 50+00 TO 54+50 LT.
 STA. 57+00 TO 71+00 RT.

* NOTE THE PAVEMENT AND BASE DEPTHS AS SHOWN ON THE PLANS ARE INTENDED TO BE NOMINAL.

WHEN SUPERELEVATION EXCEEDS 3/4" PER FOOT LOW SIDE SHOULDER SHALL HAVE SAME SLOPE AS PAVEMENT.

PROJECT DESIGN ENGINEER	DATE
DESIGN - DETAILED	1/22/76
CHECKED	
REVISIONS	
FIELD CHANGES	

PLANS

STATE OF MAINE
 DEPARTMENT OF TRANSPORTATION


TYPICAL SECTIONS

NEWRY S-0178(3)

SHEET OF AUGUSTA, MAINE

3" HOT BITUMINOUS PAVEMENT *

F.R.W.A. REG. NO.	STATE	PROJECT NUMBER	SHEET NO.	TOTAL SHEETS
1	MAINE	RS-0178(3)	3	48

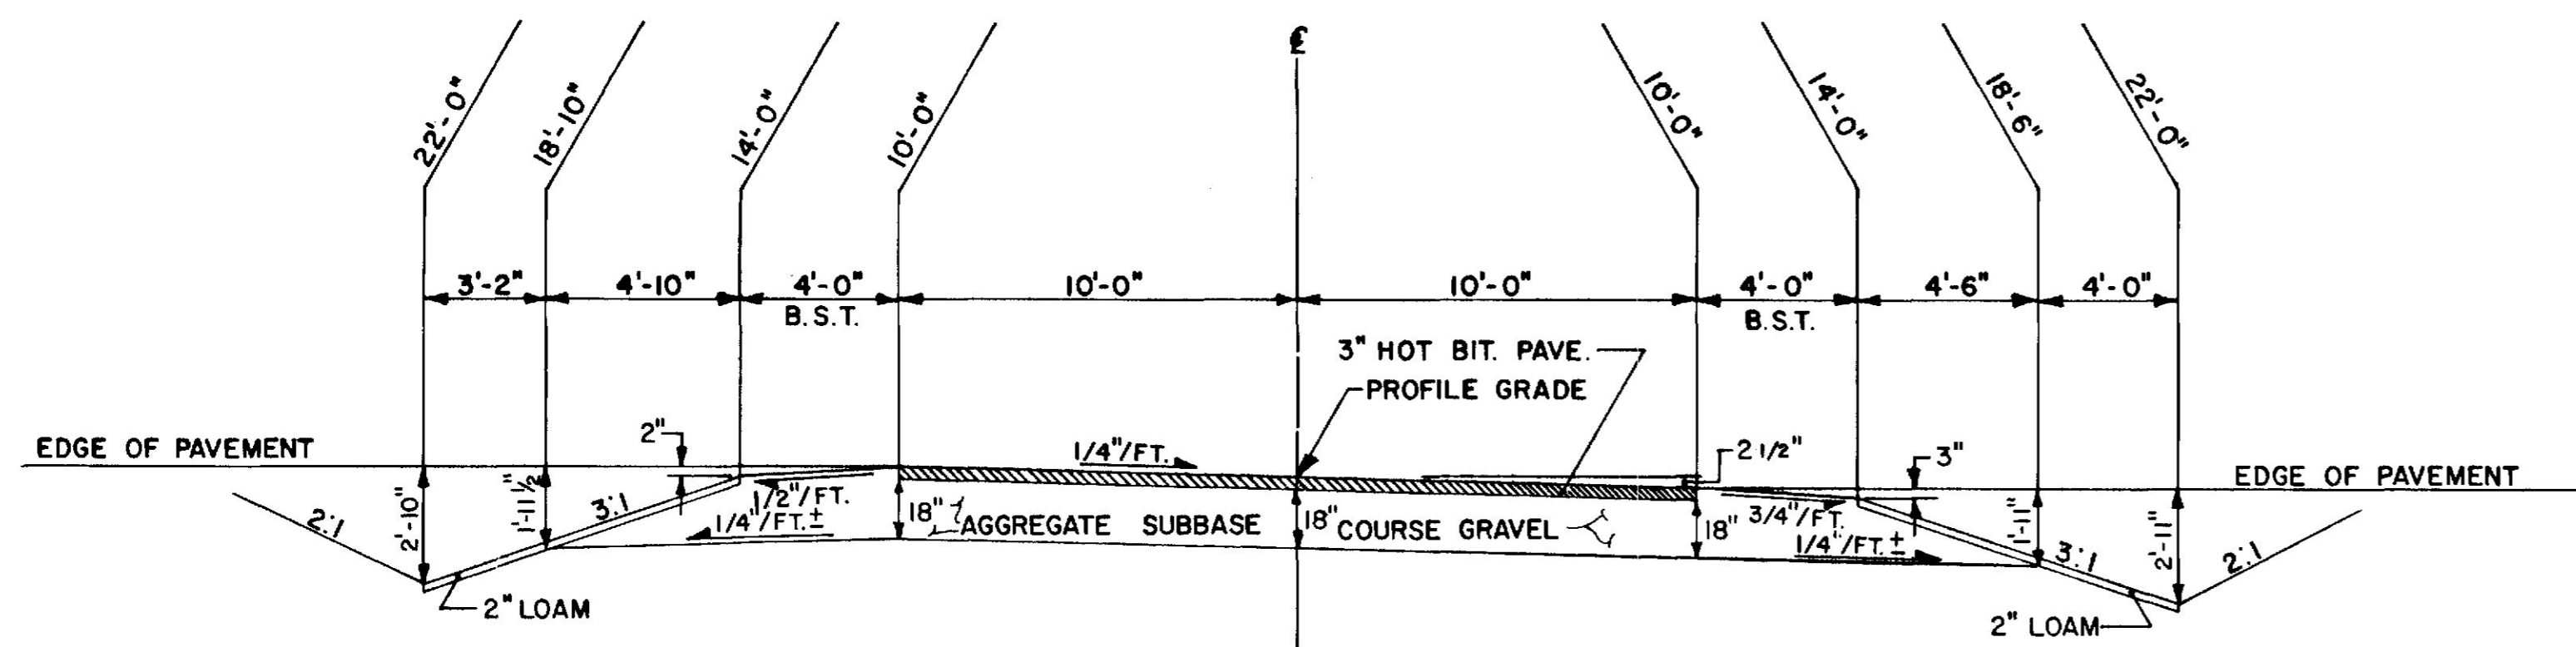

4 FT. SHLD. - HIGH SIDE

20 FT. PAVEMENT

4 FT. SHLD. - NORMAL

AGGREGATE SUBBASE COURSE GRAVEL = 38.91 C.Y./100 L.F.

18" AGGREGATE SUBBASE COURSE GRAVEL = 111.11 C.Y./100 L.F.

AGGREGATE SUBBASE COURSE GRAVEL = 36.42 C.Y./100 L.F.

TYPICAL SECTION-CONNECTORS

CONNECTOR AT STA. 62+50
 STA. 11+50 TO 13+00 LT. MAINLINE EDGE OF PAVEMENT TO STA. 13+00 RT.
 MAINLINE EDGE OF PAVEMENT TO STA. 11+50 LT.

CONNECTOR AT STA. 79+25
 MAINLINE EDGE OF PAVEMENT TO STA. 12+00 RT.
 MAINLINE EDGE OF PAVEMENT TO STA. 12+00 LT.

* NOTE: THE PAVEMENT AND BASE DEPTHS AS SHOWN ON THE PLANS ARE INTENDED TO BE NOMINAL.

WHEN SUPERELEVATION EXCEEDS 3/4" PER FOOT LOW SIDE SHOULDER SHALL HAVE SAME SLOPE AS PAVEMENT.

PROJECT DESIGN ENGINEER	BY	DATE
DESIGN - DETAILED		
CHECKED		
REVISIONS		
FIELD CHANGES		



PLANS

STATE OF MAINE
 DEPARTMENT OF TRANSPORTATION

TYPICAL SECTIONS

NEWRY RS-0178(3)

SHEET OF AUGUSTA, MAINE

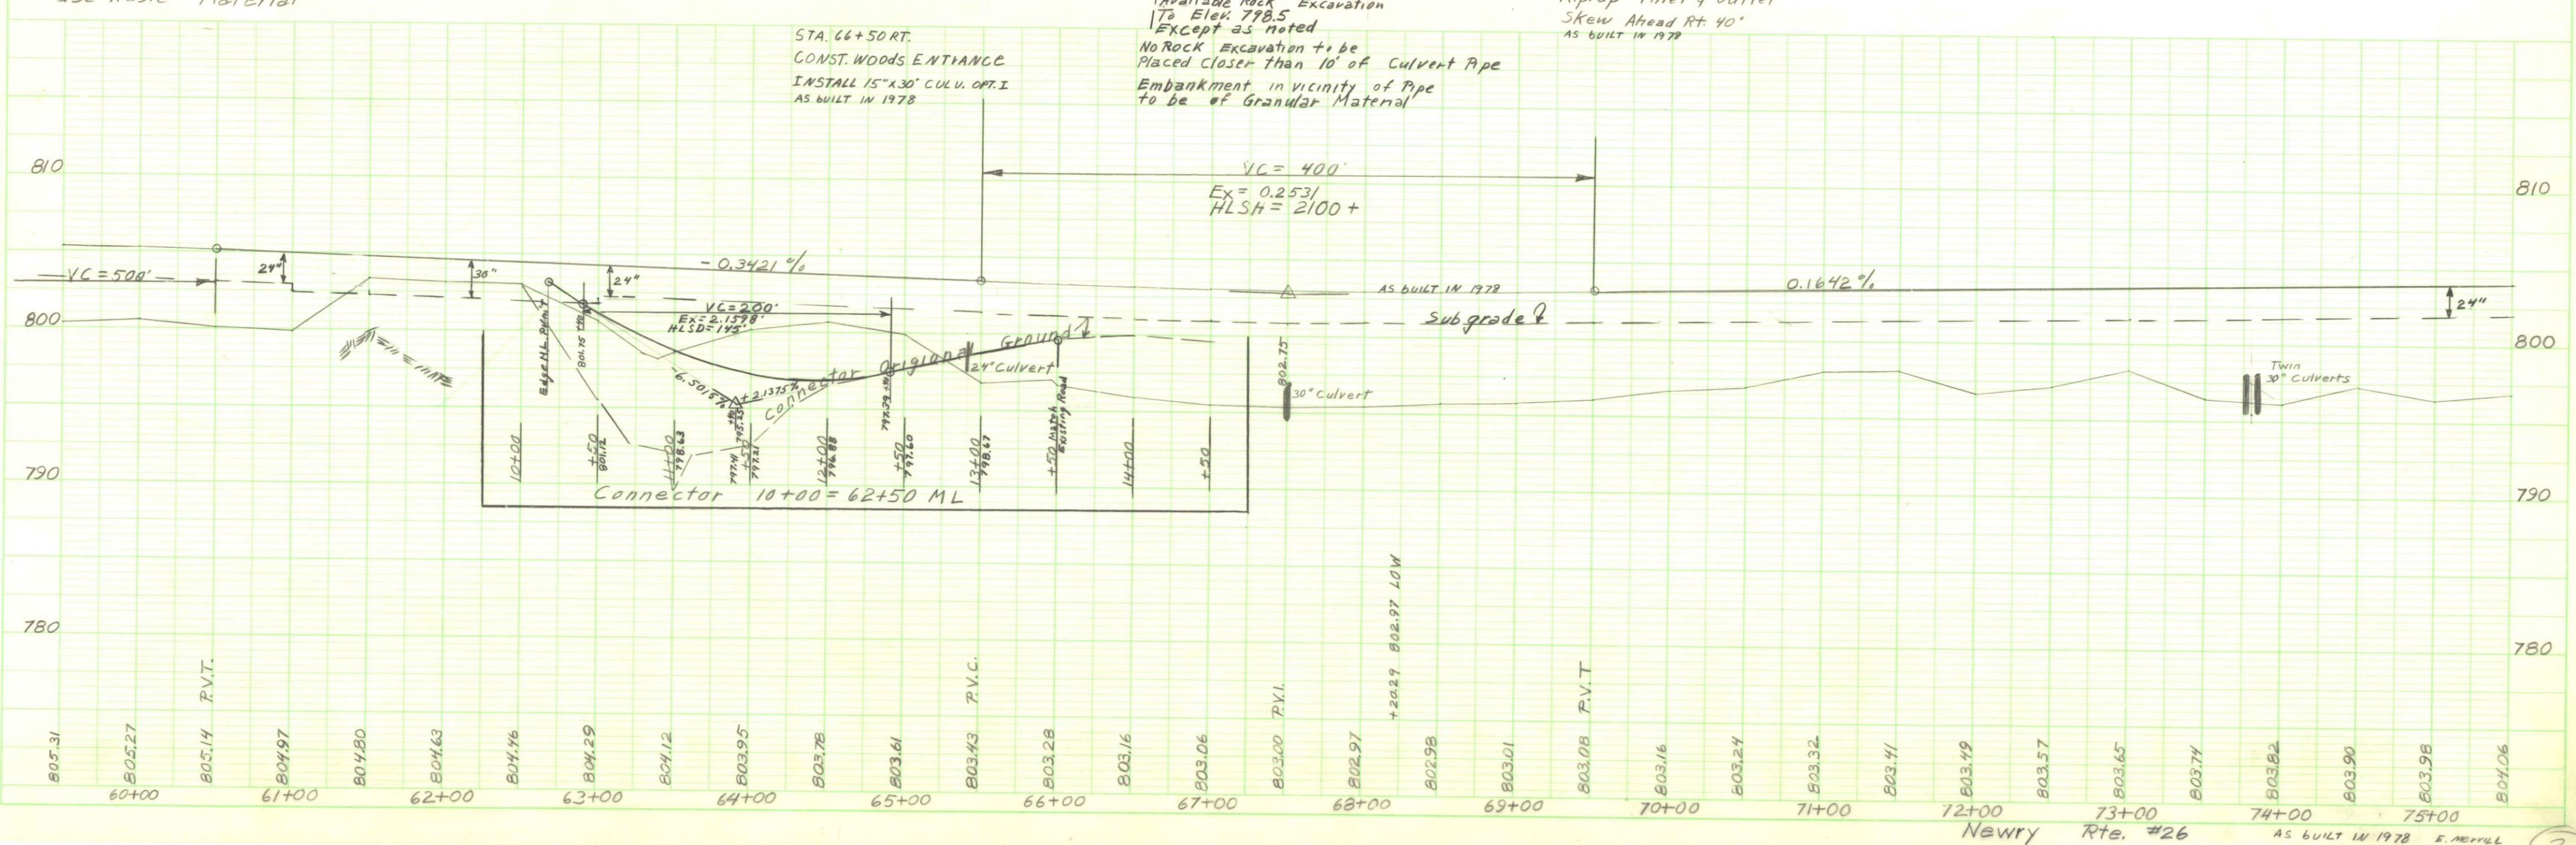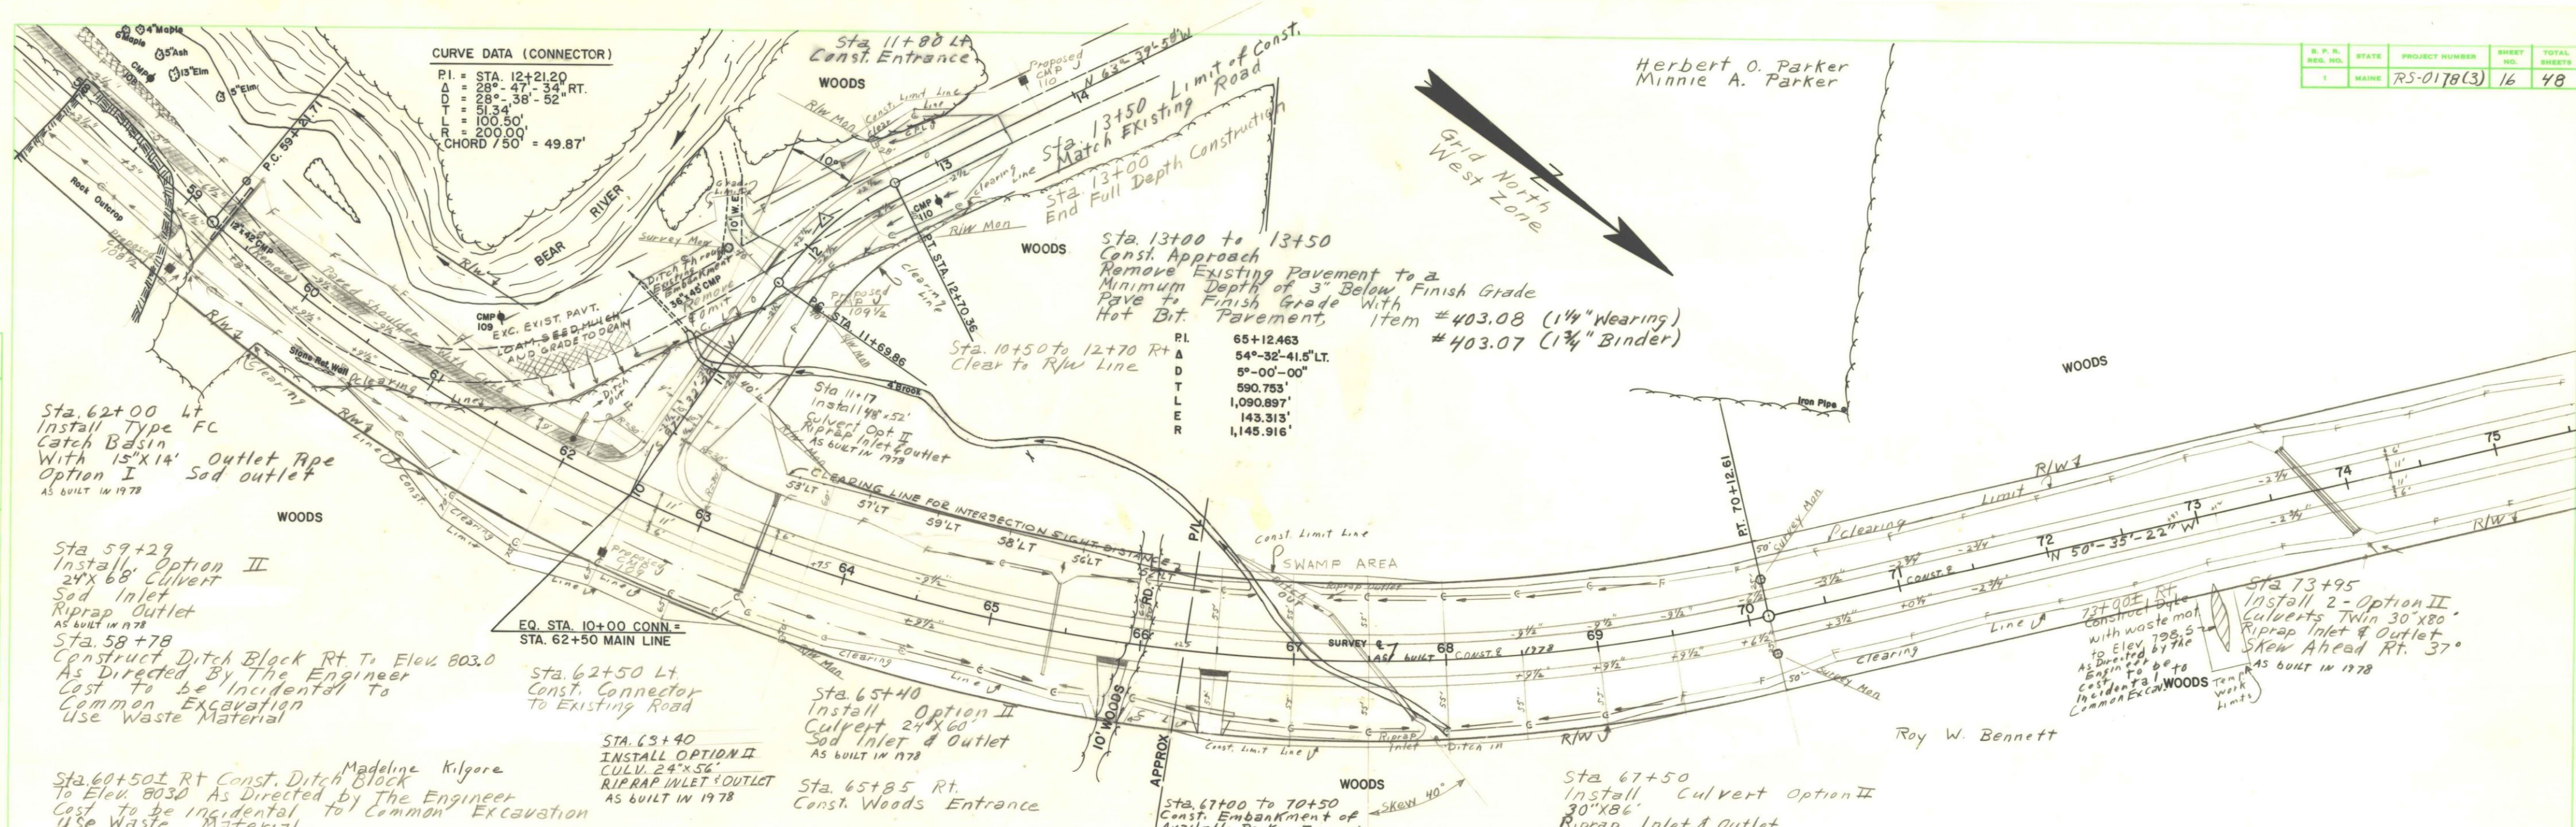



DATE
 BY
 SURVEYED
 ALIGNED
 CHECKED
 NOTE BOOK
 NO. 7756

DATE
 BY
 SURVEYED
 PLOTTED
 CHECKED
 NOTE BOOK
 NO. 7756

CURVE DATA (CONNECTOR)
 P.I. = STA. 11+21.08
 Δ = 38°-03'-00" LT.
 D = 38°-11'-50"
 T = 51.72'
 L = 99.61'
 R = 150.00'

PLAN
 SURVEYED BY: [blank]
 DRAWN BY: [blank]
 CHECKED BY: [blank]
 DATE: [blank]
 NOTE: [blank]

PROFILE
 SURVEYED BY: [blank]
 DRAWN BY: [blank]
 CHECKED BY: [blank]
 DATE: [blank]
 NOTE: [blank]

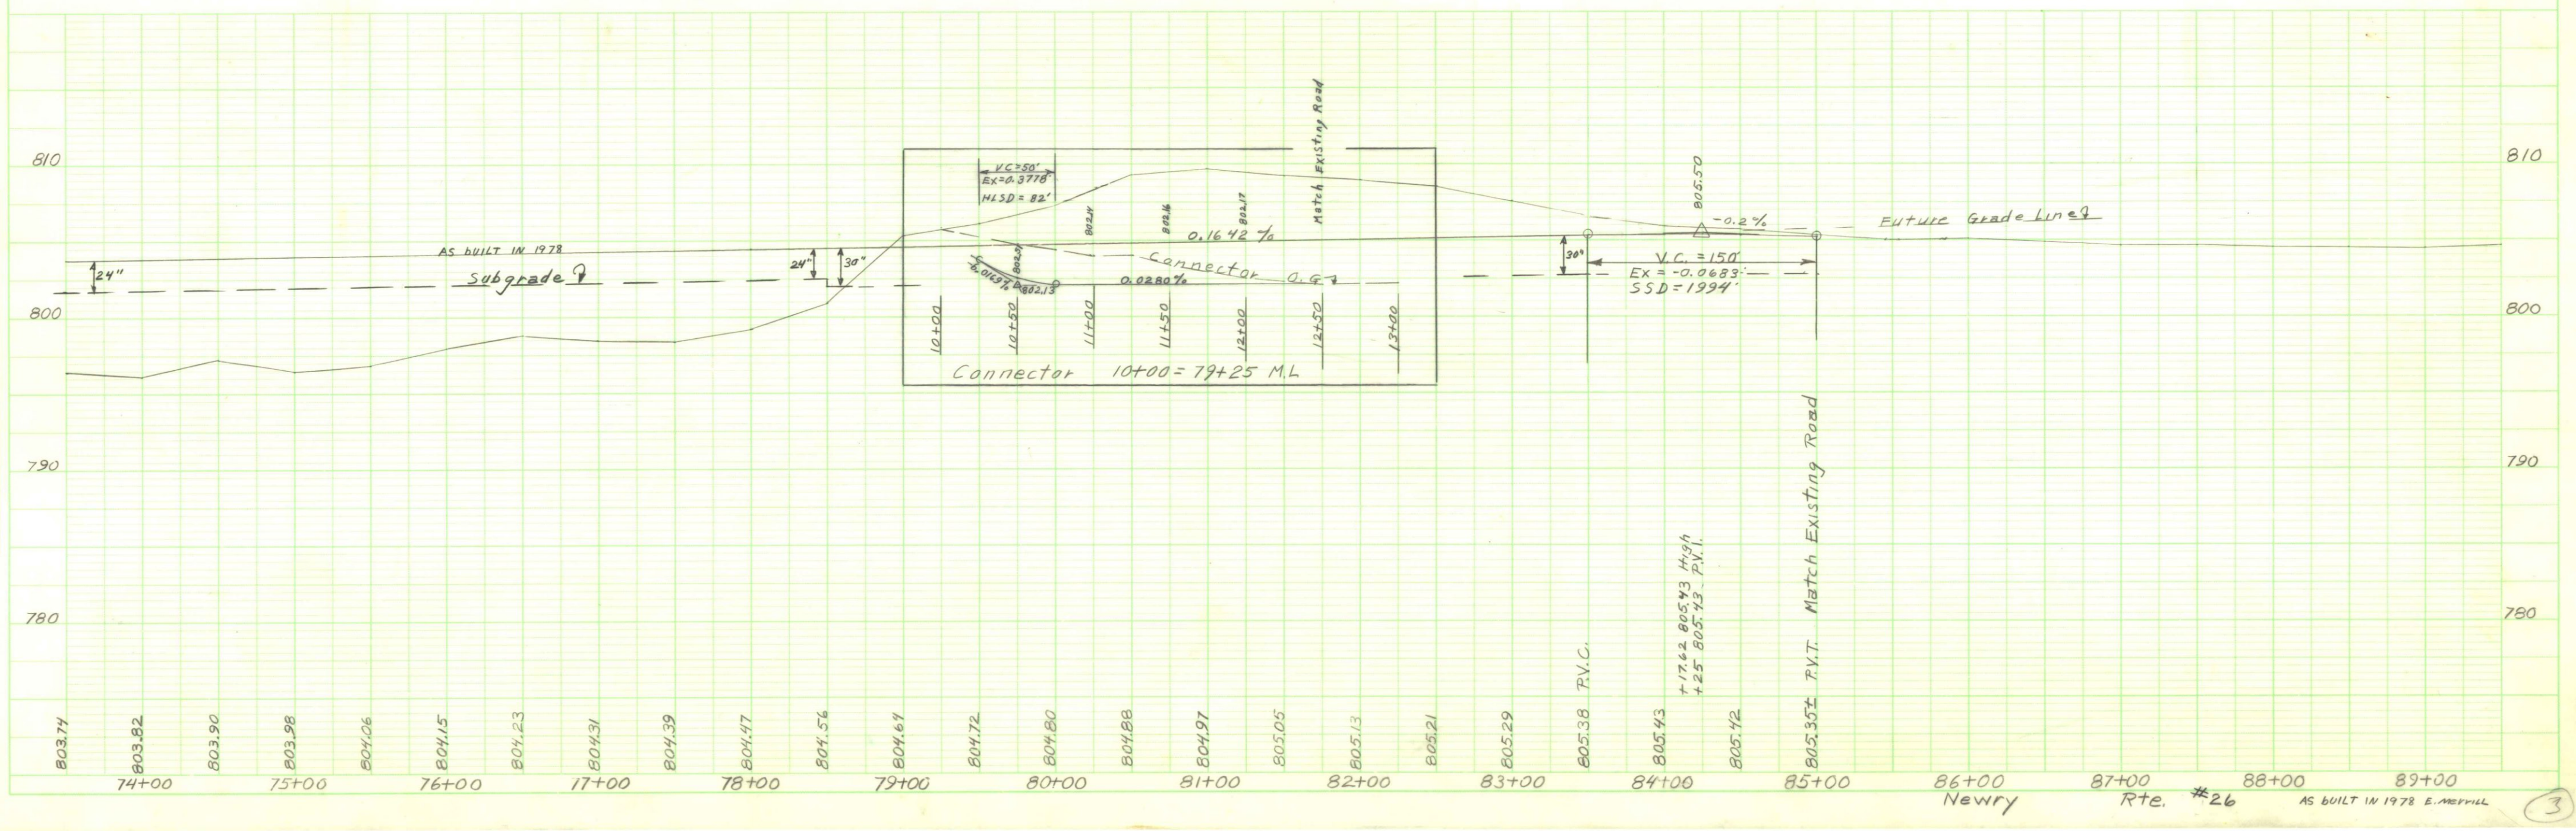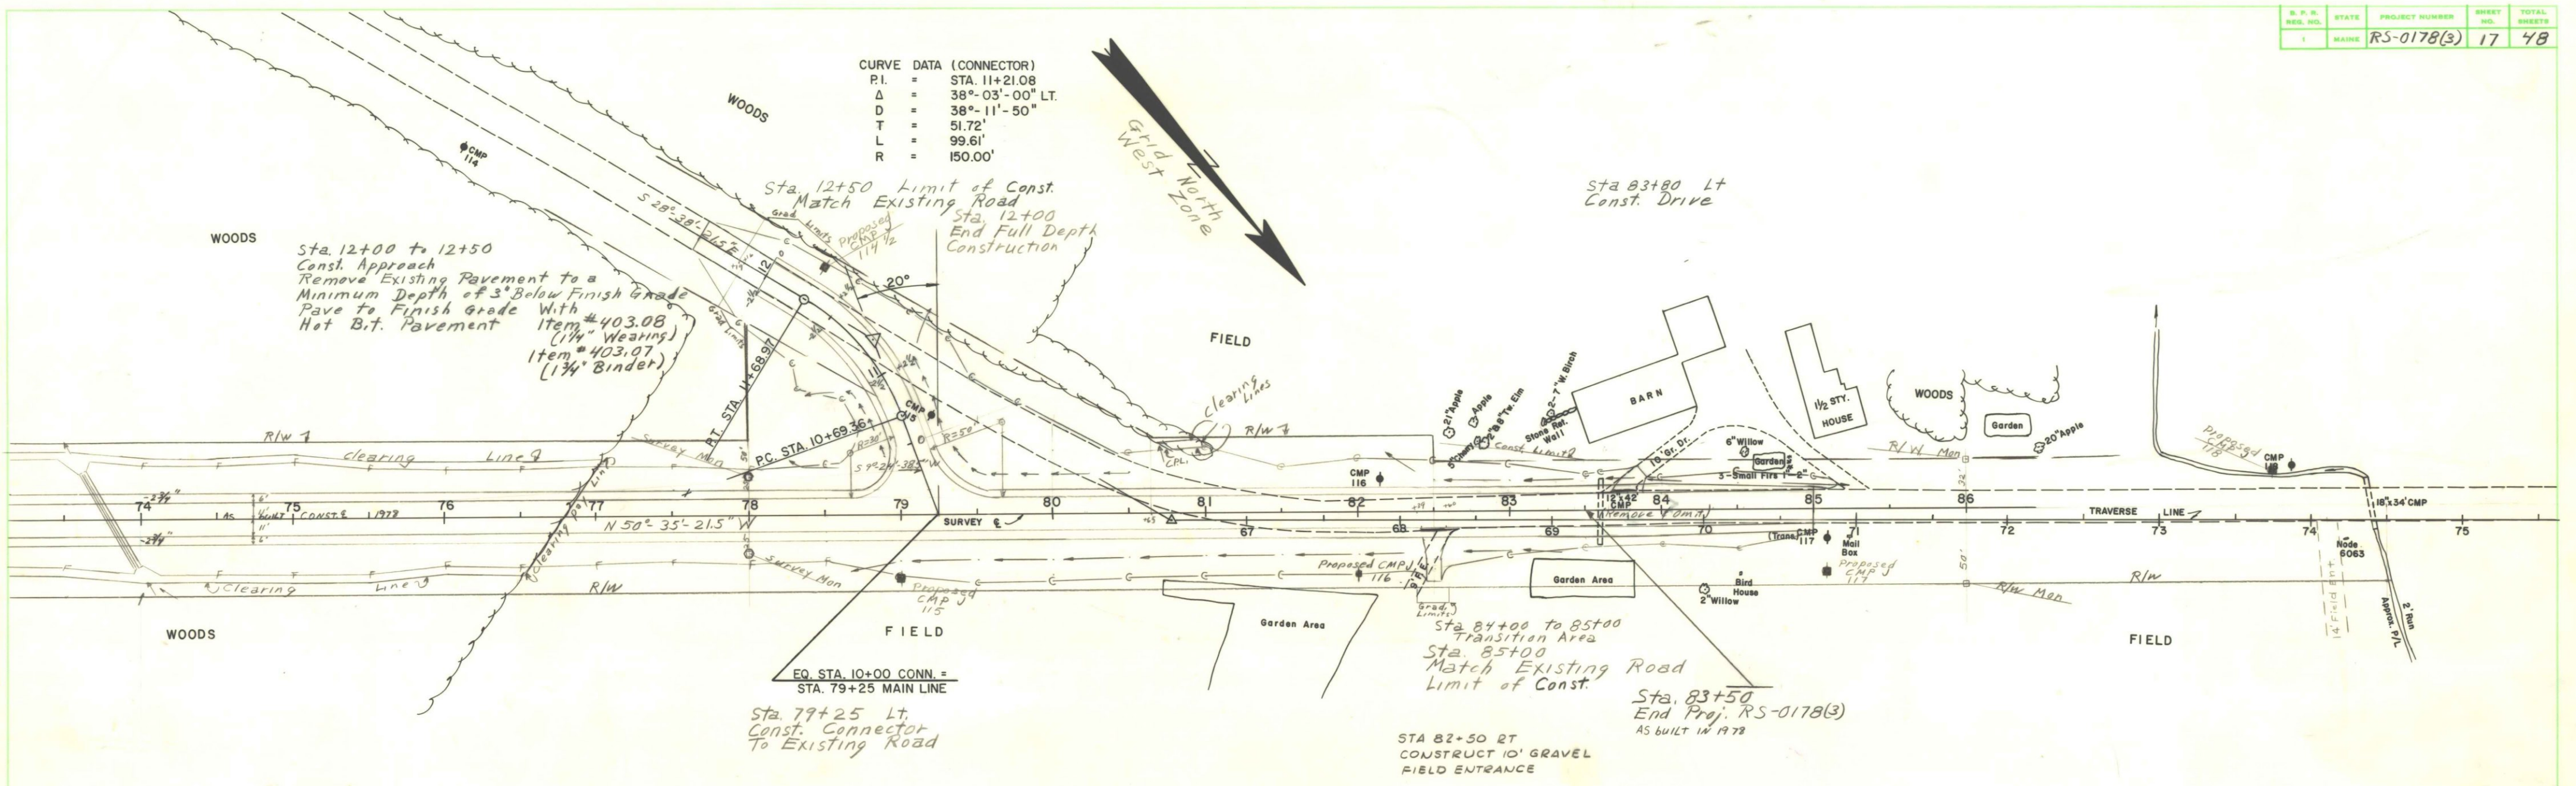

STATE OF MAINE DEPARTMENT OF TRANSPORTATION



BUREAU OF HIGHWAYS NEWRY OXFORD COUNTY MAINE FEDERAL AID SECONDARY PROJECT NO. RS-0178(5)


Reel 213

CONVENTIONAL SIGNS	
COUNTY LINES	-----
TOWN LINES	-----
PROPERTY LINES	-----
R/W LINES - EXISTING	=====
R/W LINES - NEW - ACCESS CONTROL	=====
R/W LINES - NEW - NO ACCESS CONTROL	=====
CULVERT - EXISTING	-----
CULVERT - PROPOSED	-----
CURBING - EXISTING	=====
CURBING - PROPOSED	=====
TRAVELLED WAY - EXISTING	=====
TRAVELLED WAY - PROPOSED	=====
UNDERGROUND UTILITIES - EXISTING	-----
UNDERGROUND UTILITIES - PROPOSED	-----
RAILROAD - SINGLE TRACK	-----
RAILROAD - DOUBLE TRACK	-----
UTILITY POLE - EXISTING	○
UTILITY POLE - JOINT OCCUPANCY	○
PROPOSED UTILITY POLE - TEMPORARY	×
PROPOSED UTILITY POLE - PERMANENT	⊕
TREES	○ hardwood ⊕ softwood
WOODS	-----

INDEX OF SHEETS	
1	TITLE SHEET
2	TYPICAL SECTION
3-4	ESTIMATED QUANTITIES & DRAINAGE
5-12	STANDARD DETAILS
13-15	MAINTENANCE OF TRAFFIC
16-17	PLAN & PROFILE
18-28	CROSS SECTIONS

TOTAL LENGTH 0.391 MILES

SCALES	PLAN	0	50	100 FEET	
	PROFILE	HOR.	0	50	100 FEET
		VER.	0	5	10 FEET
	CROSS SECTIONS	0	5	10 FEET	

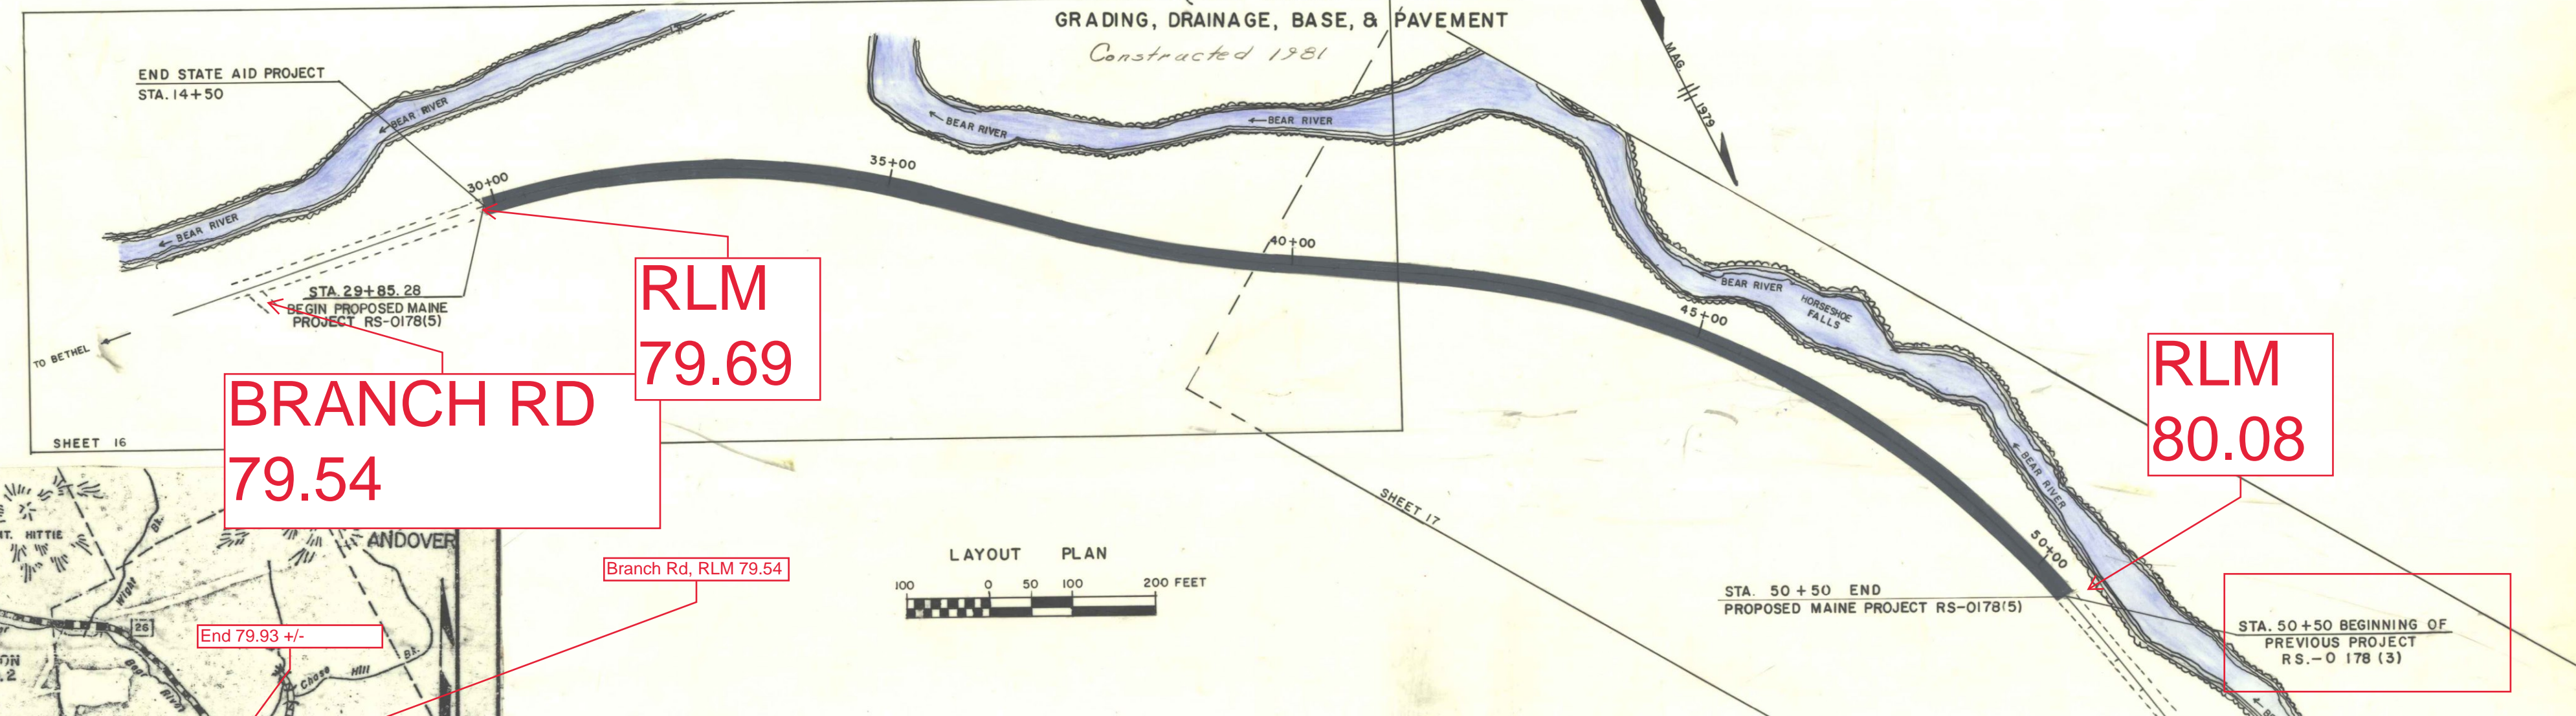

RLM 79.69
BRANCH RD 79.54

RLM 80.08

Branch Rd, RLM 79.54



End 79.93 +/-

STA. 50+50 END PROPOSED MAINE PROJ. NO. RS-0178(5)

STA. 29+85.28 BEGIN PROPOSED MAINE PROJ. NO. RS-0178(5)

STA. 50+50 END PROPOSED MAINE PROJECT RS-0178(5)

STA. 50+50 BEGINNING OF PREVIOUS PROJECT RS.-0 178 (3)

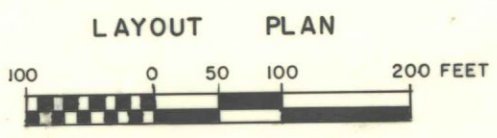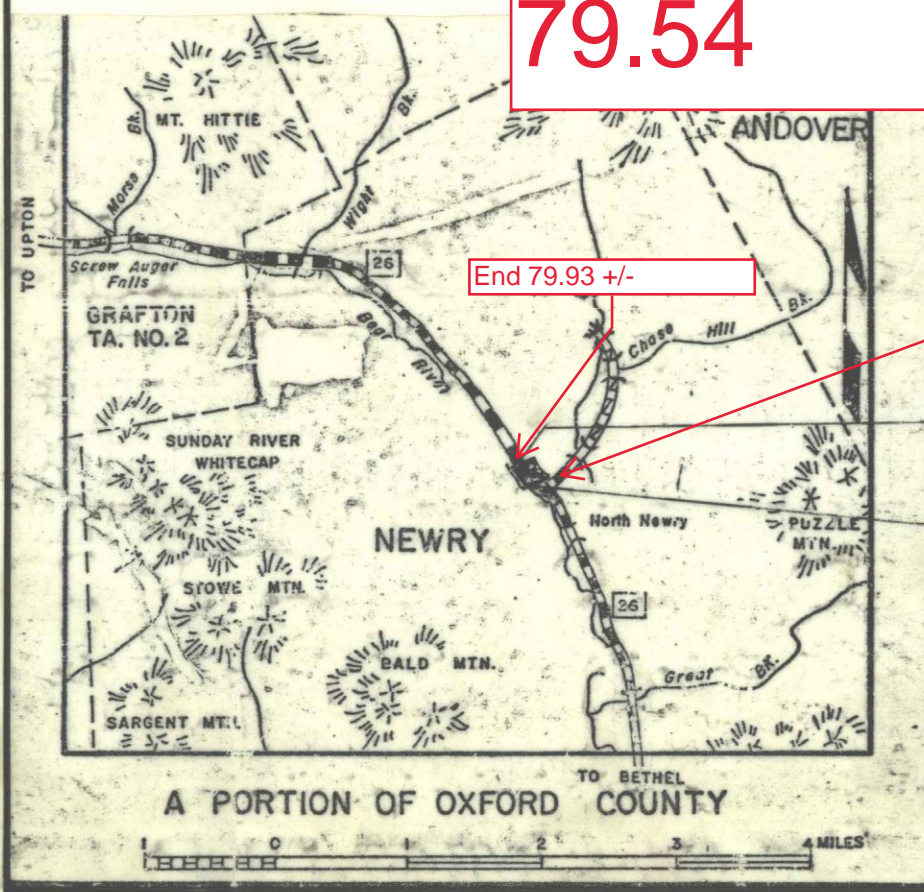

TRAFFIC DATA	
A.D.T.	1980 425
A.D.T.	2000 595
D.H.V.	119
T. (%) (AADT)	10
D. (%)	60
V.	50
P.S.D. (%)	0
18 KIPS	P2.0 2.2

NOTE
All work contemplated under this contract to be governed by and in conformity with the STANDARD SPECIFICATIONS (revision of June 1968) and supplementals thereto except modified on the plans and in the special provisions.



APPROVED:

STATE OF MAINE
DEPARTMENT OF TRANSPORTATION

Richard A. Luettich, Sr.
ACTING COMMISSIONER

DATE
4/9/80

Richard A. Luettich, Sr.
CHIEF ENGINEER AND BUREAU DIRECTOR

DATE
4/9/80

UNITED STATES
DEPARTMENT OF TRANSPORTATION
FEDERAL HIGHWAY ADMINISTRATION
REGION 1


APPROVED: _____
DIVISION ADMINISTRATOR DATE

DD-33

DRAWING 44-132-30926
JANUARY 1962

3" HOT BIT. PAVEMENT *

F.W.A. REG. NO.	STATE	PROJECT NUMBER	SHEET NO.	TOTAL SHEETS
1	MAINE	RS-0178(5)	2	28

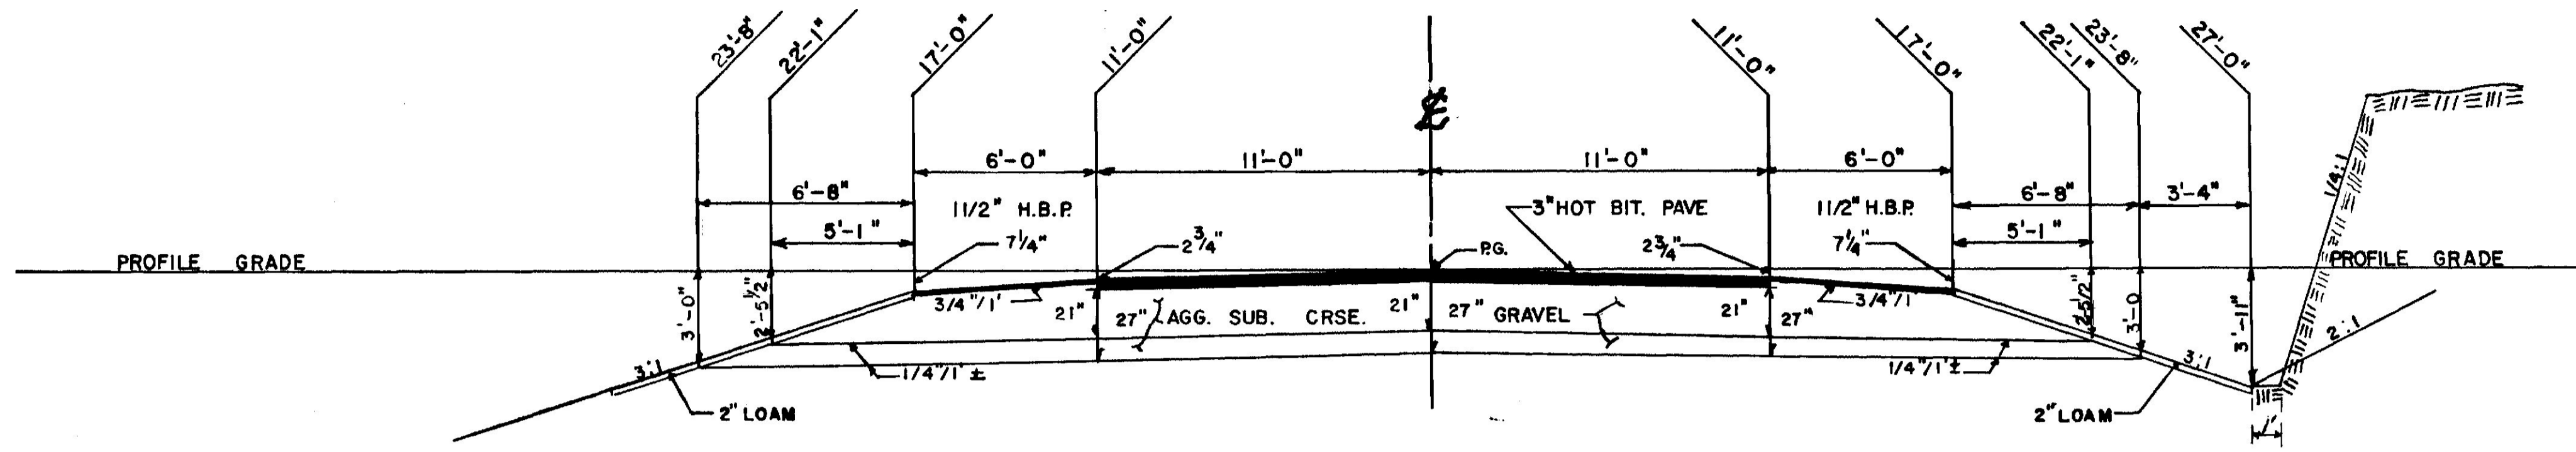


6 FT. SHLD. NORMAL
 21" AGG. SUBBASE CRSE. GRAVEL = 56.55 C.Y./100 L.F.
 Sta. 33+25Rt - 35+50Rt
 Sta. 40+50Rt - 45+50Rt

22 FT. PAVEMENT
 21" AGG. SUBBASE - 11' WIDE = 142.59 C.Y./100 L.F.
 27" AGG. SUBBASE - 11' WIDE = 183.33 C.Y./100 L.F.

6 FT. SHLD. NORMAL
 27" AGG. SUBBASE CRSE. GRAVEL = 78.57 C.Y./100 L.F.
 Sta. 30+00Rt - 33+25Rt
 Sta. 35+50Rt - 37+00Rt
 Sta. 37+00Lt - 39+50Lt
 Sta. 45+50Rt - 50+50Rt

NORMAL

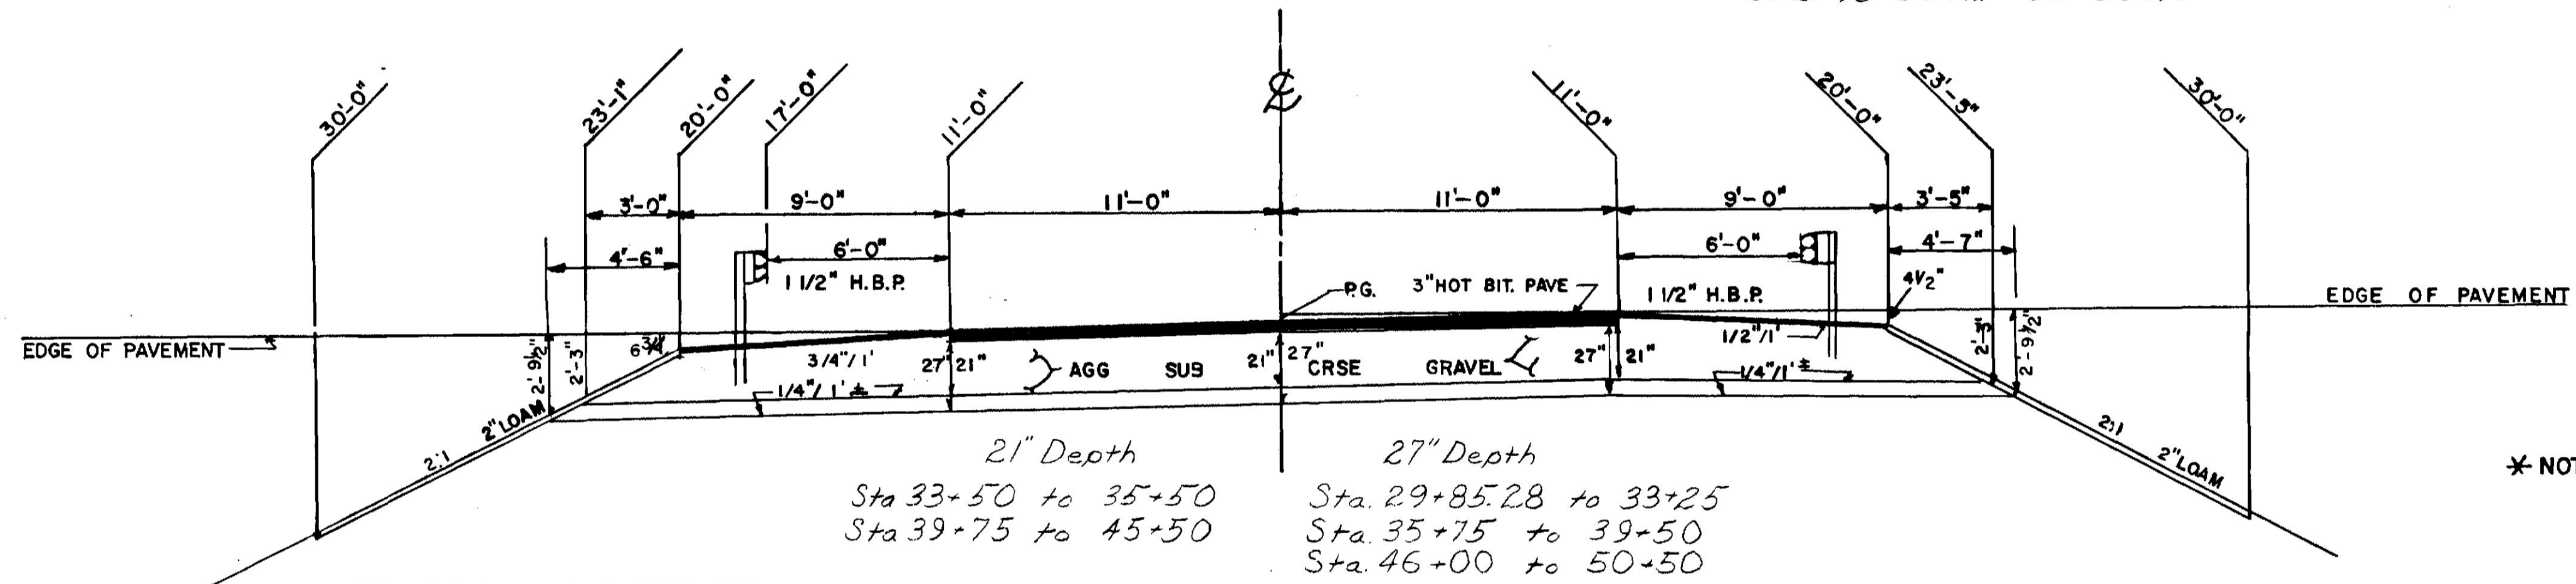

9 FT. SHLD. - LOW SIDE G.R.
 21" AGG. SUBBASE - GRAVEL = 60.65 C.Y./100 L.F.
 27" AGG. SUBBASE - GRAVEL = 83.88 C.Y./100 L.F.

21" Depth
 Sta. 33+50 to 35+50
 Sta. 39+75 to 45+50

27" Depth
 Sta. 29+85.28 to 33+25
 Sta. 35+75 to 39+50
 Sta. 46+00 to 50+50


9 FT. SHLD. - HIGH SIDE G.R.
 21" AGG. SUBBASE CRSE. GRAVEL = 73.81 C.Y./100 L.F.
 27" AGG. SUBBASE CRSE. GRAVEL = 98.27 C.Y./100 L.F.

21"
 Sta. 33+50Lt - 35+50Lt
 Sta. 43+00Lt - 45+50Lt

27"
 Sta. 30+00Lt - 31+50Lt
 Sta. 35+50Lt - 36+50Lt
 Sta. 45+50Lt - 47+00Lt

SUPERELEVATED

* NOTE: THE PAVEMENT AND BASE DEPTHS AS SHOWN ON THE PLANS ARE INTENDED TO BE NOMINAL. WHEN SUPERELEVATION EXCEEDS 3/4" PER FOOT LOW SIDE SHOULDER SHALL HAVE SAME SLOPE AS PAVEMENT.

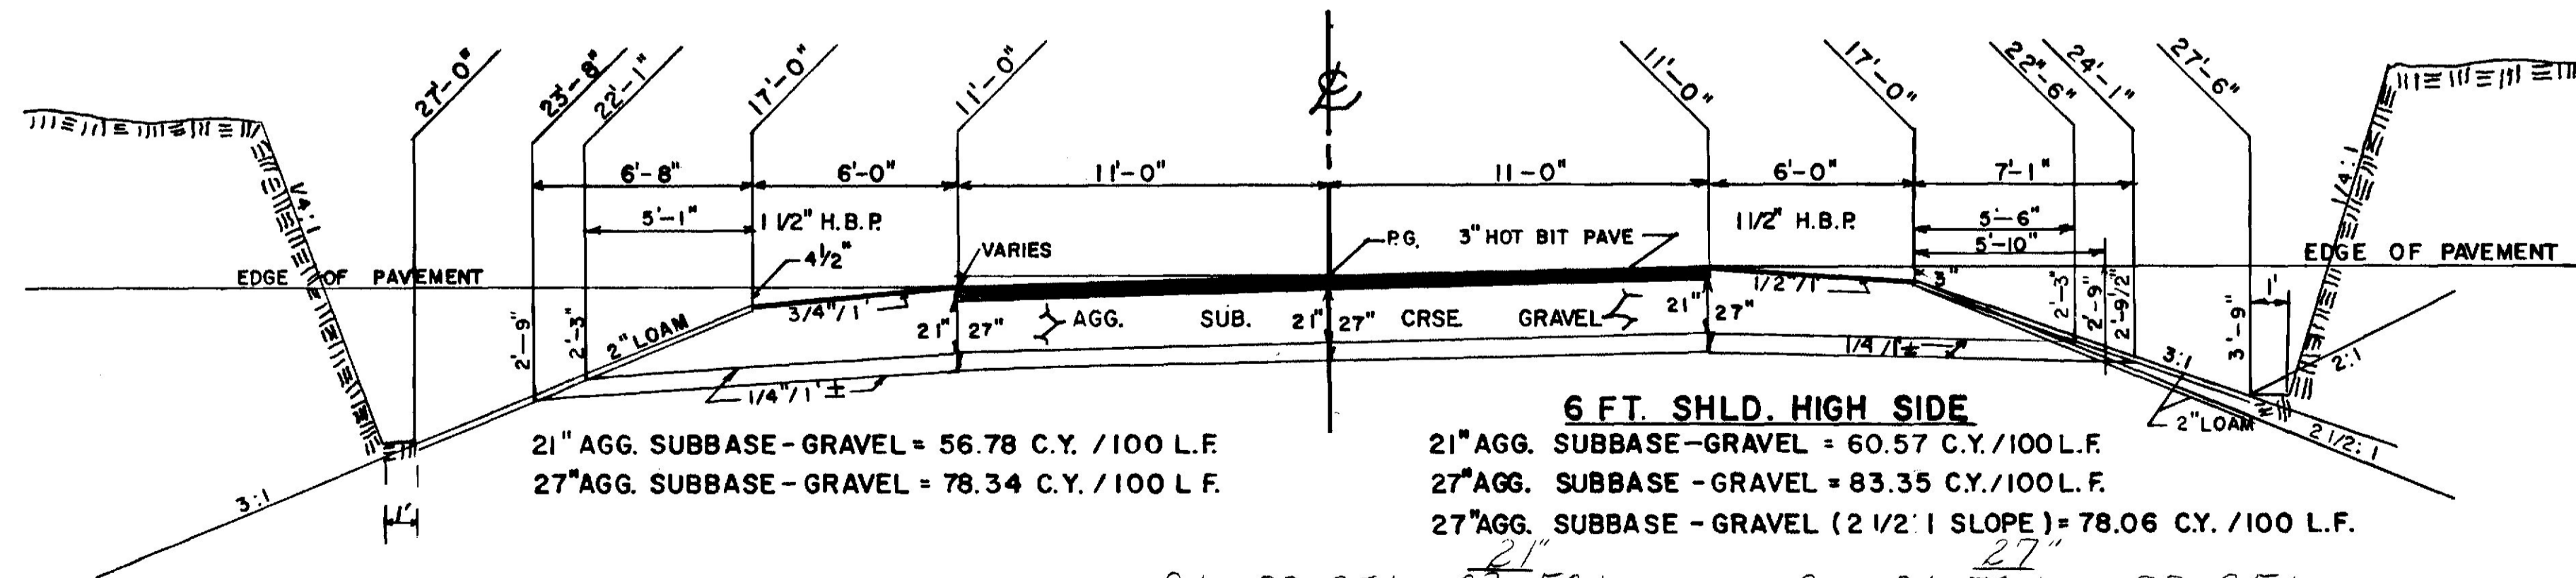

6 FT. SHLD. HIGH SIDE
 21" AGG. SUBBASE - GRAVEL = 56.78 C.Y./100 L.F.
 27" AGG. SUBBASE - GRAVEL = 78.34 C.Y./100 L.F.


6 FT. SHLD. HIGH SIDE
 21" AGG. SUBBASE - GRAVEL = 60.57 C.Y./100 L.F.
 27" AGG. SUBBASE - GRAVEL = 83.35 C.Y./100 L.F.
 27" AGG. SUBBASE - GRAVEL (2 1/2' / 1 SLOPE) = 78.06 C.Y./100 L.F.

21"
 Sta. 33+25Lt - 33+50Lt
 Sta. 39+50Lt - 43+00Lt
 Sta. 39+50Rt - 40+50Rt

27"
 Sta. 31+50Lt - 33+25Lt
 Sta. 37+00Rt - 39+50Rt
 Sta. 47+00Rt - 50+50Rt

STATE OF MAINE
 DEPARTMENT OF TRANSPORTATION

TYPICAL SECTIONS
 NEWRY PROJ. RS-0178(5)

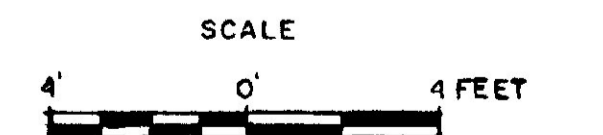


SHEET / OF / AUGUSTA, MAINE

NEWRY PROJ. RS-0178 (5) RTE.26

PROJECT DESIGN ENGINEER	BY	DATE
DESIGN - DETAILED		
CHECKED		
REVISIONS		
FIELD CHANGES		

PLANS

THOMAS R. BARTHOLOMEW

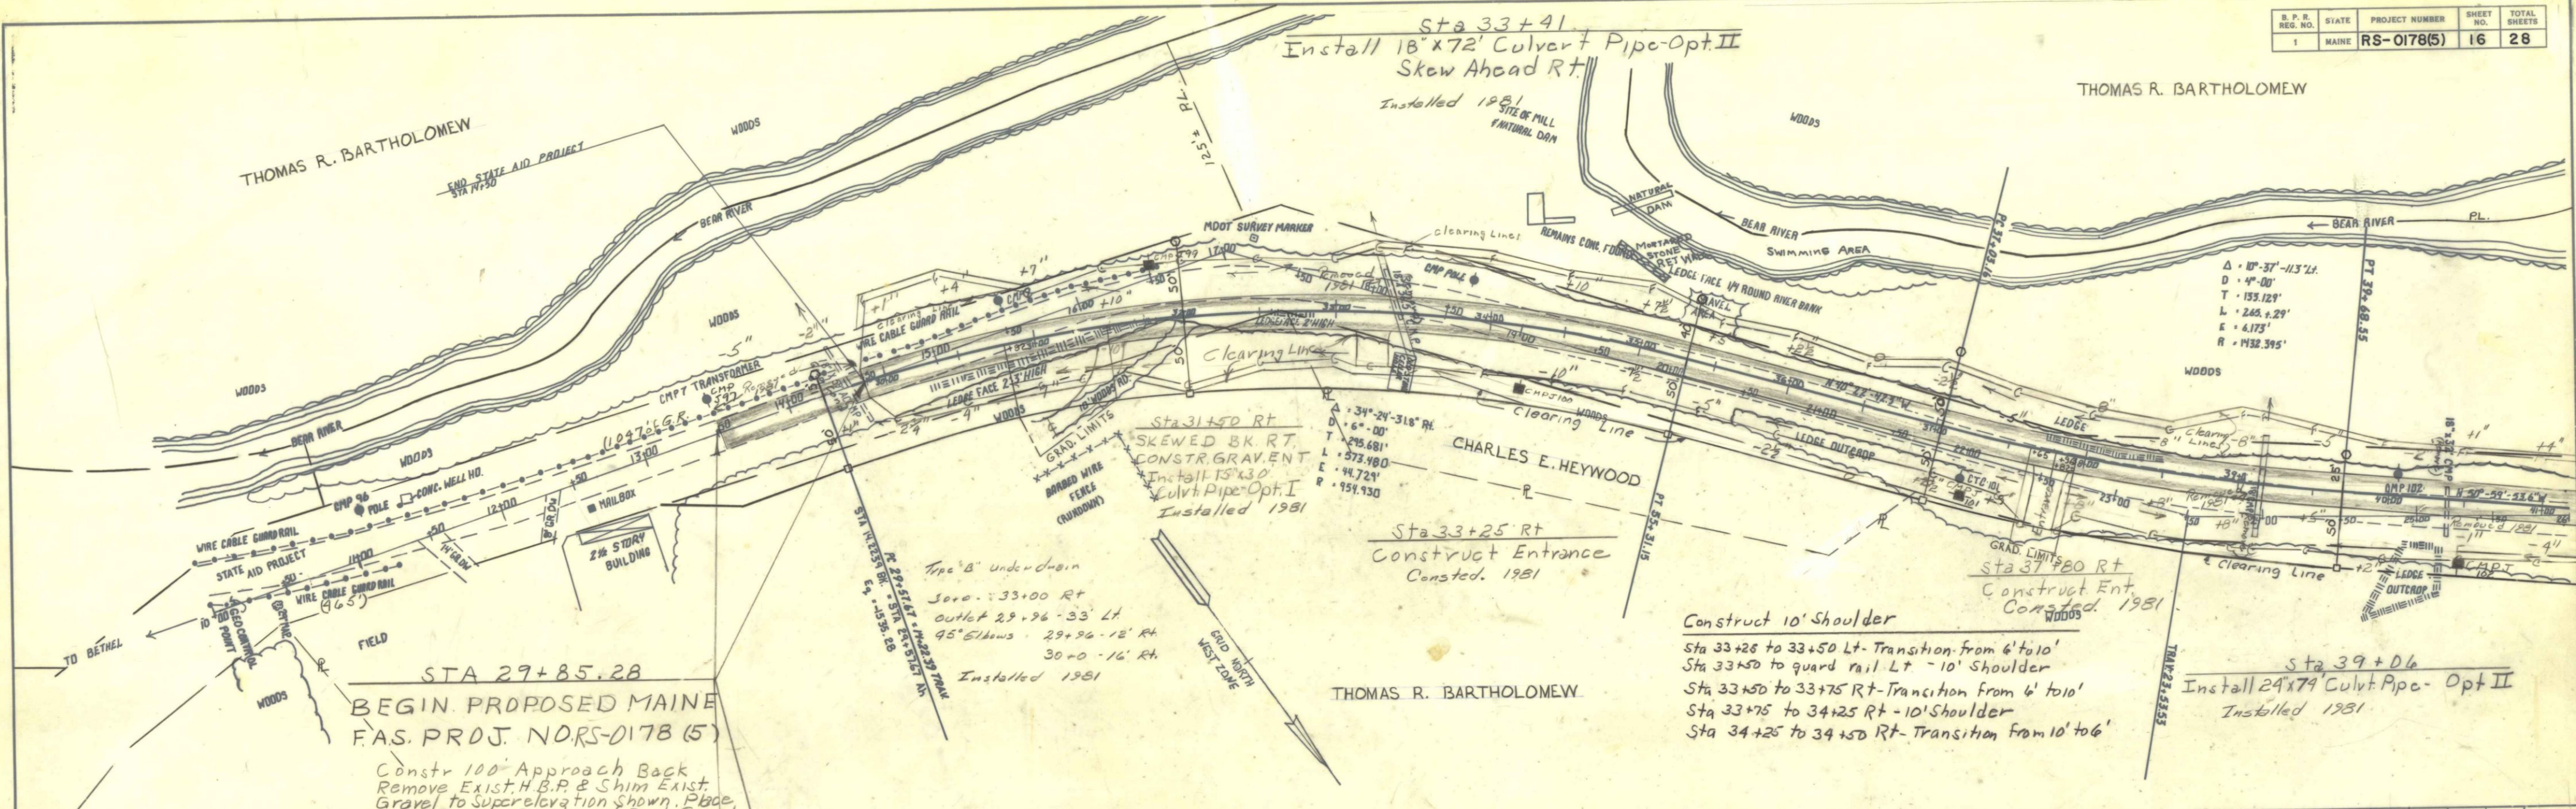

STA 29+85.28
 BEGIN PROPOSED MAINE
 F.A.S. PRD. NORS-0178 (5)

Constr 100' Approach Back
 Remove Exist. H.B.P. & Shim Exist.
 Gravel to Superelevation Shown. Place
 3" H.B.P. Fine Grading of Exist. Gravel
 Will be Considered Incidental
 to Item 304.10

27' Agg. Subbase Crse. 21' Agg. Subbase Crse. 27' Agg. Subbase Crse.

SURVEY MONUMENTS

STA. 14+22.39 BK. = -15' LT.
 P.C. 29+57.67 AHD.
 STA. 32+00.00 -50' LT.
 P.T. STA. 35+31.15 -40' LT.
 P.C. STA. 37+03.16 -50' LT.
 P.T. STA. 39+68.55 -25' LT.

R/W MONUMENTS


STA. 14+22.39 BK. = -50' RT.
 P.C. 29+57.67 AHD.
 STA. 32+00.00 -50' RT.
 P.T. STA. 35+31.15 -50' RT.
 P.C. STA. 37+03.16 -50' RT.
 P.T. STA. 39+68.55 -50' RT.

Clearing
 Sta 29+87 to 31+00 Lt
 Sta 32+99 to 45+50 Lt
 Sta 30+00 to 36+85 Rt
 Sta 30+20 to 41+50 Rt


Guard Rail Type 3 - Single Rail Installed 1981
 Sta 28+80 to 31+80 Lt. - 300 L.F.
 Sta 34+10 to 34+85 Lt - 275 "
 Guard Rail Type 3 - Circular - Greater Than 15' Radius
 Sta 31+80 to 31+92.5 Lt 12.5 L.F.
 Sta 33+97.5 to 34+10 Lt 12.5 L.F.
 Sta 36+85 to 36+97.5 Lt 12.5 L.F.
 Installed 1981

VC=300
 Ext = 0.8163
 H.L.S.D = 12.33'

VC=600
 Ext = 1.9998
 S.S.D = 5.61'

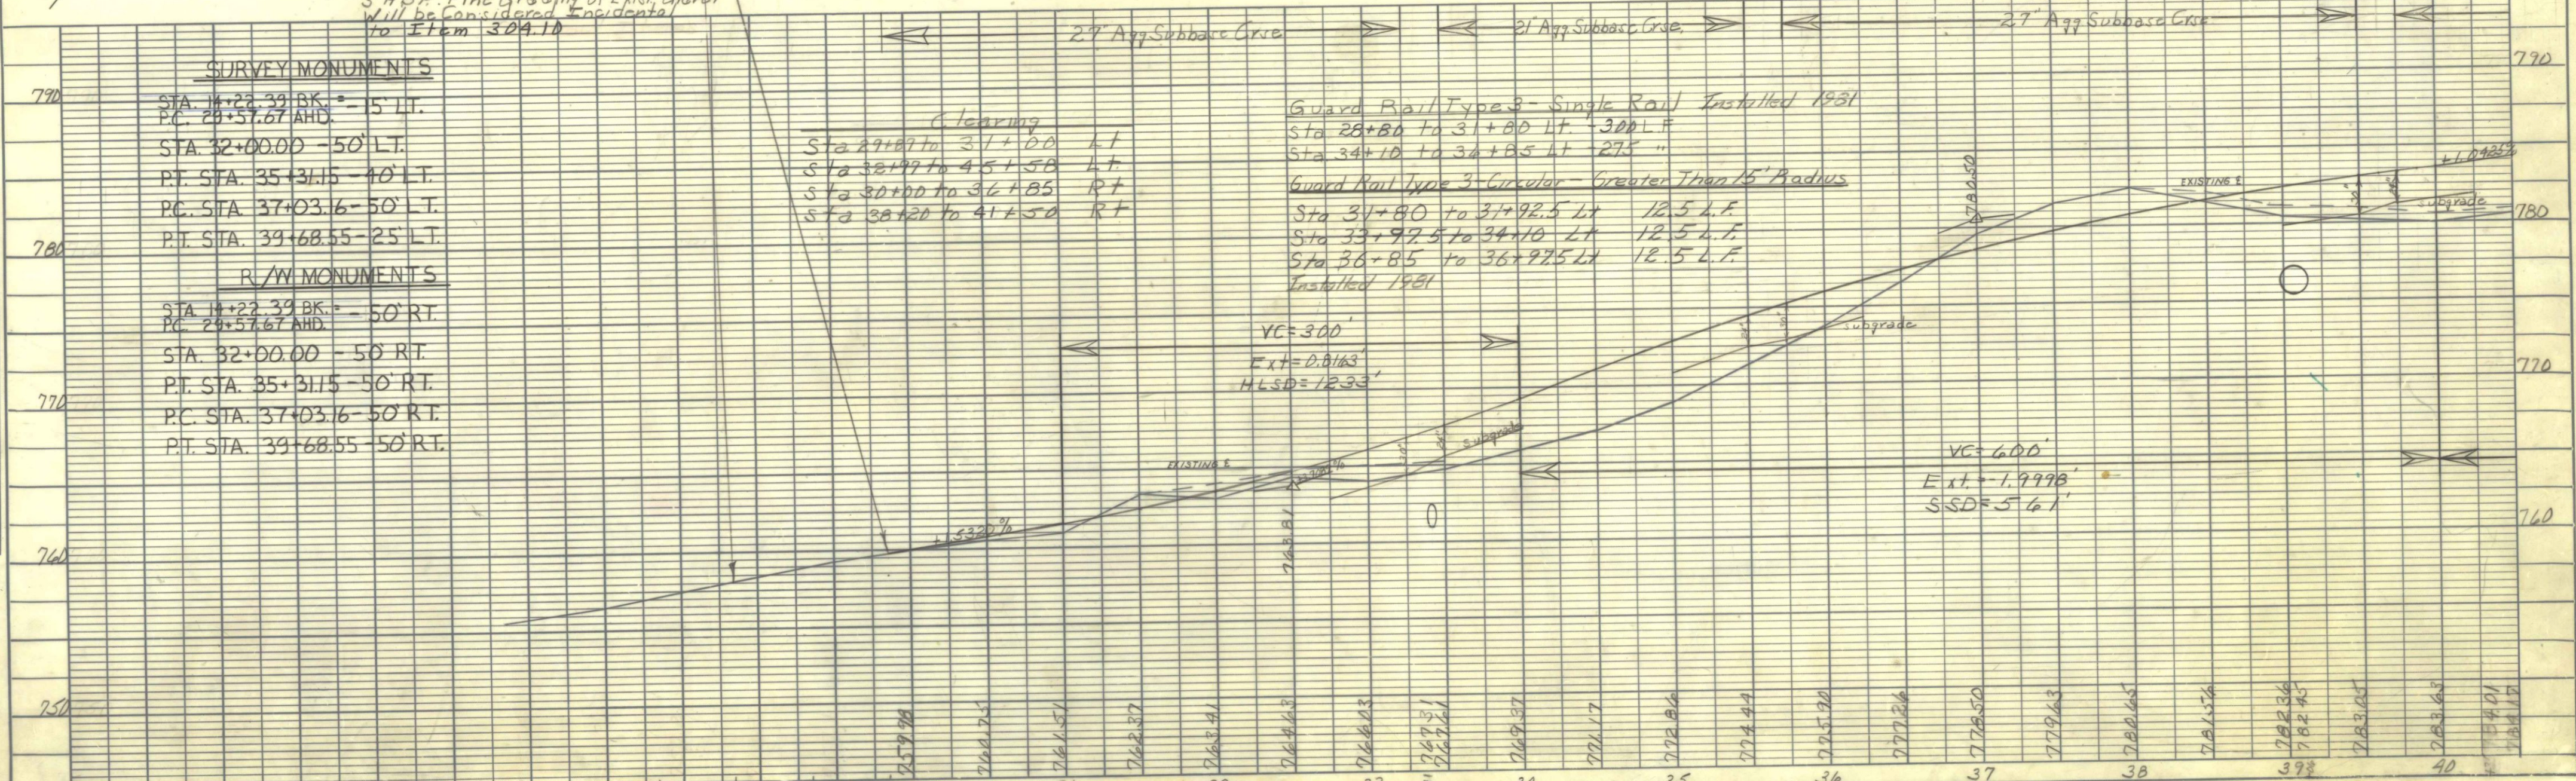

DATE: 10/17/81
 BY: T.R.B.
 CHECKED: G.L.
 NO. 2574

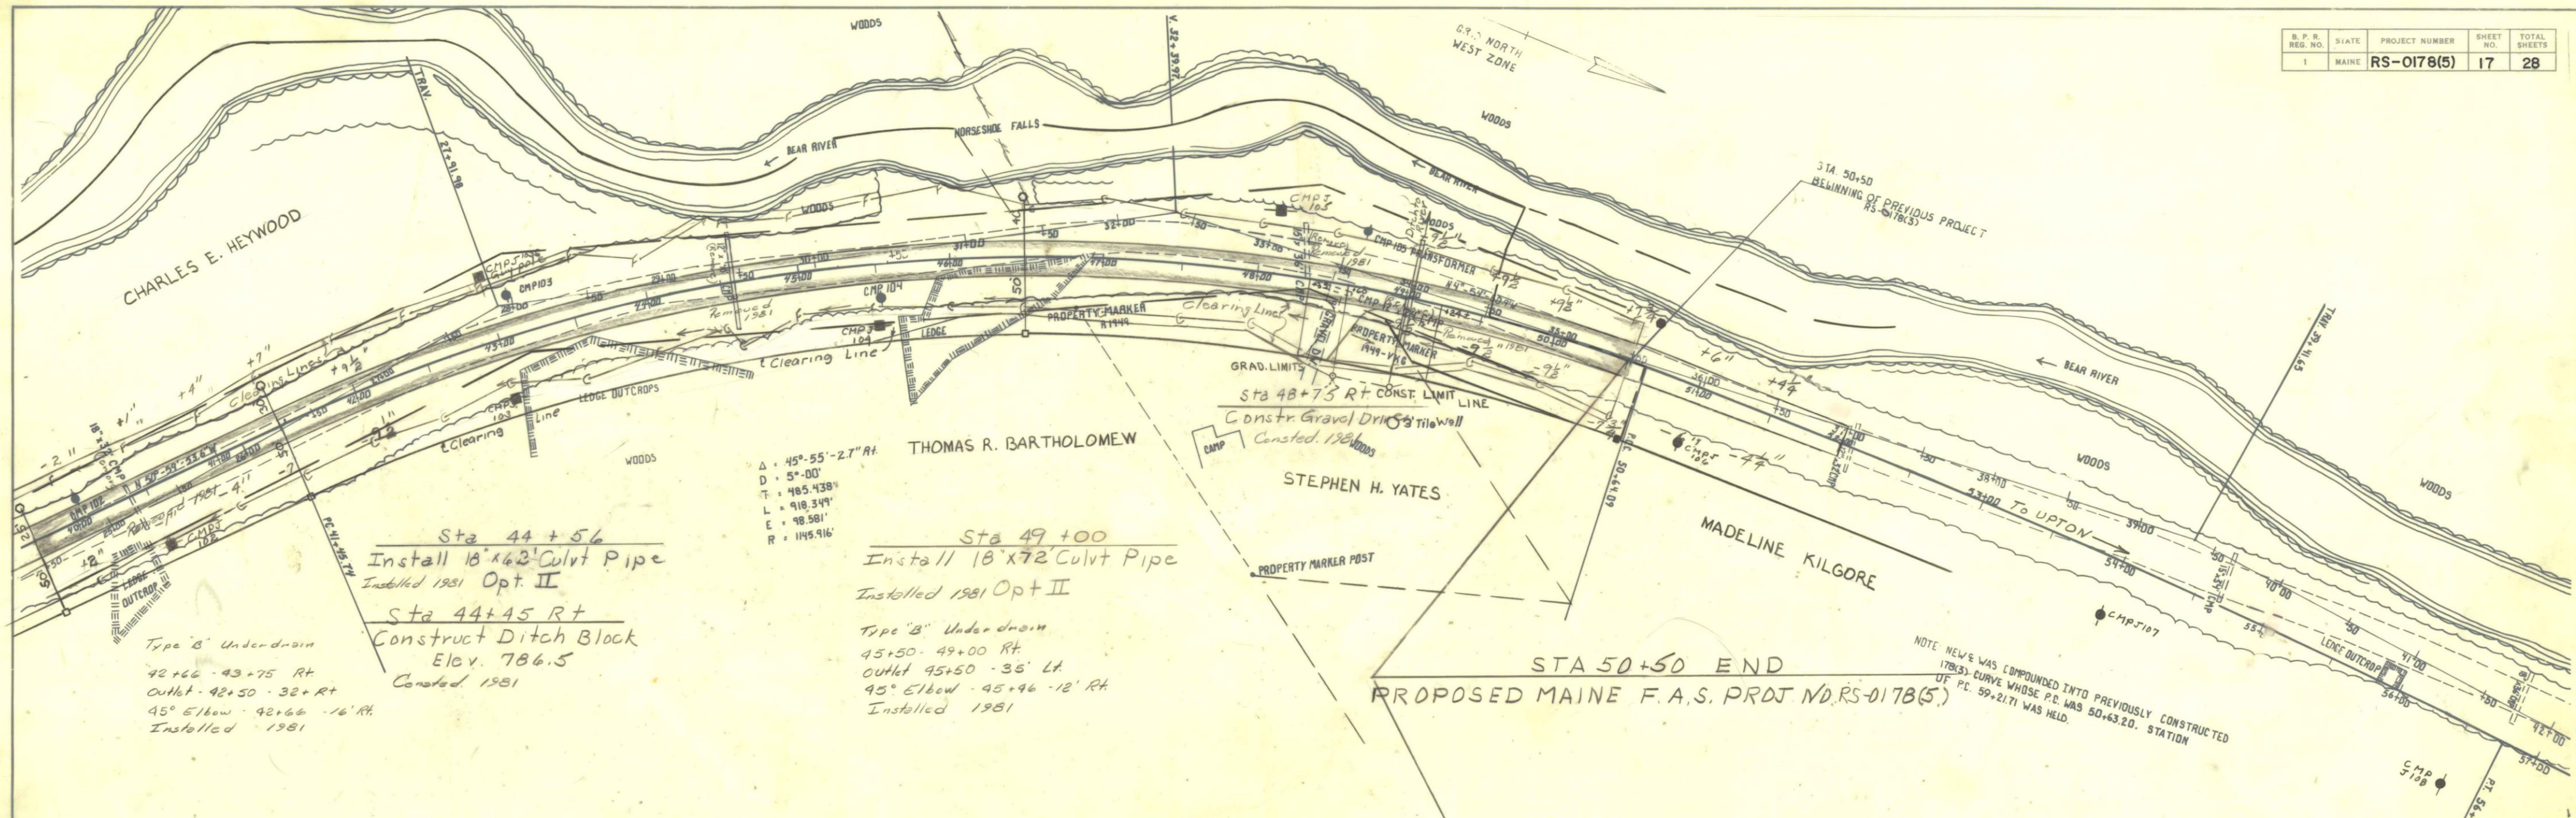

Sta 44+56
 Install 18"x62" Culvt Pipe
 Installed 1981 Opt. II

Sta 44+45 R+
 Construct Ditch Block
 Elev. 786.5
 Constructed 1981

Type "B" Under-drain
 42+66 - 43+75 Rt
 Outlet 42+50 - 32+ Rt
 45° Elbow 42+66 - 16' Rt
 Installed 1981

△ = 45°-55'-27" Rt
 D = 5°-00'
 T = 485.438'
 L = 918.349'
 E = 98.581'
 R = 145.916'

Sta 49+00
 Install 18"x72" Culvt Pipe
 Installed 1981 Opt II

Type "B" Under-drain
 45+50 - 49+00 Rt
 Outlet 45+50 - 35' Lt
 45° Elbow 45+46 - 12' Rt
 Installed 1981

STA 50+50 END
 PROPOSED MAINE F.A.S. PROJ. NO. RS-0178(5)

NOTE: NEW WAS COMPOUNDED INTO PREVIOUSLY CONSTRUCTED 178(5) CURVE WHOSE P.C. WAS 50+63.20. STATION OF P.C. 59+21.71 WAS HELD.

DATE: 7/13/89
 BY: K. Brown, C. Brown, J. L. Lacey
 SURVEYED: 7/13/89
 CHECKED: 7/13/89
 NO. 8594

