



STATE OF MAINE DEPARTMENT OF TRANSPORTATION

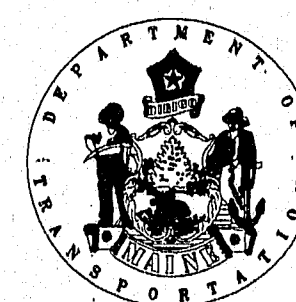


PLANS

FERRY HILL BRIDGE OVER STILLWATER RIVER IN THE TOWN OF ORONO PENOBSCOT COUNTY PROJECT NO. BH-1401(9) PROJECT LENGTH 0.156 MILES

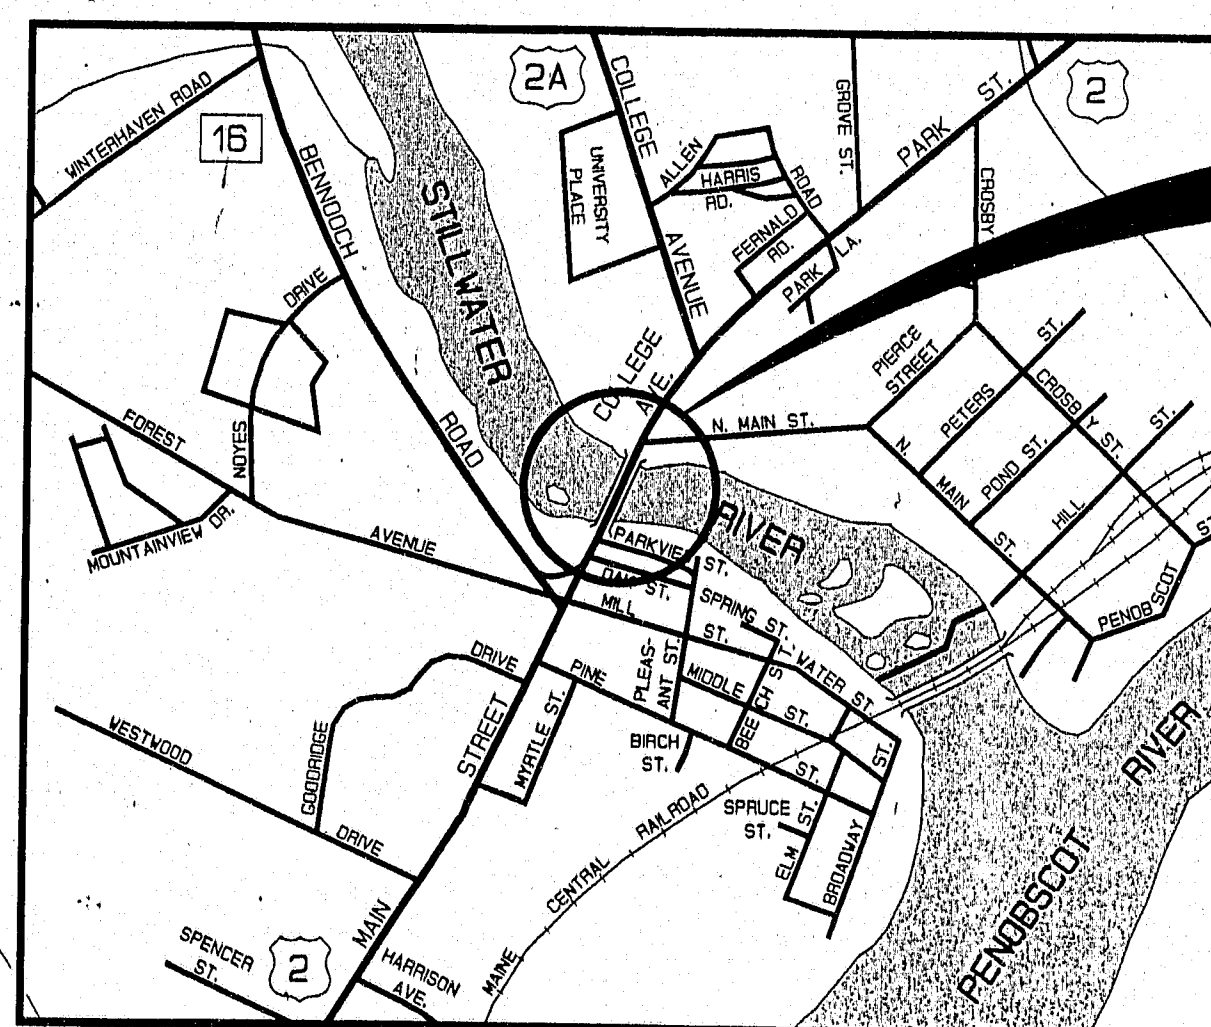

LOCATION MAP

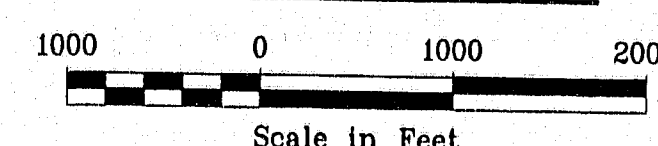

TRAFFIC DATA

A.A.D.T. 1991	20,390
A.A.D.T. 2011	37,030
D.H.V.	3,700
T.(X)D.H.V.	2
D.(X)D.H.V.	65
V.	25 mph
P.S.D.(%)	N/A
18 KIPS (p2.5)	253

NOTE
ALL WORK CONTEMPLATED UNDER THIS CONTRACT TO BE GOVERNED BY AND IN CONFORMITY WITH THE STANDARD SPECIFICATIONS (REVISION OF OCTOBER 1990) AND SUPPLEMENTALS THERETO AS MODIFIED ON THE PLANS AND IN THE SPECIAL PROVISIONS.

APPROVED:

STATE OF MAINE
DEPARTMENT OF TRANSPORTATION

COMMISSIONER
CHIEF ENGINEER

3-16-1992
DATE
3-16-1992
DATE

UNITED STATES
DEPARTMENT OF TRANSPORTATION
FEDERAL HIGHWAY ADMINISTRATION

REGION 1

APPROVED:

DIVISION ADMINISTRATOR

DATE

INDEX OF SHEETS

SHEET NO.	DESCRIPTION
1.	TITLE SHEET
2.	ESTIMATED QUANTITIES
3.	GENERAL PLAN
4.	TYPICAL SECTIONS
5.	PROFILE & CONSTRUCTION
6.	GENERAL PLAN WITH DETOUR
7-8.	PROFILE & DETOUR
9.	ABUTMENT 1
10.	ABUTMENT 2
11-12.	STRUCTURAL STEEL
13.	MISC. STRUCTURAL STEEL DETAILS
14-15.	SUPERSTRUCTURE PLAN
16-17.	SUPERSTRUCTURE DETAILS
18.	BRIDGE LIGHTING
19.	INSTRUMENT HOUSE & DETAILS
20.	4-BAR TRAFFIC RAIL
21.	PALE PANEL DETAILS
22.	4-BAR CONCRETE END POST
23-24.	REINFORCING STEEL SCHEDULE
25-28.	CROSS SECTIONS

STANDARD DETAIL SHEETS

29.	BD 302-89 EXPANSION DEVICE
30.	(HD-1)
31.	(HD-4)
32.	(HD-5)
33.	(HD-6)
34-36.	(HD-10) thru (HD-12)
37.	(HD-14)
38.	(HD-16)
39.	T2 CONCRETE FOUNDATION
40.	T3 JUNCTION BOXES AND CONDUIT TRENCH
41.	T4 HIGHWAY LIGHTING
42-43.	RIGHT-OF-WAY MAP

SPECIFICATIONS
DESIGN: Load Factor Design per AASHTO Standard Specifications for Highway Bridges 1989 and Interim Specifications 1990 and 1991.
CONTRACT: State of Maine, Department of Transportation, Standard Specifications, Highways and Bridges, Revision of October 1990.

DESIGN LOADING

LIVE LOAD: HS20

MATERIALS

CONCRETE: All Class A
REINFORCING STEEL: ASTM A615 Grade 60
STRUCTURAL STEEL: All Material
High Strength Bolts
ASTM A36
ASTM A325 Type 1

BASIC DESIGN STRESSES

CONCRETE: $f'_c = 3000$ psi
REINFORCING STEEL: $f_y = 60,000$ psi
STRUCTURAL STEEL:
ASTM A36 $F_y = 36,000$ psi
ASTM A325 $F_v = 25,000$ psi

Plans of the existing bridge are available for the Contractor's reference at the Bridge Design Office in Augusta. The plans are reproductions of original drawings as prepared for the construction of the bridge and it is very unlikely that the plans will show any construction field changes or any alterations which may have been made to the bridge during its life span.

REEL 304

ORONO

F.H.W.A. RES. NO.	STATE	PROJECT NUMBER	SHEET NO.	TOTAL SHEETS
1	MAINE	BH-1401(9)	1	43

"Revised As Built" 109-40
1993
260

PROJECT DESIGN ENGINEER
 DATE 12/13/92
 REVISIONS
 1. 12/13/92
 2. 12/13/92
 3. 12/13/92
ESTIMATED QUANTITIES			
ITEM NO.	DESCRIPTION	QUANTITY	UNIT
111.50	SCHEDULE OF WORK	1	LS
201.12	SELECTIVE CLEARING AND THINNING	.33	AC
202.10	REMOVING EXISTING SUPERSTRUCTURE--PROP. OF CONTR.	1	LS
202.17	REMOVING EXISTING STRUCTURAL CONCRETE	1	LS
202.203	PAVEMENT BUTT JOINTS	530	SY
203.20	COMMON EXCAVATION	25	CY
304.10	AGGREGATE SUBBASE COURSE--GRAVEL	115	CY
403.07	HOT BITUMINOUS PAVEMENT, GRADING B	260	TONS
403.10	HOT BITUMINOUS PAVEMENT, GRADING D	340	TONS
403.101	HOT BIT. PVMT., GRD D (SIDEWALKS, SHIMS, DRIVES, INCIDENTALS)	140	TONS
403.121	HOT BITUMINOUS PAVEMENT, GRADING E (SHIMMING)	220	TONS
409.15	BITUMINOUS TACK COAT, APPLIED	70	GAL
502.219	STRUCTURAL CONCRETE, ABUTS & RET WALLS	1	LS
502.26	STRUC CONC RDWY & SW SLABS ON STL BRIDGES	1	LS
502.4711	SILICA FUME ADDITIVE	1	LS
503.12	REINFORCING STEEL FABRICATED & DELIVERED	176,500	LB
503.13	REINFORCING STEEL PLACING	176,500	LB
504.70	STRUCTURAL STEEL FAB & DELIVERED	1	LS
504.71	STRUCTURAL STEEL ERECTION	1	LS
505.08	SHEAR CONNECTORS	1	LS
506.18	CONTAINMENT AND POLLUTION CONTROL	1	LS
506.19	DISPOSAL OF HAZARDOUS OR TOXIC MATERIAL	1	LS
507.0945	ALUMINUM BRIDGE RAILING, 4 BAR WITH PALES	900	LF
508.13	MEMBRANE WATERPROOFING	1	LS
510.127	SPECIAL DETOUR, 24' RDWY WIDTH VEH. & PED. TRAF. SEPARATE	1	LS
514.06	CURING BOX FOR CONCRETE CYLINDERS	1	EACH
515.21	PROTECTIVE COATING FOR CONCRETE SURFACES	1	LS
520.21	EXPANSION DEVICE--GLAND SEAL	2	EACH
526.301	TEMPORARY CONCRETE BARRIER TYPE I	1	LS
527.32	PORTABLE CRASH BARRELS	12	EA
540.10	BRIDGE INSTRUMENTATION	1	LS
604.10	ADJUSTING MANHOLE OR CATCH BASIN TO GRADE	7	EACH
605.17	GUARD RAIL TYPE 3B--SINGLE RAIL	325	LF
606.22	GUARD RAIL TYPE 3B--OVER 15 FOOT RADIUS	50	LF
606.25	TERMINAL CONNECTOR	4	EA
606.265	TERMINAL END--SINGLE RAIL--GALVANIZED STEEL	2	EACH
606.35	GUARD RAIL DELINEATOR POST	5	EACH
606.775	BREAKAWAY CABLE TERMINAL--GALVANIZED	4	EA
609.11	VERTICAL CURB TYPE 1	164	LF
609.132	VERTICAL BRIDGE CURB TYPE 1B	900	LF

ESTIMATED QUANTITIES			
ITEM NO.	DESCRIPTION	QUANTITY	UNIT
609.23	TERMINAL CURB TYPE 1	14	EACH
609.31	CURB TYPE 3	421	LF
609.38	RESET CURB TYPE 1	431	LF
610.08	PLAIN RIPRAP	25	CY
610.18	STONE DITCH PROTECTION	10	CY
614.18	APPLYING FERTILIZER TO EXISTING GRASSED AREAS	108	LB
615.07	LOAM	160	CY
616.08	SODDING	118	SY
618.13	SEEDING METHOD NUMBER 1	7	UNIT
618.14	SEEDING METHOD NUMBER 2	30	UNIT
618.15	TEMPORARY SEEDING	10	LB
618.16	CROWN VETCH SEED	5	LB
618.20	ANNUAL RYE	4	LB
618.25	APPLIED WATER	4	MG
619.12	MULCH	50	UNIT
621.138	SMALL DECIDUOUS TREE GRP A	2	EA
621.138	FLORIBUNDA CRABAPPLE (1 1/2"-2" CAL)	2	EA
621.273	LARGE DECIDUOUS TREES GRP A (2"-2 1/2" CAL)	8	EA
621.273	RED MAPLE	10	EA
621.273	GREEN ASH (SUMMIT)	10	EA
621.397	DWARF EVERGREENS GRP C (18"-24") JAPANESE SPREADING YEW	18	EA
621.546	DECIDUOUS SHRUBS GRP A (2"-3") REGAL PRIVET	141	EA
621.547	DECIDUOUS SHRUBS GRP B (2"-3") AMERICAN CRANBERRY BUSH	112	EA
621.547	RED OSIER DOGWOOD	81	EA
626.11	PRECAST CONCRETE JUNCTION BOX	1	EA
626.21	METALLIC CONDUIT	1	EA
626.33	30 INCH FOUNDATION	1	EA
626.33	18 INCH FOUNDATION	1	EA
627.61	4 INCH SOLID WHITE PAVEMENT MARKING LINE	1700	LF
627.63	4 INCH SOLID YELLOW PAVEMENT MARKING LINE	1700	LF
627.67	REMOVING PAVEMENT MARKINGS	275	SF
627.68	TEMP. 4" PAINTED PAVEMENT MARKING LINE, YELLOW OR WHITE	3300	LF
629.05	HAND LABOR, STRAIGHT TIME	8	MH
631.12	ALL PURPOSE EXCAVATOR (INCLUDING OPERATOR)	4	HR
631.72	TRUCK--LARGE (INCLUDING OPERATOR)	1	HR
634.16	HIGHWAY LIGHTING	1	LS
634.21	CONVENTIONAL LIGHT STANDARD	1	EACH
637.07	SPRINKLING	41	MG
637.08	CALCIUM CHLORIDE	5	TONS
638.01	EMBEDDED WORK IN STRUCTURES	1	LS
639.18	FIELD OFFICE TYPE A	1	EACH
639.22	TESTING FACILITIES BITUMINOUS MIXES	1	LS
639.23	TESTING FACILITIES CONCRETE	1	LS
645.116	REINSTALL REGULATORY, WARNING, CONFIRMATION AND ROUTE MARKER ASSEMBLY SIGN	2	EACH
652.31	TYPE I BARRICADE	15	EACH
652.311	TYPE II BARRICADE	5	EACH
652.33	DRUM	5	EACH
652.34	CONE	15	EACH
652.35	CONSTRUCTION SIGNS	360	SF
652.361	MAINTENANCE OF TRAFFIC CONTROL DEVICES	1	LS
652.38	FLAGGER	500	MH
656.50	BALED HAY, IN PLACE	24	EACH
656.51	SANDBAG, IN PLACE	24	EACH
656.55	DUMPED STONE	8	CY
656.631	15" TEMPORARY SILT FENCE	75	LF
656.632	30" TEMPORARY SILT FENCE	800	LF
659.10	MOBILIZATION	1	LS
660.21	ON-THE-JOB TRAINING (BID)	1000	MH


- GENERAL CONSTRUCTION NOTES**
- Remove all existing pavement from paved driveway from Sta. 7+92+ to Sta. 8+79+ left and repave as directed by the Engineer in the field.
 - For easements, construction limits and right-of-way lines refer to Right-of-Way Map.
 - Place a 1'-6" wide strip of sod on the side slopes along the top of the riprap.
 - The clearing limits shown on the plans are approximate. The exact limits will be established in the field by the Engineer. Payment for clearing will be incidental to contract items.
 - Place loam, 2" deep, on slopes as directed by the Engineer in the field.
 - Do not excavate for Aggregate Subbase Course where existing material is suitable as determined by the Engineer. Payment for shaping and compacting of the existing subbase and layers of new subbase 6" or less thick, in areas where the Engineer directs the Contractor not to excavate to the subgrade line shown on the plans, will be made in accordance with subsection 104.03, Extra Work.
 - One guardrail delineator post shall be installed at each guardrail end.
 - Breakaway cable terminals shall be installed concurrently with the placement of each section of beam guardrail.
 - All hardware used on Cable Guardrail which is to be removed, shall be carefully salvaged by the Contractor and will remain the property of the Department. Associated guardrail cable and posts shall become property of the Contractor.
 - Sodded gutters shall be constructed, after paving and shoulder work is completed, where it is apparent that runoff will cause continual erosion.
 - Guardrail posts shall be cut to length in the field, as required to clear obstructions by a minimum of 6 inches. Cut posts shall be imbedded 9 inches in a concrete base 2'-0" square by 1'-0" thick. The concrete mix shall be as approved by the Engineer. Any costs for cutting posts and constructing bases will be considered incidental to guardrail items.
 - The removal of the existing approach slab under the sidewalk will not be paid for directly, but will be considered incidental to related contract items.
 - Structural excavation and backfill for abutments will not be paid for directly, but will be considered incidental to related contract items.
 - The approaches to the temporary detour shall be paved with 2" of hot bituminous pavement. Pavement will be paid for under Item 403.07.
 - Hot Bituminous Pavement, Grading B. The bituminous curb for the temporary detour will be paid for under Item 609.31, Curb Type 3.
 - All guard rail items necessary for the temporary detour shall be considered incidental to Item 510.12, Special Detour.
 - The lighting on the temporary detour shall be installed in accordance with Section 634 of the Standard Specifications and as detailed on the plans. Payment for all labor, materials, and incidentals necessary to complete this work will be considered incidental to Item 510.12, Special Detour.
 - The luminaire to be used for the permanent highway lighting system shall be a 250 watt HPS Retractable Luminaire, Cat No. RPX250 125W or an approved equal. These luminaires may be used for the temporary detour lighting, but any damage to them shall be repaired at the Contractor's expense.
 - Removal of the existing concrete bridge deck will be paid for under Item 202.10, Removing Existing Superstructure, Property of Contractor. This work will include, but not be limited to, removal of existing exterior beams removal of existing angles necessary to modify floorbeams, and modifications of existing structural steel.

109-41

Revisions as of 5/9/92

STATE OF MAINE
 DEPARTMENT OF TRANSPORTATION
 261
 FERRY HILL BRIDGE
 OVER
 STILLWATER RIVER
 IN THE TOWN OF
 ORONO
 PENOBSCOT COUNTY
 ESTIMATED QUANTITIES
 SHEET 2 OF 43 AUGUSTA, MAINE March, 1992

F.R.W.A.	STATE	PROJECT NUMBER	SHEET NO.	TOTAL SHEETS
1	MAINE	8H-1901 (9)	43	43

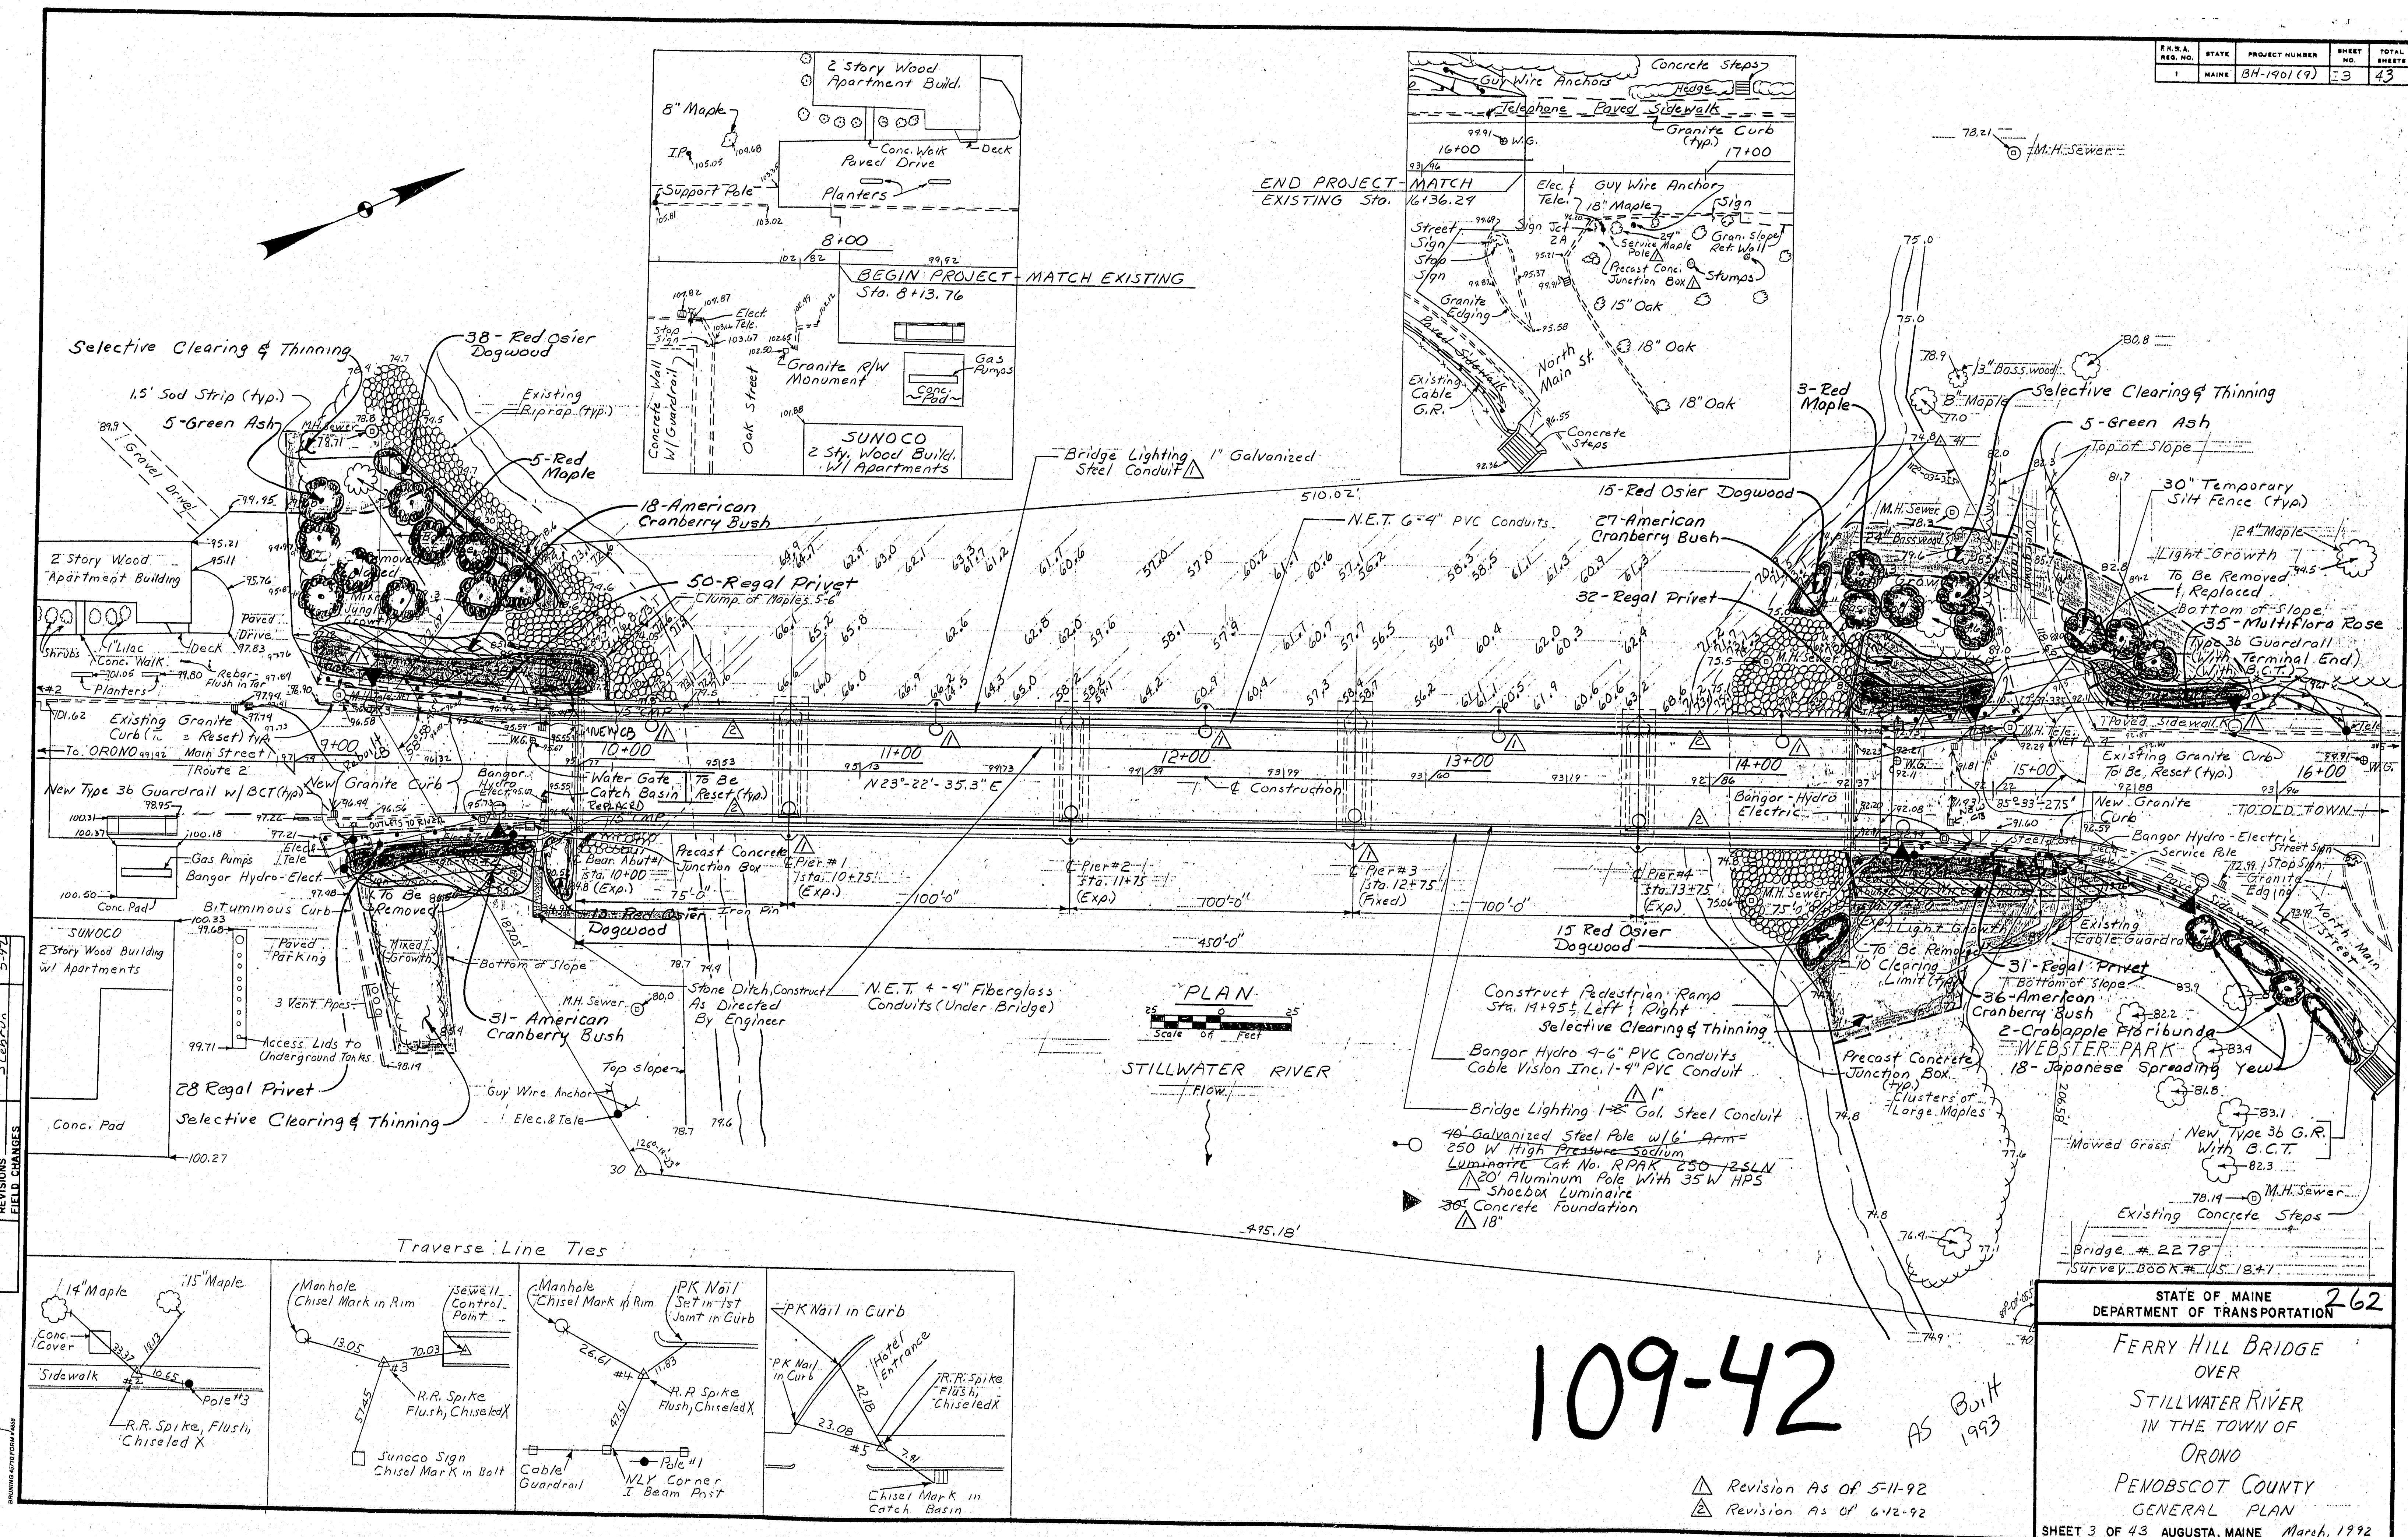

PROJECT DESIGN ENGINEER	DATE	3-7-92
	BY	MAH/ML
	CHECKED	MAH
	REVISIONS	5-16-92
	FIELD CHANGES	5-17-92
PLANS	DESIGN - DETAIL	MAH
	CHECKED	MAH
	REVISIONS	5-16-92
	FIELD CHANGES	5-17-92
	DATE	3-7-92


109-42

AS BUILT
1993

- △ Revision AS OF 5-11-92
- △ Revision AS OF 6-12-92

STATE OF MAINE
DEPARTMENT OF TRANSPORTATION
262
FERRY HILL BRIDGE
OVER
STILLWATER RIVER
IN THE TOWN OF
ORONO
PENOBSCOT COUNTY
GENERAL PLAN
SHEET 3 OF 43 AUGUSTA, MAINE March, 1992




P.R.A. NO.	STATE	PROJECT NUMBER	SHEET NO.	TOTAL SHEETS
1	MAINE	BH-1901 (9)	3	43

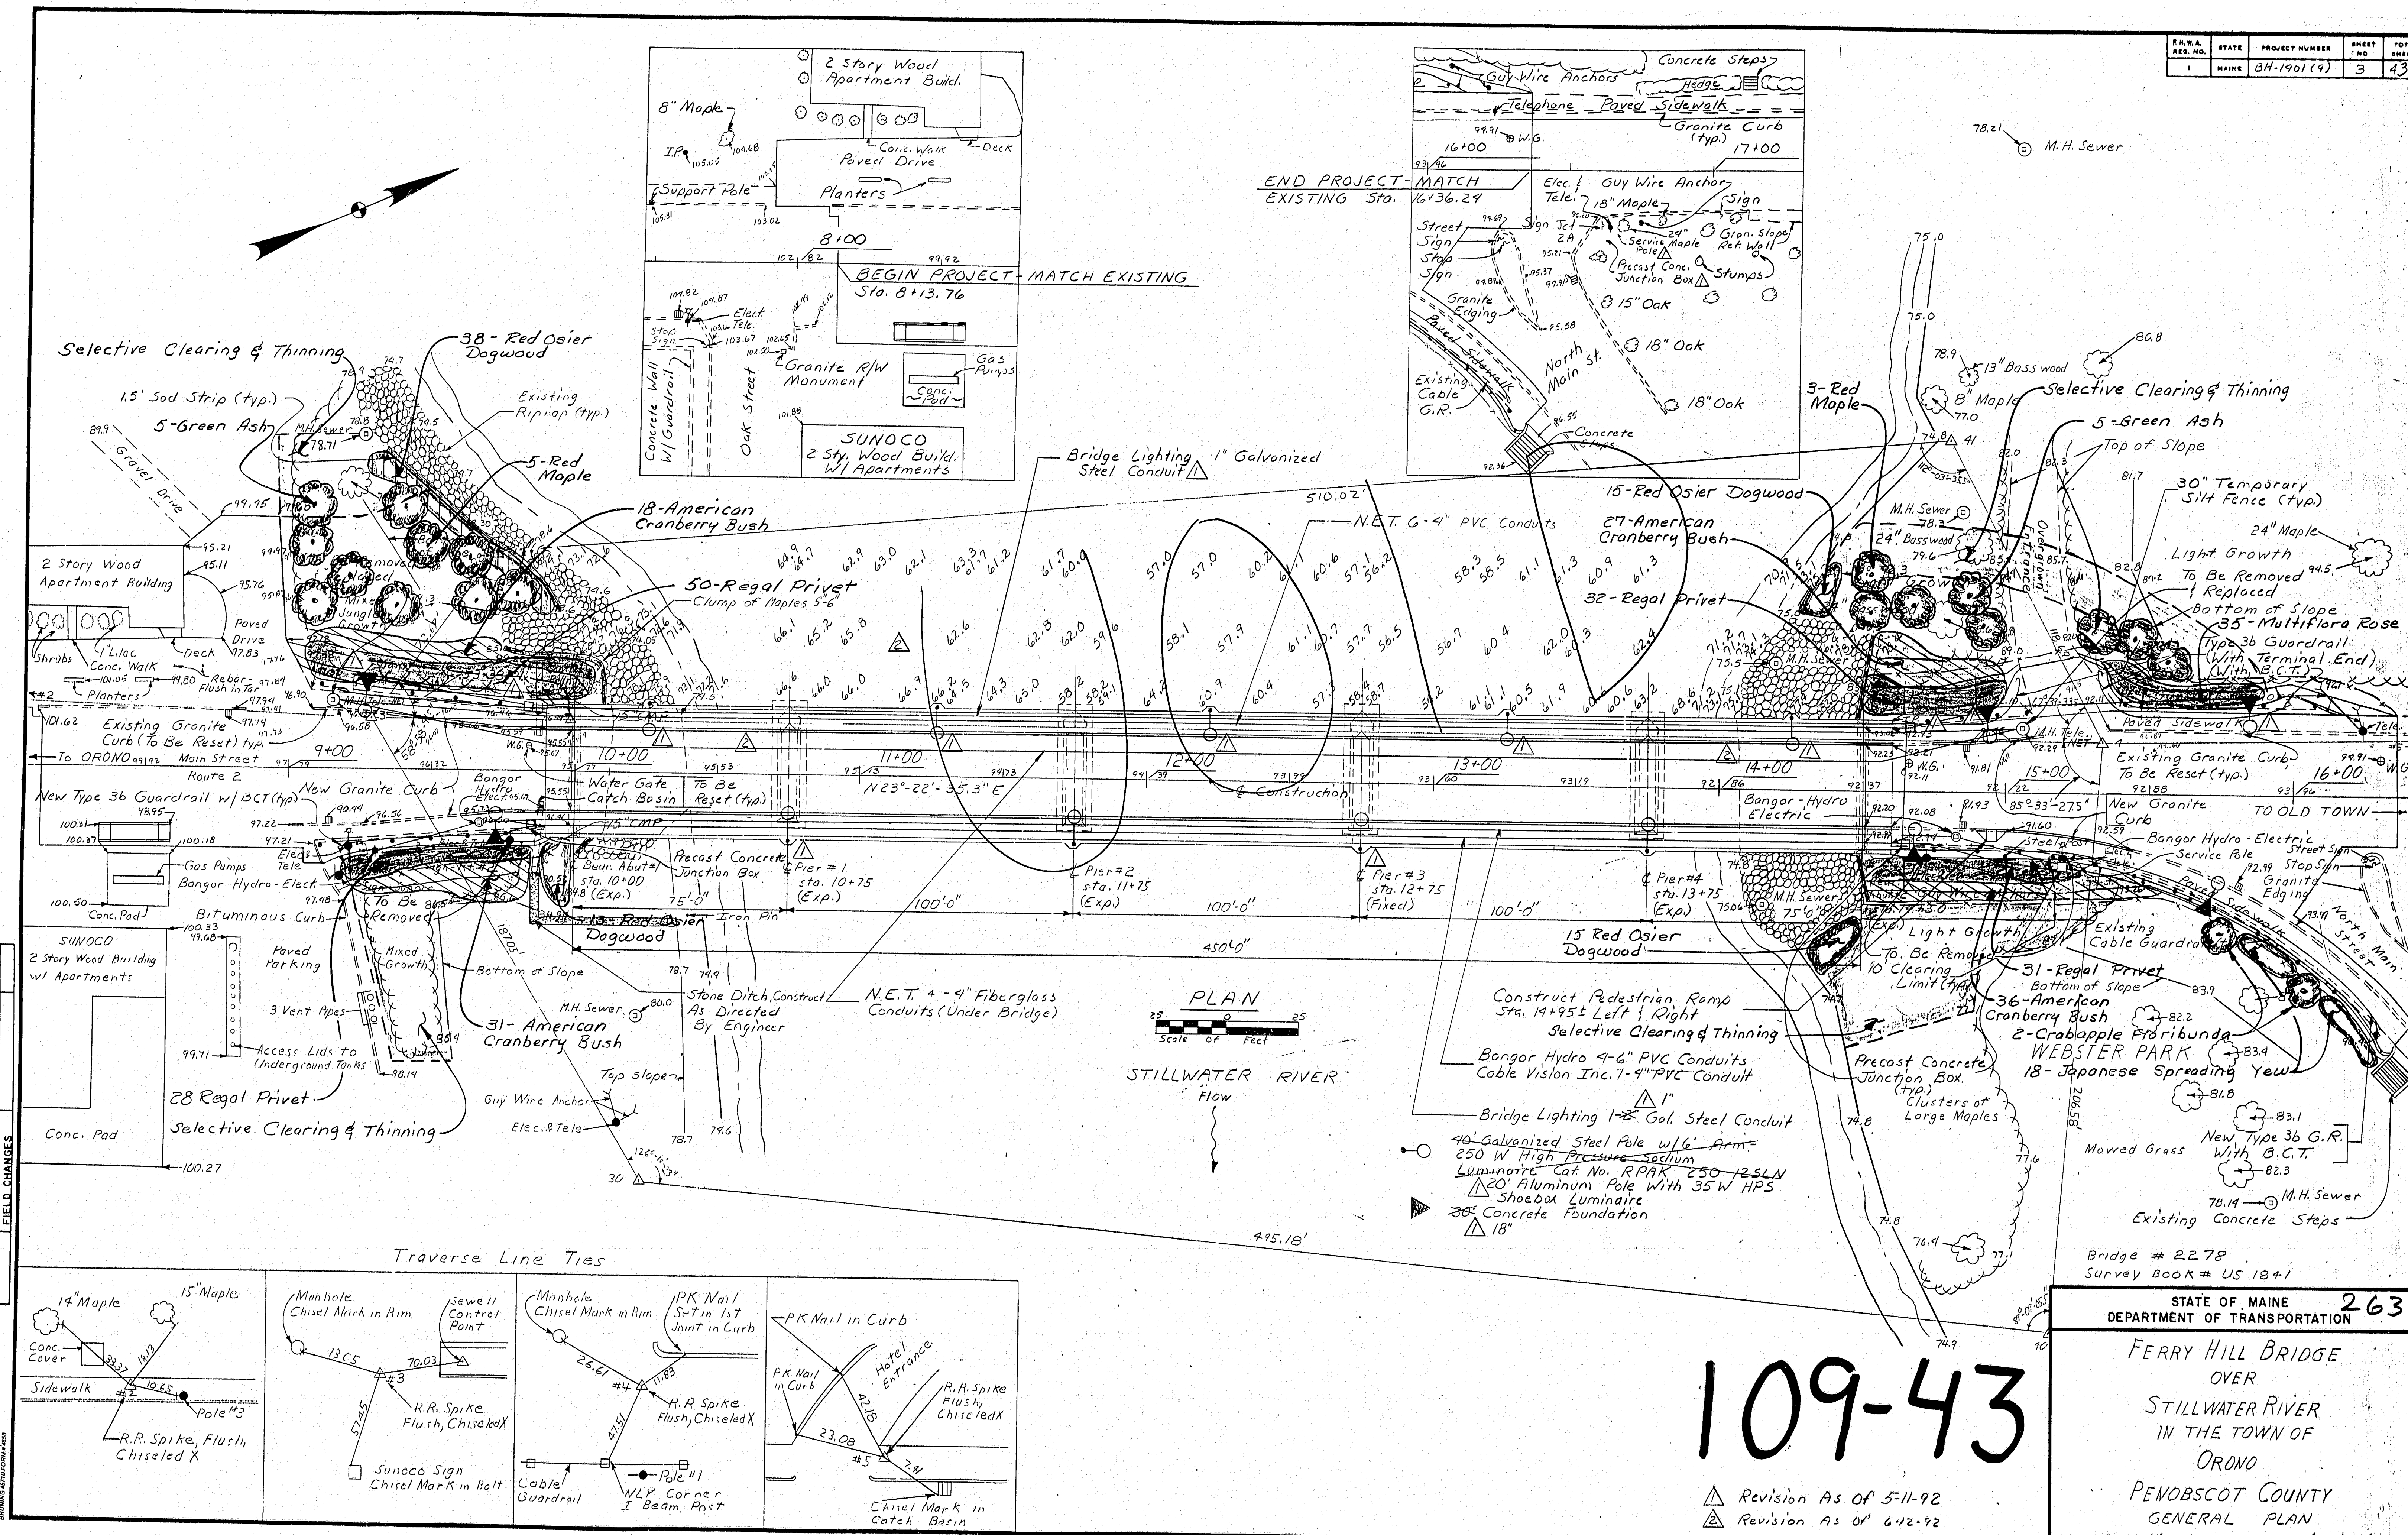

109-43

- Revision As of 5-11-92
- Revision As of 6-12-92

STATE OF MAINE
DEPARTMENT OF TRANSPORTATION
263
FERRY HILL BRIDGE
OVER
STILLWATER RIVER
IN THE TOWN OF
ORONO
PENOBSCOT COUNTY
GENERAL PLAN
SHEET 3 OF 43 AUGUSTA, MAINE March, 1992

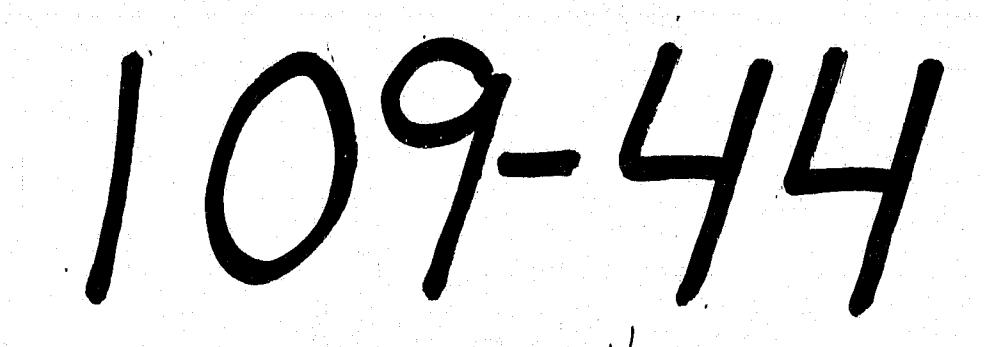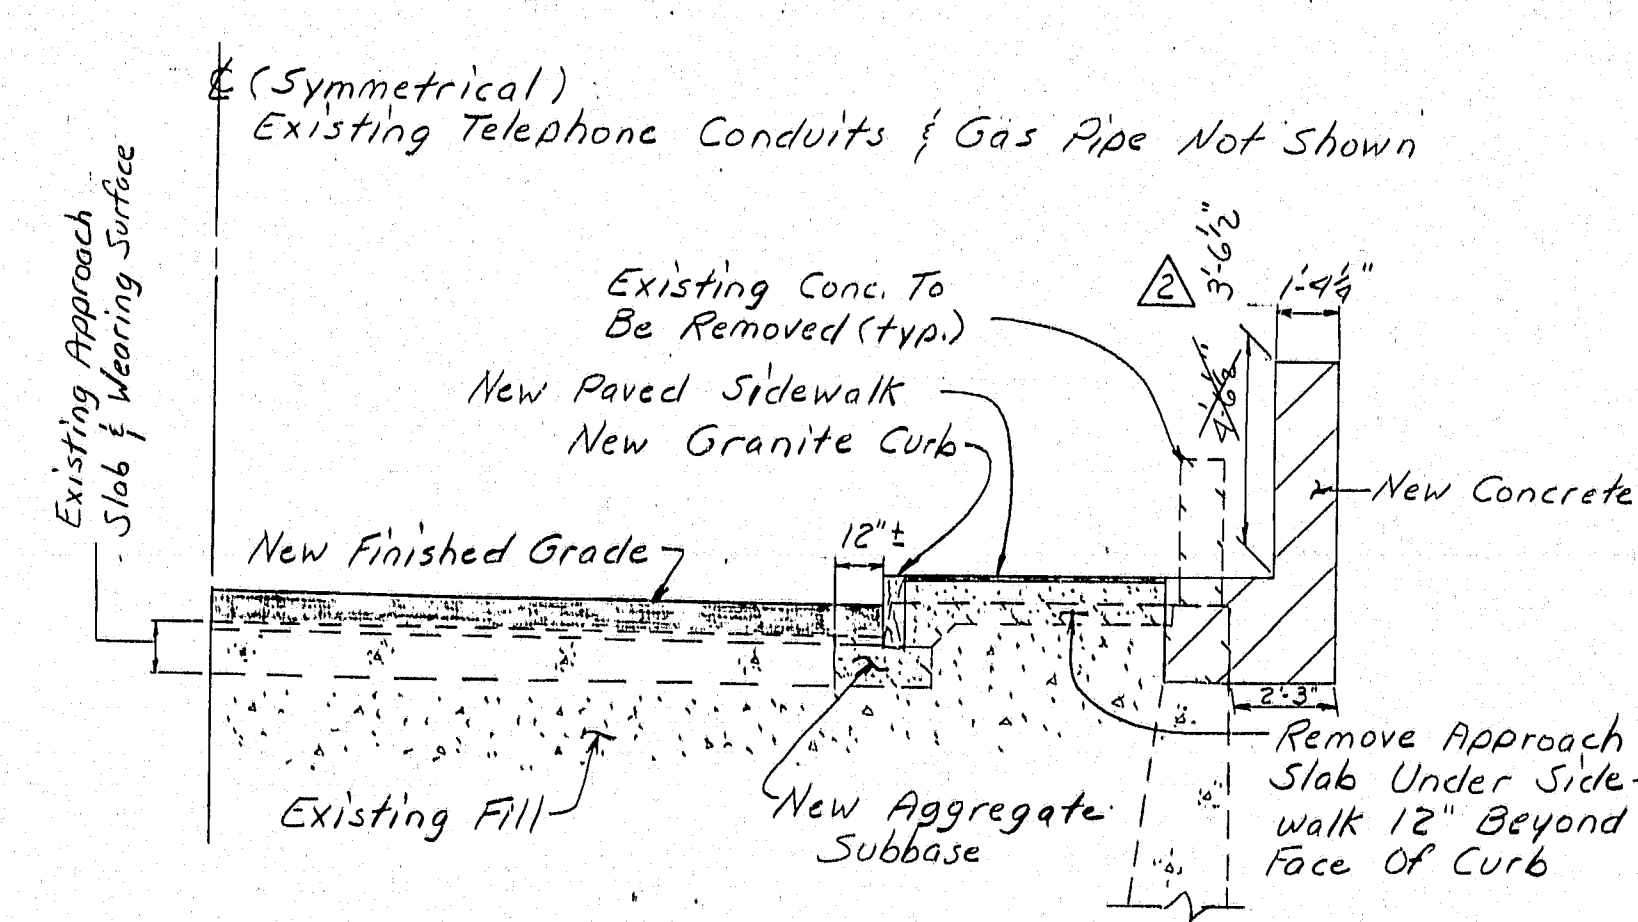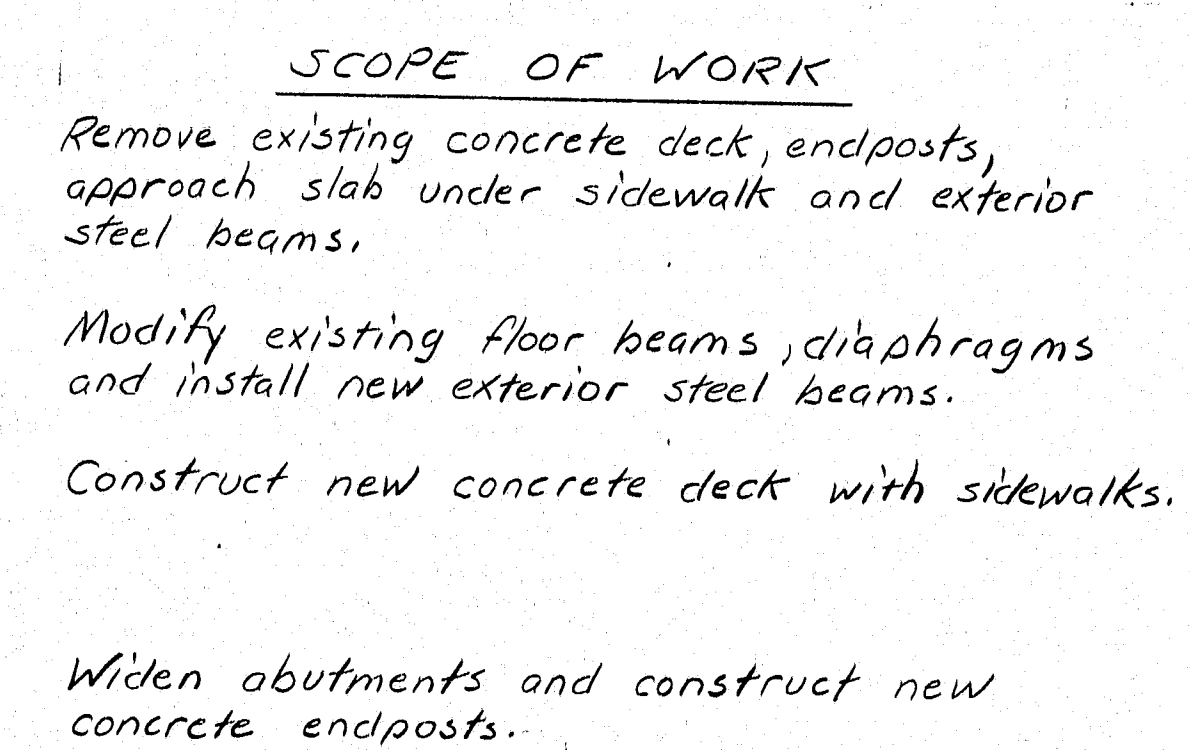

STATE OF MAINE
DEPARTMENT OF TRANSPORTATION





264

FERRY HILL BRIDGE
OVER
STILLWATER RIVER
IN THE TOWN OF
ORONO
PENOBSCOT COUNTY
TYPICAL SECTIONS

SHEET 4 OF 43 AUGUSTA, MAINE March, 1992

PROJECT DESIGN ENGINEER		BY	DATE
DESIGN - DETAILED		M.H.W.	5-6-68
CHECKED		JAF	3-92
REVISIONS			
FIELD CHANGES		5-6-68	5-92

STATE	PROJECT NUMBER	SHEET NO.	TOTAL SHEETS
MAINE	BA-1901(9)	5	43

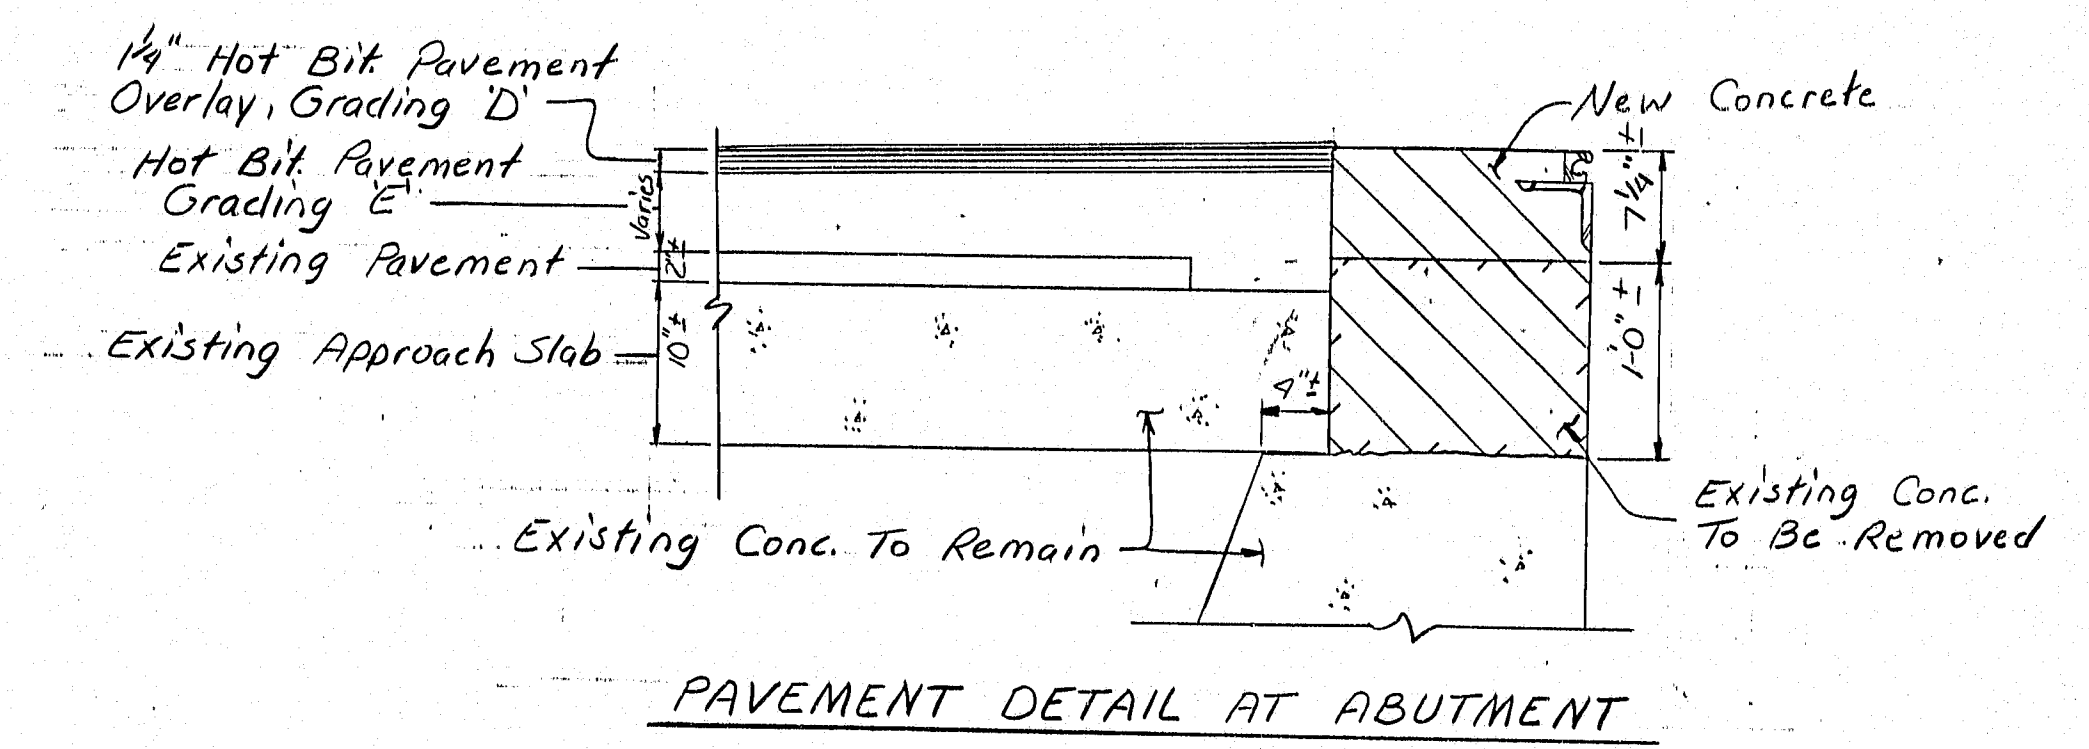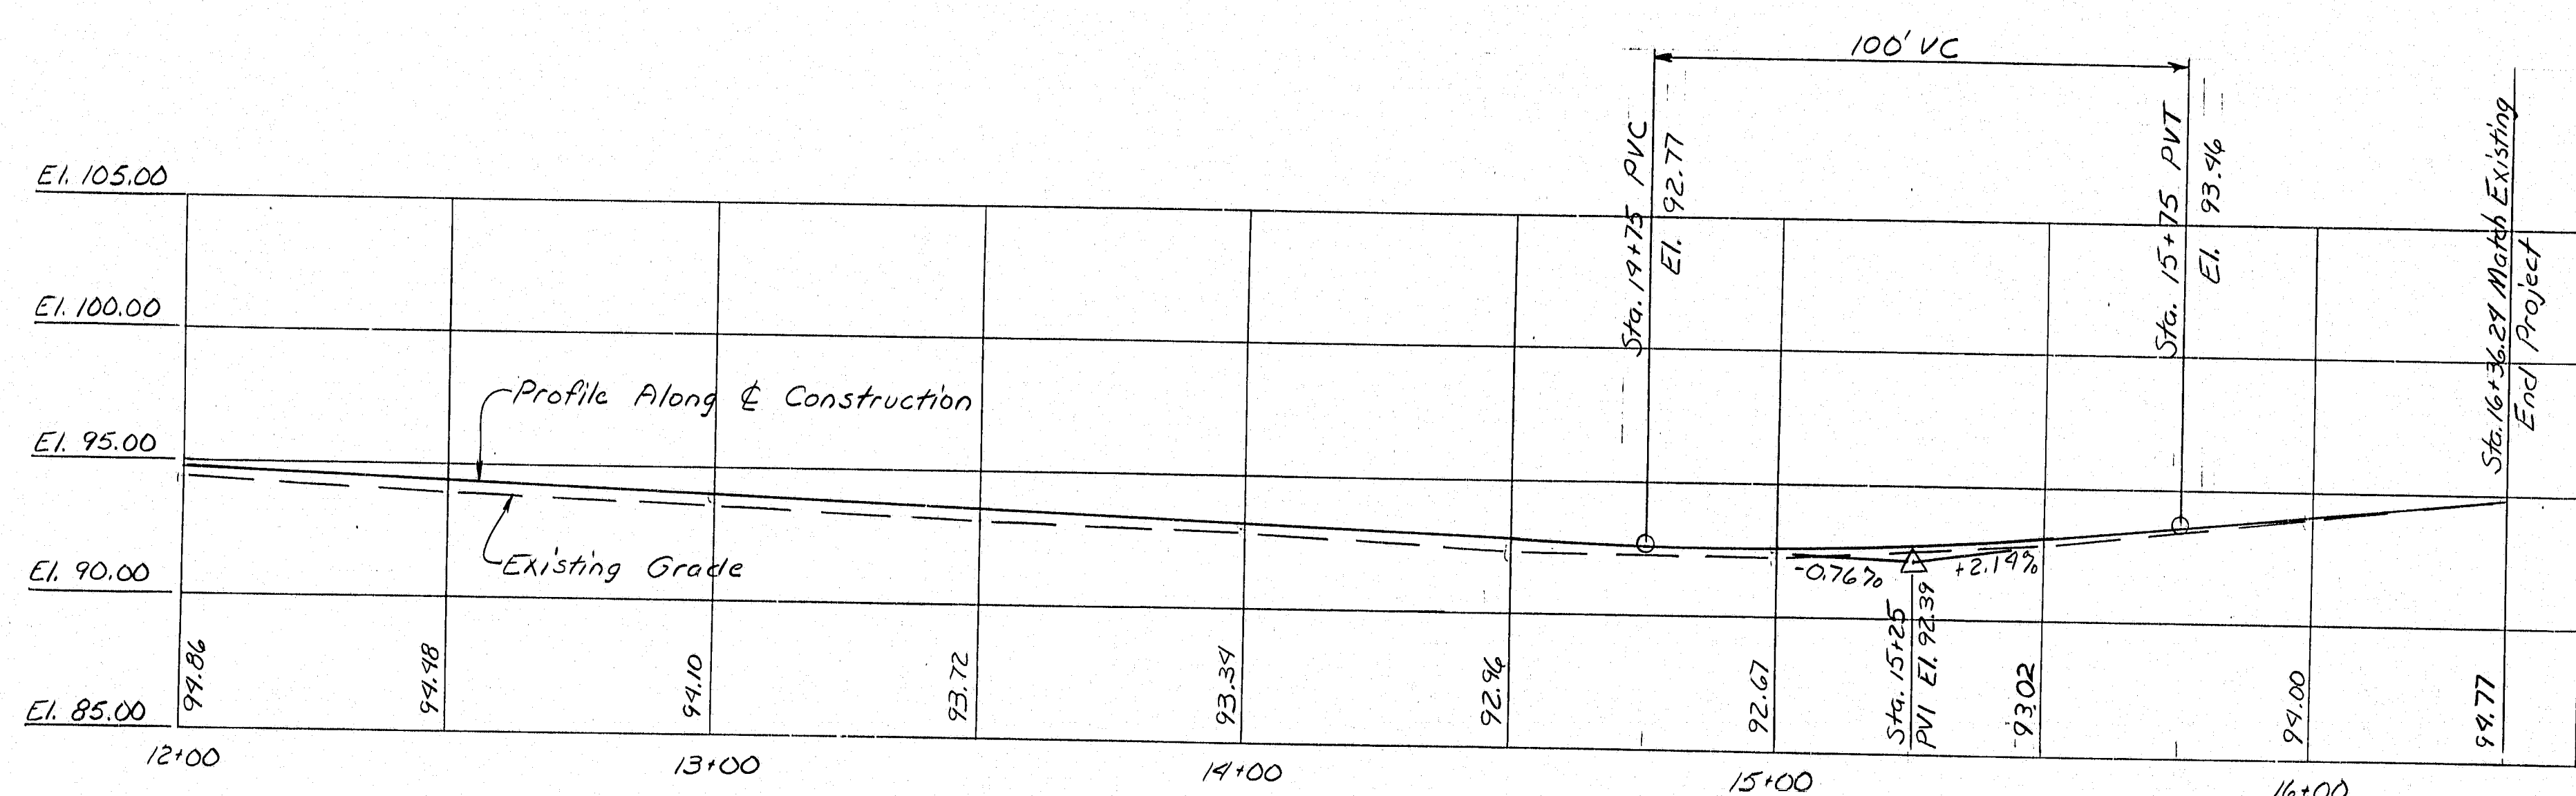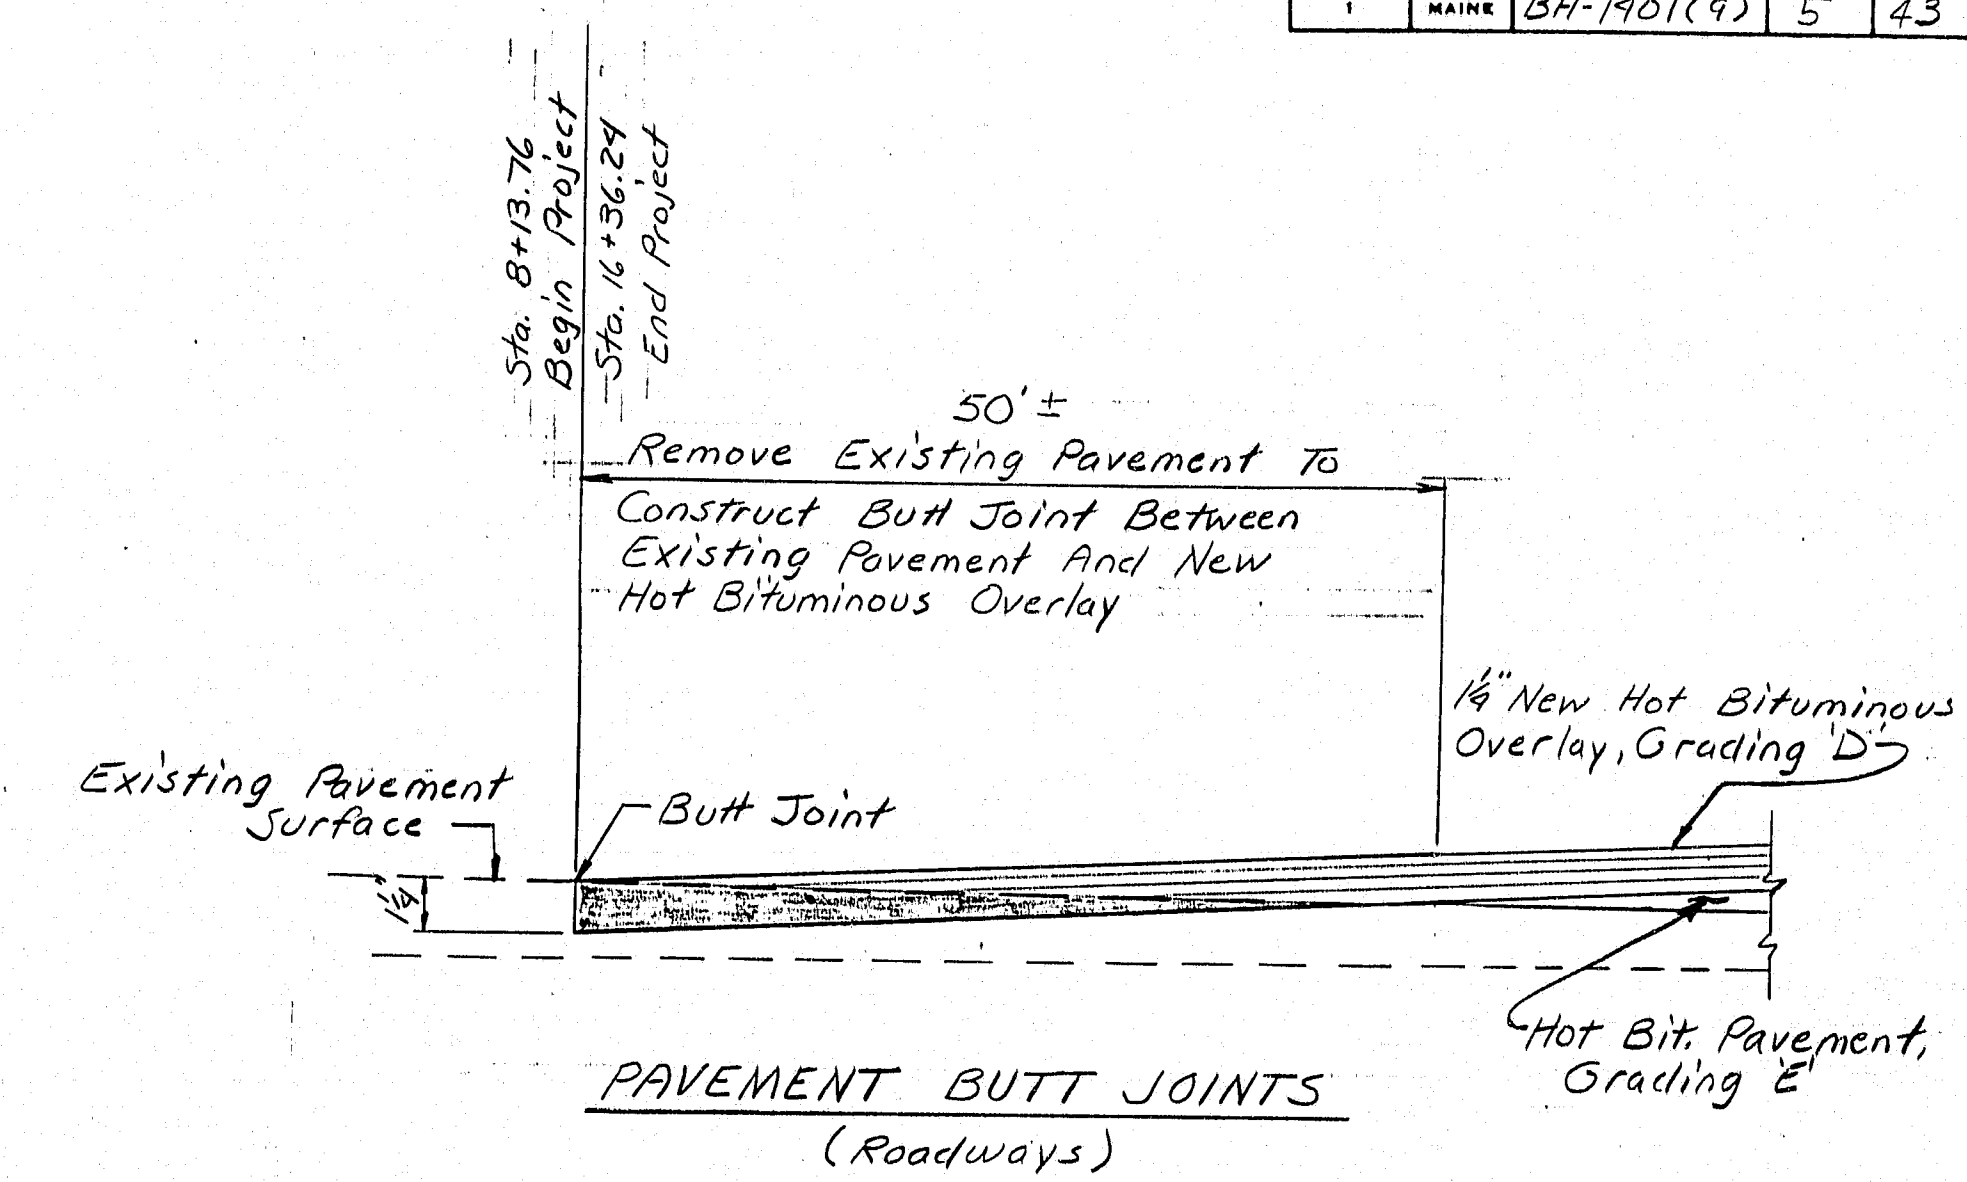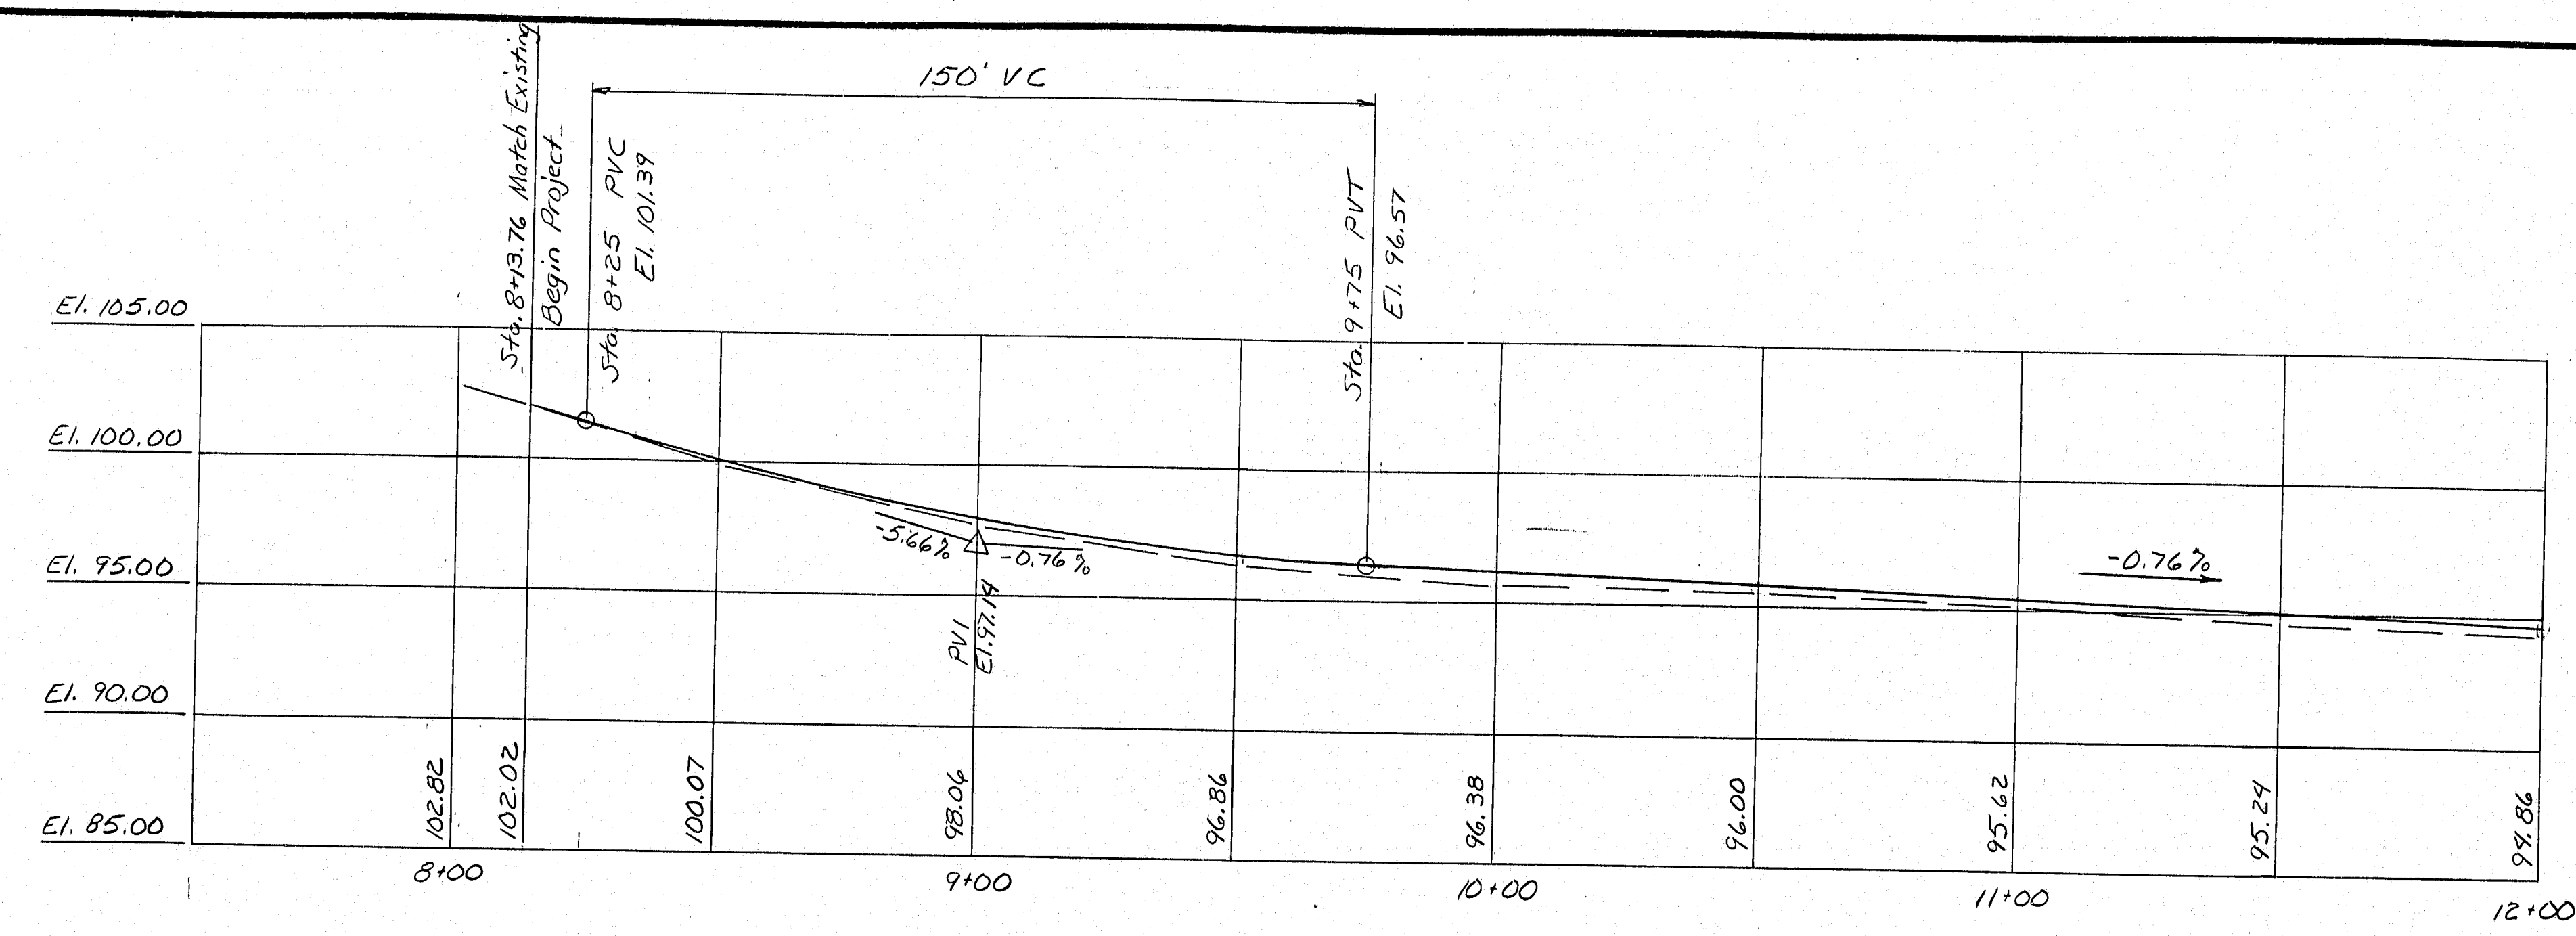

109-45

PROJECT DESIGN ENGINEER	DATE
MAINE	10-97
CHECKED	DATE
MAINE	3-98
FIELD CHANGES	DATE
MAINE	6-98

Station	Offset	To	Station	Offset	To
8+11 ±	20' ± LH		8+15 ±	20' ± LH	
8+79 ±	20' ± LH		8+83 ±	20' ± LH	
9+08 ±	20' ± LH		9+12 ±	20' ± LH	
8+35 ±	20' ± RH		8+39 ±	20' ± RH	
8+55 ±	20' ± RH		8+59 ±	20' ± RH	
8+55 ±	20' ± RH		8+59 ±	20' ± RH	
9+01 ±	20' ± RH		9+05 ±	20' ± RH	
14+89 ±	17' ± LH	17.4	14+93 ±	17' ± LH	17.4
14+97 ±	17' ± LH	17.75	15+01 ±	17' ± LH	18
15+09 ±	17' ± LH	18.7	15+13 ±	19' ± LH	
15+36 ±	20' ± LH		15+40 ±	20' ± LH	
14+89 ±	16' ± RH		14+93 ±	16' ± RH	
14+97 ±	16' ± RH		15+01 ±	16' ± RH	

Station	Offset	To	Station	Offset	To
8+11 ±	20' ± LH		8+79 ±	20' ± LH	68' ±
9+08 ±	20' ± LH		9+16 ±	20' ± LH	8' ±
9+75 ±	15' ± LH		9+89 ±	19' ± LH	14' ±
8+33 ±	21' ± RH		8+58 ±	20' ± RH	25' ±
9+01 ±	20' ± RH		9+25 ±	20' ± RH	24' ±
9+75 ±	15' ± RH		9+89 ±	19' ± RH	14' ±
14+89 ±	17' ± LH		14+93 ±	17' ± LH	26' ±
15+36 ±	20' ± LH		16+36 ±	20' ± LH	100' ±
14+60 ±	19' ± LH		15+01 ±	15' ± RH	91' ±
15+44 ±	21' ± RH		16+41 ±	78' ± RH	115' ±

Station	Offset	To	Station	Offset	To
8+11 ±	20' ± LH		8+79 ±	20' ± LH	68' ±
9+08 ±	20' ± LH		9+16 ±	20' ± LH	8' ±
9+75 ±	15' ± LH		9+89 ±	19' ± LH	14' ±
8+33 ±	21' ± RH		8+58 ±	20' ± RH	25' ±
9+01 ±	20' ± RH		9+25 ±	20' ± RH	24' ±
9+75 ±	15' ± RH		9+89 ±	19' ± RH	14' ±
14+89 ±	17' ± LH		14+93 ±	17' ± LH	26' ±
15+36 ±	20' ± LH		16+36 ±	20' ± LH	100' ±
14+60 ±	19' ± LH		15+01 ±	15' ± RH	91' ±
15+44 ±	21' ± RH		16+41 ±	78' ± RH	115' ±

Station	Offset	To	Station	Offset	To
9+39 ±	13.3' ± LH		9+75 ±	16' ± LH	71' ±
9+75 ±	16' ± LH		9+99 ±	16' ± LH	24' ±
8+39 ±	20' ± RH		8+55 ±	20' ± RH	16' ±
9+62 ±	17' ± RH		9+75 ±	16' ± RH	13' ±
9+75 ±	16' ± RH		9+99 ±	16' ± RH	24' ±
14+75 ±	16' ± LH		14+89 ±	17.4' ± LH	19' ±
15+01 ±	14' ± RH		15+44 ±	21' ± RH	94' ±
15+01 ±	18' ± LH		15+09 ±	18.7' ± LH	8' ±

Replace Bituminous Curb As Directed By The Engineer At Sta. 9+10 ± RH

Station	Offset	To	Station	Offset	To
15+04.75 ±	38' ± LH				
15+31.5 ±	42' ± LH				

Station	Offset	To	Station	Offset	To
9+17.5 ± RH			9+92.5 ± RH		
9+17.5 ± LH			9+92.5 ± LH		
15+72.5 ± LH			15+97.5 ± LH		
16+11 ± RH			16+30 ± RH		

Station	Offset	To	Station	Offset	To
9+92.5 ±	23' ± LH		9+92.5 ±	22' ± LH	50' ±
9+92.5 ±	23' ± RH		9+92.5 ±	22' ± RH	50' ±
14+57.5 ±	22' ± LH		14+88.75 ±	22' ± LH	31.25' ±
15+97.5 ±	26' ± LH		15+72.5 ±	26' ± LH	25' ±
14+57.5 ±	22' ± RH		15+20 ±	22' ± RH	62.5' ±
15+20 ±	22' ± RH		16+11 ±	60' ± RH	100' ±

Station	Offset	To	Station	Offset	To
14+88.75 ±	22' ± LH		15+04.75 ±	38' ± LH	25' ±
15+31.5 ±	42' ± LH		15+97.5 ±	26' ± LH	25' ±

* 6' Offset From Face of Curb


AS BUILT 1993

Revisions as of 6/19/92

STATE OF MAINE
DEPARTMENT OF TRANSPORTATION
FERRY HILL BRIDGE
STILLWATER RIVER
ORONO
PENOBSCOT COUNTY
PROFILE & CONSTRUCTION
SHEET 5 OF 43 AUGUSTA, MAINE March, 1992

Adjust cross slope of the Temporary Detour so that water flows away from the paved driveway at Sta. 8+83± to Sta. 9+08± L.R.

STATE	PROJECT NUMBER	SHEET NO.	TOTAL SHEETS
MAINE	BH-1901(9)	6	43

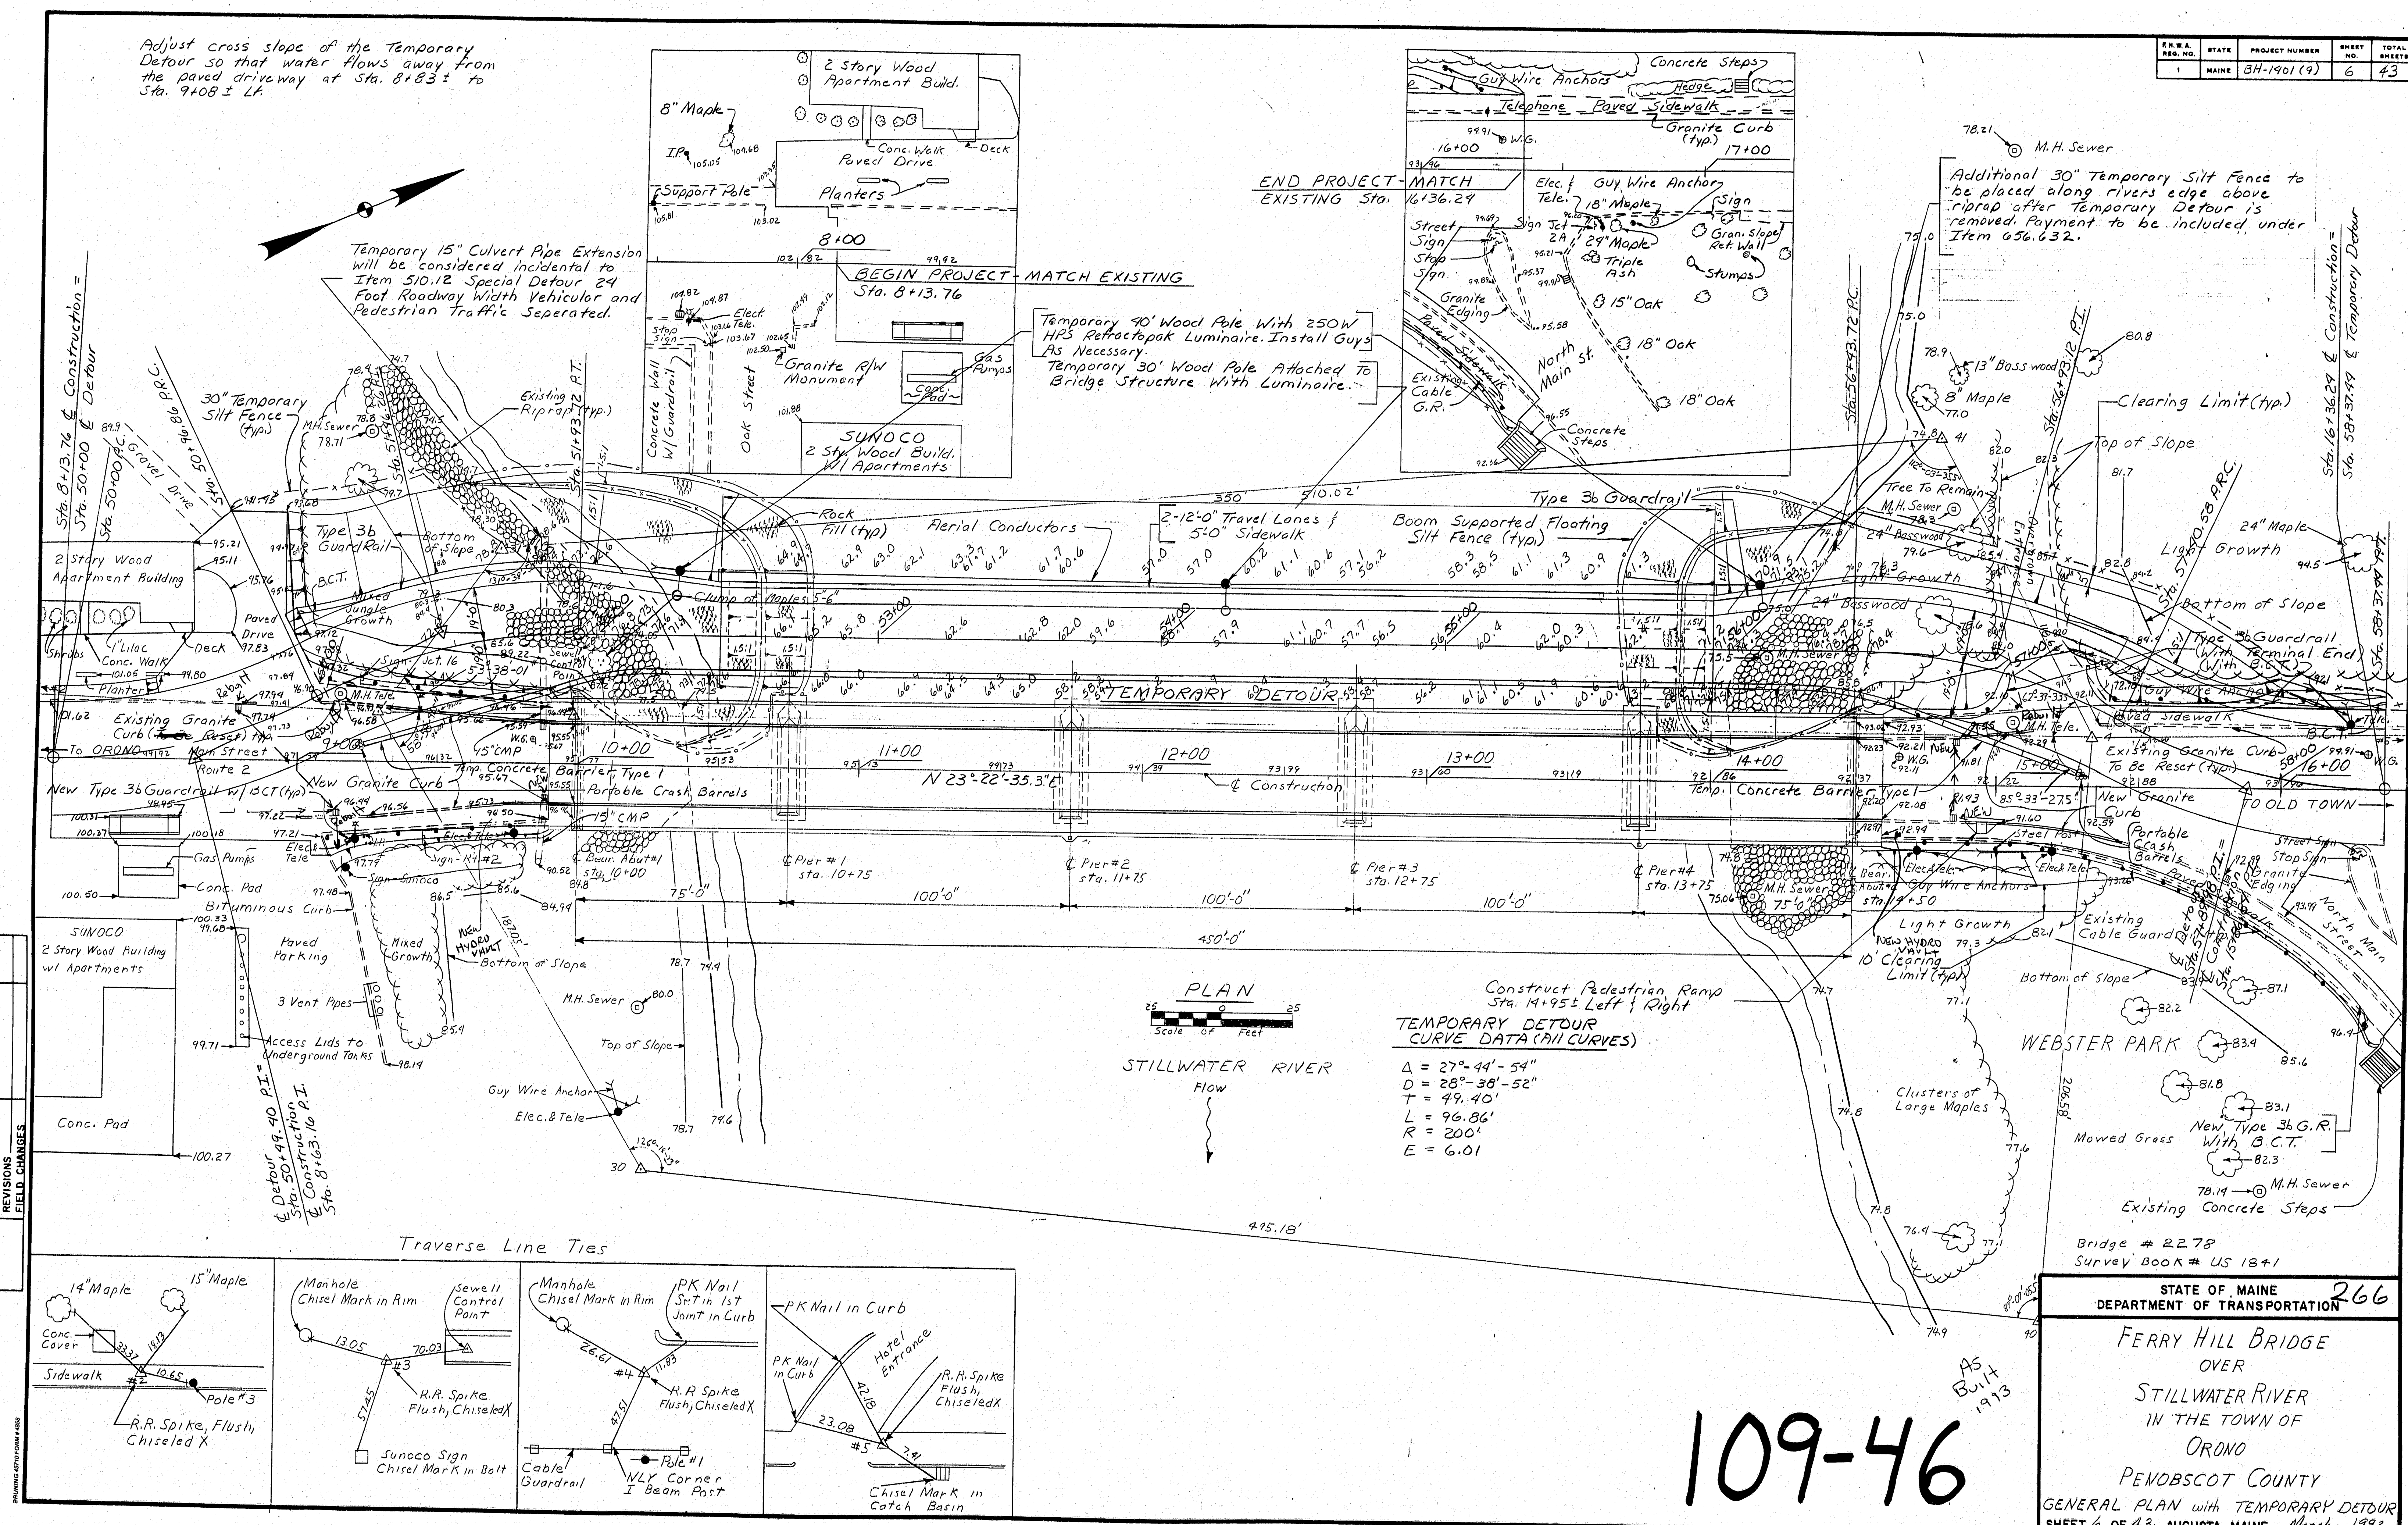

Construct Pedestrian Ramp Sta. 14+95± Left & Right

TEMPORARY DETOUR CURVE DATA (ALL CURVES)

$\Delta = 27^{\circ}44' - 54^{\circ}$
 $D = 28^{\circ}38' - 52^{\circ}$
 $T = 49.40'$
 $L = 96.86'$
 $R = 200'$
 $E = 6.01'$

PLAN


Scale of Feet

0 25 50

STILLWATER RIVER

Flow

Traverse Line Ties

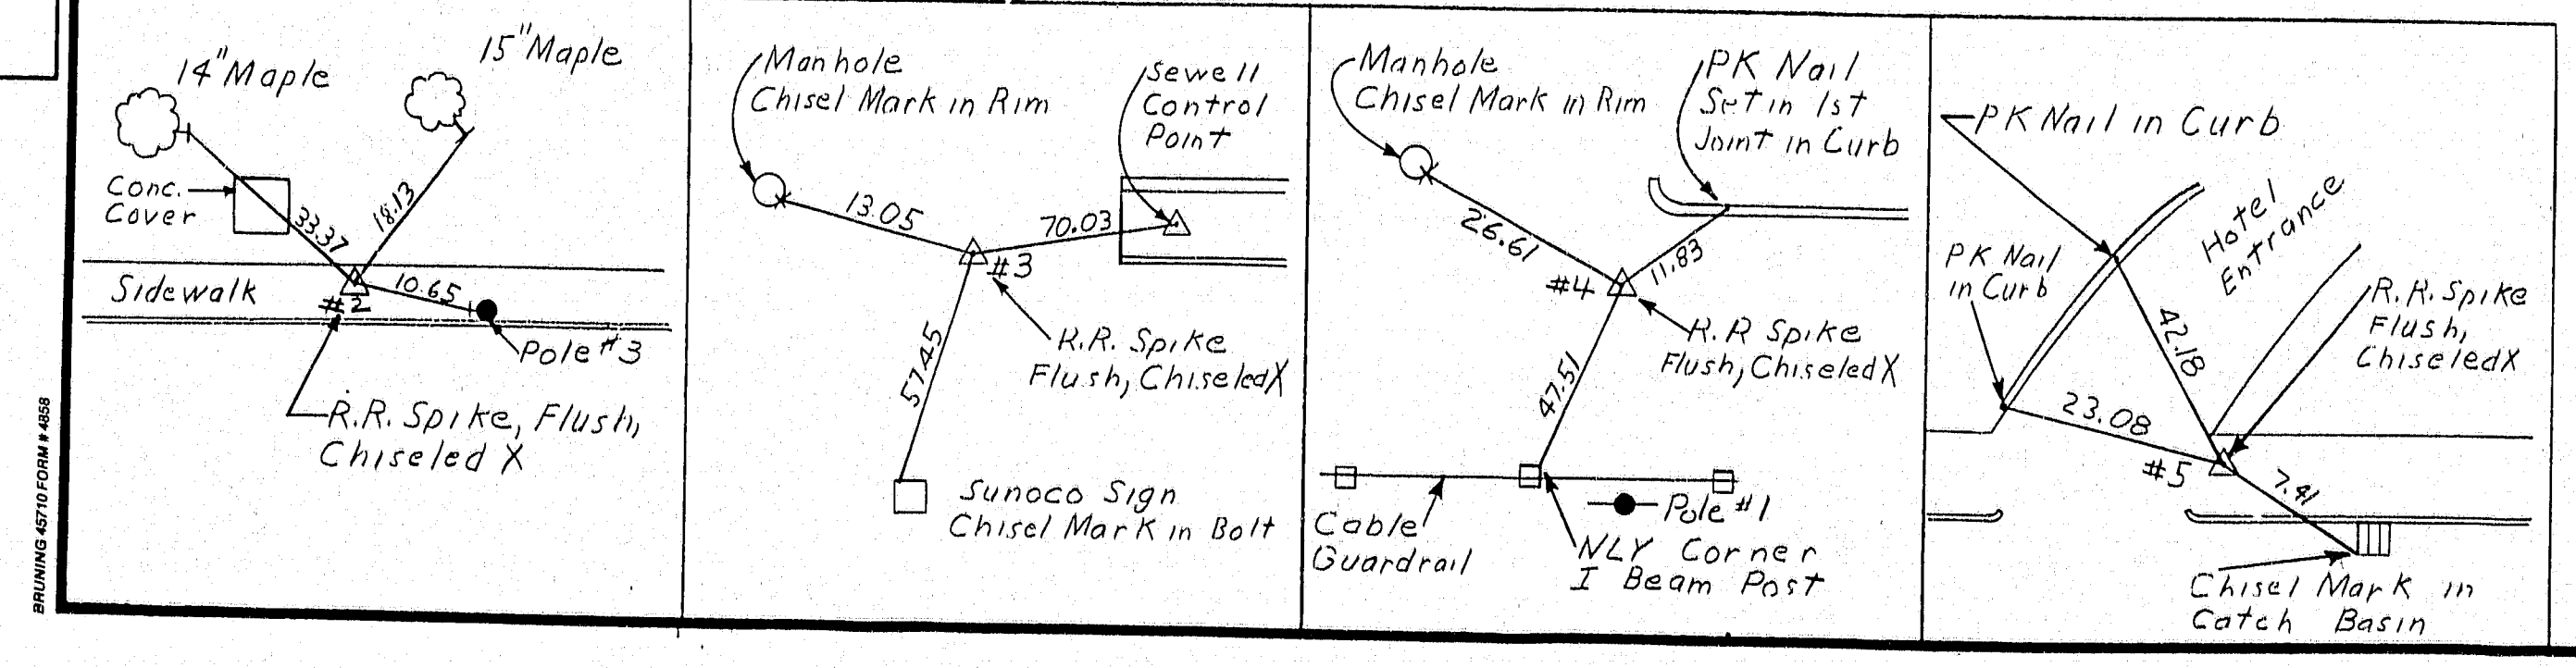

STATE OF MAINE
 DEPARTMENT OF TRANSPORTATION

266

FERRY HILL BRIDGE
 OVER
 STILLWATER RIVER
 IN THE TOWN OF
 ORONO
 PENOBSCOT COUNTY

GENERAL PLAN WITH TEMPORARY DETOUR
 SHEET 6 OF 43 AUGUSTA, MAINE March, 1992

109-46

PROJECT DESIGN ENGINEER
 DESIGN-DETAILED
 REVISIONS
 FIELD CHANGES


DATE
 7-11
 5-12

BY
 MHW/SLB
 JAF


Survey Plotted by MHW/SLB

PROJECT DESIGN DRIVER	DATE
BY	2/19/92
CHECKED	2/19/92
REVISIONS	5/9/92
FIELD CHANGES	
PLANS	

15JUN92-010100

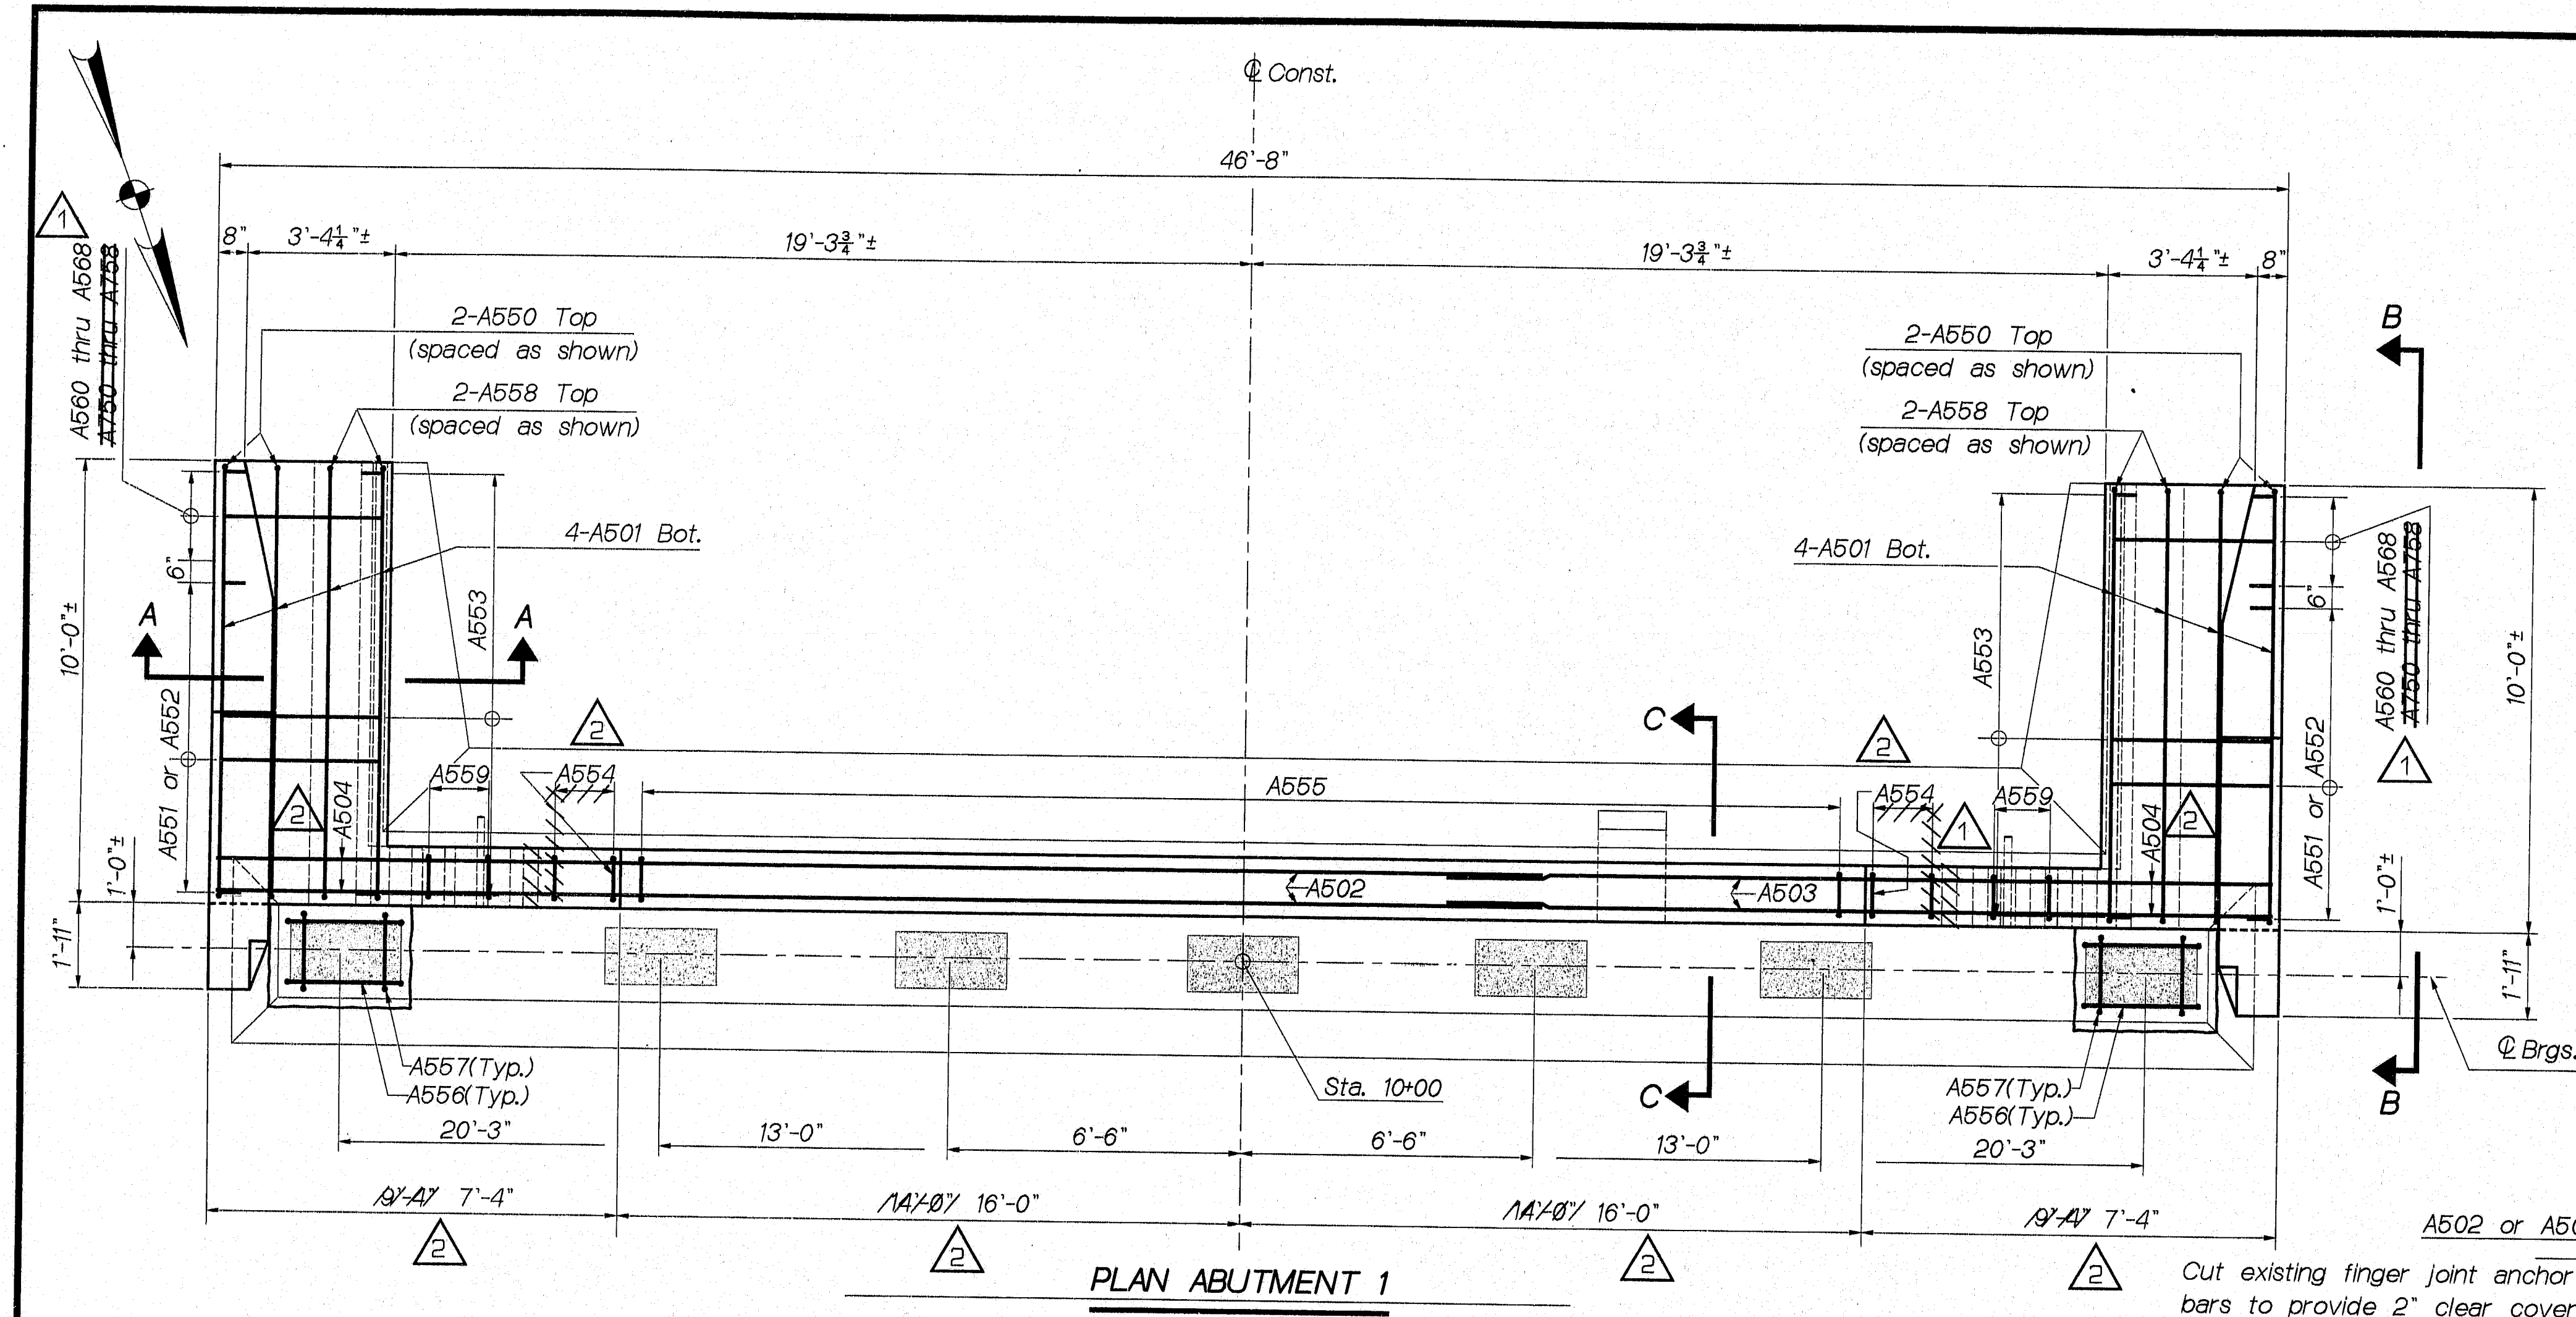


PLAN ABUTMENT 1

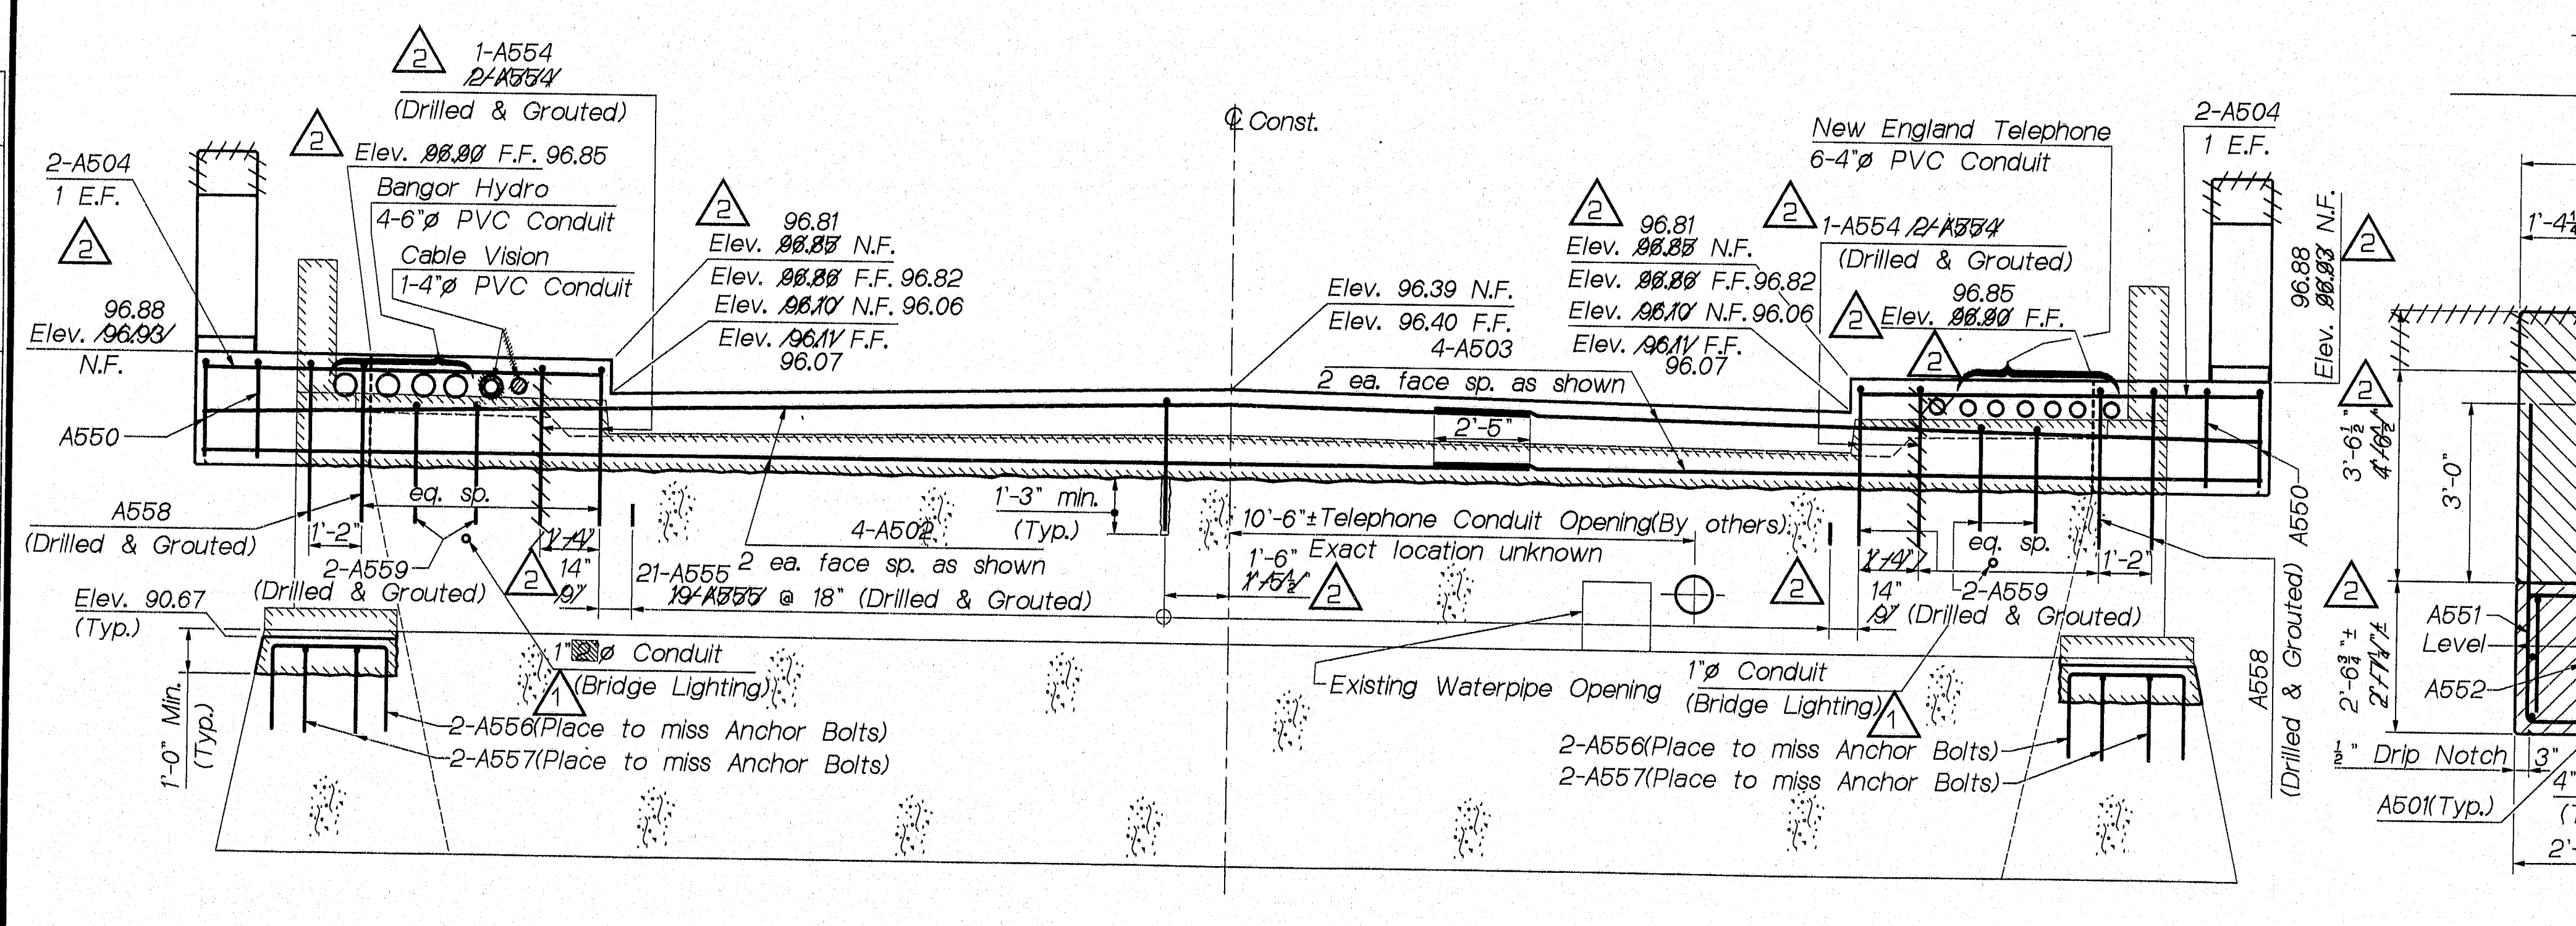


ELEVATION ABUTMENT 1

- ABUTMENT NOTES**
- Reinforcing steel shall have 2 inches cover unless otherwise indicated.
 - Protective coating for concrete surfaces shall be applied to the following areas:
Top of concrete curb and sidewalk.
Top of abutment backwalls and 1'± below top of backwalls on the back side.
All exposed surfaces of Concrete End Posts.
Fascias down to the drip notch.
 - Approved Bonding Agent shall be applied to all existing concrete surfaces to be in contact with the new concrete. Payment will be incidental to Item 502.219, Structural Concrete, Abutments and Retaining Walls.
 - Saw cut along wingwall fascia to maintain a straight concrete removal line. Payment will be incidental to Item 202.17, Removing Existing Structural Concrete.
 - The existing concrete shall be removed so as not to damage the existing reinforcing steel and anchor bars. Any damaged existing reinforcing steel shall be replaced at the contractors expense.
 - All grout shall contain a non-shrink additive. Payment for grout will be considered incidental to Item 503.13 Reinforcing Steel, Placing.
 - The existing bearing pedestals for the exterior beams, which are to be removed and reset, shall be secured by 2 - 1"Ø swaged anchor bolts with 10" embedment length. Payment for anchor bolts will be considered incidental to Item 503.12, Reinforcing Steel, Fabricated and Delivered.
 - Removal of existing concrete for the abutments will be paid for under Item 202.17, Removing Existing Structural Concrete.
 - Silica Fume Additive shall be used for capping top of abutments.

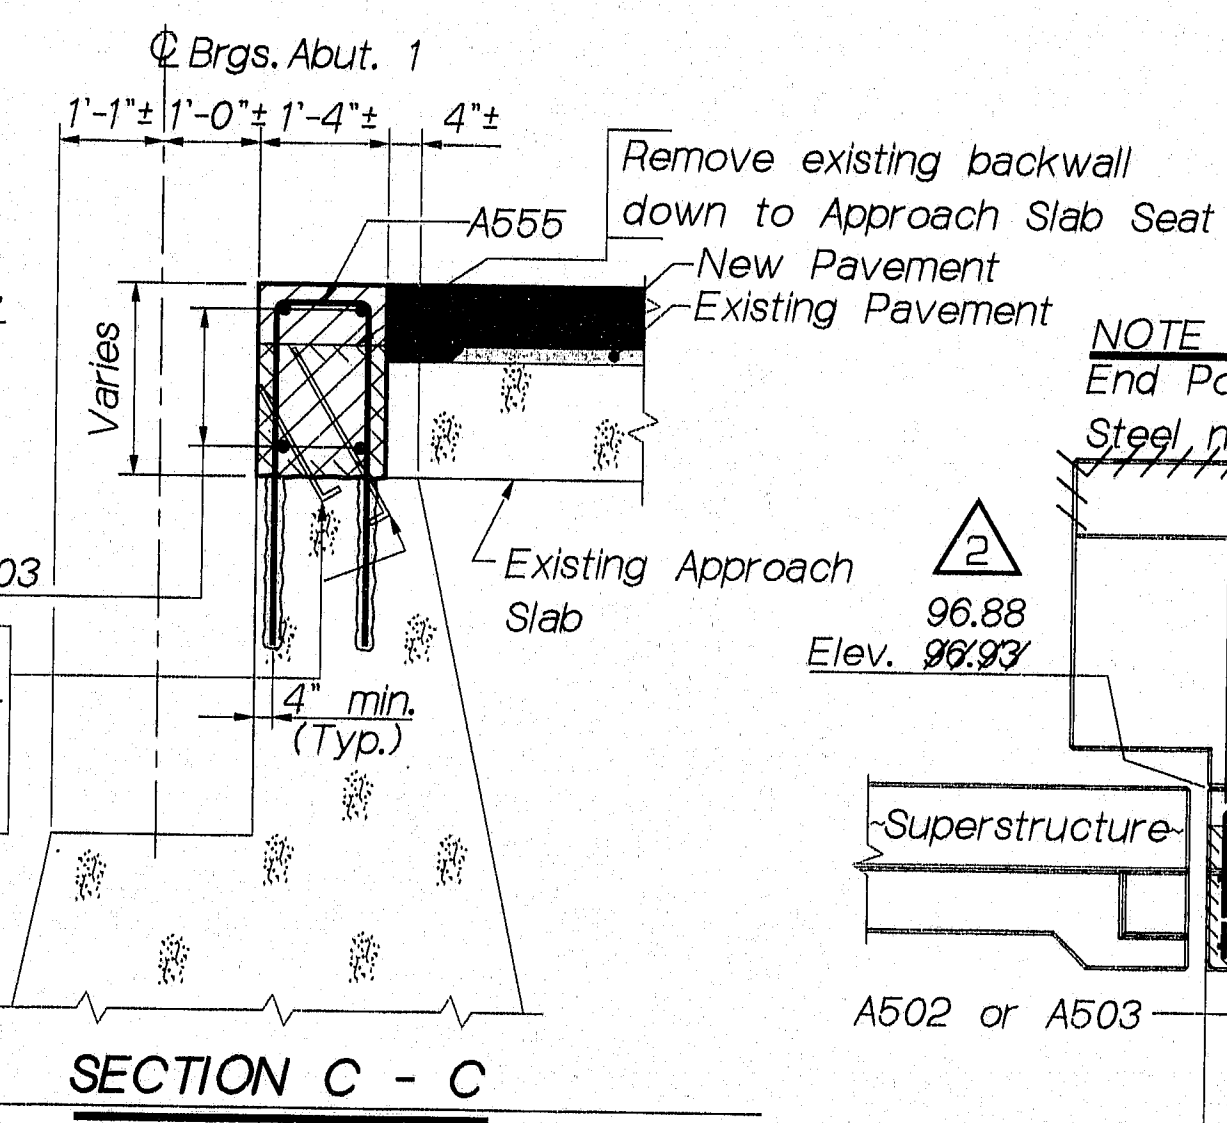


SECTION C - C

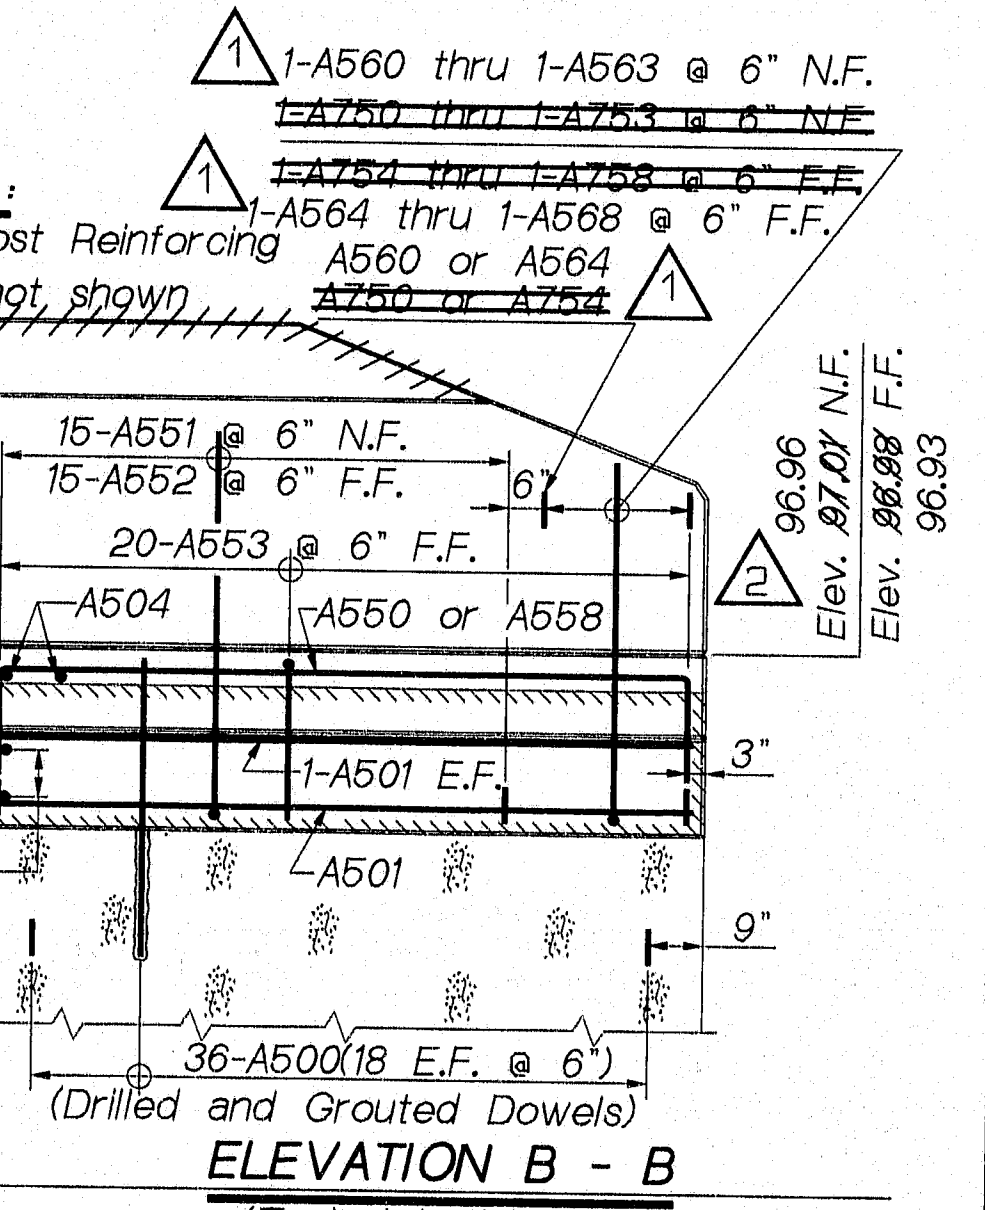

ELEVATION B - B

- LEGEND**
- New concrete
 - Existing concrete to remain
 - Existing concrete to be removed
 - Revision as of 5/9/92
 - Revision as of 6/17/92

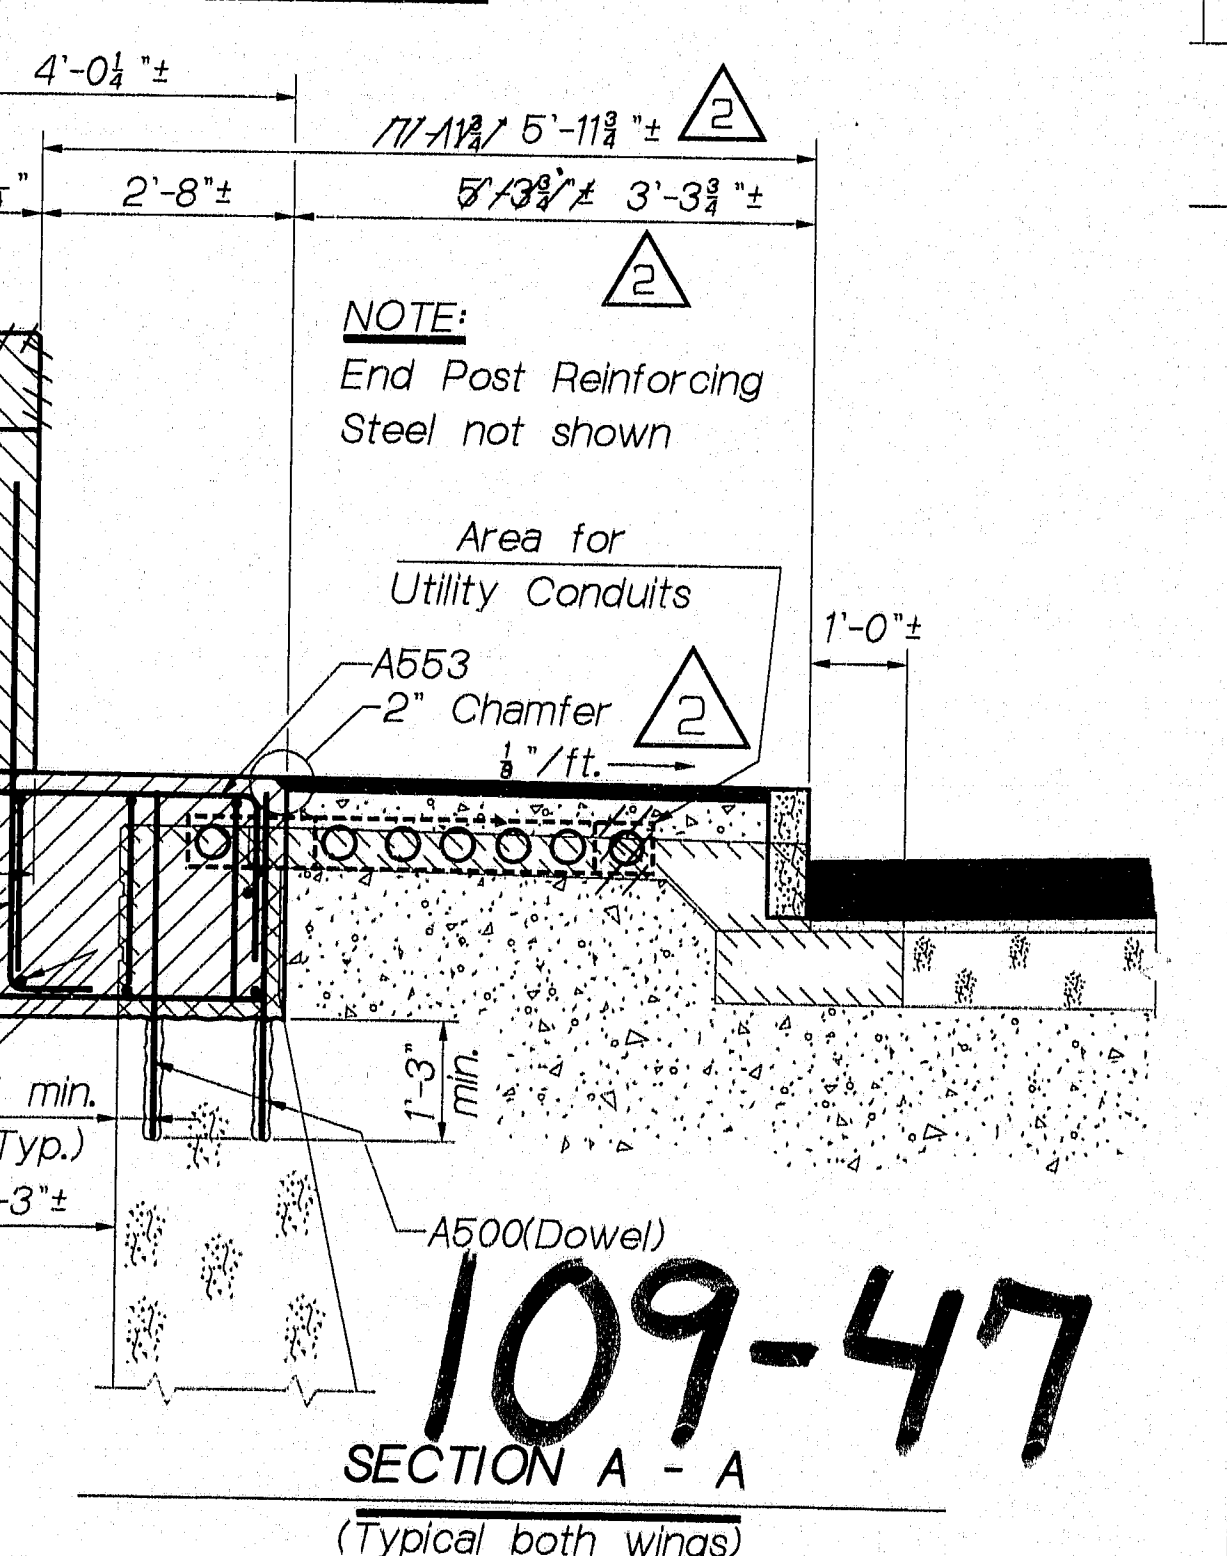

SECTION A - A






STATE OF MAINE
DEPARTMENT OF TRANSPORTATION

FERRY HILL BRIDGE
OVER
STILLWATER RIVER
IN THE TOWN OF
ORONO
PENOBSCOT COUNTY

ABUTMENT 1

SHEET 9 OF 43 AUGUSTA, MAINE March, 1992

F.P.W.A. RES. NO.	STATE	PROJECT NUMBER	SHEET NO.	TOTAL SHEETS
1	MAINE	BH-1401(9)	10	43

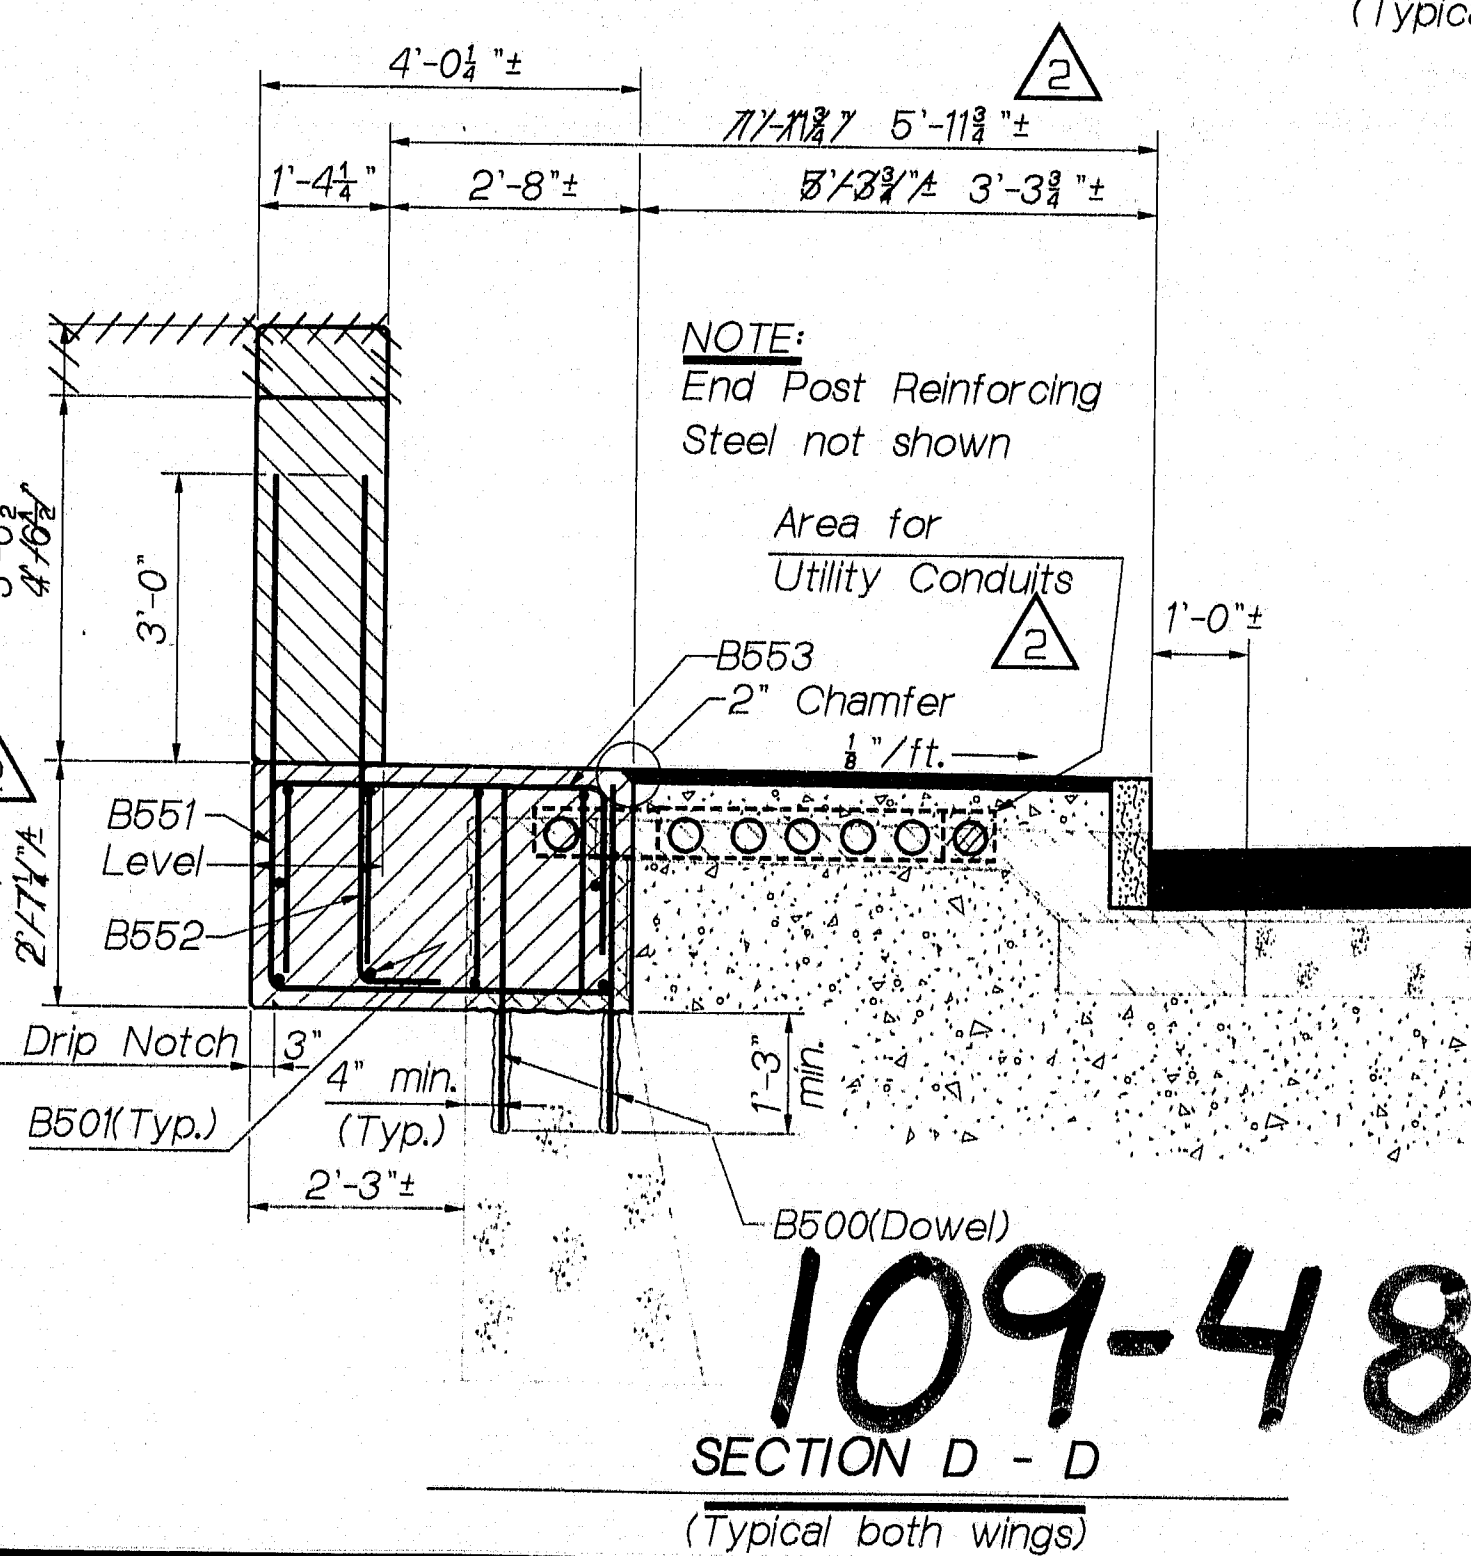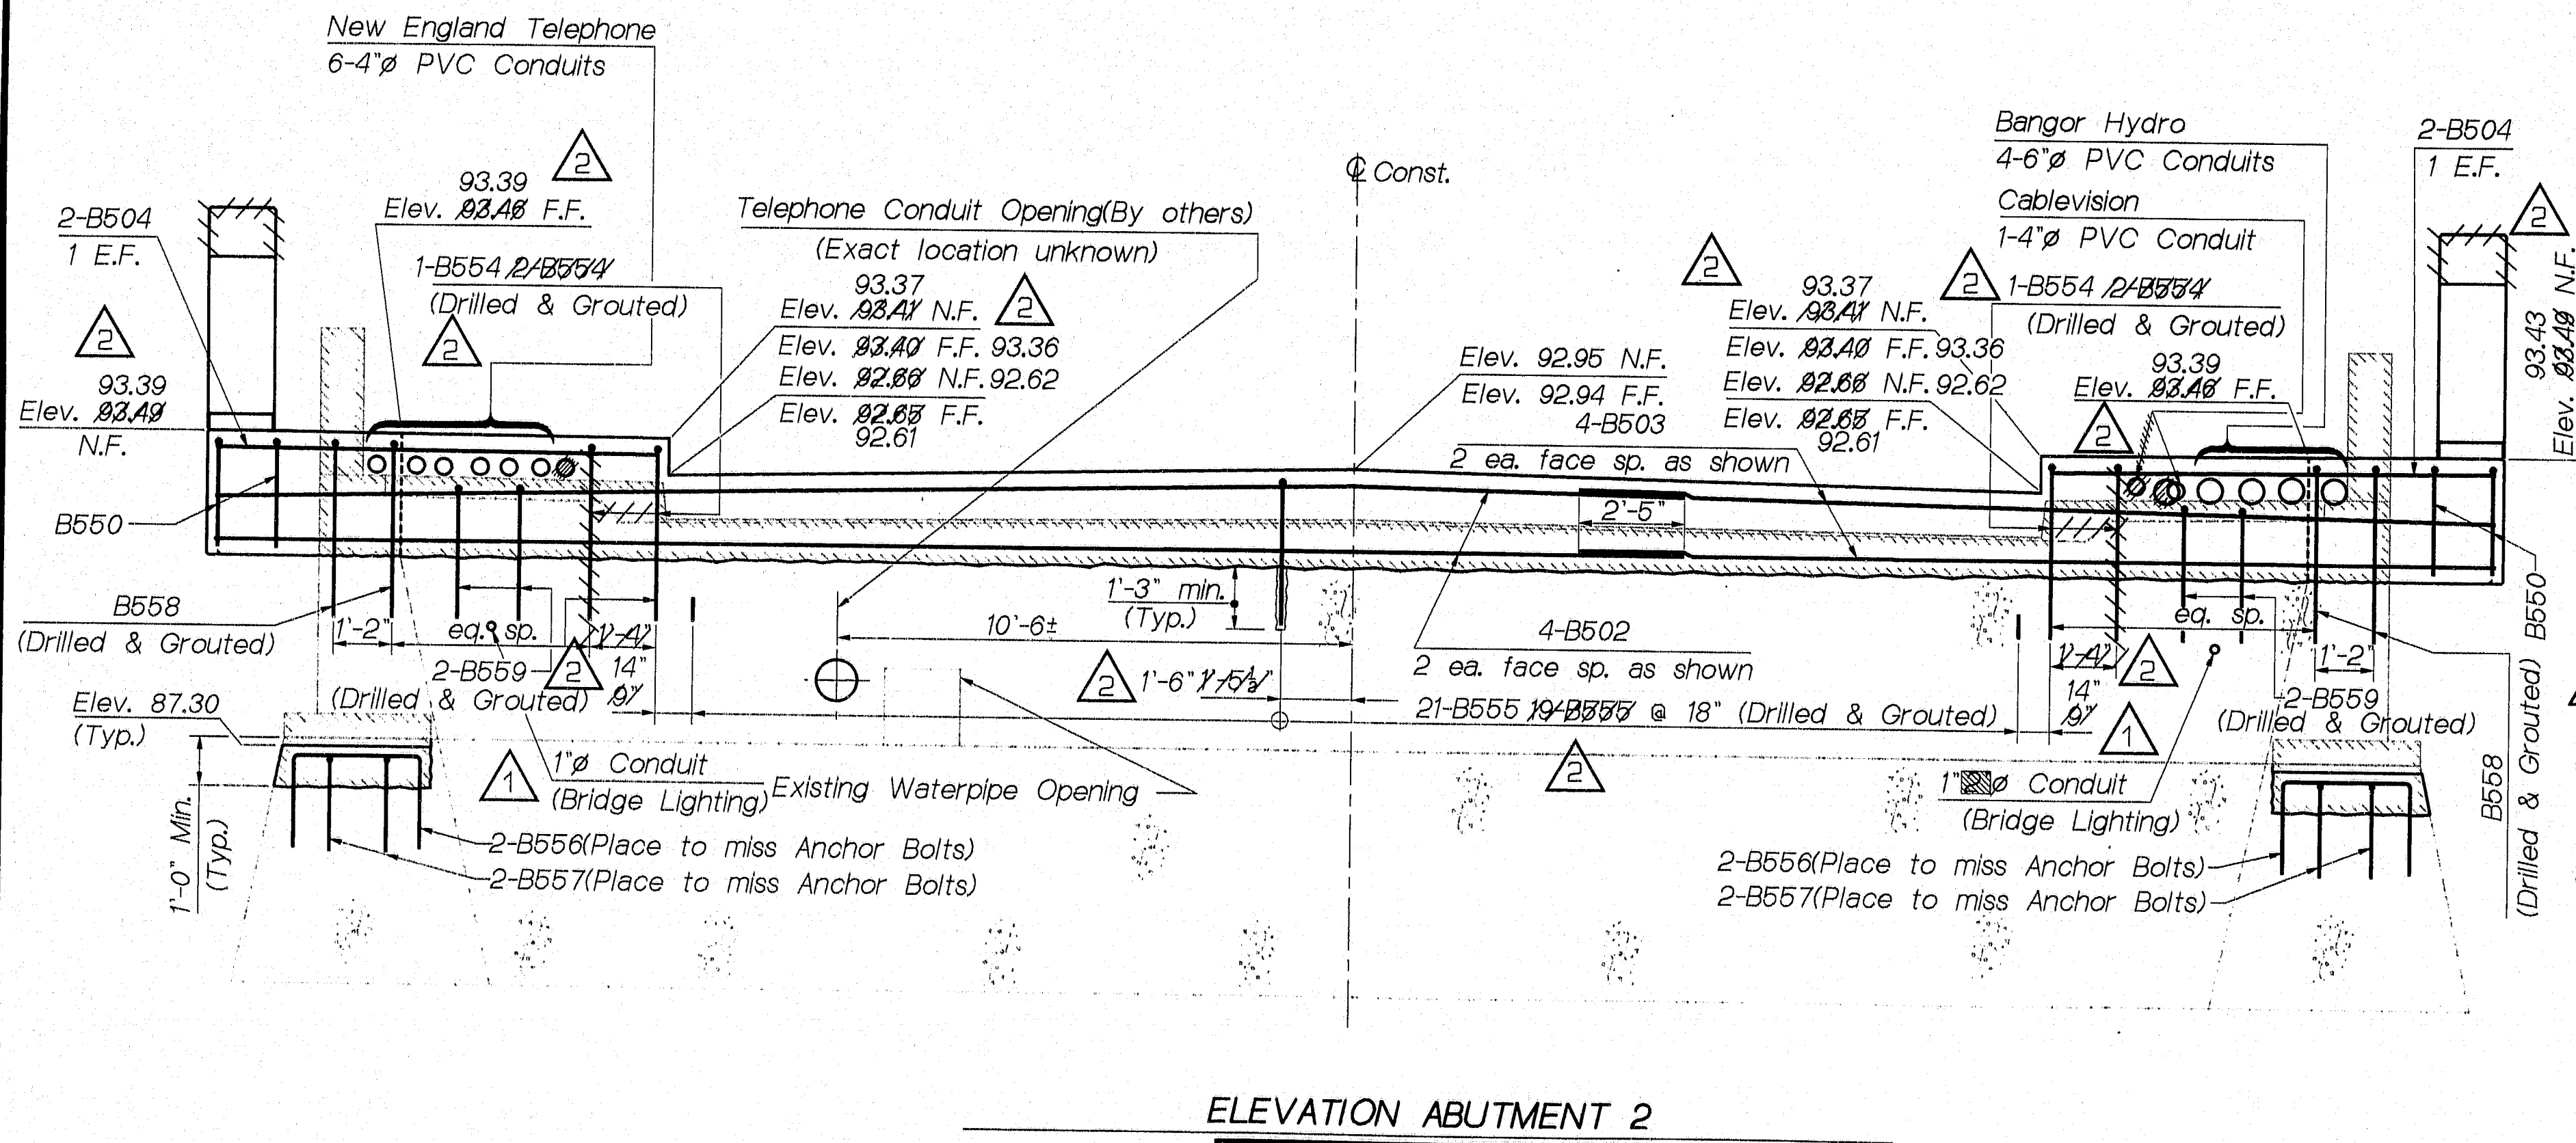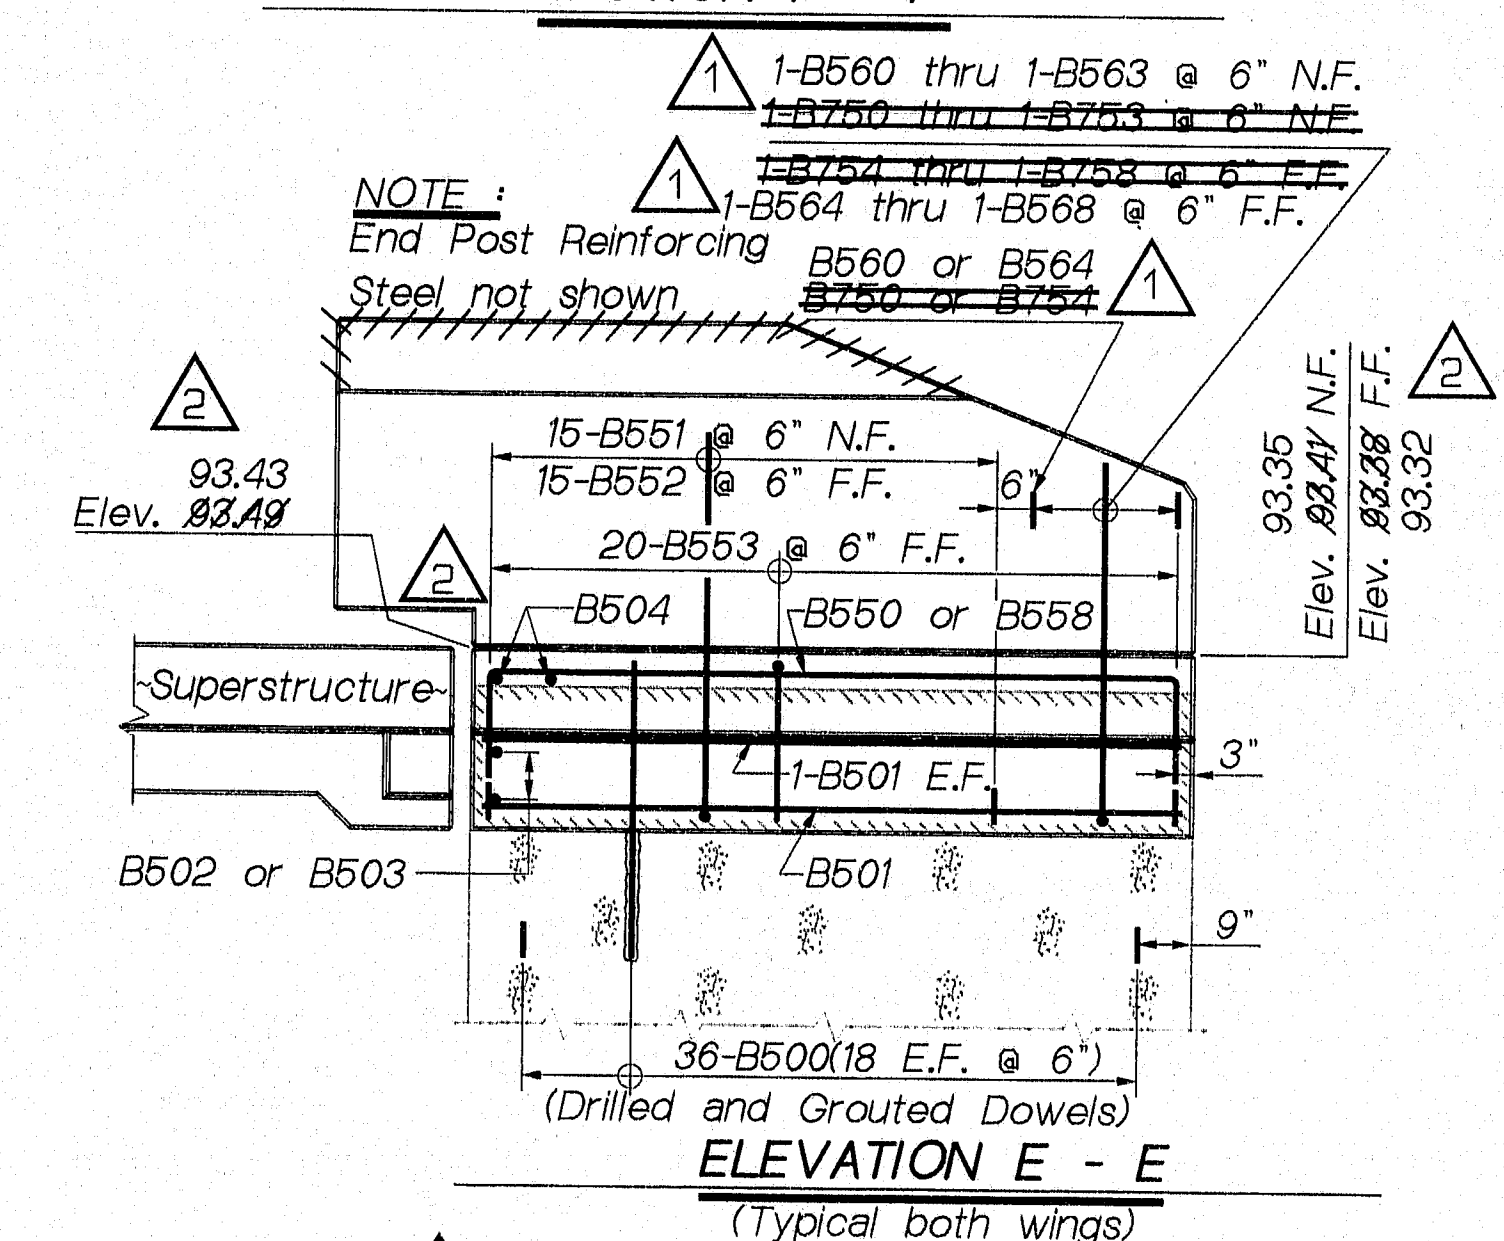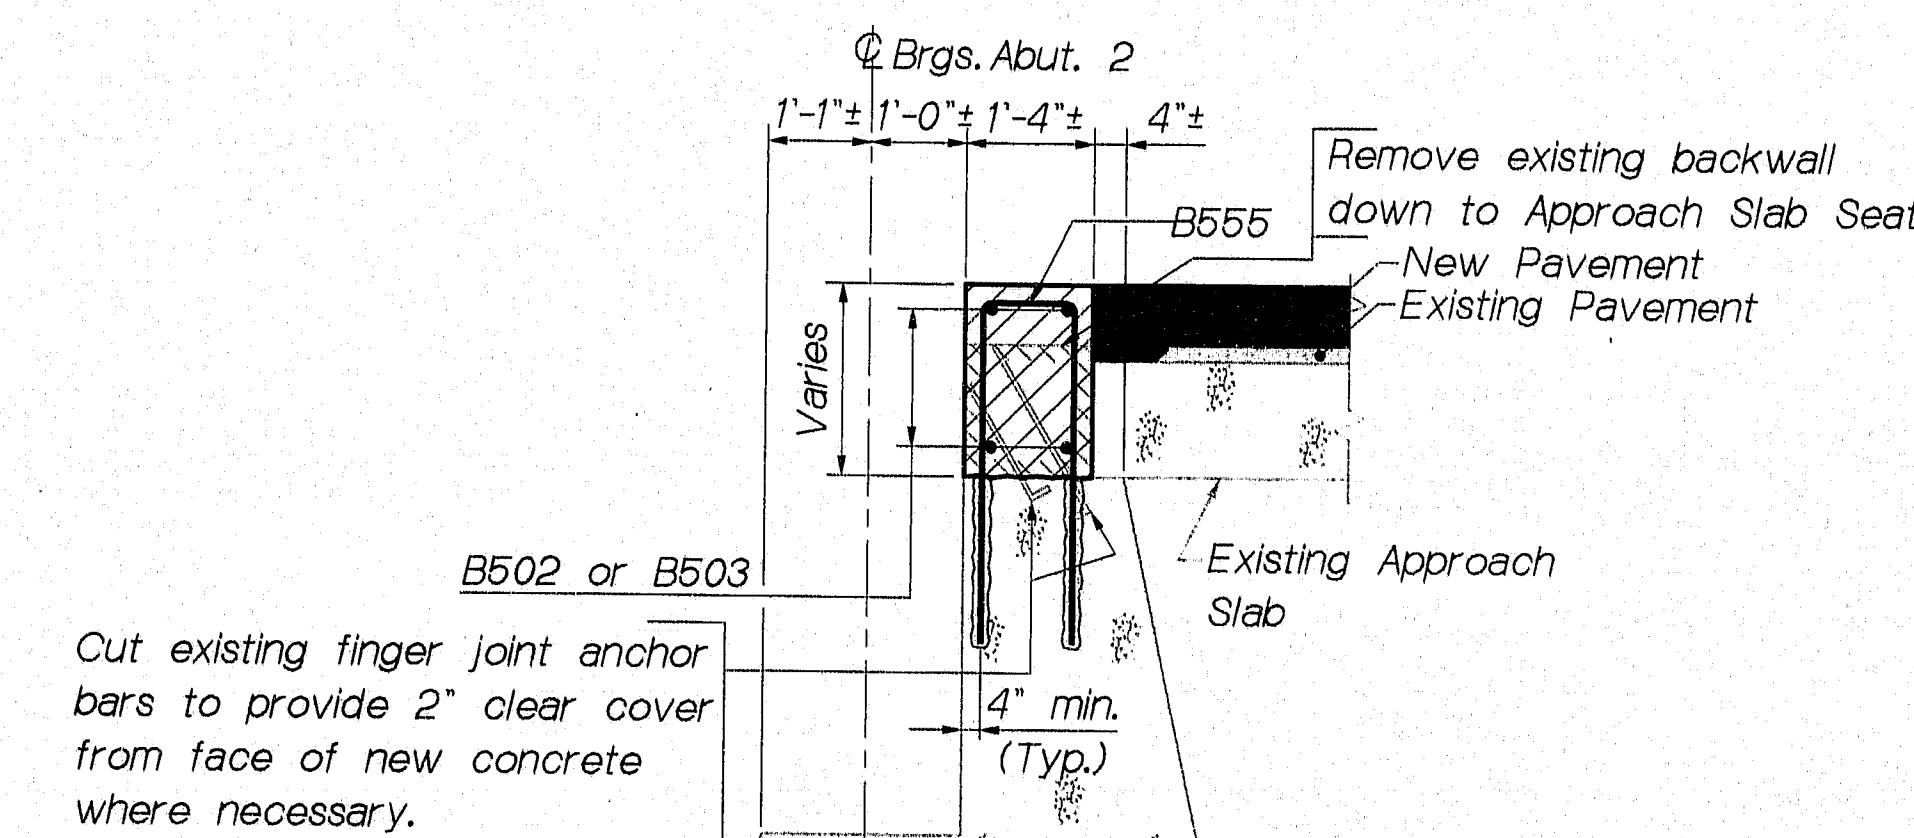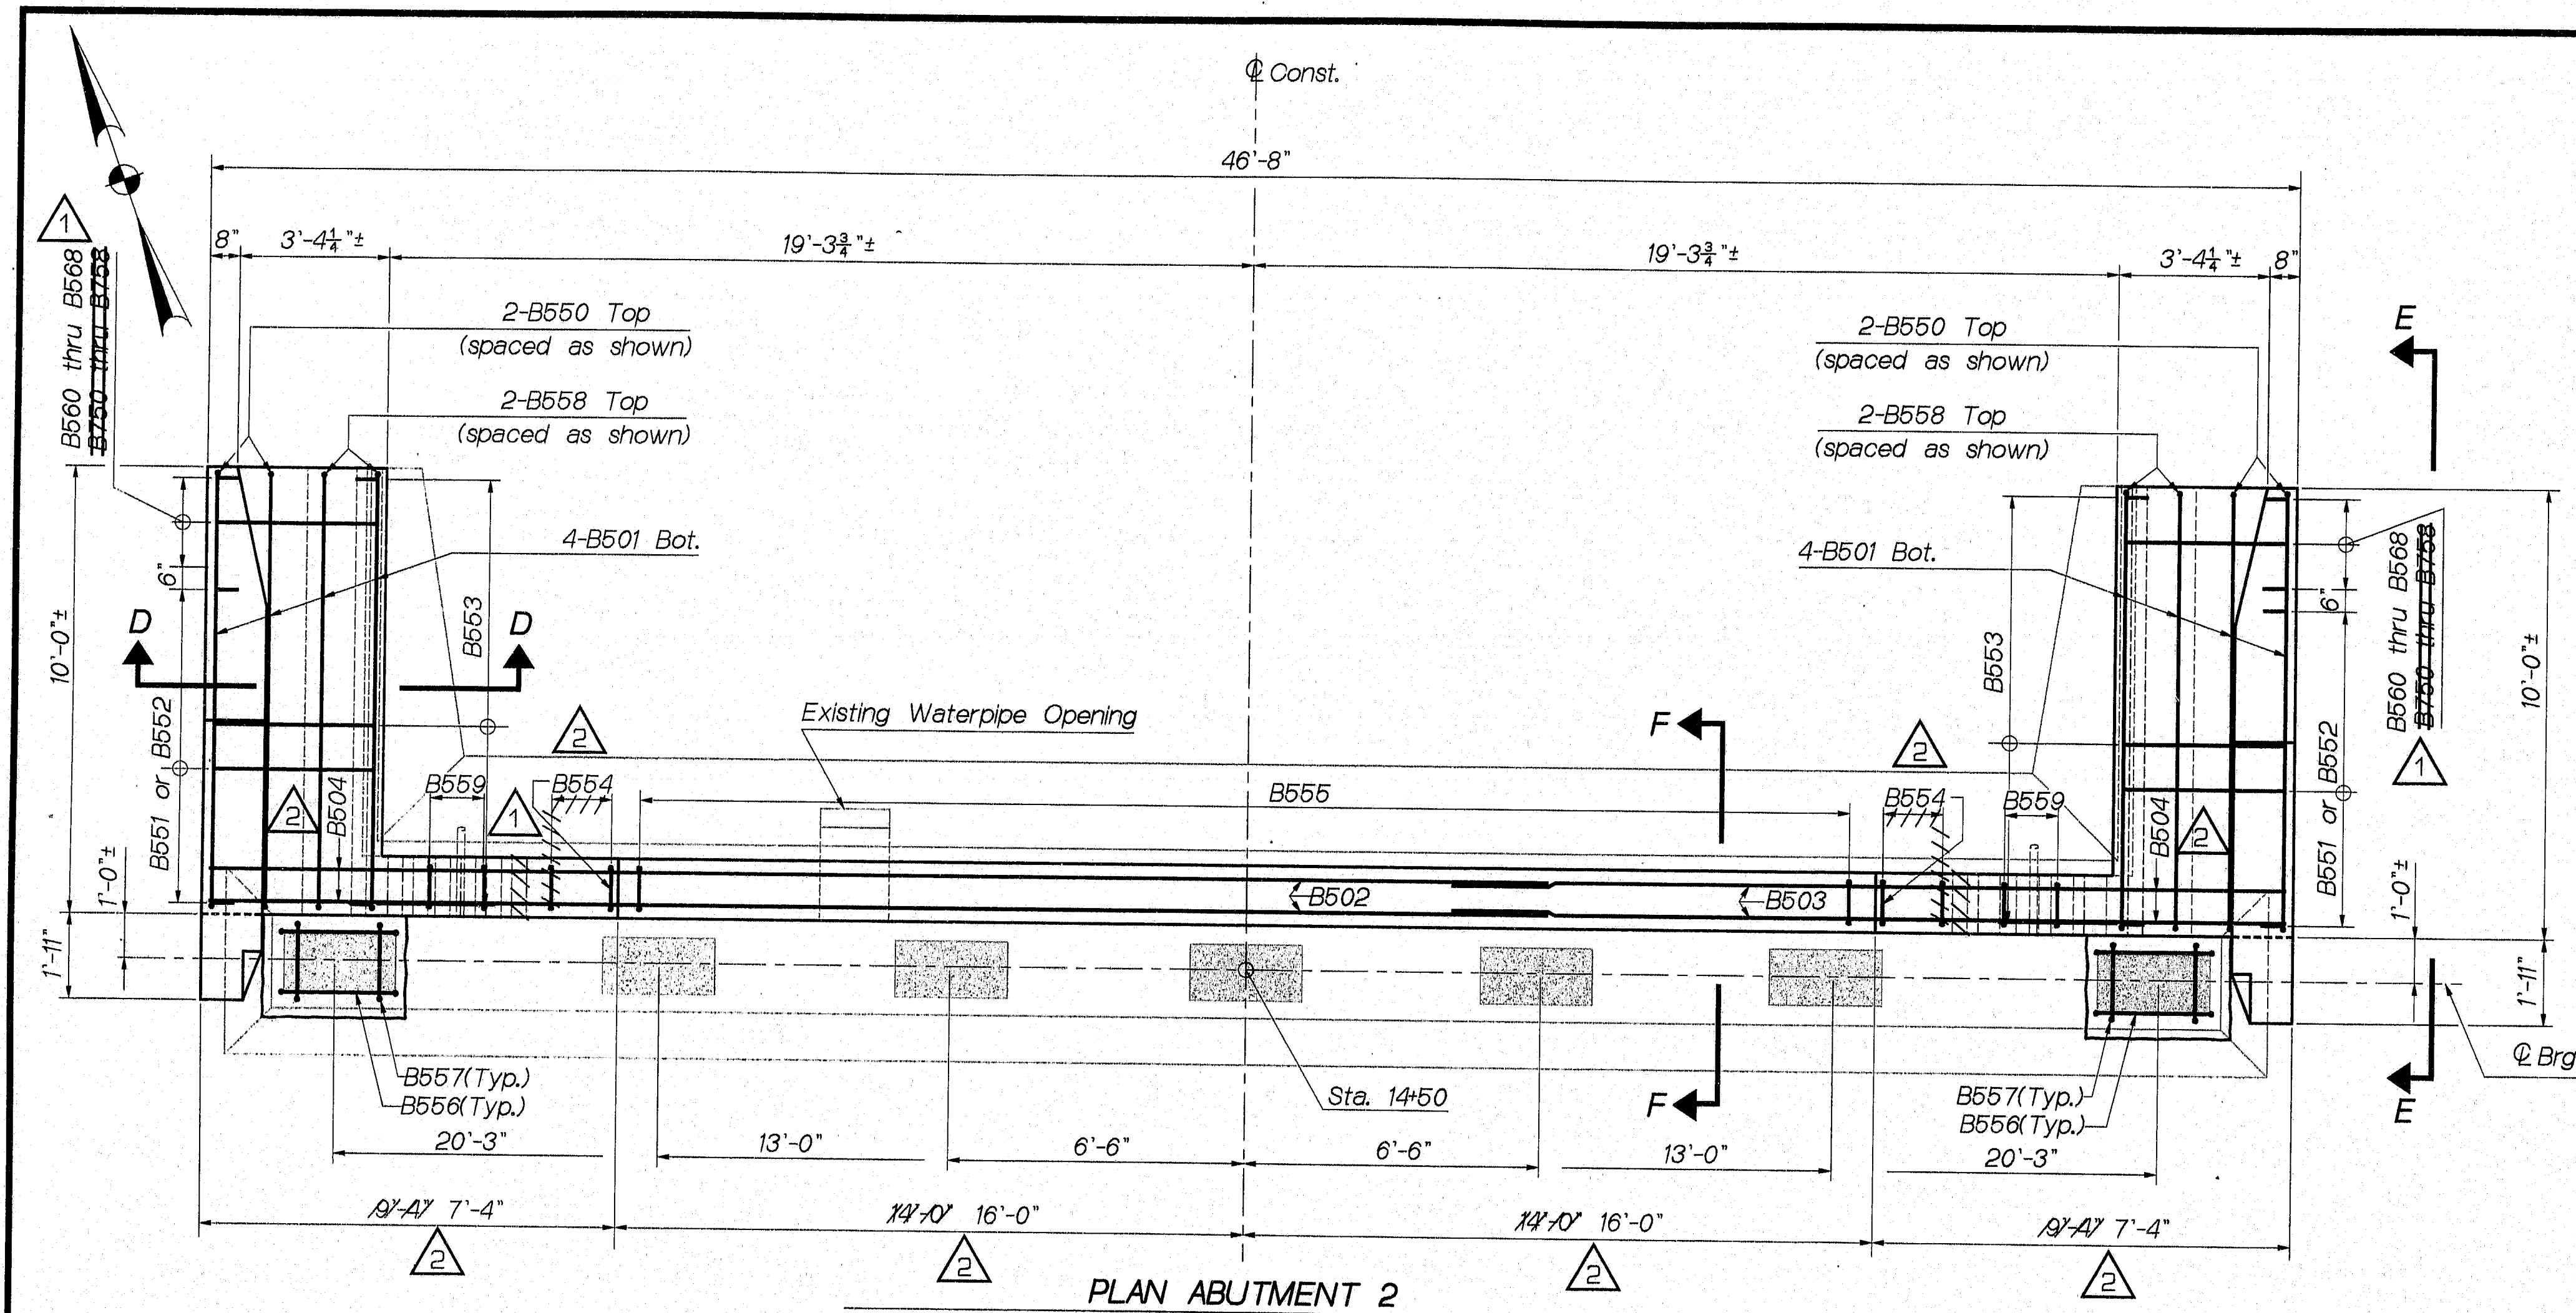

- LEGEND**
- New concrete
 - Existing concrete to remain
 - Existing concrete to be removed
 - Revision as of 5/9/92
 - Revision as of 6/17/92

STATE OF MAINE
DEPARTMENT OF TRANSPORTATION


FERRY HILL BRIDGE
OVER
STILLWATER RIVER
IN THE TOWN OF
ORONO
PENOBSCOT COUNTY
ABUTMENT 2

SHEET 10 OF 43 AUGUSTA, MAINE March, 1992

PROJECT DESIGN NUMBER	DATE
109-48	2/2/92
DESIGN-DETAILED	2/2/92
REVISED	2/2/92
FIELD CHANGES	5/9/92

15JUN92-010100


109-48

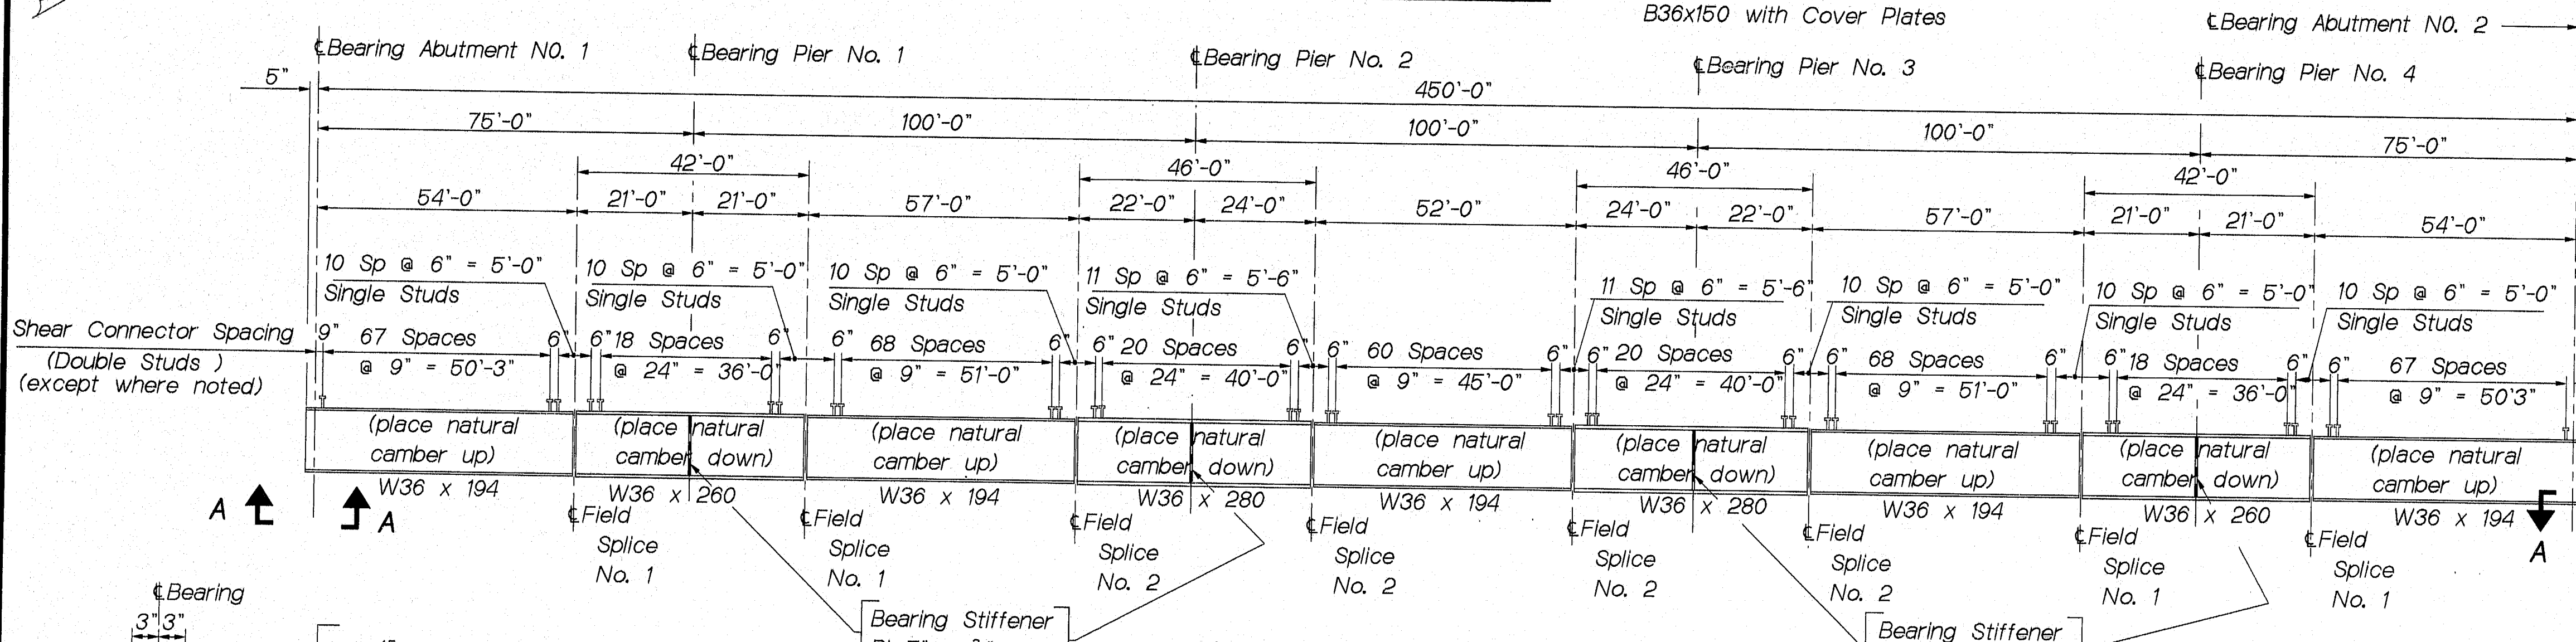

FRAMING PLAN

Technical drawing of a VIF A - A cross-section of a bearing assembly. The drawing shows a central web with four bolt holes. Dimensions include a total width of 3 1/2 inches, a web width of 5 inches, and a web thickness of 3/8 inch. The bearing abutment is shown on the right, with a note "Drill 1/8 inch diameter for 7/8 inch bolts". The bearing is labeled "Bearing" and the abutment is labeled "Bearing Abutment N".

VIEW A - A

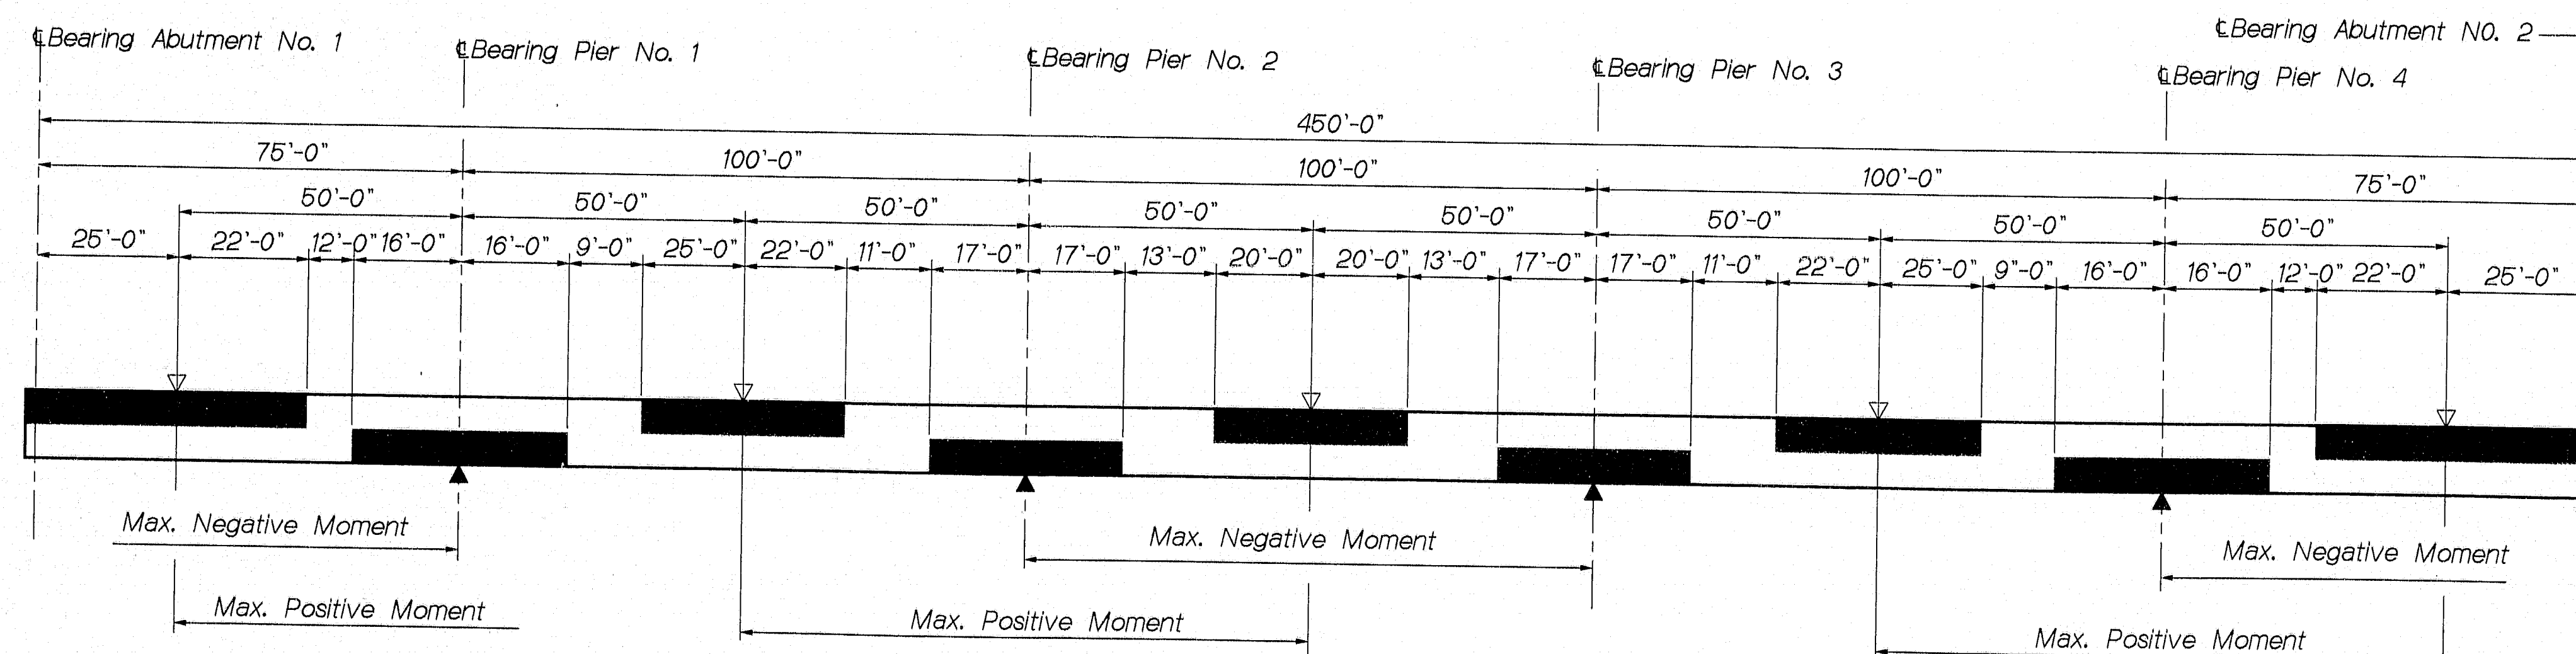

BEAM STRESS DIAGRAM

STRUCTURAL STEEL NOTES


- 1-----Bearing stiffeners shall be plumb after erection and dead loading of the structure. Intermediate web stiffeners may be either plumb or normal to the top flange.
- 2-----Filler plates may be steel conforming to the requirements of ASTM A36 and mill tests will not be required for filler plates.
- 3-----It is anticipated that the bearings at Abutment 1 and Abutment 2 will move $\frac{1}{4}$ " away from the fixed bearings due to the placement of the superstructure concrete. No separate payment will be made for resetting the bearings to the final position if an adjustment is required.
- 4-----Splice connections shall be made with $\frac{3}{4}$ " $\varnothing$ ASTM A325 High Tensile Strength Bolts with $\frac{3}{4}$ " $\varnothing$ holes.
- 5-----Remove and reset existing bearings, Exterior beams Abutment No. 1 and Abutment No. 2.
- 6-----At locations marked with an asterisk (*A1) the designated diaphragms shall be changed to a type A1 diaphragm as required to accommodate the Contractor's deck placement sequence. No extra compensation will be allowed for any diaphragms so substituted, and any additional cost will be considered incidental to the contract items.
- 7-----New structural steel shall receive one shop coat of paint in accordance with Section 504 and Special Provision 506. Payment will not be made directly but will be considered incidental to Item 504.70, Structural Steel, Fabricated and Delivered.

BASIC DESIGN STRESSES


STRUCTURAL STEEL: ASTM A36 _____ $F_y = 36,000$ psi.
ASTM A325 _____ $F_v = 25,000$ psi.

MATERIALS

STRUCTURAL STEEL: All Material _____ ASTM A36
High Strength Bolts ASTM A325 - (Type 1)

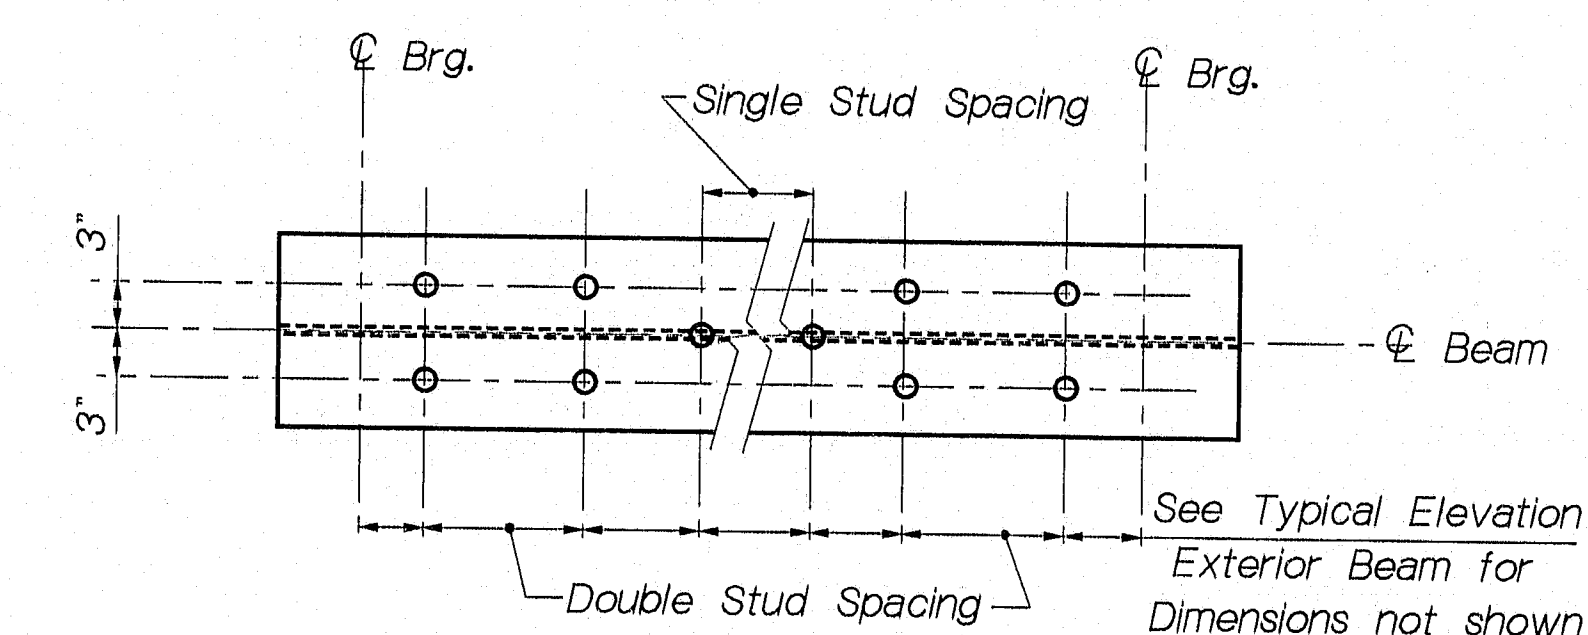

STUD LAYOUT

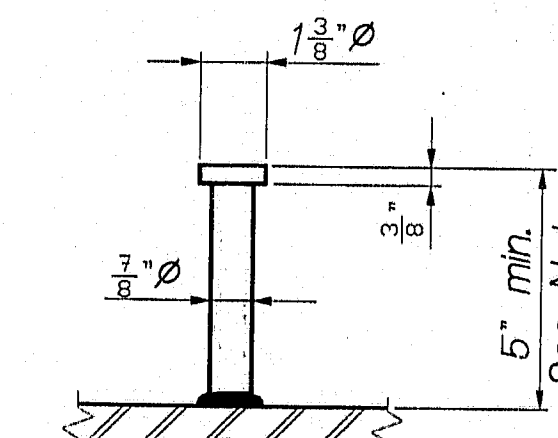

STUD DETAIL

NOTE:
Studs shall project at least
two inches above the bottom
of the slab.

NOTE: Shaded areas always in compression all other areas are in tension or have stress reversals


STATE OF MAINE
DEPARTMENT OF TRANSPORTATION

FERRY HILL BRIDGE
OVER
STILLWATER RIVER
IN THE TOWN OF
ORONO
PENOBSCOT COUNTY
STRUCTURAL STEEL


SHEET 11 OF 43 AUGUSTA, MAINE March, 1992

PIN. NO. 004867.00









F.I.R.V.A. REV. NO.	STATE	PROJECT NUMBER	SHEET NO.	TOTAL SHEETS
1	MAINE	BH-140(19)	12	43

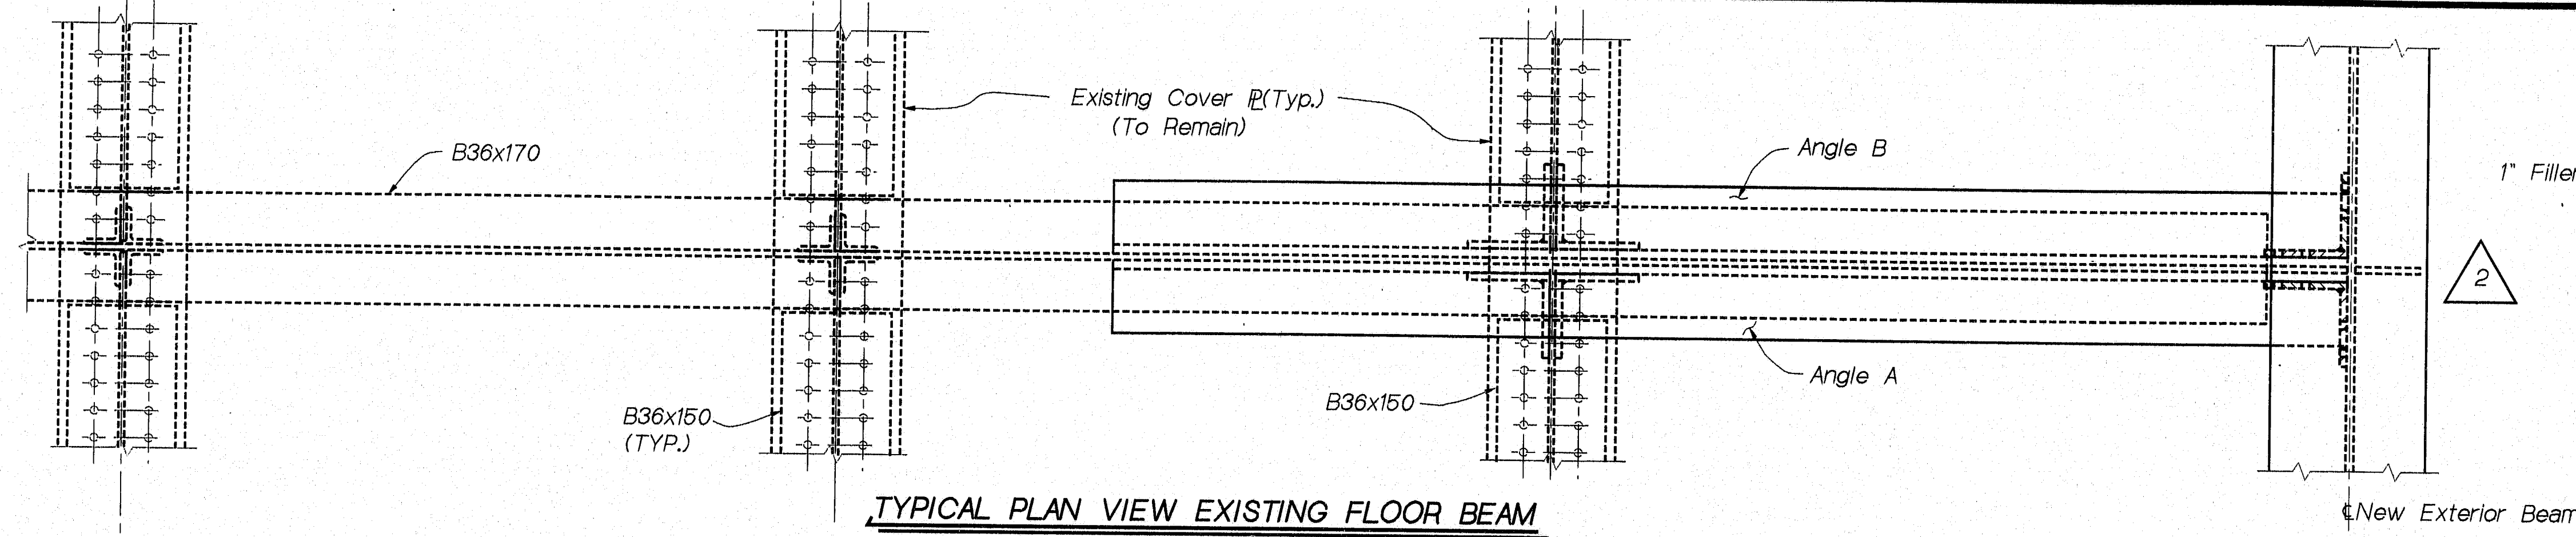

TYPICAL PLAN VIEW EXISTING FLOOR BEAM

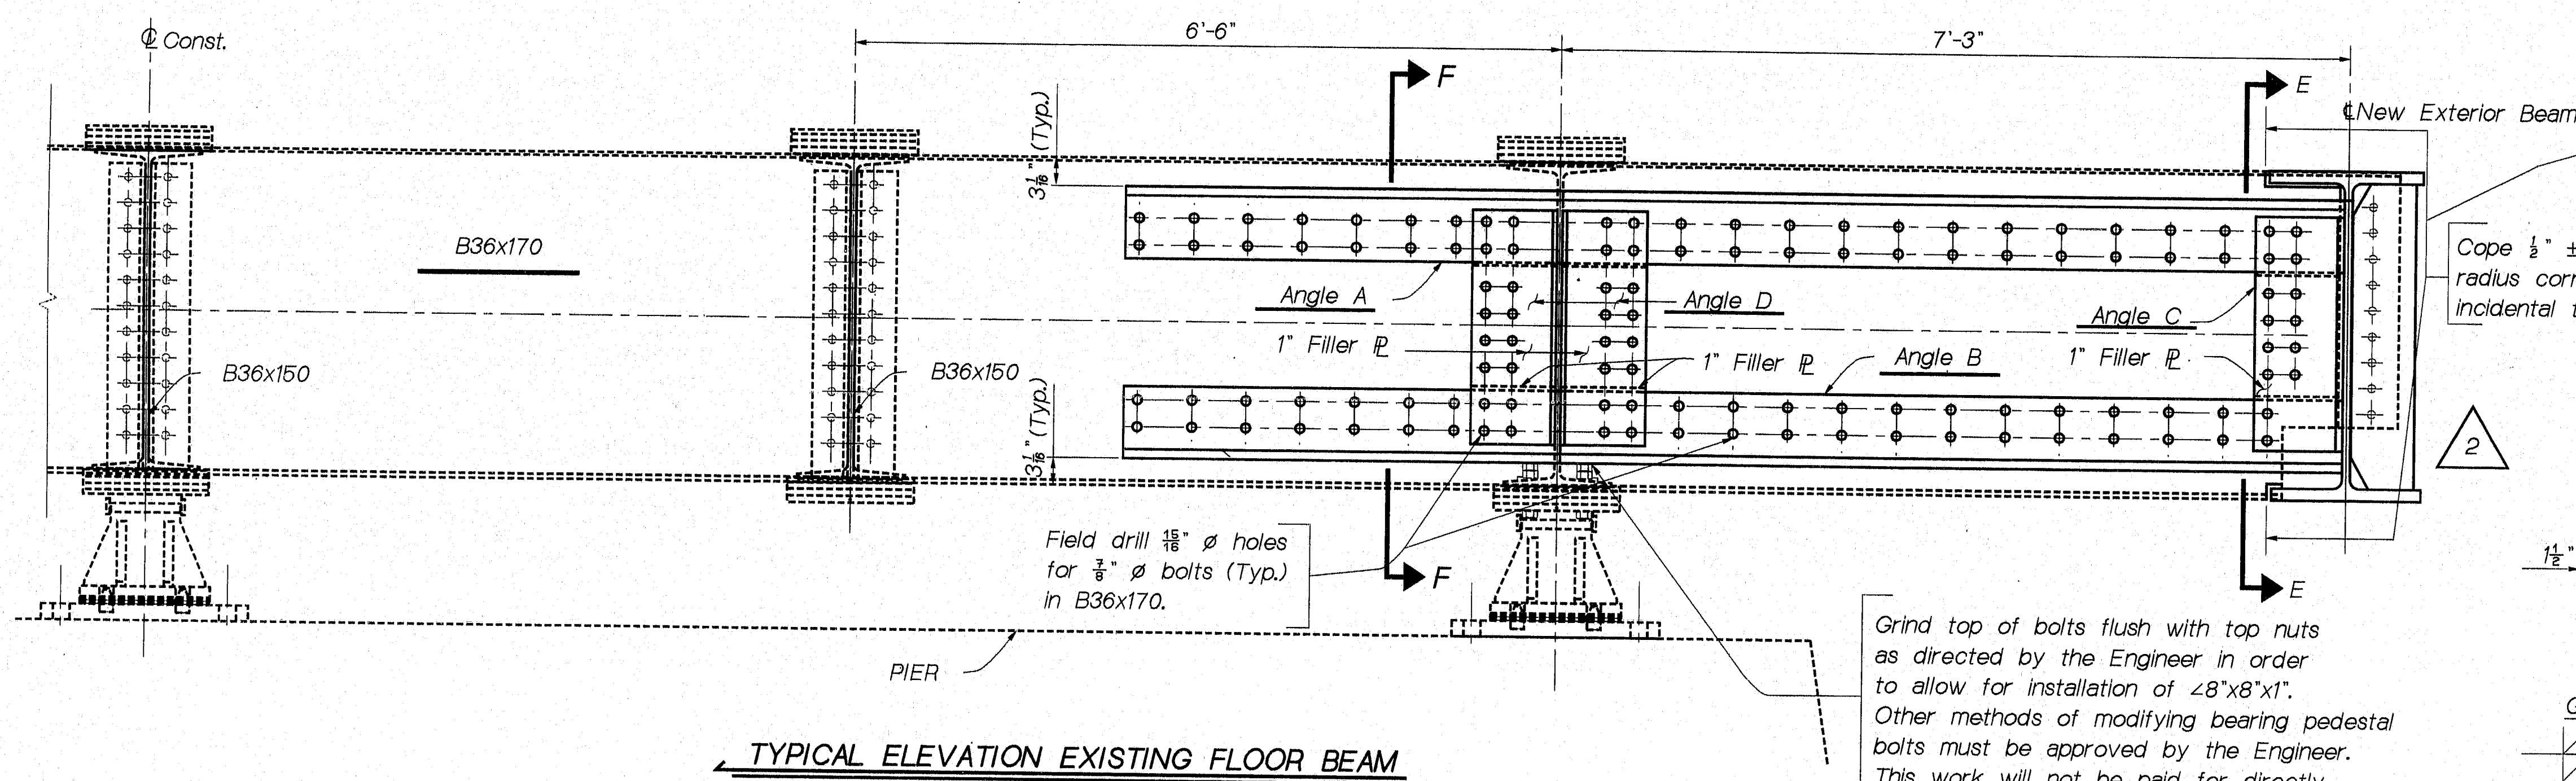

TYPICAL ELEVATION EXISTING FLOOR BEAM

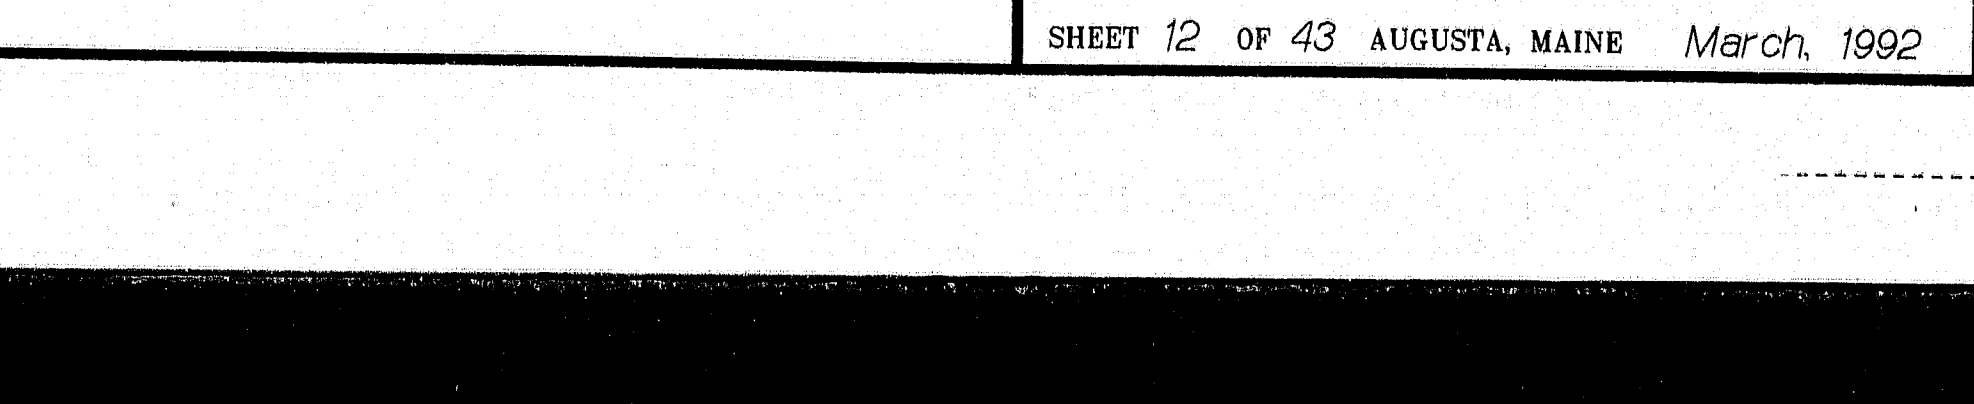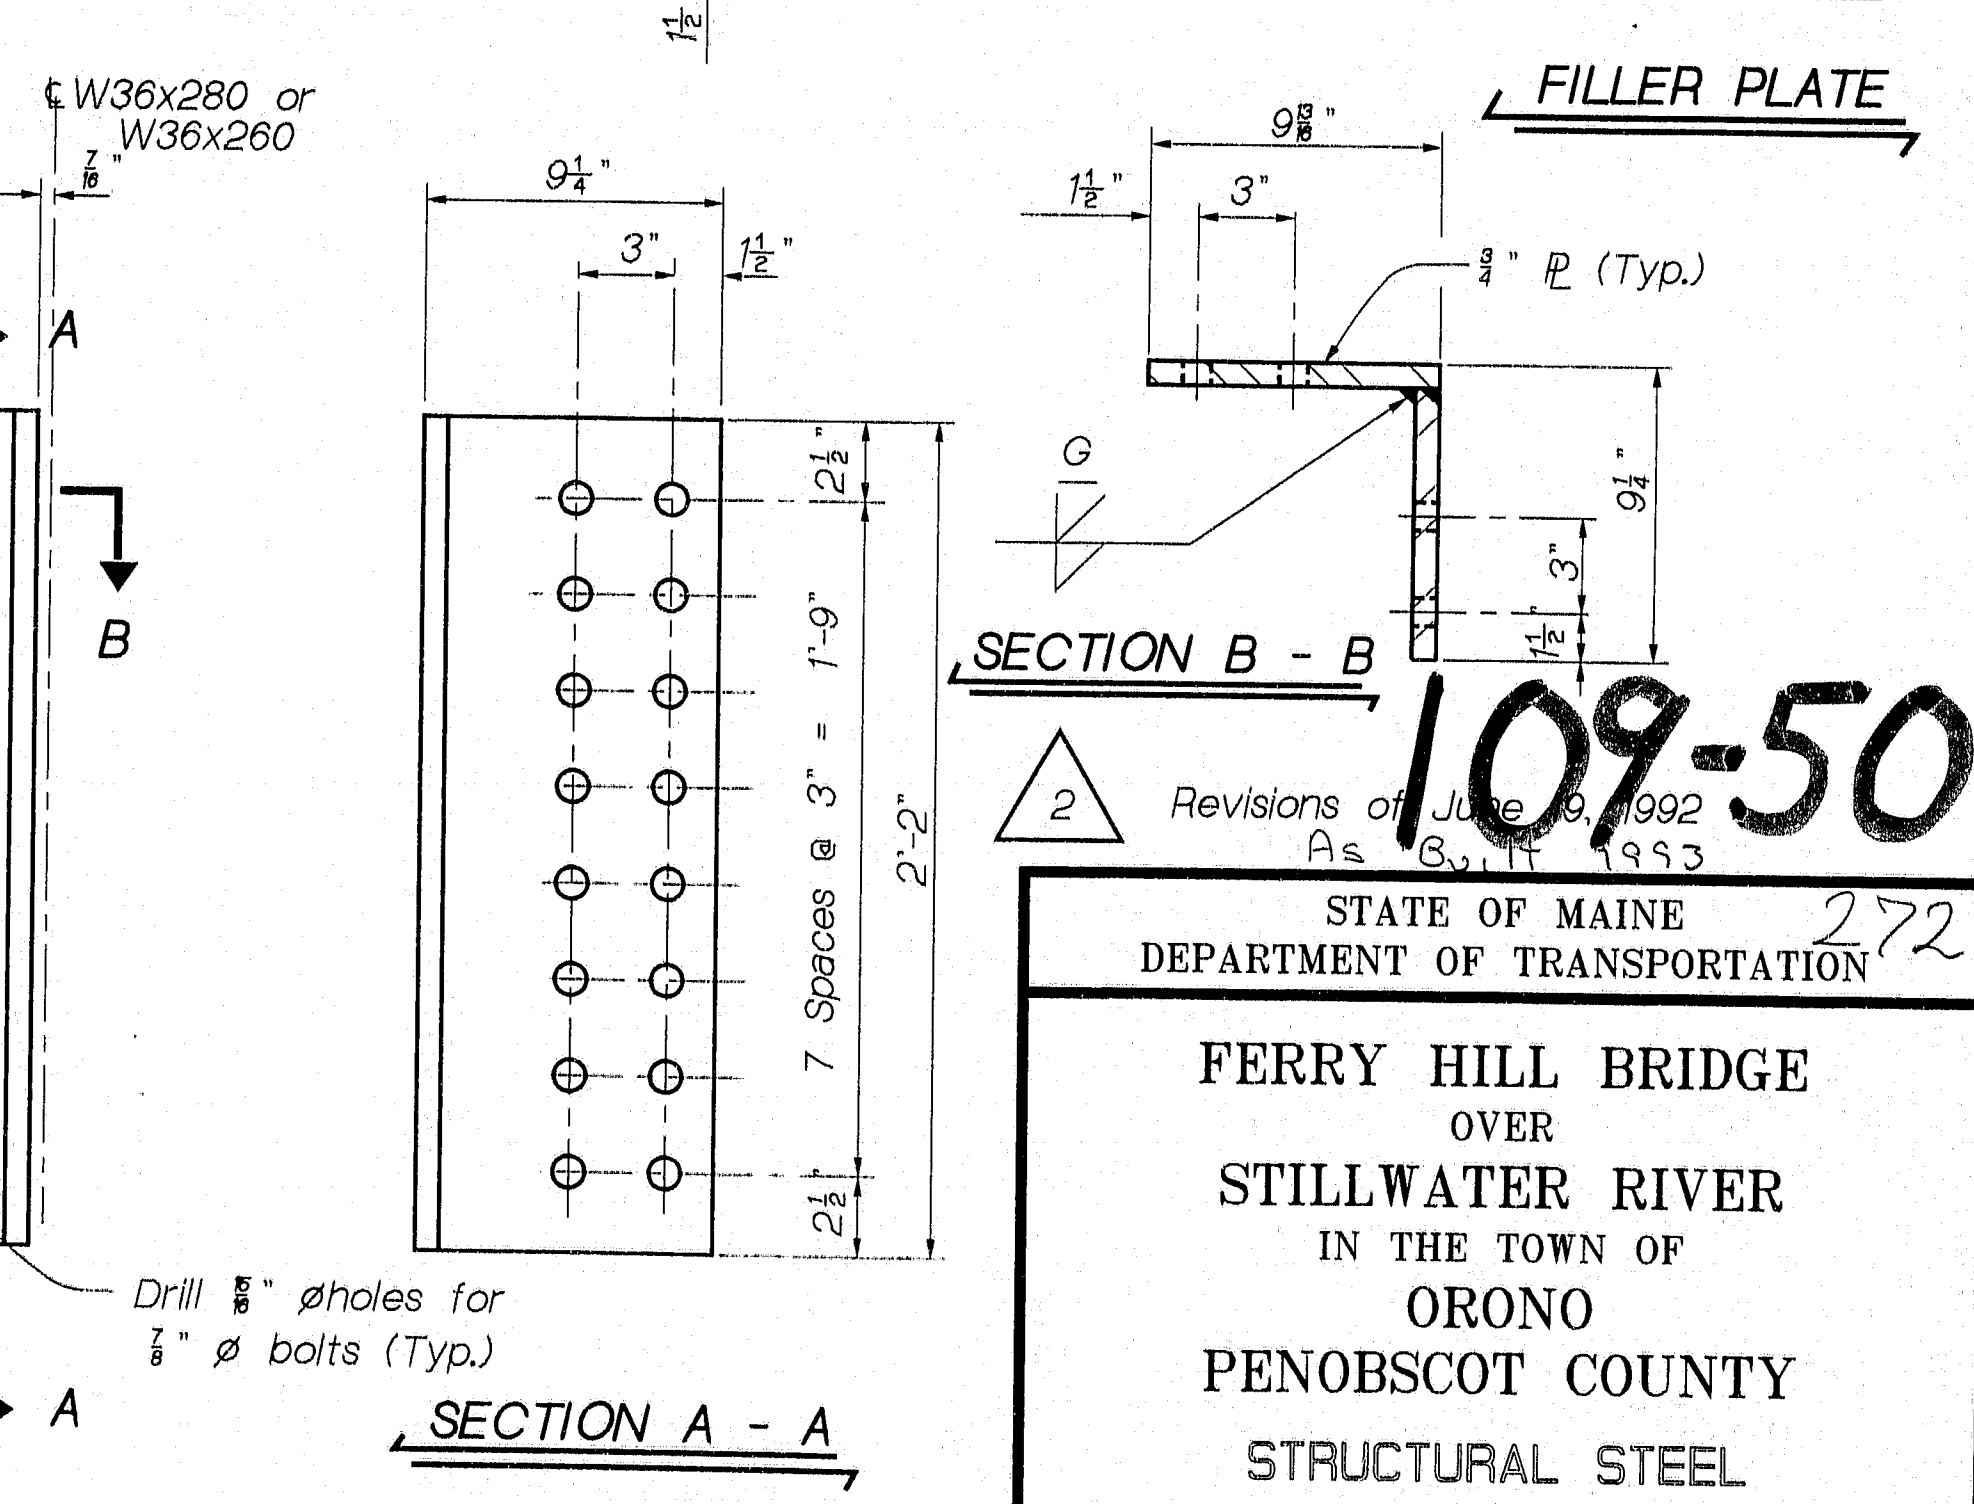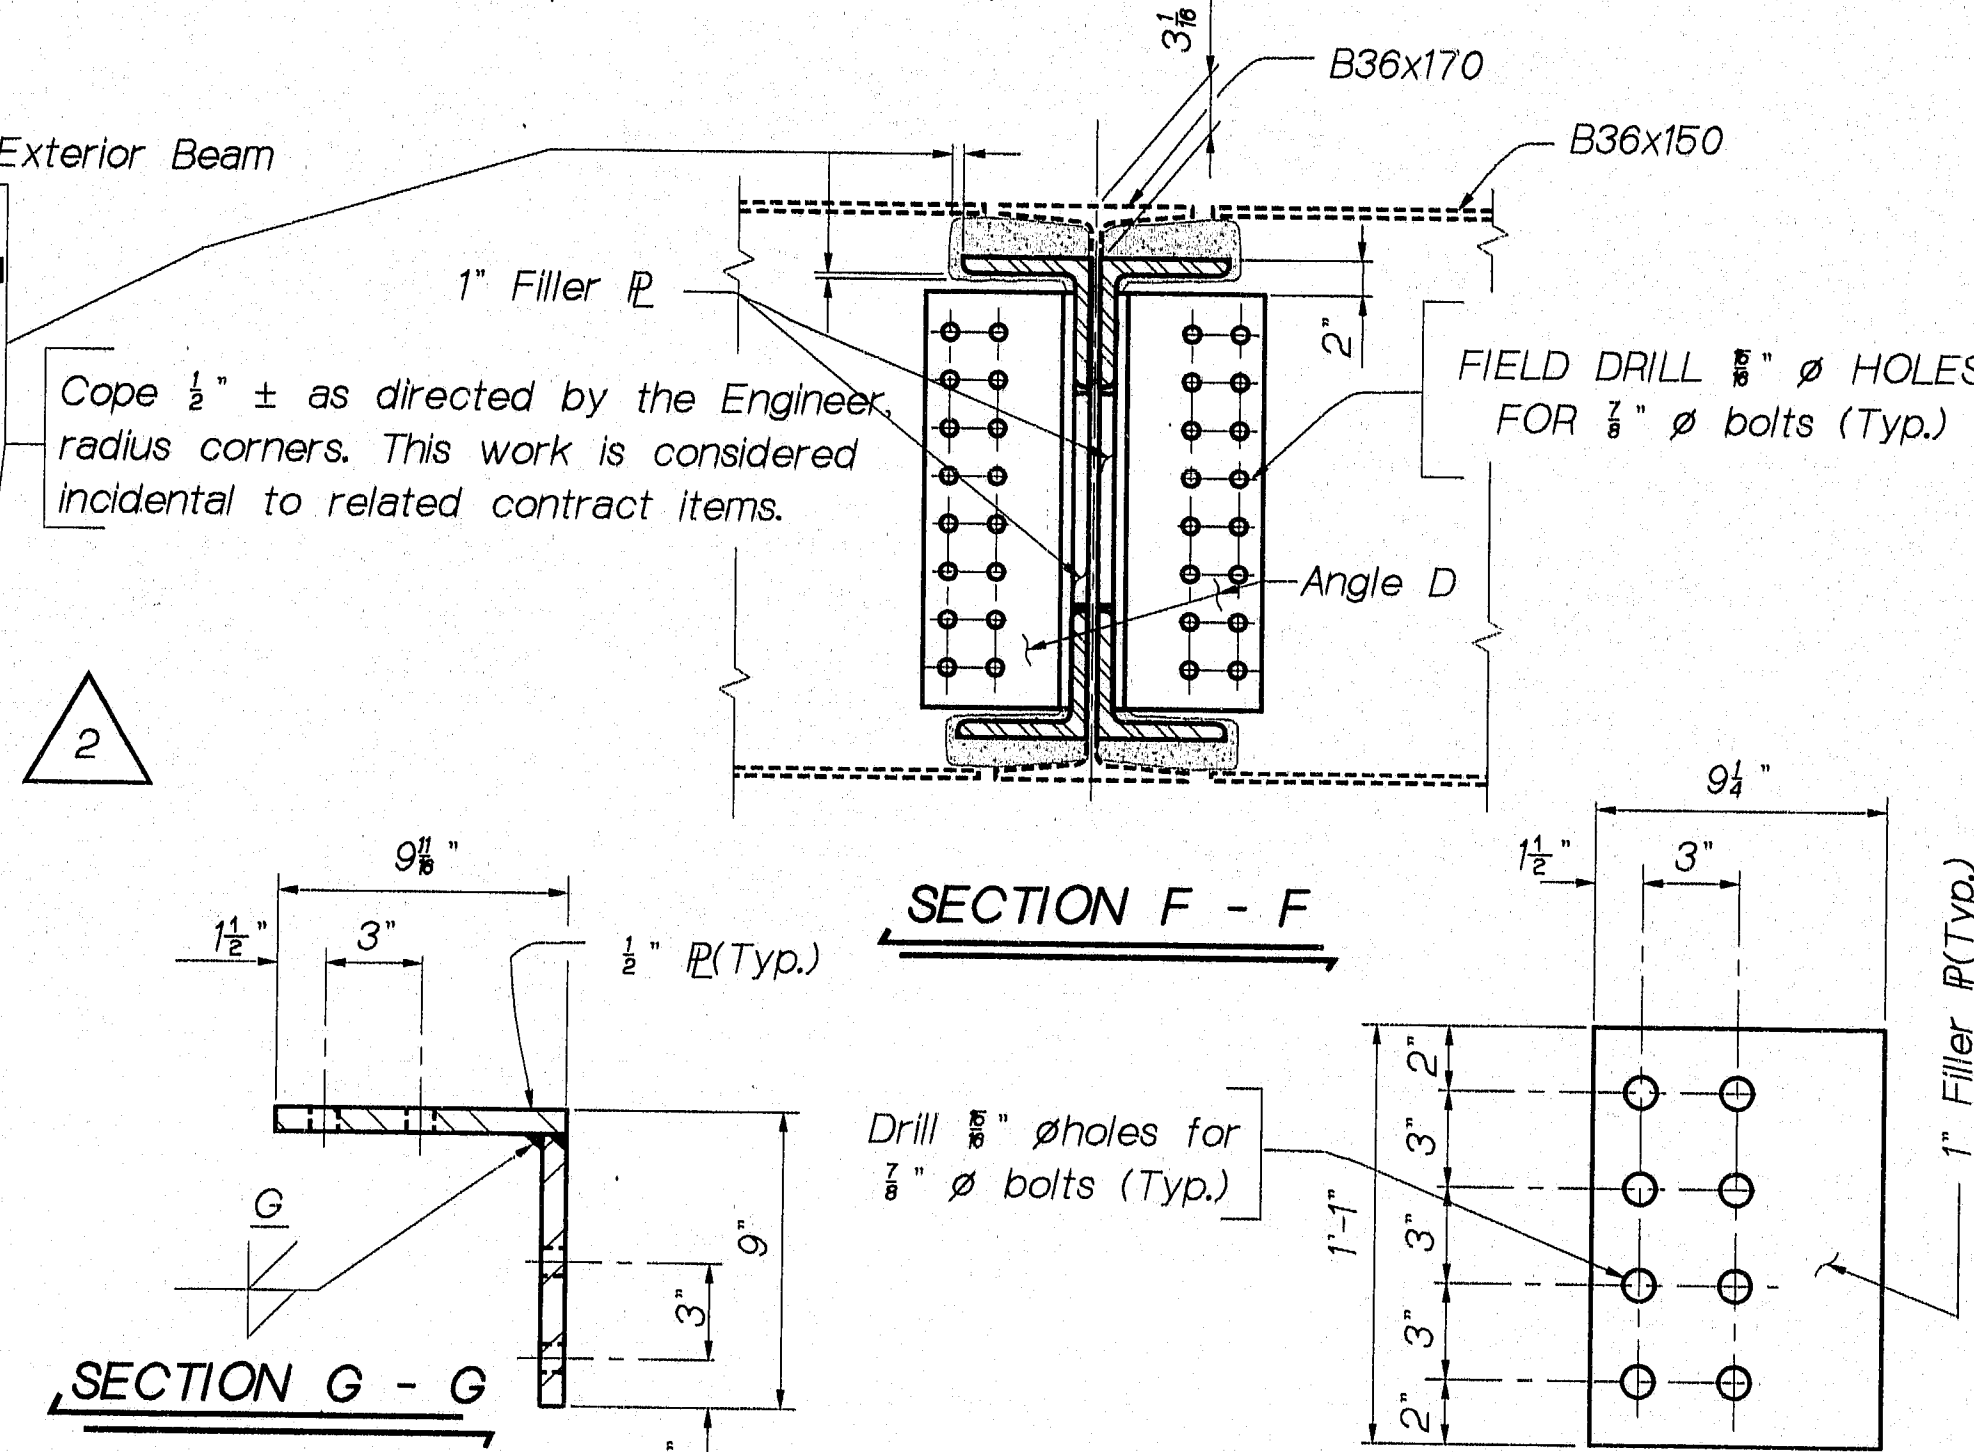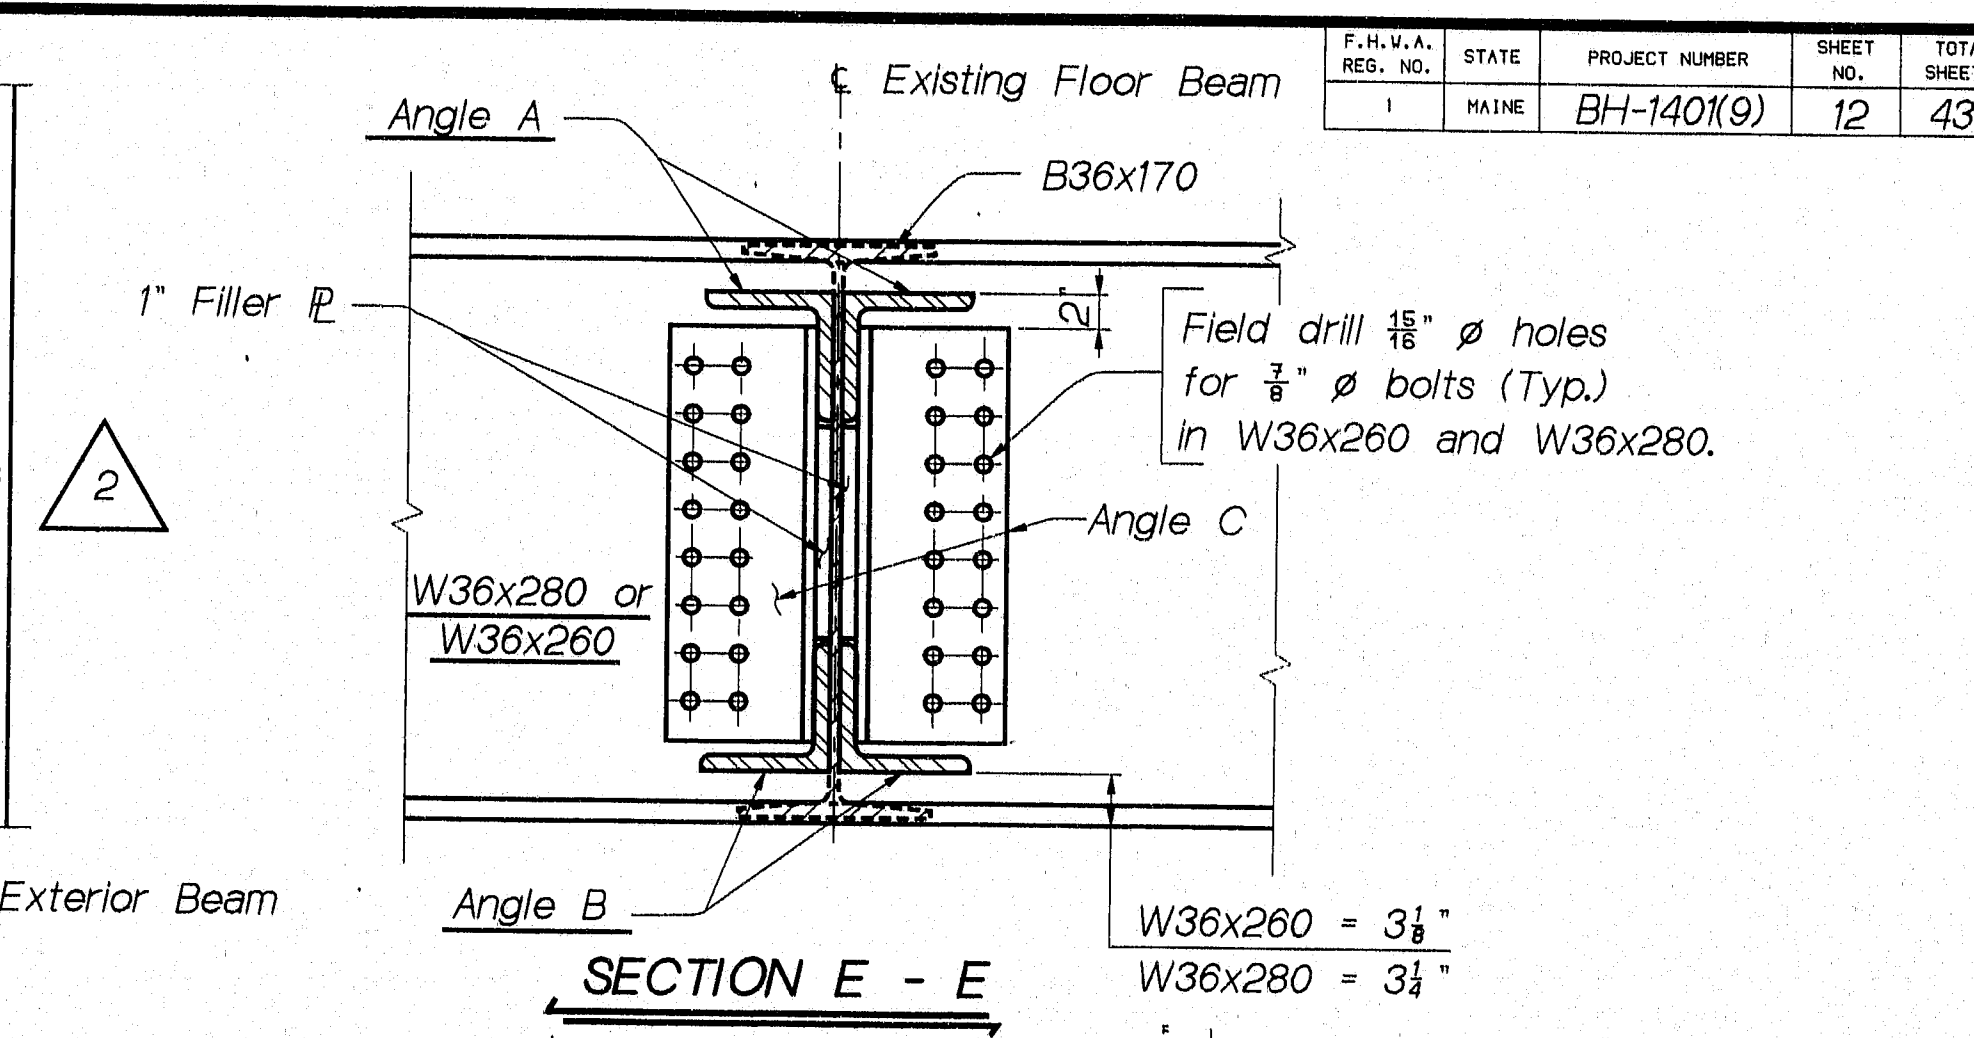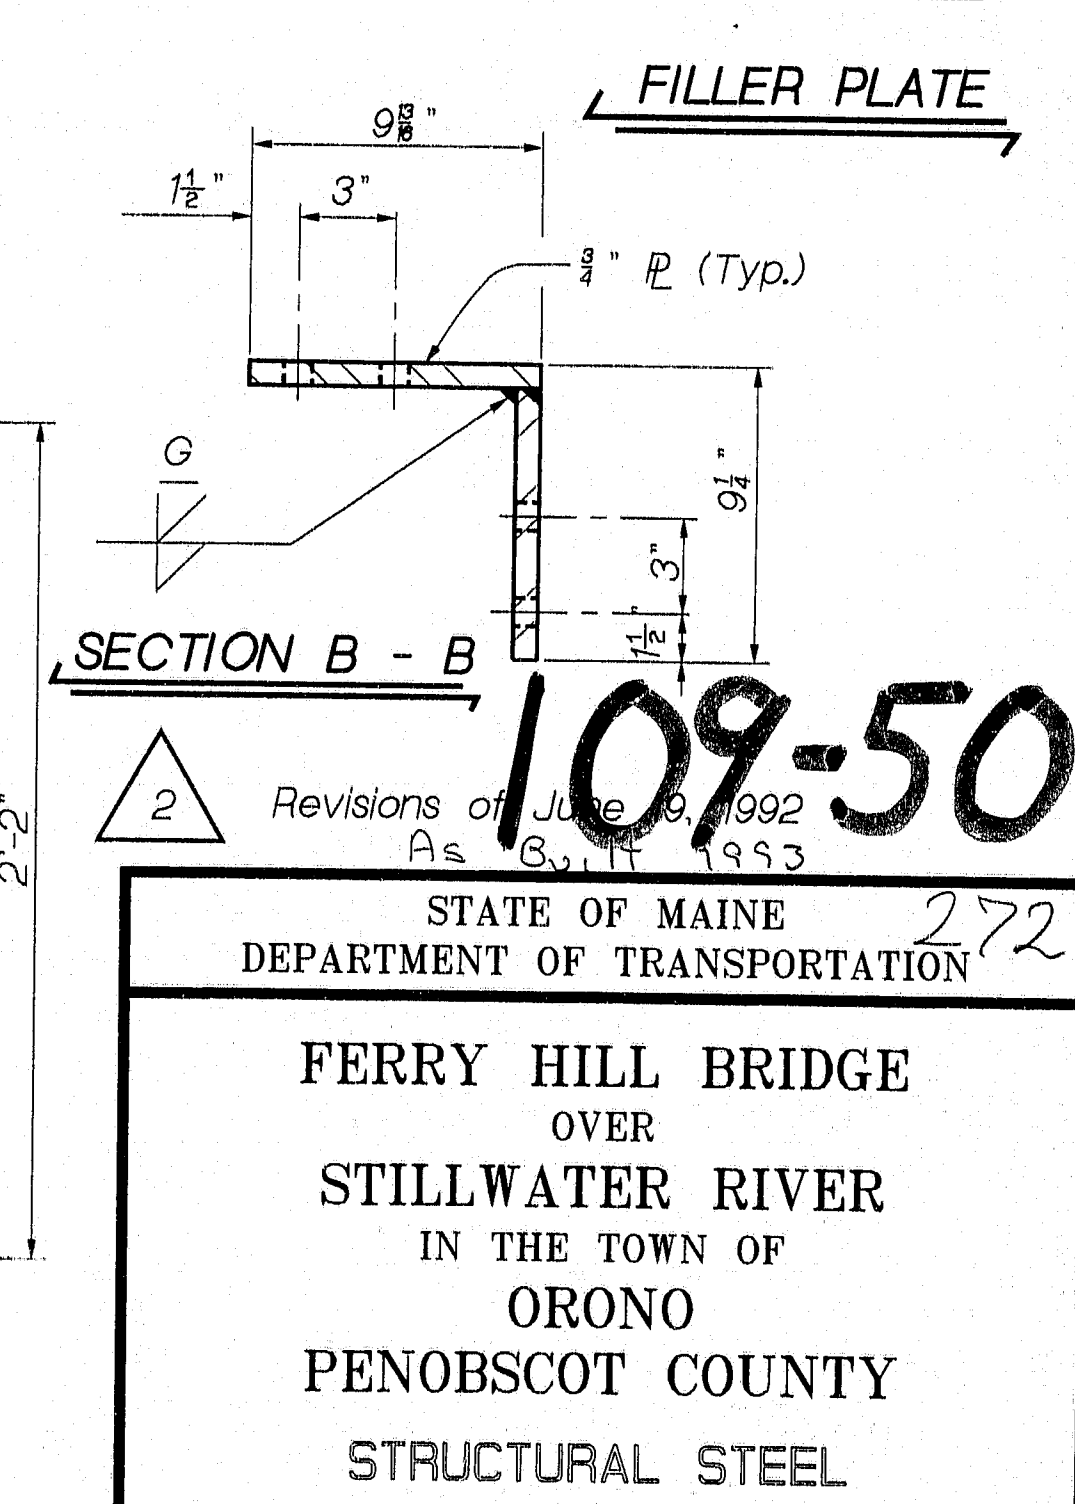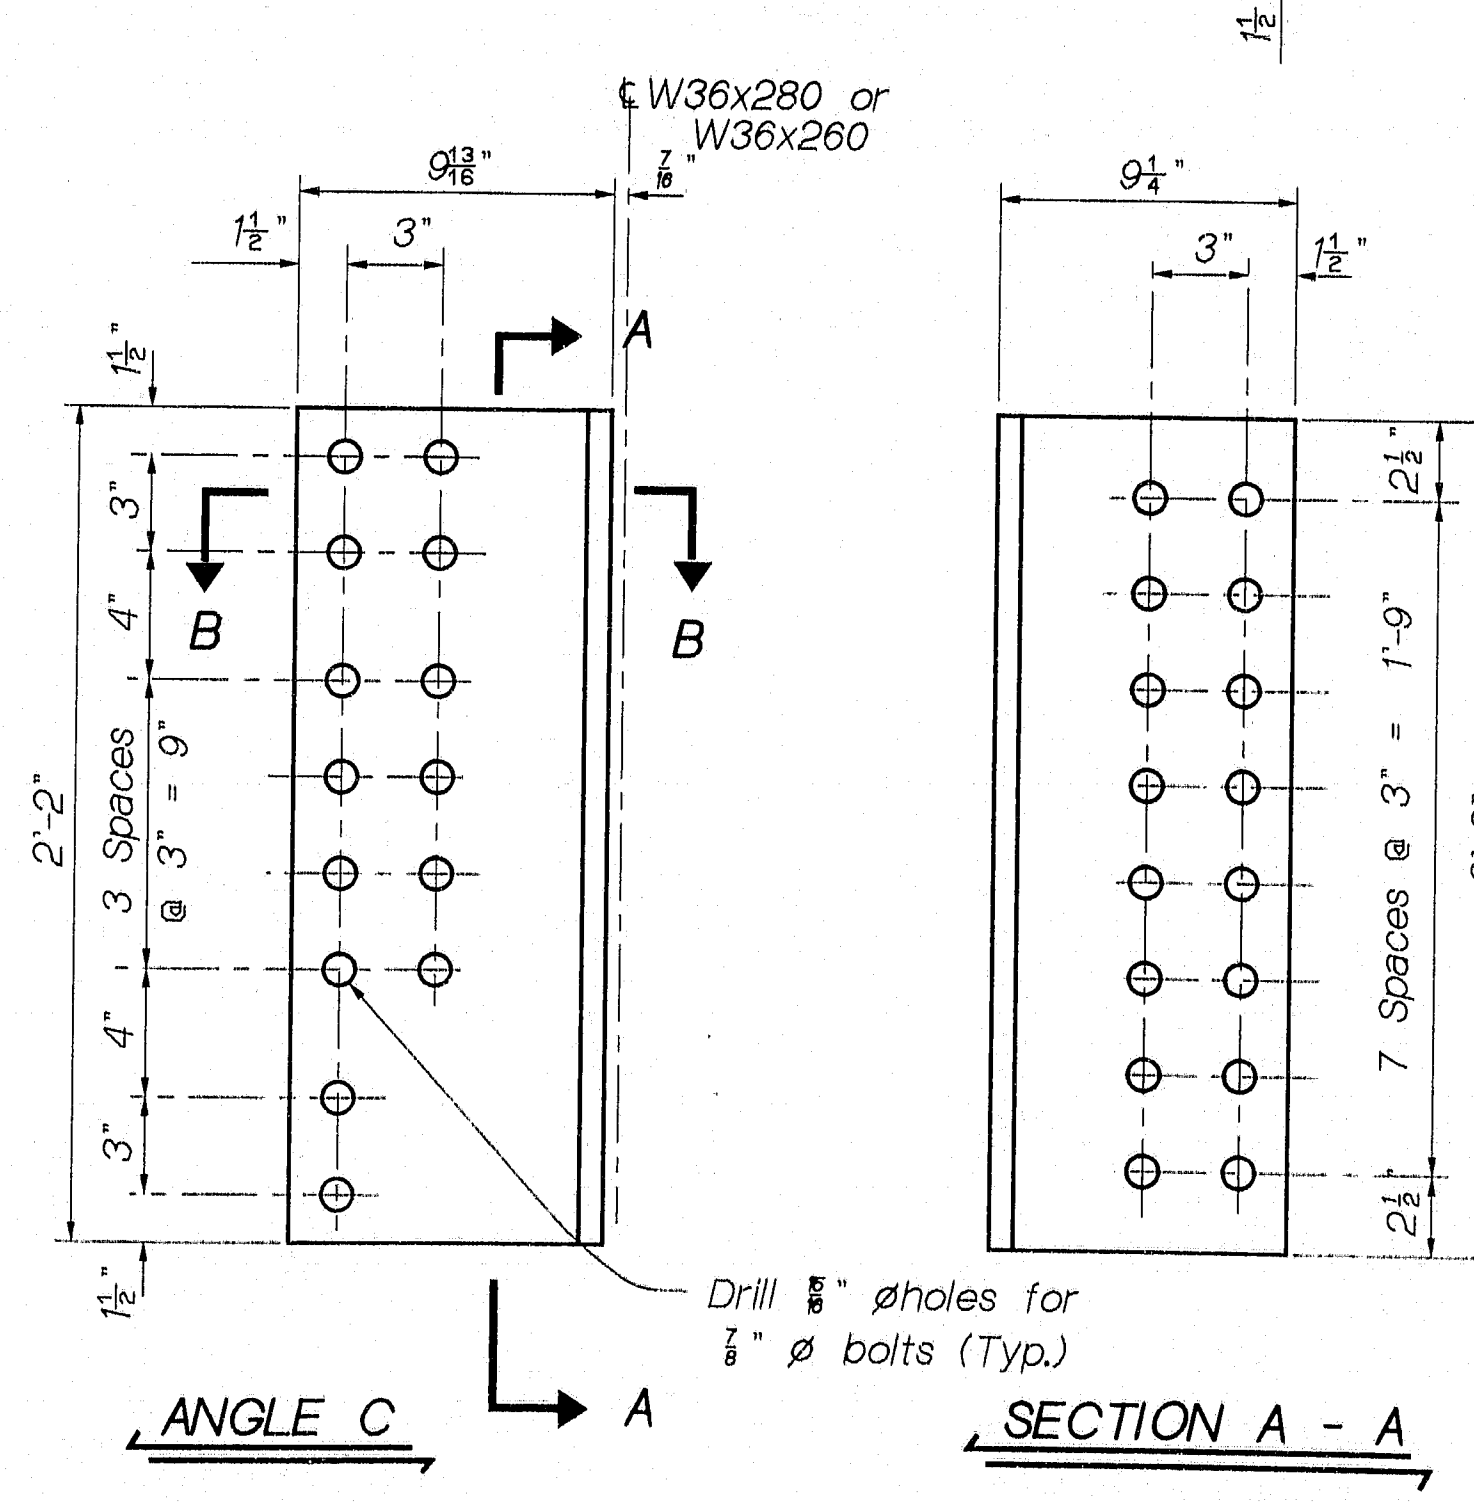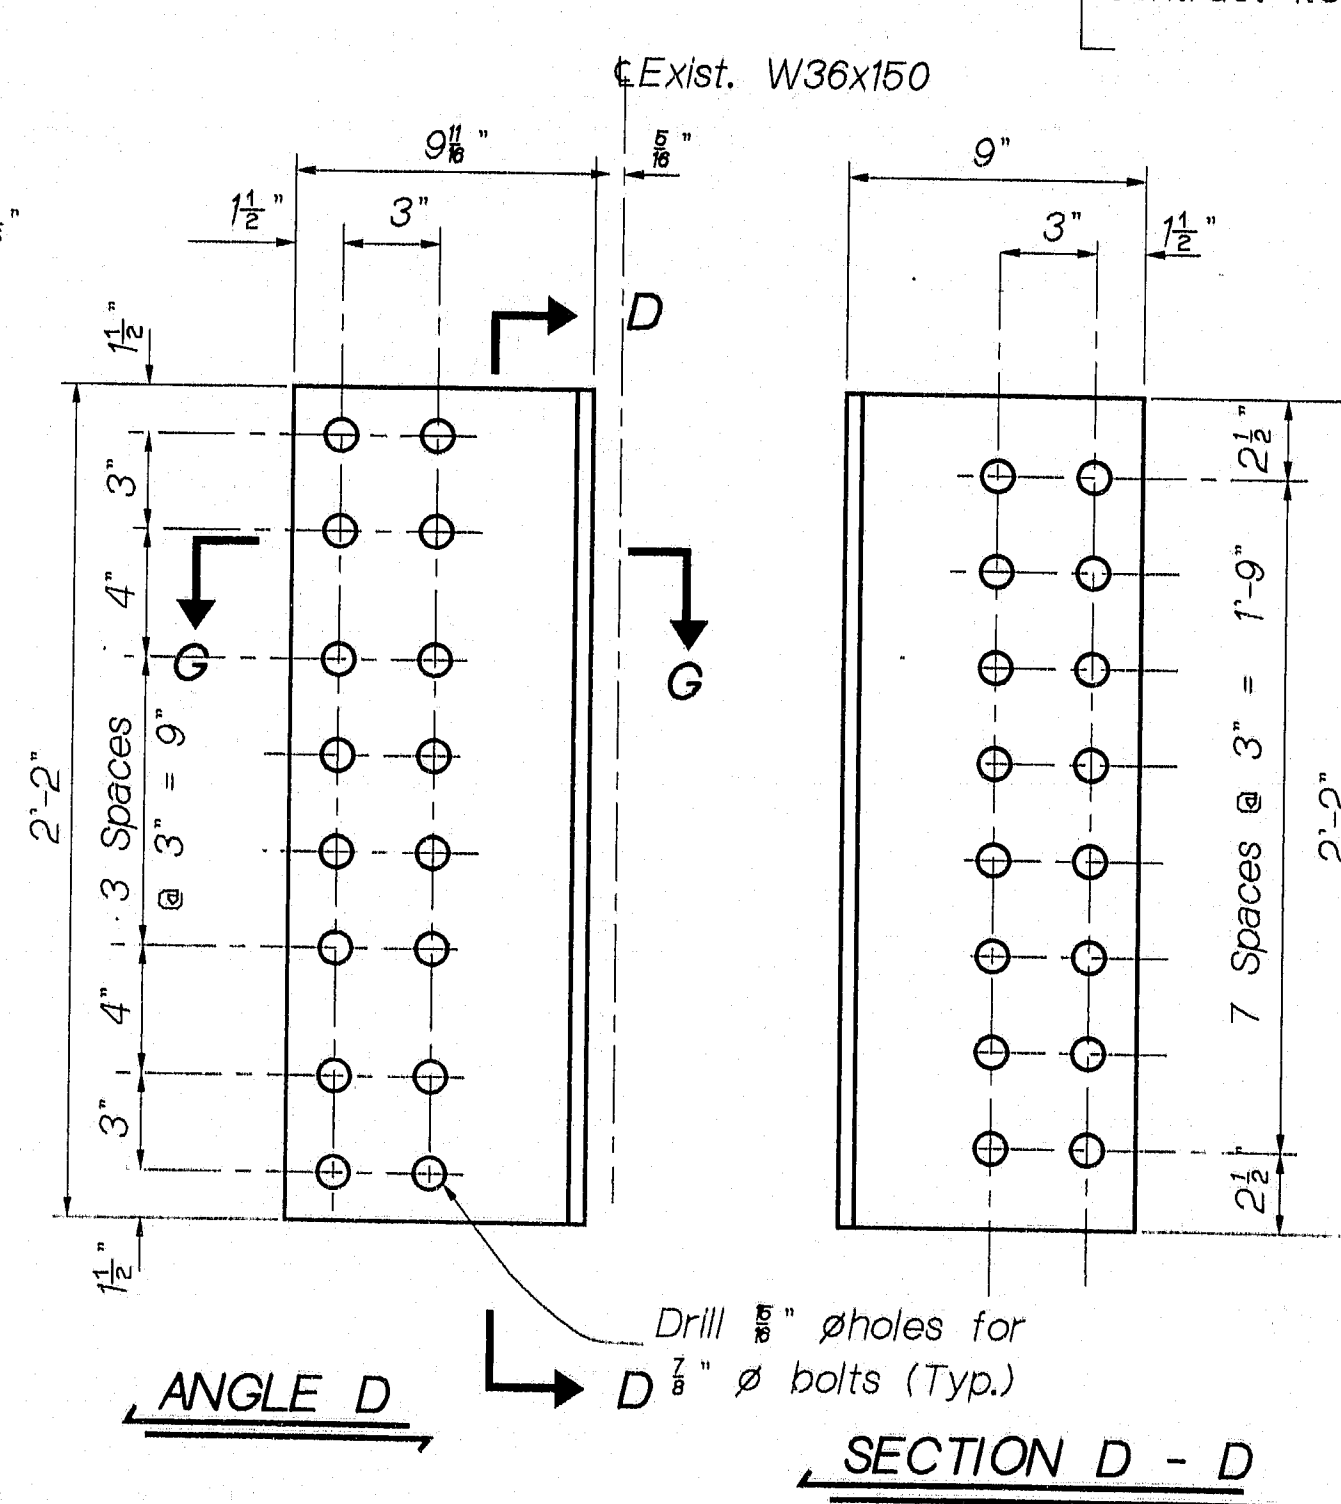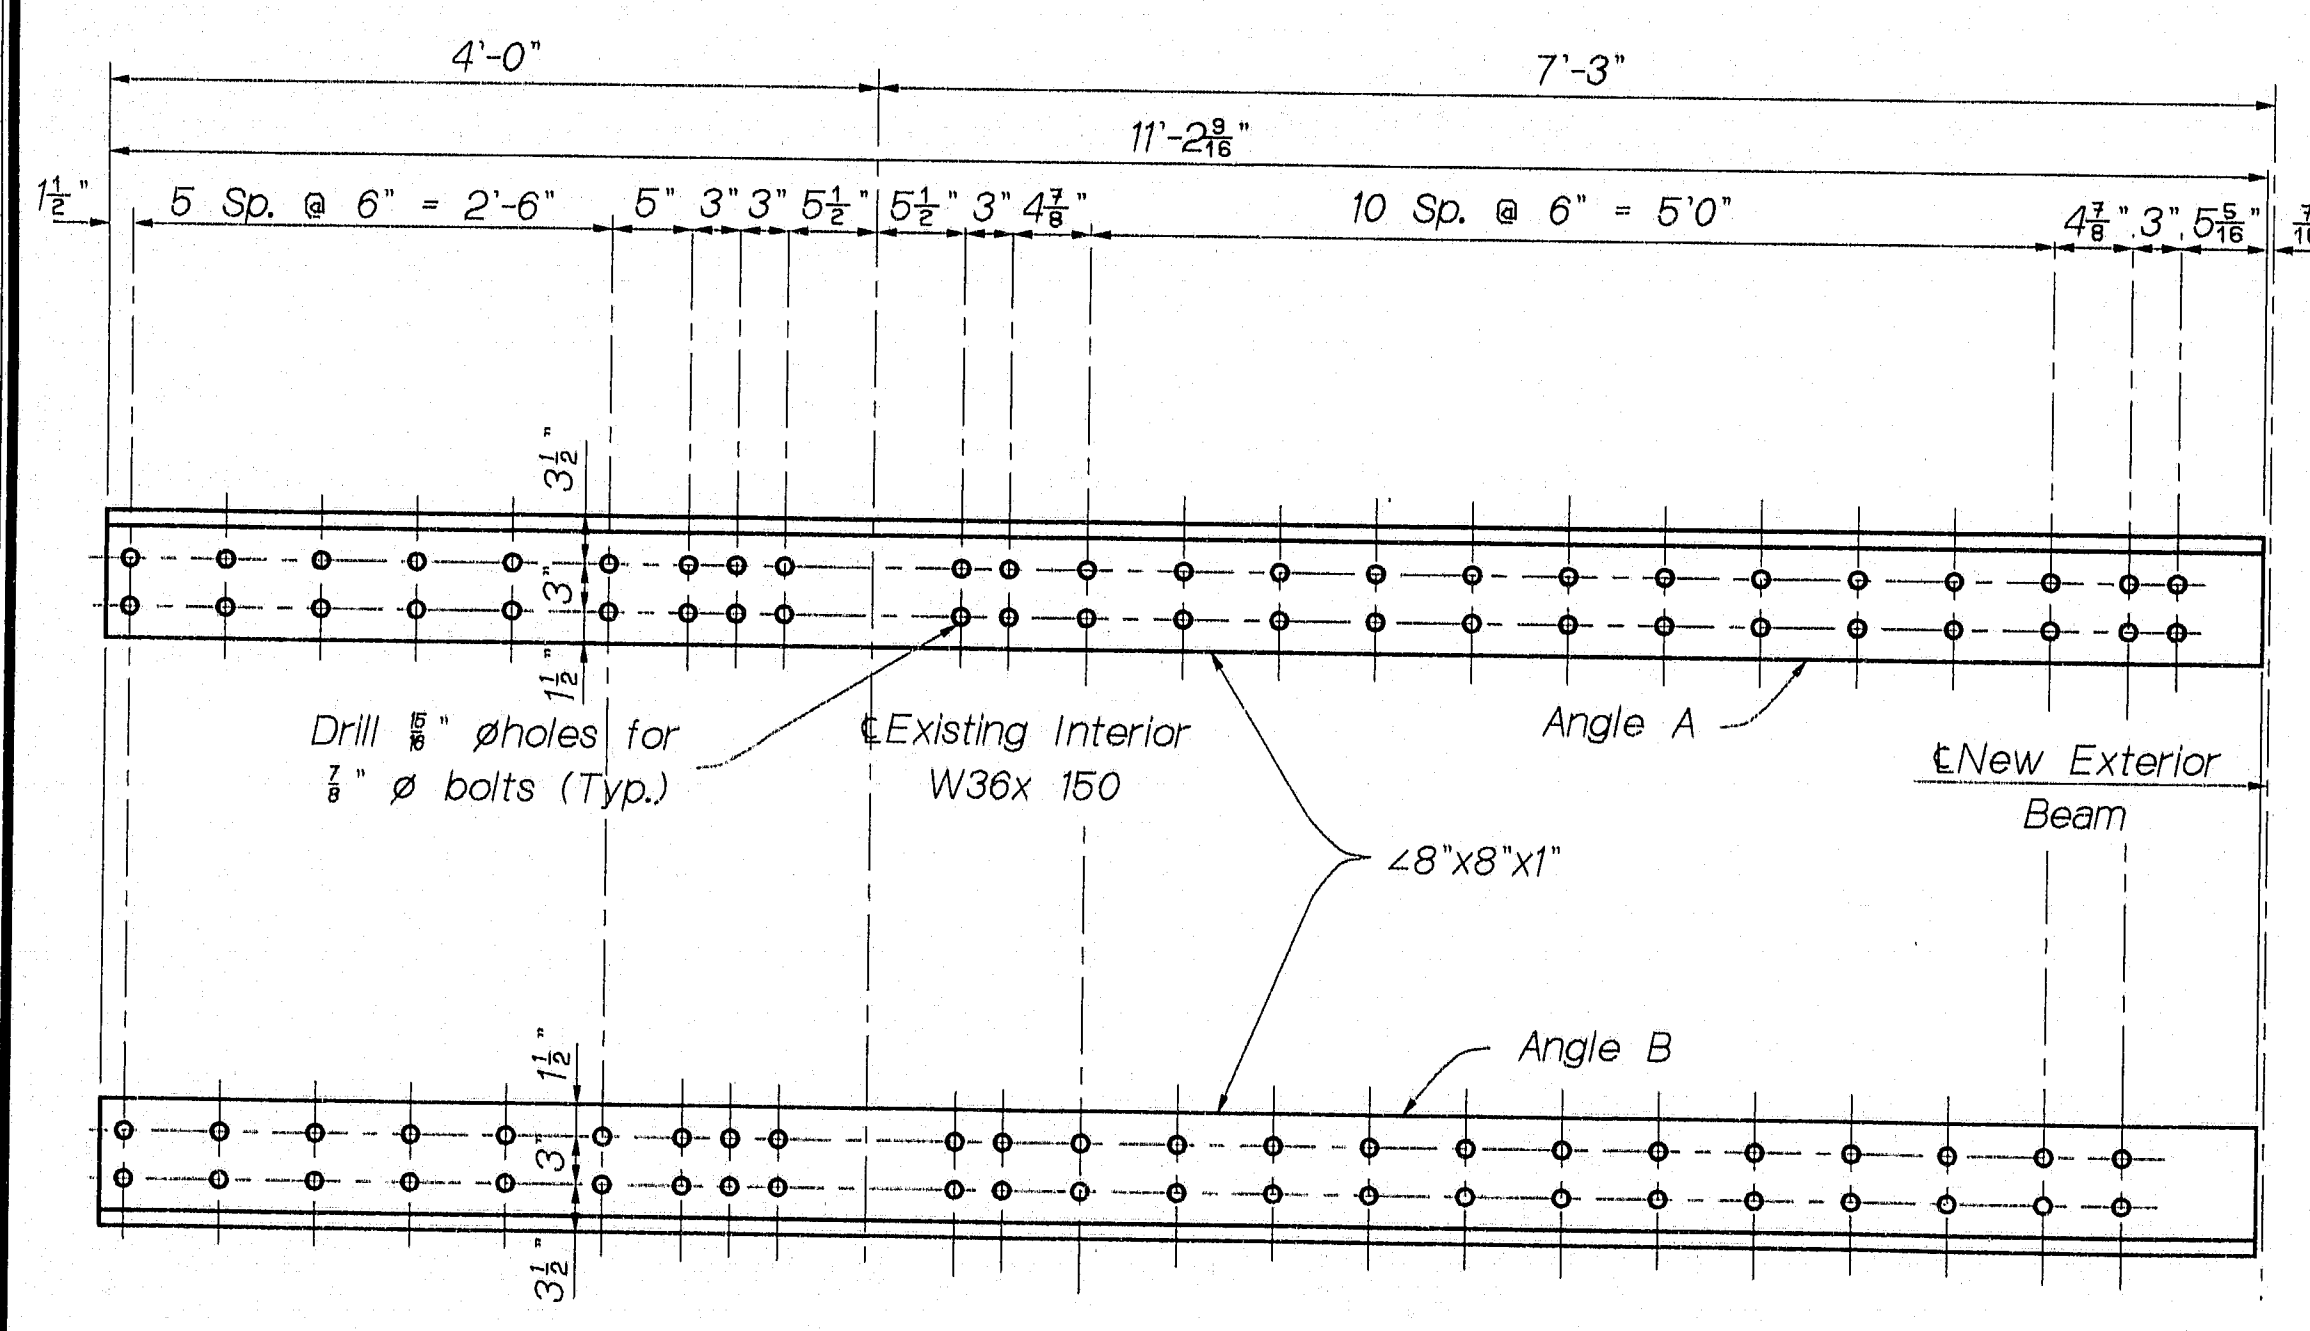

PROJECT DESIGN ENGINEER	DATE
BY J. NORMAN R. CH	
DESIGN-DETAILED	CHECKED
REVISIONS	FIELD CHANGES

13 JUN 92-010.100

109-50




Revisions of June 9, 1992
As 8.11.1993

STATE OF MAINE
DEPARTMENT OF TRANSPORTATION

FERRY HILL BRIDGE
OVER
STILLWATER RIVER
IN THE TOWN OF
ORONO
PENOBSCOT COUNTY
STRUCTURAL STEEL


SHEET 12 OF 43 AUGUSTA, MAINE March, 1992

- 1) All bolts shall be $\frac{1}{2}$ "-Ø H.S. Bolts. Hole sizes for bolts shall conform to Section 504.23 of the Standard Specifications, and edge-distances shall be $1\frac{1}{2}$ " min. unless otherwise shown.
- 2) Connection plates and gusset plates shall have a minimum thickness of $\frac{3}{8}$ " and shall have sufficient width to provide erection clearance. Connection plates shall have a minimum width of 7".
- 3) Depending on the skew-angle, stiffeners and connection plates shall be welded to the web plates with either fillet welds or a single bevel groove weld. Fillet welds shall be the minimum size specified by the AWS Structural Welding Code D1.5, table 2.2, unless otherwise shown. Fit-up shall meet the requirements of AWS D1.5, Art. 3.3, Assembly.
- 4) All stiffeners and connection plates shall extend to both the top and bottom flanges and shall be welded to the flanges with a fillet weld on both sides of the plate except as indicated by note 5 and/or 6. Fillet weld size shall be as specified under note 3.
- 5) Connection plates and stiffeners used as connection plates shall be connected to flanges in tension and stress reversal areas with the "Tension-Flange Connection" detail. All other stiffeners shall fit within $\frac{1}{16}$ " (tight fit) at flanges in tension and stress reversal areas and shall not be welded.
- 6) Bearing stiffeners shall be machined to have full bearing and shall have a fillet weld on each side.
- 7) All fillet welds which connect stiffeners or connection plates to either a flange or web plate, shall be started and stopped approximately $\frac{1}{8}$ " inch from the ends or edges of the plate.
- 8) Bolt tension-flange connection plate to flange before welding stiffener or diaphragm connection plate to it.
- 9) All holes in new steel that are to be matched to holes in existing steel shall be drilled in the field. Edge distance to bolt shall be $1\frac{1}{2}$ " minimum, unless otherwise noted.

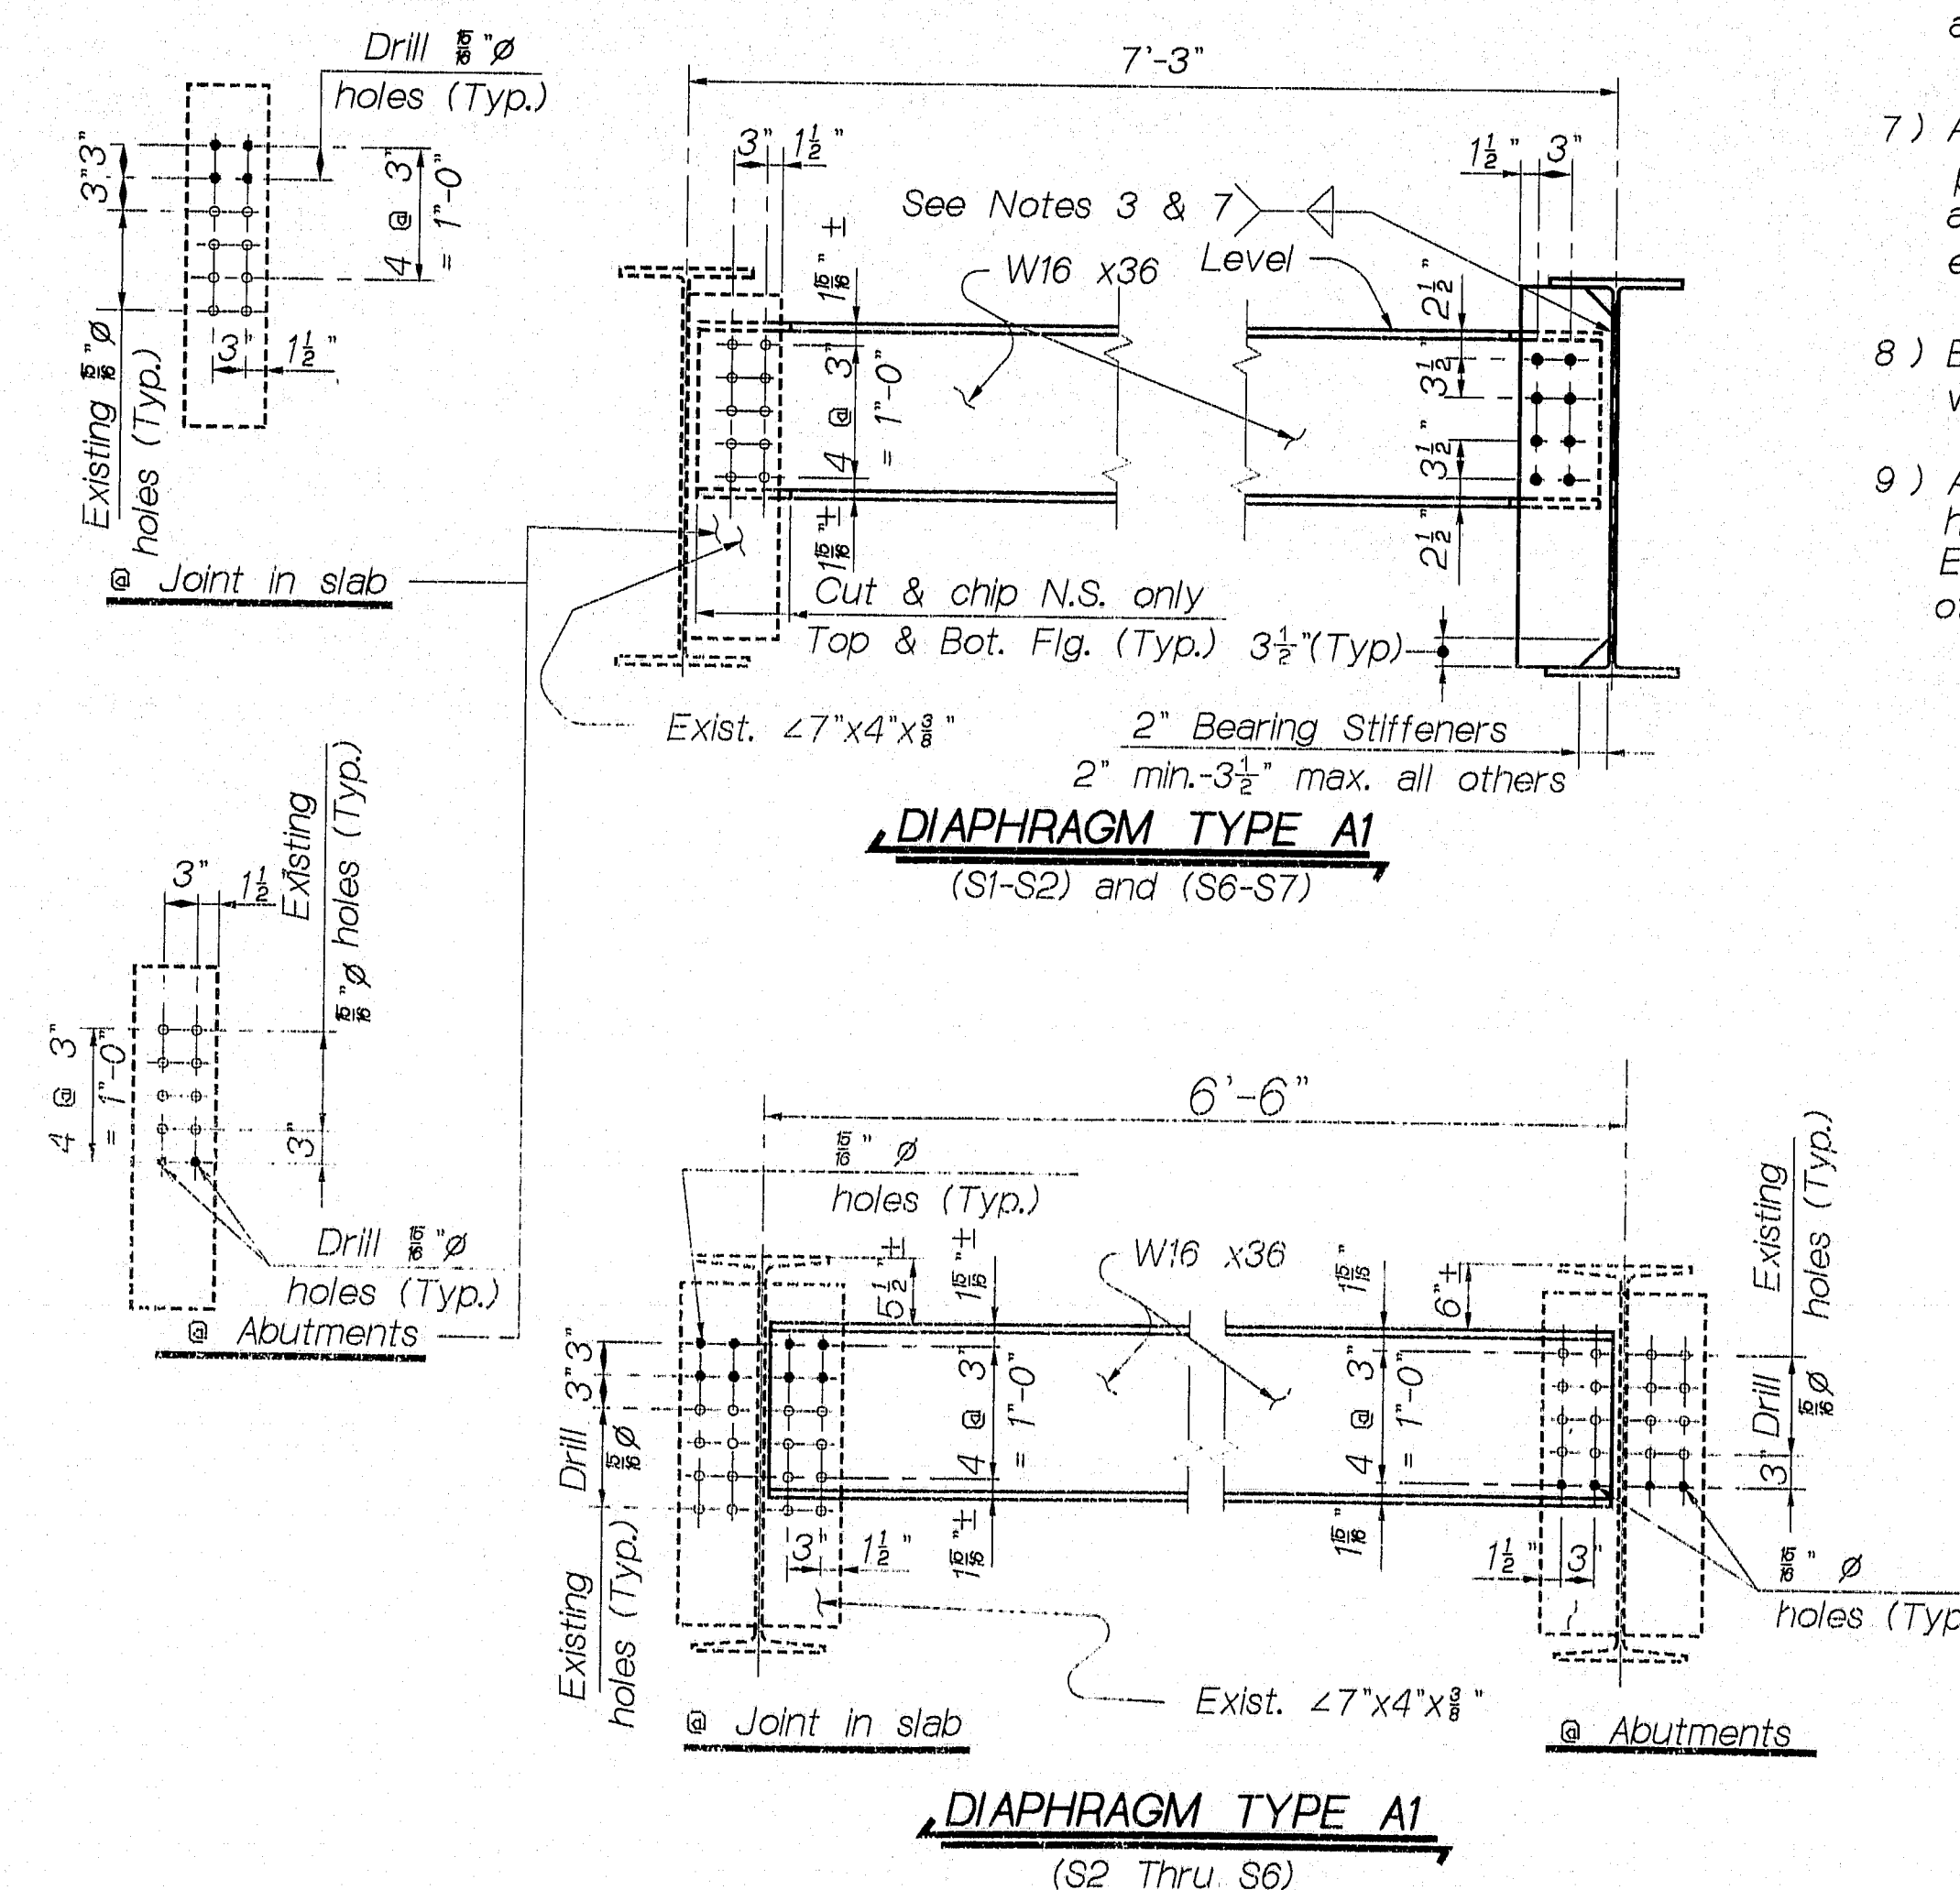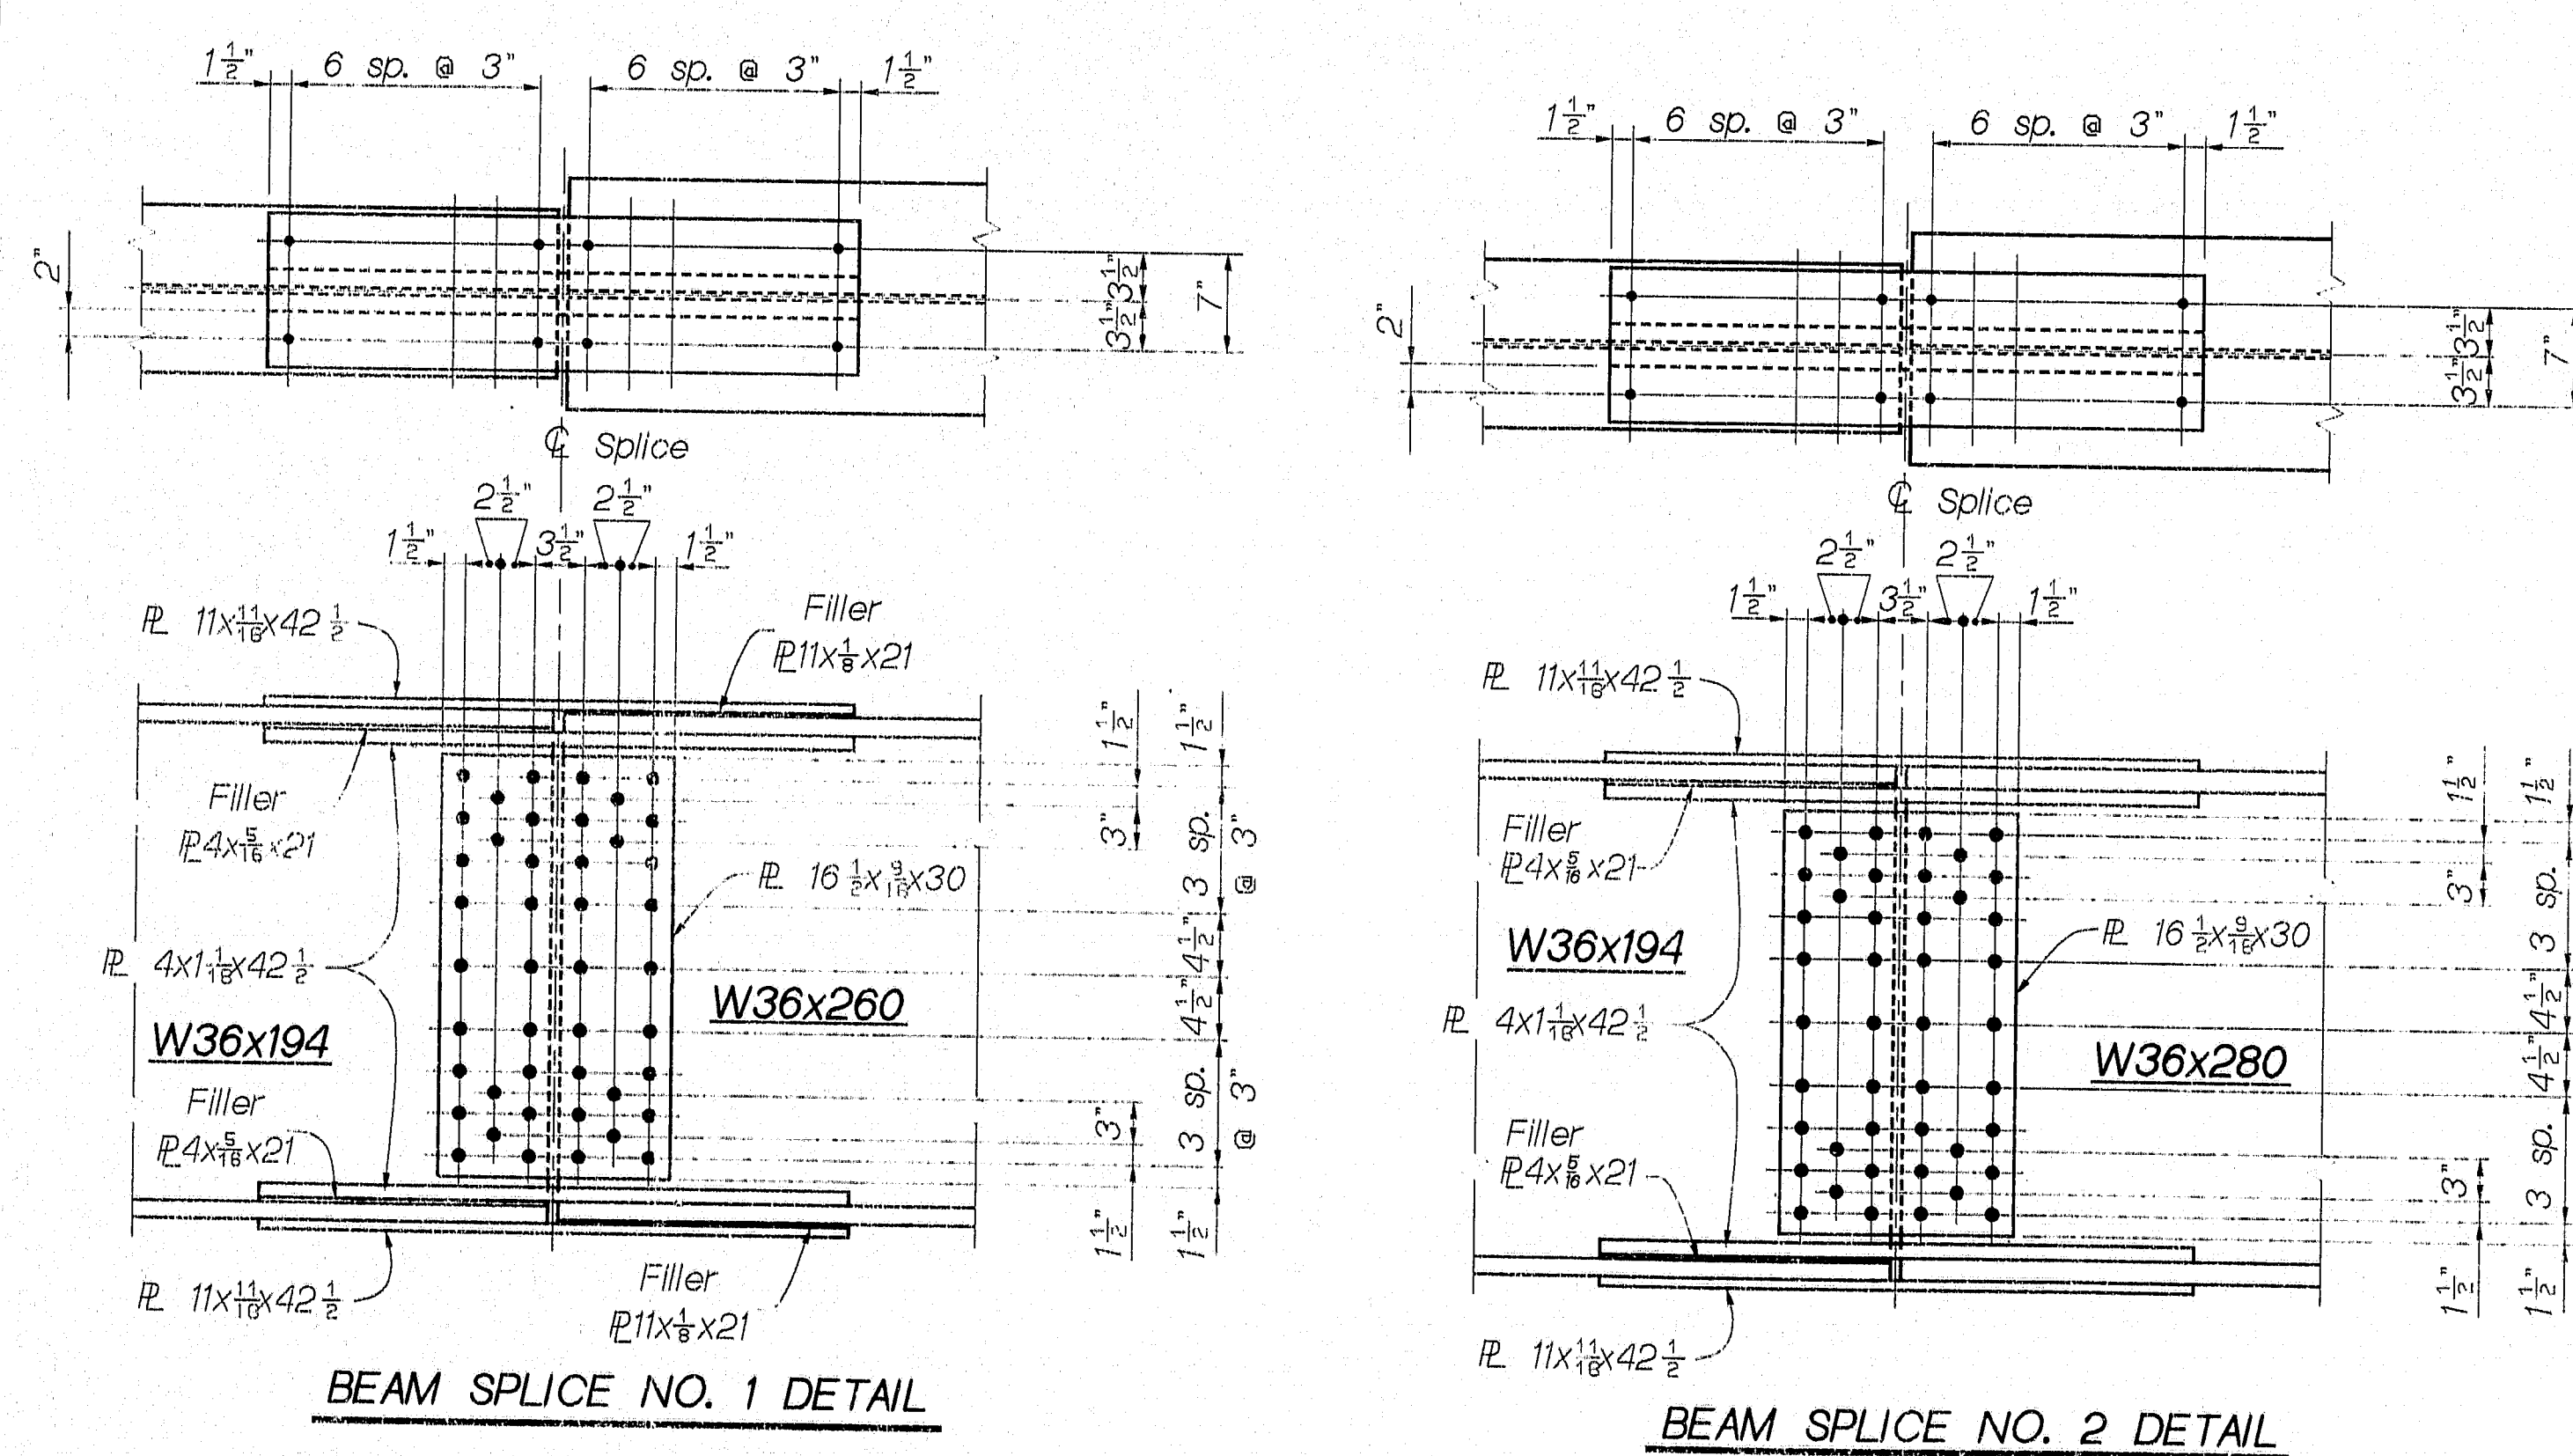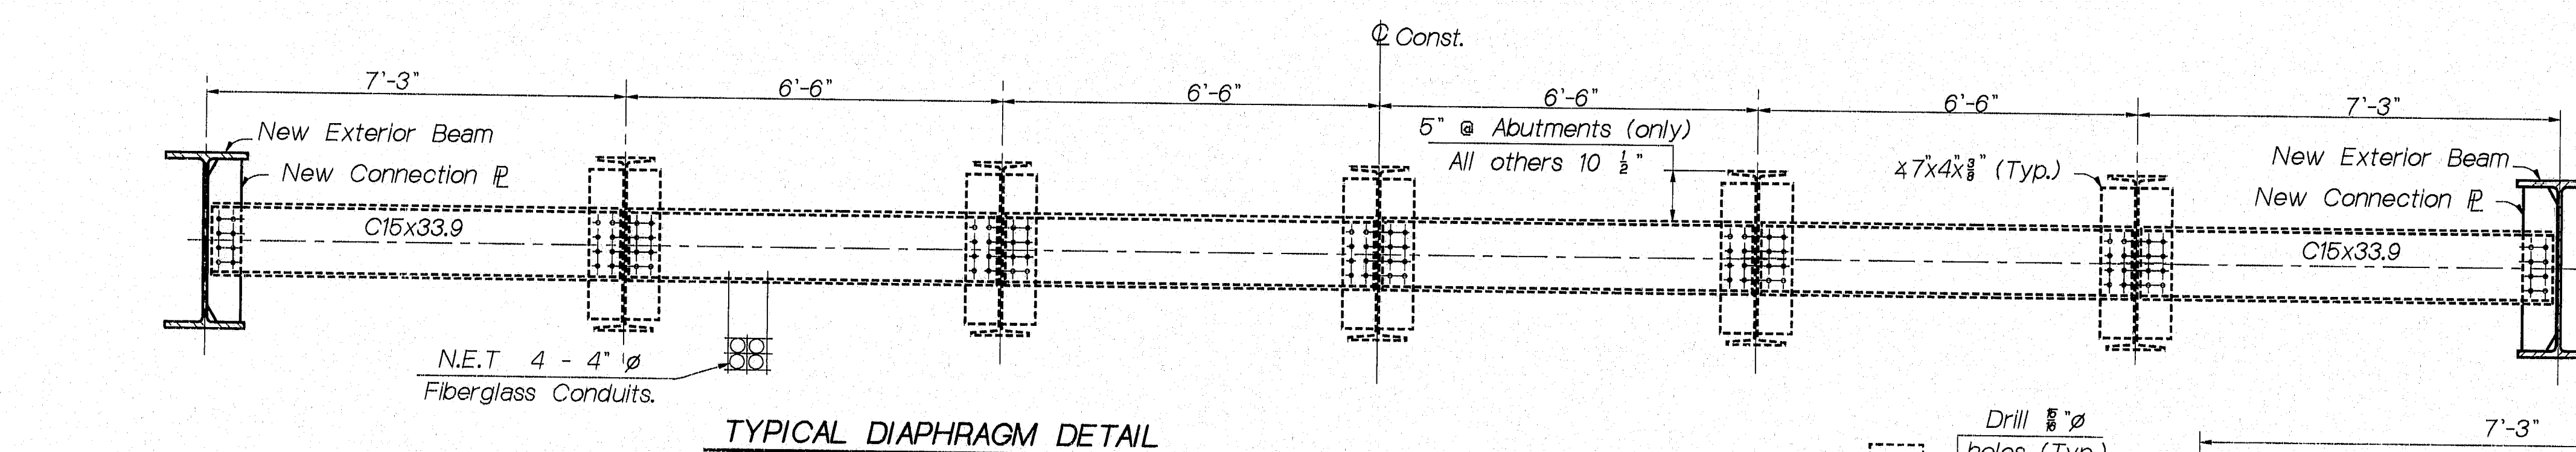

109-51


AS Buil
1993

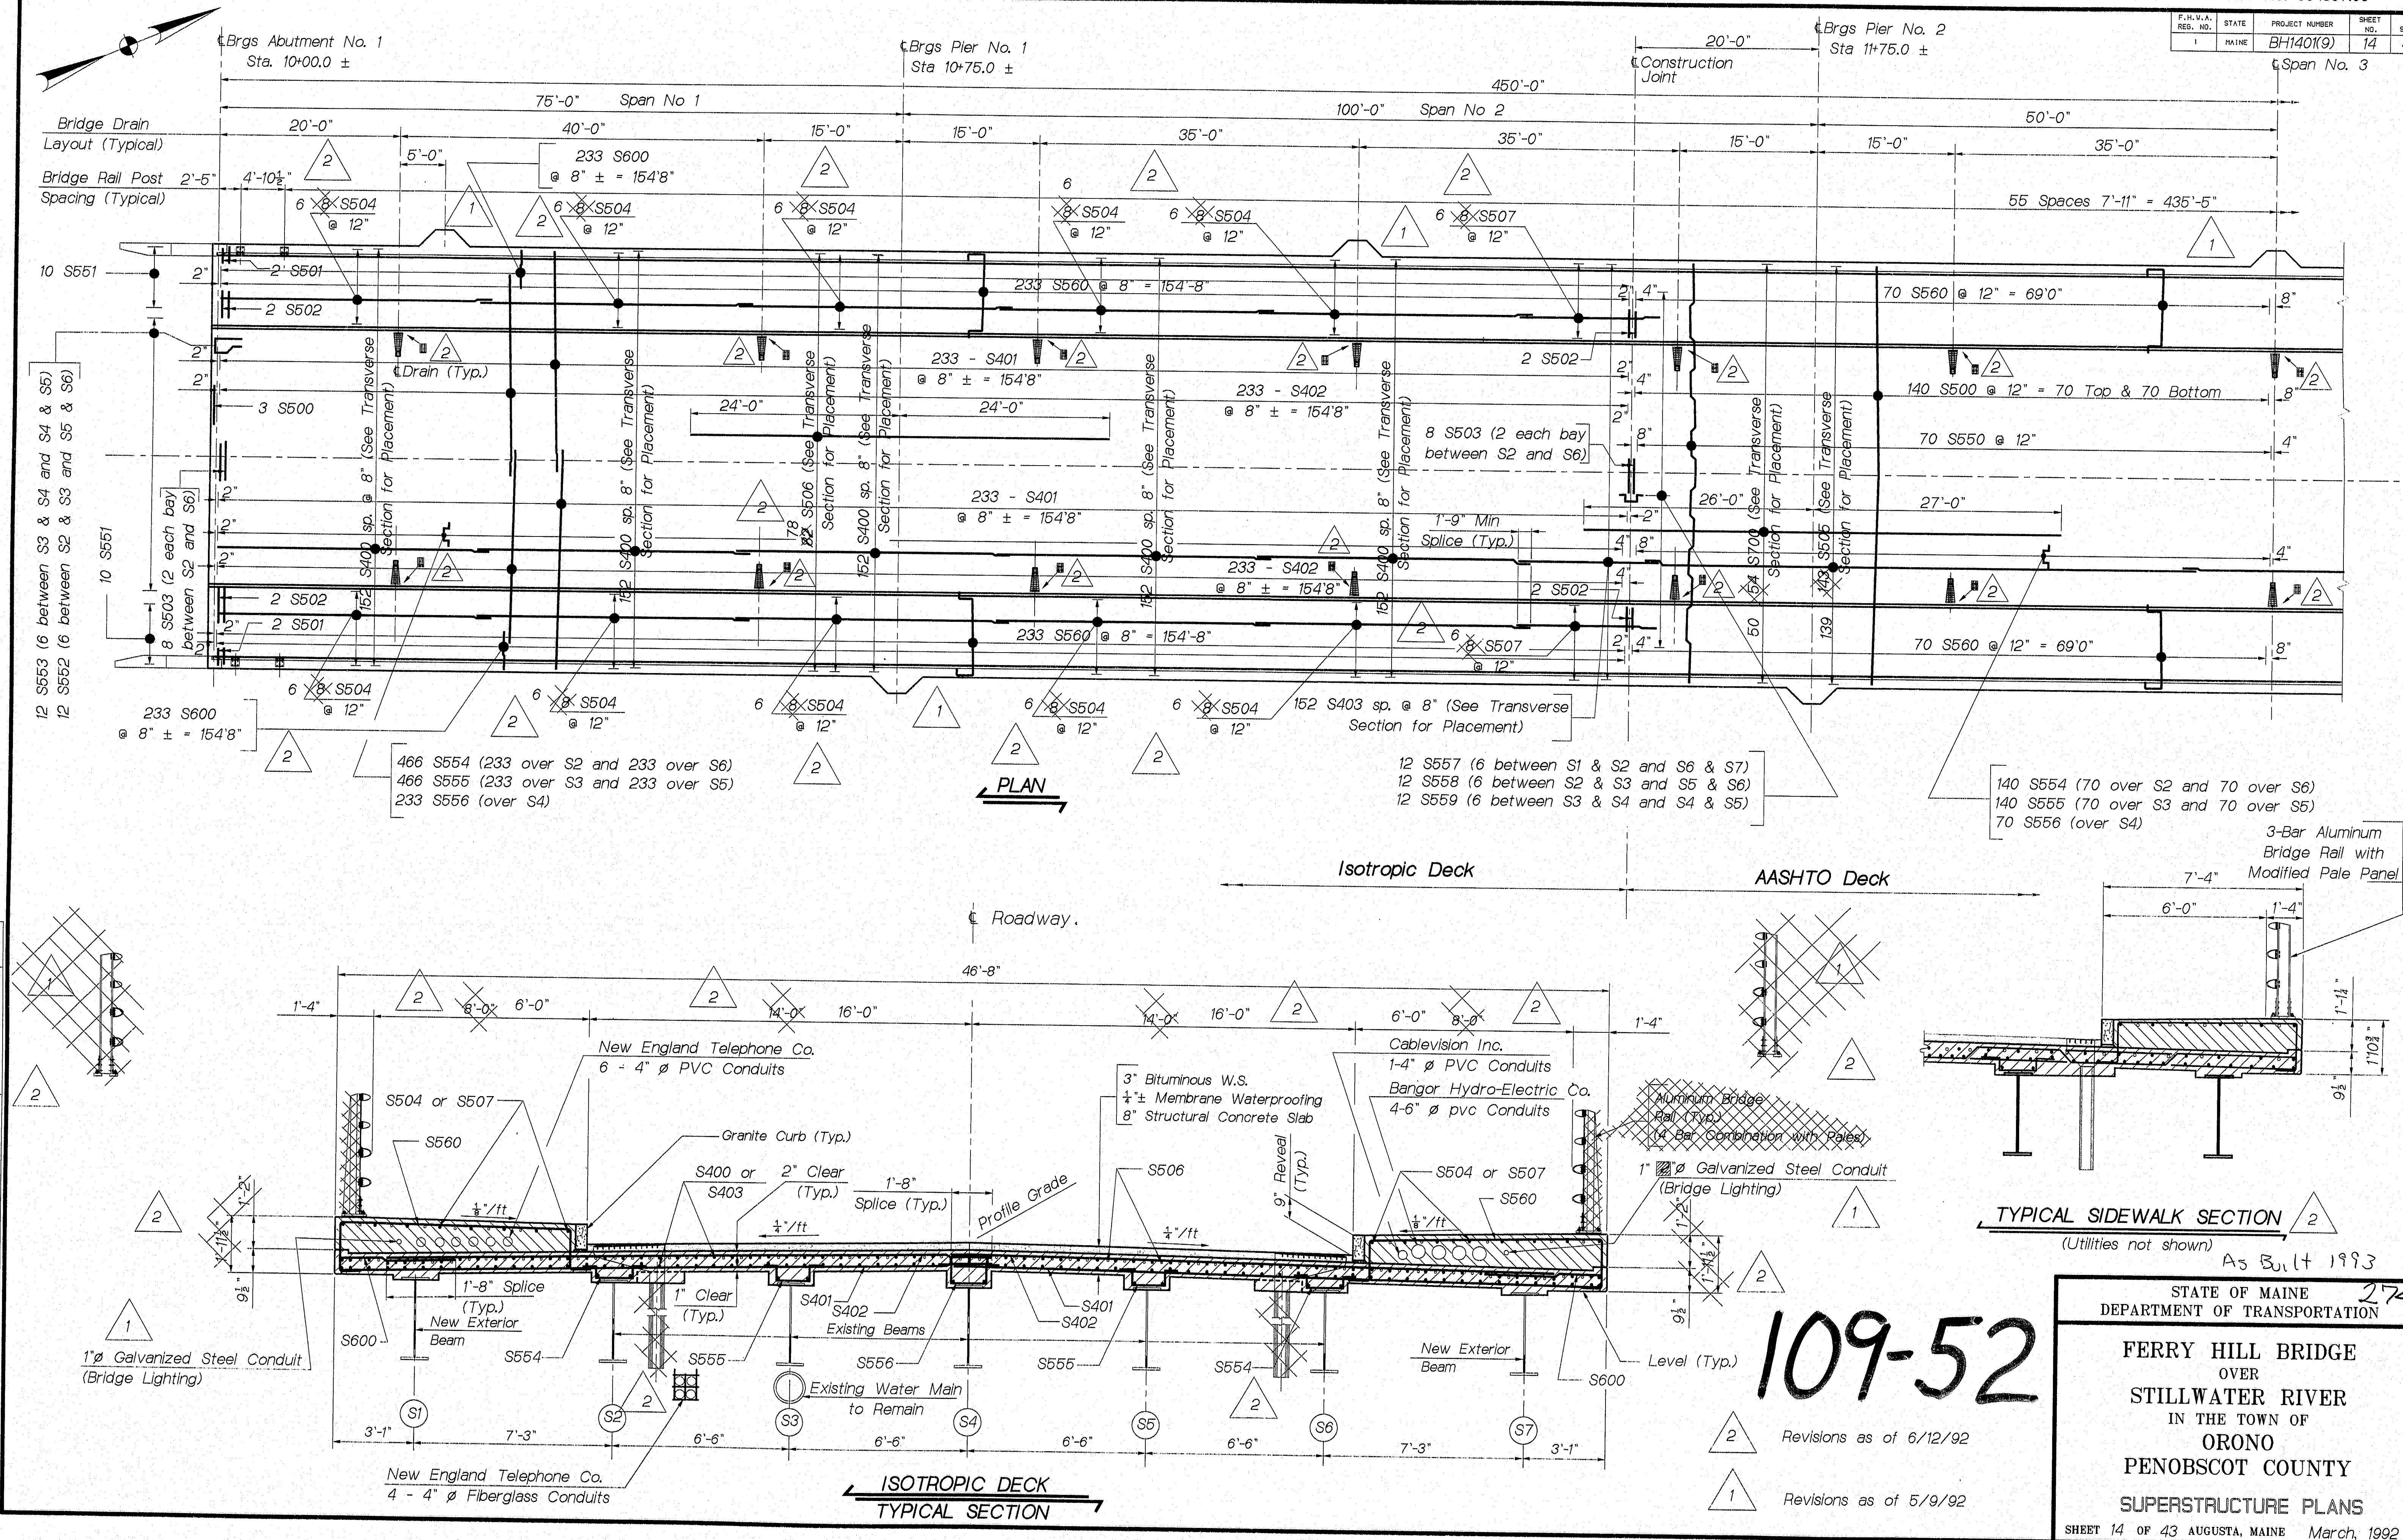

109-52


Revisions as of 6/12/92

Revisions as of 5/9/92

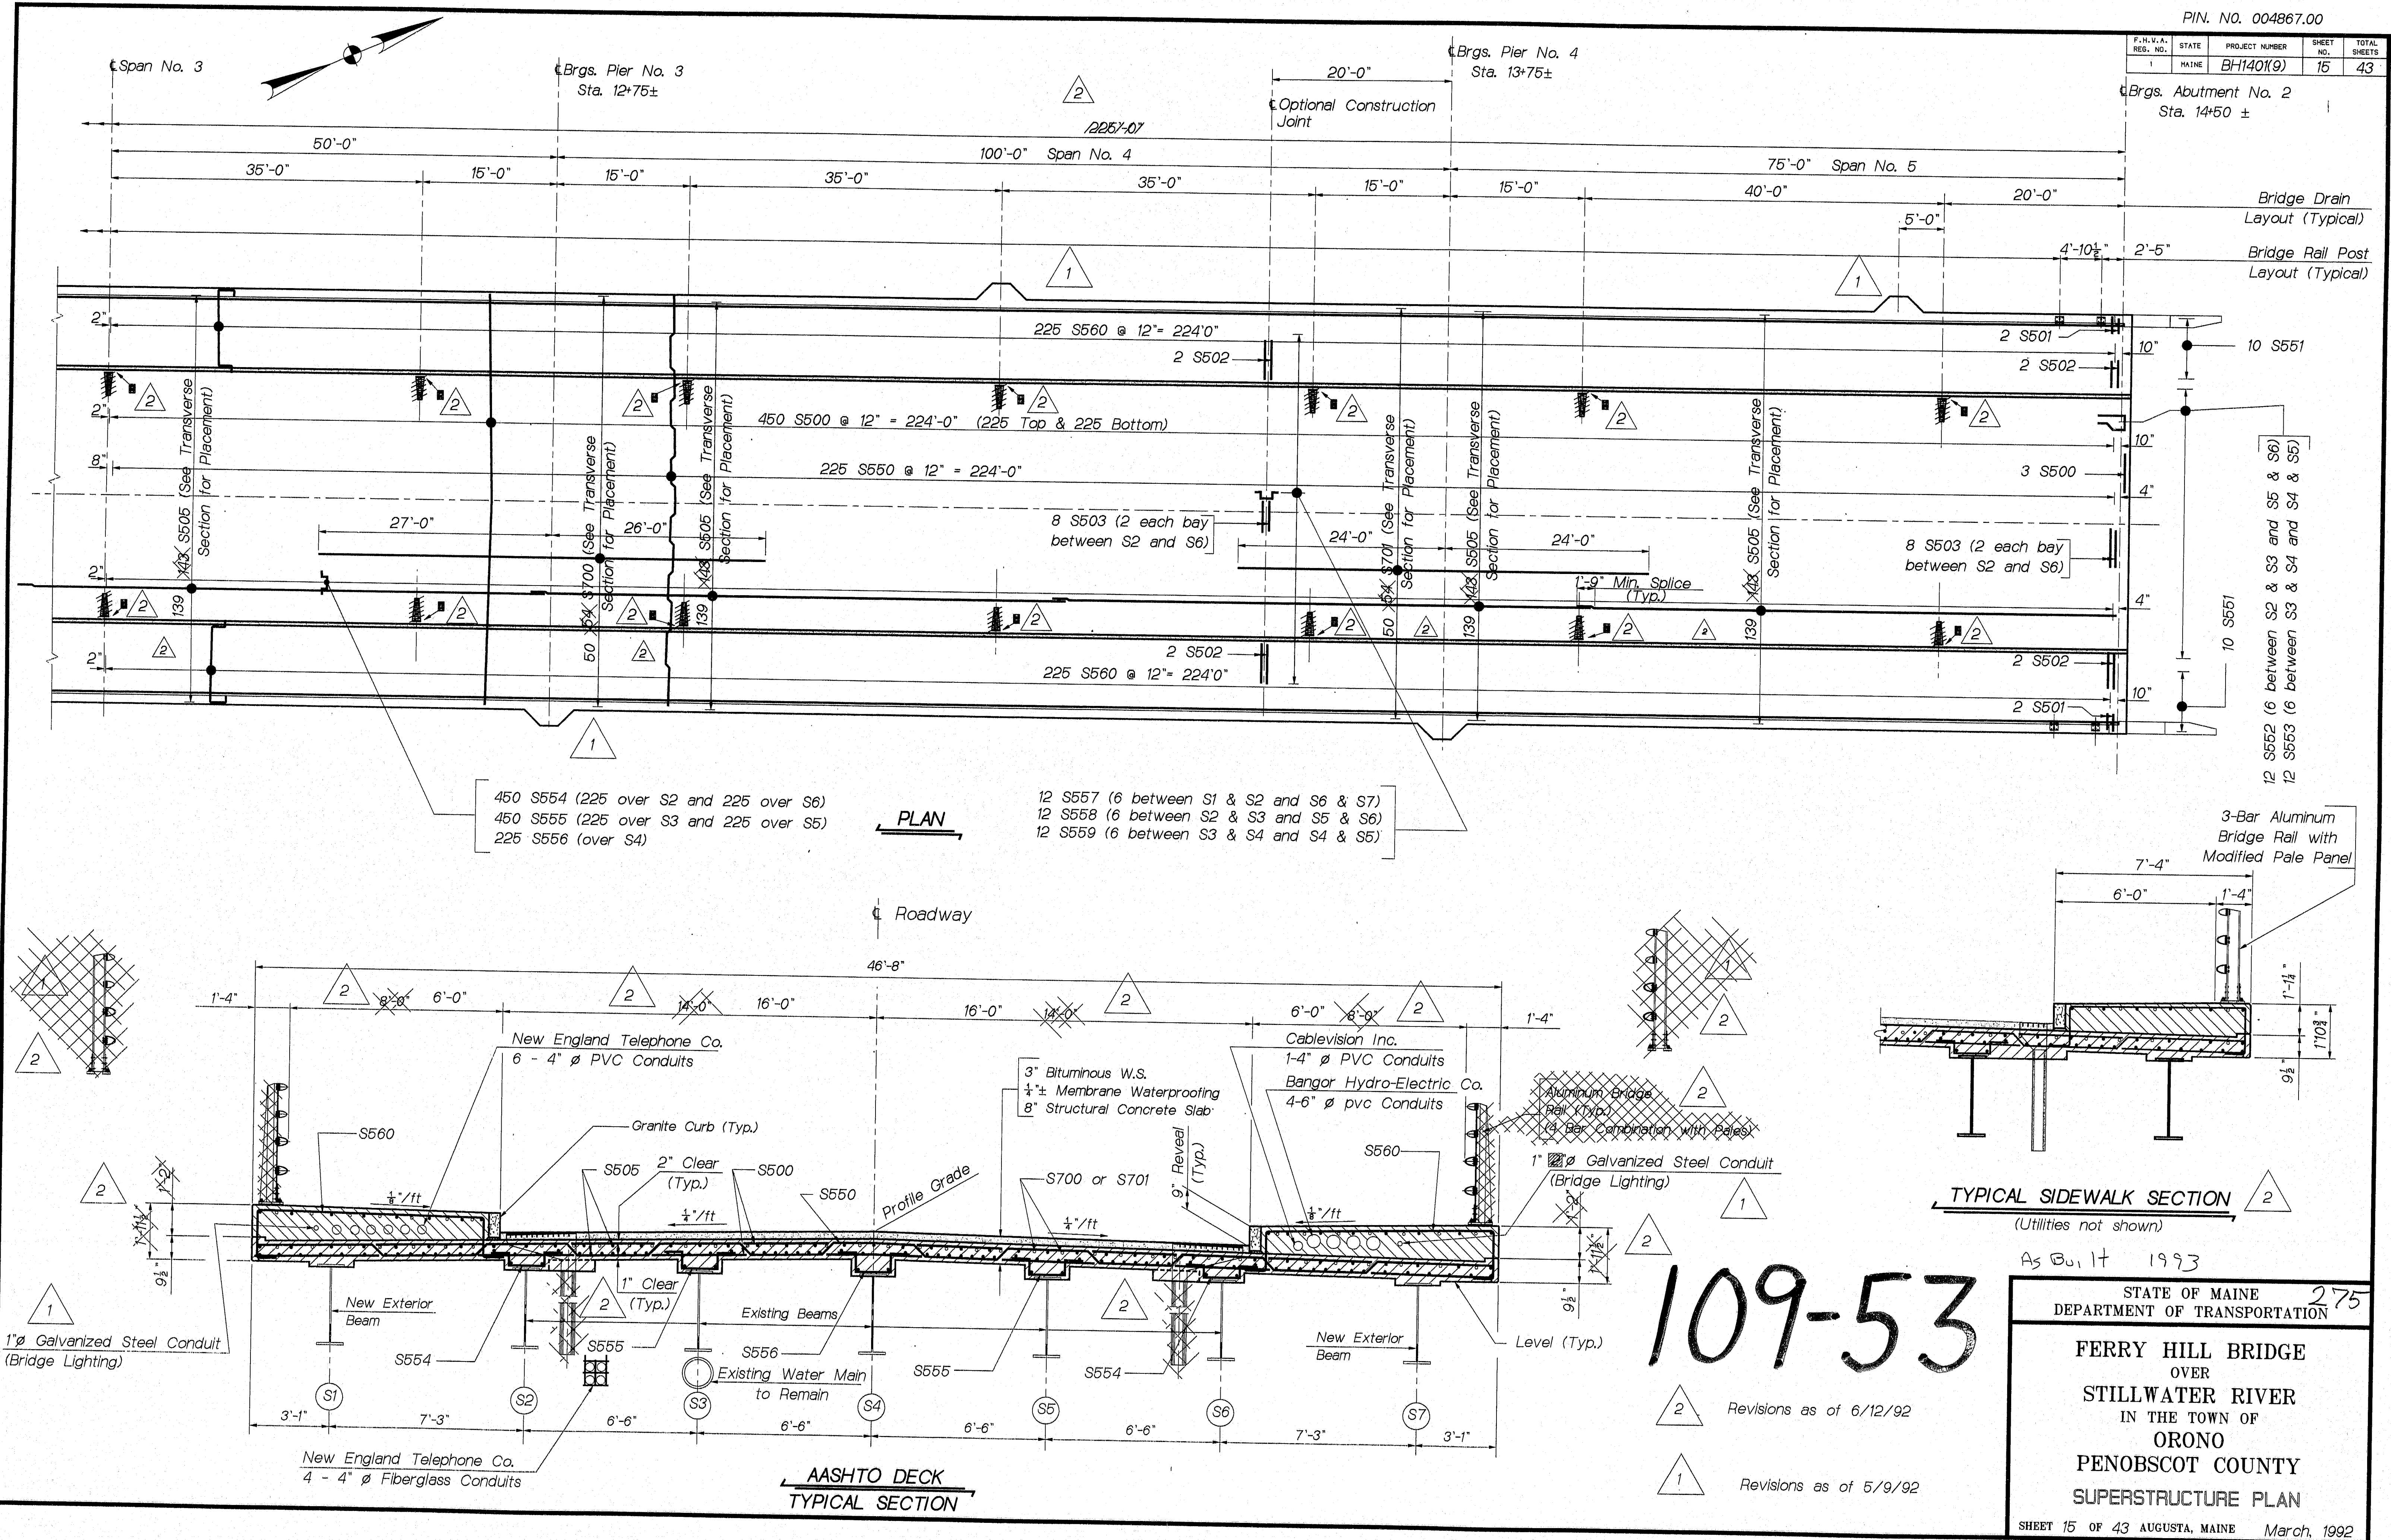



PIN. NO. 004867.00

F.H.W.A. RES. NO.	STATE	PROJECT NUMBER	SHEET NO.	TOTAL SHEETS
1	MAINE	BH140(19)	16	43

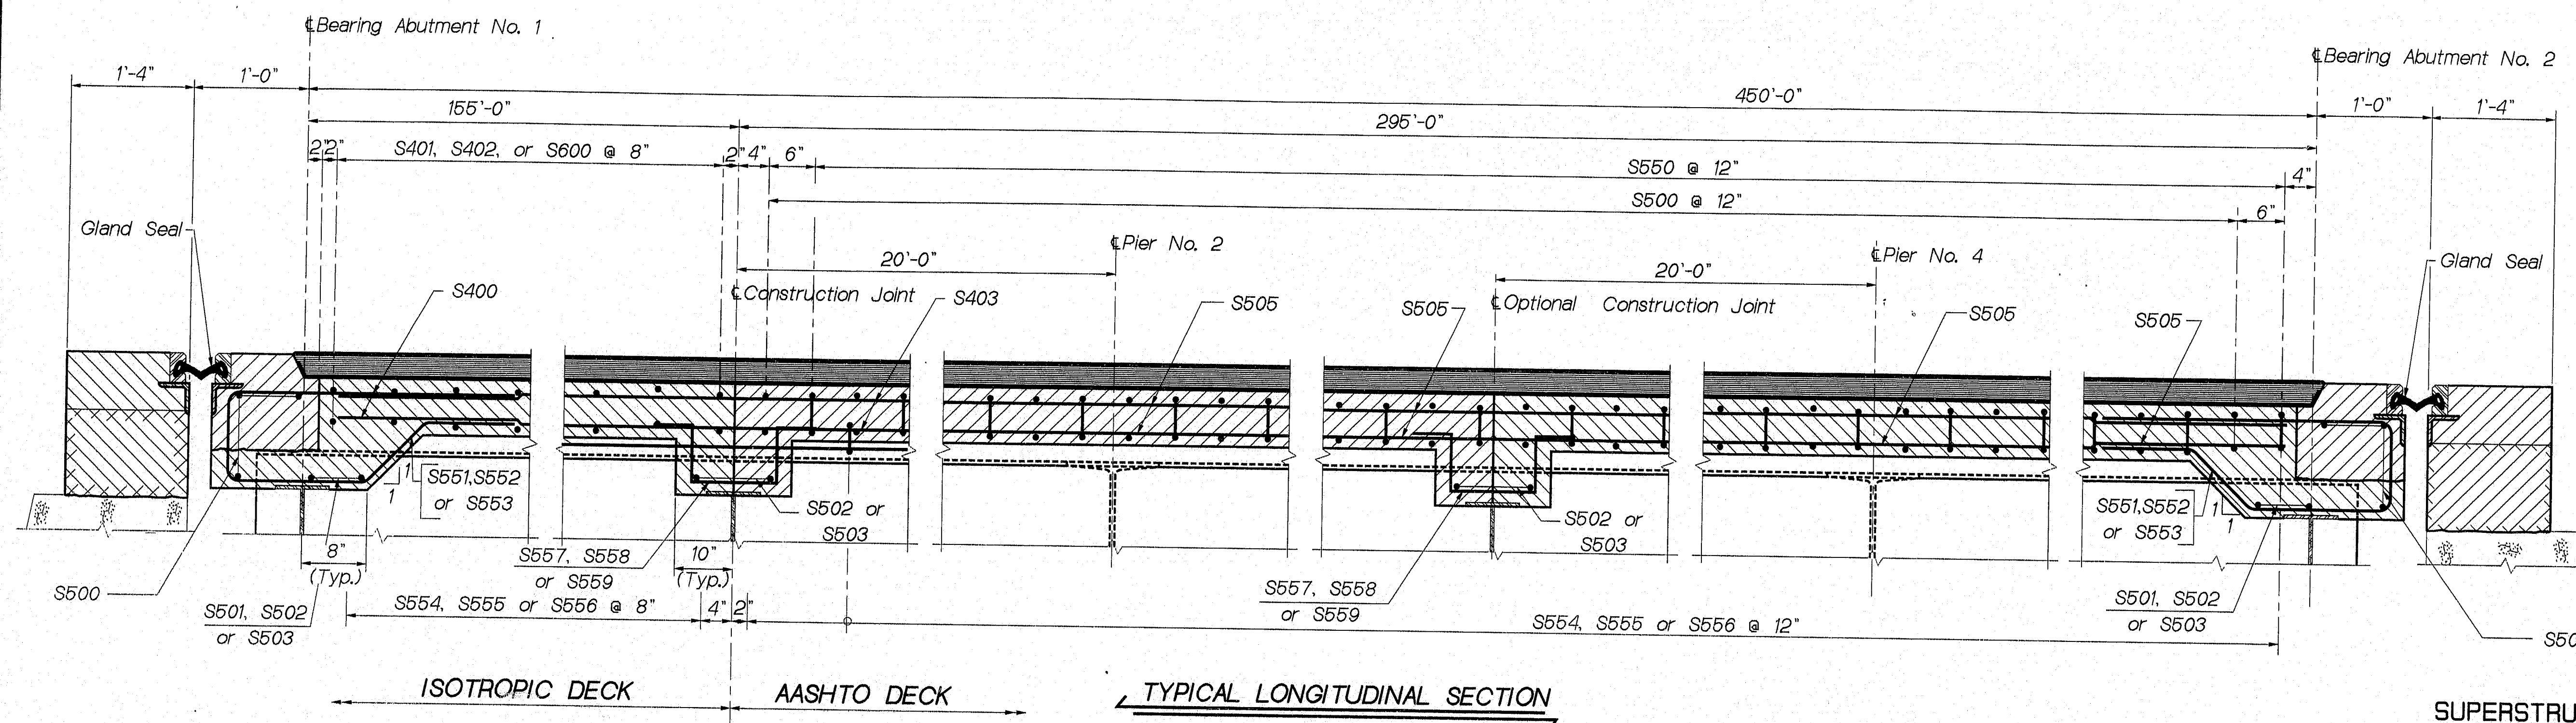

SUPERSTRUCTURE NOTES

- Form a 1" V-groove on the fascias at the horizontal joint between the curb and the slab.
- Reinforcing steel shall have a minimum cover of 2" unless otherwise indicated.
- Adjust reinforcing steel to fit around the drains in a manner approved by the Engineer. Do not cut transverse reinforcing bars.
- Mortar for bedding and for joints in the granite curb shall contain an approved non-shrink additive.
- Protective coating for concrete surfaces shall be applied to the following areas:
Top of sidewalks.
Fascias down to the drip notch.
Top of blockout at ends of Superstructure Slab.
- All curb and sidewalk concrete shall contain a Silica Fume Additive.
- The superstructure slab concrete placement shall start at abutment 1 and shall terminate at the construction joint 20' before pier 2. Successive placements shall proceed from the end of the previous placement and terminate at abutment 2 with the Contractor having the option of a construction joint near pier 4. The placement sequence of the superstructure slab concrete shall be approved by the Engineer.
- Concrete in a placement shall be kept plastic one complete span behind the span being placed. A minimum of five days shall elapse between successive partial placements.

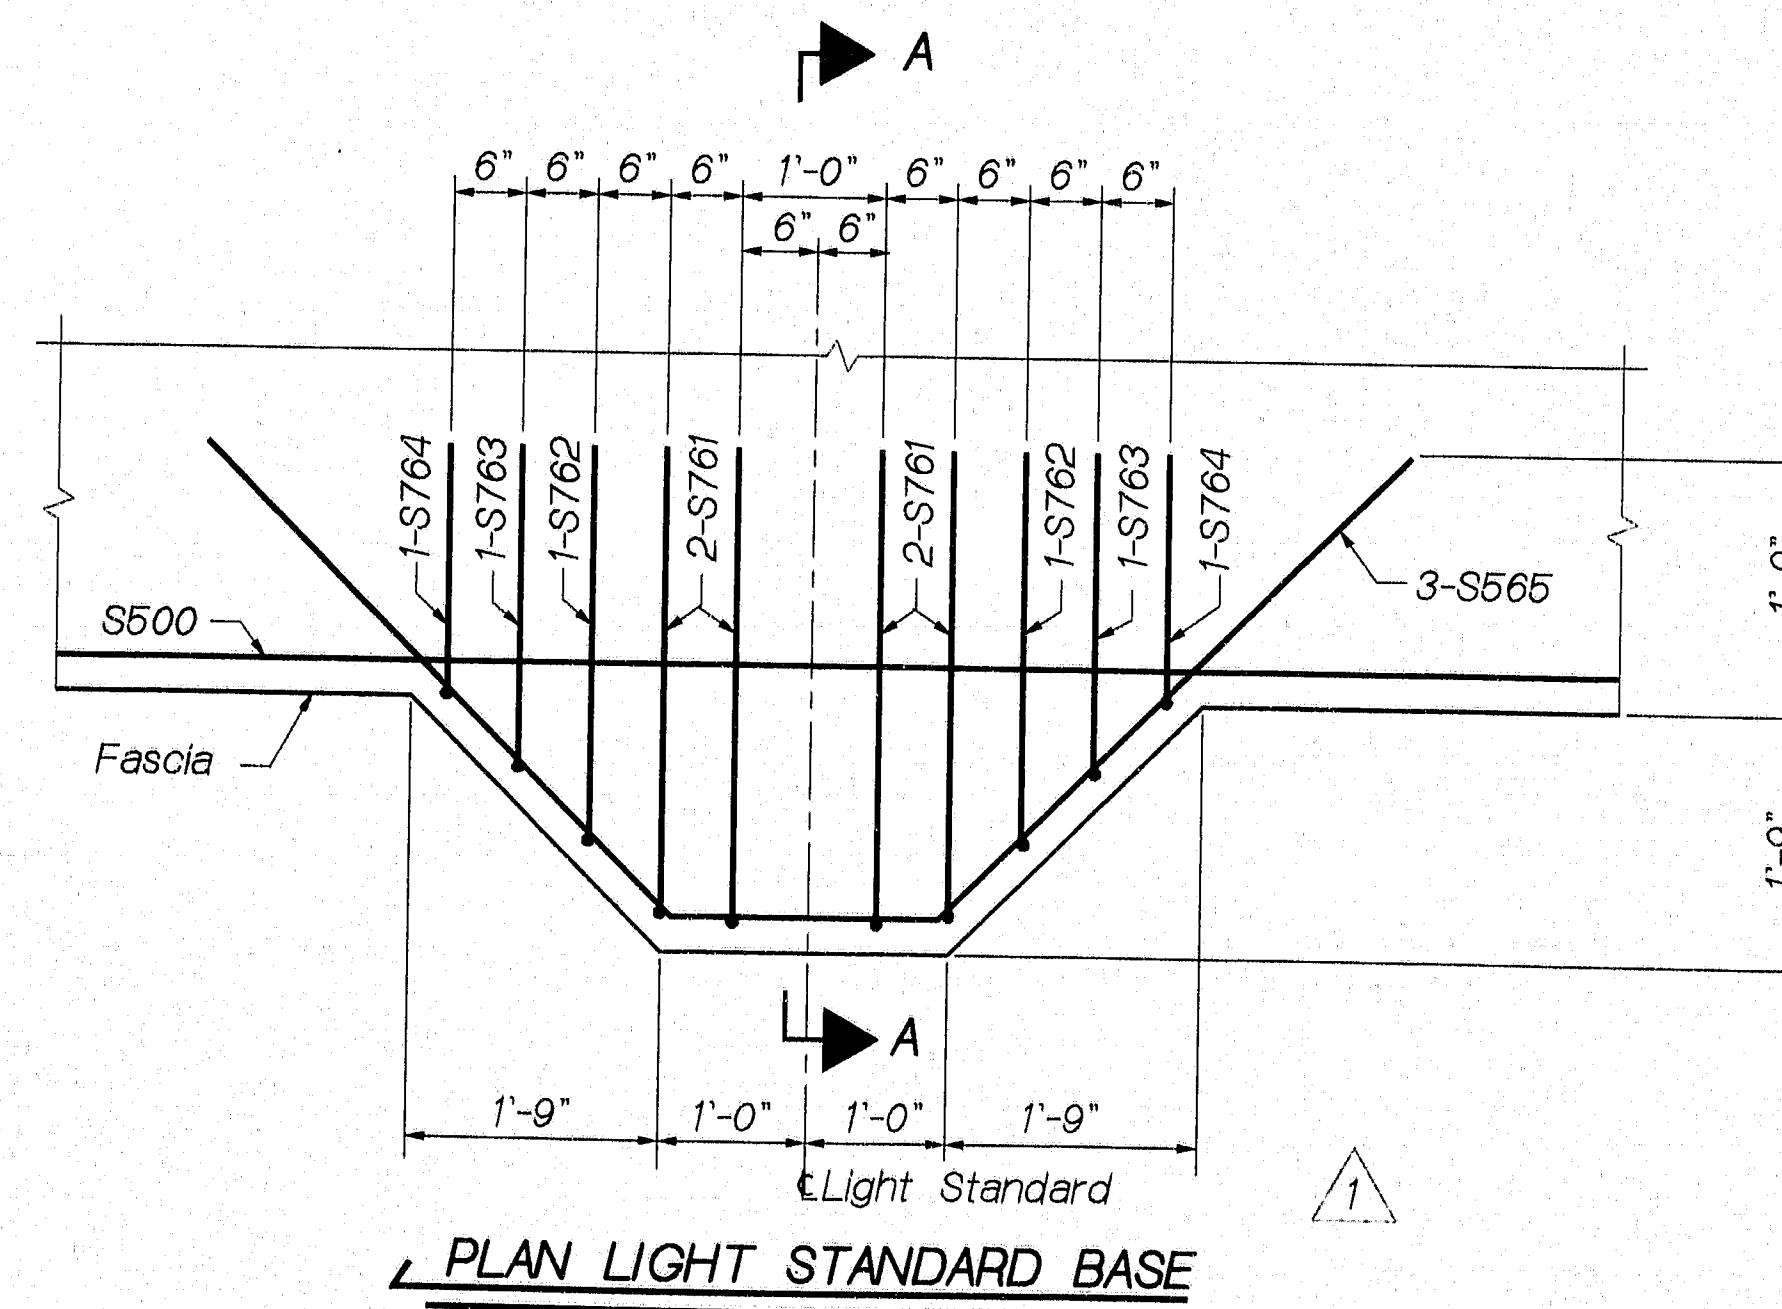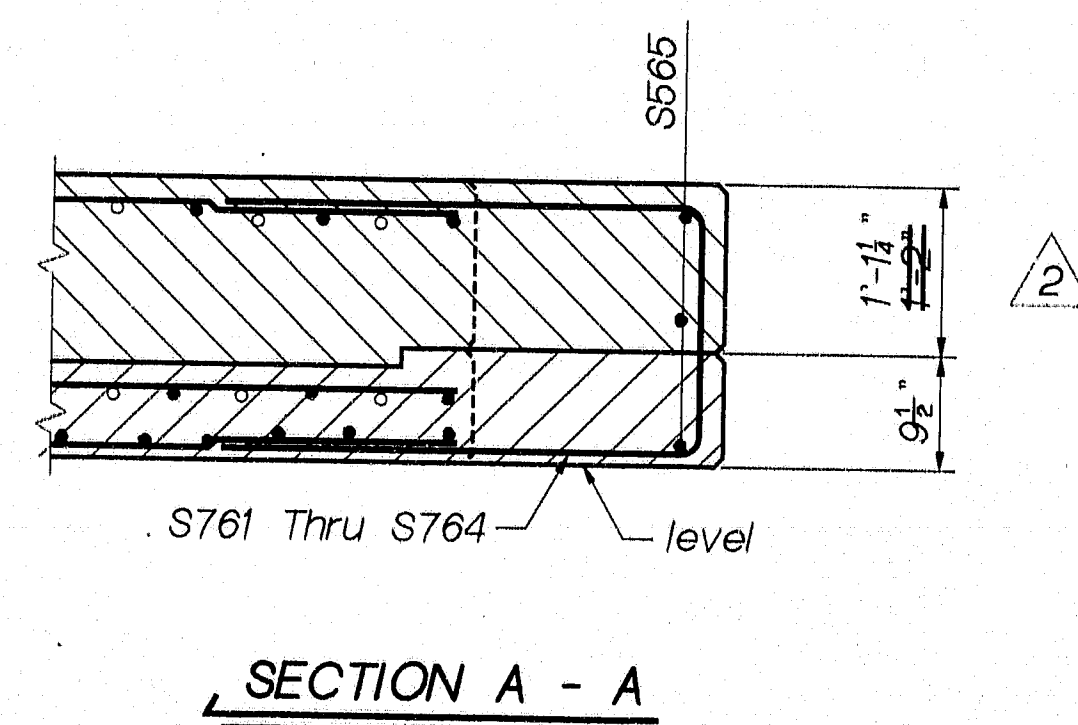

Revisions as of 6/17/92

Revisions as of 5/9/92

As Built 1993

STATE OF MAINE
DEPARTMENT OF TRANSPORTATION

FERRY HILL BRIDGE
OVER
STILLWATER RIVER
IN THE TOWN OF
ORONO
PENOBSCOT COUNTY
SUPERSTRUCTURE DETAILS

SHEET 16 OF 43 AUGUSTA, MAINE March, 1992





109-54

PROJECT DESIGN ENGINEER	DATE
BY R.A. Normand	7/92
CHECKED R.A. Normand	5/9/92
FIELD CHANGES	

22 JUN 92 0100.40

PIN. NO. 004867.00

F.H.W.A. REG. NO.	STATE	PROJECT NUMBER	SHEET NO.	TOTAL SHEETS
1	MAINE	BH-1401(9)	18	43

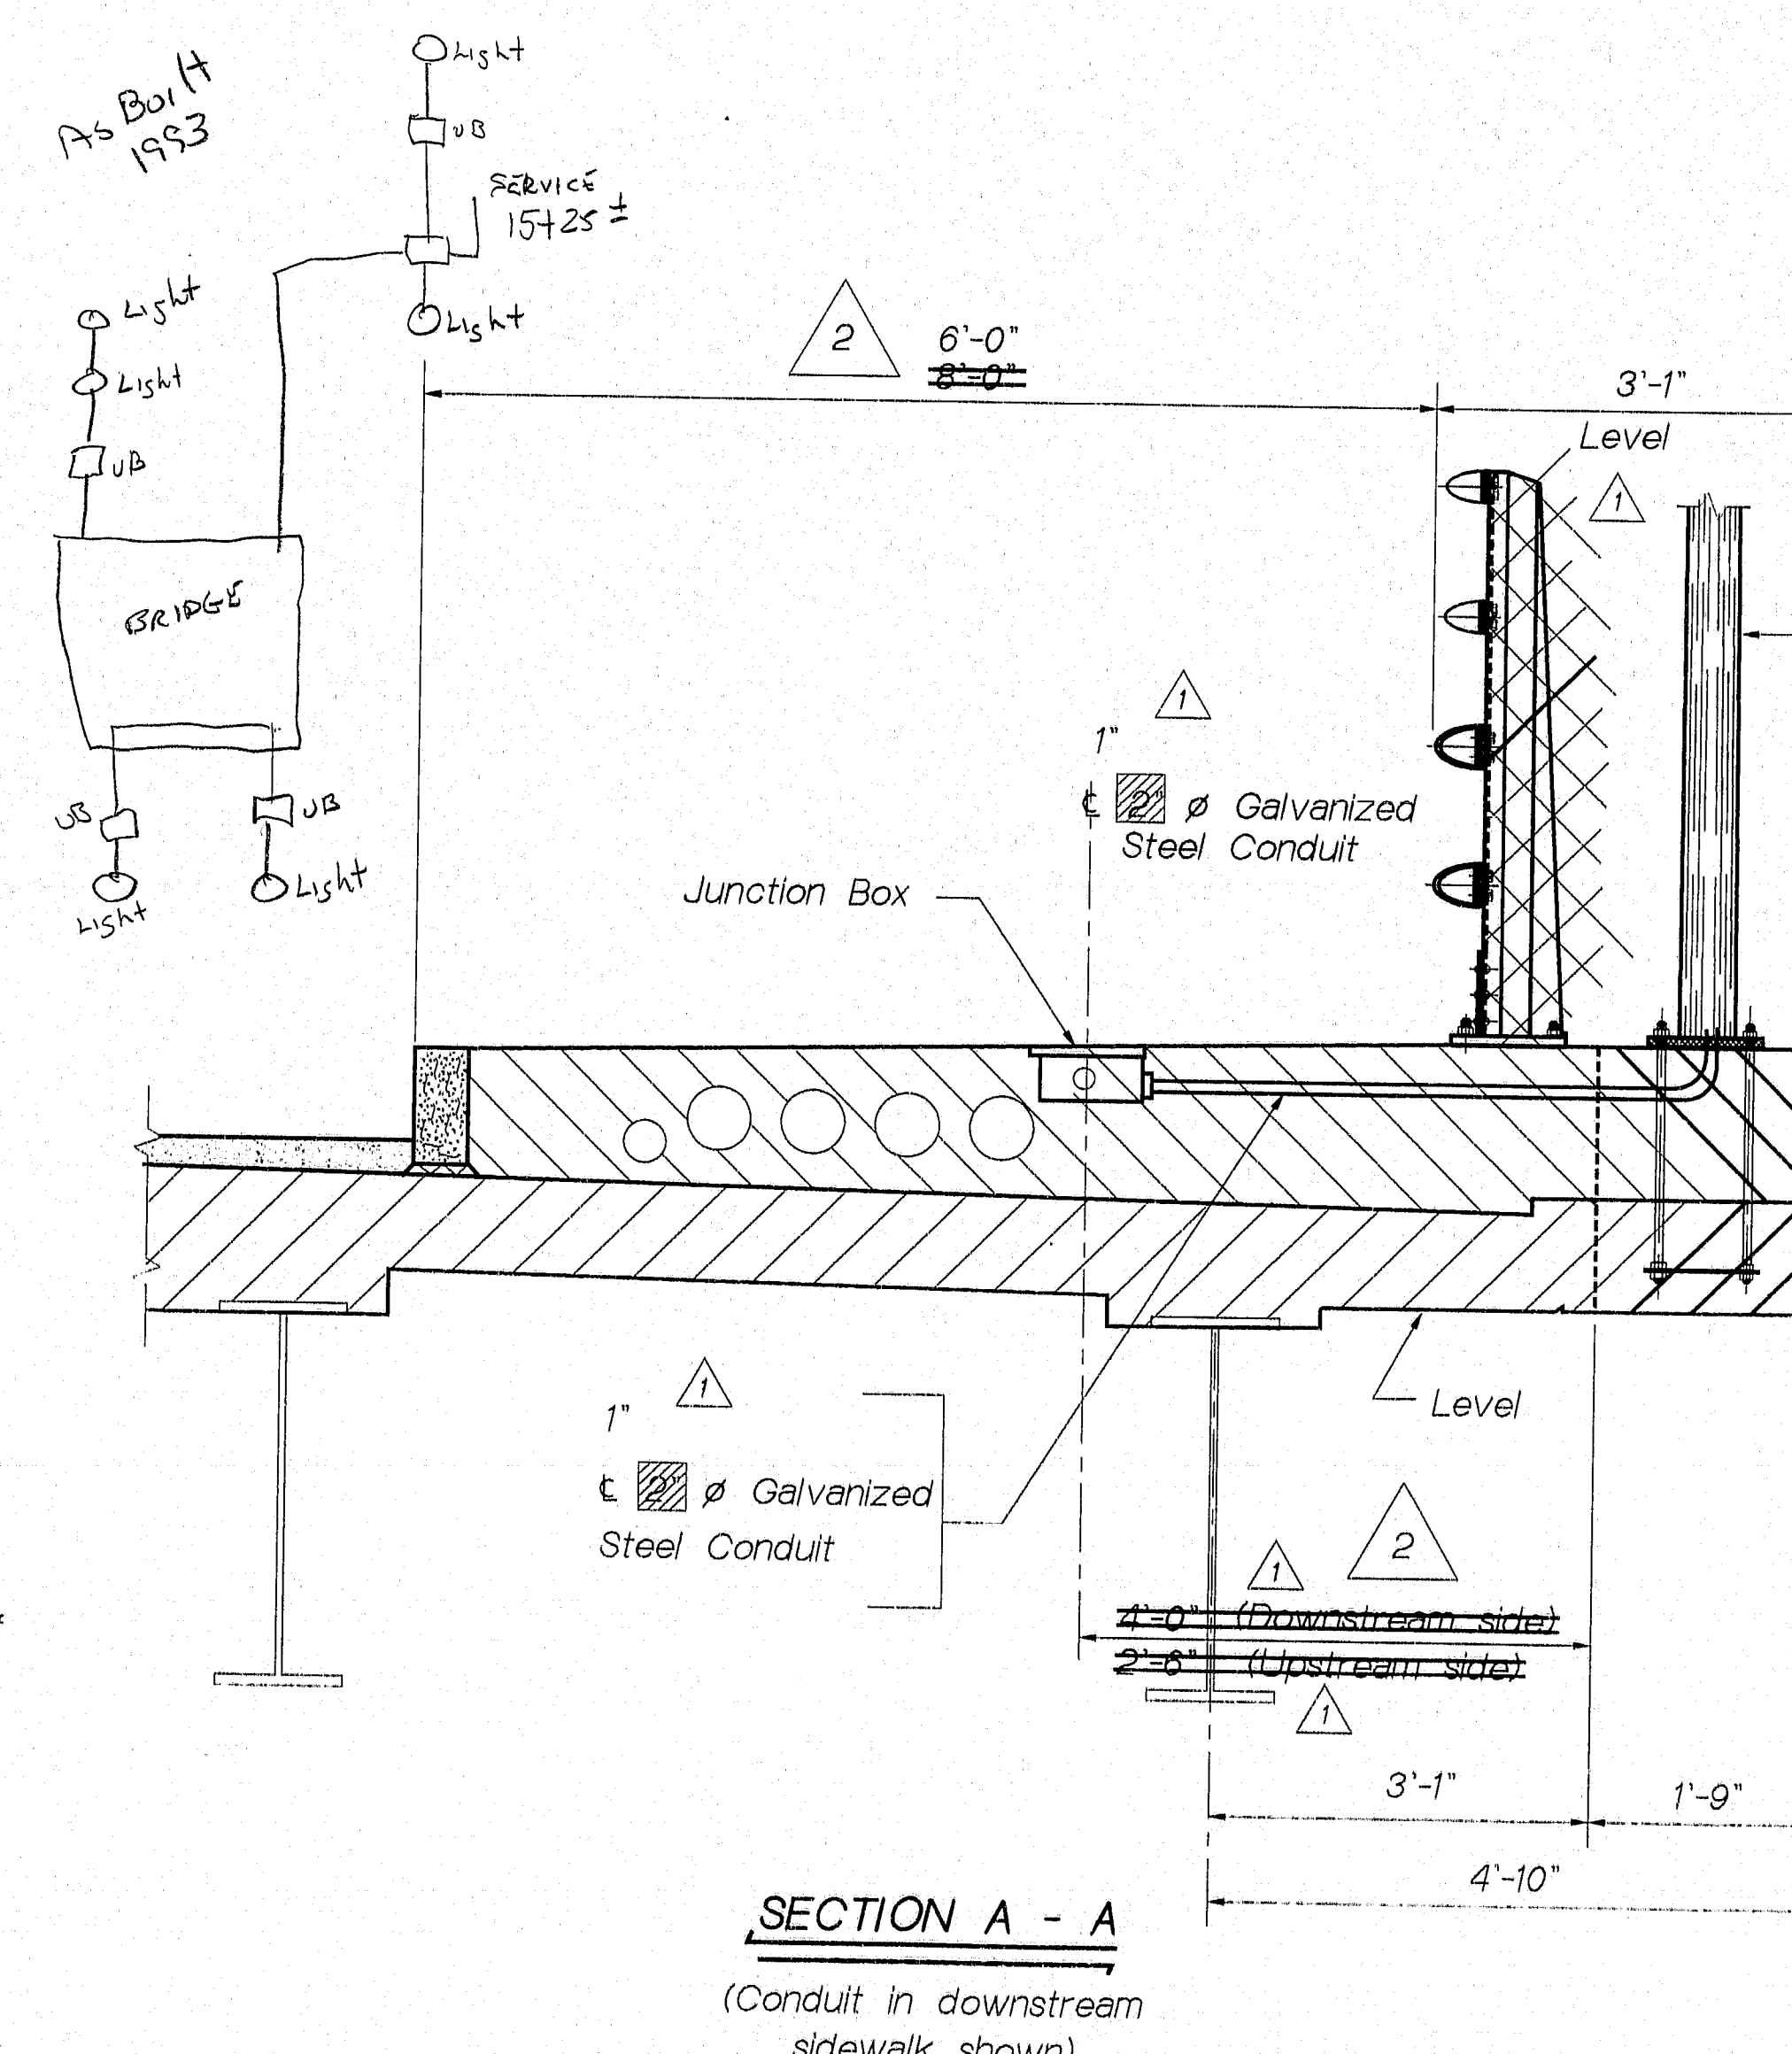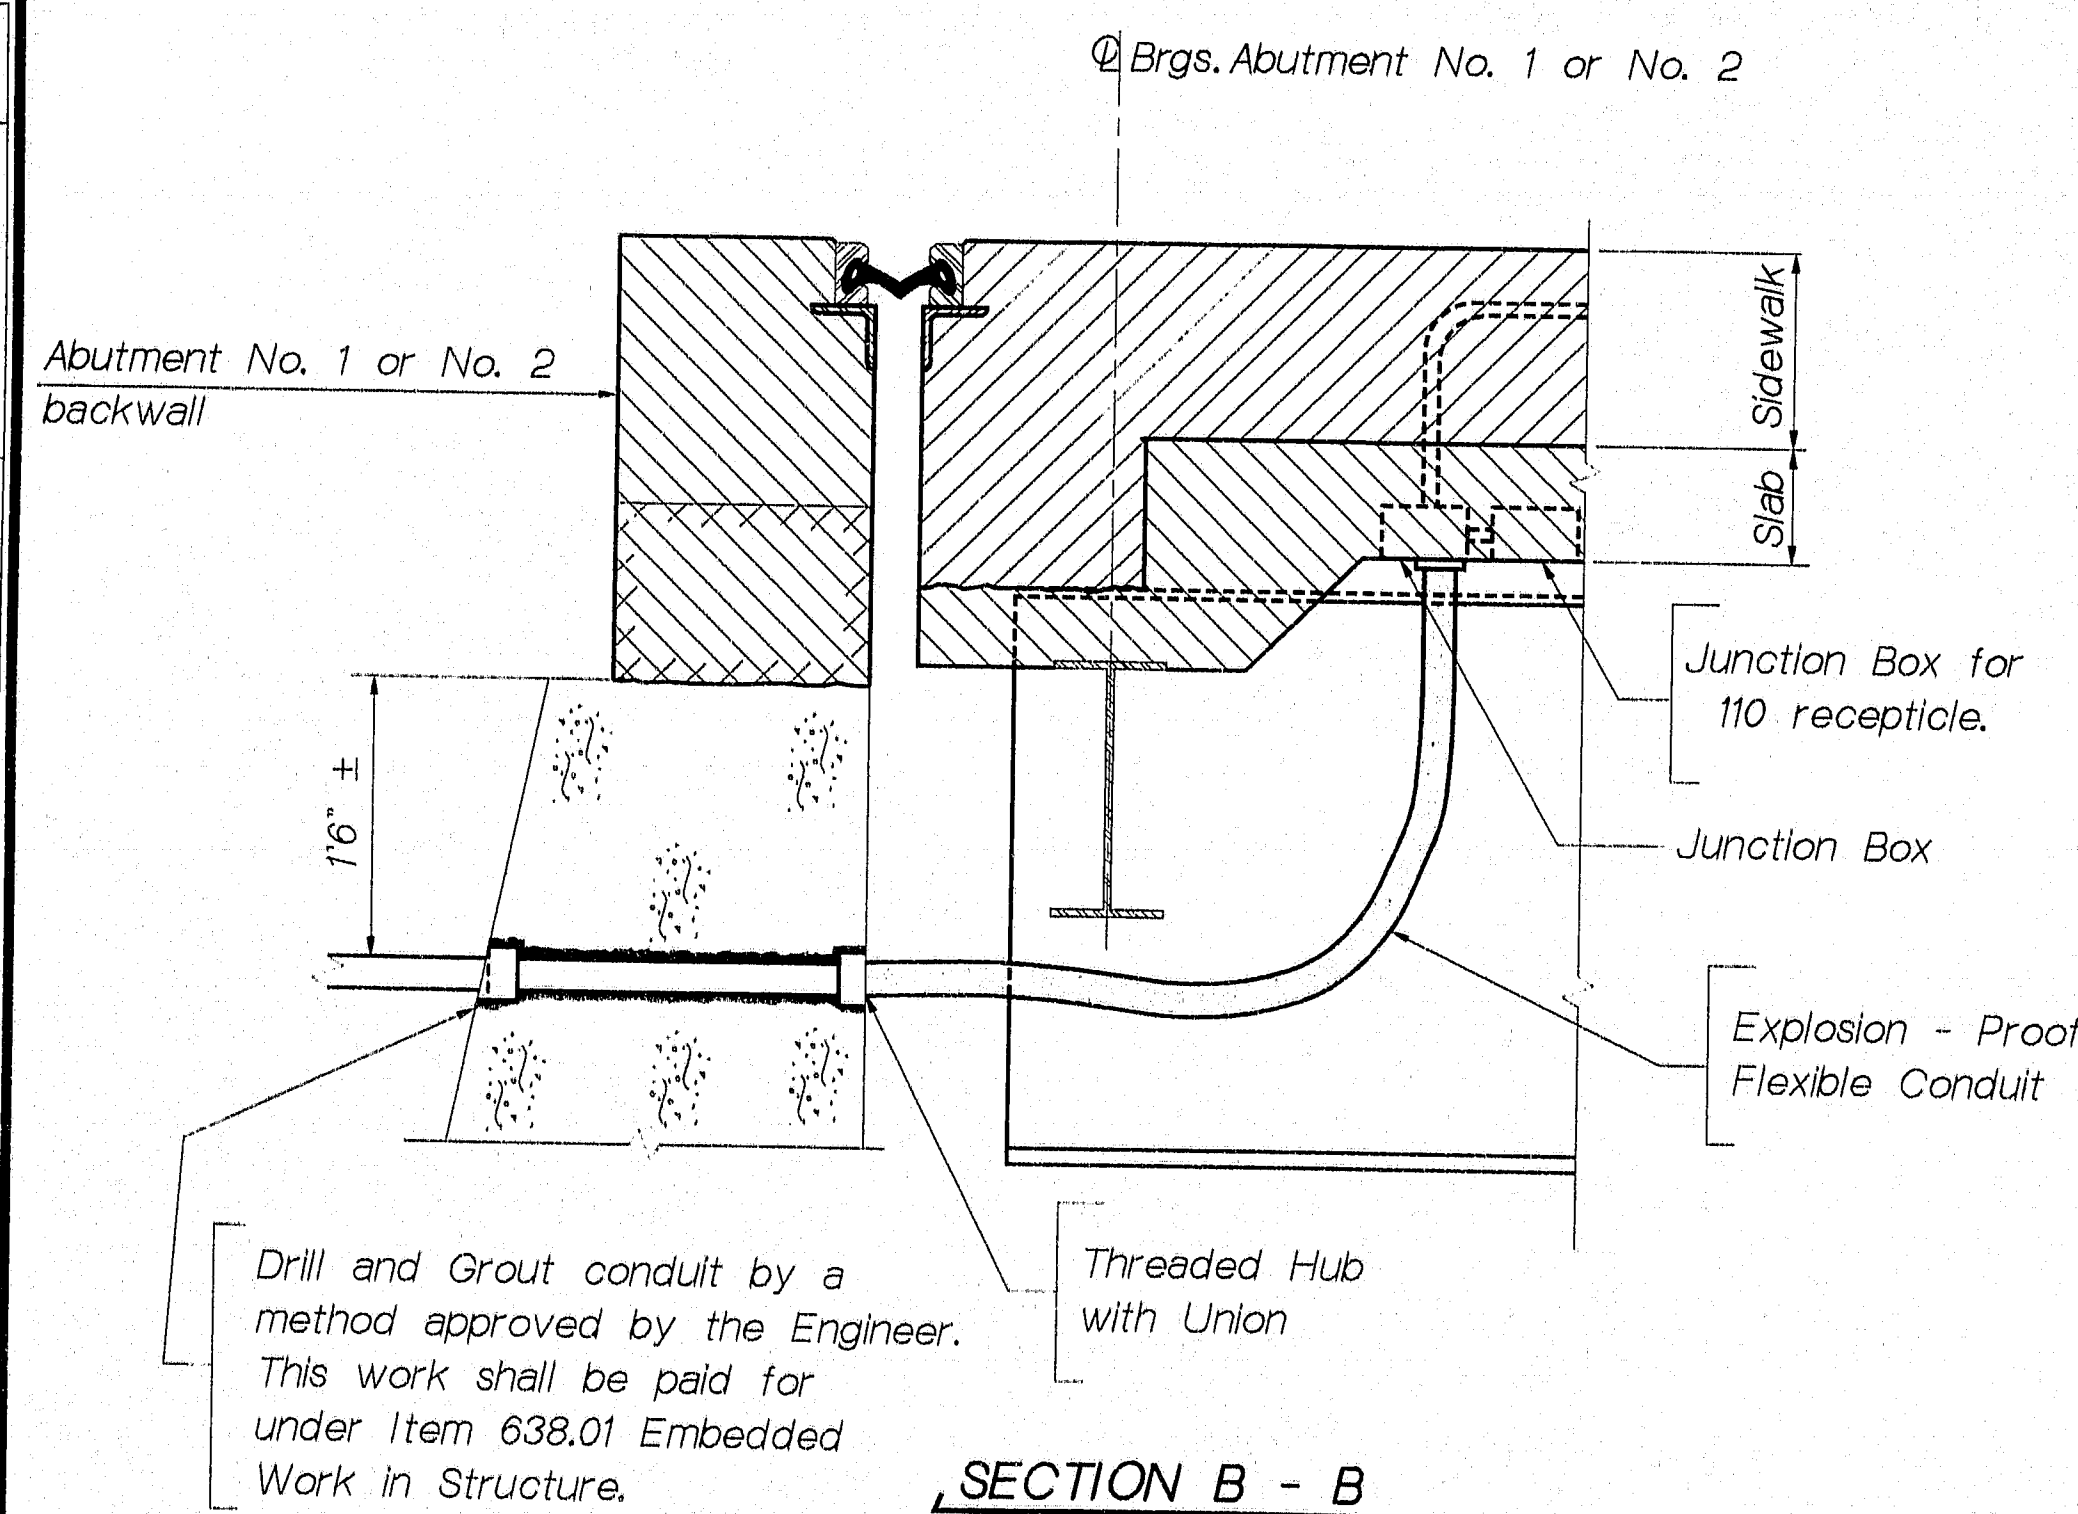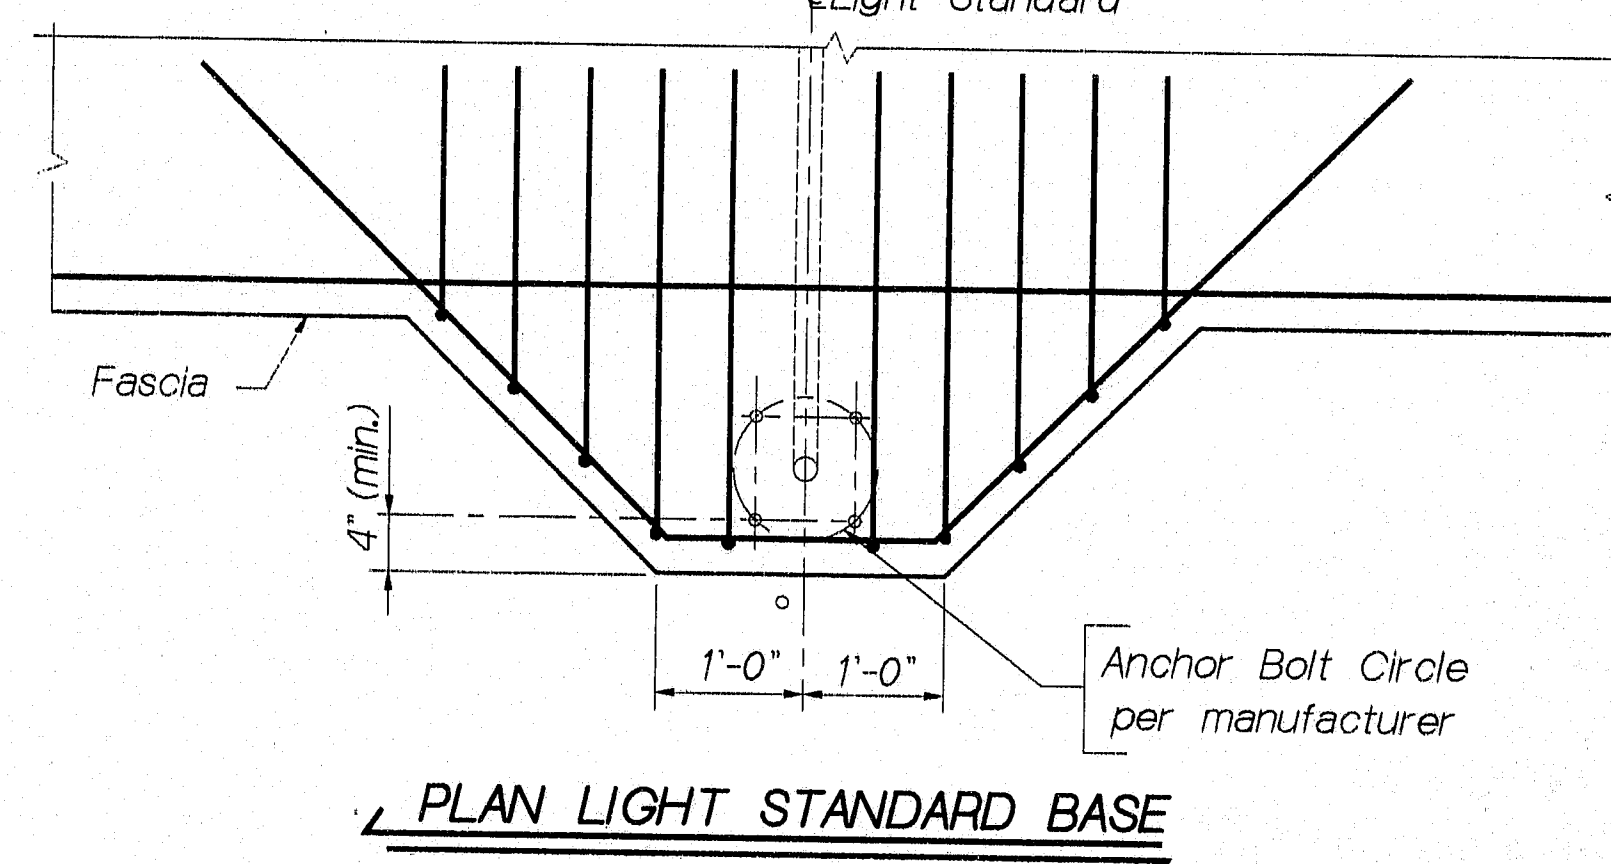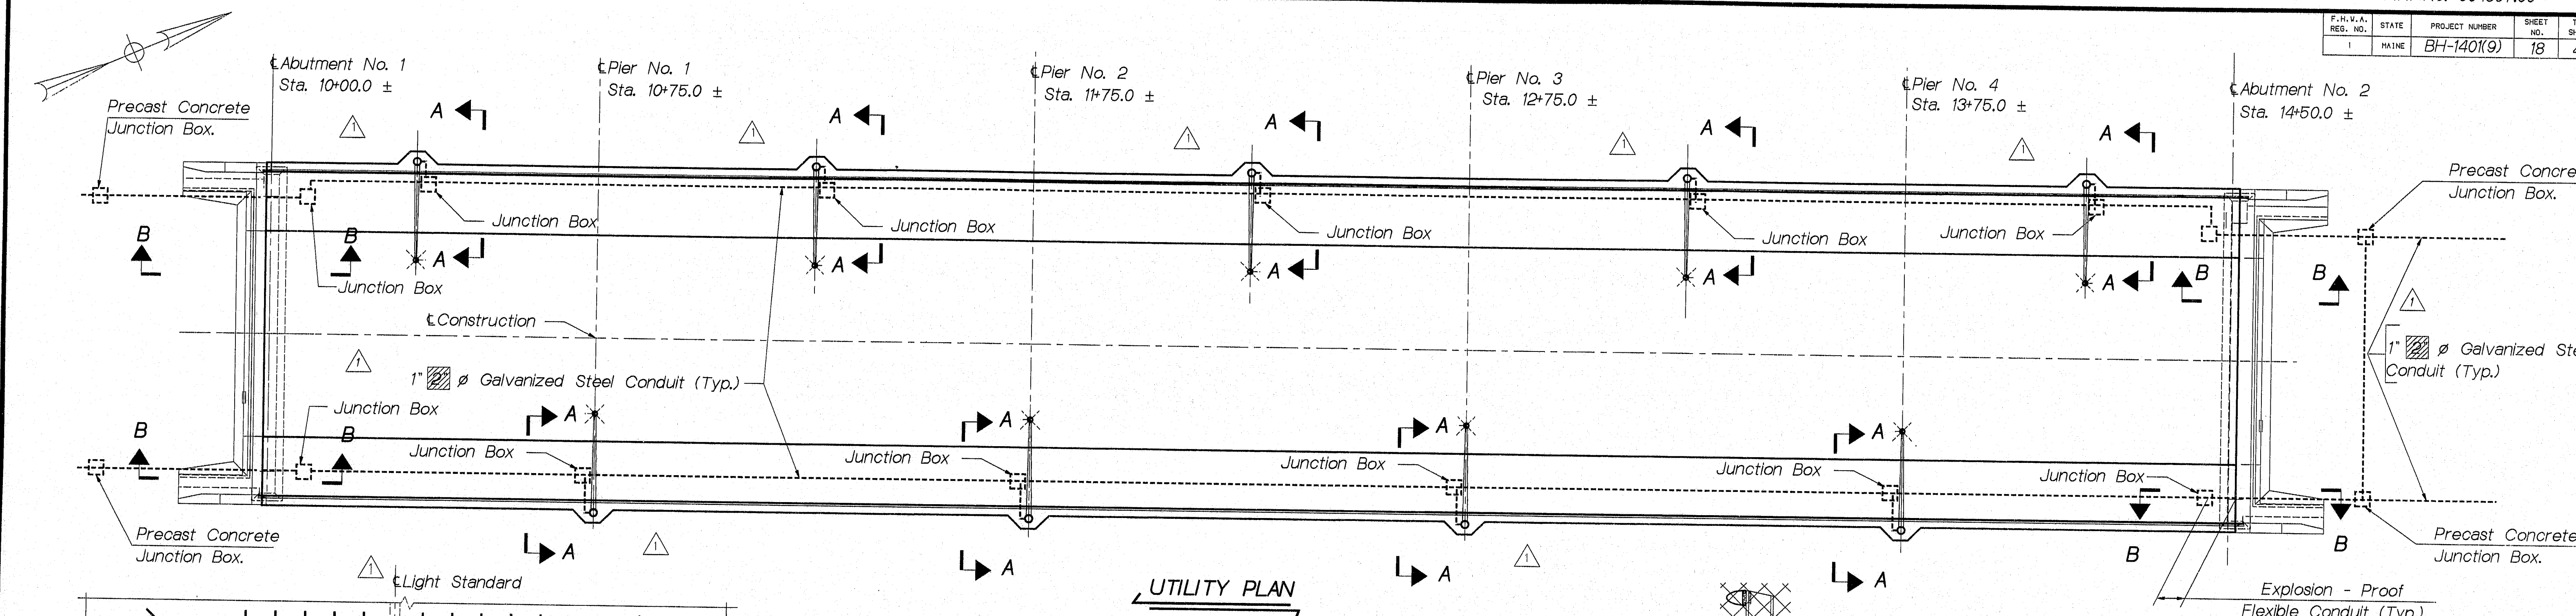

UTILITY NOTES

- 1) The utilities involved in this contract are as follows:
Bangor Hydro - Electric Company.
New England Telephone Company.
Cable Vision Inc.
Orono Veazie Water District.
Town of Orono Sewer
- 2) The Contractor shall install the utilities in the sidewalk however, the utilities will provide all necessary hardware required for installation. Installing conduits and related hardware will not be paid for directly but shall be considered incidental to the various contract items.
- 3) Telephone conduits hanging from diaphragms will be provided and installed by utility.
- 4) Exact location of utilities will be determined in field by the Engineer.
- 5) The existing gas pipe in the upstream sidewalk of the bridge and within 10' ± of the abutment backwalls shall be removed by the Contractor. The exact limit of removal shall be determined by the Engineer. The ends of the gas pipe are to be sealed by a method approved by the Engineer. The fire department shall be notified 48 hours in advance before work is begun. The Contractor shall provide certification that the gas pipe has been purged to the fire department. The removal of the gas pipe will not be paid for directly, but will be considered incidental to related contract items and shall become the property of the Contractor.

- 6) The existing telephone conduits shall be removed by the contractor and shall become the property of the Contractor. The removal of the telephone conduit will not be paid for directly, but will be considered incidental to related contract items.

Revisions as of 6/17/92

Revisions as of 5/9/92

STATE OF MAINE
DEPARTMENT OF TRANSPORTATION

FERRY HILL BRIDGE
OVER
STILLWATER RIVER
IN THE TOWN OF
ORONO
PENOBSCOT COUNTY
BRIDGE LIGHTING


SHEET 18 OF 43 AUGUSTA, MAINE March, 1992





PROJECT ENGINEER	DATE
BY	2/92
DESIGN-DETAILED	2/92
REVISIONS	5/9/92
FIELD CHANGES	

22JUN92-010040

PLANS	DESIGN-DETAILED	<i>KJ</i>	<i>R.J.Nimmon</i>	<i>1/92</i>
	CHECKED			
	REVISIONS		<i>R.J.Nimmon</i>	<i>5/92</i>
	FIELD CHANGES			

BI ANIC

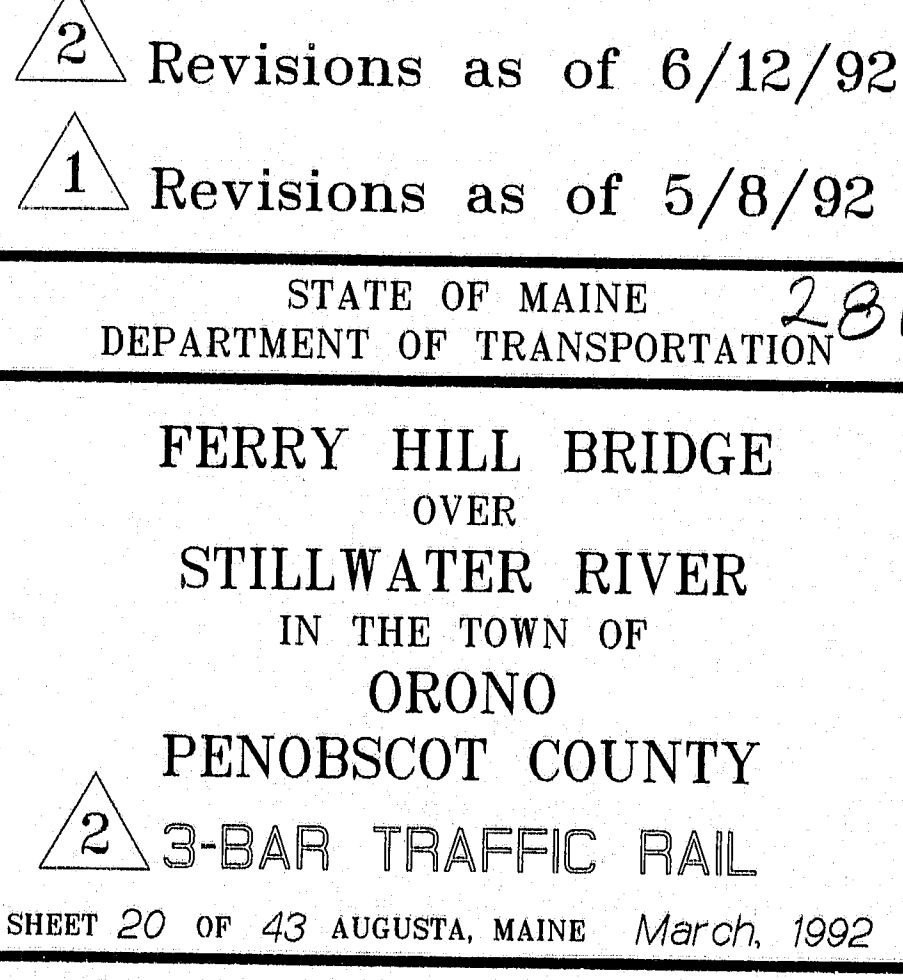

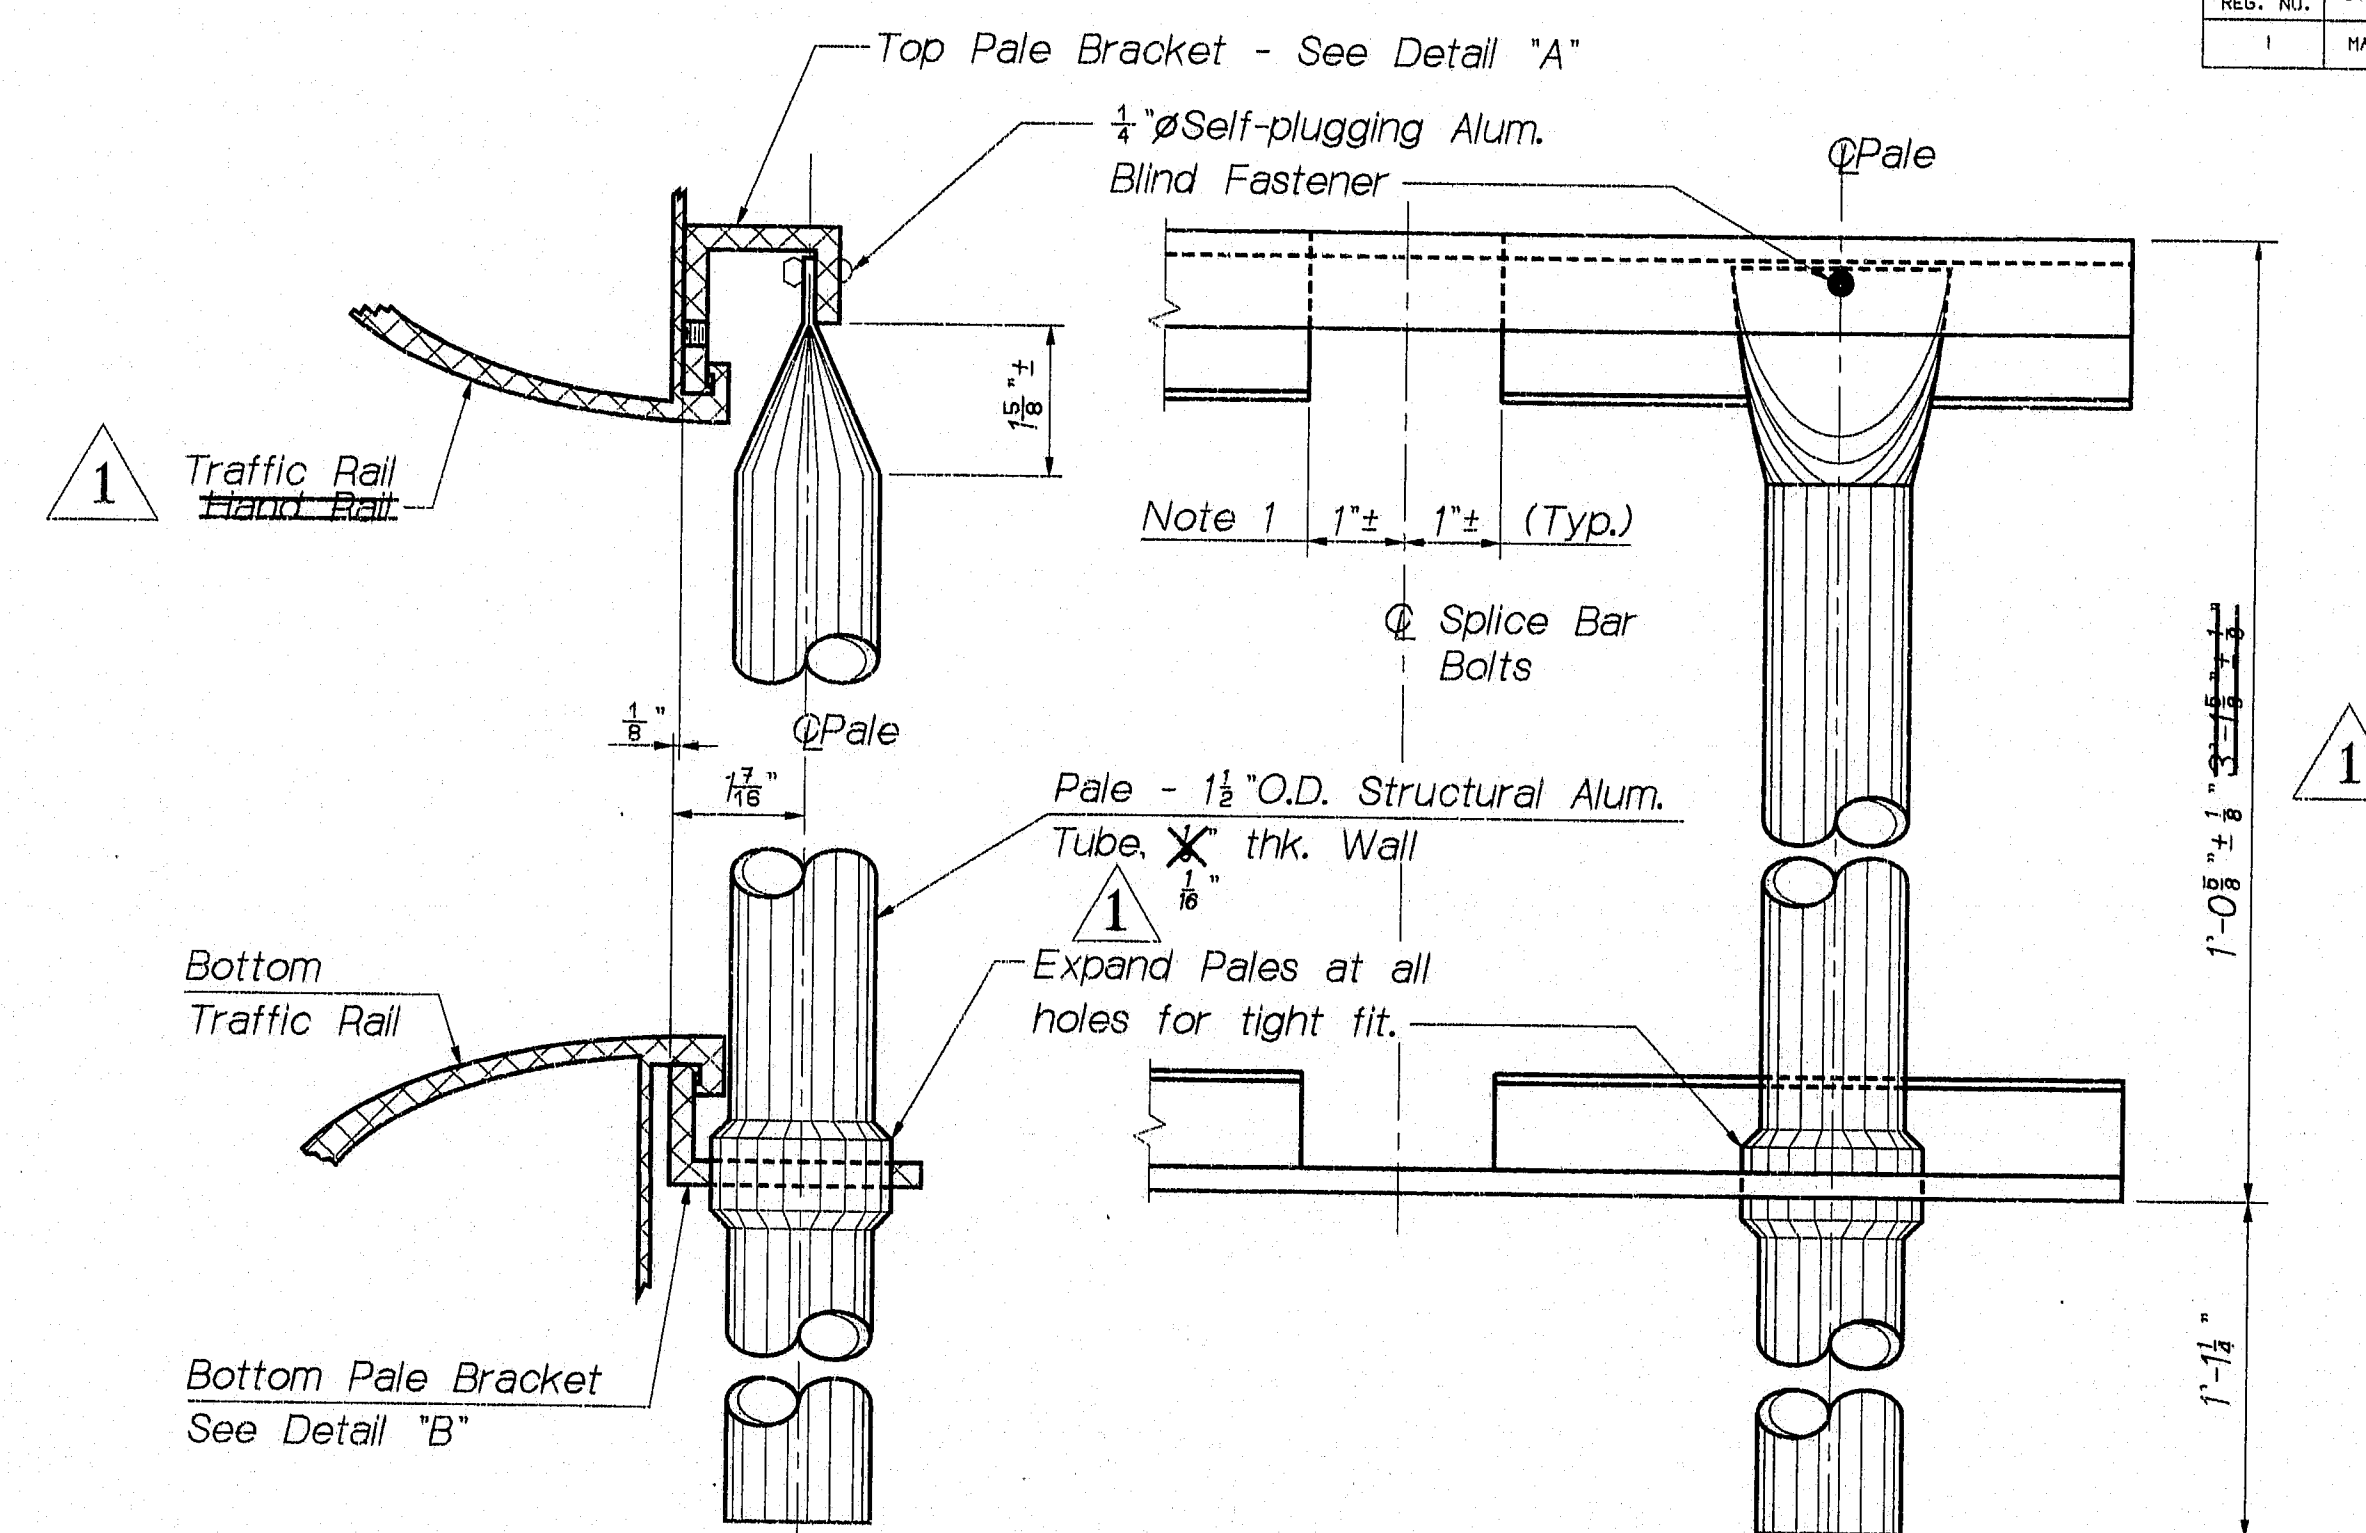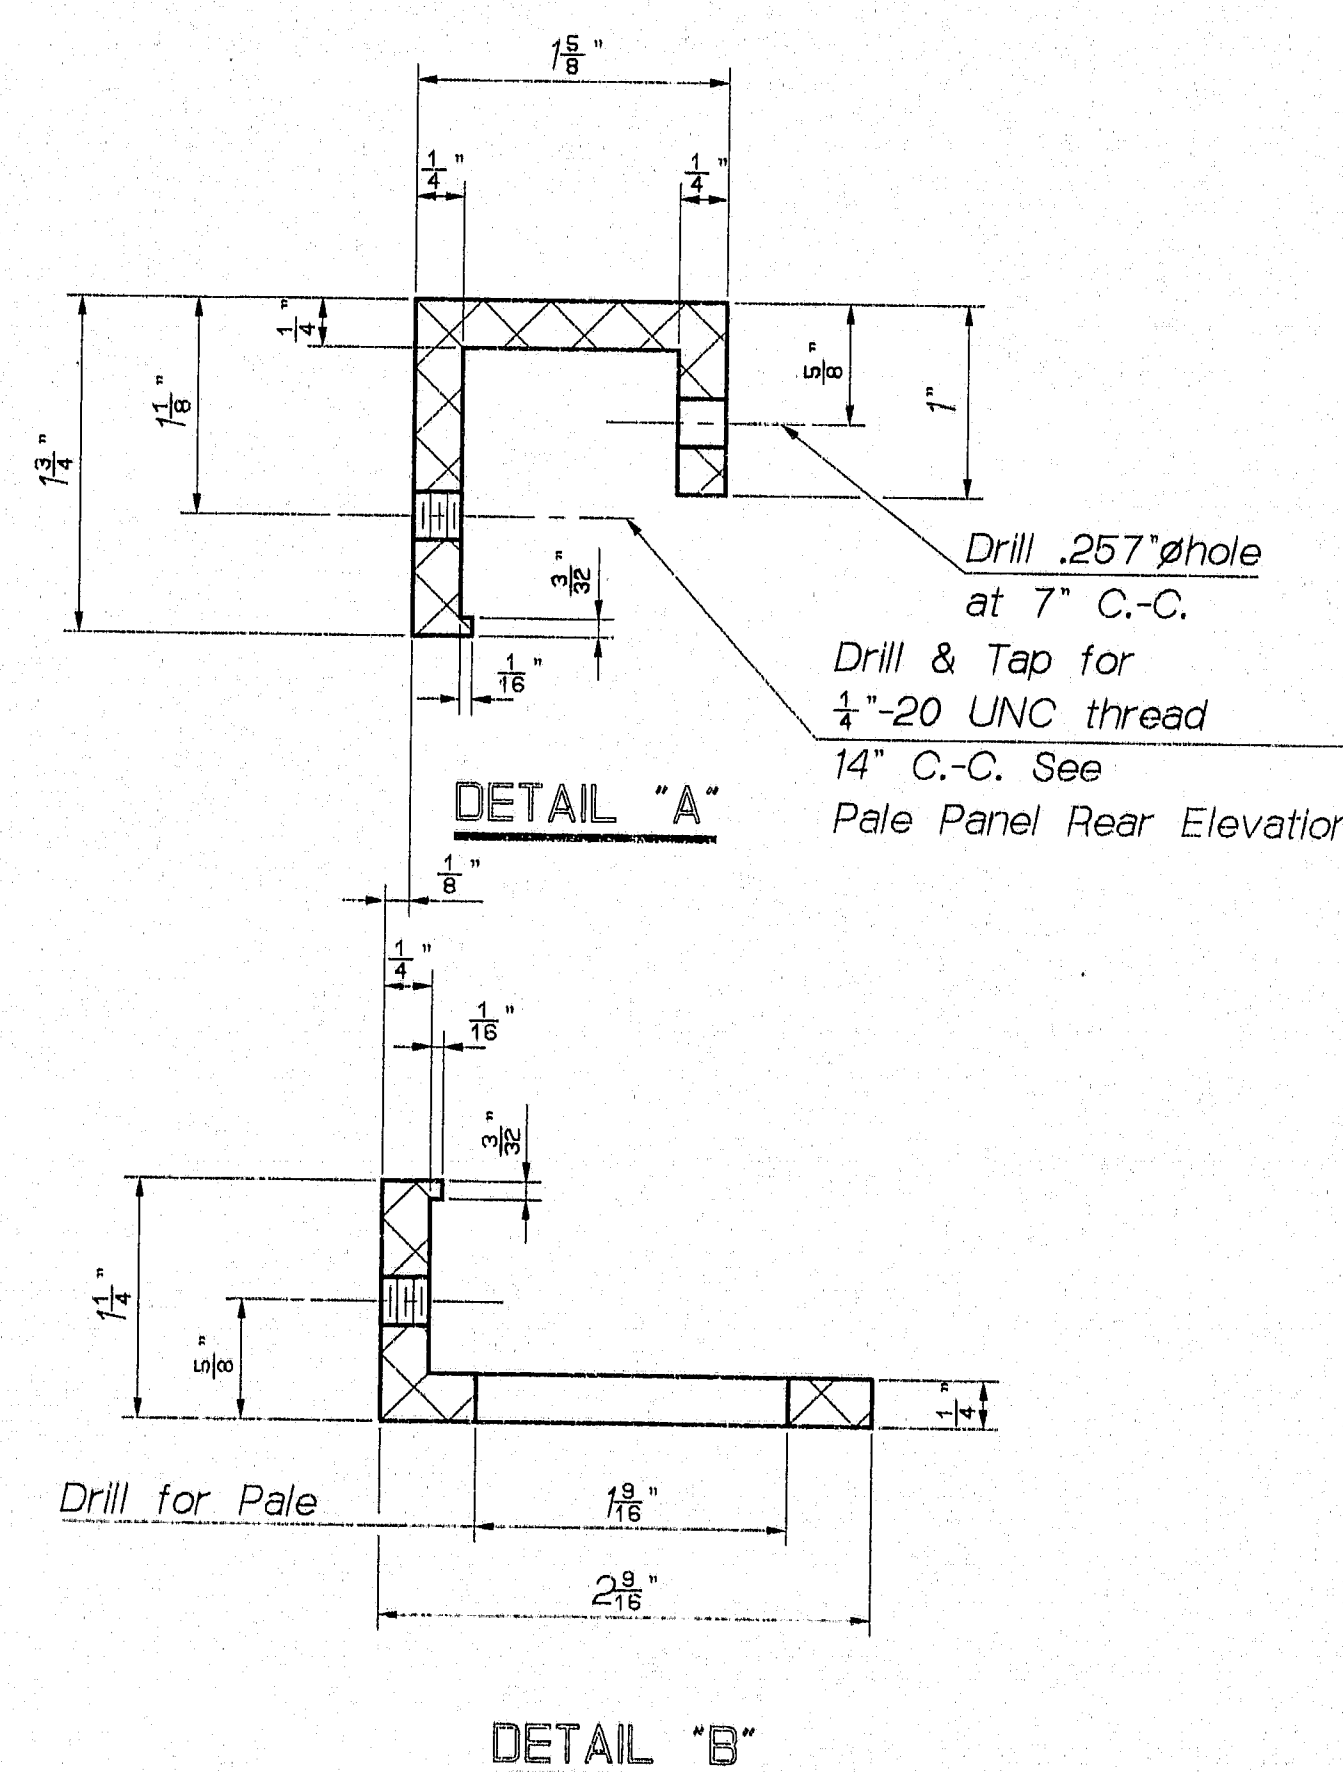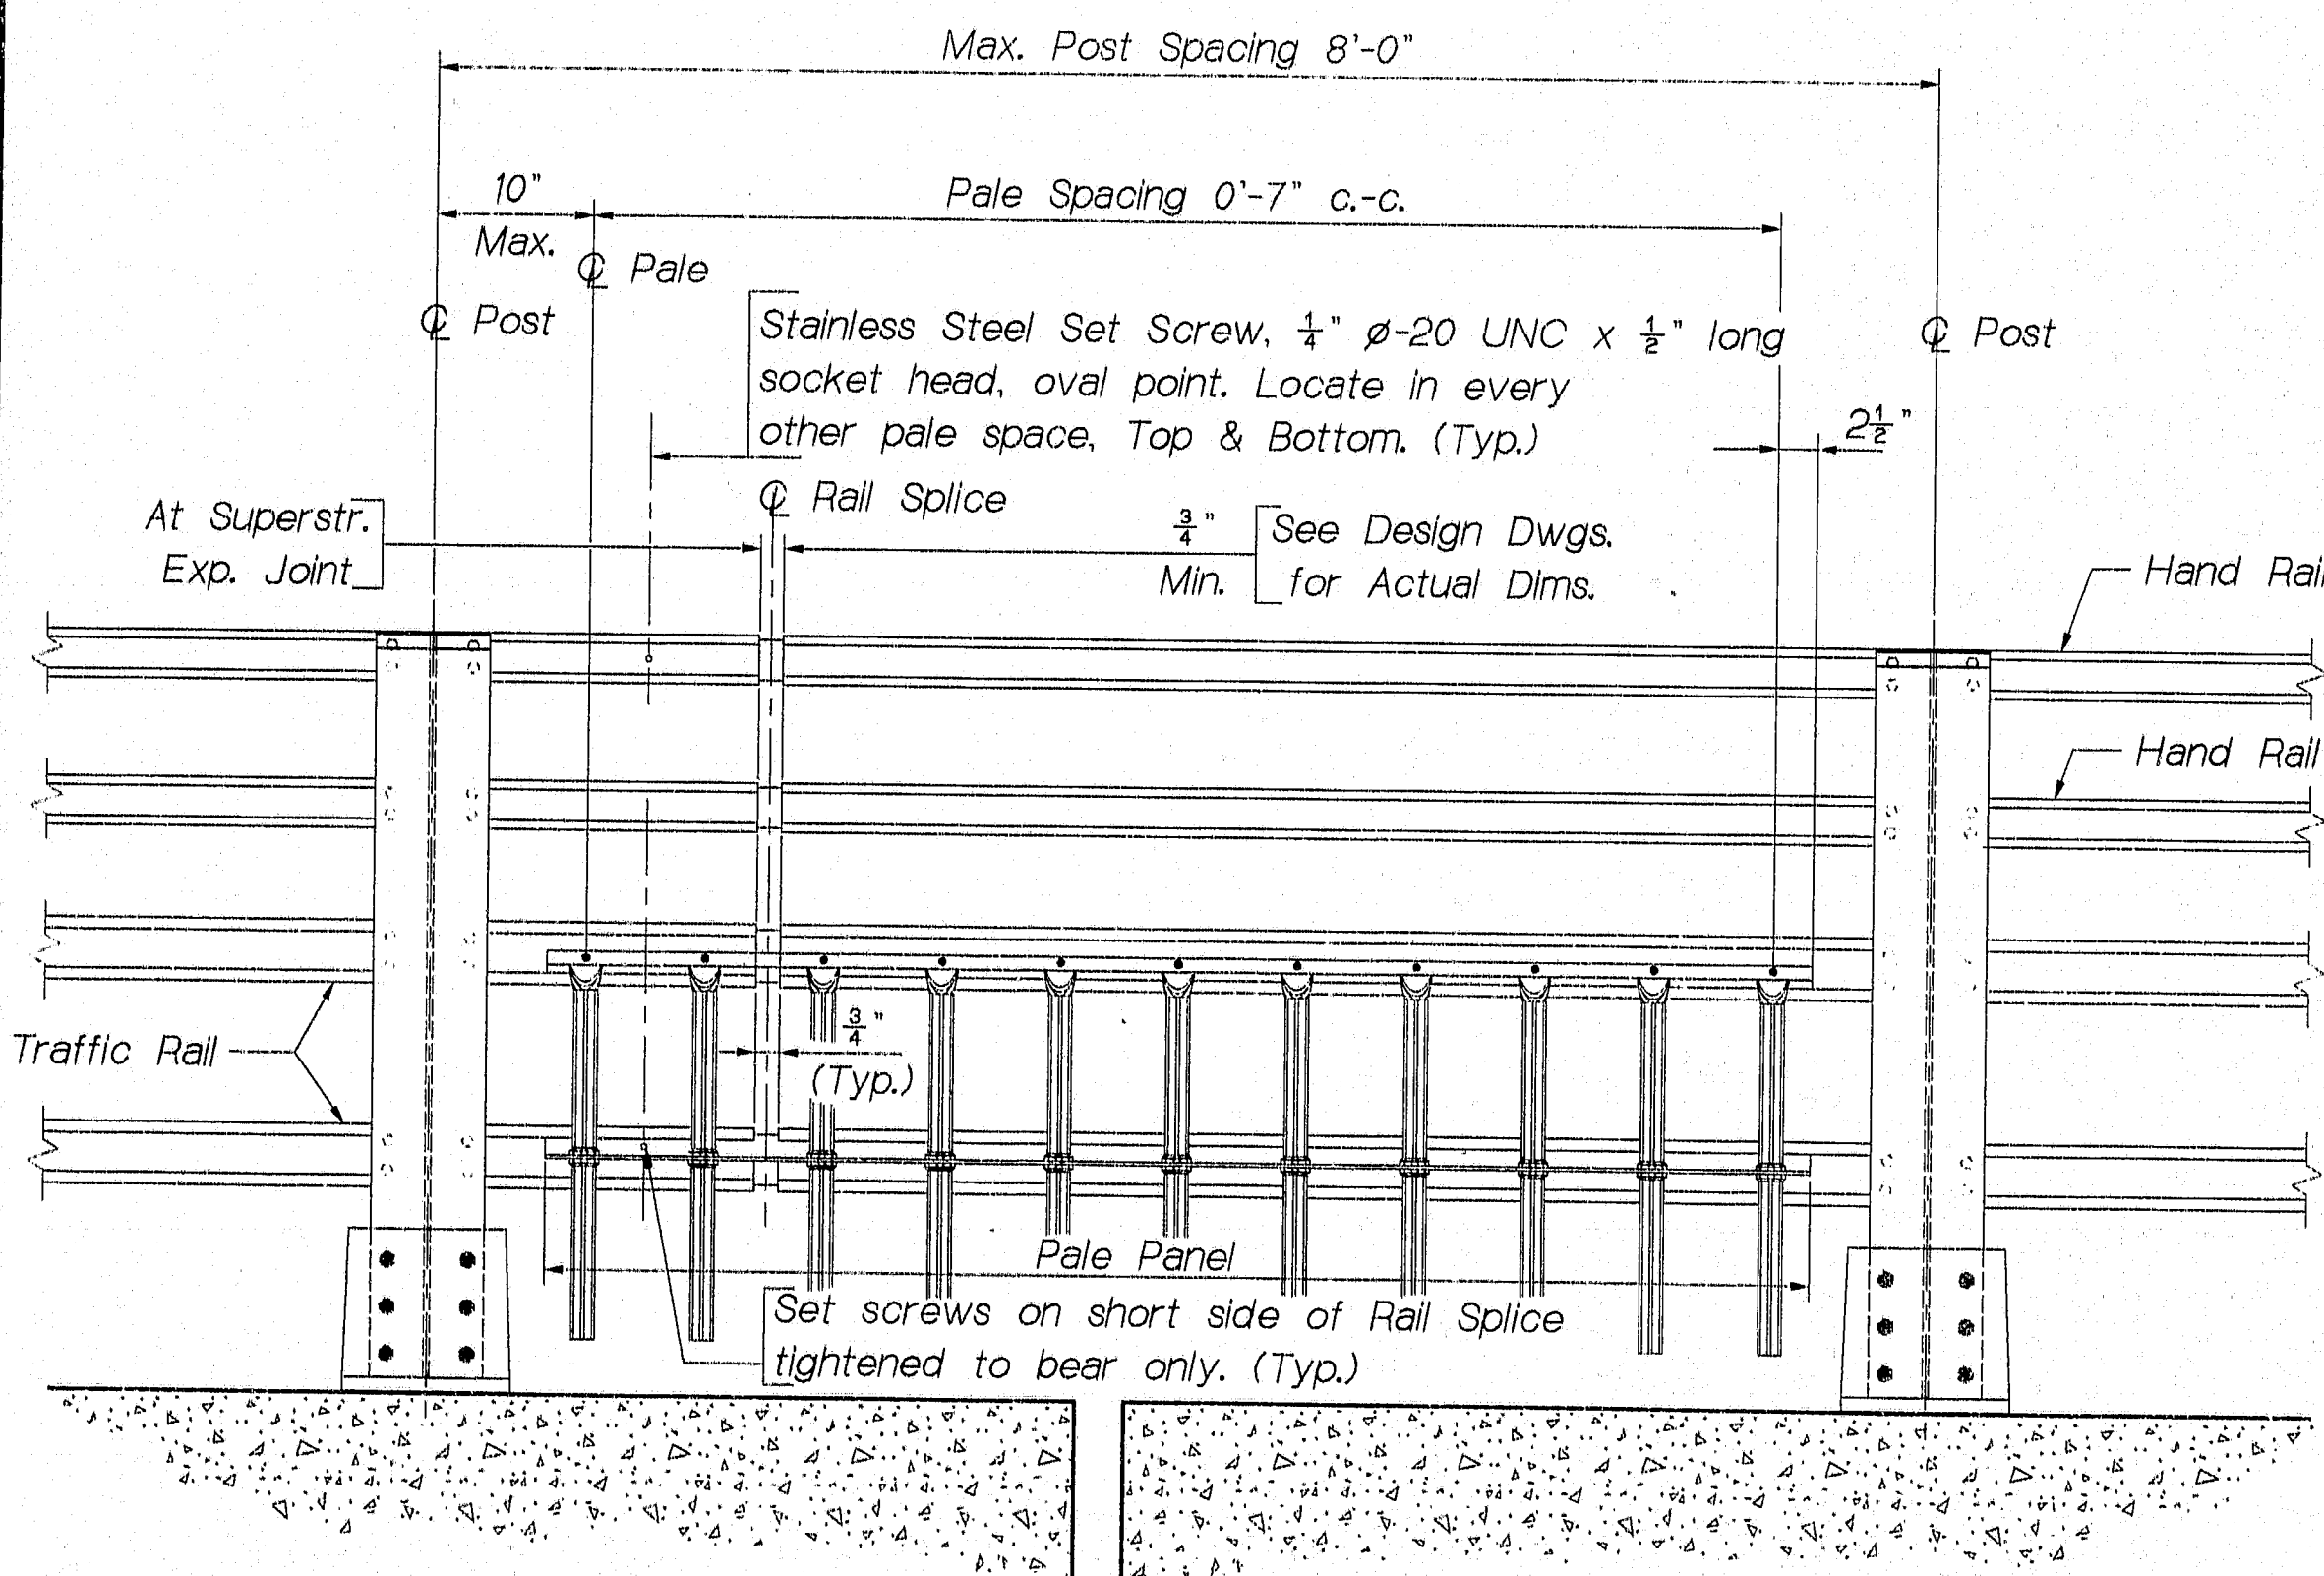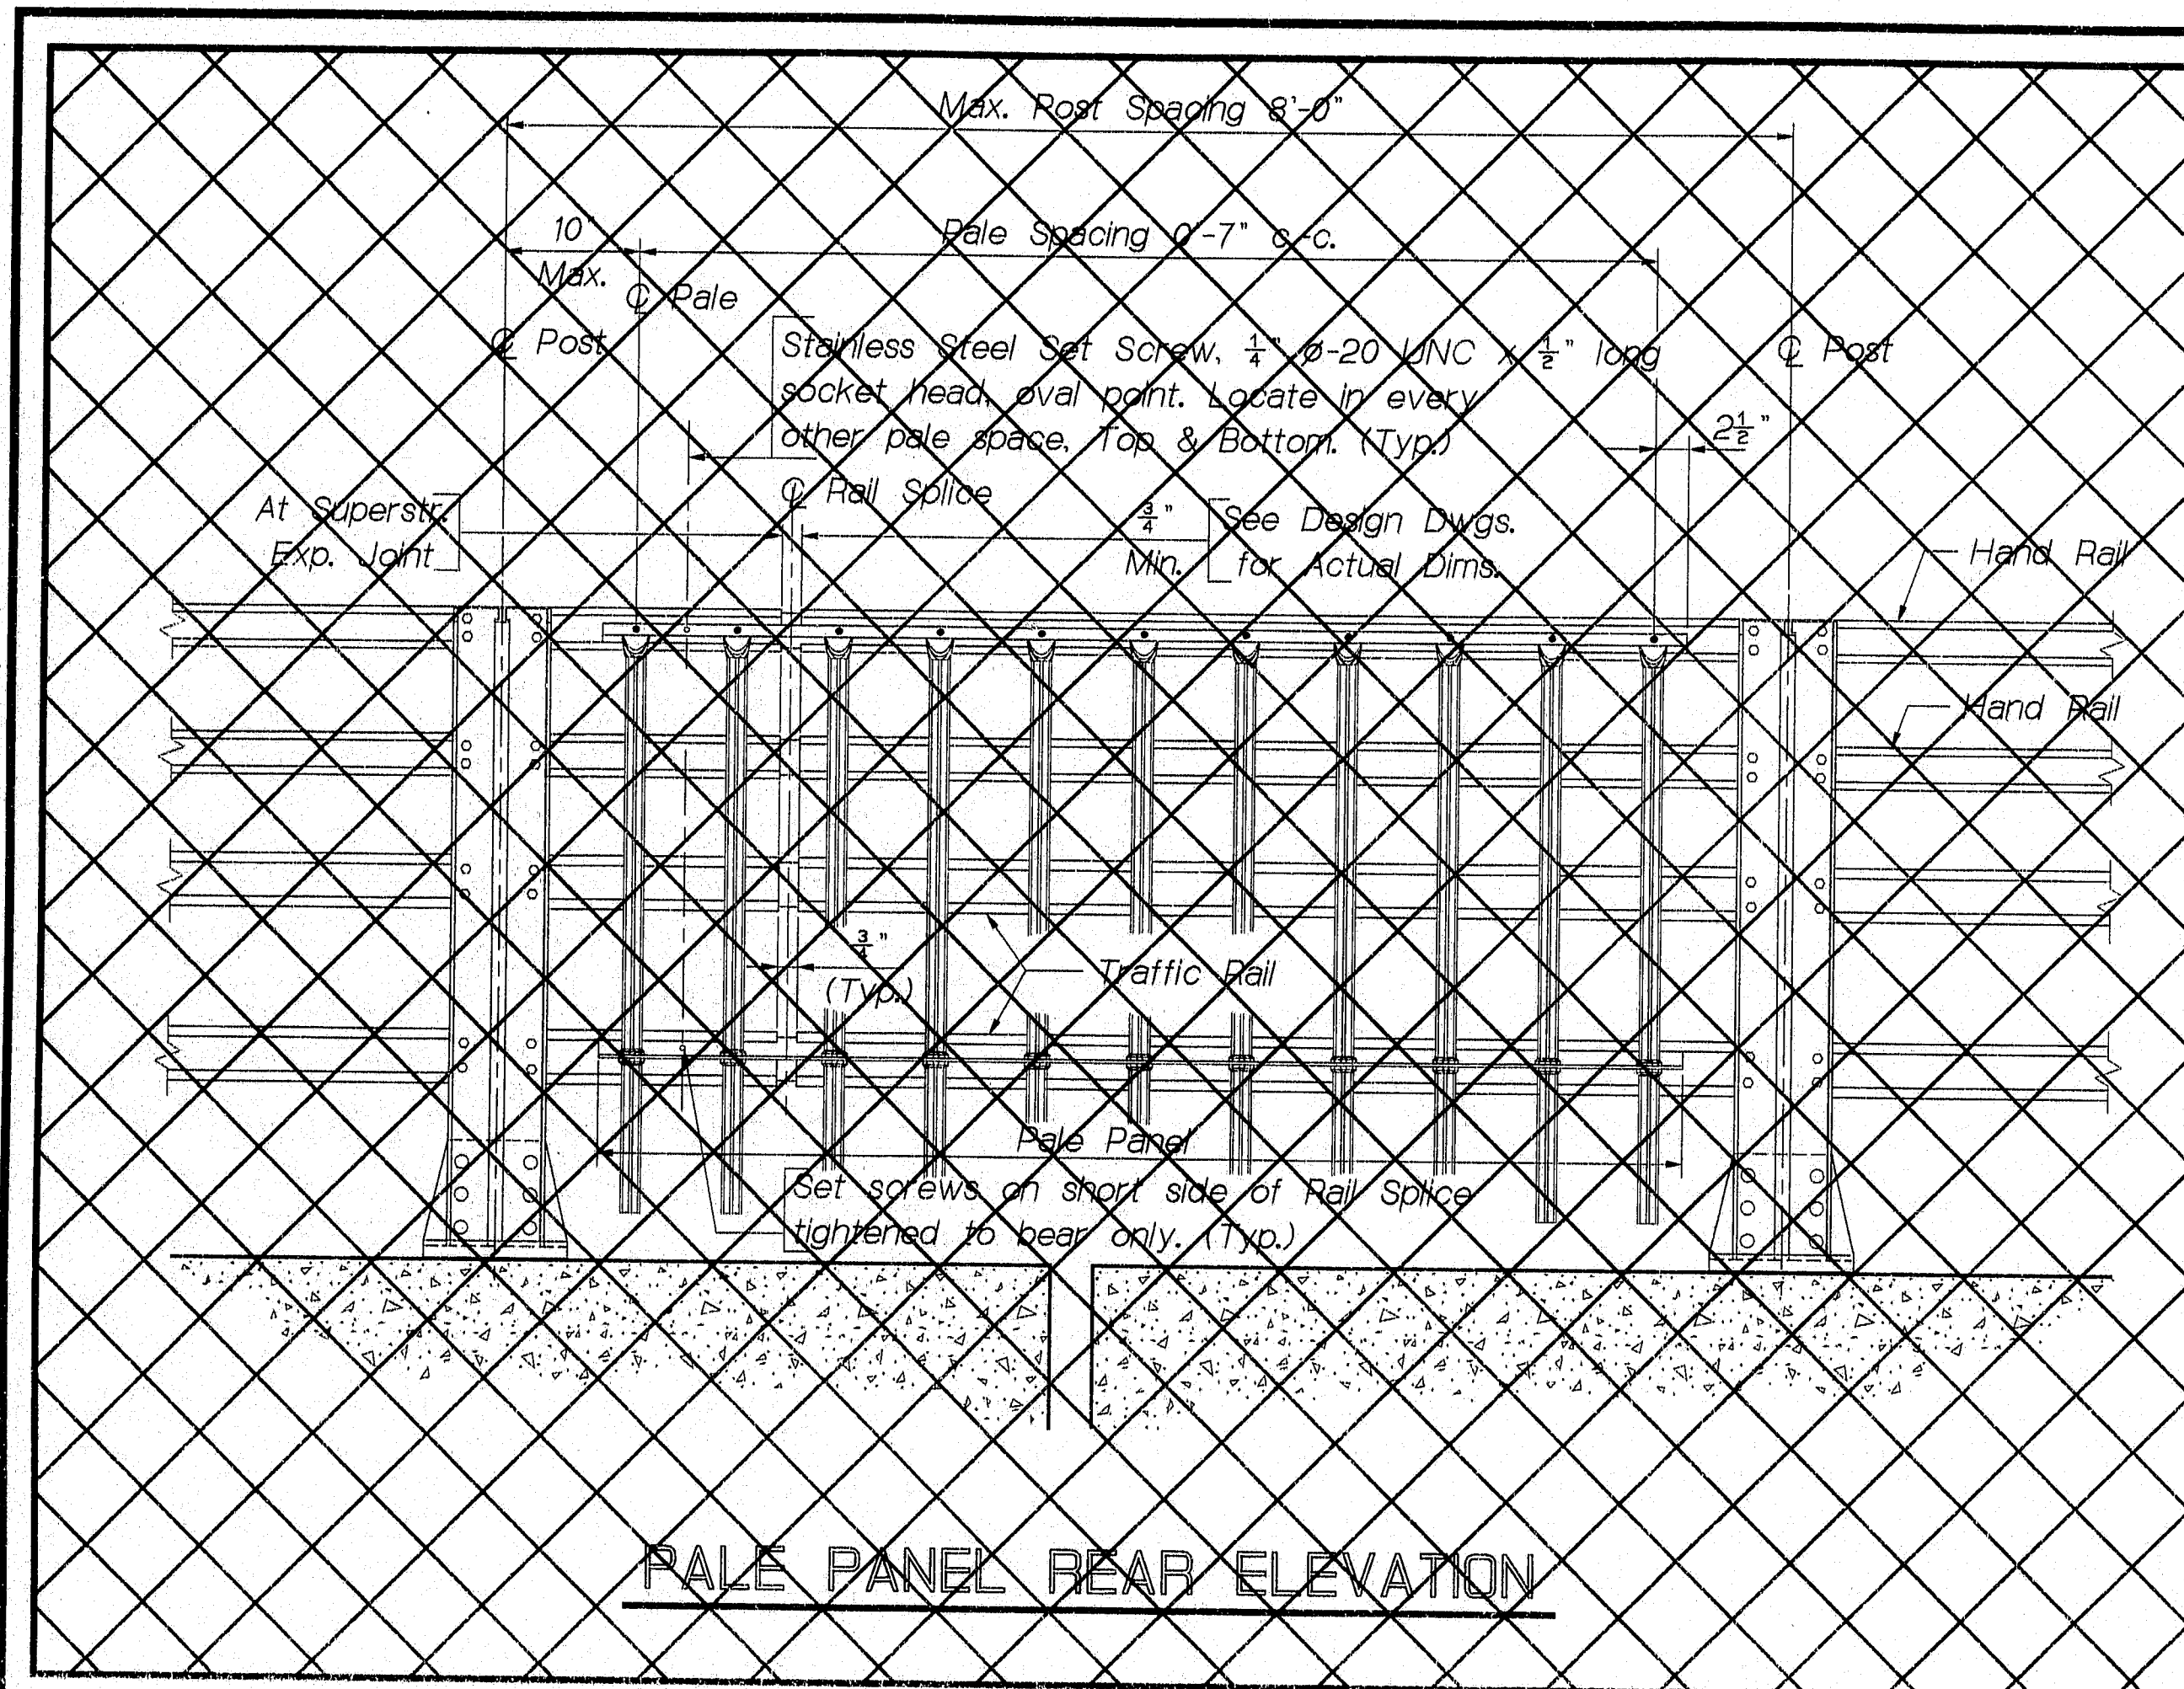

NOTE 1. Remove vertical leg and horizontal leg of pale panel extrusions to a depth of 3/8" at all splice bar bolt locations.

109-59

1 Revisions as of 5/8/92

STATE OF MAINE
DEPARTMENT OF TRANSPORTATION





FERRY HILL BRIDGE
OVER
STILLWATER RIVER
IN THE TOWN OF
ORONO

PENOBSCOT COUNTY
PALE PANEL DETAILS



SHEET 21 OF 43 AUGUSTA, MAINE March, 1992

PROJECT DESIGN ENGINEER	DATE
BY R.J. Wason	1/92
CHECKED R.J. Wason	5/92
REVISIONS	
FIELD CHANGES	


13MA 92-0-00000

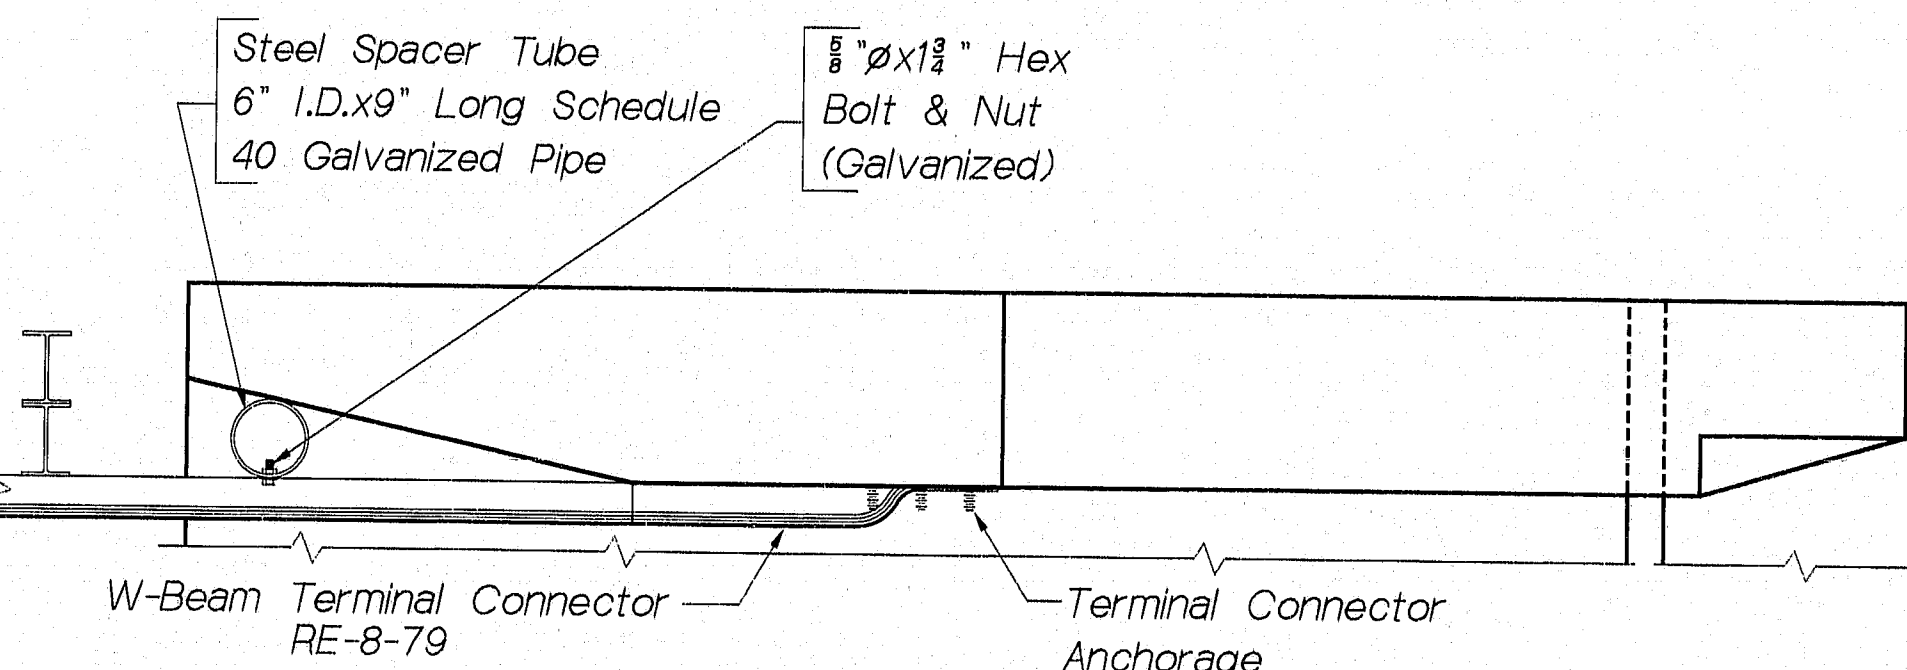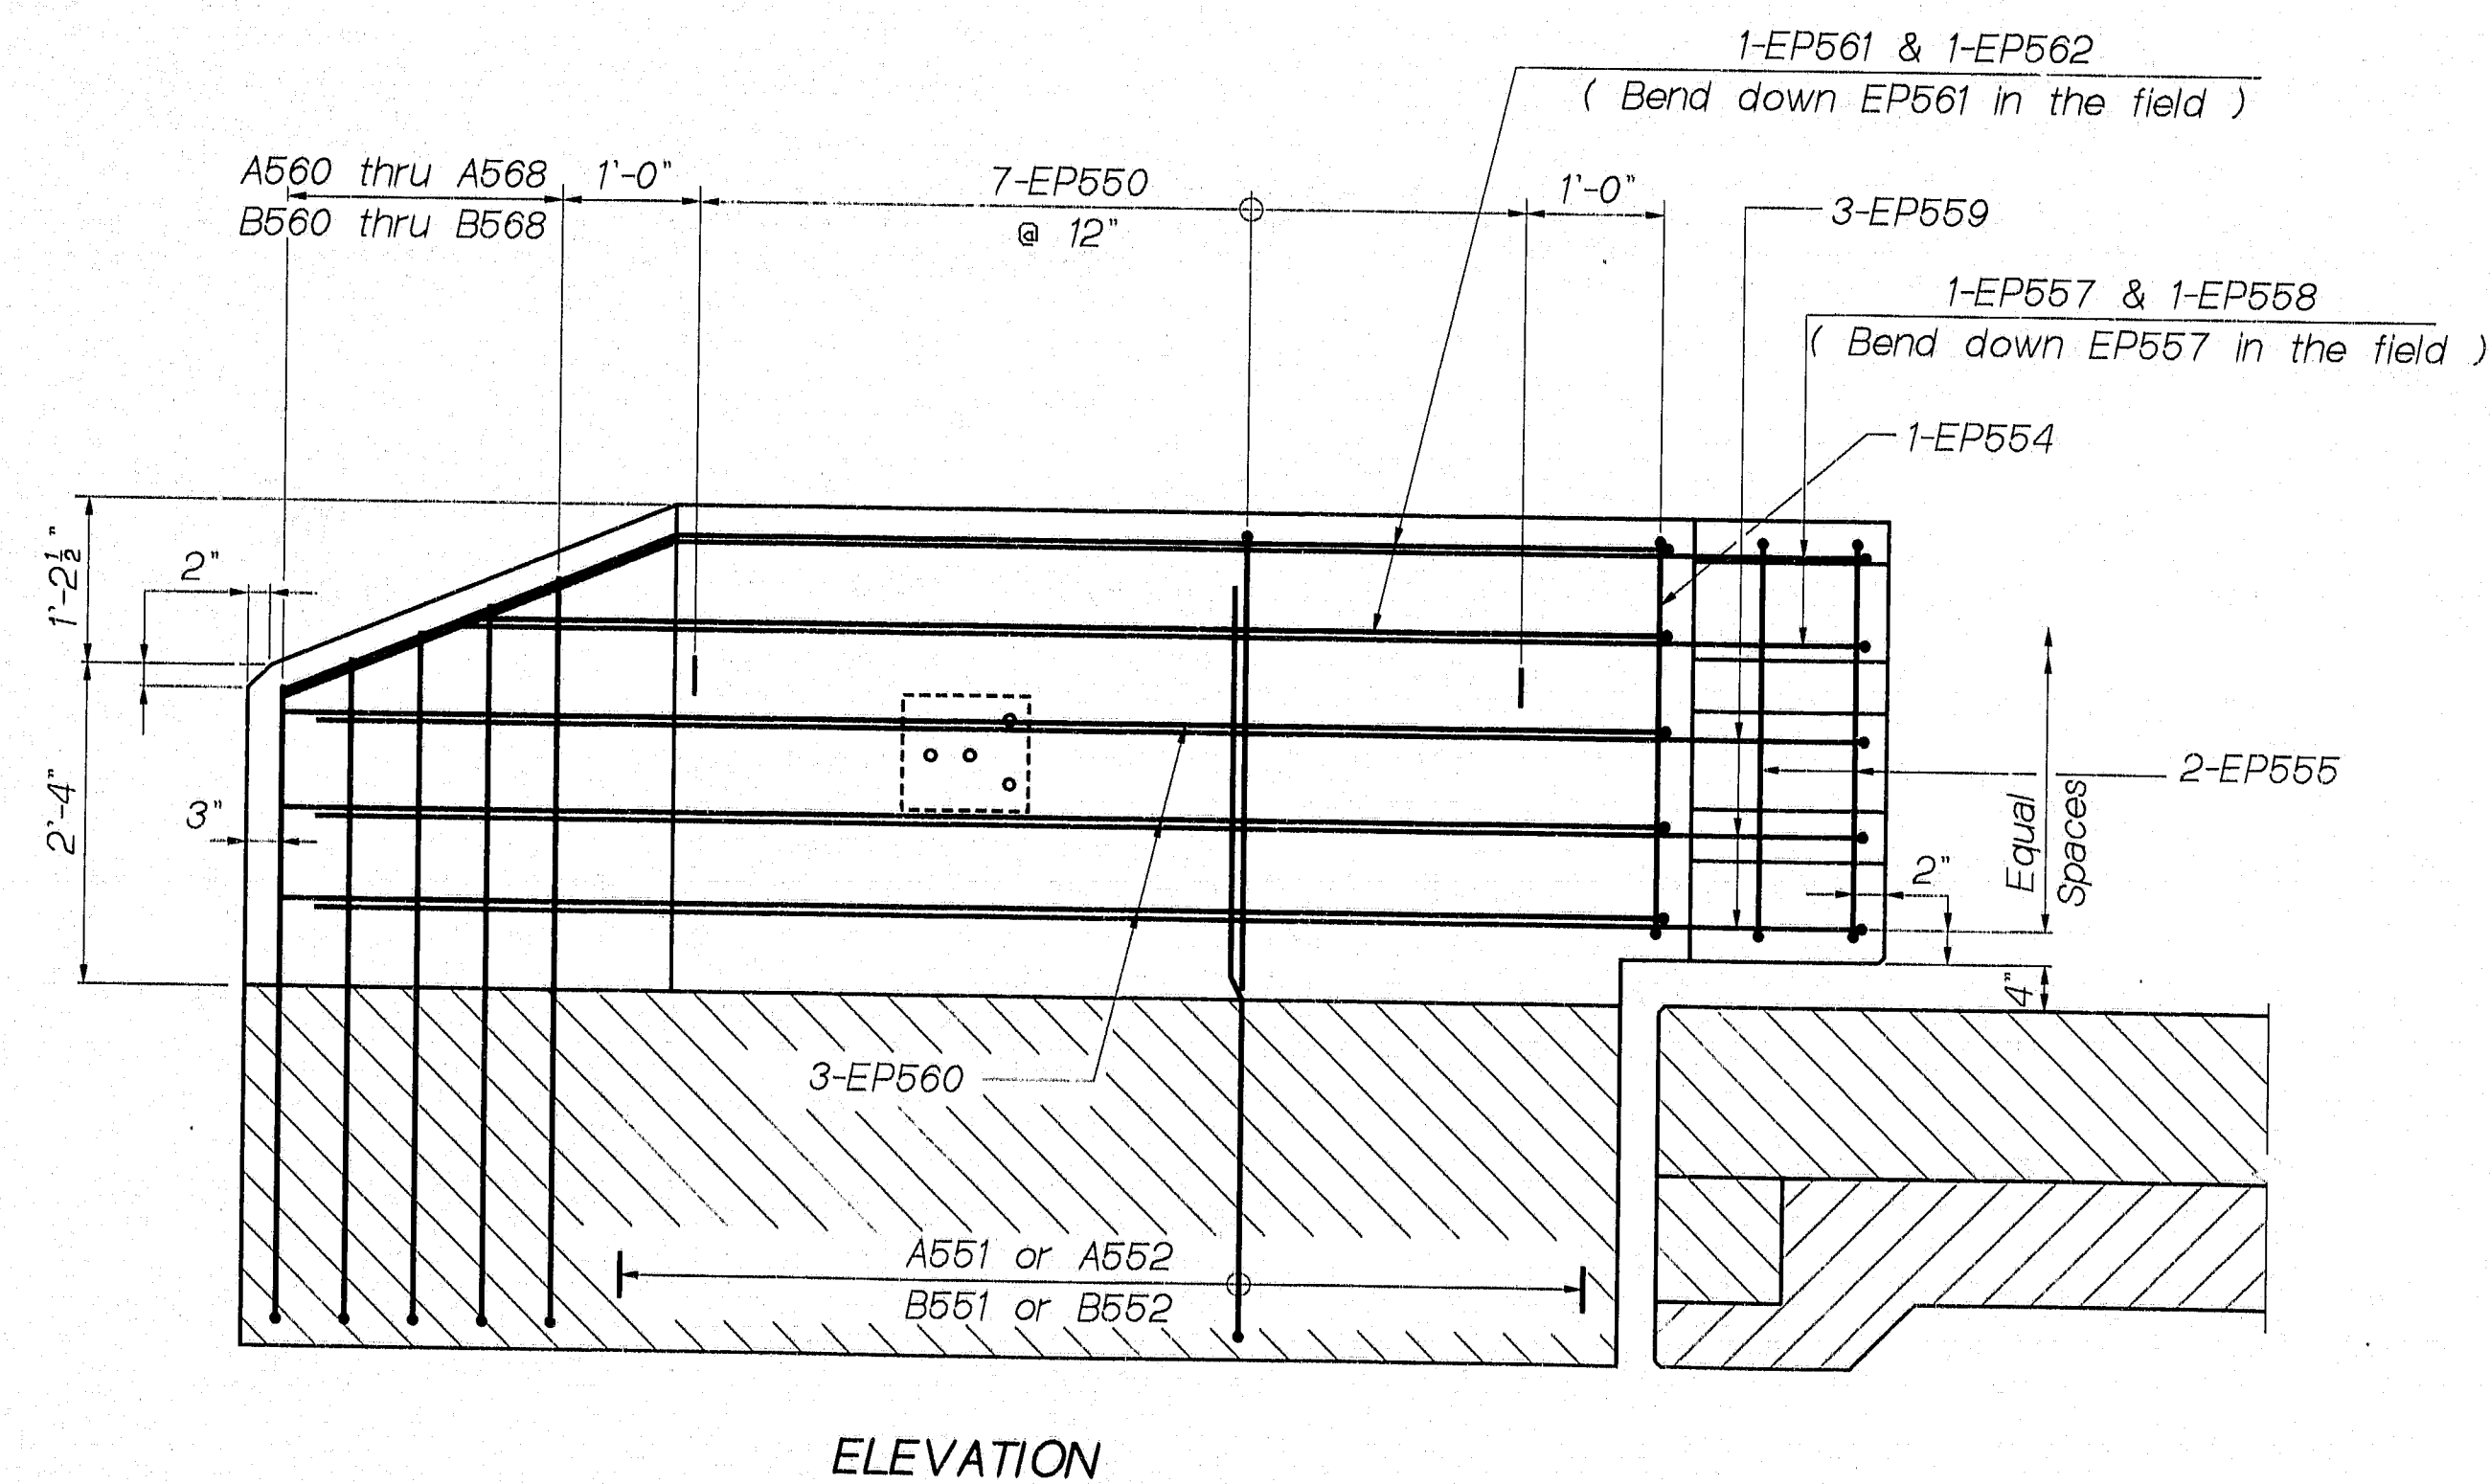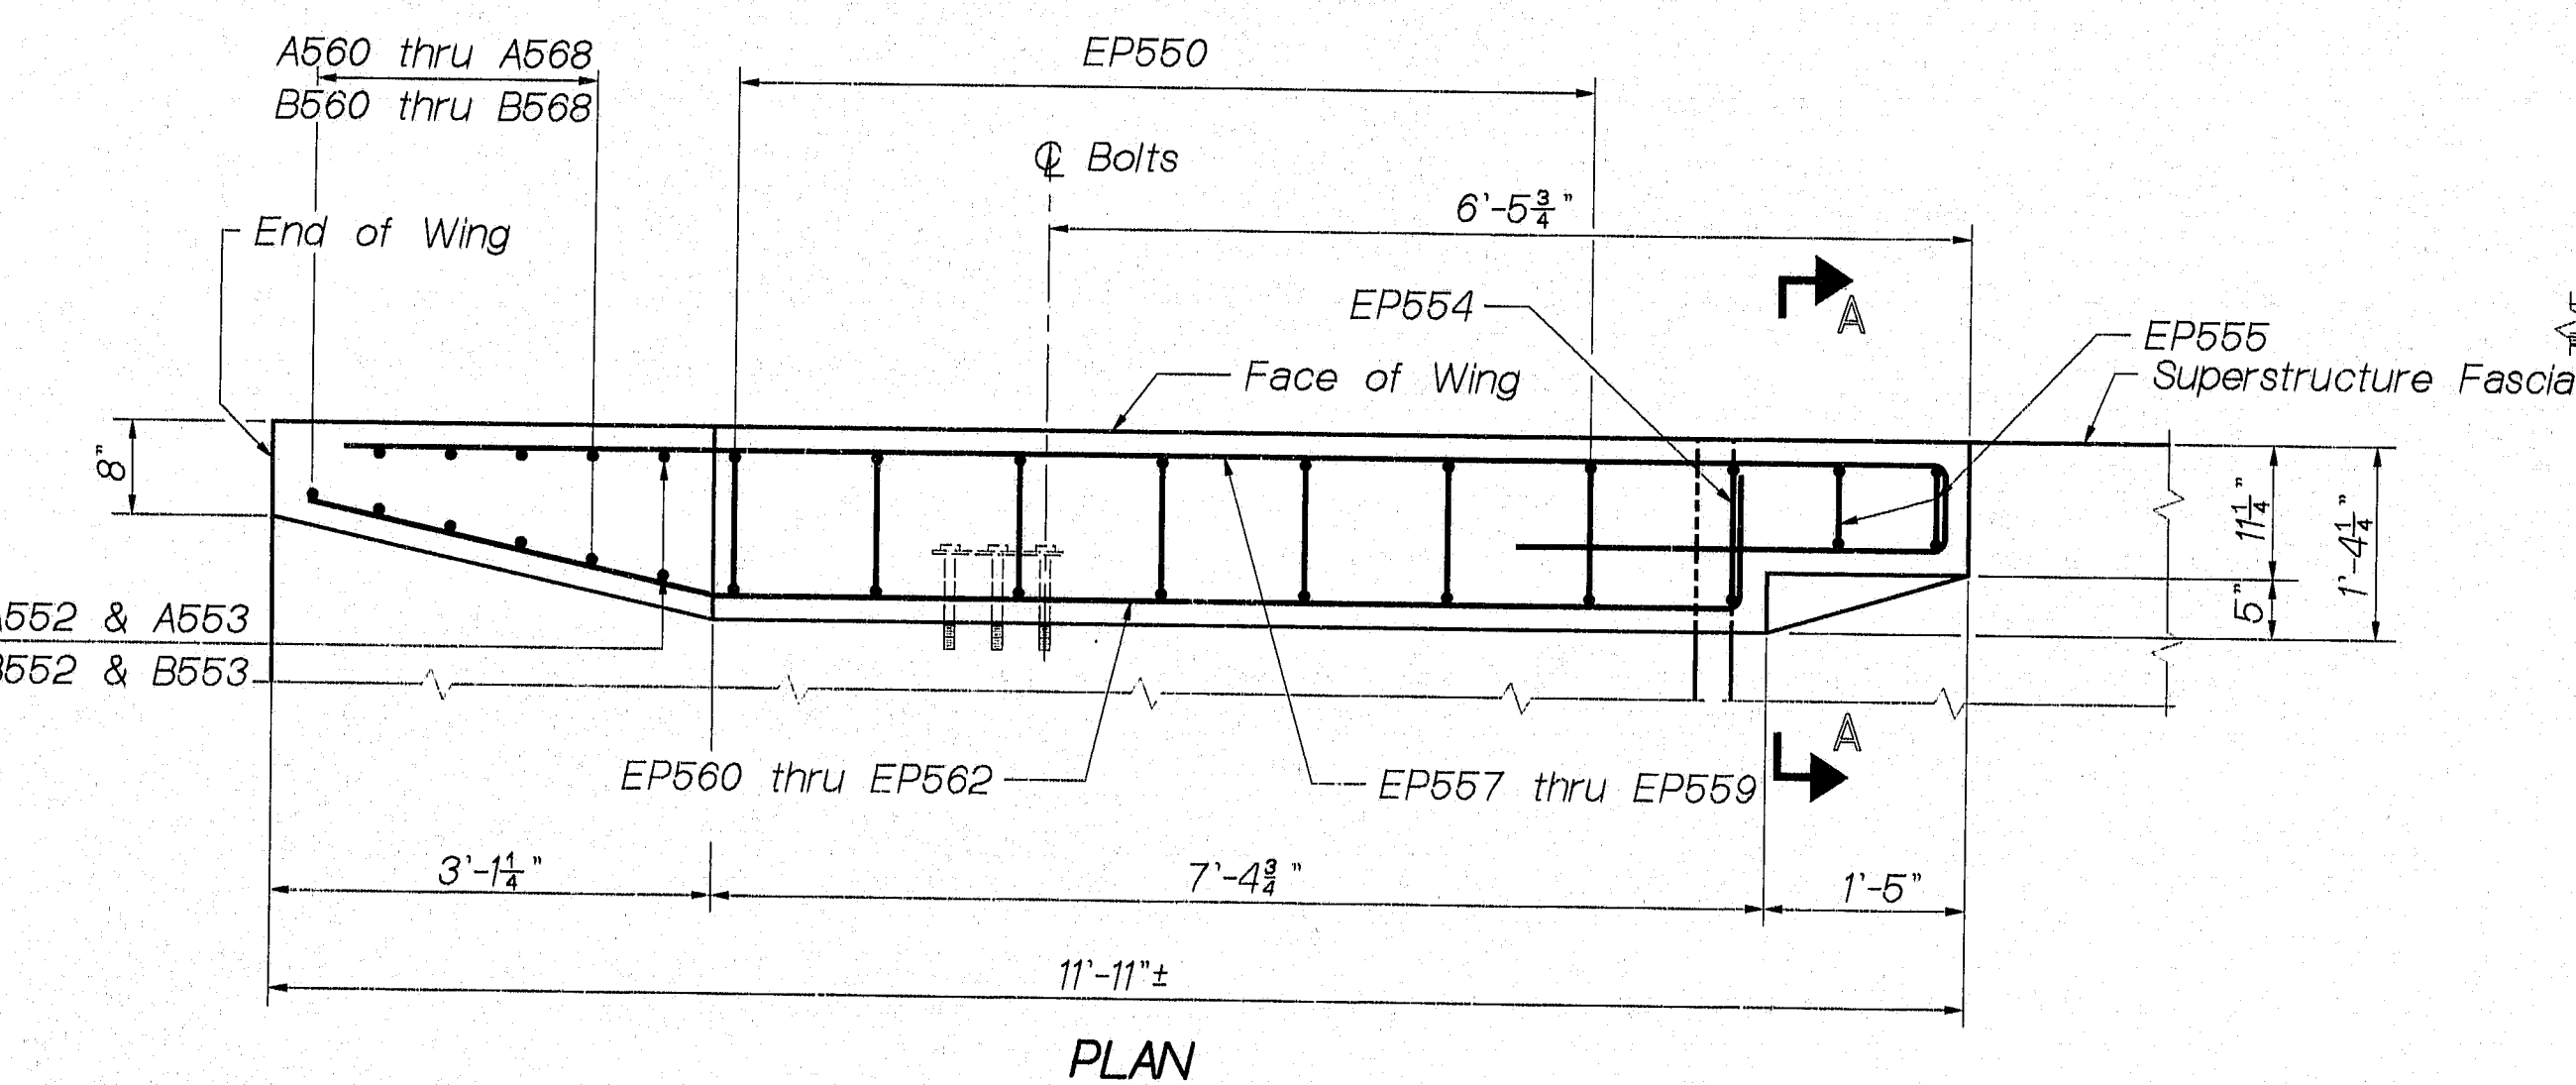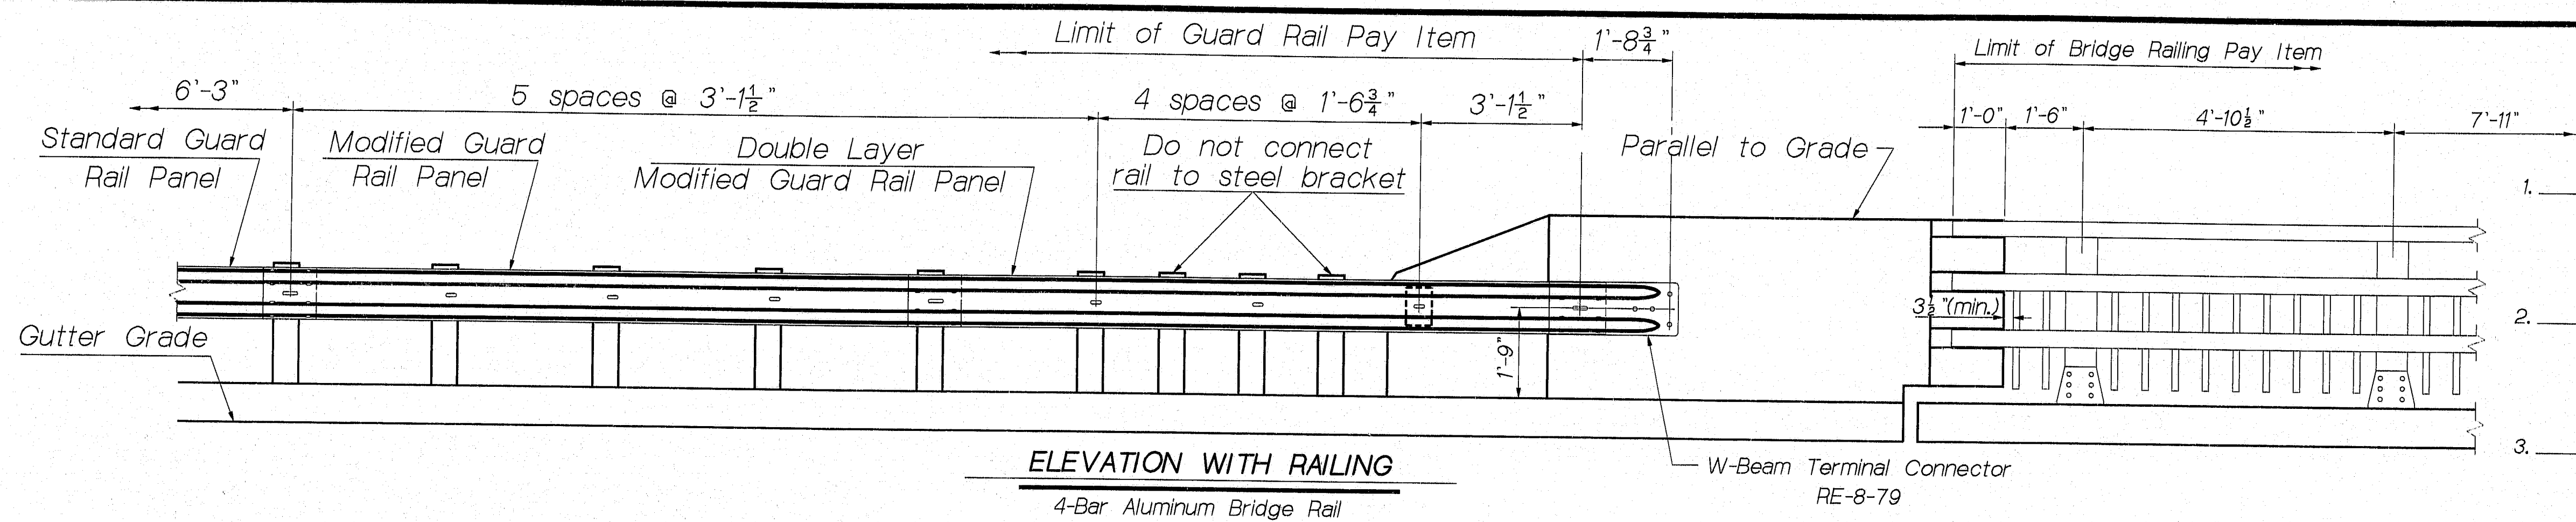

PLAN END POST & GUARD RAIL

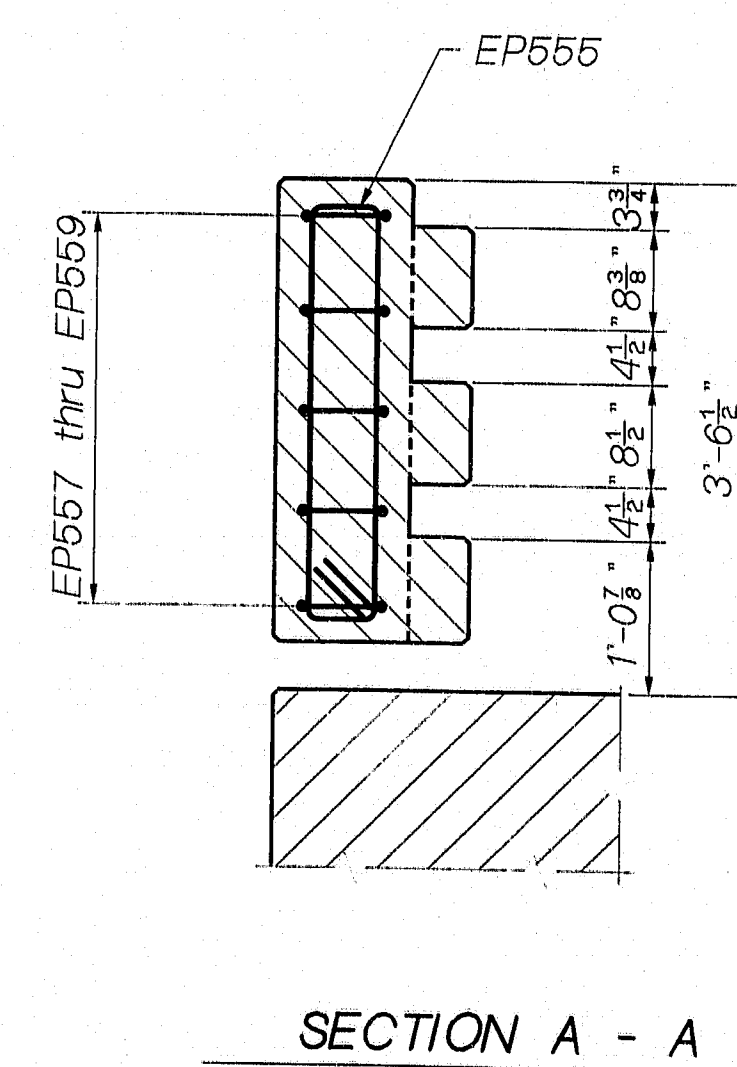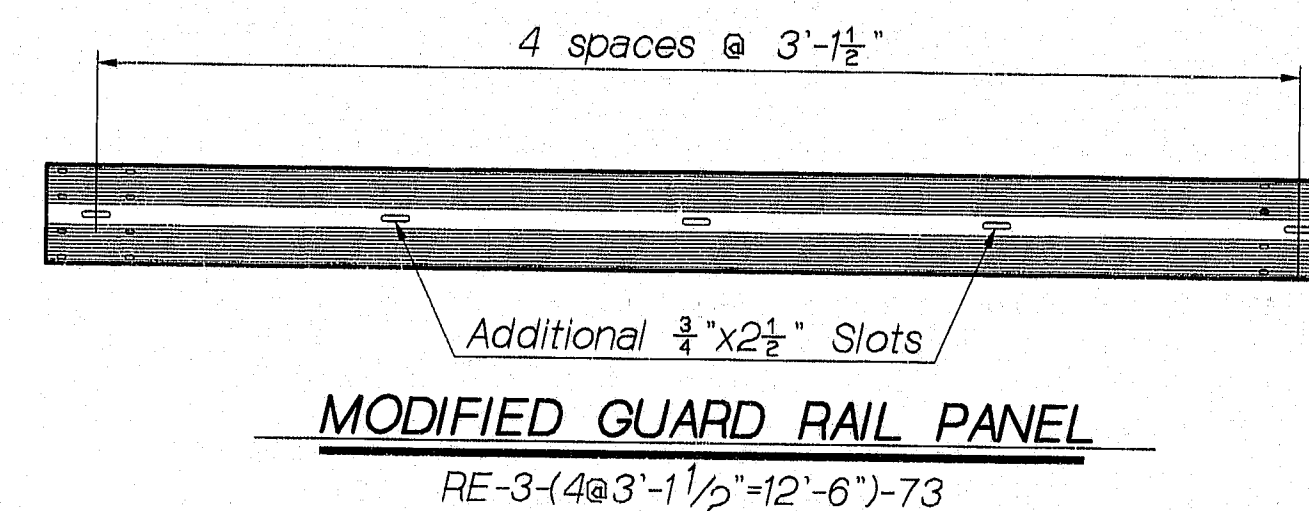

SECTION A - A

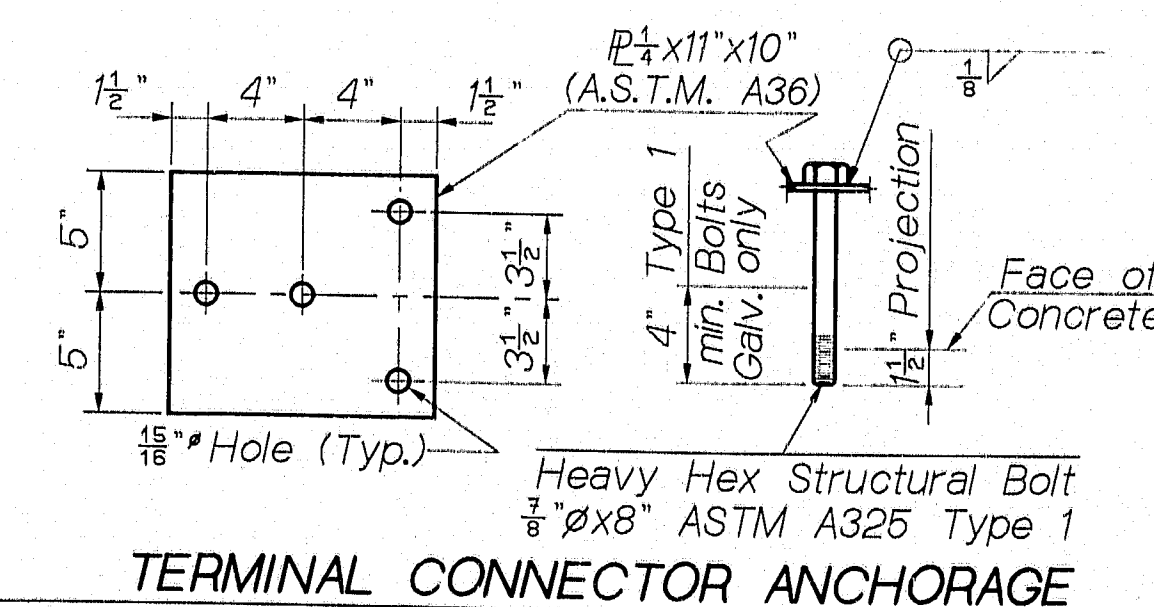

TERMINAL CONNECTOR ANCHORAGE

NOTES

1. Nuts and washers for 1/2" anchor bolts shall be incidental to Guard Rail Pay Items. Nuts shall conform to A.S.T.M. A563, Grade DH, galvanized in accordance with A.S.T.M. A153, or Grade C3, plain.
2. Additional holes in the Modified Guard Rail Panel may be made by drilling, punching or any other method that produces a neat, clean hole of the required size. Burning of holes will not be allowed.
3. Spacer Tube shall conform to the requirements of A.S.T.M. A53, galvanized, Grade B Type E or S. Hex bolt and nut on spacer tube shall conform to A.S.T.M. A307. Payment for spacer tube, bolt and nut shall be incidental to the Guard Rail pay item.
4. Reinforcing Steel shall have 2" min. concrete cover.
5. After installation of Guard Rail is complete, upset the thread on the anchor bolts in three places around each bolt, at the junction of the nut and the exposed thread, with a center punch or similar tool.
6. Terminal Connector Anchorage shall be incidental to the applicable concrete pay item.
7. End Post shall be constructed normal to grade unless otherwise shown on the Design Drawings.
8. All accessories (posts, bolts, nuts etc.) shall be as detailed for Standard Type 3 Guard Rail, except as otherwise detailed.
9. Concrete shall be Class A with a silica fume additive.

109-60

Revised End Post Sheet
as of 6/15/92

STATE OF MAINE
DEPARTMENT OF TRANSPORTATION

FERRY HILL BRIDGE
OVER
STILLWATER RIVER
IN THE TOWN OF
ORONO
PENOBSCOT COUNTY

3-BAR CONCRETE END POST

SHEET 22 OF 43 AUGUSTA, MAINE March, 1992

DATE	BY	DATE	BY
2/92	R.J.M/M	2/92	R.J.M/M
6/92	R.J.M/M	6/92	R.J.M/M


22JUN92-0100.40

REINFORCING STEEL SCHEDULE

STRAIGHT BARS								BENT BARS																			
MARK	NO.	LENGTH	LOCATION	MARK	NO.	LENGTH	LOCATION	MARK	NO.	LENGTH	LOCATION	MARK	NO.	LENGTH	TYPE	A	B	C	D	E	F	G	H	O	R	LOCATION	
ABUTMENT NO. 1								ABUTMENT NO. 1																			
A500	72	3'-5"	DOWEL (WINGS)									A550	4	14'-2"	S	2'-3"	9'-8"	2'-3"									WINGS
A501	12	9'-8"	WINGS									A551	30	9'-1"	L	5'-5"	3'-8"										
A502	4	30'-0"	BACKWALL									A552	30	6'-2"		5'-5"	0'-9"										
A503	4	18'-9"	BACKWALL									A553	40	5'-5"	↓	3'-8"	1'-9"	↓	↓								
A504	4	7'-0"	BACKWALL									A554	2	8'-2"	S	3'-8"	0'-10"	3'-8"									BACKWALL
												A555	21	7'-0"		3'-1"	0'-10"	3'-1"									BACKWALL
												A556	4	6'-8"		2'-0"	2'-8"	2'-0"									BRIDGE SEAT
												A557		5'-7"		2'-0"	1'-7"	2'-0"									BRIDGE SEAT
												A558		16'-8"		3'-8"	9'-4"	3'-8"									WINGS
												A559	↓	6'-2"	↓	2'-8"	0'-10"	2'-8"	↓	↓	↓	↓	↓	↓	↓	↓	BACKWALL
												A560	2	9'-0"	L	5'-4"	3'-8"										WINGS
												A561		8'-10"		5'-2"											
												A562		8'-8"		5'-0"											
												A563		8'-5"		4'-9"	↓										
												A564		6'-1"		5'-4"	0'-9"										
												A565		5'-11"		5'-2"											
												A566		5'-9"		5'-0"											
												A567		5'-6"		4'-9"											
												A568		5'-4"	↓	4'-7"	↓	↓	↓	↓	↓	↓	↓	↓	↓	↓	↓
ABUTMENT NO. 2								ABUTMENT NO. 2																			
												B550	4	14'-2"	S	2'-3"	9'-8"	2'-3"									WINGS
												B551	30	9'-1"	L	5'-5"	3'-8"										
												B552	30	6'-2"		5'-5"	0'-9"										
												B553	40	5'-5"	↓	3'-8"	1'-9"	↓	↓								
												B554	2	8'-2"	S	3'-8"	0'-10"	3'-8"									BACKWALL
												B555	21	7'-0"		3'-1"	0'-10"	3'-1"									BACKWALL
												B556	4	6'-8"		2'-0"	2'-8"	2'-0"									BRIDGE SEAT
												B557		5'-7"		2'-0"	1'-7"	2'-0"									BRIDGE SEAT
												B558		16'-8"		3'-8"	9'-4"	3'-8"									WINGS
												B559	↓	6'-2"	↓	2'-8"	0'-10"	2'-8"	↓	↓	↓	↓	↓	↓	↓	↓	BACKWALL
												B560	2	9'-0"	L	5'-4"	3'-8"										WINGS
												B561		8'-10"		5'-2"											
												B562		8'-8"		5'-0"											
												B563		8'-5"		4'-9"	↓										
												B564		6'-1"		5'-4"	0'-9"										
												B565		5'-11"		5'-2"											
												B566		5'-9"		5'-0"											
												B567		5'-6"		4'-9"											
												B568		5'-4"	↓	4'-7"	↓	↓	↓	↓	↓	↓	↓	↓	↓	↓	↓

F.H.V.A. RES. NO.	STATE	PROJECT NUMBER	SHEET NO.	TOTAL SHEETS
1	MAINE	BH-1401(9)	23	43

TYPE-BENDING DIAGRAMS

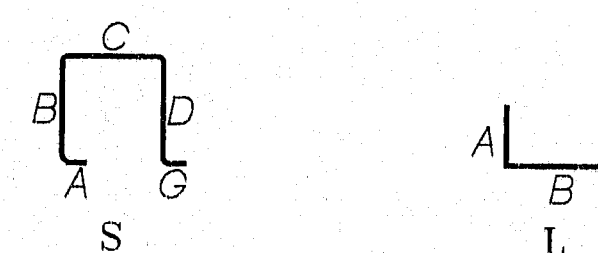

All dimensions are out to out of reinforcing bar
Bending details and hooks shall conform to the
recommendations of the current revision of
ACI Standard 318
Reinforcing Bar: ASTM A615 Grade 60

GENERAL NOTES

- 1-First digit(s) following the letter of the mark indicates size of the bar:
Mark (A502) bar size-#5
Mark (P1001) bar size-#10
Mark (S603) bar size-#6
- 2-Each truss bar, Type B, may be replaced by two (2) straight bars (one top and one bottom) of the same bar size as the truss bar. Payment in either case shall be based on truss bars as scheduled on plans.

Revision as of	6/92
Bar number change	5/92
REVISIONS	DATE

STATE OF MAINE
DEPARTMENT OF TRANSPORTATION

FERRY HILL BRIDGE
OVER
STILLWATER RIVER
IN THE TOWN OF
ORONO
PENOBSCOT COUNTY
REINFORCING STEEL SCHEDULE
SHEET 23 OF 43 AUGUSTA, MAINE March, 1992

109-61

PROJECT DESIGN ENGINEER	DATE
BY RJD/orth	2/92
CHECKED R.J.W./orth	5/92
DESIGN-DETAILED	
CHECKED	
REVISIONS	
REVISIONS	

18JUN92-010100

REINFORCING STEEL SCHEDULE																							
STRAIGHT BARS								BENT BARS															
MARK	NO.	LENGTH	LOCATION	MARK	NO.	LENGTH	LOCATION	MARK	NO.	LENGTH	TYPE	A	B	C	D	E	F	G	H	O	R	LOCATION	
SUPERSTRUCTURE								ENDPOST															
S400	760	30'-0"	LONGITUDINAL SLAB					EP550	28	7'-6"	S	3'-4"	0'-10"	3'-4"									ENDPOST
S401	466	24'-0"	TRANSVERSE SLAB					EP551	28	8'-4"		3'-4"	3'-8"	3'-8"									
S402	466	21'-6"	TRANSVERSE SLAB					EP552	28	8'-2"		4'-2"	4'-2"	4'-2"									
S403	152	18'-4"	LONGITUDINAL SLAB					EP553	46	9'-8"		4'-4"	4'-4"	4'-4"									
								EP554	4	8'-4"	H	0'-6"	0'-10"	2'-10"	0'-10"	2'-10"							
								EP555	8	7'-6"	H	0'-6"	0'-5"	2'-10"	0'-5"	2'-10"							
S500	596	46'-4"	TRANSVERSE SLAB					EP556	4	15'-2"	S	1'-7"	0'-7"	3'-0"									
S501	8	2'-9"	TRANSVERSE HAUNCH					EP557	4	15'-3"	S	11'-8"	0'-7"	3'-0"									
S502	16	6'-11"						EP558	1	13'-10"		10'-3"											
S503	32	6'-2"						EP559	12	14'-10"		11'-3"											
S504	60	30'-0"	LONGITUDINAL SWLK					EP560	12	11'-2"	SJ	2'-11"	7'-3"	1'-0"									
S505	695	60'-0"	LONGITUDINAL SLAB					EP561	4	11'-4"		3'-1"	7'-3"										
S506	69	48'-0"	LONG'L. @ PIER 1					EP562	1	9'-9"		1'-6"	7'-3"										
S507	12	18'-4"	LONGITUDINAL SWLK					EP563	1	9'-6"		1'-3"	7'-3"										
S600	466	4'-2"	TRANSVERSE SLAB																				
S700	100	53'-0"	LONG'L. @ PIER 2,3																				
S701	50	48'-0"	LONG'L. @ PIER 4																				


GENERAL NOTES	
1-First digit(s) following the letter of the mark indicates size of the bar:	
Mark (A502) bar size=#5	
Mark (P1001) bar size=#10	
Mark (S603) bar size=#6	
2-Each truss bar, Type B, may be replaced by two (2) straight bars (one top and one bottom) of the same bar size as the truss bar. Payment in either case shall be based on truss bars as scheduled on plans.	

	Revisions as of	6/15/92
	Revisions as of	5/9/92
REVISIONS		DATE
STATE OF MAINE		<i>288</i>
DEPARTMENT OF TRANSPORTATION		
FERRY HILL BRIDGE OVER STILLWATER RIVER IN THE TOWN OF ORONO PENOBSCOT COUNTY		
REINFORCING STEEL SCHEDULE		
SHEET 24 of 43 AUGUSTA, MAINE <i>March, 1992</i>		


109-62

PLAN. NO. 004867.00



DATE	STATE	PROJECT NUMBER	SHEET NO.	TOTAL SHEETS
8/92	MAINE	BH-1401(9)	248	13

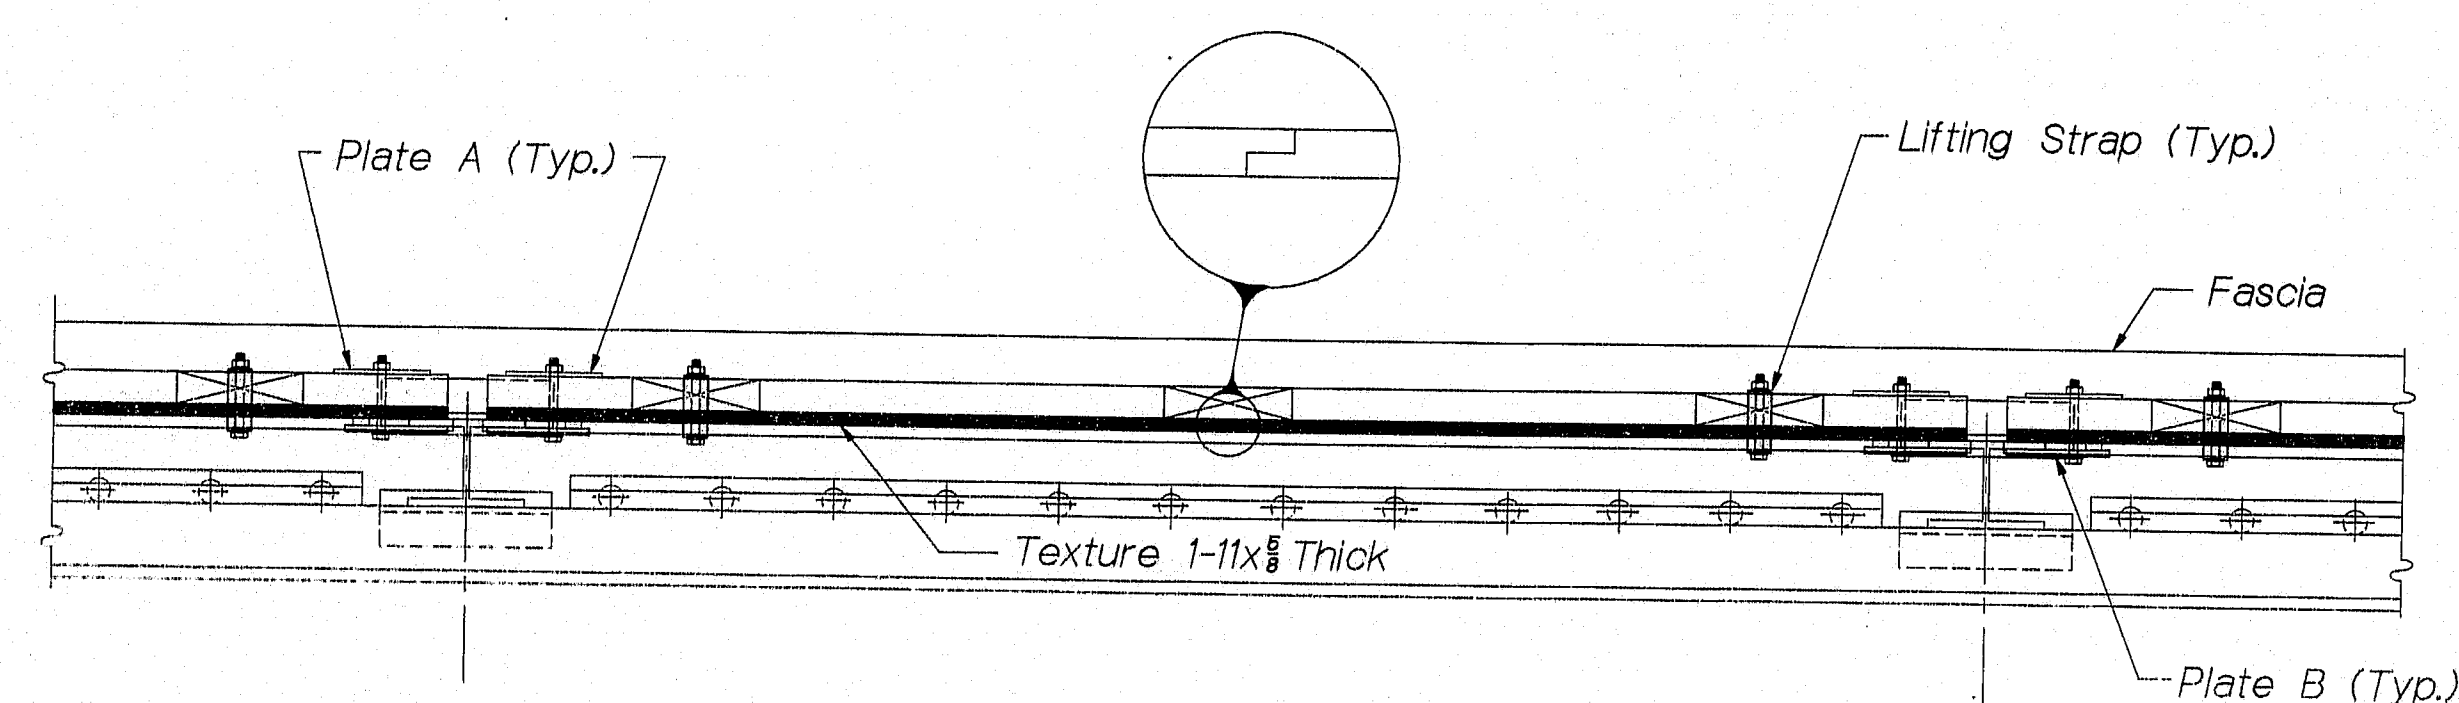

PLAN

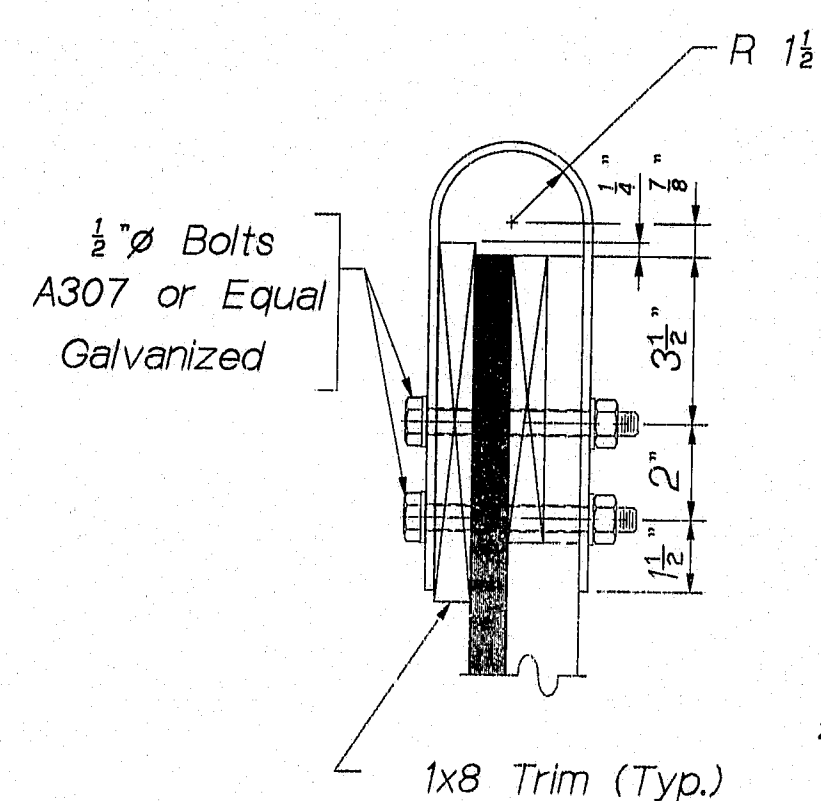


LIFTING STRAP

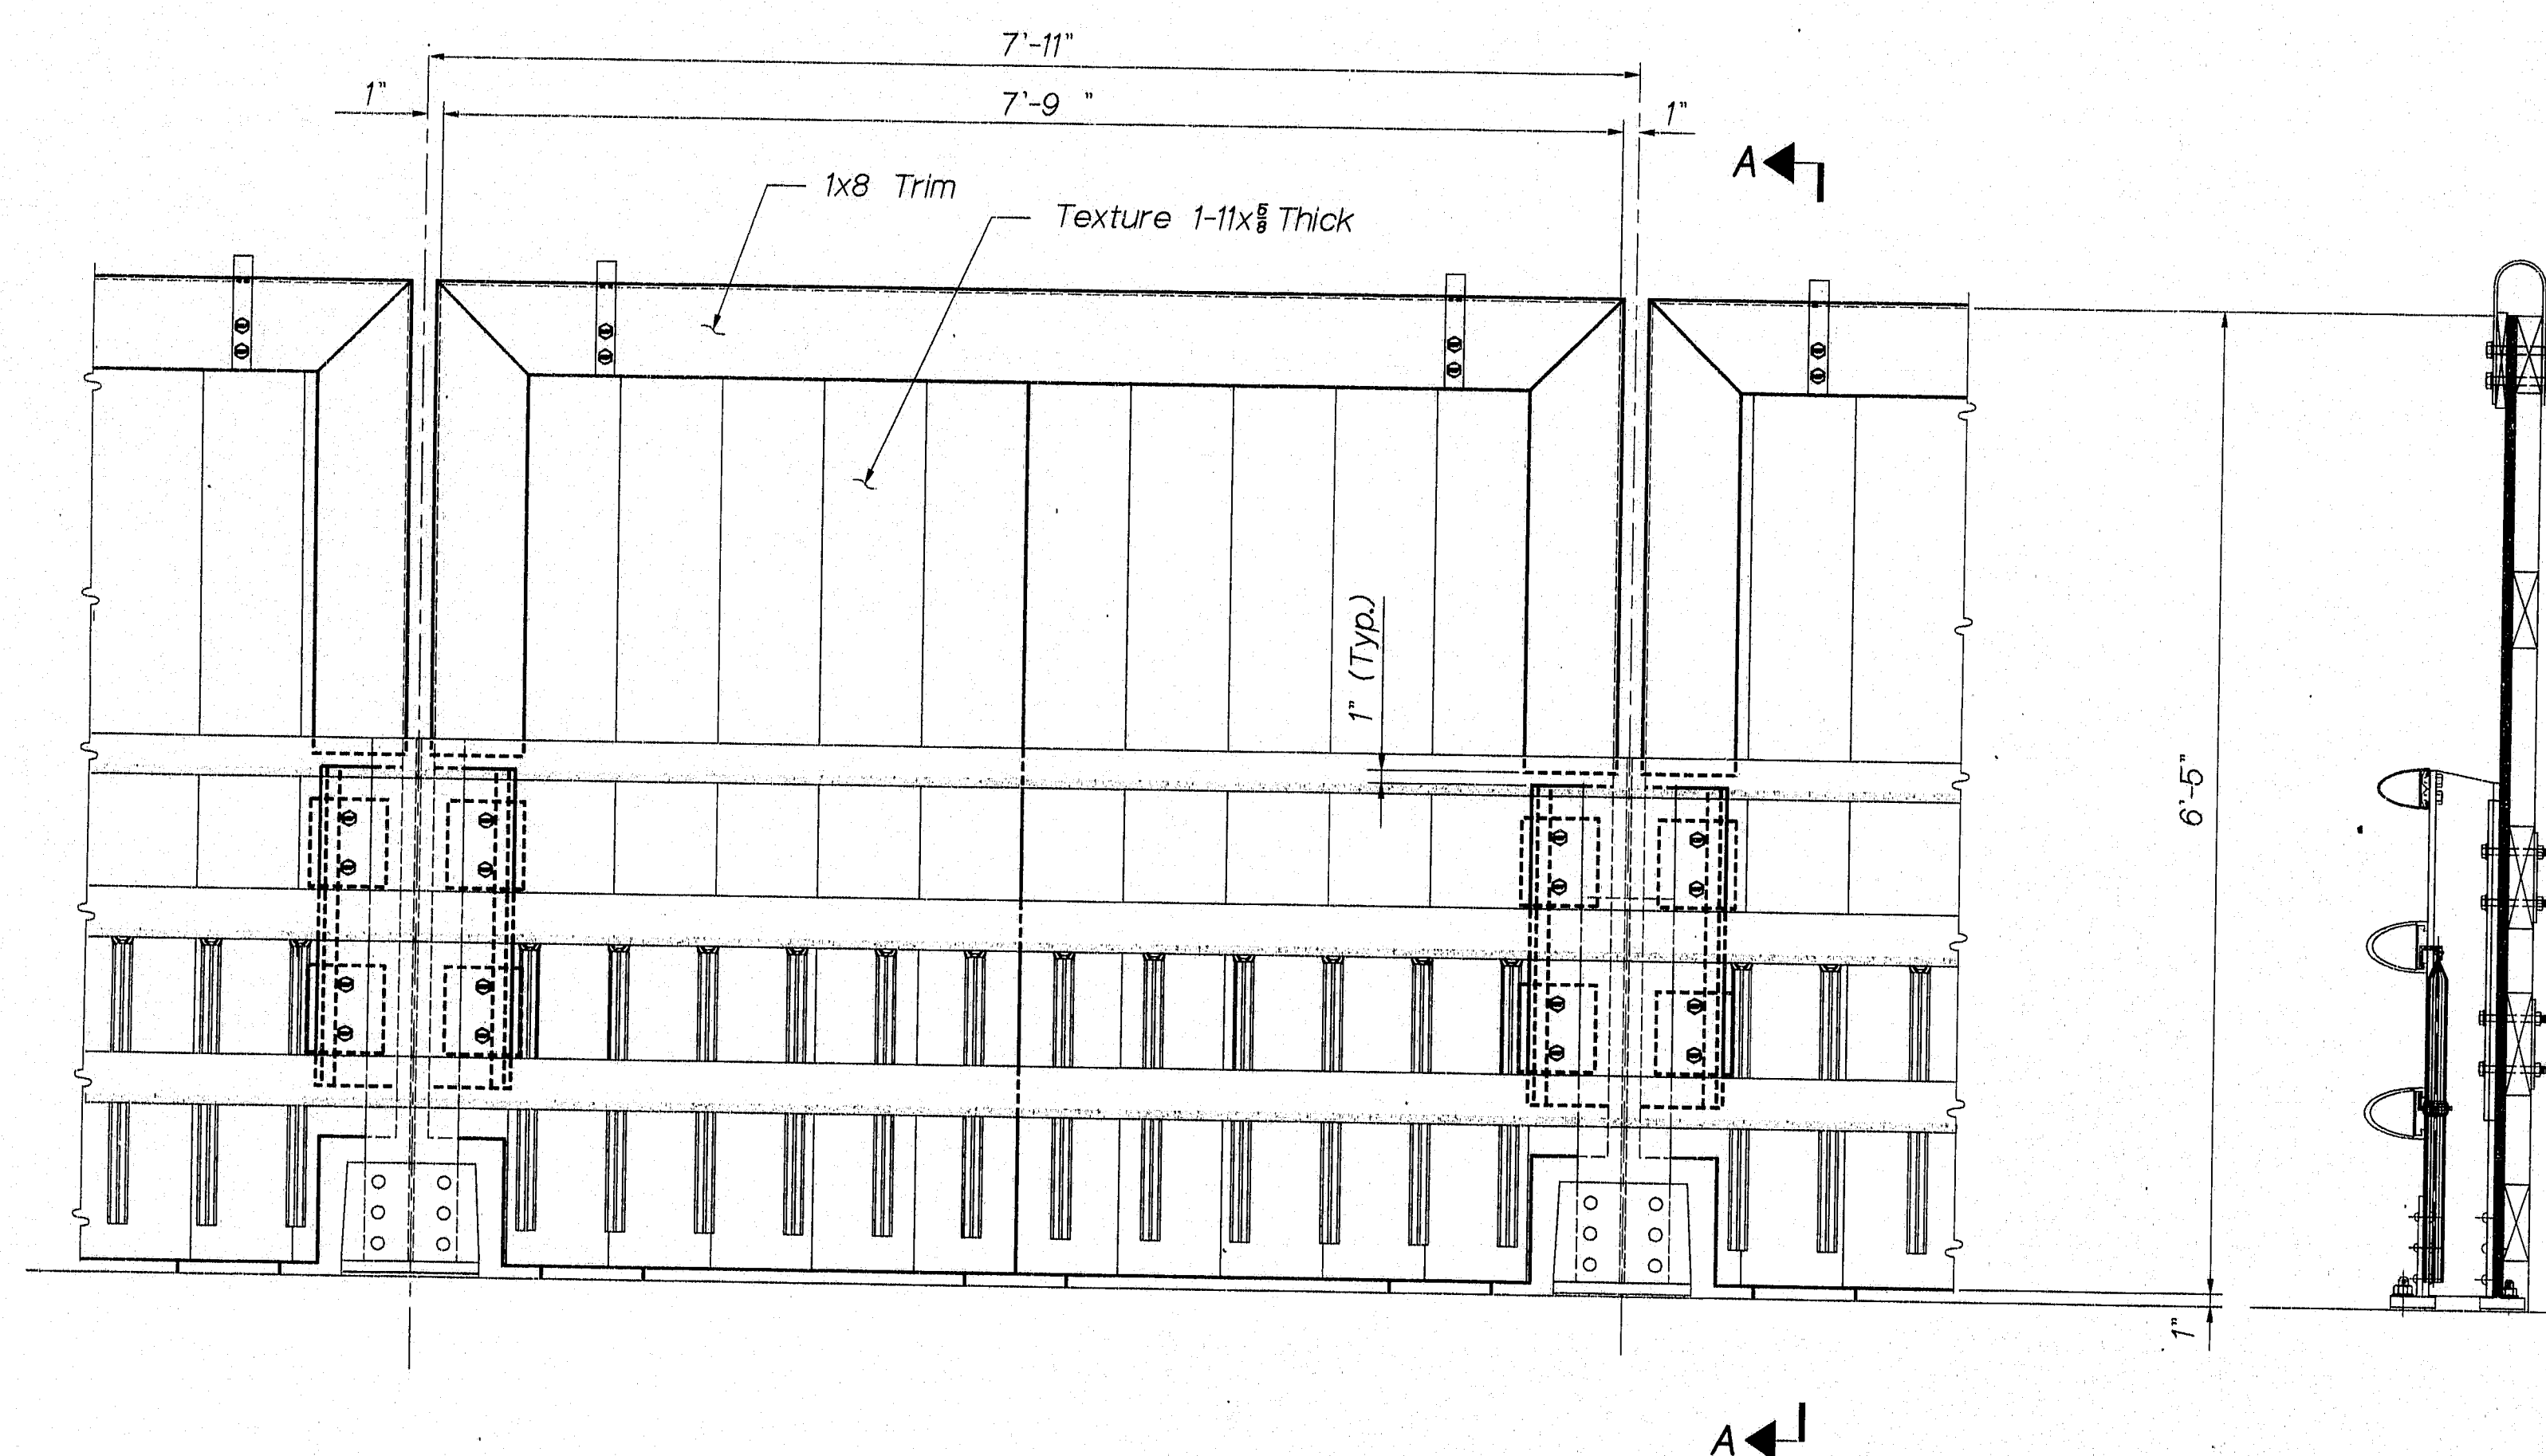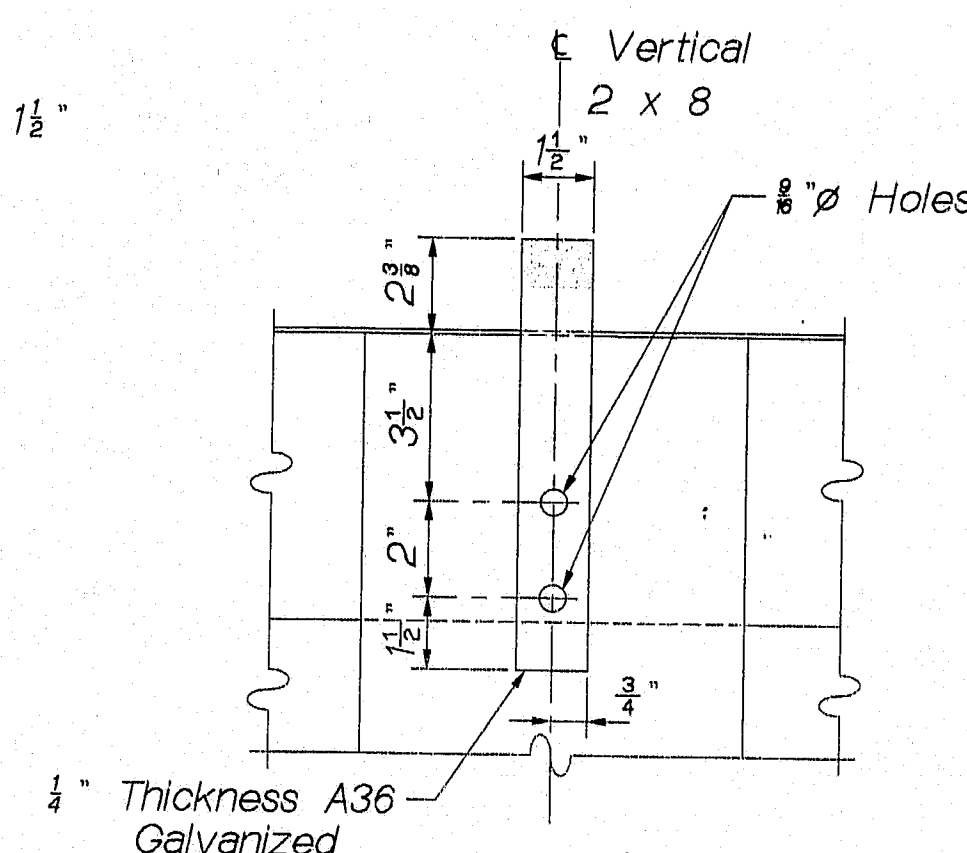


FRONT ELEVATION

SECTION A - A
(Upstream Side)

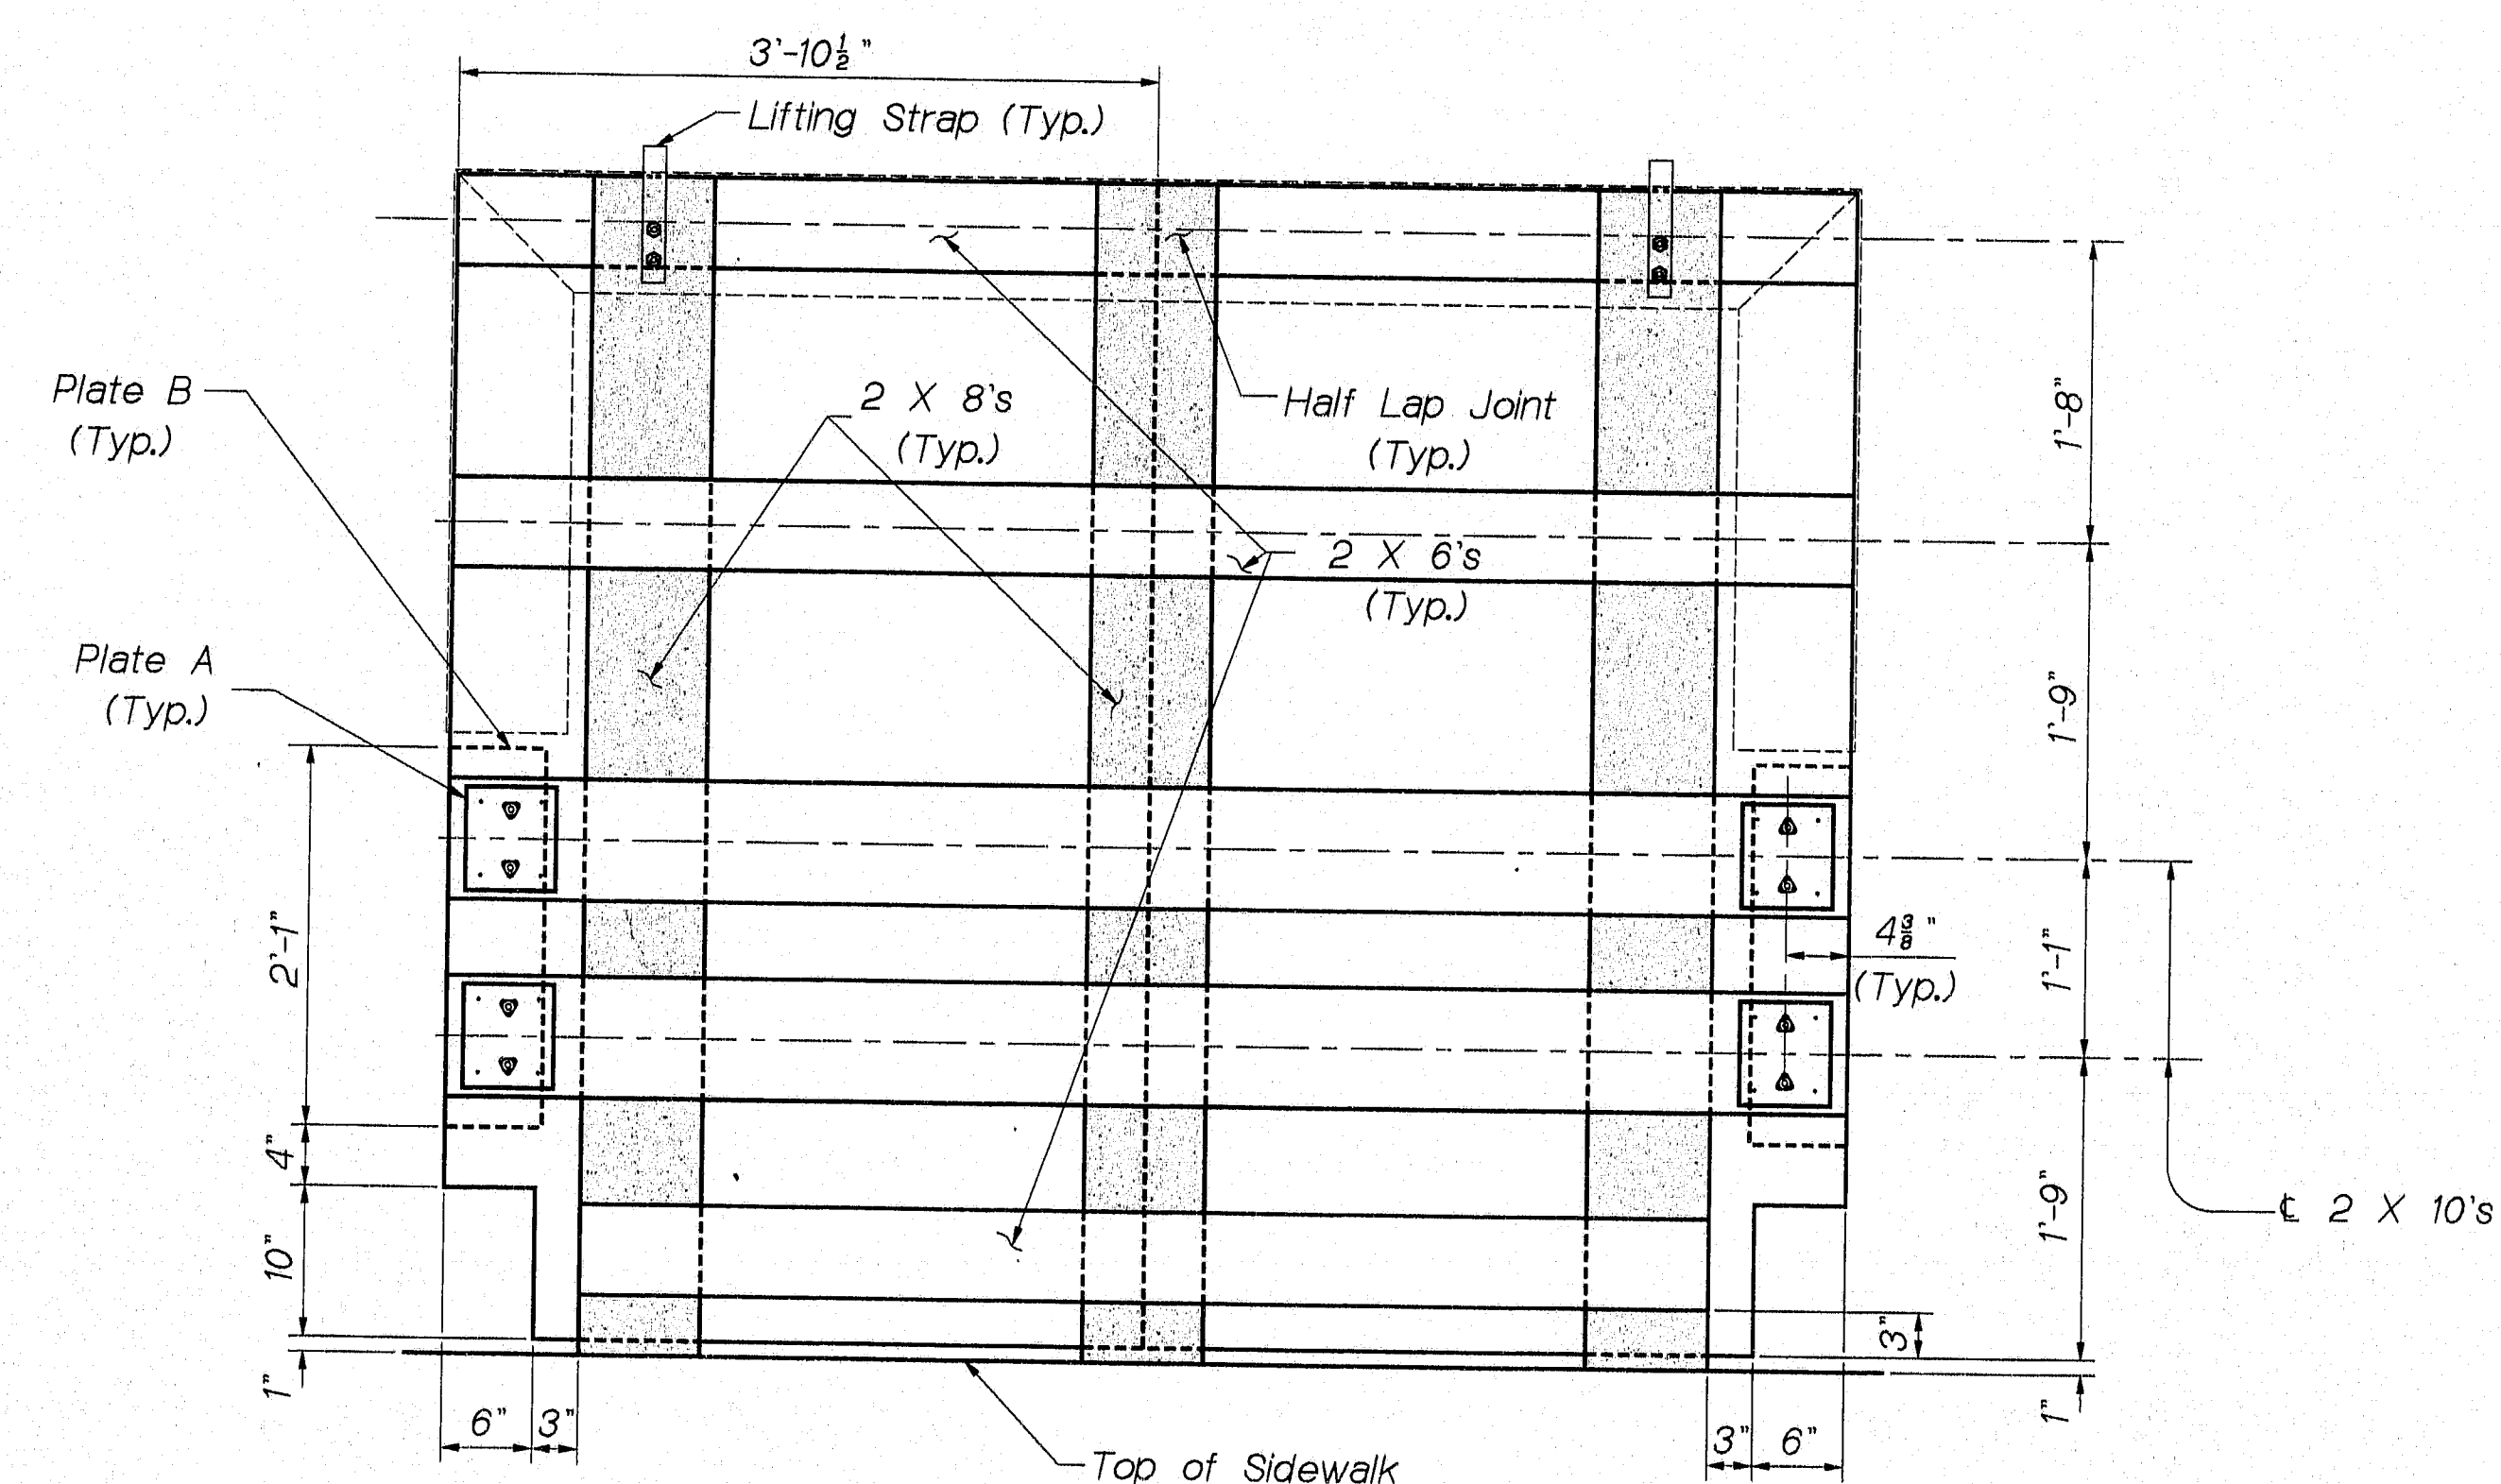

REAR ELEVATION

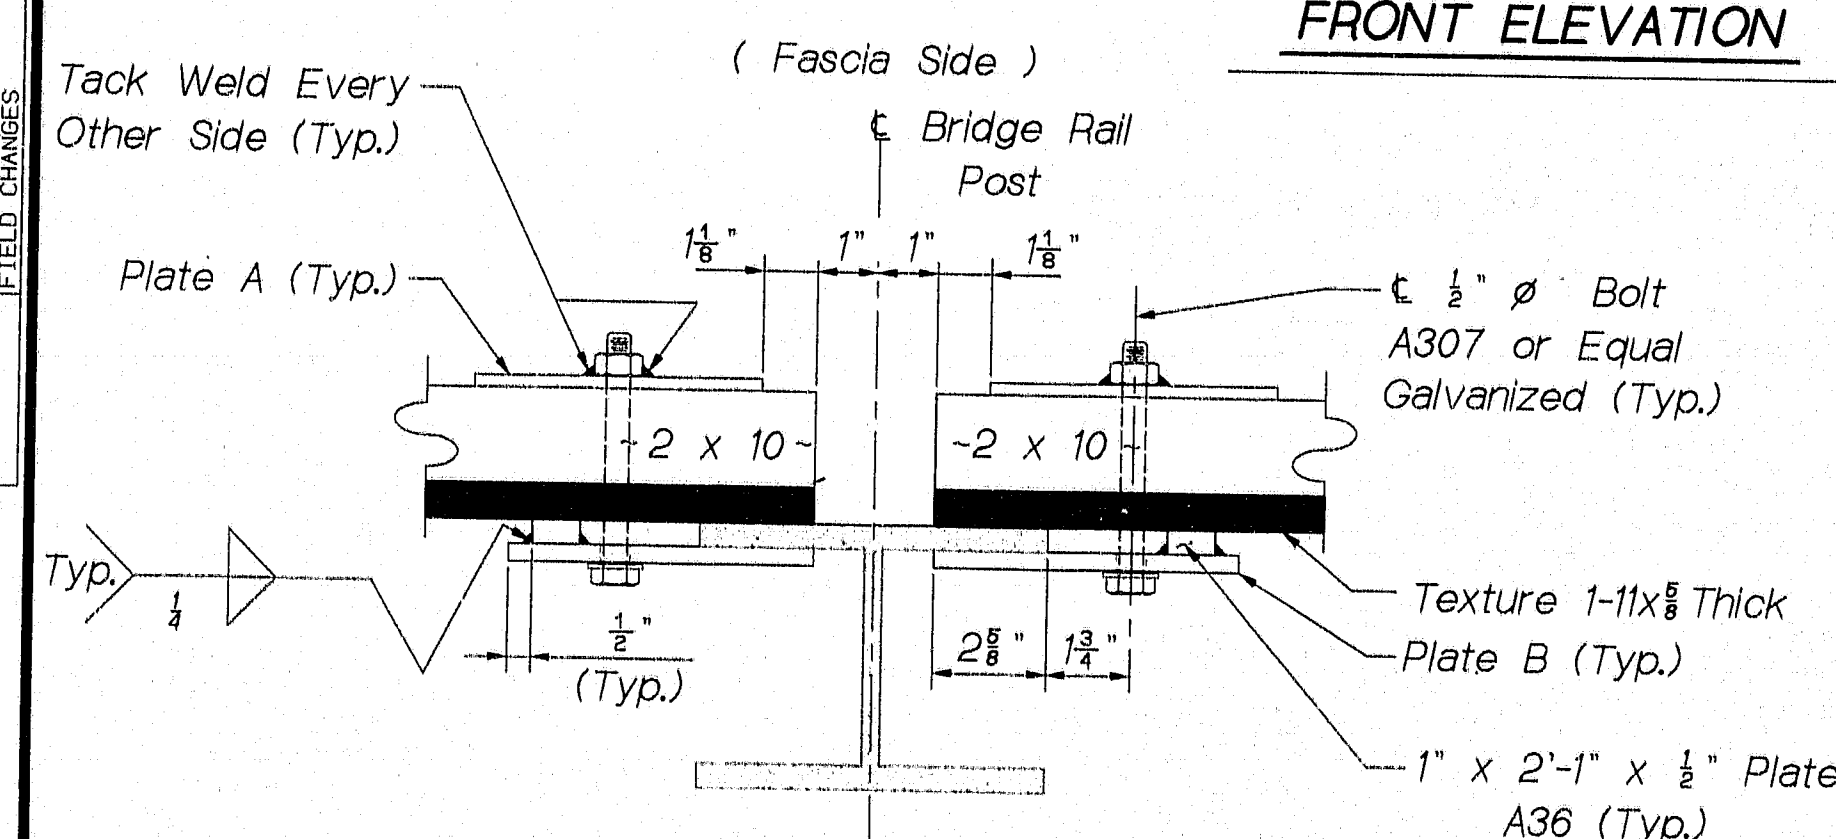

WINDBREAK CONNECTION DETAIL

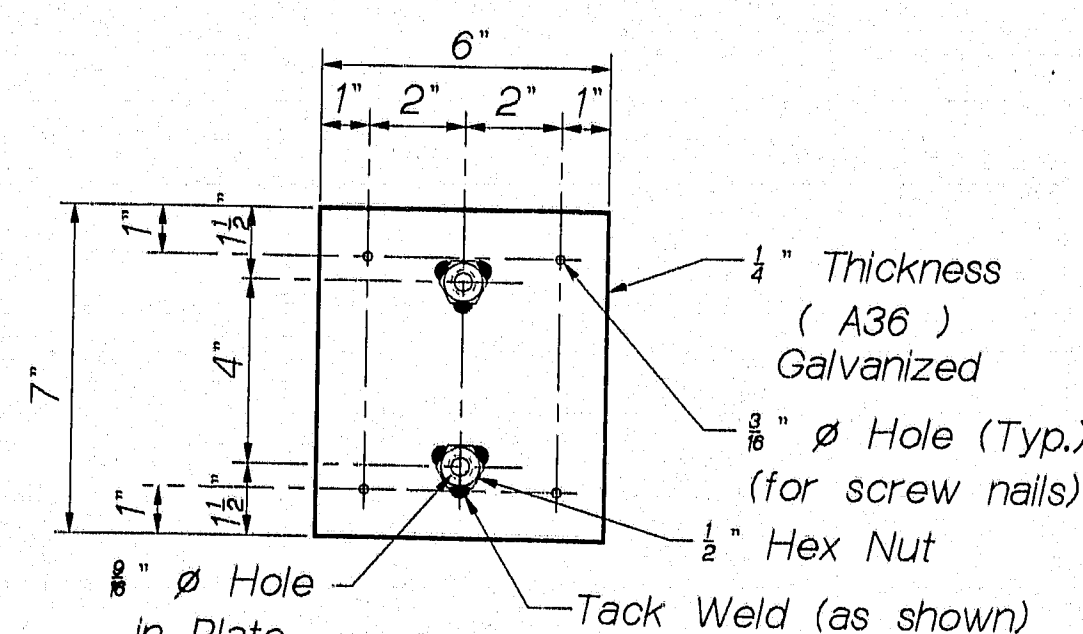


PLATE A

Note: Use Zinc plated Hardened Screw Nails with flat heads, 2" long, or equivalent.

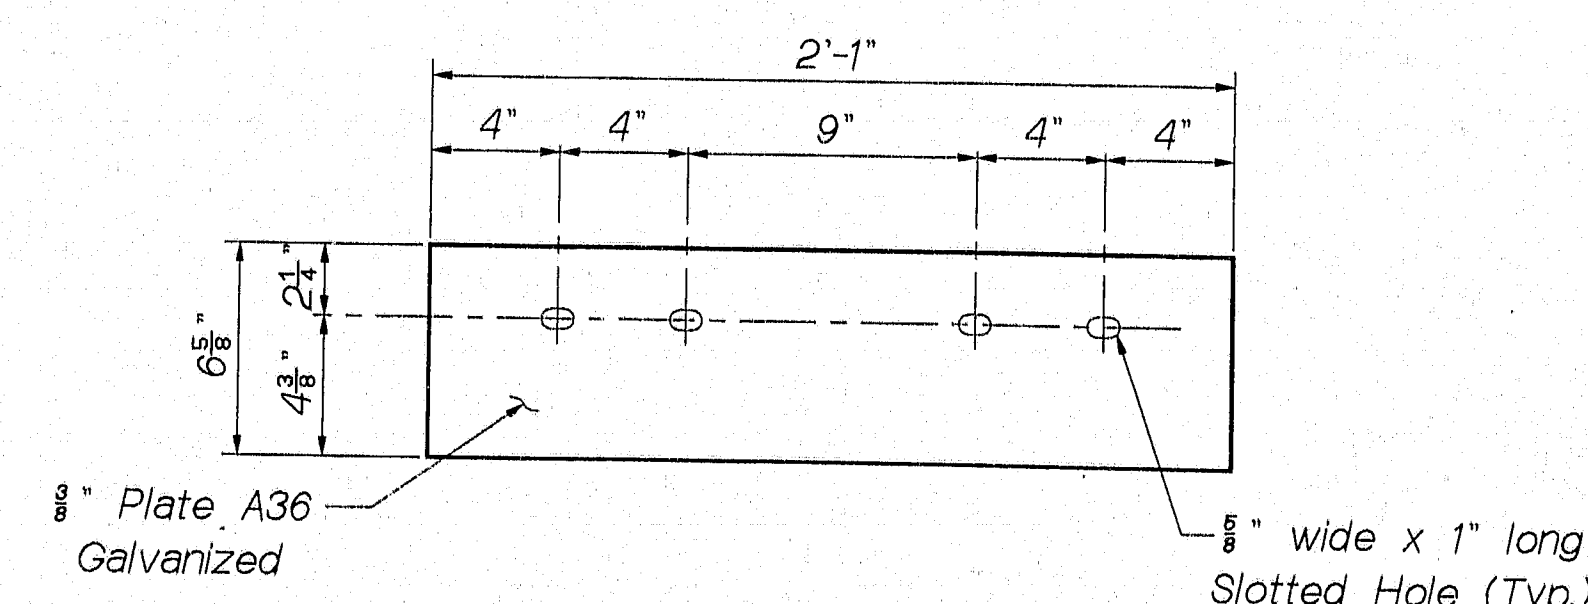


PLATE B

109-63

STATE OF MAINE
DEPARTMENT OF TRANSPORTATION


FERRY HILL BRIDGE
OVER
STILLWATER RIVER
IN THE TOWN OF
ORONO
PENOBSCOT COUNTY

WINDBREAK


SHEET 248 OF 248 AUGUSTA, MAINE July 6, 1992

PIN. NO. 004867.00


F.H.W.A. REV. NO.	STATE	PROJECT NUMBER	SHEET NO.	TOTAL SHEETS
1	MAINE	88-1401 (9)	24 C	43

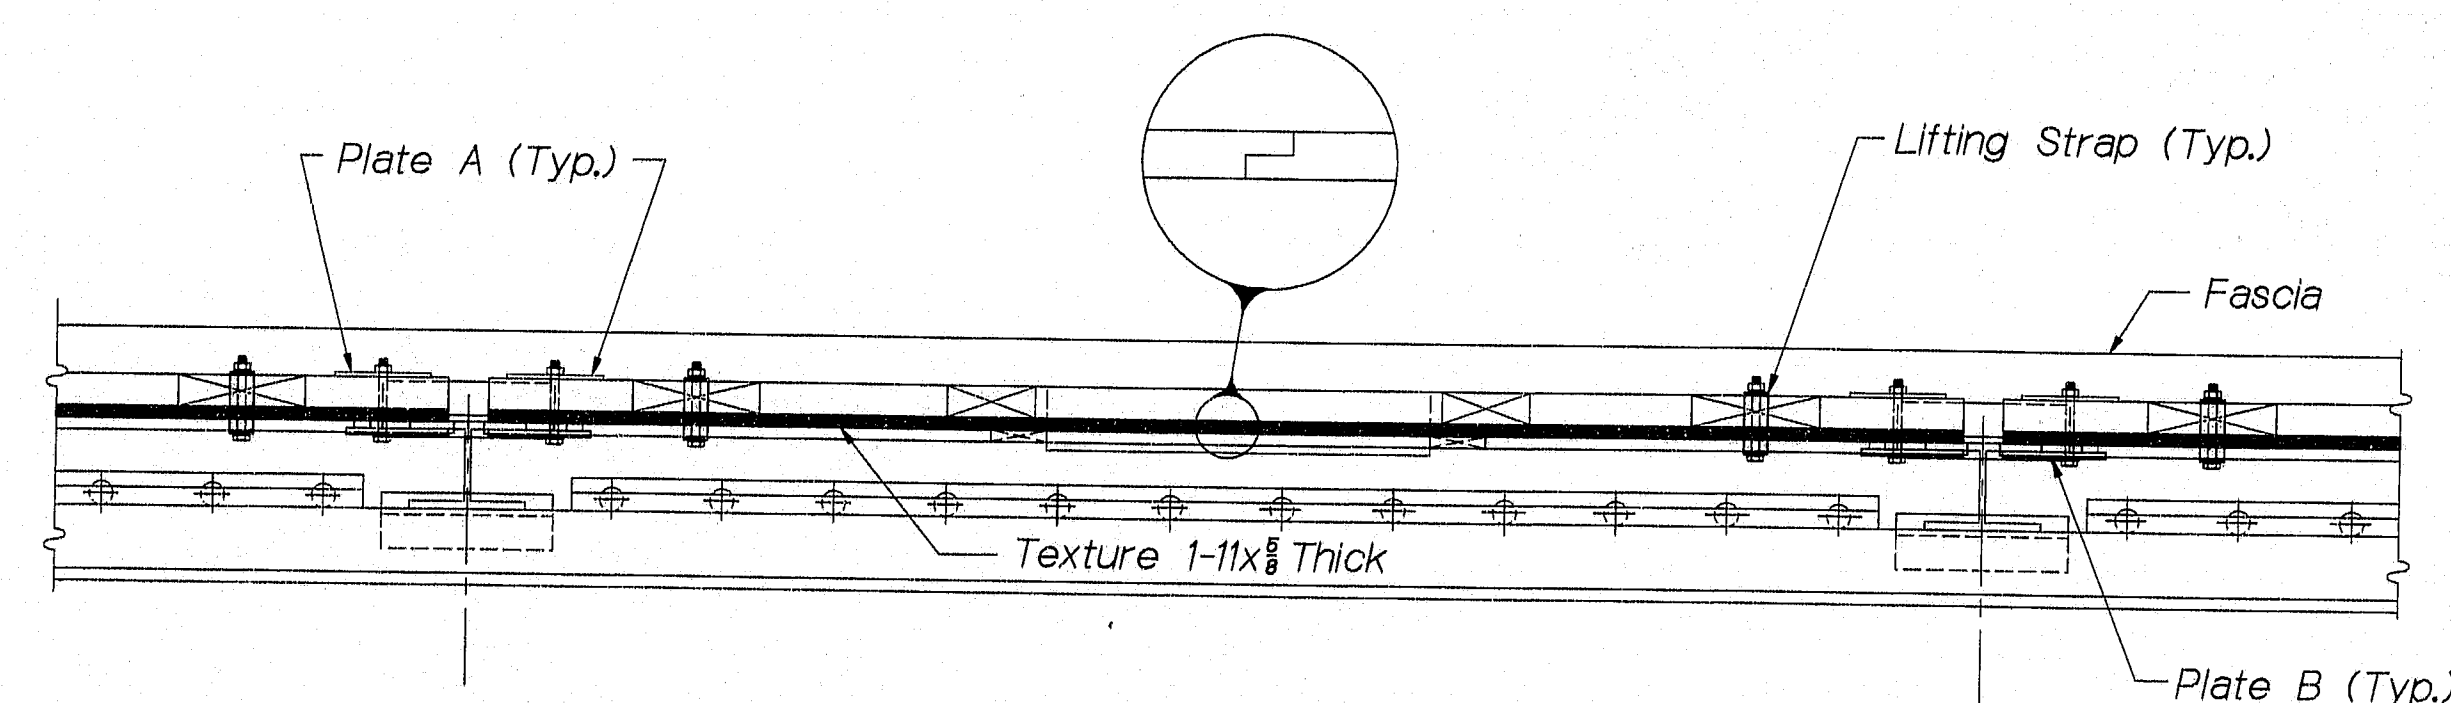


PLAN

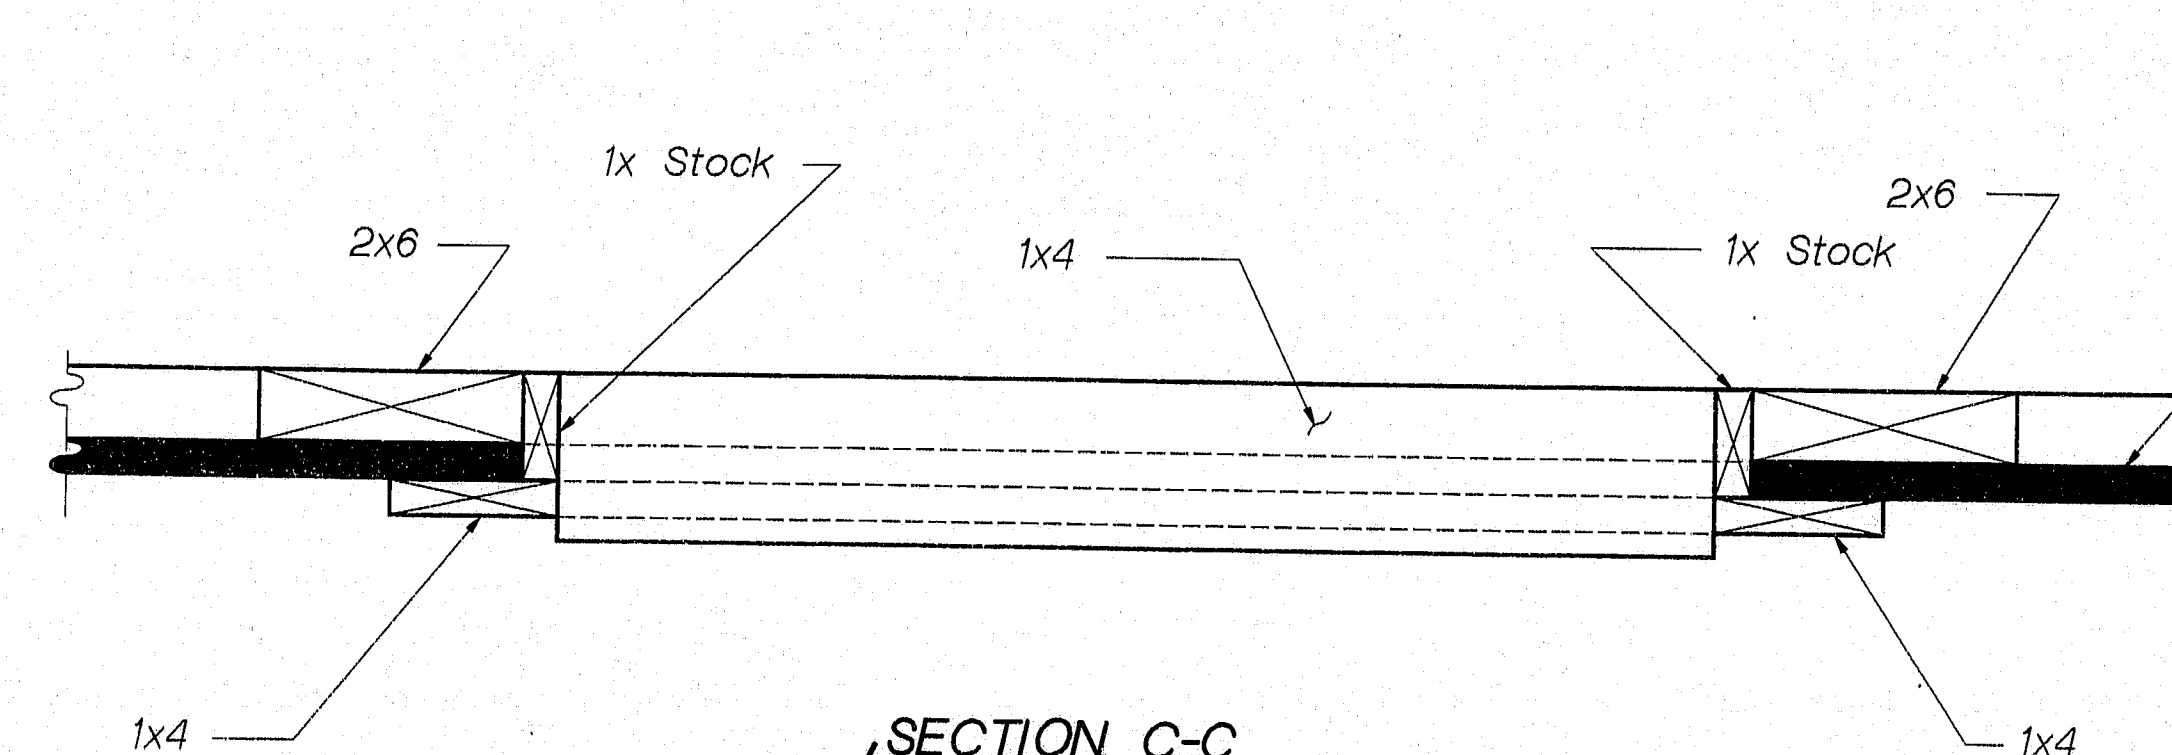

SECTION C-C

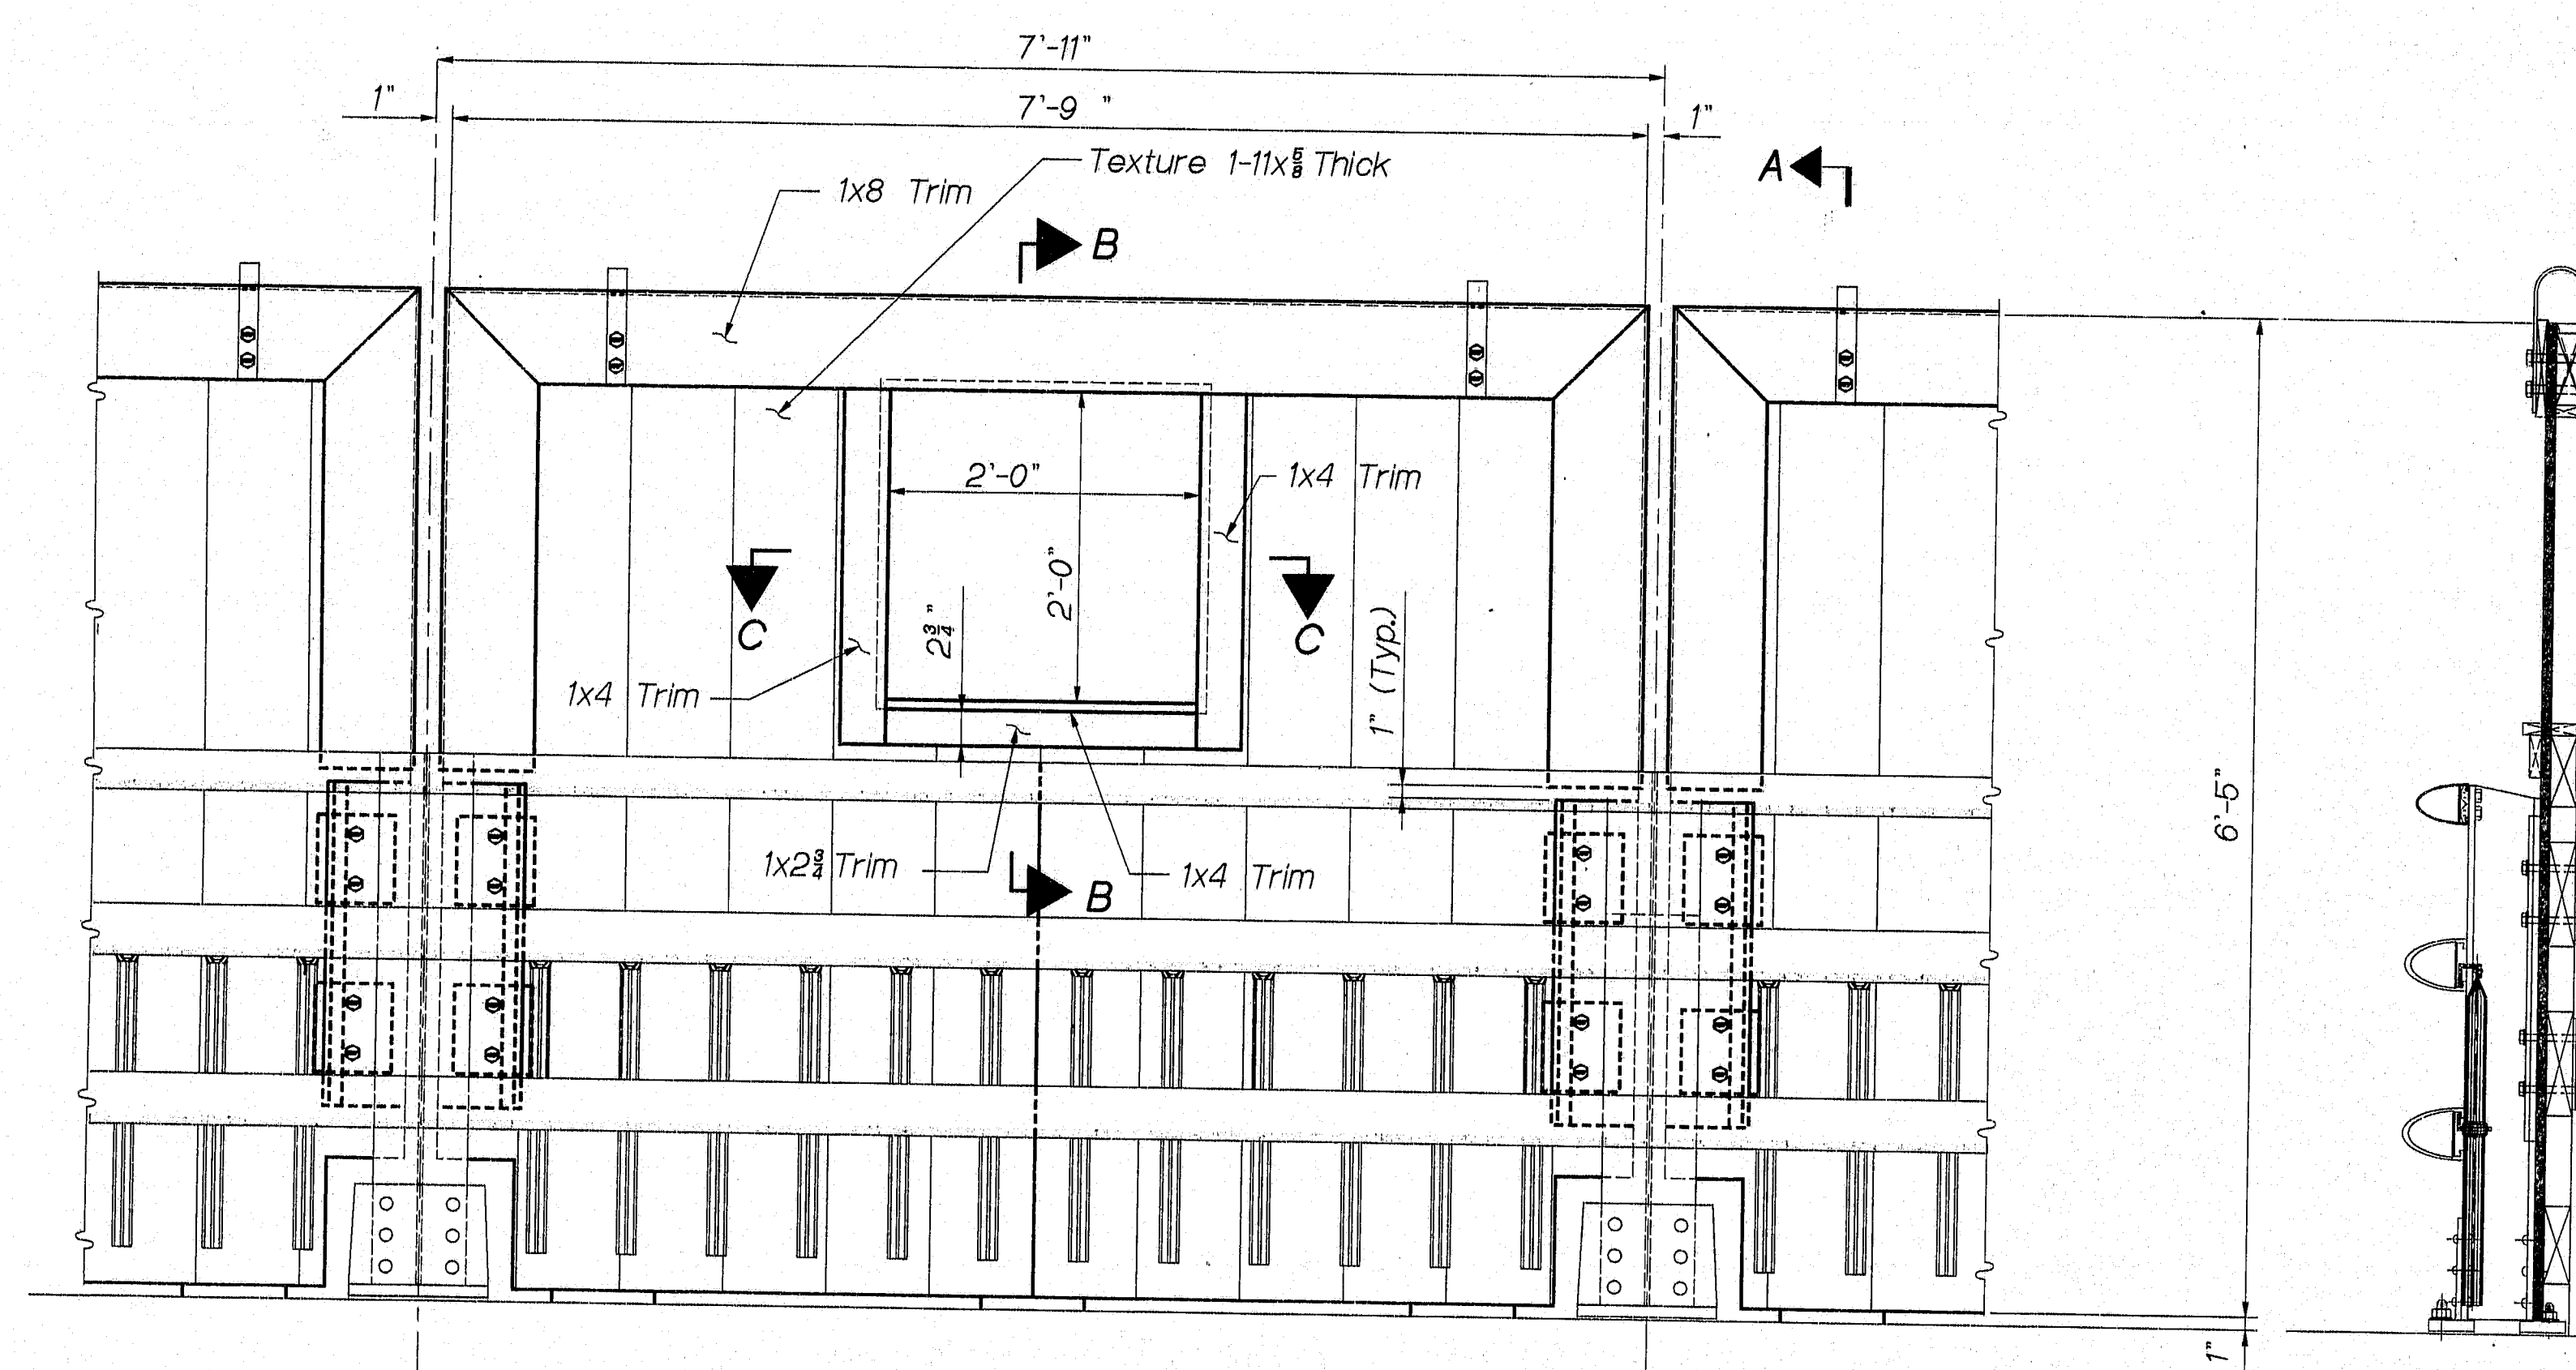

FRONT ELEVATION

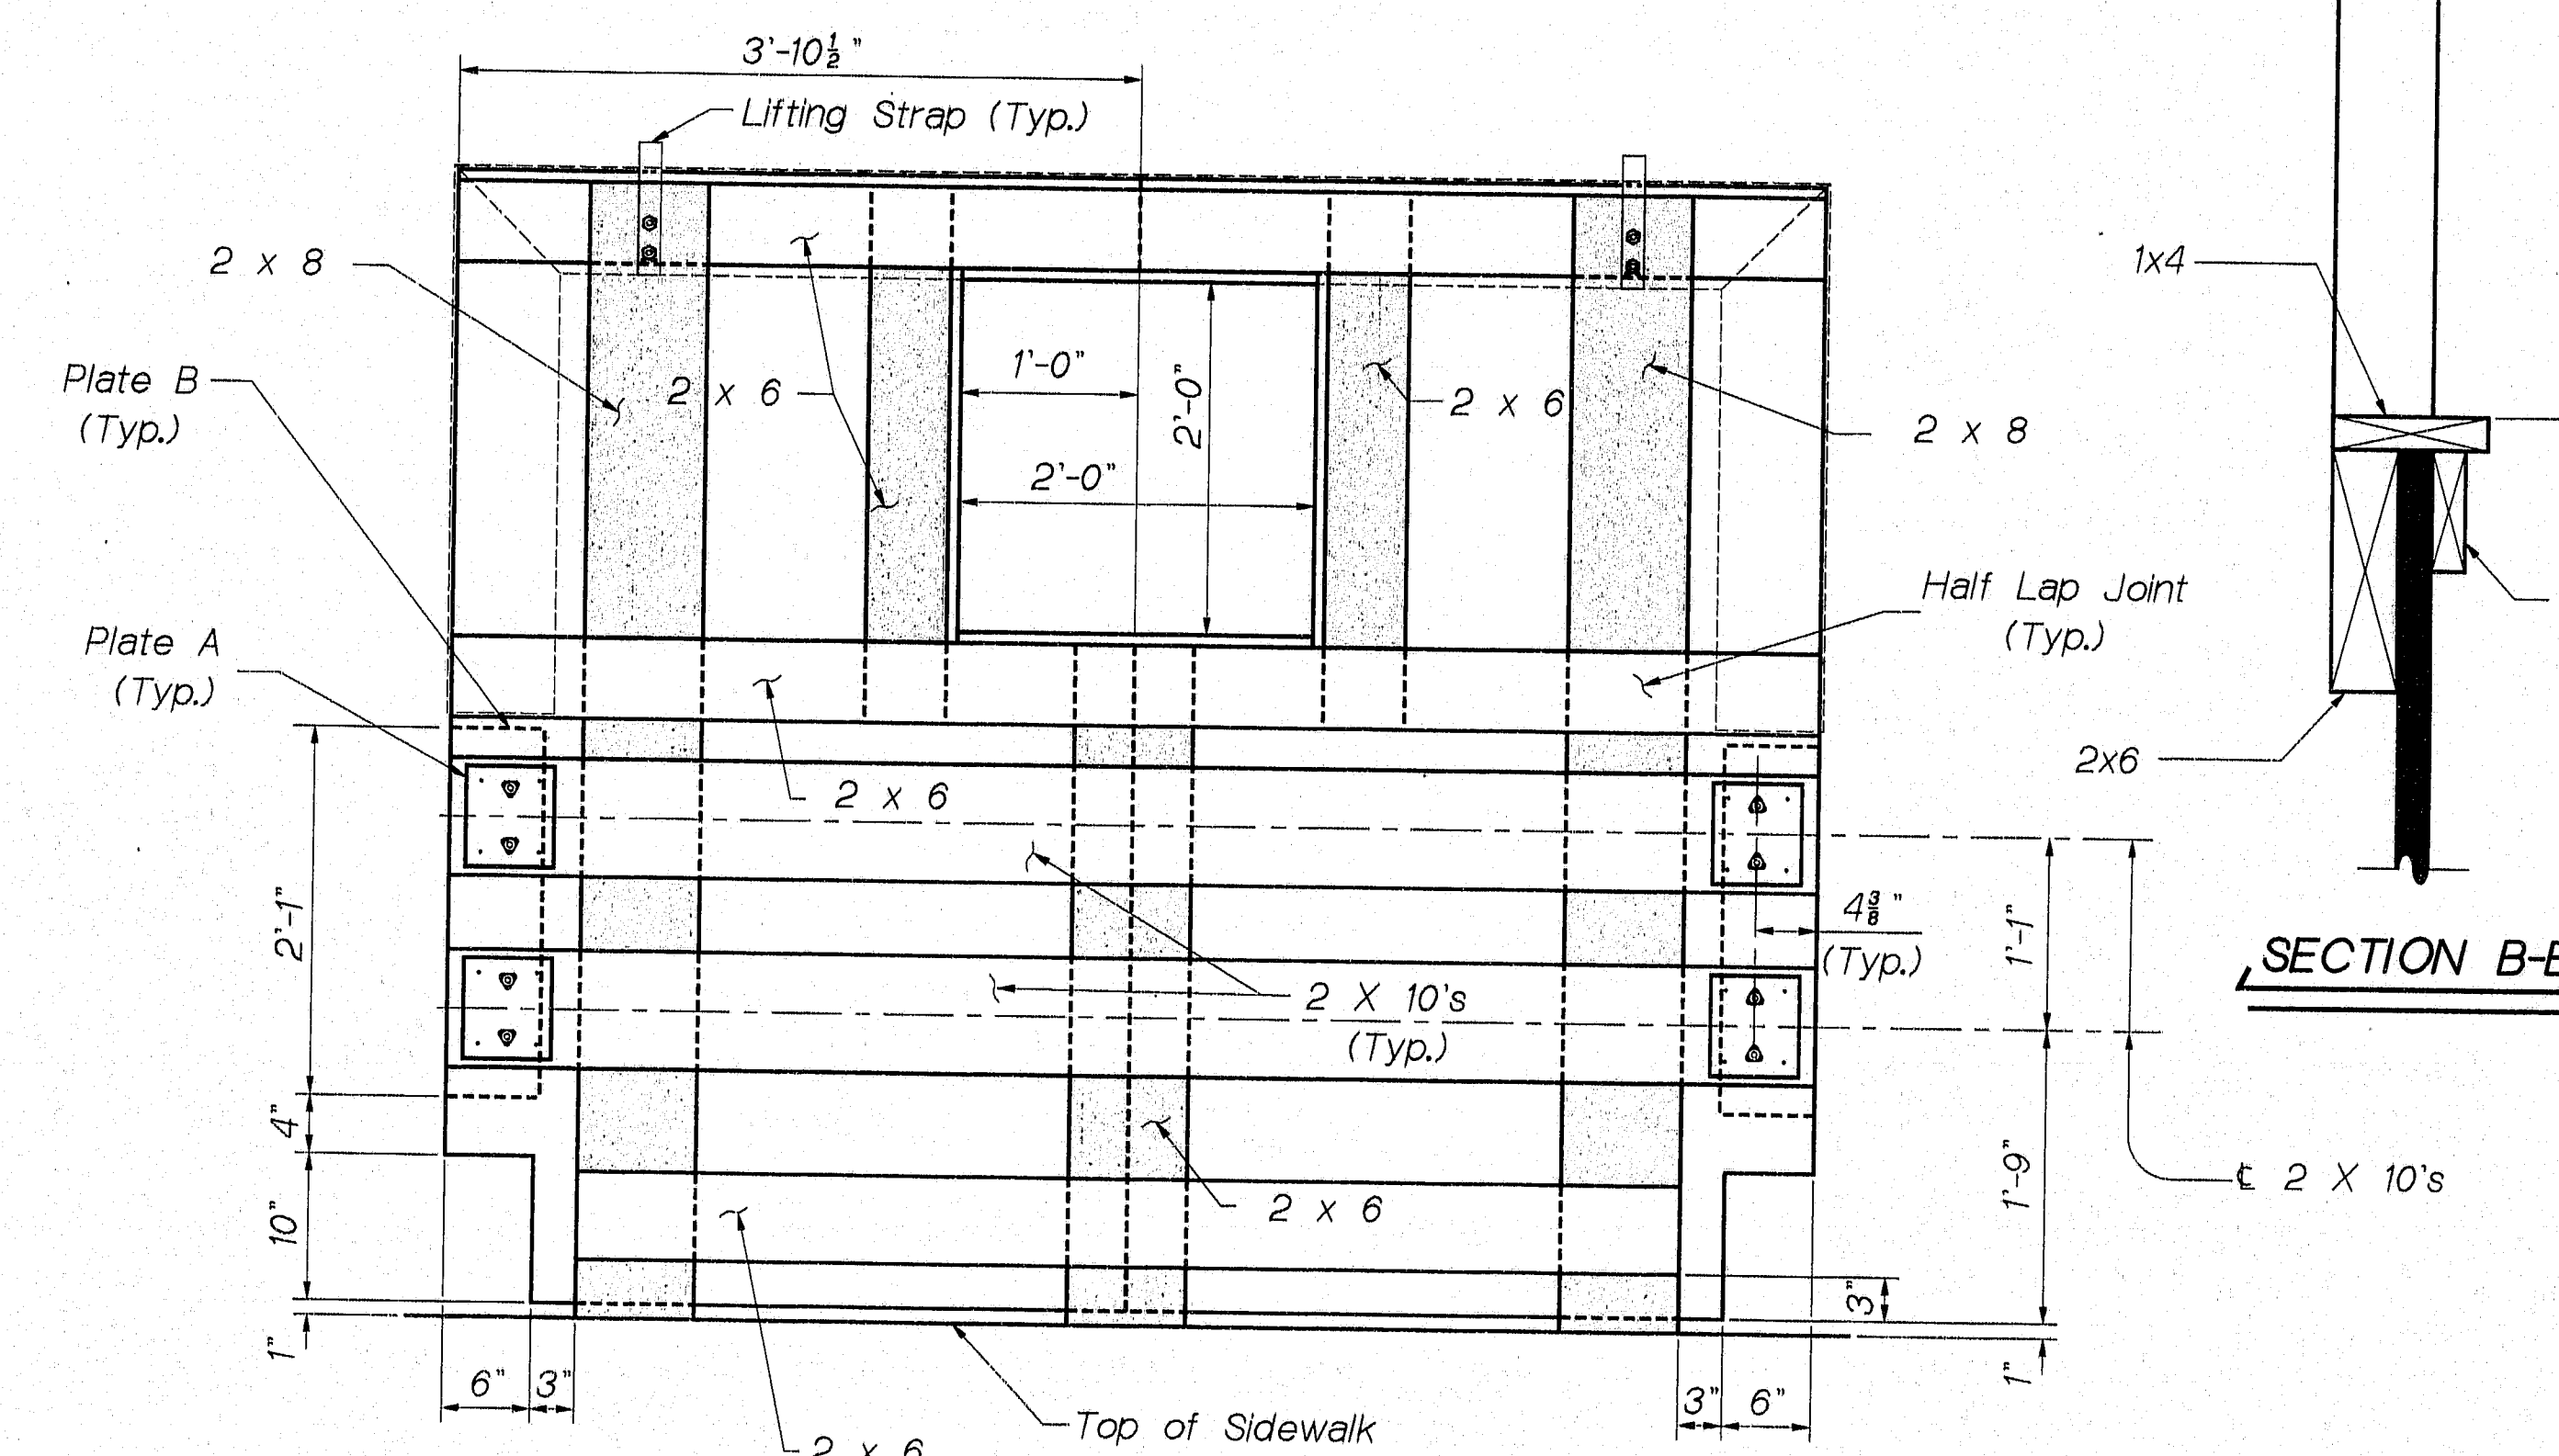

REAR ELEVATION

SECTION A - A
(Upstream Side)

NOTES

- 1) The 2x timber frame and 1x stock material shall consist of select structural grade Southern Yellow Pine or equivalent. All timber framing and 1x stock material shall be treated in accordance with AWPA C5 with Chromated Copper Arsenate with a minimum retention of 0.40 PCF.
- 2) The plywood panels shall be American Plywood Association 303 Siding Texture 1-11 1/8" thickness with grooves at 8" on center.
- 3) All wood surfaces shall be stained with a suitable exterior stain having a light gray color. A primer coat and 2 finish coats shall be applied in accordance with the manufacturer's recommendations, and as approved by the Engineer. Pressure treated timber shall be air dried a minimum of 21 days prior to staining.
- 4) All metal hardware shall be hot dipped galvanized in accordance with ASTM A123.
- 5) Windbreak panels shall be securely assembled using galvanized wood screws unless noted otherwise. There shall be a minimum of four wood screws at each half lap joint in the 2x frame, elsewhere the wood screws shall be spaced a maximum distance of 9" apart. The heads of the screws shall be driven flush with the surface of the wood.
- 6) The Contractor shall construct 52 windbreak panels (2 extra) without windows and 5 windbreak panels with windows. The windbreak is to be located on the upstream side of the bridge.

109-64

STATE OF MAINE
DEPARTMENT OF TRANSPORTATION

FERRY HILL BRIDGE
OVER
STILLWATER RIVER
IN THE TOWN OF
ORONO
PENOBSCOT COUNTY
WINDBREAK-WINDOW

SHEET 24 OF 43 AUGUSTA, MAINE July 6, 1992


PROJECT DESIGN ENGINEER	DATE
DESIGN-DETAILED	6/92
CHECKED	
APPROVED	
REVISIONS	
REVISIONS	

17-JLVB2-010050

PIN. 004867.00

F.H.D.A. REG. NO.	STATE	PROJECT NUMBER	SHEET NO.	TOTAL SHEETS
1	MAINE	BH-140(19)	24D	43


2 Brgs.
Abutment No. 1

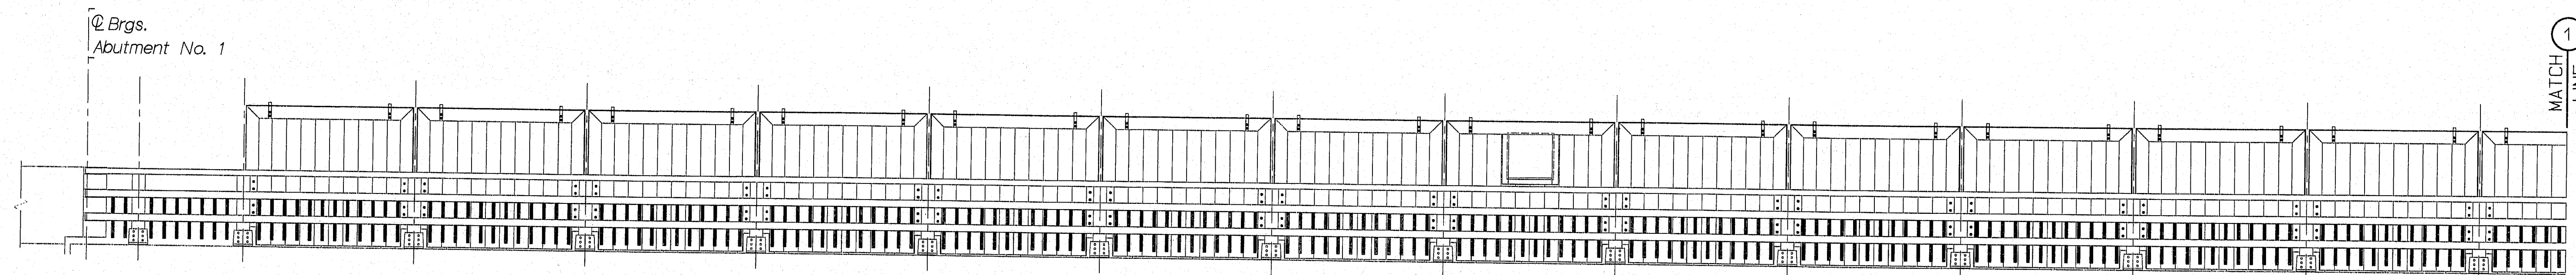

ELEVATION

MATCH
LINE 1


MATCH
LINE 2

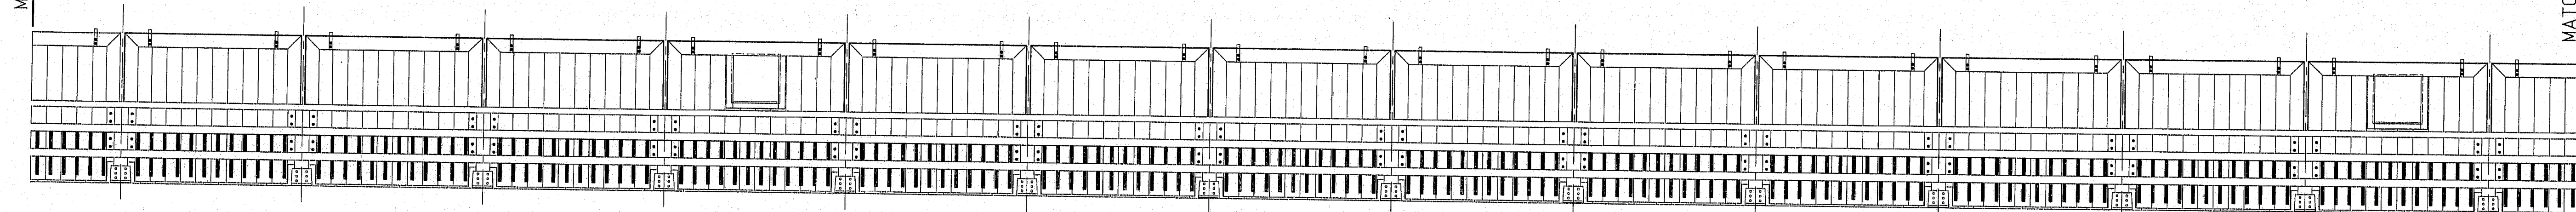

ELEVATION

MATCH
LINE 2


MATCH
LINE 3

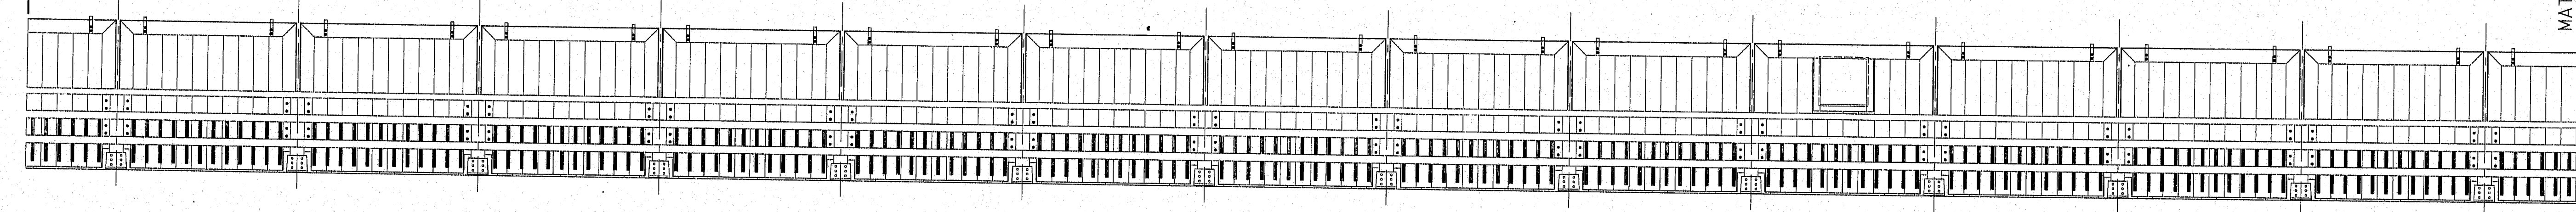

ELEVATION

MATCH
LINE 3

2 Brgs.
Abutment No. 2

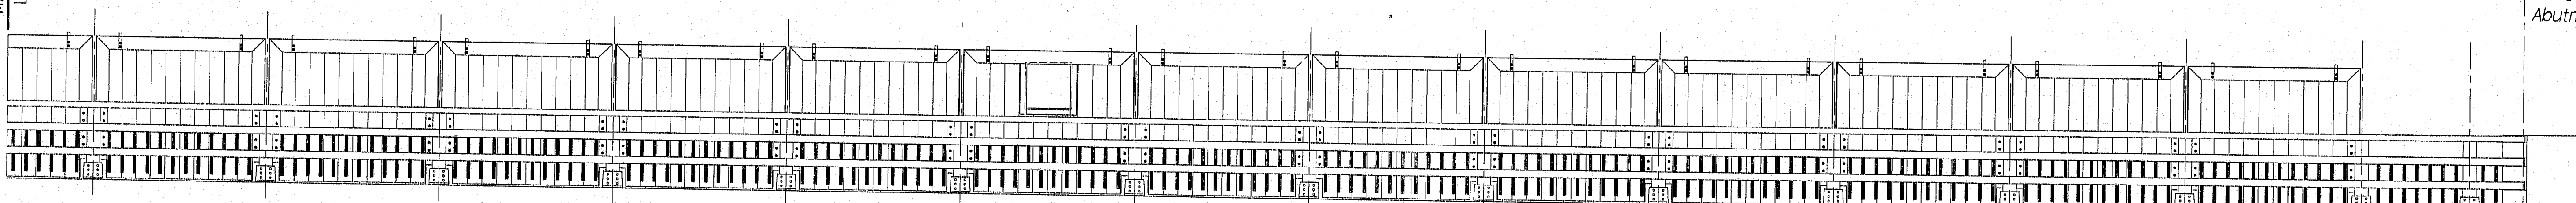

ELEVATION

109-65

STATE OF MAINE 291
DEPARTMENT OF TRANSPORTATION

FERRY HILL BRIDGE
OVER
STILLWATER RIVER
IN THE TOWN OF
ORONO
PENOBSCOT COUNTY

FULL ELEVATION WINDBREAK

SHEET 24 OF 43 AUGUSTA, MAINE


PROJECT DESIGN ENGINEER	DATE
BY	7/2/2007
DESIGN-DETAILED	
CHECKED	
FIELD CHANGES	

PLANS

25 JUN 92-010040

[illegible]

F.H.W.A. REG. NO.	STATE	PROJECT NUMBER	SHEET NO.	TOTAL SHEETS

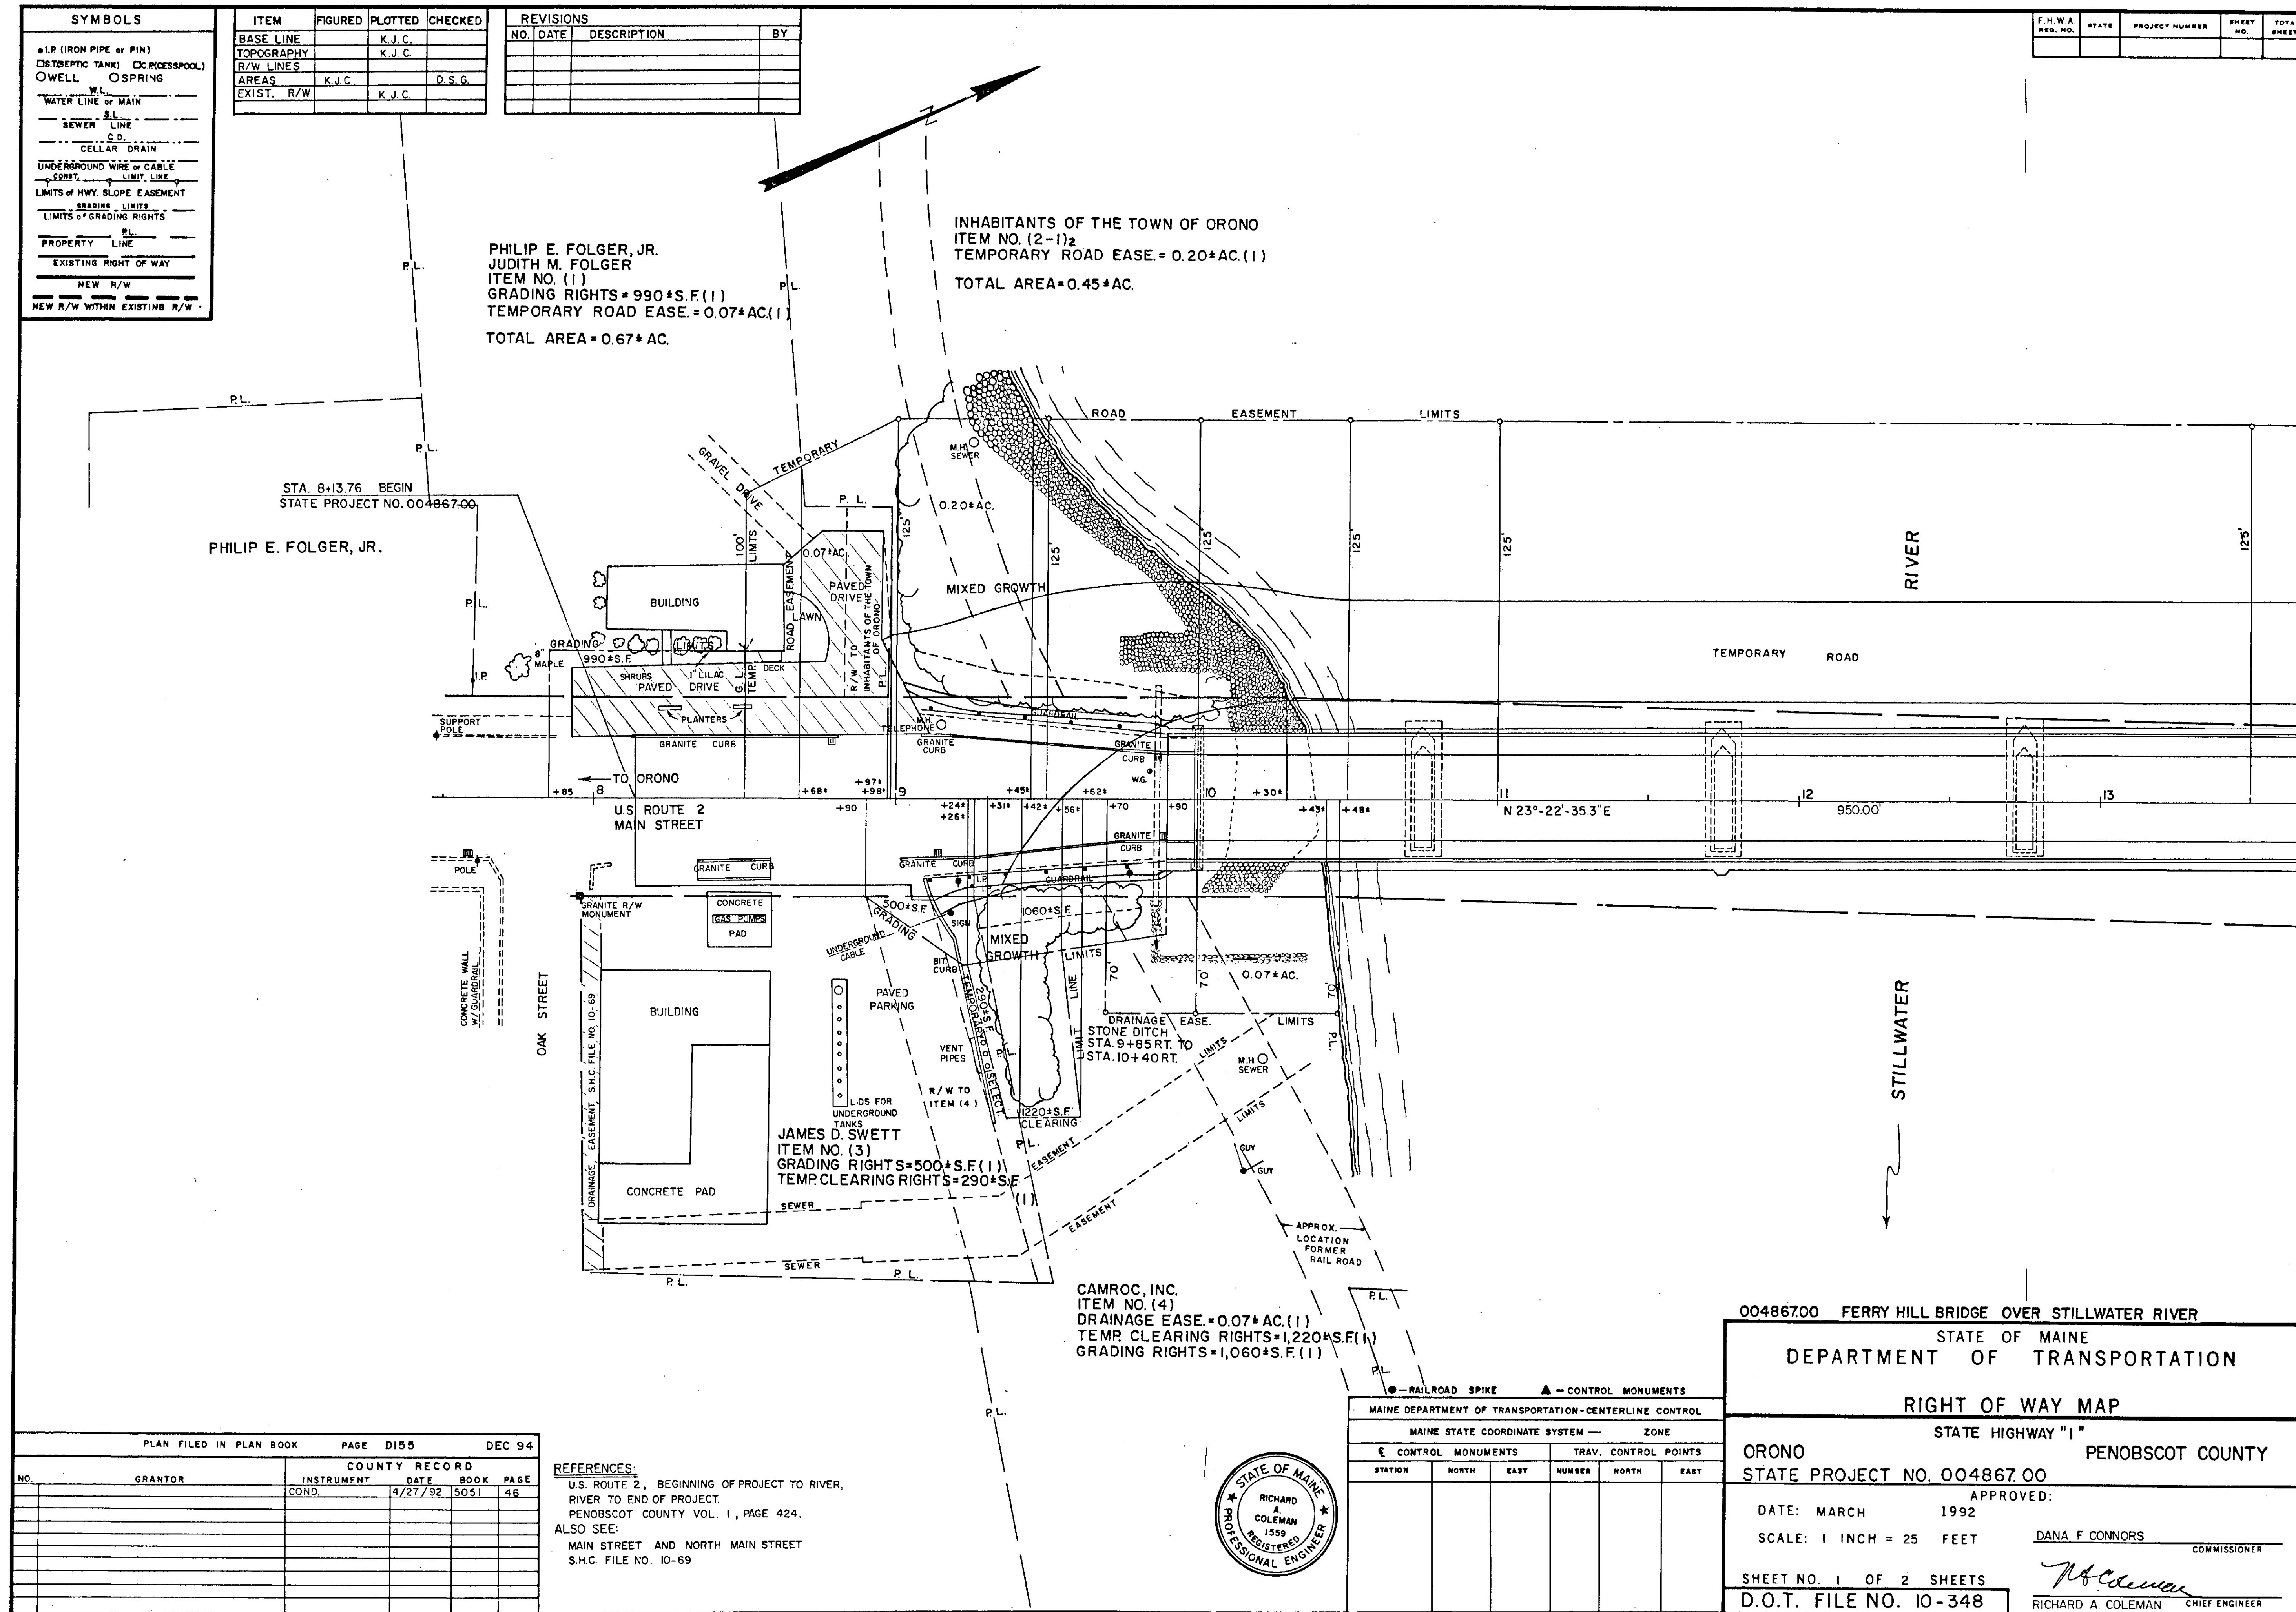[illegible]

REFERENCES:
U.S. ROUTE 2, BEGINNING OF PROJECT TO RIVER
RIVER TO END OF PROJECT.
PENOBSCOT COUNTY VOL. 1, PAGE 424.
ALSO SEE:
MAIN STREET AND NORTH MAIN STREET
S.H.C. FILE NO. 10-69

[illegible]

004867.00 FERRY HILL BRIDGE OVER STILLWATER RIVER

STATE OF MAINE
DEPARTMENT OF TRANSPORTATION

RIGHT OF WAY MAP

ORONO STATE HIGHWAY "1" PENOBSCOT COUNTY

DATE: MARCH 1992
SCALE: 1 INCH = 25 FEET

VED:

DANA F. CONNORS

COMMISSIONER

SHEET NO. 1 OF 2 SHEETS
D.O.T. FILE NO. 10-348


Richard A. Colfman
RICHARD A. COLFMAN CHIEF ENGINEER

SYMBOLS	
• I.P. (IRON PIPE or PIN)	
□ SEPTIC TANK	□ CESSPOOL
○ WELL	○ SPRING
— W.L.	
— WATER LINE or MAIN	
— S.W.	
— SEWER LINE	
— C.D.	
— CELLAR DRAIN	
— UNDERGROUND WIRE or CABLE	
— COMST.	
— LIMIT LINE	
— LIMITS of HWY. SLOPE EASEMENT	
— GRADING LIMITS	
— LIMITS of GRADING RIGHTS	
— PL.	
— PROPERTY LINE	
— EXISTING RIGHT OF WAY	
— NEW R/W	
— NEW R/W WITHIN EXISTING R/W	

ITEM	FIGURED	PLOTTED	CHECKED
BASE LINE		K.J.C.	
TOPOGRAPHY		K.J.C.	
R/W LINES			
AREAS	K.J.C.		D.S.G.
EXIST. R/W		K.J.C.	


REVISIONS		
NO.	DATE	DESCRIPTION

F.H.W.A. REG. NO.	STATE	PROJECT NUMBER	SHEET NO.	TOTAL SHEETS

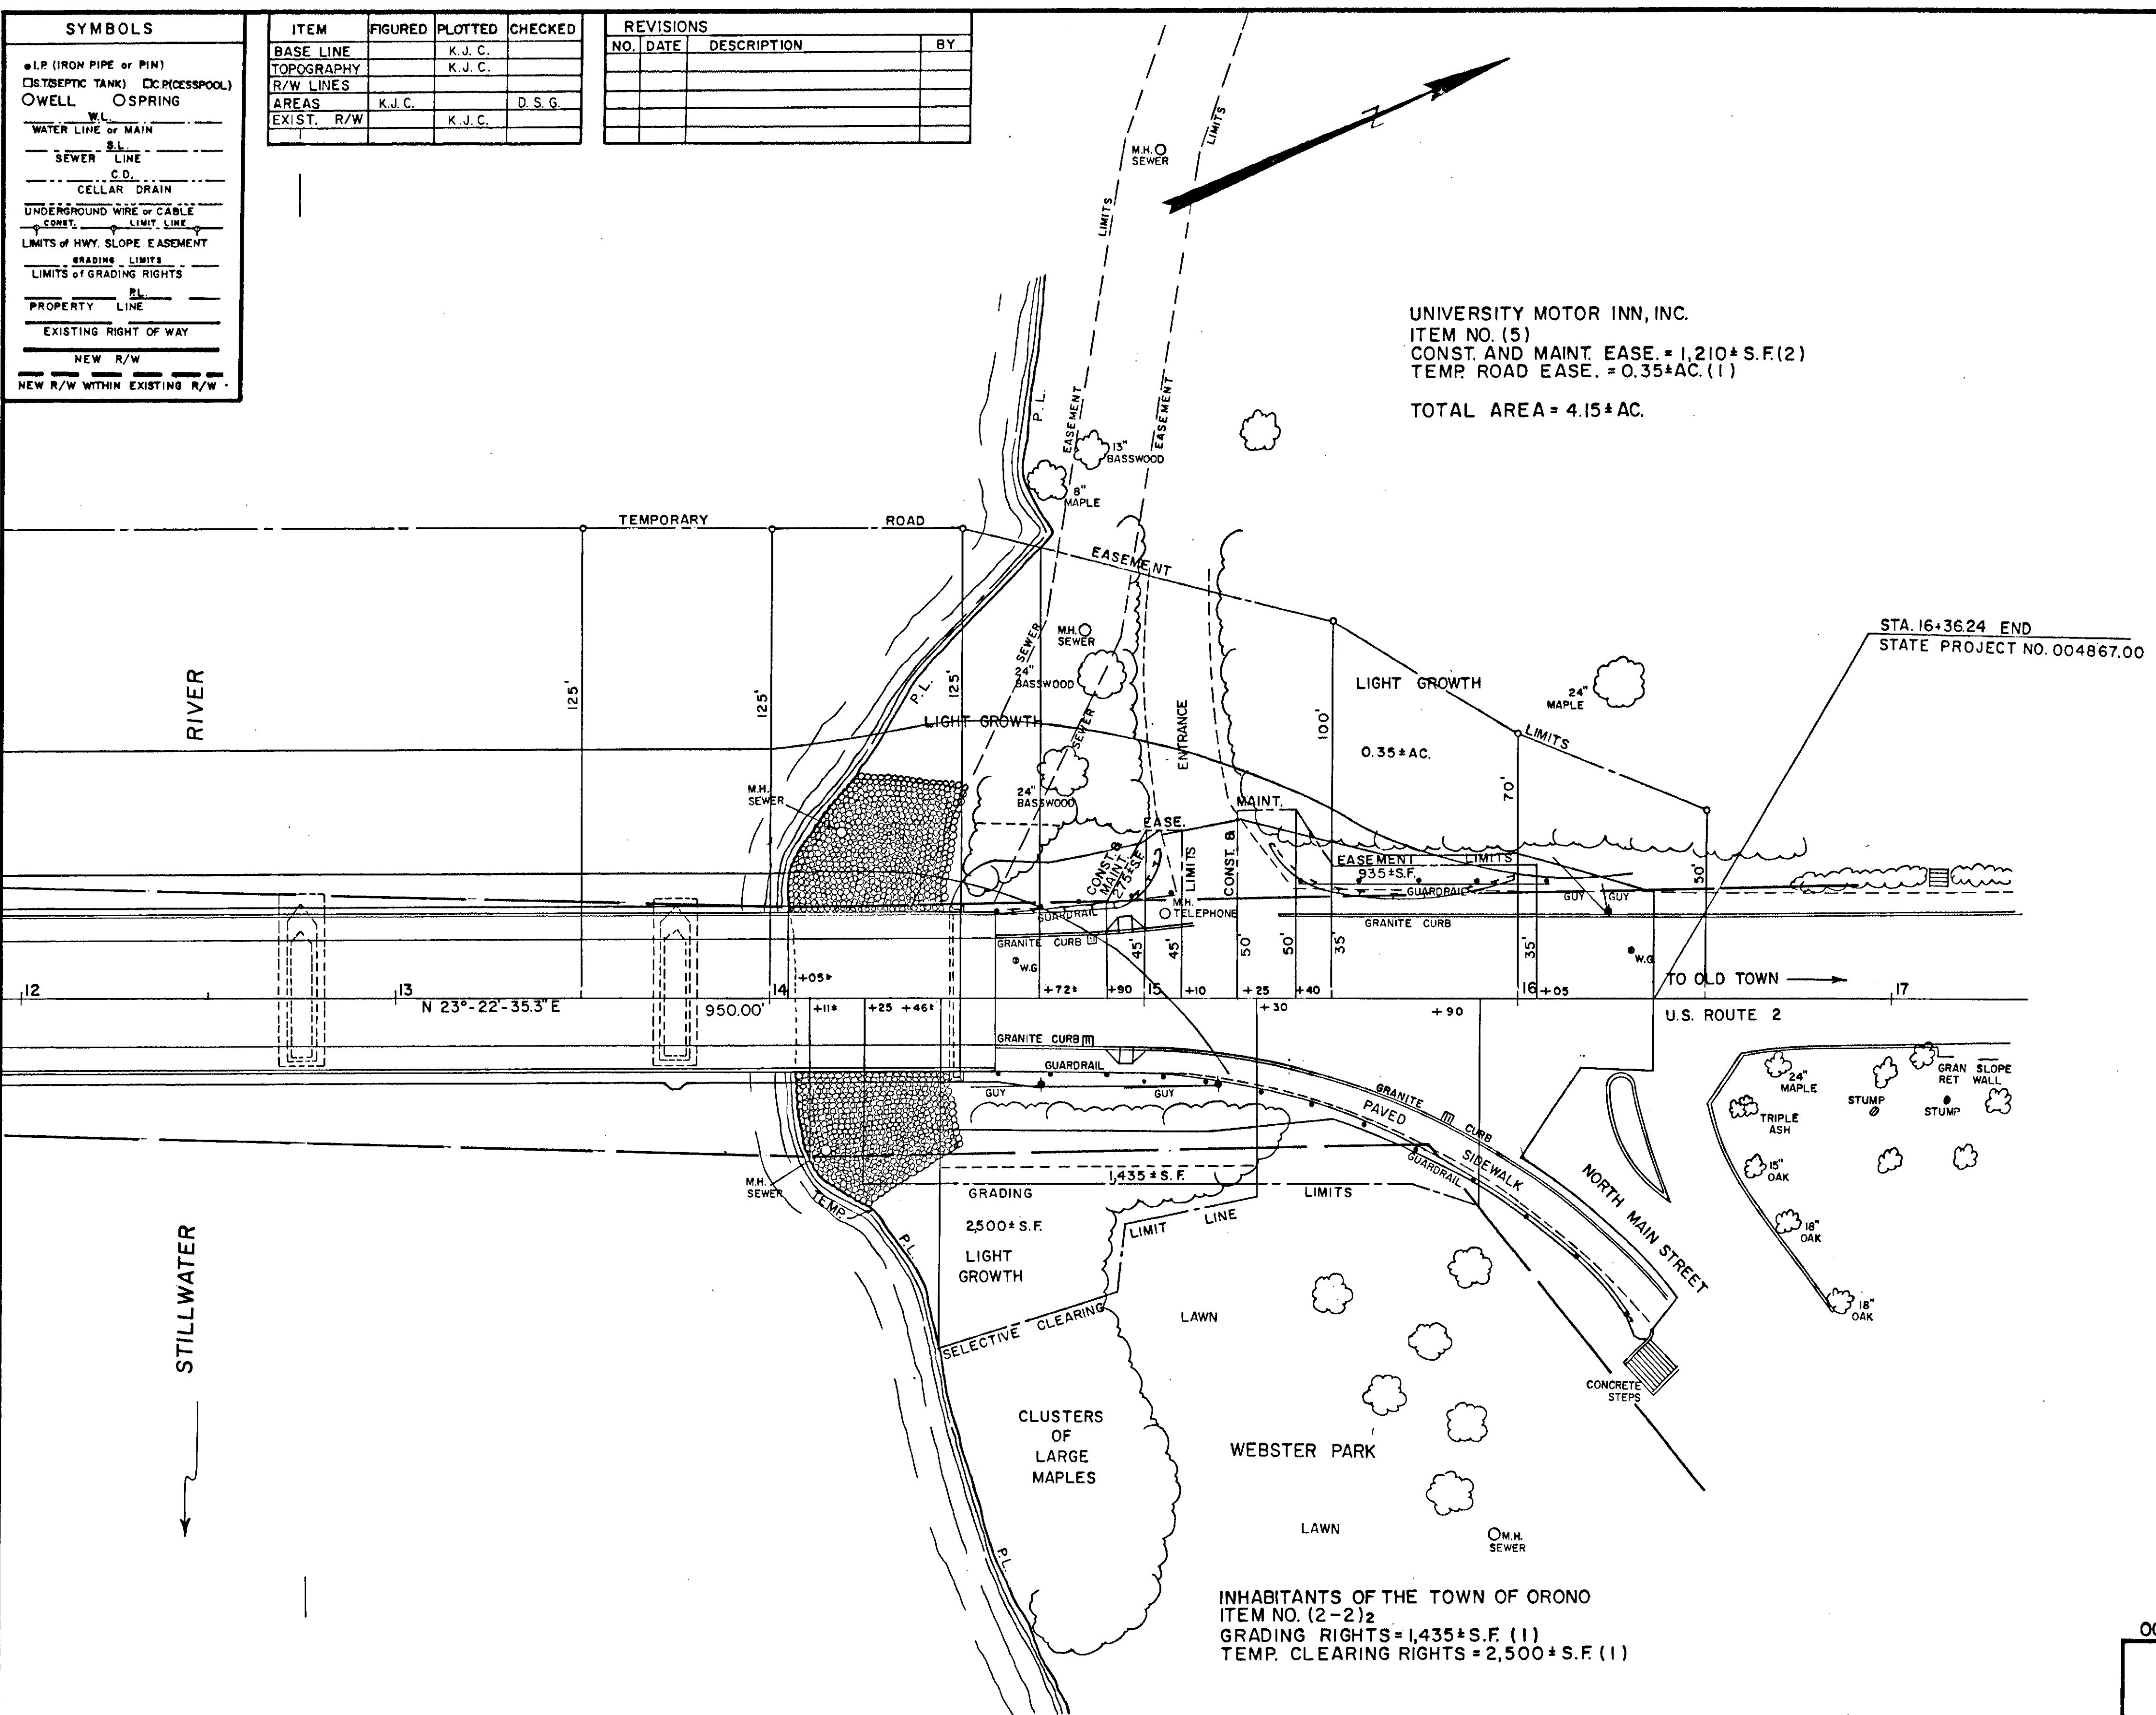

PLAN FILED IN PLAN BOOK		PAGE	D156	DEC 94
COUNTY RECORD				
NO.	GRANTOR	INSTRUMENT	DATE	BOOK PAGE
		COND.	4/27/92	5051 46

REFERENCES:
U.S. ROUTE 2, BEGINNING OF PROJECT TO RIVER,
RIVER TO END OF PROJECT
PENOBSCOT COUNTY VOL. 1, PAGE 424.
ALSO SEE:
MAIN STREET AND NORTH MAIN STREET
S.H.C. FILE NO. 10-69

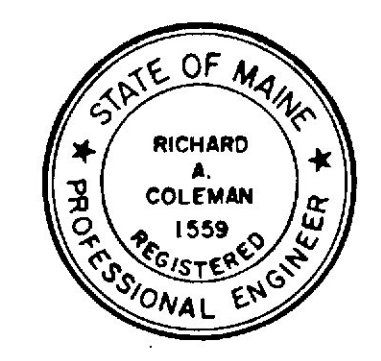

MAINE DEPARTMENT OF TRANSPORTATION-CENTERLINE CONTROL					
MAINE STATE COORDINATE SYSTEM — ZONE					
CONTROL MONUMENTS			TRAV. CONTROL POINTS		
STATION	NORTH	EAST	NUMBER	NORTH	EAST

004867.00 FERRY HILL BRIDGE OVER STILLWATER RIVER

STATE OF MAINE
DEPARTMENT OF TRANSPORTATION

RIGHT OF WAY MAP

STATE HIGHWAY "1"

ORONO PENOBSCOT COUNTY
STATE PROJECT NO. 004867.00

DATE: MARCH 1992
SCALE: 1 INCH = 25 FEET

SHEET NO. 2 OF 2 SHEETS
D.O.T. FILE NO. 10-348

APPROVED:
DANA F. CONNORS
COMMISSIONER

RICHARD A. COLEMAN
CHIEF ENGINEER