


Filename: ...P01_Pylon_Access_Details.dgn


Username: wjohnson

Date: 10/14/2004


Division: BRIDGE

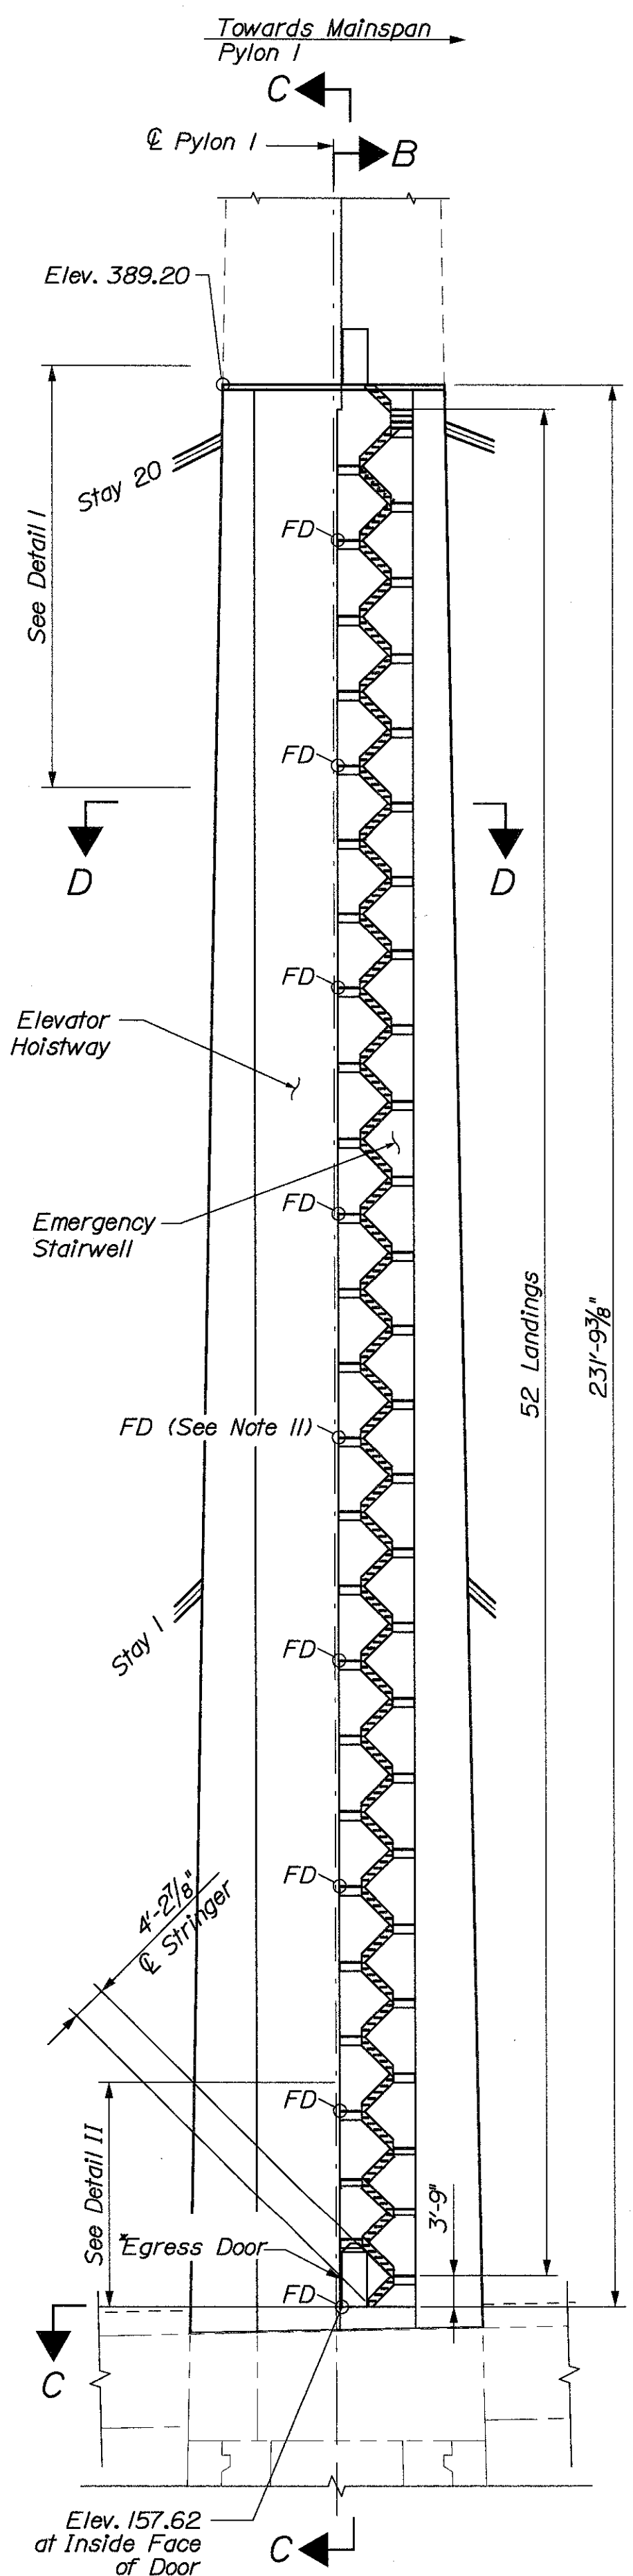


SECTION A-A
*See Egress Door Detail

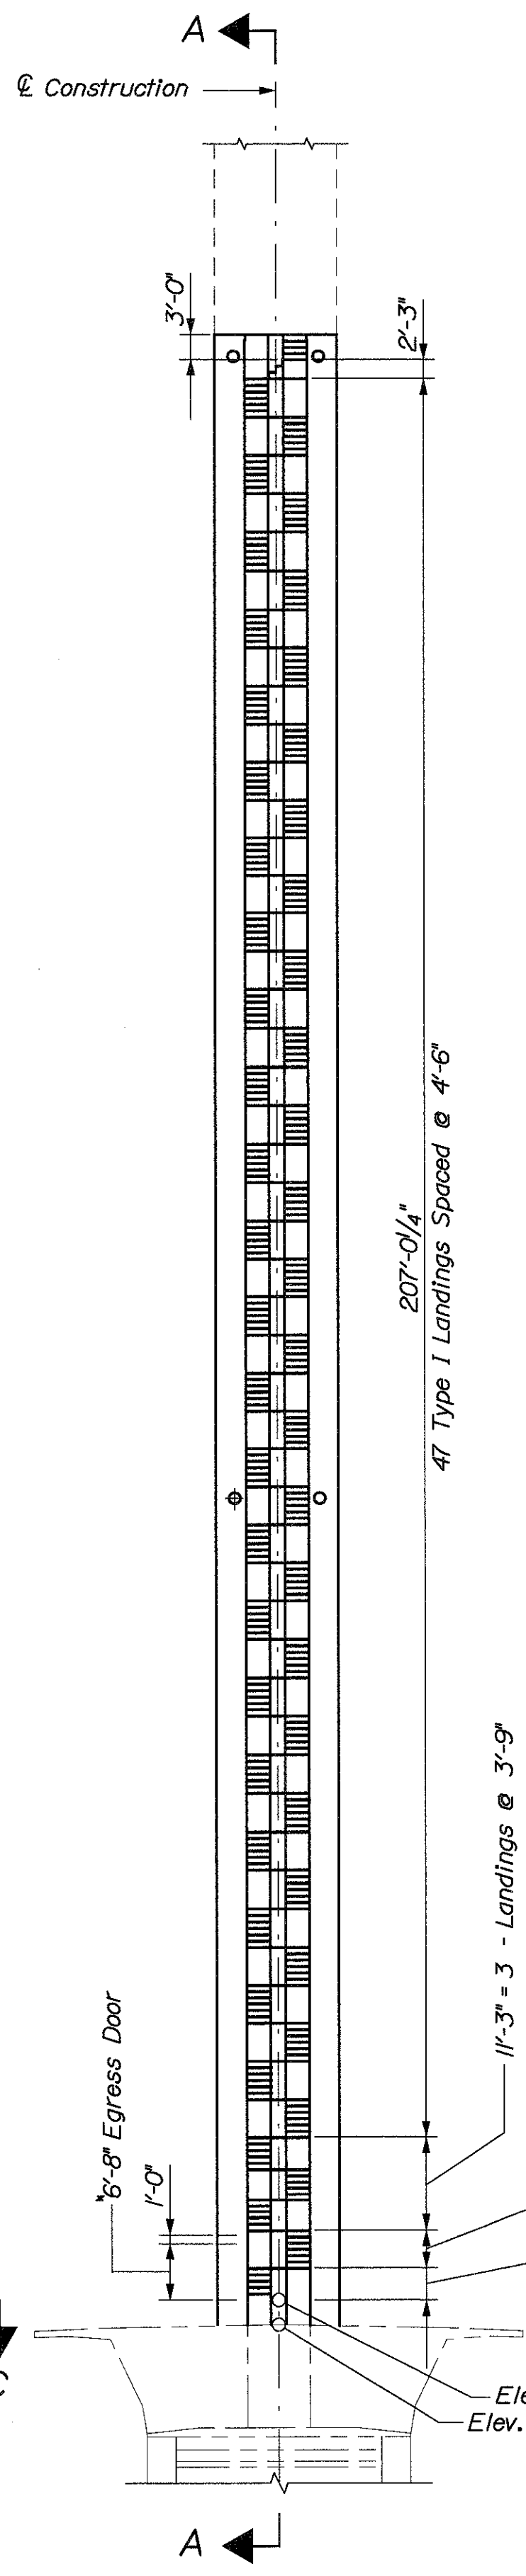


SECTION B-B

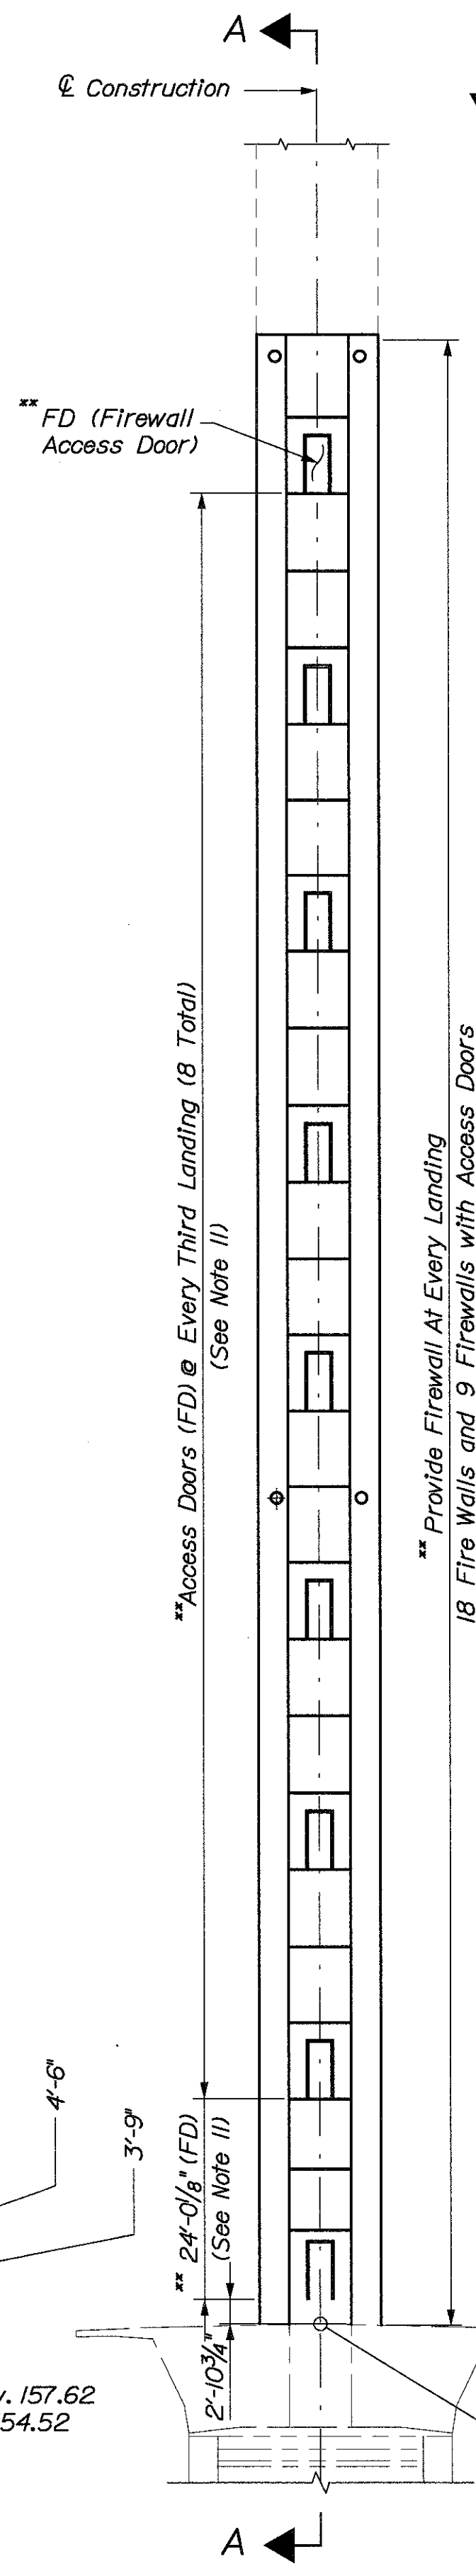


SECTION C-C
**See Firewall Detail

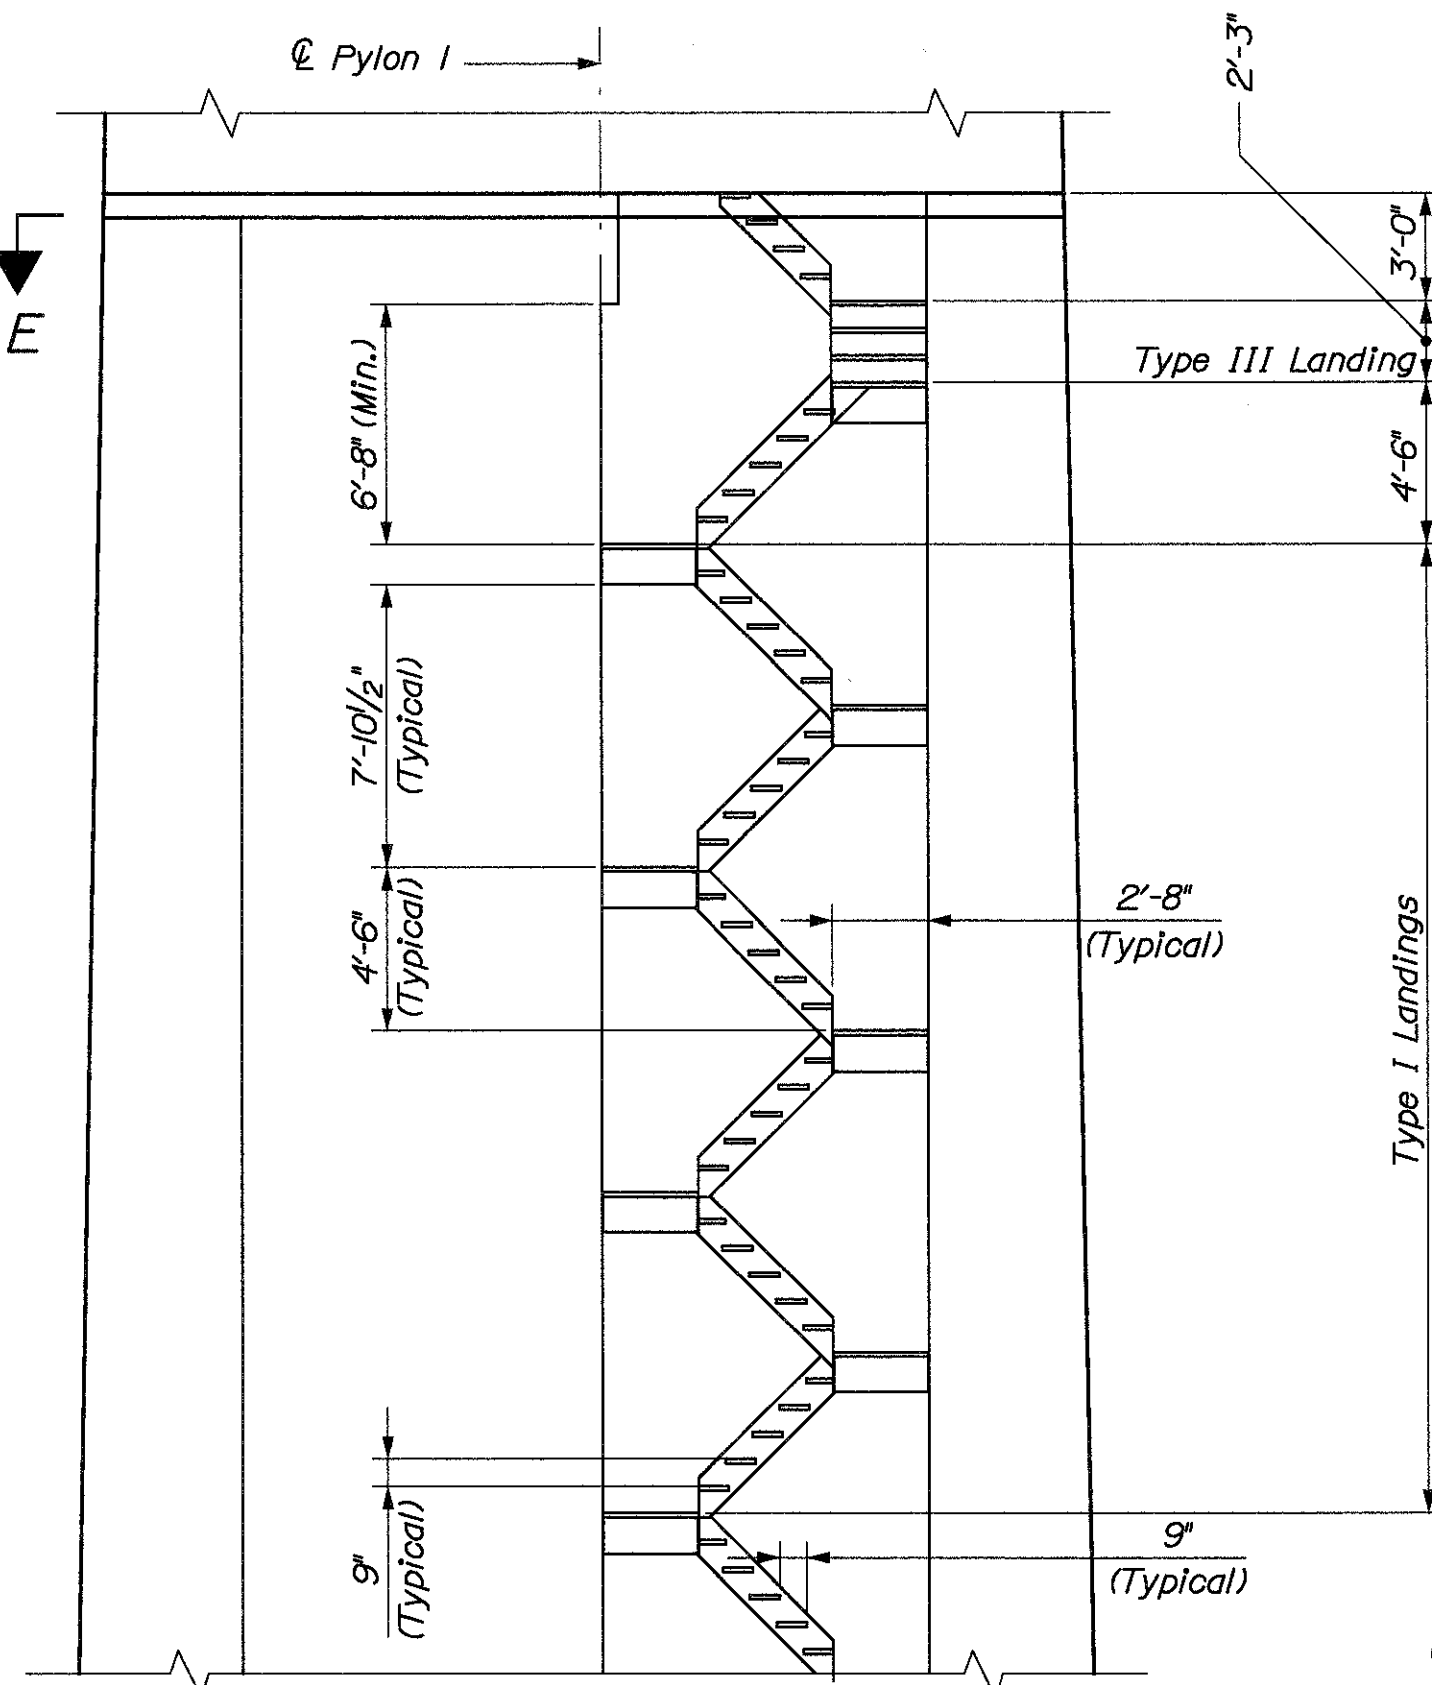

DETAIL I
Upstation

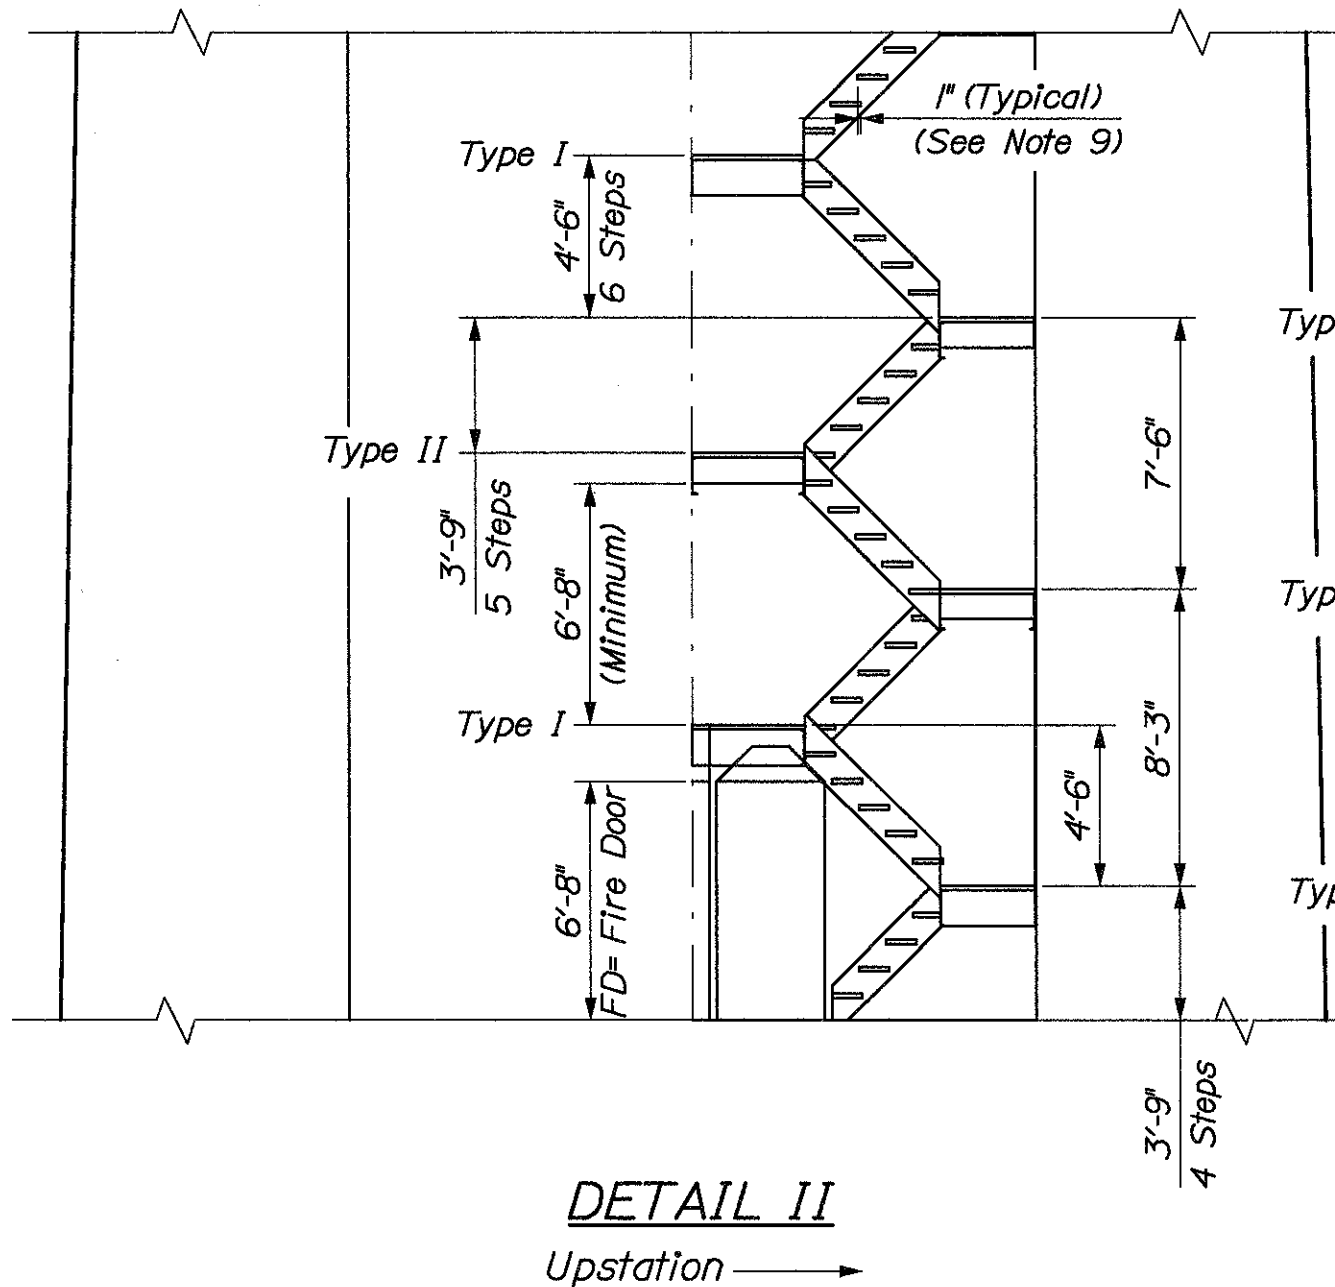

DETAIL II
Upstation

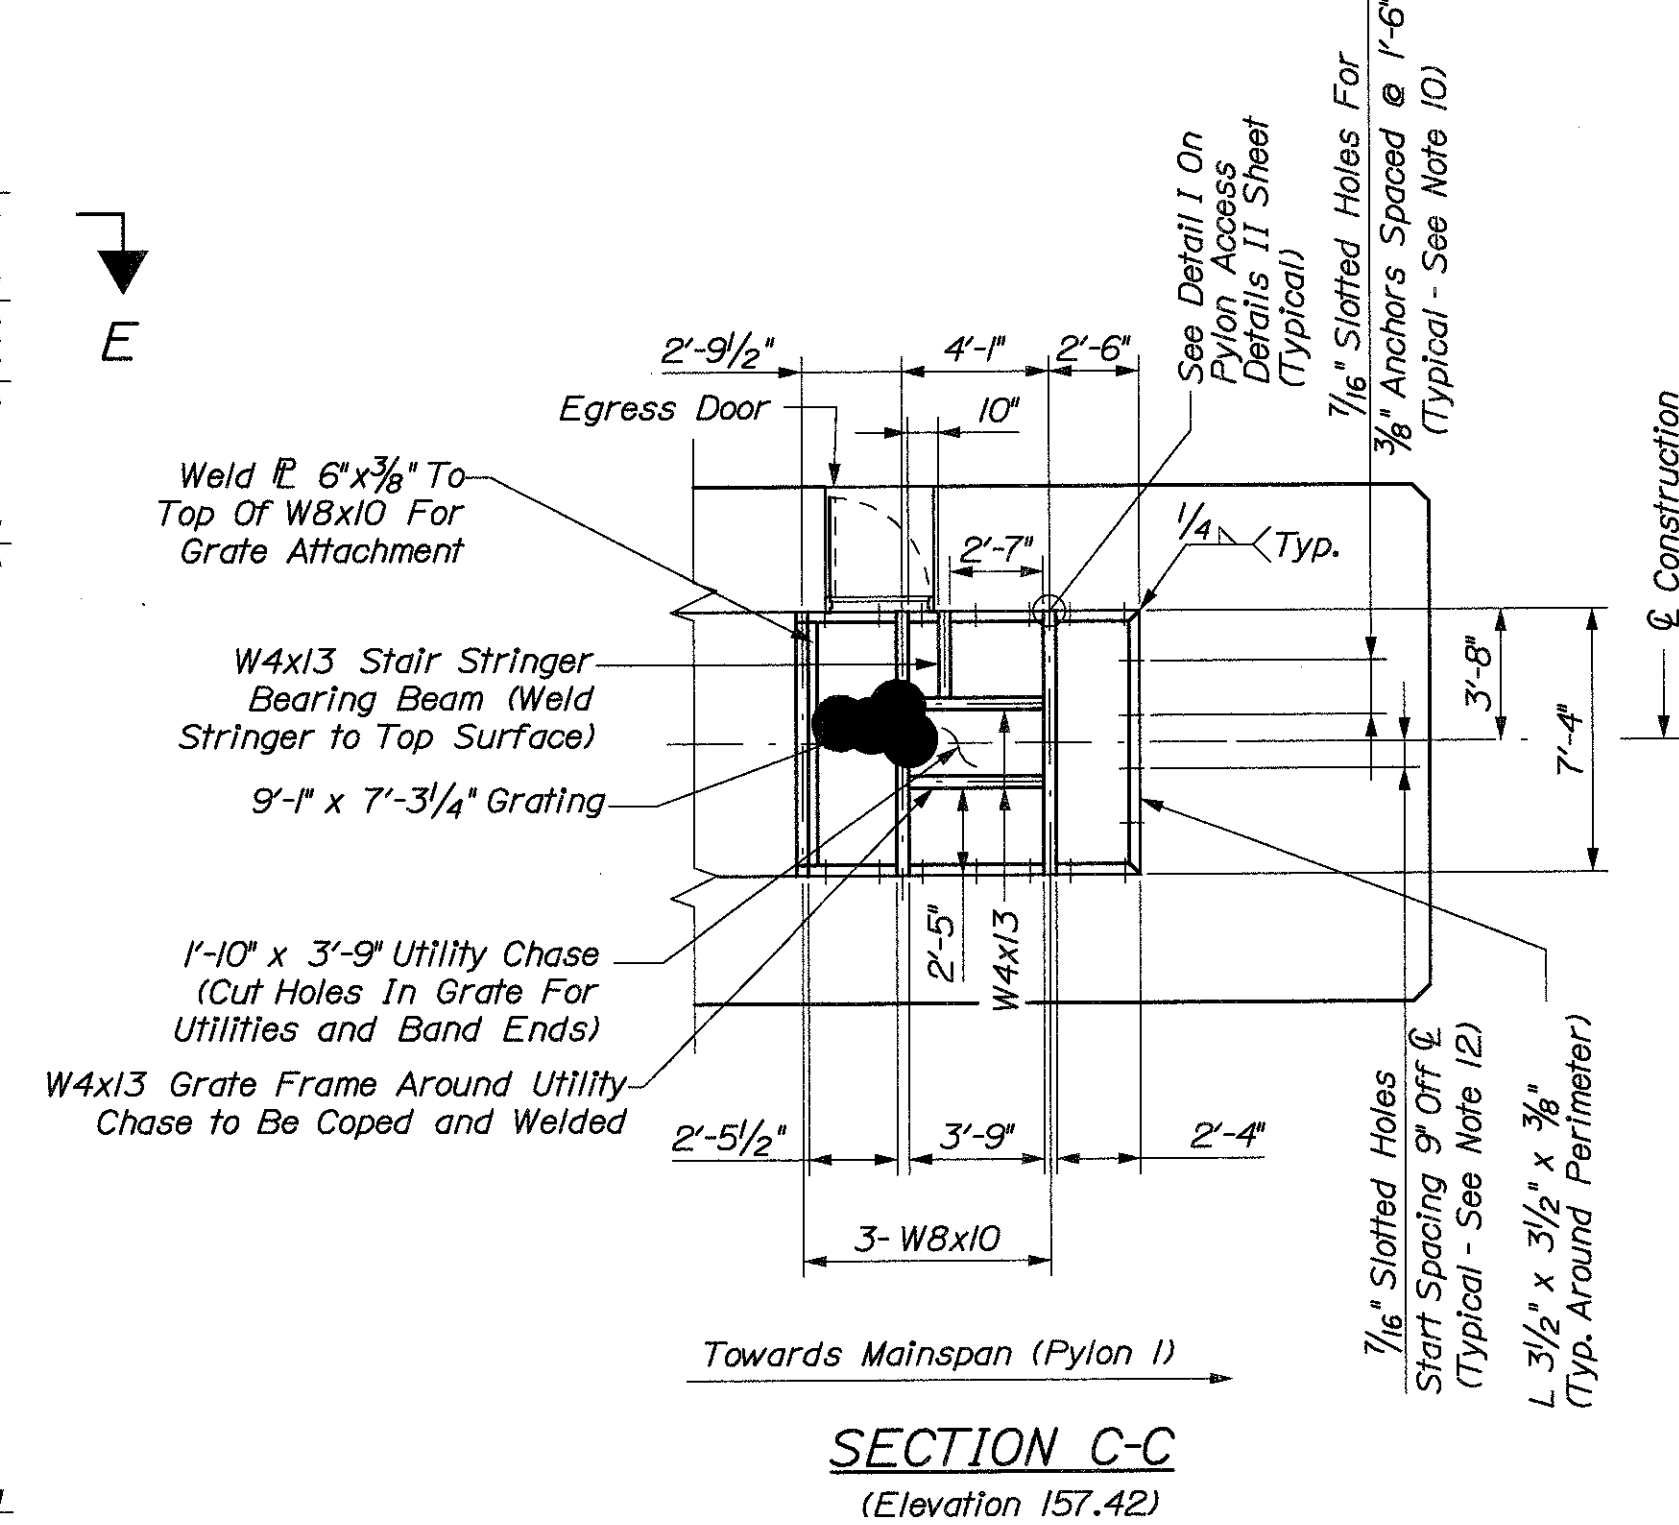

SECTION C-C
(Elevation 157.42)


NOTES

(Notes apply to Pylon Access Details I-IV sheets unless otherwise noted)

1. Details and comments on Pylon Access Details I thru IV drawings apply to Pylon I only.
2. See Pylon Access Details V sheet for Egress Door Detail, Firewall Detail and Railing Details.
3. See Pylon Access Details II - IV sheets for stair details and Type I - III landing details.
4. Cost of stairs, landings, firewalls, egress doors, associated hardware, labor, installation etc. is incidental to Pay Item 502.2191 - Structural Concrete, (Pylon Maintenance Access System).
5. Structural steel shapes shall conform to ASTM A992, angles shall conform to ASTM A36 and bolts shall conform to ASTM A325.
6. All steel, including grating, shall be hot-dipped galvanized in accordance with ASTM A123. Hardware shall be galvanized in accordance with ASTM A153.
7. Contractor shall provide detailed Shop Drawings for guide rail attachment locations and details of elevator access platform and supporting structural steel shown. Elevator lateral load design requirement is 0.8 Kips per rail with less than 1/8" deflection.
8. Grating for platforms shall be galvanized with 1 1/2" x 1/8" bearing bars 13/16" on center, with cross bars at 4" on center. All edges shall be banded. Bearing bar spanning direction shall be as shown (otherwise run 1 1/2" bars in direction of short span). Grating shall completely cover the platform area. Grating shall be cut to clear 4" x 4" x 3/8" angle hangers. Attach grating to supporting steel beams by welding or with steel clips per manufacturer's recommendations.
9. Bar grating for stair treads shall be galvanized steel welded type bar grating with 1" x 1/8" bearing bars 13/16" on center, with cross bars at 4" on center. All edges shall be banded. Bearing bar shall be positioned in direction of span between stringers. Grating shall completely cover the 2 1/2" x 2 1/2" x 3/8" tread angles and be positioned so lower tread extends 1" past nose of upper tread (grating dimension = 10" (minimum) x 2'-8"). Attach grating to supporting angle by welding every other bearing bar to top of angle.
10. Bolt anchorage hardware shall be from the Department Approved Product List, or approved equal. Anchor group shall have a combined working shear capacity and a minimum working tension capacity as shown in the plans. Contractor shall submit proposed system for review by the Department prior to use. Bolt anchorages shall be installed in strict accordance with the selected manufacturer's recommendations.
11. FD = 2'-8" x 6'-8" firewall door access locations. Maximum 36" spacing between access doors. Locate doors at landing levels. For additional detailed information see Pylon Access Details II, III & V sheets. See Architectural Drawings - A01 - A43, Lower Pylon Elevator Hoistway Details I - II and Lower Pylon Mechanical Room Details I - V.
12. Field verify all dimensions prior to fabrication and coordinate final grating dimensions accordingly.
13. Dimensions provided are for general information. Adjustments in steel lengths due to coping, tolerances, etc. are not included unless specifically stated.
14. All welds shall be in strict accordance with AWS D1.5 and all welders shall be AWS certified.
15. Minimum stair and landing walkway clearance shall be 2'-8".

ESTIMATED QUANTITIES / PYLON PIER 1 ACCESS		
ITEM	UNIT	QUANTITY
Structural Steel	Lb.	47,470
1 1/2" x 1/8" Galvanized Grating	Lb.	8,070
1" x 1/8" Galvanized Grating	Lb.	2,960

Estimated Quantities Are For Information Only. Quantity Excludes Bolts For Connections.

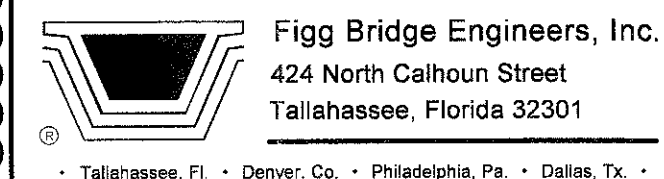

STATE OF MAINE
DEPARTMENT OF TRANSPORTATION

PROSPECT-VERONA BRIDGE
PENOBSCOT RIVER
PROSPECT\VERONA WALDO\HANCOCK CTY

SHEET NUMBER
P1
OF P15

DATE: 9-05-04
BY: T. COOPER
CHECKED: T. COOPER
DESIGN: T. COOPER
DESIGN: T. COOPER
REVISIONS: 1
REVISIONS: 2
REVISIONS: 3
REVISIONS: 4
FIELD CHANGES

DATE: 9-05-04
BY: T. COOPER
CHECKED: T. COOPER
DESIGN: T. COOPER
DESIGN: T. COOPER
REVISIONS: 1
REVISIONS: 2
REVISIONS: 3
REVISIONS: 4
FIELD CHANGES

DATE: 9-05-04
BY: T. COOPER
CHECKED: T. COOPER
DESIGN: T. COOPER
DESIGN: T. COOPER
REVISIONS: 1
REVISIONS: 2
REVISIONS: 3
REVISIONS: 4
FIELD CHANGES

DATE: 9-05-04
BY: T. COOPER
CHECKED: T. COOPER
DESIGN: T. COOPER
DESIGN: T. COOPER
REVISIONS: 1
REVISIONS: 2
REVISIONS: 3
REVISIONS: 4
FIELD CHANGES

PROF. OF MAINE
Christopher Burgess
10624
REGISTERED PROFESSIONAL ENGINEER

DATE: 15 Oct 04
P.E. NUMBER: 1500004


BRIDGE NO. 6421
PIN: 7965.55, 7965.56
BRIDGE PLANS

Date:10/14/2004


Username: wjohnson

Division: BRIDGE


Filename: ...P02_Pylon_Access_Details_1.dgn

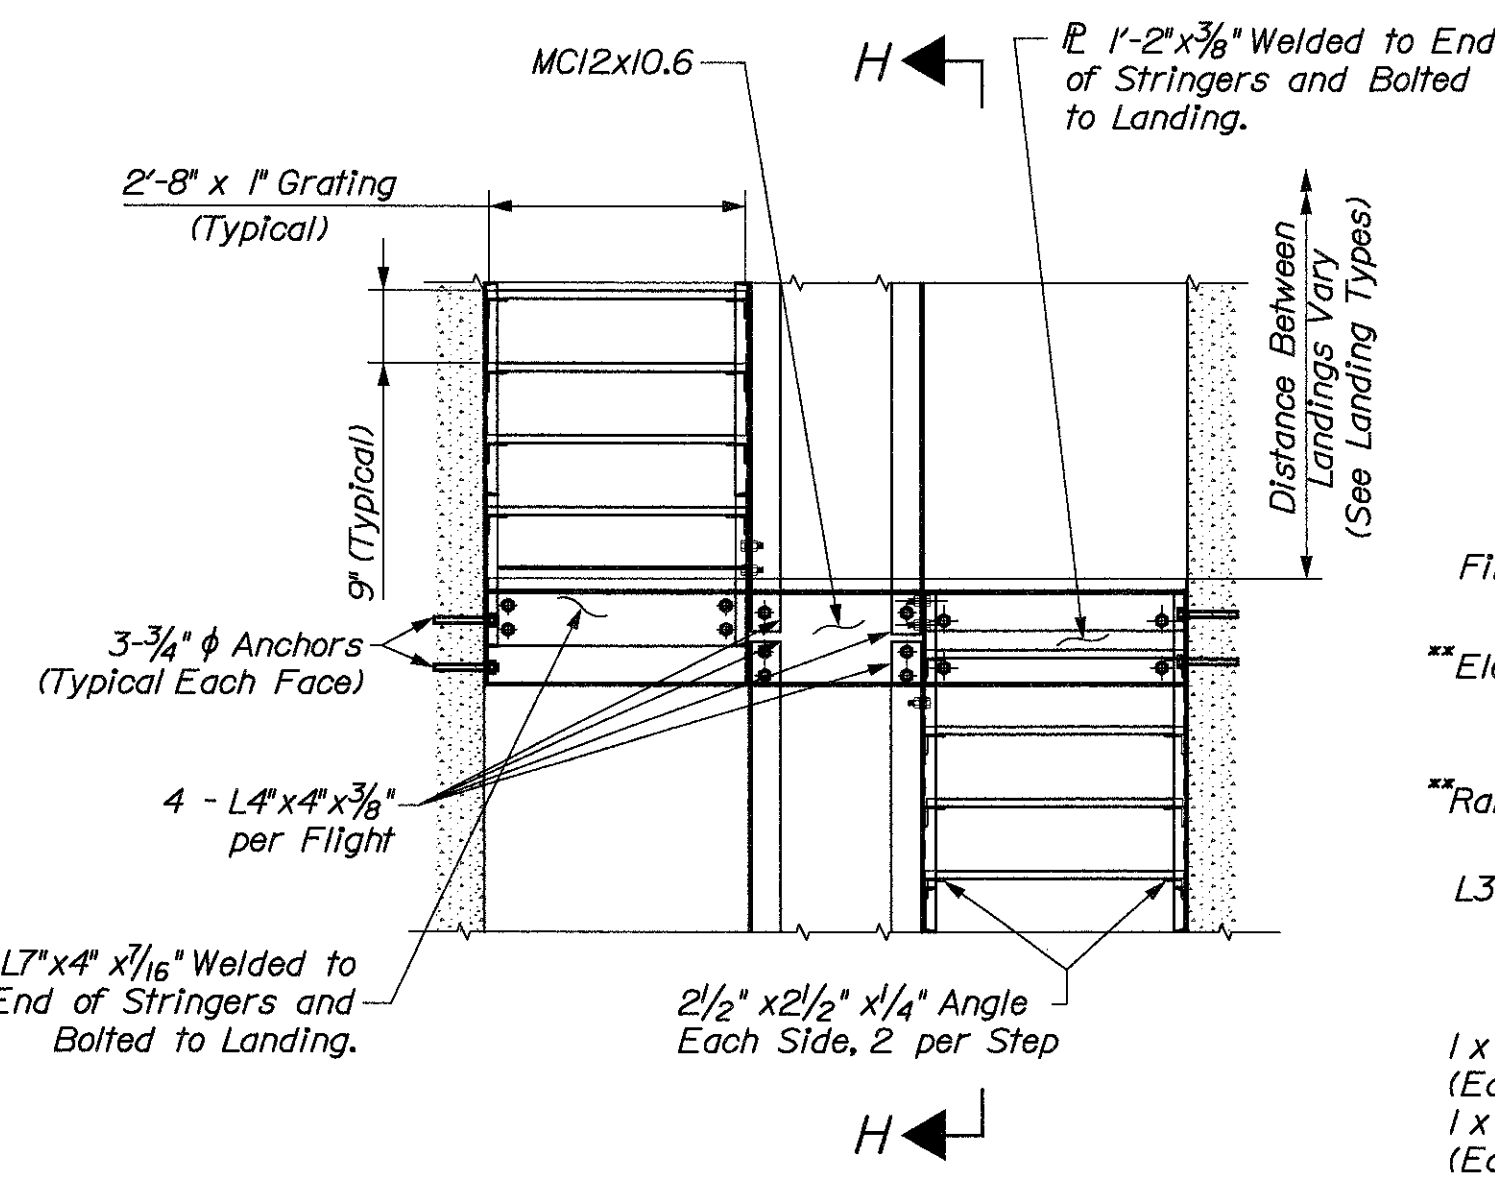


SECTION G-G
Typical Elevation - Type I Landing
(Anchors to Pylon on Far Side Not Shown For Clarity)

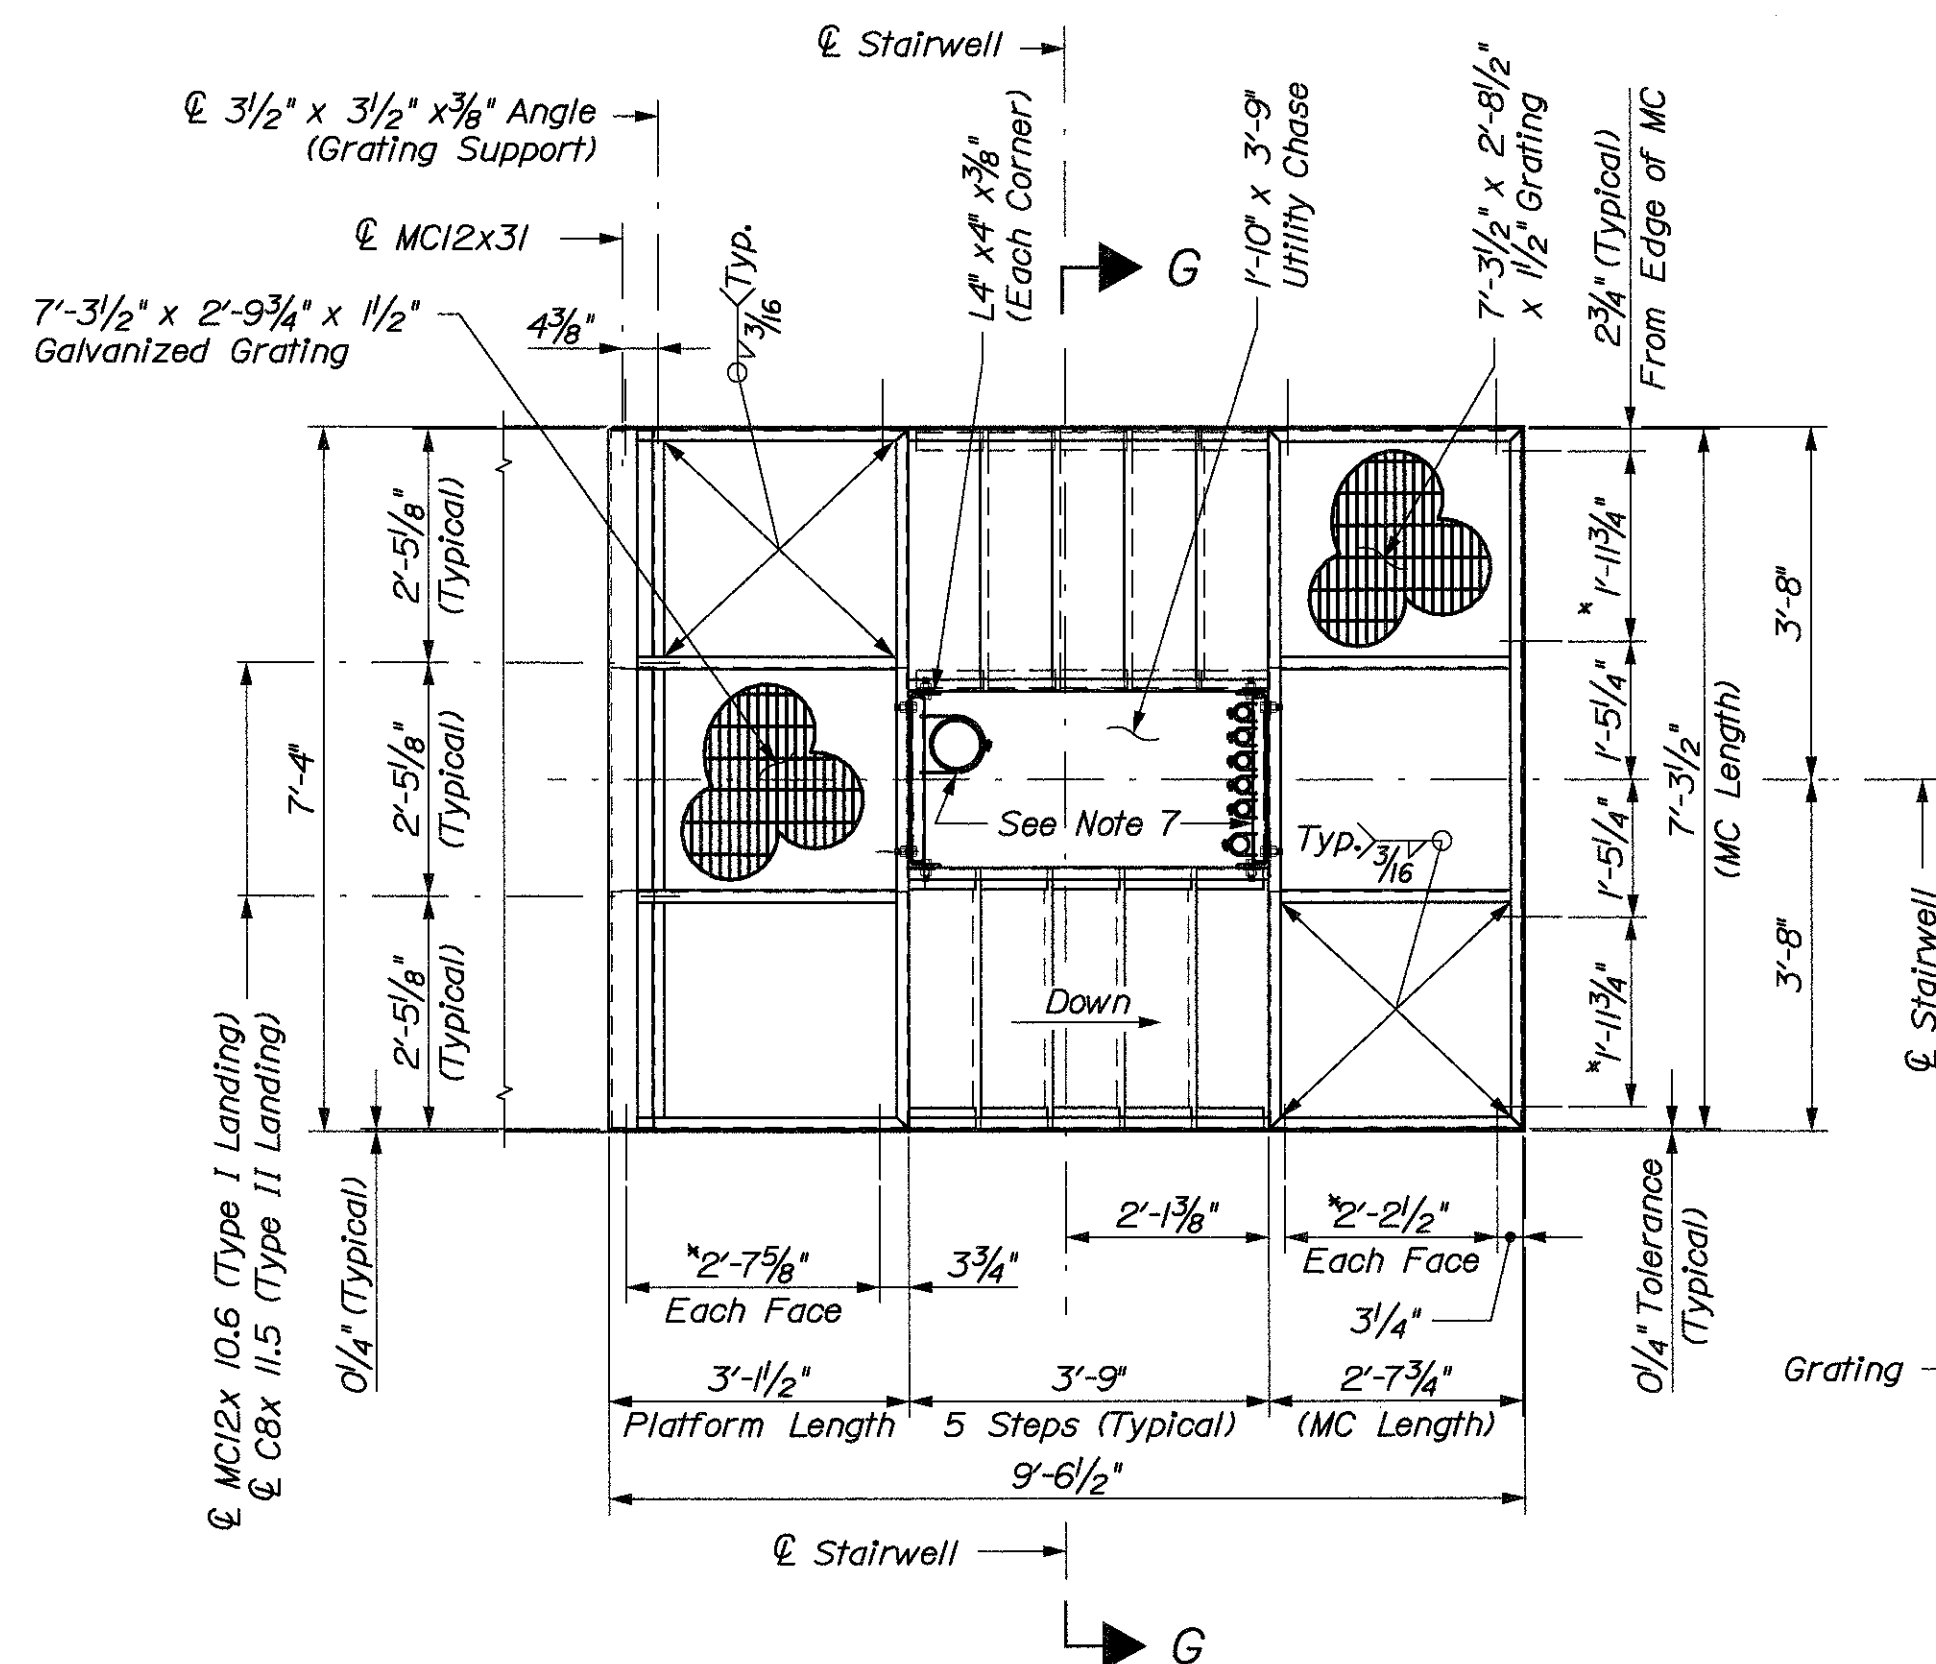


SECTION D-D
(Type I Landings Type II Landing Similar)
Slotted holes for 3/4" phi Anchors (See Note 3)

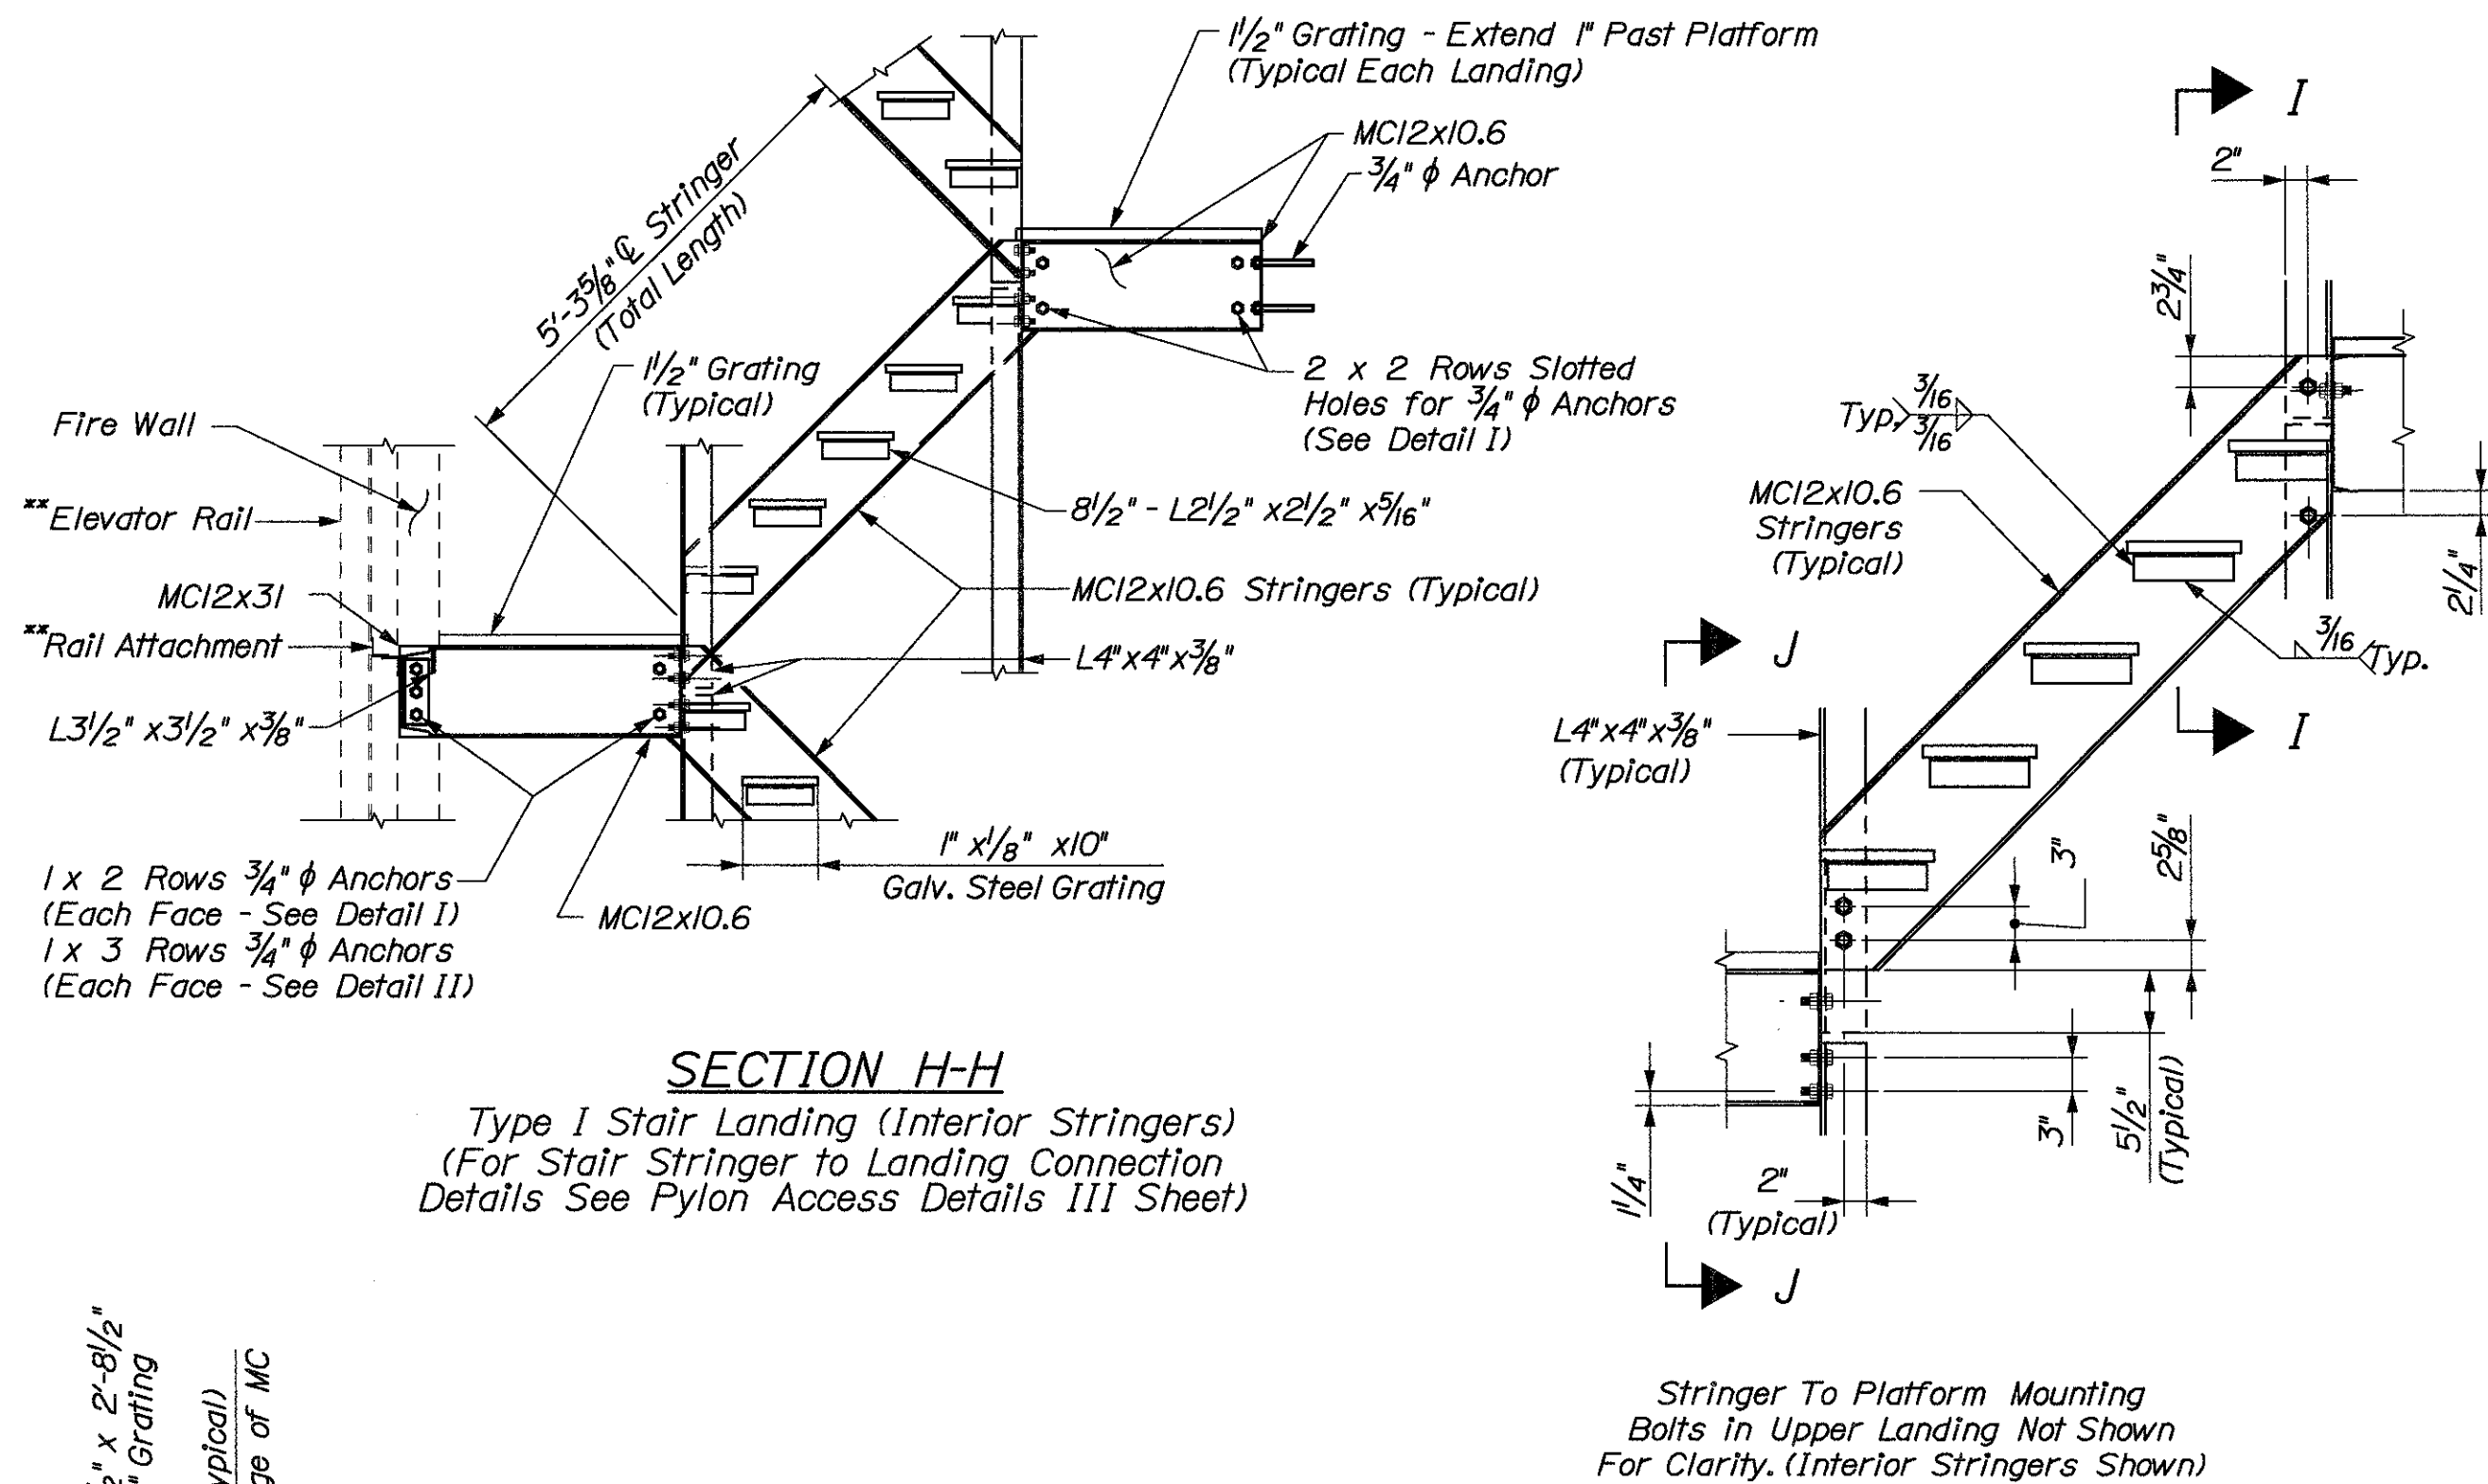


SECTION H-H
Type I Stair Landing (Interior Stringers)
(For Stair Stringer to Landing Connection
Details See Pylon Access Details III Sheet)

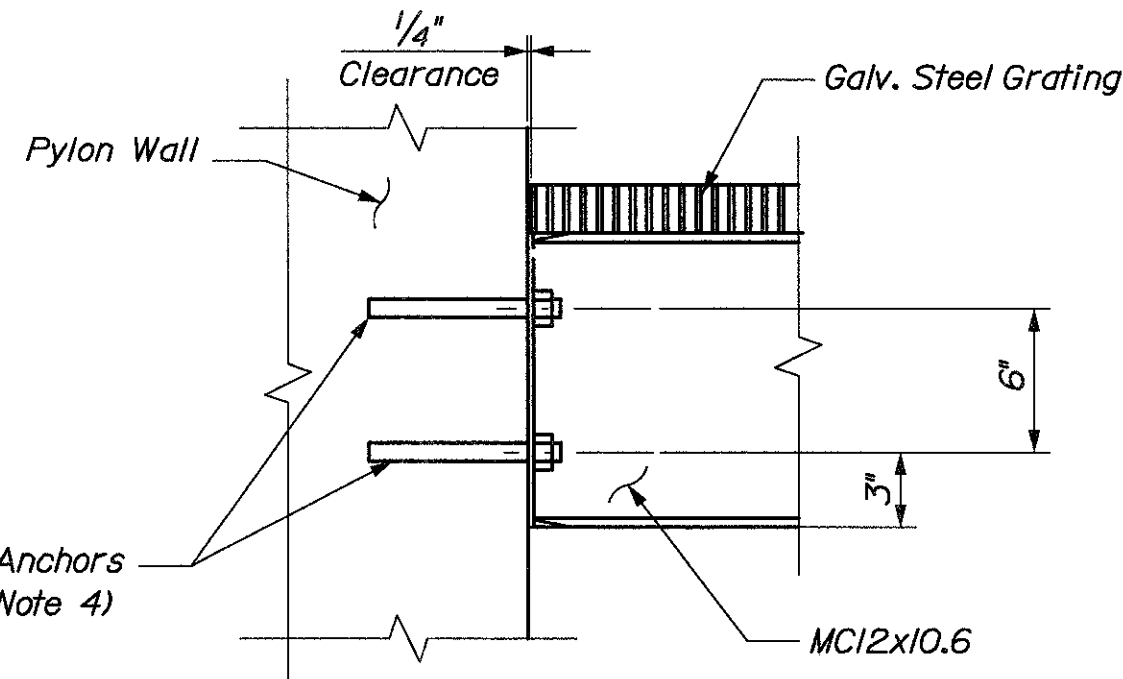

DETAIL I - TYPICAL ANCHOR DETAIL

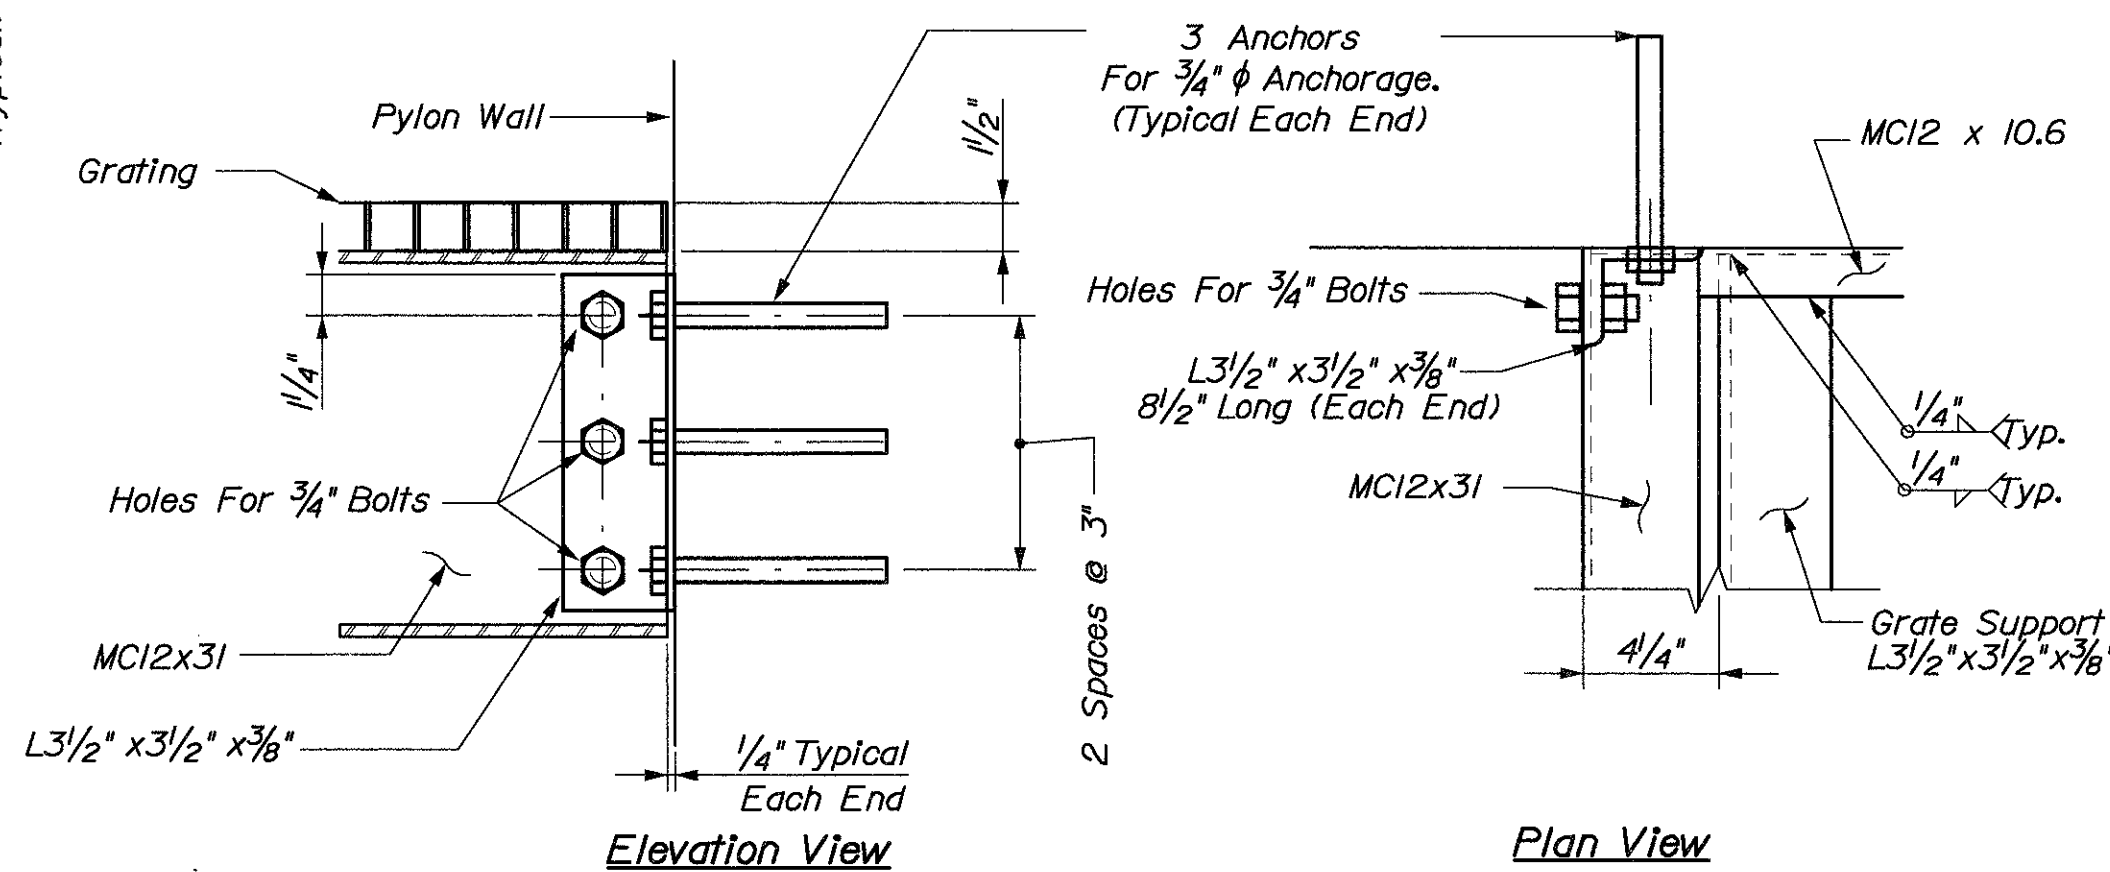

DETAIL II
Detail Is Typical For All MC12x31 Bolted Beam Connections

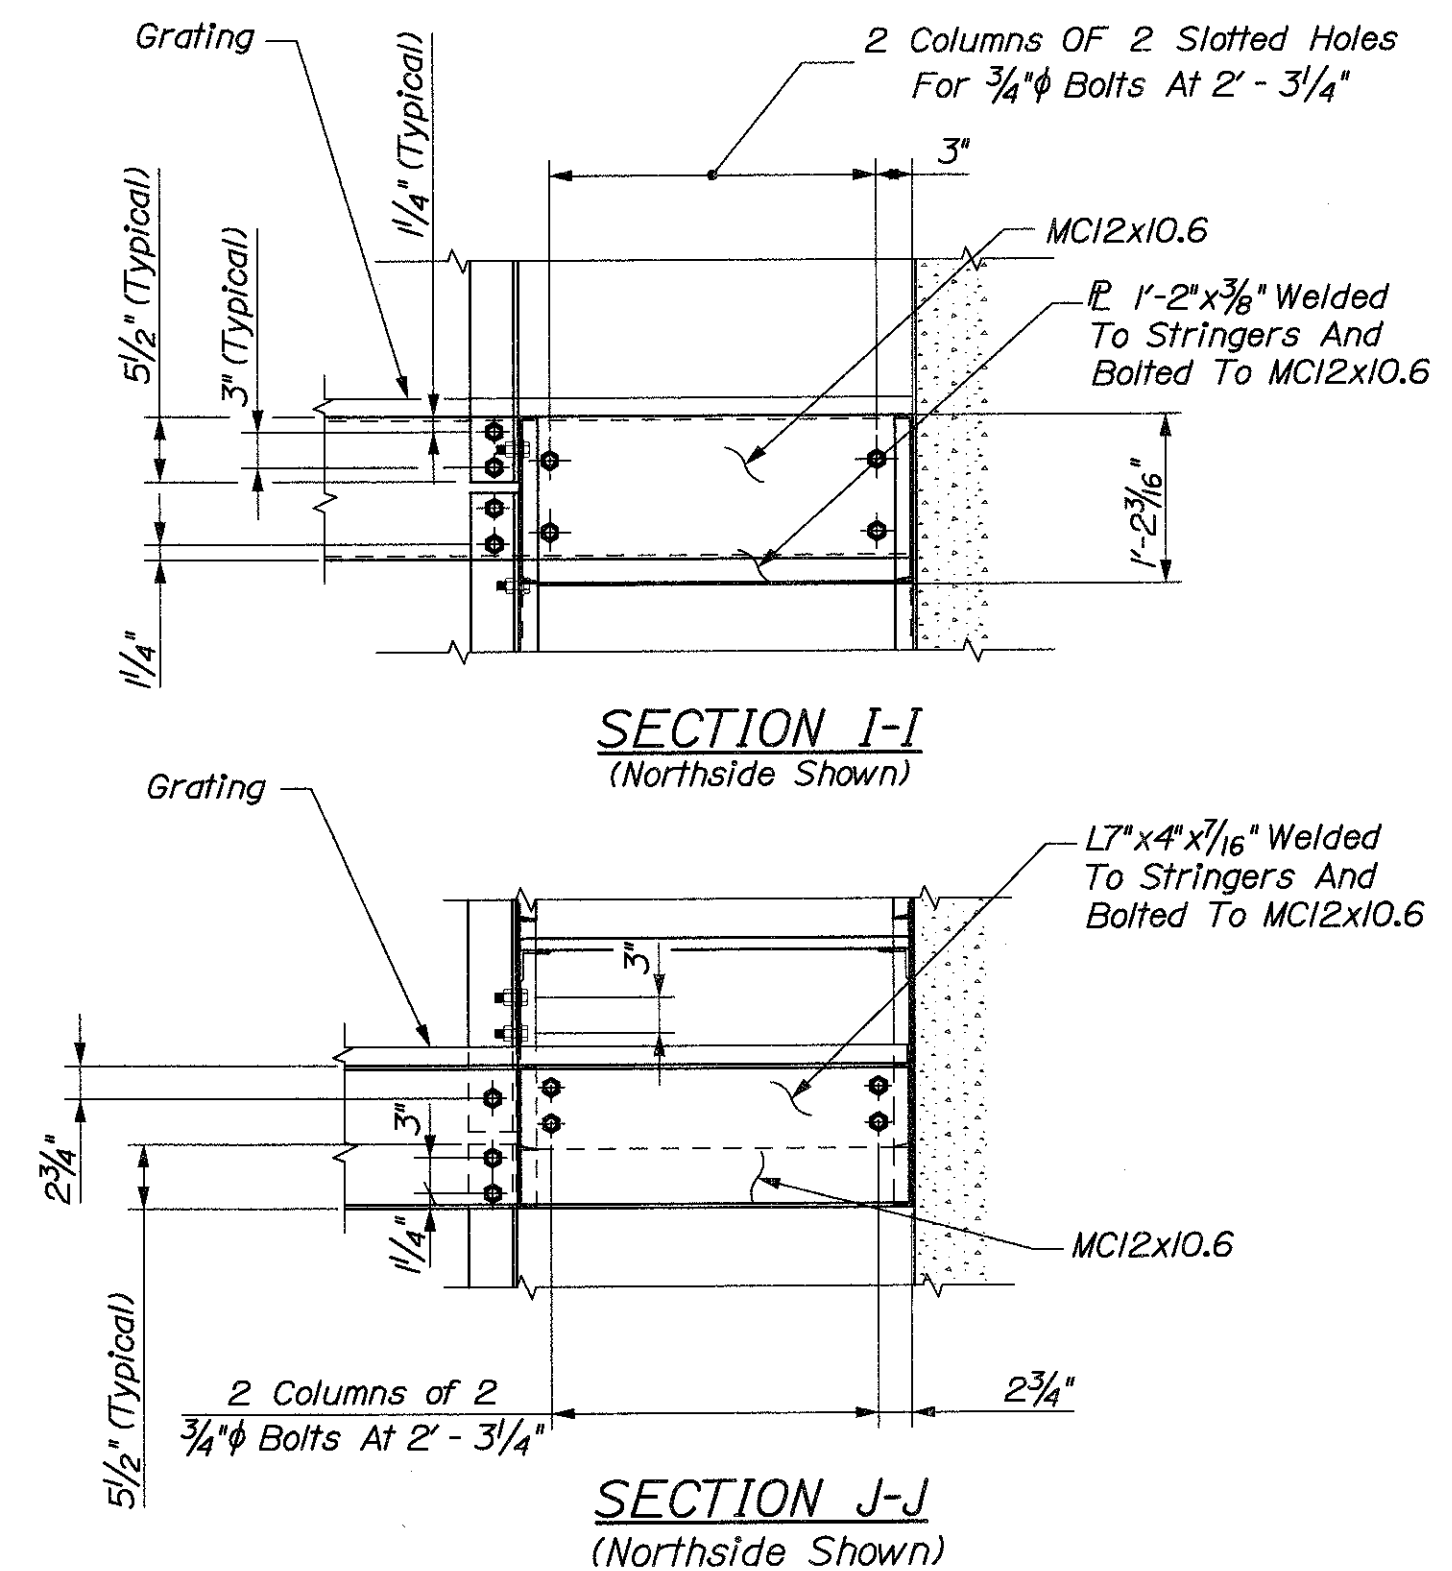

SECTION I-I
(Northside Shown)

SECTION J-J
(Northside Shown)

NOTES

1. North Side Shown at Landings, South Side is Similar but With Stringers in Opposite Direction (Section H-H Becomes South Side of Upper Landing). Anchor Bolts Are Not Shown For Clarity.
2. See Type I Stringer to Landing Connection Details On Pylon Access Details III Sheet For Additional Information.

NOTES



1. The Contractor shall provide detailed Shop Drawings for Emergency Access Stairwell System and supporting structural steel shown.
2. For additional notes see Pylon Access Details I sheet.
3. All bolts shall be 3/4" phi ASTM A325 and galvanized in accordance with ASTM A153.
4. Bolt anchorage hardware shall be from the Department Approved Product List, or approved equal. Anchor group shall have a combined working shear capacity of 4,600 lbs. and a minimum working tension capacity of 3,750 lbs. Contractor shall submit proposed system for review by the Department prior to use. Bolt anchorages shall be installed in strict accordance with the selected manufacturer's recommendations.
5. Stair railings are not shown for clarity. Refer to Pylon Access Details V sheet for stair railings and post layout information.
6. Dimensions provided are for general information. Adjustments in steel lengths due to coping, tolerances, etc. are not included unless specifically stated.
7. Cost of materials, labor and installation is incidental to pay items; 900.15400 Fire Protection, 634.1966 Aviation Lighting Wire and Conduit, 634.1968 Maintenance Wire and Conduit, 634.1969 Observatory Lighting Wire and Conduit and Special Provision 655 - Electrical, Water supply pipe and utility conduit runs continuous through pylon access. Maximum support spacing is 10 vertical feet. For water supply pipe and utility conduit details, see Pylon Access Detail V sheet.

Date:10/14/2004

Username: wjohnson

Division: BRIDGE




Filename: ...P03_Pylon_Access_Details_III.dgn

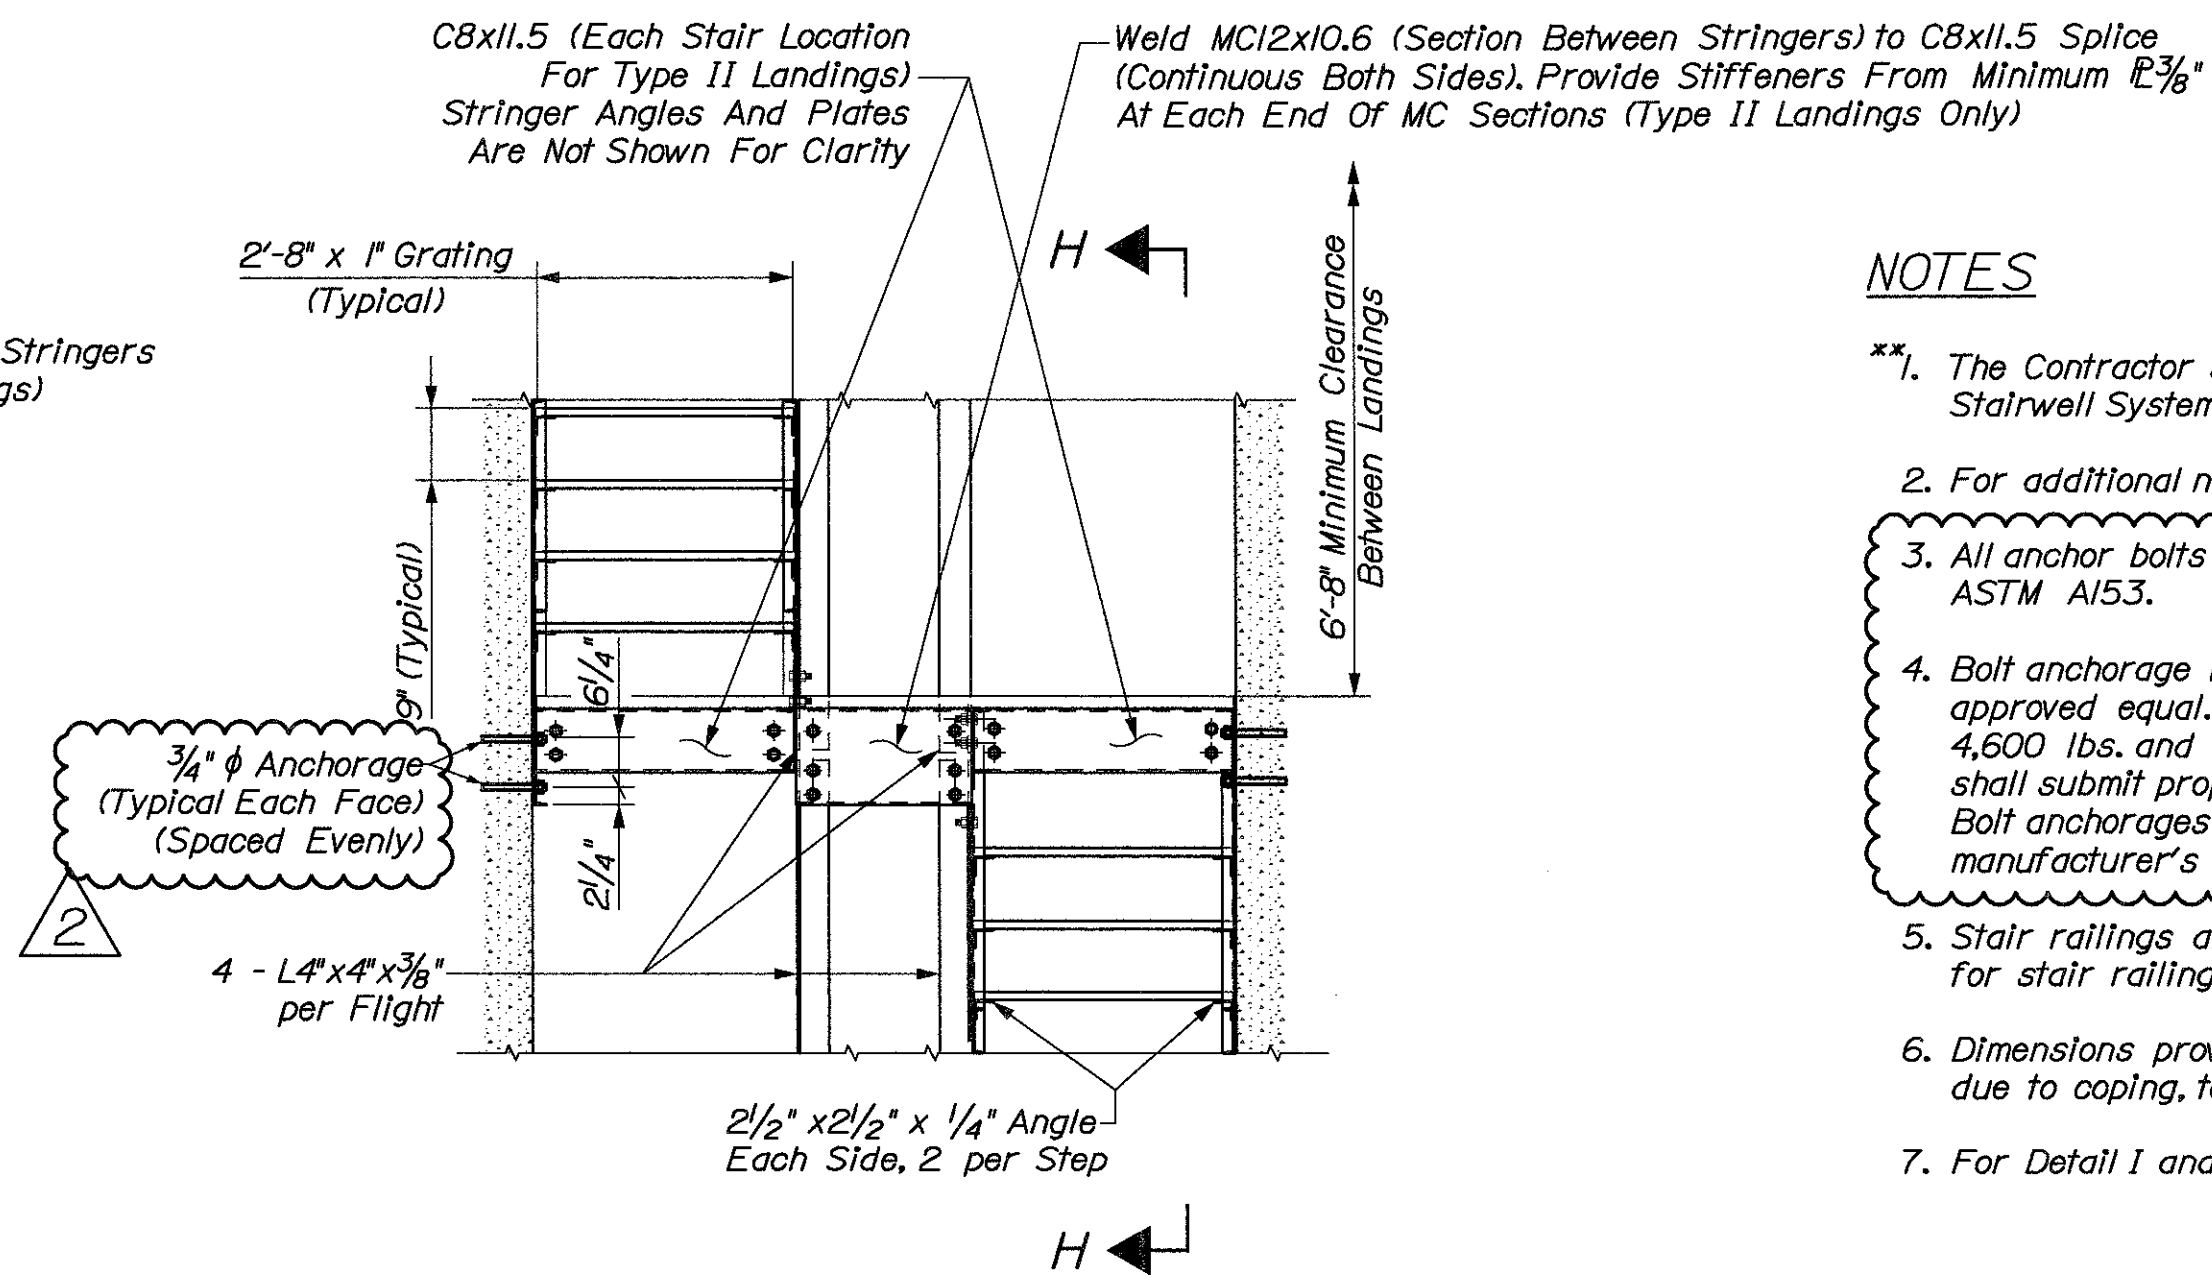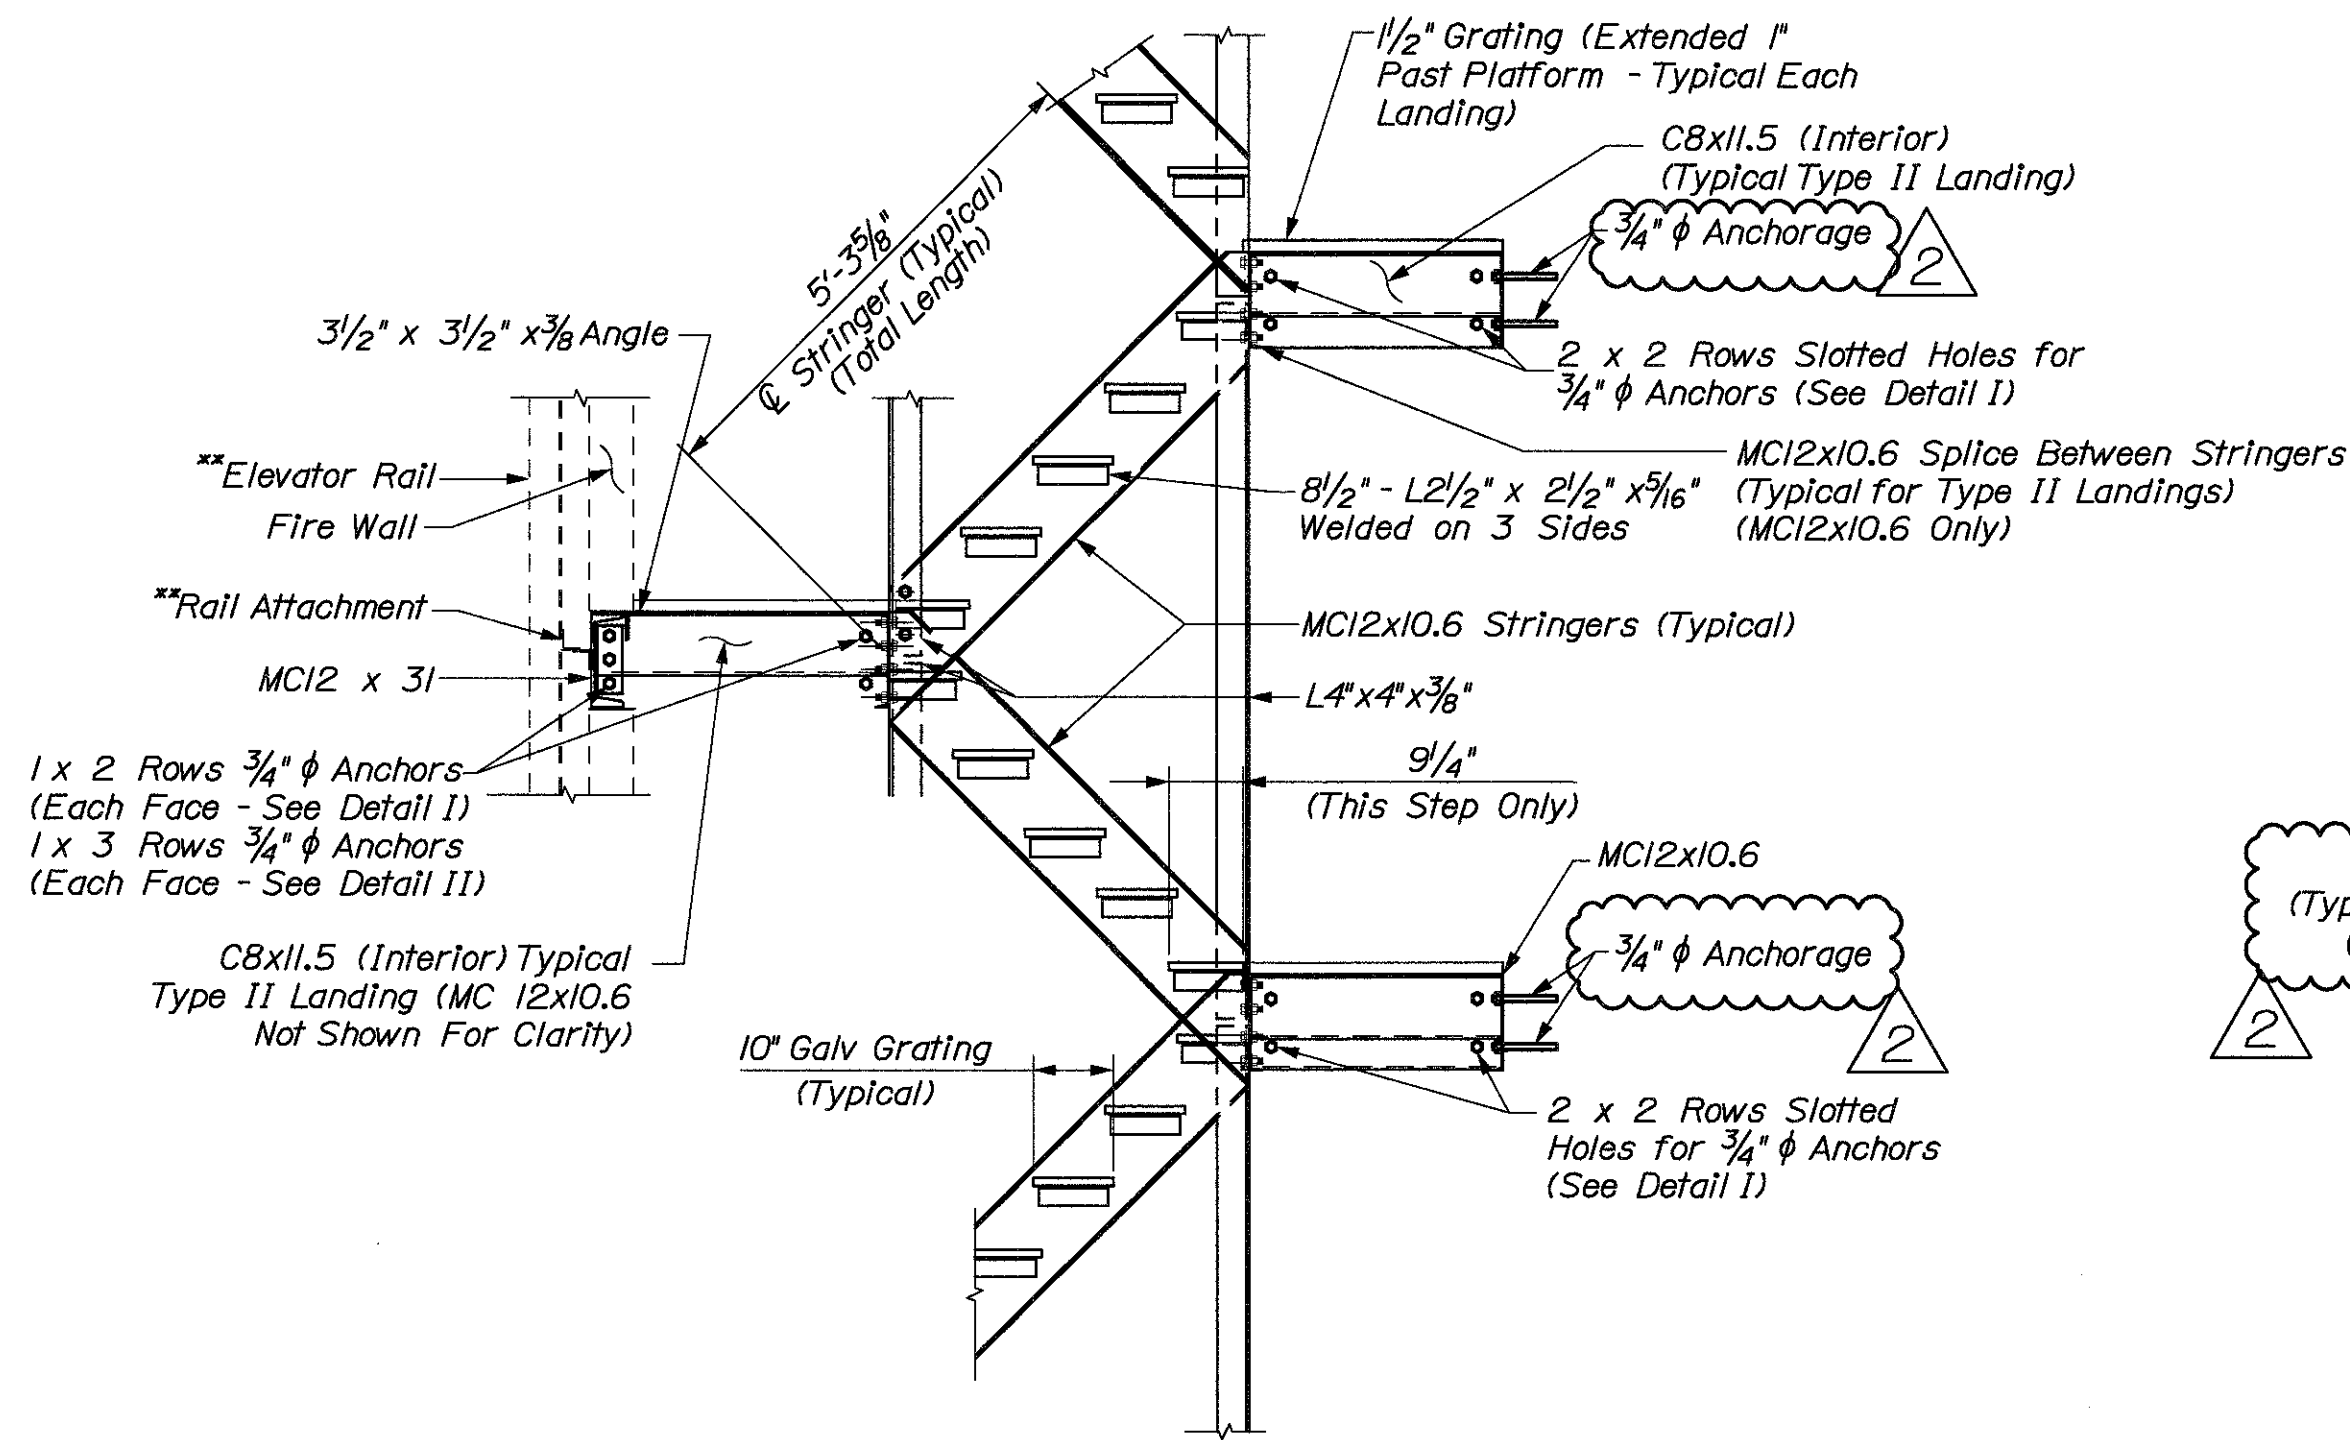

NOTES

1. The Contractor shall provide detailed Shop Drawings for Emergency Access Stairwell System and supporting structural steel shown.
2. For additional notes see Pylon Access Details I sheet.
3. All anchor bolts shall be 3/4\"/>
4. Bolt anchorage hardware shall be from the Department Approved Product List, or approved equal. Anchor group shall have a combined working shear capacity of 4,600 lbs. and a minimum working tension capacity of 3,750 lbs. Contractor shall submit proposed system for review by the Department prior to use. Bolt anchorages shall be installed in strict accordance with the selected manufacturer's recommendations.
5. Stair railings are not shown for clarity. Refer to Pylon Access Details V sheet for stair railings and post layout information.
6. Dimensions provided are for general information. Adjustments in steel lengths due to coping, tolerances, etc. are not included unless specifically stated.
7. For Detail I and Detail II see Pylon Access Details II sheet.

TYPE II STAIR LANDINGS (Interior Stringers Shown - All Landings Illustrated are Type II)

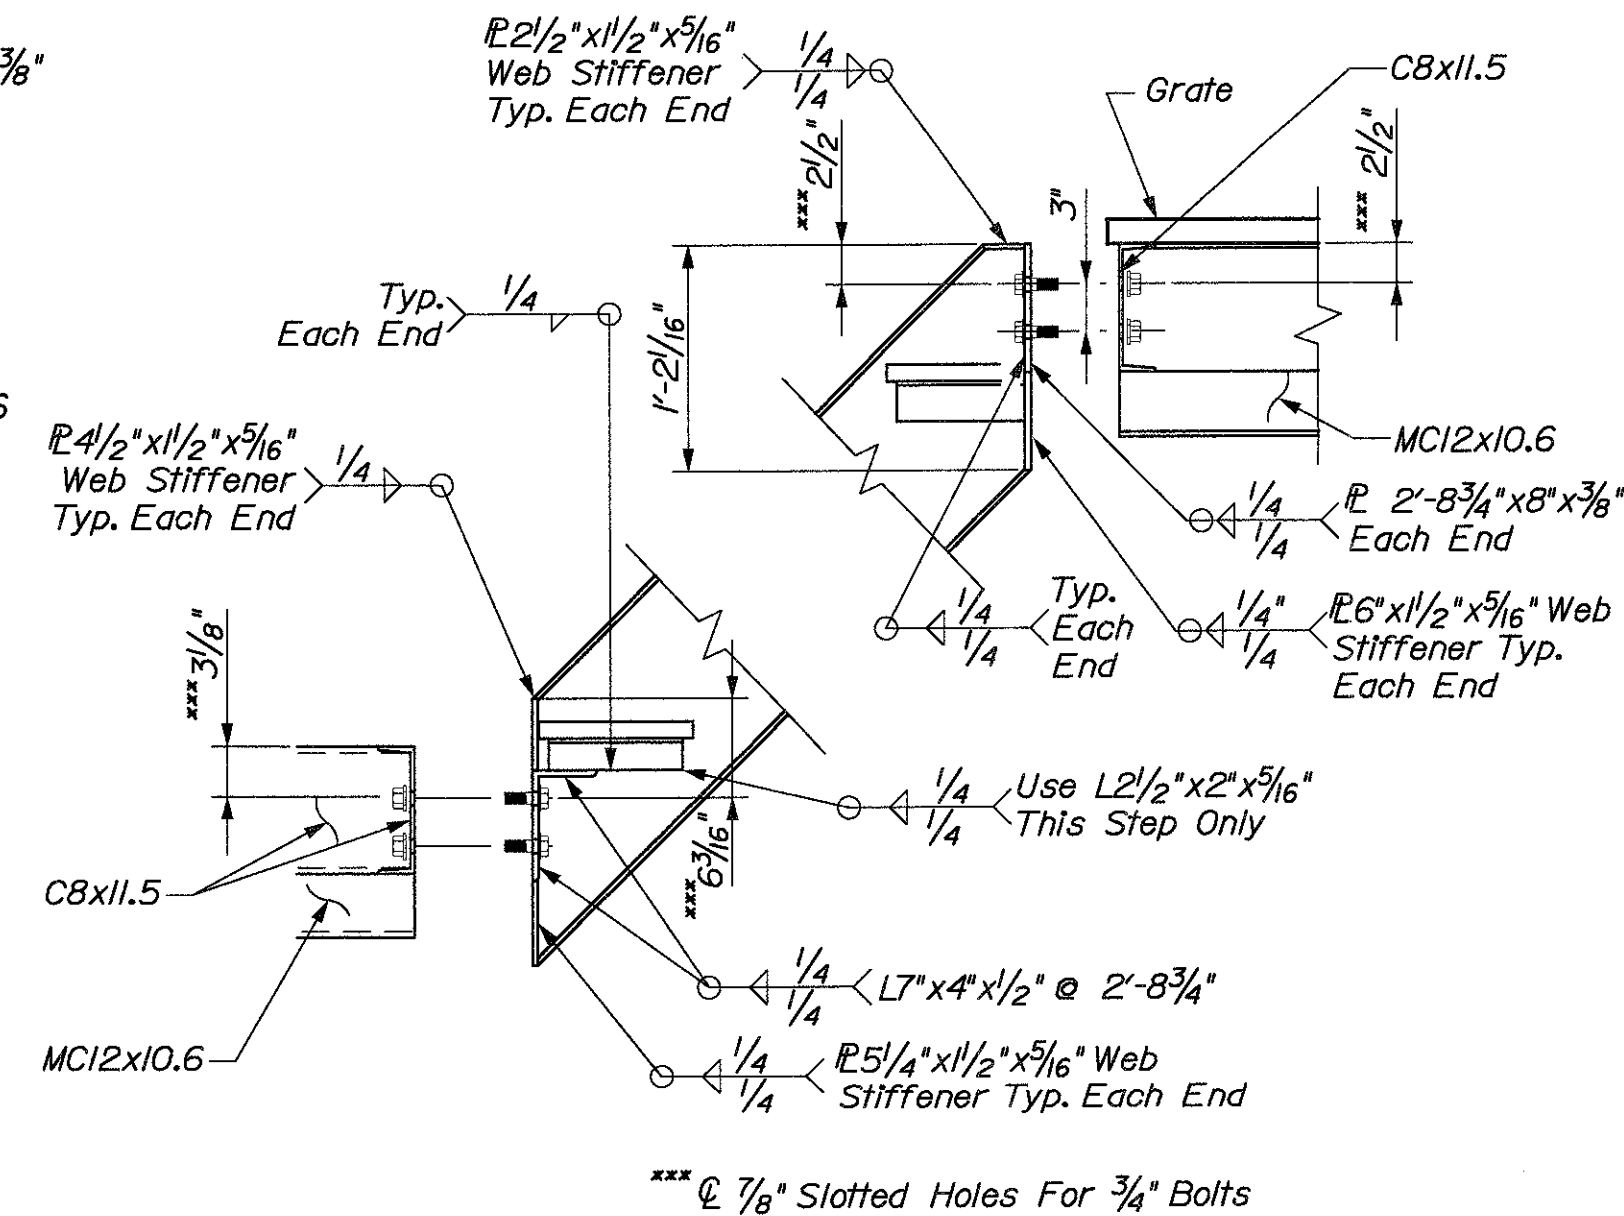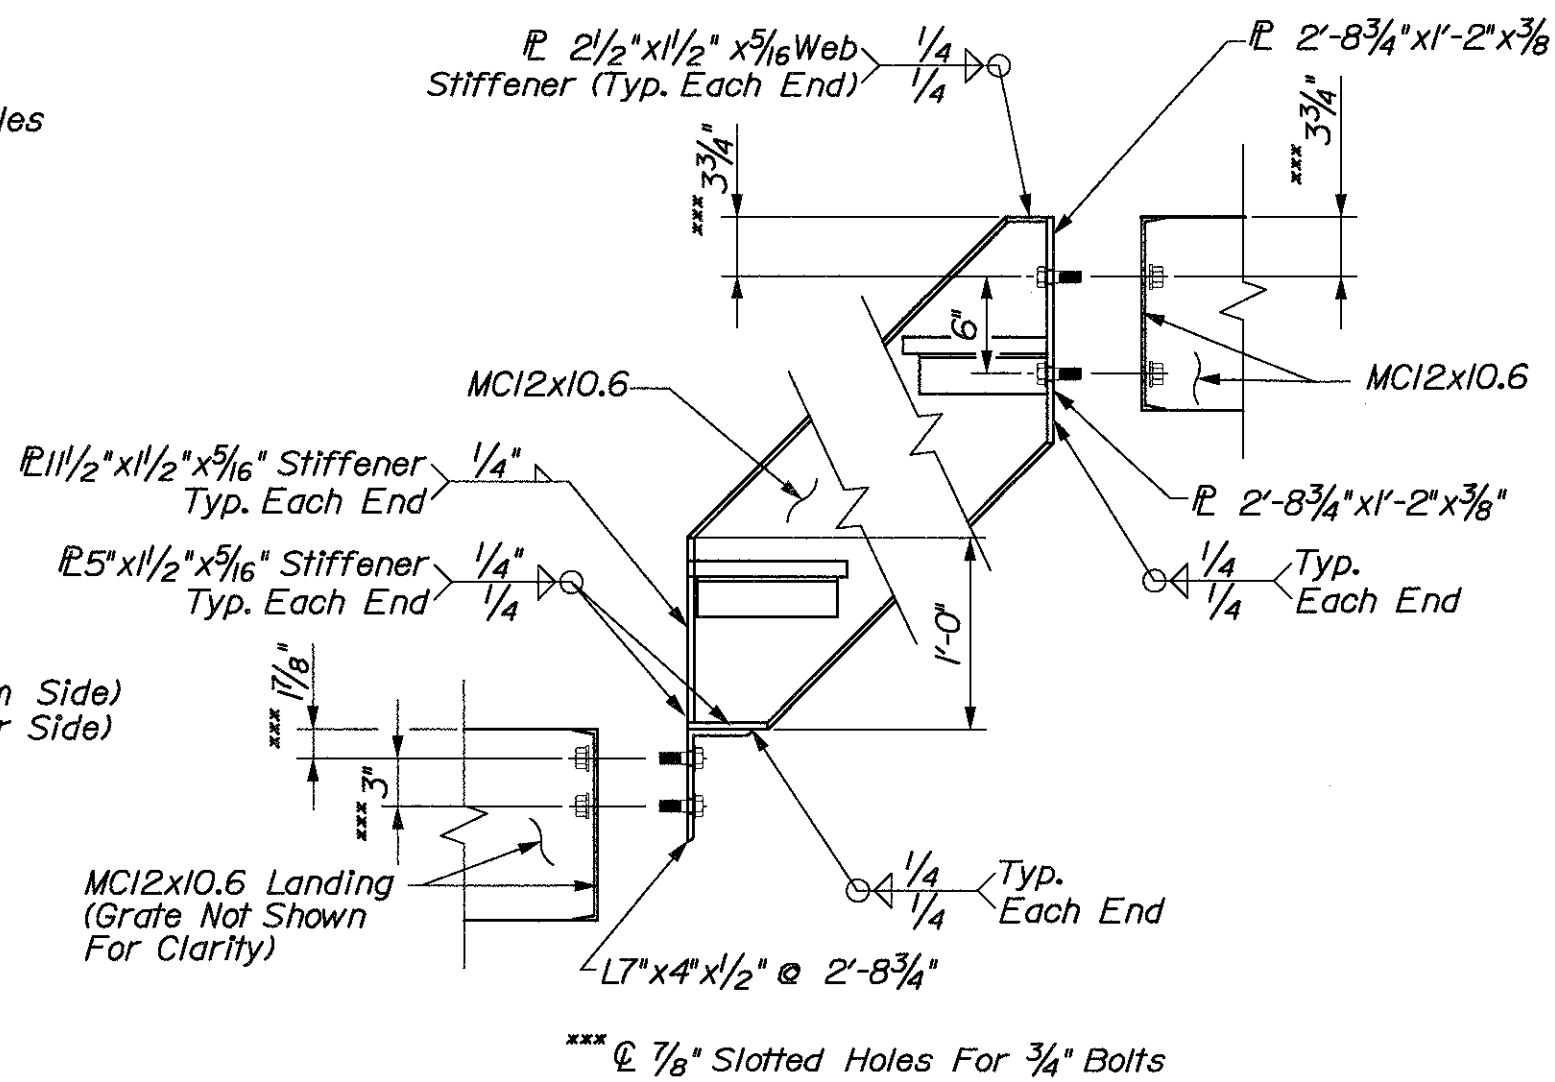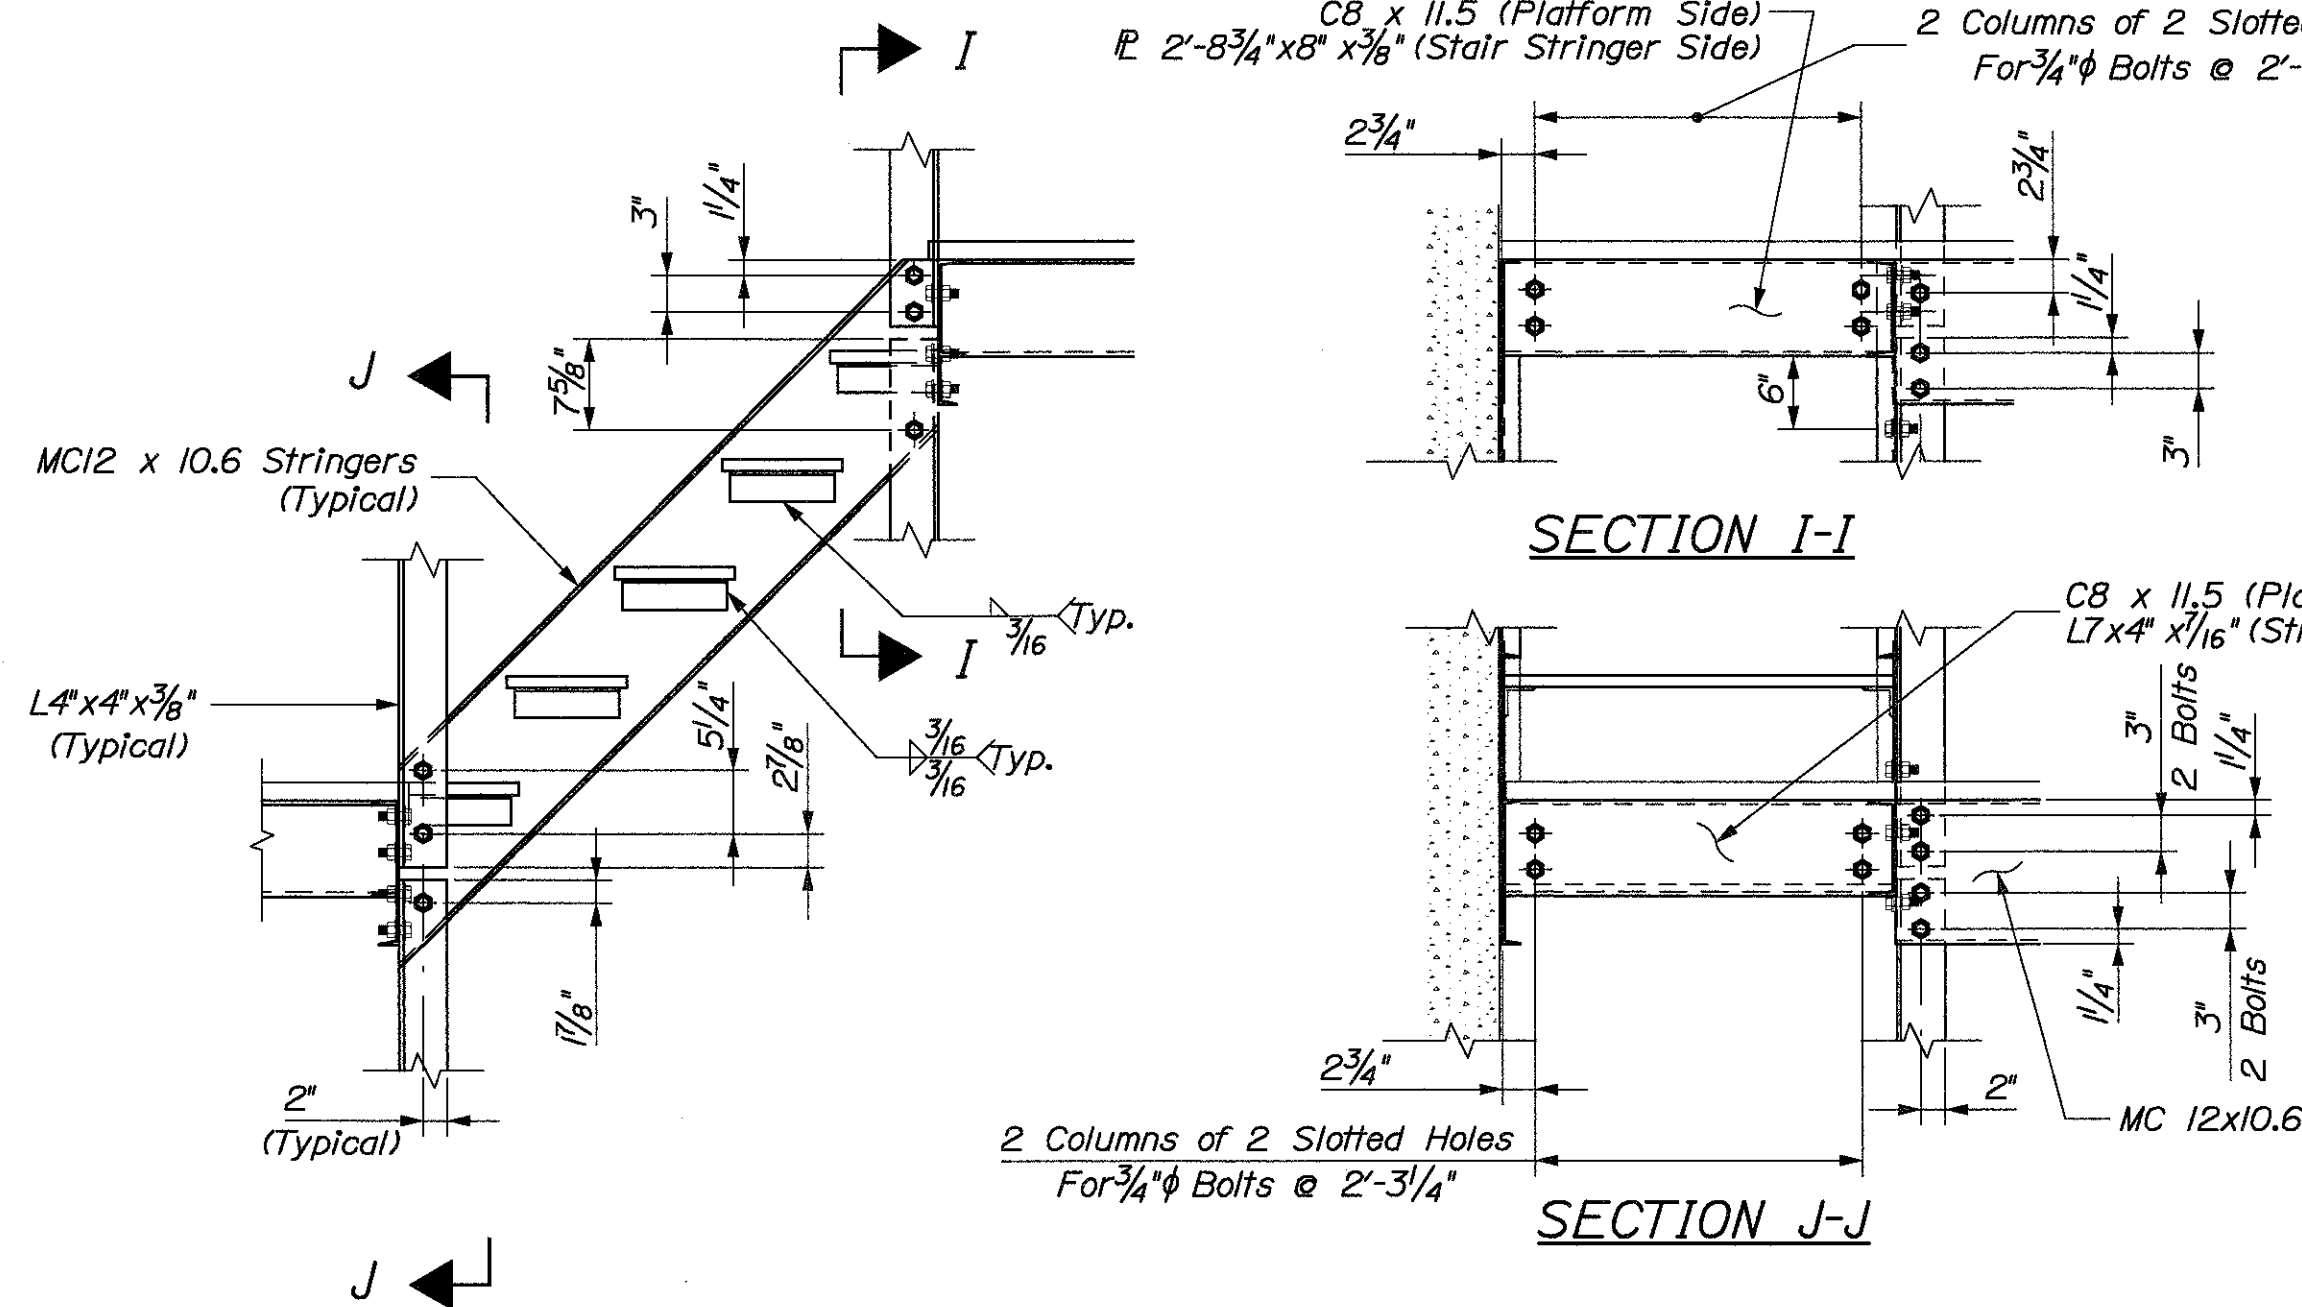

Stringer To Platform Mounting Bolts In
Lower Landing Is Not Shown For Clarity

TYPE II LANDING CONNECTION DETAILS

Notes:
All Bolts Shown Are Galvanized 3/4\"/>

STATE OF MAINE DEPARTMENT OF TRANSPORTATION		BRIDGE NO. 6421		PIN 7965.55, 7965.56		BRIDGE PLANS	
PROSPECT-VERONA BRIDGE PENOBSCOT RIVER PROSPECT\VERONA WALDO\HANCOCK CTY		PYLON ACCESS DETAILS III		SHEET NUMBER P3		OF P15	
PROJ. MANAGER W. JOHNSON	DESIGN-DETAILED I. COOPER	CHECKED-REVIEWED C. BURGESS	DATE 9-09-04	BY I. COOPER	DATE 9-09-04	WELD SYMBOL NOTES NOTES: ANCHORAGES	DATE 10-15-04
REVISIONS 1 REVISIONS 2 REVISIONS 3 REVISIONS 4 FIELD CHANGES				REVISIONS 1 REVISIONS 2 REVISIONS 3 REVISIONS 4 FIELD CHANGES			


Figg Bridge Engineers, Inc.
424 North Calhoun Street
Tallahassee, Florida 32301
Tallahassee, FL • Denver, CO • Philadelphia, PA • Dallas, TX

Date:10/14/2004




Username: stfl

Division: BRIDGE

Filename: ... \P04_Pylon_Access_Details_IV.dgn

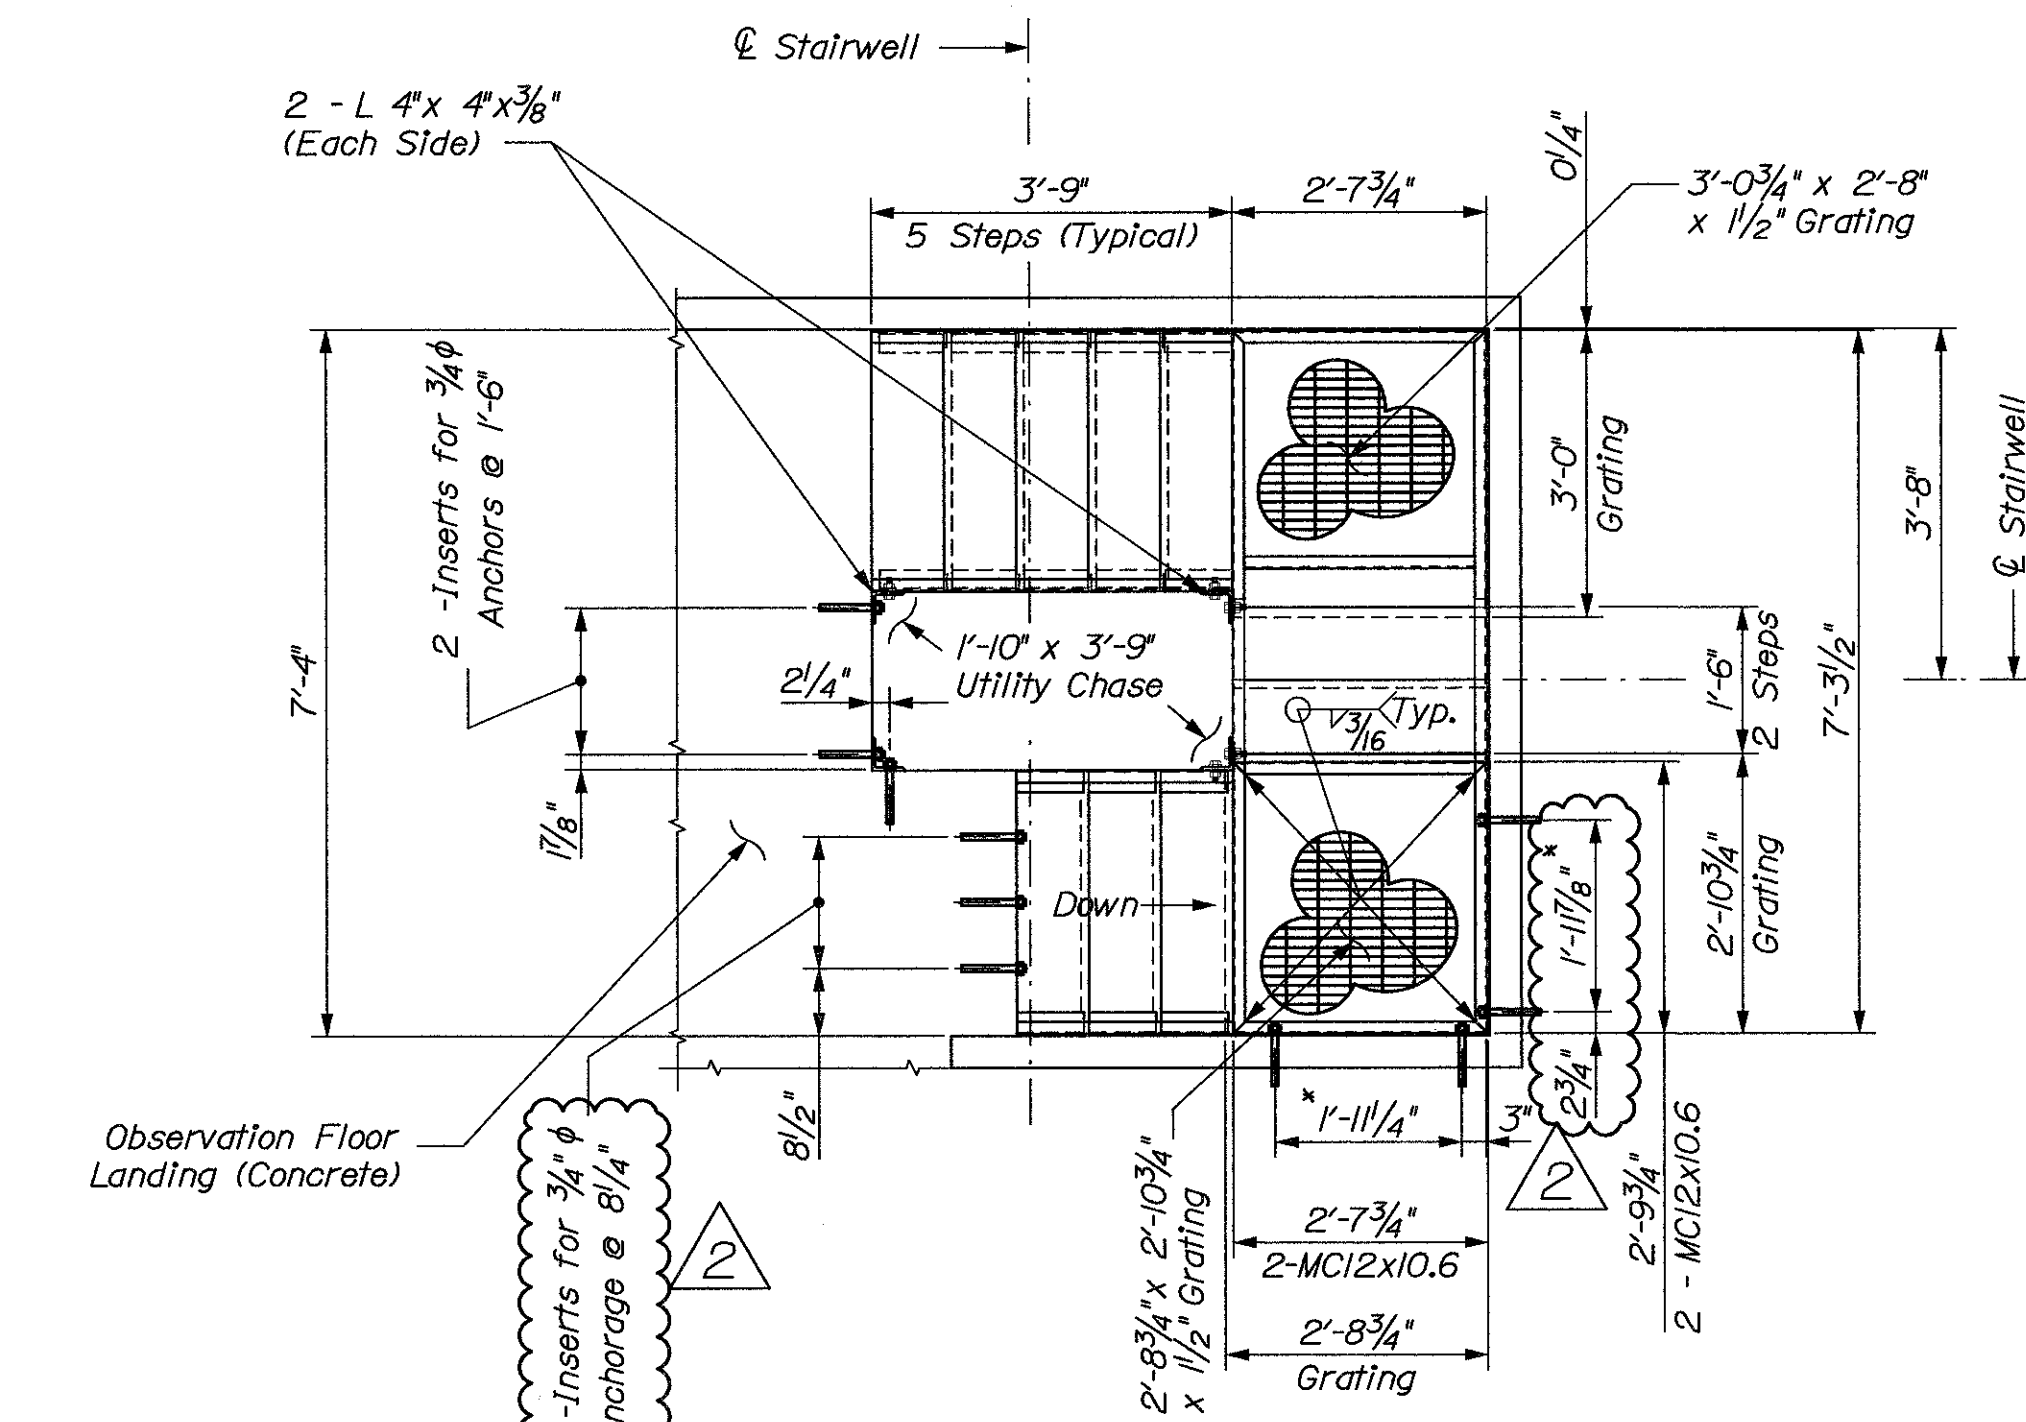

SECTION E-E

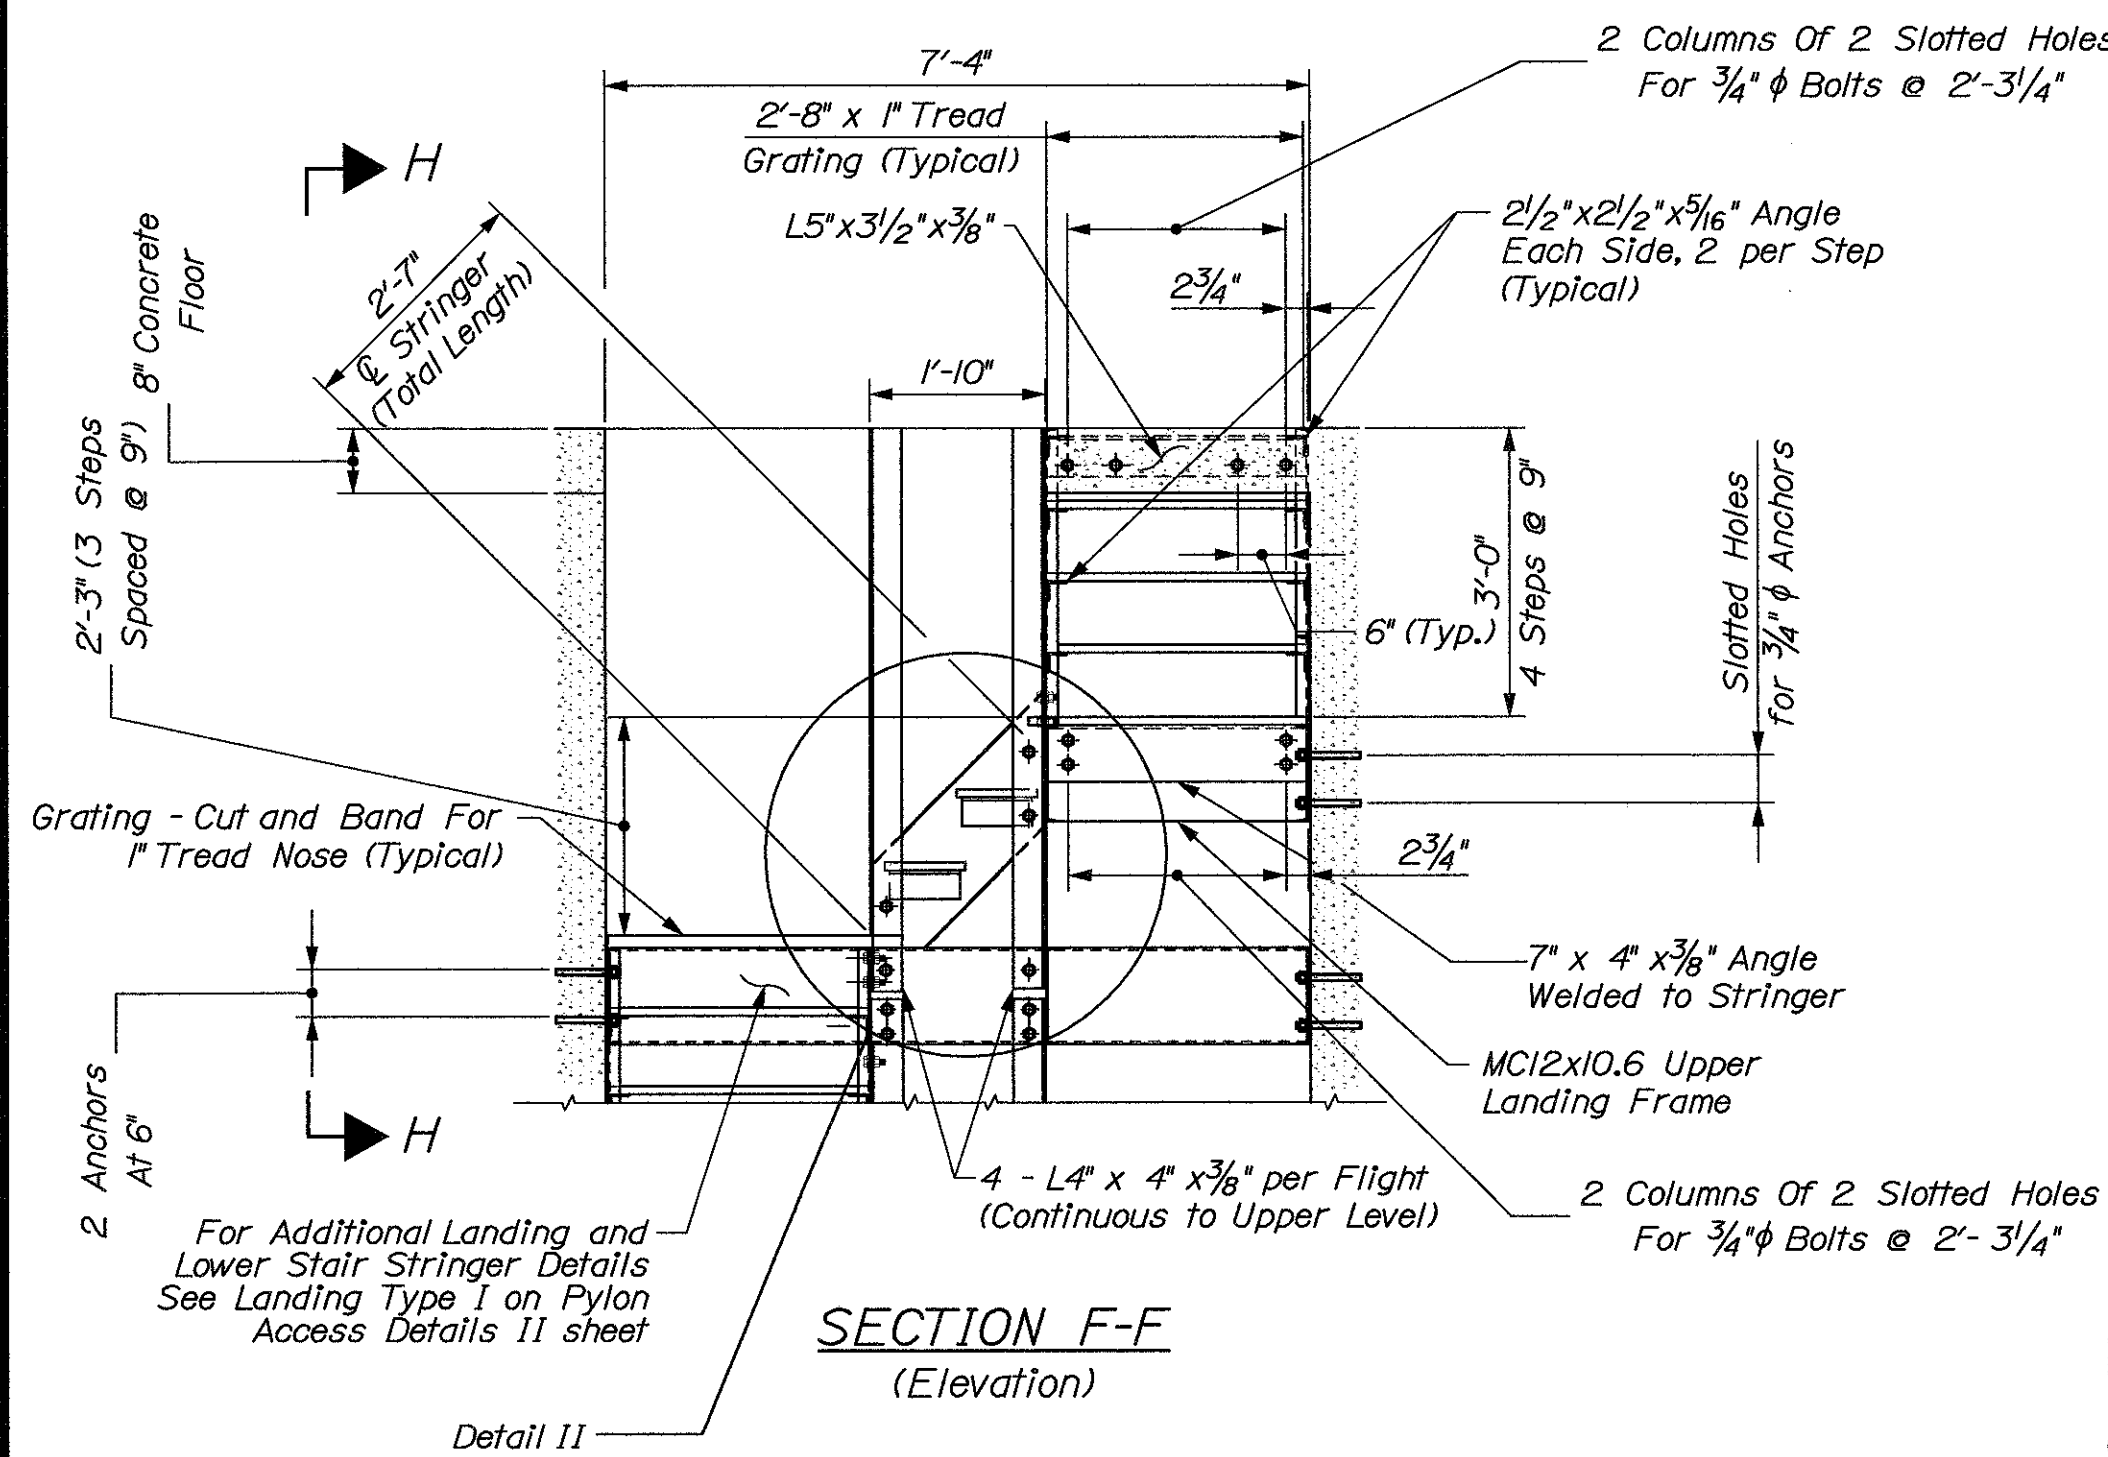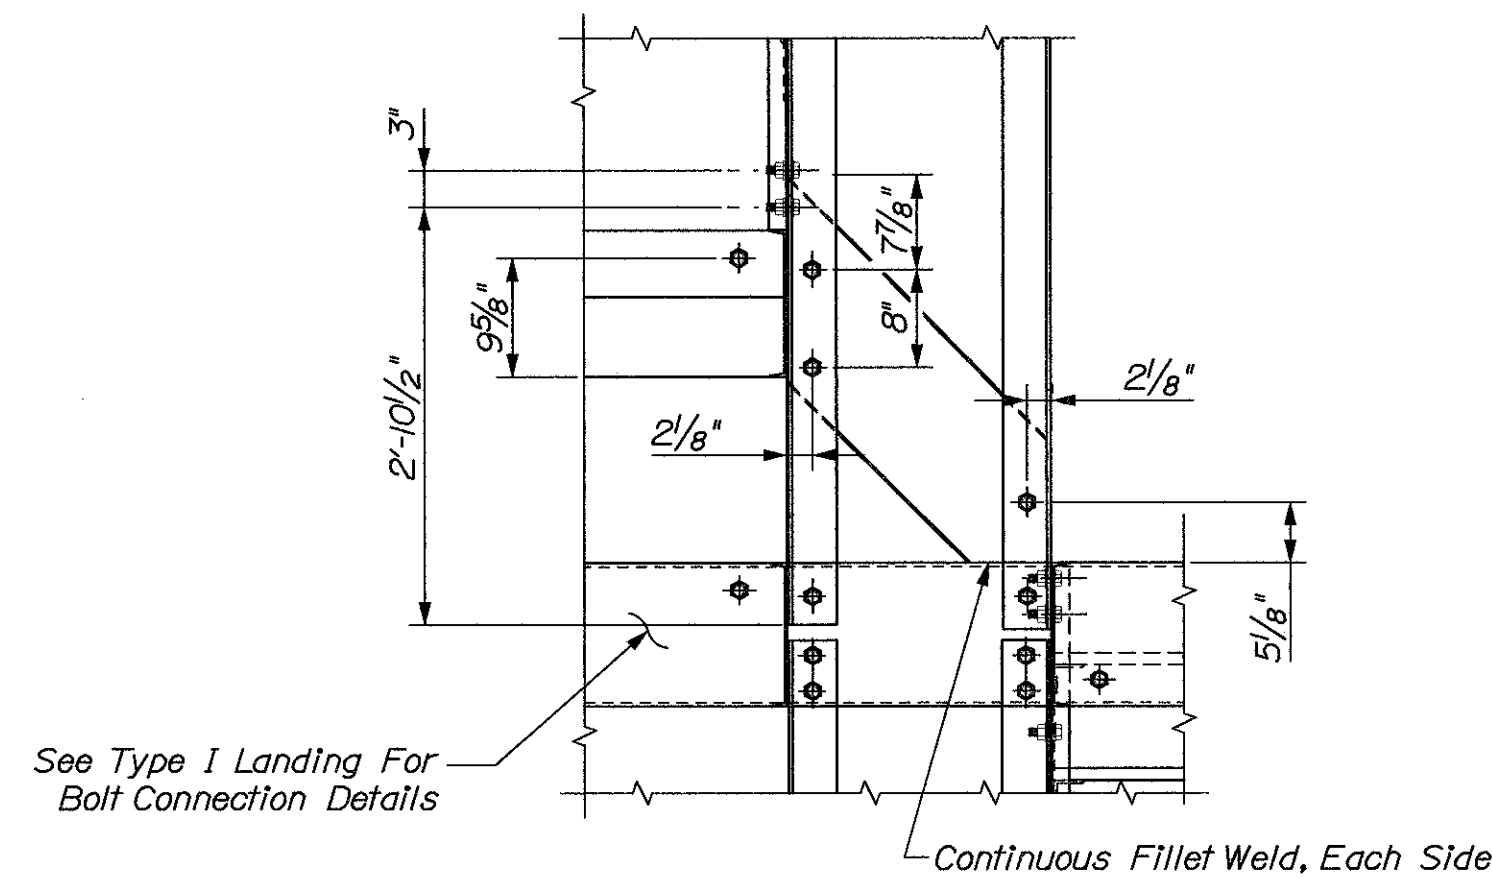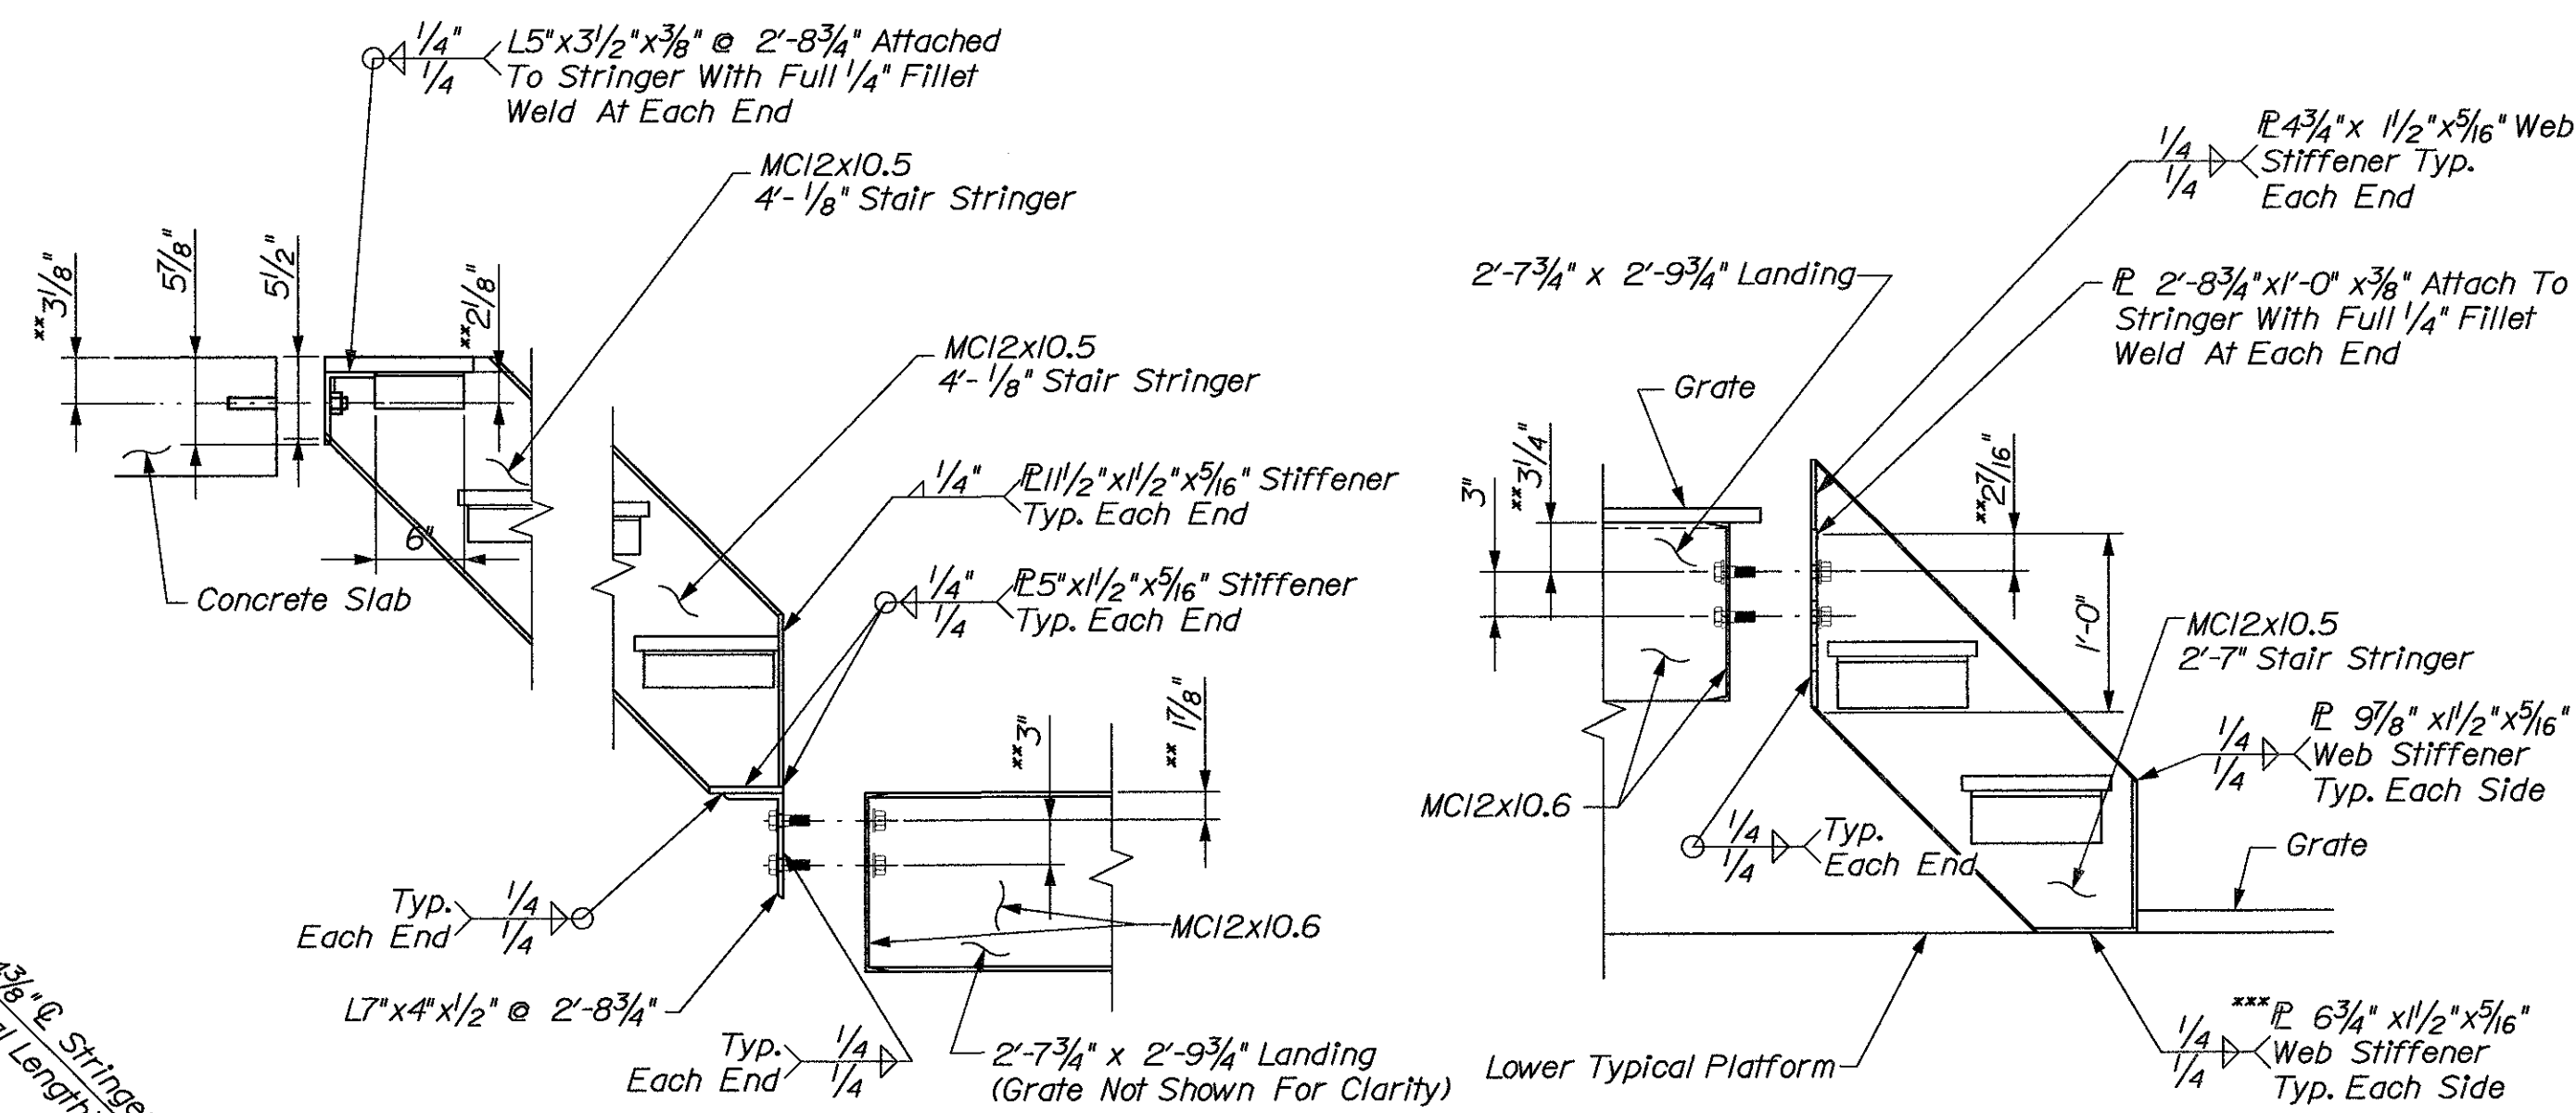SECTION F-F
(Elevation)DETAIL II
(Stair Treads And Angles Are Not Shown For Clarity)STRINGER TO LANDING CONNECTION DETAIL
(SIDE VIEW - EXPLODED - TYPE III LANDING)


NOTES

1. The Contractor shall provide detailed Shop Drawings for Emergency Access Stairwell System and supporting structural steel shown.
2. For additional notes see Pylon Access Details I sheet.
3. All bolts shall be 3/4" ϕ ASTM 325 and galvanized in accordance with ASTM A153.
4. Bolt anchorage hardware shall be from the Department Approved Product List, or approved equal. Anchor group will have a combined working shear capacity of 4,600 lbs. and a minimum working tension capacity of 3,750 lbs. Contractor shall submit proposed system for review by the Department prior to use. Bolt anchorages shall be installed in strict accordance with the selected manufacturers' recommendations.
5. Stair railings are not shown for clarity. Refer to Pylon Access Details V sheet for stair railings and post layout information.
6. Dimensions provided are for general information. Adjustments in steel lengths due to coping, tolerances, etc. are not included unless specifically stated.


TYPE III STAIR LANDINGS
(Interior Stringers)

SECTION H-H


DETAIL I - TYPICAL ANCHOR DETAIL

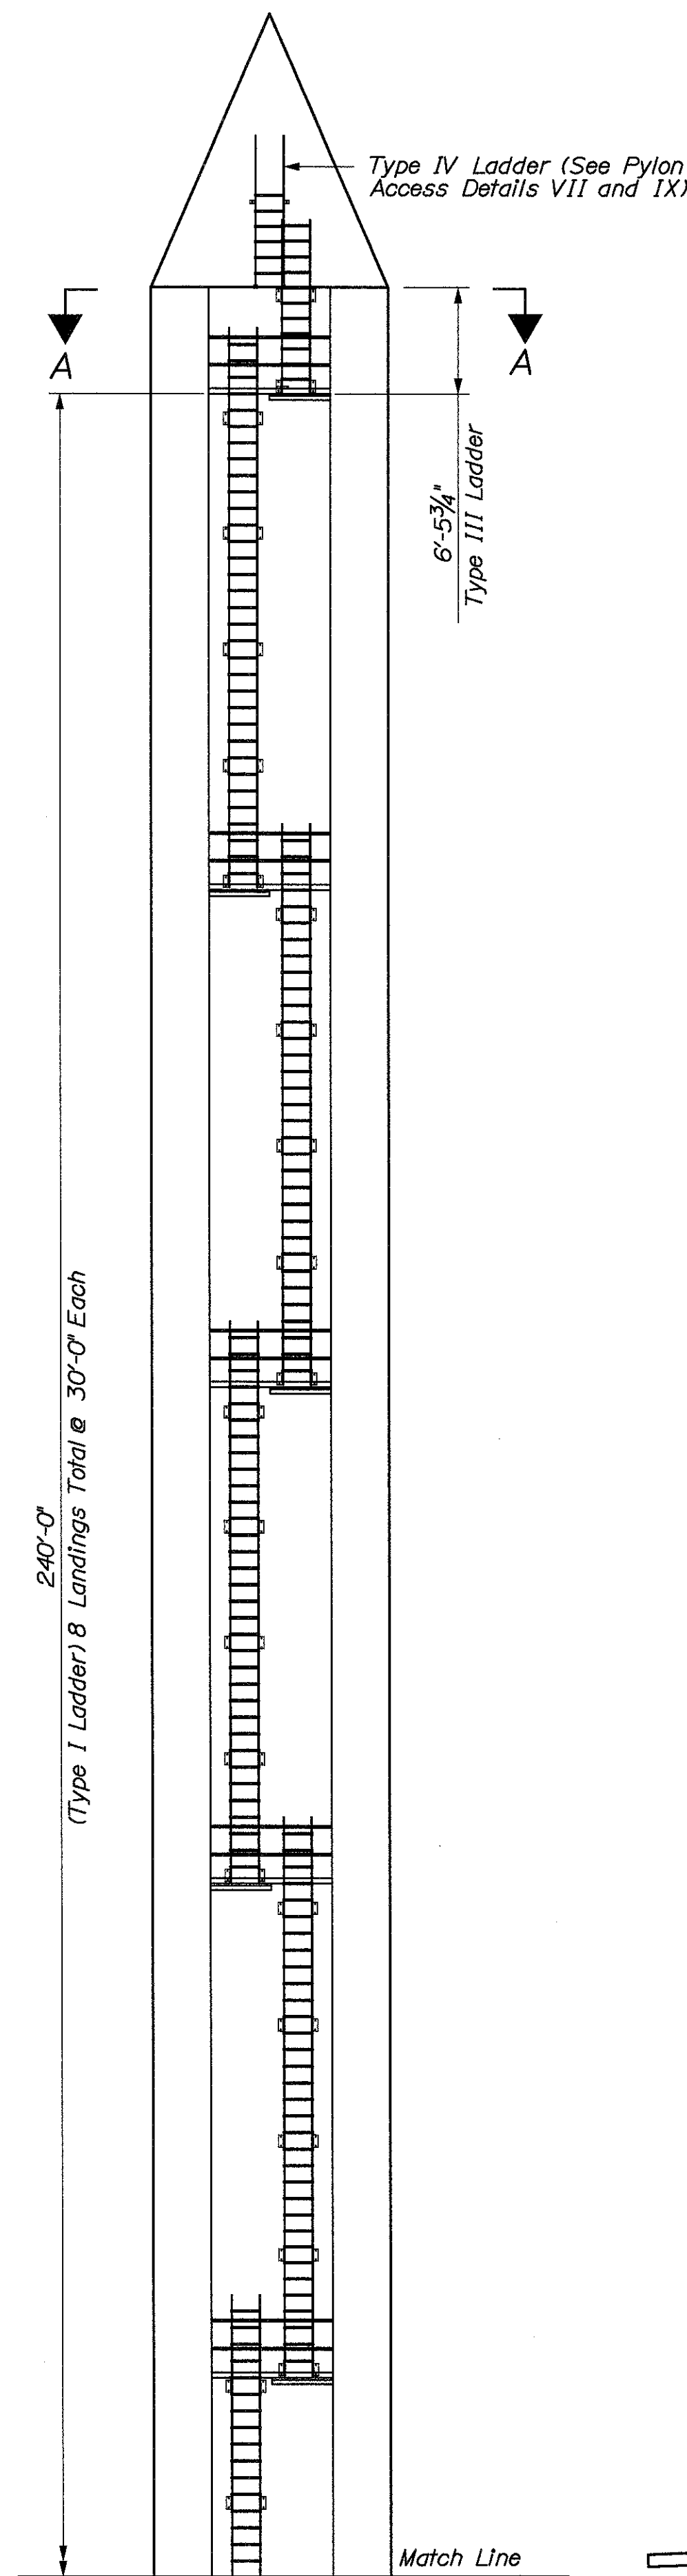

ELEVATION
(Looking Towards Main Span)

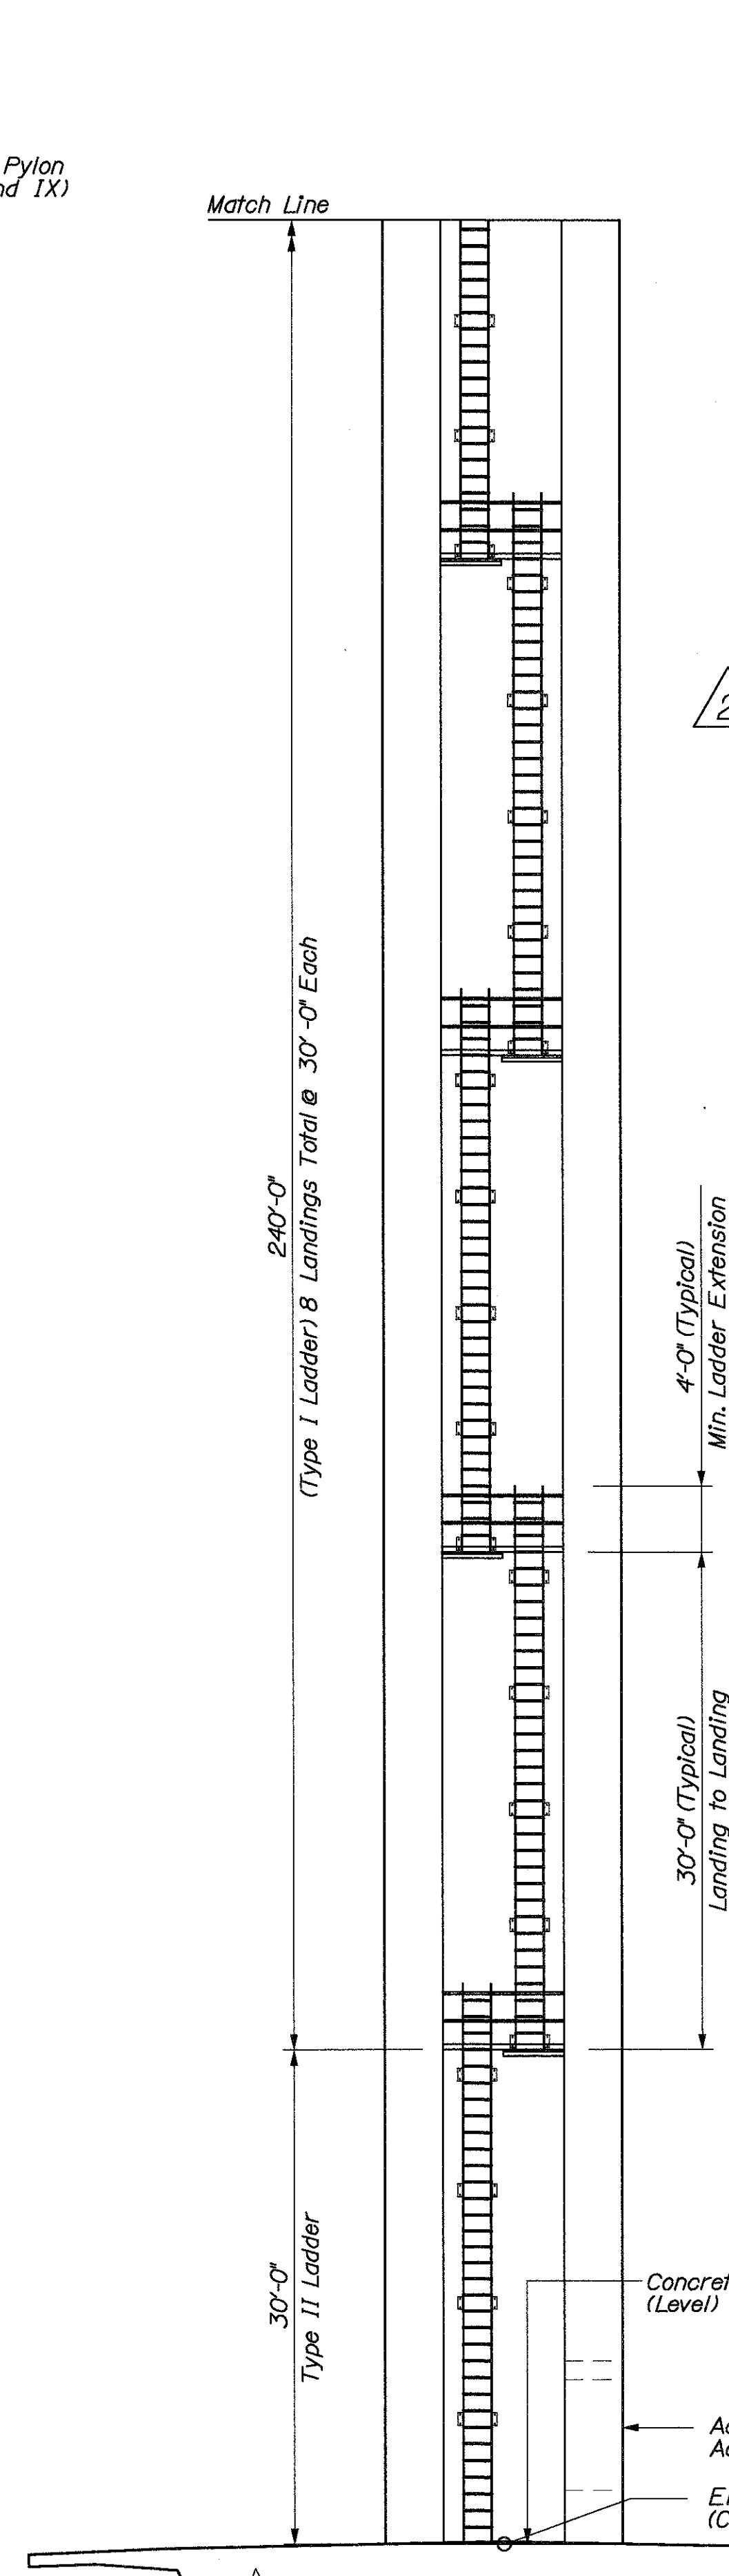


ELEVATION
(Looking Towards Main Span)

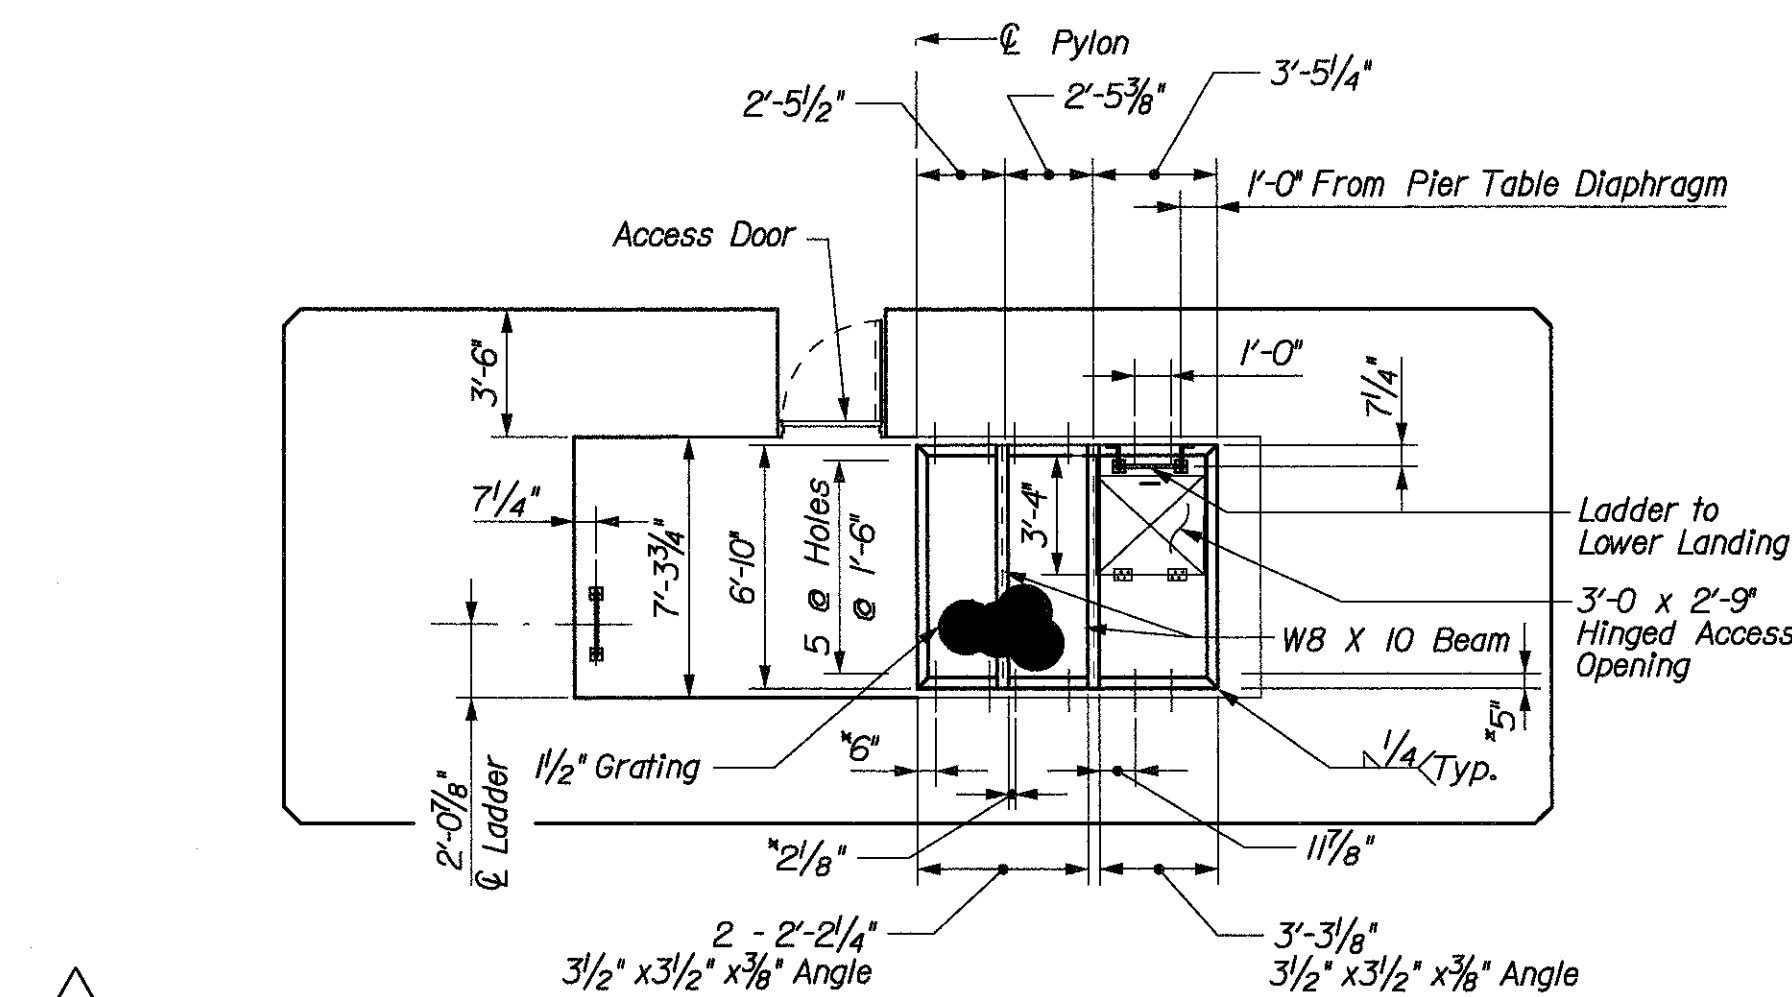

SECTION AT DECK LEVEL

NOTES

1. *Hinged Access Opening to be pad locked with matching keys (See Note 4 on Pylon Access Details V sheet - Access Door Details).*
2. *Set Beams so grating is flush Pylon Floor Concrete.*
3. *For Beam To Concrete Wall Connection See Detail I on Pylon Access Details VII Sheet.*
- * 4. *Dimensions Shown are to Holes for $\frac{3}{8}$ " ϕ Bolts. Typical spacing 1'-6" from first bolt hole. Bolt anchorage hardware shall be from the Department Approved Product List, or approved equal. Anchor group shall have a combined working shear capacity of 2,000 lbs. and a minimum working tension capacity of 2,000 lbs. Contractor shall submit proposed system for review by the Department prior to use. Bolt anchorages shall be installed in strict accordance with the selected manufacturer's recommendations. See Detail I.*

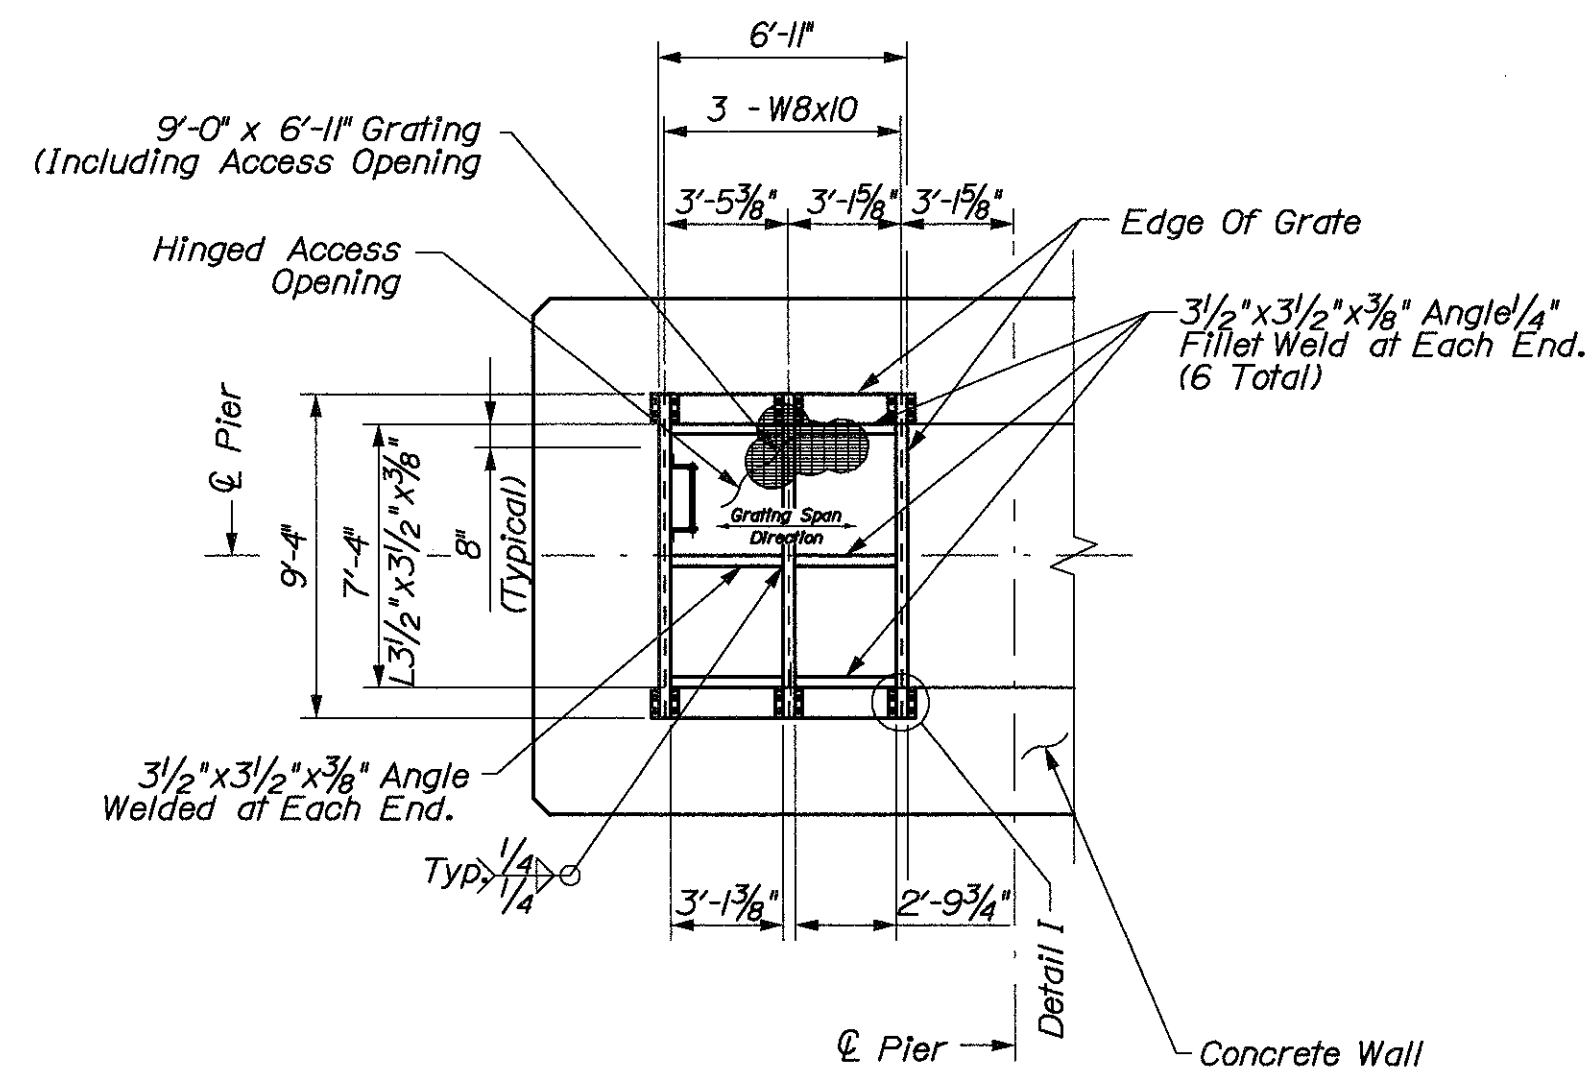


SECTION A-A

Platform Details (For Upper Ladder And Railing
Details See Pylon Access Details VII Sheet)

Bolt anchorage hardware shall be from the Department Approved Product List, or approved equal. Anchor group shall have a combined working shear capacity of 4,600 lbs. and a minimum working tension capacity of 3,750 lbs. Contractor shall submit proposed system for review by the Department prior to use. Bolt anchorages shall be installed in strict accordance with the selected manufacturer's recommendations. See Detail 1.


ESTIMATED QUANTITIES / PYLON PIER 2 ACCESS		
ITEM	UNIT	QUANTITY
Structural Steel	Lb.	9,030
1/2" x 1/8" Galvanized Grating	Lb.	2,262

Estimated Quantities Are For Information Only. Quantity Excludes Bolts For Connections.

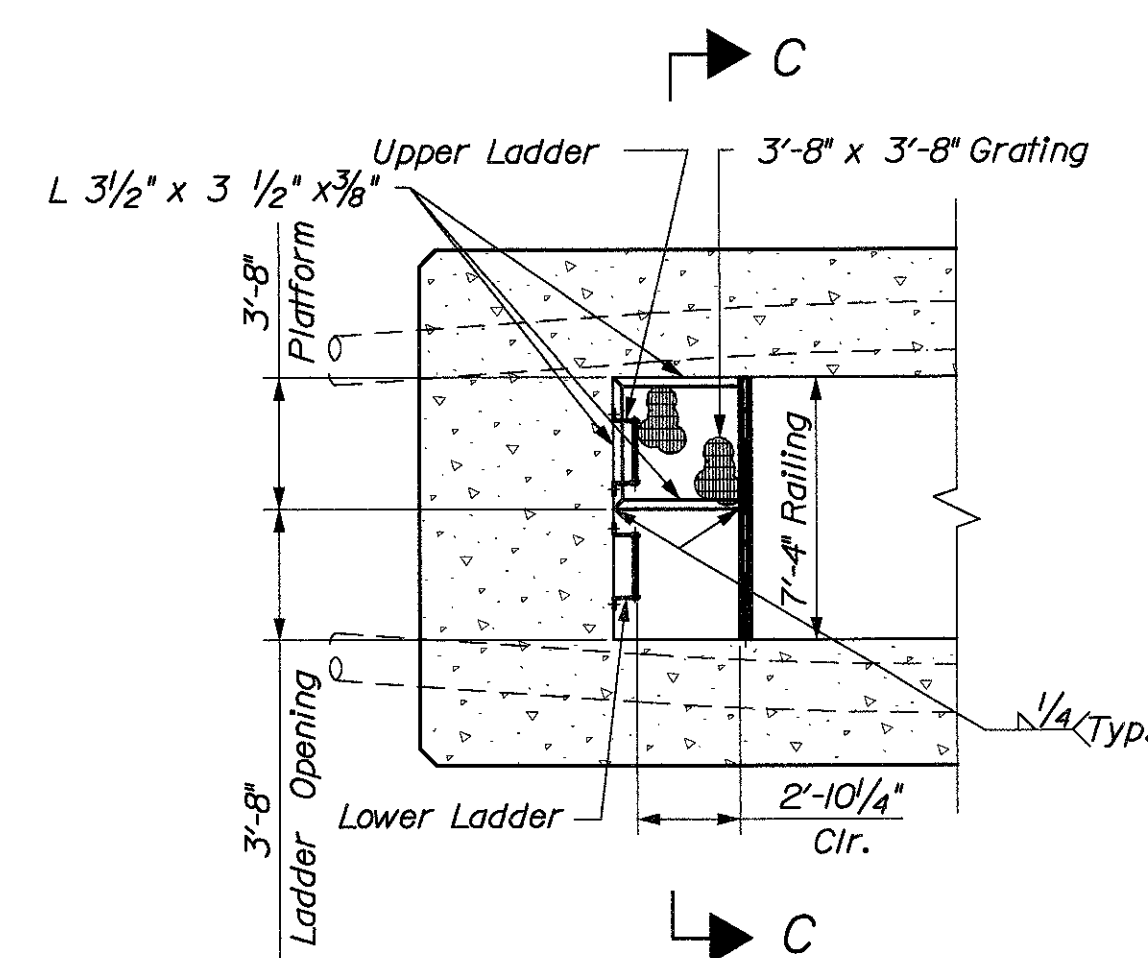

TYPICAL UPPER PYLON DETAIL

For Beam To Concrete Wall Connection See Detail I on Pylon Access Details VII Sheet.
(Platform and Ladder Opening Alternates Sides at Each Landing)

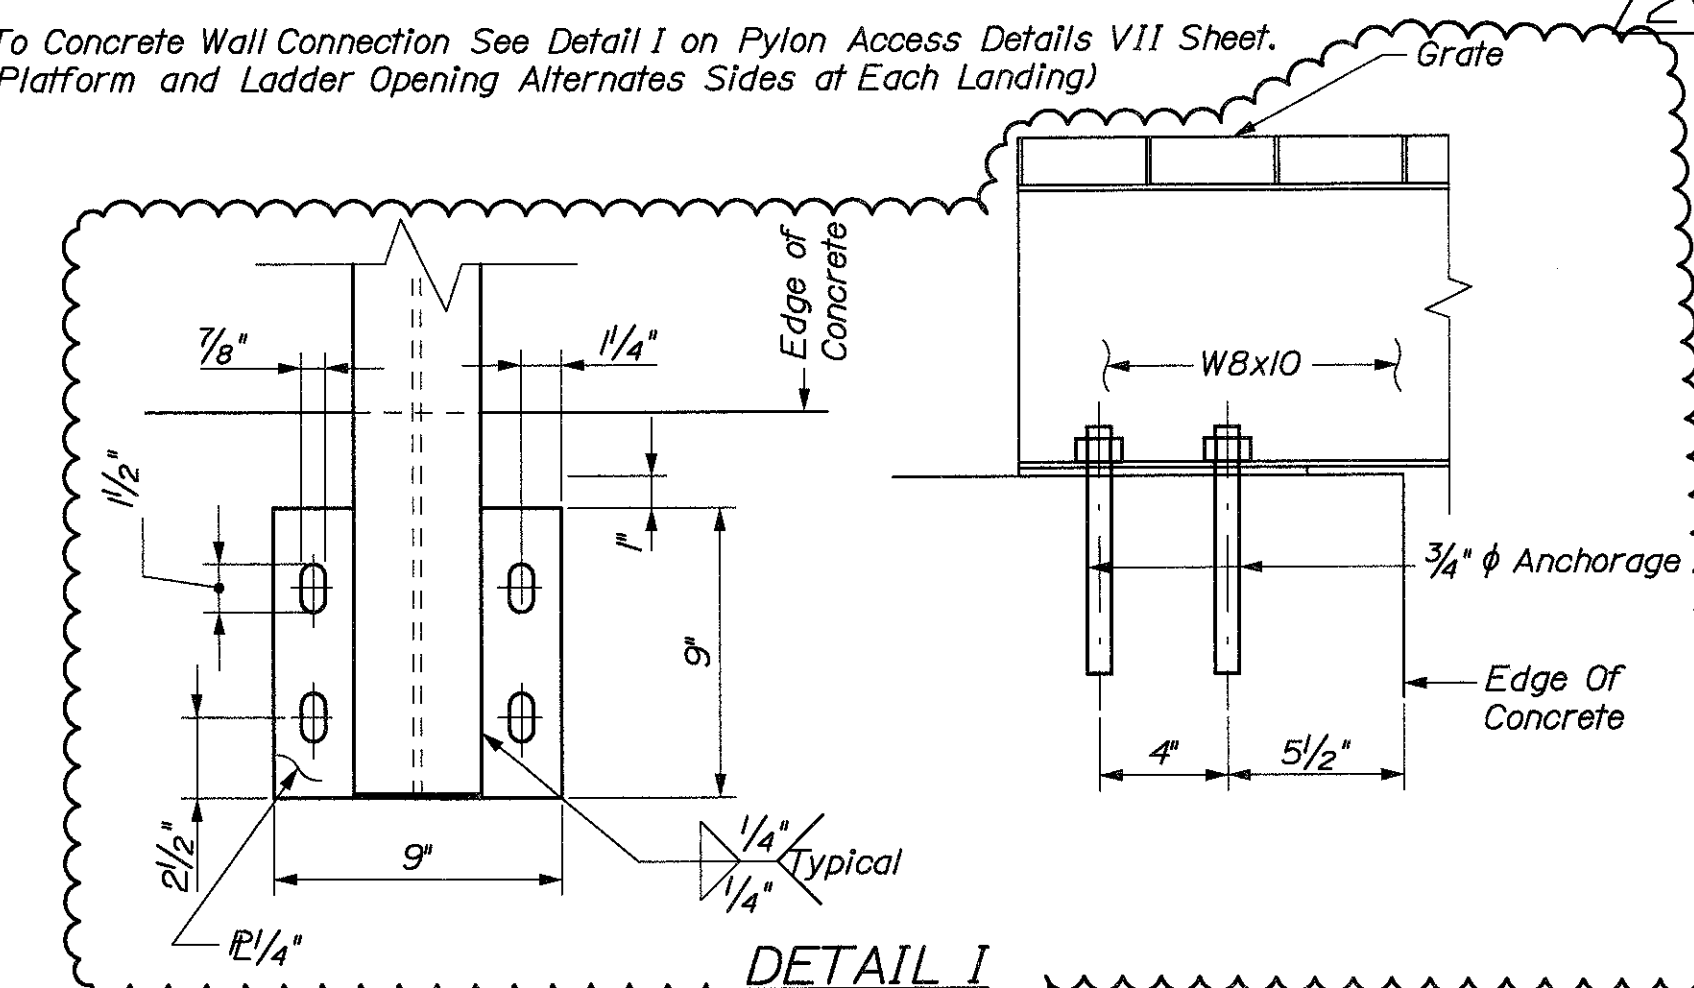


DETAIL I

NOTES

NOTES
(Notes apply to Pylon Access Details VI - IX sheets unless otherwise noted)


1. Information on Pylon Access Details VI and IX sheets apply to Pylon Pier 2 only.
2. For pylon access door details see Pylon Access Details V sheet.
3. Work this sheet with Pylon Access Details VII - IX sheets.
4. All fabricated steel items, including grating, are to be hot dipped galvanized in accordance with ASTM A123 after fabrication, and shall be assembled with galvanized anchors and hardware in accordance with ASTM A153.
5. Shop drawings shall be submitted for all access hardware as a complete system for review and approval by the Department.
6. Cost of all ladder materials, associated hardware, labor, installation, etc. are incidental to Item 502.2191 - Structural Concrete (Pylon Maintenance Access System).
7. Ladder rungs shall be spaced to provide platform rung to be flush with top of platform grating. Maximum rung spacing is 12".
8. Railing posts shall be 2" nominal diameter schedule 40 pipe. Railing shall be 1 1/2" nominal diameter schedule 40 pipe.
9. Fall Prevention Device shall be Miller TranScender Model TRS30, or approved equal, for each Type I and Type II Ladder. Contractor shall provide to the Department 2 cable sleeves, Model TRCS-SC, or approved equal, Maximum of 2 climbers attached to a single Fall Prevention Device. Alternate location of device on ladder towards center for close transfer of cable sleeve at each landings. Miller Fall Protection, 1345 15th St, Franklin, PA 16323 (1-800-673-5242) website www.millerfallprotection.com.
10. Dimensions provided are for general information. Adjustments in steel lengths due to coping, tolerances etc. are not included unless specifically stated.
11. Bar grating for platforms shall be galvanized steel welded type bar grating with 1 1/2" x 1/8" bearing bars 1 1/6" on center, with cross bars at 4" on center. All edges shall be banded. Bearing bar spanning direction shall be as shown (bearing bars shall run with the short span between braces). Grating shall completely cover the landing platform. Attach grating to supporting steel by welding or with steel clips per manufacturer's recommendations.

12. All bolts shall conform to ASTM A325.
13. Field verify all dimensions prior to fabrication.
14. Platform design load = 100 pounds per square foot.
15. All welds shall be in strict accordance with AWS D1.5.
All Welders shall be certified.

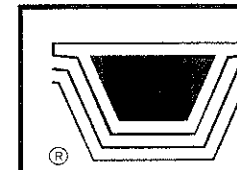

Figg Bridge Engineers, Inc.
424 North Calhoun Street
Tallahassee, Florida 32301

• Tallahassee, Fl. • Denver, Co. • Philadelphia, Pa. • Dallas, Tx. •

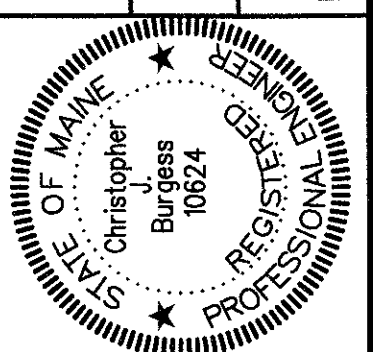

Chris J. Bungen
 SIGNATURE
 10624
 P.E. NUMBER
 15oct 04
 DATE








PROJ. MANAGER	W.J. ROHLER	BY	DATE
DESIGN-DETAILED	T.COOPER	T.COOPER	9-09-04
CHECKED-REVIEWED	C.BURGESS	C.BURGESS	9-09-04
DESIGN-DETAILED2			
DESIGN-DETAILED3			
REVISIONS 1	SECTION A-A, NOTES		9-23-04
REVISIONS 2	DETAIL, NOTES, ANCHORS		10-15-04
REVISIONS 3			
REVISIONS 4			
FIELD CHANGES			

PROSPECT-VERONA BRIDGE
PENOBSCOT RIVER
PROSPECT\VERONA WALDO\HANCOCK CTY

SHEET NUMBER

P6

OF P15

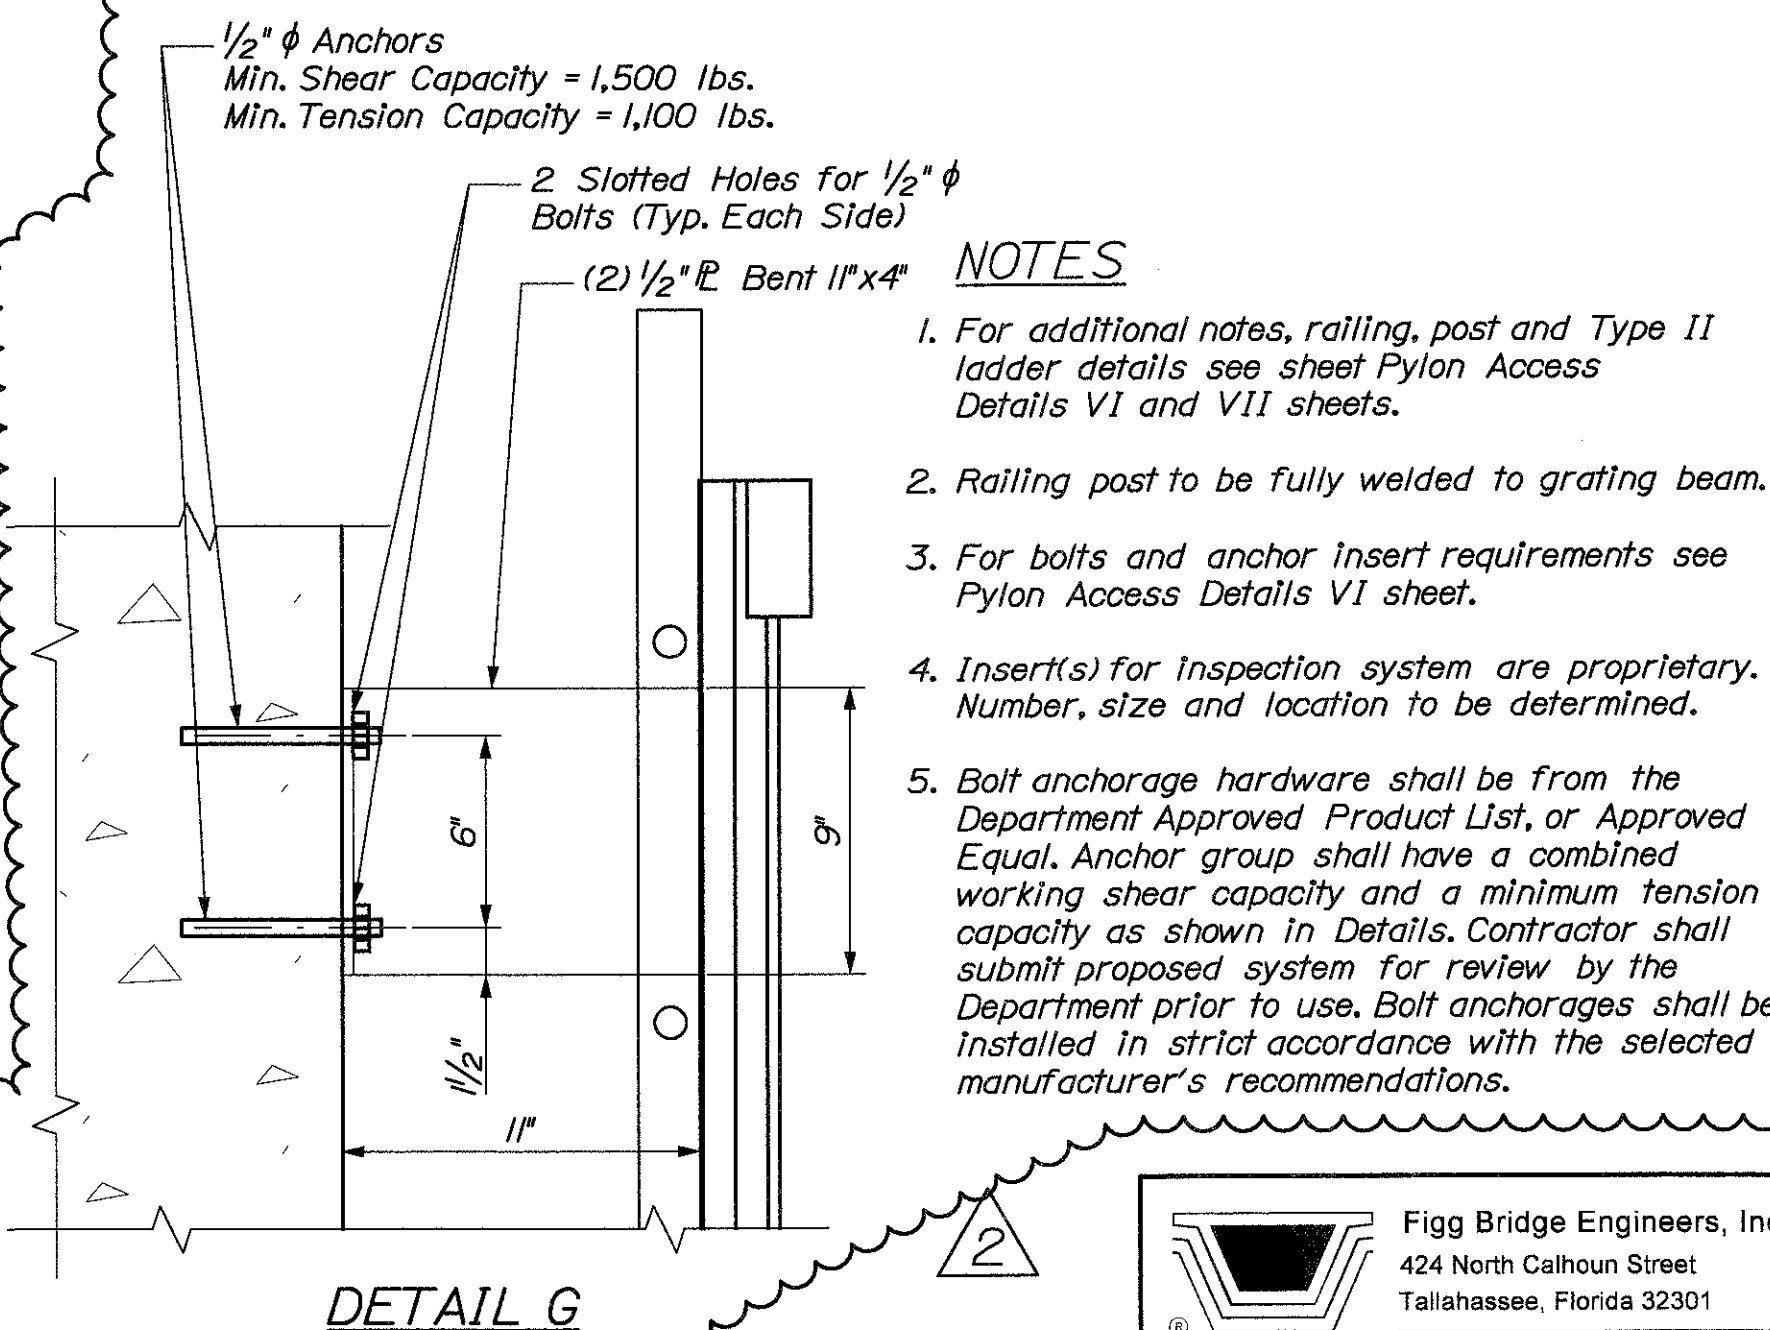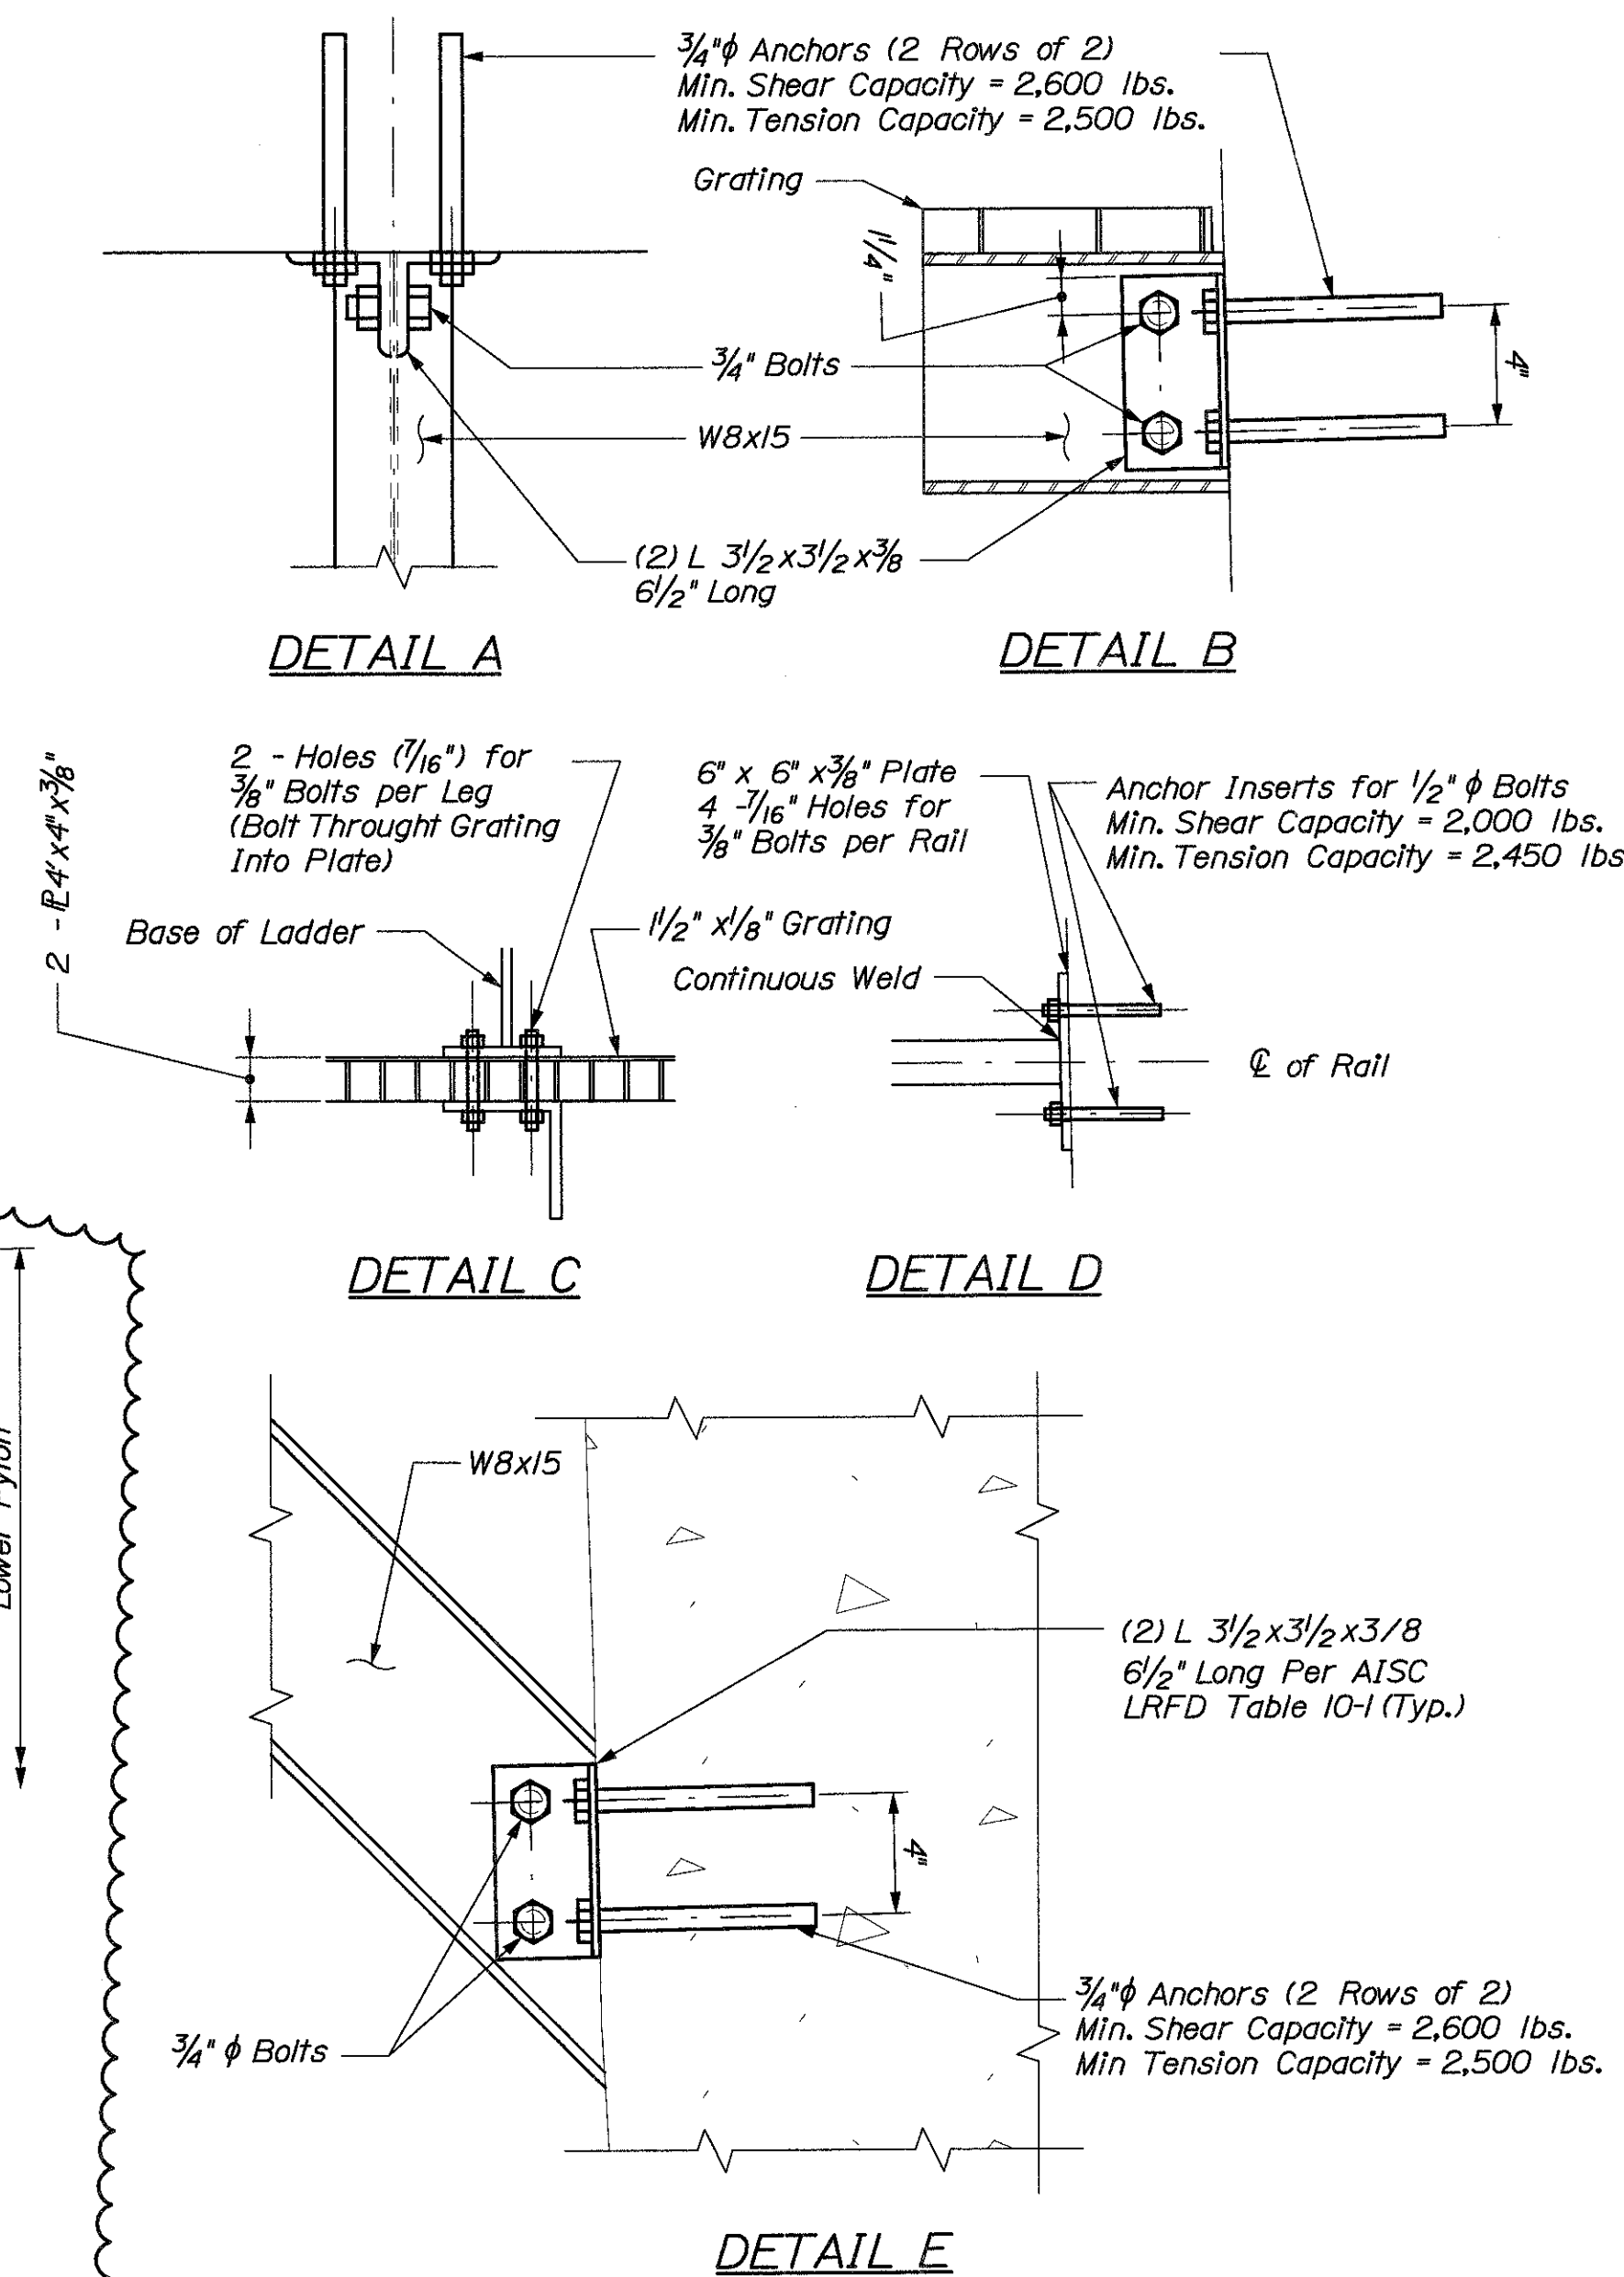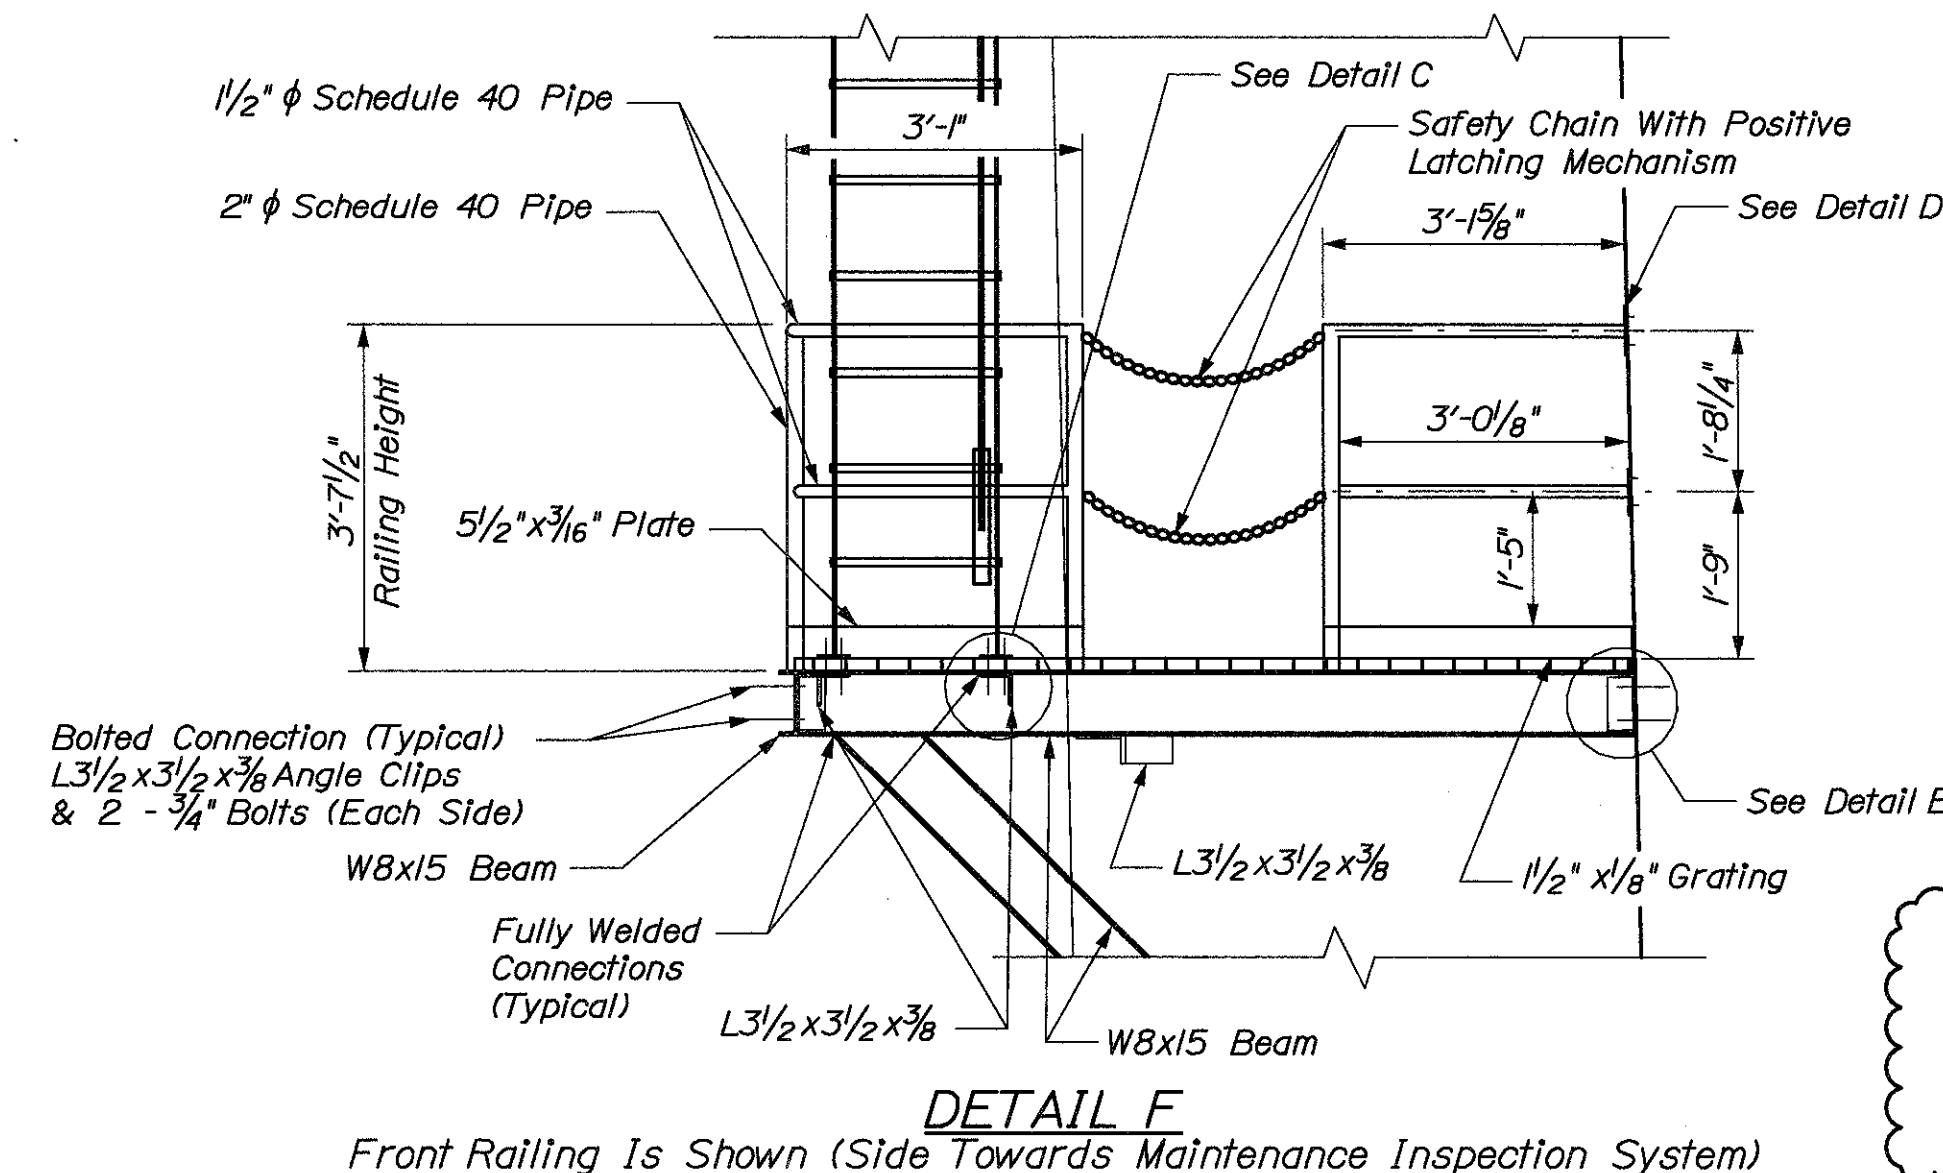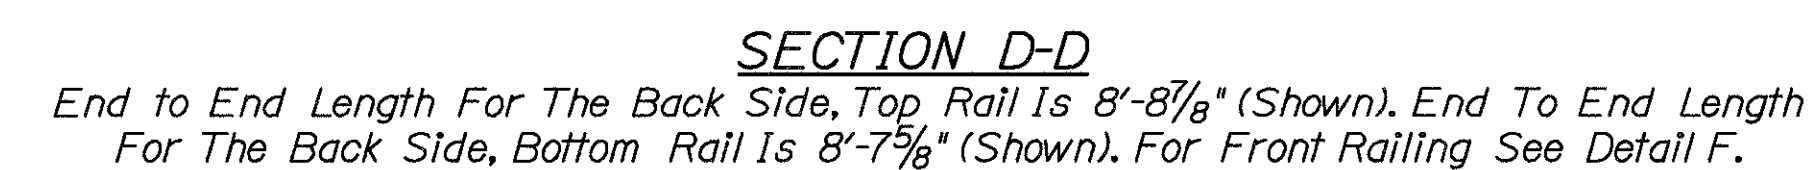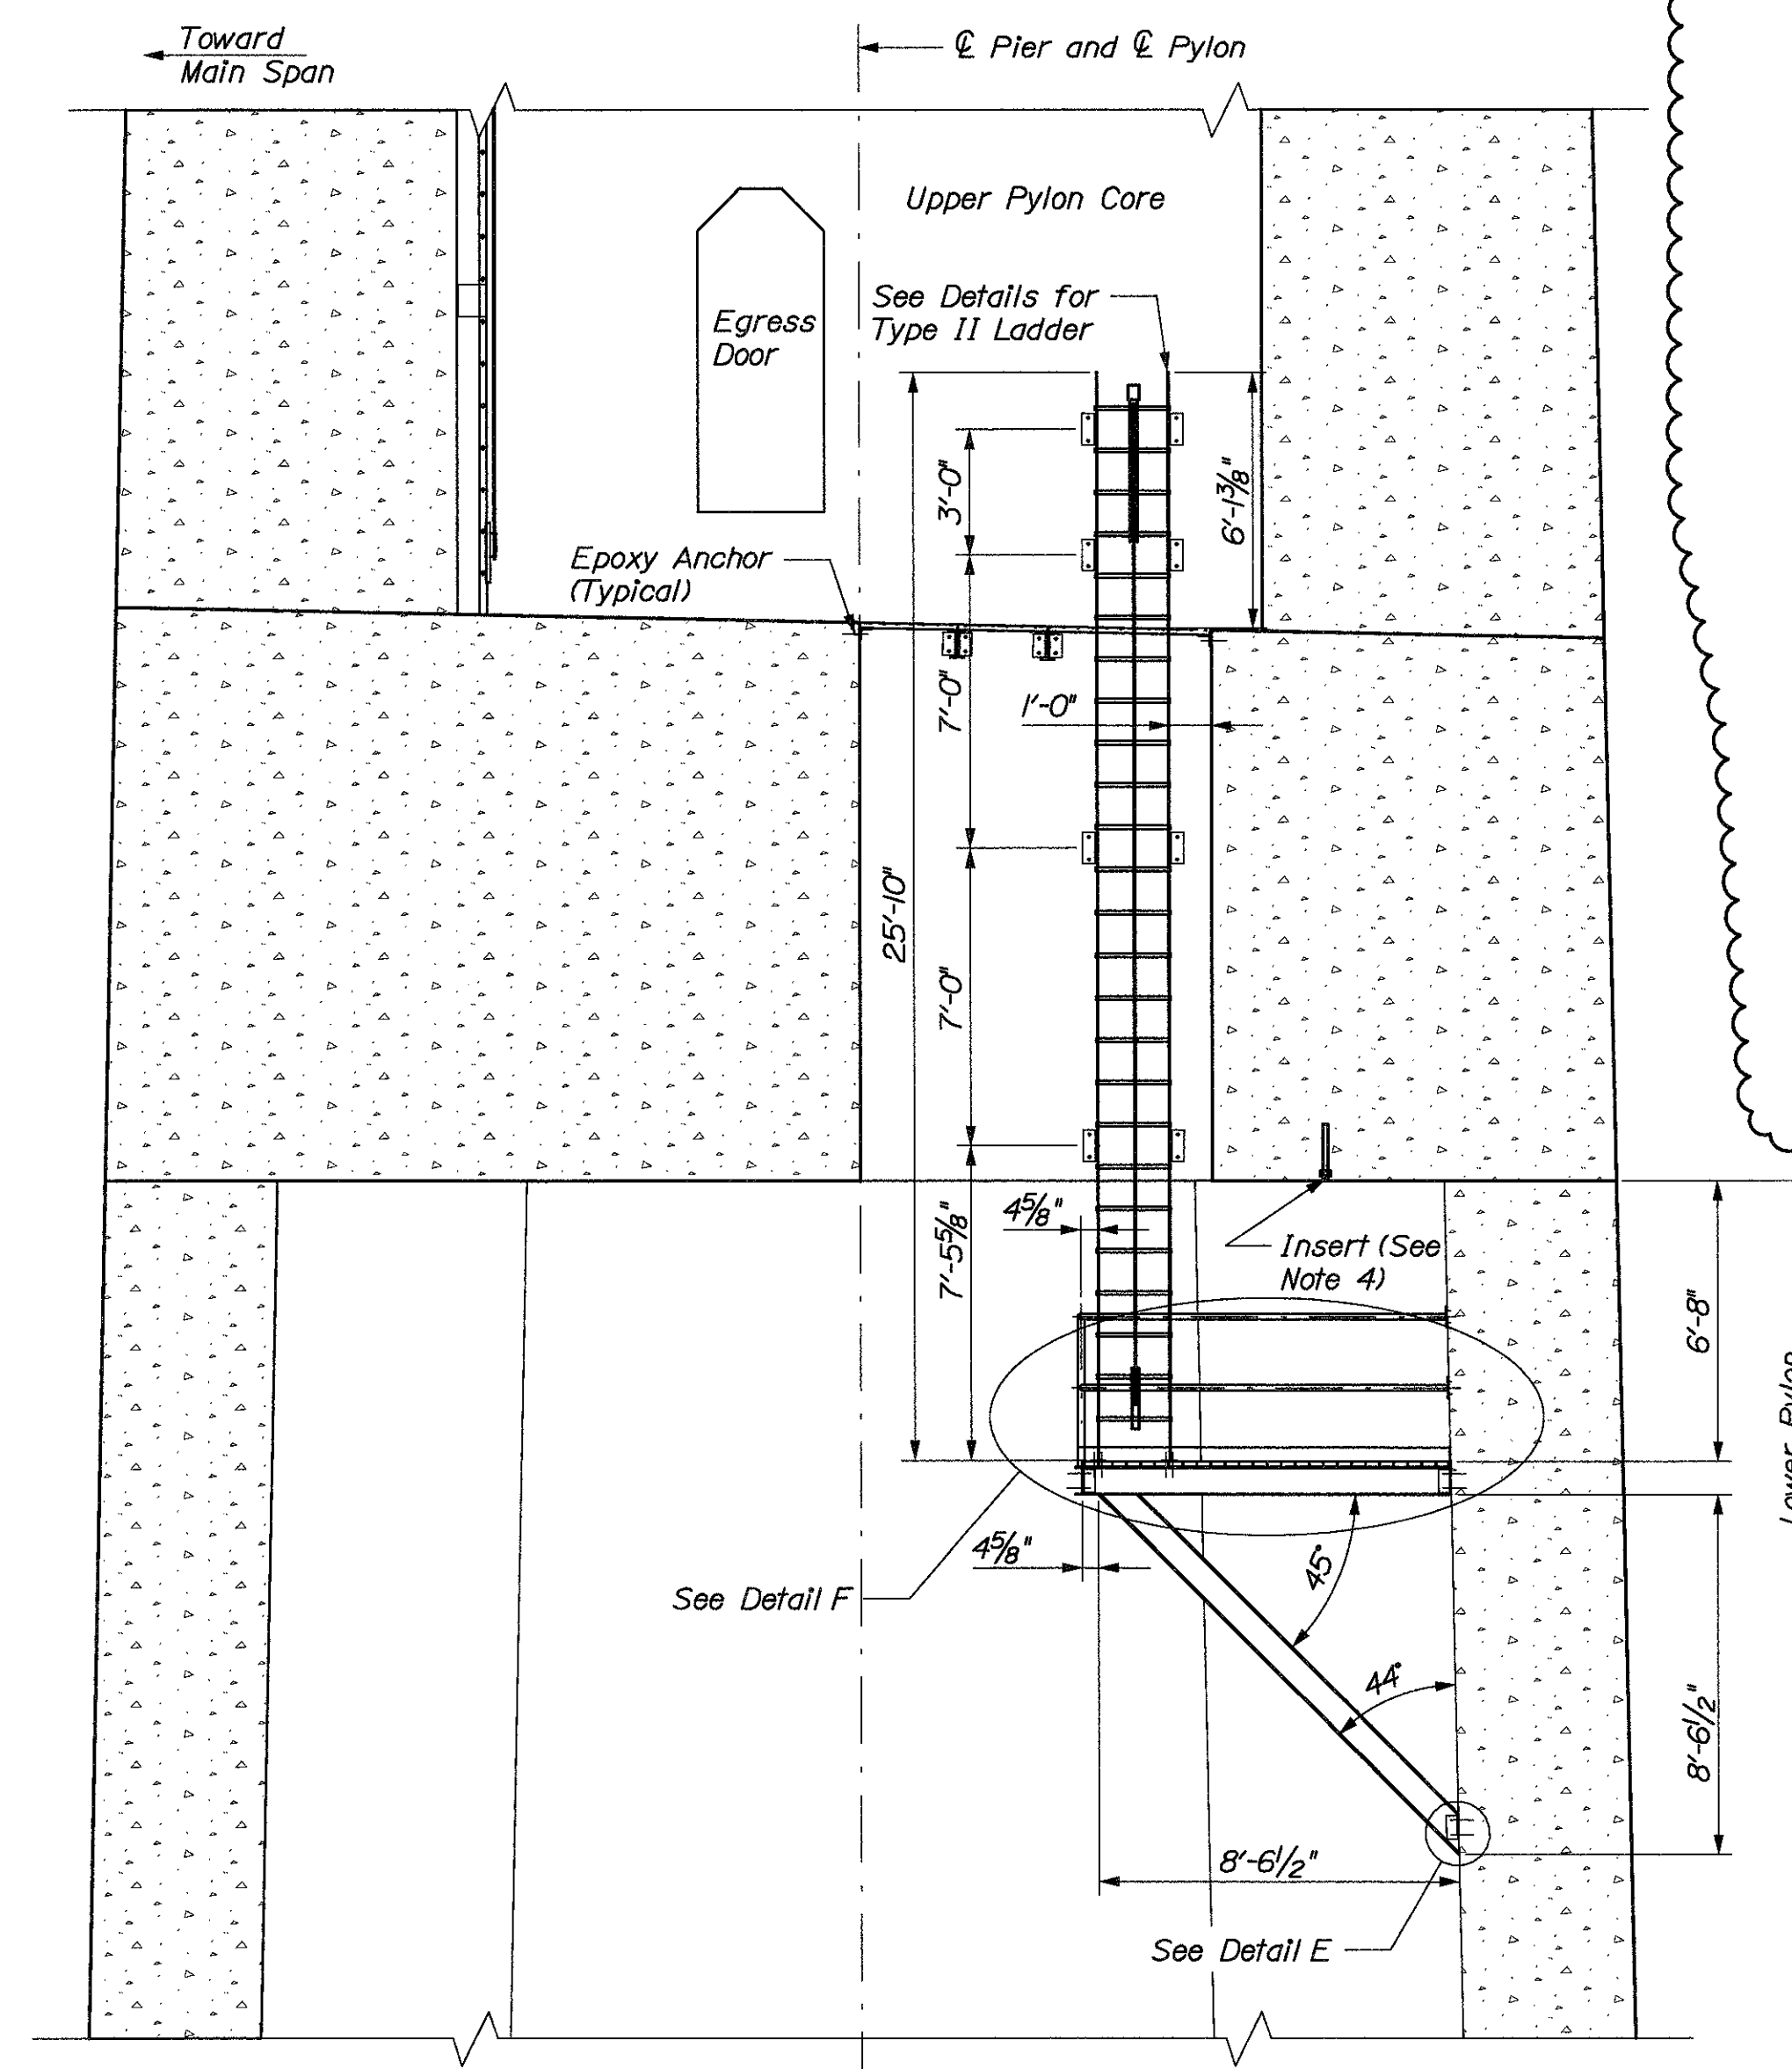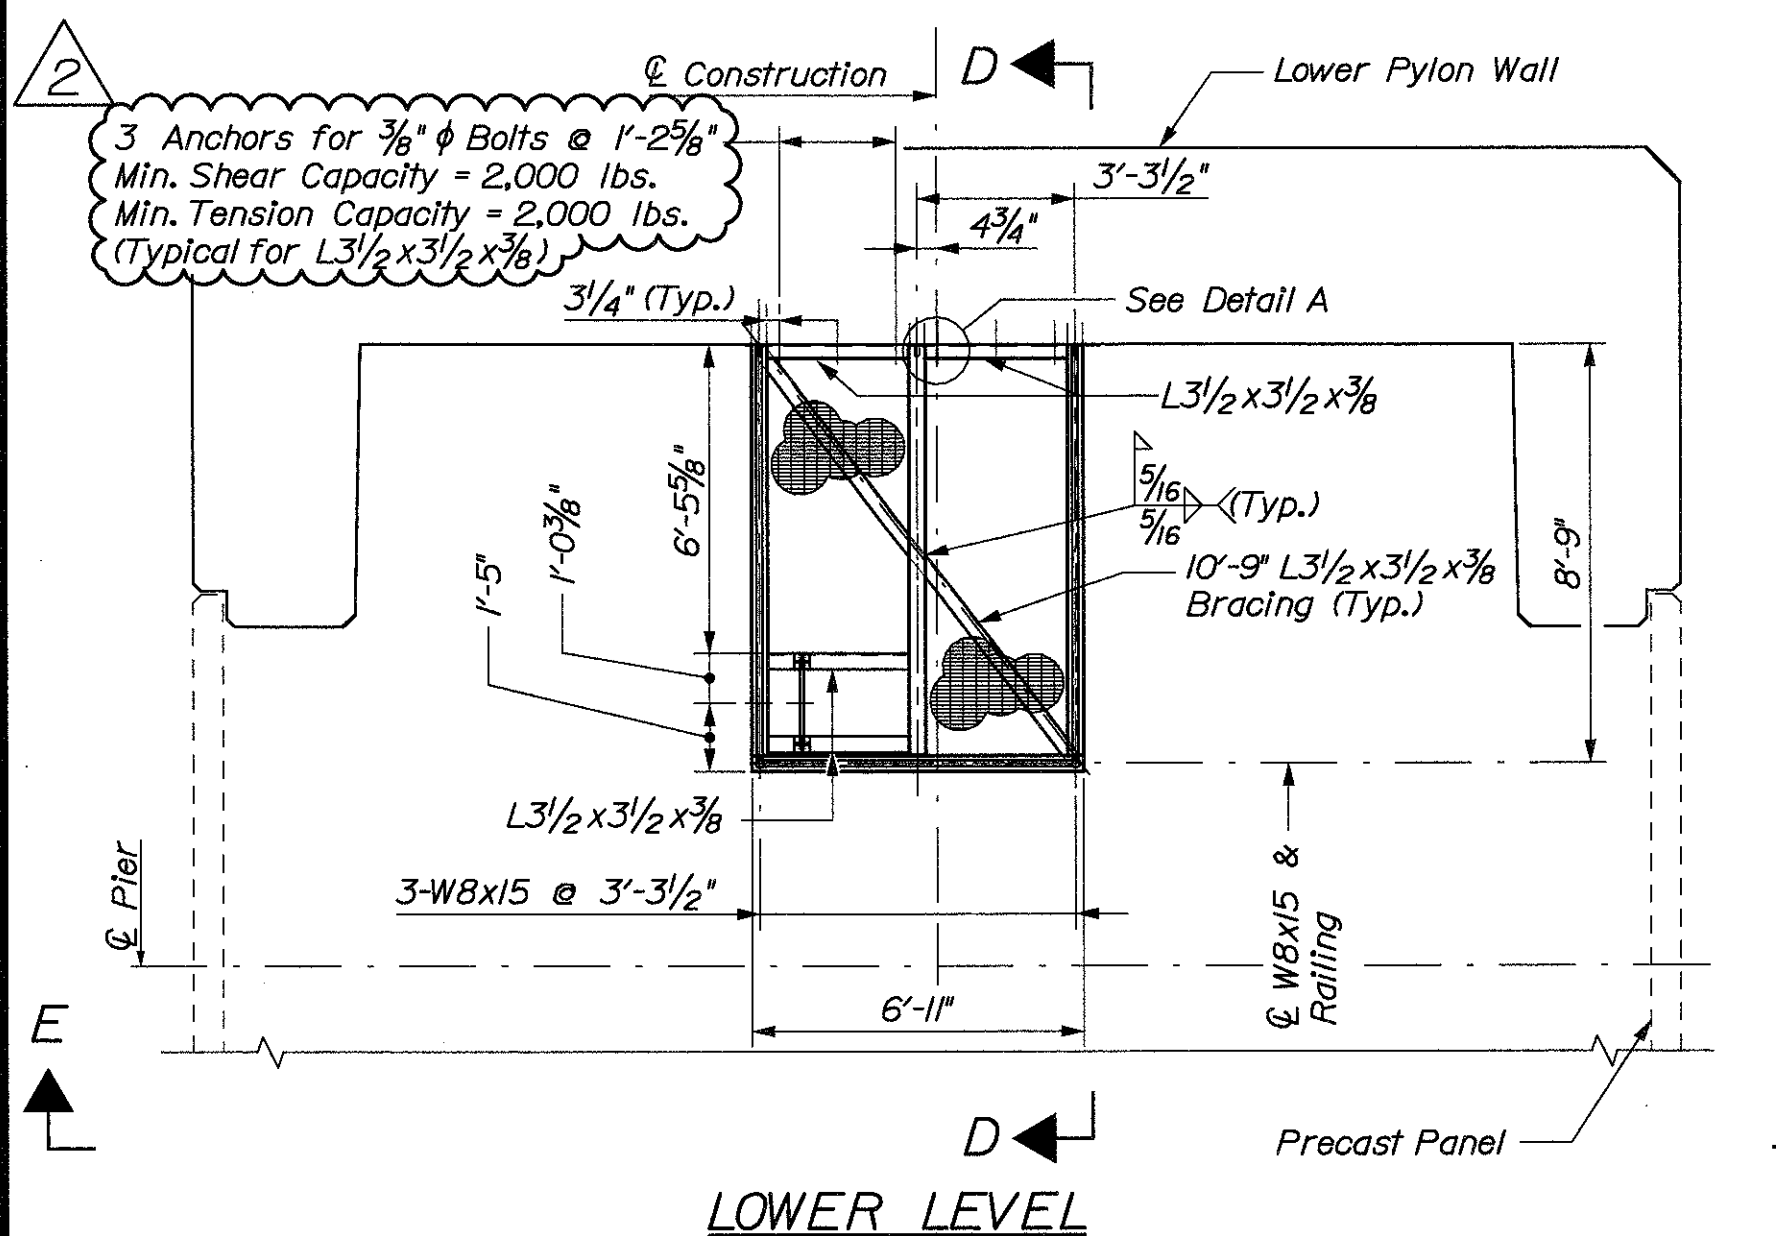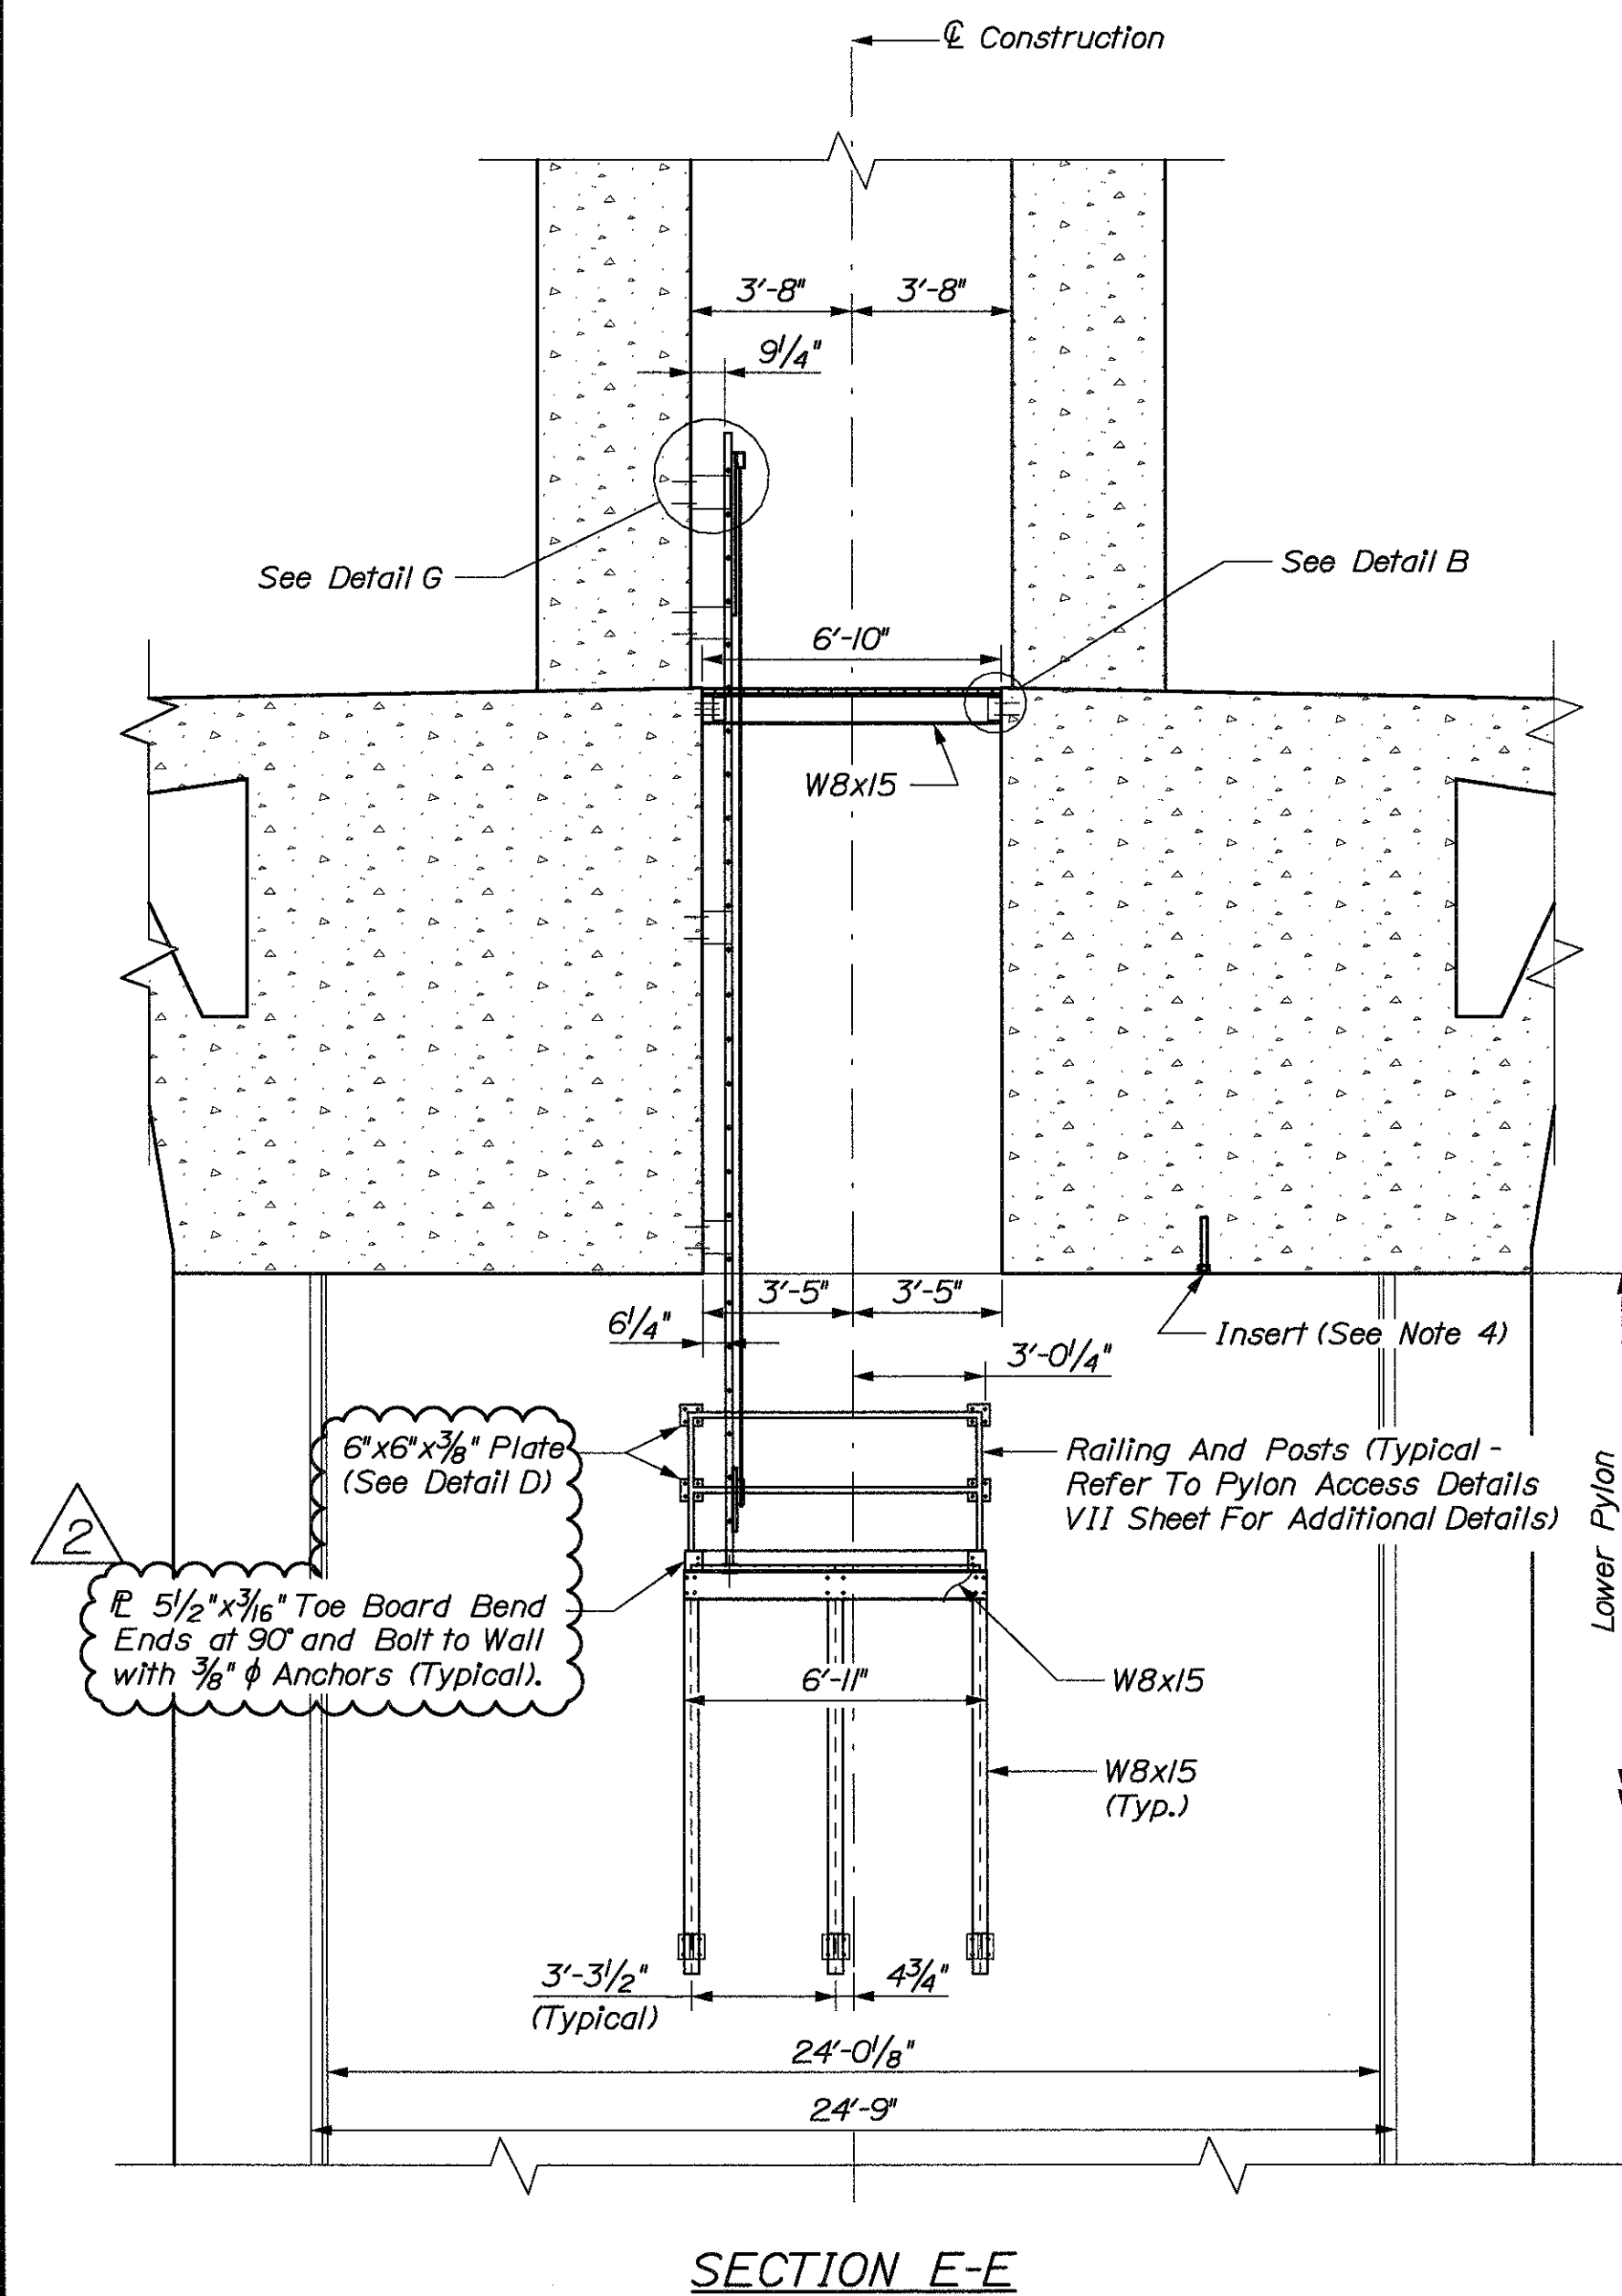

- ## NOTES
1. *For additional notes, railing, post and Type II ladder details see sheet Pylon Access Details VI and VII sheets.*
 2. *Railing post to be fully welded to grating beam.*
 3. *For bolts and anchor Insert requirements see Pylon Access Details VI sheet.*
 4. *Insert(s) for Inspection system are proprietary. Number, size and location to be determined.*
 5. *Bolt anchorage hardware shall be from the Department Approved Product List, or Approved Equal. Anchor group shall have a combined working shear capacity and a minimum tension capacity as shown in Details. Contractor shall submit proposed system for review by the Department prior to use. Bolt anchorages shall be installed in strict accordance with the selected manufacturer's recommendations.*

Filename: ... \P07_Pylon_Access_Details_Vlla.dgn Division: BRIDGE

TYPE II LADDER DETAILS

TYPE III LADDER DETAILS

TYPE IV LADDER DETAILS

SECTION C-C

SECTION D-D

SECTION E-E

*Holes For $\frac{3}{8}"\phi$ Anchors
(See Note 16)

Section F-F

NOTES

NOTES
(Notes apply to Pylon Access Details VI - IX sheets unless otherwise noted)

1. Work this sheet with Pylon Access Details VI, VIII and IX sheets.
2. For additional notes see Pylon Access Details VI, VIII and IX sheets.
3. 6"x6"x $\frac{3}{8}$ " railing end plates shall be attached to the pylon with 4 - $\frac{3}{8}$ " ϕ (16 per landing) galvanized bolts.
4. Welding of post and railing members to each other and to frame and end plates shall be $\frac{1}{8}$ " fillet welds.
5. Ladder rungs shall be spaced to provide platform rung to be flush with top of platform grating. Maximum rung spacing is 12".
6. Railing posts shall be 2" nominal diameter schedule 40 pipe. Railing shall be 1 $\frac{1}{2}$ " nominal diameter schedule 40 pipe.
7. Dimensions provided are for general information. Adjustments in steel lengths due to coping, tolerances etc. are not included unless specifically stated.
8. Bolt anchorage hardware shall be from the Department Approved Product List, or approved equal. Anchor group shall have a combined working shear capacity and a minimum working tension capacity as shown in the Details. Contractor shall submit proposed system for review by the Department prior to use. Bolt anchorages shall be installed in strict accordance with the selected manufacturer's recommendations.
9. All bolts shall conform to ASTM A325.
10. Field verify all dimensions prior to fabrication.

Elevation View


Plan View

DETAIL I


Detail Is Typical for All Bolted Beam Connections

GRATING DETAIL

(Provide Grating Clips for Tie Down to Angles and Flanges)

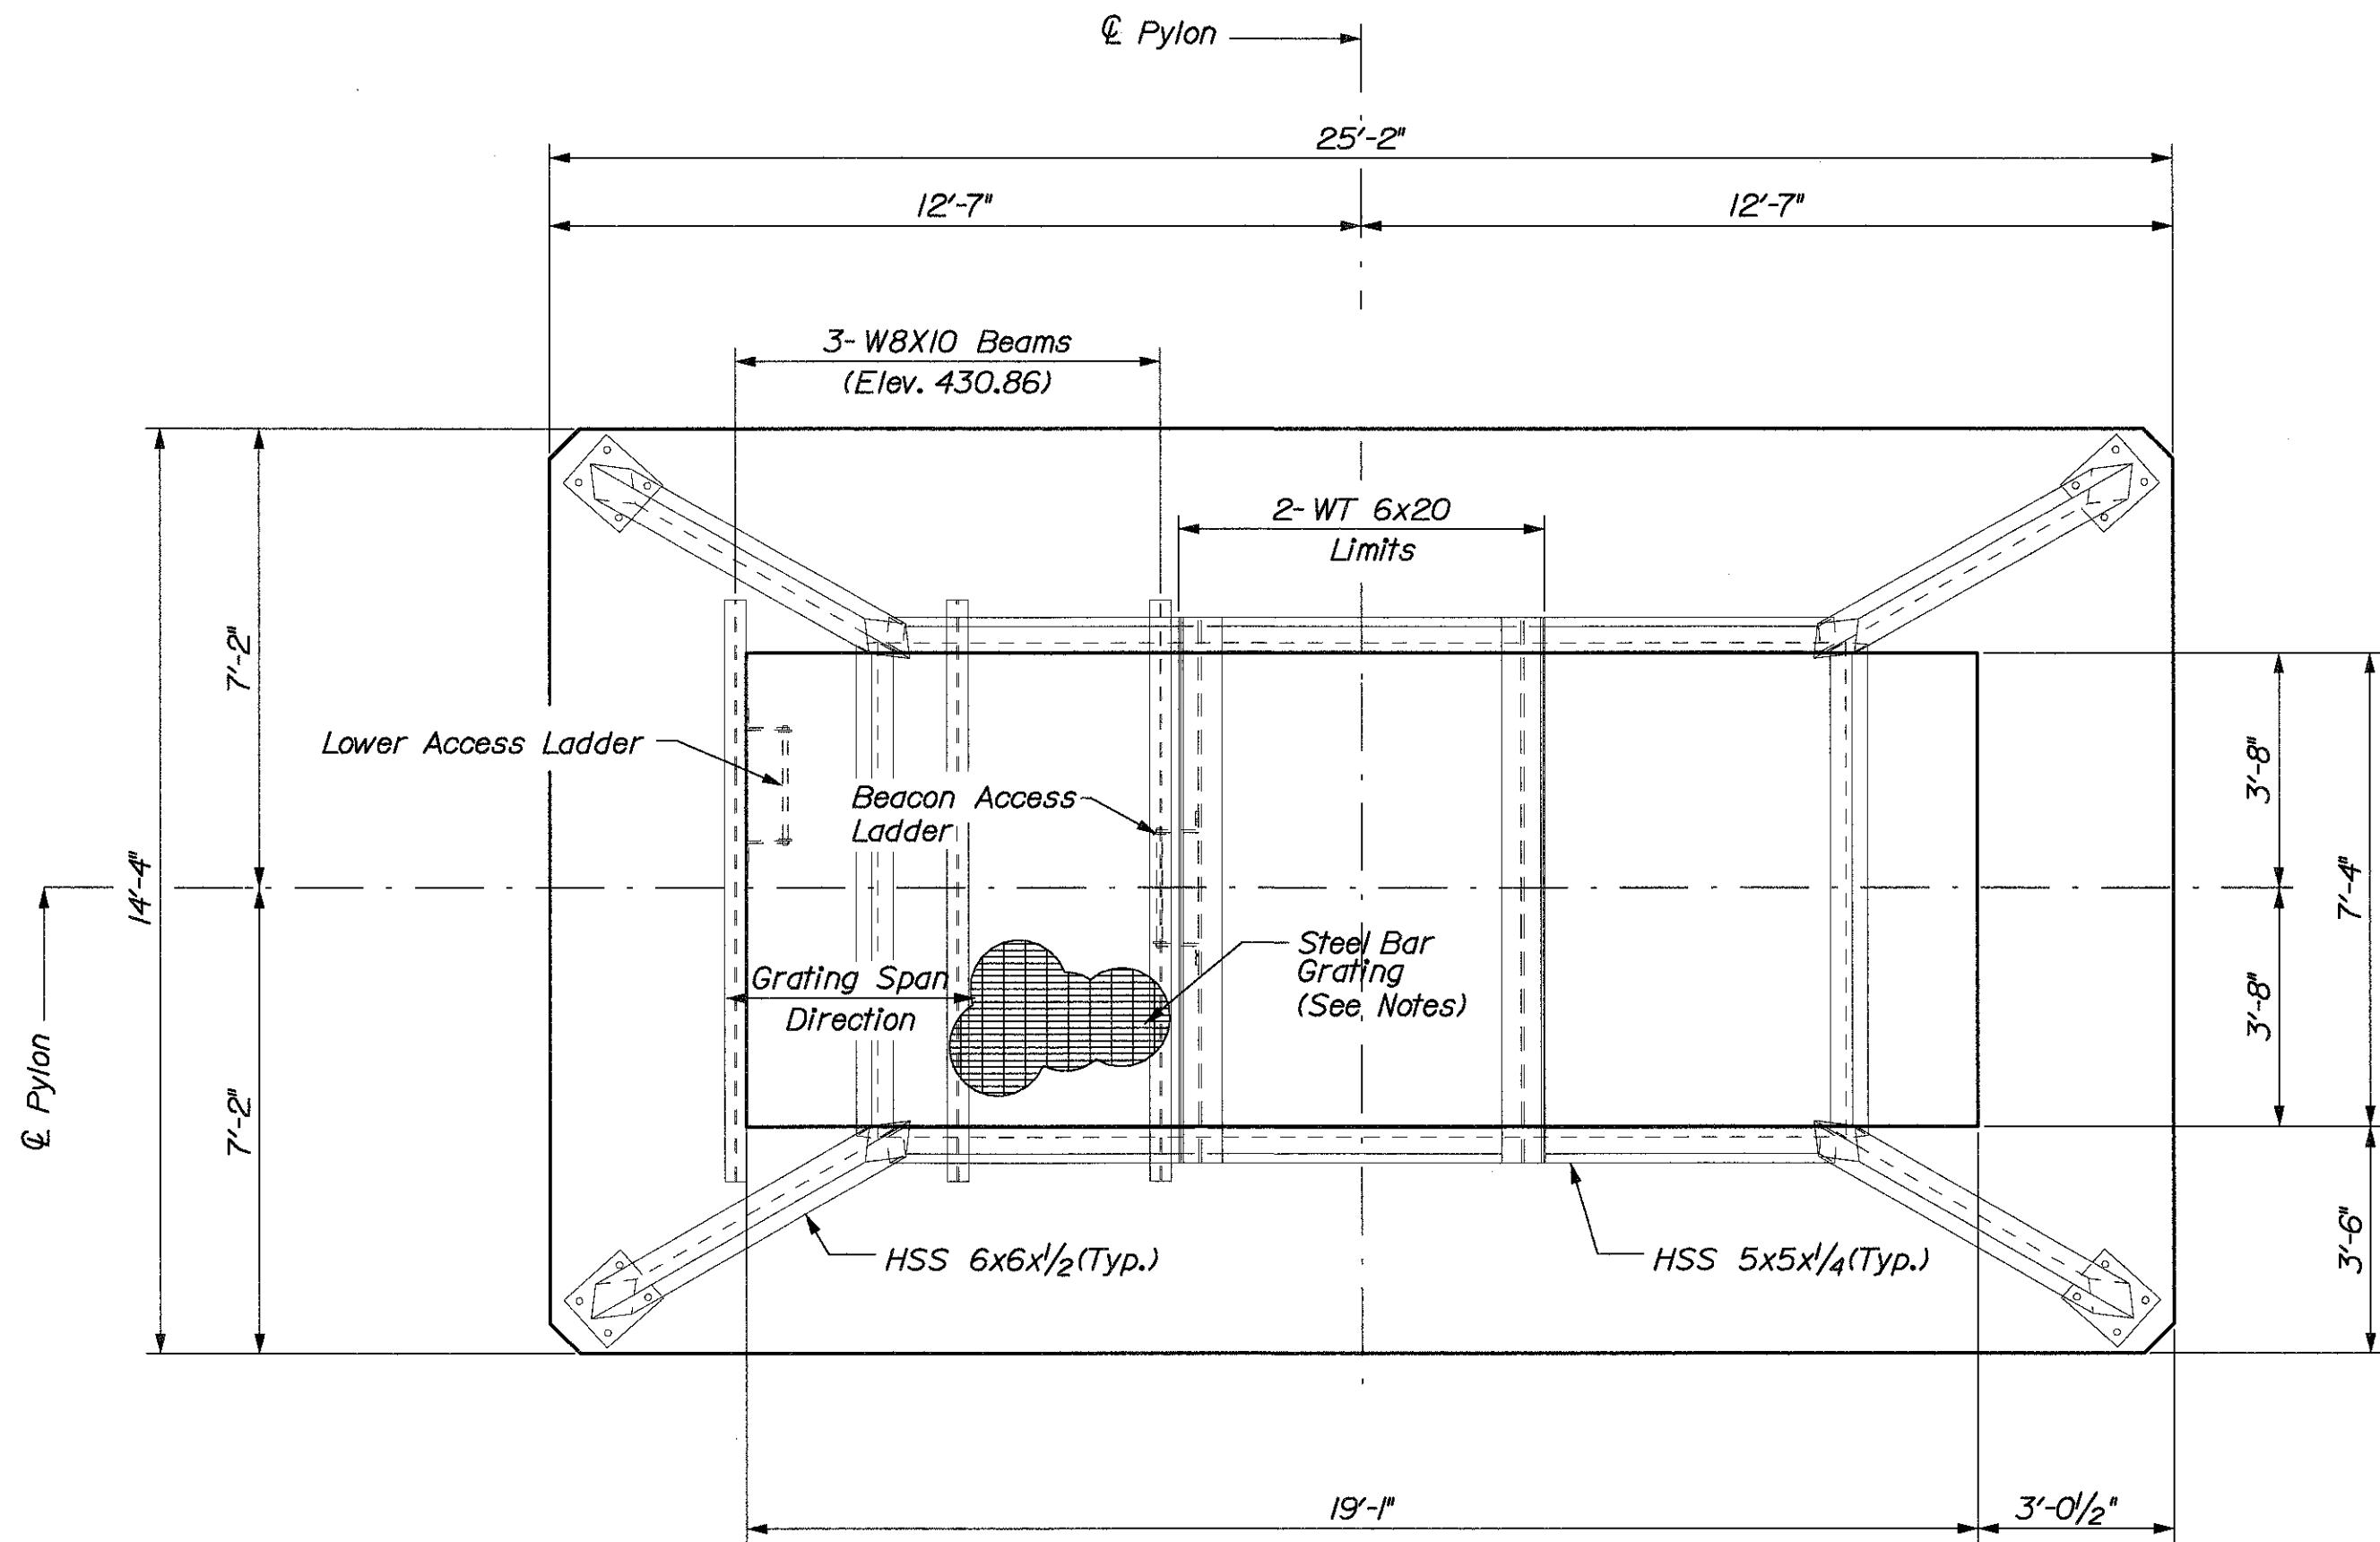


T.O.S. ELEVATION 436.36'
ROOF STRUCTURE PLAN

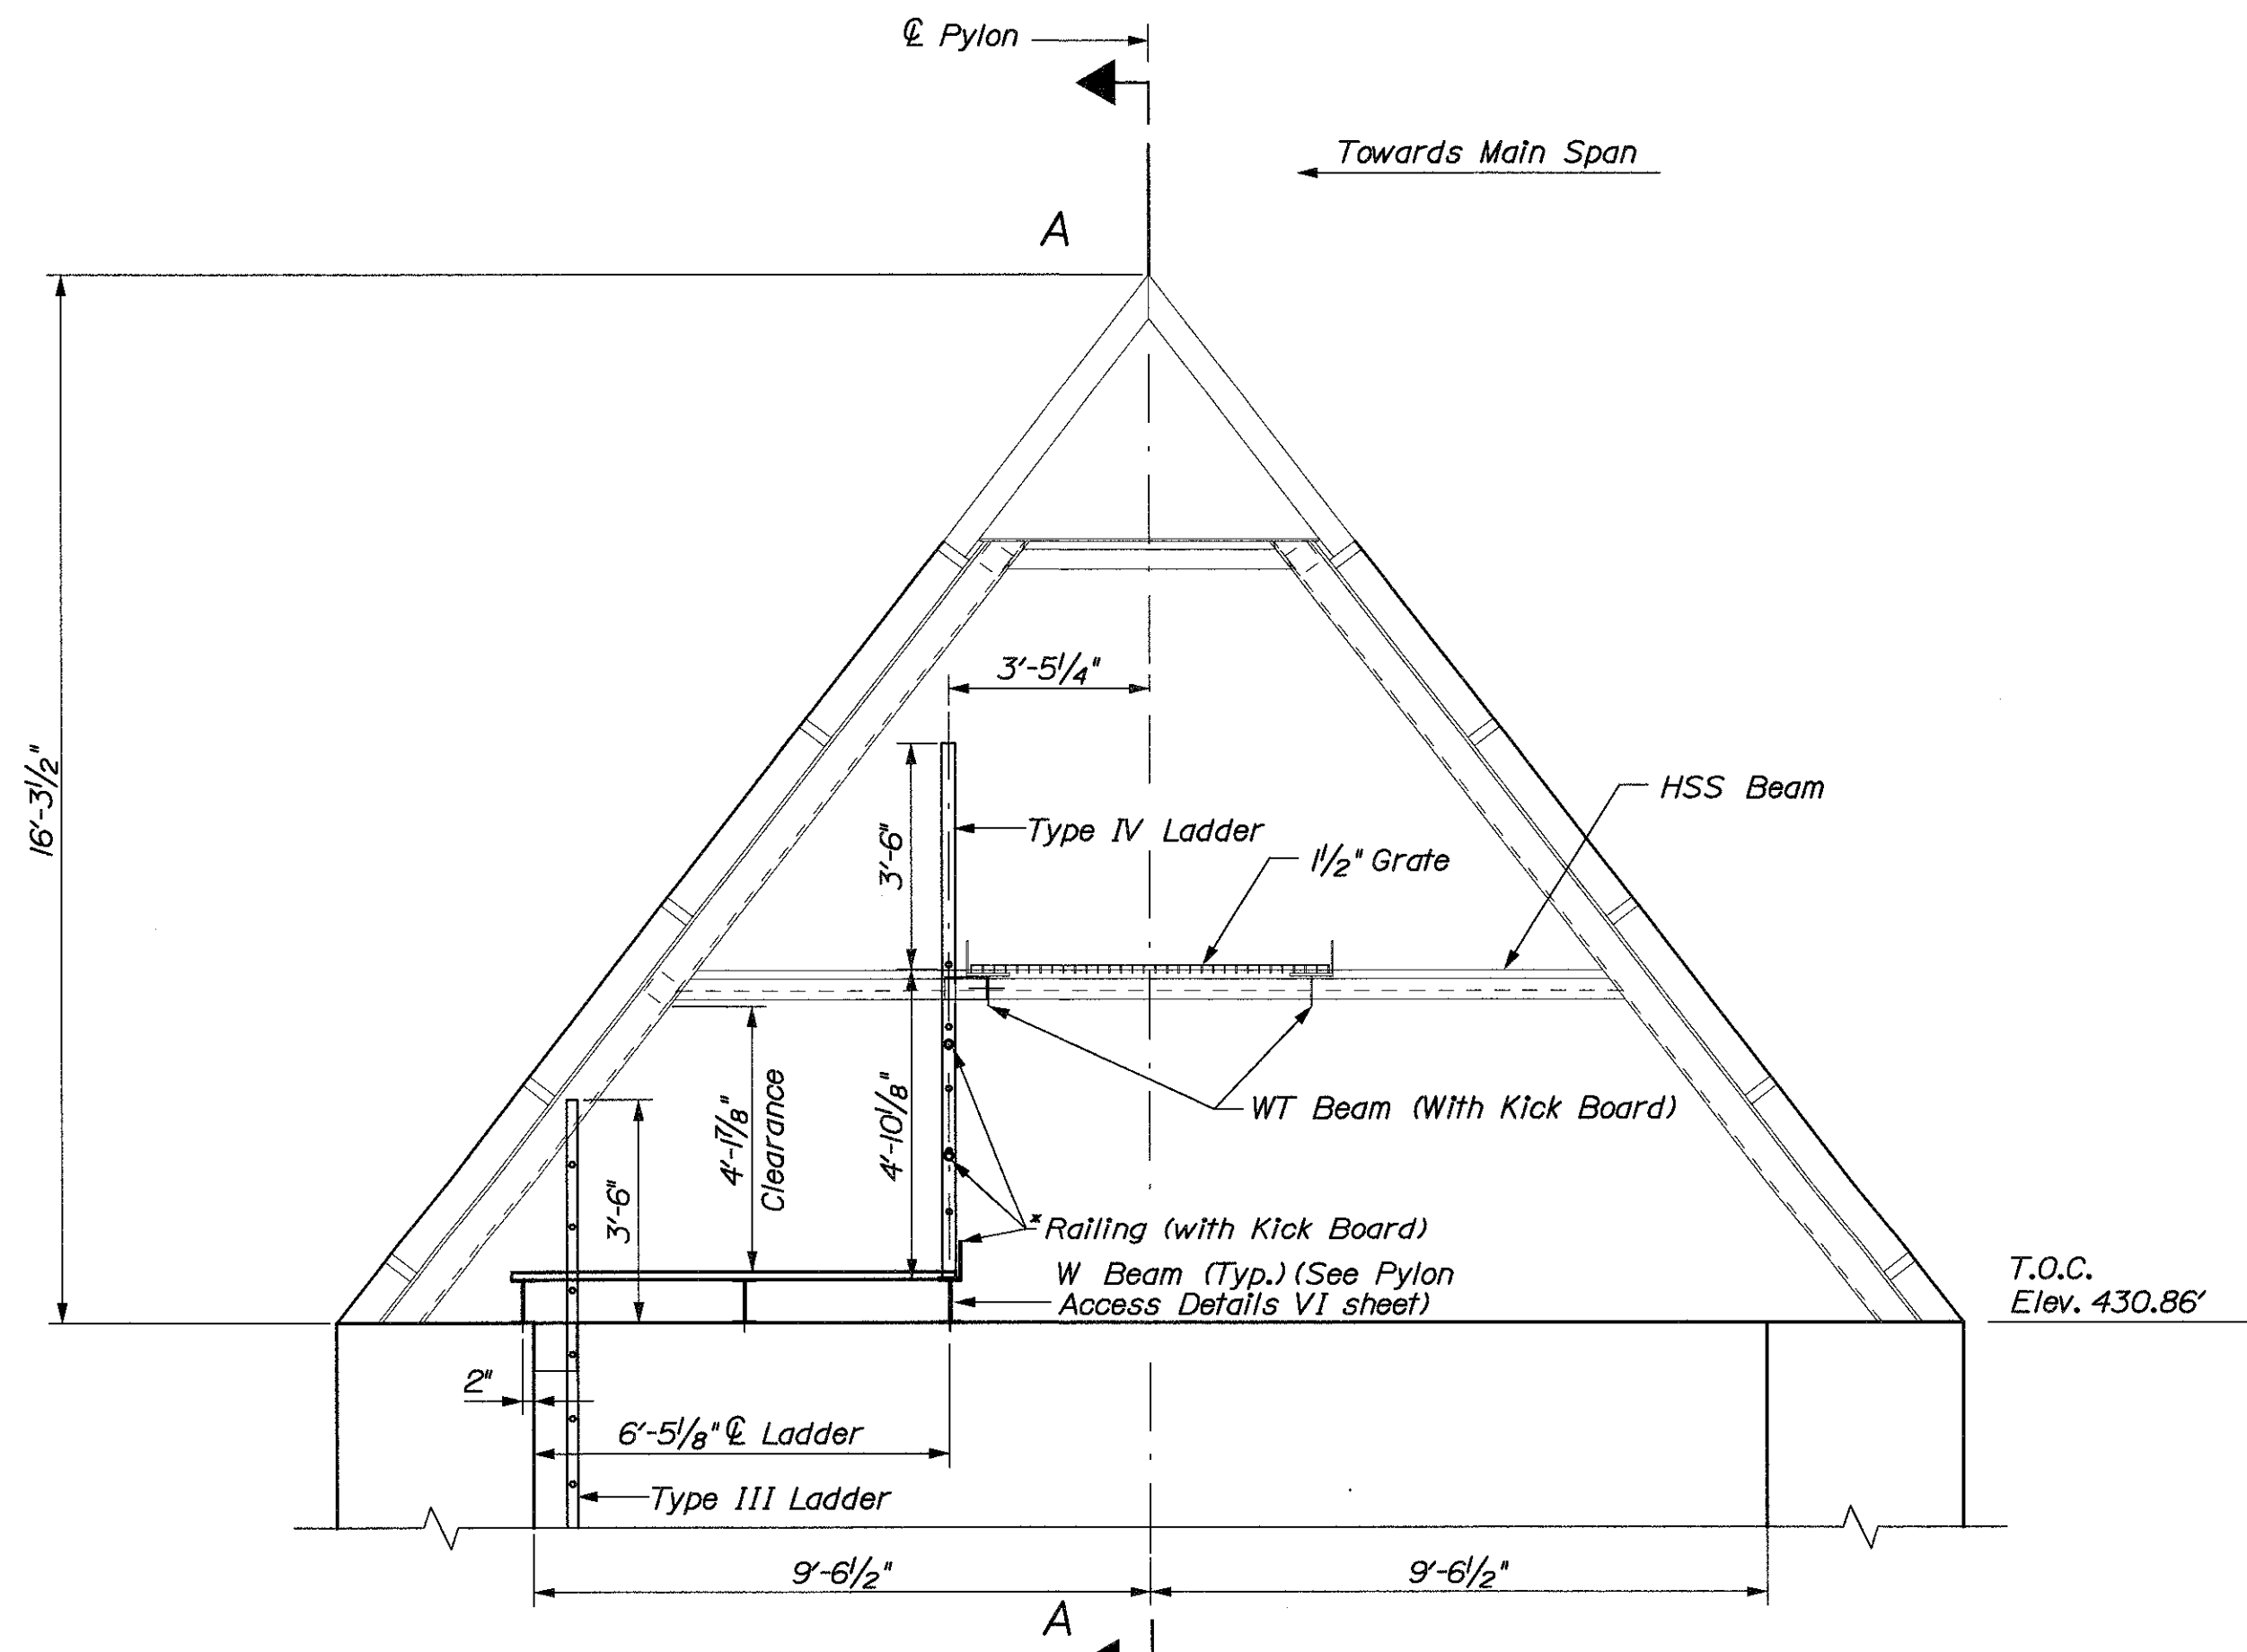

VERONA BEACON LIGHT ACCESS
(Looking North)

NOTES

1. For additional notes refer to Pylon Access Details VI and VIII.
2. Field verify all dimensions prior to fabrication.
3. Work ladder details with Pylon Top Observatory Roof Details I and II sheets and Pylon Access Details VI and VII sheet.
4. For Ladder Types III and IV refer to Pylon Access Details VII sheet. For W8x10 Beam details refer to Pylon Access Details VI sheet.
5. For Railing Fabrication Details See Pylon Access Details VII sheet.
6. T.O.S. = Top of Steel T.O.C. = Top of Concrete


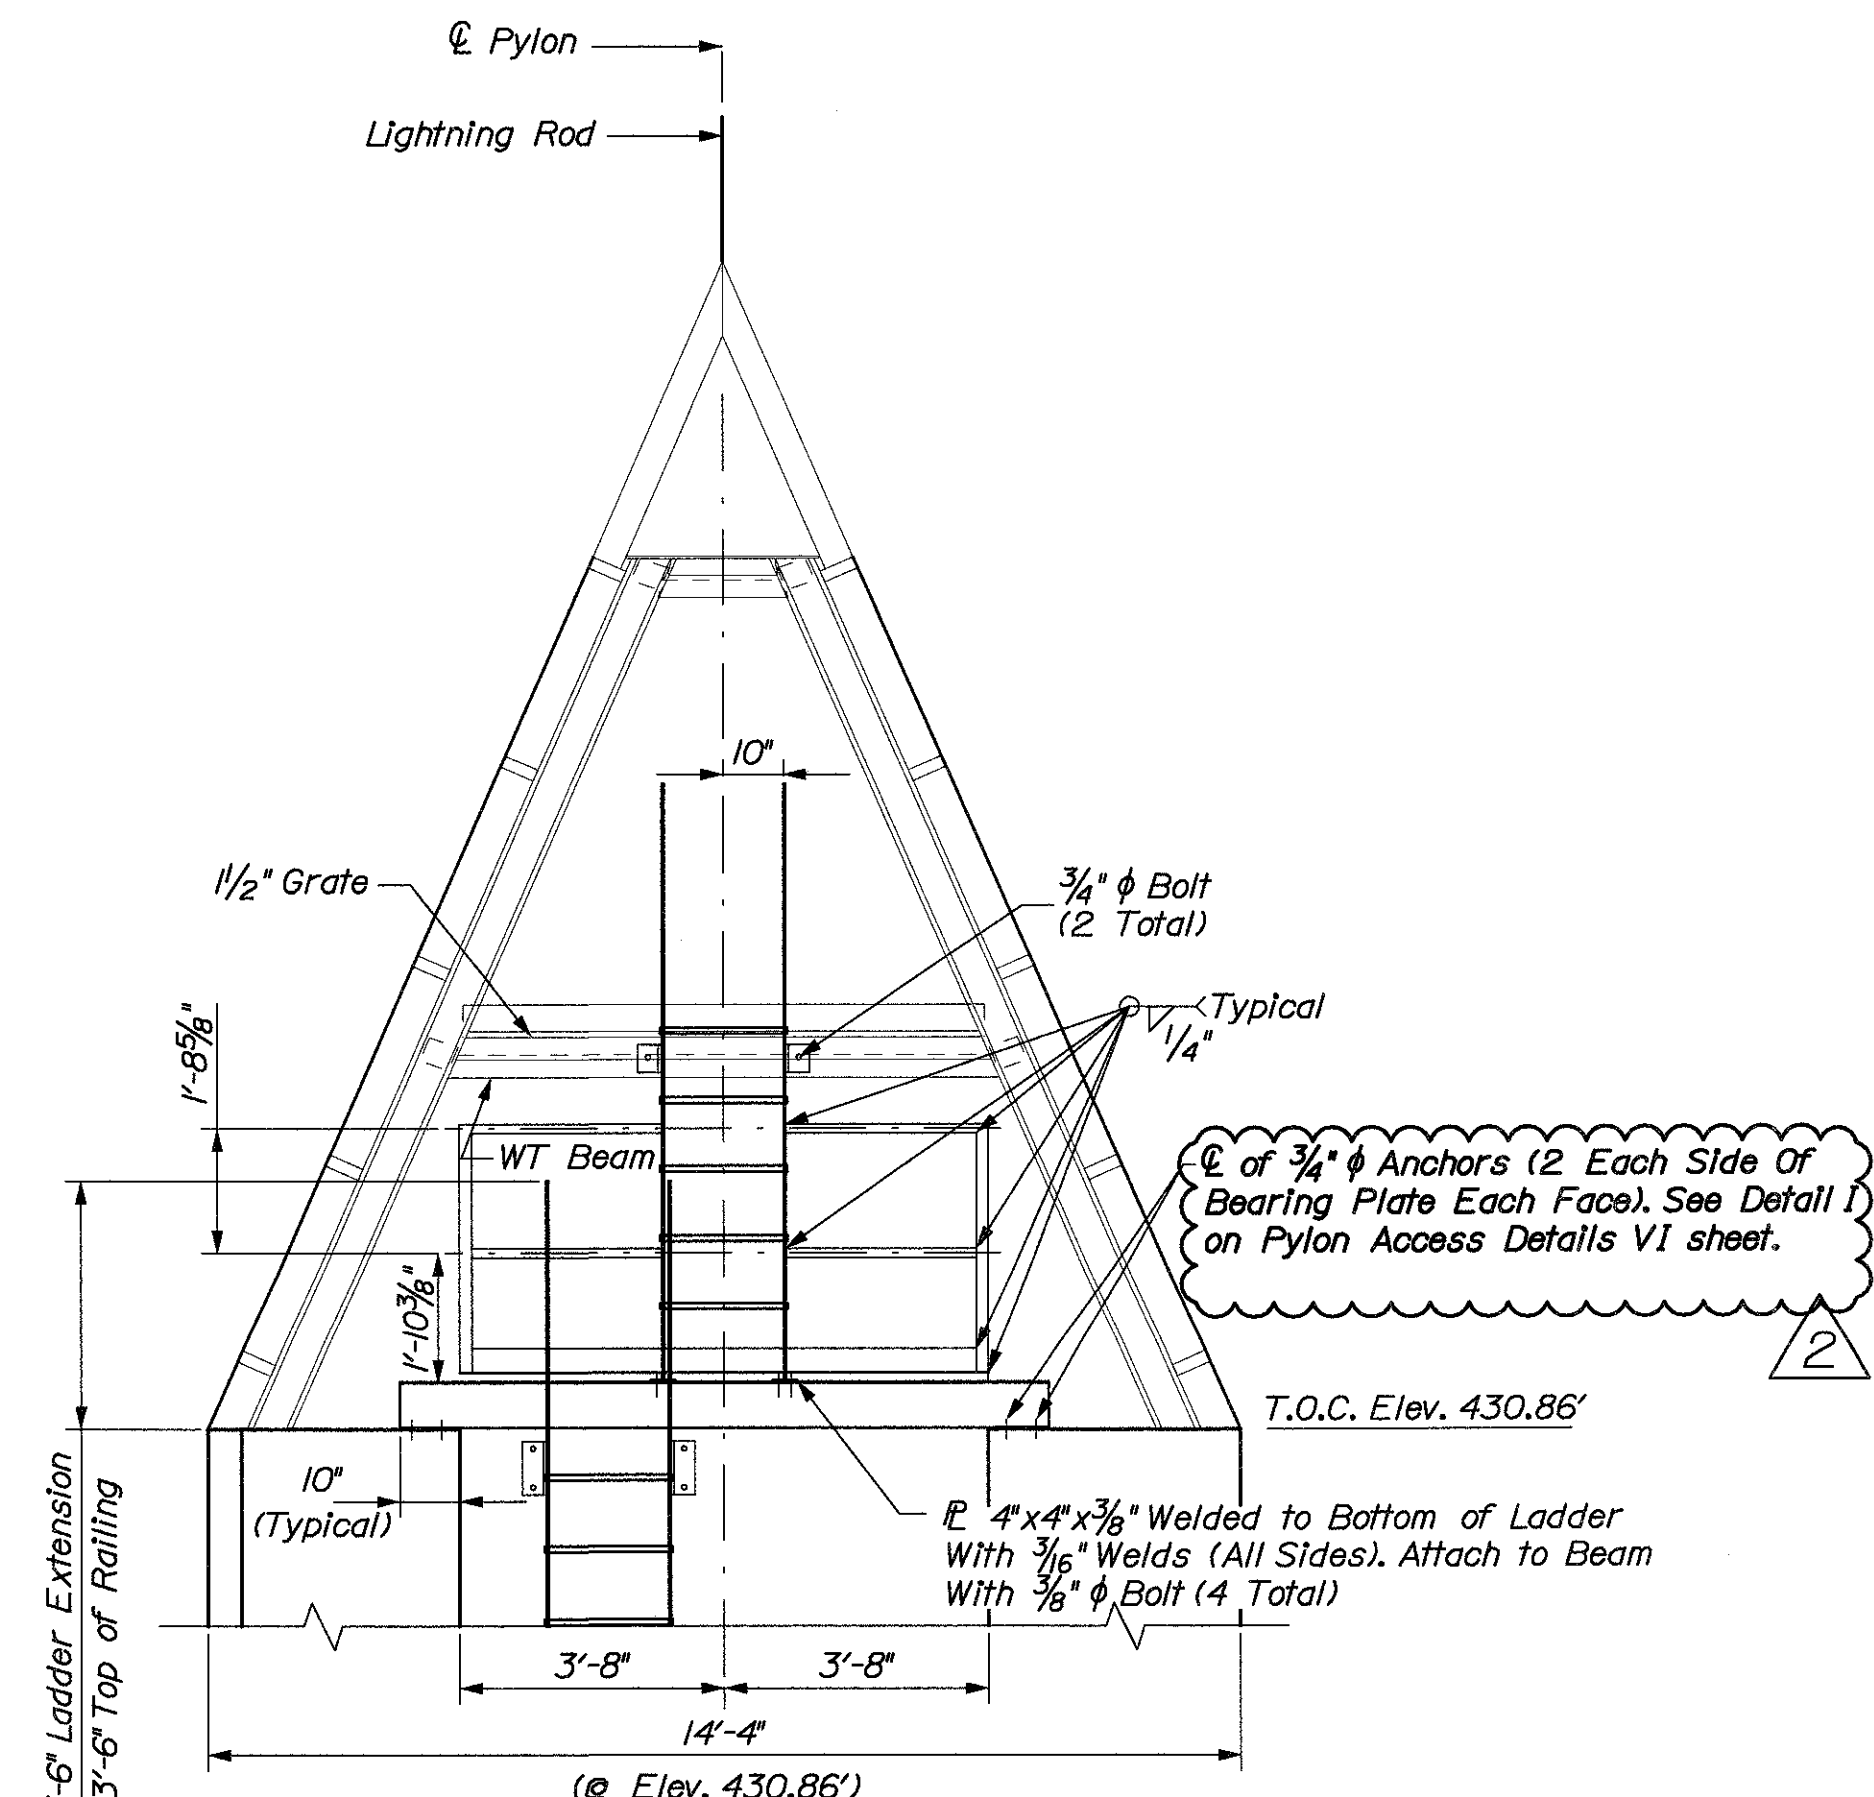


SECTION A-A
(Verona Beacon Light Access - Looking Towards Main Span)

STATE OF MAINE DEPARTMENT OF TRANSPORTATION		BRIDGE NO. 6421 PIN 7965.55, 7965.56	
PROSPECT-VERONA BRIDGE PENOBSCOT RIVER PROSPECT-VERONA WALDO-HANCOCK CTY		Pylon Access DETAILS IX	
SHEET NUMBER P7C		P15	

PROFESSIONAL ENGINEER
STATE OF MAINE
Christopher Burgess
10624
150004
DATE

PROJ. MANAGER	W. JOHNSON	BY	DATE
DESIGN-DETAILED	T. COOPER	M. FREANEY	9-08-04
CHECKED-REVIEWED	C. BURGESS	T. COOPER	9-08-04
DESIGN-DETAILED			
REVISIONS 1	PLATFORM AND RAILING		9-23-04
REVISIONS 2	REFERENCES/ANCHORS		10-15-04
REVISIONS 3			
REVISIONS 4			
FIELD CHANGES			

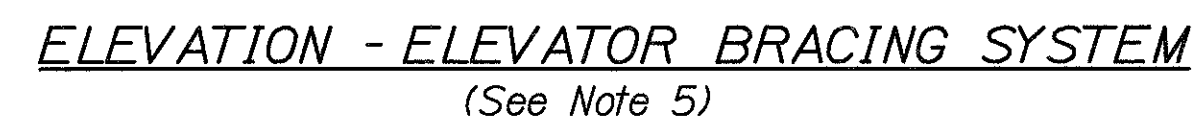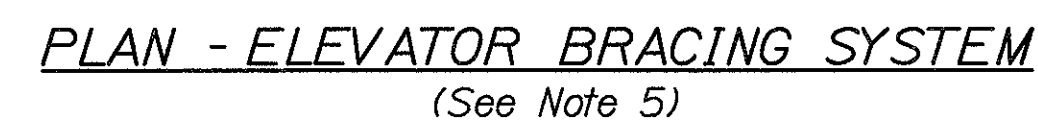

1. O.C. Denotes on Center.
2. All Structural Steel Shall Conform to ASTM A572 Gr. 50, and the AISI Specifications. All Steel Shall be Hot-Dipped Galvanized in Accordance With ASTM A123. Hardware Shall be Galvanized in Accordance With ASTM A153. Uncoated Areas Shall be Repaired in Accordance With ASTM A780.
3. All Welding Shall be Performed by Certified Welders per AWS "Standard Qualification Procedure" to Perform the Type of Work Required. All Welding Shall be in Accordance with the AWS Welding Code. Arc Welding Electrodes Shall be E70 Series for A572 Material.
4. Shop Drawings Shall be Submitted for the Department's Review in Accordance with the Project Specifications.
5. The Elevator Bracing System Shall be Provided at Seven (7) Locations Along the Height of the Lower Pylon at Pylon 1. The Top of Steel Elevations are as Follows: 54.0', 68.0', 82.0', 94.0', 106.0', 118.0', and 130.0'. The As-Built Dimensions of the Lower Pylon Shall be Field Verified Prior to Fabrication of the Elevator Bracing System Components.
6. The Elevator Bracing System is Intended to Provide Lateral Support for the Elevator Guide Rails, but is Not Intended to Provide Vertical Support for the Guide Rails. Contractor Shall Provide Detailed Shop Drawings for Guide Rail Locations and Attachment Details.
7. The $\frac{3}{4}$ " Diameter Epoxy Anchors Shall be from the Department Approved Product List, or Equivalent. Epoxy Anchors Shall have a Minimum Allowable Shear Capacity of 7.5 Kips and a Minimum Allowable Tensile Capacity of 7.5 Kips. The Contractor Shall Submit the Proposed System for Review by the Department Prior to Use. Install Anchors in Strict Accordance with Selected Manufacturer's Recommendations.
8. The WT 9x38 Shall be Placed to Provide a Level Horizontal Surface to Support the W14x30 Beam.
9. For Section A-A Thru Section F-F, See Lower Pylon Elevator Hoistway Details II Sheet.
10. All Costs Associated With Materials, Fabrication and Installation of the Elevator Bracing System Shall be Incidental to the Pay Item 800.8003, Structural Steel, Fabricated and Delivered (Rolled), Observatory Pylon.






ESTIMATED QUANTITIES / ELEVATOR HOISTWAY		
ITEM	UNIT	QUANTITY
<i>Structural Steel, Fabricated and Delivered (Rolled), Observatory Pylon</i>	<i>LB</i>	<i>27,300</i>

Date:09/22/2004


Username: wjohnson

Division: BRIDGE


Filename: ...\\P11_lower pylon panel det 2.dgn

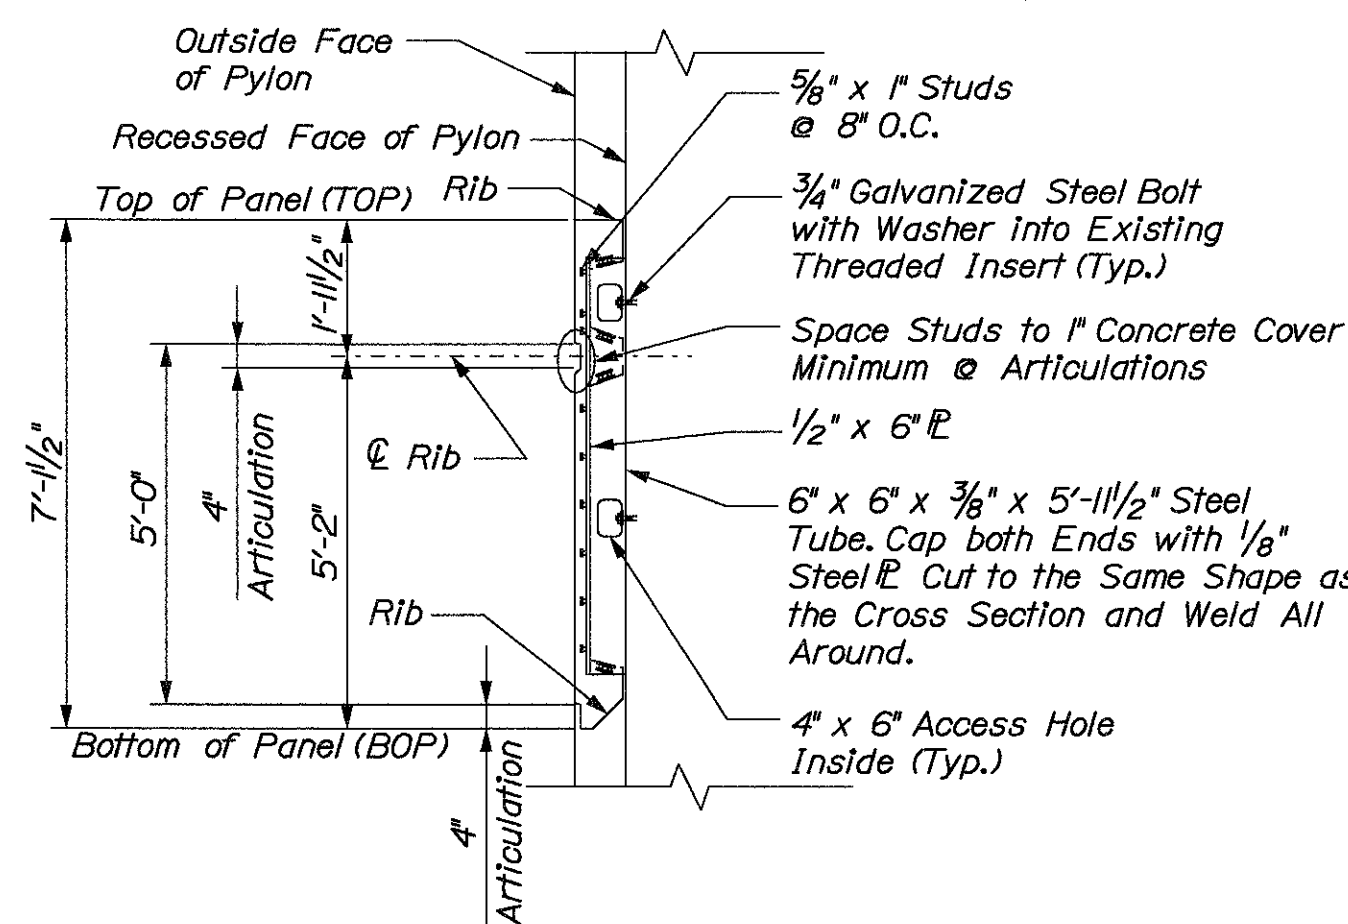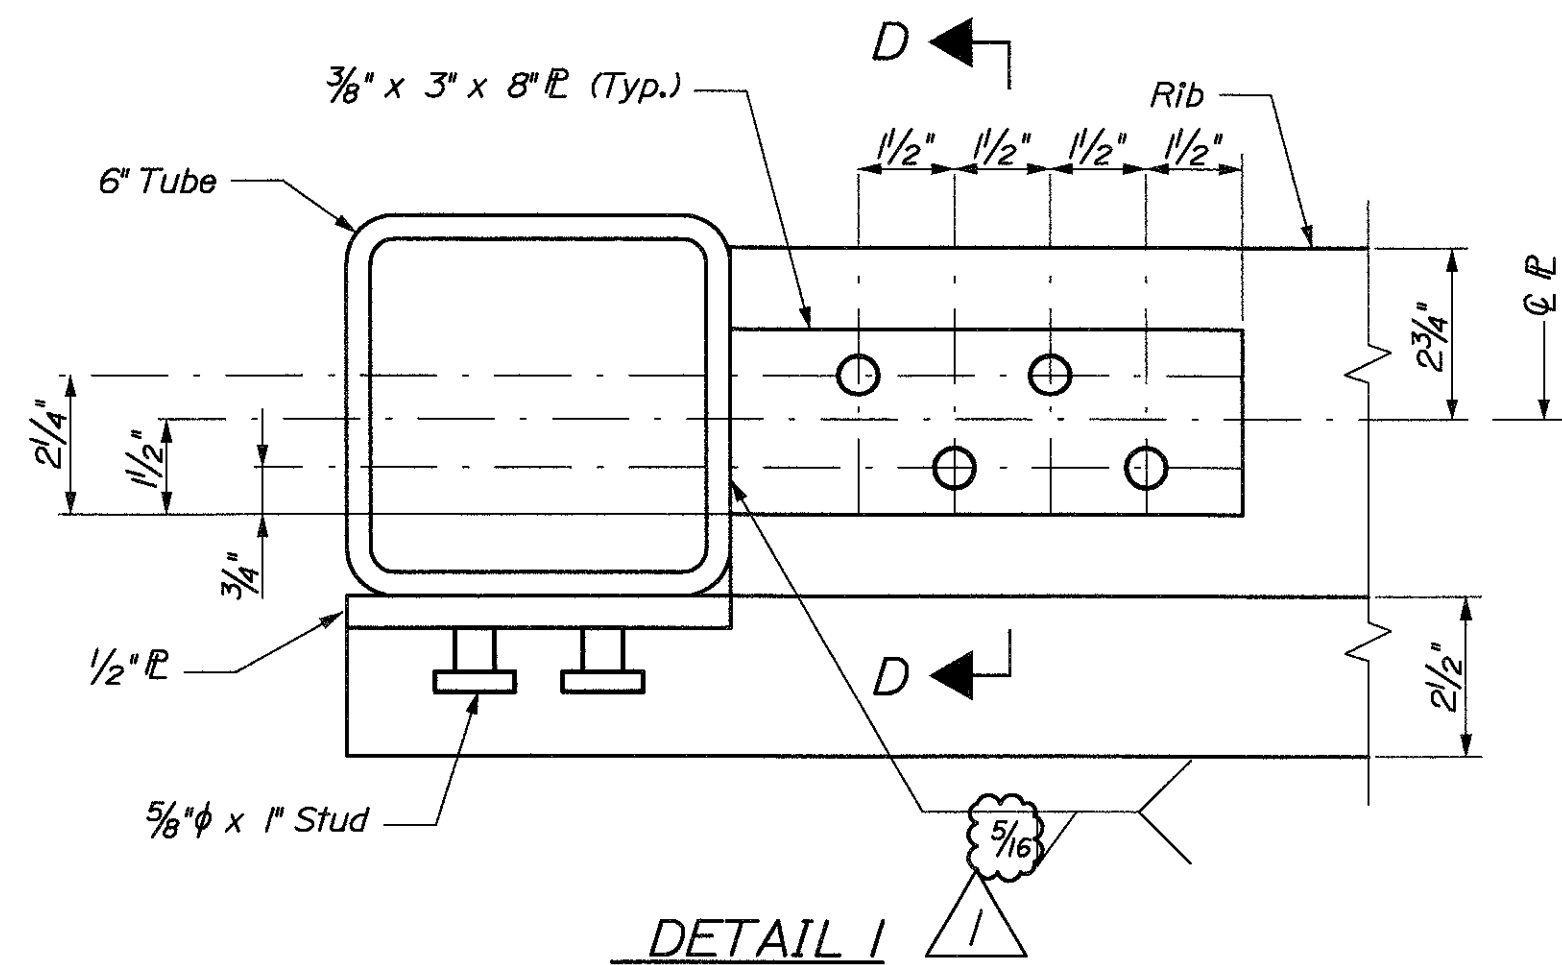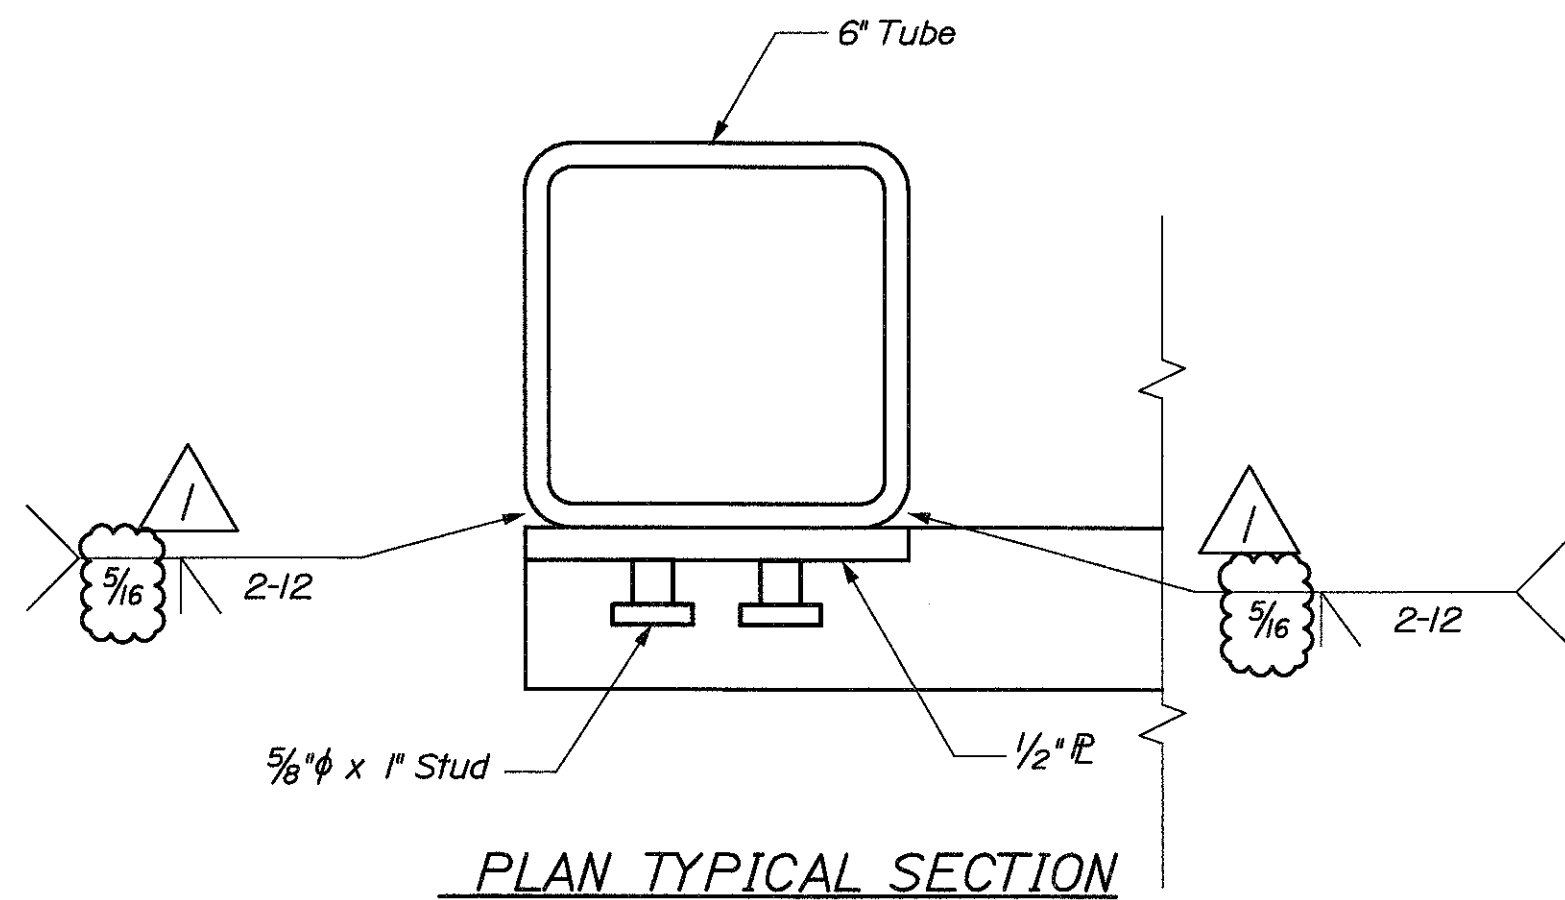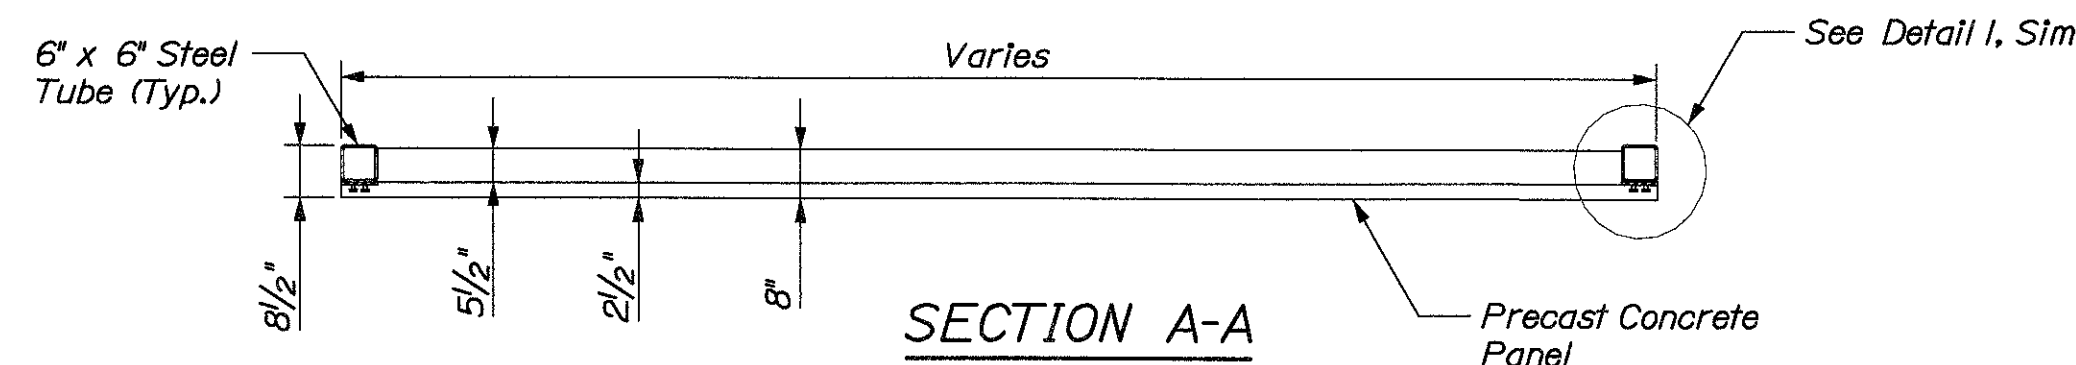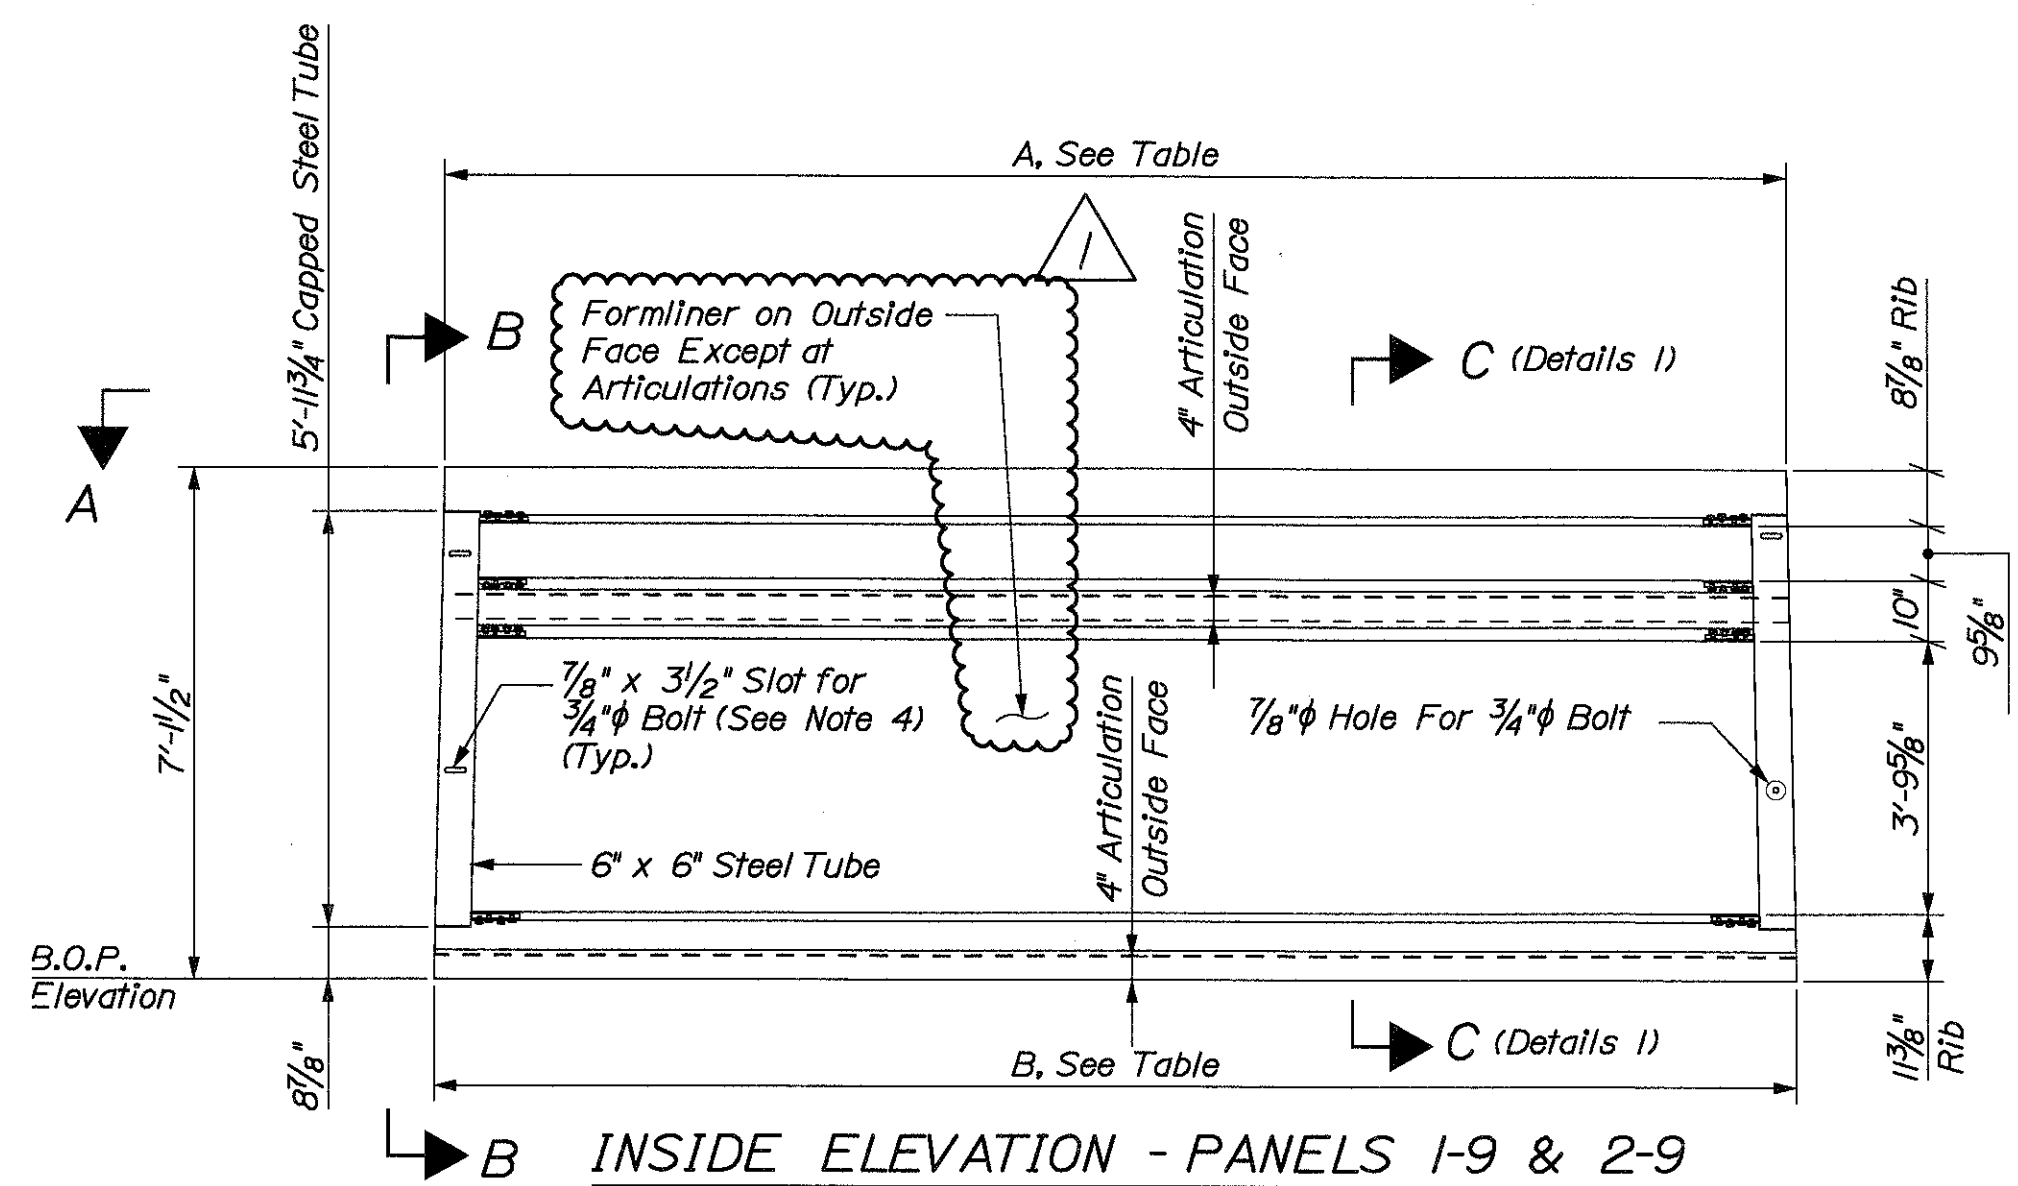


SECTION B-B

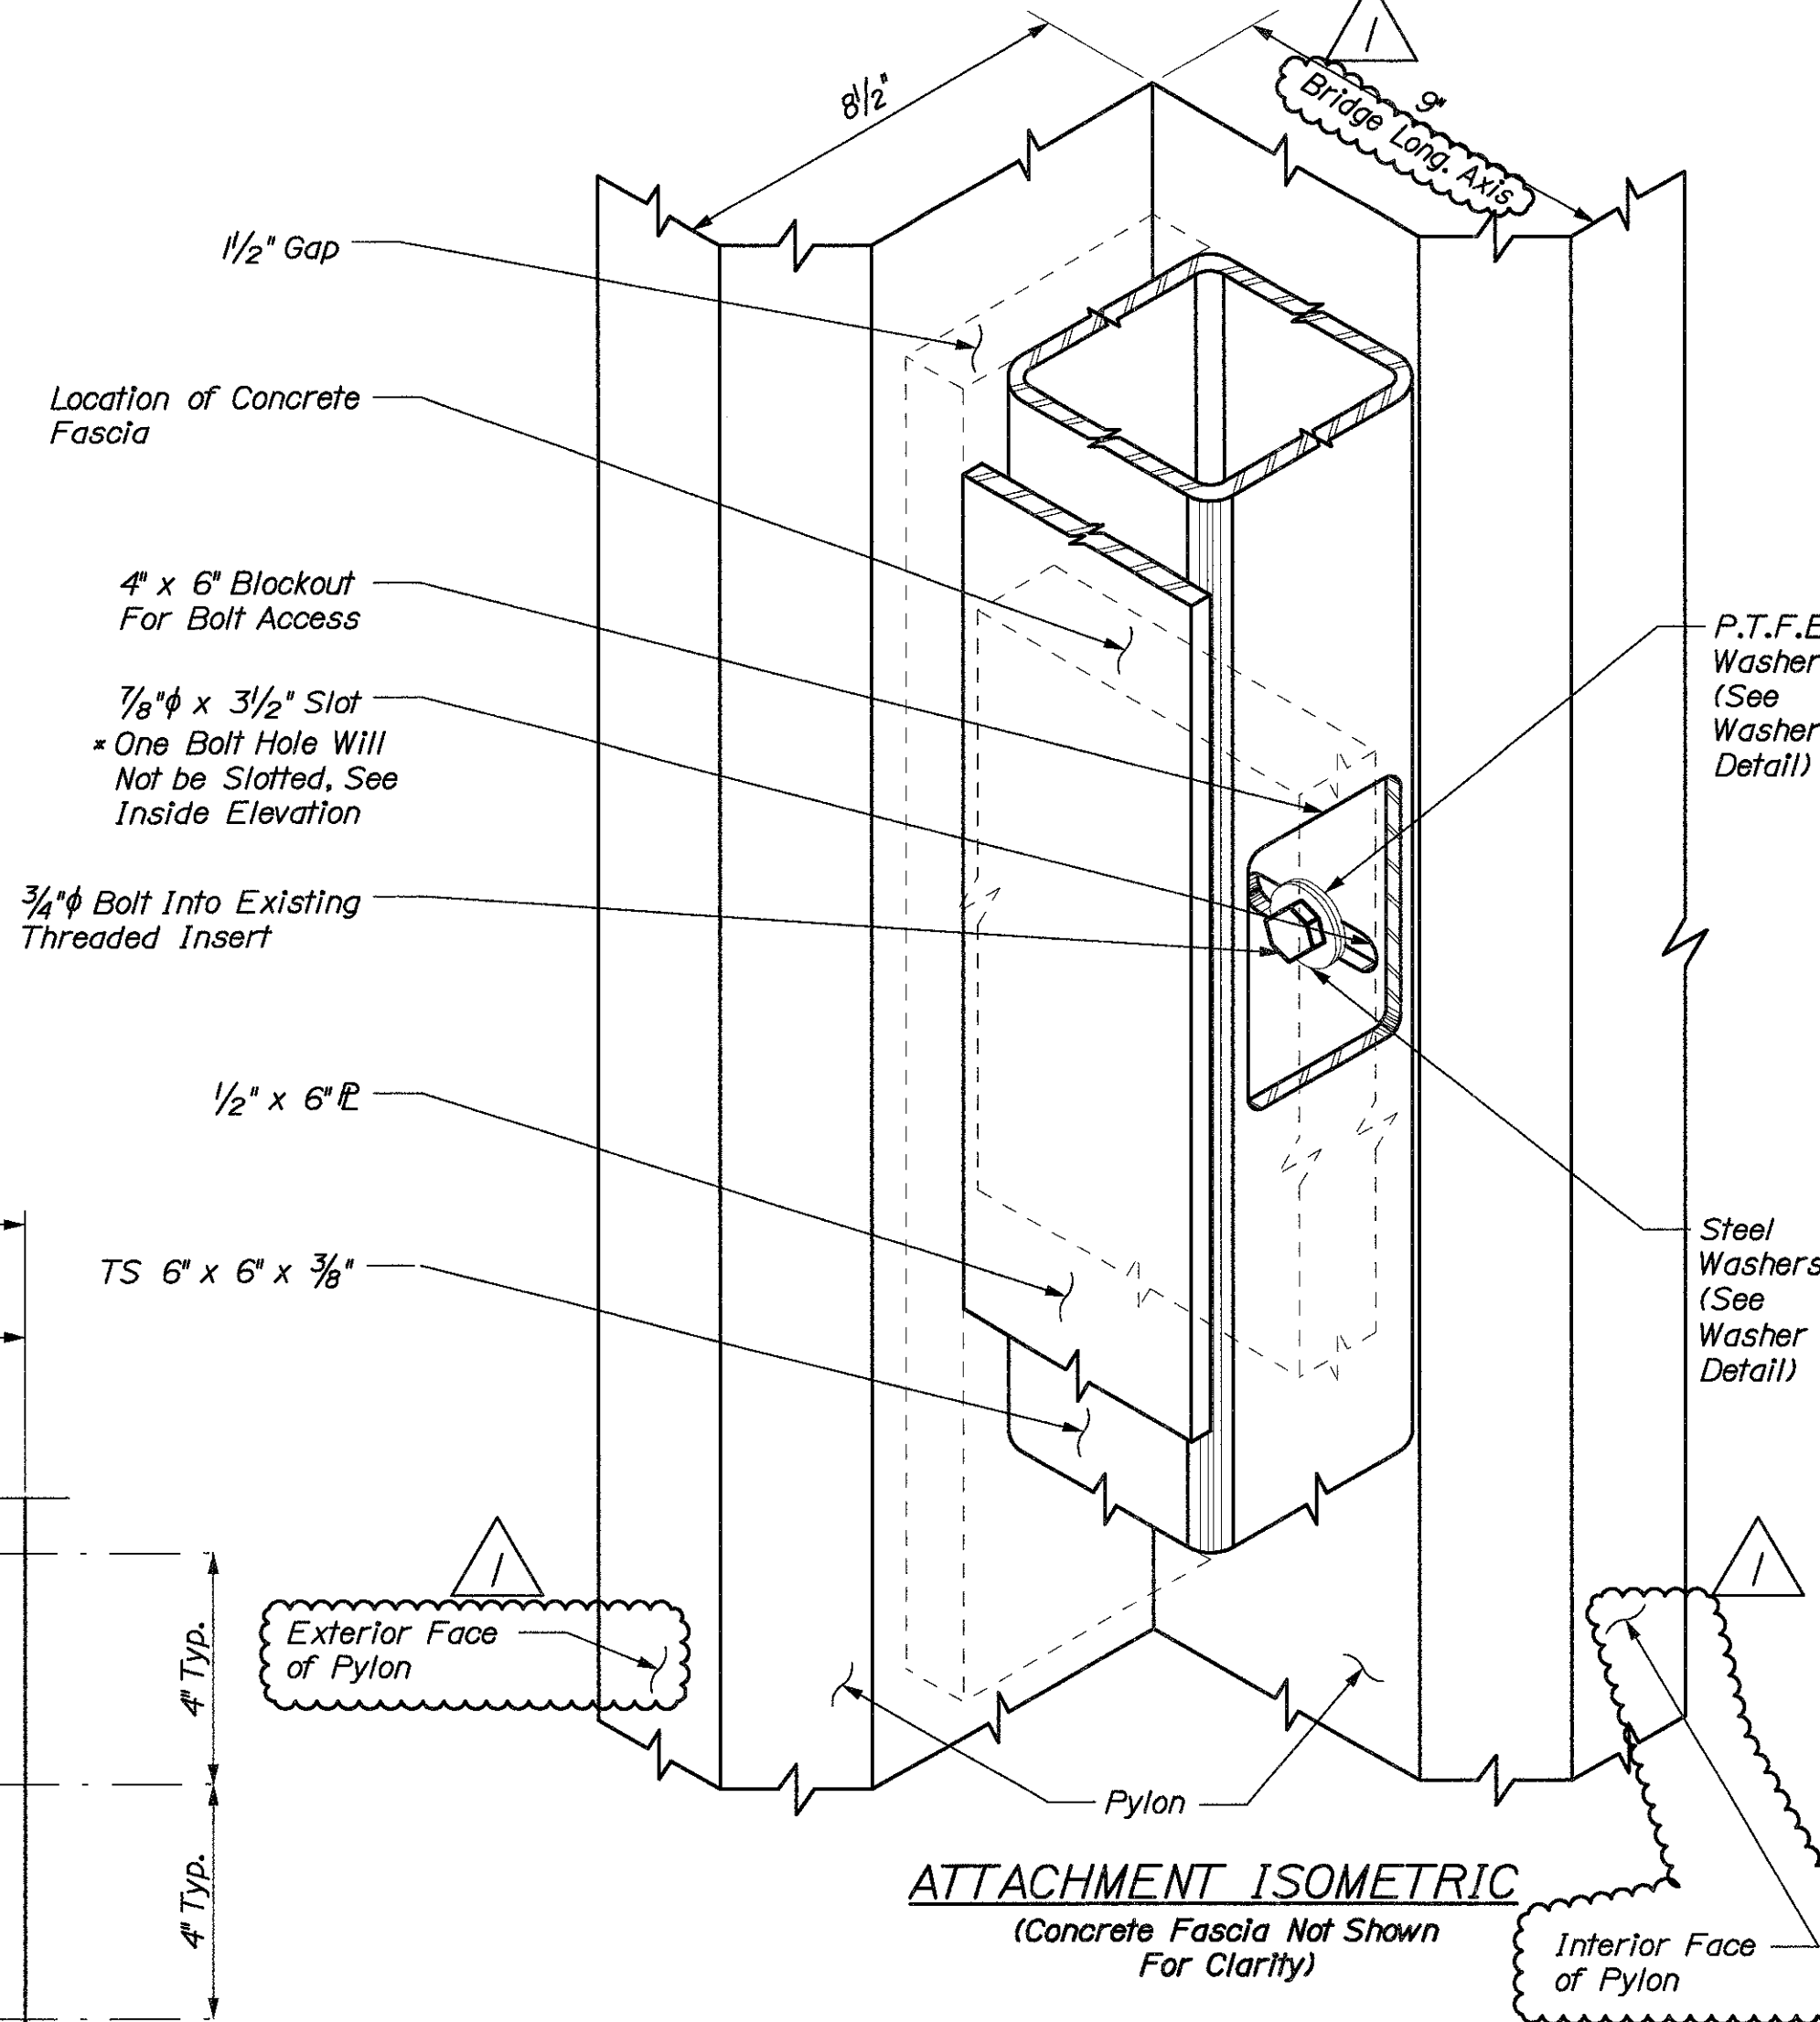


ATTACHMENT ISOMETRIC
(Concrete Fascia Not Shown For Clarity)

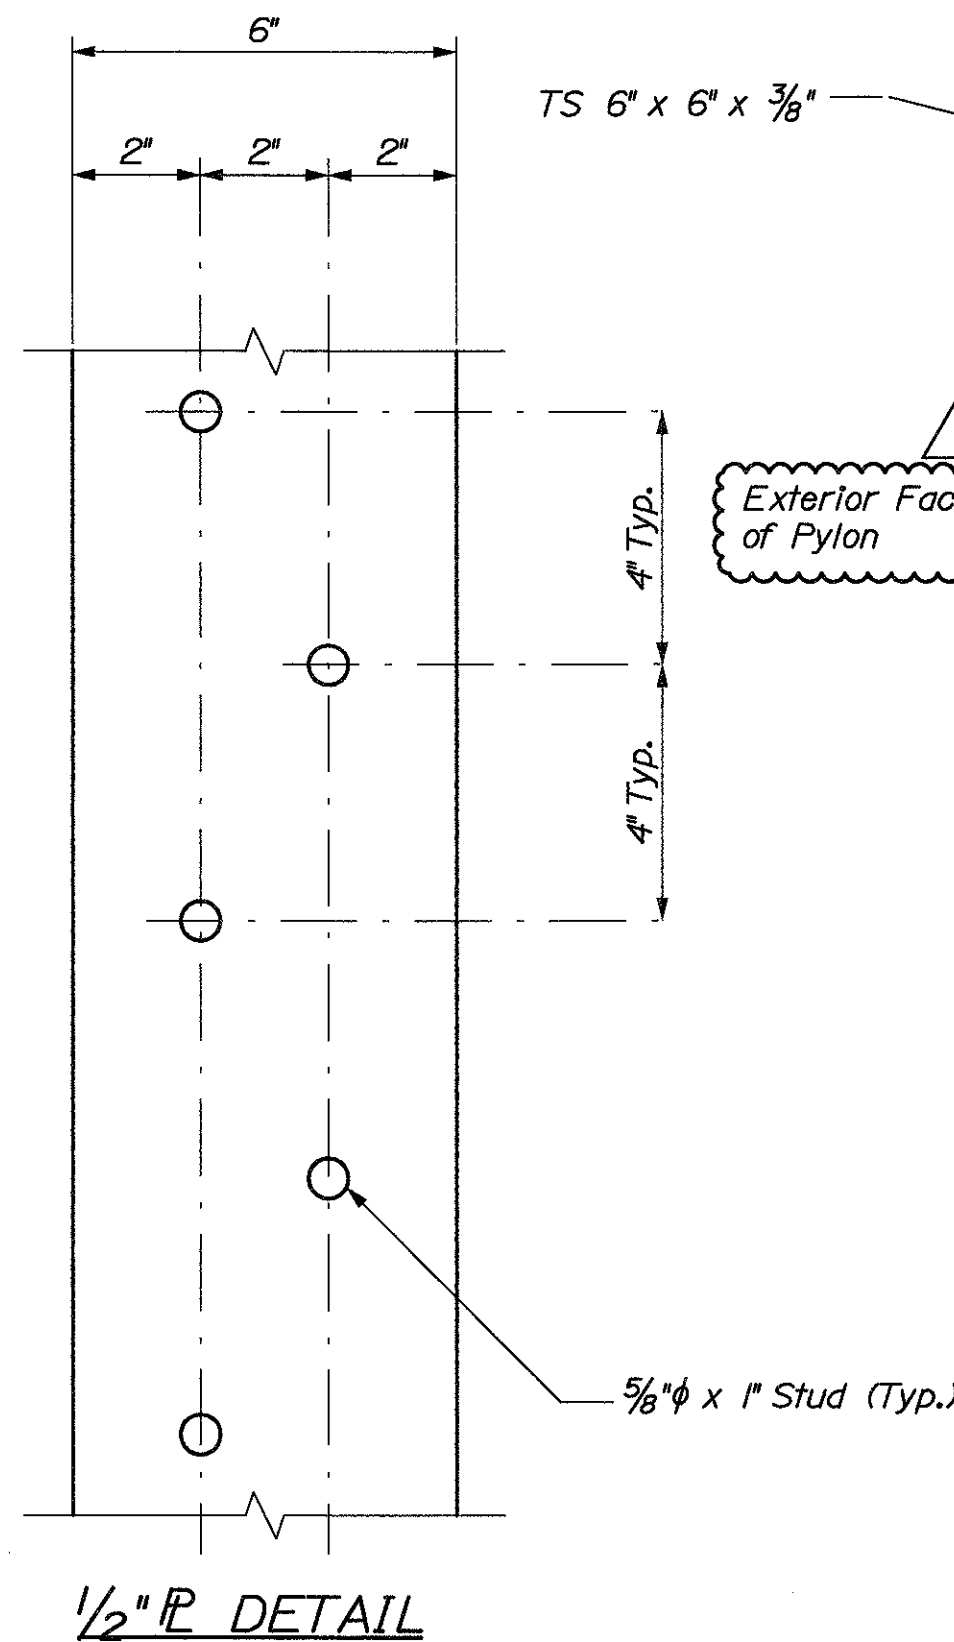

1/2" L DETAIL

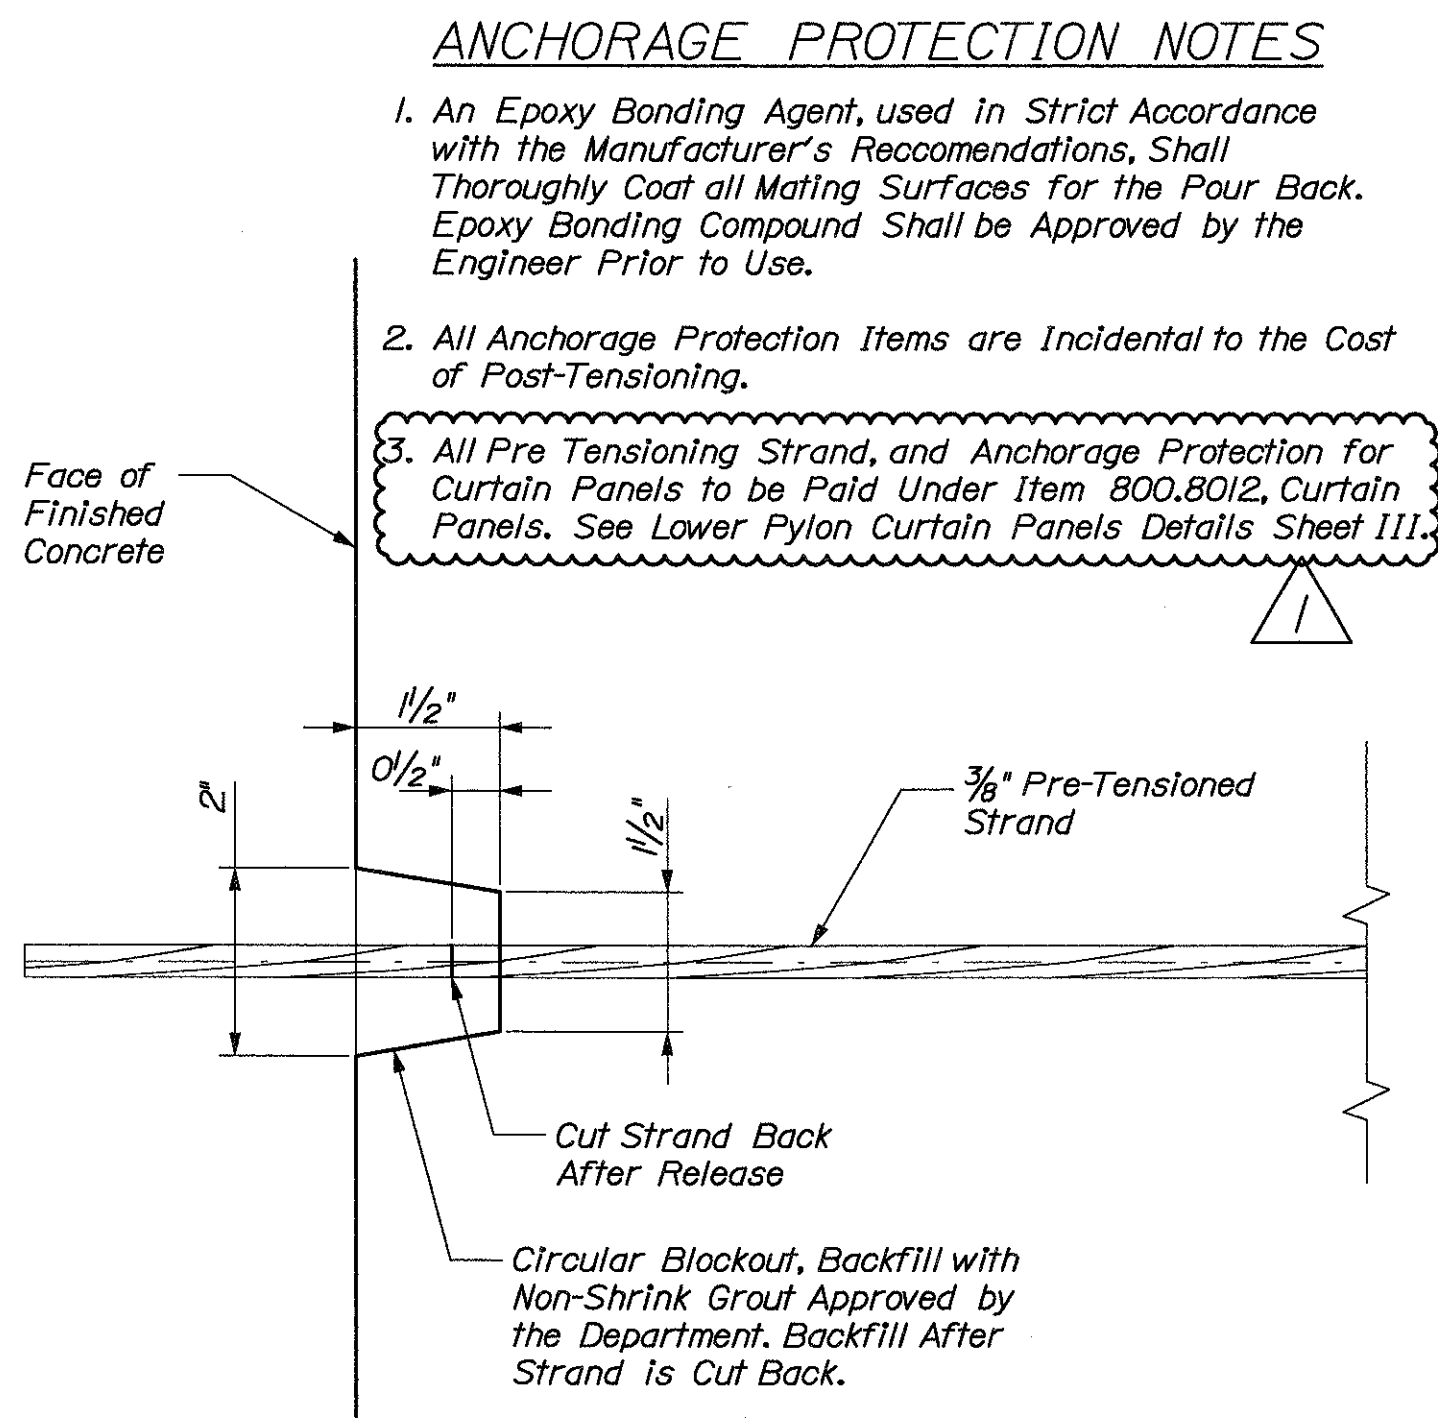

ANCHORAGE PROTECTION DETAIL

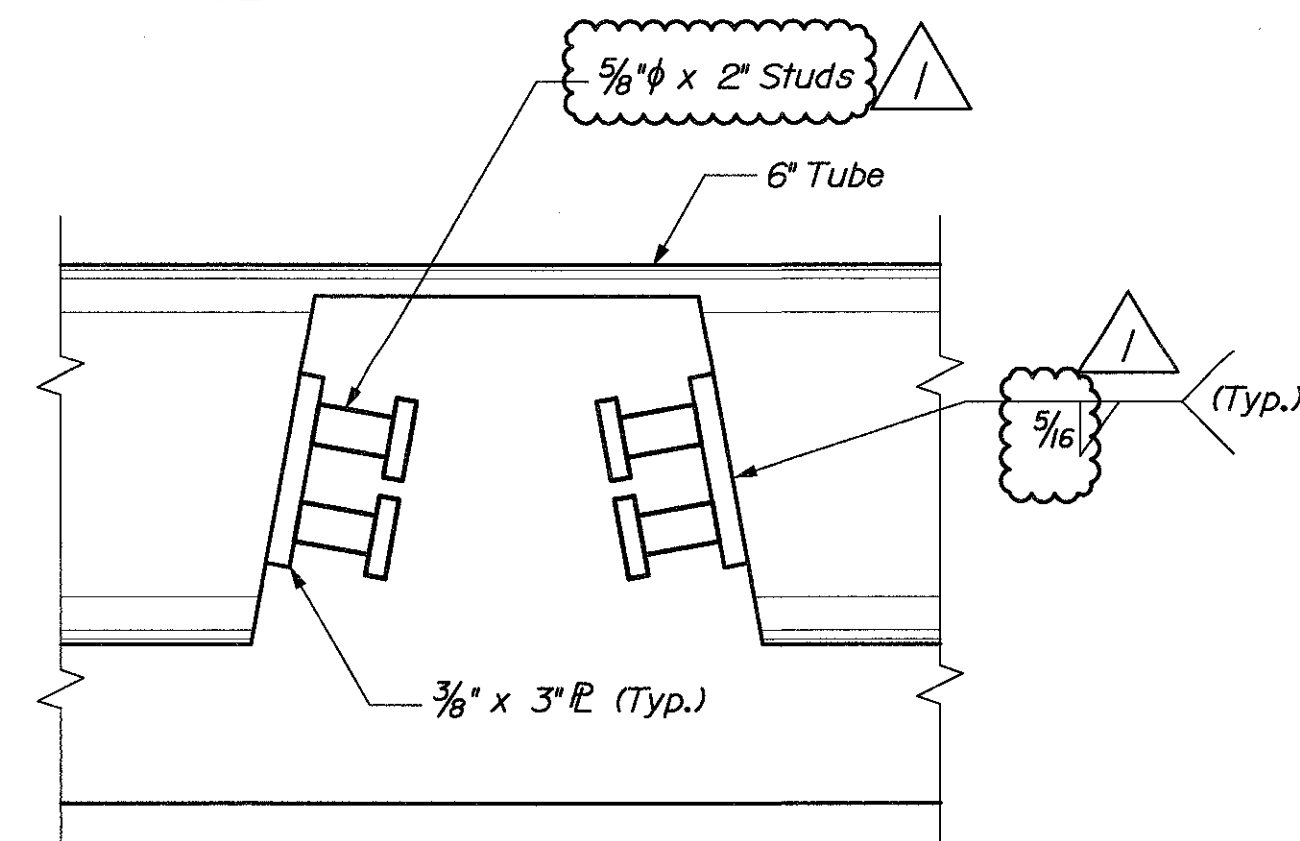


SECTION D-D


NOTES:
1. See Notes on Lower Pylon Curtain Panels Details 1 Sheet.

Figg Bridge Engineers, Inc.
424 North Calhoun Street
Tallahassee, Florida 32301
Tallahassee, FL • Denver, CO • Philadelphia, PA • Dallas, TX •

STATE OF MAINE DEPARTMENT OF TRANSPORTATION		BRIDGE NO. 6421		PIN 7965.55, 7965.56		BRIDGE PLANS	
PROSPECT-VERONA BRIDGE PENOBSCOT RIVER PROSPECT-VERONA WALDO-HANCOCK CTY		DATE 09/09/04		BY C. BURGESS		CHECKED-REVIEWED C. BURGESS	
DESIGN-REVIEWED C. BURGESS		DESIGN-REVIEWED C. BURGESS		DESIGN-REVIEWED C. BURGESS		DESIGN-REVIEWED C. BURGESS	
REVISIONS 1		REVISIONS 2		REVISIONS 3		REVISIONS 4	
FIELD CHANGES		FIELD CHANGES		FIELD CHANGES		FIELD CHANGES	
SHEET NUMBER P11		DATE 23 Sept 04		P.E. NUMBER 10624		DATE 23 Sept 04	
OF P15							

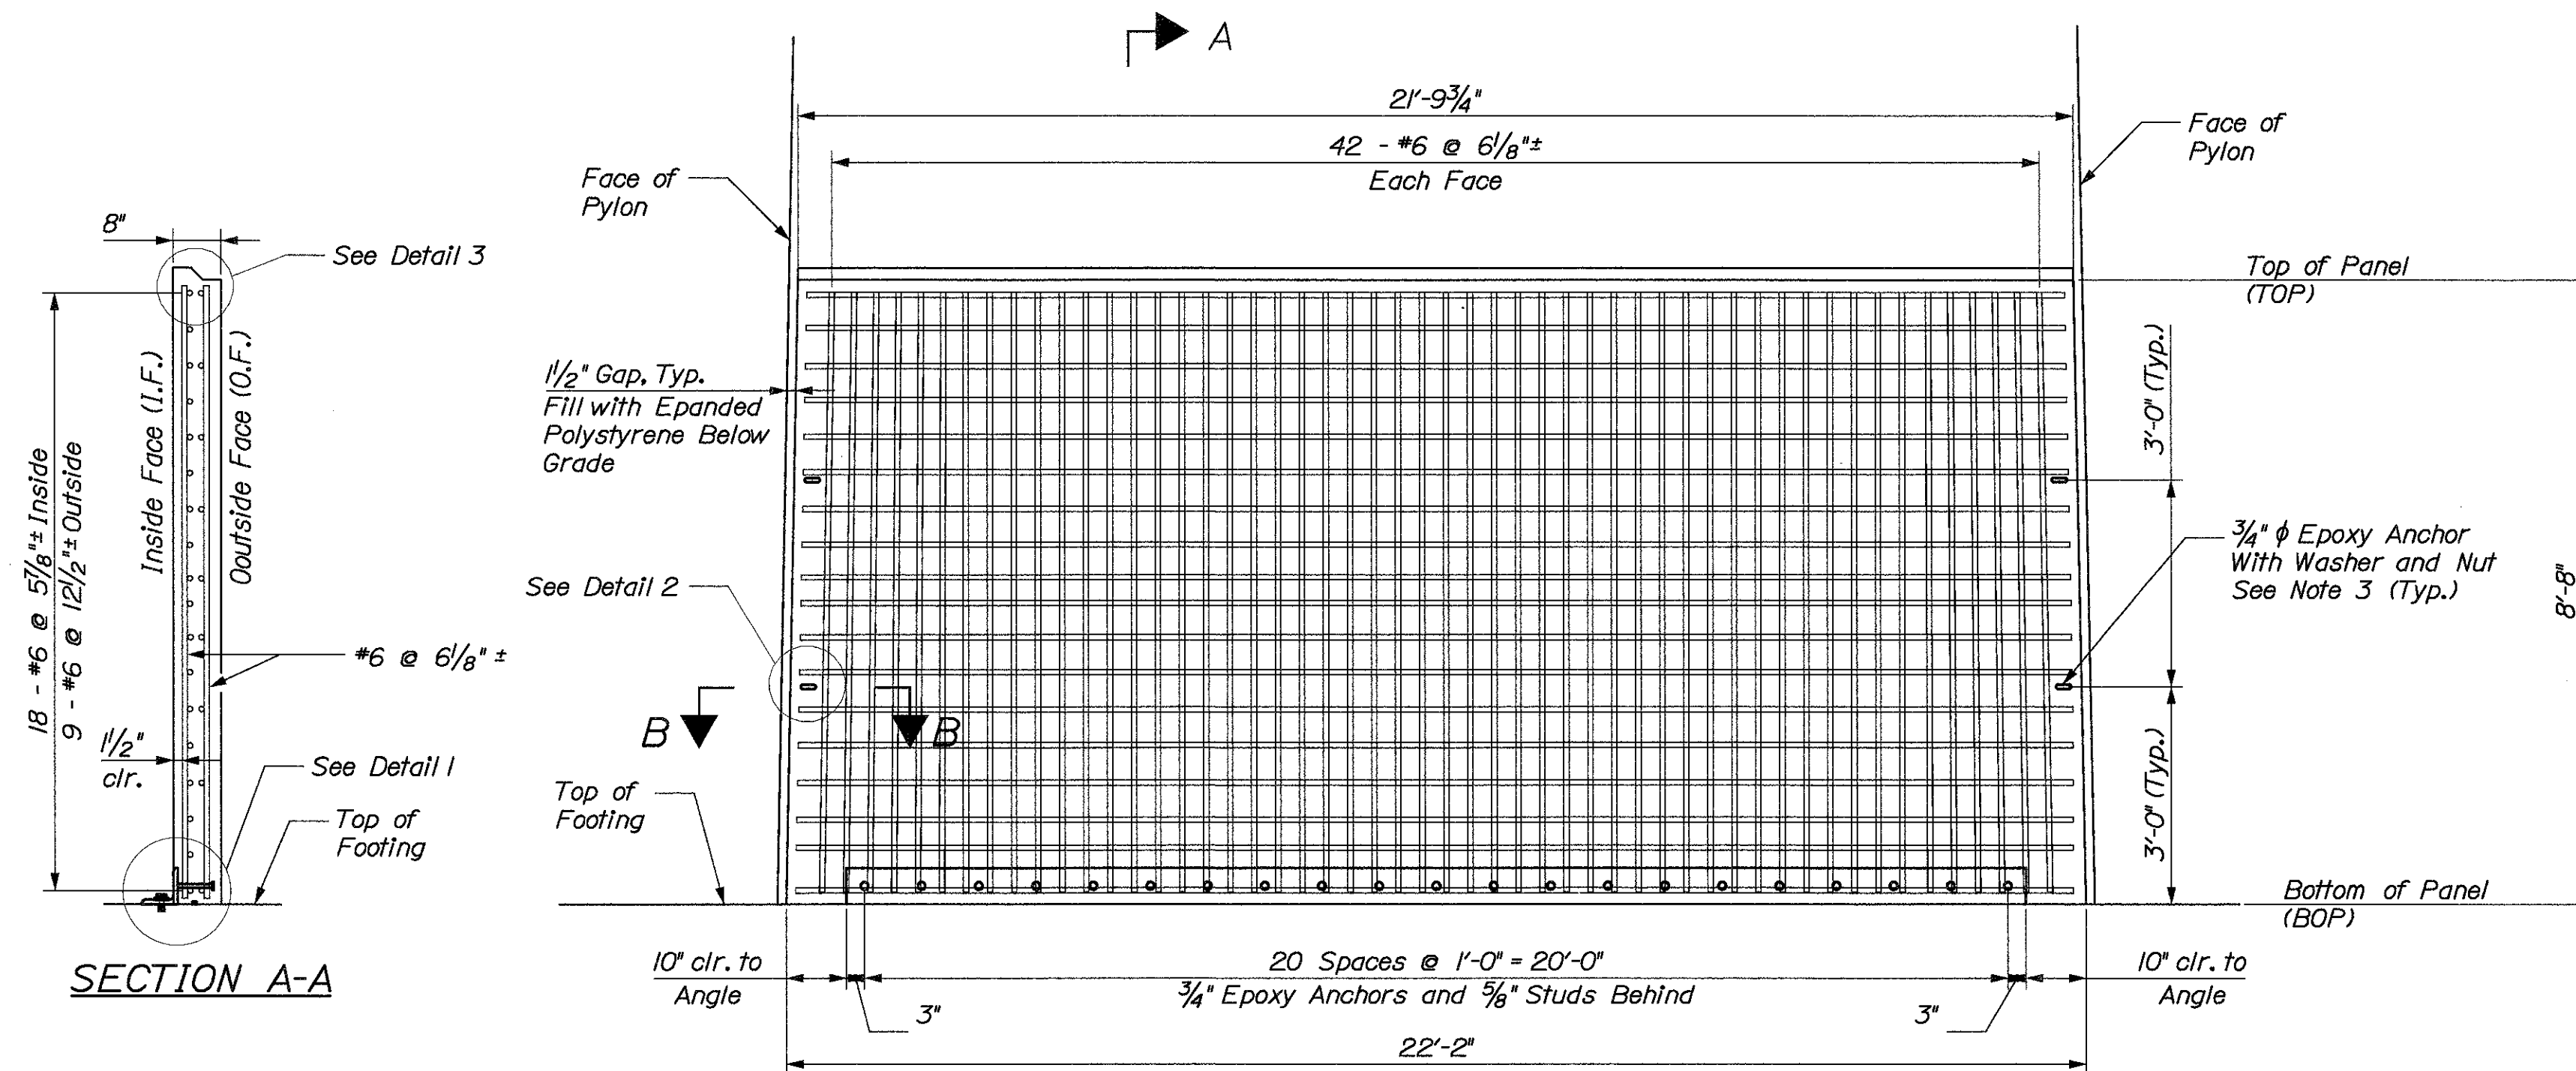

PANEL (2-1) - ELEVATION

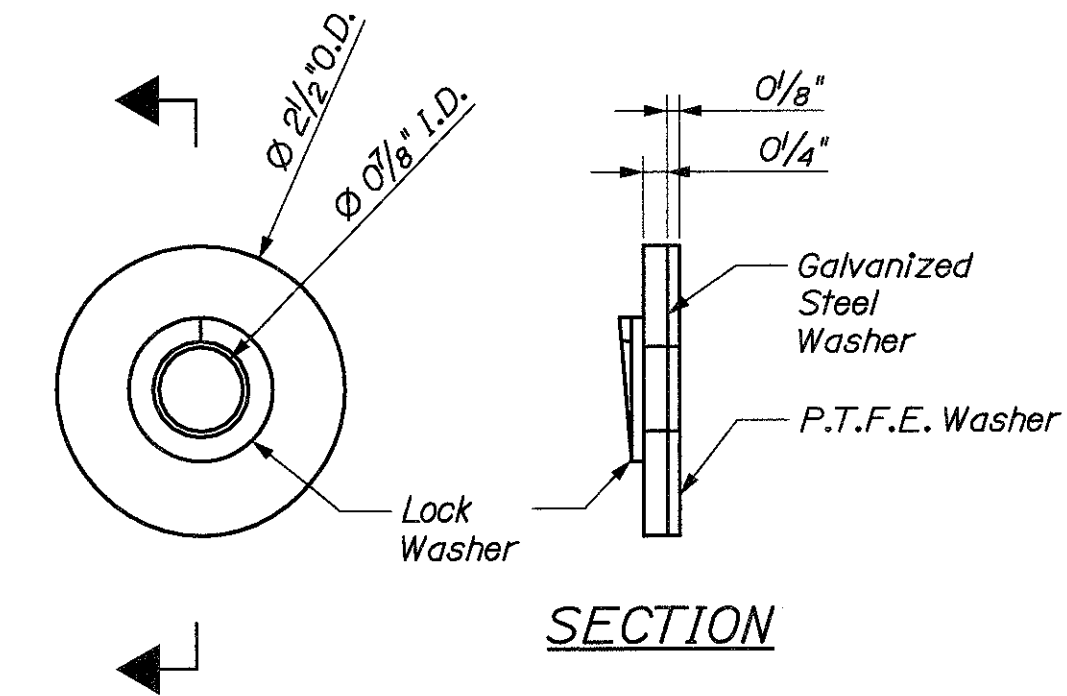


TYPICAL WASHER DETAIL


ESTIMATED QUANTITIES / PYLON CURTAIN PANELS			
NUMBER	ITEM	UNIT	QUANTITY
800,80/2	Curtain Panels (See Note 10)	LS	1

NOTES


1. Concrete Used for Cast in Place Panel 2-l Shall Have Minimum Concrete 28 Day Strength, f'c, of 4500 psi
2. Reinforcement Shall be Uncoated (Black) Bars Grade 60.
3. Epoxy Anchors Shall Have a Safe Working Shear Load of 5000 lbs. Minimum, and a Safe Working Tension Load of 3000 lbs., and Shall be Approved by the Department.
4. Concrete Cover Shall be 2" Unless Noted Otherwise.
5. Studs Shall have a Minimum Tensile Strength of 55,000 psi. Studs Shall be Arc Stud Welded to Angle per AWS Specifications.
6. Bolts and Washers Shall be Galvanized in Accordance With the Specifications.
7. Expanding Waterstop Shall Consist of 75% Sodium Bentonite and 25% Butyl Rubber and Shall be Installed per Manufacturer's Directions. Waterstop shall be Made Continuous Along Bottom and Sides of the Panel. Material Certificate Shall be Submitted to the Department for Approval.
8. Bond Breaker Shall be Applied per Manufacturer's Directions. Material Certificate Shall be Submitted to the Department for Approval.
9. All Materials and Labor For Curtain Panels Including Structural Steel, Concrete, Pre Tensioning Strand, Studs, Reinforcement, and Attachment Hardware to be Paid Under Item Number 800.8012, Curtain Panels.
10. Approximate Total Area of Precast Curtain Panels For Both Pylons is 8275 Sq. Ft. Approximate Total Quantities of Cast-In-Place Curtain Panels For Both Pylons are 9.4 CY of Concrete and 3860 Lbs. of Reinforcing Steel.

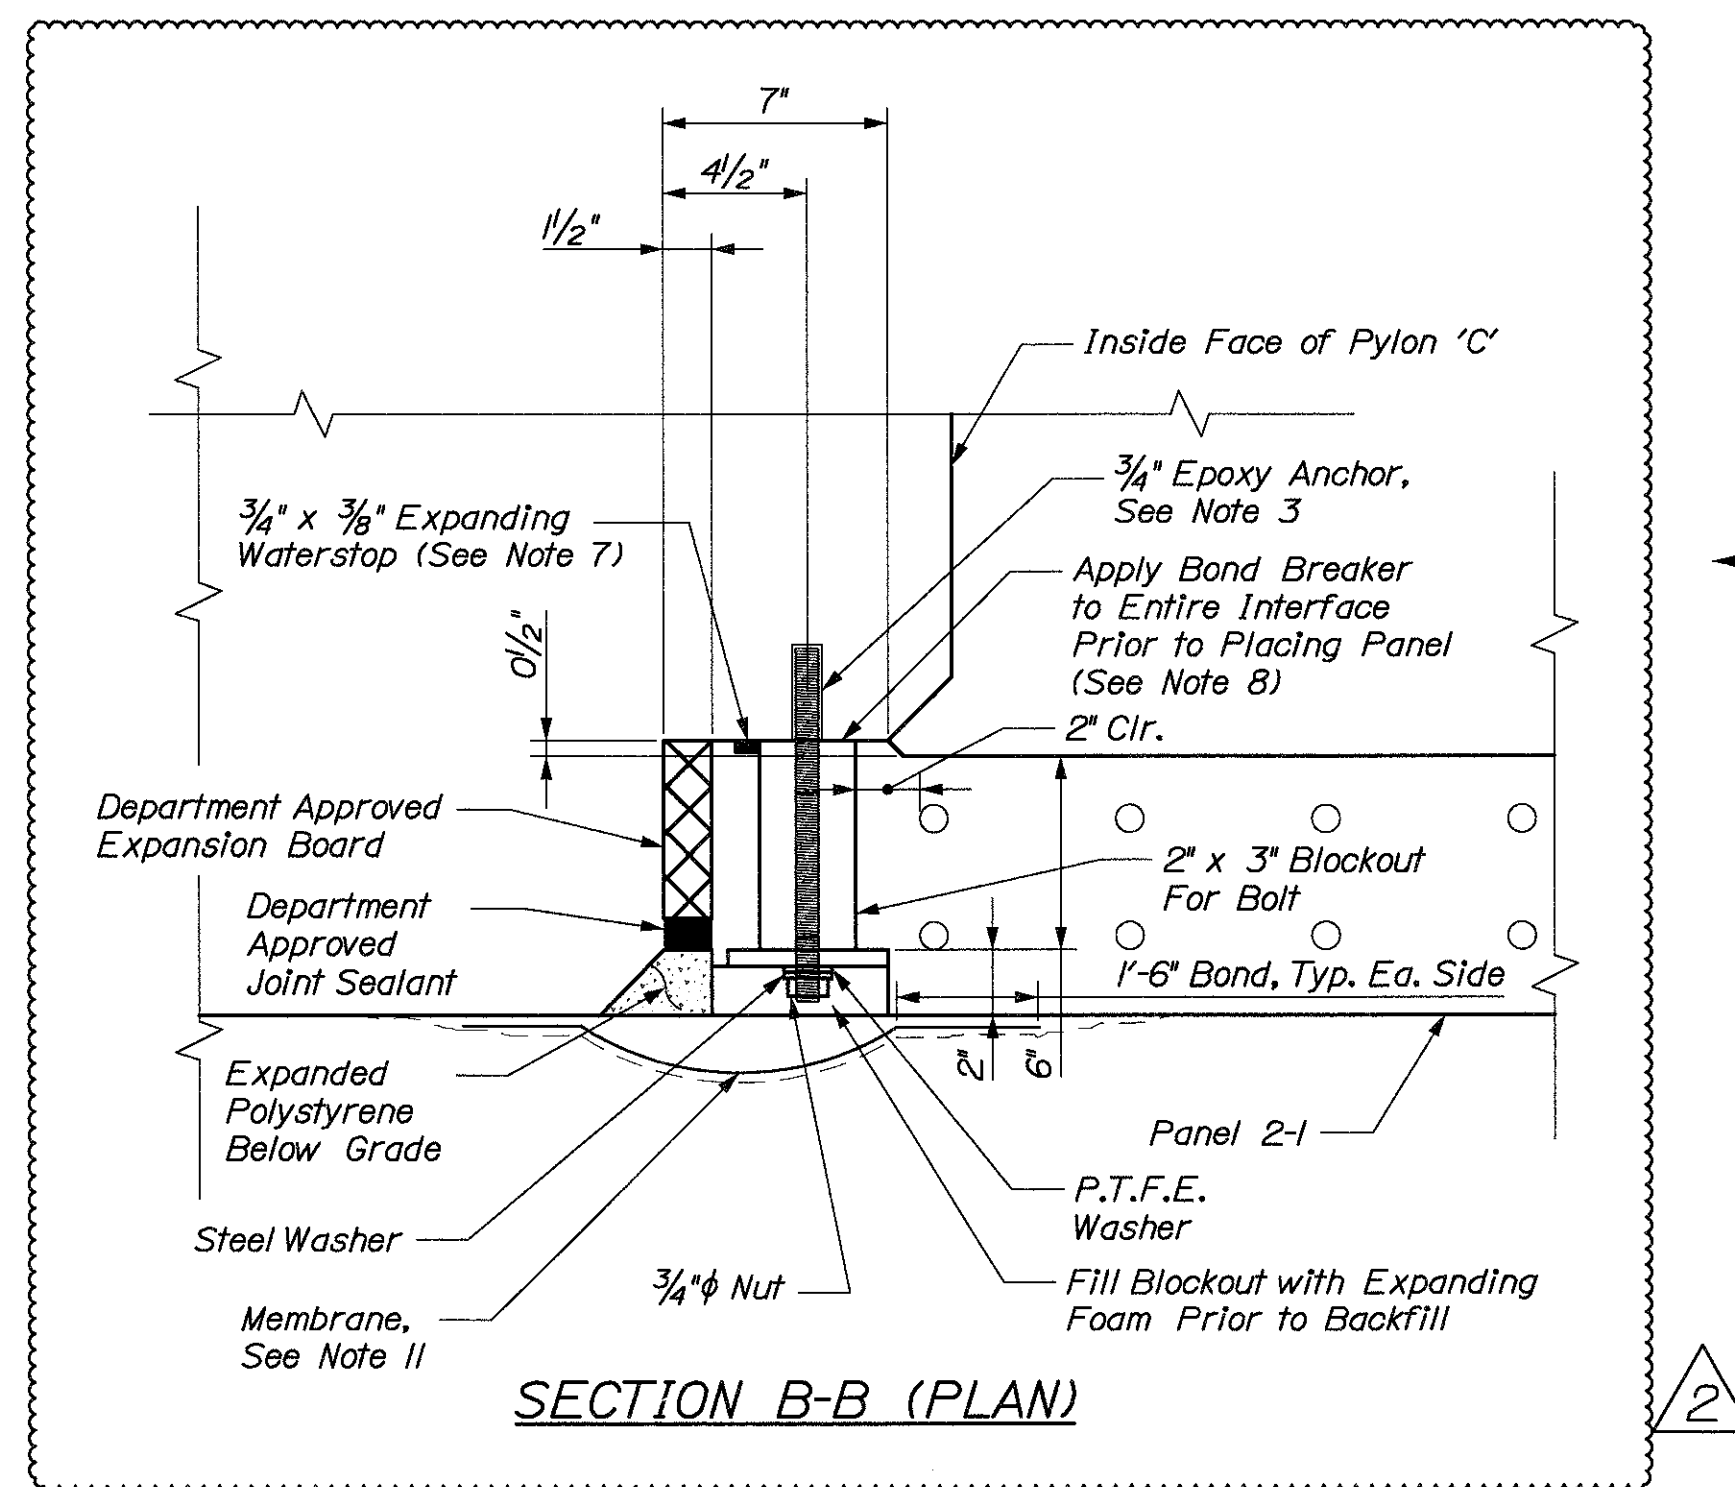


SECTION B-B (PLAN)

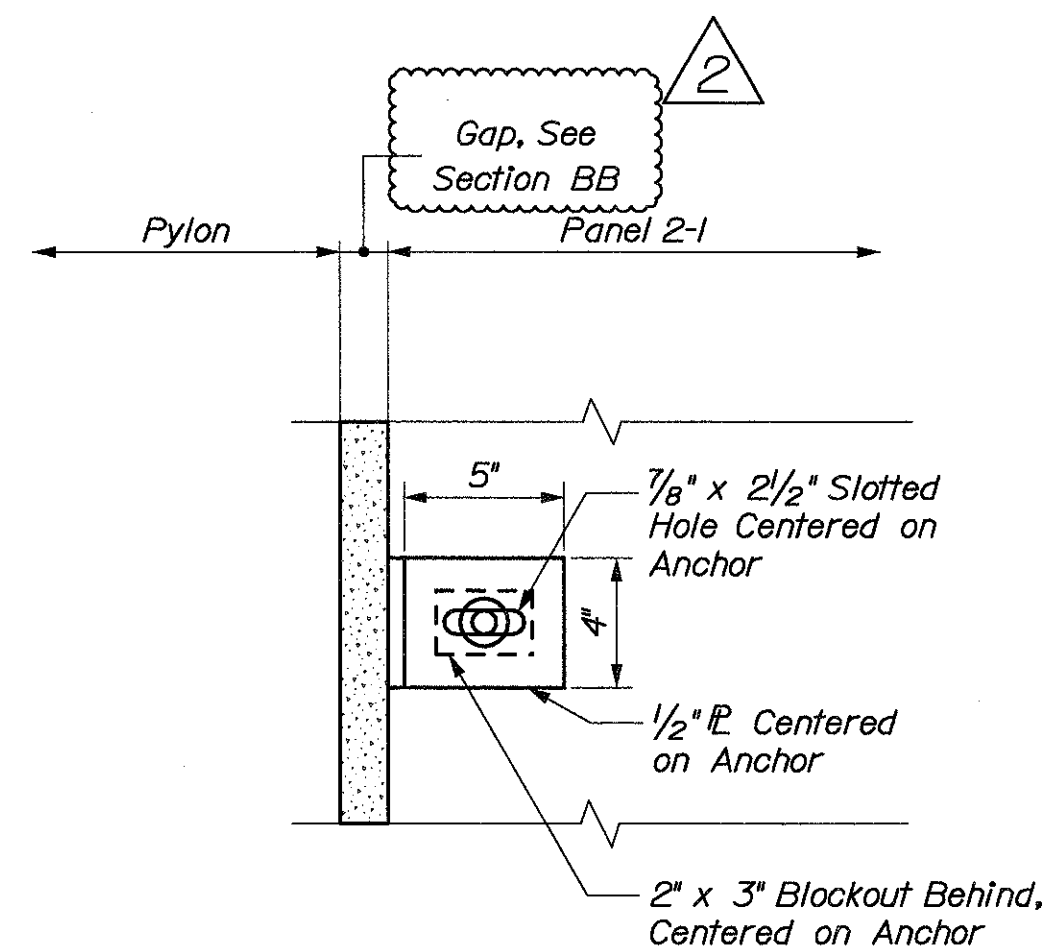

DETAIL 2

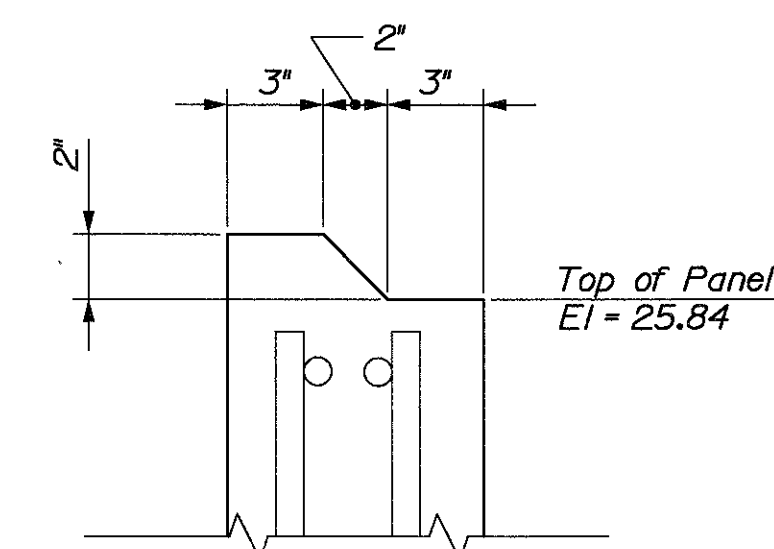

DETAIL 3

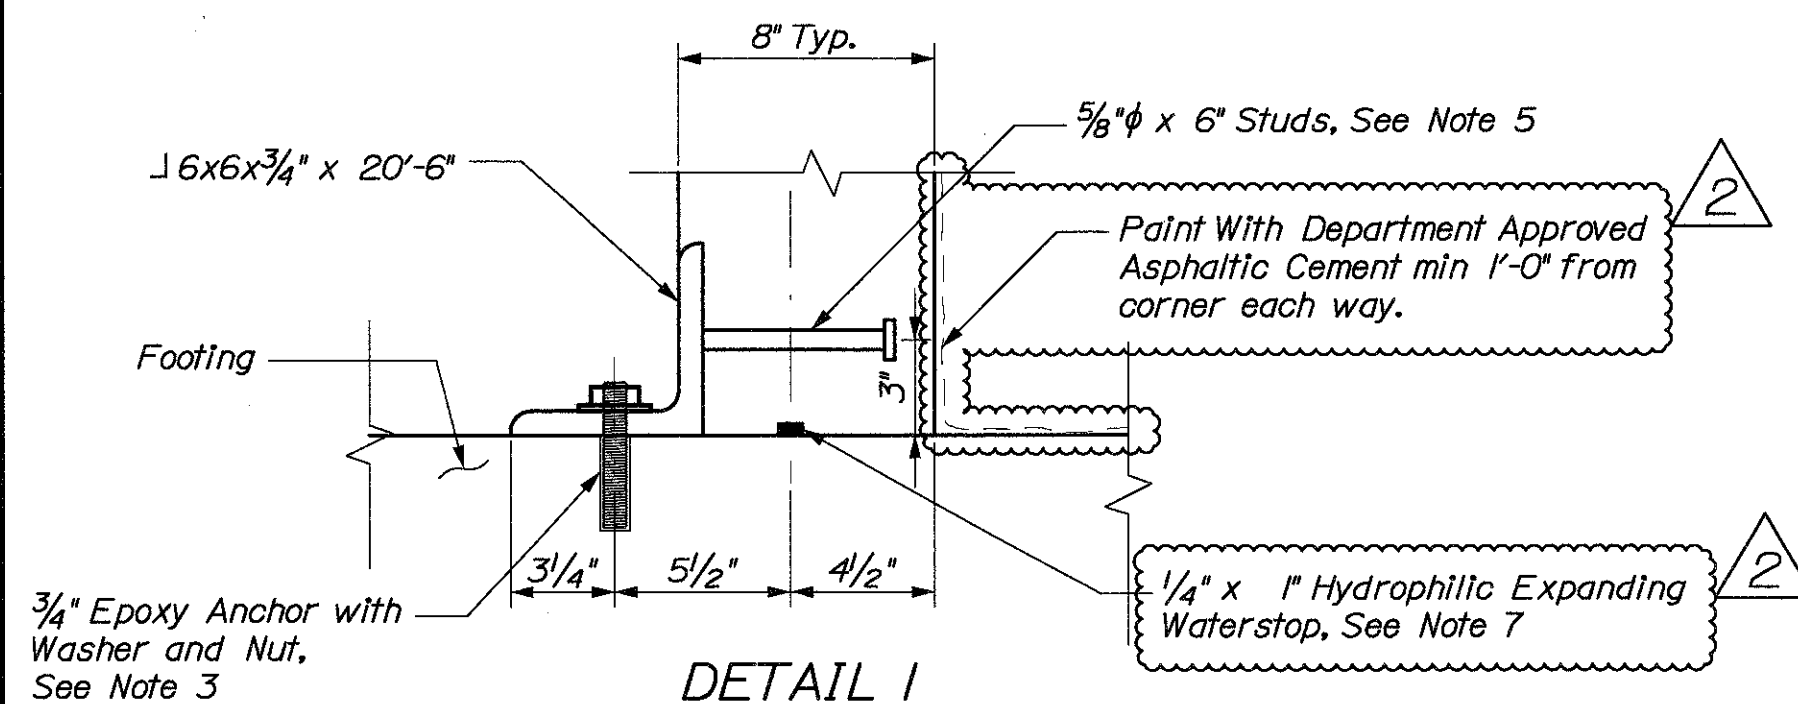


DETAIL 1

Filename: ...\\P12A Pylon_Entrance_Details.dgn


Username: wjohnson

Division: BRIDGE


Date: 10/14/2004

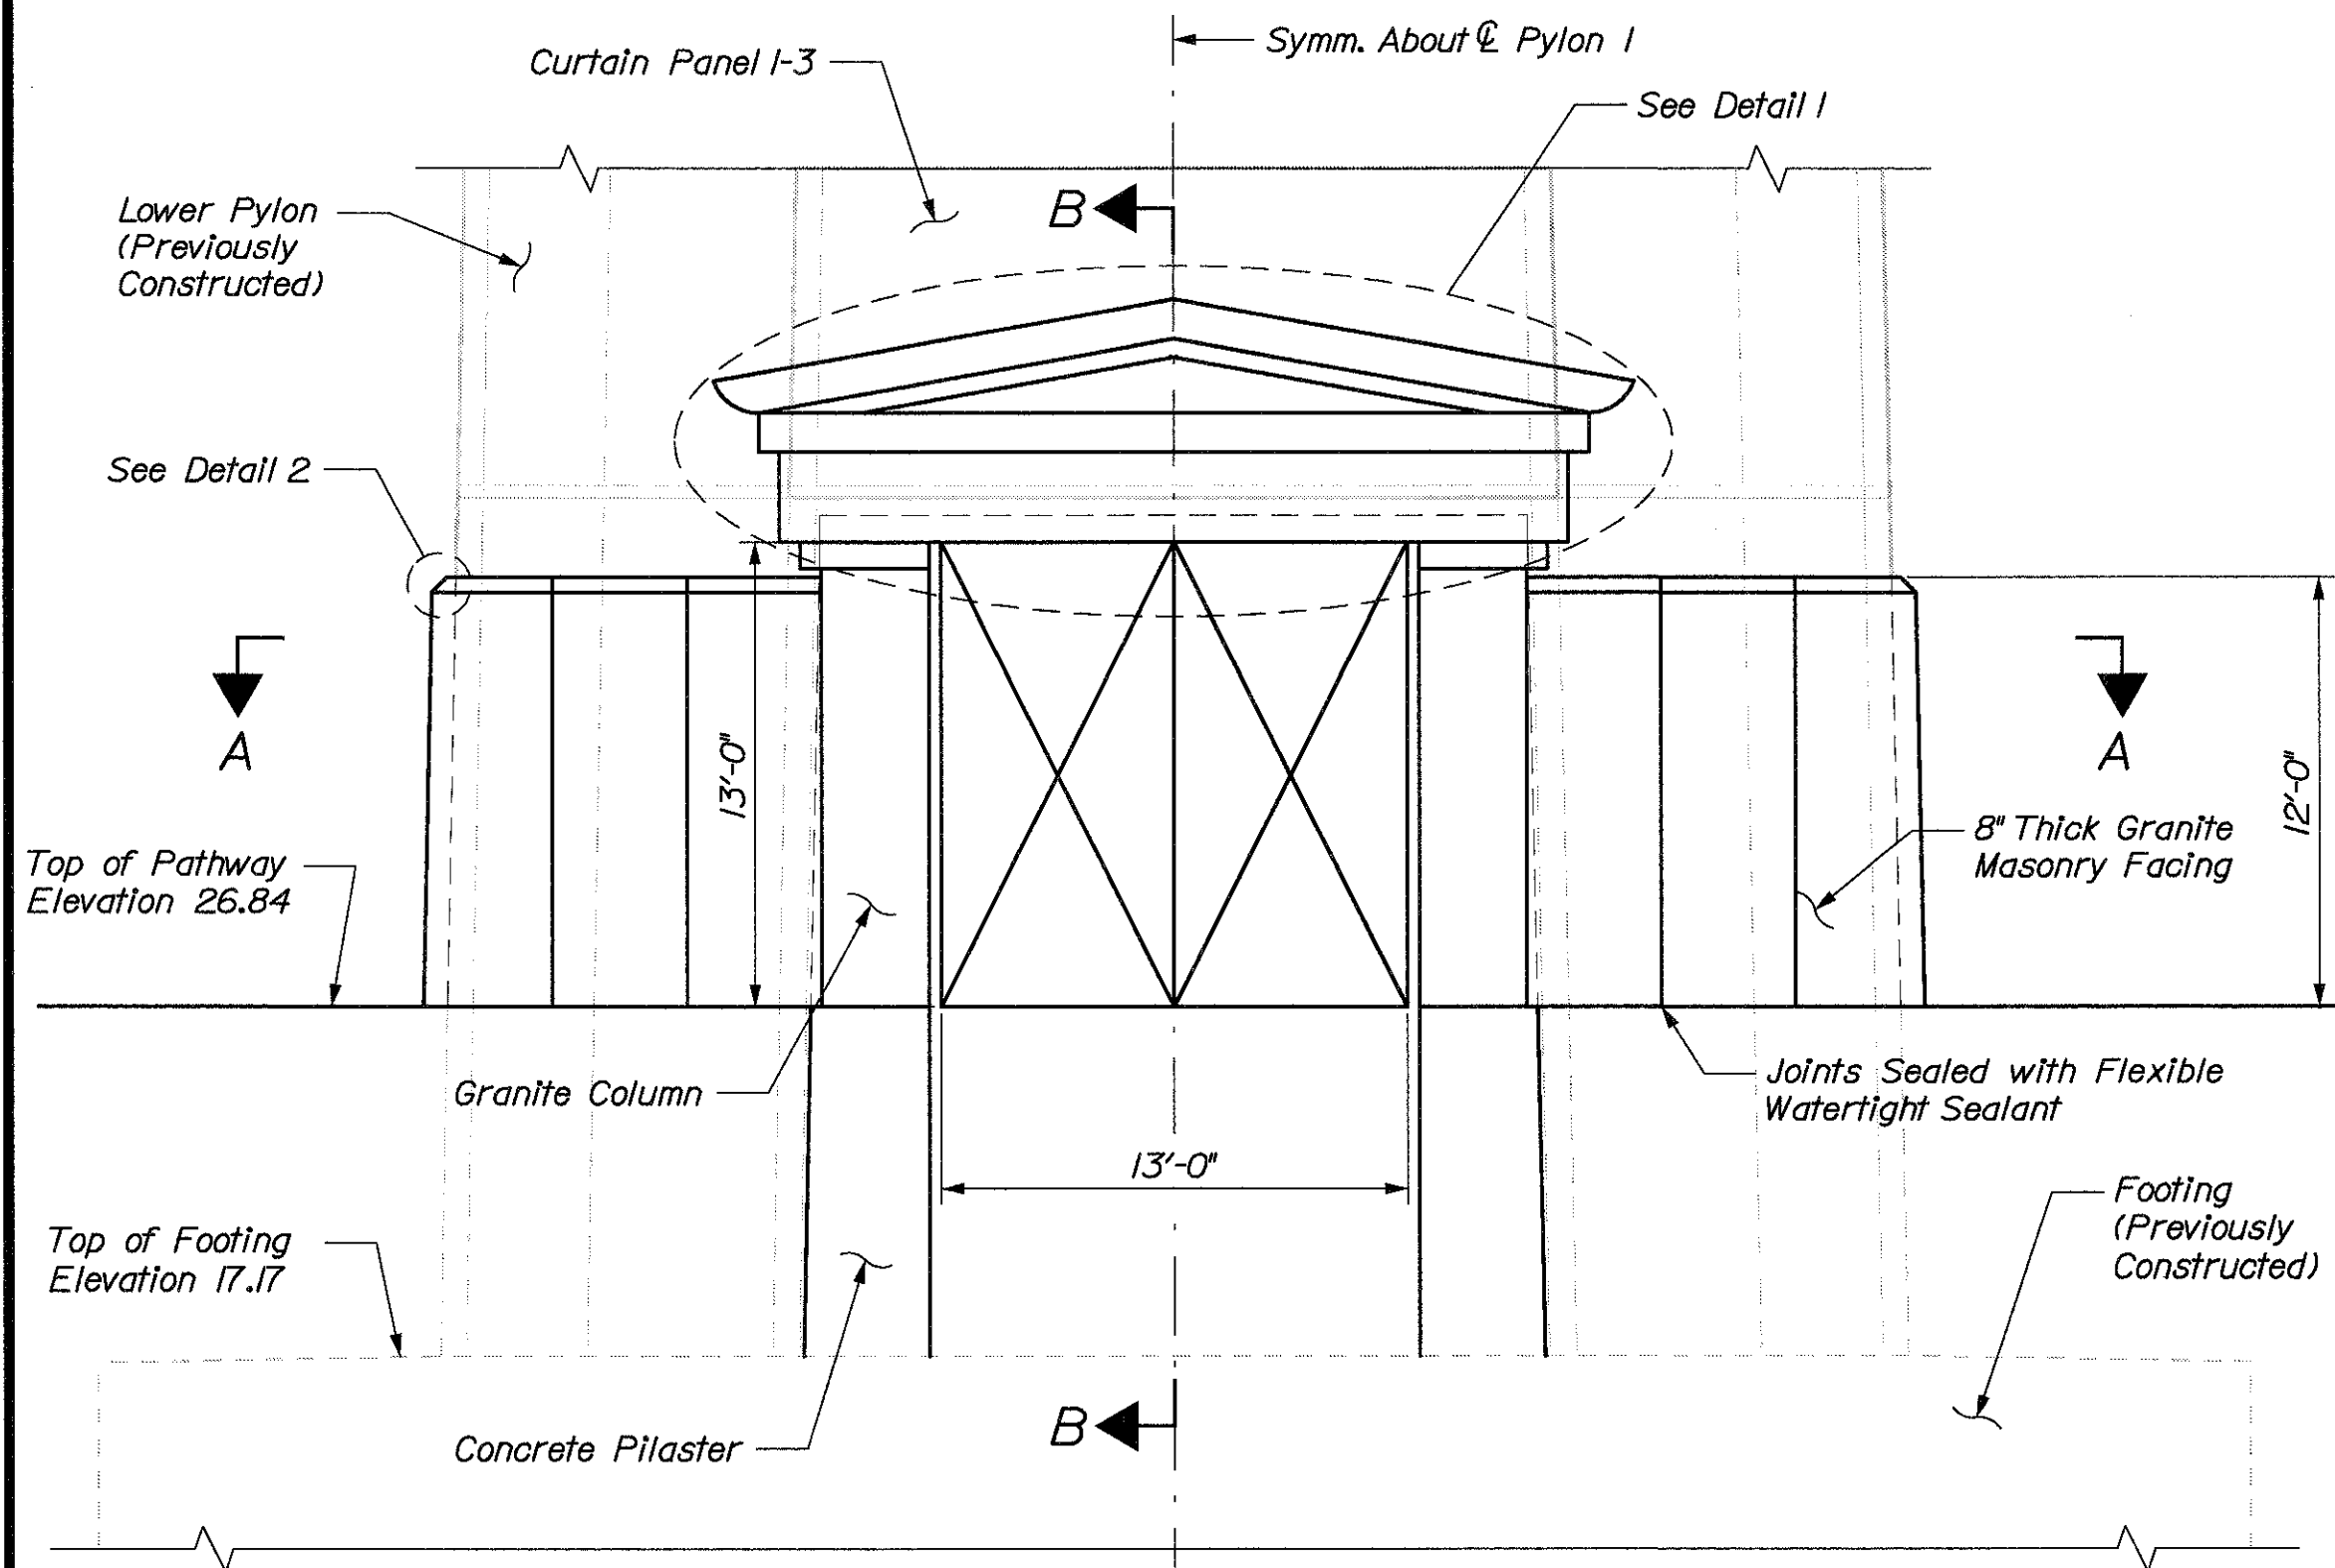


GRANITE PORTICO ELEVATION
(Looking South)

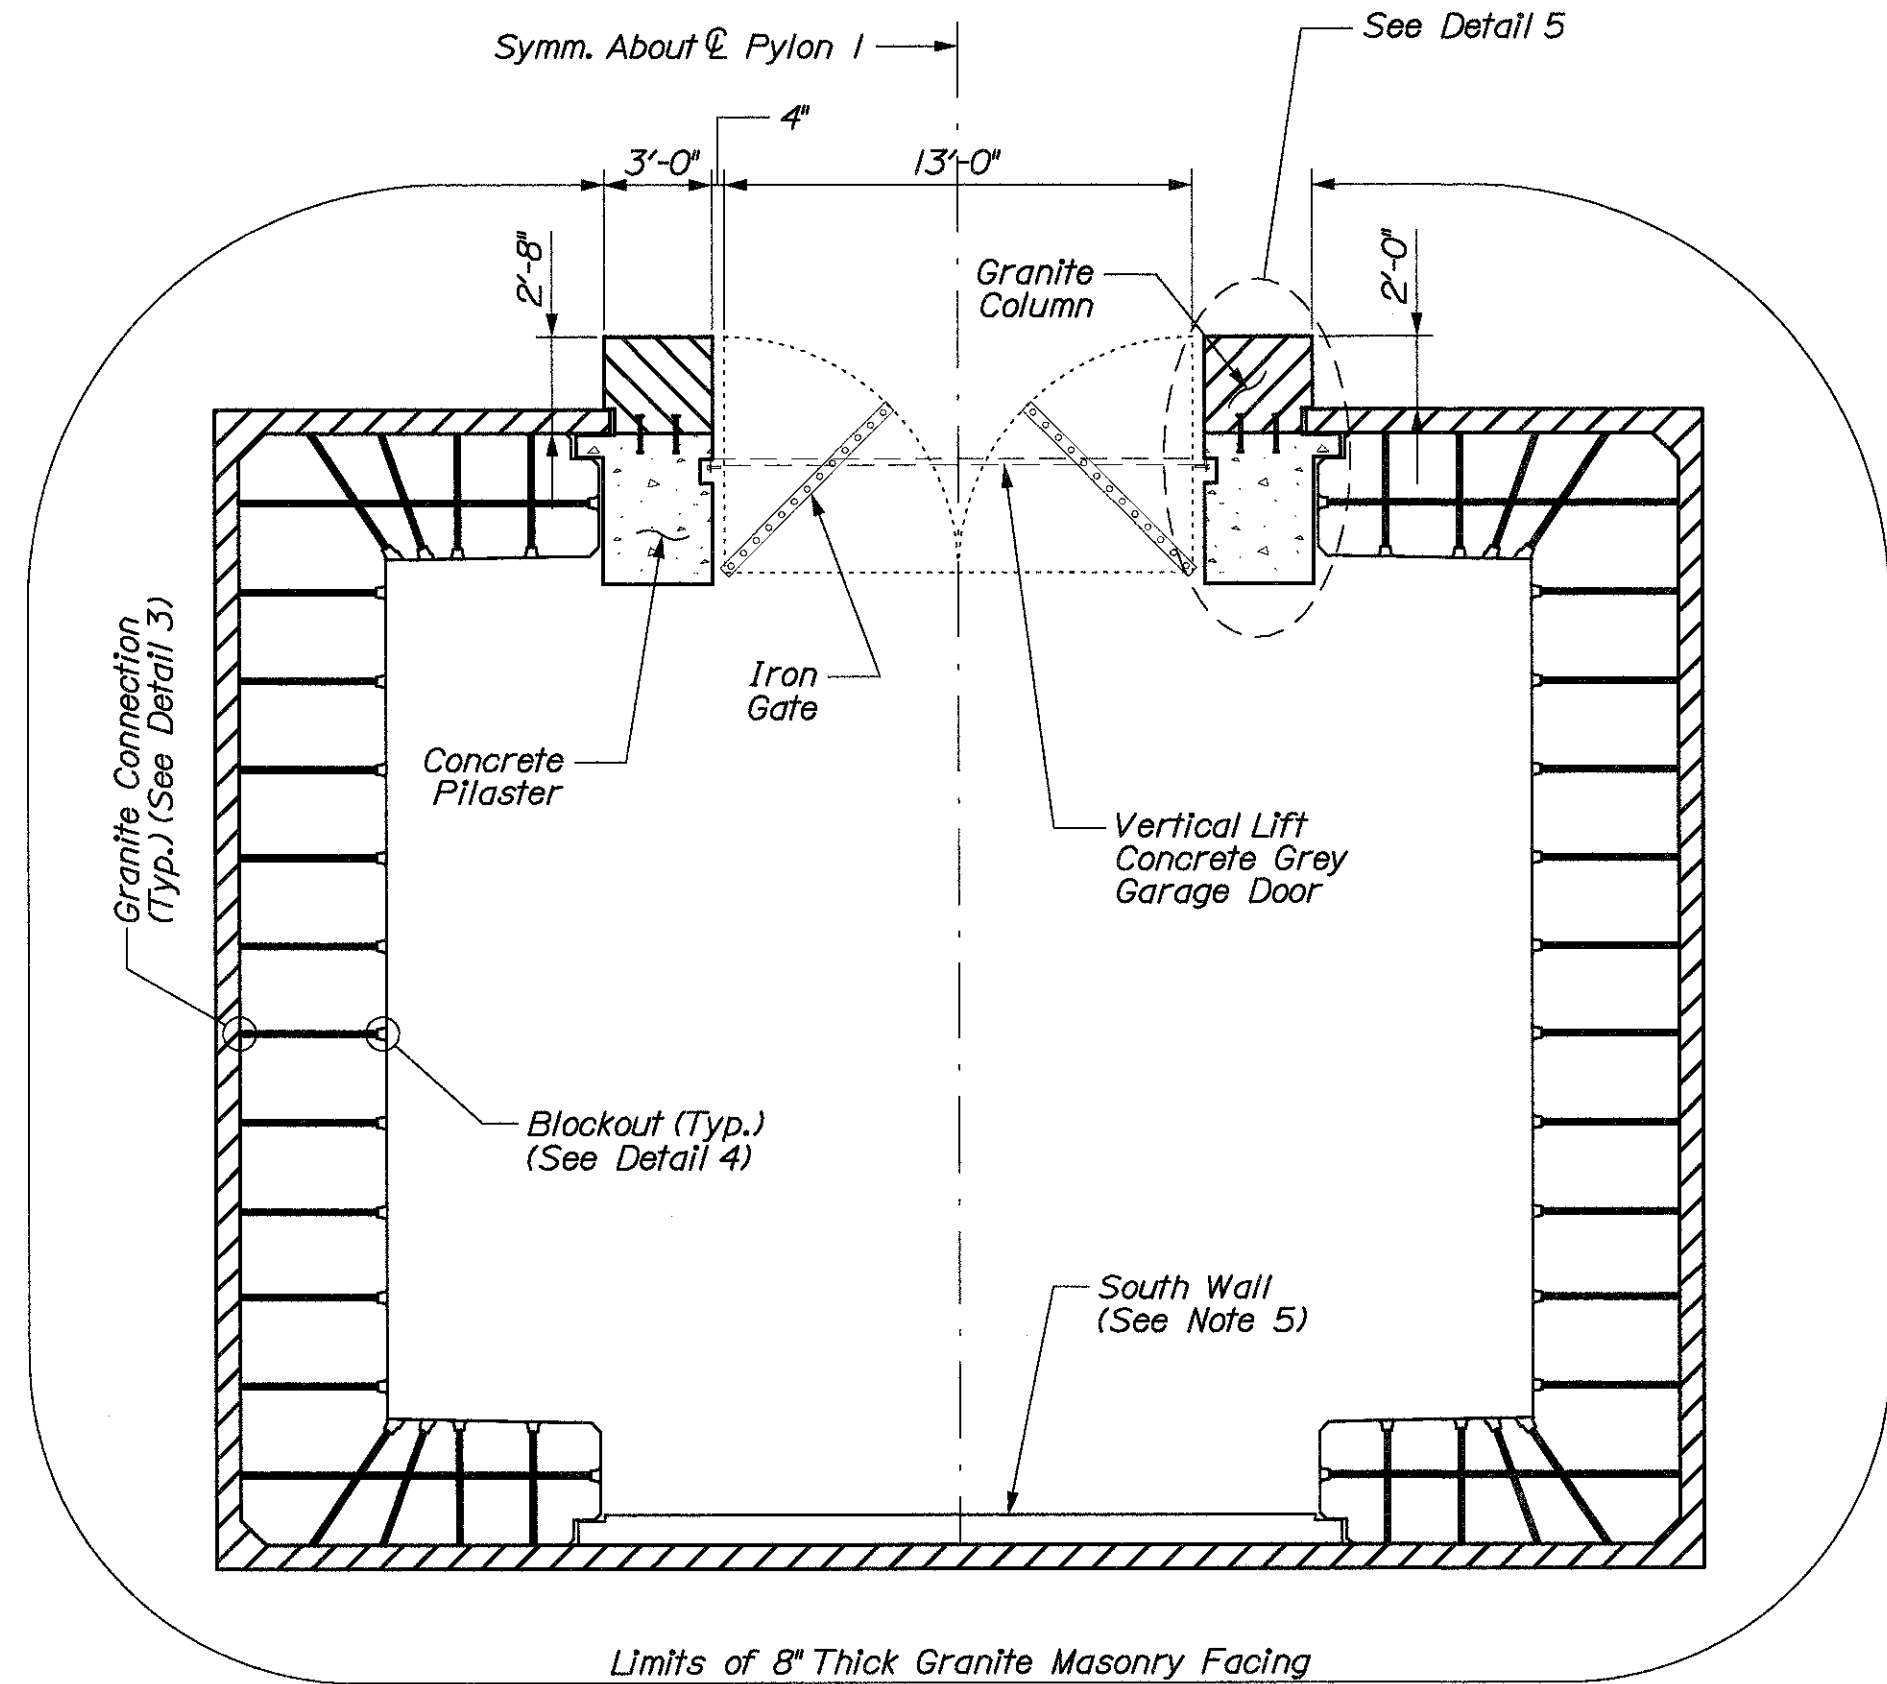


SECTION A-A

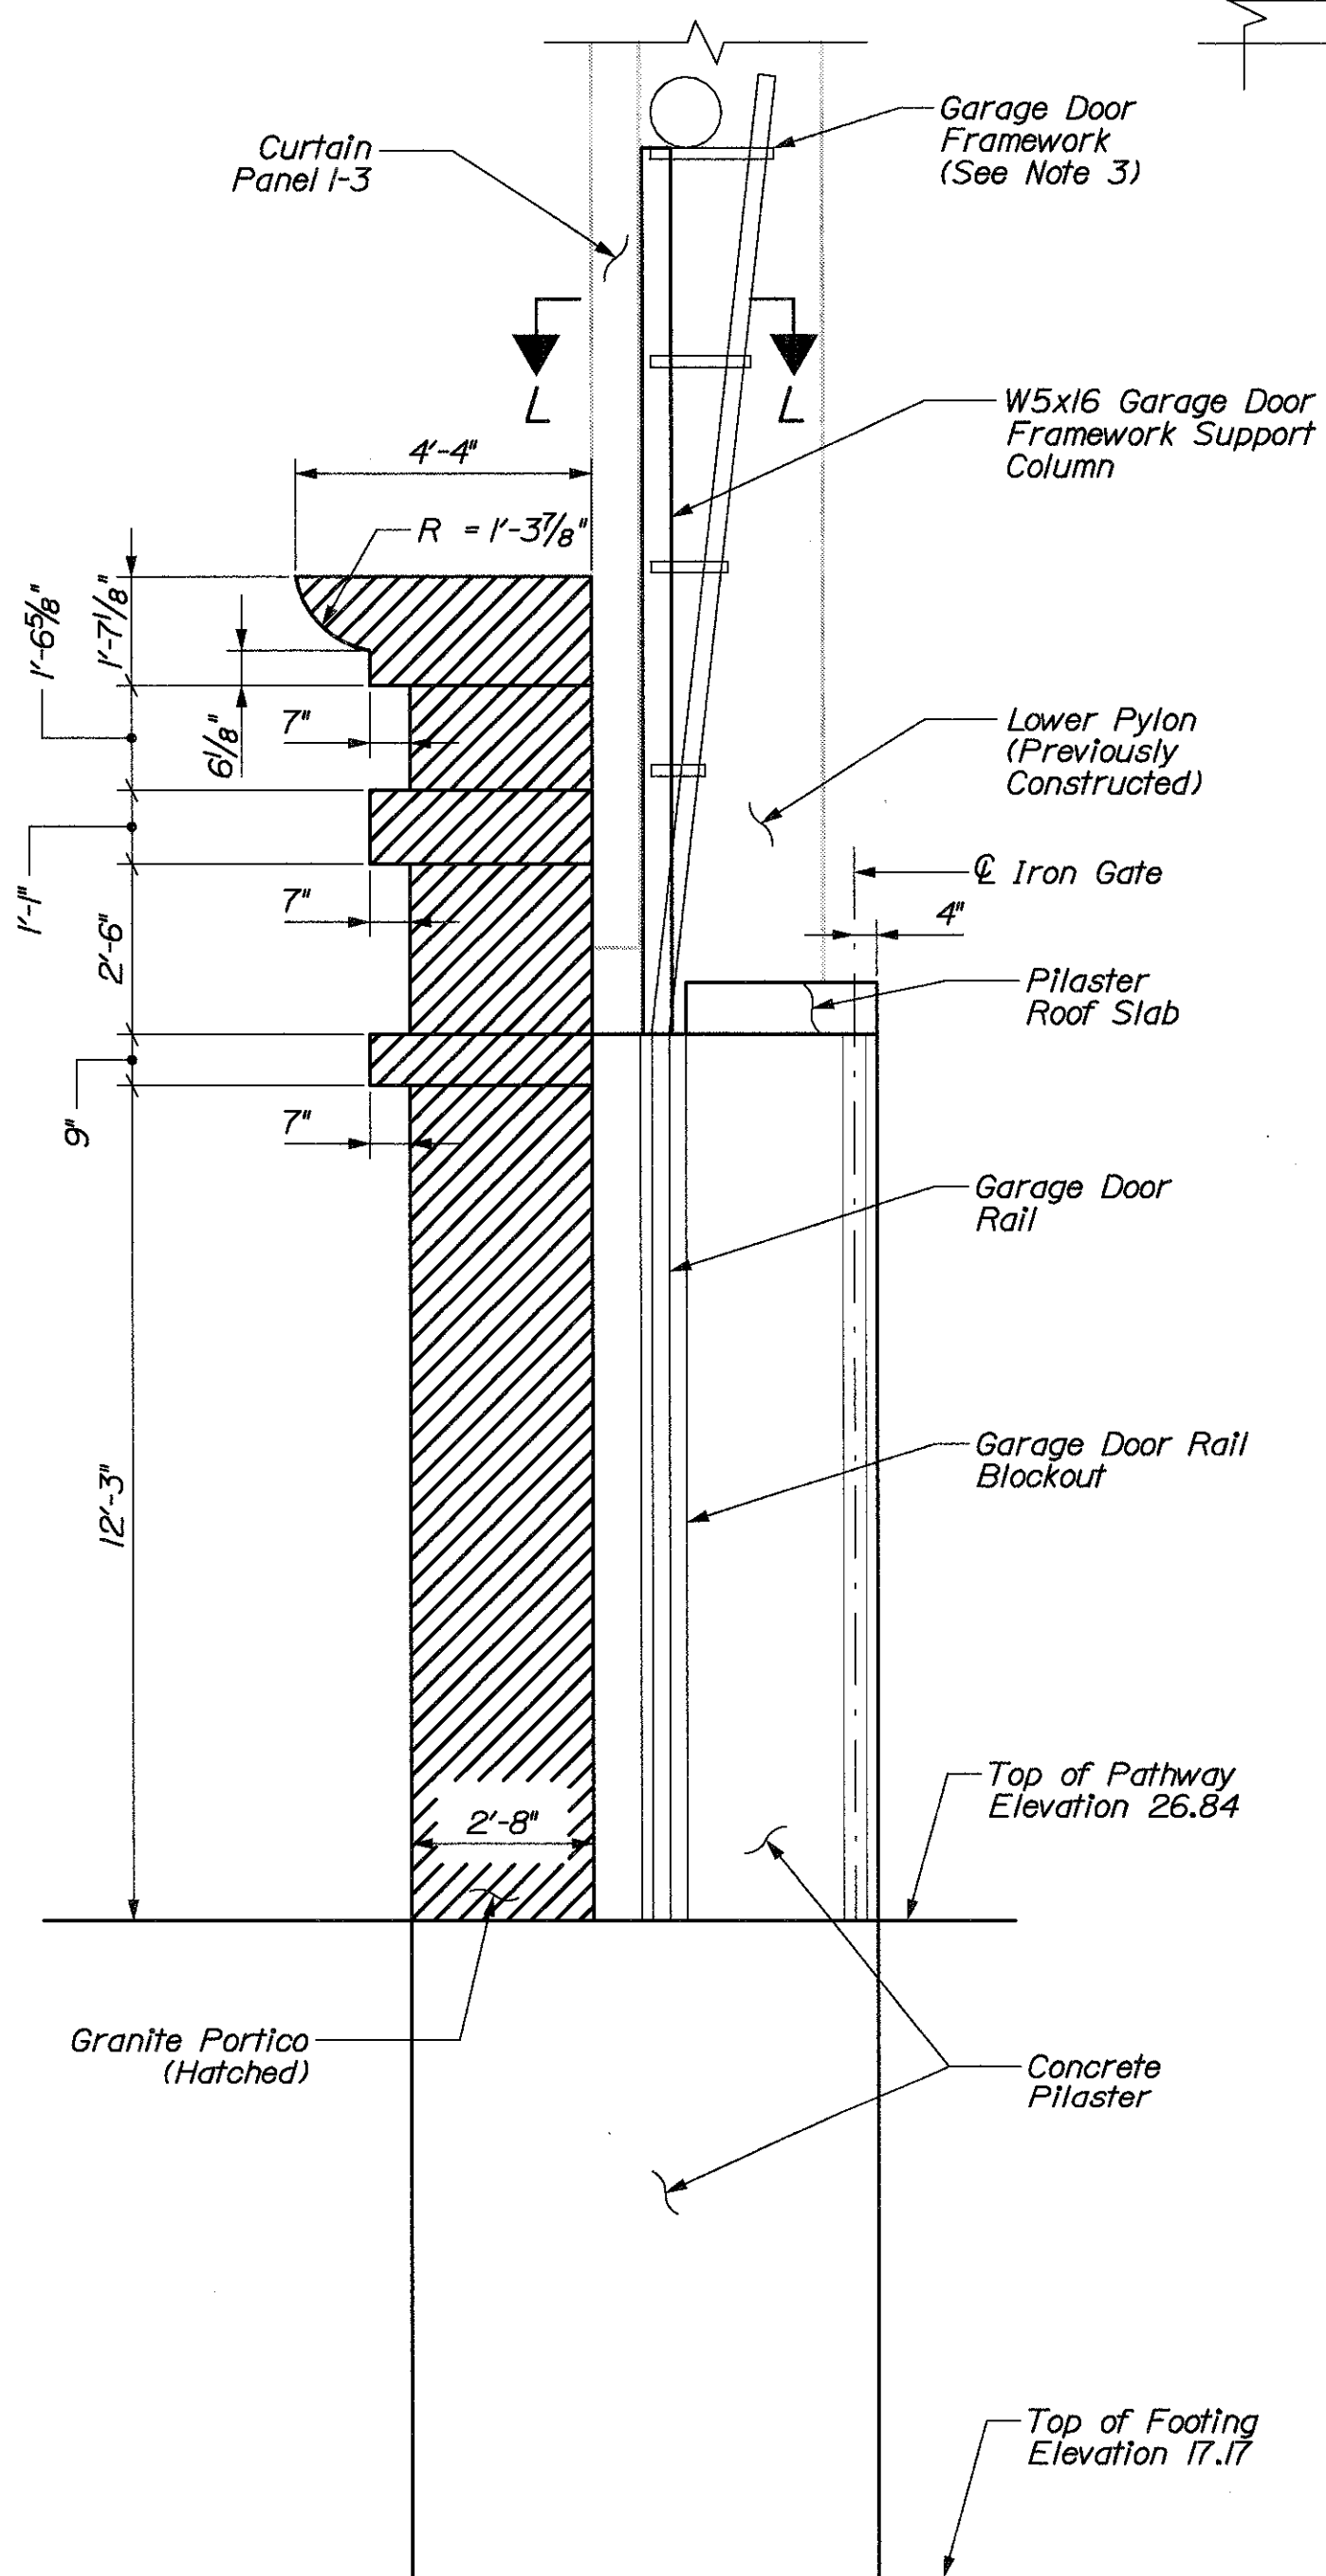

SECTION B-B

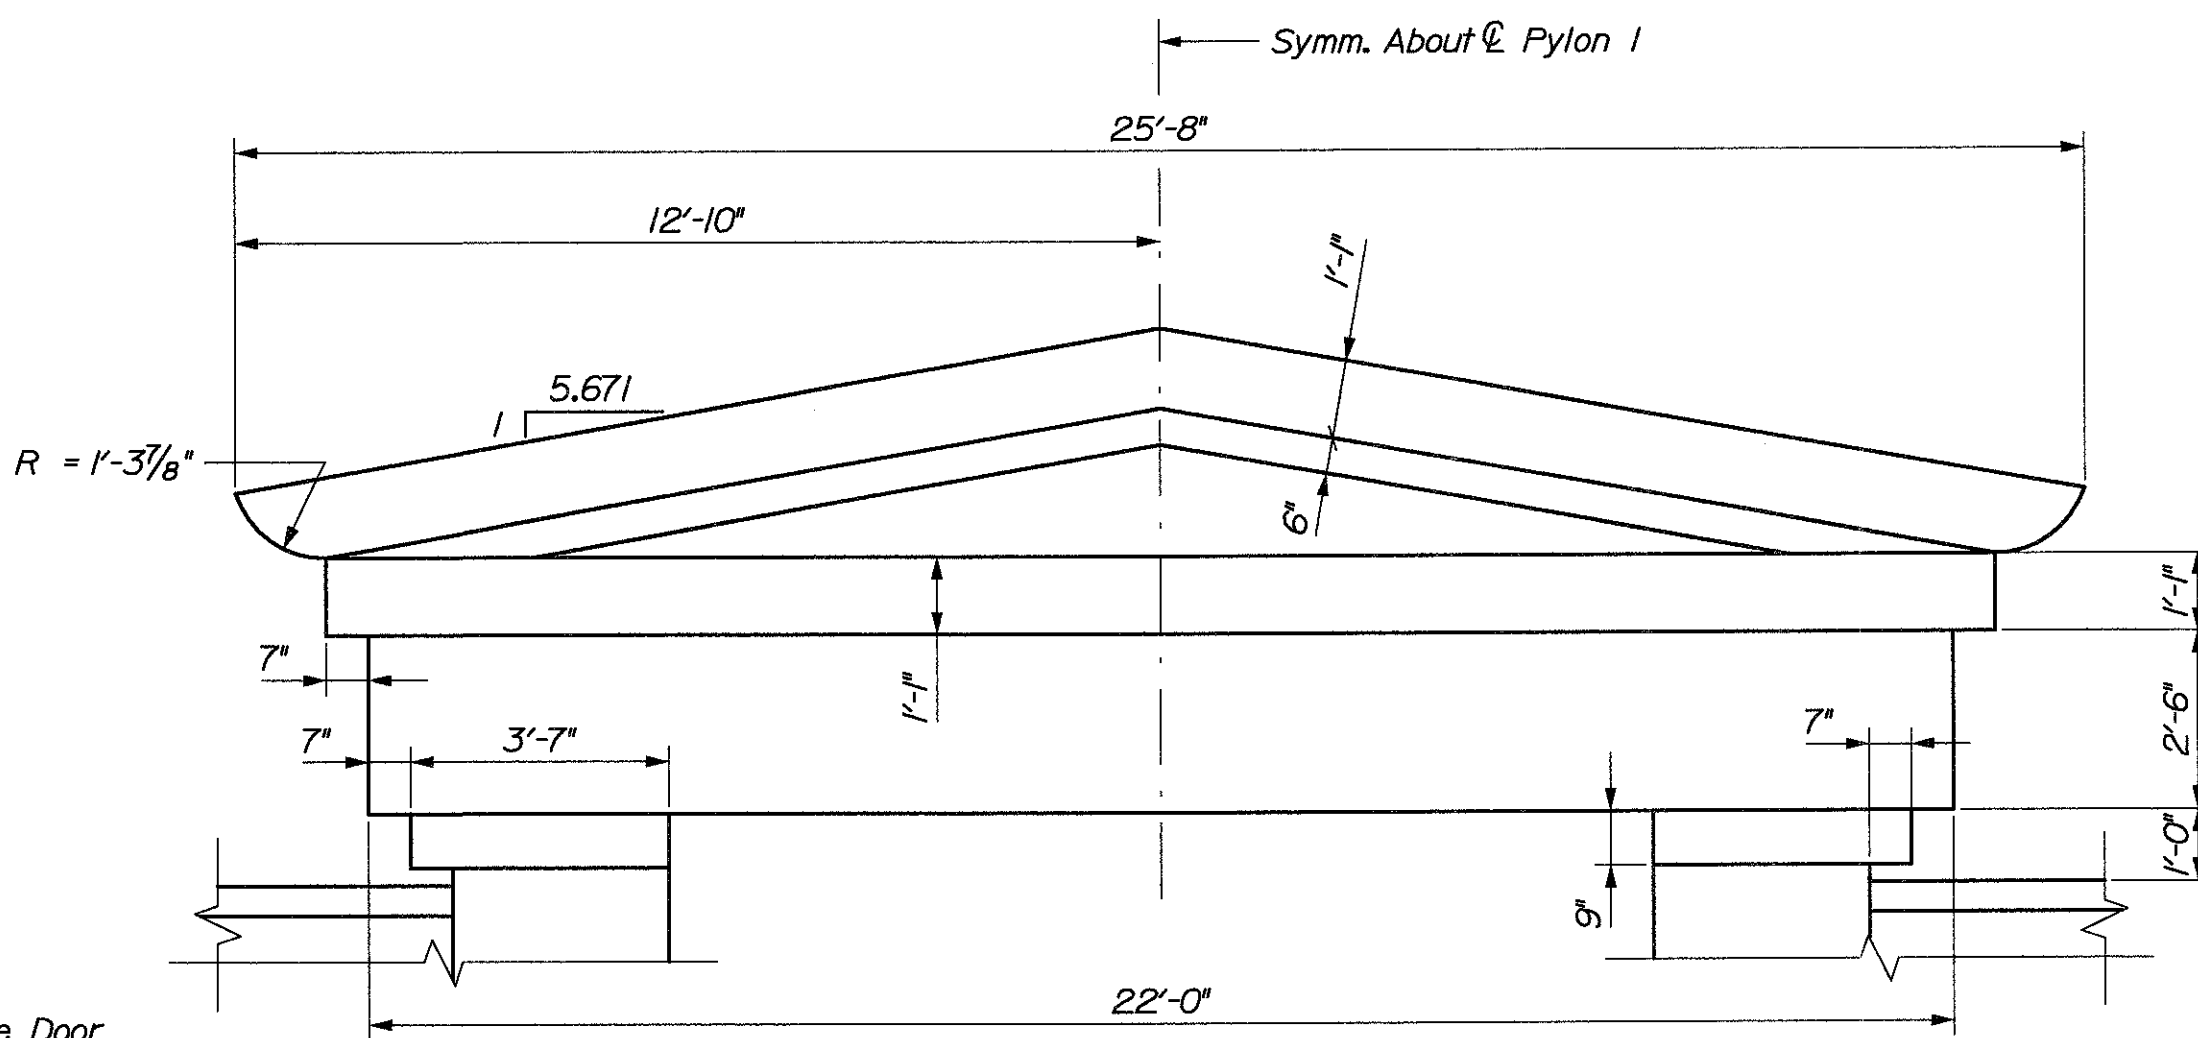

DETAIL 1

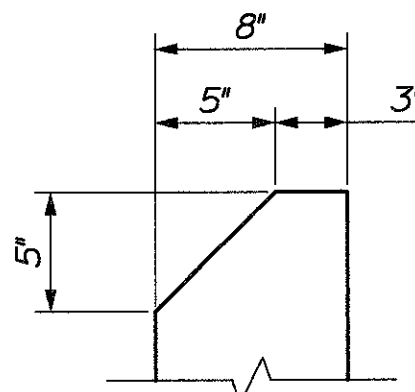

DETAIL 2


Typ. Granite Chamfer

NOTES

1. Contractor shall submit shop drawings for granite and all associated hardware.
2. Iron gate is to be modelled after the Fort Knox entrance. Contractor shall submit shop drawings of Iron Gate and attachments.
3. The garage door framework above the pilasters shall be attached to the W5x16 garage door framework support columns, not the curtain panels. Contractor shall submit shop drawings for garage door, framework and hardware.
4. All labor, materials and placement of iron gate, garage door, garage door framework support column, granite, associated anchors, pourbacks in anchor blockouts, pilaster concrete and reinforcement are paid under Item 525.30 Granite Portico.
5. For South Wall details, see Lower Pylon Mechanical Room Details I-III sheets.
6. For Section L-L, Details 4, 5 & 6, see Lower Pylon Entrance Details III sheet.


BENT BARS														
MARK	QTY.	LENGTH	TYPE	A	B	C	D	E	F	G	H	O	R	LOCATION
P401	8	7'-4 1/2"	FC	2'-5/2"	2'-5/2"	2'-5/2"								Pilaster Roof Slab
P403	28	2'-6"	FC	1'-0"	0'-6"	1'-0"								Pilaster Roof Slab
P404	8	3'-10 1/2"	L	2'-2 1/2"	1'-8"									Pilaster
P405	26	4'-3"	FC	1'-4 1/2"	0'-5"	2'-5 1/2"								Pilaster - A Set
P406	46	3'-11 1/2"	FC	1'-9 1/2"	0'-4 1/2"	1'-9 1/2"								Pilaster - A & B Set
P407	46	6'-4 1/2"	FC	1'-4 1/2"	2'-6 1/2"	2'-5 1/2"								Pilaster - A & B Set
P408	26	7'-10 1/2"	FC	2'-0"	3'-10 1/2"	2'-0"								Pilaster - A Set
P409	20	3'-4 1/2"	L	2'-4 1/2"	1'-0"									Pilaster - A Set
P411	20	6'-11 1/2"	FC	1'-4 1/2"	3'-1 1/2"	2'-5 1/2"								Pilaster - B Set
P412	20	11'-6"	FC	2'-5 1/2"	6'-7"	2'-5 1/2"								Pilaster - B Set
P610	6	26'-7 1/2"	FC	3'-7 1/2"	19'-4 1/2"	3'-7 1/2"								Pilaster Roof Slab
P612	12	4'-7 1/2"	L	3'-7 1/2"	1'-0"									Pilaster Roof Slab
P613	12	7'-5"	L	5'-5"	2'-0"									Pilaster
P614	12	5'-2"	FC	1'-0"	3'-2"	1'-0"								Pilaster
MARK	QTY.	LENGTH	TYPE	A	B	C	D	E	F	G	H	O	R	LOCATION

STRAIGHT BARS			
MARK	QTY.	LENGTH	LOCATION
P402	28	2'-6 1/2"	Pilaster Roof Slab
P413	26	3'-0"	Pilaster - B Set
P601	16	10'-6"	Pilaster
P602	40	23'-6"	Pilaster
P611	6	19'-4 1/2"	Pilaster Roof Slab
MARK	QTY.	LENGTH	LOCATION

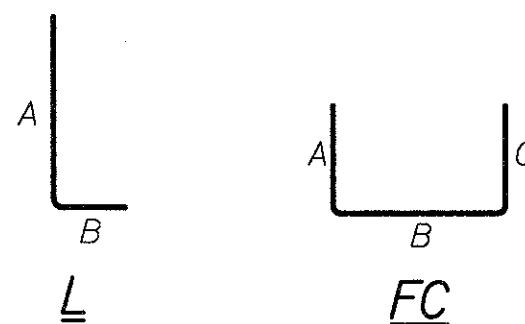


P 6 01

 |
 |
 | Bar Number
 |
 | Bar Size
 |
 | Pilaster

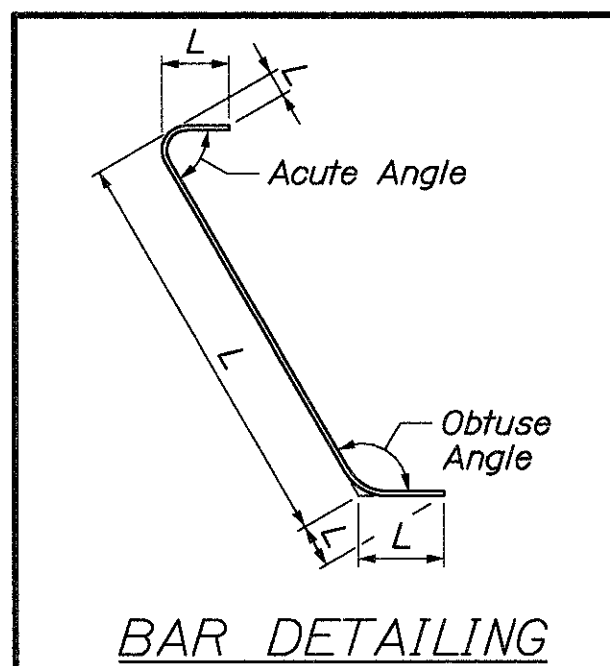


1. All dimensions given are out-to-out of bar.
2. Reinforcement steel shall be uncoated (black) bars.
3. P601 and P602 bar length required for doweling into footing is assumed to be l_d for calculation of bar quantities.
4. All labor, materials and placement of iron gate, garage door, garage door framework support column, granite, associated anchors, pourbacks in anchor blockouts, pilaster concrete and reinforcement are paid under item 525.30 Granite Portico.


ESTIMATED QUANTITIES / PILASTERS FOR INFORMATION ONLY		
ITEM	UNIT	QUANTITY
Concrete, f'c = 4,500 psi	CY	31.3
Reinforcing Steel	LB	2,089

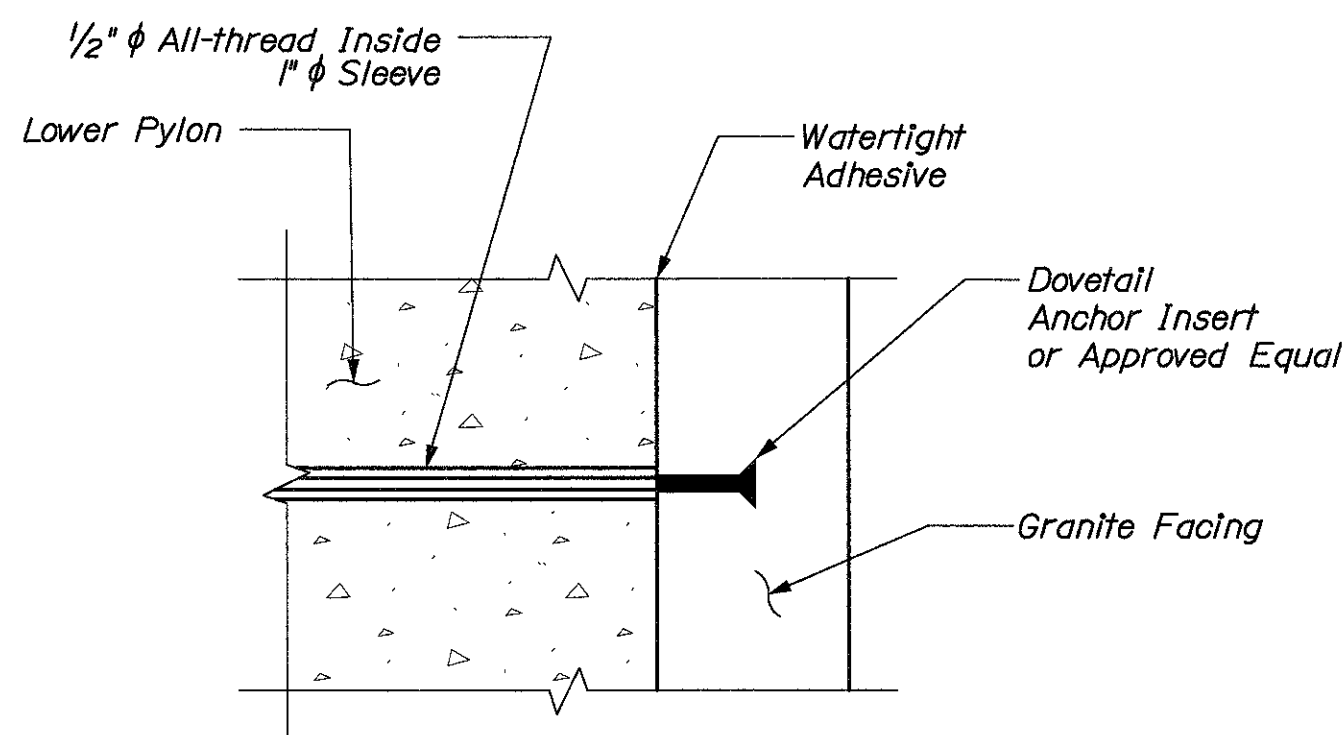


DETAIL 3

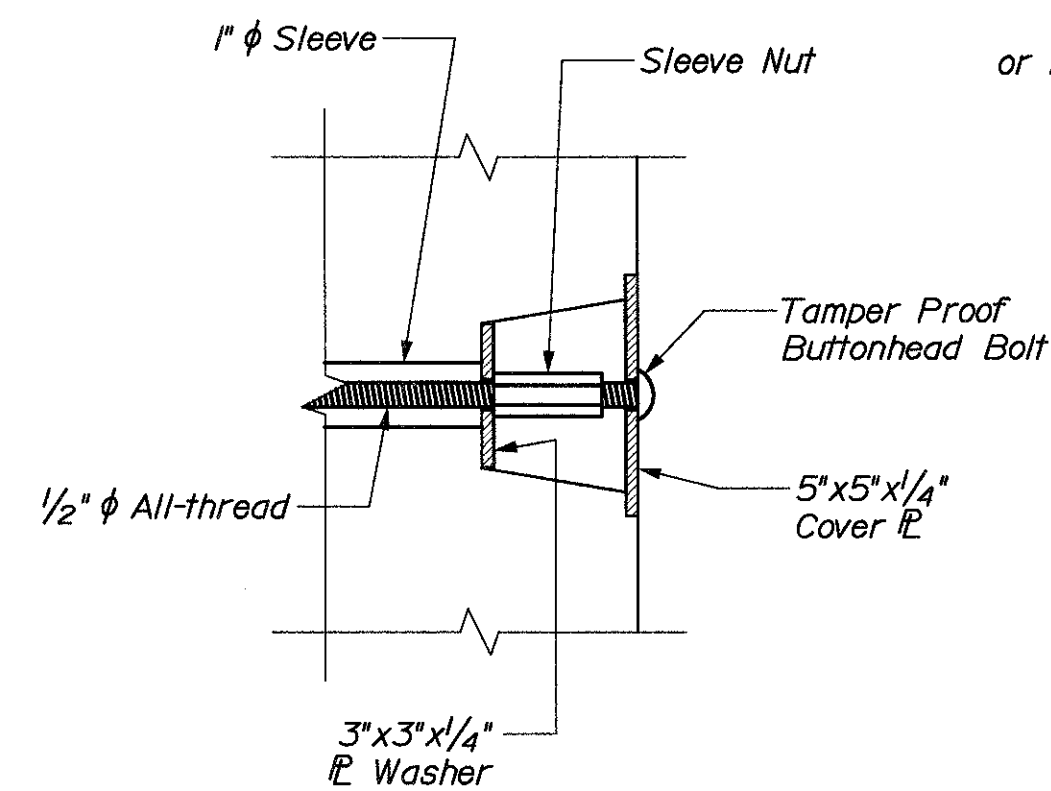


DETAIL 4

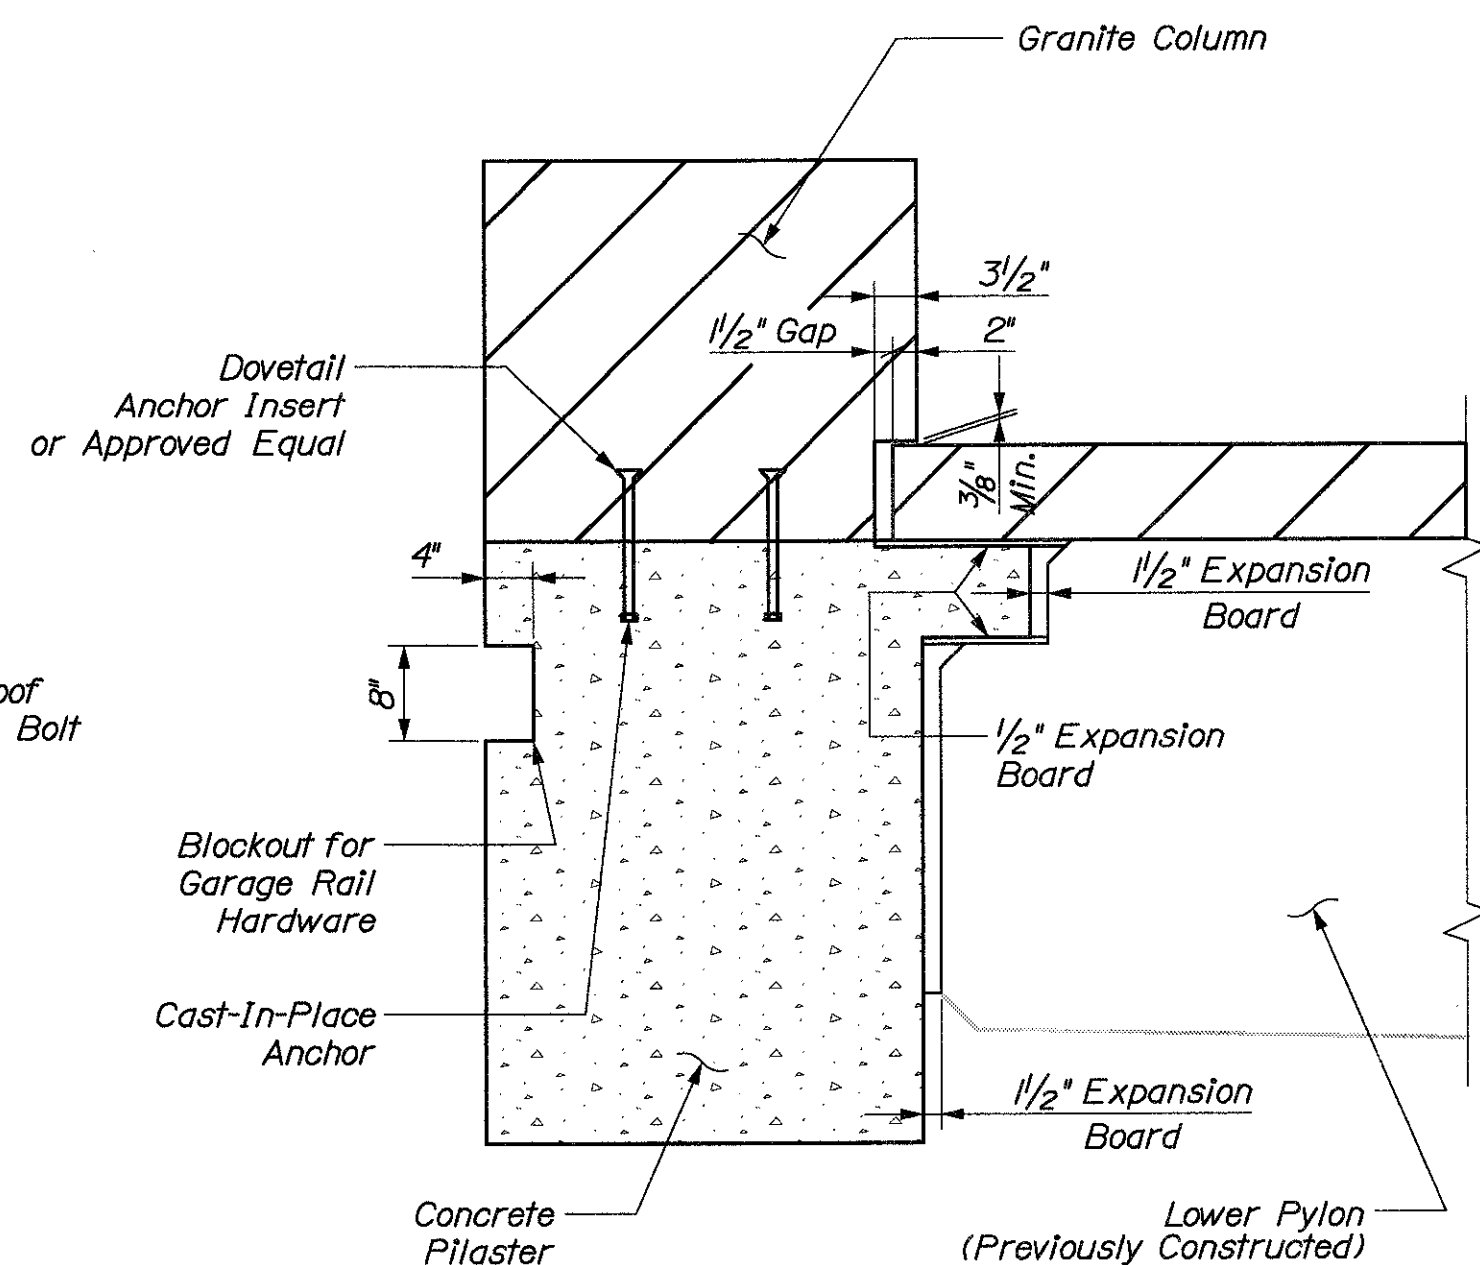


DETAIL 5

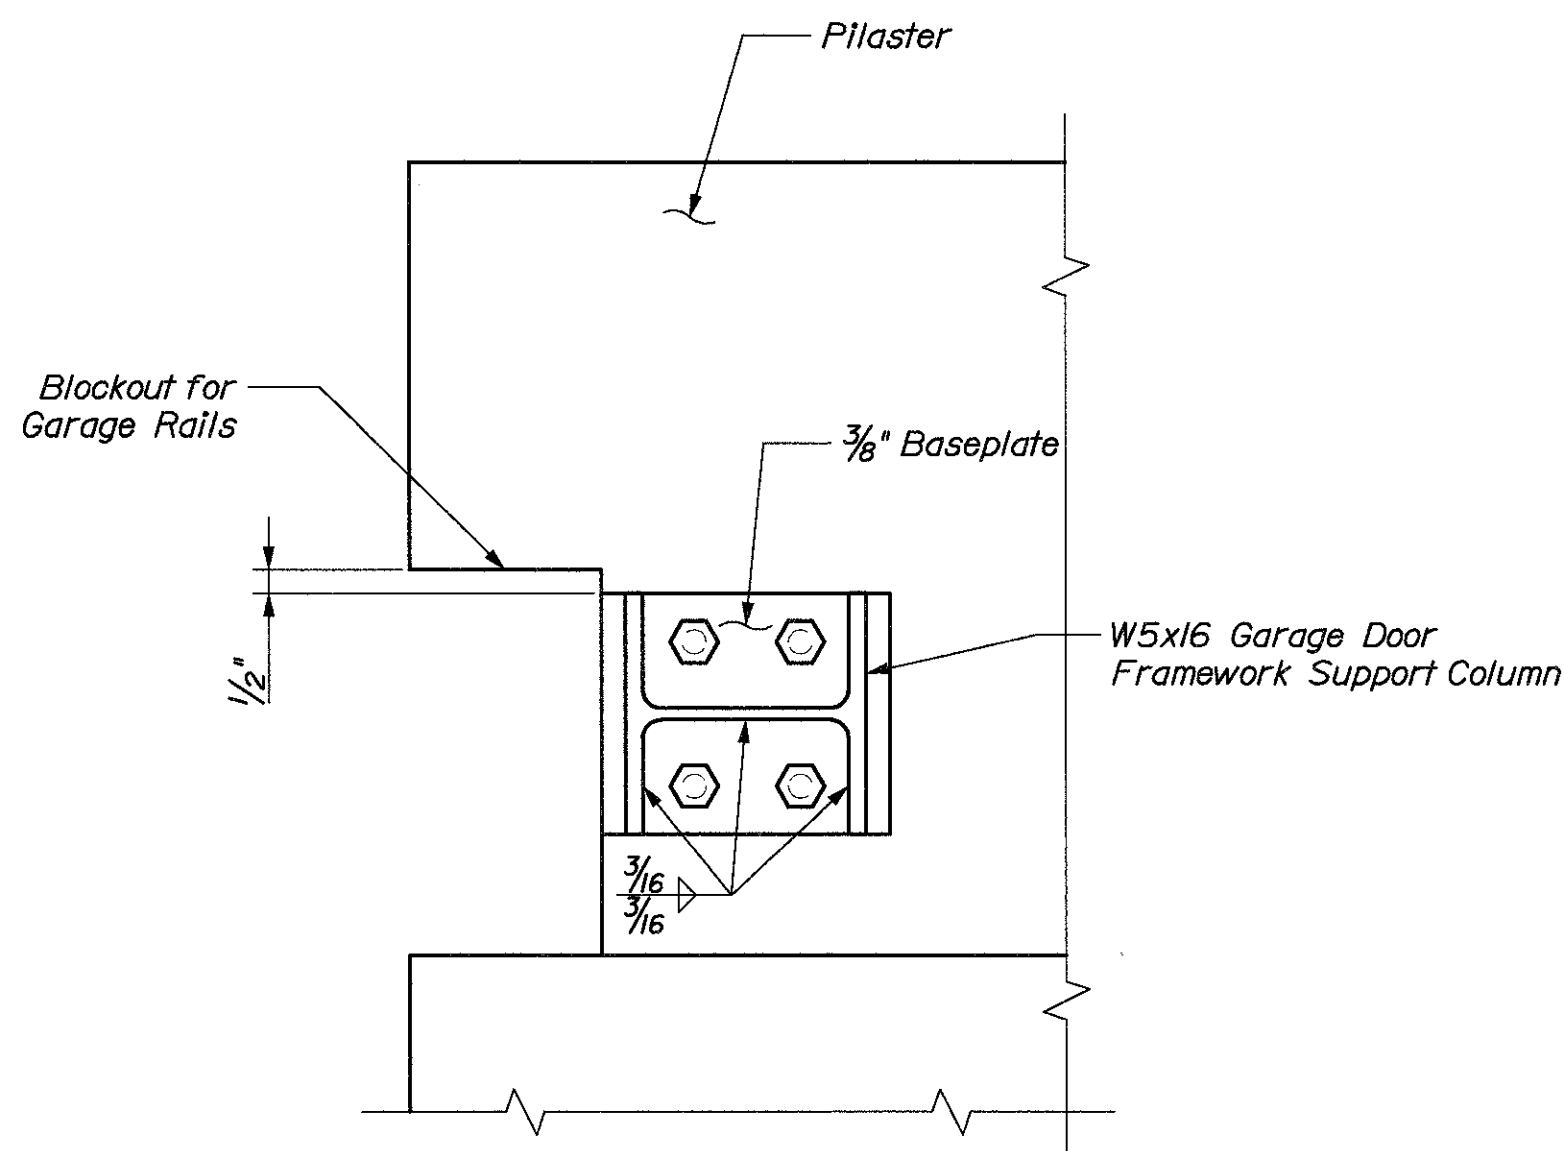

DETAIL 6

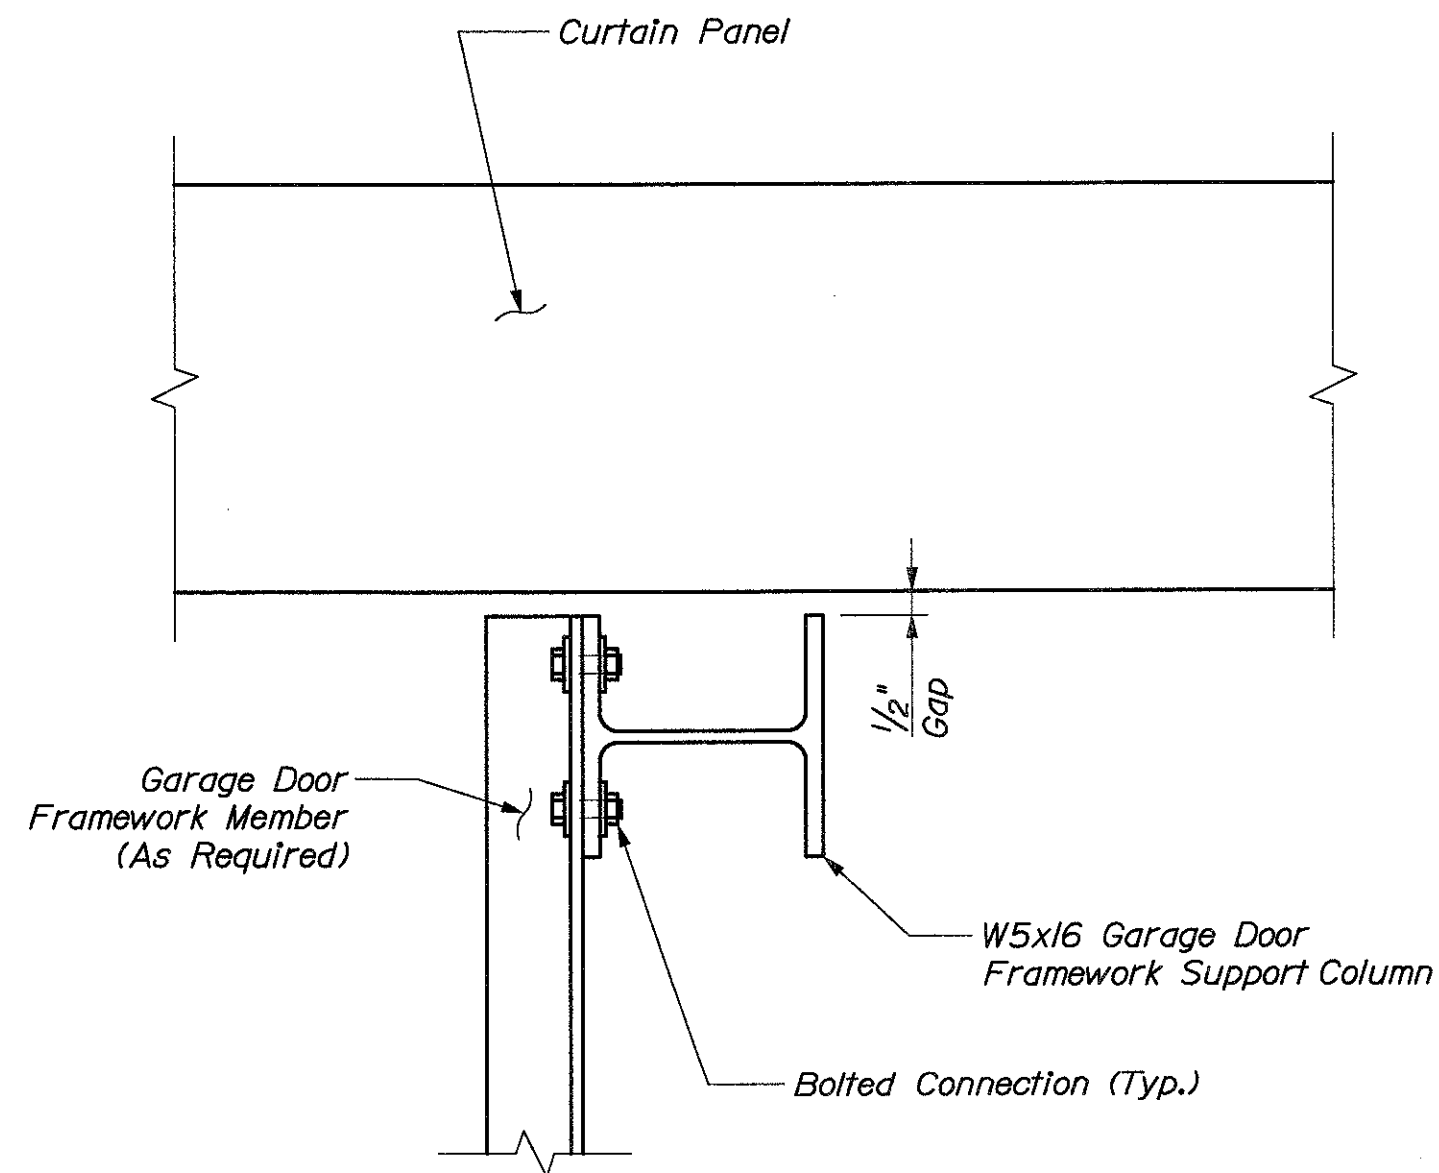

SECTION L-L

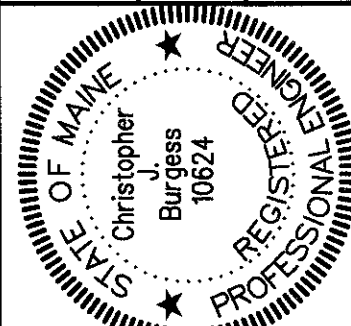

Signature Chin/Burgin
 Signature 10634
 P.E. NUMBER 1500 04
 DATE

PROJ. MANAGER	W.J. ROLLEDER	BY	DATE
DESIGN-DETAILED	W. JOHNSON	W. JOHNSON	10-15-04
DESIGN-REVIEWED	C. BURGESS	C. BURGESS	10-15-04
DESIGN-DETAILED2			
DESIGN-DETAILED3			
DESIGN-REVISIONS 1			
DESIGN-REVISIONS 2			
DESIGN-REVISIONS 3			
DESIGN-REVISIONS 4			


PROSPECT-VERONA BRIDGE
PENOBSCOT RIVER
PROSPECT\VERONA WALDO\HANCOCK CTY

PYLON ENTRANCE
DETAILS III

SHEET NUMBER

P12C

OF 15

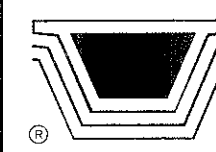

Figg Bridge Engineers, Inc.
424 North Calhoun Street
Tallahassee, Florida 32301


• Tallahassee, Fl. • Denver, Co. • Philadelphia, Pa. • Dallas, Tx.

File: \\P13_LowerPylon_Mech_Room_Det.dgn

Division: BRIDGE

Username: sfll

Date: 10/14/2004




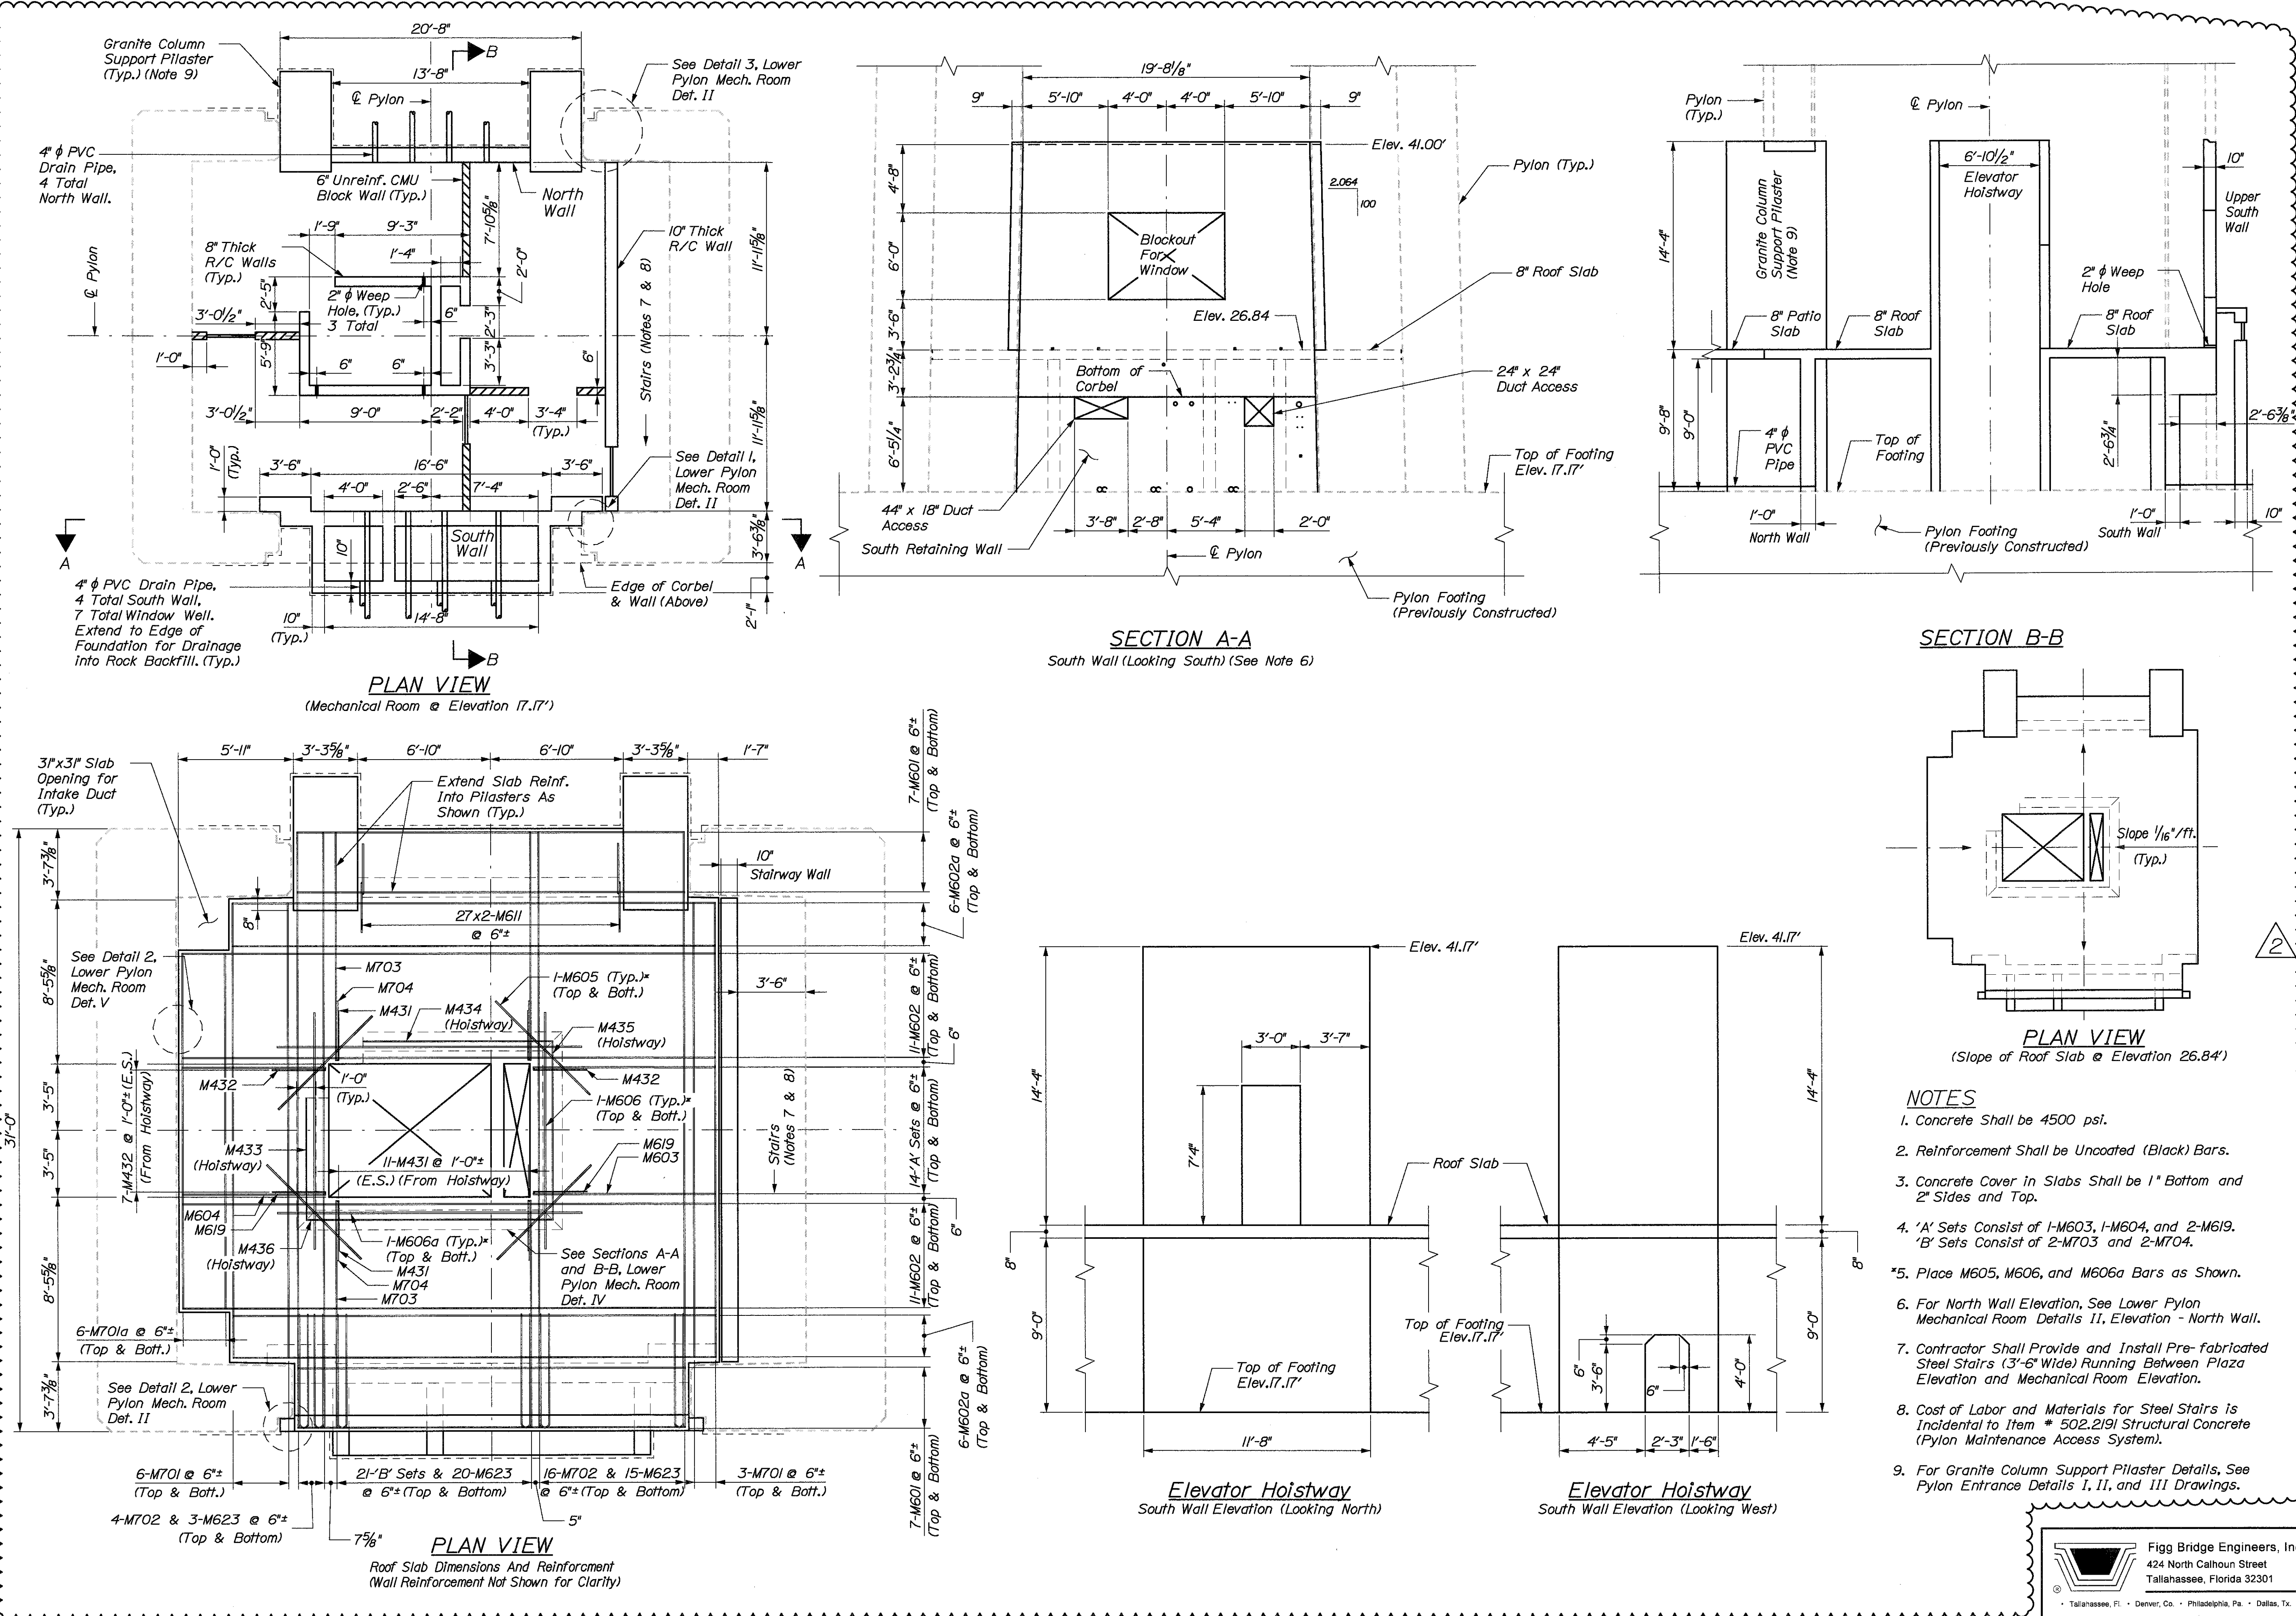


- NOTES**
- Concrete Shall be 4500 psi.
 - Reinforcement Shall be Uncoated (Black) Bars.
 - Concrete Cover in Slabs Shall be 1" Bottom and 2" Sides and Top.
 - 'A' Sets Consist of 1-M603, 1-M604, and 2-M619. 'B' Sets Consist of 2-M703 and 2-M704.
 - Place M605, M606, and M606a Bars as Shown.
 - For North Wall Elevation, See Lower Pylon Mechanical Room Details 11, Elevation - North Wall.
 - Contractor Shall Provide and Install Pre-fabricated Steel Stairs (3'-6" Wide) Running Between Plaza Elevation and Mechanical Room Elevation.
 - Cost of Labor and Materials for Steel Stairs is Incidental to Item # 502.2191 Structural Concrete (Pylon Maintenance Access System).
 - For Granite Column Support Pilaster Details, See Pylon Entrance Details 1, II, and III Drawings.


Figg Bridge Engineers, Inc.
424 North Calhoun Street
Tallahassee, Florida 32301

STATE OF MAINE DEPARTMENT OF TRANSPORTATION		BRIDGE NO. 8421 PIN 7965.55, 7965.56	
PROSPECT-VERONA BRIDGE PENOBSCOT RIVER PROSPECT/VERONA WALDO/HANCOCK CTY		LOWER PYLON MECHANICAL ROOM DET. I	
SHEET NUMBER P13		OF P15	




PROJ. MANAGER	BY	DATE	SIGNATURE	DATE
W. J. ROHLER <td>K. M. LAUGH<td>9-9-04<td>Christopher Burgess<td>10-15-04</td></td></td></td>	K. M. LAUGH <td>9-9-04<td>Christopher Burgess<td>10-15-04</td></td></td>	9-9-04 <td>Christopher Burgess<td>10-15-04</td></td>	Christopher Burgess <td>10-15-04</td>	10-15-04
DESIGN-DETAILED <td>C. BURGESS<td>9-9-04<td>P.E. NUMBER<td></td></td></td></td>	C. BURGESS <td>9-9-04<td>P.E. NUMBER<td></td></td></td>	9-9-04 <td>P.E. NUMBER<td></td></td>	P.E. NUMBER <td></td>	
CHECKED-REVIEWED <td><td><td>10624<td></td></td></td></td>	<td><td>10624<td></td></td></td>	<td>10624<td></td></td>	10624 <td></td>	
DESIGN-DETAILED <td><td><td><td></td></td></td></td>	<td><td><td></td></td></td>	<td><td></td></td>	<td></td>	
REVISIONS 1 <td><td><td><td></td></td></td></td>	<td><td><td></td></td></td>	<td><td></td></td>	<td></td>	
REVISIONS 2 <td><td><td><td></td></td></td></td>	<td><td><td></td></td></td>	<td><td></td></td>	<td></td>	
REVISIONS 3 <td><td><td><td></td></td></td></td>	<td><td><td></td></td></td>	<td><td></td></td>	<td></td>	
REVISIONS 4 <td><td><td><td></td></td></td></td>	<td><td><td></td></td></td>	<td><td></td></td>	<td></td>	
FIELD CHANGES <td><td><td><td></td></td></td></td>	<td><td><td></td></td></td>	<td><td></td></td>	<td></td>	

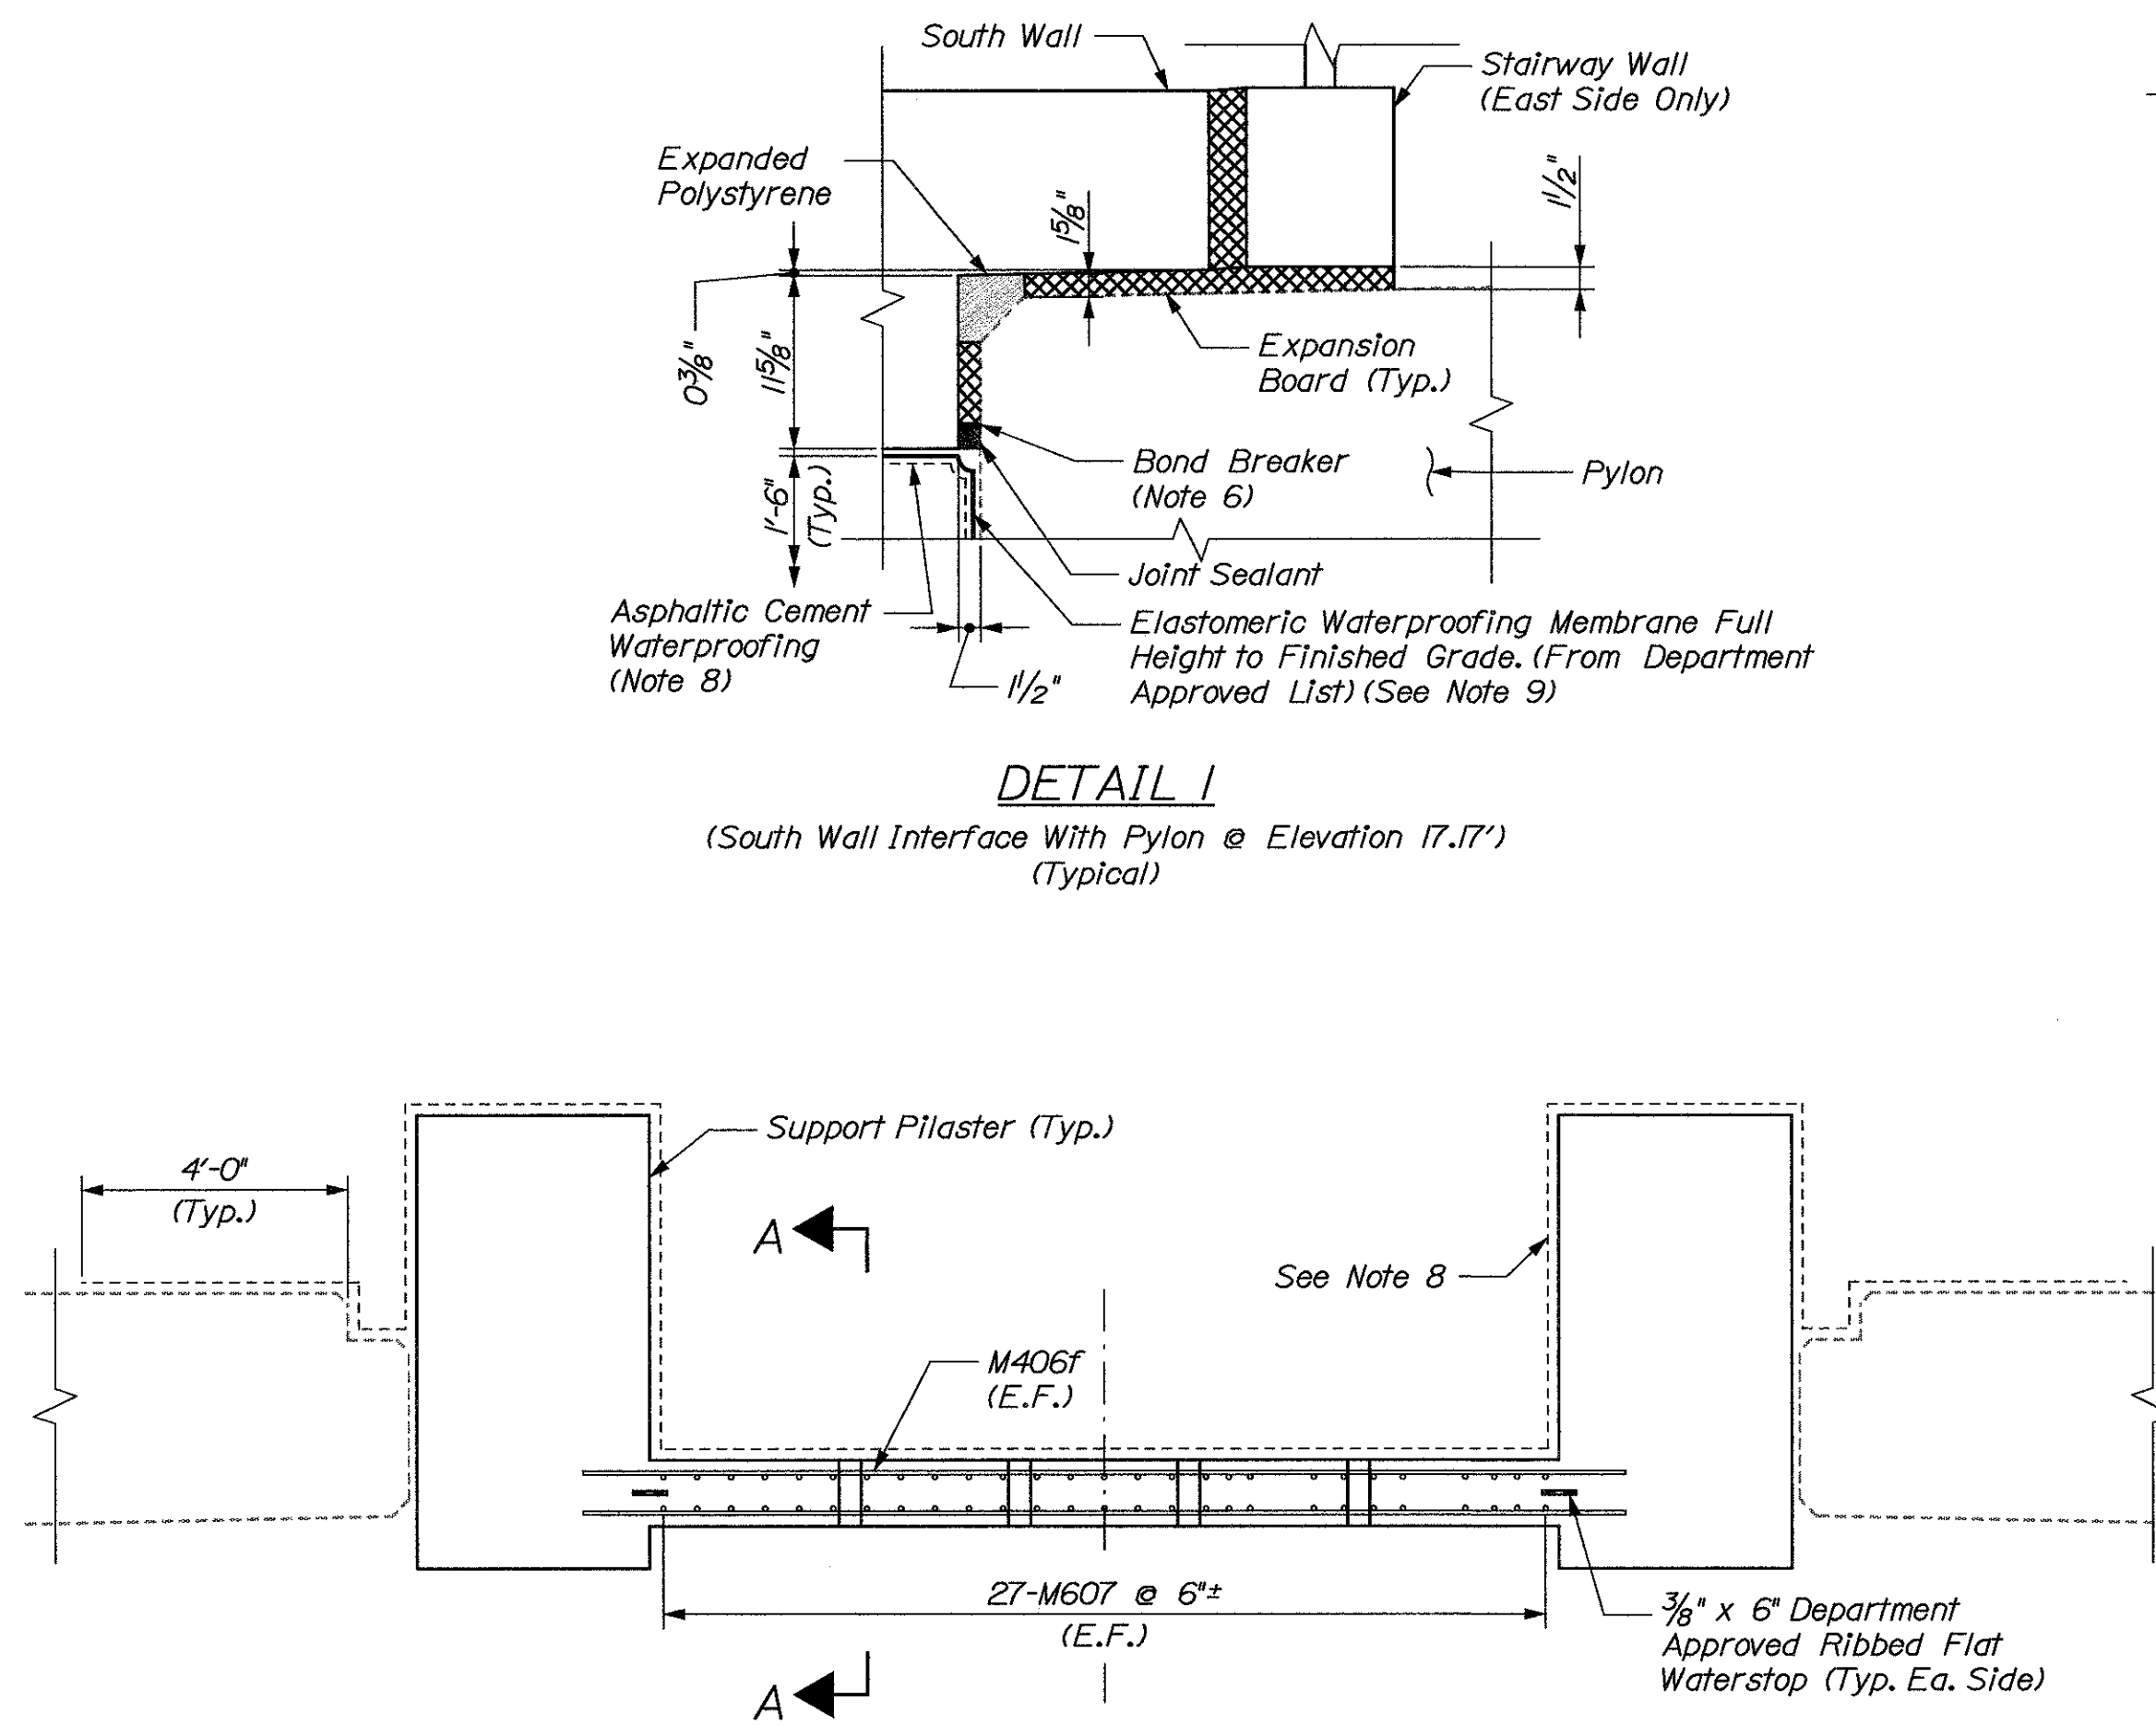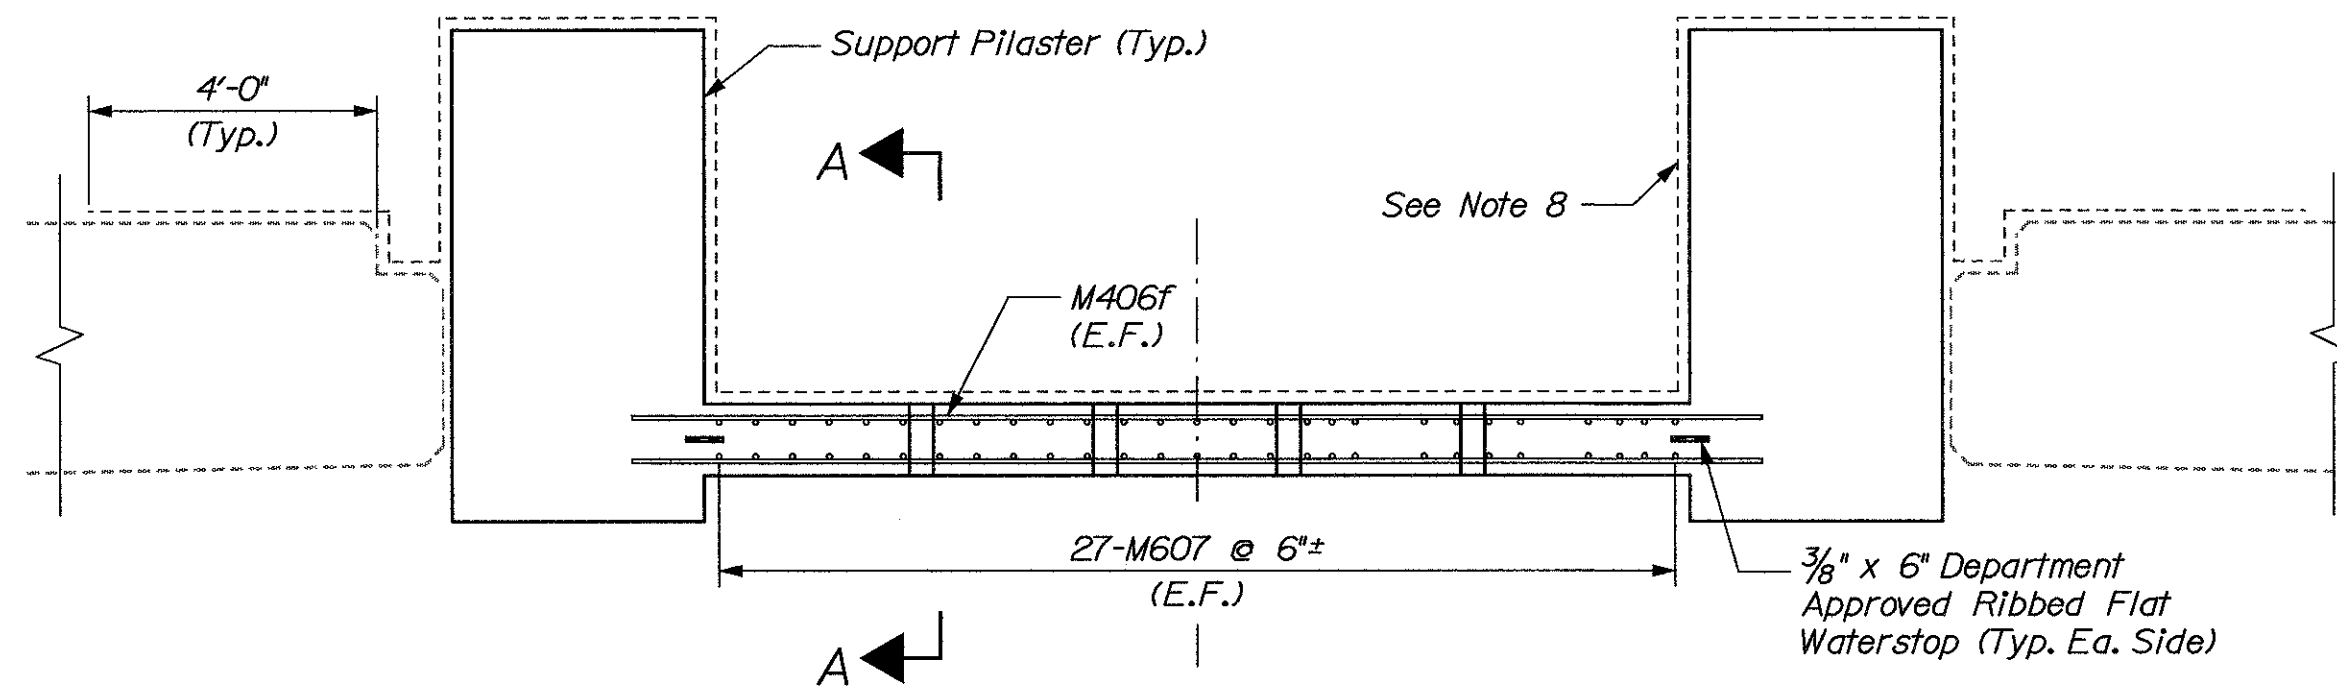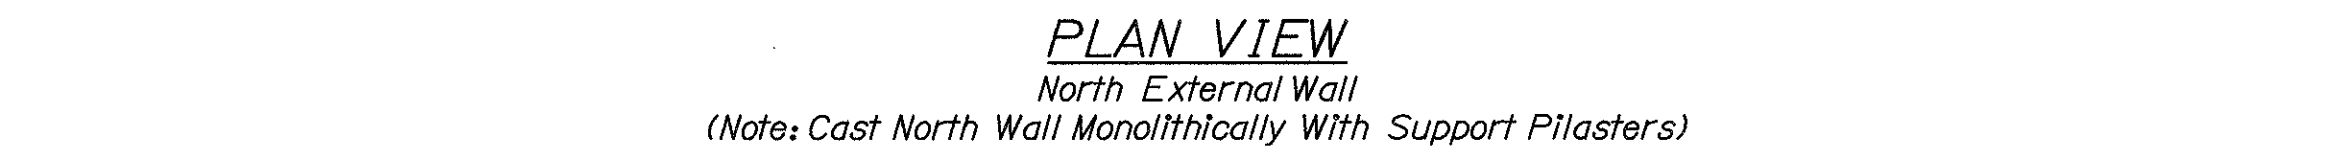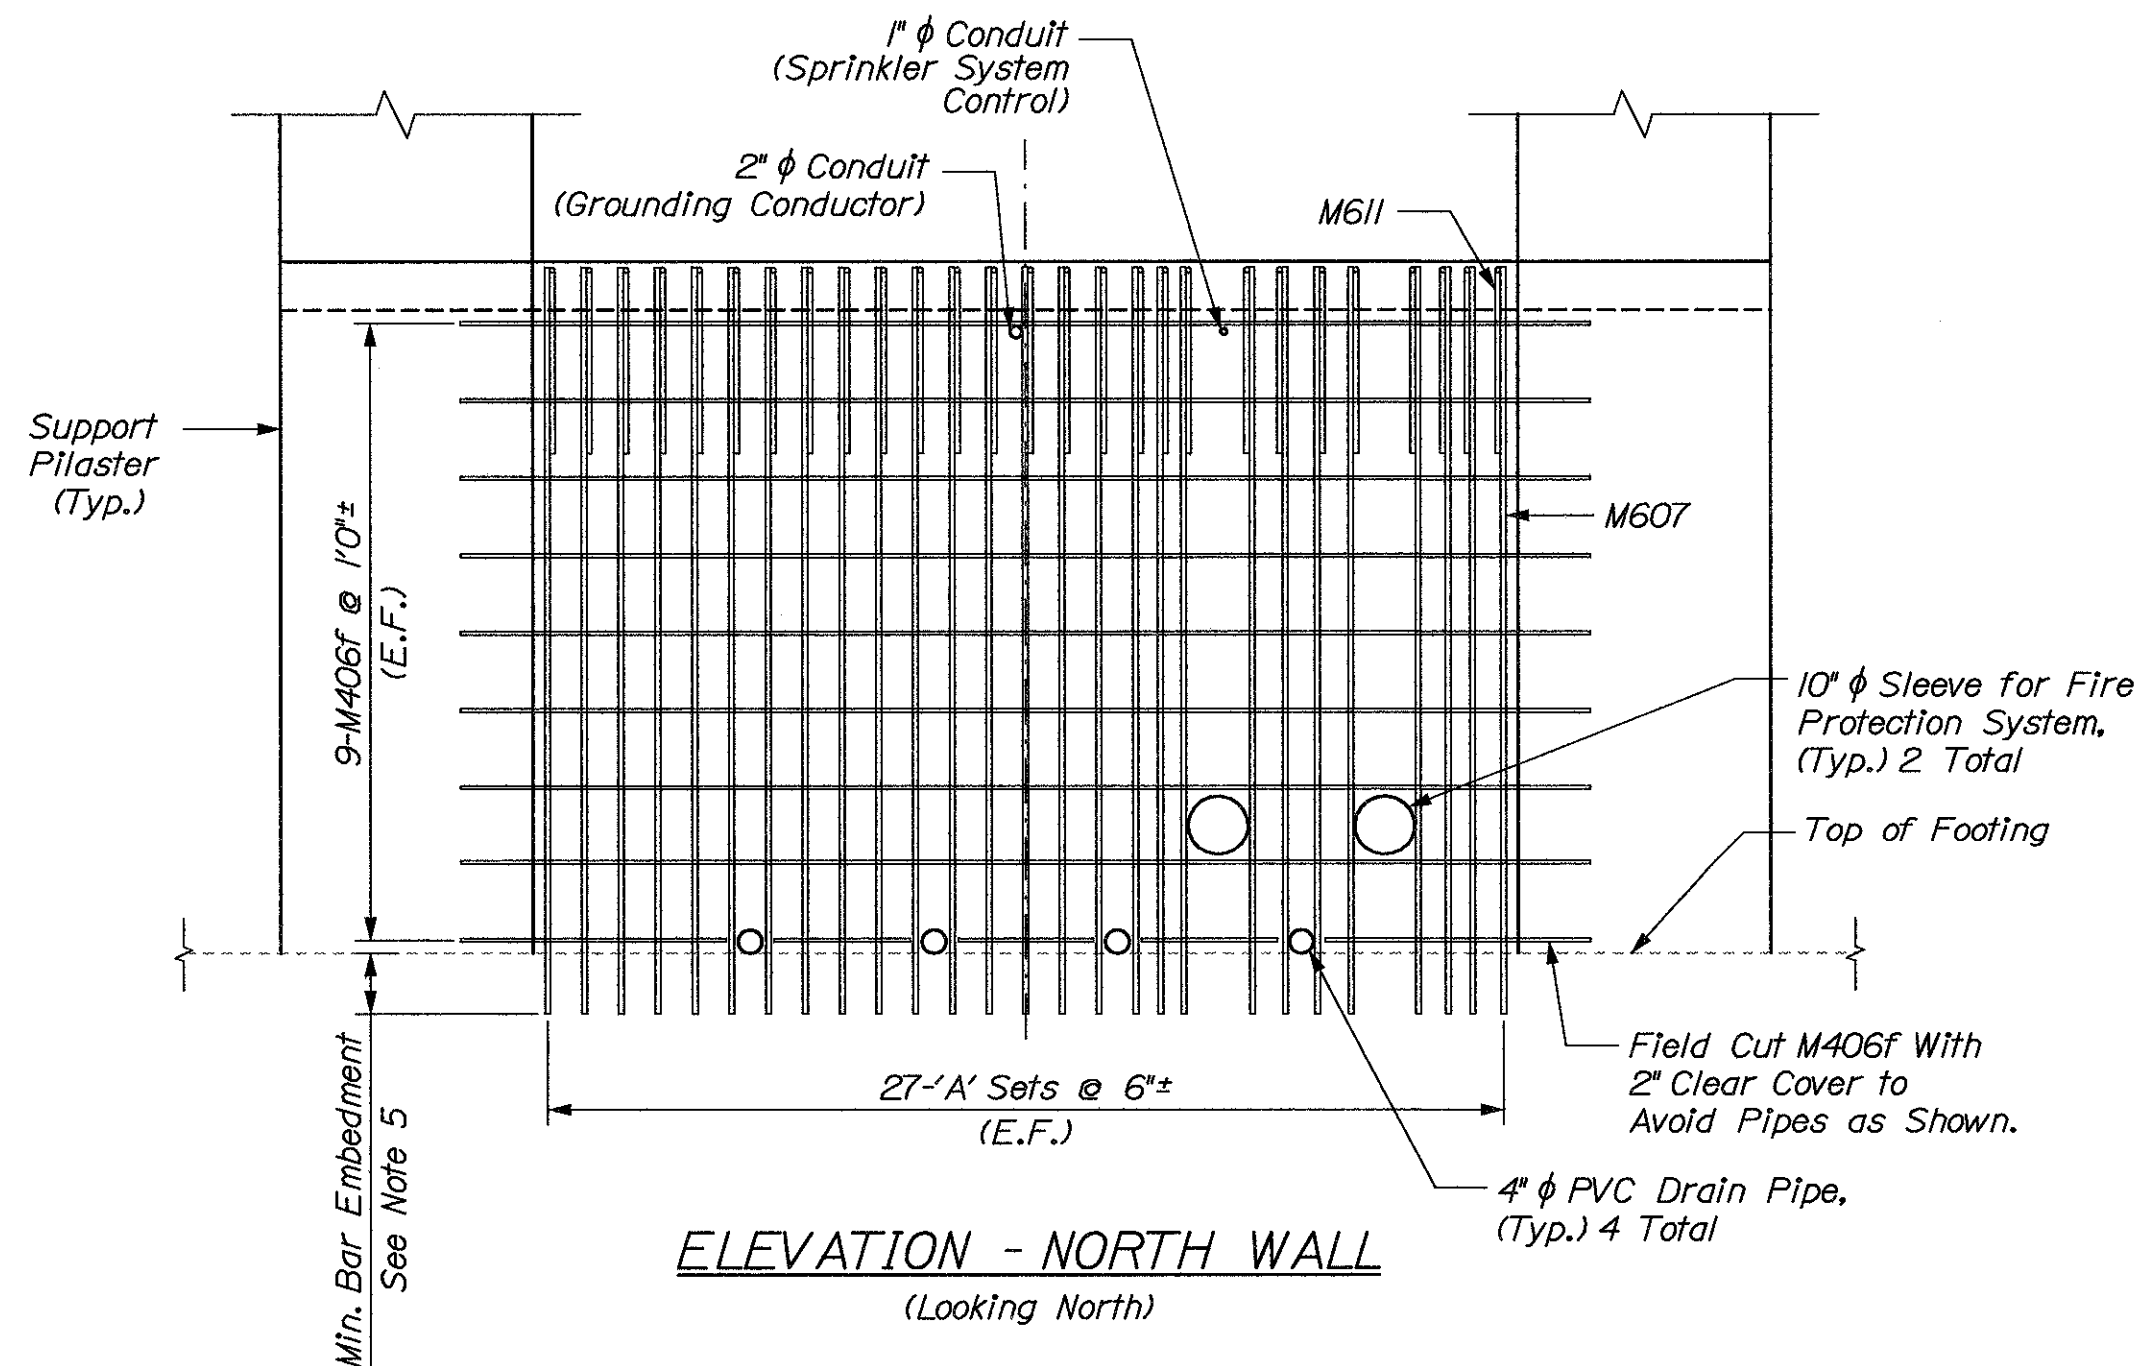**DETAIL 1**(South Wall Interface With Pylon @ Elevation 17.17')
(Typical)**DETAIL 2**(Upper South Wall Interface With Pylon)
(Typical)**PLAN VIEW**North External Wall
(Note: Cast North Wall Monolithically With Support Pilasters)**ELEVATION - NORTH WALL**


(Looking North)

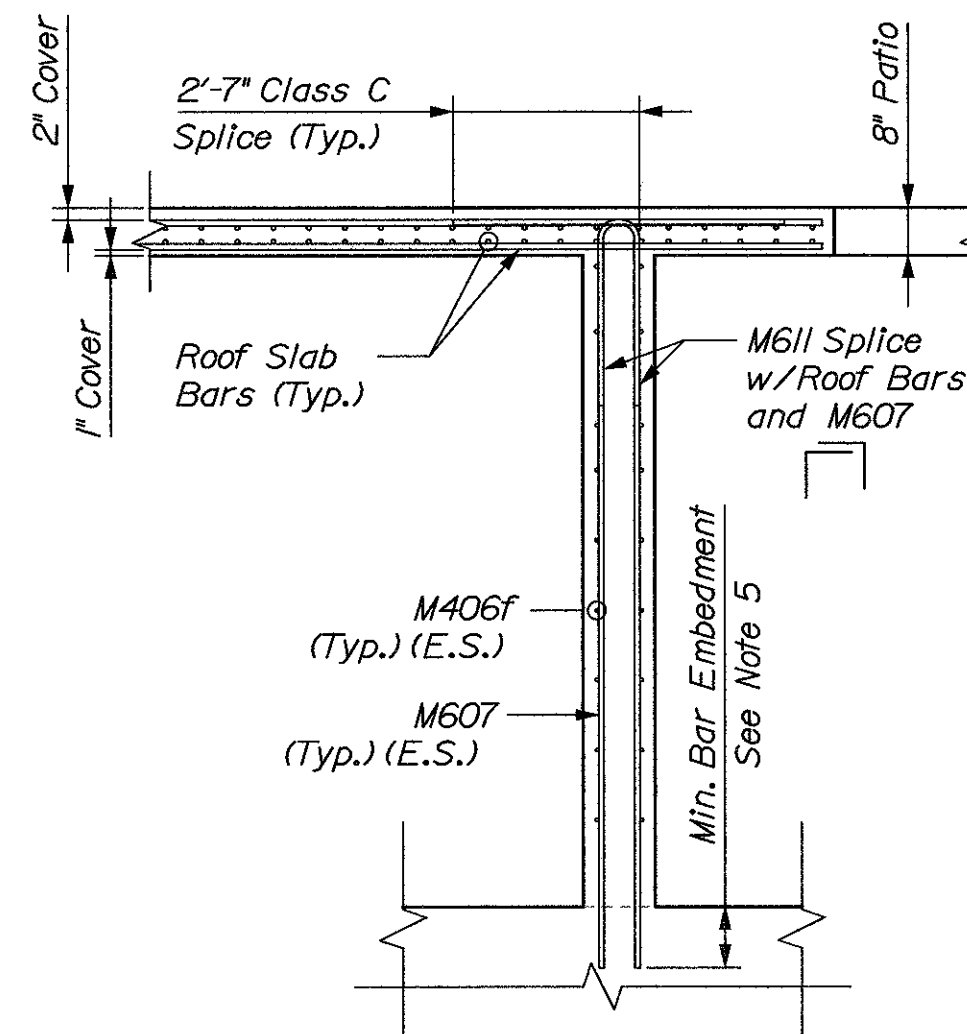**SECTION A-A - NORTH WALL****NOTES:**

- Concrete Shall be 4500 psi.
- Reinforcement Shall be Uncoated (Black) Bars.
- Concrete Cover Shall be 2" Unless Otherwise Noted.
- Expanding Waterstop Shall Consist of 75% Sodium Bentonite and 25% Butyl Rubber and Shall be Installed per Manufacturer's Directions. Material Certificate Shall be Submitted to the Department for Approval.
- Embed M607 Dowels Into Top of Pylon with Adhesive Anchor System From Department Approved List. Embedment Shall Develop the Full Tensile Strength of the Bars.
- Bond Breaker Shall be Applied per Manufacturer's Directions. Material Certificate Shall be Submitted to the Department for Approval.

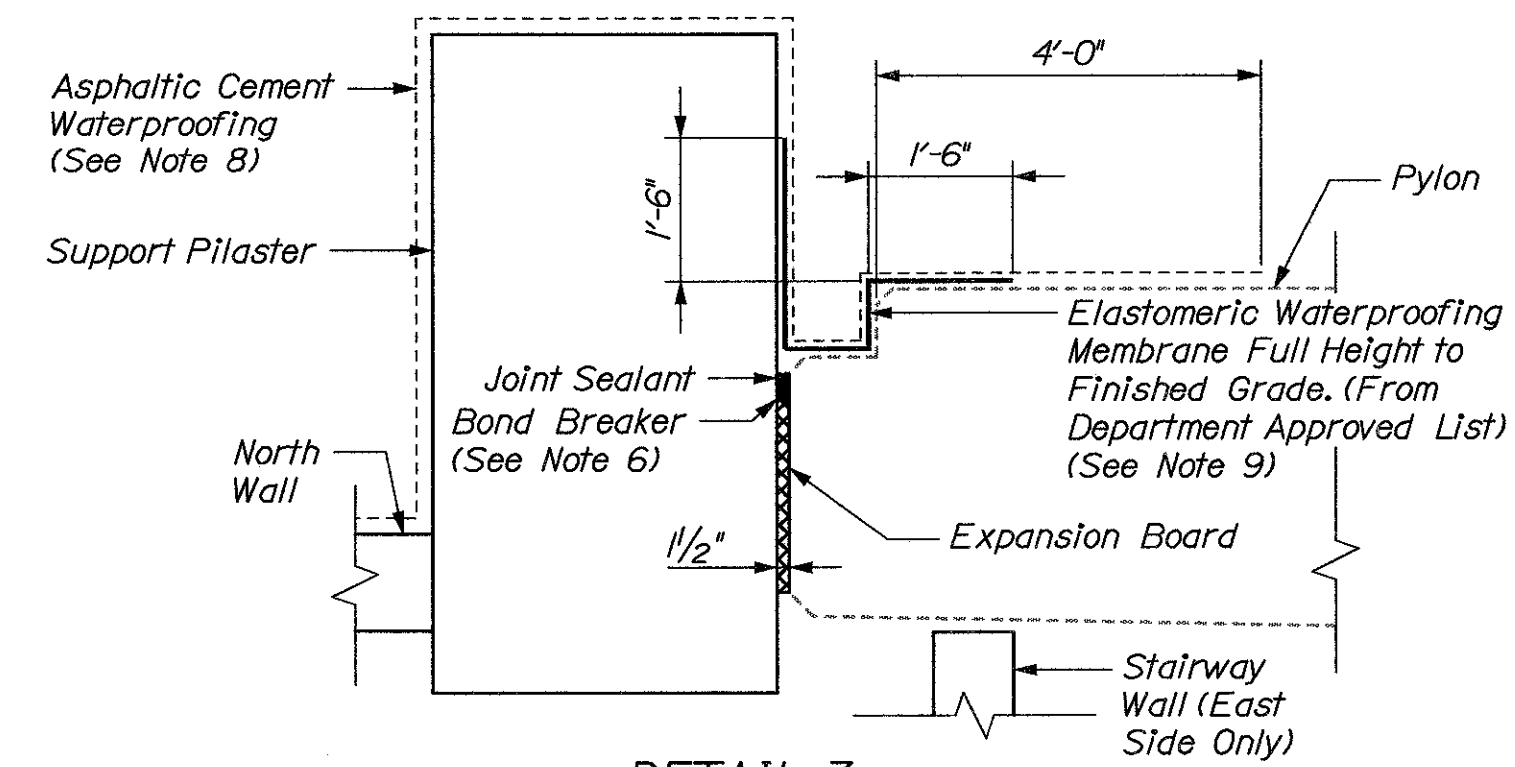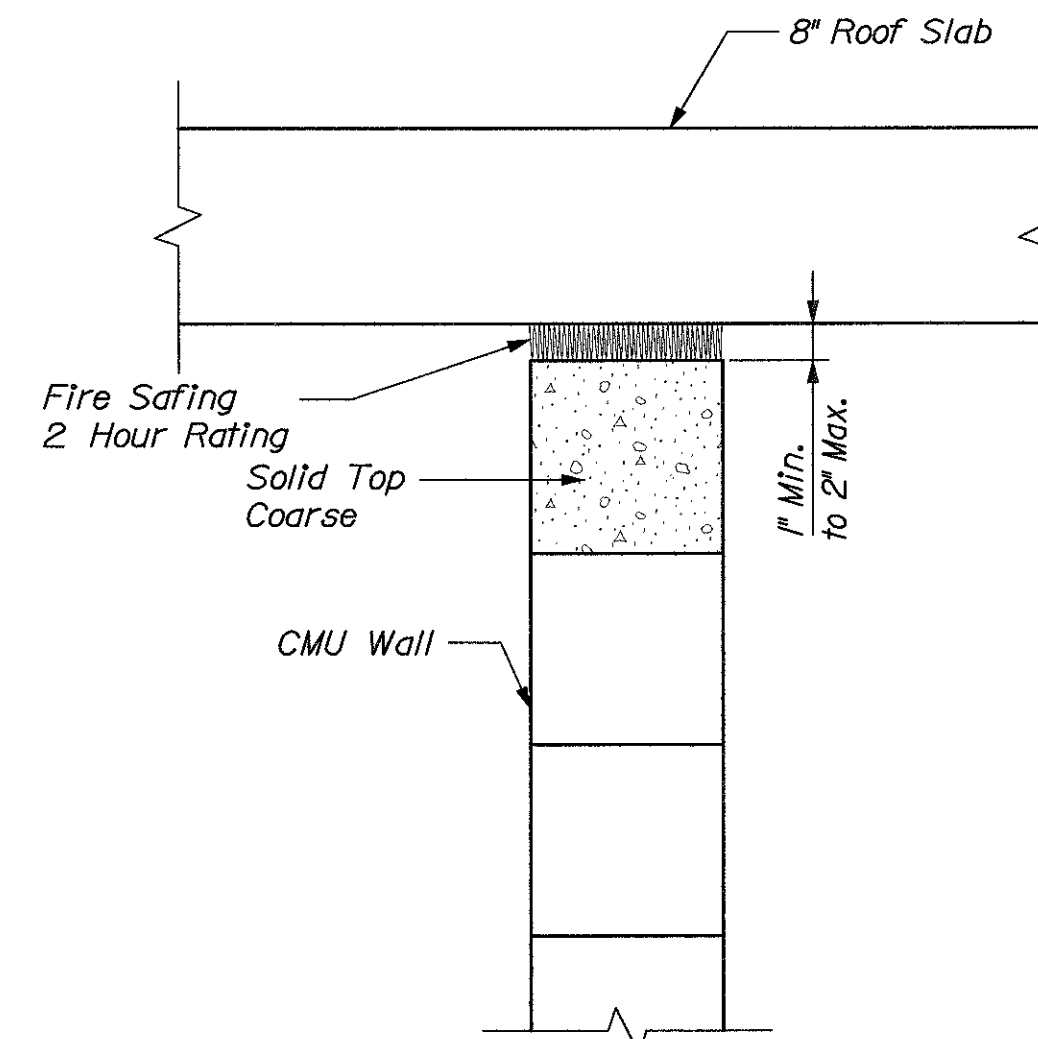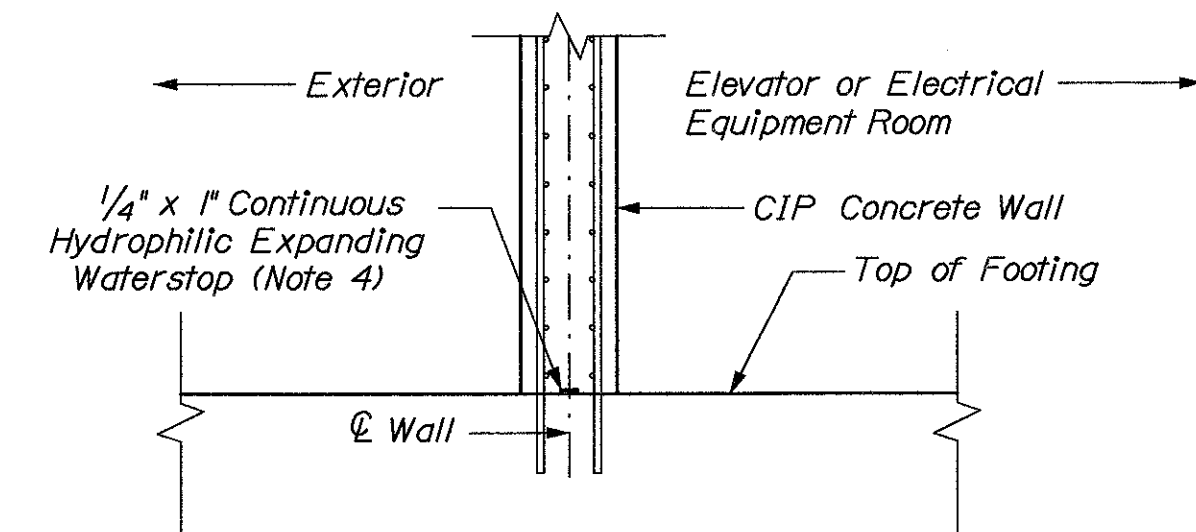**DETAIL 3**(North Wall Interface With Pilaster and Pylon)
(Typical)**DETAIL 4**(Roof Slab to CMU Wall Connection)
(Typical)**WATERSTOP AT NORTH AND SOUTH WALLS**

- 'A' Set Consists of: I-M607 and I-M611.
- Apply Asphaltic Cement Waterproofing to Entire Surface of All Walls Below Finished Grade to the Limits Shown.
- Adhere Membrane to Concrete With Adhesive Full Height in Indicated Regions Only, Using Department Approved Materials and Procedures. Membrane Shall be Free to Move in Corners as Shown.
- Contractor Shall Coordinate Exact Location and Size of All Wall Penetrations With Architectural (and Mechanical) and Electrical Requirements.

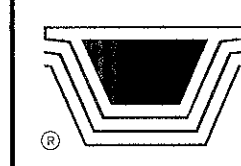

Figg Bridge Engineers, Inc.
424 North Calhoun Street
Tallahassee, Florida 32301


Tallahassee, FL • Denver, CO • Philadelphia, Pa. • Dallas, TX •

STATE OF MAINE DEPARTMENT OF TRANSPORTATION		BRIDGE NO. 6421		PIN 7965.55, 7965.56		BRIDGE PLANS	
PROSPECT-VERONA BRIDGE PENOBSCOT RIVER PROSPECT/VERONA WALDO/HANCOCK CTY		DATE 9-9-04 9-9-04		BY E. ADAMS C. BURGESS		DESIGN-REVIEWED C. BURGESS	
LOWER PYLON MECHANICAL ROOM DET. II		DATE 9-23-04 10-15-04		BY NOTES, REBARS, SECTIONS ENTIRE SHEET		DESIGN-REVIEWED C. BURGESS	
SHEET NUMBER P14		DATE 10-15-04		P.E. NUMBER 1500-04		FIELD CHANGES	

Filename: ...P14a_LowerPylon_Mech_Room_Det III.dwg
Date: 10/14/2004


Username: sfall

BRIDGE

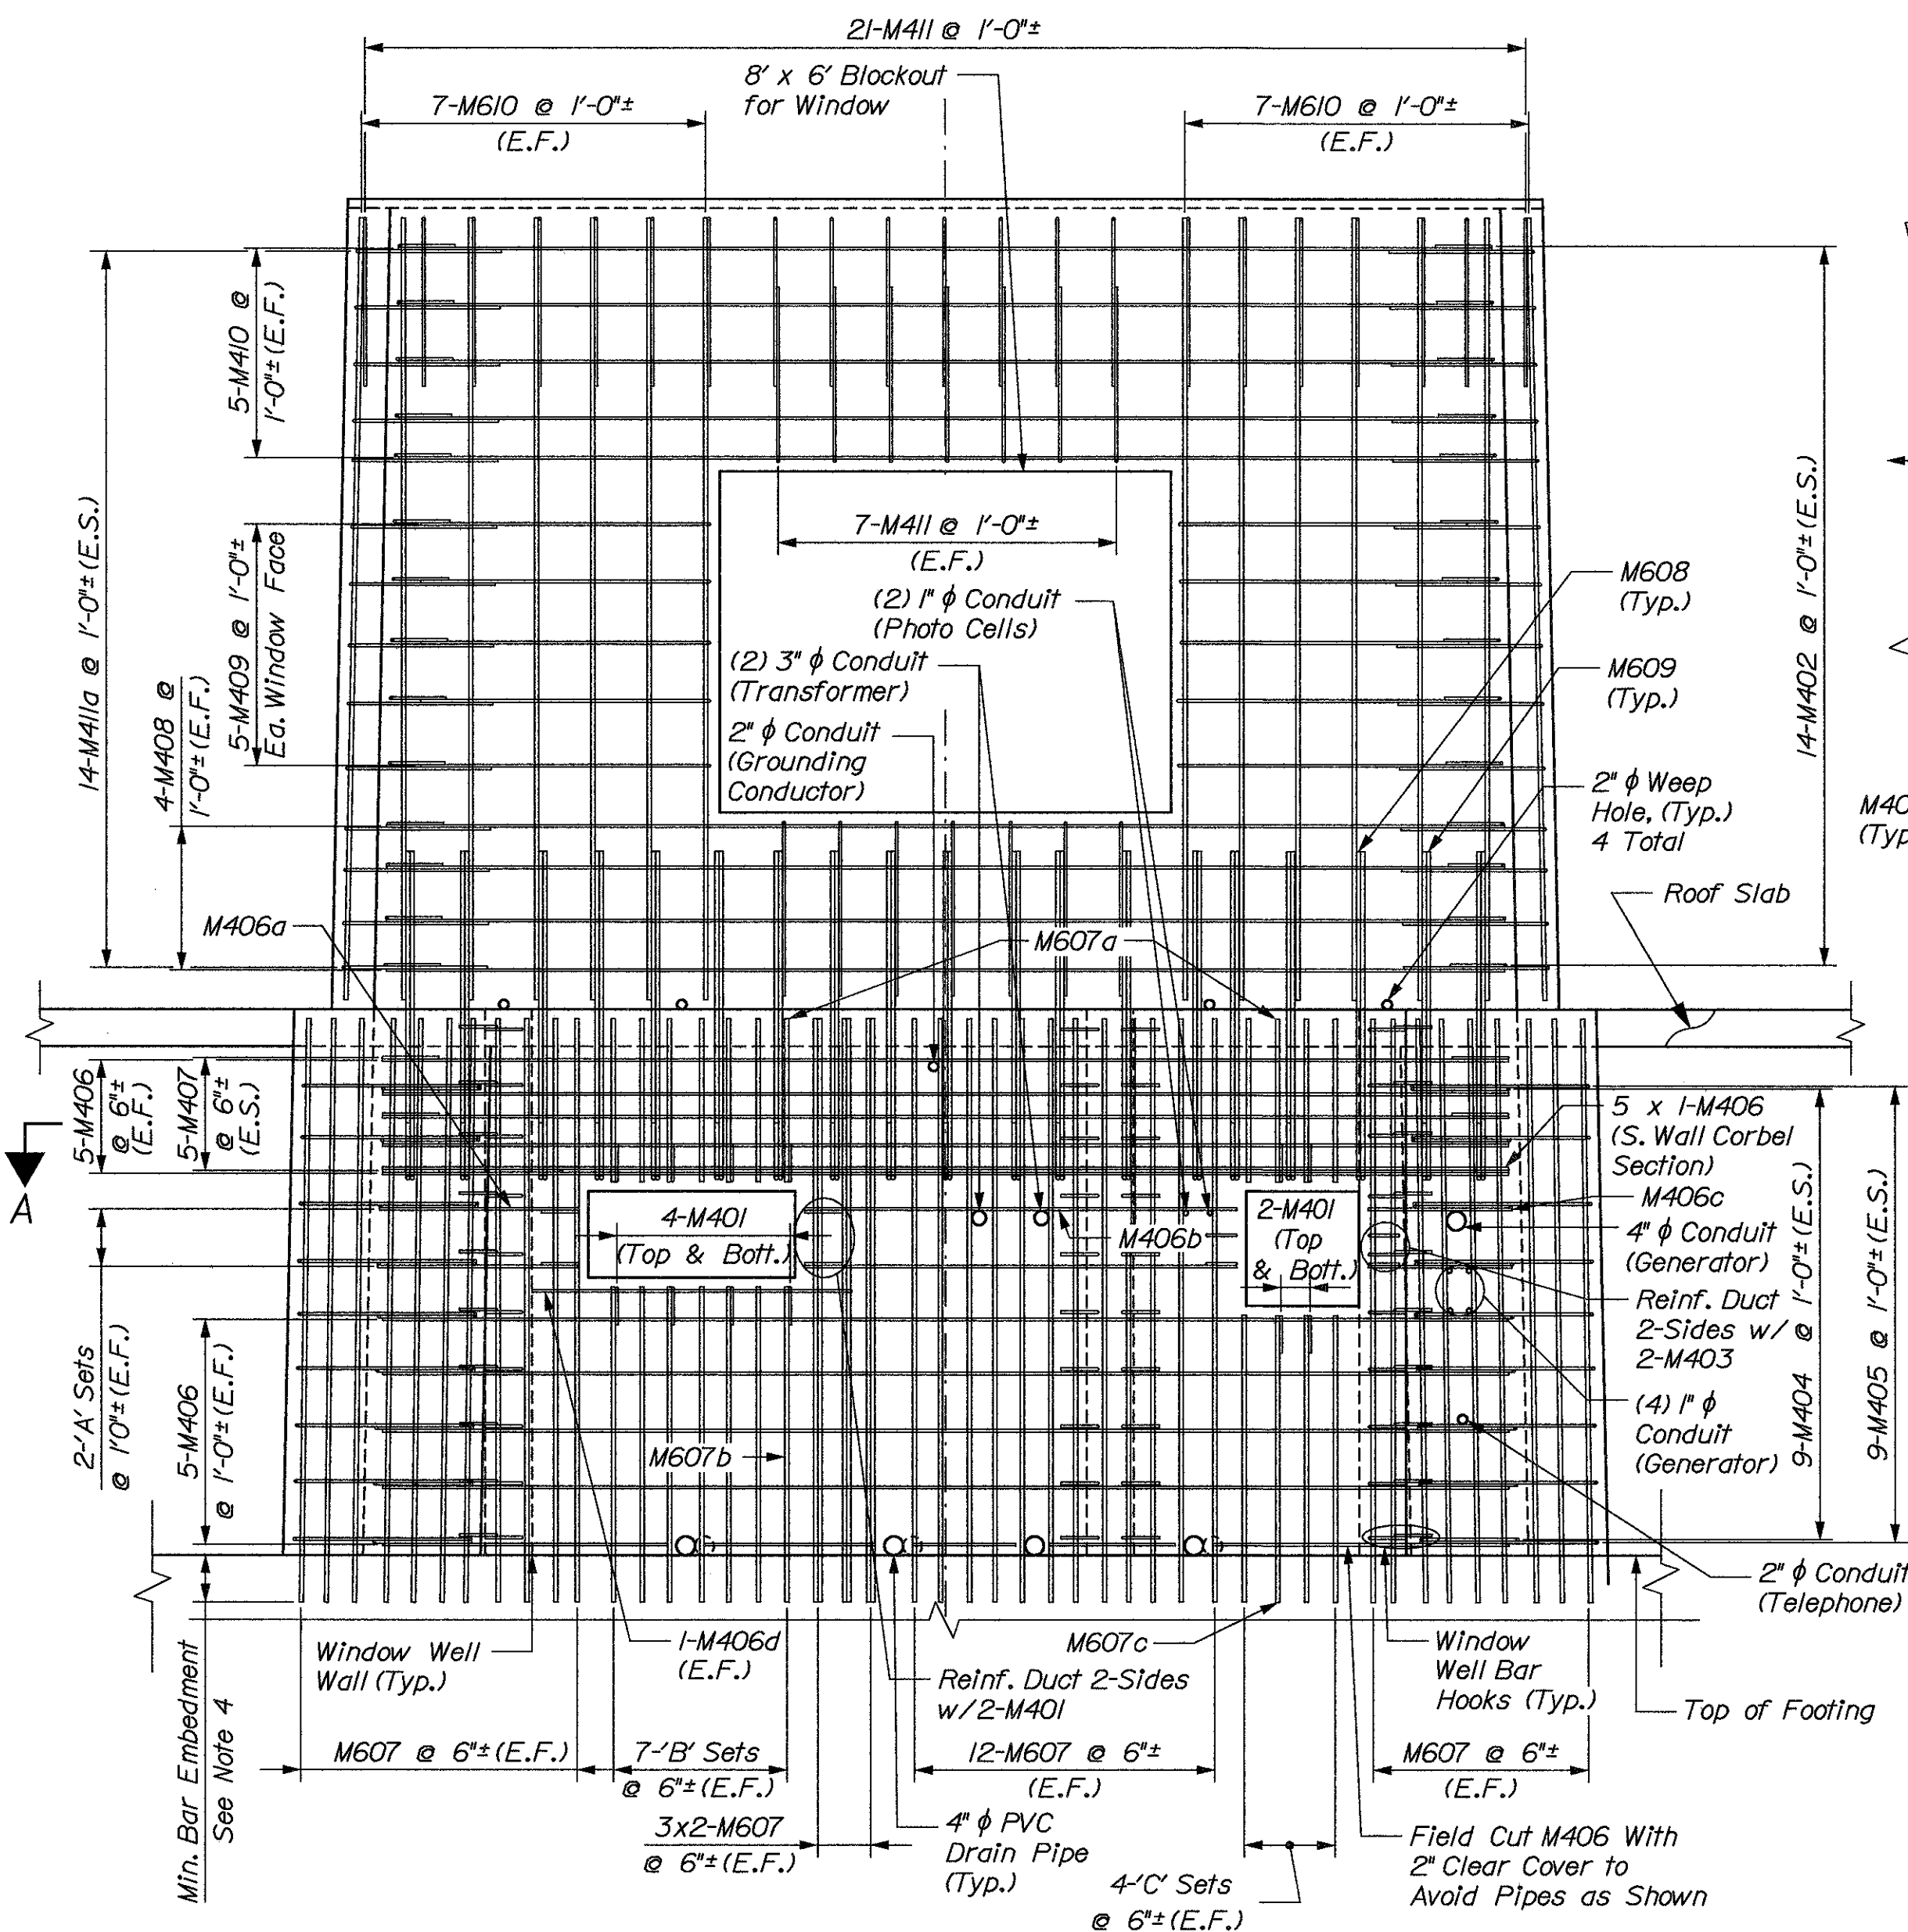


ELEVATION - SOUTH WALL


(Looking South) (Window Well Reinforcement Not Shown for Clarity)

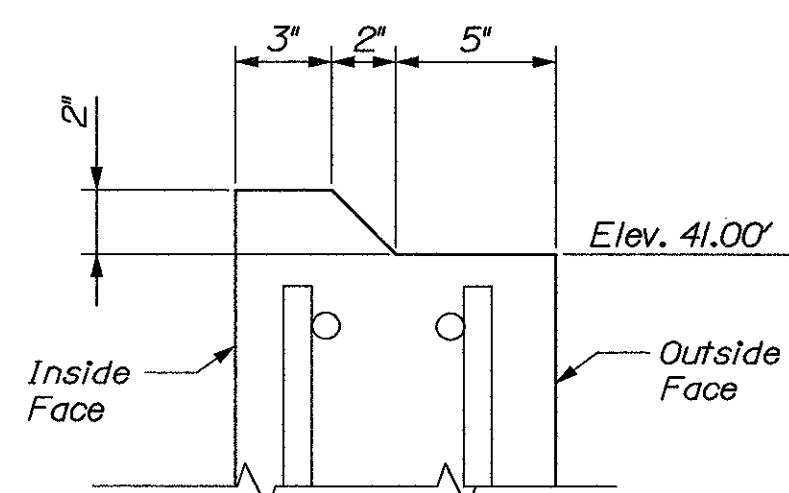

DETAIL I
(Top of South Wall)

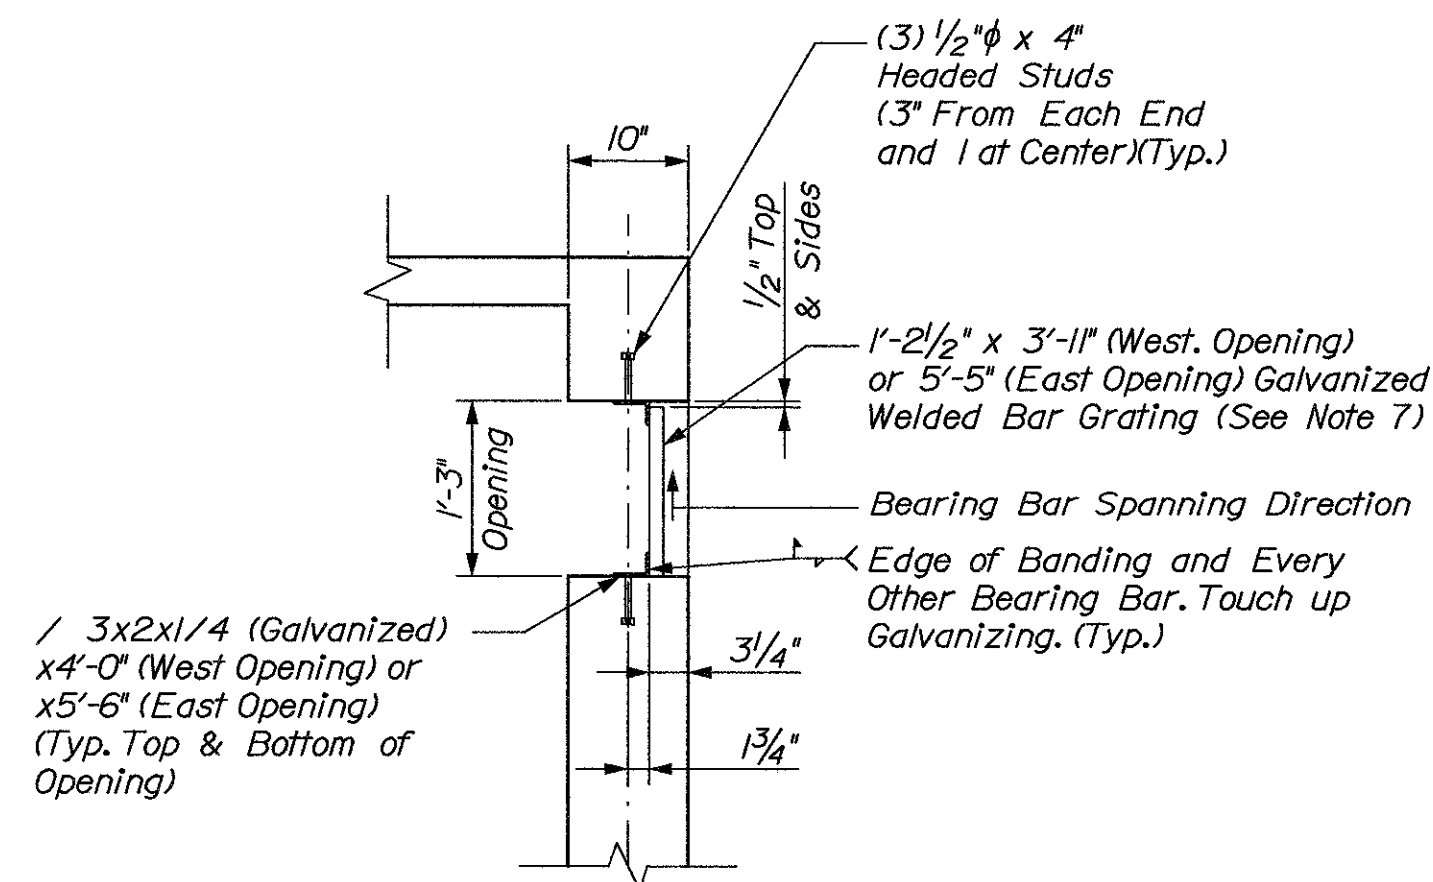


SOUTH WALL GRATING DETAIL
(Mechanical Room Exhaust Air)

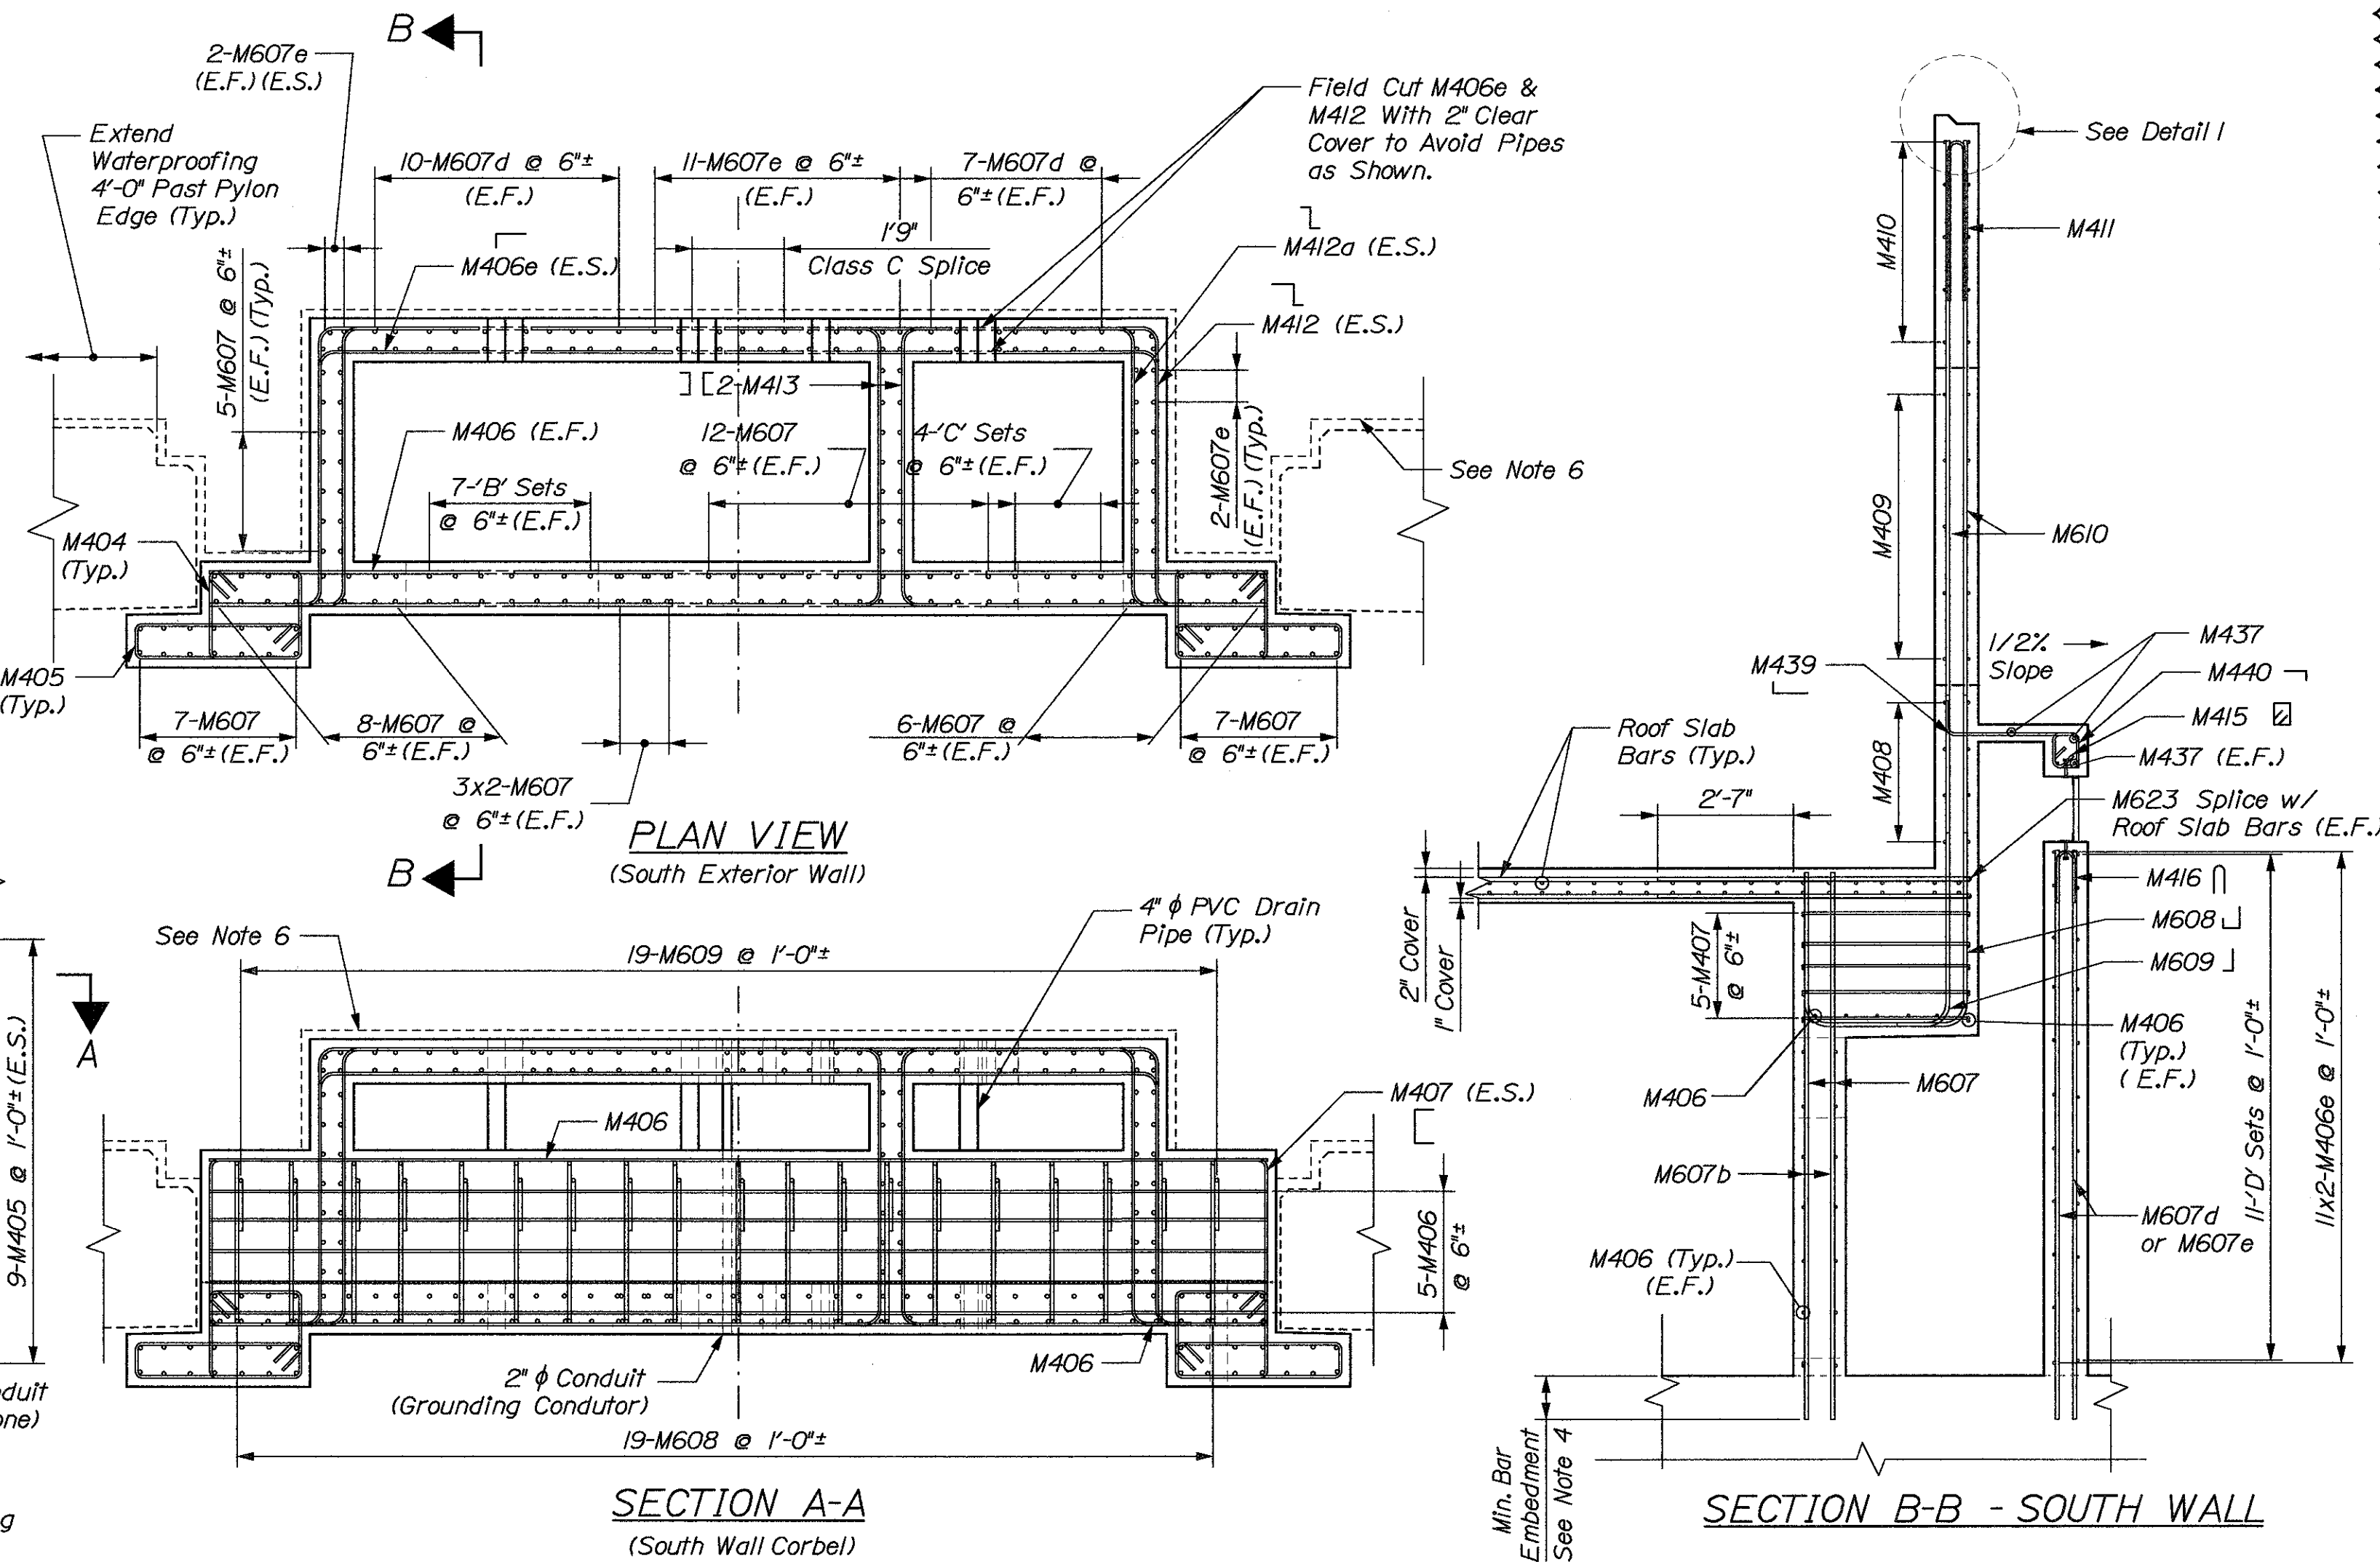

SECTION A-A
(South Wall Corbel)


SECTION B-B - SOUTH WALL

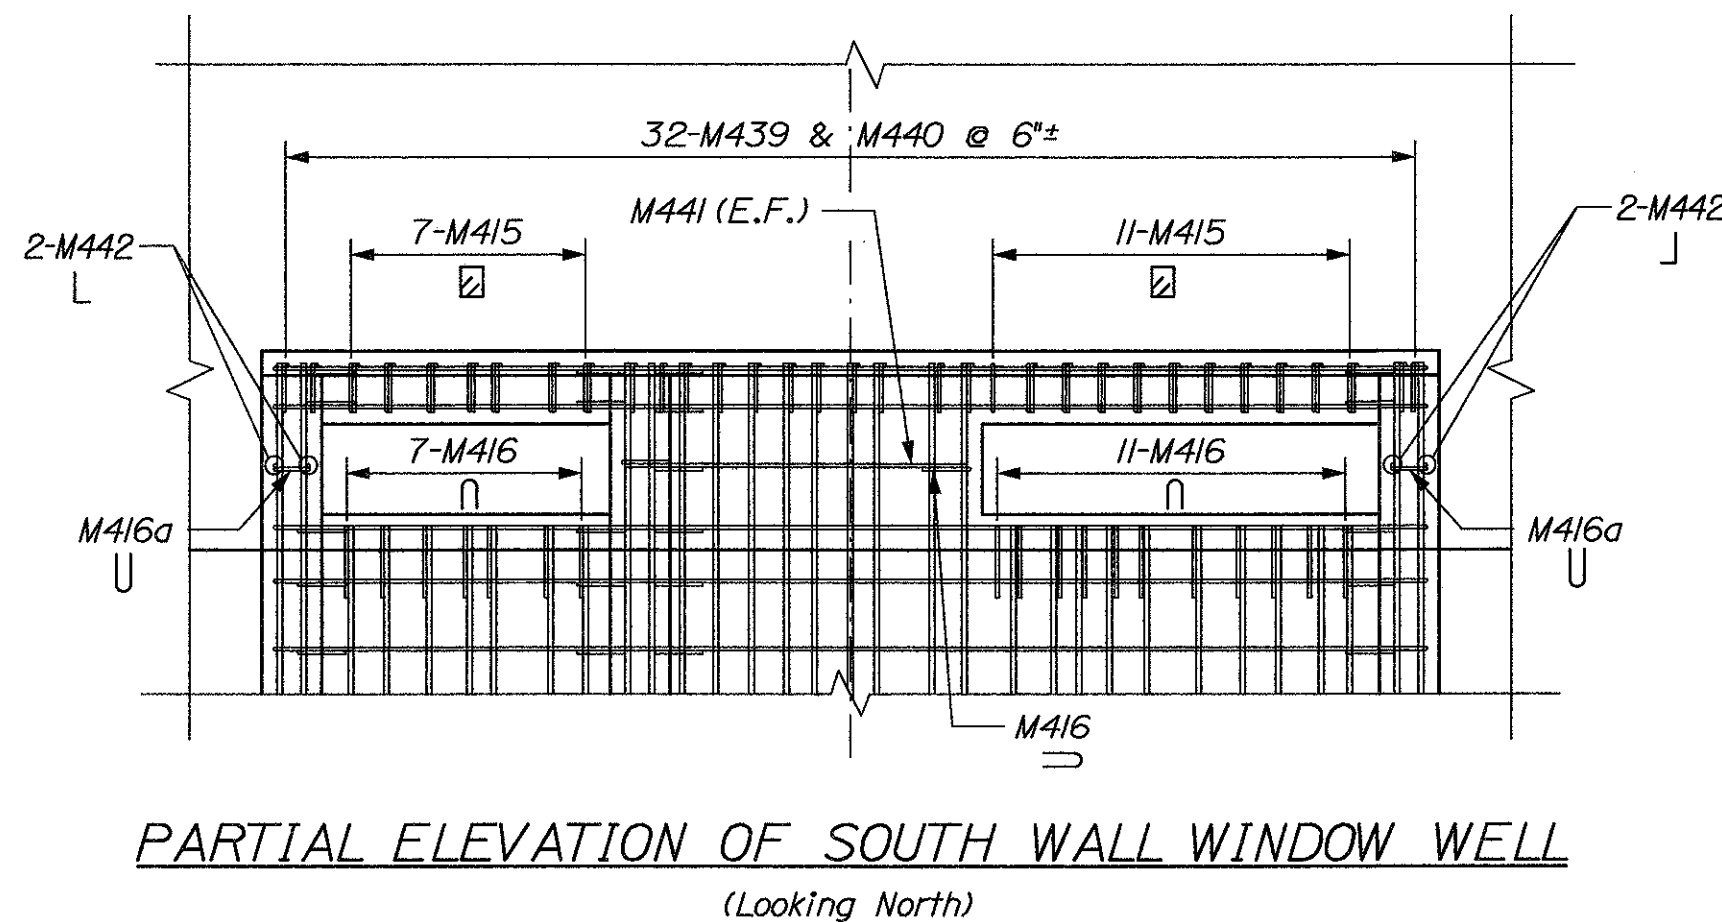

PARTIAL ELEVATION OF SOUTH WALL WINDOW WELL
(Looking North)


NOTES:

- Concrete Shall be 4500 psi.
- Reinforcement Shall be Uncoated (Black) Bars.
- Concrete Cover Shall be 2" Unless Otherwise Noted.
- Embed M607, M607b, and M607c Dowels Into Top of Pylon With Adhesive Anchor System From Department Approved List. Embedment Shall Develop the Full Tensile Strength of the Bars.
- 'A' Set Consists of: 1-M406a, 1-M406b, and 1-M406c.
'B' Set Consists of: 1-M607a and 1-M607b.
'C' Set Consists of: 1-M607a and 1-M607c.
'D' Set Consists of: 2-M412 and 2-M412a.
- Apply Asphaltic Cement Waterproofing to Entire Surface of All Walls Below Finished Grade to the Limits Shown.
- Bar Grating Shall be Galvanized Steel Welded Type With 1" x 3/16" Bearing Bars 13/16" on Center, With Cross Bars 4" on Center. All Edges Shall be Banded. Weld Grating to Support Angles as Shown.
- All Wall Penetrations Shall be Sealed Watertight.
- Contractor Shall Coordinate Exact Location and Size of All Wall Penetrations With Architectural (and Mechanical) and Electrical Requirements.

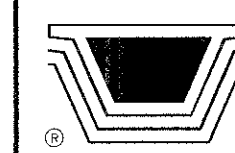

Figg Bridge Engineers, Inc.
424 North Calhoun Street
Tallahassee, Florida 32301
Tallahassee, FL • Denver, CO • Philadelphia, PA • Dallas, TX •

STATE OF MAINE
DEPARTMENT OF TRANSPORTATION

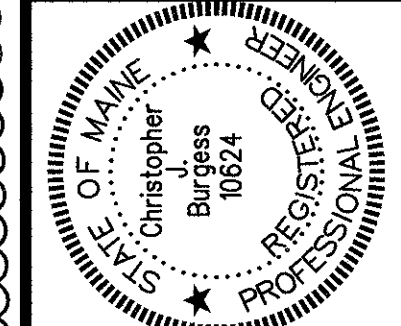

PROJECT-VERONA BRIDGE
PENOBSCOT RIVER
PROSPECT/VERONA WALDO/HANCOCK CTY
MECHANICAL ROOM DET. III

PROJ. MANAGER	W. JOHLEPER	BY	DATE
DESIGN-DETAILED	E. ADAMS	E. ADAMS	9-9-04
CHECKED-REVIEWED	C. BURRESS	C. BURRESS	9-9-04
DESIGN-DETAILED	C. BURRESS	C. BURRESS	9-9-04
REVISIONS	1	ENTIRE SHEET	10-15-04
REVISIONS	2		
REVISIONS	3		
REVISIONS	4		
FIELD CHANGES			




PROSPECT-VERONA BRIDGE
PENOBSCOT RIVER
PROSPECT/VERONA WALDO/HANCOCK CTY
MECHANICAL ROOM DET. III

SHEET NUMBER

P14A


OF P15

BRIDGE NO. 6421
PIN
7965.55, 7695.56
BRIDGE PLANS

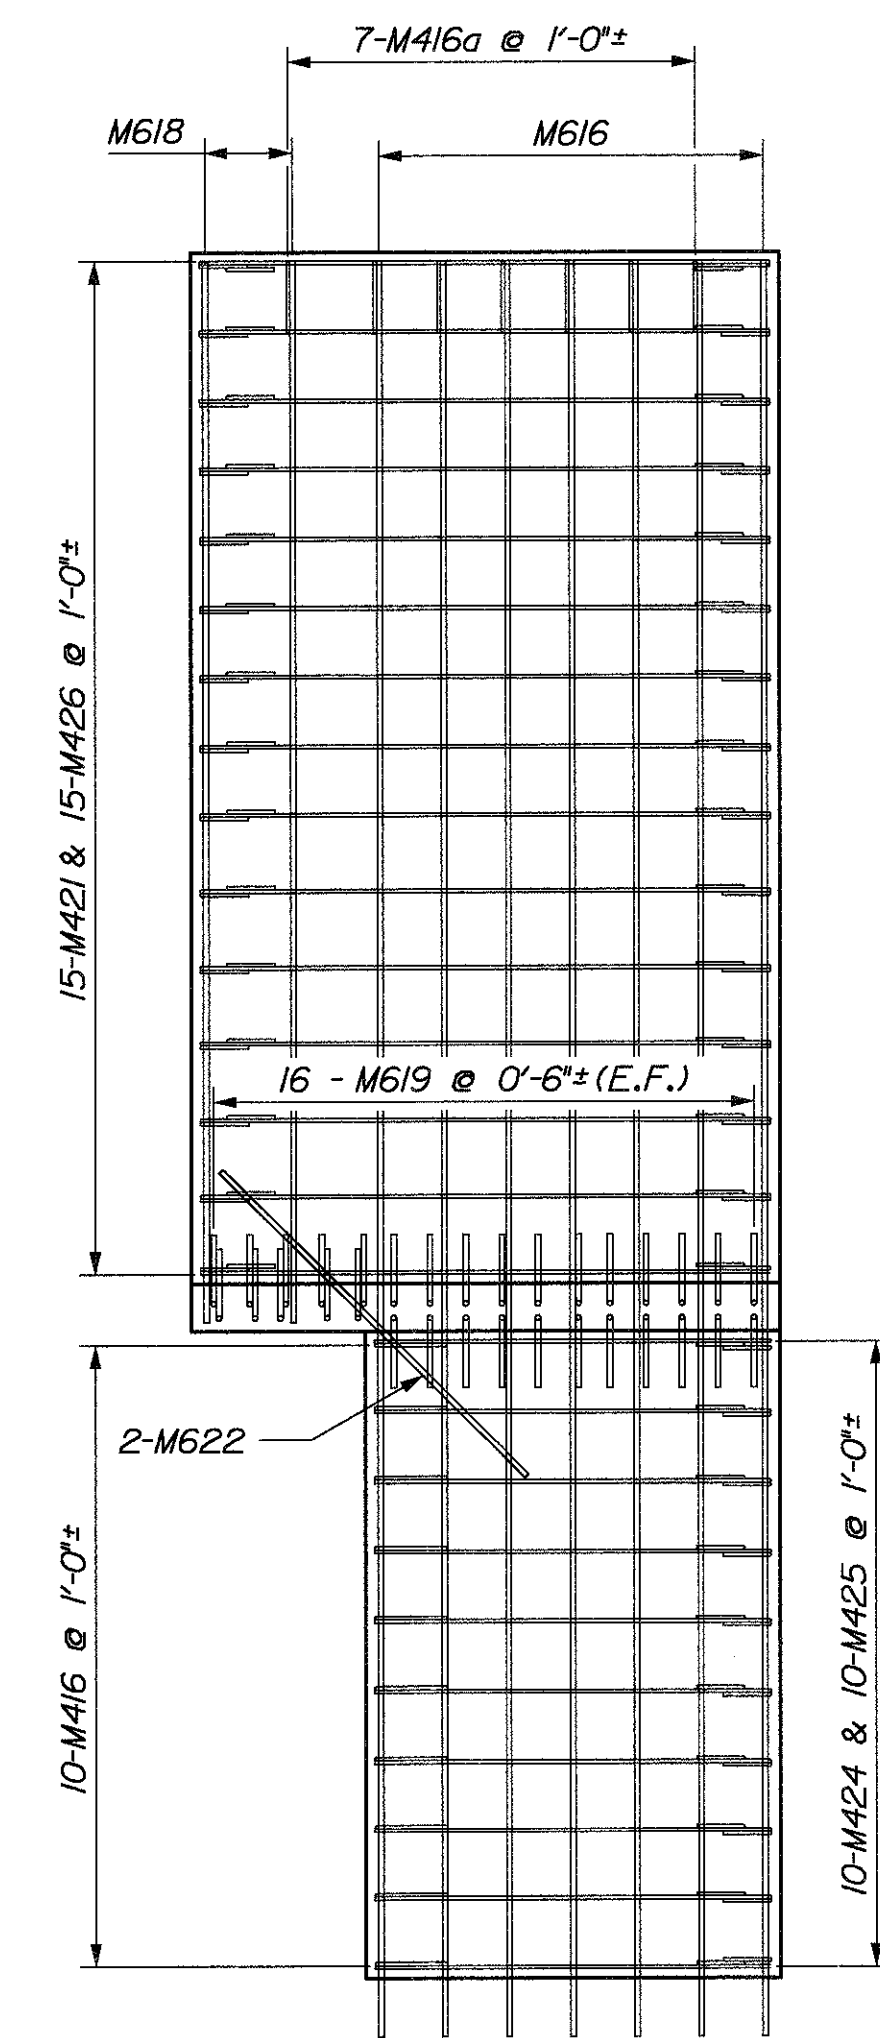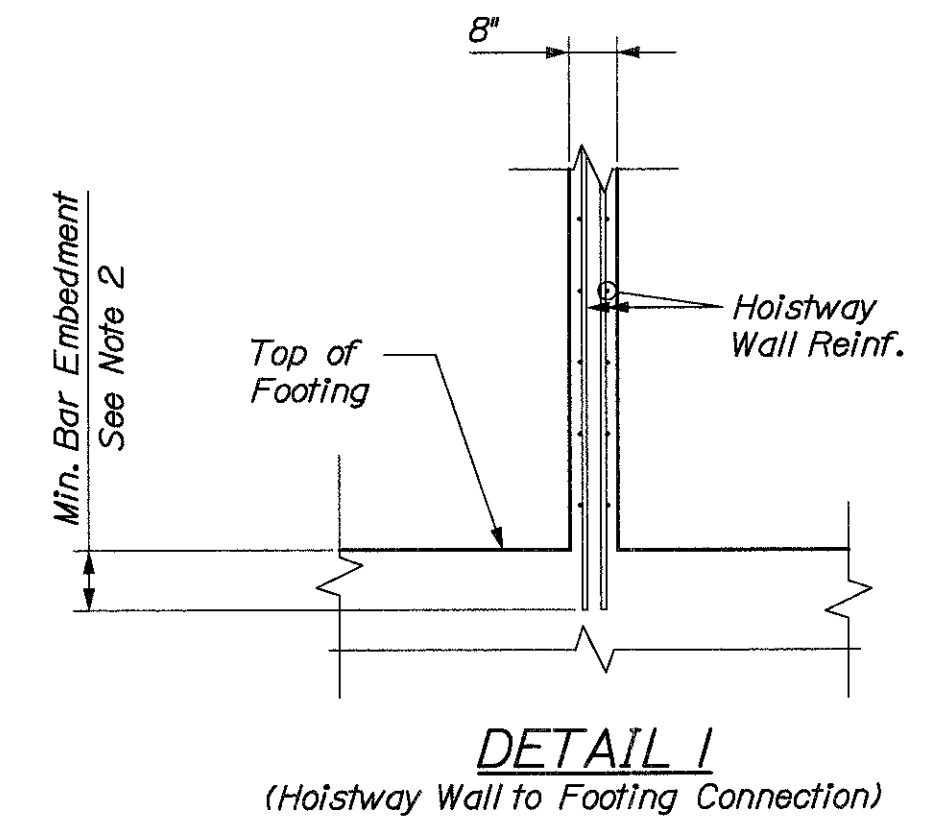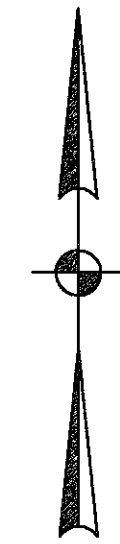






WEST HOISTWAY WALL

1. Contractor Shall Coordinate Exact Location and Size of All Wall Penetrations With Architectural (and Mechanical) and Electrical Requirements.
2. Embed M616 and M617 Dowels into Top of Pylon with Adhesive Anchor System From Department Approved List. Embedment Shall Develop the Full Tensile Strength of the Bars.

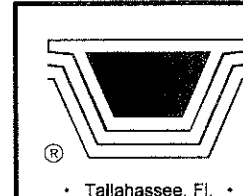

Figg Bridge Engineers, Inc.
424 North Calhoun Street
Tallahassee, Florida 32301

• Tallahassee, Fl. • Denver, Co. • Philadelphia, Pa. • Dallas, Tx. •

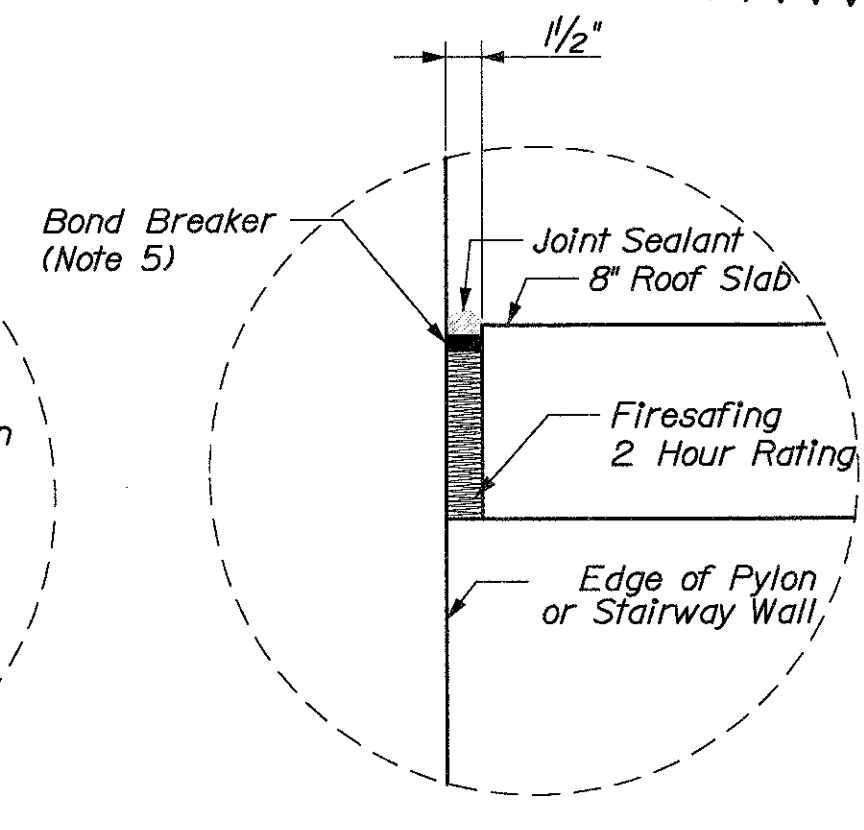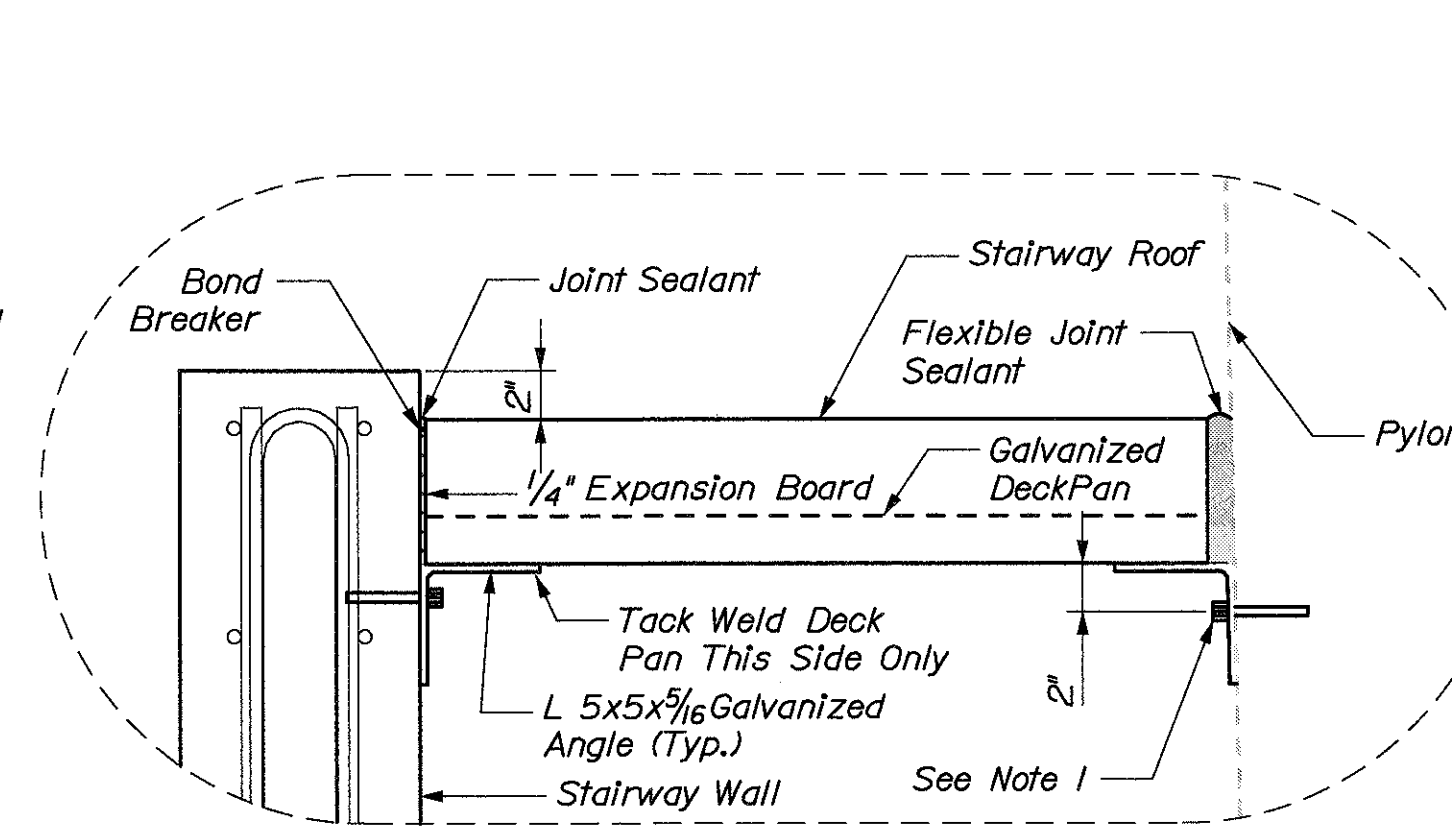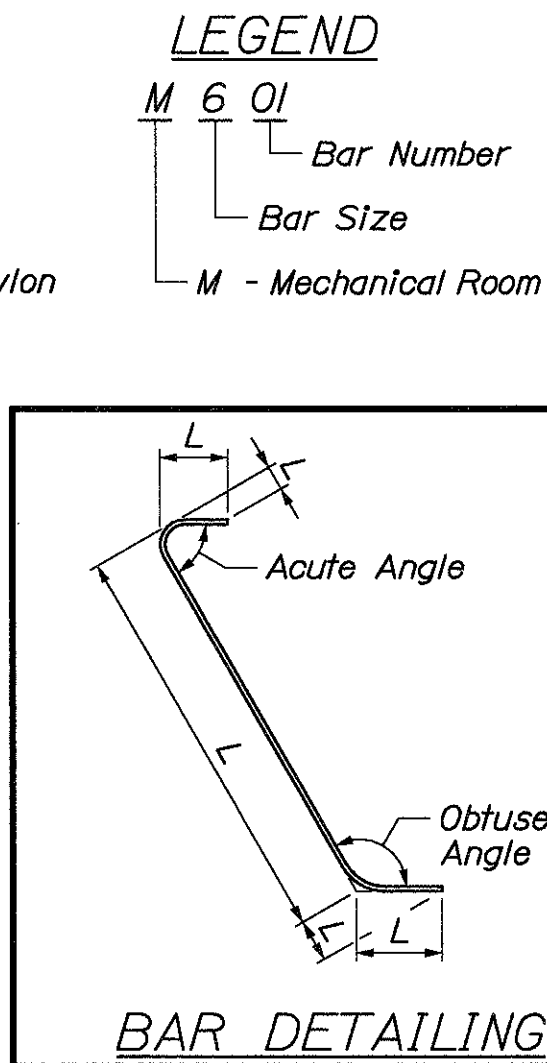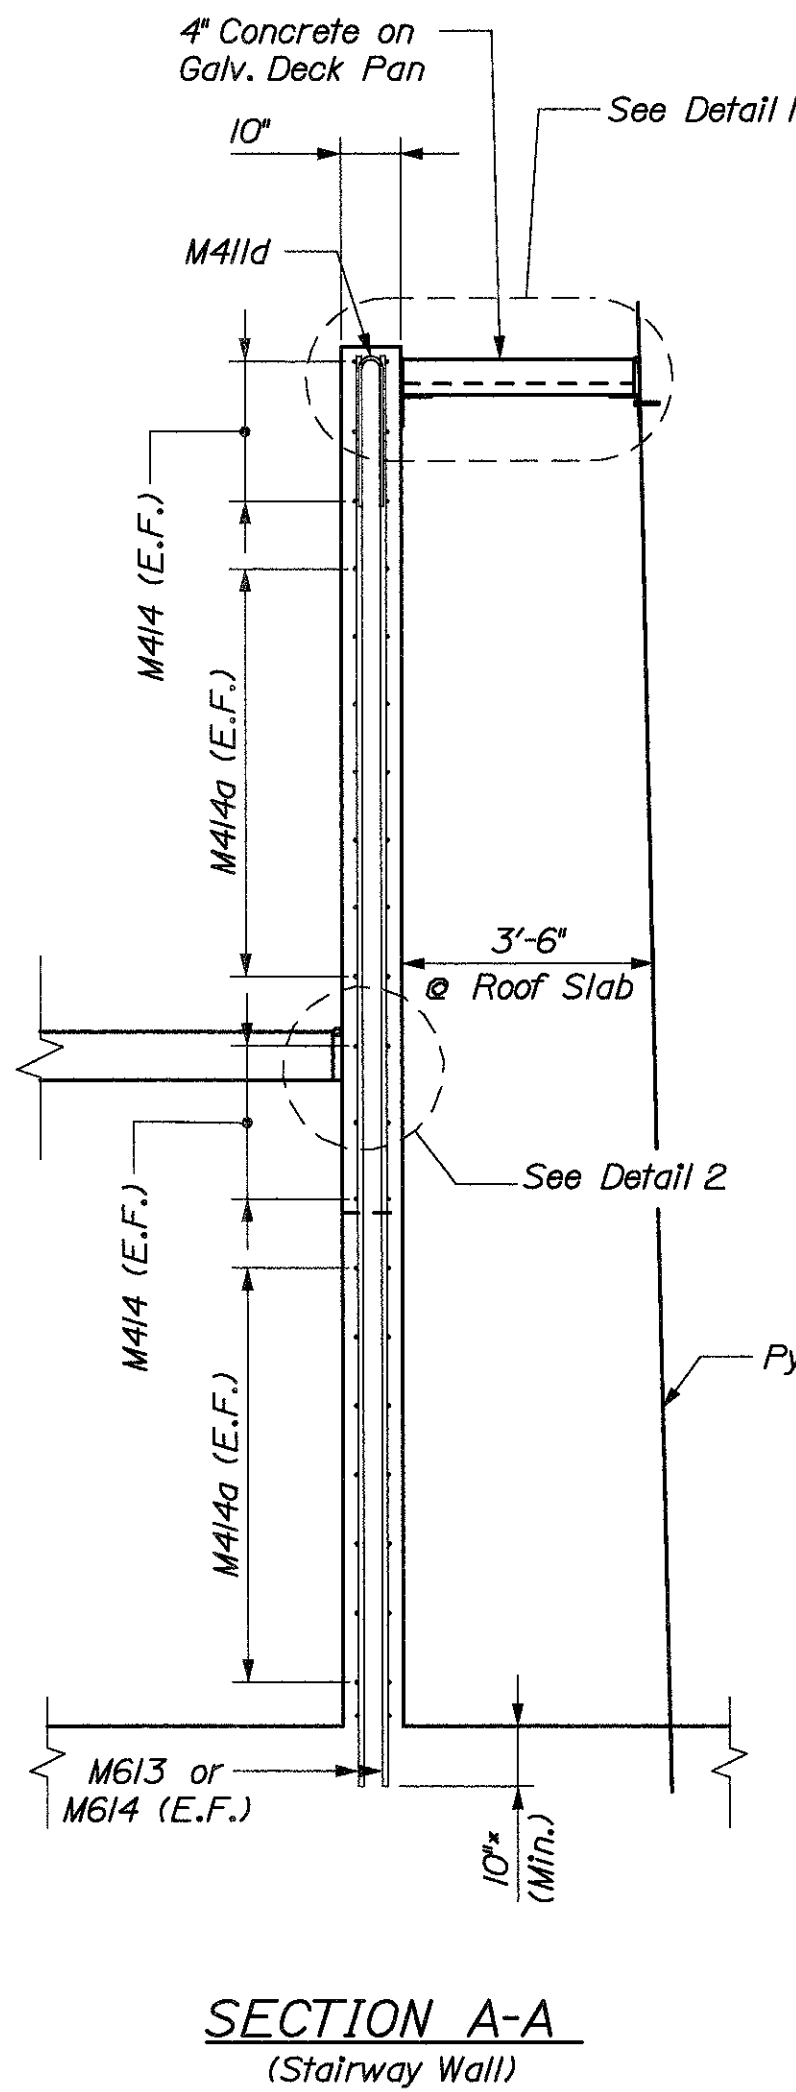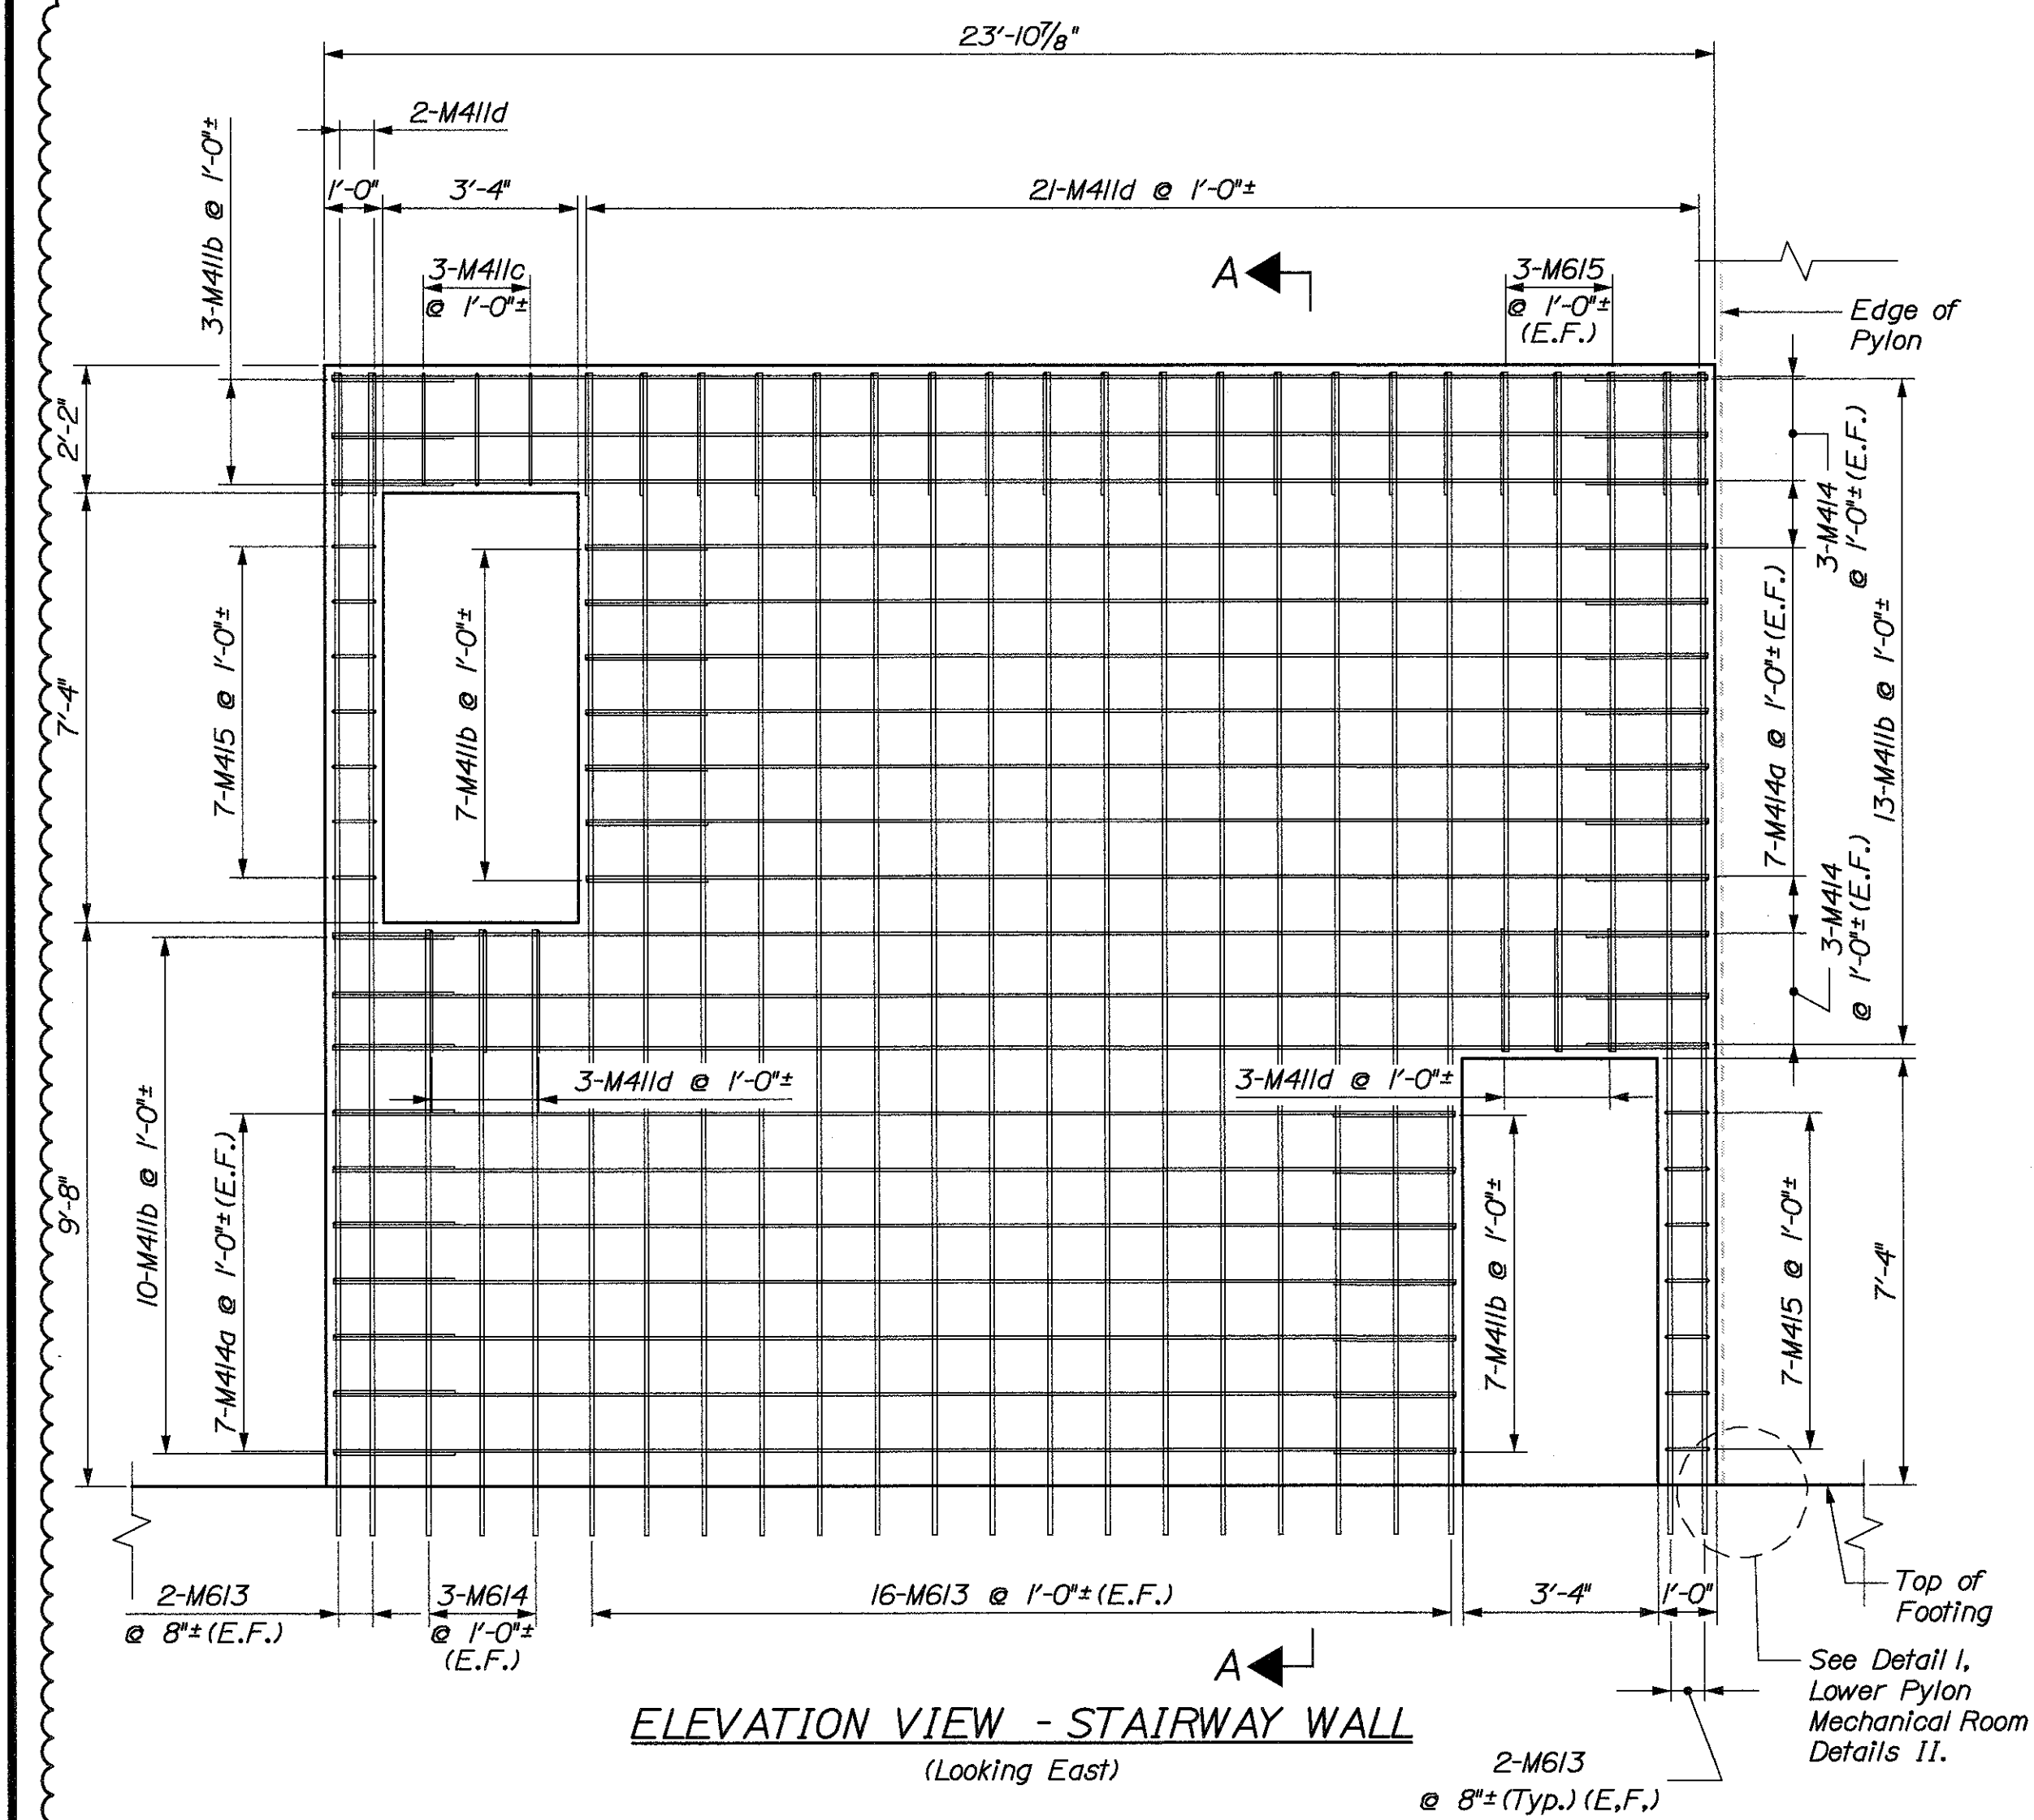


REINFORCING STEEL SCHEDULE

STRAIGHT BARS							
MARK	QTY.	LENGTH	LOCATION	MARK	QTY.	LENGTH	LOCATION
M406	20	19'-11 ³ / ₄ "	South Wall	M606	4	12'-2"	Roof Slab
M406a	4	3'-6 ¹ / ₂ "	South Wall	M606a	4	15'-8"	Roof Slab
M406b	4	7'-8"	South Wall	M607	190	10'-4"	South Wall
M406c	4	2'-6 ¹ / ₂ "	South Wall	M607a	22	2'-10 ³ / ₄ "	South Wall
M406d	2	5'-8"	North Wall	M607b	14	5'-7 ¹ / ₄ "	South Wall
M406f	18	15'-8"	South Wall	M607c	8	5'-1 ¹ / ₄ "	South Wall
M408	8	19'-9 ⁵ / ₈ "	South Wall	M607d	34	10'-10"	South Wall
M410	10	19'-4 ⁵ / ₈ "	South Wall	M607e	38	13'-1"	South Wall
M414	12	23'-5 ¹ / ₄ "	Stairway Wall	M610	28	13'-9 ⁵ / ₈ "	South Wall
M414a	28	19'-1 ¹ / ₄ "	Stairway Wall	M613	40	19'-10"	Stairway Wall
M430	4	2'-9"	Hoistway Walls	M614	6	10'-4"	Stairway Wall
M433	1	6'-2 ³ / ₄ "	Hoistway Walls	M615	6	11'-6"	Stairway Wall
M434	1	9'-9 ¹ / ₄ "	Hoistway Walls	M616	80	24'-8 ¹ / ₂ "	Hoistway Walls
M435	1	9'-1 ³ / ₈ "	Hoistway Walls	M617	4	10'-4 ¹ / ₂ "	Hoistway Walls
M436	1	12'-8 ⁵ / ₈ "	Hoistway Walls	M618	8	14'-9"	Hoistway Walls
M437	4	16'-0"	South Wall	M620	2	19'-9"	Hoistway Walls
M441	2	4'-8 ¹ / ₈ "	South Wall	M621	4	6'-9"	Hoistway Walls
M601	28	19'-9 ¹ / ₄ "	Roof Slab	M622	4	6'-0"	Hoistway Walls
M602	44	27'-5 ¹ / ₄ "	Roof Slab	M701	18	23'-5 ¹ / ₄ "	Roof Slab
M602a	12	24'-10 ¹ / ₄ "	Roof Slab	M701a	12	18'-3 ¹ / ₄ "	Roof Slab
M603	28	10'-2 ⁵ / ₈ "	Roof Slab	M702	40	30'-8"	Roof Slab
M604	28	7'-4 ⁵ / ₈ "	Roof Slab	M703	84	11'-9"	Roof Slab
M605	4	6'-10"	Roof Slab				
MARK	QTY.	LENGTH	LOCATION	MARK	QTY.	LENGTH	LOCATION

BENT BARS														
MARK	QTY.	LENGTH	TYPE	A	B	C	D	E	F	G	H	O	R	LOCATION
M401	16	2'-0"	FC	0'-8"	0'-8"	0'-8"	-	-	-	-	-	-	-	South Wall
M402	28	2'-6"	FC	1'-0"	0'-6"	1'-0"	-	-	-	-	-	-	-	South Wall
M403	4	3'-3"	H	0'-4 1/2"	0'-8"	0'-7"	0'-8"	0'-7"	-	0'-4 1/2"	-	-	-	South Wall
M404	18	7'-7"	H	0'-4 1/2"	1'-9"	1'-8"	1'-9"	1'-8"	-	0'-4 1/2"	-	-	-	South Wall
M405	18	8'-5"	H	0'-4 1/2"	3'-2"	0'-8"	3'-2"	0'-8"	-	0'-4 1/2"	-	-	-	South Wall
M406e	20	9'-6 1/2"	L	8'-10 1/2"	0'-8"	-	-	-	-	-	-	-	-	South Wall
M407	10	5'-2 3/8"	FC	1'-0"	3'-2 3/8"	1'-0"	-	-	-	-	-	-	-	South Wall
M409	10	10'-9 1/2"	FC	5'-1 3/4"	0'-6"	5'-1 3/4"	-	-	-	-	-	-	-	South Wall
M411	35	6'-1"	U	3'-0 1/2"	3'-0 1/2"	-	-	-	-	-	-	-	-	South Wall
M411a	28	5'-7 3/4"	FC	2'-6 1/8"	0'-6"	2'-6 1/8"	-	-	-	-	-	-	-	South Wall
M411b	40	4'-8"	FC	2'-1"	0'-6"	2'-1"	-	-	-	-	-	-	-	Stairway Wall
M411c	3	5'-3"	H	0'-4 1/2"	1'-10"	0'-6"	1'-10"	0'-6"	-	0'-4 1/2"	-	-	-	Stairway Wall
M411d	29	4'-2"	U	2'-1"	2'-1"	-	-	-	-	-	-	-	-	Stairway Wall
M412	20	14'-9 1/8"	T	8'-10 1/2"	5'-3 3/8"	0'-8"	-	-	-	-	-	-	-	South Wall
M412a	20	6'-11 1/8"	T	0'-8"	4'-9 1/8"	0'-8"	-	-	-	-	-	-	-	South Wall
M413	22	6'-7 3/8"	FC	0'-8"	5'-3 3/8"	0'-8"	-	-	-	-	-	-	-	South Wall
M415	32	3'-1"	H	0'-4 1/2"	0'-8"	0'-6"	0'-8"	0'-6"	-	0'-4 1/2"	-	-	-	Stairway and South Walls
M416	42	2'-0"	FC	1'-0"	1'-0"	-	-	-	-	-	-	-	-	Hoistway Walls
M416a	49	2'-3 1/8"	FC	1'-0"	0'-3 1/8"	1'-0"	-	-	-	-	-	-	-	Hoistway Walls
M417	20	9'-8"	L	9'-0"	0'-8"	-	-	-	-	-	-	-	-	Hoistway Walls
M418	66	12'-9"	FC	0'-8"	11'-5"	0'-8"	-	-	-	-	-	-	-	Hoistway Walls
MARK	QTY.	LENGTH	TYPE	A	B	C	D	E	F	G	H	O	R	LOCATION


Quantities Provided for Information Only

ESTIMATED QUANTITIES / MECHANICAL ROOM		
ITEM	UNIT	QUANTITY
Concrete, f'c = 4500 psi	CY	95.2
Reinforcing Steel	LB	28,146
6" Unreinf. CMU Block Wall	SY	215.3

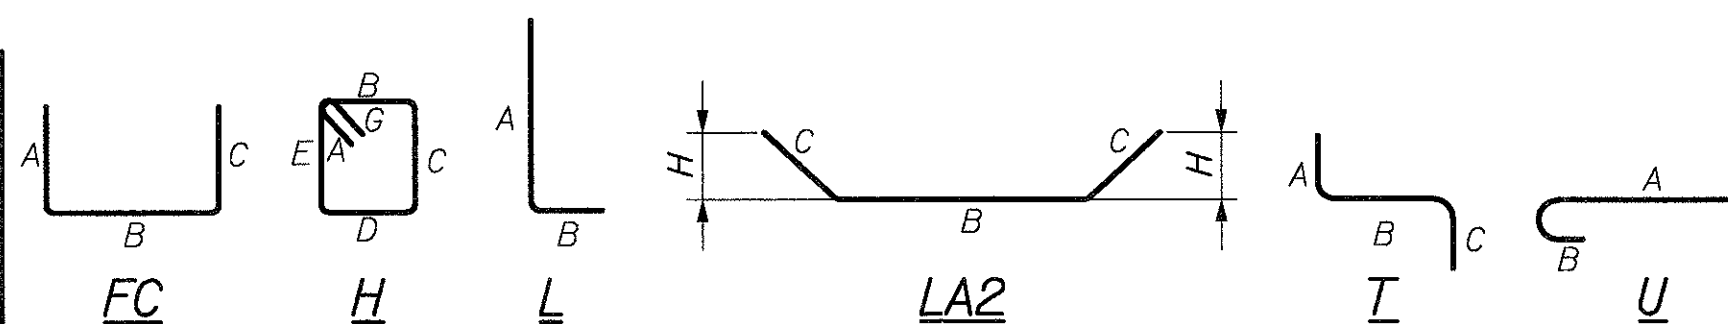

NOTES

- Embed 3/8" Threaded Rods Using Adhesive Anchor System From Department Approved List. (Minimum Embedment of 3" @ 4'-0" O.C.)
- Embed M613 and M614 Dowels a Minimum of 10" into Top of Pylon with Adhesive Anchor System From Department Approved List. Embedment Shall Develop the Full Tensile Strength of the Bars.
- Concrete Cover Shall be 2" Unless Otherwise Noted.
- Cost of All Materials and Labor for Lower Pylon Mechanical Room is Incidental to Item Number 800.8007, Lower Pylon Mechanical Room.
- Bond Breaker Shall be Applied per Manufacturer's Directions. Material Certificate Shall be Submitted to the Department for Approval.

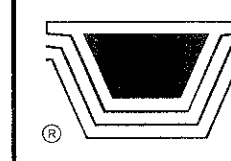

Figg Bridge Engineers, Inc.
424 North Calhoun Street
Tallahassee, Florida 32301