

ALBION RAYNES

CONST. 1975  
STA 1372+00 (SQUARE END) S.B.  
INSTALL 6'6" x 90' C.A.D.  
HAND LAID RIP RAP AROUND  
INLET & OUTLET.  
0.165 TH. RCCMAD  
0.164 TH. CAP. SEE SPECIAL PROVISIONS  
CAMBER CULVERT 10' @ E ROWY &  
8' @ EDGES OF SHOULDER

SOLOMON KLEIN  
JEANNETTE KLEIN

CONST. 1975  
STA 1386+00 S.B.  
INSTALL 30" x 12' RCP CLASS III  
HAND LAID RIP RAP AROUND  
INLET & OUTLET

STATE	PROJECT NUMBER	SHEET NO.	TOTAL SHEETS
MAINE	I-95-5(37)	29	155

STA 1364+00.00 S.B. - 12' LT. =  
STA 64+00 RAMP "B"

CONST. 1975  
STA 1377+00 TO 1378+16.65 RT. S.B.  
INSTALL 24' x 56' RCP CLASS III

CONST. 1975  
STA 1390+00 S.B.  
INSTALL 24' x 120' RCP CLASS III

STA 1368+00 TO 1373+00 N.B.  
STA 1366+00 TO 1373+00 N.B. LT.  
PLACE ROCK EMBANKMENT AT TOE  
TO ELEV. 167.00 OR S.G. BREAK.  
MIN. DEPTH 3 FT. THE REMAIN-  
ING AREA OUTSIDE THE 1 1/2:1  
SLOPE MAY BE USED TO STORE  
WASTE OR MUCK.

CONST. 1975  
STA 1376+00 (SQUARE END)  
INSTALL 6'6" x 108' C.A.D. N.B.  
HAND LAID RIP RAP AROUND  
INLET AND OUTLET.  
0.165 TH. RCCMAD  
0.164 TH. CAP. SEE SPECIAL PROVISIONS  
CAMBER CULVERT 10' @ ROWY &  
8' @ EDGES OF SHOULDER

STA 1374+50.00 N.B. - 12' RT. =  
STA 74+50.00 RAMP "C"


CONST. 1975  
STA 1378+00 S.B. TO 1380+00 N.B.  
CONSTRUCT MAINT. TURNAROUND  
SEE I-95 PLAN SHEET FROM  
STA 1305+00 TO 1335+00 FOR  
TYPICAL SECTION

CONST. 1975  
STA 1387+00 N.B.  
INSTALL 30" x 100' RCP CLASS III  
HAND LAID RIP RAP AROUND  
INLET & OUTLET.

STA 1386+150 N.B. RT.  
CONSTRUCT DITCH BLOCK  
ELEV. 172.0

STA 1387+00 TO 1387+50, N.B.  
PLACE EROSION CONTROL  
MESH (STANDARD) IN DITCH RT.

WALTER E. JAMES

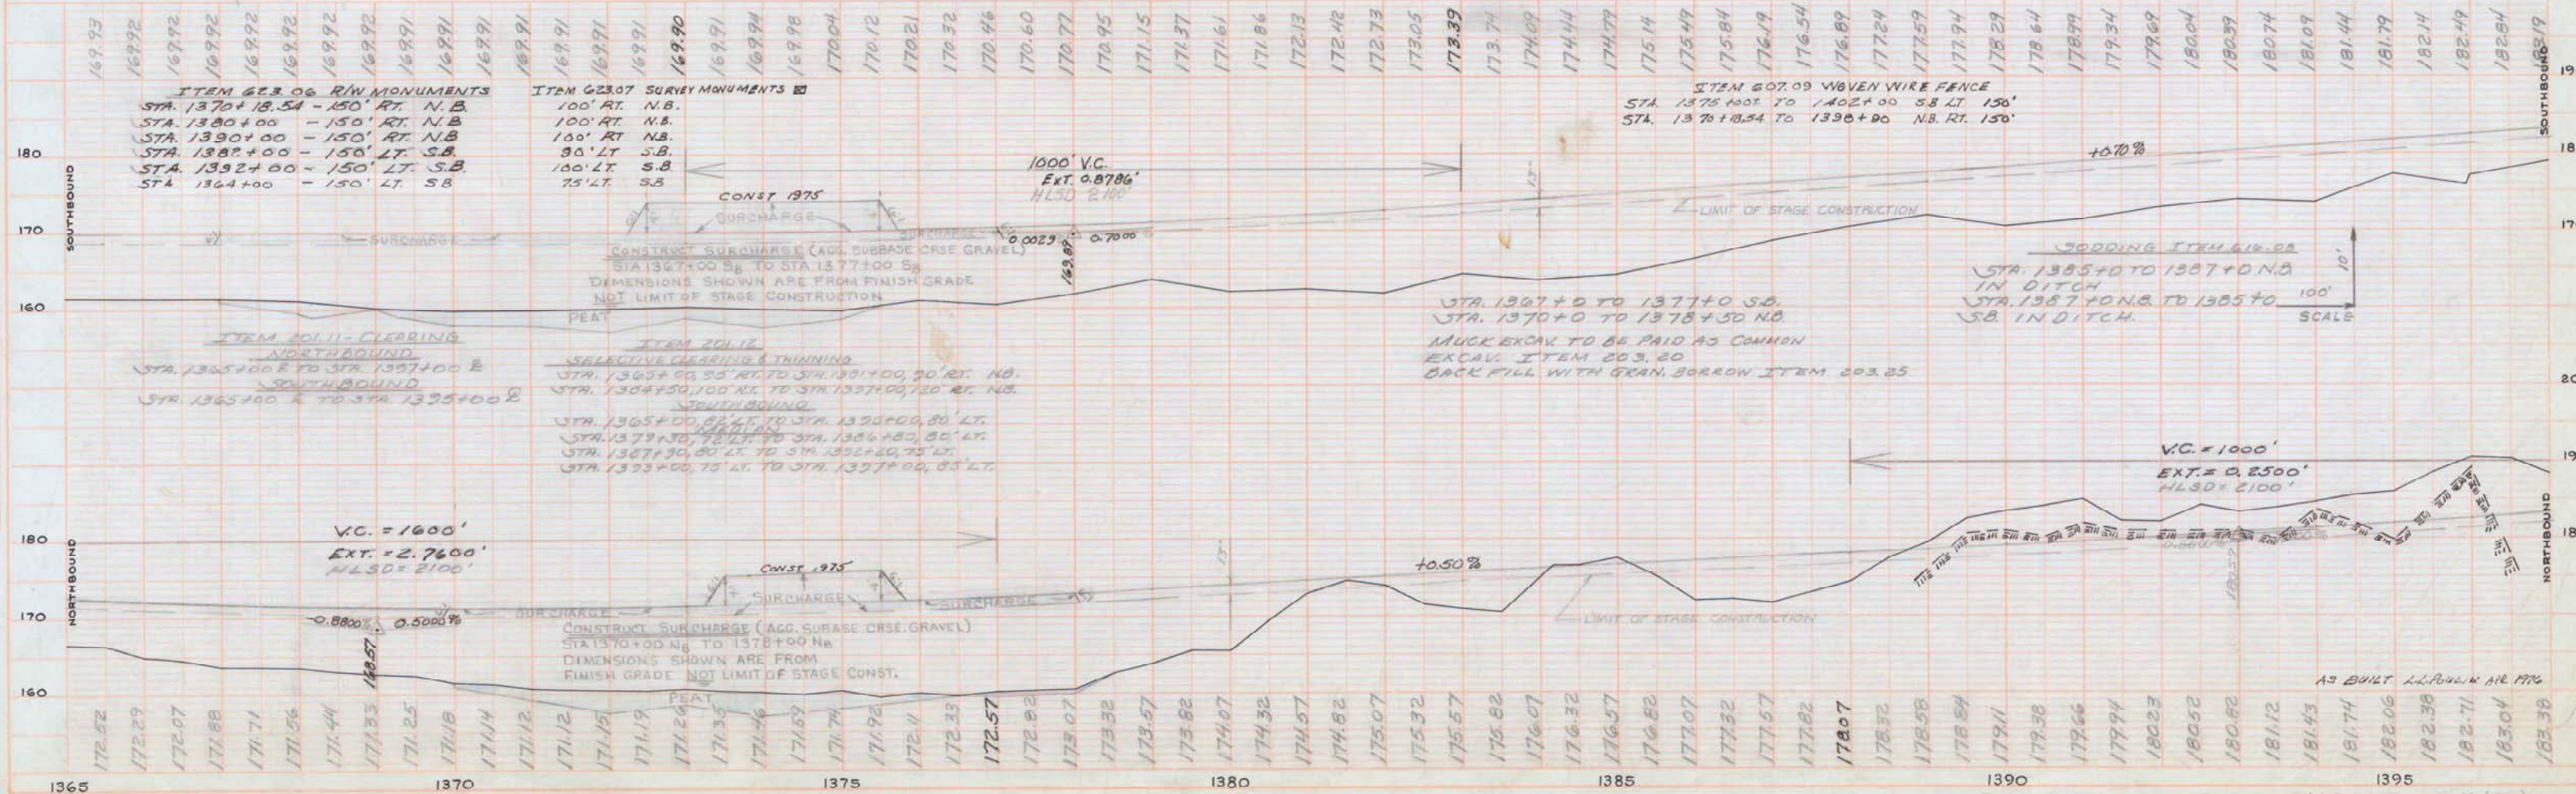

BOWDOINHAM-RICHMOND I-95-5(37)