

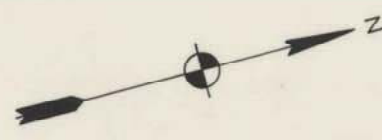
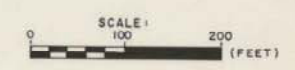


CONTRACT 2

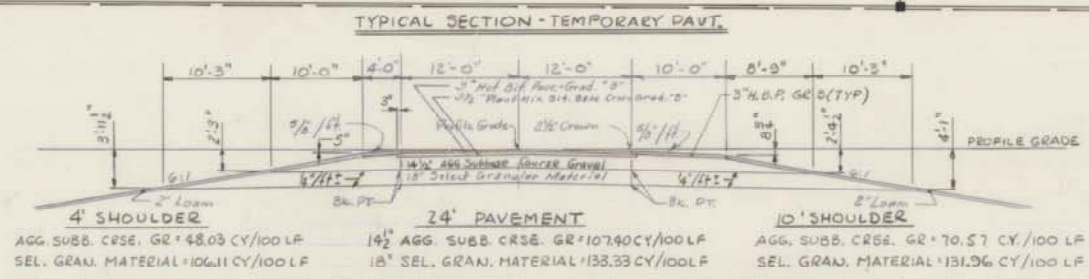

PLAN
SURVEYOR
PLOTTER
NOTE BOOK
NO.

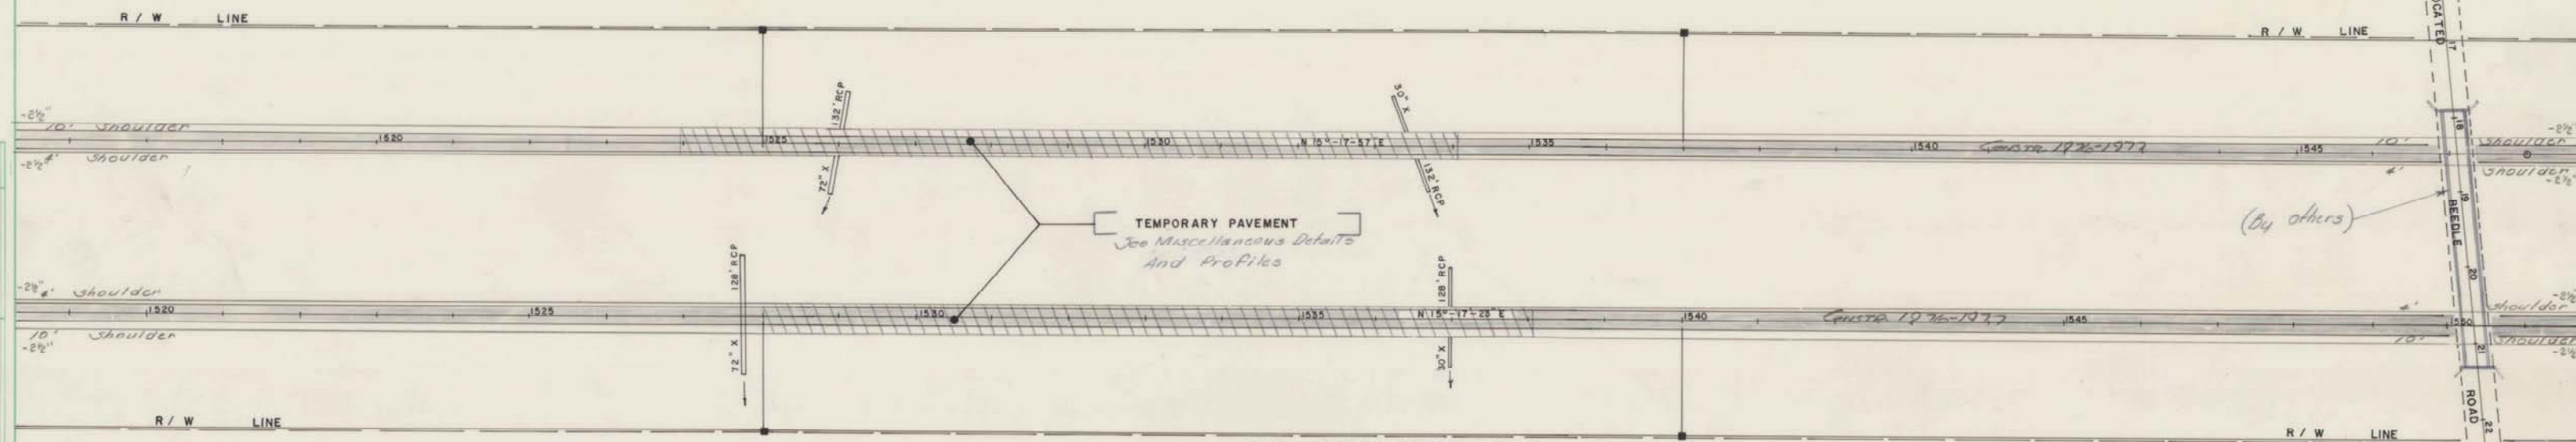

PROFILE
SURVEYOR
PLOTTER
NOTE BOOK
NO.

