

STATE OF MAINE DEPARTMENT OF TRANSPORTATION

BUREAU OF HIGHWAYS



TOPSHAM SAGADAHOC COUNTY MAINE FEDERAL AID INTERSTATE PROJECT NO. 1-95-5(22)76

TOTAL LENGTH 2.609 MILES

PLAN 1 IN. = 100 FT.
SCALES: PROFILE HOR. 1 IN. = 100 FT.
VERT. 1 IN. = 10 FT.
CROSS SECTION 1 IN. = 10 FT.

A GRADING DRAINAGE & BASE PROJECT
PROJECT COMPLETED 1974



ON MICROFILM Reel 181

CONVENTIONAL SIGNS

COUNTY LINES	=====	TRAVELLED WAY - PROPOSED	=====
TOWN LINES	-----	UNDERGROUND UTILITIES - EXISTING	-----
PROPERTY LINES	-----	UNDERGROUND UTILITIES - PROPOSED	-----
R/W LINES - EXISTING	=====	RAILROAD - SINGLE TRACK	=====
R/W LINES - NEW - ACCESS CONTROL	=====	RAILROAD - DOUBLE TRACK	=====
R/W LINES - NEW - NO ACCESS CONTROL	=====	UTILITY POLE - EXISTING	=====
CULVERT - EXISTING	=====	UTILITY POLE - JOINT OCCUPANCY	=====
CULVERT - PROPOSED	=====	PROPOSED UTILITY POLE - TEMPORARY	=====
CURBING - EXISTING	=====	PROPOSED UTILITY POLE - PERMANENT	=====
CURBING - PROPOSED	=====	TREES	=====
TRAVELLED WAY - EXISTING	=====	WOODS	=====

INDEX OF SHEETS

SHEET NO.	DESCRIPTION
1	TITLE SHEET
2	TYPICAL SECTIONS
3	ESTIMATED QUANTITIES & SUMMARY OF BORROW
4	DRAINAGE & SPECIAL DETAILS
5-13	STANDARD DETAILS
14	GENERAL NOTES
15-20	PLAN & PROFILE 1-95
21-69	1-95 N.B. X-SECTIONS
70-117	1-95 S.B. X-SECTIONS

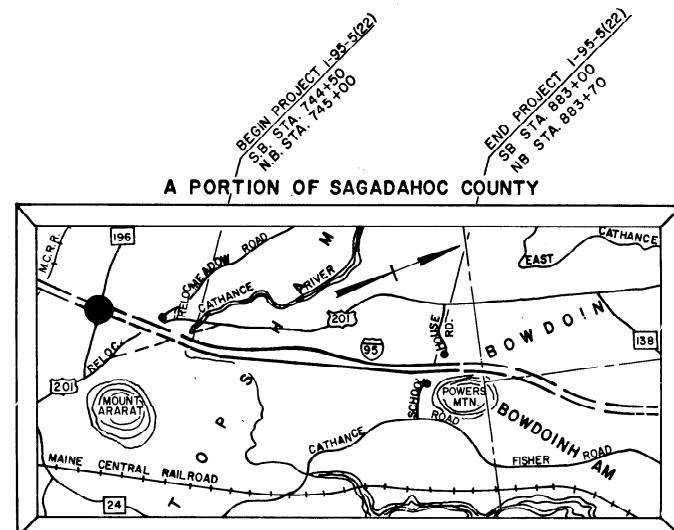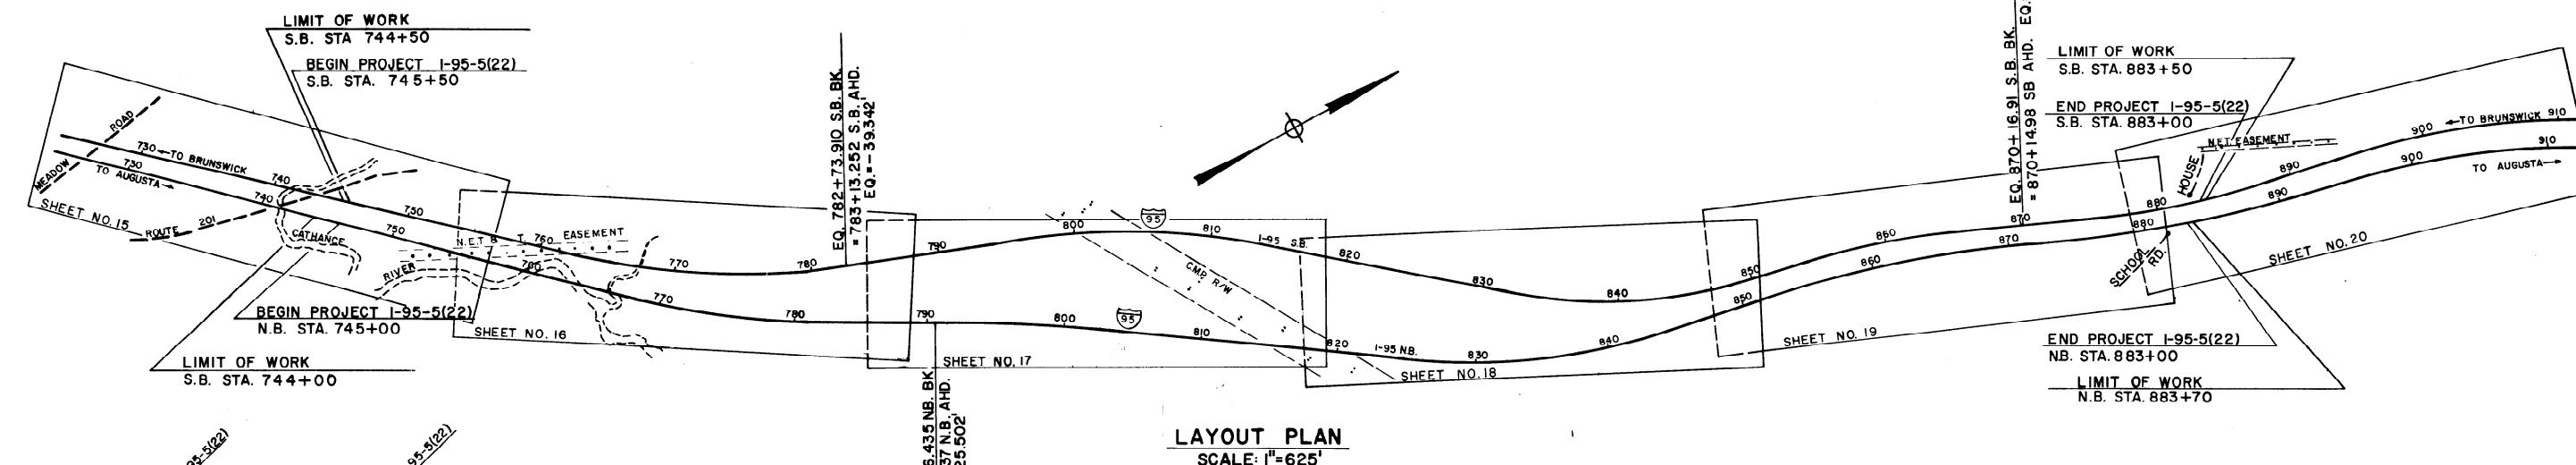

NOTE:
ALL WORK CONTEMPLATED UNDER THIS CONTRACT SHALL BE GOVERNED BY AND IN CONFORMITY WITH THE STANDARD SPECIFICATIONS (REVISION OF JUNE 1968) AND SUPPLEMENTS THERETO, EXCEPT AS MODIFIED ON THE PLANS AND IN THE SPECIAL PROVISIONS.

TRAFFIC DATA	
A.D.T. 1974	11,160
A.D.T. 1994	20,680
D.H.V.	2.688
T. (%)	10%
D. (%)	60%
V.	70 MPH
P.S.D. (%)	100%
18 KIPS	959

APPROVED: STATE OF MAINE
DEPARTMENT OF TRANSPORTATION
COMMISSIONER
BUREAU DIRECTOR & CHIEF ENGINEER
DATE
AUG. 16, 1972

UNITED STATES
DEPARTMENT OF TRANSPORTATION
FEDERAL HIGHWAY ADMINISTRATION
REGION 1
APPROVED:
DIVISION ENGINEER
DATE