


F.H.W.A. REG. NO.	STATE	PROJECT NUMBER	SHEET NO.	TOTAL SHEETS
1	MAINE	I-95-5(44) 81	6	55

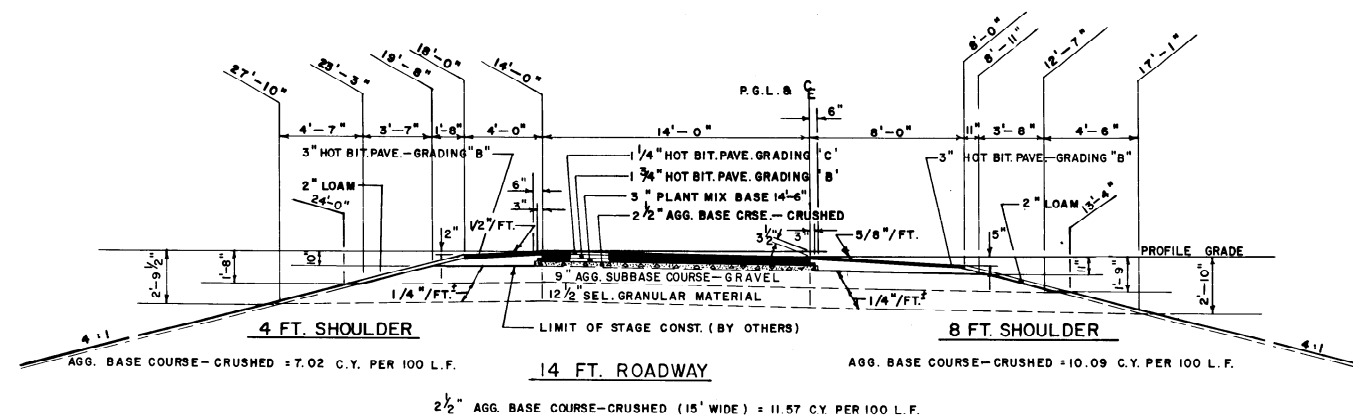

BOWDOINHAM-RICHMOND-GARDINER 203-1 2000  
I-95-5(44).81 Cont. # 2