


FEB 64
AUSTIN
HILL
05 0822

PROFILE
DATE 05-08-75
BY JARY TRUSS

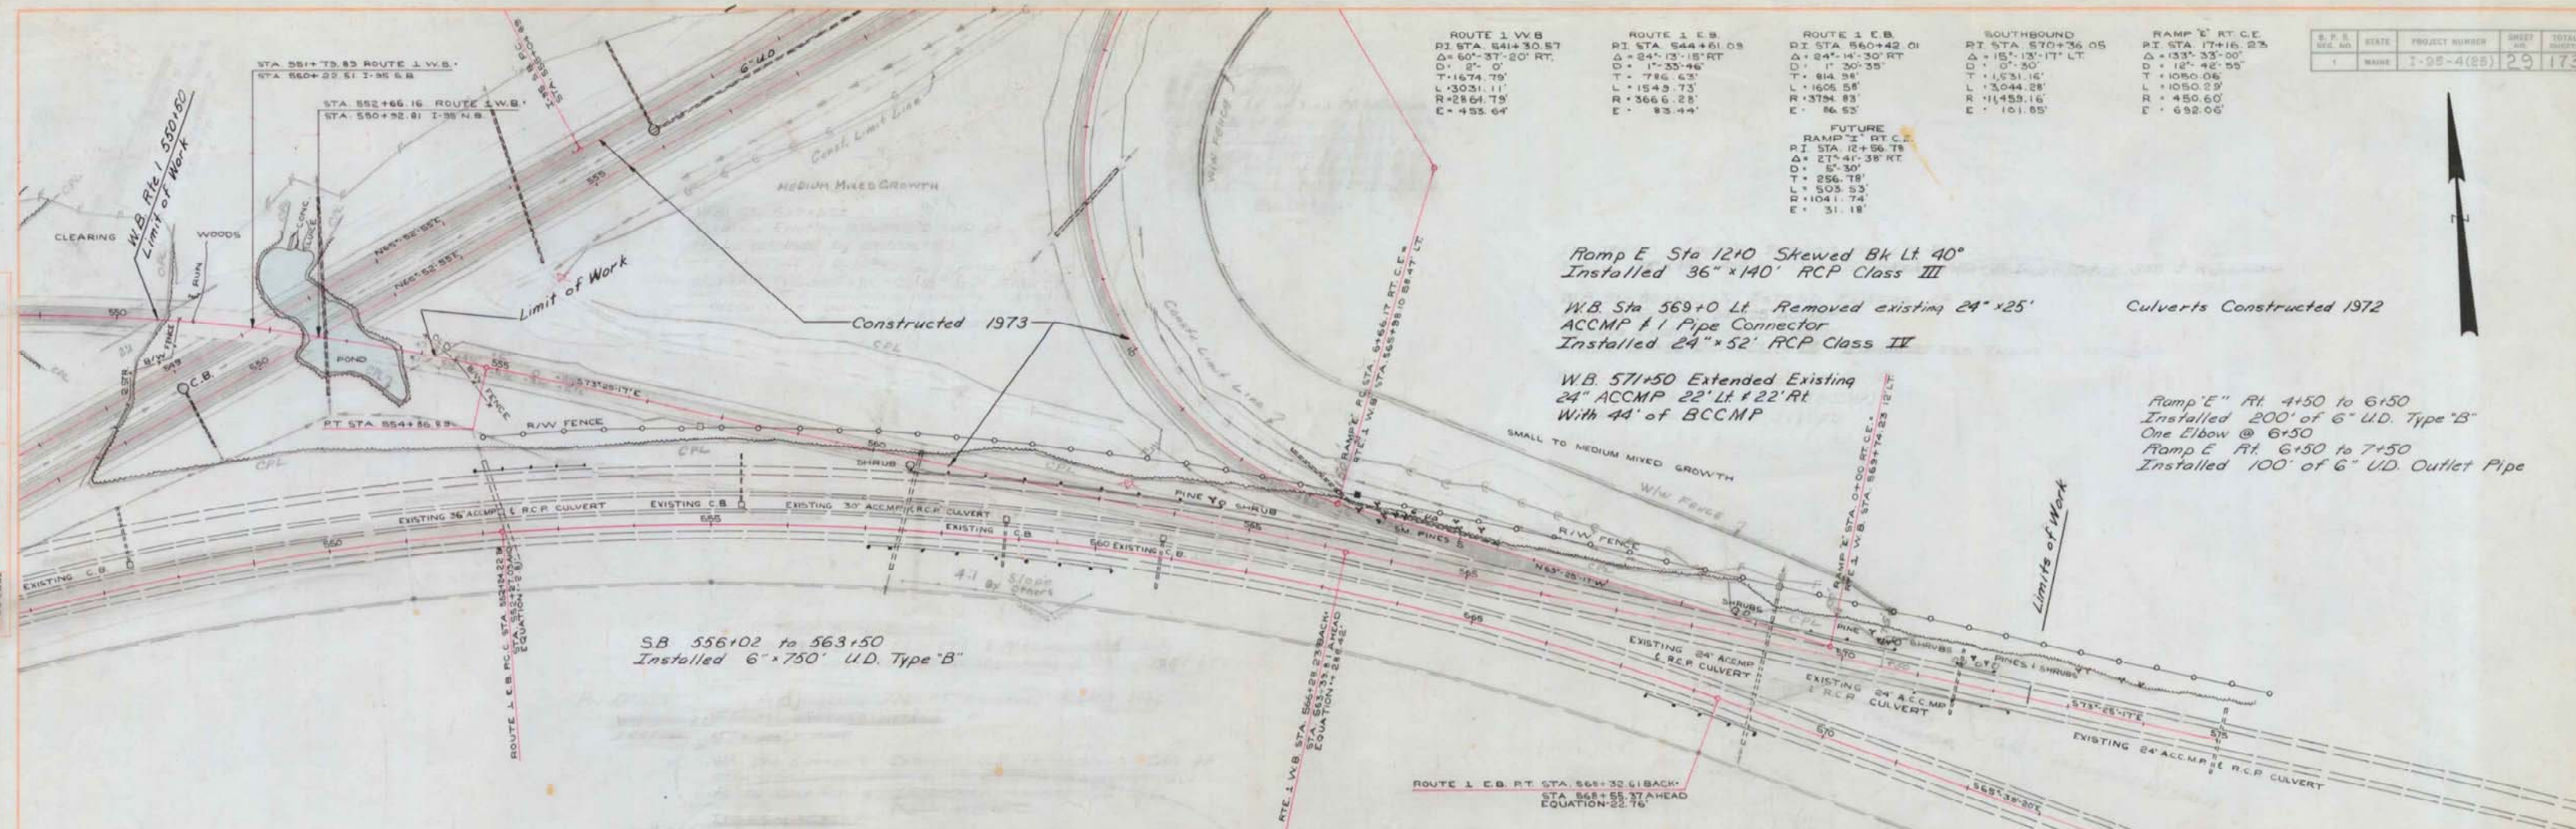

Right of Way Monuments
Ramp E Rt. C.E. 6+66.17 150' Right
Ramp E Rt. C.E. 0+00 100' Right
W.B. 570+50 75' Left

Survey Monuments
Ramp E Rt. C.E. 6+66.17 Right
Ramp E Rt. C.E. 0+00 Right

Installed W.W. Fence & Metal Posts, 6" Inside RIW Line
W.B. Lt. Sta 570+55 to Ramp E Rt. Sta 0+00
Ramp E Rt. 0+00 to 6+66.17
Ramp E Rt. 6+66.17 to 17+16.46