

DATE	BY



  

DATE	BY

DATE	BY

DATE	BY

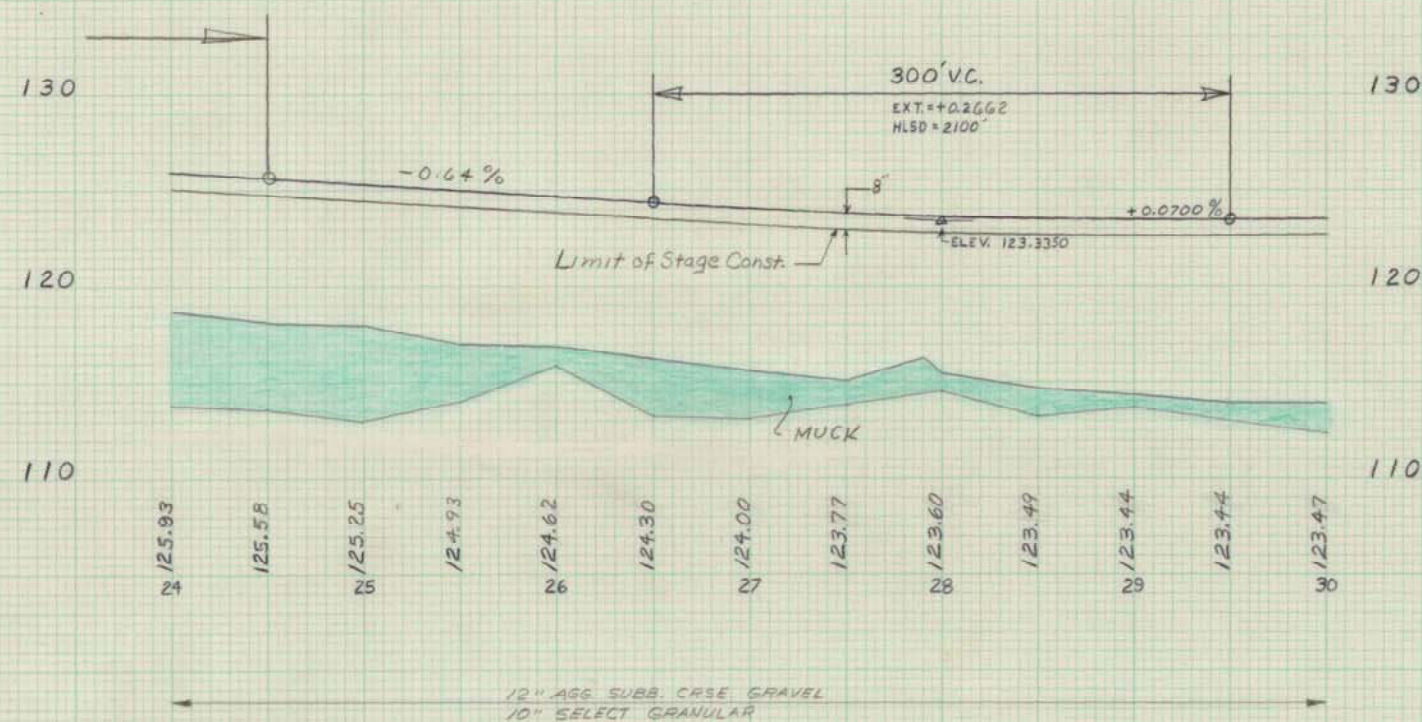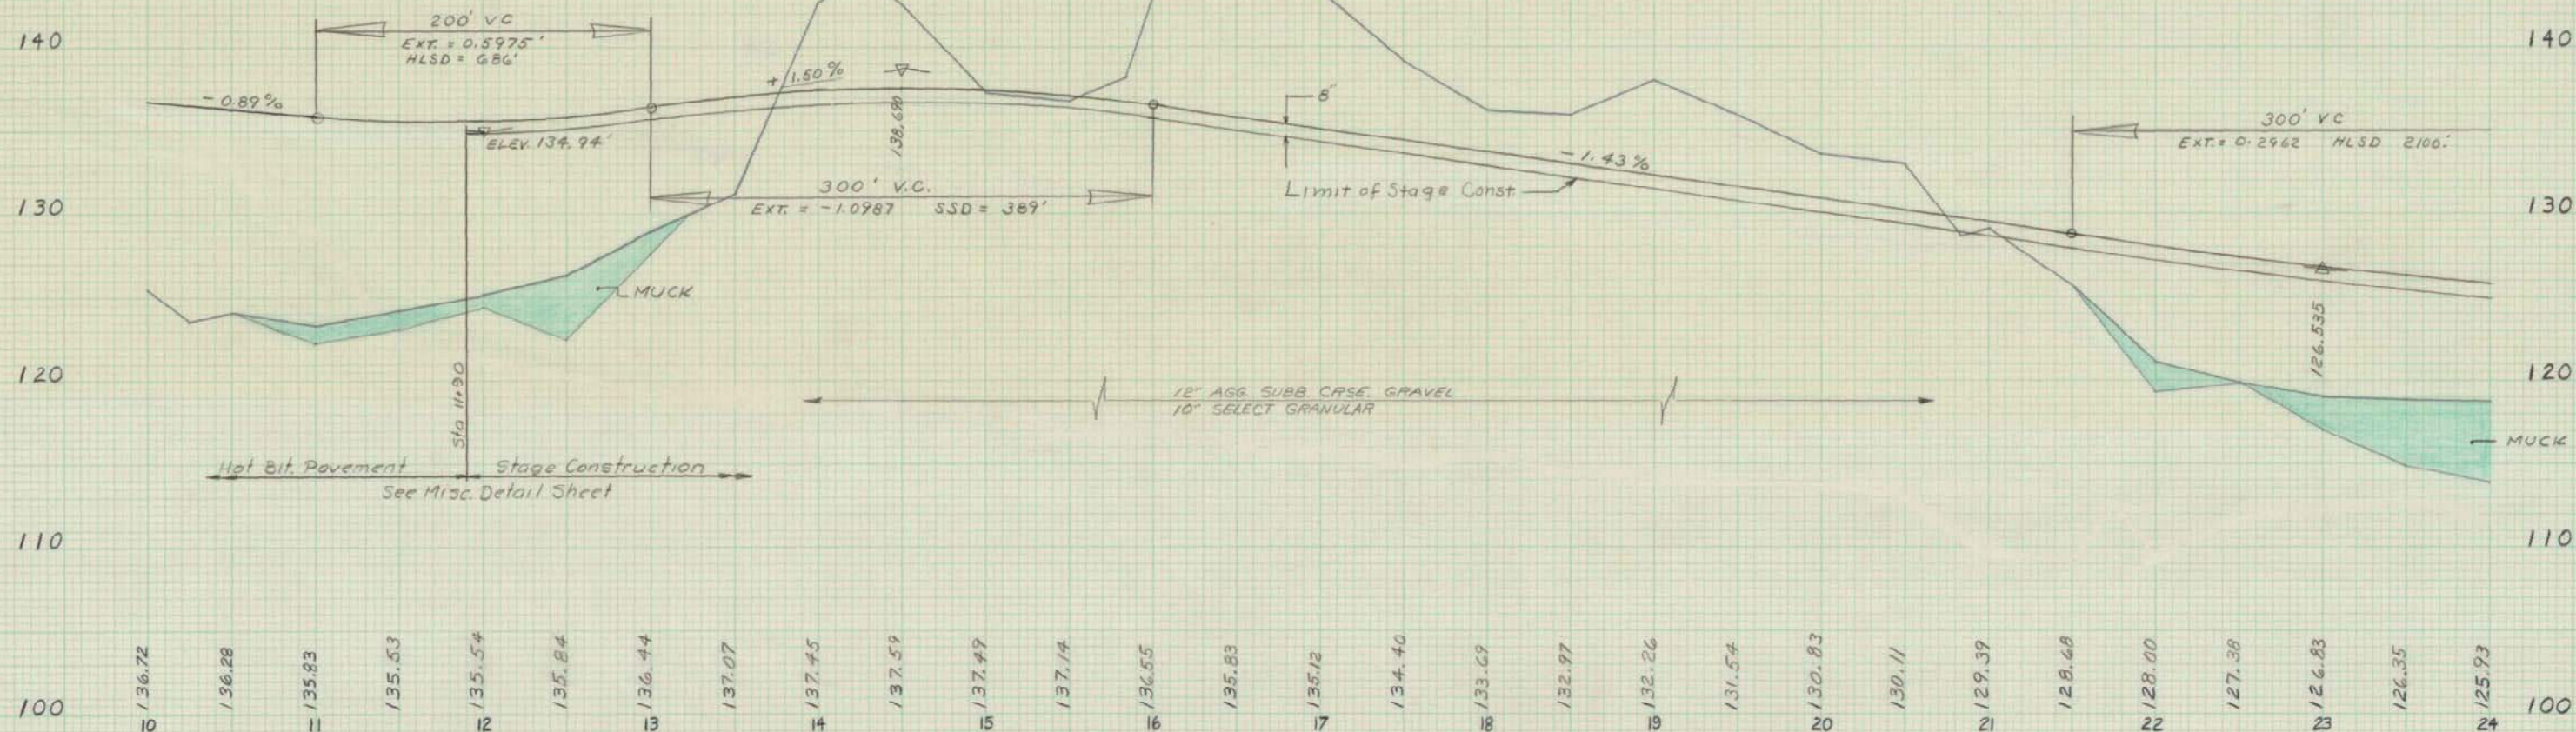

Grubbing in Fill  
Sta 13+25 to 13+75  
Sta 20+00 to 22+75

RAMP "B"

SCALE: HOR. 1"=50'  
VERT. 1"=5'