F.A.P. NO.	STATE	PROJECT NUMBER	SHEET NO.	TOTAL SHEETS
1	MAINE	I-95-5(37)	26	155

CONST. 1975
STA 1277+17-64' RT TO 1277+45 18 RT S.B
INSTALL 6" x 60' U.D OUTLET

STA 1277+45 TO 1285+20 RT S.B
INSTALL 6" x 775' U.D TYPE B
INV. 3'-3" BELOW SUBGRADE

STA 1273+0 TO 1273+50 S.B.
Place Sod IN Ditch Left

CONST. 1975
STA. 1277+25 INSTALL
24" x 104' RCP CLASS III S.B
STA 1276+50 S.B RIGHT CONSTRUCT
DITCH BLOCK EL 163.6

VERA KOTOW

CENTRAL MAINE POWER CO.
(Easement Rights)

DITCH OUT TO 800' LT. TO DRAIN

CONST 1975
STA. 1296+00 INSTALL S.B
24" X 120' RCP CLASS III
SKD. BK. LT. 30°

CONST 1975
STA 1297+00 TO 1297+40 RT S.B
INSTALL 6" x 58' U.D OUTLET

STA 1297+40 to 1305+00 RT S.B
INSTALL TYPE 'B' U.D.

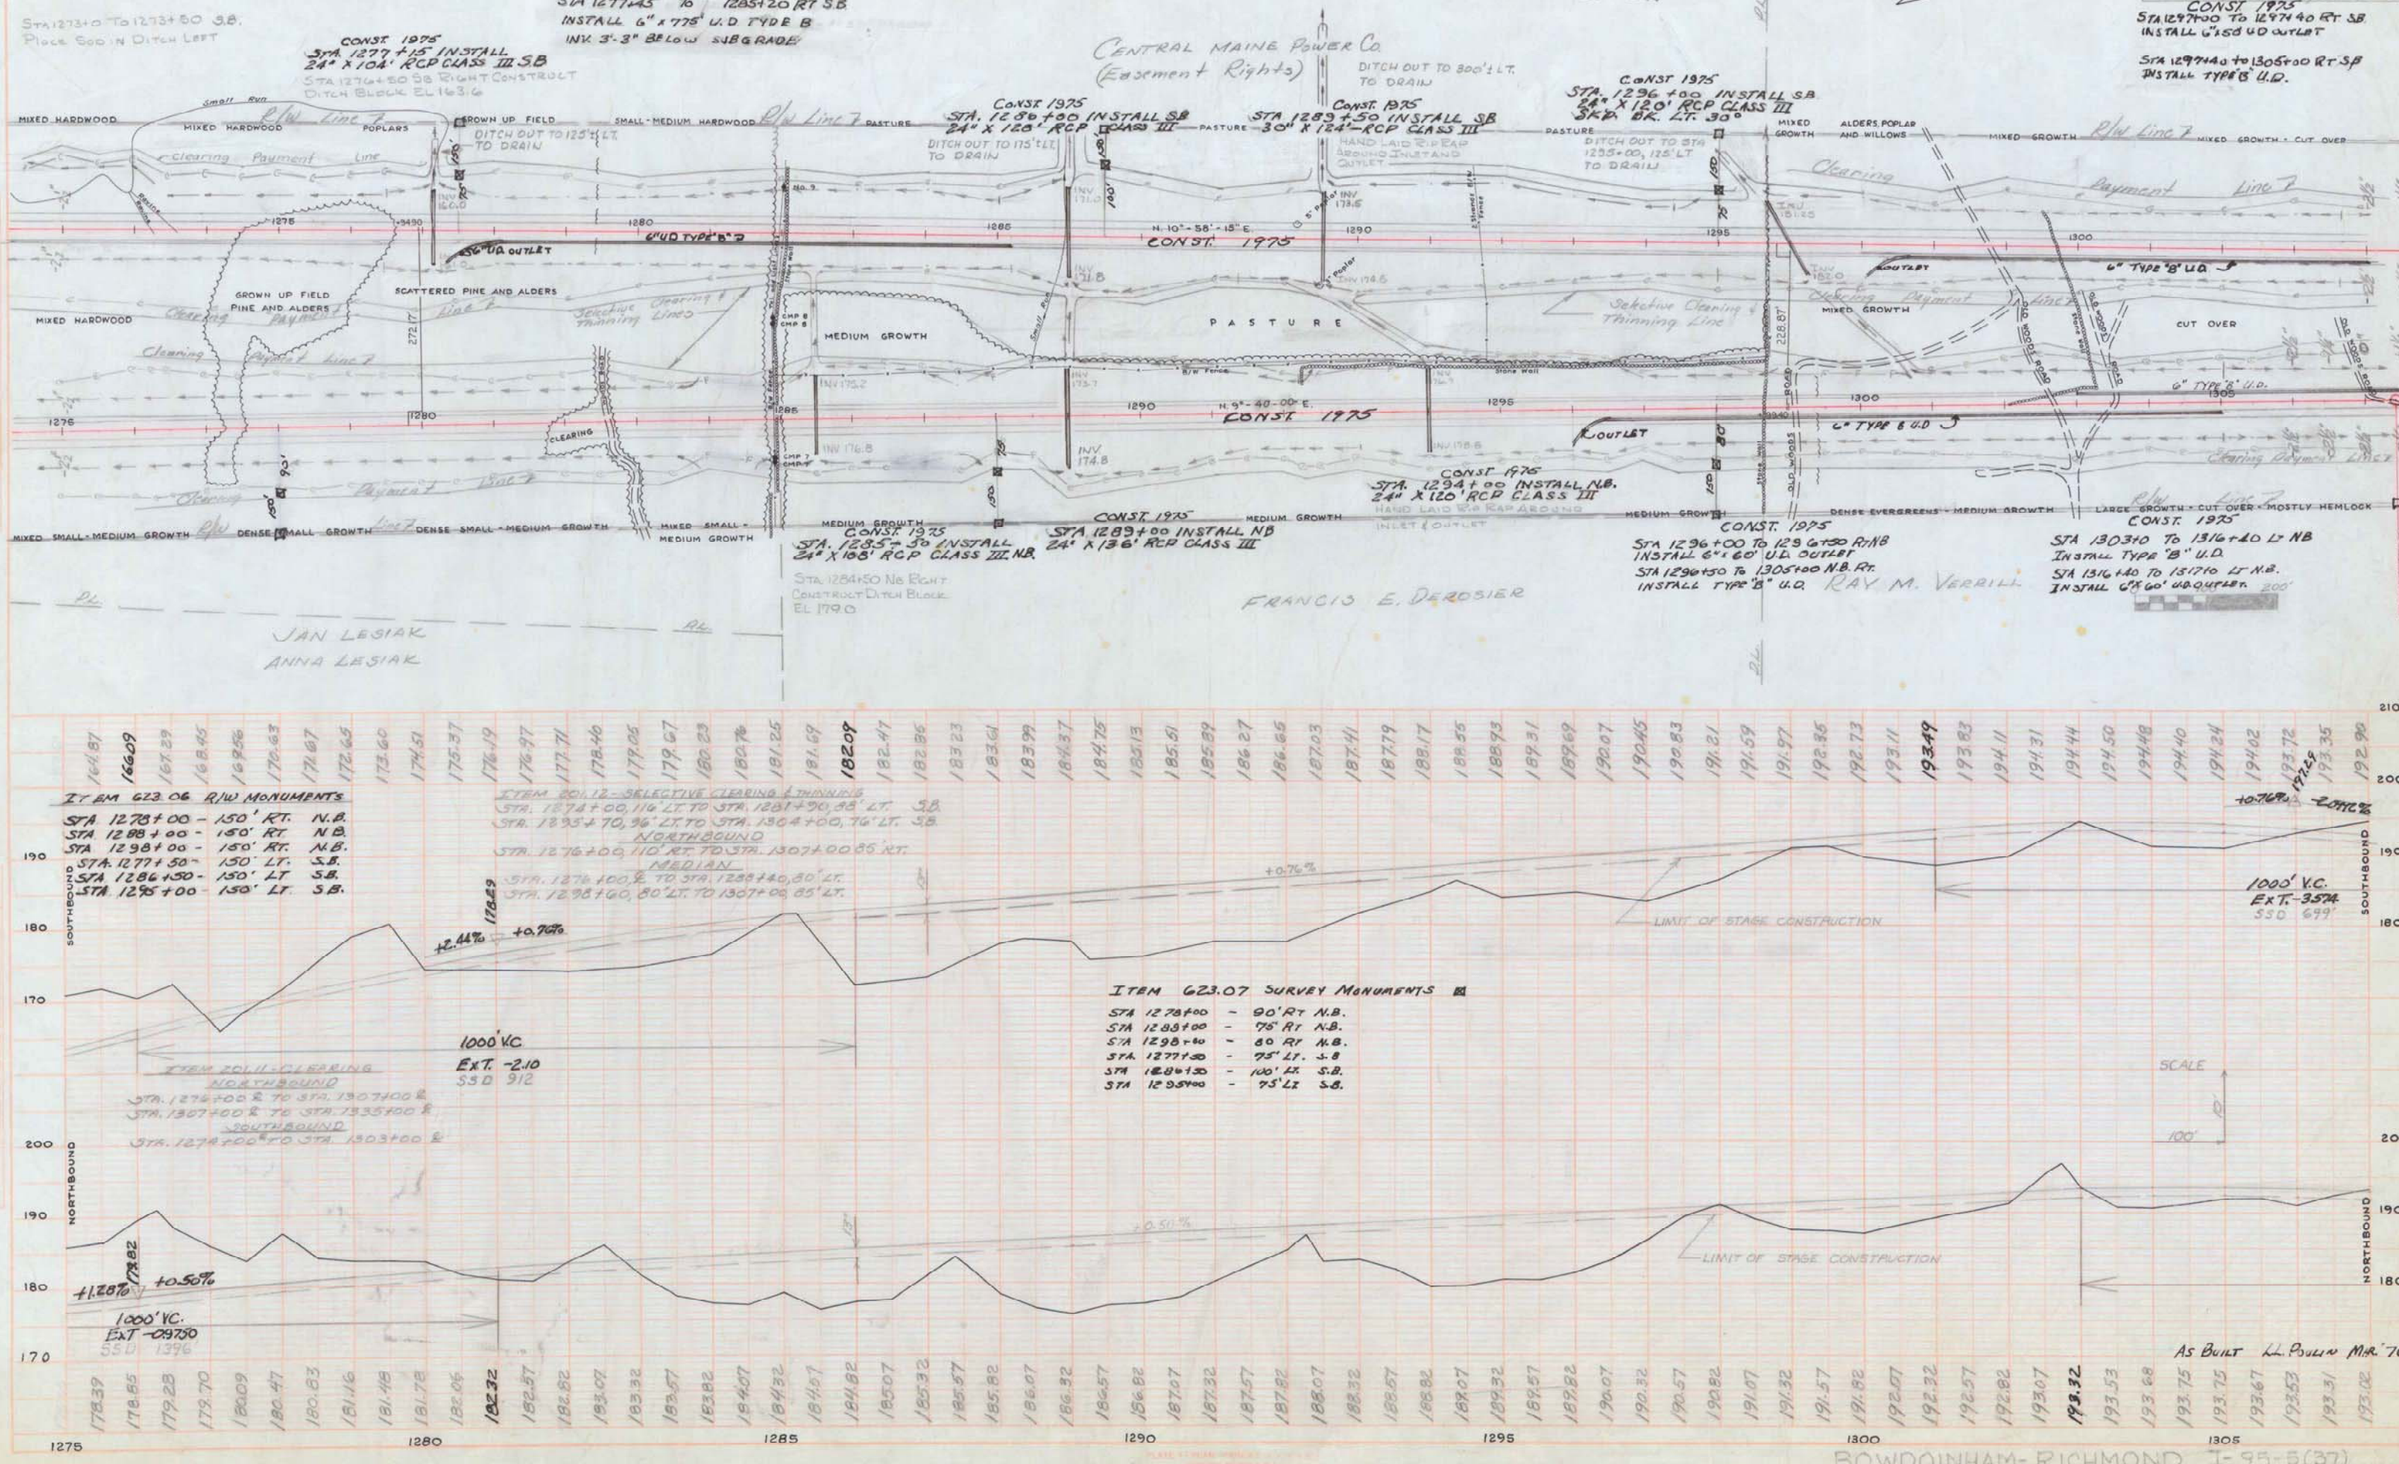

ITEM 623.06 R/W MONUMENTS

STA 1278+00	-	150' RT.	N.B.
STA 1288+00	-	150' RT	N.B.
STA 1298+00	-	150' RT.	N.B.
STA. 1277+50	-	150' LT.	S.B.
STA 1286+50	-	150' LT	S.B.
STA 1295+00	-	150' LT.	S.B.

ITEM 201.12 - SELECTIVE CLEARING & THINNING
STA. 1274+00, 116 LT. TO STA. 1281+90, 88' LT. S.B.
STA. 1293+70, 96' LT. TO STA. 1304+00, 76' LT. S.B.
NORTHBOUND
STA. 1276+00, 110' RT. TO STA. 1307+00 85' RT.
MEDIAN
STA. 1276+00, ℄ TO STA. 1288+40, 80' LT.
STA. 1298+60, 80' LT. TO 1307+00, 85' LT.

ITEM 201.11 - CLEARING
NORTHBOUND
STA. 1276+00 ℄ TO STA. 1307+00 ℄
STA. 1307+00 ℄ TO STA. 1335+00 ℄
SOUTHBOUND
STA. 1274+00 TO STA. 1303+00 ℄

ITEM 623.07 SURVEY MONUMENTS

STA 1278+00	-	90' RT	N.B.
STA 1288+00	-	75' RT	N.B.
STA 1298+60	-	80 RT	N.B.
STA. 1277+50	-	75' LT.	S.B
STA 1286+50	-	100' LT.	S.B.
STA 1295+00	-	75' LT	S.B.

BOWDOINHAM-RICHMOND I-95-5(37)