



B. P. R. REG. NO.	STATE	PROJECT NUMBER	SHEET NO.	TOTAL SHEETS
1	MAINE	I-95-5(10)	19	145

RESERVED AREA

THE AREA FROM STA 1545+35 TO 1576+50 NB
AND STA 1545+30 TO 1573+50 SB, BOUNDED
ON THE LT. BY THE PROPOSED RIGHT OF WAY,
WILL BE AVAILABLE TO THE CONTRACTOR October 1st 1972

STA. 1560+00 S.B.

INSTALL 54" X 164 BCCMP (INSTALL WITH 12" CAMBER @ 4%)
STANDARD CURB END TREATMENT SOD & RIPLEAP
CONSTRUCT CROSS DITCH
STA 1560+00 S-B RT TO STA 1562+00 N.B. LT. 1972-1973

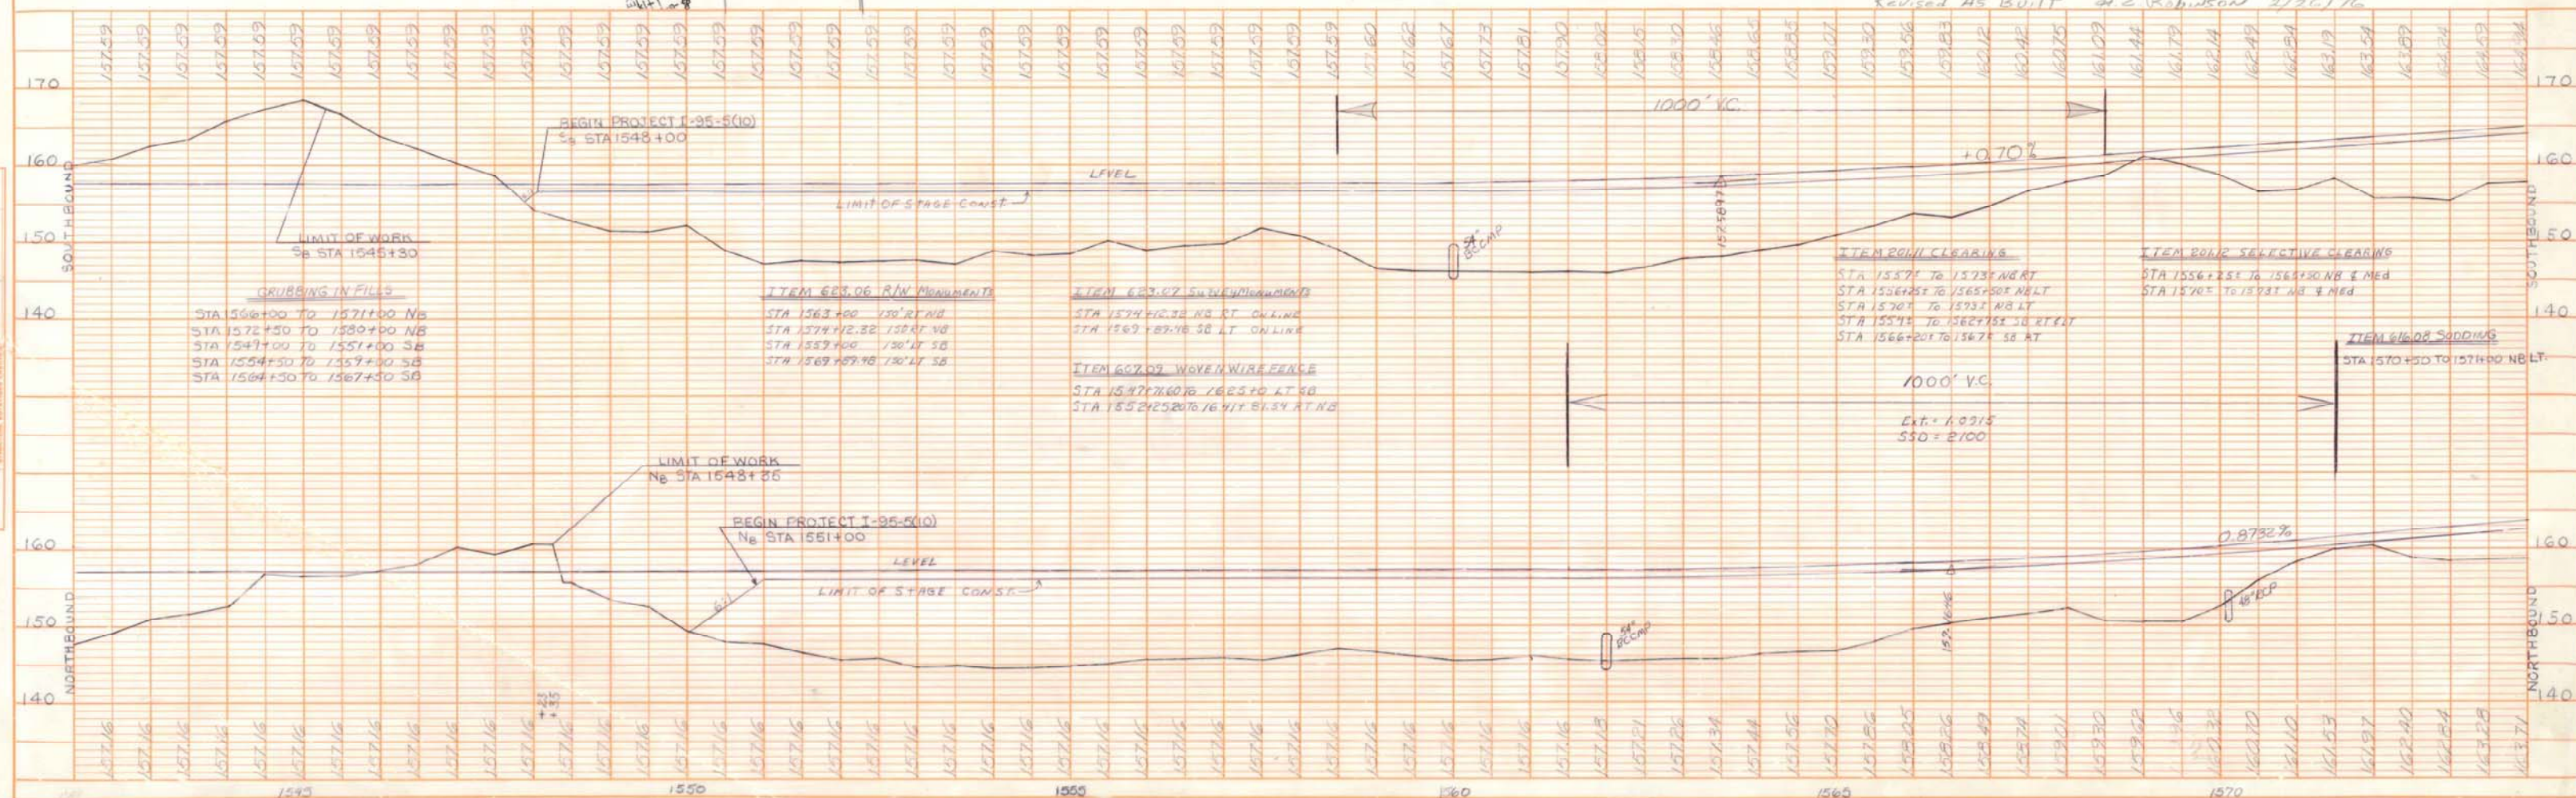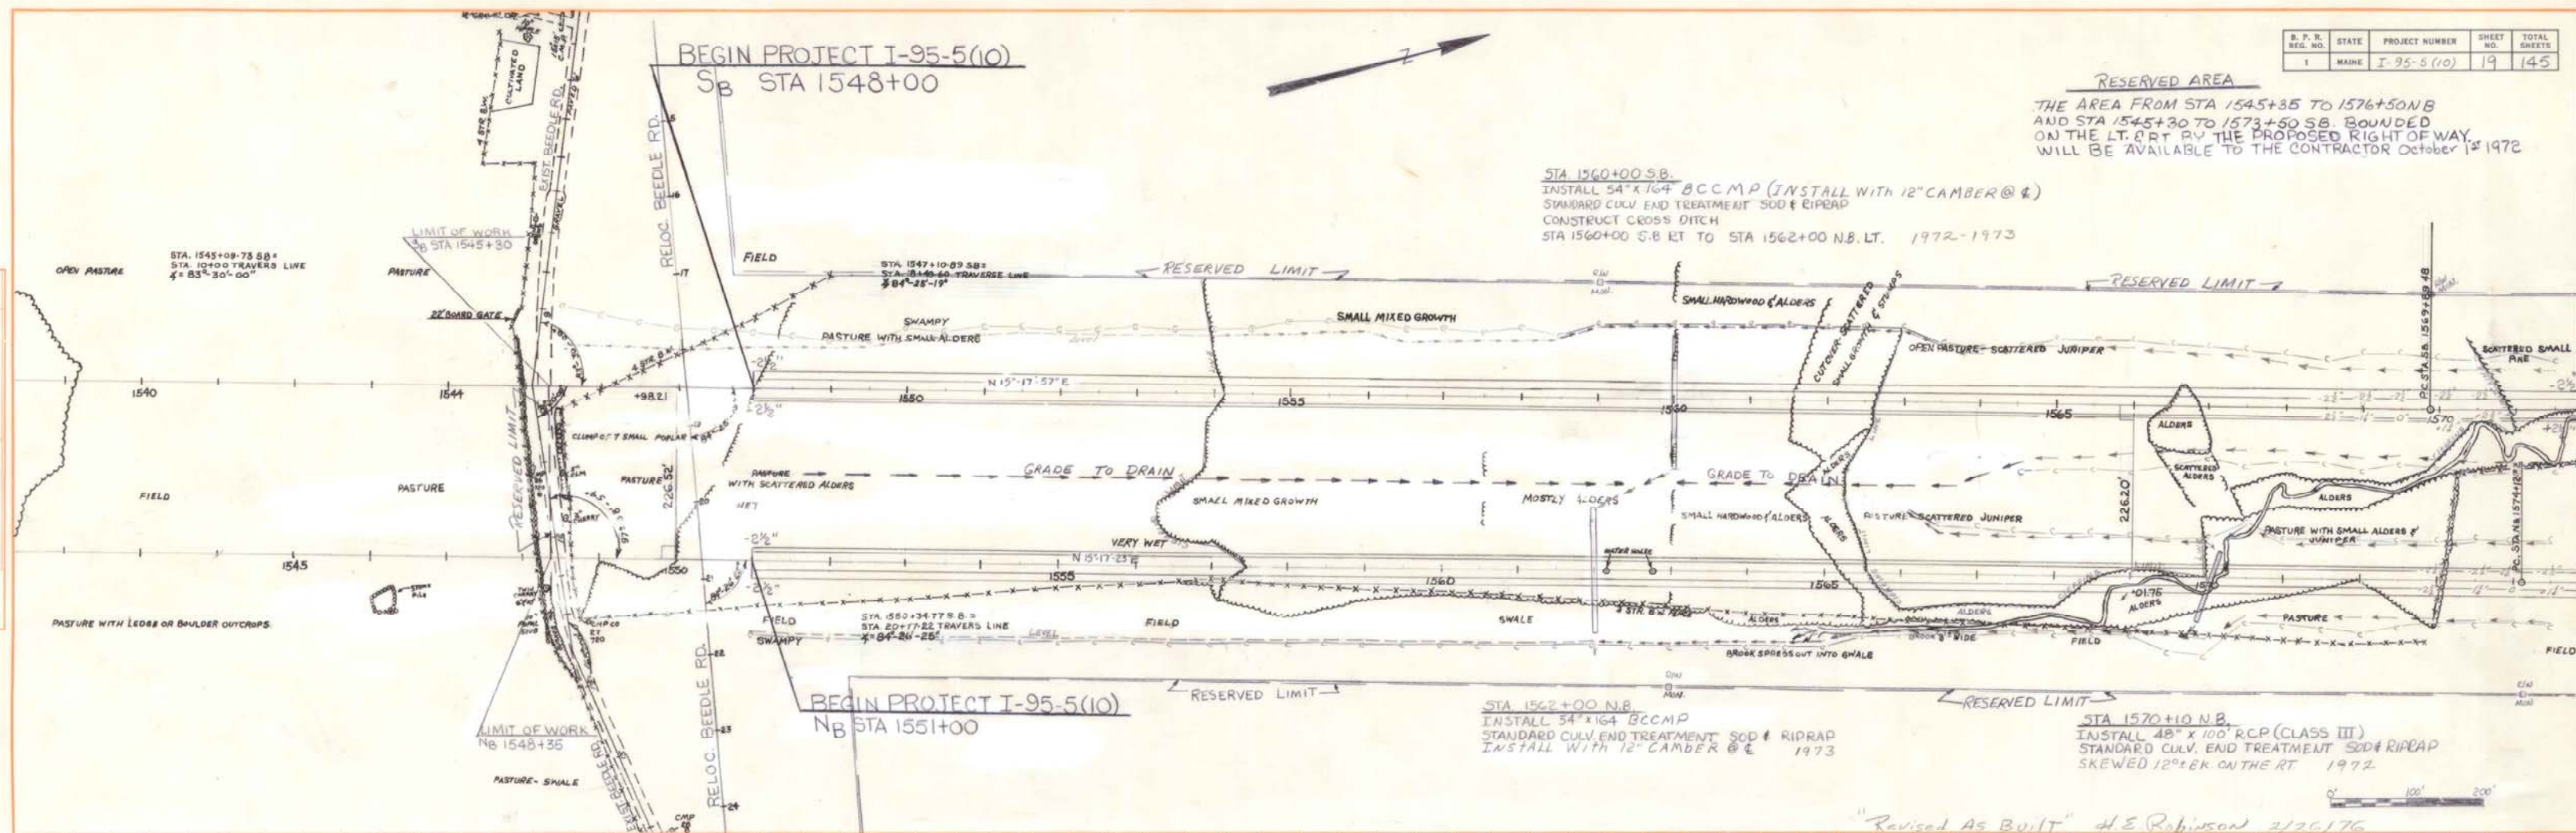

RICHMOND - GARDINER - WEST GARDINER