



**PLAN**  
 DATE: \_\_\_\_\_  
 BY: \_\_\_\_\_  
 CHECKED: \_\_\_\_\_  
 APPROVED: \_\_\_\_\_  
 NOTE: DATE OF NOT REVISIONS

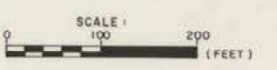

**PROFILE**  
 DATE: 8/22/1974  
 BY: T. J. J. J.  
 CHECKED: \_\_\_\_\_  
 APPROVED: \_\_\_\_\_  
 NOTE: DATE OF NOT REVISIONS

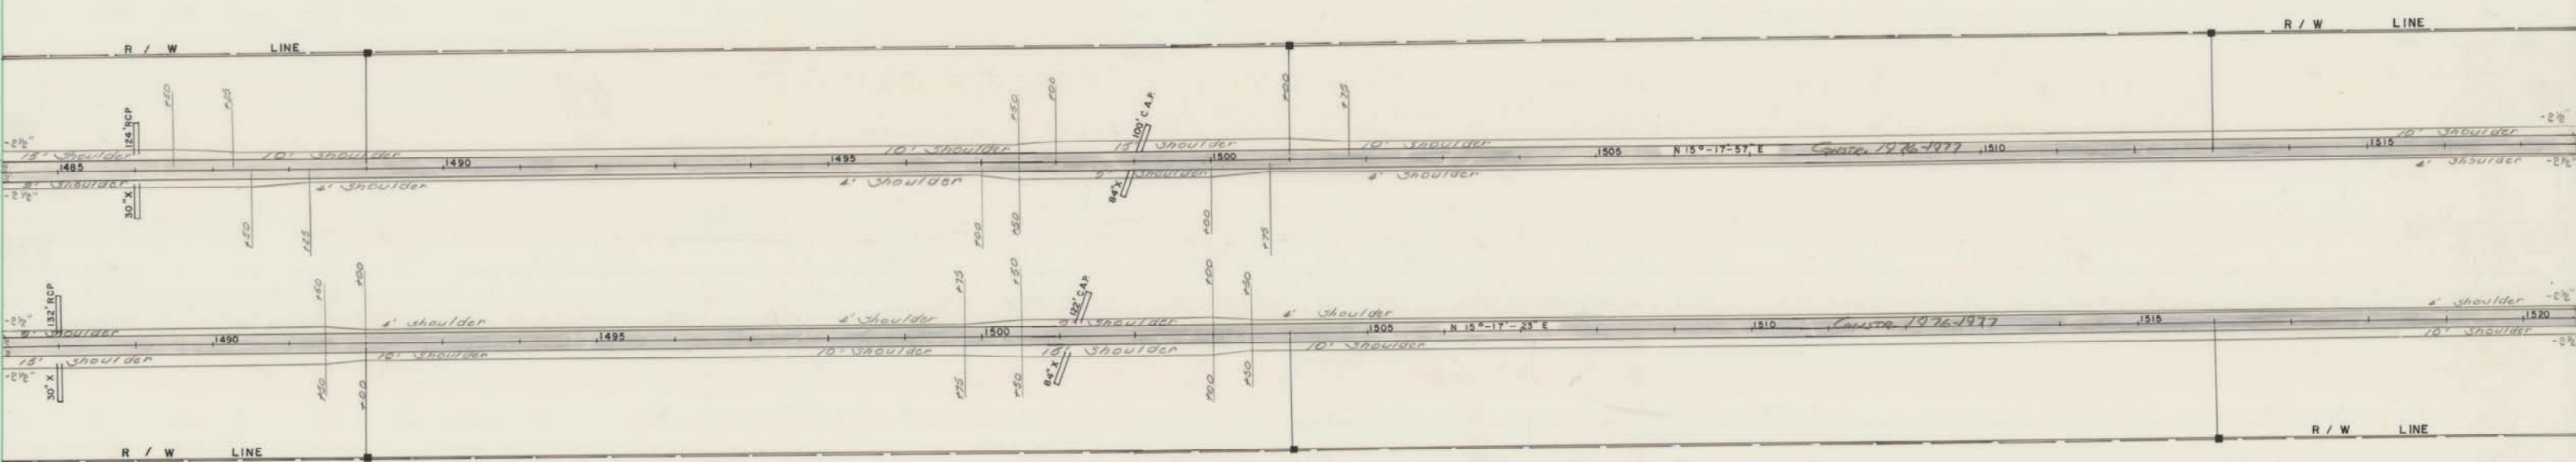