F.A.P. RES. NO.	STATE	PROJECT NUMBER	SHEET NO.
1	MAINE	95-5 (31)	22

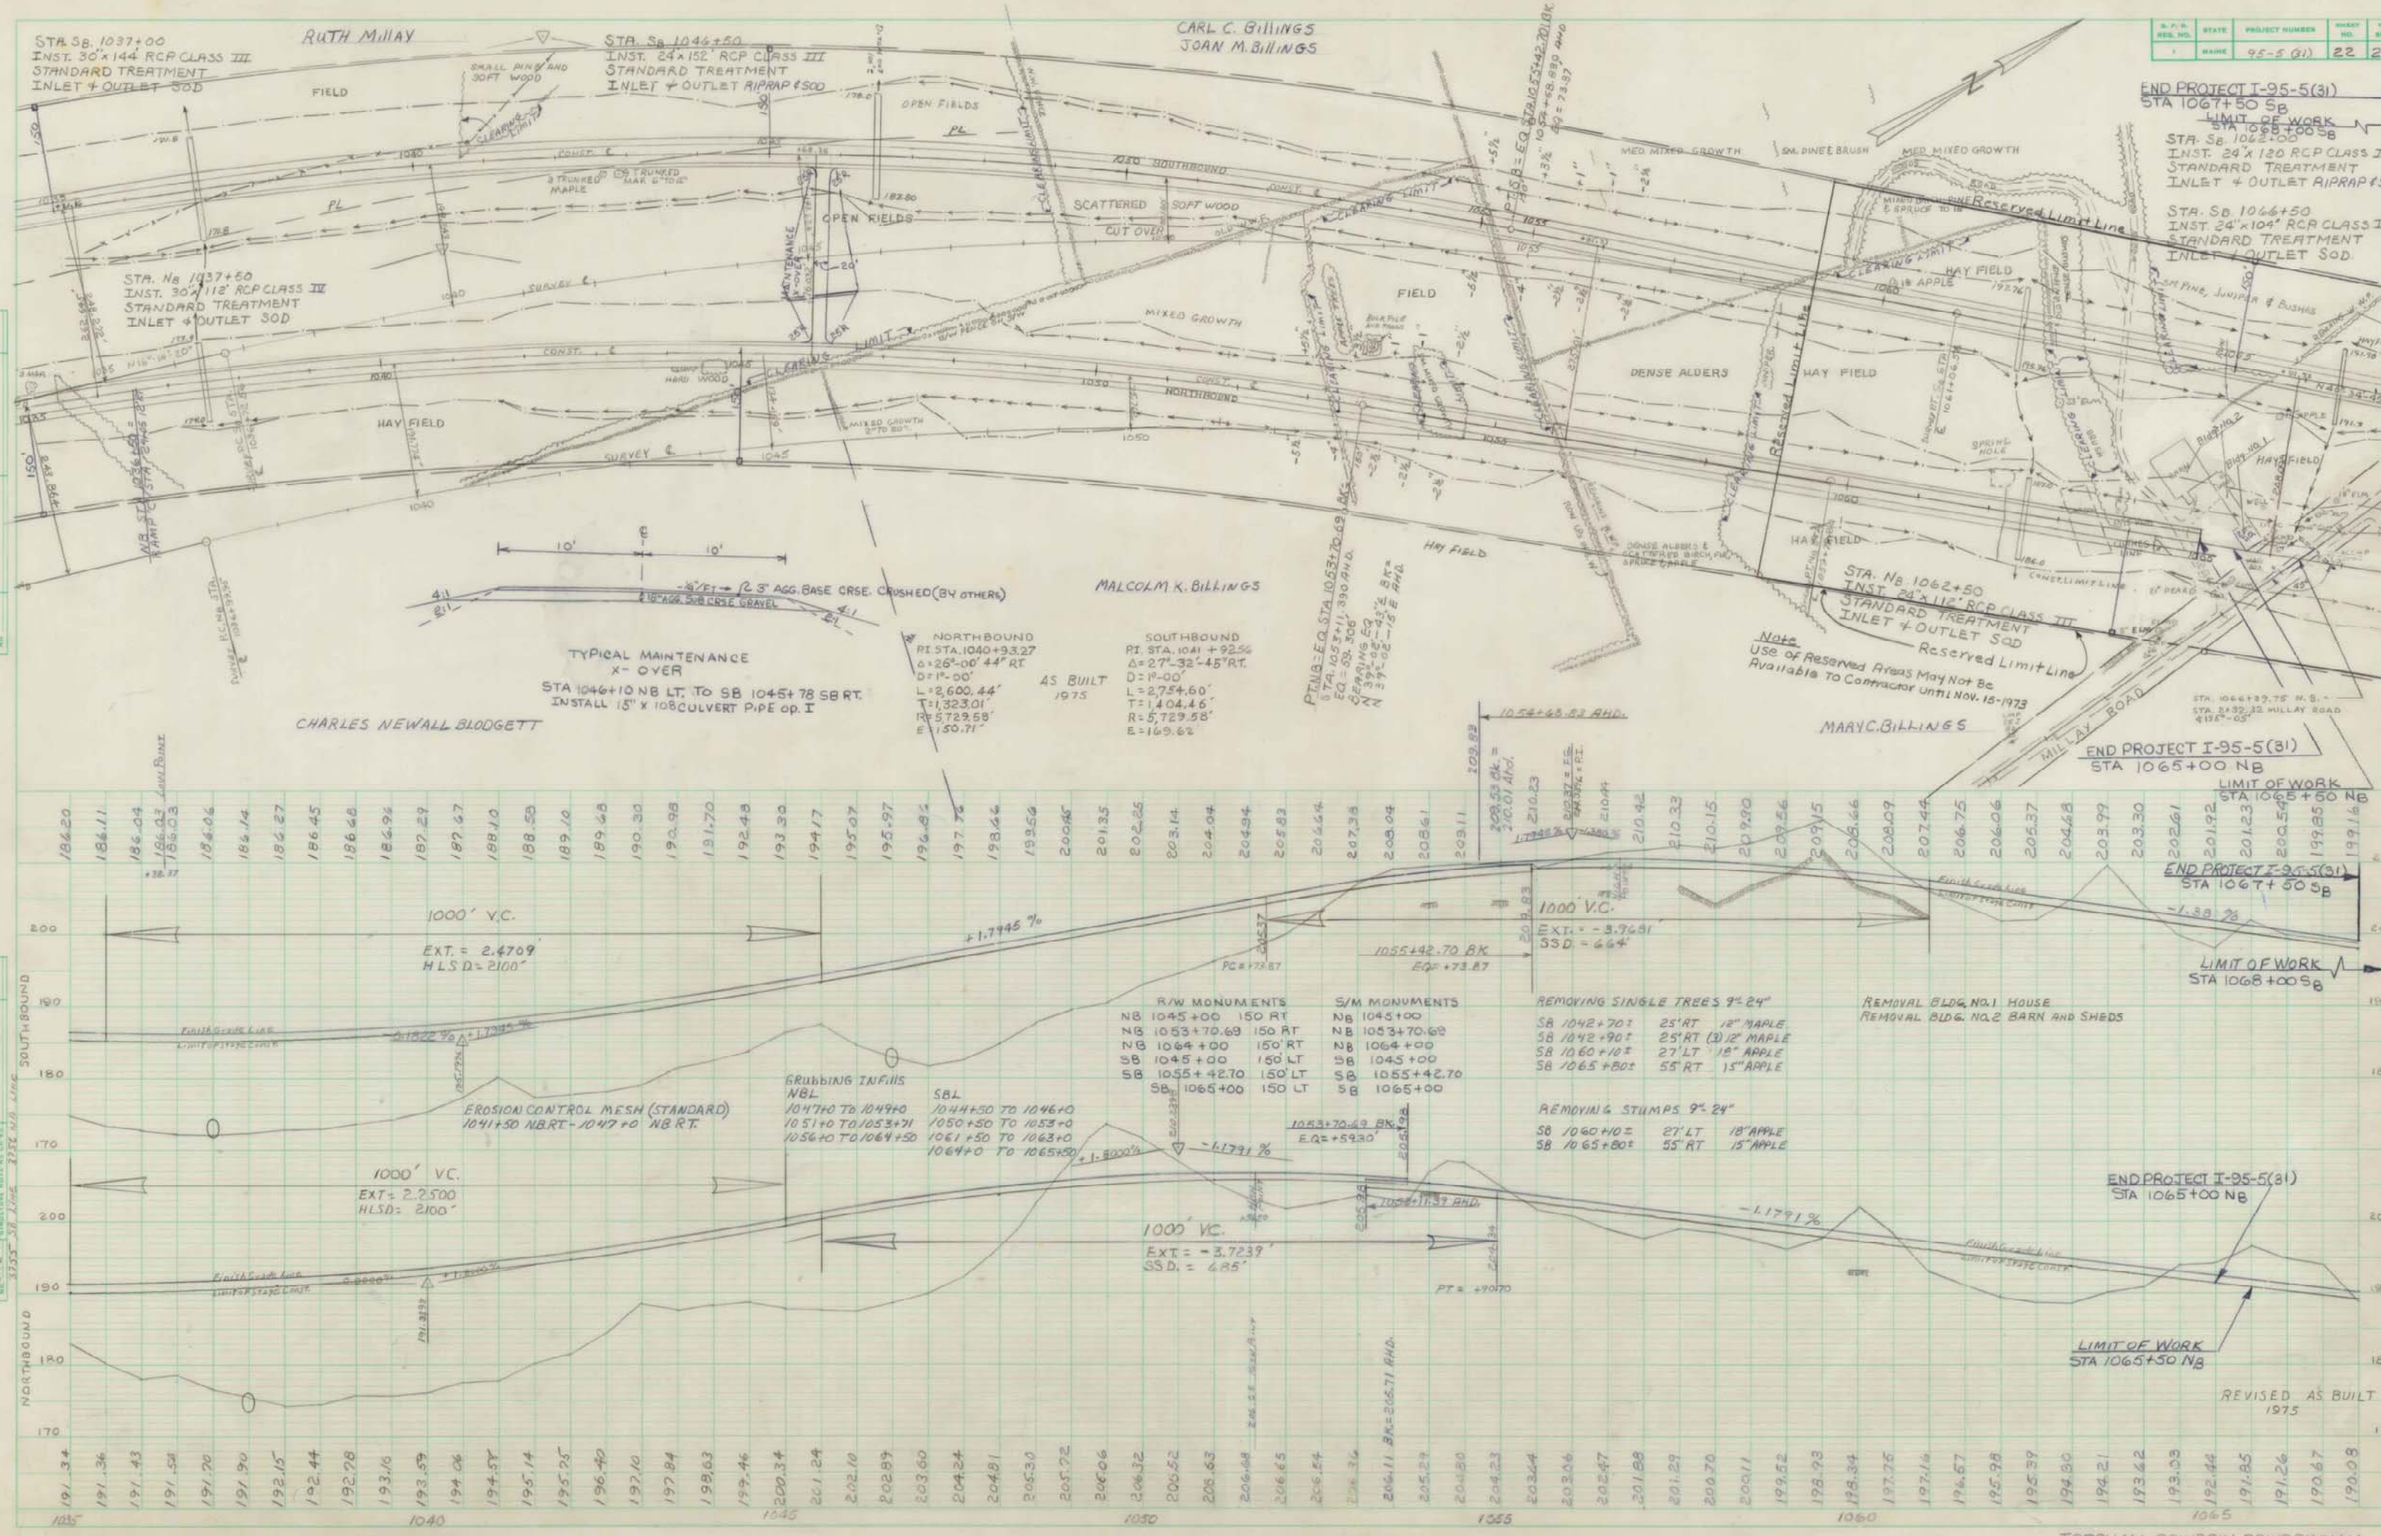

TOPSHAM, BOWDOIN, BOWDOINHAM