
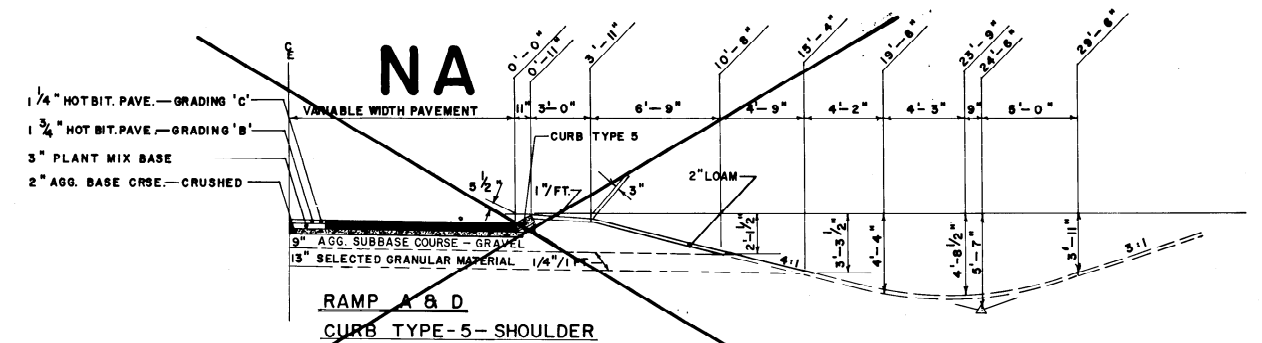
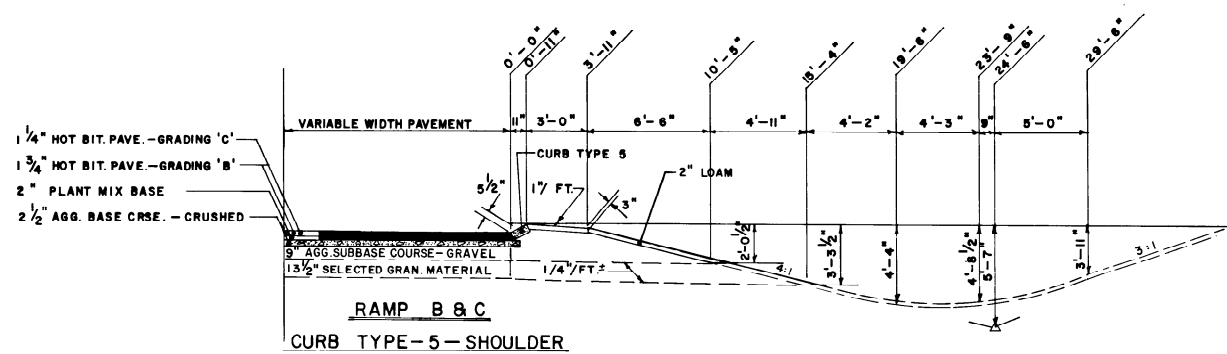
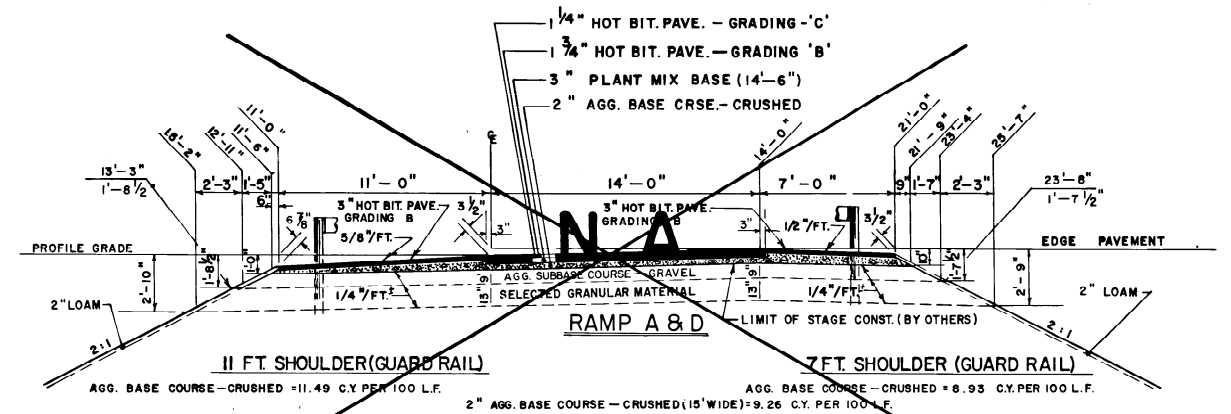




3" HOT BITUMINOUS PAVEMENT

P.W.A. REV. NO.	STATE	PROJECT NUMBER	SHEET NO.	TOTAL SHEETS
1	MAINE	I-95-5 (14) B1	4	53

CONTRACT 2

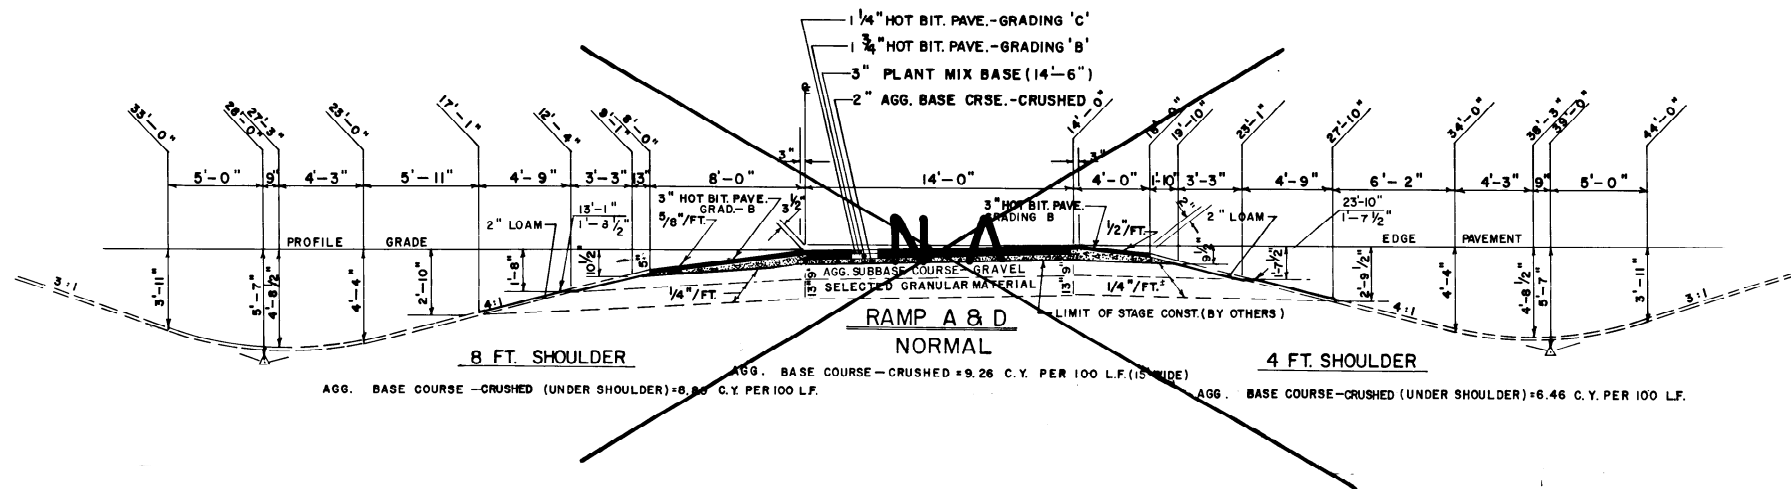

NOTE:
THE PAVEMENT AND BASE DEPTHS AS SHOWN
ON THE PLANS ARE INTENDED TO BE NOMINAL.

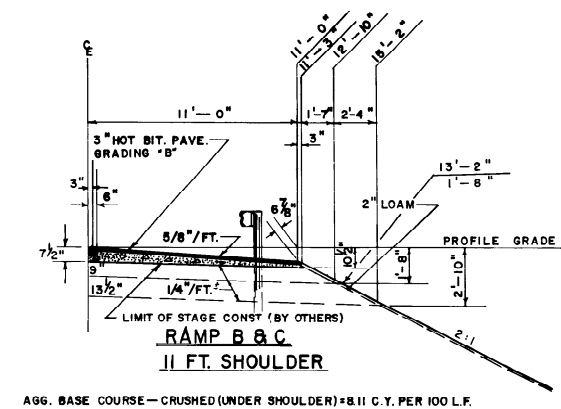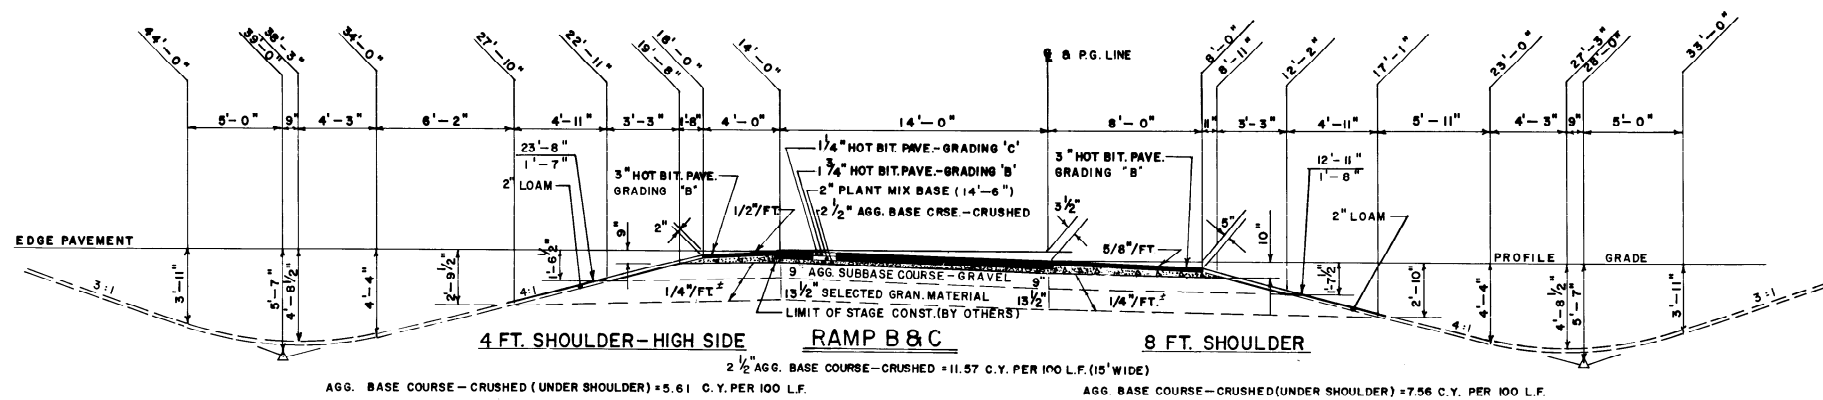

STATE OF MAINE
DEPARTMENT OF TRANSPORTATION

TYPICAL SECTIONS

RAMPS B & C
ROUTE 138
INTERCHANGE

SCALE: 0 5 10 (FEET)
SHEET OF AUGUSTA, MAINE

BOWDOINHAM-RICHMOND-GARDINER I-95-5 (14) B1 Cont. # 2

PROJECT DESIGN ENGINEER	DATE
DESIGN-DETAILED	5/17/92
CHECKED	
REVISIONS	
FIELD CHANGES	