


PLAN
 SURVEYED
 PLOTTED
 ALIGNED
 BY
 DATE

PROFILE
 SURVEYED
 PLOTTED
 ALIGNED
 BY
 DATE

| SHEET NO. | TOTAL SHEETS |
|-----------|--------------|
| 31 | 53 |

CONTRACT 2

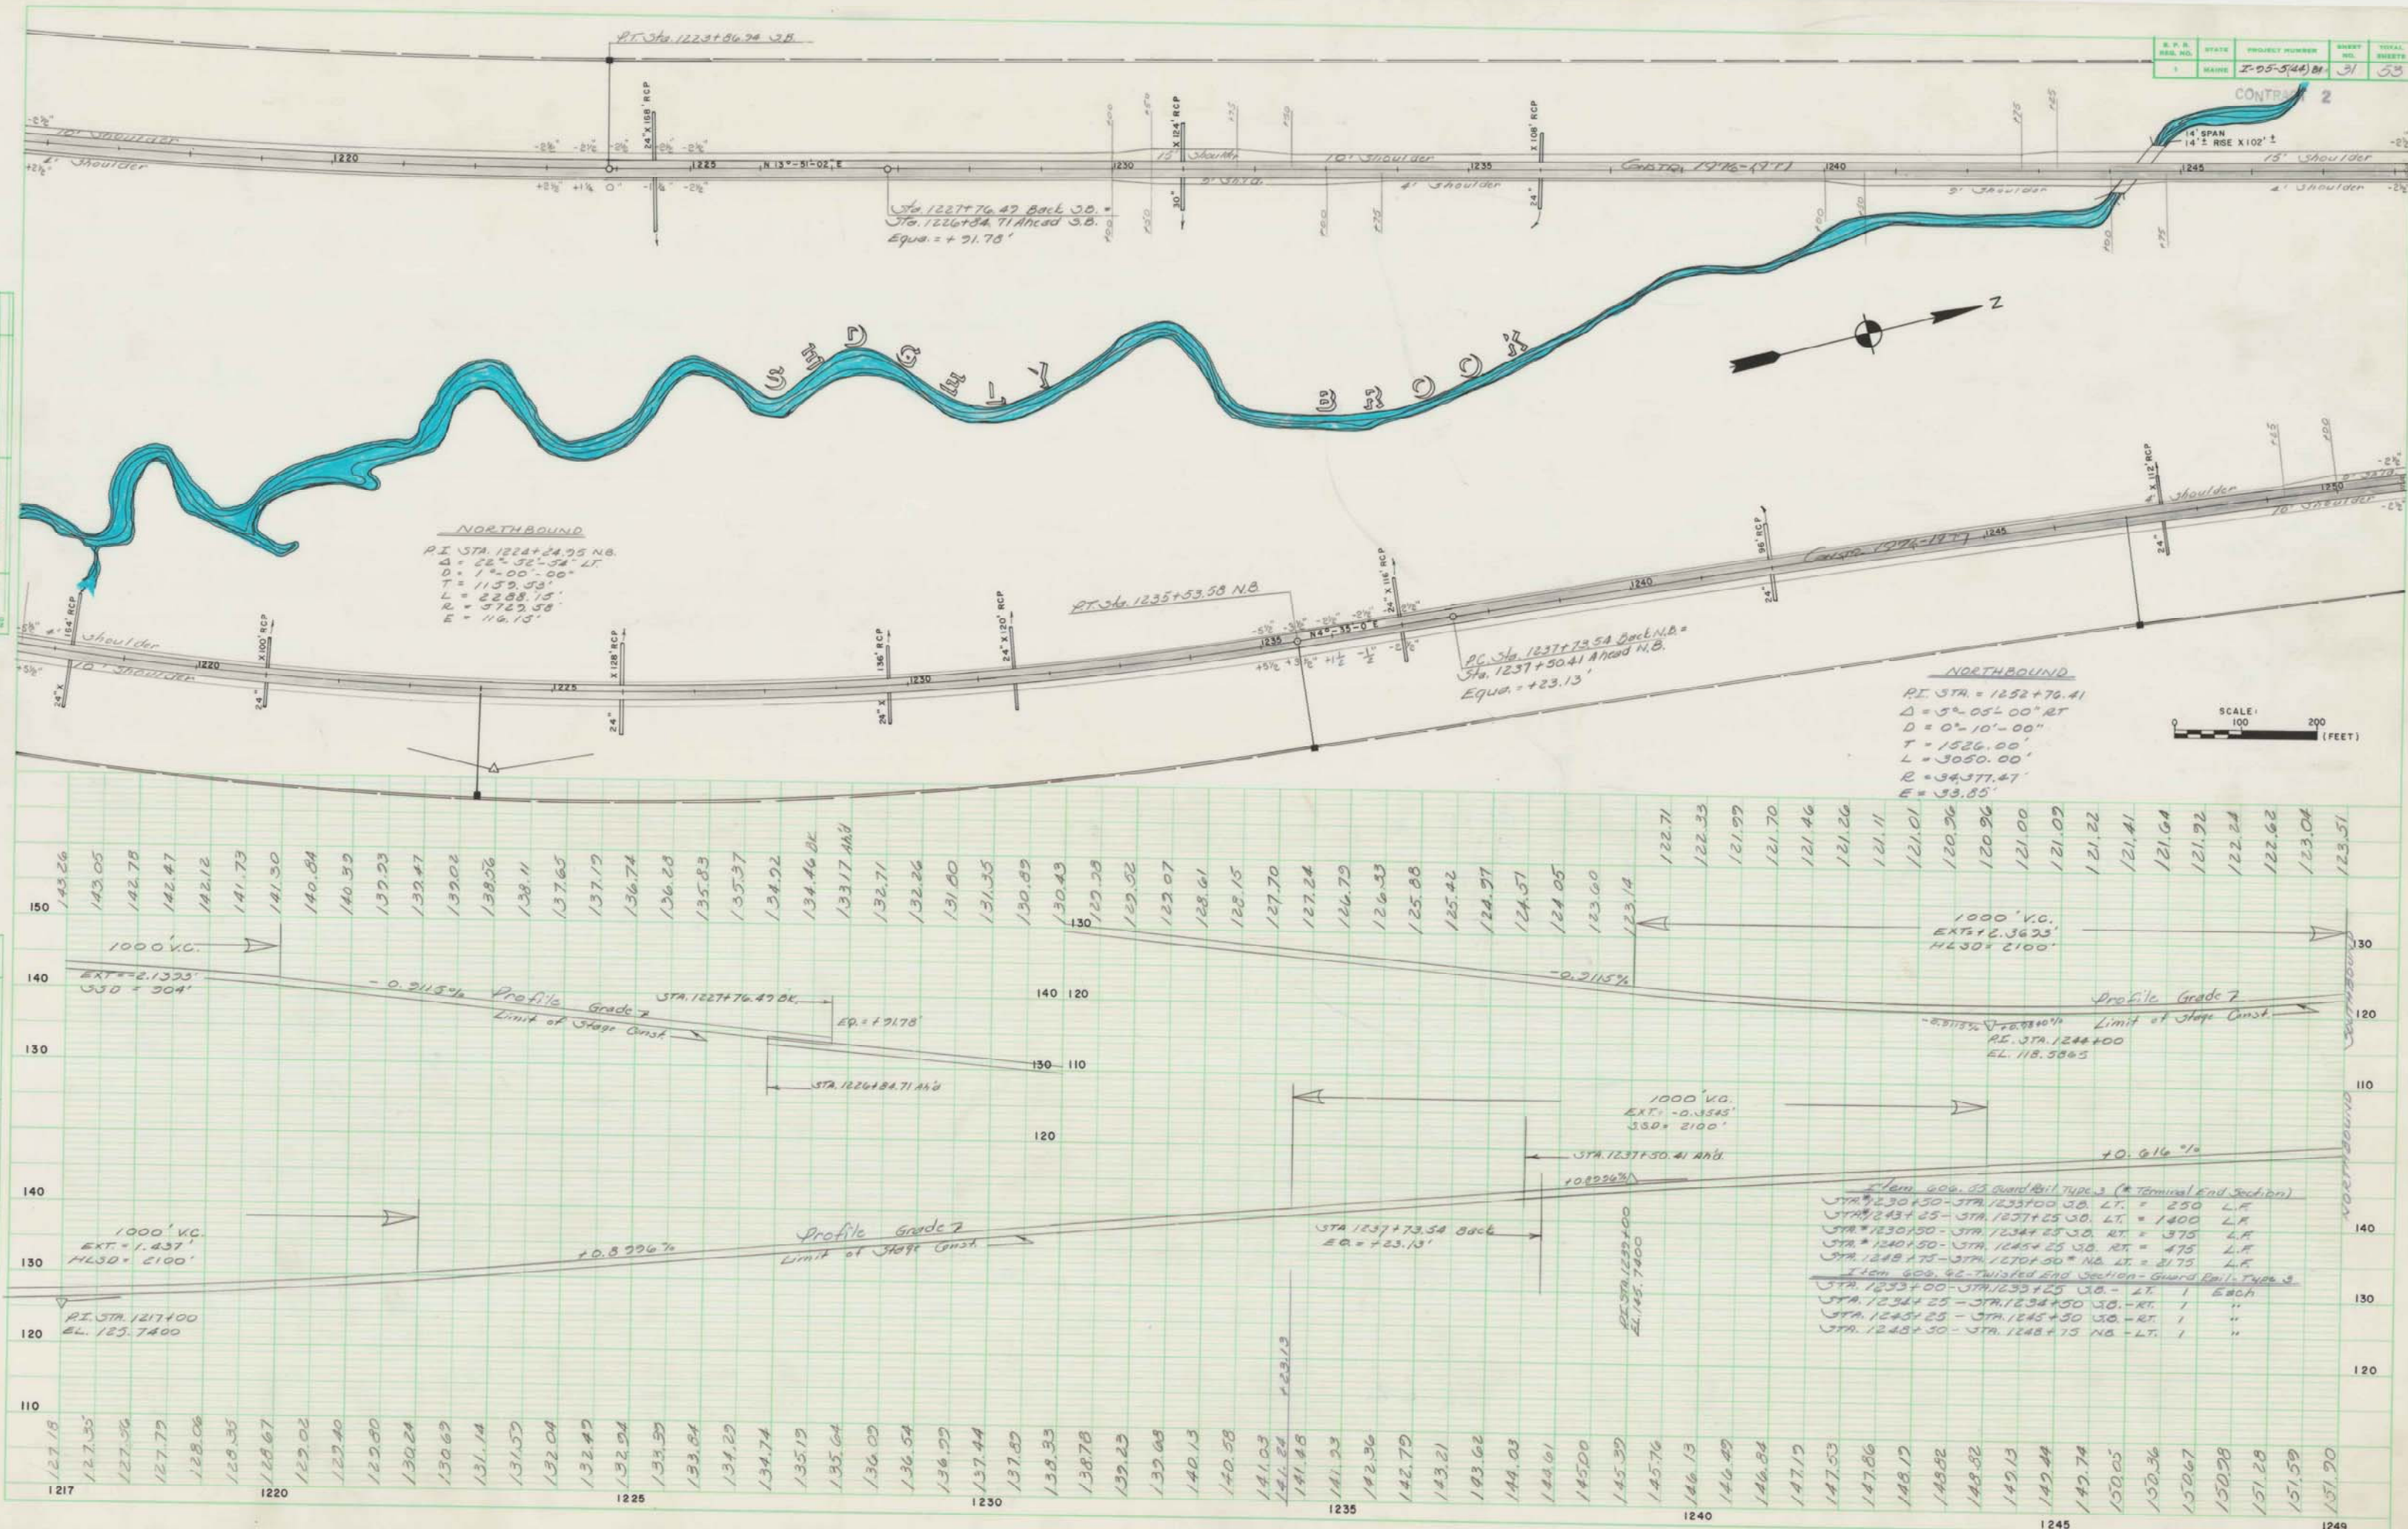

SCALE: 1" = 100' (FEET)