


DATE	
BY	
REVIEWED	
PLOTTED	
NOTE BOOK	
AREA CHECKED	

DATE	8/2/81
BY	D. B. D. J. J.
REVIEWED	
PLOTTED	
NOTE BOOK	
AREA CHECKED	

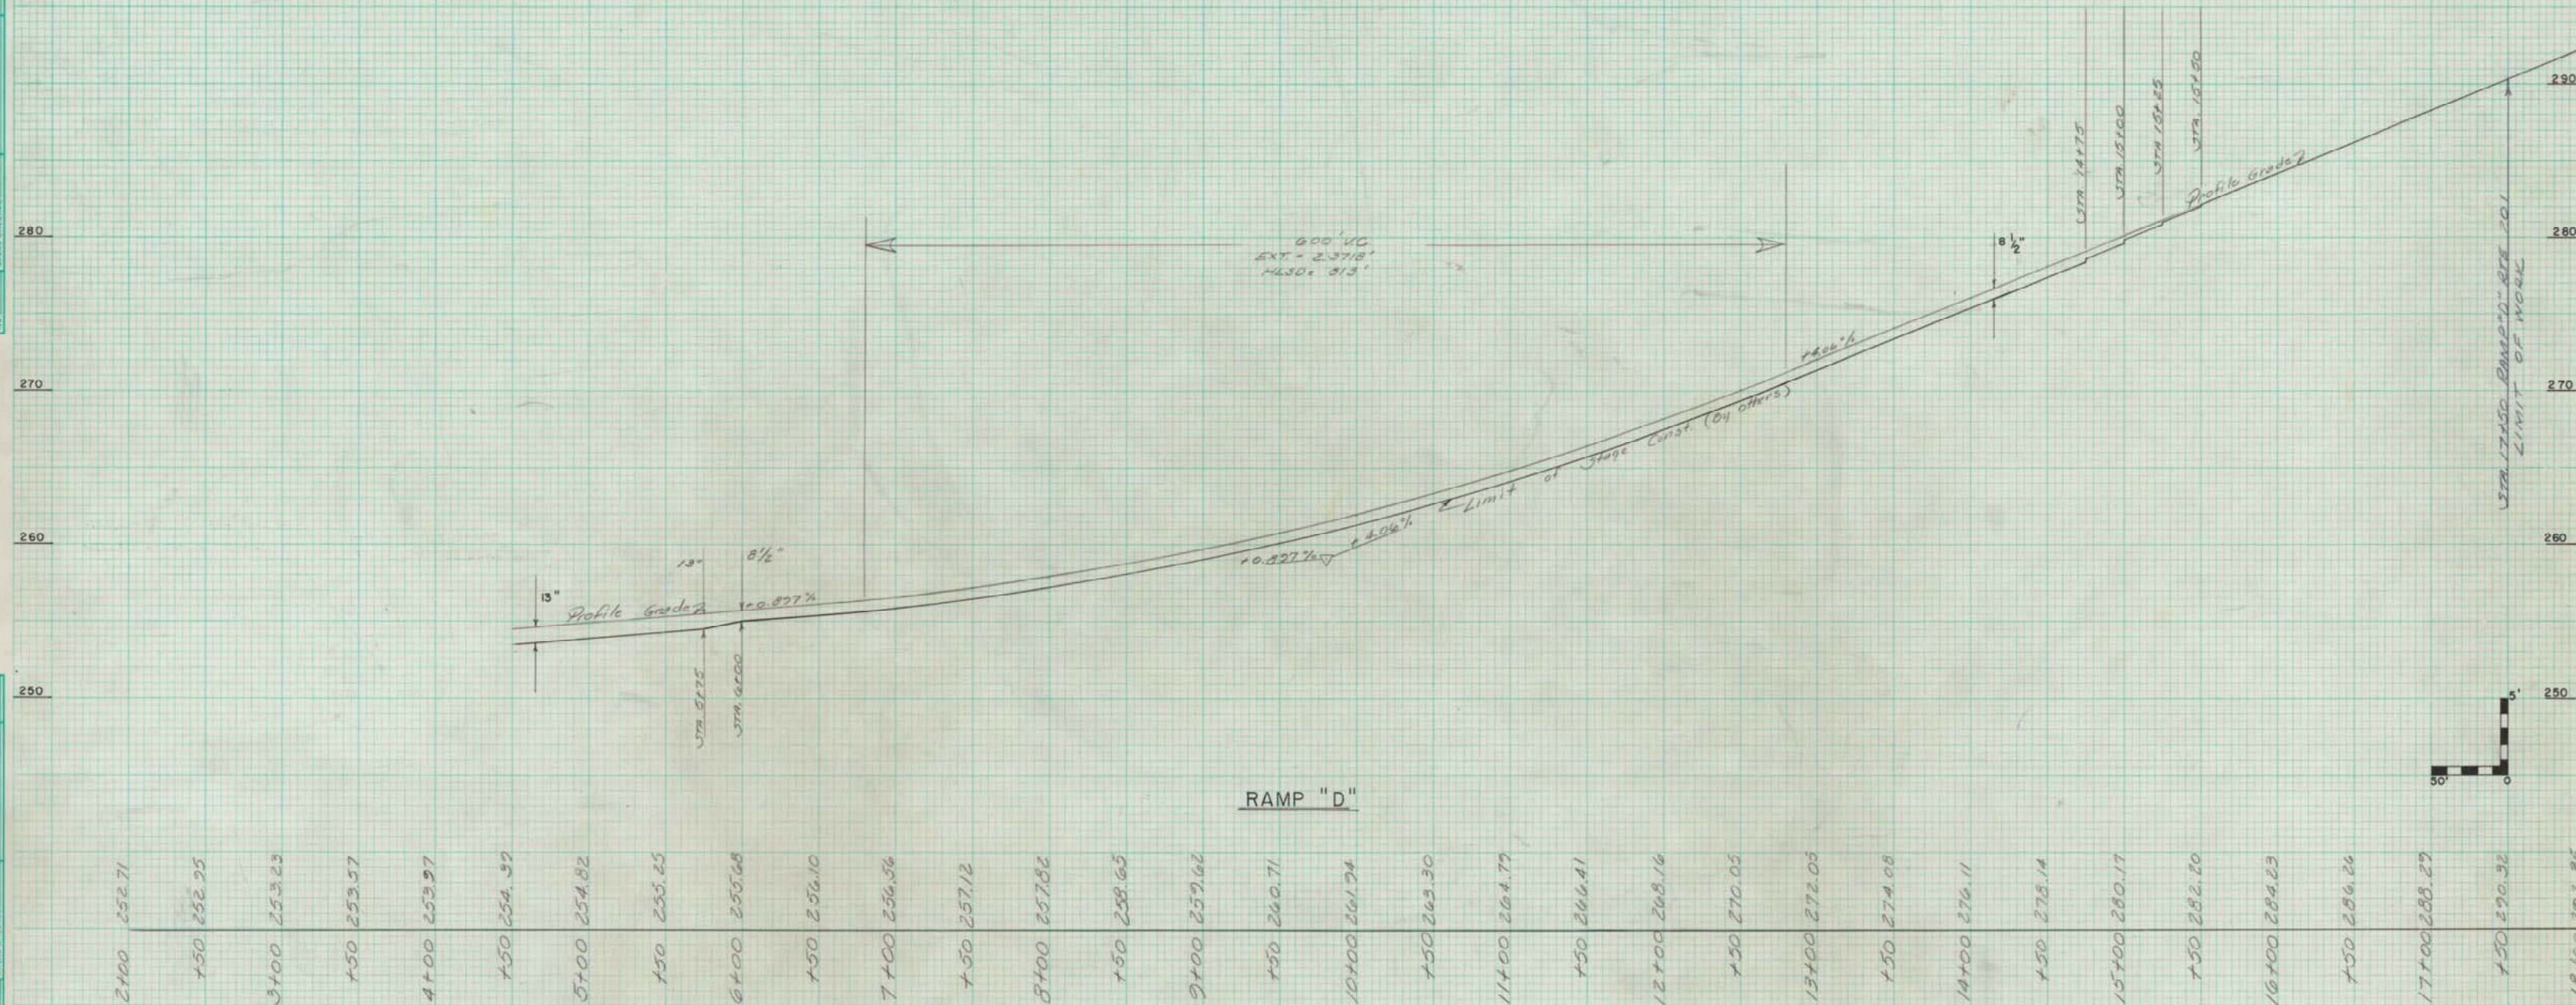

STATE OF MAINE  
DEPARTMENT OF TRANSPORTATION

RAMP "D" PROFILE  
ROUTE 201 INTERCHANGE

AUGUSTA, MAINE

BOWDOINHAM - RICHMOND - GARDNER  
Z-95-5(44)81 Cont. #2