


FINAL SURVEY	DATE
NO. 1	1/13/75
NO. 2	
NO. 3	
NO. 4	
NO. 5	
NO. 6	
NO. 7	
NO. 8	
NO. 9	
NO. 10	

ORIGINAL SURVEY	DATE
NO. 1	1/13/75
NO. 2	
NO. 3	
NO. 4	
NO. 5	
NO. 6	
NO. 7	
NO. 8	
NO. 9	
NO. 10	

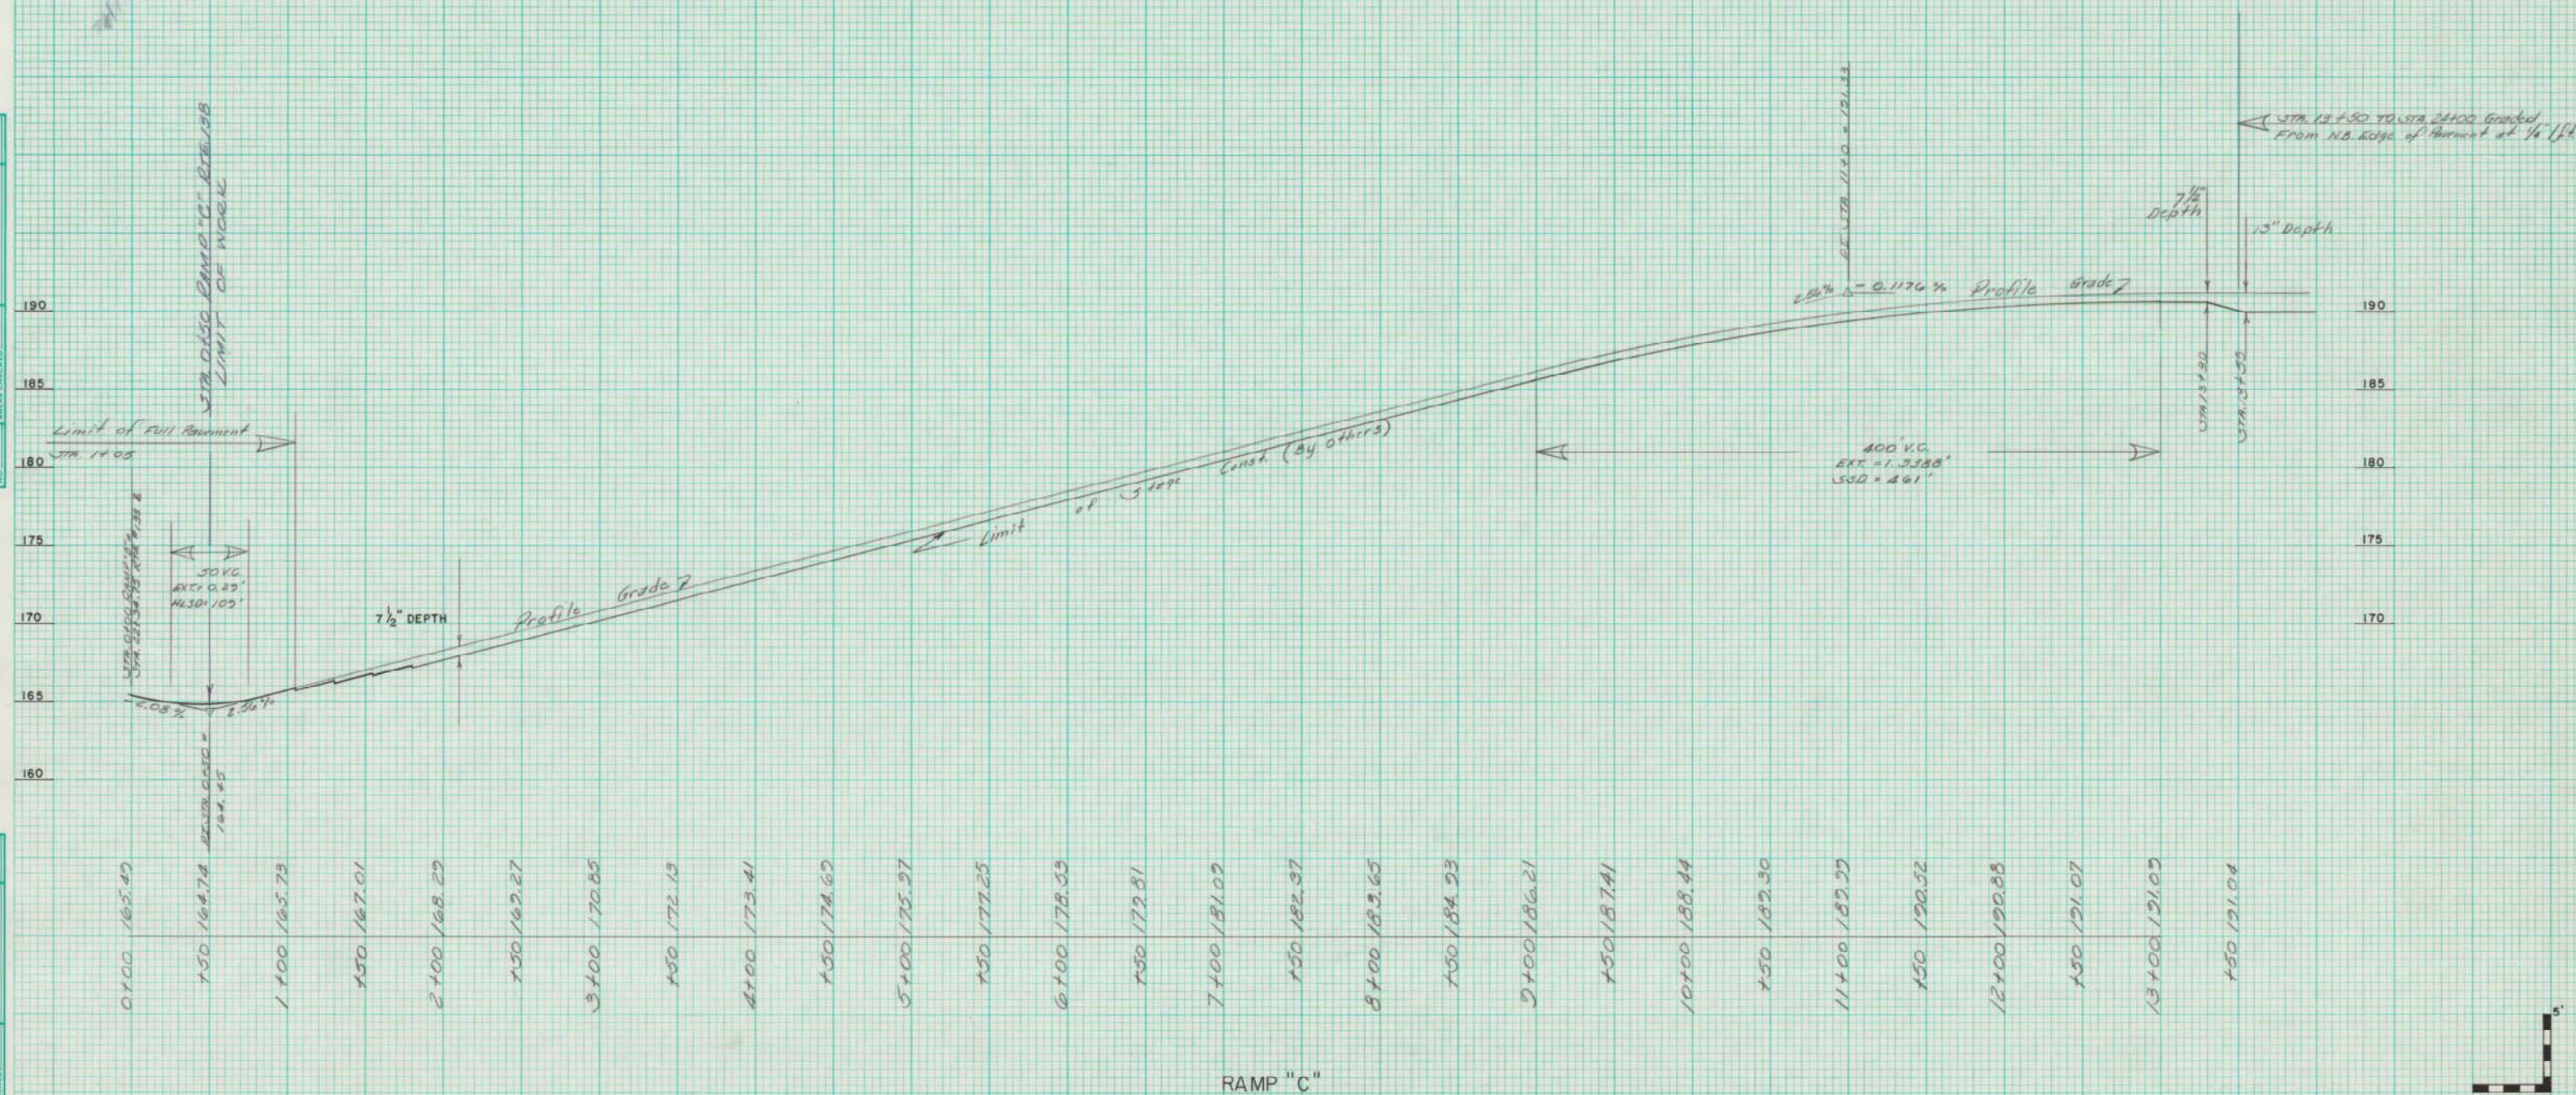

RAMP "C"

STATE OF MAINE
DEPARTMENT OF TRANSPORTATION

RAMP "C" PROFILE
ROUTE 138 INTERCHANGE

AUGUSTA, MAINE

BOWDOINHAM-RICHMOND-GARDINER
Z-95-5(44)81 Cont # 2