
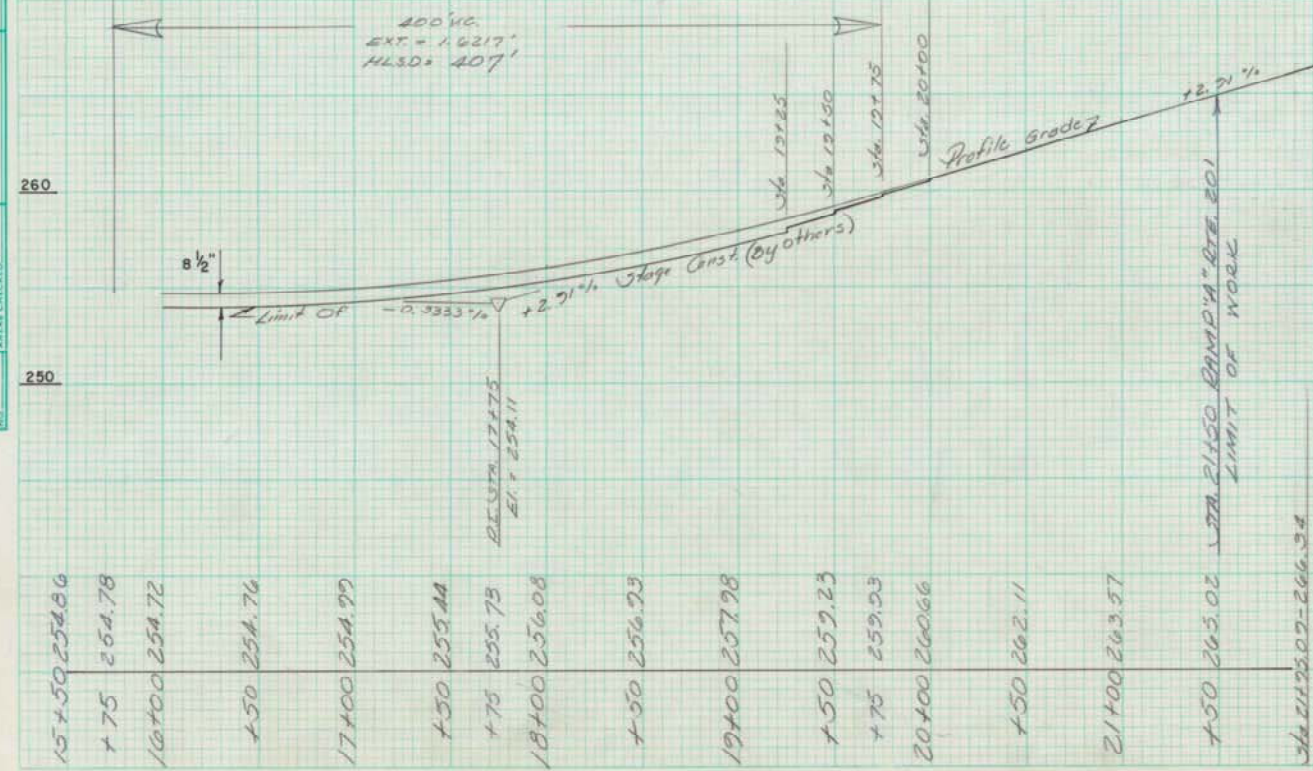


DATE	
BY	
REVIEWED	
PLANNED	
DESIGNED	
CONSTRUCTED	
MAINTAINED	
NO.	

DATE	9/6/75
BY	D. S. S.
REVIEWED	
PLANNED	
DESIGNED	
CONSTRUCTED	
MAINTAINED	
NO.	

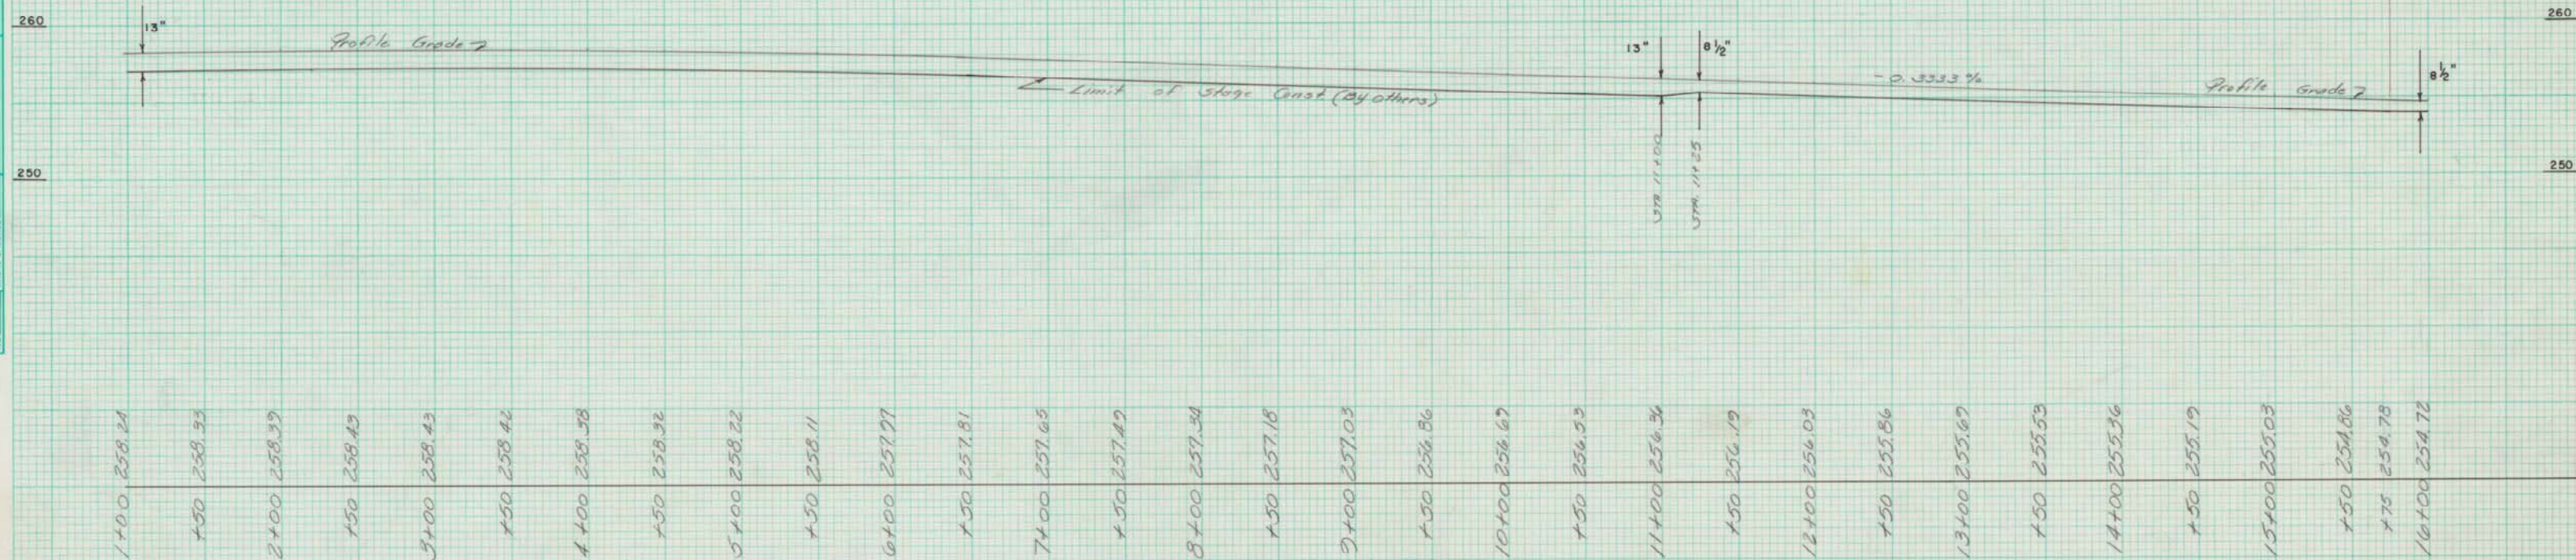

NOTE: STA 1+00 TO STA 10+00
GRADES ON RAMP "A" ARE FROM
MAIN LINE EDGE OF PAVEMENT AT 1/4" / FT.

STATE OF MAINE
DEPARTMENT OF TRANSPORTATION
RAMP "A" PROFILE
ROUTE 201 INTERCHANGE

AUGUSTA, MAINE

BOWDOINHAM RICHMOND - GARDINER
I-95-S(44) 81 Cont. #2