R. P. R. REG. NO.	STATE	PROJECT NUMBER	SHEET NO.	TOTAL SHEETS
1	MAINE	I-95-3(44) B1	33	53

CONTRACT 2

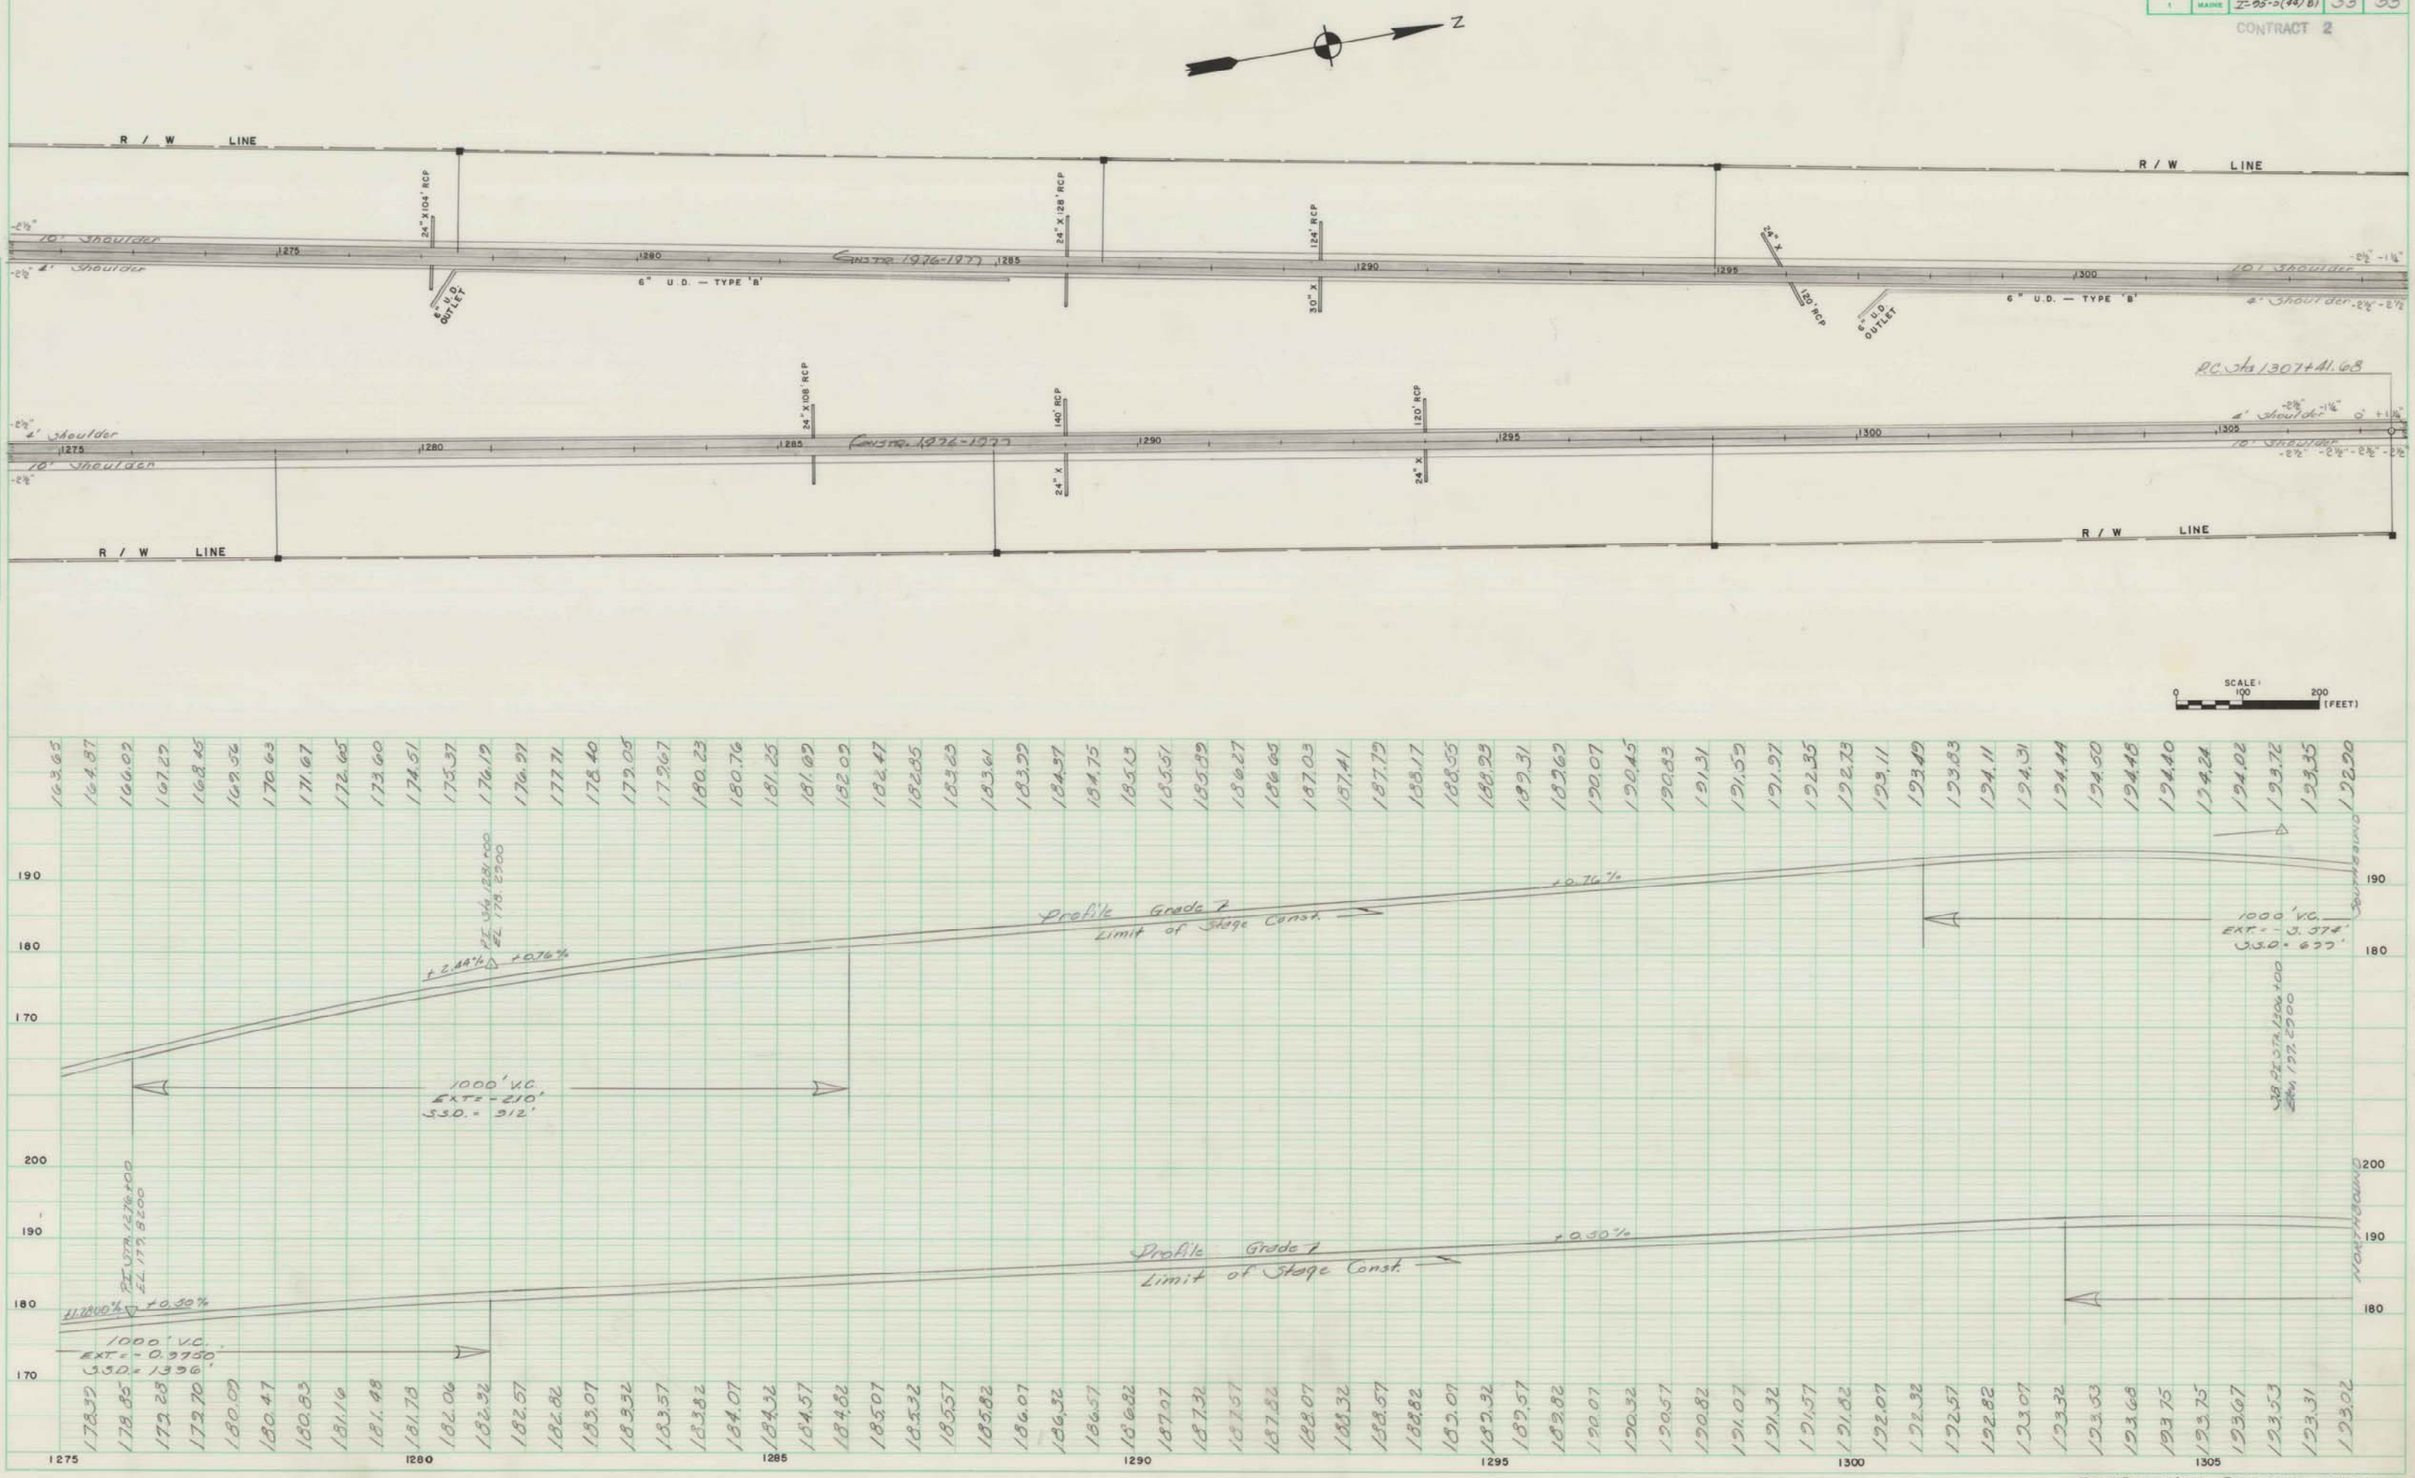

PLAN — SURVEYED: PLOTTED: ALIGNMENT CHECKED: B.M. NOTES: C.P. NAS CHECKED: NOTE BOOK NO. — BY: JCC — DATE

PROFILE — SURVEYED: PLOTTED: GRADES CHECKED: B.M. NOTES: STRUCTURE NOTE NO. CK. NO. — BY: JCC — DATE 1/23/78

BOWDOINHAM-RICHMOND-GARDINER
I-95-3(44)B1 Cont. #2