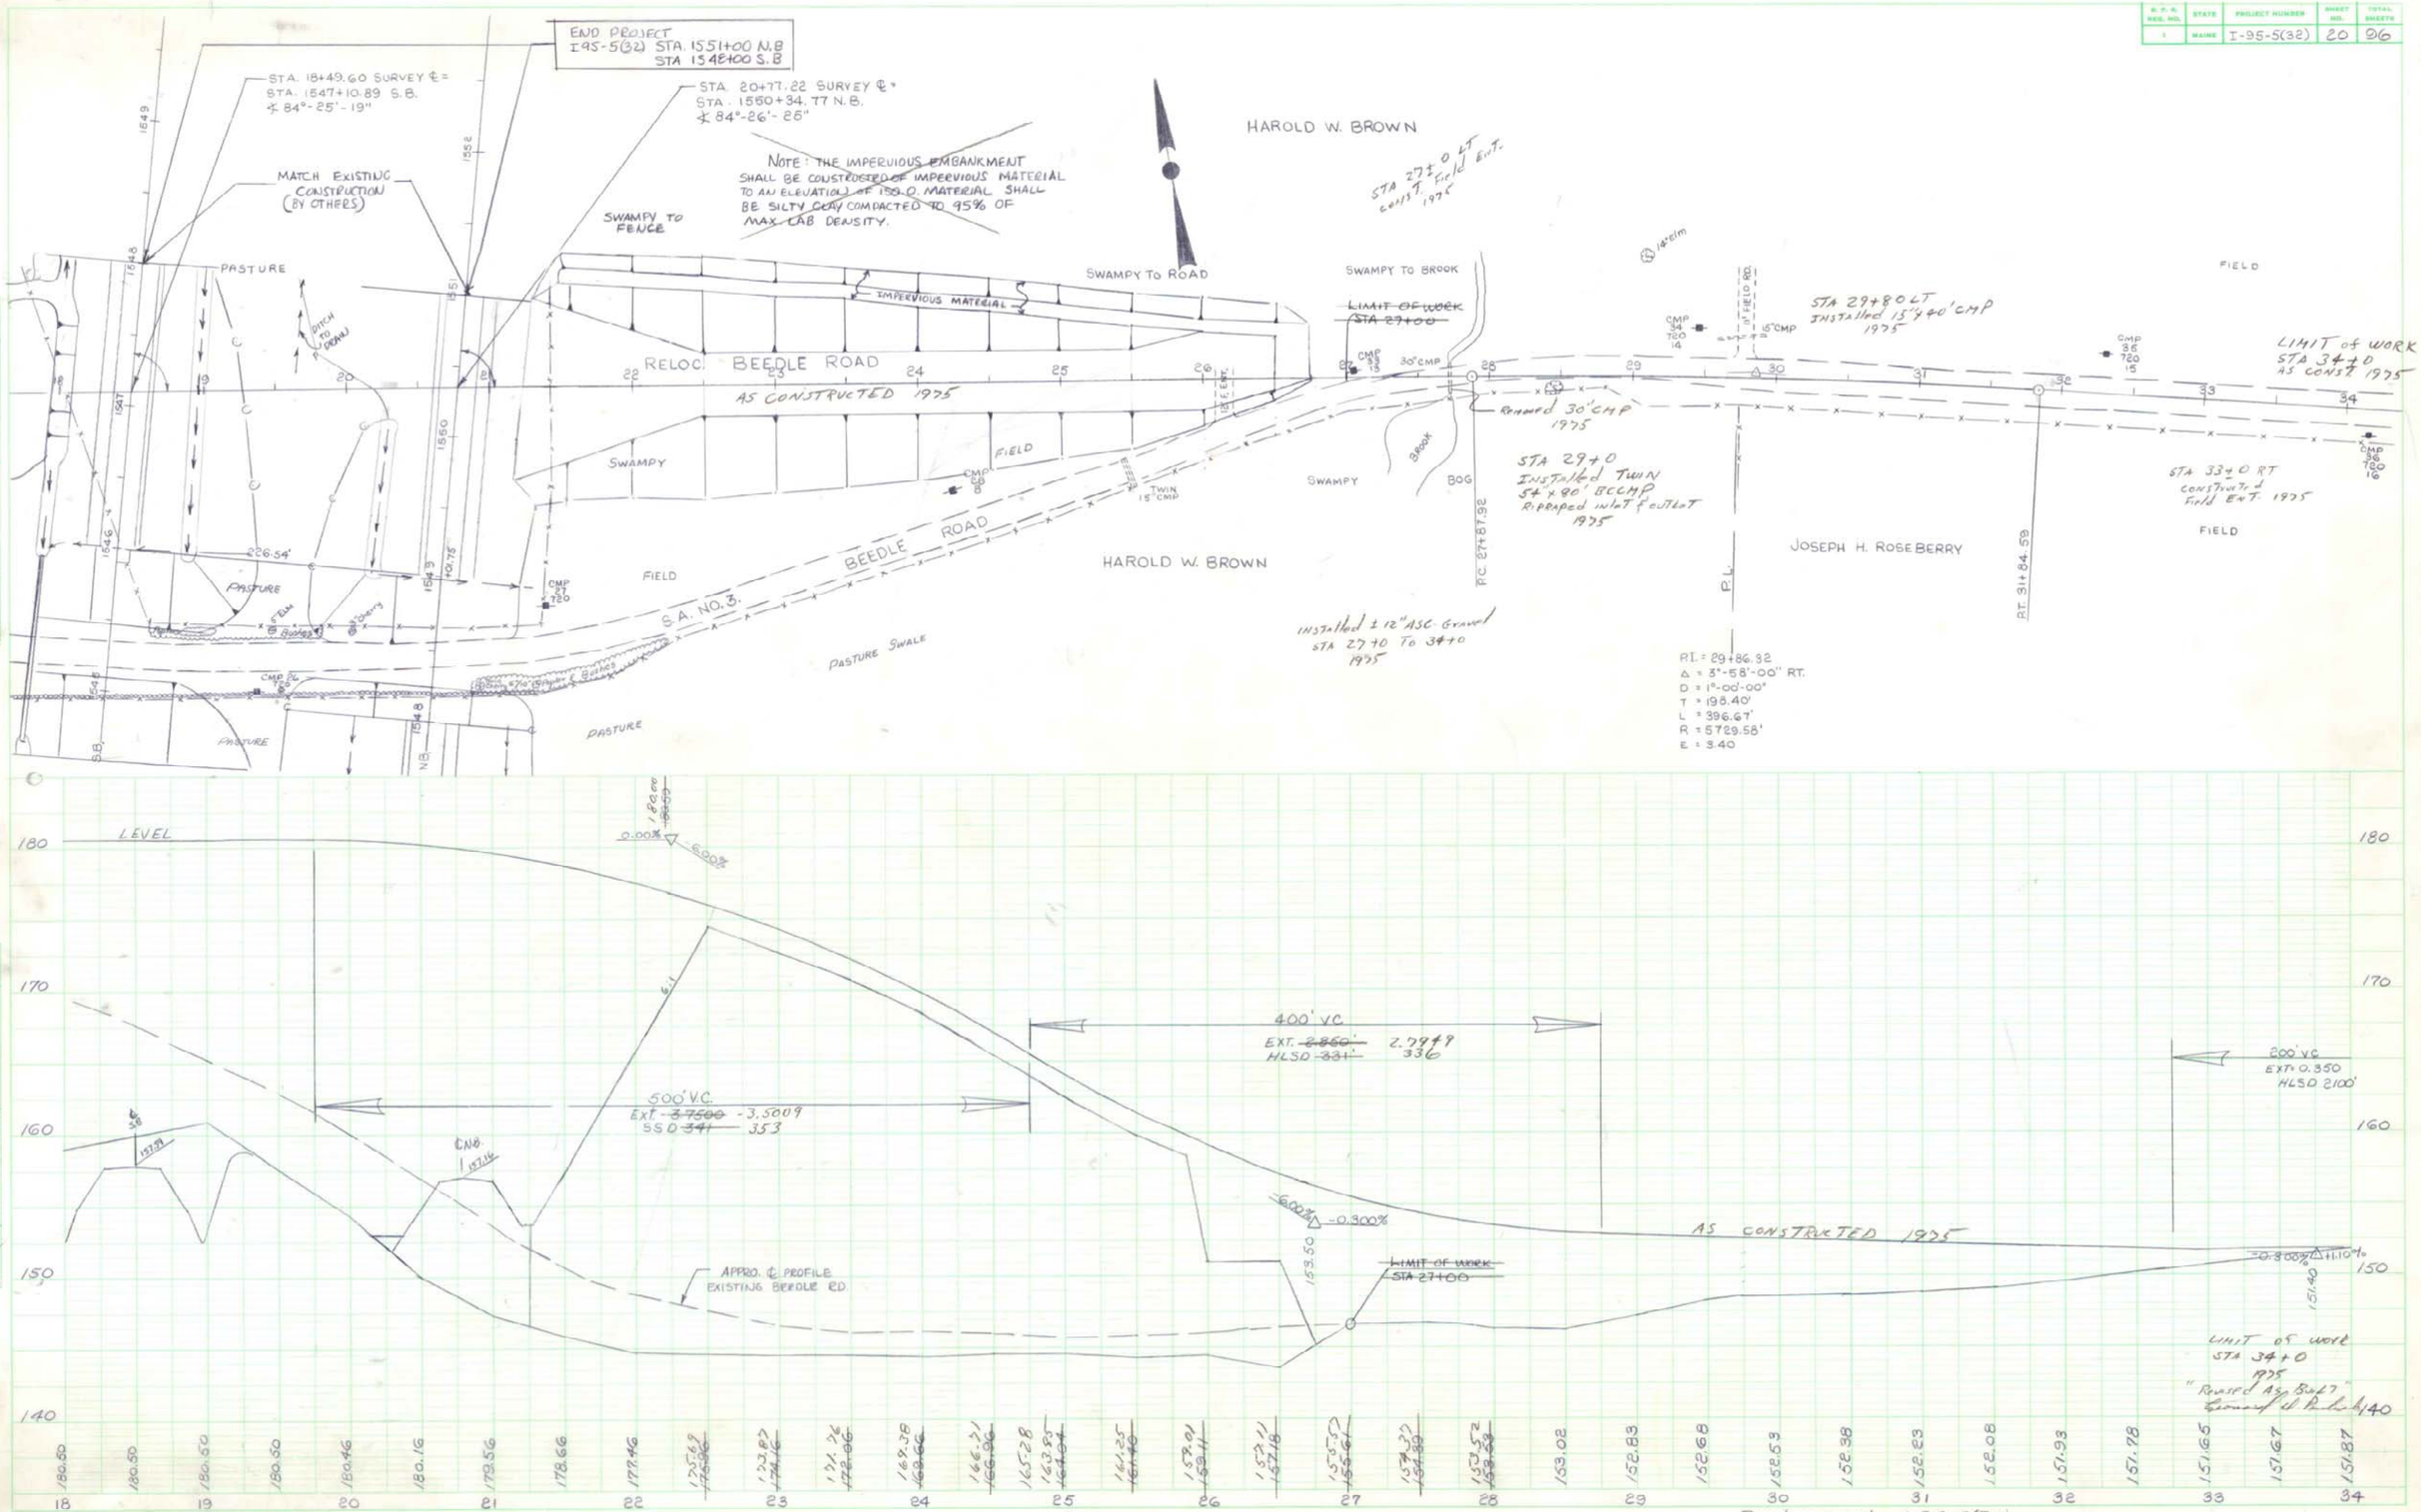F. P. A. ROAD NO.	STATE	PROJECT NUMBER	SHEET NO.	TOTAL SHEETS
I	MAINE	I-95-5(32)	20	26