


DATE
BY
CHECKED
APPROVED
NOTED
PLAN

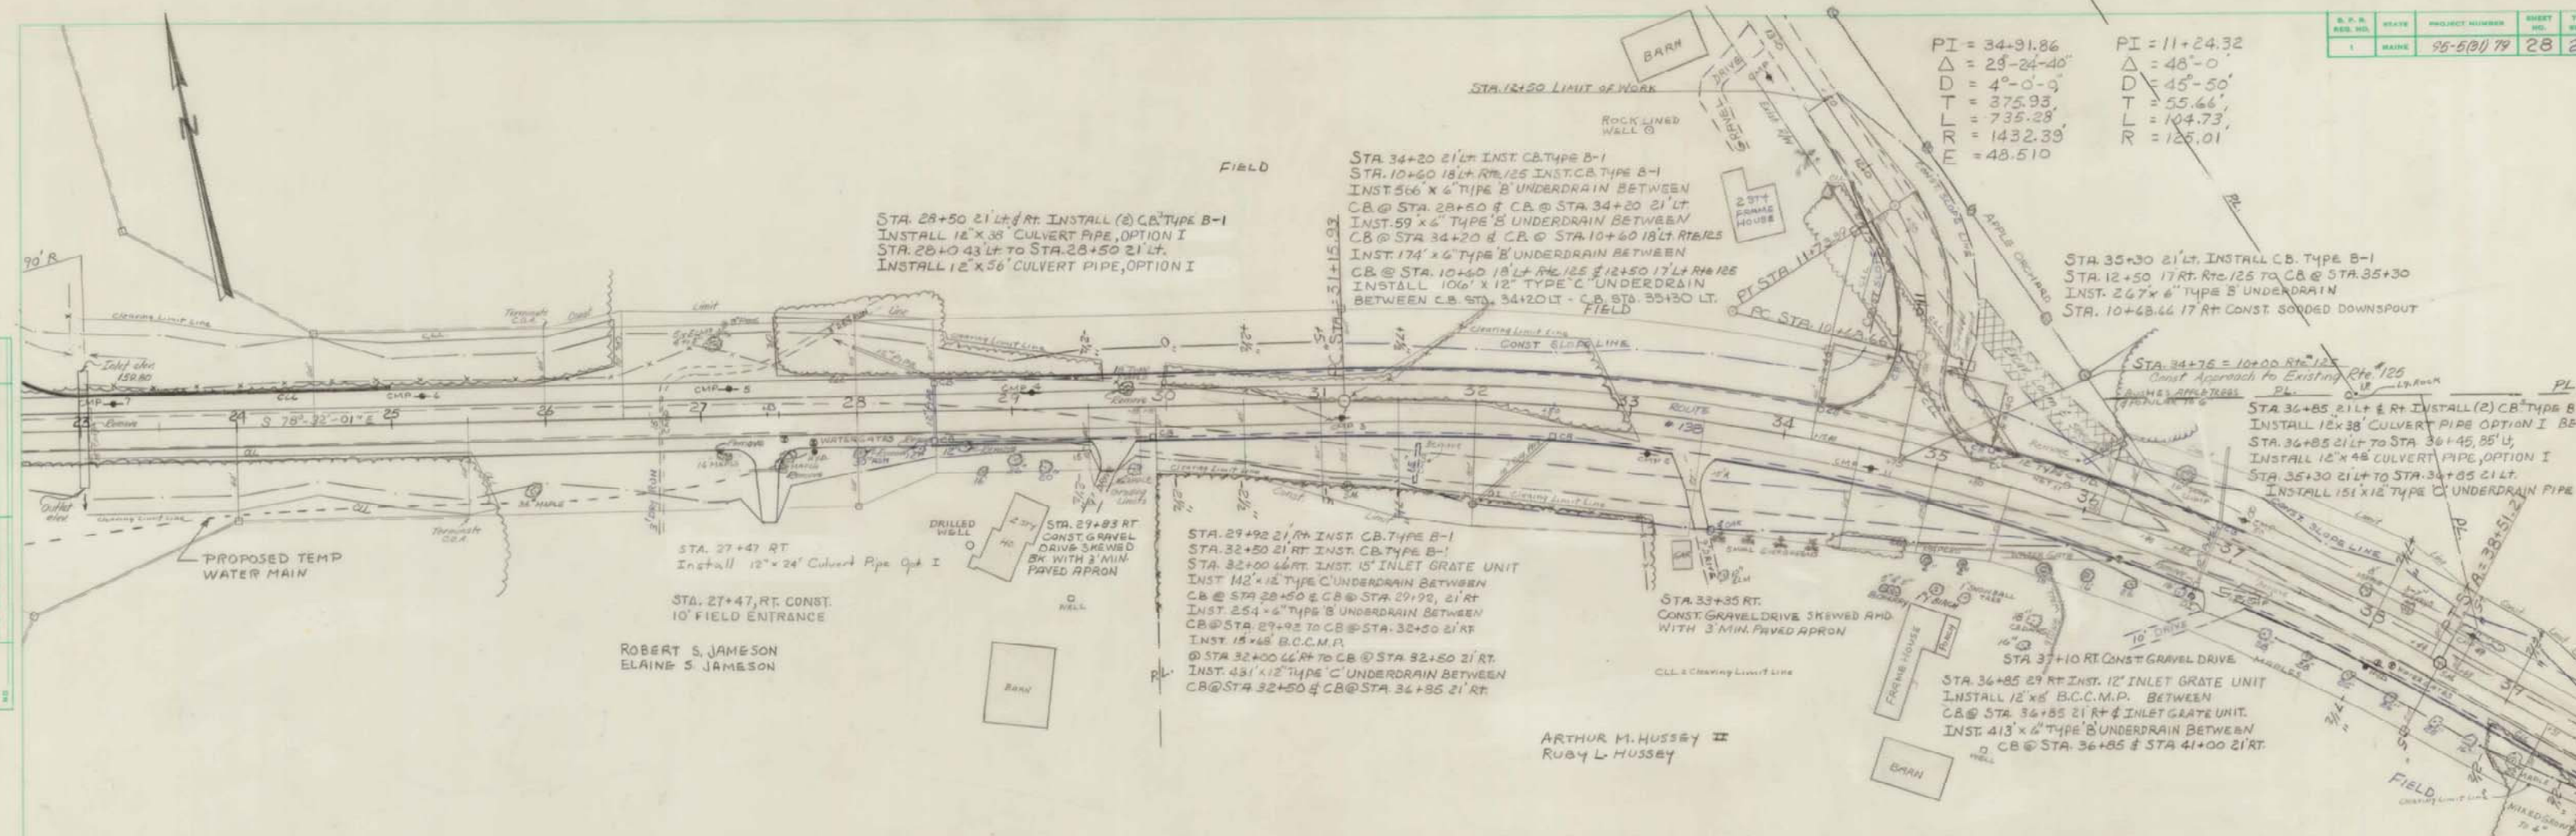

Curb Type 3a (Rte. 138 East End Jct with Rte. 125)

Sta. 28+50, 22' LT. Rte. 138 to Sta. 11+73.39, 17' LT. Rte. 125 = 757.98 L.F.
Sta. 11+73.39, 17' RT. Rte. 125 to Sta. 37+00, 22' LT. Rte. 138 = 360.46 L.F.
Sta. 28+50, 22' RT. Rte. 138 to Sta. 29+50, 22' LT. Rte. 138 = 100.00 L.F.
Sta. 29+50, 22' RT. Rte. 138 to Sta. 33+30, 22' RT. Rte. 138 = 350.00 L.F.
Sta. 33+70, 22' RT. Rte. 138 to Sta. 36+95, 22' RT. Rte. 138 = 330.00 L.F.
Sta. 37+25, 22' RT. Rte. 138 to Sta. 40+00, 22' RT. Rte. 138 = 280.00 L.F.

RIGHT OF WAY MONUMENTS
RTE 138 STA 28+00 60' RT.
RTE 138 STA 34+17.40 60' RT.
RTE 138 STA 38+51.21 50' RT.
OLD RTE 125 STA 11+73.39 30' LT.

SURVEY MARKER
RTE 138 31+15.93 60' LT.
RTE 138 31+15.93 55' RT.
RTE 138 38+51.21 SET ON LINE

DATE
BY
CHECKED
APPROVED
NOTED
PROFILE

