

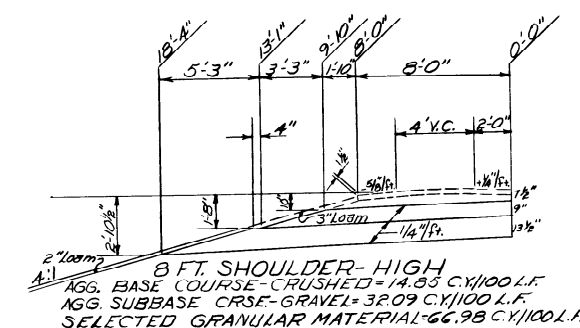
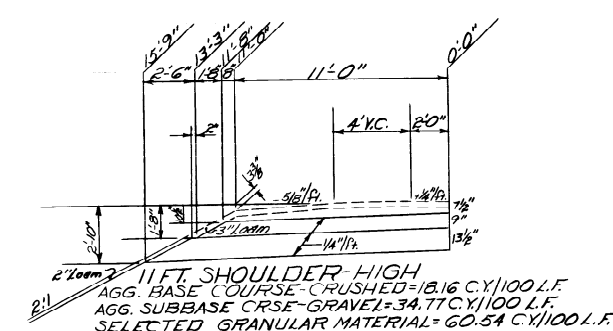
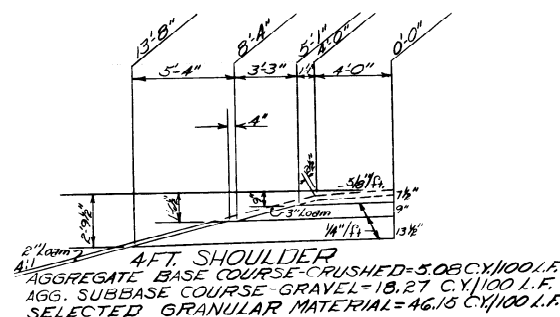
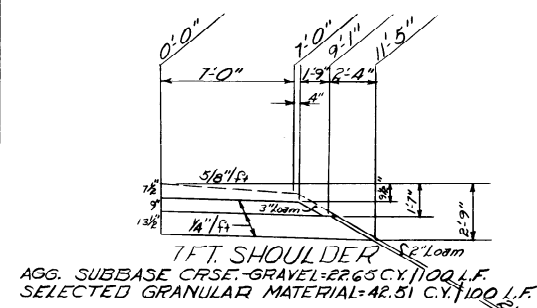
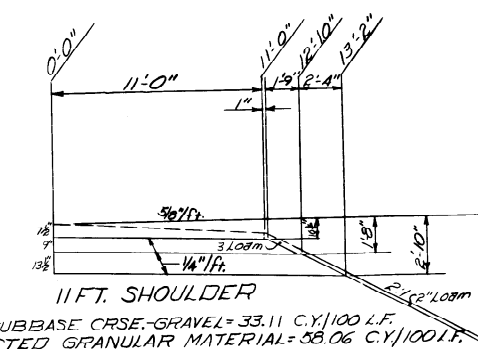
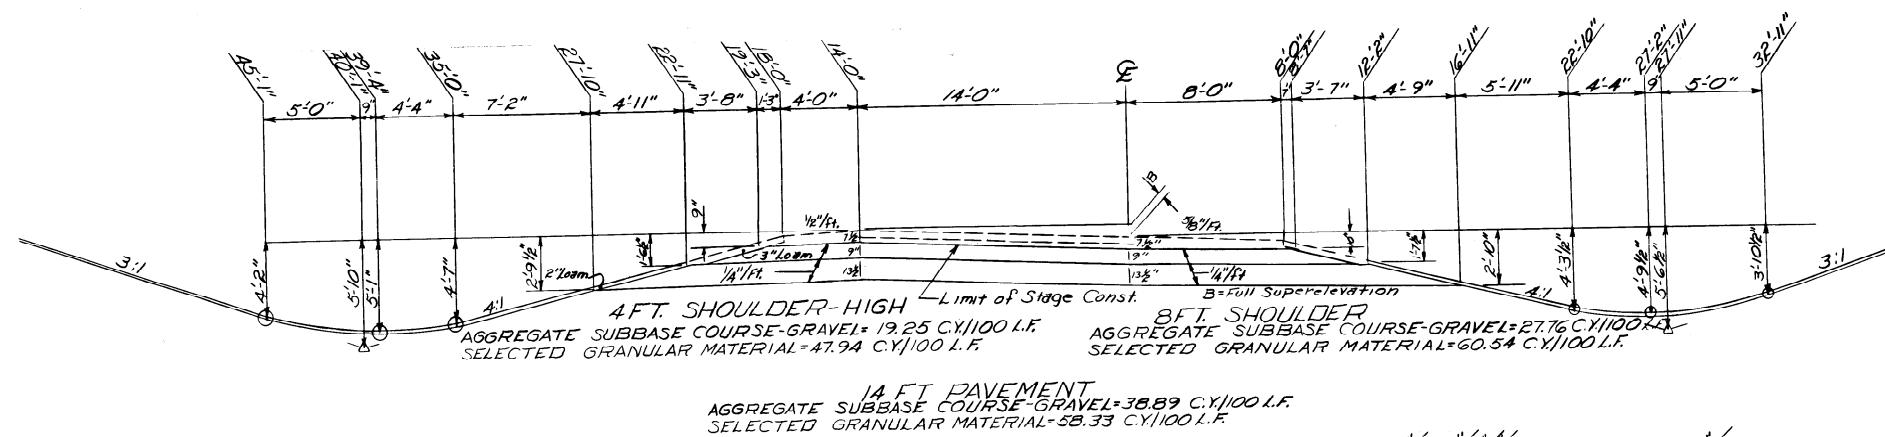
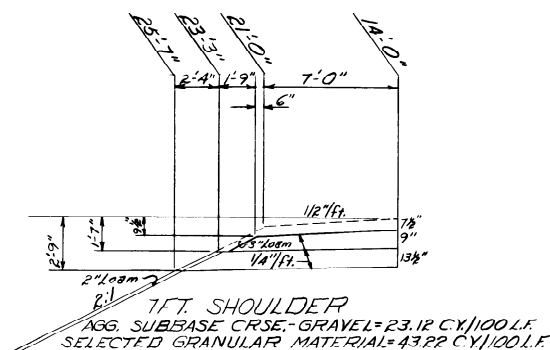
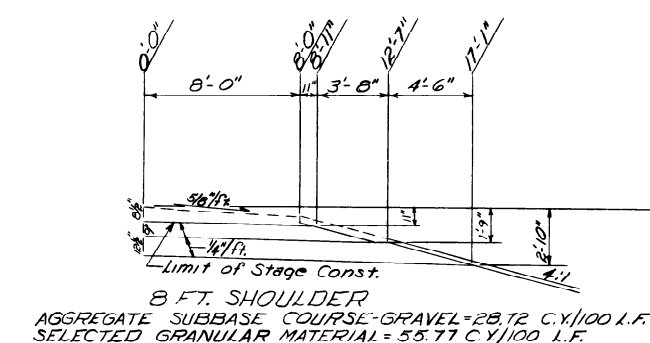


**STAGE CONSTRUCTION
GRADING, DRAINAGE & AGG. SUBBASE CRSE.***

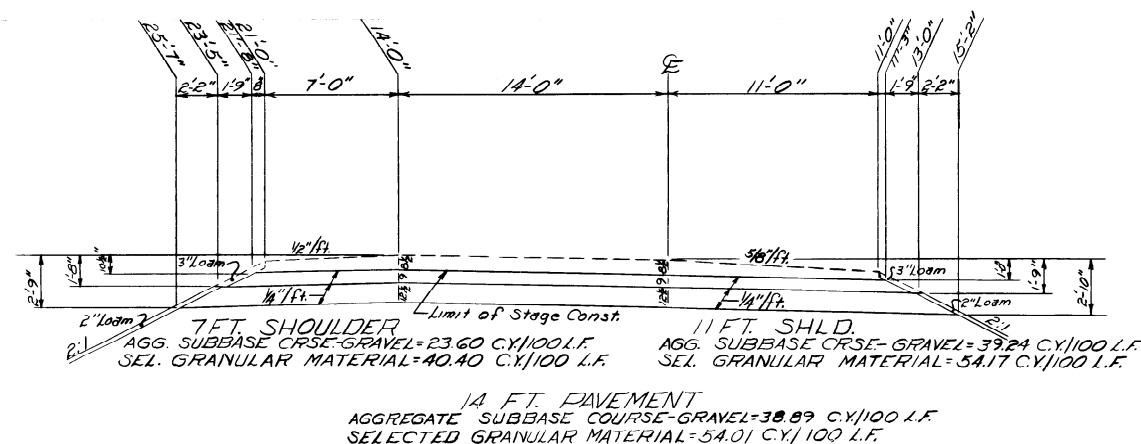

RAMPS B & C

RAMPS A & D

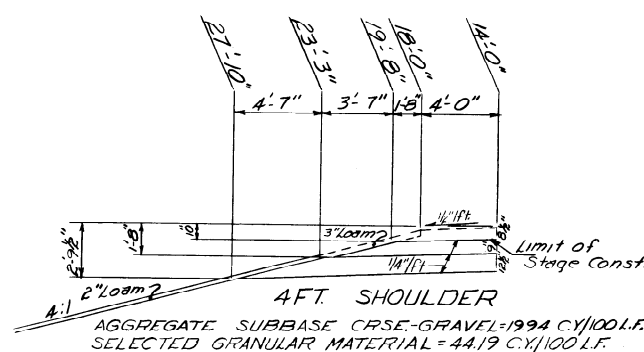

* The pavement & base depths as shown on the plans are intended to be nominal.

Revised AS BUILT H.E. Johnson 2/11/12
DEPARTMENT OF TRANSPORTATION

TYPICAL SECTIONS
Ramps A,B,C,D
Richmond-Gardiner-West Gard.
8' 1 2 3 4 5 6'