

HAROLD MILLAY

S. P. R.	STATE	PROJECT NUMBER	SHEET NO.	TOTAL SHEETS
1	MAINE	I-95-5(32)	15	36

STA. 1444+50 S.B.
INSTALL 24" X 156" R.C.P. CLASS III
STD. END TREATMENT - SOD INLET & OUTLET
INSTALLED 24" X 156" R.C.P. 1975

STA. 1455+85 S.B.
INSTALL 24" X 156" R.C.P. CLASS III
STEEL END TREATMENT - SOD INLET & OUTLET
INSTALLED 24" X 156" R.C.P. 1975

STA. 1447+15 N.B.
CONSTRUCT DITCH ACROSS TO CULV. INLET
@ 1444+50 S.B. 2' BOTTOM - 4:1 SIDES

STA. 1460+00 N.B.
INSTALL 24" X 148" R.C.P. CLASS III
STEEL END TREATMENT - SOD INLET & OUTLET
INSTALLED 24" X 148" R.C.P. 1975
STA. 1460+00 S.B.
CONSTRUCT DITCH FROM CULV. INLET
TO CULV. OUTLET 1455+85 S.B.
2' BOTTOM - 4:1 SIDES


STANLEY E. FARLEY, MD.

NORTH BOUND
P.I. STA. 1447+09.17
 $\Delta = 17^{\circ} 07' 58''$ LT.
D = 0' 30"
T = 178.17'
L = 348.57'
E = 129.28'
R = 11459.16'

SOUTH BOUND
P.I. STA. 1444+69.50
 $\Delta = 16^{\circ} 31' 09''$ LT.
D = 0' 30"
T = 166.346'
L = 3303.84'
E = 120.11'

PLAN	DATE	BY	CHKD.
1	10/1/75	PM	PM

PROFILE	DATE	BY	CHKD.
1	10/1/75	PM	PM

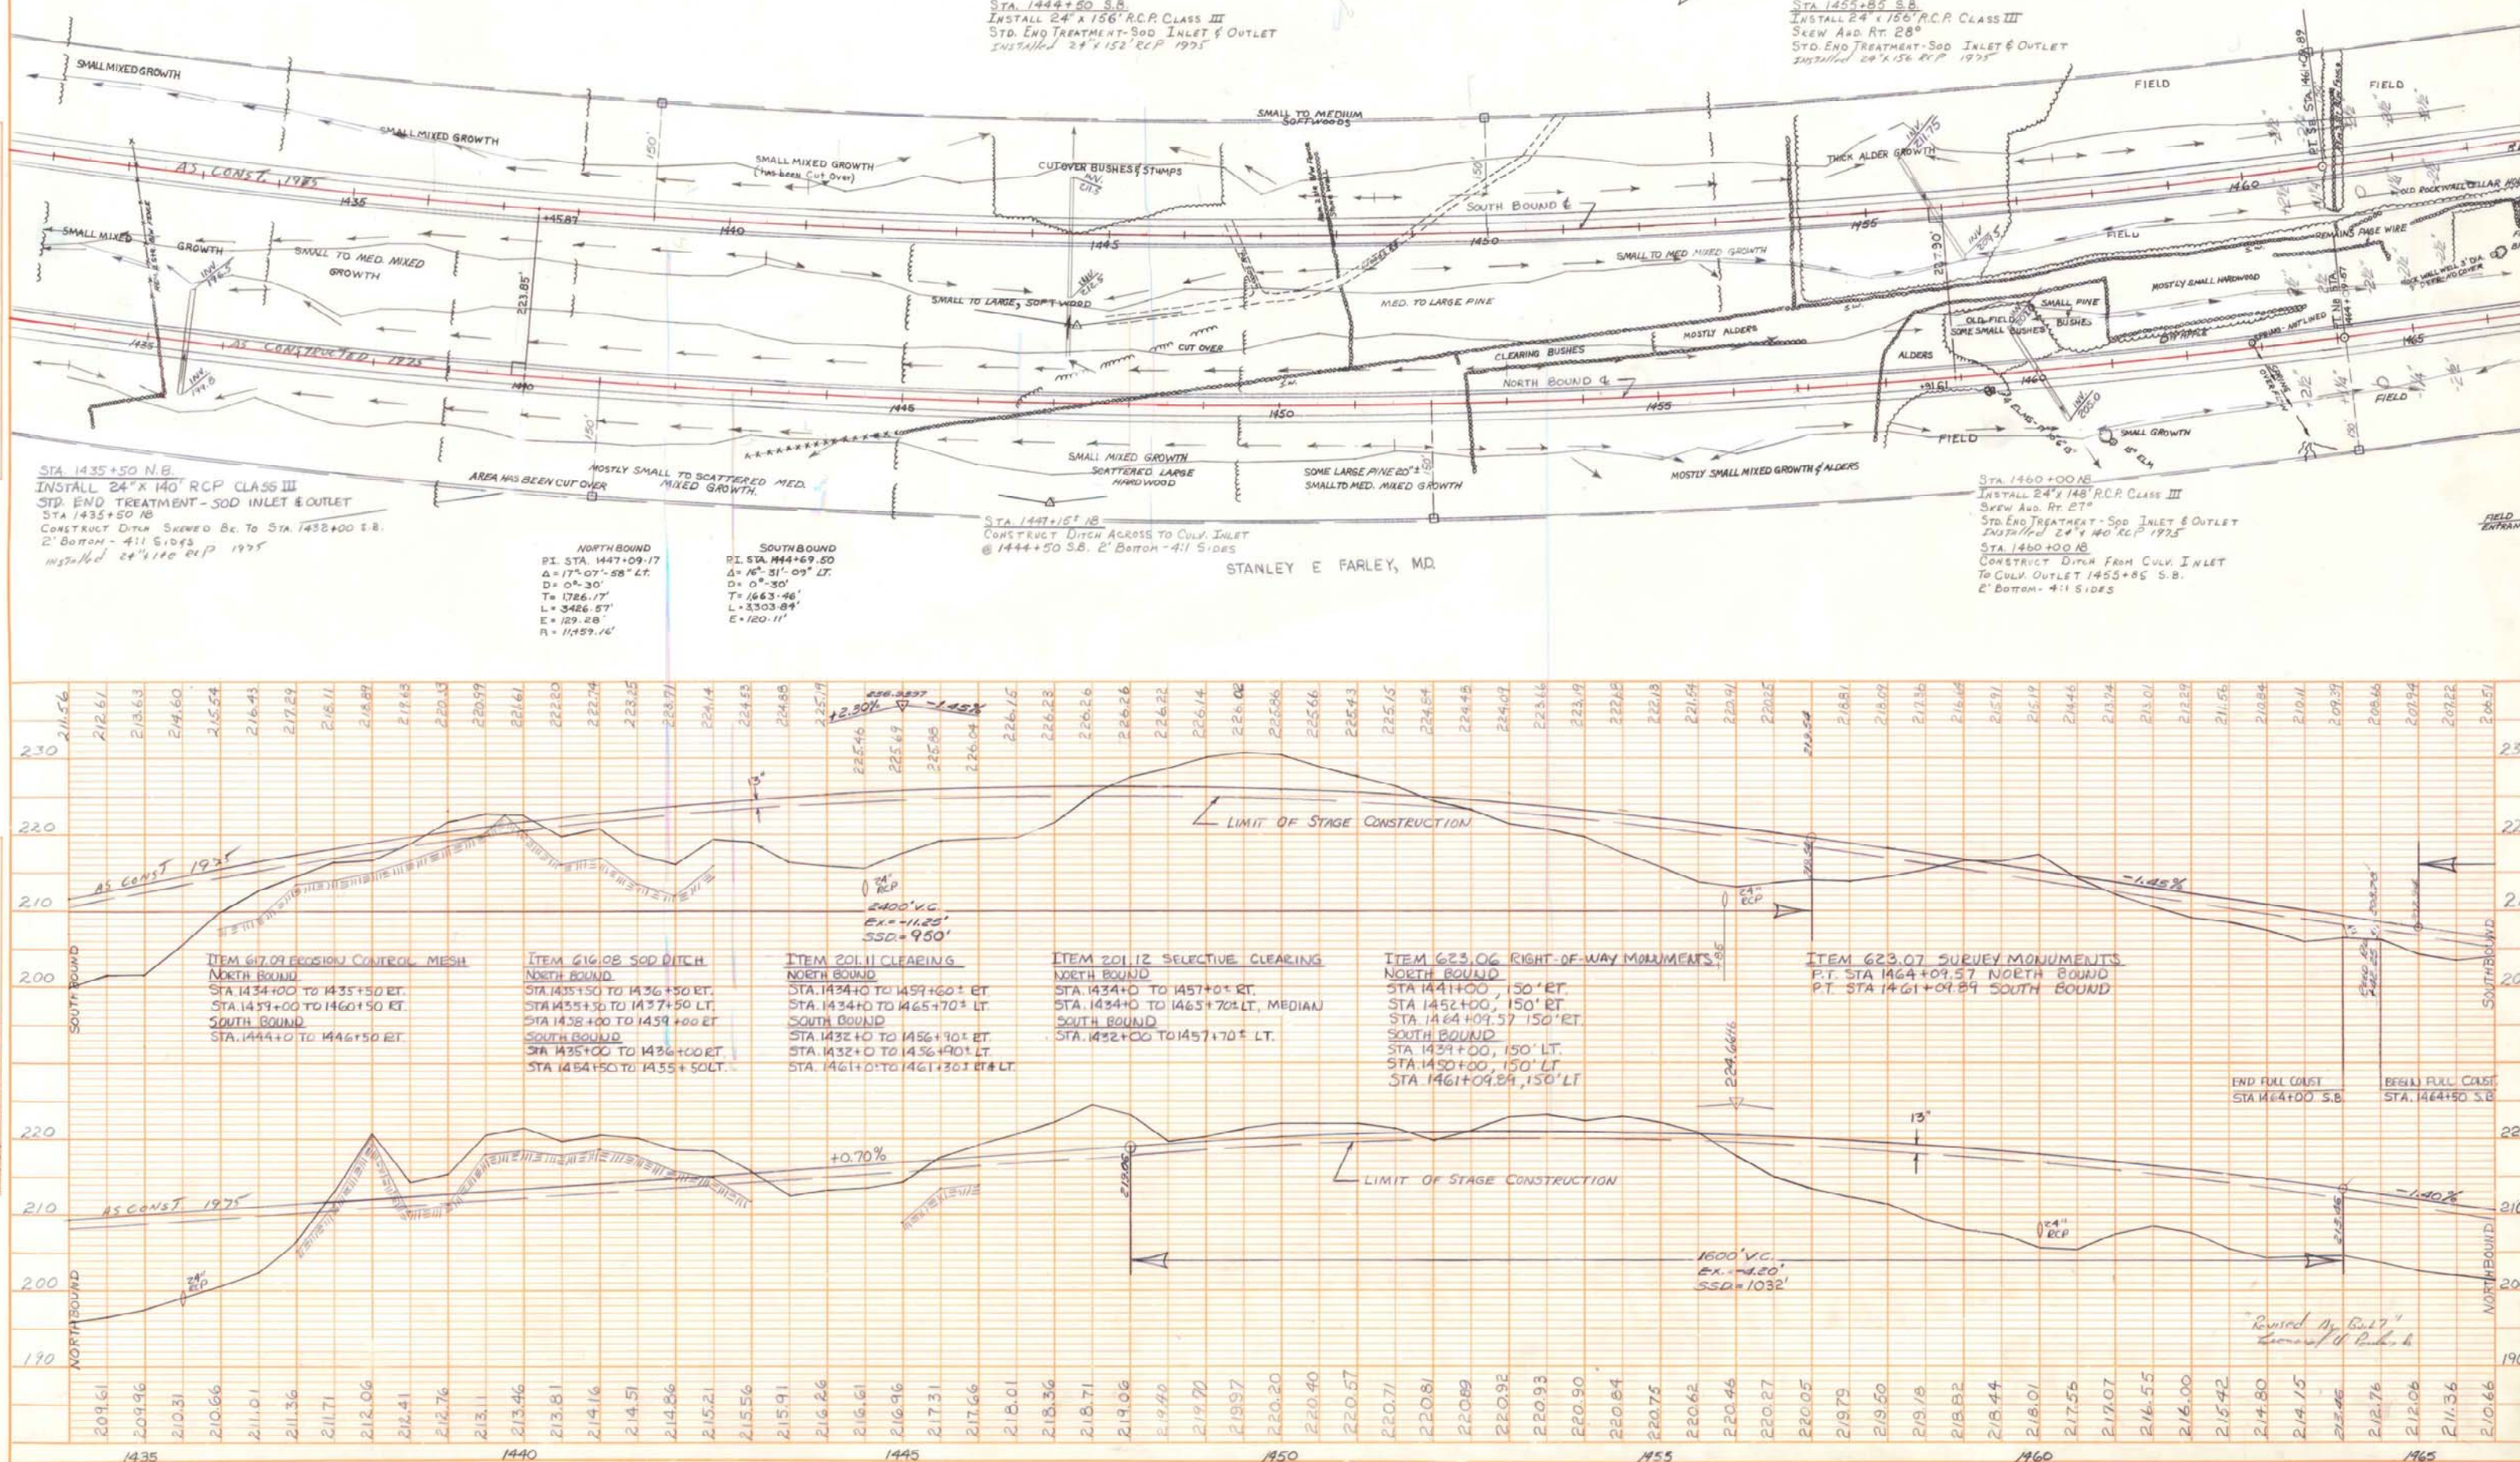

Richmond 1-95-5(32)