


PLANS	DESIGN - CHECKED	DATE
	BY	8/22/2017
	CHECKED	
	DATE	
	FILED	
	SCALE	

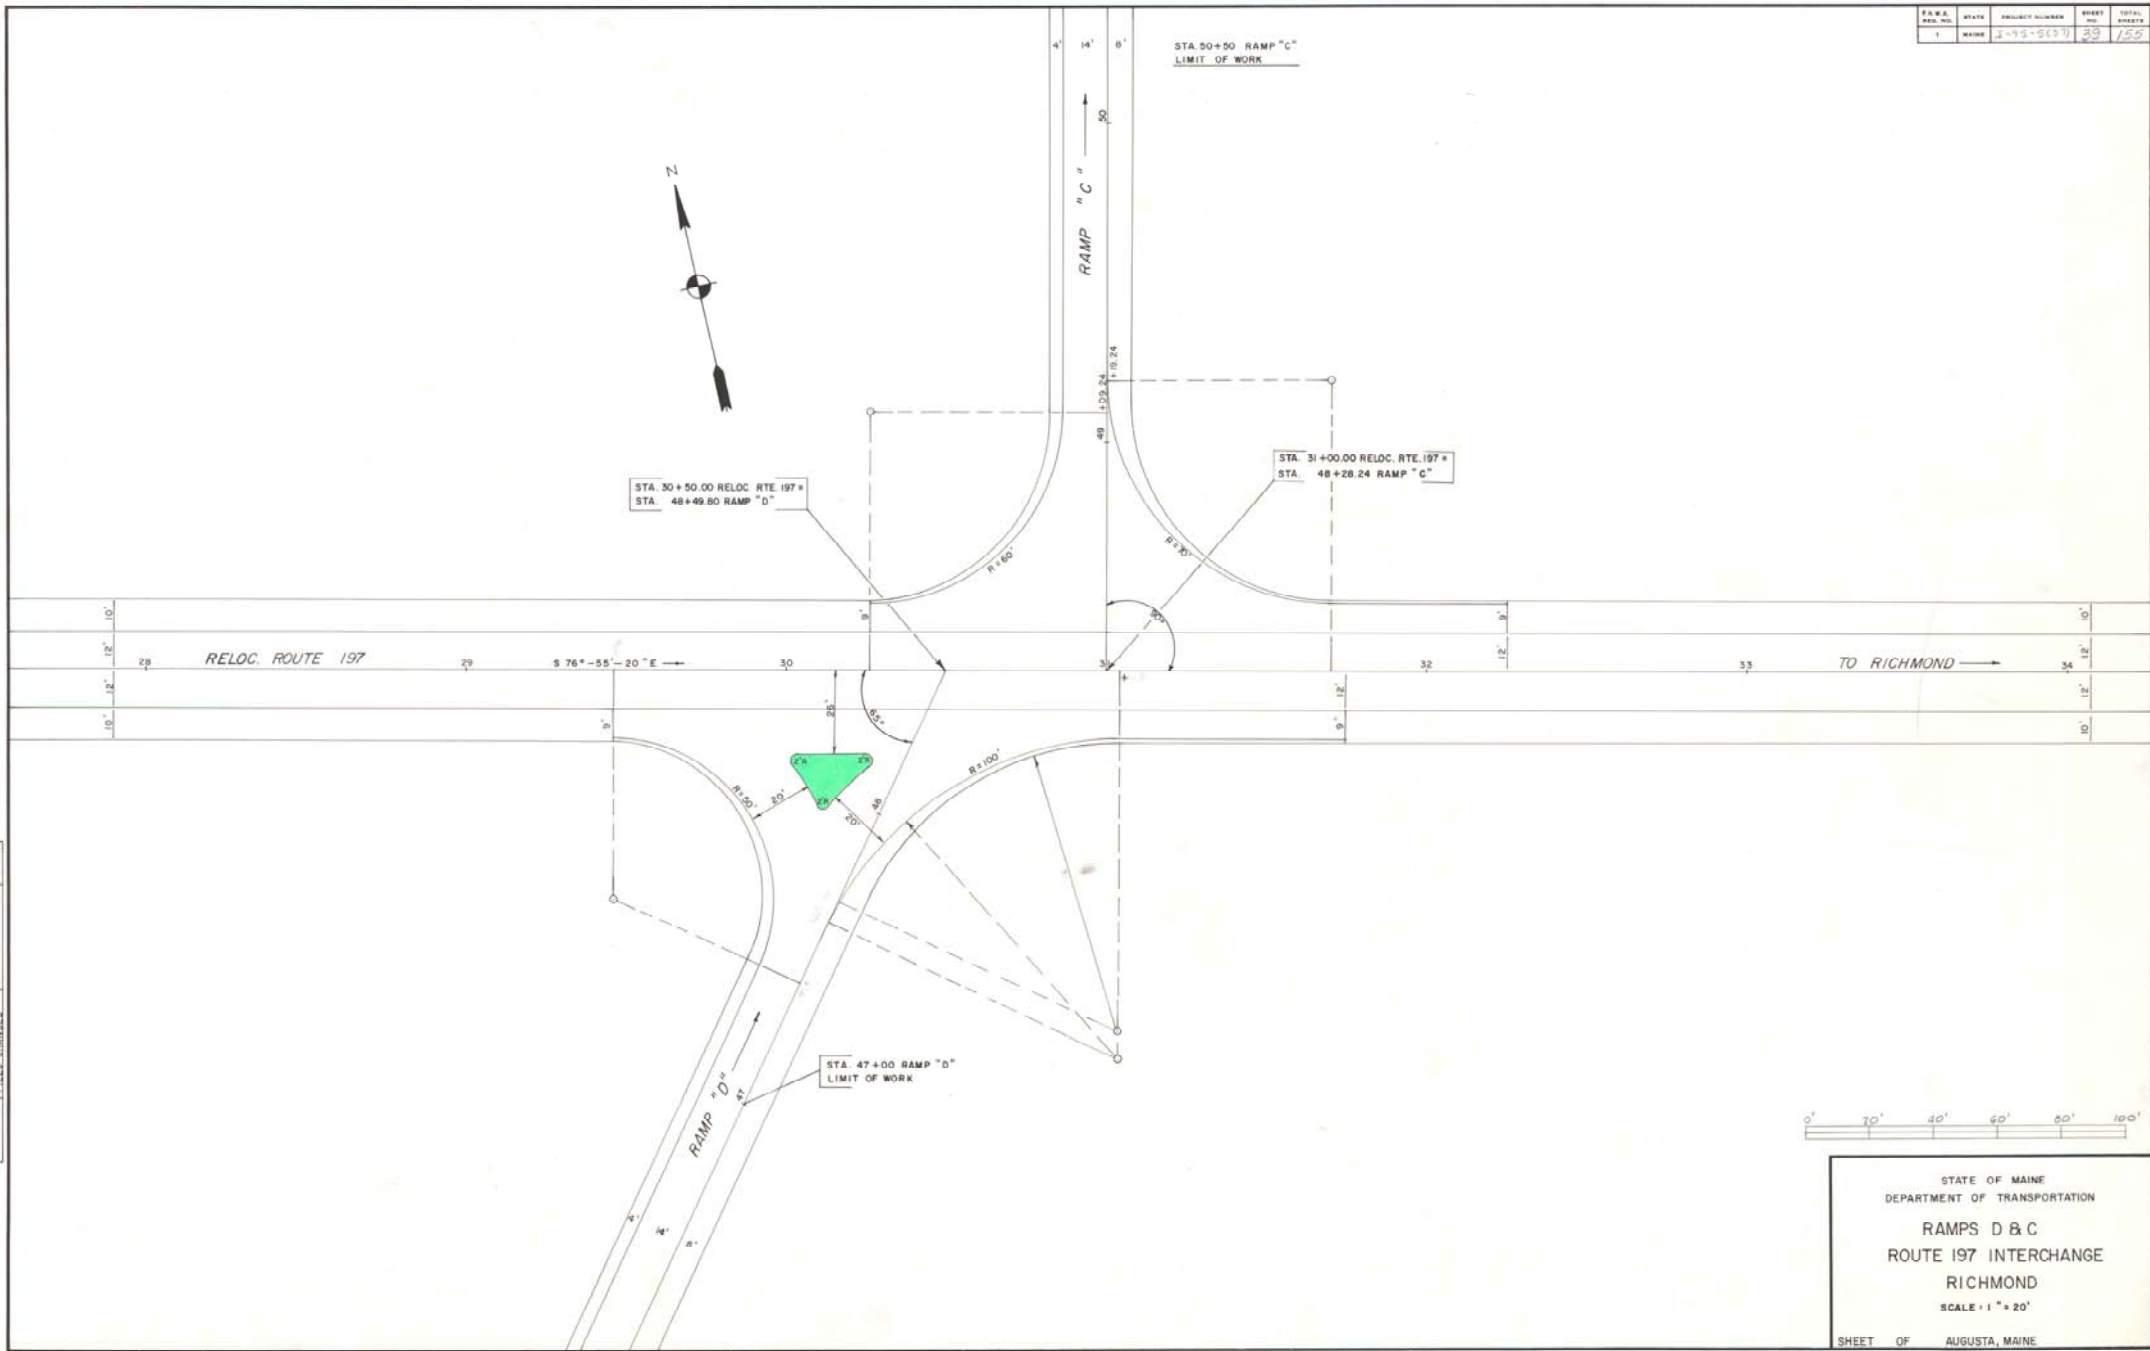

BOWDOINHAM — RICHMOND 1-95-5 (37)