

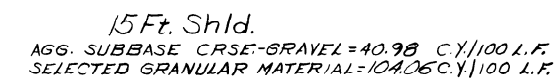
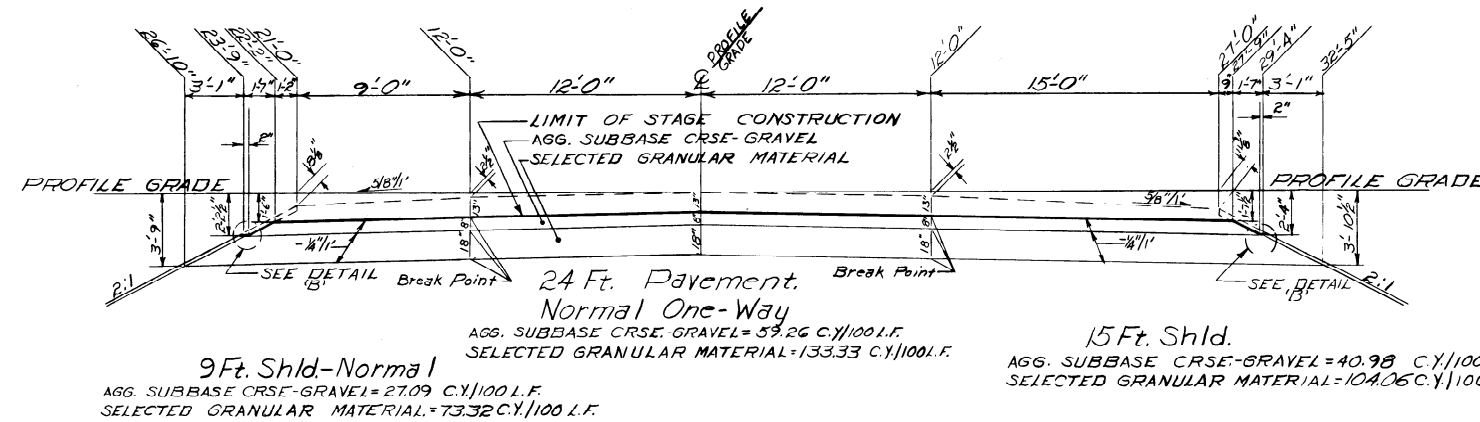
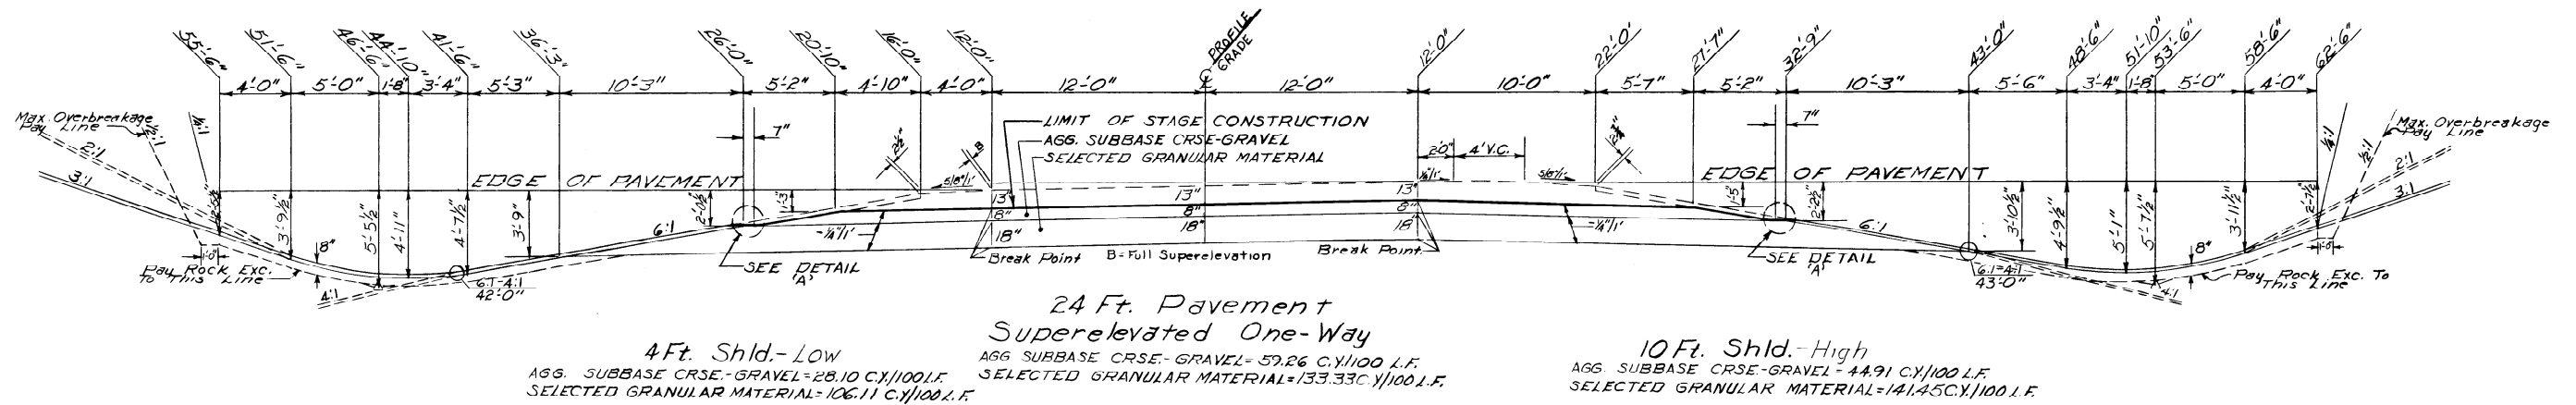


STAGE CONST.-GRADING & AGG. SUBBASE CRSE. GRAVEL*

S. P. R. RES. NO.	STATE	PROJECT NUMBER	SHEET NO.	TOTAL SHEETS
1	MAINE	I-95-5(32)	2	96

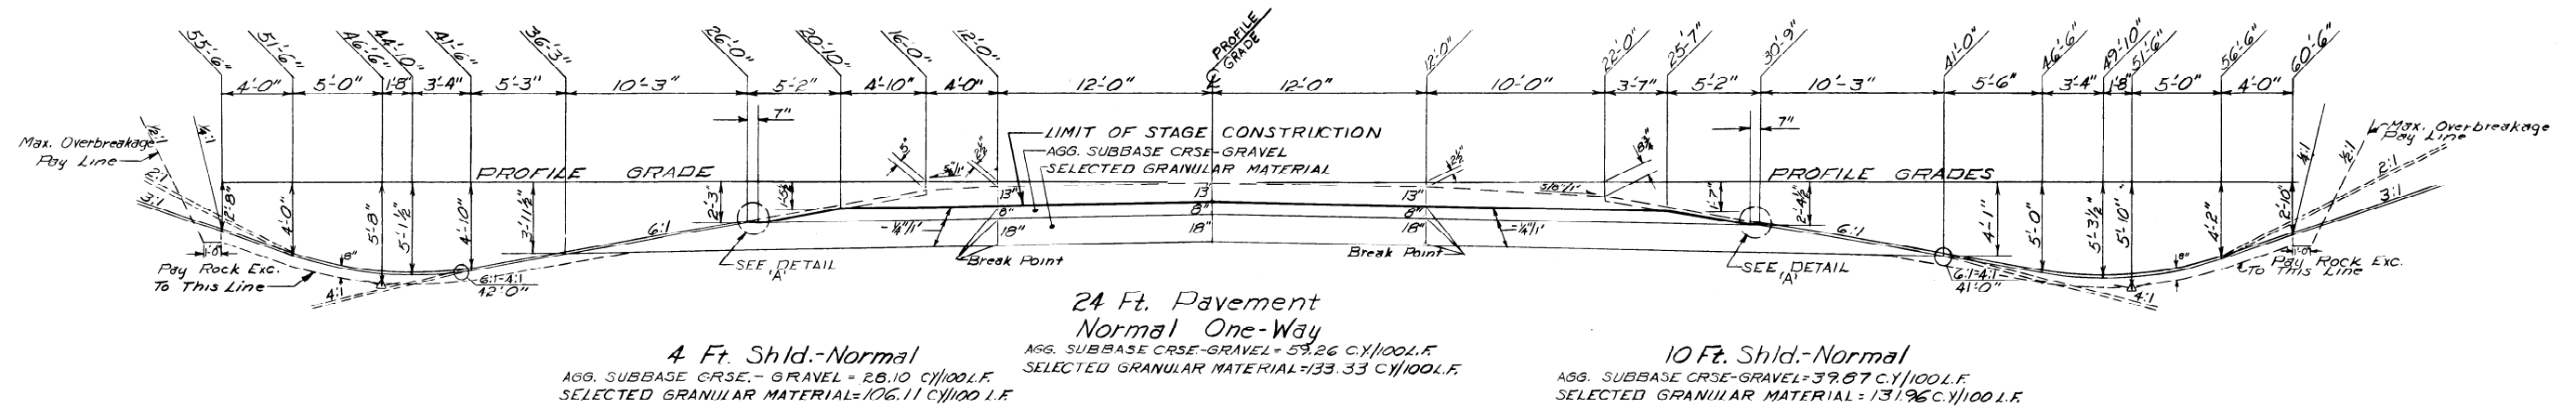

DETAIL FOR LOAMING

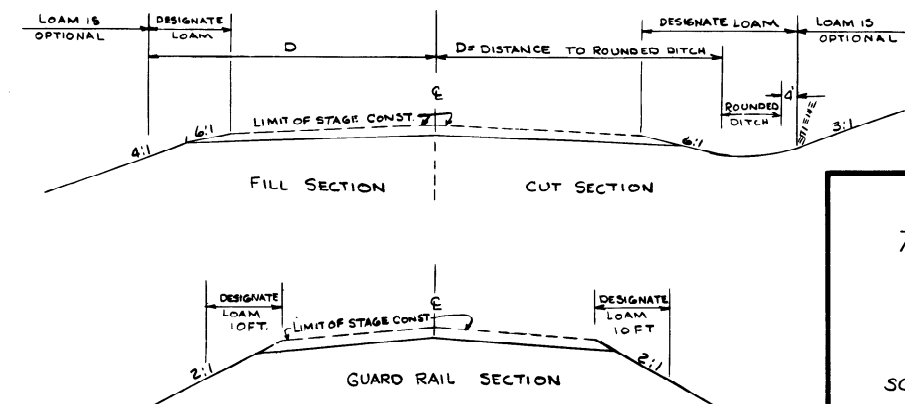

STATE HIGHWAY COMMISSION

TYPICAL SECTIONS
I-95

SCALE: 1"=5' Horiz.
1"=5' Vert.

SHEET OF AUGUSTA, MAINE

RICHMOND 1-95-5(32)

203-1 2000

* The pavement and base depths as shown on the plans are intended to be nominal.

PLANS	DESIGN - DETAILED	CHECKED	BY	DATE
	WTF	GRJ	WTF	2/12
	REVISIONS			
	FIELD CHANGES			