

STATE OF MAINE STATE HIGHWAY COMMISSION

PLANS

BRUNSWICK CUMBERLAND COUNTY MAINE FEDERAL AID INTERSTATE PROJECT NO. I-95-4 (25) 73

TOTAL LENGTH = 1.411 MILES

MAIN LINE
SCALES

PLAN 1 IN. = 100 FT.
PROFILE { HOR. 1 IN. = 100 FT.
VER. 1 IN. = 10 FT.
CROSS SECTIONS 1 IN. = 10 FT.
PLAN 1 IN. = 50 FT.
PROFILE { HOR. 1 IN. = 50 FT.
VER. 1 IN. = 5 FT.
CROSS SECTIONS 1 IN. = 5 FT.

SIDE ROAD &
RAMP SCALES

GRADING, DRAINAGE, AND BASE

Project Complete 1973

BRUNSWICK

TOPSHAM

TRAFFIC FLOW DATA

RIVER ROAD

A.D.T. 1970 ---- 975
A.D.T. 1990 ---- 1,560
D.H.V. ---- 203
T. ---- 11%
D. ---- 60%
V. ---- 50 M.P.H.

NOTE:

All Work Contemplated Under This Contract Shall Be Governed By, And In Conformity With The Standard Specification (Revision Of June 1968) And Supplements Thereof, Except As Modified On The Plans And In The Special Provisions.



N.B. STA. 619+50
END PROJ. I-95-4 (25)
BEGIN PROJ. I-95-4(21)

APPROVED:
MAINE STATE HIGHWAY COMMISSION

DATE
12-9-70


DEPARTMENT OF TRANSPORTATION
FEDERAL HIGHWAY ADMINISTRATION
REGION 1

APPROVED:

12-9-70
12-9-70
12-9-70
12-9-70

DIVISION ENGINEER DATE

"Revised As Built" by Jerry Trussell 2-28-75
BRUNSWICK I-95-4(25)

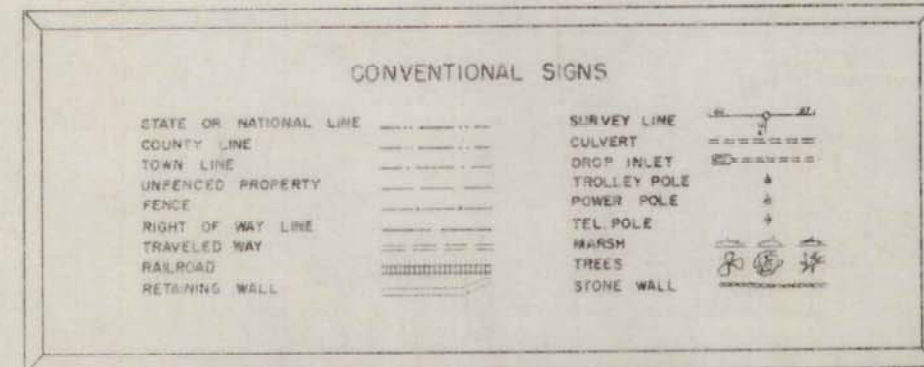

LIMIT OF WORK
RTE. 1 CONN. (W.B.) STA. 463+00.00 = I-95 (S.B.)
STA. 463+03.00 AHD. STA. 463+00.00 BK.
I-95 (S.B.) EQUATION = -3.00'

N.B. STA. 545+00
BEGIN PROJ. I-95-4 (25)

LIMIT OF CONST.
W.B. STA. 517+00

LIMIT OF CONST.
W.B. STA. 523+00

LIMIT OF CONST.
W.B. STA. 550+50

RIVER ROAD P.T. STA. 47+55.08 BK.
STA. 48+15.95 AHD. EQ. = -60.87'

LIMIT OF WORK
STA. 49+00

LIMIT OF WORK
S.B. STA. 619+00

LIMIT OF WORK
S.B. STA. 542+50

RTE. 1 CONN. (E.B.) P.C.C. STA. 552+24.22 BK.
STA. 552+27.03 AHD. EQ. = -2.81'

RTE. 1 CONN. (W.B.) STA. 566+28.23 BK.
STA. 563+39.81 AHD. EQ. = +288.42'

RTE. 1 CONN. (E.B.) P.T. STA. 568+32.61 BK.
STA. 568+55.37 AHD. EQ. = -22.76'

LIMIT OF WORK
RAMP "E" STA. 0+00


LIMIT OF WORK
STA. 15+50

LAYOUT PLAN
SCALE: 1" = 1,000'

TRAFFIC FLOW DATA

I-95 (South of Rte. 1) I-95 (North of Rte. 1)

A.D.T. 1970 ---- 15,820 ---- 8,290
A.D.T. 1990 ---- 28,860 ---- 15,860
D.H.V. ---- 3,088 ---- 1,816
T. ---- 7% ---- 10%
D. ---- 60% ---- 60%
V. ---- 70 M.P.H. ---- 70 M.P.H.

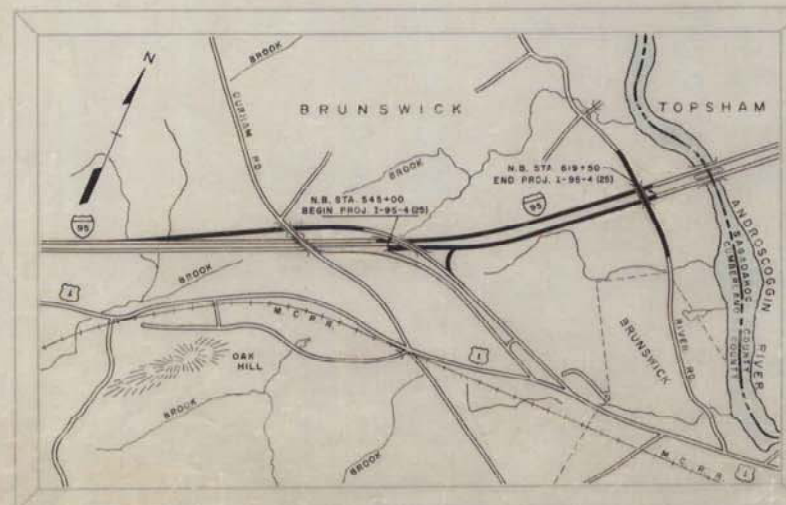

A PORTION OF CUMBERLAND & SAGADAHOC COUNTIES
SCALE: 1" = 1/2 mile