
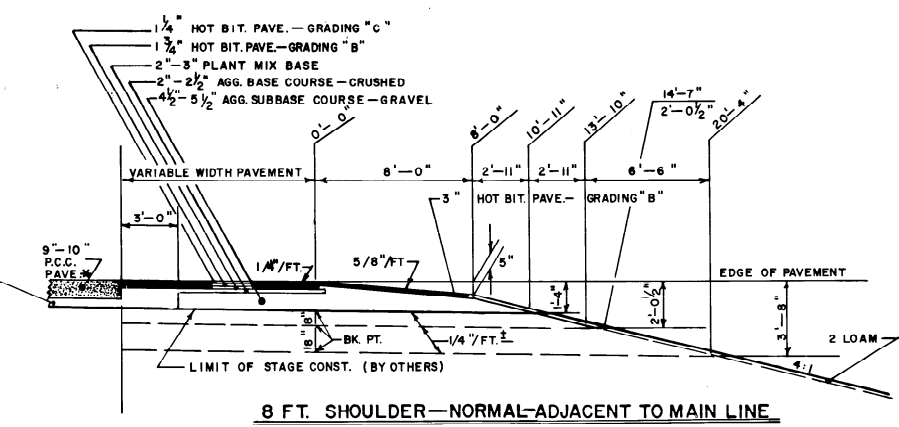
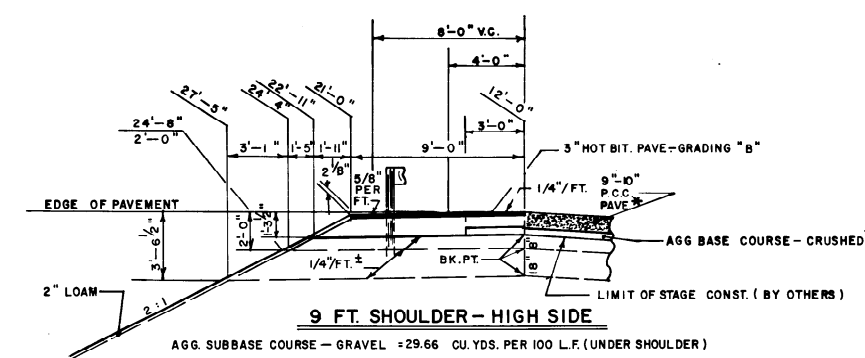
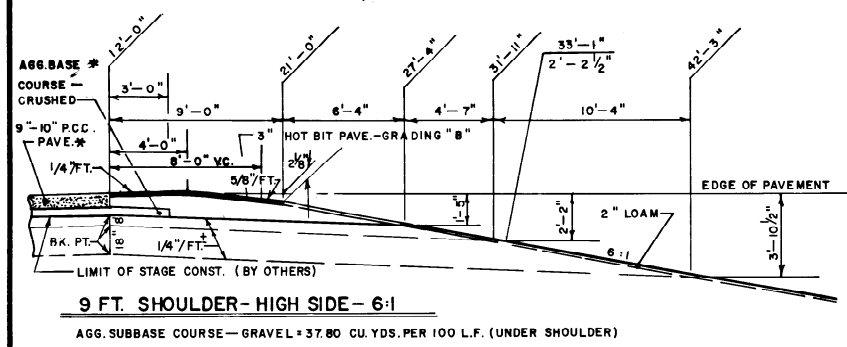



# PORTLAND CEMENT CONCRETE PAVEMENT

F.H.W.A. REV. NO.	STATE	PROJECT NUMBER	SHEET NO.	TOTAL SHEETS
1	MAINE	7-95-5(44)B1	3	53

CONTRACT 2

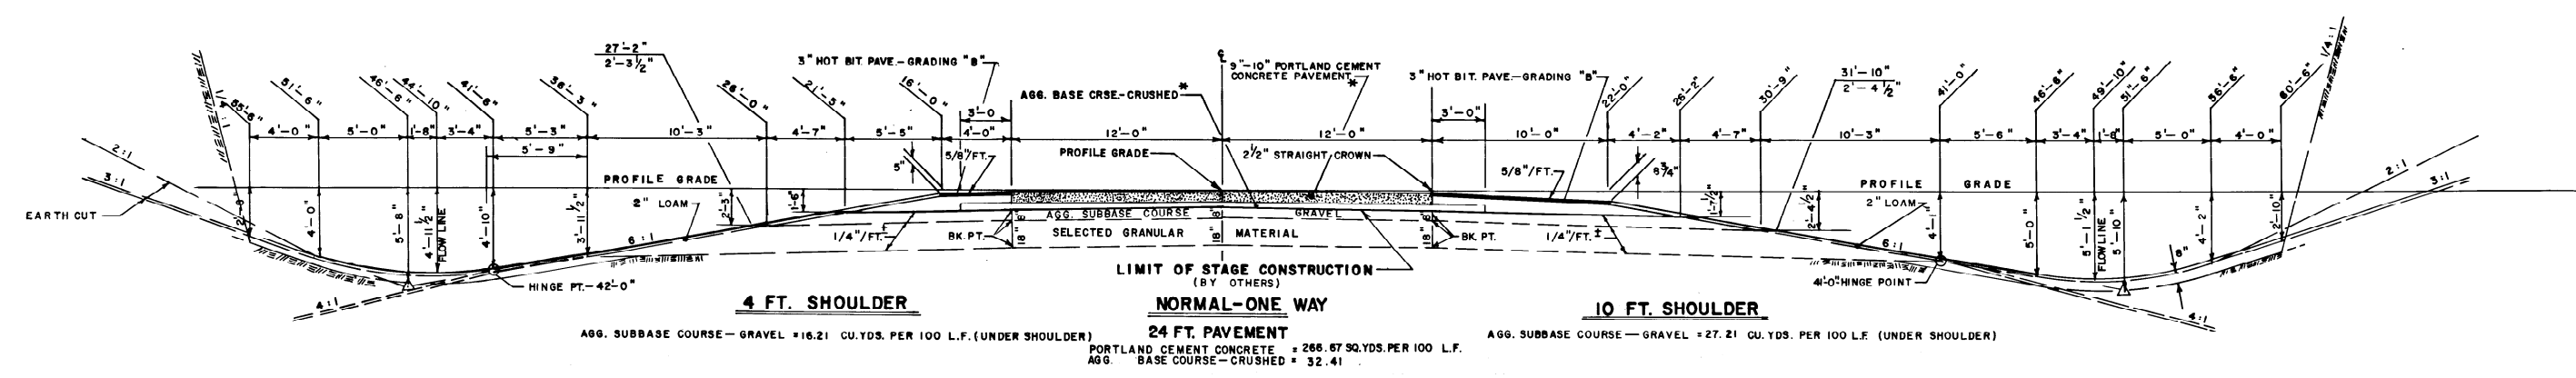


ROUTE 197 RAMPS ABC&D - AGG. SUBBASE COURSE - GRAVEL = 24.34 CU. YDS. PER 100 L.F. (UNDER SHOULDER)  
 ROUTE 201 RAMPS A & D - AGG. SUBBASE COURSE - GRAVEL = 24.31 CU. YDS. PER 100 L.F. ( " " )

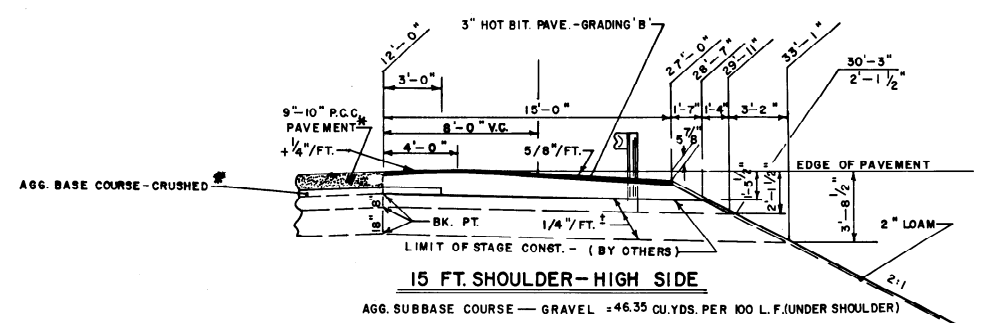

**NOTE:**  
 \* FOR TABULATION OF FLEXURE STRENGTHS AND DEPTHS OF P.C.C. PAVEMENT AND AGGREGATE BASE COURSE-CRUSHED SEE SHEET NO. 7

**NOTE:**  
 THE QUANTITIES SHOWN FOR AGGREGATE BASE COURSE-CRUSHED AND AGGREGATE SUBBASE COURSE-GRAVEL PER 100 LINEAR FEET HAVE BEEN COMPUTED ON A DEPTH OF 3 1/2\"/>

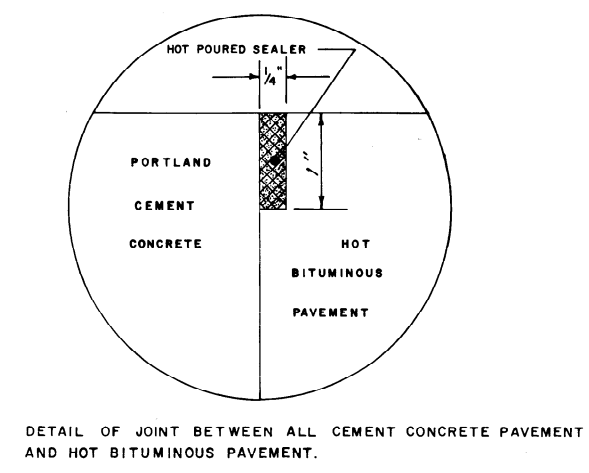

STATE OF MAINE  
 DEPARTMENT OF TRANSPORTATION

**MAIN LINE  
 TYPICAL SECTIONS**

0 5 10 15

SHEET OF AUGUSTA, MAINE

COWDINHAM - RICHMOND - GARDINER 2001 2000  
 7-95-5(44)B1 Cont. # 2

PROJECT DESIGN ENGINEER	BY	DATE
DESIGN - DETAILED	WAG	4/7/78
CHECKED		
REVISIONS		
FIELD CHANGES		

**PLANS**