




SOUTHBOUND
 P.I. STA. 570+36.05
 $\Delta = 15^\circ 13' 17''$ LT.
 $D = 0^\circ 30'$
 $T = 1,531.16'$
 $L = 3,044.28'$
 $R = 11,459.16'$
 $E = 101.85'$

NORTHBOUND

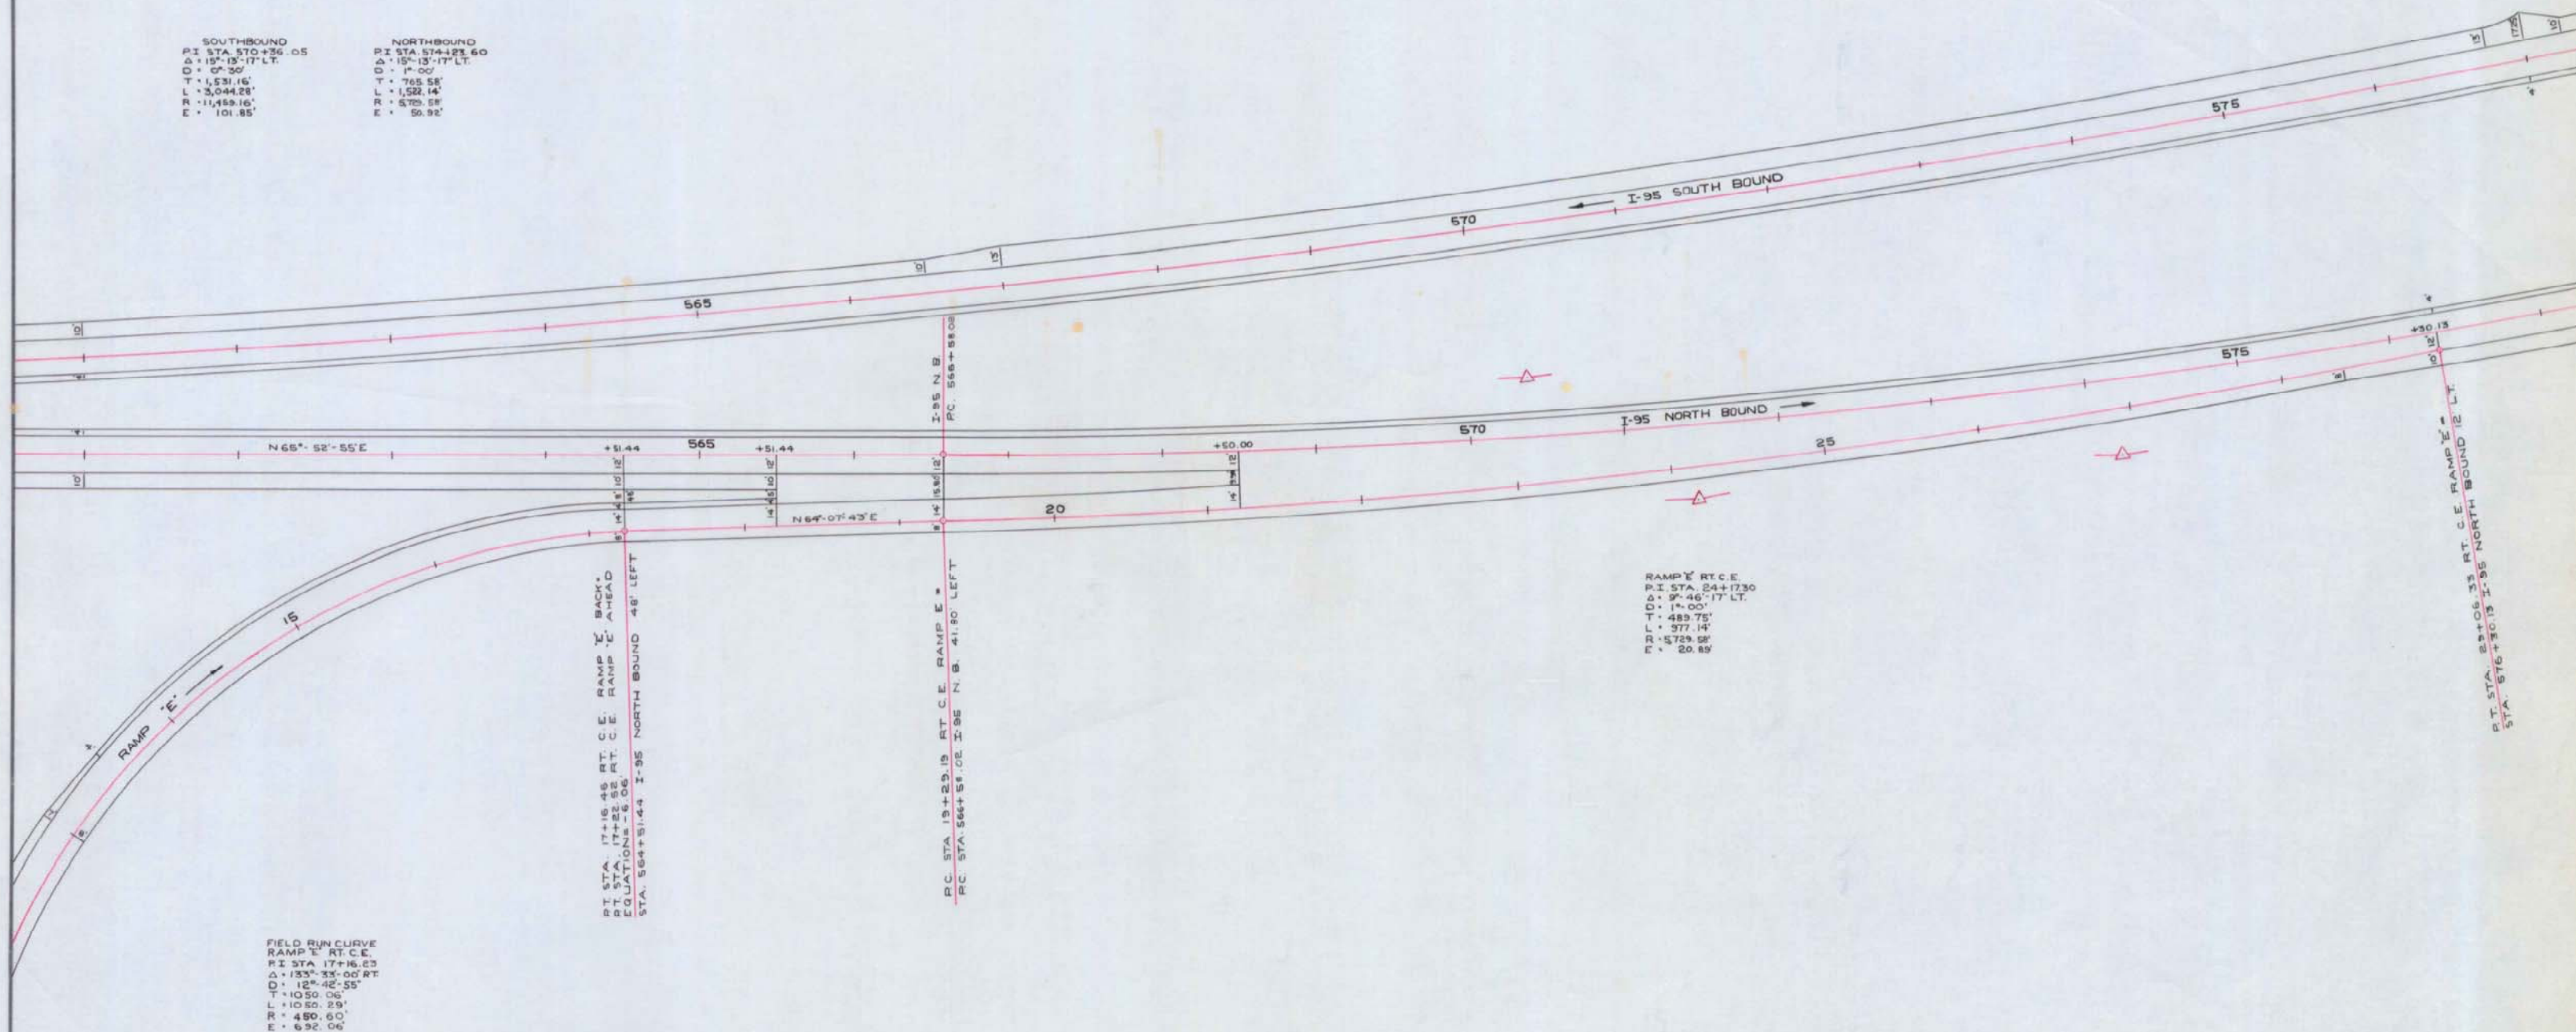

RAMP "E" ACCELERATION
 I-95 NORTH BOUND
 GEOMETRICS
 SCALE 1"=50'