
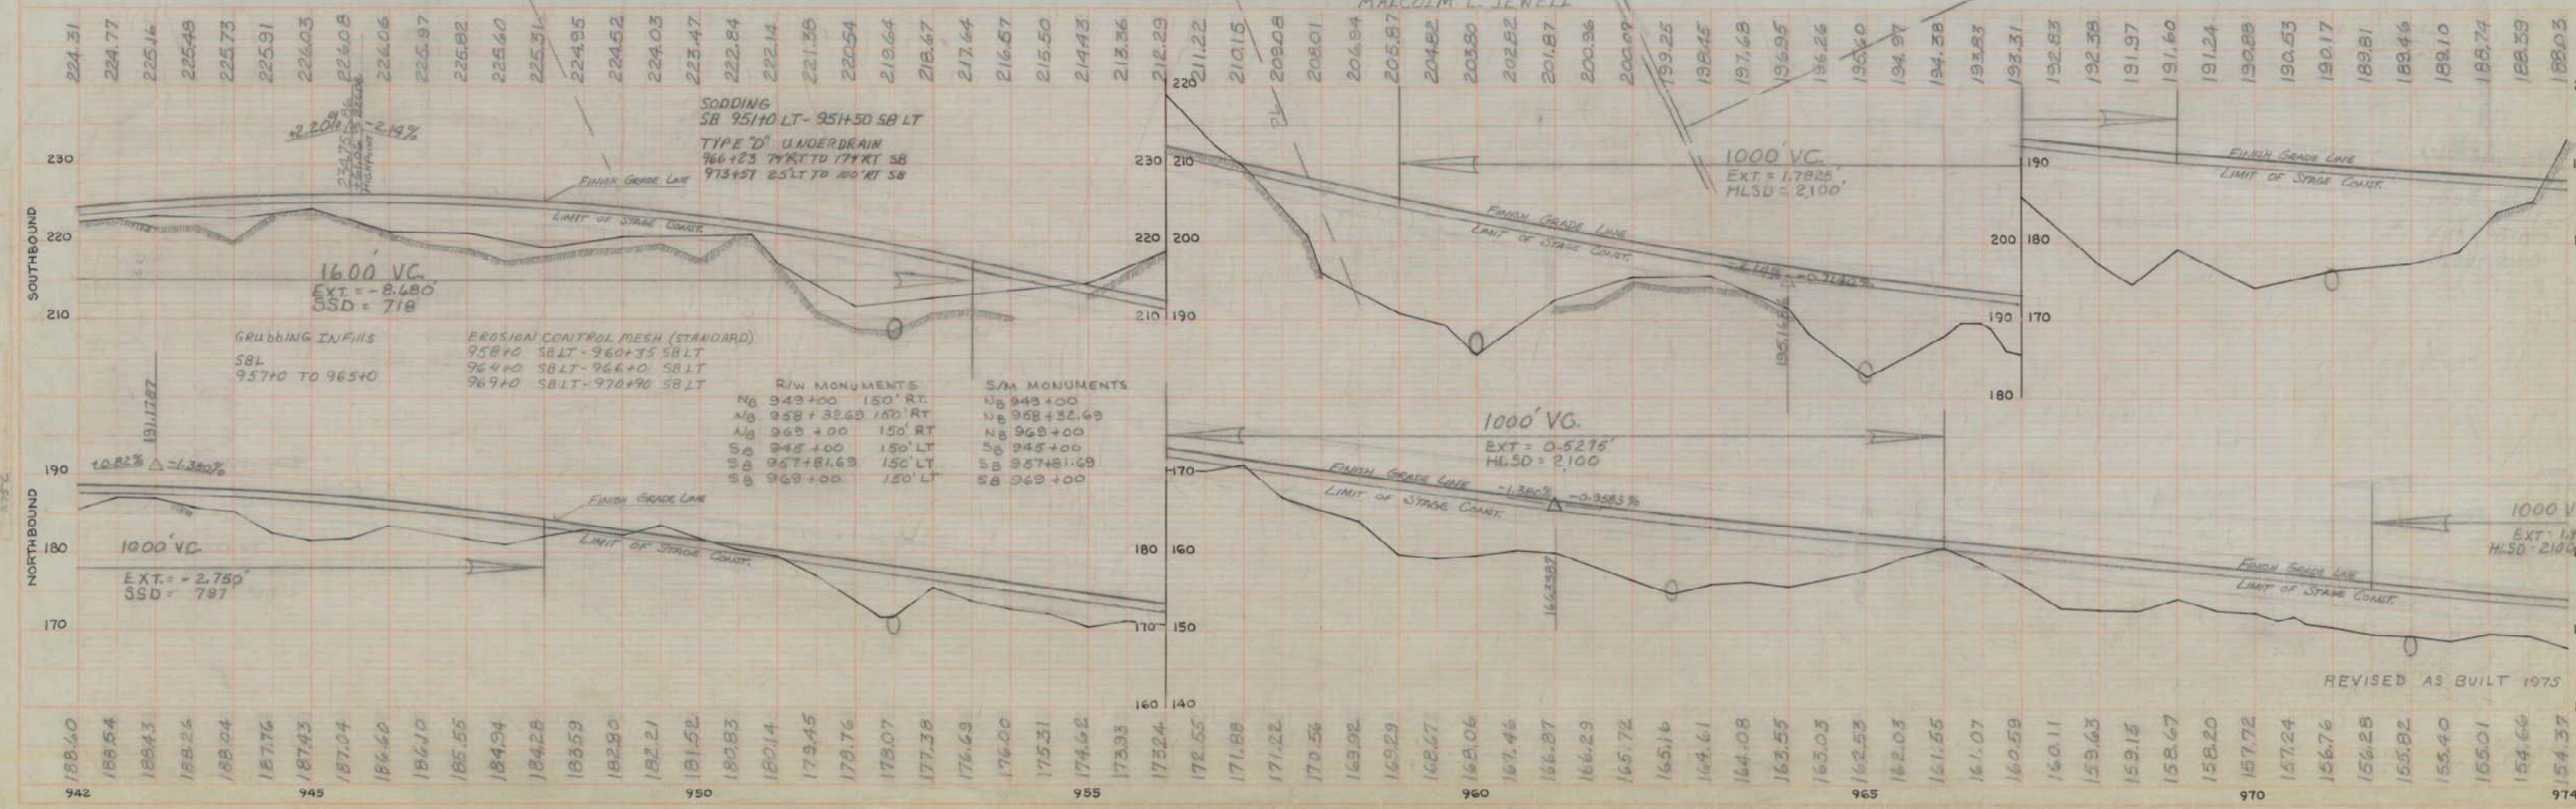


LUCILLE L. JEWELL
 MALCOLM L. JEWELL

EMERY W. BOOKER

RUSSELL MCIVER

MED. MIXED GROWTH
 2"-8" MAPLE & PINE
 1"-4" SPRUCE & BIRCH

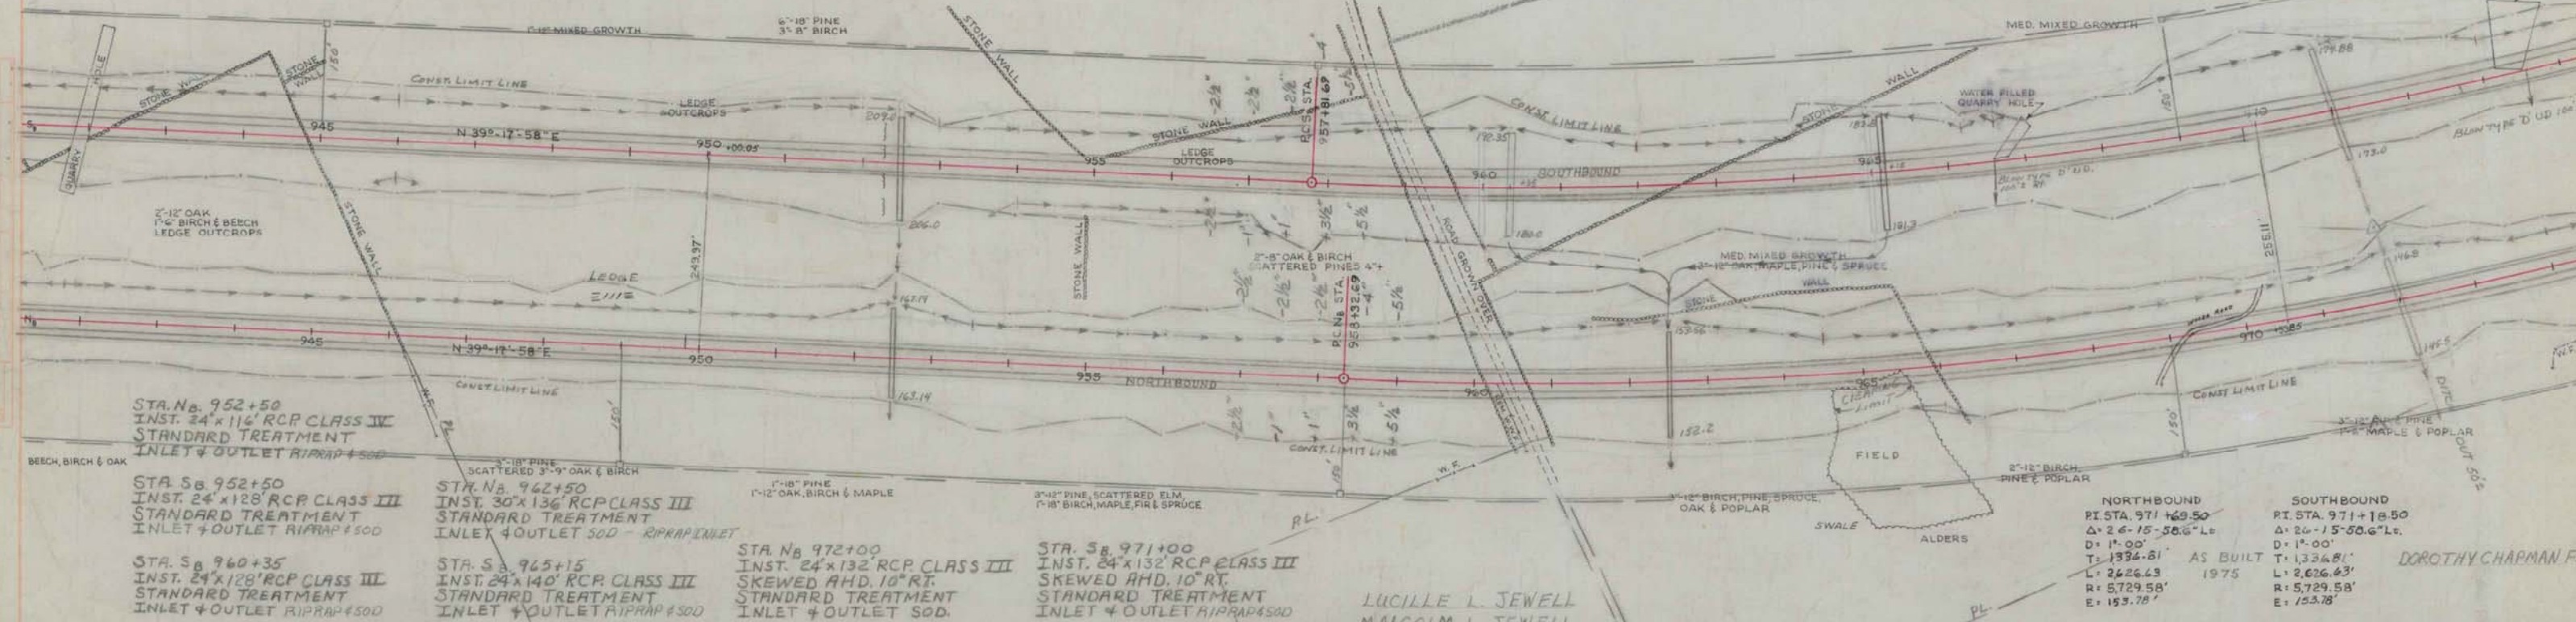

TOPSHAM, BOWDOIN, BOWDOINHAM

REVISOR WEST JARDNER