



CONTRACT 2.

PLAN
 SURVEYED BY: [Signature]
 DESIGNED BY: [Signature]
 CHECKED BY: [Signature]
 DATE: 11/15/74
 SHEET NO. 36

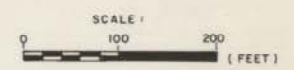

PROFILE
 SURVEYED BY: [Signature]
 DESIGNED BY: [Signature]
 CHECKED BY: [Signature]
 DATE: 11/15/74
 SHEET NO. 36

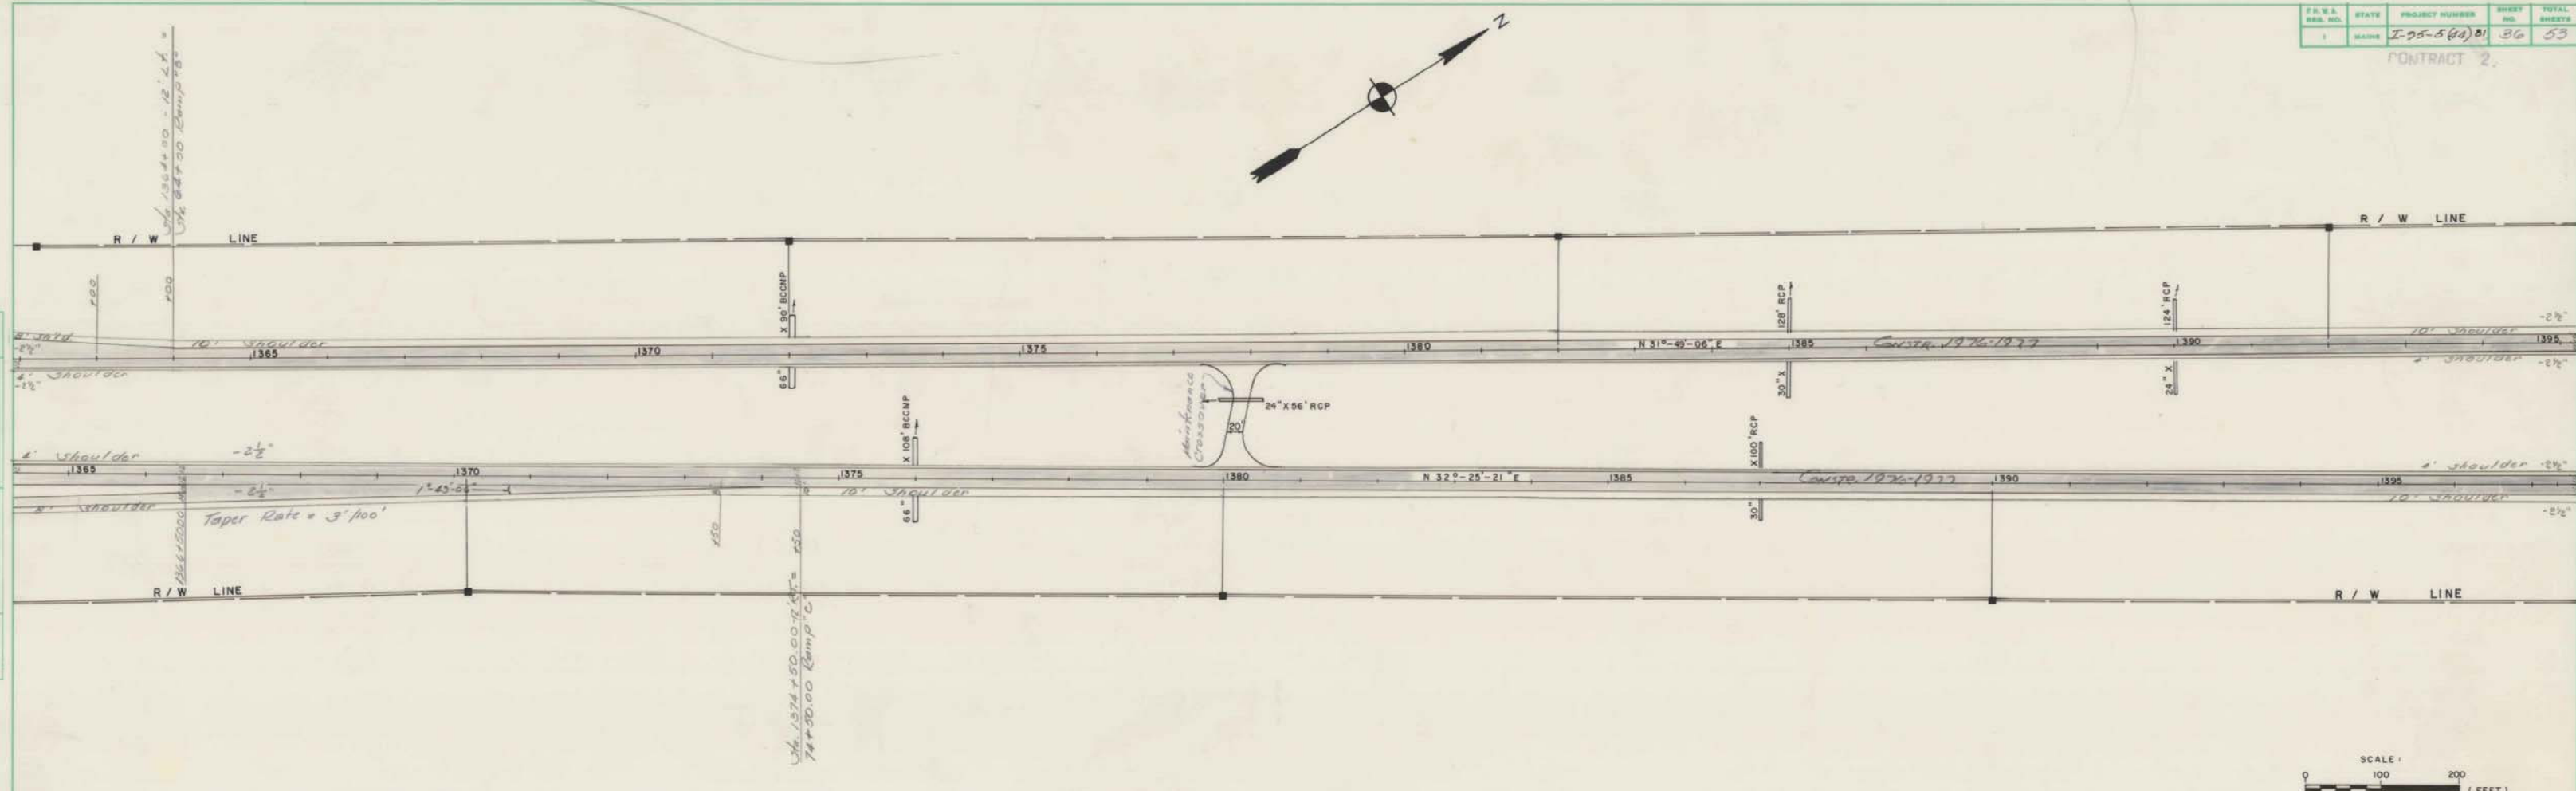