R. P. R. REG. NO.	STATE	PROJECT NUMBER	SHEET NO.	TOTAL SHEETS
1	MAINE	I-95-5(36)	38	175

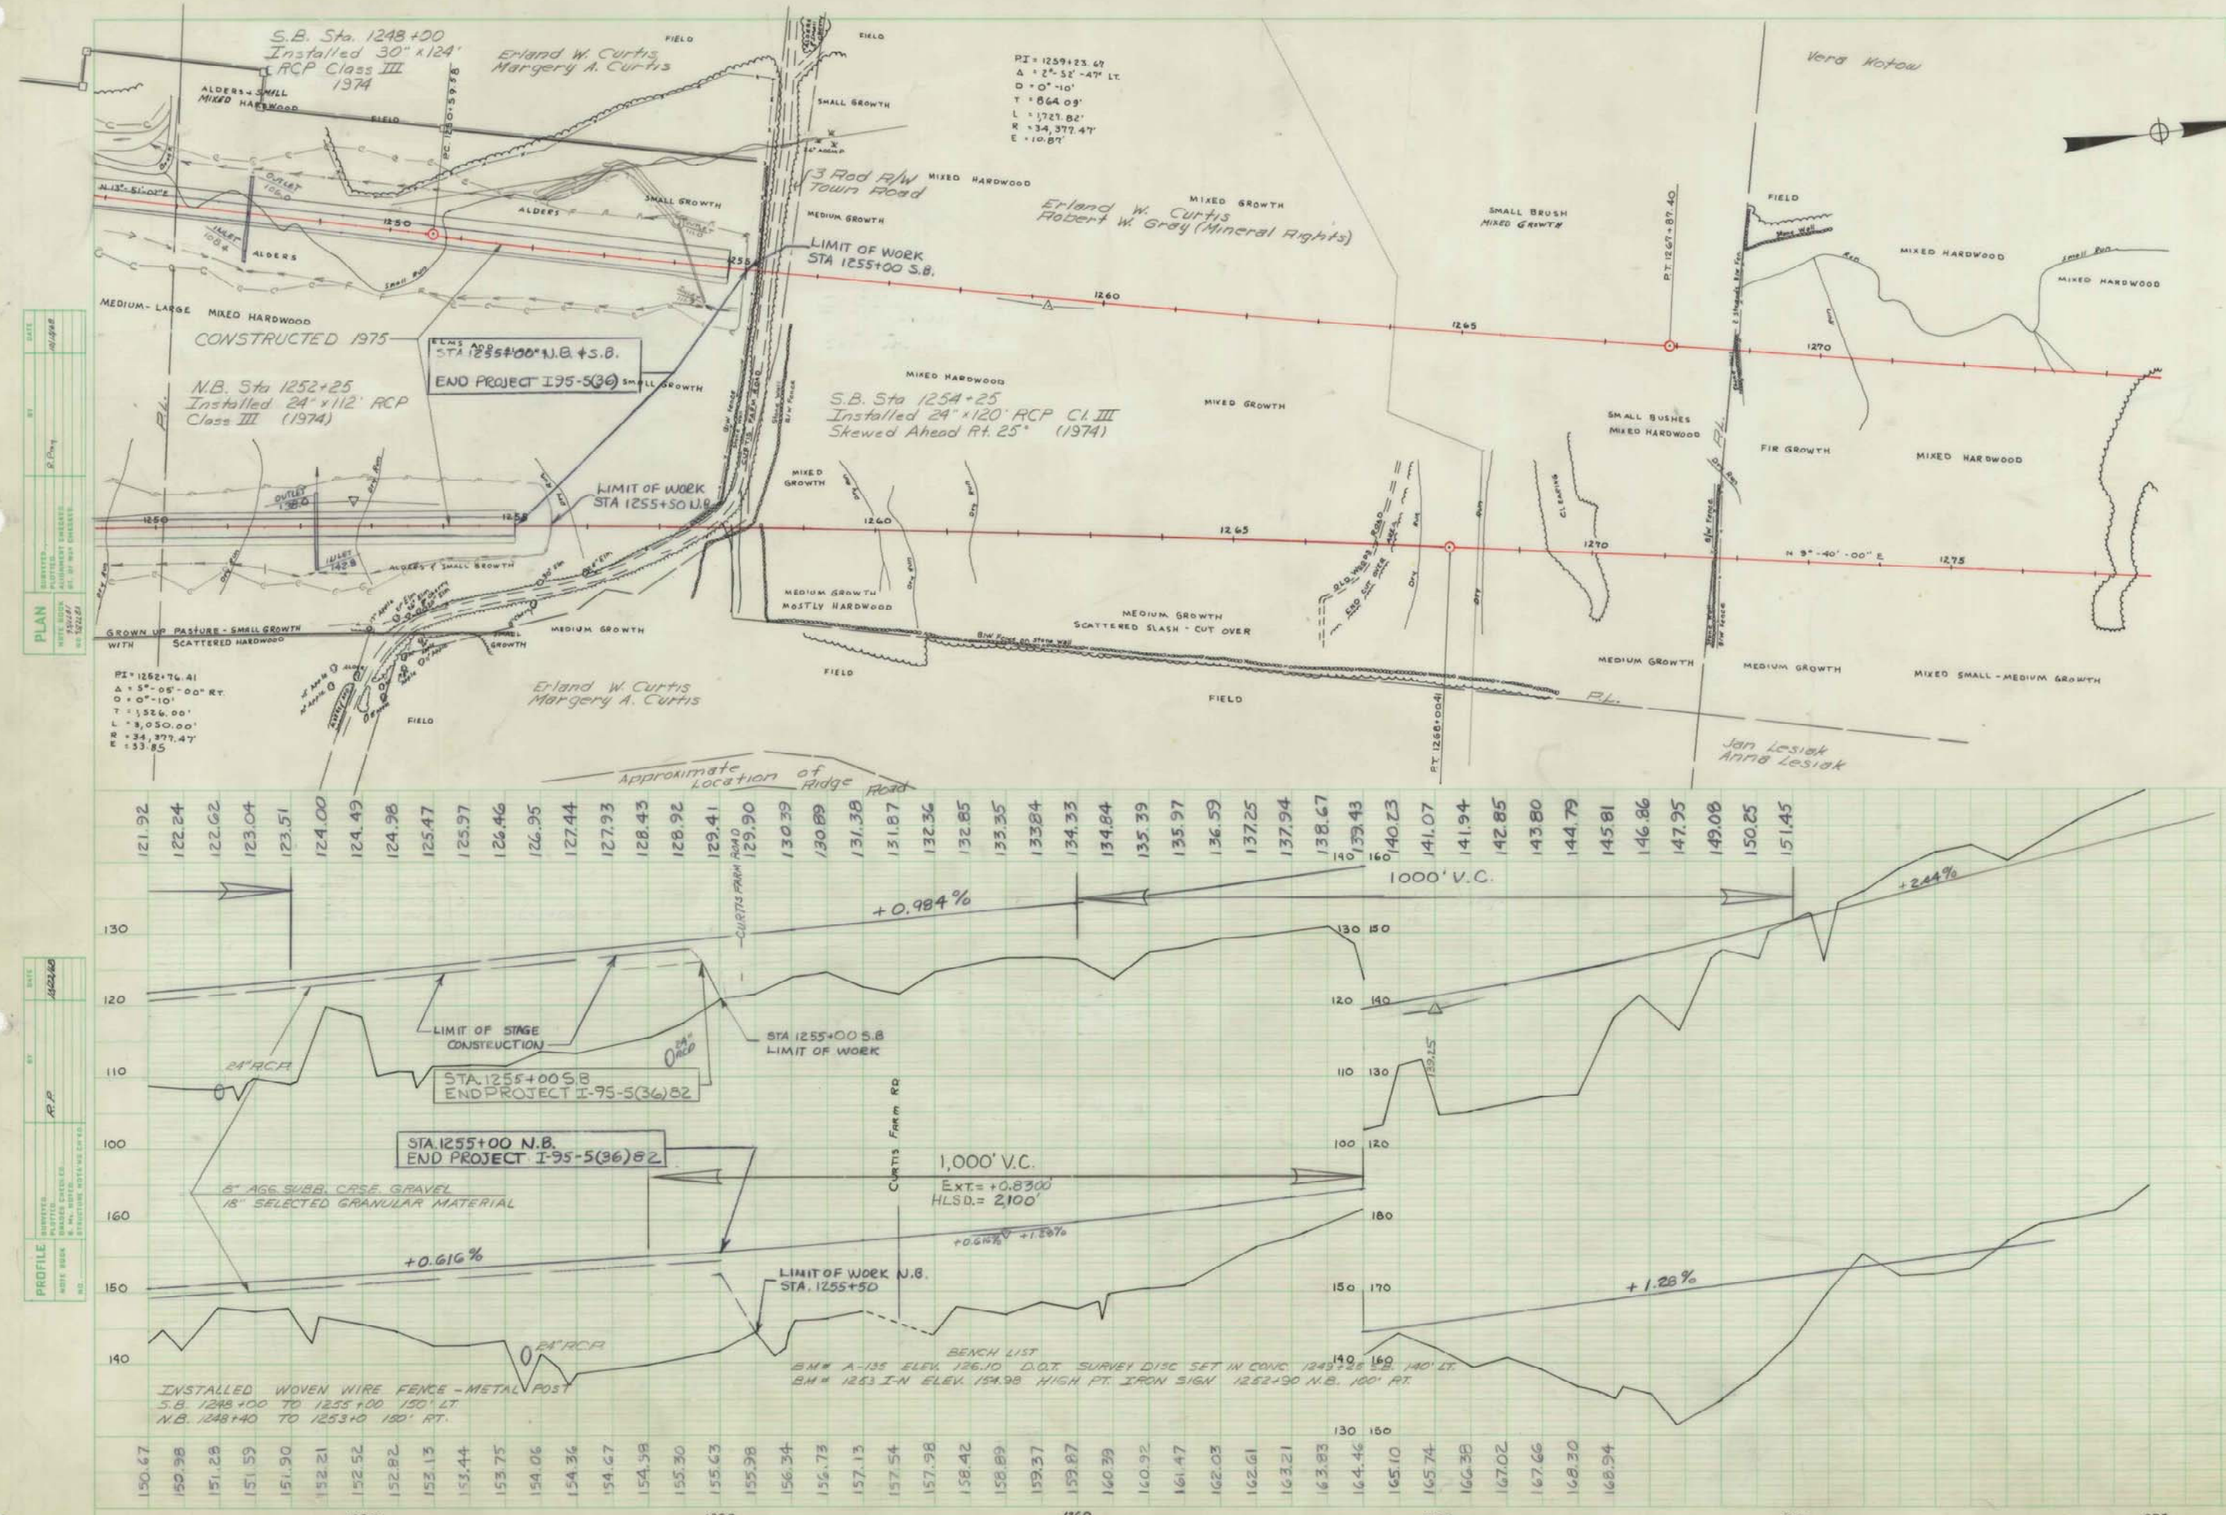

I-95-5(36) BOWDOINHAM