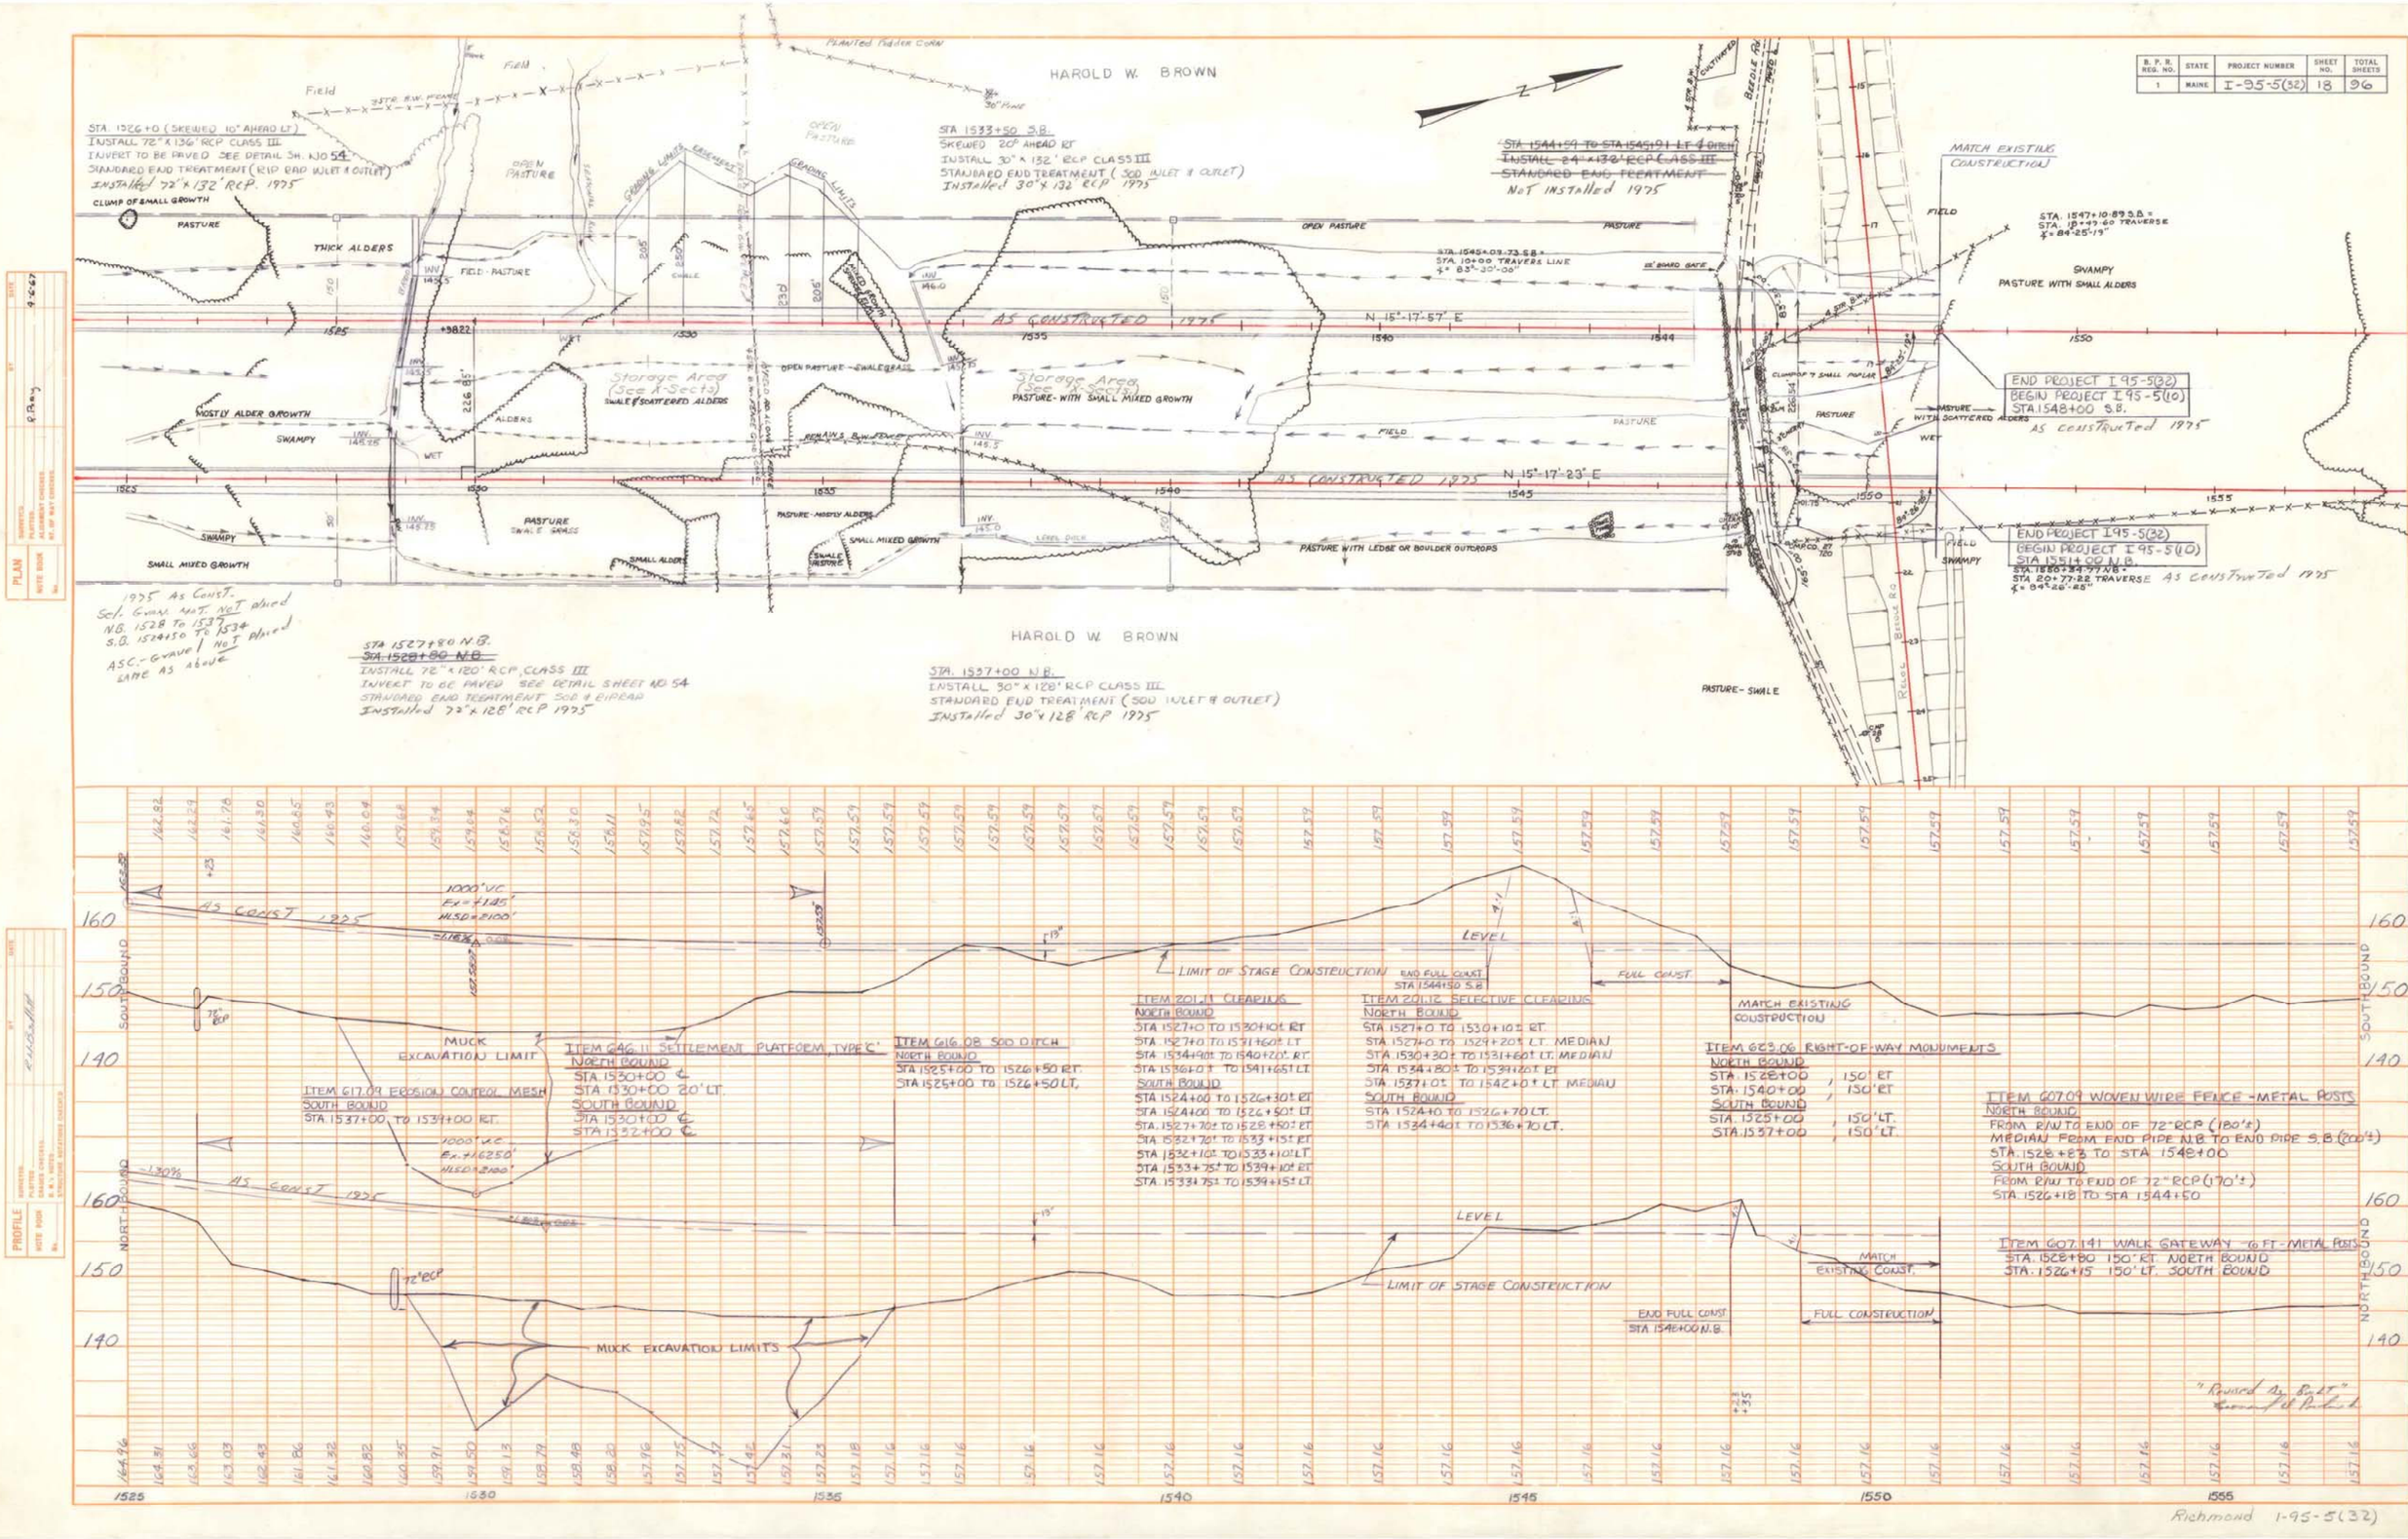

B. P. R. REG. NO. | STATE | PROJECT NUMBER | SHEET NO. | TOTAL SHEETS
1 | MAINE | I-95-5(32) | 18 | 96
HAROLD W. BROWN
STA. 1526+0 (SKEWED 10° AHEAD LT)
INSTALL 72" x 136' RCP CLASS III
INVERT TO BE PAVED SEE DETAIL SH. NO 54
STANDARD END TREATMENT (RIP RAP WLET & OUTLET)
INSTALLED 72" x 132' RCP. 1975
STA 1533+50 S.B.
SKEWED 20° AHEAD RT
INSTALL 30" x 132' RCP CLASS III
STANDARD END TREATMENT (SOD INLET & OUTLET)
INSTALLED 30" x 132' RCP 1975
STA 1544+59 TO STA 1545+91 LT & DITCH
INSTALL 24" x 132' RCP CLASS III
STANDARD END TREATMENT
NOT INSTALLED 1975
MATCH EXISTING CONSTRUCTION
STA. 1547+10.89 S.B. =
STA. 18+47.60 TRAVERSE
∡ = 84°-25'-19"
SWAMPY
PASTURE WITH SMALL ALDERS
END PROJECT I 95-5(32)
BEGIN PROJECT I 95-5(10)
STA. 1548+00 S.B.
AS CONSTRUCTED 1975
END PROJECT I 95-5(32)
BEGIN PROJECT I 95-5(10)
STA 1551+00 N.B.
STA 1550+34.77 N.B. =
STA 20+77.22 TRAVERSE
∡ = 84°-26'-25"
AS CONSTRUCTED 1975
N 15°-17'-57" E
N 15°-17'-23" E
AS CONSTRUCTED 1975
STA. 1545+09.73 S.B. =
STA. 10+00 TRAVERS LINE
∡ = 83°-30'-00"
Storage Area (See X-Sects)
SWALE & SCATTERED ALDERS
PASTURE - WITH SMALL MIXED GROWTH
PASTURE WITH LEDGE OR BOULDER OUTCROPS
PASTURE - SWALE
MOSTLY ALDER GROWTH
SMALL MIXED GROWTH
THICK ALDERS
CLUMP OF SMALL GROWTH
OPEN PASTURE
PASTURE
FIELD
SWAMPY
SMALL ALDERS
PASTURE - MOSTLY ALDERS
SMALL MIXED GROWTH
PASTURE - SWALE GRASS
1975 AS CONST.
Sel. Gran. MAT. NOT placed
N.B. 1528 TO 1537
S.B. 1524+50 TO 1534
ASC.-Gravel NOT placed
SAME AS above
STA 1527+80 N.B.
STA 1528+80 N.B.
INSTALL 72" x 120' RCP, CLASS III
INVERT TO BE PAVED SEE DETAIL SHEET NO 54
STANDARD END TREATMENT SOD & RIPRAP
INSTALLED 72" x 128' RCP 1975
STA. 1537+00 N.B.
INSTALL 30" x 128' RCP CLASS III
STANDARD END TREATMENT (SOD INLET & OUTLET)
INSTALLED 30" x 128' RCP 1975
1000' VC
Ex = +1.45'
HLSD = 2100'
AS CONST 1975
LEVEL
LIMIT OF STAGE CONSTRUCTION
END FULL CONST
STA 1544+50 S.B.
FULL CONST.
MATCH EXISTING CONSTRUCTION
MUCK EXCAVATION LIMIT
ITEM 617.09 EROSION CONTROL MESH
SOUTH BOUND
STA. 1537+00 TO 1539+00 RT.
ITEM 646.11 SETTLEMENT PLATFORM, TYPE 'C'
NORTH BOUND
STA. 1530+00 ℄
STA. 1530+00 20' LT.
SOUTH BOUND
STA. 1530+00 ℄
STA. 1532+00 ℄
ITEM 616.08 SOD DITCH
NORTH BOUND
STA 1525+00 TO 1526+50 RT.
STA 1525+00 TO 1526+50 LT.
ITEM 201.11 CLEARING
NORTH BOUND
STA 1527+0 TO 1530+10± RT
STA 1527+0 TO 1531+60± LT
STA 1534+90± TO 1540+20± RT.
STA 1536+0± TO 1541+65± LT.
SOUTH BOUND
STA 1524+00 TO 1526+30± RT
STA 1524+00 TO 1526+50± LT
STA 1527+70± TO 1528+50± RT
STA 1532+70± TO 1533+15± RT
STA 1532+10± TO 1533+10± LT
STA 1533+75± TO 1539+10± RT
STA 1533+75± TO 1539+15± LT
ITEM 201.12 SELECTIVE CLEARING
NORTH BOUND
STA 1527+0 TO 1530+10± RT.
STA 1527+0 TO 1529+20± LT. MEDIAN
STA 1530+30± TO 1531+60± LT. MEDIAN
STA 1534+80± TO 1539+20± RT
STA 1537+0± TO 1542+0± LT MEDIAN
SOUTH BOUND
STA 1524+0 TO 1526+70 LT.
STA 1534+40± TO 1536+70 LT.
ITEM 623.06 RIGHT-OF-WAY MONUMENTS
NORTH BOUND
STA. 1528+00 , 150' RT
STA. 1540+00 , 150' RT
SOUTH BOUND
STA. 1525+00 , 150' LT.
STA. 1537+00 , 150' LT.
ITEM 607.09 WOVEN WIRE FENCE - METAL POSTS
NORTH BOUND
FROM R/W TO END OF 72" RCP (180'±)
MEDIAN FROM END PIPE N.B. TO END PIPE S.B. (200'±)
STA. 1528+83 TO STA 1548+00
SOUTH BOUND
FROM R/W TO END OF 72" RCP (170'±)
STA. 1526+18 TO STA 1544+50
ITEM 607.141 WALK GATEWAY - 6 FT - METAL POSTS
STA. 1528+80 150' RT. NORTH BOUND
STA. 1526+15 150' LT. SOUTH BOUND
MUCK EXCAVATION LIMITS
END FULL CONST
STA 1548+00 N.B.
MATCH EXISTING CONST.
FULL CONSTRUCTION
SOUTH BOUND
NORTH BOUND
"Revised As Built"
Richmond 1-95-5(32)