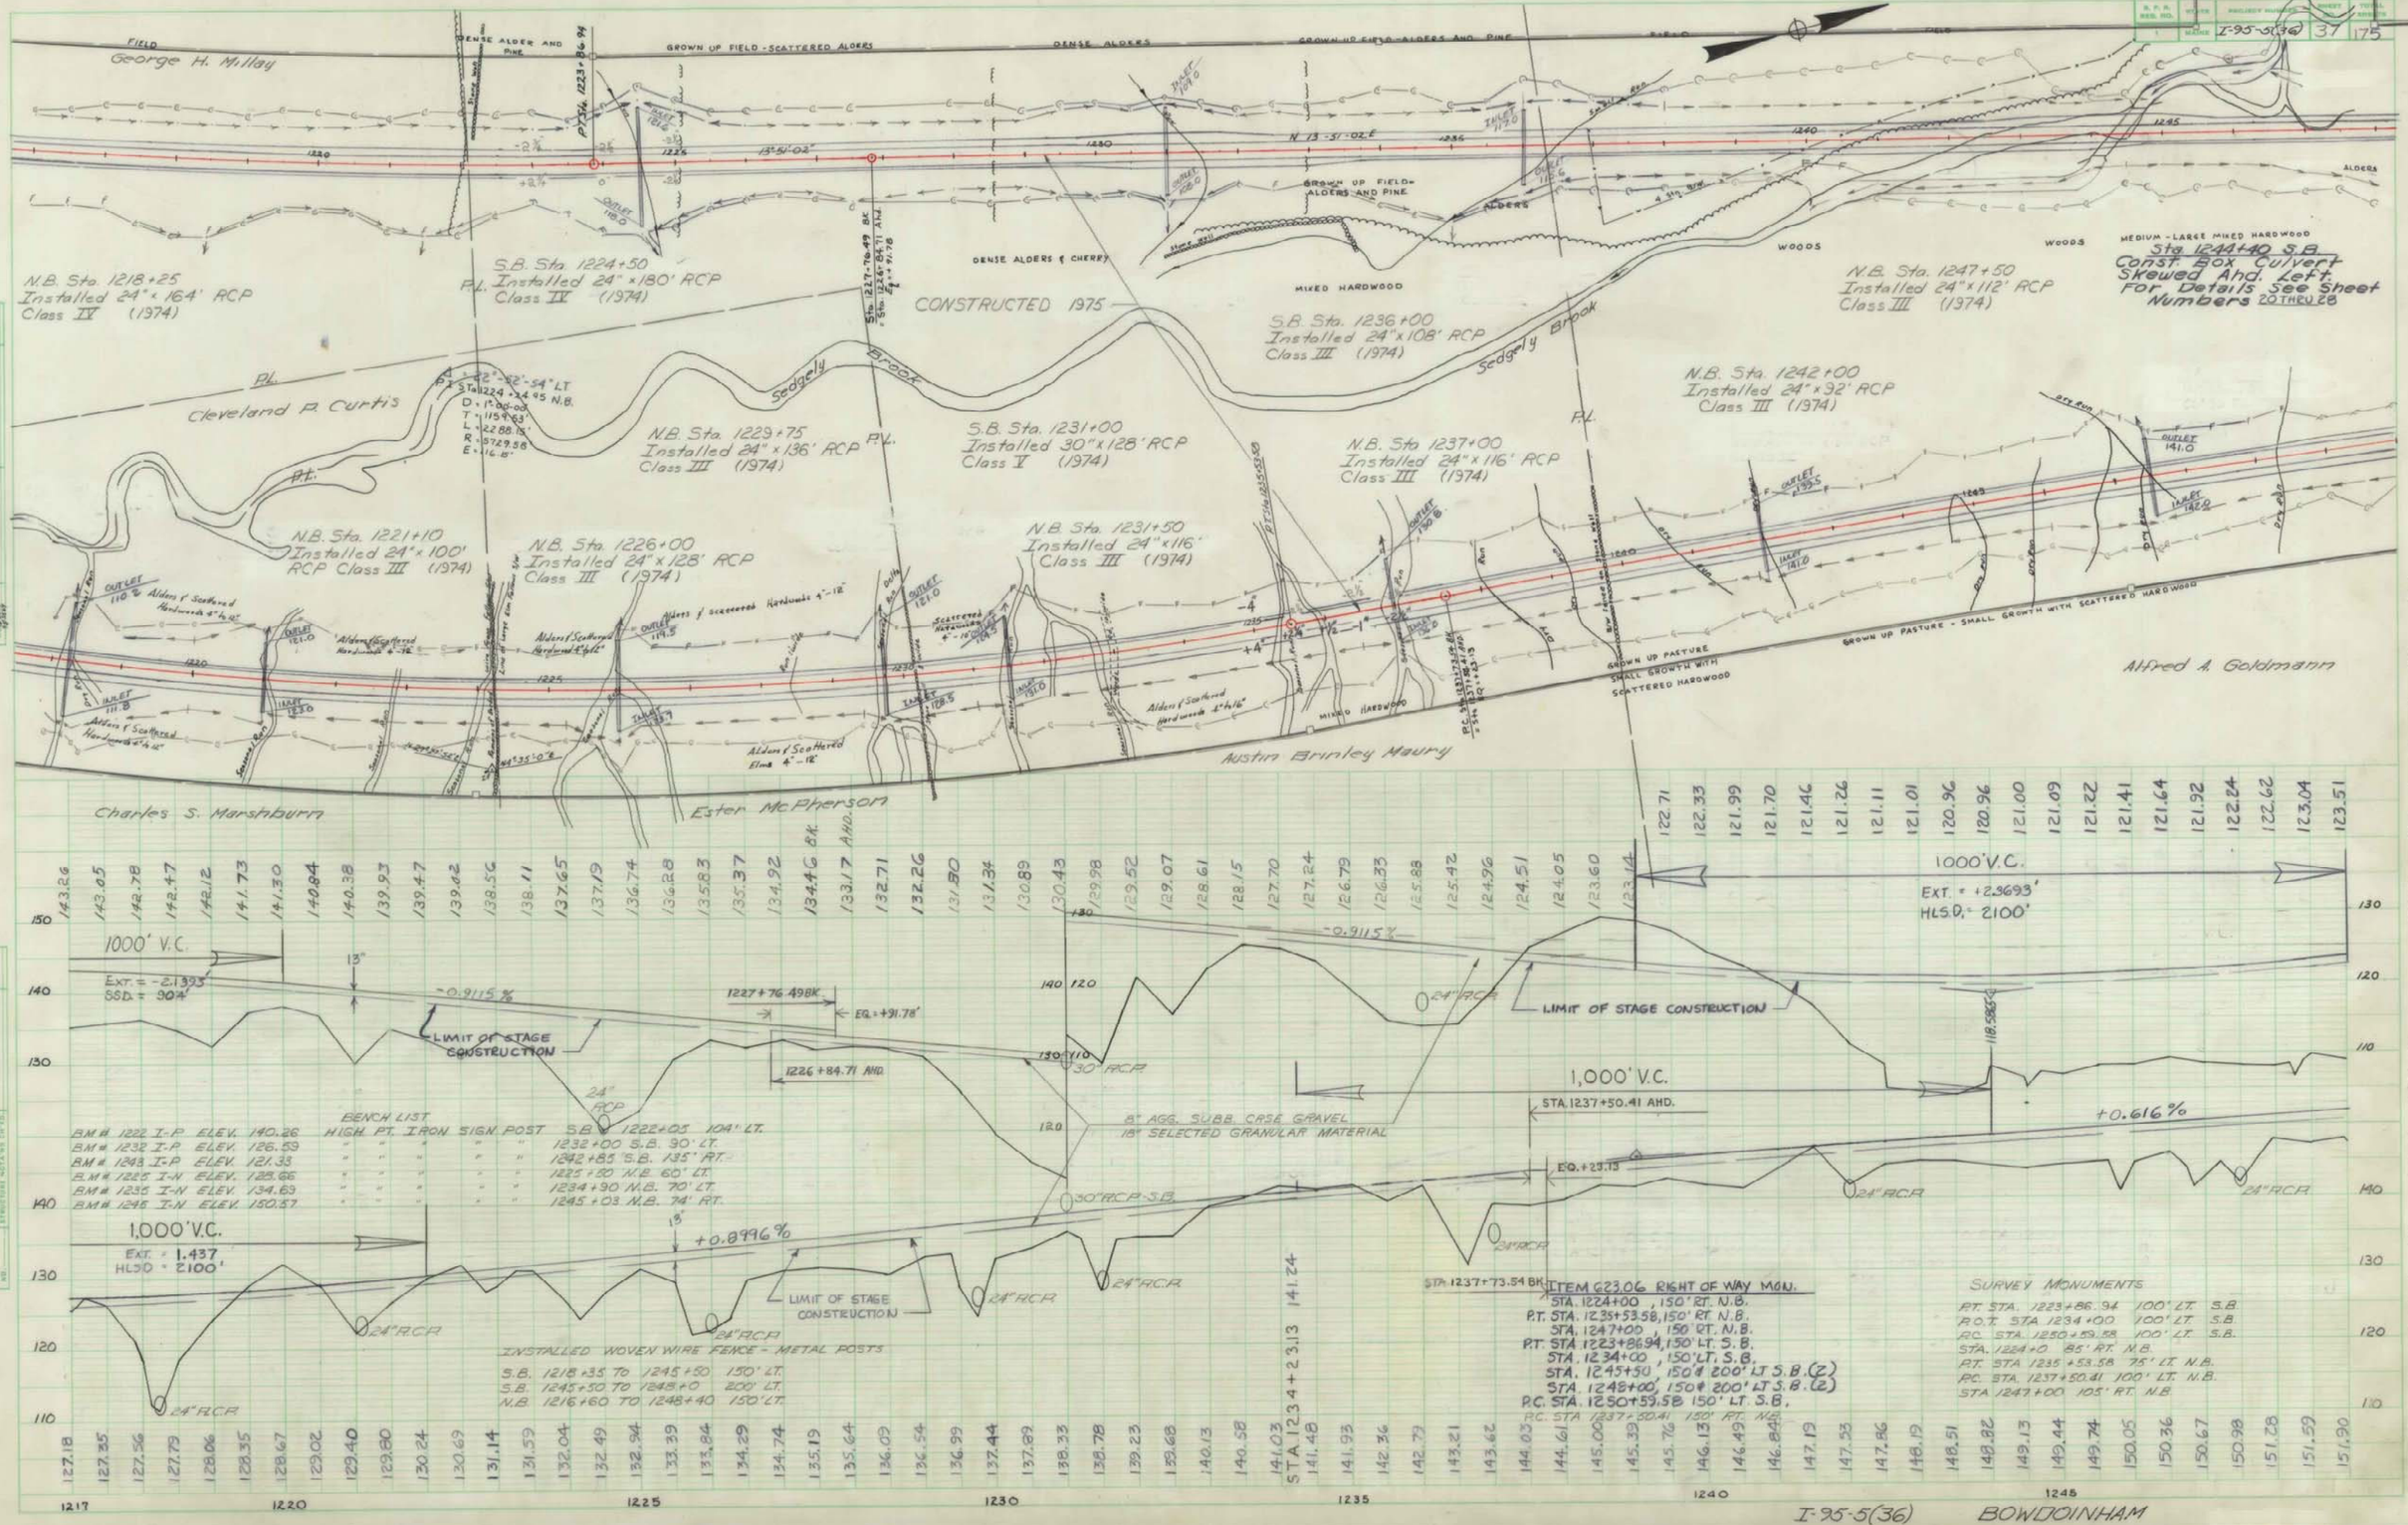
George H. Millay
Cleveland P. Curtis
Charles S. Marshburn
Ester McPherson
Austin Brinley Maury
Alfred A. Goldmann
Sedgely Brook
CONSTRUCTED 1975
N.B. Sta. 1218+25 Installed 24" x 164' RCP Class IV (1974)
S.B. Sta. 1224+50 Installed 24" x 180' RCP Class IV (1974)
N.B. Sta. 1221+10 Installed 24" x 100' RCP Class III (1974)
N.B. Sta. 1226+00 Installed 24" x 128' RCP Class III (1974)
N.B. Sta. 1229+75 Installed 24" x 136' RCP Class III (1974)
S.B. Sta. 1231+00 Installed 30" x 128' RCP Class V (1974)
N.B. Sta. 1231+50 Installed 24" x 116' Class III (1974)
S.B. Sta. 1236+00 Installed 24" x 108' RCP Class III (1974)
N.B. Sta. 1237+00 Installed 24" x 116' RCP Class III (1974)
N.B. Sta. 1242+00 Installed 24" x 92' RCP Class III (1974)
N.B. Sta. 1247+50 Installed 24" x 112' RCP Class III (1974)
Sta 1244+40 S.B. Const Box Culvert Skewed Ahd. Left For Details See Sheet Numbers 20 THRU 28
GROWN UP FIELD - SCATTERED ALDERS
DENSE ALDERS
GROWN UP FIELD - ALDERS AND PINE
DENSE ALDERS & CHERRY
MIXED HARDWOOD
WOODS
MEDIUM - LARGE MIXED HARDWOOD
GROWN UP PASTURE - SMALL GROWTH WITH SCATTERED HARDWOOD
N 13-51-02 E
1000' V.C.
EXT. = -2.1393'
SSD. = 904'
-0.9115 %
LIMIT OF STAGE CONSTRUCTION
1227+76.49 BK
EQ. = +91.78'
1226+84.71 AHD.
24" RCP
30" RCP
8" AGG. SUBB. CRSE GRAVEL
18" SELECTED GRANULAR MATERIAL
30" RCP-S.B.
24" RCP
1,000' V.C.
STA. 1237+50.41 AHD.
EQ. = 23.13
+0.616 %
1000' V.C.
EXT. = +2.3693'
HLSD. = 2100'
1,000' V.C.
EXT. = 1.437
HLSD = 2100'
+0.8996 %
BENCH LIST
B.M.# 1222 I-P ELEV. 140.26
B.M.# 1232 I-P ELEV. 126.59
B.M.# 1243 I-P ELEV. 121.33
B.M.# 1225 I-N ELEV. 128.66
B.M.# 1235 I-N ELEV. 134.69
B.M.# 1245 I-N ELEV. 150.57
HIGH PT. IRON SIGN. POST S.B. 1222+05 104' LT.
1232+00 S.B. 90' LT.
1242+85 S.B. 135' RT.
1225+80 N.B. 60' LT.
1234+90 N.B. 70' LT.
1245+03 N.B. 74' RT.
INSTALLED WOVEN WIRE FENCE - METAL POSTS
S.B. 1218+35 TO 1245+50 150' LT.
S.B. 1245+50 TO 1248+0 200' LT.
N.B. 1216+60 TO 1248+40 150' LT.
ITEM 623.06 RIGHT OF WAY MON.
STA. 1224+00, 150' RT. N.B.
P.T. STA. 1235+53.58, 150' RT. N.B.
STA. 1247+00, 150' RT. N.B.
P.T. STA 1223+86.94, 150' LT. S.B.
STA. 1234+00, 150' LT. S.B.
STA. 1245+50, 150' & 200' LT S.B. (2)
STA. 1248+00, 150' & 200' LT S.B. (2)
P.C. STA. 1250+59.58 150' LT. S.B.
P.C. STA 1237+50.41 150' RT. N.B.
SURVEY MONUMENTS
P.T. STA. 1223+86.94 100' LT. S.B.
P.O.T. STA 1234+00 100' LT. S.B.
P.C. STA. 1250+59.58 100' LT. S.B.
STA. 1224+0 85' RT. N.B.
P.T. STA 1235+53.58 75' LT. N.B.
P.C. STA. 1237+50.41 100' LT. N.B.
STA 1247+00 105' RT. N.B.
I-95-5(36)
BOWDOINHAM