



| | |
|--------------|----|
| DATE | BY |
| | |
| FINAL SURVEY | |
| NOTE BOOK | |
| AREA CHECKED | |

| | |
|-----------------|----|
| DATE | BY |
| | |
| ORIGINAL SURVEY | |
| NOTE BOOK | |
| AREA CHECKED | |

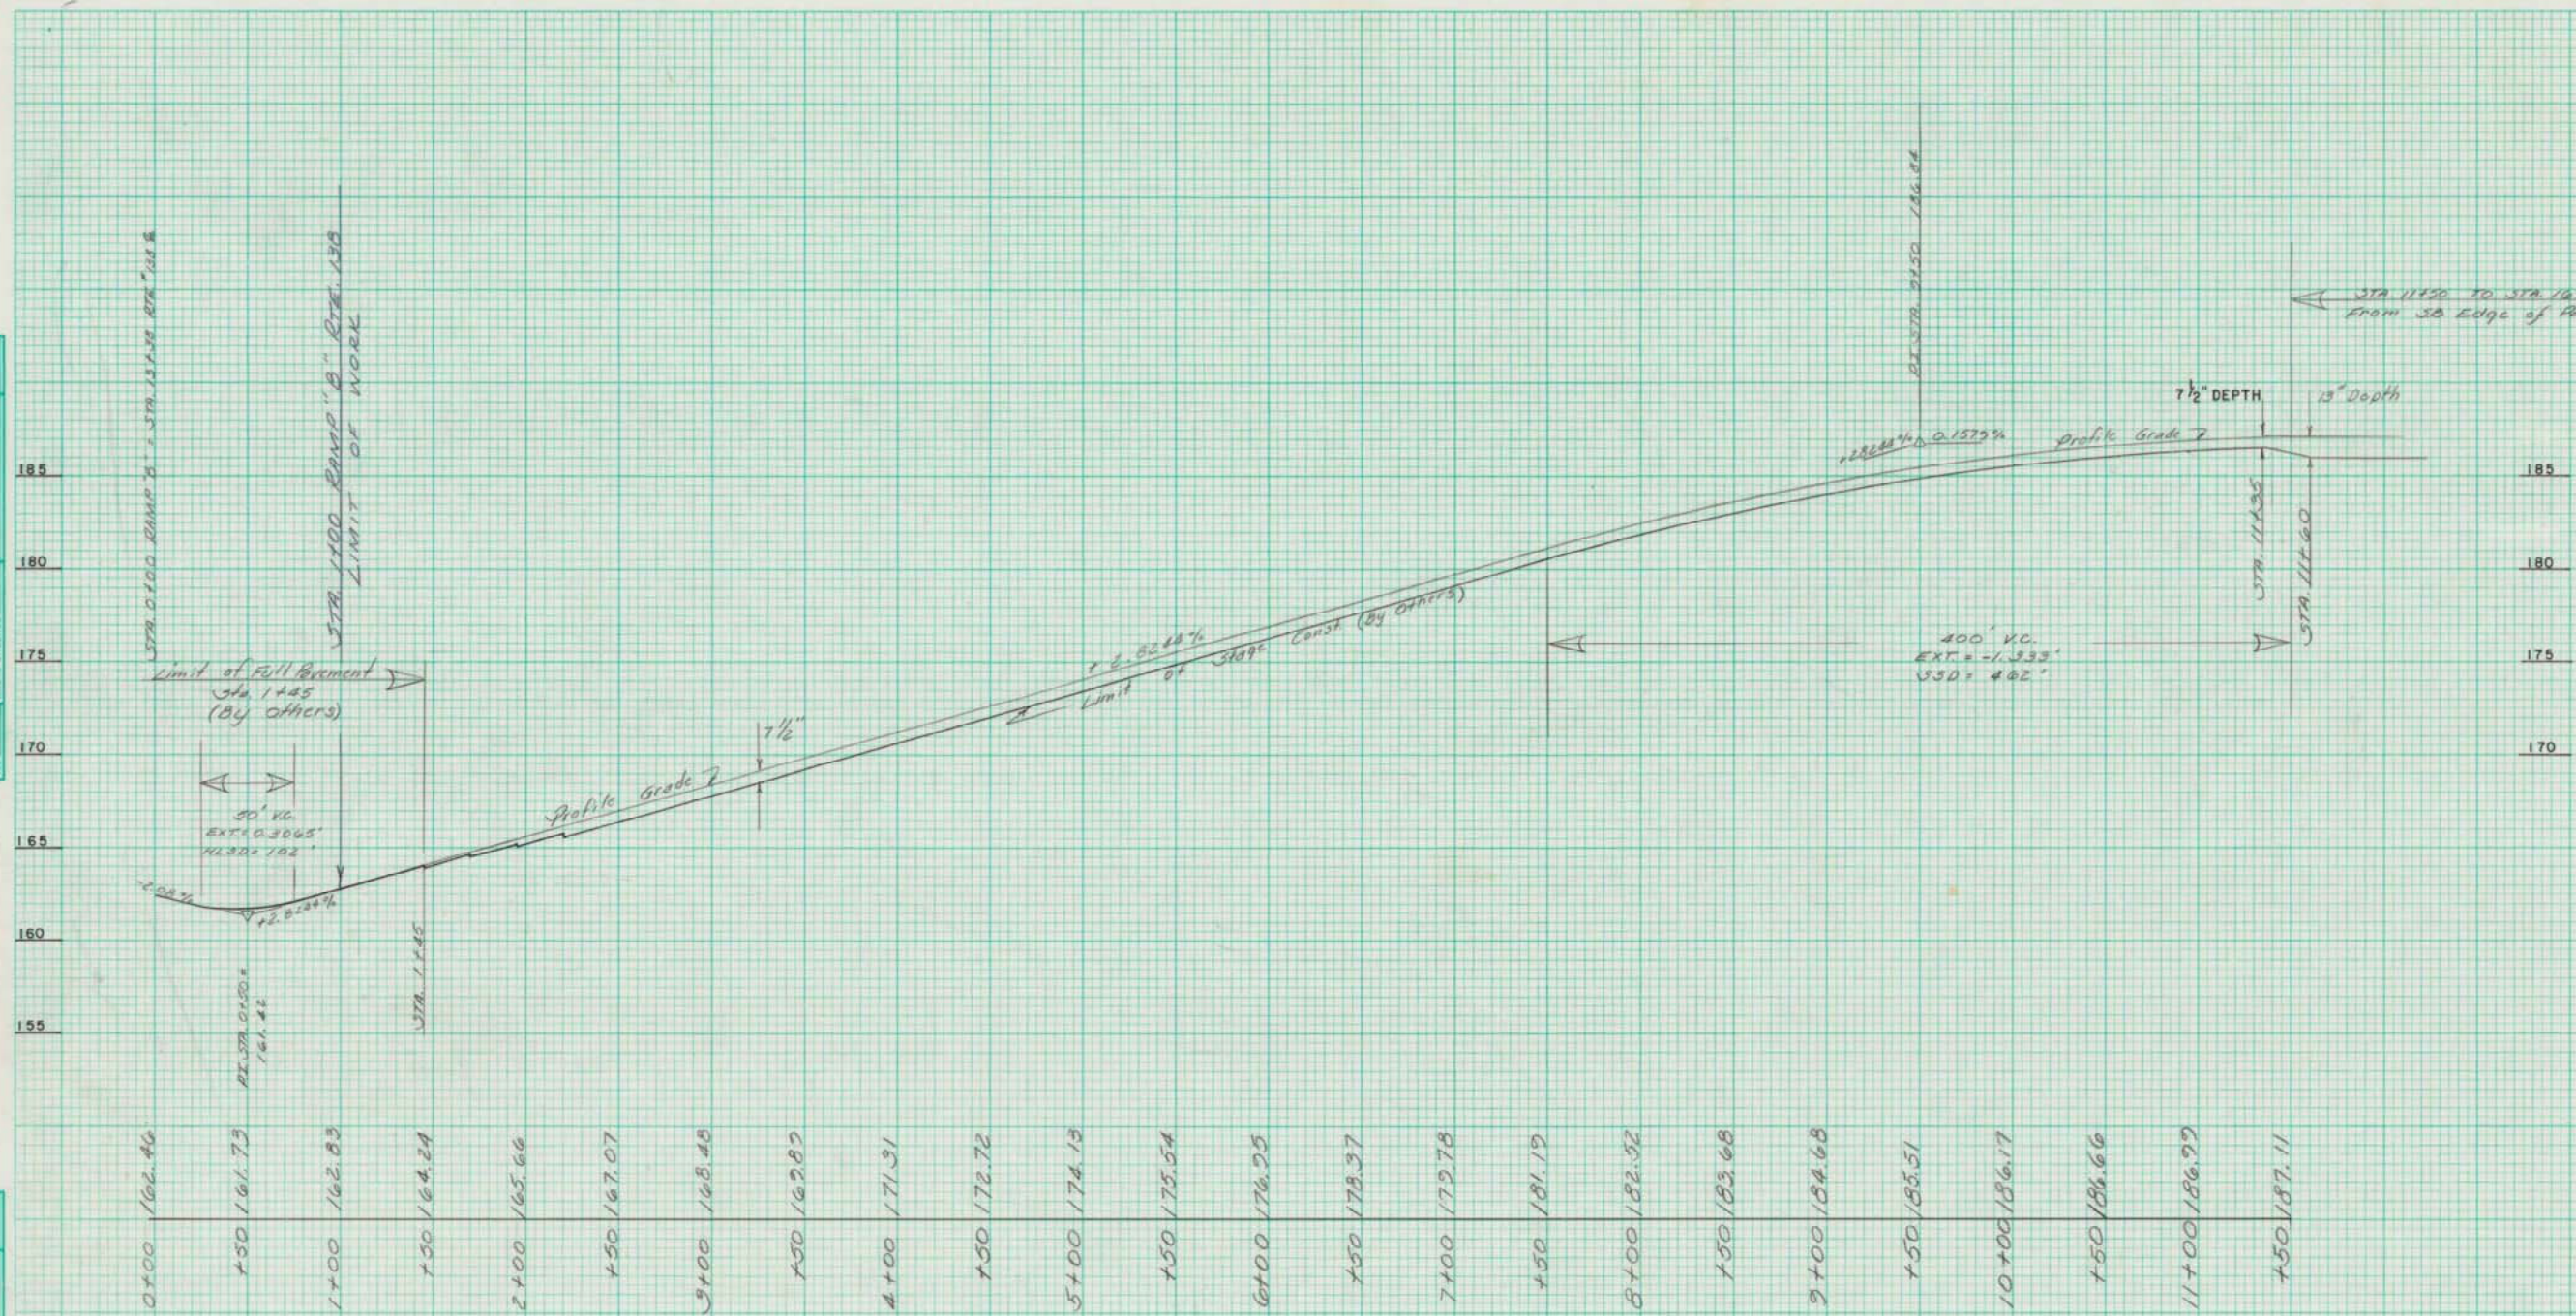

RAMP "B"

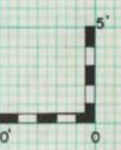

STATE OF MAINE
DEPARTMENT OF TRANSPORTATION

RAMP "B" PROFILE
ROUTE 138 INTERCHANGE

AUGUSTA, MAINE
BOWDOINHAM - RICHMOND - GARDINER
I-95-5(44) 81 Cont. #2