


STA. 102+100 35' LT. TO STA. 102+100 29' LT. SB.
INSTALL 100' TYPE 'B' UNDERDRAIN
STA. 102+100 35' LT. TO 83' LT. SB.
INSTALL 46' TYPE 'B' OUTLET PIPE

MONA J. SKELTON

RUTH MILLAY

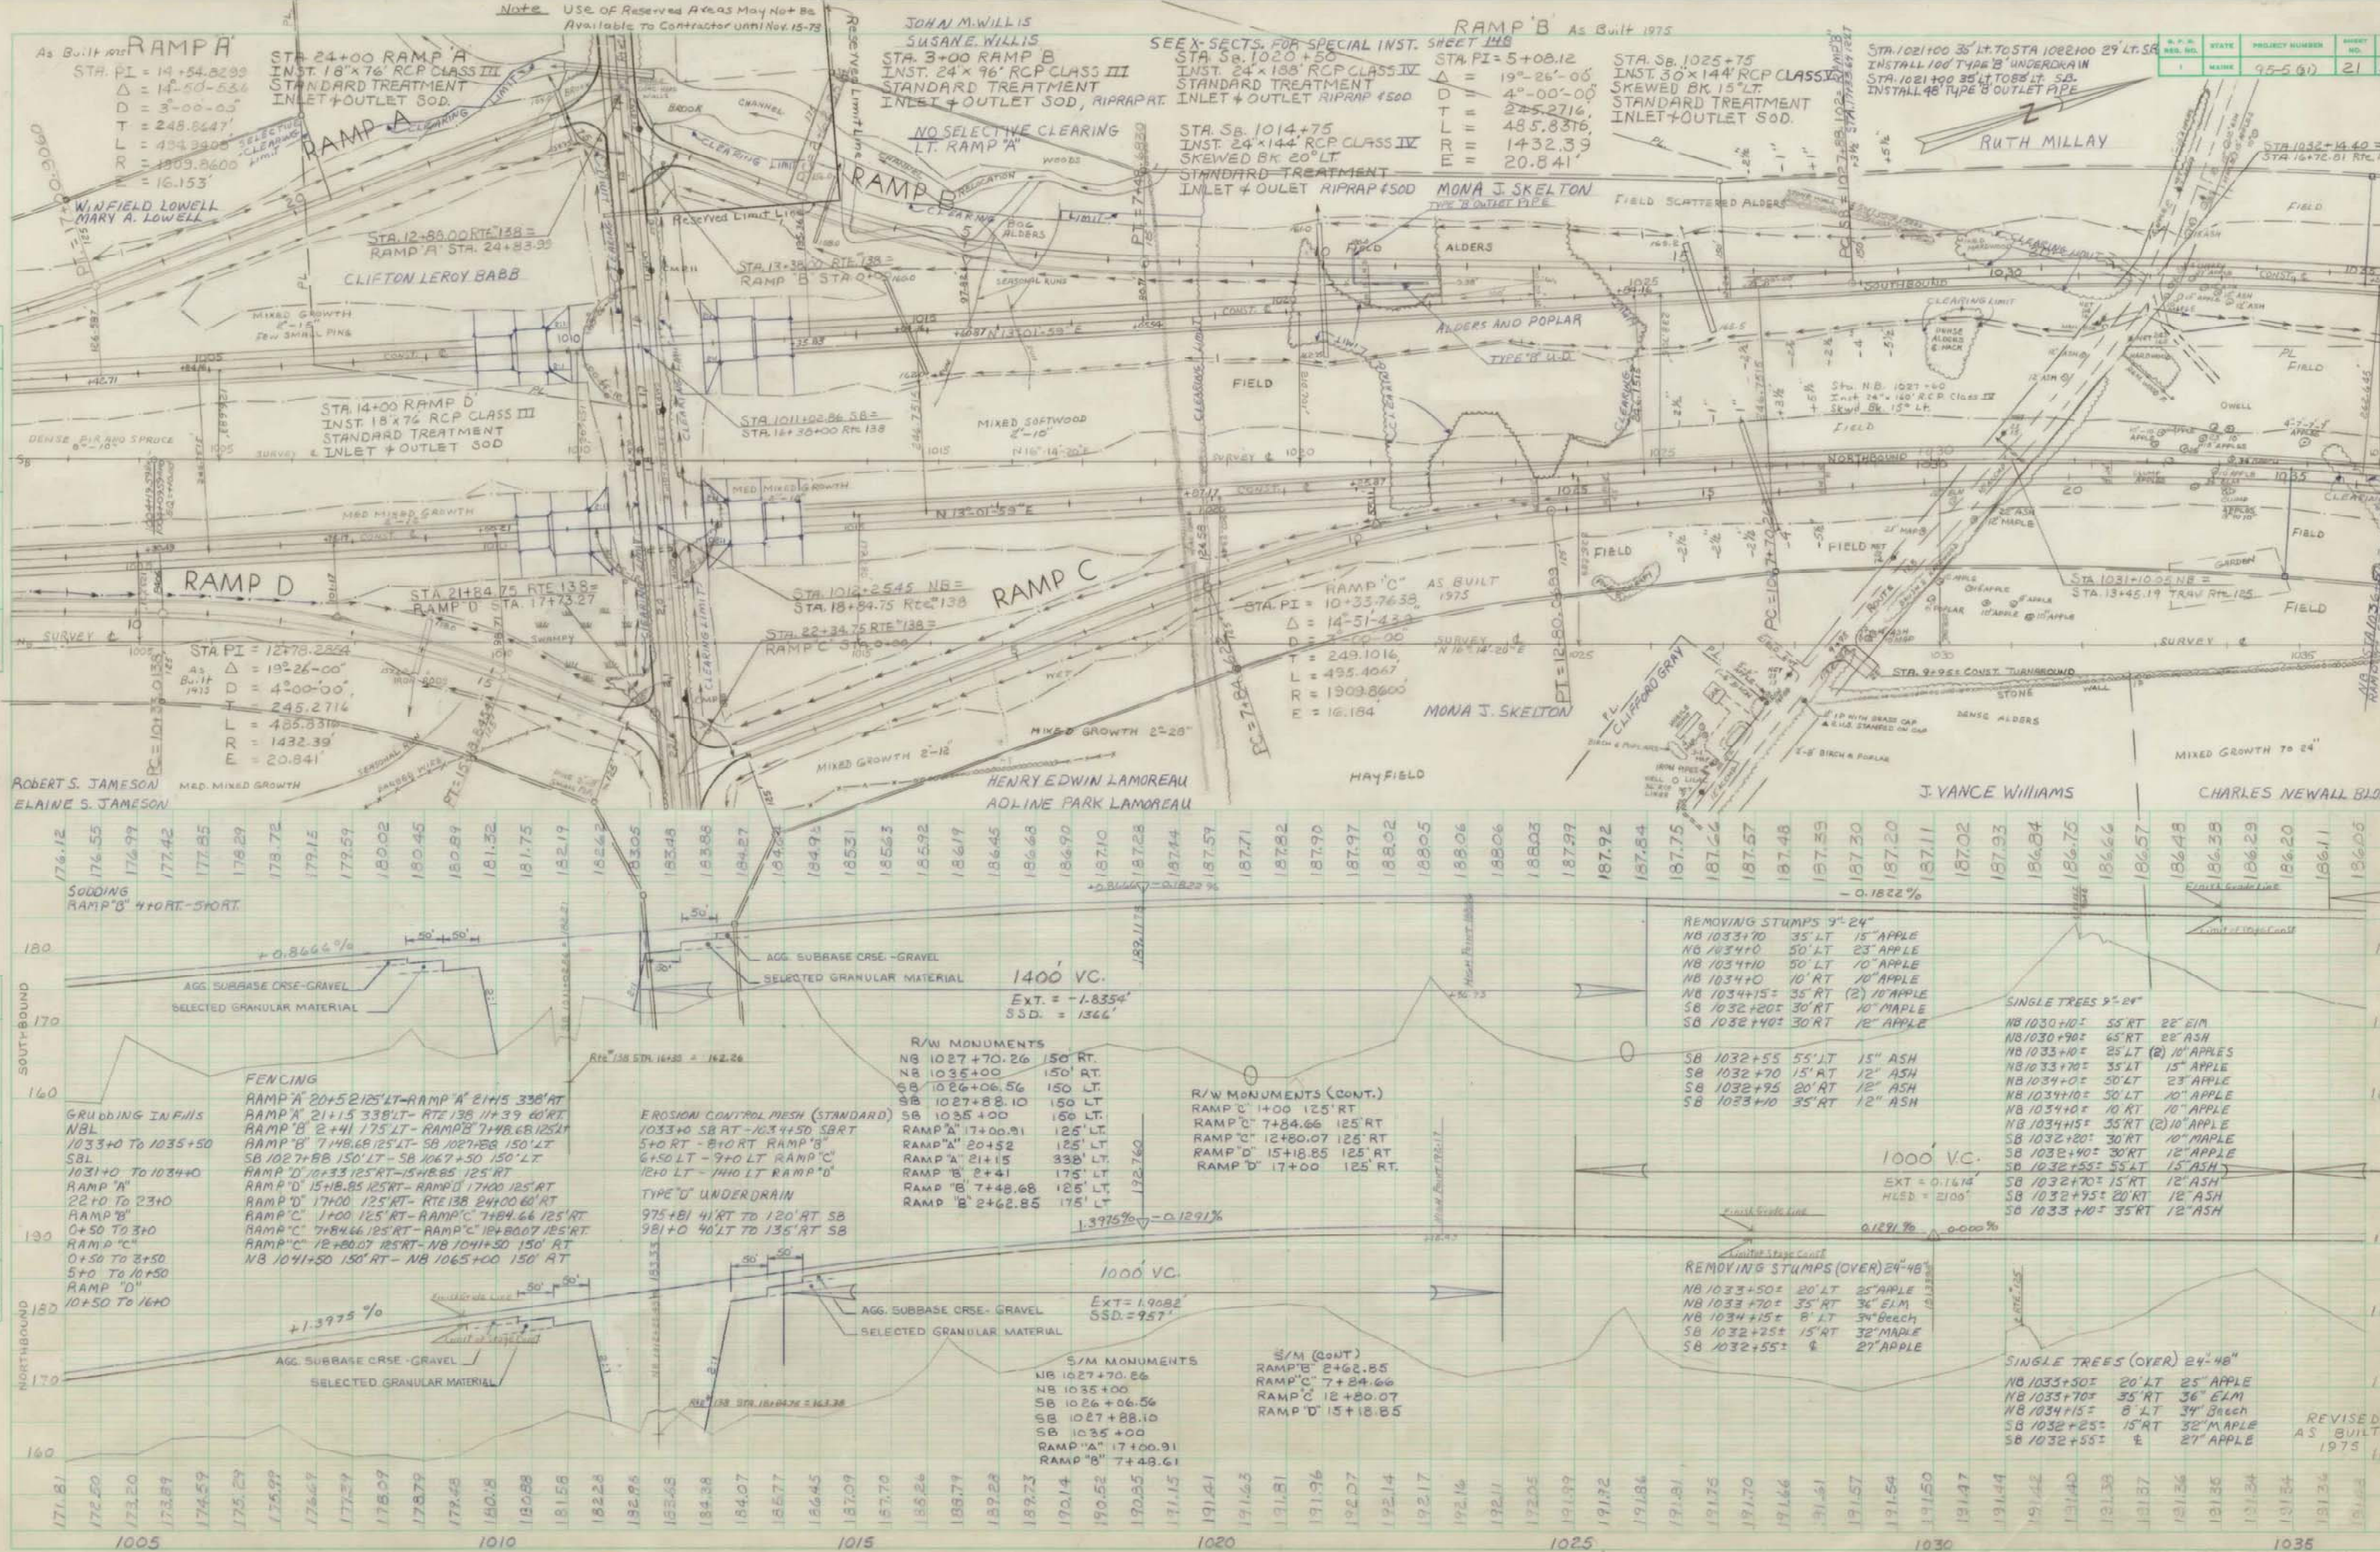

TOPSHAM, BOWDOIN, BOWDOINHAM